

NOTES:
 1. SEE TABLE 3 ON SHEET 7 FOR STATION RANGE OF WHEN EXCAVATION OF SUBGRADE WITH GEOTEXTILE FABRIC AND GRANULAR MATERIAL, TYPE B ARE USED INSTEAD OF CEMENT STABILIZED SUBGRADE.

2. THE SUPERELEVATED SECTION EDGE OF PAVEMENT UNDERDRAINS SHIFT LATERAL LOCATIONS WHEN THE TRANSITIONING LANE EXCEEDS 0.000, NOT AT WHERE THE PAVEMENT FIRST BEGINS THE CROSS SLOPE TRANSITION.



3. THE SOUTHBOUND (SB) AND NORTHBOUND (NB) PROFILE GRADES ARE IDENTICAL EXCEPT FOR THE FOLLOWING STATION RANGES:
 73+83.80 - 77+50.00
 94+00.00 - 151+50.00
 153+05.00 - 171+12.50
 274+77.50 - 279+31.20

4. SEE SHEET 9 FOR OPTION B - CONCRETE PAVEMENT BUILDUP TYPICAL SECTIONS.

5. APPLY ITEM 875 - LONGITUDINAL JOINT ADHESIVE (1 LB/4 FT) WHERE ITEM 442 SURFACE COURSE IS UTILIZED.

6. PER CMS 202.05, AS MODIFIED BY SS 800 (07-17-2020), PAVEMENT REMOVED INCLUDES REMOVAL OF AC PAVEMENT, PCC PAVEMENT AND/OR COMPOSITE AC OVER PCC PAVEMENT.




SUBGRADE STABILIZATION - SEE NOTE 1
 ITEM 204 - EXCAVATION OF SUBGRADE, 12" DEEP
 OR
 ITEM 206 - CEMENT STABILIZED SUBGRADE, 12" DEEP

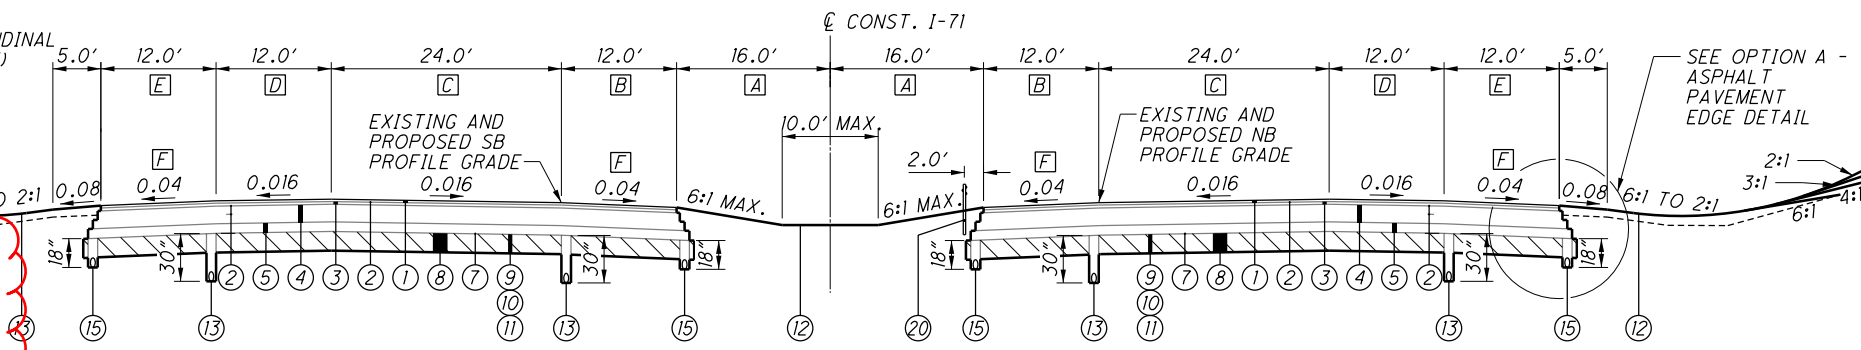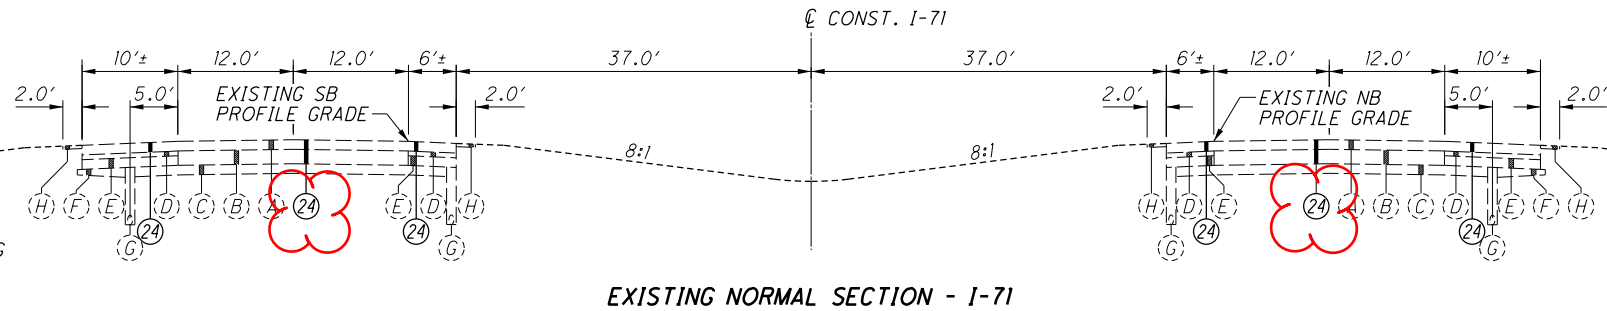

SOUTHBOUND
 STA 0+00.00 TO STA 74+37.03
 STA 156+83.16 TO STA 157+24.60
 STA 159+38.16 TO STA 163+61.21
 STA 165+86.69 TO STA 170+03.84
 STA 218+41.28 TO STA 279+31.20

NORTHBOUND
 STA 0+00.00 TO STA 74+37.03
 STA 156+83.16 TO STA 156+95.89
 STA 159+09.45 TO STA 163+32.83
 STA 165+58.31 TO STA 170+03.84
 STA 218+41.28 TO STA 279+31.20

* SEE SHEETS 903-908 FOR SUPERELEVATION DETAILS

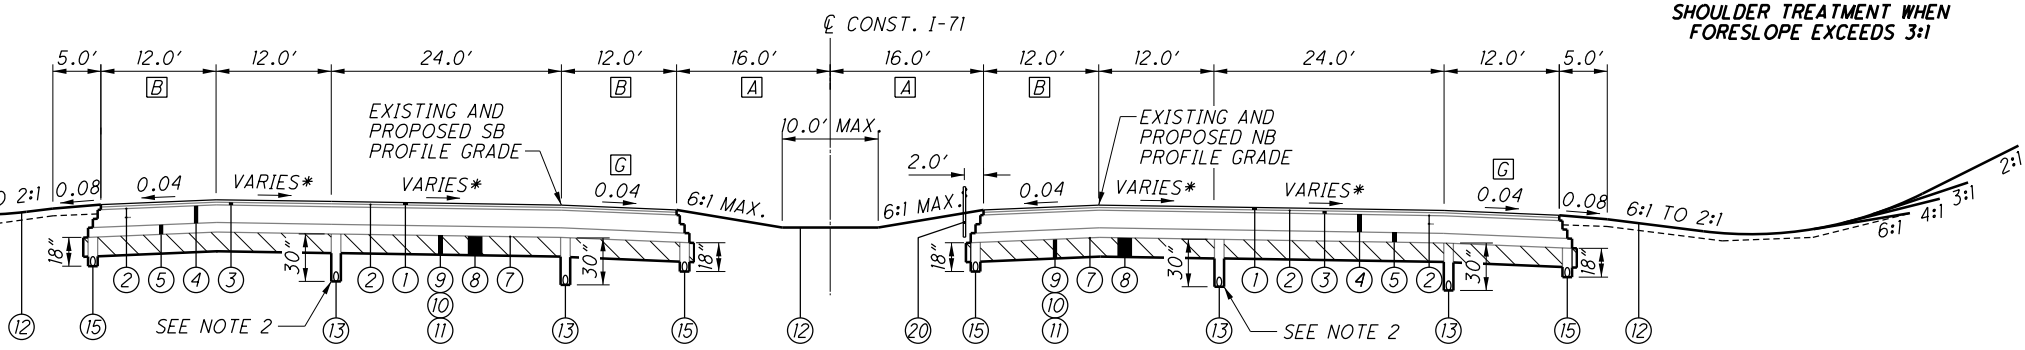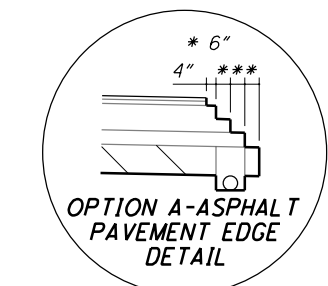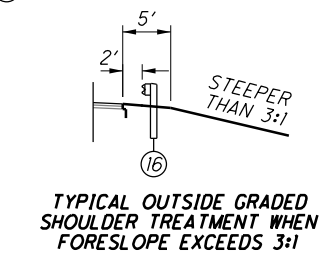

SOUTHBOUND
 STA 74+37.03 TO STA 74+50.00 (*0.016 - 0.015)
 STA 94+00.00 TO STA 156+83.16 (*0.020 - 0.016)

NORTHBOUND
 STA 74+37.03 TO STA 74+50.00 (*0.016 - 0.015)
 STA 94+00.00 TO STA 156+83.16 (*0.020 - 0.016)

LEGEND

- (A) EXISTING ASPHALT OVERLAY (6" AVERAGE DEPTH)
- (B) EXISTING REINFORCED PCC (9" AVERAGE DEPTH)
- (C) EXISTING AGGREGATE BASE (6" AVERAGE DEPTH)
- (D) EXISTING BITUMINOUS AGGREGATE (3" AVERAGE DEPTH)
- (E) EXISTING STABILIZED AGGREGATE SHOULDER (VARIABLE DEPTH)
- (F) EXISTING AGGREGATE BASE (VARIABLE DEPTH)
- (G) EXISTING 6" PIPE UNDERDRAIN
- (H) EXISTING COMPACTED AGGREGATE (2" AVERAGE DEPTH)
- (I) EXISTING CONCRETE BARRIER, TYPE A
- (J) EXISTING ASPHALT SURFACE COURSE (VARIABLE DEPTH)
- (K) EXISTING ASPHALT INTERMEDIATE COURSE (1 3/4" AVERAGE DEPTH)
- (L) EXISTING ASPHALT BASE (11" AVERAGE DEPTH)
- (M) EXISTING NON-REINFORCED CONCRETE (13 1/2" AVERAGE DEPTH)

- (1) ITEM 442 - 1/2" ASPHALT CONCRETE SURFACE COURSE, 12.5 MM, TYPE A, (447), AS PER PLAN
- (2) ITEM 407 - NON-TRACKING TACK COAT
- (3) ITEM 442 - 3/4" ASPHALT CONCRETE INTERMEDIATE COURSE, 19 MM, TYPE A, (446)
- (4) ITEM 302 - ASPHALT CONCRETE BASE, AS PER PLAN, 11" (2 LIFTS)
- (5) ITEM 304 - 6" AGGREGATE BASE
- (6) ITEM 526 - APPROACH SLAB (T=17")
- (7) ITEM 204 - SUBGRADE COMPACTION AND PROOF ROLLING
- (8) ITEM 206 - CEMENT STABILIZED SUBGRADE, 12" DEEP
- (9) ITEM 204 - EXCAVATION OF SUBGRADE, 12" DEEP
- (10) ITEM 204 - GEOTEXTILE FABRIC
- (11) ITEM 204 - 12" GRANULAR MATERIAL, TYPE B
- (12) ITEM 659 - SEEDING AND MULCHING
- (13) ITEM 605 - 6" SHALLOW PIPE UNDERDRAINS
- (14) ITEM 605 - 6" UNCLASSIFIED PIPE UNDERDRAINS

- (15) ITEM 605 - 6" BASE PIPE UNDERDRAINS
- (16) ITEM 606 - GUARDRAIL, TYPE MGS
- (17) ITEM 622 - SINGLE SLOPE CONCRETE BRIDGE RAILING
- (18) ITEM 452 - 12 1/2" NON-REINFORCED CONCRETE PAVEMENT CLASS QC IP WITH QC/OA, OR ITEM 452 - NON-REINFORCED CONCRETE PAVEMENT, MISC.: 12 1/2" CLASS QC MS WITH QC/OA
- (19) ITEM 622 - CONCRETE BARRIER, SINGLE SLOPE, TYPE C1
- (20) ITEM 606 - CABLE BARRIER (ONLY ON NORTHBOUND SIDE)
- (21) NOT USED
- (22) ITEM 452 - 13 1/2" NON-REINFORCED CONCRETE PAVEMENT CLASS QC IP WITH QC/OA
- (23) ITEM 526 - APPROACH SLAB (T=15")
- (24) ITEM 202 - PAVEMENT REMOVED
- (25) LONGITUDINAL JOINT
- (26) ITEM 254 - PAVEMENT PLANING, ASPHALT CONCRETE
- (27) ITEM 254 - PAVEMENT PLANING, PORTLAND CEMENT CONCRETE
- (28) ITEM 848 - OVERLAY, MISC.: CONCRETE PAVEMENT CLASS QC IP WITH QC/OA

TABLE 1
 PAVED SHOULDER WIDTH TRANSITIONS

| SB OUTSIDE SHOULDER | NB OUTSIDE SHOULDER |
|-----------------------------------|-----------------------------------|
| 12' AT STA 20+20.00 TO | 12' AT STA 21+81.85 TO |
| 14' AT STA 20+70.00 | 14' AT STA 21+91.85 |
| 14' AT STA 21+63.15 TO | 14' AT STA 23+00.00 TO |
| 12' AT STA 21+73.15 | 12' AT STA 23+50.00 |
| 12' AT STA 125+00.00 TO | 12' AT STA 125+96.74 TO |
| 14' AT STA 125+50.00 | 14' AT STA 126+06.74 |
| 14' AT STA 126+43.03 TO | 14' AT STA 126+95.00 TO |
| 12' AT STA 126+53.03 | 12' AT STA 127+45.00 |
| 12' AT STA 142+80.00 TO *** | 12' AT STA 156+25.00 TO |
| 14' AT STA 143+30.00 | 14' AT STA 156+35.00 |
| 14' AT STA 148+20.00 TO *** | 14' AT STA 158+83.79 TO |
| 12' AT STA 148+30.00 | 12' AT STA 159+33.79 |
| 12' AT STA 155+50.26 TO | 12' AT STA 161+00.00 TO |
| 8' AT STA 158+77.76 | 8' AT STA 162+00.00 (DECEL LANE) |
| 8' AT STA 163+42.83 TO | 8' AT STA 162+75.00 TO |
| 10' AT STA 163+92.78 (ACCEL LANE) | 10' AT STA 162+85.00 (DECEL LANE) |
| 10' AT STA 166+55.00 TO | 10' AT STA 165+27.82 TO |
| 8' AT STA 166+65.00 (ACCEL LANE) | 8' AT STA 165+77.85 (DECEL LANE) |

| SB MEDIAN SHOULDER | NB MEDIAN SHOULDER |
|-------------------------|----------------------------|
| 12' AT STA 156+67.42 TO | 12' AT STA 155+59.46 TO ** |
| 14' AT STA 157+17.42 | 14' AT STA 156+84.93 |
| 14' AT STA 159+49.12 TO | 14' AT STA 159+16.64 TO |
| 12' AT STA 159+59.12 | 12' AT STA 160+39.50 ** |
| 12' AT STA 163+04.11 TO | 12' AT STA 162+36.48 TO ** |
| 14' AT STA 163+54.11 | 14' AT STA 163+21.78 |
| 14' AT STA 166+12.00 TO | 14' AT STA 165+65.41 TO |
| 12' AT STA 166+22.00 | 12' AT STA 166+65.41 ** |

** REQUIRED FOR MAINTENANCE OF TRAFFIC
 *** REQUIRED FOR NOISE BARRIER

X:\4037000\121957.16\107201\roadway\sheet\107201G01.dgn Sheet 8/8/2020 2:56:38 PM 1458515


TYPICAL SECTIONS

FRA-71-0:00


ITEM 204 - EXCAVATION OF SUBGRADE, 12" DEEP

NOTES:


1. SEE SHEET 6 FOR LEGEND.
2. THE SUPERELEVATED SECTION EDGE OF PAVEMENT UNDERDRAINS SHIFT LATERAL LOCATIONS WHEN THE TRANSITIONING LANE EXCEEDS 0.000, NOT AT WHERE THE PAVEMENT FIRST BEGINS THE CROSS SLOPE TRANSITION.
3. STANDARD LONGITUDINAL JOINTS AS PER BP-2.1 SHALL BE PLACED ALONG THE CENTER OF ALL RAMPS AND AT THEIR EDGES OF PAVEMENT.
4. SEE SHEETS 1021-1030 FOR PAVEMENT JOINT DETAILS.
5. RAMPS SHALL BE PER SHOWN CONCRETE BUILDUP REGARDLESS OF MAINLINE OPTIONAL PAVEMENT SELECTED.
6. BALLOON 18 SHALL CONSIST OF ITEM 452, 12 1/2" NON-REINFORCED CONCRETE PAVEMENT, CLASS 1P WITH OC/OA EXCEPT AS MODIFIED BY NOTES 7 & 8.
7. CONSTRUCT THE INTERSECTION AREA PAVEMENT USING ITEM 452 NON-REINFORCED CONCRETE PAVEMENT, MISC.: 12 1/2" CLASS OC MS WITH OC/OA. THIS IS THE PORTION OF RAMPS B & D CONSTRUCTED DURING THE PHASE 2 WEEKEND WORK ZONE DETAILED ON SHEET 262.
8. CONSTRUCT THE PHASE 3, WEEKEND 1 WORK ZONE AND PHASE 3, WEEKEND 2 WORK ZONE PAVEMENT DETAILED ON SHEET 319 USING ITEM 452 NON-REINFORCED CONCRETE PAVEMENT, MISC.: 12 1/2" CLASS OC MS WITH OC/OA. THIS INCLUDES PORTIONS OF BOTH RAMPS A & C.

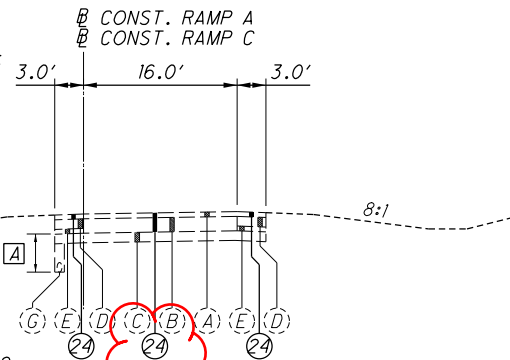


EXISTING NORMAL SECTION - RAMPS A AND C

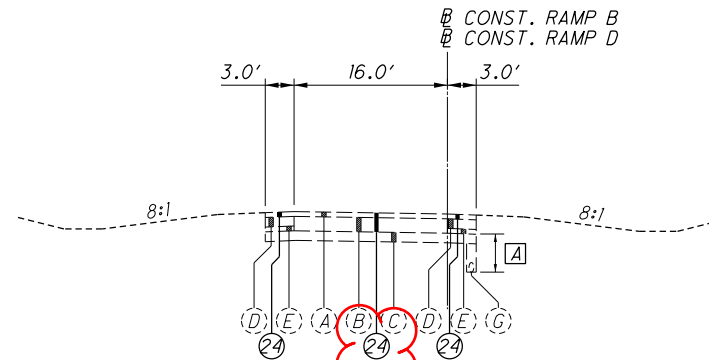

EXISTING NORMAL SECTION - RAMPS B AND D

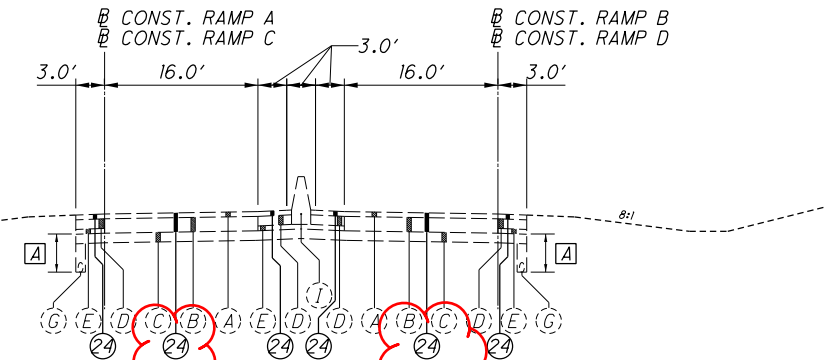


EXISTING COMBINED SECTION - RAMPS

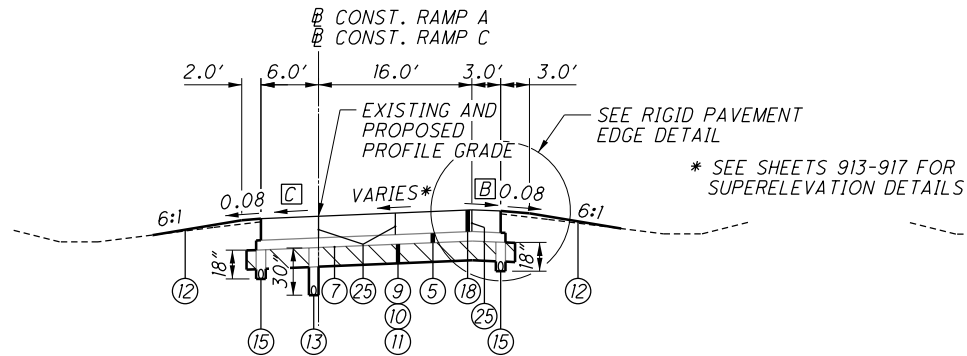

SUPERELEVATED SECTION - RAMPS A AND C


RAMP A - STA 177+00.00 TO STA 177+85.22
 **RAMP A - STA 177+85.22 TO STA 178+21.47
 RAMP A - STA 178+21.47 TO STA 184+68.33
 RAMP C - STA 176+27.38 TO STA 180+80.97
 SEE COMBINED SECTIONS FOR REMAINDER OF RAMP C LENGTH

** NORMAL SECTION WITH 0.016 CROSS SLOPE FOR THIS STATION RANGE SEE NOTE 6

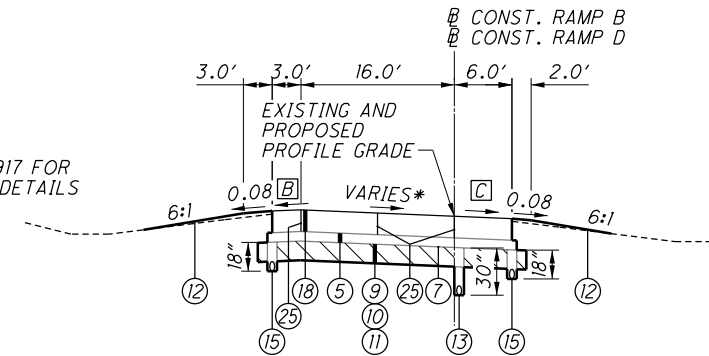

SUPERELEVATED SECTION - RAMPS B AND D


RAMP B - STA 170+70.83 TO STA 178+27.64
 RAMP D - STA 168+88.15 TO STA 176+07.85
 SEE COMBINED SECTIONS FOR REMAINDER OF RAMP D LENGTH
 SEE NOTE 6

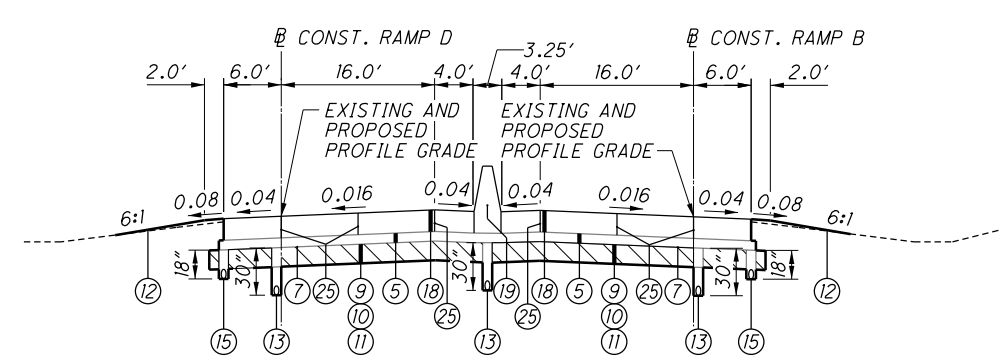


NORMAL COMBINED SECTION - RAMPS B AND D

RAMP B - STA 160+70.81 TO STA 165+43.98
 RAMP D - STA 180+82.83 TO STA 185+56.00


INTERSECTION AREA
 RAMP B/D - STA 159+51.81 TO STA 160+70.81 (SAME PAVEMENT BUILD-UP)
 SEE NOTES 6 & 7

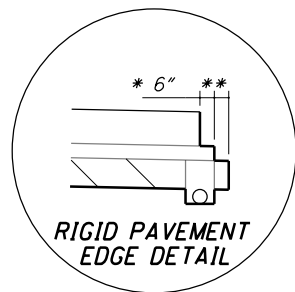


RIGID PAVEMENT EDGE DETAIL

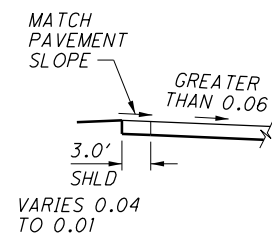


MATCH PAVEMENT SLOPE

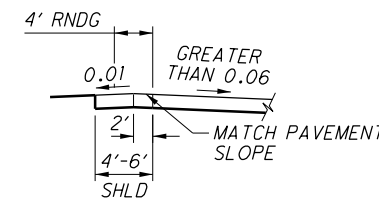

MATCH PAVEMENT SLOPE

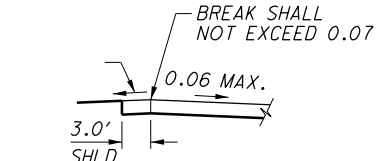


BREAK SHALL NOT EXCEED 0.07

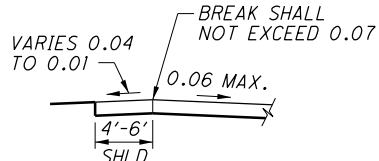

BREAK SHALL NOT EXCEED 0.07

DETAIL A
 HIGH SIDE OF SUPERELEVATED SECTION

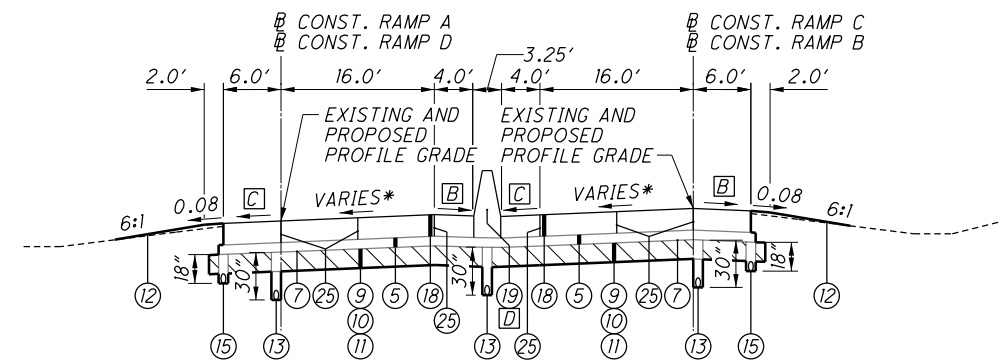

SUPERELEVATED COMBINED SECTION - RAMPS

RAMP A/C - STA 165+61.56 TO STA 171+22.86
 RAMP B/D - STA 165+43.98 TO STA 170+70.83
 MIRROR SECTION
 RAMP A/C - STA 171+22.86 TO STA 177+00.00

INTERSECTION AREA
 RAMP A/C - STA 164+35.95 TO STA 165+61.56 (SAME PAVEMENT BUILD-UP)
 SEE NOTES 6 & 8

STATIONS LISTED FOR THIS SECTION ARE FOR RAMPS A AND B

X:\4037000\121957.16\107201\roadway\sheet\107201G\003.dgn Sheet 8/8/2020 2:58:48 PM 1458s.js

LANES OPEN DURING HOLIDAYS AND SPECIAL EVENTS

NO WORK SHALL BE PERFORMED AND THE SAME NUMBER OF LANES AS WERE AVAILABLE AT THE START OF THE PROJECT SHALL BE OPEN TO TRAFFIC DURING THE FOLLOWING DESIGNATED HOLIDAYS OR EVENTS:

| HOLIDAYS | |
|----------------|----------------|
| CHRISTMAS | FOURTH OF JULY |
| NEW YEAR'S EVE | LABOR DAY |
| MEMORIAL DAY | THANKSGIVING |

THE PERIOD OF TIME THAT THE LANES ARE TO BE OPEN DEPENDS ON THE DAY OF THE WEEK ON WHICH THE HOLIDAY FALLS. THE FOLLOWING SCHEDULE SHALL BE USED TO DETERMINE THIS PERIOD:

| DAY OF HOLIDAY | TIMES ALL LANES MUST BE OPEN TO TRAFFIC |
|----------------|---|
| SUNDAY | 12:00 NOON FRIDAY THROUGH 6:00 AM MONDAY |
| MONDAY | 12:00 NOON FRIDAY THROUGH 6:00 AM TUESDAY |
| TUESDAY | 12:00 NOON MONDAY THROUGH 6:00 AM WEDNESDAY |
| WEDNESDAY | 12:00 NOON TUESDAY THROUGH 6:00 AM THURSDAY |
| THURSDAY | 12:00 NOON WEDNESDAY THROUGH 6:00 AM FRIDAY |
| THANKSGIVING | 5:00 AM WEDNESDAY THROUGH 6:00 AM MONDAY |
| FRIDAY | 12:00 NOON THURSDAY THROUGH 6:00 AM MONDAY |
| SATURDAY | 12:00 NOON FRIDAY THROUGH 6:00 AM MONDAY |

NO EXTENSIONS OF TIME SHALL BE GRANTED FOR DELAYS IN MATERIAL DELIVERIES, UNLESS SUCH DELAYS ARE INDUSTRY WIDE, OR FOR LABOR STRIKES, UNLESS SUCH STRIKES ARE AREA WIDE.

SHOULD THE CONTRACTOR FAIL TO MEET ANY OF THESE REQUIREMENTS, THE CONTRACTOR SHALL BE ASSESSED A DISINCENTIVE PER THE LANE VALUE CONTRACT (PN 127).

PERMITTED LANE CLOSURES

THE EXISTING NUMBER OF LANES IN EACH DIRECTION SHALL BE MAINTAINED AT ALL TIMES EXCEPT DURING PERIODS OF WORK AT WHICH TIME LANES MAY BE CLOSED IN ACCORDANCE WITH THE LANE VALUE CONTRACT TABLE FOR EACH LOCATION UNLESS OTHERWISE SHOWN IN THE PLANS.

LENGTH AND DURATION OF LANE CLOSURES AND RESTRICTIONS SHALL BE AT THE APPROVAL OF THE ENGINEER. IT IS THE INTENT TO MINIMIZE THE IMPACT TO THE TRAVELING PUBLIC. LANE CLOSURES OR RESTRICTIONS OVER SEGMENTS OF THE PROJECT IN WHICH NO WORK IS ANTICIPATED WITHIN A REASONABLE TIME FRAME, AS DETERMINED BY THE ENGINEER, SHALL NOT BE PERMITTED. THE LEVEL OF UTILIZATION OF MAINTENANCE OF TRAFFIC DEVICES SHALL BE COMMENSURATE WITH THE WORK IN PROGRESS.

ALL WORK AND TRAFFIC CONTROL DEVICES SHALL BE IN ACCORDANCE WITH CMS 614 AND OTHER APPLICABLE PORTIONS OF THE SPECIFICATIONS, AS WELL AS THE OHIO MANUAL OF UNIFORM TRAFFIC CONTROL DEVICES.

PAYMENT FOR ALL LABOR, EQUIPMENT AND MATERIALS SHALL BE INCLUDED IN THE LUMP SUM CONTRACT PRICE FOR ITEM 614, MAINTAINING TRAFFIC, AS PER PLAN, UNLESS SEPARATELY ITEMIZED IN THE PLAN.

PUBLIC OUTREACH AND NOTIFICATION (ROAD CLOSURE)

THE CONTRACTOR SHALL BE RESPONSIBLE FOR CONTACTING THE DISTRICT 6 PUBLIC INFORMATION OFFICE VIA EMAIL AT D06.PIO@DOT.STATE.OH.US TO COORDINATE EFFORTS TO NOTIFY ALL LOCAL COUNTY, STATE AND FEDERAL EMERGENCY SERVICES, SCHOOL DISTRICTS AND ADJACENT RESIDENTS AND BUSINESSES OF THE UPCOMING CLOSURE. ADVANCE NOTIFICATION SHALL OCCUR NO LATER THAN FOURTEEN (14) DAYS PRIOR TO CLOSING THE ROAD. IT, SUBSEQUENT TO THE ADVANCE NOTIFICATION, THE START DATE IS CHANGED, THAN A NEW SEVEN (7) DAY NOTIFICATION WILL BE REQUIRED. THE ROAD CANNOT BE CLOSED UNLESS PRIOR NOTIFICATION HAS BEEN ACCOMPLISHED. THE SAME PARTIES SHALL BE NOTIFIED WHEN THE CLOSURE HAS CONCLUDED AND THE ROAD IS BACK OPEN TO TRAFFIC. ALL NOTIFICATIONS SHALL BE MADE UTILIZING THE TEMPLATE PROVIDED BY THE DISTRICT 6 PUBLIC NOTIFICATION OFFICE.

PUBLIC OUTREACH AND NOTIFICATION (RESURFACING PROJECTS)

THE CONTRACTOR SHALL BE RESPONSIBLE FOR CONTACTING THE DISTRICT 6 PUBLIC INFORMATION OFFICE VIA EMAIL AT D06.PIO@DOT.STATE.OH.US TO COORDINATE EFFORTS TO NOTIFY ADJACENT RESIDENTS AND BUSINESSES OF THE UPCOMING RESURFACING PROJECT. ADVANCE NOTIFICATION SHALL OCCUR NO LATER THAN FOURTEEN (14) DAYS PRIOR TO THE FIRST DAY OF WORK. ALL NOTIFICATIONS SHALL BE MADE UTILIZING THE TEMPLATE PROVIDED BY THE DISTRICT 6 PUBLIC NOTIFICATION OFFICE.

NOTICE OF CLOSURE SIGN

NOTICE OF CLOSURE SIGNS, W20-H13, SHALL BE ERECTED BY THE CONTRACTOR PRIOR TO THE SCHEDULED ROAD OR RAMP CLOSURE IN ACCORDANCE WITH THE NOTICE OF CLOSURE TIME TABLE BELOW. AT THE APPROVAL OF THE ENGINEER, PORTABLE CHANGEABLE MESSAGE SIGNS MAY BE USED IN LIEU OF THE STANDARD FLATSHEET SIGN FOR CLOSURE DURATIONS OF LESS THAN 1 WEEK.

THE SIGNS SHALL BE ERECTED ON THE RIGHT-HAND SIDE OF THE ROAD/RAMP FACING TRAFFIC. THEY SHALL BE PLACED SO AS NOT TO INTERFERE WITH THE VISIBILITY OF ANY OTHER TRAFFIC CONTROL SIGNS. ON ROADWAYS, THEY SHOULD BE ERECTED AT OR NEAR THE POINT OF CLOSURE. THE SIGNS MAY BE ERECTED ANYWHERE ON RAMPS AS LONG AS THEY ARE VISIBLE TO THE MOTORISTS USING THE RAMP. ON ENTRANCE RAMPS, THE SIGN SHALL BE ERECTED WELL IN ADVANCE OF THE MERGE AREA TO AVOID DISTRACTING MOTORISTS.

| ITEM | DURATION OF CLOSURE | SIGN DISPLAY TO PUBLIC | NOTIFICATION DUE TO DISTRICT 6 COMMUNICATIONS OFFICE |
|----------------------|----------------------|-----------------------------------|--|
| RAMP & ROAD CLOSURES | >=2 WEEKS | 14 CALENDAR DAYS PRIOR TO CLOSURE | 21 CALENDAR DAYS PRIOR TO CLOSURE |
| | >12 HOURS & <2 WEEKS | 7 CALENDAR DAYS PRIOR TO CLOSURE | 14 CALENDAR DAYS PRIOR TO CLOSURE |
| | <12 HOURS | 2 BUSINESS DAYS PRIOR TO CLOSURE | 4 BUSINESS DAYS PRIOR TO CLOSURE |

THE SIGN SHALL DISPLAY THE DATE OF THE CLOSURE IN MMM-DD FORMAT AND THE NUMBER OF DAYS OF THE CLOSURE. THE LAST LINE OF THE W20-H13 SIGN SHALL DISPLAY THE PHONE NUMBER OF THE DISTRICT 6 PUBLIC INFORMATION CONSTRUCTION LINE, (740)833-8268, WHICH A MOTORIST MAY CALL FOR ADDITIONAL INFORMATION.

NOTIFICATION OF TRAFFIC RESTRICTIONS

THROUGHOUT THE DURATION OF THE PROJECT, THE CONTRACTOR SHALL NOTIFY THE PROJECT ENGINEER IN WRITING OF ALL TRAFFIC RESTRICTIONS AND UPCOMING MAINTENANCE OF TRAFFIC CHANGES. THE CONTRACTOR SHALL ENSURE THE WRITTEN NOTIFICATION IS SUBMITTED IN A TIMELY MANNER TO ALLOW THE PROJECT ENGINEER TO MEET THE REQUIRED TIME FRAMES SET FORTH IN THE TABLE BELOW TO INFORM SPECIAL HAULING PERMITS SECTION (HAULING.PERMITS@DOT.OHIO.GOV) AND THE DISTRICT PUBLIC INFORMATION OFFICE PIO (D06.PIO@DOT.OHIO.GOV). THIS NOTIFICATION SHALL BE RECEIVED BY THE PROJECT ENGINEER PRIOR TO THE PHYSICAL SETUP OF ANY APPLICABLE SIGNS OR MESSAGE BOARDS.

INFORMATION SHOULD INCLUDE BUT IS NOT LIMITED TO ALL CONSTRUCTION ACTIVITIES THAT IMPACT OR INTERFERE WITH TRAFFIC AND SHALL LIST THE SPECIFIC LOCATION, TYPE OF WORK, ROAD STATUS, DATE AND TIME OF RESTRICTION, DURATION OF RESTRICTION, NUMBER OF LANES MAINTAINED, NUMBER OF LANES CLOSED, MINIMUM VERTICAL CLEARANCE, MINIMUM WIDTH OF DRIVABLE PAVEMENT, DETOUR ROUTES IF APPLICABLE, AND ANY OTHER INFORMATION REQUESTED BY THE PROJECT ENGINEER.

| ITEM | DURATION OF CLOSURE | NOTIFICATION DUE TO DISTRICT 6 COMMUNICATIONS OFFICE | SIGN DISPLAYED TO PUBLIC |
|---|----------------------|--|-----------------------------------|
| RAMP & ROAD CLOSURES | >=2 WEEKS | 21 CALENDAR DAYS PRIOR TO CLOSURE | 14 CALENDAR DAYS PRIOR TO CLOSURE |
| | >12 HOURS & <2 WEEKS | 14 CALENDAR DAYS PRIOR TO CLOSURE | 7 CALENDAR DAYS PRIOR TO CLOSURE |
| | <12 HOURS | 4 BUSINESS DAYS PRIOR TO CLOSURE | 2 BUSINESS DAYS PRIOR TO CLOSURE |
| LANE CLOSURE & RESTRICTIONS | >=2 WEEKS | 14 CALENDAR DAYS PRIOR TO CLOSURE | |
| | <2 WEEKS | 5 BUSINESS DAYS PRIOR TO CLOSURE | |
| START OF CONSTRUCTION & TRAFFIC PATTERN CHANGES | N/A | 14 CALENDAR DAYS PRIOR TO IMPLEMENTATION | |

ANY UNFORESEEN CONDITIONS NOT SPECIFIED IN THE PLANS REQUIRING TRAFFIC RESTRICTIONS SHALL ALSO BE REPORTED TO THE PROJECT ENGINEER USING THE NOTIFICATION TIME FRAME TABLE.

NOTIFICATION OF CONSTRUCTION INITIATION

AT LEAST FOURTEEN DAYS PRIOR TO STARTING INITIAL CONSTRUCTION ACTIVITIES, THE CONTRACTOR SHALL ADVISE THE DISTRICT OFFICE OF COMMUNICATIONS VIA EMAIL AT D06.PIO@DOT.OHIO.GOV, THE DISTRICT WORK ZONE TRAFFIC MANAGER VIA EMAIL AT D06.MOT@DOT.OHIO.GOV AND THE CENTRAL OFFICE SPECIAL HAUL PERMITS SECTION VIA EMAIL AT HAULING.PERMITS@DOT.OHIO.GOV OF THE ANTICIPATED START DATE OF ANY CONSTRUCTION ACTIVITIES INCLUDING BUT NOT LIMITED TO THE PLACING OF WORK ZONE SIGNS. THE NOTIFICATION SHALL ALSO INCLUDE THE PROJECT NUMBER, PID, NAME AND PHONE NUMBER OF THE CONTRACTOR, A POINT OF CONTACT AND THE ANTICIPATED IMPACT ON TRAFFIC. THE CONTRACTOR WILL IMMEDIATELY INFORM THE DISTRICT OFFICE OF COMMUNICATIONS AND THE DISTRICT WORK ZONE TRAFFIC MANAGER OF ANY AND ALL DELAYS AND/OR CHANGES REGARDING THE CONSTRUCTION INITIATION DATE.

PRE-MAINTENANCE OF TRAFFIC MEETING

A PRE-MAINTENANCE OF TRAFFIC MEETING SHALL BE HELD (MINIMUM 10 WORK DAYS) PRIOR TO WORK BEGINNING OR ANY CHANGE OF PHASING. THIS MEETING SHALL INCLUDE THE DISTRICT MAINTENANCE OF TRAFFIC ENGINEER (D06.MOT@DOT.STATE.OH.US) AS WELL AS THE CONTRACTOR AND ANY OF HIS SUB-CONTRACTORS INVOLVED WITH TEMPORARY TRAFFIC CONTROL. FOR COLUMBUS SECTIONS OF ROADWAY, ALSO INCLUDE THE TEMPORARY CONTROL COORDINATOR (614-645-6269 OR 614-645-5845) FROM THE CITY OF COLUMBUS TRANSPORTATION DIVISION.

DRUM REQUIREMENTS

IN ADDITION TO THE REQUIREMENTS OF THE PLANS, SPECIFICATION AND PROPOSAL, DRUMS FURNISHED BY THE CONTRACTOR SHALL BE NEW AND UNUSED AT THE TIME OF ARRIVAL ON THE PROJECT. ANY DRUMS BROUGHT ON THE PROJECT, WHICH HAVE PREVIOUSLY BEEN USED ELSEWHERE, WILL NOT BE ACCEPTED.

PAYMENT FOR DRUMS SHALL BE INCLUDED IN THE LUMP SUM PRICE BID FOR MAINTAINING TRAFFIC UNLESS SEPARATELY ITEMIZED.

WORK ZONE MARKINGS

THE FOLLOWING ESTIMATED QUANTITIES HAVE BEEN CARRIED TO THE GENERAL SUMMARY FOR APPLICATION TO THE SURFACE COURSE (PRIOR TO INSTALLATION OF PERMANENT MARKINGS) FOR WORK ZONE PAVEMENT MARKINGS PER THE REQUIREMENTS OF C&MS 614.04 AND 614.11.

- ITEM 614, LANE LINE, CLASS III, 6", 642 PAINT
24.56 MILE
- ITEM 614, EDGE LINE, CLASS III, 6", 642 PAINT
25.58 MILE
- ITEM 614, CHANNELIZING LINE, CLASS III, 12", 642 PAINT
4051 FT
- ITEM 614, DOTTED LINE, CLASS III, 12", 642 PAINT
4714 FT

ITEM 614 - DETOUR SIGNING

SIZE AND PLACEMENT OF DETOUR SIGNS (M4-9) SHOULD FOLLOW THE REQUIREMENTS OF THE OMUTCD SECTION 6F.03, SECTION 2A.11 AND TABLE 6F.01. DETOUR SIGNING SHALL PROVIDE DRIVERS ADEQUATE TIME TO CLEARLY READ THE SIGNS AND MAKE THE PROPER DECISIONS AT EACH REQUIRED TURNING MOVEMENT. THE DESIGNATED DETOUR ROUTE SHALL BE SIGNED IN ACCORDANCE WITH THE REQUIREMENTS BELOW:

- APPROXIMATELY 1500 FEET PRIOR TO TIP OF THE PAINTED GORE AT AN INTERCHANGE WHEN EXITING A HIGH SPEED (45 MPH OR HIGHER) FACILITY.
- AT OR NEAR THE EXISTING SIGN IN THE GORE OF AN INTERCHANGE RAMP.
- AT OR NEAR THE FIRST EXISTING LANE ASSIGNMENT SIGN ON AN INTERCHANGE EXIT RAMP.
- AT OR NEAR THE EXISTING LANE ASSIGNMENT SIGN OR EXISTING ROUTE MARKER AT THE END OF AN EXIT RAMP.
- APPROXIMATELY 500 FEET PRIOR TO A REQUIRED TURN AT AN INTERSECTION NOT CONTROLLED BY A STOP SIGN (FOR 45 MPH OR HIGHER ONLY).
- AT OR NEAR THE EXISTING LANE ASSIGNMENT SIGN OR EXISTING ROUTE MARKER AT AN INTERSECTION.
- EVERY TWO MILES ALONG A TANGENT SECTION BETWEEN TURNING MOVEMENTS OUTSIDE A CITY.
- EVERY TWO BLOCKS ALONG A TANGENT SECTION BETWEEN TURNING MOVEMENTS WITHIN A CITY.
- AT ANY OTHER INTERSECTION OR DECISION POINT WHERE THE DETOUR ROUTE IS CONTRARY TO THE NORMAL, EXPECTED TURNING MANEUVER OR OTHERWISE UNCLEAR.

DETOUR SIGNS SHALL BE PLACED, WHEN POSSIBLE, NEXT TO BUT NOT BLOCKING EXISTING ROUTE MARKERS OR LANE ASSIGNMENT SIGNS. DETOUR SIGNS SHALL NOT OBSCURE OR BE OBSCURED BY OTHER EXISTING OR TEMPORARY SIGNS.

DETOUR SIGNS SHALL BE ERECTED AND/OR UNCOVERED PRIOR TO THE ROAD OR RAMP BEING CLOSED TO TRAFFIC BUT NO EARLIER THAN FOUR HOURS PRIOR TO THE CLOSURE. DETOUR SIGNS SHALL BE COVERED AND/OR REMOVED NO LATER THAN FOUR HOURS FOLLOWING THE ROAD OR RAMP RE-OPENING TO TRAFFIC.

PAYMENT FOR ACCEPTED QUANTITIES WILL BE MADE AT THE CONTRACT UNIT PRICE. PAYMENT SHALL BE FOR ALL MATERIALS, LABOR, INCIDENTALS AND EQUIPMENT FOR FURNISHING, PROPER SIGN PLACEMENT AND SIZING, TIMELY ERECTING AND/OR UNCOVERING OF SIGNS, MAINTAINING SIGNS, AND TIMELY COVERING AND/OR REMOVING SIGNS AND SUPPORTS.

THE FOLLOWING ESTIMATED QUANTITIES HAVE BEEN CARRIED TO THE GENERAL SUMMARY.

ITEM 614 - DETOUR SIGNING = LUMP SUM

TRAFFIC INCIDENT MANAGEMENT (TIM) DURING MOT

OHIO TIM IS OHIO'S TRAFFIC INCIDENT MANAGEMENT PROGRAM WHICH IS COMMITTED TO MAINTAINING THE SAFE AND EFFECTIVE FLOW OF TRAFFIC DURING EMERGENCIES AS TO PREVENT FURTHER DAMAGE, INJURY OR UNDUE DELAY OF THE MOTORING PUBLIC. IN ADDITION TO COMPLYING WITH THE PROVISION OF OMUTCD CHAPTER 6I, CONTROL OF TRAFFIC THROUGH TRAFFIC INCIDENT MANAGEMENT AREAS, THE CONTRACTOR SHALL ACTIVELY PARTICIPATE IN TIM PLANNING AND IMPLEMENTATION AS OUTLINED BELOW.

1. SUPERINTENDENT SHALL IDENTIFY THE INDIVIDUAL PERSONS ON THE PROJECT WHO WILL, OR MAY NEED TO, PERFORM THE DUTIES HEREIN. AT A MINIMUM, INCLUDE THE SUPERINTENDENT, FOREMEN AND SUPERVISORS (OR EQUIVALENT) AS WELL AS THE WORKSITE TRAFFIC SUPERVISOR (WTS; IF APPLICABLE TO THE PROJECT). THESE INDIVIDUALLY IDENTIFIED PERSONS SHALL COLLECTIVELY BE KNOWN AS CONTRACTOR TRAFFIC INCIDENT MANAGEMENT (TIM) CONTACTS. NOTIFY THE PROJECT ENGINEER OF THE CONTRACTOR TIM CONTACTS (ALONG WITH CONTACT INFORMATION FOR EACH) AT OR BEFORE THE PRECONSTRUCTION MEETING.
2. SUPERINTENDENT SHALL NOTIFY THE ENGINEER IMMEDIATELY IF ANY CONTRACTOR TIM CONTACT IS ADDED, REMOVED OR THE CONTACT INFORMATION CHANGES OVER THE COURSE OF THE PROJECT.
3. PRIOR THE FIRST DAY OF WORK IN THE FIELD, EACH CONTRACTOR TIM CONTACT ON THE PROJECT SHALL HAVE ATTENDED AND SUCCESSFULLY COMPLETED OHIO TIM TRAINING PROVIDED BY THE DEPARTMENT OR DESIGNEE. TRAINING INFORMATION CAN BE FOUND AT WWW.OHIOTIM.COM.
4. SUPERINTENDENT, AT A MINIMUM, SHALL ATTEND AND ACTIVELY PARTICIPATE IN A DEPARTMENT SCHEDULED TIM MEETING BEFORE CONSTRUCTION WORK BEGINS AND BEFORE EACH PHASE CHANGE. THESE MEETINGS WILL RESULT IN A DEPARTMENT ISSUED PROJECT SPECIFIC TRAFFIC INCIDENT MANAGEMENT PLAN (TIMP). AT THE TIM MEETINGS THE ATTENDING CONTRACTOR TIM CONTACTS SHALL:
 - A. COLLABORATE WITH ODOT AND SAFETY FORCES;
 - B. SHARE PROJECT SPECIFIC DETAILS THAT IMPACT TIM RESPONDERS; AND
 - C. RECOMMEND WAYS TO INCORPORATE NECESSARY EMERGENCY ACCESS AND OTHER TIM ELEMENTS FOR TIM RESPONDERS GIVEN PROJECT SPECIFIC WORK BEING COMPLETED AND PROJECT SPECIFIC PHASING.
5. CONTRACTOR TIM CONTACTS SHALL IMPLEMENT COMPONENTS OF THE RESULTING TIMP (SUCH AS APPROVED EMERGENCY INGRESS/EGRESS POINTS, ETC), AS DIRECTED BY THE ENGINEER IN ACCORDANCE WITH 109.05.
6. CONTRACTOR TIM CONTACTS SHALL PERFORM, AT A MINIMUM, THE FOLLOWING FUNCTIONS WHEN AN INCIDENT/CRASH OCCURS:
 - A. IF OBSERVED OR PRESENT WHEN OCCURS, CALL 911 AND THEN NOTIFY THE TRAFFIC MANAGEMENT CENTER (TMC) TO PROVIDE THE FOLLOWING:
 - I. LOCATION, INCLUDING MILEPOST NUMBER AND DIRECTION OF TRAVEL
 - II. NUMBER AND TYPE OF VEHICLES INVOLVED, IF KNOWN
 - III. ESTIMATED EXTENT OF DAMAGE OR INJURY, IF KNOWN
 - IV. ESTIMATED NUMBER OF PATIENTS INVOLVED, IF KNOWN
 - V. ANY POTENTIAL HAZARDOUS CONDITIONS, IF KNOWN
 - VI. THE PLACARD NUMBER ON ANY HAZARDOUS MATERIALS PLACARD FROM A SAFE DISTANCE, IF APPLICABLE AND VISIBLE

B. FOLLOWING AN INCIDENT/CRASH:

- I. INITIATE TRAFFIC MANAGEMENT/PROVIDE TEMPORARY TRAFFIC CONTROL AS INDICATED IN THE TIMP, AS DIRECTED BY THE ENGINEER IN ACCORDANCE WITH 109.05.
- II. RECOMMEND ROADWAY REPAIR NEEDS.
- III. PROVIDE REPAIR RESOURCES AND INITIATE REPAIRS, AS DIRECTED BY THE ENGINEER IN ACCORDANCE WITH 109.05.
- IV. ATTEND AND PARTICIPATE IN AN AFTER ACTION REVIEW (AAR).

ALL COSTS, UNLESS OTHERWISE SPECIFIED, RESULTING FROM THE ABOVE REQUIREMENTS SHALL BE CONSIDERED TO BE INCLUDED IN THE LUMP SUM PRICE FOR ITEM 614, MAINTAINING TRAFFIC, AS PER PLAN. FAILURE TO PERFORM THE REQUIREMENTS OF THIS PLAN NOTE WILL RESULT IN A DAILY FINE OF 2% OF ITEM 614, MAINTAINING TRAFFIC, AS PER PLAN AND MAY RESULT IN ONE OR MORE CONTRACTOR TIM CONTACTS BEING REMOVED FROM THE LIST OF OHIO TIM TRAINED INDIVIDUALS (AT THE SOLE DISCRETION OF THE OHIO TIM EXECUTIVE COMMITTEE). IN THE EVENT AN INDIVIDUAL IS REMOVED FROM THE OHIO TIM TRAINED LIST, THE INDIVIDUAL WILL BE REMOVED FROM CONTRACTOR TIM CONTACT RESPONSIBILITIES ON ALL PROJECTS.

ITEM 614 MAINTAINING TRAFFIC MISC: BRIDGE DECK AND PAVEMENT PATCHING:

THIS WORK WILL BE AS DIRECTED BY THE ENGINEER AND WILL INCLUDE ALL ASSOCIATED MOT COSTS WITH THE ACTIVITY. THE COST FOR THIS ITEM SHALL BE \$1.00. THE FIXED AMOUNT SHOWN IN THE PROPOSAL IS INCLUDED (AS ANY OTHER BID ITEMS) IN THE TOTAL BID AMOUNT. THIS FIXED AMOUNT IS THE DEPARTMENT'S ESTIMATE OF THE TOTAL COST OF BRIDGE DECK AND PAVEMENT PATCHING WORK, THIS ITEM OF WORK EXCLUDES THE FOUR REPAIR TYPES LISTED IN THE ITEM - PAVEMENT FOR MAINTAINING TRAFFIC-APP, REQUIRED TO BE PERFORMED WITHIN THE WORK LIMITS AS DIRECTED BY THE ENGINEER. C&MS TABLE 104.02-2 DOES NOT APPLY TO REDUCTIONS IN THIS CONTRACT ITEM. FORCE ACCOUNT RECORDS SHALL BE KEPT TO TRACK AND ULTIMATELY DETERMINE THE AMOUNT OF THE PAY ITEM USED. THE WORK ITEM SHALL INCLUDE ALL WORK, AS DIRECTED BY THE ENGINEER, NEEDED TO RE-ESTABLISH A REASONABLY SAFE AND PASSABLE CONDITION OF THE DECK AND/OR PAVEMENT FOR THE DURATION OF THE REQUIRED UPCOMING MOT PHASES. THE CONTRACTOR SHALL MEET WITH THE ENGINEER TO ESTABLISH THE WORK AFTER EXECUTION OF THE CONTRACT. THE CONTRACTOR'S PROPOSED PHASING AND PHASING DURATIONS WILL ASSIST THE ENGINEER IN DETERMINING THE EXTENT OF THE WORK. THIS WORK IS ONLY INTENDED TO ESTABLISH A SAFE AND DRIVABLE CONDITION FOR THE DURATION OF THE PROJECT. THIS DOES NOT RELIEVE THE CONTRACTOR OF THE RESPONSIBILITIES OF 614.02B.

ITEM 614 MAINTAINING TRAFFIC MISC: BRIDGE DECK AND PAVEMENT PATCHING = \$180,000 EACH

ITEM 615, PAVEMENT FOR MAINTAINING TRAFFIC, CLASS A, AS PER PLAN

PRE-PHASE 1 WORK DETAILS EXISTING SHOULDERS THAT SHALL BE RECONSTRUCTED PRIOR TO SHIFTING TRAFFIC. THE EXISTING SHOULDERS SHALL BE PLANED 9 INCHES DOWN TO THE EXISTING ITEM 304 (AGGREGATE WHICH WILL REMAIN IN PLACE) AND REPAVED WITH CLASS A PAVEMENT FOR MAINTAINING TRAFFIC. THE CONTRACTOR SHALL CONSTRUCT 7 1/2 INCHES OF ITEM 302, ASPHALT CONCRETE BASE IN ONE LIFT AND 1 1/2 INCHES OF ITEM 441, TYPE 1 IN ANOTHER LIFT. THE CROSS SLOPE OF THE RECONSTRUCTED SHOULDER SHALL MATCH THE ADJACENT TRAVEL LANE.

IN ADDITION TO THE SHOULDER RECONSTRUCTION, THE CONTRACTOR SHALL MILL 1 FOOT INTO THE ADJACENT TRAVEL LANE, TO A DEPTH OF 1 1/2 INCHES. THIS 1 FOOT WIDE SECTION SHALL THEN BE RESURFACED WITH 1 1/2 INCHES OF ITEM 441, TYPE I.

ALL COST ASSOCIATED WITH PLANING AND REPAVING OF EXISTING SHOULDERS, INCLUDING THE 1' WIDE SECTION OF THE ADJACENT LANE, SHALL BE INCIDENTAL TO ITEM 615, PAVEMENT FOR MAINTAINING TRAFFIC, CLASS A, AS PER PLAN.

ITEM 615, ROADS FOR MAINTAINING TRAFFIC, AS PER PLAN

A LUMP SUM QUANTITY HAS BEEN PROVIDED PER SECTION 615 OF ODOT'S CONSTRUCTION AND MATERIALS SPECIFICATIONS (CMS). THE FOLLOWING QUANTITIES HAVE BEEN INCLUDED IN THE PLAN FOR INFORMATION ONLY. PAYMENT FOR ALL COSTS ASSOCIATED WITH TEMPORARY EARTHWORK, GUARDRAIL, RUMBLE STRIPS OUTSIDE THE FULL DEPTH PAVEMENT AND DRAINAGE SHALL BE INCLUDED IN THE CONTRACTOR PRICE PER LUMP SUM FOR ITEM 615, ROADS FOR MAINTAINING TRAFFIC.

| | |
|---|--------------|
| CONCRETE OPTION | |
| EXCAVATION FOR MAINTAINING TRAFFIC | 3922 CU. YD. |
| EMBANKMENT FOR MAINTAINING TRAFFIC | 6964 CU. YD. |
| ITEM 411 STABILIZED CRUSHED AGGREGATE | 2214 CU. YD. |
| ITEM 606 GUARDRAIL, TYPE MGS | 2225 FT. |
| ITEM 606 ANCHOR ASSEMBLY, MGS TYPE E | 15 EACH |
| ITEM 606 ANCHOR ASSEMBLY, MGS TYPE B | 2 EACH |
| ITEM 606 ANCHOR ASSEMBLY, MGS TYPE T | 6 EACH |
| ITEM 606 MGS BRIDGE TERMINAL ASSEMBLY, TYPE 1 | 3 EACH |
| ITEM 611 12" CONDUIT, TYPE B | 62 FT. |
| ITEM 611 15" CONDUIT, TYPE B | 172 FT. |
| ITEM 611 18" CONDUIT, TYPE B | 95 FT. |
| ITEM 611 CATCH BASIN, NO.2-2B | 2 EACH |
| ITEM 618 RUMBLE STRIPS, SHOULDER (ASPHALT CONCRETE) | 200 FT. |

| | |
|---|--------------|
| ASPHALT OPTION | |
| EXCAVATION FOR MAINTAINING TRAFFIC | 4016 CU. YD. |
| EMBANKMENT FOR MAINTAINING TRAFFIC | 5535 CU. YD. |
| ITEM 411 STABILIZED CRUSHED AGGREGATE | 2241 CU. YD. |
| ITEM 606 GUARDRAIL, TYPE MGS | 8075 FT. |
| ITEM 606 ANCHOR ASSEMBLY, MGS TYPE E | 21 EACH |
| ITEM 606 ANCHOR ASSEMBLY, MGS TYPE B | 2 EACH |
| ITEM 606 ANCHOR ASSEMBLY, MGS TYPE T | 11 EACH |
| ITEM 606 MGS BRIDGE TERMINAL ASSEMBLY, TYPE 1 | 4 EACH |
| ITEM 606 MGS BRIDGE TERMINAL ASSEMBLY, TYPE 2 | 1 EACH |
| ITEM 611 12" CONDUIT, TYPE B | 62 FT. |
| ITEM 611 15" CONDUIT, TYPE B | 172 FT. |
| ITEM 611 18" CONDUIT, TYPE B | 95 FT. |
| ITEM 611 CATCH BASIN, NO.2-2B | 2 EACH |
| ITEM 618 RUMBLE STRIPS, SHOULDER (ASPHALT CONCRETE) | 200 FT. |

ADDITIONALLY, THE TEMPORARY PAVEMENT LEFT IN PLACE FROM PROJECT FRA-71-5.29 PID 84868 FROM STA. 59+00 SB TO STA. 71+37 SB, FROM STA. 61+90 NB TO STA. 71+37 NB, FROM STA. 96+80 SB TO STA. 109+50 SB AND FROM STA. 96+80 NB TO STA. 112+50 NB SHALL BE REMOVED AND SHALL BE INCIDENTAL TO ITEM 615 ROADS FOR MAINTAINING TRAFFIC.

WHEN UNDERCUTS ARE NECESSARY FOR MAINLINE PAVEMENT OR EMBANKMENT CONSTRUCTION, EVALUATE THE NEED FOR TEMPORARY ROAD UNDERCUTS IF WITHIN A CLOSE PROXIMITY TO THE MAINLINE UNDERCUTS. A GEOTECHNICAL EVALUATION SHOULD BE CONSIDERED TO DETERMINE IF THE EXISTING SOIL CONDITIONS ARE ADEQUATE TO SUPPORT THE TEMPORARY ROAD. ADDITIONAL SOIL BORINGS ALONG THE TEMPORARY ROAD ARE NOT NORMALLY REQUIRED. UNDERCUTS WILL BE PAID FOR SEPARATELY UNDER THE APPROPRIATE 204 ITEMS.




CALCULATED
BER
CHECKED
SMM

**MAINTENANCE OF TRAFFIC PLAN-PRE-PHASE 1
(CONCRETE OPTION) I-71 - STA. 810+00 TO STA. 826+00**

FRA-71-0-00

46
1312

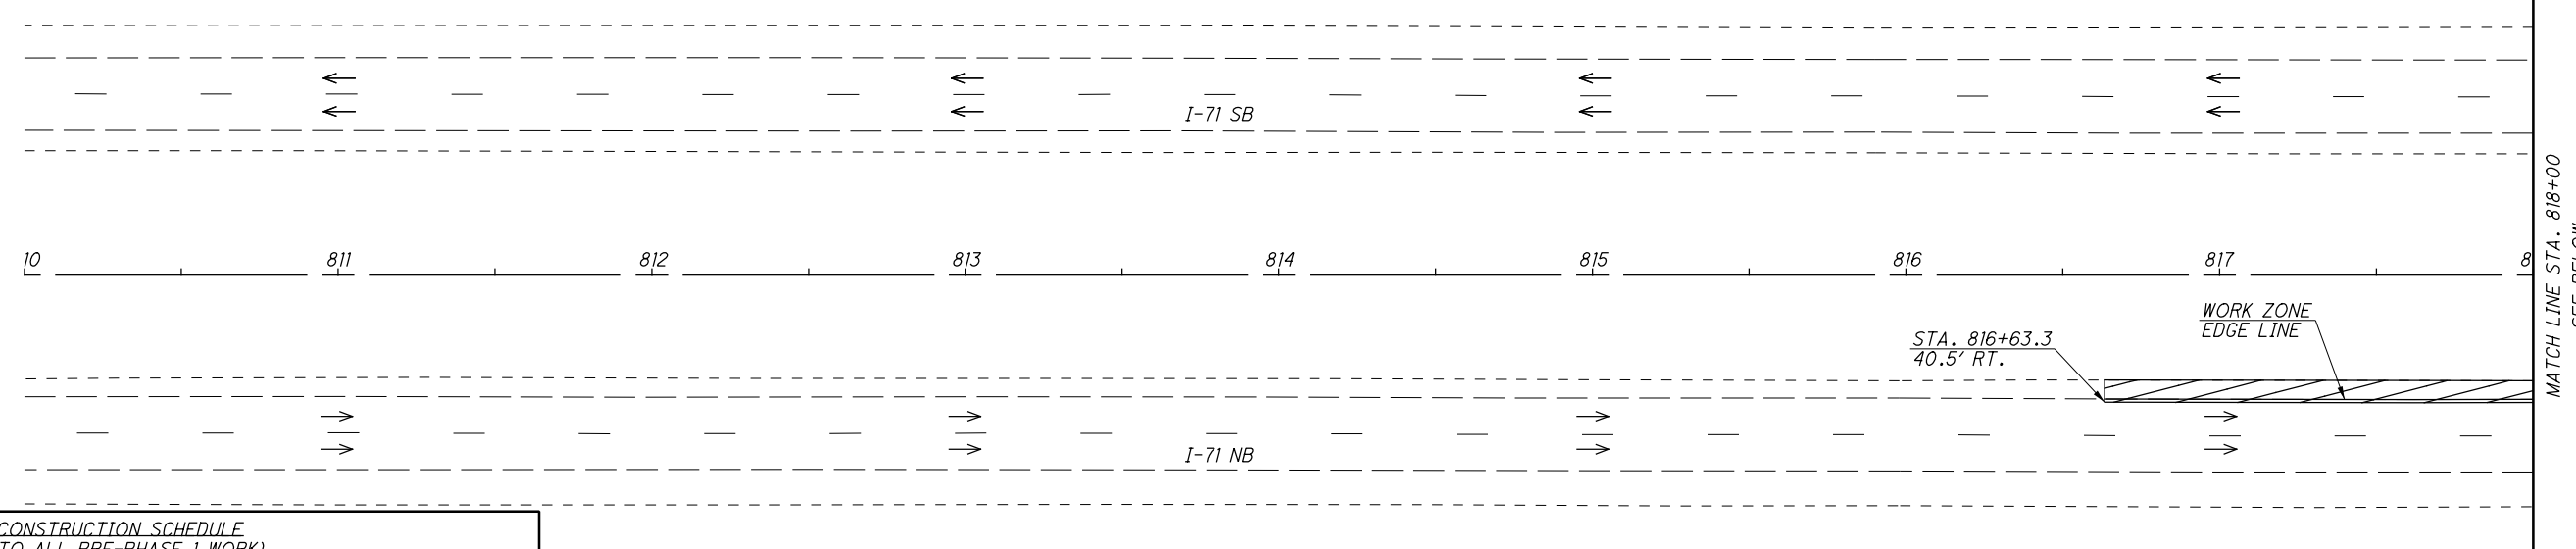

MATCH LINE STA. 818+00
SEE BELOW



PRE-PHASE 1 CONSTRUCTION SCHEDULE
(APPLICABLE TO ALL PRE-PHASE 1 WORK)

THE CONTRACTOR SHALL COMPLETE PRE-PHASE 1 IN PIECES, AND SHALL LIMIT THE LENGTH OF WORK ZONE TO THAT WHICH CAN BE COMPLETED OVER TWO CONSECUTIVE NIGHTS:

NIGHT 1:
PLANE 9 INCHES OF EXISTING SHOULDER AND REPLACE WITH 7.5 INCHES OF AGGREGATE BASE. ALSO PLANE 1.5 INCHES OF EXISTING PAVEMENT, 1 FOOT INTO THE ADJACENT TRAVEL LANE

NEXT MORNING:
OPEN RIGHT LANE (11 FEET WIDE) WITH DRUM PLACED IN THE DROPOFF. ADD "NO EDGE LINE" SIGN (W8-H12a-48), 500 FEET IN ADVANCE OF THE WORK ZONE. (SEE INTERIM CONDITION IN TYPICAL SECTIONS)

NIGHT 2:
APPLY 1.5 INCHES OF SURFACE COURSE TO THE SHOULDER AND THE 1 FOOT AREA ADJACENT. INSTALL ITEM, 614 WORK ZONE EDGE LINE TO RESTORE 12' RIGHT LANE.

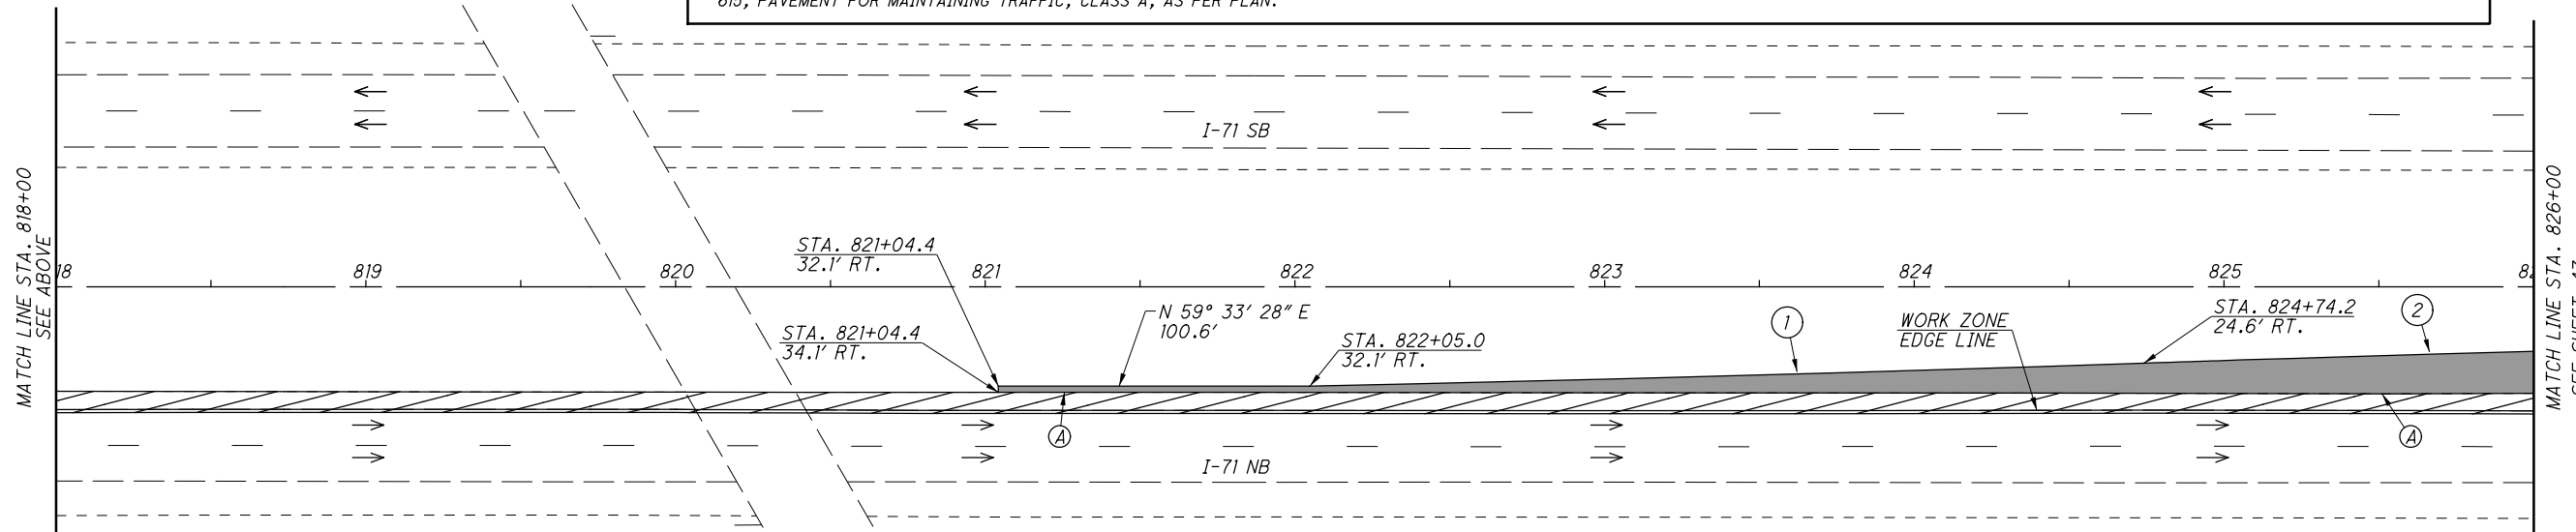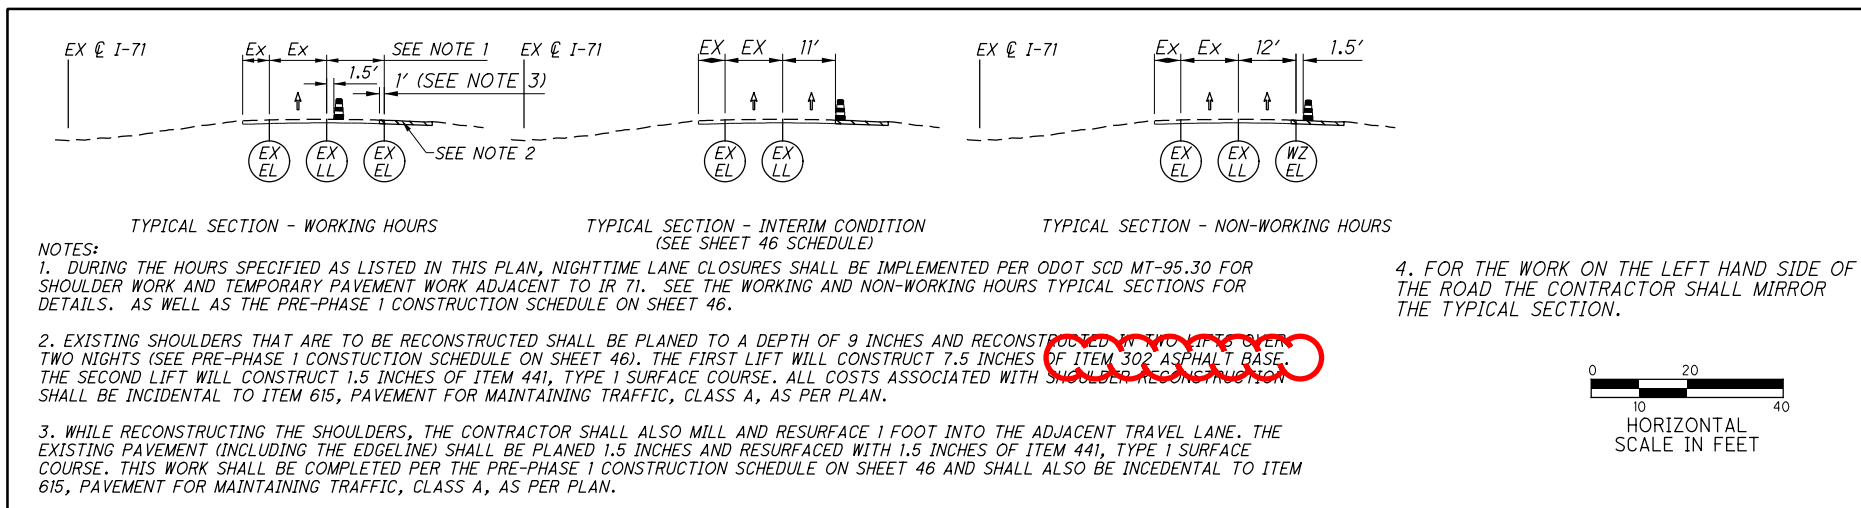

MATCH LINE STA. 826+00
SEE SHEET 47

| | |
|---|--|
| ① Δ = 0° 40' 26" (LT) Dc = 0° 15' 01" R = 22,904' T = 134.72 L = 269.43 E = 0.40' C = 269.43' C.B. = N 57° 57' 23" E | ② Δ = 1° 54' 02" (RT) Dc = 0° 14' 59" R = 22,932' T = 380.36' L = 760.66' E = 3.154' C = 760.62' C.B. = N 58° 35' 40" E |
|---|--|

LEGEND

SHOULDER RECONSTRUCTION


TEMPORARY PAVEMENT CONSTRUCTED THIS PHASE

OPEN TRAVEL LANE




Ⓐ - MEET/MATCH EXISTING EDGE OF SHOULDER

J:\20130212\ODOT\FRA\107201\mot\sheet107201MP152.dgn 8/6/2020 3:47:02 AM brieder

J:\20130212\ODOT\FRA\107201\mot\sheet\107201MP15.3.dgn 8/6/2020 3:48:03 AM brieder

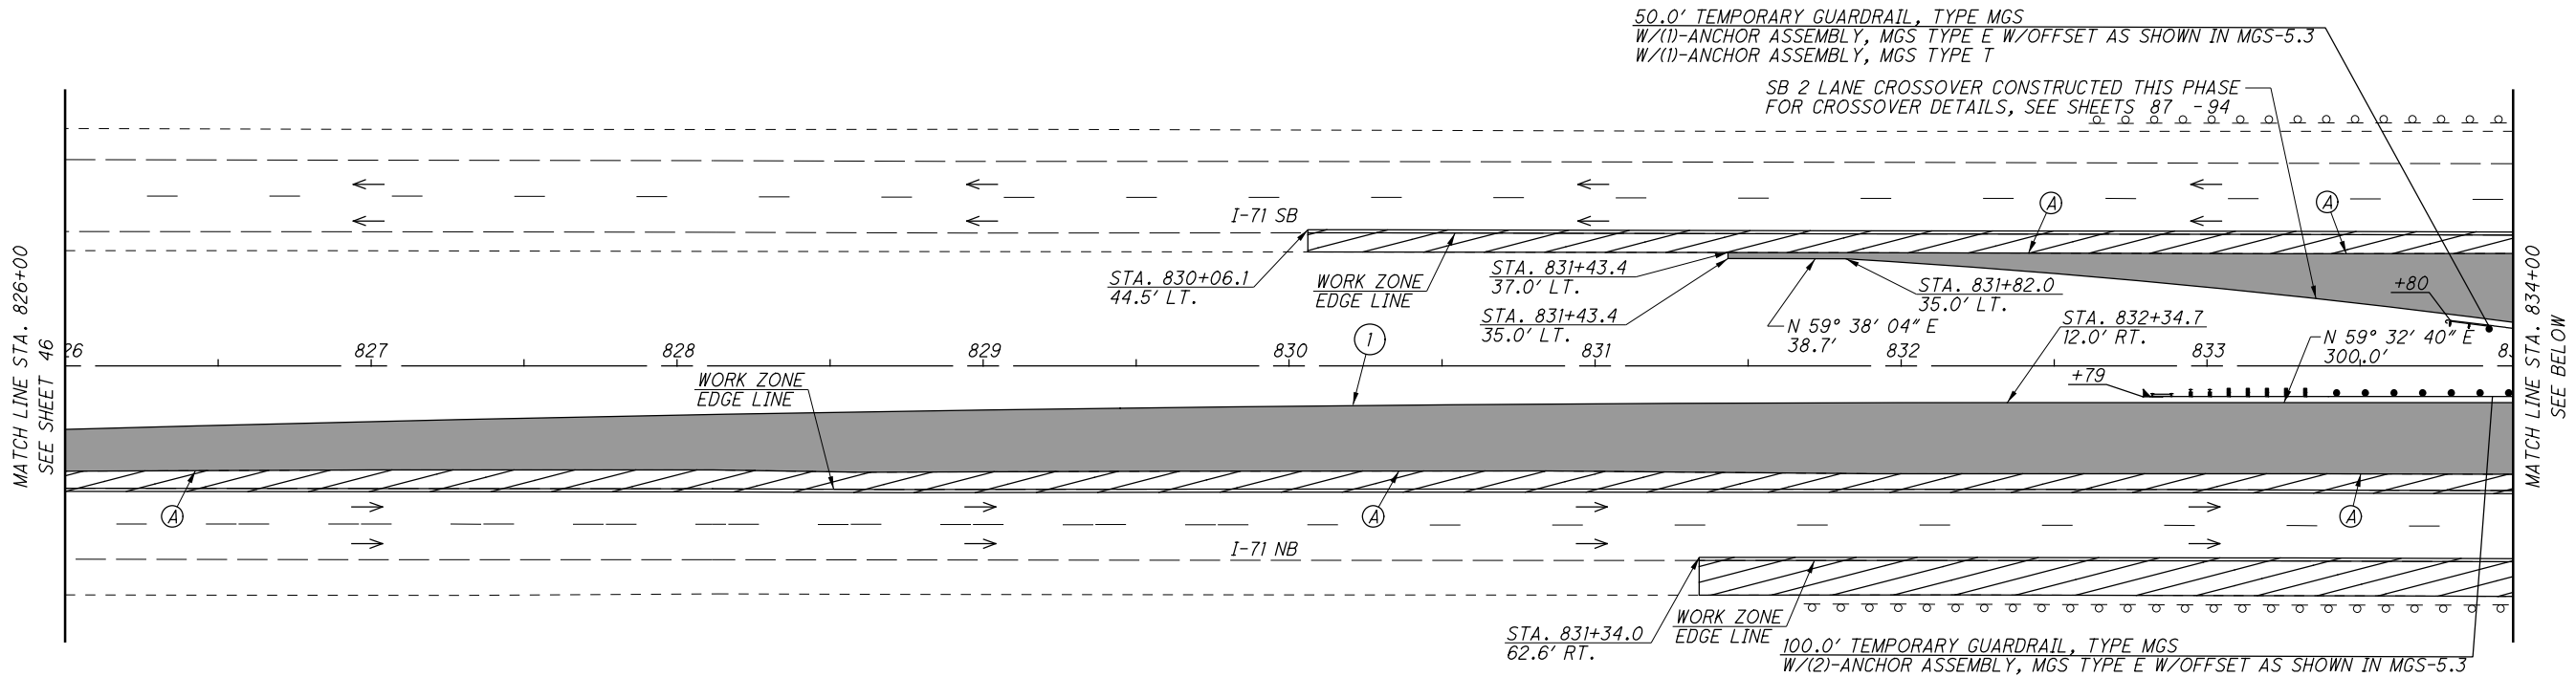

① $\Delta = 1^\circ 54' 02''$ (RT)
 $D_c = 0^\circ 14' 59''$
 $R = 22,932'$
 $T = 380.36'$
 $L = 760.66'$
 $E = 3.15'$
 $C = 760.62'$
 $C.B. = N 58^\circ 35' 40'' E$

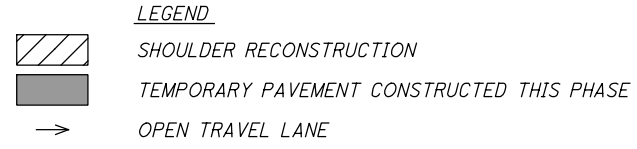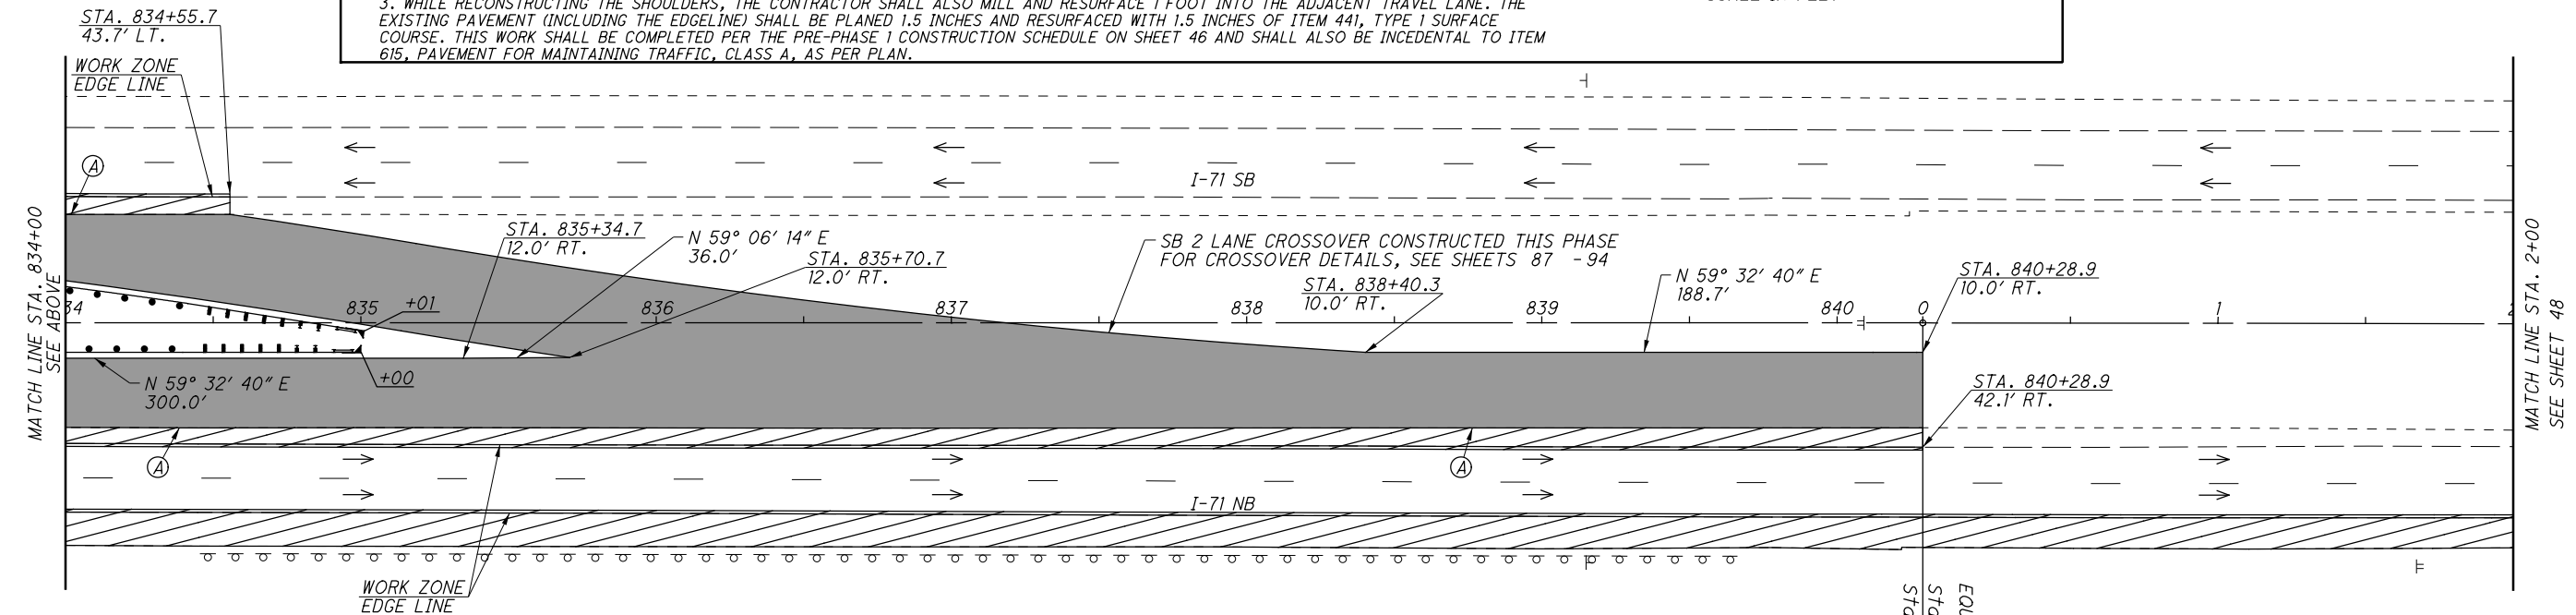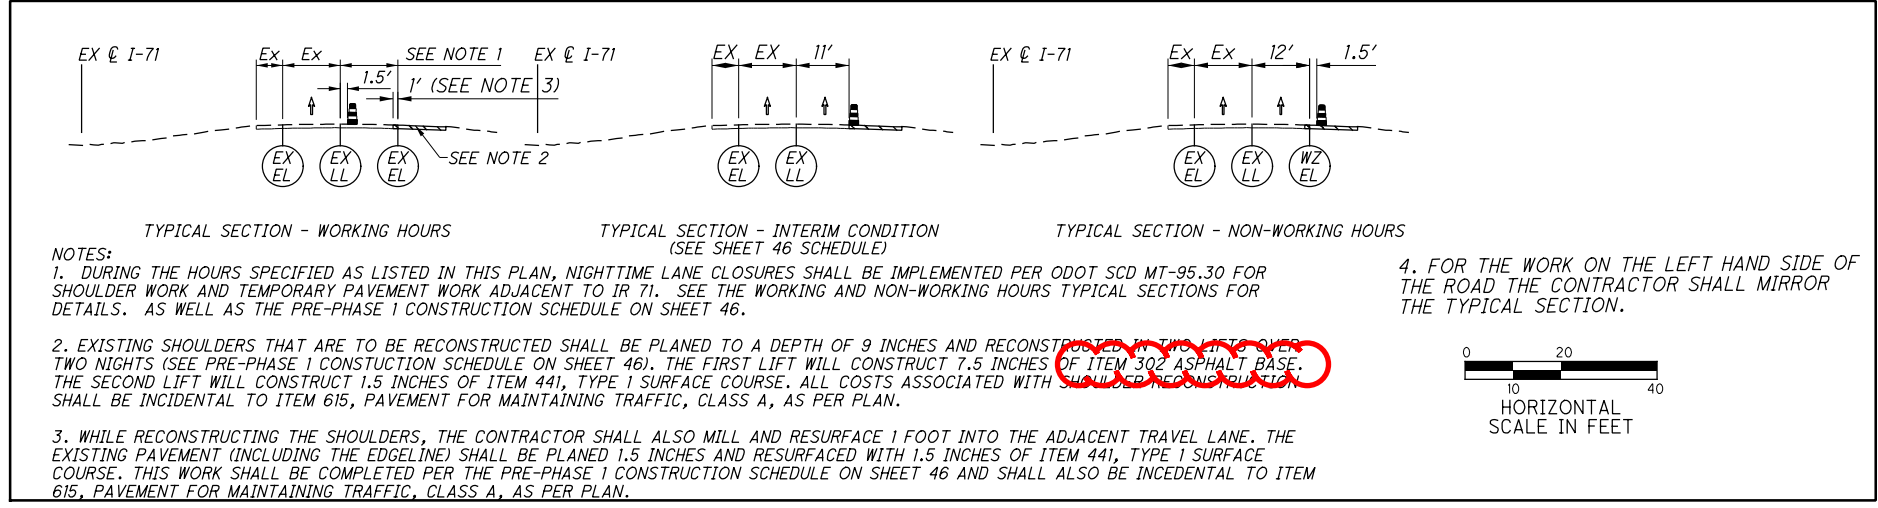

EQUATION:
 $STG\ 840+28.99\ BK =$
 $STG\ 0+00.00\ AH$

Ⓐ - MEET/MATCH EXISTING EDGE OF SHOULDER




CALCULATED BY: BER
 CHECKED BY: SMM

MAINTENANCE OF TRAFFIC PLAN-PRE-PHASE 1
(CONCRETE OPTION) I-71 - STA. 826+00 TO STA. 2+00

FRA-71-0.00

J:\20130212\ODOT\FRA\107201\mot\sheets\107201MP154.dgn 8/6/2020 3:49:01 AM brieder

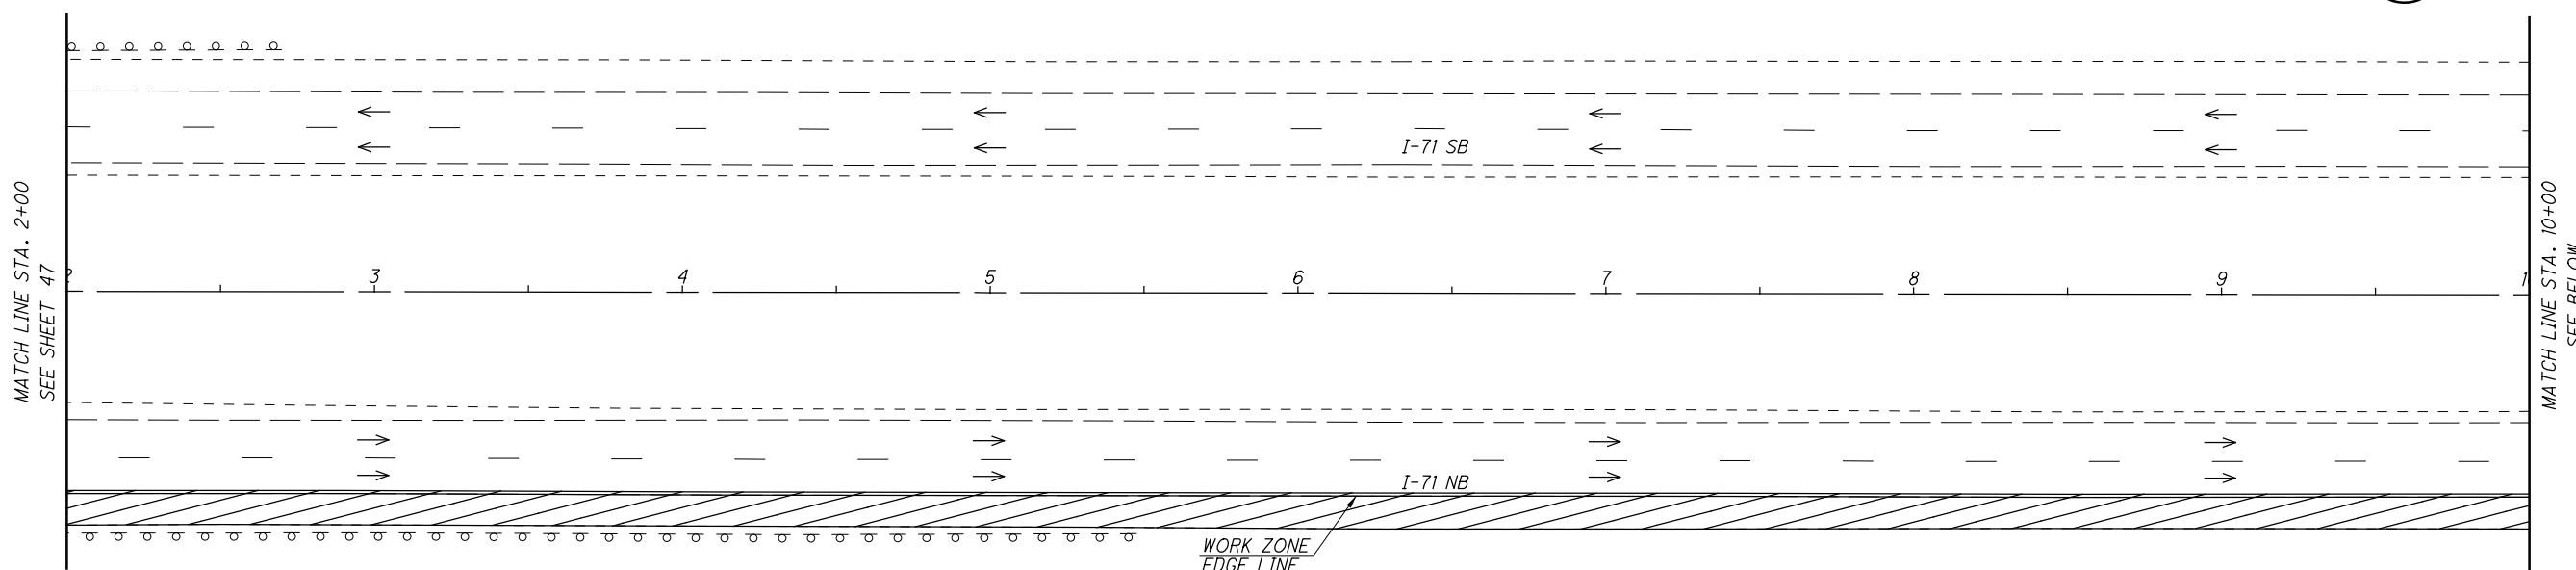

TYPICAL SECTION - WORKING HOURS **TYPICAL SECTION - INTERIM CONDITION** **TYPICAL SECTION - NON-WORKING HOURS**


(SEE SHEET 46 SCHEDULE)

NOTES:

1. DURING THE HOURS SPECIFIED AS LISTED IN THIS PLAN, NIGHTTIME LANE CLOSURES SHALL BE IMPLEMENTED PER ODOT SCD MT-95.30 FOR SHOULDER WORK AND TEMPORARY PAVEMENT WORK ADJACENT TO I-71. SEE THE WORKING AND NON-WORKING HOURS TYPICAL SECTIONS FOR DETAILS. AS WELL AS THE PRE-PHASE 1 CONSTRUCTION SCHEDULE ON SHEET 46.

2. EXISTING SHOULDERS THAT ARE TO BE RECONSTRUCTED SHALL BE PLANED TO A DEPTH OF 9 INCHES AND RECONSTRUCTED WITH TWO LIFTS OVER TWO NIGHTS (SEE PRE-PHASE 1 CONSTRUCTION SCHEDULE ON SHEET 46). THE FIRST LIFT WILL CONSTRUCT 7.5 INCHES OF ITEM 302 ASPHALT BASE. THE SECOND LIFT WILL CONSTRUCT 1.5 INCHES OF ITEM 441, TYPE 1 SURFACE COURSE. ALL COSTS ASSOCIATED WITH SHOULDER RECONSTRUCTION SHALL BE INCIDENTAL TO ITEM 615, PAVEMENT FOR MAINTAINING TRAFFIC, CLASS A, AS PER PLAN.

3. WHILE RECONSTRUCTING THE SHOULDERS, THE CONTRACTOR SHALL ALSO MILL AND RESURFACE 1 FOOT INTO THE ADJACENT TRAVEL LANE. THE EXISTING PAVEMENT (INCLUDING THE EDGELINE) SHALL BE PLANED 1.5 INCHES AND RESURFACED WITH 1.5 INCHES OF ITEM 441, TYPE 1 SURFACE COURSE. THIS WORK SHALL BE COMPLETED PER THE PRE-PHASE 1 CONSTRUCTION SCHEDULE ON SHEET 46 AND SHALL ALSO BE INCIDENTAL TO ITEM 615, PAVEMENT FOR MAINTAINING TRAFFIC, CLASS A, AS PER PLAN.

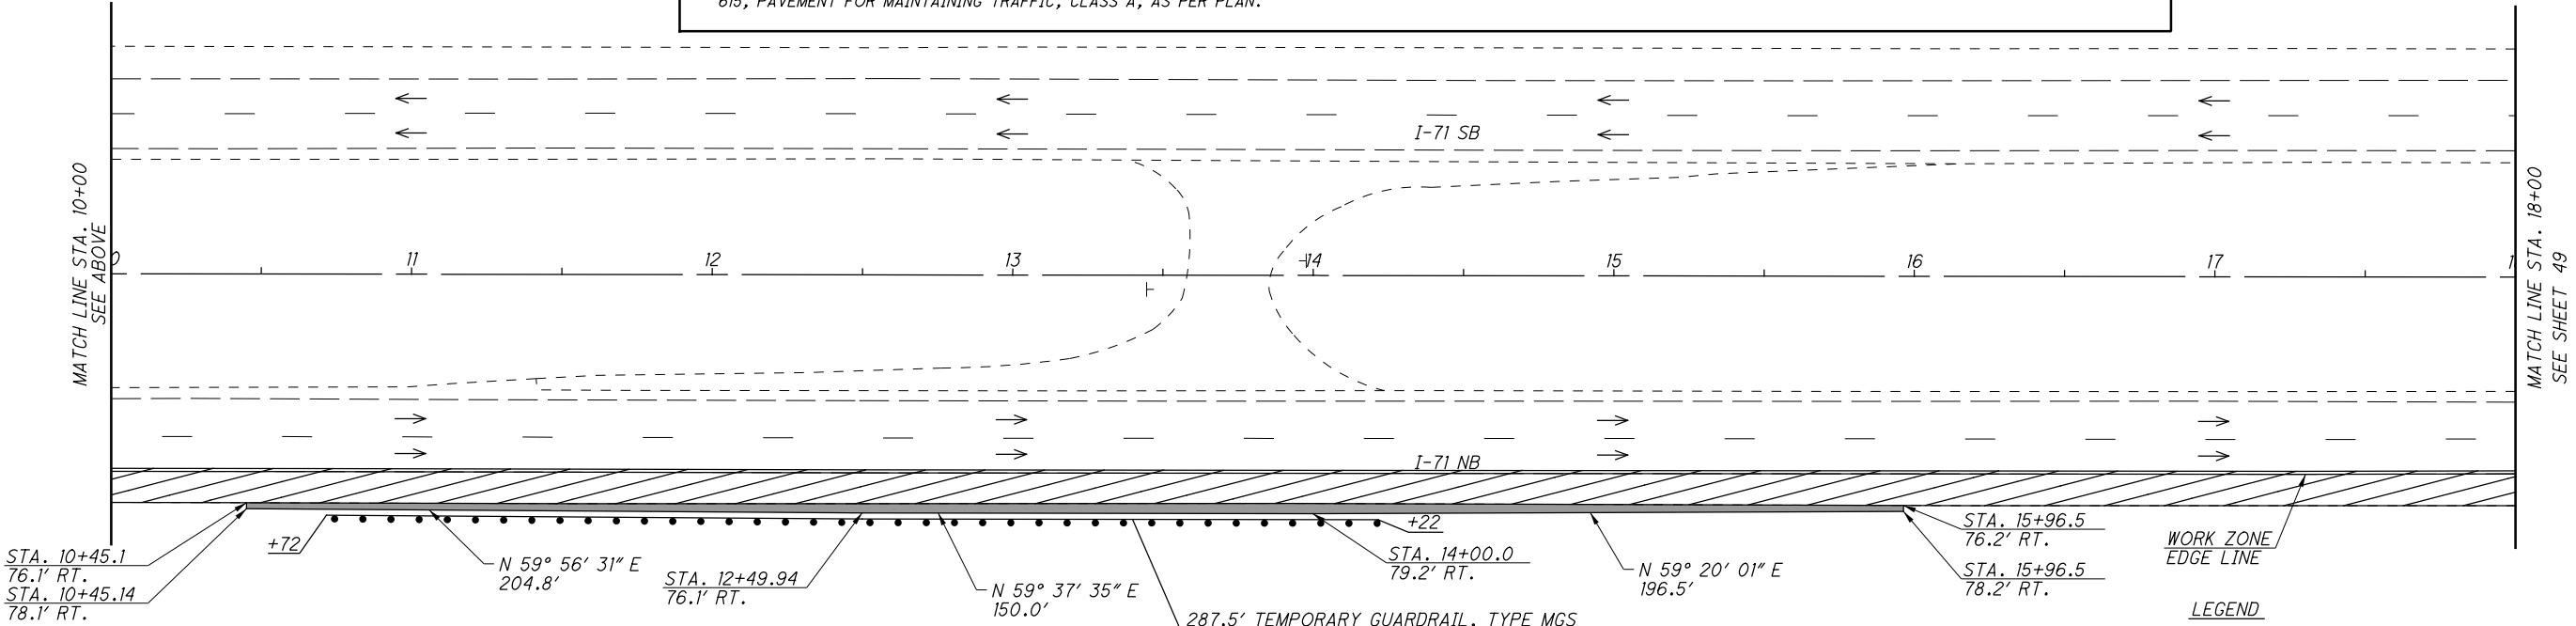

STA. 10+45.1
76.1' RT.
STA. 10+45.14
78.1' RT.

+72

N 59° 56' 31" E
204.8'

STA. 12+49.94
76.1' RT.

N 59° 37' 35" E
150.0'

287.5' TEMPORARY GUARDRAIL, TYPE MGS
W/(1)-ANCHOR ASSEMBLY, MGS TYPE E W/OFFSET AS SHOWN IN MGS-5.3
W/(1)-ANCHOR ASSEMBLY, MGS TYPE T

STA. 14+00.0
79.2' RT.

N 59° 20' 01" E
196.5'

STA. 15+96.5
76.2' RT.
STA. 15+96.5
78.2' RT.

WORK ZONE
EDGE LINE

LEGEND


- SHOULDER RECONSTRUCTION
- TEMPORARY PAVEMENT CONSTRUCTED THIS PHASE
- OPEN TRAVEL LANE

CALCULATED BY BER CHECKED BY SMM
MAINTENANCE OF TRAFFIC PLAN-PRE-PHASE 1
(CONCRETE OPTION) I-71 - STA. 2+00 TO STA. 18+00


FRA-71-0.00

J:\20130212\ODOT\FRA\107201\mot\sheet\107201MP155.dgn 8/6/2020 5:12:41 AM brieder

MATCH LINE STA. 18+00
SEE SHEET 48

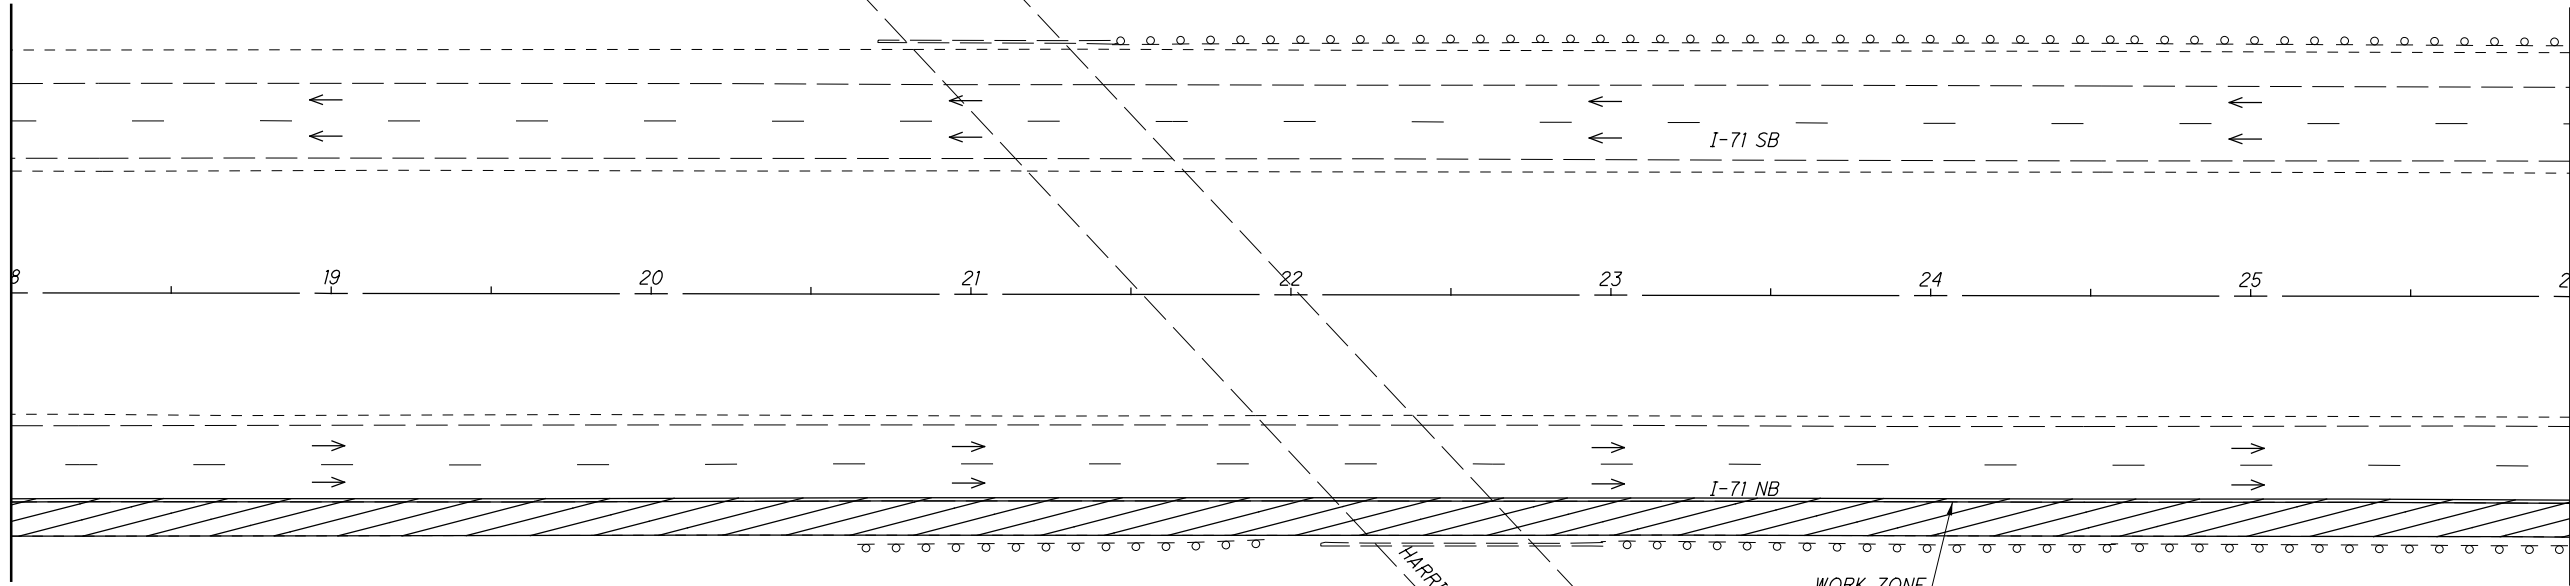

MATCH LINE STA. 26+00
SEE BELOW

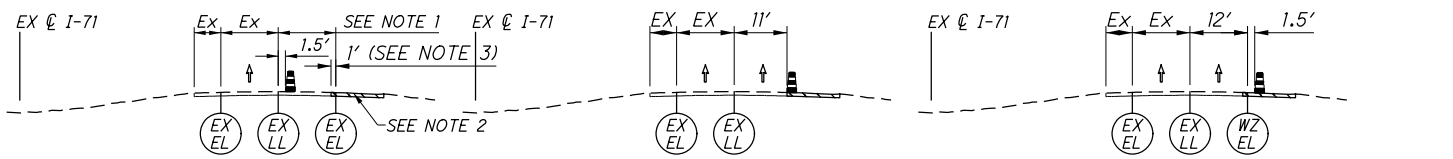


TYPICAL SECTION - WORKING HOURS TYPICAL SECTION - INTERIM CONDITION (SEE SHEET 46 SCHEDULE) TYPICAL SECTION - NON-WORKING HOURS

- NOTES:
1. DURING THE HOURS SPECIFIED AS LISTED IN THIS PLAN, NIGHTTIME LANE CLOSURES SHALL BE IMPLEMENTED PER ODOT SCD MT-95.30 FOR SHOULDER WORK AND TEMPORARY PAVEMENT WORK ADJACENT TO I-71. SEE THE WORKING AND NON-WORKING HOURS TYPICAL SECTIONS FOR DETAILS. AS WELL AS THE PRE-PHASE 1 CONSTRUCTION SCHEDULE ON SHEET 46.
 2. EXISTING SHOULDERS THAT ARE TO BE RECONSTRUCTED SHALL BE PLANED TO A DEPTH OF 9 INCHES AND RECONSTRUCTED IN TWO LIFTS OVER TWO NIGHTS (SEE PRE-PHASE 1 CONSTRUCTION SCHEDULE ON SHEET 46). THE FIRST LIFT WILL CONSTRUCT 7.5 INCHES OF ITEM 302 ASPHALT BASE. THE SECOND LIFT WILL CONSTRUCT 1.5 INCHES OF ITEM 441, TYPE 1 SURFACE COURSE. ALL COSTS ASSOCIATED WITH SHOULDER RECONSTRUCTION SHALL BE INCIDENTAL TO ITEM 615, PAVEMENT FOR MAINTAINING TRAFFIC, CLASS A, AS PER PLAN.
 3. WHILE RECONSTRUCTING THE SHOULDERS, THE CONTRACTOR SHALL ALSO MILL AND RESURFACE 1 FOOT INTO THE ADJACENT TRAVEL LANE. THE EXISTING PAVEMENT (INCLUDING THE EDGE LINE) SHALL BE PLANED 1.5 INCHES AND RESURFACED WITH 1.5 INCHES OF ITEM 441, TYPE 1 SURFACE COURSE. THIS WORK SHALL BE COMPLETED PER THE PRE-PHASE 1 CONSTRUCTION SCHEDULE ON SHEET 46 AND SHALL ALSO BE INCIDENTAL TO ITEM 615, PAVEMENT FOR MAINTAINING TRAFFIC, CLASS A, AS PER PLAN.



MATCH LINE STA. 26+00
SEE ABOVE

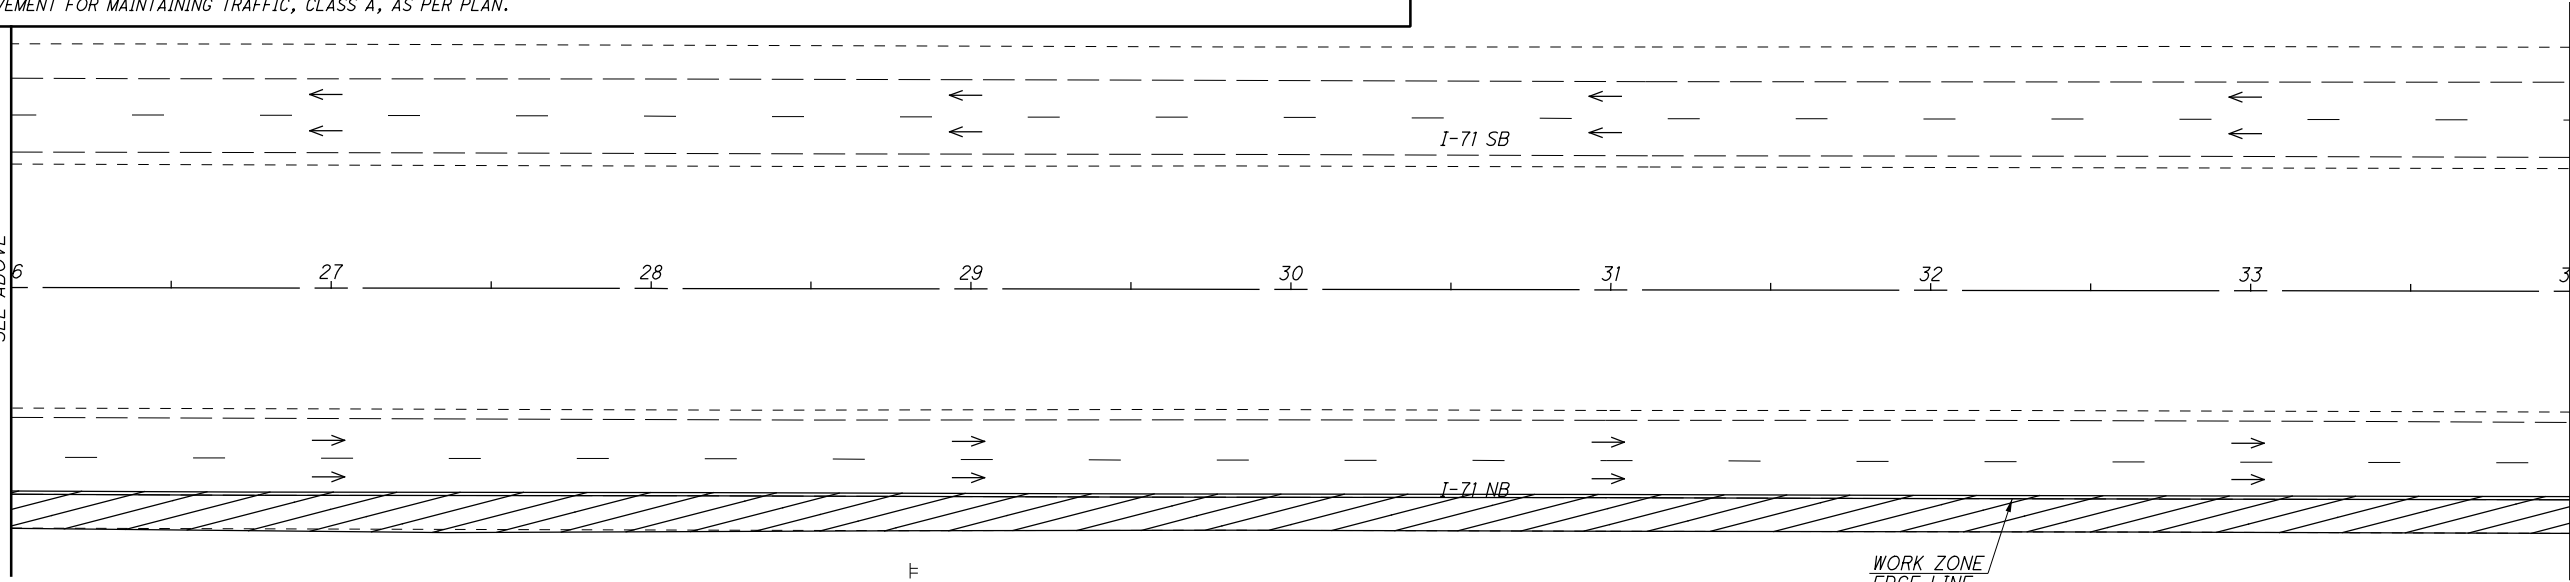

MATCH LINE STA. 34+00
SEE SHEET 50

- LEGEND
- SHOULDER RECONSTRUCTION
 - OPEN TRAVEL LANE

MAINTENANCE OF TRAFFIC PLAN-PRE-PHASE 1
(CONCRETE OPTION) I-71 - STA. 18+00 TO STA. 34+00

FRA-71-0.00


CALCULATED BY: BER
 CHECKED BY: SMM
 HORIZONTAL SCALE IN FEET
 0 15 30 60



J:\20130212\ODOT\FRA\107201\mot\sheet\107201MP156.dgn 8/6/2020 3:51:21 AM brieder

MATCH LINE STA. 34+00
SEE SHEET 49

MATCH LINE STA. 42+00
SEE BELOW

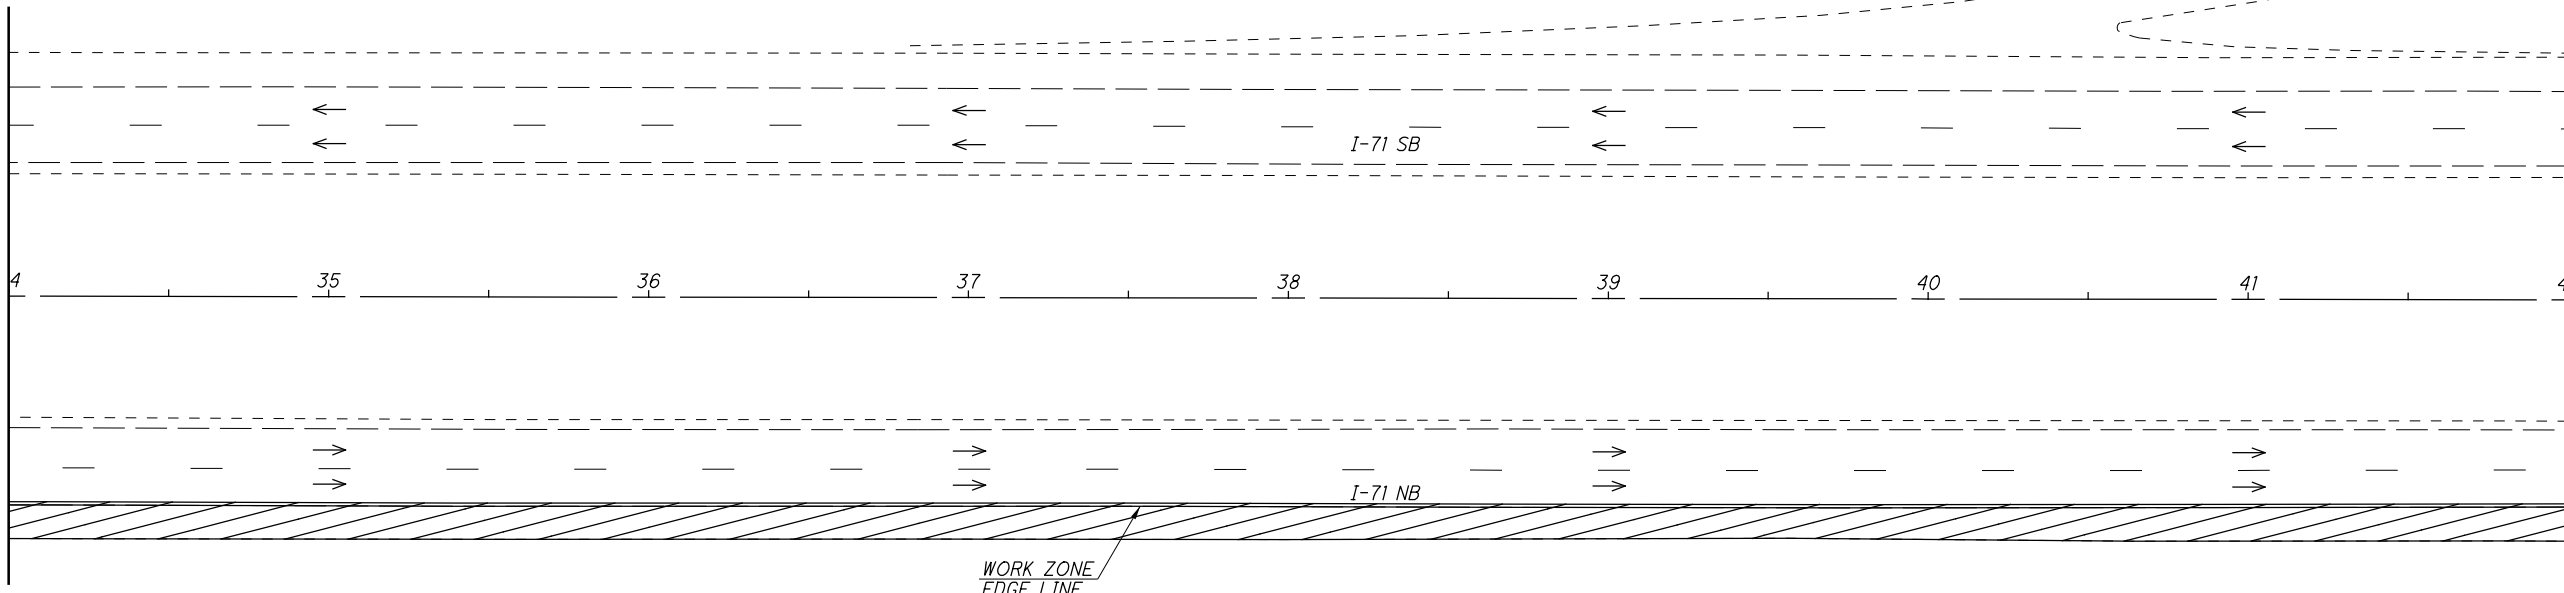

| |
|------------|
| CALCULATED |
| BER |
| CHECKED |
| SMM |

**MAINTENANCE OF TRAFFIC PLAN-PRE-PHASE 1
(CONCRETE OPTION) I-71 - STA. 34+00 TO STA. 50+00**

FRA-71-0.00

50
1312

EX @ I-71 EX EX SEE NOTE 1 EX @ I-71 EX EX 11' EX @ I-71 EX EX 12' 1.5'

SEE NOTE 2 SEE NOTE 3 EX EL EX LL EX EL EX LL WZ EL

TYPICAL SECTION - WORKING HOURS TYPICAL SECTION - INTERIM CONDITION (SEE SHEET 46 SCHEDULE) TYPICAL SECTION - NON-WORKING HOURS


NOTES:
 1. DURING THE HOURS SPECIFIED AS LISTED IN THIS PLAN, NIGHTTIME LANE CLOSURES SHALL BE IMPLEMENTED PER ODOT SCD MT-95.30 FOR SHOULDER WORK AND TEMPORARY PAVEMENT WORK ADJACENT TO I-71. SEE THE WORKING AND NON-WORKING HOURS TYPICAL SECTIONS FOR DETAILS. AS WELL AS THE PRE-PHASE 1 CONSTRUCTION SCHEDULE ON SHEET 46.
 2. EXISTING SHOULDERS THAT ARE TO BE RECONSTRUCTED SHALL BE PLANED TO A DEPTH OF 9 INCHES AND RECONSTRUCTED IN TWO LIFTS OVER TWO NIGHTS (SEE PRE-PHASE 1 CONSTRUCTION SCHEDULE ON SHEET 46). THE FIRST LIFT WILL CONSTRUCT 7.5 INCHES OF ITEM 302 ASPHALT BASE. THE SECOND LIFT WILL CONSTRUCT 1.5 INCHES OF ITEM 441, TYPE 1 SURFACE COURSE. ALL COSTS ASSOCIATED WITH SHOULDER RECONSTRUCTION SHALL BE INCIDENTAL TO ITEM 615, PAVEMENT FOR MAINTAINING TRAFFIC, CLASS A, AS PER PLAN.
 3. WHILE RECONSTRUCTING THE SHOULDERS, THE CONTRACTOR SHALL ALSO MILL AND RESURFACE 1 FOOT INTO THE ADJACENT TRAVEL LANE. THE EXISTING PAVEMENT (INCLUDING THE EDGELINE) SHALL BE PLANED 1.5 INCHES AND RESURFACED WITH 1.5 INCHES OF ITEM 441, TYPE 1 SURFACE COURSE. THIS WORK SHALL BE COMPLETED PER THE PRE-PHASE 1 CONSTRUCTION SCHEDULE ON SHEET 46 AND SHALL ALSO BE INCIDENTAL TO ITEM 615, PAVEMENT FOR MAINTAINING TRAFFIC, CLASS A, AS PER PLAN.

0 10 20 40
HORIZONTAL SCALE IN FEET





MATCH LINE STA. 42+00
SEE ABOVE

MATCH LINE STA. 50+00
SEE SHEET 51

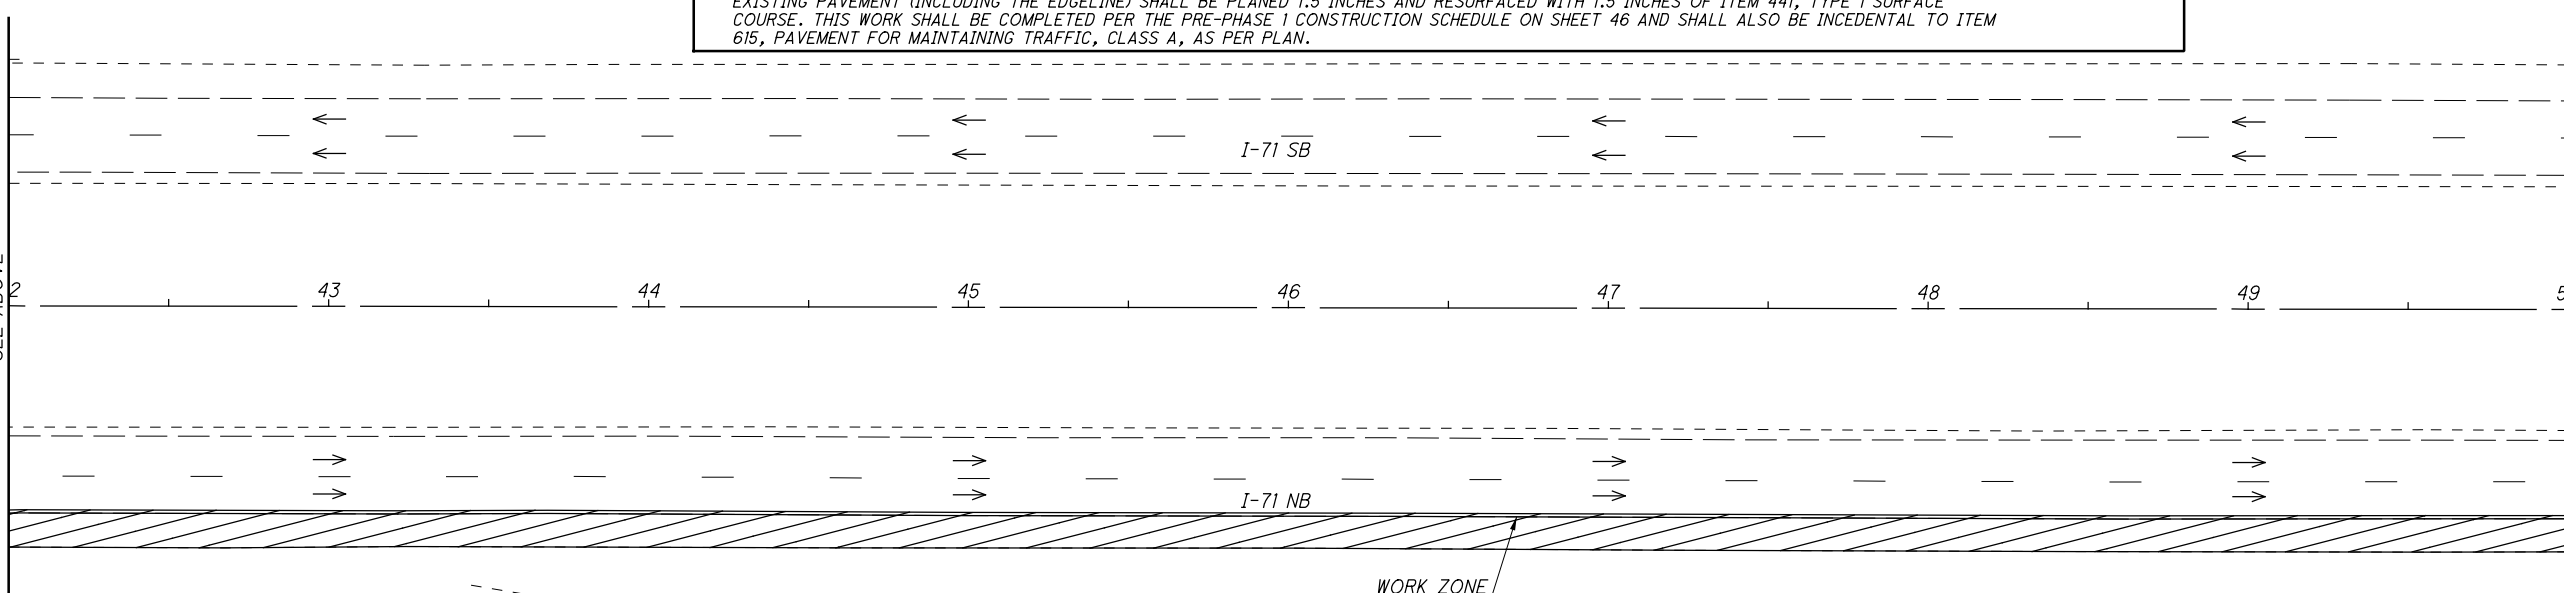

LEGEND
 SHOULDER RECONSTRUCTION
 OPEN TRAVEL LANE

J:\20130212\ODOT\FRA\107201\mot\sheet\107201MP157.dgn 8/6/2020 3:52:33 AM brieder

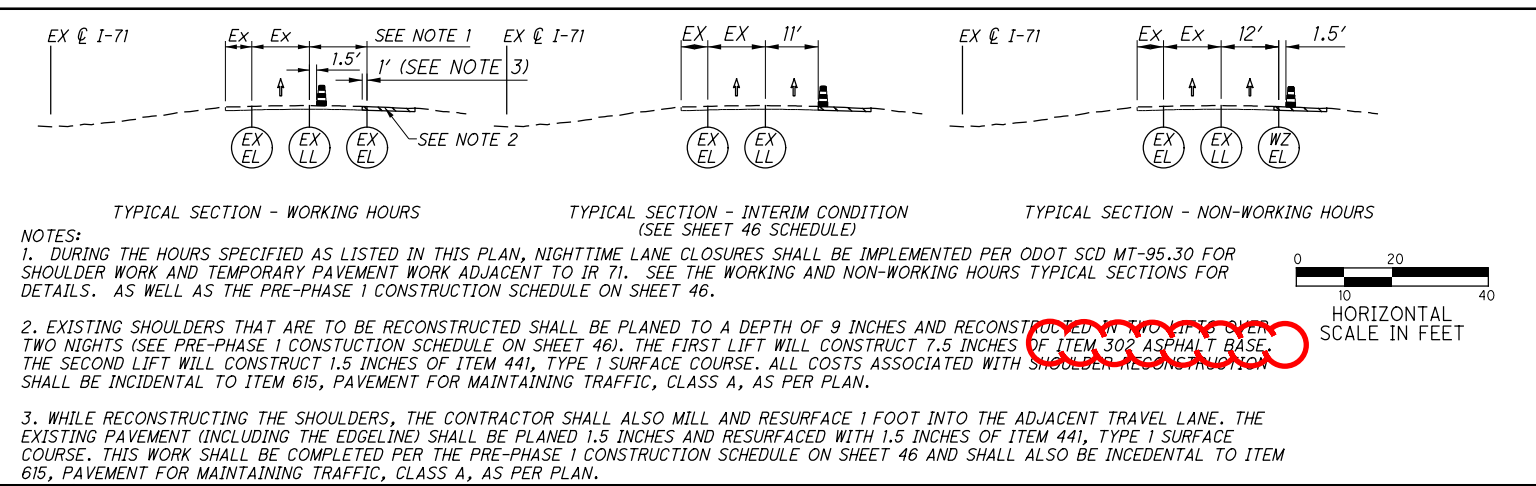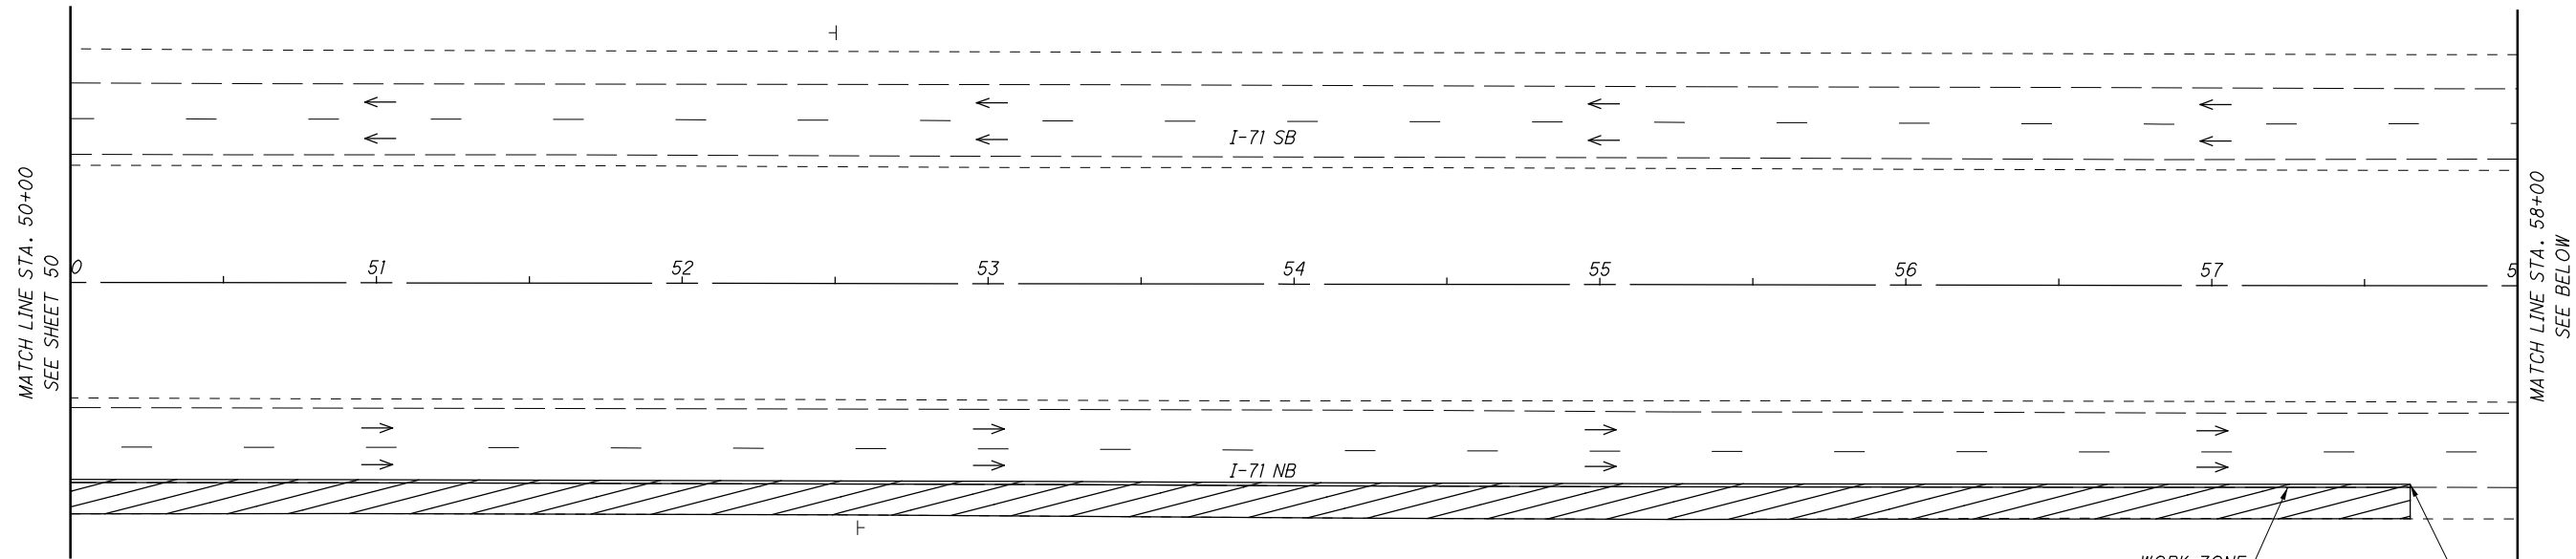


NOTES:

1. DURING THE HOURS SPECIFIED AS LISTED IN THIS PLAN, NIGHTTIME LANE CLOSURES SHALL BE IMPLEMENTED PER ODOT SCD MT-95.30 FOR SHOULDER WORK AND TEMPORARY PAVEMENT WORK ADJACENT TO I-71. SEE THE WORKING AND NON-WORKING HOURS TYPICAL SECTIONS FOR DETAILS. AS WELL AS THE PRE-PHASE 1 CONSTRUCTION SCHEDULE ON SHEET 46.

2. EXISTING SHOULDERS THAT ARE TO BE RECONSTRUCTED SHALL BE PLANNED TO A DEPTH OF 9 INCHES AND RECONSTRUCTED IN TWO LIFTS OVER TWO NIGHTS (SEE PRE-PHASE 1 CONSTRUCTION SCHEDULE ON SHEET 46). THE FIRST LIFT WILL CONSTRUCT 7.5 INCHES OF ITEM 302 ASPHALT BASE. THE SECOND LIFT WILL CONSTRUCT 1.5 INCHES OF ITEM 441, TYPE 1 SURFACE COURSE. ALL COSTS ASSOCIATED WITH SHOULDER RECONSTRUCTION SHALL BE INCIDENTAL TO ITEM 615, PAVEMENT FOR MAINTAINING TRAFFIC, CLASS A, AS PER PLAN.

3. WHILE RECONSTRUCTING THE SHOULDERS, THE CONTRACTOR SHALL ALSO MILL AND RESURFACE 1 FOOT INTO THE ADJACENT TRAVEL LANE. THE EXISTING PAVEMENT (INCLUDING THE EDGELINE) SHALL BE PLANNED 1.5 INCHES AND RESURFACED WITH 1.5 INCHES OF ITEM 441, TYPE 1 SURFACE COURSE. THIS WORK SHALL BE COMPLETED PER THE PRE-PHASE 1 CONSTRUCTION SCHEDULE ON SHEET 46 AND SHALL ALSO BE INCIDENTAL TO ITEM 615, PAVEMENT FOR MAINTAINING TRAFFIC, CLASS A, AS PER PLAN.

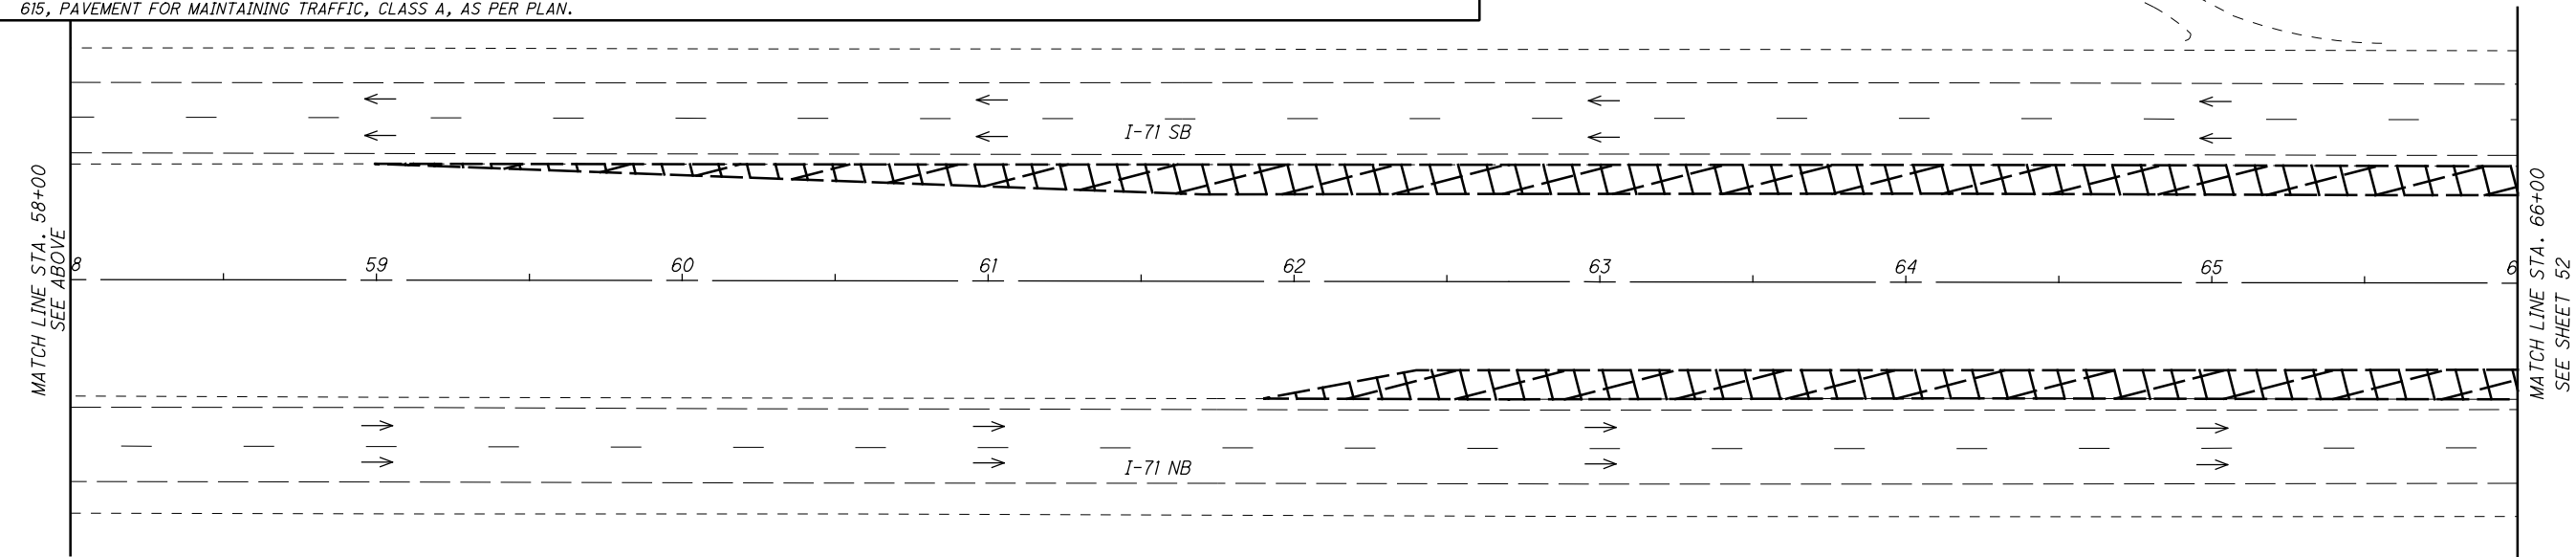

LEGEND




SHOULDER RECONSTRUCTION

TEMPORARY PAVEMENT LEFT IN PLACE FROM THE FRA-71-1.53 PROJECT

OPEN TRAVEL LANE


| | | |
|------------------------------|-------------------------------------|--|
| HORIZONTAL SCALE IN FEET | CALCULATED BER CHECKED SMM | MAINTENANCE OF TRAFFIC PLAN-PRE-PHASE 1 (CONCRETE OPTION) I-71 - STA. 50+00 TO STA. 66+00 |
| FRA-71-0.00 | | |
| | | 51 1312 |

J:\20130212\ODOT\FRA\107201\mot\sheet\107201MP158.dgn 8/6/2020 3:53:46 AM brieder

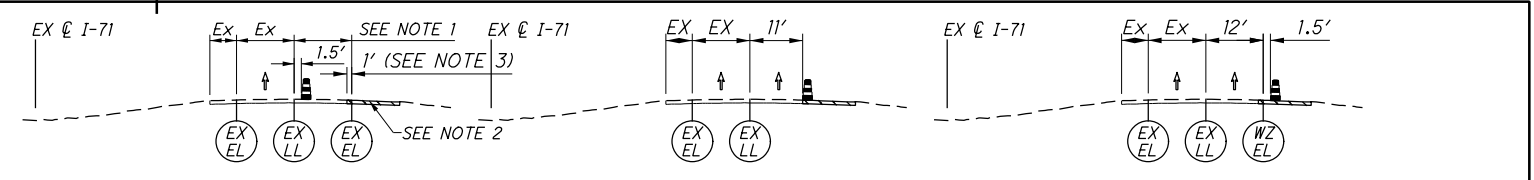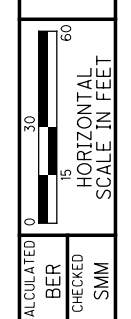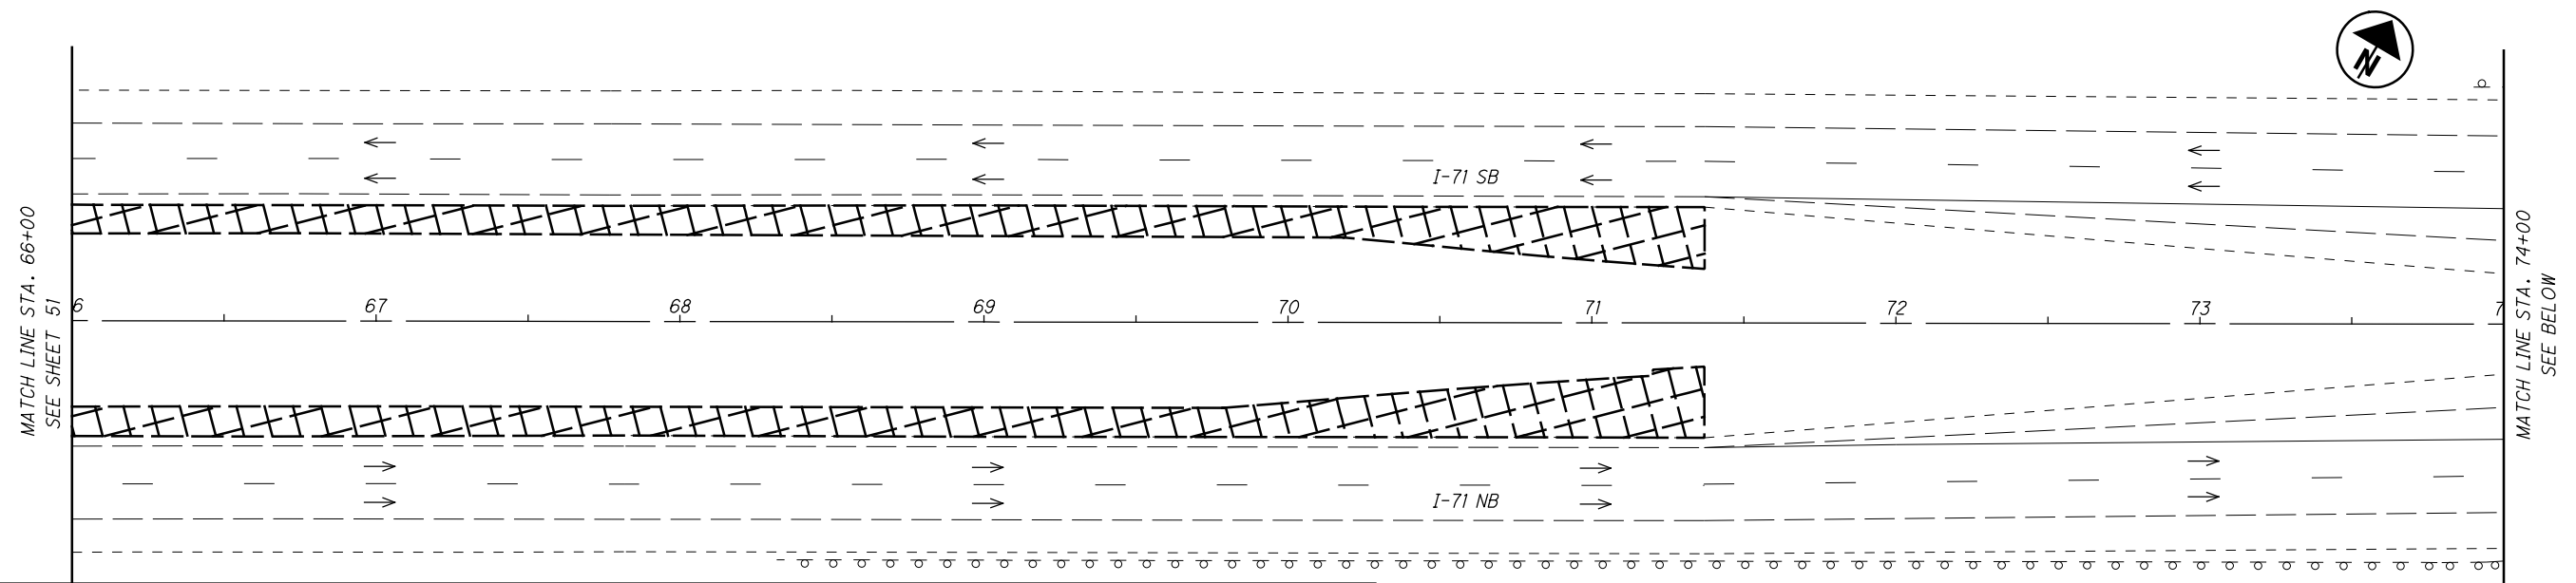

TYPICAL SECTION - WORKING HOURS TYPICAL SECTION - INTERIM CONDITION (SEE SHEET 46 SCHEDULE) TYPICAL SECTION - NON-WORKING HOURS

NOTES:
 1. DURING THE HOURS SPECIFIED AS LISTED IN THIS PLAN, NIGHTTIME LANE CLOSURES SHALL BE IMPLEMENTED PER ODOT SCD MT-95.30 FOR SHOULDER WORK AND TEMPORARY PAVEMENT WORK ADJACENT TO I-71. SEE THE WORKING AND NON-WORKING HOURS TYPICAL SECTIONS FOR DETAILS. AS WELL AS THE PRE-PHASE 1 CONSTRUCTION SCHEDULE ON SHEET 46.
 2. EXISTING SHOULDERS THAT ARE TO BE RECONSTRUCTED SHALL BE PLANED TO A DEPTH OF 9 INCHES AND RECONSTRUCTED WITH TWO LIFTS OVER TWO NIGHTS (SEE PRE-PHASE 1 CONSTRUCTION SCHEDULE ON SHEET 46). THE FIRST LIFT WILL CONSTRUCT 7.5 INCHES OF ITEM 302 ASPHALT BASE. THE SECOND LIFT WILL CONSTRUCT 1.5 INCHES OF ITEM 441, TYPE 1 SURFACE COURSE. ALL COSTS ASSOCIATED WITH SHOULDER RECONSTRUCTION SHALL BE INCIDENTAL TO ITEM 615, PAVEMENT FOR MAINTAINING TRAFFIC, CLASS A, AS PER PLAN.
 3. WHILE RECONSTRUCTING THE SHOULDERS, THE CONTRACTOR SHALL ALSO MILL AND RESURFACE 1 FOOT INTO THE ADJACENT TRAVEL LANE. THE EXISTING PAVEMENT (INCLUDING THE EDGELINE) SHALL BE PLANED 1.5 INCHES AND RESURFACED WITH 1.5 INCHES OF ITEM 441, TYPE 1 SURFACE COURSE. THIS WORK SHALL BE COMPLETED PER THE PRE-PHASE 1 CONSTRUCTION SCHEDULE ON SHEET 46 AND SHALL ALSO BE INCIDENTAL TO ITEM 615, PAVEMENT FOR MAINTAINING TRAFFIC, CLASS A, AS PER PLAN.




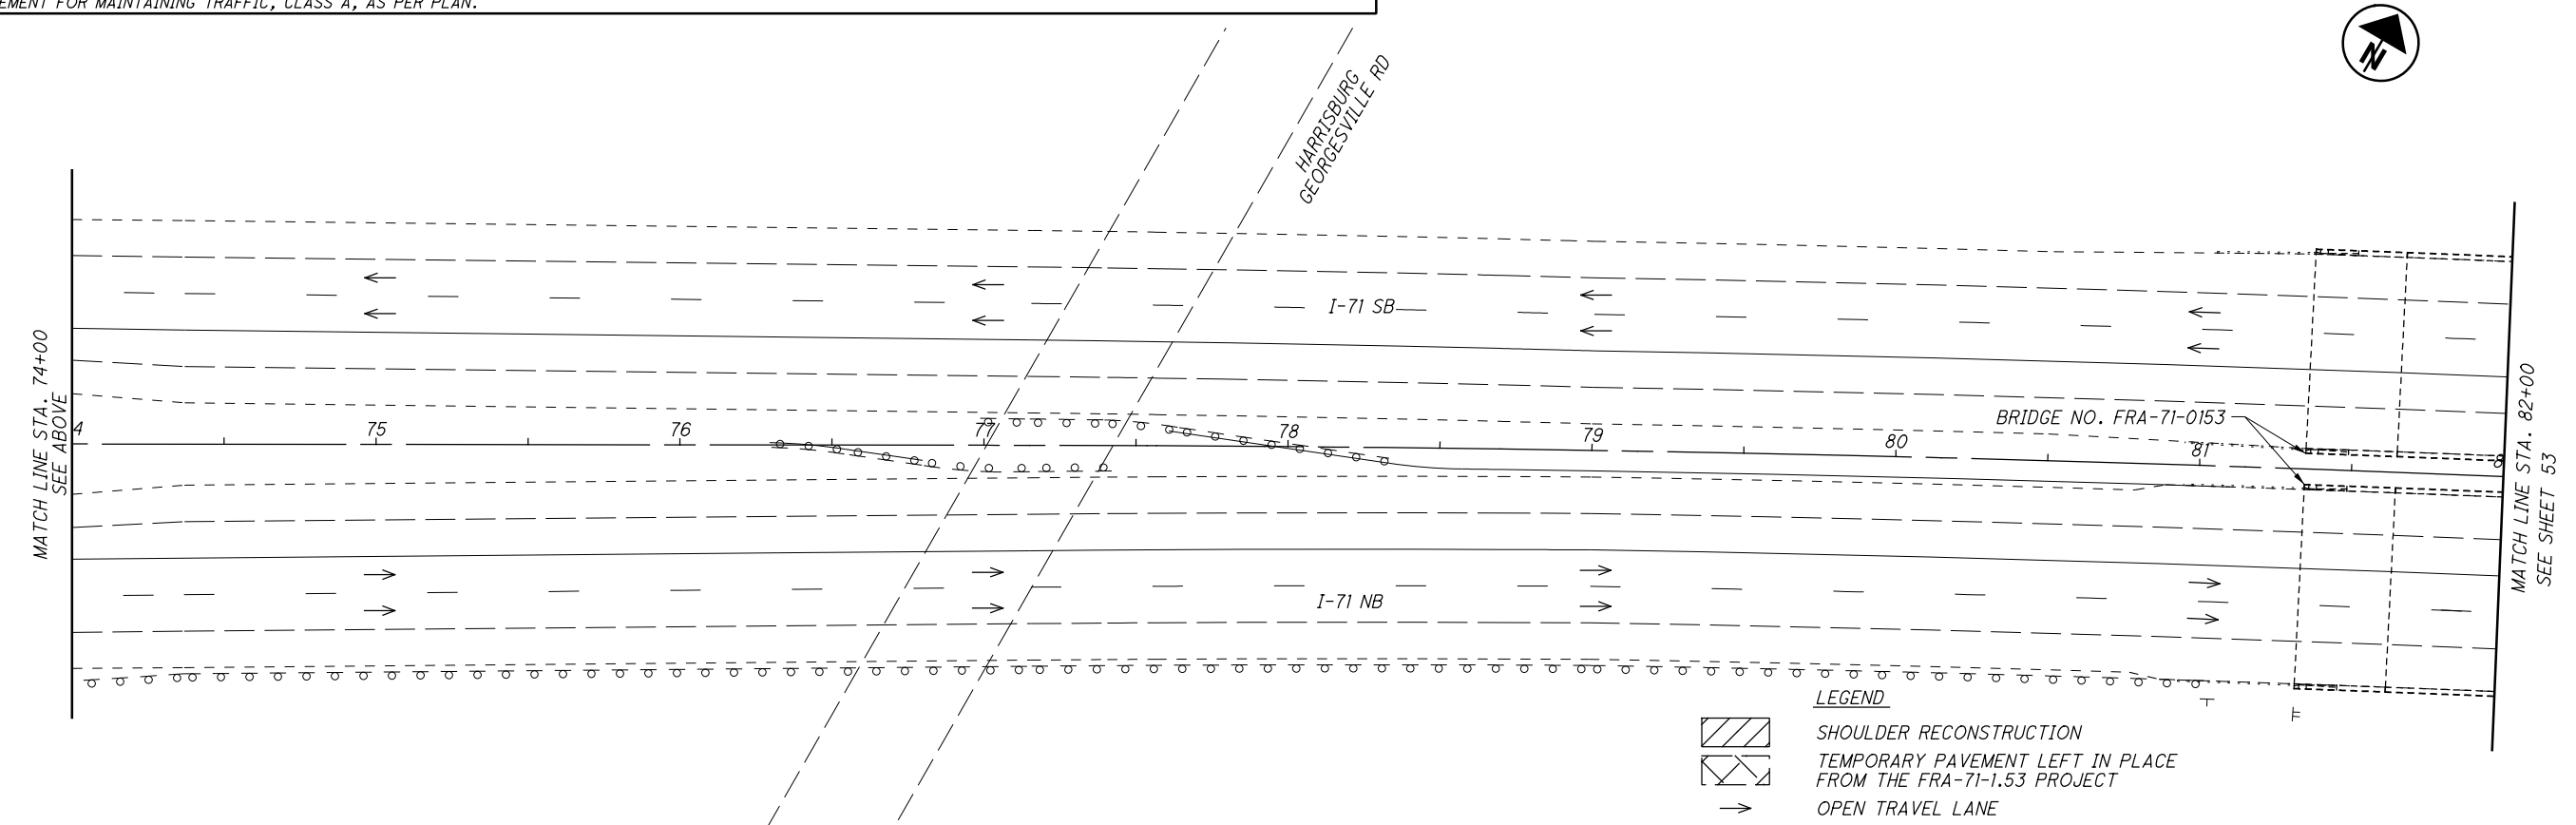


LEGEND
 SHOULDER RECONSTRUCTION
 TEMPORARY PAVEMENT LEFT IN PLACE FROM THE FRA-71-1.53 PROJECT
 OPEN TRAVEL LANE

MAINTENANCE OF TRAFFIC PLAN-PRE-PHASE 1
 (CONCRETE OPTION) I-71 - STA. 66+00 TO STA. 82+00

FRA-71-0.00
 52
 1312



J:\20130212\ODOT\FRA\107201\mot\sheet\107201MP159.dgn 8/6/2020 3:54:56 AM brieder

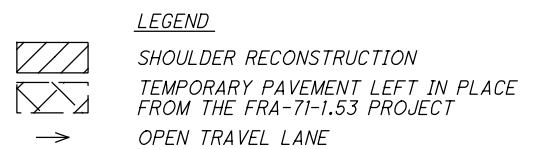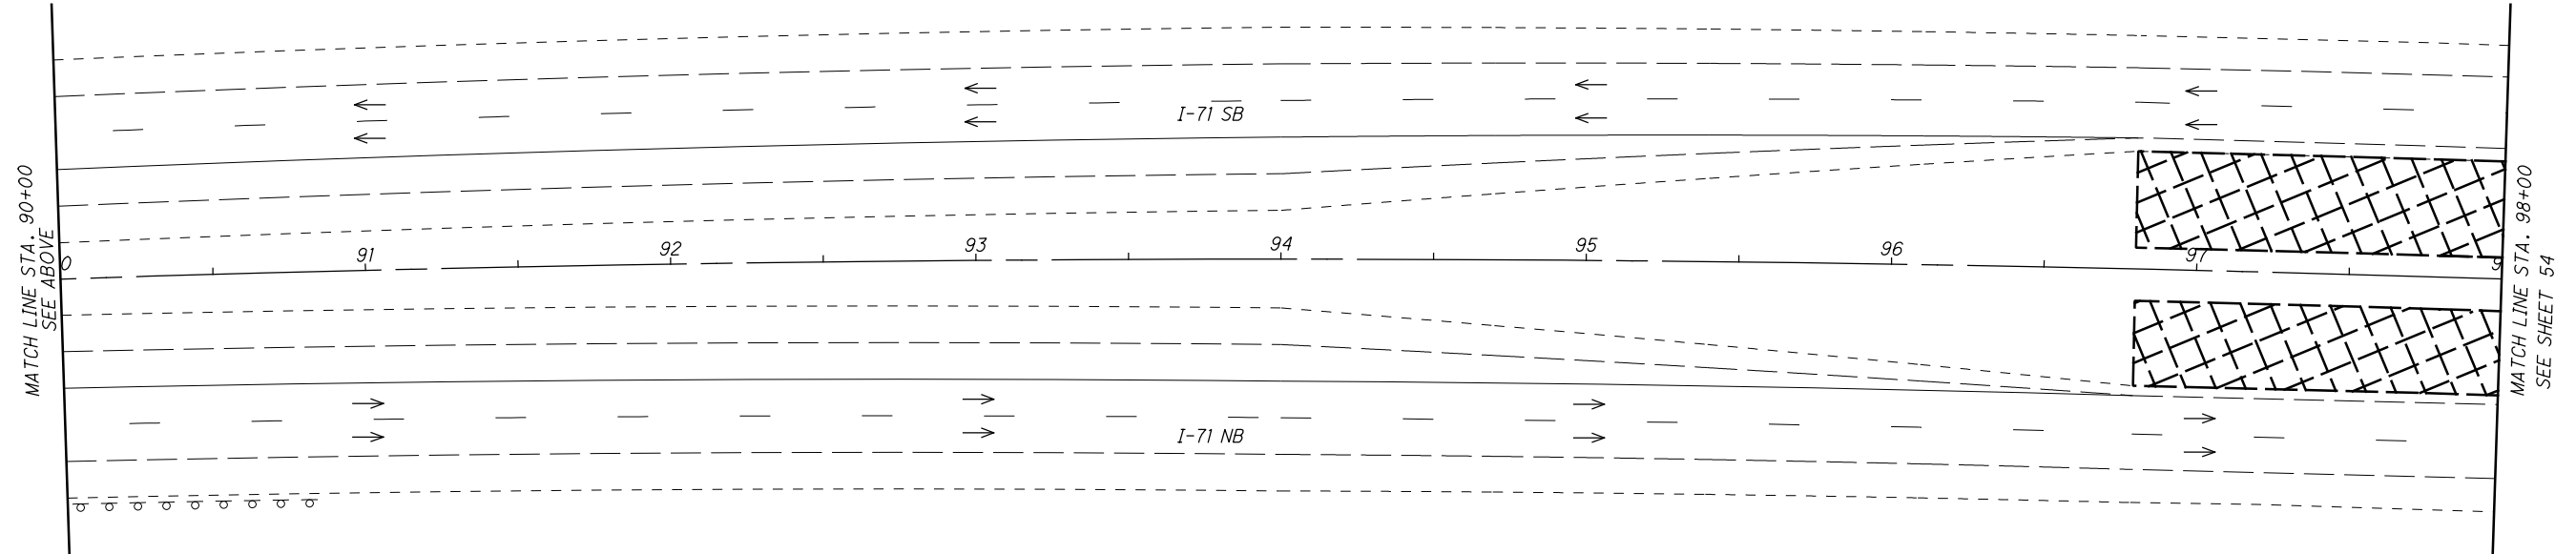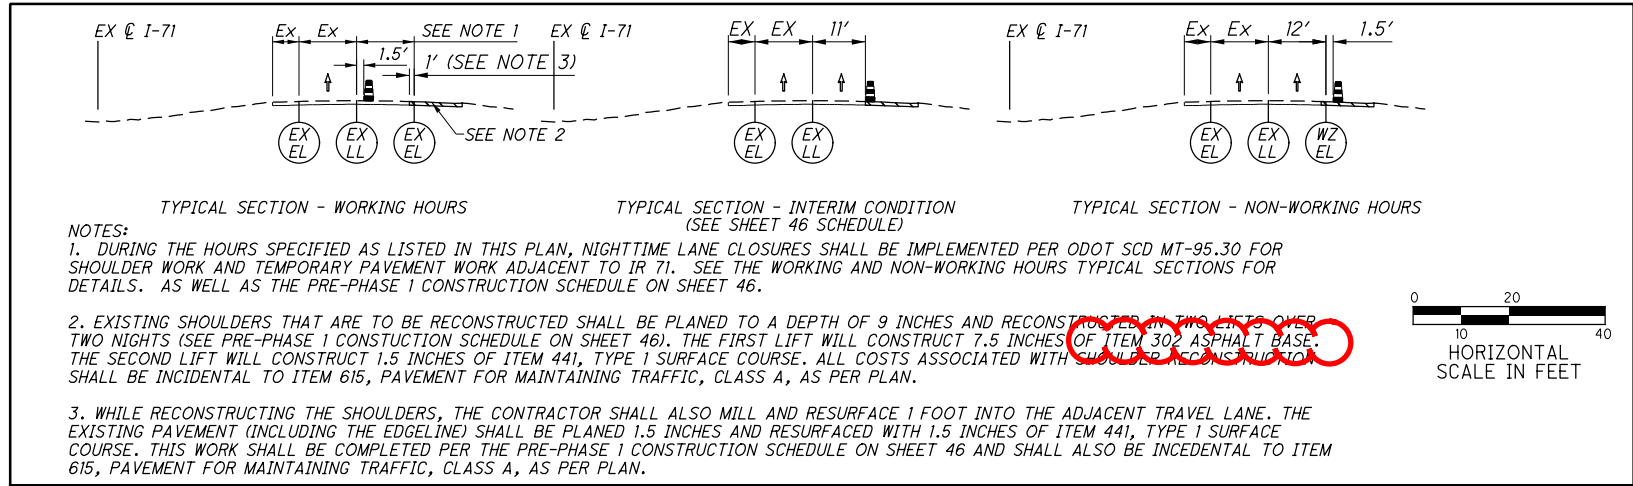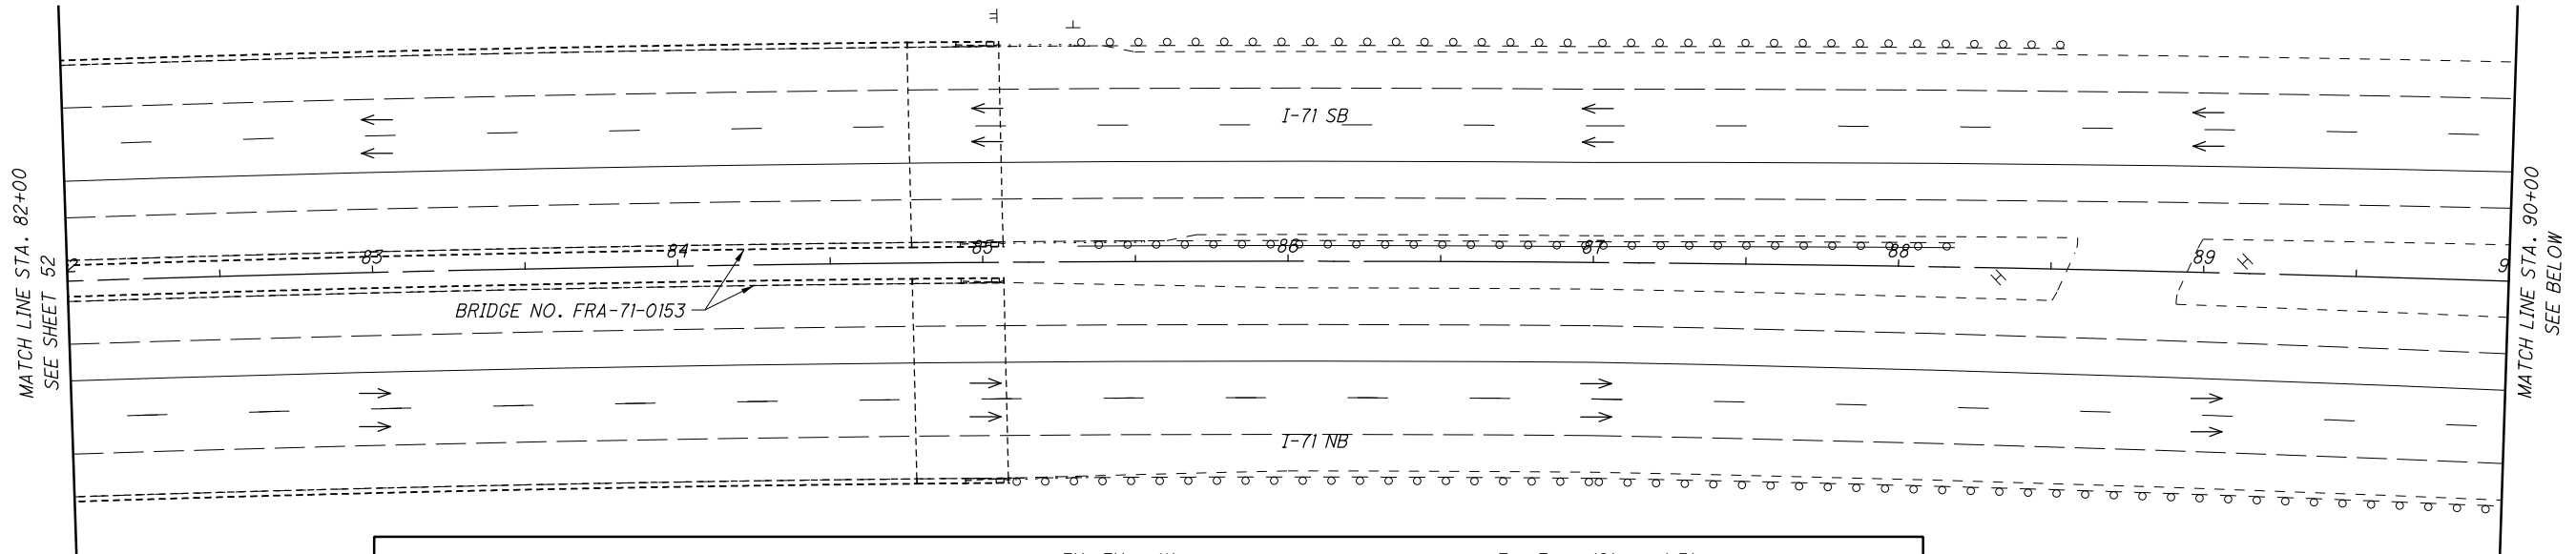

MAINTENANCE OF TRAFFIC PLAN-PRE-PHASE 1
(CONCRETE OPTION) I-71 - STA. 82+00 TO STA. 98+00

FRA-71-0.00

J:\20130212\ODOT\FRA\107201\mot\sheet\107201MP160.dgn 8/6/2020 3:56:11 AM brieder

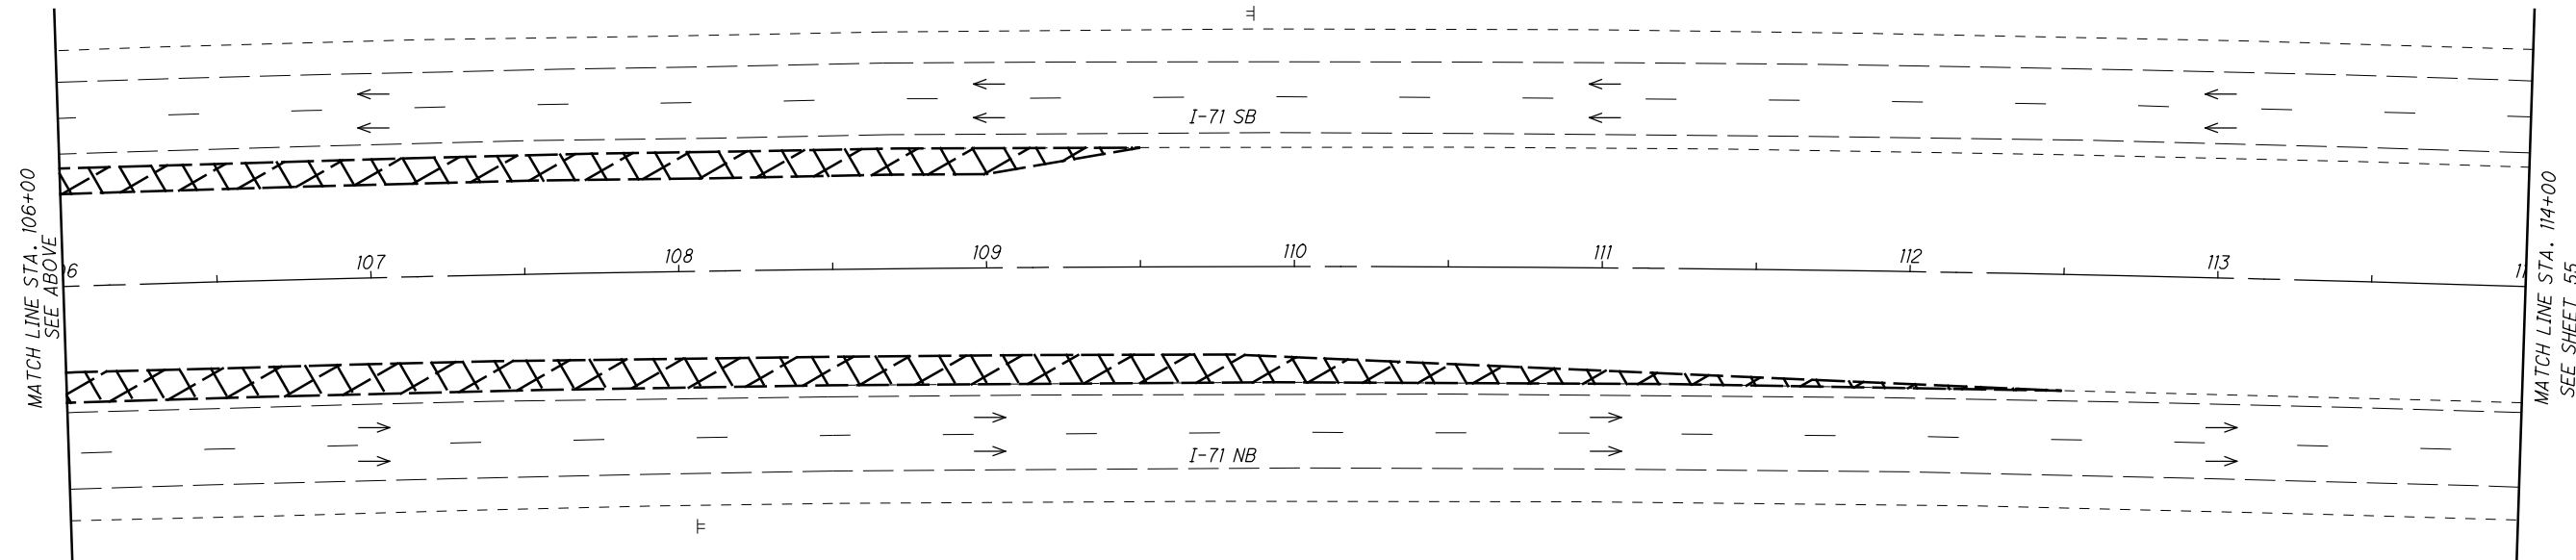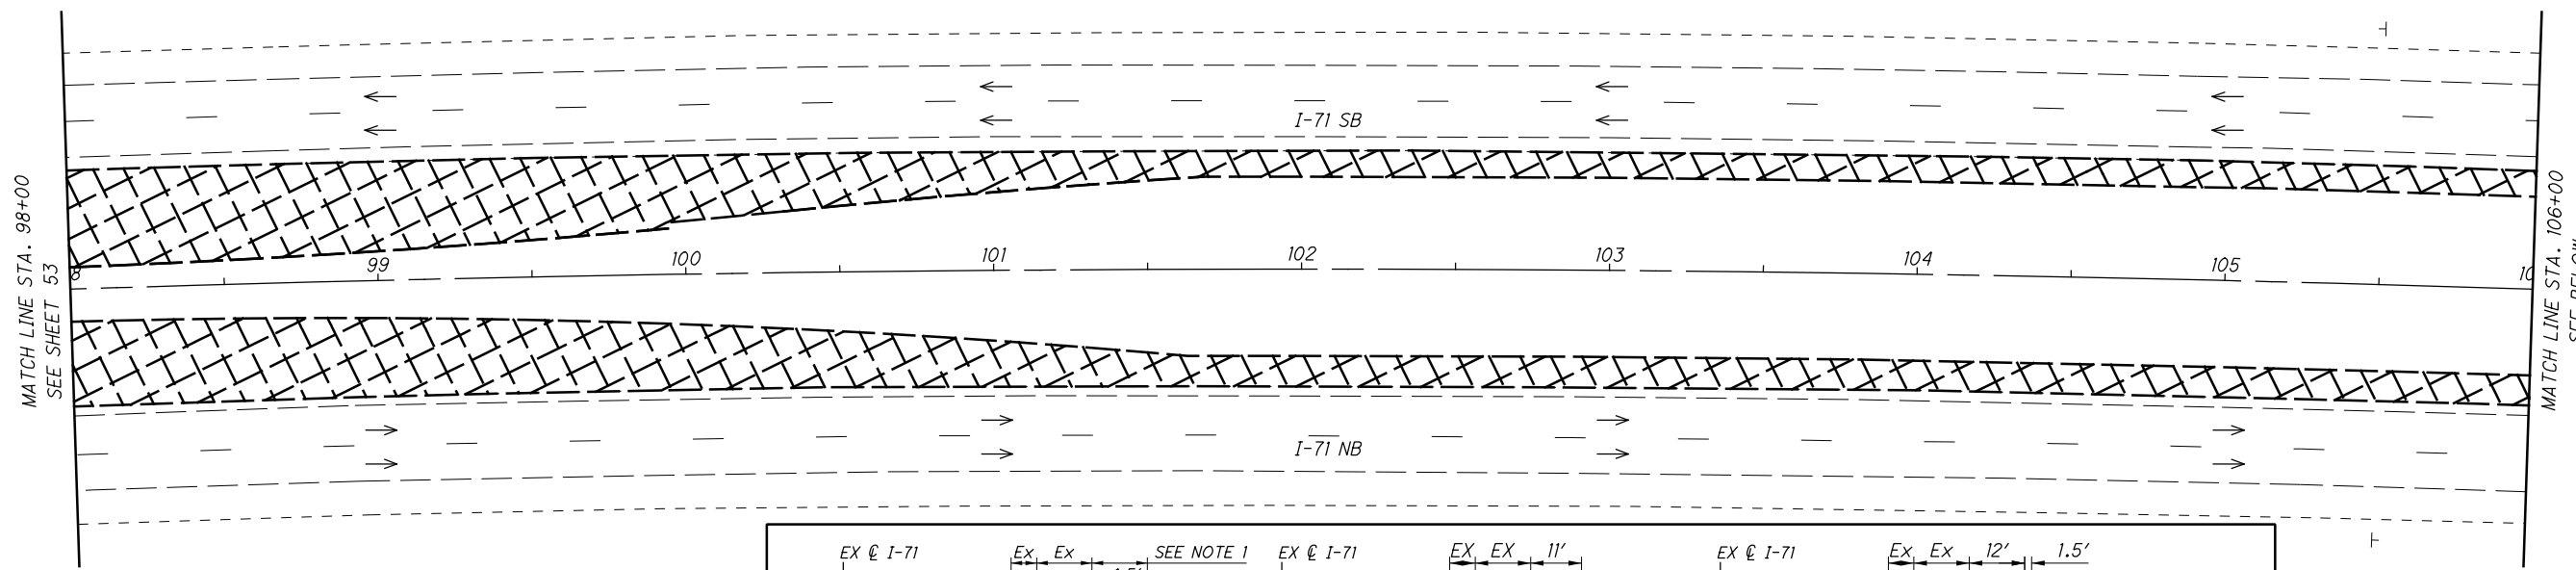

TYPICAL SECTION - WORKING HOURS

TYPICAL SECTION - INTERIM CONDITION
(SEE SHEET 46 SCHEDULE)

TYPICAL SECTION - NON-WORKING HOURS

NOTES:

- DURING THE HOURS SPECIFIED AS LISTED IN THIS PLAN, NIGHTTIME LANE CLOSURES SHALL BE IMPLEMENTED PER ODOT SCD MT-95.30 FOR SHOULDER WORK AND TEMPORARY PAVEMENT WORK ADJACENT TO I-71. SEE THE WORKING AND NON-WORKING HOURS TYPICAL SECTIONS FOR DETAILS. AS WELL AS THE PRE-PHASE 1 CONSTRUCTION SCHEDULE ON SHEET 46.
- EXISTING SHOULDERS THAT ARE TO BE RECONSTRUCTED SHALL BE PLANED TO A DEPTH OF 9 INCHES AND RECONSTRUCTED IN TWO LIFTS OVER TWO NIGHTS (SEE PRE-PHASE 1 CONSTRUCTION SCHEDULE ON SHEET 46). THE FIRST LIFT WILL CONSTRUCT 7.5 INCHES OF ITEM 302 ASPHALT BASE. THE SECOND LIFT WILL CONSTRUCT 1.5 INCHES OF ITEM 441, TYPE 1 SURFACE COURSE. ALL COSTS ASSOCIATED WITH SHOULDER RECONSTRUCTION SHALL BE INCIDENTAL TO ITEM 615, PAVEMENT FOR MAINTAINING TRAFFIC, CLASS A, AS PER PLAN.
- WHILE RECONSTRUCTING THE SHOULDERS, THE CONTRACTOR SHALL ALSO MILL AND RESURFACE 1 FOOT INTO THE ADJACENT TRAVEL LANE. THE EXISTING PAVEMENT (INCLUDING THE EDGELINE) SHALL BE PLANED 1.5 INCHES AND RESURFACED WITH 1.5 INCHES OF ITEM 441, TYPE 1 SURFACE COURSE. THIS WORK SHALL BE COMPLETED PER THE PRE-PHASE 1 CONSTRUCTION SCHEDULE ON SHEET 46 AND SHALL ALSO BE INCIDENTAL TO ITEM 615, PAVEMENT FOR MAINTAINING TRAFFIC, CLASS A, AS PER PLAN.

HORIZONTAL SCALE IN FEET

- LEGEND**
- SHOULDER RECONSTRUCTION
 - TEMPORARY PAVEMENT LEFT IN PLACE FROM THE FRA-71-1.53 PROJECT
 - OPEN TRAVEL LANE





CALCULATED
BER
CHECKED
SMM

**MAINTENANCE OF TRAFFIC PLAN-PRE-PHASE 1
(CONCRETE OPTION) I-71 - STA. 98+00 TO STA. 114+00**

FRA-71-0.00

J:\20130212\ODOT\FRA\107201\mot\sheet\107201MP162.dgn 8/6/2020 3:58:26 AM brieder

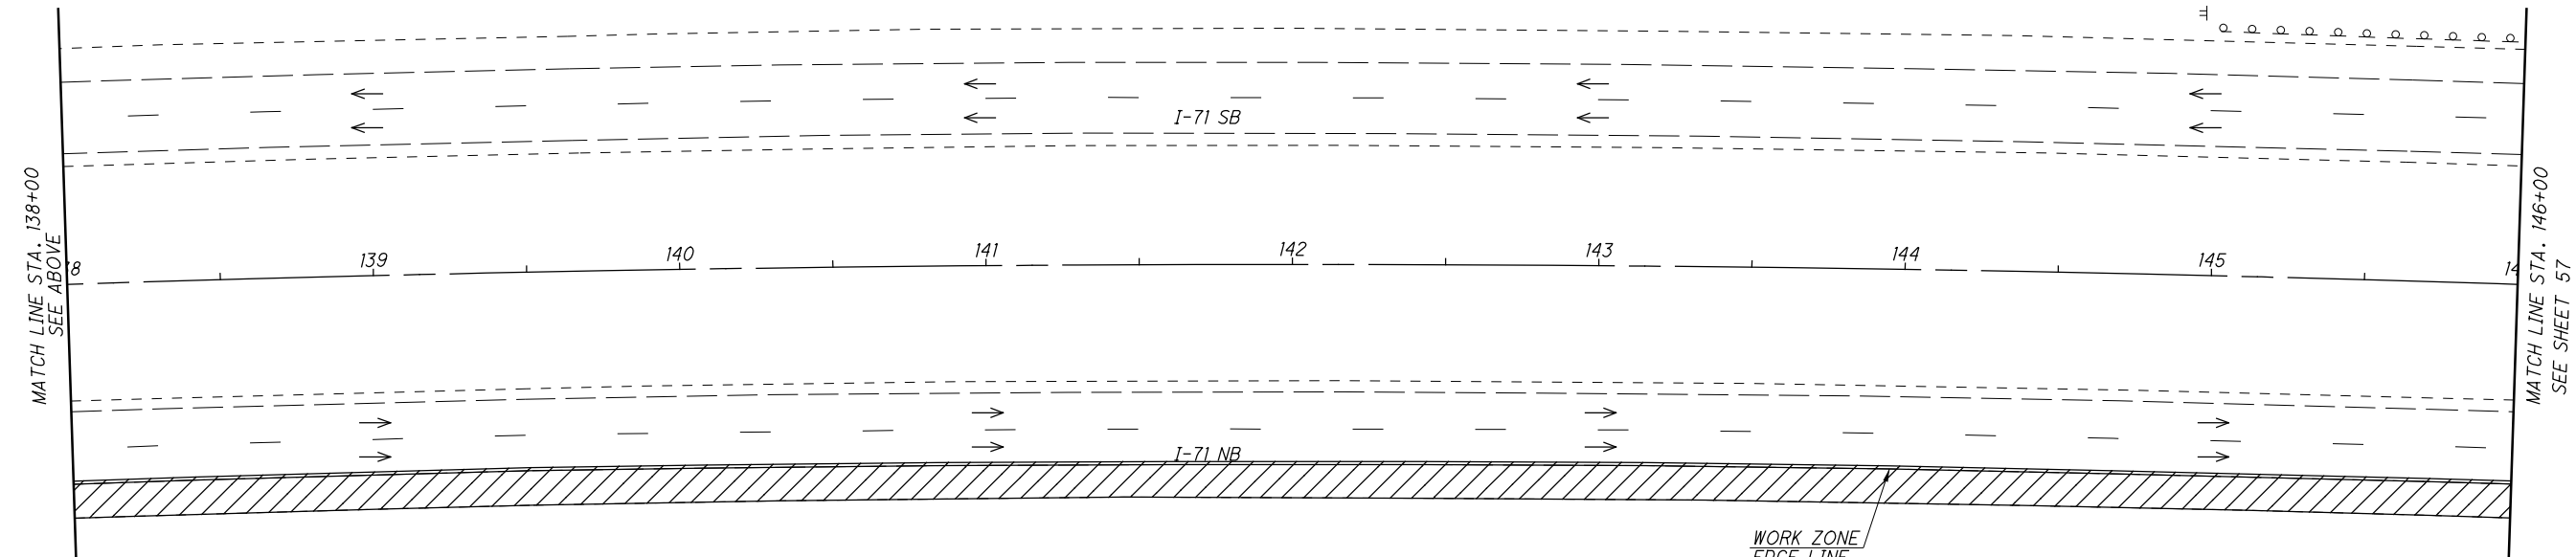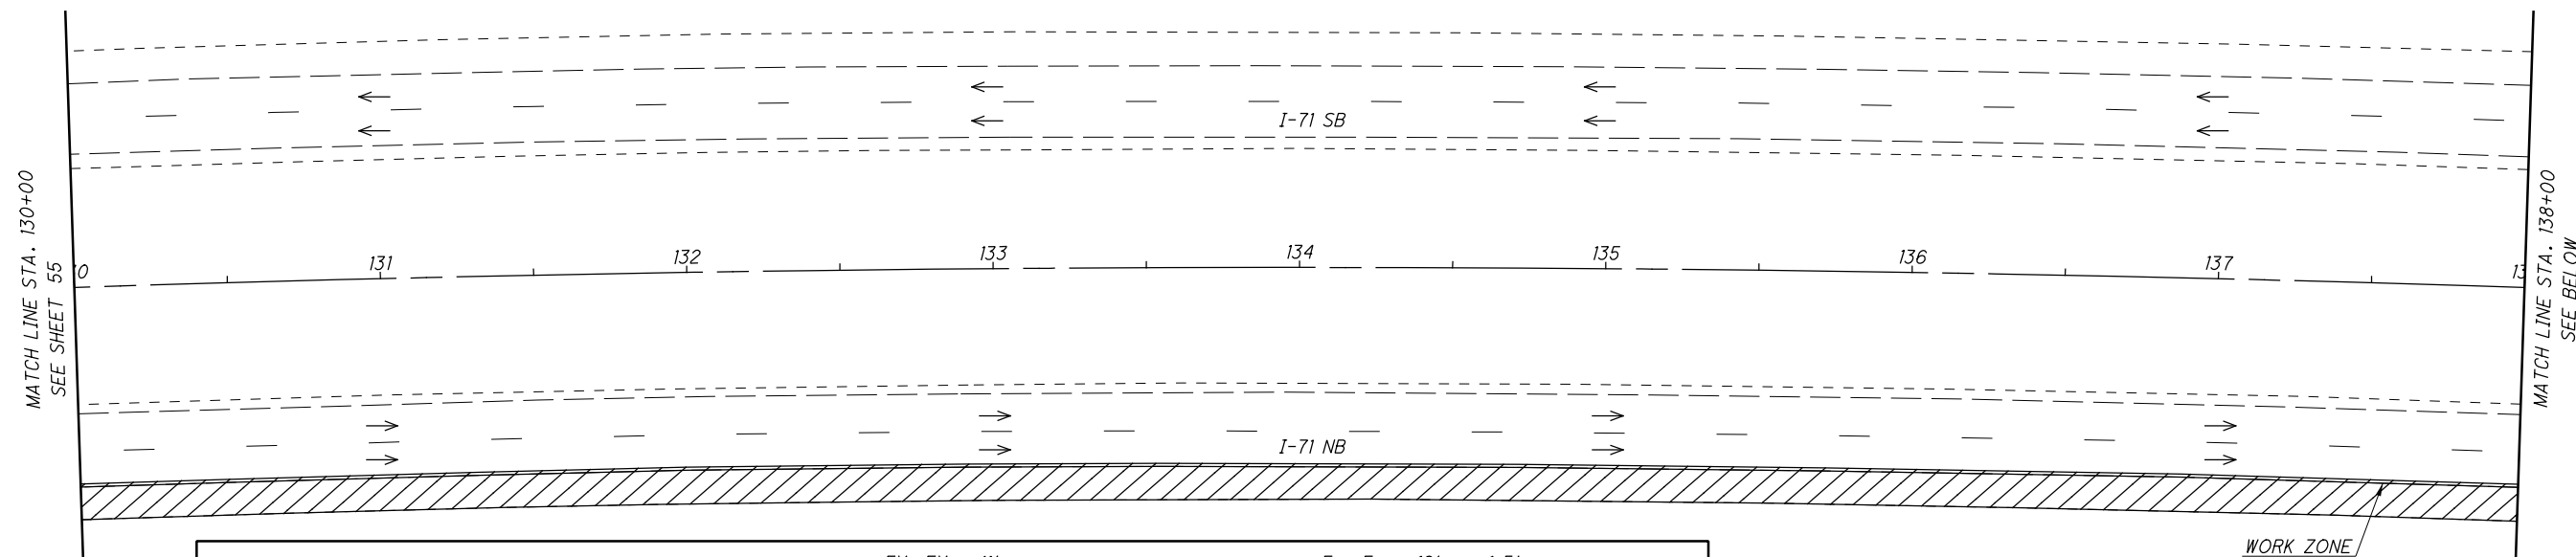

TYPICAL SECTION - WORKING HOURS


TYPICAL SECTION - INTERIM CONDITION
(SEE SHEET 46 SCHEDULE)

TYPICAL SECTION - NON-WORKING HOURS

NOTES:

- DURING THE HOURS SPECIFIED AS LISTED IN THIS PLAN, NIGHTTIME LANE CLOSURES SHALL BE IMPLEMENTED PER ODOT SCD MT-95.30 FOR SHOULDER WORK AND TEMPORARY PAVEMENT WORK ADJACENT TO I-71. SEE THE WORKING AND NON-WORKING HOURS TYPICAL SECTIONS FOR DETAILS. AS WELL AS THE PRE-PHASE 1 CONSTRUCTION SCHEDULE ON SHEET 46.
- EXISTING SHOULDERS THAT ARE TO BE RECONSTRUCTED SHALL BE PLANED TO A DEPTH OF 9 INCHES AND RECONSTRUCTED IN TWO LIFTS OVER TWO NIGHTS (SEE PRE-PHASE 1 CONSTRUCTION SCHEDULE ON SHEET 46). THE FIRST LIFT WILL CONSTRUCT 7.5 INCHES OF ITEM 302 ASPHALT BASE. THE SECOND LIFT WILL CONSTRUCT 1.5 INCHES OF ITEM 441, TYPE 1 SURFACE COURSE. ALL COSTS ASSOCIATED WITH SHOULDER RECONSTRUCTION SHALL BE INCIDENTAL TO ITEM 615, PAVEMENT FOR MAINTAINING TRAFFIC, CLASS A, AS PER PLAN.
- WHILE RECONSTRUCTING THE SHOULDERS, THE CONTRACTOR SHALL ALSO MILL AND RESURFACE 1 FOOT INTO THE ADJACENT TRAVEL LANE. THE EXISTING PAVEMENT (INCLUDING THE EDGELINE) SHALL BE PLANED 1.5 INCHES AND RESURFACED WITH 1.5 INCHES OF ITEM 441, TYPE 1 SURFACE COURSE. THIS WORK SHALL BE COMPLETED PER THE PRE-PHASE 1 CONSTRUCTION SCHEDULE ON SHEET 46 AND SHALL ALSO BE INCIDENTAL TO ITEM 615, PAVEMENT FOR MAINTAINING TRAFFIC, CLASS A, AS PER PLAN.

① $\Delta = 25^\circ 24' 09''$ (RT)
 $D_c = 0^\circ 28' 02''$
 $R = 12,265.67'$
 $T = 2764.46'$
 $L = 5438.06'$
 $E = 307.67'$
 $C = 5393.64'$
 $C.B. = N 80^\circ 11' 26'' E$

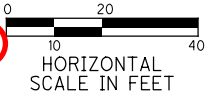

LEGEND
 SHOULDER RECONSTRUCTION
 OPEN TRAVEL LANE


| | | | |
|------------|-----|---------|-----|
| CALCULATED | BER | CHECKED | SMM |
| | | | |

**MAINTENANCE OF TRAFFIC PLAN-PRE-PHASE 1
(CONCRETE OPTION) I-71 - STA. 130+00 TO STA. 146+00**

FRA-71-0.00


56
1312

J:\20130212\ODOT\FRA\107201\mot\sheet\107201MP163.dgn 8/6/2020 3:59:32 AM brieder

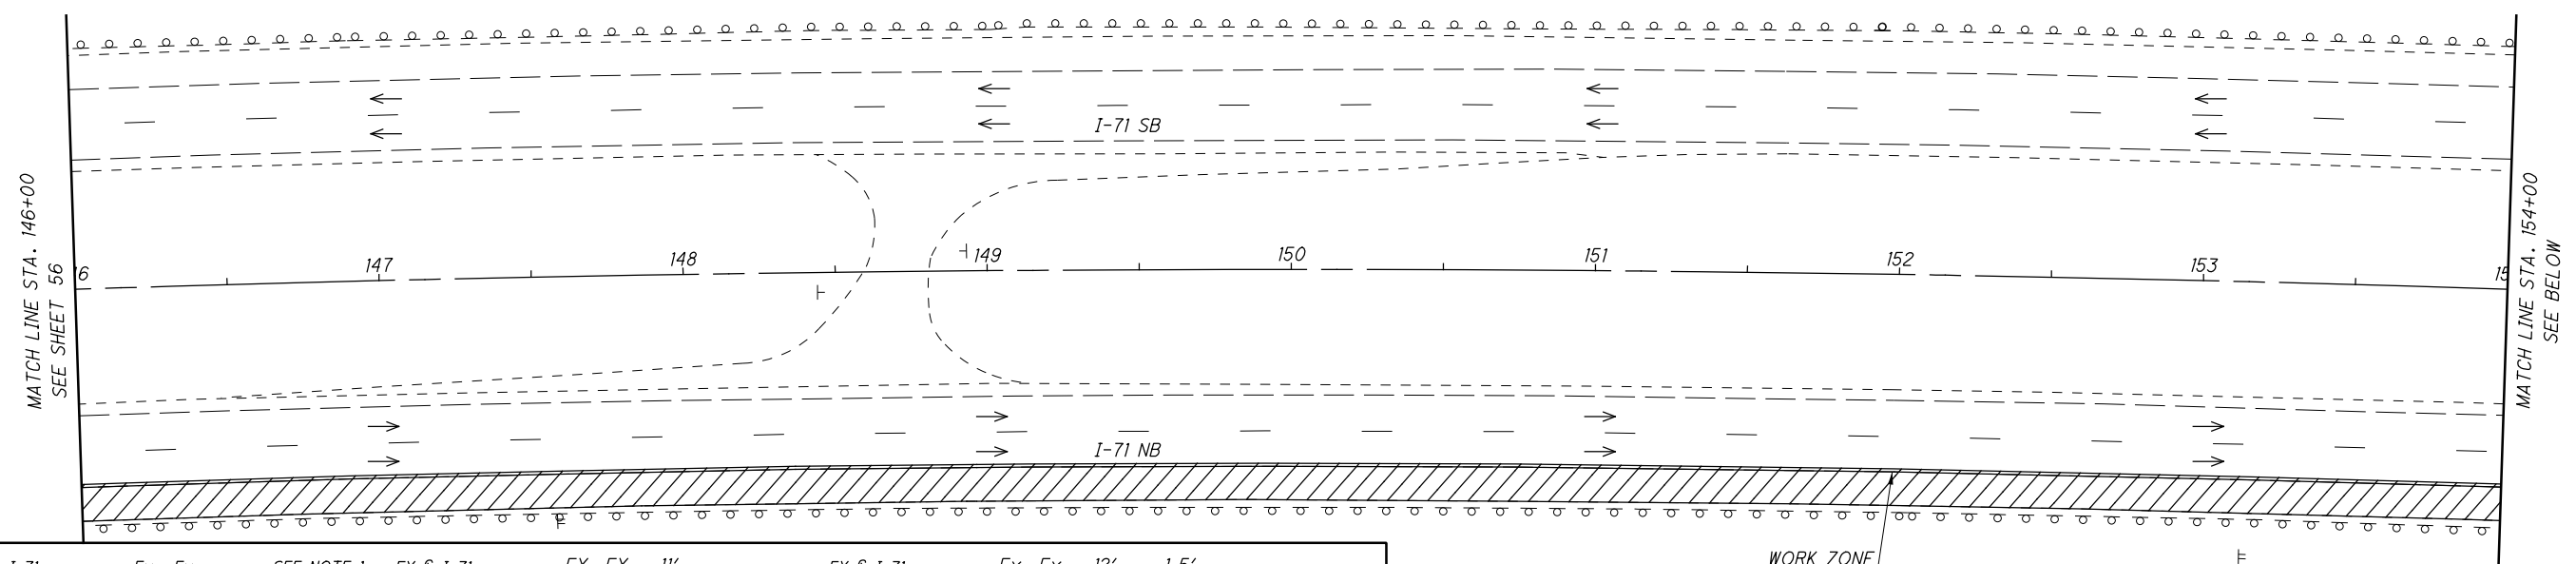



CALCULATED
BER
CHECKED
SMM

**MAINTENANCE OF TRAFFIC PLAN-PRE-PHASE 1
(CONCRETE OPTION) I-71 - STA. 146+00 TO STA. 162+00**

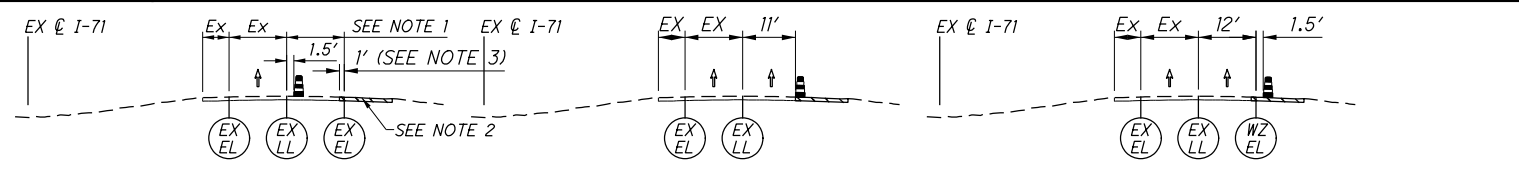

TYPICAL SECTION - WORKING HOURS TYPICAL SECTION - INTERIM CONDITION (SEE SHEET 46 SCHEDULE) TYPICAL SECTION - NON-WORKING HOURS

NOTES:
 1. DURING THE HOURS SPECIFIED AS LISTED IN THIS PLAN, NIGHTTIME LANE CLOSURES SHALL BE IMPLEMENTED PER ODOT SCD MT-95.30 FOR SHOULDER WORK AND TEMPORARY PAVEMENT WORK ADJACENT TO I-71. SEE THE WORKING AND NON-WORKING HOURS TYPICAL SECTIONS FOR DETAILS. AS WELL AS THE PRE-PHASE 1 CONSTRUCTION SCHEDULE ON SHEET 46.
 2. EXISTING SHOULDERS THAT ARE TO BE RECONSTRUCTED SHALL BE PLANNED TO A DEPTH OF 9 INCHES AND RECONSTRUCTED IN TWO LIFTS OVER TWO NIGHTS (SEE PRE-PHASE 1 CONSTRUCTION SCHEDULE ON SHEET 46). THE FIRST LIFT WILL CONSTRUCT 7.5 INCHES OF ITEM 302 ASPHALT BASE. THE SECOND LIFT WILL CONSTRUCT 1.5 INCHES OF ITEM 441, TYPE 1 SURFACE COURSE. ALL COSTS ASSOCIATED WITH SHOULDER RECONSTRUCTION SHALL BE INCIDENTAL TO ITEM 615, PAVEMENT FOR MAINTAINING TRAFFIC, CLASS A, AS PER PLAN.
 3. WHILE RECONSTRUCTING THE SHOULDERS, THE CONTRACTOR SHALL ALSO MILL AND RESURFACE 1 FOOT INTO THE ADJACENT TRAVEL LANE. THE EXISTING PAVEMENT (INCLUDING THE EDGE LINE) SHALL BE PLANNED 1.5 INCHES AND RESURFACED WITH 1.5 INCHES OF ITEM 441, TYPE 1 SURFACE COURSE. THIS WORK SHALL BE COMPLETED PER THE PRE-PHASE 1 CONSTRUCTION SCHEDULE ON SHEET 46 AND SHALL ALSO BE INCIDENTAL TO ITEM 615, PAVEMENT FOR MAINTAINING TRAFFIC, CLASS A, AS PER PLAN.

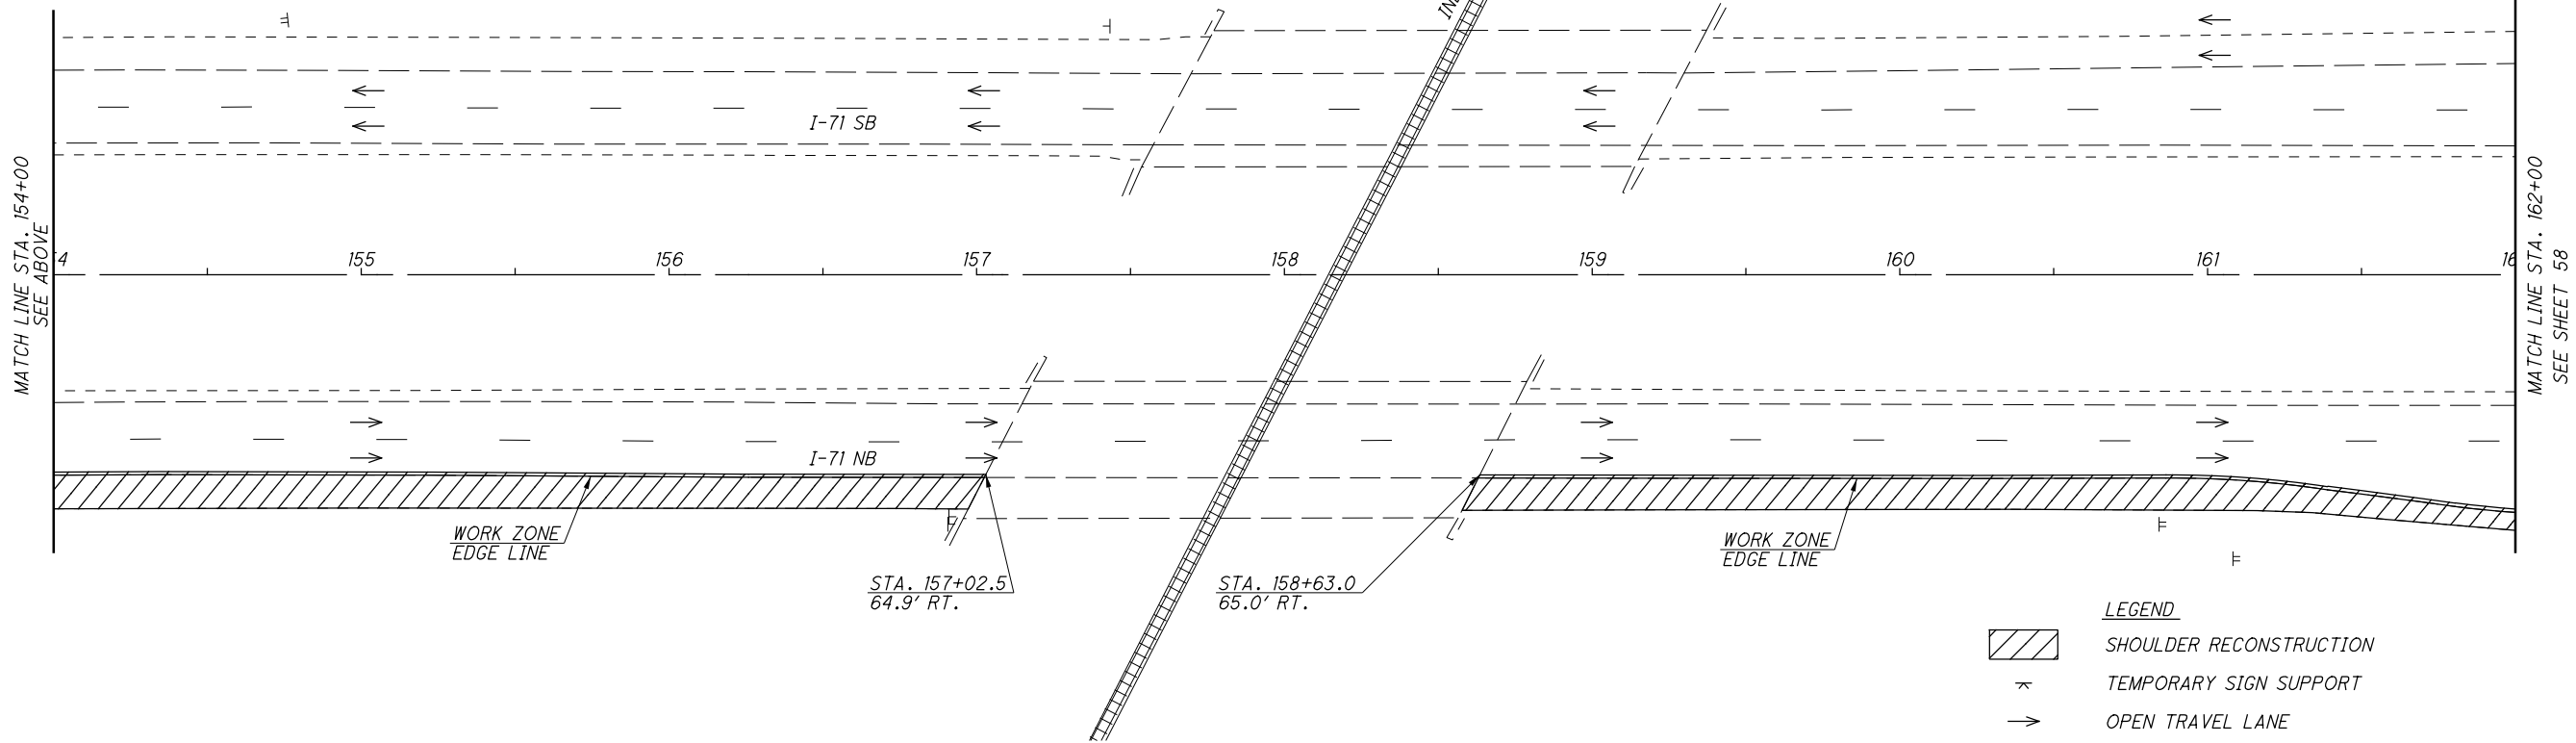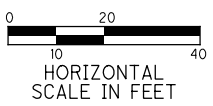

LEGEND
 SHOULDER RECONSTRUCTION
 TEMPORARY SIGN SUPPORT
 OPEN TRAVEL LANE

FRA-71-0.00



J:\20130212\ODOT\FRA\107201\mot\sheet\107201MP164.dgn 8/6/2020 4:00:46 AM brieder

MATCH LINE STA. 162+00
SEE SHEET 57

MATCH LINE STA. 170+00
SEE ABOVE


MATCH LINE STA. 170+00
SEE BELOW

MATCH LINE STA. 178+00
SEE SHEET 59

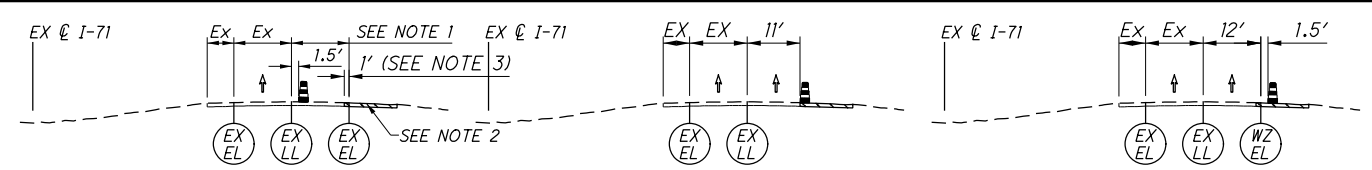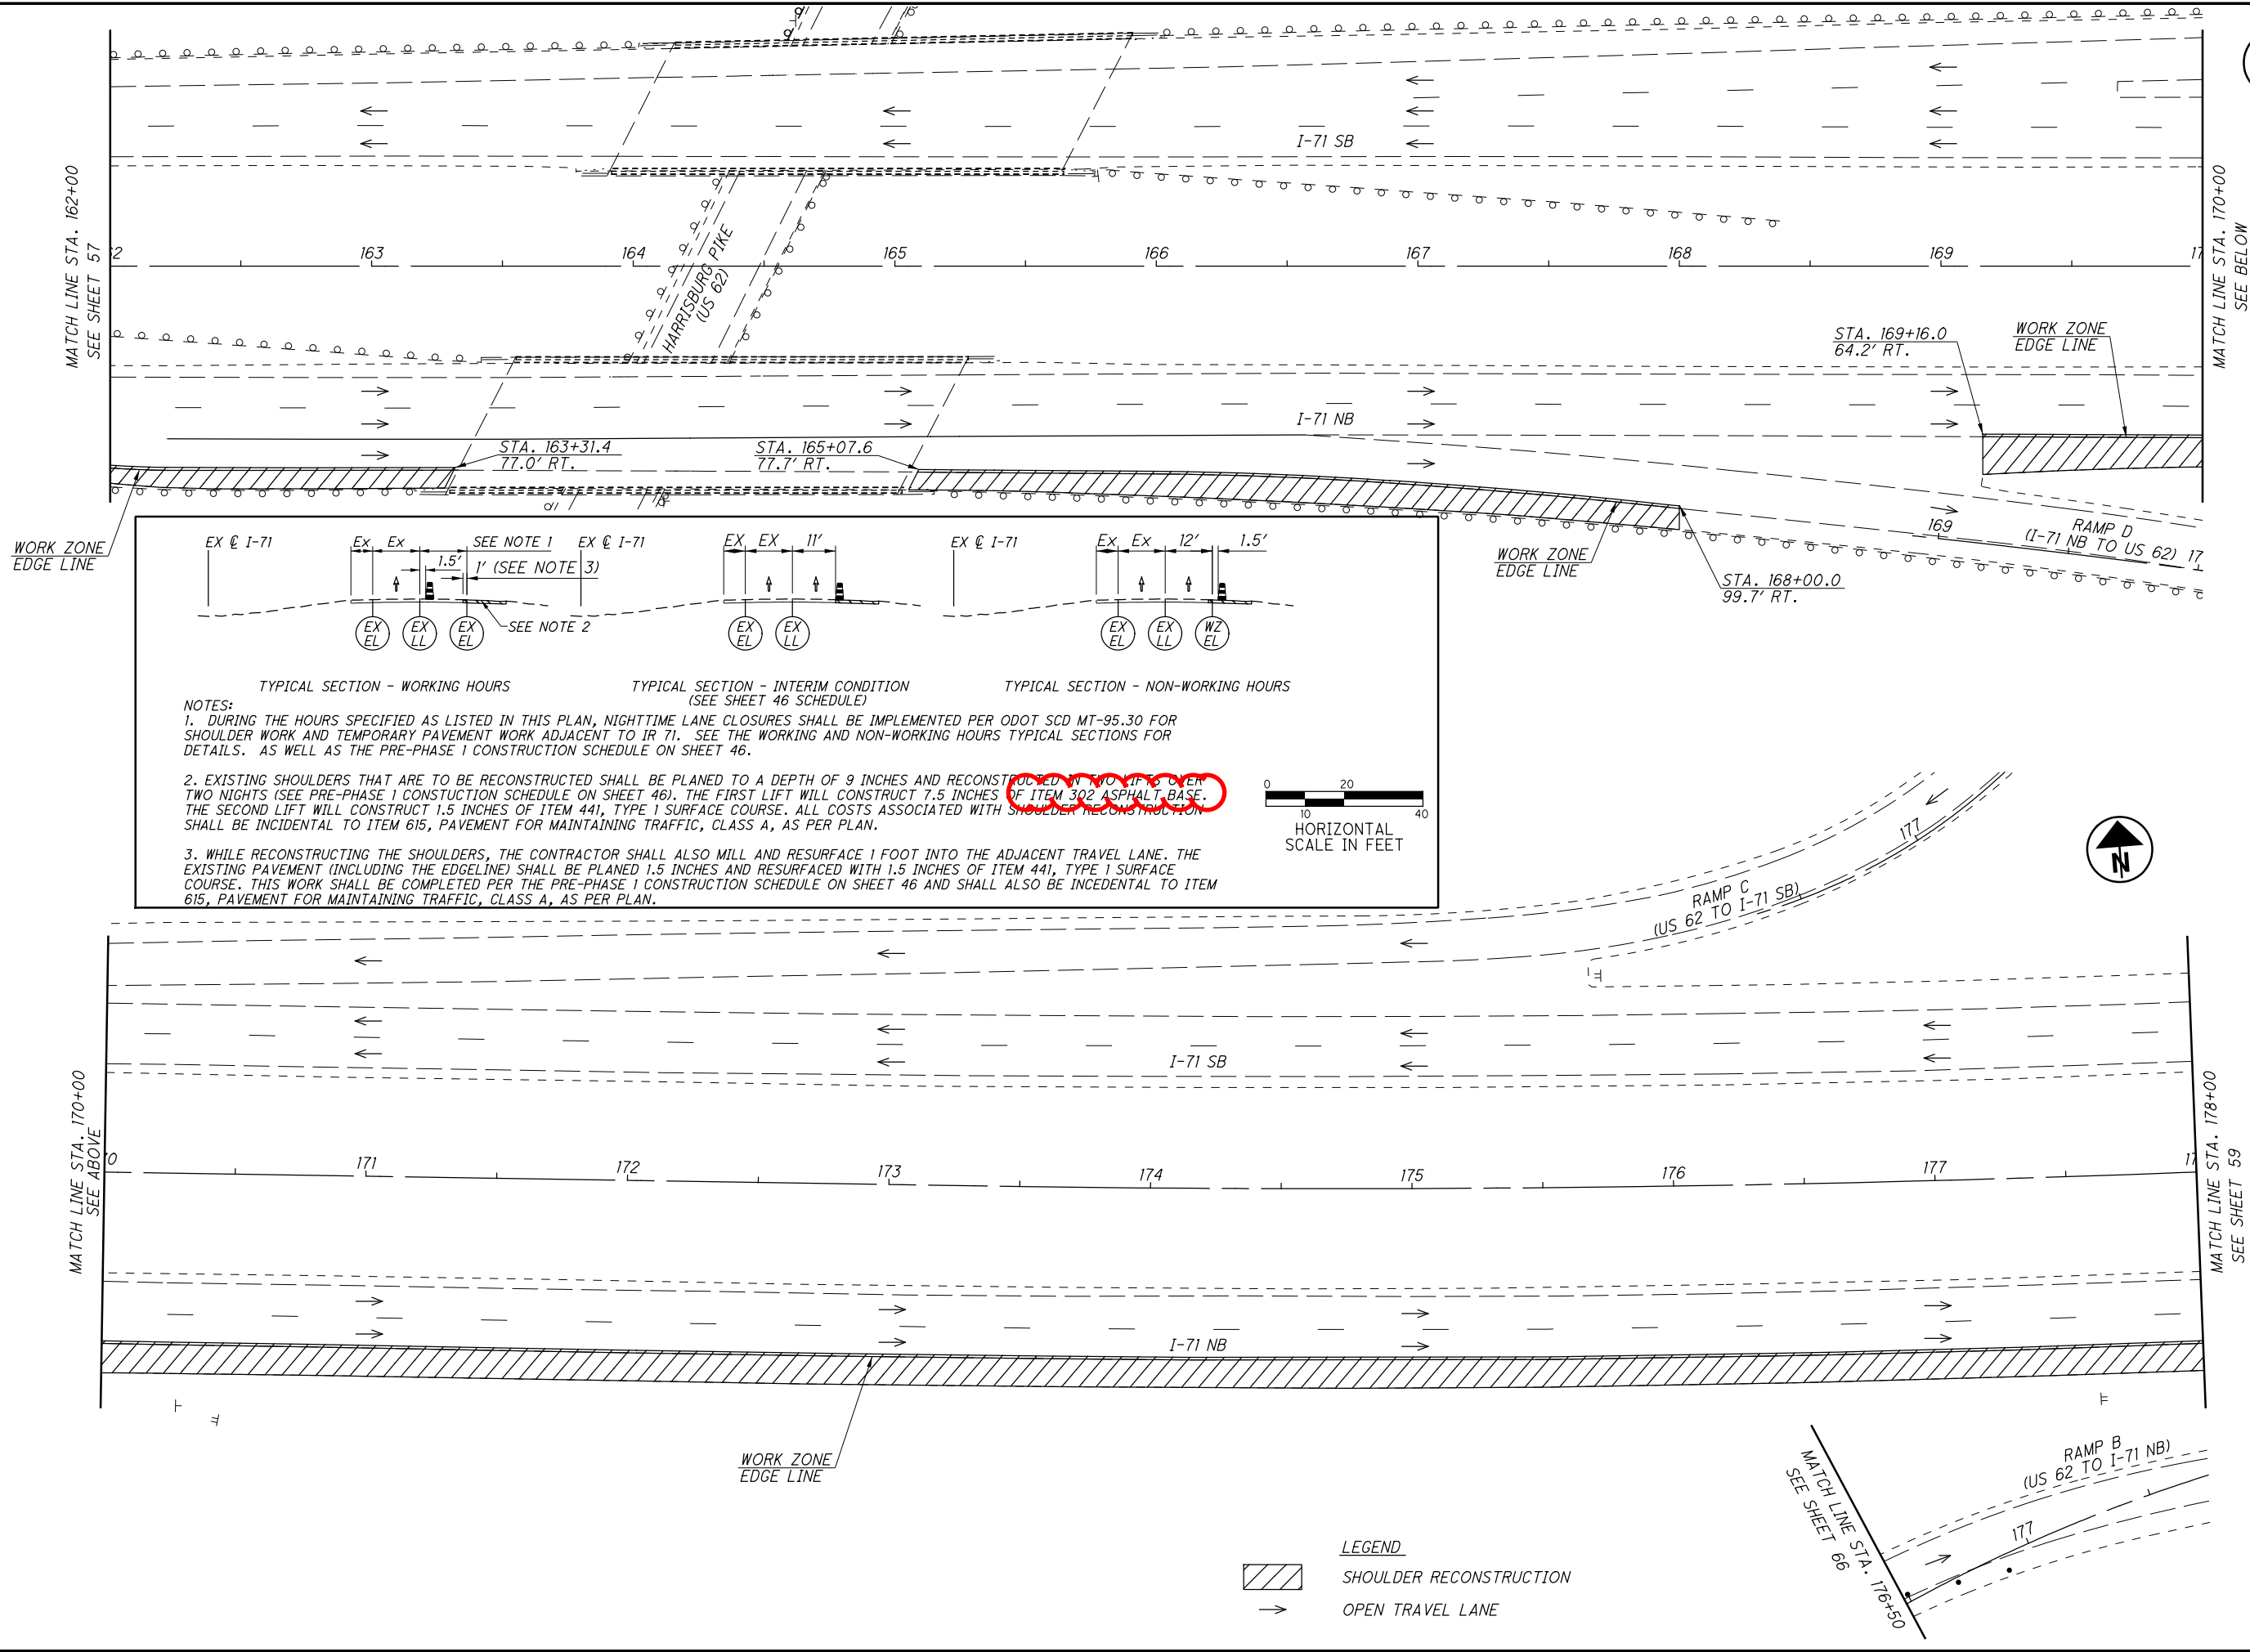

TYPICAL SECTION - WORKING HOURS TYPICAL SECTION - INTERIM CONDITION (SEE SHEET 46 SCHEDULE)
 TYPICAL SECTION - NON-WORKING HOURS

NOTES:
 1. DURING THE HOURS SPECIFIED AS LISTED IN THIS PLAN, NIGHTTIME LANE CLOSURES SHALL BE IMPLEMENTED PER ODOT SCD MT-95.30 FOR SHOULDER WORK AND TEMPORARY PAVEMENT WORK ADJACENT TO I-71. SEE THE WORKING AND NON-WORKING HOURS TYPICAL SECTIONS FOR DETAILS. AS WELL AS THE PRE-PHASE 1 CONSTRUCTION SCHEDULE ON SHEET 46.
 2. EXISTING SHOULDERS THAT ARE TO BE RECONSTRUCTED SHALL BE PLANNED TO A DEPTH OF 9 INCHES AND RECONSTRUCTED IN TWO LIFTS OVER TWO NIGHTS (SEE PRE-PHASE 1 CONSTRUCTION SCHEDULE ON SHEET 46). THE FIRST LIFT WILL CONSTRUCT 7.5 INCHES OF ITEM 302 ASPHALT BASE. THE SECOND LIFT WILL CONSTRUCT 1.5 INCHES OF ITEM 441, TYPE 1 SURFACE COURSE. ALL COSTS ASSOCIATED WITH SHOULDER RECONSTRUCTION SHALL BE INCIDENTAL TO ITEM 615, PAVEMENT FOR MAINTAINING TRAFFIC, CLASS A, AS PER PLAN.
 3. WHILE RECONSTRUCTING THE SHOULDERS, THE CONTRACTOR SHALL ALSO MILL AND RESURFACE 1 FOOT INTO THE ADJACENT TRAVEL LANE. THE EXISTING PAVEMENT (INCLUDING THE EDGELINE) SHALL BE PLANNED 1.5 INCHES AND RESURFACED WITH 1.5 INCHES OF ITEM 441, TYPE 1 SURFACE COURSE. THIS WORK SHALL BE COMPLETED PER THE PRE-PHASE 1 CONSTRUCTION SCHEDULE ON SHEET 46 AND SHALL ALSO BE INCIDENTAL TO ITEM 615, PAVEMENT FOR MAINTAINING TRAFFIC, CLASS A, AS PER PLAN.

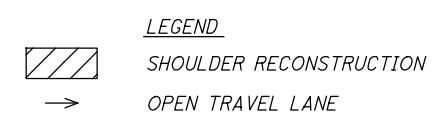



 
| | | | |
|------------|-----|---------|-----|
| CALCULATED | BER | CHECKED | SMM |
| | | | |


MAINTENANCE OF TRAFFIC PLAN-PRE-PHASE 1
 (CONCRETE OPTION) I-71 - STA. 162+00 TO STA. 178+00

FRA-71-0.00


J:\20130212\ODOT\FRA\107201\mot\sheet\107201MP165.dgn 8/6/2020 4:01:53 AM brieder

(A) - MEET/MATCH PROPOSED
EDGE OF SHOULDER

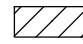LEGEND
 SHOULDER RECONSTRUCTION
 TEMPORARY PAVEMENT CONSTRUCTED THIS PHASE
 OPEN TRAVEL LANE


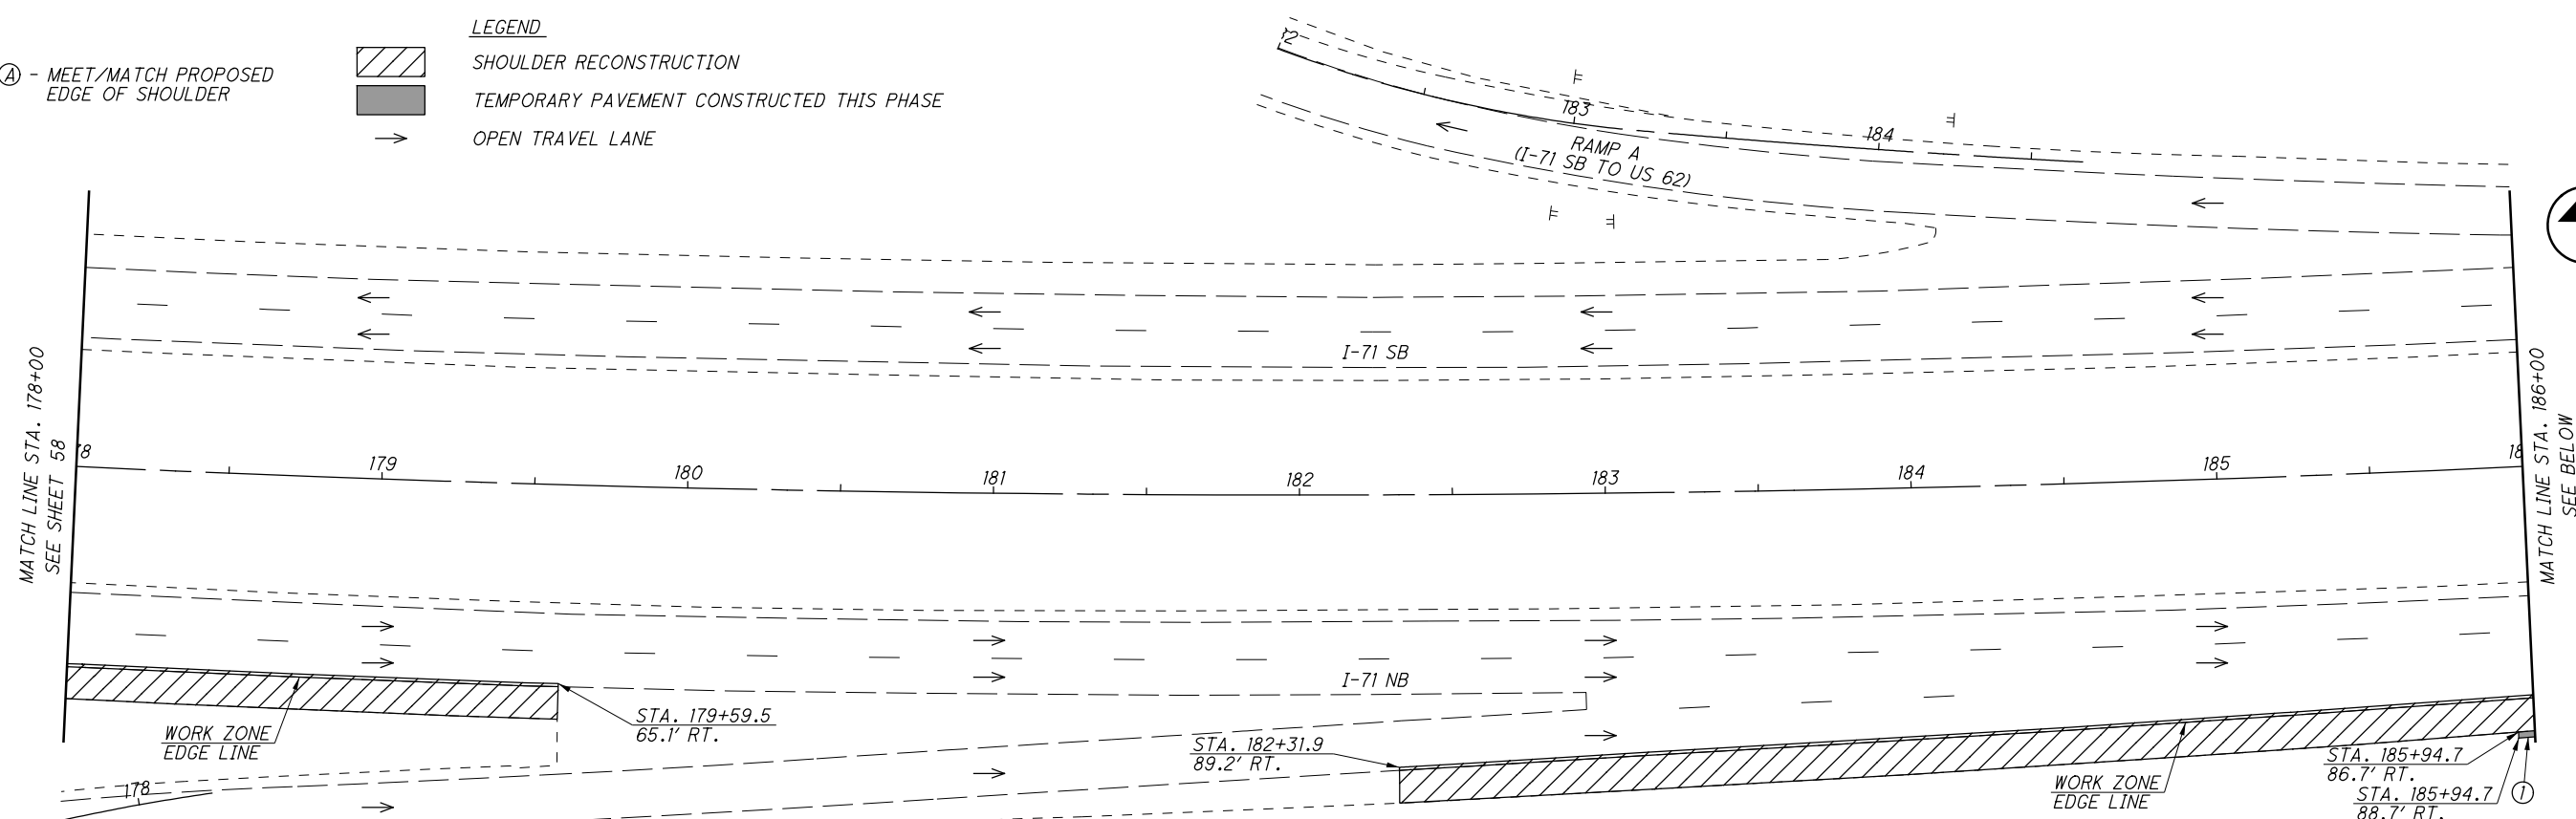


(1) $\Delta = 3^\circ 09' 28''$ (LT)
 $D_c = 0^\circ 29' 03''$
 $R = 11,837'$
 $T = 326.28'$
 $L = 652.39'$
 $E = 4.50'$
 $C = 652.31'$
 $C.B. = N 84^\circ 03' 10'' E$

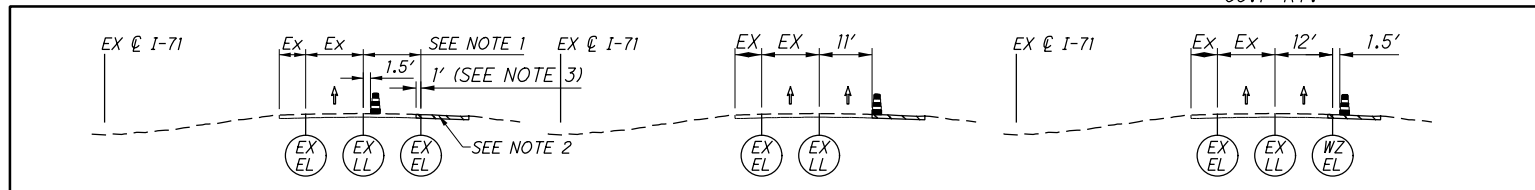

NOTES:



- DURING THE HOURS SPECIFIED AS LISTED IN THIS PLAN, NIGHTTIME LANE CLOSURES SHALL BE IMPLEMENTED PER ODOT SCD MT-95.30 FOR SHOULDER WORK AND TEMPORARY PAVEMENT WORK ADJACENT TO I-71. SEE THE WORKING AND NON-WORKING HOURS TYPICAL SECTIONS FOR DETAILS. AS WELL AS THE PRE-PHASE 1 CONSTRUCTION SCHEDULE ON SHEET 46.
- EXISTING SHOULDERS THAT ARE TO BE RECONSTRUCTED SHALL BE PLANNED TO A DEPTH OF 9 INCHES AND RECONSTRUCTED IN TWO LIFTS OVER TWO NIGHTS (SEE PRE-PHASE 1 CONSTRUCTION SCHEDULE ON SHEET 46). THE FIRST LIFT WILL CONSTRUCT 7.5 INCHES OF ITEM 302 ASPHALT BASE. THE SECOND LIFT WILL CONSTRUCT 1.5 INCHES OF ITEM 441, TYPE 1 SURFACE COURSE. ALL COSTS ASSOCIATED WITH SHOULDER RECONSTRUCTION SHALL BE INCIDENTAL TO ITEM 615, PAVEMENT FOR MAINTAINING TRAFFIC, CLASS A, AS PER PLAN.
- WHILE RECONSTRUCTING THE SHOULDERS, THE CONTRACTOR SHALL ALSO MILL AND RESURFACE 1 FOOT INTO THE ADJACENT TRAVEL LANE. THE EXISTING PAVEMENT (INCLUDING THE EDGELINE) SHALL BE PLANNED 1.5 INCHES AND RESURFACED WITH 1.5 INCHES OF ITEM 441, TYPE 1 SURFACE COURSE. THIS WORK SHALL BE COMPLETED PER THE PRE-PHASE 1 CONSTRUCTION SCHEDULE ON SHEET 46 AND SHALL ALSO BE INCIDENTAL TO ITEM 615, PAVEMENT FOR MAINTAINING TRAFFIC, CLASS A, AS PER PLAN.

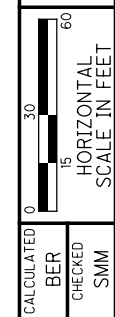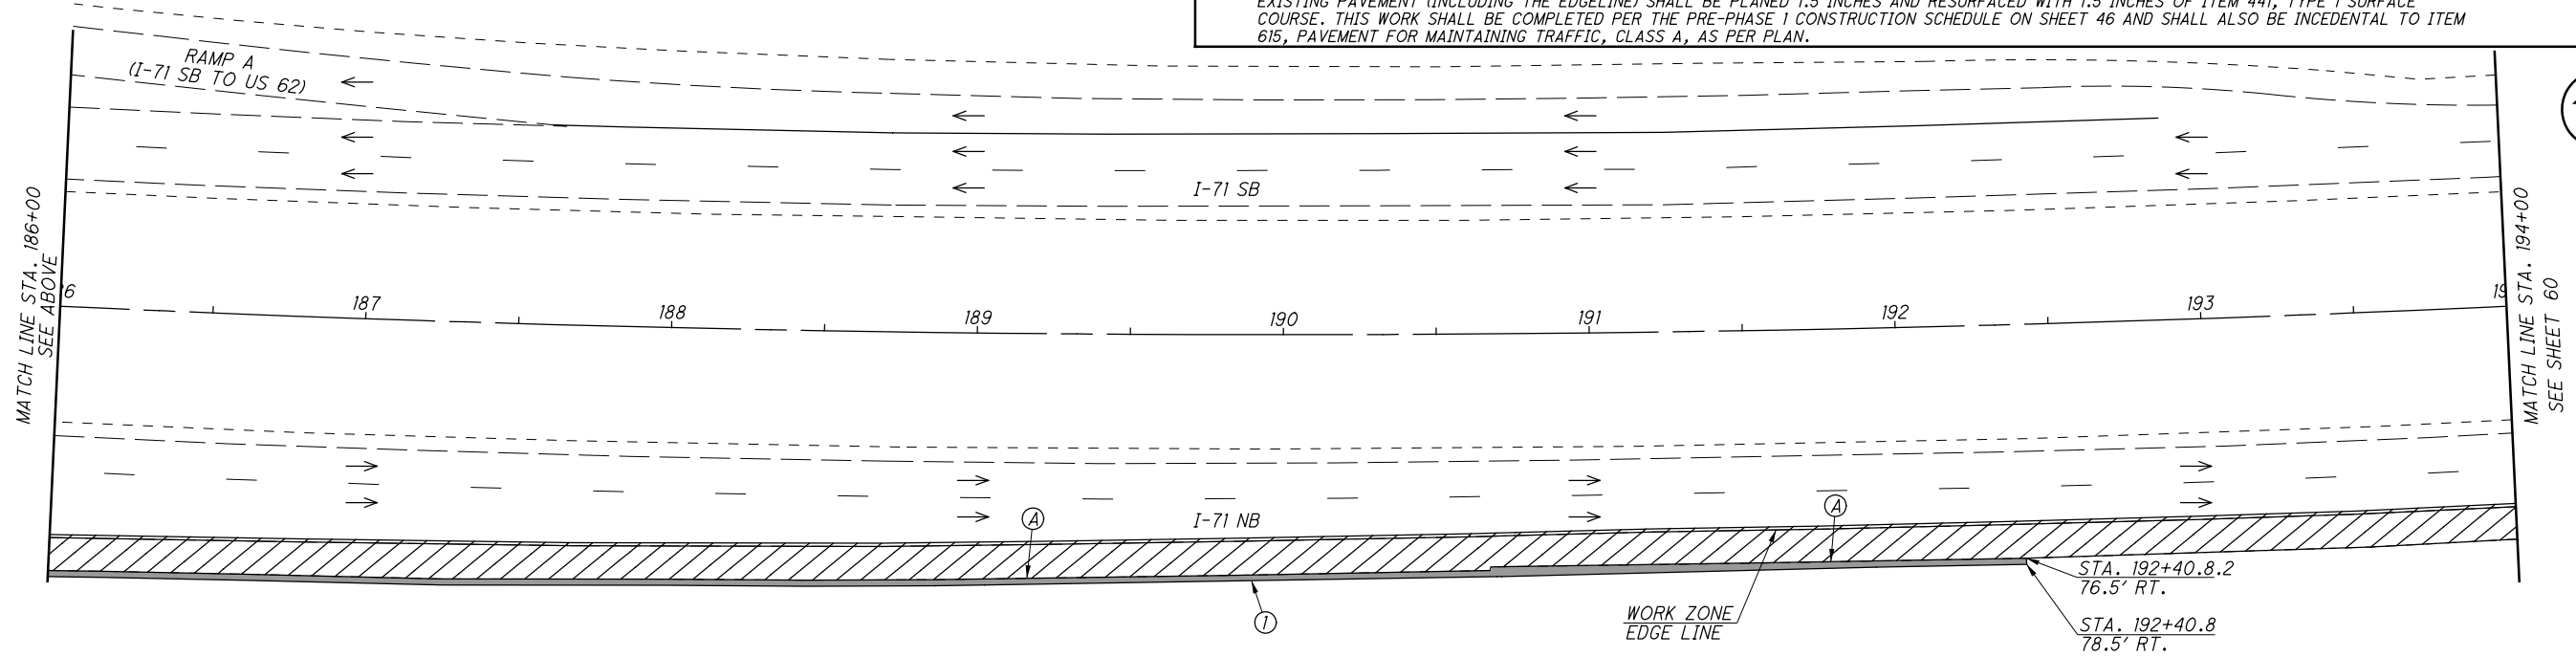

CALCULATED BER CHECKED SMM
MAINTENANCE OF TRAFFIC PLAN-PRE-PHASE 1
(CONCRETE OPTION) I-71 - STA. 178+00 TO STA. 194+00


FRA-71-0-00
 59
 1312

J:\20130212\ODOT\FRA\107201\mot\sheets\107201MP166.dgn 8/6/2020 4:03:01 AM brieder

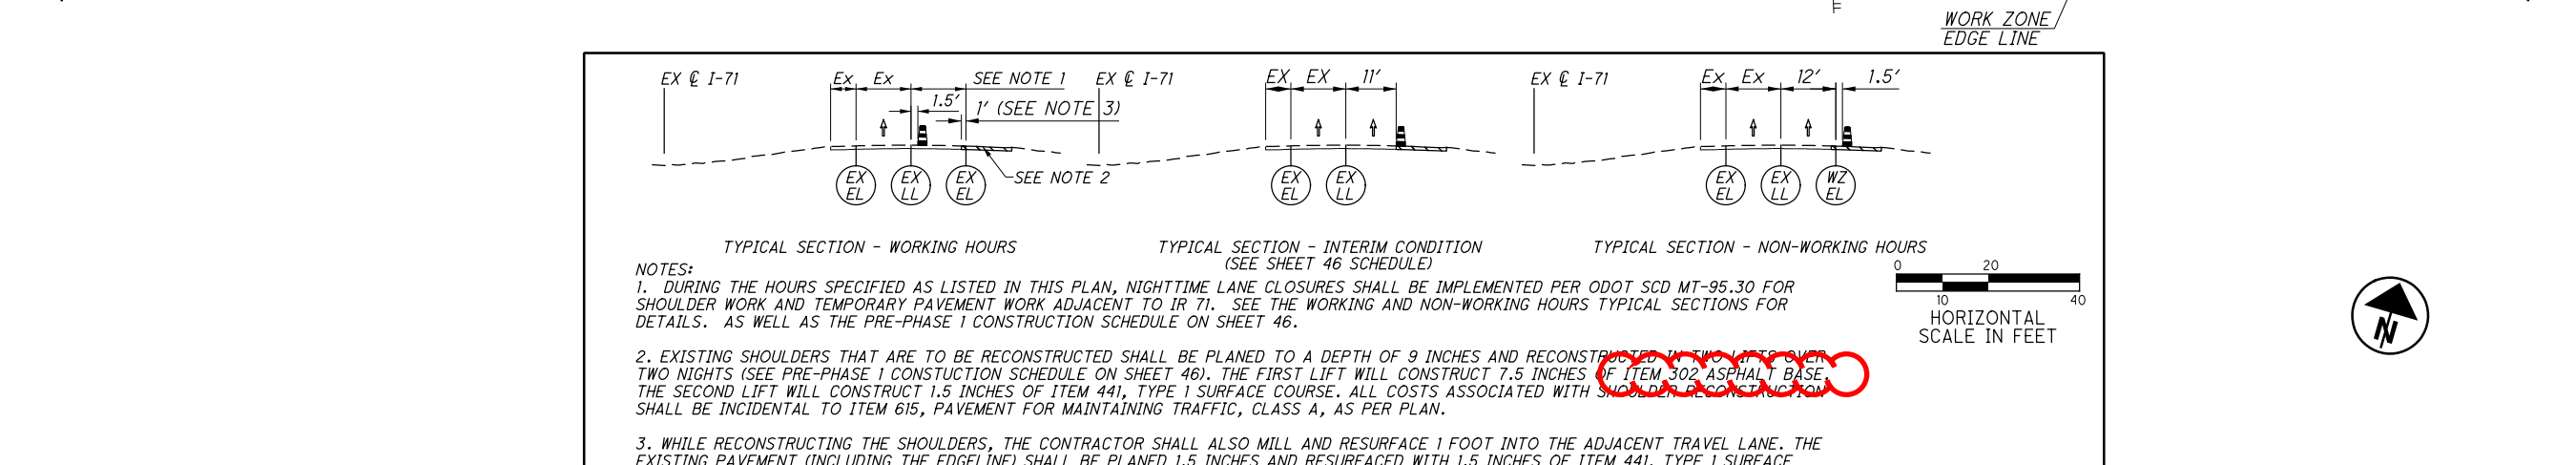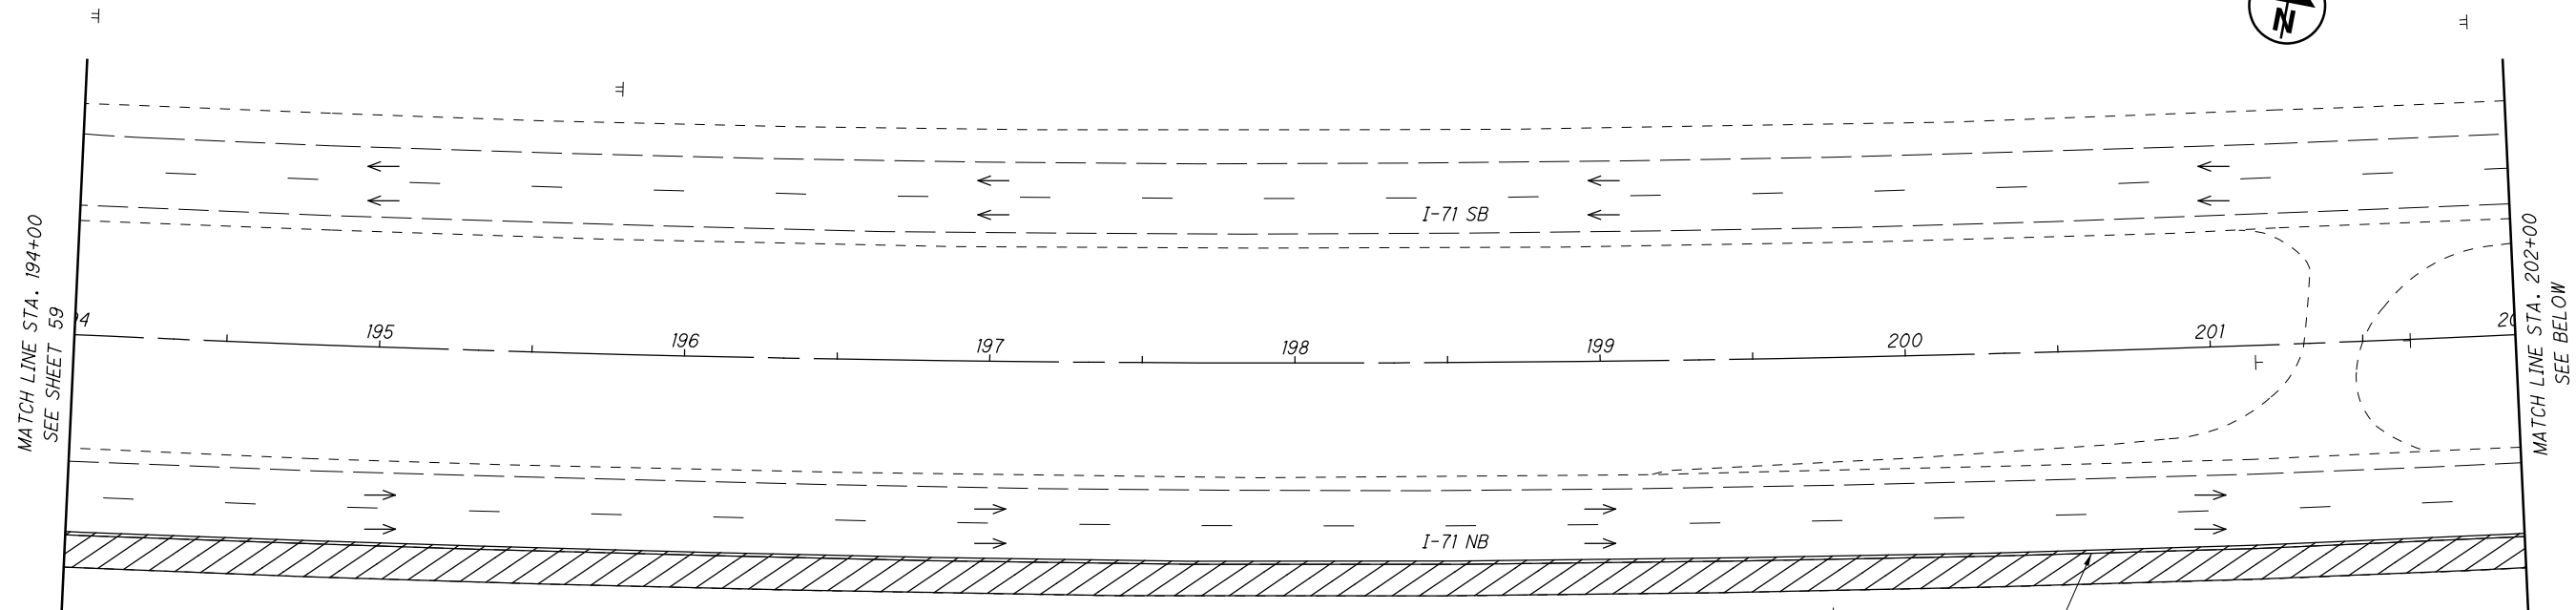

NOTES:

- DURING THE HOURS SPECIFIED AS LISTED IN THIS PLAN, NIGHTTIME LANE CLOSURES SHALL BE IMPLEMENTED PER ODOT SCD MT-95.30 FOR SHOULDER WORK AND TEMPORARY PAVEMENT WORK ADJACENT TO I-71. SEE THE WORKING AND NON-WORKING HOURS TYPICAL SECTIONS FOR DETAILS. AS WELL AS THE PRE-PHASE 1 CONSTRUCTION SCHEDULE ON SHEET 46.
- EXISTING SHOULDERS THAT ARE TO BE RECONSTRUCTED SHALL BE PLANED TO A DEPTH OF 9 INCHES AND RECONSTRUCTED IN TWO LIFTS OVER TWO NIGHTS (SEE PRE-PHASE 1 CONSTRUCTION SCHEDULE ON SHEET 46). THE FIRST LIFT WILL CONSTRUCT 7.5 INCHES OF ITEM 302 ASPHALT BASE. THE SECOND LIFT WILL CONSTRUCT 1.5 INCHES OF ITEM 441, TYPE 1 SURFACE COURSE. ALL COSTS ASSOCIATED WITH SHOULDER RECONSTRUCTION SHALL BE INCIDENTAL TO ITEM 615, PAVEMENT FOR MAINTAINING TRAFFIC, CLASS A, AS PER PLAN.
- WHILE RECONSTRUCTING THE SHOULDERS, THE CONTRACTOR SHALL ALSO MILL AND RESURFACE 1 FOOT INTO THE ADJACENT TRAVEL LANE. THE EXISTING PAVEMENT (INCLUDING THE EDGELINE) SHALL BE PLANED 1.5 INCHES AND RESURFACED WITH 1.5 INCHES OF ITEM 441, TYPE 1 SURFACE COURSE. THIS WORK SHALL BE COMPLETED PER THE PRE-PHASE 1 CONSTRUCTION SCHEDULE ON SHEET 46 AND SHALL ALSO BE INCIDENTAL TO ITEM 615, PAVEMENT FOR MAINTAINING TRAFFIC, CLASS A, AS PER PLAN.

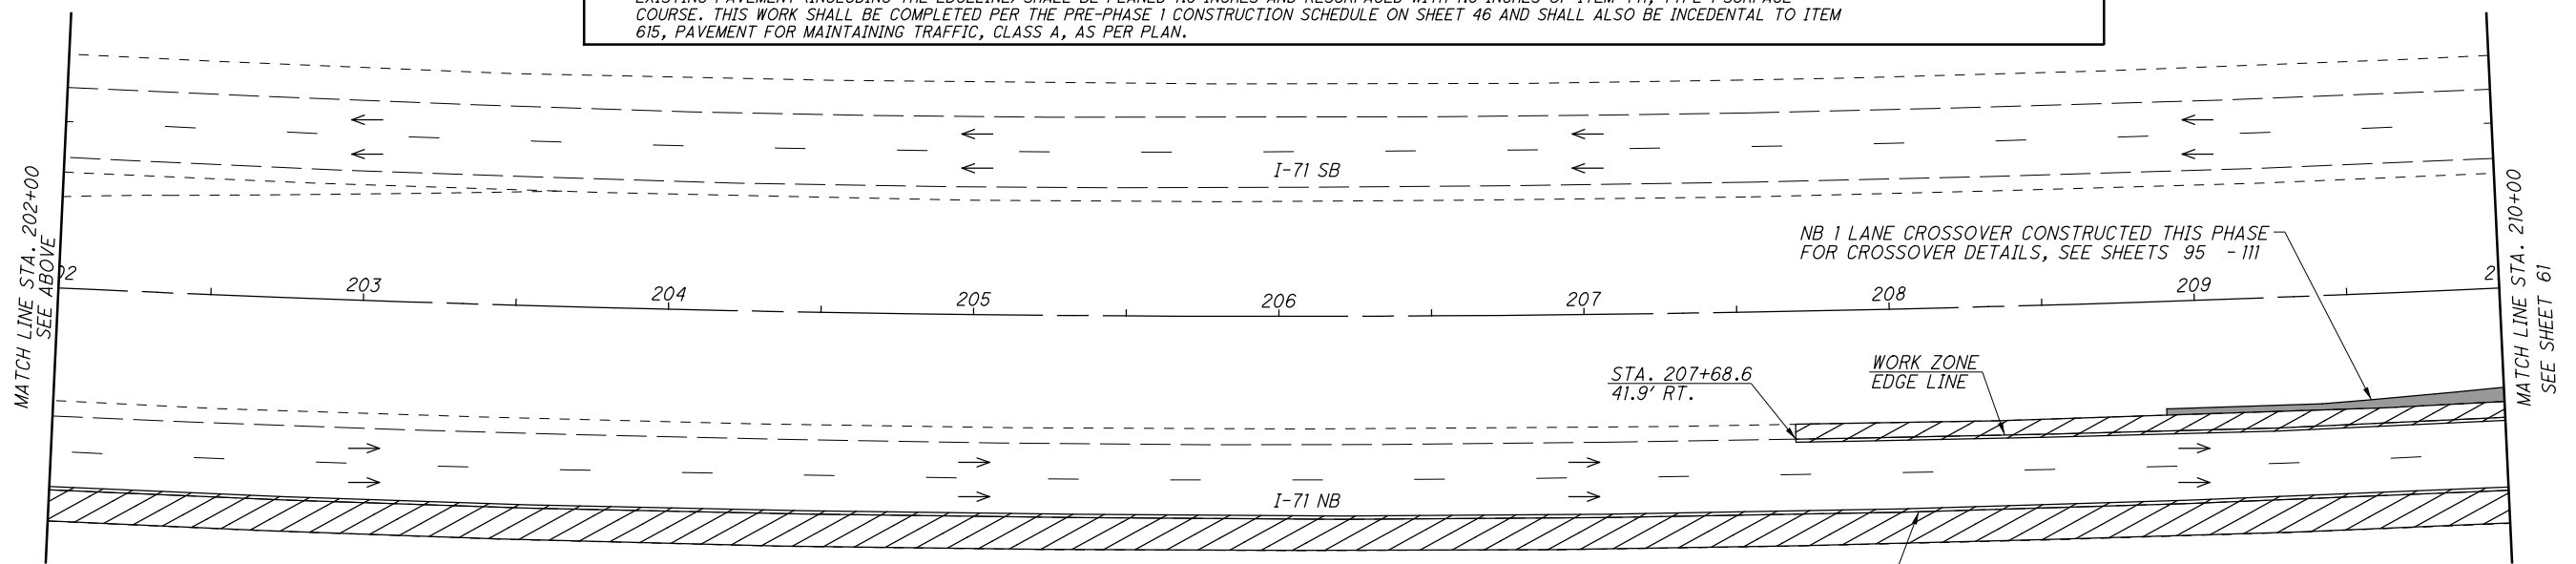

LEGEND

SHOULDER RECONSTRUCTION

OPEN TRAVEL LANE





CALCULATED
BER
CHECKED
SMM

**MAINTENANCE OF TRAFFIC PLAN-PRE-PHASE 1
(CONCRETE OPTION) I-71 - STA. 194+00 TO STA. 210+00**

FRA-71-0.00

60
1312

J:\20130212\ODOT\FRA\107201\mot\sheets\107201MP167.dgn 8/6/2020 4:04:10 AM brieder

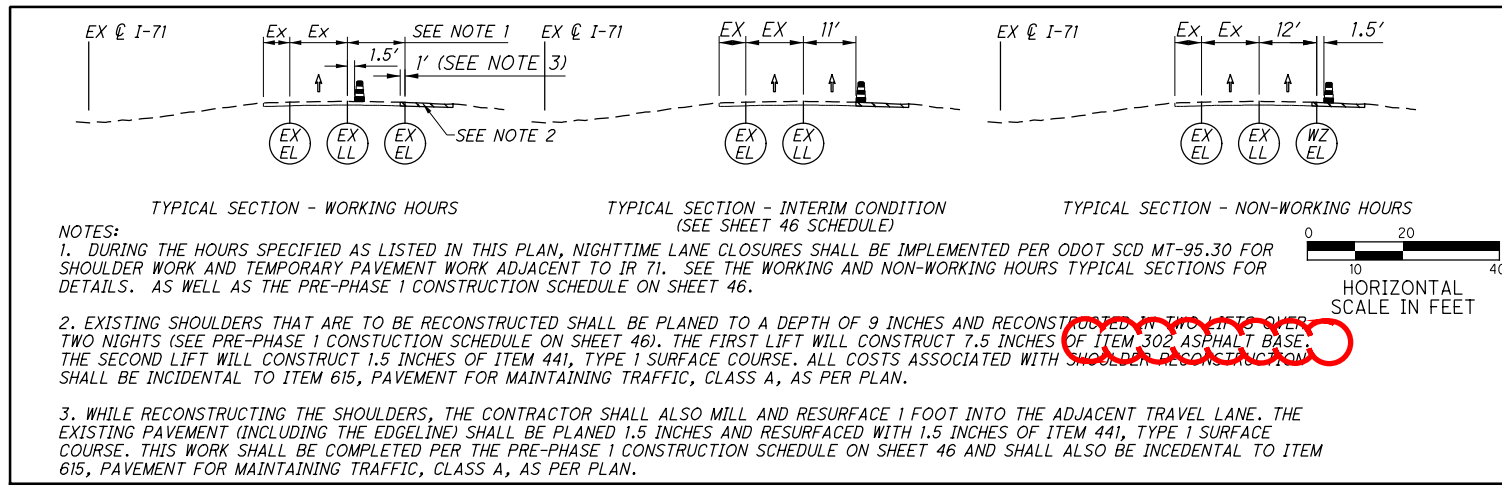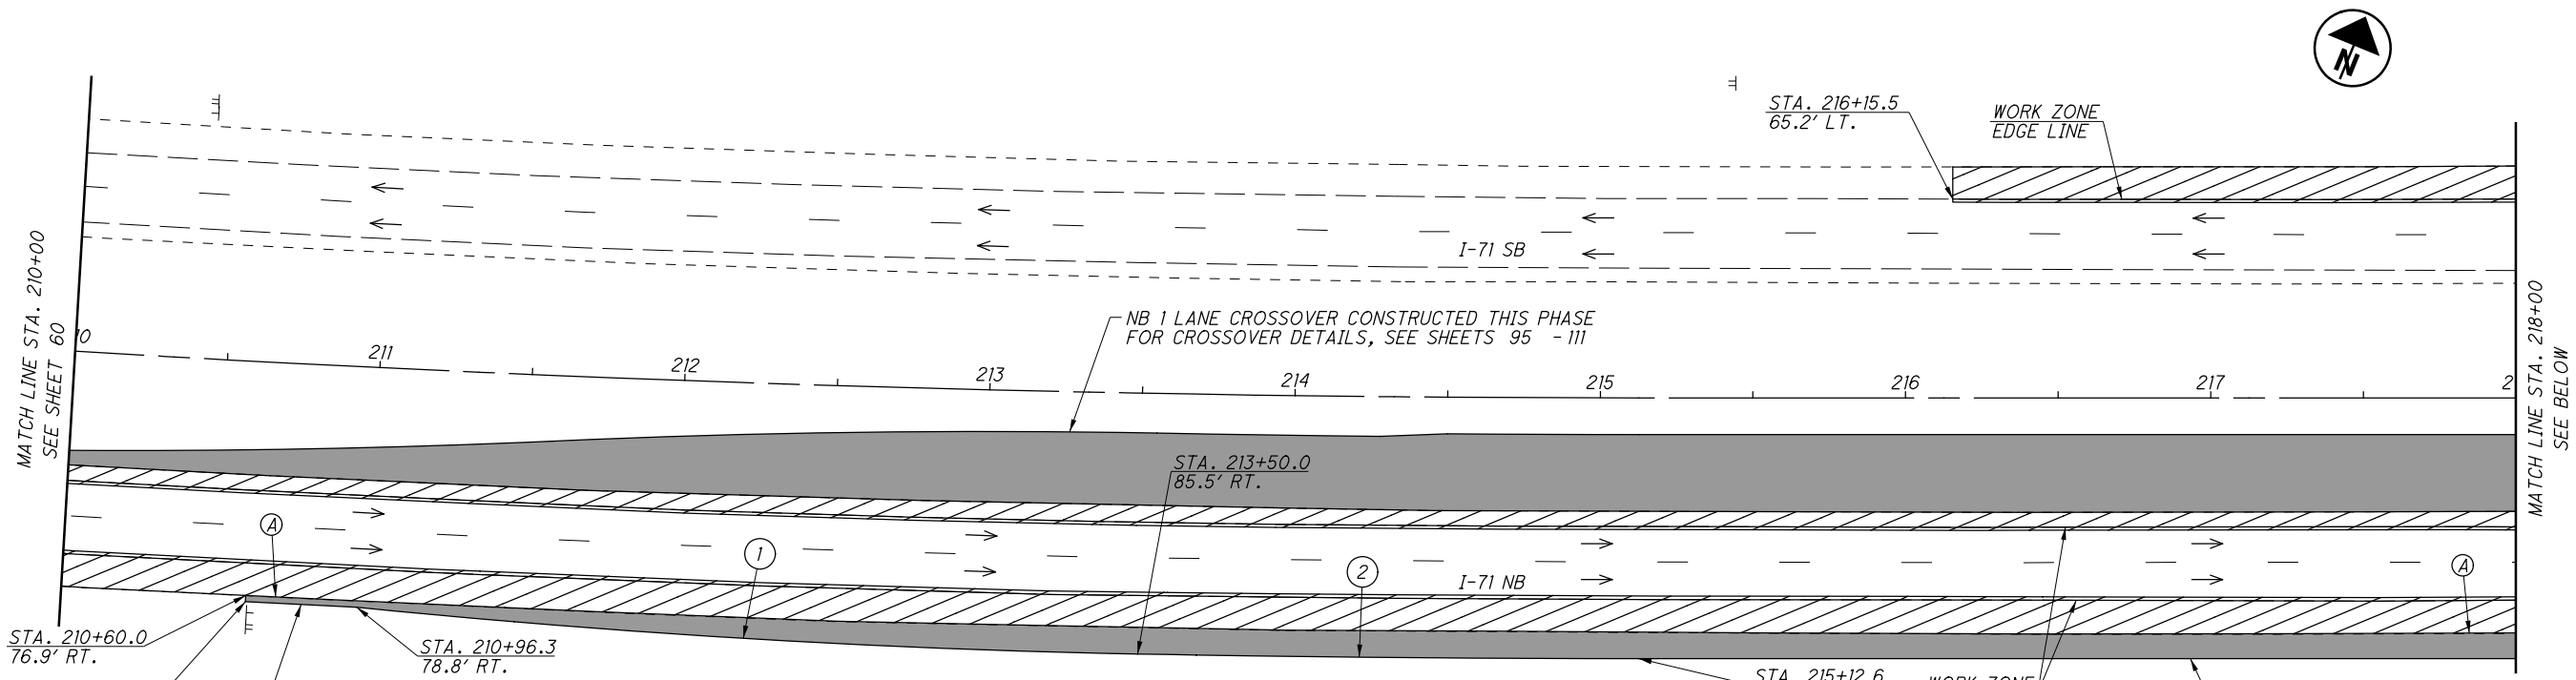


NOTES:

- DURING THE HOURS SPECIFIED AS LISTED IN THIS PLAN, NIGHTTIME LANE CLOSURES SHALL BE IMPLEMENTED PER ODOT SCD MT-95.30 FOR SHOULDER WORK AND TEMPORARY PAVEMENT WORK ADJACENT TO I-71. SEE THE WORKING AND NON-WORKING HOURS TYPICAL SECTIONS FOR DETAILS. AS WELL AS THE PRE-PHASE 1 CONSTRUCTION SCHEDULE ON SHEET 46.
- EXISTING SHOULDERS THAT ARE TO BE RECONSTRUCTED SHALL BE PLANED TO A DEPTH OF 9 INCHES AND RECONSTRUCTED IN TWO LIFTS OVER TWO NIGHTS (SEE PRE-PHASE 1 CONSTRUCTION SCHEDULE ON SHEET 46). THE FIRST LIFT WILL CONSTRUCT 7.5 INCHES OF ITEM 302 ASPHALT BASE. THE SECOND LIFT WILL CONSTRUCT 1.5 INCHES OF ITEM 441, TYPE 1 SURFACE COURSE. ALL COSTS ASSOCIATED WITH SHOULDER RECONSTRUCTION SHALL BE INCIDENTAL TO ITEM 615, PAVEMENT FOR MAINTAINING TRAFFIC, CLASS A, AS PER PLAN.
- WHILE RECONSTRUCTING THE SHOULDERS, THE CONTRACTOR SHALL ALSO MILL AND RESURFACE 1 FOOT INTO THE ADJACENT TRAVEL LANE. THE EXISTING PAVEMENT (INCLUDING THE EDGELINE) SHALL BE PLANED 1.5 INCHES AND RESURFACED WITH 1.5 INCHES OF ITEM 441, TYPE 1 SURFACE COURSE. THIS WORK SHALL BE COMPLETED PER THE PRE-PHASE 1 CONSTRUCTION SCHEDULE ON SHEET 46 AND SHALL ALSO BE INCIDENTAL TO ITEM 615, PAVEMENT FOR MAINTAINING TRAFFIC, CLASS A, AS PER PLAN.

① $\Delta = 4^\circ 41' 28''$ (LT)
 $D_c = 1^\circ 49' 43''$
 $R = 3133.22'$
 $T = 128.23'$
 $L = 256.33'$
 $E = 2.62'$
 $C = 256.25'$
 $C.B. = N 71^\circ 04' 27'' E$

② $\Delta = 1^\circ 05' 02''$ (LT)
 $D_c = 0^\circ 39' 37''$
 $R = 8679.87'$
 $T = 82.12'$
 $L = 164.23'$
 $E = 0.39'$
 $C = 164.23'$
 $C.B. = N 68^\circ 11' 18'' E$

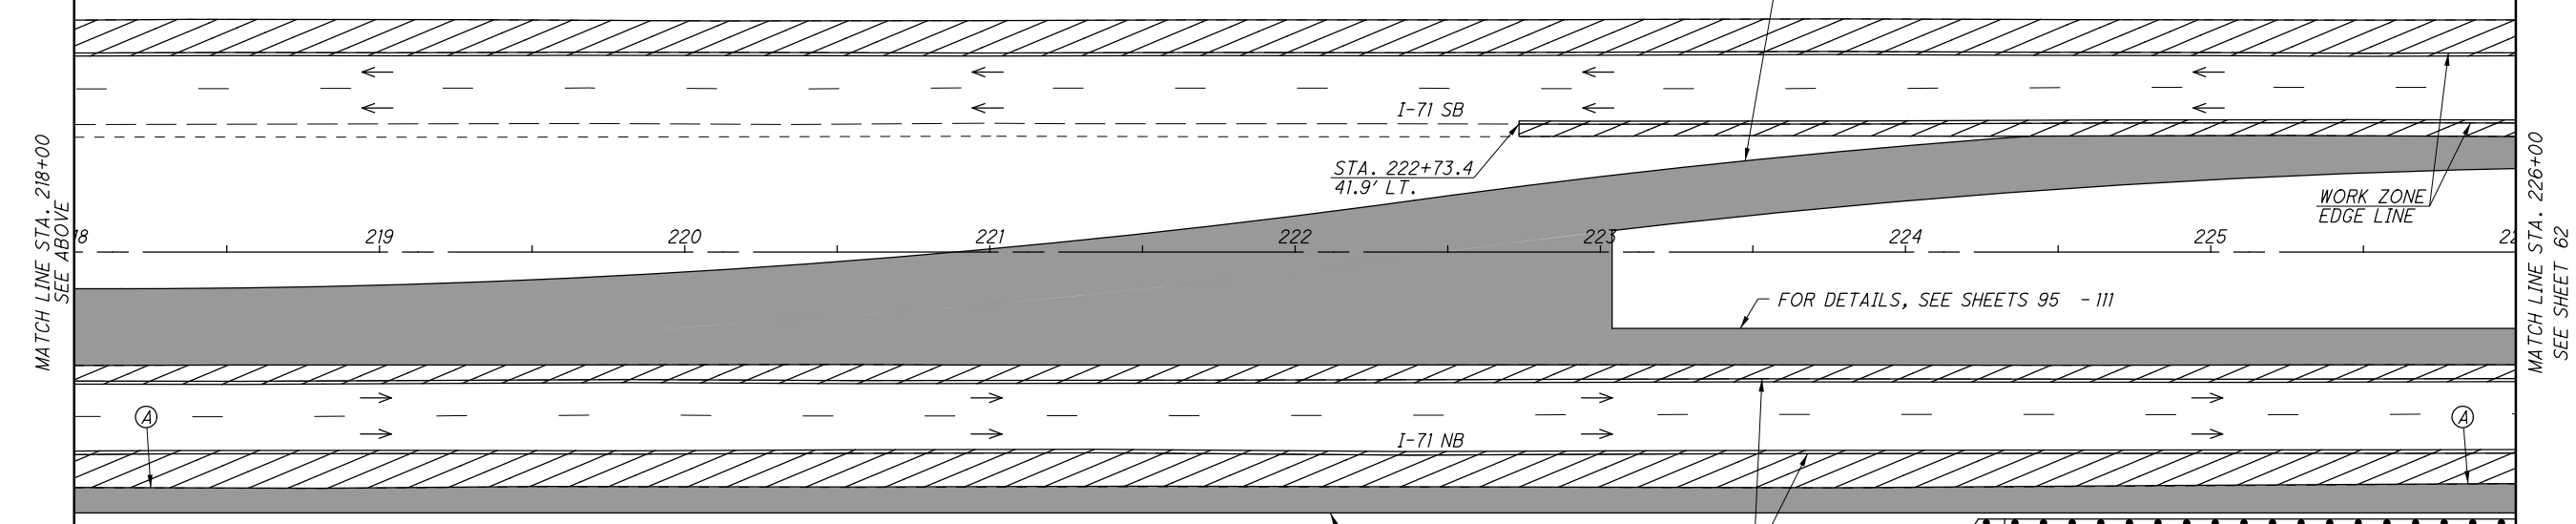

LEGEND

- TEMPORARY PAVEMENT CONSTRUCTED THIS PHASE
- SHOULDER RECONSTRUCTION
- OPEN TRAVEL LANE

Ⓐ - MEET/MATCH EXISTING EDGE OF SHOULDER


412.5' TEMPORARY GUARDRAIL, TYPE MGS W/(1)-ANCHOR ASSEMBLY, MGS TYPE E W/OFFSET AS SHOWN IN MGS-5.3 W/(1)-ANCHOR ASSEMBLY, MGS TYPE T

MAINTENANCE OF TRAFFIC PLAN-PRE-PHASE 1 (CONCRETE OPTION) I-71 - STA. 210+00 TO STA. 226+00


FRA-71-0.00

61
1312

CALCULATED
BER
CHECKED
SMM

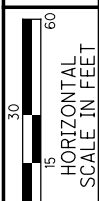


J:\20130212\ODOT\FRA\107201\mot\sheet\107201MP168.dgn 8/6/2020 4:05:19 AM brieder

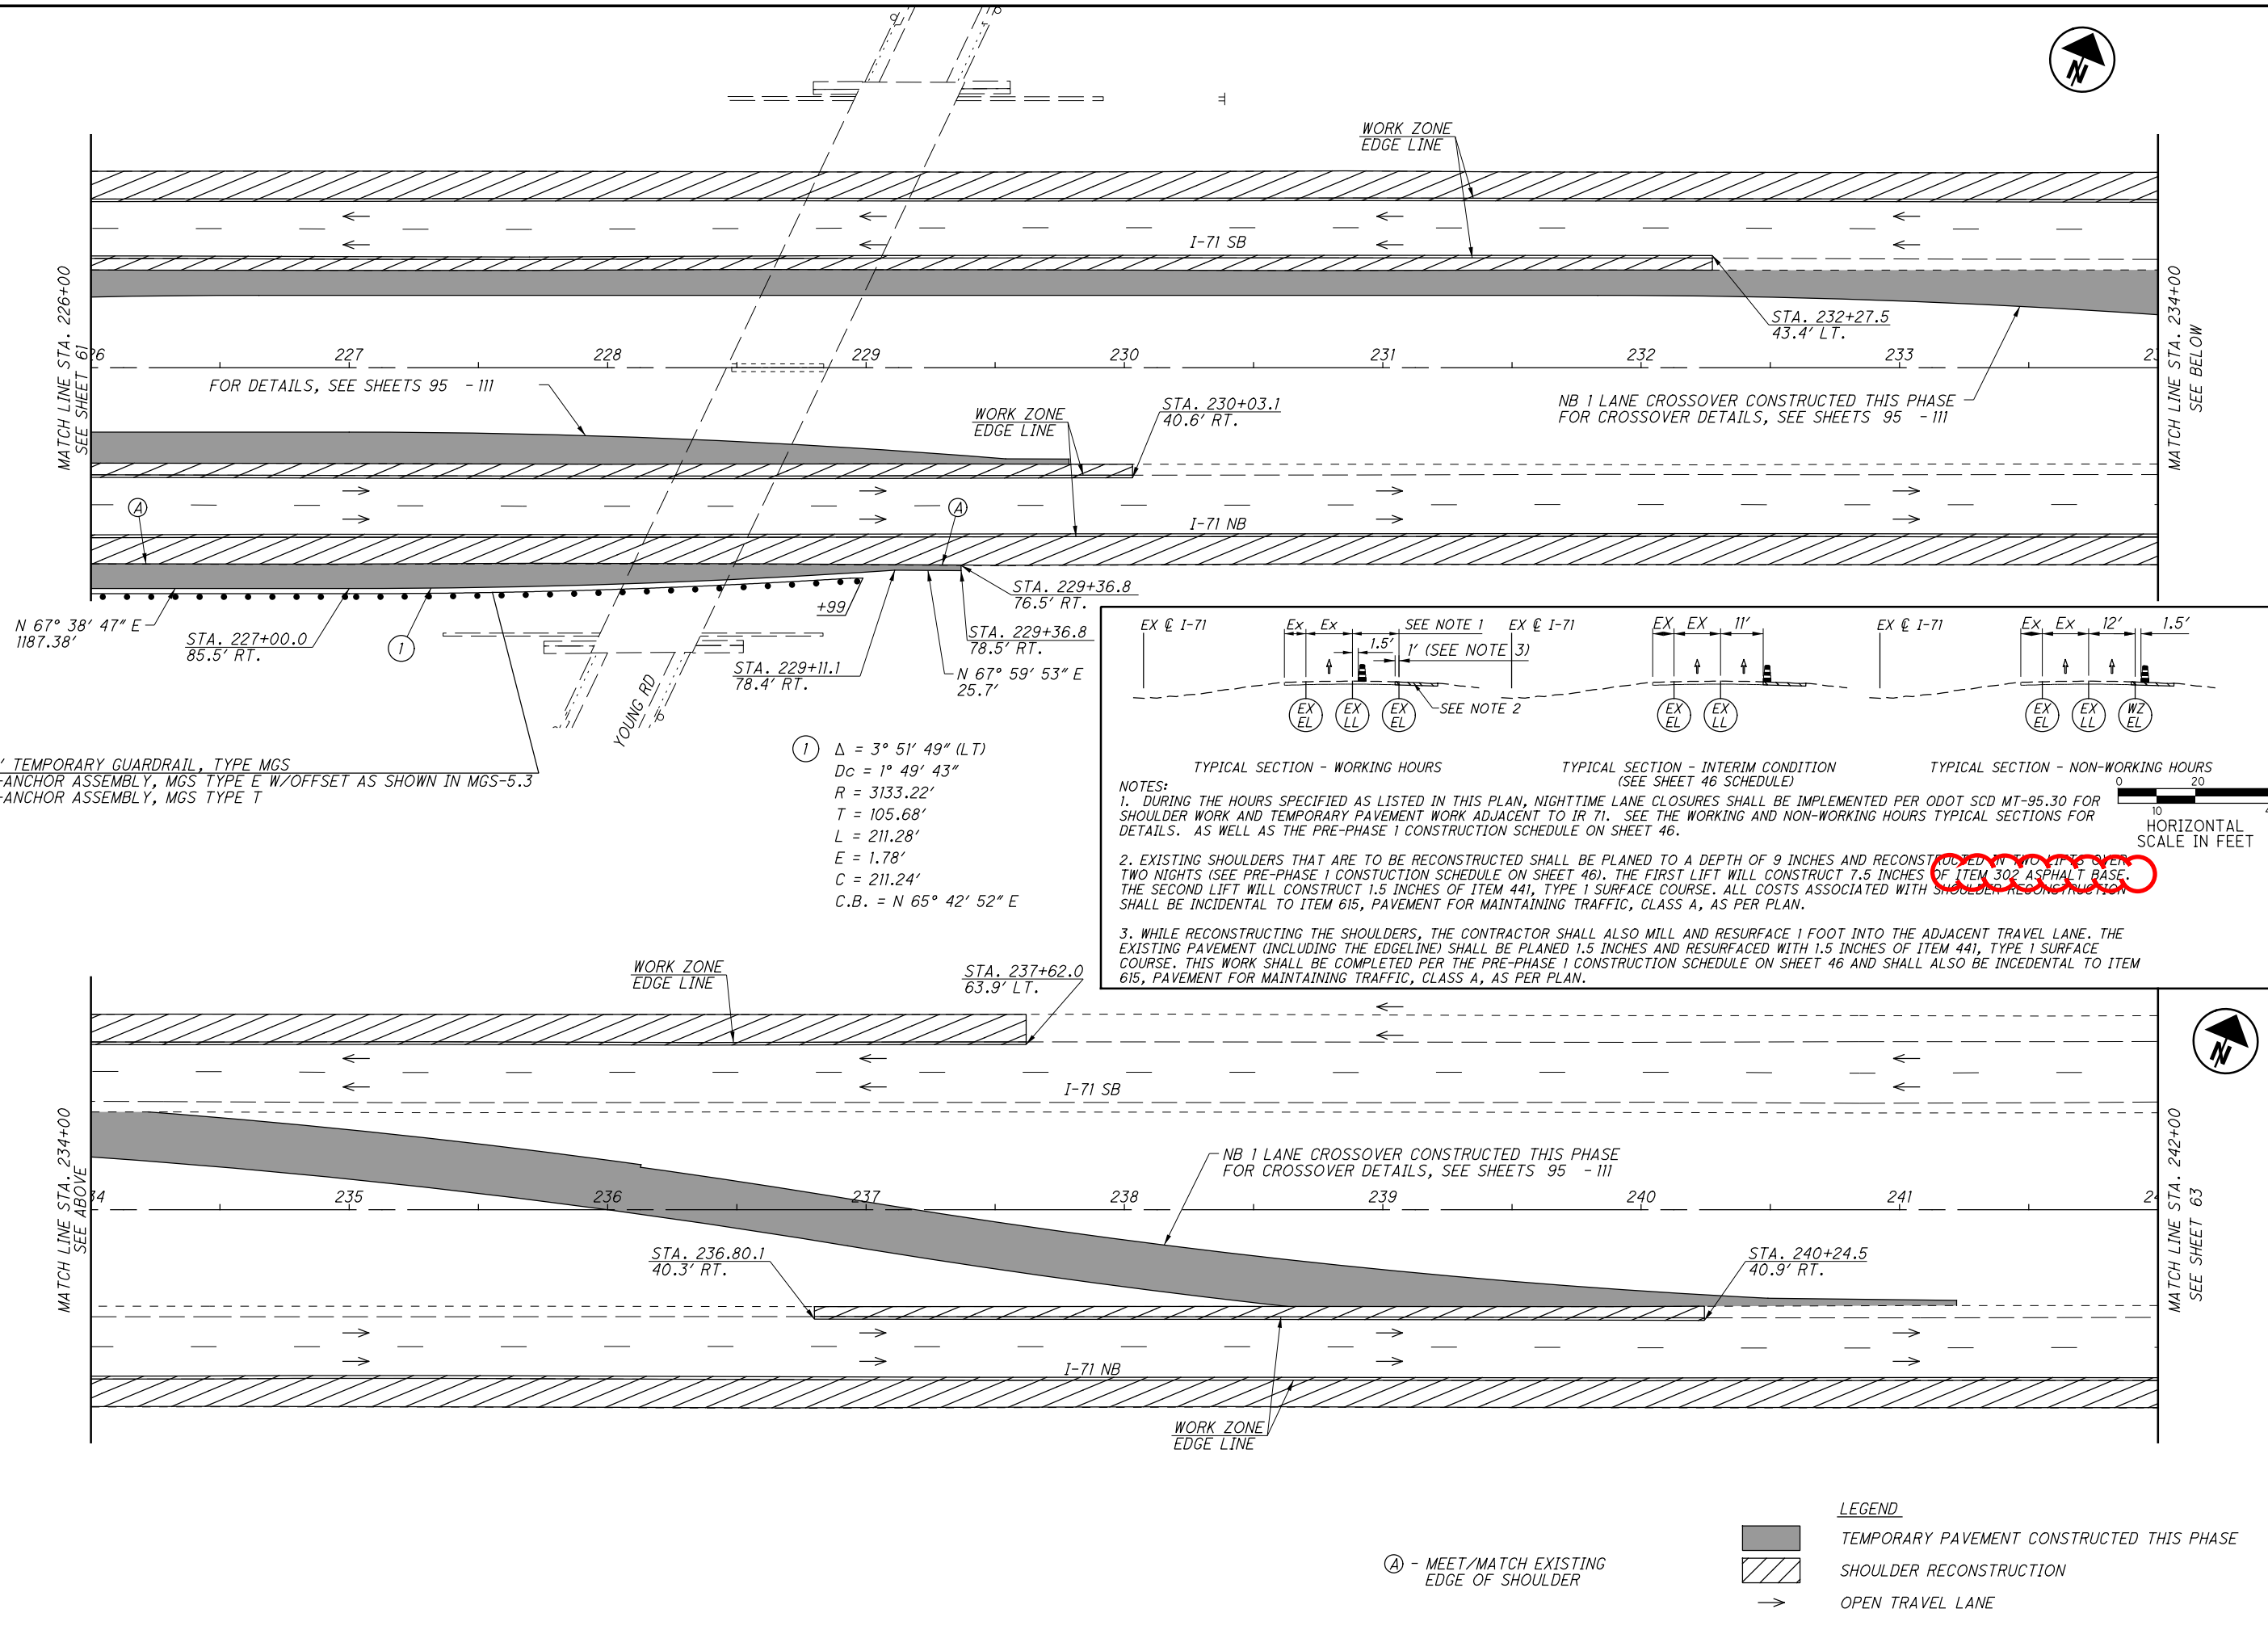

412.5' TEMPORARY GUARDRAIL, TYPE MGS
W/(1)-ANCHOR ASSEMBLY, MGS TYPE E W/OFFSET AS SHOWN IN MGS-5.3
W/(1)-ANCHOR ASSEMBLY, MGS TYPE T

① $\Delta = 3^\circ 51' 49''$ (LT)
 $D_c = 1^\circ 49' 43''$
 $R = 3133.22'$
 $T = 105.68'$
 $L = 211.28'$
 $E = 1.78'$
 $C = 211.24'$
C.B. = N $65^\circ 42' 52''$ E

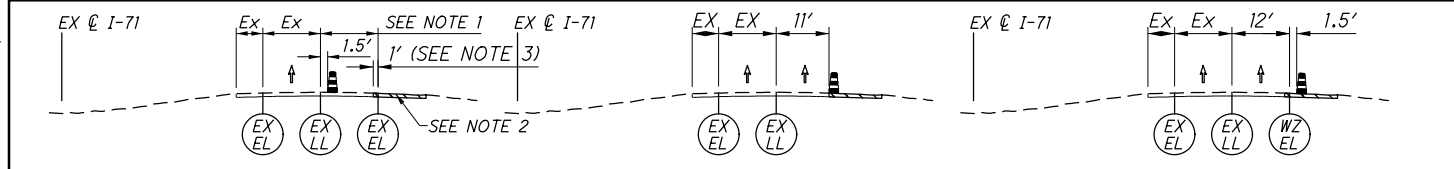

NOTES:
1. DURING THE HOURS SPECIFIED AS LISTED IN THIS PLAN, NIGHTTIME LANE CLOSURES SHALL BE IMPLEMENTED PER ODOT SCD MT-95.30 FOR SHOULDER WORK AND TEMPORARY PAVEMENT WORK ADJACENT TO I-71. SEE THE WORKING AND NON-WORKING HOURS TYPICAL SECTIONS FOR DETAILS. AS WELL AS THE PRE-PHASE 1 CONSTRUCTION SCHEDULE ON SHEET 46.
2. EXISTING SHOULDERS THAT ARE TO BE RECONSTRUCTED SHALL BE PLANED TO A DEPTH OF 9 INCHES AND RECONSTRUCTED IN TWO LIFTS OVER TWO NIGHTS (SEE PRE-PHASE 1 CONSTRUCTION SCHEDULE ON SHEET 46). THE FIRST LIFT WILL CONSTRUCT 7.5 INCHES OF ITEM 302 ASPHALT BASE. THE SECOND LIFT WILL CONSTRUCT 1.5 INCHES OF ITEM 441, TYPE 1 SURFACE COURSE. ALL COSTS ASSOCIATED WITH SHOULDER RECONSTRUCTION SHALL BE INCIDENTAL TO ITEM 615, PAVEMENT FOR MAINTAINING TRAFFIC, CLASS A, AS PER PLAN.
3. WHILE RECONSTRUCTING THE SHOULDERS, THE CONTRACTOR SHALL ALSO MILL AND RESURFACE 1 FOOT INTO THE ADJACENT TRAVEL LANE. THE EXISTING PAVEMENT (INCLUDING THE EDGELINE) SHALL BE PLANED 1.5 INCHES AND RESURFACED WITH 1.5 INCHES OF ITEM 441, TYPE 1 SURFACE COURSE. THIS WORK SHALL BE COMPLETED PER THE PRE-PHASE 1 CONSTRUCTION SCHEDULE ON SHEET 46 AND SHALL ALSO BE INCIDENTAL TO ITEM 615, PAVEMENT FOR MAINTAINING TRAFFIC, CLASS A, AS PER PLAN.


LEGEND

TEMPORARY PAVEMENT CONSTRUCTED THIS PHASE
SHOULDER RECONSTRUCTION
OPEN TRAVEL LANE

MAINTENANCE OF TRAFFIC PLAN-PRE-PHASE 1
(CONCRETE OPTION) I-71 - STA. 226+00 TO STA. 242+00
FRA-71-0.00
 CALCULATED BY BER CHECKED BY SMM
 62
 1312

J:\20130212\ODOT\FRA\107201\mot\sheet\107201MP169.dgn 8/6/2020 4:06:26 AM brieder

MATCH LINE STA. 242+00
SEE SHEET 62

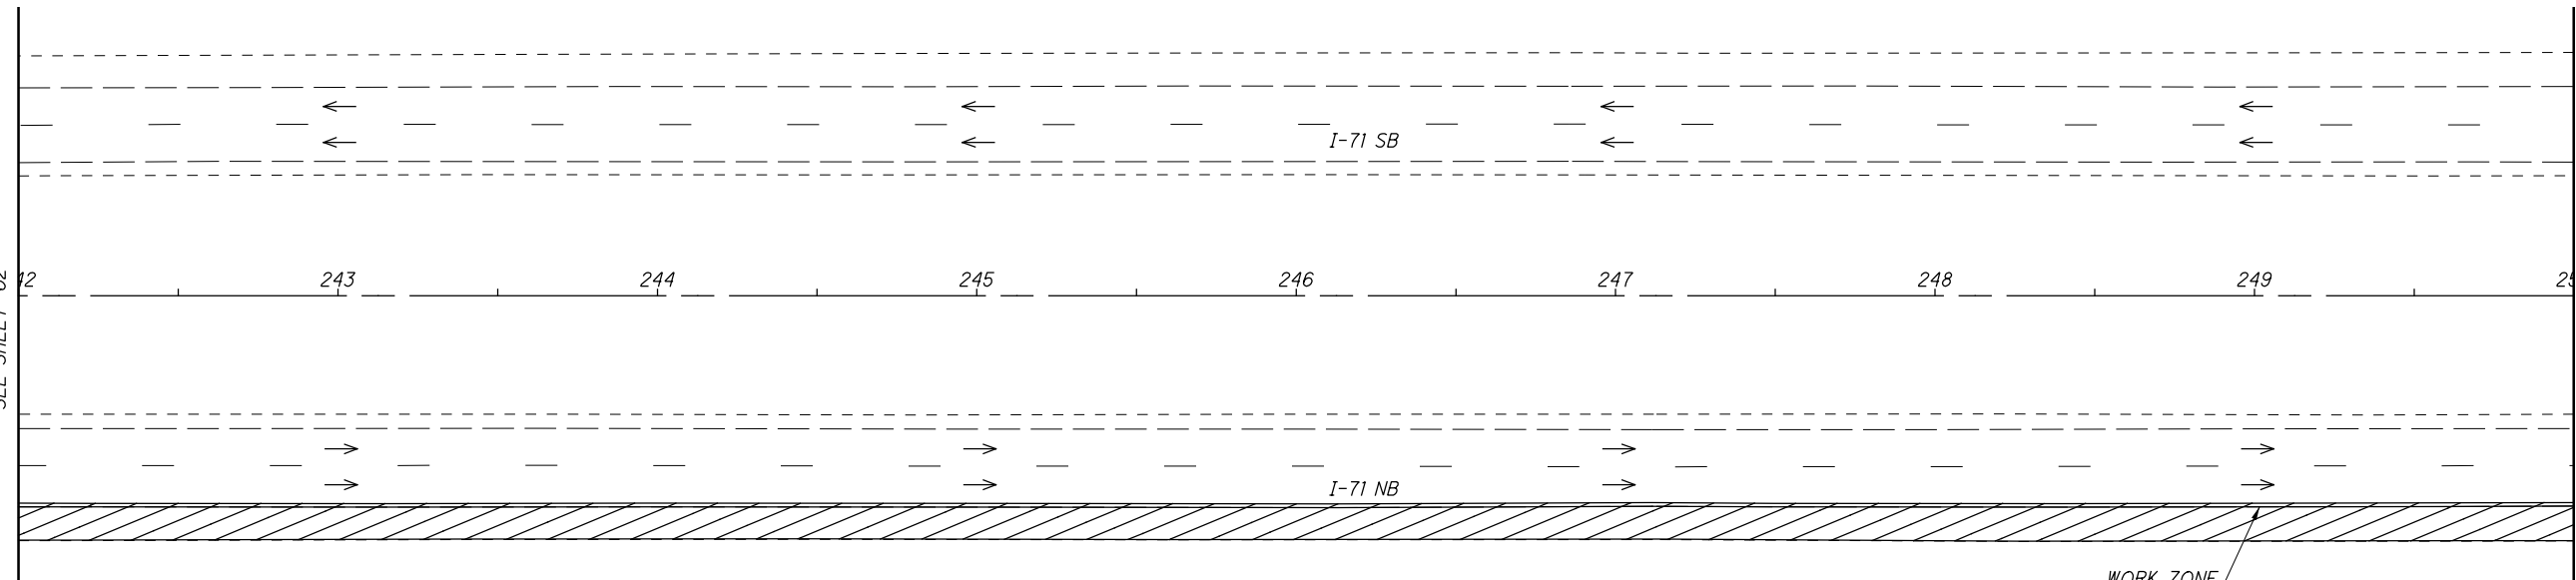

MATCH LINE STA. 250+00
SEE BELOW


NOTES:

- DURING THE HOURS SPECIFIED AS LISTED IN THIS PLAN, NIGHTTIME LANE CLOSURES SHALL BE IMPLEMENTED PER ODOT SCD MT-95.30 FOR SHOULDER WORK AND TEMPORARY PAVEMENT WORK ADJACENT TO I-71. SEE THE WORKING AND NON-WORKING HOURS TYPICAL SECTIONS FOR DETAILS. AS WELL AS THE PRE-PHASE 1 CONSTRUCTION SCHEDULE ON SHEET 46.
- EXISTING SHOULDERS THAT ARE TO BE RECONSTRUCTED SHALL BE PLANED TO A DEPTH OF 9 INCHES AND RECONSTRUCTED IN TWO LIFTS OVER TWO NIGHTS (SEE PRE-PHASE 1 CONSTRUCTION SCHEDULE ON SHEET 46). THE FIRST LIFT WILL CONSTRUCT 7.5 INCHES OF ITEM 302 ASPHALT BASE. THE SECOND LIFT WILL CONSTRUCT 1.5 INCHES OF ITEM 441, TYPE 1 SURFACE COURSE. ALL COSTS ASSOCIATED WITH SHOULDER RECONSTRUCTION SHALL BE INCIDENTAL TO ITEM 615, PAVEMENT FOR MAINTAINING TRAFFIC, CLASS A, AS PER PLAN.
- WHILE RECONSTRUCTING THE SHOULDERS, THE CONTRACTOR SHALL ALSO MILL AND RESURFACE 1 FOOT INTO THE ADJACENT TRAVEL LANE. THE EXISTING PAVEMENT (INCLUDING THE EDGELINE) SHALL BE PLANED 1.5 INCHES AND RESURFACED WITH 1.5 INCHES OF ITEM 441, TYPE 1 SURFACE COURSE. THIS WORK SHALL BE COMPLETED PER THE PRE-PHASE 1 CONSTRUCTION SCHEDULE ON SHEET 46 AND SHALL ALSO BE INCIDENTAL TO ITEM 615, PAVEMENT FOR MAINTAINING TRAFFIC, CLASS A, AS PER PLAN.

HORIZONTAL SCALE IN FEET

WORK ZONE
EDGE LINE

MATCH LINE STA. 250+00
SEE ABOVE

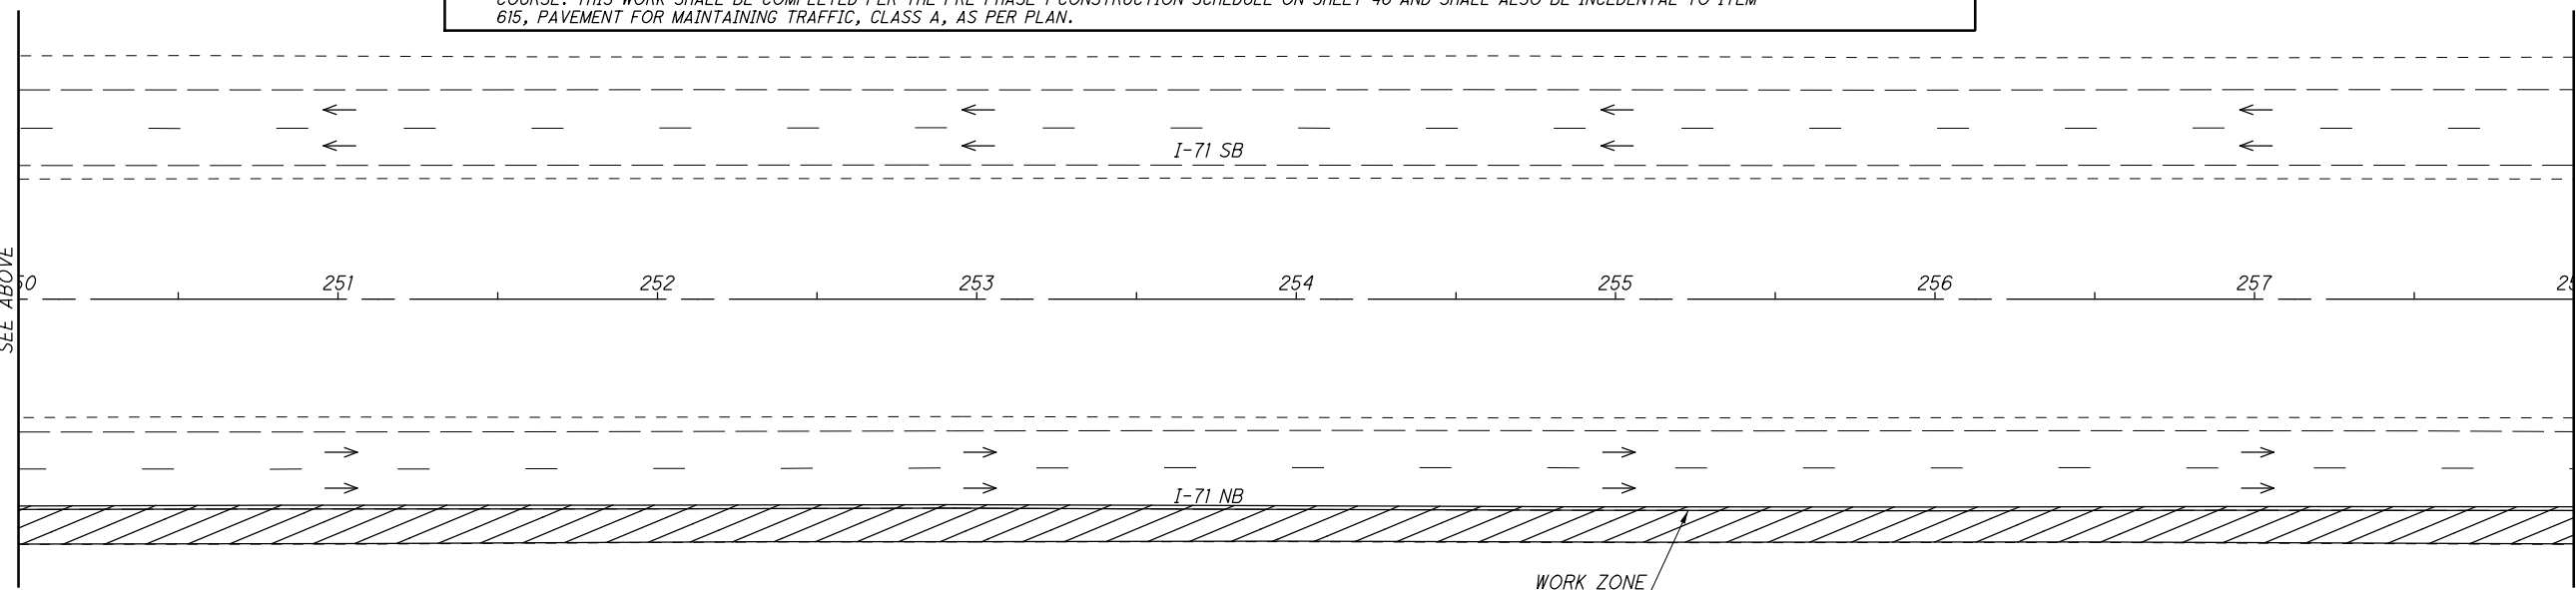

MATCH LINE STA. 258+00
SEE SHEET 64

WORK ZONE
EDGE LINE

LEGEND


SHOULDER RECONSTRUCTION

OPEN TRAVEL LANE

**MAINTENANCE OF TRAFFIC PLAN-PRE-PHASE 1
(CONCRETE OPTION) I-71 - STA. 242+00 TO STA. 258+00**


FRA-71-0.00

CALCULATED
BER
CHECKED
SMM

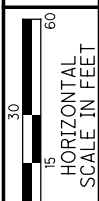


J:\20130212\ODOT\FRA\107201\mot\sheet\107201MP170.dgn 8/6/2020 4:07:38 AM brieder

MATCH LINE STA. 258+00
SEE SHEET 63

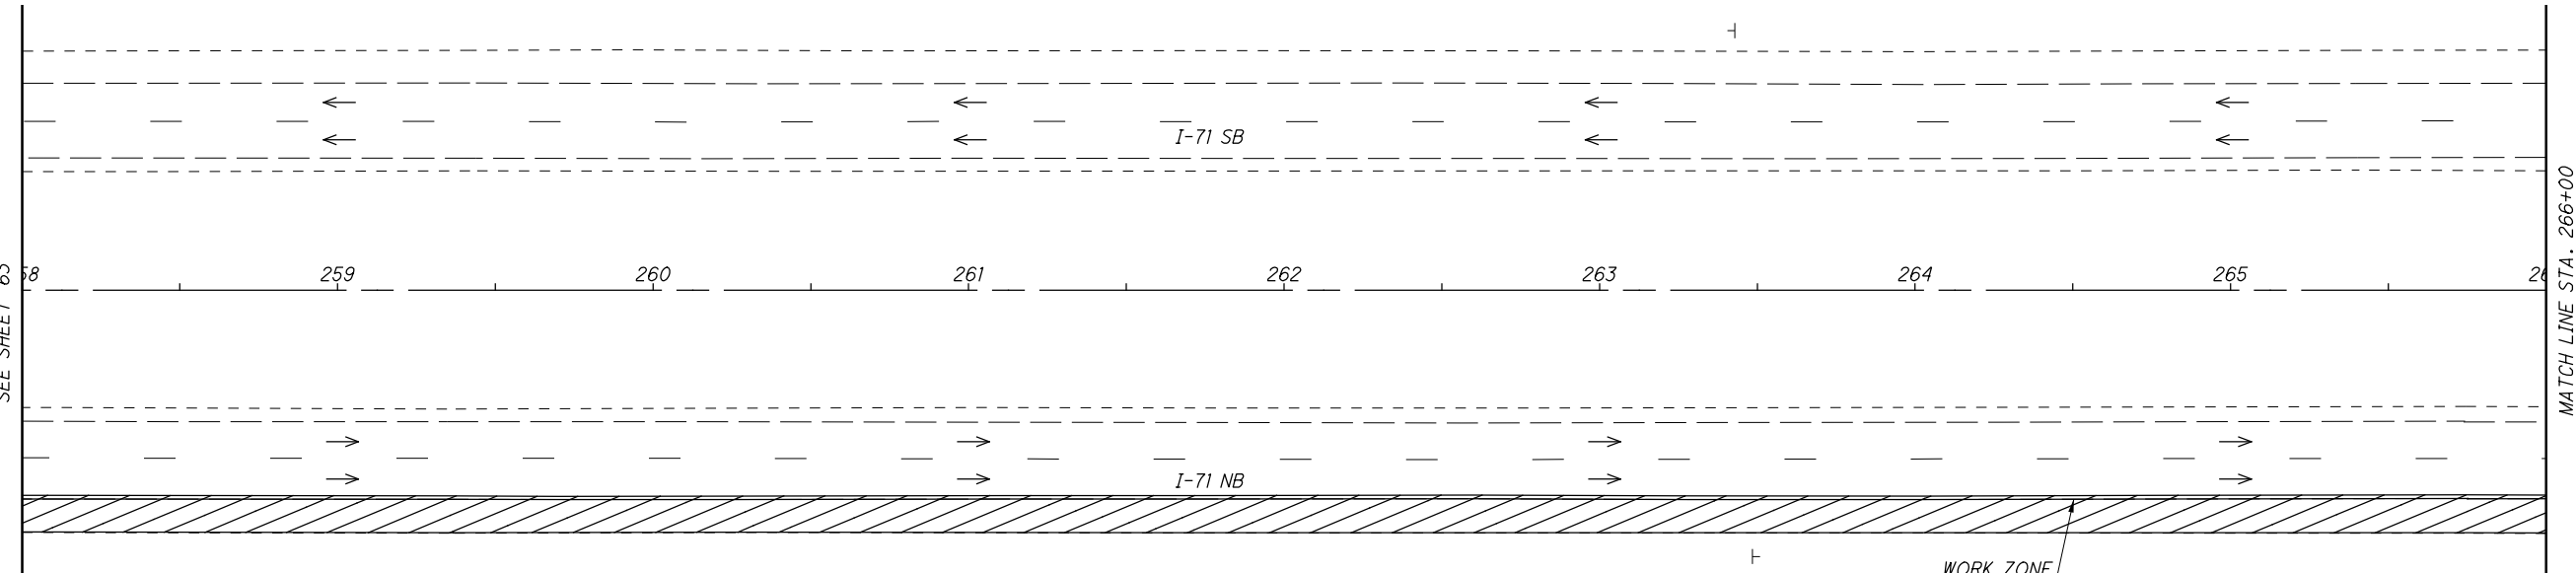


MATCH LINE STA. 266+00
SEE BELOW

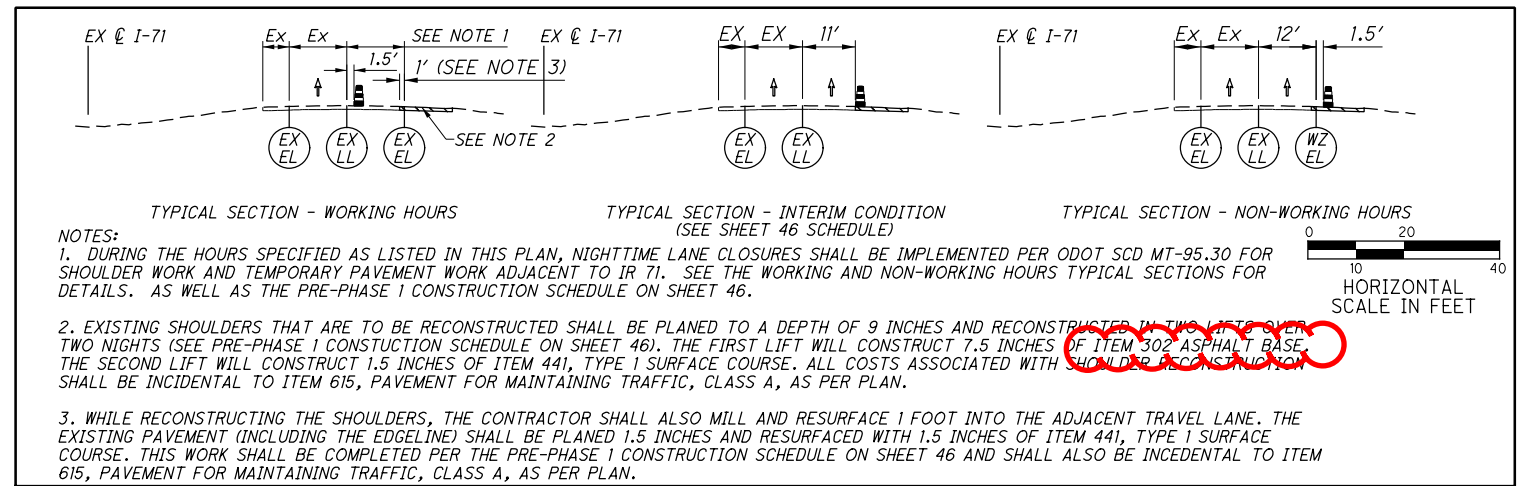

WORK ZONE
EDGE LINE




MATCH LINE STA. 266+00
SEE ABOVE

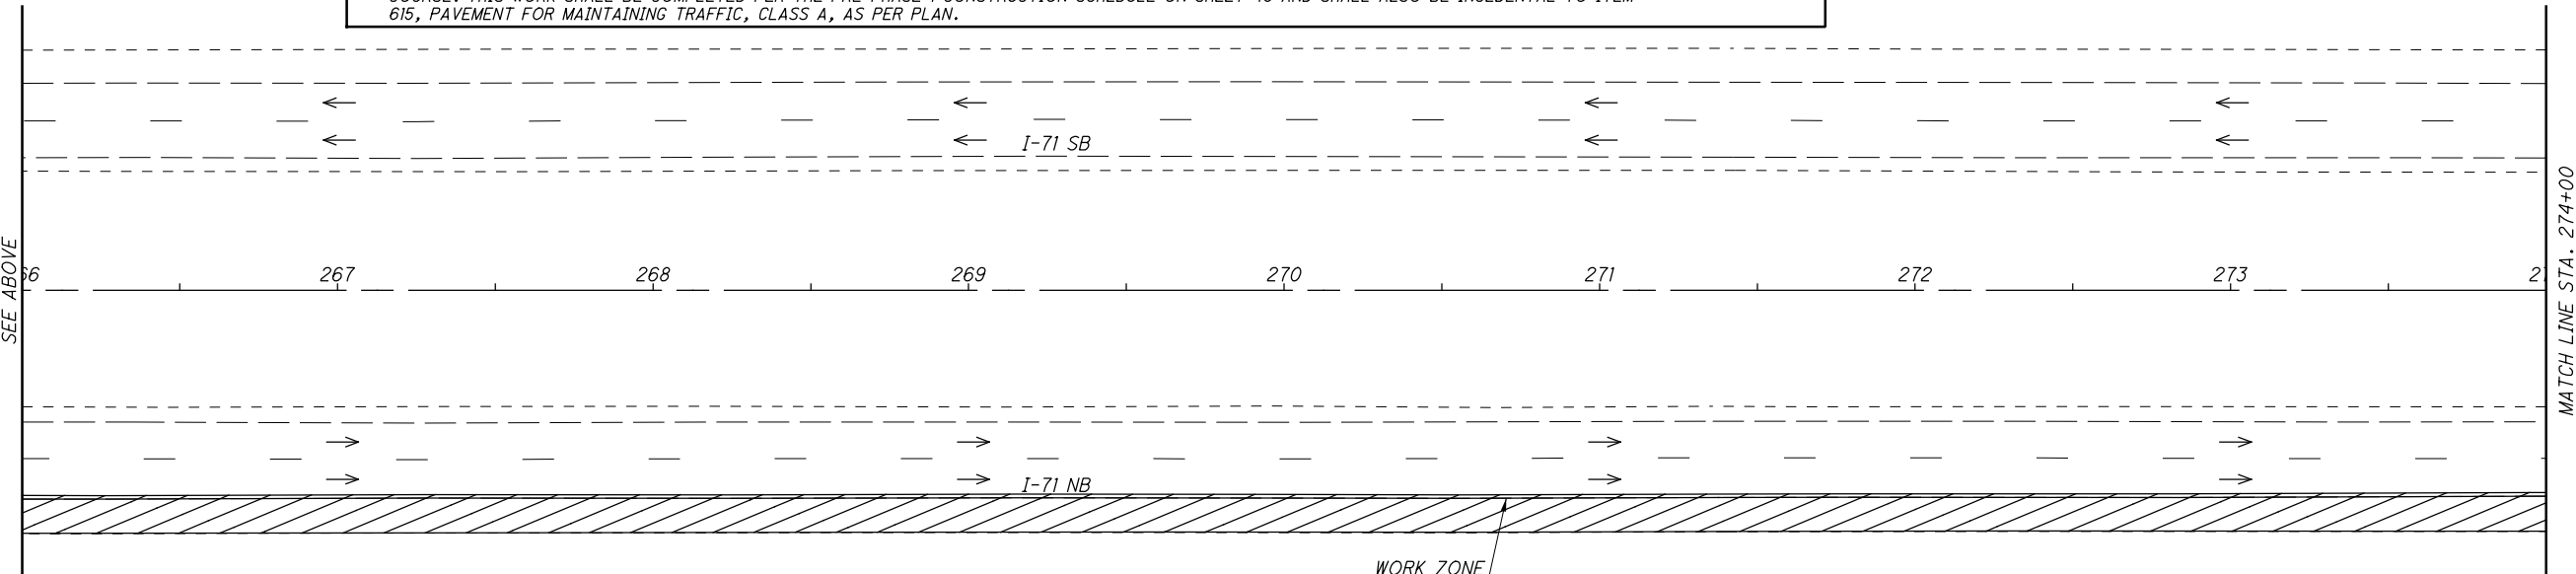

MATCH LINE STA. 274+00
SEE SHEET 65

WORK ZONE
EDGE LINE

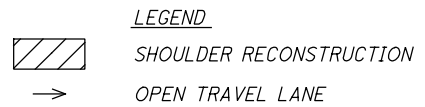

MAINTENANCE OF TRAFFIC PLAN-PRE-PHASE 1
(CONCRETE OPTION) I-71 - STA. 258+00 TO STA. 274+00

FRA-71-0.00


64
1312



CALCULATED
BER
CHECKED
SMM

J:\20130212\ODOT\FRA\107201\mot\sheet\107201MP171.dgn 8/6/2020 4:08:50 AM brieder

MATCH LINE STA. 274+00
SEE SHEET 64

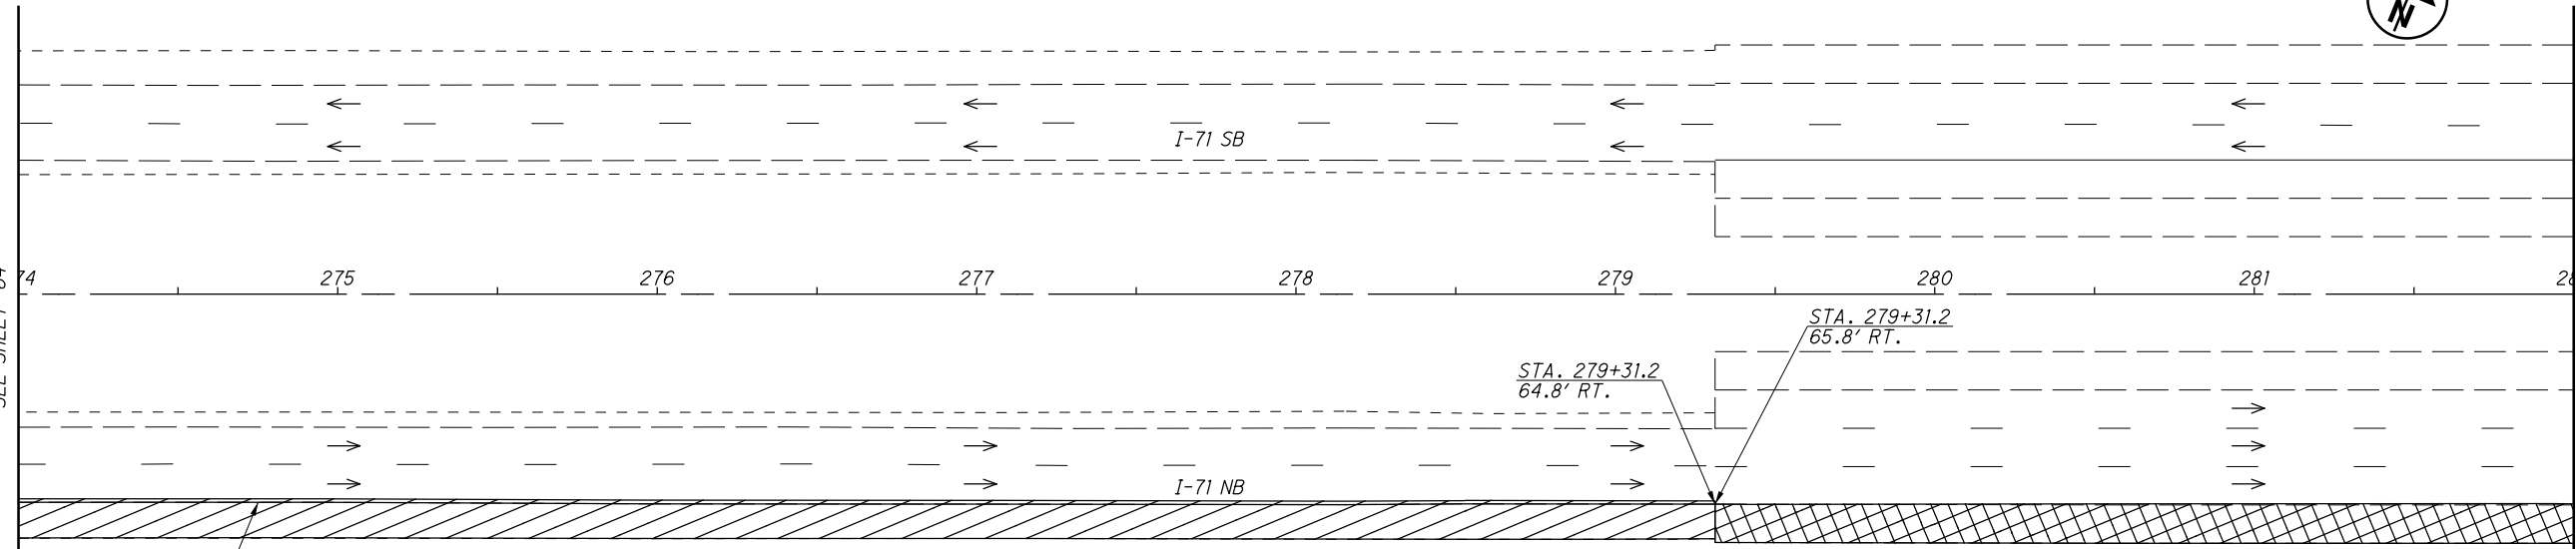

MATCH LINE STA. 282+00
SEE BELOW

WORK ZONE
EDGE LINE


TYPICAL SECTION - WORKING HOURS
SEE NOTE 1
SEE NOTE 2
SEE NOTE 3

TYPICAL SECTION - INTERIM CONDITION
(SEE SHEET 46 SCHEDULE)


TYPICAL SECTION - NON-WORKING HOURS

NOTES:

- DURING THE HOURS SPECIFIED AS LISTED IN THIS PLAN, NIGHTTIME LANE CLOSURES SHALL BE IMPLEMENTED PER ODOT SCD MT-95.30 FOR SHOULDER WORK AND TEMPORARY PAVEMENT WORK ADJACENT TO I-71. SEE THE WORKING AND NON-WORKING HOURS TYPICAL SECTIONS FOR DETAILS. AS WELL AS THE PRE-PHASE 1 CONSTRUCTION SCHEDULE ON SHEET 46.
- EXISTING SHOULDERS THAT ARE TO BE RECONSTRUCTED SHALL BE PLANED TO A DEPTH OF 9 INCHES AND RECONSTRUCTED IN TWO LIFTS OVER TWO NIGHTS (SEE PRE-PHASE 1 CONSTRUCTION SCHEDULE ON SHEET 46). THE FIRST LIFT WILL CONSTRUCT 7.5 INCHES OF ITEM 302 ASPHALT BASE. THE SECOND LIFT WILL CONSTRUCT 1.5 INCHES OF ITEM 441, TYPE 1 SURFACE COURSE. ALL COSTS ASSOCIATED WITH SHOULDER RECONSTRUCTION SHALL BE INCIDENTAL TO ITEM 615, PAVEMENT FOR MAINTAINING TRAFFIC, CLASS A, AS PER PLAN.
- WHILE RECONSTRUCTING THE SHOULDERS, THE CONTRACTOR SHALL ALSO MILL AND RESURFACE 1 FOOT INTO THE ADJACENT TRAVEL LANE. THE EXISTING PAVEMENT (INCLUDING THE EDGELINE) SHALL BE PLANED 1.5 INCHES AND RESURFACED WITH 1.5 INCHES OF ITEM 441, TYPE 1 SURFACE COURSE. THIS WORK SHALL BE COMPLETED PER THE PRE-PHASE 1 CONSTRUCTION SCHEDULE ON SHEET 46 AND SHALL ALSO BE INCIDENTAL TO ITEM 615, PAVEMENT FOR MAINTAINING TRAFFIC, CLASS A, AS PER PLAN.
- THE SHOULDER RESURFACING SHOWN ON THIS SHEET SHALL CONSIST OF PLANING OFF 1.5 INCHES OF EXISTING PAVEMENT AND RESURFACING WITH 1.5 INCHES OF ITEM 441, TYPE 1. THIS RESURFACING SHALL ALSO BE INCIDENTAL TO ITEM 615, PAVEMENT FOR MAINTAINING TRAFFIC, CLASS A, AS PER PLAN.

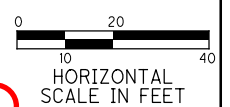

MATCH LINE STA. 282+00
SEE ABOVE

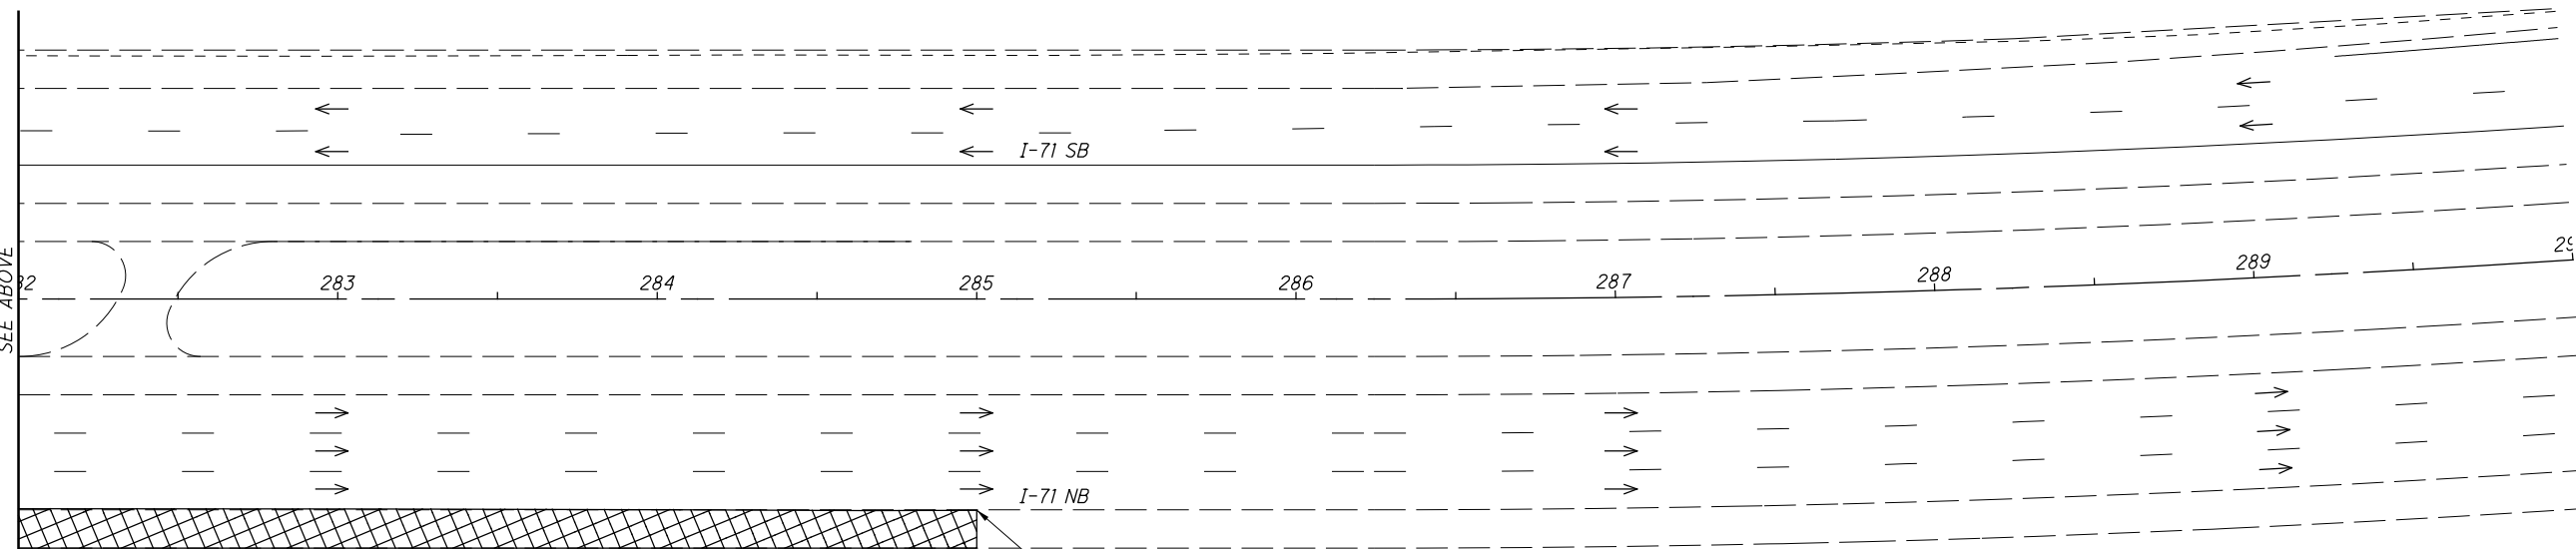

STA. 285+00.0
66.1' RT.



LEGEND

- SHOULDER RECONSTRUCTION
- SHOULDER RESURFACING (SEE NOTE 4)
- OPEN TRAVEL LANE

CALCULATED BY BER CHECKED BY SMM
MAINTENANCE OF TRAFFIC PLAN-PRE-PHASE 1
(CONCRETE OPTION) I-71 - STA. 274+00 TO STA. 290+00

FRA-71-0.00

J:\20130212\ODOT\FRA\107201\mot\sheet\107201MP173.dgn 8/7/2020 1:59:07 PM rshannon

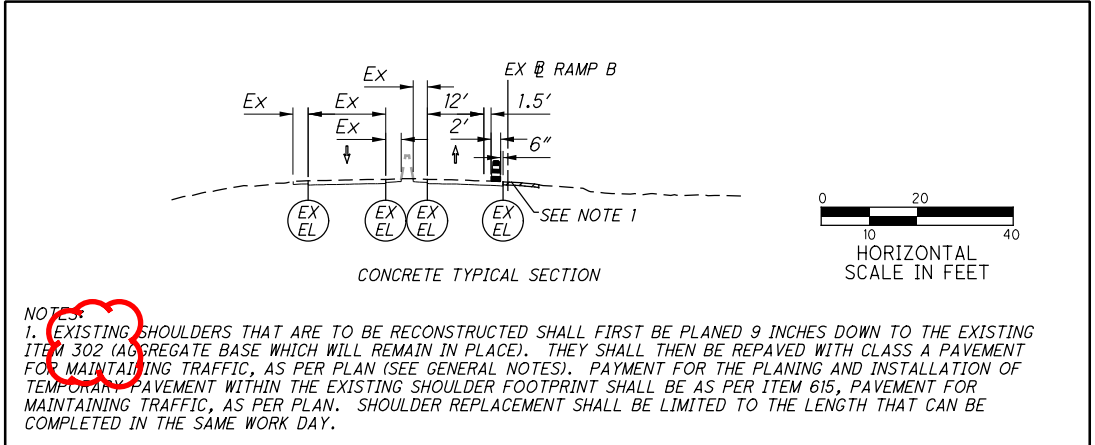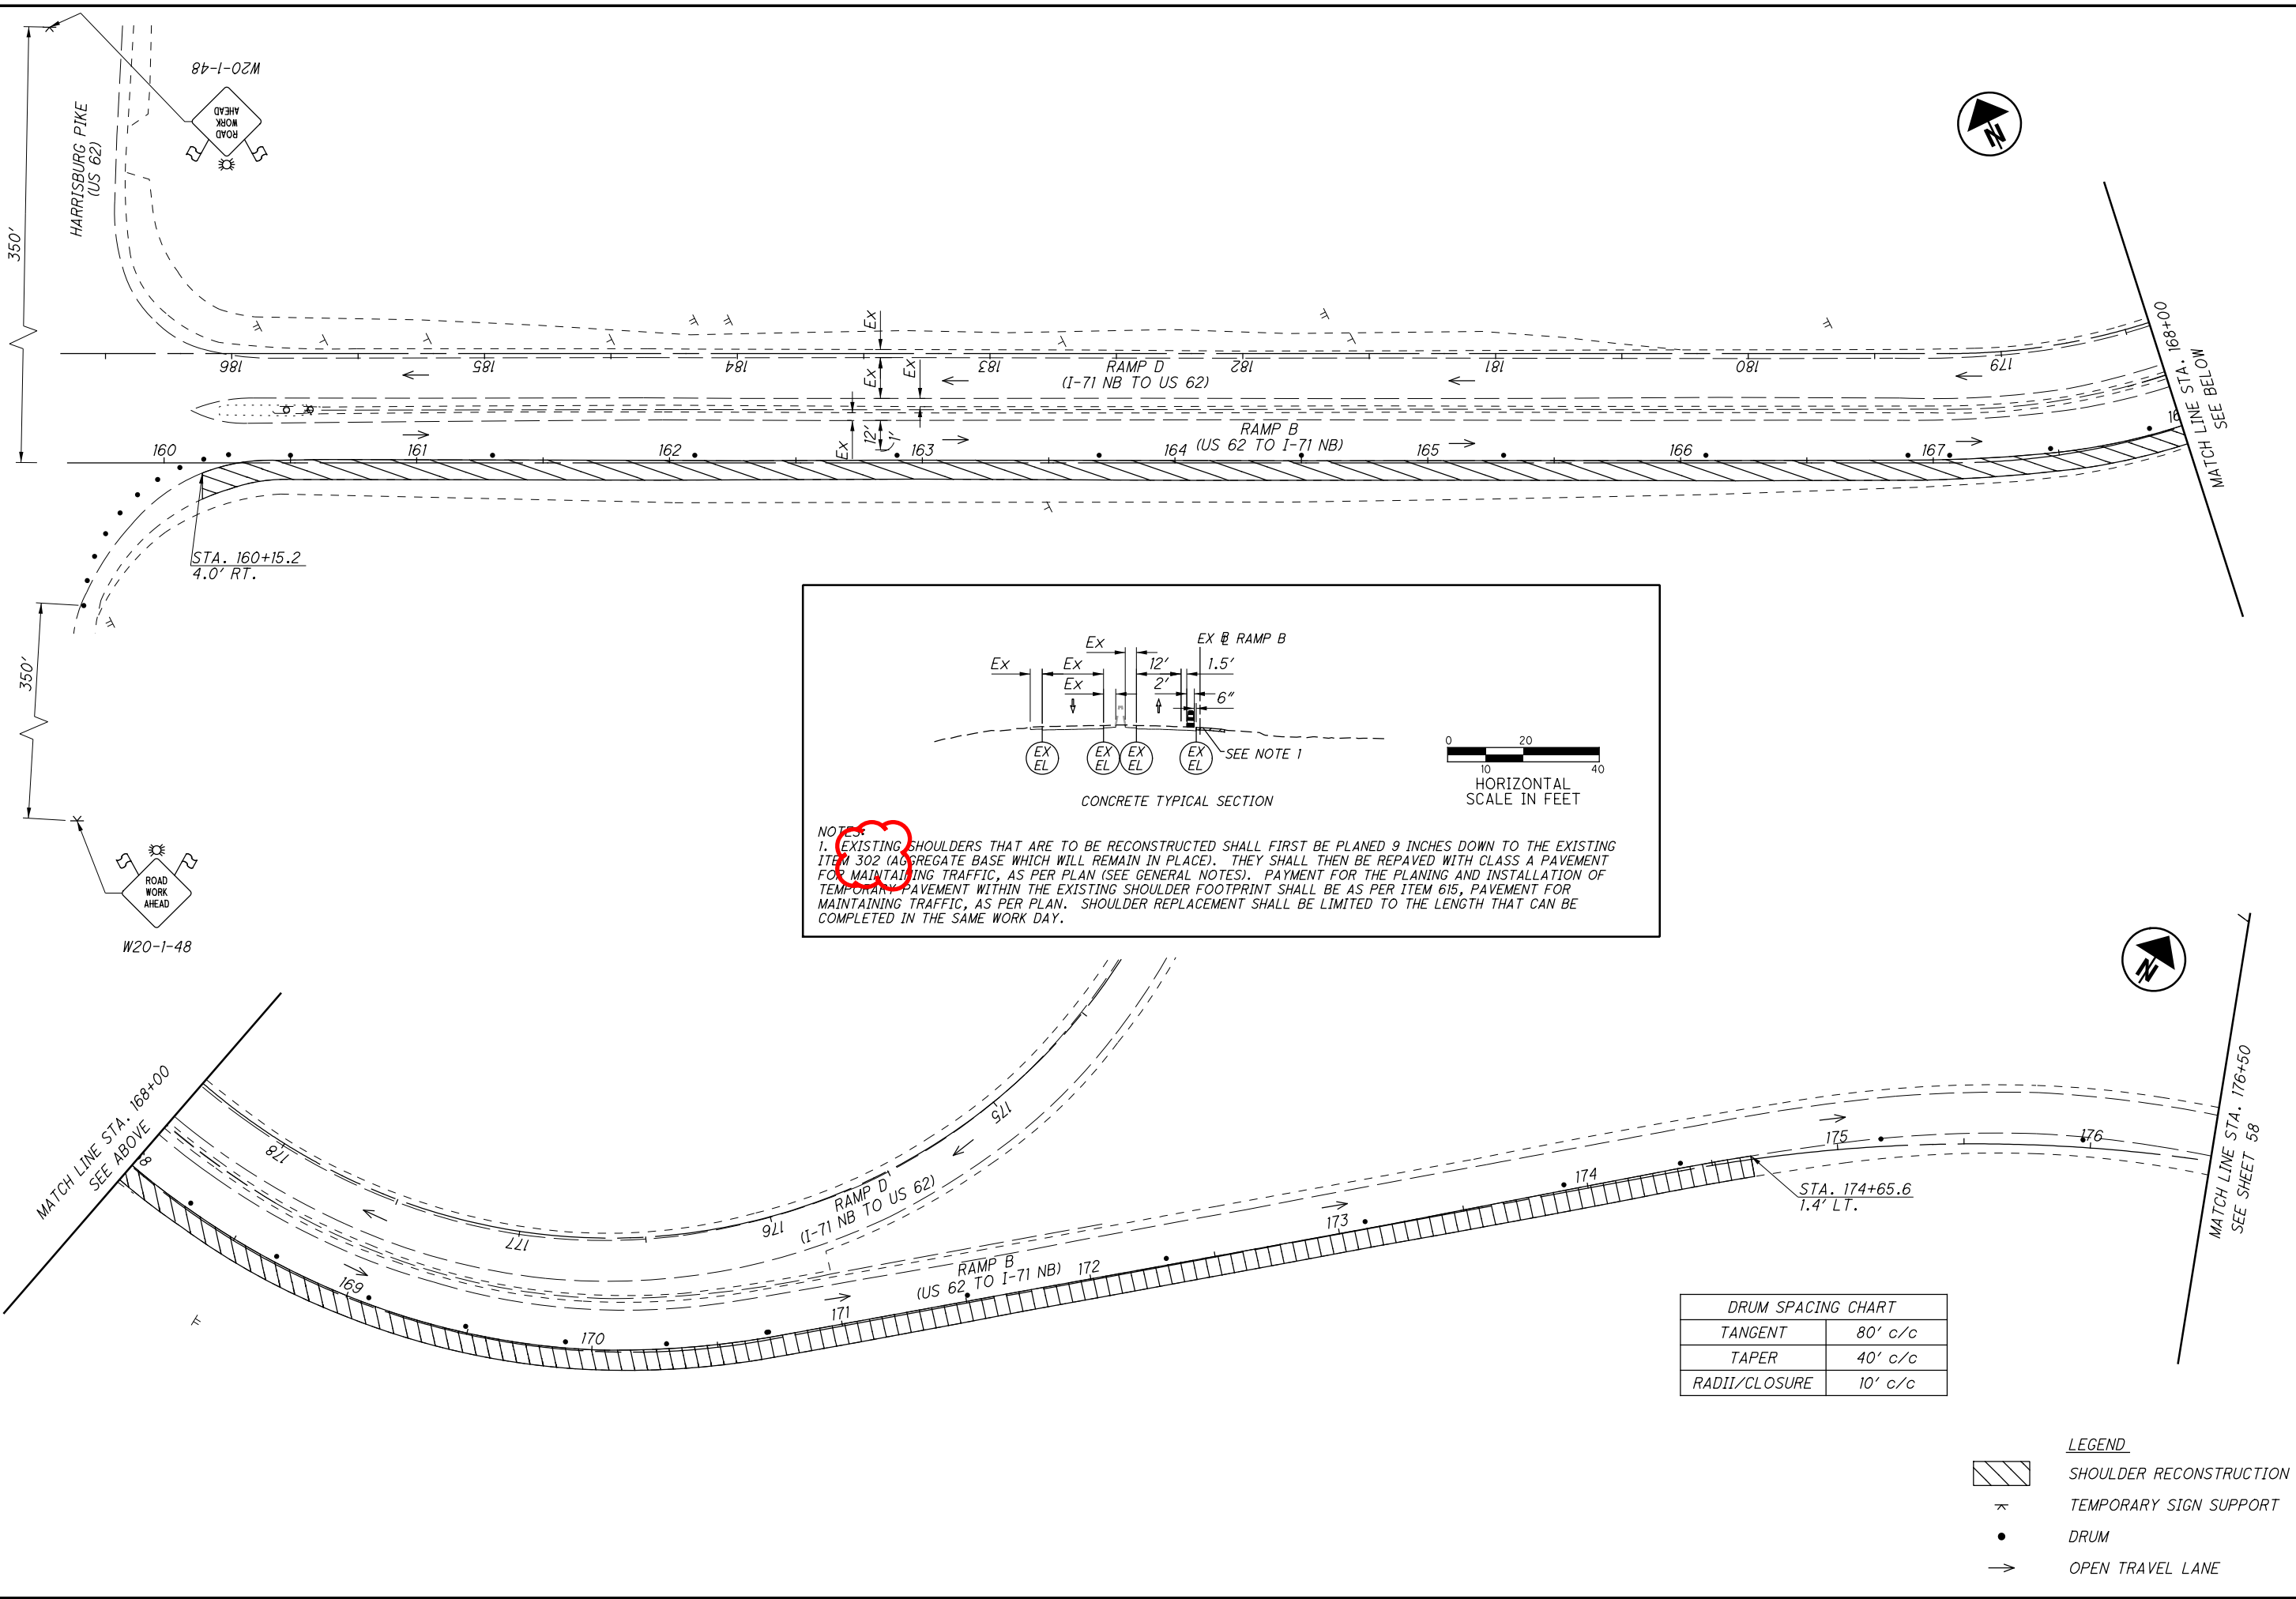

NOTES:
 1. EXISTING SHOULDERS THAT ARE TO BE RECONSTRUCTED SHALL FIRST BE PLANED 9 INCHES DOWN TO THE EXISTING ITEM 302 (AGGREGATE BASE WHICH WILL REMAIN IN PLACE). THEY SHALL THEN BE REPAVED WITH CLASS A PAVEMENT FOR MAINTAINING TRAFFIC, AS PER PLAN (SEE GENERAL NOTES). PAYMENT FOR THE PLANING AND INSTALLATION OF TEMPORARY PAVEMENT WITHIN THE EXISTING SHOULDER FOOTPRINT SHALL BE AS PER ITEM 615, PAVEMENT FOR MAINTAINING TRAFFIC, AS PER PLAN. SHOULDER REPLACEMENT SHALL BE LIMITED TO THE LENGTH THAT CAN BE COMPLETED IN THE SAME WORK DAY.

| DRUM SPACING CHART | |
|--------------------|---------|
| TANGENT | 80' c/c |
| TAPER | 40' c/c |
| RADII/CLOSURE | 10' c/c |

- LEGEND**
- SHOULDER RECONSTRUCTION
 - TEMPORARY SIGN SUPPORT
 - DRUM
 - OPEN TRAVEL LANE

MAINTENANCE OF TRAFFIC PLAN-PRE-PHASE 1
RAMP B - STA. 160+00 TO STA. 176+50

FRA-71-0.00

CALCULATED
BER

CHECKED
SMM

HORIZONTAL SCALE IN FEET

66


1312



CALCULATED
BY BER
CHECKED
BY SMM

**MAINTENANCE OF TRAFFIC PLAN-PRE-PHASE 1
(ASPHALT OPTION) I-71 - STA. 810+00 TO STA. 826+00**

FRA-71-0-00

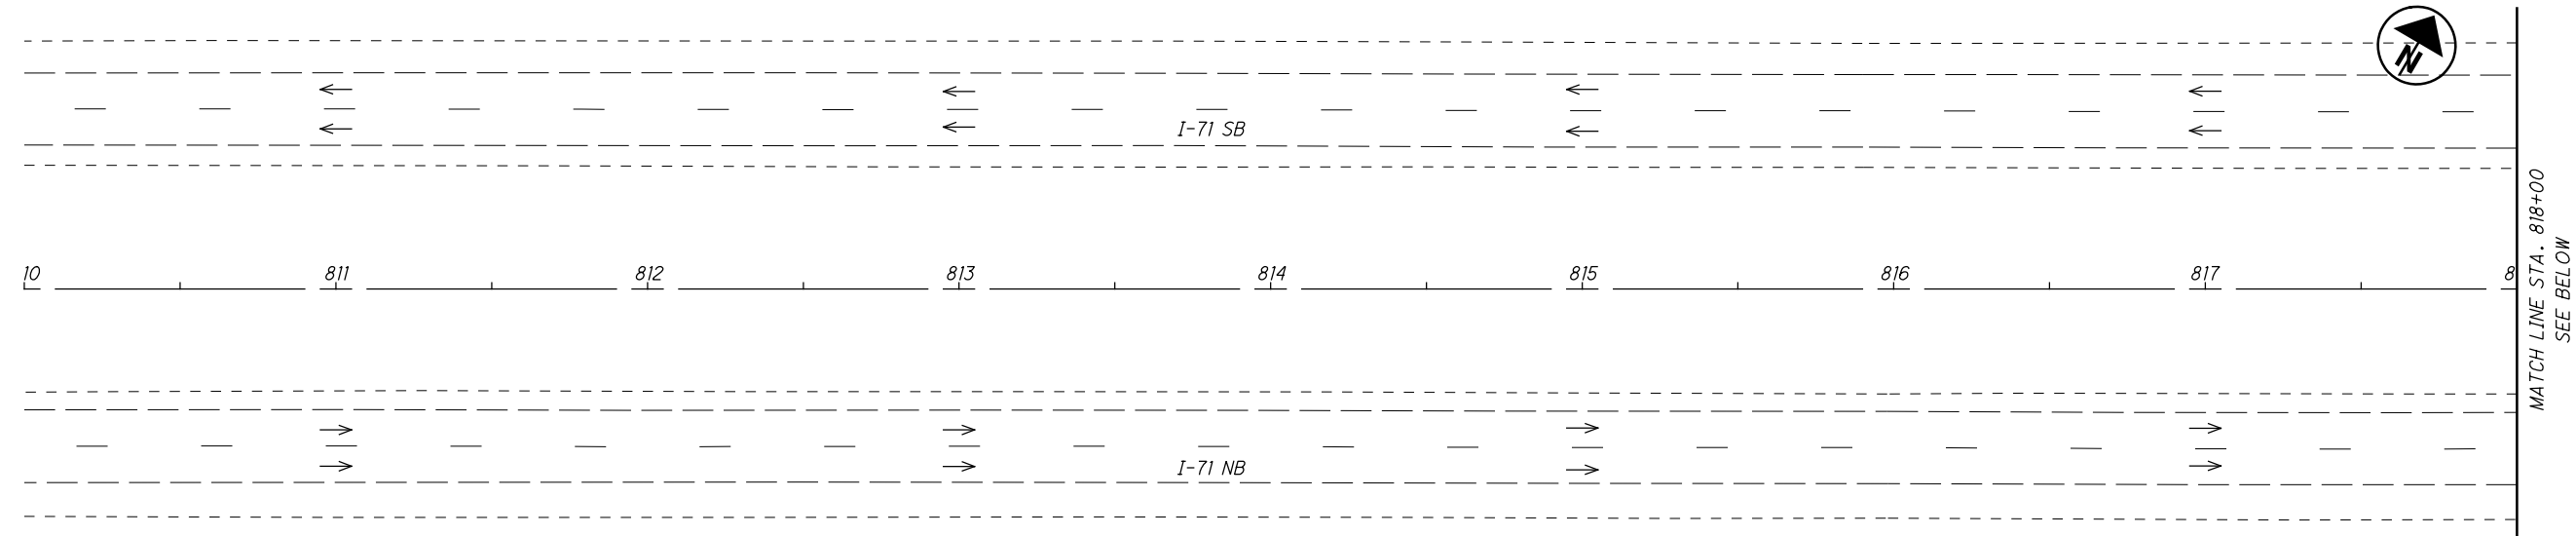

MATCH LINE STA. 818+00
SEE BELOW



PRE-PHASE 1 CONSTRUCTION SCHEDULE
(APPLICABLE TO ALL PRE-PHASE 1 WORK)

THE CONTRACTOR SHALL COMPLETE PRE-PHASE 1 IN PIECES, AND SHALL LIMIT THE LENGTH OF WORK ZONE TO THAT WHICH CAN BE COMPLETED OVER TWO CONSECUTIVE NIGHTS:

NIGHT 1:
PLANE 9 INCHES OF EXISTING SHOULDER AND REPLACE WITH 7.5 INCHES OF AGGREGATE BASE. ALSO PLANE 1.5 INCHES OF EXISTING PAVEMENT, 1 FOOT INTO THE ADJACENT TRAVEL LANE


NEXT MORNING:
OPEN RIGHT LANE (11 FEET WIDE) WITH DRUM PLACED IN THE DROPOFF. ADD "NO EDGE LINE" SIGN (W8-H12a-48), 500 FEET IN ADVANCE OF THE WORK ZONE. (SEE INTERIM CONDITION IN TYPICAL SECTIONS)

NIGHT 2:
APPLY 1.5 INCHES OF SURFACE COURSE TO THE SHOULDER AND THE 1 FOOT AREA ADJACENT. INSTALL ITEM, 614 WORK ZONE EDGE LINE TO RESTORE 12' RIGHT LANE.

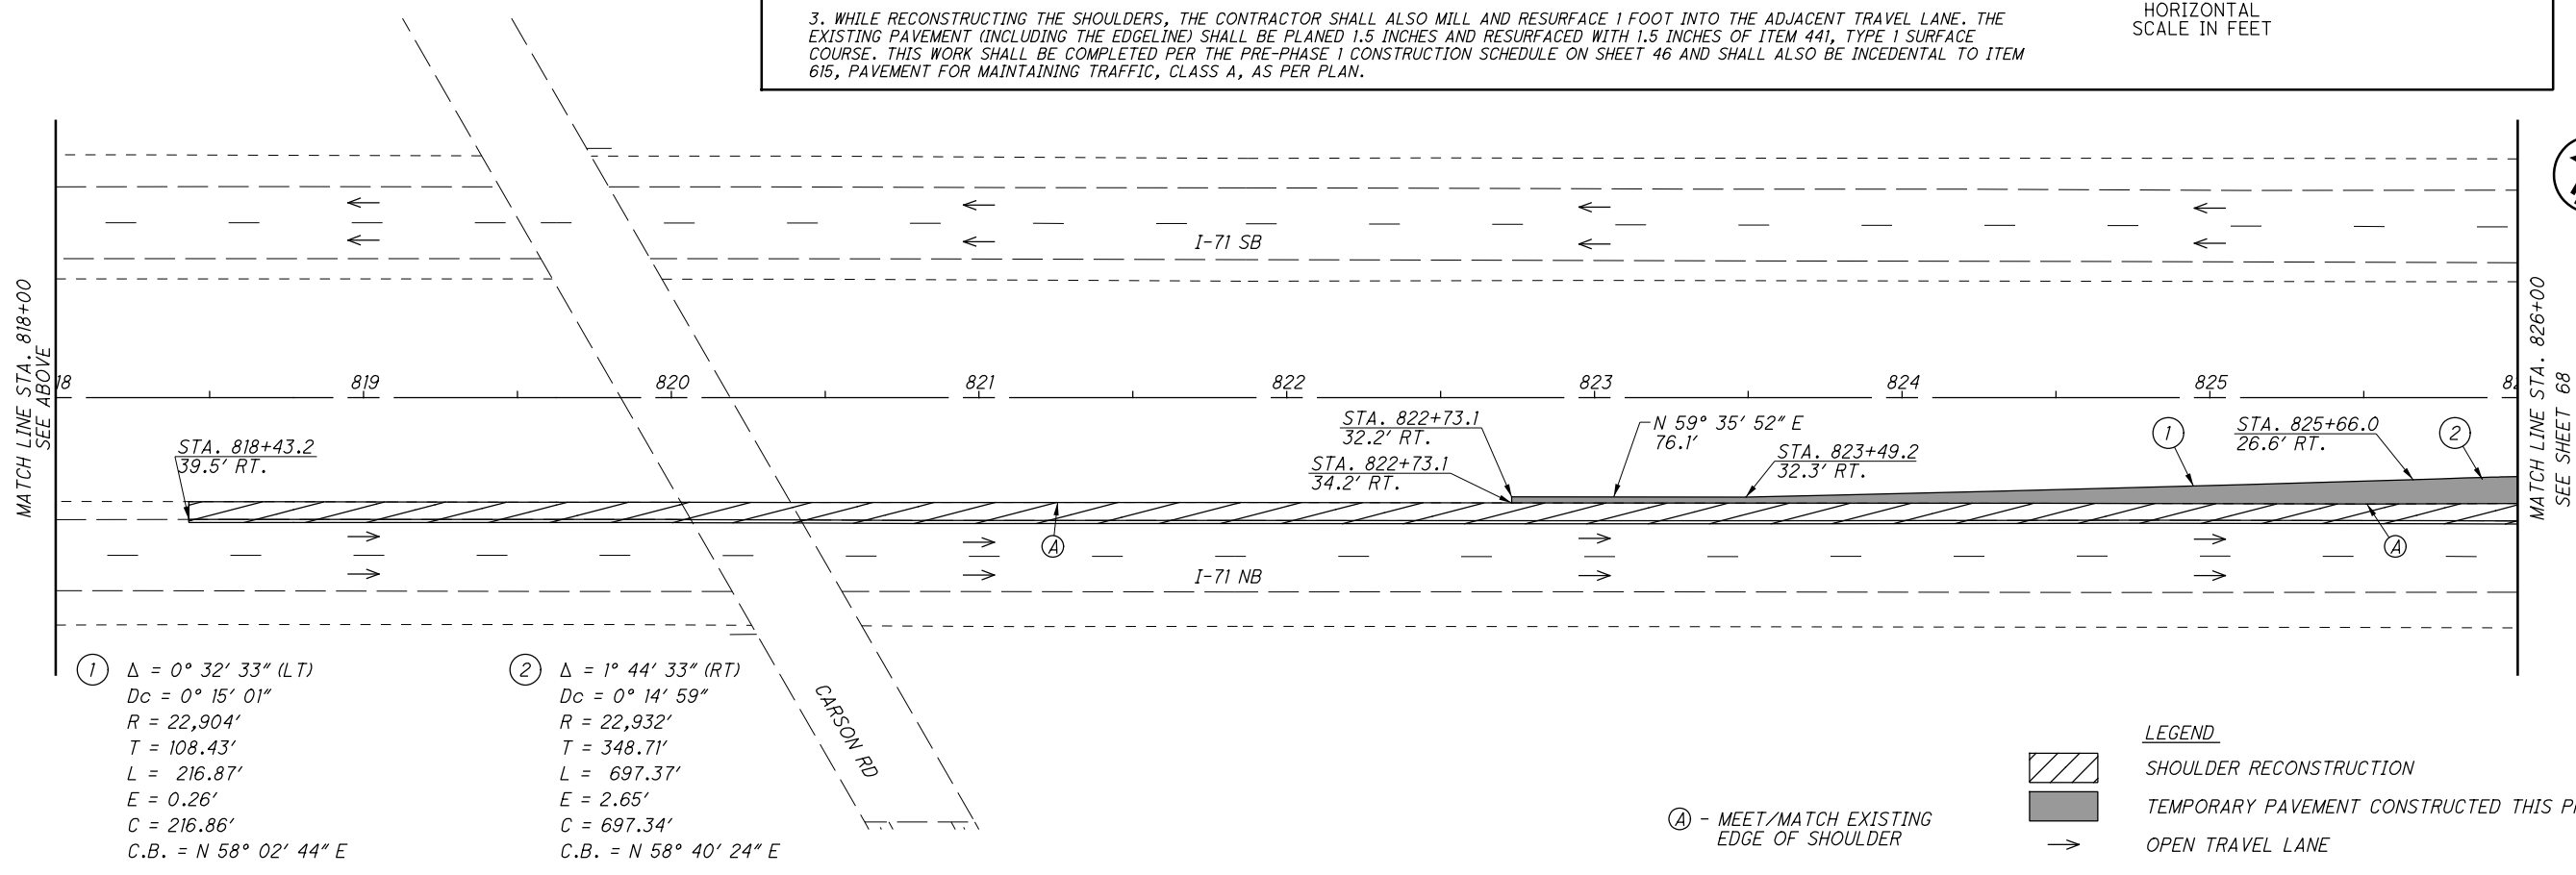
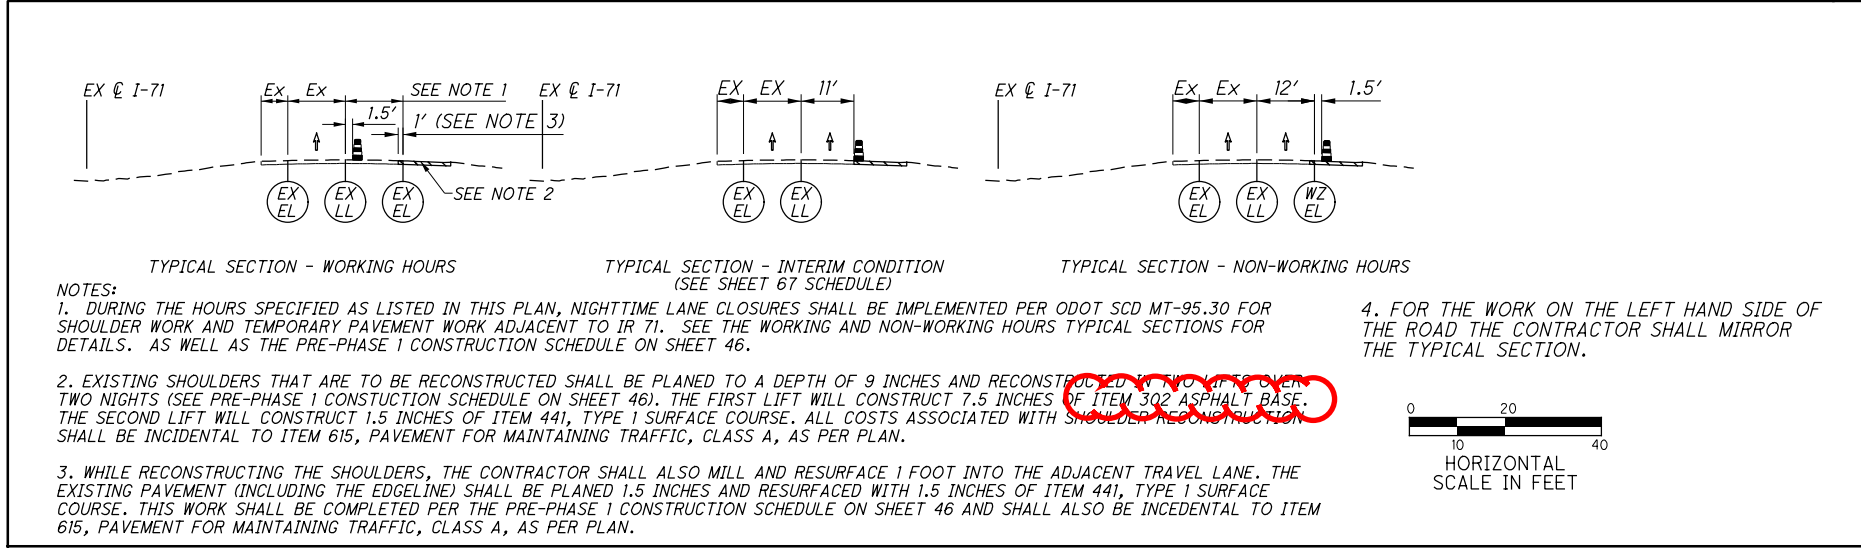


J:\20130212\ODOT\FRA\107201\mot\sheets\107201MP256.dgn 8/6/2020 4:11:10 AM brieder

J:\20130212\ODOT\FRA\107201\mot\sheet\107201MP257.dgn 8/6/2020 4:12:25 AM brieder

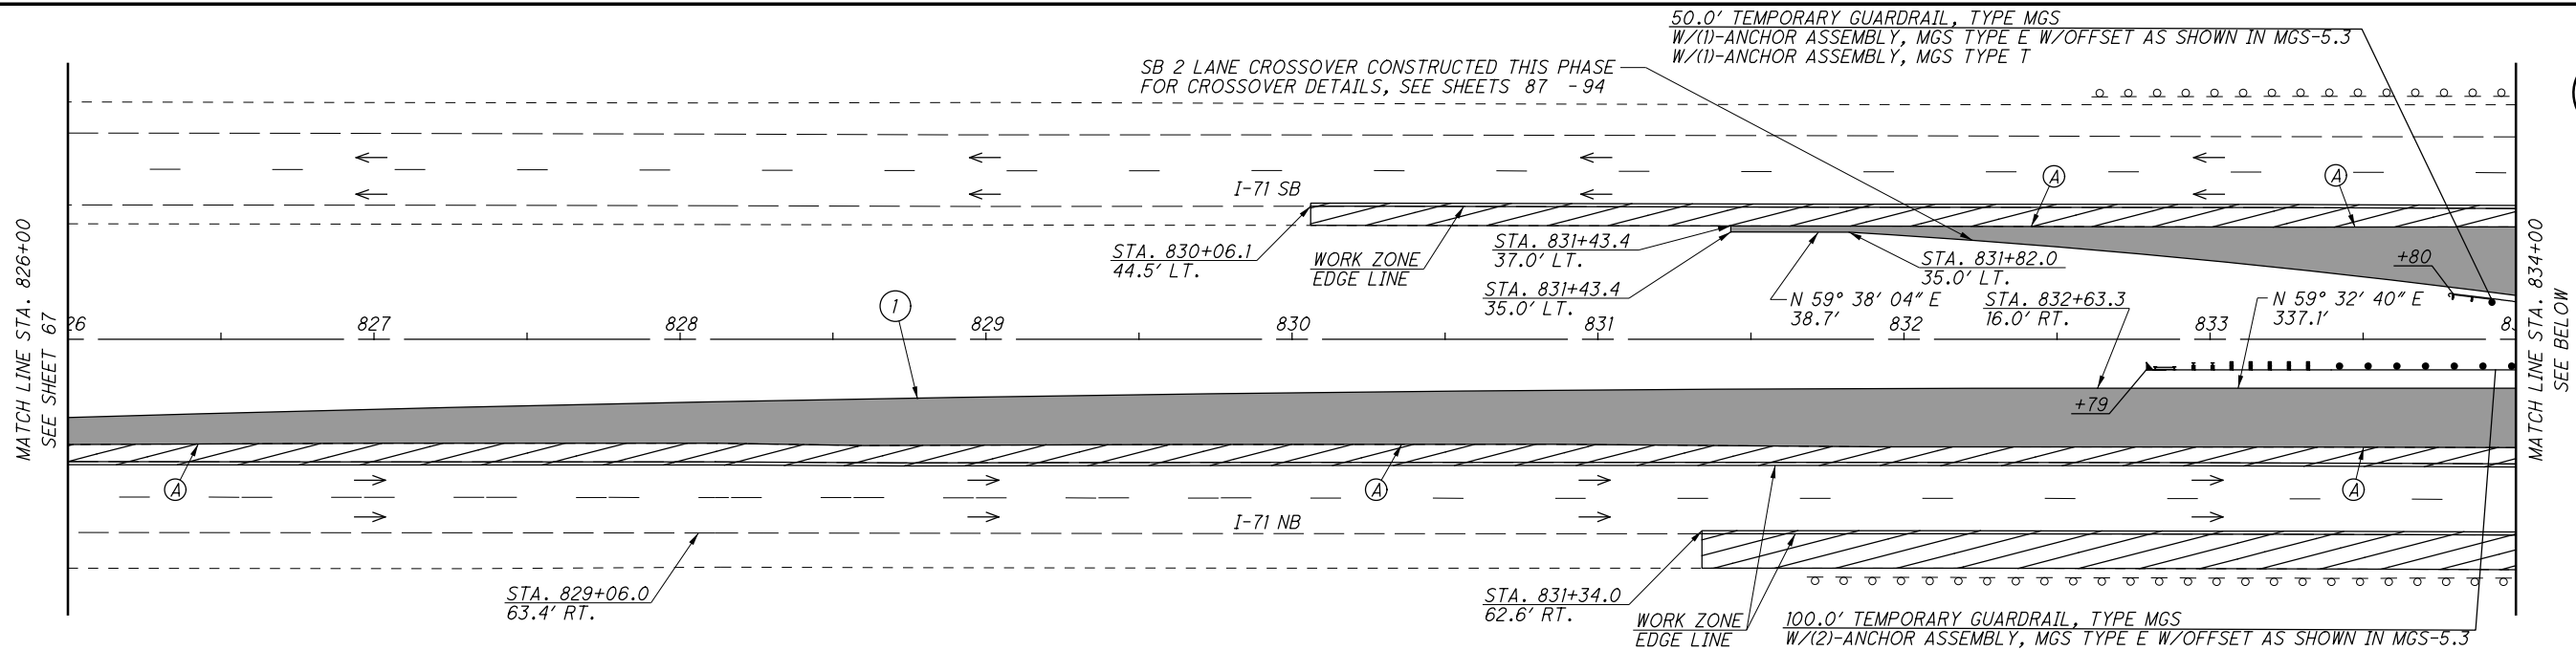

① $\Delta = 1^\circ 44' 33''$ (RT)
 $D_c = 0^\circ 14' 59''$
 $R = 22,932'$
 $T = 348.71'$
 $L = 697.37'$
 $E = 2.65'$
 $C = 697.34'$
 $C.B. = N 58^\circ 40' 24'' E$

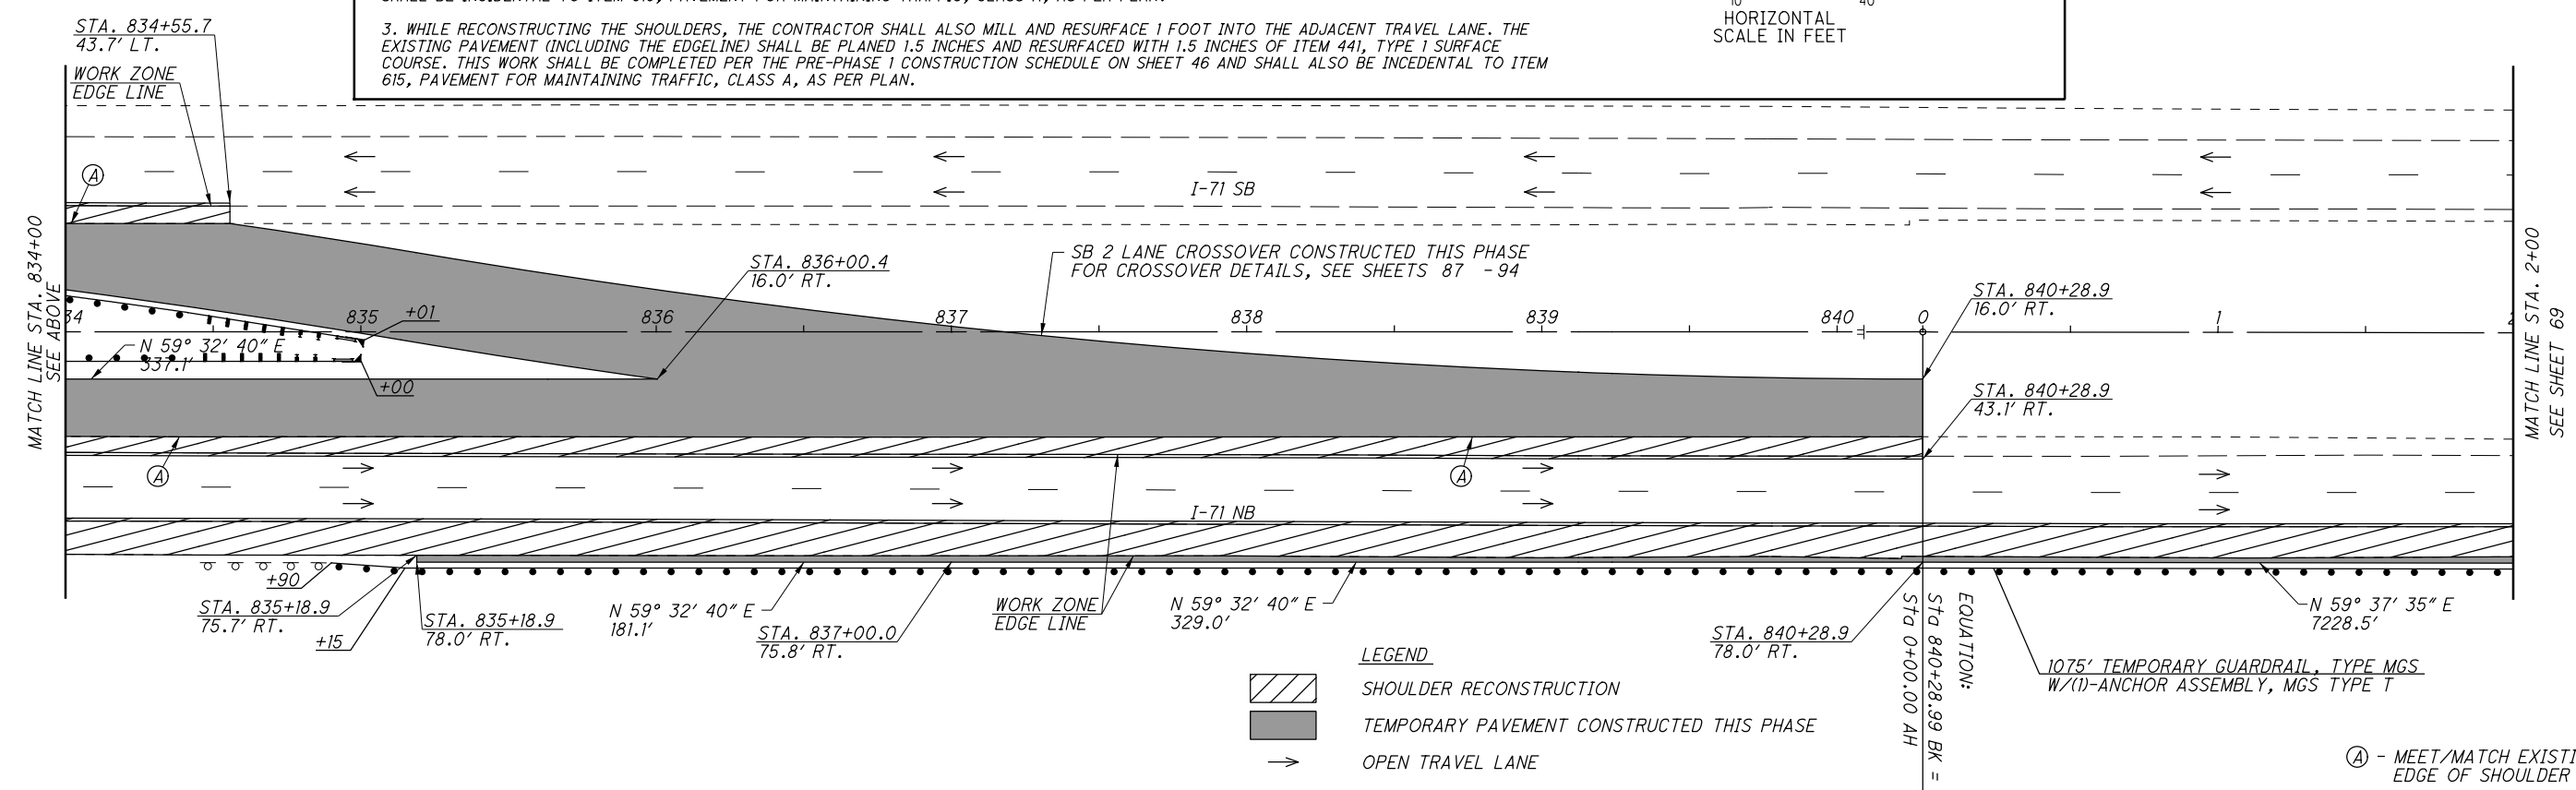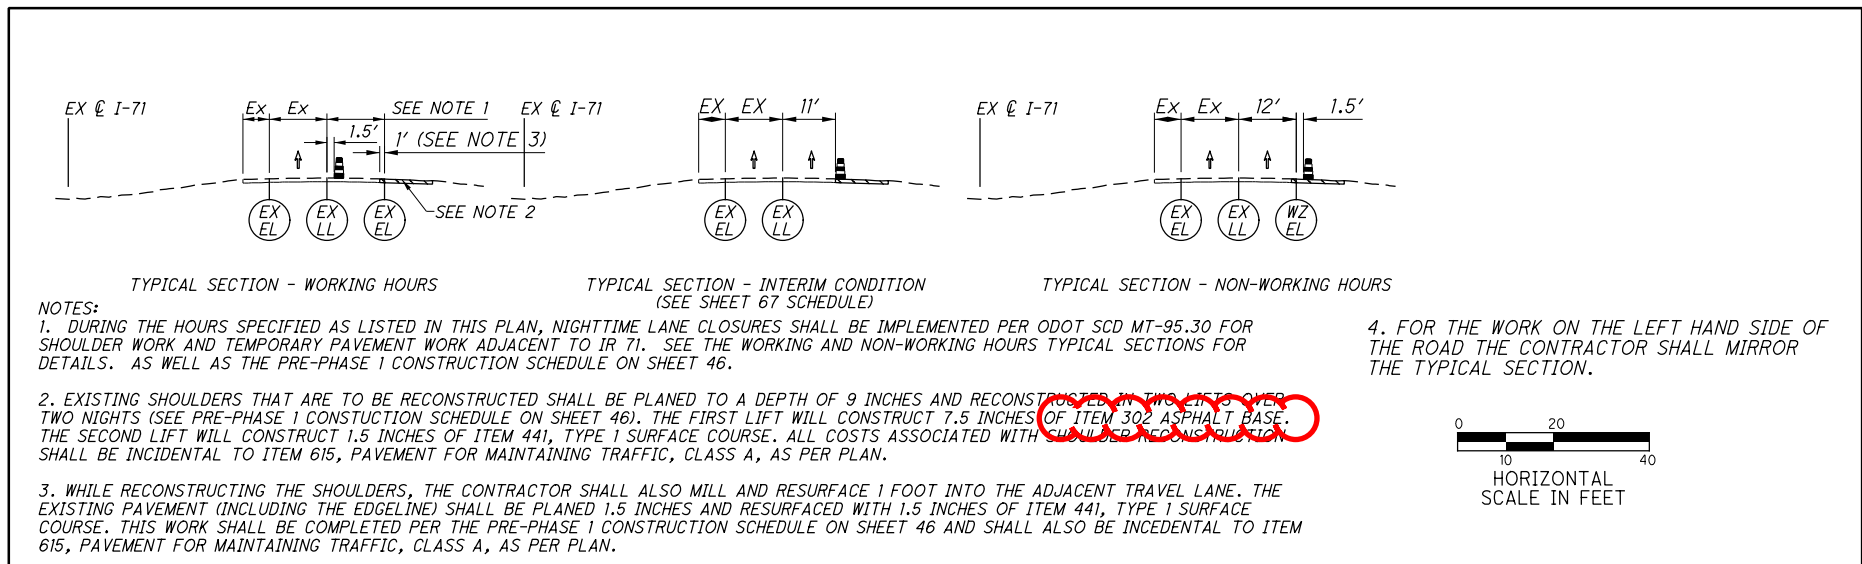

LEGEND
 SHOULDER RECONSTRUCTION
 TEMPORARY PAVEMENT CONSTRUCTED THIS PHASE
 OPEN TRAVEL LANE

EQUATION:
 $STG\ 840+28.9\ BK = STG\ 0+00.00\ AH$
 1075' TEMPORARY GUARDRAIL, TYPE MGS W/(1)-ANCHOR ASSEMBLY, MGS TYPE T

Ⓐ - MEET/MATCH EXISTING EDGE OF SHOULDER


MAINTENANCE OF TRAFFIC PLAN-PRE-PHASE 1 (ASPHALT OPTION) I-71 - STA. 826+00 TO STA. 2+00

FRA-71-0:00



CALCULATED
BER
CHECKED
SMM



J:\20130212\ODOT\FRA\107201\mot\sheet\107201MP281.dgn 8/6/2020 4:13:38 AM brieder

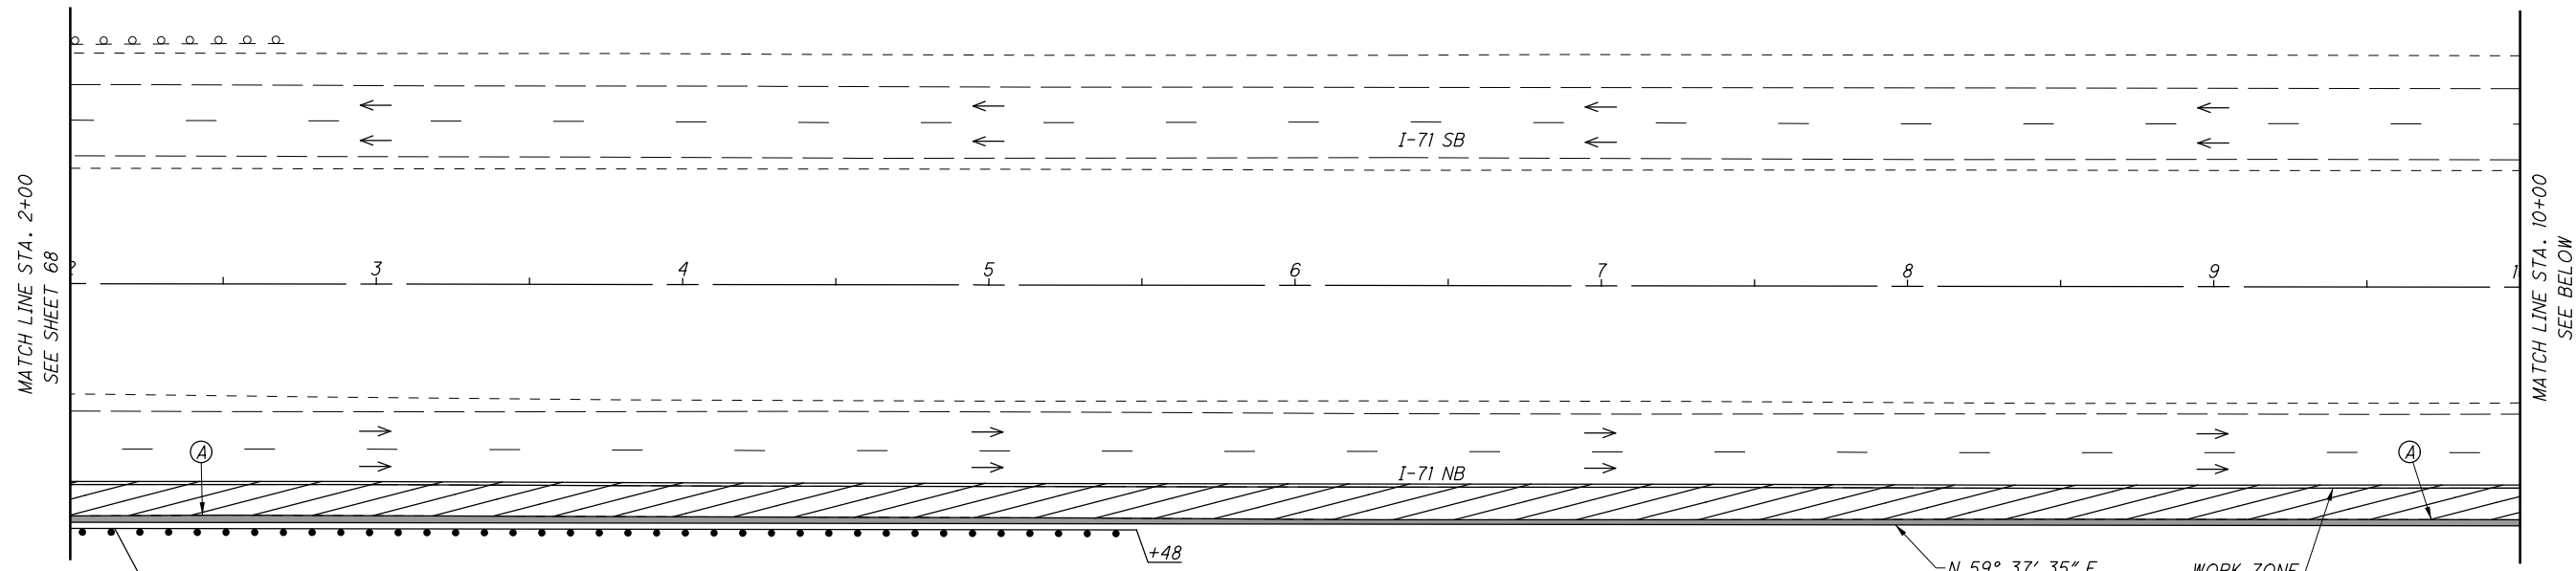

1075' TEMPORARY GUARDRAIL, TYPE MGS W/(1)-ANCHOR ASSEMBLY, MGS TYPE T

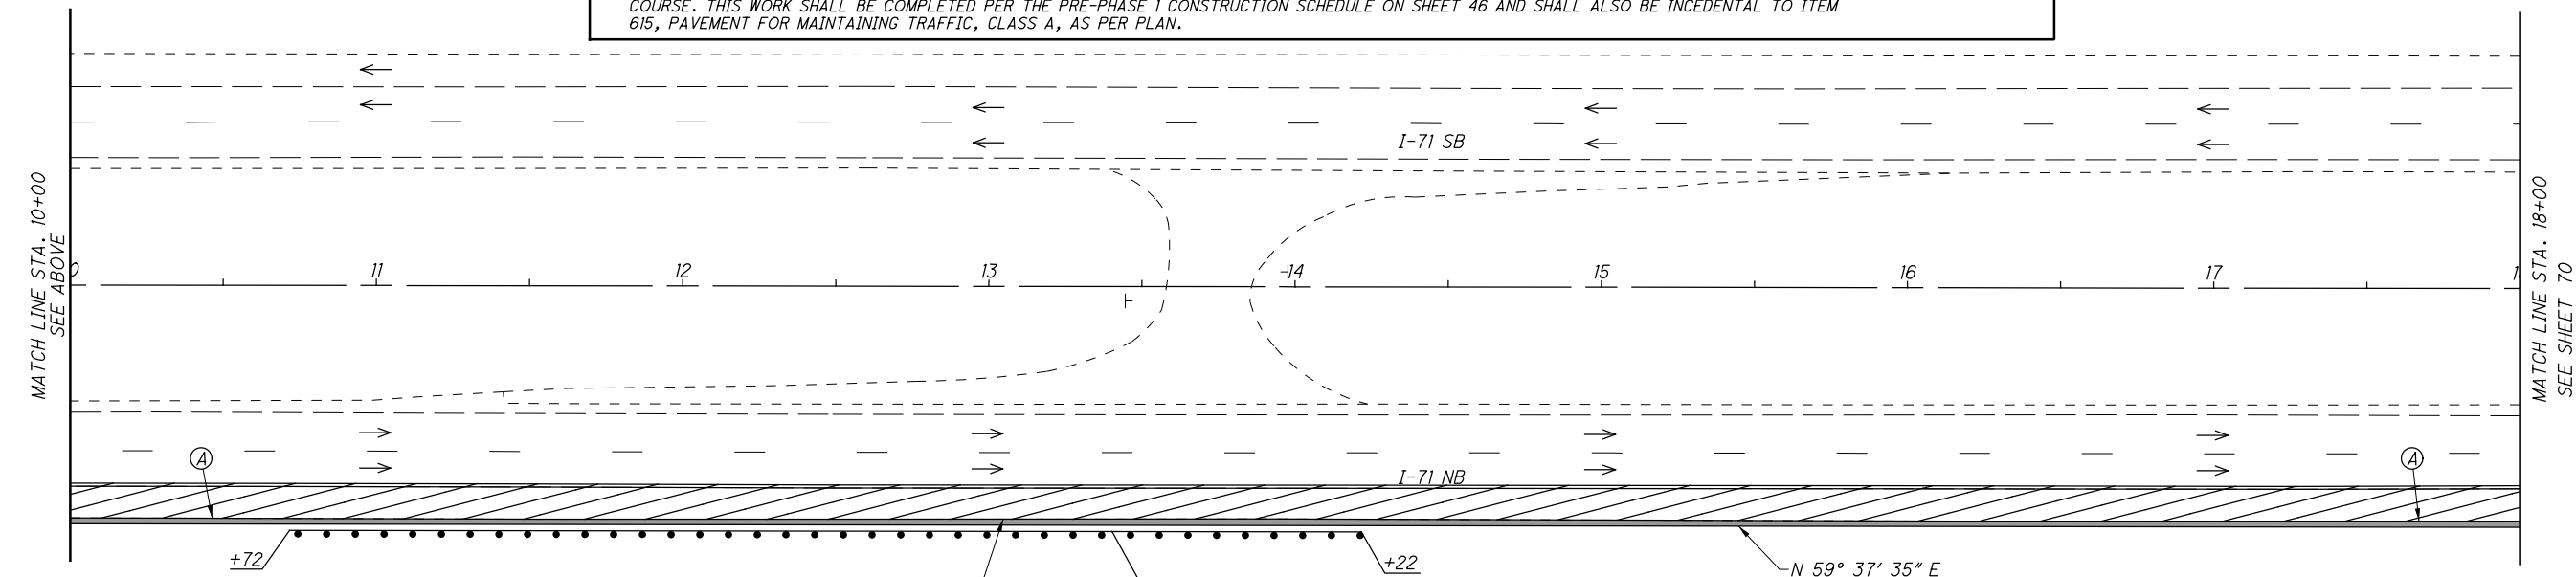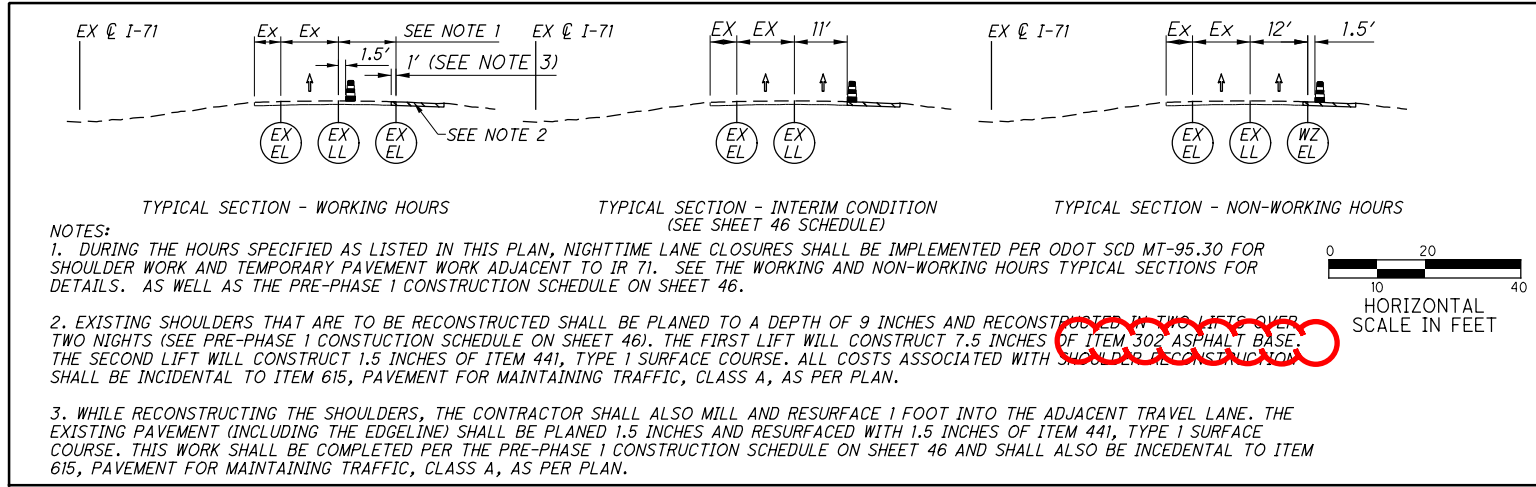


+72

WORK ZONE EDGE LINE

287.5' TEMPORARY GUARDRAIL, TYPE MGS W/(1)-ANCHOR ASSEMBLY, MGS TYPE E W/(1)-ANCHOR ASSEMBLY, MGS TYPE T

+22

N 59° 37' 35" E 7228.5'

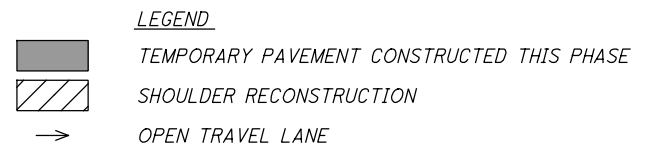

(A) - MEET/MATCH EXISTING EDGE OF SHOULDER



MAINTENANCE OF TRAFFIC PLAN-PRE-PHASE 1 (ASPHALT OPTION) I-71 - STA. 2+00 TO STA. 18+00



FRA-71-0.00

69 1312




CALCULATED BER CHECKED SMM

J:\20130212\ODOT\FRA\107201\mot\sheet\107201MP282.dgn 8/6/2020 4:14:55 AM brieder

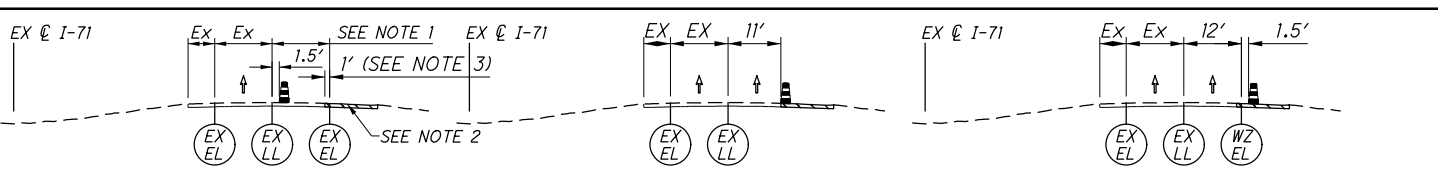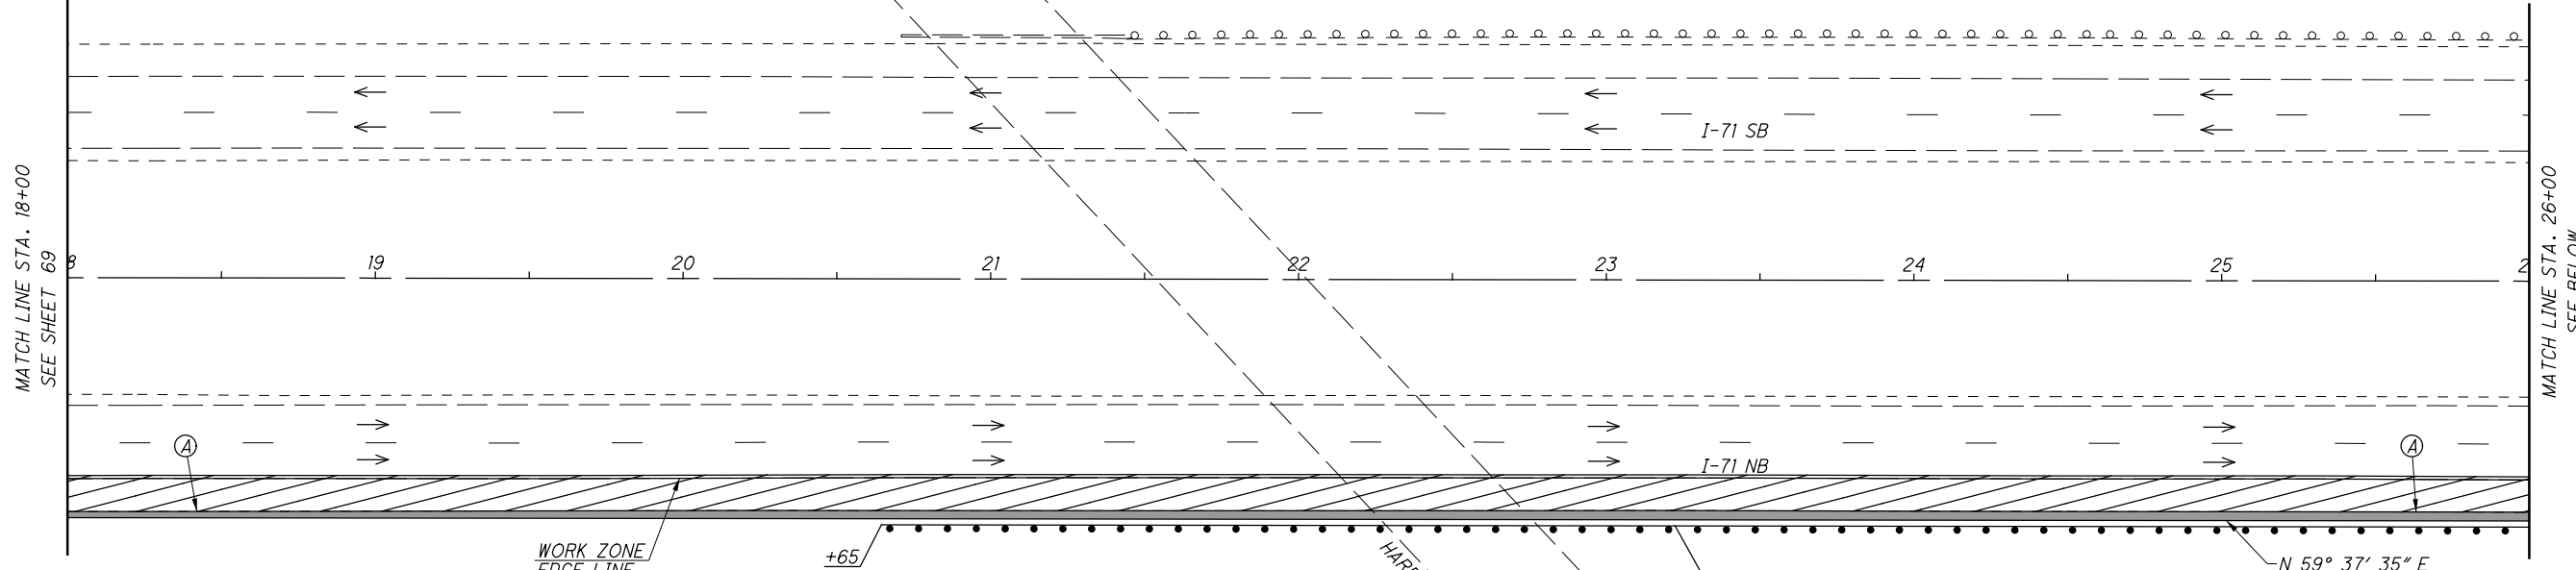

TYPICAL SECTION - WORKING HOURS TYPICAL SECTION - INTERIM CONDITION (SEE SHEET 46 SCHEDULE) TYPICAL SECTION - NON-WORKING HOURS

NOTES:
 1. DURING THE HOURS SPECIFIED AS LISTED IN THIS PLAN, NIGHTTIME LANE CLOSURES SHALL BE IMPLEMENTED PER ODOT SCD MT-95.30 FOR SHOULDER WORK AND TEMPORARY PAVEMENT WORK ADJACENT TO I-71. SEE THE WORKING AND NON-WORKING HOURS TYPICAL SECTIONS FOR DETAILS. AS WELL AS THE PRE-PHASE 1 CONSTRUCTION SCHEDULE ON SHEET 46.
 2. EXISTING SHOULDERS THAT ARE TO BE RECONSTRUCTED SHALL BE PLANED TO A DEPTH OF 9 INCHES AND RECONSTRUCTED IN TWO LIFTS OVER TWO NIGHTS (SEE PRE-PHASE 1 CONSTRUCTION SCHEDULE ON SHEET 46). THE FIRST LIFT WILL CONSTRUCT 7.5 INCHES OF ITEM 302 ASPHALT BASE. THE SECOND LIFT WILL CONSTRUCT 1.5 INCHES OF ITEM 441, TYPE 1 SURFACE COURSE. ALL COSTS ASSOCIATED WITH SHOULDER RECONSTRUCTION SHALL BE INCIDENTAL TO ITEM 615, PAVEMENT FOR MAINTAINING TRAFFIC, CLASS A, AS PER PLAN.
 3. WHILE RECONSTRUCTING THE SHOULDERS, THE CONTRACTOR SHALL ALSO MILL AND RESURFACE 1 FOOT INTO THE ADJACENT TRAVEL LANE. THE EXISTING PAVEMENT (INCLUDING THE EDGELINE) SHALL BE PLANED 1.5 INCHES AND RESURFACED WITH 1.5 INCHES OF ITEM 441, TYPE 1 SURFACE COURSE. THIS WORK SHALL BE COMPLETED PER THE PRE-PHASE 1 CONSTRUCTION SCHEDULE ON SHEET 46 AND SHALL ALSO BE INCIDENTAL TO ITEM 615, PAVEMENT FOR MAINTAINING TRAFFIC, CLASS A, AS PER PLAN.

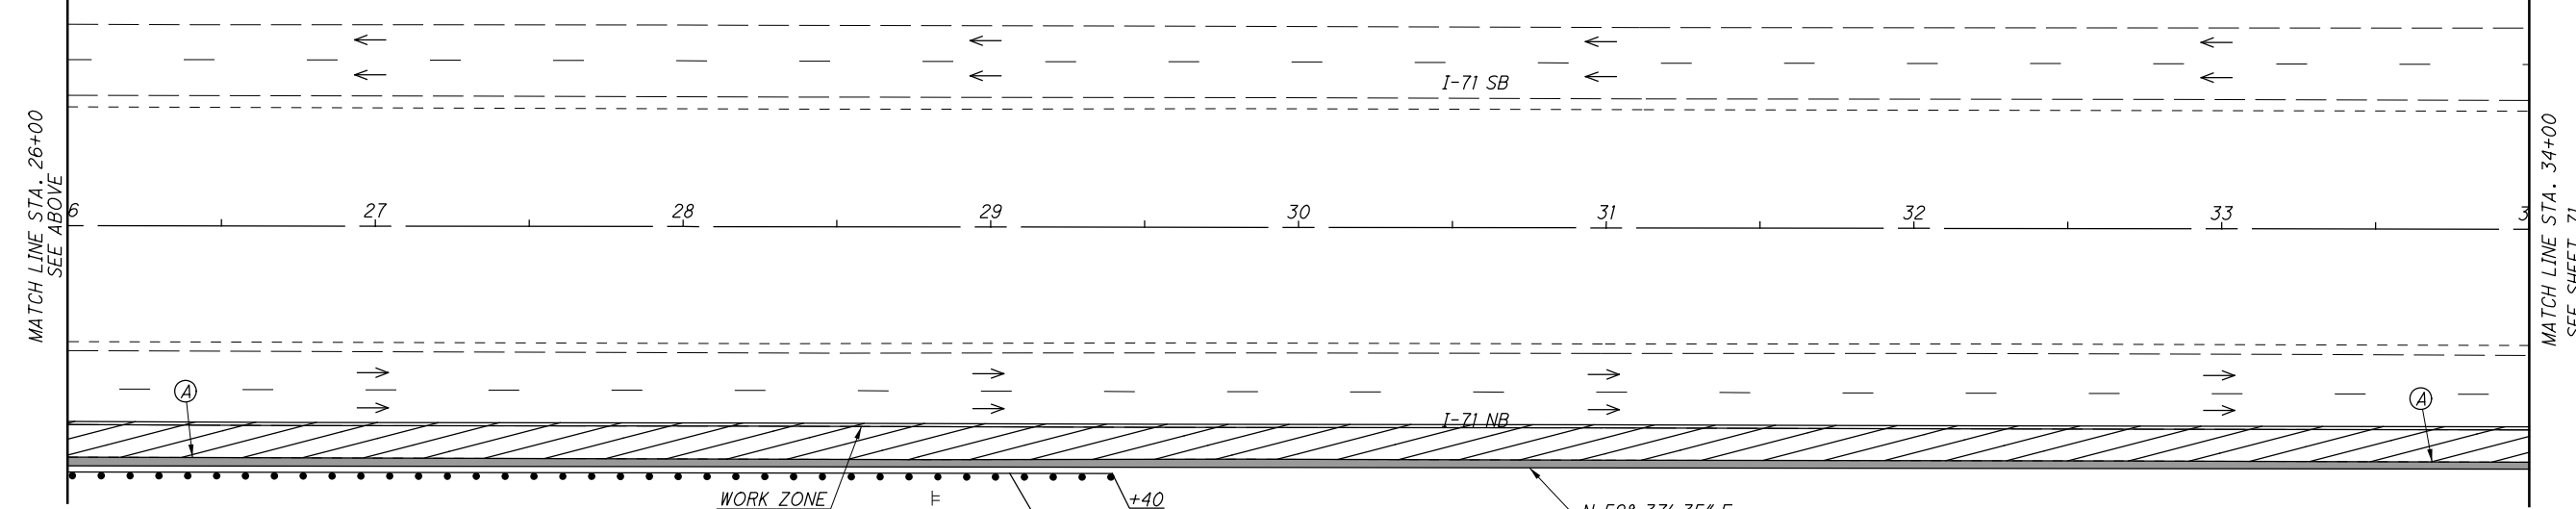


812.5' TEMPORARY GUARDRAIL, TYPE MGS
 W/(I)-ANCHOR ASSEMBLY, MGS TYPE E W/OFFSET AS SHOWN IN MGS-5.3
 W/(I)-ANCHOR ASSEMBLY, MGS TYPE T

LEGEND
 TEMPORARY PAVEMENT CONSTRUCTED THIS PHASE
 SHOULDER RECONSTRUCTION
 OPEN TRAVEL LANE

(A) - MEET/MATCH EXISTING EDGE OF SHOULDER

CALCULATED BY BER CHECKED BY SMM
MAINTENANCE OF TRAFFIC PLAN-PRE-PHASE 1 (ASPHALT OPTION) I-71 - STA. 18+00 TO STA. 34+00
FRA-71-0.00
 70
 1312

J:\20130212\ODOT\FRA\107201\mot\sheet\107201MP283.dgn 8/6/2020 4:16:08 AM brieder

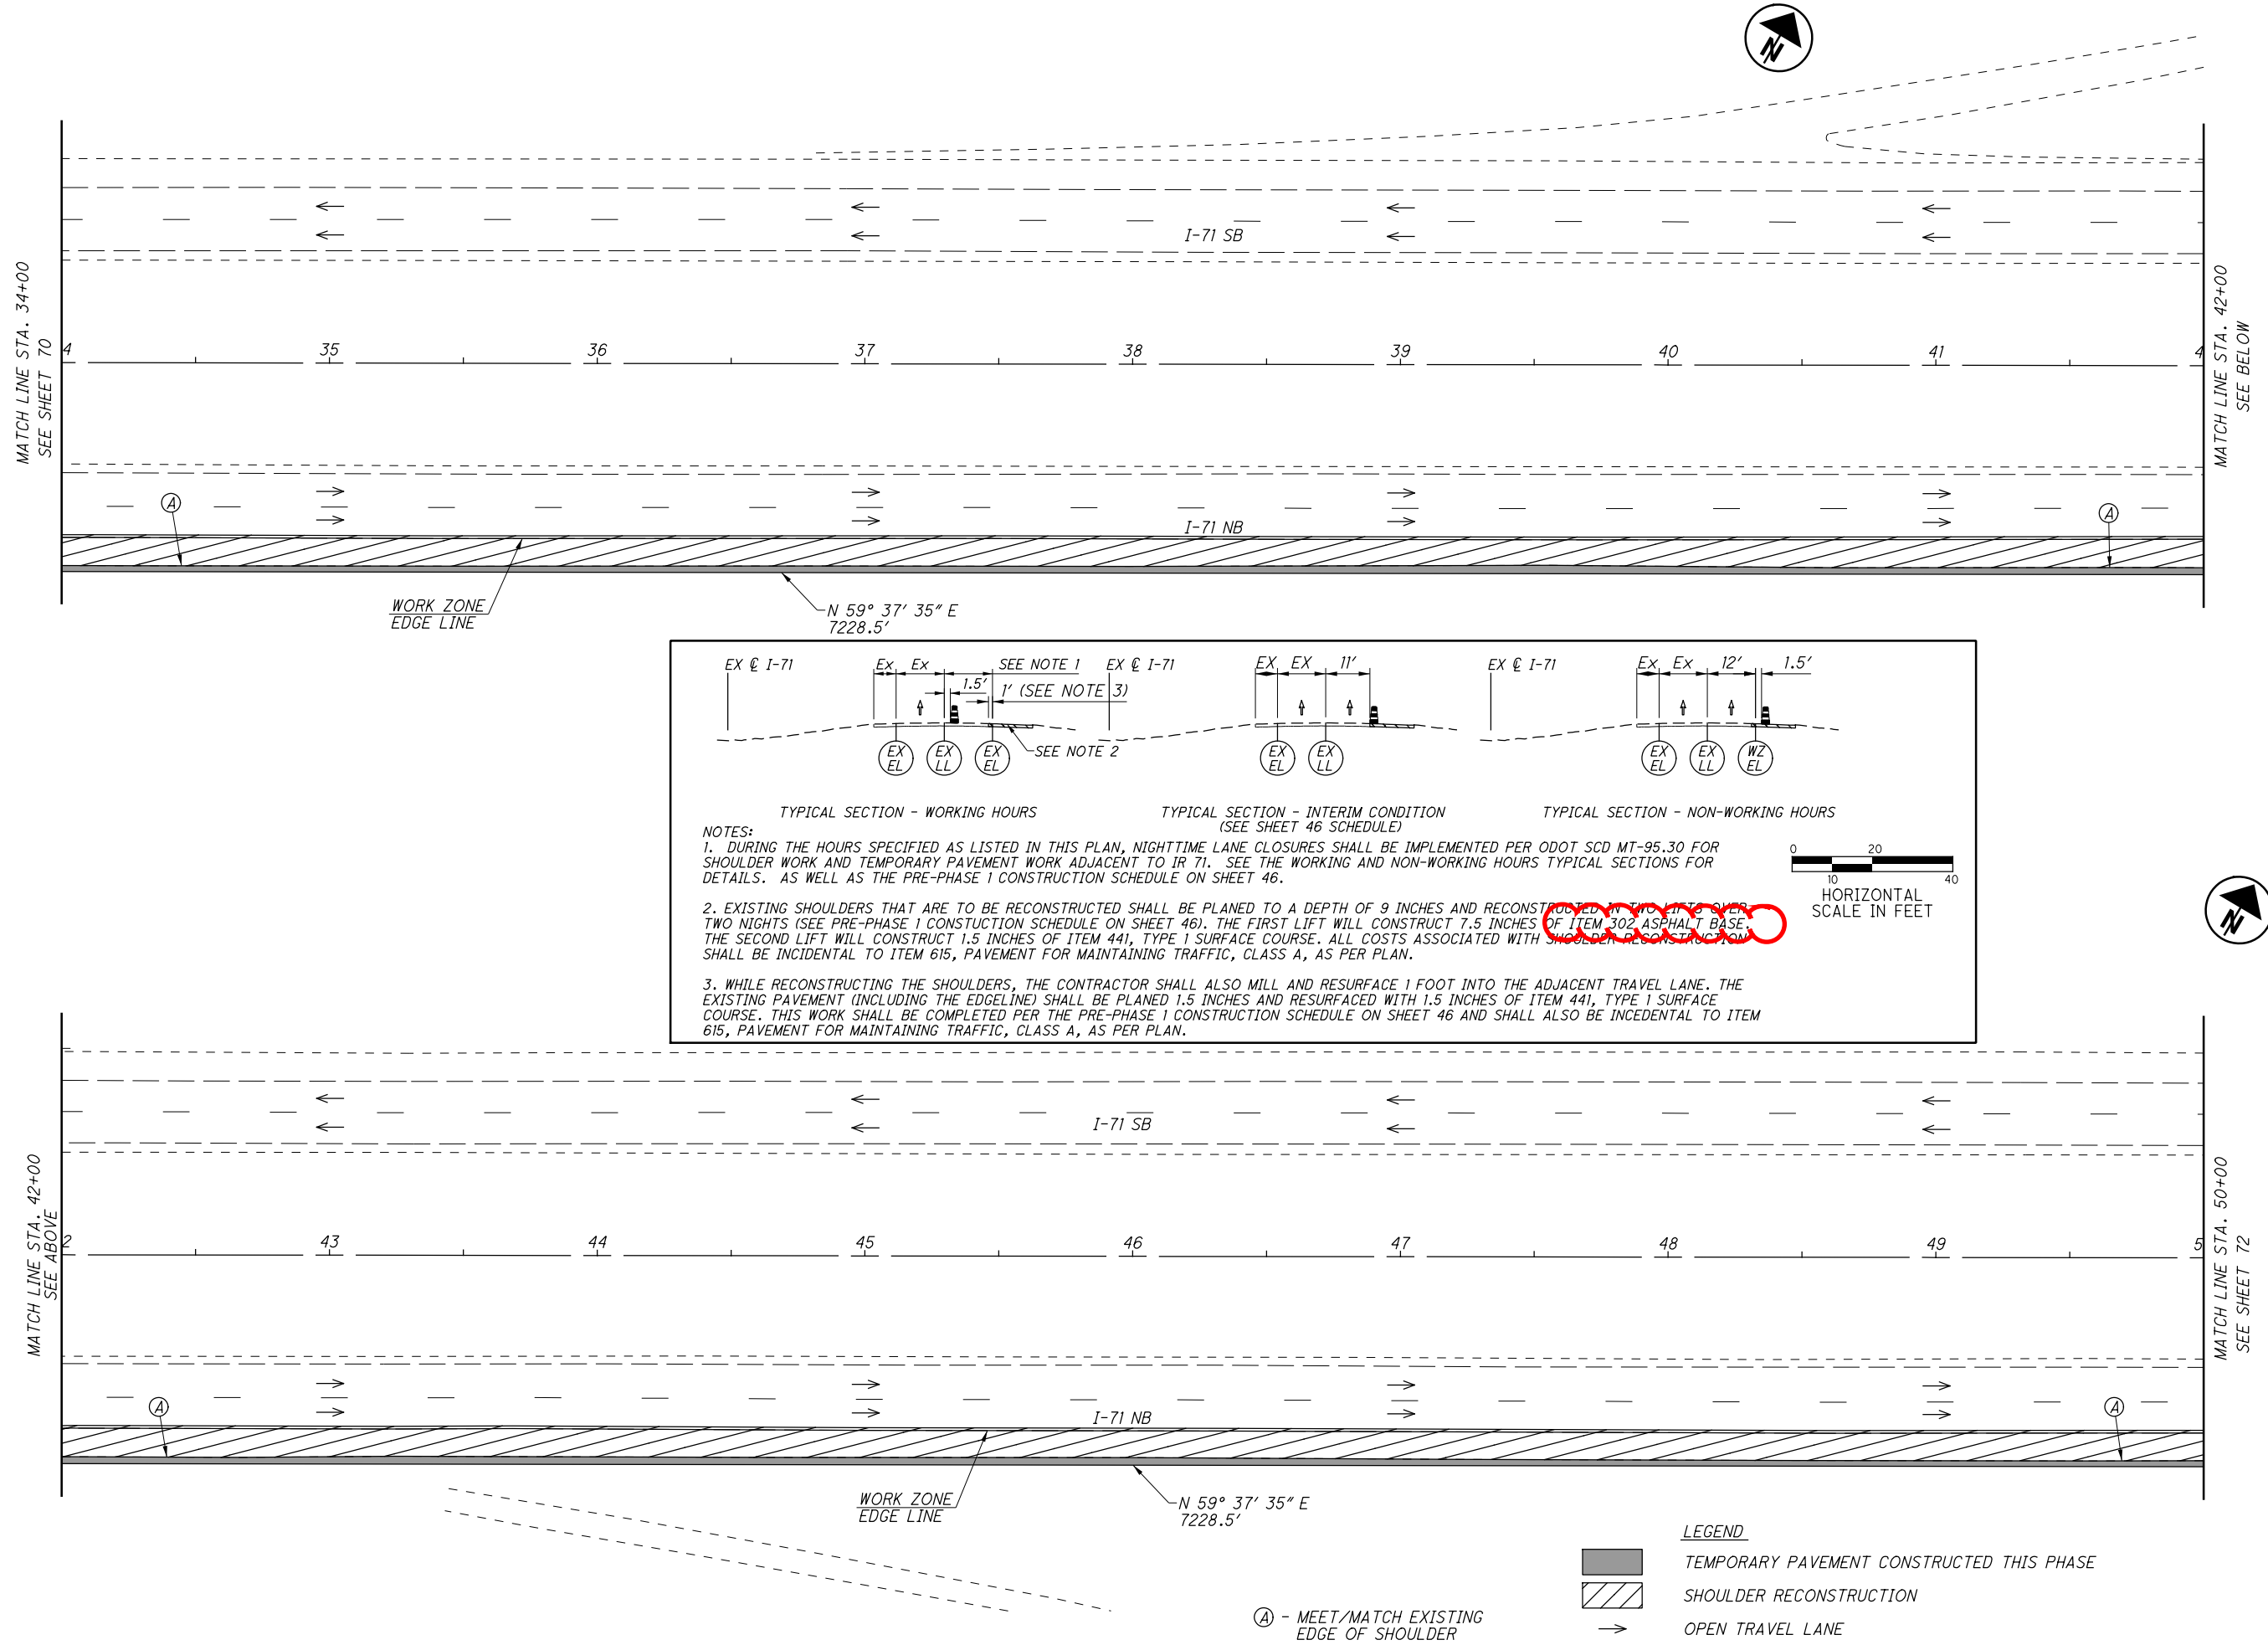

N 59° 37' 35" E
7228.5'

EX @ I-71

TYPICAL SECTION - WORKING HOURS

EX @ I-71

TYPICAL SECTION - INTERIM CONDITION
(SEE SHEET 46 SCHEDULE)

EX @ I-71

TYPICAL SECTION - NON-WORKING HOURS

SEE NOTE 1
SEE NOTE 2
SEE NOTE 3

NOTES:

1. DURING THE HOURS SPECIFIED AS LISTED IN THIS PLAN, NIGHTTIME LANE CLOSURES SHALL BE IMPLEMENTED PER ODOT SCD MT-95.30 FOR SHOULDER WORK AND TEMPORARY PAVEMENT WORK ADJACENT TO I-71. SEE THE WORKING AND NON-WORKING HOURS TYPICAL SECTIONS FOR DETAILS. AS WELL AS THE PRE-PHASE 1 CONSTRUCTION SCHEDULE ON SHEET 46.
2. EXISTING SHOULDERS THAT ARE TO BE RECONSTRUCTED SHALL BE PLANED TO A DEPTH OF 9 INCHES AND RECONSTRUCTED IN TWO LIFTS OVER TWO NIGHTS (SEE PRE-PHASE 1 CONSTRUCTION SCHEDULE ON SHEET 46). THE FIRST LIFT WILL CONSTRUCT 7.5 INCHES OF ITEM 302 ASPHALT BASE. THE SECOND LIFT WILL CONSTRUCT 1.5 INCHES OF ITEM 441, TYPE 1 SURFACE COURSE. ALL COSTS ASSOCIATED WITH SHOULDER RECONSTRUCTION SHALL BE INCIDENTAL TO ITEM 615, PAVEMENT FOR MAINTAINING TRAFFIC, CLASS A, AS PER PLAN.
3. WHILE RECONSTRUCTING THE SHOULDERS, THE CONTRACTOR SHALL ALSO MILL AND RESURFACE 1 FOOT INTO THE ADJACENT TRAVEL LANE. THE EXISTING PAVEMENT (INCLUDING THE EDGELINE) SHALL BE PLANED 1.5 INCHES AND RESURFACED WITH 1.5 INCHES OF ITEM 441, TYPE 1 SURFACE COURSE. THIS WORK SHALL BE COMPLETED PER THE PRE-PHASE 1 CONSTRUCTION SCHEDULE ON SHEET 46 AND SHALL ALSO BE INCIDENTAL TO ITEM 615, PAVEMENT FOR MAINTAINING TRAFFIC, CLASS A, AS PER PLAN.

0 10 20 40
HORIZONTAL SCALE IN FEET

MAINTENANCE OF TRAFFIC PLAN-PRE-PHASE 1
(ASPHALT OPTION) I-71 - STA. 34+00 TO STA. 50+00


FRA-71-0.00

71
1312

CALCULATED
BER
CHECKED
SMM

0 15 30 45 60
HORIZONTAL SCALE IN FEET

J:\20130212\ODOT\FRA\107201\mot\sheet\107201MP284.dgn 8/6/2020 4:17:16 AM brieder

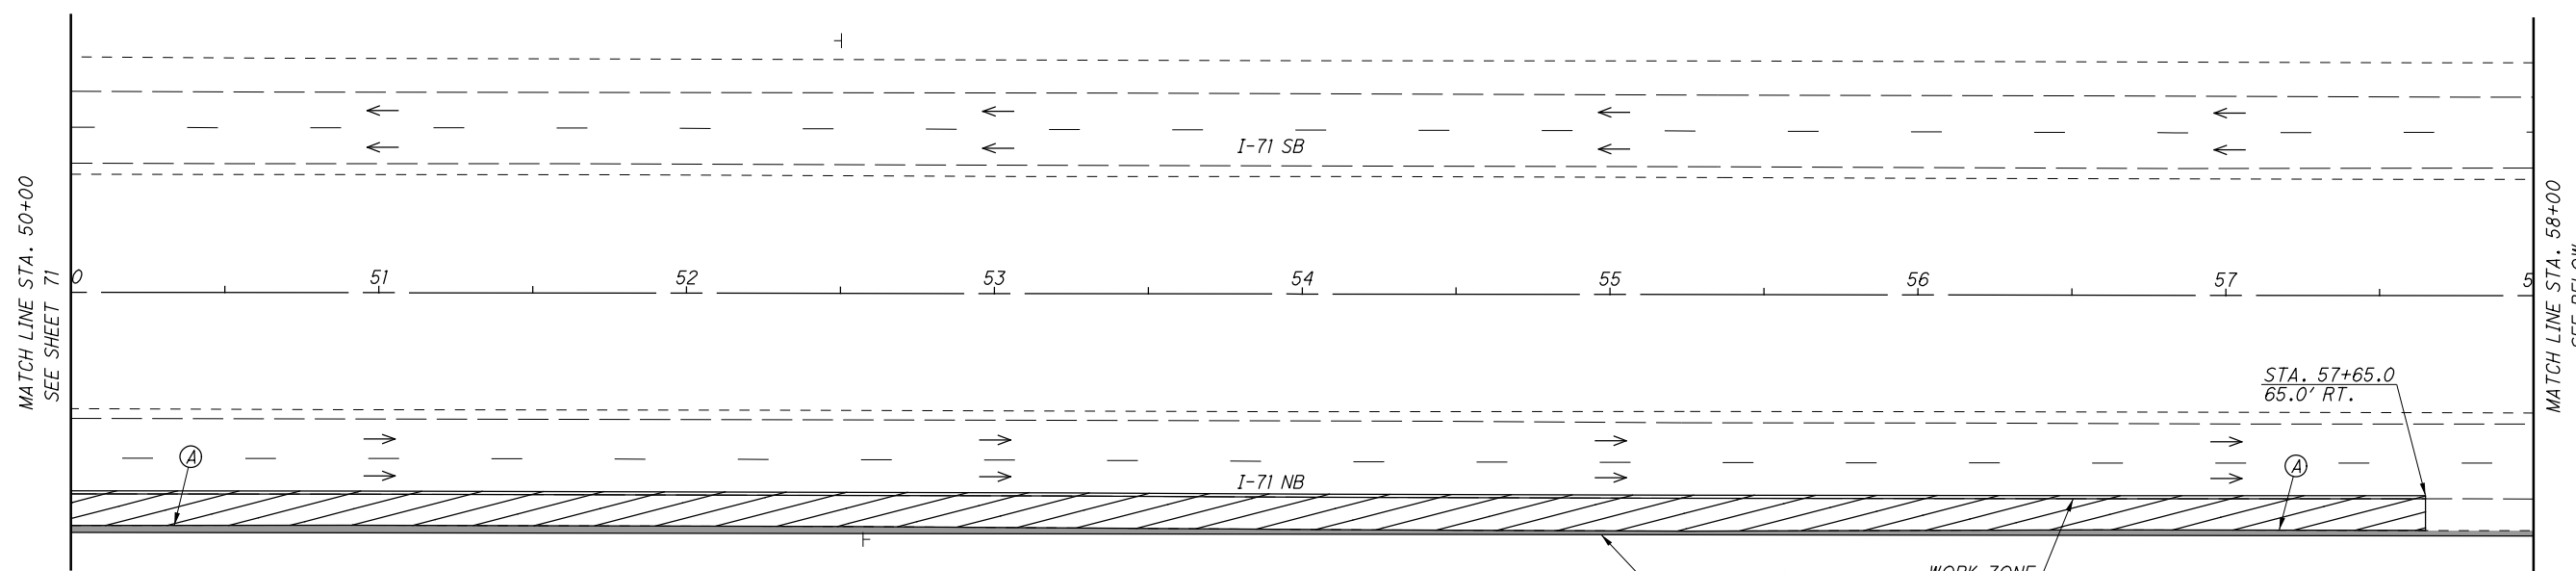

EX @ I-71 EX EX SEE NOTE 1 EX @ I-71 EX EX 11' EX @ I-71 EX EX 12' 1.5'

SEE NOTE 2 SEE NOTE 3


EX EL EX LL EX EL EX EL EX LL EX EL EX LL WZ EL

TYPICAL SECTION - WORKING HOURS TYPICAL SECTION - INTERIM CONDITION (SEE SHEET 46 SCHEDULE) TYPICAL SECTION - NON-WORKING HOURS

NOTES:

- DURING THE HOURS SPECIFIED AS LISTED IN THIS PLAN, NIGHTTIME LANE CLOSURES SHALL BE IMPLEMENTED PER ODOT SCD MT-95.30 FOR SHOULDER WORK AND TEMPORARY PAVEMENT WORK ADJACENT TO I-71. SEE THE WORKING AND NON-WORKING HOURS TYPICAL SECTIONS FOR DETAILS. AS WELL AS THE PRE-PHASE 1 CONSTRUCTION SCHEDULE ON SHEET 46.
- EXISTING SHOULDERS THAT ARE TO BE RECONSTRUCTED SHALL BE PLANED TO A DEPTH OF 9 INCHES AND RECONSTRUCTED IN TWO LIFTS OVER TWO NIGHTS (SEE PRE-PHASE 1 CONSTRUCTION SCHEDULE ON SHEET 46). THE FIRST LIFT WILL CONSTRUCT 7.5 INCHES OF ITEM 302 ASPHALT BASE. THE SECOND LIFT WILL CONSTRUCT 1.5 INCHES OF ITEM 441, TYPE 1 SURFACE COURSE. ALL COSTS ASSOCIATED WITH SHOULDER RECONSTRUCTION SHALL BE INCIDENTAL TO ITEM 615, PAVEMENT FOR MAINTAINING TRAFFIC, CLASS A, AS PER PLAN.
- WHILE RECONSTRUCTING THE SHOULDERS, THE CONTRACTOR SHALL ALSO MILL AND RESURFACE 1 FOOT INTO THE ADJACENT TRAVEL LANE. THE EXISTING PAVEMENT (INCLUDING THE EDGELINE) SHALL BE PLANED 1.5 INCHES AND RESURFACED WITH 1.5 INCHES OF ITEM 441, TYPE 1 SURFACE COURSE. THIS WORK SHALL BE COMPLETED PER THE PRE-PHASE 1 CONSTRUCTION SCHEDULE ON SHEET 46 AND SHALL ALSO BE INCIDENTAL TO ITEM 615, PAVEMENT FOR MAINTAINING TRAFFIC, CLASS A, AS PER PLAN.

0 10 20 40
HORIZONTAL SCALE IN FEET

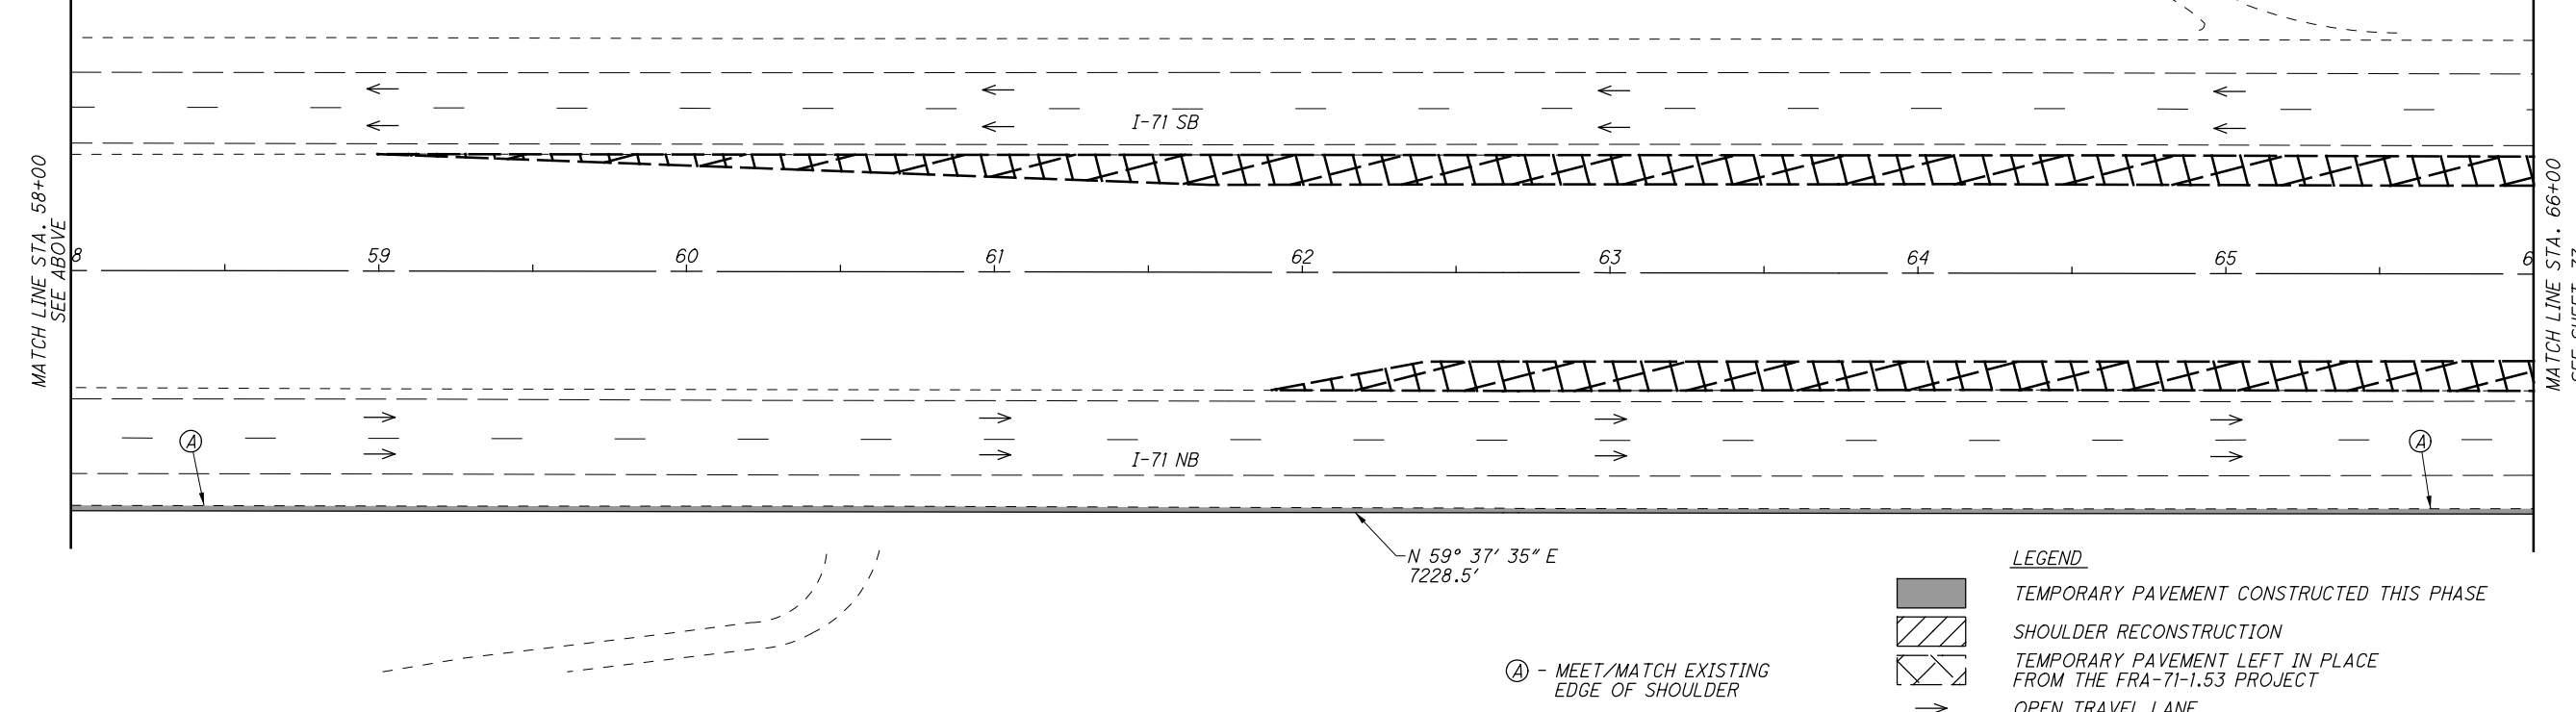

LEGEND

- TEMPORARY PAVEMENT CONSTRUCTED THIS PHASE
- SHOULDER RECONSTRUCTION
- TEMPORARY PAVEMENT LEFT IN PLACE FROM THE FRA-71-1.53 PROJECT
- OPEN TRAVEL LANE

(A) - MEET/MATCH EXISTING EDGE OF SHOULDER



CALCULATED BER CHECKED SMM


MAINTENANCE OF TRAFFIC PLAN-PRE-PHASE 1 (ASPHALT OPTION) I-71 - STA. 50+00 TO STA. 66+00

FRA-71-0.00

72
1312

0 15 30 60
HORIZONTAL SCALE IN FEET

J:\20130212\ODOT\FRA\107201\mot\sheet\107201MP285.dgn 8/6/2020 4:18:24 AM brieder

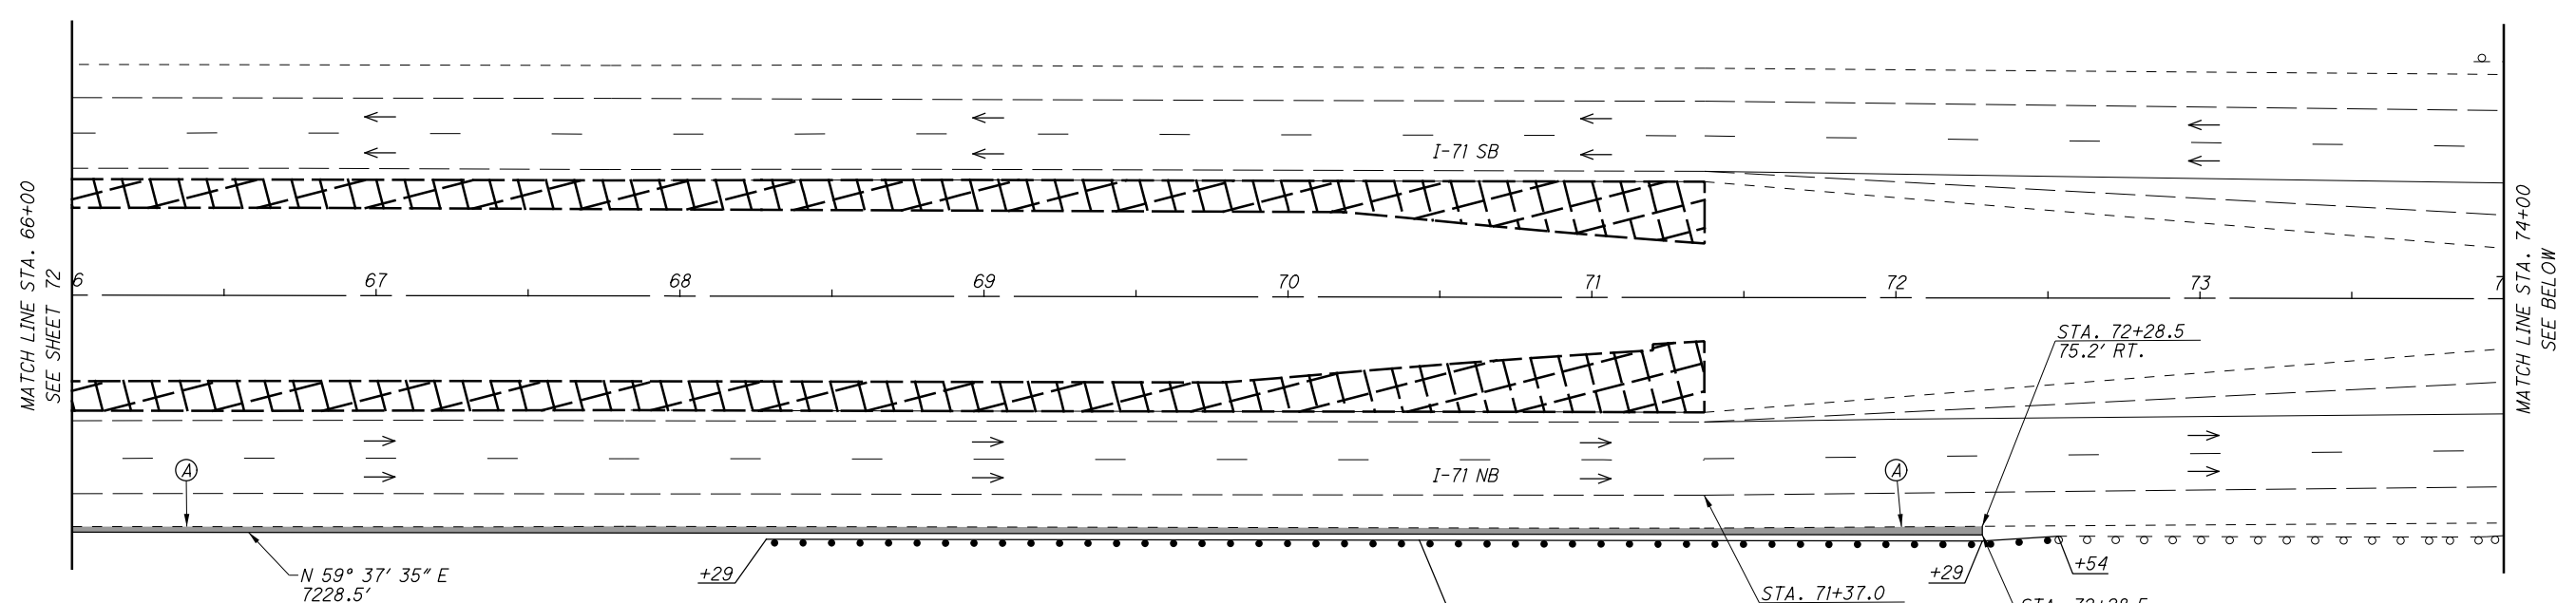

EX @ I-71

SEE NOTE 1

EX @ I-71

EX @ I-71

SEE NOTE 2

SEE NOTE 3

1.5'

11'

12'

1.5'

EX EL

EX LL

EX EL

EX LL

EX EL

EX LL

WZ EL

TYPICAL SECTION - WORKING HOURS

TYPICAL SECTION - INTERIM CONDITION (SEE SHEET 46 SCHEDULE)

TYPICAL SECTION - NON-WORKING HOURS

NOTES:

1. DURING THE HOURS SPECIFIED AS LISTED IN THIS PLAN, NIGHTTIME LANE CLOSURES SHALL BE IMPLEMENTED PER ODOT SCD MT-95.30 FOR SHOULDER WORK AND TEMPORARY PAVEMENT WORK ADJACENT TO I-71. SEE THE WORKING AND NON-WORKING HOURS TYPICAL SECTIONS FOR DETAILS. AS WELL AS THE PRE-PHASE 1 CONSTRUCTION SCHEDULE ON SHEET 46.


2. EXISTING SHOULDERS THAT ARE TO BE RECONSTRUCTED SHALL BE PLANED TO A DEPTH OF 9 INCHES AND RECONSTRUCTED IN TWO LIFTS OVER TWO NIGHTS (SEE PRE-PHASE 1 CONSTRUCTION SCHEDULE ON SHEET 46). THE FIRST LIFT WILL CONSTRUCT 7.5 INCHES OF ITEM 302 ASPHALT BASE. THE SECOND LIFT WILL CONSTRUCT 1.5 INCHES OF ITEM 441, TYPE 1 SURFACE COURSE. ALL COSTS ASSOCIATED WITH SHOULDER RECONSTRUCTION SHALL BE INCIDENTAL TO ITEM 615, PAVEMENT FOR MAINTAINING TRAFFIC, CLASS A, AS PER PLAN.

3. WHILE RECONSTRUCTING THE SHOULDERS, THE CONTRACTOR SHALL ALSO MILL AND RESURFACE 1 FOOT INTO THE ADJACENT TRAVEL LANE. THE EXISTING PAVEMENT (INCLUDING THE EDGELINE) SHALL BE PLANED 1.5 INCHES AND RESURFACED WITH 1.5 INCHES OF ITEM 441, TYPE 1 SURFACE COURSE. THIS WORK SHALL BE COMPLETED PER THE PRE-PHASE 1 CONSTRUCTION SCHEDULE ON SHEET 46 AND SHALL ALSO BE INCIDENTAL TO ITEM 615, PAVEMENT FOR MAINTAINING TRAFFIC, CLASS A, AS PER PLAN.

0 10 20 40


HORIZONTAL SCALE IN FEET

350' TEMPORARY GUARDRAIL, TYPE MGS
W/(1)-ANCHOR ASSEMBLY, MGS TYPE E W/OFFSET AS SHOWN IN MGS-5.3

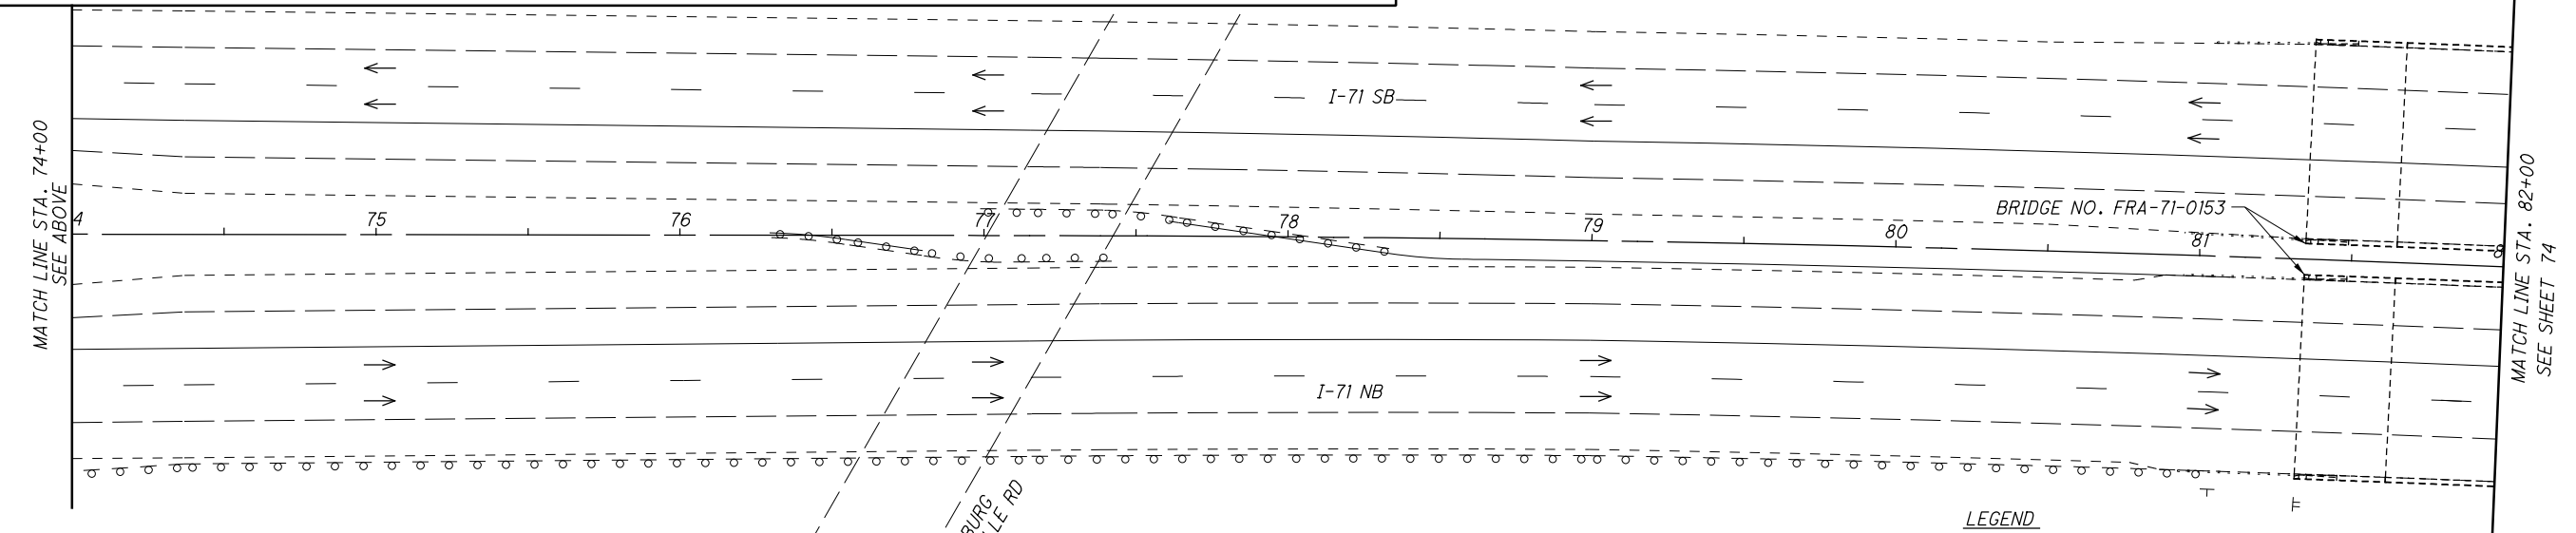

(A) - MEET/MATCH EXISTING
EDGE OF SHOULDER

- LEGEND
- TEMPORARY PAVEMENT CONSTRUCTED THIS PHASE
 - SHOULDER RECONSTRUCTION
 - TEMPORARY PAVEMENT LEFT IN PLACE FROM THE FRA-71-1.53 PROJECT
 - OPEN TRAVEL LANE

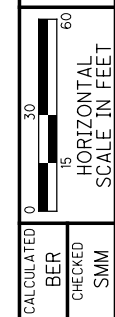


CALCULATED
BER
CHECKED
SMM

**MAINTENANCE OF TRAFFIC PLAN-PRE-PHASE 1
(ASPHALT OPTION) I-71 - STA. 66+00 TO STA. 82+00**

FRA-71-0.00

73
1312

J:\20130212\ODOT\FRA\107201\mot\sheet\107201MP286.dgn 8/6/2020 4:19:36 AM brieder

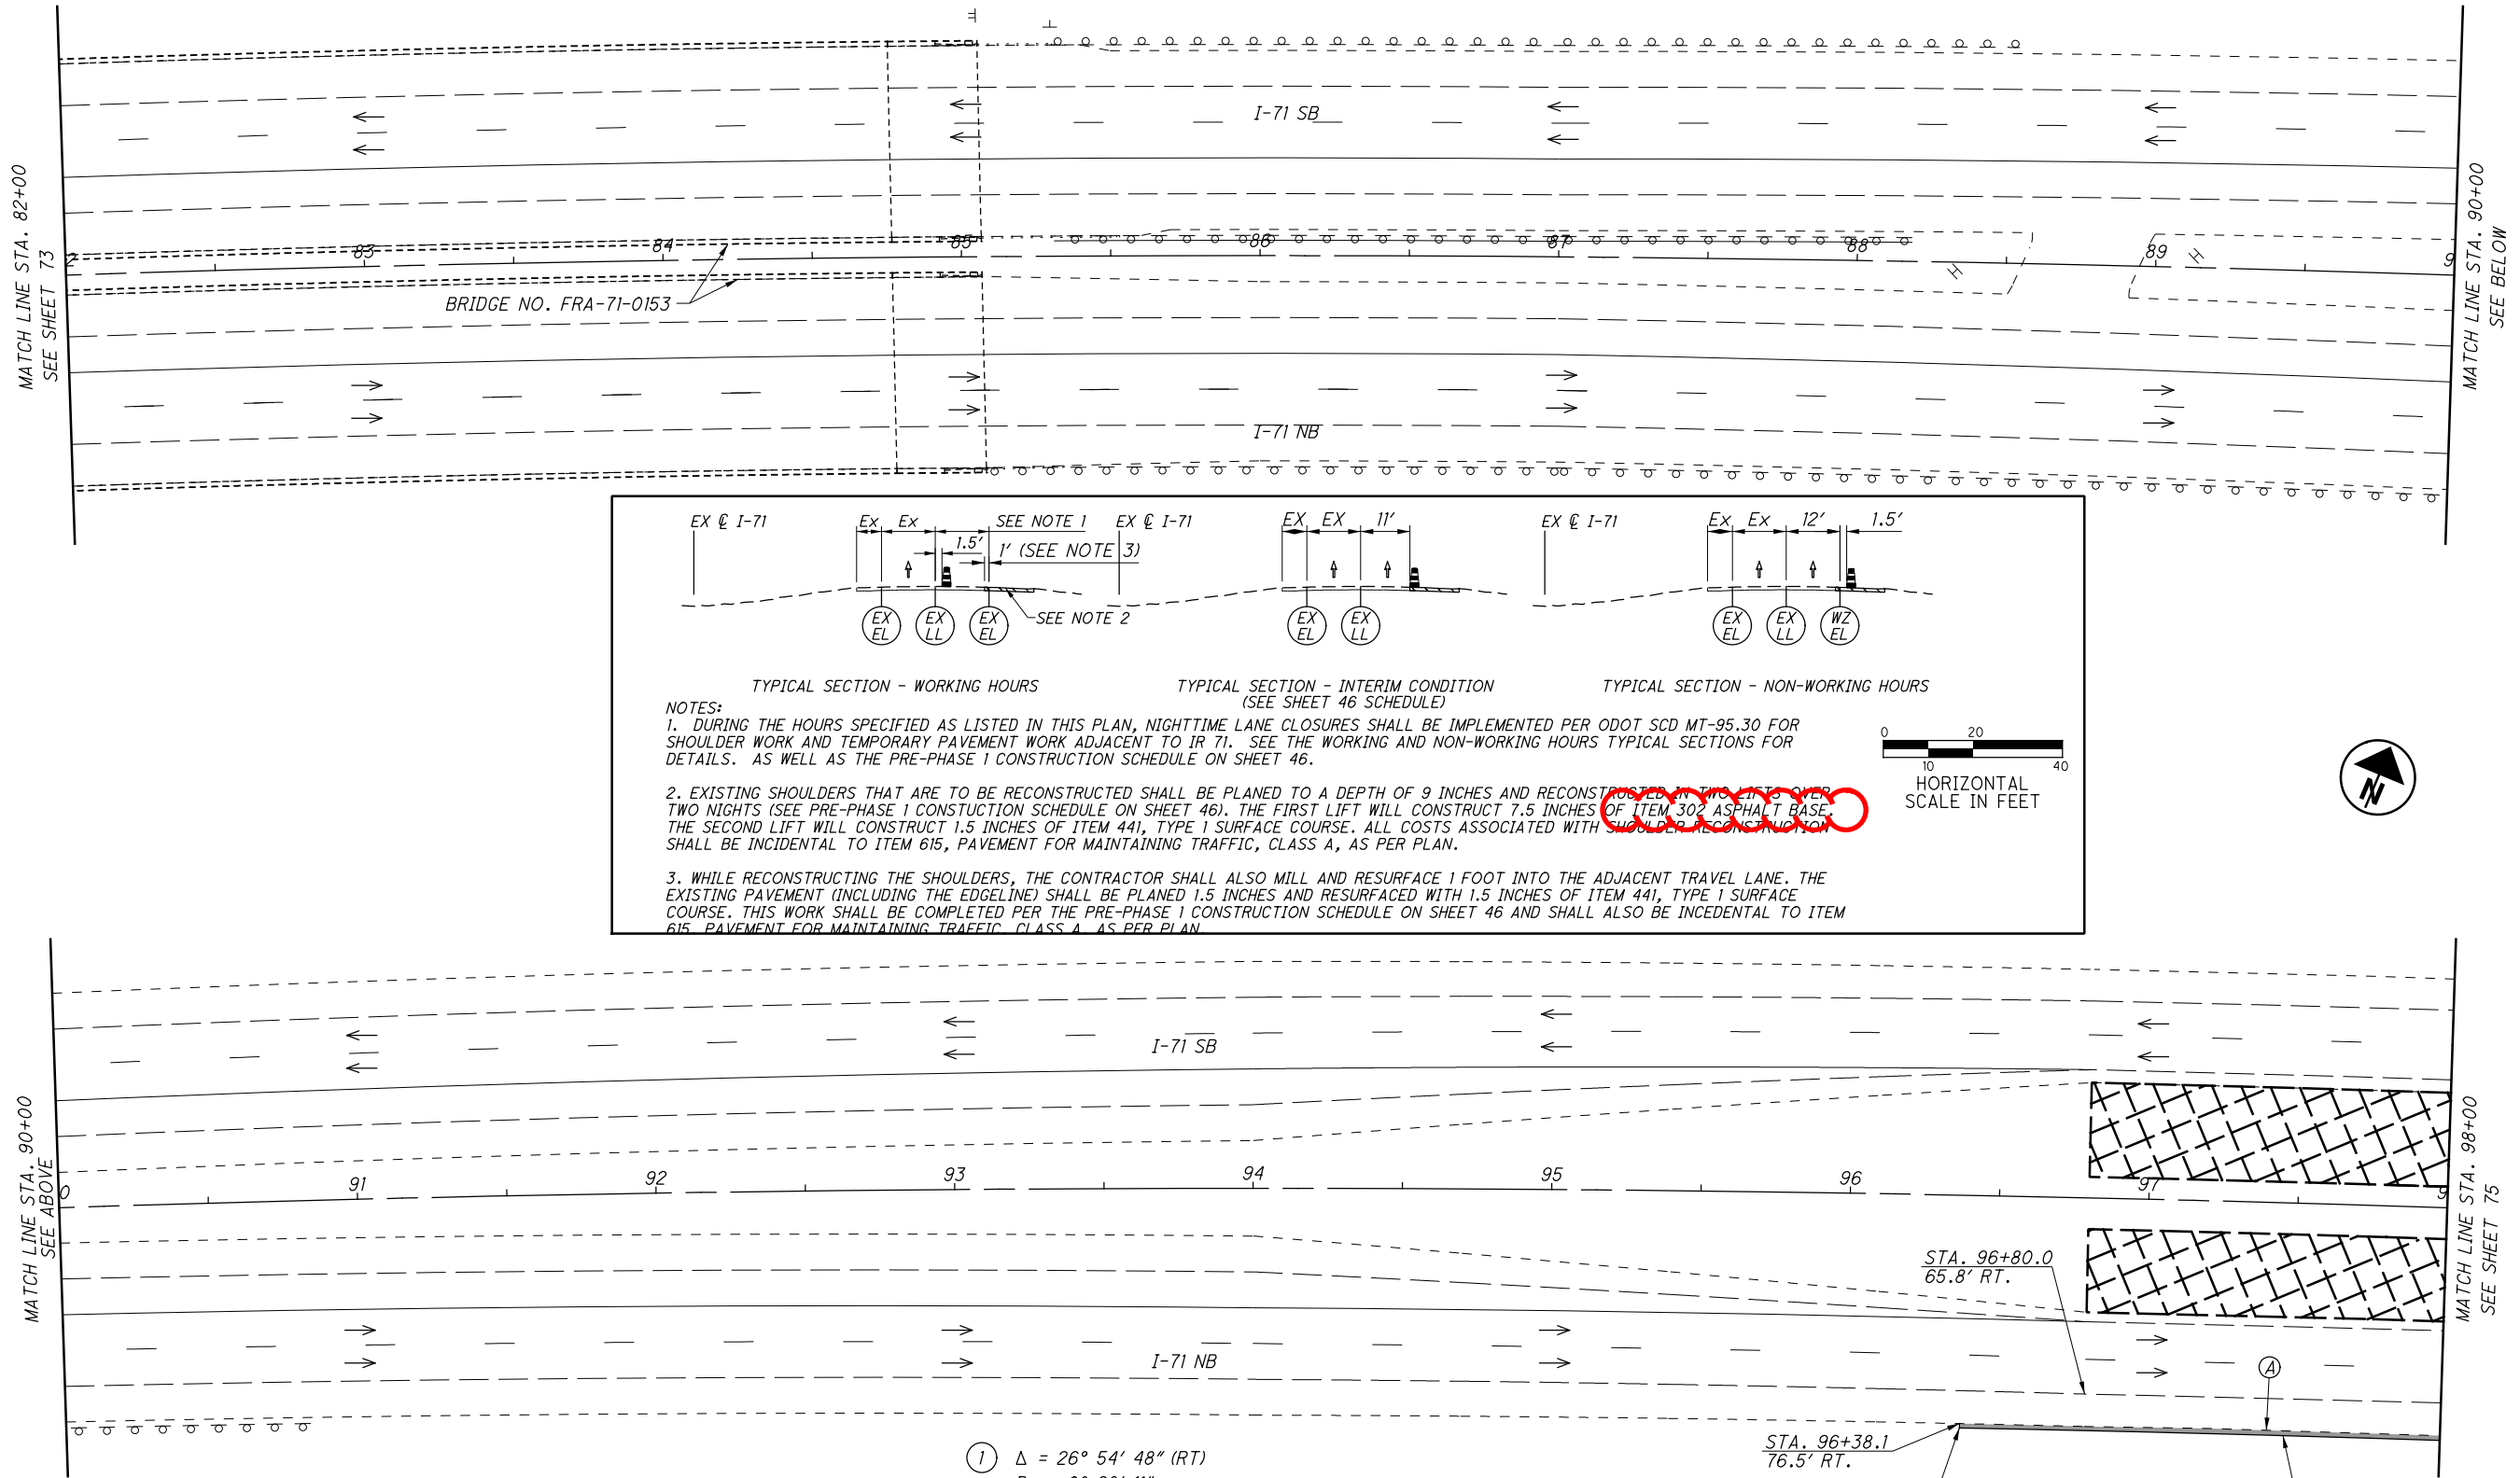

EX @ I-71 EX EX SEE NOTE 1 EX @ I-71 EX EX 11' EX @ I-71 EX EX 12' 1.5'

SEE NOTE 2 SEE NOTE 3 SEE NOTE 2

EX EL EX LL EX EL EX EL EX LL EX EL EX LL EX EL

TYPICAL SECTION - WORKING HOURS TYPICAL SECTION - INTERIM CONDITION (SEE SHEET 46 SCHEDULE) TYPICAL SECTION - NON-WORKING HOURS

NOTES:

- DURING THE HOURS SPECIFIED AS LISTED IN THIS PLAN, NIGHTTIME LANE CLOSURES SHALL BE IMPLEMENTED PER ODOT SCD MT-95.30 FOR SHOULDER WORK AND TEMPORARY PAVEMENT WORK ADJACENT TO I-71. SEE THE WORKING AND NON-WORKING HOURS TYPICAL SECTIONS FOR DETAILS. AS WELL AS THE PRE-PHASE 1 CONSTRUCTION SCHEDULE ON SHEET 46.
- EXISTING SHOULDERS THAT ARE TO BE RECONSTRUCTED SHALL BE PLANED TO A DEPTH OF 9 INCHES AND RECONSTRUCTED IN TWO LIFTS OVER TWO NIGHTS (SEE PRE-PHASE 1 CONSTRUCTION SCHEDULE ON SHEET 46). THE FIRST LIFT WILL CONSTRUCT 7.5 INCHES OF ITEM 302 ASPHALT BASE. THE SECOND LIFT WILL CONSTRUCT 1.5 INCHES OF ITEM 441, TYPE 1 SURFACE COURSE. ALL COSTS ASSOCIATED WITH SHOULDER RECONSTRUCTION SHALL BE INCIDENTAL TO ITEM 615, PAVEMENT FOR MAINTAINING TRAFFIC, CLASS A, AS PER PLAN.
- WHILE RECONSTRUCTING THE SHOULDERS, THE CONTRACTOR SHALL ALSO MILL AND RESURFACE 1 FOOT INTO THE ADJACENT TRAVEL LANE. THE EXISTING PAVEMENT (INCLUDING THE EDGELINE) SHALL BE PLANED 1.5 INCHES AND RESURFACED WITH 1.5 INCHES OF ITEM 441, TYPE 1 SURFACE COURSE. THIS WORK SHALL BE COMPLETED PER THE PRE-PHASE 1 CONSTRUCTION SCHEDULE ON SHEET 46 AND SHALL ALSO BE INCIDENTAL TO ITEM 615 PAVEMENT FOR MAINTAINING TRAFFIC CLASS A AS PER PLAN.

HORIZONTAL SCALE IN FEET

(A) - MEET/MATCH EXISTING EDGE OF SHOULDER

- LEGEND**
- TEMPORARY PAVEMENT CONSTRUCTED THIS PHASE
 - SHOULDER RECONSTRUCTION
 - TEMPORARY PAVEMENT LEFT IN PLACE FROM THE FRA-71-1.53 PROJECT
 - OPEN TRAVEL LANE

(1) $\Delta = 26^\circ 54' 48''$ (RT)
 $D_c = 0^\circ 28' 11''$
 $R = 12,199.67'$
 $T = 2919.11'$
 $L = 5730.47'$
 $E = 344.38'$
 $C = 5677.93'$
 $C.B. = N 82^\circ 03' 26'' E$

STA. 96+80.0
65.8' RT.

STA. 96+38.1
76.5' RT.

STA. 93+68.1
78.0' RT.




**MAINTENANCE OF TRAFFIC PLAN-PRE-PHASE 1
 (ASPHALT OPTION) I-71 - STA. 82+00 TO STA. 98+00**

FRA-71-0.00

CALCULATED BER CHECKED SMM

0 30 60
HORIZONTAL SCALE IN FEET

J:\20130212\ODOT\FRA\107201\mot\sheet\107201MP287.dgn 8/6/2020 4:20:44 AM brieder

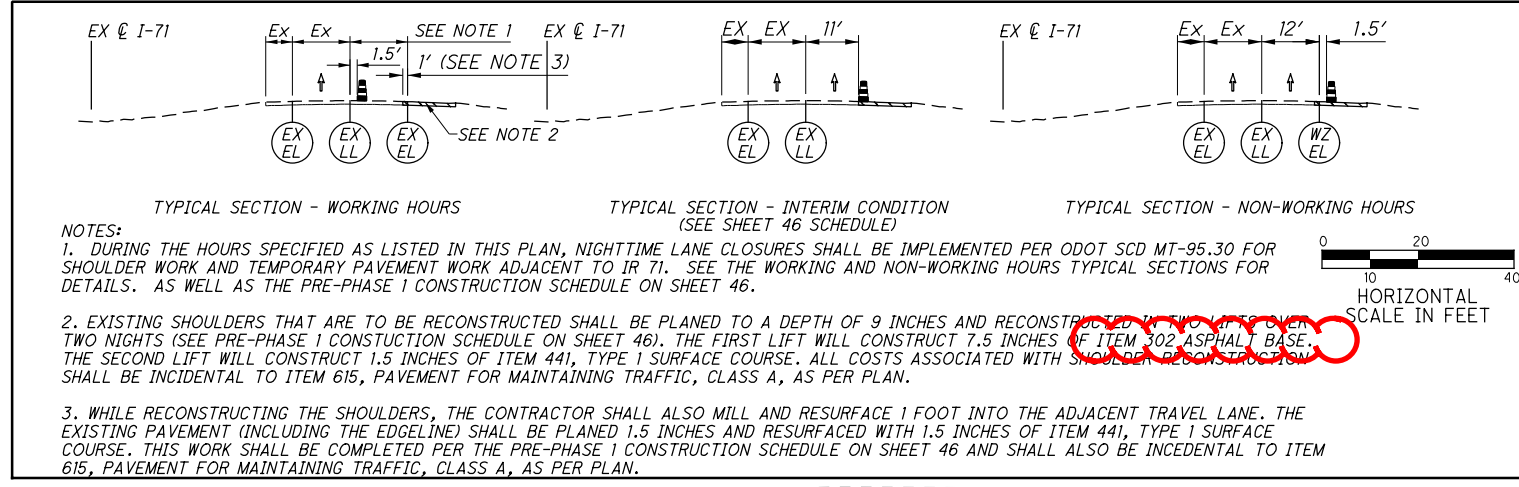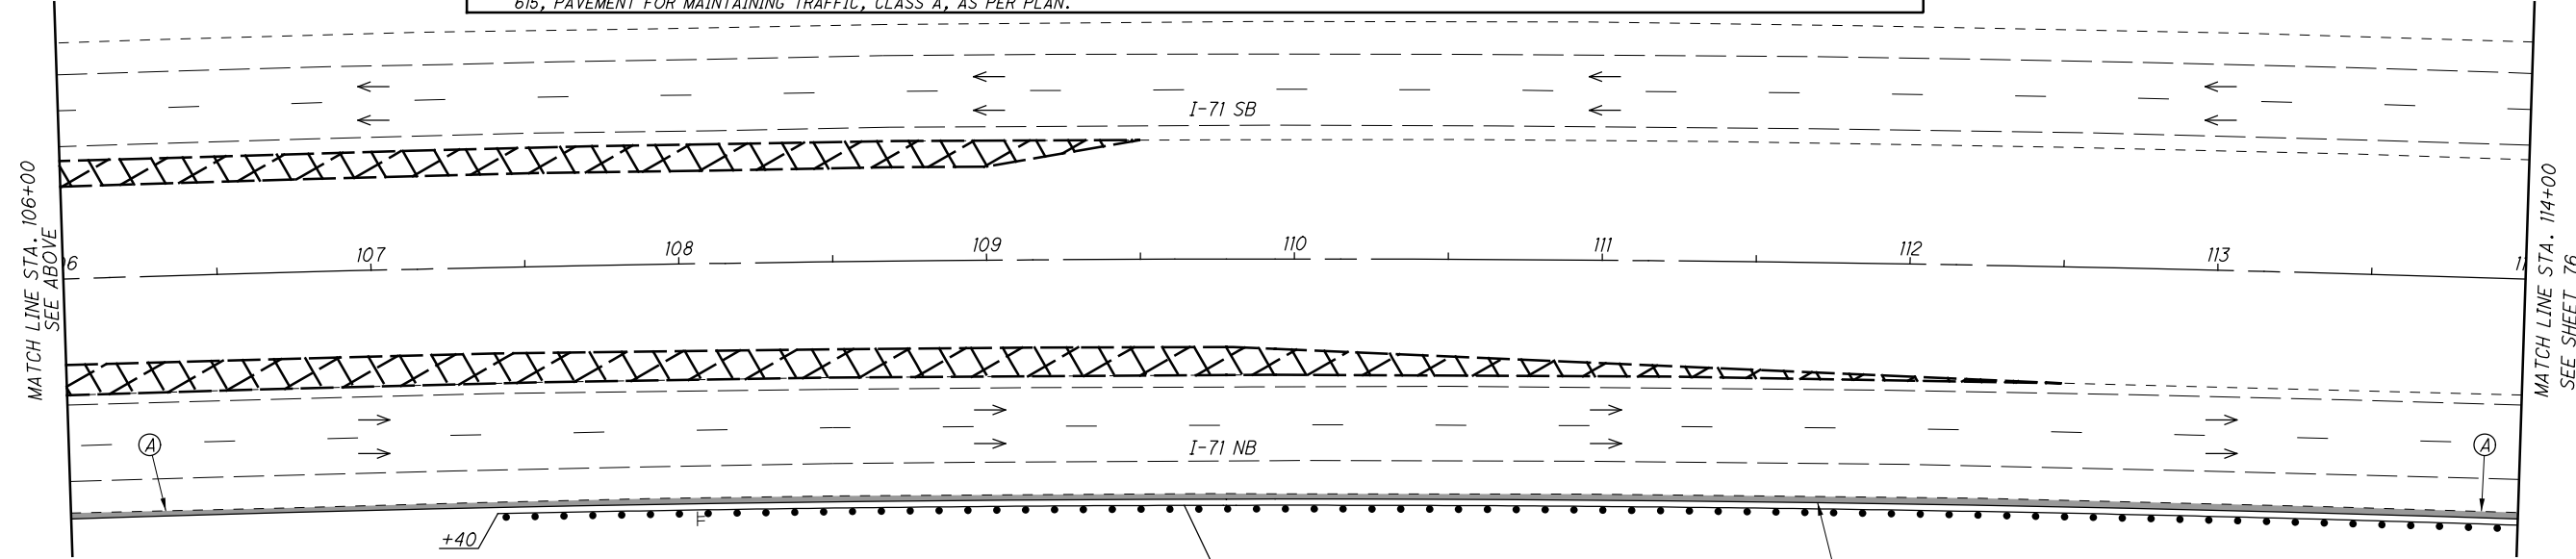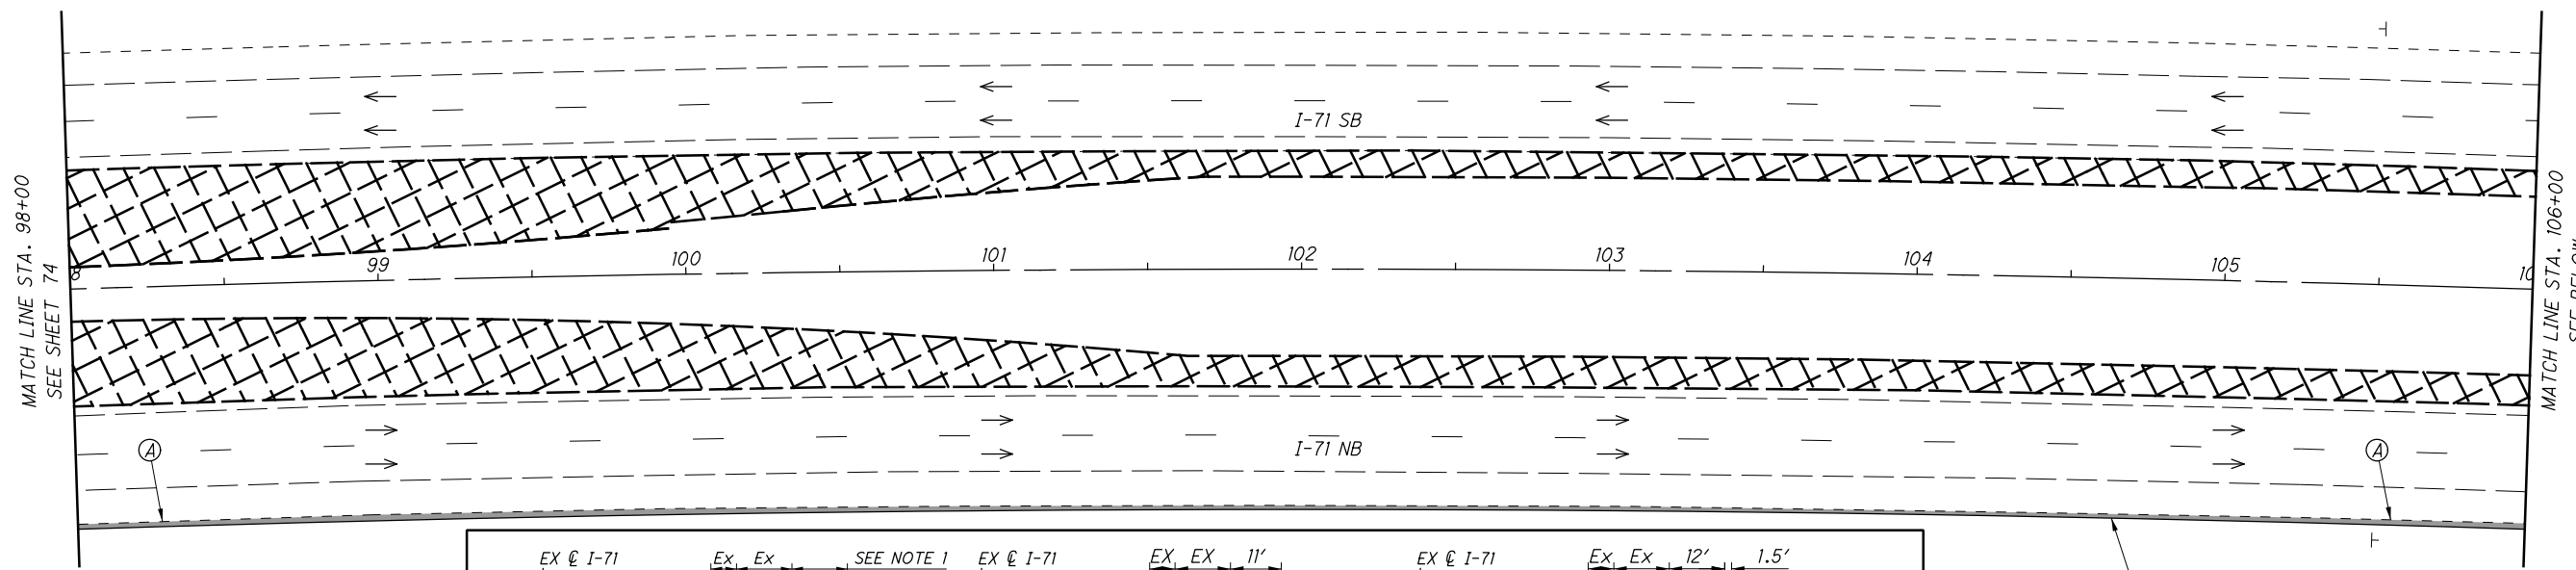

NOTES:
 1. DURING THE HOURS SPECIFIED AS LISTED IN THIS PLAN, NIGHTTIME LANE CLOSURES SHALL BE IMPLEMENTED PER ODOT SCD MT-95.30 FOR SHOULDER WORK AND TEMPORARY PAVEMENT WORK ADJACENT TO I-71. SEE THE WORKING AND NON-WORKING HOURS TYPICAL SECTIONS FOR DETAILS. AS WELL AS THE PRE-PHASE 1 CONSTRUCTION SCHEDULE ON SHEET 46.
 2. EXISTING SHOULDERS THAT ARE TO BE RECONSTRUCTED SHALL BE PLANED TO A DEPTH OF 9 INCHES AND RECONSTRUCTED IN TWO LIFTS OVER TWO NIGHTS (SEE PRE-PHASE 1 CONSTRUCTION SCHEDULE ON SHEET 46). THE FIRST LIFT WILL CONSTRUCT 7.5 INCHES OF ITEM 302 ASPHALT BASE. THE SECOND LIFT WILL CONSTRUCT 1.5 INCHES OF ITEM 441, TYPE 1 SURFACE COURSE. ALL COSTS ASSOCIATED WITH SHOULDER RECONSTRUCTION SHALL BE INCIDENTAL TO ITEM 615, PAVEMENT FOR MAINTAINING TRAFFIC, CLASS A, AS PER PLAN.
 3. WHILE RECONSTRUCTING THE SHOULDERS, THE CONTRACTOR SHALL ALSO MILL AND RESURFACE 1 FOOT INTO THE ADJACENT TRAVEL LANE. THE EXISTING PAVEMENT (INCLUDING THE EDGELINE) SHALL BE PLANED 1.5 INCHES AND RESURFACED WITH 1.5 INCHES OF ITEM 441, TYPE 1 SURFACE COURSE. THIS WORK SHALL BE COMPLETED PER THE PRE-PHASE 1 CONSTRUCTION SCHEDULE ON SHEET 46 AND SHALL ALSO BE INCIDENTAL TO ITEM 615, PAVEMENT FOR MAINTAINING TRAFFIC, CLASS A, AS PER PLAN.


① $\Delta = 26^\circ 54' 48''$ (RT)
 $D_c = 0^\circ 28' 11''$
 $R = 12,199.67'$
 $T = 2919.11'$
 $L = 5730.47'$
 $E = 344.38'$
 $C = 5677.93'$
 $C.B. = N 82^\circ 03' 26'' E$



Ⓐ - MEET/MATCH EXISTING EDGE OF SHOULDER

- LEGEND**
- TEMPORARY PAVEMENT CONSTRUCTED THIS PHASE
 - SHOULDER RECONSTRUCTION
 - TEMPORARY PAVEMENT LEFT IN PLACE FROM THE FRA-71-1.53 PROJECT
 - OPEN TRAVEL LANE

775' TEMPORARY GUARDRAIL, TYPE MGS
 W/(I)-ANCHOR ASSEMBLY, MGS TYPE E W/OFFSET AS SHOWN IN MGS-5.3
 W/(I)-ANCHOR ASSEMBLY, MGS TYPE T


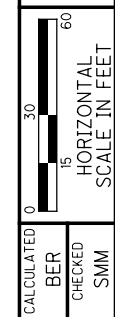


MAINTENANCE OF TRAFFIC PLAN-PRE-PHASE 1 (ASPHALT OPTION) I-71 - STA. 98+00 TO STA. 114+00

FRA-71-0.00

75
1312

J:\20130212\ODOT\FRA\107201\mot\sheet\107201MP288.dgn 8/6/2020 4:21:57 AM brieder

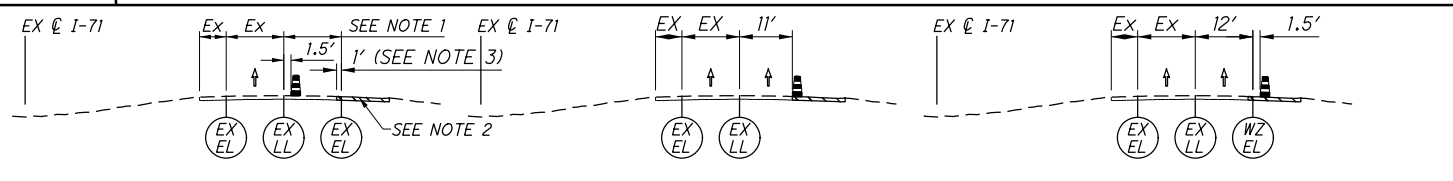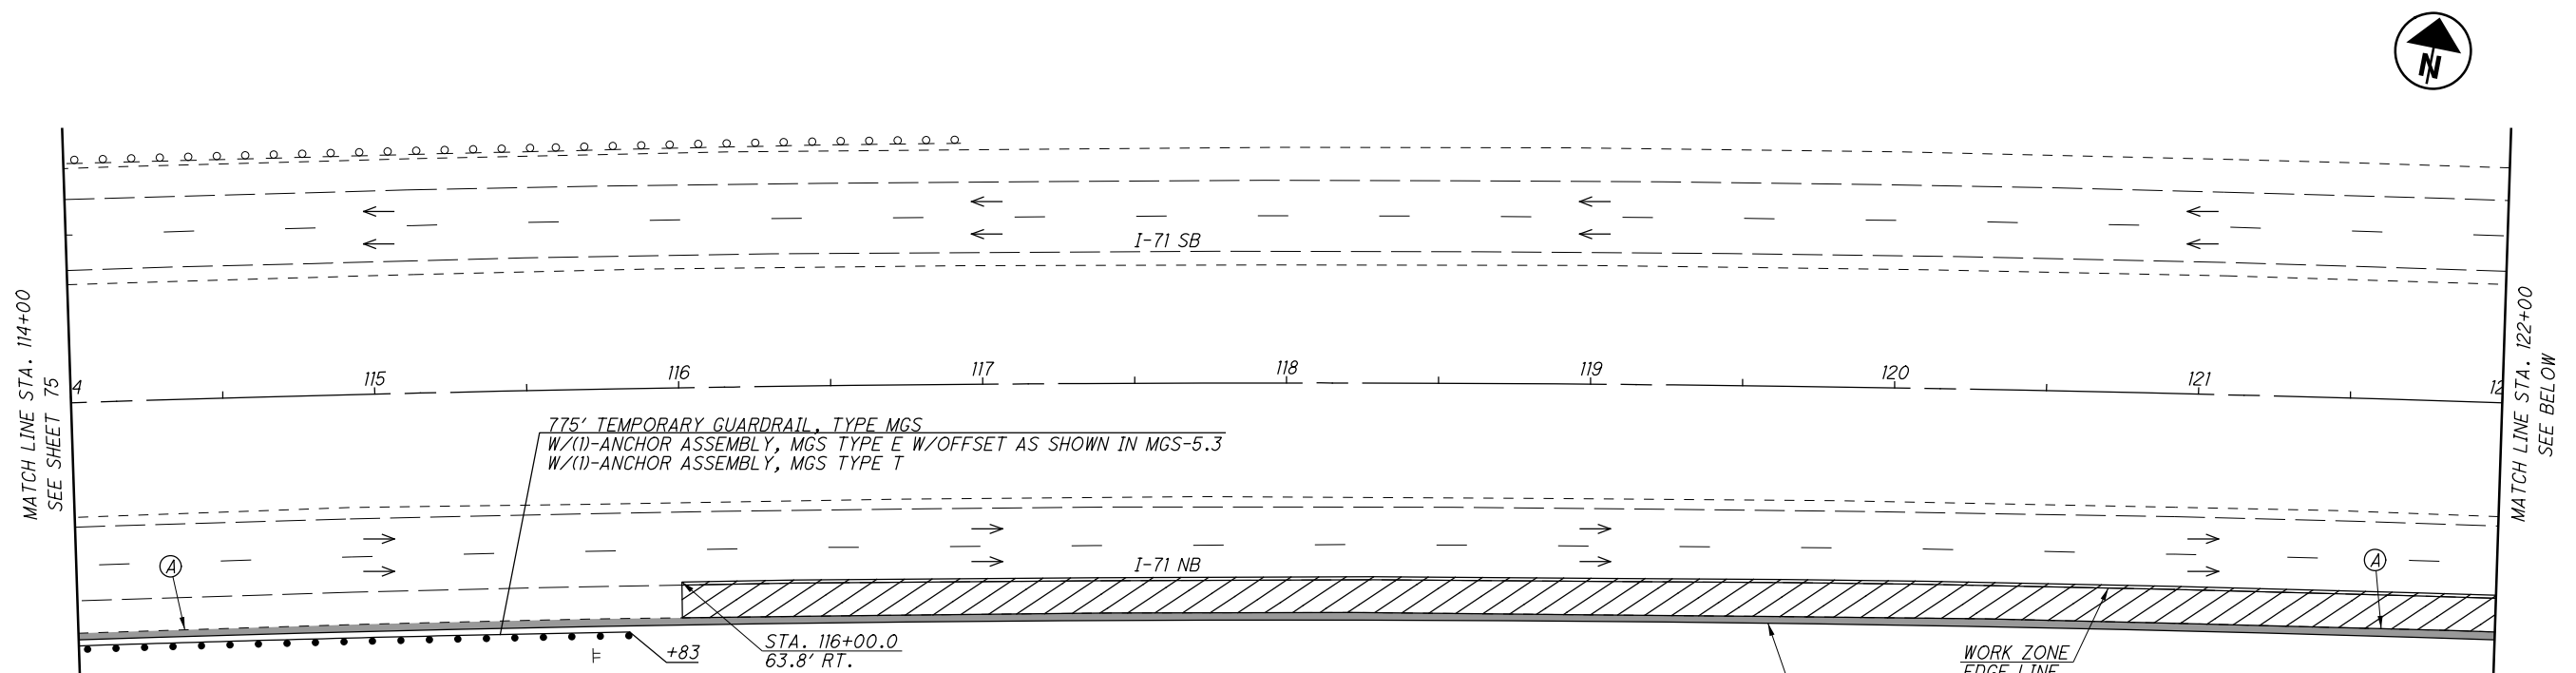

TYPICAL SECTION - WORKING HOURS TYPICAL SECTION - INTERIM CONDITION (SEE SHEET 46 SCHEDULE) TYPICAL SECTION - NON-WORKING HOURS

NOTES:


1. DURING THE HOURS SPECIFIED AS LISTED IN THIS PLAN, NIGHTTIME LANE CLOSURES SHALL BE IMPLEMENTED PER ODOT SCD MT-95.30 FOR SHOULDER WORK AND TEMPORARY PAVEMENT WORK ADJACENT TO I-71. SEE THE WORKING AND NON-WORKING HOURS TYPICAL SECTIONS FOR DETAILS. AS WELL AS THE PRE-PHASE 1 CONSTRUCTION SCHEDULE ON SHEET 46.

2. EXISTING SHOULDERS THAT ARE TO BE RECONSTRUCTED SHALL BE PLANNED TO A DEPTH OF 9 INCHES AND RECONSTRUCTED IN TWO LIFTS OVER TWO NIGHTS (SEE PRE-PHASE 1 CONSTRUCTION SCHEDULE ON SHEET 46). THE FIRST LIFT WILL CONSTRUCT 7.5 INCHES OF ITEM 302 ASPHALT BASE. THE SECOND LIFT WILL CONSTRUCT 1.5 INCHES OF ITEM 441, TYPE 1 SURFACE COURSE. ALL COSTS ASSOCIATED WITH SHOULDER RECONSTRUCTION SHALL BE INCIDENTAL TO ITEM 615, PAVEMENT FOR MAINTAINING TRAFFIC, CLASS A, AS PER PLAN.

3. WHILE RECONSTRUCTING THE SHOULDERS, THE CONTRACTOR SHALL ALSO MILL AND RESURFACE 1 FOOT INTO THE ADJACENT TRAVEL LANE. THE EXISTING PAVEMENT (INCLUDING THE EDGELINE) SHALL BE PLANNED 1.5 INCHES AND RESURFACED WITH 1.5 INCHES OF ITEM 441, TYPE 1 SURFACE COURSE. THIS WORK SHALL BE COMPLETED PER THE PRE-PHASE 1 CONSTRUCTION SCHEDULE ON SHEET 46 AND SHALL ALSO BE INCIDENTAL TO ITEM 615, PAVEMENT FOR MAINTAINING TRAFFIC, CLASS A, AS PER PLAN.



① $\Delta = 26^\circ 54' 48''$ (RT)
 $D_c = 0^\circ 28' 11''$
 $R = 12,199.67'$
 $T = 2919.11'$
 $L = 5730.47'$
 $E = 344.38'$
 $C = 5677.93'$
 $C.B. = N 82^\circ 03' 26'' E$

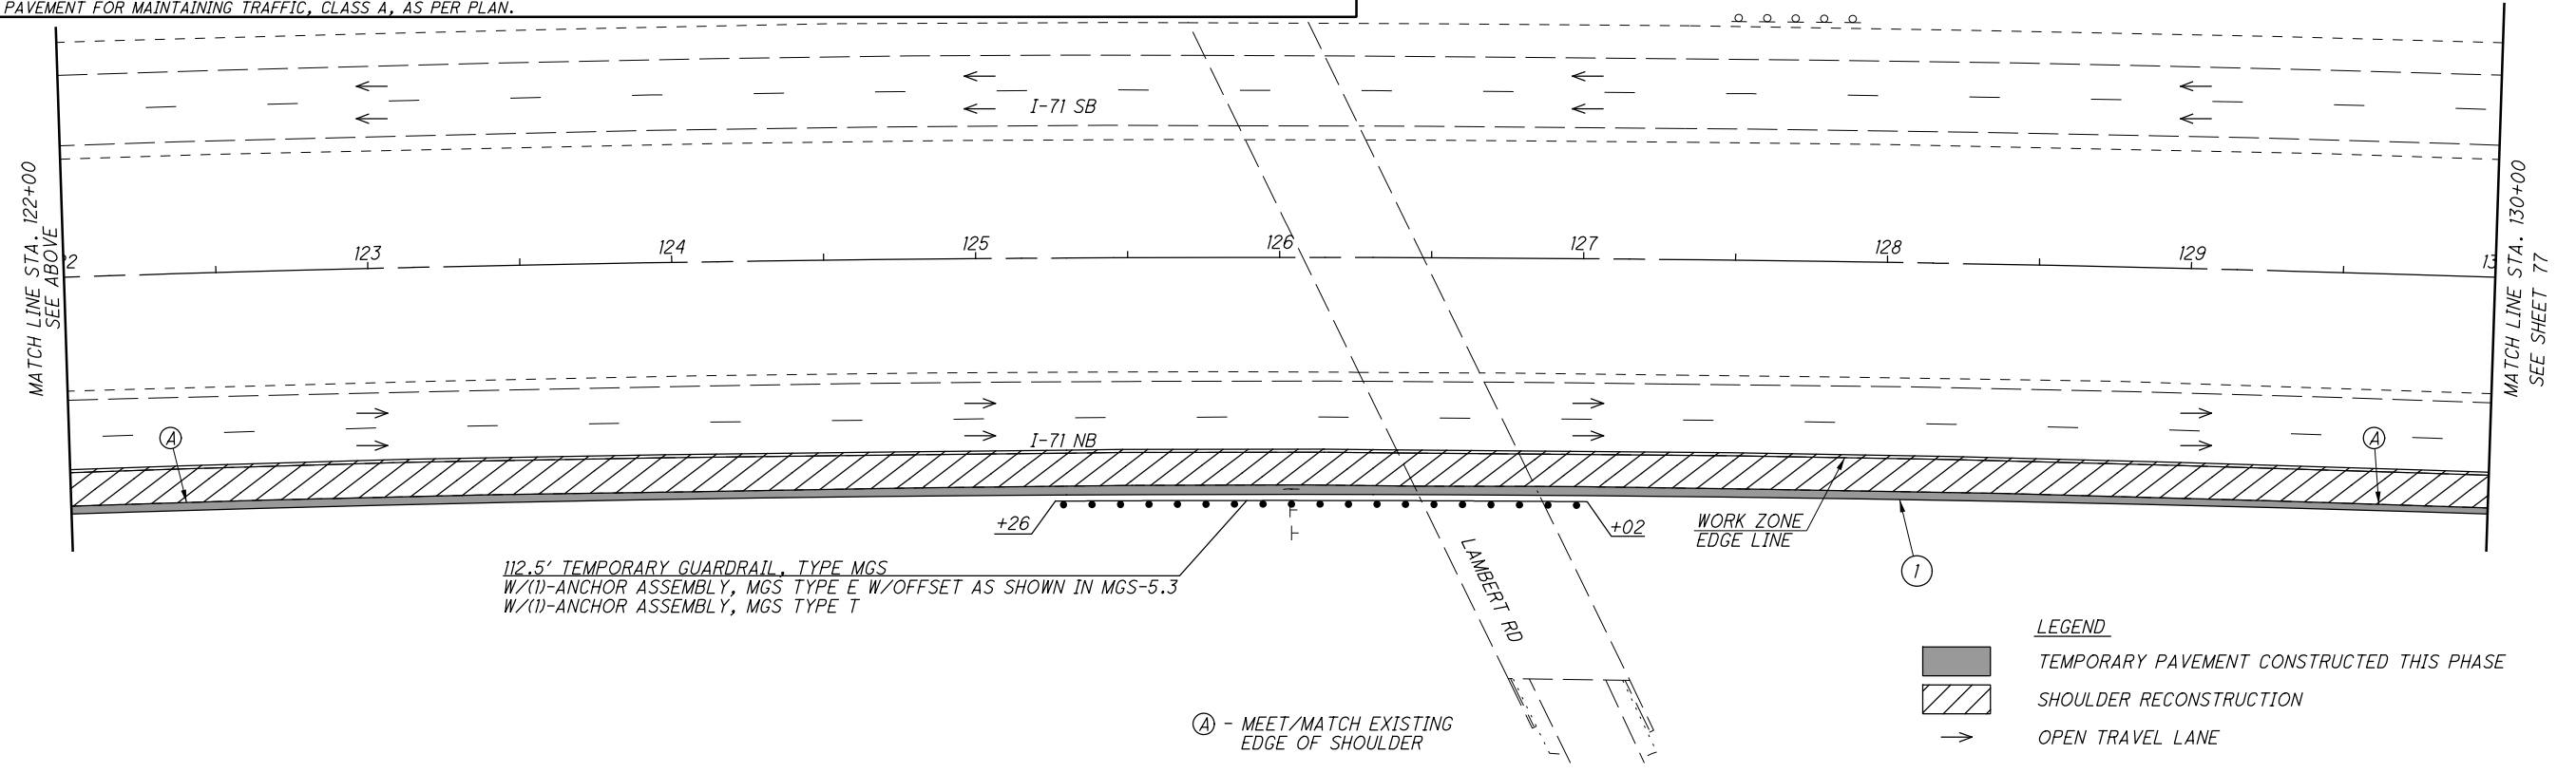

LEGEND

TEMPORARY PAVEMENT CONSTRUCTED THIS PHASE

SHOULDER RECONSTRUCTION

OPEN TRAVEL LANE

Ⓐ - MEET/MATCH EXISTING
EDGE OF SHOULDER

MAINTENANCE OF TRAFFIC PLAN-PRE-PHASE 1
(ASPHALT OPTION) I-71 - STA. 114+00 TO STA. 130+00



FRA-71-0.00

76
1312

CALCULATED
BER
CHECKED
SMM

0 15 30 60
HORIZONTAL
SCALE IN FEET


J:\20130212\ODOT\FRA\107201\mot\sheet\107201MP290.dgn 8/6/2020 4:24:23 AM brieder

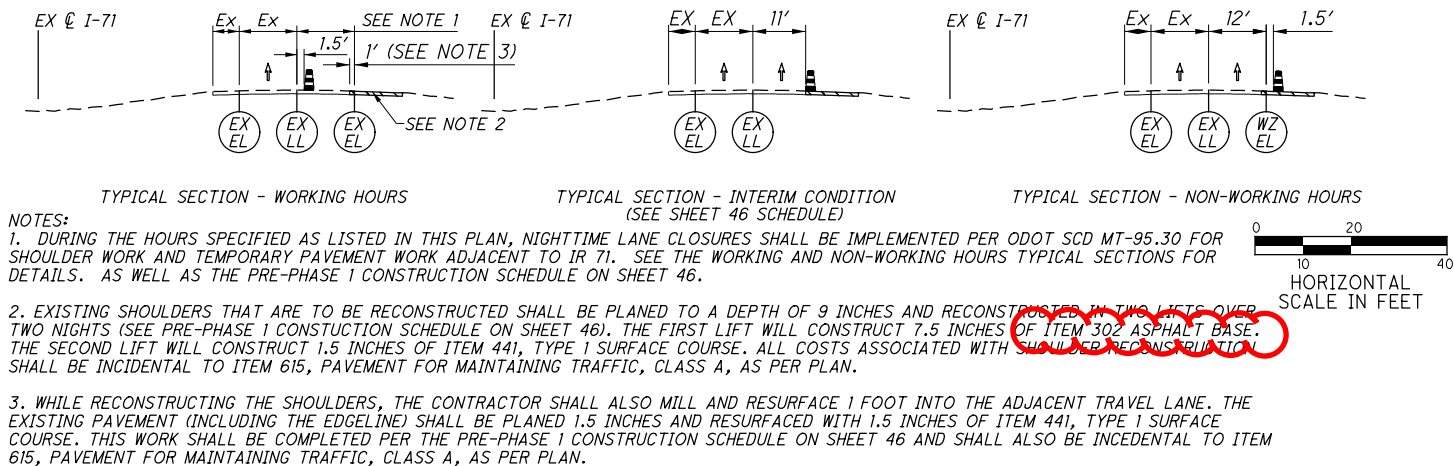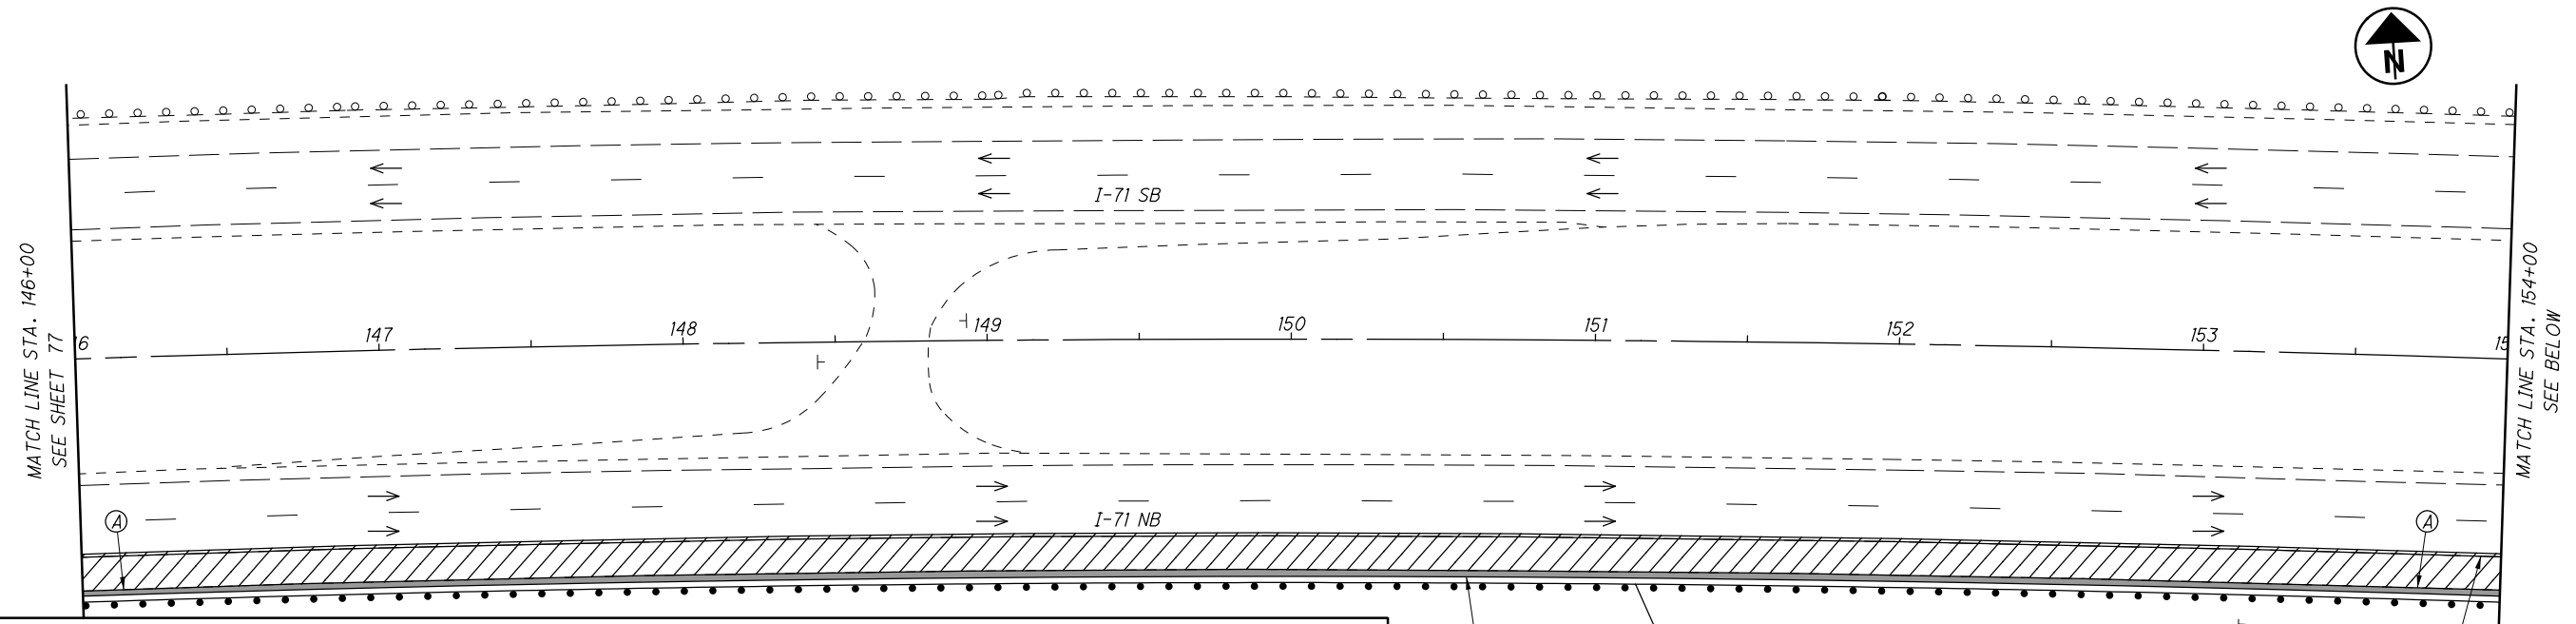

NOTES:
 1. DURING THE HOURS SPECIFIED AS LISTED IN THIS PLAN, NIGHTTIME LANE CLOSURES SHALL BE IMPLEMENTED PER ODOT SCD MT-95.30 FOR SHOULDER WORK AND TEMPORARY PAVEMENT WORK ADJACENT TO I-71. SEE THE WORKING AND NON-WORKING HOURS TYPICAL SECTIONS FOR DETAILS. AS WELL AS THE PRE-PHASE 1 CONSTRUCTION SCHEDULE ON SHEET 46.
 2. EXISTING SHOULDERS THAT ARE TO BE RECONSTRUCTED SHALL BE PLANED TO A DEPTH OF 9 INCHES AND RECONSTRUCTED IN TWO LIFTS OVER TWO NIGHTS (SEE PRE-PHASE 1 CONSTRUCTION SCHEDULE ON SHEET 46). THE FIRST LIFT WILL CONSTRUCT 7.5 INCHES OF ITEM 302 ASPHALT BASE. THE SECOND LIFT WILL CONSTRUCT 1.5 INCHES OF ITEM 441, TYPE 1 SURFACE COURSE. ALL COSTS ASSOCIATED WITH SHOULDER RECONSTRUCTION SHALL BE INCIDENTAL TO ITEM 615, PAVEMENT FOR MAINTAINING TRAFFIC, CLASS A, AS PER PLAN.
 3. WHILE RECONSTRUCTING THE SHOULDERS, THE CONTRACTOR SHALL ALSO MILL AND RESURFACE 1 FOOT INTO THE ADJACENT TRAVEL LANE. THE EXISTING PAVEMENT (INCLUDING THE EDGELINE) SHALL BE PLANED 1.5 INCHES AND RESURFACED WITH 1.5 INCHES OF ITEM 441, TYPE 1 SURFACE COURSE. THIS WORK SHALL BE COMPLETED PER THE PRE-PHASE 1 CONSTRUCTION SCHEDULE ON SHEET 46 AND SHALL ALSO BE INCIDENTAL TO ITEM 615, PAVEMENT FOR MAINTAINING TRAFFIC, CLASS A, AS PER PLAN.

1475' TEMPORARY GUARDRAIL, TYPE MGS
 W/(1)-ANCHOR ASSEMBLY, MGS TYPE E W/OFFSET AS SHOWN IN MGS-5.3
 W/(1)-MGS BRIDGE TERMINAL ASSEMBLY, TYPE 1

① $\Delta = 26^\circ 54' 48''$ (RT)
 $D_c = 0^\circ 28' 11''$
 $R = 12,199.67'$
 $T = 2919.11'$
 $L = 5730.47'$
 $E = 344.38'$
 $C = 5677.93'$
 $C.B. = N 82^\circ 03' 26'' E$

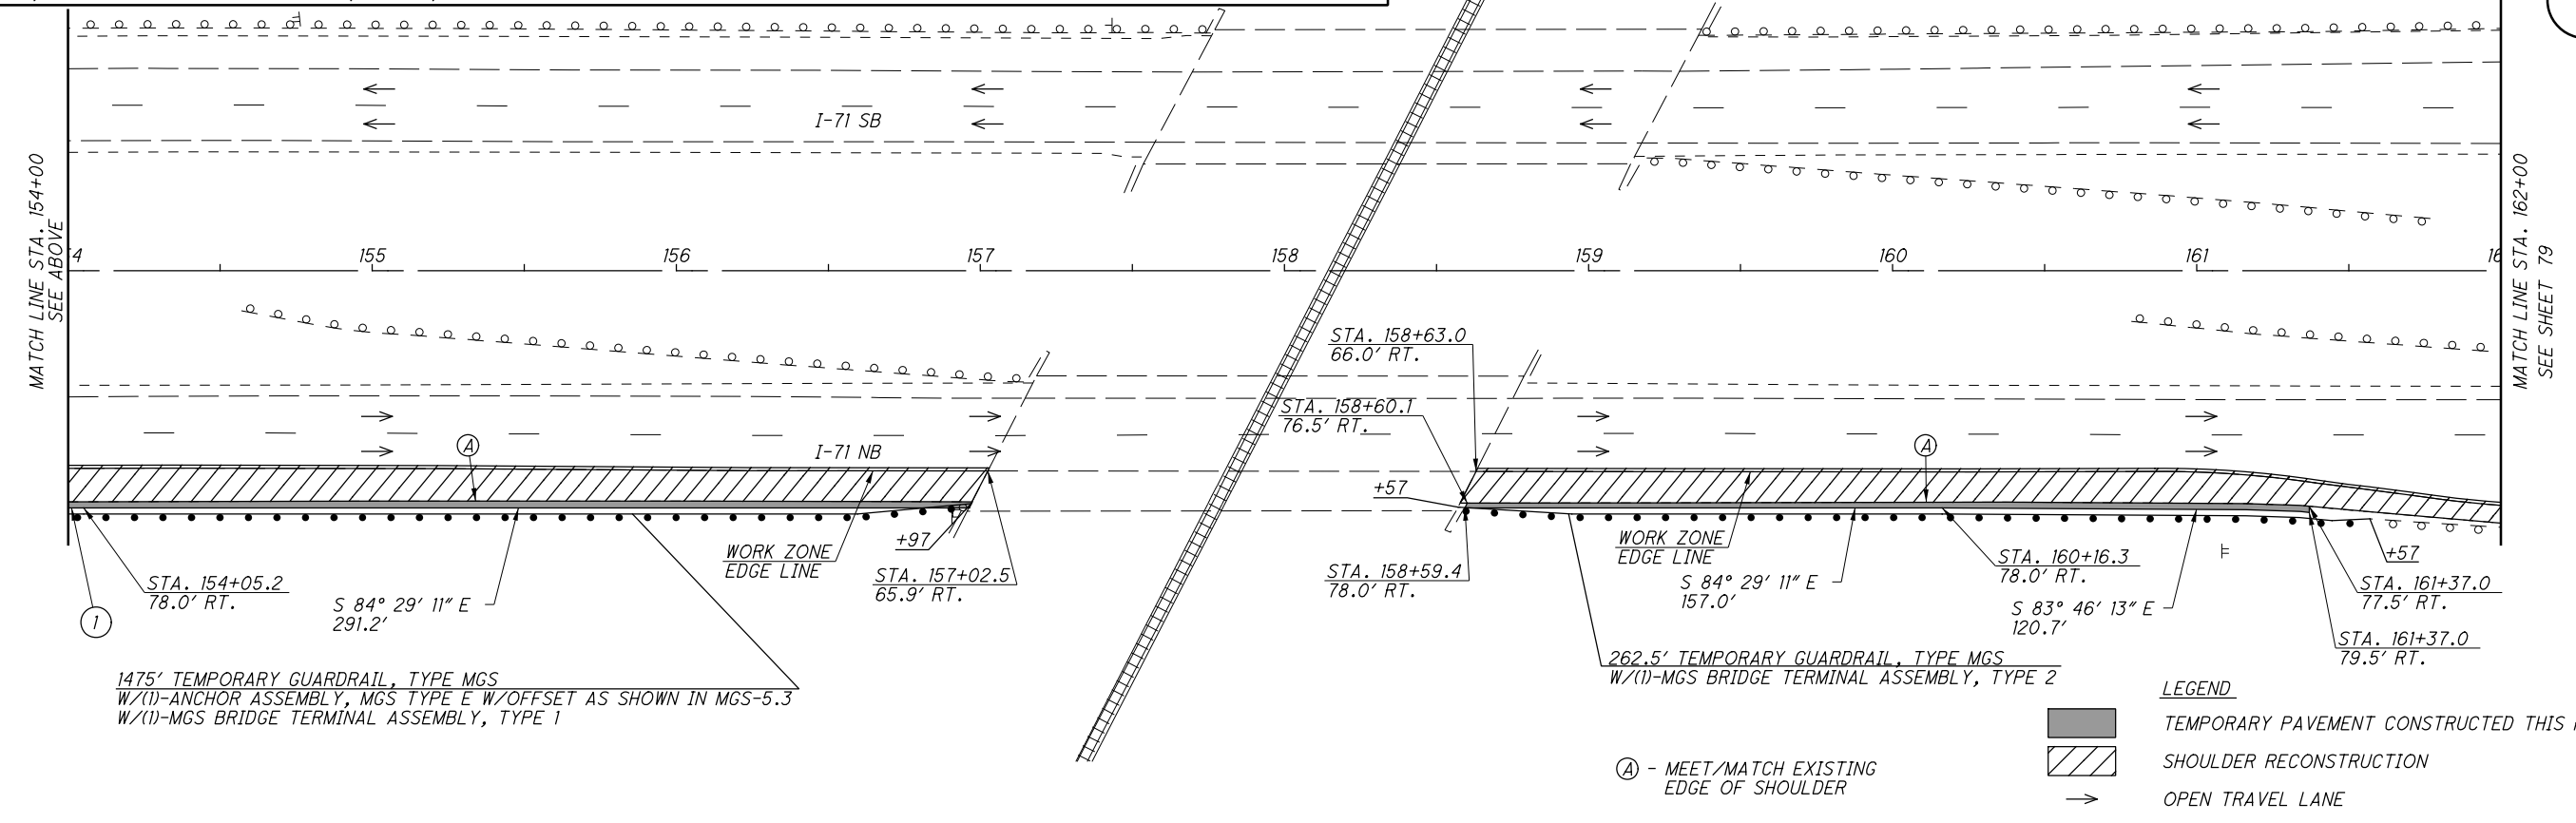

1475' TEMPORARY GUARDRAIL, TYPE MGS
 W/(1)-ANCHOR ASSEMBLY, MGS TYPE E W/OFFSET AS SHOWN IN MGS-5.3
 W/(1)-MGS BRIDGE TERMINAL ASSEMBLY, TYPE 1

262.5' TEMPORARY GUARDRAIL, TYPE MGS
 W/(1)-MGS BRIDGE TERMINAL ASSEMBLY, TYPE 2

LEGEND
 TEMPORARY PAVEMENT CONSTRUCTED THIS PHASE
 SHOULDER RECONSTRUCTION
 OPEN TRAVEL LANE

MAINTENANCE OF TRAFFIC PLAN-PRE-PHASE 1
(ASPHALT OPTION) I-71 - STA. 146+00 TO STA. 162+00



FRA-71-0.00

78
 1312

CALCULATED
 BER
 CHECKED
 SMM


0 30 60
 HORIZONTAL
 SCALE IN FEET

J:\20130212\ODOT\FRA\107201\mot\sheet\107201MP291.dgn 8/6/2020 4:25:31 AM brieder

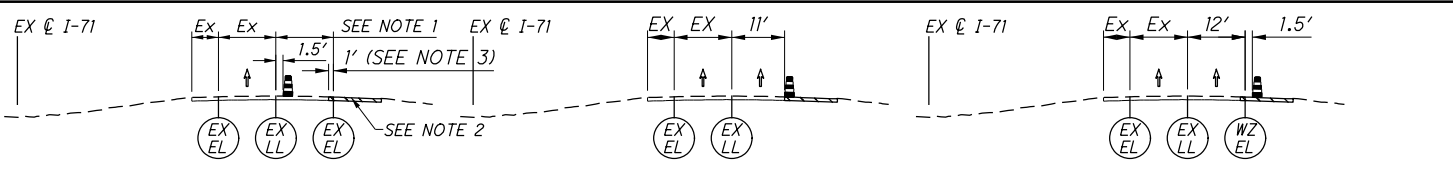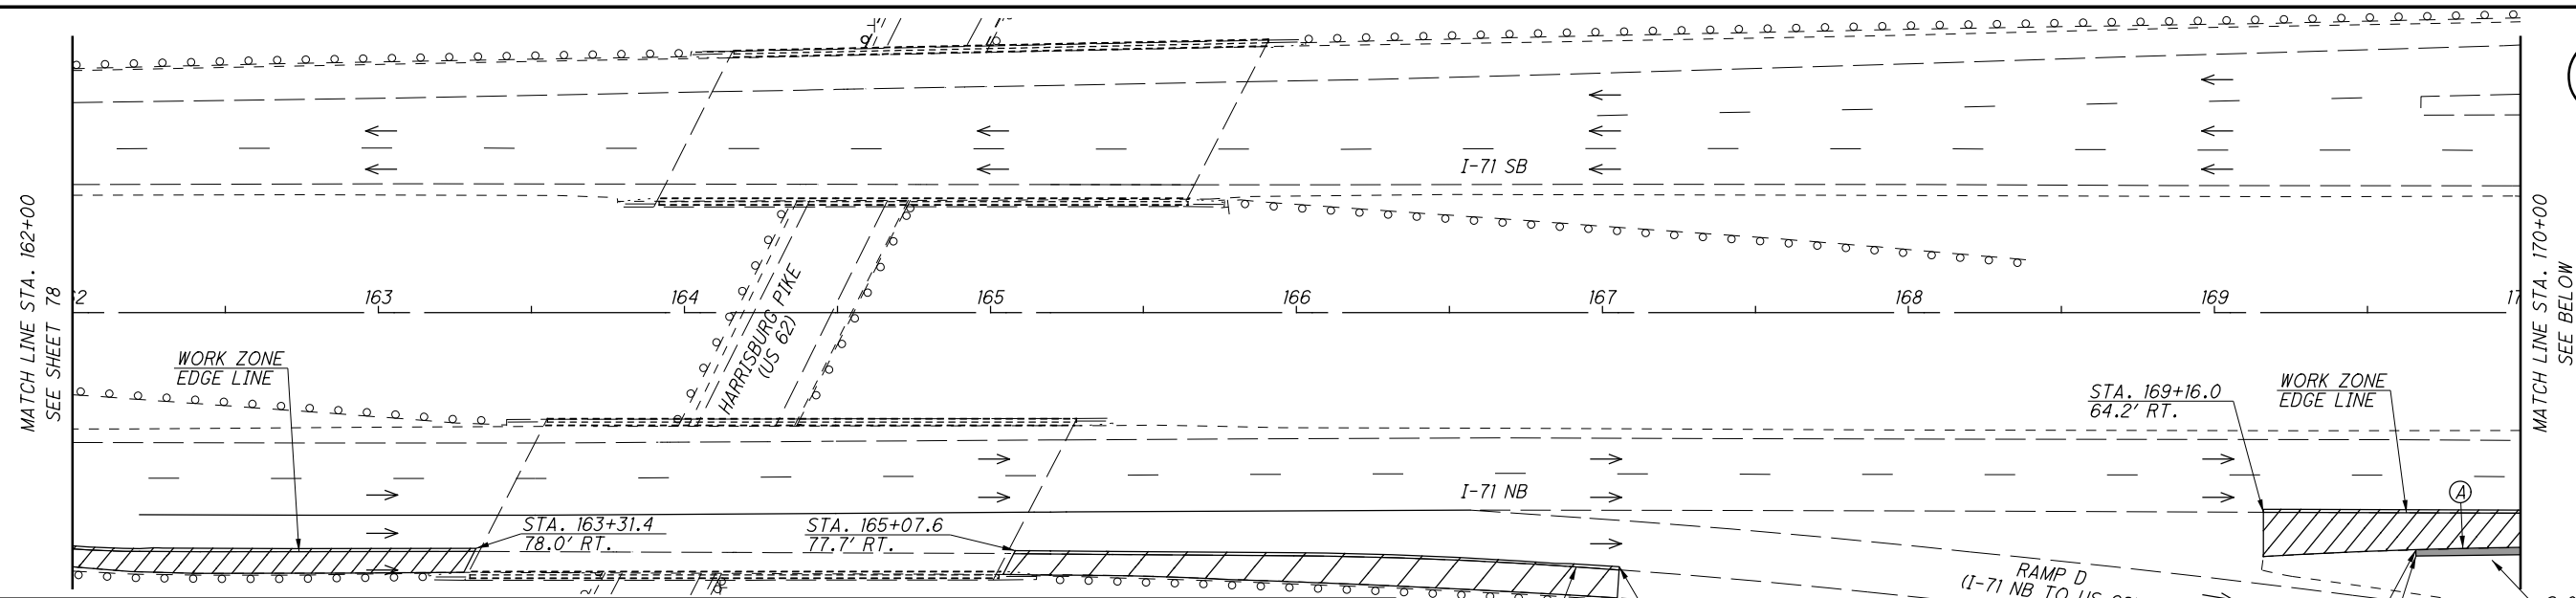


NOTES:

- DURING THE HOURS SPECIFIED AS LISTED IN THIS PLAN, NIGHTTIME LANE CLOSURES SHALL BE IMPLEMENTED PER ODOT SCD MT-95.30 FOR SHOULDER WORK AND TEMPORARY PAVEMENT WORK ADJACENT TO I-71. SEE THE WORKING AND NON-WORKING HOURS TYPICAL SECTIONS FOR DETAILS. AS WELL AS THE PRE-PHASE 1 CONSTRUCTION SCHEDULE ON SHEET 46.
- EXISTING SHOULDERS THAT ARE TO BE RECONSTRUCTED SHALL BE PLANNED TO A DEPTH OF 9 INCHES AND RECONSTRUCTED IN TWO LIFTS OVER TWO NIGHTS (SEE PRE-PHASE 1 CONSTRUCTION SCHEDULE ON SHEET 46). THE FIRST LIFT WILL CONSTRUCT 7.5 INCHES OF ITEM 302 ASPHALT BASE. THE SECOND LIFT WILL CONSTRUCT 1.5 INCHES OF ITEM 441, TYPE 1 SURFACE COURSE. ALL COSTS ASSOCIATED WITH SHOULDER RECONSTRUCTION SHALL BE INCIDENTAL TO ITEM 615, PAVEMENT FOR MAINTAINING TRAFFIC, CLASS A, AS PER PLAN.
- WHILE RECONSTRUCTING THE SHOULDERS, THE CONTRACTOR SHALL ALSO MILL AND RESURFACE 1 FOOT INTO THE ADJACENT TRAVEL LANE. THE EXISTING PAVEMENT (INCLUDING THE EDGELINE) SHALL BE PLANNED 1.5 INCHES AND RESURFACED WITH 1.5 INCHES OF ITEM 441, TYPE 1 SURFACE COURSE. THIS WORK SHALL BE COMPLETED PER THE PRE-PHASE 1 CONSTRUCTION SCHEDULE ON SHEET 46 AND SHALL ALSO BE INCIDENTAL TO ITEM 615, PAVEMENT FOR MAINTAINING TRAFFIC, CLASS A, AS PER PLAN.

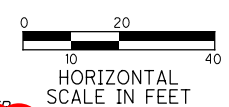

① $\Delta = 2^\circ 46' 57''$ (LT)
 $Dc = 0^\circ 39' 39''$
 $R = 8672.37'$
 $T = 210.63'$
 $L = 421.18'$
 $E = 2.56'$
 $C = 421.14'$
 $C.B. = S 85^\circ 52' 39'' E$

② $\Delta = 2^\circ 02' 44''$ (LT)
 $Dc = 0^\circ 58' 08''$
 $R = 5926.19'$
 $T = 105.79'$
 $L = 211.56'$
 $E = 0.94'$
 $C = 211.55'$
 $C.B. = S 87^\circ 33' 41'' E$

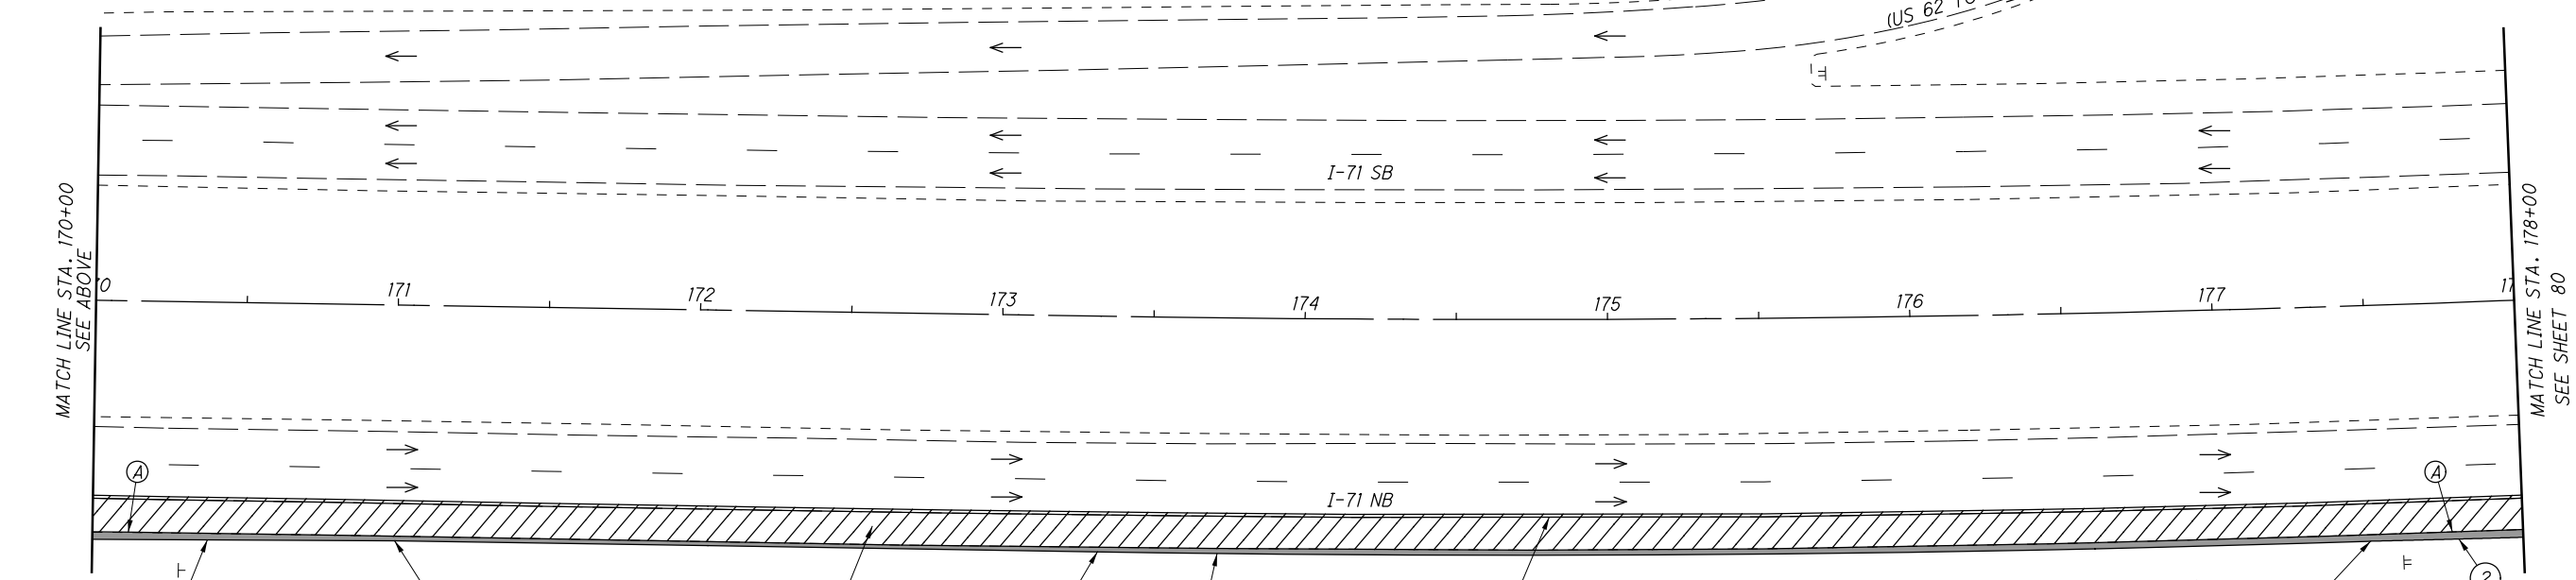

LEGEND

- TEMPORARY PAVEMENT CONSTRUCTED THIS PHASE
- SHOULDER RECONSTRUCTION
- OPEN TRAVEL LANE

Ⓐ - MEET/MATCH EXISTING EDGE OF SHOULDER




CALCULATED BY BER CHECKED BY SMM

MAINTENANCE OF TRAFFIC PLAN-PRE-PHASE 1 (ASPHALT OPTION) I-71 - STA. 162+00 TO STA. 178+00

FRA-71-0.00

79
1312

| | | |
|---|---|---|
| ① $\Delta = 2^\circ 02' 44''$ (LT) Dc = $0^\circ 58' 08''$ R = 5926.19' T = 105.79' L = 211.56' E = 0.94' C = 211.55' C.B. = S $87^\circ 33' 41''$ E | ② $\Delta = 4^\circ 23' 50''$ (LT) Dc = $0^\circ 34' 49''$ R = 9874.62' T = 379.10' L = 757.83' E = 7.28' C = 757.65' C.B. = N $84^\circ 25' 29''$ E | ③ $\Delta = 12^\circ 36' 44''$ (LT) Dc = $0^\circ 39' 38''$ R = 8673.84' T = 958.55' L = 1909.35' E = 52.80' C = 1905.50' C.B. = N $76^\circ 38' 15''$ E |
|---|---|---|

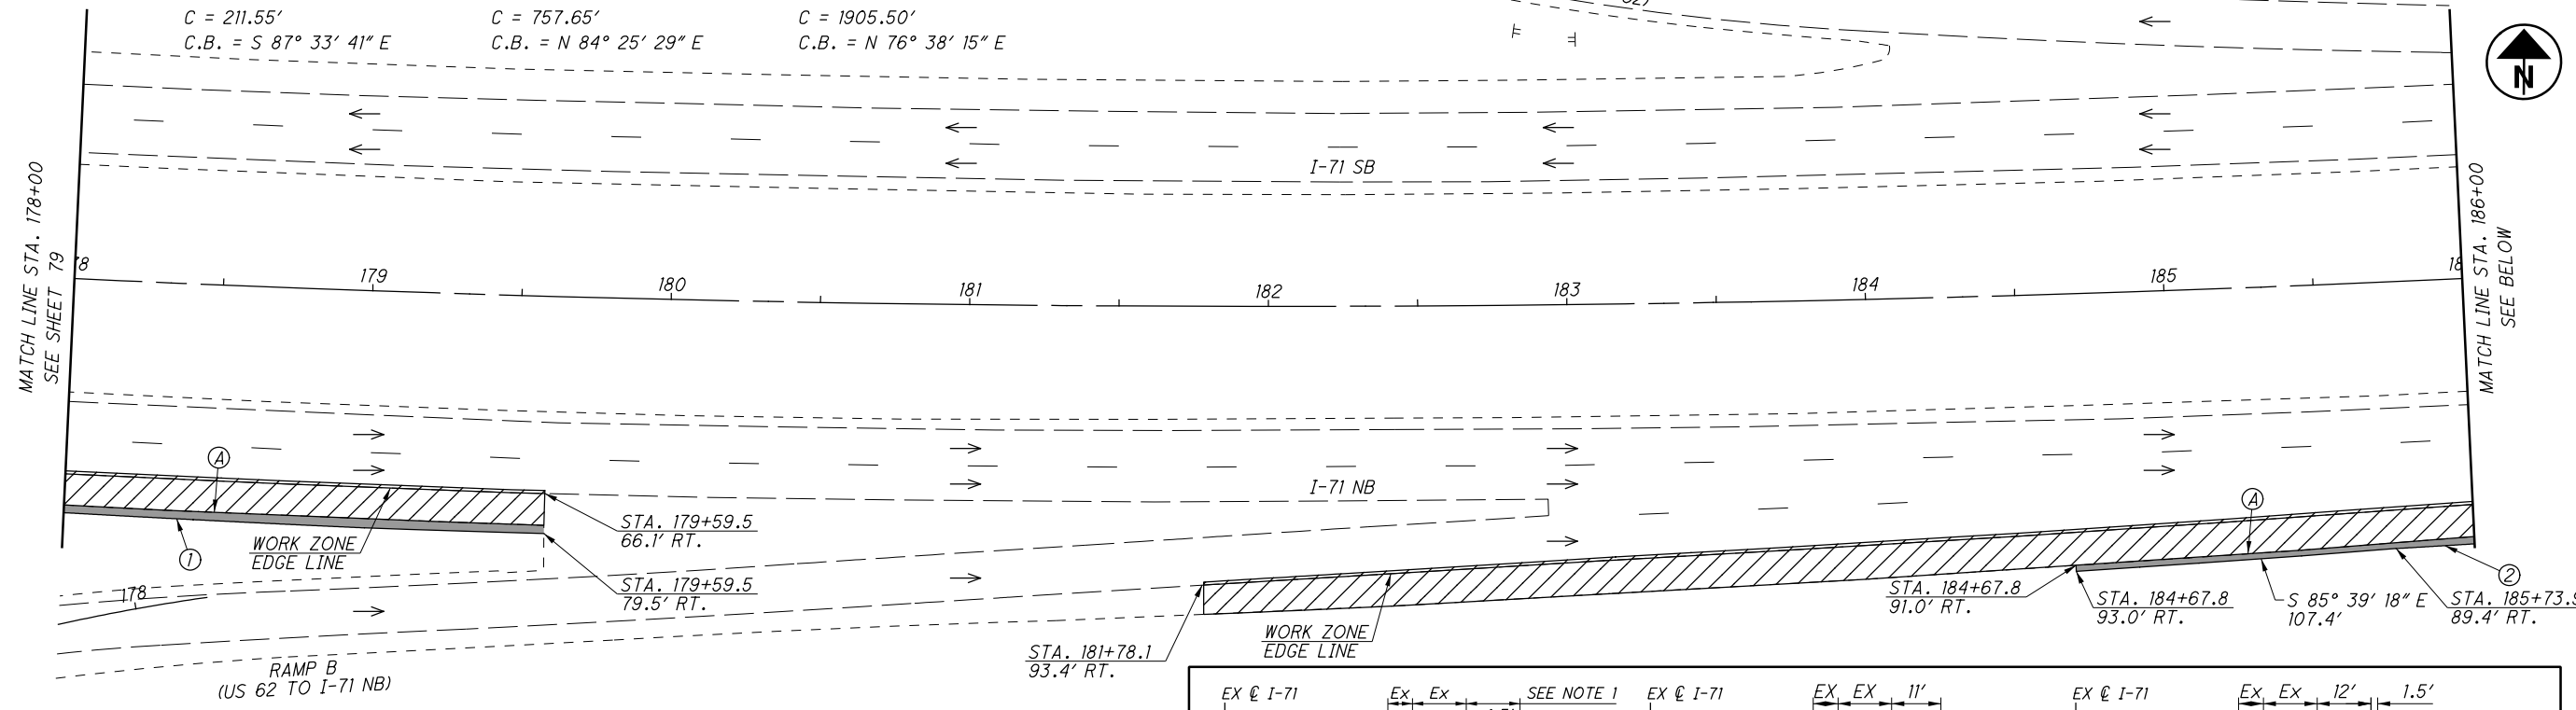

① - MEET/MATCH PROPOSED EDGE OF SHOULDER

LEGEND

- SHOULDER RECONSTRUCTION
- TEMPORARY PAVEMENT CONSTRUCTED THIS PHASE
- OPEN TRAVEL LANE


TYPICAL SECTION - WORKING HOURS

TYPICAL SECTION - INTERIM CONDITION (SEE SHEET 46 SCHEDULE)

TYPICAL SECTION - NON-WORKING HOURS

NOTES:

- DURING THE HOURS SPECIFIED AS LISTED IN THIS PLAN, NIGHTTIME LANE CLOSURES SHALL BE IMPLEMENTED PER ODOT SCD MT-95.30 FOR SHOULDER WORK AND TEMPORARY PAVEMENT WORK ADJACENT TO I-71. SEE THE WORKING AND NON-WORKING HOURS TYPICAL SECTIONS FOR DETAILS. AS WELL AS THE PRE-PHASE 1 CONSTRUCTION SCHEDULE ON SHEET 46.
- EXISTING SHOULDERS THAT ARE TO BE RECONSTRUCTED SHALL BE PLANED TO A DEPTH OF 9 INCHES AND RECONSTRUCTED IN TWO LIFTS OVER TWO NIGHTS (SEE PRE-PHASE 1 CONSTRUCTION SCHEDULE ON SHEET 46). THE FIRST LIFT WILL CONSTRUCT 7.5 INCHES OF ITEM 302 ASPHALT BASE. THE SECOND LIFT WILL CONSTRUCT 1.5 INCHES OF ITEM 441, TYPE 1 SURFACE COURSE. ALL COSTS ASSOCIATED WITH SHOULDER RECONSTRUCTION SHALL BE INCIDENTAL TO ITEM 615, PAVEMENT FOR MAINTAINING TRAFFIC, CLASS A, AS PER PLAN.
- WHILE RECONSTRUCTING THE SHOULDERS, THE CONTRACTOR SHALL ALSO MILL AND RESURFACE 1 FOOT INTO THE ADJACENT TRAVEL LANE. THE EXISTING PAVEMENT (INCLUDING THE EDGELINE) SHALL BE PLANED 1.5 INCHES AND RESURFACED WITH 1.5 INCHES OF ITEM 441, TYPE 1 SURFACE COURSE. THIS WORK SHALL BE COMPLETED PER THE PRE-PHASE 1 CONSTRUCTION SCHEDULE ON SHEET 46 AND SHALL ALSO BE INCIDENTAL TO ITEM 615, PAVEMENT FOR MAINTAINING TRAFFIC, CLASS A, AS PER PLAN.

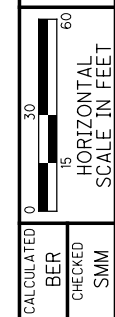

CALCULATED BY BER CHECKED BY SMM
MAINTENANCE OF TRAFFIC PLAN-PRE-PHASE 1
(ASPHALT OPTION) I-71 - STA. 178+00 TO STA. 194+00

FRA-71-0.00


80
 1312

J:\20130212\ODOT\FRA\107201\mot\sheet\107201MP292.dgn 8/6/2020 4:26:42 AM brieder

J:\20130212\ODOT\FRA\107201\mot\sheet\107201MP293.dgn 8/6/2020 4:27:54 AM brieder

MATCH LINE STA. 194+00
SEE SHEET 80

MATCH LINE STA. 202+00
SEE BELOW

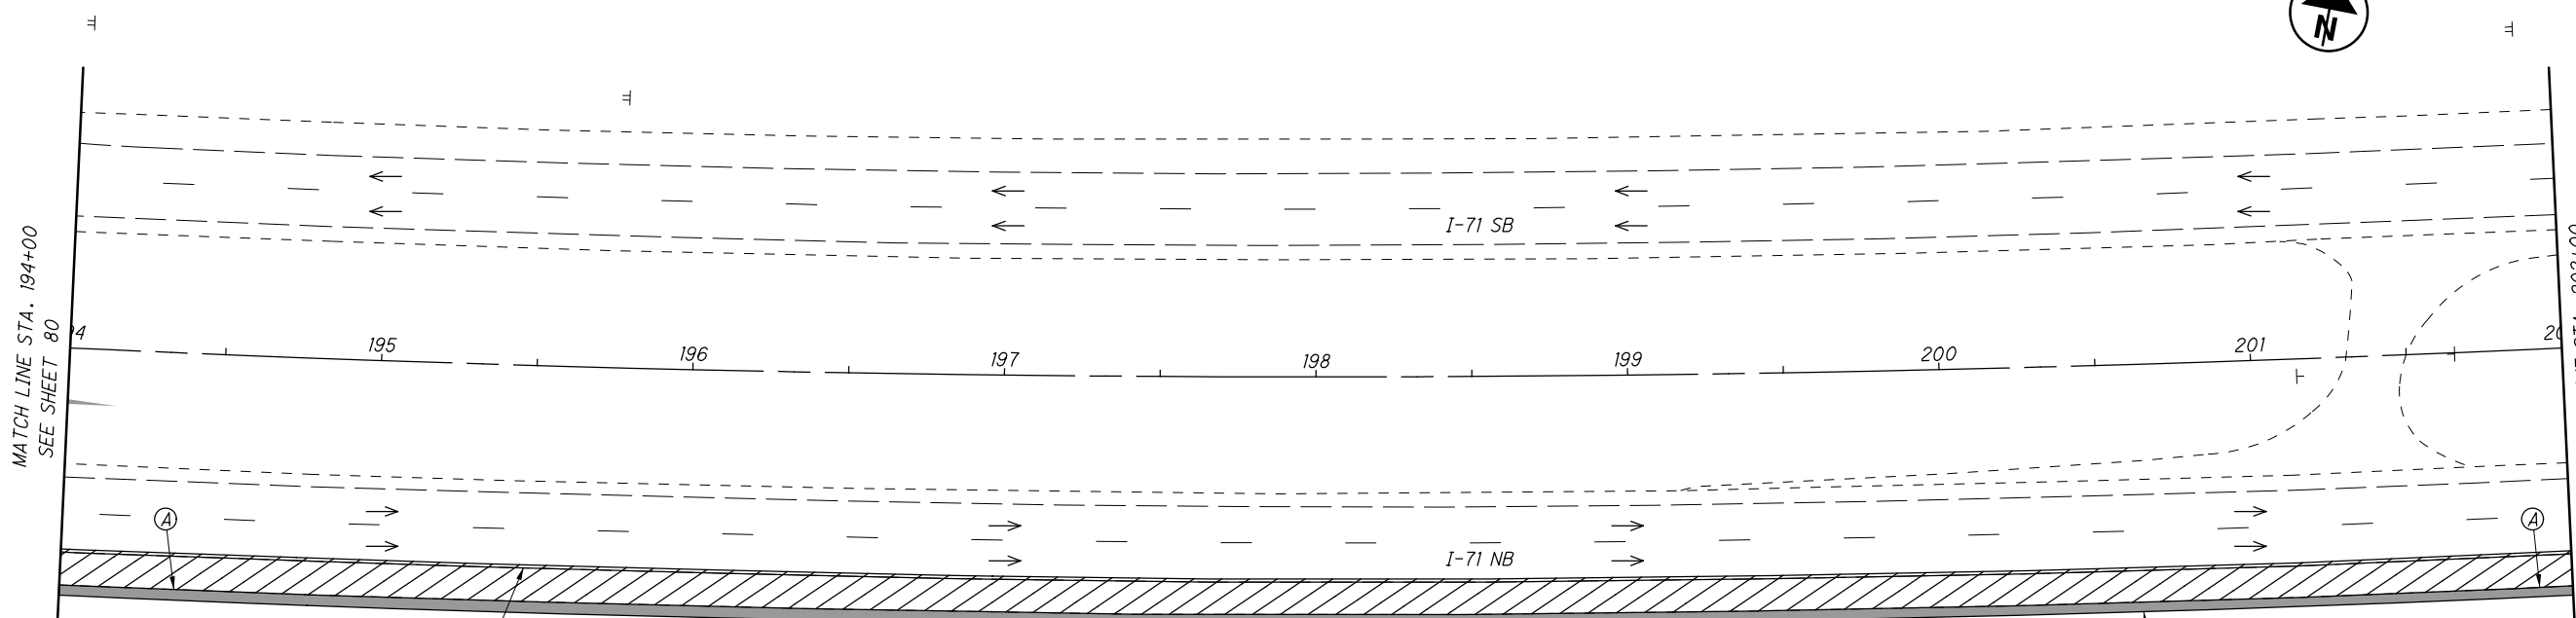

TYPICAL SECTION - WORKING HOURS
 EX @ I-71, EX, EX, 1.5', SEE NOTE 1, EX @ I-71, EX, EX, 11', EX @ I-71, EX, EX, 12', 1.5'

TYPICAL SECTION - INTERIM CONDITION
 (SEE SHEET 46 SCHEDULE)

TYPICAL SECTION - NON-WORKING HOURS


NOTES:
 1. DURING THE HOURS SPECIFIED AS LISTED IN THIS PLAN, NIGHTTIME LANE CLOSURES SHALL BE IMPLEMENTED PER ODOT SCD MT-95.30 FOR SHOULDER WORK AND TEMPORARY PAVEMENT WORK ADJACENT TO I-71. SEE THE WORKING AND NON-WORKING HOURS TYPICAL SECTIONS FOR DETAILS. AS WELL AS THE PRE-PHASE 1 CONSTRUCTION SCHEDULE ON SHEET 46.
 2. EXISTING SHOULDERS THAT ARE TO BE RECONSTRUCTED SHALL BE PLANED TO A DEPTH OF 9 INCHES AND RECONSTRUCTED IN TWO LIFTS OVER TWO NIGHTS (SEE PRE-PHASE 1 CONSTRUCTION SCHEDULE ON SHEET 46). THE FIRST LIFT WILL CONSTRUCT 7.5 INCHES OF ITEM 302 ASPHALT BASE. THE SECOND LIFT WILL CONSTRUCT 1.5 INCHES OF ITEM 441, TYPE 1 SURFACE COURSE. ALL COSTS ASSOCIATED WITH SHOULDER RECONSTRUCTION SHALL BE INCIDENTAL TO ITEM 615, PAVEMENT FOR MAINTAINING TRAFFIC, CLASS A, AS PER PLAN.
 3. WHILE RECONSTRUCTING THE SHOULDERS, THE CONTRACTOR SHALL ALSO MILL AND RESURFACE 1 FOOT INTO THE ADJACENT TRAVEL LANE. THE EXISTING PAVEMENT (INCLUDING THE EDGELINE) SHALL BE PLANED 1.5 INCHES AND RESURFACED WITH 1.5 INCHES OF ITEM 441, TYPE 1 SURFACE COURSE. THIS WORK SHALL BE COMPLETED PER THE PRE-PHASE 1 CONSTRUCTION SCHEDULE ON SHEET 46 AND SHALL ALSO BE INCIDENTAL TO ITEM 615, PAVEMENT FOR MAINTAINING TRAFFIC, CLASS A, AS PER PLAN.

HORIZONTAL SCALE IN FEET

① $\Delta = 12^\circ 36' 44''$ (LT)
 $D_c = 0^\circ 39' 38''$
 $R = 8673.84'$
 $T = 958.55'$
 $L = 1909.35'$
 $E = 52.80'$
 $C = 1905.50'$
 $C.B. = N 76^\circ 38' 15'' E$

MATCH LINE STA. 202+00
SEE ABOVE

MATCH LINE STA. 210+00
SEE SHEET 82

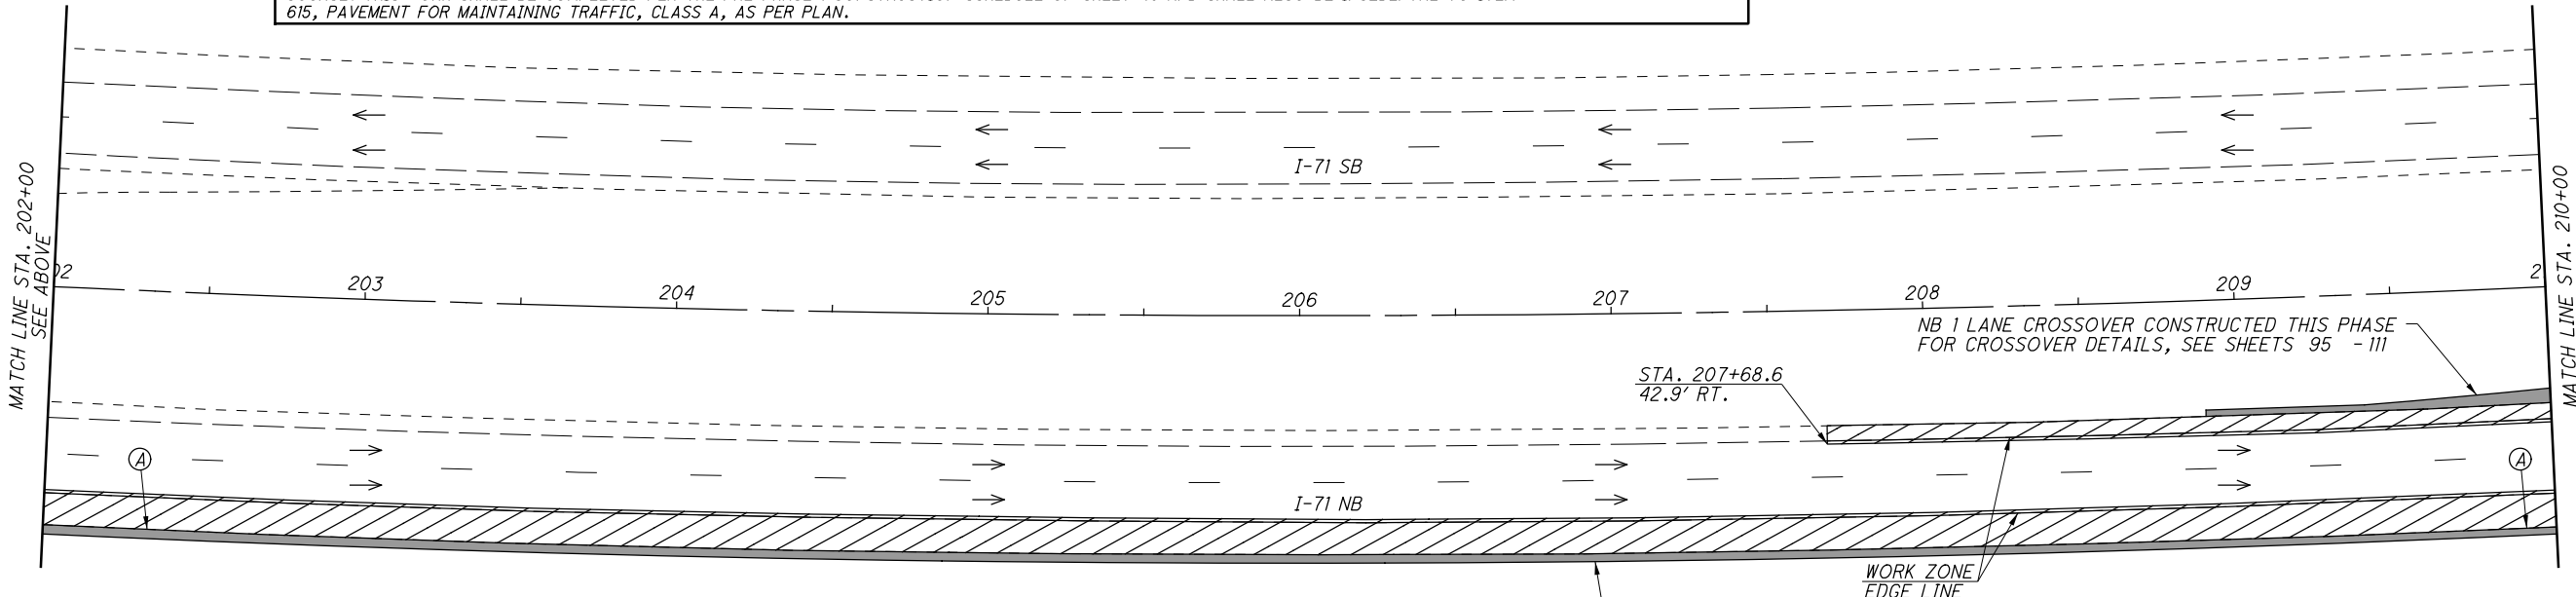

①


Ⓐ - MEET/MATCH EXISTING EDGE OF SHOULDER

LEGEND


- TEMPORARY PAVEMENT CONSTRUCTED THIS PHASE
- SHOULDER RECONSTRUCTION
- OPEN TRAVEL LANE

**MAINTENANCE OF TRAFFIC PLAN-PRE-PHASE 1
 (ASPHALT OPTION) I-71 - STA. 194+00 TO STA. 210+00**

FRA-71-0.00

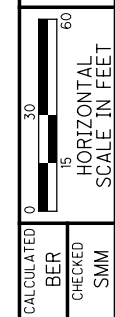

J:\20130212\ODOT\FRA\107201\mot\sheet\107201MP295.dgn 8/6/2020 4:30:18 AM brieder

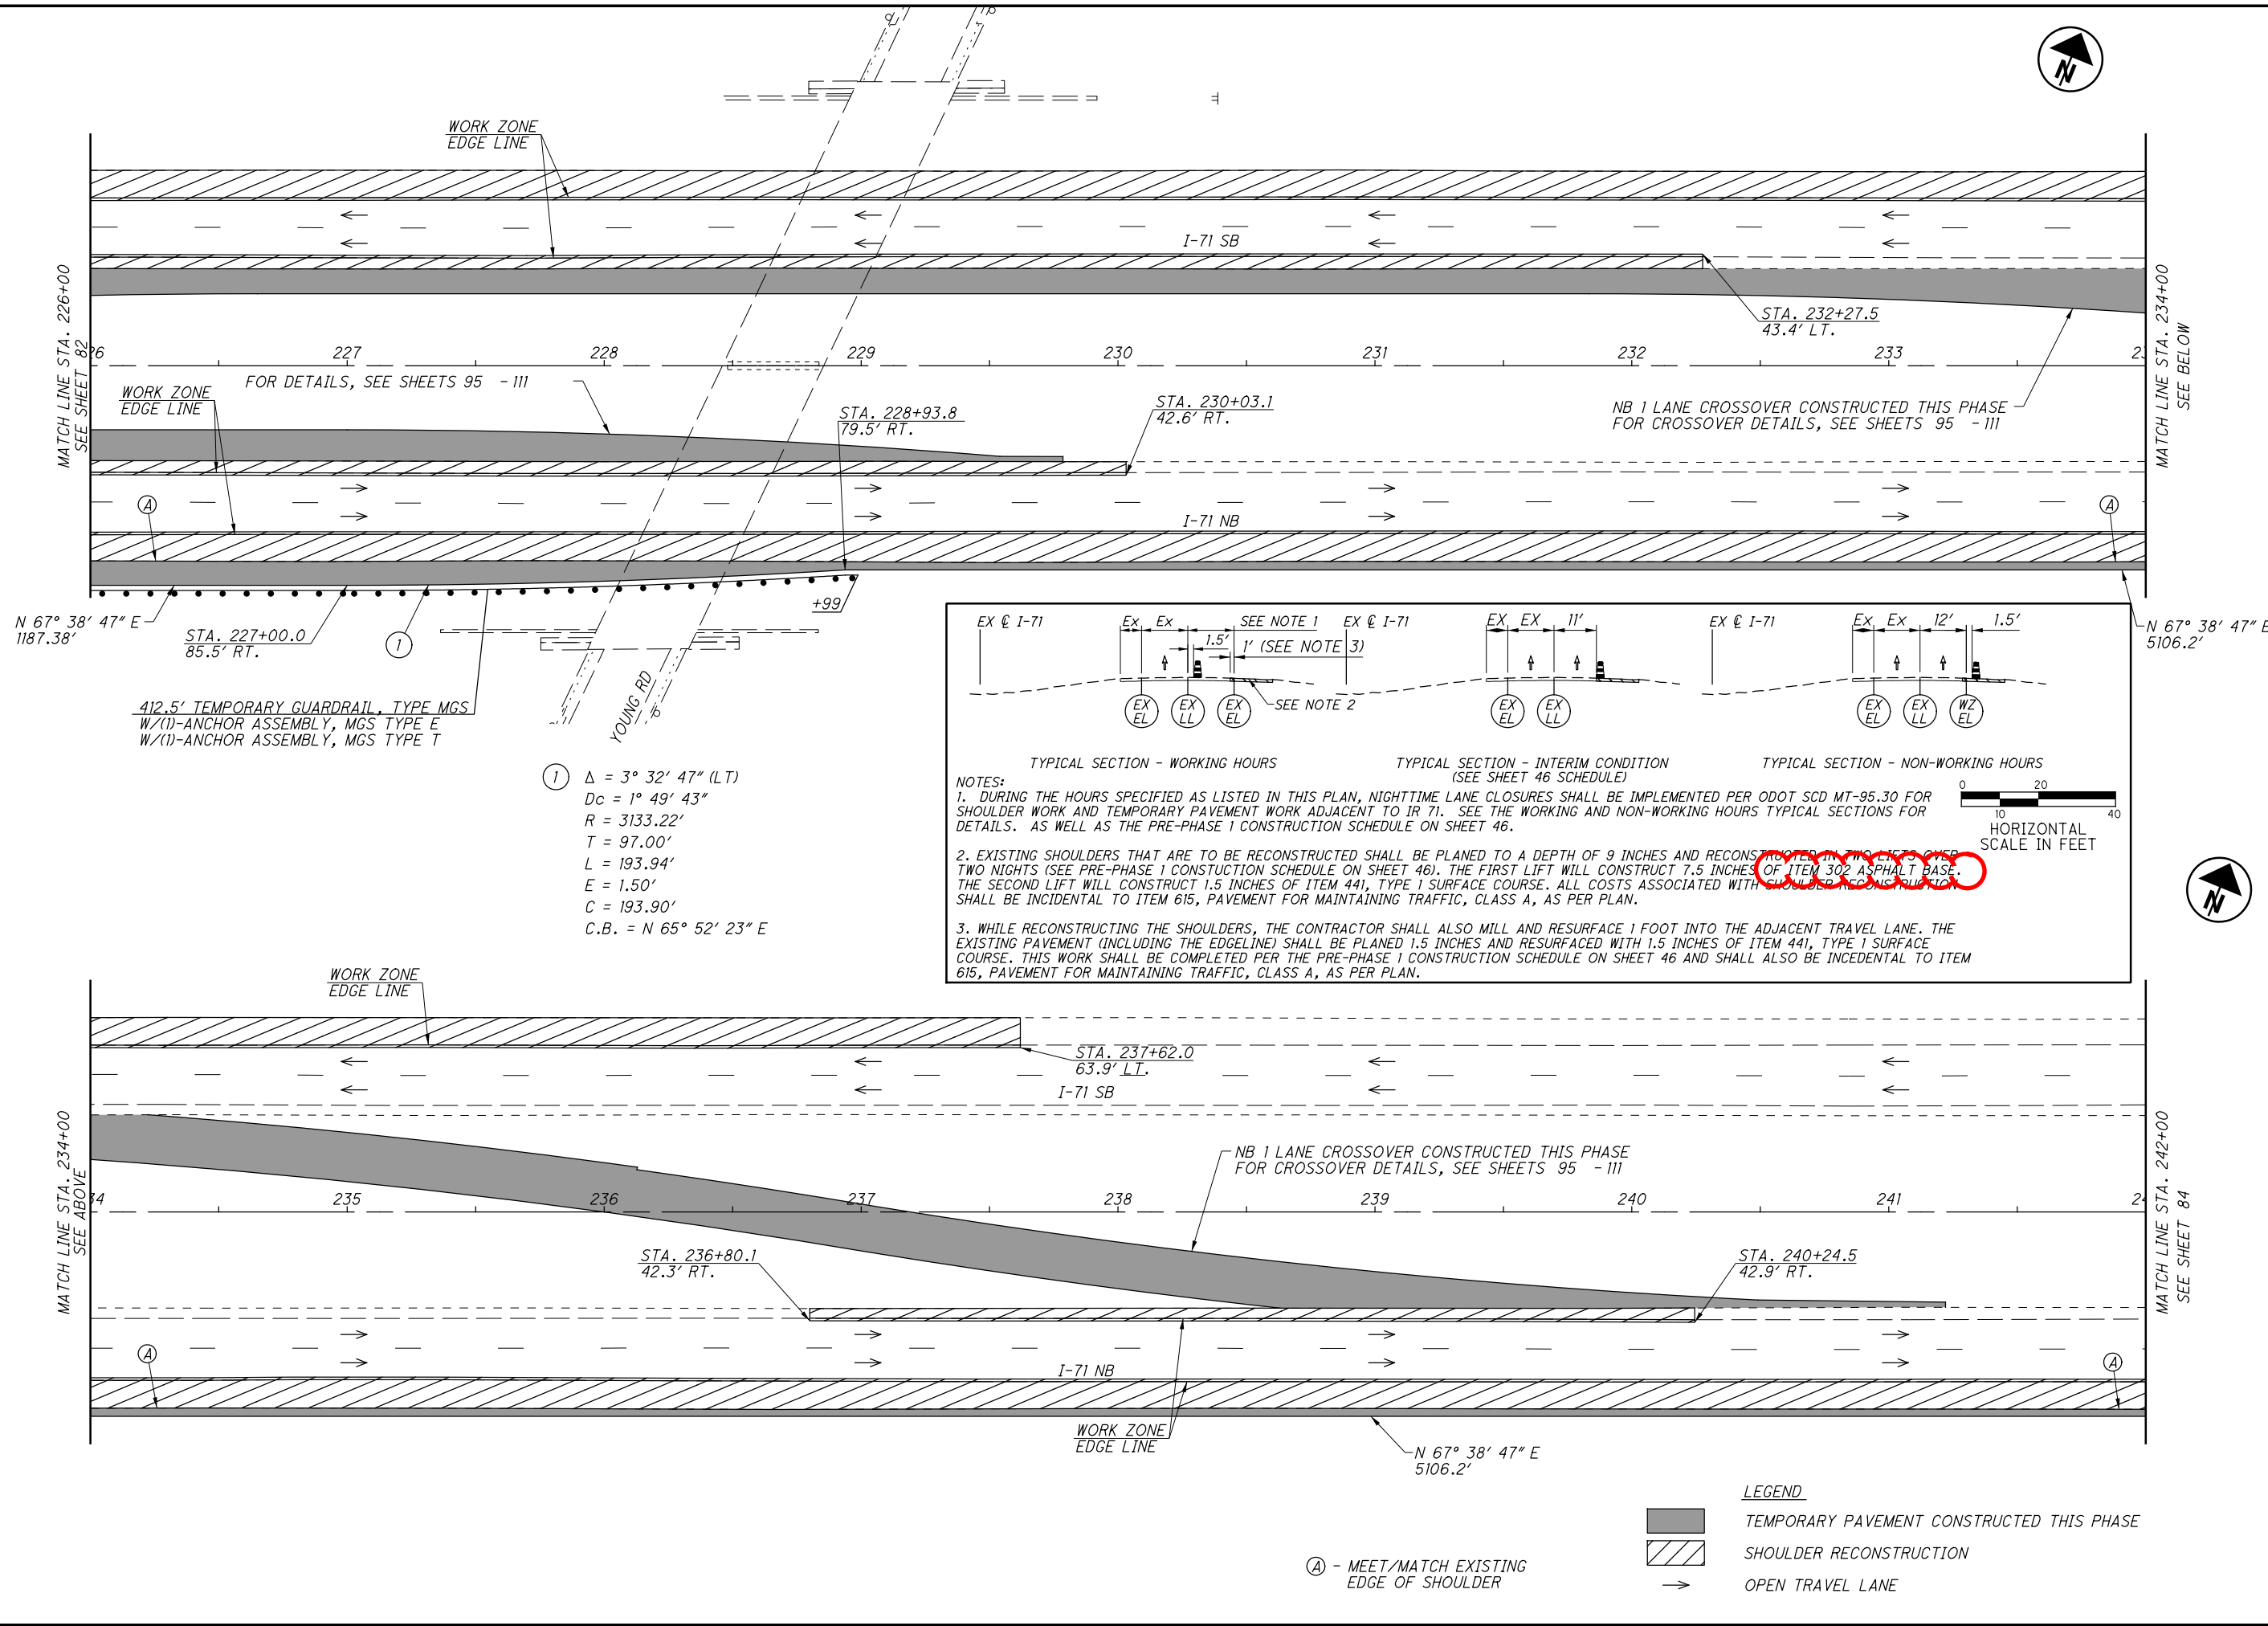


MATCH LINE STA. 226+00
SEE SHEET 82

N 67° 38' 47" E
1187.38'


FOR DETAILS, SEE SHEETS 95 - 111

412.5' TEMPORARY GUARDRAIL, TYPE MGS
W/(1)-ANCHOR ASSEMBLY, MGS TYPE E
W/(1)-ANCHOR ASSEMBLY, MGS TYPE T

① Δ = 3° 32' 47" (LT)
Dc = 1° 49' 43"
R = 3133.22'
T = 97.00'
L = 193.94'
E = 1.50'
C = 193.90'
C.B. = N 65° 52' 23" E

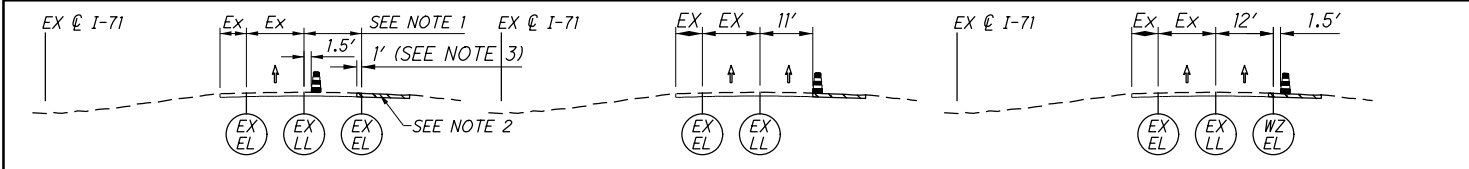

NOTES:
 1. DURING THE HOURS SPECIFIED AS LISTED IN THIS PLAN, NIGHTTIME LANE CLOSURES SHALL BE IMPLEMENTED PER ODOT SCD MT-95.30 FOR SHOULDER WORK AND TEMPORARY PAVEMENT WORK ADJACENT TO I-71. SEE THE WORKING AND NON-WORKING HOURS TYPICAL SECTIONS FOR DETAILS. AS WELL AS THE PRE-PHASE 1 CONSTRUCTION SCHEDULE ON SHEET 46.
 2. EXISTING SHOULDERS THAT ARE TO BE RECONSTRUCTED SHALL BE PLANED TO A DEPTH OF 9 INCHES AND RECONSTRUCTED IN TWO LIFTS OVER TWO NIGHTS (SEE PRE-PHASE 1 CONSTRUCTION SCHEDULE ON SHEET 46). THE FIRST LIFT WILL CONSTRUCT 7.5 INCHES OF ITEM 302 ASPHALT BASE. THE SECOND LIFT WILL CONSTRUCT 1.5 INCHES OF ITEM 441, TYPE 1 SURFACE COURSE. ALL COSTS ASSOCIATED WITH SHOULDERS RECONSTRUCTION SHALL BE INCIDENTAL TO ITEM 615, PAVEMENT FOR MAINTAINING TRAFFIC, CLASS A, AS PER PLAN.
 3. WHILE RECONSTRUCTING THE SHOULDERS, THE CONTRACTOR SHALL ALSO MILL AND RESURFACE 1 FOOT INTO THE ADJACENT TRAVEL LANE. THE EXISTING PAVEMENT (INCLUDING THE EDGELINE) SHALL BE PLANED 1.5 INCHES AND RESURFACED WITH 1.5 INCHES OF ITEM 441, TYPE 1 SURFACE COURSE. THIS WORK SHALL BE COMPLETED PER THE PRE-PHASE 1 CONSTRUCTION SCHEDULE ON SHEET 46 AND SHALL ALSO BE INCIDENTAL TO ITEM 615, PAVEMENT FOR MAINTAINING TRAFFIC, CLASS A, AS PER PLAN.

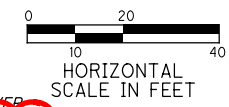

MATCH LINE STA. 234+00
SEE ABOVE

N 67° 38' 47" E
5106.2'

LEGEND

 TEMPORARY PAVEMENT CONSTRUCTED THIS PHASE
 SHOULDER RECONSTRUCTION
 OPEN TRAVEL LANE

Ⓐ - MEET/MATCH EXISTING
EDGE OF SHOULDER

MATCH LINE STA. 234+00
SEE BELOW

MATCH LINE STA. 242+00
SEE SHEET 84

CALCULATED BER CHECKED SMM

**MAINTENANCE OF TRAFFIC PLAN-PRE-PHASE 1
(ASPHALT OPTION) I-71 - STA. 226+00 TO STA. 242+00**



FRA-71-0.00

83
1312

J:\20130212\ODOT\FRA\107201\mot\sheet\107201MP296.dgn 8/6/2020 4:31:31 AM brieder

MATCH LINE STA. 242+00
SEE SHEET 83

MATCH LINE STA. 250+00
SEE BELOW

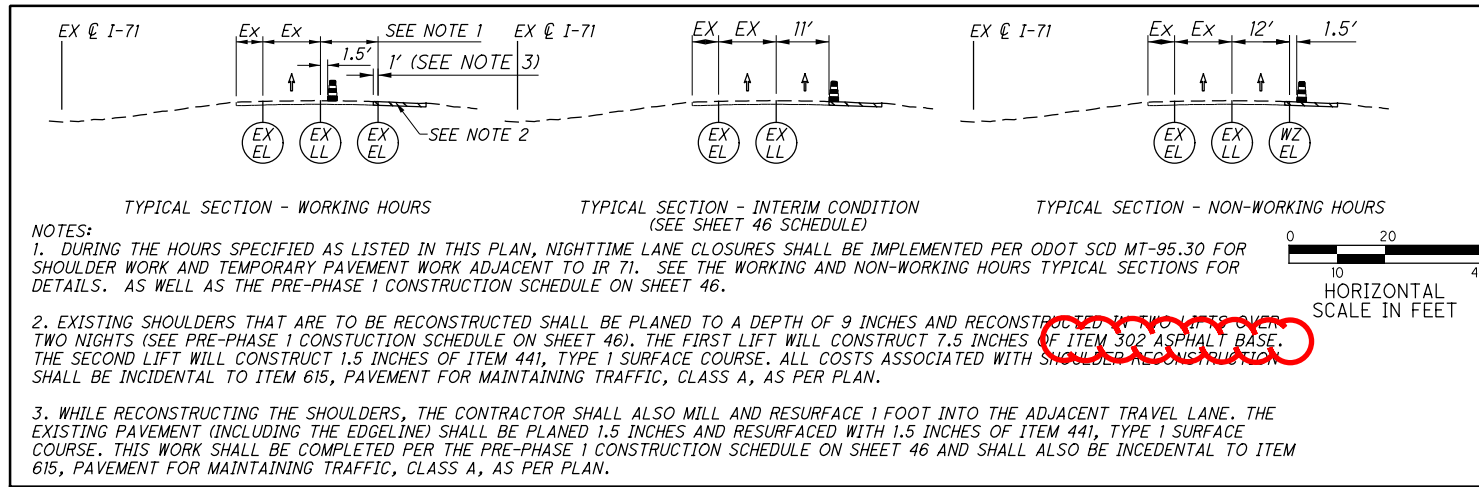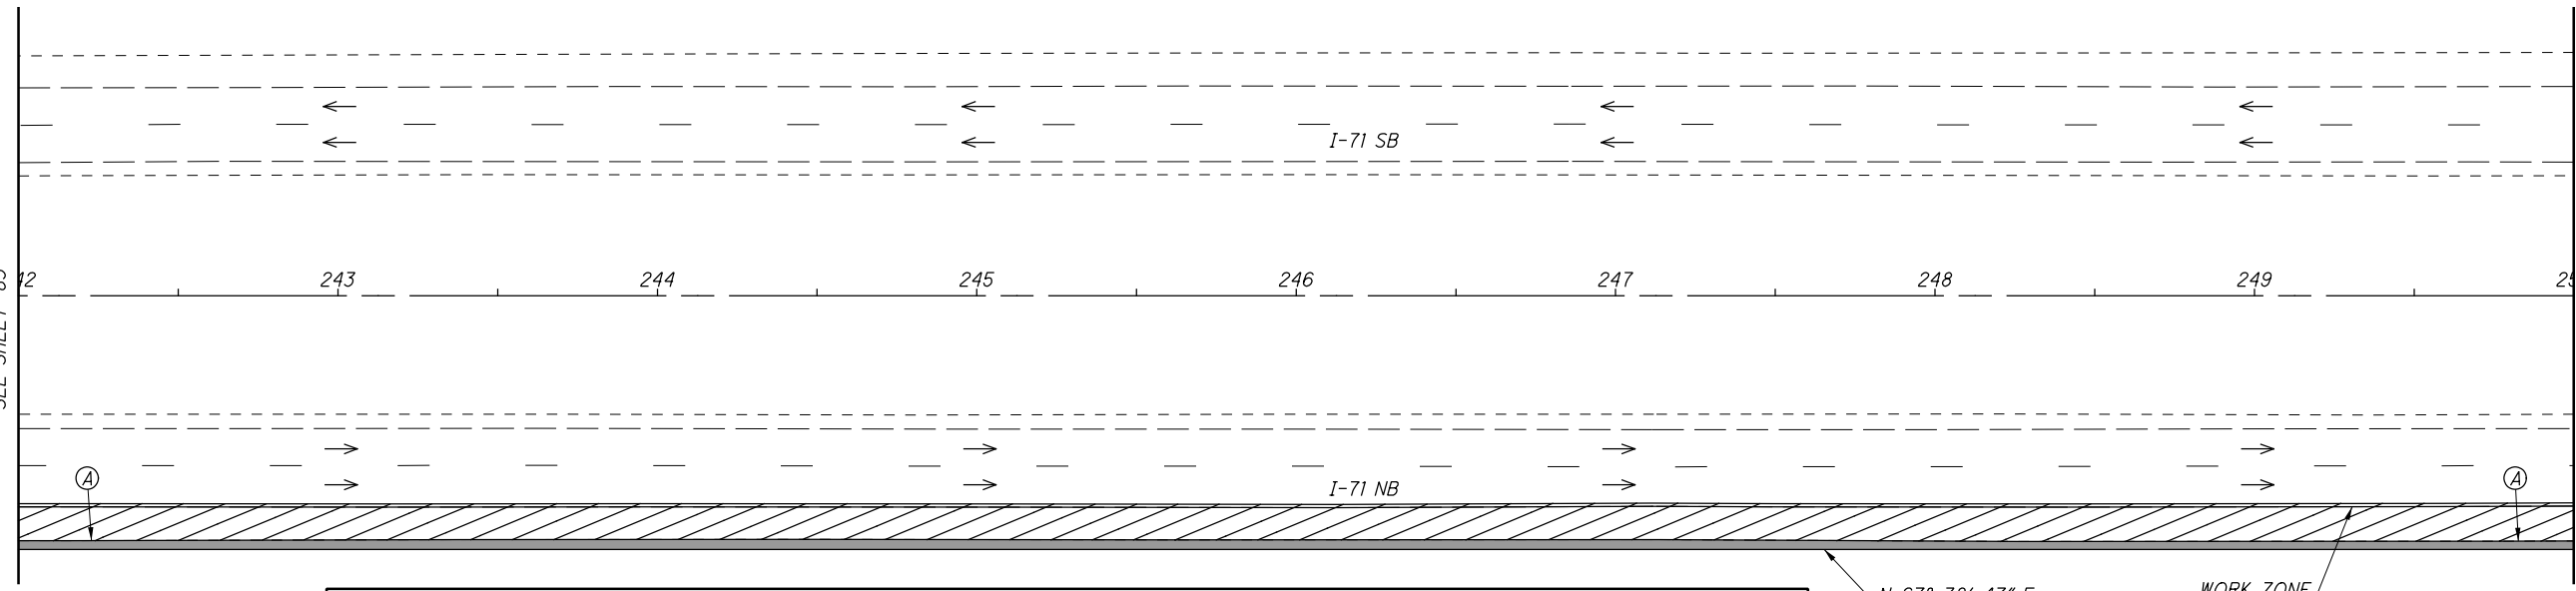


N 67° 38' 47" E
5106.2'

WORK ZONE
EDGE LINE

MATCH LINE STA. 250+00
SEE ABOVE


 
 
MATCH LINE STA. 258+00
SEE SHEET 85

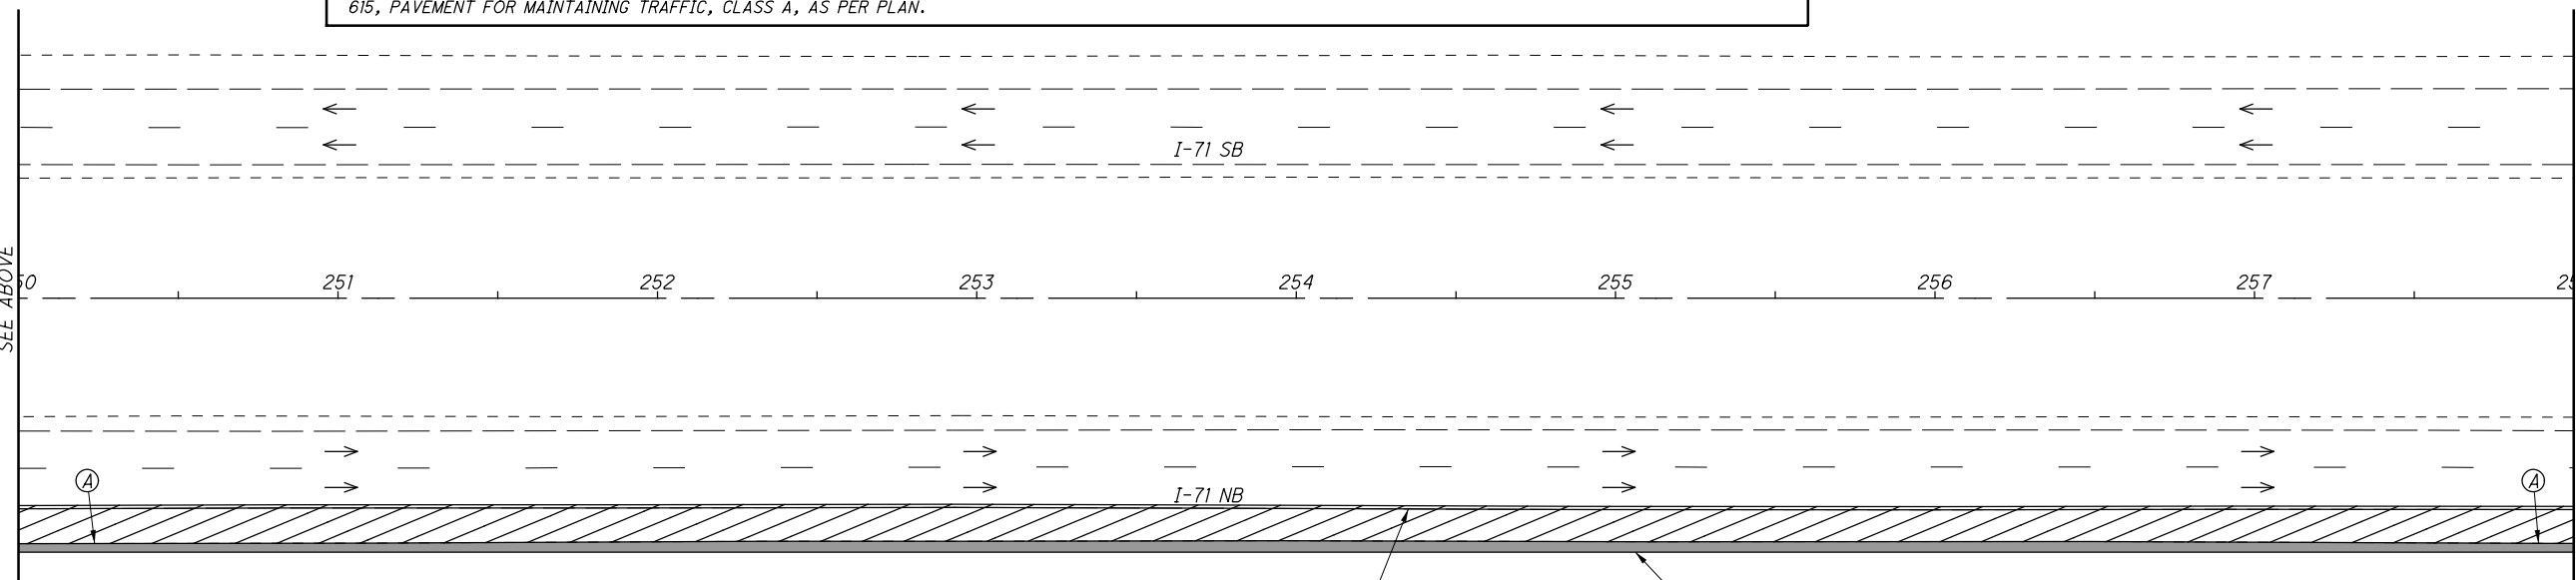

WORK ZONE
EDGE LINE

N 67° 38' 47" E
5106.2'

LEGEND

-  TEMPORARY PAVEMENT CONSTRUCTED THIS PHASE
-  SHOULDER RECONSTRUCTION
-  OPEN TRAVEL LANE

(A) - MEET/MATCH EXISTING
EDGE OF SHOULDER

**MAINTENANCE OF TRAFFIC PLAN-PRE-PHASE 1
(ASPHALT OPTION) I-71 - STA. 242+00 TO STA. 258+00**


FRA-71-0.00

CALCULATED
BER
CHECKED
SMM




J:\20130212\ODOT\FRA\107201\mot\sheet\107201MP297.dgn 8/6/2020 4:32:44 AM brieder


MATCH LINE STA. 258+00
SEE SHEET 84

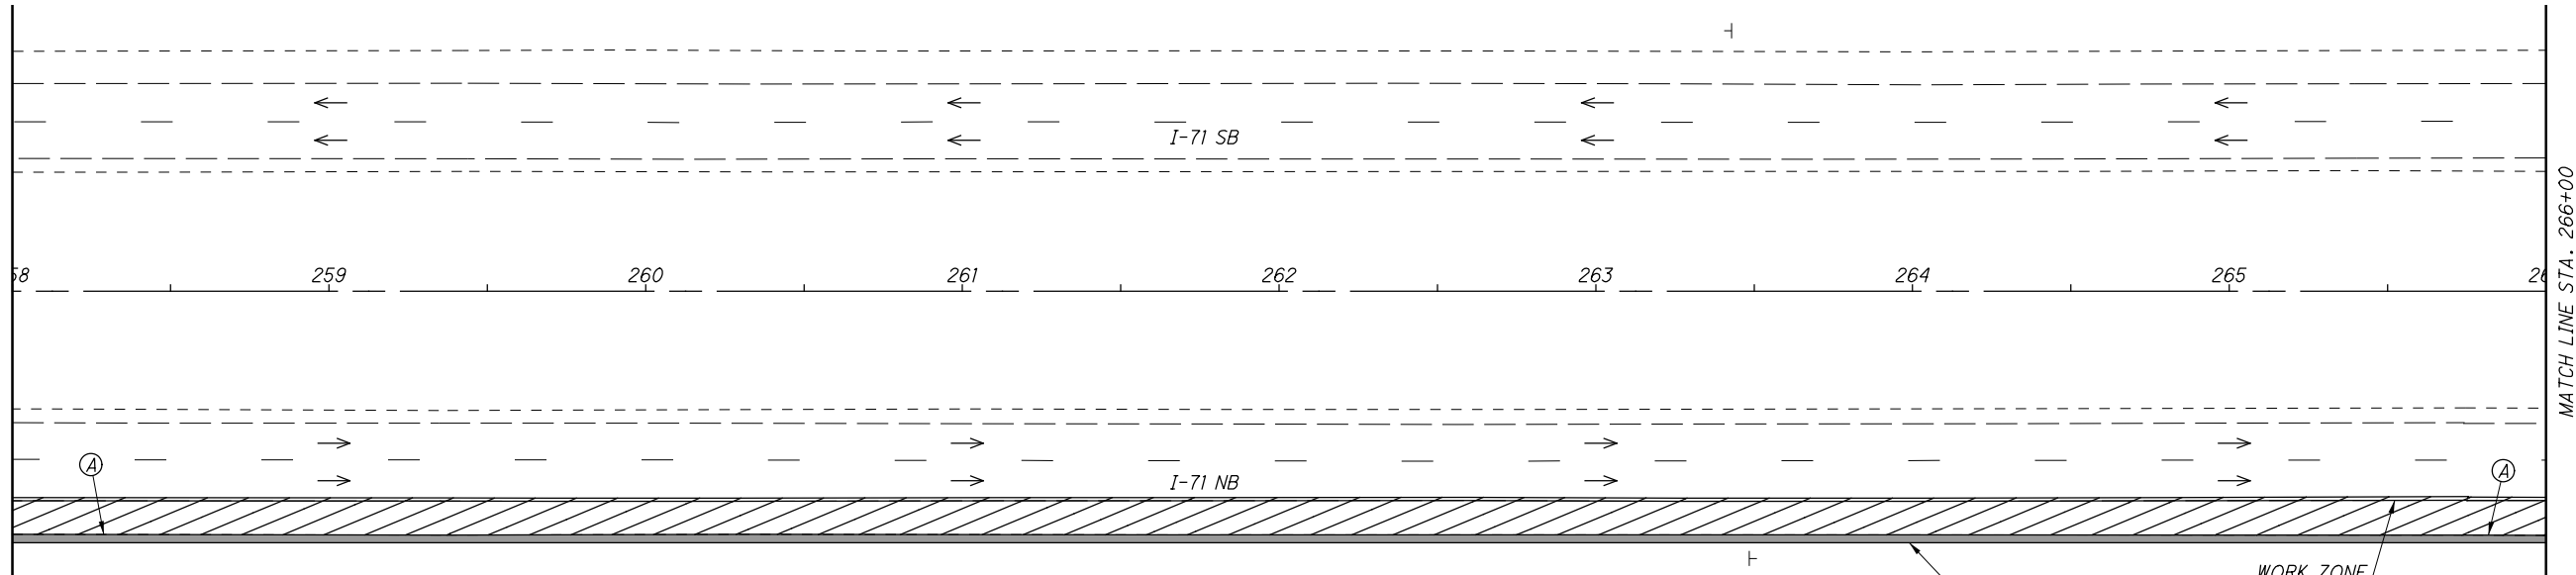

MATCH LINE STA. 266+00
SEE BELOW

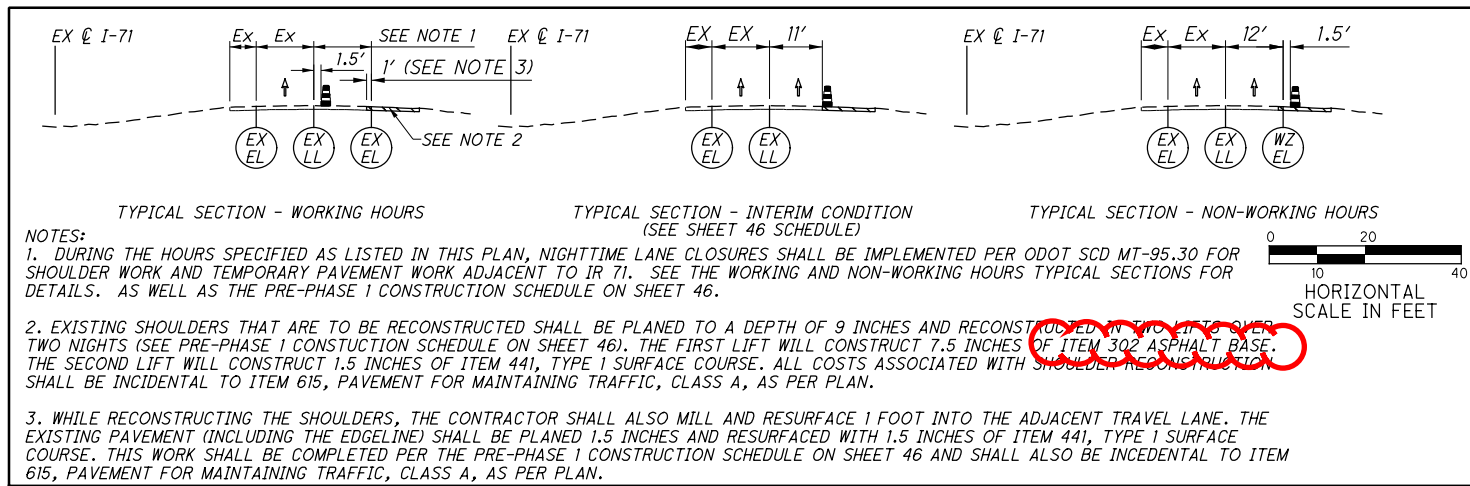

MATCH LINE STA. 266+00
SEE ABOVE

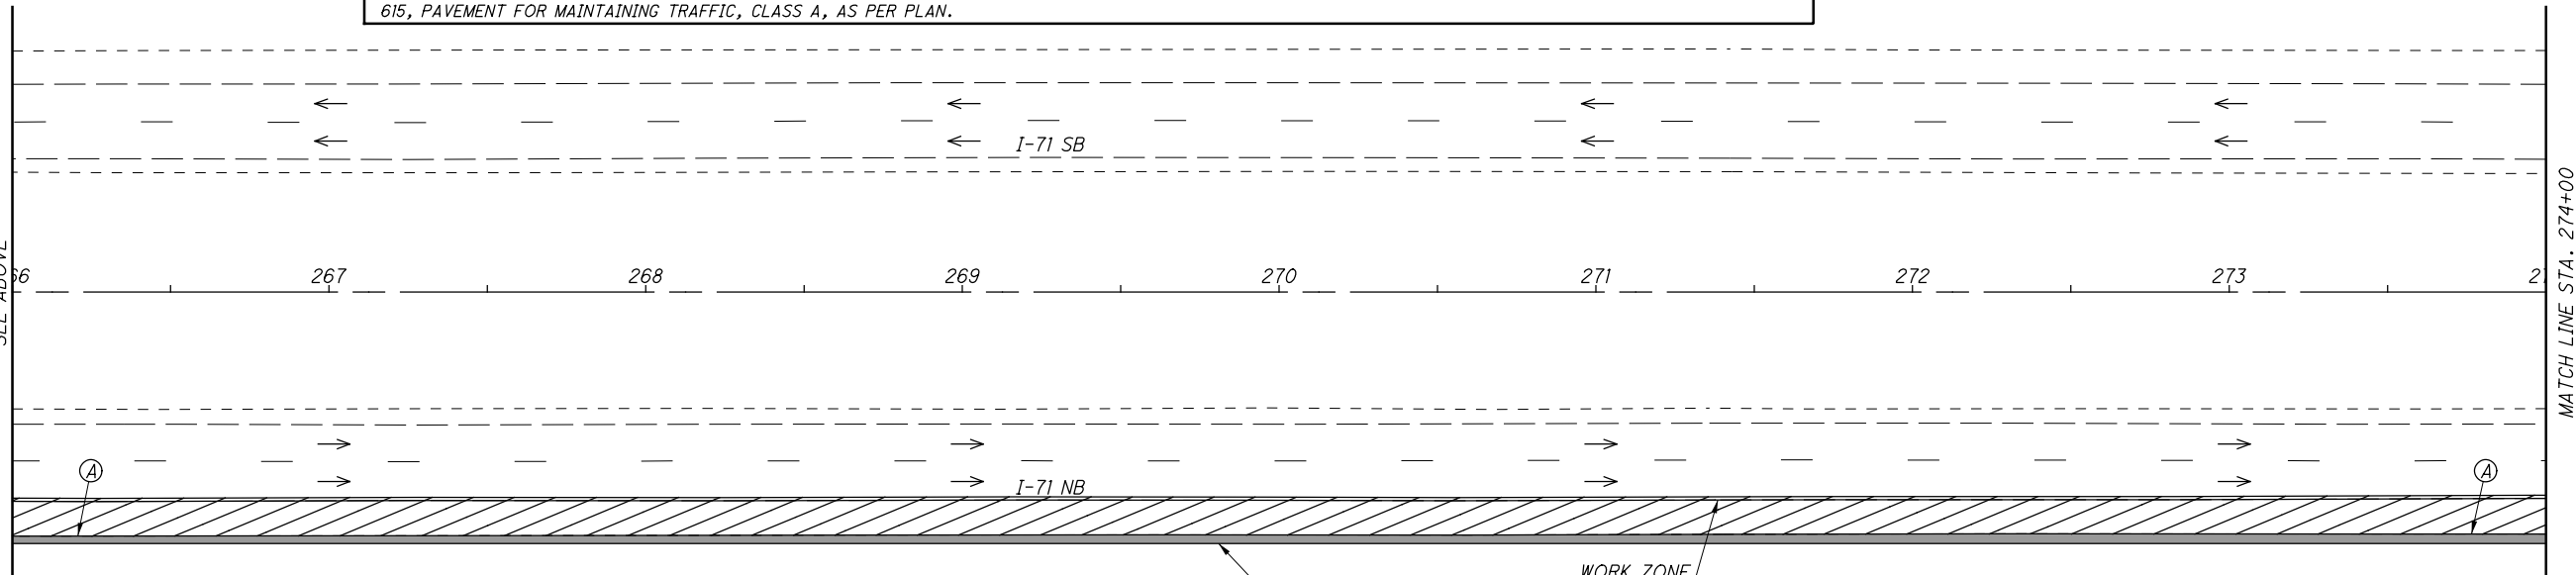

MATCH LINE STA. 274+00
SEE SHEET 86

LEGEND

| | |
|--|---|
| | TEMPORARY PAVEMENT CONSTRUCTED THIS PHASE |
| | SHOULDER RECONSTRUCTION |
| | OPEN TRAVEL LANE |

(A) - MEET/MATCH EXISTING EDGE OF SHOULDER


**MAINTENANCE OF TRAFFIC PLAN-PRE-PHASE 1
(ASPHALT OPTION) I-71 - STA. 258+00 TO STA. 274+00**

FRA-71-0.00

| | | | |
|------------|-----|---------|-----|
| CALCULATED | BER | CHECKED | SMM |
| | | | |



J:\20130212\ODOT\FRA\107201\mot\sheet\107201MP298.dgn 8/6/2020 4:33:57 AM brieder

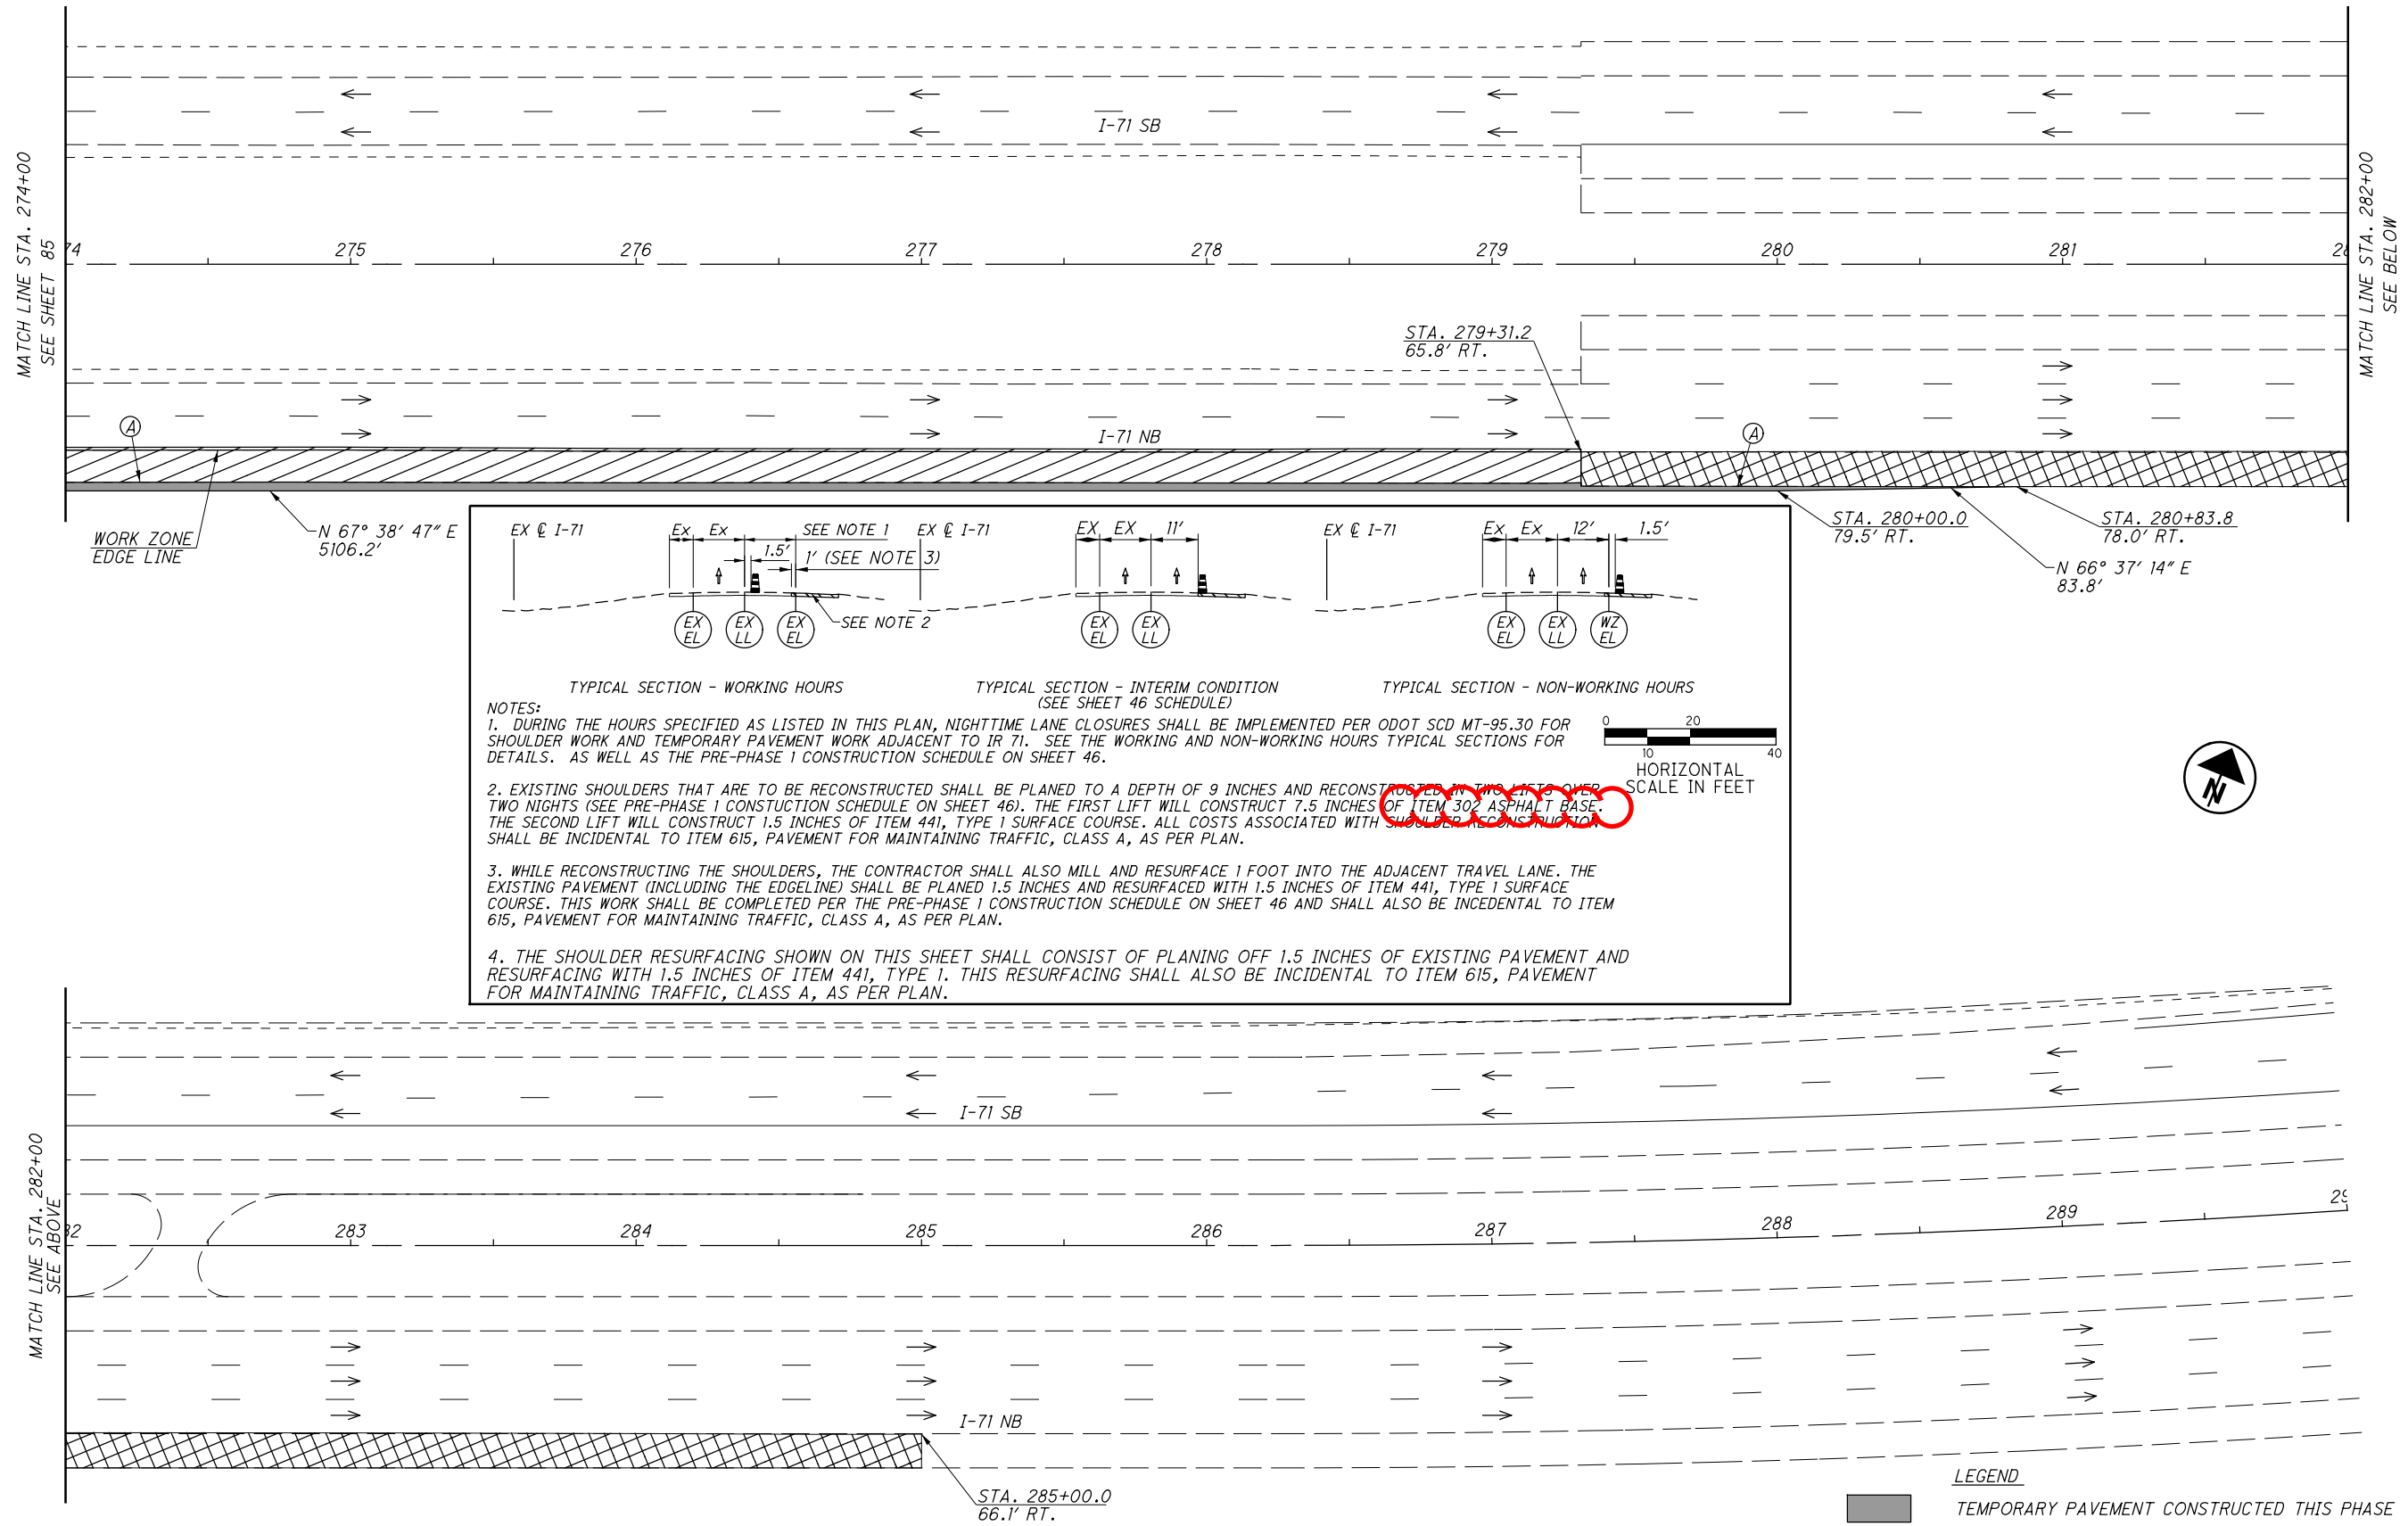

EX & I-71 Ex Ex SEE NOTE 1 EX & I-71 EX EX 11' EX & I-71 Ex Ex 12' 1.5'

SEE NOTE 2 1.5' 1' (SEE NOTE 3) EX EL EX LL EX EL EX EL EX LL EX EL EX LL WZ EL

TYPICAL SECTION - WORKING HOURS TYPICAL SECTION - INTERIM CONDITION (SEE SHEET 46 SCHEDULE) TYPICAL SECTION - NON-WORKING HOURS

NOTES:
 1. DURING THE HOURS SPECIFIED AS LISTED IN THIS PLAN, NIGHTTIME LANE CLOSURES SHALL BE IMPLEMENTED PER ODOT SCD MT-95.30 FOR SHOULDER WORK AND TEMPORARY PAVEMENT WORK ADJACENT TO I-71. SEE THE WORKING AND NON-WORKING HOURS TYPICAL SECTIONS FOR DETAILS. AS WELL AS THE PRE-PHASE 1 CONSTRUCTION SCHEDULE ON SHEET 46.
 2. EXISTING SHOULDERS THAT ARE TO BE RECONSTRUCTED SHALL BE PLANED TO A DEPTH OF 9 INCHES AND RECONSTRUCTED IN TWO LIFTS OVER TWO NIGHTS (SEE PRE-PHASE 1 CONSTRUCTION SCHEDULE ON SHEET 46). THE FIRST LIFT WILL CONSTRUCT 7.5 INCHES OF ITEM 302 ASPHALT BASE. THE SECOND LIFT WILL CONSTRUCT 1.5 INCHES OF ITEM 441, TYPE 1 SURFACE COURSE. ALL COSTS ASSOCIATED WITH SHOULDER RECONSTRUCTION SHALL BE INCIDENTAL TO ITEM 615, PAVEMENT FOR MAINTAINING TRAFFIC, CLASS A, AS PER PLAN.
 3. WHILE RECONSTRUCTING THE SHOULDERS, THE CONTRACTOR SHALL ALSO MILL AND RESURFACE 1 FOOT INTO THE ADJACENT TRAVEL LANE. THE EXISTING PAVEMENT (INCLUDING THE EDGELINE) SHALL BE PLANED 1.5 INCHES AND RESURFACED WITH 1.5 INCHES OF ITEM 441, TYPE 1 SURFACE COURSE. THIS WORK SHALL BE COMPLETED PER THE PRE-PHASE 1 CONSTRUCTION SCHEDULE ON SHEET 46 AND SHALL ALSO BE INCIDENTAL TO ITEM 615, PAVEMENT FOR MAINTAINING TRAFFIC, CLASS A, AS PER PLAN.
 4. THE SHOULDER RESURFACING SHOWN ON THIS SHEET SHALL CONSIST OF PLANING OFF 1.5 INCHES OF EXISTING PAVEMENT AND RESURFACING WITH 1.5 INCHES OF ITEM 441, TYPE 1. THIS RESURFACING SHALL ALSO BE INCIDENTAL TO ITEM 615, PAVEMENT FOR MAINTAINING TRAFFIC, CLASS A, AS PER PLAN.

0 20 40
 HORIZONTAL SCALE IN FEET

- LEGEND**
- TEMPORARY PAVEMENT CONSTRUCTED THIS PHASE
 - SHOULDER RECONSTRUCTION
 - SHOULDER RESURFACING (SEE NOTE 4)
 - OPEN TRAVEL LANE

(A) - MEET/MATCH EXISTING EDGE OF SHOULDER

MAINTENANCE OF TRAFFIC PLAN-PRE-PHASE 1 (ASPHALT OPTION) I-71 - STA. 274+00 TO STA. 290+00

FRA-71-0.00

CALCULATED BER
 CHECKED SMM

0 15 30 60
 HORIZONTAL SCALE IN FEET

X:\4037000\121957.16\107201\roadway\sheets\107201GG003.dgn Sheet 8/8/2020 5:32:53 PM 1458s.js

| SHEET NUM. | | | | | | PART. | | | | ITEM | ITEM EXT | GRAND TOTAL | UNIT | DESCRIPTION | SEE SHEET NO. |
|------------|----|-----|-----|-----|-----|-----------|-----------|-----------|-----------|------|----------|-------------|------|---|---------------|
| 12 | 13 | 400 | 401 | 402 | 928 | 01/IMS/PV | 02/NHS/PV | 03/IMS/BR | 04/IMS/BR | | | | | | |
| | | 50 | | | | | | | | 611 | 08200 | 50 | FT | 18" CONDUIT, TYPE F, 707.05, TYPE C OR 707.21 | |
| | | | 205 | | | | | | | 611 | 08900 | 205 | FT | 21" CONDUIT, TYPE B | |
| | | | 64 | | | | | | | 611 | 08900 | 64 | FT | 21" CONDUIT, TYPE B, 706.02 | |
| | | | 34 | | | | | | | 611 | 09100 | 34 | FT | 21" CONDUIT, TYPE C, 706.02 | |
| | | | 90 | | | | | | | 611 | 10200 | 90 | FT | 24" CONDUIT, TYPE A, 706.02, 707.01 ALUMINIZED, 707.21, 707.33 WITH WELDED BELL | |
| | | | 100 | | | | | | | 611 | 10200 | 100 | FT | 24" CONDUIT, TYPE A 706.02 OR 30" CONDUIT, TYPE A, 707.01, 707.02, 707.04, 707.05, 707.07 OR 707.21 | |
| | | | 184 | | | | | | | 611 | 10400 | 184 | FT | 24" CONDUIT, TYPE B | |
| | | | 119 | | | | | | | 611 | 10400 | 119 | FT | 24" CONDUIT, TYPE B, 706.02 | |
| | | | 8 | | | | | | | 611 | 10600 | 8 | FT | 24" CONDUIT, TYPE C, 706.02 | |
| | | | 999 | | | | | | | 611 | 10600 | 999 | FT | 24" CONDUIT, TYPE C | |
| 50 | | | | | | | | | | 611 | 10600 | 50 | FT | 24" CONDUIT, TYPE C, FOR DRAINAGE CONNECTION | |
| 250 | | | | | | | | | | 611 | 10601 | 250 | FT | 24" CONDUIT, TYPE C, AS PER PLAN | 12 |
| | | | | | 26 | | | | | 611 | 13200 | 26 | FT | 30" CONDUIT, TYPE A, 706.02 | |
| | | | 113 | | | | | | | 611 | 13400 | 113 | FT | 30" CONDUIT, TYPE B | |
| | | | 501 | | | | | | | 611 | 13600 | 501 | FT | 30" CONDUIT, TYPE C | |
| | | | 34 | | | | | | | 611 | 13600 | 34 | FT | 30" CONDUIT, TYPE C, 706.02 | |
| | | | 40 | | | | | | | 611 | 14200 | 40 | FT | 30" CONDUIT, TYPE F, 707.05 | |
| | | | 245 | | | | | | | 611 | 16400 | 245 | FT | 36" CONDUIT, TYPE B, 706.02 | |
| 250 | | | | | | | | | | 611 | 16601 | 250 | FT | 36" CONDUIT, TYPE C, AS PER PLAN | 12 |
| | | | | | 32 | | | | | 611 | 20700 | 32 | FT | 48" CONDUIT, TYPE A, 706.02 | |
| | | | | | 24 | | | | | 611 | 20700 | 24 | FT | 48" CONDUIT, TYPE A, 707.07 | |
| | | | | | 24 | | | | | 611 | 26000 | 24 | FT | 72" CONDUIT, TYPE A, 707.07 | |
| | | | | | 232 | | | | | 611 | 52500 | 232 | FT | 24" X 38" CONDUIT, TYPE A, 706.04 | |
| | | | | | 227 | | | | | 611 | 52700 | 227 | FT | 29" X 45" CONDUIT, TYPE A, 706.04 | |
| | | | | | 304 | | | | | 611 | 95001 | 304 | FT | 10' X 5' CONDUIT, TYPE A, 706.05, AS PER PLAN | 937 |
| | | | 192 | | | | | | | 611 | 96600 | 192 | FT | CONDUIT, BORED OR JACKED, 18", TYPE B | 12 |
| | | | 7 | | | | 6 | | | 611 | 98180 | 7 | EACH | CATCH BASIN, NO. 3A | |
| | | | 7 | | | | | | | 611 | 98300 | 7 | EACH | CATCH BASIN, NO. 5 | |
| | | | 11 | | | | | | | 611 | 98341 | 11 | EACH | CATCH BASIN, NO. 5A | |
| | | | 3 | | | | | | | 611 | 98370 | 3 | EACH | CATCH BASIN, NO. 6 | |
| | | | 48 | | | | 29 | | | 611 | 98410 | 48 | EACH | CATCH BASIN, NO. 8 | |
| | | | 7 | | 1 | | 1 | | | 611 | 98434 | 8 | EACH | CATCH BASIN, NO. 8A | |
| | | | 4 | | | | | | | 611 | 98470 | 4 | EACH | CATCH BASIN, NO. 2-2B | |
| | | | 11 | | | | | | | 611 | 99110 | 11 | EACH | INLET, NO. 3 FOR SINGLE SLOPE BARRIER, TYPE C1 | |
| | | | | 6 | | | | | | 611 | 99574 | 6 | EACH | MANHOLE, NO. 3 | |
| | 2 | | | 92 | | | | | | 611 | 99710 | 94 | EACH | PRECAST REINFORCED CONCRETE OUTLET | |
| | | | | | | | | | | 611 | 99900 | 1 | EACH | DRAINAGE STRUCTURE, MISC.:DETAIL AND CONSTRUCTION BLIND TAP | 929 |
| | | | | | 165 | | | | | 615 | 20000 | 165 | SY | PAVEMENT FOR MAINTAINING TRAFFIC, CLASS A | |
| | | | | | | | | | | | | | | DRAINAGE ALTERNATE 1A | |
| | | | | | 260 | | | | | 833 | 10000 | 260 | FT | CONDUIT RENEWAL USING SPRAY APPLIED STRUCTURAL LINER, ROUND CONDUIT 72" DIAMETER | 930 |
| | | | | | | | | | | | | | | DRAINAGE ALTERNATE 1B | |
| | | | | | 260 | | | | | 837 | 10000 | 260 | FT | LINER PIPE 66" ID 707.18, .19, .20, .24, .35, 748.06 (66" OD), SS938, 707.75 | 930 |
| | | | | | 260 | | | | | 837 | 21000 | 260 | FT | BACKFILL FOR LINER PIPE | 930 |
| | | | | | | | | | | | | | | DRAINAGE ALTERNATE 2A | |
| | | | | | 663 | | | | | 899 | 10000 | 663 | FT | CURED-IN-PLACE PIPE LINER, 48" DIAMETER | 931 |
| | | | | | | | | | | | | | | DRAINAGE ALTERNATE 2B | |
| | | | | | 663 | | | | | 837 | 10000 | 663 | FT | LINER PIPE 42" ID 707.18, .19, .20, .35, .42, .43, 748.06 (42" OD), SS938, 707.75 | 931 |
| | | | | | 663 | | | | | 837 | 21000 | 663 | FT | BACKFILL FOR LINER PIPE | 931 |

GENERAL SUMMARY

FRA - 71 - 0:00

X:\4037000\121957.16\107201\roadway\sheet\107201G004.dgn Sheet 8/8/2020 5:35:06 PM 1458s.js

| SHEET NUM. | | | | | | | | | | PART. | | | | ITEM | ITEM EXT | GRAND TOTAL | UNIT | DESCRIPTION | SEE SHEET NO. |
|-------------------------|-----|-------|-------|-----------|-----------|-----------|--|--|--|-----------|-----------|-----------|-----------|------|----------|-------------|------|--|---------------|
| 13 | 400 | 402 | 1103 | ASPH CALC | CONC CALC | RAMP CALC | | | | 01/IMS/PV | 02/NHS/PV | 03/IMS/BR | 04/IMS/BR | | | | | | |
| PAVEMENT | | | | | | | | | | | | | | | | | | | |
| 150 | | | | | | | | | | 150 | | | | 251 | 01021 | 150 | SY | PARTIAL DEPTH PAVEMENT REPAIR (442), AS PER PLAN, TYPE 1 | 13 |
| 600 | | | | | | | | | | 600 | | | | 251 | 01021 | 600 | SY | PARTIAL DEPTH PAVEMENT REPAIR (442), AS PER PLAN, TYPE 2 | 13 |
| 3,000 | | | | | | | | | | 3,000 | | | | 251 | 01021 | 3,000 | SY | PARTIAL DEPTH PAVEMENT REPAIR (442), AS PER PLAN, TYPE 3 | 13 |
| | | | | | | 3,871 | | | | 3,871 | | | | 304 | 20000 | 3,871 | CY | AGGREGATE BASE | |
| | | | | | | 18,610 | | | | 18,610 | | | | 452 | 15060 | 18,610 | SY | 12.5" NON-REINFORCED CONCRETE PAVEMENT, CLASS OC 1P WITH OC/OA | |
| | | | | | | 3,291 | | | | 3,291 | | | | 452 | 19200 | 3,291 | SY | NON-REINFORCED CONCRETE PAVEMENT, MISC.:12.5" CLASS OC MS WITH OC/OA | 13A |
| | 350 | | | | | | | | | 350 | | | | 609 | 24510 | 350 | FT | CURB, TYPE 4-C | |
| PAVEMENT OPTIONS | | | | | | | | | | | | | | | | | | | |
| ASPHALT OPTION | | | | | | | | | | | | | | | | | | | |
| | | | | 43,290 | | | | | | 43,290 | | | | 254 | 01000 | 43,290 | SY | PAVEMENT PLANING, ASPHALT CONCRETE (1.5" THICK) | |
| | | | | 108,694 | | | | | | 72,825 | 35,869 | | | 302 | 46001 | 108,694 | CY | ASPHALT CONCRETE BASE, AS PER PLAN | 13A |
| | | | | 60,969 | | | | | | 40,849 | 20,120 | | | 304 | 20000 | 60,969 | CY | AGGREGATE BASE | |
| | | | | 63,362 | | | | | | 42,241 | 21,121 | | | 407 | 20000 | 63,362 | GAL | NON-TRACKING TACK COAT | |
| | | | | 19,955 | | | | | | 13,303 | 6,652 | | | 442 | 00100 | 19,955 | CY | ANTI-SEGREGATION EQUIPMENT | |
| | | | | 16,977 | | | | | | 11,375 | 5,602 | | | 442 | 10100 | 16,977 | CY | ASPHALT CONCRETE INTERMEDIATE COURSE, 19 MM, TYPE A (446) | |
| | | 19.58 | | 16,360 | | | | | | 10,907 | 5,453 | | | 442 | 10301 | 16,360 | CY | ASPHALT CONCRETE SURFACE COURSE, 12.5 MM, TYPE A (447), AS PER PLAN | 13 |
| | | 400 | | | | | | | | 13.12 | 6.46 | | | 618 | 40600 | 19.58 | MILE | RUMBLE STRIPS, SHOULDER (ASPHALT CONCRETE) | |
| | | | | | | | | | | 264 | 136 | | | 618 | 40200 | 400 | FT | RUMBLE STRIPS, SHOULDER (CONCRETE) | |
| CONCRETE OPTION | | | | | | | | | | | | | | | | | | | |
| | | | | 32,208 | | | | | | 32,208 | | | | 254 | 01000 | 32,208 | SY | PAVEMENT PLANING, ASPHALT CONCRETE (1.5" THICK) | |
| | | | | 11,083 | | | | | | 7,389 | 3,694 | | | 254 | 01010 | 11,083 | SY | PAVEMENT PLANING, PORTLAND CEMENT CONCRETE (1.5" THICK) | |
| | | | | 59,389 | | | | | | 39,791 | 19,598 | | | 304 | 20000 | 59,389 | CY | AGGREGATE BASE | |
| | | | | 4,511 | | | | | | 3,007 | 1,504 | | | 407 | 20000 | 4,511 | GAL | NON-TRACKING TACK COAT | |
| | | | | 819 | | | | | | 546 | 273 | | | 442 | 00100 | 819 | CY | ANTI-SEGREGATION EQUIPMENT | |
| | | | | 8 | | | | | | 5 | 3 | | | 442 | 10100 | 8 | CY | ASPHALT CONCRETE INTERMEDIATE COURSE, 19 MM, TYPE A (446) | |
| | | | | 1,354 | | | | | | 903 | 451 | | | 442 | 10300 | 1,354 | CY | ASPHALT CONCRETE SURFACE COURSE, 12.5 MM, TYPE A (447) | |
| | | | | 349,075 | | | | | | 233,880 | 115,195 | | | 452 | 16060 | 349,075 | SY | 13.5" NON-REINFORCED CONCRETE PAVEMENT, CLASS OC 1P WITH OC/OA | |
| | | 19.66 | | | | | | | | 12.98 | 6.68 | | | 618 | 40700 | 19.66 | MILE | RUMBLE STRIPS, SHOULDER (CONCRETE) | |
| | | | | 11,083 | | | | | | 7,389 | 3,694 | | | 848 | 90000 | 11,083 | SY | OVERLAY, MISC.:CONCRETE PAVEMENT CLASS OC 1P WITH OC/OA | |
| LIGHTING | | | | | | | | | | | | | | | | | | | |
| | | | 12 | | | | | | | 12 | | | | 625 | 00450 | 12 | EACH | CONNECTION, FUSED PULL APART | |
| | | | 21 | | | | | | | 21 | | | | 625 | 00480 | 21 | EACH | CONNECTION, UNFUSED PERMANENT | |
| | | | 6 | | | | | | | 6 | | | | 625 | 10490 | 6 | EACH | LIGHT POLE, CONVENTIONAL, AT15B35 | |
| | | | 4 | | | | | | | 4 | | | | 625 | 13200 | 4 | EACH | LIGHT TOWER, BBBB100 | |
| | | | 6 | | | | | | | 6 | | | | 625 | 14000 | 6 | EACH | LIGHT POLE FOUNDATION, 24" X 6' DEEP | |
| | | | 4 | | | | | | | 4 | | | | 625 | 15200 | 4 | EACH | LIGHT TOWER FOUNDATION, 36" X 25' DEEP | |
| | | | 7,191 | | | | | | | 7,191 | | | | 625 | 23200 | 7,191 | FT | NO. 4 AWG 2400 VOLT DISTRIBUTION CABLE | |
| | | | 696 | | | | | | | 696 | | | | 625 | 23400 | 696 | FT | NO. 10 AWG POLE AND BRACKET CABLE | |
| | | | 2,768 | | | | | | | 2,768 | | | | 625 | 24320 | 2,768 | FT | 1-1/2" DUCT CABLE WITH THREE NO. 4 AWG 2400 VOLT CABLES | |
| | | | 1,417 | | | | | | | 1,417 | | | | 625 | 25400 | 1,417 | FT | CONDUIT, 2", 725.04 | |
| | | | 257 | | | | | | | 257 | | | | 625 | 25401 | 257 | FT | CONDUIT, 2", 725.04, AS PER PLAN | 1101 |
| | | | 389 | | | | | | | 389 | | | | 625 | 25500 | 389 | FT | CONDUIT, 3", 725.04 | |
| | | | 166 | | | | | | | 166 | | | | 625 | 25902 | 166 | FT | CONDUIT, JACKED OR DRILLED, 725.04, 3" | |
| | | | 6 | | | | | | | 6 | | | | 625 | 26253 | 6 | EACH | LUMINAIRE, CONVENTIONAL, SOLID STATE (LED), AS PER PLAN, 480V | 1101 |
| | | | 16 | | | | | | | 16 | | | | 625 | 26263 | 16 | EACH | LUMINAIRE, HIGH MAST, SOLID STATE (LED), AS PER PLAN, 480V | 1101 |
| | | | 2 | | | | | | | 2 | | | | 625 | 27503 | 2 | EACH | LUMINAIRE, UNDERPASS, SOLID STATE (LED), AS PER PLAN, 480V | 1101 |
| | | | 4,299 | | | | | | | 4,299 | | | | 625 | 29000 | 4,299 | FT | TRENCH | |
| | | | 4 | | | | | | | 4 | | | | 625 | 29920 | 4 | EACH | STRUCTURE JUNCTION BOX | |
| | | | 8 | | | | | | | 8 | | | | 625 | 30700 | 8 | EACH | PULL BOX, 725.08, 18" | |
| | | | 2 | | | | | | | 2 | | | | 625 | 30706 | 2 | EACH | PULL BOX, 725.08, 24" | |
| | | | 14 | | | | | | | 14 | | | | 625 | 32000 | 14 | EACH | GROUND ROD | |
| | | | 1 | | | | | | | 1 | | | | 625 | 33000 | 1 | EACH | STRUCTURE GROUNDING SYSTEM | |
| | | | 1 | | | | | | | 1 | | | | 625 | 34001 | 1 | EACH | POWER SERVICE, AS PER PLAN | 1101 |
| | | | 4,299 | | | | | | | 4,299 | | | | 625 | 36000 | 4,299 | FT | PLASTIC CAUTION TAPE | |
| | | | LS | | | | | | | LS | | | | 625 | 37001 | LS | | SERVICE TO UNDERPASS LIGHTING, AS PER PLAN | 1101 |

GENERAL SUMMARY

FRA - 71 - 0:00

CALCULATED
DCB
CHECKED
DLW

387
1312

X:\4037000\121957.16\107201\Roadway\Sheets\107201G006.dgn_Sheet 8/8/2020 5:37:15 PM 1458sj

| SHEET NUM. | | | | | | | | PART. | | | | ITEM | ITEM EXT | GRAND TOTAL | UNIT | DESCRIPTION | SEE SHEET NO. |
|--|--|--|--|--|--|--|--|-----------|-----------|-----------|-----------|---------|----------|-------------|---|-------------|---------------|
| | | | | | | | | 01/IMS/PV | 02/NHS/PV | 03/IMS/BR | 04/IMS/BR | | | | | | |
| STRUCTURE OVER 20 FOOT SPAN (FRA-71-0296L (SOUTHBOUND)) | | | | | | | | | | | | | | | | | |
| LS | | | | | | | | | | LS | | 202 | 11203 | LS | PORTIONS OF STRUCTURE REMOVED, OVER 20 FOOT SPAN, AS PER PLAN | 1111 | |
| 150 | | | | | | | | | | 150 | | 202 | 22900 | 150 | APPROACH SLAB REMOVED | | |
| 721 | | | | | | | | | | 721 | | 202 | 23500 | 721 | WEARING COURSE REMOVED | | |
| LS | | | | | | | | | | LS | | 503 | 11101 | LS | COFFERDAMS AND EXCAVATION BRACING, AS PER PLAN | 1112 | |
| LS | | | | | | | | | | LS | | 503 | 21300 | LS | UNCLASSIFIED EXCAVATION | | |
| LS | | | | | | | | | | LS | | 505 | 11100 | LS | PILE DRIVING EQUIPMENT MOBILIZATION | | |
| 1,440 | | | | | | | | | | 950 | 490 | 507 | 00100 | 1,440 | STEEL PILES HP10X42, FURNISHED | | |
| 1,280 | | | | | | | | | | 844 | 436 | 507 | 00150 | 1,280 | STEEL PILES HP10X42, DRIVEN | | |
| 720 | | | | | | | | | | 475 | 245 | 507 | 00200 | 720 | STEEL PILES HP12X53, FURNISHED | | |
| 640 | | | | | | | | | | 422 | 218 | 507 | 00250 | 640 | STEEL PILES HP12X53, DRIVEN | | |
| 48 | | | | | | | | | | 48 | | 507 | 93300 | 48 | STEEL POINTS OR SHOES | | |
| 124,430 | | | | | | | | | | 82,123 | 42,307 | 509 | 10001 | 124,430 | LB EPOXY COATED REINFORCING STEEL, AS PER PLAN | 1111 | |
| 500 | | | | | | | | | | 330 | 170 | 509 | 20001 | 500 | REINFORCING STEEL, REPLACEMENT OF EXISTING REINFORCING STEEL, AS PER PLAN | 1111 | |
| 564 | | | | | | | | | | 372 | 192 | 510 | 10000 | 564 | EACH DOWEL HOLES WITH NONSHRINK, NONMETALLIC GROUT | | |
| 459 | | | | | | | | | | 302 | 157 | 511 | 21522 | 459 | CY CLASS QC2 CONCRETE WITH QC/OA, SUPERSTRUCTURE | | |
| 2 | | | | | | | | | | 1 | 1 | 511 | 33500 | 2 | EACH SEMI-INTEGRAL DIAPHRAGM GUIDE | | |
| 92 | | | | | | | | | | 60 | 32 | 511 | 42012 | 92 | CY CLASS QC1 CONCRETE WITH QC/OA, PIER ABOVE FOOTINGS | | |
| 168 | | | | | | | | | | 110 | 58 | 511 | 43512 | 168 | CY CLASS QC1 CONCRETE WITH QC/OA, ABUTMENT INCLUDING FOOTING | | |
| 28 | | | | | | | | | | 18 | 10 | 511 | 46510 | 28 | CY CLASS QC1 CONCRETE, FOOTING | | |
| 962 | | | | | | | | | | 634 | 328 | 512 | 10050 | 962 | SY SEALING OF CONCRETE SURFACES (NON-EPOXY) | | |
| 41 | | | | | | | | | | 27 | 14 | 512 | 33000 | 41 | SY TYPE 2 WATERPROOFING | | |
| 211,190 | | | | | | | | | | 140,793 | 70,397 | 513 | 10260 | 211,190 | LB STRUCTURAL STEEL MEMBERS, LEVEL 3 | | |
| 6,156 | | | | | | | | | | 4,062 | 2,094 | 513 | 20000 | 6,156 | EACH WELDED STUD SHEAR CONNECTORS | | |
| 17 | | | | | | | | | | 11 | 6 | 516 | 13600 | 17 | SF 1" PREFORMED EXPANSION JOINT FILLER | | |
| 253 | | | | | | | | | | 166 | 87 | 516 | 13900 | 253 | SF 2" PREFORMED EXPANSION JOINT FILLER | | |
| 179 | | | | | | | | | | 118 | 61 | 516 | 14020 | 179 | FT SEMI-INTEGRAL ABUTMENT EXPANSION JOINT SEAL | | |
| 18 | | | | | | | | | | 11 | 7 | 516 | 44100 | 18 | EACH ELASTOMERIC BEARING WITH INTERNAL LAMINATES AND LOAD PLATE (NEOPRENE) (11" x 18" x 2.05" WITH 12" x 19" x 2.0" LOAD PLATE) | | |
| 18 | | | | | | | | | | 11 | 7 | 516 | 44101 | 18 | EACH ELASTOMERIC BEARING WITH INTERNAL LAMINATES AND LOAD PLATE (NEOPRENE), AS PER PLAN (10" x 14" x 2.95" WITH 11" x 15" x 1.5" LOAD PLATE) | 1516 | |
| 139 | | | | | | | | | | 91 | 48 | 518 | 21200 | 139 | CY POROUS BACKFILL WITH GEOTEXTILE FABRIC | | |
| 205 | | | | | | | | | | 135 | 70 | 518 | 40000 | 205 | FT 6" PERFORATED CORRUGATED PLASTIC PIPE | | |
| 40 | | | | | | | | | | 26 | 14 | 518 | 40011 | 40 | FT 6" NON-PERFORATED CORRUGATED PLASTIC PIPE, INCLUDING SPECIALS, AS PER PLAN | 1131 | |
| 2 | | | | | | | | | | 2 | | 523 | 20000 | 2 | EACH DYNAMIC LOAD TESTING | | |
| 379 | | | | | | | | | | 250 | 129 | 526 | 25011 | 379 | SY REINFORCED CONCRETE APPROACH SLABS WITH QC/OA (T=15"), AS PER PLAN | 1184-1188 | |
| 146 | | | | | | | | | | 96 | 50 | 526 | 90030 | 146 | FT TYPE C INSTALLATION | | |
| 48 | | | | | | | | | | 31 | 17 | SPECIAL | 53000400 | 48 | EACH STRUCTURES : CAPSULE ADHESIVE ANCHORES | 1155 | |
| 325 | | | | | | | | | | 214 | 111 | 607 | 39900 | 325 | FT VANDAL PROTECTION FENCE, 6' STRAIGHT, COATED FABRIC | | |
| 61 | | | | | | | | | | 40 | 21 | 846 | 00110 | 61 | CF POLYMER MODIFIED ASPHALT EXPANSION JOINT SYSTEM | | |
| STRUCTURE OVER 20 FOOT SPAN (FRA-71-0296R (NORTHBOUND)) | | | | | | | | | | | | | | | | | |
| LS | | | | | | | | | | LS | | 202 | 11203 | LS | PORTIONS OF STRUCTURE REMOVED, OVER 20 FOOT SPAN, AS PER PLAN | 1111 | |
| 150 | | | | | | | | | | 150 | | 202 | 22900 | 150 | SY APPROACH SLAB REMOVED | | |
| 721 | | | | | | | | | | 721 | | 202 | 23500 | 721 | SY WEARING COURSE REMOVED | | |
| LS | | | | | | | | | | LS | | 503 | 11101 | LS | COFFERDAMS AND EXCAVATION BRACING, AS PER PLAN | 1112 | |
| LS | | | | | | | | | | LS | | 503 | 21300 | LS | UNCLASSIFIED EXCAVATION | | |
| LS | | | | | | | | | | LS | | 505 | 11100 | LS | PILE DRIVING EQUIPMENT MOBILIZATION | | |
| 1,440 | | | | | | | | | | 950 | 490 | 507 | 00100 | 1,440 | FT STEEL PILES HP10X42, FURNISHED | | |
| 1,280 | | | | | | | | | | 844 | 436 | 507 | 00150 | 1,280 | FT STEEL PILES HP10X42, DRIVEN | | |
| 720 | | | | | | | | | | 475 | 245 | 507 | 00200 | 720 | FT STEEL PILES HP12X53, FURNISHED | | |
| 640 | | | | | | | | | | 422 | 218 | 507 | 00250 | 640 | FT STEEL PILES HP12X53, DRIVEN | | |
| 48 | | | | | | | | | | 31 | 17 | 507 | 93300 | 48 | EACH STEEL POINTS OR SHOES | | |

GENERAL SUMMARY

FRA - 71 - 0 : 00

389
1312

X:\4037000\121957.16\107201\roadway\sheets\107201GG010.dgn Sheet 8/8/2020 5:40:40 PM 1458sjjs

| SHEET NUM. | | | | | | | | | | PART. | | | | ITEM | ITEM EXT | GRAND TOTAL | UNIT | DESCRIPTION | SEE SHEET NO. |
|------------|---------|--------|--------|-------|--------|-------|--|--|--|-----------|-----------|-----------|-----------|---------|----------|-------------|------|--|---------------|
| 28 | 34 | 35 | 36 | 37 | 38 | 39 | | | | 01/IMS/PV | 02/NHS/PV | 03/IMS/BR | 04/IMS/BR | | | | | | |
| | 10 | | | | | | | | | 5 | 5 | | | 614 | 12500 | 10 | EACH | REPLACEMENT SIGN | |
| | 100 | | | | | | | | | 50 | 50 | | | 614 | 12600 | 100 | EACH | REPLACEMENT DRUM | |
| | 3 | 2 | | | | | | | | 1 | 4 | | | 614 | 12756 | 5 | EACH | WORK ZONE CROSSOVER LIGHTING SYSTEM | |
| | | 5 | 18 | 105 | 14 | 210 | | | | 347 | 5 | | | 614 | 12800 | 352 | EACH | WORK ZONE RAISED PAVEMENT MARKER | |
| | | 2,144 | 829 | 608 | 1,362 | 993 | | | | 5,482 | 454 | | | 614 | 12801 | 5,936 | EACH | WORK ZONE RAISED PAVEMENT MARKER, AS PER PLAN | 21 |
| | 144 | | | | | | | | | 144 | | | | 614 | 13000 | 144 | CY | ASPHALT CONCRETE FOR MAINTAINING TRAFFIC | |
| | | 1,840 | 2,134 | 51 | 3,753 | 153 | | | | 5,328 | 2,603 | | | 614 | 13310 | 7,931 | EACH | BARRIER REFLECTOR, TYPE 1, ONE-WAY | |
| | | 156 | 14 | | 128 | | | | | 255 | 43 | | | 614 | 13312 | 298 | EACH | BARRIER REFLECTOR, TYPE 2, ONE-WAY | |
| | | 775 | 713 | | 279 | 51 | | | | 1,708 | 110 | | | 614 | 13350 | 1,818 | EACH | OBJECT MARKER, ONE WAY | |
| | | 14 | | 17 | | | | | | 31 | | | | 614 | 13360 | 31 | EACH | OBJECT MARKER, TWO WAY | |
| | 180,000 | | | | | | | | | 180,000 | | | | 614 | 18000 | 180,000 | EACH | MAINTAINING TRAFFIC, MISC.: BRIDGE DECK AND PAVEMENT PATCHING | 22 |
| | 22 | | | | | | | | | 11 | 11 | | | 614 | 18601 | 22 | SNMT | PORTABLE CHANGEABLE MESSAGE SIGN, AS PER PLAN | 20 |
| | 24.56 | 4.66 | 5.16 | | 10.32 | | | | | 16.8 | 3.61 | | | 614 | 20066 | 20.31 | MILE | WORK ZONE LANE LINE, CLASS I, 6", 807 PAINT | |
| | 25.76 | 15.06 | 13.46 | | 23.28 | 45 | | | | 16.38 | 8.18 | | | 614 | 20560 | 24.56 | MILE | WORK ZONE LANE LINE, CLASS III, 6", 642 PAINT | |
| | 25.58 | | | | | | | | | 17.05 | 8.53 | | | 614 | 22360 | 25.58 | MILE | WORK ZONE EDGE LINE, CLASS III, 6", 642 PAINT | |
| | | 10,006 | 4,069 | | 5,546 | | | | | 11,712 | 1,849 | | | 614 | 2310 | 19,361 | FT | WORK ZONE CHANNELIZING LINE, CLASS I, 12", 807 PAINT | |
| | 4,051 | | | | | | | | | 2,701 | 1,350 | | | 614 | 23690 | 4,051 | FT | WORK ZONE CHANNELIZING LINE, CLASS III, 12", 642 PAINT | |
| | | 1,460 | 1,200 | | 2,468 | 420 | | | | 4,599 | 969 | | | 614 | 24208 | 6,598 | FT | WORK ZONE DOTTED LINE, CLASS I, 2", 642 PAINT | |
| | 4,714 | | | | | | | | | 3,143 | 1,571 | | | 614 | 24618 | 4,714 | FT | WORK ZONE DOTTED LINE, CLASS III, 12", 642 PAINT | |
| | | | | | 142 | | | | | 95 | 47 | | | 614 | 25210 | 142 | FT | WORK ZONE TRANSVERSE/DIAGONAL LINE, CLASS II, 642 PAINT | |
| | | | 25 | | 14 | 16 | | | | 45 | 10 | | | 614 | 26200 | 55 | FT | WORK ZONE STOP LINE, CLASS I, 642 PAINT | |
| | | 212 | | | 156 | 155 | | | | 419 | 104 | | | 614 | 28200 | 523 | FT | WORK ZONE GORE MARKING, CLASS II, 642 PAINT | |
| | LS | | | | | | | | | LS | LS | | | 615 | 10001 | LS | | ROADS FOR MAINTAINING TRAFFIC, AS PER PLAN | 22 |
| | 19,429 | 4,130 | | | 1,543 | | | | | 24,588 | 514 | | | 615 | 20000 | 25,102 | SY | PAVEMENT FOR MAINTAINING TRAFFIC, CLASS A | |
| | 36,888 | 286 | | | 376 | | | | | 37,425 | 125 | | | 615 | 20001 | 37,550 | SY | PAVEMENT FOR MAINTAINING TRAFFIC, CLASS A, AS PER PLAN | 22 |
| | 300 | | | | | | | | | 300 | | | | 615 | 25001 | 300 | SY | PAVEMENT FOR MAINTAINING TRAFFIC, CLASS B, AS PER PLAN, TYPE 1 | 23 |
| | 6,844 | | | | | | | | | 6,844 | | | | 615 | 25001 | 6,844 | SY | PAVEMENT FOR MAINTAINING TRAFFIC, CLASS B, AS PER PLAN, TYPE 2 | 23 |
| | 2,000 | | | | | | | | | 2,000 | | | | 615 | 25001 | 2,000 | SY | PAVEMENT FOR MAINTAINING TRAFFIC, CLASS B, AS PER PLAN, TYPE 3 | 23 |
| | 500 | | | | | | | | | 500 | | | | 615 | 25001 | 500 | SY | PAVEMENT FOR MAINTAINING TRAFFIC, CLASS B, AS PER PLAN, TYPE 4 | 23 |
| | 962 | | | | | | | | | 481 | 481 | | | 616 | 10000 | 962 | MGAL | WATER | |
| | | 30,060 | 32,710 | | 32,820 | 2,410 | | | | 86,257 | 11,743 | | | 622 | 41100 | 98,000 | FT | PORTABLE BARRIER, UNANCHORED | |
| | | 480 | 480 | | | | | | | 960 | | | | 622 | 41110 | 960 | FT | PORTABLE BARRIER, ANCHORED | |
| | | 1,380 | | | 28,790 | | | | | 20,573 | 9,597 | | | 622 | 80000 | 30,170 | FT | GLARE SCREEN | |
| | | | | 11.65 | | 25.58 | | | | 11.65 | | | | 644 | 00104 | 37.23 | MILE | EDGE LINE, 6" | |
| | | | | 11.11 | | 21.76 | | | | 11.11 | | | | 644 | 00204 | 32.87 | MILE | LANE LINE, 6" | |
| | | | | 1,622 | | 4,051 | | | | 1,622 | | | | 644 | 00404 | 5,673 | FT | CHANNELIZING LINE, 12" | |
| | | | | | | 4,714 | | | | 4,714 | | | | 644 | 01510 | 4,714 | FT | DOTTED LINE, 6" | |
| | | | | 1,653 | | | | | | 1,653 | | | | 644 | 01520 | 1,653 | FT | DOTTED LINE, 12" | |
| | | | | 1.69 | | | | | | 1.69 | | | | 646 | 10010 | 1.69 | MILE | EDGE LINE, 6" | |
| | | | | 0.3 | | | | | | 0.3 | | | | 646 | 10110 | 0.3 | MILE | LANE LINE, 6" | |
| | | | | 25 | | | | | | 25 | | | | 646 | 10400 | 25 | FT | STOP LINE | |
| | | | | 226 | | | | | | 226 | | | | 646 | 20510 | 226 | FT | DOTTED LINE, 12" | |
| | 18 | | | | | | | | | 18 | | | | SPECIAL | 64620710 | 18 | EACH | AIR SPEED ZONE MARKING | 23 |
| | 160 | | | | | | | | | 80 | 80 | | | 808 | 18700 | 160 | SNMT | DIGITAL SPEED LIMIT (DSL) SIGN ASSEMBLY | |
| | | | | | | | | | | | | | | | | | | INCIDENTALS | |
| LS | LS | | | | | | | | | LS | LS | | | 108 | 10000 | LS | | CPM PROGRESS SCHEDULE | |
| | | | | | | | | | | LS | LS | | | 614 | 11001 | LS | | MAINTAINING TRAFFIC, AS PER PLAN | 16 |
| | | | | | | | | | | 24 | | | | 619 | 16021 | 24 | MNTH | FIELD OFFICE, TYPE C, AS PER PLAN | 13 |
| | | | | | | | | | | LS | LS | | | 623 | 10000 | LS | | CONSTRUCTION LAYOUT STAKES AND SURVEYING | |
| | | | | | | | | | | LS | LS | | | 624 | 10000 | LS | | MOBILIZATION | |

GENERAL SUMMARY

FRA - 71 - 0:00

CALCULATED
DCB
CHECKED
DLW

X:\4037000\121957.16\107201\roadway\sheet\107201GS001.dgn Sheet 8/7/2020 6:46:23 PM 1458sjjs

| SHEET NO. | 202 | 202 | 202 | 202 | 202 | 202 | 202 | 202 | 202 | 202 | 202 | 202 | SPECIAL | SPECIAL | 202 | 601 | 601 | 601 | 601 | 601 | 602 | 605 | 605 | 605 | 605 | 606 |
|------------------------------------|--------------------------|-------------------------------|--------------------------------|----------------------|-----------------------------------|------------------------------|-------------------------|-----------------------------------|-----------------------------------|-------------------------|-----------------------------|-------------------------------|--------------------------------------|------------------------------------|---------------------|----------------------|---------------------------------------|---------------------------------------|---|---|------------------------|-----------------------------------|--|--|--------------------------------|---------------------------|
| | HEADWALL REMOVED EACH | CONCRETE MEDIAN REMOVED SY | CONCRETE BARRIER REMOVED FT | GUTTER REMOVED SY | PIPE REMOVED, 24" AND UNDER FT | PIPE REMOVED, OVER 24" FT | GUARDRAIL REMOVED FT | GUARDRAIL REMOVED FOR REUSE FT | IMPACT ATTENUATOR REMOVED EACH | MANHOLE REMOVED EACH | CATCH BASIN REMOVED EACH | CATCH BASIN ABANDONED EACH | FILL AND PLUG EXISTING CONDUIT FT | PIPE CLEANOUT, 24" AND UNDER FT | FENCE REMOVED FT | RIPRAP, TYPE D SY | TIED CONCRETE BLOCK MAT, TYPE 1 SY | TIED CONCRETE BLOCK MAT, TYPE 2 SY | ROCK CHANNEL PROTECTION, TYPE B WITH FILTER CY | ROCK CHANNEL PROTECTION, TYPE C WITH FILTER CY | CONCRETE MASONRY CY | 6" SHALLOW PIPE UNDERDRAINS FT | 6" SHALLOW PIPE UNDERDRAINS, AS PER PLAN FT | 6" UNCLASSIFIED PIPE UNDERDRAINS FT | 6" BASE PIPE UNDERDRAINS FT | GUARDRAIL, TYPE MGS FT |
| 482 | | | | | | 820 | | | | | | | | | | | | | | | | | | | | 887.5 |
| 485 | | | | | 77 | | | | | 2 | | | | | | | | | | 1.78 | 0.45 | | | | | |
| 488 | | | | | | 355 | | | | | | | | | | | | | | | | | | | | 150 |
| 491 | 2 | | | | 171 | 227 | 340 | | | 3 | | | | | | | | | | | | | | | | 375 |
| 494 | | | 75 | | | 146 | | | | | | | | | | | | | | 1.67 | 0.27 | | | | | |
| 497 | | | 90 | | 161 | 1456 | | | | 3 | | | | | | | | | | | | | | | | 1450 |
| 500 | | | | | | | | | | | | | | | | 19 | | | | 9.6 | 0.60 | | | | | |
| 503 | | | | | 44 | 60 | | | 1 | 3 | | | | | | | | | | | | | | | | |
| 506 | | | | | | | | | | | | | | | | 19 | | | | 2 | 1.36 | | | | | 150 |
| 509 | 1 | | | | 31 | 355 | | | 1 | 4 | | | | | | | | | | | | | | | | |
| 512 | | | | | | | | | | | | | | | | | | | 3.7 | | 0.37 | | | | | |
| 515 | | | | | 194 | | | | | 2 | | | | | | | | | | | | | | | | |
| 518 | | | | | 8 | | | | | 1 | | | | | | | | | | 1.67 | 0.33 | | | | | |
| 521 | | | | | 9 | | | | | 1 | | | | | | | | | | | | | | | | 150 |
| 524 | | | | | 491 | | 625 | | | 5 | 1 | | | | | | | | | 1.67 | 0.27 | | | | | 437.5 |
| 527 | | | | | | | 63 | 600 | | | | | | | | | | | | | | | | | | 250 |
| 530 | | | | | | | | | | | | | | | | | | | | | | | | | | |
| 533 | | | | | | | | | | | | | | | | | | | | | | | | | | |
| 536 | | | | | 386 | | | | | 4 | | | | | | | | | | | | | | | | |
| 539 | | | | | | | | | | | | | | | | | | | | 1.33 | 0.33 | | | | | |
| 542 | | | | | | | 1553 | | | | | | | | | | | | | | | | | | | 1475 |
| 545 | | | | | 98 | | | | | 2 | | | | | | | | | | 1.33 | 0.27 | | | | | |
| 548 | | | | | 1008 | 513 | | | | 7 | | | | | | | | | | | | | | | | |
| 551 | | | 68 | | 190 | | 100 | | | 3 | | | | | | | | | | | | | | | | 725 |
| 554 | | | 69 | | | | 164 | | | | | | | | | | | | | | | | | | | 50 |
| 557 | | | | | 190 | | | | | 3 | | | | | | | | | | | | | | | | |
| 560 | | | | | | | 1600 | | | | | | | | | | | | | | | | | | | 1562.5 |
| 563 | | | | | 73 | | 1287 | | | 2 | | | | 51 | | | | 27 | | 1.33 | 0.25 | | | | | |
| 566 | | | | | 200 | | | | | 3 | | | | | | | | | | 1.33 | 0.27 | | | | | 912.5 |
| 569 | | | | | | | 262 | | | | | | | | | | | | | | | | | | | |
| 572 | | | | | 69 | | 1454 | | | 2 | | | | | 462 | | | 161 | | 3.99 | 0.81 | | | | | 812.5 |
| 575 | | | | | 18 | | 840 | 312.5 | | 1 | | | | | 173 | | 1.78 | 62 | | 1.33 | 0.52 | | | | | 1150 |
| 578 | 1 | | | | 80 | 9 | 738 | | | 1 | | | | 52 | | | 71 | | 1.33 | 0.27 | | | | | | 725 |
| 581 | | | | | 58 | | | | | 1 | | | | | | | | | | 1.33 | 0.25 | | | | | |
| 584 | | | | | 40 | | | | | 1 | | | | | 75 | | | 1.78 | | | 0.25 | | | | | |
| 587 | | | | | 32 | | | | | 1 | | | | | 93 | | | 1.78 | | 1.33 | 0.58 | | | | | 150 |
| 590 | | | | | | | | | | | | | | | | | | | | | | | | | | |
| 593 | | | | | 106 | | | | | 1 | | | | | | | | | | 1.78 | | 0.33 | | | | 150 |
| 596 | | | | | | | | | | | | | | | | | | | | | | | | | | |
| 599 | | | | | 66 | | | | | 2 | | | | | 157 | | | | | | 0.62 | | | | | |
| 602 | | | | | | | | | | | | | | | | | | | | | | | | | | |
| 605 | | | | | 104 | | | | | 1 | | | | | | | | | | 1.78 | | 0.33 | | | | |
| 608 | | | | | 103 | | | | | 1 | | | | | | | | | | 1.78 | | 0.33 | | | | |
| 611 | | | | | | | | | | | | | | | | | | | | | | | | | | |
| 614 | | | | | 113 | | | | | 1 | | | | | | | | | | | 1.33 | 0.33 | | | | 100 |
| 617 | | | | | 120 | | | | | 1 | | | | | | | | | | | | | | | | |
| 620 | | | | | 96 | | | | | 1 | | | | 192 | | | | | | | | | | | | |
| 623 | | | | | 108 | | | | | 1 | | | | | | | | | | | 1.33 | 0.33 | | | | |
| TOTALS CARRIED TO SHEET 399 | 4 | 0 | 302 | 0 | 4444 | 1164 | 11,803 | 912.5 | 0 | 2 | 64 | 1 | 192 | 538 | 635 | 38 | 16.02 | 321 | 3.70 | 35.68 | 10.05 | 0 | 0 | 0 | 0 | 11,663 |

| | | | |
|---------------------------|-----|---------|-----|
| CALCULATED | DCB | CHECKED | SJS |
| ROADWAY SUBSUMMARY | | | |
| FRA - 71 - 0:00 | | | |
| (395) 1312 | | | |

X:\4037000\121957.16\107201\roadway\sheet\107201GS002.dgn Sheet 8/7/2020 6:45:28 PM 1458s.js

| SHEET NO. | 606 | 606 | 606 | 606 | 606 | 606 | 606 | 606 | 606 | 606 | 607 | 609 | 611 | 611 | 611 | 611 | 611 | 611 | 611 | 611 | 611 | 611 | 611 | 611 | 611 |
|------------------------------------|-------------------------------------|-----------------------------|-----------------------------|-----------------------------|--------------------------------------|--------------------------------------|---|---|--|---|------------------|----------------|---|---------------------|-----------------------------|---------------------|-----------------------------|--|------------------------------------|---------------------|-----------------------------|---------------------|-----------------------------|-----------------------------|--|
| | GUARDRAIL, BARRIER DESIGN, TYPE MGS | GUARDRAIL REBUILT, TYPE MGS | ANCHOR ASSEMBLY, MGS TYPE B | ANCHOR ASSEMBLY, MGS TYPE T | MGS BRIDGE TERMINAL ASSEMBLY, TYPE 1 | MGS BRIDGE TERMINAL ASSEMBLY, TYPE 2 | IMPACT ATTENUATOR, TYPE 1 (BIDIRECTIONAL) | IMPACT ATTENUATOR, TYPE 2 (BIDIRECTIONAL) | GUARDRAIL, MISC.: TENSIONED CABLE WITH CONCRETE FOUNDATION LINE POSTS (SOCKETED) | GUARDRAIL, MISC.: TENSIONED CABLE ANCHOR TERMINAL | FENCE, TYPE 4TRA | CURB, TYPE 4-C | 6" CONDUIT, TYPE F FOR UNDERDRAIN OUTLETS | 15" CONDUIT, TYPE B | 15" CONDUIT, TYPE B, 706.02 | 15" CONDUIT, TYPE C | 15" CONDUIT, TYPE C, 706.02 | 15" CONDUIT, TYPE F, 707.05 TYPE C OR 707.21 | 15" CONDUIT, TYPE F, 707.05 TYPE C | 18" CONDUIT, TYPE B | 18" CONDUIT, TYPE B, 706.02 | 18" CONDUIT, TYPE C | 18" CONDUIT, TYPE C, 706.02 | 18" CONDUIT, TYPE C, 706.08 | 18" CONDUIT, TYPE F, 707.05 TYPE C OR 707.21 |
| | FT | FT | EACH | EACH | EACH | EACH | EACH | EACH | FT | EACH | FT | FT | FT | FT | FT | FT | FT | FT | FT | FT | FT | FT | FT | FT | FT |
| 482 | | | 1 | 1 | | | | | 1340 | 2 | | | | | | | | | | | | | | | |
| 485 | | | | | | | | | | | | | | | | | | | | | | | | | |
| 488 | | | 1 | 1 | | | | | | | | | | | | | | | | | | | | | |
| 491 | | | 2 | 2 | | | | | 2600 | 2 | | | | | | | | | | | | | | | |
| 494 | 50 | | | | | | | | | | | | | 95 | | | | | | | | | | | |
| 497 | 50 | | 2 | 3 | 2 | 1 | 1 | | | | | 36 | | | | | | | | | | | | | |
| 500 | | | | | | | | | | | | | | | | | | | | | | | | | |
| 503 | | | | | | | | | | | | | | | | | | | | | | | | | |
| 506 | | | 1 | 1 | | | | | 2100 | 2 | | | | | | | | | | | | | | | |
| 509 | | | | | | | | | | | | | | | | | | | | | | | | | |
| 512 | | | | | | | | | | | | | | | | | | | | | | | | | |
| 515 | | | | | | | | | | | | | | | | | | | | | | | | | |
| 518 | | | | | | | | | 1750 | 2 | | | | | | | | | | | | | | | |
| 521 | | | 1 | 1 | | | | | | | | | | | | | | | | | | | | | |
| 524 | | | 1 | | | | | | | | | | | | | | | | | | | | | | |
| 527 | | 600 | | 1 | | | | | | | | | | | | | | | | | | | | | |
| 530 | | | | | | | | | | | | | | | | | | | | | | | | | |
| 533 | | | | | | | | | 2100 | 2 | | | | | | | | | | | | | | | |
| 536 | | | | | | | | | | | | | | | | | | | | | | | | | |
| 539 | | | | | | | | | | | | | | | | | | | | | | | | | |
| 542 | | | 2 | 2 | | | | | 1479 | 2 | | | | | | | | | | | | | | | |
| 545 | | | | | | | | | | | | | | | | | | | | | | | | | |
| 548 | | | | | | | | | | | | | | | | | | | | | | | | | |
| 551 | | | 3 | 2 | 1 | | | | | | | | | | | | | | | | | | | | |
| 554 | | | 1 | | 1 | | | | 2222 | 2 | | 36 | | | | | | | | | | | | | |
| 557 | | | | | | | | | | | | | | | | | | | | | | | | | |
| 560 | | | 1 | | 1 | | | | | | | | | | | | | | | | | | | | |
| 563 | | | | | | | | | | | | | | | | | | | | | | | | | |
| 566 | | | | | 1 | 1 | | | 675 | 2 | | 18 | | 75 | | | | | | | | | | | |
| 569 | 125 | | | | 1 | | 1 | | | | | | | | | | | | | | | | | | |
| 572 | 287.5 | | | | 3 | 2 | | | | | 408 | 129 | | | | | | | | | | | | | |
| 575 | 75 | 312.5 | 1 | 2 | 2 | 2 | | | 1835 | 2 | 90 | 97 | | | | | | | | | | | | | |
| 578 | | | 1 | | 1 | | | | | | | 34 | | 92 | 40 | 49 | | | | | | | | | |
| 581 | | | | | | | | | | | | | | | | | | | | | | | | | |
| 584 | | | | | | | | | | | | | | | | | | | | | | | | | |
| 587 | | | 1 | 1 | | | | | 1803 | 2 | | | | 61 | | | | | | | | | | | |
| 590 | | | | | | | | | | | | | | | | | | | | | | | | | |
| 593 | | | 1 | 1 | | | | | | | | | | | | | | | | | | | | | |
| 596 | | | | | | | | | | | | | | | | | | | | | | | | | |
| 599 | | | | | | | | | 2212 | 2 | | | | | | | | | | | | | | | |
| 602 | | | | | | | | | | | | | | | | | | | | | | | | | |
| 605 | | | | | | | | | | | | | | | | | | | | | | | | | |
| 608 | | | | | | | | | | | | | | | | | | | | | | | | | |
| 611 | | | | | | | | | 2800 | 2 | | | | | | | | | | | | | | | |
| 614 | 100 | | | 2 | | | | | | | | | | | | | | | | | | | | | |
| 617 | | | | | | | | | | | | | | | | | | | | | | | | | |
| 620 | | | | | | | | | | | | | | | | | | | | | | | | | |
| 623 | | | | | | | | | | | | | | | | | | | | | | | | | |
| TOTALS CARRIED TO SHEET 400 | 687.5 | 912.5 | 20 | 20 | 13 | 6 | 5 | 0 | 22,916 | 24 | 498 | 350 | 0 | 323 | 260 | 5757 | 90 | 210 | 88 | 859 | 187 | 1569 | 56 | 20 | 50 |

| | | | |
|--|---------|-----|------|
| CALCULATED | DCB | | |
| | CHECKED | | |
| SJS | | | |
| ROADWAY SUBSUMMARY | | | |
| FRA - 71 - 0:00 | | | |
| <table border="1"> <tr> <td>396</td> </tr> <tr> <td>1312</td> </tr> </table> | | 396 | 1312 |
| 396 | | | |
| 1312 | | | |

X:\4037000\121957.16\107201\roadway\sheets\107201GS004.dgn Sheet 8/7/2020 6:49:39 PM 1458s.js

| SHEET NO. | 202 | 202 | 202 | 202 | 202 | 202 | 202 | 202 | 202 | 202 | 202 | 202 | SPECIAL | SPECIAL | 202 | 601 | 601 | 601 | 601 | 601 | 602 | 605 | 605 | 605 | 605 | 606 |
|-----------------------------------|--------------------------|-------------------------------|--------------------------------|----------------------|-----------------------------------|------------------------------|-------------------------|-----------------------------------|-----------------------------------|-------------------------|-----------------------------|-------------------------------|--------------------------------------|------------------------------------|---------------------|----------------------|---------------------------------------|---------------------------------------|---|---|------------------------|-----------------------------------|--|--|--------------------------------|---------------------------|
| | HEADWALL REMOVED EACH | CONCRETE MEDIAN REMOVED SY | CONCRETE BARRIER REMOVED FT | GUTTER REMOVED SY | PIPE REMOVED, 24" AND UNDER FT | PIPE REMOVED, OVER 24" FT | GUARDRAIL REMOVED FT | GUARDRAIL REMOVED FOR REUSE FT | IMPACT ATTENUATOR REMOVED EACH | MANHOLE REMOVED EACH | CATCH BASIN REMOVED EACH | CATCH BASIN ABANDONED EACH | FILL AND PLUG EXISTING CONDUIT FT | PIPE CLEANOUT, 24" AND UNDER FT | FENCE REMOVED FT | RIPRAP, TYPE D SY | TIED CONCRETE BLOCK MAT, TYPE 1 SY | TIED CONCRETE BLOCK MAT, TYPE 2 SY | ROCK CHANNEL PROTECTION, TYPE B WITH FILTER CY | ROCK CHANNEL PROTECTION, TYPE C WITH FILTER CY | CONCRETE MASONRY CY | 6" SHALLOW PIPE UNDERDRAINS FT | 6" SHALLOW PIPE UNDERDRAINS, AS PER PLAN FT | 6" UNCLASSIFIED PIPE UNDERDRAINS FT | 6" BASE PIPE UNDERDRAINS FT | GUARDRAIL, TYPE MGS FT |
| 626 | | | | | | | | | | | | | | | | | | | | | | | | | | |
| 629 | | | | | 115 | | | | | 1 | | | | | | | | | | 1.33 | 0.33 | | | | | |
| 632 | | | | | | | | | | | | | | | | | | | | | | | | | | |
| 635 | | | | | 98 | | | | | 1 | | | | | | | | | | 1.33 | 0.33 | | | | | |
| 638 | | | | | | | | | | | | | | | | | | | | | | | | | | |
| 641 | | | | | 111 | | | | | 1 | | | | | | | 1.78 | | | | 0.39 | | | | | |
| 644 | | | | | | | | | | | | | | | | | | | | | | | | | | |
| 647 | | | | | | | | | | | | | | | | | | | | | | | | | | |
| 653 | | 10 | 1217 | | | | | 1 | | | | | | | | | 3.56 | | | | 0.54 | | | | | |
| 659 | | 18 | 1153 | | 39 | | | 1 | | | | | | | | 1.78 | | | 1.67 | 0.93 | | | | | | |
| 665 | 2 | | | 39 | 143 | | | | | 2 | | | | | | | | | 1.56 | 0.92 | | | | | | |
| 670 | 2 | | | 5 | 80 | | | | | 1 | | | | | | 1.78 | | | 2.08 | 1.47 | | | | | | |
| 945 | | | | | | | | | | | | | | | | | 5.40 | | | | | 6980 | | | 6956 | |
| 946 | | | | | | | | | | | | | | | | | 5.40 | | | | | 6939 | | | 6939 | |
| 947 | | | | | | | | | | | | | | | | | 3.60 | | | | | 7117 | | | 7122 | |
| 948 | | | | | | | | | | | | | | | | | 1.80 | | | | | 5741 | | | 5741 | |
| 949 | | | | | | | | | | | | | | | | | 7.20 | | | | | 3016 | | 372 | 3016 | |
| 950 | | | | | | | | | | | | | | | | | 5.40 | | | | | 4102 | | 22 | 4104 | |
| 951 | | | | | | | | | | | | | | | | | 9.00 | | | | | 8321 | | 87 | 9032 | |
| 952 | | | | | | | | | | | | | | | | | 1.80 | | | | | 9500 | 525 | 2088 | 6686 | |
| 953 | | | | | | | | | | | | | | | | | 7.20 | | | | | 4866 | 615 | 297 | 4808 | |
| 954 | | | | | | | | | | | | | | | | | 5.40 | | | | | 7463 | | 328 | 4714 | |
| 955 | | | | | | | | | | | | | | | | | 14.40 | | | | | 7787 | | | 5959 | |
| 956 | | | | | | | | | | | | | | | | | 16.20 | | | | | 5956 | | | 6864 | |
| 957 | | | | | | | | | | | | | | | | | 10.80 | | | | | 9953 | | | 9948 | |
| 958 | | | | | | | | | | | | | | | | | 14.40 | | | | | 7172 | | | 7670 | |
| 959 | | | | | | | | | | | | | | | | | 14.40 | | | | | 7957 | | | 8247 | |
| 960 | | | | | | | | | | | | | | | | | 3.60 | | | | | 2154 | | 152 | 1864 | |
| 961 | | | | | | | | | | | | | | | | | 1.80 | | | | | 3022 | | 117 | 2630 | |
| 962 | | | | | | | | | | | | | | | | | 3.60 | | | | | 2926 | | | 2515 | |
| 963 | | | | | | | | | | | | | | | | | 10.80 | | | | | 1712 | | 181 | 2293 | |
| 964 | | | | | | | | | | | | | | | | | 12.60 | | | | | 1665 | | | 2383 | |
| TOTALS FROM THIS SHEET | 4 | 28 | 2370 | 44 | 586 | 0 | 0 | 2 | 0 | 6 | 0 | | | 0 | 0 | 163.70 | 0 | 0 | 7.97 | 4.91 | 114,349 | 1140 | 3644 | 109,491 | 0 | |
| TOTALS FROM SHEET 395 | 4 | 0 | 302 | 0 | 4444 | 1164 | 11,803 | 0 | 2 | 64 | 1 | 192 | 538 | 635 | 38 | 16.02 | 321 | 3.7 | 35.68 | 10.05 | 0 | 0 | 0 | 0 | 11,663 | |
| TOTALS CARRIED TO GENERAL SUMMARY | 8 | 28 | 2672 | 44 | 5030 | 1164 | 11,803 | 2 | 2 | 70 | 1 | 192 | 538 | 635 | 38 | 179.72 | 321 | 3.7 | 43.65 | 14.96 | 114,349 | 1140 | 3644 | 109,491 | 11,663 | |

ROADWAY SUBSUMMARY

FRA - 71 - 0.00

CALCULATED
DCB
CHECKED
SJS

399
1312




X:\4037000\121957.16\107201\roadway\sheets\107201GS005.dgn_Sheet 8/7/2020 6:51:48 PM 1458sjs


| SHEET NO. | 606 | 606 | 606 | 606 | 606 | 606 | 606 | 606 | 606 | 606 | 607 | 609 | 611 | 611 | 611 | 611 | 611 | 611 | 611 | 611 | 611 | 611 | 611 | 611 |
|-----------------------------------|-------------------------------------|-----------------------------|-----------------------------|-----------------------------|--------------------------------------|--------------------------------------|--|---|--|---|------------------|----------------|---|---------------------|-----------------------------|---------------------|-----------------------------|---|-------------------------------------|---------------------|-----------------------------|---------------------|-----------------------------|-----------------------------|
| | GUARDRAIL, BARRIER DESIGN, TYPE MGS | GUARDRAIL REBUILT, TYPE MGS | ANCHOR ASSEMBLY, MGS TYPE B | ANCHOR ASSEMBLY, MGS TYPE T | MGS BRIDGE TERMINAL ASSEMBLY, TYPE 1 | MGS BRIDGE TERMINAL ASSEMBLY, TYPE 2 | IMPACT ATTENUATOR, TYPE 1 (BIDIRECTIONAL), 75 MPH, 36" | IMPACT ATTENUATOR, TYPE 2 (BIDIRECTIONAL), 35MPH, 36" | GUARDRAIL, MISC.: TENSIONED CABLE WITH CONCRETE FOUNDATION LINE POSTS (SOCKETED) | GUARDRAIL, MISC.: TENSIONED CABLE ANCHOR TERMINAL | FENCE, TYPE 47RA | CURB, TYPE 4-C | 6" CONDUIT, TYPE F FOR UNDERDRAIN OUTLETS | 15" CONDUIT, TYPE B | 15" CONDUIT, TYPE B, 706.02 | 15" CONDUIT, TYPE C | 15" CONDUIT, TYPE C, 706.02 | 15" CONDUIT, TYPE F, 707.05, TYPE C OR 707.21 | 15" CONDUIT, TYPE F, 707.05, TYPE C | 18" CONDUIT, TYPE B | 18" CONDUIT, TYPE B, 706.02 | 18" CONDUIT, TYPE C | 18" CONDUIT, TYPE C, 706.02 | 18" CONDUIT, TYPE C, 706.08 |
| | FT | FT | EACH | EACH | EACH | EACH | EACH | FT | EACH | FT | FT | FT | FT | FT | FT | FT | FT | FT | FT | FT | FT | FT | FT | FT |
| 626 | | | | | | | | 3050 | 2 | | | | | | | | | | | | | | | |
| 629 | | | | | | | | | | | | | | | | | | | | 115 | | 293 | | |
| 632 | | | | | | | | | | | | | | | | | | | | | | | | |
| 635 | | | | | | | | | | | | | | | | | | | | 116 | | 292 | | |
| 638 | | | | | | | | | | | | | | | | | | | | | | | | |
| 641 | | | | | | | | | | | | | | | | | | | | | | | | |
| 644 | | | | | | | | | | | | | | | | | | | | | | | 292 | |
| 647 | | | | | | | | | | | | | | | | | | | | | | | | |
| 653 | | | | | | | | | | 1 | | | | 188 | 357 | | | | | | | | | |
| 659 | | | | | | | | | | 1 | | | | 182 | 20 | | | | | | 39 | | | |
| 665 | | | | | | | | | | | | | | | | | | | | | | | | |
| 670 | | | | | | | | | | | | | | | 53 | | | | | | | | | |
| 945 | | | | | | | | | | | | | 526 | | | | | | | | | | | |
| 946 | | | | | | | | | | | | 698 | | | | | | | | | | | | |
| 947 | | | | | | | | | | | | 778 | | | | | | | | | | | | |
| 948 | | | | | | | | | | | | 527 | | | | | | | | | | | | |
| 949 | | | | | | | | | | | | 343 | | | | | | | | | | | | |
| 950 | | | | | | | | | | | | 238 | | | | | | | | | | | | |
| 951 | | | | | | | | | | | | 666 | | | | | | | | | | | | |
| 952 | | | | | | | | | | | | 634 | | | | | | | | | | | | |
| 953 | | | | | | | | | | | | 438 | | | | | | | | | | | | |
| 954 | | | | | | | | | | | | 474 | | | | | | | | | | | | |
| 955 | | | | | | | | | | | | 719 | | | | | | | | | | | | |
| 956 | | | | | | | | | | | | 628 | | | | | | | | | | | | |
| 957 | | | | | | | | | | | | 567 | | | | | | | | | | | | |
| 958 | | | | | | | | | | | | 581 | | | | | | | | | | | | |
| 959 | | | | | | | | | | | | 607 | | | | | | | | | | | | |
| 960 | | | | | | | | | | | | 152 | | | | | | | | | | | | |
| 961 | | | | | | | | | | | | 187 | | | | | | | | | | | | |
| 962 | | | | | | | | | | | | 143 | | | | | | | | | | | | |
| 963 | | | | | | | | | | | | 213 | | | | | | | | | | | | |
| 964 | | | | | | | | | | | | 252 | | | | | | | | | | | | |
| TOTALS FROM THIS SHEET | 0 | 0 | 0 | 0 | 0 | 0 | 2 | 3050 | 2 | 0 | 0 | 9371 | 370 | 430 | 0 | 0 | 0 | 0 | 231 | 39 | 877 | 0 | 0 | 0 |
| TOTALS FROM SHEET 396 | 687.5 | 912.5 | 20 | 20 | 13 | 6 | 5 | 22,916 | 24 | 498 | 350 | 0 | 323 | 260 | 5757 | 90 | 210 | 88 | 859 | 187 | 1569 | 56 | 20 | 50 |
| TOTALS CARRIED TO GENERAL SUMMARY | 687.5 | 912.5 | 20 | 20 | 13 | 6 | 5 | 25,966 | 26 | 498 | 350 | 9371 | 693 | 690 | 5757 | 90 | 210 | 88 | 1090 | 226 | 2446 | 56 | 20 | 50 |

| | |
|--------------------|------------|
| ROADWAY SUBSUMMARY | CALCULATED |
| | DCB |
| FRA - 71 - 0.00 | CHECKED |
| | SJS |

400
1312

X:\4037000\121957.16\107201\roadway\sheets\107201GP034.dgn Sheet 8/7/2020 7:04:12 PM 1458sjs

-  ITEM 670 - DITCH EROSION PROTECTION, WIDTH = 11' UNLESS NOTED
-  ROCK CHANNEL PROTECTION, TYPE C w/FILTER
-  ITEM 601, TIED CONC. BLOCK MAT, TYPE 2 PER DM-4.1

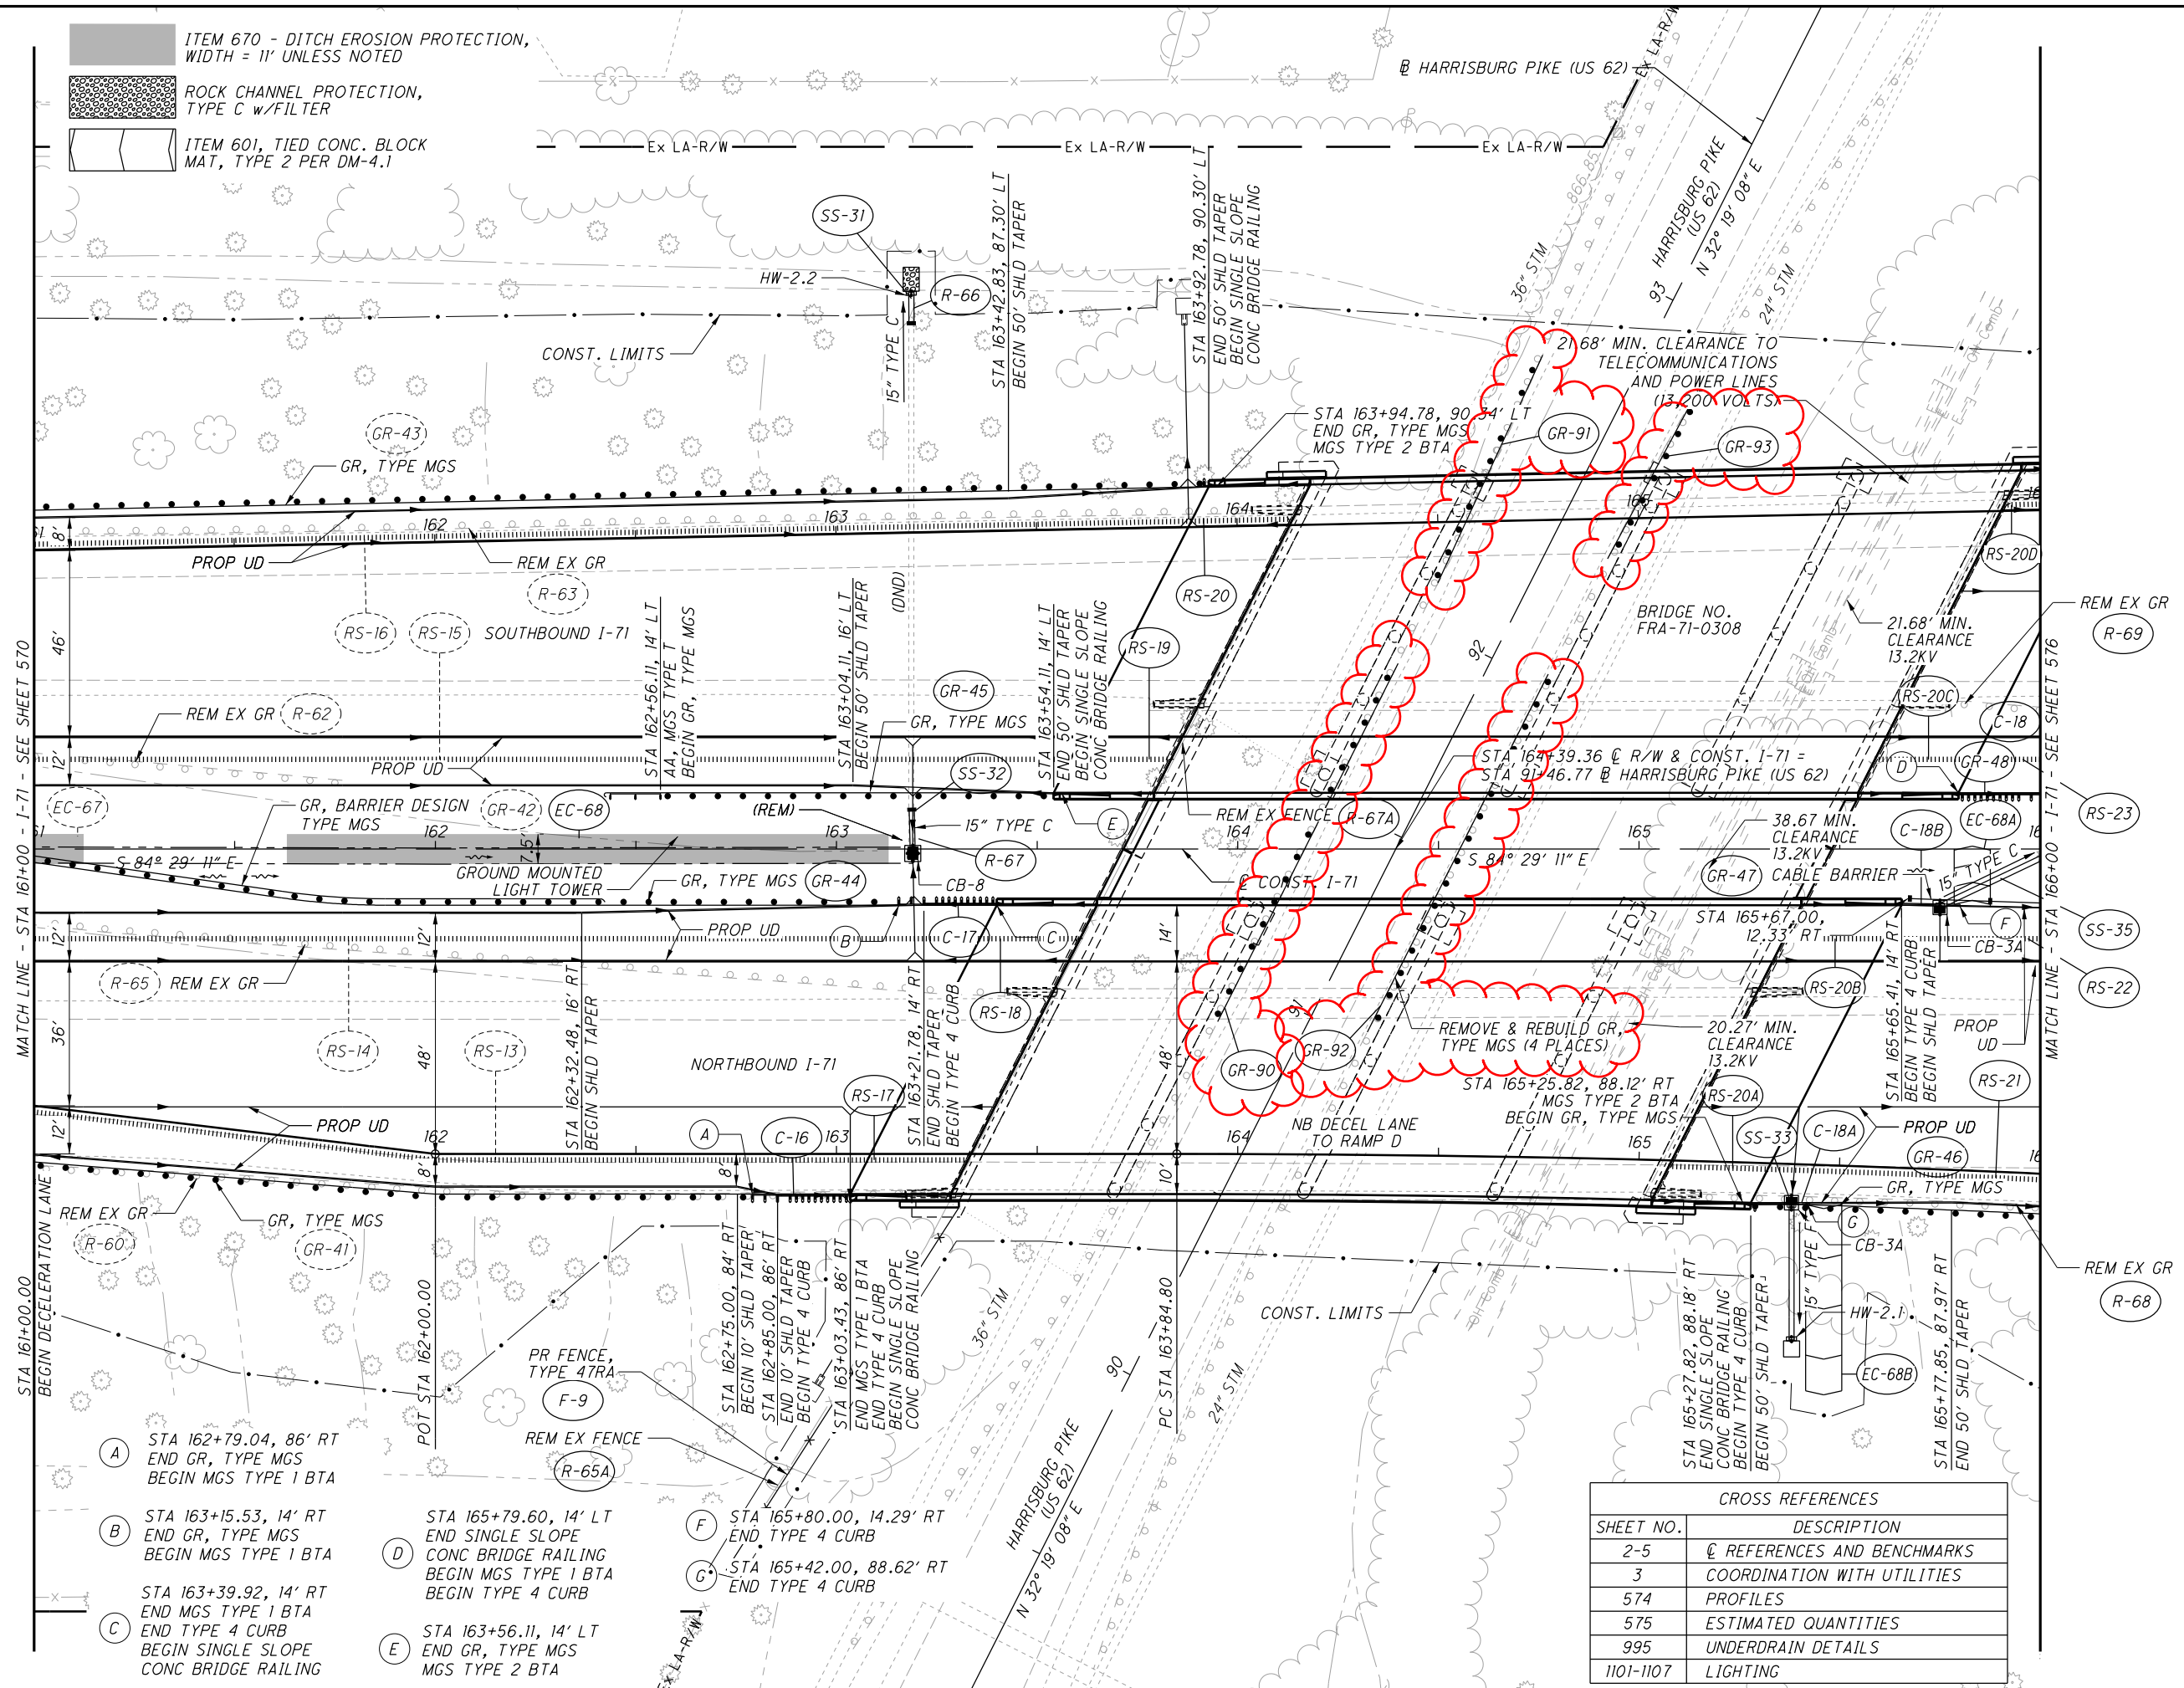

MATCH LINE - STA 161+00 - I-71 - SEE SHEET 570

MATCH LINE - STA 166+00 - I-71 - SEE SHEET 576

- (A) STA 162+79.04, 86' RT
END GR, TYPE MGS
BEGIN MGS TYPE 1 BTA
- (B) STA 163+15.53, 14' RT
END GR, TYPE MGS
BEGIN MGS TYPE 1 BTA
- (C) STA 163+39.92, 14' RT
END MGS TYPE 1 BTA
END TYPE 4 CURB
BEGIN SINGLE SLOPE
CONC BRIDGE RAILING

- (D) STA 165+79.60, 14' LT
END SINGLE SLOPE
CONC BRIDGE RAILING
BEGIN MGS TYPE 1 BTA
BEGIN TYPE 4 CURB
- (E) STA 163+56.11, 14' LT
END GR, TYPE MGS
MGS TYPE 2 BTA

- (F) STA 165+80.00, 14.29' RT
END TYPE 4 CURB
- (G) STA 165+42.00, 88.62' RT
END TYPE 4 CURB

| CROSS REFERENCES | |
|------------------|-----------------------------|
| SHEET NO. | DESCRIPTION |
| 2-5 | ☉ REFERENCES AND BENCHMARKS |
| 3 | COORDINATION WITH UTILITIES |
| 574 | PROFILES |
| 575 | ESTIMATED QUANTITIES |
| 995 | UNDERDRAIN DETAILS |
| 1101-1107 | LIGHTING |



PLAN - I-71
STA 161+00 TO STA 166+00

FRA-71-0.00

573
1312

X:\4037000\121957.16\107201\Roadway\Drawings\0720034.dgn Sheet 8/7/2020 6:47:07 PM 1458s.js

| REF. NO. | SHEET NO. | STATION | | SIDE | 202 | 202 | 202 | 202 | 202 | 601 | 601 | 601 | 602 | 606 | 606 | 606 | 606 | 606 | 606 | 606 | 606 | 607 | 609 | 611 | 611 | 611 | 611 | 618 | 618 | 626 | 670 | | | |
|----------------------------------|-------------------------|---------|--------|-------|-----------------------------|-------------------|-----------------------------|---------------------|---------------|---------------------------------|---------------------------------|---|------------------|---------------------|-------------------------------------|-----------------------------|-----------------------------|-----------------------------|--------------------------------------|--------------------------------------|--|---|------------------|----------------|-----------------------------|---|-------------------------------------|---------------------|--------------------|---------------------------|-----------------------------------|-----------------------------------|--------------------------|-----|
| | | | | | PIPE REMOVED, 24" AND UNDER | GUARDRAIL REMOVED | GUARDRAIL REMOVED FOR REUSE | CATCH BASIN REMOVED | FENCE REMOVED | TIED CONCRETE BLOCK MAT, TYPE 1 | TIED CONCRETE BLOCK MAT, TYPE 2 | ROCK CHANNEL PROTECTION, TYPE C WITH FILTER | CONCRETE MASONRY | GUARDRAIL, TYPE MGS | GUARDRAIL, BARRIER DESIGN, TYPE MGS | GUARDRAIL REBUILT, TYPE MGS | ANCHOR ASSEMBLY, MGS TYPE B | ANCHOR ASSEMBLY, MGS TYPE T | MCS BRIDGE TERMINAL ASSEMBLY, TYPE 1 | MCS BRIDGE TERMINAL ASSEMBLY, TYPE 2 | GUARDRAIL, MISC.: TENSIONED CABLE WITH CONCRETE FOUNDATION LINE POSTS (SOCKETED) | GUARDRAIL, MISC.: TENSIONED CABLE ANCHOR TERMINAL | FENCE, TYPE 4TRA | CURB, TYPE 4-C | 15" CONDUIT, TYPE C, 706.02 | 15" CONDUIT, TYPE F, 705.07, TYPE C OR 707.21 | 15" CONDUIT, TYPE F, 705.07, TYPE C | CATCH BASIN, NO. 3A | CATCH BASIN, NO. 8 | RUMBLE STRIPS, (CONCRETE) | RUMBLE STRIPS, (ASPHALT CONCRETE) | BARRIER REFLECTOR, TYPE 2 (I-WAY) | DITCH EROSION PROTECTION | |
| | | | | | FT | FT | FT | EACH | FT | SY | SY | CY | CY | FT | FT | FT | EACH | EACH | EACH | EACH | FT | EACH | FT | SY | FT | FT | FT | EACH | EACH | FT | MI | EACH | SY | |
| R-65A | 573 | 162+72 | 163+28 | RT | | | | | 95 | | | | | | | | | | | | | | | | | | | | | | | | | |
| R-66 | 573 | 163+19 | | LT | 8 | | | | | | | | | | | | | | | | | | | | | | | | | | | | | |
| R-67 | 573 | 163+19 | | LT | 10 | | | 1 | | | | | | | | | | | | | | | | | | | | | | | | | | |
| R-67A | 573 | 163+55 | 163+90 | RT/LT | | | | | 78 | | | | | | | | | | | | | | | | | | | | | | | | | |
| R-68 | 573, 576 | 165+13 | 170+85 | RT | | 575 | | | | | | | | | | | | | | | | | | | | | | | | | | | | |
| R-69 | 573, 576 | 165+74 | 168+38 | LT | | 265 | | | | | | | | | | | | | | | | | | | | | | | | | | | | |
| C-16 | 573 | 162+85 | 163+03 | RT | | | | | | | | | | | | | | | | | | 18 | | | | | | | | | | | | |
| C-17 | 573 | 163+22 | 163+40 | RT | | | | | | | | | | | | | | | | | | 18 | | | | | | | | | | | | |
| C-18 | 573, 576 | 165+80 | 166+12 | LT | | | | | | | | | | | | | | | | | | 32 | | | | | | | | | | | | |
| C-18A | 573 | 165+28 | 165+42 | RT | | | | | | | | | | | | | | | | | | 14 | | | | | | | | | | | | |
| C-18B | 573 | 165+65 | 165+80 | RT | | | | | | | | | | | | | | | | | | 15 | | | | | | | | | | | | |
| EC-68 | 573 | 161+63 | 163+12 | CL | | | | | | | | | | | | | | | | | | | | | | | | | | 125 | | | | |
| EC-68A | 573 | 165+79 | 165+88 | RT | | | | | | 14 | | | | | | | | | | | | | | | | | | | | | | | | |
| EC-68B | 573 | 165+42 | 165+51 | RT | | | | | | 48 | | | | | | | | | | | | | | | | | | | | | | | | |
| F-9 | 573 | 162+72 | 163+30 | RT | | | | | | | | | | | | | | | | | | 90 | | | | | | | | | | | | |
| GR-44 | 573 | 162+41 | 163+40 | RT | | | | | | | | | | 75 | | | | 1 | | | | | | | | | | | | | | | | |
| GR-45 | 573 | 162+56 | 163+54 | LT | | | | | | | | | 100 | | | | 1 | | 1 | | | | | | | | | | | | | | | |
| GR-46 | 573, 576 | 165+26 | 170+85 | RT | | | | | | | | | 562.5 | | | | 1 | | 1 | | | | | | | | | | | | | | | |
| GR-47 | 573, 576, 579, 582, 585 | 165+67 | 184+00 | RT | | | | | | | | | | | | | | | 1835 | 2 | | | | | | | | | | 12 | | | | |
| GR-48 | 573, 576, 579 | 165+80 | 170+91 | LT | | | | | | | | | 487.5 | | | 1 | | 1 | | | | | | | | | | | | 10 | | | | |
| RS-17 | 573 | 163+08 | 163+33 | RT | | | | | | | | | | | | | | | | | | | | | | | | | | 25 | | | | |
| RS-18 | 573 | 163+36 | 163+61 | RT | | | | | | | | | | | | | | | | | | | | | | | | | | 25 | | | | |
| RS-19 | 573 | 163+58 | 163+83 | LT | | | | | | | | | | | | | | | | | | | | | | | | | | 25 | | | | |
| RS-20 | 573 | 163+88 | 164+13 | LT | | | | | | | | | | | | | | | | | | | | | | | | | | 25 | | | | |
| RS-20A | 573 | 165+07 | 165+32 | RT | | | | | | | | | | | | | | | | | | | | | | | | | | 25 | | | | |
| RS-20B | 573 | 165+36 | 165+61 | RT | | | | | | | | | | | | | | | | | | | | | | | | | | 25 | | | | |
| RS-20C | 573 | 165+59 | 165+84 | LT | | | | | | | | | | | | | | | | | | | | | | | | | | 25 | | | | |
| RS-20D | 573, 576 | 165+91 | 166+16 | LT | | | | | | | | | | | | | | | | | | | | | | | | | | 25 | | | | |
| RS-21 | 573, 576 | 165+32 | 167+90 | LT | | | | | | | | | | | | | | | | | | | | | | | | | | 0.05 | | | | |
| RS-22 | 573, 642 | 165+61 | 279+31 | LT | | | | | | | | | | | | | | | | | | | | | | | | | | 2.15 | | | | |
| RS-23 | 573, 642 | 165+84 | 279+31 | RT | | | | | | | | | | | | | | | | | | | | | | | | | | 2.15 | | | | |
| SS-31 | 573 | 163+19 | | LT | | | | | | | | 1.33 | 0.25 | | | | | | | | | | | | | | | | | | | | | |
| SS-32 | 573 | 163+19 | | LT/RT | | | | | | | | | | | | | | | | | | | 10 | | | | | | | 8 | | | | |
| SS-33 | 573 | 165+38 | | RT | | | | | | 1.78 | | | 0.27 | | | | | | | | | | | 41 | | | 1 | | 1 | | | | | |
| GR-90 | 573 | 90+88 | 91+88 | LT | | | | | | | | | | | | | | | | | | | | | | | | | | 100 | | | | |
| GR-91 | 573 | 92+10 | 92+73 | LT | | | | | | | | | | | | | | | | | | | | | | | | | | 62.5 | | | | |
| GR-92 | 573 | 91+03 | 92+03 | RT | | | | | | | | | | | | | | | | | | | | | | | | | | 100 | | | | |
| GR-93 | 573 | 92+35 | 92+85 | RT | | | | | | | | | | | | | | | | | | | | | | | | | | 50 | | | | |
| TOTALS CARRIED TO SHEETS 395-398 | | | | | 18 | 840 | 312.5 | 1 | 173 | 1.78 | 62 | 1.33 | 0.52 | 1150.0 | 75 | 312.5 | 1 | 2 | 2 | 2 | 2 | 1835 | 2 | 90 | 97 | 10 | 41 | 8 | 1 | 1 | 200 | 4.35 | 22 | 125 |

ESTIMATED QUANTITIES

FRA - 71 - 0:00

CALCULATED
DCB
CHECKED
SJS

575
1312

X:\4037000\121957.16\107201\drainage\sheets\107201DS002.dgn_Sheet 8/7/2020 3:44:57 PM 1458s.js

| REF. NO. | SHEET NO. | STATION | | SIDE | 601 | 601 | 602 | 611 | 611 | 611 | 611 | 611 | 611 | 611 | 611 | 615 | 670 | 833 | 836 | 836 | 836 | 837 | 837 | 837 | 899 |
|--|-----------|---------|--------|-------|---|---|------------------|-----------------------------|-----------------------------|-----------------------------|-----------------------------|-----------------------------------|-----------------------------------|---|---------------------|---|---|--------------------------------------|---|---|---|---|--|---|--|
| | | FROM | TO | | ROCK CHANNEL PROTECTION, TYPE B WITH FILTER | ROCK CHANNEL PROTECTION, TYPE C WITH FILTER | CONCRETE MASONRY | 30" CONDUIT, TYPE A, 706.02 | 48" CONDUIT, TYPE A, 706.02 | 48" CONDUIT, TYPE A, 707.07 | 72" CONDUIT, TYPE A, 707.07 | 24" X 38" CONDUIT, TYPE A, 706.04 | 29" X 45" CONDUIT, TYPE A, 706.04 | 10' X 5' CONDUIT, TYPE A, 706.05, AS PER PLAN | CATCH BASIN, NO. 8A | DRAINAGE STRUCTURE, MISC.-DETAIL AND CONSTRUCTION BLIND TAP | PAVEMENT FOR MAINTAINING TRAFFIC, CLASS A | DITCH EROSION PROTECTION MAT, TYPE A | CONDUIT RENEWAL USING SPRAY APPLIED STRUCTURAL LINER, ROUND CONDUIT 72" DIAMETER (ALTERNATE 1A) | SEEDING AND EROSION CONTROL WITH TURF REINFORCING MAT, TYPE 1 | SEEDING AND EROSION CONTROL WITH TURF REINFORCING MAT, TYPE 3 | LINER PIPE 42" ID 707.18, .19, .20, .35, .42, .43, 748.06(42" OD), S5938, 707.75 (ALTERNATE 2B) | LINER PIPE 66" ID 707.18, .19, .20, .24, .35, 748.06(66" OD), S5938, 707.75 (ALTERNATE 1B) | BACKFILL FOR LINER PIPE (ALTERNATE 1B AND 2B) | CURED-IN-PLACE PIPE LINER, 48" DIAMETER (ALTERNATE 2A) |
| | | | | | CY | CY | CY | FT | FT | FT | FT | FT | FT | FT | FT | SY | SY | FT | SY | SY | SY | FT | FT | FT | FT |
| | 929 | 12+33 | 13+61 | LT&RT | | 2.9 | 1.0 | | | | | | | | 227 | | | | | | 155.8 | | | | |
| | 930 | 27+48 | 28+28 | LT&RT | | | 34.6 | | | 24 | | | | | | | 25.8 | 260 | 48.3 | | | | 260 | 260 | |
| | 931 | 54+16 | 57+67 | LT&RT | | | 18.2 | | 24 | | | | | | | | 71.2 | | | | | 663 | 663 | 663 | |
| | 933 | 147+96 | 147+94 | LT&RT | 14.8 | | 18.2 | | 32 | | | | | | | | | | | | | | | | |
| | 934 | 166+51 | 166+51 | LT&RT | | 2.8 | 1.1 | 26 | | | | | | | | | | | | | | | | | |
| | 935 | 189+43 | 189+43 | LT&RT | | 3.3 | 0.9 | | | | | 232 | | | | 1 | | | | | | | | | |
| | 937 | 224+40 | 226+45 | LT&RT | | 27.0 | | | | | | | | 304 | | 165 | | | | | 47.6 | | | | |
| TOTALS CARRIED TO GENERAL SUMMARY | | | | | 14.8 | 36 | 74 | 26 | 32 | 24 | 24 | 232 | 227 | 304 | 1 | 1 | 165 | 97 | 260 | 48.3 | 203.4 | 663 | 260 | 923 | 663 |


CULVERT SUBSUMMARY

FRA - 71 - 0:00

CALCULATED
 MAH
 CHECKED
 CTW

928
 1312

X:\4037000\21957.16\107201\structures\FRA071_0296C\sheet\071_0296CSP001.dgn Sheet 8/7/2020 7:39:35 AM 1420djc

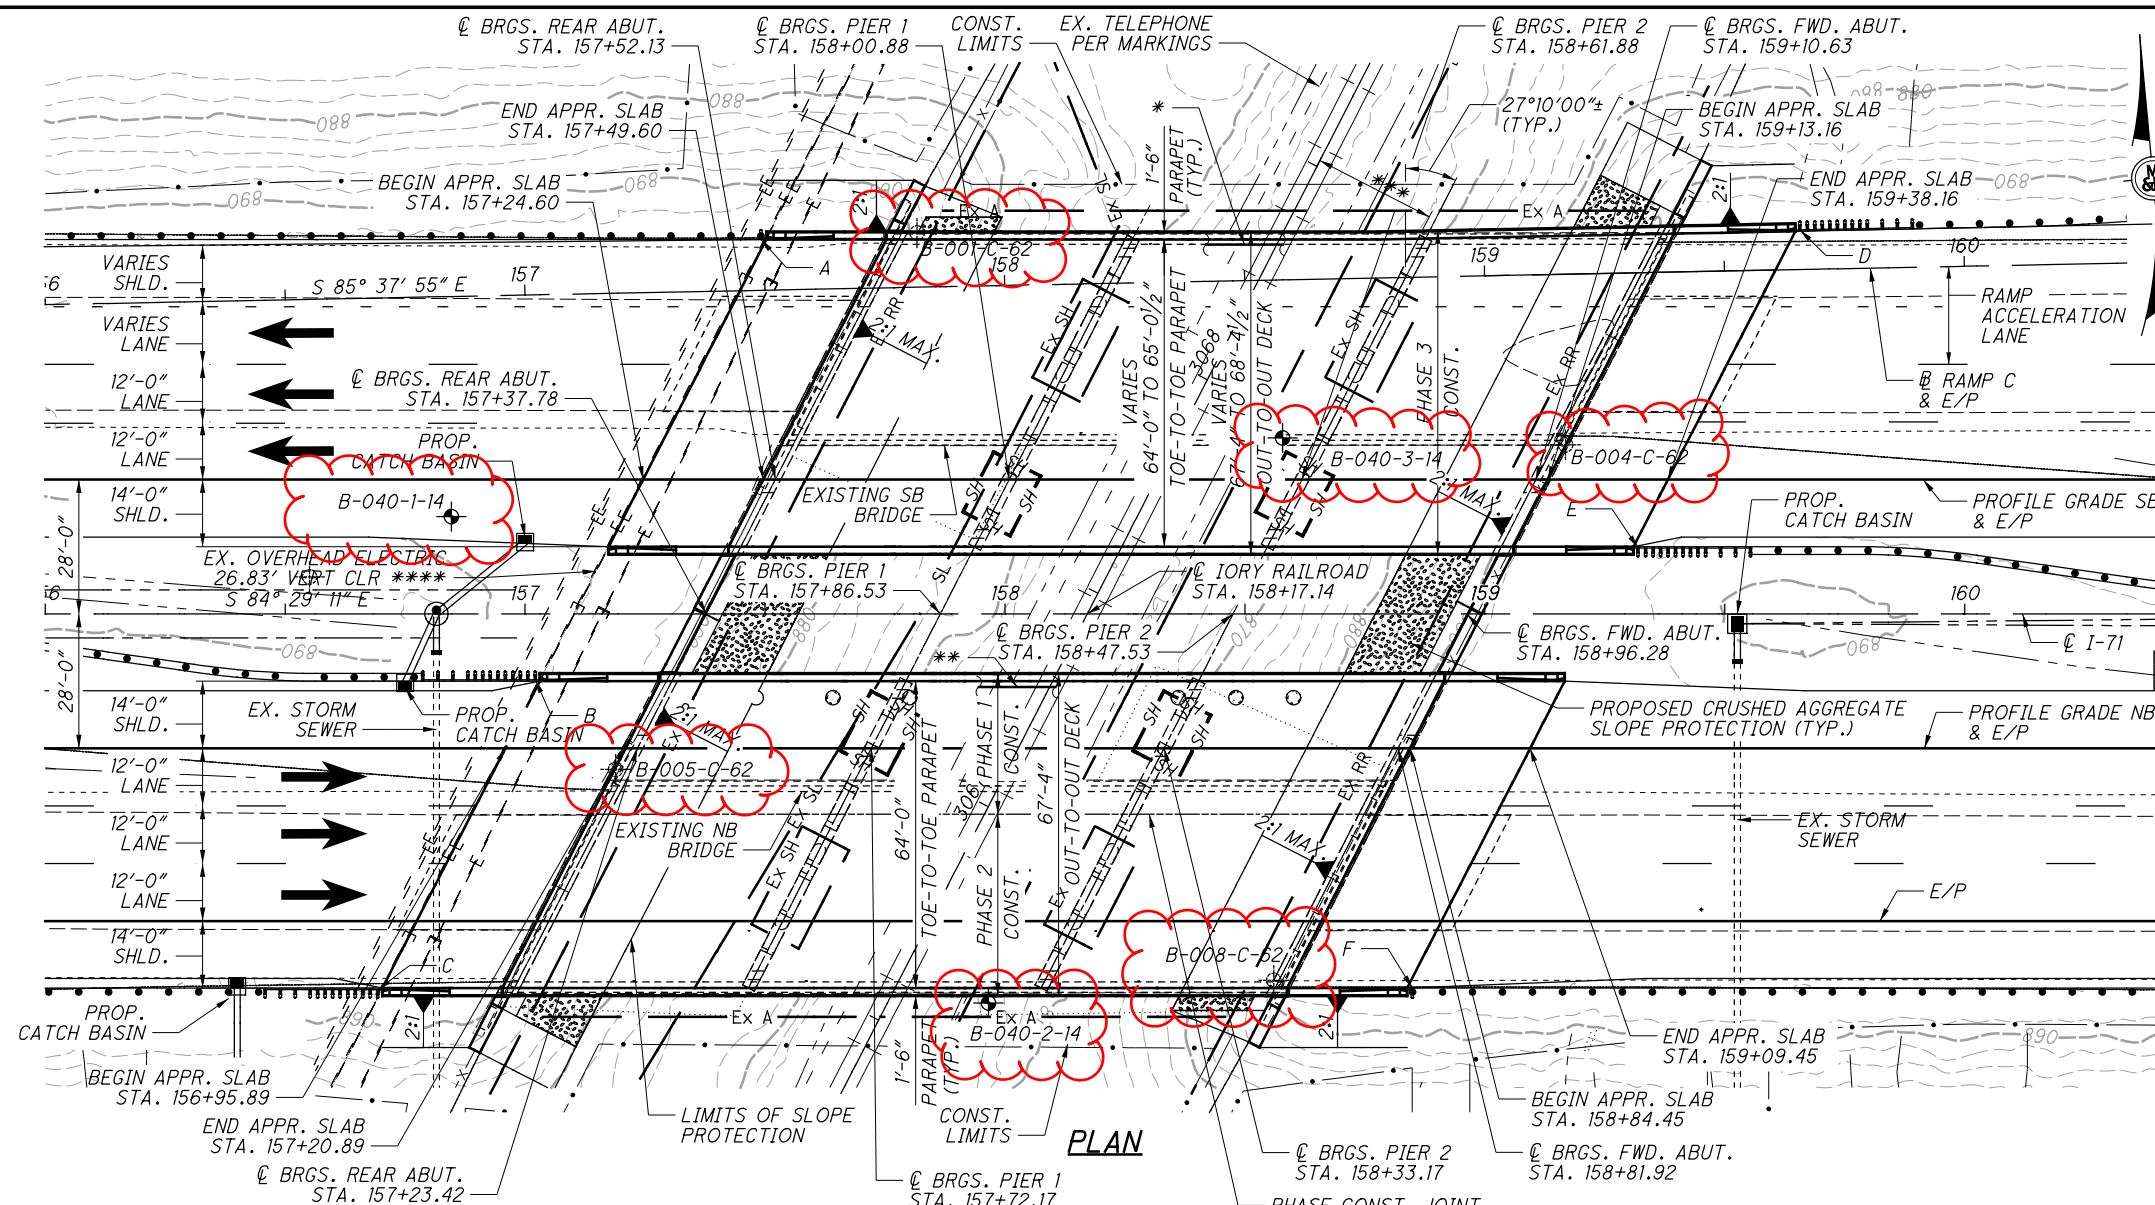

| BENCHMARK DATA | |
|---|--|
| BM #1 STA. 144+70.84, EL. 873.71, 0.22' LT., CONC. MONUMENT | |
| BM #2 STA. 154+09.79, EL. 889.71, 0.27' LT., CONC. MONUMENT | |
| BM #3 STA. 165+70.88, EL. 890.64, 0.08' LT., CONC. MONUMENT | |
| BM #4 STA. 173+31.13, EL. 879.92, 0.05' RT., CONC. MONUMENT | |

FOR ADDITIONAL BENCHMARK INFORMATION. SEE ROADWAY PLAN SHEET 5 OF 1369.


NOTES
 EARTHWORK LIMITS SHOWN ARE APPROXIMATE. ACTUAL SLOPES SHALL CONFORM TO PLAN CROSS SECTIONS.
 FOR GUARDRAIL POST STATIONS, SEE SHEET 2/86.

DESIGN TRAFFIC:
 2017 ADT = 44,670 2017 ADTT = 13,401
 2037 ADT = 64,070 2037 ADTT = 19,221
 DIRECTIONAL DISTRIBUTION = 55%

- LEGEND:**
- ⊕ BORING LOCATION
 - ⊕ HISTORIC BORING LOCATION
 - ▨ LIMITS OF CRUSHED AGGREGATE SLOPE PROTECTION
 - * 22'-9 1/2" ACTUAL MIN. EXISTING VERTICAL CLEARANCE
 - ** 23'-0" REQUIRED MIN. VERTICAL CLEARANCE
23'-3 3/4" ACTUAL MIN. VERTICAL CLEARANCE
 - *** 25'-0" REQUIRED MIN. HORIZONTAL CLEARANCE
25'-7 3/8" ACTUAL MIN. HORIZONTAL CLEARANCE
 - **** SEE UTILITY COORDINATION NOTE ON SHEET 3 OF 1312.

| EXISTING STRUCTURE | |
|-------------------------|--|
| TYPE: | CONTINUOUS WELDED STEEL BEAM WITH CONCRETE DECK AND SUBSTRUCTURE |
| SPANS: | 48'-9" ± - 61'-0" ± - 48'-9" ± C/C BRGS. |
| ROADWAY: | 39'-8" ± F/F CURB |
| LOADING: | CF-2000 (57) ADEQUATE FOR AASHO ALTERNATE LOADING |
| SKEW: | 27°-10' ± LF |
| APPROACH SLABS: | AS-1-54 (25'-0" ±) |
| ALIGNMENT: | TANGENT |
| CROWN: | 0.016 ± FT/FT NORMAL CROWN |
| WEARING SURFACE: | 3" ± BITUMINOUS ASPHALT CONCRETE |
| STRUCTURAL FILE NUMBER: | 2506904L/2506939R |
| DATE BUILT: | 1964 |
| DISPOSITION: | REPLACE SUPERSTRUCTURE & WIDEN SUBSTRUCTURE |


| PROPOSED STRUCTURE | |
|--------------------|--|
| TYPE: | THREE-SPAN CONTINUOUS A709-50W STEEL BEAM WITH COMPOSITE REINFORCED CONCRETE DECK ON WIDENED SEMI-INTEGRAL ABUTMENTS AND REINFORCED CONCRETE T-TYPE PIERS. |
| SPANS: | 48'-9" ± - 61'-0" ± - 48'-9" ± C/C BRGS. |
| ROADWAY: | 64'-0" T/T PARAPET NB & 64'-0" TO 65'-0 1/2" T/T PARAPET SB |
| LOADING: | HS20-44 CASE I, ALTERNATE MILITARY, 60 PSF FWS |
| SKEW: | 27°-10' ± LF |
| APPROACH SLABS: | 25'-0" LONG (AS-1-81) |
| ALIGNMENT: | TANGENT |
| CROWN: | 0.016 FT/FT |
| WEARING SURFACE: | 1" MONOLITHIC CONCRETE |
| COORDINATES: | LATITUDE 39°49'30" N LONGITUDE 83°08'37" W |

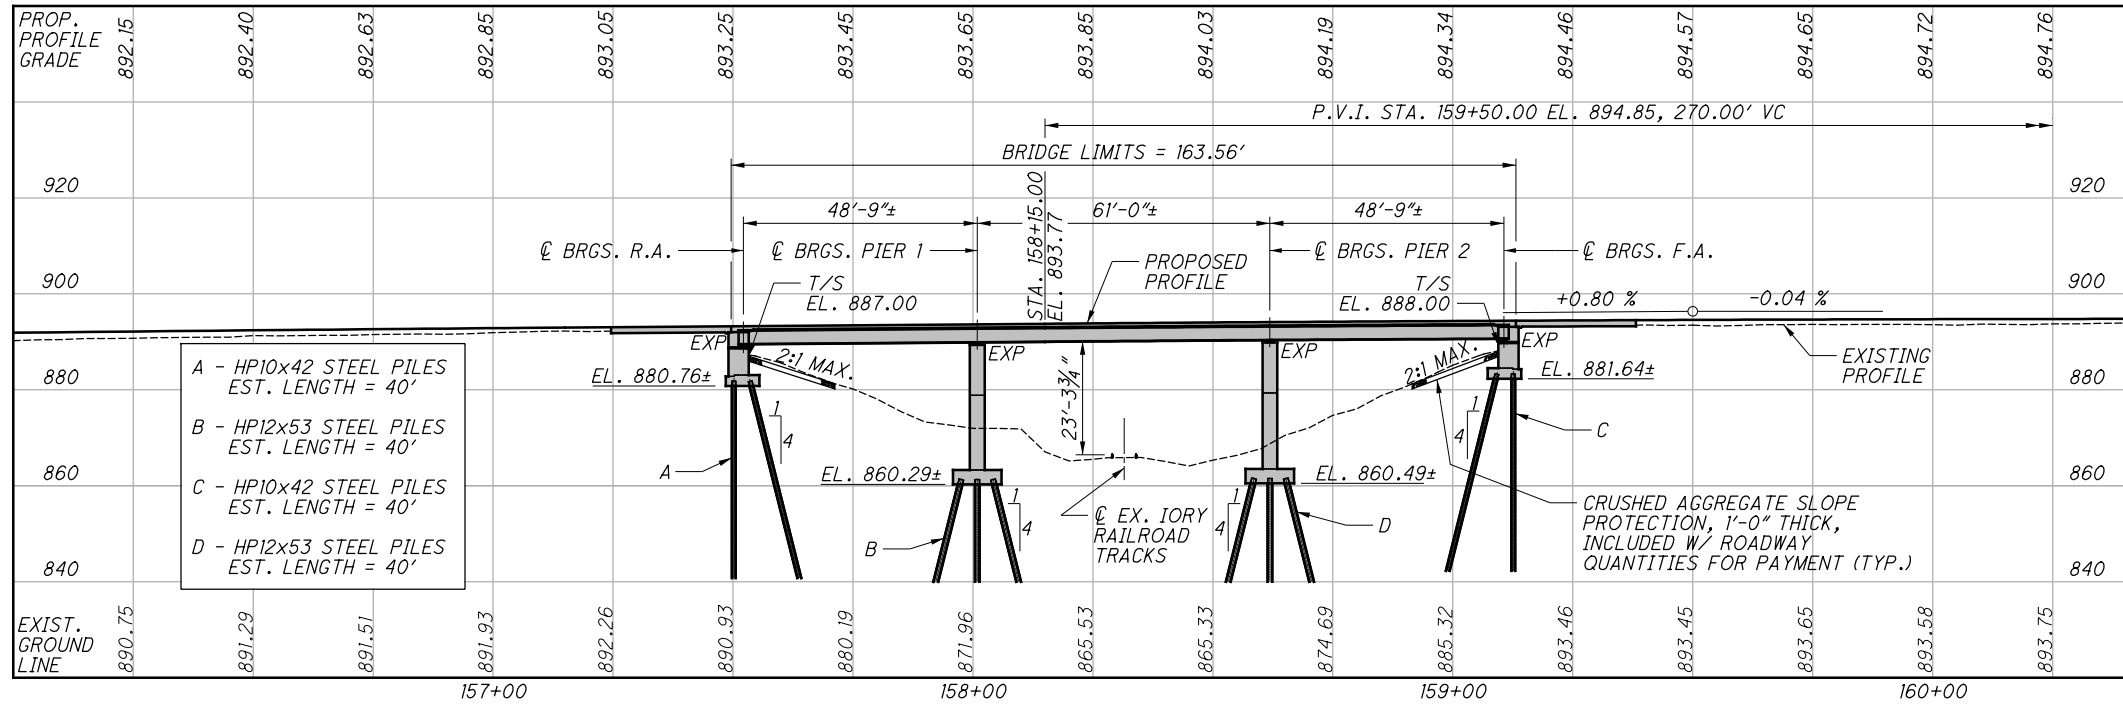

PROFILE ALONG PROFILE GRADE LINE SB

DESIGN AGENCY: Mead & Hunt
 DATE: 8/8/2016
 REVIEWED: KVB
 DRAWN: DJC
 DESIGNED: LYH
 CHECKED: CMH
 FRANKLIN: STA. 157+49.60
 BRIDGE NO.: FRA-71-0298 L/R
 OVER INDIANA & OHIO RAILWAY COMPANY
 SITE PLAN
 PID No. 107201
 1/86
 1108
 1312

X:\4037000\21957.16\107201\structures\FRA071_0296C\sheet\071_0296CSP002.dgn Sheet 8/7/2020 7:40:19 AM 1420djc

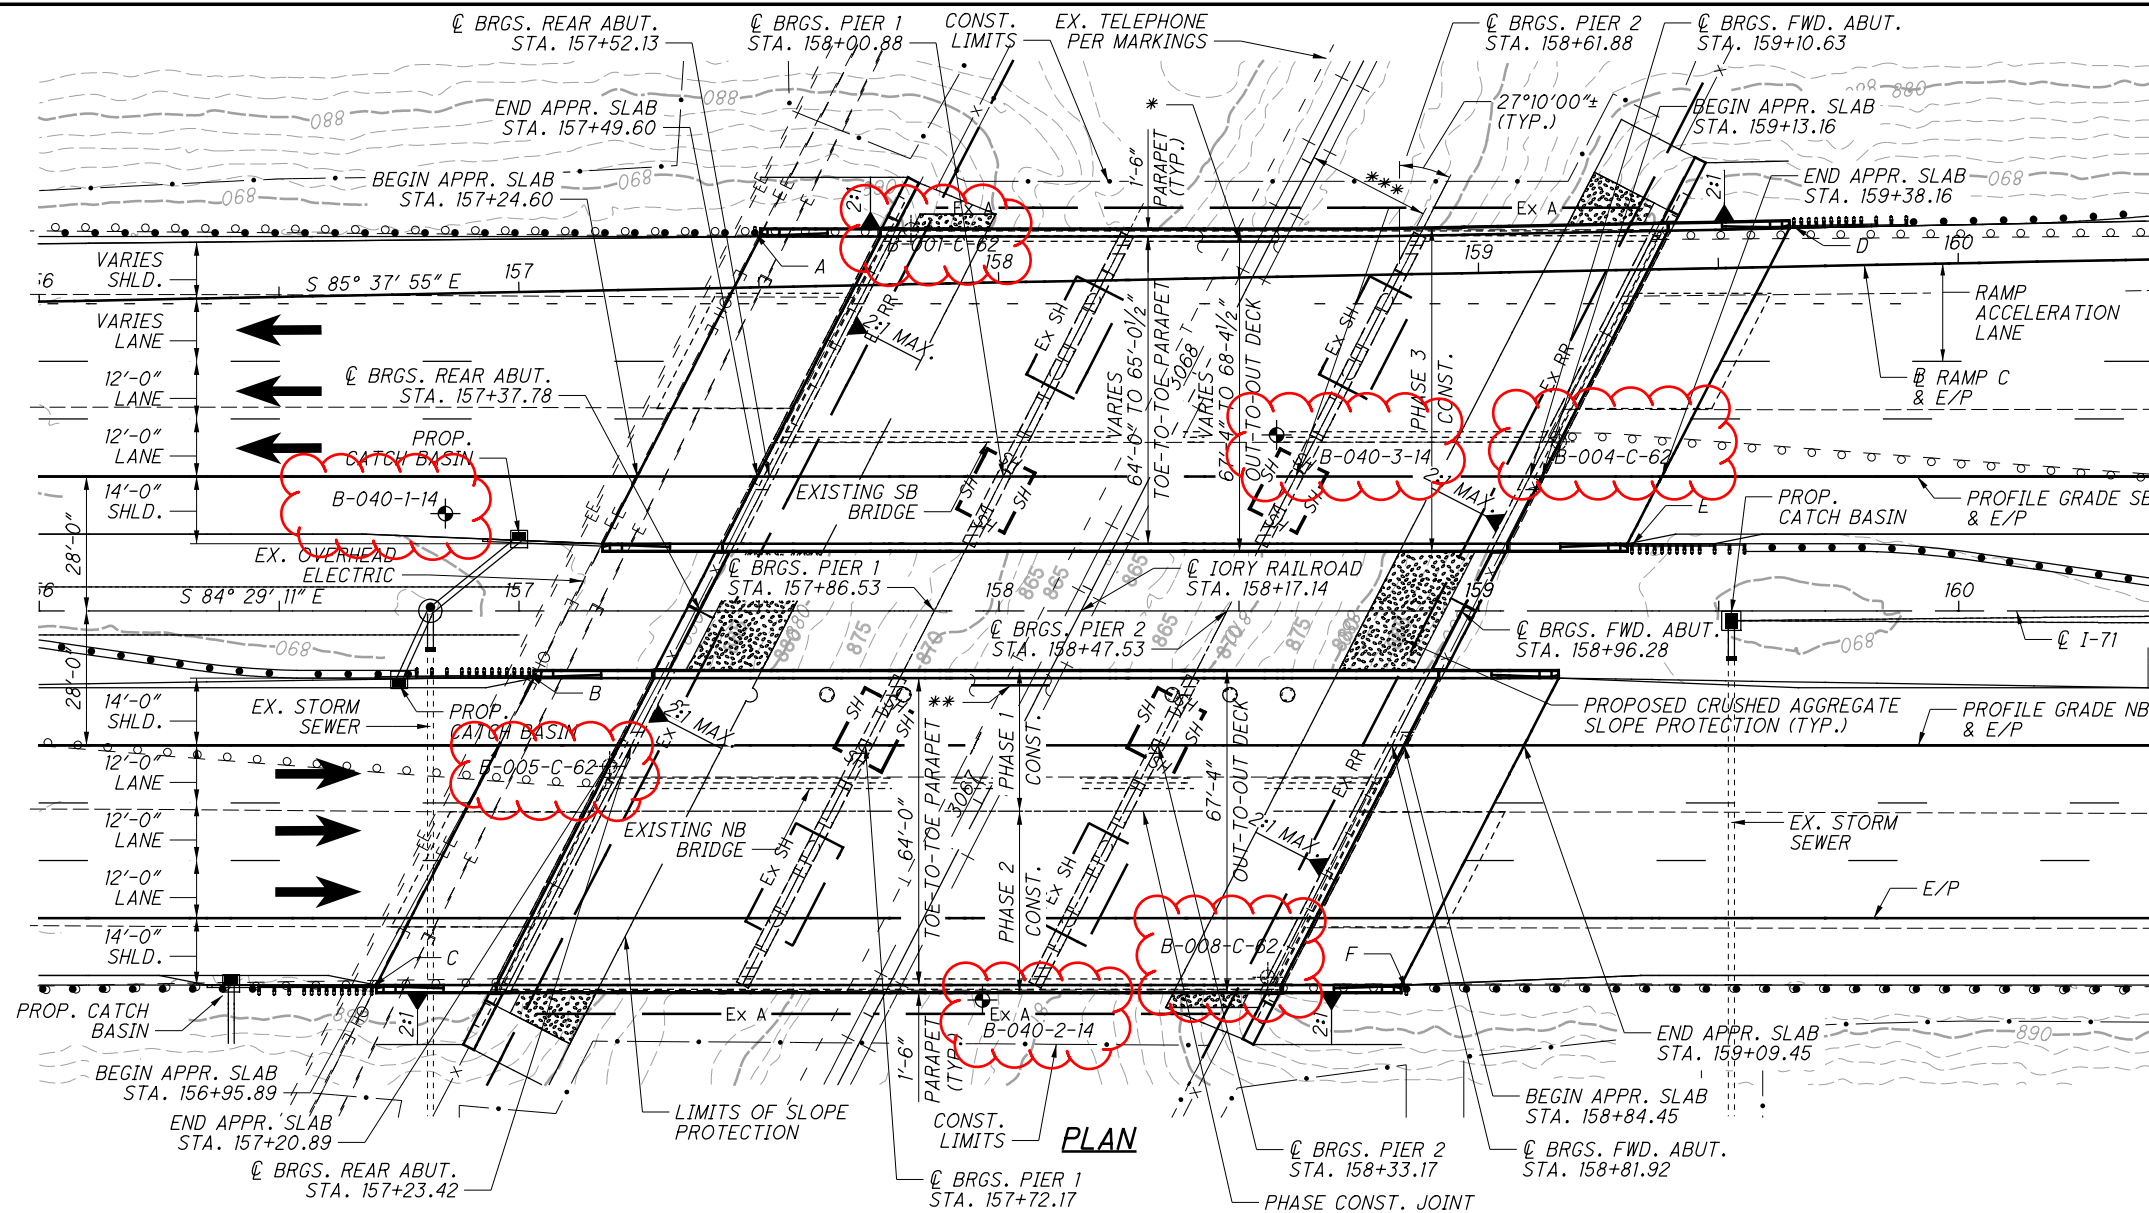


PROPOSED WORK

1. WIDEN ABUTMENTS AND PIERS
2. RETROFIT PIER STEM
3. REMOVE SUPERSTRUCTURE REPLACE WITH NEW ROLLED BEAMS AND COMPOSITE DECK
4. CONVERT ABUTMENTS TO SEMI-INTEGRAL
5. REPLACE ABUTMENT AND PIER BEARINGS
6. REPLACE APPROACH SLAB
7. SEAL CONCRETE SURFACES
8. PAINT STEEL BEAMS

GUARDRAIL POST STATIONING

- | | |
|--------------|--------------|
| A: 157+49.14 | D: 159+65.65 |
| B: 157+02.12 | E: 159+31.93 |
| C: 156+69.28 | F: 158+84.92 |

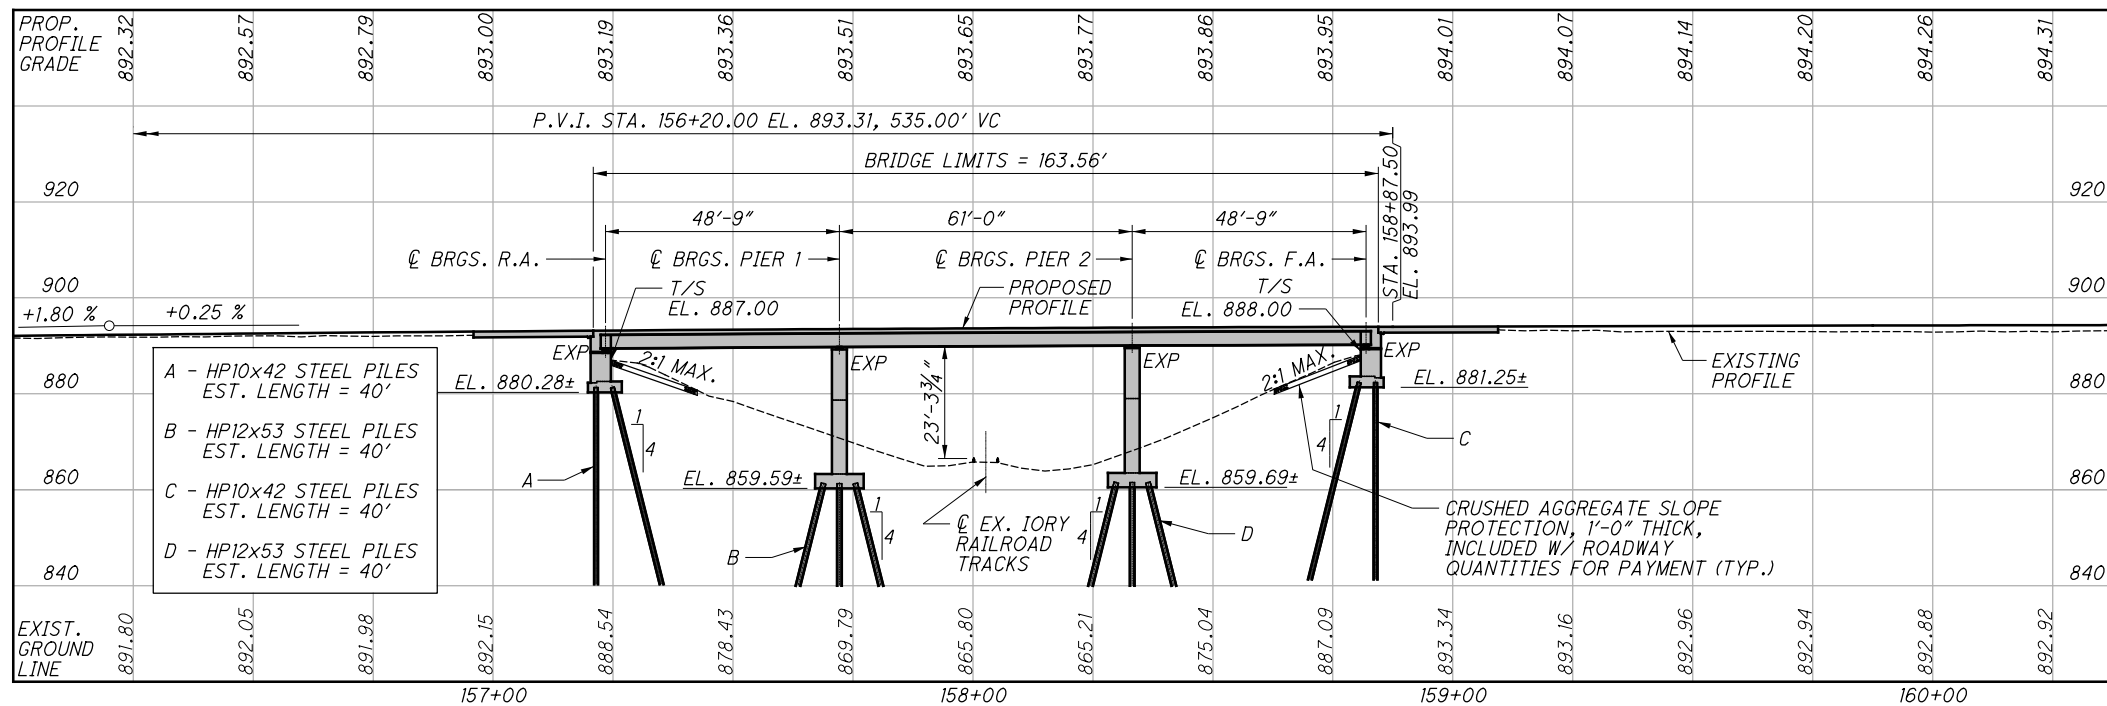

PROFILE ALONG PROFILE GRADE LINE NB

| |
|---|
| DESIGN AGENCY Mead & Hunt |
| DATE 8/8/2016 |
| REVIEWED KVB |
| DRAWN DJC |
| DESIGNED LYH |
| FRANKLIN |
| BRIDGE NO. FRA-71-0298 L/R |
| OVER INDIANA & OHIO RAILWAY COMPANY |
| STA. 157+20.89 |
| STA. 158+84.45 |
| SITE PLAN |
| PID No. 107201 |
| 2 / 86 |
| 1109 1312 |

X:\4037000\21957.16\10720\structures\FRA071_0296C\sheets\071_0296CE0001.dgn Sheet 8/7/2020 10:45:08 AM 1420djc

| ESTIMATED QUANTITIES | | | | | | | | | | | | | | |
|----------------------|-----------|------------|------------|------|--|------------|--------|---------|------|------------|--------|---------|------|---------|
| ITEM | EXTENSION | SOUTHBOUND | NORTHBOUND | UNIT | DESCRIPTION | SOUTHBOUND | | | | NORTHBOUND | | | | SHEET # |
| | | | | | | ABUT. | PIERS | SUPER. | GEN. | ABUT. | PIERS | SUPER. | GEN. | |
| 202 | 11203 | LS | LS | LS | PORTIONS OF STRUCTURE REMOVED, OVER 20 FOOT SPAN, AS PER PLAN | LS | | | | LS | | | | 4,13 |
| 202 | 22900 | 150 | 150 | SY | APPROACH SLAB REMOVED | | | | 150 | | | | 150 | |
| 202 | 23500 | 721 | 721 | SY | WEARING COURSE REMOVED | | | 721 | | | | 721 | | |
| 503 | 11101 | LS | LS | LS | COFFERDAMS AND EXCAVATION BRACING, AS PER PLAN | | LS | | | LS | LS | | | 5, 13 |
| 503 | 21300 | LS | LS | LS | UNCLASSIFIED EXCAVATION | LS | LS | | | LS | LS | | | |
| 505 | 11100 | LS | LS | LS | PILE DRIVING EQUIPMENT MOBILIZATION | LS | LS | | | LS | LS | | | |
| 507 | 00100 | 1,440 | 1,440 | FT | STEEL PILES HP10X42, FURNISHED | 1,440 | | | | 1,440 | | | | |
| 507 | 00150 | 1,280 | 1,280 | FT | STEEL PILES HP10X42, DRIVEN | 1,280 | | | | 1,280 | | | | |
| 507 | 00200 | 720 | 720 | FT | STEEL PILES HP12X53, FURNISHED | | 720 | | | | 720 | | | |
| 507 | 00250 | 640 | 640 | FT | STEEL PILES HP12X53, DRIVEN | | 640 | | | | 640 | | | |
| 507 | 93300 | 48 | 48 | EACH | STEEL POINTS OR SHOES | 32 | 16 | | | 32 | 16 | | | |
| 509 | 10001 | 124,430 | 123,297 | LB | EPOXY COATED REINFORCING STEEL, AS PER PLAN | 12,441 | 19,162 | 92,827 | | 12,113 | 19,231 | 91,953 | | 4 |
| 509 | 20001 | 500 | 500 | LB | REINFORCING STEEL, REPLACEMENT OF EXISTING REINFORCING STEEL, AS PER PLAN | | | 500 | | | | 500 | | 4 |
| 510 | 10000 | 564 | 556 | EACH | DOWEL HOLES WITH NONSHRINK, NONMETALLIC GROUT | 220 | 344 | | | 208 | 348 | | | |
| 511 | 21522 | 459 | 458 | CY | CLASS QC2 CONCRETE WITH QC/QA, SUPERSTRUCTURE | | | 459 | | | | 458 | | |
| 511 | 33500 | 2 | 2 | EACH | SEMI-INTEGRAL DIAPHRAGM GUIDE | 2 | | | | 2 | | | | |
| 511 | 42012 | 92 | 81 | CY | CLASS QC1 CONCRETE WITH QC/QA, PIER ABOVE FOOTINGS | | 92 | | | | 81 | | | |
| 511 | 43512 | 168 | 166 | CY | CLASS QC1 CONCRETE WITH QC/QA, ABUTMENT INCLUDING FOOTING | 168 | | | | 166 | | | | |
| 511 | 46510 | 28 | 28 | CY | CLASS QC1 CONCRETE, FOOTING | | 28 | | | | 28 | | | |
| 512 | 10050 | 962 | 950 | SY | SEALING OF CONCRETE SURFACES (NON-EPOXY) | 72 | 461 | 429 | | 66 | 456 | 428 | | |
| 512 | 33000 | 41 | 41 | SY | TYPE 2 WATERPROOFING | 41 | | | | 41 | | | | |
| 513 | 10260 | 211,190 | 210,946 | LB | STRUCTURAL STEEL MEMBERS, LEVEL 3 | | | 211,190 | | | | 210,946 | | |
| 513 | 20000 | 6,156 | 6,156 | EACH | WELDED STUD SHEAR CONNECTORS | | | 6,156 | | | | 6,156 | | |
| 516 | 13600 | 17 | 17 | SF | 1" PREFORMED EXPANSION JOINT FILLER | | | 17 | | | | 17 | | |
| 516 | 13900 | 253 | 254 | SF | 2" PREFORMED EXPANSION JOINT FILLER | 253 | | | | 254 | | | | |
| 516 | 14020 | 179 | 178 | FT | SEMI-INTEGRAL ABUTMENT EXPANSION JOINT SEAL | 179 | | | | 178 | | | | |
| 516 | 44100 | 18 | 18 | EACH | ELASTOMERIC BEARING WITH INTERNAL LAMINATES AND LOAD PLATE (NEOPRENE) (11" x 18" x 2.05" WITH 12" x 19" x 2.0" LOAD PLATE) | | 18 | | | | 18 | | | |
| 516 | 44101 | 18 | 18 | EACH | ELASTOMERIC BEARING WITH INTERNAL LAMINATES AND LOAD PLATE (NEOPRENE) (10" x 14" x 2.95" WITH 11" x 15" x 1.5" LOAD PLATE), AS PER PLAN | 18 | | | | 18 | | | | 49 |
| 518 | 12301 | 0 | 10 | EACH | SCUPPERS, INCLUDING SUPPORTS, AS PER PLAN | | | | | | | 10 | | 75, 76 |
| 518 | 21200 | 139 | 140 | CY | POROUS BACKFILL WITH GEOTEXTILE FABRIC | 139 | | | | 140 | | | | |
| 518 | 40000 | 205 | 204 | FT | 6" PERFORATED CORRUGATED PLASTIC PIPE | 205 | | | | 204 | | | | |
| 518 | 40011 | 40 | 40 | FT | 6" NON-PERFORATED CORRUGATED PLASTIC PIPE, INCLUDING SPECIALS, AS PER PLAN | 40 | | | | 40 | | | | 24 |
| 523 | 20000 | 2 | 2 | EACH | DYNAMIC LOAD TESTING | 1 | 1 | | | 1 | 1 | | | |
| 526 | 25011 | 379 | 375 | SY | REINFORCED CONCRETE APPROACH SLABS WITH QC/QA (T=15"), AS PER PLAN | | | | 379 | | | | 375 | 77-80 |
| 526 | 90030 | 146 | 144 | FT | TYPE C INSTALLATION | | | | 146 | | | | 144 | |
| SPECIAL | 53000400 | 48 | 48 | EACH | STRUCTURE, MISC.: CAPSULE ADHESIVE ANCHORS | | 48 | | | | 48 | | | 48 |
| * 601 | 20001 | 62 | 62 | SY | CRUSHED AGGREGATE SLOPE PROTECTION, AS PER PLAN | 62 | | | | 62 | | | | 5 |
| 607 | 39900 | 325 | 325 | FT | VANDAL PROTECTION FENCE, 6' STRAIGHT, COATED FABRIC | | | 325 | | | | 325 | | |
| 846 | 00110 | 61 | 60 | CF | POLYMER MODIFIED ASPHALT EXPANSION JOINT SYSTEM | | | | 61 | | | | 60 | |

* - FOR INFORMATION ONLY. PAID FOR UNDER ROADWAY QUANTITIES.

DESIGN AGENCY: Mead & Hunt
 4700 LAKEHURST CT, STE 110
 DUBLIN, OH 43016
 (614) 782-5900 PHONE

DATE: 8/8/2016
 REVIEWED: KVB
 DRAWN: DJC
 DESIGNED: DJC


STRUCTURE FILE NUMBER: 2506904L/2506939R
 CHECKED: LYH/MAB

ESTIMATED QUANTITIES
 BRIDGE NO. FRA-71-0298 L/R
 OVER INDIANA & OHIO RAILWAY COMPANY


FRA-71-0.00
 PID No. 107201

6/86
 1113
 1312

X:\4037000\2195716\107201\structures\FRA071_0296C\sheet\071_0296C\5002.dgn Sheet 8/7/2020 10:46:06 AM 1420djc

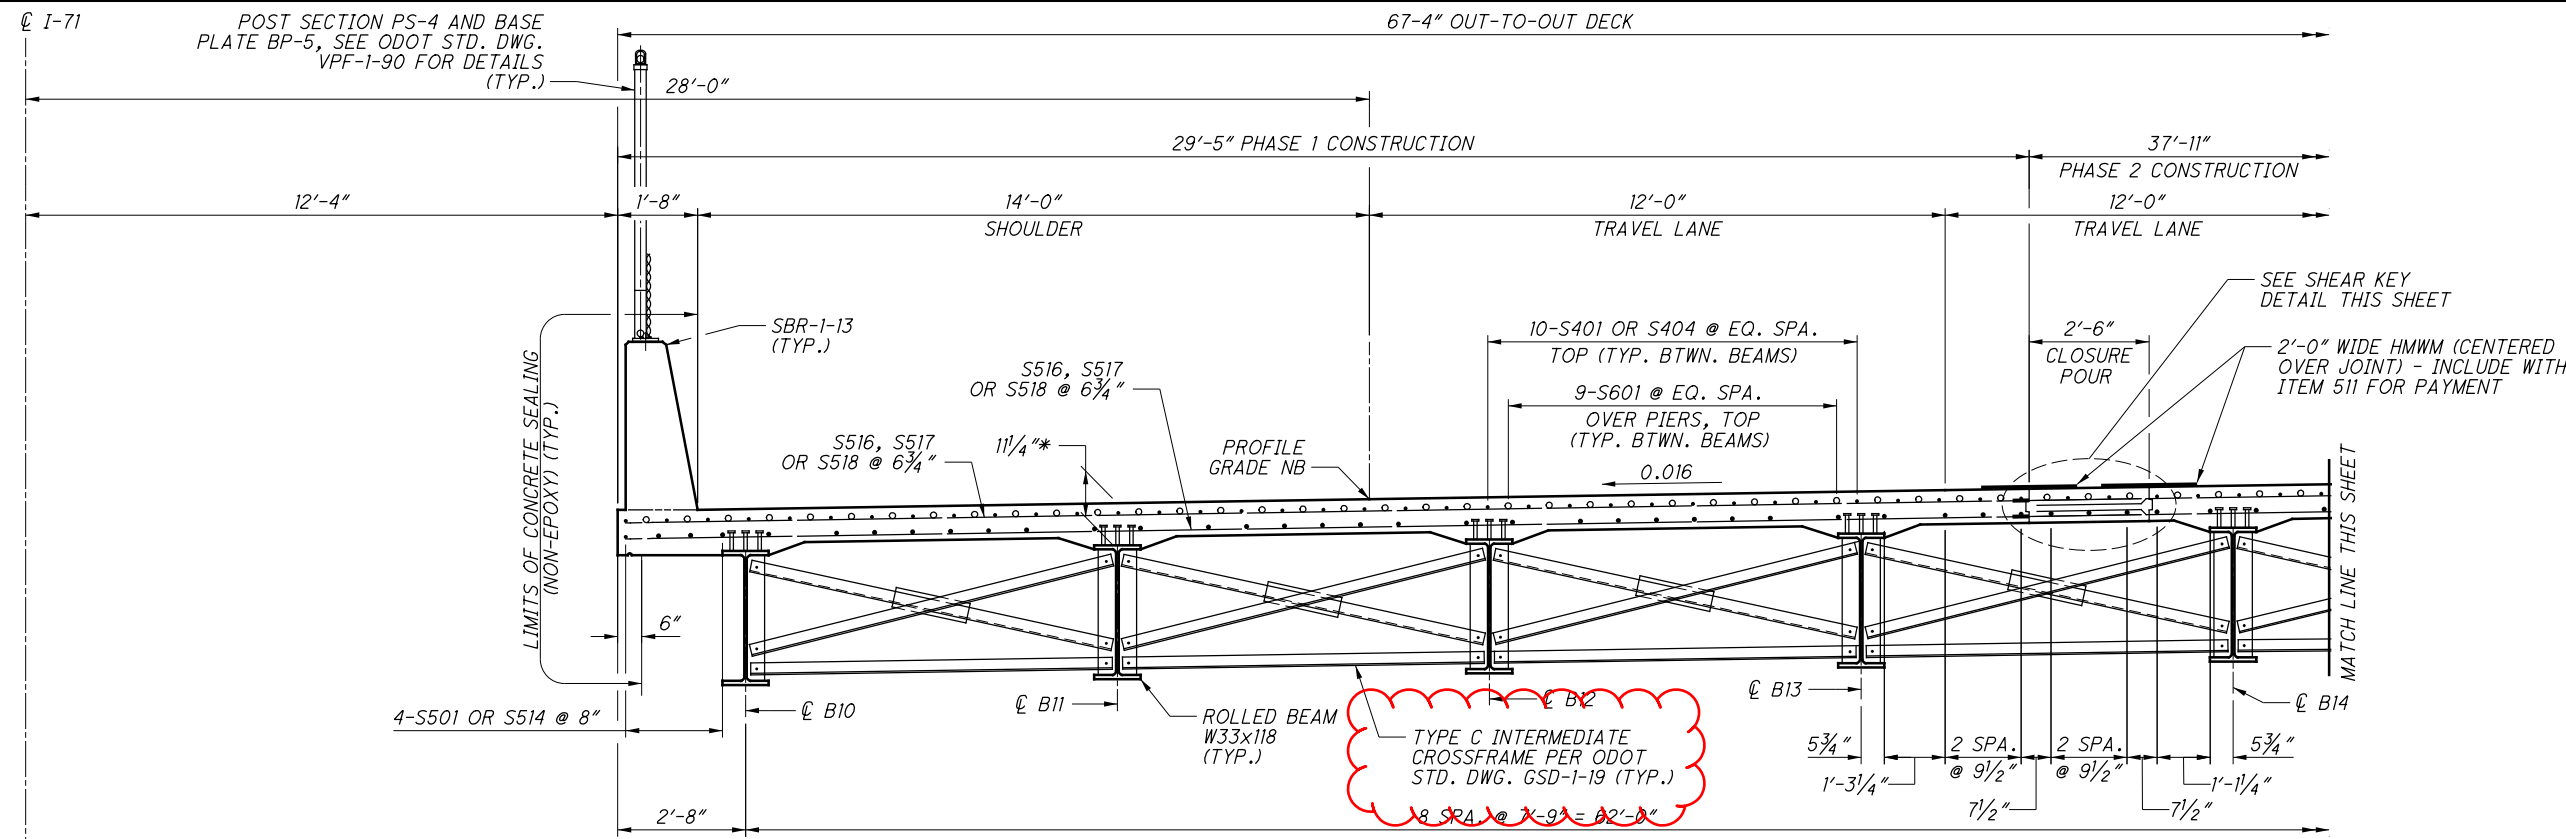

TRANSVERSE SECTION - NORTHBOUND

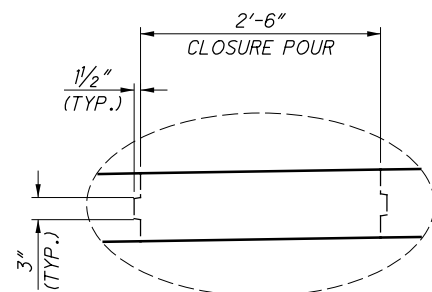


SHEAR KEY DETAIL

NOTES:

- FOR DECK REINFORCING PLAN, SEE SHEET 68/86.
- FOR PARAPET ELEVATION AND REINFORCING, SEE SHEET 69/86.
- CROSS FRAMES IN THE BAY BETWEEN BEAMS B13 AND B14 SHALL NOT BE PERMANENTLY ATTACHED UNTIL THE CONCRETE DECKS AND PARAPETS LOCATED IN THE ADJACENT PHASES HAVE BEEN PLACED. CROSSFRAMES BETWEEN B13 AND B14 SHALL BE INSTALLED PERMANENTLY PRIOR TO THE PLACEMENT OF THE CLOSURE POUR.
- DECK SLAB CONCRETE QUANTITY: THE ESTIMATED QUANTITY OF DECK SLAB CONCRETE IS BASED ON THE CONSTANT DECK SLAB THICKNESS, AS SHOWN, PLUS THE QUANTITY OF CONCRETE THAT FORMS EACH BEAM/GIRDER HAUNCH. THE ESTIMATE ASSUMES A CONSTANT HAUNCH THICKNESS OF INCHES AND A CONSTANT HAUNCH WIDTH OUTSIDE THE EDGE OF EACH BEAM/GIRDER FLANGE OF 9 INCHES. DEVIATE FROM THIS HAUNCH THICKNESS AS NECESSARY TO PLACE THE DECK SURFACE AT THE FINISHED GRADE. THE ALLOWABLE TOLERANCE FOR THE HAUNCH WIDTH OUTSIDE THE EDGE OF EACH BEAM/GIRDER FLANGE IS ±3 INCHES.

THE HAUNCH THICKNESS WAS MEASURED AT THE CENTERLINE OF THE BEAM/GIRDER, FROM THE SURFACE OF THE DECK TO THE BOTTOM OF THE TOP FLANGE MINUS THE DECK SLAB THICKNESS. THE AREA OF ALL EMBEDDED STEEL PLATES HAS BEEN DEDUCTED FROM THE HAUNCH QUANTITY IN ACCORDANCE WITH 511.24.

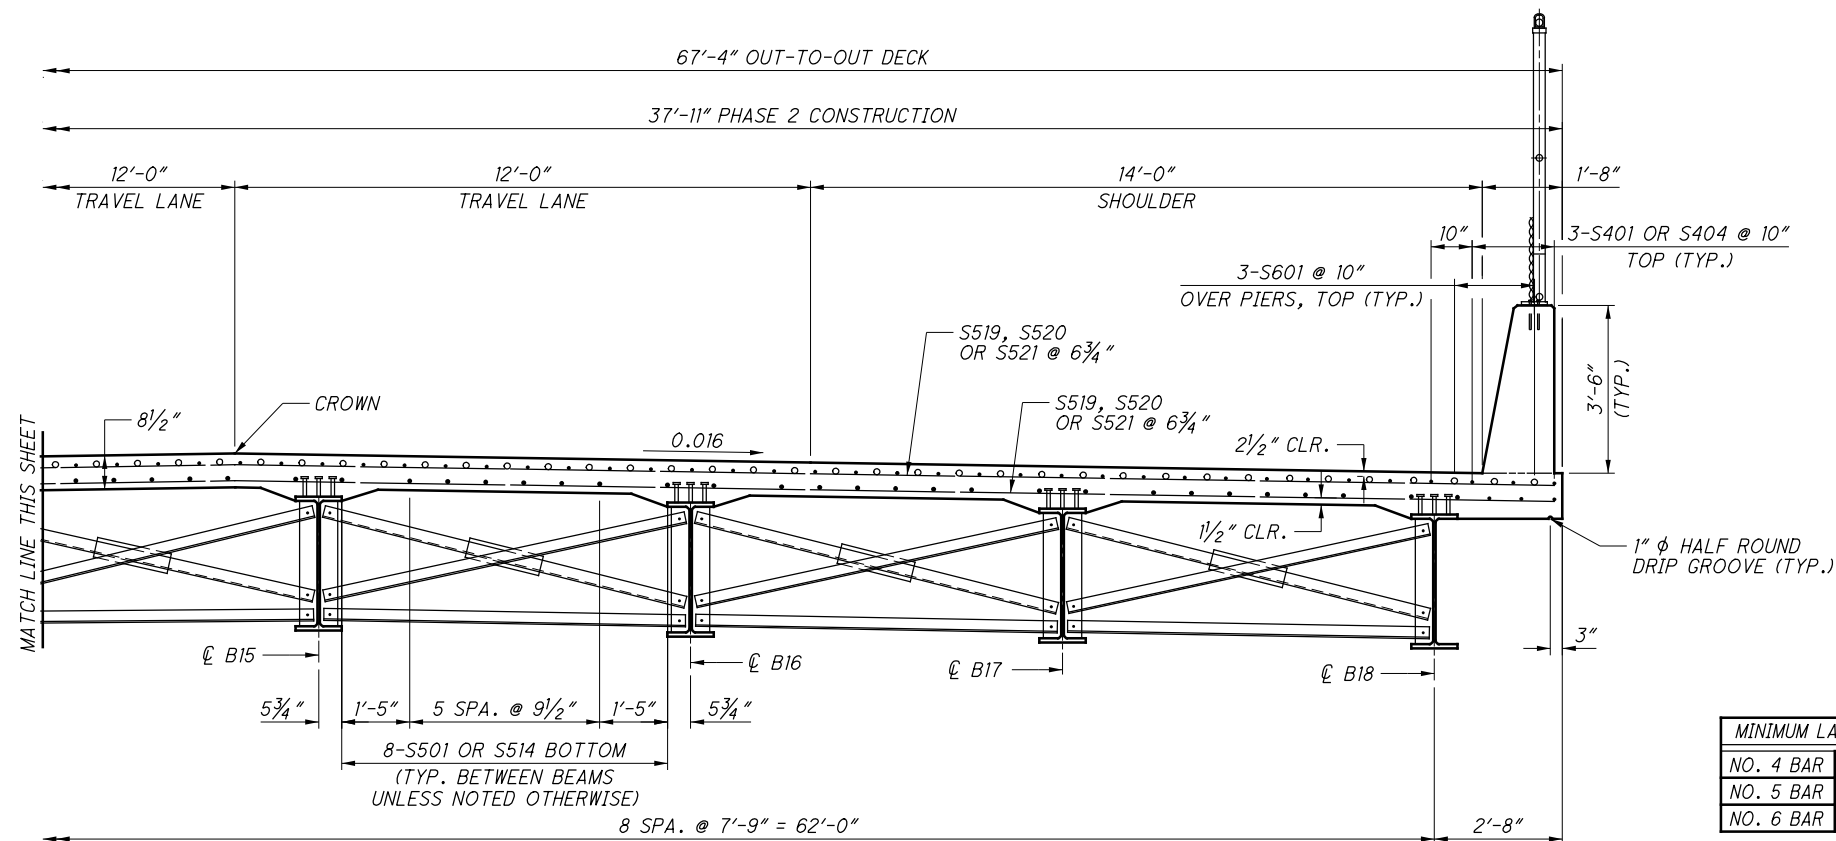

TRANSVERSE SECTION - NORTHBOUND

| MINIMUM LAP LENGTHS | |
|---------------------|-------|
| NO. 4 BAR | 2'-3" |
| NO. 5 BAR | 2'-7" |
| NO. 6 BAR | 4'-1" |

LEGEND:

* - DIMENSION MEASURED FROM TOP OF SLAB TO TOP OF WEB

DESIGN AGENCY: Mead & Hunt
 4700 LAKEHURST CT, STE 110
 DUBLIN, OH 43016
 (614) 782-5900 PHONE

DATE: 8/8/2016
 REVIEWED: KVB
 STRUCTURE FILE NUMBER: 2506904L/2506939R

DRAWN: DJC
 CHECKED: MLH

DESIGNED: RLC


TRANSVERSE SECTION - NORTHBOUND BRIDGE
 BRIDGE NO. FRA-71-0296 L/R
 OVER INDIANA & OHIO RAILWAY COMPANY

FRA-71-0.00
 PID No. 107201

67/86

1174
 1312

X:\4037000\21957.16\107201\structures\FRA071_0308C\SP001.dgn Sheet 8/7/2020 6:20:28 PM 1458sjs

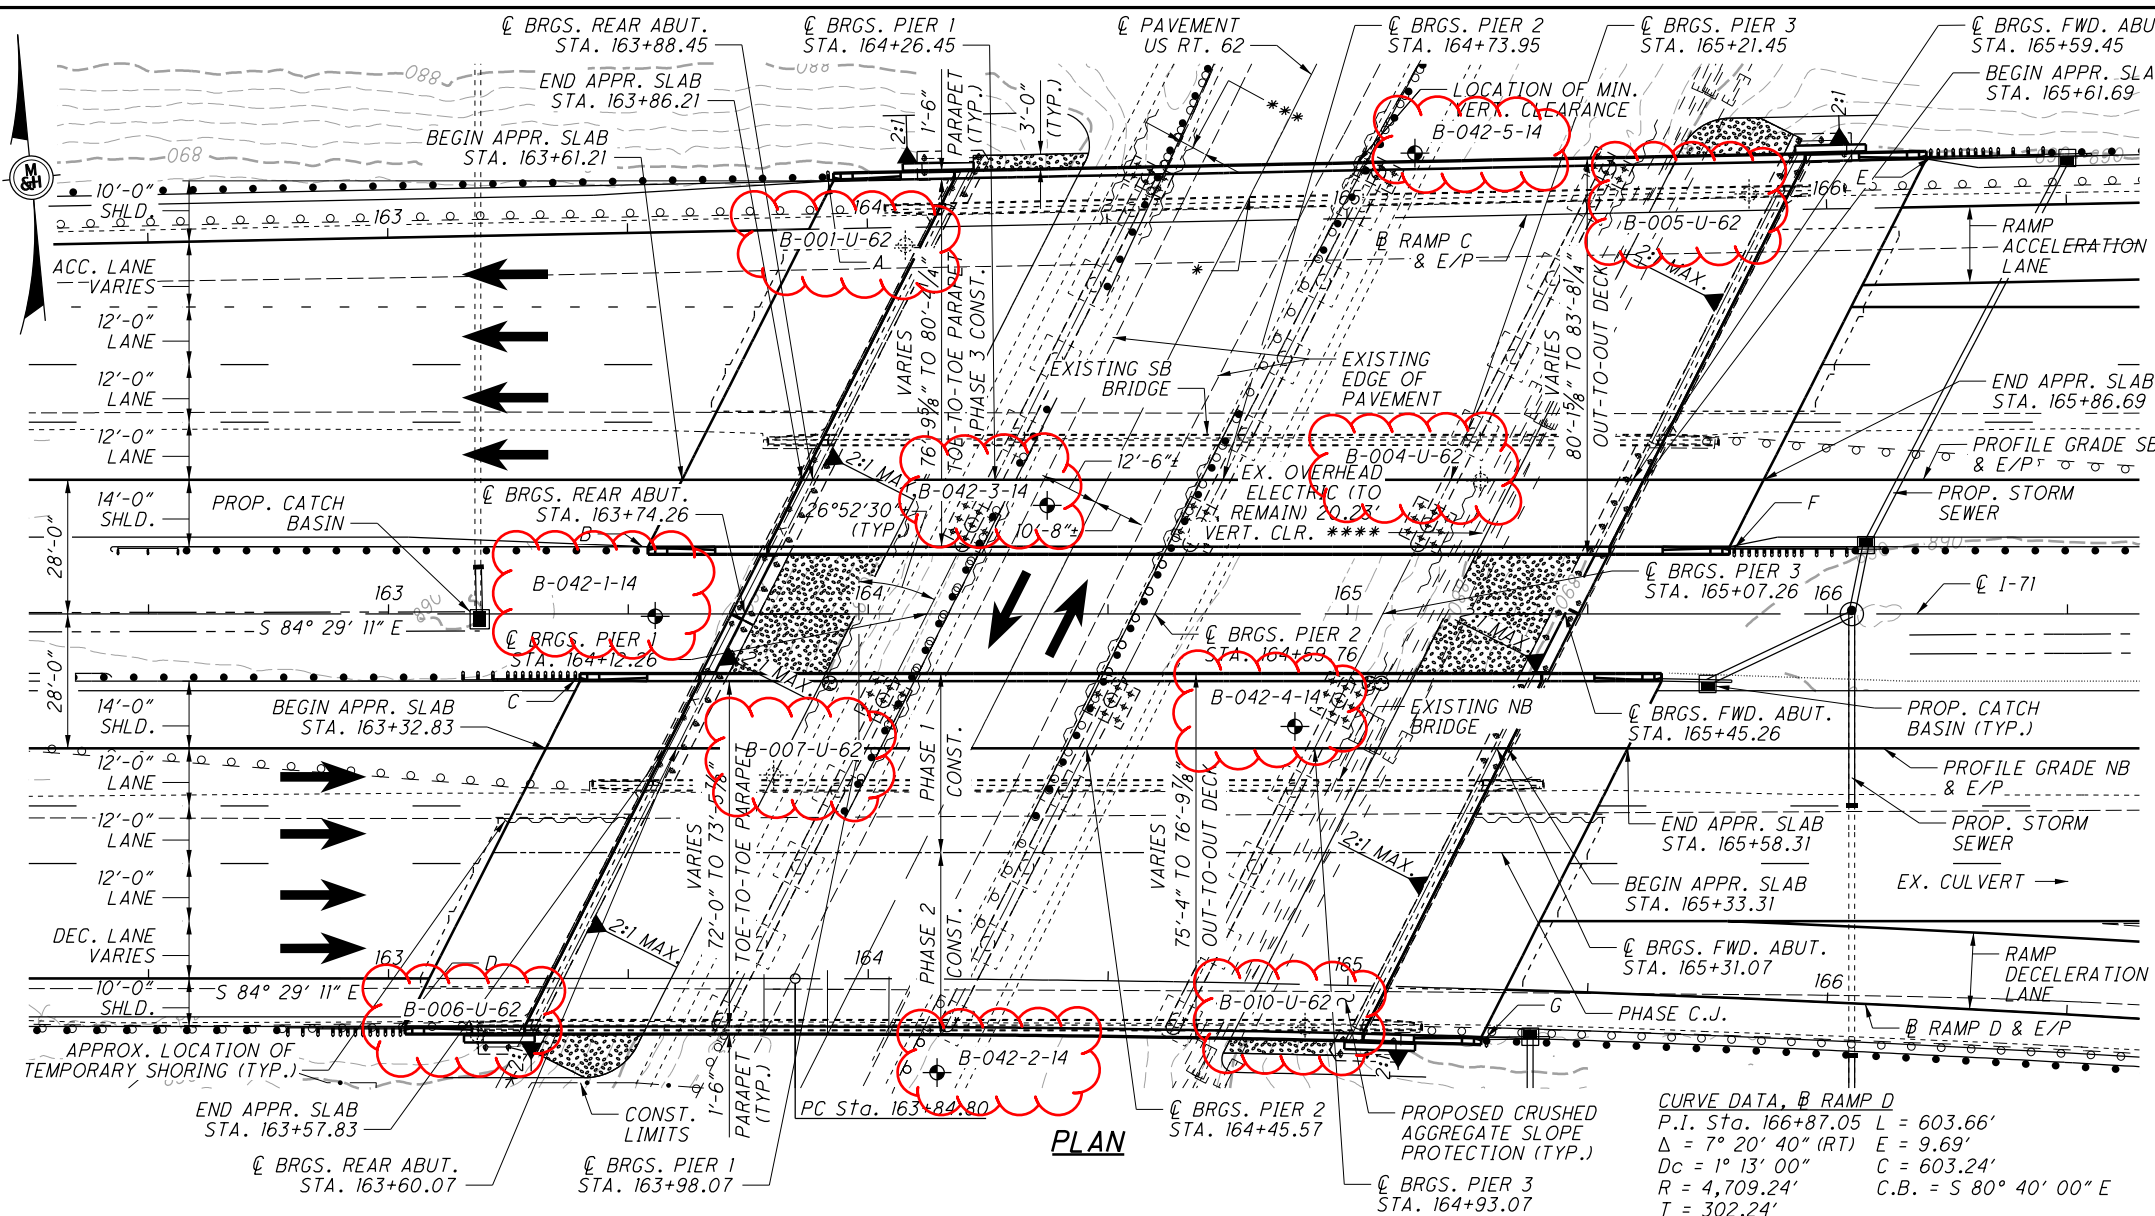

PLAN

| BENCHMARK DATA | |
|---|--|
| BM #1 STA. 144+70.84, EL. 873.71, 0.22' LT., CONC. MONUMENT | |
| BM #2 STA. 154+09.79, EL. 889.71, 0.27' LT., CONC. MONUMENT | |
| BM #3 STA. 165+70.88, EL. 890.64, 0.08' LT., CONC. MONUMENT | |
| BM #4 STA. 173+31.13, EL. 879.92, 0.05' RT., CONC. MONUMENT | |

FOR ADDITIONAL BENCHMARK INFORMATION. SEE ROADWAY PLAN SHEET 5 OF 1369.


NOTES
EARTHWORK LIMITS SHOWN ARE APPROXIMATE. ACTUAL SLOPES SHALL CONFORM TO PLAN CROSS SECTIONS.

DESIGN TRAFFIC:
2017 ADT = 44,670 2017 ADTT = 13,401
2037 ADT = 64,070 2037 ADTT = 19,221
DIRECTIONAL DISTRIBUTION = 55%

- LEGEND:**
- BORING LOCATION
 - HISTORIC BORING LOCATION
 - * 11'-11 7/8" ACTUAL MIN. EXISTING VERTICAL CLEARANCE
 - ** 16'-6" REQUIRED MIN. VERTICAL CLEARANCE
16'-8" ACTUAL MIN. VERTICAL CLEARANCE
 - *** 12'-0" REQUIRED MIN. HORIZONTAL CLEARANCE
7'-3" ACTUAL MIN. HORIZONTAL CLEARANCE
 - **** SEE UTILITY COORDINATION NOTE ON SHEET 3 OF 1312.
 - LIMITS OF CRUSHED AGGREGATE SLOPE PROTECTION

| EXISTING STRUCTURE | |
|-------------------------|--|
| TYPE: | CONTINUOUS CONCRETE SLAB WITH CONCRETE SUBSTRUCTURE |
| SPANS: | 38'-0" ± - 47'-6" ± - 47'-6" ± - 38'-0" ± C/C BRGS. |
| ROADWAY: | NORTHBOUND 47'-8" ± F/F CURB SOUTHBOUND VARIES 45'-10 1/2" ± TO 49'-6 1/2" ± F/F CURB |
| LOADING: | CF-2000 (57) ADEQUATE FOR AASHO ALTERNATE LOADING |
| SKIEW: | 26°-52'-30" ± LF |
| APPROACH SLABS: | AS-1-54 (25'-0" ±) (SPECIAL) |
| ALIGNMENT: | TANGENT |
| CROWN: | 0.016 ± FT/FT NORMAL CROWN |
| WEARING SURFACE: | 3" ± BITUMINOUS ASPHALT CONCRETE |
| STRUCTURAL FILE NUMBER: | 2506963/2506998 |
| DATE BUILT: | 1964 |
| DISPOSITION: | SLAB REPLACEMENT AND SUBSTRUCTURE WIDENING |

| PROPOSED STRUCTURE | |
|--------------------|--|
| TYPE: | CONTINUOUS REINFORCED CONCRETE SLAB WITH CAP AND COLUMN PIERS AND SEMI-INTEGRAL ABUTMENTS |
| SPANS: | 38'-0" - 47'-6" - 47'-6" - 38'-0" C/C BRGS. |
| ROADWAY: | NORTHBOUND VARIES 72'-0" TO 73'-5 7/8" T/T PARAPET SOUTHBOUND VARIES 76'-9 1/2" TO 80'-4 1/4" T/T PARAPET |
| LOADING: | HS20-44, ALTERNATE MILITARY, 60 PSF FWS |
| SKIEW: | 26°-52'-30" ± LF |
| APPROACH SLABS: | 25'-0" LONG (AS-1-81) |
| ALIGNMENT: | TANGENT |
| CROWN: | 0.016 FT/FT |
| WEARING SURFACE: | 1" MONOLITHIC CONCRETE |
| COORDINATES: | LATITUDE 39°49'29" N LONGITUDE 83°08'28" W |

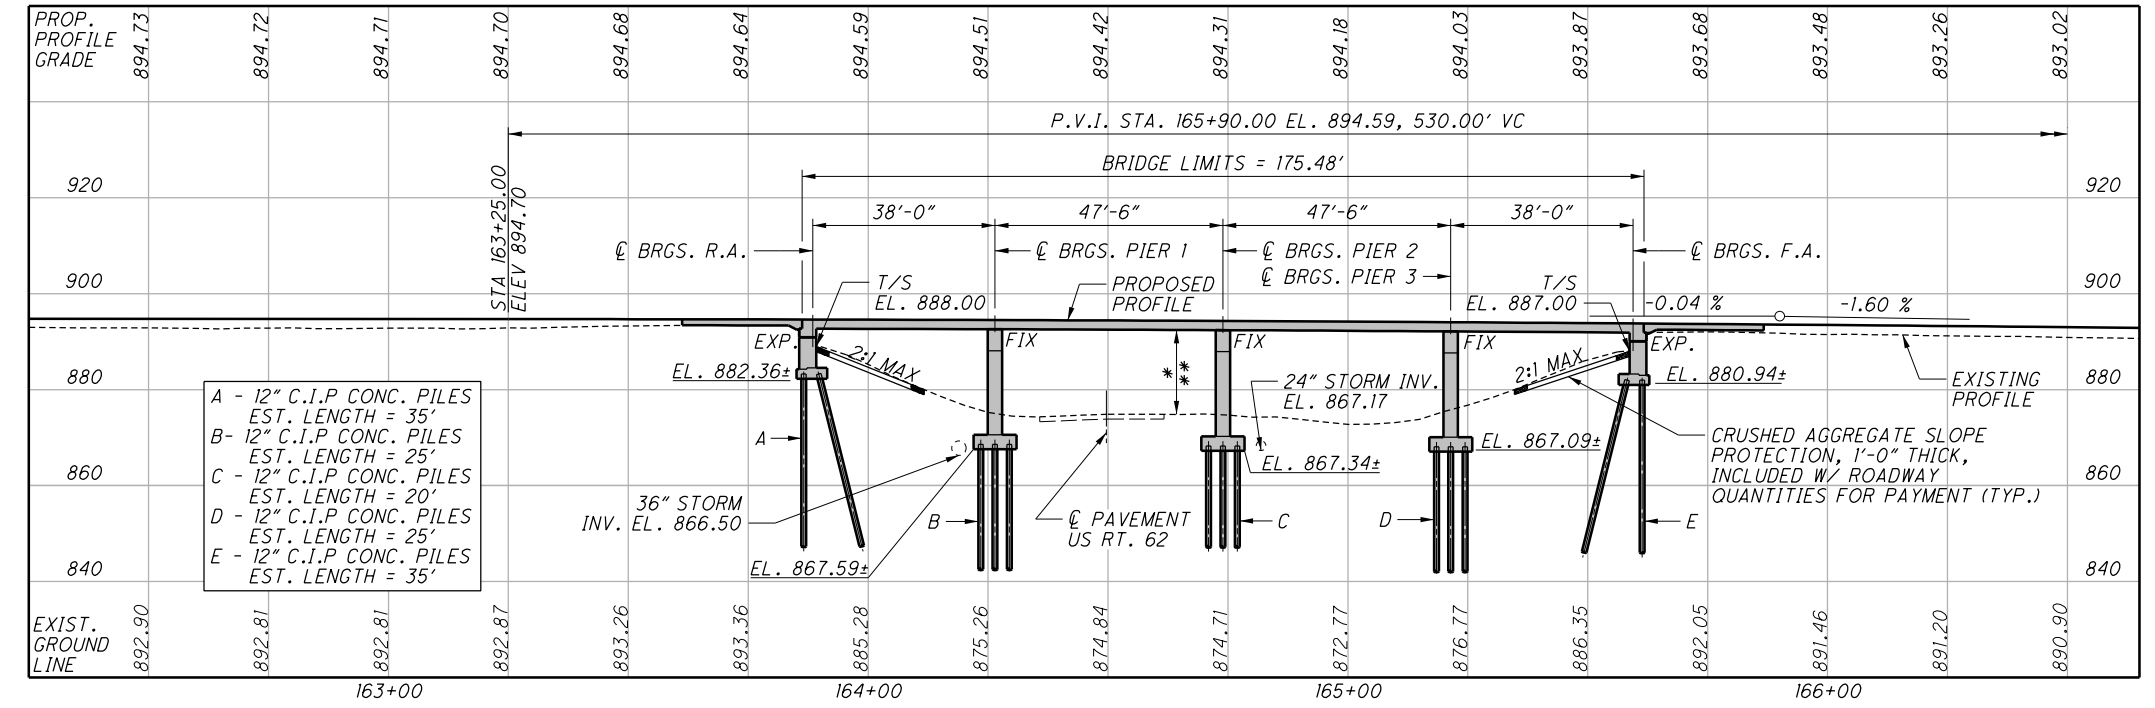


PROFILE ALONG PROFILE GRADE LINE SB

- A - 12" C.I.P. CONC. PILES EST. LENGTH = 35'
- B - 12" C.I.P. CONC. PILES EST. LENGTH = 25'
- C - 12" C.I.P. CONC. PILES EST. LENGTH = 20'
- D - 12" C.I.P. CONC. PILES EST. LENGTH = 25'
- E - 12" C.I.P. CONC. PILES EST. LENGTH = 35'

DESIGN AGENCY: Mead & Hunt
 DATE: 6/30/2015
 REVIEWED: KVB
 DRAWN: DJC
 DESIGNED: LYH
 CHECKED: CMH
 FRANKLIN COUNTY
 STA. 163+86.21
 STA. 165+61.69
 SITE PLAN
 BRIDGE NO. FRA-71-0308 L/R
 OVER US ROUTE 62
 FRA-71-0.00
 PID No. 107201
 1/80
 1194
 1312

X:\4037000\21957.16\107201\structures\FRA071_0308C\SP002.dgn Sheet 8/7/2020 6:21:22 PM 14585js

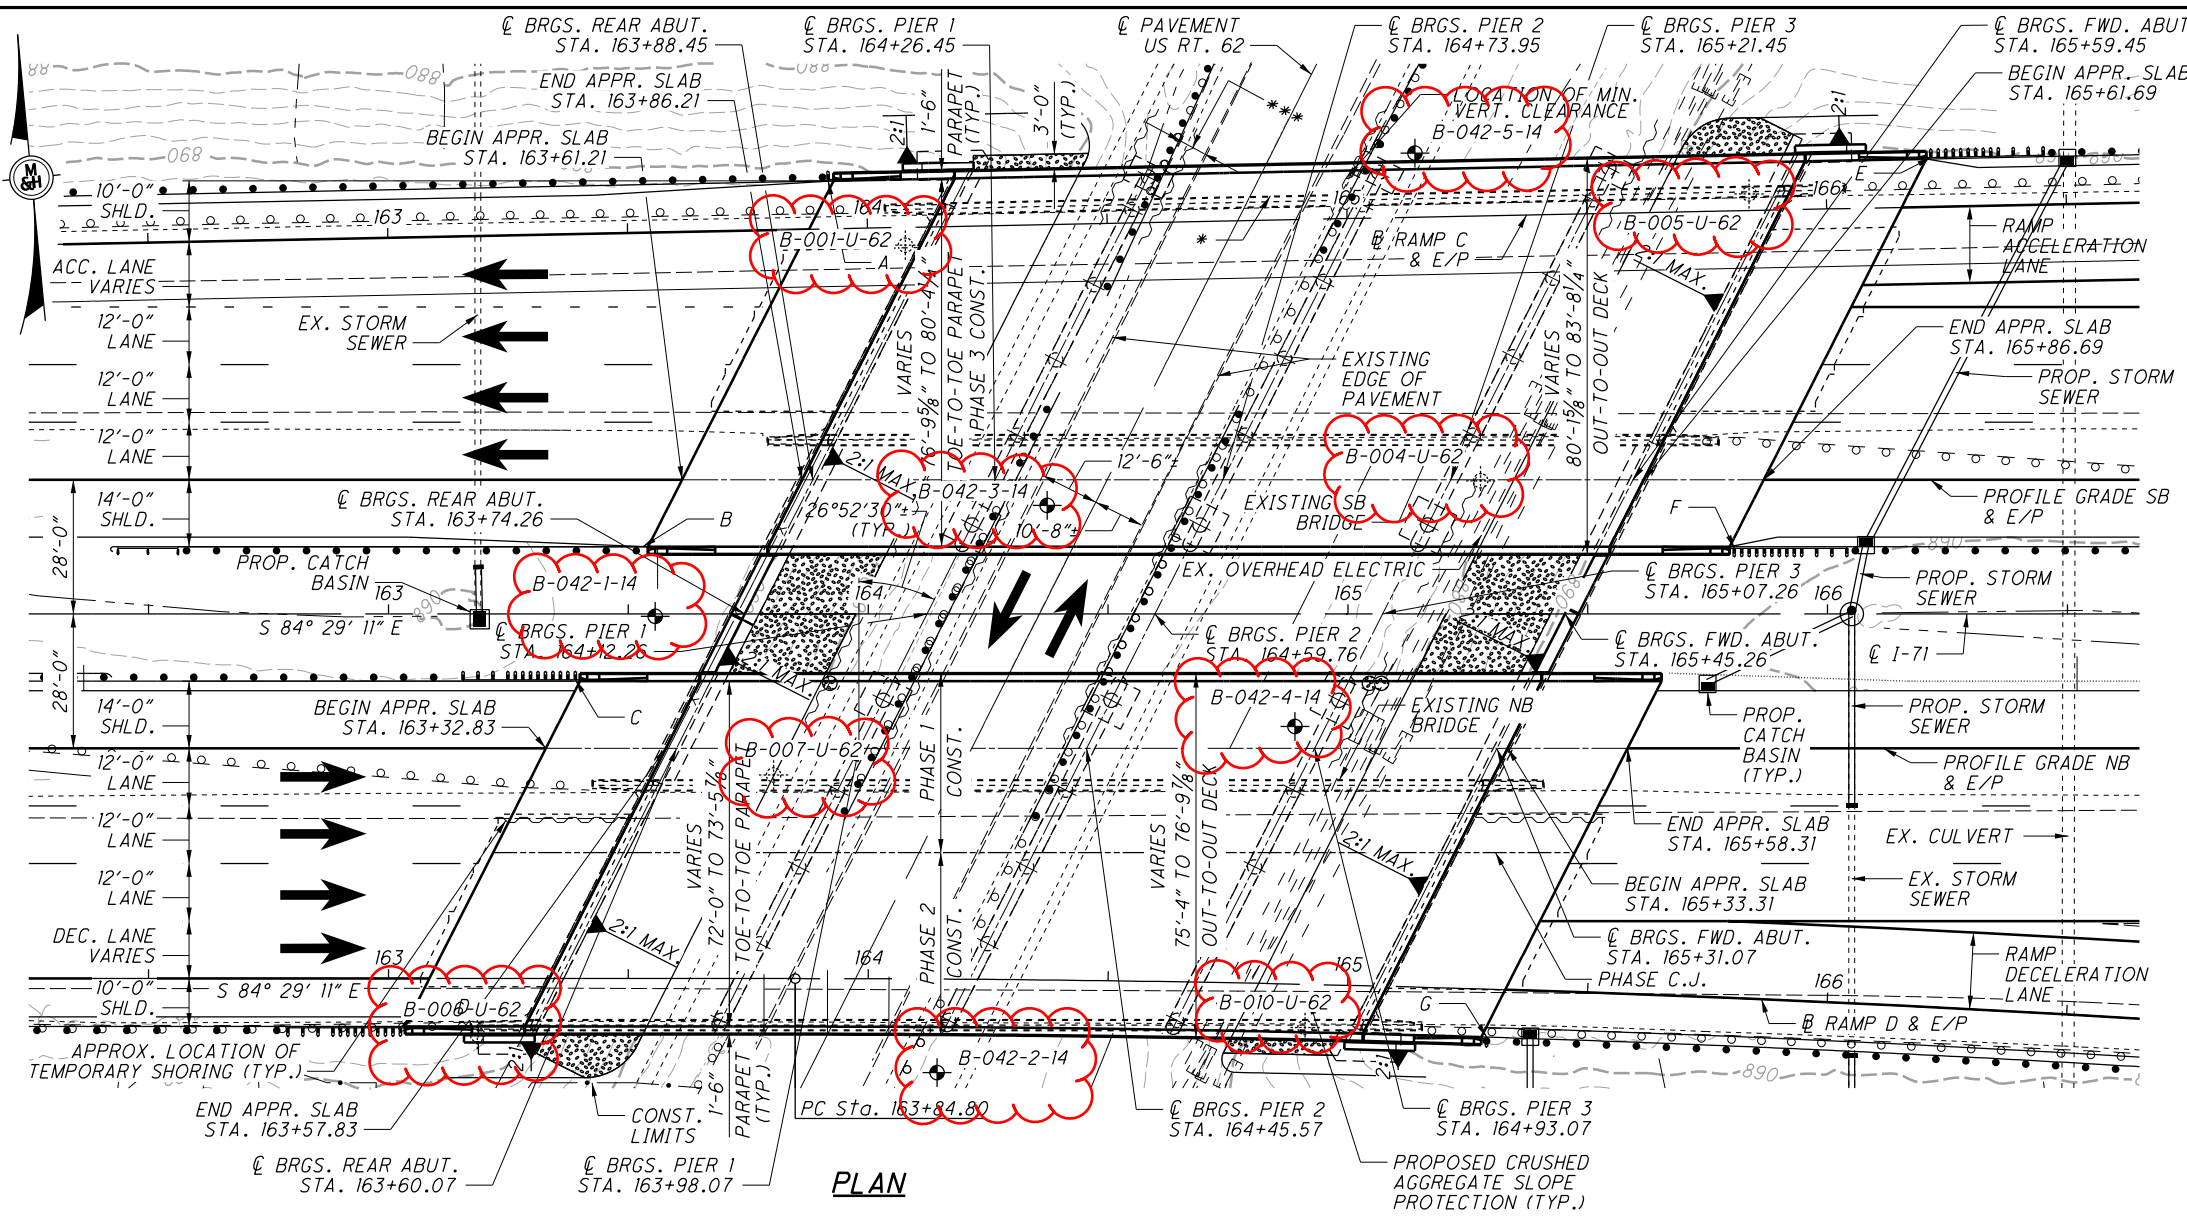

PROPOSED WORK

1. WIDEN ABUTMENTS AND PIERS
2. REPLACE EXISTING PIER CAPS
3. REMOVE SUPERSTRUCTURE AND REPLACE WITH CONTINUOUS REINFORCED CONCRETE SLAB
4. CONVERT ABUTMENTS TO SEMI-INTEGRAL
5. REPLACE APPROACH SLAB
6. SEAL CONCRETE SURFACES

GUARDRAIL POST STATIONING



- | | |
|--------------|--------------|
| A: 163+91.64 | E: 166+21.52 |
| B: 163+52.99 | F: 165+80.56 |
| C: 163+38.96 | G: 165+28.92 |
| D: 163+02.48 | |

NOTE:

FOR LEGEND, EXISTING & PROPOSED STRUCTURE, SEE SHEET 1/80.

CURVE DATA, RAMP K

P.I. Sta. 166+87.05
 $\Delta = 7^\circ 20' 40''$ (RT)
 $D_c = 1^\circ 13' 00''$
 $R = 4,709.24'$
 $T = 302.24'$
 $L = 603.66'$
 $E = 9.69'$
 $C = 603.24'$
 $C.B. = S 80^\circ 40' 00'' E$

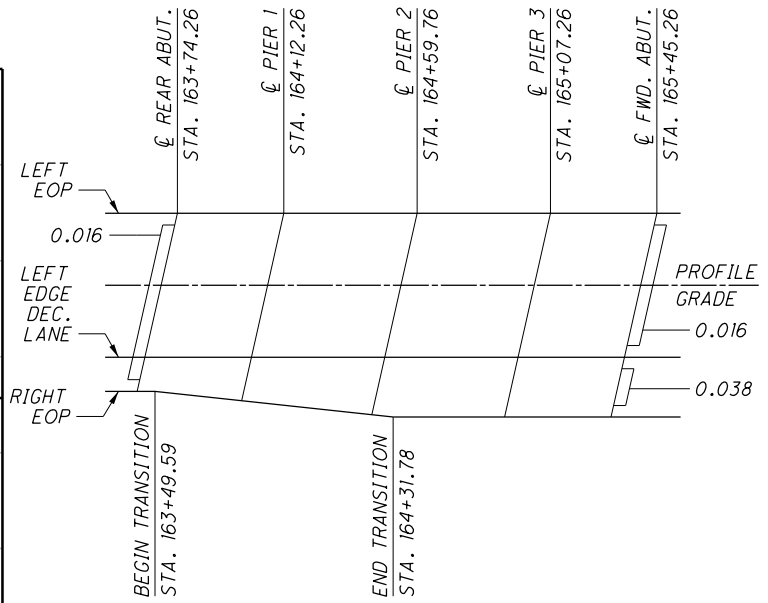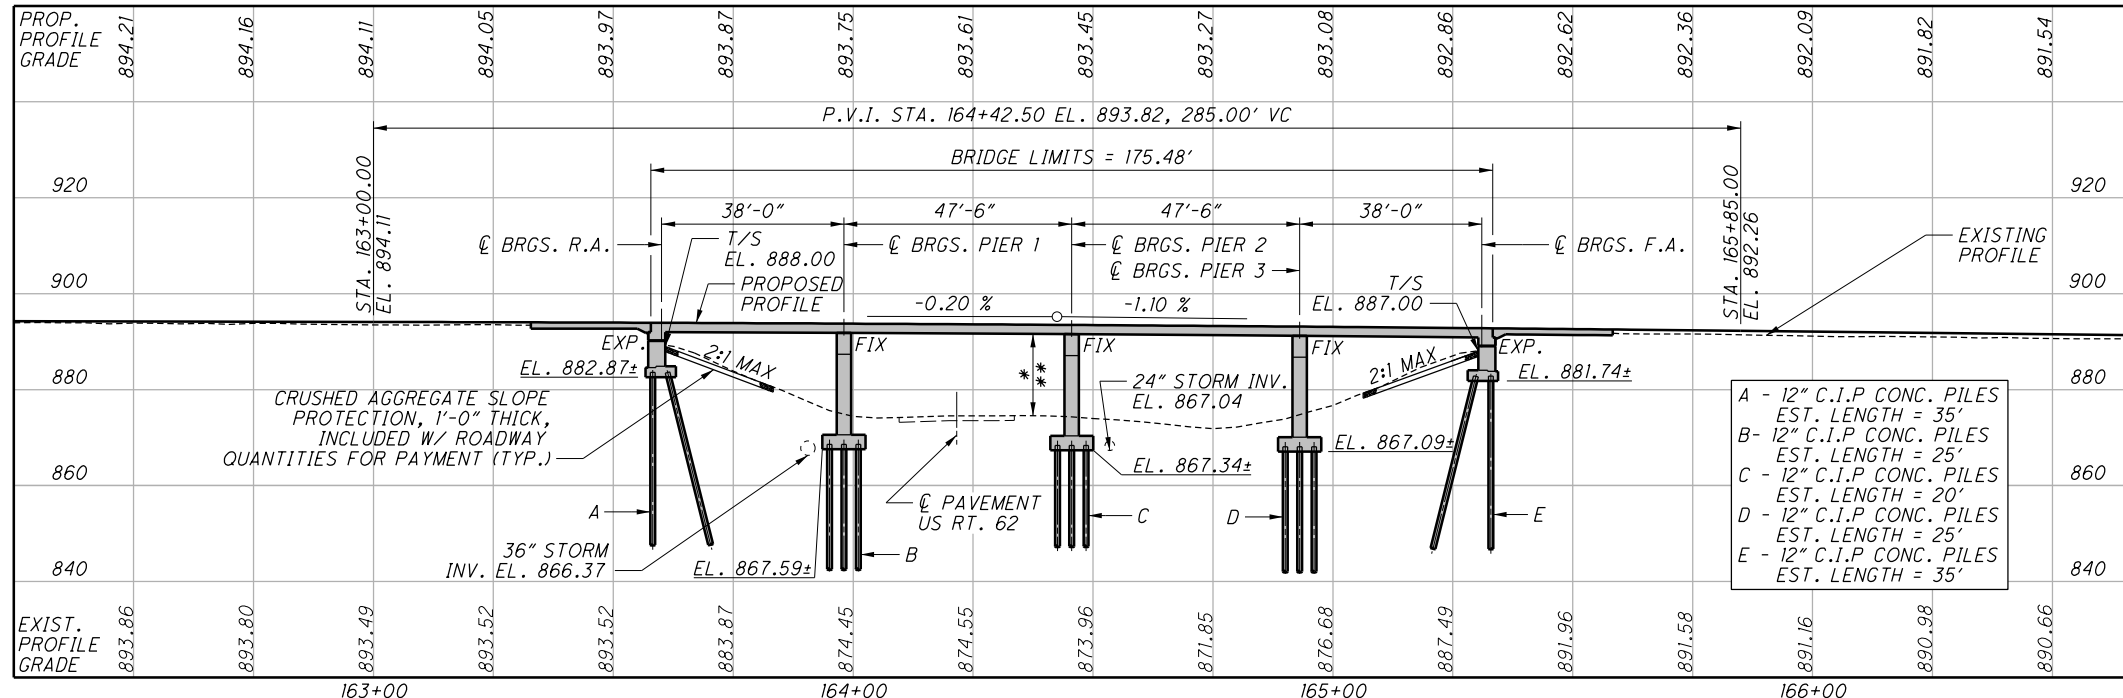

SUPERELEVATION TRANSITION DIAGRAM

NORTHBOUND BRIDGE ONLY
 ALL STATIONS GIVEN ALONG CL I-71
 SEE ROADWAY SUPERELEVATION PROFILES FOR ADDITIONAL INFORMATION

| | | | | |
|--------------------------|--------------------------|------------------------|------------------------|--|
| DESIGN AGENCY | DATE 6/30/2015 | REVIEWED KVB | DESIGNED LYH | FRANKLIN COUNTY STA. 163+57.83 STA. 165+33.31 |
| DESIGN LYH | DATE 6/30/2015 | REVIEWED DUC | CHECKED CMH | FRANKLIN COUNTY STA. 163+57.83 STA. 165+33.31 |
| DESIGN LYH | DATE 6/30/2015 | REVIEWED DUC | CHECKED CMH | FRANKLIN COUNTY STA. 163+57.83 STA. 165+33.31 |
| DESIGN LYH | DATE 6/30/2015 | REVIEWED DUC | CHECKED CMH | FRANKLIN COUNTY STA. 163+57.83 STA. 165+33.31 |

FRA-71-0.00
 PID No. 107201

BRIDGE NO. FRA-71-0308 L/R
 OVER US ROUTE 62

2 / 80

1195
1312

X:\4037000\121957.16\107201\Roadway\Sheets\107201\G007.dgn Sheet 8/10/2020 8:49:10 AM 1458s.js

| SHEET NUM. | | | | | | | | PART. | | | | ITEM | ITEM EXT | GRAND TOTAL | UNIT | DESCRIPTION | SEE SHEET NO. | CALCULATED | DCB | CHECKED | Q/LW |
|------------|-----------|-----------|-----------|--|--|--|--|-------|--|---------|--------|---------|----------|-------------|------|--|---------------|------------|-----|---------|-----------|
| 01/IMS/PV | 02/NHS/PV | 03/IMS/BR | 04/IMS/BR | | | | | | | | | | | | | | | | | | |
| 408 | | | | | | | | | | | | | | | | | | | | | |
| 123,297 | | | | | | | | | | 81,376 | 41,921 | 509 | 10001 | 123,297 | LB | EPOXY COATED REINFORCING STEEL, AS PER PLAN | | | | | 1111 |
| 500 | | | | | | | | | | 330 | 170 | 509 | 20001 | 500 | LB | REINFORCING STEEL, REPLACEMENT OF EXISTING REINFORCING STEEL, AS PER PLAN | | | | | 1111 |
| 556 | | | | | | | | | | 366 | 190 | 510 | 10000 | 556 | EACH | DOWEL HOLES WITH NONSHRINK, NONMETALLIC GROUT | | | | | |
| 458 | | | | | | | | | | 302 | 156 | 511 | 21522 | 458 | CY | CLASS QC2 CONCRETE WITH QC/OA, SUPERSTRUCTURE | | | | | |
| 2 | | | | | | | | | | 1 | 1 | 511 | 33500 | 2 | EACH | SEMI-INTEGRAL DIAPHRAGM GUIDE | | | | | |
| 81 | | | | | | | | | | 53 | 28 | 511 | 42012 | 81 | CY | CLASS QC1 CONCRETE WITH QC/OA, PIER ABOVE FOOTINGS | | | | | |
| 166 | | | | | | | | | | 109 | 57 | 511 | 43512 | 166 | CY | CLASS QC1 CONCRETE WITH QC/OA, ABUTMENT INCLUDING FOOTING | | | | | |
| 28 | | | | | | | | | | 18 | 10 | 511 | 46510 | 28 | CY | CLASS QC1 CONCRETE, FOOTING | | | | | |
| 950 | | | | | | | | | | 627 | 323 | 512 | 10050 | 950 | SY | SEALING OF CONCRETE SURFACES (NON-EPOXY) | | | | | |
| 41 | | | | | | | | | | 27 | 14 | 512 | 33000 | 41 | SY | TYPE 2 WATERPROOFING | | | | | |
| 210,946 | | | | | | | | | | 140,631 | 70,315 | 513 | 10260 | 210,946 | LB | STRUCTURAL STEEL MEMBERS, LEVEL 3 | | | | | |
| 6,156 | | | | | | | | | | 4,062 | 2,094 | 513 | 20000 | 6,156 | EACH | WELDED STUD SHEAR CONNECTORS | | | | | |
| 17 | | | | | | | | | | 11 | 6 | 516 | 13600 | 17 | SF | 1" PREFORMED EXPANSION JOINT FILLER | | | | | |
| 254 | | | | | | | | | | 167 | 87 | 516 | 13900 | 254 | SF | 2" PREFORMED EXPANSION JOINT FILLER | | | | | |
| 178 | | | | | | | | | | 117 | 61 | 516 | 14020 | 178 | FT | SEMI-INTEGRAL ABUTMENT EXPANSION JOINT SEAL | | | | | |
| 18 | | | | | | | | | | 11 | 7 | 516 | 44100 | 18 | EACH | ELASTOMERIC BEARING WITH INTERNAL LAMINATES AND LOAD PLATE (NEOPRENE) | | | | | |
| | | | | | | | | | | | | | | | | (11" x 18" x 2.05" WITH 12" x 19" x 2.0" LOAD PLATE) | | | | | |
| 18 | | | | | | | | | | 11 | 7 | 516 | 44101 | 18 | EACH | ELASTOMERIC BEARING WITH INTERNAL LAMINATES AND LOAD PLATE (NEOPRENE), AS PER PLAN | | | | | 1516 |
| | | | | | | | | | | | | | | | | (10" x 14" x 2.95" WITH 11" x 15" x 1.5" LOAD PLATE) | | | | | |
| 10 | | | | | | | | | | 6 | 4 | 518 | 12301 | 10 | EACH | SCUPPERS, INCLUDING SUPPORTS, AS PER PLAN | | | | | 1182-1183 |
| 140 | | | | | | | | | | 92 | 48 | 518 | 21200 | 140 | CY | POROUS BACKFILL WITH GEOTEXTILE FABRIC | | | | | |
| 204 | | | | | | | | | | 134 | 70 | 518 | 40000 | 204 | FT | 6" PERFORATED CORRUGATED PLASTIC PIPE | | | | | |
| 40 | | | | | | | | | | 26 | 14 | 518 | 40011 | 40 | FT | 6" NON-PERFORATED CORRUGATED PLASTIC PIPE, INCLUDING SPECIALS, AS PER PLAN | | | | | 1131 |
| 2 | | | | | | | | | | 2 | | 523 | 20000 | 2 | EACH | DYNAMIC LOAD TESTING | | | | | |
| 375 | | | | | | | | | | 247 | 128 | 526 | 25011 | 375 | SY | REINFORCED CONCRETE APPROACH SLABS WITH QC/OA (T=15"), AS PER PLAN | | | | | 1184-1188 |
| 144 | | | | | | | | | | 95 | 49 | 526 | 90030 | 144 | FT | TYPE C INSTALLATION | | | | | |
| 48 | | | | | | | | | | 31 | 17 | SPECIAL | 53000400 | 48 | EACH | STRUCTURES : CAPSULE ADHESIVE ANCHORES | | | | | 1155 |
| 325 | | | | | | | | | | 214 | 111 | 607 | 39900 | 325 | FT | VANDAL PROTECTION FENCE, 6' STRAIGHT, COATED FABRIC | | | | | |
| 60 | | | | | | | | | | 39 | 21 | 846 | 00110 | 60 | CF | POLYMER MODIFIED ASPHALT EXPANSION JOINT SYSTEM | | | | | |
| | | | | | | | | | | | | | | | | STRUCTURE OVER 20 FOOT SPAN (FRA-71-0308L (SOUTHBOUND)) | | | | | |
| LS | | | | | | | | | | LS | | 202 | 11203 | LS | | PORTIONS OF STRUCTURE REMOVED, OVER 20 FOOT SPAN, AS PER PLAN | | | | | 1197 |
| 220 | | | | | | | | | | 220 | | 202 | 22900 | 220 | SY | APPROACH SLAB REMOVED | | | | | |
| 931 | | | | | | | | | | 931 | | 202 | 23500 | 931 | SY | WEARING COURSE REMOVED | | | | | |
| LS | | | | | | | | | | LS | | 503 | 11101 | LS | | COFFERDAMS AND EXCAVATION BRACING, AS PER PLAN | | | | | 1197 |
| LS | | | | | | | | | | LS | | 503 | 21300 | LS | | UNCLASSIFIED EXCAVATION | | | | | |
| LS | | | | | | | | | | LS | | 505 | 11100 | LS | | PILE DRIVING EQUIPMENT MOBILIZATION | | | | | |
| 2,310 | | | | | | | | | | 1,478 | 832 | 507 | 00500 | 2,310 | FT | 12" CAST-IN-PLACE REINFORCED CONCRETE PILES, DRIVEN | | | | | |
| 2,715 | | | | | | | | | | 1,737 | 978 | 507 | 00550 | 2,715 | FT | 12" CAST-IN-PLACE REINFORCED CONCRETE PILES, FURNISHED | | | | | |
| 263,185 | | | | | | | | | | 168,438 | 94,747 | 509 | 10001 | 263,185 | LB | EPOXY COATED REINFORCING STEEL, AS PER PLAN | | | | | 1197 |
| 500 | | | | | | | | | | 320 | 180 | 509 | 20001 | 500 | LB | REINFORCING STEEL, REPLACEMENT OF EXISTING REINFORCING STEEL, AS PER PLAN | | | | | 1197 |
| 226 | | | | | | | | | | 144 | 82 | 510 | 10000 | 226 | EACH | DOWEL HOLES WITH NONSHRINK, NONMETALLIC GROUT | | | | | |
| 1,151 | | | | | | | | | | 736 | 415 | 511 | 32212 | 1,151 | CY | CLASS QC2 CONCRETE WITH QC/OA, SUPERSTRUCTURE | | | | | |
| 184 | | | | | | | | | | 117 | 67 | 511 | 41012 | 184 | CY | CLASS QC1 CONCRETE WITH QC/OA, PIER ABOVE FOOTINGS | | | | | |
| 166 | | | | | | | | | | 106 | 60 | 511 | 43512 | 166 | CY | CLASS QC1 CONCRETE WITH QC/OA, ABUTMENT INCLUDING FOOTING | | | | | |
| 44 | | | | | | | | | | 28 | 16 | 511 | 46510 | 44 | CY | CLASS QC1 CONCRETE, FOOTING | | | | | |
| 1,227 | | | | | | | | | | 785 | 442 | 512 | 10050 | 1,227 | SY | SEALING OF CONCRETE SURFACES (NON-EPOXY) | | | | | |
| 51 | | | | | | | | | | 32 | 19 | 512 | 33000 | 51 | SY | TYPE 2 WATERPROOFING | | | | | |
| 17 | | | | | | | | | | 10 | 7 | 516 | 13600 | 17 | SF | 1" PREFORMED EXPANSION JOINT FILLER | | | | | |
| 93 | | | | | | | | | | 59 | 34 | 516 | 13900 | 93 | SF | 2" PREFORMED EXPANSION JOINT FILLER | | | | | |
| 204 | | | | | | | | | | 130 | 74 | 516 | 14020 | 204 | FT | SEMI-INTEGRAL ABUTMENT EXPANSION JOINT SEAL | | | | | |
| 47 | | | | | | | | | | 30 | 17 | 516 | 43100 | 47 | EACH | ELASTOMERIC BEARING WITH INTERNAL LAMINATES ONLY (NEOPRENE) (8" x 11" x 1.474) | | | | | |
| 151 | | | | | | | | | | 96 | 55 | 518 | 21200 | 151 | CY | POROUS BACKFILL WITH GEOTEXTILE FABRIC | | | | | |
| 215 | | | | | | | | | | 137 | 78 | 518 | 40000 | 215 | FT | 6" PERFORATED CORRUGATED PLASTIC PIPE | | | | | |

GENERAL SUMMARY

FRA-71-0-00

390
1312