

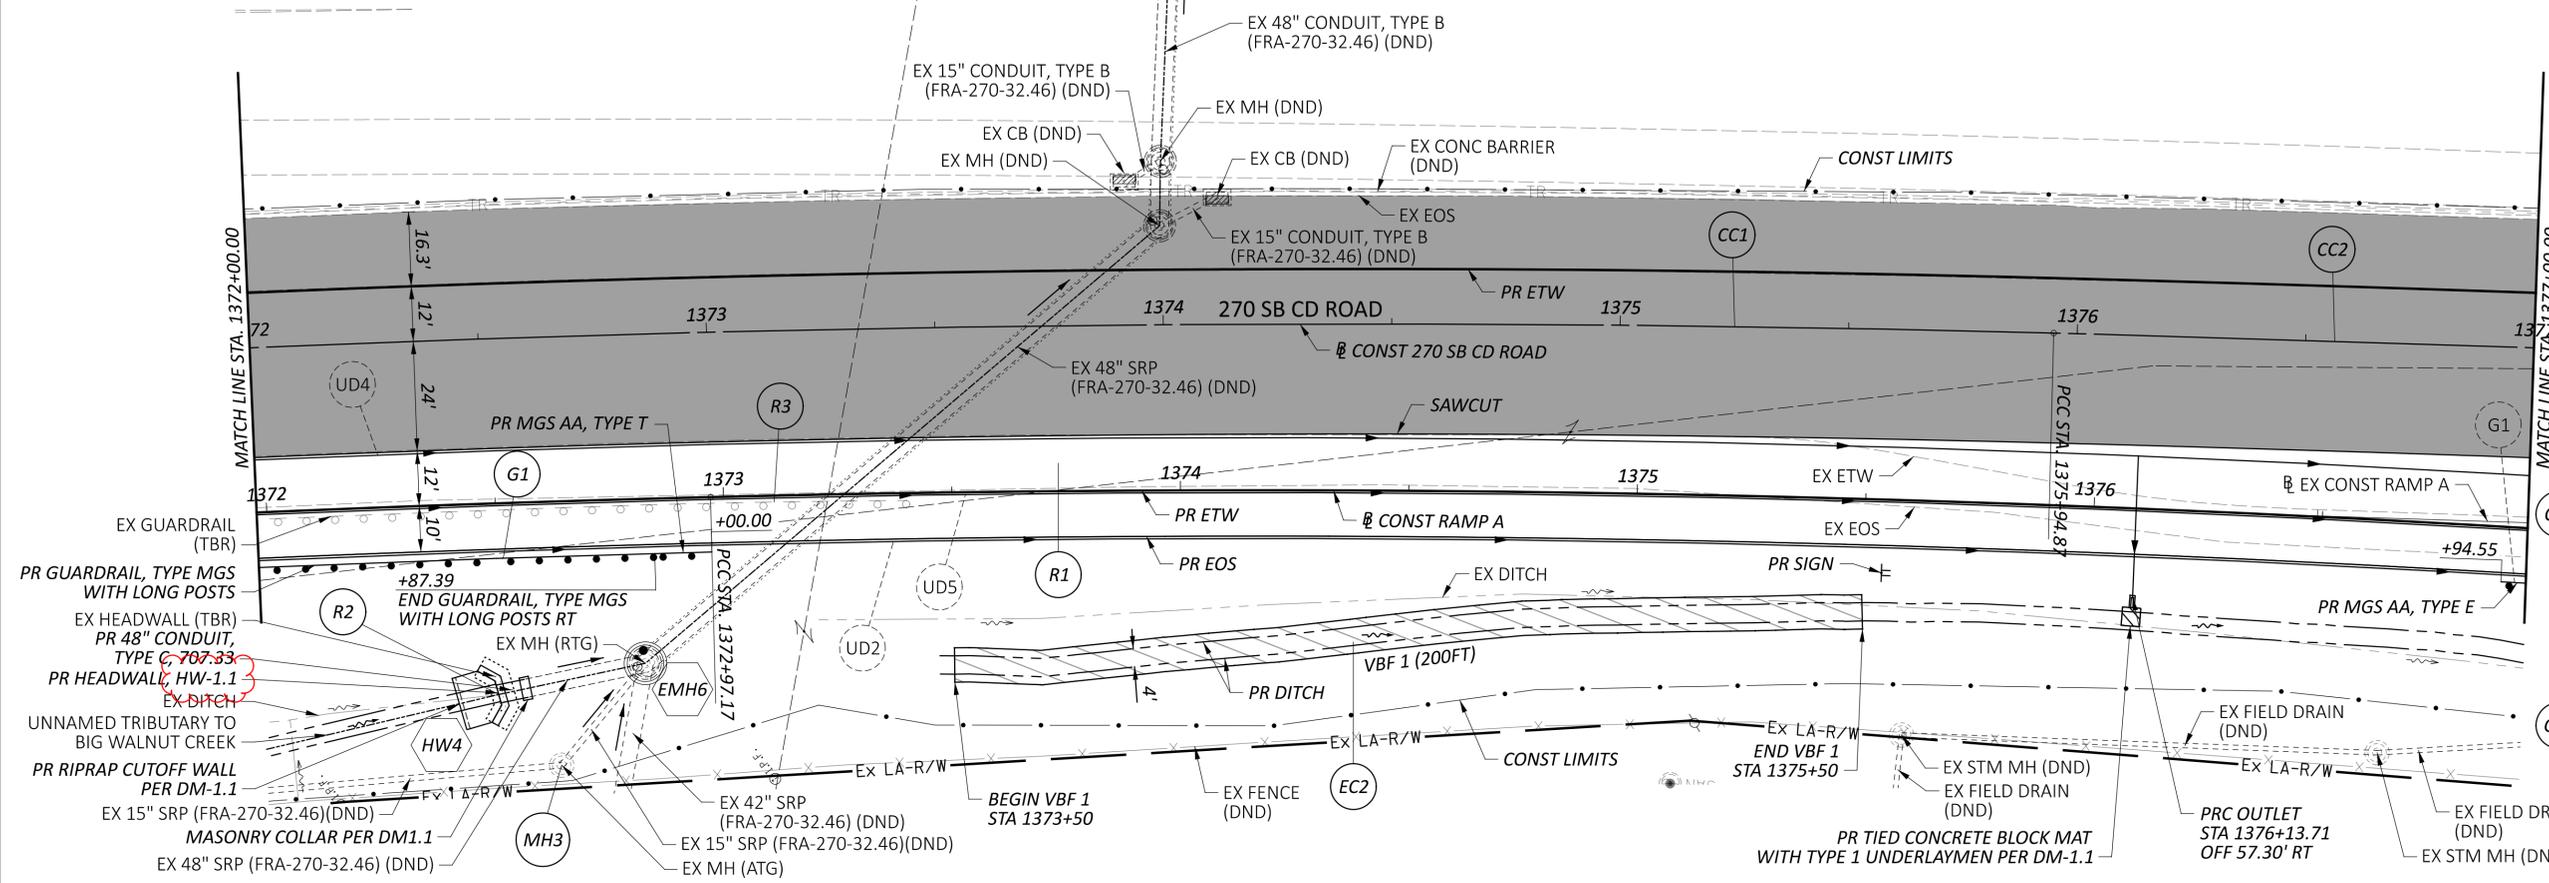


- RESURFACING
 - DITCH EROSION PROTECTION

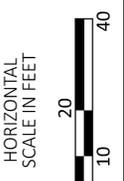

CURVE DATA
 P.I. = STA. 1371+38.16
 $\Delta = 09^{\circ}09'13''$ RT
 $D_c = 01^{\circ}00'00''$
 $R = 5,729.58'$
 $T = 458.66'$
 $L = 915.37'$
 $E = 18.33'$
 $e_{max} = \pm 2.7\%$
 D.S. = 70 MPH

CURVE DATA
 P.I. = STA. 1379+74.32
 $\Delta = 03^{\circ}34'46''$ RT
 $D_c = 00^{\circ}28'18''$
 $R = 12,144.17'$
 $T = 379.45'$
 $L = 758.66'$
 $E = 5.93'$
 $e_{max} = N/A$
 D.S. = 70 MPH

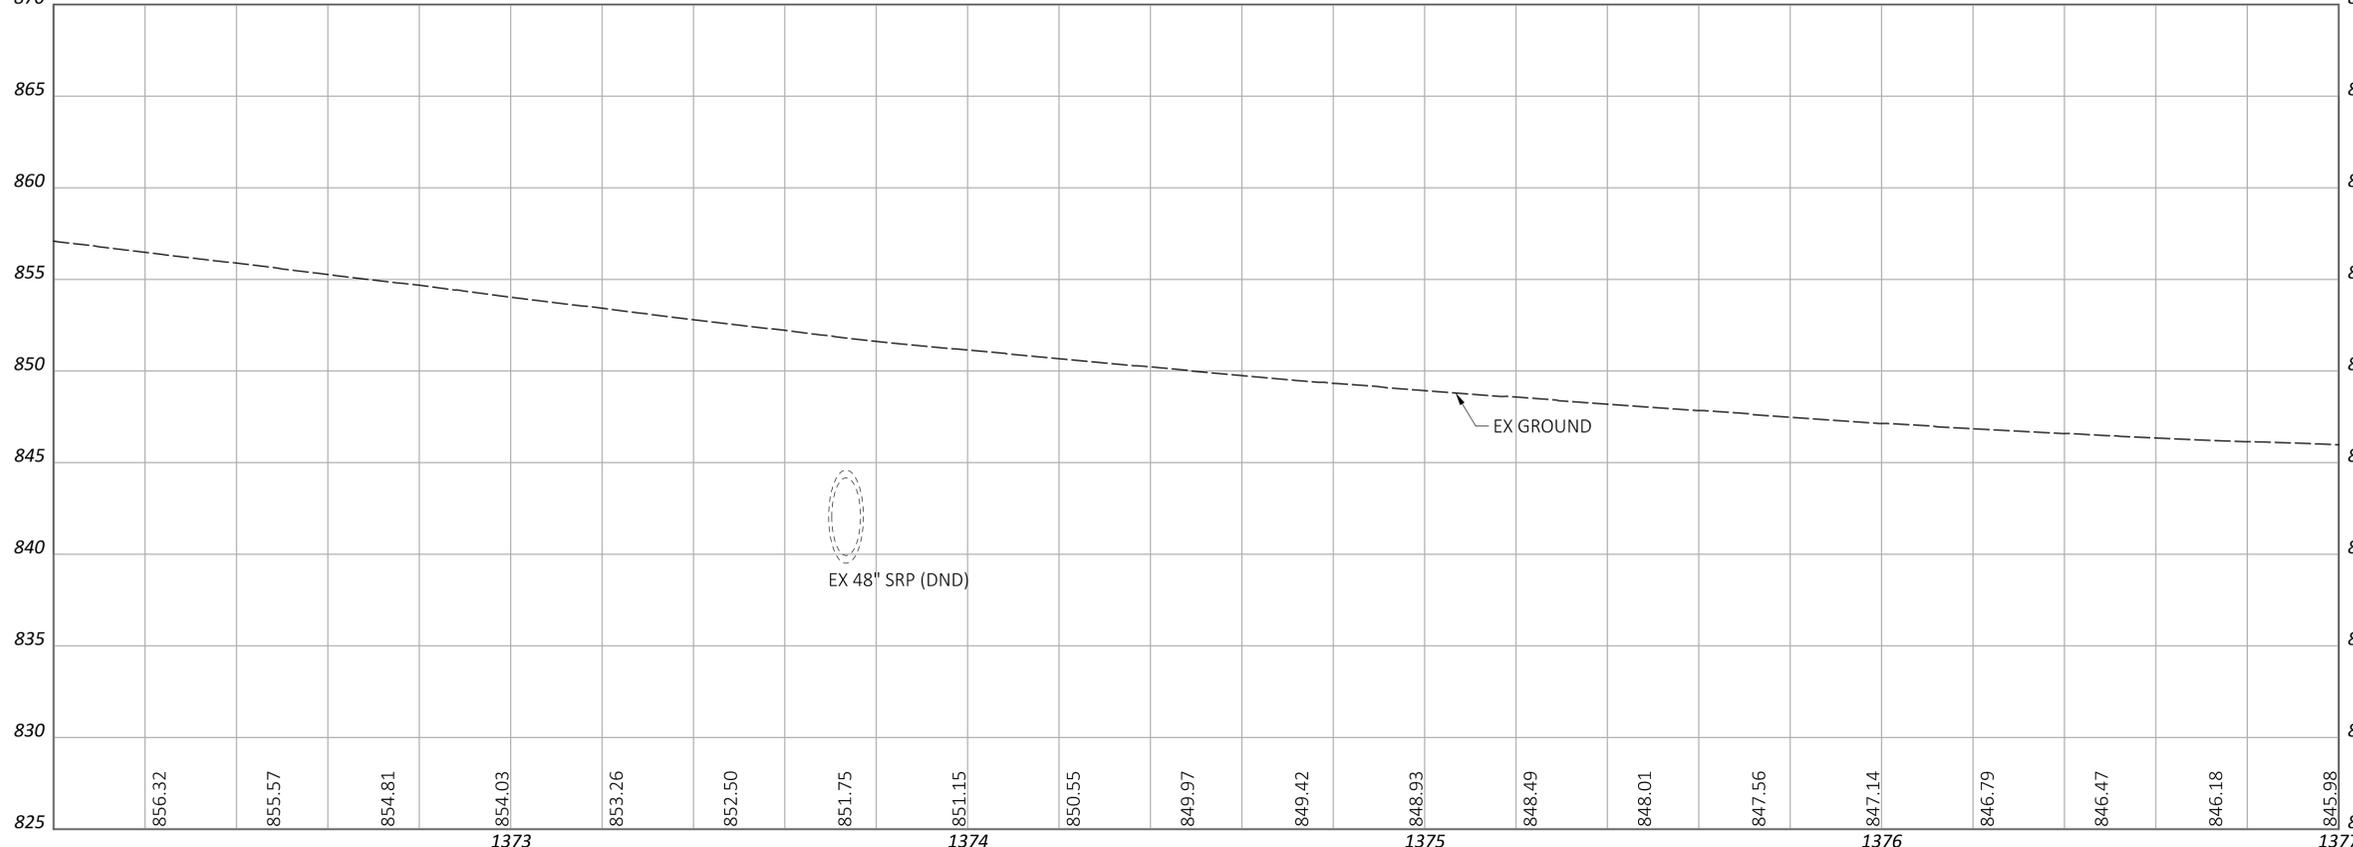

PLAN AND PROFILE - 270 SB CD ROAD
 STA 1372+00.00 TO STA 1377+00.00

DESIGN AGENCY



DESIGNER
 BLM

REVIEWER
 SJB 08/29/25

PROJECT ID
 113663

SHEET TOTAL
 P.78 192

SHEET NO.	REF NO.	LOCATION	STATION TO STATION		SIDE	644	644	644	644	644		645	645	645		646		807	807		850	850	
						CENTER LINE	CHANNELIZING LINE, 12"	STOP LINE	TRANSVERSE/DIAGONAL LINE	CHEVRON MARKING		STOP LINE, TYPE A1	PAVEMENT MARKING, MISC. CENTER LINE, SOLID, DOUBLE, YELLOW, GROOVED	PAVEMENT MARKING, MISC. CHANNELIZING LINE, GROOVED, WITH CONTRAST		STOP LINE		WET REFLECTIVE EPOXY PAVEMENT MARKING, CHANNELIZING LINE, 12"	WET REFLECTIVE THERMOPLASTIC PAVEMENT MARKING, CHANNELIZING LINE, 12"		GROOVING FOR 12" RECESSED PAVEMENT MARKING, (ASPHALT)	GROOVING FOR 12" RECESSED PAVEMENT MARKING, (CONCRETE)	
						FT	FT	FT	FT	FT		FT	MI	FT		FT		FT	FT		FT	FT	
P.150	DY-1	EASTON WAY	61+02	-	61+25	RT																	
P.152 - P.153	DY-2	EASTON WAY	72+00	-	76+07	RT/LT	407																
P.152 - P.153	DY-3	EASTON WAY	72+00	-	76+77	RT	477																
P.153 - P.154	DY-4	EASTON WAY	76+77	-	80+12	RT							335										
P.145 - P.146	CH-1	RAMP A	1375+54	-	1382+42	LT												688			688		
P.146	CH-2	I.R. 270 C-D ROAD	1379+23	-	1382+50	RT												327			327		
P.146	CH-3	RAMP A	1379+16	-	1382+42	LT												326			326		
P.146 - P.147, P.149, P.152	CH-4	RAMP A	1382+42	-	1390+74	LT													832			832	
P.147, P.149, P.152	CH-5	RAMP A	1384+20	-	1390+74	LT													654			654	
P.150	CH-6	EASTON WAY	61+02	-	62+15	LT		113															
P.150 - P.151	CH-7	EASTON WAY	61+02	-	69+38	LT		836															
P.150 - P.151	CH-8	EASTON WAY	61+02	-	66+80	LT		578															
P.150 - P.151	CH-9	EASTON WAY	61+02	-	67+80	LT		678															
P.150 - P.151	CH-10	EASTON WAY	61+02	-	67+80	LT		678															
P.153 - P.154	CH-11	EASTON WAY	76+77	-	80+12	RT								335									
P.153	CH-12	EASTON WAY	80+12	-	80+70	RT/LT								64									
P.153	CH-13	EASTON WAY	80+25	-	80+70	RT/LT								51									
P.153	CH-14	EASTON WAY	80+70	-	80+87	RT		38															
P.153	CH-15	EASTON WAY	80+70	-	80+92	LT		64															
P.150	SL-1	EASTON WAY	61+02			RT/LT			78														
P.152	SL-2	RAMP A	1391+09			LT									36								
P.152	SL-3	EASTON WAY	72+68			LT			36														
P.154	SL-4	EASTON WAY	80+12			RT						24											
P.152 - P.153	YT-1	EASTON WAY	70+28	-	76+07	RT/LT				180													
P.150	TC-1	EASTON WAY	61+02	-	62+15	LT										32							
SUB-TOTALS							907 FT						335 FT									3749-E	
TOTALS CARRIED TO GENERAL SUMMARY							0.17 MI	2985	114	180	32		24	0.06 MI	450		36		1341	1486		1341	1486

PAVEMENT MARKING ESTIMATED QUANTITIES

DESIGN AGENCY

 DESIGNER
 BDM
 REVIEWER
 SMM 08/29/25
 PROJECT ID
 113663
 SHEET TOTAL
 P.135 192

SHEET NO.	REF NO.	LOCATION	STATION TO STATION		SIDE	644	644	647	
						LANE ARROW	DOTTED LINE, 6"	PAVEMENT MARKING, MISC.:LANE ARROW, TYPE B90, WITH CONTRAST	
						EACH	FT	EACH	
P.150	A-1	EASTON WAY	TO	61+38	LT	1			
P.150	A-2	EASTON WAY		61+32	LT	1			
P.150	A-3	EASTON WAY		61+32	RT/LT	1			
P.150	A-4	EASTON WAY		62+00	LT	1			
P.150	A-5	EASTON WAY		62+00	LT	1			
P.150	A-6	EASTON WAY		62+00	RT/LT	1			
P.150	A-7	EASTON WAY		62+72	LT	1			
P.150	A-8	EASTON WAY		62+66	LT	1			
P.150	A-9	EASTON WAY		62+66	RT/LT	1			
P.151	A-10	EASTON WAY		65+18	LT	1			
P.151	A-11	EASTON WAY		66+27	LT	1			
P.151	A-12	EASTON WAY		66+27	RT/LT	1			
P.151	A-13	EASTON WAY		67+63	LT	1			
P.151	A-14	EASTON WAY		69+85	LT	1			
P.153	A-15	EASTON WAY		77+20	RT			1	
P.153	A-16	EASTON WAY		77+20	RT			1	
P.153	A-17	EASTON WAY		78+48	RT			1	
P.153	A-18	EASTON WAY		78+48	RT			1	
P.154	A-19	EASTON WAY		79+14	RT			1	
P.154	A-20	EASTON WAY		79+14	RT			1	
P.154	A-21	EASTON WAY		79+82	RT			1	
P.154	A-22	EASTON WAY		79+82	RT			1	
P.143	A-23	I.R. 270 C-D ROAD		1368+54	RT	1			
P.145	A-24	RAMP A		1375+64	LT	1			
P.150	AC-1	EASTON WAY		61+32	LT	1			
P.150	AC-2	EASTON WAY		62+66	LT	1			
P.150	AC-3	STELZER ROAD		159+46	LT	1			
P.151	AC-4	EASTON WAY		65+12	LT	1			
P.151	AC-5	EASTON WAY		67+57	LT	1			
P.155	AC-6	STELZER ROAD		160+14	LT	1			
P.155	AC-7	STELZER ROAD		160+80	LT	1			
P.155	AC-8	STELZER ROAD		162+57	LT	1			
P.143	AC-9	I.R. 270 C-D ROAD		1368+60	RT	1			
P.145	AC-10	RAMP A		1375+69	LT	1			
P.143	-	P.145	WD-1	I.R. 270 C-D ROAD	1367+45	-	1375+54	RT	809
P.151	-	P.152	WD-2	EASTON WAY	69+38	-	72+87	LT	350
P.151	-	P.152	WD-3	EASTON WAY	69+46	-	70+93	LT	147
P.151	-	P.152	WD-4	EASTON WAY	69+46	-	72+58	RT/LT	312
P.152	-	P.152	WD-5	EASTON WAY	69+98	-	70+92	RT/LT	94
SUB-TOTALS						26	1712	8	
TOTALS CARRIED TO GENERAL SUMMARY						26	1712	8	

PAVEMENT MARKING ESTIMATED QUANTITIES

DESIGN AGENCY



DESIGNER

BDM

REVIEWER

SMM 08/29/25

PROJECT ID

113663

SHEET TOTAL

P.136 192

STATE OF OHIO DEPARTMENT OF TRANSPORTATION

FRA-270-32.92
CITY OF COLUMBUS
FRANKLIN COUNTY

SIGNATURES ON THIS PAGE SIGNIFY ONLY THE CONCURRENCE WITH THE GENERAL PURPOSES AND GENERAL LOCATION OF THE PROJECT. ALL TECHNICAL DETAILS REMAIN THE RESPONSIBILITY OF THE ENGINEER(S) PREPARING THE PLANS.

Richie Dimmerling II P.E. 2/10/2026
DESIGN SECTION ENGINEER, DIVISION OF DESIGN AND CONSTRUCTION DATE

Steve Wasosky 2/17/2026
ADMINISTRATOR, DIVISION OF POWER DATE

RMV T&P Robert Priestas 2/12/2026
ADMINISTRATOR, DIVISION OF SEWERAGE AND DRAINAGE DATE

TEH John Newsome 2/12/2026
ADMINISTRATOR, DIVISION OF WATER DATE

Kristen L. Althaus by KJH 2/17/2026
DIRECTOR, DEPARTMENT OF PUBLIC UTILITIES DATE

A-C 2/19/2026
FIRE PREVENTION BUREAU, DIVISION OF FIRE DATE

Darryl Joyce 2/17/2026
ENGINEERING SUPERVISOR, DEPARTMENT OF TECHNOLOGY DATE

Don E. Evans for Bernita A Reese 2/17/2026
DIRECTOR, DEPARTMENT OF RECREATION AND PARKS DATE

J.A.S. 2/19/2026
CITY ENGINEER/ADMINISTRATOR, DIVISION OF DESIGN AND CONSTRUCTION DATE

Kelly Scooco 2/19/2026
DIRECTOR, DEPARTMENT OF PUBLIC SERVICE DATE

CITY OF COLUMBUS SIGNATURES

FRA-270-32.92

MODEL: Sheet PAPER SIZE: 8.5x11 (in.) DATE: 2/5/2026 TIME: 3:30:42 PM USER: s.sheel J:\20200412\DDOT\02_FRA-270-32.92 at Easton Way\FRA1113663\00-Engineering\Roadway\Sheets\113663_GT002.dgn

DESIGN AGENCY



DESIGNER	BLM
REVIEWER	SJB 06-02-25
PROJECT ID	113663
SHEET	TOTAL
1	1