


Curve Data
 $\Delta = 12^\circ 15' L$
 $D = 5^\circ 00'$
 $T = 122.97$
 $L = 245.00$


Curve Data
 $\Delta = 6^\circ 20' R$
 $D = 5^\circ 00'$
 $T = 63.39$
 $L = 126.7$



Curve Data
 $\Delta = 7^\circ 45' R$
 $D = 3^\circ 30'$
 $T = 110.88$
 $L = 221.43$

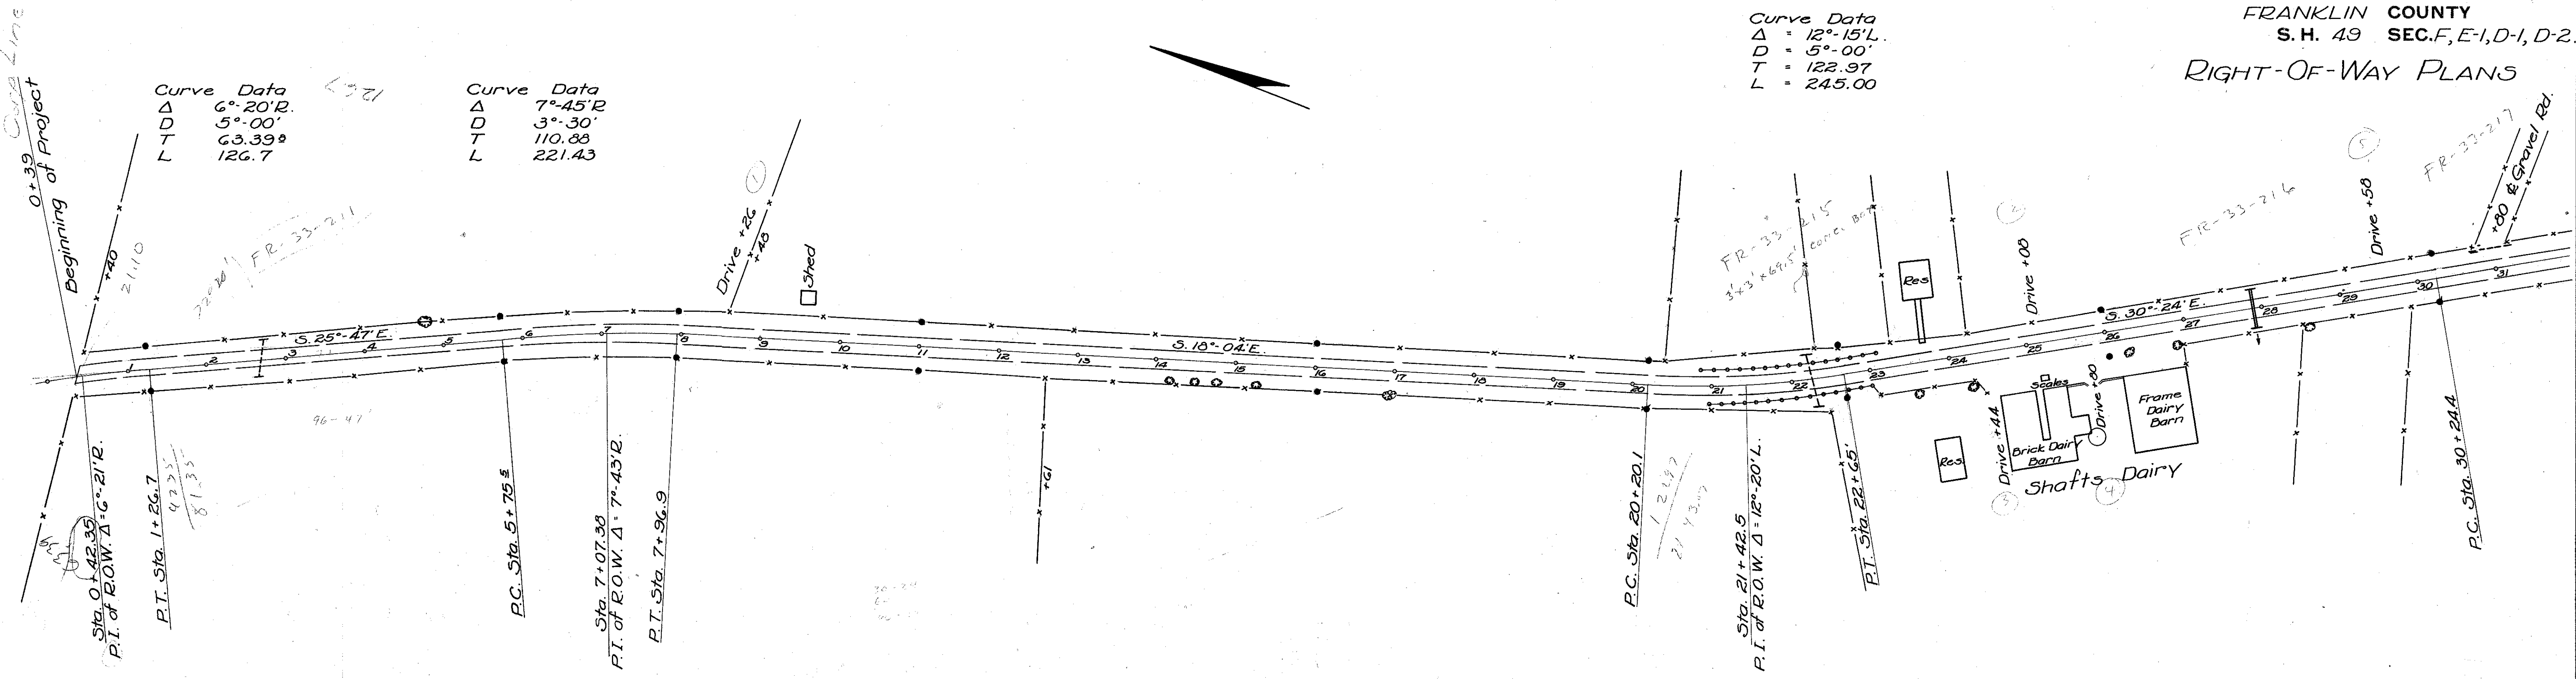

Note: All bearings are in reference to R.O.W.
 All Monuments are set on P.C. and P.T. of construction and on the survey of R.O.W.
 All Right of Way is 60' unless shown otherwise
 See Note Book #122.

Curve Data
 $\Delta = 4^\circ 05' R$
 $D = 1^\circ 00'$
 $T = 204.61$
 $L = 408.32$


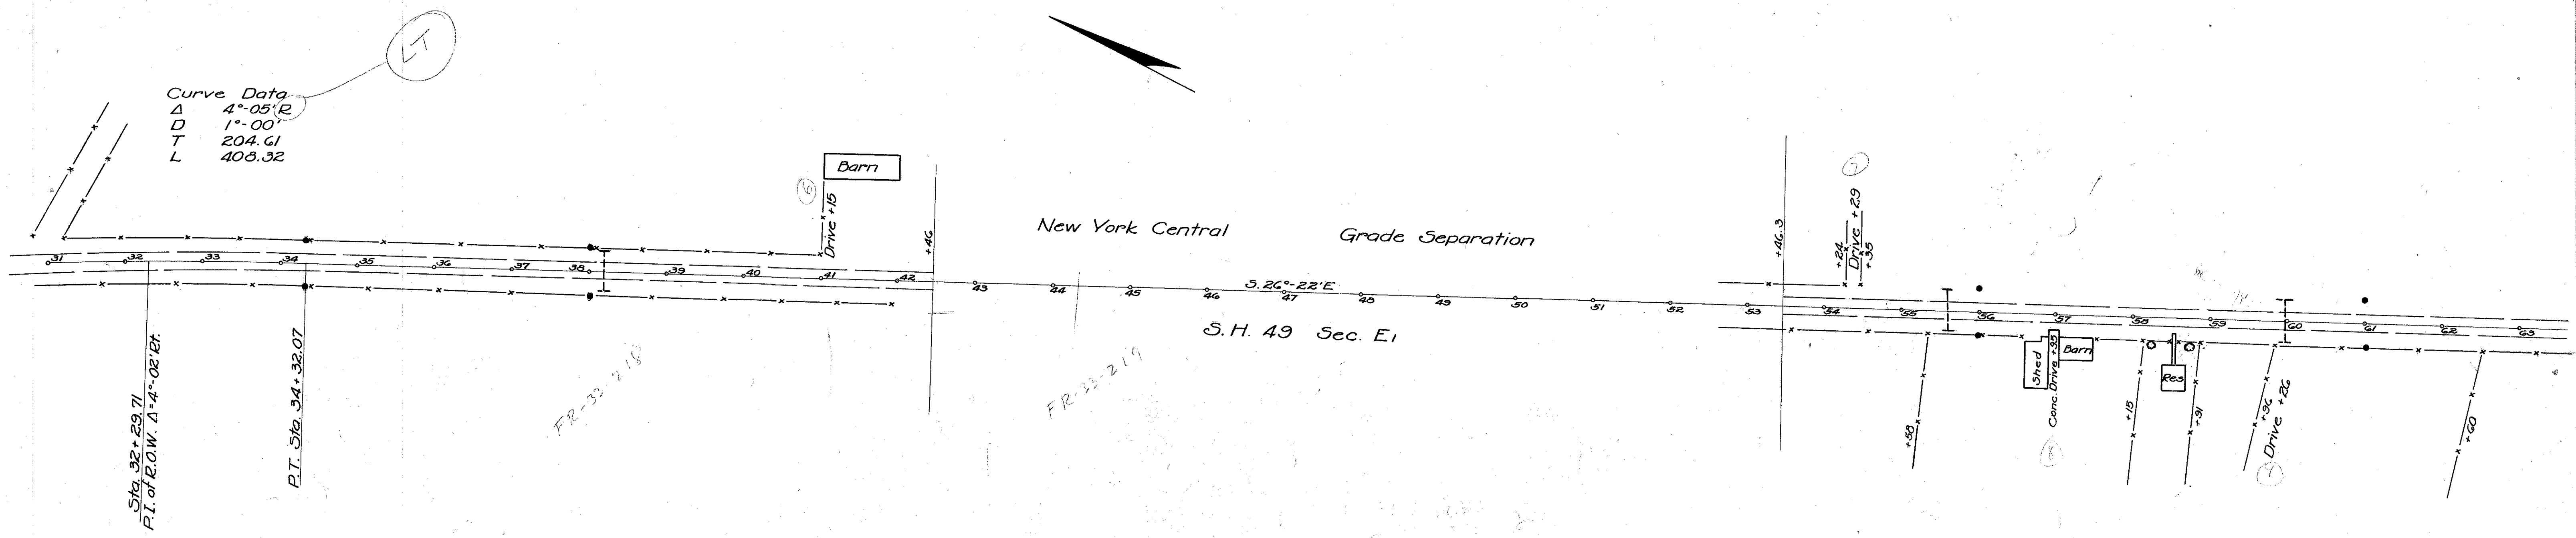


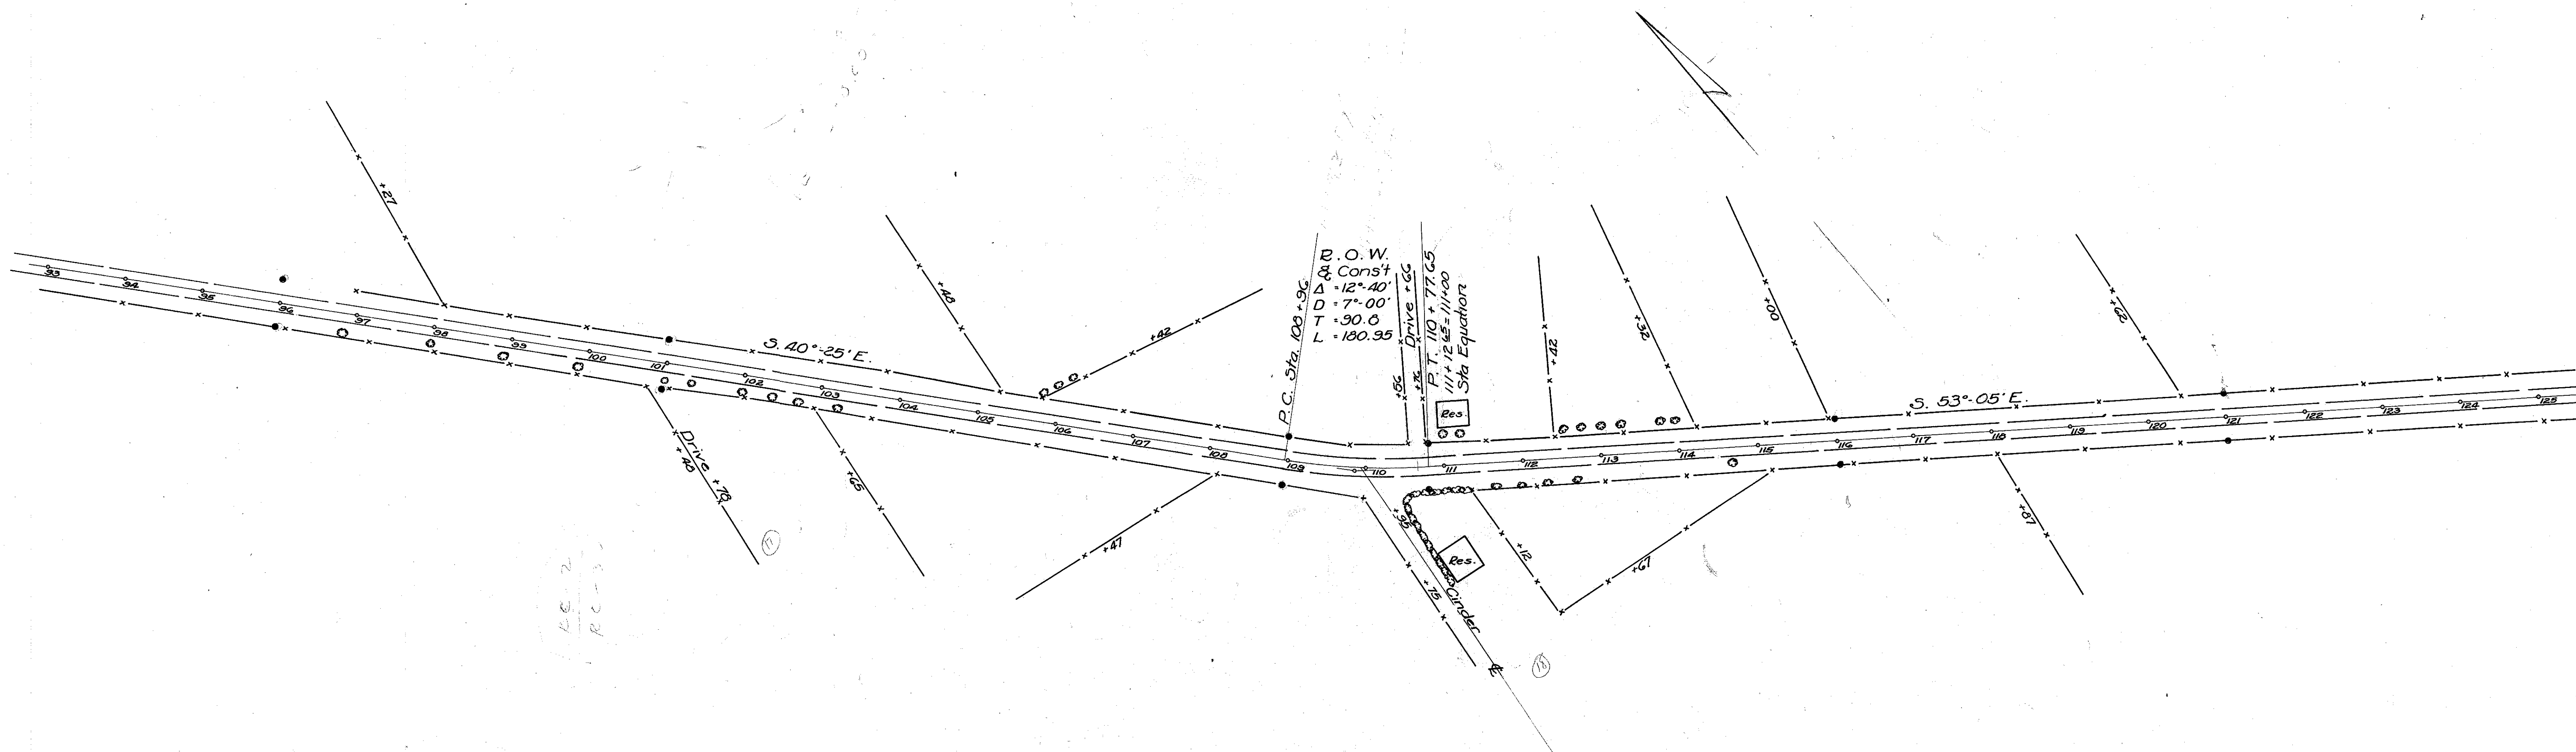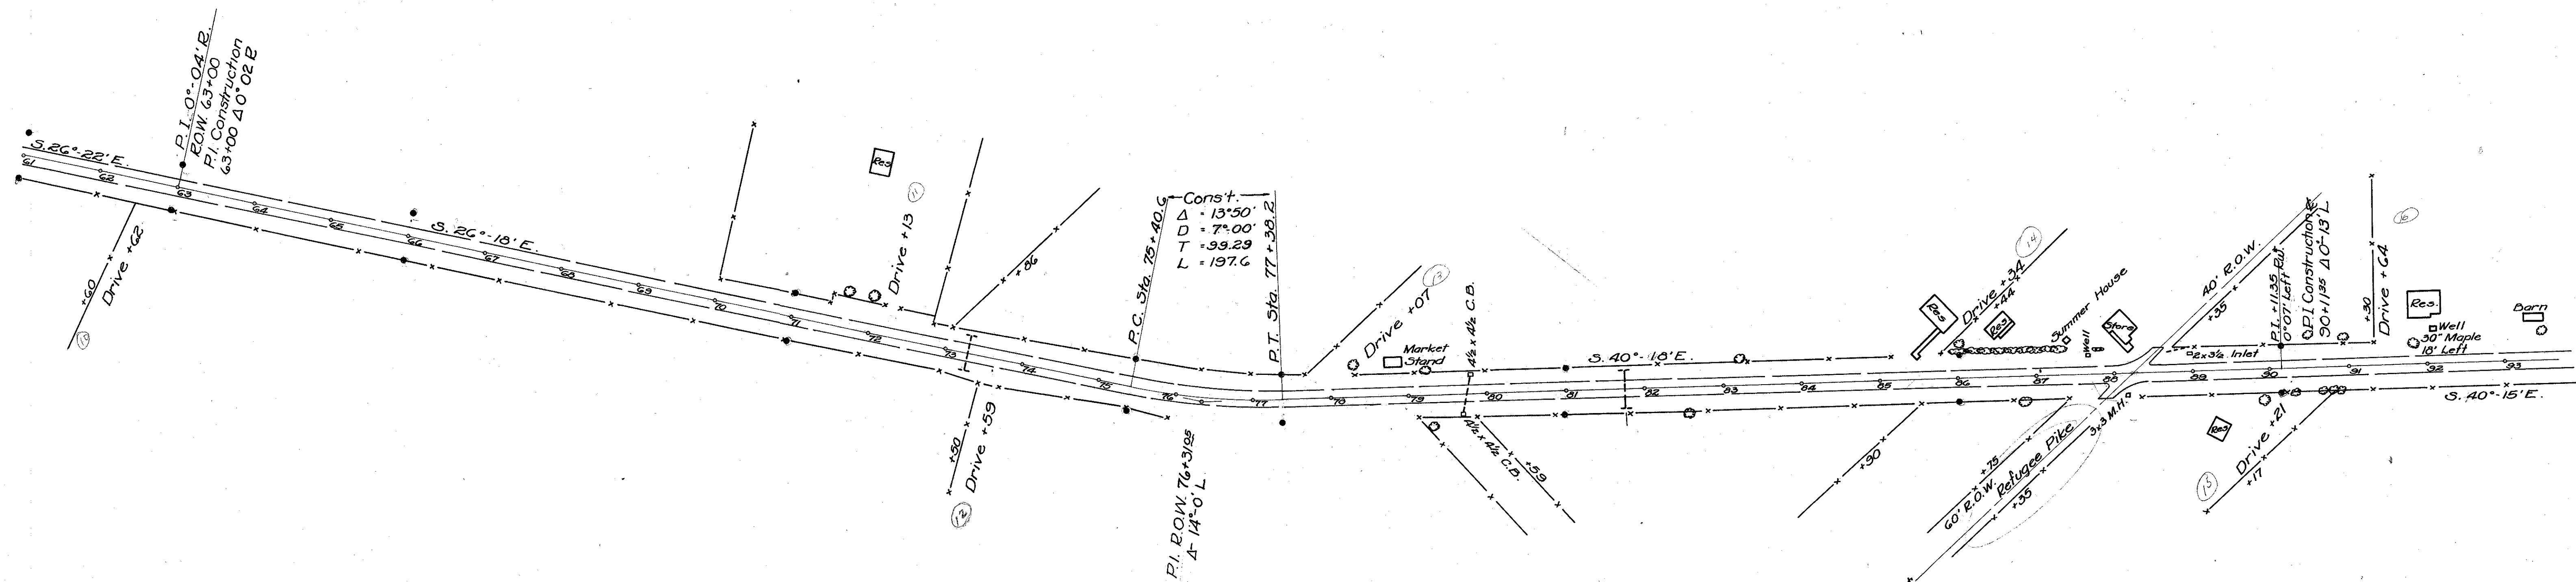

FED. RD. DIST. NO.	STATE	FED. AID PROJECT	FISCAL YEAR
10	OHIO		1932

FRANKLIN COUNTY
S. H. 49 SEC. F. E-1, D-1, D-2

RIGHT-OF-WAY PLANS

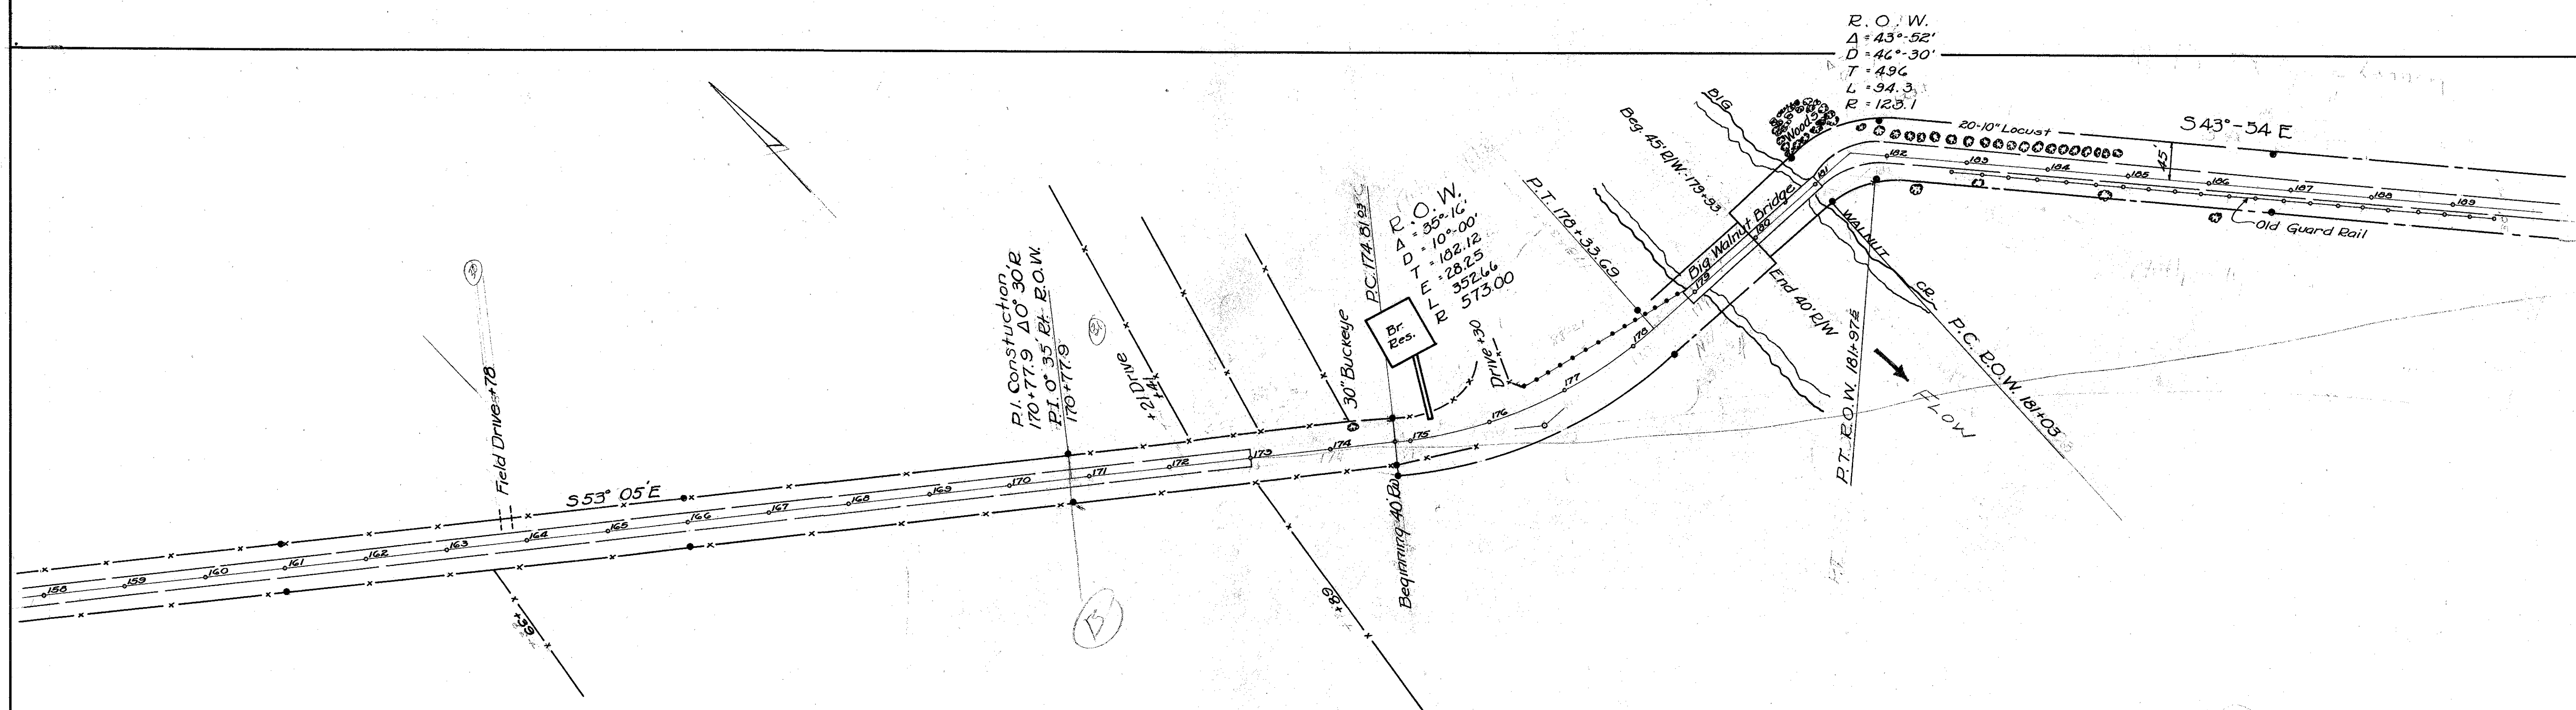
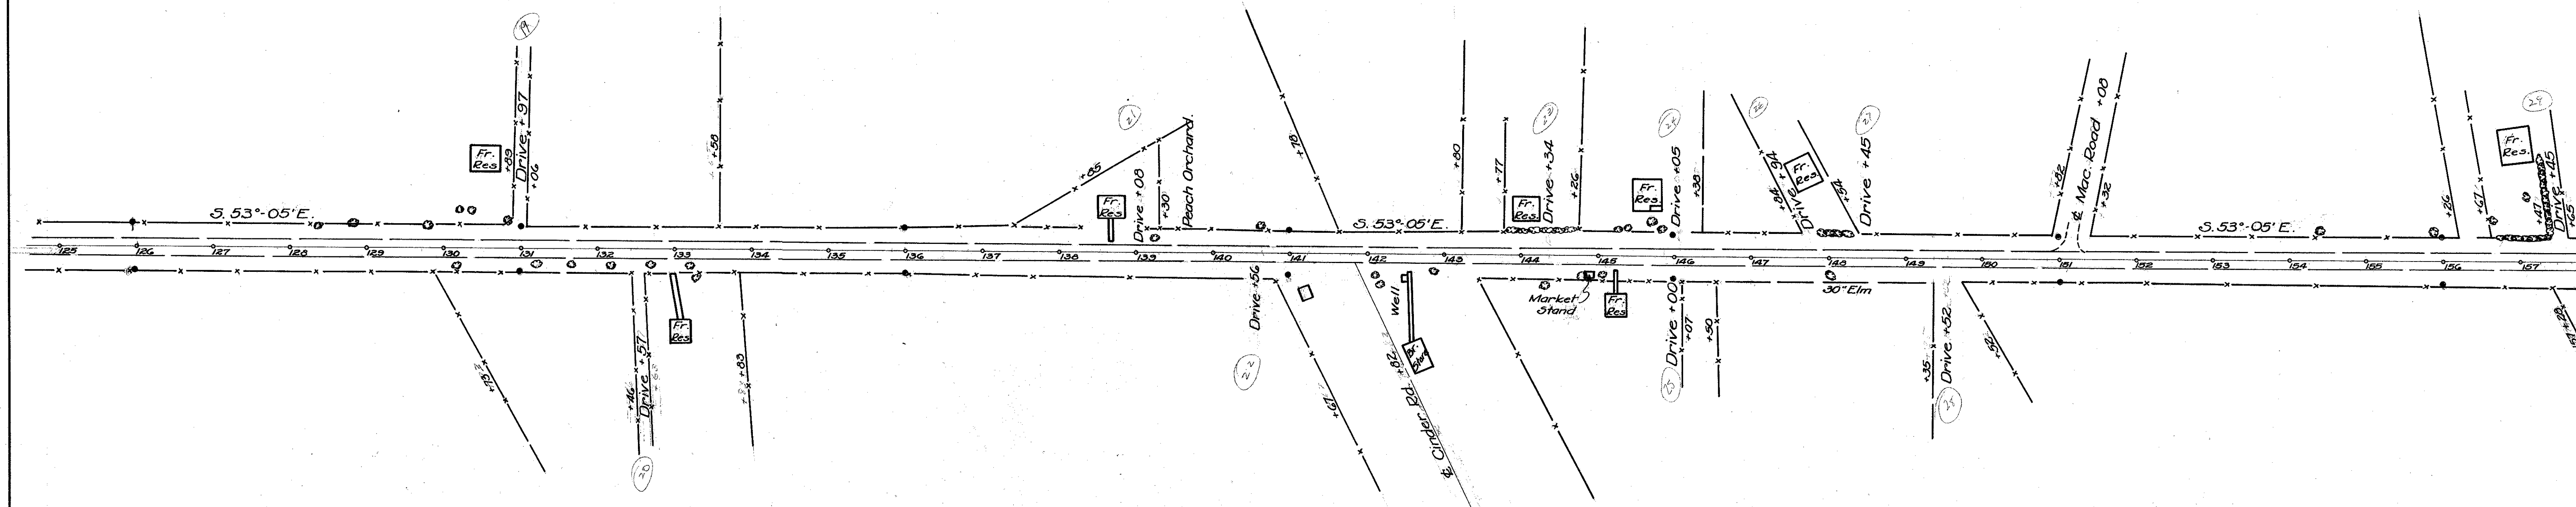


FED. RD. DIST. NO.	STATE	FED. AID PROJECT	FISCAL YEAR
10	OHIO		1932



FRANKLIN COUNTY
S. H. 49 SEC. F, E-1, D-1, D-2

RIGHT OF-WAY PLANS

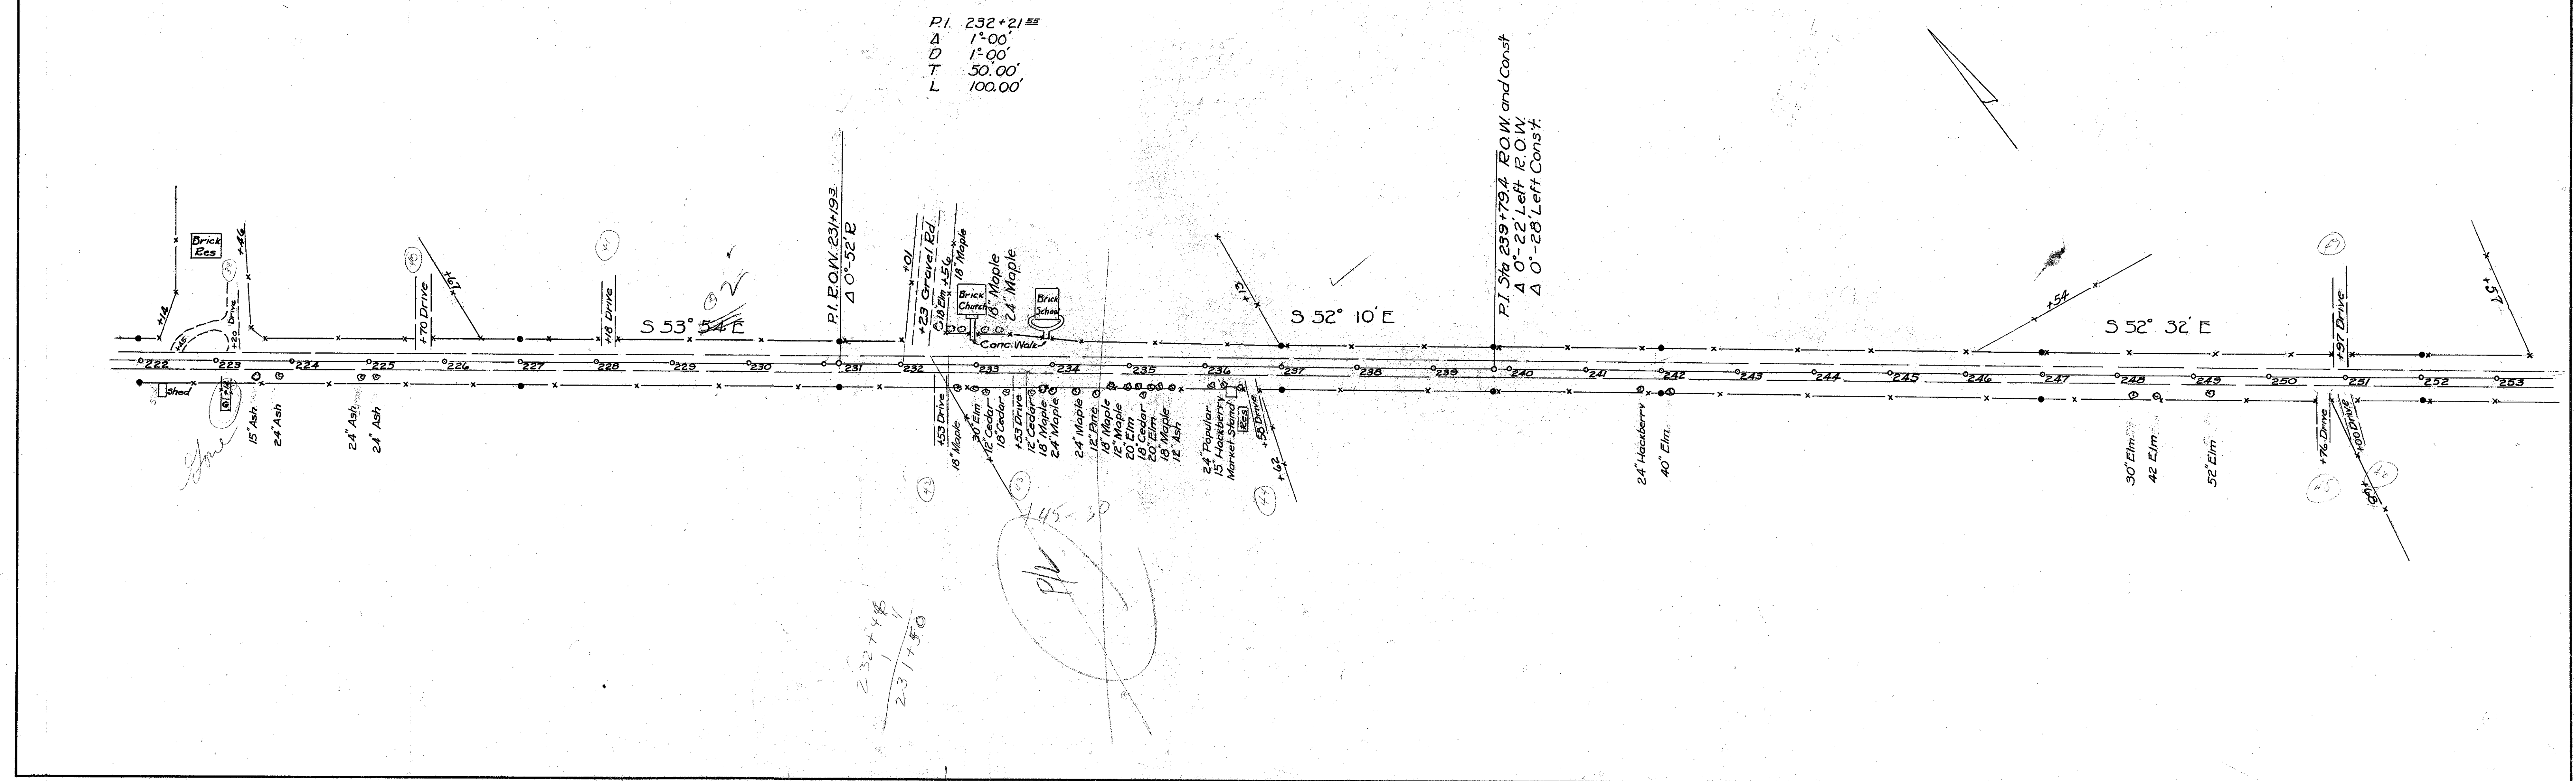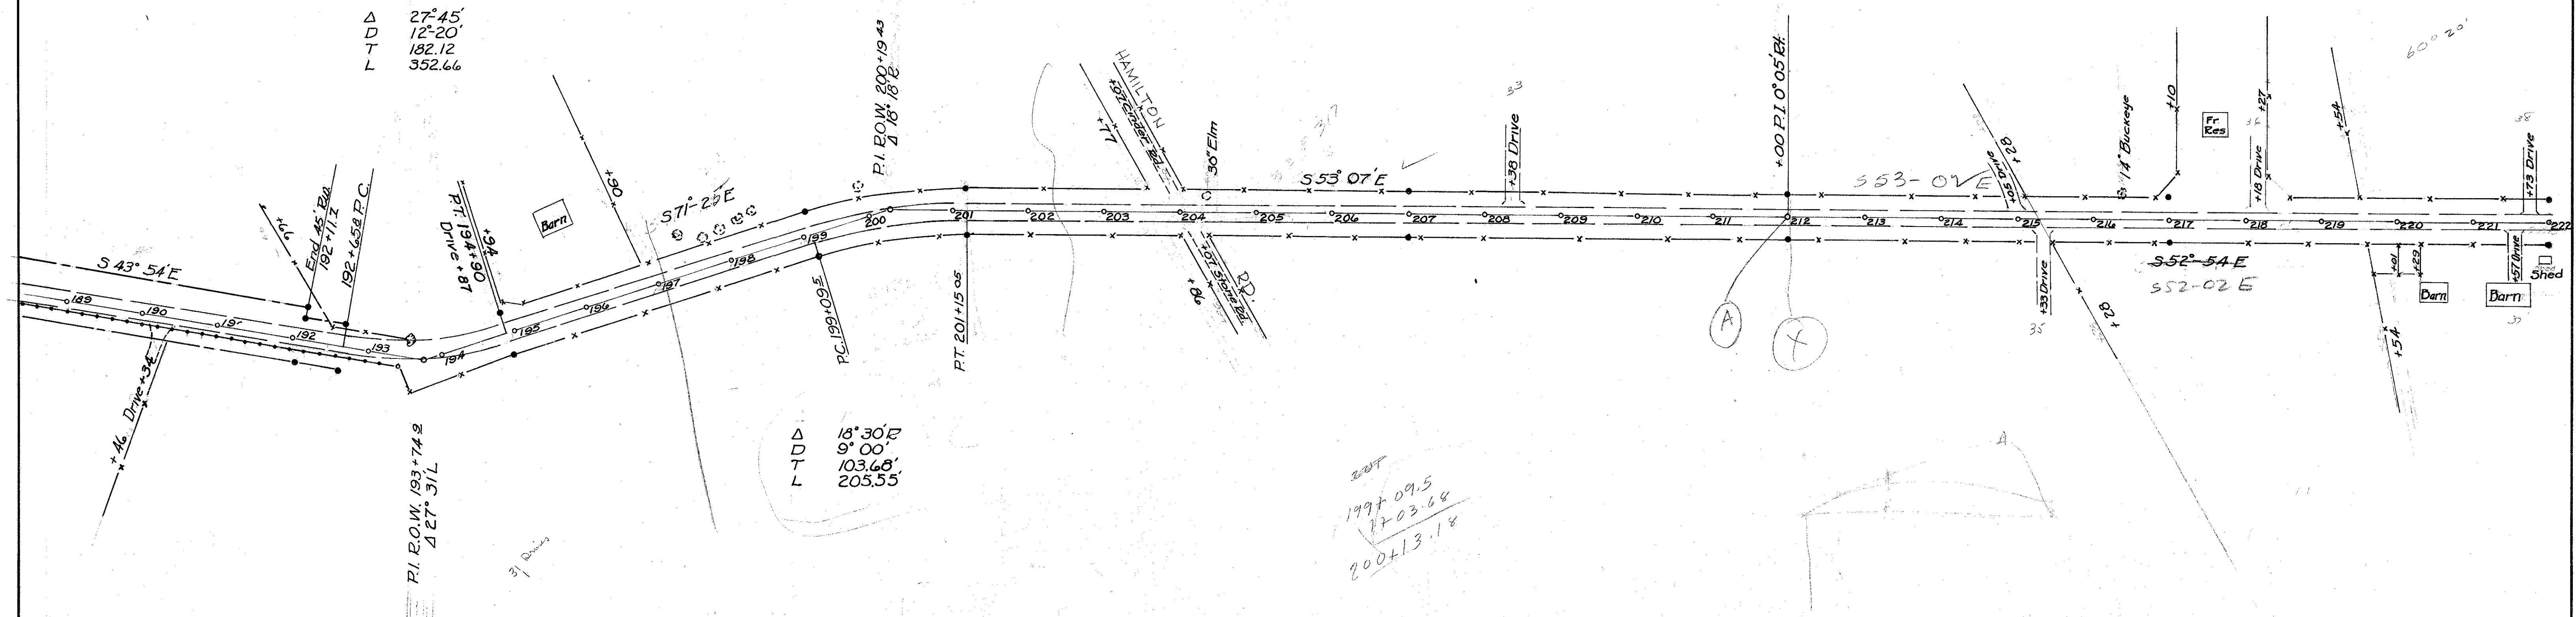

FED. RD. DIST. NO.	STATE	FED. AID PROJECT	FISCAL YEAR	
10	OHIO		1932	6

FRANKLIN COUNTY
S.H. 49 SEC. F, E-1, D-1, D-2
RIGHT-OF-WAY PLANS

