

***MRW-288-0.50 /
FRA-71-17.03R***

INDEX OF SHEETS:

	TITLE SHEET	1	
	GENERAL SUMMARY	2	
MRW-288-0.50			FRA-71-17.03R
GENERAL NOTES	3	GENERAL NOTES	12
MAINTENANCE OF TRAFFIC	4-5	MAINTENANCE OF TRAFFIC	13-15
STRUCTURES OVER 20 FOOT SPAN		STRUCTURES OVER 20 FOOT SPAN	
BRIDGE NO. MRW-288-0050	6-11	BRIDGE NO. FRA-71-17.03	16-20

CURRENT ADT (2024)	2,845
DESIGN YEAR ADT (2044)	3,145
DESIGN HOURLY VOLUME (2044)	345
DIRECTIONAL DISTRIBUTION	50%
TRUCKS (24 HOUR B&C)	11%
DESIGN SPEED	55 MPH
LEGAL SPEED	55 MPH
DESIGN FUNCTIONAL CLASSIFICATION:	RURAL MAJOR COLLECTOR
NHS PROJECT	NO
DESIGN EXCEPTIONS	NONE REQUIRED
ADA DESIGN WAIVERS	NONE REQUIRED

PORTION TO BE IMPROVED	
INTERSTATE HIGHWAY	
FEDERAL ROUTES	
STATE ROUTES	
COUNTY & TOWNSHIP ROADS	
OTHER ROADS	

FRA-71-17.03R

22,217
22,217
1,499
N/A
14%
55 MPH
55 MPH
PRINCIPAL ARTERIAL
INTERSTATE
NO
NONE REQUIRED
NONE REQUIRED

STANDARD CONSTRUCTION DRAWINGS

GSD-1-19 7/19/24	MT-95.40 7/18/25
	MT-98.29 7/18/25
	MT-101.60 1/17/25

[illegible]

THIS PROJECT WILL REPAIR THE EXISTING STEEL BEAM ENDS AND ABUTMENT BEARINGS OF SR-288 STRUCTURE SFN 5902827 OVER FLAT RUN.

PROJECT EARTH DISTURBED AREA:	0.01 ACRES
ESTIMATED CONTRACTOR EARTH DISTURBED AREA:	0.25 ACRES
NOTICE OF INTENT EARTH DISTURBED AREA:	0.26 ACRES, NO NO

THIS PROJECT CONSISTS OF VARIOUS STRUCTURAL STEEL REPAIRS INCLUDING THE DRILLING OF STRESS RELIEF HOLES TO PREVENT THE PROPOGATION OF EXISTING FATIGUE CRACKS, REMOVAL OF EXISTING INTERMEDIATE CROSSFRAMES, AND INSTALLATION OF NEW INTERMEDIATE AND PIER CROSSFRAMES.

PROJECT EARTH DISTURBED AREA:	0.01 ACRES
ESTIMATED CONTRACTOR EARTH DISTURBED AREA:	0.25 ACRES
NOTICE OF INTENT EARTH DISTURBED AREA:	0.26 ACRES, NO NO

NONE

NONE

THIS IMPROVEMENT IS ESPECIALLY DESIGNED FOR THROUGH TRAFFIC AND HAS BEEN DECLARED A LIMITED ACCESS HIGHWAY OR FREEWAY BY ACTION OF THE DIRECTOR IN ACCORDANCE WITH THE PROVISIONS OF SECTION 5511.02 OF THE OHIO REVISED CODE.

THE STANDARD SPECIFICATIONS OF THE STATE OF OHIO, DEPARTMENT OF
TRANSPORTATION, INCLUDING SUPPLEMENTAL SPECIFICATIONS LISTED IN
THE PLANS, CHANGES LISTED IN THE PROPOSAL, AND THE SUPPLEMENTAL
SPECIFICATION 800 VERSION INDICATED ON THE PROPOSAL SHALL GOVERN
THIS IMPROVEMENT.

I HEREBY APPROVE THESE PLANS AND DECLARE THAT THE MAKING OF THIS IMPROVEMENT WILL REQUIRE THE PART TIME CLOSING OF THE HIGHWAY TO TRAFFIC, AS NOTED ON SHEET 5. DURING WHICH TIME DETOURS WILL BE PROVIDED AS SHOWN HEREIN. PROVISIONS FOR THE MAINTENANCE AND SAFETY OF TRAFFIC WILL BE AS SET FORTH ON THE PLANS AND ESTIMATES.



Anthony C Turowski

Anthony Turowski, P.E.
District 6 Deputy Director


Pamela Boratyn
Director, Department of Transportation

ENGINEER'S SEAL
MAINTENANCE OF TRAFFIC



ENGINEER'S SEAL

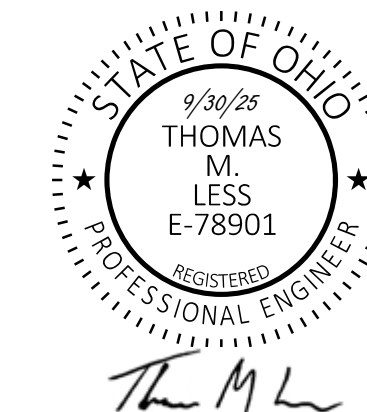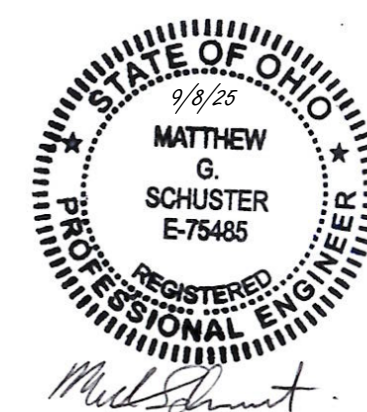

The map shows Morrow County, Ohio, with its county boundaries and major roads. A black arrow points to the project location, which is situated near the intersection of Ohio State Route 61 and Ohio State Route 19. The map also shows the town of Washington and the town of Saint James. The Gallion Reservoir is located to the north of the project location. The map includes a grid of townships and ranges, with labels such as T-33, T-31, T-35, T-49, R-10, R-11, R-12, R-99, R-100. The map also shows the townships of Winchester, Sostale, Iberia, and Bettis. The map includes a scale bar and a north arrow.

MRW-288-0.50 LOCATION MAP

LATITUDE: N40°40'49" LONGITUDE: W82°48'45"

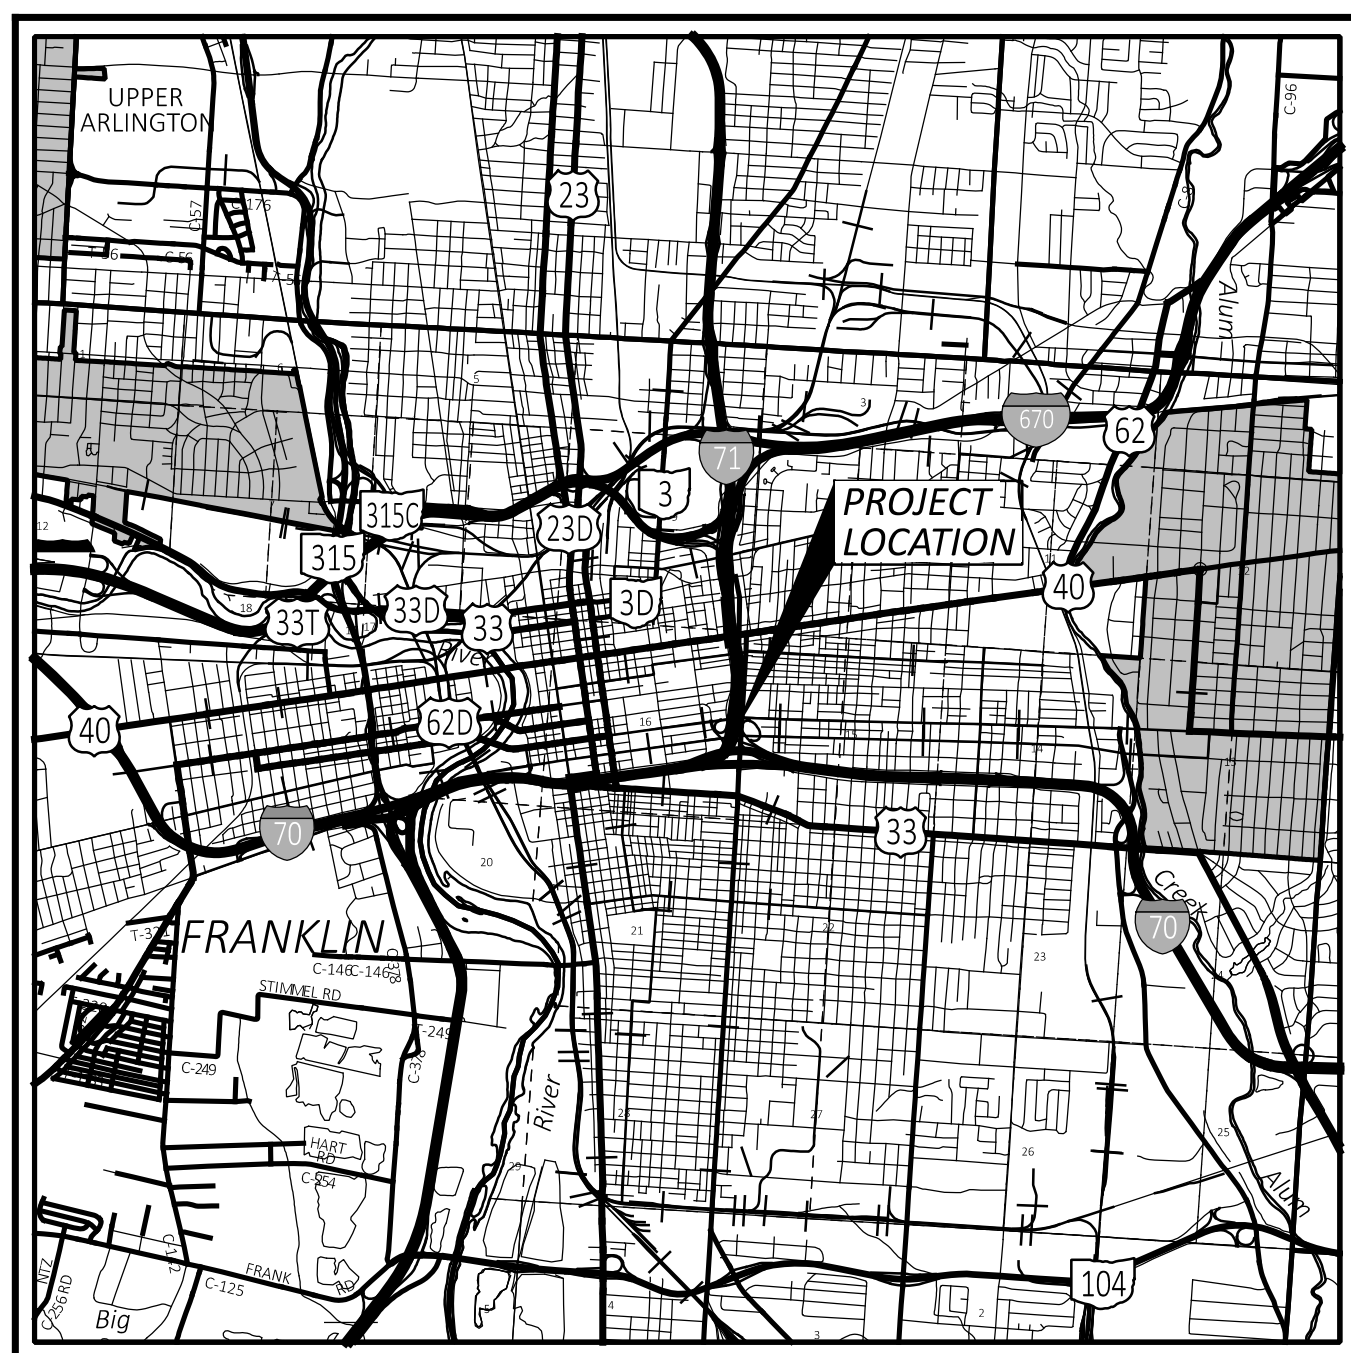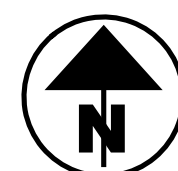

FRA-71-17.03R LOCATION MAP

LATITUDE: N39°57'25" LONGITUDE: W82°58'58"



UNDERGROUND UTILITIES
Contact Two Working Days Before You Dig
 OHIO811.org Before You Dig
OHIO811, 8-1-1, or 1-800-362-2764 (Non members must be called directly)

PLAN PREPARED BY:



MRW-288-00.50

MODEL: Sheet PAPER SIZE: 34x22 (in.) DATE: 10/23/2025 TIME: 3:44:04 PM USER: Less
G:\GIDE\Clients\ODOT\10023855_MRW-288-0.50_ODOT_D6_D9_GES_Task_6S\110058400-Engineering\Roadway\Sheets\110058_GG001.dgn

[illegible]

GENERAL SUMMARY

DESIGN AGENCY



DESIGNER

ICB

REVIEWER

TMI 06-

PROJECT ID:

122844

125044

SHEET 1 TOTAL

2