


# SCHEMATIC PLAN

F.H.A. REGION	STATE	PROJECT
5	OHIO	

FRA-270-52.16

FRA-270-(438)101
BEGIN PROJECT
STA. = 530+00
SLM. = 52.16

BEGIN WORK
STA. = 532+25
SLM. = 52.12

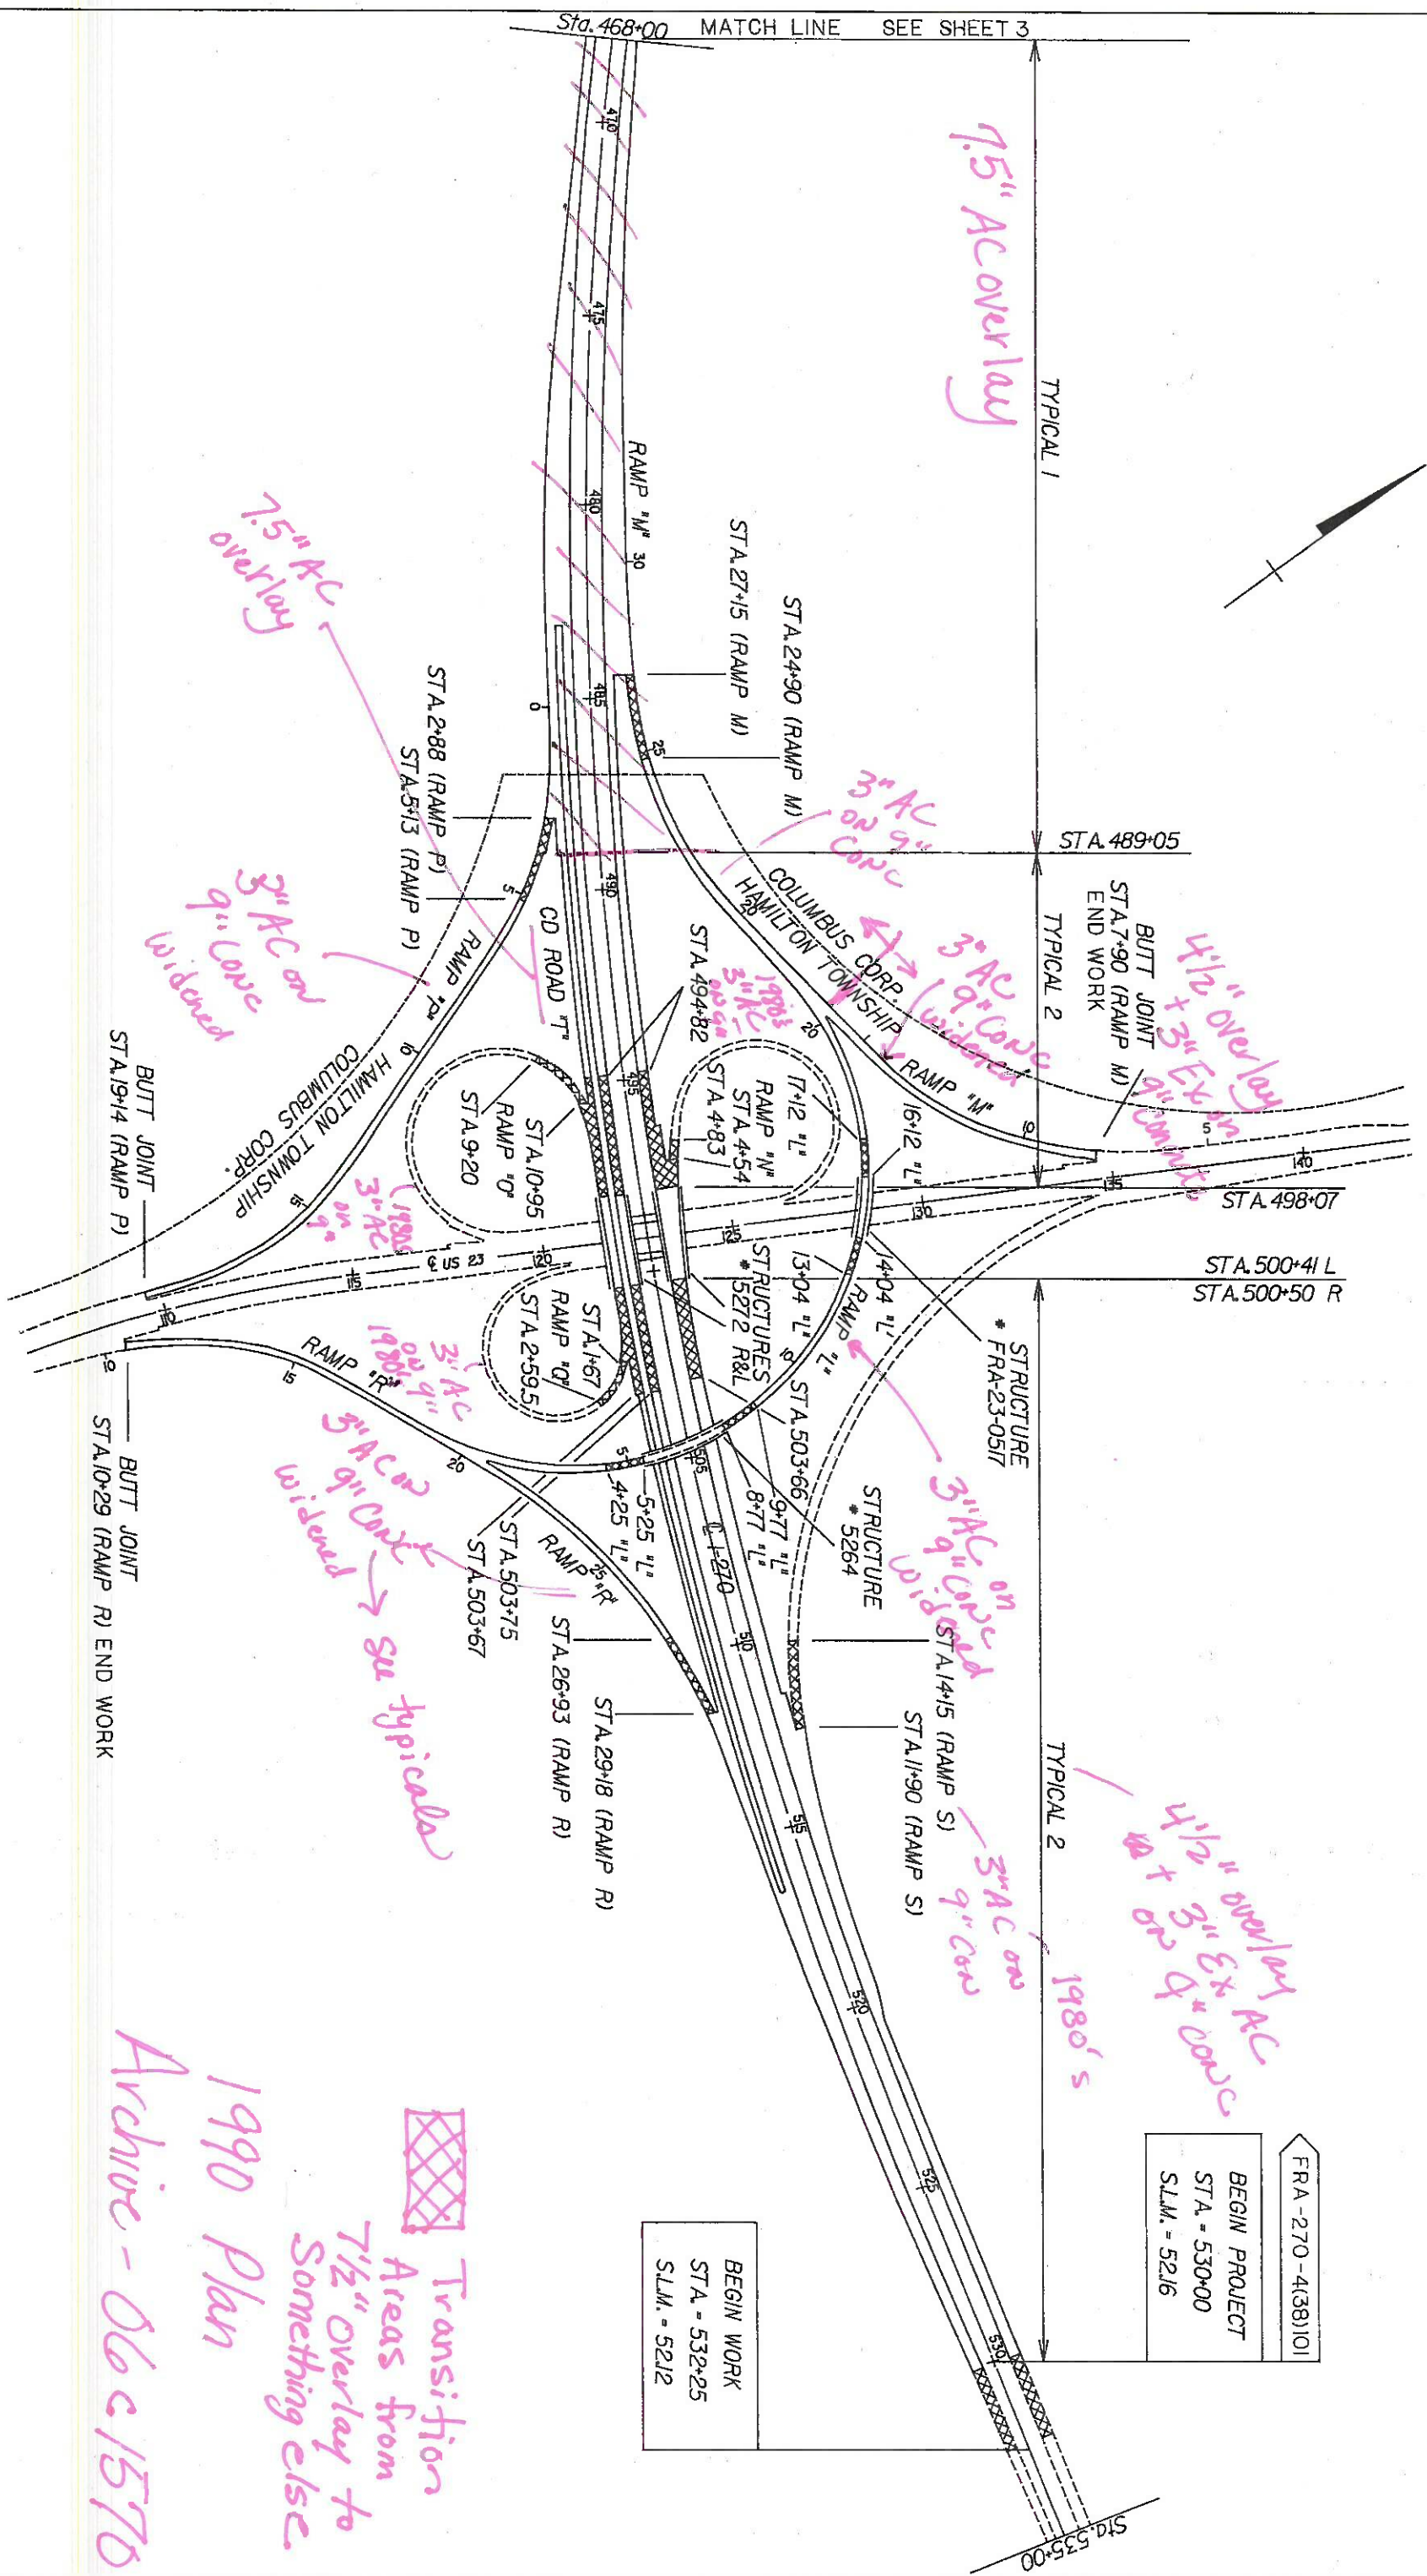

Transition Areas from 7 1/2" Overlay to Something else  
 1990 Plan  
 Archive - Dec 1575

IR-270 STA. 468+00 TO STA. 535+00