

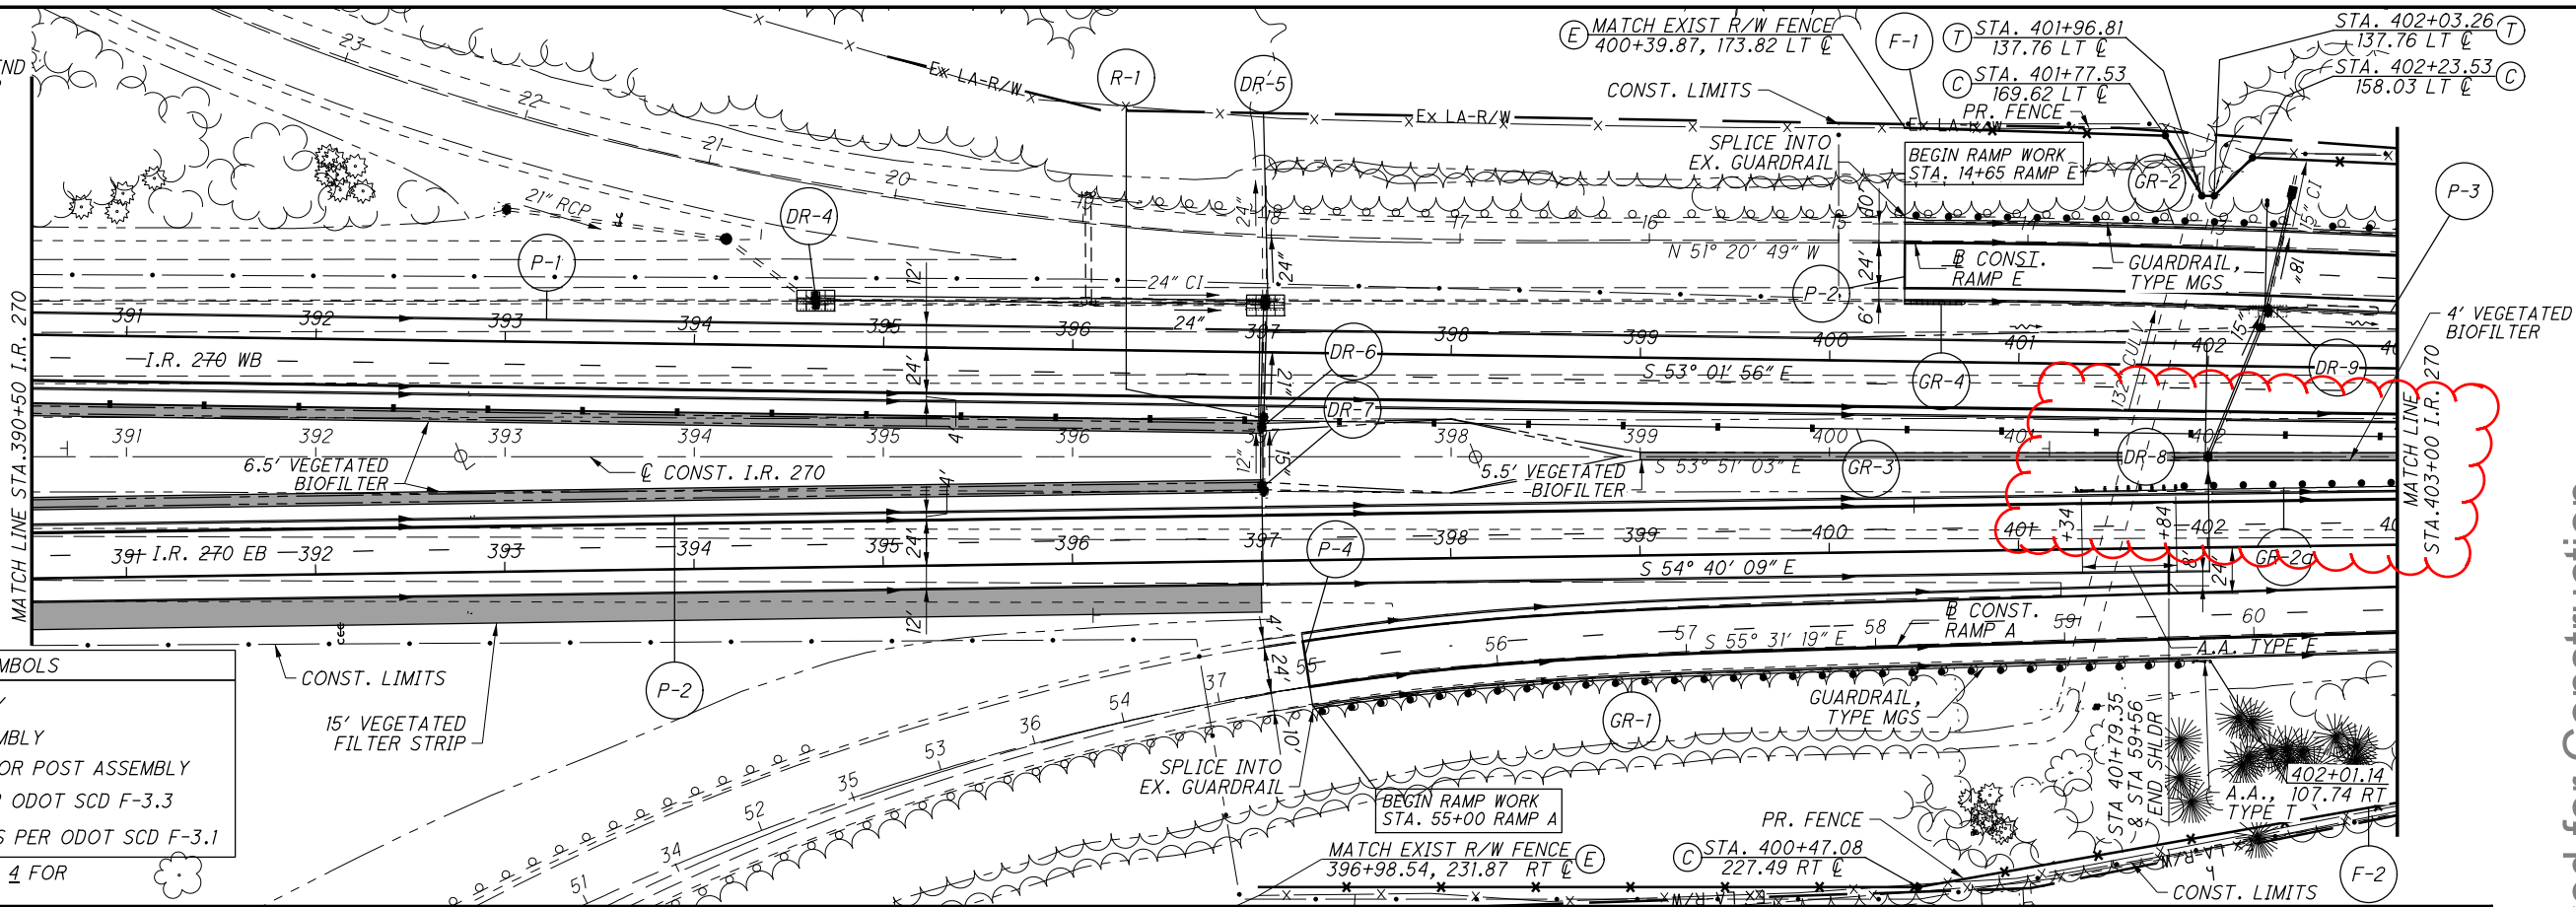
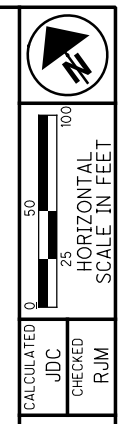


F:\FRA\92610\roadway\sheet\92610GP002.dgn 12/10/2014 1:17:37 PM bshepherd

NOTES:  
 1. SEE SHEET 20 FOR LEGEND  
 2. SEE SHEET 77 - 87 FOR UNDERDRAIN DETAILS

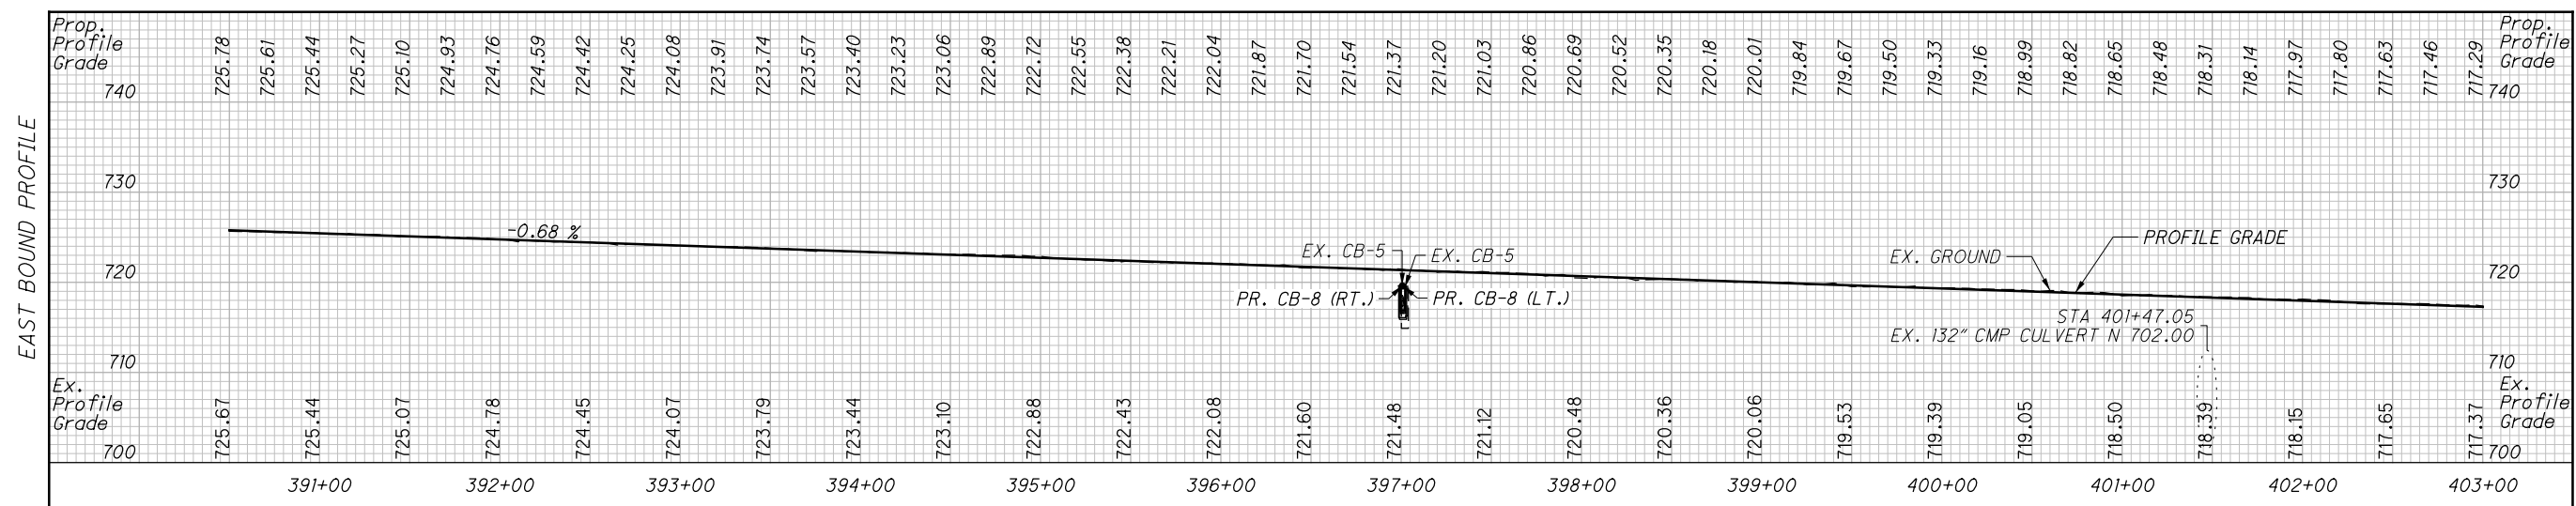

- R/W FENCE SYMBOLS
- (E) END POST ASSEMBLY
  - (C) CORNER POST ASSEMBLY
  - (I) INTERMEDIATE ANCHOR POST ASSEMBLY
  - (T) TERMINAL POST PER ODOT SCD F-3.3
  - (B) DETAILS AT BRIDGES PER ODOT SCD F-3.1
- SEE SHEETS 3 & 4 FOR CURVE DATA

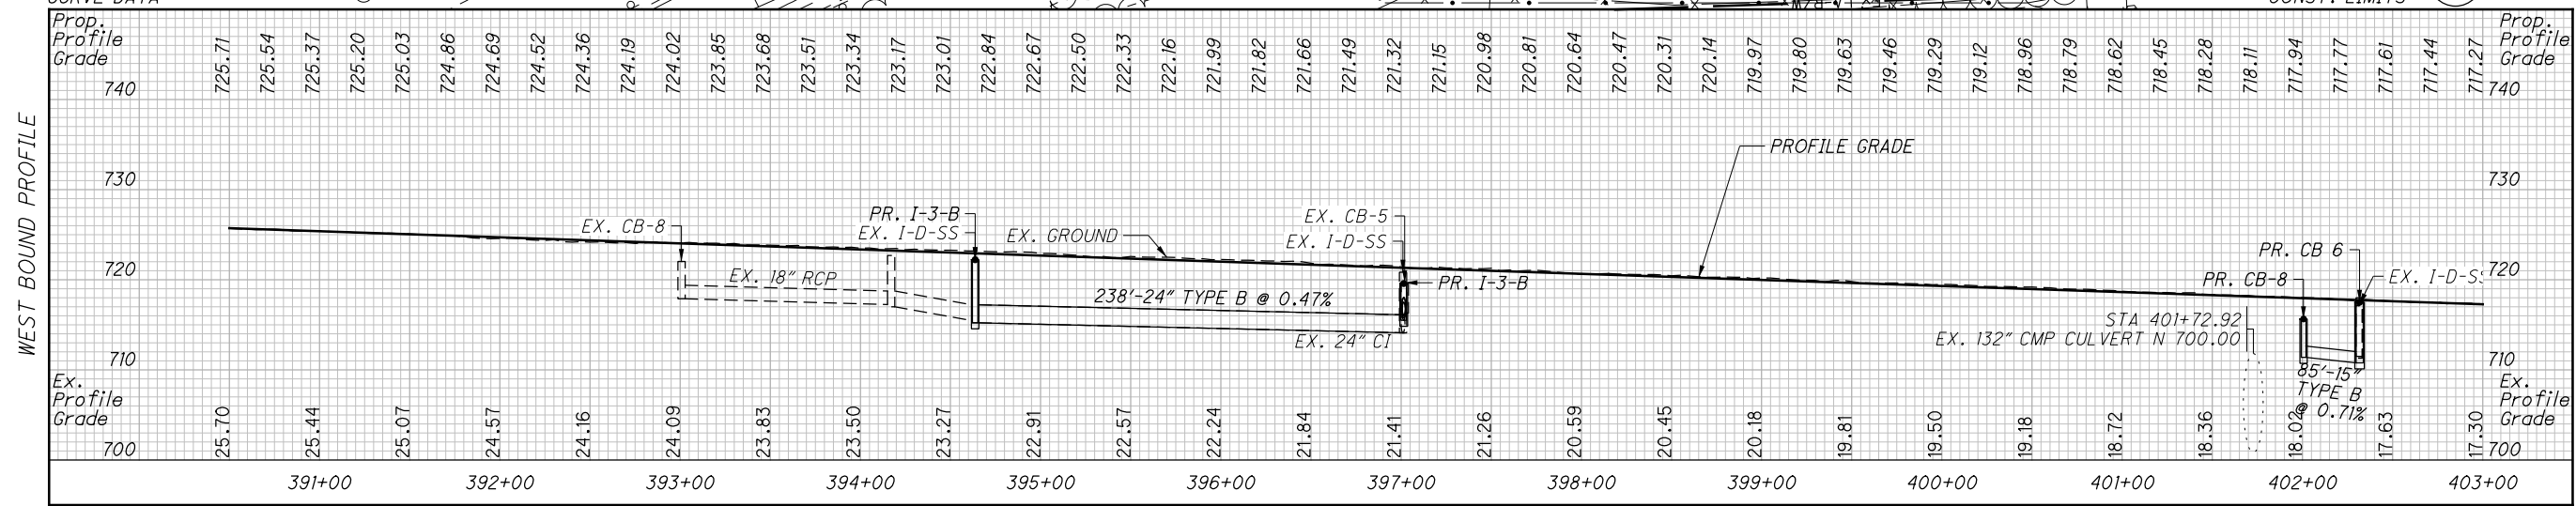


S-006-7 Revision 2 Approved for Construction

PLAN AND PROFILE

STA. 390+50 TO STA. 403+00

FRA-270-52.72

SEE SHEETS 77 - 87 FOR UNDERDRAIN LOCATIONS AND DETAILS

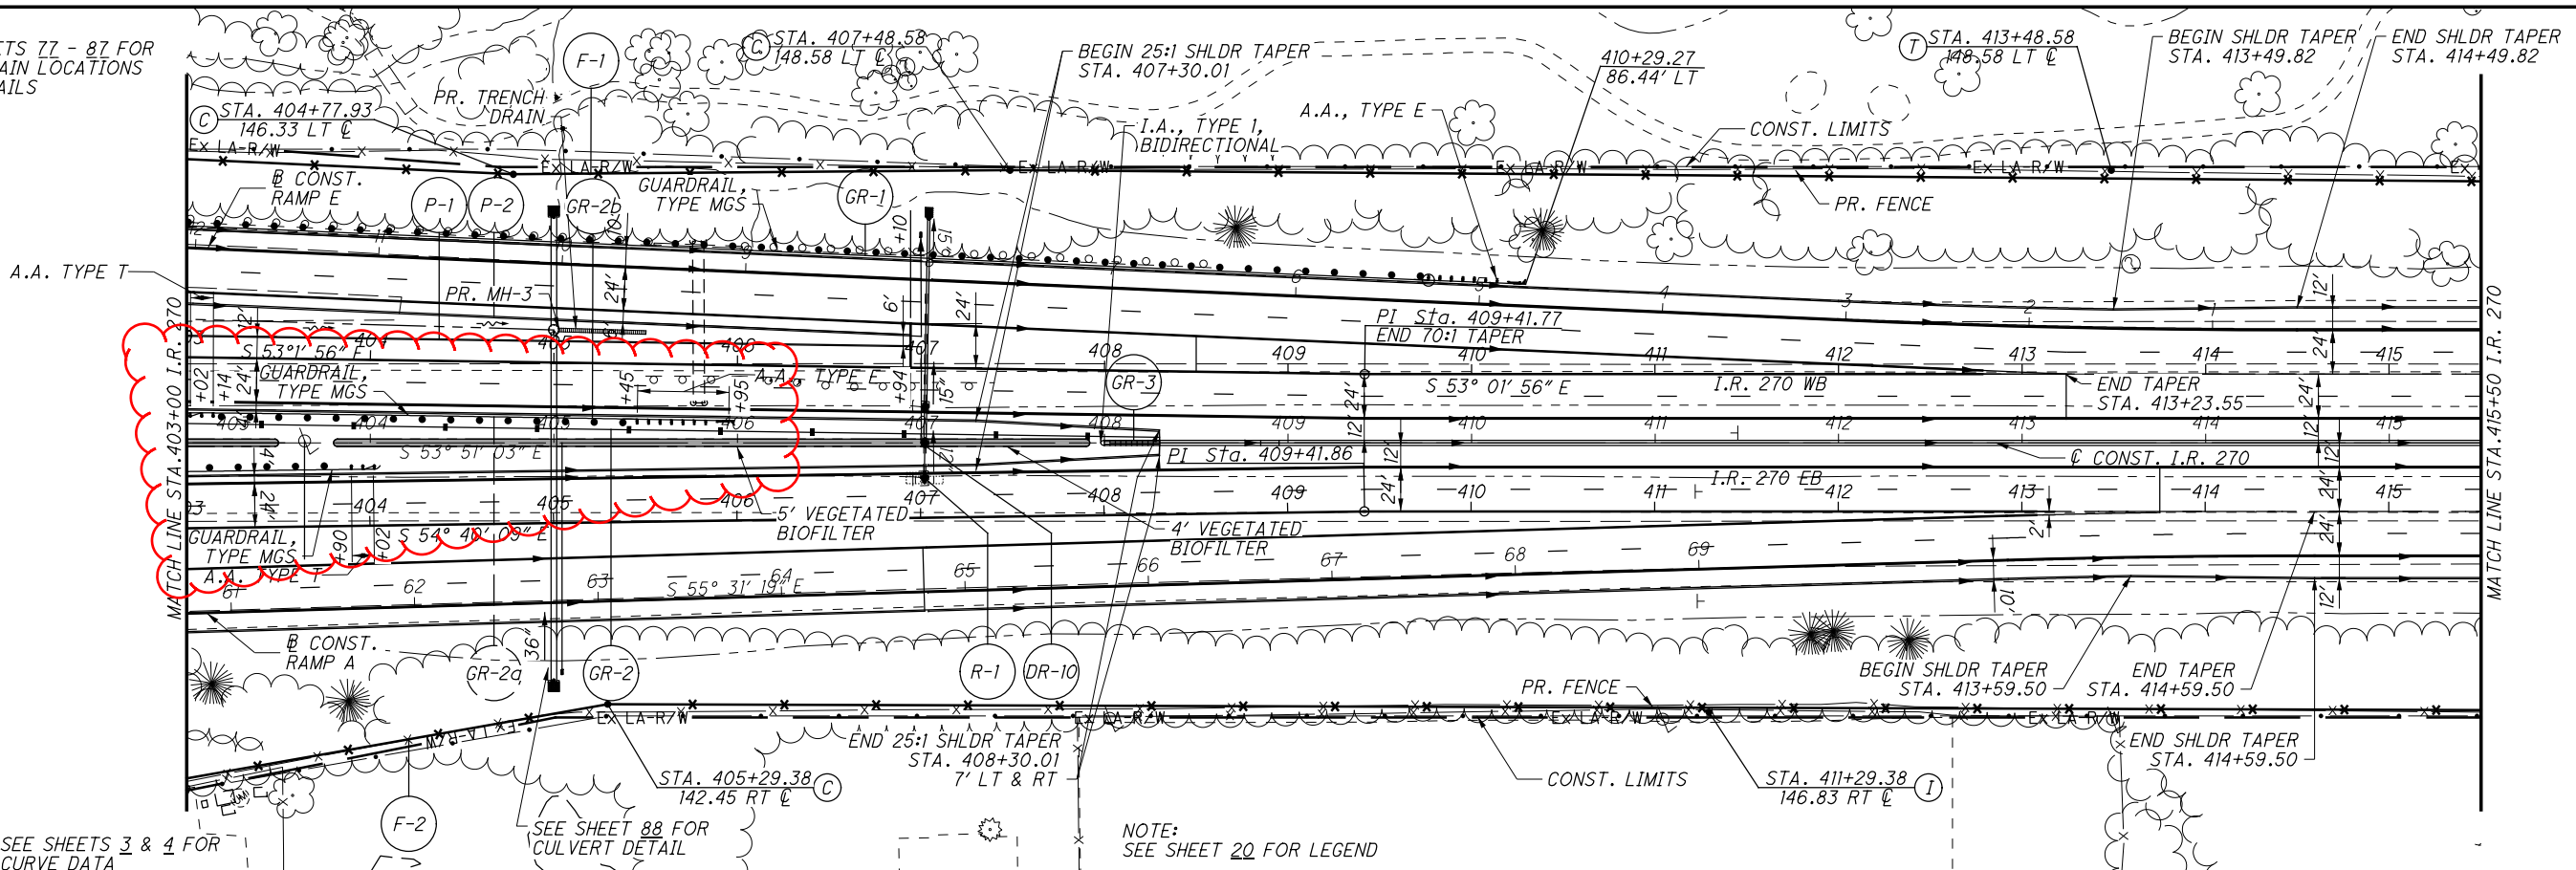


SEE SHEETS 3 & 4 FOR CURVE DATA



SEE SHEET 88 FOR CULVERT DETAIL

NOTE: SEE SHEET 2Q FOR LEGEND

WEST BOUND PROFILE

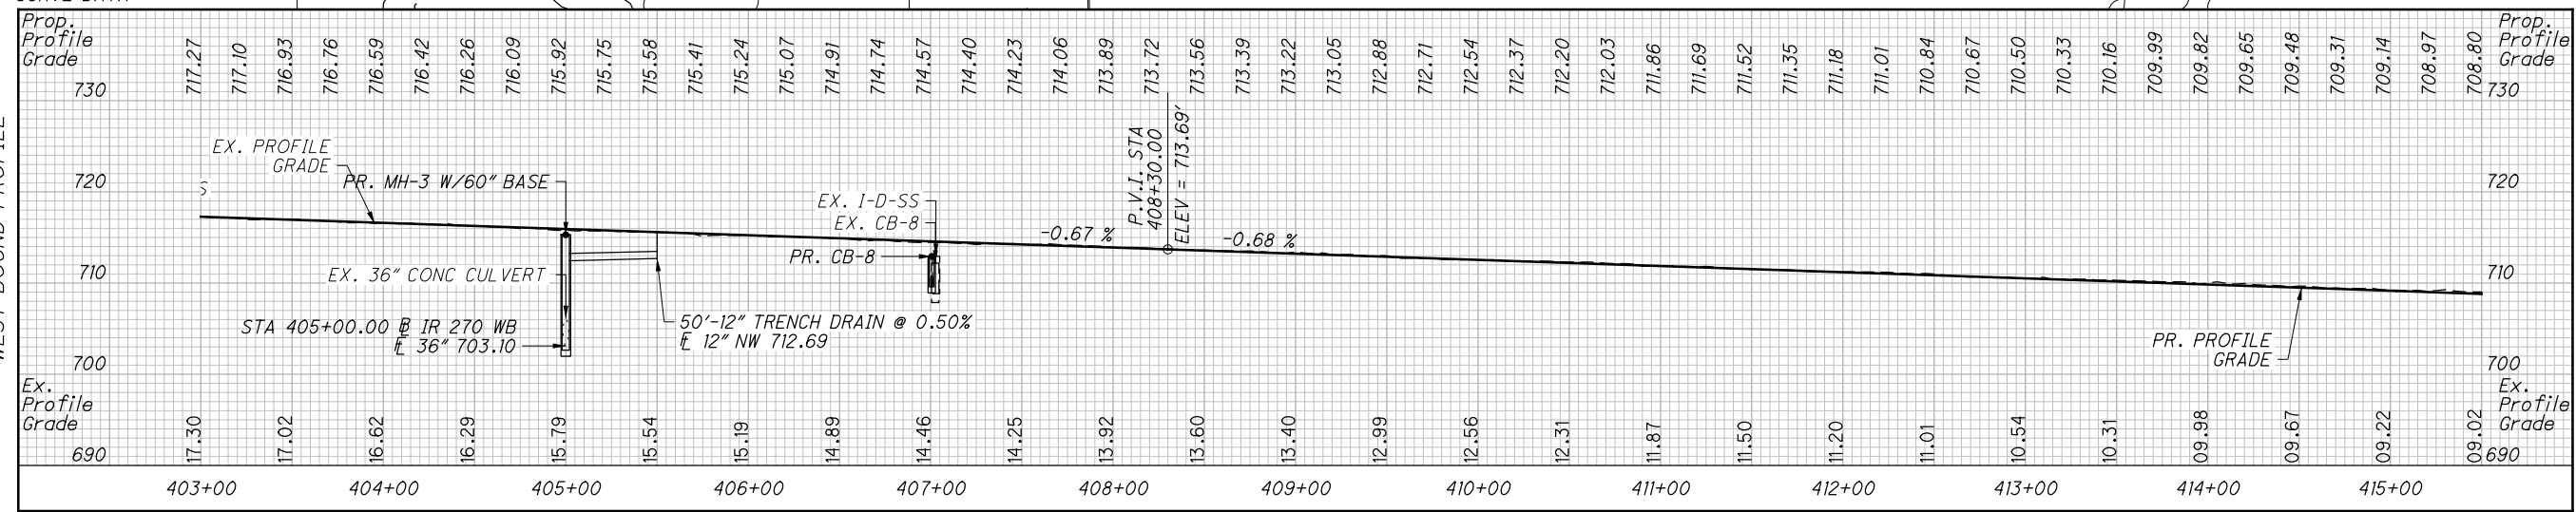

EAST BOUND PROFILE

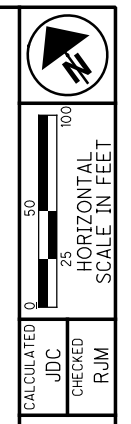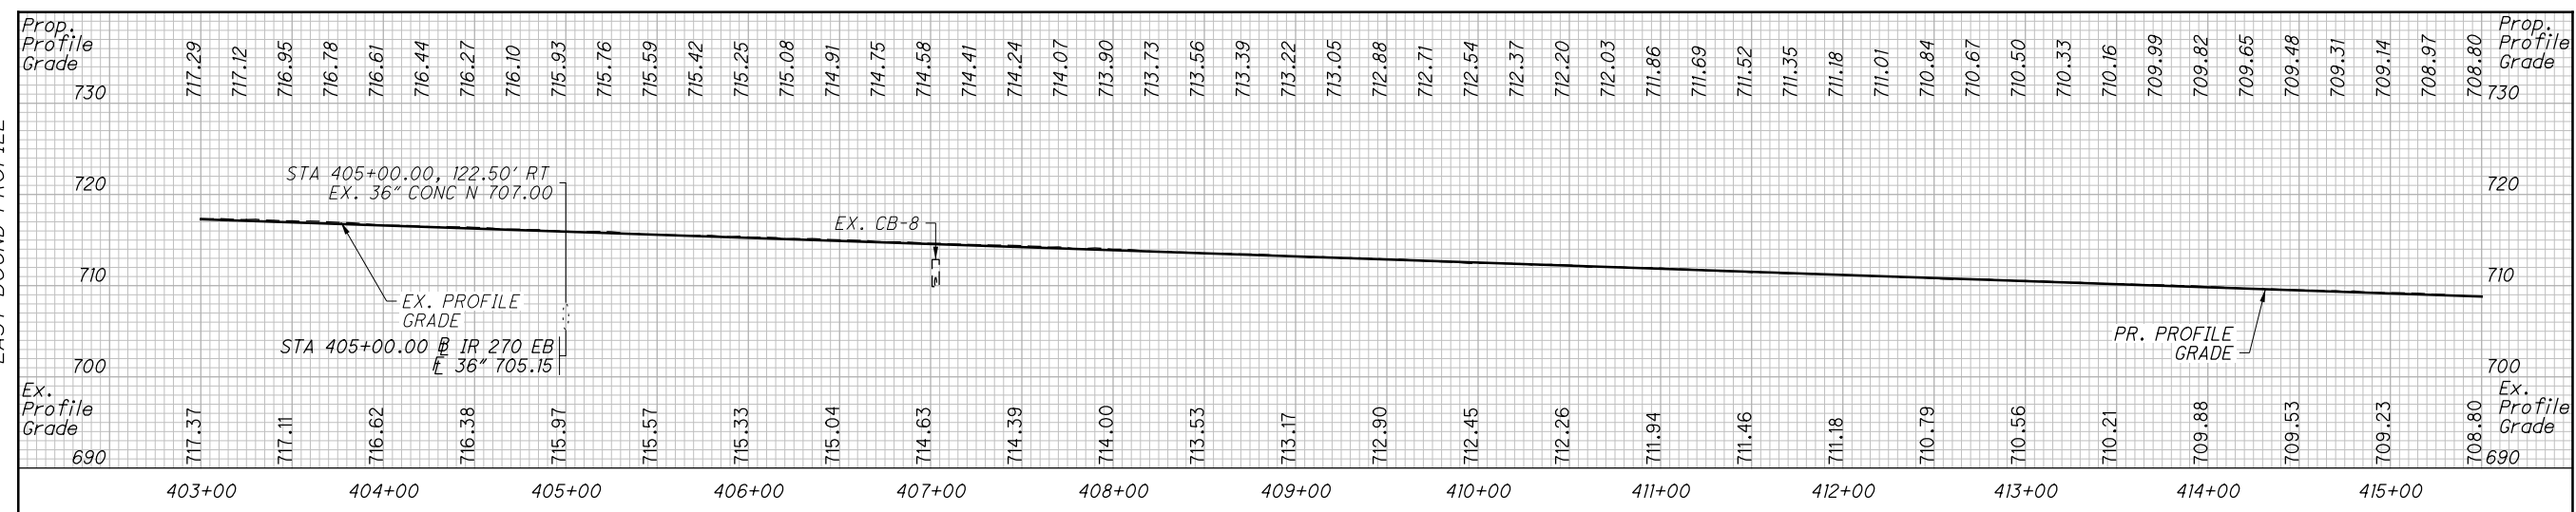

S-006-7 Revision 2 Approved for Construction  
**PLAN AND PROFILE**  
**STA. 403+00 TO STA. 415+50**

FRA-270-52.72  
 22  
 114