


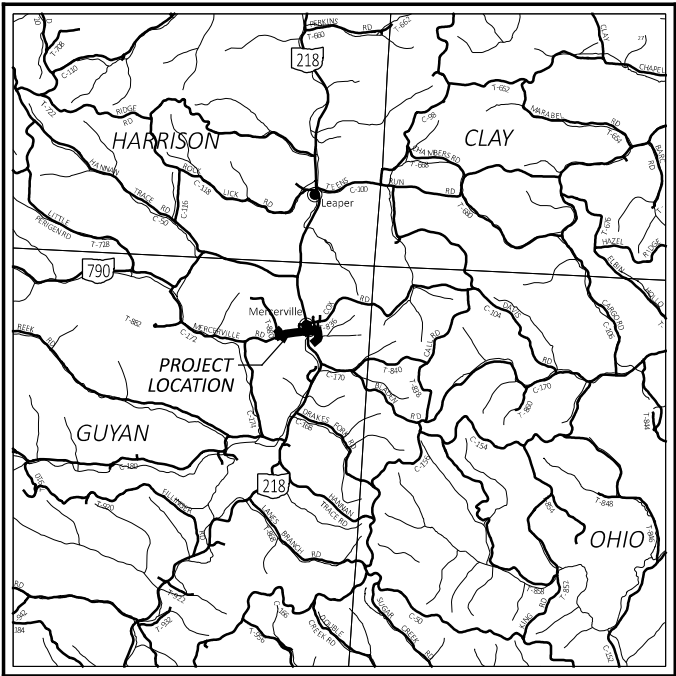

LOCATION MAP

LATITUDE: 38°39'41" LONGITUDE: 82°16'14"



PORTION TO BE IMPROVED	=====
INTERSTATE HIGHWAY	=====
FEDERAL ROUTES	=====
STATE ROUTES	=====
COUNTY & TOWNSHIP ROADS	=====
OTHER ROADS	=====

DESIGN DESIGNATION

CURRENT ADT (2023)	35
DESIGN YEAR ADT (2025)	N/A
DESIGN HOURLY VOLUME (20)	N/A
DIRECTIONAL DISTRIBUTION	N/A
TRUCKS (24 HOUR B&C)	N/A
DESIGN SPEED	45
LEGAL SPEED	45
DESIGN FUNCTIONAL CLASSIFICATION:	
07 LOCAL ROAD	
NHS PROJECT	NO

DESIGN EXCEPTIONS

ADA DESIGN WAIVERS

UNDERGROUND UTILITIES


Contact Two Working Days
Before You Dig


Before You Dig

OHIO811, 8-1-1, or 1-800-362-2764
(Non members must be called directly)

PLAN PREPARED BY:


ARCHITECTURE • ENGINEERING • PLANNING
SURVEYING • CONSTRUCTION SERVICES
6121 HUNTLEY RD
COLUMBUS, OH 43229
(614) 888-0040

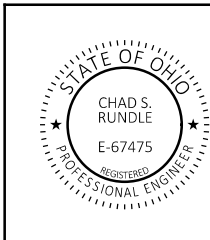

INDEX OF SHEETS:

TITLE SHEET	1
TYPICAL SECTIONS	2
GENERAL NOTES	3-4
MOT NOTES	4A
GENERAL SUMMARY	5-6
ROADWAY SUB-SUMMARY	7-8
PROJECT SITE PLAN	9
PLAN AND PROFILE	10 - 17
CROSS SECTIONS	18 - 41
INTERSECTION DETAILS	42 - 43
CULVERT DETAIL	44
DRAINAGE PROFILES	45
TRAFFIC CONTROL SUBSUMMARY	46 - 47
TRAFFIC CONTROL PLAN	48 - 51

Addendum #1
02/17/2026

STANDARD CONSTRUCTION DRAWINGS						SUPPLEMENTAL SPECIFICATIONS	SPECIAL PROVISIONS
BP-4.1	7/19/13	HW-2.2	7/20/18			800-2023 7/18/25	WATERWAY PERMIT 8/5/25
BP-5.1	7/18/25					832 7/18/25	
BP-7.1	7/18/25	HL-20.11	7/18/25				
		HL-60.11	7/21/17				
CB-2-2A, 2B, 2C	7/19/24						
CB-2-3, 2-4	7/19/24	TC-41.20	10/18/13				
CB-6	7/19/24	TC-41.30	4/21/23				
		TC-41.50	10/18/13				
DM-1.1	1/17/25	TC-42.20	10/18/13				
		TC-52.10	10/18/13				
MH-3	7/19/24	TC-52.20	1/15/21				
		TC-74.10	7/21/23				
RM-5.1	7/18/14	TC-87.10	7/18/25				
RM-5.2	7/21/23						
		MT-97.10	1/16/26				
HW-2.1	7/15/22	MT-103.20	1/16/26				

Addendum #1
02/17/2026

FEDERAL PROJECT NUMBER

E240981

RAILROAD INVOLVEMENT

NONE

PROJECT DESCRIPTION

CONSTRUCTION OF A SHARED USE PATH FROM SOUTH GALLIA HIGH SCHOOL TO HANNAH TRACE ELEMENTARY. PROPOSED PATH WILL FOLLOW THE ALIGNMENTS OF OLD HANNAH TRACE ROAD, MERCERVILLE ROAD, CROSS S.R. 218, THEN USE THE PAVEMENT OF STATION STREET BEFORE FOLLOWING A NEW ALIGNMENT TO THE SOUTH AND CROSSING A STREAM BY CULVERT TO END AT HANNAH TRACE ELEMENTARY.

EARTH DISTURBED AREAS

PROJECT EARTH DISTURBED AREA:	1.33 ACRES
ESTIMATED CONTRACTOR EARTH DISTURBED AREA:	0.25 ACRES
NOTICE OF INTENT EARTH DISTURBED AREA:	1.58 ACRES

2023 SPECIFICATIONS

THE STANDARD SPECIFICATIONS OF THE STATE OF OHIO, DEPARTMENT OF TRANSPORTATION, INCLUDING SUPPLEMENTAL SPECIFICATIONS LISTED IN THE PLANS, CHANGES LISTED IN THE PROPOSAL, AND THE SUPPLEMENTAL SPECIFICATION 800 VERSION INDICATED ON THE PROPOSAL SHALL GOVERN THIS IMPROVEMENT.

DESIGN AGENCY



DESIGNER

EMH

REVIEWER


CSR 04/24/25


PROJECT ID


120712

SHEET TOTAL


1 51

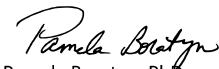
Pamela Boratyn, PhD
Director, Department of Transportation

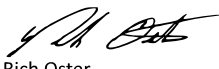

Rich Oster
District 10 Deputy Director

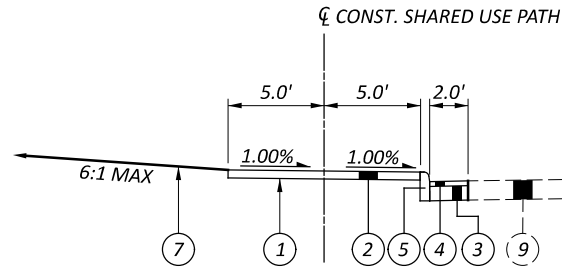


SHARED USE PATH - NORMAL SECTION
STA. 10+45.84 TO STA. 12+92.74

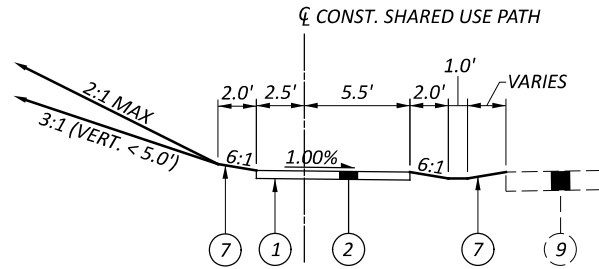


SHARED USE PATH - NORMAL SECTION
STA. 100+26.20 TO STA 108+15.00

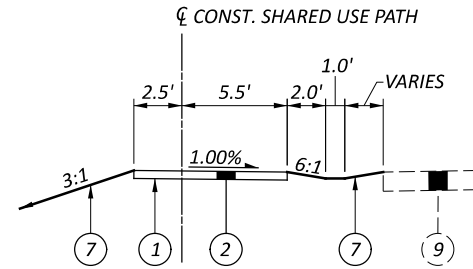


SHARED USE PATH - NORMAL SECTION
STA 109+20.00 TO STA 111+51.22

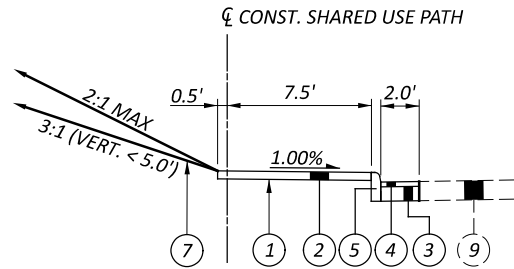


SHARED USE PATH - NORMAL SECTION
STA. 111+94.00 TO STA. 113+13.00

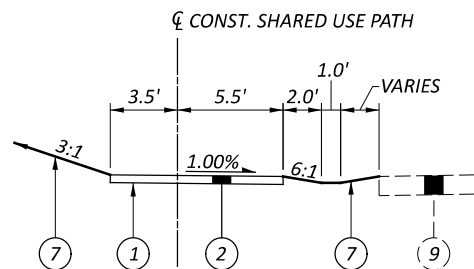


SHARED USE PATH - NORMAL SECTION
STA 113+65.00 TO STA 115+13.00

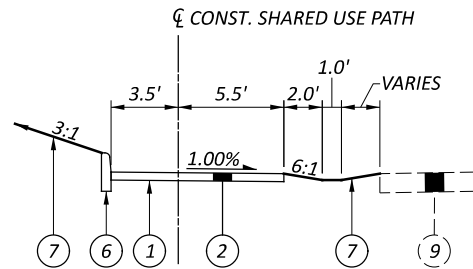


SHARED USE PATH - NORMAL SECTION
STA 113+25.00 TO STA 113+65.00
STA 114+35.00 TO STA 115+13.00

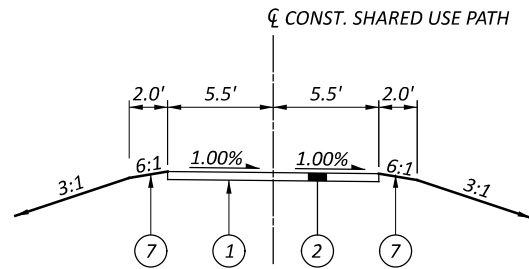


SHARED USE PATH - NORMAL SECTION
STA 300+90.00 TO STA 301+00.00

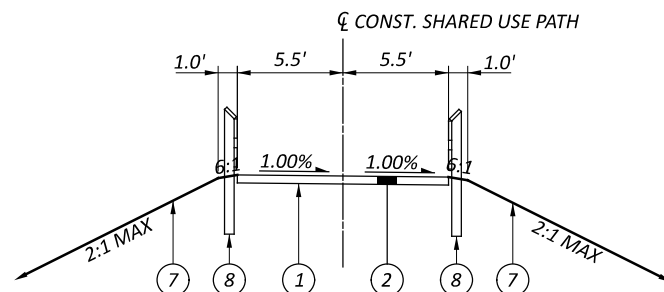

SHARED USE PATH - NORMAL SECTION
STA 301+00.00 TO STA 302+50.00

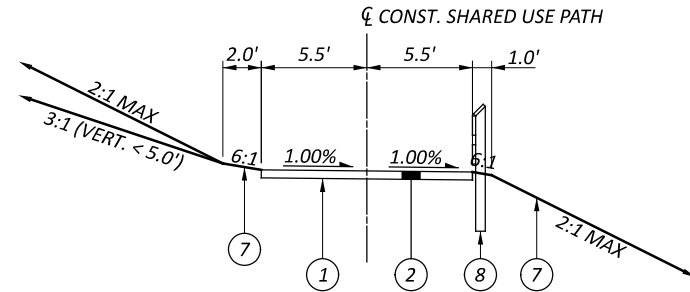


SHARED USE PATH - NORMAL SECTION
STA 302+50.00 TO STA 303+50.00

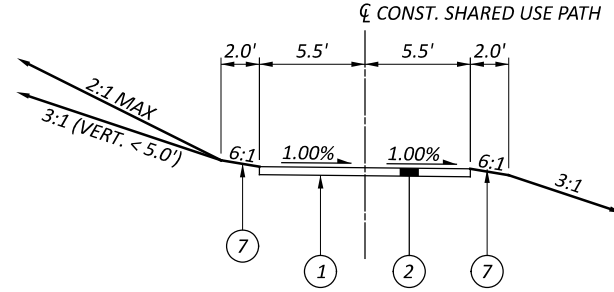

SHARED USE PATH - NORMAL SECTION
STA 303+50.00 TO STA 304+36.25

LEGEND

- 1 ITEM 204 - SUBGRADE COMPACTION
- 2 ITEM 608 - 5" CONCRETE WALK
- 3 ITEM 304 - 9" AGGREGATE BASE
- 4 ITEM 442 - 3" ASPHALT CONCRETE SURFACE COURSE, TYPE 1, (449), PG64-22
- 5 ITEM 609 - CURB, TYPE 6
- 6 ITEM 609 - CURB, TYPE 6, AS PER PLAN
- 7 ITEM 659 - SEEDING AND MULCHING
- 8 ITEM 607- FENCE, MISC. : WOOD BIKE RAILING
- 9 EXISTING ROADWAY MATERIALS

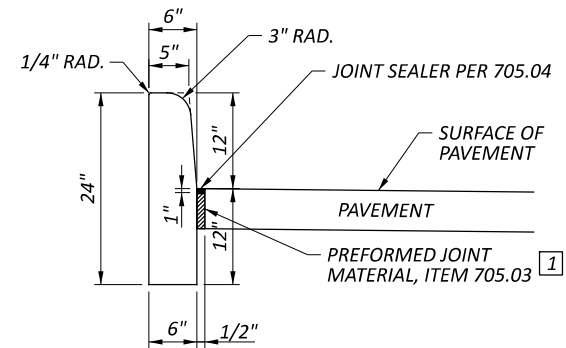

NOTES

JOINTS: 1" EXPANSION JOINTS SHALL EXTEND UP TO THE TOP OF THE CURB AND SHALL BE CONSTRUCTED IN THE CURB AND GUTTER SECTION IN SUCH A MANNER THAT THE JOINT SEAL WILL EXTEND THE FULL WIDTH OF THE GUTTER AND INTO THE CURB FACE A SUFFICIENT DISTANCE TO SEAL THE JOINT TO AN ELEVATION OF AT LEAST 2" ABOVE THE FLOW LINE OF THE GUTTER. DOWEL BARS SHALL BE USED IN THE CURB AND GUTTER SECTION AT EXPANSION JOINTS AND TO THE SURFACE OF THE PAVEMENT.

TRANSVERSE EXPANSION JOINT MATERIAL SHALL MEET THE REQUIREMENTS OF ITEM 705.03.

1 EXPANSION JOINT MATERIAL AND JOINT SEALER ARE NOT REQUIRED FOR THE PORTION OF THE CURB THAT IS ADJACENT TO A FLEXIBLE PAVEMENT TYPE. BOTH MATERIALS ARE REQUIRED, AS DETAILED, FOR THE FULL HEIGHT OF RIGID PAVEMENT AND CONCRETE BASES.

ITEM 609 - CURB, TYPE 6, AS PER PLAN

UTILITIES

LISTED BELOW ARE ALL UTILITIES LOCATED WITHIN THE PROJECT CONSTRUCTION LIMITS TOGETHER WITH THEIR RESPECTIVE OWNERS:

BUCKEYE RURAL ELECTRIC
4848 STATE ROUTE 325
RIO GRANDE, OH 45674
CONTACT: STEVE ELLIOTT
PHONE: 740-379-2080

GALLIA RURAL WATER
308 BURNETT ROAD
GALLIPOLIS, OH 45631
CONTACT: BRUCE LUCAS
PHONE: 740-446-9221

AT&T
160 NORTH SIXTH STREET
ZANESVILLE, OH 43701
CONTACT: BARRETT TAMASOVICH
PHONE: 740-454-3552

HORIZON
1123 GOODALE BLVD., SUITE 550
COLUMBUS, OH 43212
CONTACT: ROGER STEELE JR.
PHONE: 740-804-7333

GALLIA COUNTY COMMISSIONERS
18 LOCUST STREET, ROOM 1292
GALLIPOLIS, OH 45631
CONTACT: THOMAS DILLON (SANITARY DEPT.)
PHONE: 740-645-5359

THE LOCATION OF THE UNDERGROUND UTILITIES SHOWN ON THE PLANS ARE AS OBTAINED FROM THE OWNERS AS REQUIRED BY SECTION 153.64 O.R.C.

WORK LIMITS

THE WORK LIMITS SHOWN ON THESE PLANS ARE FOR PHYSICAL CONSTRUCTION ONLY. PROVIDE THE INSTALLATION AND OPERATION OF ALL WORK ZONE TRAFFIC CONTROL AND WORK ZONE TRAFFIC CONTROL DEVICES REQUIRED BY THESE PLANS WHETHER INSIDE OR OUTSIDE THESE WORK LIMITS.

CLEARING AND GRUBBING

ALTHOUGH THERE ARE NO TREES OR STUMPS SPECIFICALLY MARKED FOR REMOVAL WITHIN THE LIMITS OF THE PROJECT, A LUMP SUM QUANTITY IS INCLUDED IN THE GENERAL SUMMARY FOR ITEM 201, CLEARING AND GRUBBING. ALL PROVISIONS AS SET FORTH IN THE SPECIFICATIONS UNDER THIS ITEM ARE INCLUDED IN THE LUMP SUM PRICE BID FOR ITEM 201, CLEARING AND GRUBBING.

SEEDING AND MULCHING

THE FOLLOWING QUANTITIES ARE PROVIDED TO PROMOTE GROWTH AND CARE OF PERMANENT SEEDED AREAS:

659, SOIL ANALYSIS TEST	2 EACH
659, TOPSOIL	100 CY
659, SEEDING AND MULCHING	2935 SY
659, REPAIR SEEDING AND MULCHING	250 SY
659, INTER-SEEDING	250 SY
659, COMMERCIAL FERTILIZER	0.30 TON
659, LIME	0.75 ACRE
659, WATER	20 MGAL

SEEDING AND MULCHING SHALL BE APPLIED TO ALL AREAS OF EXPOSED SOIL BETWEEN THE RIGHT-OF-WAY LINES, AND WITHIN THE CONSTRUCTION LIMITS FOR AREAS OUTSIDE THE RIGHT-OF-WAY LINES COVERED BY WORK AGREEMENT OR SLOPE EASEMENT. QUANTITY CALCULATIONS FOR SEEDING AND MULCHING ARE BASED ON THESE LIMITS.

ENDANGERED BAT HABITAT REMOVAL

THIS PROJECT IS LOCATED WITHIN THE KNOWN HABITAT RANGES OF THE FEDERALLY LISTED AND PROTECTED INDIANA BAT, AND NORTHERN LONG-EARED BAT. NO TREES SHALL BE REMOVED UNDER THIS PROJECT FROM APRIL 1 THROUGH SEPTEMBER 30. ALL NECESSARY TREE REMOVAL SHALL OCCUR FROM OCTOBER 1 THROUGH MARCH 31. THIS REQUIREMENT IS NECESSARY TO AVOID AND MINIMIZE IMPACTS TO THESE SPECIES AS REQUIRED BY THE ENDANGERED SPECIES ACT (ESA). FOR THE PURPOSES OF THIS NOTE, A TREE IS DEFINED AS: A LIVE, DYING, OR DEAD WOODY PLANT, WITH A TRUNK 3 INCHES OR GREATER IN DIAMETER AT A HEIGHT OF 4.5 FEET ABOVE THE GROUND SURFACE, AND WITH A MINIMUM HEIGHT OF 13 FEET.

DUST CONTROL

THE CONTRACTOR SHALL FURNISH AND APPLY WATER FOR DUST CONTROL AS DIRECTED BY THE ENGINEER. THE FOLLOWING ESTIMATED QUANTITIES HAVE BEEN INCLUDED FOR DUST CONTROL PURPOSES:

ITEM 616, WATER 2 M. GAL.

MANHOLES, CATCH BASINS AND INLETS REMOVED OR ABANDONED

CAREFULLY REMOVE AND STORE ALL CASTINGS WITHIN THE RIGHT OF WAY FOR SALVAGE BY TOWNSHIP FORCES.

PAYMENT FOR ALL OF THE ABOVE IS INCLUDED IN THE CONTRACT PRICE FOR THE PERTINENT 202 ITEM.

REVIEW OF DRAINAGE FACILITIES

PRIOR TO THE START OF WORK AND AGAIN BEFORE FINAL ACCEPTANCE, PERFORM AN INSPECTION WITH REPRESENTATIVES OF THE DEPARTMENT, CONTRACTOR AND LOCALS OF ALL EXISTING DRAINAGE FACILITIES THAT ARE TO REMAIN IN SERVICE WHICH MAY BE AFFECTED BY THE WORK. THE CONDITION OF THE EXISTING CONDUITS AND THEIR APPURTENANCES IS DETERMINED FROM FIELD OBSERVATIONS. RECORDS OF THE INSPECTION ARE MAINTAINED BY THE DEPARTMENT.

CONFIRM ALL EXISTING SEWERS INSPECTED INITIALLY BY THE ABOVE-MENTIONED PARTIES ARE MAINTAINED AND LEFT IN A CONDITION COMPARABLE TO THAT DETERMINED BY THE ORIGINAL INSPECTION. THE CONTRACTOR IS RESPONSIBLE TO CORRECT ANY CHANGE IN THE CONDITION RESULTING FROM THEIR OPERATIONS AS DIRECTED AND APPROVED BY THE ENGINEER. PAYMENT FOR ALL OPERATIONS DESCRIBED ABOVE IS INCLUDED IN THE CONTRACT PRICE FOR THE PERTINENT 611 CONDUIT ITEMS.

EXISTING SUBSURFACE DRAINAGE

PROVIDE UNOBSTRUCTED OUTLETS FOR ALL EXISTING UNDERDRAINS OR AGGREGATE DRAINS ENCOUNTERED DURING CONSTRUCTION.

PROVIDE AN OUTLET PER STANDARD CONSTRUCTION DRAWING DM-1.1 FOR ALL UNDERDRAINS THAT OUTLET TO A SLOPE. UNDERDRAINS THAT CAN BE CONNECTED TO THE NEW OR EXISTING UNDERDRAINS AT THE END OF THE PROJECT LIMITS AS WELL AS ALL NECESSARY BENDS OR BRANCHES REQUIRED FOR CONNECTION ARE INCLUDED IN THE BASIS OF PAYMENT FOR UNCLASSIFIED PIPE UNDERDRAINS.

THE FOLLOWING ESTIMATED QUANTITIES HAVE BEEN INCLUDED IN THE GENERAL SUMMARY FOR THE WORK NOTED ABOVE:

ITEM 605, AGGREGATE DRAINS 100 FT.

CROSSINGS AND CONNECTIONS TO EXISTING PIPES AND UTILITIES

WHERE PLANS PROVIDE FOR A PROPOSED CONDUIT TO BE CONNECTED TO, OR CROSS OVER OR UNDER AN EXISTING SEWER OR UNDERGROUND UTILITY, LOCATE THE EXISTING PIPES OR UTILITIES BOTH AS TO LINE AND GRADE BEFORE STARTING TO LAY THE PROPOSED CONDUIT.

IF IT IS DETERMINED THAT THE ELEVATION OF THE EXISTING CONDUIT, OR EXISTING APPURTENANCE TO BE CONNECTED, DIFFERS FROM THE PLAN ELEVATION OR RESULTS IN A CHANGE IN THE PLAN CONDUIT SLOPE, NOTIFY THE ENGINEER BEFORE STARTING CONSTRUCTION OF ANY PORTION OF THE PROPOSED CONDUIT WHICH WILL BE AFFECTED BY THE VARIANCE IN THE EXISTING ELEVATIONS.

IF IT IS DETERMINED THAT THE PROPOSED CONDUIT WILL INTERSECT AN EXISTING SEWER OR UNDERGROUND UTILITY IF CONSTRUCTED AS SHOWN ON THE PLAN, NOTIFY THE ENGINEER BEFORE STARTING CONSTRUCTION OF ANY PORTION OF THE PROPOSED CONDUIT WHICH WOULD BE AFFECTED BY THE INTERFERENCE WITH AN EXISTING FACILITY.

PAYMENT FOR ALL THE OPERATIONS DESCRIBED ABOVE IS INCLUDED IN THE CONTRACT PRICE FOR THE PERTINENT 611 CONDUIT ITEM.

ITEM SPECIAL - MAILBOX REMOVED AND RESET

THIS WORK SHALL CONSIST OF FURNISHING AND ERECTING MAILBOX SUPPORTS AND ANY ASSOCIATED MOUNTING HARDWARE IN ACCORDANCE WITH PLAN DETAILS, AND ATTACHING AN OWNER-SUPPLIED MAILBOX AT LOCATIONS SPECIFIED IN THE PLAN, OR OTHERWISE ESTABLISHED BY THE ENGINEER.

WOOD POSTS SHALL BE NOMINAL 4 INCHES BY 4 INCHES SQUARE OR 4.5 INCHES DIAMETER ROUND, AND CONFORM TO 710.14. STEEL POSTS SHALL BE NOMINAL PIPE SIZE 2 INCHES I.D., AND CONFORM TO AASHTO M 181.

ALL HARDWARE INCLUDING BUT NOT LIMITED TO PLATES, SCREWS, BOLTS, AND ETC. SHALL BE COMMERCIAL-GRADE GALVANIZED STEEL.

POSTS SHALL BE SET PER THE FIRST PARAGRAPH OF 606.03, AND SHALL IN NO INSTANCE BE ENCASED IN CONCRETE. SUPPORT HARDWARE SHALL ACCOMMODATE EITHER A SINGLE OR A DOUBLE MAILBOX INSTALLATION, AND NO MORE THAN TWO BOXES MAY BE MOUNTED ON A SINGLE POST.

THE MAILBOX SHALL BE SECURELY AND NEATLY ATTACHED BY THE CONTRACTOR TO THE NEW SUPPORT. THE CONTRACTOR SHALL FURNISH ALL NECESSARY ATTACHMENT HARDWARE (NUTS, BOLTS, PLATES, SPACERS, AND WASHERS) AS NECESSARY TO ACCOMMODATE THE COMPLETE INSTALLATION.

IN THE ABSENCE OF A NEW BOX SUPPLIED BY THE OWNER, THE CONTRACTOR SHALL SALVAGE THE EXISTING BOX AND PLACE IT ON THE NEW SUPPORT. DUE CARE SHALL BE EXERCISED IN SUCH AN OPERATION, AND THE CONTRACTOR SHALL BE RESPONSIBLE FOR REPAIRING OR REPLACING ANY BOX DAMAGED BY IMPROPER HANDLING ON HIS PART, AS JUDGED AND DIRECTED BY THE ENGINEER.

THE CONTRACTOR SHALL BE RESPONSIBLE FOR COORDINATING WITH THE LOCAL POST MASTER REGARDING THE TIMING OF THE MOVEMENT OF ANY MAILBOX TO A NEW LOCATION. PAYMENT UNDER THIS ITEM SHALL BE LIMITED TO FINAL PERMANENT INSTALLATIONS. TEMPORARY INSTALLATIONS SHALL BE IN ACCORDANCE WITH 107.10. HOWEVER, THE SAME MATERIAL AND SIZE LIMITATIONS AS FOR PERMANENT INSTALLATIONS SHALL APPLY.

MAILBOX SUPPORTS, COMPLETE IN PLACE, WILL BE PAID FOR AT THE CONTRACT UNIT PRICE PER EACH, FOR ITEM SPECIAL MAILBOX SUPPORT SYSTEM, (SINGLE) (DOUBLE).

ITEM 625 - REMOVE AND REERECT EXISTING LIGHT POLE, AS PER PLAN

THIS WORK SHALL CONSIST OF REMOVAL AND REERCTION OF EXISTING LIGHT POLES ON NEW FOUNDATIONS AND REMOVAL OF EXISTING LIGHT POLE FOUNDATION

ANY EXISTING WIRE CONNECTIONS SHALL BE DISCONNECTED AT THE POLE BASE, PULLED BACK AND RECONNECTED TO POLE AT NEW LOCATION. ANY NECESSARY CONNECTION KITS, CONDUIT, TRENCHING, OR OTHER ITEMS NECESSARY TO COMPLETE THE NEW CONNECTION ARE INCLUDED AS PART OF THIS ITEM.

EXISTING LIGHT POLE FOUNDATION REMOVAL WILL BE DONE IN ACCORDANCE WITH ODOT CMS SECTION 625.21.

REMOVE AND REERECT EXISTING LIGHT POLE, WILL BE PAID FOR AT THE CONTRACT UNIT PRICE PER EACH, FOR ITEM 625 REMOVE AND REERECT EXISTING LIGHT POLE, AS PER PLAN.

ITEM 630 - REMOVAL OF GROUND MOUNTED MAJOR SIGN AND REERECTION, AS PER PLAN

THIS WORK SHALL CONSIST OF REMOVAL AND REERECTION OF THE EXISTING "SOUTH GALLIA MIDDLE SCHOOL AND HIGH SCHOOL" SIGN, BRICK FOUNDATION, AND ASSOCIATED LANDSCAPED AREA AT A NEW LOCATION.

REMOVE AND REERECT GROUND MOUNTED MAJOR SIGN, WILL BE PAID FOR AT THE CONTRACT UNIT PRICE PER EACH, FOR ITEM 630 REMOVAL OF GROUND MOUNTED MAJOR SIGNA AND REERECTION, AS PER PLAN.

DESIGN AGENCY



DESIGNER

EMH

REVIEWER

CSR 04/24/25

PROJECT ID

120712

SHEET

TOTAL

3

51

630 SIGNING MISC.: SOLAR-POWERED RECTANGULAR RAPID FLASHING BEACON (RRFB) SIGN ASSEMBLY

THIS WORK SHALL CONSIST OF FURNISHING AND INSTALLING A SOLAR POWERED RECTANGULAR RAPID FLASHING BEACON (RRFB) SIGN ASSEMBLY. THE FLASHING UNIT SHALL BE SOLAR POWERED, PEDESTRIAN ACTIVATED, AND 2-SIDED WITH TWO LED ARRAY BASED YELLOW INDICATIONS ON EACH SIDE. MULTIPLE UNITS SHALL BE WIRELESSLY CONTROLLED AND SYNCHRONIZED. THE UNIT SHALL BE COMPLIANT WITH THE MOST CURRENT OHIO MANUAL OF UNIFORM TRAFFIC CONTROL DEVICES (OMUTCD) AND FHWA INTERIM APPROVAL FOR RRFBs (IA-21).

GENERAL REQUIREMENTS -

EACH RRFB SHALL CONSIST OF TWO RAPIDLY FLASHED RECTANGULAR-SHAPED YELLOW INDICATIONS HAVING LED ARRAY BASED LIGHT SOURCE.

EACH RRFB SHALL BE A COMPLETE ASSEMBLY, CONSISTING OF BUT NOT LIMITED TO, SIGNAGE, SIGN MOUNTING HARDWARE, INDICATIONS AND ELECTRICAL COMPONENTS (WIRING, SOLID-STATE CIRCUIT BOARDS, ETC.).

EACH RRFB SHALL CONTAIN A PEDESTRIAN INDICATION LIGHT VISIBLE BY THE PEDESTRIAN IN THE DIRECTION OF TRAVEL.

FUNCTIONAL REQUIREMENTS -

EACH RRFB SHALL UTILIZE SOLAR POWER.

EACH RRFB SHALL BE ACTIVATED BY ADA COMPLIANT PUSHBUTTONS.

THE RRFB SHALL BE NORMALLY DARK, SHALL INITIATE OPERATION ONLY UPON PEDESTRIAN ACTUATION, AND SHALL CEASE OPERATION AFTER A PREDETERMINED TIME LIMIT (BASED ON OMUTCD PROCEDURES).

EACH REMOTE RRFB SHALL BE WIRELESSLY ACTIVATED.

ALL RRFB LIGHT INDICATIONS SHALL BE WIRELESSLY SYNCHRONIZED (ALL LIGHTS WILL TURN ON WITHIN 120 MSEC AND REMAIN SYNCHRONIZED THROUGHOUT THE DURATION OF THE FLASHING CYCLE).

THE UNIT SHALL BE CAPABLE OF RUNNING 14 DAYS WITHOUT SUNLIGHT.

MATERIALS -

FURNISH A COMPLETE ASSEMBLY, CONSISTING OF BUT NOT LIMITED TO, SIGNAGE, SIGN MOUNTING HARDWARE, INDICATIONS, AND ELECTRICAL COMPONENTS (WIRING, SOLID-STATE CIRCUIT BOARDS, ETC.). THE RRFB ASSEMBLY INCLUDES THE FOLLOWING ITEMS:

1. RRFB INDICATIONS

- A. EACH RRFB INDICATION LENS SHALL BE A MINIMUM SIZE OF APPROXIMATELY 5" WIDE X 2" HIGH.
- B. THE RRFB INDICATIONS SHALL BE ALIGNED HORIZONTALLY, WITH THE LONGER DIMENSION OF THE INDICATION HORIZONTAL. THERE SHALL BE TWO INDICATIONS ON THE FRONT AND TWO INDICATIONS ON THE BACK.
- C. EACH RRFB SHALL BE SUPPLIED WITH ALL REQUIRED HARDWARE TO INSTALL ASSEMBLY. ALL EXPOSED HARDWARE SHALL BE ANTI-VANDAL.
- D. EACH RRFB SHALL BE LOCATED BETWEEN THE BOTTOM OF THE CROSSING WARNING SIGN AND THE TOP OF THE SUPPLEMENTAL DOWNWARD DIAGONAL ARROW PLAQUE.

- E. THE LIGHT INTENSITY OF THE YELLOW INDICATIONS SHALL MEET THE MINIMUM CLASS 1 SPECIFICATIONS OF SOCIETY OF AUTOMOTIVE ENGINEERS (SAE) STANDARD J595 (DIRECTIONAL FLASHING OPTICAL WARNING DEVICES FOR AUTHORIZED EMERGENCY, MAINTENANCE, AND SERVICE VEHICLES) DATED JANUARY, 2005.
- F. TO MINIMIZE EXCESSIVE GLARE DURING NIGHTTIME CONDITIONS, AN AUTOMATIC SIGNAL DIMMING DEVICE SHALL BE USED TO REDUCE THE BRILLIANCE OF THE RRFB INDICATIONS.
- G. An LED PEDESTRIAN CONFIRMATION LIGHT DIRECTED AT AND VISIBLE TO PEDESTRIANS IN THE CROSSWALK SHALL BE INSTALLED INTEGRAL TO THE RRFB OR PUSHBUTTON TO GIVE CONFIRMATION THAT THE RRFB IS IN OPERATION.
- H. THE PEDESTRIAN CONFIRMATION LIGHT SHALL HAVE A MINIMUM AREA OF 0.5 SQUARE INCHES AND BE CONSPICUOUS TO PEDESTRIAN AT ALL DISTANCES FROM THE BEGINNING OF THE CONTROLLED CROSSWALK TO A POINT 10 FEET FROM THE END OF THE CONTROLLED CROSSWALK DURING BOTH DAY AND NIGHT.

2. SIGNS

- A. ALL SIGN ASSEMBLIES SHALL USE ANTI-VANDAL FASTENERS TO MOUNT COMPONENTS TO SIGN AND SIGN TO FIXTURE.
- B. PEDESTRIAN PUSHBUTTONS SIGNS SHALL BE PROVIDED AND INCLUDE THE LEGEND "PUSH BUTTON TO TURN ON WARNING LIGHTS". SIGNS SHOULD BE MOUNTED ADJACENT TO OR INTEGRAL WITH EACH PEDESTRIAN PUSHBUTTON.
- C. TWO SETS OF SIGNS SHALL BE REQUIRED PER UNIT FOR VIEW FROM EACH APPROACH.
- D. ASSURE SIGN MEETS THE REQUIREMENTS OF C&MS 630.

3. CONTROL CIRCUIT

- A. THE CONTROL CIRCUIT SHALL HAVE THE CAPABILITY OF INDEPENDENTLY FLASHING UP T TWO INDEPENDENT OUTPUTS. THE LED LIGHT OUTPUTS AND FLASH PATTERN SHALL BE COMPLETELY PROGRAMMABLE.
- B. THE CONTROL CIRCUIT SHALL BE SEALED WATERTIGHT TO ELIMINATE DIRT CONTAMINATION AND ALLOW FOR SAFE HANDLING IN ALL WEATHER CONDITIONS.
- C. THE LEDS SHALL BE SEALED AGAINST DUST AND MOISTURE INTRUSION AS PER THE REQUIREMENTS OF NEMA STANDARD 250-1991 FOR TYPE 4 ENCLOSURE AND TO PROTECT ALL INTERNAL LED AND ELECTRICAL COMPONENTS.

4. BATTERY AND SOLAR PANELS

- A. BATTERY UNIT SHALL BE A 12VDC, 35 AHR MINIMUM, SEALED GEL OR AGM LEAD ACID BATTERY. BATTERIES SHALL HAVE A WRITTEN TWO YEAR FULL REPLACEMENT WARRANTY.
- B. THE SOLAR PANEL SHALL PROVIDE A MINIMUM OF 40 WATTS PEAK TOTAL OUTPUT.
- C. THE SOLAR PANEL SHALL BE MOUNTED TO AN ALUMINUM PLATE AND BRACKET AT AN ANGLE OF 45 DEGREES - 60 DEGREES TO PROVIDE MAXIMUM OUTPUT.
- D. ALL FASTENERS USED SHALL BE ANTI-VANDAL.

5. WIRELESS RADIO

- A. RADIO CONTROL SHALL OPERATE ON A 900 MHZ FREQUENCY HOPPING SPREAD SPECTRUM NETWORK, WI-FI OR APPROVED EQUAL.
 - B. RADIO SHALL INTEGRATE COMMUNICATION OF RRFB CONTROL CIRCUIT TO ACTIVATE SIGN FROM PUSHBUTTON INPUT.
 - C. THE RADIO SHALL BE SYNCHRONIZED SO ALL OF THE REMOTE RRFB LIGHT INDICATIONS WILL TURN ON WITHIN 120 MSEC OF EACH OTHER AND REMAIN SYNCHRONIZED THROUGH-OUT THE DURATION OF THE FLASHING CYCLE.
6. PUSHBUTTON
- A. THE PUSHBUTTON SHALL BE CAPABLE OF CONTINUOUS OPERATION OVER A TEMPERATURE RANGE OF -30 DEGREES F TO +165 DEGREES F.
 - B. PUSHBUTTON SHALL BE ADA COMPLIANT.
7. PEDESTAL SHAFT AND BASE - MOUNT ON A STANDARD 4.5-INCH OD ALUMINUM PEDESTAL POLE WITH BREAKAWAY BASE. A 14 FOOT POLE SHALL BE PROVIDED AND FIELD ADJUSTED AND CAPPED TO MAINTAIN THE PROPER SIGN MOUNTING HEIGHTS, UNLESS SPECIFIED OTHERWISE IN THE PLANS. POLE AND BASE MANUFACTURER SHALL BE LISTED ON ODOT'S QUALIFIED PRODUCTS LIST.

CONSTRUCTION -

THE RRFB SHALL BE ASSEMBLED AND CONSTRUCTED BY THE CONTRACTOR AS SHOWN AND SPECIFIED ON THE PLANS.

WARRANTY -

WARRANTY SHALL BE TWO YEARS FROM THE DATE OF FINAL ACCEPTANCE.

MEASUREMENT -

THE DEPARTMENT WILL MEASURE THE ITEM COMPLETE IN PLACE, INCLUDING ALL MATERIALS, TESTING, LABOR AND SOFTWARE FOR A FULLY FUNCTIONAL UNIT.

PAYMENT -

PAYMENT WILL BE AT THE CONTRACT UNIT PRICE PER EACH FOR ITEM 630 "SIGNING MISC.: SOLAR POWERED RECTANGULAR RAPID FLASHING BEACON (RRFB) SIGN ASSEMBLY".

SURVEY CONTROL POINTS							
POINT	NORTHING	EASTING	ELEVATION	DESCRIPTION	ALIGNMENT	STATION	OFFSET
SV1	240661.89	2031775.29	763.06	IRON PIN W/CAP	MERCERVILLE RD.	96+24.77	40.58' RT
SV2	240947.65	2033229.27	744.99	IRON PIN W/CAP	MERCERVILLE RD.	111+16.04	52.50' RT
SV3	240909.84	2033546.59	751.23	IRON PIN W/CAP	MERCERVILLE RD.	114+22.97	132.76' RT
SV4	241072.70	2034031.05	774.71	IRON PIN	STATION ST.	203+45.02	16.82' RT
SV5	241040.51	2034223.10	774.93	IRON PIN W/CAP	STATION ST.	205+33.36	66.31' RT
					CONNECTOR PATH	300+70.01	11.79' RT

DESIGN AGENCY



DESIGNER

EMH

REVIEWER

CSR 04/24/25

PROJECT ID

120712

SHEET

TOTAL

4

51

ITEM 614 – MAINTAINING TRAFFIC

A MINIMUM OF ONE LANE OF TRAFFIC IN EACH DIRECTION SHALL BE MAINTAINED AT ALL TIMES BY USE OF THE EXISTING PAVEMENT.

LENGTH AND DURATION OF LANE CLOSURES AND RESTRICTIONS SHALL BE AT THE APPROVAL OF THE ENGINEER. IT IS THE INTENT TO MINIMIZE THE IMPACT TO THE TRAVELING PUBLIC. LANE CLOSURES OR RESTRICTIONS OVER SEGMENTS OF THE PROJECT IN WHICH NO WORK IS ANTICIPATED WITHIN A REASONABLE TIME FRAME, AS DETERMINED BY THE ENGINEER, SHALL NOT BE PERMITTED. THE LEVEL OF UTILIZATION OF MAINTENANCE OF TRAFFIC DEVICES SHALL BE COMMENSURATE WITH THE WORK IN PROGRESS.

ALL WORK AND TRAFFIC CONTROL DEVICES SHALL BE IN ACCORDANCE WITH C&MS 614 AND OTHER APPLICABLE PORTIONS OF THE SPECIFICATIONS, AS WELL AS THE OHIO MANUAL OF UNIFORM TRAFFIC CONTROL DEVICES. PAYMENT FOR ALL LABOR, EQUIPMENT AND MATERIALS SHALL BE INCLUDED IN THE LUMP SUM CONTRACT PRICE FOR ITEM 614, MAINTAINING TRAFFIC, UNLESS SEPARATELY ITEMIZED IN THE PLAN.

DRIVEWAY ACCESS

THE CONTRACTOR SHALL MAINTAIN ACCESS TO DRIVEWAYS TO THE FULLEST EXTENT POSSIBLE. IT IS UNDERSTOOD THAT FOR SHORT PERIODS OF TIME, THE FULL ACCESS TO DRIVEWAYS MAY NOT BE POSSIBLE. THE CONTRACTOR SHALL MAKE ACCOMMODATIONS TO THE RESIDENT OR BUSINESS SO THAT DURING THESE SHORT INTERVALS, THE HOME OR BUSINESS OWNER CAN STILL HAVE ACCESS TO PARK NEAR THEIR RESIDENCE OR BUSINESS.

PROPERTIES WITH MULTIPLE ACCESS POINTS: WORK AT ONE DRIVE AT A TIME. PROPERTIES WITH A SINGLE ACCESS POINT: MAINTAIN ACCESSES TO PROPERTY AT ALL TIMES USING ONE OF THE FOLLOWING METHODS: REPLACE DRIVEWAY USING PART WIDTH CONSTRUCTION, BACKFILL OPEN EXCAVATION WITH 304.02 AGGREGATE FOR TEMPORARY ACCESSES, OR USE STEEL PLATES TO SPAN OPEN EXCAVATIONS. BEFORE ACCESS TO A DRIVEWAY IS INTERRUPTED, THE CONTRACTOR SHALL GIVE PRIOR NOTICE TO THE OCCUPANT OF THE PROPERTY.

THE CONTRACTOR SHALL BE RESPONSIBLE TO ENSURE THAT US MAIL OR ANY OTHER DELIVERY WITHIN THE PROJECT LIMITS IS NOT DISRUPTED BY CONSTRUCTION OPERATIONS.

MAINTAINING BUSINESS ACCESS

THE CONTRACTOR SHALL MAINTAIN ACCESS TO BUSINESSES TO THE FULLEST EXTENT POSSIBLE. IT IS UNDERSTOOD THAT FOR SHORT PERIODS OF TIME, THE FULL ACCESS TO BUSINESSES MAY NOT BE POSSIBLE. THE CONTRACTOR SHALL MAKE ACCOMMODATIONS TO THE RESIDENT OR BUSINESS SO THAT DURING THESE SHORT INTERVALS, THE BUSINESS OWNER CAN STILL HAVE ACCESS TO ENTER THE BUSINESS.

PROPERTIES WITH A SINGLE ACCESS POINT: MAINTAIN ACCESSES TO PROPERTY AT ALL TIMES USING ONE OF THE FOLLOWING METHODS: TEMPORARY STONE BASE ON GROUND, OR PLYWOOD GANGWAYS ACROSS BARE GROUND TO A BUILDINGS DOOR. BEFORE ACCESS TO A BUSINESS IS INTERRUPTED, THE CONTRACTOR SHALL GIVE PRIOR NOTICE TO THE OCCUPANT OF THE PROPERTY.

Addendum #1
02/17/2026

DESIGN AGENCY



DESIGNER

EMH

REVIEWER

CSR 02/17/26

PROJECT ID

120712

SHEET

4A

TOTAL

51

MODEL: GenSum SH1 PAPERSIZE: 17x11 (in.) DATE: 2/17/2026 TIME: 12:32:40 PM USER: enimes
X:\Projects\2024\2428\315400 Guyan Twp Mercerville Path TAP\120712\400-Engineering\Roadway\Sheets\120712_GG001.dgn

SHEET NUMBER													PART.	ITEM	ITEM EXT	GRAND TOTAL	UNIT	DESCRIPTION	SEE SHEET NO.
3	7	8	46	47								01/ENH							
																	ROADWAY		
												LS	201	11000	LS		CLEARING AND GRUBBING		
	93											93	202	23000	93	SY	PAVEMENT REMOVED		
	18											18	202	32000	18	FT	CURB REMOVED		
	1,412											1,412	202	35100	1,412	FT	PIPE REMOVED, 24" DIAMETER AND UNDER		
	28											28	202	35200	28	FT	PIPE REMOVED, OVER 24" DIAMETER		
	5											5	202	58100	5	EACH	CATCH BASIN REMOVED		
	104											104	202	75000	104	FT	FENCE REMOVED		
												456	203	10000	456	CY	EXCAVATION		
												1,285	203	20000	1,285	CY	EMBANKMENT		
	2,135											2,135	204	10000	2,135	SY	SUBGRADE COMPACTION		
												2	204	45000	2	HOURL	PROOF ROLLING		
	410											410	607	98000	410	FT	FENCE, MISC.: WOOD BIKE RAILING	1	
	17,257											17,257	608	12000	17,257	SF	5" CONCRETE WALK		
	1,051											1,051	608	15000	1,051	SF	8" CONCRETE WALK		
	921											921	608	52000	921	SF	CURB RAMP		
	169											169	608	53020	169	SF	DETECTABLE WARNING		
	424											424	609	26000	424	FT	CURB, TYPE 6		
	118											118	609	26001	118	FT	CURB, TYPE 6, AS PER PLAN	2	
	15											15	SPECIAL	69050350	15	EACH	MAILBOX REMOVED AND RESET	3	
	2											2	SPECIAL	69050610	2	EACH	BOLLARD, HINGED	1	
																	EROSION CONTROL		
2												2	659	00100	2	EACH	SOIL ANALYSIS TEST		
100												100	659	00300	100	CY	TOPSOIL		
2,935												2,935	659	10000	2,935	SY	SEEDING AND MULCHING		
250												250	659	14000	250	SY	REPAIR SEEDING AND MULCHING		
250												250	659	15000	250	SY	INTER-SEEDING		
0.3												0.3	659	20000	0.3	TON	COMMERCIAL FERTILIZER		
0.75												0.75	659	31000	0.75	ACRE	LIME		
22												22	659	35000	22	MGAL	WATER		
												LS	832	15000	LS		STORM WATER POLLUTION PREVENTION PLAN		
												LS	832	15002	LS		STORM WATER POLLUTION PREVENTION INSPECTIONS		
												LS	832	15010	LS		STORM WATER POLLUTION PREVENTION INSPECTION SOFTWARE		
												19,350	832	30000	19,350	EACH	EROSION CONTROL		
																	DRAINAGE		
		32										32	601	32100	32	CY	ROCK CHANNEL PROTECTION, TYPE B WITH FILTER		
		20										20	602	20000	20	CY	CONCRETE MASONRY		
		134										134	605	06000	134	FT	4" BASE PIPE UNDERDRAINS		
100												100	605	31100	100	FT	AGGREGATE DRAINS		
		10										10	611	00410	10	FT	4" CONDUIT, TYPE F FOR UNDERDRAIN OUTLET		
		24										24	611	04600	24	FT	12" CONDUIT, TYPE C		
		5										5	611	05900	5	FT	15" CONDUIT, TYPE B		
		115										115	611	06100	115	FT	15" CONDUIT, TYPE C		
		328										328	611	07400	328	FT	18" CONDUIT, TYPE B		
		235										235	611	07600	235	FT	18" CONDUIT, TYPE C		
		95										95	611	10400	95	FT	24" CONDUIT, TYPE B		
		804										804	611	10600	804	FT	24" CONDUIT, TYPE C		
		27										27	611	13400	27	FT	30" CONDUIT, TYPE B		
		53										53	611	34000	53	FT	120" CONDUIT, TYPE A		

GENERAL SUMMARY

DESIGN AGENCY



DESIGNER

EMH

REVIEWER

CAM 11/17/25

PROJECT ID

120712

SHEET	TOTAL
-------	-------

5	5
---	---

[illegible]

ROADWAY SUBSUMMARY	
DESIGN AGENCY	
	
DESIGNER	
EMH	
REVIEWER	
CAM 11/14/25	
PROJECT ID	
120712	
SHEET	TOTAL
7	51

MODEL: Sheet PAPER SIZE: 17x11 (in.) DATE: 2/17/2026 TIME: 12:32:44 PM USER: ehimes
X:\Projects\2024\2428\315400 Guyan Twp Mercersville Path TAP\120712\400-Engineering\Drainage\Sheets\120712_DS001.dgn

[illegible]

DRAINAGE SUBSUMMARY

DESIGN AGENCY




DESIGNER
EMH

REVIEWER
CAM 11/17/25

PROJECT ID	120712
------------	--------

SHEET	TOTAL
8	5

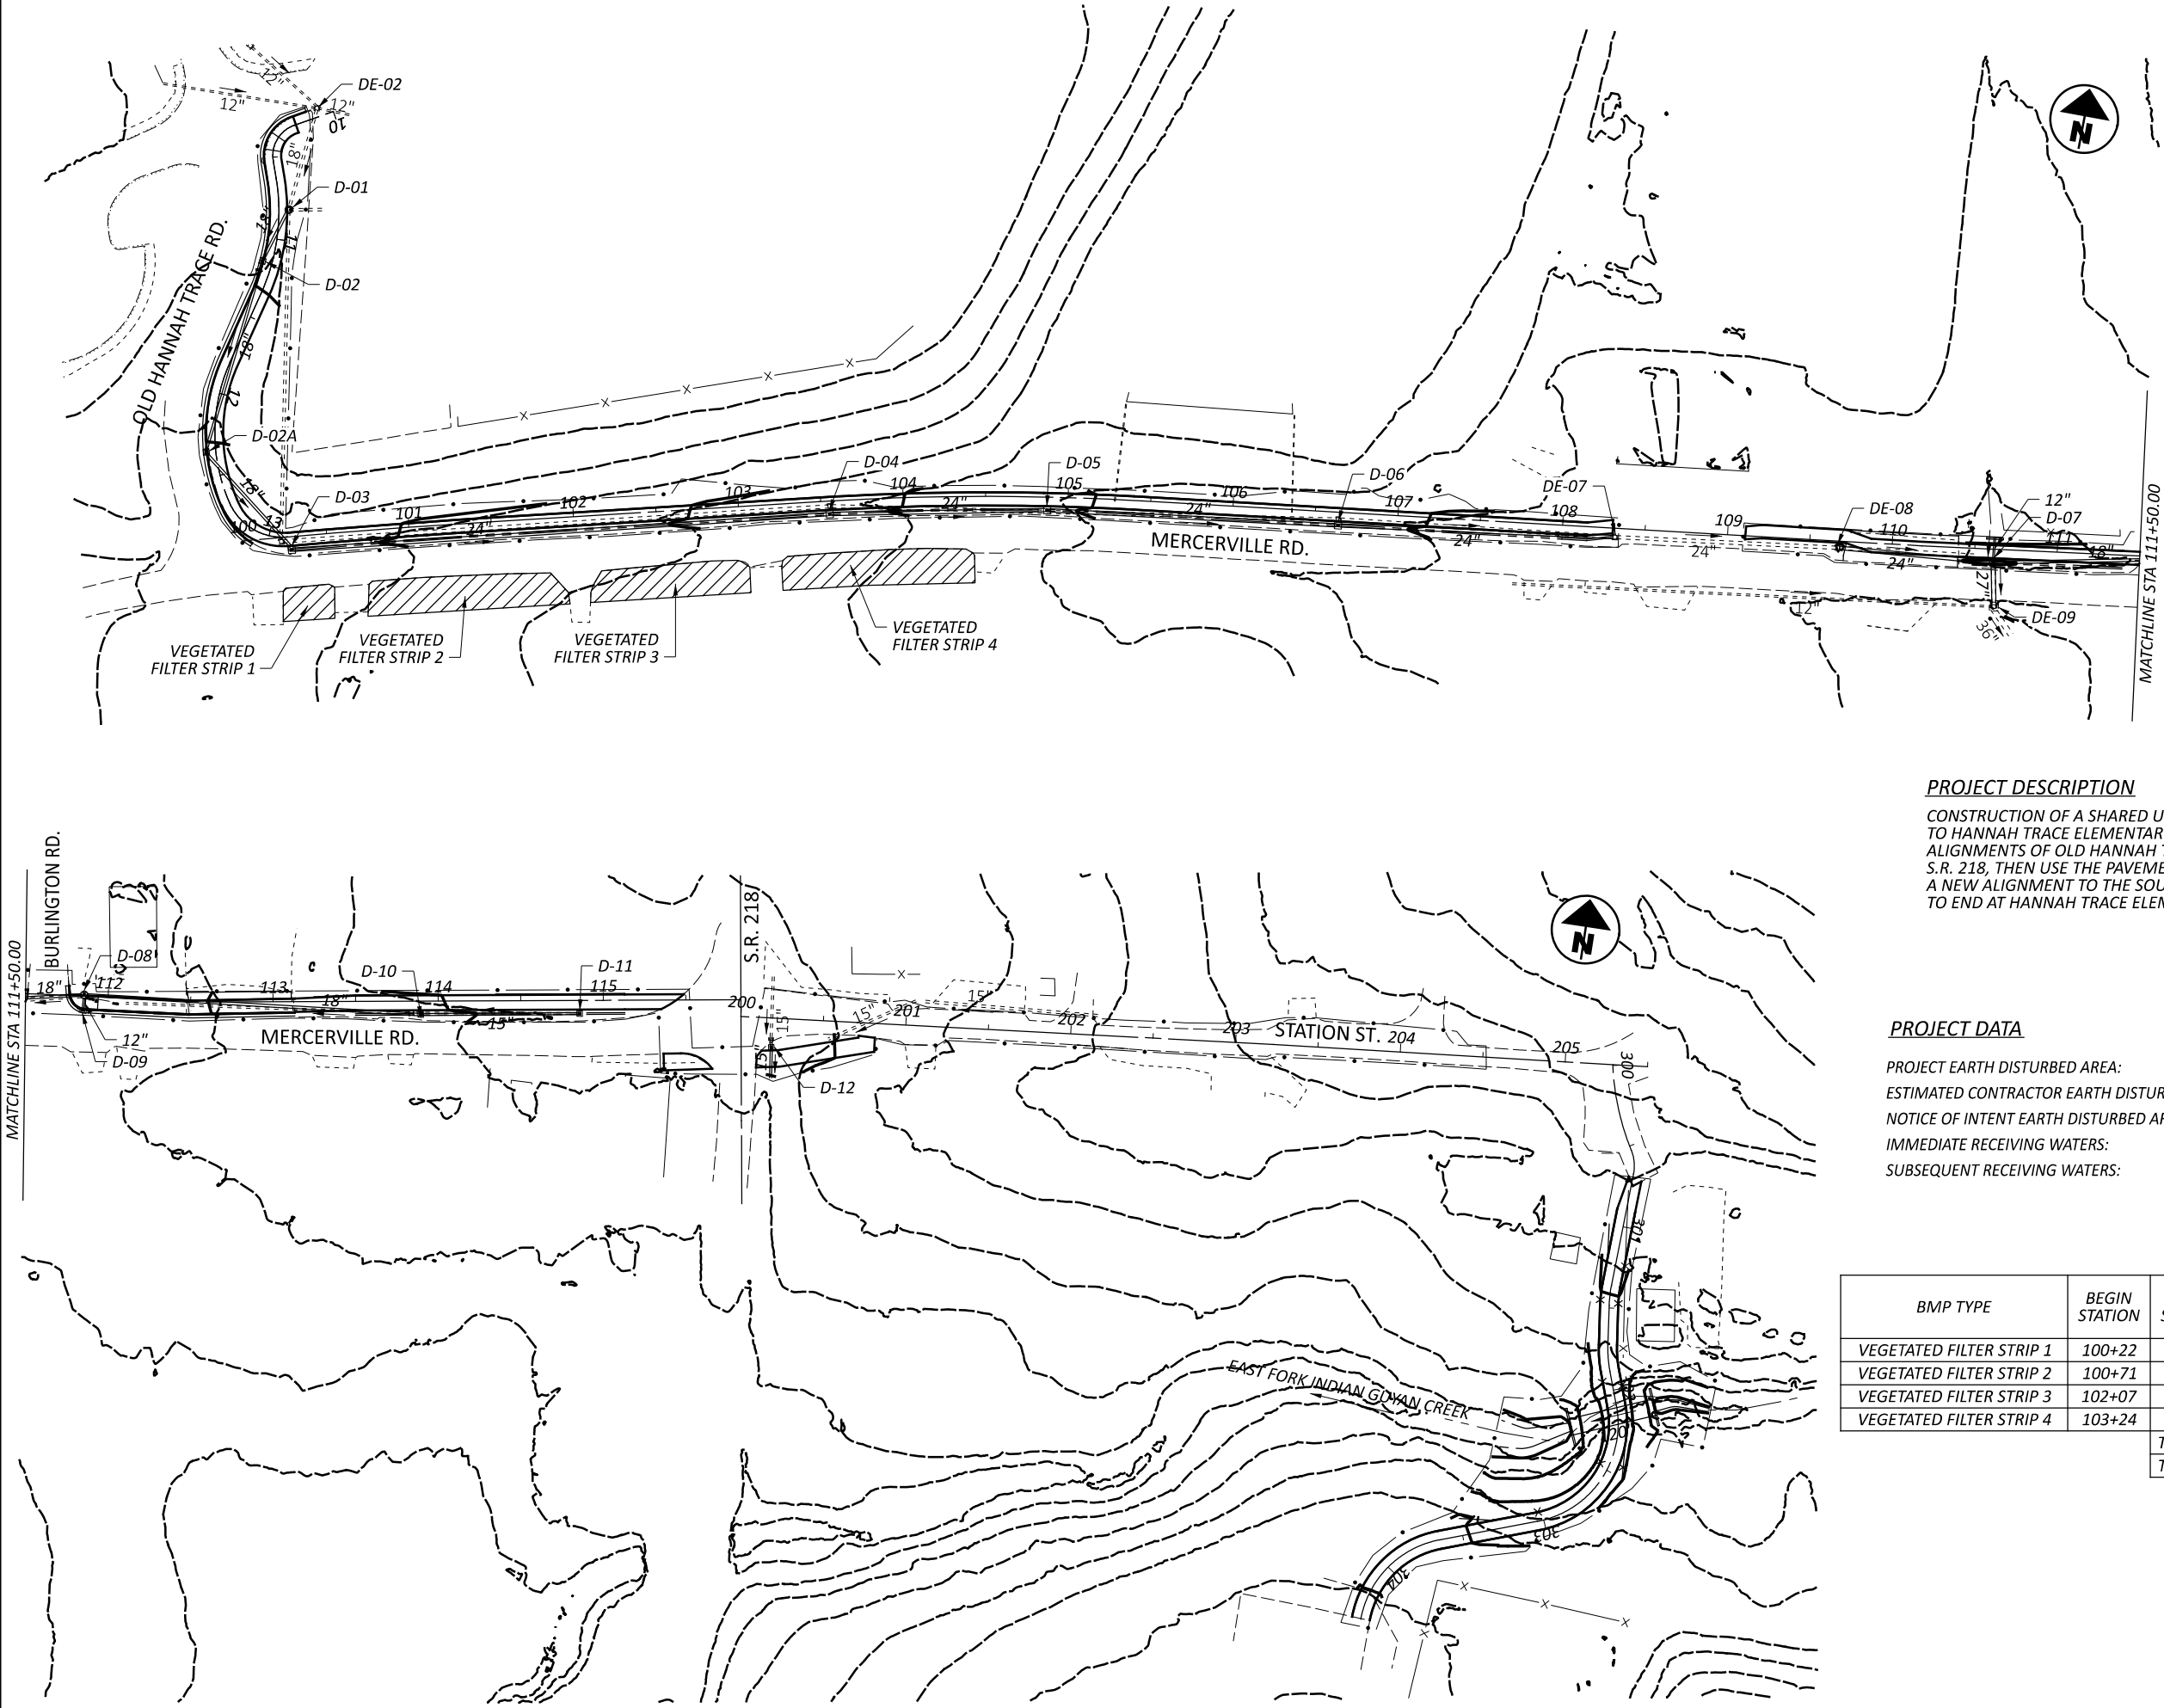

EXISTING ELEVATION DATA

2021 OGRIPS LIDAR DATA
TILE NUMBERS :
BS20310241 BS20310240
BS20320241 BS20320240
BS20330241 BS20330240

LATITUDE : 38°39'41"
LONGITUDE : -82°16'14"

* LATITUDE AND LONGITUDE TO
APPROXIMATE CENTER OF PROJECT.

LEGEND

- EX. CATCH BASIN OR INLET
- PROP. CB-2-2B, CB-2-3
- PROP. CB-3A, CB-6
- PROP. MH-3
- VEGETATED BIOFILTER


PROJECT DESCRIPTION

CONSTRUCTION OF A SHARED USE PATH FROM SOUTH GALLIA HIGH SCHOOL TO HANNAH TRACE ELEMENTARY. PROPOSED PATH WILL FOLLOW THE ALIGNMENTS OF OLD HANNAH TRACE ROAD, MERCERVILLE ROAD, CROSS S.R. 218, THEN USE THE PAVEMENT OF STATION STREET BEFORE FOLLOWING A NEW ALIGNMENT TO THE SOUTH AND CROSSING A STREAM BY CULVERT TO END AT HANNAH TRACE ELEMENTARY.

PROJECT DATA

PROJECT EARTH DISTURBED AREA: 1.33 ACRES
ESTIMATED CONTRACTOR EARTH DISTURBED AREA: 0.25 ACRES
NOTICE OF INTENT EARTH DISTURBED AREA: 1.58 ACRES
IMMEDIATE RECEIVING WATERS: EAST FORK INDIAN GUYAN CREEK
SUBSEQUENT RECEIVING WATERS: INDIAN GUYAN CREEK

BMP TYPE	BEGIN STATION	END STATION	BMP WIDTH (FT)	EDA TREATMENT CREDIT (AC)
VEGETATED FILTER STRIP 1	100+22	100+52	20	0.03
VEGETATED FILTER STRIP 2	100+71	11+94	20	0.09
VEGETATED FILTER STRIP 3	102+07	103+06	20	0.08
VEGETATED FILTER STRIP 4	103+24	104+43	20	0.10
TREATMENT PROVIDED				0.30 AC
TREATMENT REQUIRED				0.24 AC

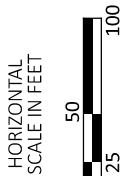

PROJECT SITE PLAN

DESIGN AGENCY



DESIGNER

EMH

REVIEWER

CAM 11/17/25

PROJECT ID



120712




SHEET

TOTAL

9

51

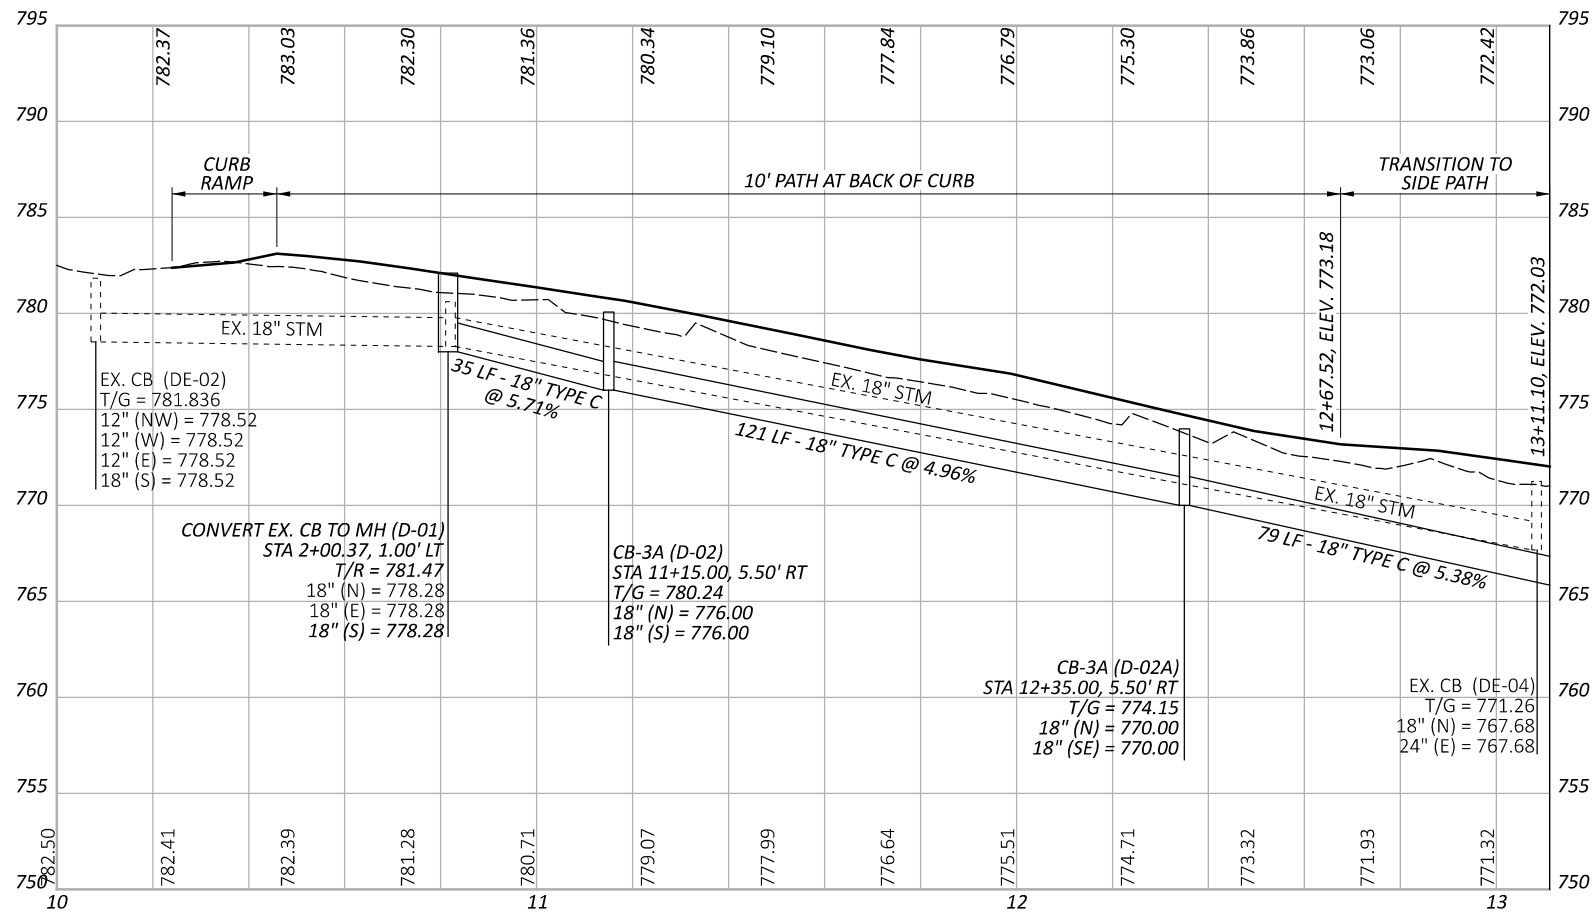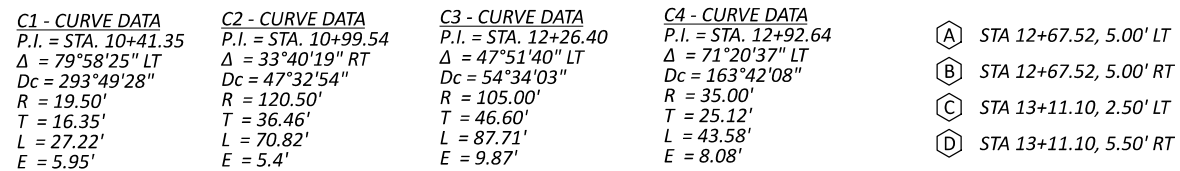

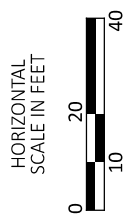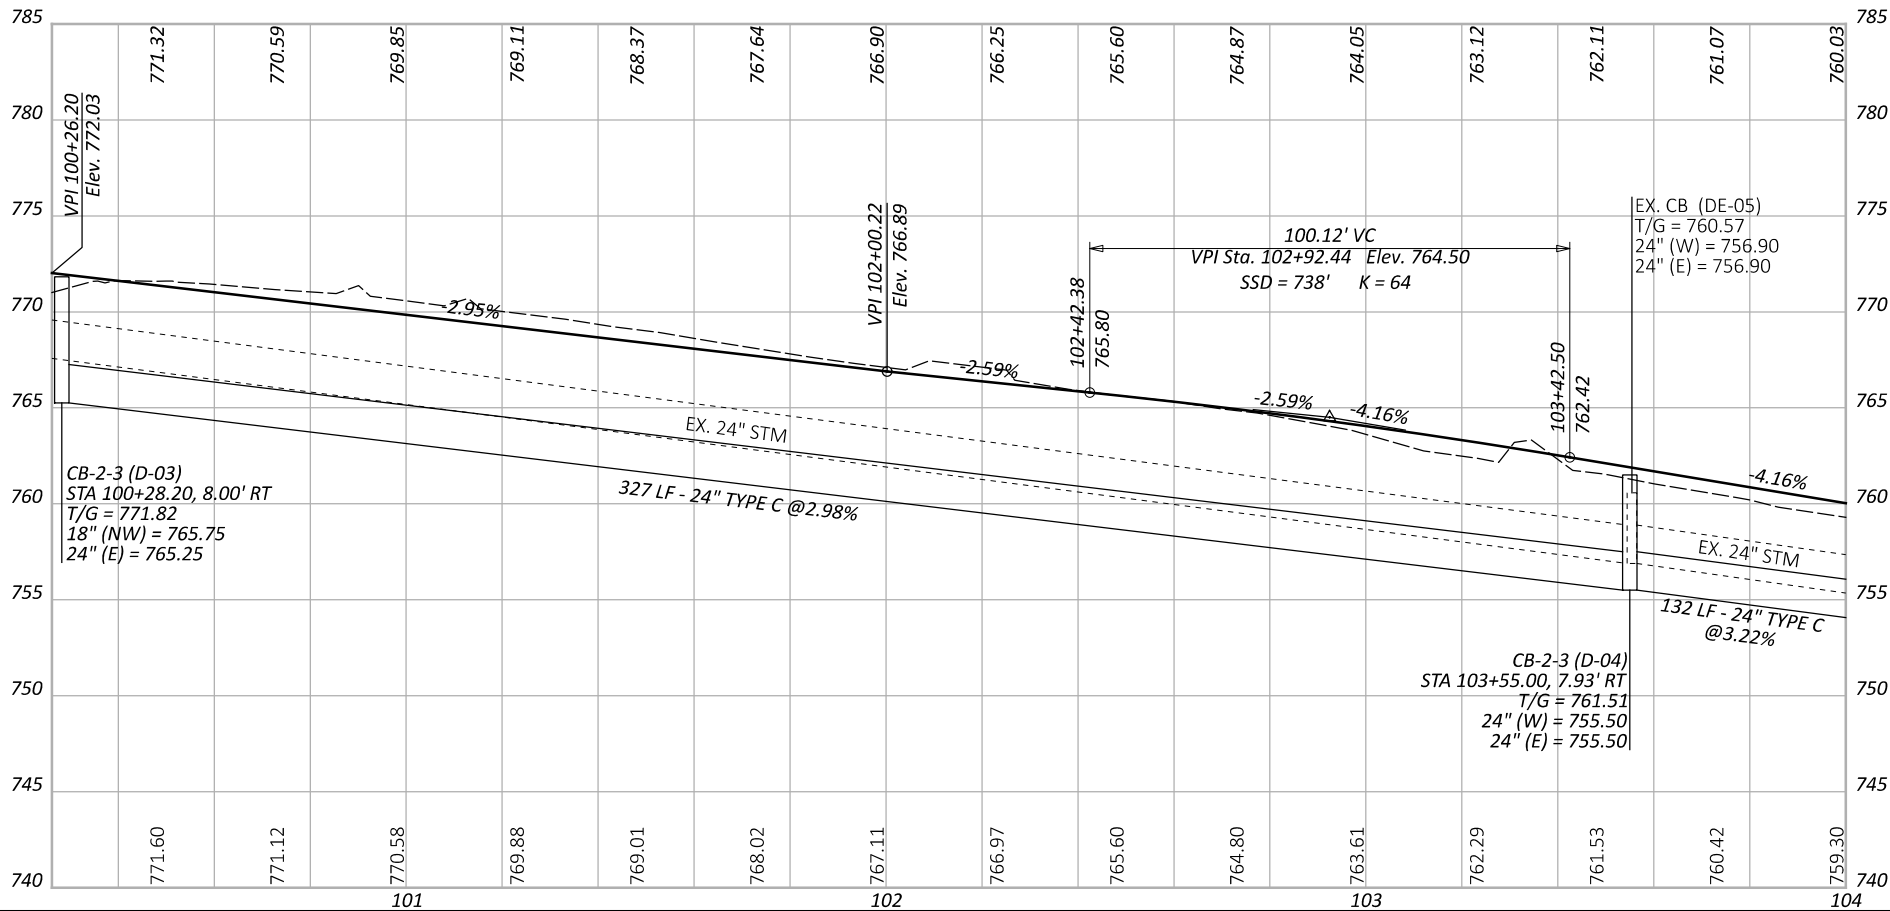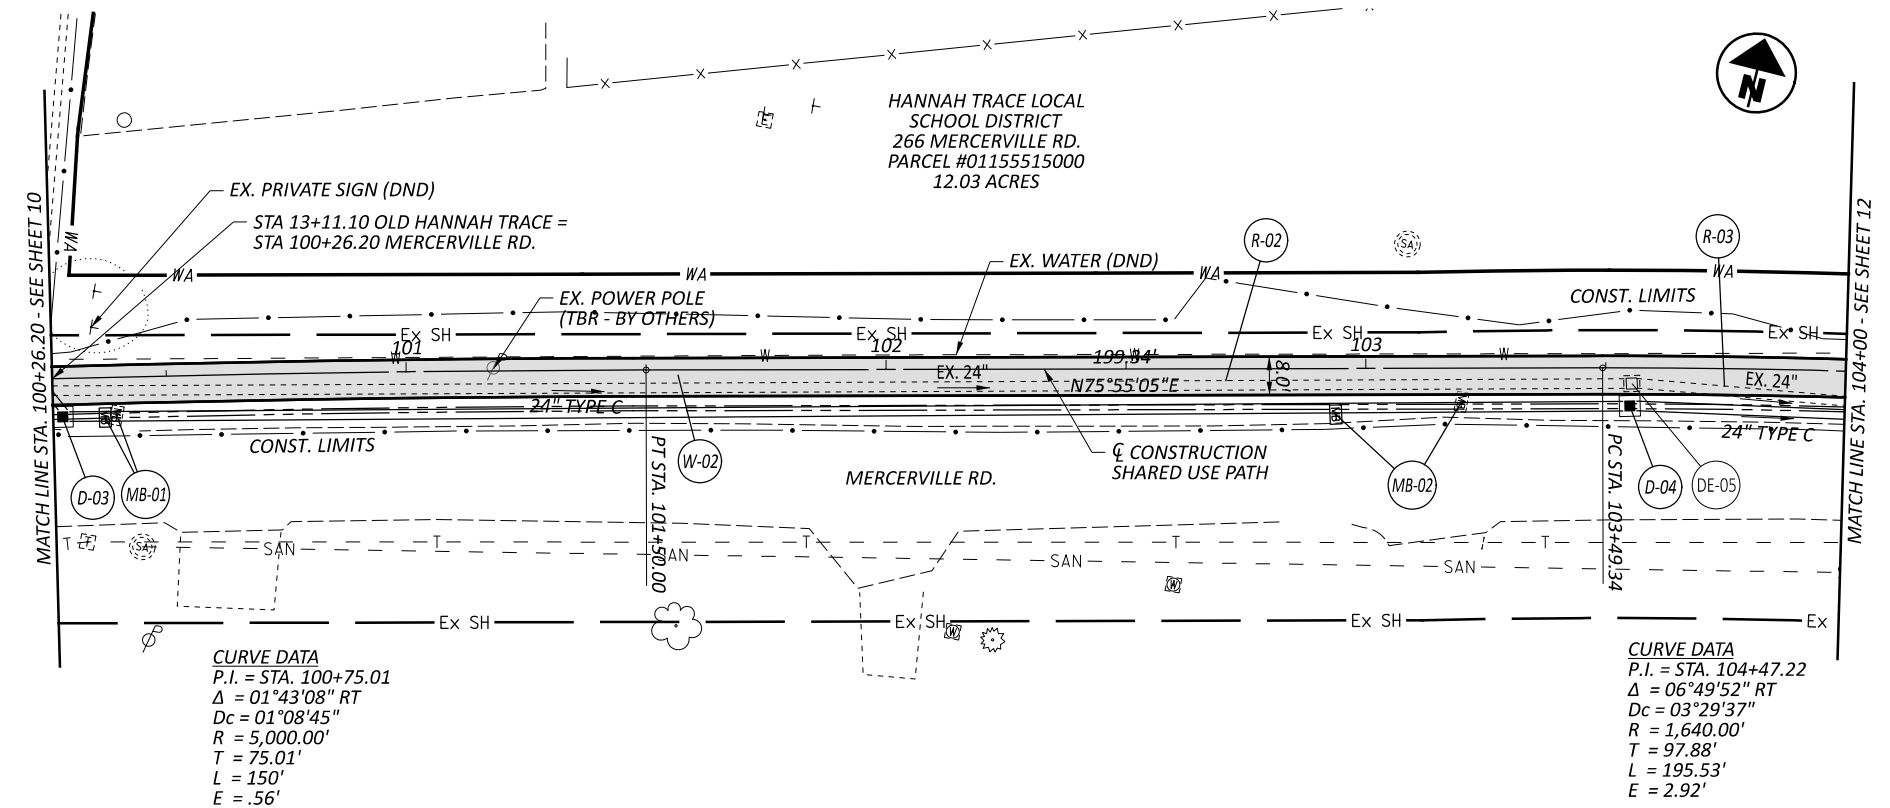

PLAN AND PROFILE
MERCERVILLE RD. - STA. 100+26.20 TO STA. 104+00.00

DESIGN AGENCY



DESIGNER

EMH

REVIEWER

CAM 11/14/25

PROJECT ID


120712


SHEET



11

TOTAL

51

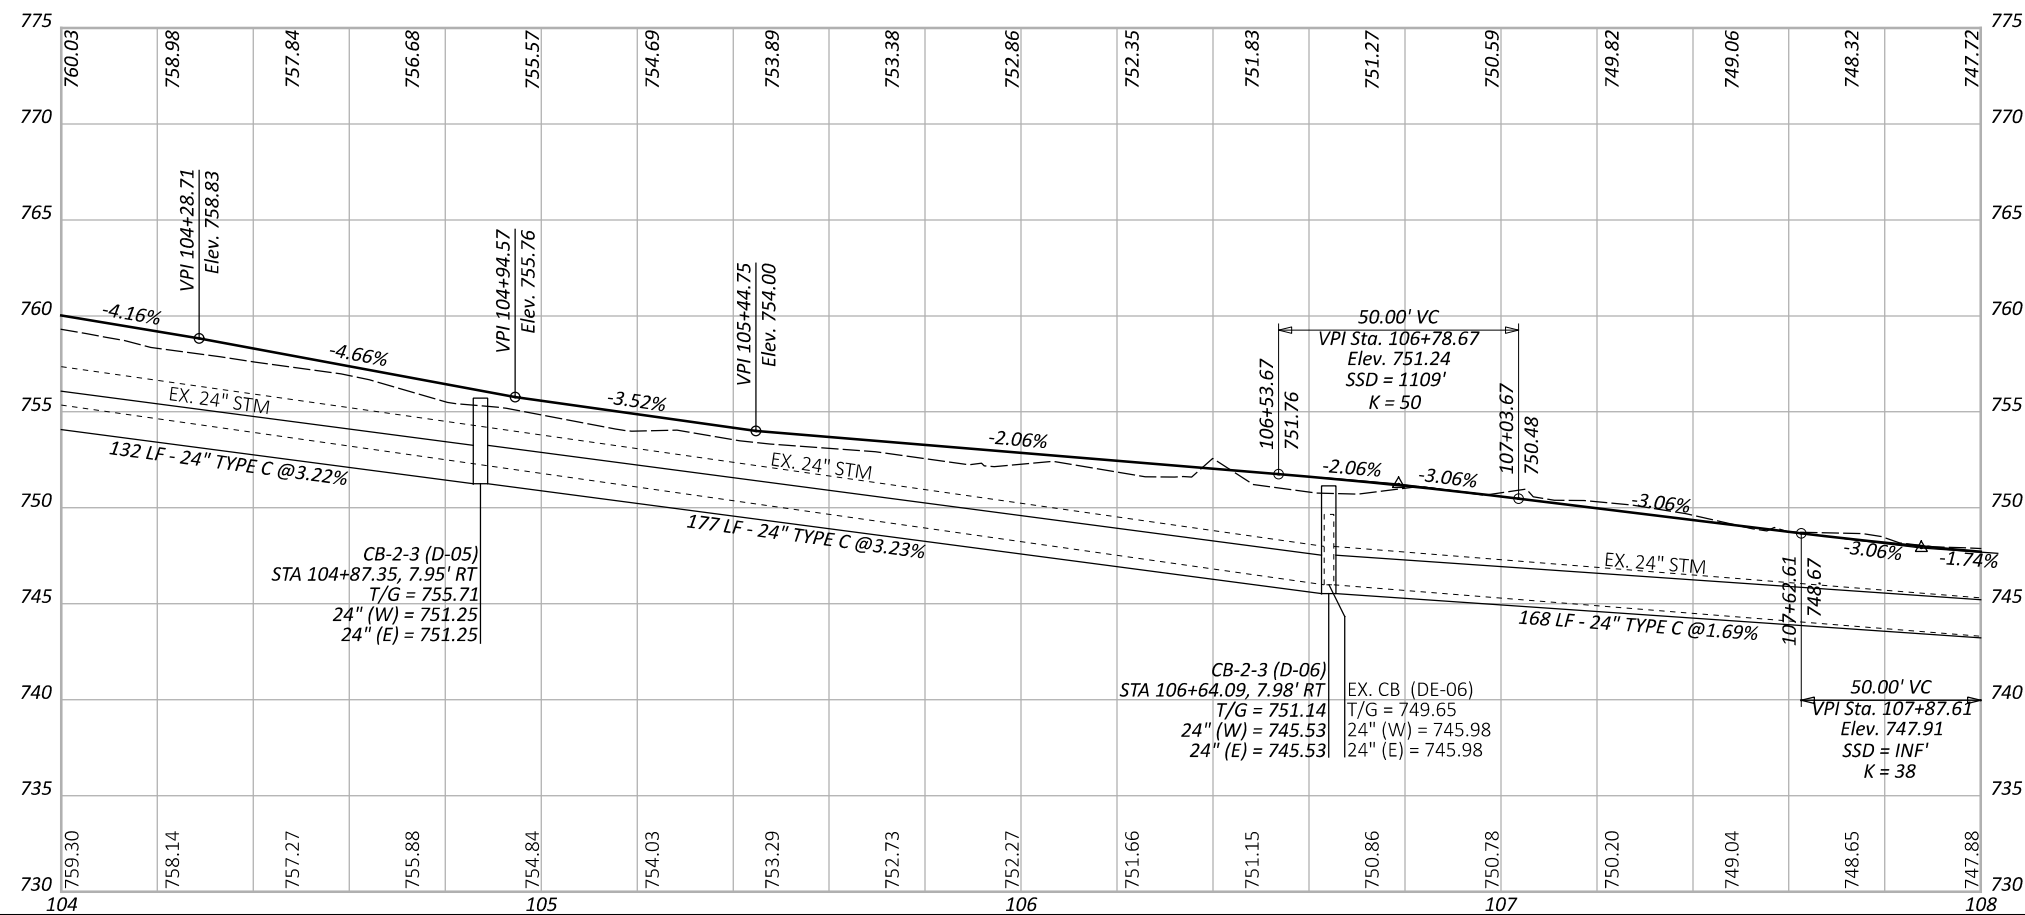

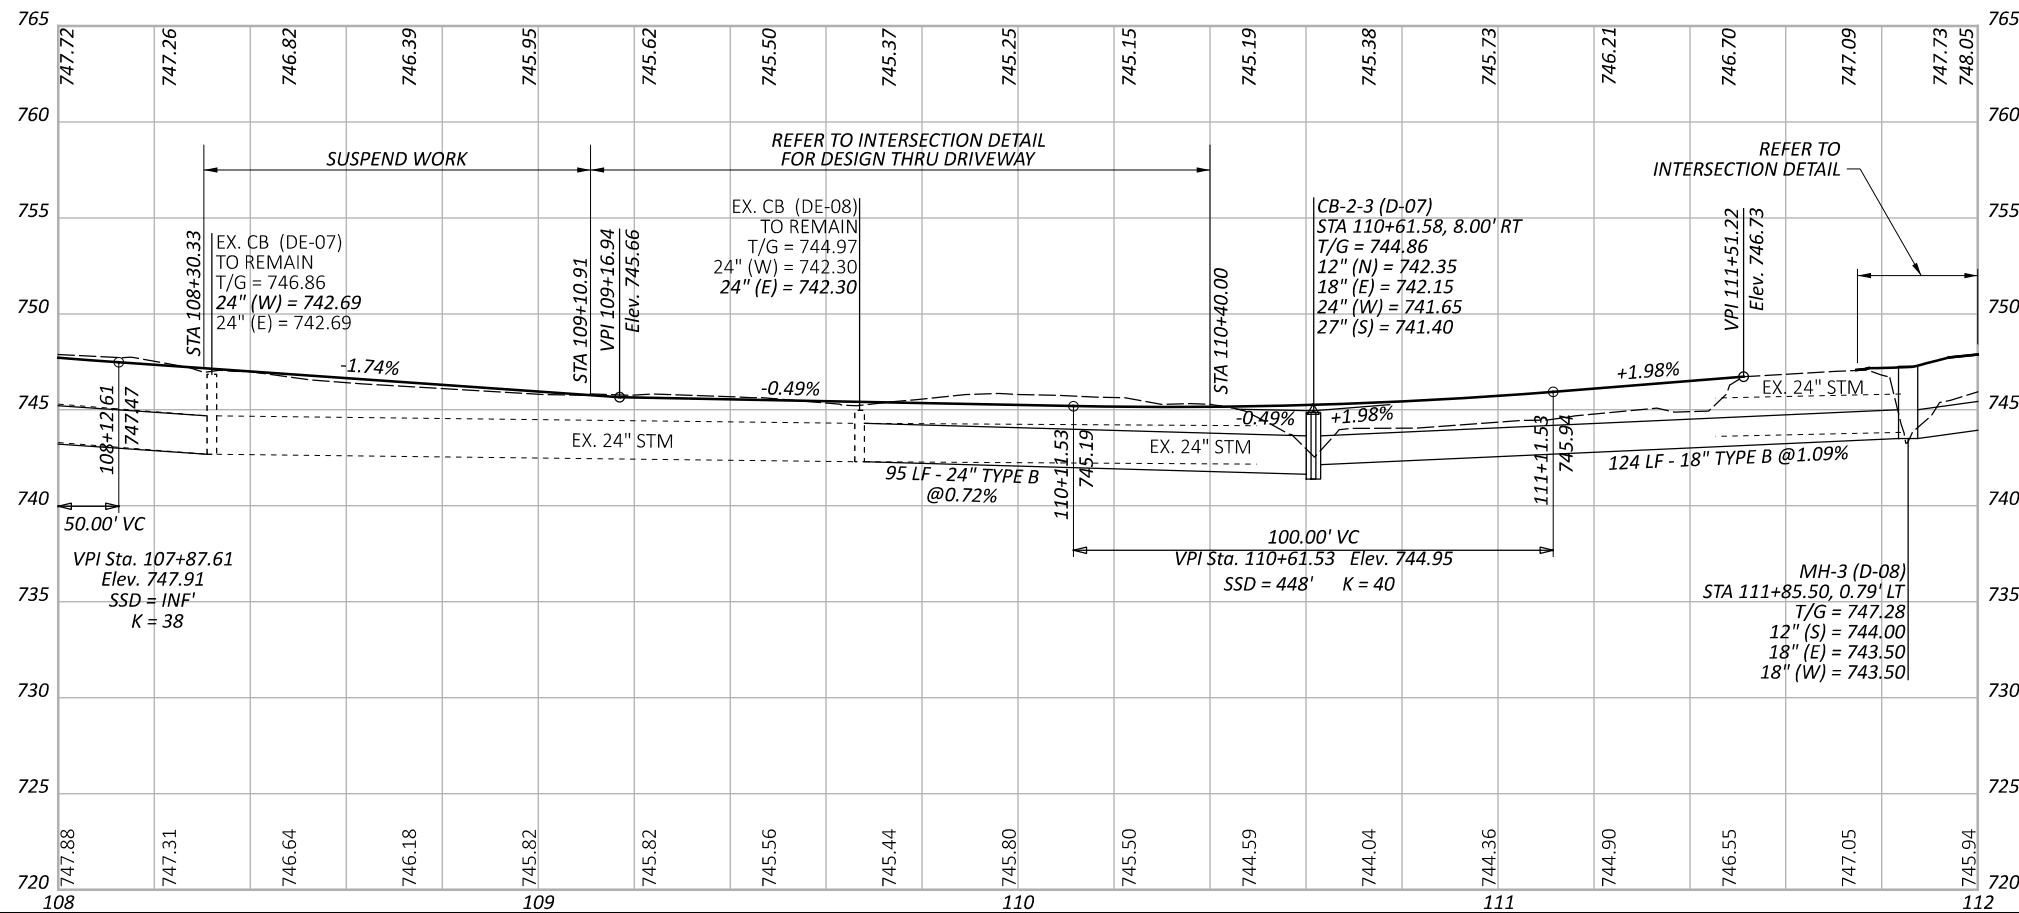

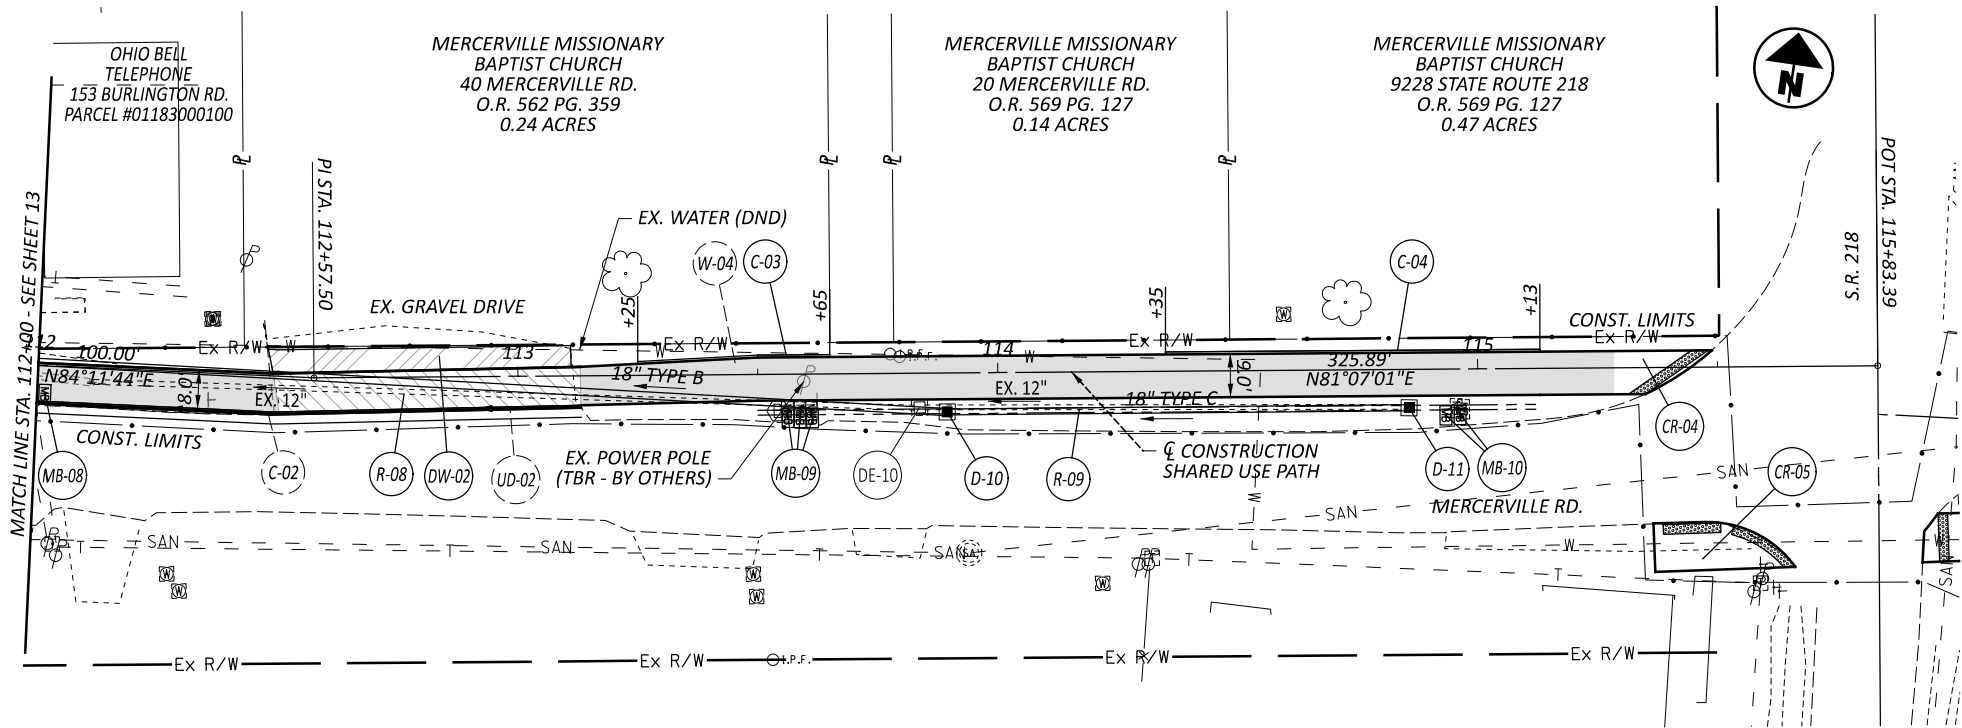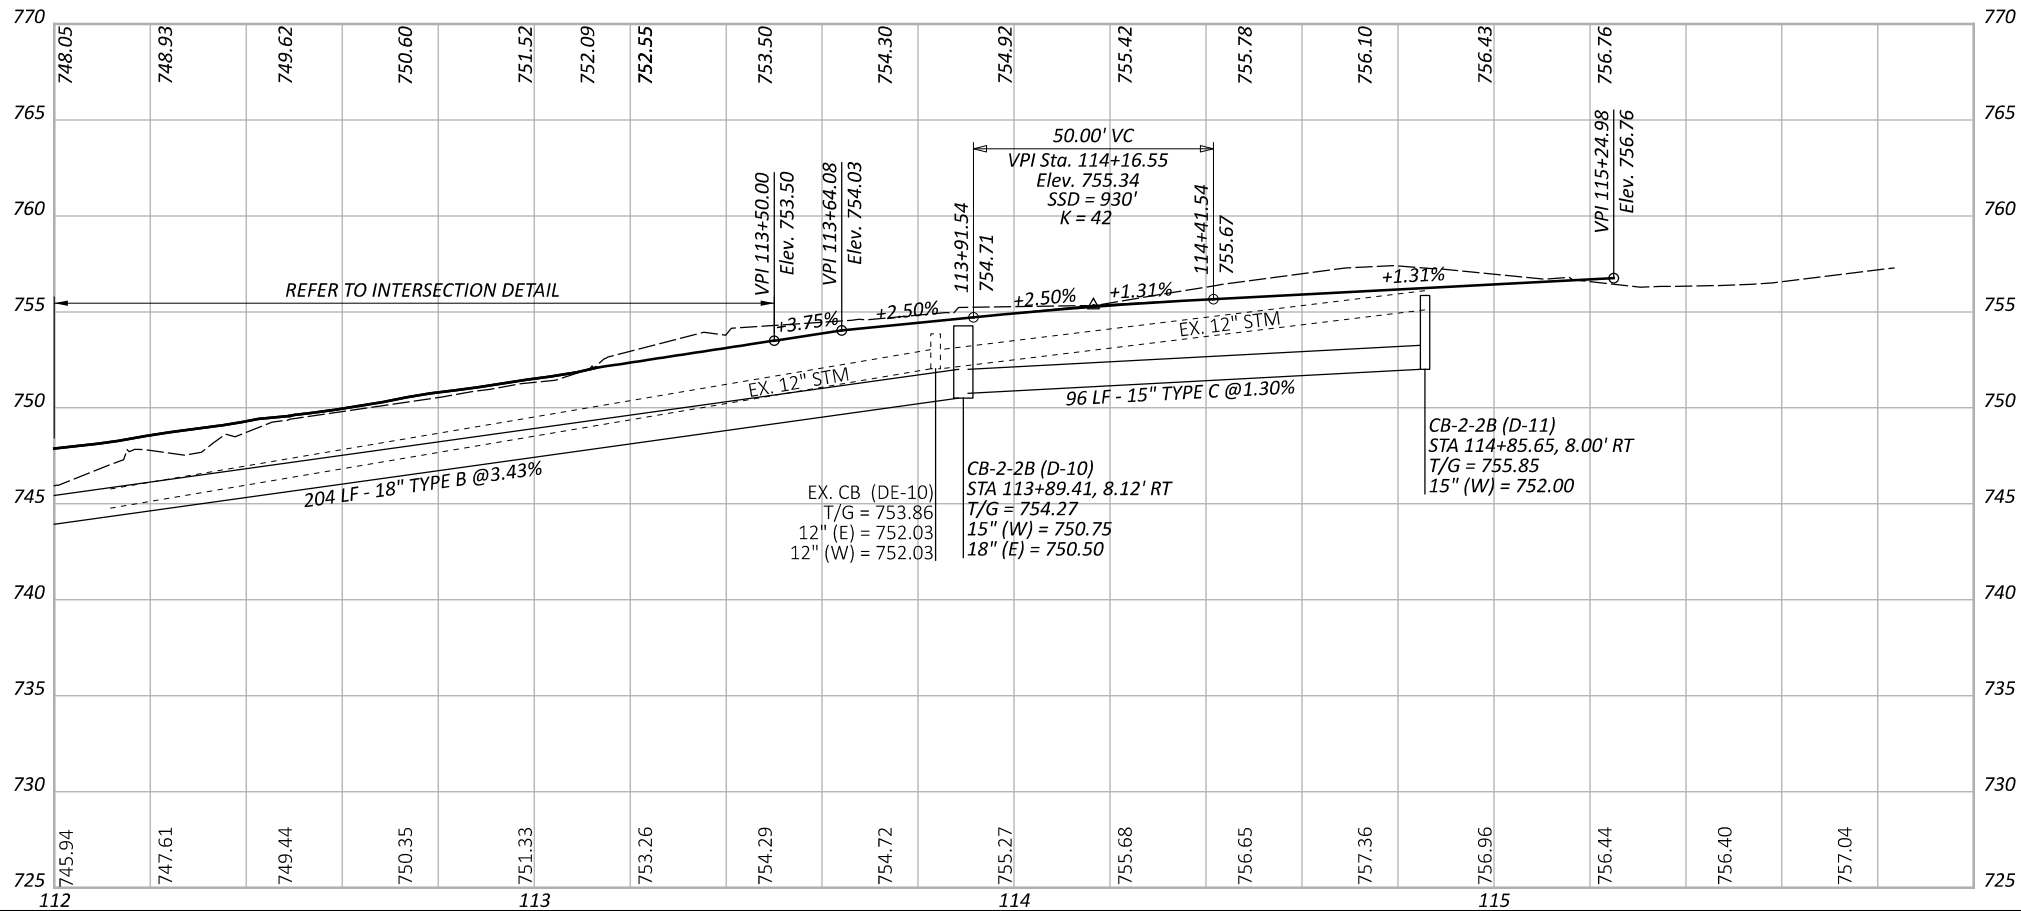

PLAN AND PROFILE
MERCERVILLE RD. - STA. 112+00.00 TO STA. 116+00.00

DESIGN AGENCY



DESIGNER
EMH



REVIEWER
CSR 04/24/25

PROJECT ID
120712

SHEET
14

TOTAL
51



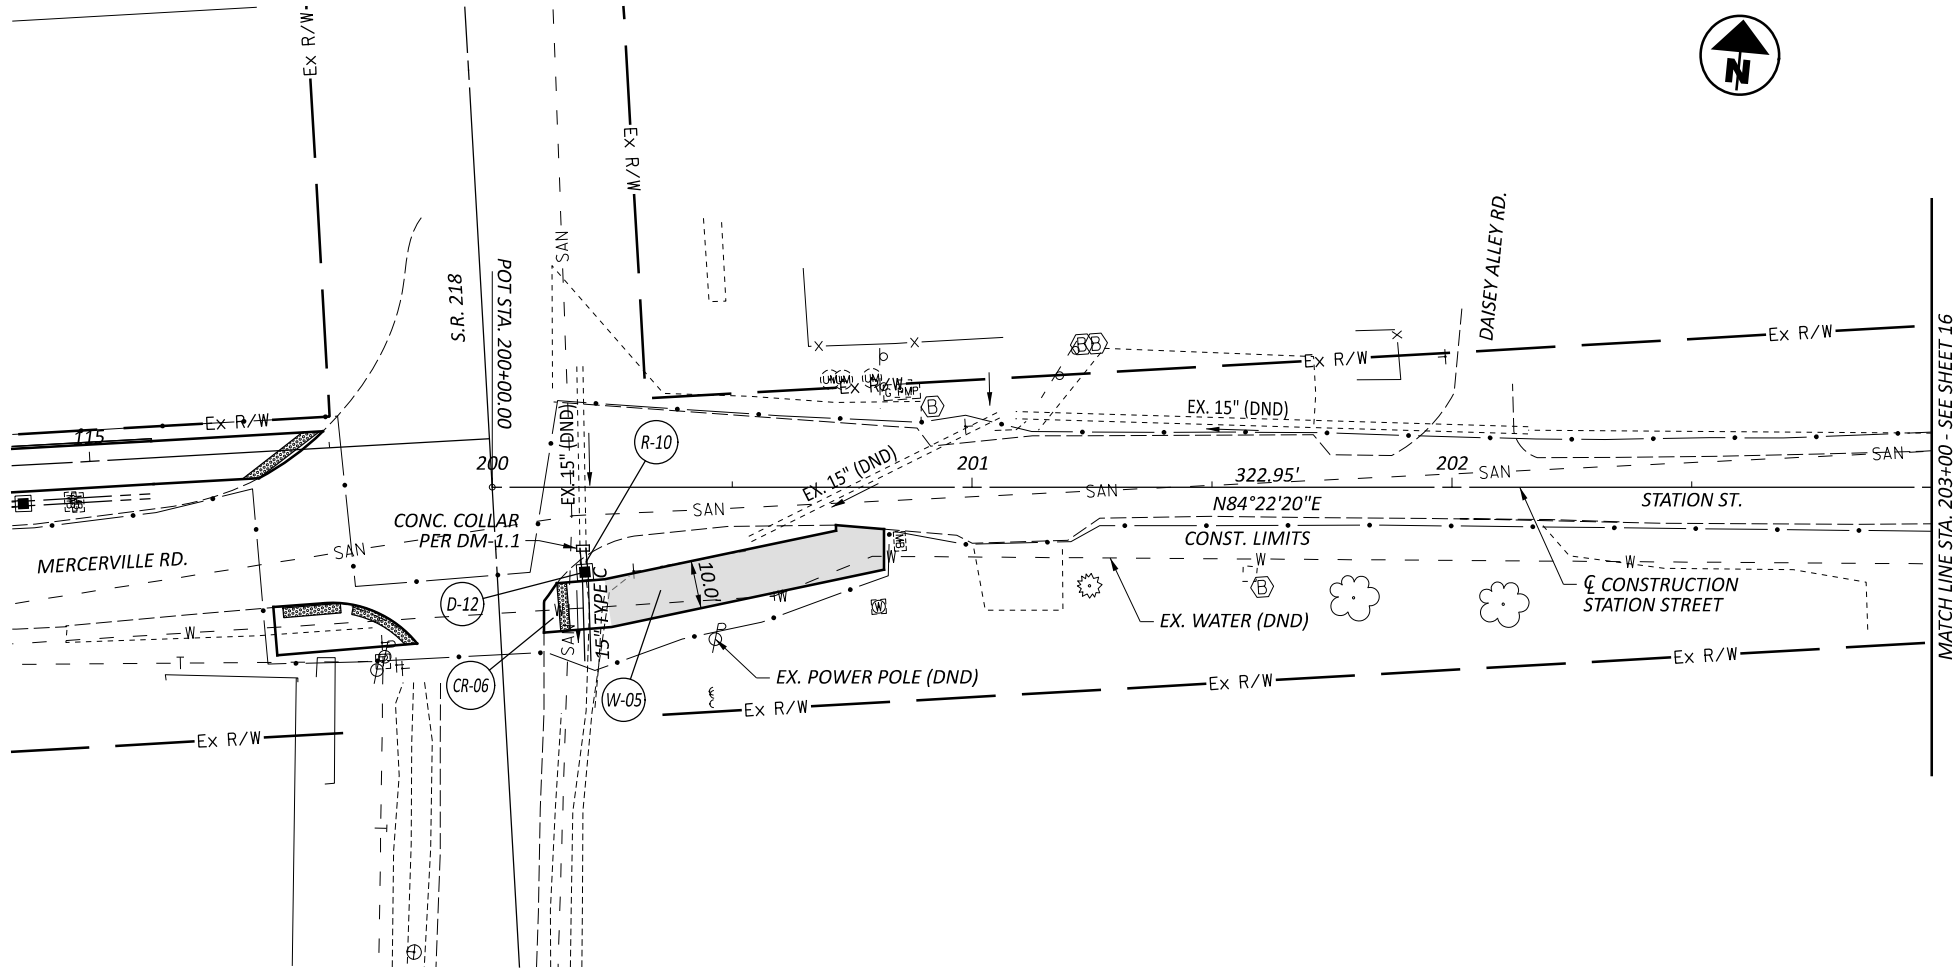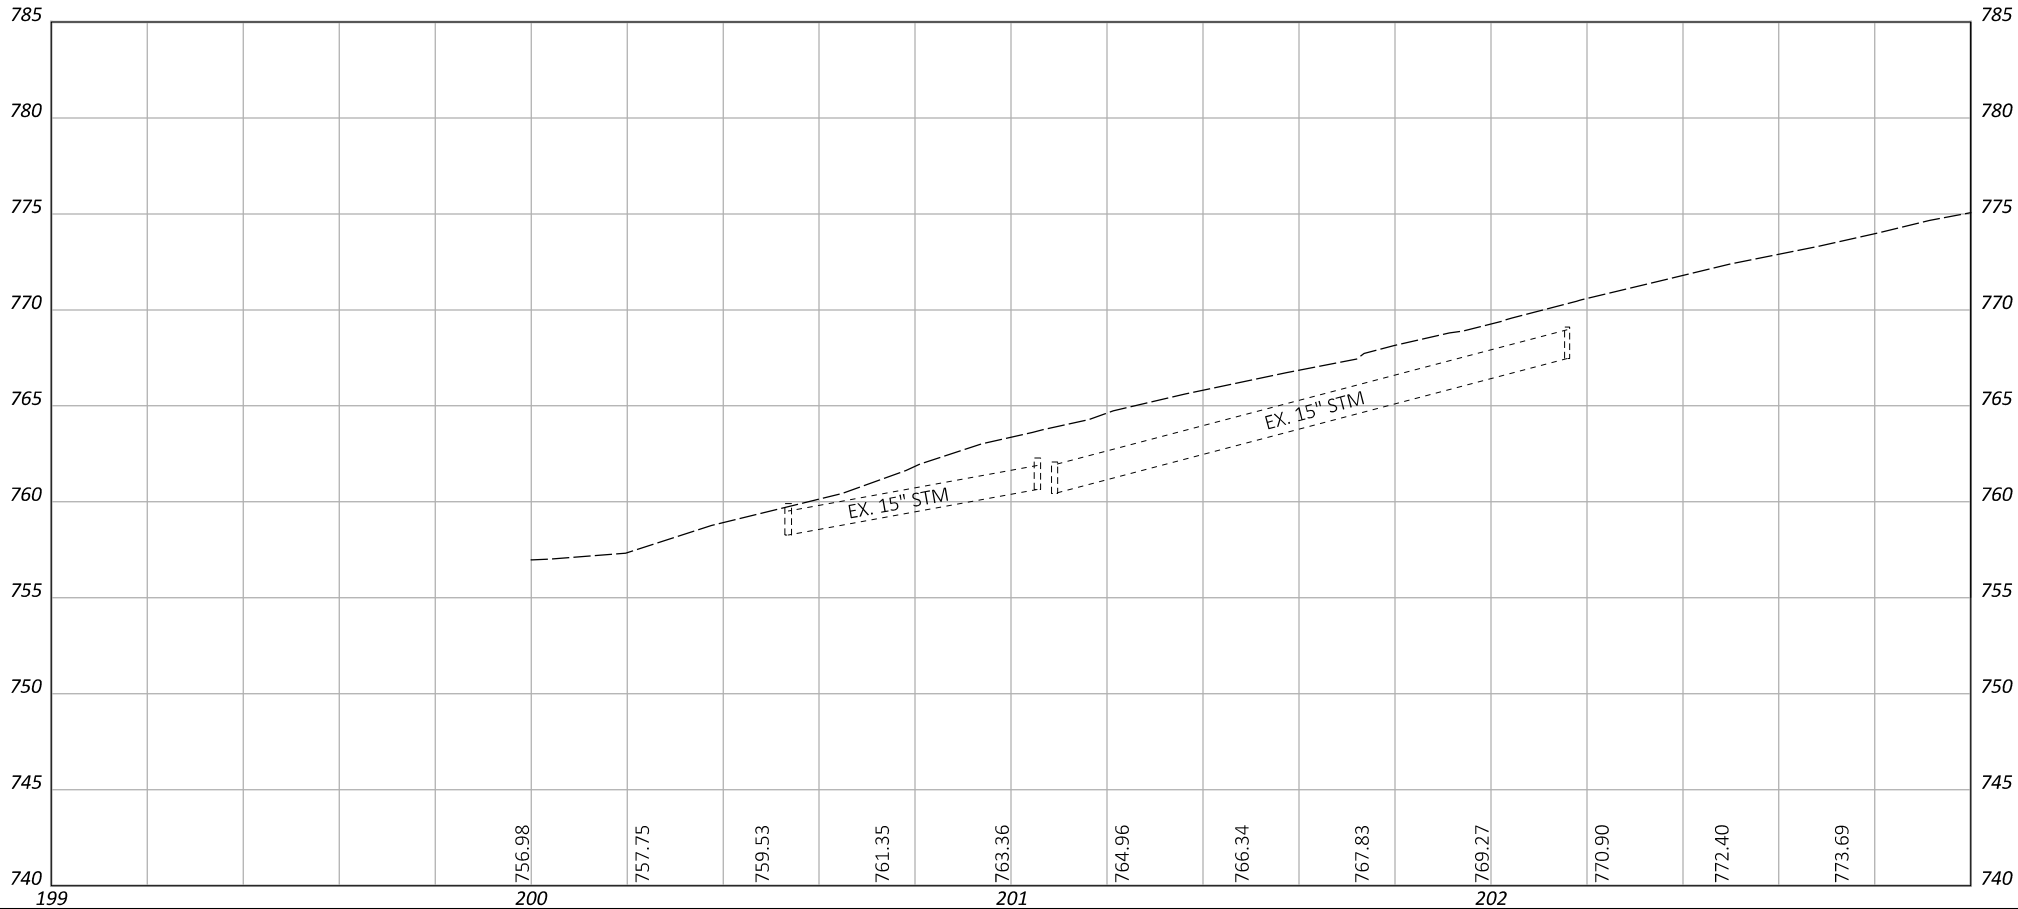

DESIGN AGENCY



DESIGNER

EMH

REVIEWER

CSR 04/24/25

PROJECT ID

120712

SHEET

15



TOTAL

51

PLAN AND PROFILE
STATION ST. - STA. 200+00.00 TO STA. 203+00.00

HORIZONTAL
SCALE IN FEET



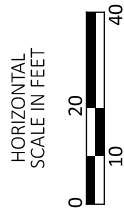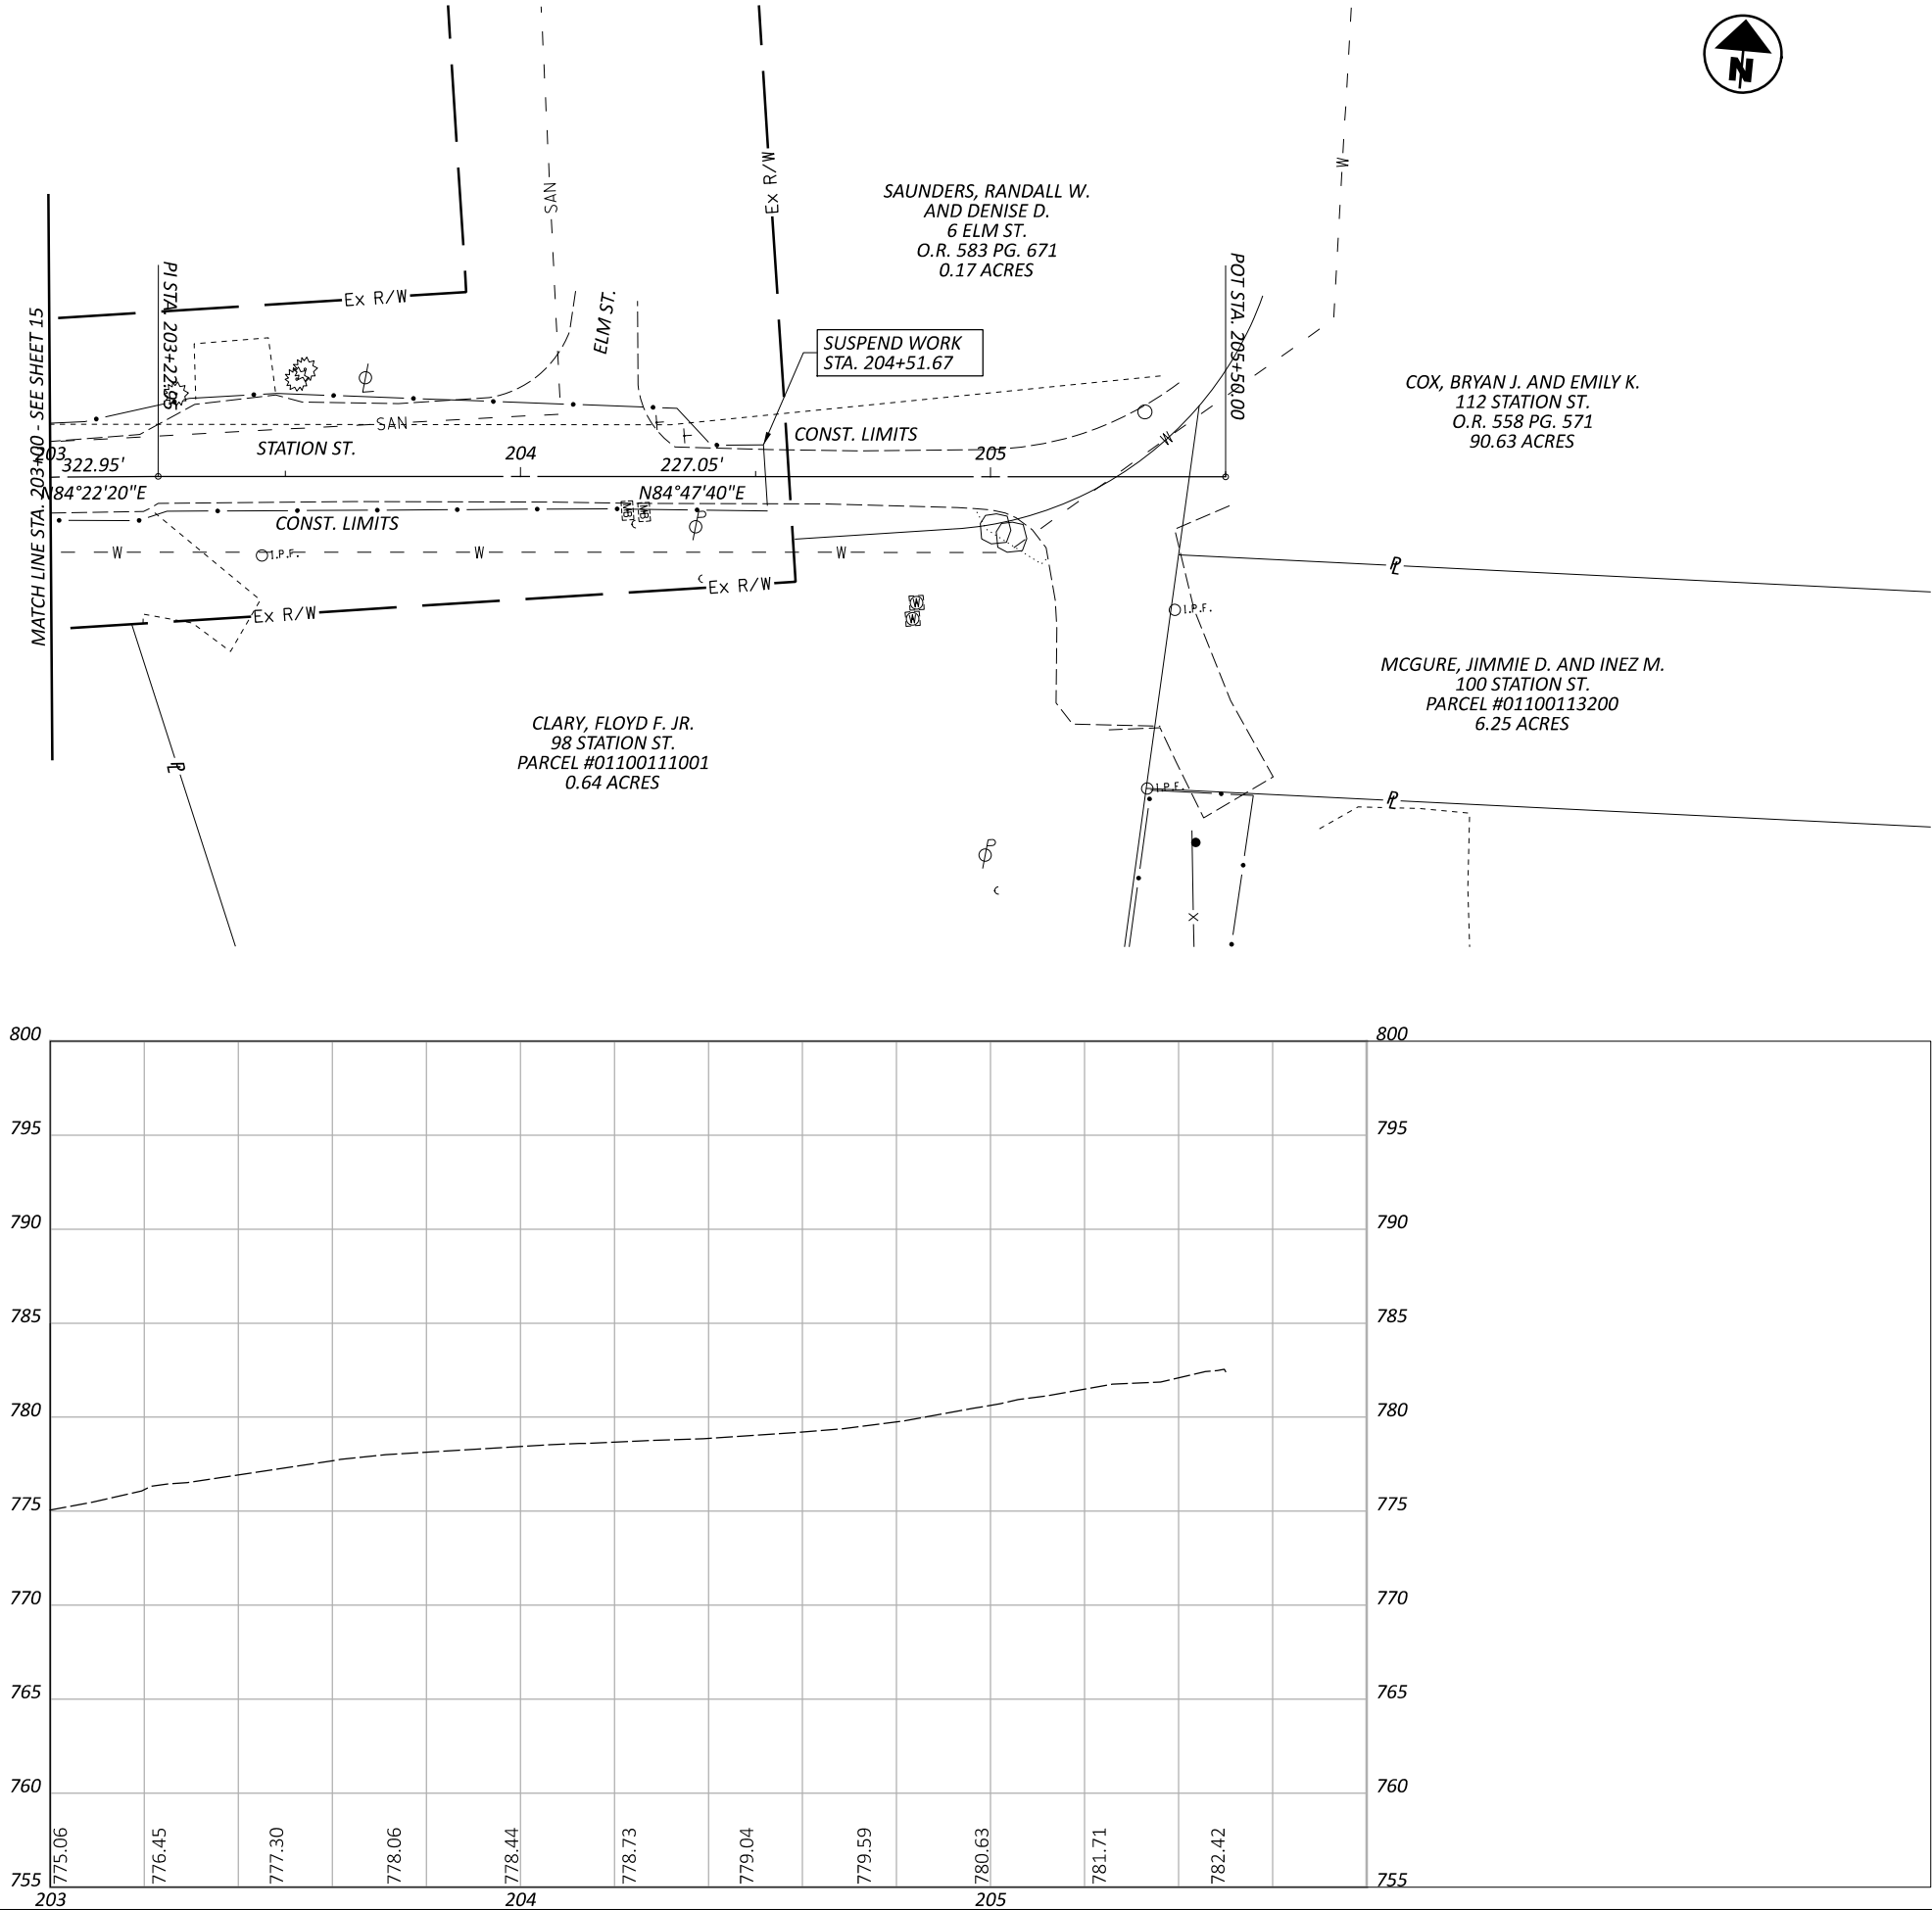

PLAN AND PROFILE
STATION ST. - STA. 203+00.00 TO STA. 205+00.00

DESIGN AGENCY



DESIGNER
EMH

REVIEWER
CSR 04/24/25

PROJECT ID
120712

SHEET TOTAL
16 51

C1 - CURVE DATA
P.I. = STA. 300+26.39
 $\Delta = 19^{\circ}41'54''$ LT
 $Dc = 36^{\circ}57'54''$
 $R = 155.00'$
 $T = 26.91'$
 $L = 53.29'$
 $E = 2.32'$


C2 - CURVE DATA
P.I. = STA. 300+60.24
 $\Delta = 33^{\circ}16'27''$ RT
 $Dc = 229^{\circ}10'59''$
 $R = 25.00'$
 $T = 7.47'$
 $L = 14.52'$
 $E = 1.09'$

C3 - CURVE DATA
P.I. = STA. 301+42.35
 $\Delta = 09^{\circ}26'25''$ LT
 $Dc = 76^{\circ}23'40''$
 $R = 75.00'$
 $T = 6.19'$
 $L = 12.36'$
 $E = 0.26'$

C4 - CURVE DATA
P.I. = STA. 301+80.51
 $\Delta = 12^{\circ}27'40''$ LT
 $Dc = 76^{\circ}23'40''$
 $R = 75.00'$
 $T = 8.19'$
 $L = 16.31'$
 $E = 0.45'$

C5 - CURVE DATA
P.I. = STA. 302+69.64
 $\Delta = 90^{\circ}00'00''$ RT
 $Dc = 95^{\circ}29'35''$
 $R = 60.00'$
 $T = 60'$
 $L = 94.25'$
 $E = 24.85'$

C6 - CURVE DATA
P.I. = STA. 304+05.25
 $\Delta = 68^{\circ}57'00''$ LT
 $Dc = 95^{\circ}29'35''$
 $R = 60.00'$
 $T = 41.20'$
 $L = 72.20'$
 $E = 12.78'$

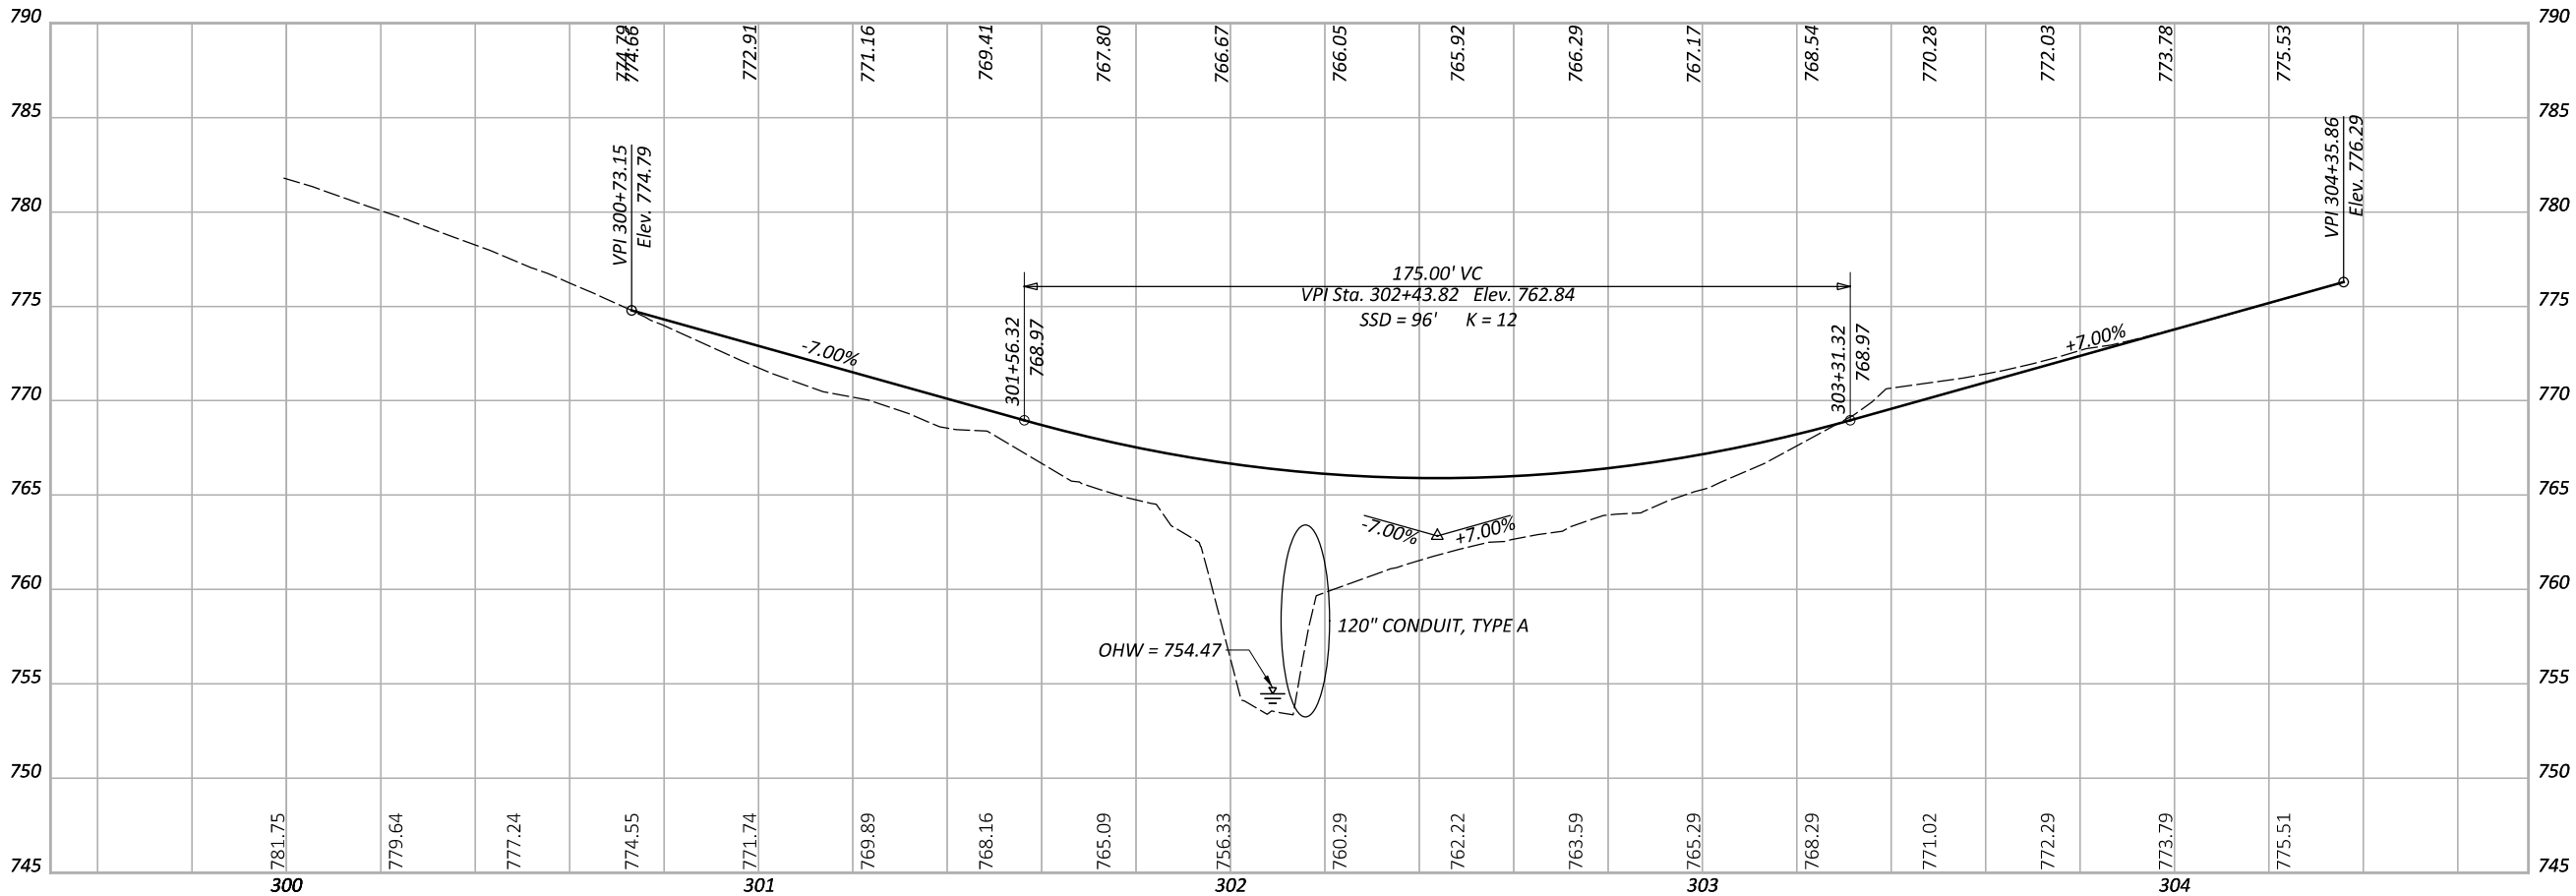

PLAN AND PROFILE
HANNAH TRACE ELEMENTARY CONNECTOR

DESIGN AGENCY



DESIGNER

EMH

REVIEWER

CAM 11/14/25

PROJECT ID


120712




SHEET

17

TOTAL




51

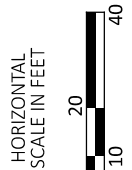

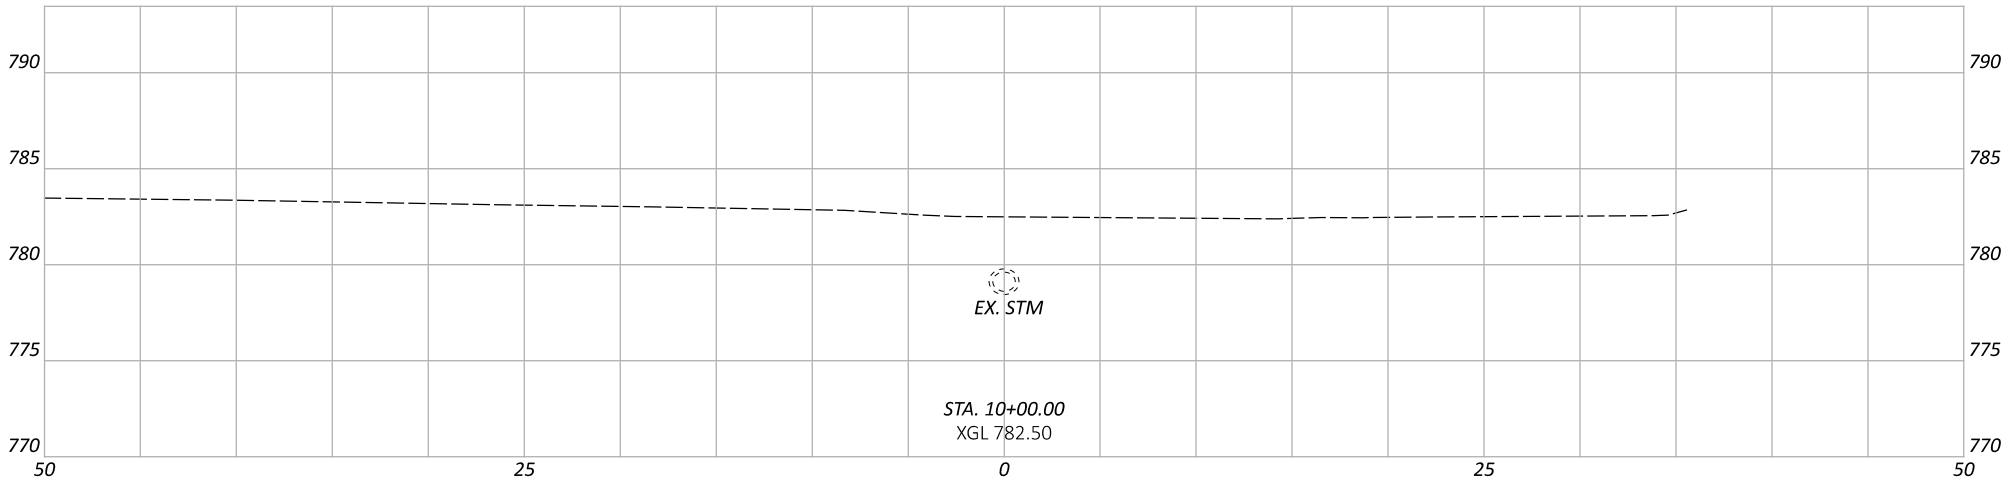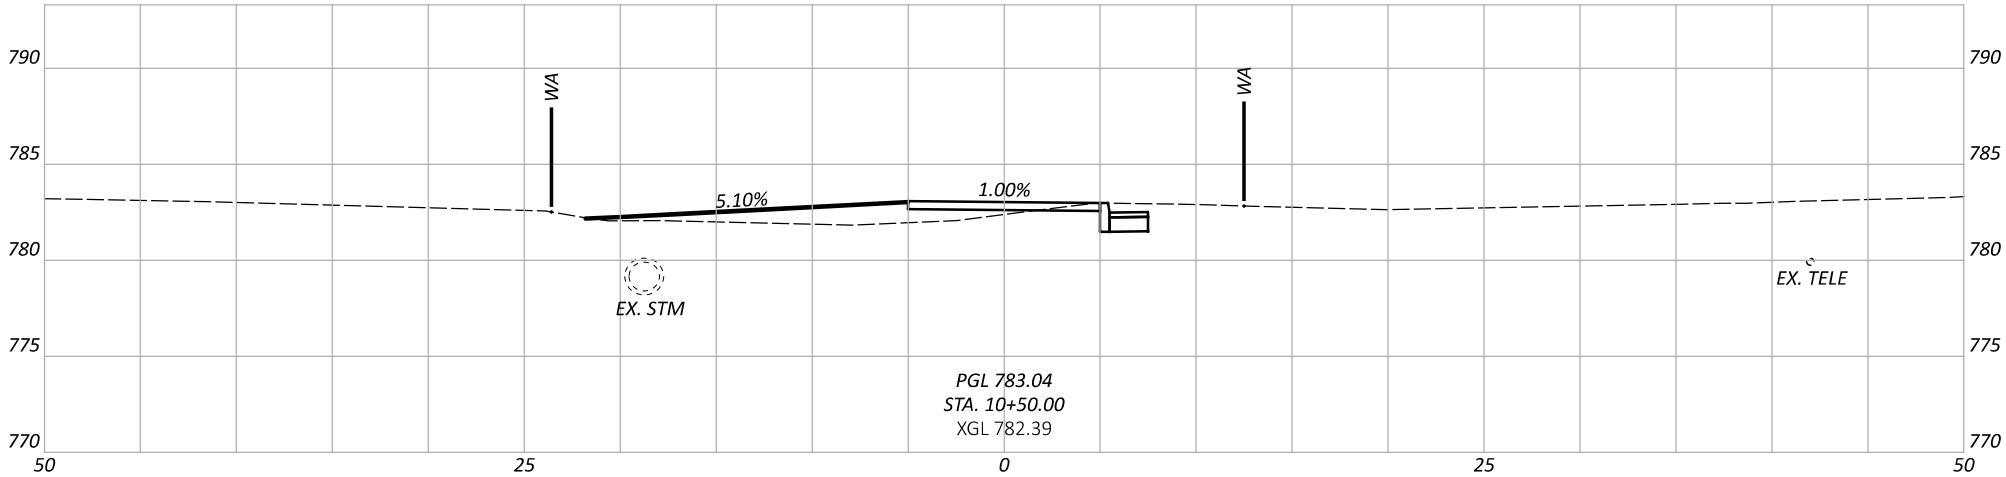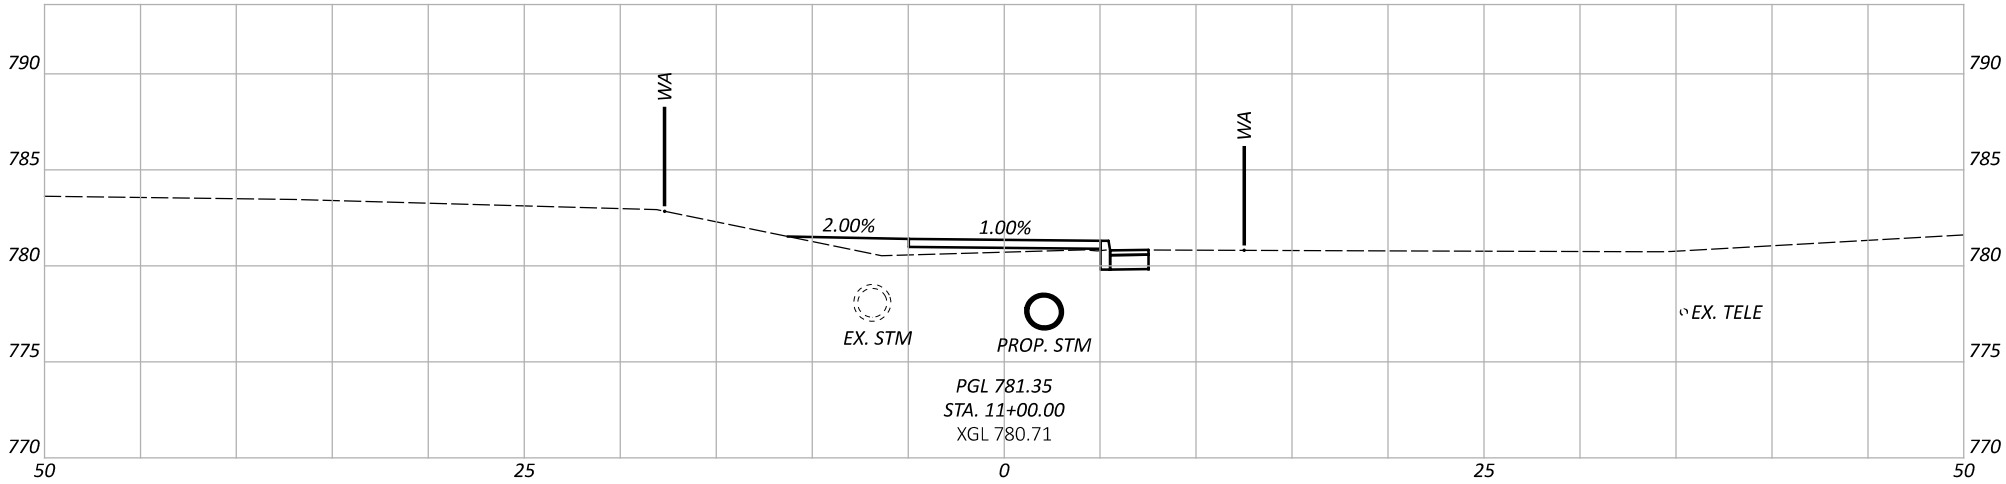

Addendum #1
02/17/2026

Hannah Trace						
Station	Cut Area (Sq.ft.)	Cut Volume (Cu.yd.)	Fill Area (Sq.ft.)	Fill Volume (Cu.yd.)	Seeding FT	Seeding (SY)
10+00.00	0.00	0.00	0.00	0.00	0.00	0.00
10+50.00	4.42	4.09	12.48	11.56	16.84	46.78
11+00.00	2.52	6.43	5.71	16.84	6.28	64.23
11+50.00	2.74	4.87	13.18	17.48	8.61	41.38
12+00.00	2.52	4.87	10.61	22.02	5.99	40.56
12+50.00	2.52	4.66	1.70	11.39	3.05	25.11
13+00.00	0.06	2.38	0.17	1.73	5.75	24.44
13+11.10	0.17	0.05	3.02	0.66	6.99	7.85
13+11.11	0.00	0.00	0.00	0.00	0.00	0.01
TOTAL		27.35		81.68		250.36

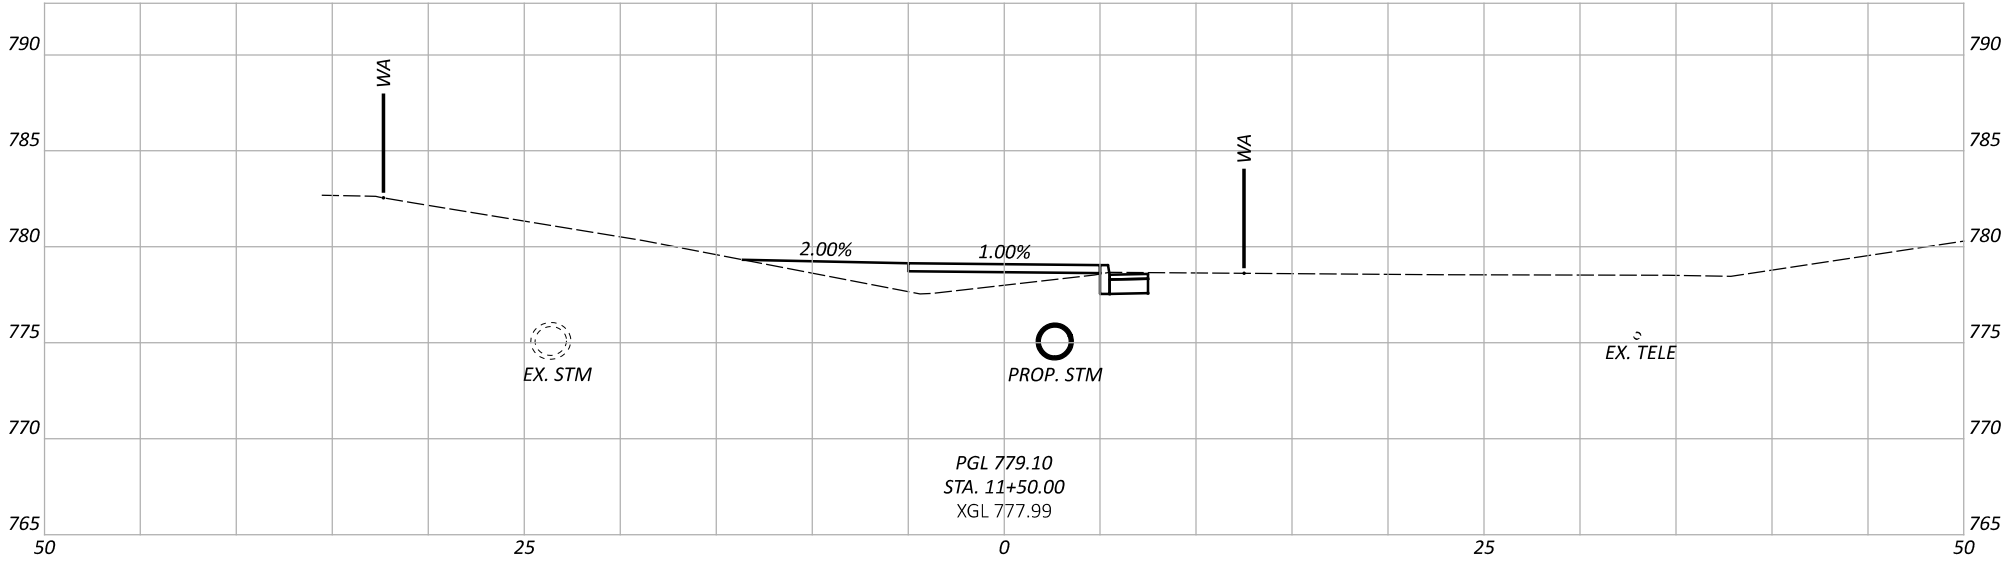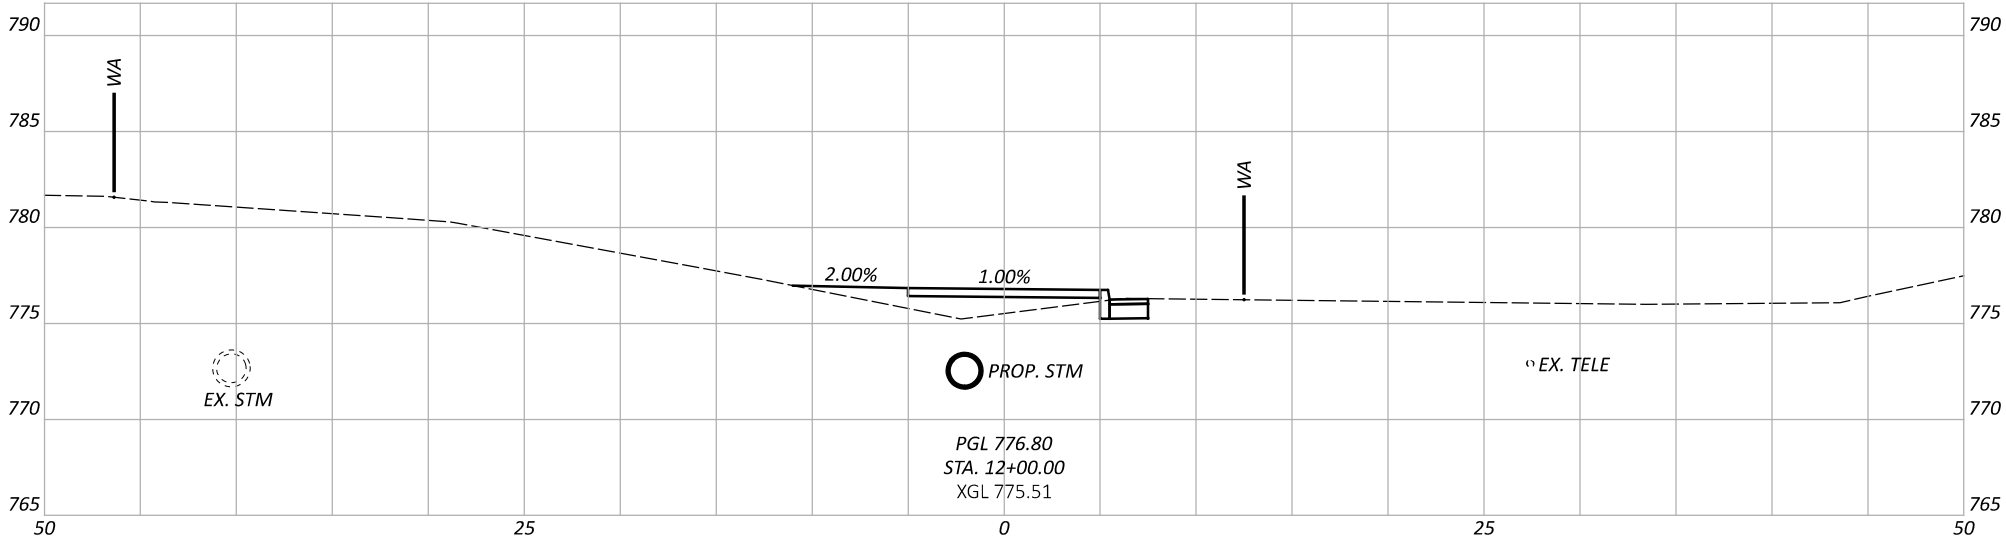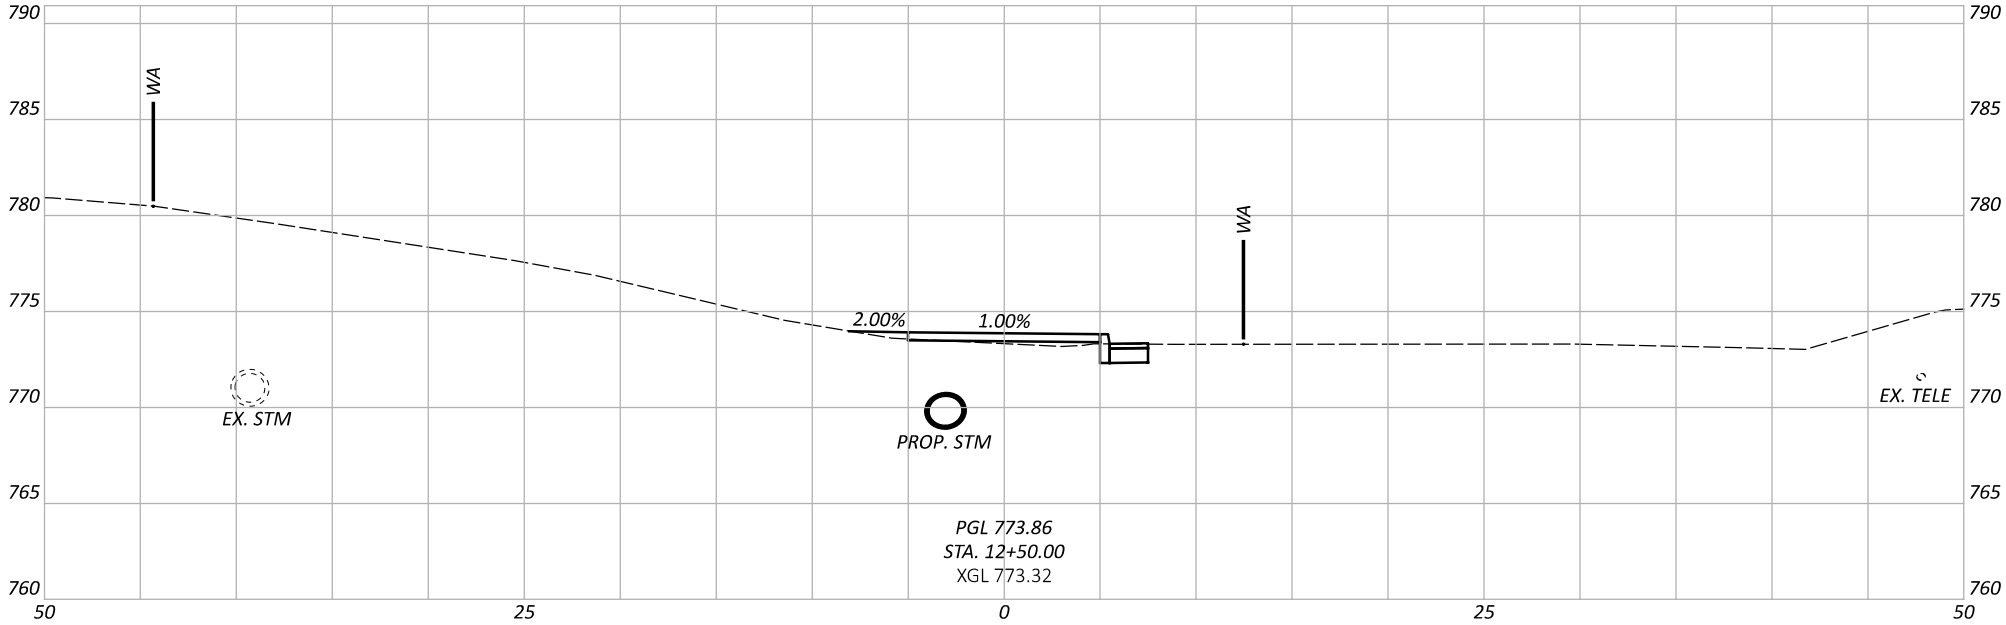

CROSS SECTIONS - OLD HANNAH TRACE RD.
STA 11+50.00 TO STA 12+50.00

DESIGN AGENCY



DESIGNER

EMH

REVIEWER

CAM 11/14/25

PROJECT ID



120712

SHEET

19

TOTAL

51

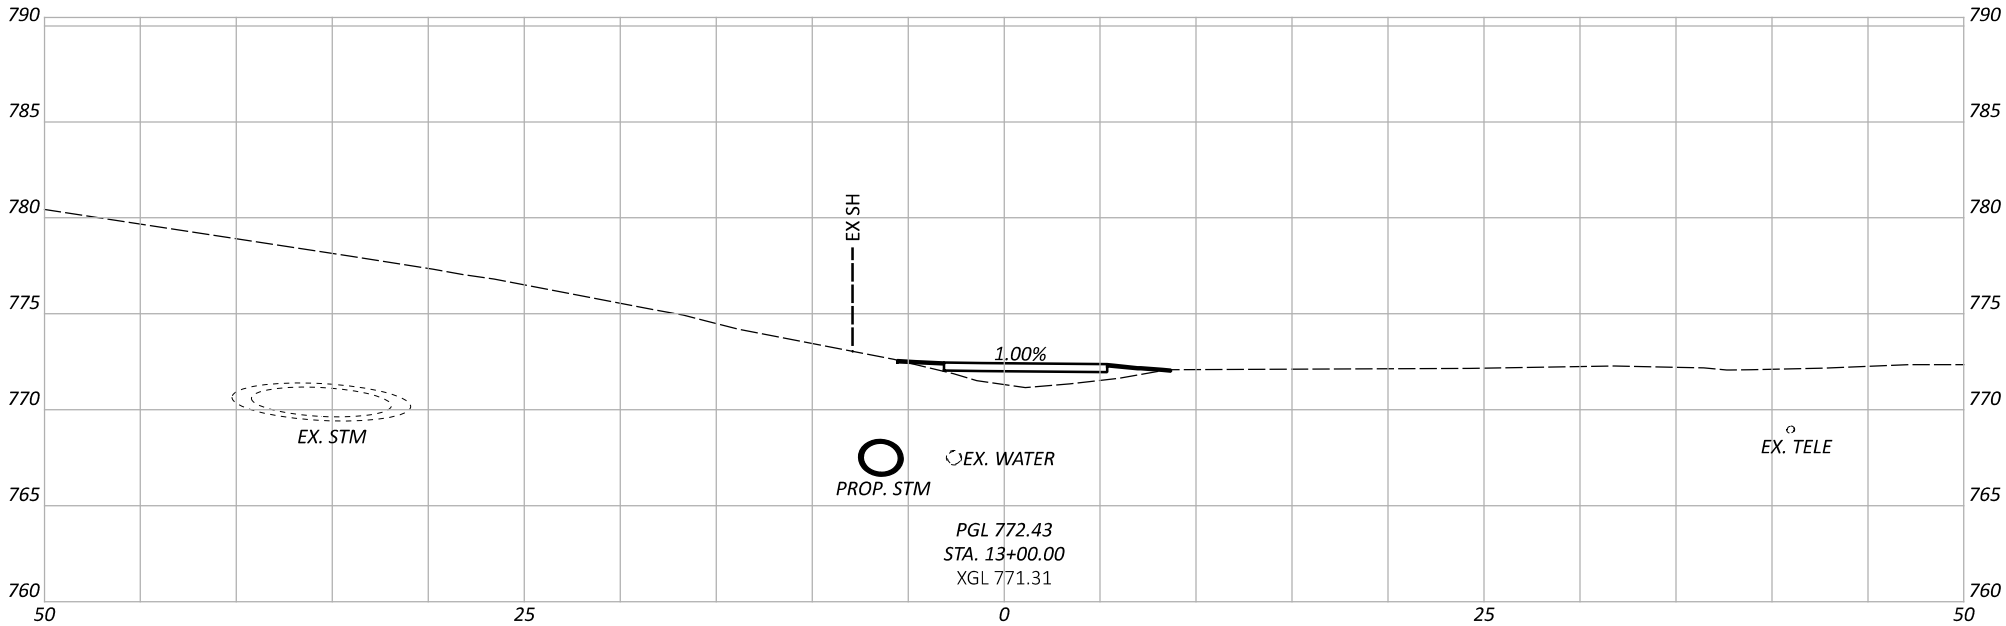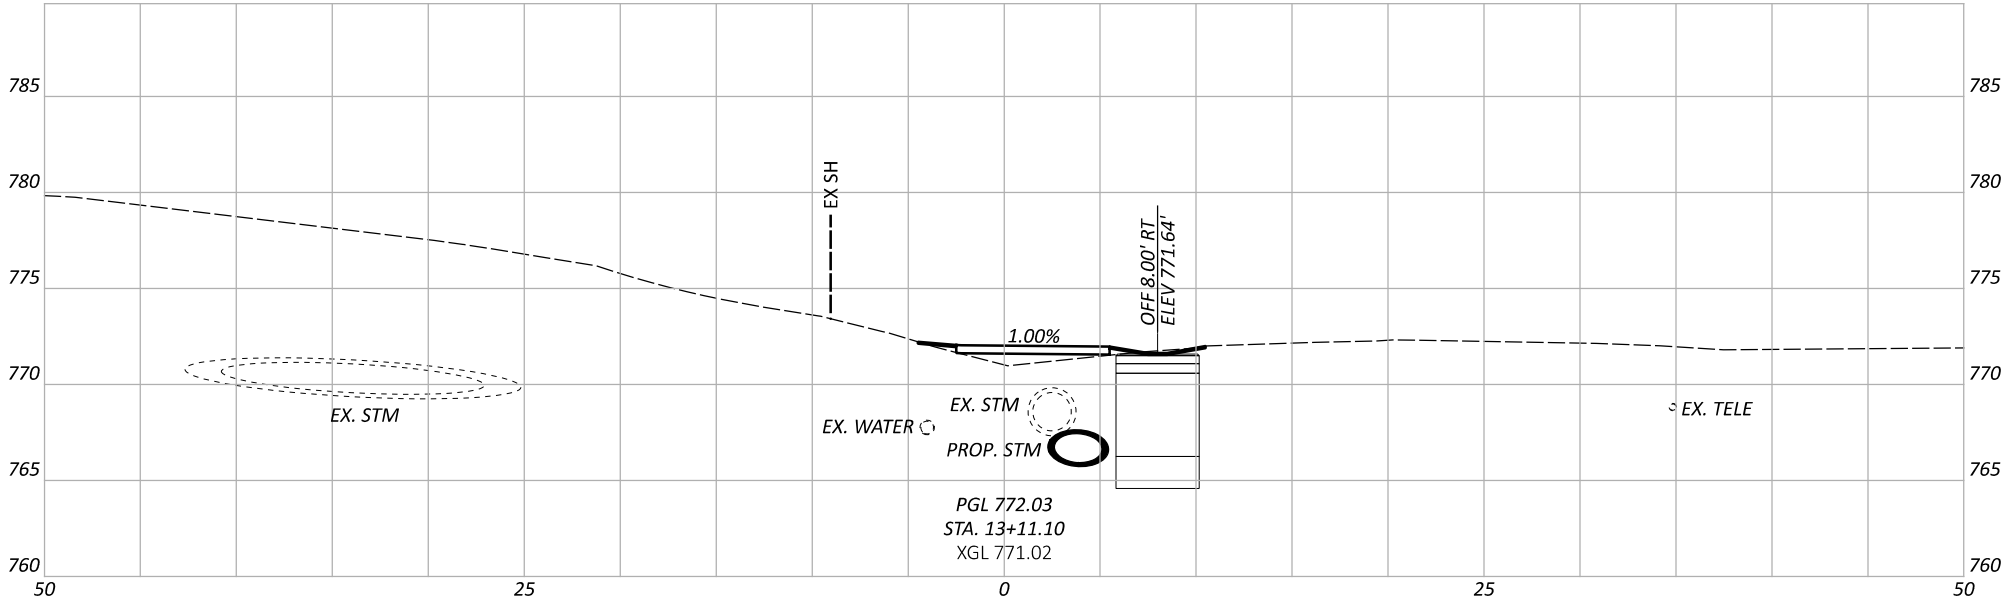

CROSS SECTIONS - OLD HANNAH TRACE RD.
STA 13+00.00 TO STA 13+11.10

DESIGN AGENCY





DESIGNER
EMH

REVIEWER
CAM 11/14/25

PROJECT ID
120712

SHEET
20

TOTAL
51

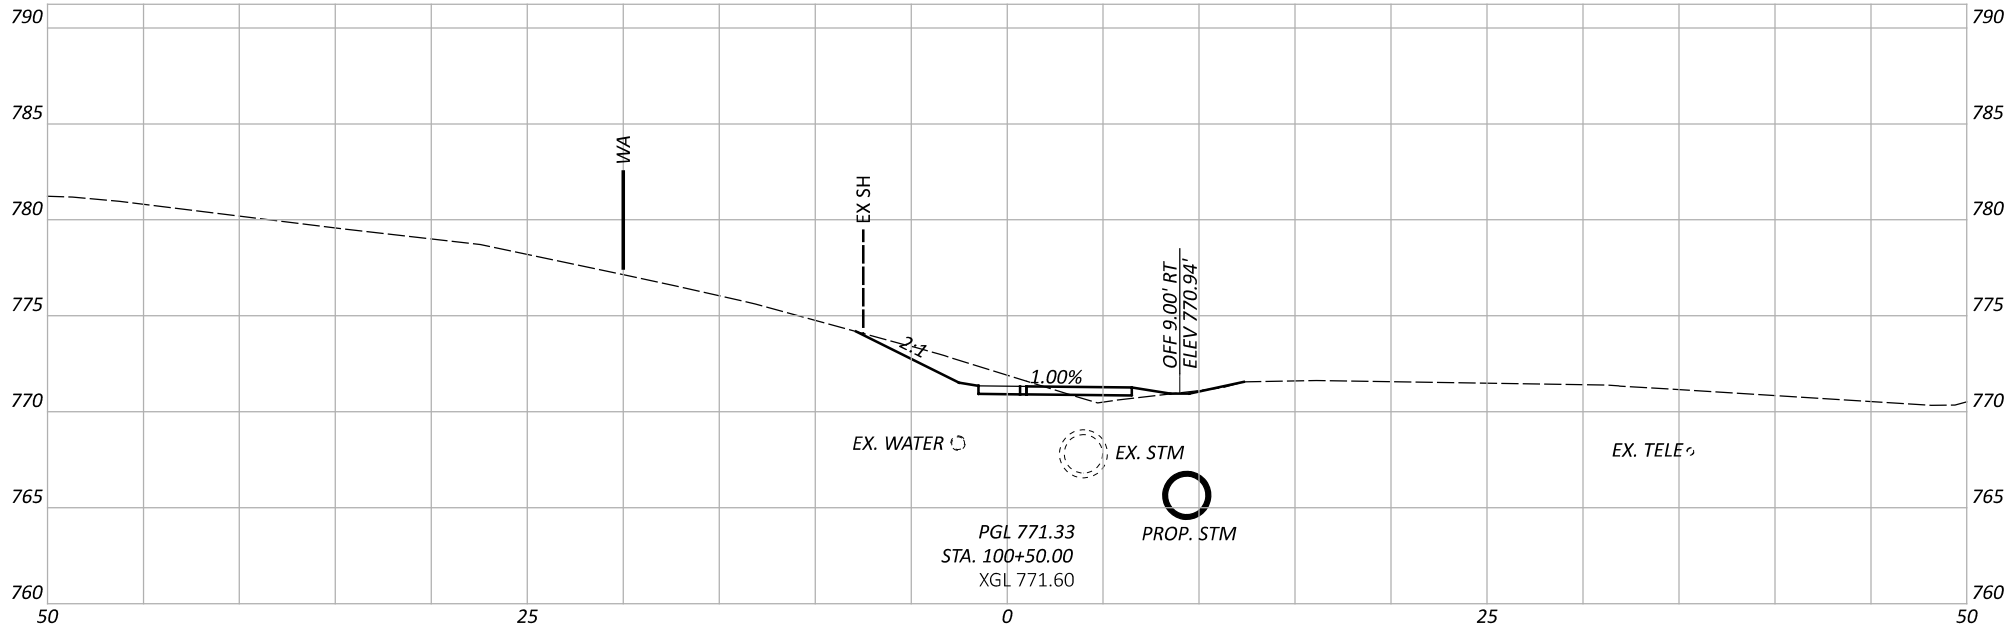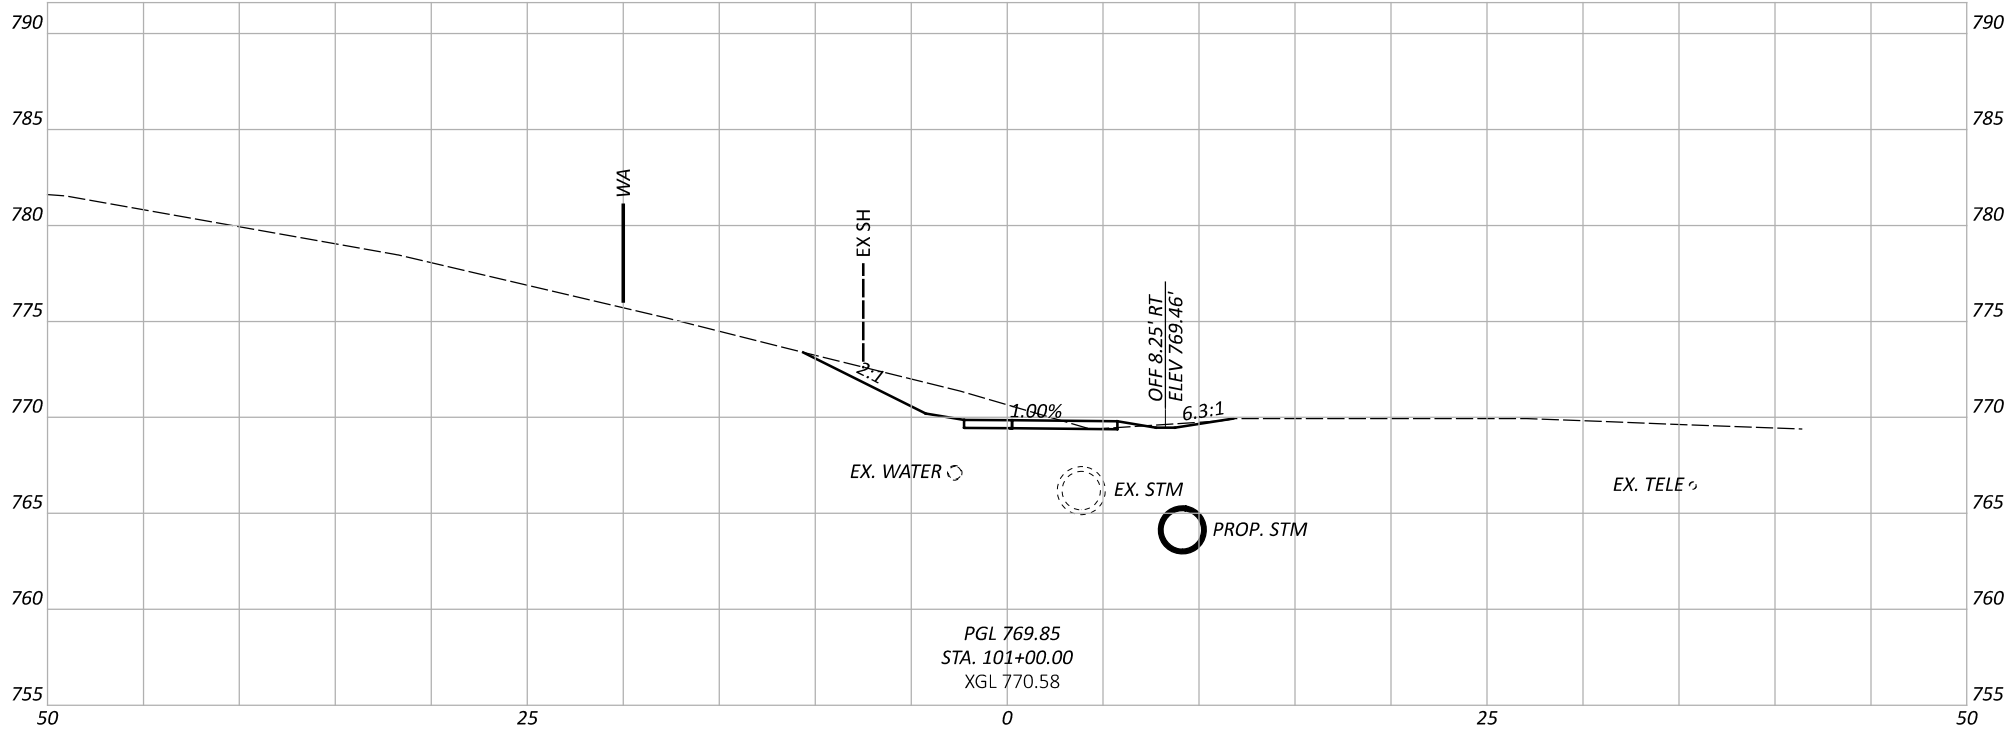

Addendum #1
02/17/2026

Mercerville Road						
Station	Cut Area (Sq.ft.)	Cut Volume (Cu.yd.)	Fill Area (Sq.ft.)	Fill Volume (Cu.yd.)	Seeding FT	Seeding (SY)
100+26.19	0	0	0	0	0	0
100+26.20	0.17	0.00	3.02	0.00	6.99	0.00
100+50.00	7.92	3.56	1.44	1.96	12.21	25.38
101+00.00	14.72	20.96	0.26	1.57	14.39	73.87
101+50.00	12.38	25.10	0.60	0.79	13.46	77.36
102+00.00	6.68	17.65	1.69	2.12	12.66	72.54
102+50.00	3.98	9.87	2.22	3.62	11.28	66.48
103+00.00	3.34	6.78	2.94	4.78	14.72	72.22
103+50.00	1.51	4.49	4.88	7.24	12.62	75.95
104+00.00	0.27	1.64	4.23	8.44	8.41	58.42
104+50.00	0.17	0.40	3.52	7.17	7.78	44.96
105+00.00	0.02	0.17	4.30	7.24	7.80	43.27
105+50.00	0.11	0.12	4.80	8.43	8.41	45.03
106+00.00	0.32	0.40	6.27	10.25	9.36	49.35
106+50.00	1.83	1.99	1.35	7.05	11.87	58.97
107+00.00	8.16	9.24	0.00	1.25	11.78	65.71
107+50.00	3.47	10.76	3.58	3.31	10.50	61.91
108+00.00	0.00	3.21	0.00	3.31	8.87	53.81
108+30.33	0.00	0.00	0.00	0.00	0.00	14.94
109+10.91	0.00	0.00	0.00	0.00	0.00	0.00
109+50.00	6.83	4.94	0.00	0.00	0.00	0.00
110+00.00	16.32	21.43	0.00	0.00	0.00	0.00
110+50.00	0.25	15.34	14.93	13.82	8.15	22.64
111+00.00	0.00	0.23	22.17	34.35	8.88	47.31
111+50.00	2.22	2.06	0.00	20.53	0.00	24.68
112+00.00	2.83	4.67	16.59	15.36	2.93	8.13
112+50.00	8.44	10.43	0.00	15.36	0.00	8.13
113+00.00	7.77	15.00	0.00	0.00	0.00	0.00
113+50.00	12.50	18.76	0.00	0.00	6.21	17.24
114+00.00	8.23	19.20	0.13	0.12	9.07	42.44
114+50.00	12.05	45.46	0.30	0.56	9.21	85.67
115+00.00	8.34	30.68	0.12	0.46	8.05	95.13
115+50.00	0.00	7.72	0.00	0.11	0.00	22.37
TOTAL		312.26		179.2		1333.91

CROSS SECTIONS - MERCERVILLE RD.
STA 100+50.00 TO STA 101+00.00

DESIGN AGENCY



DESIGNER

EMH

REVIEWER

CSR 04/24/25

PROJECT ID



120712



SHEET



21



TOTAL

51

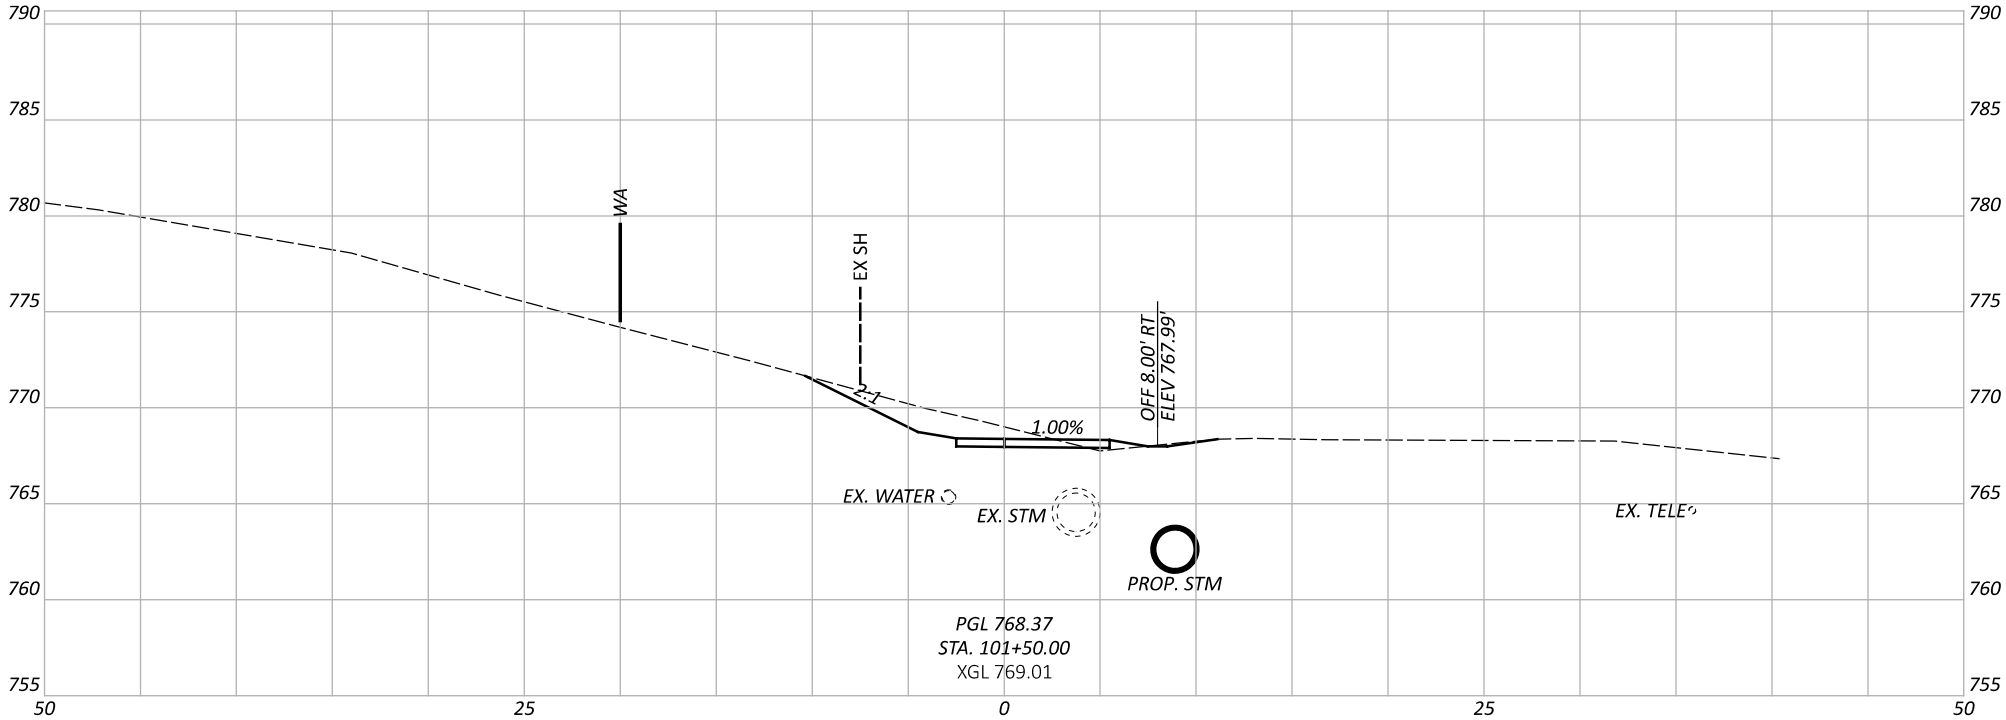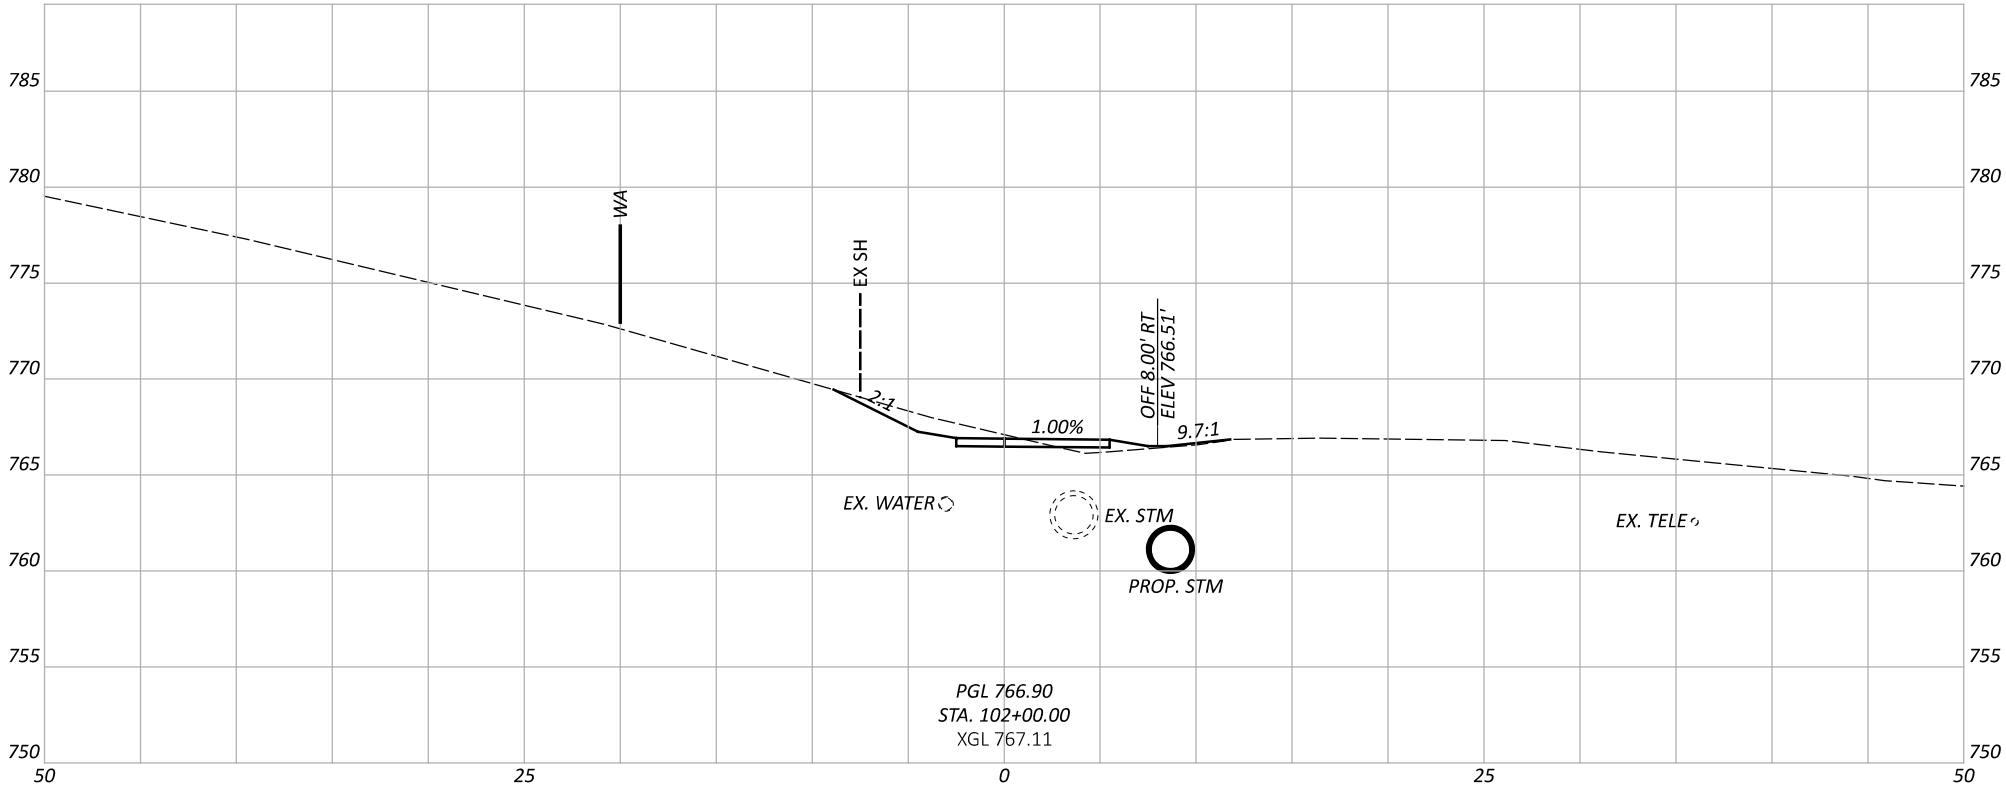

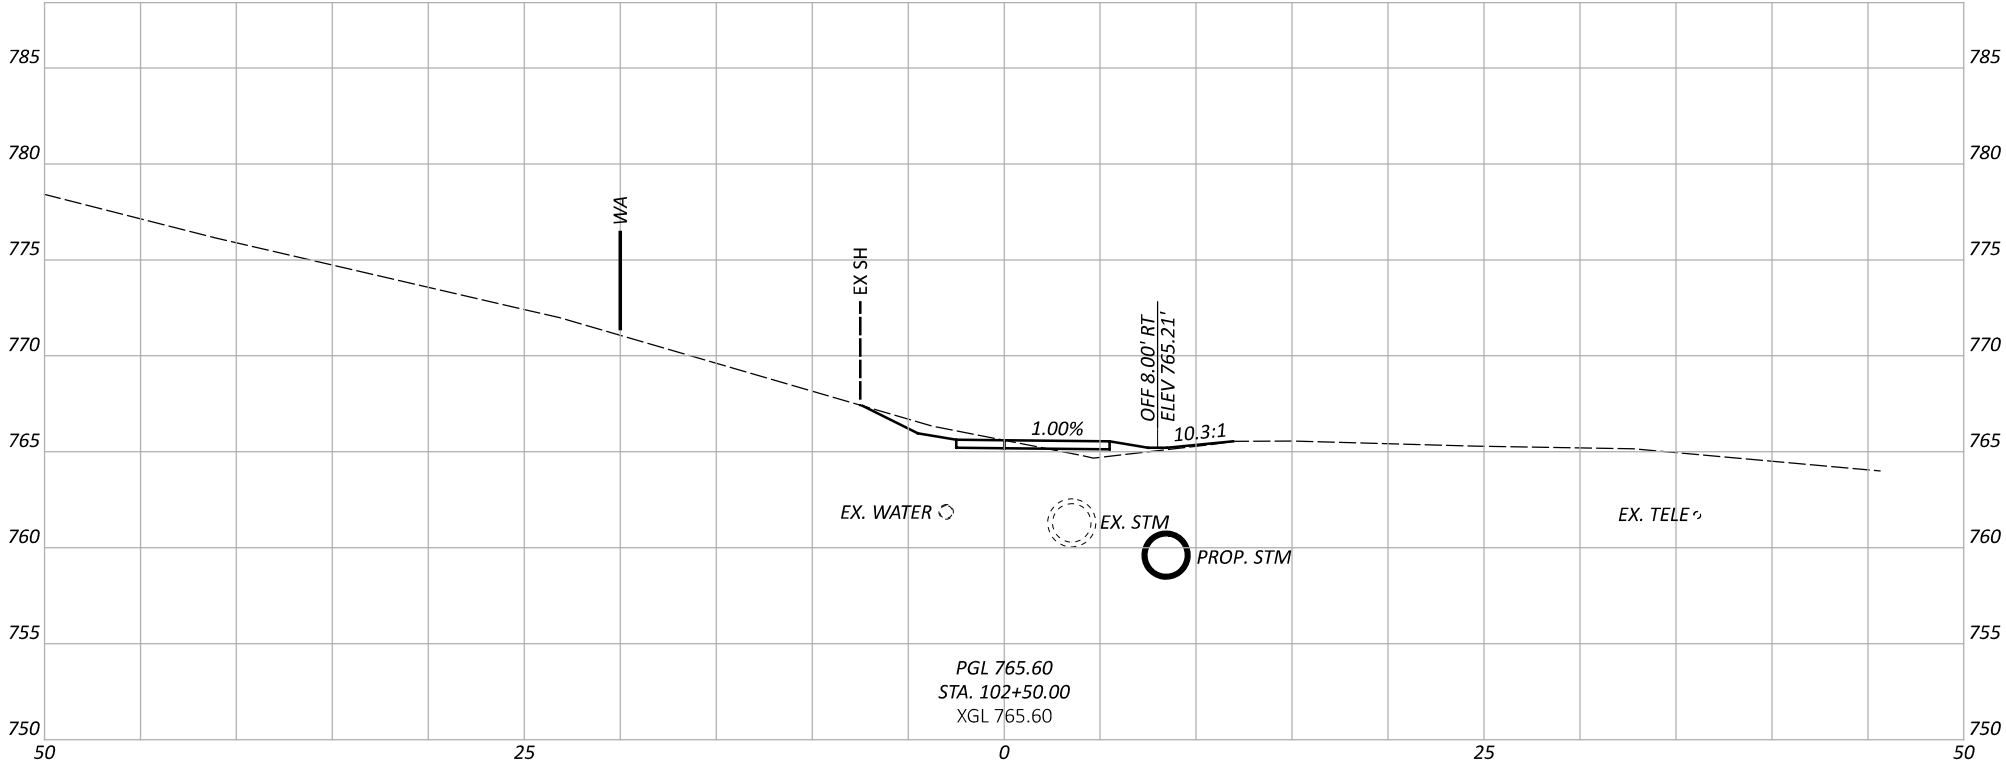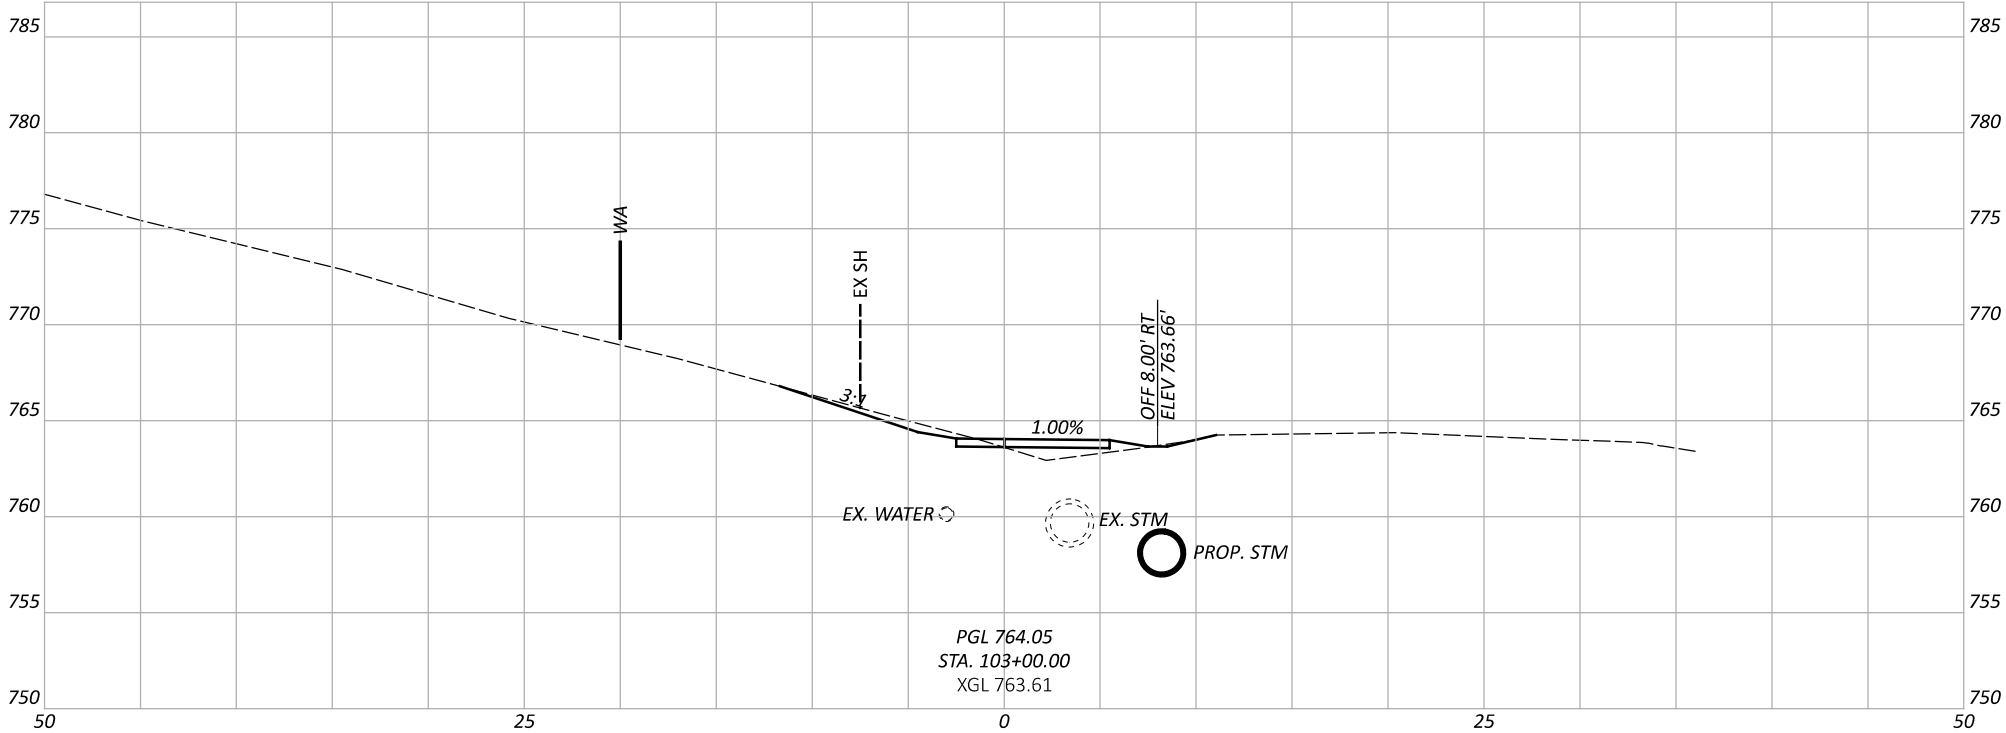

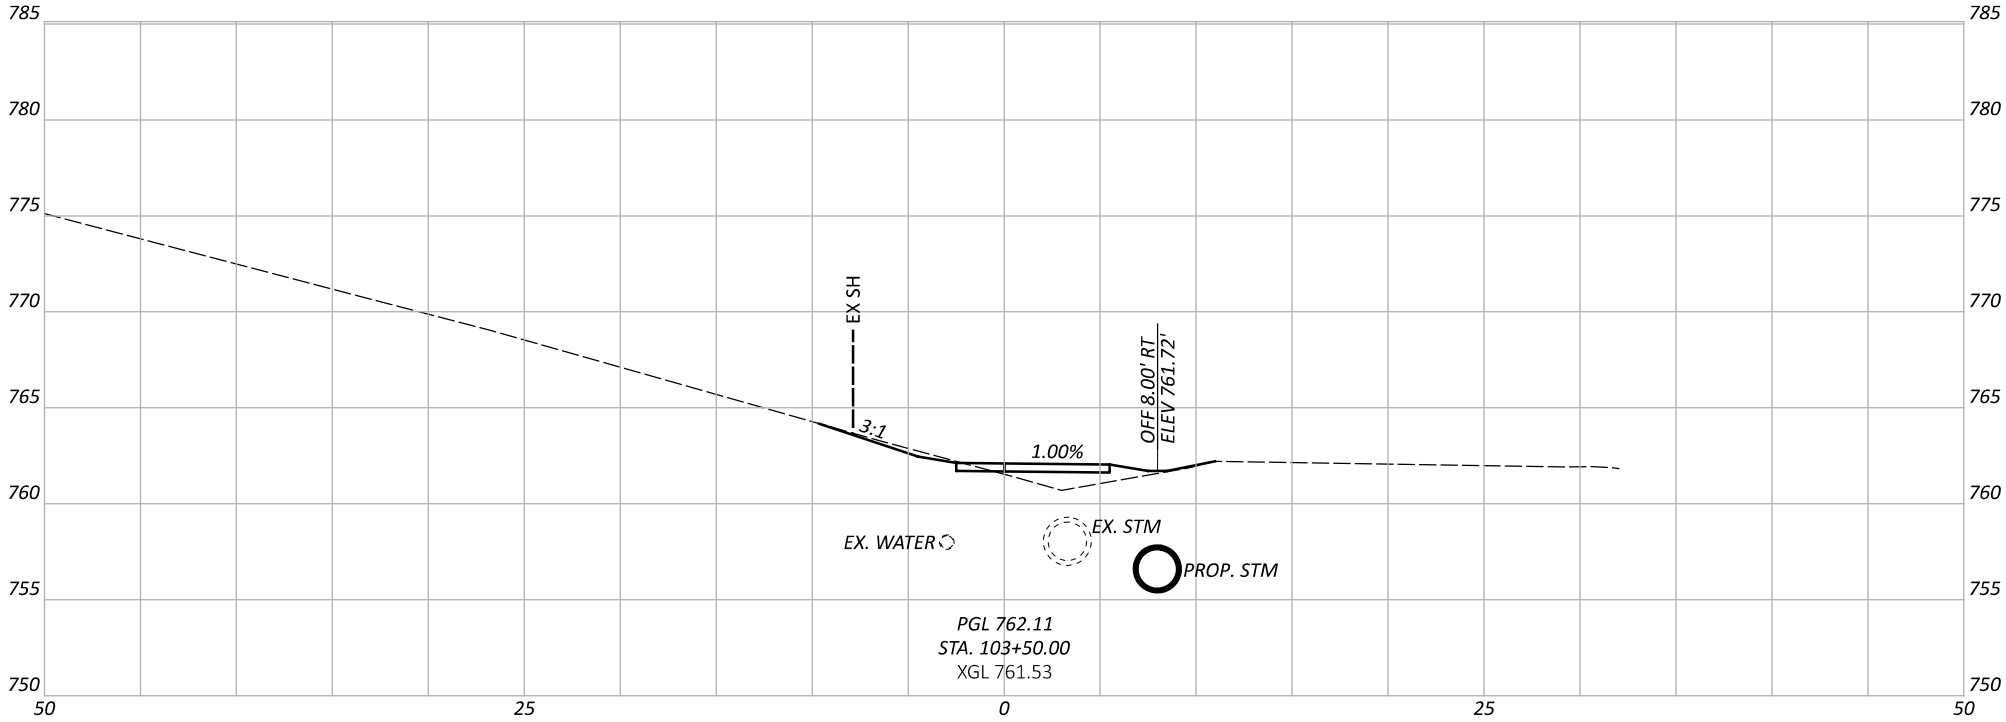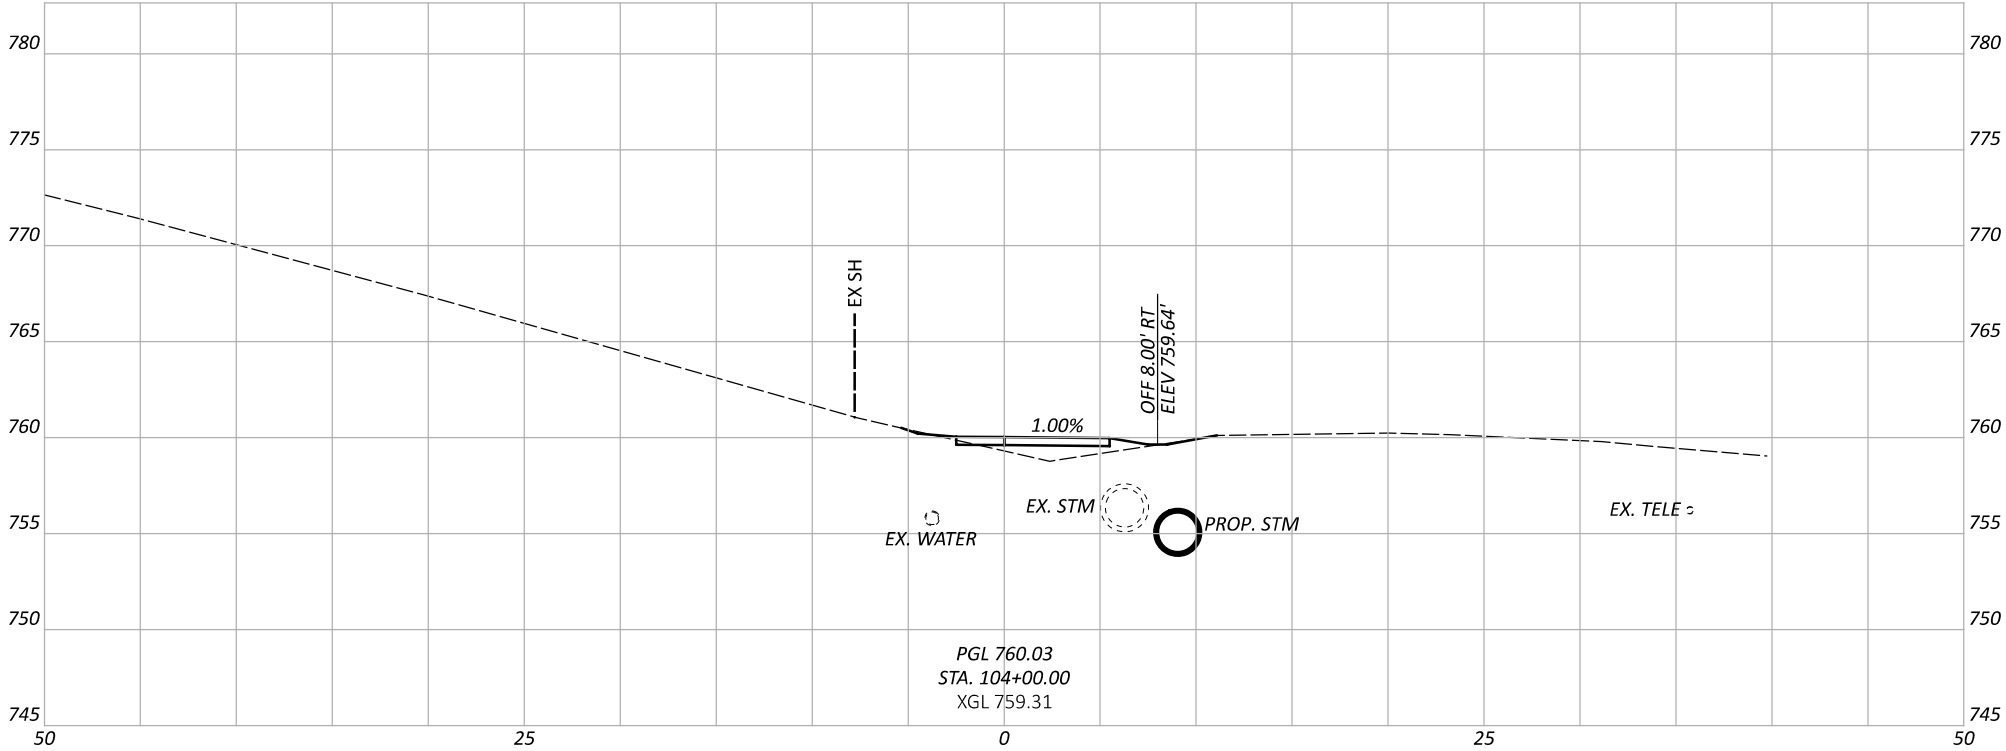

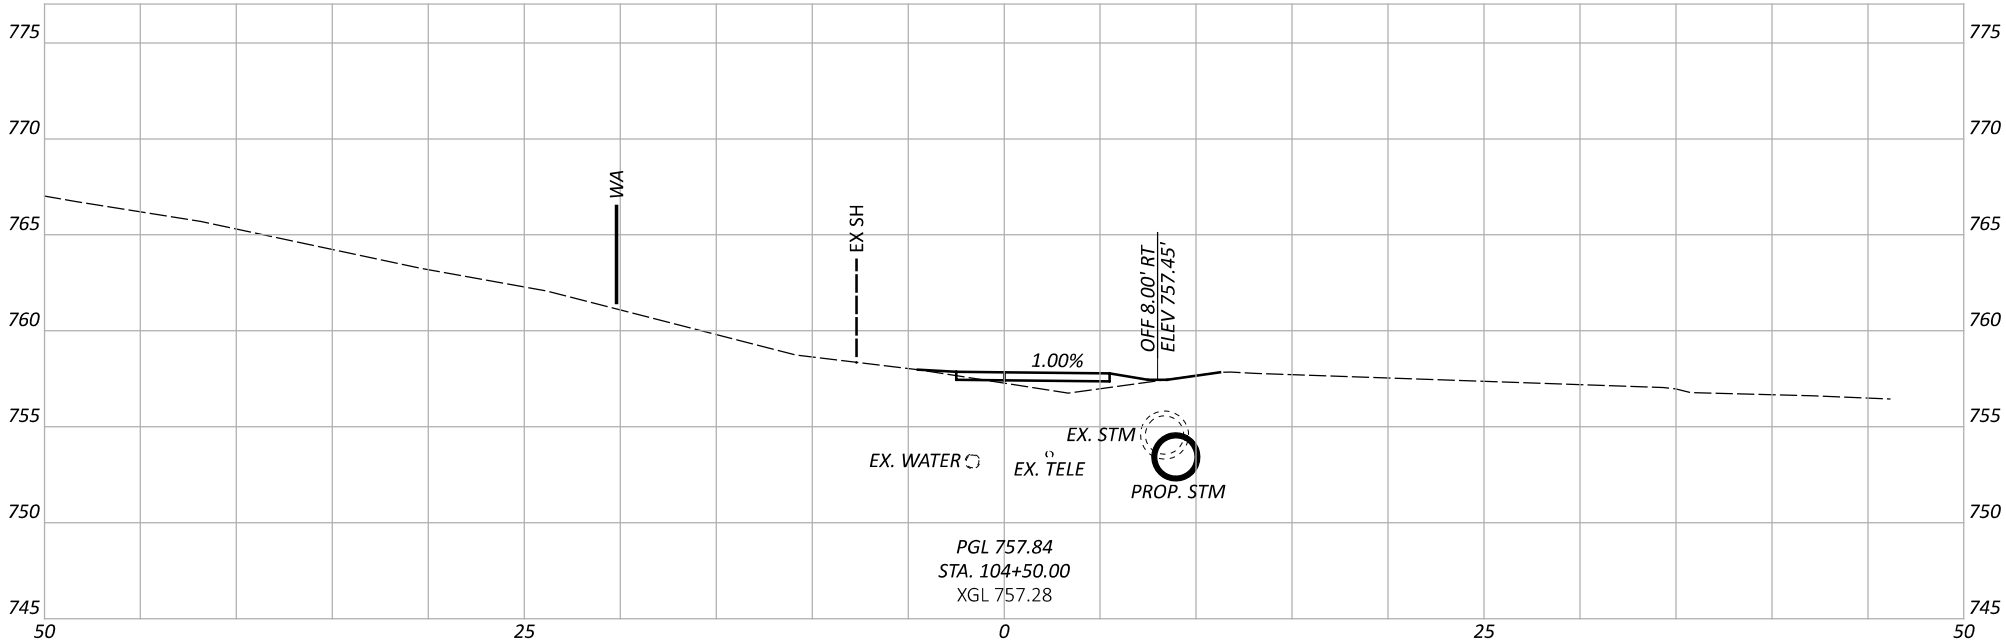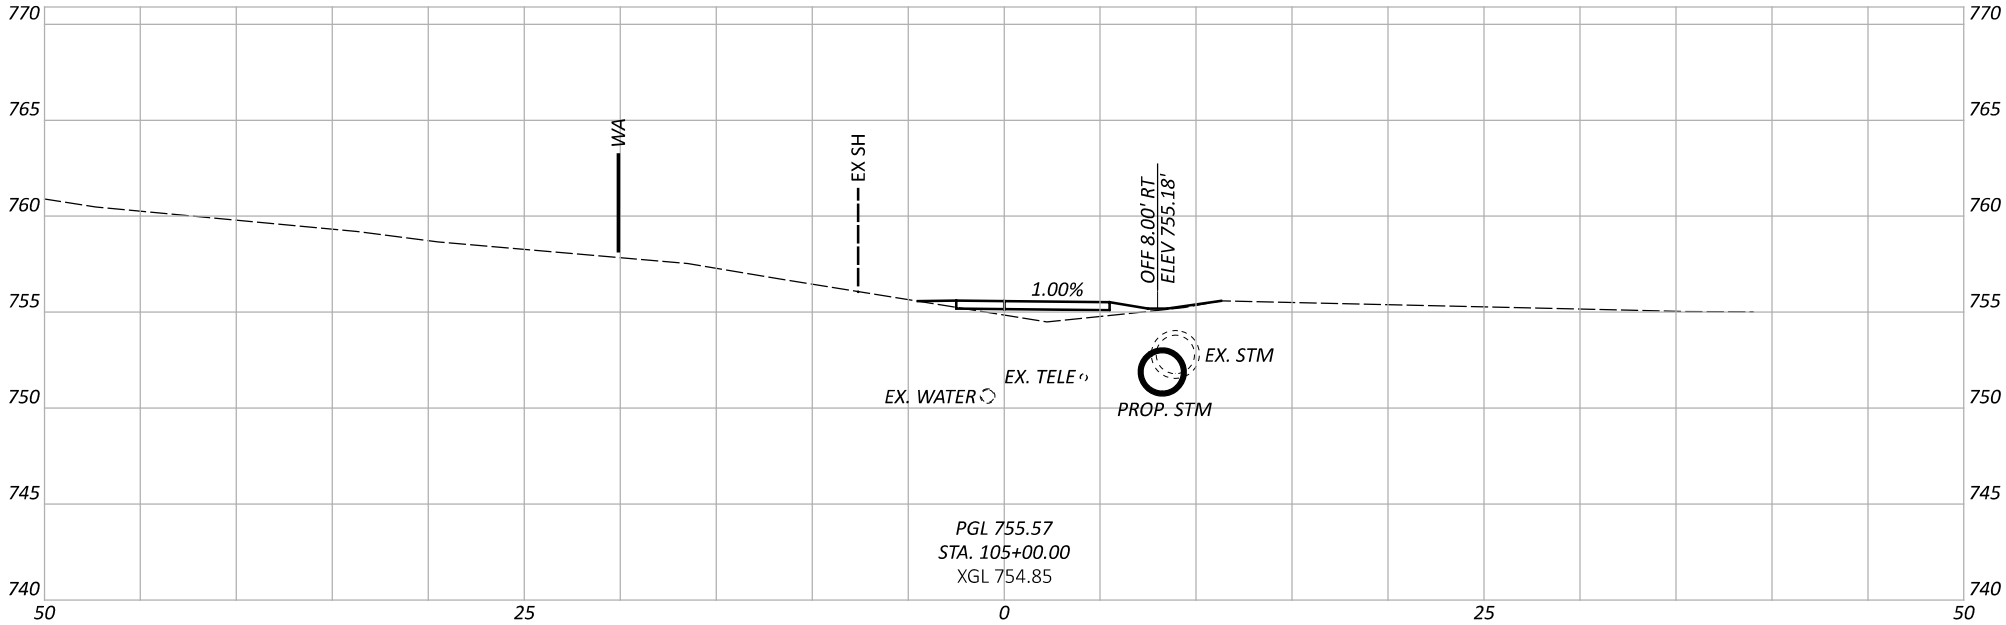

CROSS SECTIONS - MERCERVILLE RD.
STA 104+50.00 TO STA 105+00.00

DESIGN AGENCY





DESIGNER
EMH

REVIEWER
CSR 04/24/25

PROJECT ID
120712

SHEET	TOTAL
25	51

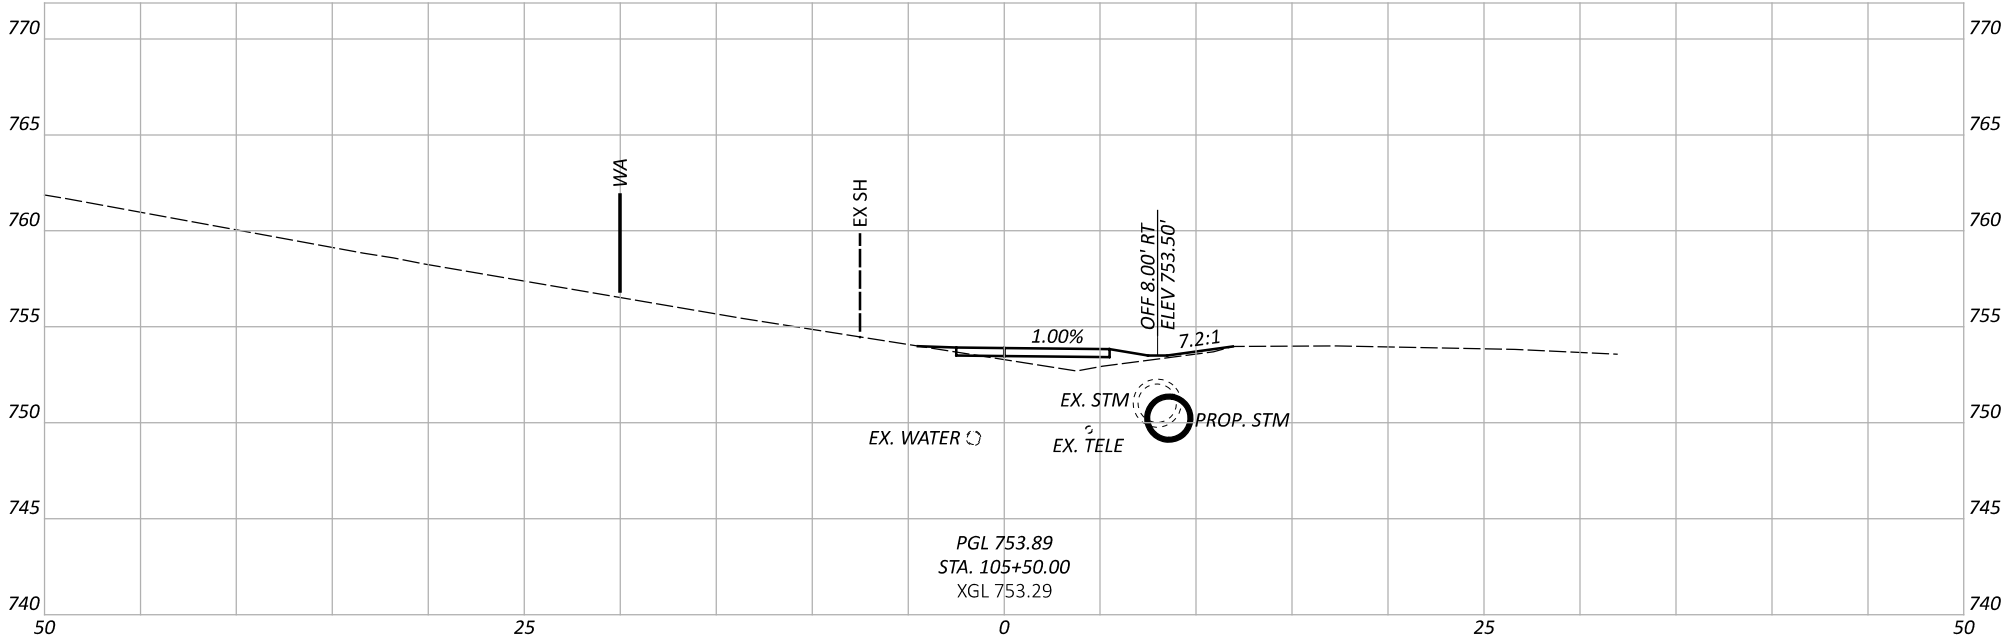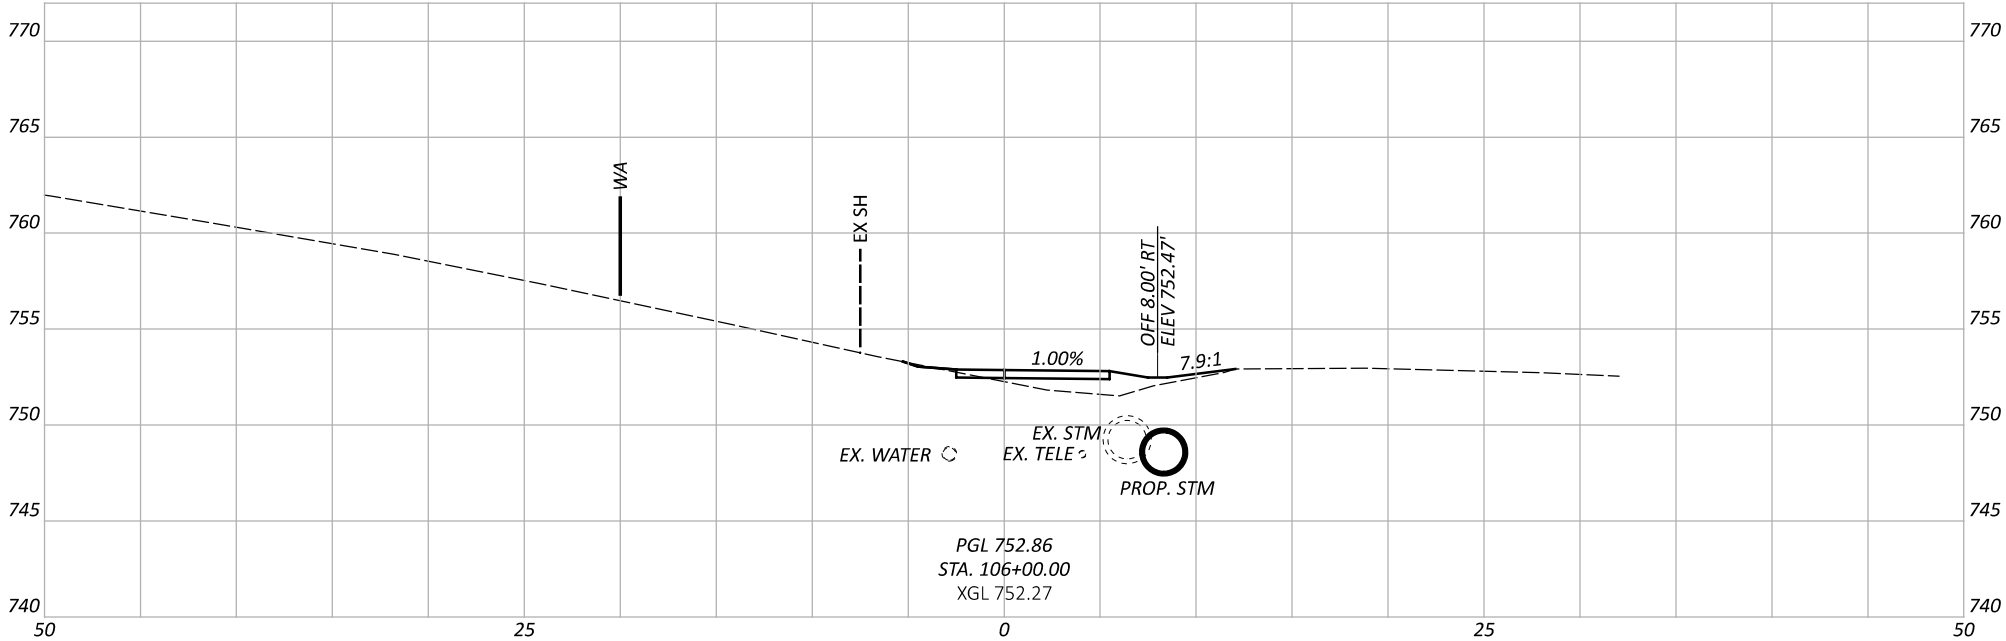

CROSS SECTIONS - MERCERVILLE RD.
STA 105+50.00 TO STA 106+00.00

DESIGN AGENCY



DESIGNER

EMH

REVIEWER

CSR 04/24/25

PROJECT ID




120712

SHEET

26

TOTAL

51

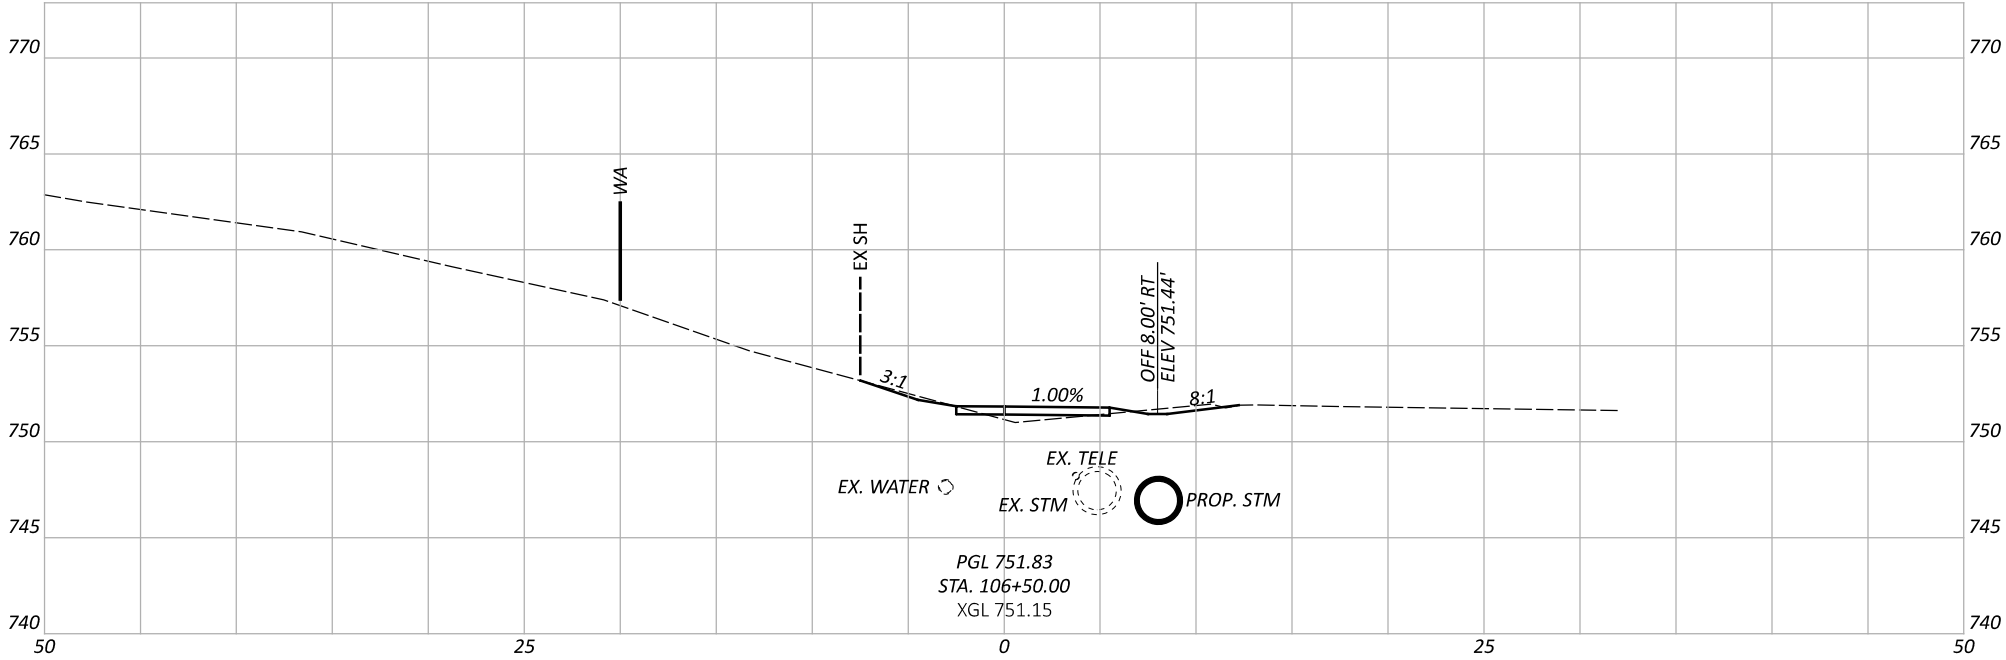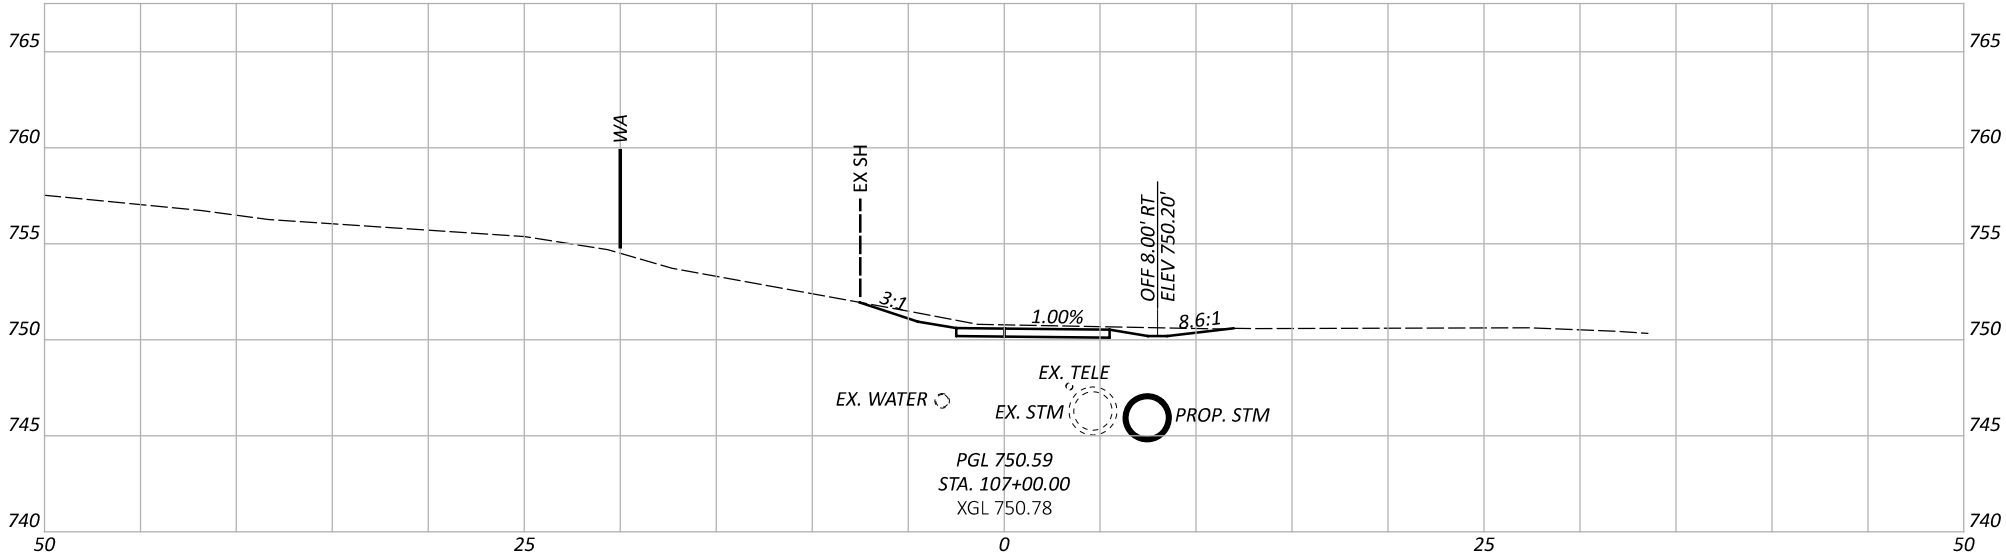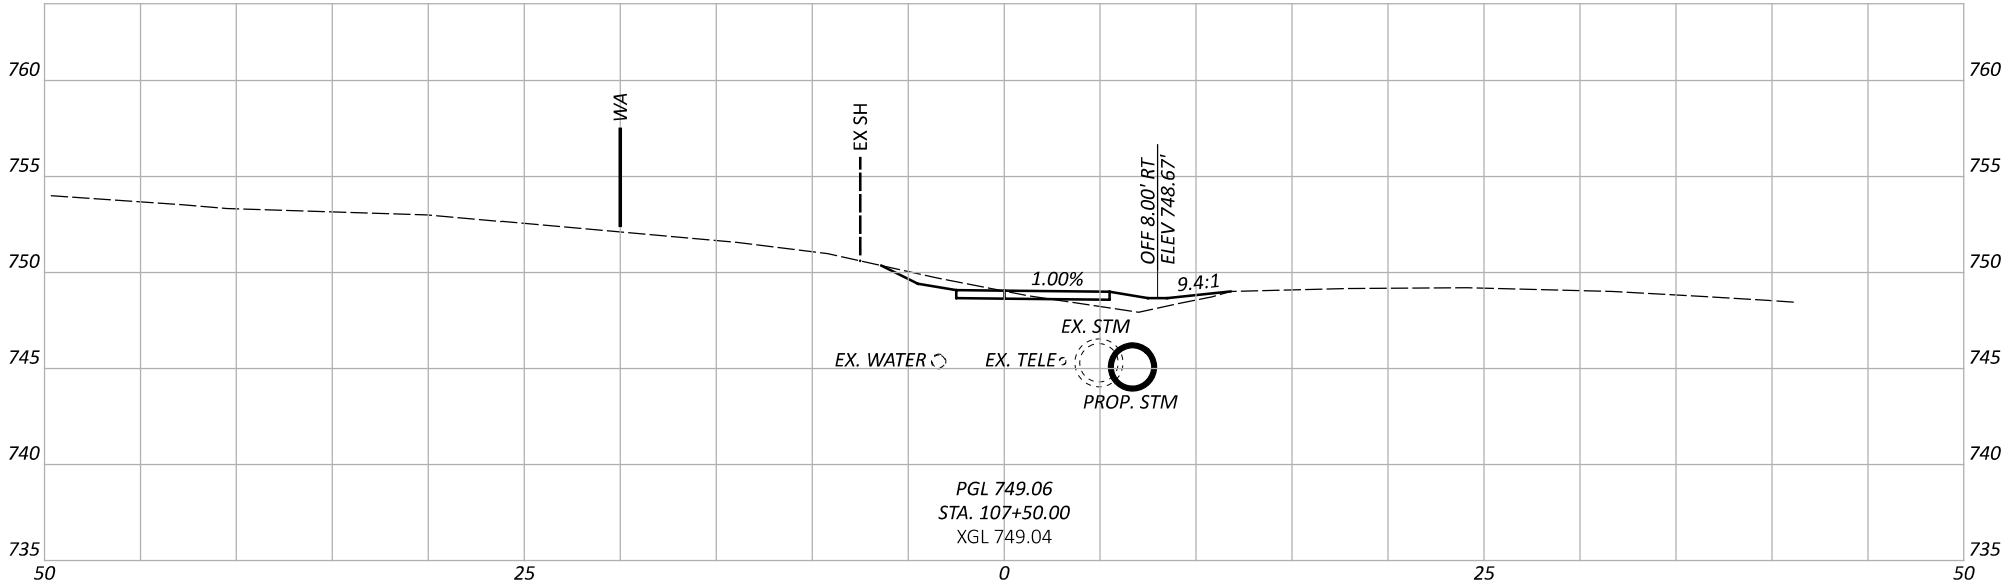

CROSS SECTIONS - MERCERVILLE RD.
STA 106+50.00 TO STA 107+50.00

DESIGN AGENCY






DESIGNER
EMH




REVIEWER
CSR 04/24/25




PROJECT ID
120712




SHEET
27

TOTAL
51

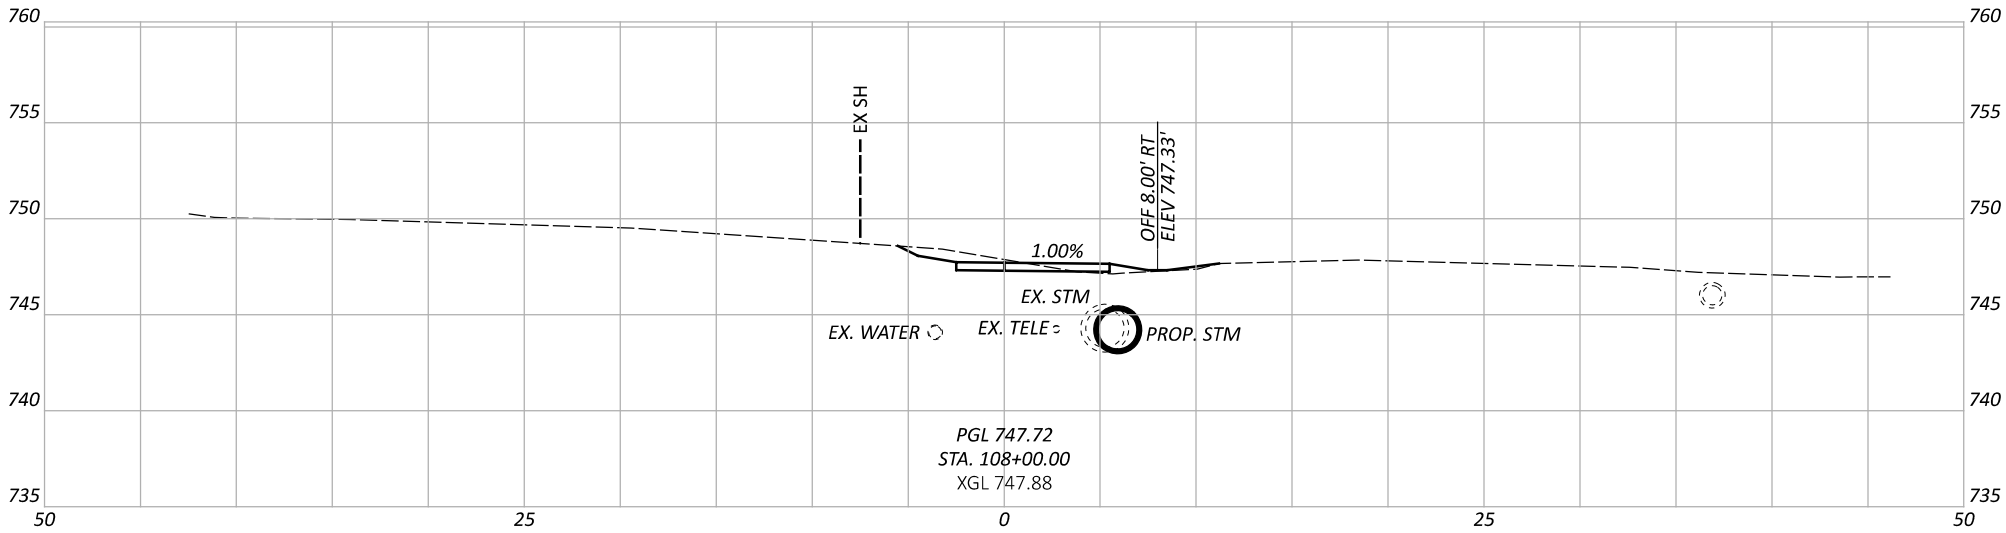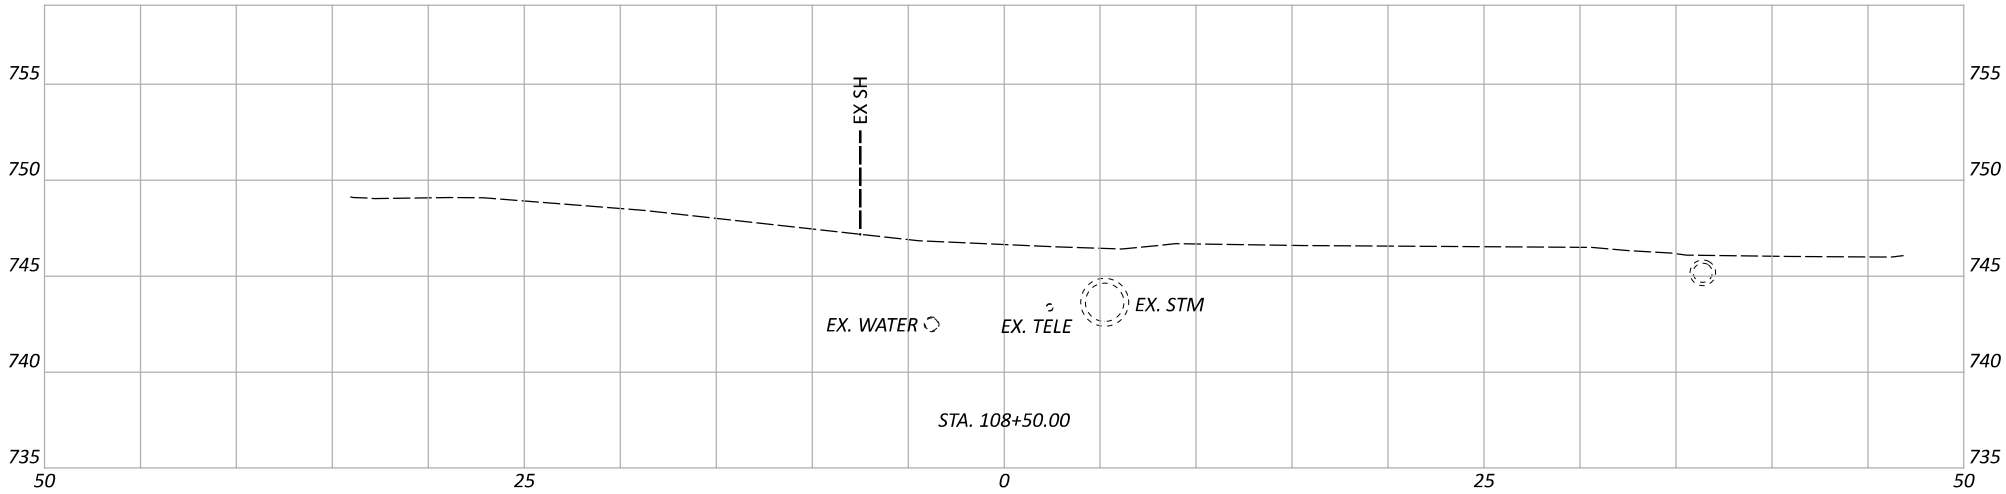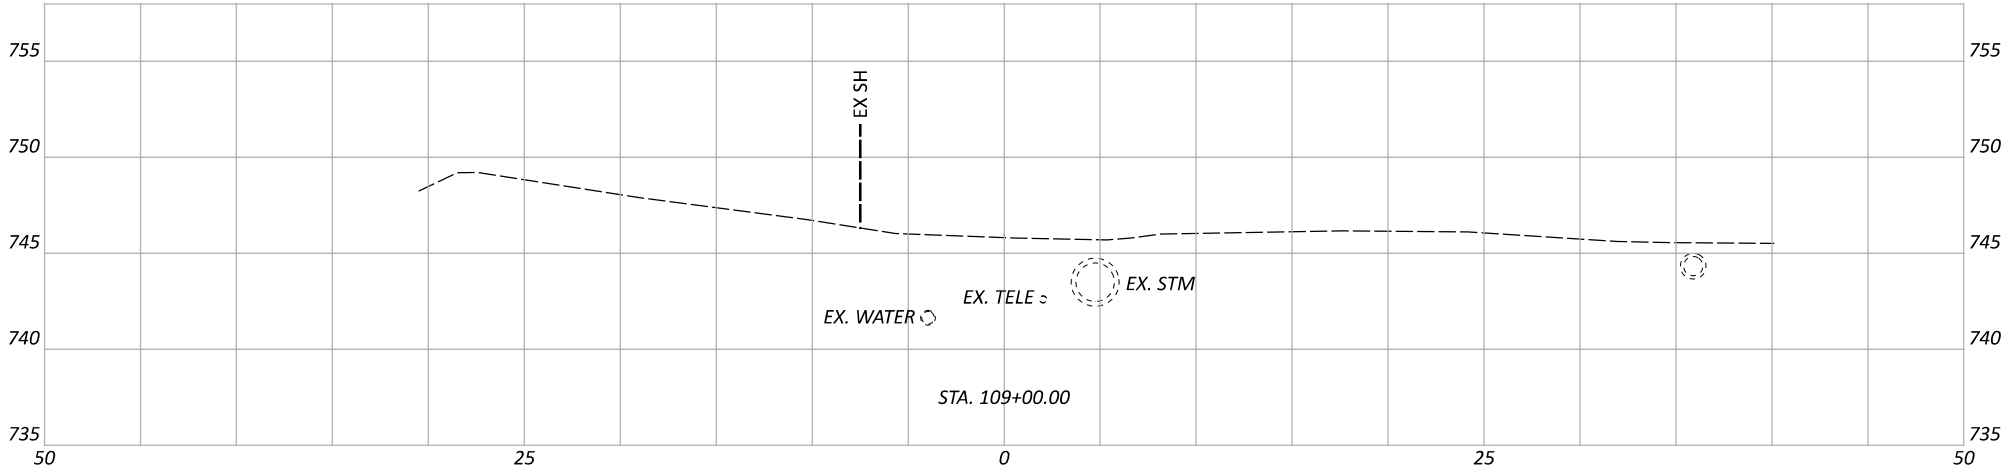

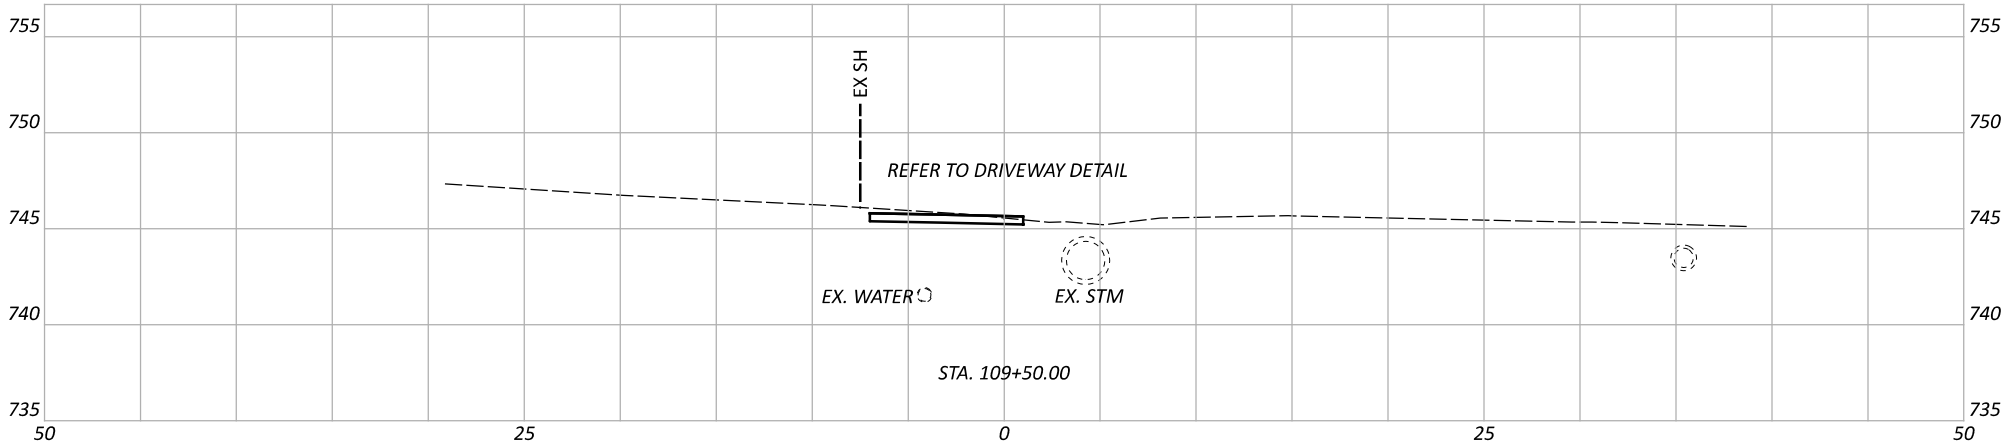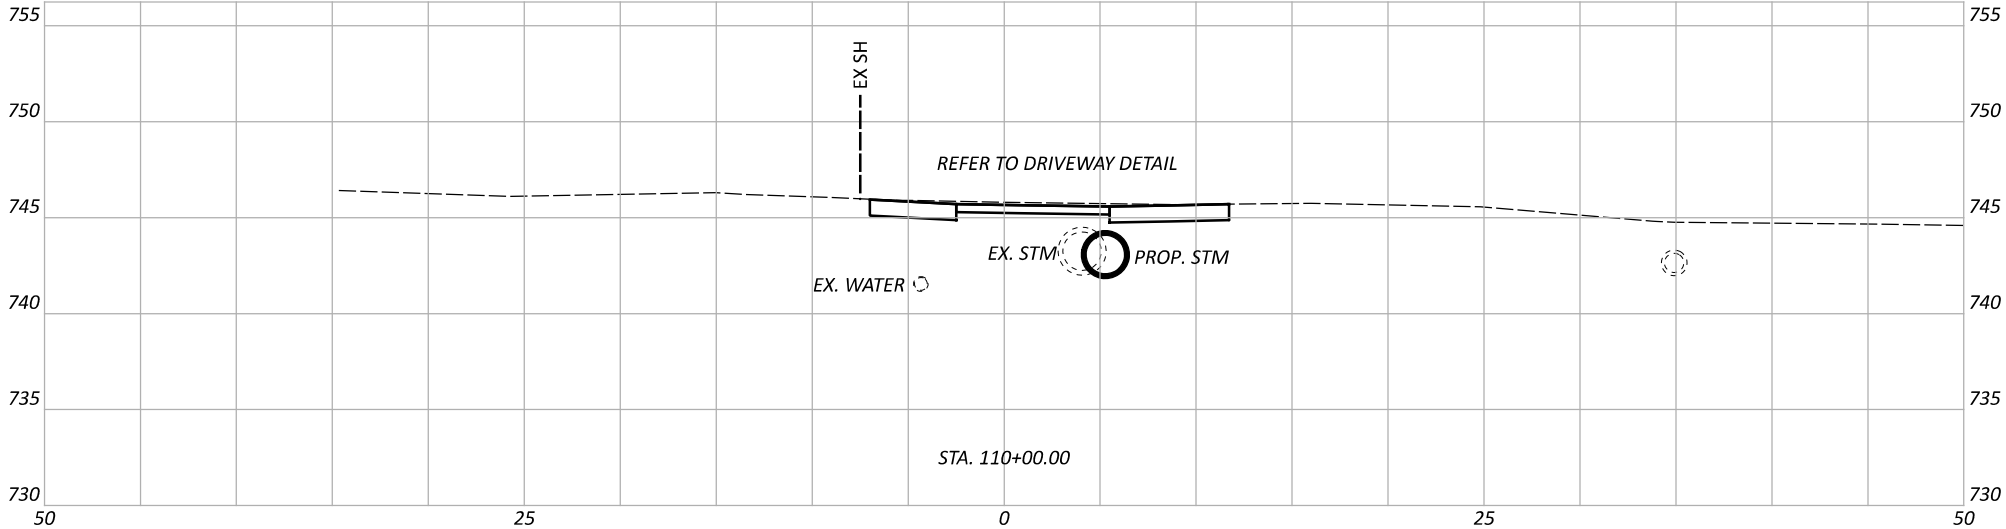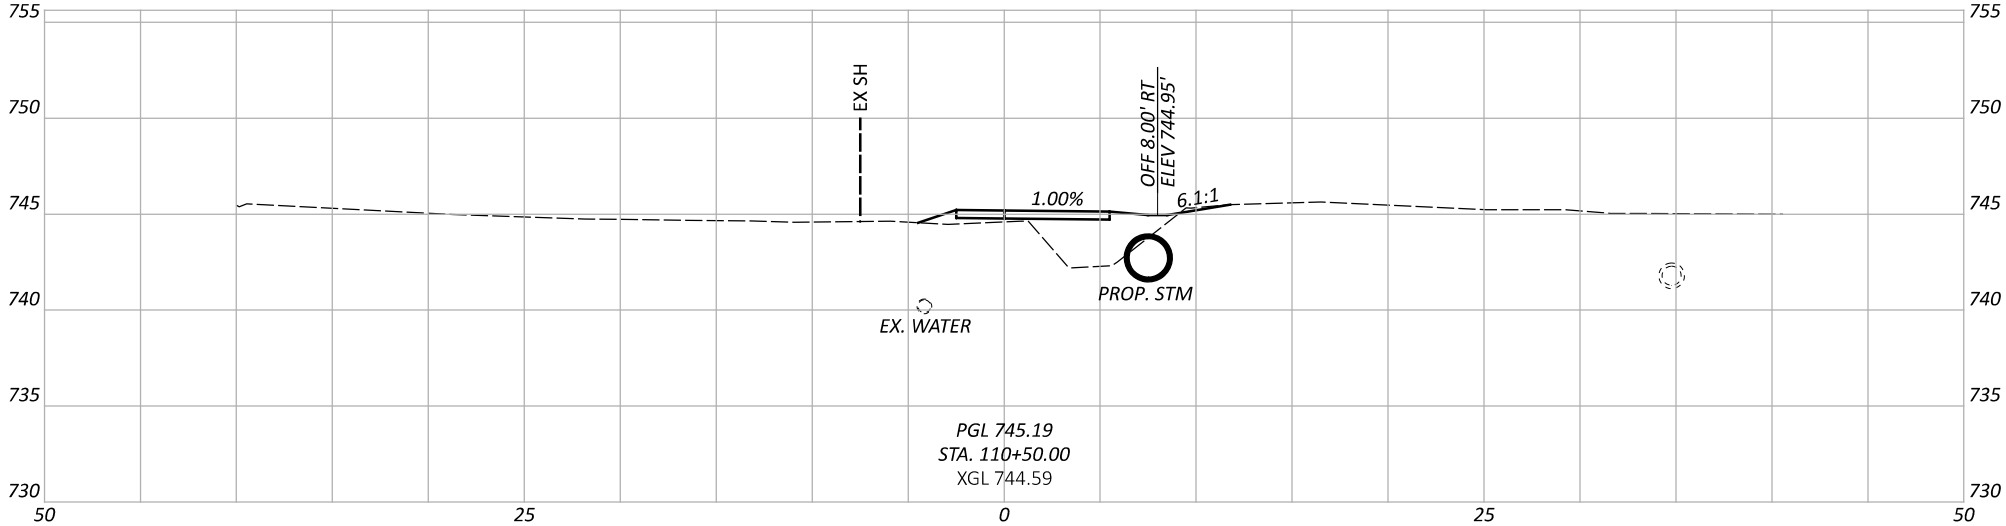

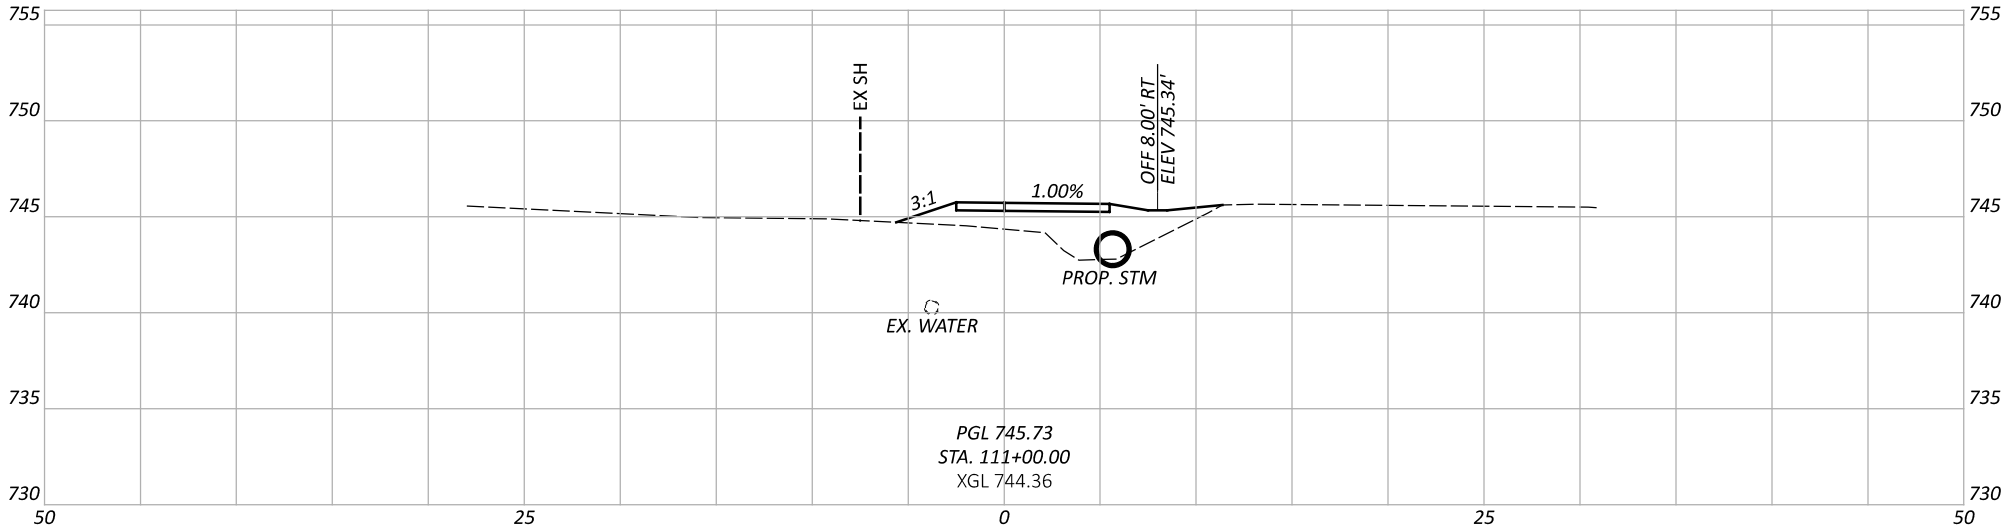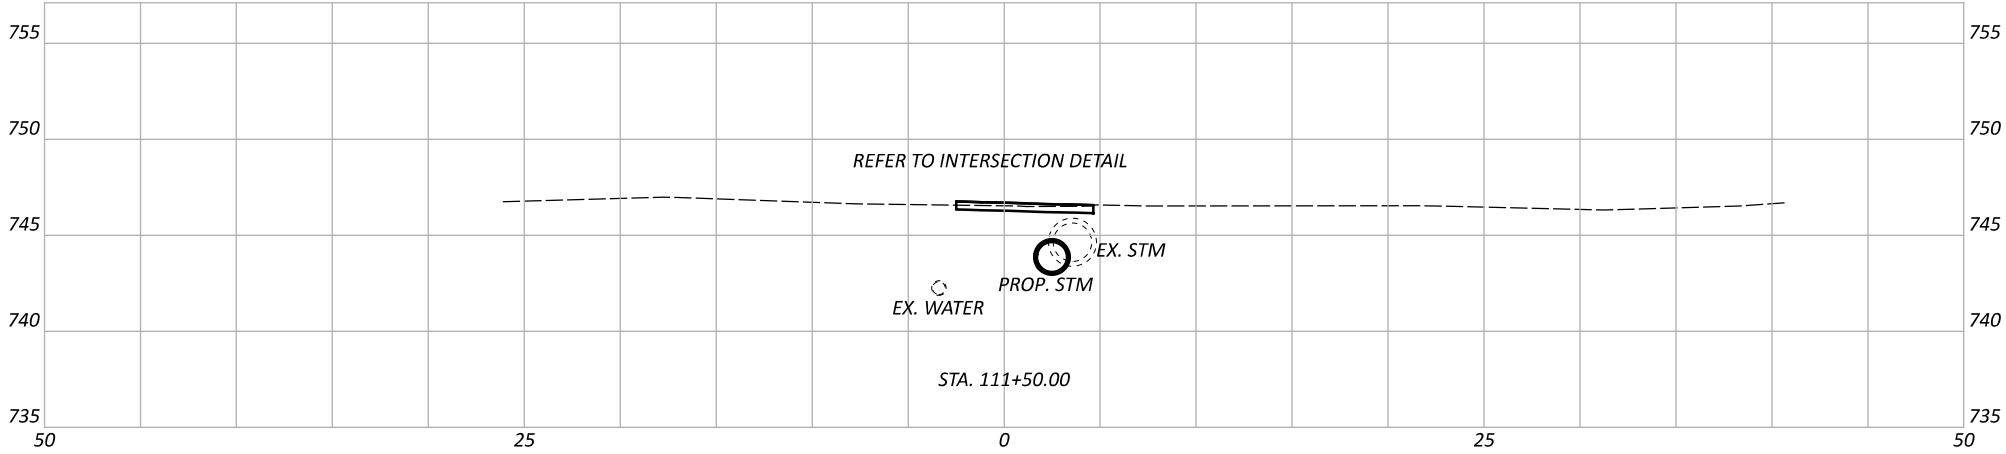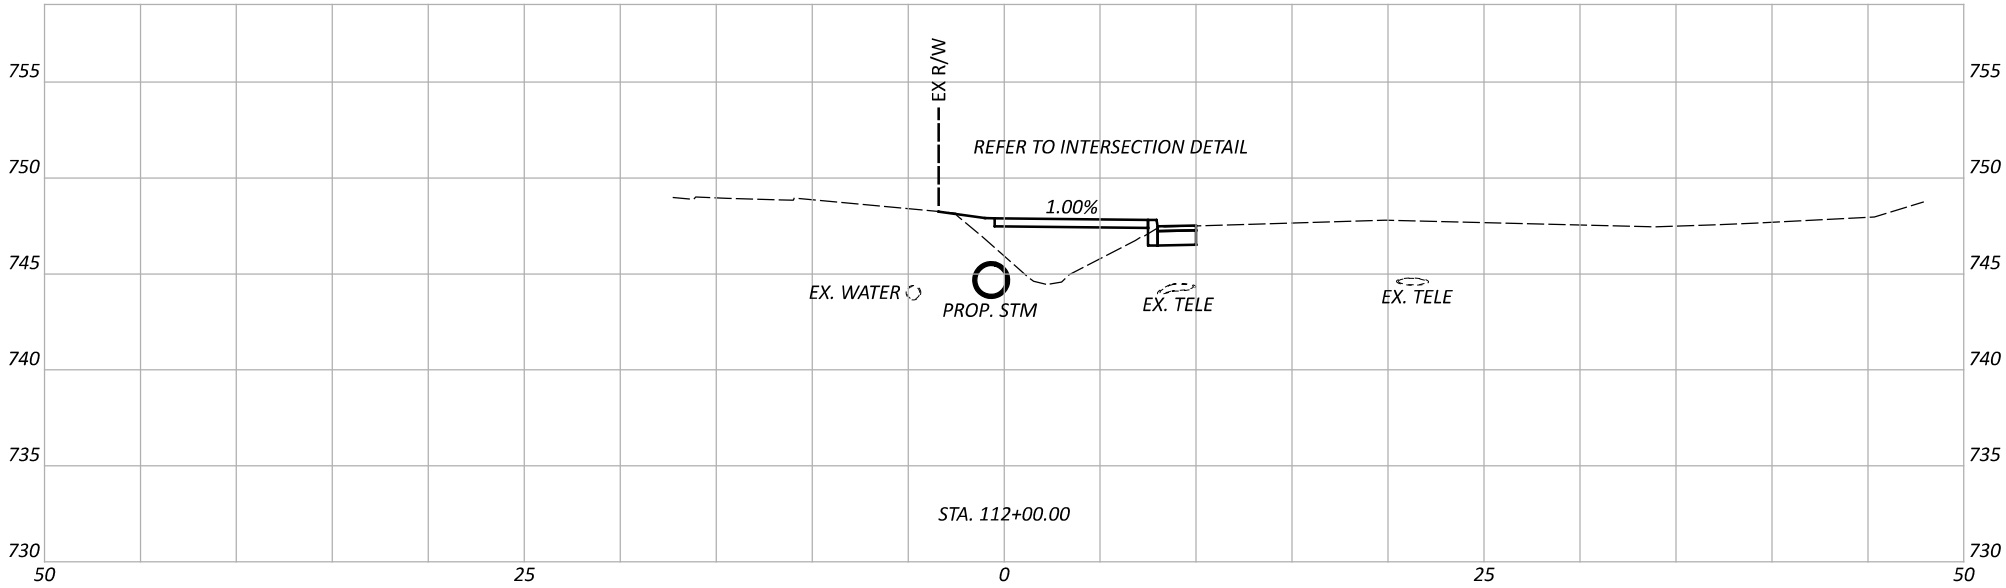

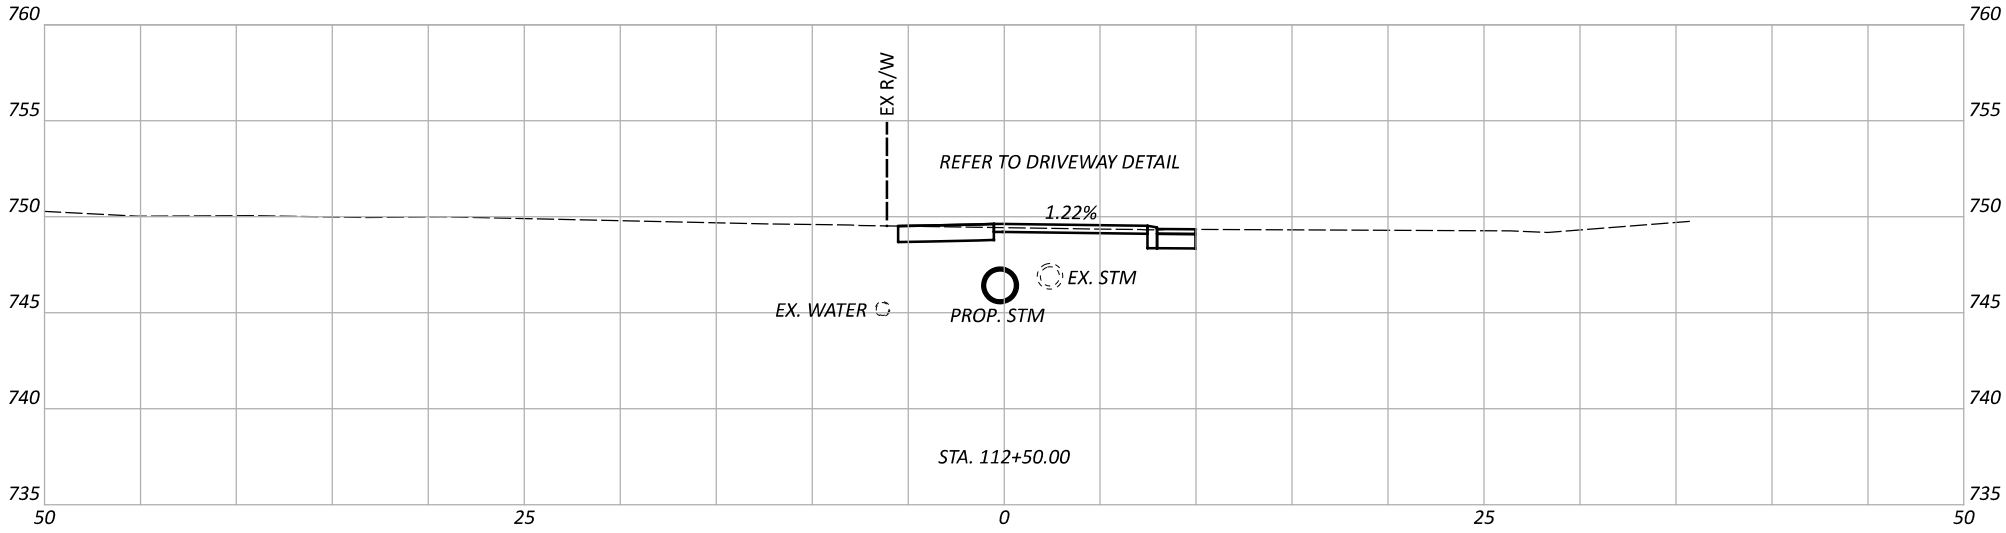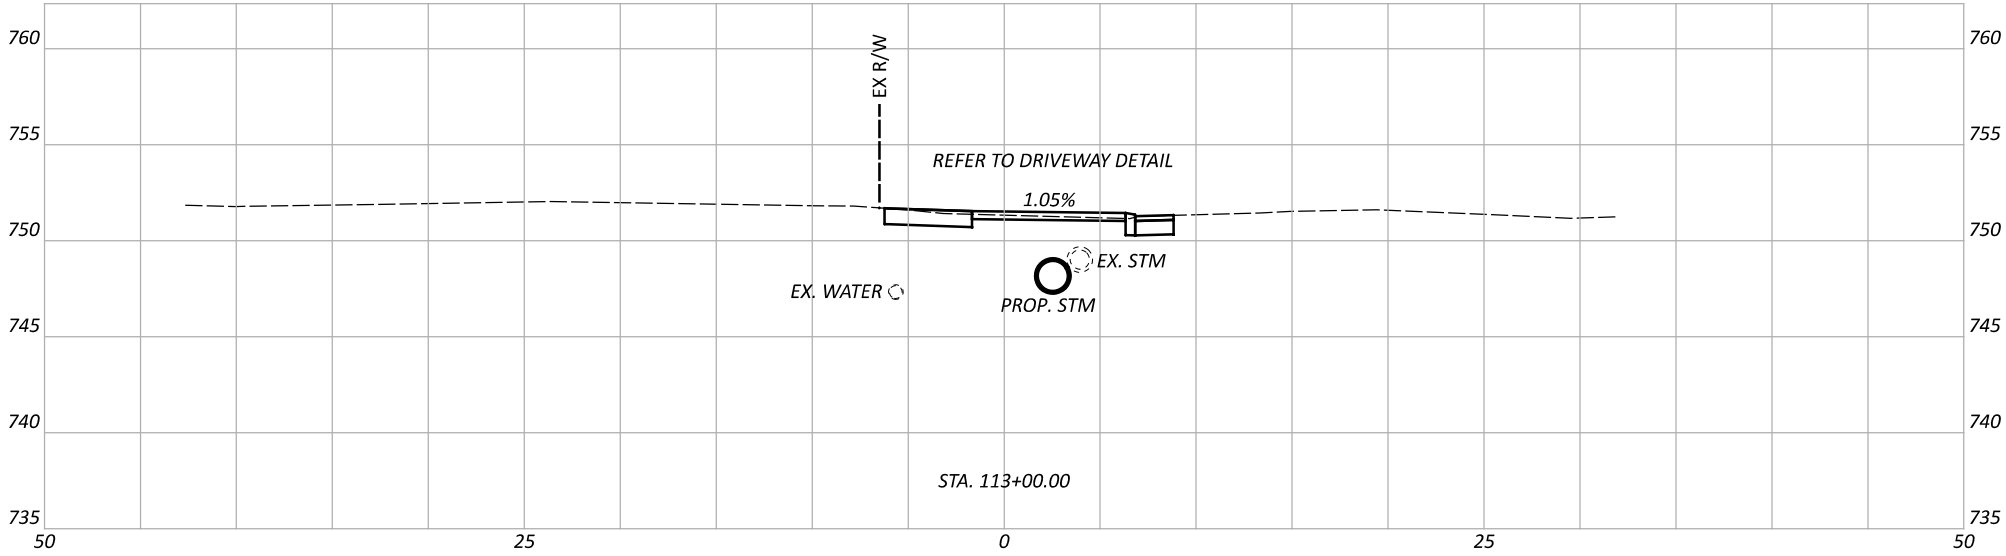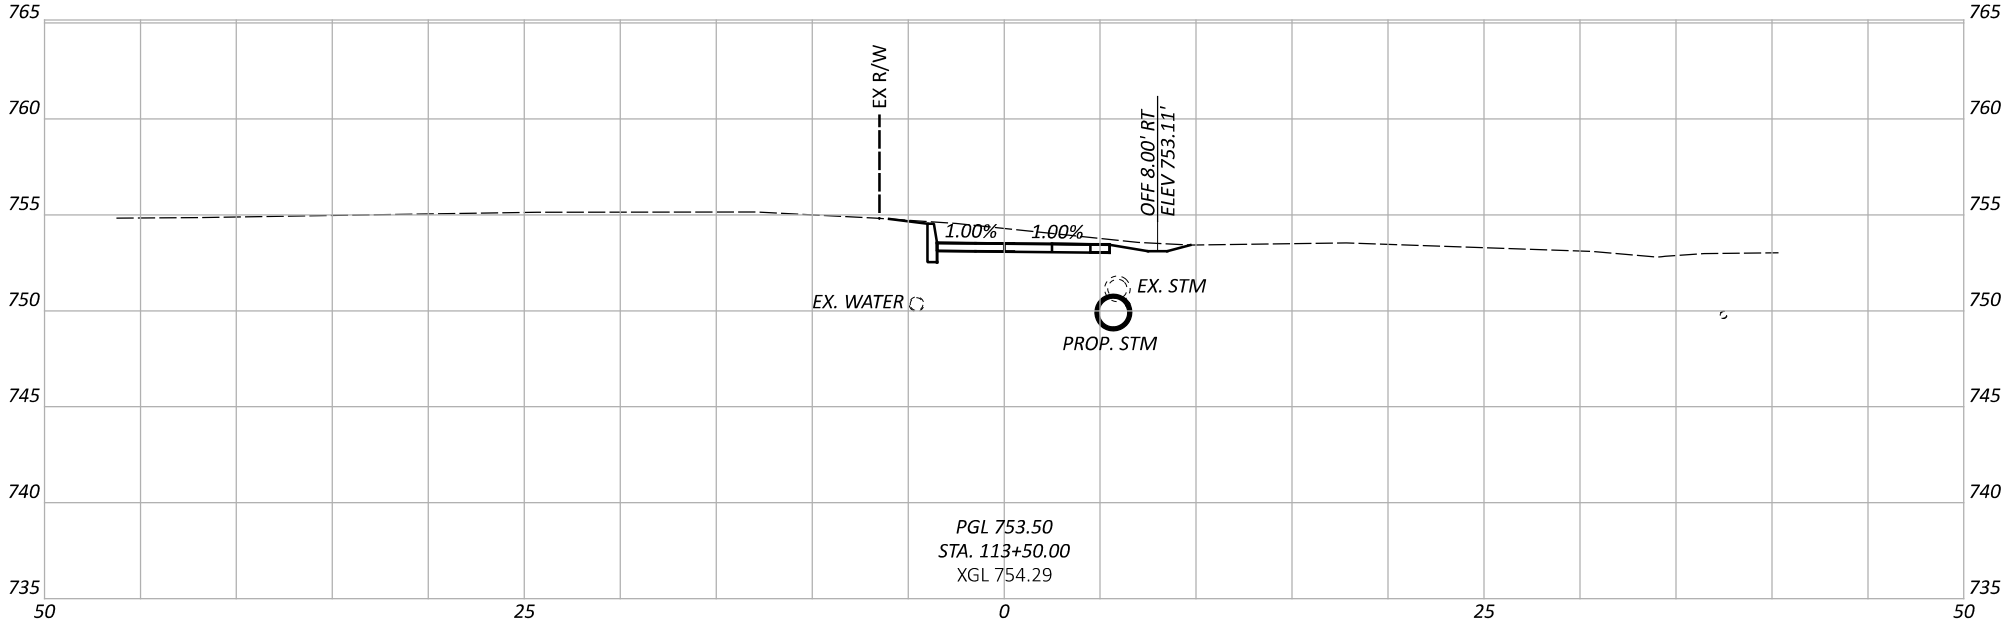

CROSS SECTIONS - MERCERVILLE RD.
STA 112+50.00 TO STA 113+50.00

DESIGN AGENCY






DESIGNER
EMH




REVIEWER
CSR 04/24/25

PROJECT ID
120712

SHEET	TOTAL
31	51

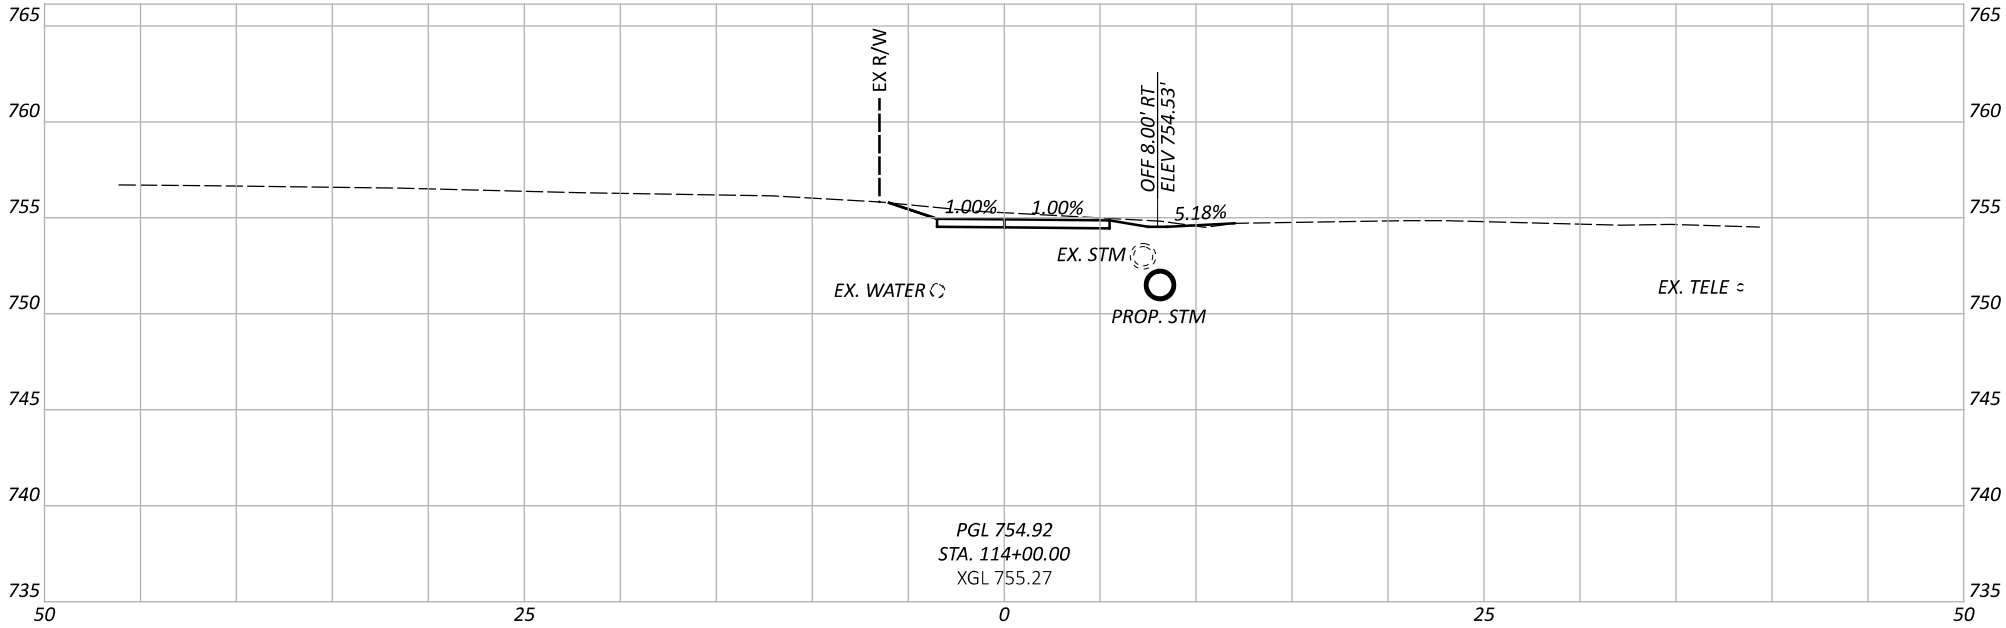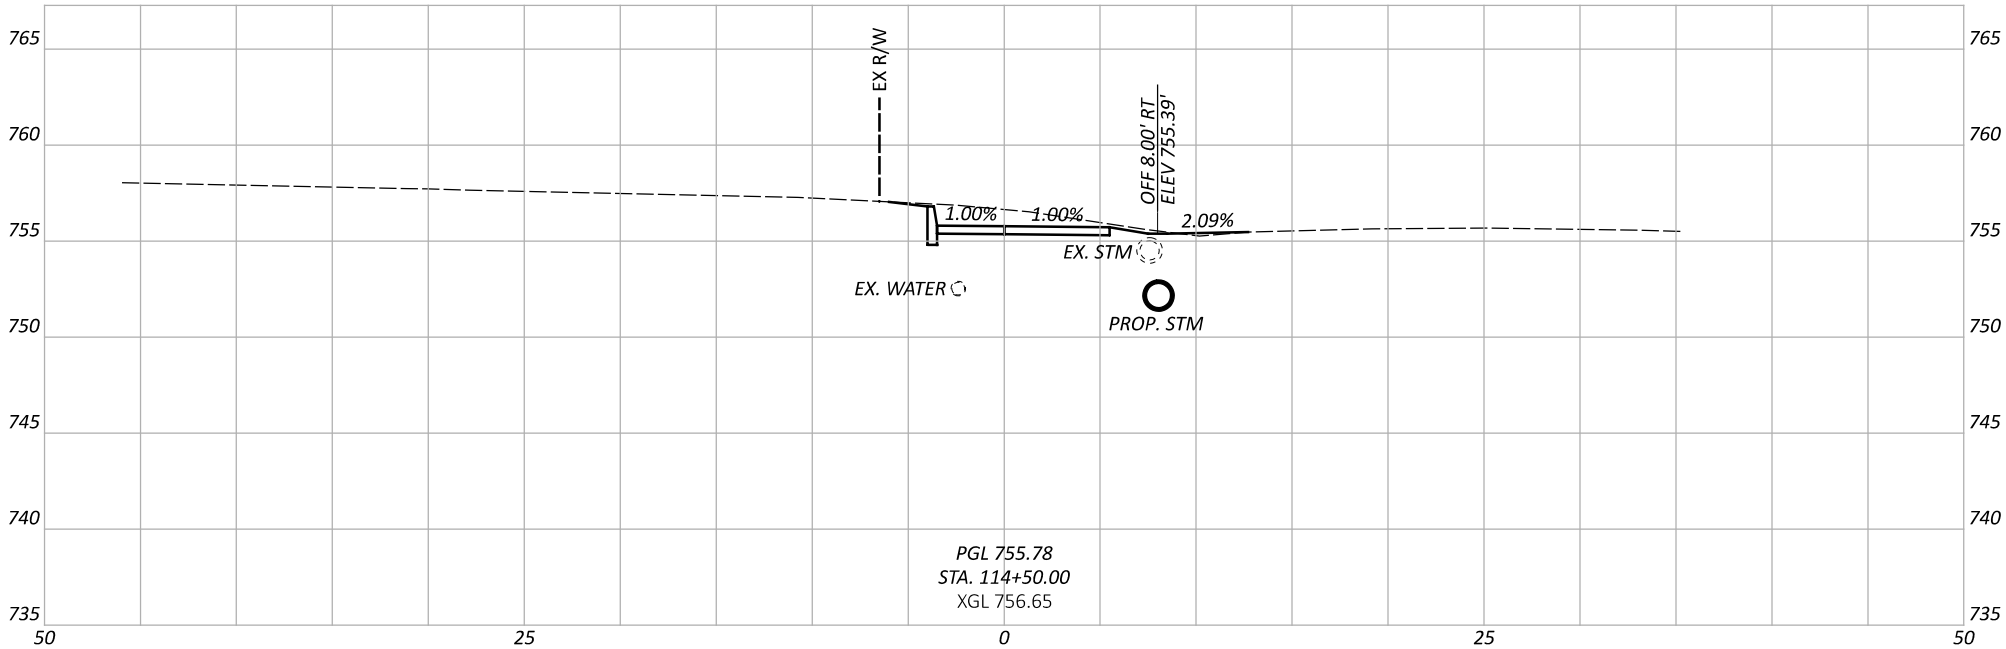

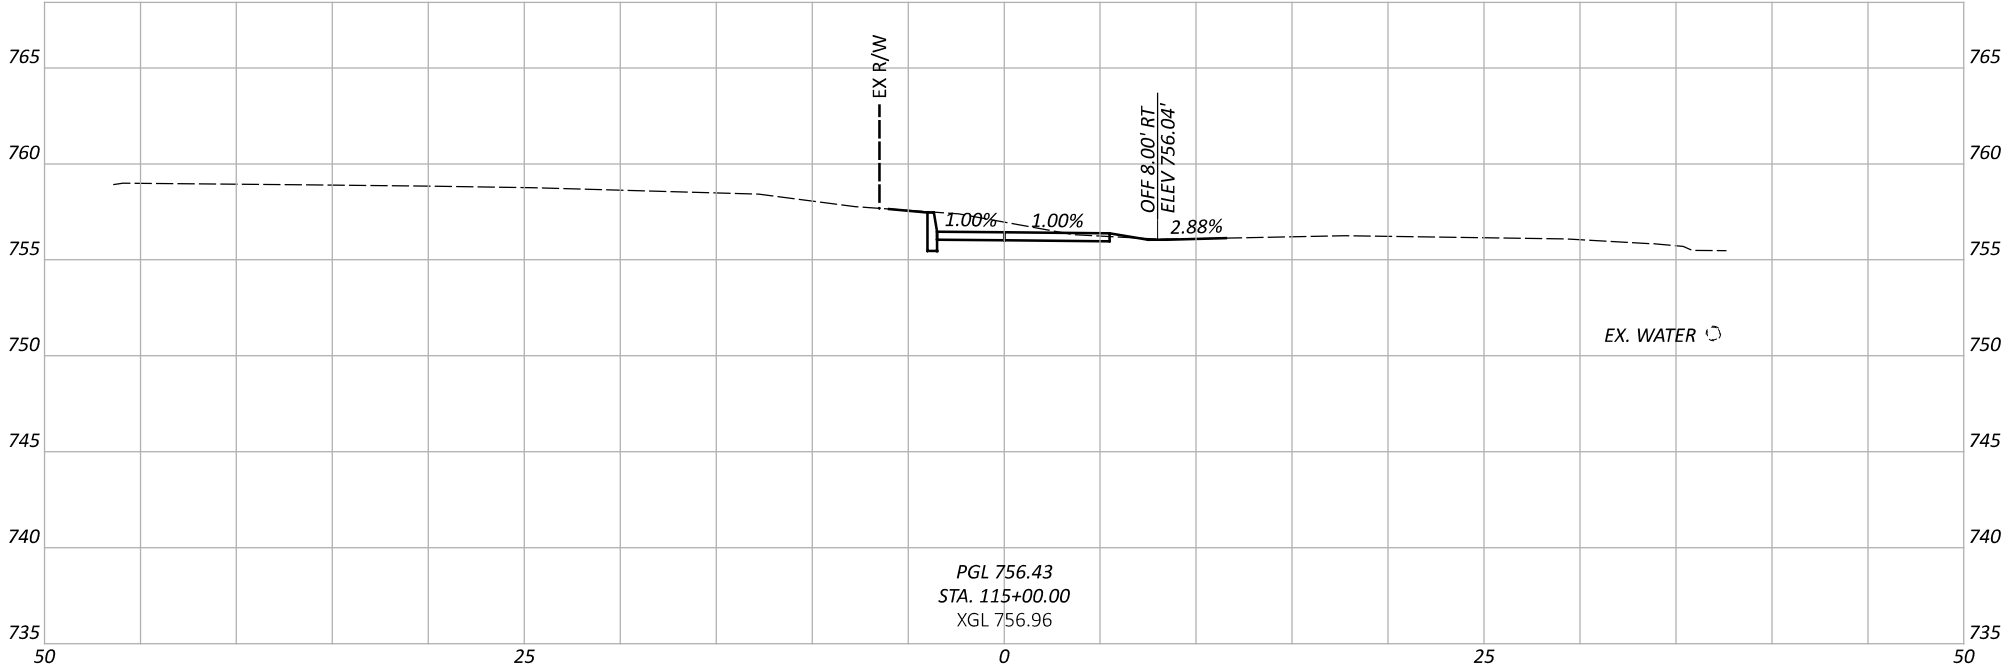

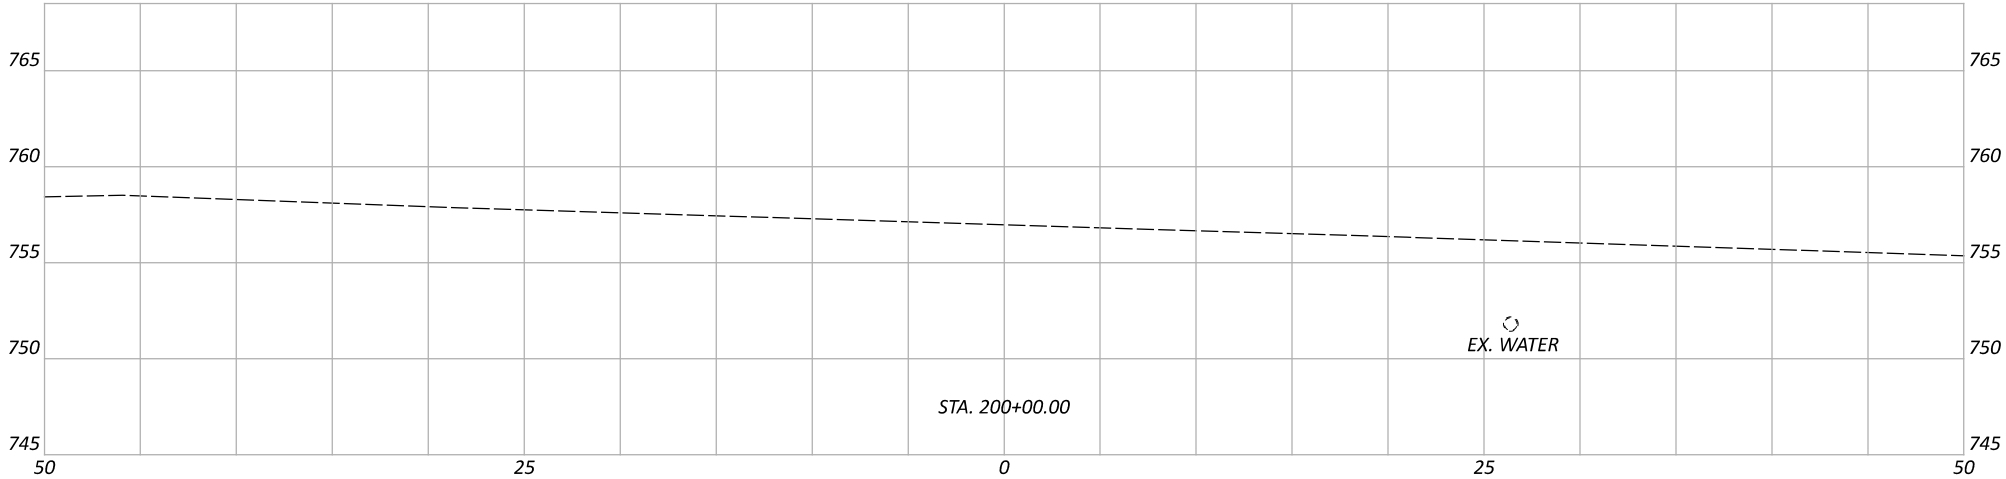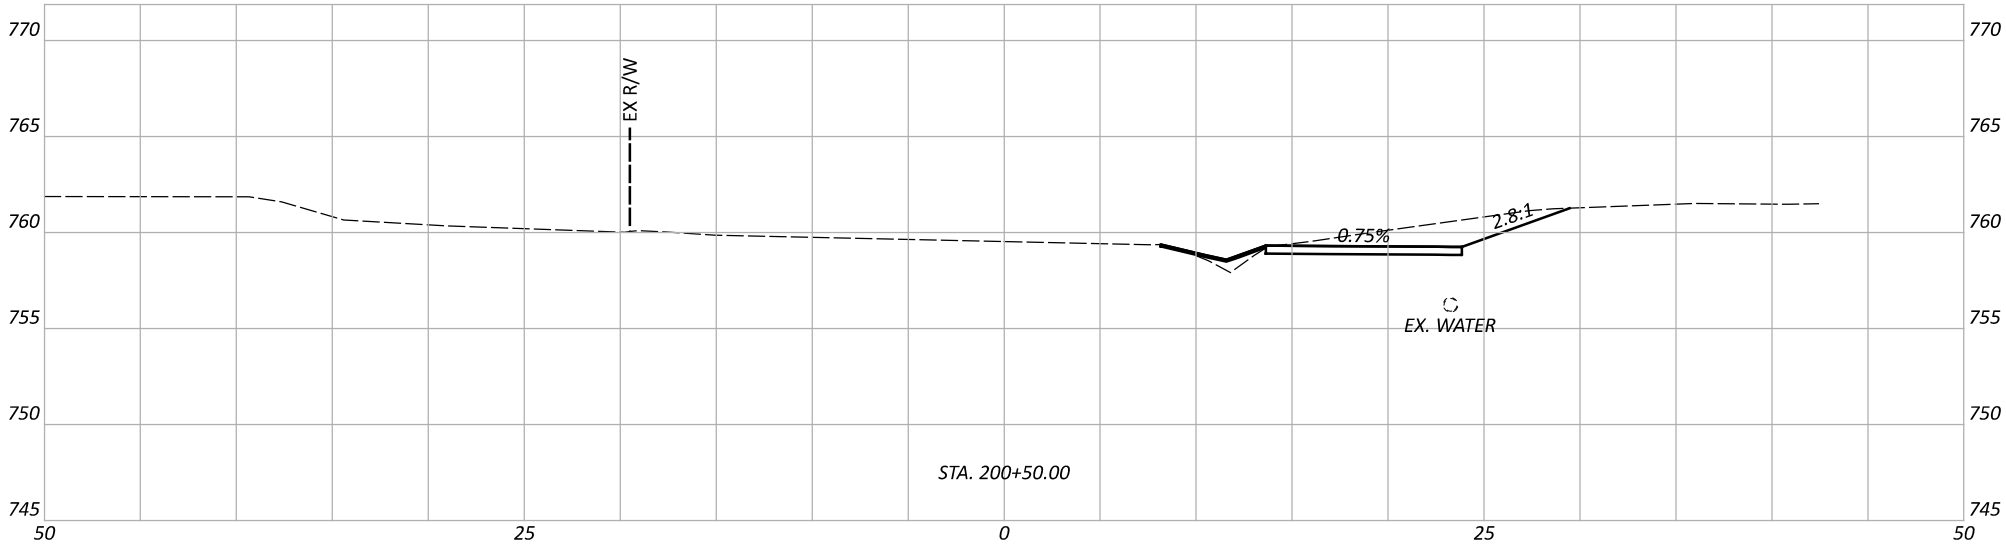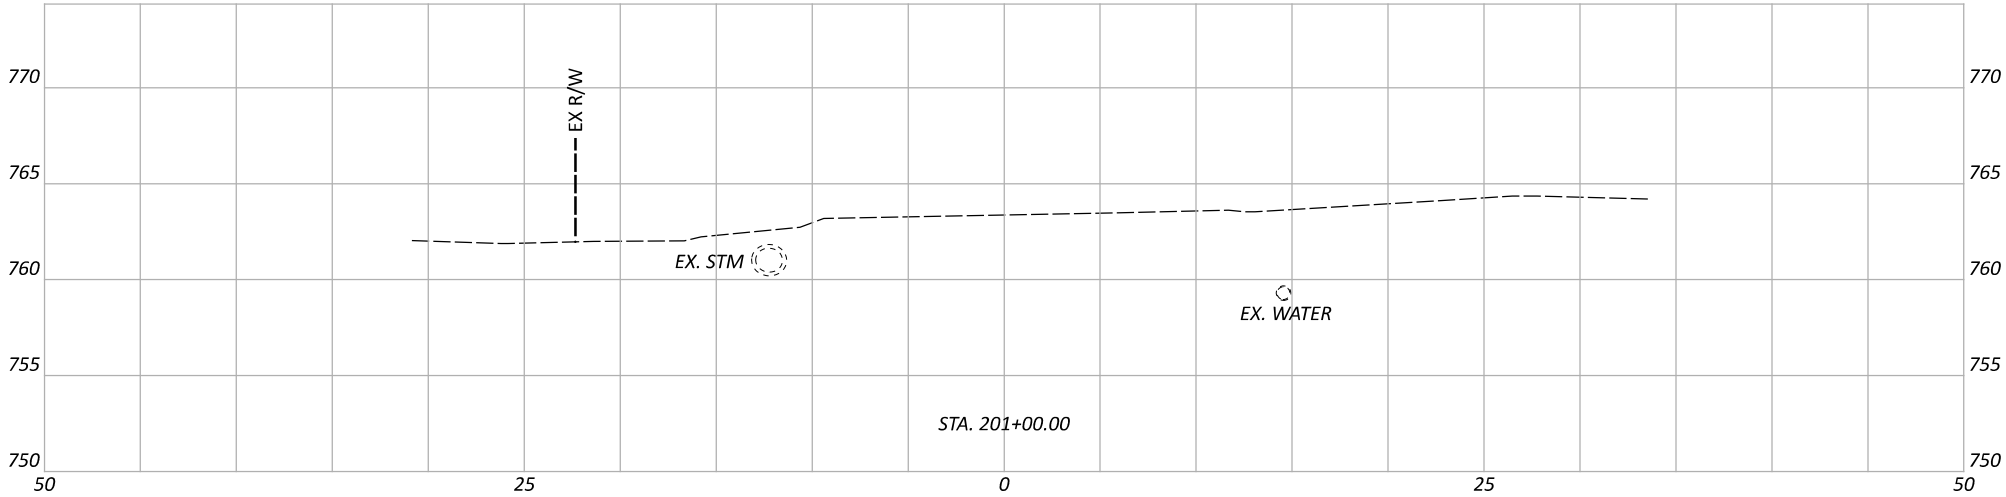

Addendum #1
02/17/2026

Station St.						
Station	Cut Area (Sq.ft.)	Cut Volume (Cu.yd.)	Fill Area (Sq.ft.)	Fill Volume (Cu.yd.)	Seeding FT	Seeding (SY)
200+00.00	0.00	0.00	0.00	0.00	0.00	0.00
200+50.00	15.30	14.17	1.06	0.98	12.16	33.76
201+00.00	0.00	14.17	0.00	0.98	0.00	33.76
201+50.00	0.00	0.00	0.00	0.00	0.00	0.00
202+00.00	0.00	0.00	0.00	0.00	0.00	0.00
202+50.00	0.00	0.00	0.00	0.00	0.00	0.00
203+00.00	0.00	0.00	0.00	0.00	0.00	0.00
203+50.00	0.00	0.00	0.00	0.00	0.00	0.00
204+00.00	0.00	0.00	0.00	0.00	0.00	0.00
204+50.00	0.00	0.00	0.00	0.00	0.00	0.00
205+00.00	0.00	0.00	0.00	0.00	0.00	0.00
205+30.70	0.00	0.00	0.00	0.00	0.00	0.00
TOTAL		28.34		1.96		67.52

CROSS SECTIONS - STATION ST.
STA 200+00.00 TO STA 201+00.00

DESIGN AGENCY



DESIGNER

EMH

REVIEWER

CSR 04/24/25

PROJECT ID




120712




SHEET



34




TOTAL

51

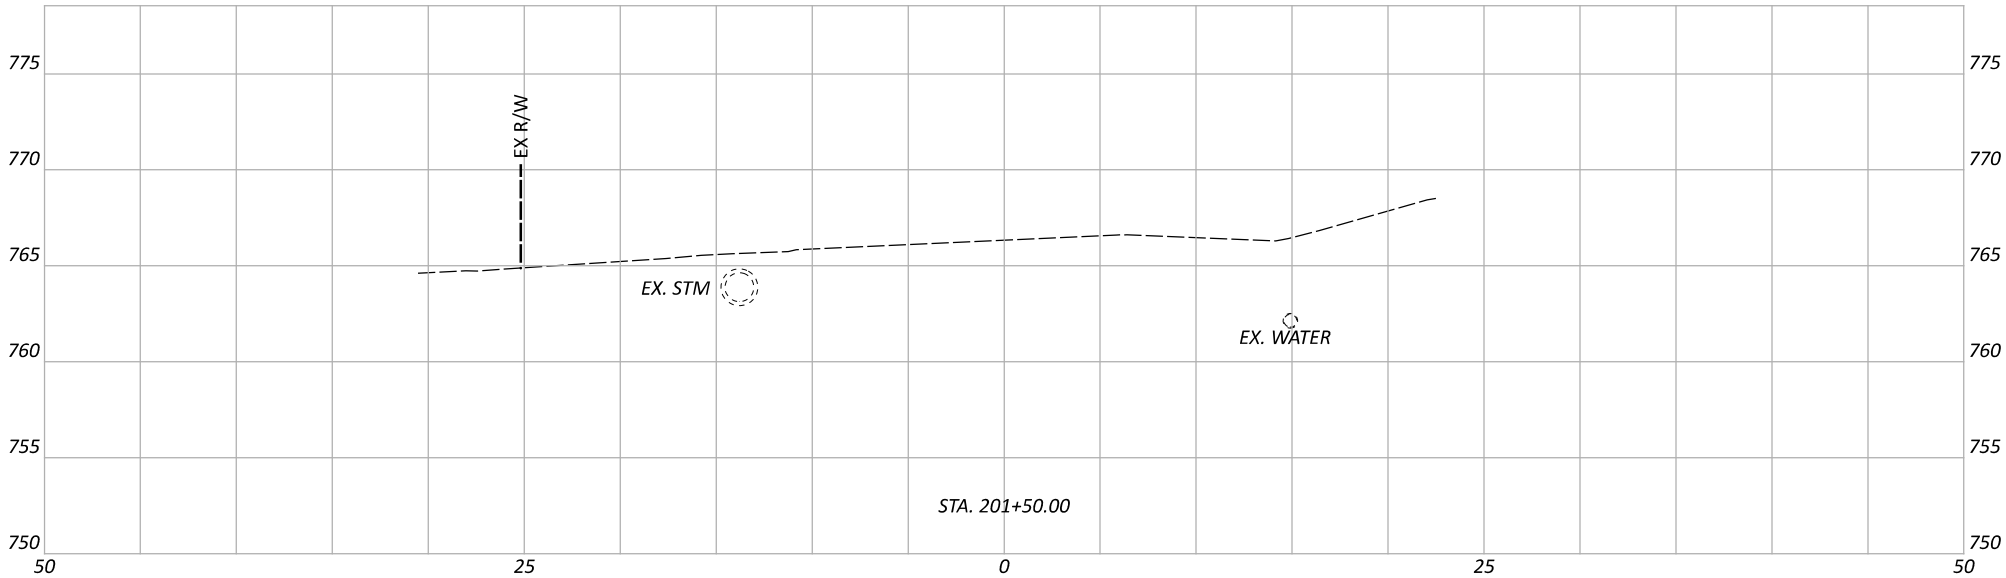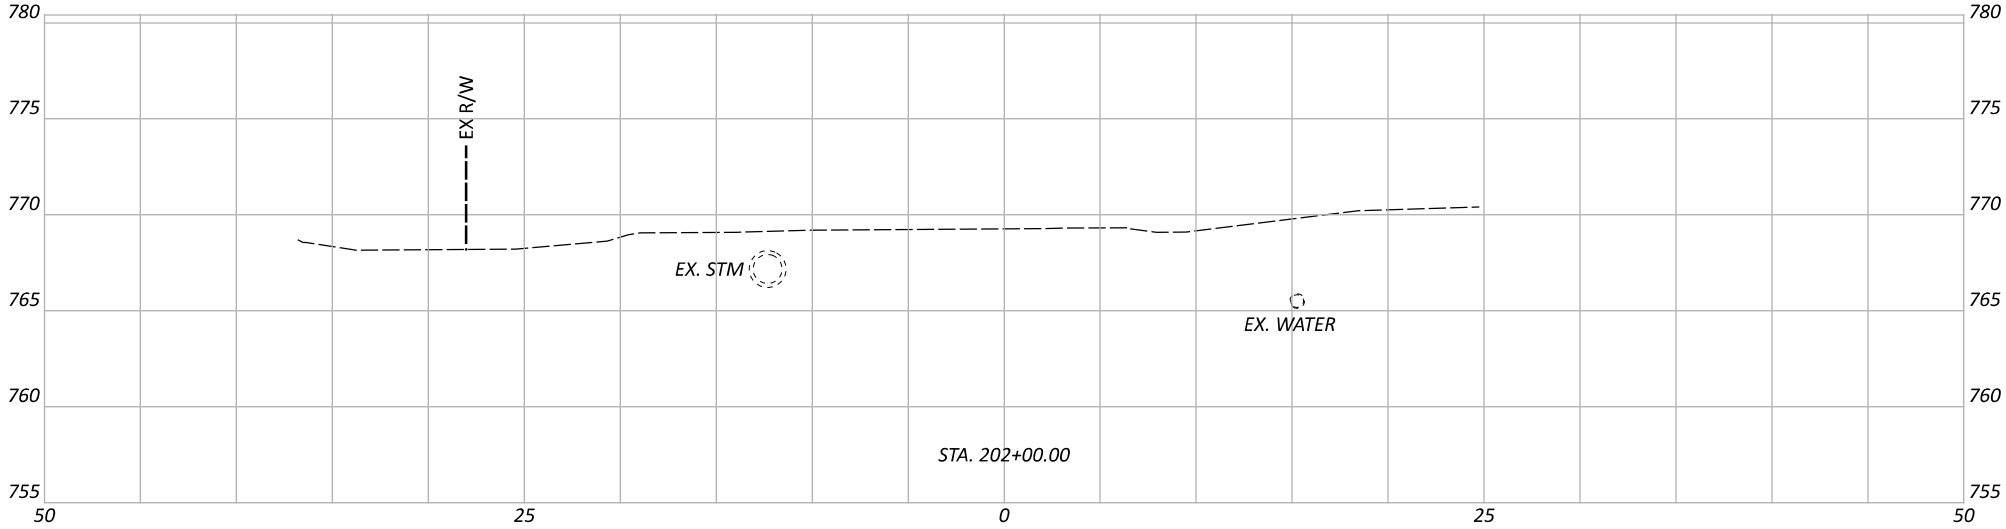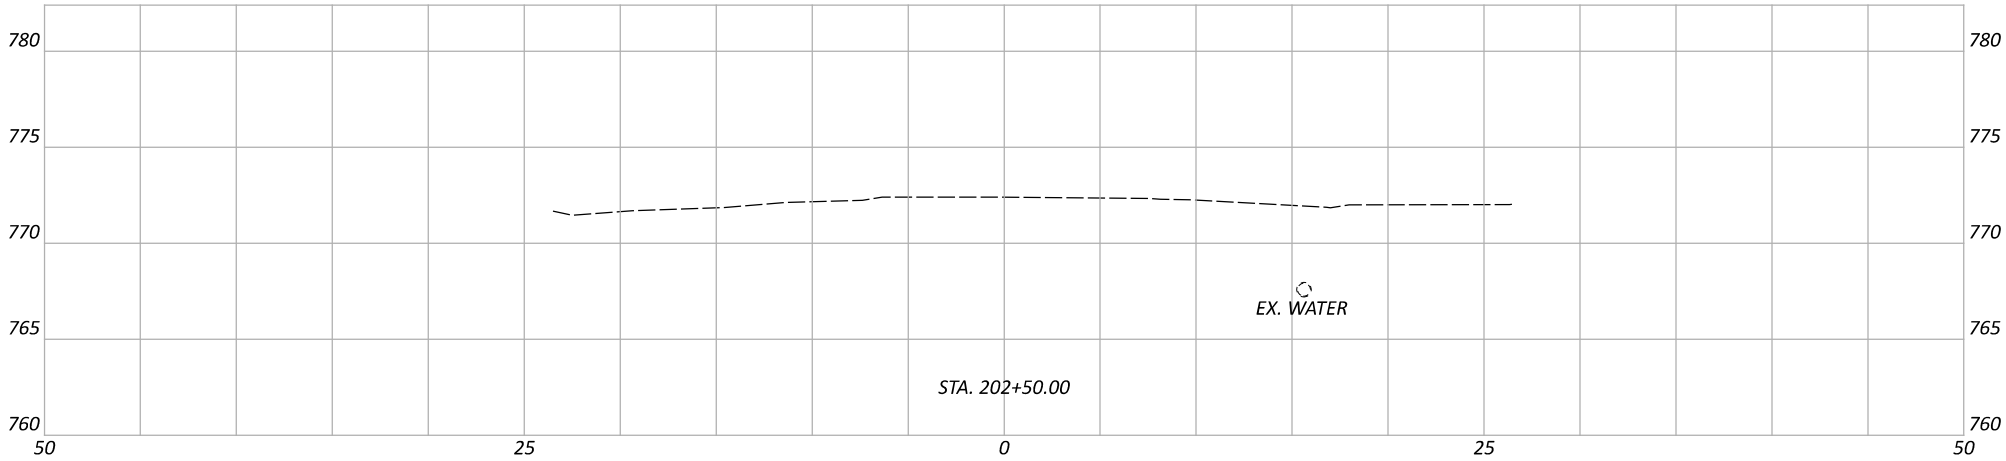

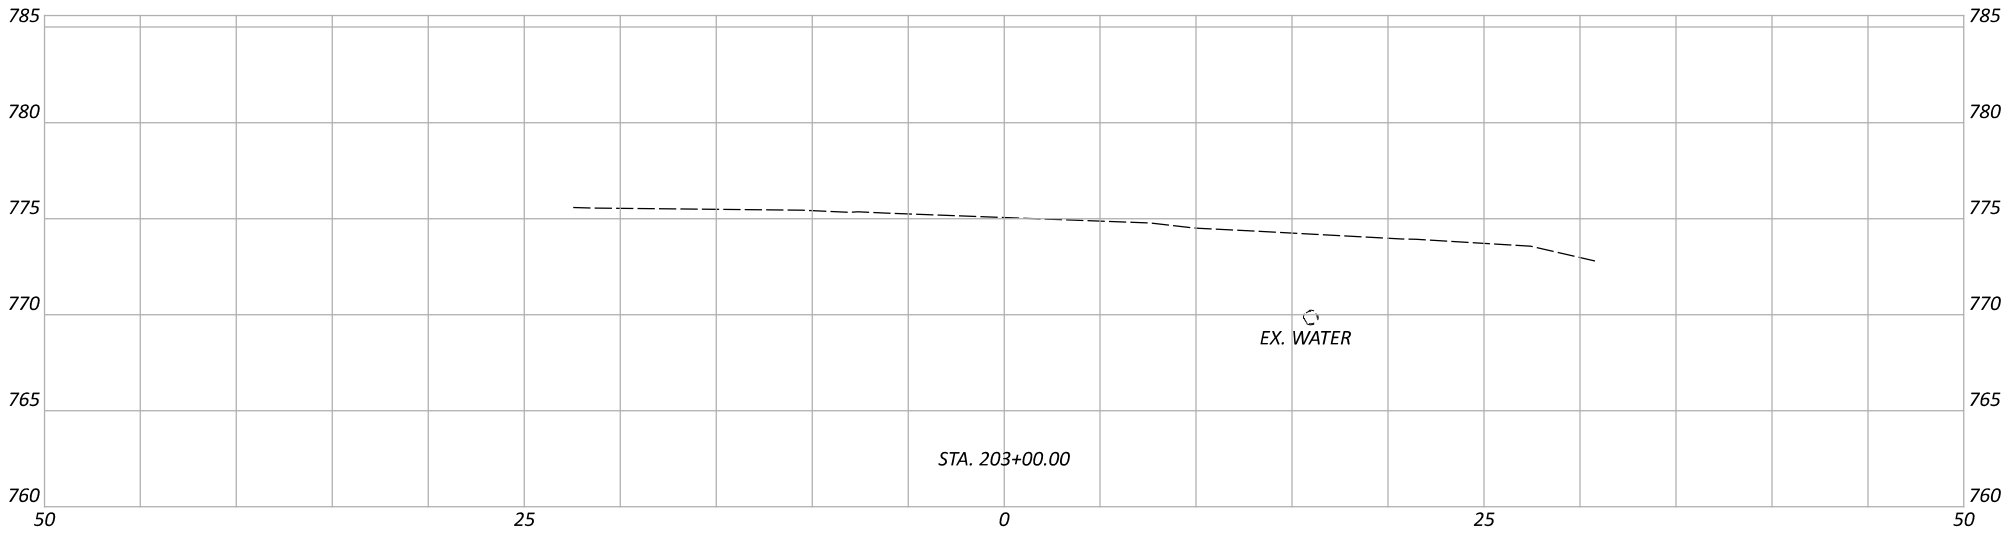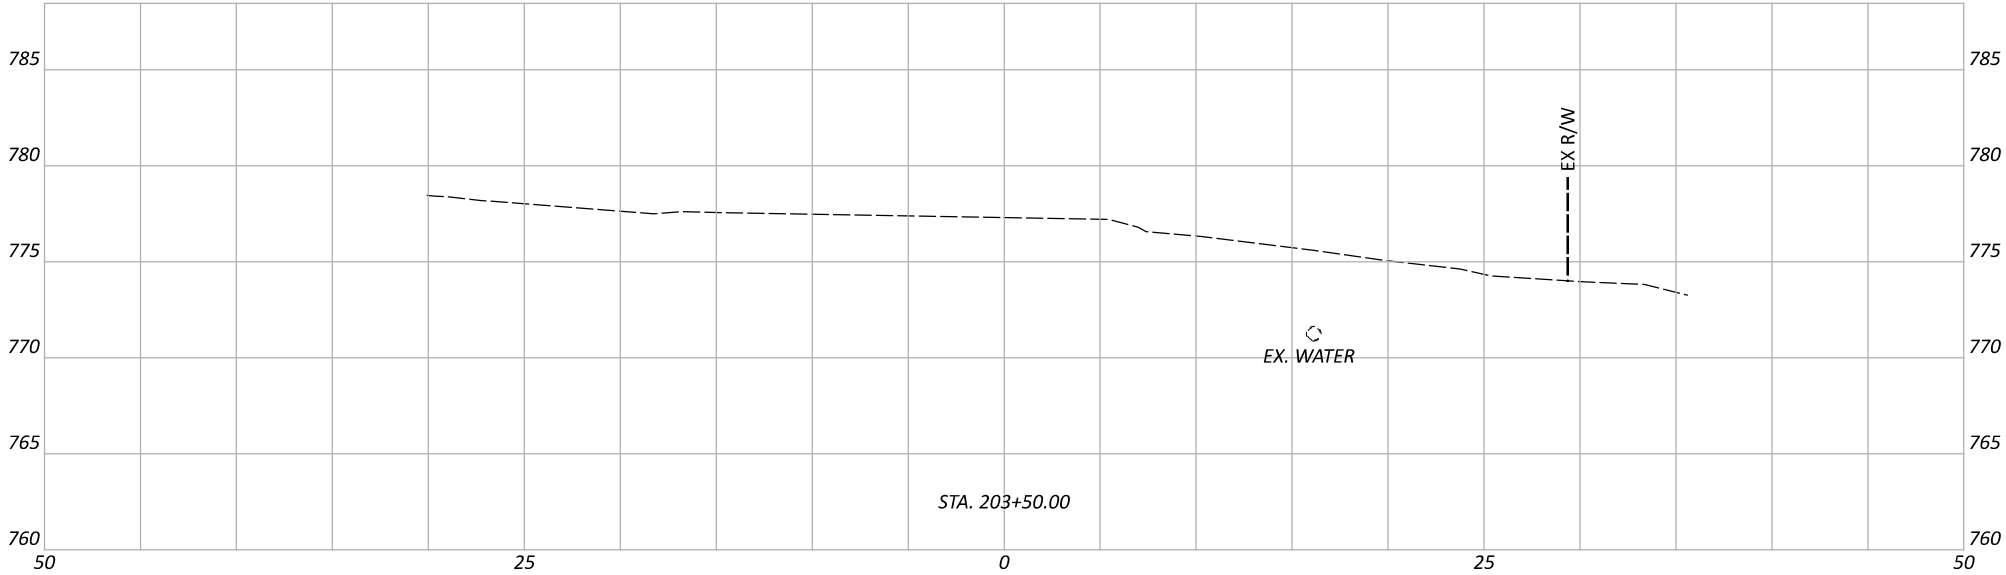
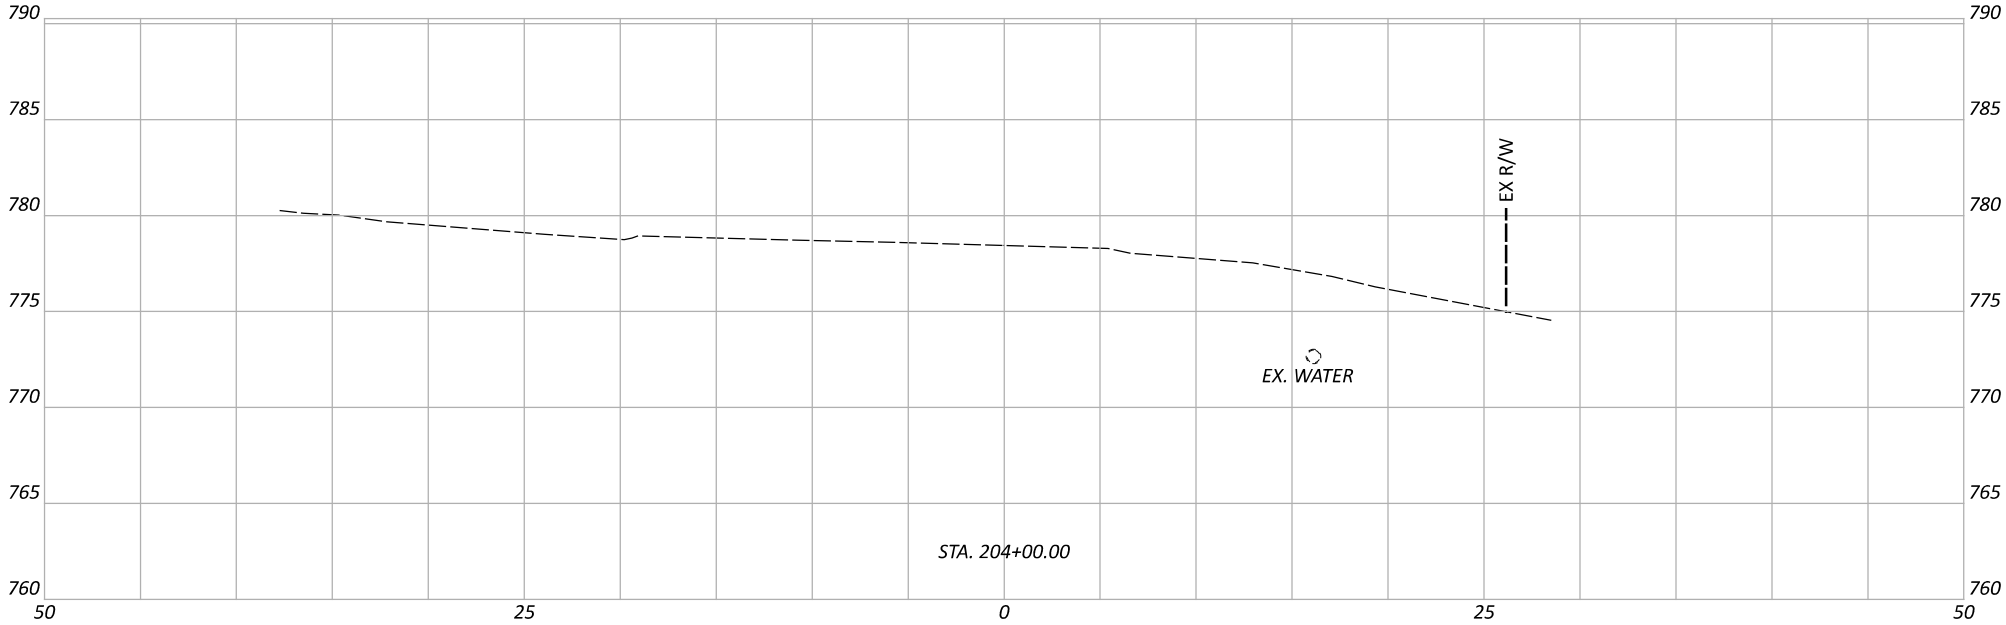


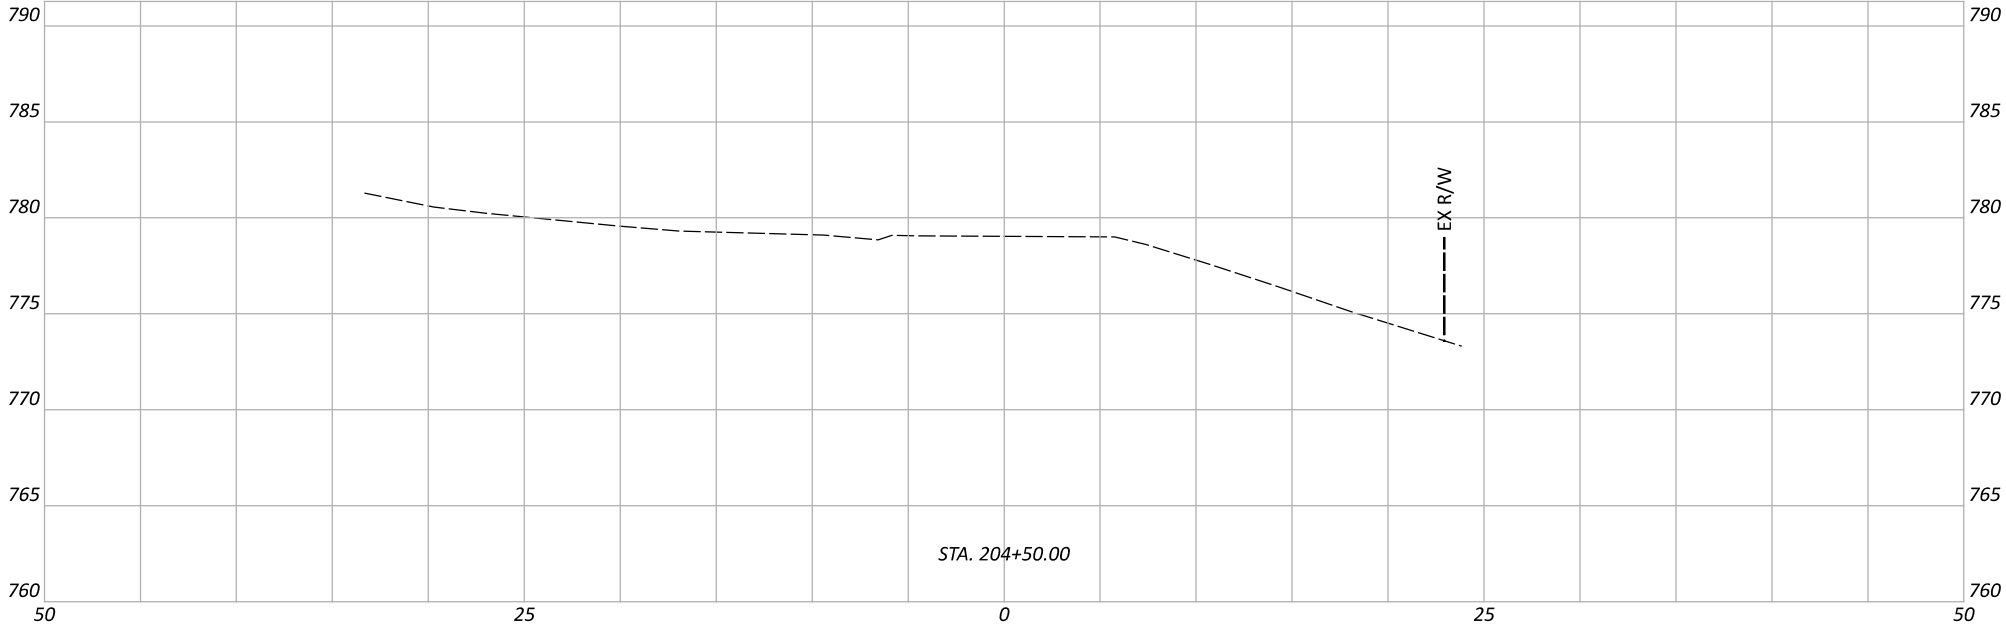
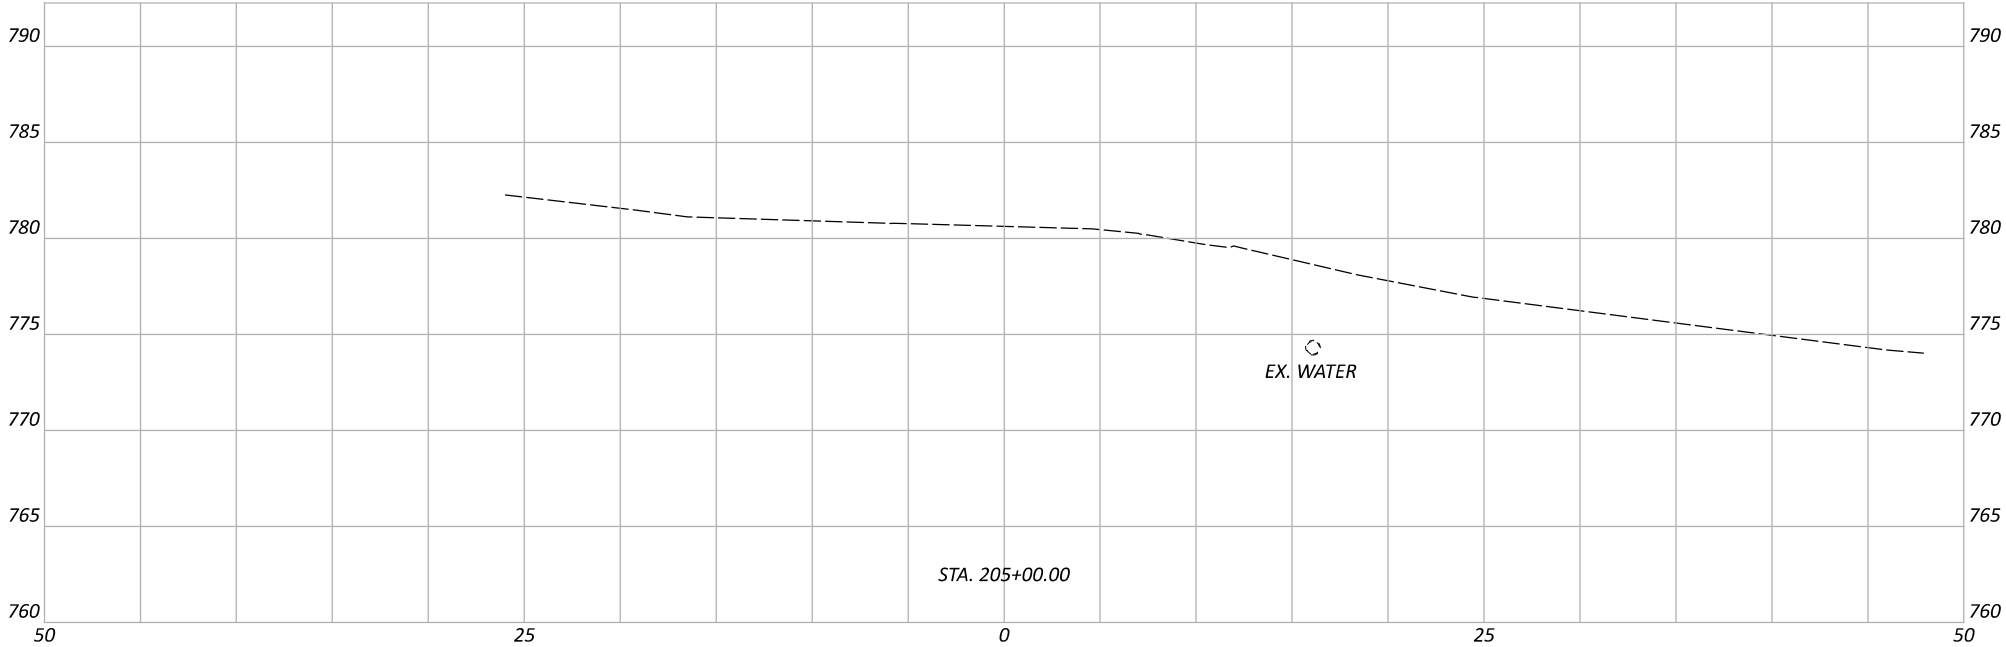


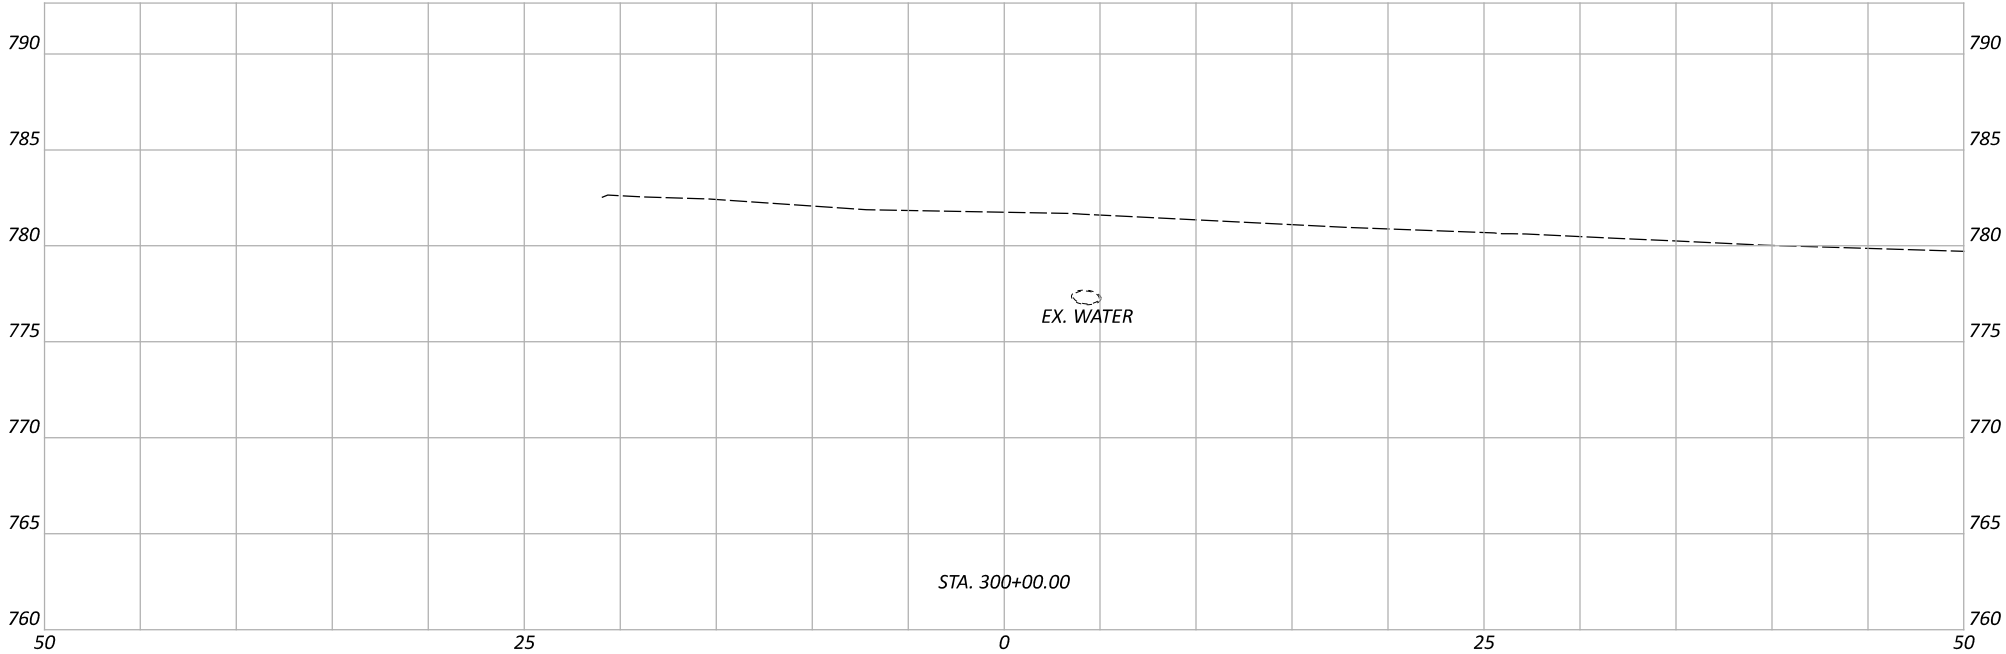
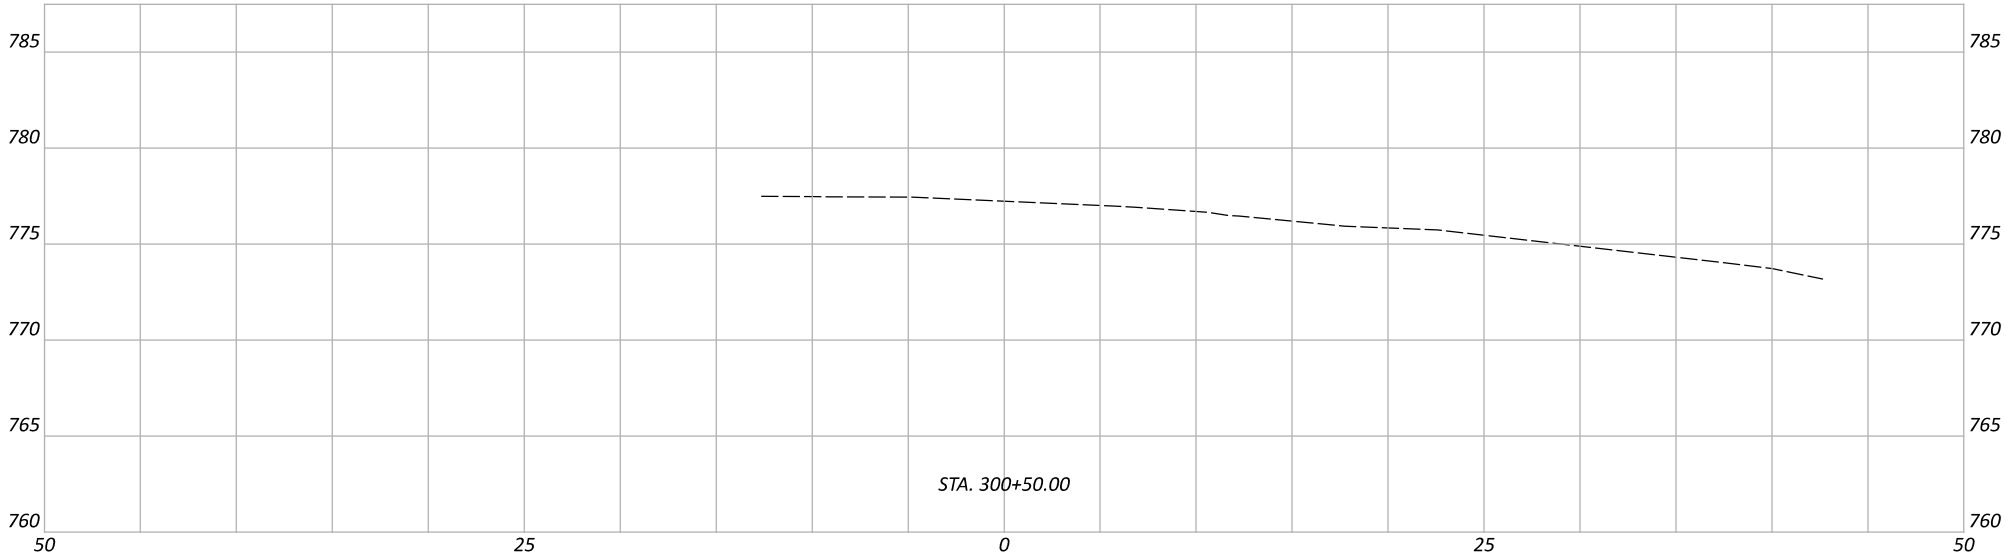
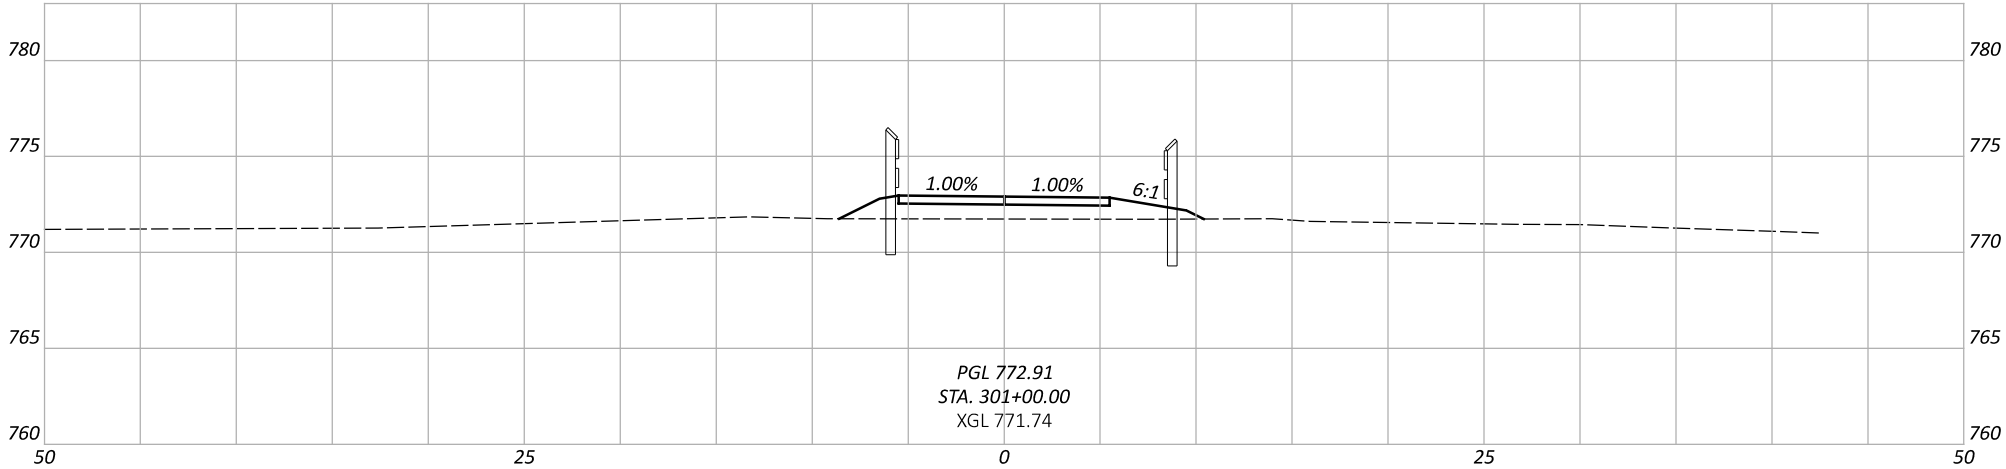


Addendum #1
02/17/2026

Hannah Trace Elementary Connector						
Station	Cut Area (Sq.ft.)	Cut Volume (Cu.yd.)	Fill Area (Sq.ft.)	Fill Volume (Cu.yd.)	Seeding FT	Seeding (SY)
300+00.00	0	0	0	0	0	0
300+50.00	0	0	0	0	0	0
301+00.00	0	0	13.897	12.87	7.99	22.19
301+50.00	0	0	15.546	27.26	6.883	41.31
302+00.00	0.826	0.76	363.509	350.98	107.628	318.09
302+50.00	8.269	8.42	104.758	433.58	16.966	346.09
303+00.00	15.24	21.77	51.913	145.07	72.061	247.3
303+50.00	17.963	30.74	1.987	49.91	15.203	242.4
304+00.00	4.735	21.02	0.495	2.3	4.922	55.9
304+36.25	0	3.18	0	0.33	0	9.91
TOTAL		85.89		1022.3		1283.19

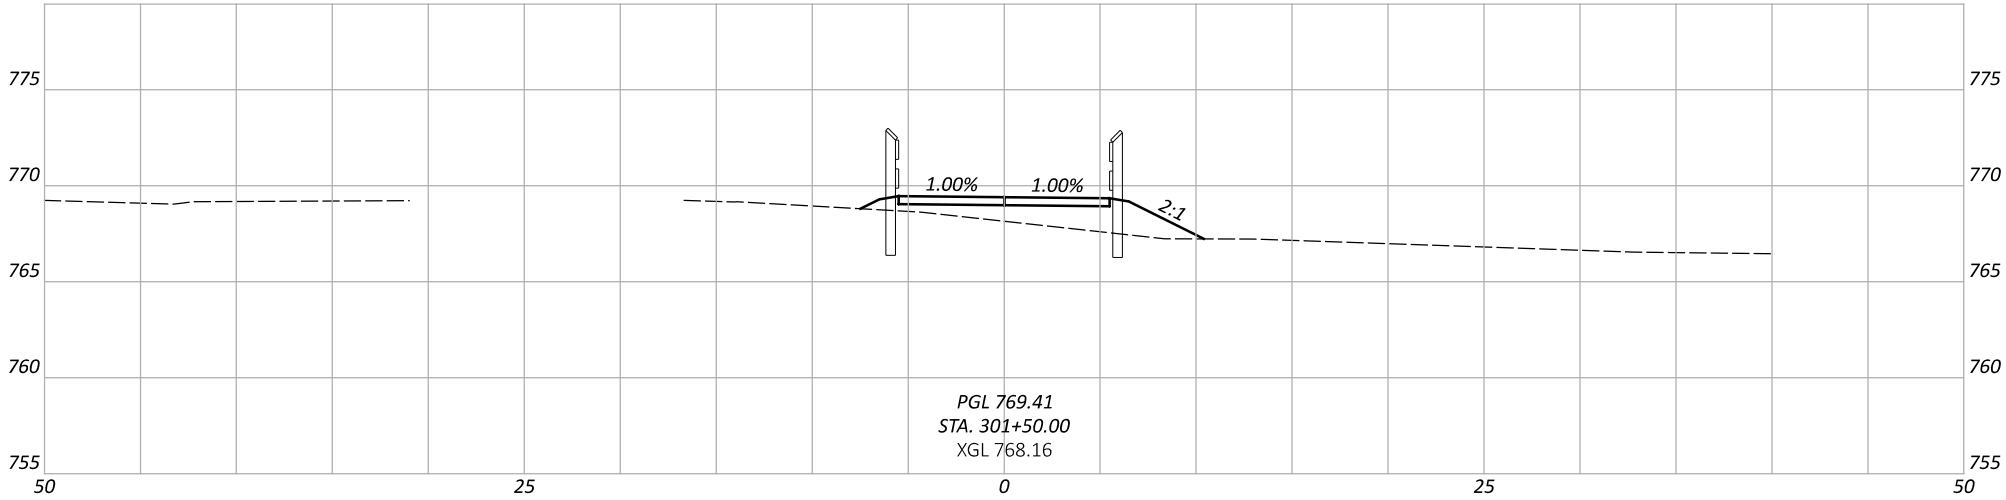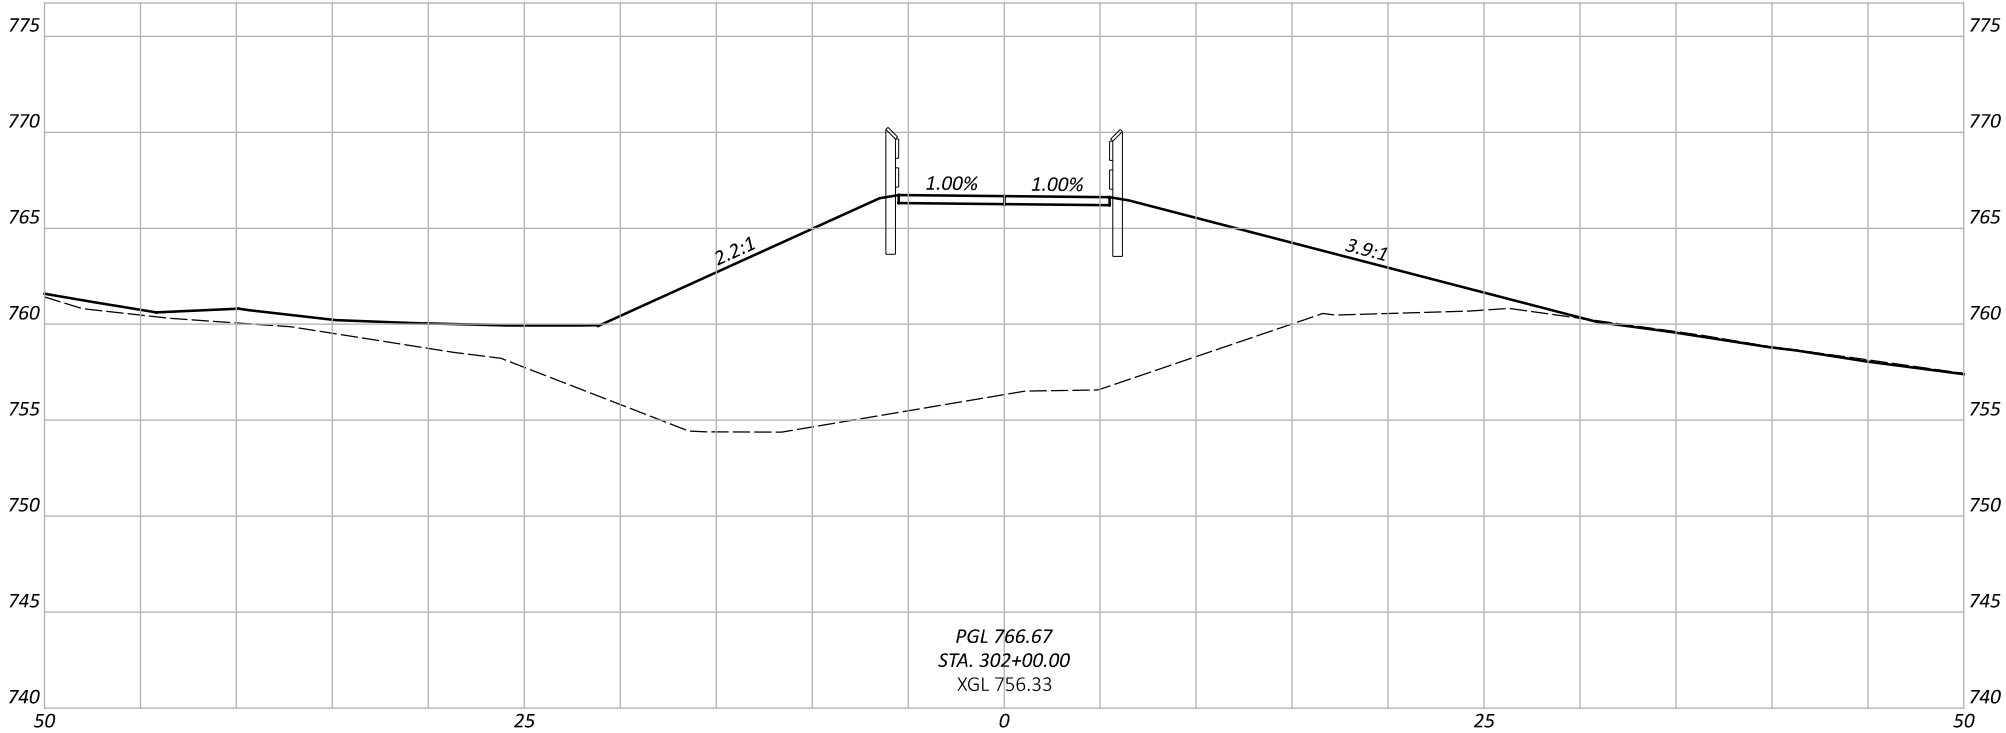

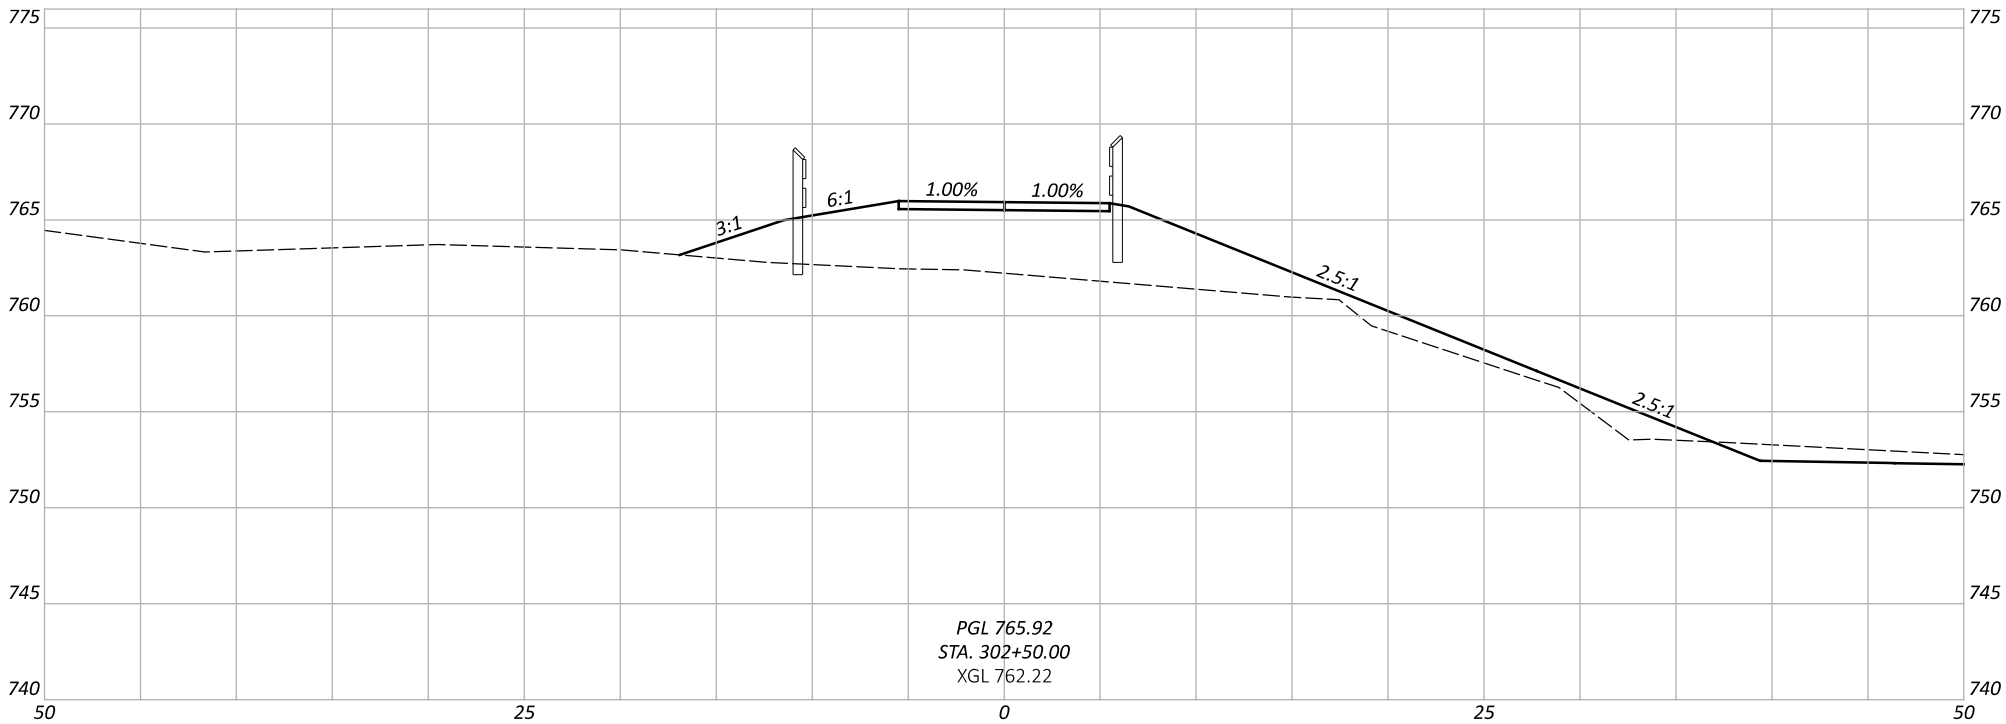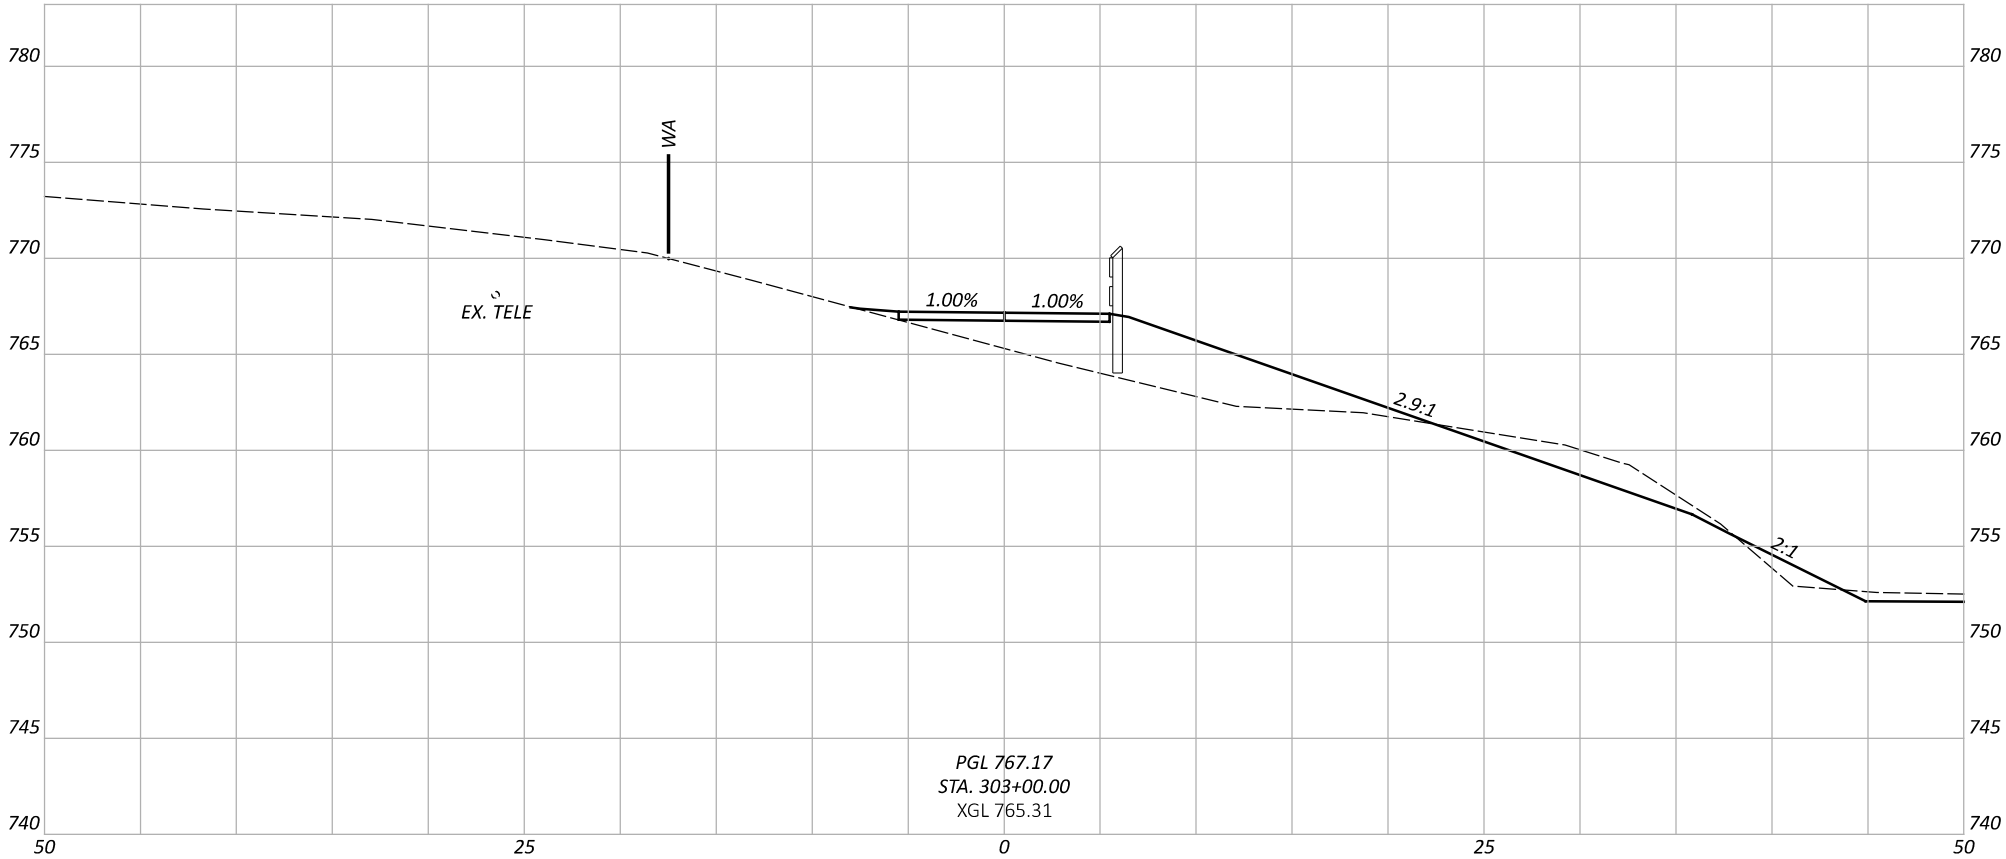

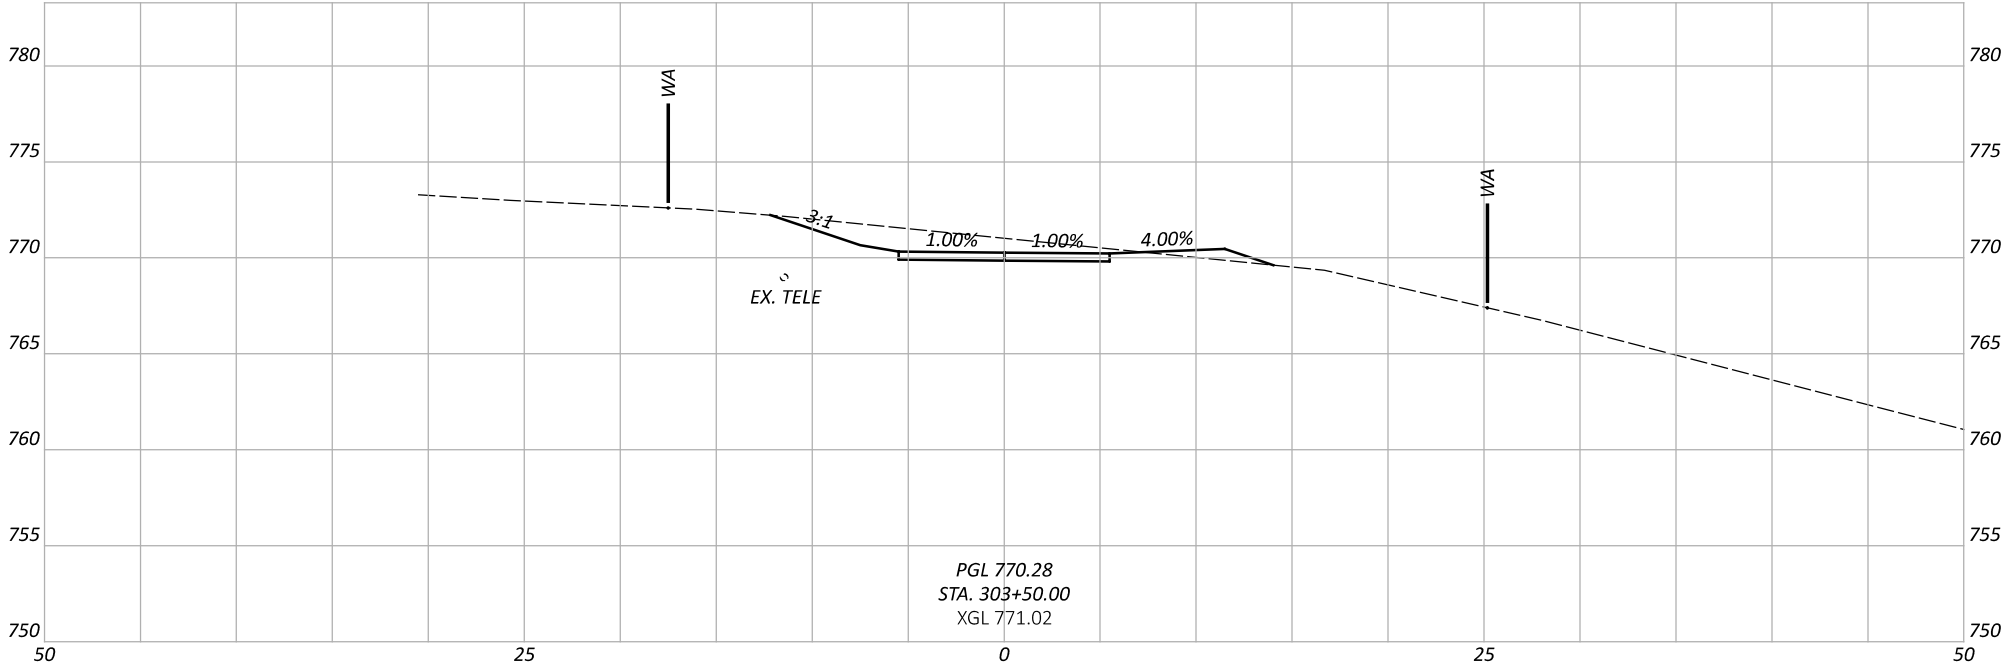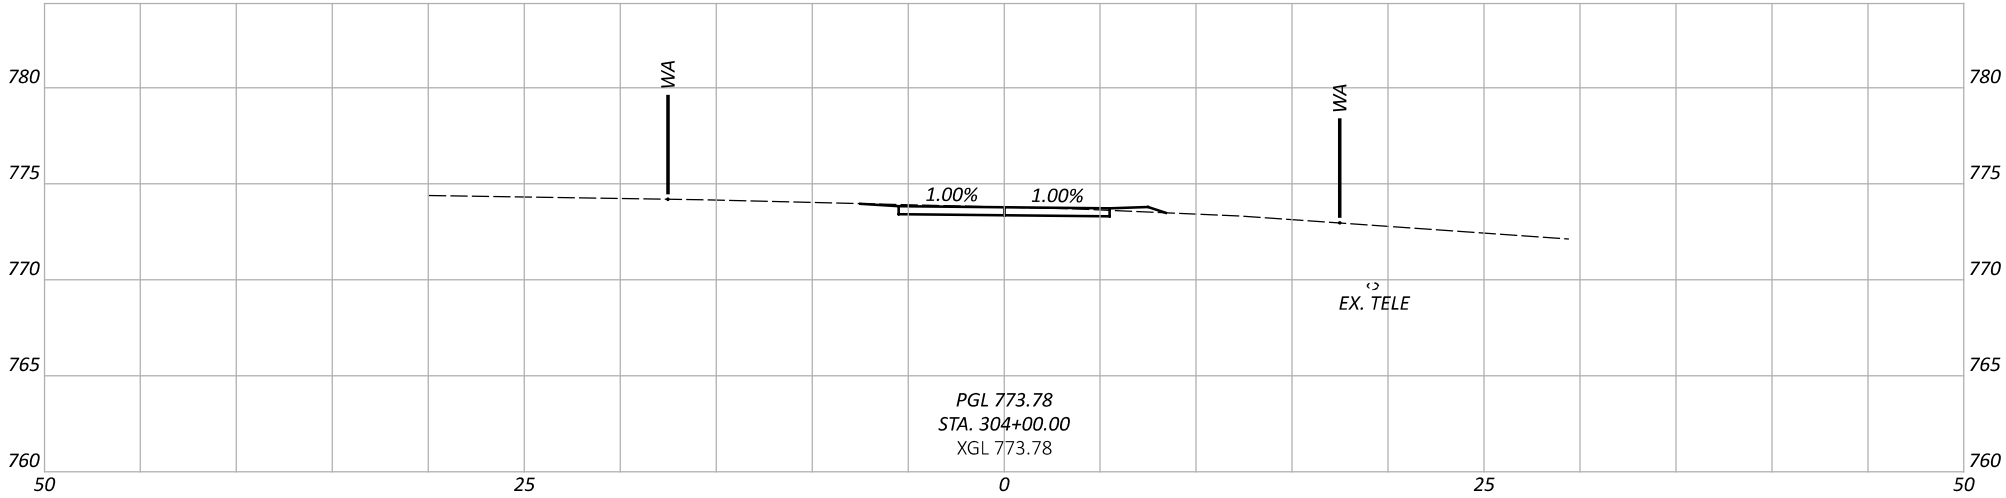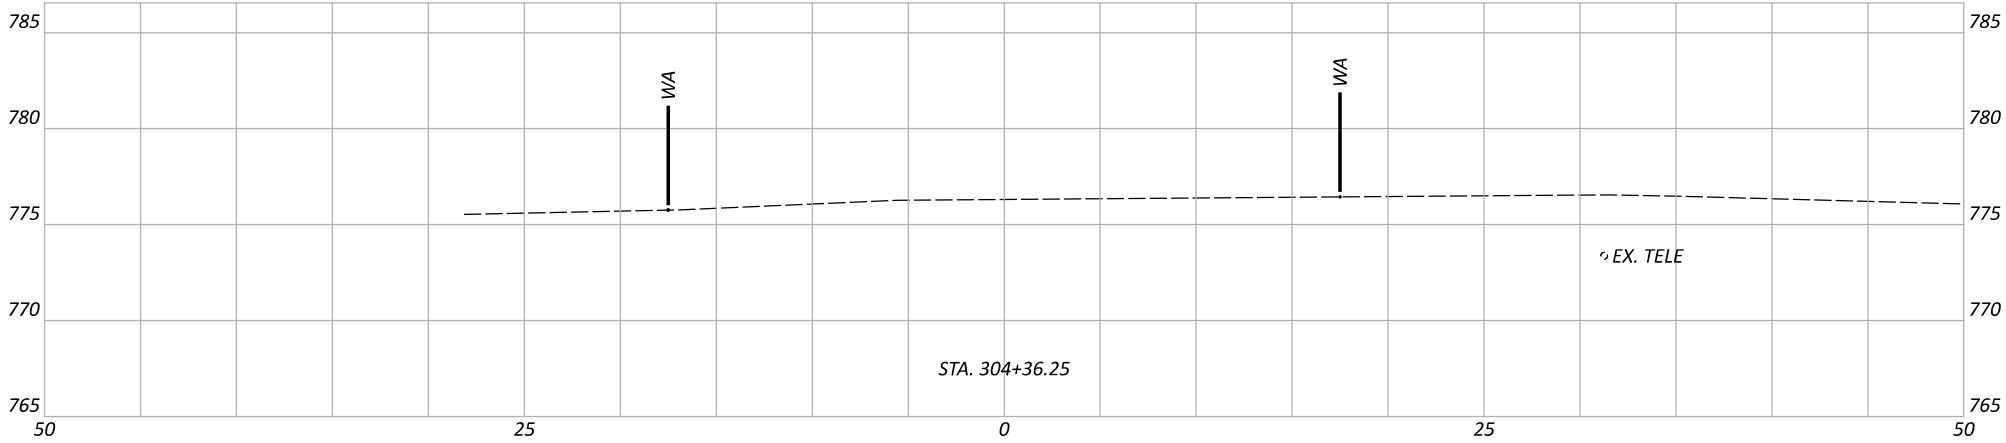

CROSS SECTIONS - HANNAH TRACE ELEMENTARY CONNECTOR
STA 303+50.00 TO STA 304+36.25

DESIGN AGENCY



DESIGNER

EMH

REVIEWER

CAM 11/14/25

PROJECT ID


120712

SHEET


41

TOTAL


51

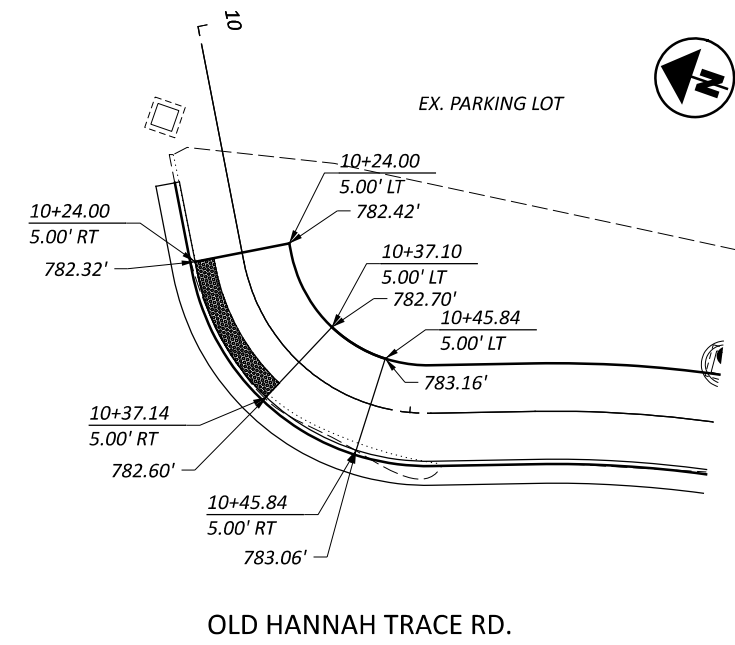

CURB RAMP DETAIL - OLD HANNAH TRACE RD.

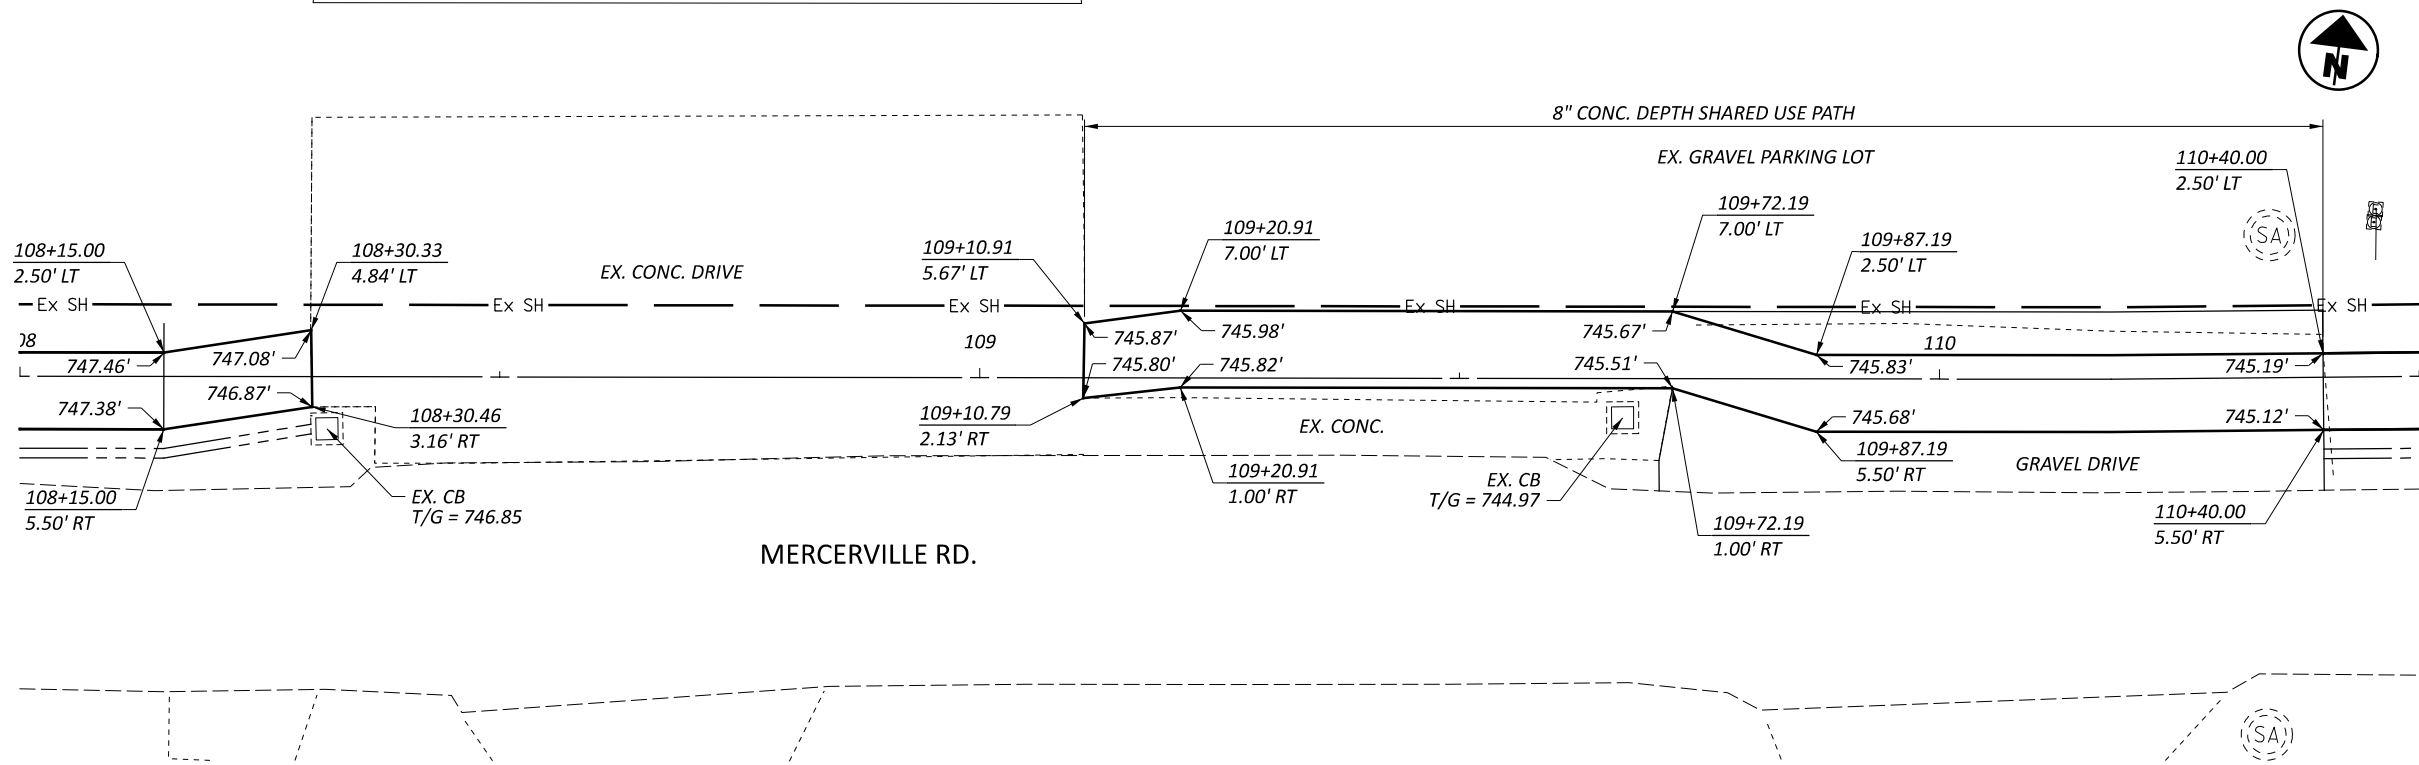

PATH DETAIL - FIRE DEPARTMENT ACCESS - MERCERVILLE RD.

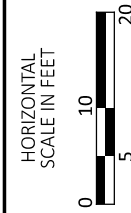

SHARED USE PATH AND CURB RAMP DETAILS

DESIGN AGENCY



DESIGNER

EMH

REVIEWER

CSR 04/24/25

PROJECT ID


120712

SHEET


42

TOTAL


51

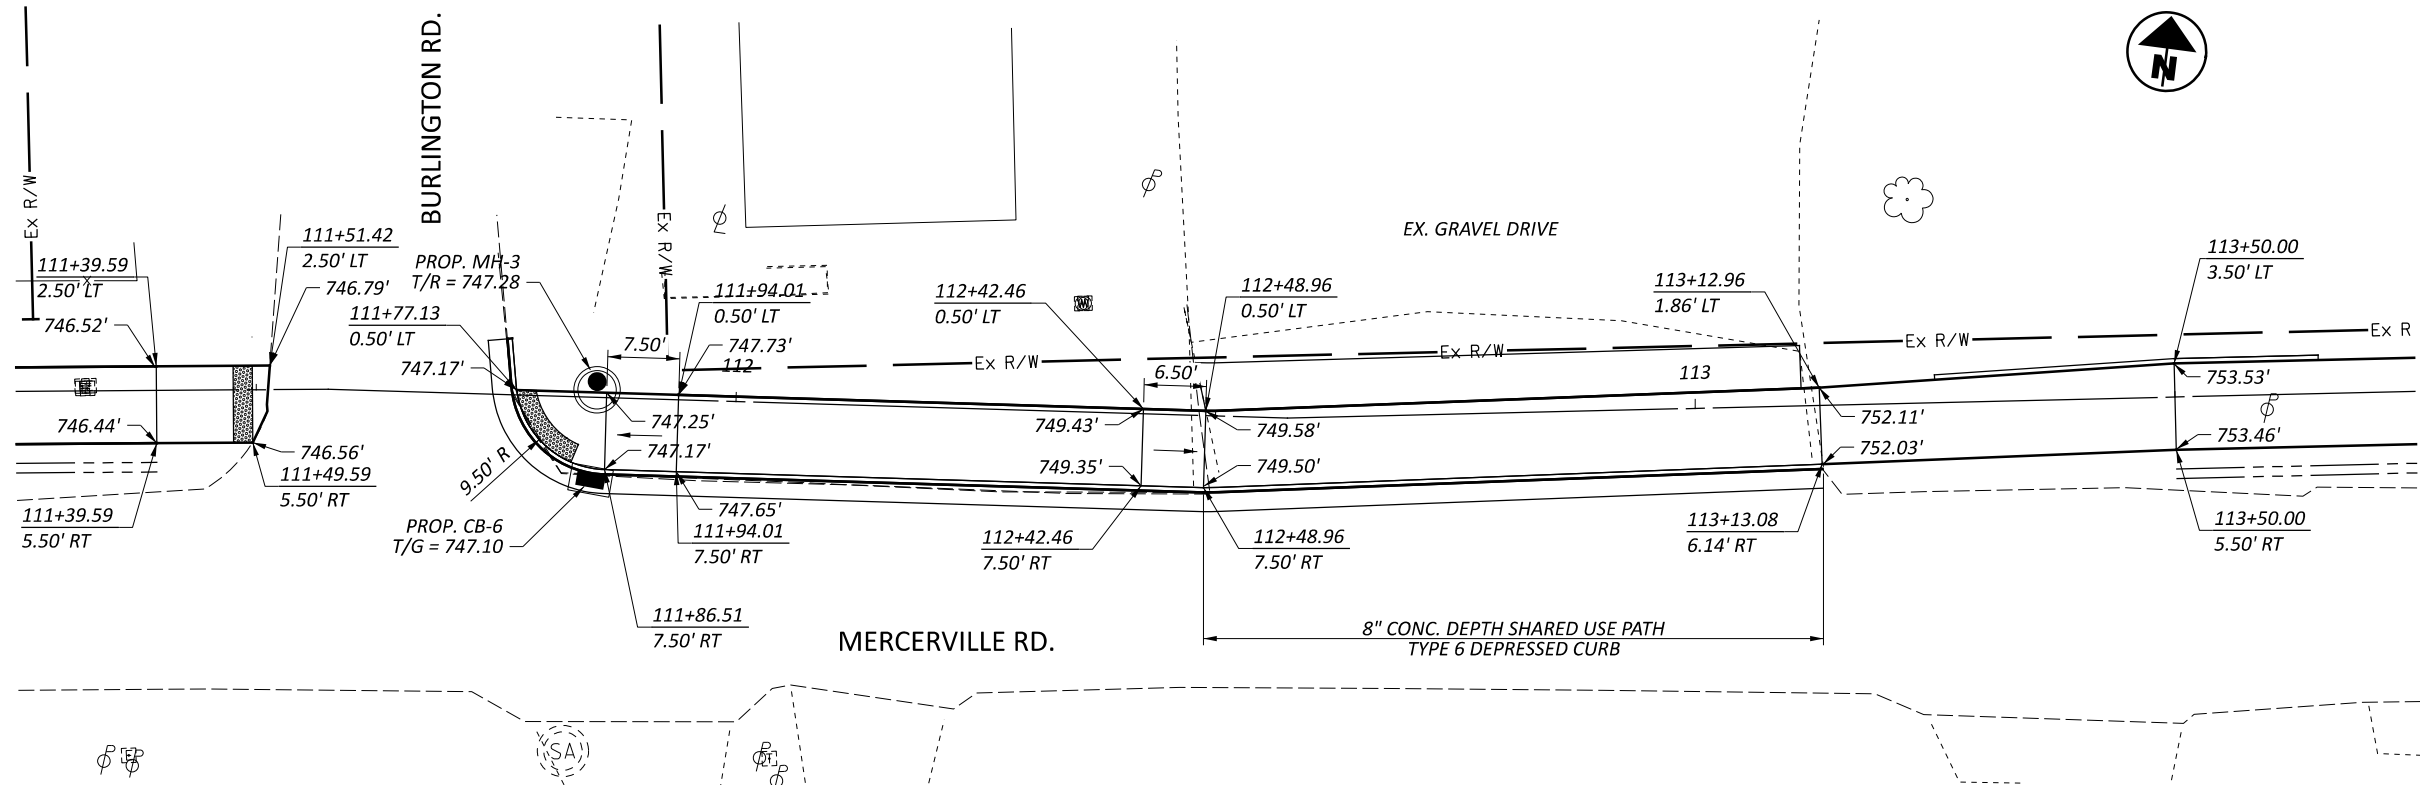

PATH DETAIL - MERCERVILLE RD. AT BURLINGTON RD.

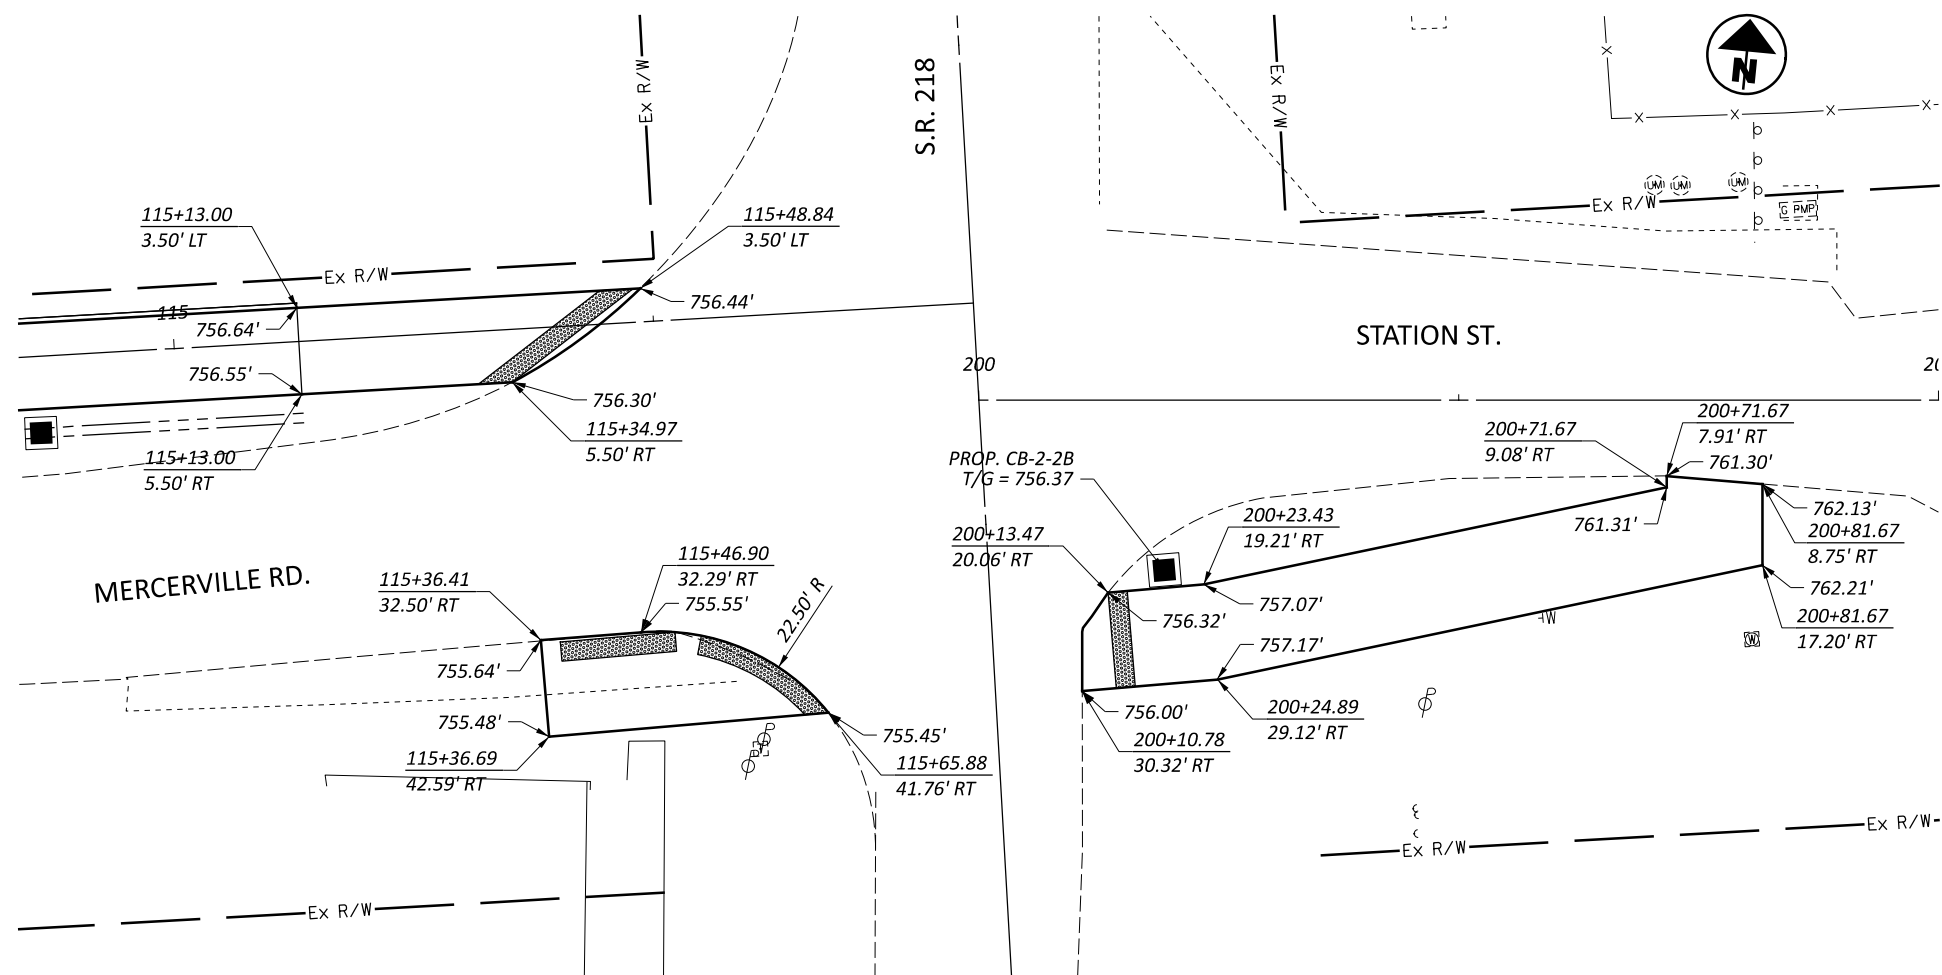

PATH DETAIL - MERCERVILLE RD./STATION ST. AT S.R. 218

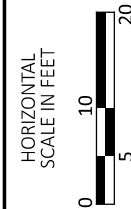

SHARED USE PATH AND CURB RAMP DETAILS

DESIGN AGENCY



DESIGNER

EMH

REVIEWER

CSR 04/24/25

PROJECT ID


120712

SHEET

43

TOTAL

51

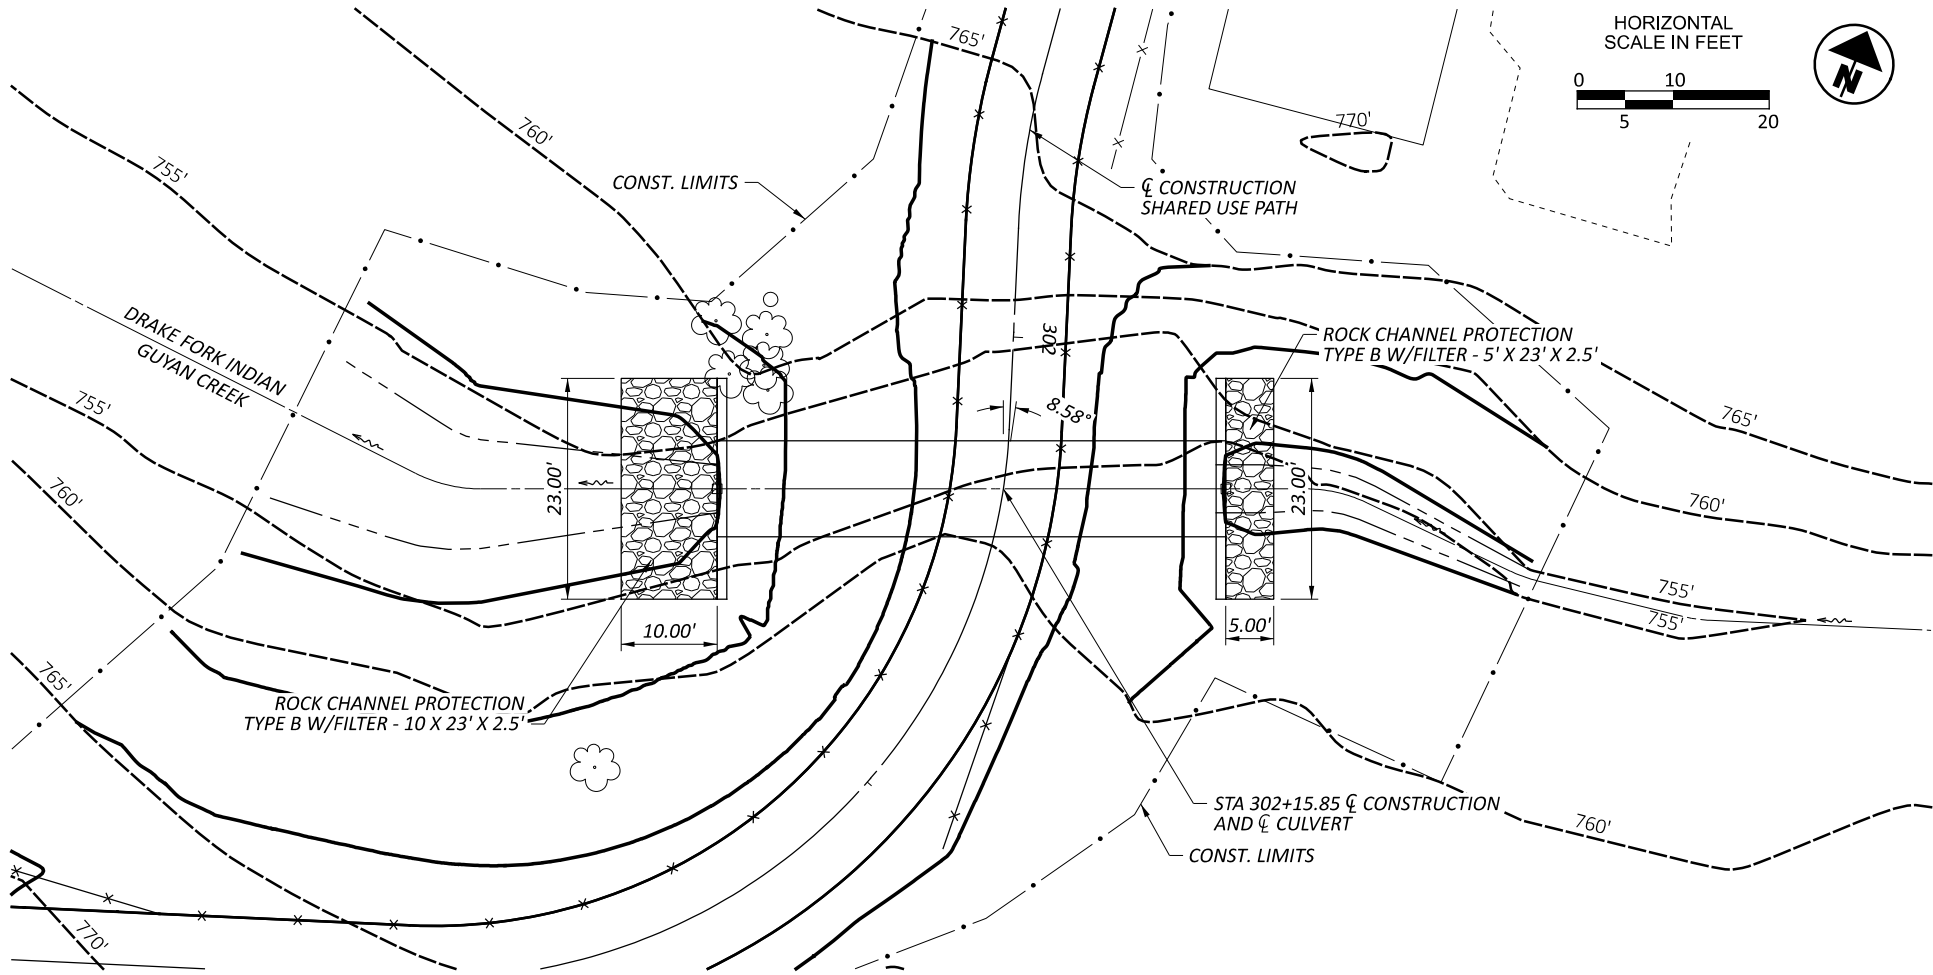


QUANTITIES CARRIED TO DRAINAGE SUBSUMMARY			
ESTIMATED QUANTITIES			
ITEM	QUANTITY	UNIT	DESCRIPTION
601	32	CY	ROCK CHANNEL PROTECTION, TYPE B WITH FILTER
602	18	CY	CONCRETE MASONRY
611	53	FT	120" CONDUIT, TYPE A


HYDRAULIC DATA

DRAINAGE AREA = 344 ACRES
Q (4%) = 230 CFS V (4%) = 11 FT/S
Q (1%) = 325 CFS V (1%) = 13 FT/S
ORDINARY HIGH WATER MARK : 754.47 FT


PROPOSED STRUCTURE

TYPE : 120" CONDUIT, TYPE A
SKEW : 8.58°
ALIGNMENT : TANGENT
CFN : XXXXXXX

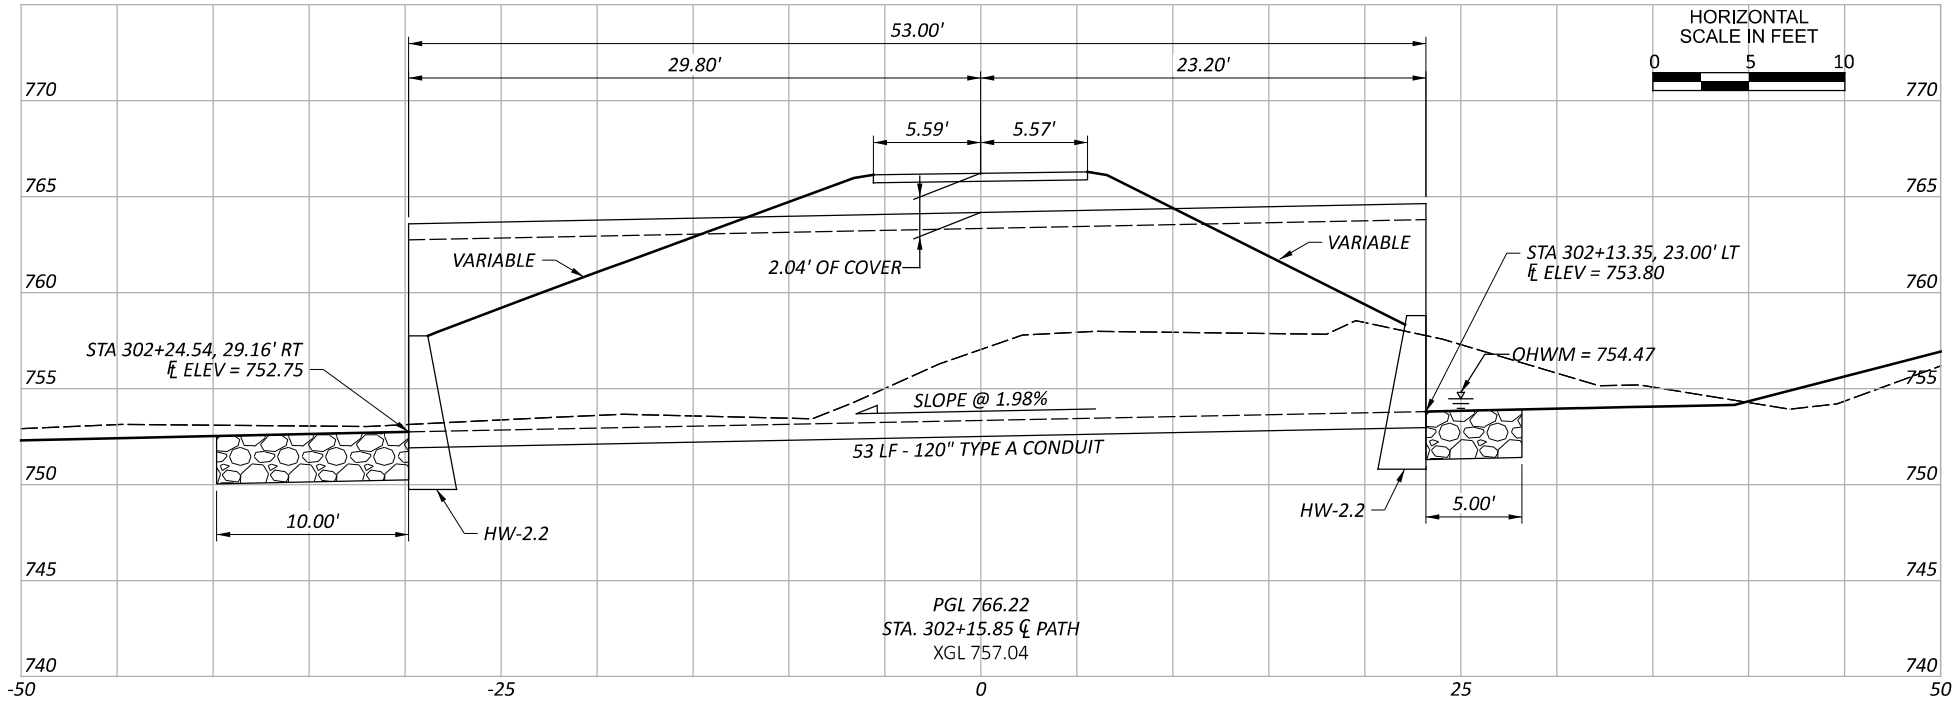


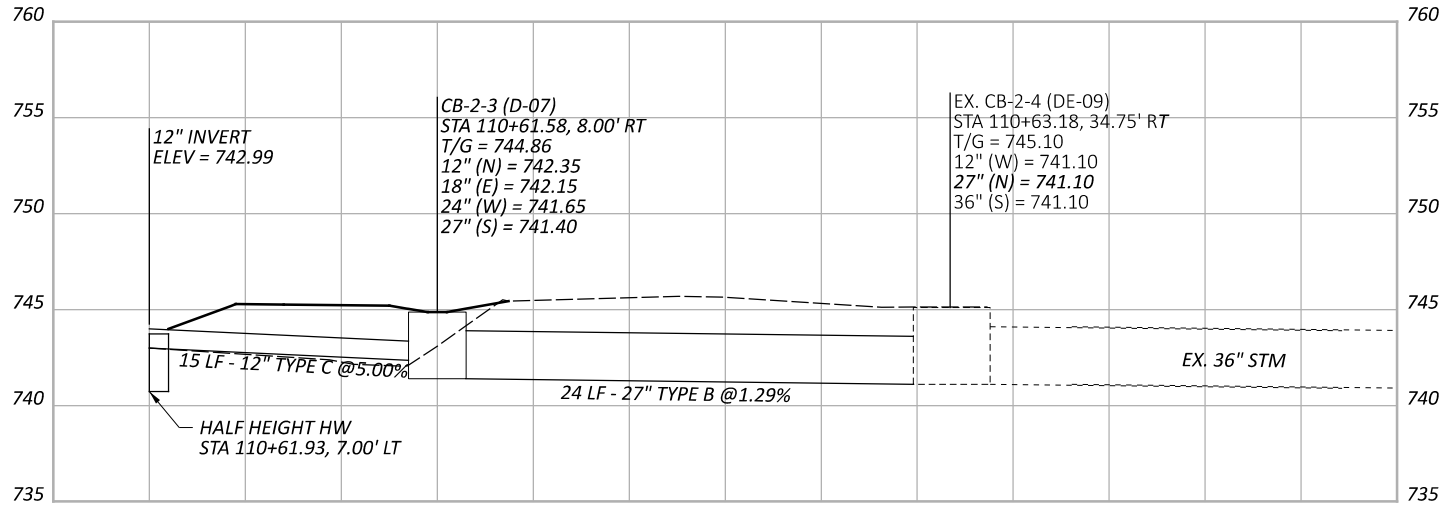

DRAINAGE PROFILE - D-07 TO DE-09

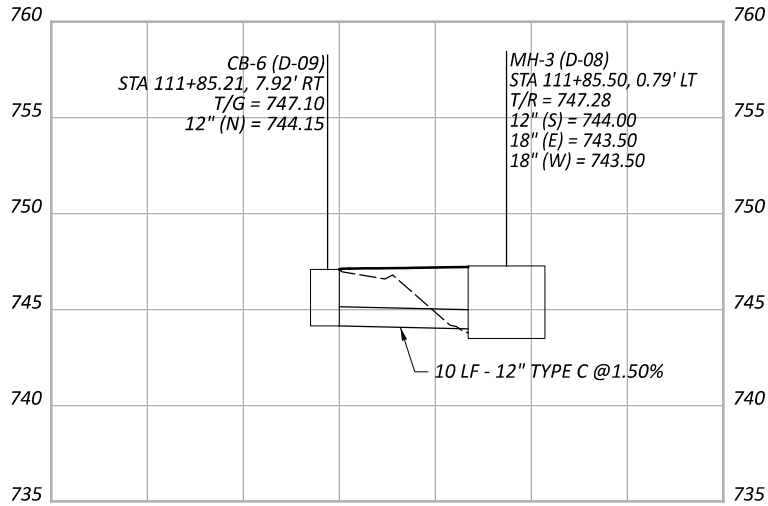

DRAINAGE PROFILE - D-09 TO D-08

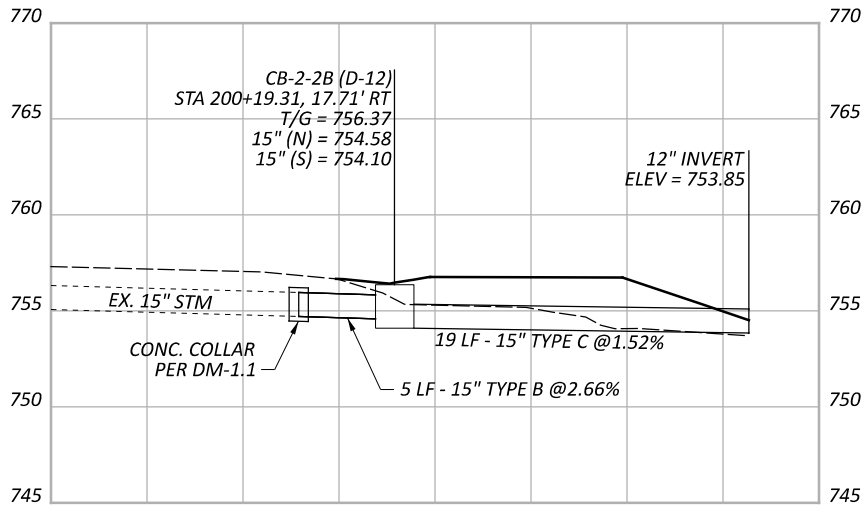

DRAINAGE PROFILE - D-12

SIGNING SUBSUMMARY	
DESIGN AGENCY	
 DLZ	
DESIGNER	
ABS	
REVIEWER	
EMH 08/15/25	
PROJECT ID	
120712	
SHEET	TOTAL
46	51

MODEL: Sheet PAPER SIZE: 17x11 (in.) DATE: 2/17/2026 TIME: 12:35:23 PM USER: ethines
X:\Projects\2024\2428\315400 Guyan Twp Mercersville Path TAP\120712\400-Engineering\Traffic\Sheets\120712_TS002.dgn

[illegible]

PAVEMENT MARKING SUBSUMMARY

DESIGN AGENCY



DESIGNER

ABS

REVIEWER


EMH 08/15/25

PROJECT II

120712

SHEET	TOTAL
-------	-------

47 | 5

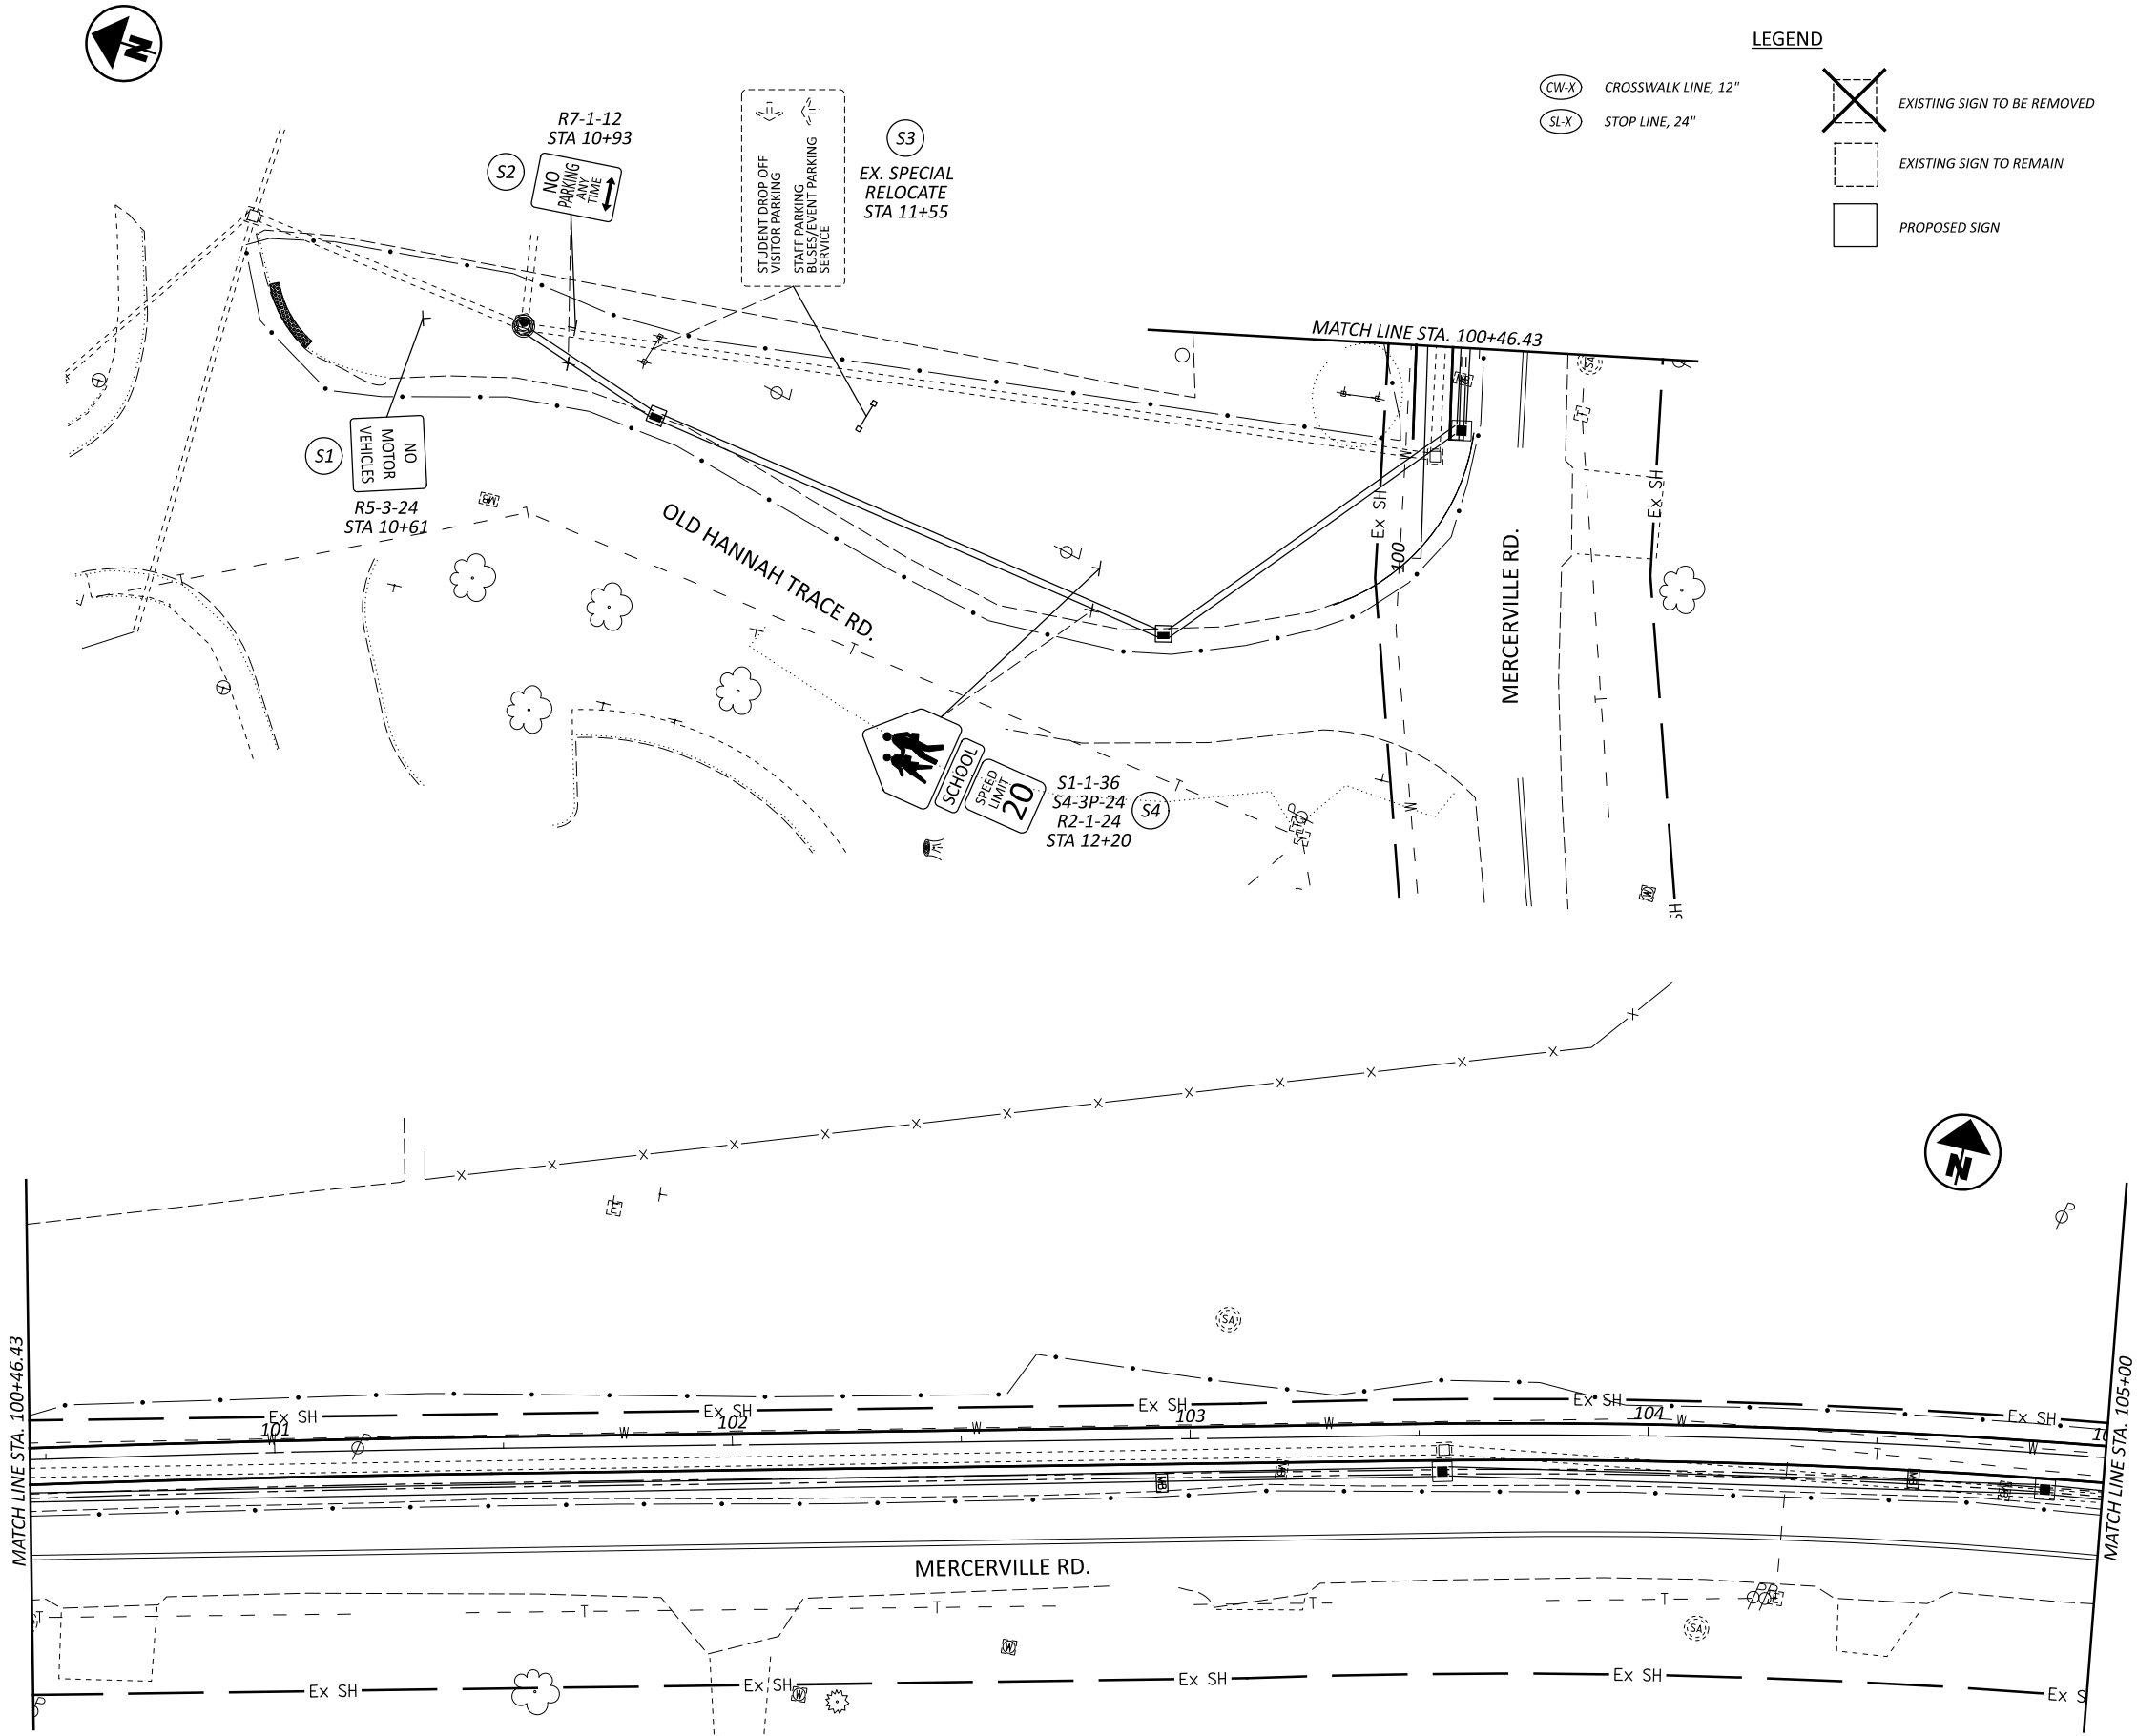

TRAFFIC CONTROL PLAN
STA 1+00 TO STA 105+00

DESIGN AGENCY



DESIGNER

EMH

REVIEWER


CSR 04/24/25

PROJECT ID

120712

SHEET TOTAL

48 51

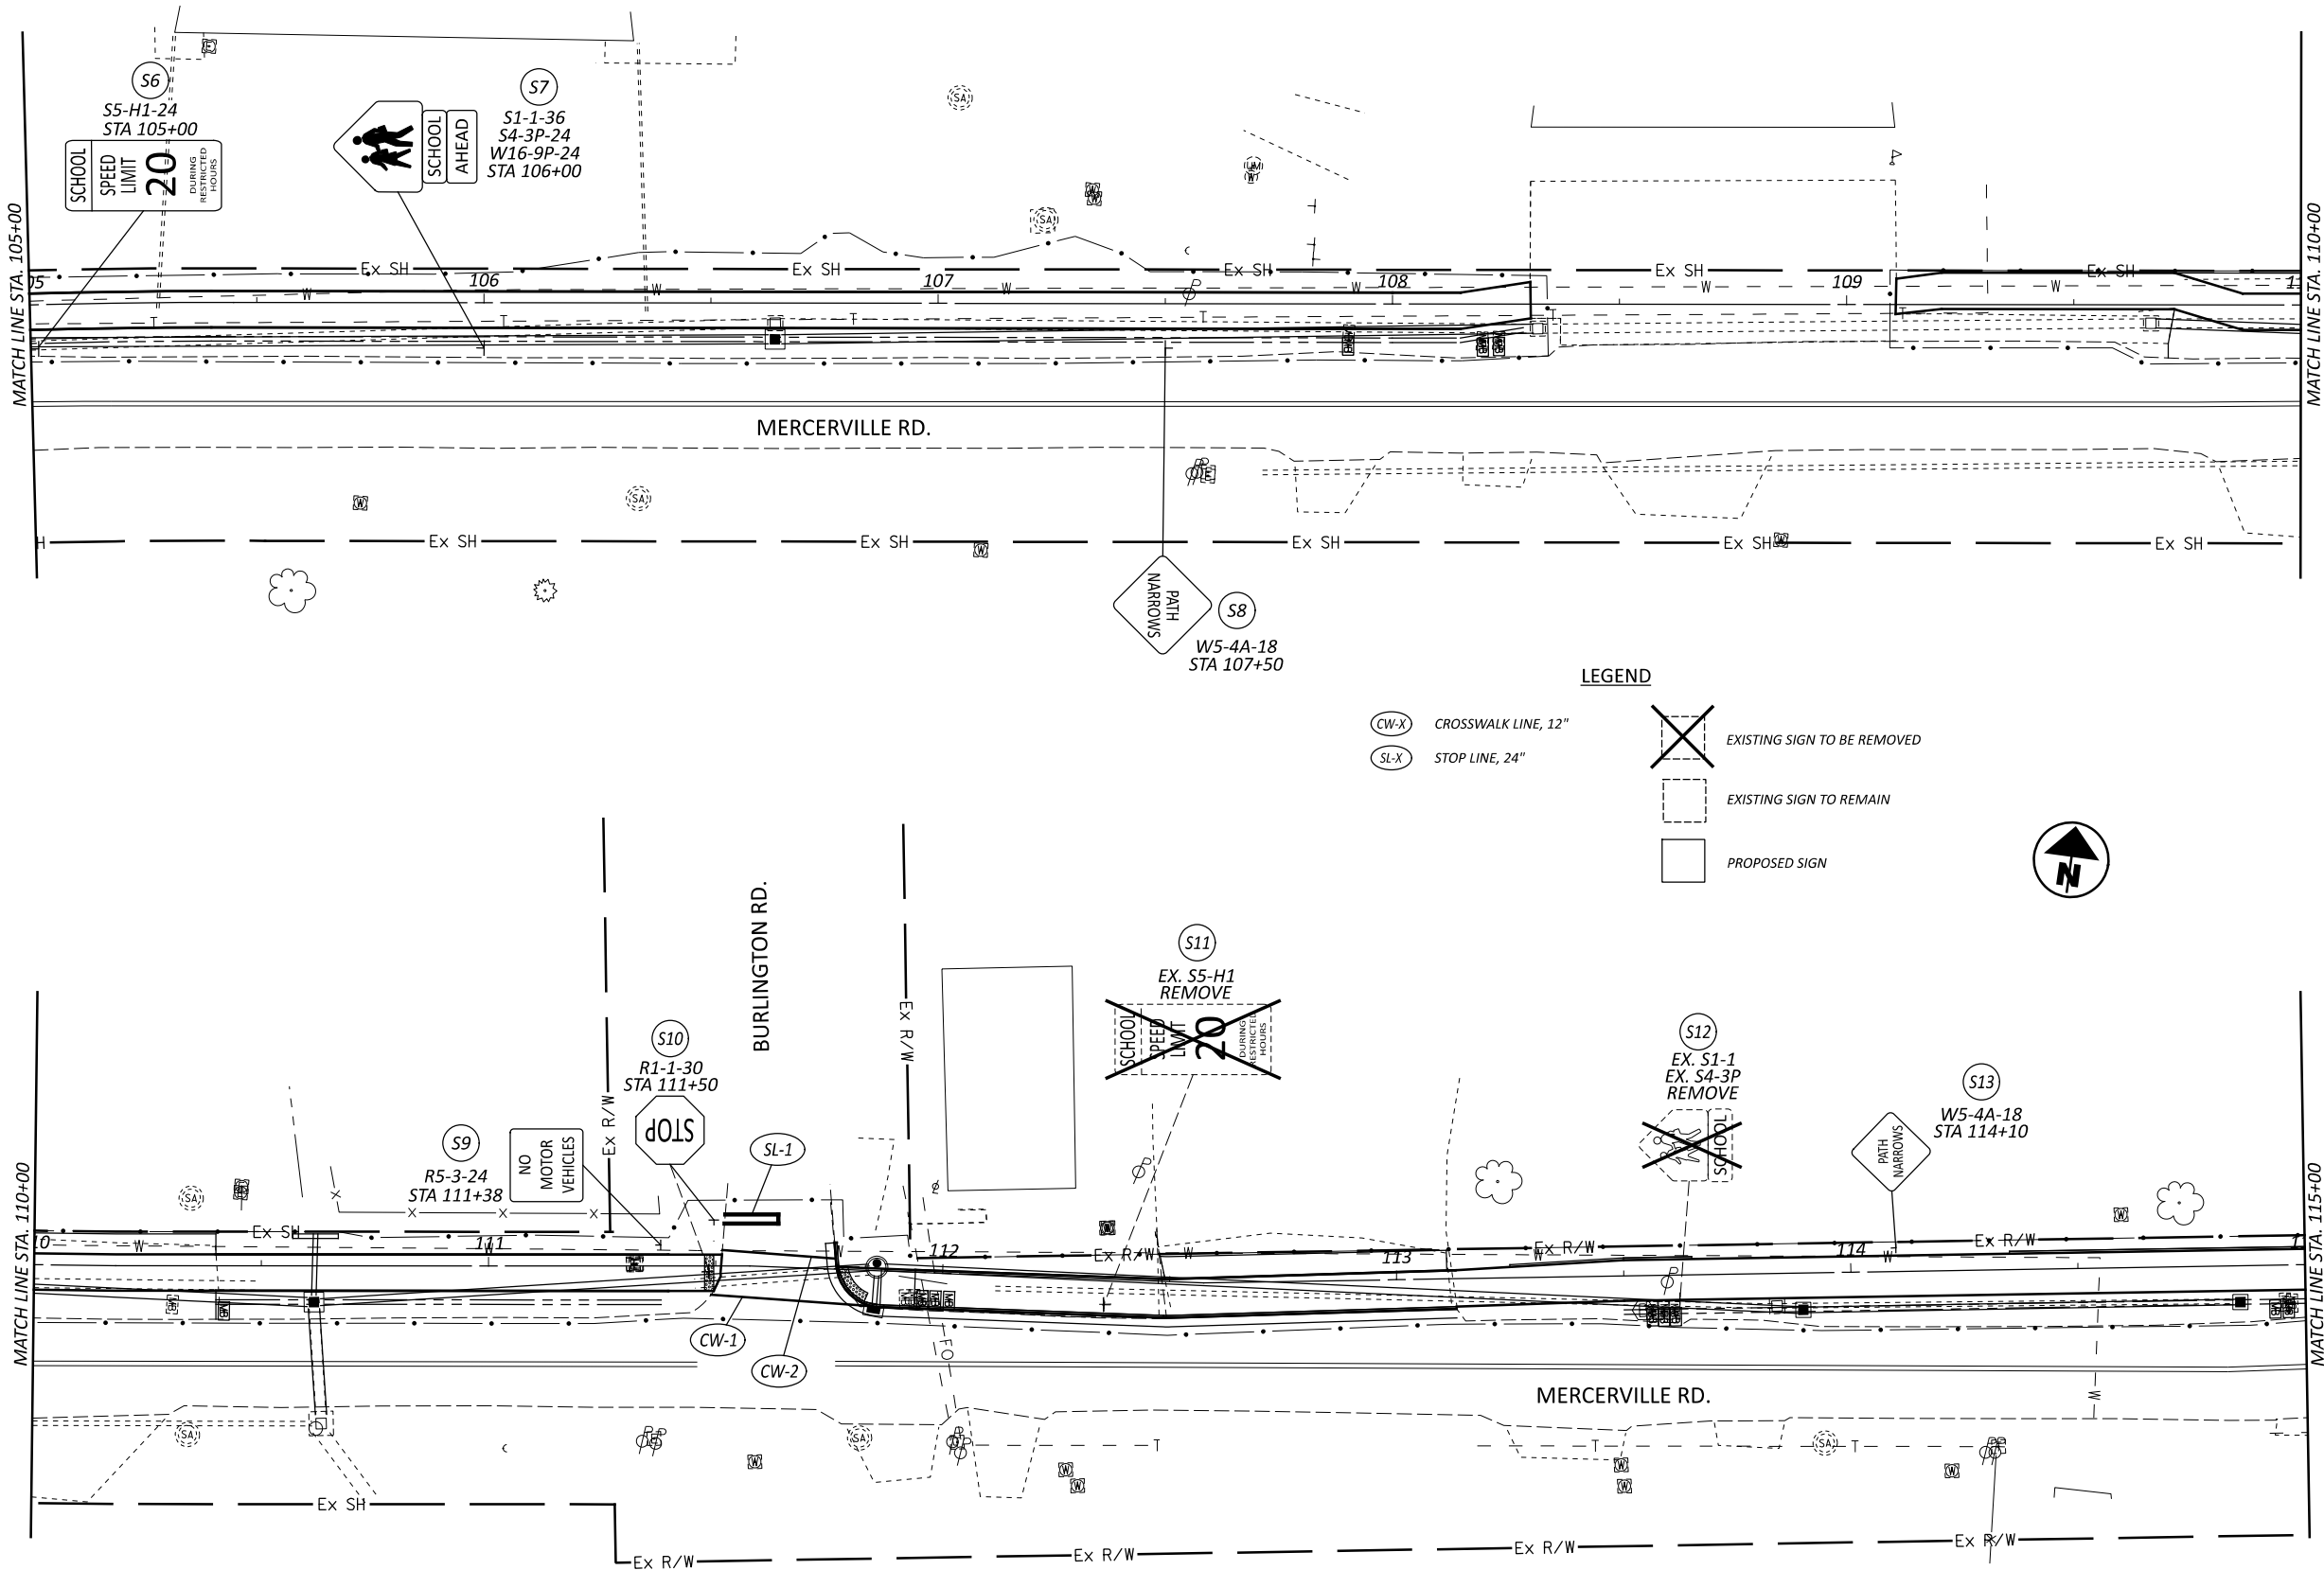

TRAFFIC CONTROL PLAN
STA 105+00 TO STA 115+00

DESIGN AGENCY



DESIGNER

EMH

REVIEWER

CSR 04/24/25

PROJECT ID

120712

SHEET


49

TOTAL

51

HORIZONTAL
SCALE IN FEET



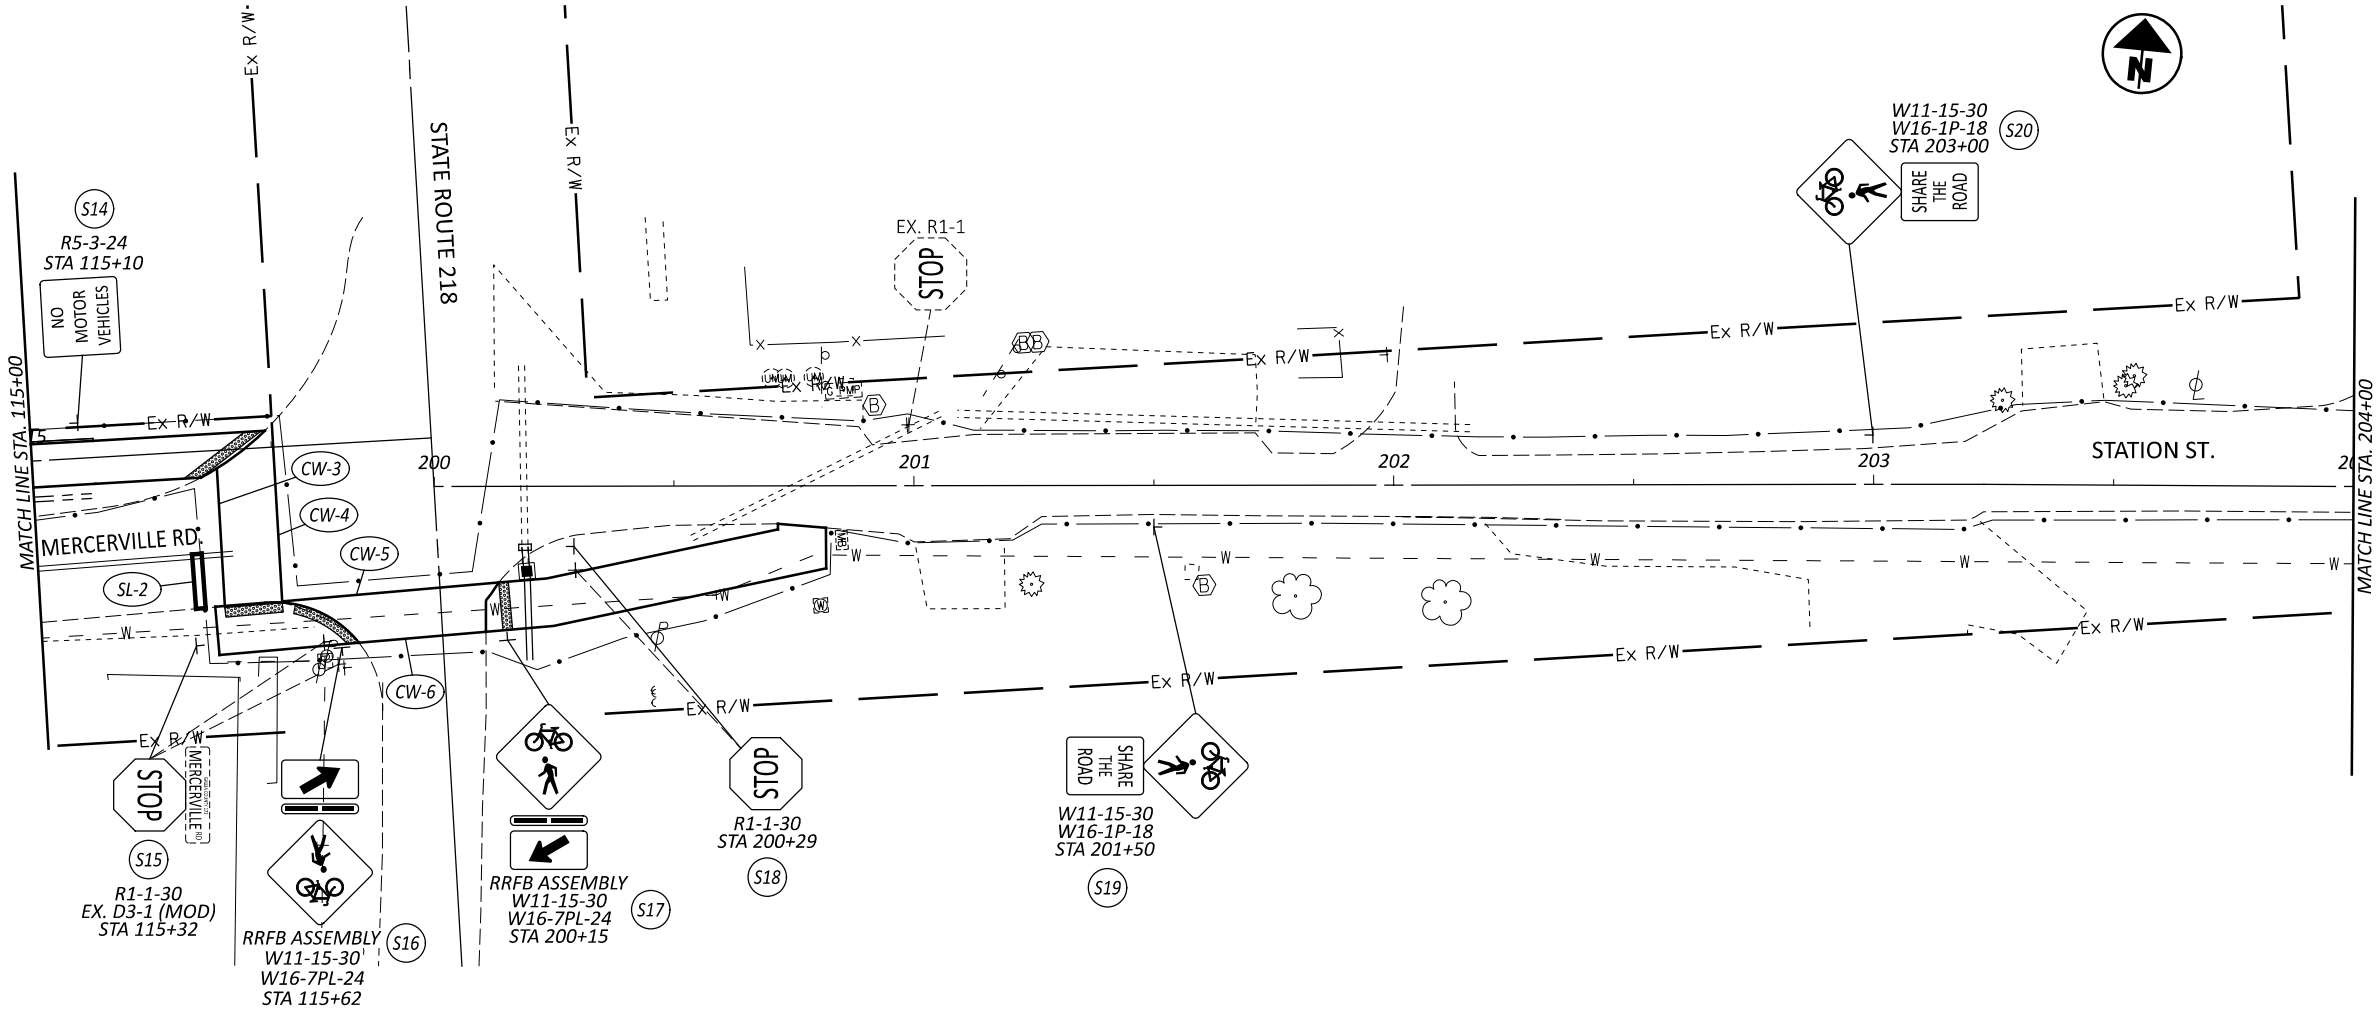

LEGEND

- CW-X CROSSWALK LINE, 12"
- SL-X STOP LINE, 24"
- EXISTING SIGN TO BE REMOVED
- EXISTING SIGN TO REMAIN
- PROPOSED SIGN

HORIZONTAL
SCALE IN FEET

0 10 20 40

TRAFFIC CONTROL PLAN
STA 115+00 TO STA 204+00

DESIGN AGENCY



DESIGNER

EMH

REVIEWER

CSR 04/24/25

PROJECT ID


120712

SHEET

50

TOTAL

51

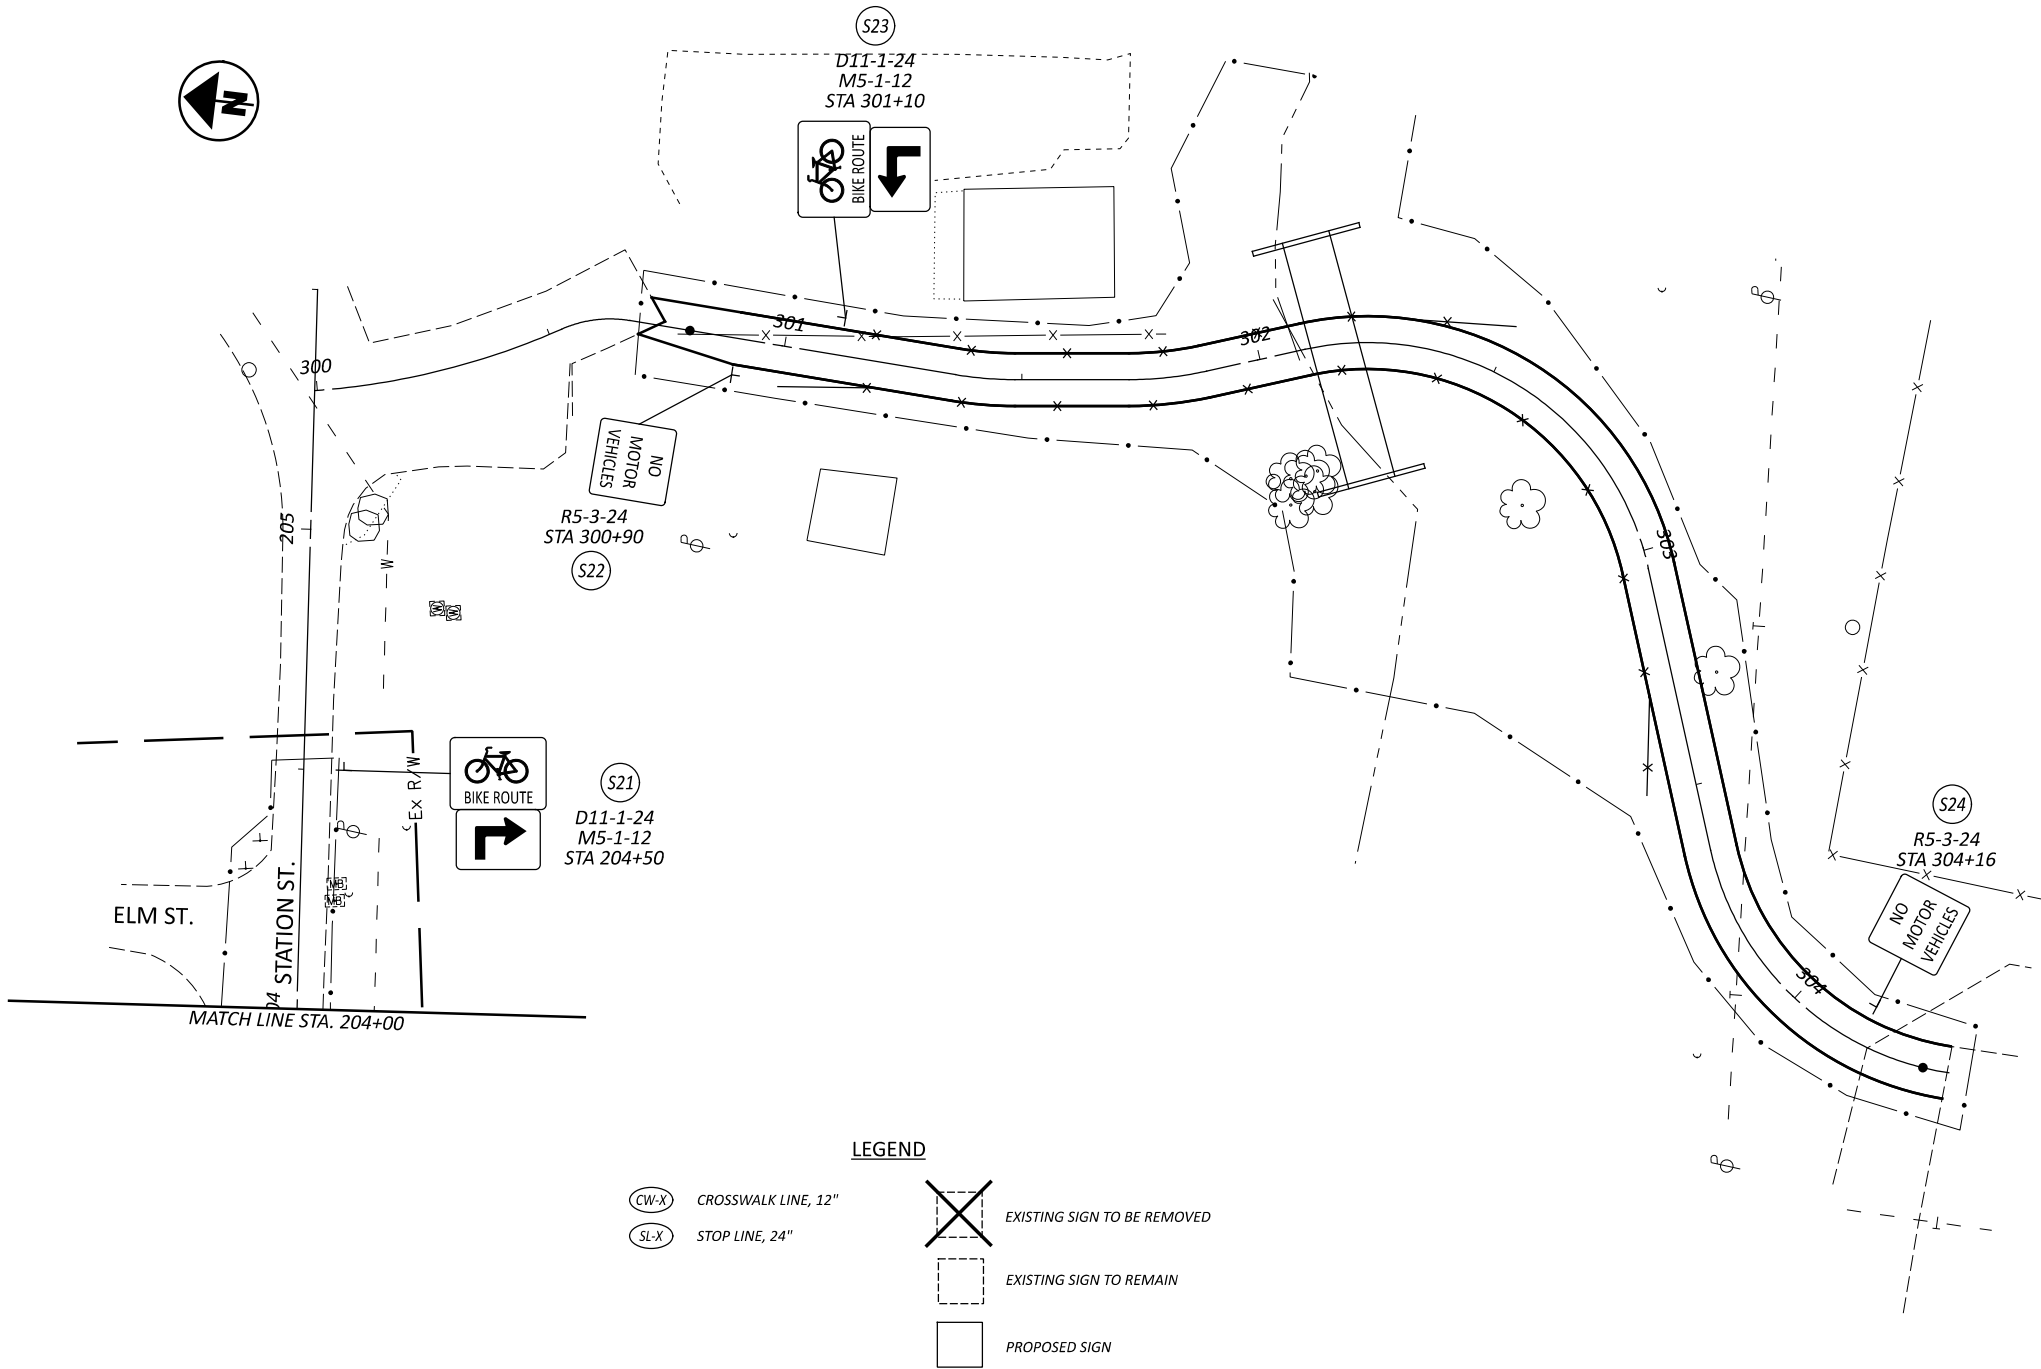

TRAFFIC CONTROL PLAN
STA 204+00 TO STA 304+36

DESIGN AGENCY



DESIGNER

EMH

REVIEWER

CSR 04/24/25

PROJECT ID

120712

SHEET

51

TOTAL

51

