

2-f

I-8

12

STATE OF OHIO DEPARTMENT OF HIGHWAYS

GE A-87-(3.16)-(6.78)

GEAUGA COUNTY RUSSELL & NEWBURY TOWNSHIPS

FED. RD. DIVISION	STATE	PROJECT	FISCAL YEAR
2	OHIO	H.I.F.	1950

GEAUGA COUNTY


1
21

CONVENTIONAL SIGNS




INDEX OF SHEETS

Title Sheet	1	Sheet	1
General Summary and Notes	2		2
PART I			
Typical Section, Plan & Profile	3		
Cross Sections	4-5-6		
Cross Sections (Channel)	7		
Structures Over 20' Span	8-9		
PART 2			
Typical Section	10		
Plan & Profile	11-12-13-14-15-16-17-18		
Cross Sections	19-20		
Cross Sections (Channel)	21		
Structures 20' Span and Under			

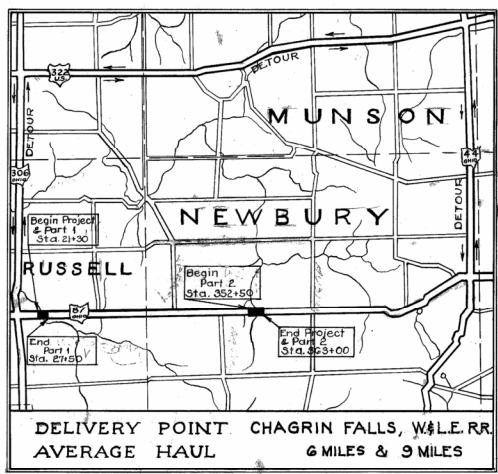

LOCATION PLAN

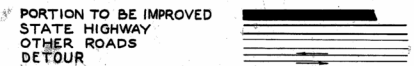

SCALE

PLAN	1" = 50'
PROFILE - HOR.	1" = 50'
PROFILE - VER.	1" = 10'

LINE DATA

PART I			
Begin Project and Part 1	Sta. 21+30		
End Part 1	Sta. 27+50		
Total Length of Part 1	620 lin. ft. = 0.117 Miles		
PART 2			
Begin Part 2	Sta. 352+50		
End Project and Part 2	Sta. 623+00		
Total Length of Part 2	1050 lin. ft. = 0.198 Miles		
Total Length of Project	1670 lin. ft. = 0.316 Miles		

STANDARD DRAWINGS			
CS-1-47	1-20-48	BC-49-51-12	9-18-47
A-1-49	1-27-49	L-2	10-1-45
P-1-49	1-27-49	L-3	2-1-47
115 No. 1	3-1-47	15-27 B.C. 3	2-20-45
115 No. 2	6-17-49	11-2, 3, 4 & 5	2-20-45
G-8-07	2-1-47		

SUPPLEMENTAL SPECIFICATIONS	
31	6-12-49

File No.	Geauga County	Geo-87(316)-(6.78)
	Sec. Russell & Newbury Townships	
	Date of Letting	194
	Contract No.	

The standard specifications of The State of Ohio Department of Highways, including changes and supplemental specifications listed in the proposal shall govern this improvement.

I hereby approve these plans and declare that the making of this improvement will require the closing of the highway to traffic and that detours will be provided as indicated on the plans.

The right of way for this improvement will be provided by the State of Ohio.

Approved: *Louis R. Draster*
Date: 4/6/49 Division Deputy Director

Approved: _____
Date: _____ Chief Engineer, Bureau of Maintenance

Approved: *Richard Orth*
Date: 1-18-50 Chief Engineer, Bureau of Bridges & R.R. Crossings

Approved: *W. J. ...*
Date: 1-22-50 Chief Engineer, Bureau of Location & Design

Approved: *V. J. ...*
Date: 1-20-50 First Asst. Director & Chief Engineer


Approved: *Waller*
Date: 1-22-50 Director of Highways

CONSTRUCTION BUREAU
APR 8 1950
6x10 INCH PHOTOLAB

994
TITLE SHEET

**PART 2 - TYPICAL SECTION
TYPE T-35**

Scale 1/4" = 1'-0"

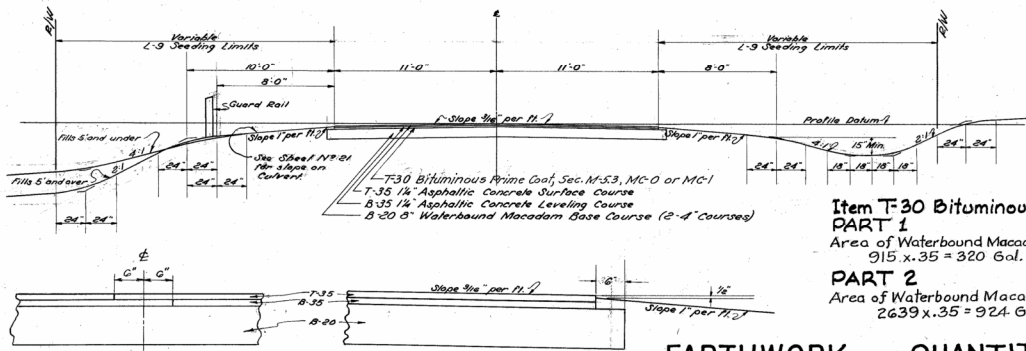

METHOD OF LAPPING
LONGITUDINAL JOINTS

PAVEMENT EDGE DETAIL

GENERAL NOTES

Item L-9 Seeding and Protecting Areas, Type "A"

Seeding quantities are calculated for all areas within the Right-of-Way Lines. All areas disturbed outside these limits are to be seeded at the contractors own expense and as specified. The grass seed mixture shall be composed of the following mixture for all areas:

- 60% Kentucky 31 Fescue
- 15% Perennial Rye Grass
- 15% Alsike Clover
- 10% Hairy Vetch

Seed shall be sown at the rate of 4 pounds per 1000 sq. ft. All legumes shall be inoculated.

Item L-9 Commercial Fertilizer (10-6-4)

Commercial Fertilizer shall be applied at the rate of 20 pounds per 1000 sq. ft. and incorporated into the soil to a depth of not less than one inch. Commercial Fertilizer shall be applied to all areas to be seeded or sodded.

Trees

Cost of removal and disposal of approximately 3 trees 12" or more in diameter shall be included in unit price bid for "Item E-1 Roadway Excavation". Trees are shown on the plans for the benefit of the contractor only, and the State of Ohio does not guarantee the accuracy hereof.

Item E-3 Channel Excavation

Channel Excavation shall be used to fill existing channel as indicated on plans. Balance of suitable material to be used in lieu of Borrow.

Item S-24 Removal of Existing Structures

This Item consists of removal and disposal of Bridge No GE-87-68A and existing 12" V.S.P. and Headwalls at Sta. 354+98 and existing concrete Steps at Sta. 356+85 as specified.

* 1/2" of the 1 1/2" thickness used in the calculations shall be considered as extra leveling material to fill the voids and irregularities in the waterbound macadam.

Seeding and Protecting (Continued) - Optional Method of Holding Mulch in Place: - The method of tying down the mulching material as shown on Standard Drawing L-3 may be replaced over suitable areas, as directed, by the use of an approved power driven rotary type mixing machine to incorporate the mulching material with the soil. Any area not treated with the machine shall have the mulching material secured by the usual method shown in the Standard Drawing.

EARTHWORK QUANTITIES

PART	Excavation	Embankment +22%	Borrow
PART 1			
Roadway Excavation Sta. 22+30 to Sta. 23+07.75	113 Cu.Yds.	228 Cu.Yds.	
Roadway Excavation Sta. 24+13.25 to Sta. 27+50	144 Cu.Yds.	196 Cu.Yds.	
Private Driveways		5 Cu.Yds.	
Total	657 Cu.Yds.	1599 Cu.Yds.	742 Cu.Yds.
PART 2			
Roadway Excavation Sta. 352+50 to Sta. 358+88	2552 Cu.Yds.	3041 Cu.Yds.	
Roadway Excavation Sta. 358+88 to Sta. 359+02		18 Cu.Yds.	
Roadway Excavation Sta. 359+02 to Sta. 363+00	621 Cu.Yds.	3027 Cu.Yds.	
Private Driveways		311 Cu.Yds.	
Concrete Steps at Sta. 356+85	2 Cu.Yds.	2 Cu.Yds.	
Total	3175 Cu.Yds.	6119 Cu.Yds.	2944 Cu.Yds.

PART 2

Item E-2 Excavation for Structures

Bridge No GE-87-68A	58 Cu.Yds.
Roadway Culvert at Sta. 354+98	25 Cu.Yds.
Total	83 Cu.Yds.

Item E-11 Water

PART	Excavation	Embankment @ 5 Gals.
PART 1		
1311 Cu.Yds. Embankment @ 5 Gals.		6555 Gals.
PART 2		
5015 Cu.Yds. Embankment @ 5 Gals.		25075 Gals.

PART 1 ITEM L-10 Sodding

South Side Ditch Sta. 23+00 to Sta. 23+32 = 32 lin. ft. 32 x 3/8 =	18 Sq.Yds.
North Side Ditch Sta. 22+50 to Sta. 23+00 = 50 lin. ft. 50 x 3/8 =	28 Sq.Yds.
Total	46 Sq.Yds.

FED. RD. DIST.	STATE	PROJECT	TYPE FUND.
2	OHIO	H.I.F.	1949

GEA-87-(316)-(6.78)
GEAUGA COUNTY

PAVEMENT CALCULATIONS

PART 1

ITEM B-20 WATERBOUND MACADAM BASE COURSE

Sta. 22+30 to Sta. 23+07.75 = (77.75 x 23) + 9 =	198.69	Sq. Yds.
Sta. 24+13.25 to Sta. 26+50 = (236.75 x 23) + 9 =	605.03	Sq. Yds.
Extra Area = 1000 + 9 =	111.11	Sq. Yds.
Total	914.83	Sq. Yds. Use 915 Sq. Yds.

ITEM T-35 ASPHALTIC CONCRETE SURFACE COURSE

Sta. 22+30 to Sta. 23+07.75 = (77.75 x 22) + 9 =	190.06	Sq. Yds.
Sta. 24+13.25 to Sta. 26+50 = (236.75 x 22) + 9 =	578.72	Sq. Yds.
Extra Area = 4000 + 9 =	444.44	Sq. Yds.
Total	1213.22	Sq. Yds.

1213.72 x 1.25 + 36 = 1517.14 Cu.Yds. Use 42 Cu.Yds.

ITEM B-35 ASPHALTIC CONCRETE LEVELING COURSE

1213.72 x 1.50 + 36 = 50.57 Cu.Yds. Use 51 Cu.Yds.

PART 2

ITEM B-20 WATERBOUND MACADAM BASE COURSE

Sta. 353+50 to Sta. 362+00 = (850 x 23) + 9 =	2172.22	Sq. Yds.
Extra Area = 4200 + 9 =	466.67	Sq. Yds.
Total	2638.89	Sq. Yds. Use 2639 Sq. Yds.

ITEM B-35 ASPHALTIC CONCRETE LEVELING COURSE

Sta. 353+50 to Sta. 362+00 = (850 x 22) + 9 =	2077.76	Sq. Yds.
Extra Area = 4000 + 9 =	444.44	Sq. Yds.
Total	2522.22	Sq. Yds.

2522.22 x 1.50 + 36 = 105.09 Cu.Yds. Use 105 Cu.Yds.

ITEM T-35 ASPHALTIC CONCRETE SURFACE COURSE


2522.22 x 1.25 + 36 = 87.58 Cu.Yds. Use 88 Cu.Yds.

GENERAL SUMMARY

ITEM	PART	PAV	TOTAL	UNIT	DESCRIPTION
E-1	857	31	5	4032	Cu.Yds. Roadway Excavation
E-4	742	29	14	3686	Cu.Yds. Borrow
E-11	7		.5	32	M.Gals. Water
B-20	915	2639	3554	Sq.Yds.	Waterbound Macadam Base Course (2-4" Course)
B-35	51	105	156	Cu.Yds.	Asphaltic Concrete Leveling Course (70-80)
T-30	320	81	4	1244	Gals. Bituminous Prime Coat, Sec. M-5.3, MC-0 or MC-1
T-35	42	38	130	Cu.Yds.	Asphaltic Concrete Surface Course, Type "A" (70-80)
I-1	12	66	78	Lin. Ft.	12" Pipe for Driveways
I-17	12	31	43	Cu. Yds.	Side Approaches, Mail Box Turnouts and Berm Material
I-15	503	236	739	Lin. Ft.	Guard Rail Removed and Stored
I-15	426.5	770	1196.5	Lin. Ft.	Guard Rail, Steel Beam, Type (Deep) as per plan
L-9	4773	9718	14491	Sq.Yds.	Seeding and Protecting, Type "A" as per plan
L-9	0.13	0.87	1.00	Tons	Commercial Fertilizer (10-6-4)
L-10	46		46	Sq.Yds.	Sodding
E-2		83	83	Cu.Yds.	Excavation for Structures
E-3		234	284	Cu.Yds.	Channel Excavation
S-1		110	120	Cu.Yds.	Concrete for Structures (Class "C")
S-4		16488	16488	Lbs.	Reinforcing Steel
S-24		Lump	Lump		Removal of Existing Structures
S-27		76	76	Lin. Ft.	18" Pipe for Roadway Culverts
I-10		6	6	Sq. Yds.	Riprap, (Type "A")
I-13		57	57	Lin. Ft.	Concrete Steps
					Structures Over 20' Span
					Estimated Quantities (Bridge No GE-87-32) See Sheet No. 9.

GENERAL SUMMARY AND NOTES

PART I TYPICAL SECTION
SCALE 1/4" = 1'-0"

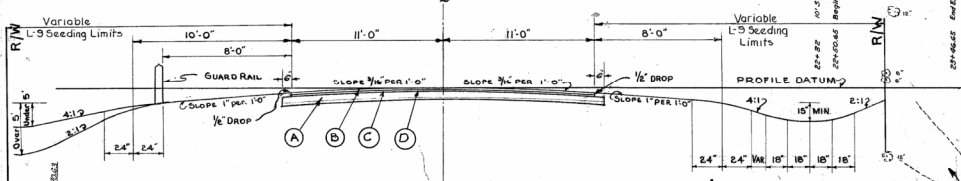


EXISTING BRIDGE DATA
 CLEAR HEIGHT = 12 FT.
 CLEAR SPAN = 40 FT.
 TYPE = CONCRETE GIRDER
 ROADWAY = 17.3 FT.
 SKEW = 0°
 LOADINGS = H-15
 TO BE REMOVED


PROPOSED BRIDGE DATA
 TYPE = CONTINUOUS REINFORCED CONCRETE SLAB,
 WITH CAPPED PILE PIERS AND ABUTMENTS
 SPANS = 32'-40'-32' CTR. TO CTR. OF BRIDGES
 ROADWAY = 38'-0"
 SKEW = 0°
 LOADINGS = S-15-46
 SURFACE COURSE = 1" MONOLITHIC
 APPROACH SLAB = NONE

JOB NO. PROJECT	DATE	SCALE	YEAR
2	OHIO	H.I.F.	1949

GEA. 87 - 3.16
 GAUGA COUNTY
 RUSSELL TOWNSHIP

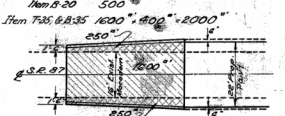

EXTRA AREA DETAIL
 From Sta. 21+30 to Sta. 22+30
 Sta. 26+50 to Sta. 27+50
 Not to Scale

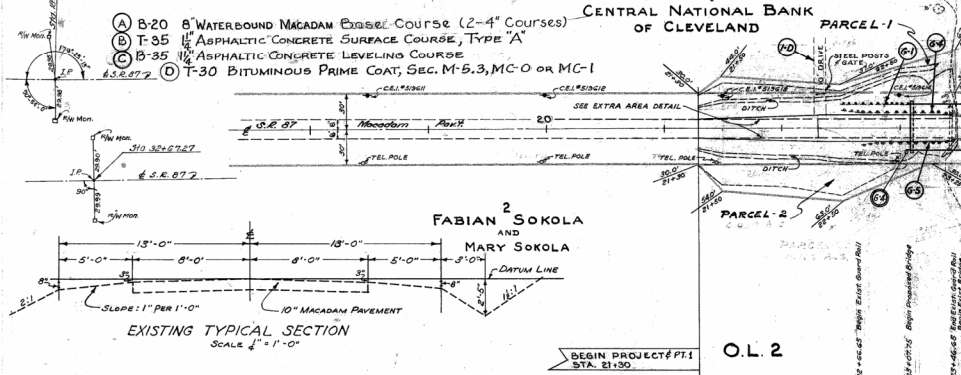

ITEM I-15.13
 GUARD RAILS


MARK	LENGTH
G-1	53.75 LIN. FT.
G-2	184.75 "
G-3	178.50 "
G-4	18.50 "
TOTAL	426.50 "

ITEM I-15
 GUARD RAILS
 REMOVED & STORED

MARK	LENGTH
G-4	35.6 LIN. FT.
G-5	79.8 "
G-6	248.0 "
G-7	75.4 "
TOTAL	503.0 "

PRIVATE DRIVEWAYS

MARK	SIDE	EMBANKMENT	12" PIPE FOR DRIVEWAYS	12" PIPE FOR DRIVEWAYS
I-D	N	3 CU. YDS.	5	12 LIN. FT.
2-D	N	1 CU. YD.	5	CU. YDS.
TOTAL		4 CU. YDS.	10	24 LIN. FT.

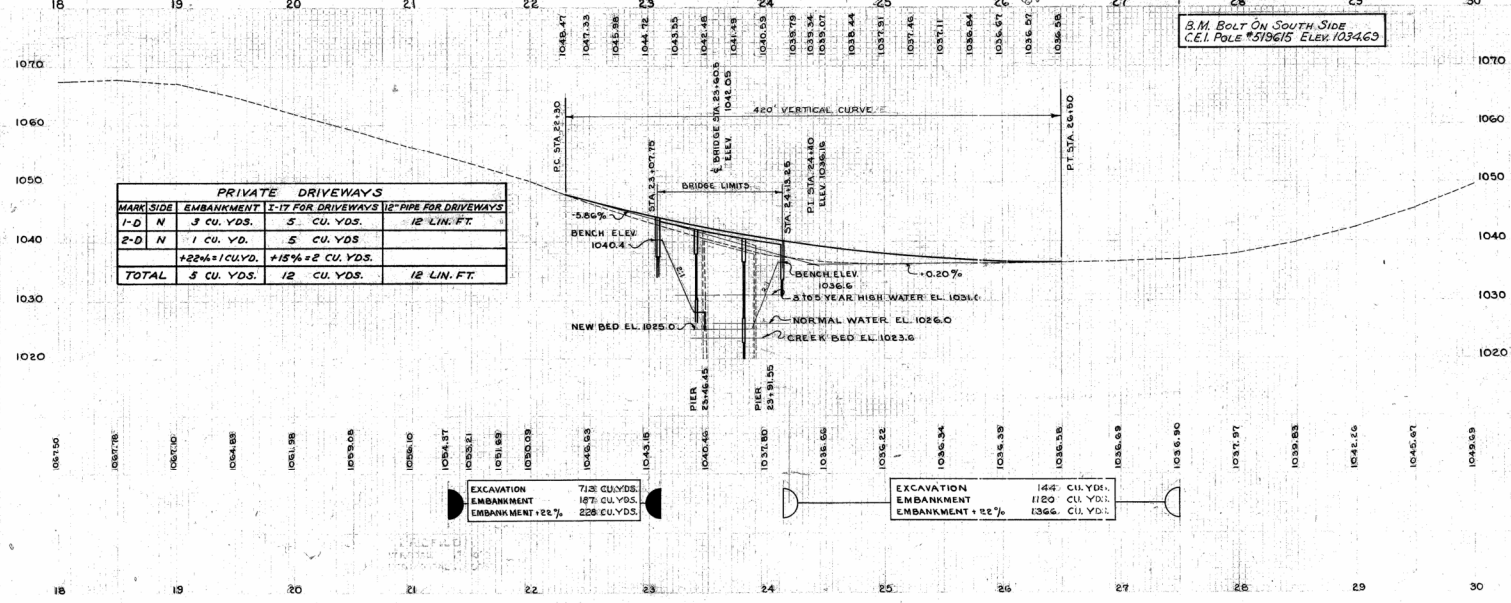

BEGIN PROJECT PT. STA. 21+00

B.M. BOLT ON SOUTH SIDE
 C.E.I. POLE #519615 ELEV. 1034.63


ACREAGE REQUIRED

Parcel 1	= 0.078 AC.
Parcel 1-A	= 0.109 AC.
Parcel 2	= 0.089 AC.
Parcel 2-A	= 0.140 AC.

UTILITIES INVOLVED :-
 Cleveland Electric Illuminating Co.
 Western Reserve Telephone Co.

GEA. 87-3.16
GEAUGA COUNTY

SEEDING SODDING	
WIDTH	AREA
Lin. Ft.	Sq. Yds.
81	105.5
179	105.0
80	104.5
270	103.5
82	103.0
459	102.0
83	101.0
146	100.0
40	99.0

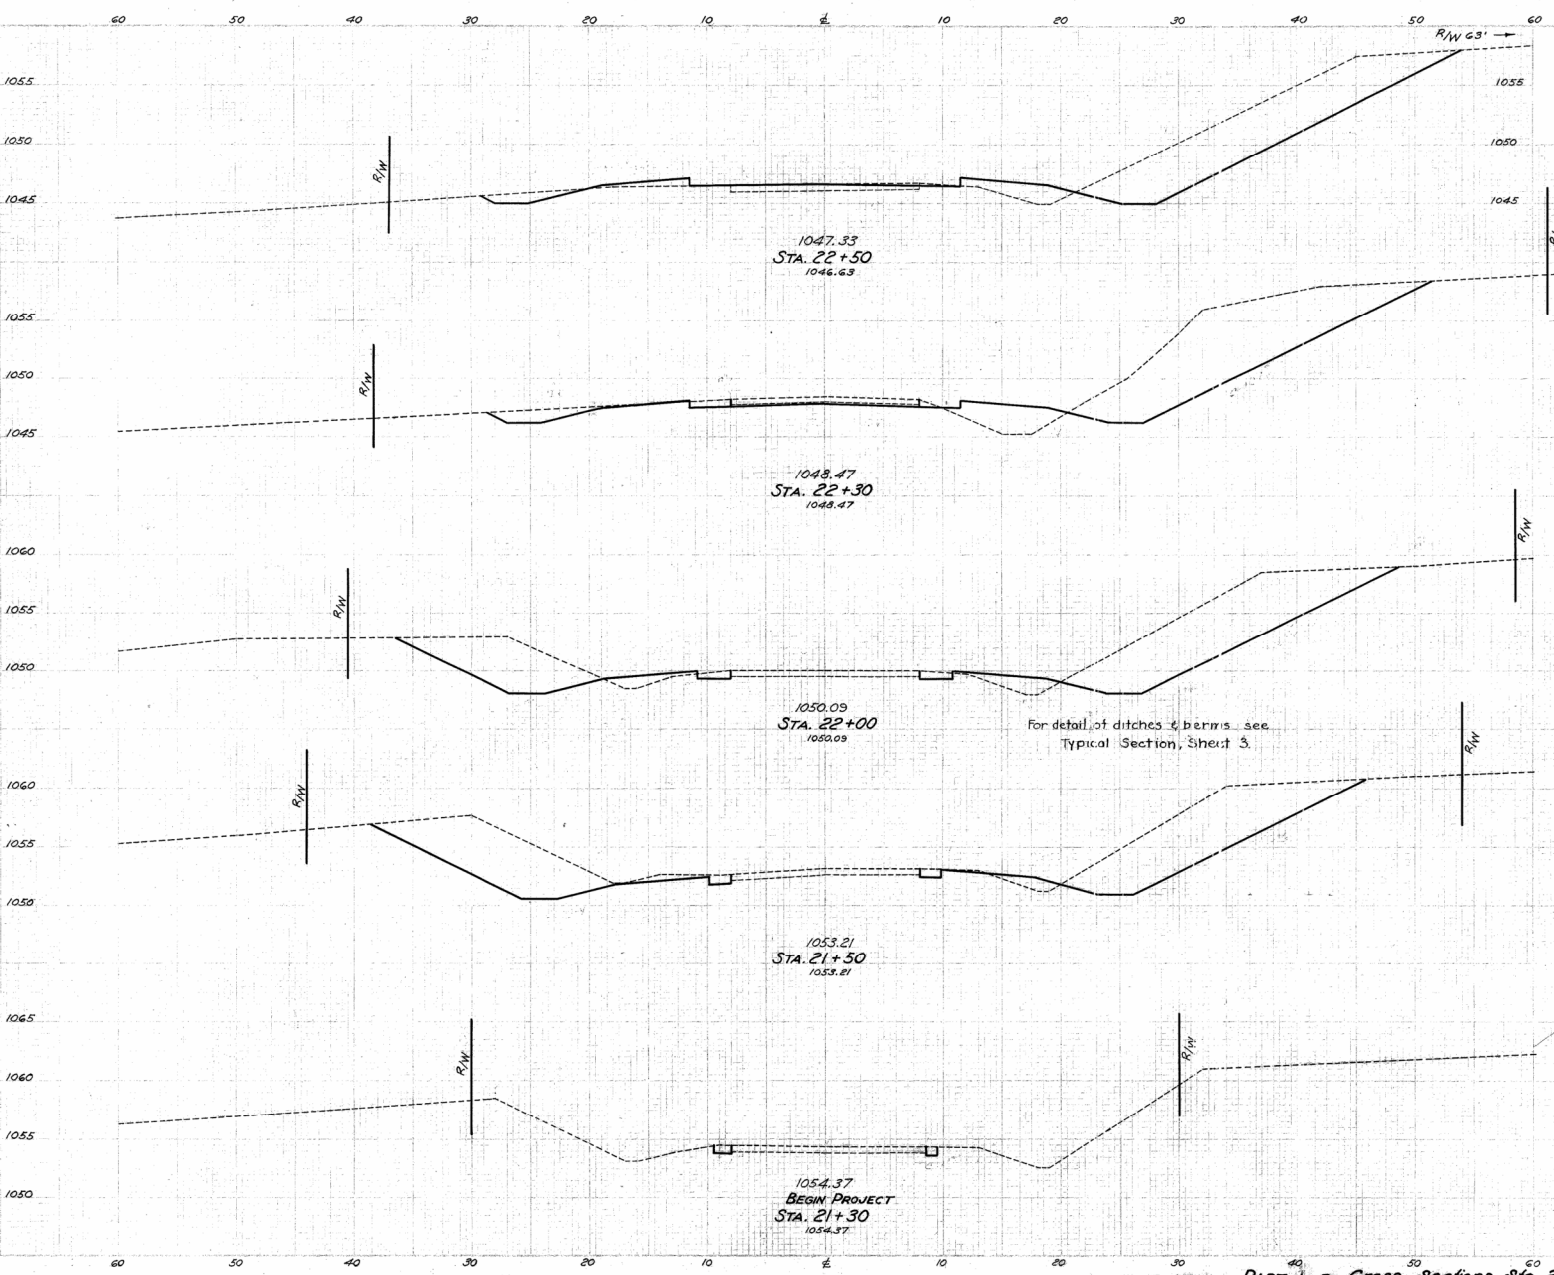


END AREA	Cu. Yds.	
	CUT	FILL
108	12	
		95
FORWARD	143	17
BACKWARD	135	17
		158
150	13	
		283
156	4	
		5.9
0		

Excavation, 73 Cu. Yds.
 Embankment, 187 Cu. Yds.
 Embankment, 2.2% 228 Cu. Yds.

PART I - Cross Sections Sta. 21+30 to Sta. 22+50

SECTION	
WIDTH	AREA
LINE FT.	Sq. Yds.
91	
75	
64	
73	
81	

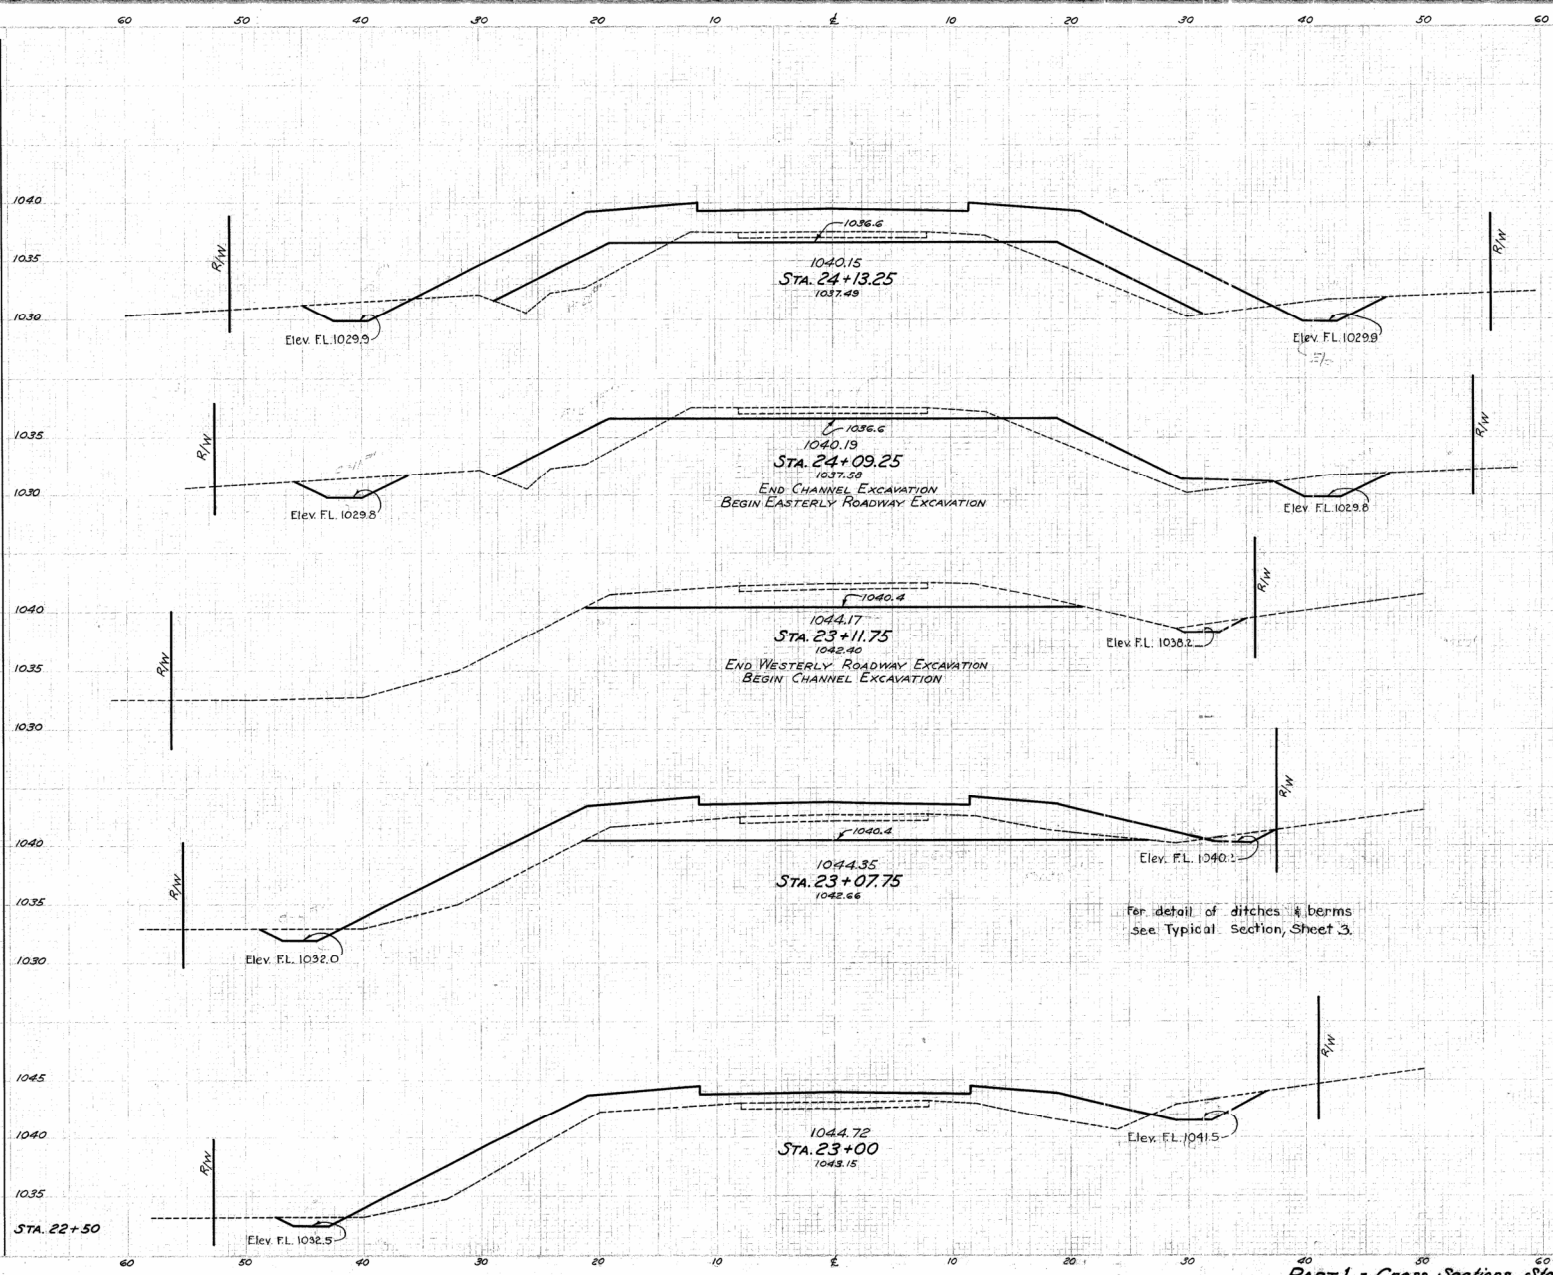


END AREA	Cu. Yds.	
	CUT	FILL
1040		
FORWARD	13	242
BACKWARD	23	50
1035		
1030		5 7
1035	44	51
1030		
1040	68	0
1035		
1030		10 0
1040		
FORWARD	73	0
BACKWARD	51	128
1035		
1030		2 33
1045		
1040	6	106
1035		106 109
1030		
STA. 22+50	108	12

For detail of ditches & berms see Typical Section, Sheet 3.

PART I - Cross Sections Sta. 23+00 to Sta. 24+13.25

SEEDING SODDING	
WIDTH	AREA
Lin. Ft.	Sq. Yds.
41	567
61	356
67	389
73	425
80	459
85	359
91	

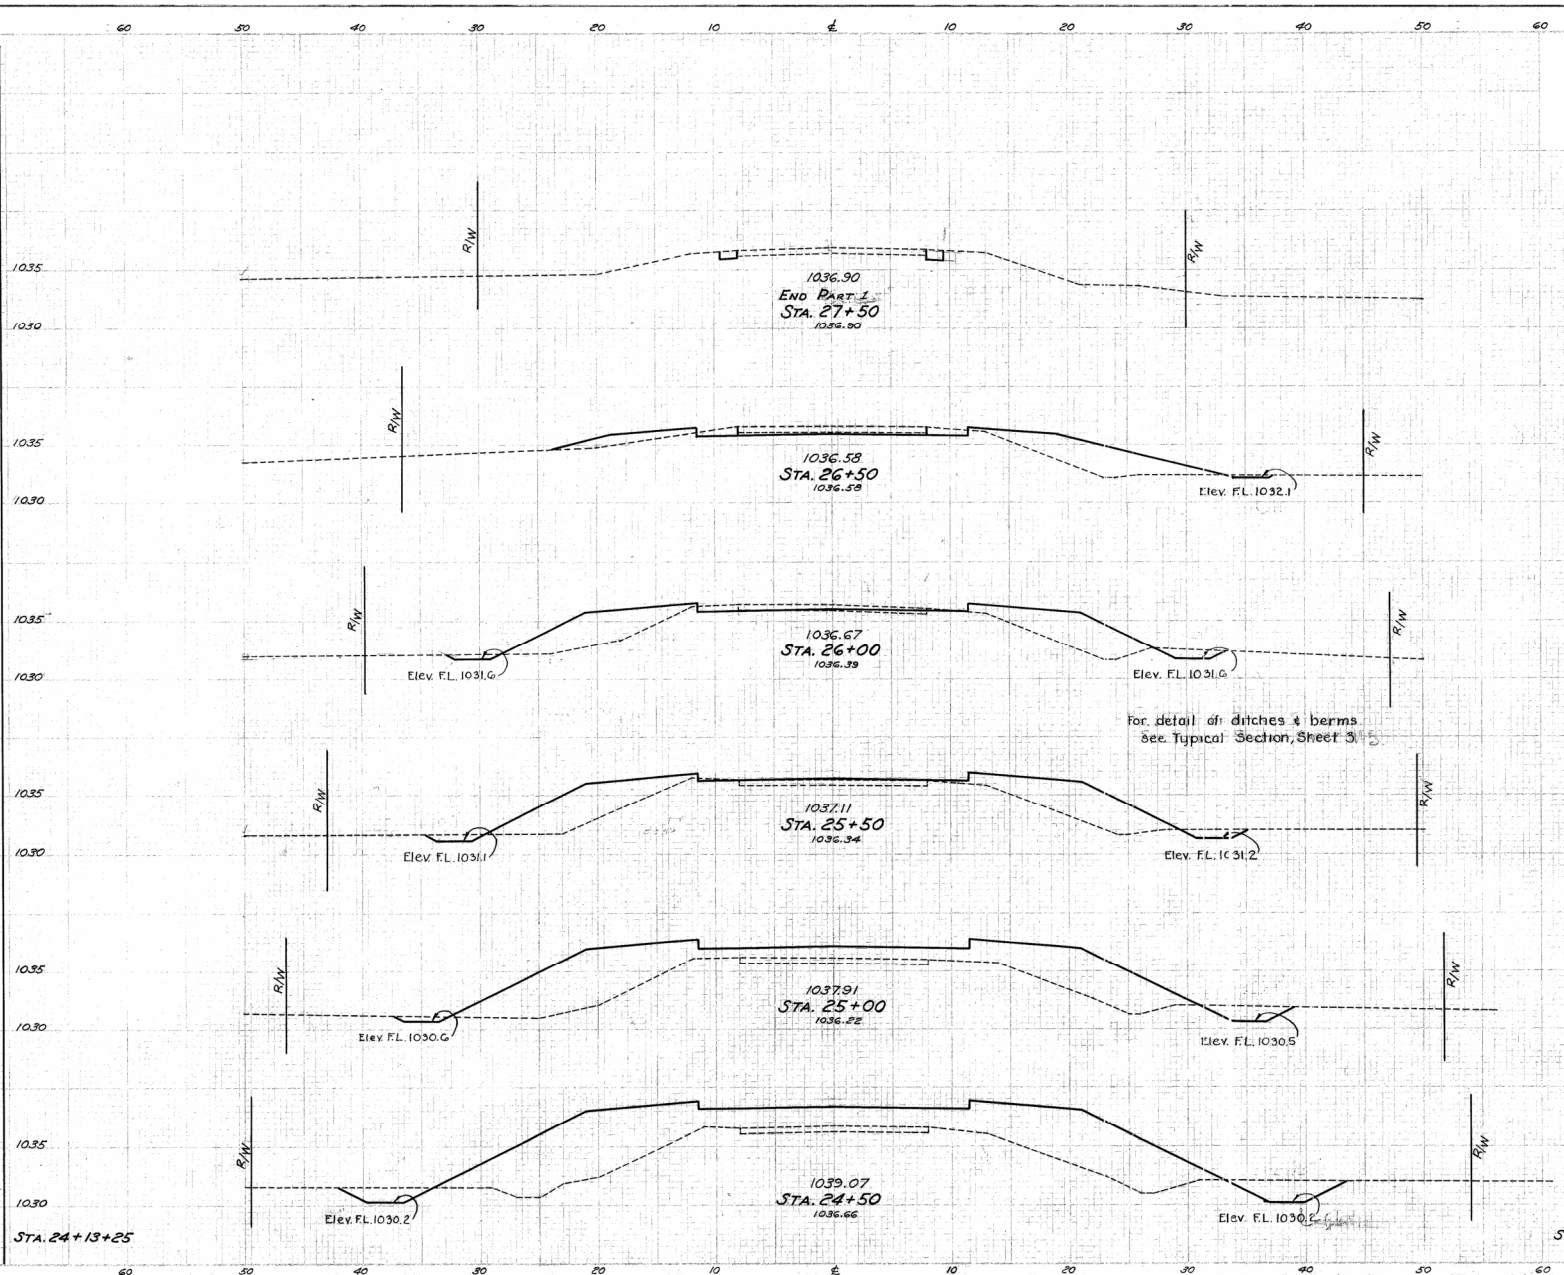

END AREA	Cu. Yds.	
	CUT	FILL
2	0	
	26	76
12 18	41	41
	28	94
14	61	
	18	126
5	75	
	14	201
10	142	
	27	316
19	199	
	26	300
19	242	



144 Cu. Yds.
1120 Cu. Yds.
Embankment 1 22% 13% 6% 2%

PART 1 - Cross Sections Sta 24+50 to Sta 27+50


GEA. 87-316
 GAUGA COUNTY

Station	Cut Area		Cu. Yds.		Sp. Yds.	
	cut	fill	cut	fill	Lim. Th.	Sp. Yds.
Sta. 1+00 (South of E)	0	0				
Sta. 0+50 (South of E)	0	0	21	3		
Sta. 0+30 (South of E)	58	9	163	19	55	132
Sta. 0+11 (South of E)	404	45	236	20	70	124
Sta. 0+25 (North of E)	391	22	302	14	70	239
Sta. 0+40 (North of E)	75	0	83	0	53	177
Sta. 1+70 (North of E)	0	0			0	

Excavation 805 Cu. Yds.
 Embankment 56 Cu. Yds.
 Embankment + 22% 68 Cu. Yds.

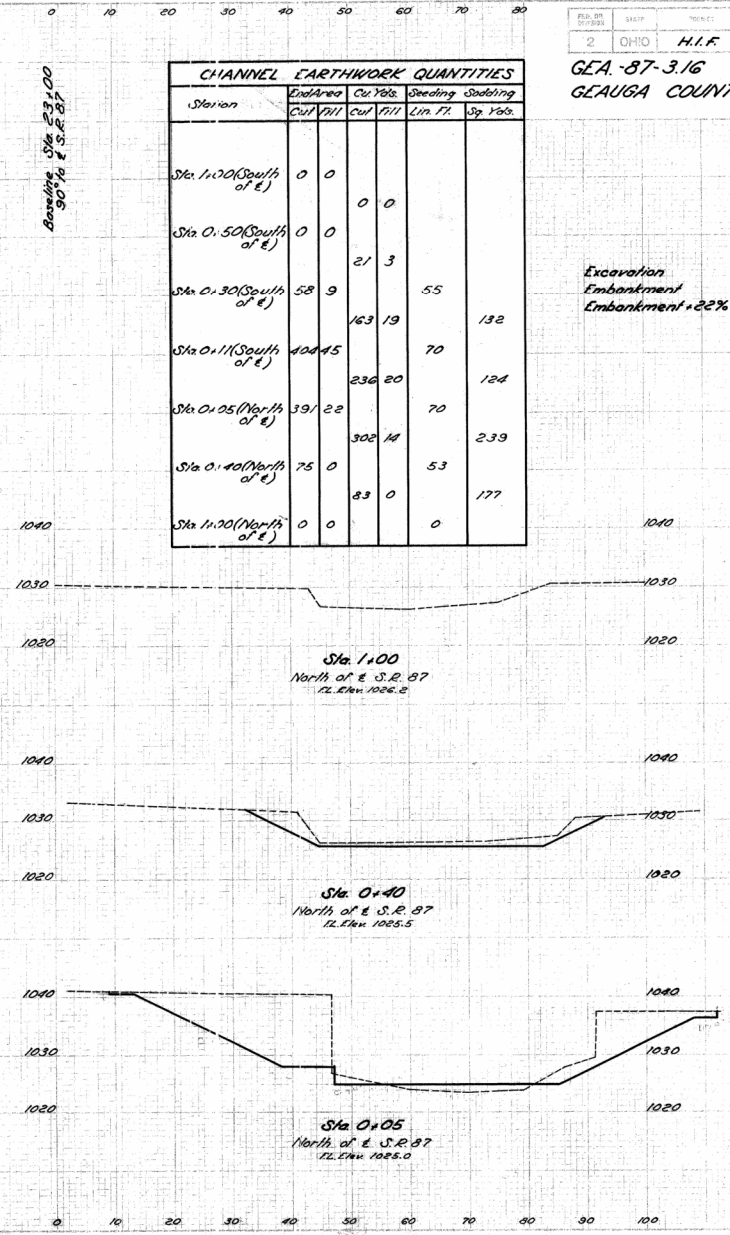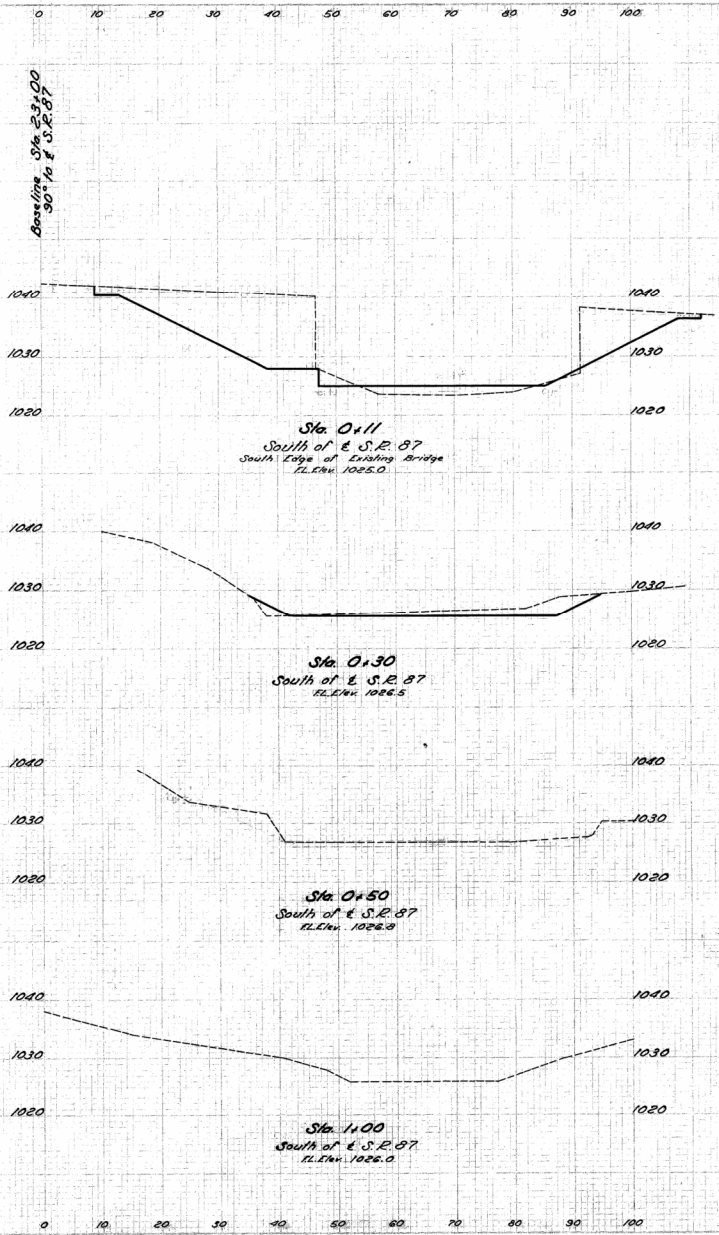

PART 1 - CHANNEL CLEANUP

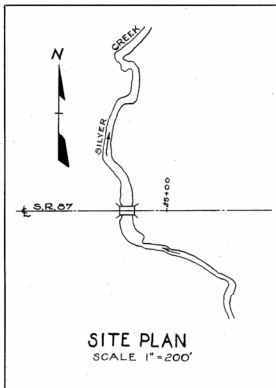


EXISTING BRIDGE DATA:-

CLEAR HEIGHT: 12 FT.
 CLEAR SPAN: 10.0 FT.
 TYPE: CONCRETE GIRDER.
 CONCRETE ABUTMENTS
 IN POOR CONDITION.
 ROADWAY WIDTH: 17.3 FT.
 WEARING SURFACE: 4" BIT MATERIAL.
 SKEW: 0°
 LOADING: H-15
 EXISTING BRIDGE TO BE REMOVED

FED. RD. DISTRICT	STATE	PROJECT	FISCAL YEAR
2	OHIO	H.I.F.	1949

GEA-87-(3.16) (6.76)
 GAUGA COUNTY
 0.44 Miles East of Russell

DRAINAGE AREA: 11.4 SQ. MI.

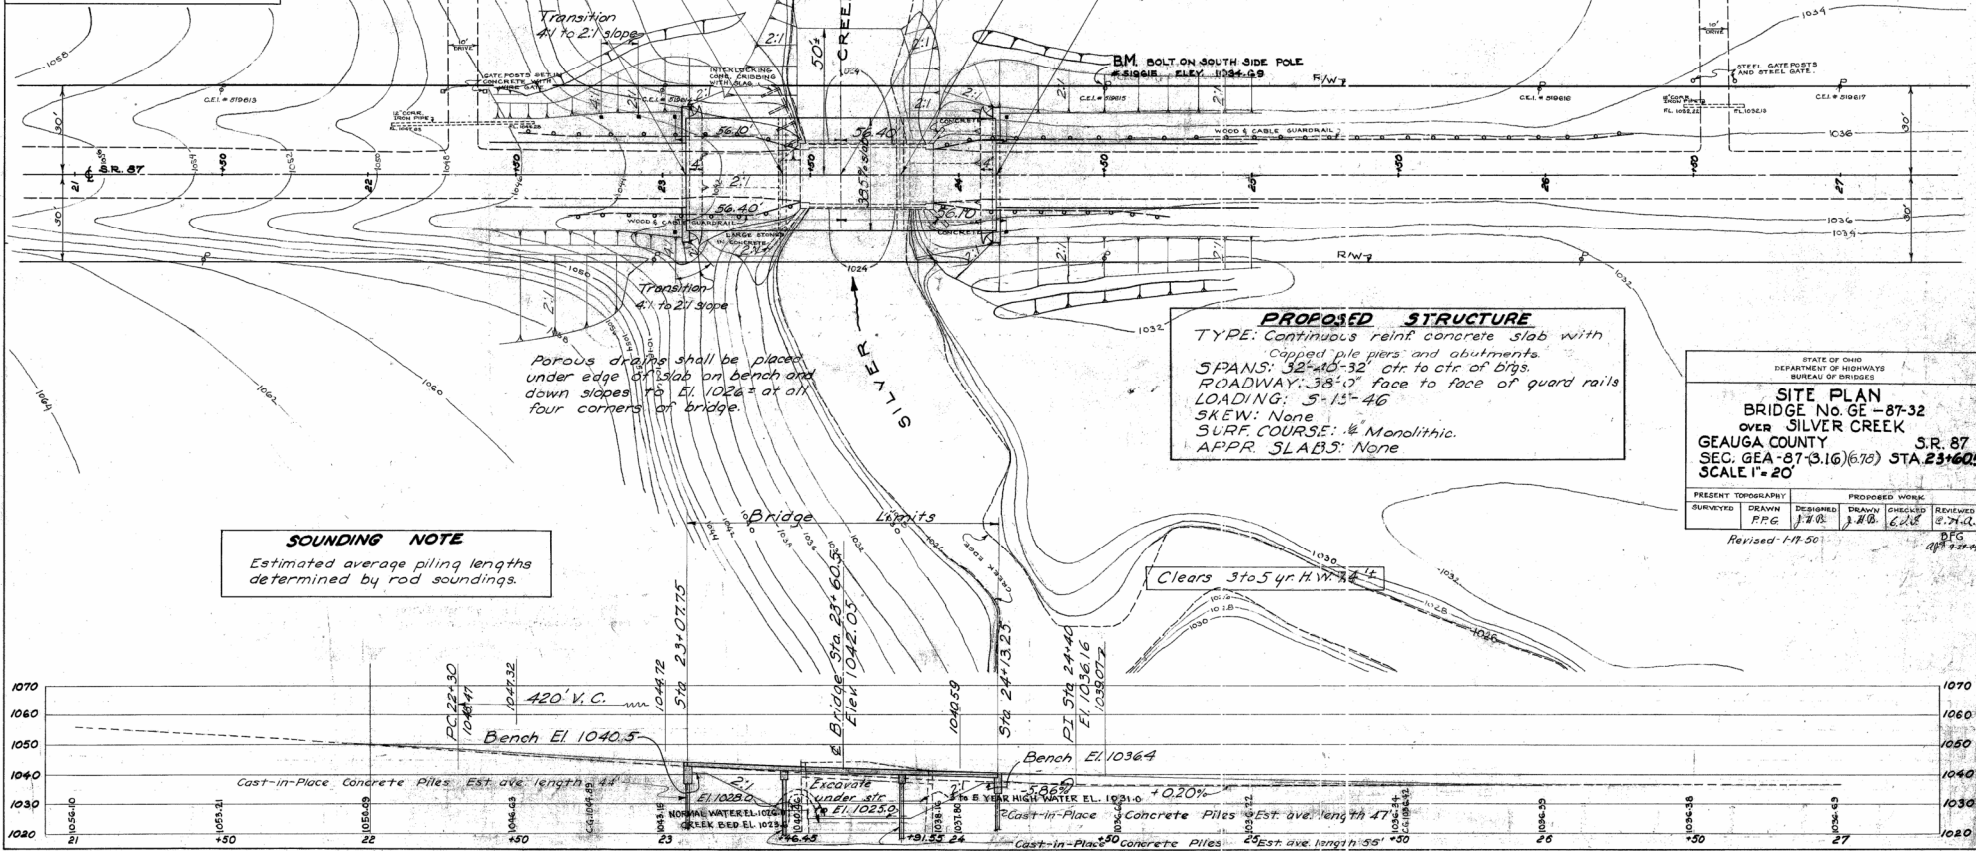


STATE OF OHIO
 DEPARTMENT OF HIGHWAYS
 BUREAU OF BRIDGES

SITE PLAN
 BRIDGE No. GE-87-32
 OVER SILVER CREEK
 GAUGA COUNTY S.R. 87
 SEC. GEA-87-(3.16) (6.76) STA 23+60.50
 SCALE 1"=20'


PRESENT TOPOGRAPHY	DESIGNED	PROPOSED WORK
SURVEYED P.P.G.	DRAWN J.W.B.	ENGR. CHECKED J.W.B. C.D.S.

Revised 1-19-50 DFG
 10/2/50


GEAUGA COUNTY
GEA-87-(3/16)(6.78)

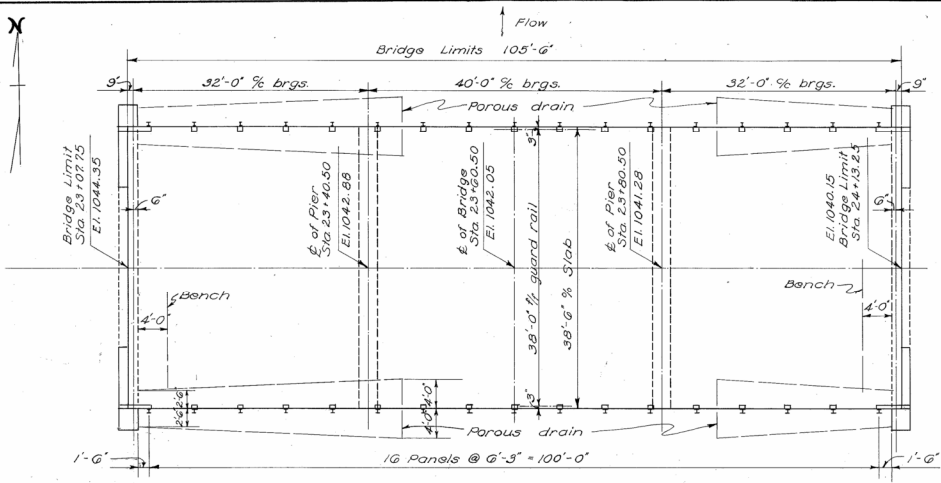

PLAN

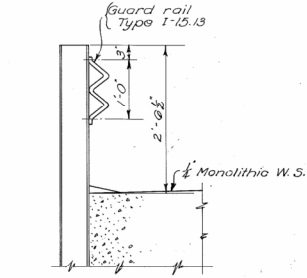

RAILING DETAIL

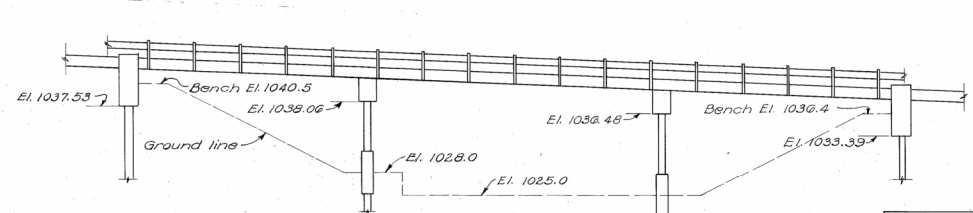

ELEVATION

GENERAL NOTES

REFERENCE shall be made to Standard Drawings CS-1-47 (revised 1-20-48), A-1-49 (dated 7-27-49), P-1-49 (dated 7-27-49), and Mb bars shown on A-1-49 shall be omitted.

EXISTING SUPERSTRUCTURE shall be removed. Suitable waste masonry may be used as bank protection of the direction of the Engineer.

EXISTING SUBSTRUCTURE - The west abutment shall be removed to Elev. 1028.0. The east abutment shall be removed to one ft. below finished ground.

EXCAVATION QUANTITY includes the removal of fill material between top of earth bench and bottom of abutment crossbeam.

PILING shall be driven to a minimum bearing capacity of 25 tons in the abutments and to a minimum bearing capacity of 35 tons in the piers.

POROUS DRAINS extending from face of abutment to Elev. 1028 shall be placed on and flush with embankment slopes of all four corners of the bridge. The drains shall be 8 ft. wide at the low end, tapering to 5 ft. wide at the face of the abutment, and one ft. thick. They shall be centered under edge of deck. They shall be composed of No. 1 gravel, stone or slag. Construction procedure shall conform essentially to Item 1-9. Trench excavation shall be included for payment with the price per cu. yd. bid for "Porous drains on embankment slopes."

ESTIMATED QUANTITIES						
Item	Total	Unit	Description	Abut.	Pier	Supers Gen'l As Built
E-2	62	Cu.Yd.	Unclassified Excavation	62		
E-3	805	Cu.Yd.	Channel Excavation			805
S-1	244	Cu.Yd.	Class "C" concrete, superstructure			244
S-1	16	Cu.Yd.	Class "C" concrete, abutments	16		
S-4	56,720	Lb.	Reinforcing Steel	4,516	3,280	48,924
S-9	16	Sq.Ft.	Premolded expansion joint filler			16
S-14	211	Lin.Ft.	Railing (Type 1-15.13 with steel posts)			211
S-16		Lump Sum	First test pile			Lump Sum
S-18	150	Lin.Ft.	12" Cast-in-place concrete piling	150	900	1,500
S-24		Lump Sum	Removal of Existing Structure			Lump Sum
S-29	31	Cu.Yd.	Porous Drains on embankment slopes			31

SUPERSTRUCTURE shall be same as shown on Standard Drawing CS-1-47 except the monolithic wearing surface shall be 1/2 inch instead of 3/4 inch.

REINFORCING STEEL LIST						
MARK	SIZE	No.	LENGTH	WEIGHT	SHAPE	BENDING DIAGRAMS
Superstructure						
A	1 1/8"	33	37'-6"	15006	Str.	
B	1 1/8"	30	27'-6"	3550	Bl.	
C	1 1/8"	30	24'-3"	3130	Bl.	
D	1 1/8"	15	24'-0"	1549	Str.	
E	1 1/8"	15	19'-3"	1242	Str.	
F	1 1/8"	78	24'-3"	8159	Str.	
G	1 1/8"	38	12'-0"	1962	Str.	
H	1 1/8"	38	7'-9"	1267	Str.	
J	3/8"	40	23'-0"	1982	Str.	
K	3/8"	20	20'-3"	608	Str.	
L	3/8"	123	36'-0"	7021	Str.	
M	3/8"	67	36'-0"	3824	Str.	
Pier						
P0a	1/2"	8	20'-11"	890	Str.	
P7a	1"	32	20'-0"	1750	Str.	
P2a	1/2"	72	5'-3"	232	Bl.	
P2b	1/2"	56	10'-4"	386	Bl.	
Abutment						
A7a	1"	48	23'-3"	3040	Str.	
A4a	3/8"	124	9'-5"	1085	Bl.	
A2a	1/2"	48	5'-3"	168	Bl.	
A2b	1/2"	8	6'-8"	96	Bl.	
A2c	1/2"	8	6'-0"	92	Bl.	
A2d	1/2"	88	3'-6"	207	Str.	
A2e	1/2"	8	9'-0"	48	Str.	
Replacement Bars						
RE9	1 1/8"	2	7'-9"	66	Str.	
RE7	1"	1	7'-4"	20	Str.	
RE6	3/8"	1	6'-6"	10	Str.	
RE4	3/8"	1	6'-1"	6	Str.	
RE2	1/2"	1	5'-8"	5	Str.	
RE0	1/2"	1	8'-2"	43	Str.	

SURFACE FINISH OF CONCRETE. Fascia of deck slab shall receive a rubbed surface finish. All other exposed surfaces except roadway surface shall be governed by the provisions of Sec. 5-122.

STATE OF OHIO
DEPARTMENT OF HIGHWAYS
BUREAU OF BRIDGES AND RAILROAD CROSSINGS

**GENERAL PLAN & ELEVATION
NOTES, QUANTITIES & STEEL LIST**

BRIDGE NO. GE-87-32
over SILVER CREEK

GEAUGA COUNTY
SEC. GEA-87 (3.16)(6.78)

DESIGNED	DRAWN	TRACED	CHECKED	REVIEWED	DATE	REVISED
J.D.J.	J.D.J.	J.D.J.	J.O.G.	B.T.G.	11-15-48	11-15-48

Revised As-Built 7/23/48

GEA 87 - 6.78
GEAUGA COUNTY
NEWBURGH TOWNSHIP

PROPOSED CULVERT DATA

Type: Concrete Slab
Roadway: 20'-0"
Clear Span: 19'-0"
Clear Height: 7'-10"
Depth: 5'
Location: H.H.15

ACREAGE REQUIRED

Parcel 1 = 0.233 AC
Parcel 2 = 0.105 AC
Parcel 3 = 0.446 AC


CHANNEL CHANGE

Parcel 1-X = 0.123 AC
Parcel 3-X = 0.192 AC


2
G. H. MEALAND et al.

UTILITIES INVOLVED -
Cleveland Electric Illuminating Company
Western Reserve Telephone Company


**END PROJECT & PART 2
STA. 363+00**

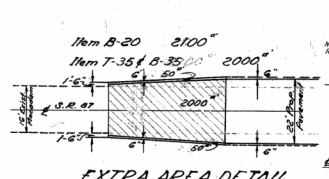

Item B-20 2100"
Item T-35 & B-35 2000"

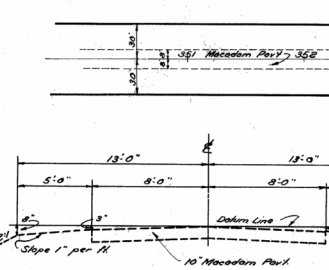

**BEGIN PART 2
STA. 352+50**

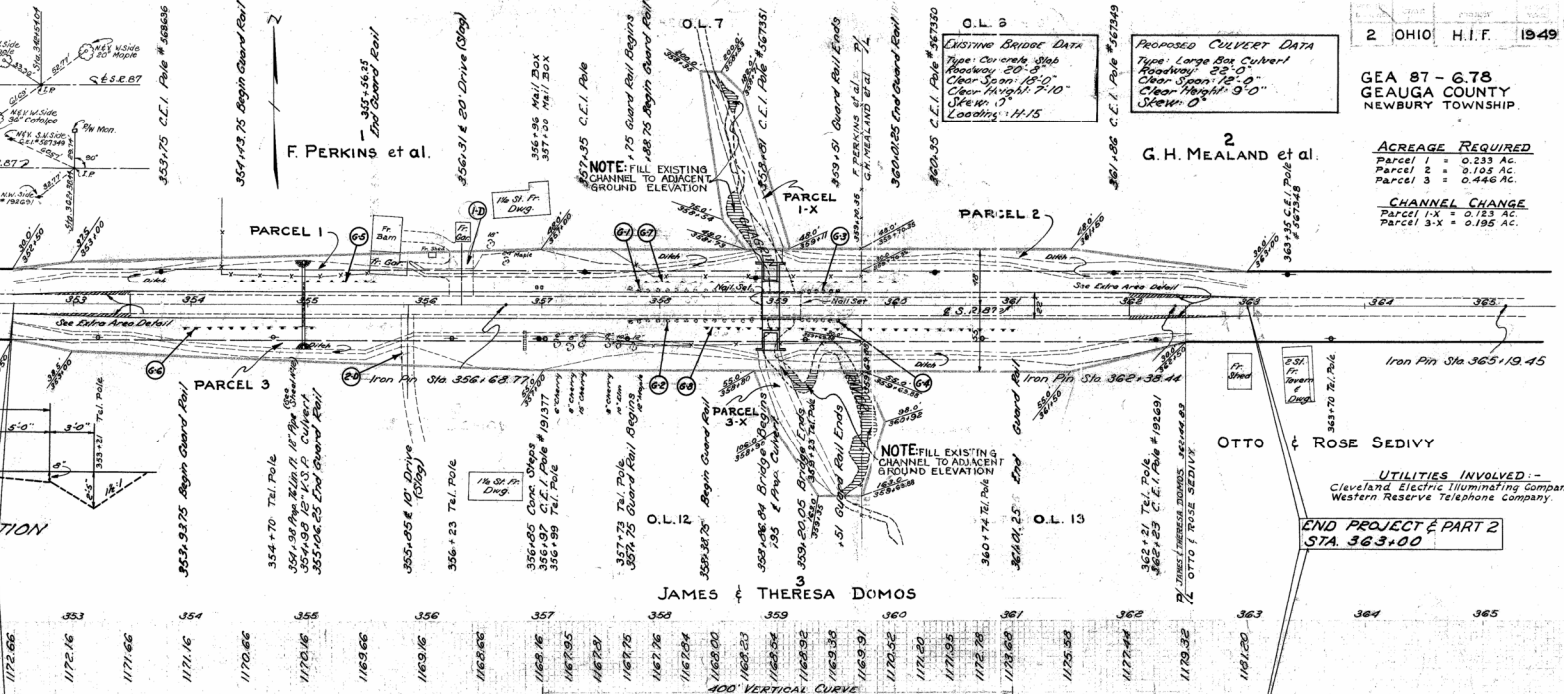


PRIVATE DRIVEWAYS

MARK	SIDE	LENGTH	EST. QUANTITIES	EST. QUANTITIES
1-D	N	18 Cu. Yds.	17 Cu. Yds.	34 Lin. Ft.
2-D	S	9 Cu. Yds.	10 Cu. Yds.	20 Lin. Ft.
Total		31 Cu. Yds.	31 Cu. Yds.	54 Lin. Ft.

GUARD RAIL

MARK	SIDE	ITEM	QUANTITIES
G-1	N	11.81 Lin. Ft.	
G-2	S	11.84 "	
G-3	N	30.95 "	
G-4	S	30.95 "	
G-5	N	142.5 Lin. Ft.	
G-6	S	142.5 "	
G-7	N	212.5 "	
G-8	S	212.5 "	
Total		888.9 Lin. Ft.	

B.M. #76 Spike N.W. corner of 1/2" 10m sq. South side of road 30' East of C.C.I. Pole # 192150 Sta. 360+54 Elev. 1163.630

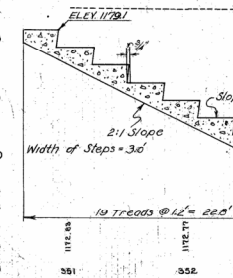

Excavation 2532 Cu. Yds.
Embankment 2493 Cu. Yds.
Embankment + 22% 3041 Cu. Yds.

Excavation 221 Cu. Yds.
Embankment 2481 Cu. Yds.
Embankment + 22% 3027 Cu. Yds.


GEAUGA COUNTY
GEA. 87-6.78

Seeding & Sodding	
Length	Area
Lin. Ft.	Sq. Yds.

End Area	Cu. Yds
Cut	Fill


63	336
58	325
59	283
43	

13	168	22	221
48	71		
66	24	106	82
41	22		
0	0		

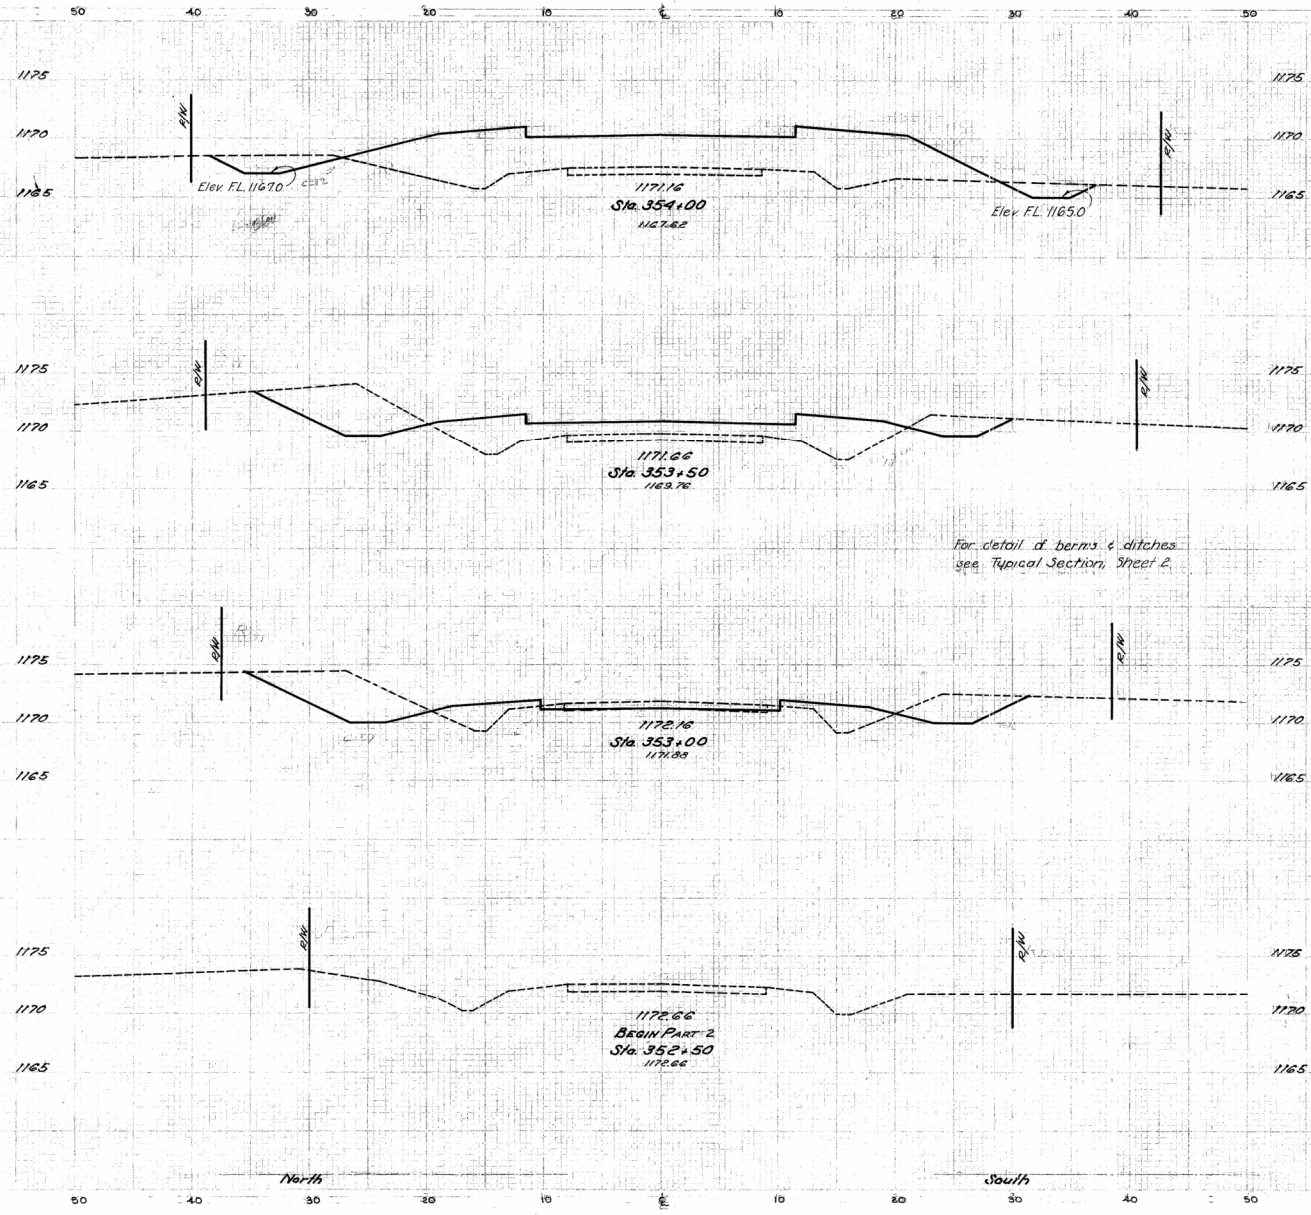

GEAUGA COUNTY
GEA. 87-6.78

Seeding & Sodding	
Length	Area
Lin. Ft.	Sq. Yds.
75	
342	
79	
433	
71	
371	
68	
364	
63	

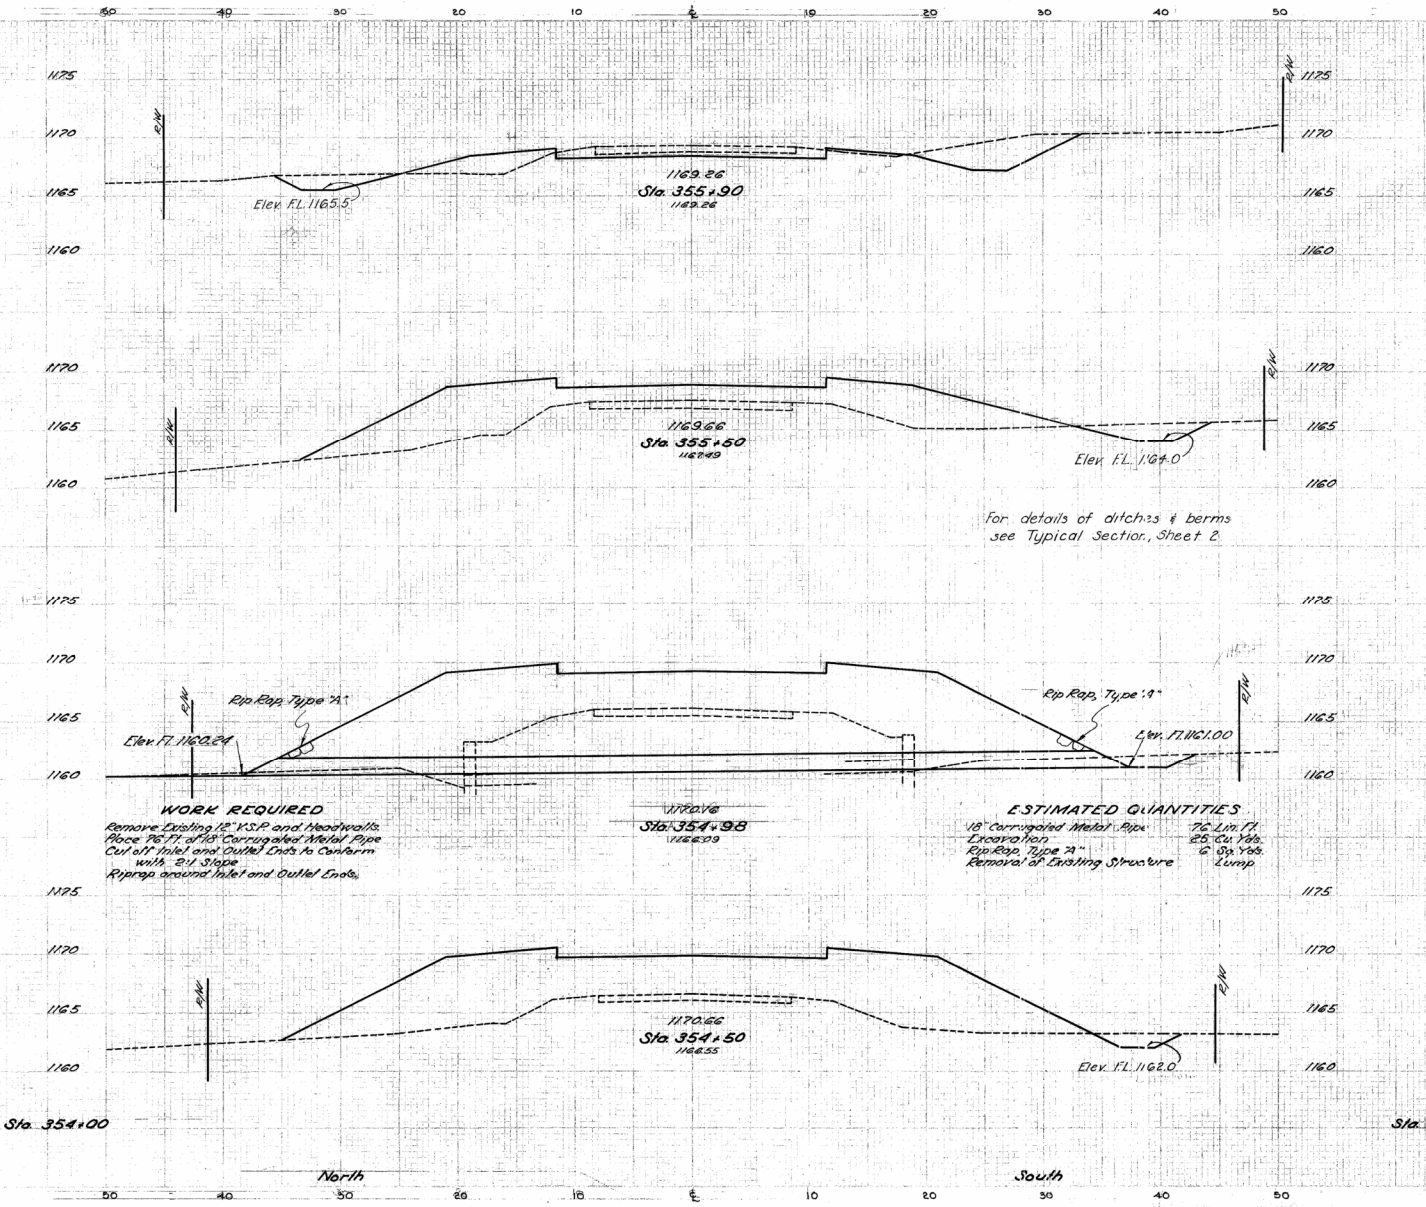

End Area		Cu. Yds.	
Cut	Fill	Cut	Fill
4.3	17		
		40	124
11	151		
		16	45.3
6	319		
		12	530
7	277		
		24	412
19	168		

For details of ditches & berms
see Typical Section, Sheet 2.


WORK REQUIRED
Remove Existing 12" K.S.P. and Headwalls.
Place 16" FT. of 18" Corrugated Metal Pipe
Cut-off Inlet and Outlet Ends to Conform
with 2:1 Slope
Riprap around Inlet and Outlet Ends.

ESTIMATED QUANTITIES
18" Corrugated Metal Pipe 76 Lin. Ft.
Excavation 25 Cu. Yds.
Riprap, Type 21 6 Sq. Yds.
Removal of Existing Structure Lump.

GEAUGA COUNTY
GEA. 87-6.78

Seeding & Sodding	
Length	Area
Lin. Ft.	Sq. Yds.

End Area		Cu. Yds.	
Cut	Fill	Cut	Fill

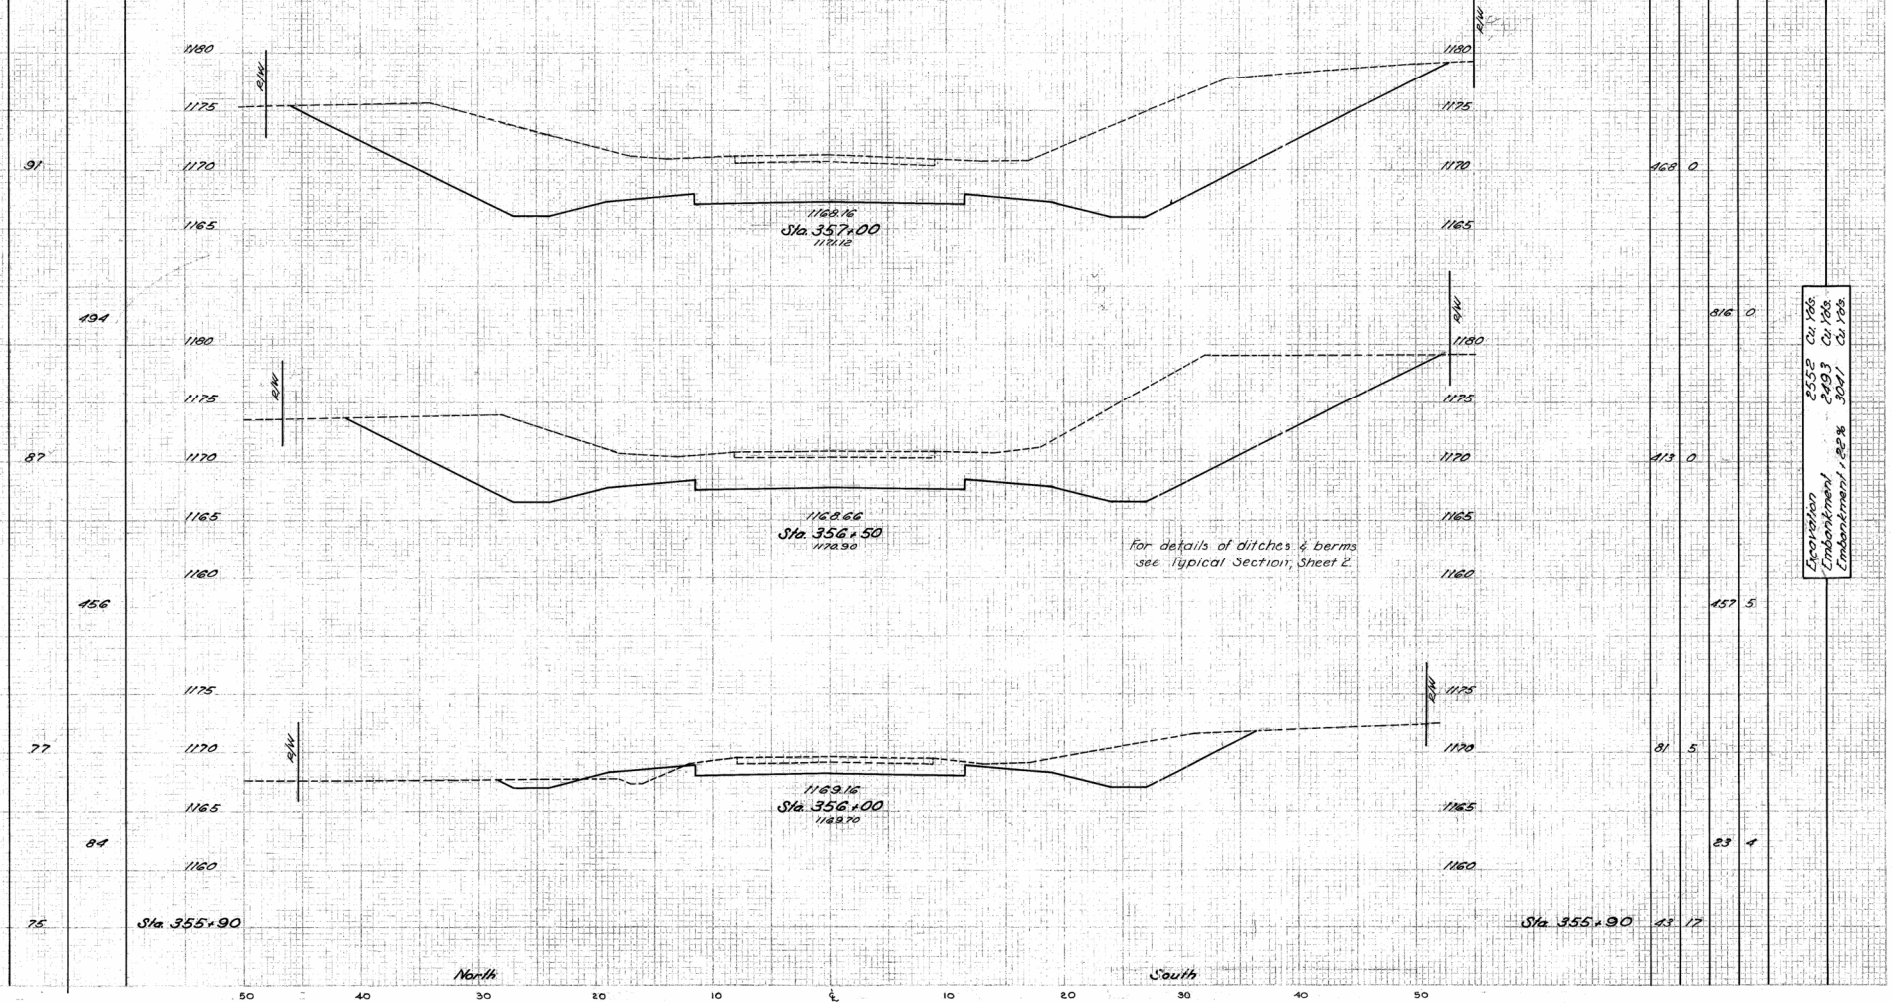


55.9	Cu. Yds.
2.03	Cu. Yds.
3.01	Cu. Yds.
Embankment 1.25%	

91	134
87	456
77	84
75	

168	0	816	0
113	0	457	5
81	5	23	4
43	17		

GEAUGA COUNTY
GEA. 87-6.78

Seeding & Sodding	
Length	Area
Lin. Ft.	Sq. Yds.
85	
469	
84	
115	
83	
348	
85	
439	
91	

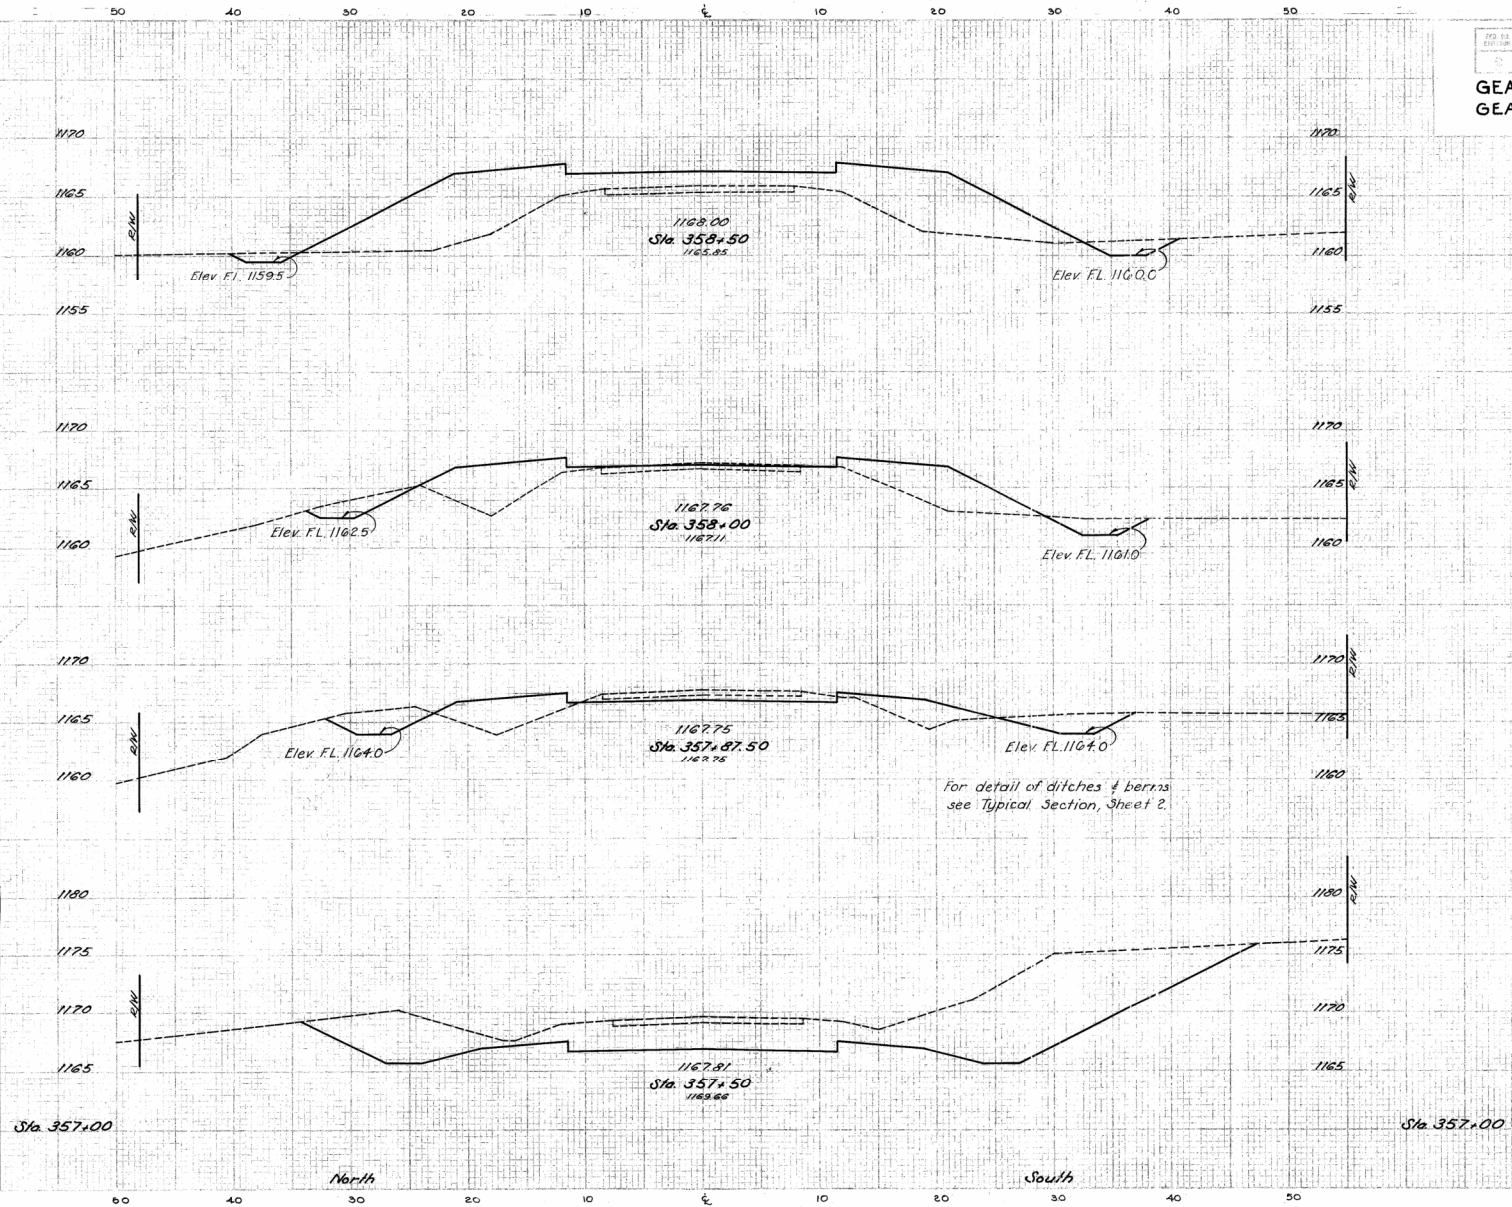

End Area	Cu. Yds.	
	Cut	Fill
11	184	
25	234	
16	69	
14	25	
43	39	
211	27	
261	0	
675	0	
168	0	

For detail of ditches & berms see Typical Section, Sheet 2.


GEAUGA COUNTY
GEA. 87-6.78

Seeding & Sodding	
Length	Area
Lin. Ft.	5q. Yds.



End Area	Cu. Yds.
Cut	Fill

85	
170	
85	
359	
85	

15	295
5	327
0	665
3	310
10	348
11	184

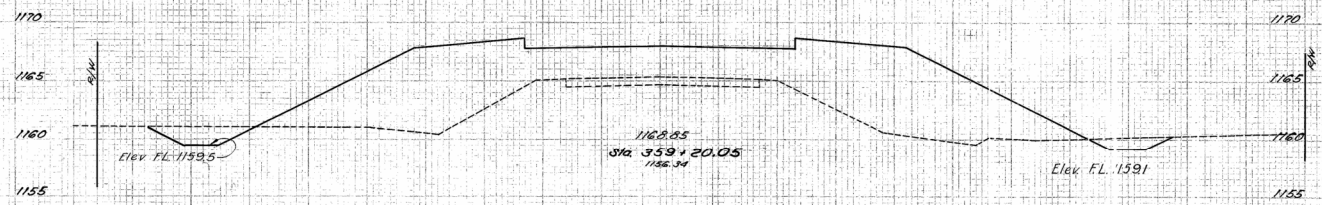

for details of ditches & berms
see Typical Section, Sheet 2.

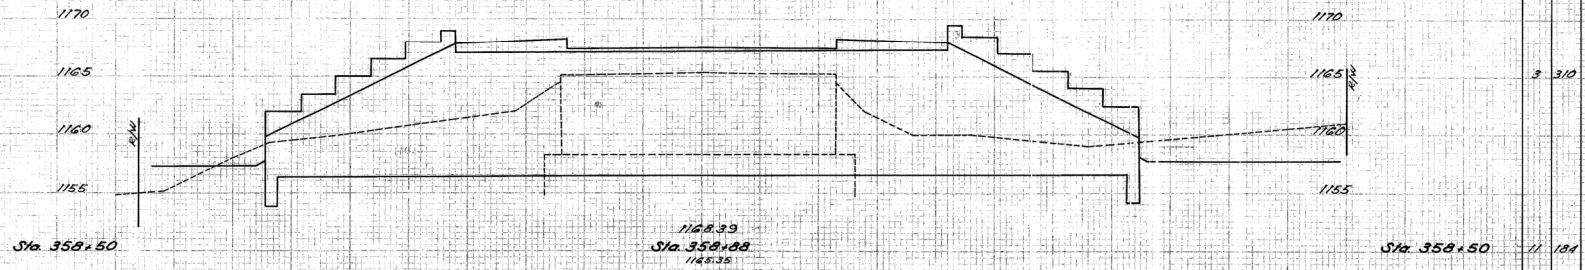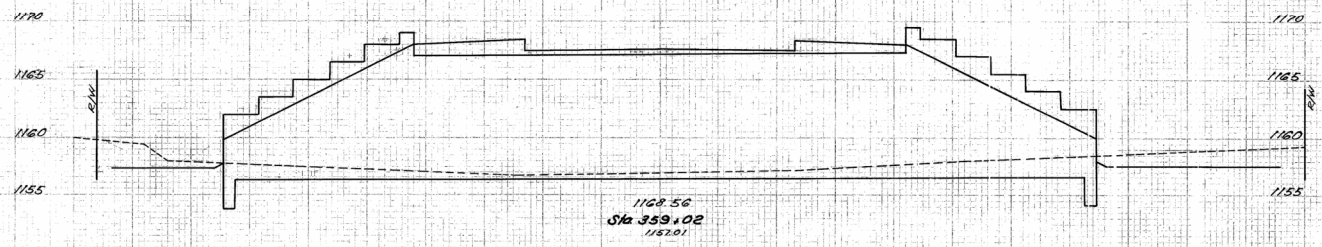

North

South


GAUGA COUNTY
GEA. 87-6.78

Seeding & Sodding	
Length	Area
Lin. Ft.	Sq. Yds.

End Area		Cu. Yds.	
Cut	Fill	Cut	Fill

84	169
85	478
87	286
85	


17	243	23	494	8	290	12	549	5	303	11	332	15	295
----	-----	----	-----	---	-----	----	-----	---	-----	----	-----	----	-----

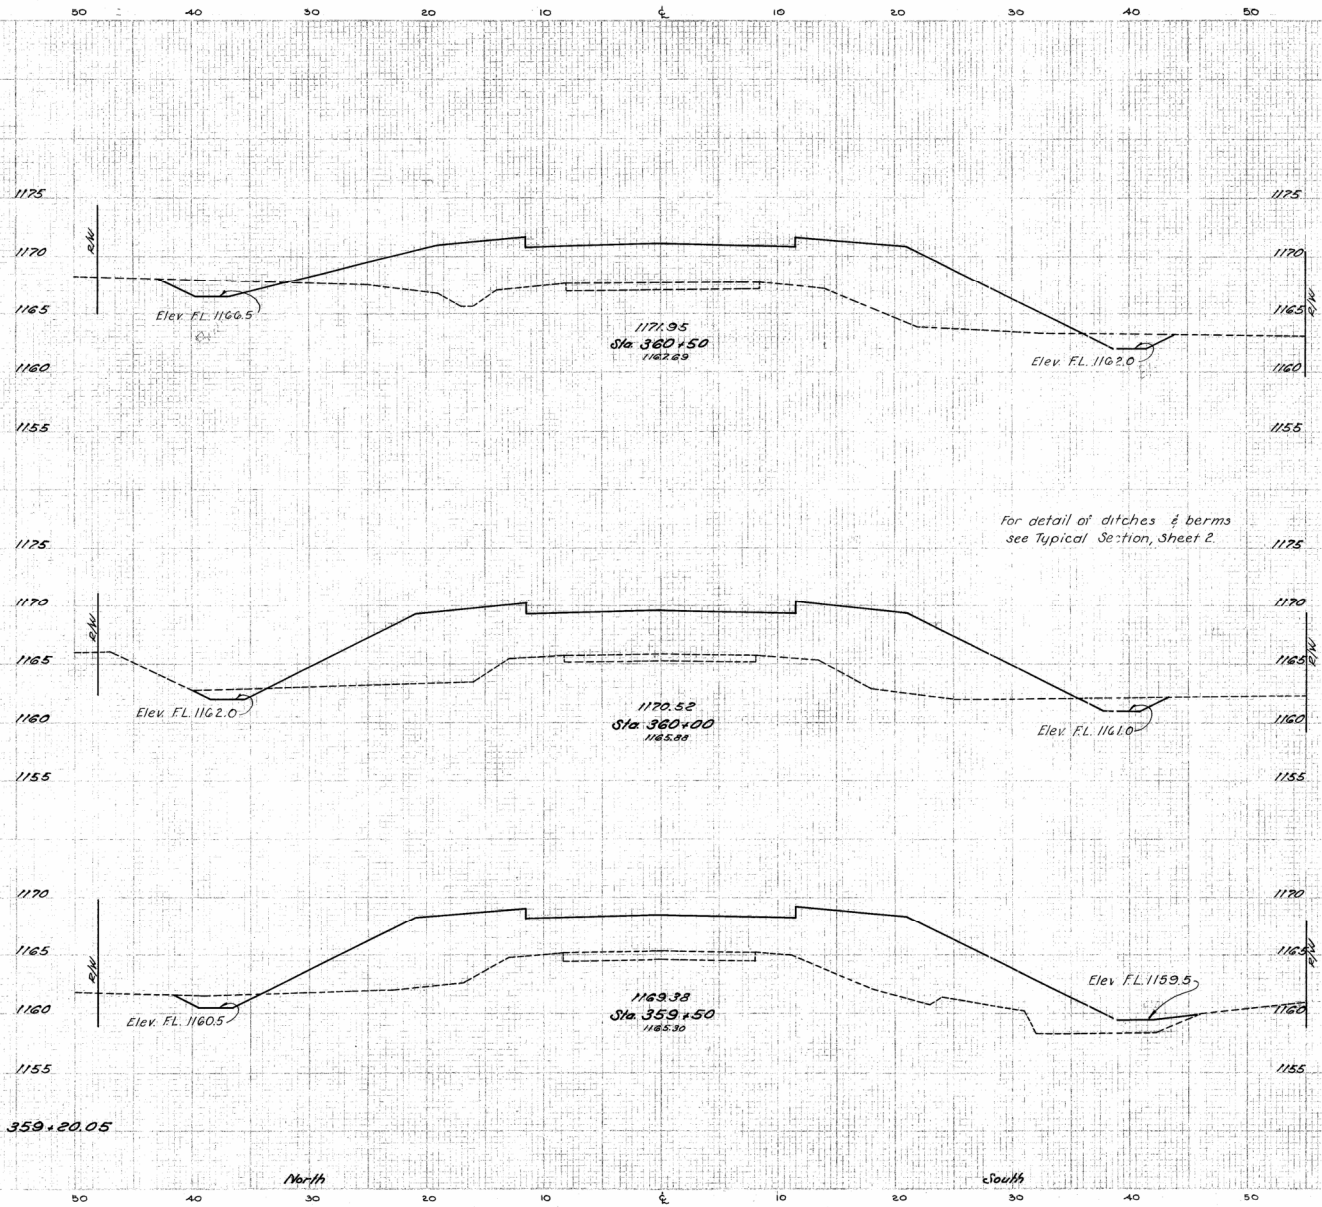

GAUGA COUNTY
GEA. 87-678

Seeding & Sodding	
Length	Area
Lin. Ft.	Sq. Yds.

End Area		Cu. Yds.	
Cut	Fill	Cut	Fill

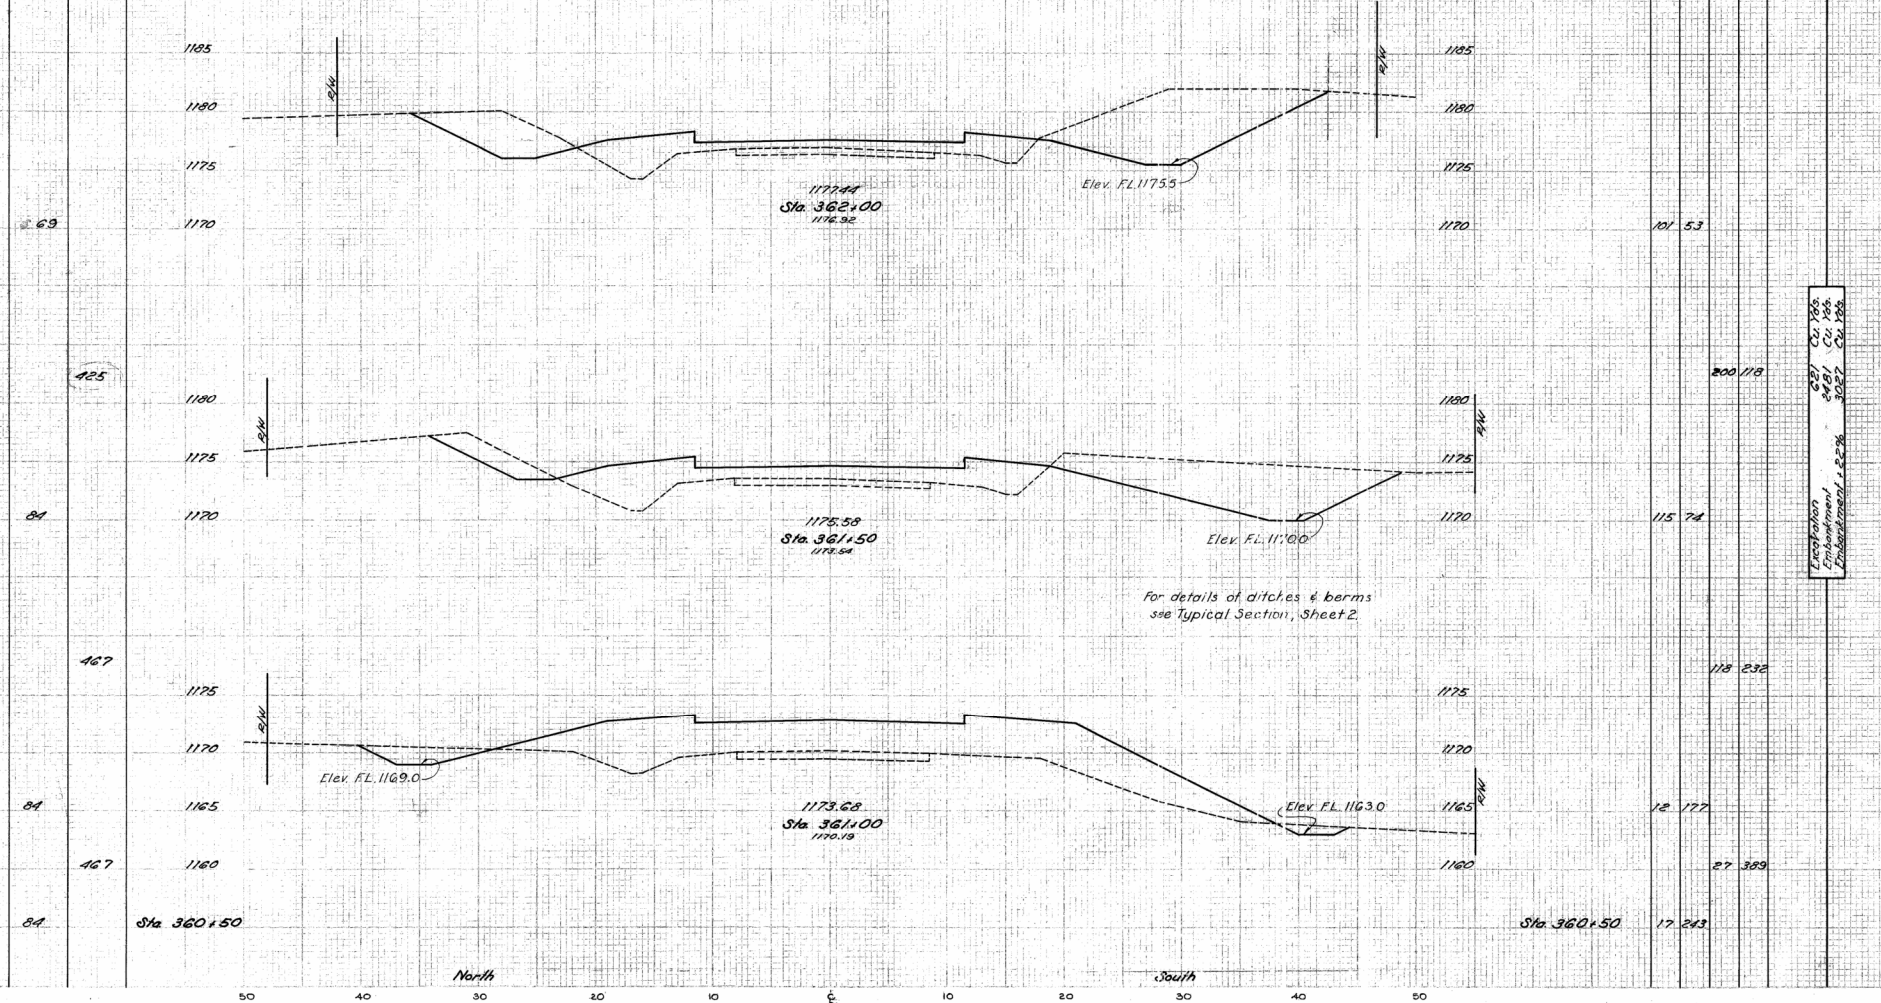

PART 2 - CROSS SECTIONS STA. 361+00 TO STA. 362+00


GEAUGA COUNTY
GEA. 87-6.78

Seeding & Sodding	
Length	Area
Lin. Ft.	Sq. Yds.

End Area		Cu. Yds.	
Cut	Fill	Cut	Fill

43	
278	
57	
167	
63	
183	
69	

0	0		
		69	6
75	7		
		72	9
81	13		
		84	31
101	53		

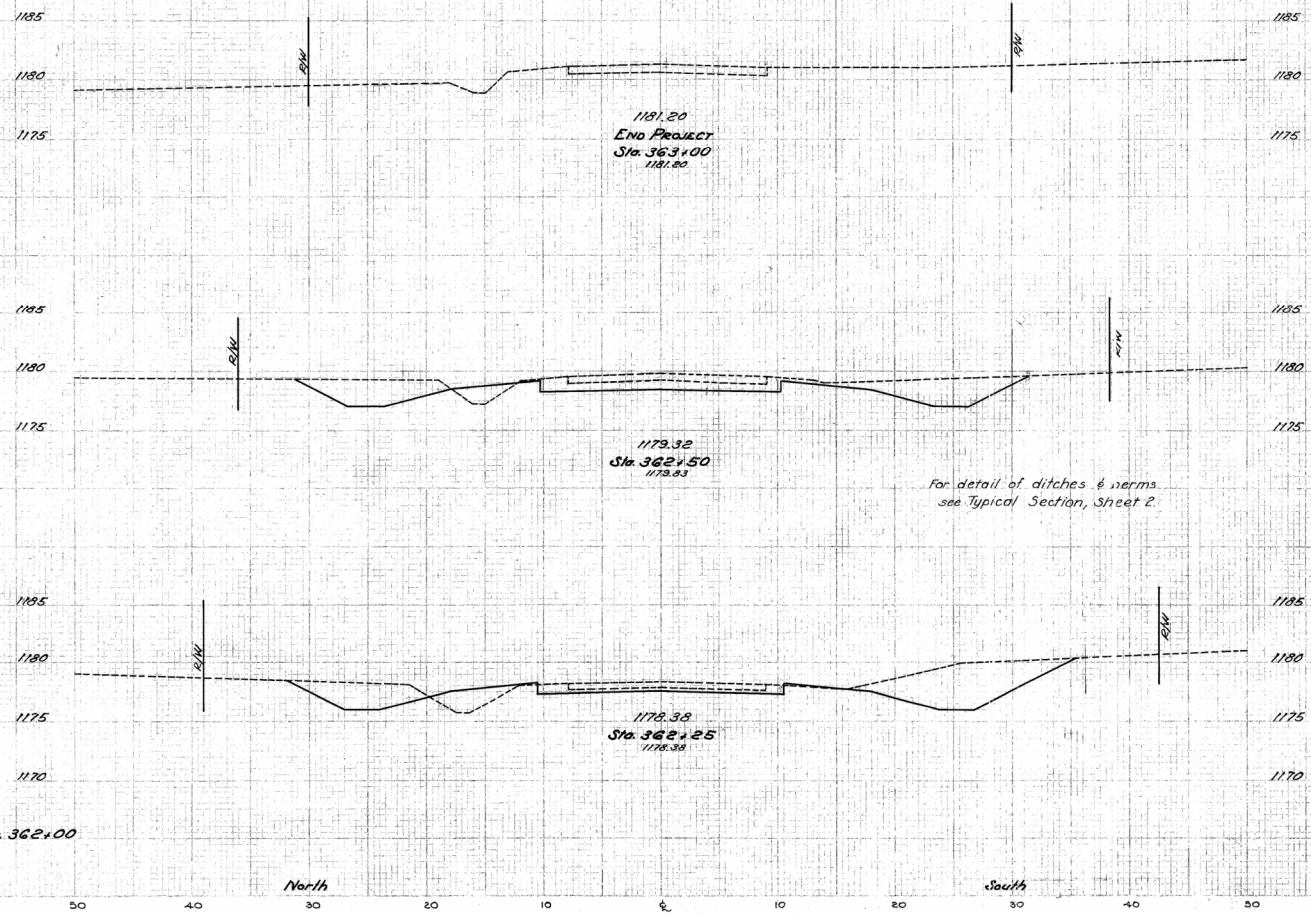

GEauga COUNTY
 GEA-87-6-78

Width	Area	Lim. Ft.	Sp. Yds.
6			
72			
20			
128			
26			
103			
11			

Seeding Sta. 325+00
 S. of & S.R. 87




End Area		Cu. Yds.	
Cut	Fill	Cut	Fill
0	0		
		18	0
19	0		
		44	0
29	0		
		38	30
9	32		
		6	8
16	0		

107 Cu. Yds.
 32 Cu. Yds.
 Embankment 1.25% slope
 46 Cu. Yds.

S.L. = Seeding Limit


Seeding	Seeding
Width	Area
Lim. Ft.	Sq. Yds.

25	40	31	292	74	425	79
----	----	----	-----	----	-----	----

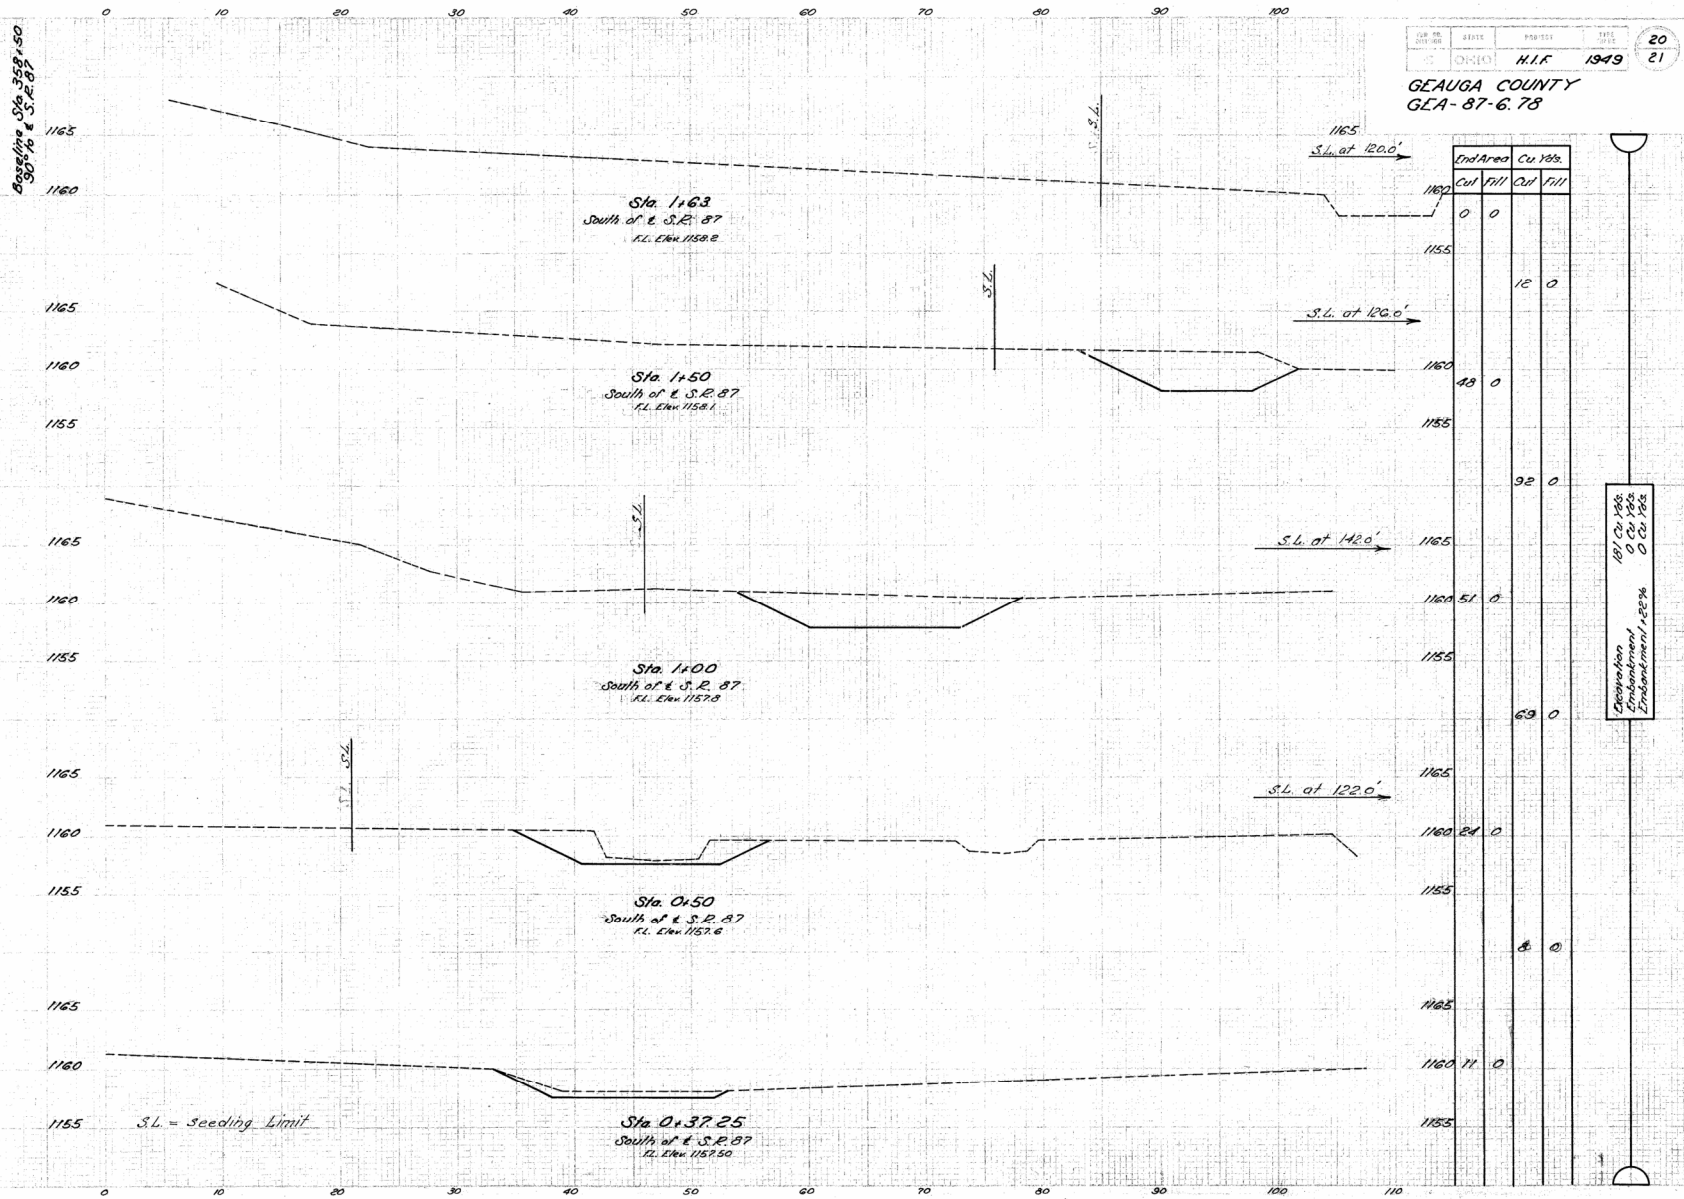


GEAUGA COUNTY
GLA-87-6.78

GEAUGA COUNTY
GEA-87-678

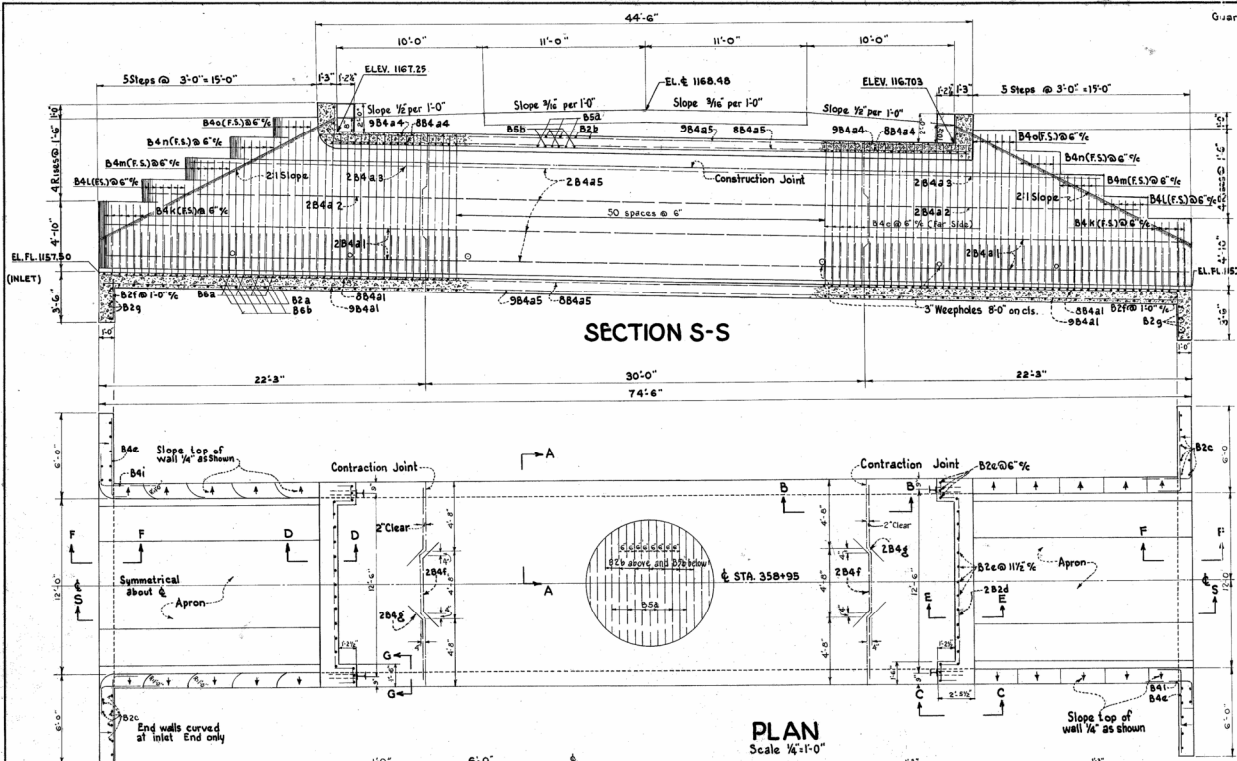


SECTION S-S

PLAN
Scale 1/4"=1'-0"

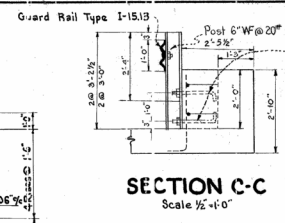


SECTION C-C
Scale 1/2"=1'-0"

1" x 18" long hook bolts or machine bolts (galvanized), Thread C, length of bolt and provide additional nuts. Fasten bolts rigidly to form during placing of concrete. (See Detail A')

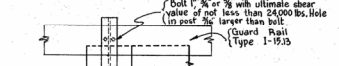

SECTION G-G
Scale 1/2"=1'-0"

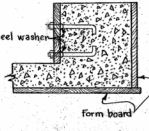

DETAIL A'

BAR SCHEDULE

MARK	SIZE	NO.	LENGTH	TOTAL WEIGHT	SHAPE
B 2 a	1/2"	75	18'-7"	1333-3	931 bt.
B 2 b	1/2"	45	13'-6"	607-6	406 St.
B 2 c	1/2"	28	7'-10"	219-4	147 St.
B 2 d	1/2"	4	17'-3"	69-0	46 bt.
B 2 e	1/2"	38	3'-0"	114-0	76 bt.
B 2 f	1/2"	28	3'-8"	102-8	63 bt.
B 2 g	1/2"	6	23'-6"	141-0	94 St.
B 4 a1	3/4"	50	21'-6"	1015-0	1121 St.
B 4 a2	3/4"	8	18'-6"	148-0	154 St.
B 4 a3	3/4"	8	15'-9"	126-0	131 St.
B 4 a4	3/4"	34	6'-6"	227-0	231 St.
B 4 a5	3/4"	50	29'-6"	1475-0	1538 St.
B 4 b	3/4"	38	9'-3"	351-6	367 St.
B 4 c	3/4"	180	10'-4"	1860-0	1940 bt.
B 4 d	3/4"	20	3'-10"	230-0	240 bt.
B 4 e	3/4"	60	7'-0"	140-3	146 bt.
B 4 f	3/4"	8	7'-0"	56-0	58 bt.
B 4 g	3/4"	16	5'-9"	92-0	96 bt.
B 4 h	3/4"	8	6'-0"	48-0	50 bt.
B 4 i	3/4"	20	3'-0"	100-4	104 bt.
B 4 j	3/4"	16	4'-8"	74-8	78 bt.
B 4 k	3/4"	24	4'-7"	110-0	115 St.
B 4 l	3/4"	24	6'-1"	148-0	152 St.
B 4 m	3/4"	24	7'-7"	182-0	190 St.
B 4 n	3/4"	24	9'-1"	218-0	221 St.
B 4 o	3/4"	24	10'-7"	254-0	265 St.
B 5 a	3/4"	45	13'-9"	786-3	1065 bt.
B 5 b	3/4"	45	13'-6"	607-6	912 St.
B 6 a	3/4"	75	19'-9"	1481-3	3028 bt.
B 6 b	3/4"	75	13'-6"	1012-6	2070 St.
B 6 c	3/4"	6	15'-2"	91-0	186 bt.
B 6 d	3/4"	6	18'-0"	108-0	221 St.

REPLACEMENT BARS

ITEM	DESCRIPTION	QUANTITY	WEIGHT	
R 2	1/2"	1	5-8"	4 St.
R 4	3/4"	1	6'-1"	6 St.
R 5	3/4"	1	6'-6"	10 St.
R 6	3/4"	1	6'-11"	14 St.
Item 5-4	Reinforcing Steel		16488 Lbs.	
Item 5-2	Structural Excavation		58 CU Yds.	
Item 5-1	Concrete for Structures		120 CU Yds.	

STATE OF OHIO
DEPARTMENT OF HIGHWAYS
BUREAU OF BRIDGES

12x9 BOX CULVERT
N2GE-87-68A

GEAUGA COUNTY SR. 87
GEA-87-678 STA. 399+03.42

DESIGNED	PPG	DRAWN	PPG	CHECKED	PPG	REVIEWED DATE	REVISION
----------	-----	-------	-----	---------	-----	---------------	----------

PART 2 CULVERT PLANS

FOUNDATION MATERIAL of approximately uniform bearing capacity is contemplated. Spots of soft earth shall be removed and be replaced with thoroughly compacted granular material.

EMBANKMENT shall be placed symmetrically on both sides of the culvert after the top slab is in place.









CONCRETE shall be Class 'C'.

NOTE: Cost of furnishing, preparing and erecting all incidentals necessary for placing guard rails on structure shall be included in unit price bid for Item 1-15 Guard Rails.


SECTION B-B
Showing
Contraction Joint Detail

SECTION D-D SECTION E-E

SECTION F-F

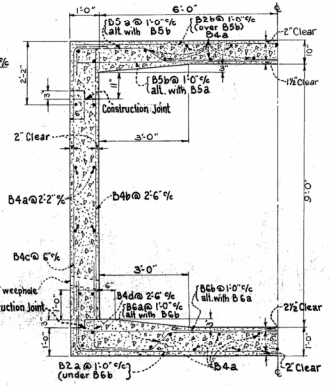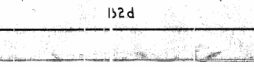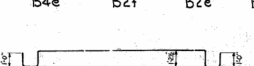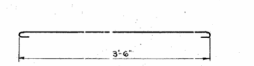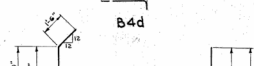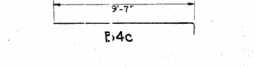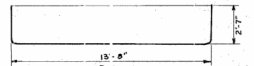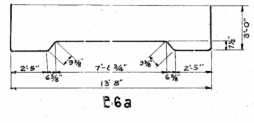

SECTION A-A
Symmetrical about &
Scale 1/2"=1'-0"

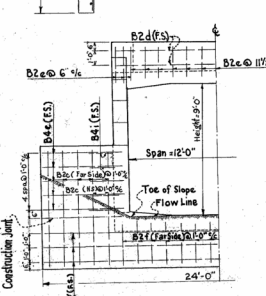

END VIEW
Symmetrical about &



FED. RD. DIVISION	STATE	PROJECT	FISCAL YEAR
2	OHIO	H. I. F.	1949

GEAUGA COUNTY
S.R.87 BRIDGE GEA-87-68A

DRAINAGE AREA 1.1² SQ. MI.

EXISTING BRIDGE DATA

TYPE: CONCRETE SLAB, CONCRETE SUBSTRUCTURE, ROADWAY
WIDTH 20'-8"
LOADING: H-15
CLEAR SPAN: 18'-0"
CLEAR HEIGHT: 7'-10"
SKEW: 0°
CONDITION: POOR

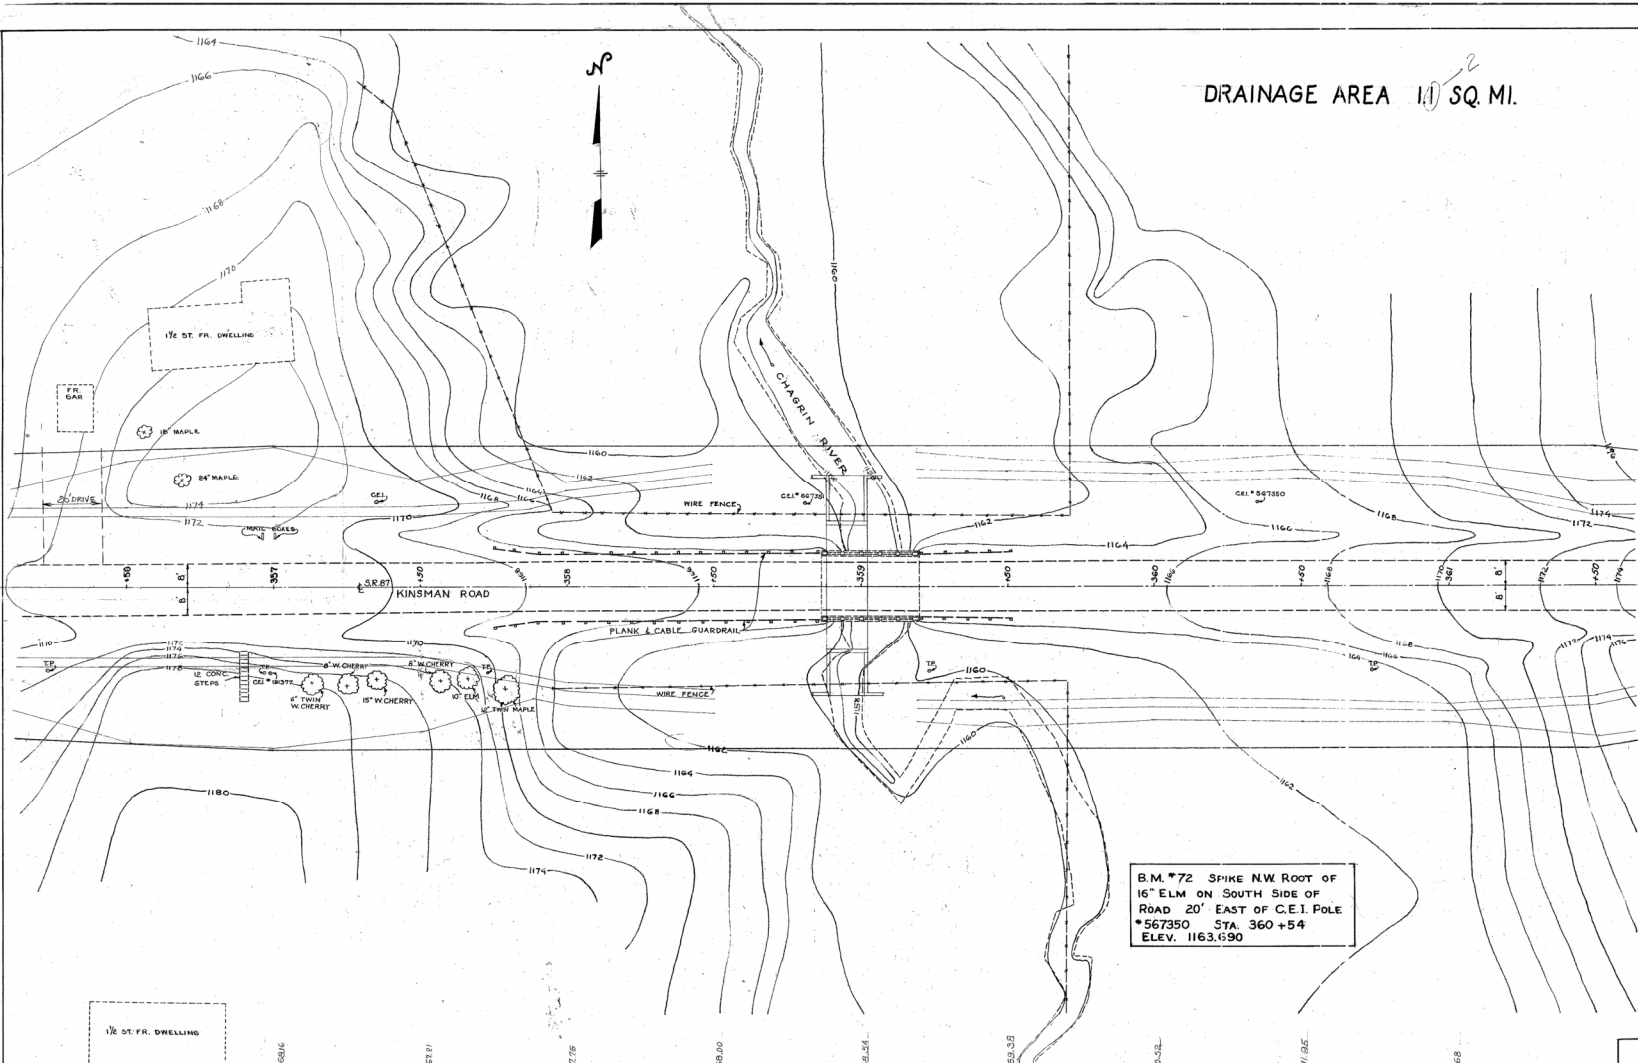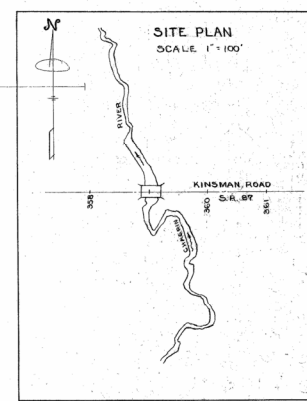


B.M. #72 SPIKE NW ROOT OF 16" ELM. ON SOUTH SIDE OF ROAD, 20' EAST OF C.E.I. POLE #567350 STA 360+54 ELEV. 1163.690

Typical Section, Line & Grade OK Rev'd 7-6-49


STATE OF OHIO
DEPARTMENT OF HIGHWAYS

SITE PLAN
KINSMAN RD. S.R. 87
A BRANCH OF CHAGRIN RIVER
BRIDGE N^o GEA-87-68A

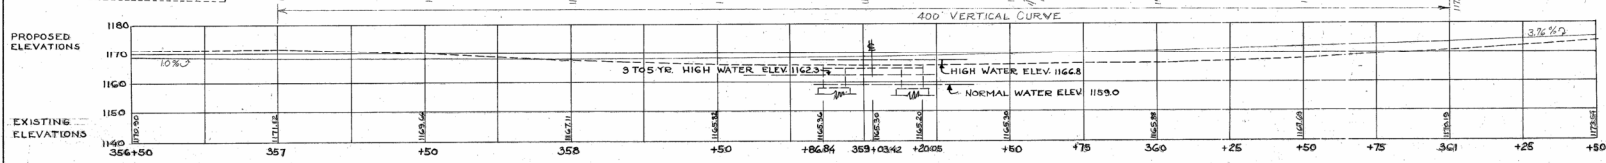

SCALE 1" = 20'

EXISTING TOPO.		PROPOSED WORK			
SURVEYED	DRAWN	DESIGNED	DRAWN	CHECKED	REVIEWED

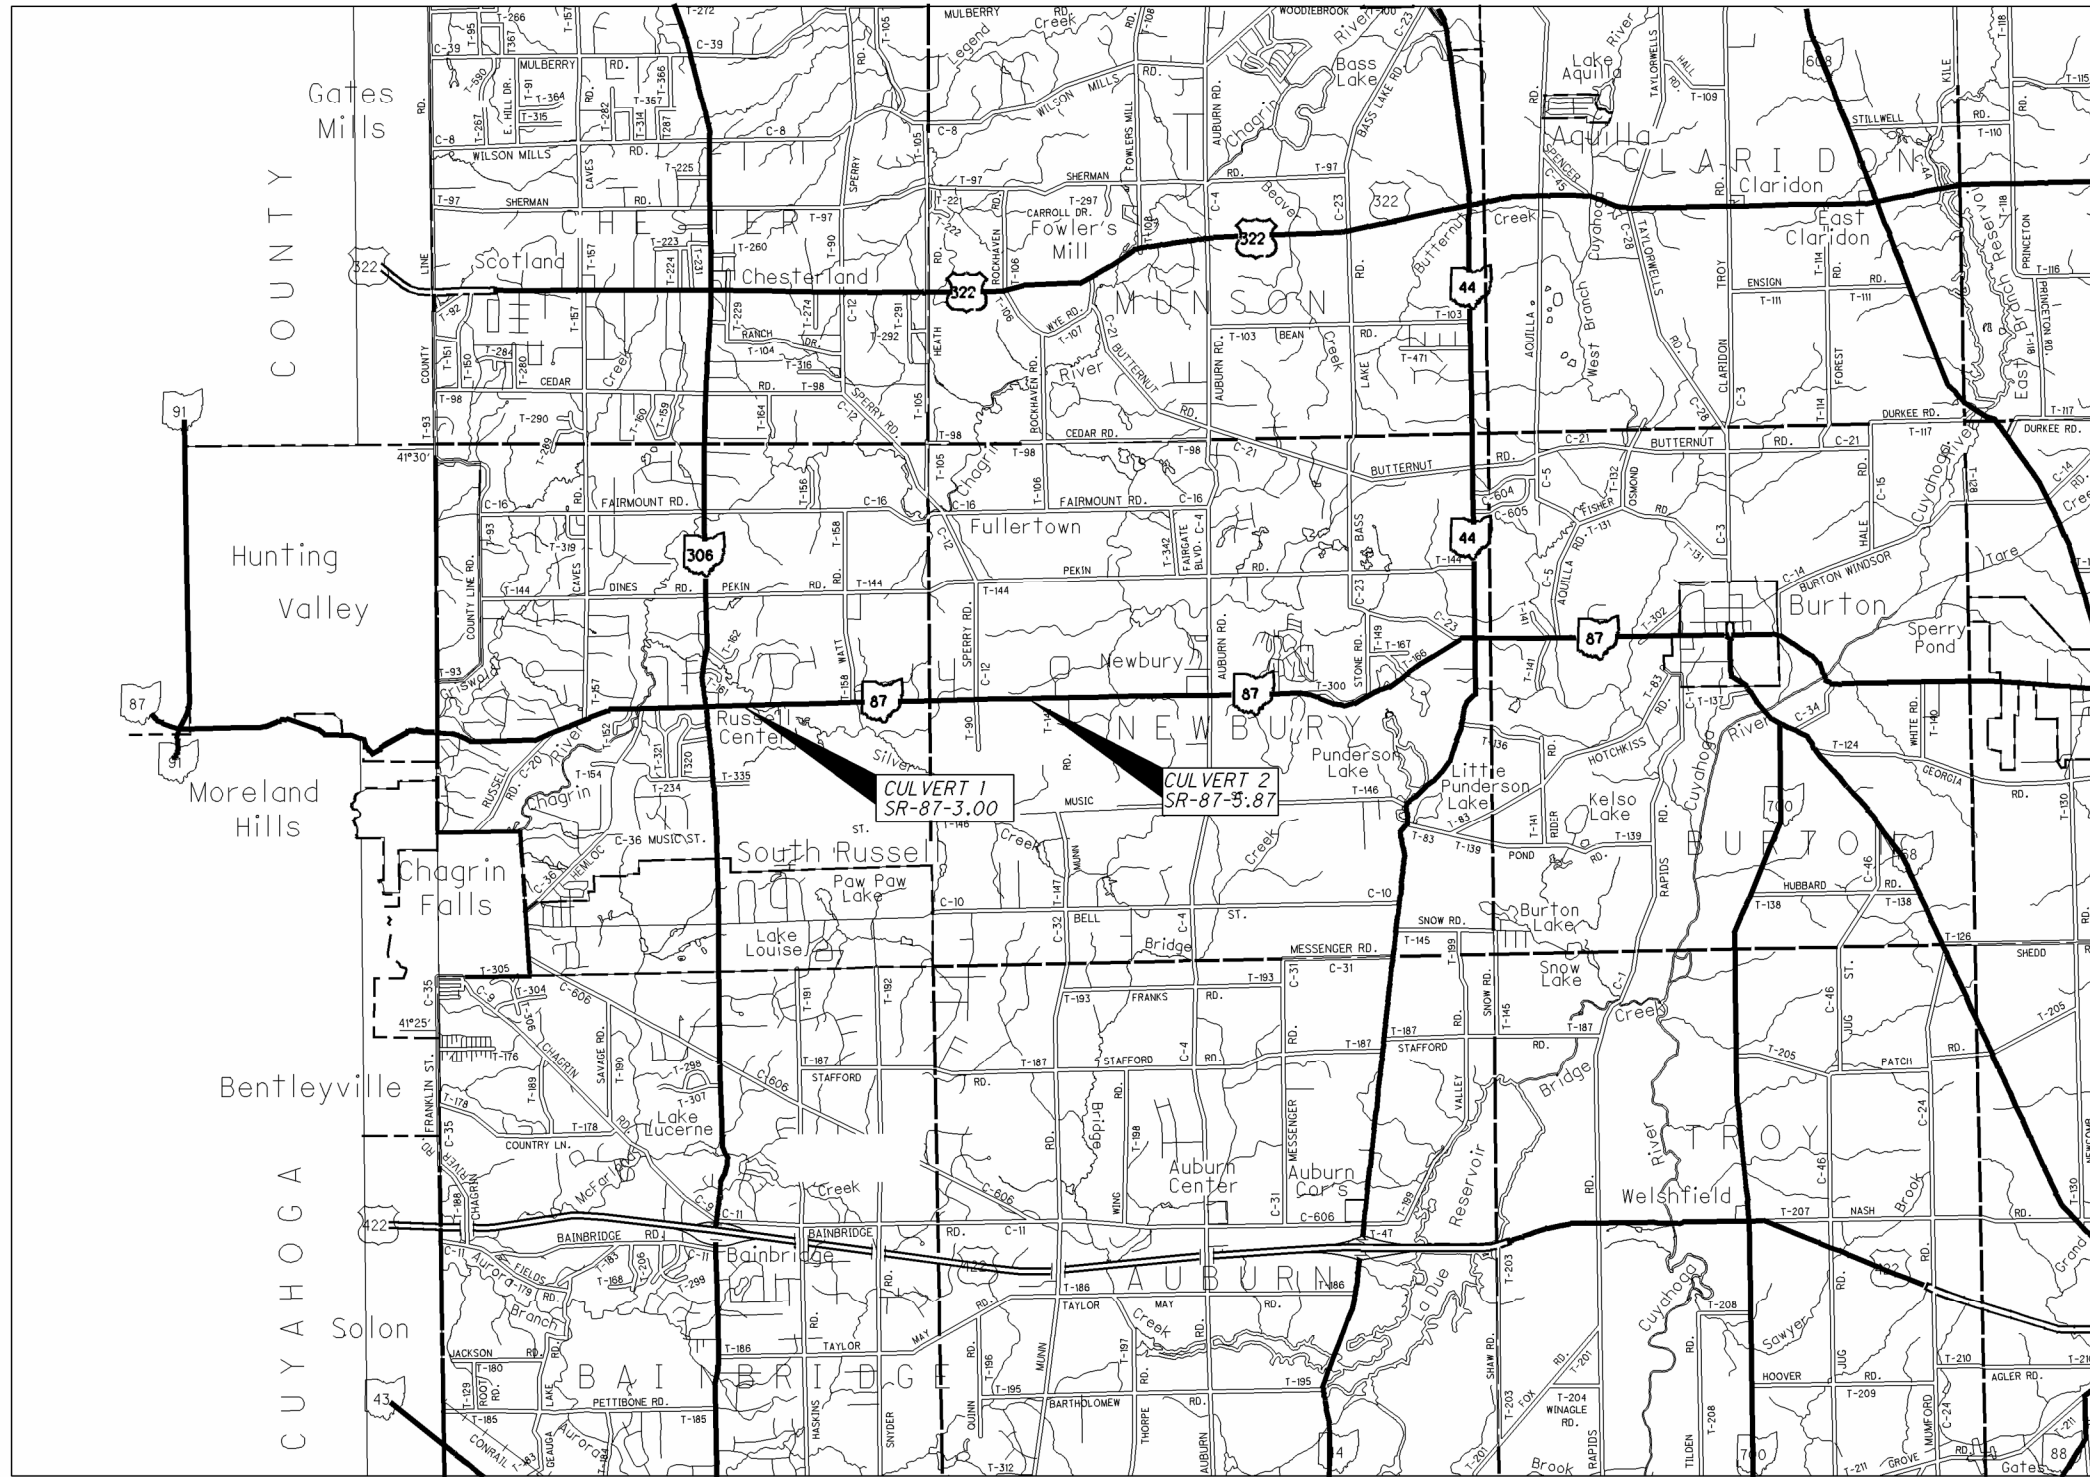

DESIGN DESIGNATION



CURRENT ADT (2007). -----
 DESIGN YEAR ADT (2029). -----
 DESIGN HOURLY VOLUME (2029). -----
 DIRECTIONAL DISTRIBUTION -----
 TRUCKS (24 HOUR B&C). -----
 DESIGN SPEED. -----
 LEGAL SPEED -----
 DESIGN FUNCTIONAL CLASSIFICATION:
 RURAL MAJOR COLLECTOR

GEA-87-3.0

6250
 11300
 1130
 55%
 2.72%
 55 MPH
 50 MPH
 50 MPH

GEA-87-5.87


6250
 7600
 1040
 55%
 2.72%
 55 MPH
 50 MPH
 50 MPH

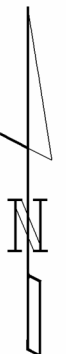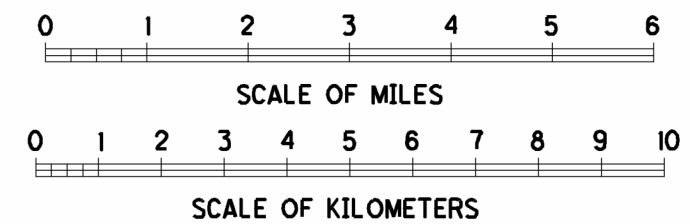

CALCULATED
 AJ5
 CHECKED
 MKM


LOCATION MAP

GEA - 3.00 / 5.87

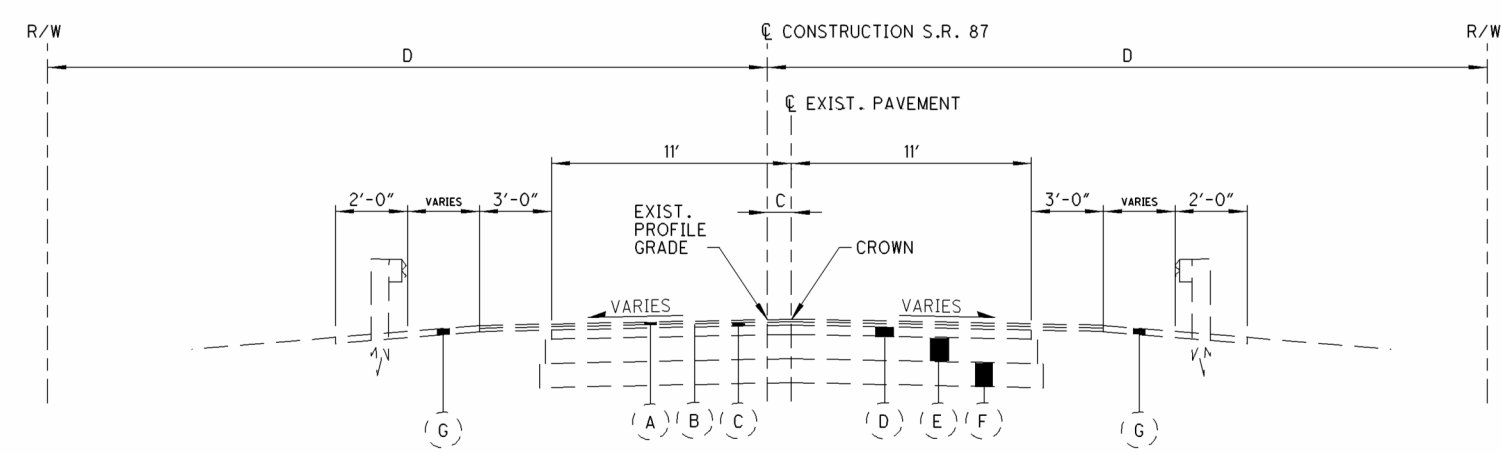

LEGEND - EXISTING

- (A) ASPHALT CONCRETE SURFACE COURSE, TYPE 1 (1.5")
- (B) ASPHALT CONCRETE INTERMEDIATE COURSE, TYPE 2, PG 64-22 (0"-1.5")
- (C) ASPHALT CONCRETE PAVEMENT SURFACE HEATER RECYCLING (2")
- (D) 3" ASPHALT CONCRETE BASE
- (E) 5" GRANULATED SLAG
- (F) 18" SUBBASE COURSE
- (G) ASPHALT CONCRETE INTERMEDIATE COURSE, TYPE 1, PG 64-22, UNDER GUARDRAIL

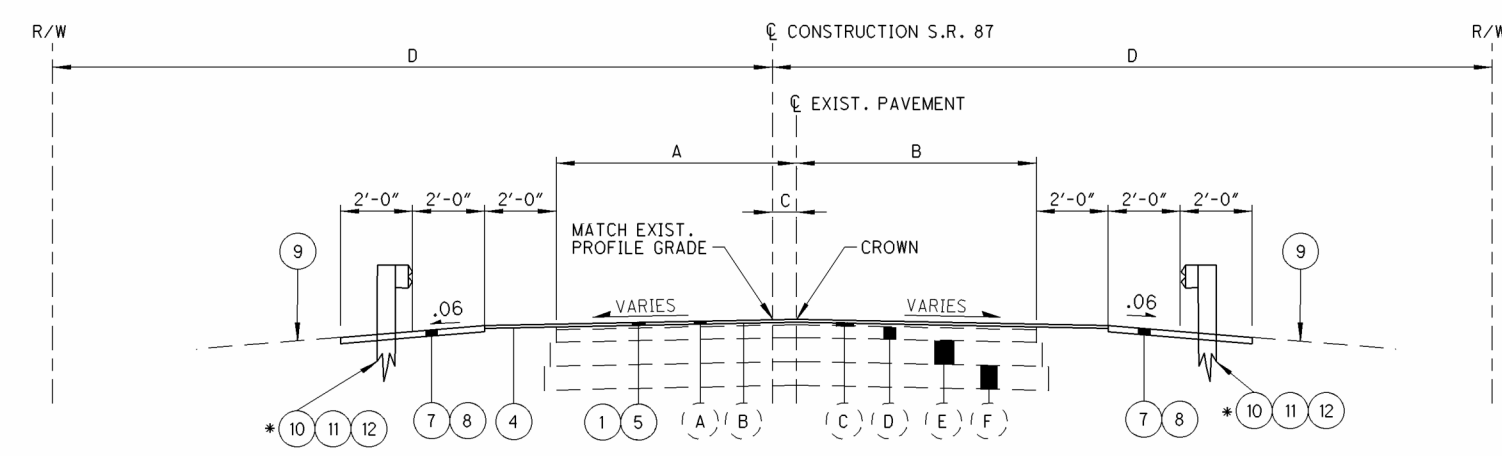


LEGEND - PROPOSED


- (1) ITEM 254 - PAVEMENT PLANING, ASPHALT CONCRETE, (T= 1/2" NOMINAL)
- (2) ITEM 304 - 6" AGGREGATE BASE
- (3) ITEM 301 - 9" ASPHALT CONCRETE BASE, PG64-22
- (4) ITEM 407 - TACK COAT
- (5) ITEM 448 - 1/2" ASPHALT CONCRETE SURFACE COURSE, TYPE 1, PG 64-22, AS PER PLAN
- (6) ITEM 448 - 1/2" ASPHALT CONCRETE INTERMEDIATE COURSE, TYPE 1, PG 64-22
- (7) ITEM 448-3" ASPHALT CONCRETE INTERMEDIATE COURSE, TYPE 1, PG 64-22, UNDER GUARDRAIL, AS PER PLAN
- (8) ITEM 209 - LINEAR GRADING, AS PER PLAN
- (9) ITEM 659 - SEEDING AND MULCHING
- (10) ITEM 606 - GUARDRAIL, TYPE 5, LONG SPAN
- (11) ITEM 606 - GUARDRAIL, TYPE 5
- (12) ITEM 202 - GUARDRAIL REMOVED

* TYPE 5 GUARDRAIL, LONG SPAN BEGINS AT APPROX. STA 158+21.5 LT/RT AND ENDS AT STA 158+46.5 LT/RT

DIMENSION TABLE				
LOCATION	A	B	C	D
GEA-87-3.00	11'-0"±	11'-0"±	6'-4"±	47'-6"±

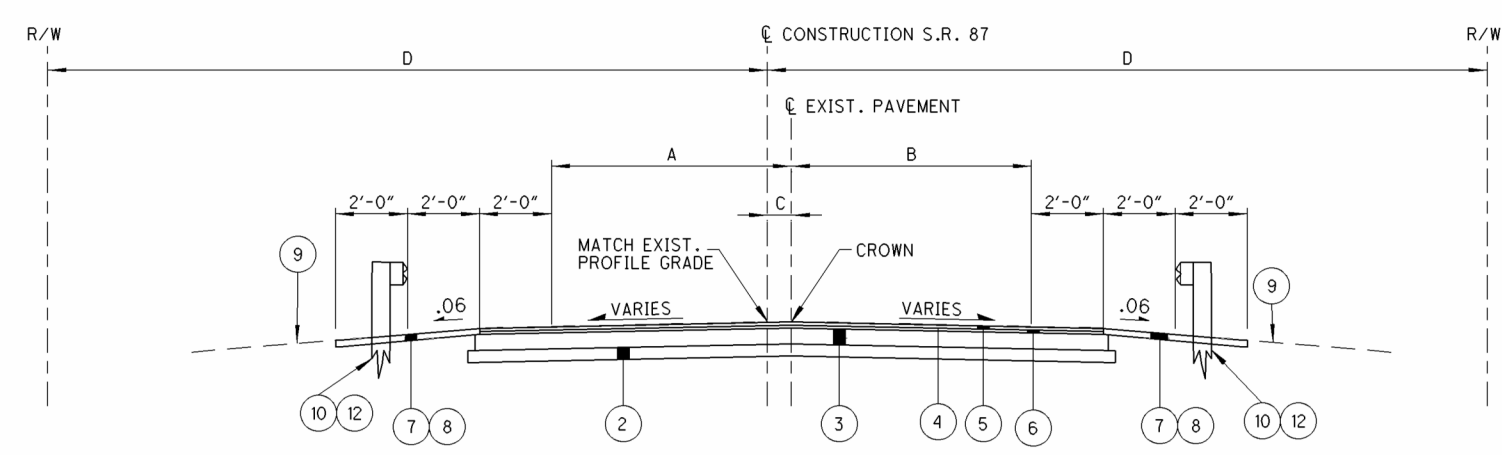


I:\PROJECTS\PID87428\Plan_Sheets\roadway\sheets\87428G\Y001.dgn 27-JAN-2011 8:41AM mmoriart

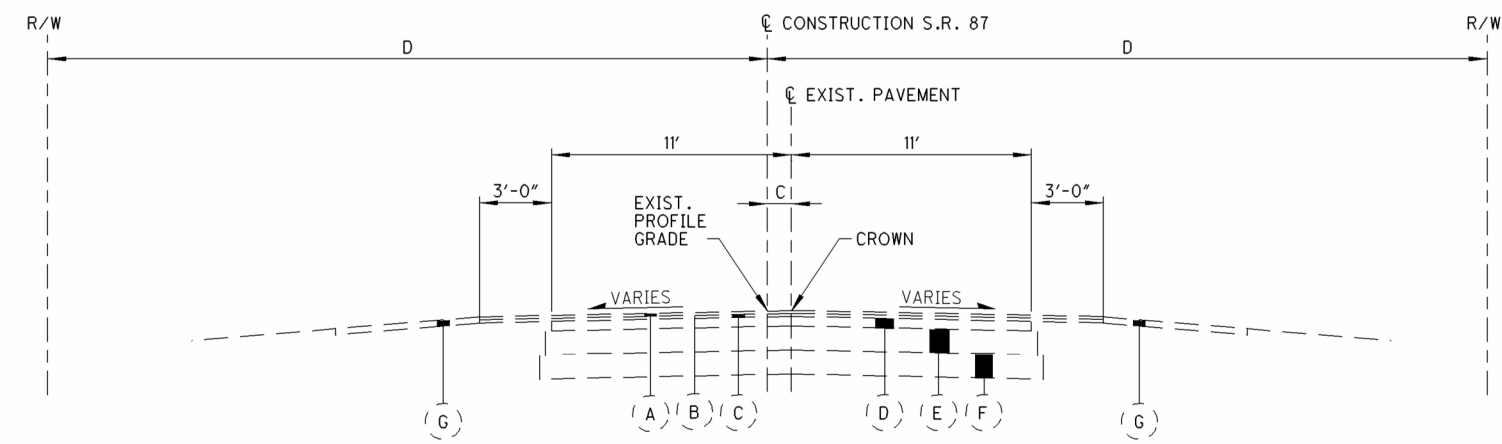


EXISTING SECTION

GEA-87-5.87

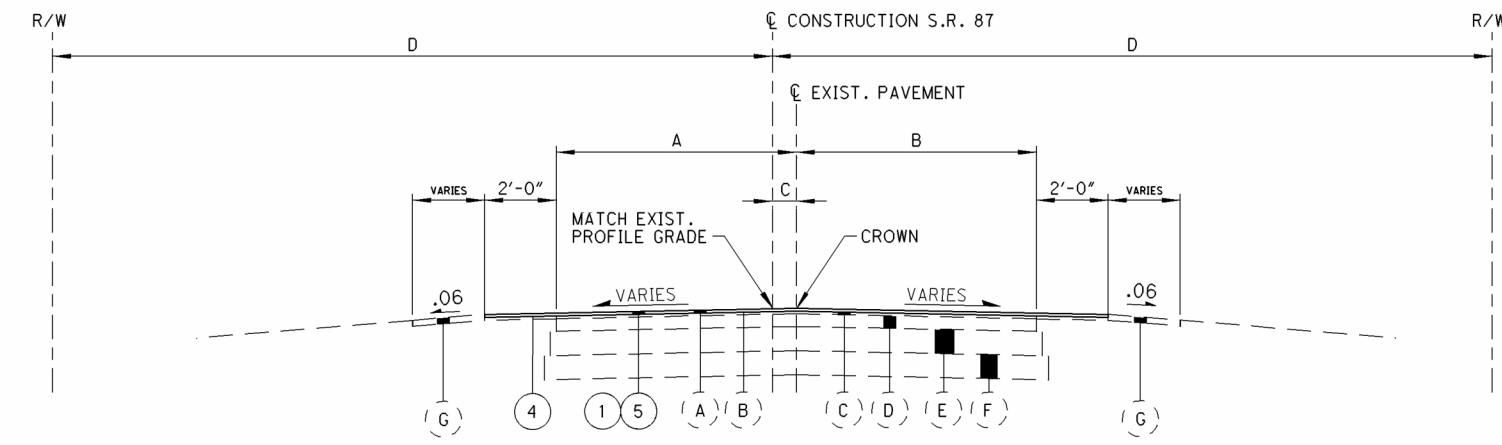

RESURFACING SECTION

STA. 309+95 TO STA. 310+12.5, SR 87 - 5.87
STA. 310+17.5 TO STA. 310+35, SR 87 - 5.87

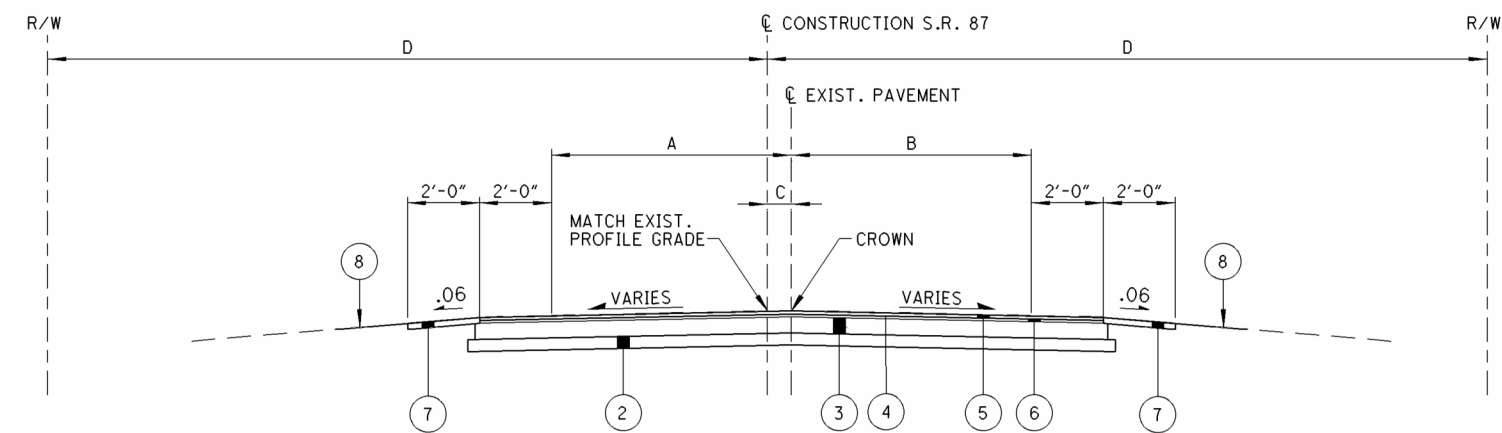

FULL DEPTH REPLACEMENT SECTION

STA. 310+12.5 TO STA. 310+17.5, SR 87 - 5.87

LEGEND - EXISTING

- (A) ASPHALT CONCRETE SURFACE COURSE, TYPE 1 (1.5")
- (B) ASPHALT CONCRETE INTERMEDIATE COURSE, TYPE 2, PG 64-22 (0"-1.5")
- (C) ASPHALT CONCRETE PAVEMENT SURFACE HEATER RECYCLING (2")
- (D) 3" ASPHALT CONCRETE BASE
- (E) 5" GRANULATED SLAG
- (F) 18" SUBBASE COURSE
- (G) ITEM 617 COMPACTED AGGREGATE

LEGEND - PROPOSED

- (1) ITEM 254 - PAVEMENT PLANING, ASPHALT CONCRETE, AS PER PLAN (T= 1/2" NOMINAL)
- (2) ITEM 304 - 6" AGGREGATE BASE
- (3) ITEM 301 - 9" ASPHALT CONCRETE BASE, PG64-22
- (4) ITEM 407 - TACK COAT
- (5) ITEM 448 - 1/2" ASPHALT CONCRETE SURFACE COURSE, TYPE 1, PG 64-22, AS PER PLAN
- (6) ITEM 448 - 1/2" ASPHALT CONCRETE INTERMEDIATE COURSE, TYPE 1, PG 64-22
- (7) ITEM 617 - 4" COMPACTED AGGREGATE
- (8) ITEM 659 - SEEDING AND MULCHING

DIMENSION TABLE				
LOCATION	A	B	C	D
GEA-87-5.87	11'-0"±	11'-0"±	6'-4"±	47'-6"±

I:\PROJECTS\PID87428\Plan_Sheets\roadway\sheets\87428G\001.dgn 27-JAN-2011 10:08AM mmoriart

UTILITIES

LISTED BELOW ARE ALL UTILITIES LOCATED WITHIN THE PROJECT CONSTRUCTION LIMITS TOGETHER WITH THEIR REPECTIVE OWNERS;

DOMINION EAST OHIO 320 SPRINGSIDE DR. FAIRLAWN, OHIO 44333 PH: (330) 664-2488 ATTN: MIKE ANTONIUS	TIME WARNER CABLE 14300 SOUTH INDUSTRIAL PKWY. MAPLE HEIGHTS, OHIO 44137 PH: (216) 663-4003 ATTEN: KIP EIGER
---	--

ILLUMINATING COMPANY
6896 MILLER RD.
BRECKSVILLE, OHIO 44141
PH: (440) 717-6845
ATTN: MARK ROBINSON

THE LOCATION OF THE UNDERGROUND UTILITIES SHOWN ON THE PLANS ARE AS OBTAINED FROM THE OWNERS AS REQUIRED BY SECTION 153.64 O.R.C.

RIGHT-OF-WAY

ALL WORK SHALL BE PERFORMED WITHIN THE EXISTING RIGHT OF WAY.

EXISTING TYPICAL SECTIONS

EXISTING TYPICAL SECTIONS HAVE BEEN TAKEN FROM THE RECORDS AND ARE BELIEVED TO REPRESENT THE EXISTING PAVEMENT BUT THE STATE OF OHIO DOES NOT GUARANTEE THE ACCURACY OF THE SAME.

FOR FURTHER INFORMATION IN REGARD TO THE EXISTING TYPICAL SECTIONS, THE CONTRACTOR SHALL REFER TO THE PREVIOUS CONSTRUCTION PLANS.

THESE PLANS MAY BE REVIEWED AT THE FOLLOWING LOCATION:

OHIO DEPARTMENT OF TRANSPORTATION
DISTRICT 12 OFFICE
5500 TRANSPORTATION BLVD.
GARFIELD HEIGHTS, OHIO 44125

CONTINGENCY QUANTITIES

THE CONTRACTOR SHALL NOT ORDER MATERIALS OR PERFORM WORK FOR ITEMS DESIGNATED BY PLAN NOTE TO BE USED "AS DIRECTED BY THE ENGINEER" UNLESS AUTHORIZED BY THE ENGINEER. THE ACTUAL WORK LOCATIONS AND QUANTITIES USED FOR SUCH ITEMS SHALL BE INCORPORATED INTO THE FINAL CHANGE ORDER GOVERNING THE COMPLETION OF THIS PROJECT.

WORK LIMITS

THE WORK LIMITS SHOWN ON THESE PLANS ARE FOR PHYSICAL CONSTRUCTION ONLY. THE INSTALLATION AND OPERATION OF ALL TEMPORARY TRAFFIC CONTROL AND TEMPORARY TRAFFIC CONTROL DEVICES REQUIRED BY THESE PLANS SHALL BE PROVIDED BY THE CONTRACTOR WHETHER INSIDE OR OUTSIDE THE WORK LIMITS.

CLEARING AN GRUBBING

ALTHOUGH THERE ARE NO TREES OR STUMPS SPECIFICALLY MARKED FOR REMOVAL WITHIN THE LIMITS OF THE PROJECT, A LUMP SUM QUANTITY HAS BEEN INCLUDED IN THE GENERAL SUMMARY FOR ITEM 201, CLEARING AND GRUBBING. ALL PROVISIONS AS SET FORTH IN THE SPECIFICATIONS UNDER THIS ITEM SHALL BE INCLUDED IN THE LUMP SUM PRICE BID FOR ITEM 201, CLEARING AND GRUBBING.

GUARDRAIL REPLACEMENT

NO HAZARD SHALL BE LEFT UNPROTECTED EXCEPT FOR THE ACTUAL TIME NECESSARY TO REMOVE THE EXISTING GUARDRAIL, PREPARE THE SITE AND INSTALL NEW GUARDRAIL IN A CONTINUOUS OPERATION. THE REMOVAL OF ALL GUARDRAIL SHALL, AT ALL TIMES, BE AS DIRECTED BY THE ENGINEER. NO GUARDRAIL SHALL BE REMOVED UNTIL THE REPLACEMENT MATERIAL IS ONSITE AND READY FOR INSTALLATION. FAILURE TO COMPLY WITH THIS REQUIREMENT SHALL BE DEEMED SUFFICIENT CAUSE TO ORDER WORK SUSPENDED UNTIL SUCH TIME AS THE ENGINEER IS ASSURED OF COMPLIANCE.

CONNECTION BETWEEN EXISTING AND PROPOSED GUARDRAIL

WHEN IT IS NECESSARY TO SPLICE PROPOSED GUARDRAIL TO EXISTING GUARDRAIL, ONLY THE EXISTING GUARDRAIL SHALL BE CUT, DRILLED OR PUNCHED. THE CONNECTION SHALL BE MADE USING W-BEAM RAIL SPLICE AS SHOWN IN AASHTO M 180. PAYMENT SHALL BE INCLUDED IN THE CONTRACT PRICE FOR THE RESPECTIVE GUARDRAIL ITEMS.

BENCHING OF FOUNDATION SLOPES

ALTHOUGH CROSS SECTIONS INDICATE SPECIFIC DIMENSIONS FOR PROPOSED BENCHING OF THE EMBANKMENT FOUNDATIONS IN CERTAIN AREAS, NO WAIVER OF THE SPECIFICATIONS IS INTENDED. ALL OTHER SLOPED EMBANKMENT AREAS SHALL BE BENCHED AS SET FORTH IN 203.05.

EQUIPMENT AND MATERIAL STORAGE

IN ORDER TO PROVIDE FOR THE SAFETY OF THE TRAVELING PUBLIC, THE CONTRACTOR'S ATTENTION IS DIRECTED TO 614.03. IN ADDITION, THE FOLLOWING PROVISIONS SHALL APPLY:

1. ANY REMOVED ITEMS SHALL NOT BE STORED ON THE RIGHT OF WAY FOR MORE THAN THIRTY (30) DAYS.
2. THE STORAGE OF EQUIPMENT, MATERIALS AND VEHICLES WITHIN THE HIGHWAY RIGHT OF WAY WILL BE PERMITTED. THE NUMBER OF AREAS AND EXACT LOCATIONS SHALL BE APPROVED BY THE ENGINEER.
3. ALL DISTURBED AREAS SHALL BE RETURNED TO THEIR ORIGINAL CONDITION AT NO EXPENSE TO THE STATE.

ITEM 619 FIELD OFFICE, TYPE B

A TYPE B FIELD OFFICE IS REQUIRED FOR THIS PROJECT. THE FOLLOWING ESTIMATED QUANTITY HAS BEEN CARRIED TO THE GENERAL SUMMARY:

ITEM 619-FIELD OFFICE, TYPE B	3 MONTHS
-------------------------------	----------

ITEM 603 - 54" CONDUIT, TYPE A, APP

THE FOLLOWING CONDUITS ARE PERMISSIBLE:
54" 706.02 (D-LOAD 1250)
54" 707.04 (0.109) 1/2" CORR.
60" 707.04 (0.109) 1" CORR.
54" 707.04 (0.079) 1/2" CORR., PAVED PER 707.07
60" 707.04 (0.079) 1" CORR., PAVED PER 707.07
60" 707.02 (0.064) 1" CORR., CONCRETE FIELD PAVING

ITEM 603 - 33" CONDUIT, TYPE A, APP

THE FOLLOWING CONDUITS ARE PERMISSIBLE:
33" 706.02 (D-LOAD 1000)
33" 707.05 (0.109) 1/2" CORR.
33" 707.04 (0.109) 1/2" CORR.
36" 707.04 (0.109) 1" CORR.
33" 707.04 (0.079) 1/2" CORR., PAVED PER 707.07
36" 707.04 (0.079) 1" CORR., PAVED PER 707.07

**ITEM 202 - PIPE REMOVED, OVER 24", AS PER PLAN
ITEM 202 - PIPE REMOVED, 24" AND UNDER, AS PER PLAN**

IN ADDITION TO THE REMOVAL OF THE EXISTING CONDUIT, THIS ITEM SHALL INCLUDE REMOVAL OF THE PAVEMENT AND PAVED SHOULDERS WITHIN THE LIMITS SHOWN ON THE PLANS. ALL WORK SHALL BE IN ACCORDANCE WITH SECTION 202 OF THE CMS.

STREAM CHANNEL EXCAVATION

THE CONTRACTOR SHALL TAKE ALL PRECAUTIONS NECESSARY TO PREVENT ANY INCIDENTAL HAULING OF MATERIAL FROM THE STREAM CHANNEL. THIS PERTAINS TO ANY EXCAVATION OPERATIONS (I.E. CHANNEL CLEANOUT, EXCAVATION FOR ROCK CHANNEL PROTECTION AND REMOVAL OF ANY TEMPORARY FILL ASSOCIATED WITH CONSTRUCTION OPERATIONS).

CROSSINGS AND CONNECTIONS TO EXISTING PIPES AND UTILITIES

WHERE PLANS PROVIDE FOR A PROPOSED CONDUIT TO BE CONNECTED TO, CROSS OVER OR UNDER AN EXISTING SEWER OR UNDERGROUND UTILITY, THE CONTRACTOR SHALL LOCATE THE EXISTING PIPES OR UTILITIES BOTH AS TO LINE AND GRADE BEFORE STARTING THE LAY OF THE PROPOSED CONDUIT.

IF IT IS DETERMINED THAT THE ELEVATION OF THE EXISTING CONDUIT OR EXISTING APPERTANANCE TO BE CONNECTED DIFFERS FROM THE PLAN ELEVATION OR RESULTS IN A CHANGE IN THE PLAN CONDUIT SLOPE, THE ENGINEER SHALL BE NOTIFIED BEFORE STARTING CONSTRUCTION OF ANY PORTION OF THE PROPOSED CONDUIT WHICH WILL BE AFFECTED BY THE VARIANCE IN THE EXISTING ELEVATIONS.

IF IT IS DETERMINED THAT THE PROPOSED CONDUIT WILL INTERSECT AN EXISTING SEWER OR UNDERGROUND UTILITY IF CONSTRUCTED AS SHOWN IN THE PLAN, THE ENGINEER SHALL BE NOTIFIED BEFORE STARTING CONSTRUCTION OF ANY PORTION OF THE PROPOSED CONDUIT WHICH WOULD BE AFFECTED BY THE INTERFERENCE WITH AN EXISTING FACILITY.

PAYMENT FOR ALL OPERATIONS DESCRIBED ABOVE SHALL BE INCLUDED IN THE CONTRACT PRICE FOR THE PERTINENT 603 ITEM.

I:\PROJECTS\PID87428\Plan_Sheets\roadway\sheet\87428GN001.dgn 25-JAN-2011 12:26PM mmoriort

ITEM 448 - ASPHALT CONCRETE, INTERMEDIATE COURSE, TYPE 1, PG 64-22, UNDER GUARDRAIL AS PER PLAN.

THIS OPERATION SHALL INCLUDE PREPERATION OF THE GRADED SHOULDER USING ITEM 209, LINEAR GRADING AS PER PLAN AND PAVING UNDER THE GUARDRAIL USING 448 ASPHALT CONCRETE INTERMEDIATE COURSE, TYPE 1, PG 64-22, UNDER GUARDRAIL AS PER PLAN.

ITEM 209, LINEAR GRADING AS PER PLAN, SHALL CONSIST OF EXCAVATION TOPSOIL AND PLACING GRANULAR MATERIAL.

ALL COLLECTED DEBRIS AND TOPSOIL, INCLUDING RHIZOMES, ROOTS AND OTHER VEGETATED MATERIAL SHALL BE REMOVED AND DISPOSED OF AS SPECIFIED IN 105.17.

THE REMOVED MATERIAL SHALL BE REPLACED WITH COMPACTABLE GRANULAR MATERIAL CONFORMING TO 703.16 PLACED TO GRADE AS DETAILED ON THE TYPICAL SECTION OR AS APPROVED BY THE ENGINEER.

ALL EQUIPMENT, MATERIALS AND LABOR REQUIRED TO PERFORM THE WORK OUTLINED ABOVE SHALL BE INCLUDED FOR PAYMENT UNDER ITEM 209, LINEAR GRADING AS PER PLAN.

PAVING UNDER GUARDRAIL SHALL CONSIST OF PLACING ITEM 448 TO THE DEPTH SPECIFIED USING ONE OF THE FOLLOWING METHODS:

METHOD A:

1. SET GUARDRAIL POSTS
2. PLACE ITEM 448

METHOD B:

1. PLACE ITEM 448
2. BORE ASPHALT AT POST LOCATIONS (MAY BE OMITTED IF STEEL POSTS ARE USED)
3. SET GUARDRAIL POSTS
4. PATCH AROUND POSTS. THE MATERIALS USED FOR PATCHING SHALL BE AN ASPHALT CONCRETE APPROVED BY THE ENGINEER. PATCHED AREAS SHALL BE COMPACTED USING EITHER HAND OR MECHANICAL METHODS. FINISHED SURFACES SHALL BE SMOOTH AND SLOPED TO DRAIN AWAY FROM POSTS.

ALL EQUIPMENT, MATERIALS AND LABOR REQUIRED TO PERFORM THE WORK OUTLINED ABOVE, WITH THE EXCEPTION OF SETTING GUARDRAIL POSTS, SHALL BE INCLUDED FOR PAYMENT UNDER ITEM 448, ASPHALT CONCRETE, INTERMEDIATE COURSE, TYPE 1, PG 64-22, UNDER GUARDRAIL AS PER PLAN.

ITEM 448- ASPHALT CONCRETE SURFACE COURSE, TYPE 1, PG 64-22, AS PER PLAN

THE COURSE AGGREGATE FOR THIS ITEM SHALL BE LIMITED TO CRUSHED CARBONATE STONE, AIR COOLED BLAST FURNACE SLAG OR A 50/50 BLEND OF AIR COOLED BLAST FURNACE SLAG (ACBFS) AND LIMESTONE (CCS).

ELEVATION DATUM

ALL ELEVATIONS ARE BASED ON ASSUMED DATUMS.

COOPERATION BETWEEN CONTRACTORS

THE CONTRACTOR SHALL COOPERATE AND COORDINATE HIS OPERATIONS WITH THE CONTRACTORS ON OTHER PROJECTS THAT MAY BE IN FORCE DURING THE LIFE OF THE CONTRACT. NO WAIVER OF ANY PROVISIONS OF 105.08 OF THE CMS IS INTENDED.

DRIVEWAY ACCESS

INGRESS AND EGRESS TO ALL RESIDENTIAL AND COMMERCIAL DRIVEWAYS WITHIN THE PROJECT AREA SHALL BE MAINTAINED THROUGHOUT THE LIFE OF THE PROJECT.

INTERIM COMPLETION DATE

THE CONTRACTOR WILL BE ALLOTTED SEVEN (7) CONSECUTIVE CALENDAR DAYS FOR ALL CULVERT REPLACEMENT WORK EXCEPT PAVING SURFACE COURSE, CULVERT HEADWALL INSTALLATION, SLOPE STABILIZATION AND FINAL PAVEMENT MARKINGS. THE WORK SHALL BE COMPLETED WITHIN SEVEN (7) CONSECUTIVE DAYS FROM THE START OF THE SIGNED ROAD CLOSURE ON SR 87.

THE DEPARTMENT WILL ASSESS ROAD USER COSTS OF **\$5,000 PER DAY** FOR EACH DAY BEYOND THE SEVEN DAY ROAD CLOSURE WHERE THE AFOREMENTIONED REQUIREMENTS ARE NOT MET.

HOLIDAY AND EVENT CLOSURES

NO WORK SHALL BE PERFORMED AND ALL EXISTING LANES SHALL BE OPEN TO TRAFFIC DURING THE FOLLOWING DESIGNATED HOLIDAYS OR EVENTS:

- MEMORIAL DAY - MAY 30, 2011
- MESPO DAY INCLUDING INDEPENDENCE DAY – JULY 2 THROUGH JULY 4, 2011
- GEAUGA COUNTY FAIR – SEPTEMBER 1 THROUGH SEPTEMBER 5, 2011
- COLUMBUS DAY – OCTOBER 10, 2011

THE PERIOD OF TIME THAT THE LANES SHALL BE OPEN ARE FROM SIX (6) AM OF THE MORNING OF THE EVENT TO TEN (10) PM OF THE LAST DAY OF THE EVENT.

THE DEPARTMENT WILL ASSESS ROAD USER COSTS IN ACCORDANCE WITH 108.07 OF THE CMS FOR FAILING TO MEET THESE REQUIREMENTS.

WORK LIMITS

THE WORK LIMITS SHOWN ON THESE PLANS ARE FOR PHYSICAL CONSTRUCTION ONLY. PROVIDE THE INSTALLATION AND OPERATION OF ALL WORK ZONE TRAFFIC CONTROL AND WORK ZONE TRAFFIC CONTROL DEVICES REQUIRED BY THESE PLANS WHETHER INSIDE OR OUTSIDE THE WORK LIMITS.

I:\PROJECTS\PD87428\Plan_Sheets\roadway\sheet\87428GN002.dgn 27-JAN-2011 10:55AM mmoriart


CALCULATED
AJS
CHECKED
MKM

GENERAL NOTES

GEA - 87 - 3.00 / 5.87

6
14


I:\PROJECTS\PD87428\Plan_Sheets\roadway\sheets\87428BM001.dgn 01-FEB-2011 12:40PM mmoriart

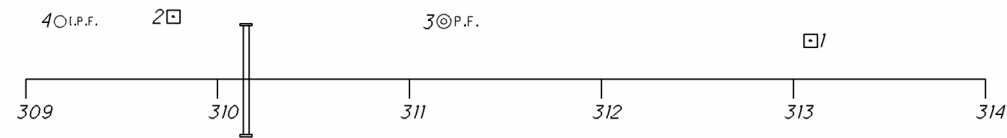

REFERENCE	STA.	OFFSET	ELEVATION
1	313+09.13	20.83' LT	1234.01
2	309+77.41	32.81' LT	1233.57
3	311+18.63	30.07' LT	1232.85
4	309+18.67	30.15' LT	1236.92

GEA-87-5.87

- ⊙P.F. PIN FOUND
- I.P.F. IRON PIN FOUND
- WOOD HUB
- P.K.S. PK NAIL SET

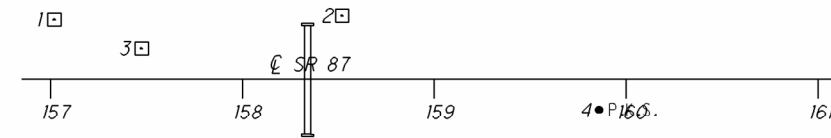

REFERENCE	STA.	OFFSET	ELEVATION
1	157+02.14	31.88' LT	1063.63
2	158+52.03	33.09' LT	1056.42
3	157+45.93	16.38' LT	1053.23
4	159+86.14	16.98' RT	1057.13

GEA-87-3.00

- ⊙P.F. PIN FOUND
- I.P.F. IRON PIN FOUND
- WOOD HUB
- P.K.S. PK NAIL SET

CALCULATED
AJS
CHECKED
MKM

BENCHMARKS AND REFERENCES

GEA-87-3.00/ VAR

I:\PROJECTS\PD87428\Plan Sheets\roadway\sheet\87428MT001.dgn 24-JAN-2011 11:15AM mmarlart

ITEM 614 - MAINTENANCE OF TRAFFIC

SET UP TEMPORARY TRAFFIC CONTROL AS DESCRIBED BELOW AND AS SHOWN.

THE CONTRACTOR SHALL CLOSE THE ROADWAY TO ALL TRAFFIC PER THE DETOUR PLAN. THE CONTRACTOR SHALL CLOSE STATE ROUTE 87 TO THROUGH TRAFFIC AT SPECIFIC CULVERT LOCATIONS PER SCD MT-101.60 AND AS SHOWN ON SHEETS 9 AND 10. ONLY ONE CULVERT LOCATION, EITHER GEA-87-3.00 OR GEA-87-5.87, CAN BE CLOSED TO THROUGH TRAFFIC AT A TIME. WHERE STATE ROUTE 87 IS CLOSED TO THROUGH TRAFFIC AT ONE CULVERT LOCATION, STATE ROUTE 87 SHALL REMAIN OPEN TO THROUGH TRAFFIC AT THE OTHER CULVERT LOCATION.

THE CONTRACTOR SHALL NOTIFY THE ENGINEER, THE GEAUGA COUNTY SHERIFFS OFFICE AND THE OHIO DEPARTMENT OF TRANSPORTATION DISTRICT 12 PUBLIC INFORMATION OFFICE BY EMAIL AT D12.PUBLICINFORMATION@DOT.STATE.OH.US OR BY FAX AT 216-584-3524 NOT LESS THAN TWENTY FOUR (24) HOURS PRIOR TO A SCHEDULED DISRUPTION OF TRAFFIC.

NOTICE OF CLOSURE SIGNS AS DETAILED IN THESE PLANS SHALL BE ERECTED BY THE CONTRACTOR AT LEAST TWO WEEKS IN ADVANCE OF THE SCHEDULED CLOSURE. THE SIGNS SHALL BE ERECTED ON THE RIGHT HAND SIDE OF THE ROAD FACING TRAFFIC. THEY SHALL BE PLACED AS TO NOT INTERFERE WITH THE VISIBILITY OF ANY OTHER TRAFFIC CONTROL SIGNS. THEY SHOULD BE ERECTED AT THE POINT OF CLOSURE.

THE CONTRACTOR SHALL PROVIDE, ERECT AND MAINTAIN 48 INCH X 30 INCH ROAD CLOSED SIGNS, SIGN SUPPORTS, BARRICADES, GATES AND LIGHTS, AS DETAILED IN SCD MT-101.60, AT THE LOCATIONS SHOWN ON SHEETS 9 AND 10, DURING PERIODS OF WHEN STATE ROUTE 87 IS CLOSED TO TRAFFIC.

THE CONTRACTOR SHALL PROVIDE, ERECT AND MAINTAIN DETOUR SIGNS AND SIGN SUPPORTS AS DETAILED IN THE OHIO MANUAL OF UNIFORM TRAFFIC CONTROL DEVICES AND AS SHOWN ON THE DETOUR MAP.

ALL WORK AND TRAFFIC CONTROL DEVICES SHALL BE IN ACCORDANCE WITH CMS 614 AND OTHER APPLICABLE PORTIONS OF THE SPECIFICATIONS, AS WELL AS, THE OHIO MANUAL OF UNIFORM TRAFFIC CONTROL DEVICES. PAYMENT FOR ALL LABOR, EQUIPMENT AND MATERIALS SHALL BE INCLUDED IN THE LUMP SUM CONTRACT PRICE FOR ITEM 614, MAINTENANCE OF TRAFFIC, UNLESS SEPARATELY ITEMIZED IN THE PLAN.

TRENCH FOR PIPE REMOVAL AND CULVERT CONSTRUCTION

THE OPEN TRENCH SHALL BE ADEQUATELY MAINTAINED AND PROTECTED WITH DRUMS OR BARRICADES AT ALL TIMES. PLACEMENT OF PROPOSED BACKFILL AND BASE MATERIAL SHALL FOLLOW CLOSELY AS POSSIBLE BEHIND THE EXCAVATION AND CONDUIT LAYING OPERATIONS. THE LENGTH OF TRENCH OPEN AT ANY ONE TIME SHALL BE HELD TO A MINIMUM AND SHALL, AT ALL TIMES, BE SUBJECT TO THE APPROVAL OF THE ENGINEER.

THE RIDING SURFACE OVER THE TRENCH SHALL BE RESTORED TO THE SAME LEVEL AS THE EXISTING PAVEMENT AT THE END OF EACH WORK DAY BY THE USE OF TEMPORARY OR PERMANENT SURFACES. ROAD PLATES SECURED IN PLACE AND OVERLAID WITH ASPHALT CONCRETE MAY BE USED FOR OVERNIGHT TRENCH CLOSURES WHERE WORK IS TO RESUME THE NEXT DAY. NO PORTION OF THE TRENCH SHALL BE LEFT OPEN OVERNIGHT.

ALL COSTS ASSOCIATED WITH THESE REQUIREMENTS SHALL BE INCLUDED FOR PAYMENT IN THE LUMP SUM CONTRACT PRICE FOR ITEM 614, MAINTAINING TRAFFIC.

ITEM 614 - MAINTAINING TRAFFIC (CONTINGENCY QUANTITIES)


THE FOLLOWING QUANTITIES ARE PROVIDED FOR USE AS DIRECTED BY THE ENGINEER FOR MAINTENANCE OF TRAFFIC.

ITEM 410 - TRAFFIC COMPACTED SURFACE, TYPE A OR B	20 CU YD
ITEM 614 - ASPHALT CONCRETE FOR MAINTAINING TRAFFIC	50 CU YD
ITEM 616 - WATER	10 MGAL


CALCULATED
AJS
CHECKED
MKM





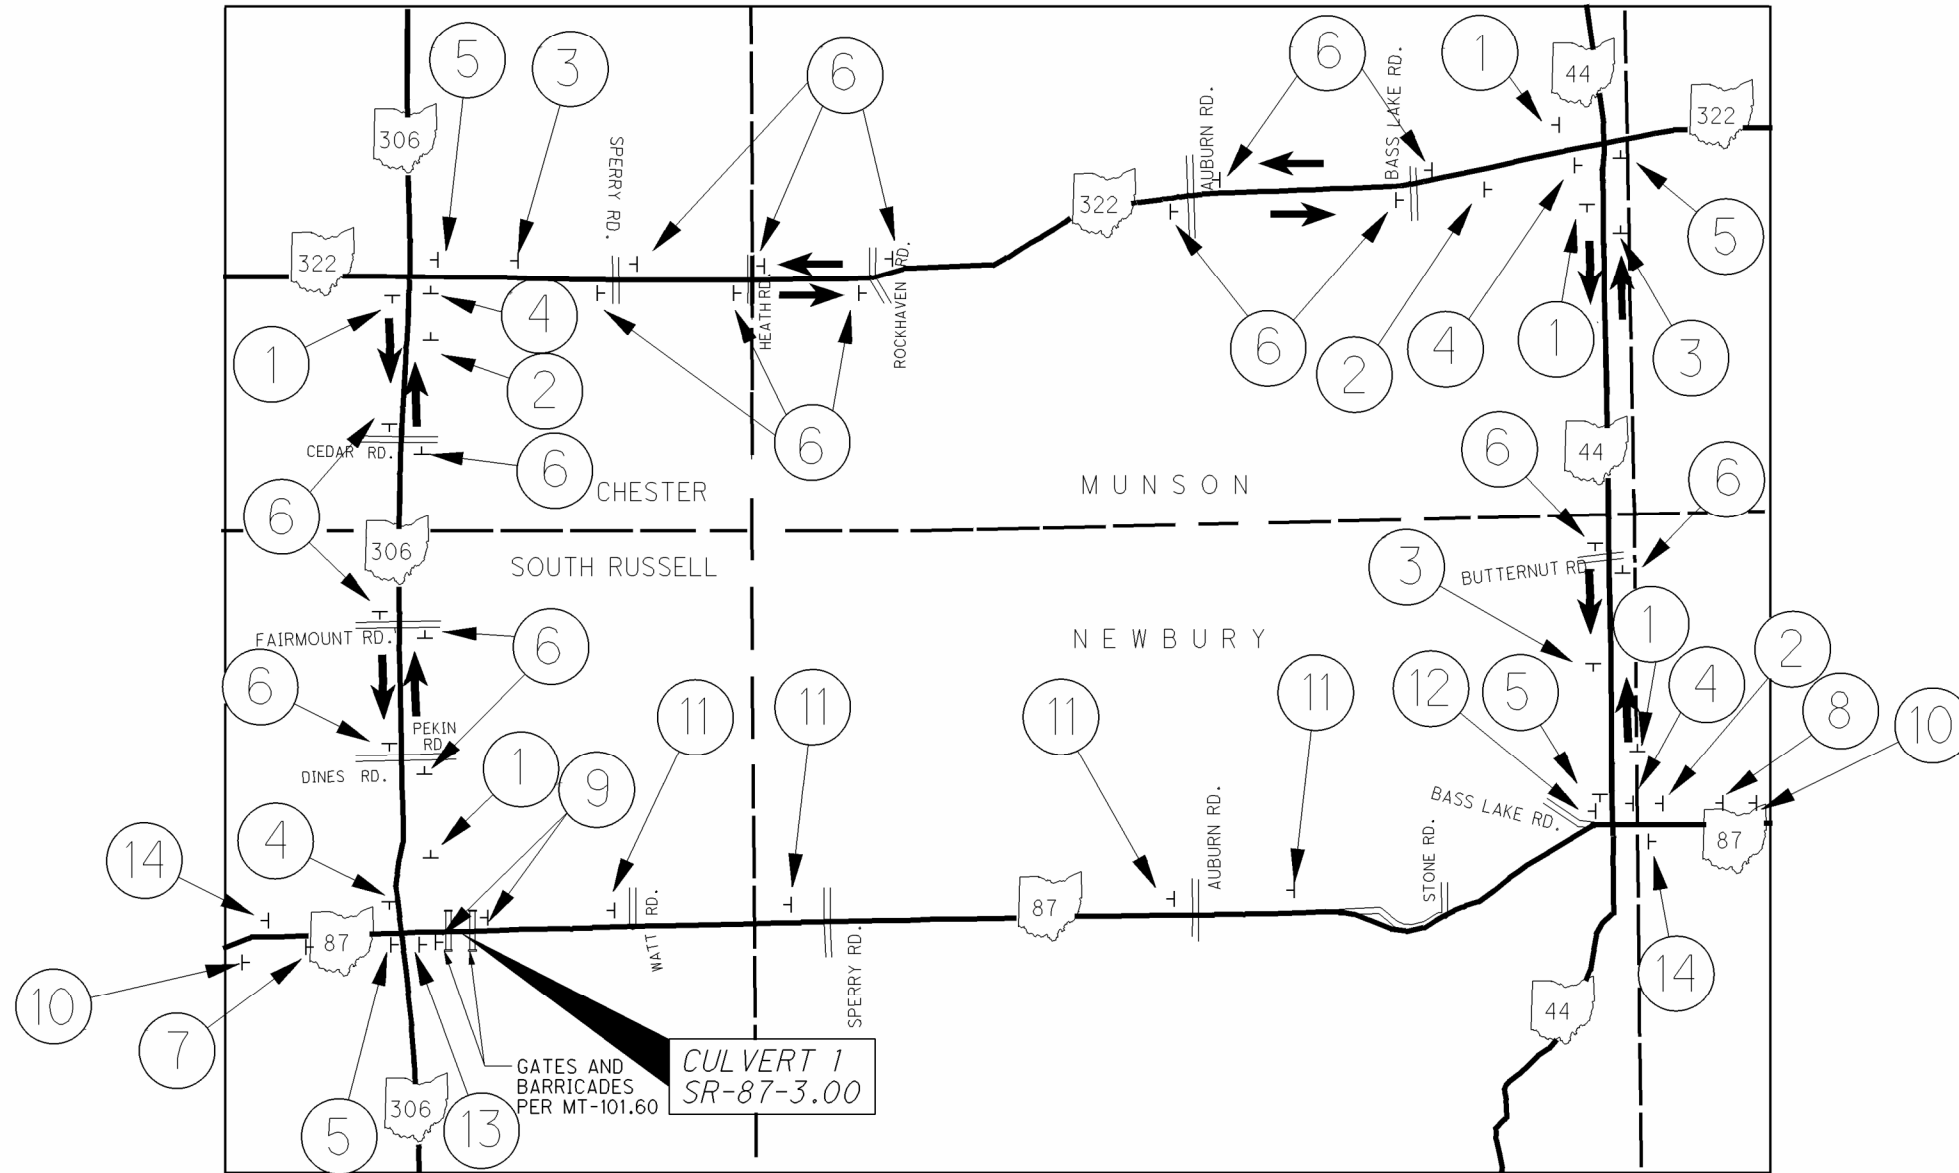



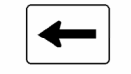


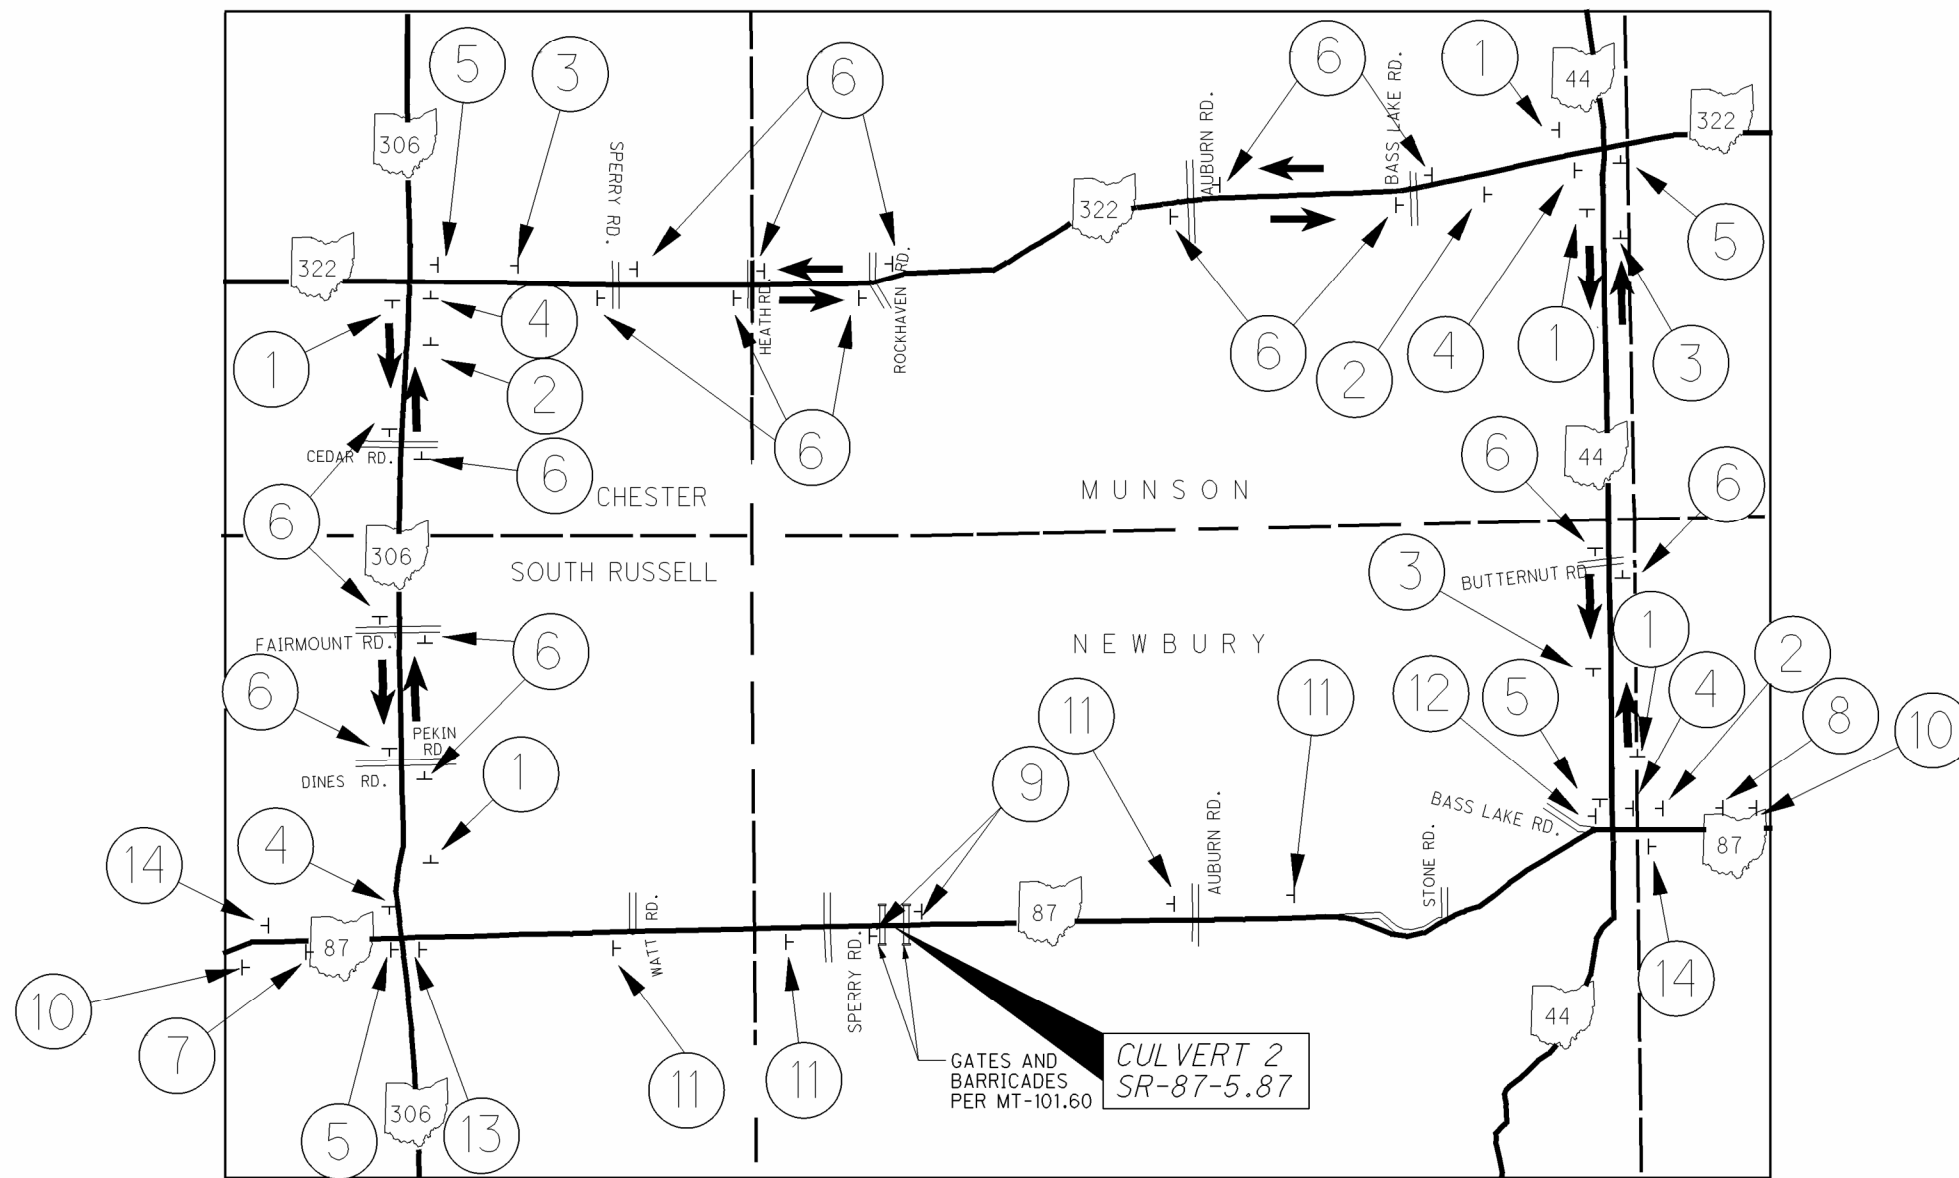

MAINTENANCE OF TRAFFIC NOTES

GEA - 87 - 3.00 / 5.87

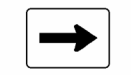

- | | | | | | |
|---|-------------------|---|--|---|---------------------------|
| ① | DETOUR
M4-8-24 | ⑥ | DETOUR
M4-8-24 | ⑭ | END
DETOUR
M4-8A-24 |
| | MI-5-30-3 | | MI-5-30-3 | | |
| ② | DETOUR
M4-8-24 | | ↑
M6-3-21 | | |
| | MI-5-30-3 | ⑦ | ROAD CLOSED
0.25 MILES AHEAD
LOCAL TRAFFIC ONLY
R11-3-60 | | |
| | M5-1R-21 | | ← DETOUR
M4-10L-48 | | |
| ③ | DETOUR
M4-8-24 | ⑧ | ROAD CLOSED
5 MILES AHEAD
LOCAL TRAFFIC ONLY
R11-3-60 | | |
| | MI-5-30-3 | | → DETOUR
M4-10R-48 | | |
| | M5-1L-21 | ⑨ | ROAD
CLOSED
R11-2-48 | | |
| ④ | DETOUR
M4-8-24 | ⑩ | ◇ DETOUR
AHEAD
W20-2-36 | | |
| | MI-5-30-3 | | ◇ ROAD
CLOSED
AHEAD
W20-3-36 | | |
| | M6-1-21 | ⑪ | ROAD CLOSED
5 MILES AHEAD
LOCAL TRAFFIC ONLY
R11-3A-60 | | |
| ⑤ | DETOUR
M4-8-24 | ⑫ | ROAD CLOSED
5 MILES AHEAD
LOCAL TRAFFIC ONLY
R11-3A-60 | | |
| | MI-5-30-3 | | ROAD CLOSED
0.25 MILES AHEAD
LOCAL TRAFFIC ONLY
R11-3A-60 | | |
| | M6-1-21 | ⑬ | | | |



- ① **DETOUR**
M4-8-24

MI-5-30-3
- ② **DETOUR**
M4-8-24

MI-5-30-3

M5-1R-21
- ③ **DETOUR**
M4-8-24

MI-5-30-3

M5-1L-21
- ④ **DETOUR**
M4-8-24

MI-5-30-3

M6-1-21
- ⑤ **DETOUR**
M4-8-24

MI-5-30-3

M6-1-21
- ⑥ **DETOUR**
M4-8-24

MI-5-30-3

M6-3-21
- ⑦ **ROAD CLOSED**
3 MILES AHEAD
LOCAL TRAFFIC ONLY
R11-3-60

M4-10L-48
- ⑧ **ROAD CLOSED**
3 MILES AHEAD
LOCAL TRAFFIC ONLY
R11-3-60

M4-10R-48
- ⑨ **ROAD CLOSED**
R11-2-48
- ⑩ **DETOUR AHEAD**
W20-2-36
- ⑪ **ROAD CLOSED AHEAD**
W20-3-36
- ⑫ **ROAD CLOSED**
3 MILES AHEAD
LOCAL TRAFFIC ONLY
R11-3A-60
- ⑬ **ROAD CLOSED**
3 MILES AHEAD
LOCAL TRAFFIC ONLY
R11-3A-60
- ⑭ **END**
DETOUR
M4-8A-24

I:\PROJECTS\PID87428\Plan Sheets\roadway\sheet87428GG001.dgn 11-MAR-2011 4:13PM astoll

SHEET NUMBER											PARTICIPATION		ITEM	ITEM EXT.	GRAND TOTAL	UNIT	DESCRIPTION	SEE SHEET NO.
5	8	12	13	14														
																	<i>ROADWAY</i>	
LUMP			2	2								201	11000	LUMP		CLEARING AND GRUBBING		
				63								202	20010	4	EACH	HEADWALL REMOVED		
												202	35101	63	FT	PIPE REMOVED, 24" AND UNDER, AS PER PLAN		
			88									202	35201	88	FT	PIPE REMOVED, OVER 24", AS PER PLAN		
			100									202	38001	100	FT	GUARDRAIL REMOVED, AS PER PLAN		
		0.02										209	60501	0.02	MILE	LINEAR GRADING, AS PER PLAN		
			50									606	13000	50	FT	GUARDRAIL, TYPE 5		
			50									606	17290	50	FT	GUARDRAIL, TYPE 5, LONG-SPAN		
																	<i>EROSION CONTROL</i>	
			8.33									601	32104	8.33	CU YD	ROCK CHANNEL PROTECTION, TYPE B WITH FABRIC FILTER		
		400										659	10000	400	SQ YD	SEEDING AND MULCHING		
		0.04										659	20000	0.04	TON	COMMERCIAL FERTILIZER		
		0.09										659	31000	0.09	ACRE	LIME		
		1.08										659	35000	1.08	MGAL	WATER		
												832	30000	2000	EACH	EROSION CONTROL		
																	<i>DRAINAGE</i>	
			24.6	1.52								602	20000	26.12	CU YD	CONCRETE MASONRY		
				16								603	01800	16	FT	8" CONDUIT, TYPE B		
				55								603	14701	55	FT	33" CONDUIT, TYPE A, AS PER PLAN		
			88									603	22201	88	FT	54" CONDUIT, TYPE A, AS PER PLAN		
		218										613	41200	218	CU YD	LOW STRENGTH MORTAR BACKFILL		
																	<i>PAVEMENT</i>	
		260										254	01000	260	SQ YD	PAVEMENT PLANING, ASPHALT CONCRETE (T=1.5")		
		10										301	46000	10	CU YD	ASPHALT CONCRETE BASE, PG64-22		
		7										304	20000	7	CU YD	AGGREGATE BASE		
		26										407	10000	26	GALLON	TACK COAT		
		11										448	47021	11	CU YD	ASPHALT CONCRETE SURFACE COURSE, TYPE 1, PG64-22, AS PER PLAN		
		8										448	46061	8	CU YD	ASPHALT CONCRETE INTERMEDIATE COURSE, TYPE 1, UNDER GUARDRAIL, PG64-22, AS PER PLAN		
		2										448	46020	2	CU YD	ASPHALT CONCRETE INTERMEDIATE COURSE, TYPE 1, PG 64-22		
		2										617	10100	2	CU YD	COMPACTED AGGREGATE		
																	<i>TRAFFIC CONTROL</i>	
		0.04										642	00090	0.04	MILE	EDGE LINE		
		0.02										642	00290	0.02	MILE	CENTER LINE		
																	<i>RETAINING WALLS</i>	
			LUMP	LUMP								503	11100	LUMP		COFFERDAMS AND EXCAVATION BRACING		
																	<i>MAINTENANCE OF TRAFFIC</i>	
		20										410	12000	20	CU YD	TRAFFIC COMPACTED SURFACE, TYPE A OR B		
		50										614	13000	50	CU YD	ASPHALT CONCRETE FOR MAINTAINING TRAFFIC		
		10										616	10000	10	MGAL	WATER		
3	LUMP											614	11000	LUMP		MAINTAINING TRAFFIC		
												619	16010	3	MONTH	FIELD OFFICE, TYPE B		
												623	10000	LUMP		CONSTRUCTION LAYOUT STAKES		
												624	10000	LUMP		MOBILIZATION		


GENERAL SUMMARY

GEA - 87 - 3.00 / 5.87

I:\PROJECTS\PD87428\Plan_Sheets\roadway\sheets\87428GY001.dgn 27-JAN-2011 10:26AM mmoriar

LOCATION	STATION TO STATION		SIDE	LENGTH L	AVERAGE WIDTH W	SURFACE AREA A A=L x W	AREAS BY CAD	209	254	301	304	407	448	448	448	617	642	642	613				
								LINEAR GRADING, AS PER PLAN	PAVEMENT PLANING, ASPHALT CONCRETE (T=1 1/2")	ASPHALT CONCRETE BASE (T=9")	AGGREGATE BASE	TACK COAT	ASPHALT CONCRETE INTERMEDIATE COURSE, TYPE 1, UNDER GUARDRAIL, PG64-22, APP	ASPHALT CONCRETE SURFACE COURSE, TYPE 1, PG64-22, APP	ASPHALT CONCRETE INTERMEDIATE COURSE, TYPE 1, PG64-22	COMPACTED AGGREGATE	CENTER LINE	EDGE LINE	LOW STRENGTH MORTAR BACKFILL				
								L 5280 MILE	A 9 SY	A x (9/12) 27 CY	A x (6/12) 27 CY	A x 0.10 9 GAL	A x(3.0/12) 27 CY	A x(1.5/12) 27 CY	A x(1.5/12) 27 CY	A x (4/12) 27 CY	L 5280 MILE	L x 2 5280 MILE	L x ABC 27 CY				
GEA-87-5.87	309+95	310+12.5	CL	17.5	26	455																	
	310+12.5	310+17.5	CL	5	26	130	180		50.56	14.44	3.61	2.41	5.06	1.44				0.60	0.60	0.86	0.003	0.007	
	310+17.5	310+35	CL	17.5	26	455			50.56				5.06					2.11	0.86	0.003	0.007		
GEA-87-3.00	158+09	158+30	CL	21	26	546		0.008	60.67				6.07	3.11							0.004	0.008	
	158+30	158+38	CL	8	26	208	623	0.003	23.11	5.78	3.85	2.31	1.19	0.96	0.96						0.002	0.003	184.59
	158+38	158+59	CL	21	26	546		0.008	60.67				6.07	3.11	2.53						0.004	0.008	
TOTALS								0.019	260.00	9.39	6.26	26.00	7.41	10.83	1.56	1.98	0.02	0.034	217.93				
TOTALS CARRIED TO GENERAL SUMMARY								0.020	260	10	7	26	8	11	2	2	0.02	0.04	218				

PAVEMENT REPAIR DETAIL

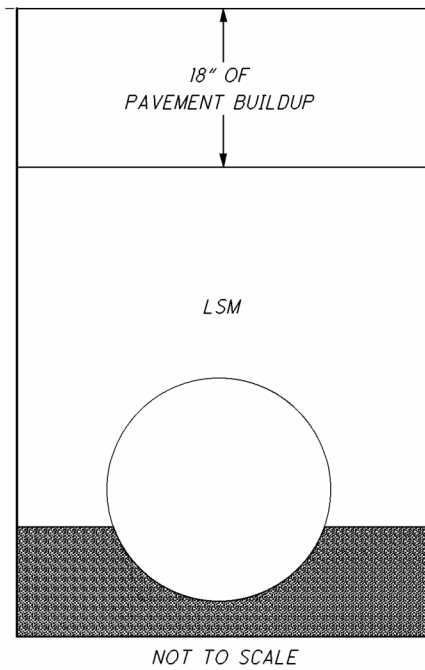

LOCATION	STATION TO STATION		AREAS BY CAD	659	659	659	659
				SEEDING AND MULCHING	COMMERCIAL FERTILIZER	LIME	WATER
				A 9 SY	A x 0.00009 9 TON	A 43560 ACRE	A x 0.0027 9 MGAL
GEA-87-5.87	309+95	310+35	1600	177.78	0.016	0.037	0.48
GEA-87-3.00	158+09	158+59	2000	222.22	0.020	0.046	0.60
TOTALS				400.00	0.036	0.083	1.08
TOTALS CARRIED TO GENERAL SUMMARY				400	0.04	0.09	1.08

CALCULATIONS

GEA-87-3.00 / 5.87

CALCULATED
AJS
CHECKED
MKM

EXISTING STRUCTURE

TYPE: 48" CIRCULAR CONCRETE PIPE

SKEW: 1°25'21" RT

ALIGNMENT: TANGENT

PROPOSED STRUCTURE

TYPE: 54" CONDUIT, TYPE A, APP

SKEW: 1°25'21" RT

ALIGNMENT: TANGENT

HYDRAULIC DESIGN DATA

DRAINAGE AREA: 94.40 ACRES

Q(25): 168.00 CFS



HW(25): 1053.79 FT

V(25): 11.84 FT/S

Q(100): 276.00 CFS

HW(100): 1061.34 FT

V(100): 16.80 FT/S

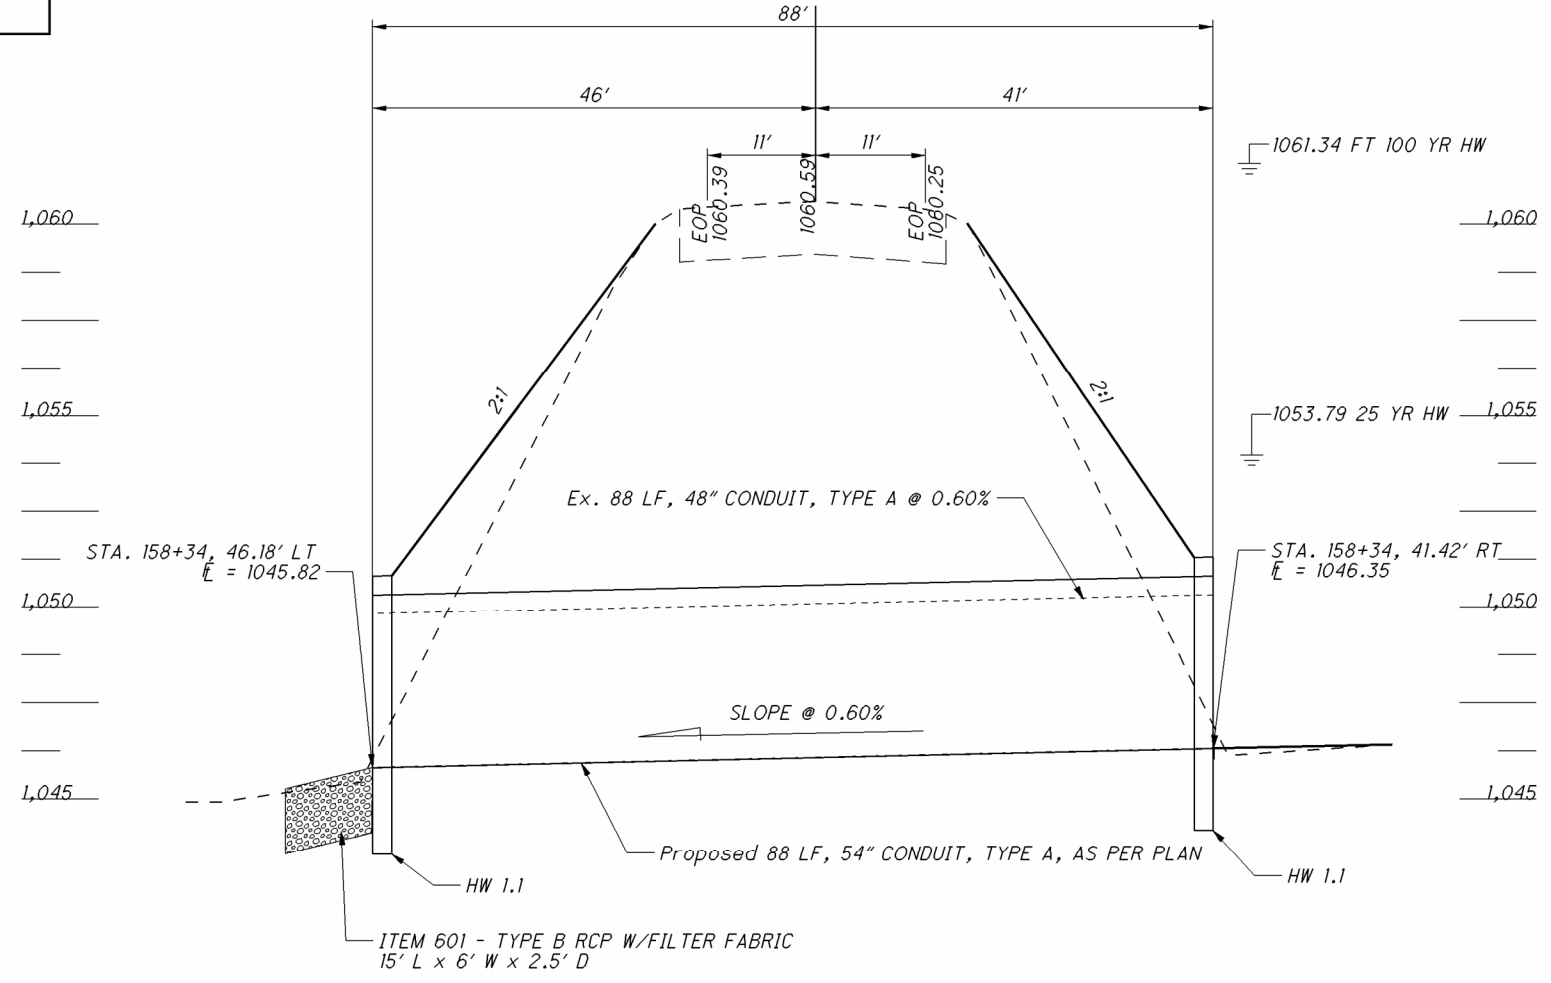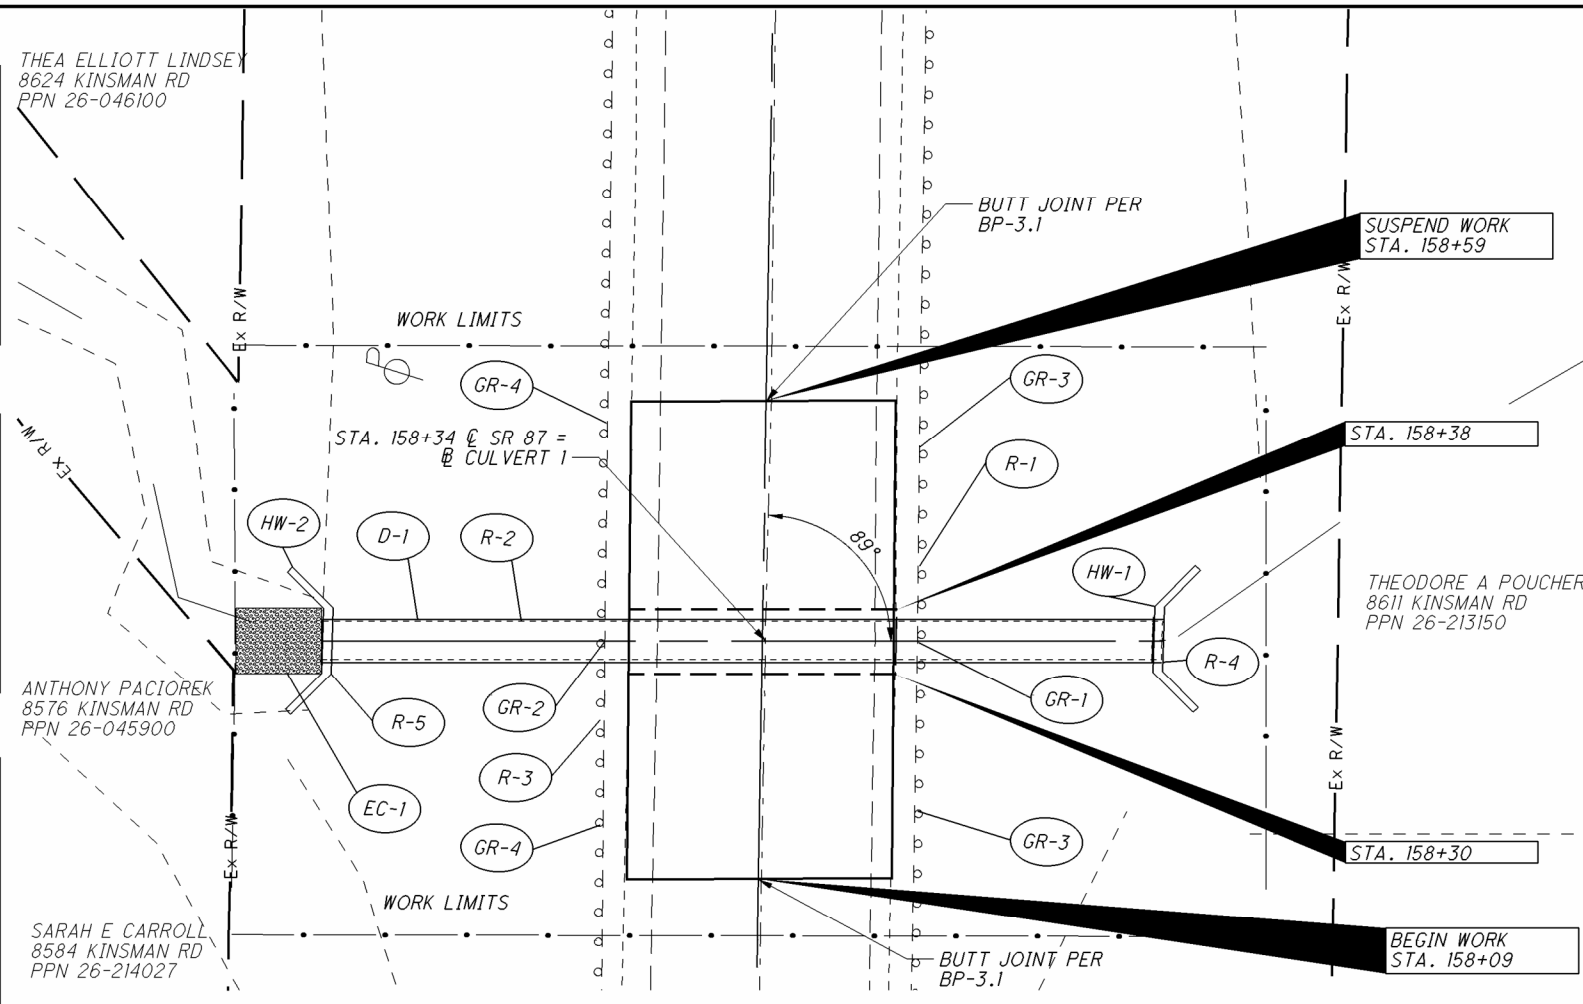

REF NO.	STATION		SIDE	ITEM DESCRIPTION	QUANTITY	UNIT	TOTALS CARRIED TO GENERAL SUMMARY						
	FROM	TO					RT	LT	RT	LT	RT	LT	
R-1	158+09	158+59	RT	COFFERDAMS AND EXCAVATION BRACING	8.33	CU YD			8.33				
R-2	158+34	158+34	CL	HEADWALL REMOVED	2	EACH							
R-3	158+09	158+59	LT	GUARDRAIL REMOVED	50	FT							
R-4	158+34	158+34	RT	PIPE REMOVED OVER 24" APP	88	FT							
R-5	158+34	158+34	LT	CONCRETE MASONRY	88	CU YD							
D-1	158+34	158+34	CL	CONCRETE MASONRY	12.3	CU YD							
EC-1	158+34	158+34	CL	CONCRETE MASONRY	12.3	CU YD							
HW-1	158+34	158+34	RT	CONCRETE MASONRY	25	CU YD							
HW-2	158+34	158+34	LT	CONCRETE MASONRY	25	CU YD							
GR-1	158+21.5	158+46.5	RT	CONCRETE MASONRY	25	CU YD							
GR-2	158+21.5	158+46.5	LT	CONCRETE MASONRY	25	CU YD							
GR-3	158+09/158+46.5	158+21.5/158+59	RT	CONCRETE MASONRY	25	CU YD							
GR-4	158+09/158+46.5	158+21.5/158+59	LT	CONCRETE MASONRY	25	CU YD							
TOTALS CARRIED TO GENERAL SUMMARY					88		8.33	2	100	2	88	24.6	50

EXISTING STRUCTURE

TYPE: 2' X 2' CONCRETE BOX

SKEW: 0°44'59" RT

ALIGNMENT: TANGENT

PROPOSED STRUCTURE

TYPE: 33" CONDUIT, TYPE A, APP

SKEW: 0°44'59" RT

ALIGNMENT: TANGENT

HYDRAULIC DESIGN DATA

DRAINAGE AREA: 21.43 ACRES

Q(25): 33.70 CFS



HW(25): 1232.40 FT

V(25): 15.69 FT/S

Q(100): 55.00 CFS

HW(100): 1235.10 FT

V(100): 17.77 FT/S

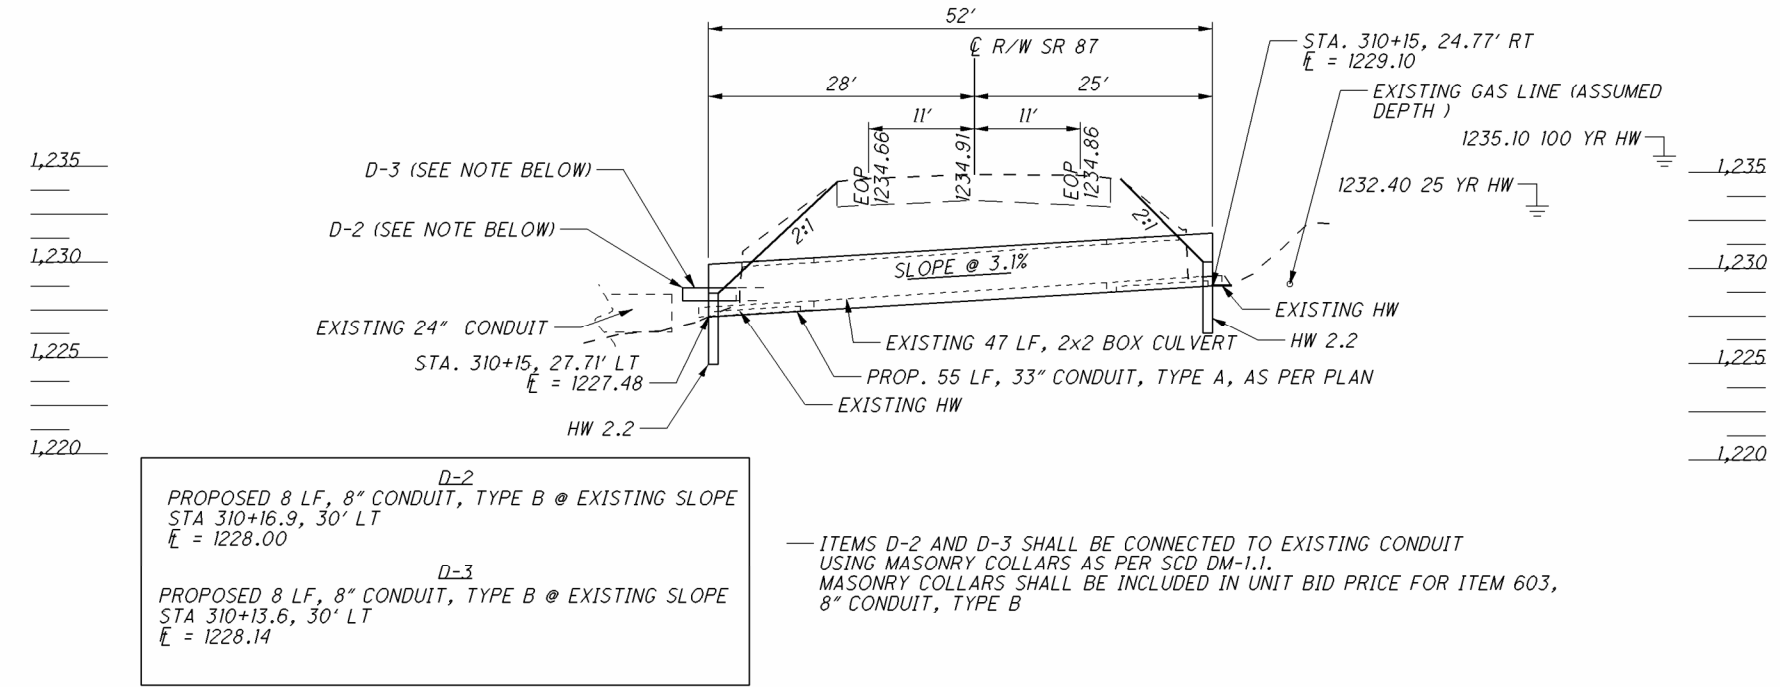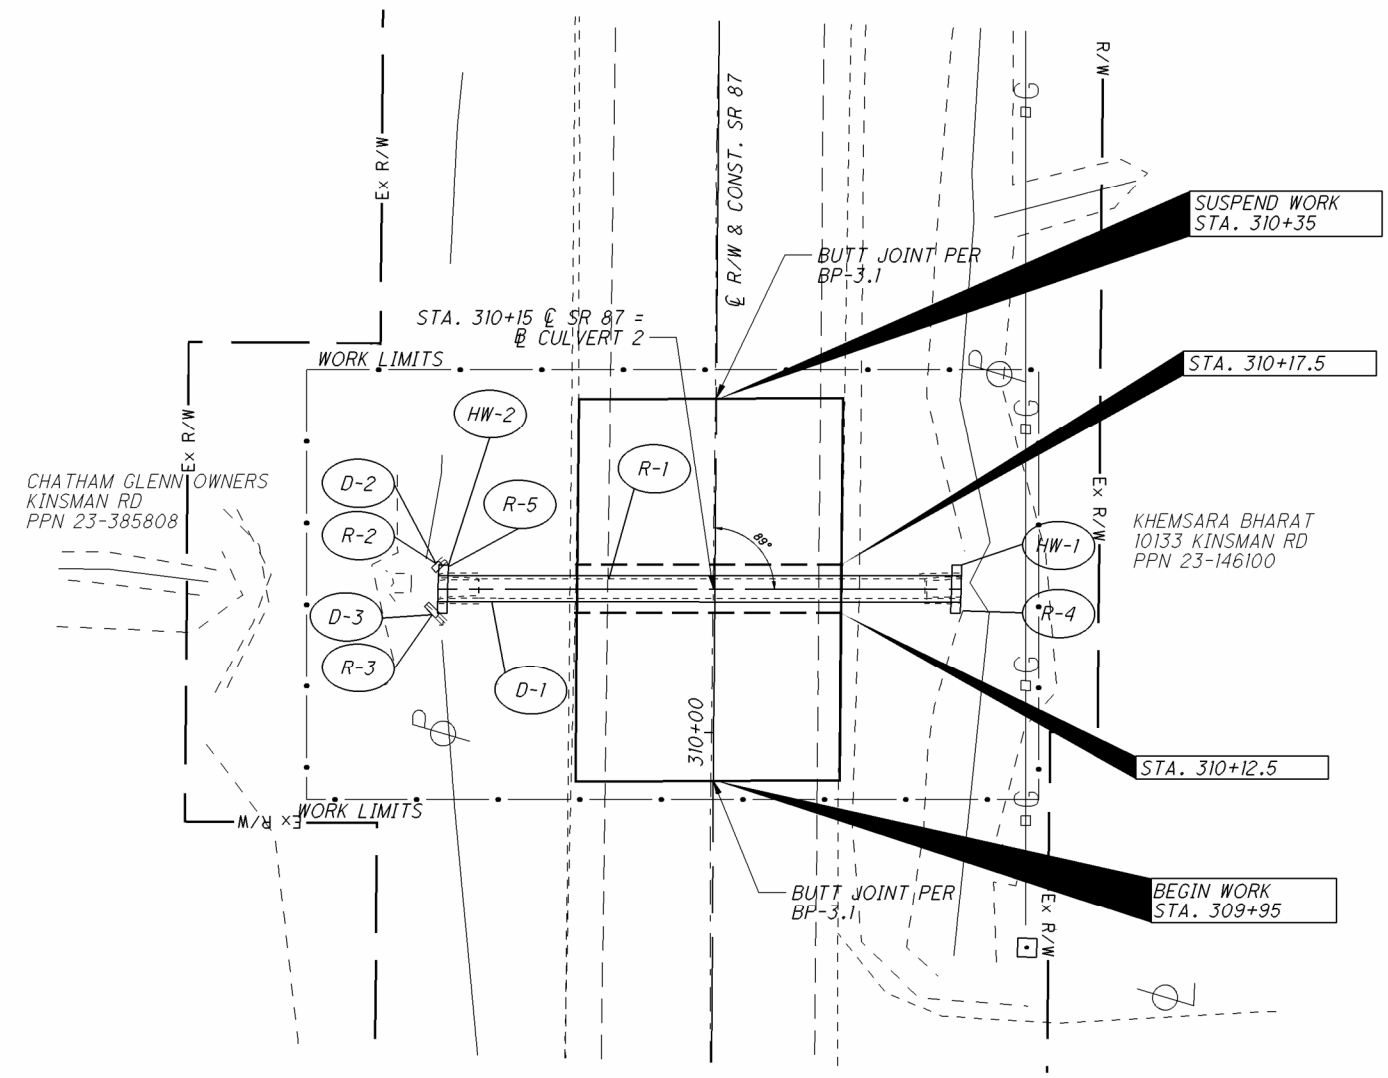

REF NO.	STATION		SIDE	ITEM	UNIT	QUANTITY	REMARKS
	FROM	TO					
R-1	310+15	310+15	€	CONCRETE MASONRY	CU YD	1.52	
R-2	310+16.9	310+16.9	LT	COFFERDAMS AND EXCAVATION BRACING	LUMP		
R-3	310+13.6	310+13.6	LT	HEADWALL REMOVED	EACH	1	
R-4	310+15	310+15	RT	PIPE REMOVED, 24" AND UNDER, APP	FT	8.0	
R-5	310+15	310+15	LT	PIPE REMOVED, 24" AND UNDER, APP	FT	8.0	
D-1	310+15	310+15	€				
D-2	310+16.9	310+16.9	LT				
D-3	310+13.6	310+13.6	LT				
HW-1	310+14.9	310+14.9	LT				
HW-2	310+14.9	310+14.9	RT				
TOTALS CARRIED TO GENERAL SUMMARY							
						63.0	
						2	
						1.52	
						55.0	
						8.0	
						8.0	
						16.0	

SPECIAL PROVISIONS

404 PERMIT WATERWAY PERMITS

CRS: GEA – 87 – 3.00/5.87

PID: 87428

U.S. ARMY CORPS OF ENGINEERS
 REGIONAL GENERAL PERMIT (RPG)
 - Section B (maintenance)

- ◆ Effective 2/18/2011
- ◆ Expires 10/23/2014

1. Waterway Permit Time Restrictions:

Complete all work in streams and wetlands depicted in the plans, Special Provisions, and/or working drawings for temporary fill by **10/23/2014**.

For work on streams and wetlands, the Department will consider the Contractor's submission of an extension to the waterway permit end date based on project constraints. In order to be considered, the Contractor must submit a justification to the Engineer at least two months prior to the waterway permit end date.

The Engineer will submit the request for a time extension to ODOT- Office of Environmental Services- Waterway Permits Unit (614-466-7100) for consideration and coordination with the USACE and/or Ohio EPA.

2. Deviations from Permitted Construction Activities

No deviation from the requirements for work in streams and wetlands depicted in the plans, Special Provisions, and/or working drawings may be made unless a modification has been submitted to ODOT and approved by the appropriate agencies (i.e., USACE, Ohio EPA, USCG, ODNR, and USFWS).

For emergency situations resulting in unanticipated impacts to streams or wetlands, provide notification (verbal or written) to the Engineer as soon as possible following discovery of the situation. Written notification to the Engineer and notification to the ODOT- Office of Environmental Services- Waterway Permits Unit must be made within 24 hours.

For non-emergency situations, notify the Engineer in writing for submission to the ODOT- Office of Environmental Services- Waterway Permits Unit (614-466-7100) for consideration and coordination with the appropriate agencies. Notification must be made at least two months prior to planned non-permitted activities. Consideration of the requested deviation is at the discretion of the Director and must be coordinated with the appropriate regulatory agencies.

3. In-Stream Work Restrictions

Work in the following sensitive streams is further restricted as follows

Stream Name / Description	Restriction Dates (N/A)
All are Unnamed Tributaries to Cuyahoga River (less than 1 square mile)	No Work Restriction Dates for all five culverts.

In-stream work has been defined as the placement and/or removal of fill materials (temporary or permanent) below ordinary high water of a stream. Examples of "fill" include (but are not limited to) bridge piers, abutments, culverts, rock channel protection, scour protection, and temporary work pads.

Fills (such as temporary work pads) placed within a stream identified in the above table outside of the

work restriction dates can continue to be worked from during the work restriction dates, but cannot be expanded, removed, or otherwise modified (below ordinary high water) until once again outside of the work restriction dates.

The Engineer will submit the request for a time extension to ODOT- Office of Environmental Services- Waterway Permits Unit (614-466-7100) for consideration and coordination with the USACE and/or Ohio EPA.

4. Materials:

Materials utilized in or adjacent to streams and wetlands on this project for temporary or permanent fill or bank protection shall consist of suitable material free from toxic contaminants in other than trace quantities. Broken asphalt is specifically excluded.

Cadmium, chromium, arsenate (CCA), creosote, and other pressure treated lumber shall not be used in structures that are placed in wetlands and streams.

5. Cultural Resources

If archeological sites or human remains are discovered, cease all work in the immediate area and notify the Engineer who will immediately contact the Office of Environmental Services – Cultural Resource Section (614-466-7100) and the Ohio Historic Preservation Office.

In the event of human remains are discovered the Engineer shall also contact the Geauga County Sherriff's Office. (440) 286-1234.

6. Water Resource Demarcation:

All streams, wetlands, lakes, and ponds indicated on the plans shall be demarcated in the field as per SS 832 prior to site disturbance. The fence shall remain in place and be maintained throughout the construction process. Following the completion of the project, the fence and posts shall be removed.

7. Spill containment:

Provide and Maintain an Oil Spill Kit with a minimum capacity of 65 gallons. The Spill Kit shall contain:

- 6 - 3 in. X 8 ft. Oil only socks
- 4 - 18 in. X18 in. Oil only pillows
- 2 - 5 in. X 10ft. Booms
- 50 - 16in. X 20 in. Oil only pads
- 10- Disposable Bags
- 1- 65 Gallon drum with lid
- 25 pounds of Granular Oil Absorbent

The Oil Spill Kit shall be located within 150 feet of any equipment working in a stream or wetland. The oil Spill Kit shall be maintained for the life of the contract. Any materials utilized during the project will be replaced within 48 hours.

All costs associated with furnishing and maintaining the above referenced spill containment kit is incidental to work.

8. Blasting:

State law requires notification to the Ohio Department of Natural Resources should blasting be required within or near stream channels (See ORC 1533.58 & CMS 107.09).

Notify Engineer, in writing, for submission to ODOT Office of Environmental Services – Waterway Permits Unit (614-466-7100) for coordination with the Ohio Department of Natural Resources.

9. Waterway Permits:


A copy of the waterway permits (i.e., USACE 404, USCG Section 9 Bridge Permit and the OEPA WQC and/or Isolated Wetland Permit) shall be kept at the work site at all times and made available to all contractors and subcontractors.

10. Bridge Inspection:


Prior to the removal of bridge structures, the underside must be carefully examined for the presence of birds and bats. Should any birds or bats be found roosting on the underside of the bridge, the Contractor is required to notify the Engineer for coordination with ODOT- Office of Environmental Services (614-466-7100).

11. Project Inspection:

Inspection of Work may include inspection by representatives of other government agencies or railroad corporations that pay a portion of the cost of the Work or regulate the Work through State and Federal law. Comments from the representatives of these agencies shall be directed to the Engineer. Please forward a copy to ODOT Office of Environmental Services. Waterway Permits Unit (614-466-7100).

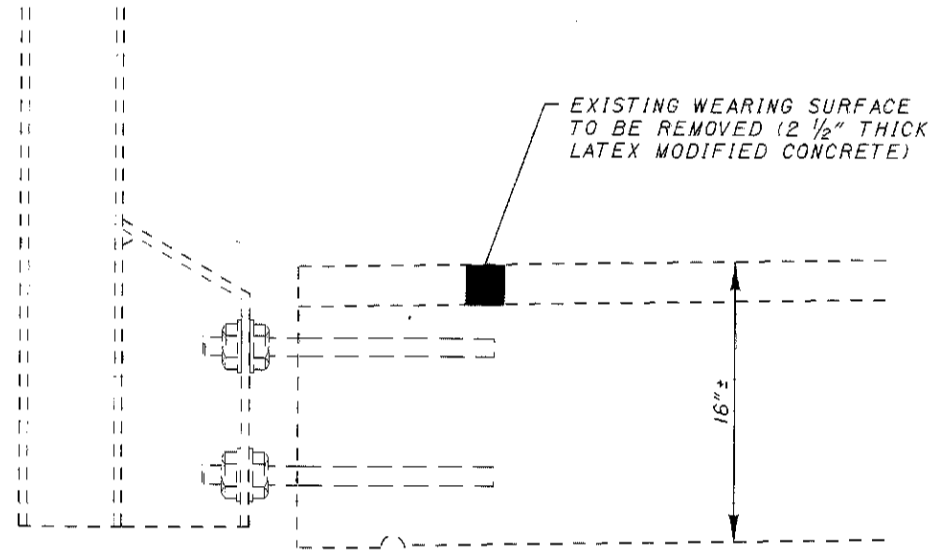


EXISTING OVERLAY DETAIL

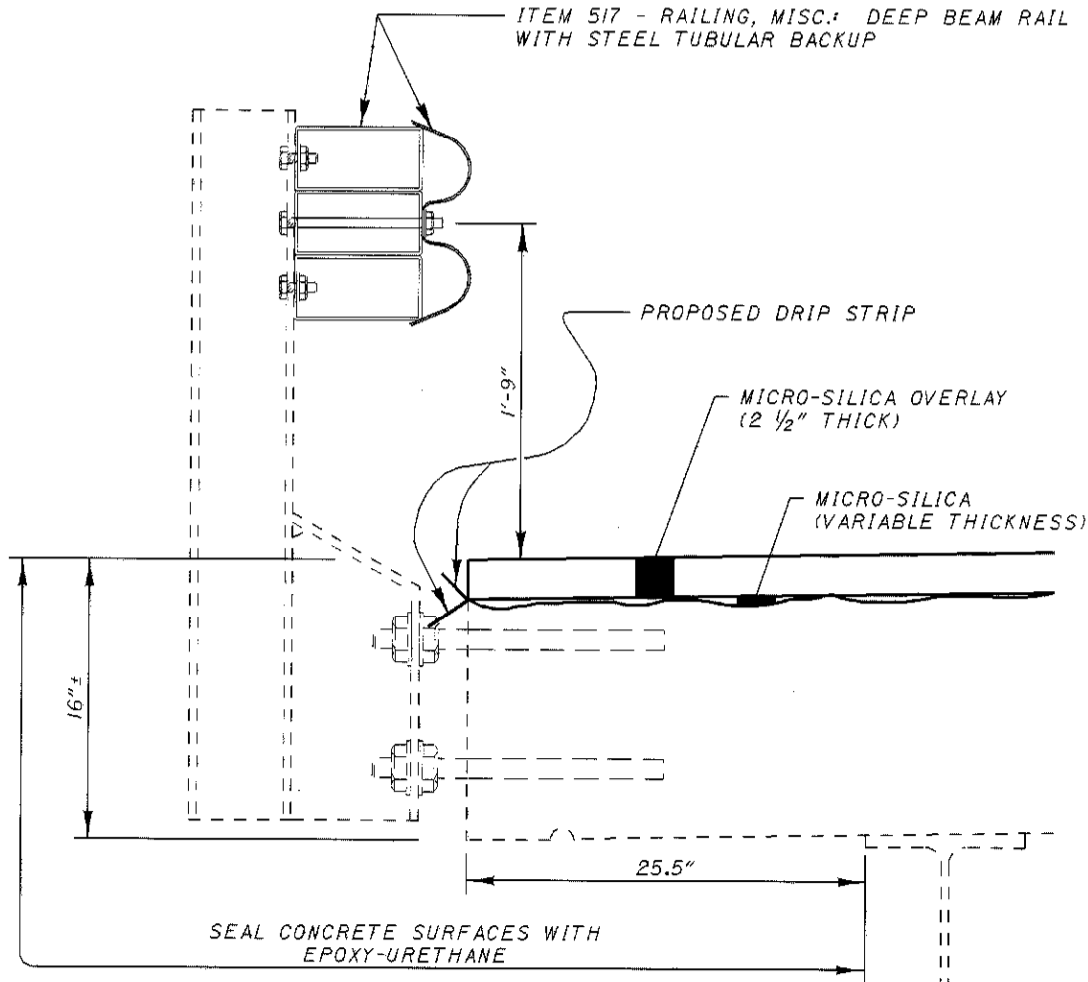


PROPOSED RAILING DETAIL

FOR DETAILS NOT SHOWN
SEE STANDARD DRAWINGS
DBR-2-73M & DS-1-94M

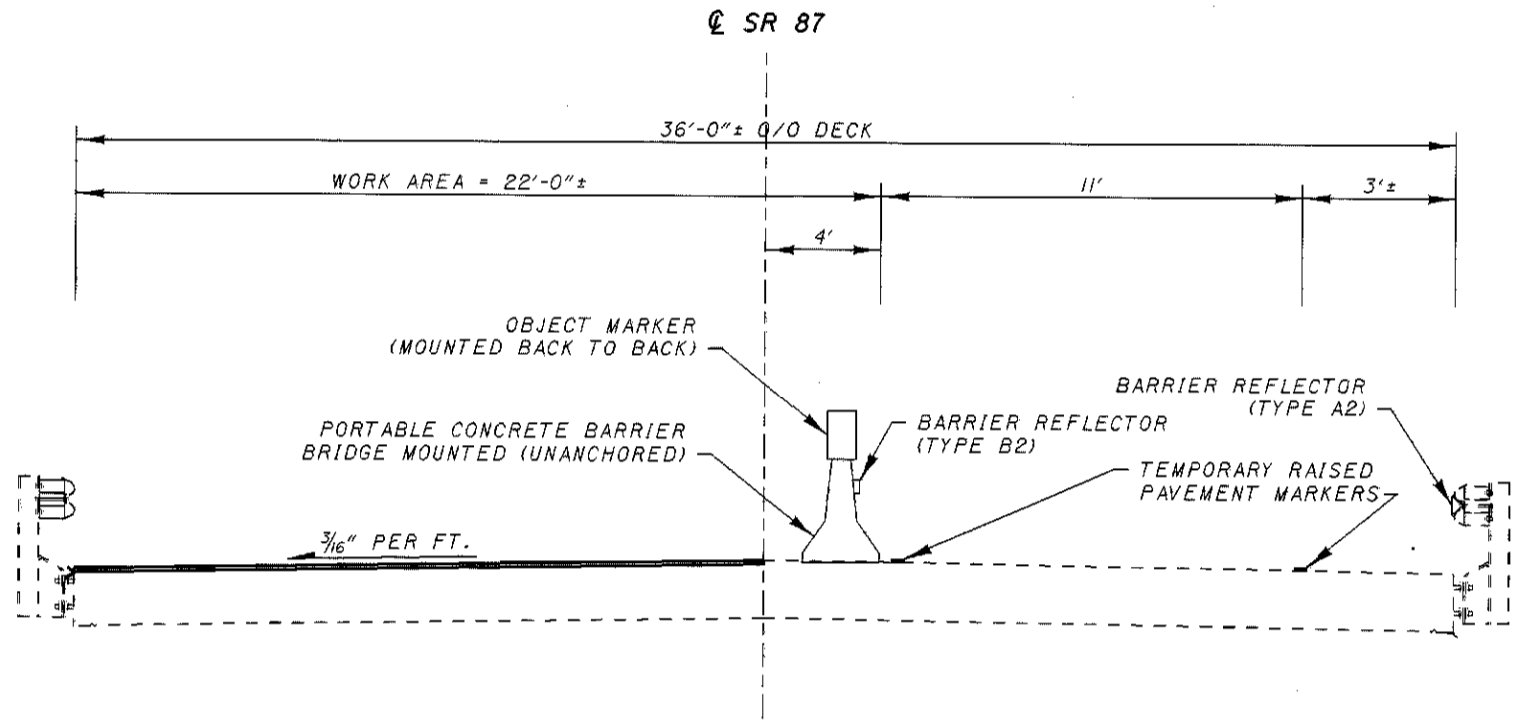

TYPICAL SECTION (PHASE A)

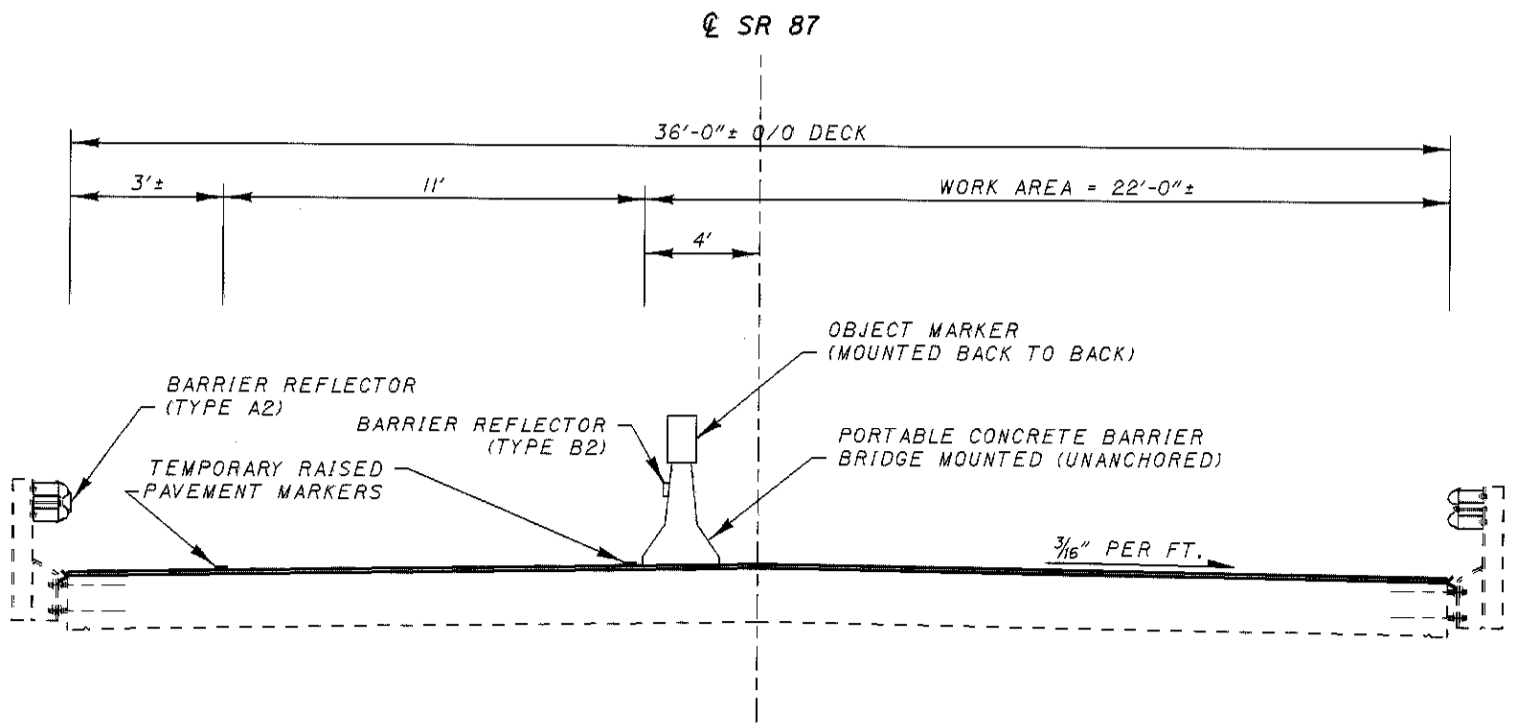


TYPICAL SECTION (PHASE B)

PLOT SUBMITTED: 25-FEB-1999 08:19


gea1213.dgn

gea1213.dgn

PLOTTED BY: nconley
 PLOTTED FROM: @project\$@p18728@gea1213.dgn

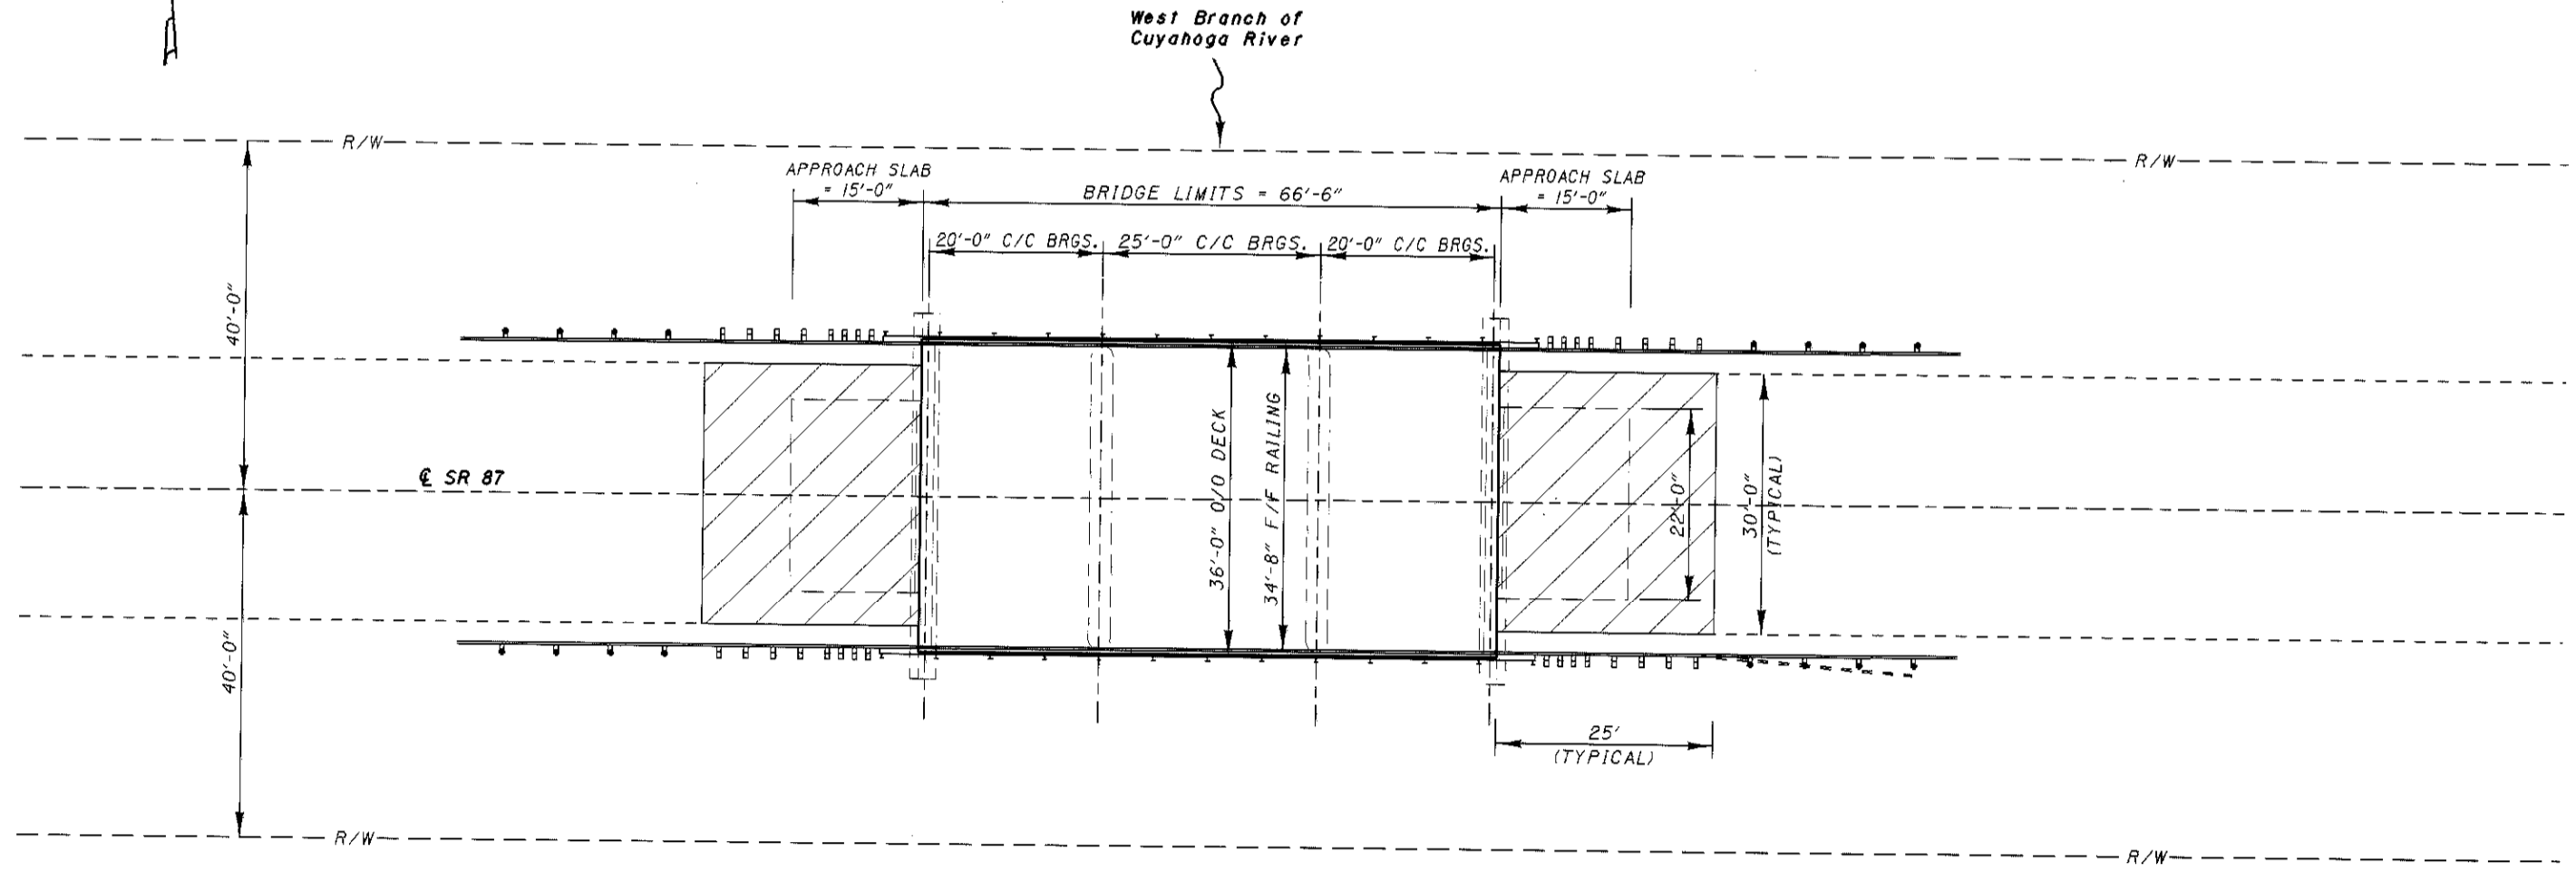

GENERAL PLAN

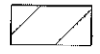 1 1/4" OF ITEM 202 - WEARING COURSE REMOVED, ASPHALT AND RESURFACED WITH ITEM 448 - ASPHALT CONCRETE SURFACE COURSE, TYPE 1, PG64-22 OVER ITEM 407 - TACK COAT. THE 25'-0" LENGTH MAY BE ADJUSTED TO FIT THE EXISTING CONDITIONS.

NOTES:

1. THE APPROACH GUARDRAIL IS NOT COMPLETELY SHOWN. FOR RAILING WORK SEE SHEET 17.
2. FOR MAINTENANCE OF TRAFFIC, SEE SHEET 18.
3. FOR ESTIMATED QUANTITIES SEE SHEET 7.

DESIGN AGENCY
 DISTRICT TWELVE
 PRODUCTION DEPARTMENT

DATE
 2/99

REVIEWED
 JUL
 STRUCTURE FILE NUMBER
 2800756

DESIGNED
 NRC
 CHECKED
 M/JM

GENERAL PLAN
 BRIDGE NO. GEA-87-12/3
 OVER WEST BRANCH OF CUYAHOGA RIVER

GEA-87-13.18/11.33/12/3/1


1/4
 16
 19

PLOT SUBMITTED: 25-FEB-1999 08:19

geal1213.dgn

geal1213.dgn


PLOTTED BY: nconley
 PLOTTED FROM: projects\pid18728\geal1213.dgn

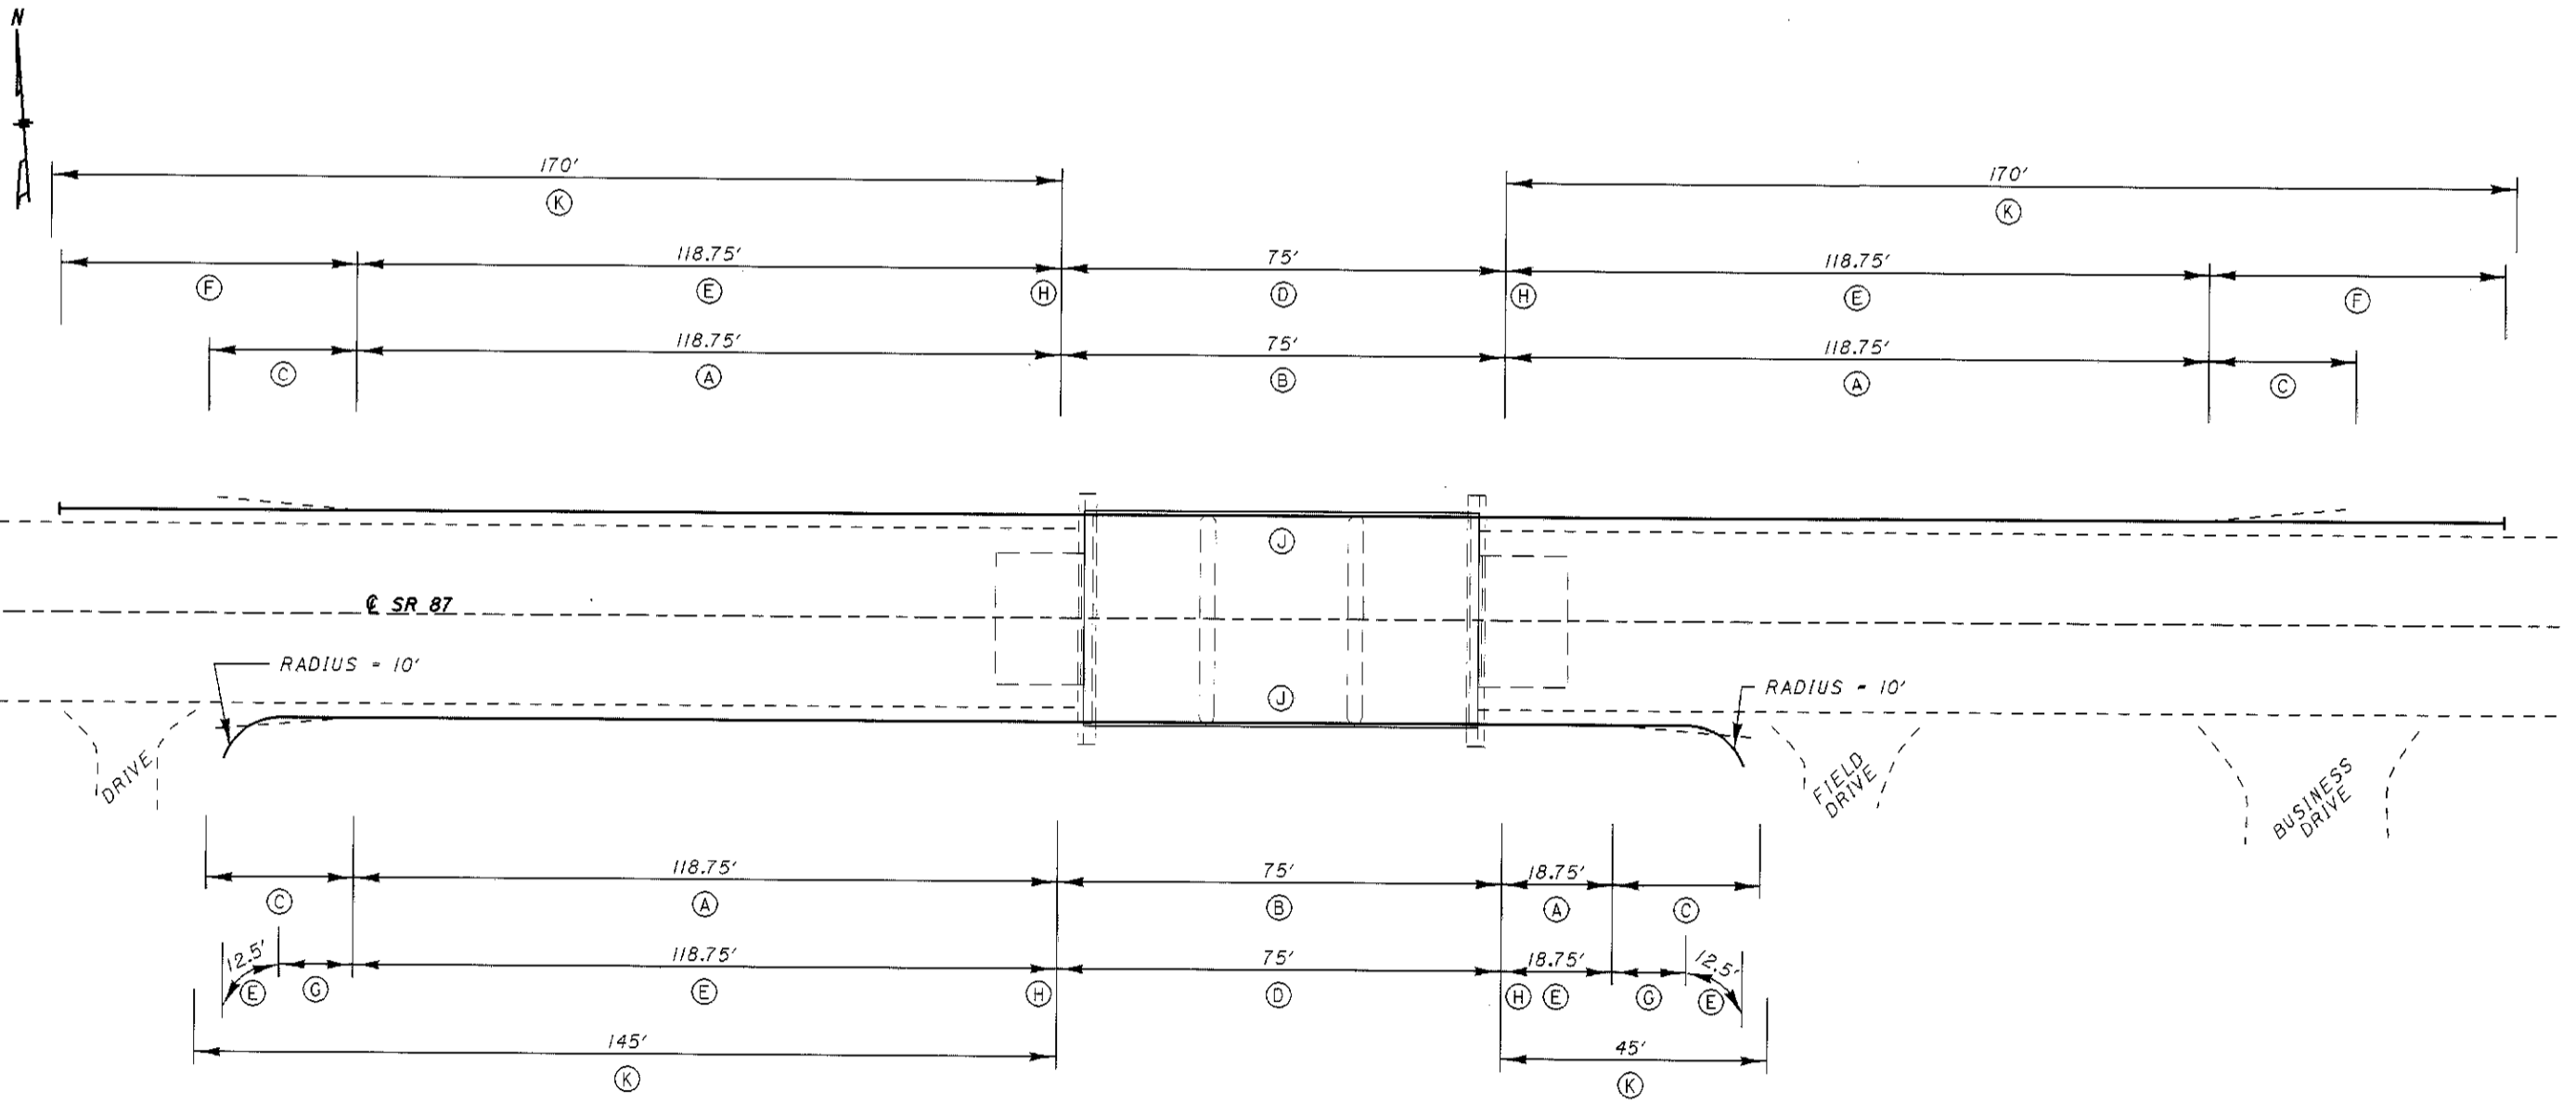

NOTE:
 FOR ITEM 517 - RAILING, MISC.: DEEP BEAM RAIL WITH STEEL TUBULAR BACKUP DETAILS, SEE SHEET 19.

LOCATION	ITEM	DESCRIPTION	UNIT	QUANTITY		TOTAL QUANTITY
				LEFT	RIGHT	
(A)	202	GUARDRAIL REMOVED	LF	237.5	137.5	375
(B)	202	BRIDGE RAILING REMOVED, AS PER PLAN	LF	75	75	150 ★
(C)	202	ANCHOR ASSEMBLY REMOVED, TYPE A	EA	2	2	4
(D)	517	RAILING, MISC.: DEEP BEAM RAIL WITH STEEL TUBULAR BACKUP	LF	75	75	150 ★
(E)	606	GUARDRAIL, TYPE 5	LF	237.5	162.5	400
(F)	606	ANCHOR ASSEMBLY, TYPE E-98	EA	2		2
(G)	606	ANCHOR ASSEMBLY, TYPE T	EA		2	2
(H)	606	BRIDGE TERMINAL ASSEMBLY, TYPE 4	EA	2	2	4
(J)	802	BARRIER REFLECTOR, TYPE A	EA	5	4	9
(K)	SPECIAL	RESHAPING BERM	LF	340	190	530

★ QUANTITY IS CARRIED TO THE STRUCTURE SUMMARY.
 ALL QUANTITIES ARE CARRIED TO THE GENERAL SUMMARY.

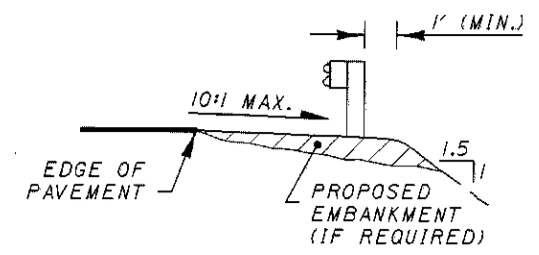

TYPICAL SECTION

DESIGN AGENCY
 DISTRICT TWELVE
 PRODUCTION DEPARTMENT

DATE
 2/799

DESIGNED
 NRC

DRAWN
 NRC

RAILING PLAN
 BRIDGE NO. GEA-87-1213
 OVER WEST BRANCH OF CUYAHOGA RIVER

STRUCTURE FILE NUMBER
 2800756


REVISION
 M/JM

GEA-87-13.18(11.33)(12.13)

2 / 4

17
 19

PLOTTED BY: nconley
 PLOTTED FROM: g:\projects\p18728\geal213.dgn
 geal213.dgn
 PLOT SUBMITTED: 25-FEB-1999 08:19


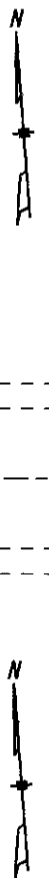


NOTES:
 PCB - PORTABLE CONCRETE BARRIER
 FOR TYPICAL SECTION, SEE SHEET 19.

FOR DETAILS NOT SHOWN,
 SEE STANDARD DRAWINGS
 MT-96.10M, MT-96.11M,
 MT-96.20M AND MT-96.25M.

SIGNAL TIMING			
A TWO PHASE CONTROLLER WITH A CABINET CAPABLE OF BEING SET WITH THE FOLLOWING SPLITS SHALL BE FURNISHED: CYCLE LENGTH IS 60 SECONDS			
	GREEN	AMBER	RED
PHASE A	15	3	13
PHASE B	15	3	13

THE ABOVE TIMING MAY BE CHANGED WITH THE APPROVAL OF THE ENGINEER.

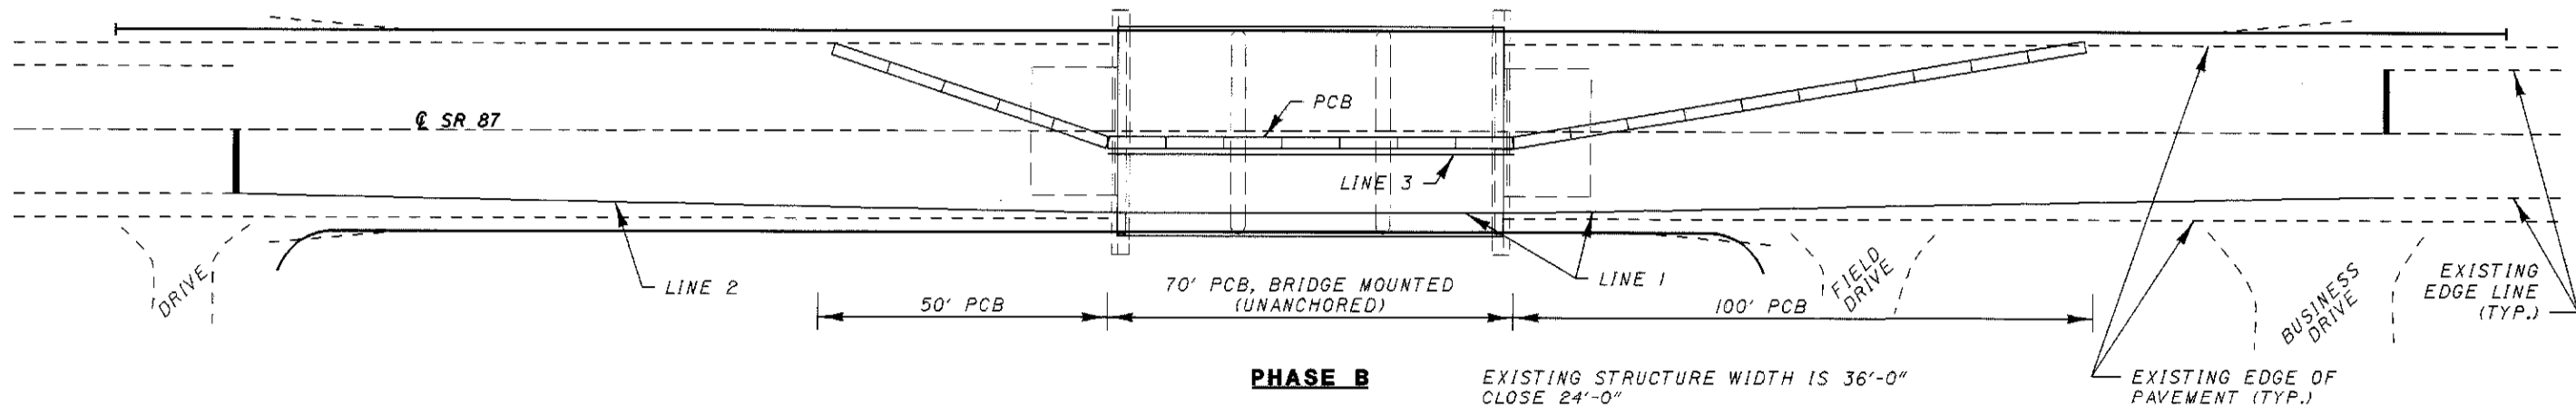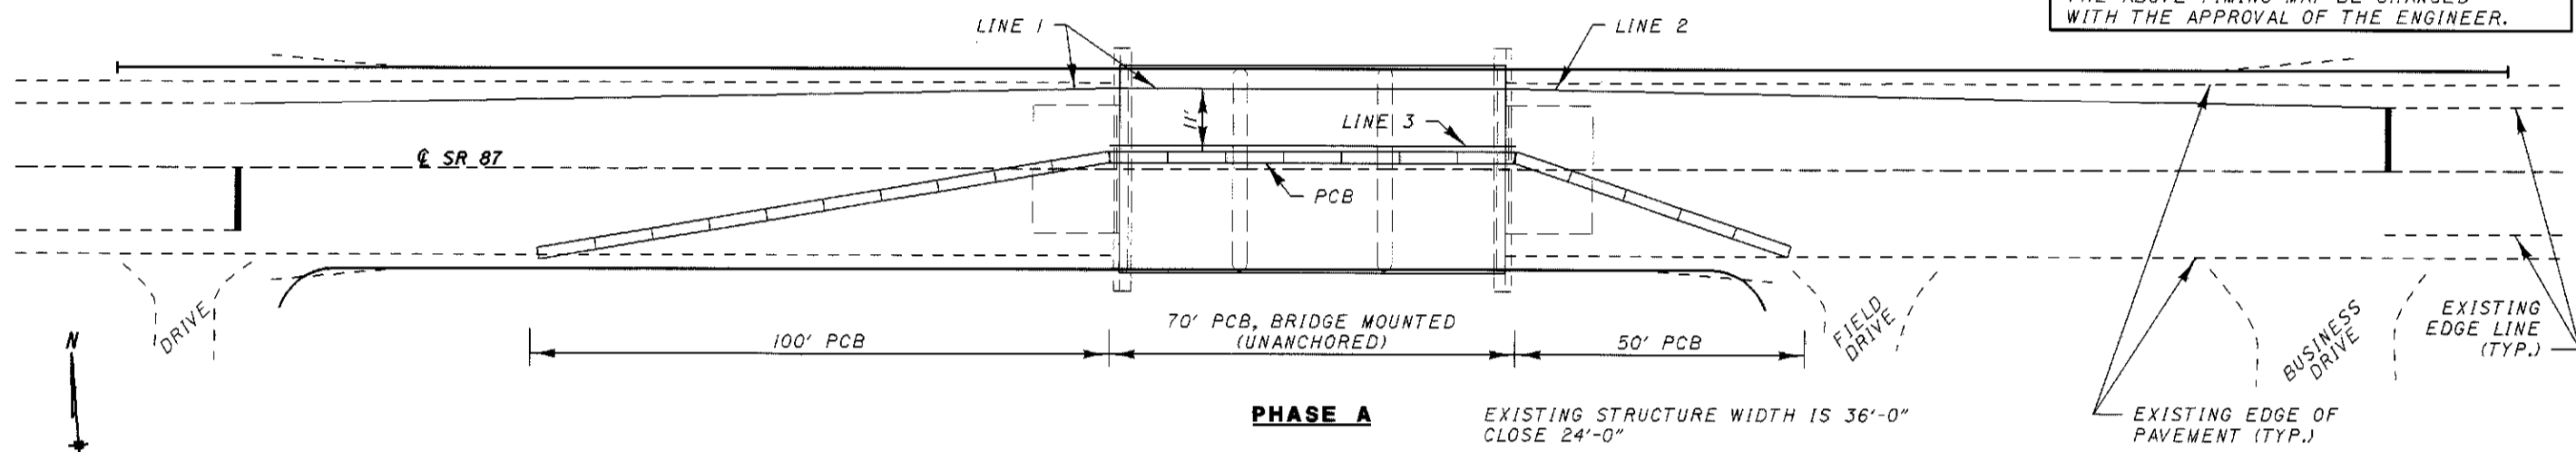

ITEM	DESCRIPTION	UNIT	QUANTITY		TOTAL QUANTITY
			PHASE A	PHASE B	
614	TEMPORARY RAISED PAVEMENT MARKER	EA	149	149	298
614	BARRIER REFLECTOR, TYPE A2	EA	17	11	28
614	BARRIER REFLECTOR, TYPE B2	EA	9	9	18
614	OBJECT MARKER	EA	10	10	20
614	TEMPORARY CENTER LINE, CLASS 1	MI	0.06		0.06
614	TEMPORARY EDGE LINE, CLASS 1	MI	0.02	0.02	0.04
614	TEMPORARY STOP LINE, CLASS 1	LF	22		22
622	PORTABLE CONCRETE BARRIER, 32"	LF	150	150	300
622	PORTABLE CONCRETE BARRIER, 32", BRIDGE MOUNTED	LF	70	70	140
624	EDGE LINE, TYPE 2	MI			0.14
624	CENTER LINE, TYPE 2	MI			0.07

ALL QUANTITIES ARE CARRIED TO THE GENERAL SUMMARY.

TEMPORARY RAISED PAVEMENT MARKERS (TYPE A)				
		SPACING	QUANTITY (WHITE)	QUANTITY (YELLOW)
PHASE A	LINE 1 - 220'	5'	45	45
	LINE 2 - 150'	5'	31	
	LINE 3 - 70'	5'	14	14
PHASE B	LINE 1 - 220'	5'	45	45
	LINE 2 - 150'	5'	31	
	LINE 3 - 70'	5'	14	14
TOTAL			180	180


DESIGN AGENCY: DISTRICT TWELVE PRODUCTION DEPARTMENT
 DATE: 2/99
 REVIEWED: JUL
 STRUCTURE FILE NUMBER: 2800756
 DRAWN: NRC
 CHECKED: MJM
 DESIGNED: NRC
 MAINTENANCE OF TRAFFIC
 BRIDGE NO. GE-A-87-1213
 OVER WEST BRANCH OF CUYAHOGA RIVER
 GE-A-87-13J8X11.33X(12.13)
 3/4
 18
 19

PLOT SUBMITTED: 25-FEB-1999 08:20


geal12.13.dgn

geal12.13.dgn

PLOTTED BY: nconloy
PLOTTED FROM: B:\projects\p18728\geal12.13.dgn

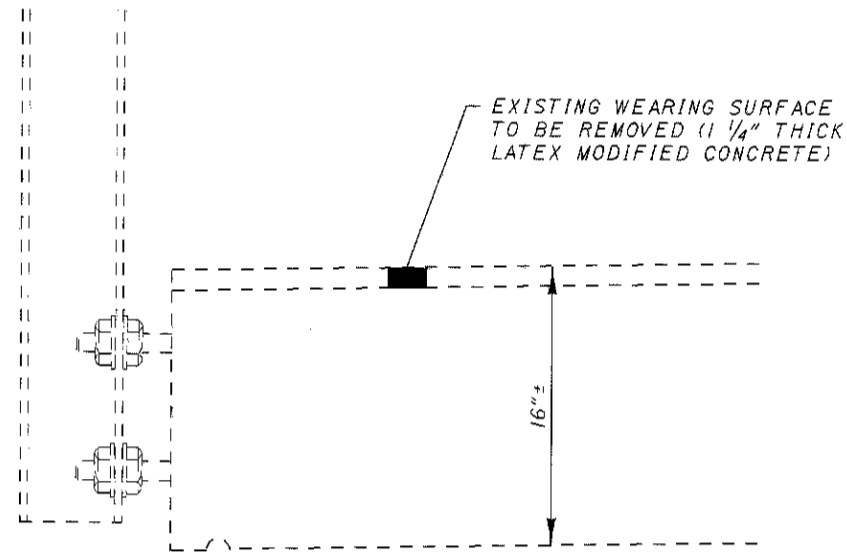


EXISTING OVERLAY DETAIL

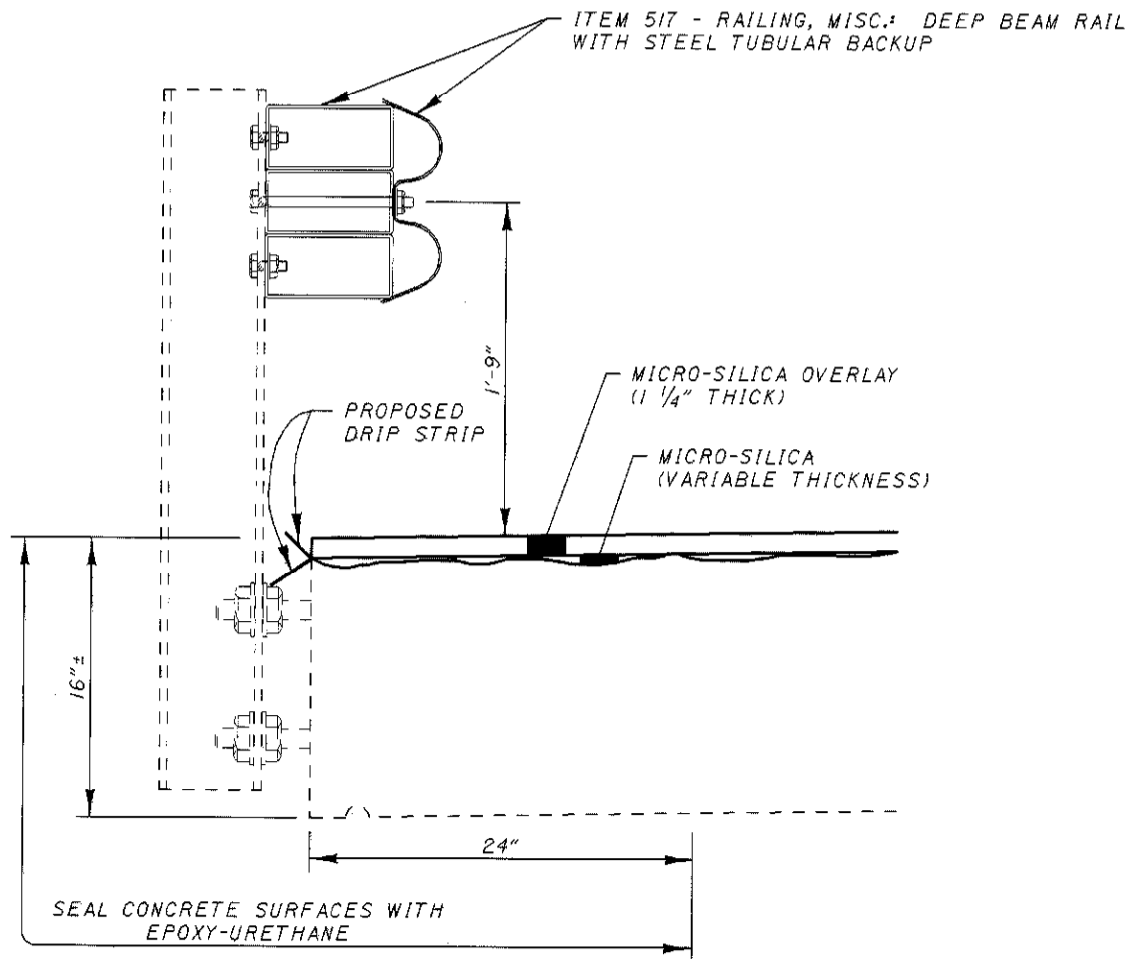


PROPOSED RAILING DETAIL

FOR DETAILS NOT SHOWN
SEE STANDARD DRAWINGS
DBR-2-73M & DS-1-94M

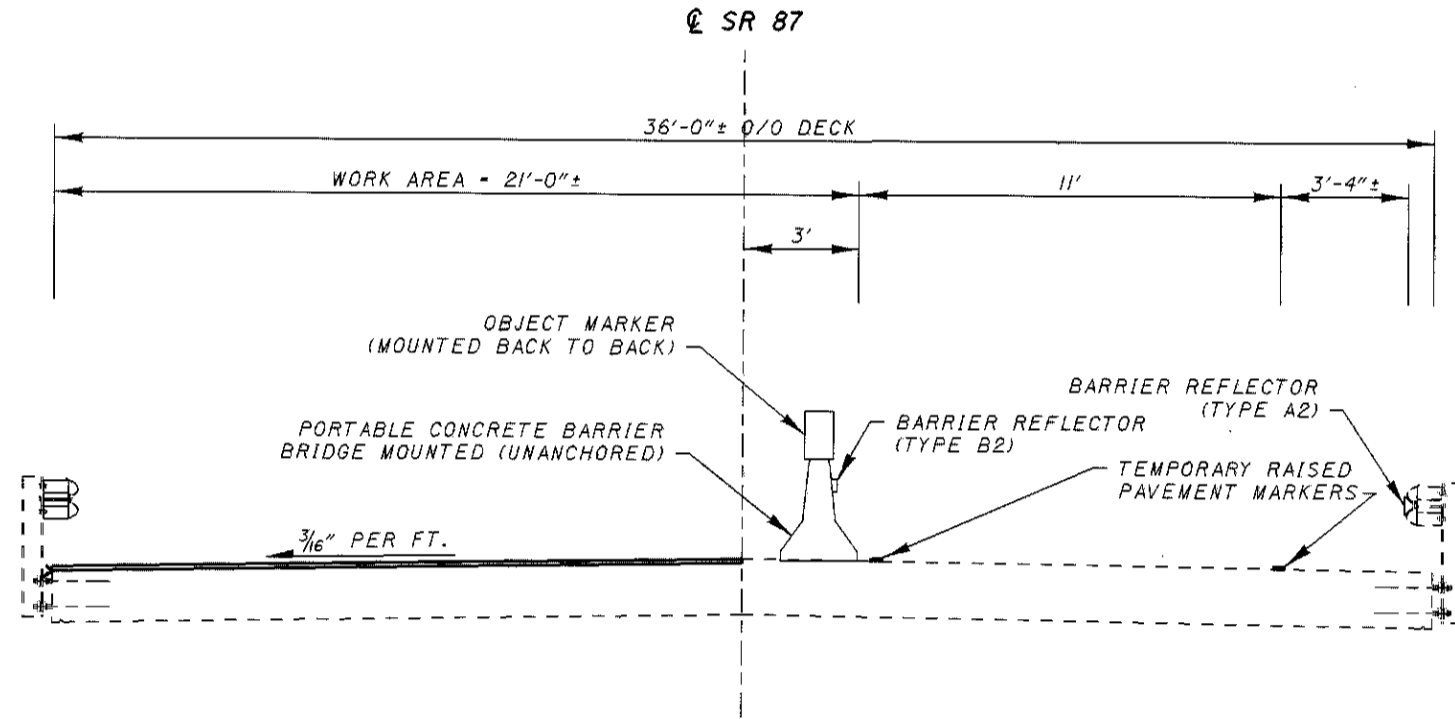

TYPICAL SECTION

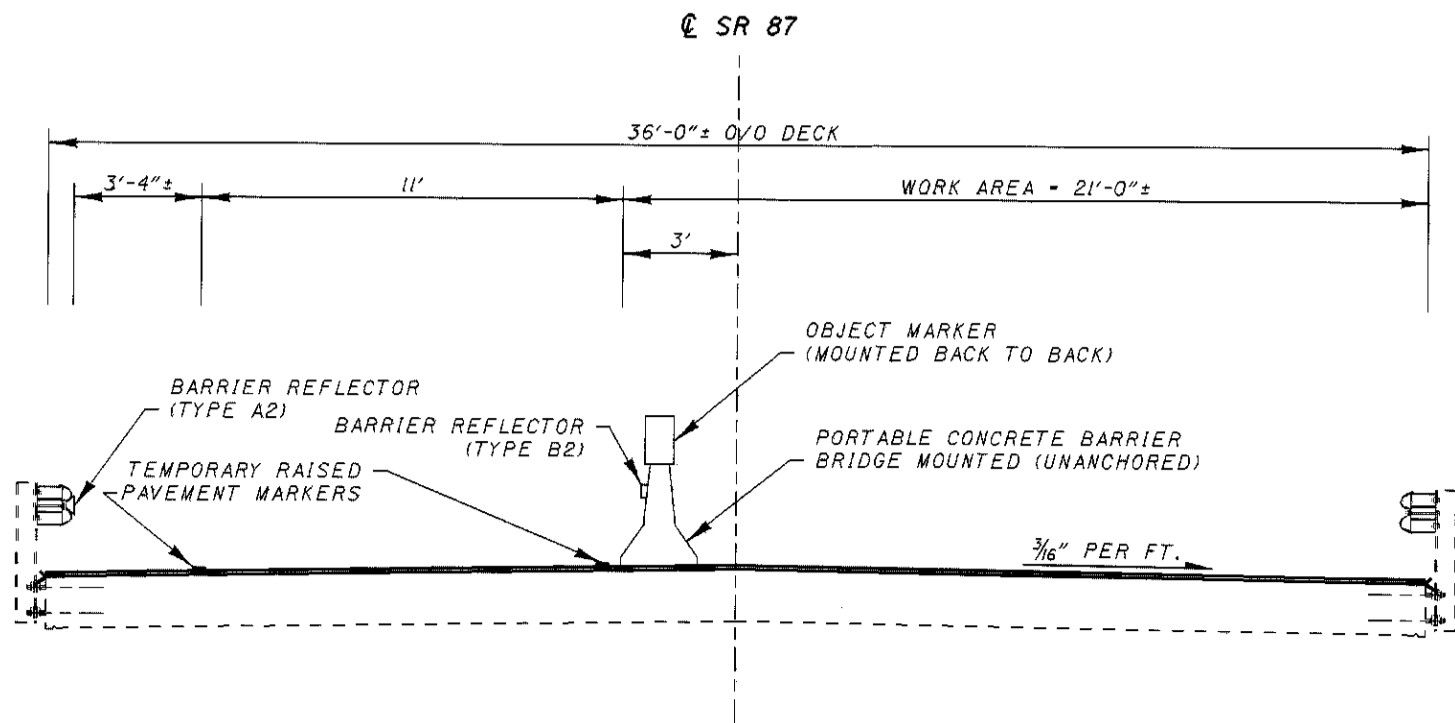

TYPICAL SECTION

DESIGN AGENCY
DISTRICT TWELVE
PRODUCTION DEPARTMENT

DATE
2/99

REVIEWED
JLL

DESIGNED
NRC

CHECKED
MJM


STRUCTURE FILE NUMBER
2800756

TYPICAL SECTION & DETAILS
BRIDGE NO. GE-A-87-12/3
OVER WEST BRANCH OF CUYAHOGA RIVER


GEA-87-13.18111.33112.131

4 / 4


19
19

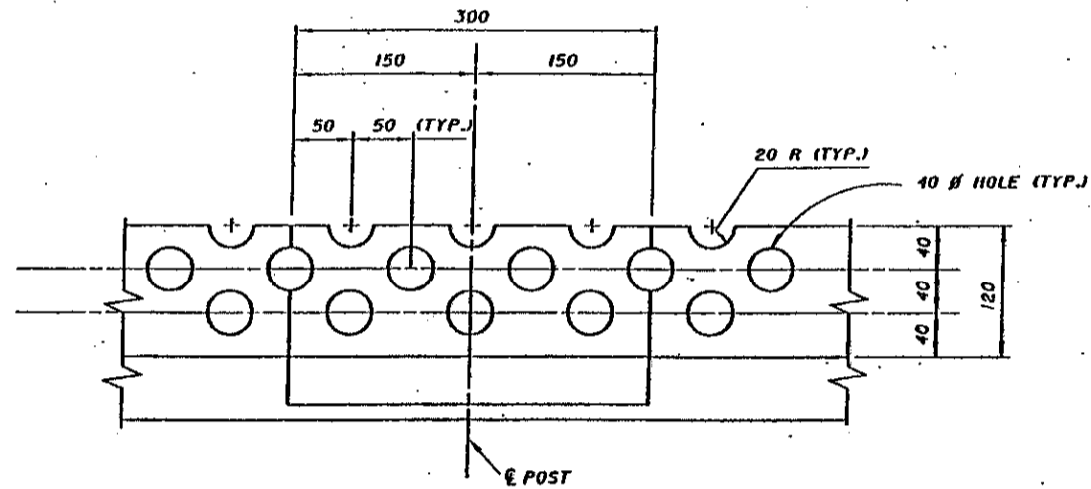


PARTIAL PLAN

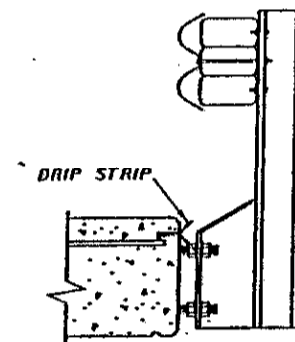


SECTION AT EDGE OF CONCRETE DECK SLAB

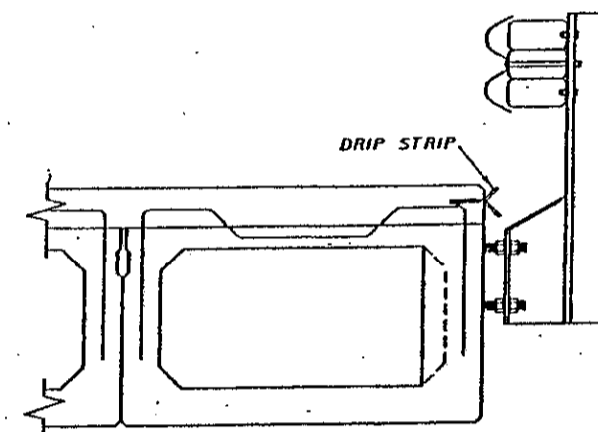


SECTION AT EDGE OF COMPOSITE PRESTRESSED BOX BEAM DECK

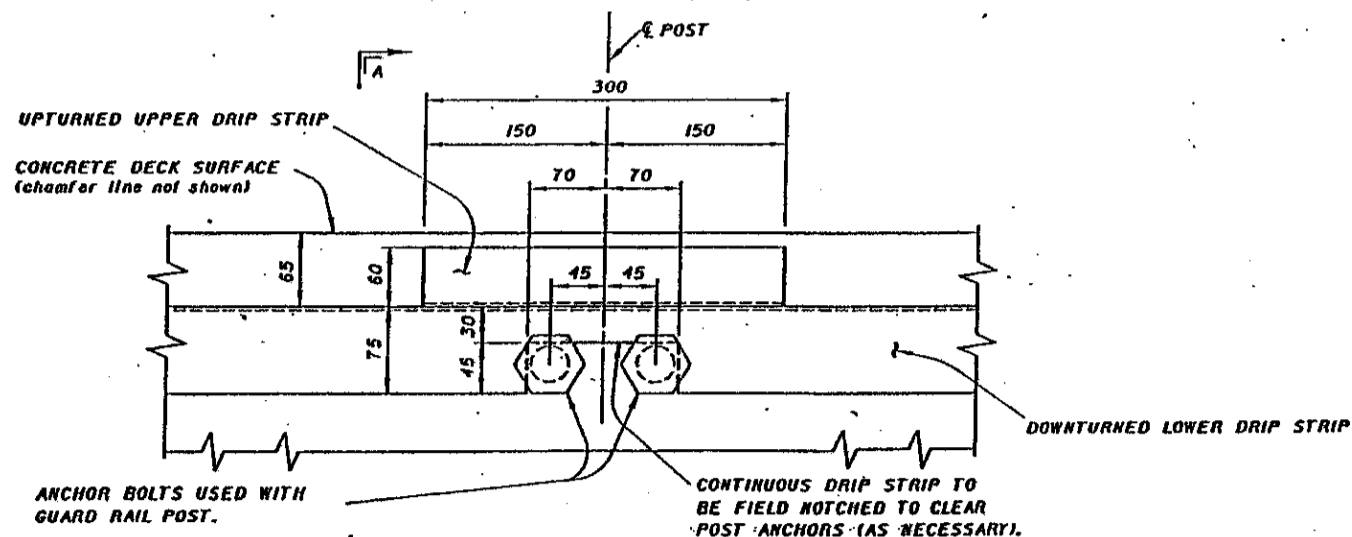

ELEVATION

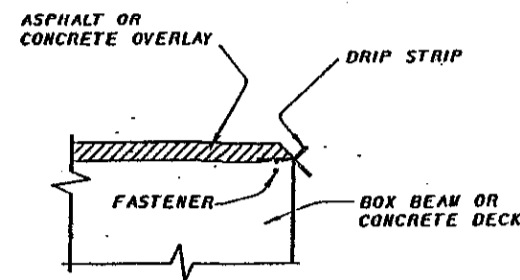

SECTION AT EDGE OF ASPHALT OR CONCRETE OVERLAY

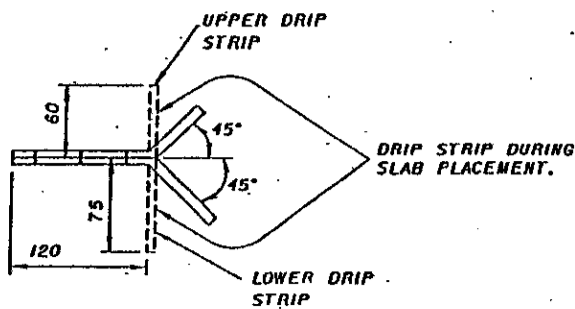

SECTION A-A

★ PRIOR TO PLACING AN ASPHALT OR CONCRETE OVERLAY, THE BENT DRIP STRIPS SHALL BE INSTALLED ALONG THE EDGE OF THE SLAB OR PRESTRESSED BOX BEAM AS SHOWN. THE DRIP STRIPS SHALL BE FASTENED WITH (32 mm length, 3 mm shank diameter) BUTTON HEAD SPIKES WITH DEFORMED SHANKS OR EXPANSION ANCHORS AT 450 mm C/C MAX. ALL INSTALLATION DEVICES SHALL EITHER BE GALVANIZED OR STAINLESS STEEL.

OTHER SIMILAR DEVICES WHICH WILL NOT DAMAGE THE CONCRETE MAY BE USED SUBJECT TO THE APPROVAL OF THE ENGINEER.

DRIP STRIP NOTES:

LOWER STAINLESS STEEL DRIP STRIP, AS DETAILED, SHALL BE INSTALLED ALONG THE FULL LENGTH OF EACH SIDE OF THE BRIDGE. IF SPLICES ARE REQUIRED IN THE LOWER DRIP STRIP, THE INDIVIDUAL PIECES SHALL BE BUTTED TIGHTLY TOGETHER, NOT LAPPED. A 300 mm LONG UPPER DRIP STRIP SHALL BE INSTALLED AT EACH RAILING POST. STRIPS SHALL BE BENT UP AT 90° AGAINST THE INSIDE FACE OF THE FORMS BEFORE CONCRETE IS PLACED. AFTER THE FORMS ARE REMOVED, THE DRIP STRIPS SHALL BE BENT TO A FINAL POSITION OF 45° AS SHOWN IN SECTION A-A.

STAINLESS STEEL SHALL BE A MINIMUM OF 0.8 mm ASTM A167, TYPE 304, MILL FINISH.

CARE SHALL BE USED WHEN STRIPPING FORMWORK SO AS NOT TO DAMAGE OR WRINKLE THE STAINLESS STEEL DRIP STRIP. TO FURTHER ENSURE THAT WRINKLING OF THE STRIPS DOES NOT OCCUR, AN ADEQUATE LENGTH BACKUP BAR SHALL BE USED DURING THE BENDING OUT OPERATION.

TOTAL QUANTITY FOR BID ITEM SHALL INCLUDE LINEAR FOOTAGE OF BOTH LOWER AND UPPER DRIP STRIPS.

PAYMENT SHALL BE AT THE CONTRACT PRICE BID FOR ITEM SPECIAL, LIN. FT. STEEL DRIP STRIP AND SHALL INCLUDE ALL MATERIALS, LABOR, TOOLS AND INCIDENTALS NECESSARY TO COMPLETE THIS ITEM.

DESIGN NO.	BUREAU OF BRIDGES AND STRUCTURAL DESIGN
STATE OF OHIO DEPARTMENT OF TRANSPORTATION	DATE 12-15-84
DESIGNED BY REZA	ENGINEER OF BRIDGES
CHECKED BY JS	
APPROVED BY LW	
DATE DS-1-94	
STANDARD	DRIP STRIP DETAIL FOR STRUCTURES WITH OVER THE SIDE DRAINAGE
1/1	

PLOT SUBMITTAL: D:25-FEB-1999 08:06

gnote.dgn

PLOTTED BY: nconley
PLOTTED FROM: i:\projects\pi\18728\gnote.dgn

REFERENCE SHALL BE MADE TO STANDARD DRAWINGS:

LISTED ON THE TITLE SHEET.

AND TO SUPPLEMENTAL SPECIFICATIONS:

LISTED ON THE TITLE SHEET.

AND TO PROPOSAL NOTES:

SEALING OF CONCRETE SURFACES

CONVERSION OF METRIC STANDARD DRAWINGS:

THE METRIC STANDARD DRAWINGS REFERENCED IN THIS PLAN SHALL BE CONVERTED TO ENGLISH UNITS USING THE SI (METRIC) TO ENGLISH CONVERSION FACTORS PROVIDED IN SECTION 109.011 OF THE CMS. THE APPENDIX OF ASTM E 380 SHALL BE UTILIZED FOR ANY ADDITIONAL CONVERSION FACTORS REQUIRED. CONVERSIONS SHALL BE APPROXIMATELY PRECISE AND SHALL REFLECT STANDARD INDUSTRY ENGLISH VALUES WHERE SUITABLE.

EXISTING STRUCTURE VERIFICATION:

DETAILS AND DIMENSIONS SHOWN ON THESE PLANS PERTAINING TO THE EXISTING STRUCTURE HAVE BEEN OBTAINED FROM PLANS OF THE EXISTING STRUCTURE AND FROM FIELD OBSERVATIONS AND MEASUREMENTS. CONSEQUENTLY, THEY ARE INDICATIVE OF THE EXISTING STRUCTURE AND THE PROPOSED WORK BUT THEY SHALL BE CONSIDERED TENTATIVE AND APPROXIMATE. THE CONTRACTOR IS REFERRED TO C.M.S. SECTIONS 102.05 AND 105.02. THE ORIGINAL CONSTRUCTION PLANS OF THE EXISTING BRIDGE ARE AVAILABLE UPON REQUEST AT THE DISTRICT 12 OFFICE OF THE OHIO DEPARTMENT OF TRANSPORTATION, GARFIELD HEIGHTS, OHIO.

CONTRACT BID PRICES SHALL BE BASED UPON A RECOGNITION OF THE UNCERTAINTIES DESCRIBED ABOVE AND UPON A PRE-BID EXAMINATION OF THE EXISTING STRUCTURE BY THE CONTRACTOR. HOWEVER, ALL PROJECT WORK SHALL BE BASED ON ACTUAL DETAILS AND DIMENSIONS WHICH HAVE BEEN VERIFIED BY THE CONTRACTOR IN THE FIELD.

DESIGN SPECIFICATIONS:

THIS STRUCTURE CONFORMS TO "STANDARD SPECIFICATIONS FOR HIGHWAY BRIDGES" ADOPTED BY THE AMERICAN ASSOCIATION OF STATE HIGHWAY AND TRANSPORTATION OFFICIALS, 1992, INCLUDING THE 1993, 1994, 1995, 1996, 1997 AND 1998 INTERIM SPECIFICATIONS, AND THE ODOT BRIDGE DESIGN MANUAL.

DESIGN DATA:

DECK PROTECTION METHOD:
MICRO-SILICA OVERLAY
STEEL DRIP STRIP

PLACING ASPHALT CONCRETE FEATHERING ON APPROACHES TO BRIDGES:

SPECIAL CARE SHALL BE TAKEN, WHEN PLACING THE ASPHALT CONCRETE FEATHERING TO EFFECT A SMOOTH TRANSITION FROM THE EXISTING APPROACH PAVEMENT TO THE BRIDGE DECK OR APPROACH SLAB. THE CONTRACTOR'S ATTENTION IS CALLED TO SECTION 404.16 OF THE CMS AND TO STANDARD DRAWING BP-3.1M FOR THE REQUIRED TOLERANCES.

LOCATIONS OF GUARDRAIL:

THE GUARDRAIL PROTECTION PROVIDED IN THIS PLAN SHALL BE LOCATED IN THE FIELD TO ASSURE THAT THE INSTALLATION WILL AFFORD THE MAXIMUM PROTECTION FOR TRAFFIC. THIS LOCATION SHALL BE POSITIONED AS FAR AS POSSIBLE FROM THE EDGE OF PAVEMENT WHILE MAINTAINING PROPER GRADE IN FRONT OF THE GUARDRAIL AS PER STANDARDS.

GUARDRAIL REPLACEMENT:

NO HAZARD SHALL BE LEFT UNPROTECTED EXCEPT FOR THE ACTUAL TIME NECESSARY TO REMOVE, GRADE, AND REINSTALL GUARDRAIL IN A CONTINUOUS OPERATION. THE REMOVAL OF ALL GUARDRAIL SHALL AT ALL TIMES BE AS DIRECTED BY THE ENGINEER. NO GUARDRAIL SHALL BE REMOVED UNTIL THE REPLACEMENT MATERIAL IS ON THE SITE, READY FOR INSTALLATION. FAILURE TO COMPLY WITH THIS REQUIREMENT SHALL BE DEEMED SUFFICIENT CAUSE TO ORDER WORK SUSPENDED ON THIS PROJECT UNTIL SUCH TIME THAT THE ENGINEER IS ASSURED OF SAID COMPLIANCE.

ITEM 202 - WEARING COURSE REMOVED, ASPHALT:

THIS ITEM OF WORK SHALL BE USED TO REMOVE THE EXISTING APPROACH SURFACE ASPHALT AS DESIGNATED IN THE PLANS.

PAYMENT FOR ALL OF THE ABOVE SHALL BE AT THE UNIT PRICE BID PER SQUARE YARD FOR ITEM 202 - WEARING COURSE REMOVED, ASPHALT AND SHALL INCLUDE ALL LABOR, EQUIPMENT, MATERIALS AND INCIDENTALS NECESSARY TO COMPLETE THE ABOVE WORK.

ITEM 202 - BRIDGE RAILING REMOVED, AS PER PLAN:

THIS ITEM SHALL BE USED TO REMOVE THE EXISTING DEEP BEAM RAIL AND TYPE I POSTS ON STRUCTURE GEA-87-0318 AS DETAILED IN THE PLANS. CARE SHALL BE TAKEN NOT TO DAMAGE THE EXISTING BRIDGE DECK. IF DAMAGE IS DONE IT SHALL BE REPAIRED AS PER THE ENGINEER AND AT THE CONTRACTOR'S EXPENSE.

PAYMENT FOR ALL OF THE ABOVE SHALL BE AT THE UNIT PRICE BID PER LINEAR FOOT FOR ITEM 202 - BRIDGE RAILING REMOVED, AS PER PLAN AND SHALL INCLUDE ALL LABOR, EQUIPMENT, MATERIALS AND INCIDENTALS NECESSARY TO COMPLETE THE ABOVE WORK.

ITEM 202 - BRIDGE RAILING REMOVED, AS PER PLAN:

THIS ITEM SHALL BE USED TO REMOVE THE EXISTING DEEP BEAM RAIL AND STEEL TUBULAR BACKUP ON STRUCTURES GEA-87-1133 AND GEA-87-1213. THE EXISTING STEEL POSTS SHALL REMAIN. THE STEEL TUBULAR BACKUP AND DEEP BEAM RAIL SHALL BE CAREFULLY DISMANTLED IN SUCH A MANNER AS TO NOT DAMAGE THE EXISTING STEEL POSTS AND THE EXISTING BRIDGE DECK. IF DAMAGE IS DONE, IT SHALL BE REPAIRED OR REPLACED WITH NEW STEEL POSTS AS PER THE ENGINEER AT THE CONTRACTOR'S EXPENSE.

THE DEEP BEAM RAIL, STEEL TUBULAR BACKUP AND ANY MISCELLANEOUS HARDWARE SHALL BECOME PROPERTY OF THE CONTRACTOR.

PAYMENT FOR ALL OF THE ABOVE SHALL BE AT THE UNIT PRICE BID PER LINEAR FOOT FOR ITEM 202 - BRIDGE RAILING REMOVED, AS PER PLAN AND SHALL INCLUDE ALL LABOR, EQUIPMENT, MATERIALS AND INCIDENTALS NECESSARY TO COMPLETE THE ABOVE WORK.

ITEM 202 - ANCHOR ASSEMBLY REMOVED, TYPE A:

THIS ITEM SHALL INCLUDE THE REMOVAL OF THE EXISTING TYPE A ANCHOR ASSEMBLY INCLUDING ALL POSTS, HARDWARE, RAIL ELEMENT, AND CONCRETE ANCHORS. ALL ITEMS REMOVED BECOME PROPERTY OF THE CONTRACTOR AND SHALL BE PROPERLY DISPOSED OF.

THE EXISTING CONCRETE ANCHOR AND POSTS SHALL BE REMOVED ENTIRELY. ALL HOLES REMAINING SHALL BE FILLED WITH GRANULAR MATERIAL OR EXCESS MATERIAL RESULTING FROM GUARDRAIL CONSTRUCTION. ALL FILL MATERIAL SHALL BE THOROUGHLY COMPACTED AND LEVELED AS DIRECTED BY THE ENGINEER.

PAYMENT FOR ALL OF THE ABOVE SHALL BE AT THE UNIT PRICE BID PER EACH FOR ITEM 202 - ANCHOR ASSEMBLY REMOVED, TYPE A AND SHALL INCLUDE ALL LABOR, EQUIPMENT, MATERIALS AND INCIDENTALS NECESSARY TO COMPLETE THE ABOVE WORK.

ITEM 202 - REMOVAL, MISC.: DRIP STRIP

THIS ITEM SHALL BE USED TO REMOVE THE EXISTING DRIP STRIP FROM EACH STRUCTURE.

PAYMENT FOR ALL OF THE ABOVE SHALL BE AT THE UNIT PRICE BID PER LINEAR FOOT FOR ITEM 202 - REMOVAL, MISC.: DRIP STRIP AND SHALL INCLUDE ALL LABOR, EQUIPMENT, MATERIALS AND INCIDENTALS NECESSARY TO COMPLETE THE ABOVE WORK.

DESIGN AGENCY		DISTRICT TWELVE	
PRODUCTION DEPARTMENT		DATE	2/99
REVIEWED	JUL	STRUCTURE FILE NUMBER	
DRAWN	MFC	REVISION	
DESIGNED	NRC	CHECKED	MJM
GENERAL NOTES			
GEA-87-13J8X11.33X1(2.13)			
		1/4	
		2/19	

PLOT SUBMITTED: 25-FEB-1999 08:06

gnote.dgn

PLOTTED BY: nconley
PLOT FROM: i:\projects\pi d18728\gnote.dgn

ITEM 203 - EMBANKMENT, AS PER PLAN:

EMBANKMENT SHALL BE PLACED AT LOCATIONS AS DIRECTED BY THE ENGINEER AS TO PROVIDE A SUITABLE AREA TO CONSTRUCT THE GUARDRAIL.

AREAS WHERE EMBANKMENT MATERIALS ARE TO BE PLACE SHALL BE SCALPED. THE REQUIREMENTS FOR MOISTURE, DENSITY CONTROL AND BENCHING SHALL BE WAIVED. THE DEPTH OF LAYERS IN WHICH THE EMBANKMENTS ARE PLACED AND THE METHOD OF COMPACTION SHALL BE DETERMINED BY THE ENGINEER. AFTER THE EMBANKMENT HAS BEEN PLACED, THE AREAS SHALL BE FERTILIZED, SEEDED, MULCHED, AND WATERED AS PER ITEM 659. THE COST SHALL BE INCLUDED IN THIS ITEM FOR PAYMENT. THE METHOD OF MEASUREMENT FOR EMBANKMENT MATERIAL SHALL BE THE NUMBER OF CUBIC YARDS MEASURED BY LOOSE VOLUME IN THE CARRIER AT THE WORK SITE, IN LIEU OF THE REQUIREMENTS OF 203.15, AND PAYMENT FOR ACCEPTED QUANTITIES WILL BE MADE AT THE CONTRACT PRICE BID PER CUBIC YARD FOR ITEM 203 - EMBANKMENT, AS PER PLAN AND SHALL INCLUDE ALL WORK DESCRIBED ABOVE AND AT ALL TIMES BE AS DIRECTED BY THE ENGINEER.

THE FOLLOWING ESTIMATED QUANTITY HAS BEEN CARRIED TO THE GENERAL SUMMARY:

ITEM 203 - EMBANKMENT, AS PER PLAN 100 CY

ITEM 407 - TACK COAT:

THE RATE OF APPLICATION OF THE 407 TACK COAT SHALL BE SUBJECT TO ADJUSTMENT AS DIRECTED BY THE ENGINEER. PLAN QUANTITIES INDICATE AN AVERAGE APPLICATION RATE OF 0.10 GALLONS PER SQUARE YARD OF TACK COAT FOR ESTIMATING PURPOSES ONLY.

ITEM SPECIAL - SEALING OF CONCRETE SURFACES (EPOXY-URETHANE):

SEAL AS PER THE DETAILS IN THE PLANS. SEE PROPOSAL NOTE "SEALING OF CONCRETE SURFACES" FOR SURFACE PREPARATION REQUIREMENTS, APPLICATION RATES, MATERIAL REQUIREMENTS, AND APPLICATION PROCEDURES.

PAYMENT FOR ALL OF THE ABOVE SHALL BE AT THE UNIT PRICE BID PER SQUARE YARD FOR ITEM SPECIAL - SEALING OF CONCRETE SURFACES (EPOXY-URETHANE) WHICH SHALL INCLUDE ALL LABOR, EQUIPMENT, MATERIALS, AND INCIDENTALS NECESSARY TO COMPLETE THE ABOVE WORK.

ITEM 517 - RAILING (DEEP BEAM RAIL WITH STEEL TUBULAR BACKUP AND TYPE 2 STEEL POSTS AND ANCHOR BOLTS), AS PER PLAN:

THIS ITEM SHALL BE USED FOR STRUCTURE GEA-87-0318 AS PER DETAILS IN THE PLAN.

ALL ITEMS REQUIRED TO CONSTRUCT THE PROPOSED BRIDGE RAIL AS SHOWN IN THE PLAN ARE INCIDENTAL TO THIS ITEM.

PAYMENT FOR ALL OF THE ABOVE SHALL BE AT THE UNIT PRICE BID PER LINEAR FOOT FOR ITEM 517 - RAILING (DEEP BEAM RAIL WITH STEEL TUBULAR BACKUP AND TYPE 2 STEEL POSTS AND ANCHOR BOLTS), AS PER PLAN AND SHALL INCLUDE ALL LABOR, EQUIPMENT, MATERIALS AND INCIDENTALS NECESSARY TO COMPLETE THE ABOVE WORK.

ITEM 517 - RAILING, MISC.: DEEP BEAM RAIL WITH STEEL TUBULAR BACKUP:

THIS ITEM SHALL BE USED ON STRUCTURES GEA-87-1133 AND GEA-87-1213.

THE BRIDGE RAILING SHALL BE CONSTRUCTED AS PER STANDARD DRAWING DBR-2-73M USING NEW DEEP BEAM RAIL, NEW TUBULAR BACKUP AND THE EXISTING STEEL POSTS. THE CONTRACTOR SHALL FURNISH NEW HARDWARE NECESSARY TO REBUILD THE RAIL.

PAYMENT FOR ALL OF THE ABOVE SHALL BE AT THE UNIT PRICE BID PER LINEAR FOOT FOR ITEM 517 - BRIDGE RAILING REBUILT AND SHALL INCLUDE ALL LABOR, EQUIPMENT, MATERIALS AND INCIDENTALS NECESSARY TO COMPLETE THE ABOVE WORK.

ITEM 517 - RAILING POST, WINGWALL MOUNTED:

THIS ITEM SHALL BE USED ON STRUCTURE GEA-87-0318 AS DETAILED IN THE PLANS.

PAYMENT FOR ALL OF THE ABOVE SHALL BE AT THE UNIT PRICE BID PER EACH FOR ITEM 517 - RAILING POST, WINGWALL MOUNTED AND SHALL INCLUDE ALL LABOR, EQUIPMENT, MATERIALS AND INCIDENTALS NECESSARY TO COMPLETE THE ABOVE WORK.

ITEM SPECIAL - STRUCTURE, MISC.: DRAINAGE HOLE:

THIS ITEM SHALL BE USED ON STRUCTURE GEA-87-1133 AS DETAILED IN THE PLANS.

PAYMENT FOR ALL OF THE ABOVE SHALL BE AT THE UNIT PRICE BID PER EACH FOR ITEM SPECIAL - STRUCTURE, MISC.: DRAINAGE HOLES AND SHALL INCLUDE ALL LABOR, EQUIPMENT, MATERIALS AND INCIDENTALS NECESSARY TO COMPLETE THE ABOVE WORK.

ITEM 673 - SEEDING AND EROSION CONTROL BLANKET, TYPE E:

THIS ITEM SHALL BE USED NEAR STRUCTURE GEA-87-0318 AT THE LOCATION DESIGNATED ON THE RAILING PLAN.

THE AREA SHALL FIRST RECEIVE ITEM 203 - EMBANKMENT, AS PER PLAN AS DIRECTED BY THE ENGINEER. THE EROSION CONTROL BLANKET LIMITS MAY BE ADJUSTED TO FIT THE CONDITIONS OF THE DITCH AND CREEK. THE DITCH SHALL BE LINED WITH THE EROSION CONTROL BLANKET AS WELL AS THE SLOPES. THIS ITEM MUST REMAIN WITHIN THE EXISTING RIGHT-OF-WAY.

THE FOLLOWING ESTIMATED QUANTITY SHALL BE USED AS DIRECTED BY THE ENGINEER:

ITEM 673 - SEEDING AND EROSION CONTROL BLANKET, TYPE E 45 SY

PAYMENT FOR ALL OF THE ABOVE SHALL BE AT THE UNIT PRICE BID PER SQUARE YARD FOR ITEM 673 - SEEDING AND EROSION CONTROL BLANKET, TYPE E WHICH SHALL INCLUDE ALL LABOR, EQUIPMENT, MATERIALS, AND INCIDENTALS NECESSARY TO COMPLETE THE ABOVE WORK.

ITEM 606 - ANCHOR ASSEMBLY, TYPE E-98:

THIS ITEM SHALL CONSIST OF FURNISHING AND INSTALLING EITHER OF THE FOLLOWING GUARDRAIL END TERMINALS.

- 1) THE ET-2000 (1997) MANUFACTURED BY SYRO INC., 1170 N. STATE STREET, GIRARD, OHIO 44420 (TELEPHONE: 330-545-4373).

THE LENGTH OF THE ET-2000 (1997) SYSTEM IS CONSIDERED TO BE 50'-0", INCLUSIVE OF TWO 25'-0" LONG RAIL ELEMENTS. INSTALLATION SHALL BE AT THE LOCATIONS SPECIFIED IN THE PLANS, IN ACCORDANCE WITH THE MANUFACTURER'S SPECIFICATIONS AS DETAILED ON THE FOLLOWING PRE-APPROVED SHOP DRAWINGS:

DWG. #	DRAWING NAME	DWG./REV. DATE	ODOT APPROVAL DATE
SS265M	ET-2000 (1997) PLAN, ELEVATIONS & SECTIONS	6/20/97	3/6/98

- 2) THE SKT-350 MANUFACTURED BY ROAD SYSTEMS, INC., 7631 NEW CASTLE DRIVE, FRANKFORT, IL 60423 (TELEPHONE: 815-464-5917).

THE LENGTH OF THE SKT-350 SYSTEM IS CONSIDERED TO BE 50'-0", INCLUSIVE OF FOUR 12'-6" LONG RAIL ELEMENTS. INSTALLATION SHALL BE AT THE LOCATIONS SPECIFIED IN THE PLANS, IN ACCORDANCE WITH THE MANUFACTURER'S SPECIFICATIONS AS DETAILED ON THE FOLLOWING PRE-APPROVED SHOP DRAWINGS:

DWG. #	DRAWING NAME	DWG./REV. DATE	ODOT APPROVAL DATE
SKT-4M	SEQUENTIAL KINKING TERMINAL (SKT-350) ASSEMBLY WITH 4 FOUNDATION TUBES	12/11/97	3/6/98

THE FACE OF THE TYPE E-98 IMPACT HEAD SHALL BE COVERED WITH A SHEET OF TYPE G REFLECTIVE SHEETING, PER CMS 730.19, APPROXIMATELY 1'-6" X 1'-6".

PAYMENT FOR THE ABOVE WORK SHALL BE MADE AT THE UNIT PRICE BID FOR ITEM 606 - ANCHOR ASSEMBLY, TYPE E-98, EACH, AND SHALL INCLUDE ALL LABOR, TOOLS, EQUIPMENT AND MATERIALS NECESSARY TO CONSTRUCT A COMPLETE AND FUNCTIONAL ANCHOR ASSEMBLY SYSTEM, INCLUDING ALL RELATED TRANSITIONS, REFLECTIVE SHEETING, HARDWARE AND GRADING, NOT SEPARATELY SPECIFIED, AS REQUIRED BY THE MANUFACTURER.

ITEM SPECIAL - RESHAPING BERM:

BERMS AND SHOULDERS AT LOCATIONS WHERE EXISTING GUARDRAIL IS REMOVED OR WHERE GUARDRAIL IS TO BE BUILT, SHALL BE RESHAPED AS DIRECTED BY THE ENGINEER TO INSURE A SMOOTH SURFACE FREE OF IRREGULARITIES. EXCESS MATERIAL RESULTING SHALL BE USED ELSEWHERE FOR THIS ITEM IF SO DIRECTED OR DISPOSED OF. THIS WORK SHALL NOT BE STARTED UNTIL AFTER THE RESURFACING AND BERM WORK HAS BEEN COMPLETED.

THE AREA IN FRONT OF THE GUARDRAIL SHALL BE GRADED AND RESHAPED TO PROVIDE AN AREA THAT HAS A SLOPE OF 10% MAX.

PAYMENT FOR ALL OF THE ABOVE SHALL BE AT THE UNIT PRICE BID PER LIN. FT. FOR ITEM SPECIAL - RESHAPING BERM WHICH SHALL INCLUDE ALL LABOR, EQUIPMENT, MATERIALS, AND INCIDENTALS NECESSARY TO COMPLETE THE ABOVE WORK.

DESIGN AGENCY: DISTRICT TWELVE PRODUCTION DEPARTMENT

DATE: 2/99

REVIEWED: JUL

DRAWN: MRC

DESIGNED: MRC

CHECKED: M/JM

GENERAL NOTES

GEA-87-13.18(11.33)(12.13)

2 / 4

3 / 19

ITEM SPECIAL - STRUCTURE, MISC.: SEALING CONCRETE WEARING SURFACE CONSTRUCTION JOINTS WITH HMWM:

A. DESCRIPTION

THIS ITEM SHALL CONSIST OF THE LABOR, MATERIALS, AND EQUIPMENT NECESSARY FOR THE APPLICATION OF SEALER TO NEW CONCRETE WEARING SURFACE CONSTRUCTION JOINTS IN ACCORDANCE WITH THESE SPECIFICATIONS, IN REASONABLY CLOSE CONFORMITY WITH THE PLANS AND THE MANUFACTURER'S RECOMMENDATIONS AND AS DIRECTED BY THE ENGINEER.

THIS WORK ITEM SHALL NOT BE PERFORMED DURING THE PERIOD BEGINNING NOVEMBER 1st AND ENDING MARCH 31st.

B. MATERIALS

THE MATERIAL USED FOR TREATING THE CONSTRUCTION JOINTS SHALL BE A LOW VISCOSITY, NON-FUMING, HIGH MOLECULAR WEIGHT METHACRYLATE (HMWM) RESIN CONFORMING TO THE FOLLOWING:

1. VISCOSITY SHALL BE LESS THAN 25 CPS (BROOKFIELD VISCOMETER, MODEL RVT WITH UL ADAPTER OR MODEL LVF, #1 SPINDLE AND UL ADAPTER @ 25 DEGREES CELSIUS (77 DEGREES FAHRENHEIT) ASTM D 1824)
2. DENSITY SHALL BE GREATER THAN 1.0 kg/L (8.4 LBS/GAL) @ 25 DEGREES CELSIUS (77 DEGREES FAHRENHEIT) (ASTM D 2849)
3. FLASH POINT SHALL BE GREATER THAN 93 DEGREES CELSIUS (200 DEGREES FAHRENHEIT) (PENSKY-MARTENS CC) (ASTM D 93)
4. VAPOR PRESSURE SHALL BE LESS THAN 1.0 mm Hg @ 25 DEGREES CELSIUS (77 DEGREES FAHRENHEIT) (ASTM D 323)
5. TG (DSL) SHALL BE GREATER THAN 58 DEGREES CELSIUS (135 DEGREES FAHRENHEIT) (ASTM D 3418)
6. SHELF LIFE SHALL BE 1 YEAR MINIMUM AT MANUFACTURER'S RECOMMENDED ENVIRONMENTAL CONSIDERATIONS.
7. GEL TIME SHALL BE GREATER THAN 40 MINUTES - 100 G MASS (ASTM D 2471) (THIN FILM)
8. PERCENT SOLIDS SHALL BE GREATER THAN 90% BY WEIGHT
9. BOND STRENGTH SHALL BE GREATER THAN 1500 PSI (ASTM 882)

THE RESIN MAY BE OBTAINED FROM ONE OF THE FOLLOWING SUPPLIERS:

3M COMPANY
3M CENTER
ST. PAUL, MN 55144-1000
PHONE: 1-612-733-7119

SIKA CORPORATION
201 POLITO AVENUE
LYNDHURST, NJ 07071
PHONE: 1-201-933-8800

ADHESIVE ENGINEERING COMPANY
CONGRESIVE 2075
1411 INDUSTRIAL ROAD
SAN CARLOS, CA 94070
PHONE: 1-415-592-7900

TRANSCO INDUSTRIES, INC.
20 JONES STREET
NEW ROCHELLE, NY 10801
PHONE: 1-914-636-1000

A COMPATIBLE PROMOTOR/INITIATOR SYSTEM CAPABLE OF PROVIDING THE SAME PHYSICAL QUALITIES OF THE HARDENED RESIN AS IF PROMOTED/INITIATED WITH 2% COBALT NAPHTHANATE (6%) AND 2% CUMENE HYDROPEROXIDE SHALL ALSO BE PROVIDED. MATERIALS SHALL BE STORED AT 18-27 DEGREES CELSIUS (65-80 DEGREES FAHRENHEIT). THE SYSTEM SHALL PROVIDE A RESIN SET TIME OF NOT LESS THAN 40 MINUTES TO NOT MORE THAN 1-1/2 HOURS AT THE TIME AND TEMPERATURE OF APPLICATION. THE GEL TIME SHALL BE ADJUSTED TO COMPENSATE FOR THE CHANGE IN TEMPERATURE THROUGHOUT THE DAY. THE TEMPERATURE OF THE SURFACES TO BE TREATED MAY RANGE FROM 10 DEGREES CELSIUS (50 DEGREES FAHRENHEIT) TO 50 DEGREES CELSIUS (120 DEGREES FAHRENHEIT). THE CONTRACTOR SHALL ARRANGE TO HAVE A TECHNICAL REPRESENTATIVE ON SITE TO PROVIDE MIXING PROPORTIONS, EQUIPMENT SUITABILITY, AND SAFETY ADVICE TO THE CONTRACTOR AND ENGINEER. ANY CONFLICT BETWEEN THESE PROVISIONS AND REPRESENTATIVE'S ADVICE SHALL BE RESOLVED AT THE JOB SITE. THE TECHNICAL REPRESENTATIVE SHALL REMAIN AT THE JOB SITE UNTIL SUCH TIME AS HE AND THE ENGINEER AGREE THAT THE CONTRACTOR IS QUALIFIED IN ALL ASPECTS OF THE APPLICATION OF THE SEALER.

THE PROMOTER AND INITIATOR, IF SUPPLIED SEPARATE FROM THE RESIN, SHALL NOT CONTACT EACH OTHER DIRECTLY. CONTAINERS OF PROMOTERS OR INITIATORS SHALL NOT BE STORED TOGETHER IN A MANNER THAT WILL ALLOW LEAKAGE OR SPILLAGE FROM ONE TO CONTACT THE CONTAINERS OR MATERIAL OF EACH OTHER.

BEFORE USING THE MATERIAL THE CONTRACTOR SHALL SUBMIT TO ODOT'S BUREAU OF TESTING COPIES OF THE MANUFACTURER'S CERTIFIED TEST DATA SHOWING THAT THE MATERIAL COMPLIES WITH THE QUALITATIVE AND QUANTITATIVE REQUIREMENTS OF THE SPECIFICATION. THE TEST DATA SHALL BE DEVELOPED BY AN INDEPENDENT APPROVED TESTING LABORATORY, AND SHALL INCLUDE THE BRAND NAME OF THE MATERIAL, NAME OF THE MANUFACTURER, NUMBER OF THE LOT TESTED AND DATE OF MANUFACTURE. WHEN THE MATERIAL HAS BEEN APPROVED BY THE DIRECTOR, FURTHER TESTING BY THE MANUFACTURER WILL NOT BE REQUIRED UNLESS THE FORMULATION OF MANUFACTURING PROCESS HAS BEEN CHANGED, IN WHICH CASE NEW CERTIFIED TEST RESULTS WILL BE REQUIRED. THE MANUFACTURER SHALL CERTIFY THAT THE FORMULATION IS THE SAME AS THAT FOR WHICH DATA HAS BEEN SUBMITTED. THE STATE RESERVES THE RIGHT TO SAMPLE AND TEST DELIVERED LOTS FOR COMPLIANCE.

C. APPLICATION

APPLICATION OF THE CONSTRUCTION JOINT SEALER MATERIAL SHALL BE IN STRICT ACCORDANCE WITH THE SUPPLIER'S CURRENT PUBLISHED INSTRUCTIONS AND/OR SPECIFIC INSTRUCTIONS OF THE MANUFACTURER'S TECHNICAL REPRESENTATIVE AND AS FOLLOWS. THE CONSTRUCTION JOINT AREA TO BE TREATED SHALL REMAIN DRY FOR A MINIMUM OF 8 HOURS AND ABOVE 10 DEGREES CELSIUS (50 DEGREES FAHRENHEIT) PRIOR TO APPLICATION. CONSTRUCTION JOINTS SHALL BE DIRECTLY SEALED WITH HMWM RESIN APPLIED WITH PLASTIC SQUEEZE BOTTLES, CAULKING OR OTHER EQUIPMENT CAPABLE OF DELIVERING A NARROW RESIN STREAM AND APPROVED BY THE ENGINEER. ADDITIONAL APPLICATION OF MATERIAL TO THE CONSTRUCTION JOINT AREA CAN BE ANTICIPATED IF THE INITIAL APPLICATION DISSIPATES FULLY INTO THE CONSTRUCTION JOINT. IN THESE AREAS, A SECOND COAT WILL BE REQUIRED AFTER THE FIRST COAT HAS STARTED TO CURE.

THE CONTRACTOR SHALL TAKE ALL STEPS NECESSARY TO PREVENT ANY RESIN FROM FLOWING INTO LANES OPEN TO TRAFFIC.

CLEANING AND FLUSHING OF EQUIPMENT, TOOLS, ETC. SHALL BE DONE WITH AN APPROPRIATE SOLVENT, AS APPROVED BY THE ENGINEER, IN SUCH A MANNER TO MINIMIZE PERSONAL AND ENVIRONMENTAL HAZARDS. WORKMEN SHOULD BE ADVISED THE RESIN WILL SOFTEN GUM RUBBER SOLES, AND A FACE-MASK SHOULD BE USED TO PROTECT FROM ACCIDENTAL SPLASHES. CLOTHING AND LEATHER SATURATED WITH RESIN WILL HARDEN AND BECOME USELESS.

A TECHNICAL REPRESENTATIVE OF THE MANUFACTURER OR SUPPLIER MUST BE PRESENT ON SITE PRIOR TO STARTING APPLICATION.

E. RESTRICTIONS

TRAFFIC AND EQUIPMENT SHALL NOT BE PERMITTED ON THE SEALED CONSTRUCTION JOINTS UNTIL THE UNTIL THE HMWM IS TACK FREE AND A MINIMUM OF 6 HOURS HAVE ELAPSED SINCE APPLICATION. THE RESIN SHALL BE PROTECTED FROM MOISTURE FOR NOT LESS THAN 4 HOURS AFTER PLACEMENT.

F. METHOD OF MEASUREMENT

SEALING CONCRETE CONSTRUCTION JOINTS WITH HMWM RESIN SHALL BE MEASURED AS THE ACTUAL LENGTH IN LINEAR FOOT OF CONSTRUCTION JOINT SEALED.

G. BASIS OF PAYMENT

ACCEPTED QUANTITIES OF SEALING NEW CONCRETE WEARING SURFACE CONSTRUCTION JOINTS WITH HMWM RESIN SHALL BE PAID FOR AT THE UNIT PRICE BID PER LINEAR FOOT WHICH PRICE AND PAYMENT SHALL BE FULL COMPENSATION FOR ALL MATERIAL, APPLICATION OF THE RESIN, PROVIDING MANUFACTURER'S TECHNICAL REPRESENTATIVE, PROTECTION OF WATERWAYS AND TRAFFIC BELOW BRIDGE, CLEAN UP AND FOR ALL LABOR, TOOLS, EQUIPMENT AND INCIDENTALS NECESSARY TO COMPLETE THE WORK.

PAYMENT SHALL BE MADE UNDER:

ITEM	UNIT	DESCRIPTION
SPECIAL	LINEAR FOOT	STRUCTURE, MISC.: SEALING CONCRETE WEARING SURFACE CONSTRUCTION JOINTS WITH HMWM RESIN

ITEM 848:

REFER TO THE FOLLOWING SUPPLEMENTAL SPECIFICATION: "BRIDGE DECK REPAIR AND OVERLAY WITH CONCRETE USING HYDRODEMOLITION".

PLOT SUBMITTED: 25-FEB-1999 08:06

gnote.dgn

PLOTTED BY: nconley
PLOTTED FROM: i:\projects\pi\18728\gnote.dgn

DISTRICT TWELVE
PRODUCTION DEPARTMENT

DATE: 1-98
REVIEWED: GWM
STRUCTURE FILE NUMBER

DRAWN: NRC
DESIGNED: JRC
CHECKED: JUL

GENERAL NOTES

GEA-87-13.18(11.33)(12.13)

PLOTTED BY: mconley
PLOTTED FROM: i:\projects\p1d18728\gnote.dgn
gnote.dgn
PLOT SUBMITTED: 25-FEB-1999 08:06

ITEM 614 - TEMPORARY CENTER LINE, CLASS 1:
ITEM 614 - TEMPORARY EDGE LINE, CLASS 1:
ITEM 614 - TEMPORARY STOP LINE, CLASS 1:

THE CONTRACTOR SHALL BE REQUIRED TO INSTALL VARIOUS TYPES OF PAVEMENT MARKINGS ACCORDING TO THE FOLLOWING CRITERIA CONTINGENT UPON THE SEQUENCE OF CONSTRUCTION. TEMPORARY PAVEMENT MARKINGS SHALL BE 740.05 TYPE C PREFORMED MATERIAL OR 642 PAINT APPLIED USING THE FOLLOWING CRITERIA: ALL TEMPORARY MARKINGS INSTALLED ON THE FINISHED ASPHALT SURFACE SHALL BE 740.05, TYPE C MATERIAL. PAINT MAY BE USED FOR TEMPORARY MARKINGS INSTALLED ON PAVEMENT THAT WILL BE RESURFACED IN THE PROJECT.

PAYMENT FOR ALL OF THE ABOVE SHALL BE AT THE UNIT PRICE BID PER MILE OR LIN. FT. FOR THE APPROPRIATE ITEM 614 WHICH SHALL INCLUDE ALL LABOR, EQUIPMENT, MATERIALS, AND INCIDENTALS NECESSARY TO COMPLETE THE ABOVE WORK.

MAINTENANCE OF TRAFFIC:

FOR STRUCTURES GEA-87-0318, GEA-87-1133 AND GEA-87-1213:

TWO LANE, TWO WAY TRAFFIC SHALL BE MAINTAINED AT ALL TIMES EXCEPT THAT THROUGH TRAFFIC ON THE ABOVE STRUCTURES SHALL HAVE A SIGNALIZED CLOSURE, AS SHOWN ON THE MAINTENANCE OF TRAFFIC SHEET (FOR EACH STRUCTURE), OF A MAXIMUM OF 20 CONSECUTIVE CALENDAR DAYS (TOTAL FOR BOTH PHASES). THE 20 CONSECUTIVE DAYS SHALL BE CONSIDERED AS AN INTERIM COMPLETION DATE (CMS 108) AND FOR EACH CALENDAR DAY BEYOND THE 20 CALENDAR DAYS THAT THE HIGHWAY REMAINS IN A SIGNALIZED CLOSURE, THE CONTRACTOR WILL BE ASSESSED LIQUIDATED DAMAGES AS PER CMS 108.07.

CLOSURES FOR STRUCTURES GEA-87-1133 AND GEA-87-1213 SHALL BE DONE CONCURRENTLY. GEA-87-0318 MAY BE DONE CONCURRENTLY.

THE LOCATION OF THE TRANSITION TAPER AND THE ADVANCE WARNING SIGNS SHOULD BE ADJUSTED TO PROVIDE FOR ADEQUATE SIGHT DISTANCE FOR THE EXISTING VERTICAL AND HORIZONTAL ROADWAY ALIGNMENT.

THE SPACING BETWEEN THE PROPOSED SIGNS SHOULD BE ADJUSTED TO NOT CONFLICT WITH AND TO PROVIDE A MINIMUM CLEARANCE OF 200 FT TO EXISTING SIGNS.

A MINIMUM OF FIVE (5) DRUMS SHALL BE USED TO CLOSE THE SHOULDER.

THE CONTRACTOR SHALL COVER ALL EXISTING SIGNS WHICH CONFLICT WITH THE TRAFFIC CONTROL PHASES SHOWN IN THE PLAN PER 614.03.

THE EXISTING CONFLICTING PAVEMENT MARKINGS AND REFLECTORS FROM THE RAISED PAVEMENT MARKERS (RPMS) SHALL BE REMOVED AND THE APPROPRIATE COLOR TEMPORARY EDGE LINES SHALL BE APPLIED ALONG THE TAPER. TEMPORARY PAVEMENT MARKINGS WHICH WOULD CONFLICT WITH FINAL TRAFFIC LANES SHALL BE REMOVABLE (740.05 TYPE C) TAPE UNLESS THE AREA WILL BE RESURFACED IN THE NEXT WORK PHASE AFTER COMPLETION OF THE WORK, TEMPORARY MARKINGS SHALL BE REMOVED IN ACCORDANCE WITH 641.10 AND THE ORIGINAL MARKINGS AND RAISED PAVEMENT MARKER REFLECTORS SHALL BE RESTORED.

WITHIN THE LENGTH OF THE CLOSURE, PROVISION SHALL BE MADE TO CONTROL TRAFFIC ENTERING FROM INTERSECTING STREETS AND DRIVEWAYS. THREE (3) DRUMS SHALL BE PLACED ACROSS THE CLOSED LANE AT EACH INTERSECTION AND DRIVEWAY.

NO EQUIPMENT OR MATERIAL SHALL BE LOCATED OTHER THAN BEHIND THE PORTABLE CONCRETE BARRIER.

FOR STRUCTURE GEA-87-1133, SEE ADDITIONAL MAINTENANCE OF TRAFFIC NOTES ON SHEET 4A 7 4.

AT ALL OTHER LOCATIONS:

TWO WAY TRAFFIC SHALL BE MAINTAINED AT ALL TIMES EXCEPT DURING WORKING HOURS, WHEN ONE LANE MAY BE CLOSED USING FLAGGERS AS PER STANDARD DRAWINGS MT-97.10M.

ALL WORK AND TRAFFIC CONTROL DEVICES SHALL BE IN ACCORDANCE WITH 614 AND ALL OTHER APPLICABLE PORTIONS OF THE CMS AS WELL AS IN ACCORDANCE WITH PART 7 OF THE OMUTCD. PAYMENT FOR ALL LABOR, EQUIPMENT AND MATERIALS TO PROVIDE THIS METHOD OF TRAFFIC CONTROL SHALL BE INCLUDED IN THE LUMP SUM BID FOR ITEM 614 - MAINTAINING TRAFFIC, UNLESS SEPARATELY ITEMIZED IN THE PLAN.

DESIGN AGENCY
DISTRICT TWELVE
PRODUCTION DEPARTMENT

DATE
2/99
REVIEWED
JLL
STRUCTURE FILE NUMBER

DRAWN
NRC
CHECKED
NRC
M/JM

GENERAL NOTES

GEA-87-1318(11.33)(12.13)

4 / 4

5
19

PLOTTED BY: nconley
 PLOTTED FROM: i:\projects\p18728\gnote.dgn
 PLOT SUBMITTED: 25-FEB-1999 08:06
 gnote.dgn

MAINTENANCE OF TRAFFIC FOR STRUCTURE GEA-87-1133:

GENERALLY THE CONTRACTOR SHALL CONDUCT HIS OPERATIONS AS TO MAKE THE PROPOSED REPAIRS WITH A MINIMUM OF HAZARD, DELAY AND INCONVENIENCE TO THE MOTORIST USING THE HIGHWAY AFFECTED BY THE WORK DONE UNDER THIS CONTRACT. FURTHERMORE, IN ADDITION TO THE CONSTRUCTION AND MATERIAL SPECIFICATIONS, THE FOLLOWING SPECIFIC PROVISIONS ARE MANDATORY:

I. NOTIFICATION:

SINCE TRAFFIC AND MAINTENANCE IS A MAJOR CONCERN OF THIS PROJECT IT IS ESSENTIAL THAT THE MOTORING PUBLIC BE ADEQUATELY FOREWARNED OF FUTURE LANE CLOSURES AND TRAFFIC CONSTRICTIONS. THEREFORE, THE CONTRACTOR SHALL SUBMIT A SCHEDULE TO THE OHIO DEPARTMENT OF TRANSPORTATION INDICATING THE DATE OF EACH LANE CLOSURE AT LEAST THREE (3) DAYS PRIOR TO THE IMPLEMENTATION OF ANY SUCH CLOSURE.

II. MAINTENANCE OF TRAFFIC SYSTEMS:

A. MINIMUM PROVISIONS. THE CONTRACTOR SHALL FURNISH AND MAINTAIN ALL NECESSARY TRAFFIC CONTROL DEVICES AS REQUIRED BY THE PLANS AND SPECIFICATIONS AND THE "OHIO MANUAL OF UNIFORM TRAFFIC CONTROL DEVICES FOR STREETS AND HIGHWAYS", HEREINAFTER REFERRED TO AS THE "MANUAL".

THE TRAFFIC CONTROL SYSTEMS IN THE "MANUAL" AND THESE PLANS CONSTITUTE THE MINIMUM PROVISIONS FOR MAINTAINING TRAFFIC. WHENEVER THE ENGINEER DEEMS ADDITIONAL OR ALTERNATIVE DEVICES NECESSARY, HE MAY DIRECT THAT THEY BE USED.

B. CONDITIONS. TWO-WAY TRAFFIC ON ONE 11 FOOT MINIMUM LANE SHALL BE MAINTAINED 24 HOURS PER DAY DURING EACH CONSTRUCTION PHASE ON GEA-87-1133.

C. FLAGGERS. THE MAINTENANCE OF TRAFFIC PLANS REQUIRE THE CONCURRENT USE OF TWO (2) FLAGGERS. ADDITIONAL FLAGGERS SHALL BE USED AS DIRECTED BY THE ENGINEER IF DEEMED NECESSARY BY THE ENGINEER.

D. ADVANCE WARNING SIGNS. ALL ADVANCE WARNING SIGNS FOR ANY TRAFFIC RESTRICTION SHALL BE ERECTED BEFORE ANY SUCH RESTRICTION IS PUT INTO EFFECT. ALL SIGNS SHALL BE COVERED OR REMOVED FROM THE VIEW OF TRAFFIC WHENEVER THEY ARE NOT APPLICABLE.

E. FAILURE TO COMPLY. IF THERE IS ANY FAILURE TO COMPLY WITH THE PROVISIONS FOR TRAFFIC MAINTENANCE SET OUT IN THE PLANS, NOTES OR "MANUAL", THE HIGHWAY IN THE VICINITY OF THE WORK SHALL BE CONSIDERED IN A CONDITION FOR THE SAFE AND CONVENIENT USE BY THE TRAVELING PUBLIC, WHICH SHALL BE A BREACH OF THIS CONTRACT.

III. SIGNALIZED CLOSING:

A. DRUMS AND TEMPORARY BARRIERS SHALL BE PLACED AS SHOWN ON THE MAINTENANCE OF TRAFFIC PLANS.

B. SIGNALS SHALL BE INSTALLED AND OPERATED IN ACCORDANCE WITH THESE PLANS AND THE REQUIREMENTS OF PART 6 OF THE "MANUAL".

C. ADEQUATE AREA ILLUINATION TO CLEARLY IDENTIFY THE WORK AREA AT NIGHT SHALL BE PROVIDED BY USING 150 WATT MINIMUM SODIUM LUMINAIRES OR 250 WATT MINIMUM MERCURY LUMINAIRES. ONE LUMINAIRE SHALL BE LOCATED ADJACENT TO EACH SIGNAL AS SHOWN IN THE MAINTENANCE OF TRAFFIC PLANS. THE MOUNTING HEIGHT FOR THE TEMPORARY LUMINAIRE SHALL BE A MINIMUM OF 27 FEET ABOVE THE PAVEMENT AND THE OVERHEAD CONDUCTOR CLEARANCE SHALL BE 20 FEET ABOVE THE PAVEMENT.

D. TEMPORARY NO PASSING LINES AND STOP LINES SHALL BE INSTALLED. REMOVABLE PAVEMENT MARKINGS MAY BE USED. EXISTING CONFLICTING PAVEMENT MARKINGS BETWEEN THE WORK AREA AND STOP LINE SHALL BE REMOVED. AFTER COMPLETEION OF WORK, TEMPORARY MARKINGS SHALL BE REMOVED IN ACCORDANCE WITH CMS 614.10.

E. THE TYPE "A" FLASHING BARRICADE WARNING LIGHTS SHALL BE MOUNTED ON DESIGNATED ADVANCE WARNING SIGNS AT ALL TIMES.

WORK SHALL BE SUSPENDED UNTIL THE CONTRACTOR COMPLIES WITH THE PROVISIONS OF THE AFOREMENTIONED ITEMS.

IV. MAINTENANCE OF TRAFFIC MATERIAL:

A. SIGNS. SIGN DIMENSIONS AND SPECIFICATIONS, INCLUDING LETTER SIZE, SHALL BE AS PROVIDED IN THE "MANUAL", OR IN SIGN DESIGN DRAWINGS PROVIDED BY THE DEPARTMENT OF TRANSPORTATION. THE SIGNS SHALL BE SUBJECT TO APPROVAL OF THE ENGINEER PRIOR TO THE START OF THE PROJECT.

B. SIGN SUPPORTS. SIGN SUPPORTS SHALL BE OF SUFFICIENT SIZE AND HEIGHT AS TO SUPPORT THE SIGNS AS THE HEIGHT INDICATED IN THE "MANUAL" ON PLATE C-1. SUPPORTS SHALL ALSO BE ADEQUATE IN MASS AND STABILITY TO PREVENT THE SIGNS FROM BEING BLOWN OVER BY THE WIND OR VEHICULAR GENERATED AIR TURBULENCE.

C. CONES. STANDARD RUBBER OR PLASTIC CONES SHALL BE USED. CONES SHALL BE AT LEAST 36" HIGH AND SHALL BE PREDOMINANTLY ORANGE IN COLOR. ALL CONES SHALL HAVE WEIGHTED BASES.

D. DRUMS. DRUMS SHALL CONFORM TO THE PERTINENT SECTIONS OF THE "MANUAL" ALL COSTS FOR INSTALLATION, MAINTENANCE AND SUBSEQUENT REMOVAL OF SAID DRUMS SHALL BE INCLUDED IN THE LUMP SUM PRICE BID FOR ITEM 614 - MAINTAINING TRAFFIC.

E. TYPE "C" STEADY BURNING BARRICADE WARNING LIGHTS SHALL BE MOUNTED ON ALL DRUMS AND TYPE "A" WARNING LIGHTS SHALL BE PLACED ON SIGNS AS SHOWN ON PLANS FOR OVERNIGHT CLOSURES.

F. CONTRACTOR MUST SUBMIT A SIGN PHASING DIAGRAM AND TIMING CHART ONE (1) WEEK PRIOR TO SIGNAL OPERATIONS FOR APPROVAL BY THE ENGINEER.

G. WHEN SIGNALS ARE NOT IN USE THEY MUST BE REMOVED OR BAGGED.

H. THE CONTRACTOR SHALL BE RESPONSIBLE FOR THE 24 HOUR PER DAY MAINTENANCE OF THE ONE LANE ROAD TRAFFIC SIGNALS. THE DAY AND NIGHT TELEPHONE NUMBERS OF THE CONTRACTOR'S SIGNAL MAINTENANCE ORGANIZATION MUST BE SUPPLIED TO THE LOCAL POLICE AGENCIES AND ODOT. THE ELAPSED TIME BETWEEN THE SIGNAL PROBLEM CALL AND SERVICEMAN'S ARRIVAL AT THE PROJECT SITE SHALL NOT EXCEED 60 MINUTES. SIGNAL INSTALLATION AND MAINTENANCE SHALL BE PERFORMED ONLY BY A QUALIFIED SIGNAL MAINTENANCE ORGANIZATION.

I. SIGNAL AND CLOSURE INSTALLATIONS SHALL BE MADE DURING DAYLIGHT ON MONDAY THROUGH THURSDAY.

J. THE CONTRACTOR, AT HIS COST, SHALL BE REQUIRED TO PROVIDE A SEPARATE POWER SERVICE CONNECTION POINT TO THE LOCAL POWER COMPANY TO PROVIDE AND MAINTAIN ELECTRIC POWER TO HIS CONSTRUCTION SIGNAL.

K. SIGNAL WIRING OTHER THAN OVERHEAD AND UNDERGROUND MUST BE APPROVED BY THE ENGINEER. ALL WIRING ATTACHED TO POLE SHALL BE PROTECTED BY CONDUIT. ALL SPLICES SHALL BE MADE BY APPROVED SPLICE KITS INSTALLED IN PULL BOXES OR APPROVED ENCLOSURES.

L. ALL TRAFFIC SIGNALS AND EQUIPMENT USED IN THE SIGNAL INSTALLATIONS, SUCH AS A SIGNAL CANLE AND SIGNAL HEADS, SHALL BE IN CONFORMANCE WITH SPECIFICATIONS 632 AND 732. HOWEVER, THE PERFORMANCE TEST PROVISIONS NOTED IN SPECIFICATIONS 632.27, PARAGRAPH 6 AND THE WORKING DRAWING REQUIREMENT OF 632.02 ARE WAIVED. THE CONTROLLER, FLASHERS, LOAD SWITCHES, CONFLICT MONITOR AND OTHER CONTROLLER ACCESSORIES SHALL COMPLY WITH SPECIFICATIONS 633 AND 733 EXCEPT THAT THE REQUIREMENTS OF 633.03 AND 633.05 ARE WAIVED. USED EQUIPMENT MEETING CURRENT ODOT SPECIFICATIONS IS ACCEPTABLE. THE CONTROLLER TO BE USED SHALL BE AN ACTUATED, 3-PHASE, SOLID STATE DIGITAL MICROPROCESSOR WITH POLE MOUNTED CABINET, IN WITH THE CMS. WHEN THE SIGNAL IS CHANGED TO A FLASH CONDITION EITHER MANUALLY OR AUTOMATICALLY, RED SHALL BE FLASHED TO ALL APPROACHED.

V. PAYMENT. TEMPORARY SIGNAL INSTALLATION IS TO BE COMPLETE AND OPERATIONAL AS PER THE PHASING DIAGRAM AND DETAILED SHEETS FOR PHASE A AND PHASE B. ALL MATERIAL, LABOR, AND EQUIPMENT REQUIRED TO INSTALL AND REMOVE THE TEMPORARY TRAFFIC CONTROL DEVICES AND SIGNALS SHALL BE INCLUDED IN THE LUMP SSUM PRICE BID FOR ITEM 614 - MAINTAINING TRAFFIC.

DESIGNED NRC	CHECKED MJM	DRAWN NRC	REVISED	DATE JUL 2/99	STRUCTURE FILE NUMBER
GENERAL NOTES					
GEA-87-13.18(11.33)(12.13)					
				4A	4
5A 19					
DESIGN AGENCY DISTRICT TWELVE PRODUCTION DEPARTMENT					

PLOT SUBMITTED: 25-FEB-1999 08:08

equan.dgn

PLOTTED BY: nconley
 PLOTTED FROM: i:\projects\p18728\equan.dgn

SHEET NO.											ITEM	EXTENSION	GRAND TOTAL	UNIT	DESCRIPTION
3	8	9	10	12	13	14	16	17	18						
		243.75			175			375			202	38000	793.75	LF	ROADWAY GUARDRAIL REMOVED
		4			4			4			202	42000	12	EA	ANCHOR ASSEMBLY REMOVED, TYPE A
100											203	20001	100	CY	EMBANKMENT, AS PER PLAN
		275			325			400			606	13000	1000	LF	GUARDRAIL, TYPE 5
					2						606	20000	2	EA	FLARED END SECTION
		3			2			2			606	22010	7	EA	ANCHOR ASSEMBLY, TYPE E-98
		1						2			606	26500	3	EA	ANCHOR ASSEMBLY, TYPE T
		4			4			4			606	35140	12	EA	BRIDGE TERMINAL ASSEMBLY, TYPE 4
		475			440			530			SPECIAL	60650000	1445	LF	RESHAPING BERM
45											673	10000	45	SY	SEEDING AND EROSION CONTROL BLANKET, TYPE E
															PAVEMENT
		178			200			167			202	23500	545	SY	WEARING COURSE REMOVED, ASPHALT
		18			20			17			407	10000	55	GAL	TACK COAT
		6.2			7.0			5.8			448	47020	19	CY	ASPHALT CONCRETE SURFACE COURSE, TYPE 1, PG64-22
															MAINTENANCE OF TRAFFIC
					370			282			614	12800	950	EA	TEMPORARY RAISED PAVEMENT MARKER
					28			28			614	13202	84	EA	BARRIER REFLECTOR, TYPE A2
					22			24			614	13302	64	EA	BARRIER REFLECTOR, TYPE B2
					24			26			614	13350	70	EA	OBJECT MARKER
					0.06			0.06			614	21000	0.18	MI	TEMPORARY CENTER LINE, CLASS 1
					0.04			0.03			614	22000	0.11	MI	TEMPORARY EDGE LINE, CLASS 1
					22			32			614	26000	76	LF	TEMPORARY STOP LINE, CLASS 1
					300			250			622	40020	850	LF	PORTABLE CONCRETE BARRIER, 32"
					220			260			622	40040	620	LF	PORTABLE CONCRETE BARRIER, 32", BRIDGE MOUNTED
															TRAFFIC CONTROL
					9			9			626	00100	27	EA	BARRIER REFLECTOR, TYPE A
					0.16			0.17			642	00102	0.47	MI	EDGE LINE, TYPE 2
					0.08			0.08			642	00302	0.23	MI	CENTER LINE, TYPE 2
								10			642	00502	10	LF	STOP LINE, TYPE 2
															GEA-87-0318, SFN 2800667 SEE STRUCTURE SUMMARY ON SHEET <u>7</u>
															GEA-87-1133, SFN 2800721 SEE STRUCTURE SUMMARY ON SHEET <u>7</u>
															GEA-87-1213, SFN 2800756 SEE STRUCTURE SUMMARY ON SHEET <u>7</u>
											614	11000	LUMP		MAINTAINING TRAFFIC
											624	10000	LUMP		MOBILIZATION

DESIGN AGENCY: DISTRICT TWELVE
 PRODUCTION DEPARTMENT
 DATE: 2/99
 REVIEWED: JUL
 STRUCTURE FILE NUMBER:
 DRAWN: NRC
 REVISION:
 DESIGNED: NRC
 CHECKED: M/JM
GENERAL SUMMARY
GEA-87-1318(11.33)(12.13)
 6
 19

PLOT SUBMITTED: 25-FEB-1999 08:08

equan.dgn

PLOTTED BY: nconley
 PLOTTED FROM: I:\projects\p1d18728\equan.dgn

ITEM	EXTENSION	QUANTITY	UNIT	DESCRIPTION
STRUCTURE NO.: GEA-87-0318, SFN 2800667				
202	38501	225	LF	BRIDGE RAILING REMOVED, AS PER PLAN
202	98200	208	LF	REMOVAL, MISC.: DRIP STRIP
SPECIAL	51267510	82	SY	SEALING OF CONCRETE SURFACE (EPOXY-URETHANE)
517	72301	237.5	LF	RAILING (DEEP BEAM RAIL WITH STEEL TUBULAR BACKUP AND TYPE 2 STEEL POSTS AND ANCHOR BOLTS), AS PER PLAN
517	76400	4	EA	RAILING POST, WINGWALL MOUNTED
SPECIAL	51822300	240	LF	STEEL DRIP STRIP
SPECIAL	53001300	106	LF	STRUCTURE, MISC.: SEALING CONCRETE WEARING SURFACE CONSTRUCTION JOINTS WITH HMWM RESIN
848	10000	452	SY	MICRO-SILICA MODIFIED CONCRETE OVERLAY USING HYDRODEMOLITION (1.25" THICK)
848	20000	452	SY	SURFACE PREPARATION USING HYDRODEMOLITION
848	30000	2	CY	MICRO-SILICA MODIFIED CONCRETE OVERLAY (VARIABLE THICKNESS), MATERIAL ONLY
848	50000	3	SY	HAND CHIPPING
848	50100	LUMP		TEST SLAB
848	50320	452	SY	EXISTING CONCRETE OVERLAY REMOVED (1.25" THICK LMC)
STRUCTURE NO.: GEA-87-1133, SFN 2800721				
202	38501	262.5	LF	BRIDGE RAILING REMOVED, AS PER PLAN
202	98200	247	LF	REMOVAL, MISC.: DRIP STRIP
SPECIAL	51267510	99	SY	SEALING OF CONCRETE SURFACE (EPOXY-URETHANE)
517	76300	262.5	LF	RAILING, MISC.: DEEP BEAM RAIL WITH STEEL TUBULAR BACKUP
SPECIAL	51822300	287	LF	STEEL DRIP STRIP
SPECIAL	53000400	16	EA	STRUCTURE, MISC.: DRAINAGE HOLE
SPECIAL	53001300	128	LF	STRUCTURE, MISC.: SEALING CONCRETE WEARING SURFACE CONSTRUCTION JOINTS WITH HMWM RESIN
848	10000	512	SY	MICRO-SILICA MODIFIED CONCRETE OVERLAY USING HYDRODEMOLITION (2.5" THICK)
848	20000	512	SY	SURFACE PREPARATION USING HYDRODEMOLITION
848	30000	2	CY	MICRO-SILICA MODIFIED CONCRETE OVERLAY (VARIABLE THICKNESS), MATERIAL ONLY
848	50000	3	SY	HAND CHIPPING
848	50320	512	SY	EXISTING CONCRETE OVERLAY REMOVED (2.5" THICK LMC)
STRUCTURE NO.: GEA-87-1213, SFN 2800756				
202	38501	150	LF	BRIDGE RAILING REMOVED, AS PER PLAN
202	98200	130	LF	REMOVAL, MISC.: DRIP STRIP
SPECIAL	51267510	50	SY	SEALING OF CONCRETE SURFACE (EPOXY-URETHANE)
517	76300	150	LF	RAILING, MISC.: DEEP BEAM RAIL WITH STEEL TUBULAR BACKUP
SPECIAL	51822300	152	LF	STEEL DRIP STRIP
SPECIAL	53001300	67	LF	STRUCTURE, MISC.: SEALING CONCRETE WEARING SURFACE CONSTRUCTION JOINTS WITH HMWM RESIN
848	10000	266	SY	MICRO-SILICA MODIFIED CONCRETE OVERLAY USING HYDRODEMOLITION (1.25" THICK)
848	20000	266	SY	SURFACE PREPARATION USING HYDRODEMOLITION
848	30000	1	CY	MICRO-SILICA MODIFIED CONCRETE OVERLAY (VARIABLE THICKNESS), MATERIAL ONLY
848	50000	2	SY	HAND CHIPPING
848	50320	266	SY	EXISTING CONCRETE OVERLAY REMOVED (1.25" THICK LMC)

DESIGN AGENCY
 DISTRICT TWELVE
 PRODUCTION DEPARTMENT

DATE
 2/99
 REVIEWED
 JUL
 STRUCTURE FILE NUMBER
 DRAWN
 NRC
 REVISION
 DESIGNED
 NRC
 CHECKED
 M.J.M.


STRUCTURE SUMMARY


GEA-87-13.18X11.33X12.13

PLOT SUBMITTED: 25-FEB-1999 08:10

goc0318.dgn


PROJECTS: pid18728@goc0318.dgn

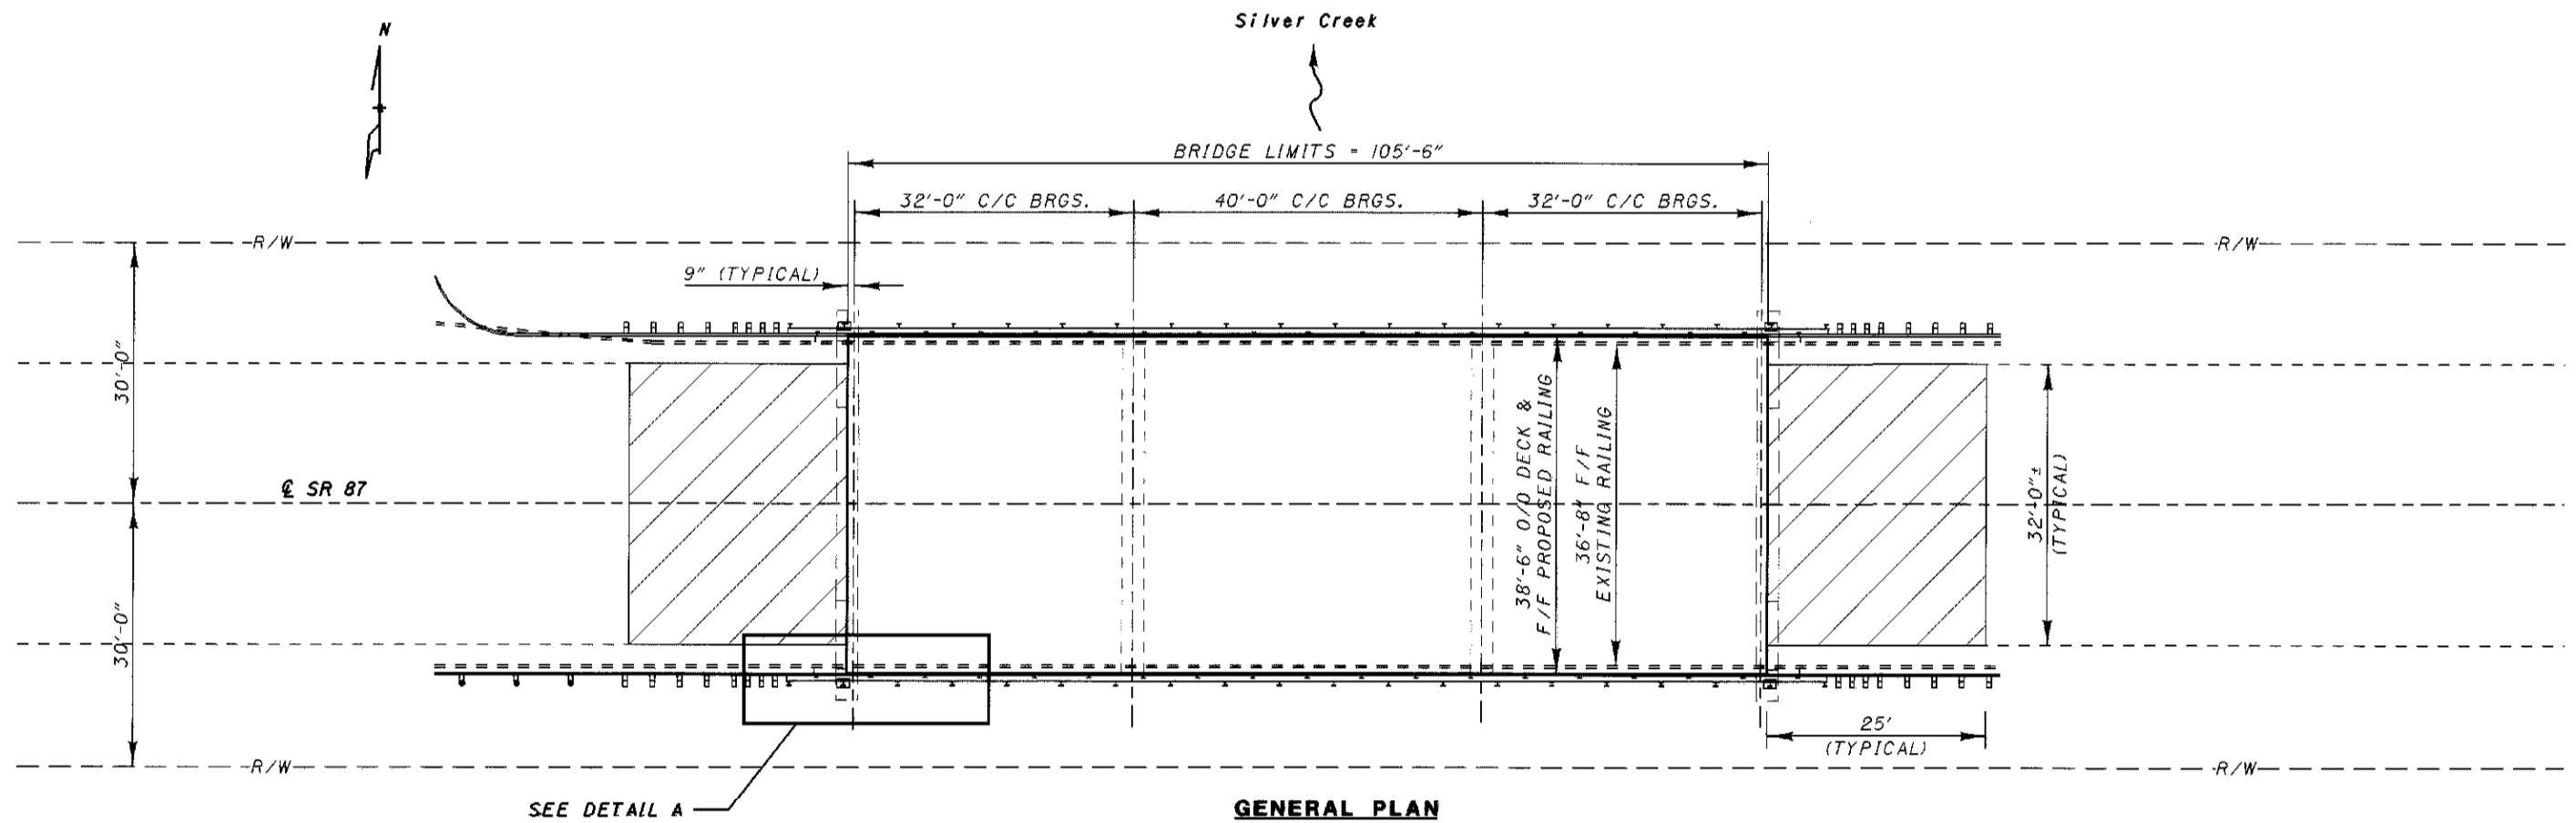

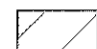 1/4" OF ITEM 202 - WEARING COURSE REMOVED, ASPHALT AND RESURFACED WITH ITEM 448 - ASPHALT CONCRETE SURFACE COURSE, TYPE 1, PG64-22 OVER ITEM 407 - TACK COAT. THE 25'-0" LENGTH MAY BE ADJUSTED TO FIT THE EXISTING CONDITIONS.


NOTES:

1. THE APPROACH GUARDRAIL IS NOT COMPLETELY SHOWN. FOR RAILING WORK SEE SHEET 9.
2. FOR MAINTENANCE OF TRAFFIC, SEE SHEET 10.
3. FOR ESTIMATED QUANTITIES SEE SHEET 7.

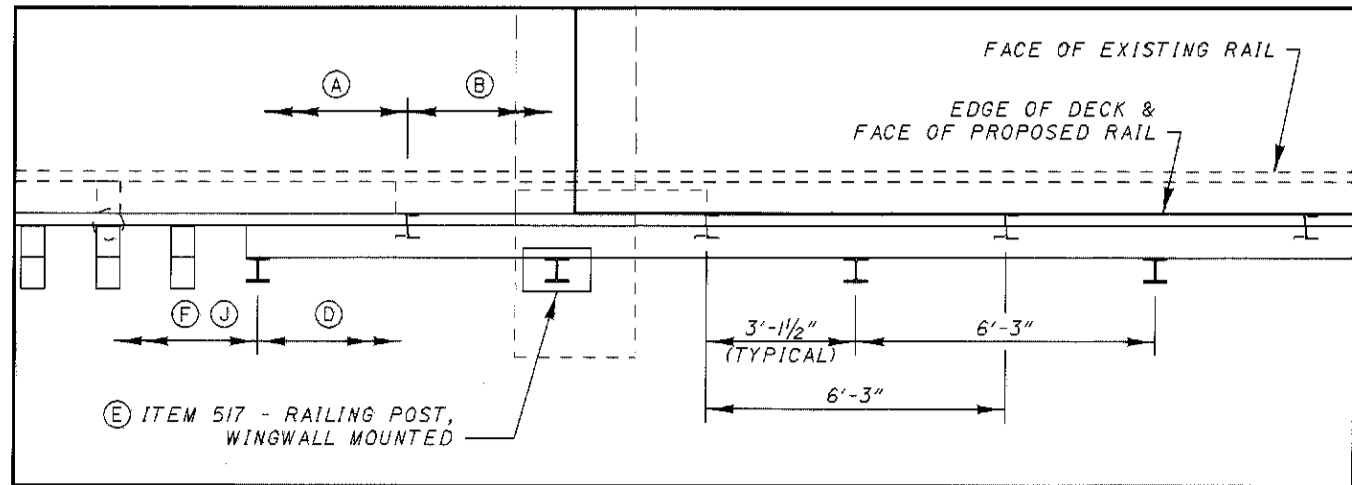

DETAIL A

A B D E F J - SEE RAILING PLAN FOR DETAILS

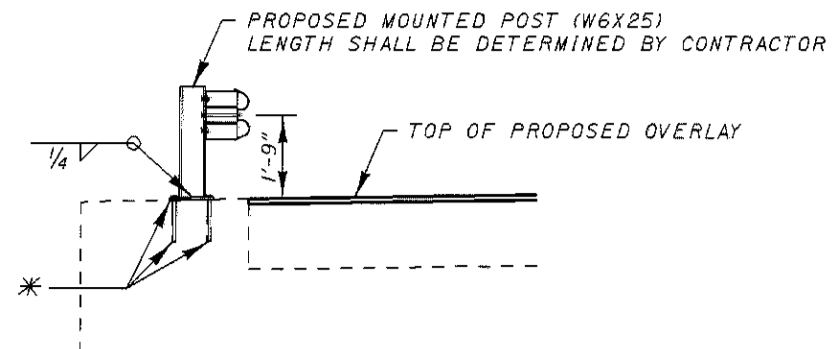

WINGWALL MOUNTED POST DETAIL

* PROPOSED 7/8" DIAMETER BOLTS AND 3/4" STEEL PLATE AS PER STANDARD DRAWING GR-2.2M. THE BOLTS SHALL BE THREADED FOR THE ENTIRE LENGTH AND DOWELED A MINIMUM OF 10" INTO THE WINGWALL. ALL DOWEL HOLES SHALL BE GROUTED WITH ANY EPOXY MORTAR.

DESIGN AGENCY DISTRICT TWELVE PRODUCTION DEPARTMENT	DATE 2/99	REVIEWED JUL	DRAWN NRC	DESIGNED NRC	CHECKED MJM	STRUCTURE FILE NUMBER 2800667
GENERAL PLAN BRIDGE NO. GE-A-87-0318 OVER SILVER CREEK						
GEA-87-13.18X11.33X12.13						
1 / 4						
19						

PLotted BY: nconley
 PLOTTED FROM: B:\projects\p18728\gea0318.dgn

PLotted BY: nconley
 PLOTTED FROM: B:\projects\p18728\gea0318.dgn



PLotted BY: nconley
 PLOTTED FROM: B:\projects\p18728\gea0318.dgn

NOTES:
 PCB - PORTABLE CONCRETE BARRIER
 FOR TYPICAL SECTION, SEE SHEET II.

FOR DETAILS NOT SHOWN,
 SEE STANDARD DRAWINGS
 MT-96.10M, MT-96.11M,
 MT-96.20M AND MT-96.25M.

SIGNAL TIMING			
	GREEN	AMBER	RED
PHASE A	15	3	13
PHASE B	15	3	13

THE ABOVE TIMING MAY BE CHANGED WITH THE APPROVAL OF THE ENGINEER.

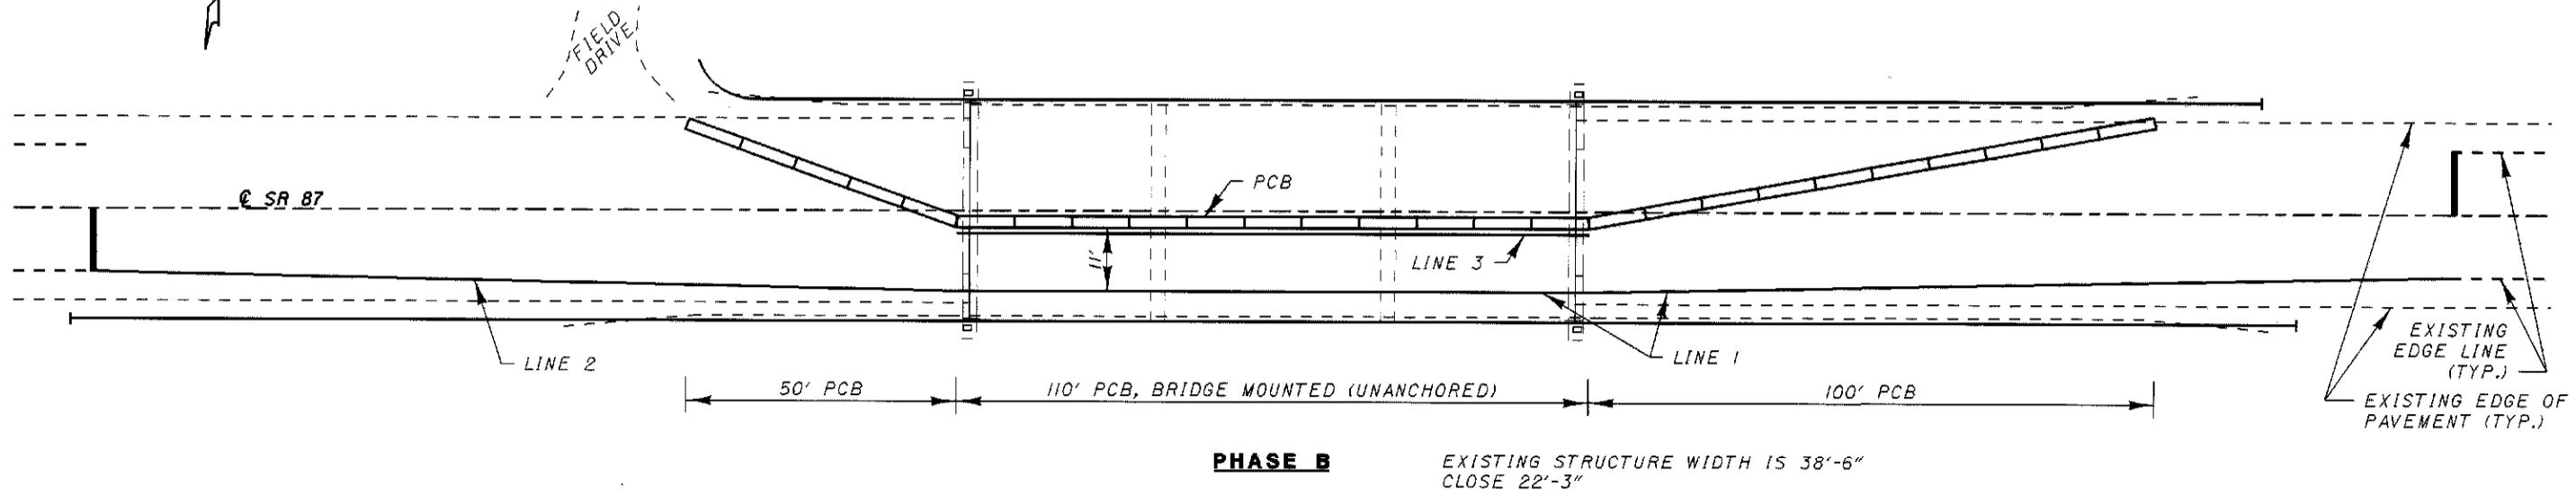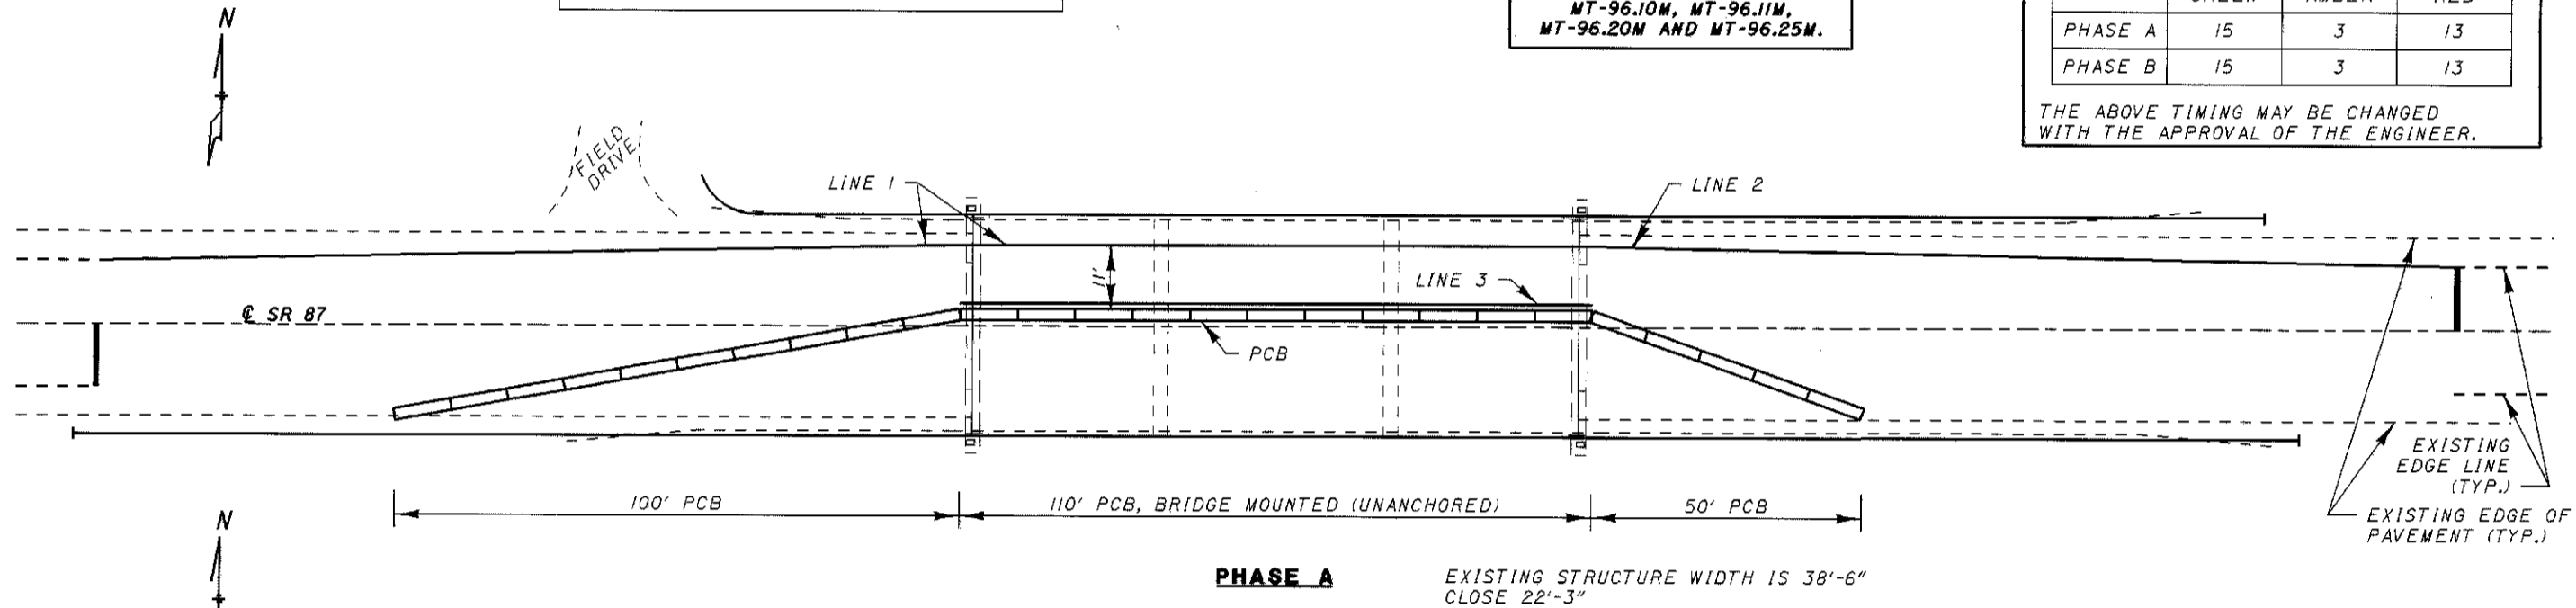

ITEM	DESCRIPTION	UNIT	QUANTITY		TOTAL QUANTITY
			PHASE A	PHASE B	
614	TEMPORARY RAISED PAVEMENT MARKER	EA	185	185	370
614	BARRIER REFLECTOR, TYPE A2	EA	12	16	28
614	BARRIER REFLECTOR, TYPE B2	EA	11	11	22
614	OBJECT MARKER	EA	12	12	24
614	TEMPORARY CENTER LINE, CLASS 1	MI	0.06		0.06
614	TEMPORARY EDGE LINE, CLASS 1	MI	0.02	0.02	0.04
614	TEMPORARY STOP LINE, CLASS 1	LF	22		22
622	PORTABLE CONCRETE BARRIER, 32"	LF	150	150	300
622	PORTABLE CONCRETE BARRIER, 32", BRIDGE MOUNTED	LF	110	110	220
624	EDGE LINE, TYPE 2	MI			0.16
624	CENTER LINE, TYPE 2	MI			0.08

ALL QUANTITIES ARE CARRIED TO THE GENERAL SUMMARY.

TEMPORARY RAISED PAVEMENT MARKERS (TYPE A)				
		SPACING	QUANTITY (WHITE)	QUANTITY (YELLOW)
PHASE A	LINE 1 - 260'	5'	54	54
	LINE 2 - 150'	5'	31	
	LINE 3 - 110'	5'	23	23
PHASE B	LINE 1 - 260'	5'	54	54
	LINE 2 - 150'	5'	31	
	LINE 3 - 110'	5'	23	23
TOTAL			216	154

DESIGN AGENCY: DISTRICT TWELVE, PRODUCTION DEPARTMENT
 DATE: 2/99
 REVIEWED: JJJ
 DRAWN: NRC
 DESIGNED: NRC
 CHECKED: M/JM
 STRUCTURE FILE NUMBER: 2800667
 MAINTENANCE OF TRAFFIC: BRIDGE NO. GEA-87-0318 OVER SILVER CREEK
 GEA-87-13.18(11.33)(12.13)
 3/4
 10/19



PLOT SUBMITTED: 25-FEB-1999 08:11

gea0318.dgn



PLOTTED BY: nconley
 PLOTTED FROM: i:\projects\p18728\gea0318.dgn

NOTE:

CONTRACTOR SHALL FLAME CUT THE EXISTING RAILING POSTS AT AN ANGLE AS SHOWN. THE REMAINING PORTION OF THE POST SHALL NOT BE HIGHER THAN THE PROPOSED BRIDGE DECK.

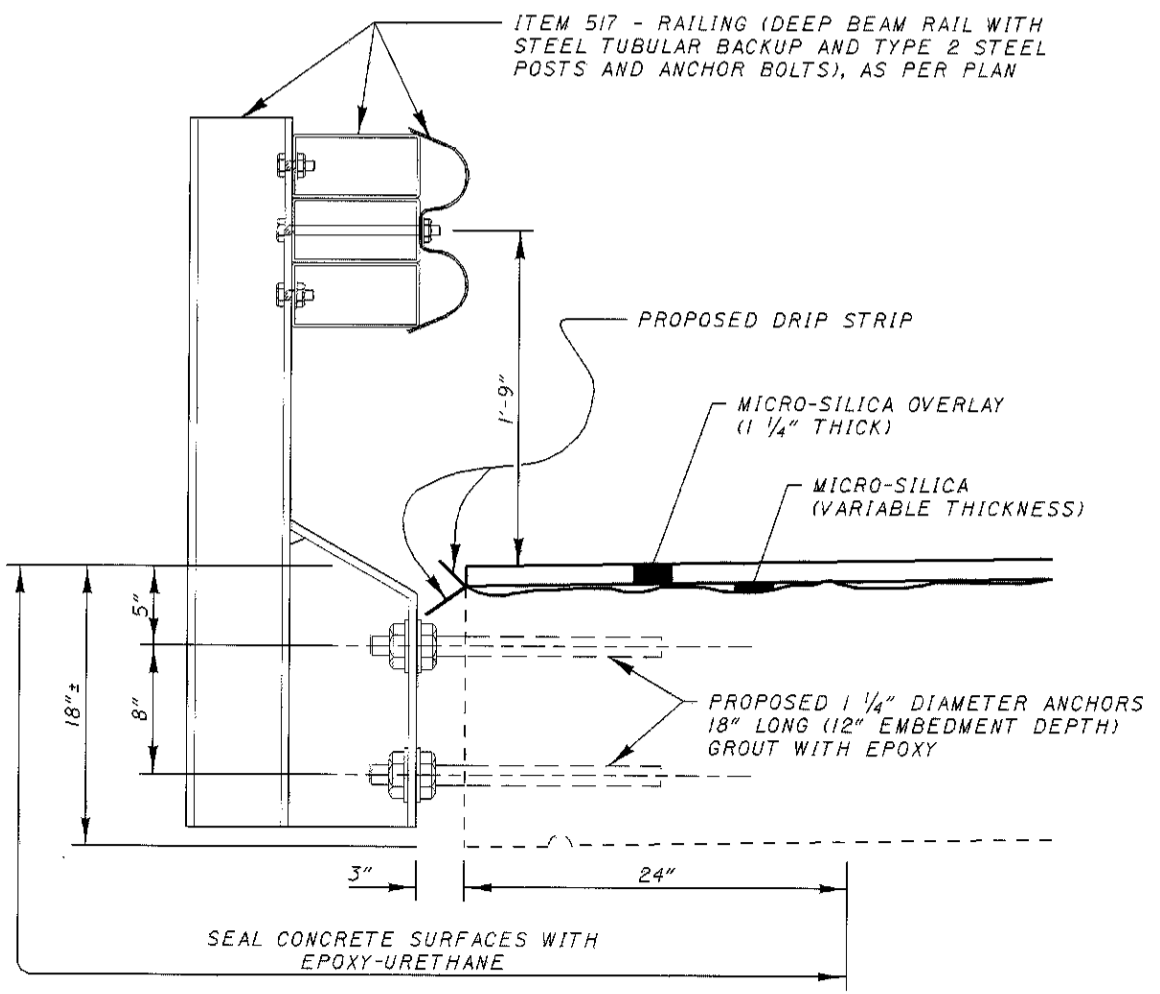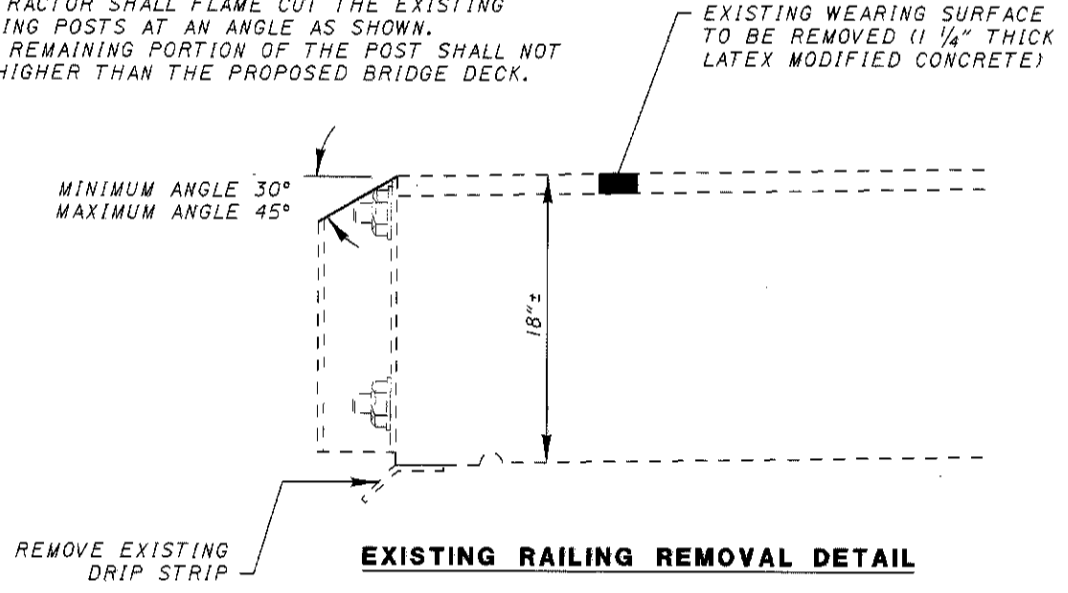

FOR DETAILS NOT SHOWN
 SEE STANDARD DRAWINGS
 DBR-2-73M & DS-1-94M

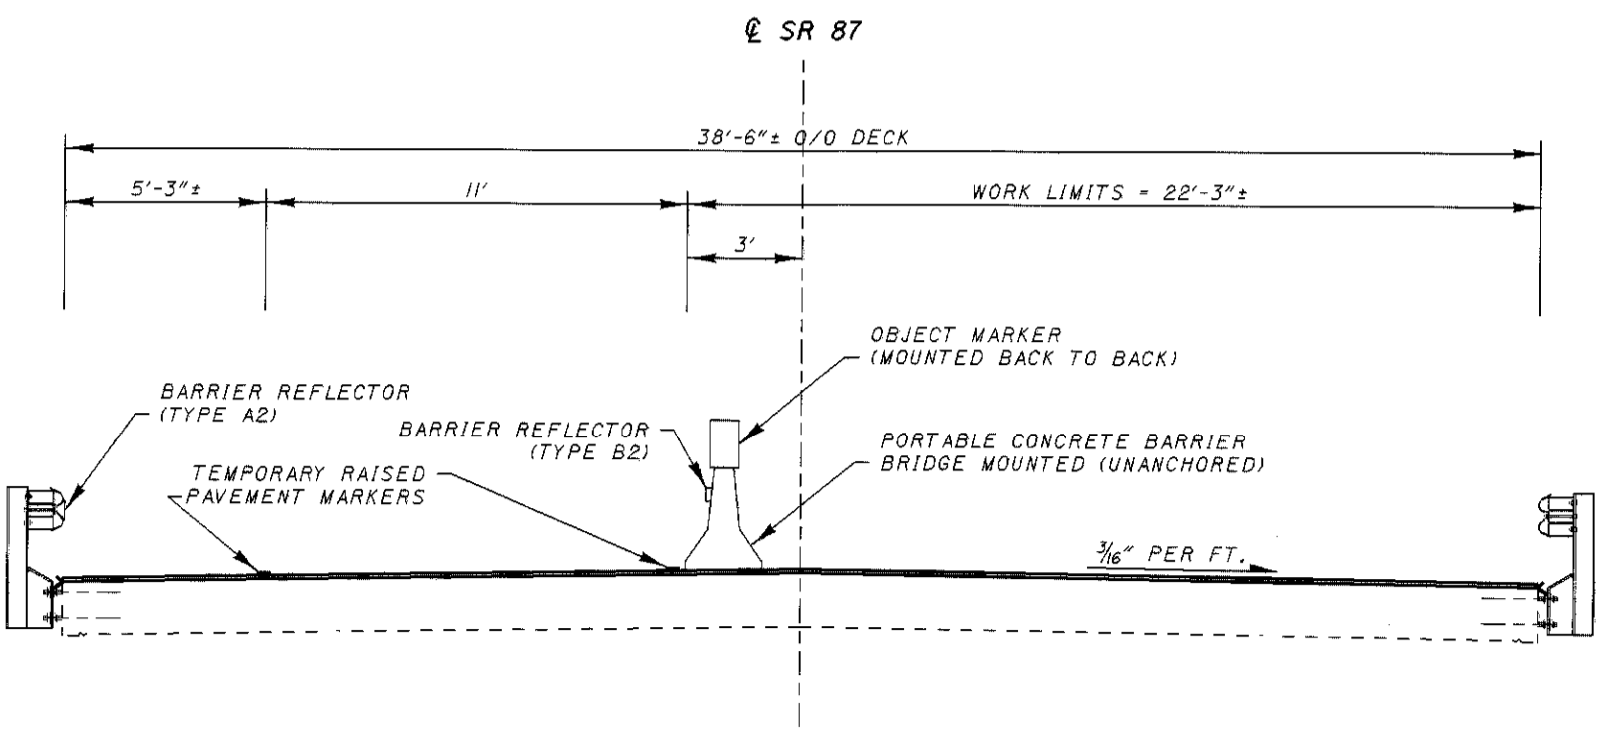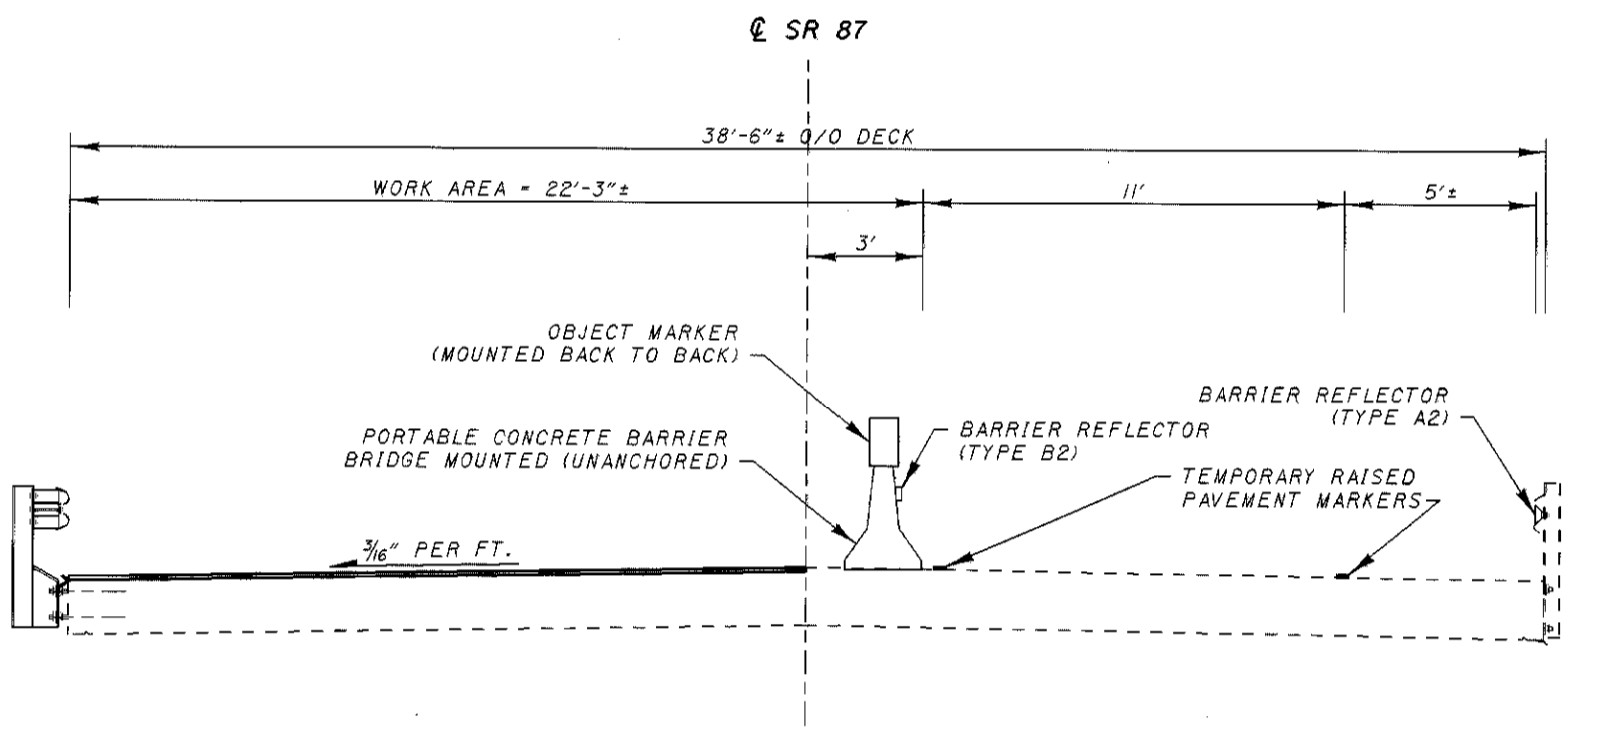

DESIGN AGENCY
 DISTRICT TWELVE
 PRODUCTION DEPARTMENT

DATE
 JUL
 REVIEWED
 JUL
 STRUCTURE FILE NUMBER
 2800667

DESIGNED
 MRC
 CHECKED
 M/JM

TYPICAL SECTION & DETAILS
 BRIDGE NO. GEA-87-0318
 OVER SILVER CREEK

GEA-87-13.18(11.33)(12.13)

4 / 4


11
 19

PLOT SUBMITT D:25-FEB-1999 08:14


geal1133.dgn


geal1133.dgn

PLOTTED BY: nconley
 PLOTTED FROM: projects\pid18728\geal1133.dgn

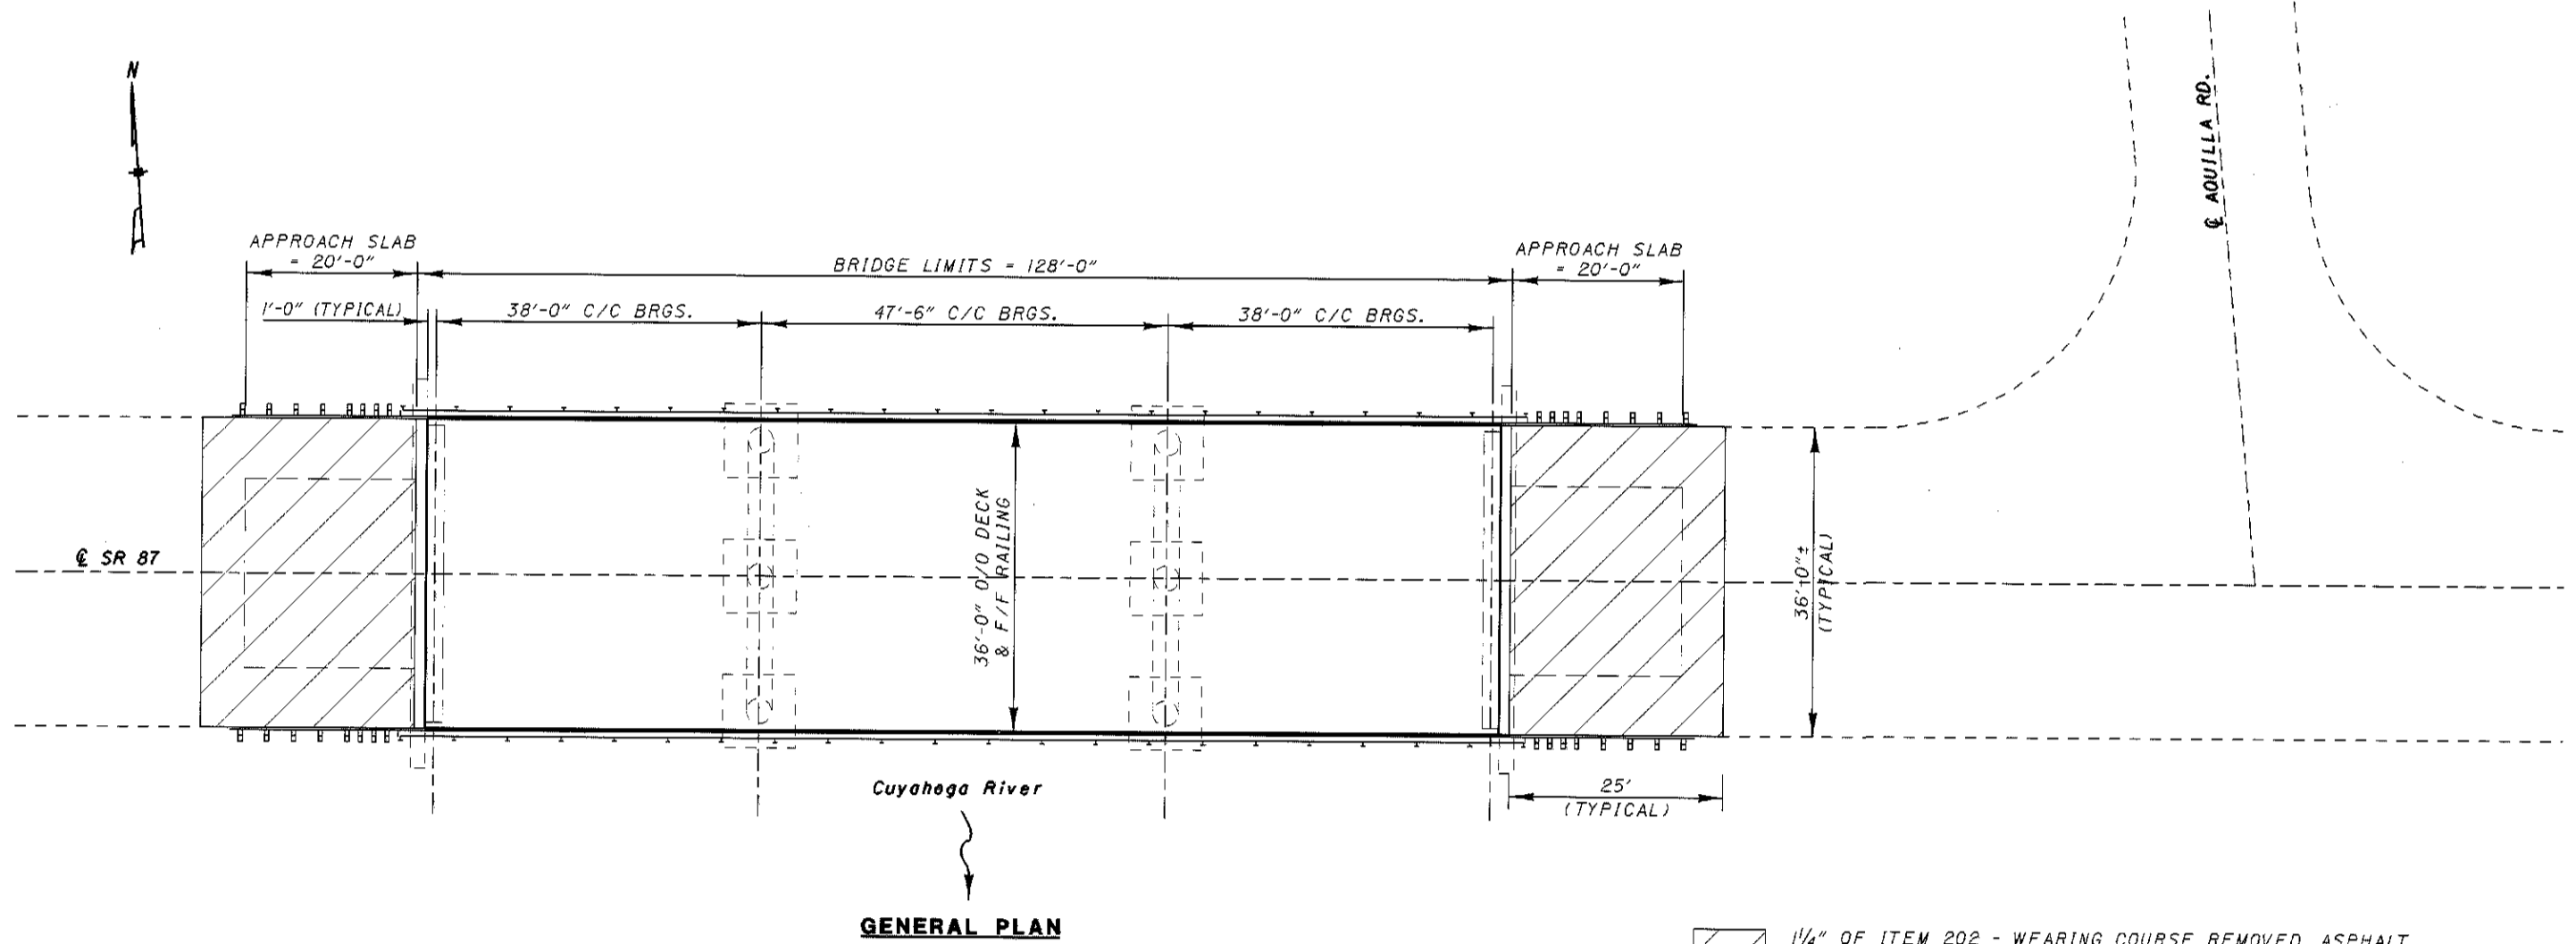


GENERAL PLAN

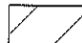 1/4" OF ITEM 202 - WEARING COURSE REMOVED, ASPHALT AND RESURFACED WITH ITEM 448 - ASPHALT CONCRETE SURFACE COURSE, TYPE 1, PG64-22 OVER ITEM 407 - TACK COAT. THE 25'-0" LENGTH MAY BE ADJUSTED TO FIT THE EXISTING CONDITIONS.

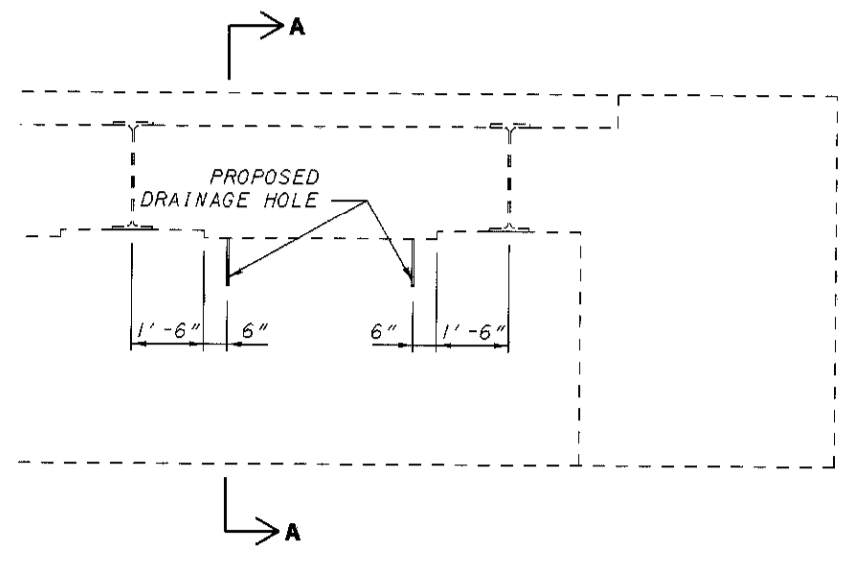

DRAINAGE HOLE DETAIL
 TYPICAL BETWEEN ALL BEAMS
 TYPICAL FORWARD AND REAR ABUTMENTS
 (8 DRAINAGE HOLES TOTAL - FORWARD
 8 DRAINAGE HOLES TOTAL - REAR)

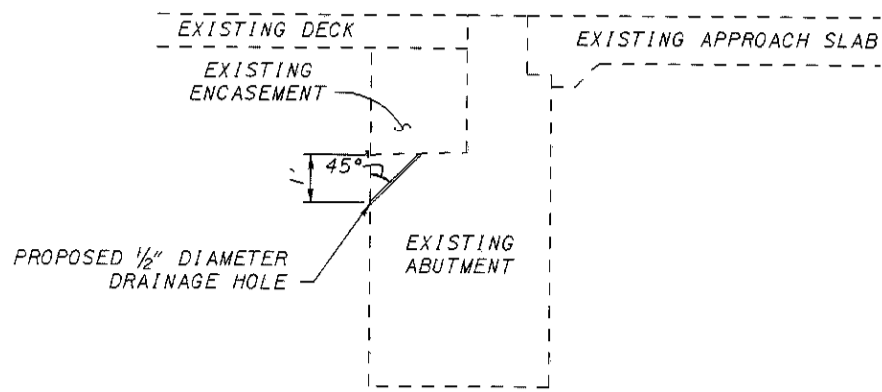

SECTION A-A

- NOTES:**
1. DRAINAGE HOLES SHALL BE CORED DRILLED AT THE LOCATIONS AND ANGLE SHOWN.
 2. THE APPROACH GUARDRAIL IS NOT COMPLETELY SHOWN. FOR RAILING WORK, SEE SHEET 13.
 3. FOR MAINTENANCE OF TRAFFIC, SEE SHEET 14.
 4. FOR ESTIMATED QUANTITIES, SEE SHEET 7.

DESIGNED	NRC	CHECKED	MJM
DRAWN	NRC	REVIEWED	JUL
DATE	2/99	STRUCTURE FILE NUMBER	2800721
DESIGN AGENCY	DISTRICT TWELVE PRODUCTION DEPARTMENT		

GENERAL PLAN
 BRIDGE NO. GE-87-1133
 OVER CUYAHOGA RIVER

GEA-87-(13.18)(11.33)(12.13)

1/4


12
19

PLOT SUBMITTED: 25-FEB-1999 08:15

geal133.dgn

geal133.dgn


PLOTTED BY: nconley
 PLOTTED FROM: projects\p1\8728\geal133.dgn

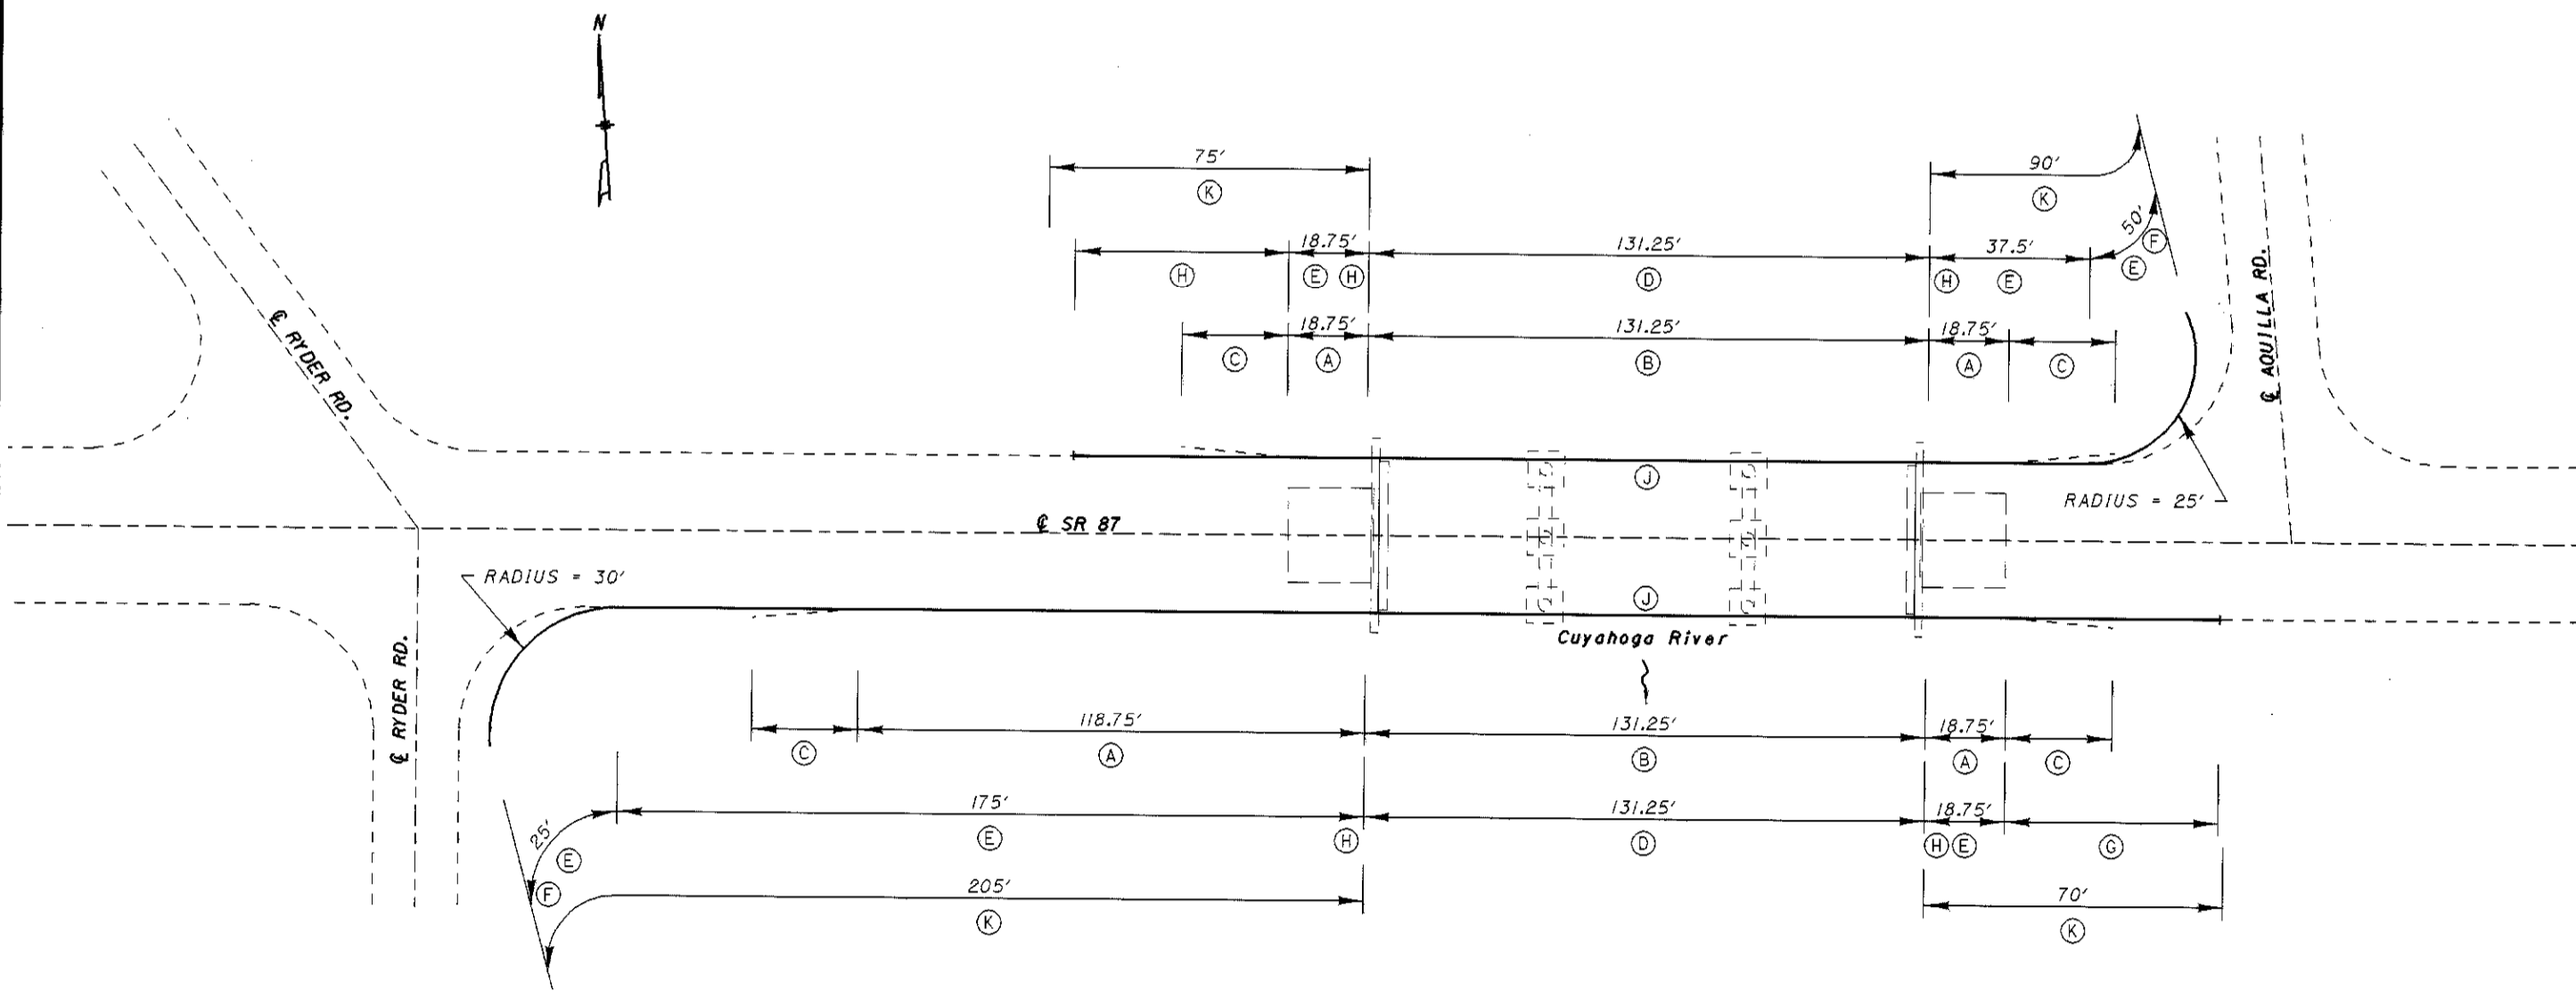

NOTE:
 FOR ITEM 517 - RAILING MISC.: DEEP BEAM RAIL WITH STEEL TUBULAR BACKUP DETAILS, SEE SHEET 15.

LOCATION	ITEM	DESCRIPTION	UNIT	QUANTITY		TOTAL QUANTITY
				LEFT	RIGHT	
(A)	202	GUARDRAIL REMOVED	LF	37.5	137.5	175
(B)	202	BRIDGE RAILING REMOVED, AS PER PLAN	LF	131.25	131.25	262.5 ★
(C)	202	ANCHOR ASSEMBLY REMOVED, TYPE A	EA	2	2	4
(D)	517	RAILING, MISC.: DEEP BEAM RAIL WITH STEEL TUBULAR BACKUP	LF	131.25	131.25	262.5 ★
(E)	606	GUARDRAIL, TYPE 5	LF	106.25	218.75	325
(F)	606	FLARED END SECTION	EA	1	1	2
(G)	606	ANCHOR ASSEMBLY, TYPE E-98	EA	1	1	2
(H)	606	BRIDGE TERMINAL ASSEMBLY, TYPE 4	EA	2	2	4
(J)	802	BARRIER REFLECTOR, TYPE A	EA	4	5	9
(K)	SPECIAL	RESHAPING BERM	LF	165	275	440

★ QUANTITY IS CARRIED TO THE STRUCTURE SUMMARY.
 ALL QUANTITIES ARE CARRIED TO THE GENERAL SUMMARY.

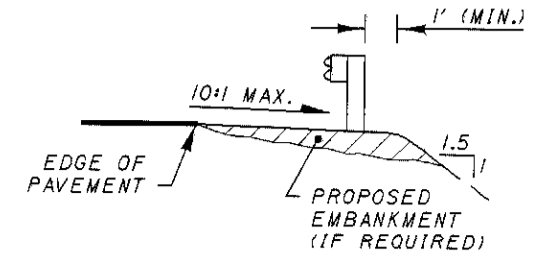

TYPICAL SECTION

DESIGN AGENCY
 DISTRICT TWELVE
 PRODUCTION DEPARTMENT

DATE
 2/99

REVIEWED
 JLL

DESIGNED
 NRC

DRAWN
 NRC

CHECKED
 MJM


STRUCTURE FILE NUMBER
 2800721

RAILING PLAN
 BRIDGE NO. 6EA-87-133
 OVER CUYAHOGA RIVER

6EA-87-133(11-33)(12/13)

2 / 4

13
 19

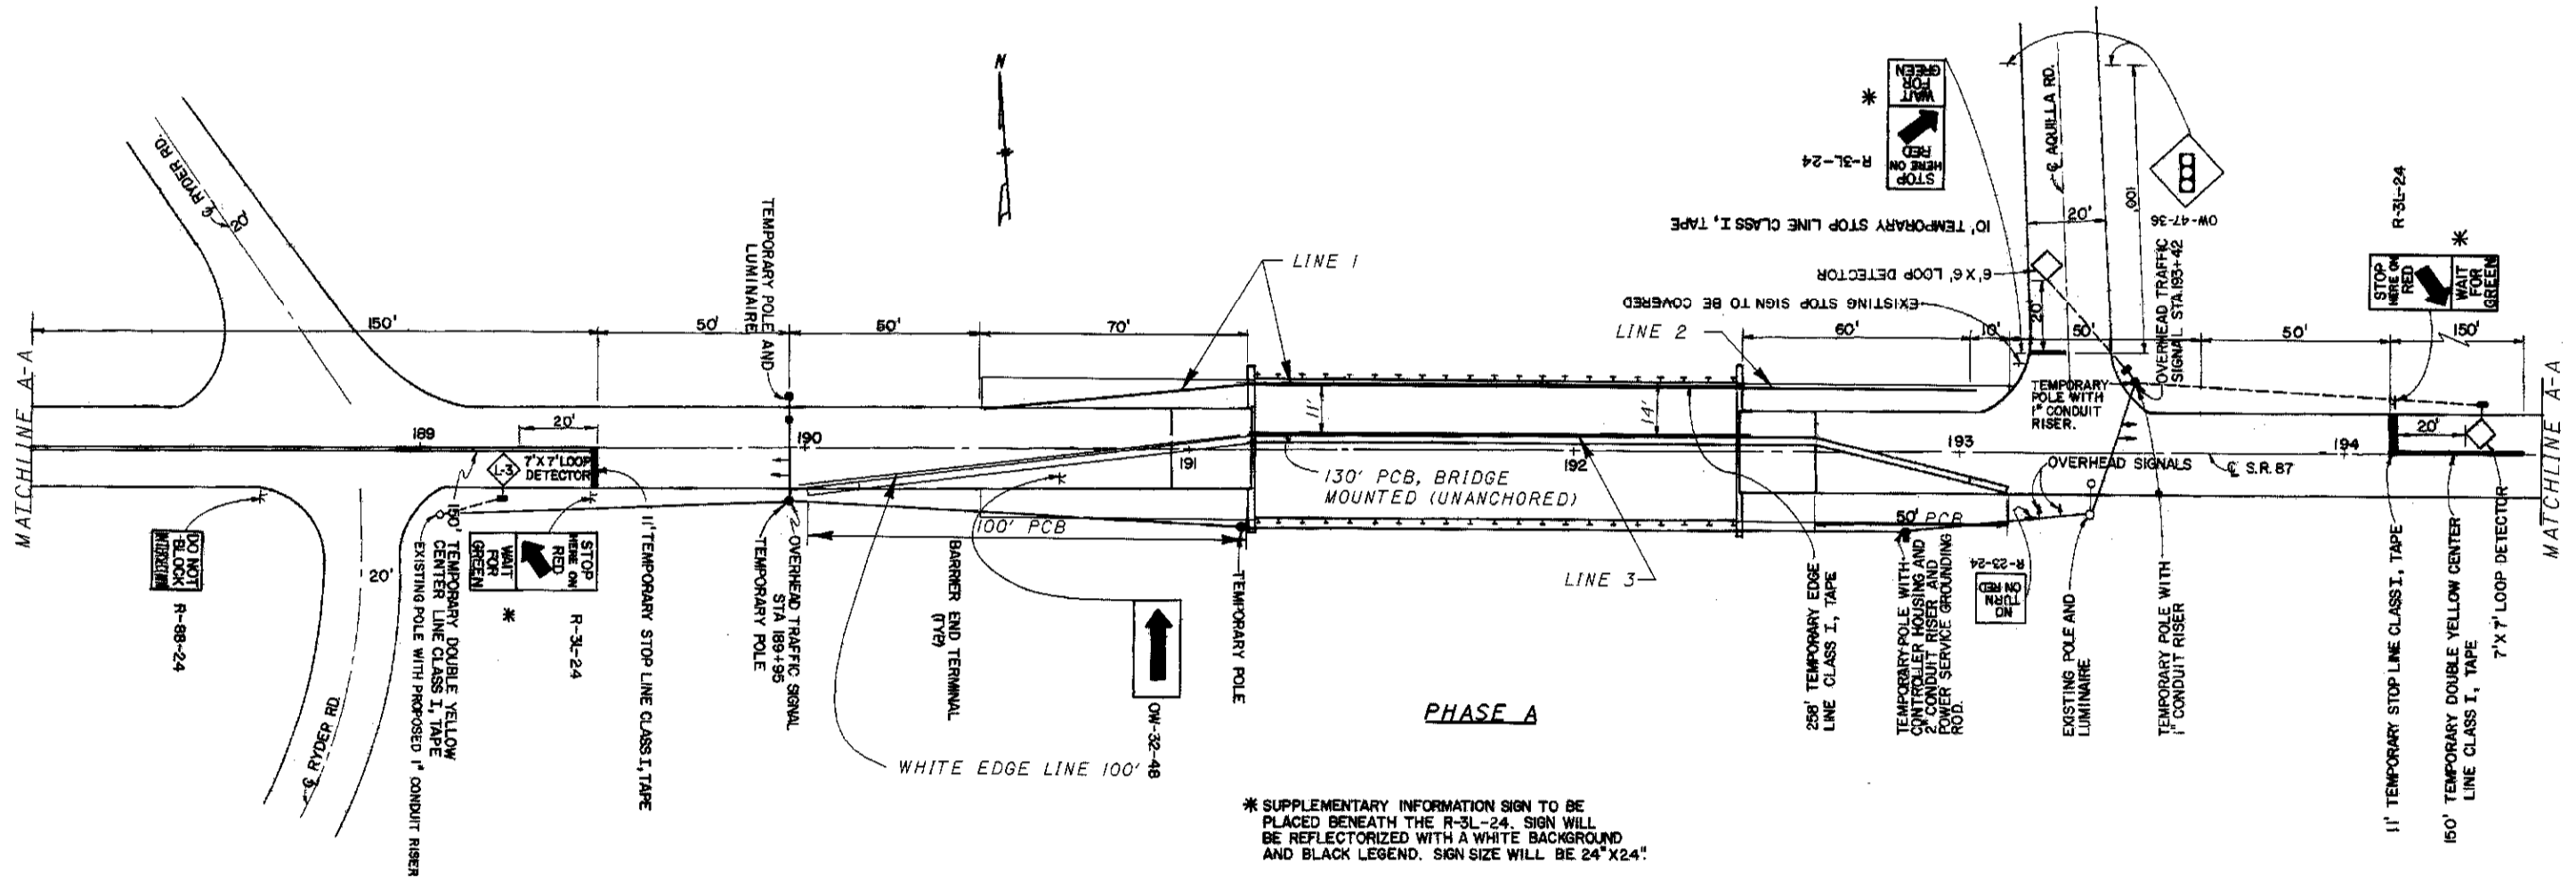

* SUPPLEMENTARY INFORMATION SIGN TO BE PLACED BENEATH THE R-3L-24. SIGN WILL BE REFLECTORIZED WITH A WHITE BACKGROUND AND BLACK LEGEND. SIGN SIZE WILL BE 24" X 24".


FOR DETAILS NOT SHOWN, SEE STANDARD DRAWINGS MT-96.10M, MT-96.11M, MT-96.20M AND MT-96.25M.

NOTES:
PCB = PORTABLE CONCRETE BARRIER
FOR TYPICAL SECTION, SEE SHEET 15.
FOR PHASE B AND DETAILS NOT SHOWN, SEE SHEET 14A.

ITEM	DESCRIPTION	UNIT	QUANTITY		TOTAL QUANTITY
			PHASE A	PHASE B	
614	TEMPORARY RAISED PAVEMENT MARKER	EA	154	128	282
614	BARRIER REFLECTOR, TYPE A2	EA	12	16	28
614	BARRIER REFLECTOR, TYPE B2	EA	12	12	24
614	OBJECT MARKER	EA	13	13	26
614	TEMPORARY CENTER LINE, CLASS 1	MI	0.06		0.06
614	TEMPORARY EDGE LINE, CLASS 1	MI	0.02	0.01	0.03
614	TEMPORARY STOP LINE, CLASS 1	LF	22		22
622	PORTABLE CONCRETE BARRIER, 32"	LF	150	100	250
622	PORTABLE CONCRETE BARRIER, 32", BRIDGE MOUNTED	LF	130	130	260
624	EDGE LINE, TYPE 2	MI			0.17
624	CENTER LINE, TYPE 2	MI			0.08
624	STOP LINE, TYPE 2	LF			10

ALL QUANTITIES ARE CARRIED TO THE GENERAL SUMMARY.


PHASE	LINE	SPACING	QUANTITY	
			(WHITE)	(YELLOW)
PHASE A	LINE 1 - 200'	5'	40	40
	LINE 2 - 60'	5'	12	
	LINE 3 - 130'	5'	26	26
PHASE B	LINE 1 - 180'	5'	36	36
	LINE 2 - 70'	5'	14	
	LINE 3 - 130'	5'	26	26
TOTAL			154	128

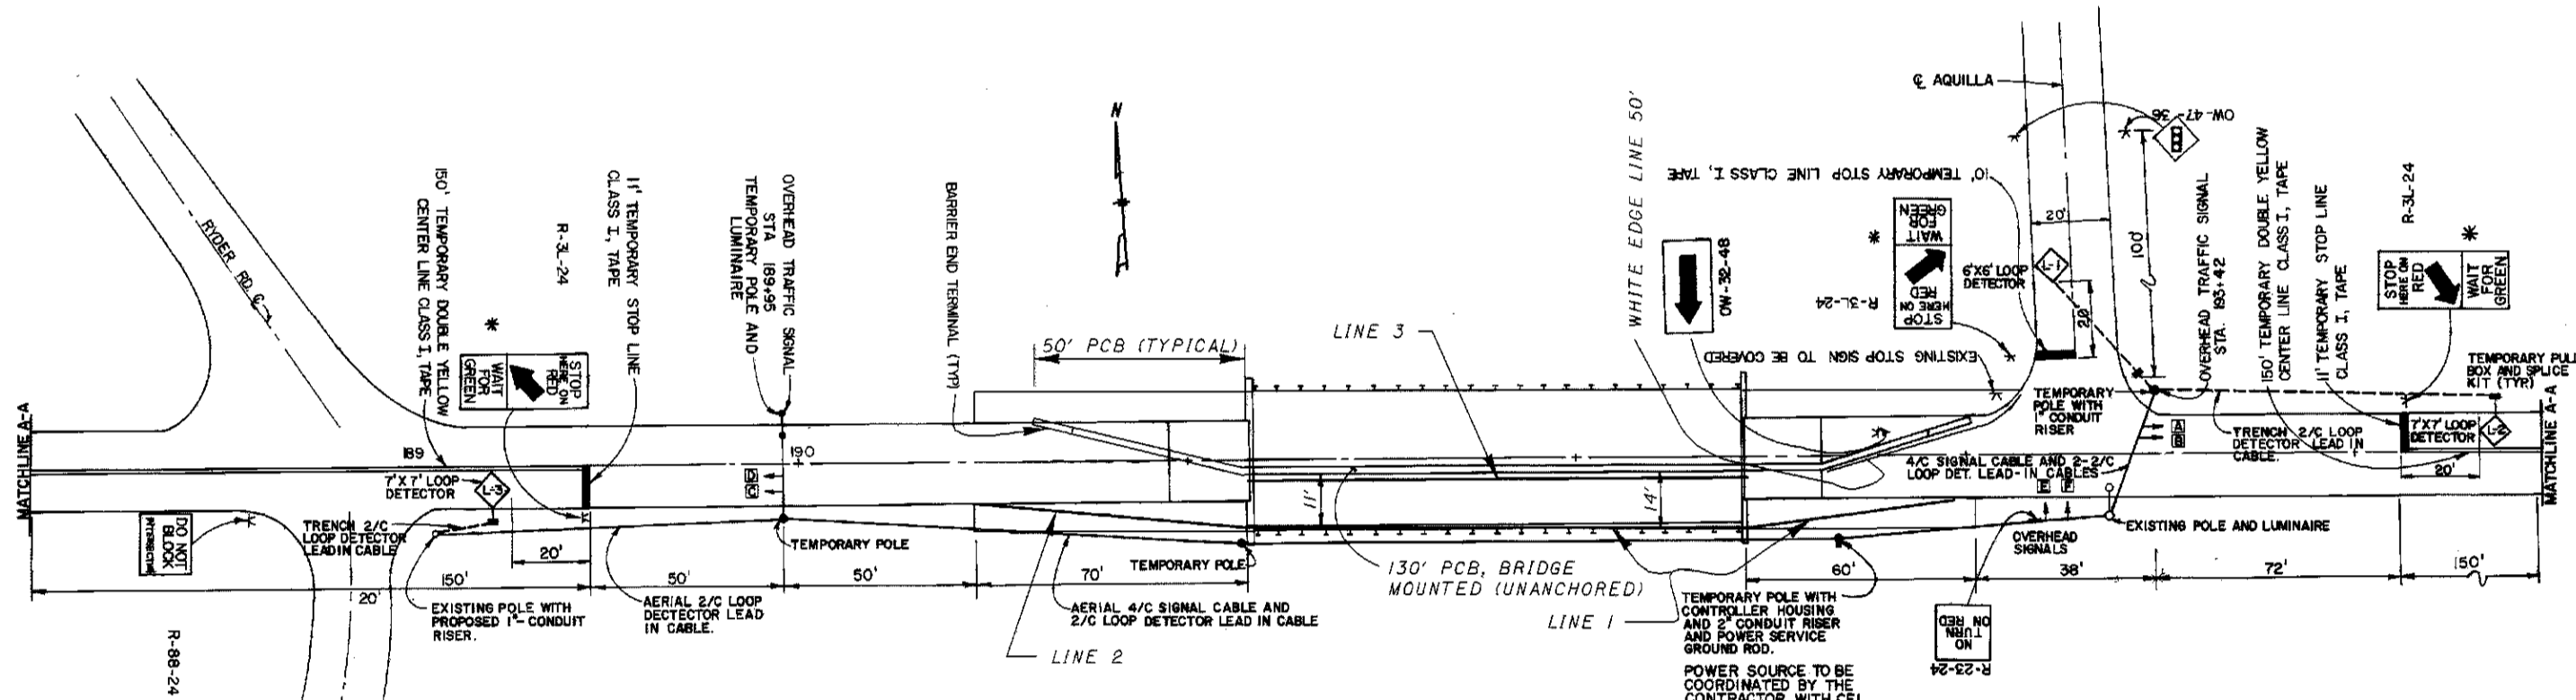


PHASE B

* SUPPLEMENTARY INFORMATION SIGN TO BE PLACED BENEATH THE R-3L-24. SIGN WILL BE REFLECTORIZED WITH A WHITE BACKGROUND AND BLACK LEGEND. SIGN SIZE WILL BE 24" x 24".


NOTES:
 PCB - PORTABLE CONCRETE BARRIER
 FOR TYPICAL SECTION, SEE SHEET 15.
 FOR PHASE A, SUMMARY QUANTITIES AND TEMPORARY RAISED PAVEMENT MARKERS, SEE SHEET 14.

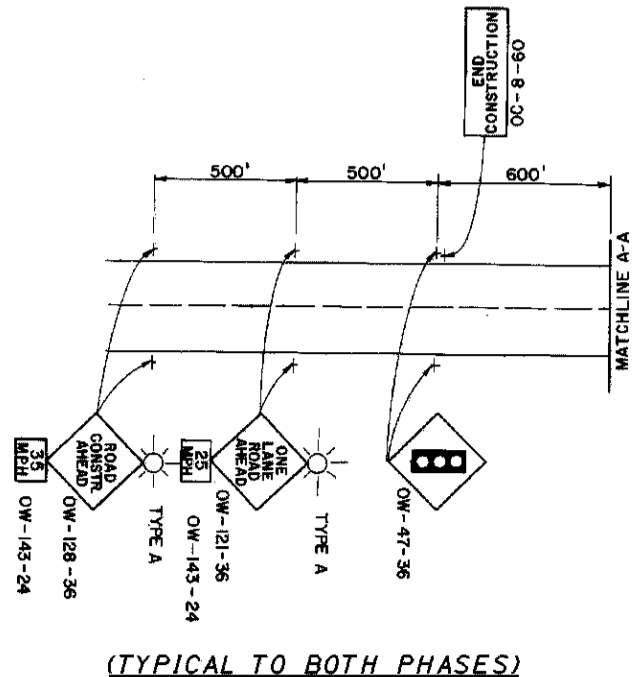

(TYPICAL TO BOTH PHASES)

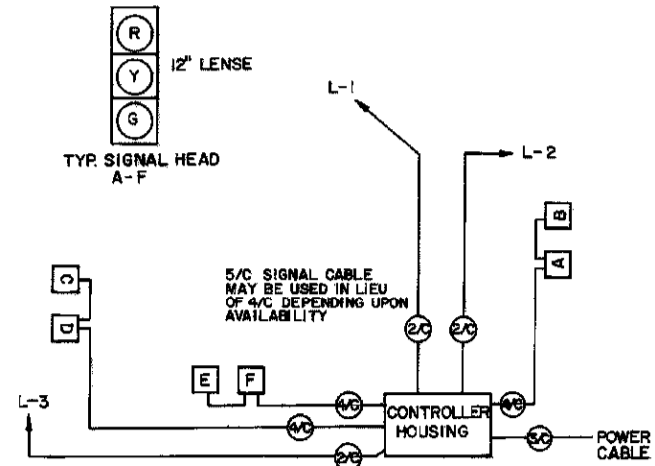

TYPICAL SIGNAL HEAD HOOK UP
 (TYPICAL TO BOTH PHASES)

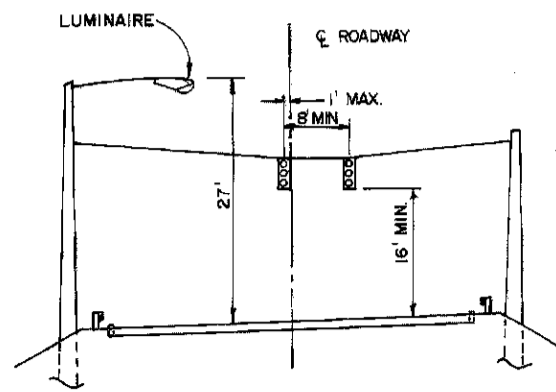

PLACEMENT OF TEMPORARY OVERHEAD TRAFFIC SIGNALS
 (TYPICAL TO BOTH PHASES)

Ø 1	ALL RED	Ø 2	Ø 3	ALL RED
+	+	+	+	+

Ø	1	2	3
MINIMUM	15	12	15
EXTENSION	4	4	4
GAP	3	3	3
MAXIMUM	40	20	40
YELLOW	3	3	3
RED	13	1	13
RECALL	L	L	ON

PHASING AND TIMING SETTINGS
 (TYPICAL TO BOTH PHASES)