



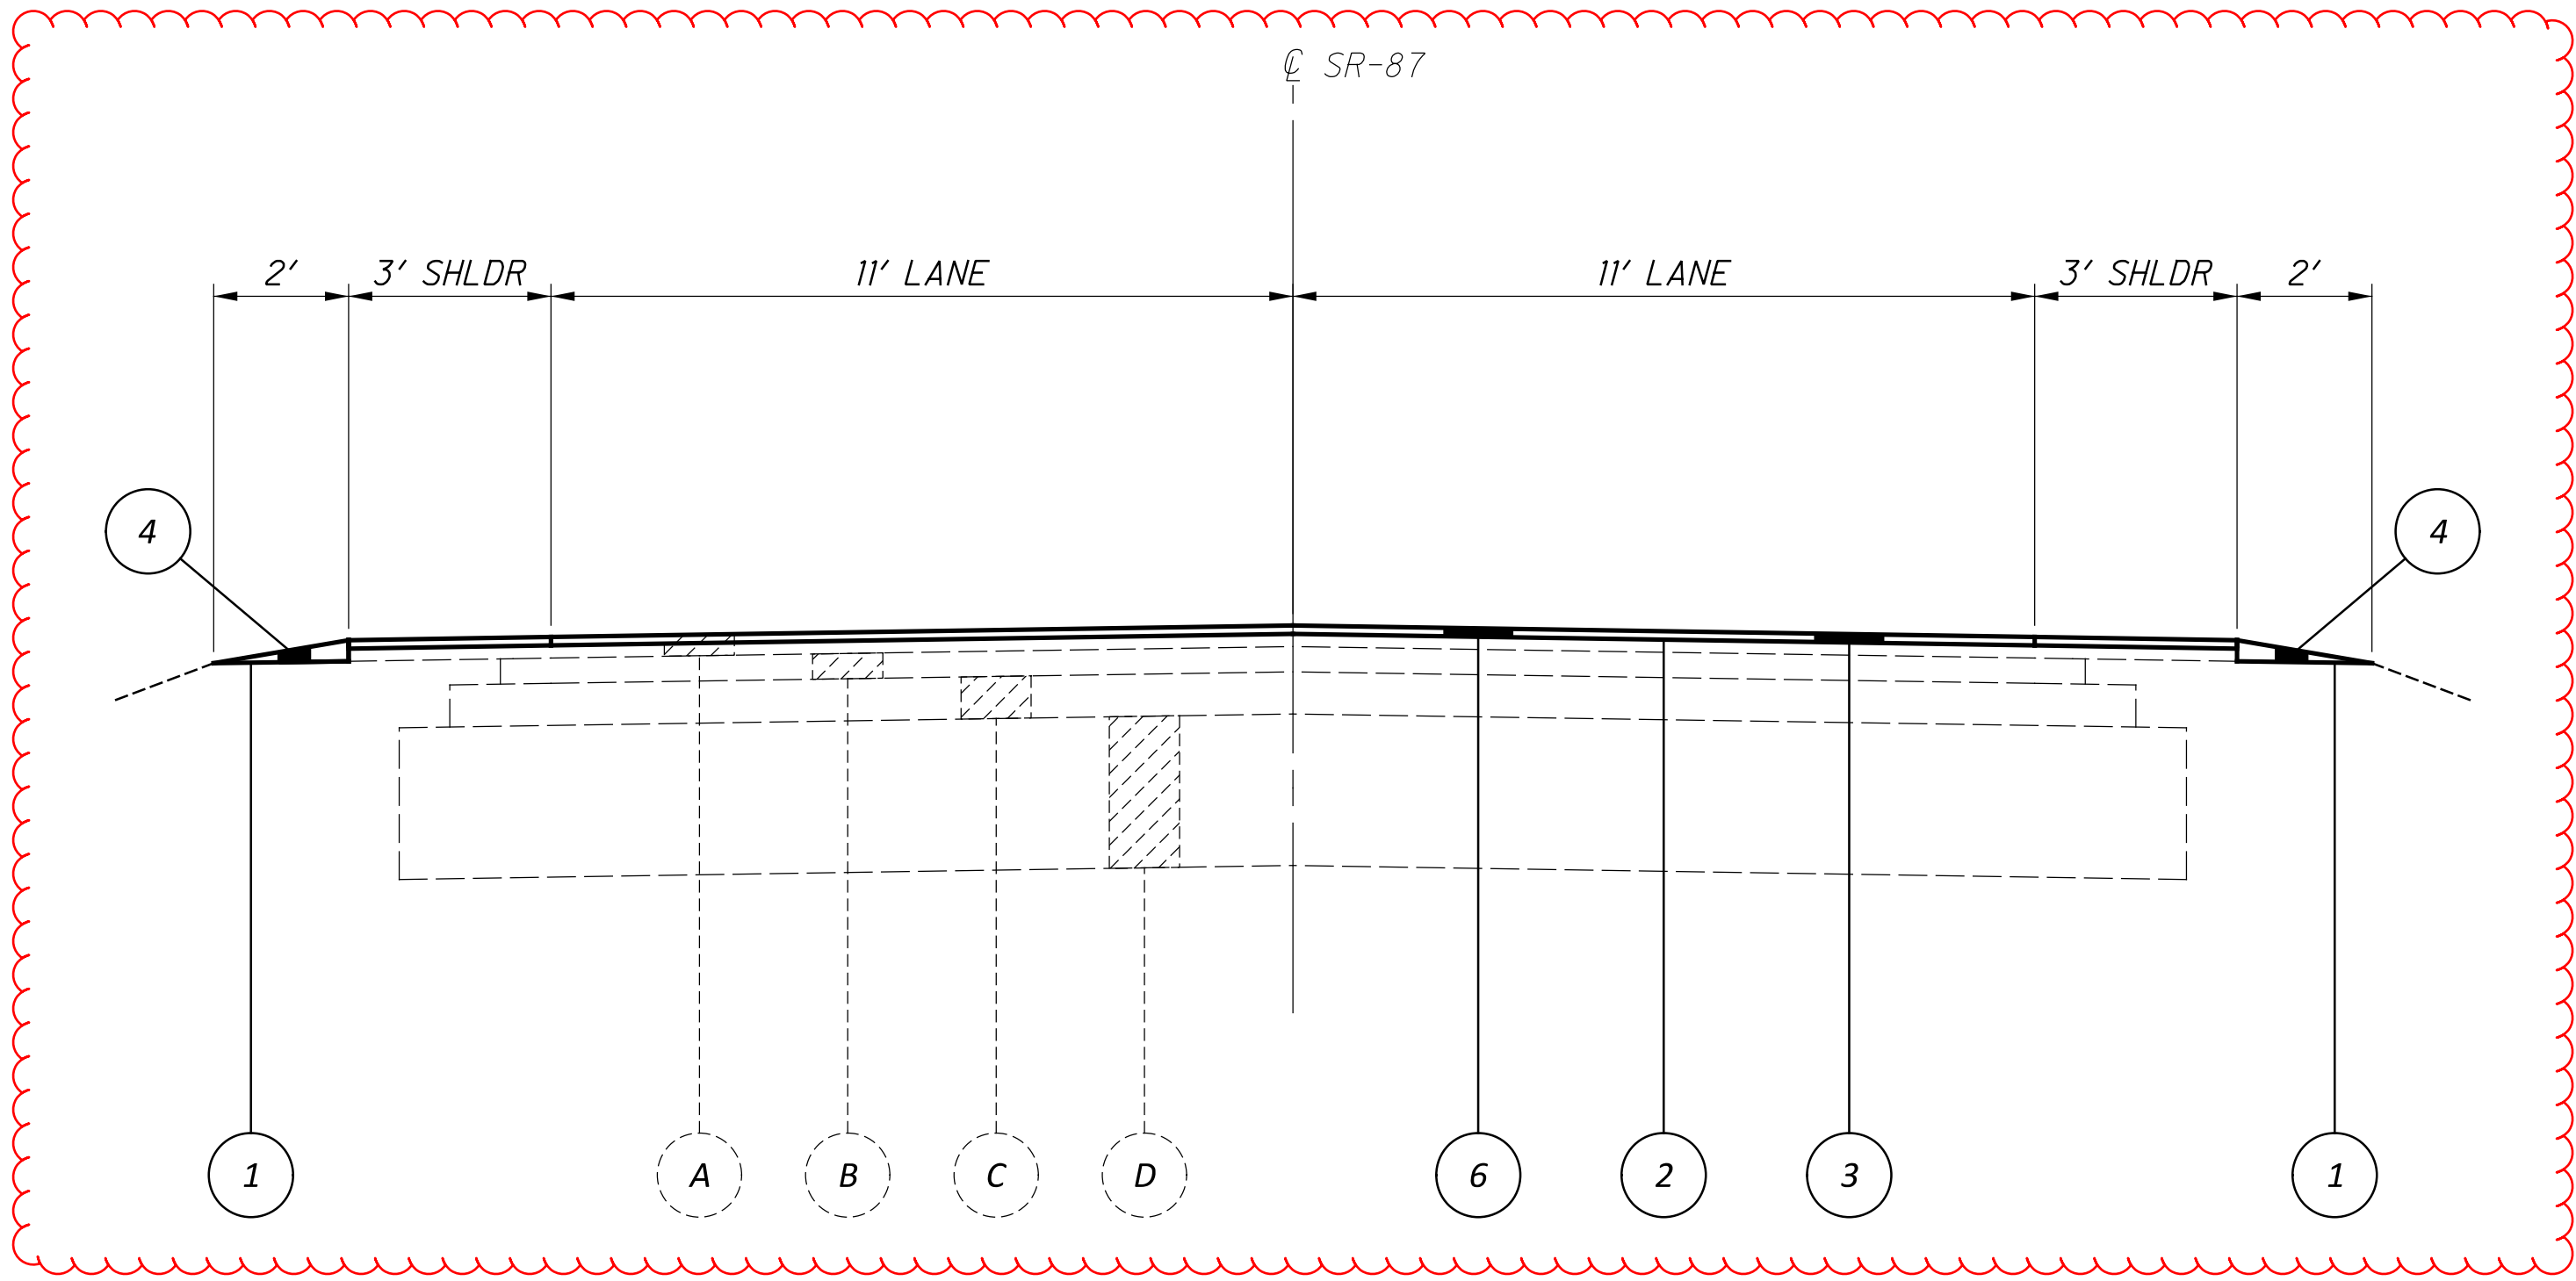

2-LANE SECTION

STA. 149+04.75 TO STA. 165+78.50
STA. 165+78.50 TO STA. 170+10.50 (BRIDGE GEA-87-0318) - NO WORK
STA. 170+10.50 TO STA. 358+23.75
STA. 358+23.75 TO STA. 358+37.75 (BRIDGE GEA-87-0680)
STA. 358+37.75 TO STA. 398+29.75

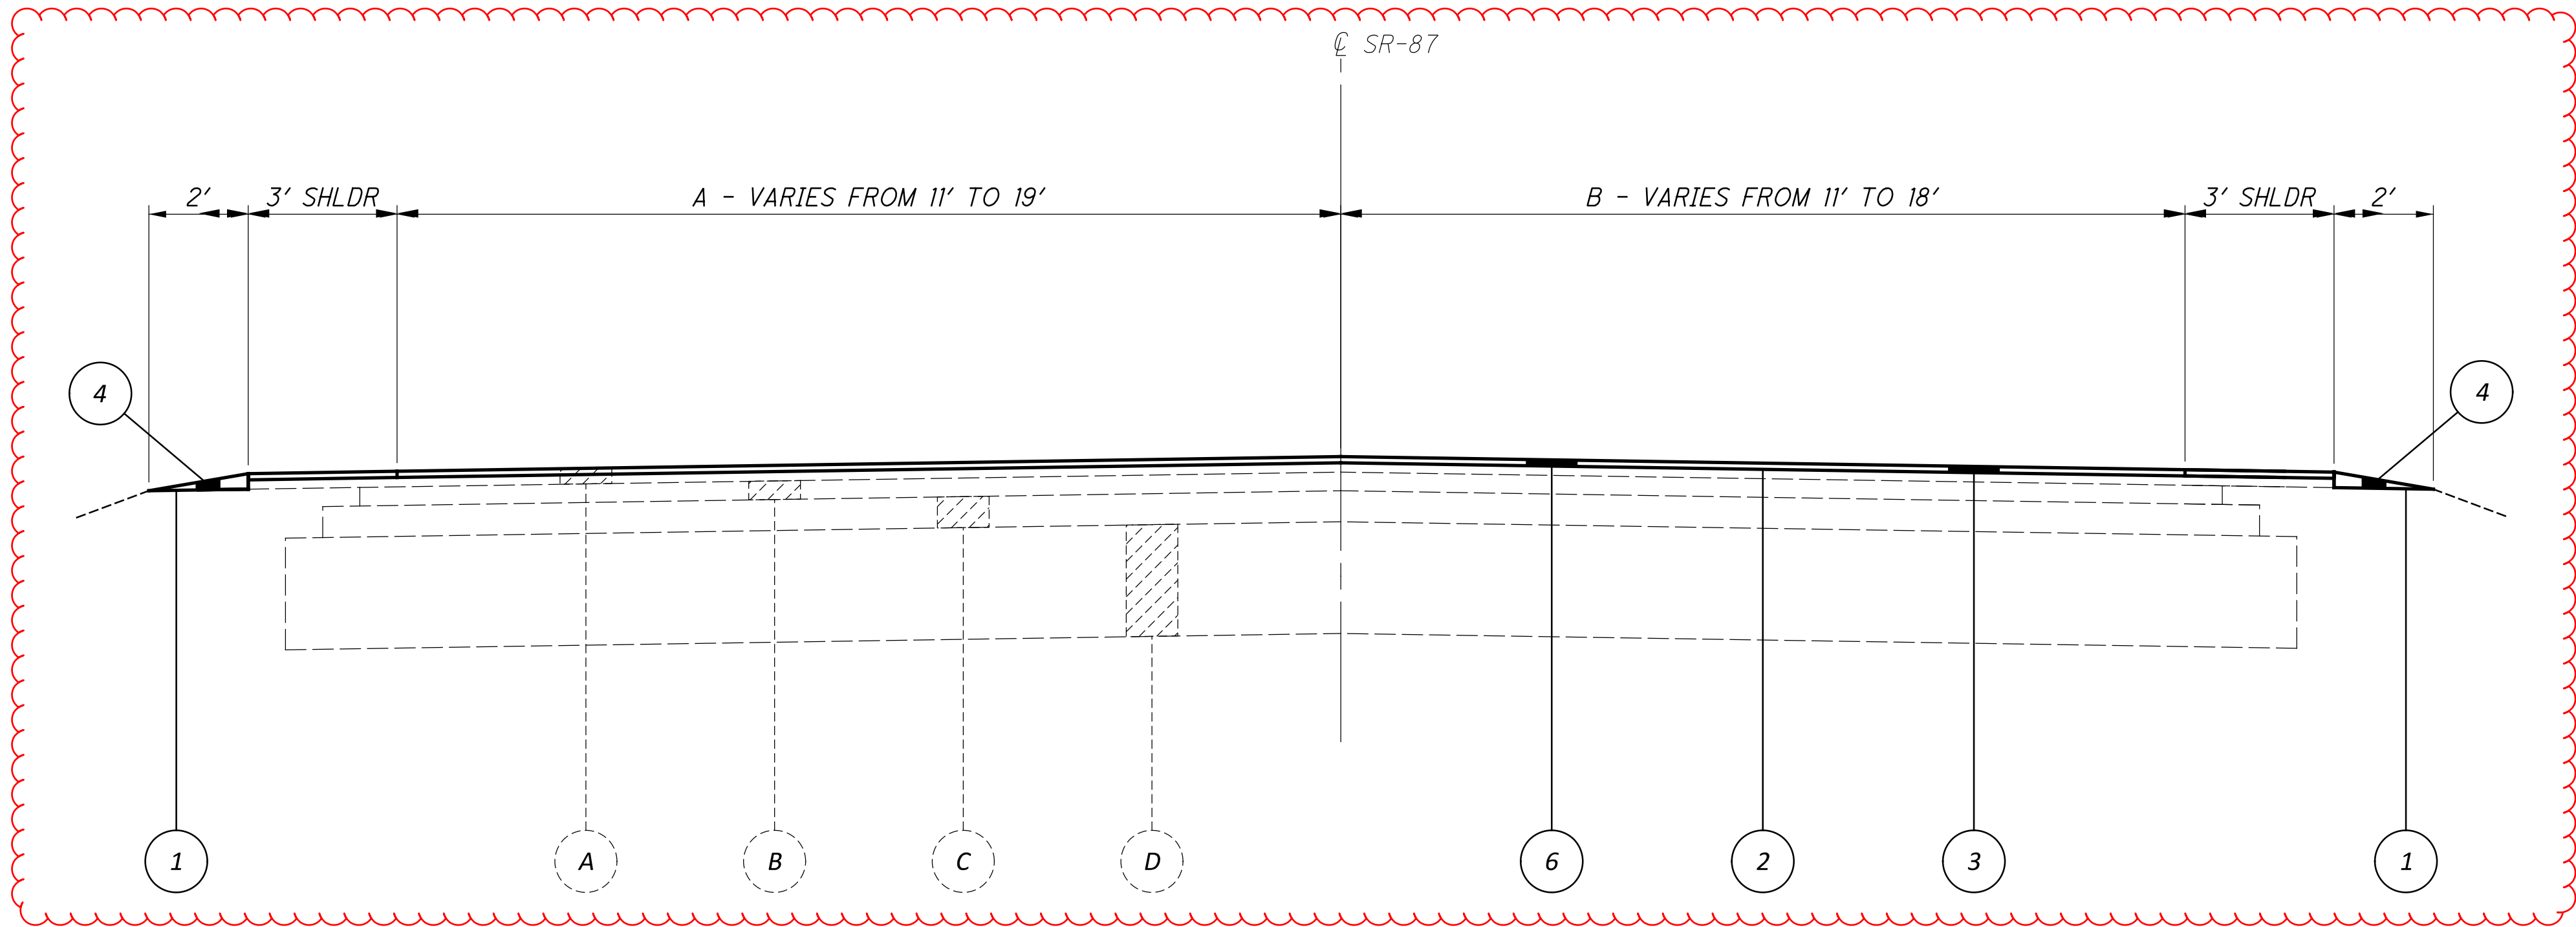

3-LANE SECTION

STA. 143+76.95 TO STA. 149+04.75
STA. 398+29.75 TO STA. 413+72.23

A - TAPERS FROM 18' AT STA. 143+76.95 TO 19' AT STA. 144+89.75
19' FROM STA. 144+89.75 TO 145+89.75
TAPERS FROM 19' AT STA. 145+89.75 TO 11' AT STA. 149+04.75
TAPERS FROM 11' AT STA. 398+29.75 TO 17' AT STA. 402+44.75
17' FROM STA. 402+44.75 TO 411+12.23
TAPERS FROM 17' AT STA. 411+12.23 TO 11' AT STA. 413+72.23


B - TAPERS FROM 18' AT STA. 143+76.95 TO 16' AT STA. 144+89.75
16' FROM STA. 144+89.75 TO 145+89.75
TAPERS FROM 16' AT STA. 145+89.75 TO 11' AT STA. 149+04.75
TAPERS FROM 11' AT STA. 398+29.75 TO 17' AT STA. 402+44.75
17' FROM STA. 402+44.75 TO STA. 411+12.23
TAPERS FROM 17' AT STA. 411+12.23 TO 11' AT STA. 413+72.23

PROPOSED LEGEND

- 1 ITEM 209 - LINEAR GRADING, AS PER PLAN
- 2 ITEM 407 - NON-TRACKING TACK COAT
- 3 ITEM 424 - 1" FINE GRADED POLYMER ASPHALT CONCRETE, TYPE B, (448)
- 4 ITEM 617 - COMPACTED AGGREGATE, AS PER PLAN
- 5 ITEM 618 - RUMBLE STRIPES, CENTER LINE (ASPHALT CONCRETE)
- 6 ITEM 897 - 1" PAVEMENT PLANING, ASPHALT CONCRETE, CLASS A


EXISTING LEGEND

- A 2½"± ASPHALT CONCRETE OVERLAY
- B 3"± ASPHALT CONCRETE BASE
- C 5"± GRANULATED SLAG
- D 18"± SUBBASE

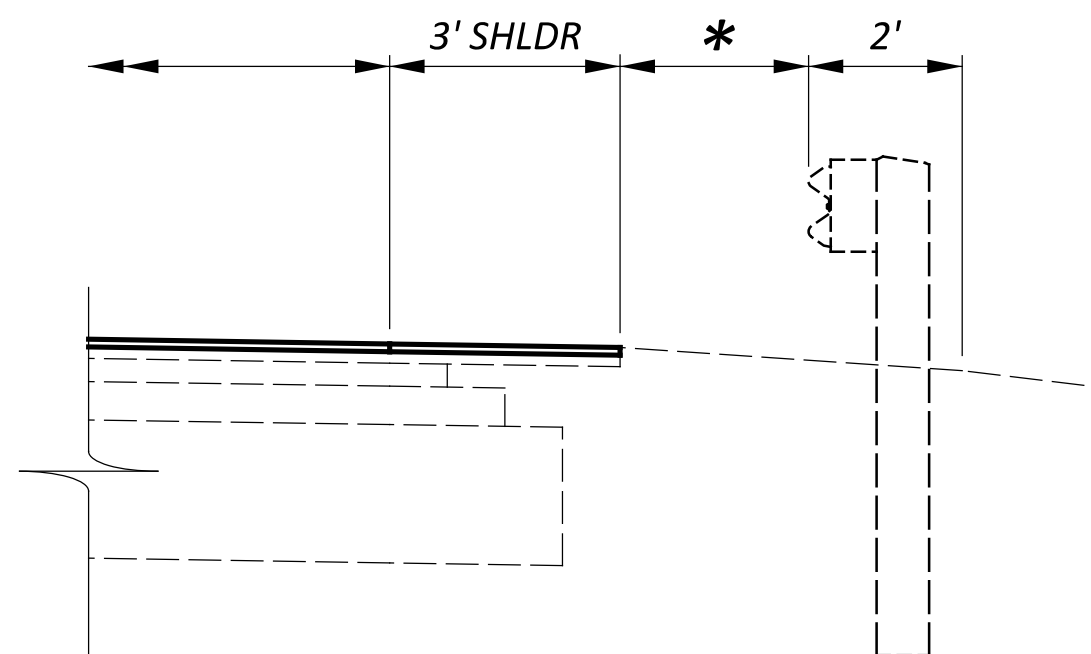

GUARDRAIL DETAIL

* VARIES

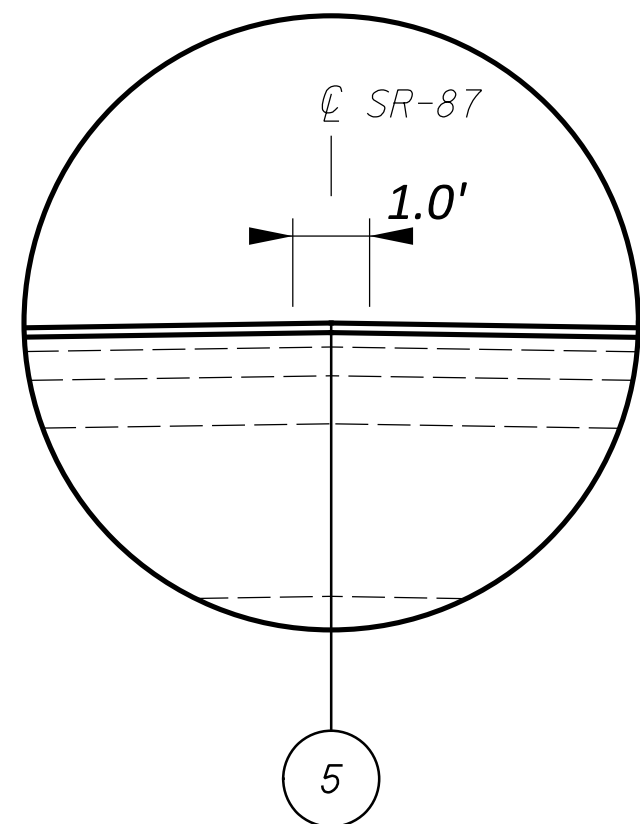

RUMBLE STRIPE

STA. 149+04.75 TO STA. 165+78.50
STA. 170+10.50 TO STA. 398+29.75