

**LEGEND**

- ① ITEM 442 - 1½" ASPHALT CONCRETE SURFACE COURSE, TYPE B, 12.5MM (448), PG70-22
- ② ITEM 441 - 1½" ASPHALT CONCRETE INTERMEDIATE COURSE, TYPE 1, PG 64-22
- ③ ITEM 407 - TACK COAT
- ④ ITEM 301 - 9" ASPHALT CONCRETE BASE, PG64-22
- ⑤ ITEM 304 - 6" AGGREGATE BASE
- ⑥ ITEM 526 - REINFORCED CONCRETE APPROACH SLAB (T=17")
- ⑦ ITEM 204 - SUBGRADE COMPACTION
- ⑧ ITEM 606 - GUARDRAIL, TYPE MGS
- ⑨ ITEM 254 - PAVEMENT PLANING, ASPHALT CONCRETE (3" DEPTH)
- ⑩ ITEM 659 - SEEDING AND MULCHING
- ⑪ ITEM 609 - CURB, TYPE 6 (SEE NOTE 7)
- ⑫ ITEM 609 - COMBINATION CURB AND GUTTER, TYPE 3
- ⑬ ITEM 609 - CURB TYPE 4-C, AS PER PLAN
- ⑭ ITEM 608 - 5" CONCRETE WALK
- ⑮ ITEM 605 - 6" BASE PIPE UNDERDRAIN AS PER SCD DM-1.2 (NOTE 10)

- Ⓐ EXISTING 10¼"± ASPHALT CONCRETE
- Ⓑ EXISTING 5"± AGGREGATE BASE

**NOTES**

- 1. FOR FURTHER INFORMATION ON CURBS, SEE SCD BP-5.1.
- 2. FOR SIDE SLOPE DETAILS, SEE CROSS SECTIONS, SHEETS P.024 - P.032.
- 3. ALL STATIONING SHOWN RELATIVE TO THE EXISTING CENTERLINE ALIGNMENTS, UNLESS OTHERWISE NOTED.
- 4. FOR PAVEMENT STEP DETAILS, SEE SHEET P.004.
- 5. SAW CUTS SHALL BE TO A SOUND PAVEMENT EDGE AS PER CMS 255. SEE SHEETS P.022 - P.023 FOR DETAILS.
- 6. FOR FURTHER MSE WALL AND MOMENT SLAB INFORMATION, SEE SHEETS P.051 - P.053.
- 7. CURB HEIGHT TRANSITIONS OVER 6 FEET FROM 6" TO 8" TO MATCH WALK HEIGHT ON APPROACH SLAB.
- 8. FOR FURTHER GRADING INFORMATION AT MSE WALLS, SEE SHEETS P.051 - P.053.
- 9. FOR MOMENT SLAB DETAILS, SEE SHEETS P.072 - P.076.
- 10. UNDERDRAIN SHALL ONLY BE PLACED ON NORTH SIDE OF BRIDGE DECK, FROM STA. 21+54.44 LT/STA. 21+47.05 RT TO STA. 23+30.00 LT/STA. 23+51.00 RT.

TYPICAL SECTIONS








DESIGN AGENCY  
**fishbeck**

DESIGNER  
JAL

REVIEWER  
JAH 05/01/24

PROJECT ID  
110563

SHEET TOTAL  
P.003 103

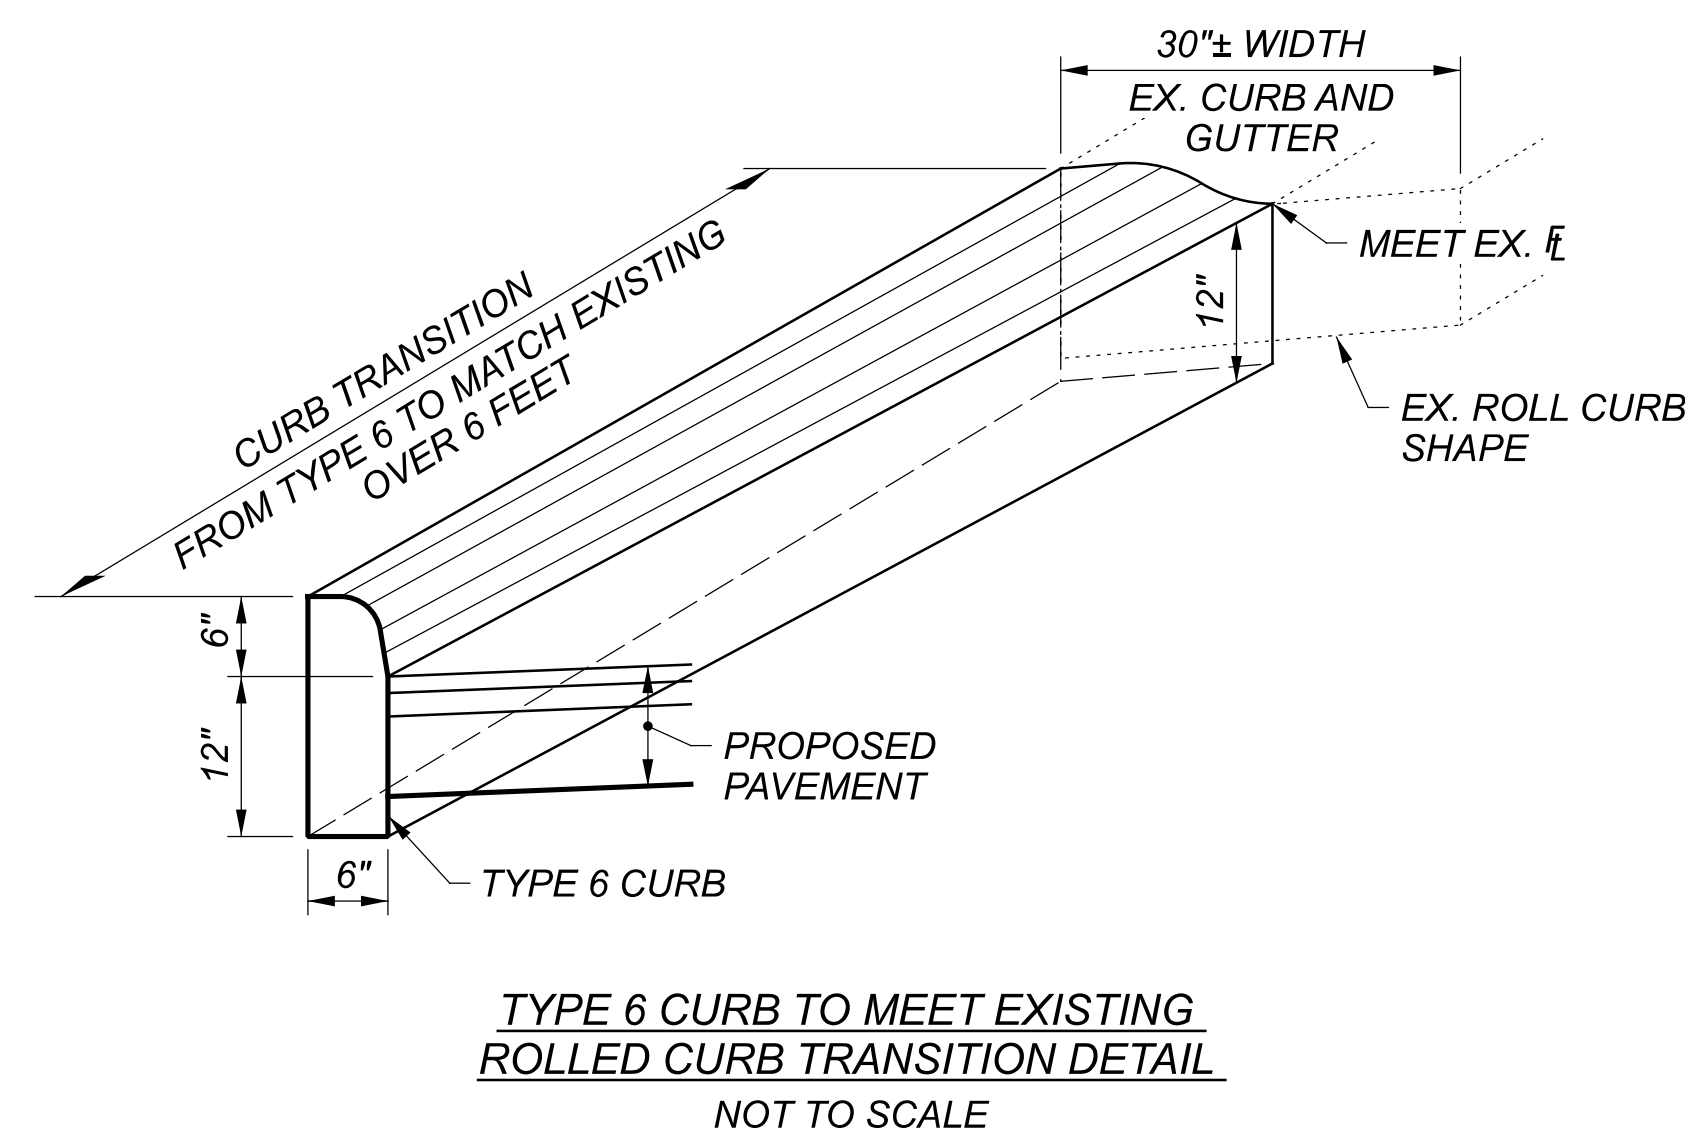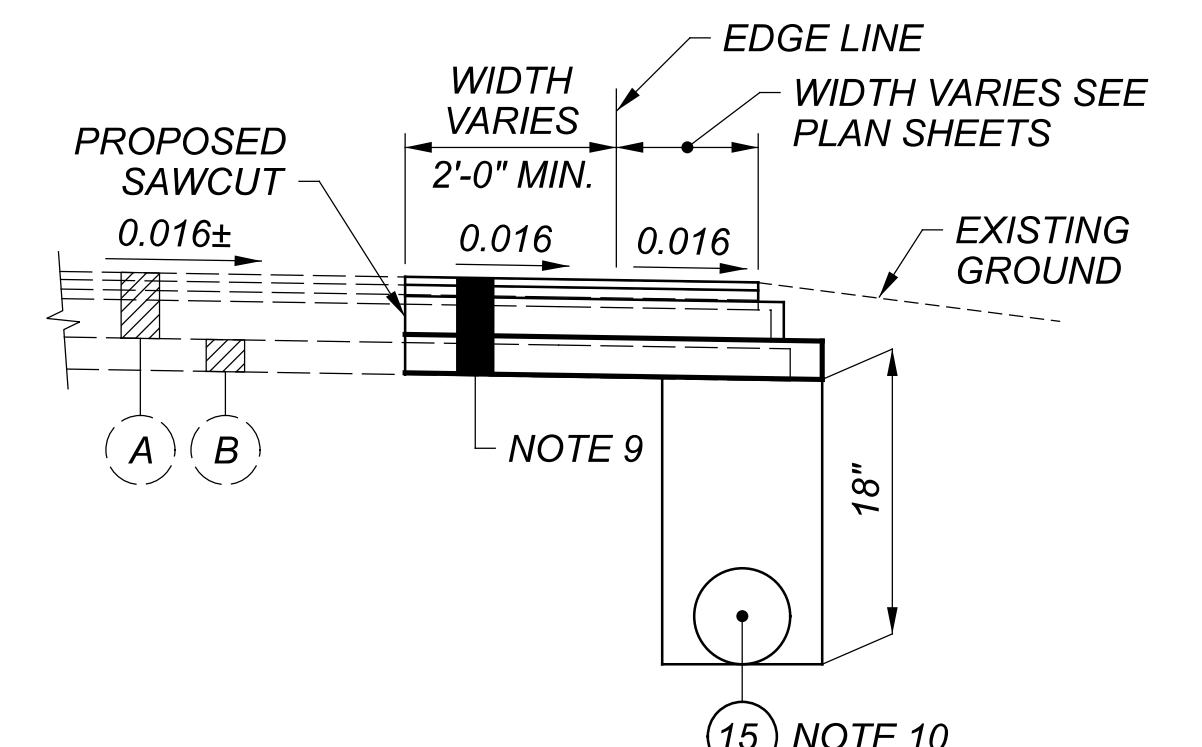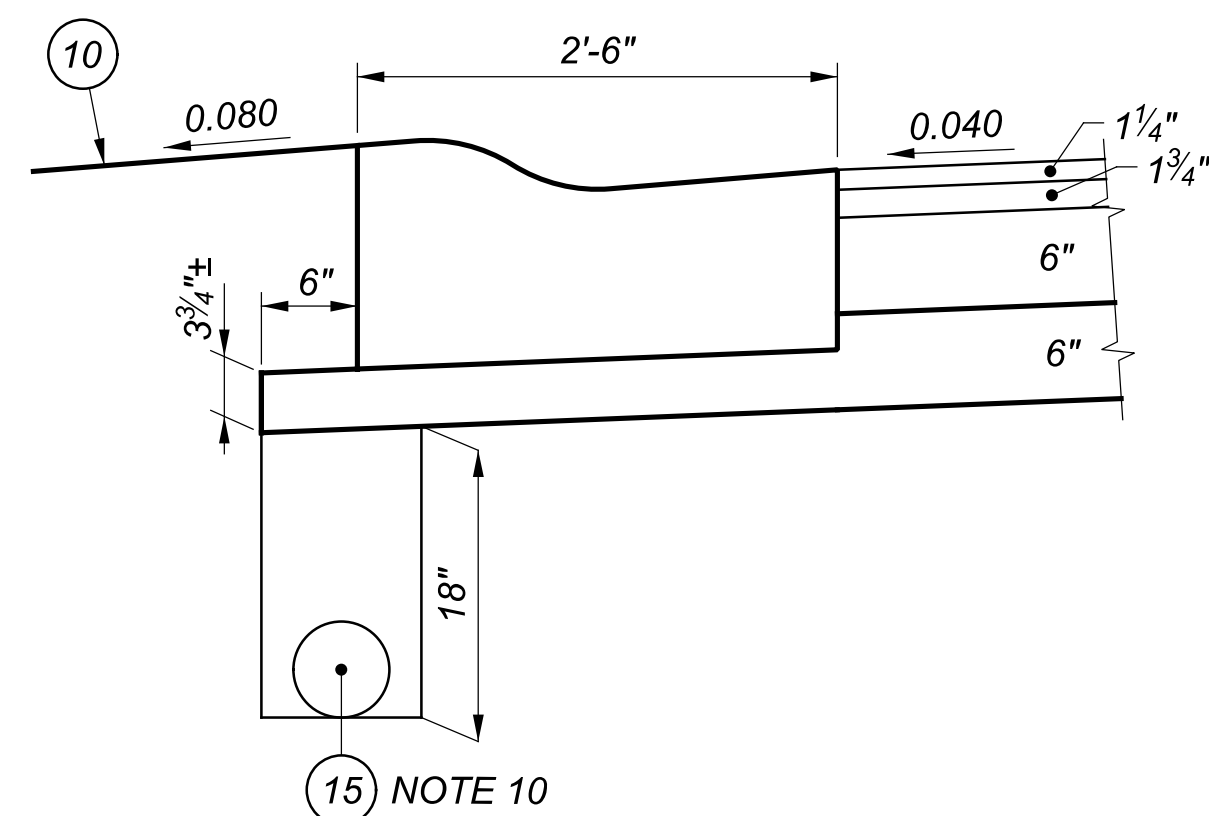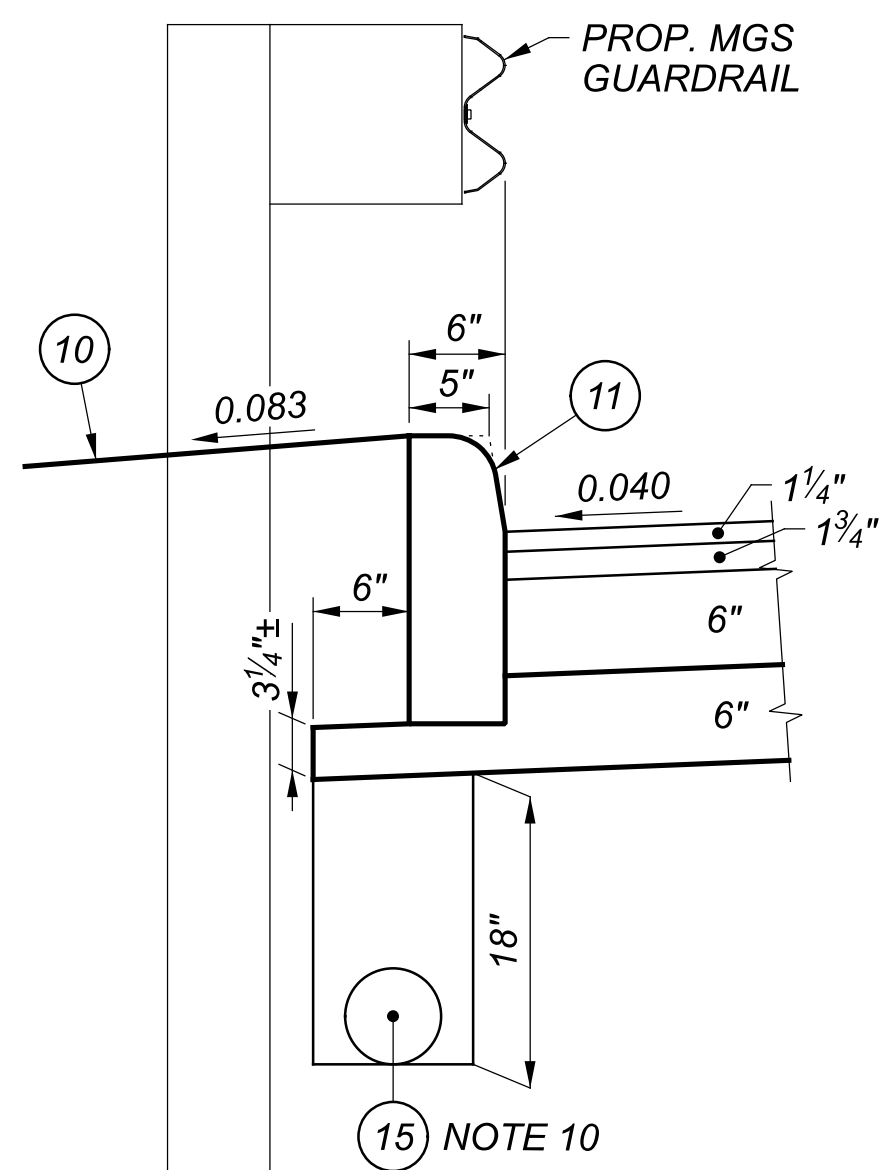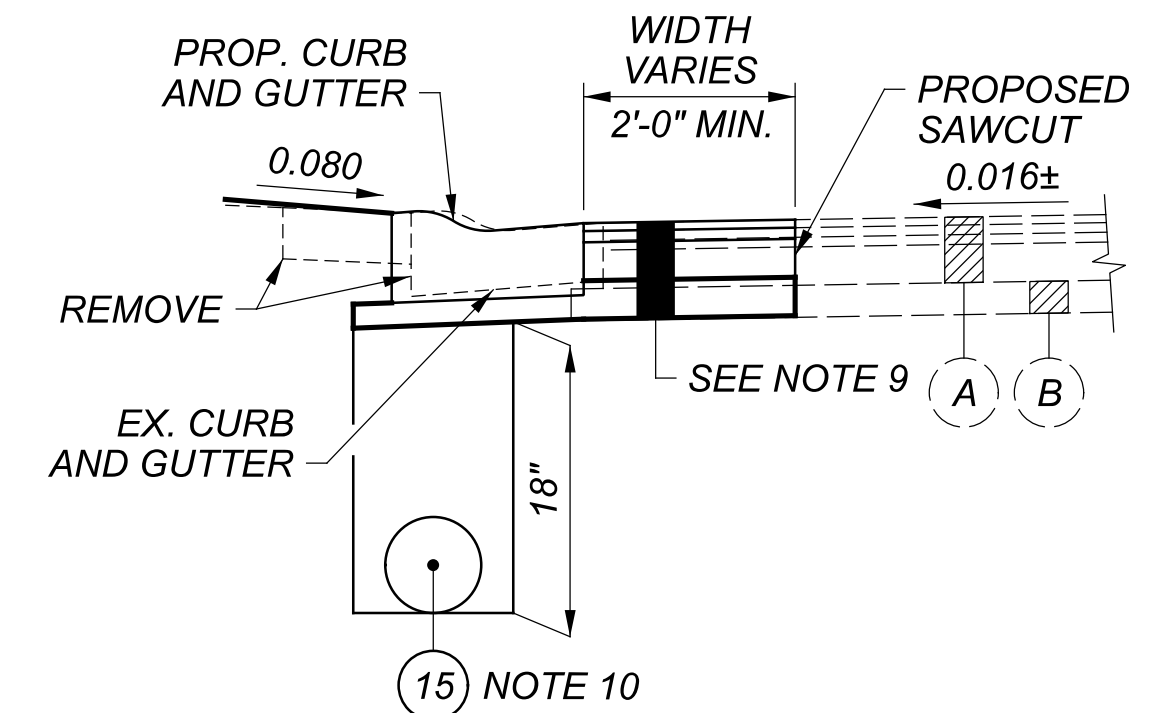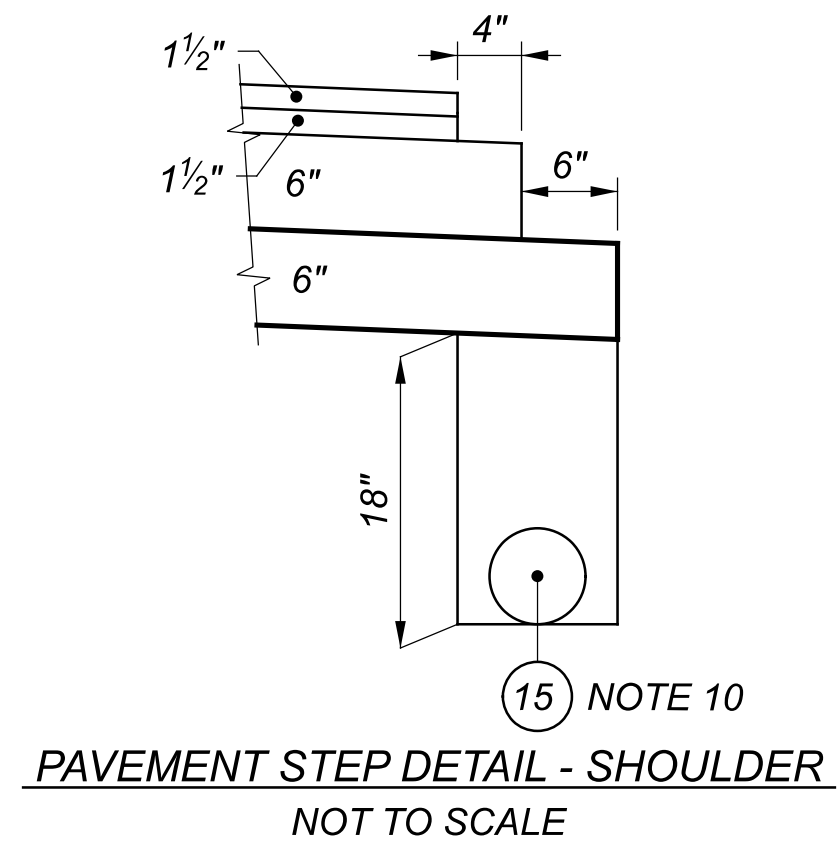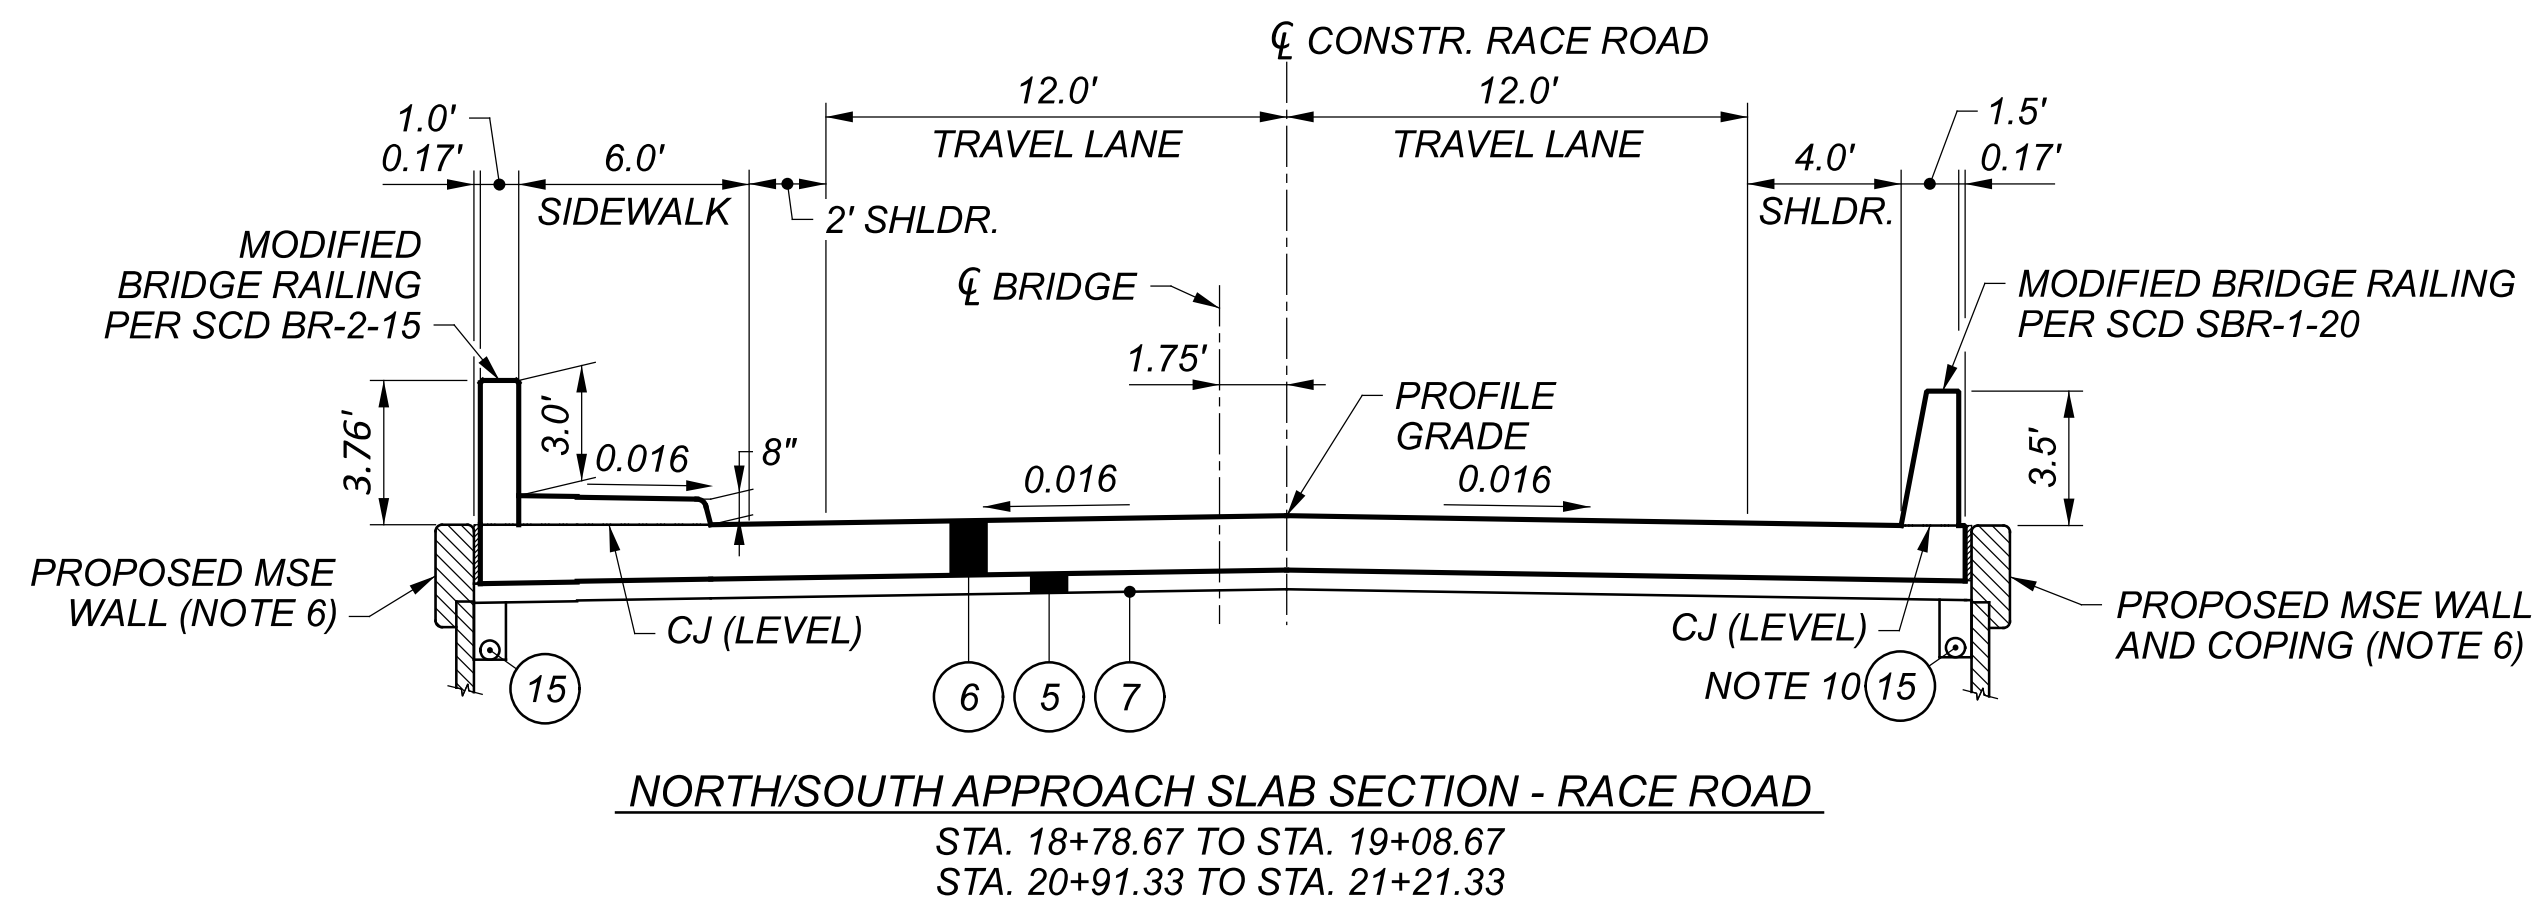



**NOTES**

- FOR FURTHER INFORMATION ON CURBS, SEE SCD BP-5.1.
- FOR SIDE SLOPE DETAILS, SEE CROSS SECTIONS, SHEETS P.024 - P.032.
- ALL STATIONING SHOWN RELATIVE TO THE EXISTING CENTERLINE ALIGNMENTS, UNLESS OTHERWISE NOTED.
- FOR LEGEND, SEE SHEET P.003.
- SAW CUTS SHALL BE TO A SOUND PAVEMENT EDGE AS PER CMS 255. SEE SHEETS P.022 - P.023 FOR DETAILS.
- FOR FURTHER MSE WALL AND MOMENT SLAB INFORMATION, SEE SHEETS P.051 - P.053.
- CURB HEIGHT TRANSITIONS OVER 6 FEET FROM 6" TO 8" TO MATCH WALK HEIGHT ON APPROACH SLAB.
- FOR FURTHER GRADING INFORMATION AT MSE WALLS, SEE SHEETS P.051 - P.053.
- FOR MOMENT SLAB DETAILS, SEE SHEETS P.072 - P.076.
- UNDERDRAIN SHALL ONLY BE PLACED ON NORTH SIDE OF BRIDGE DECK, FROM STA. 21+54.44 LT/STA. 21+47.05 RT TO STA. 23+30.00 LT/STA. 23+51.00 RT.




REF NO.	SHEET NO.	STATION TO STATION				SIDE	202	601	601	602	605	611	611	611	611	611	836
		FT	SY	SY	CY		FT	FT	FT	FT	FT	EACH	EACH	EACH	SY		
D-1	P.023	21+84.60	TO	22+15.00	LT				0.2			33		1		1	
D-2	P.023	22+15.00	TO	22+80.00	LT						65			1			
D-3	P.023	22+37.30	TO	22+62.90	LT	26											
UD-1	P.023	21+54.44	TO	23+30.00	LT		2			176			16		1		
UD-2	P.023	21+47.05	TO	23+51.00	RT		2			196			14		1		
EC-1	P.023	20+81.00	TO	21+49.58	RT			31									
EC-2	P.023	20+80.90	TO	21+49.58	LT			31									
EC-3	P.023	21+49.58	TO	22+89.43	RT												63
EC-4	P.023	21+49.58	TO	21+84.94	LT												16
TOTALS CARRIED TO GENERAL SUMMARY						26	4	62	0.2	372	65	33	30	2	2	1	79

DRAINAGE SUBSUMMARY

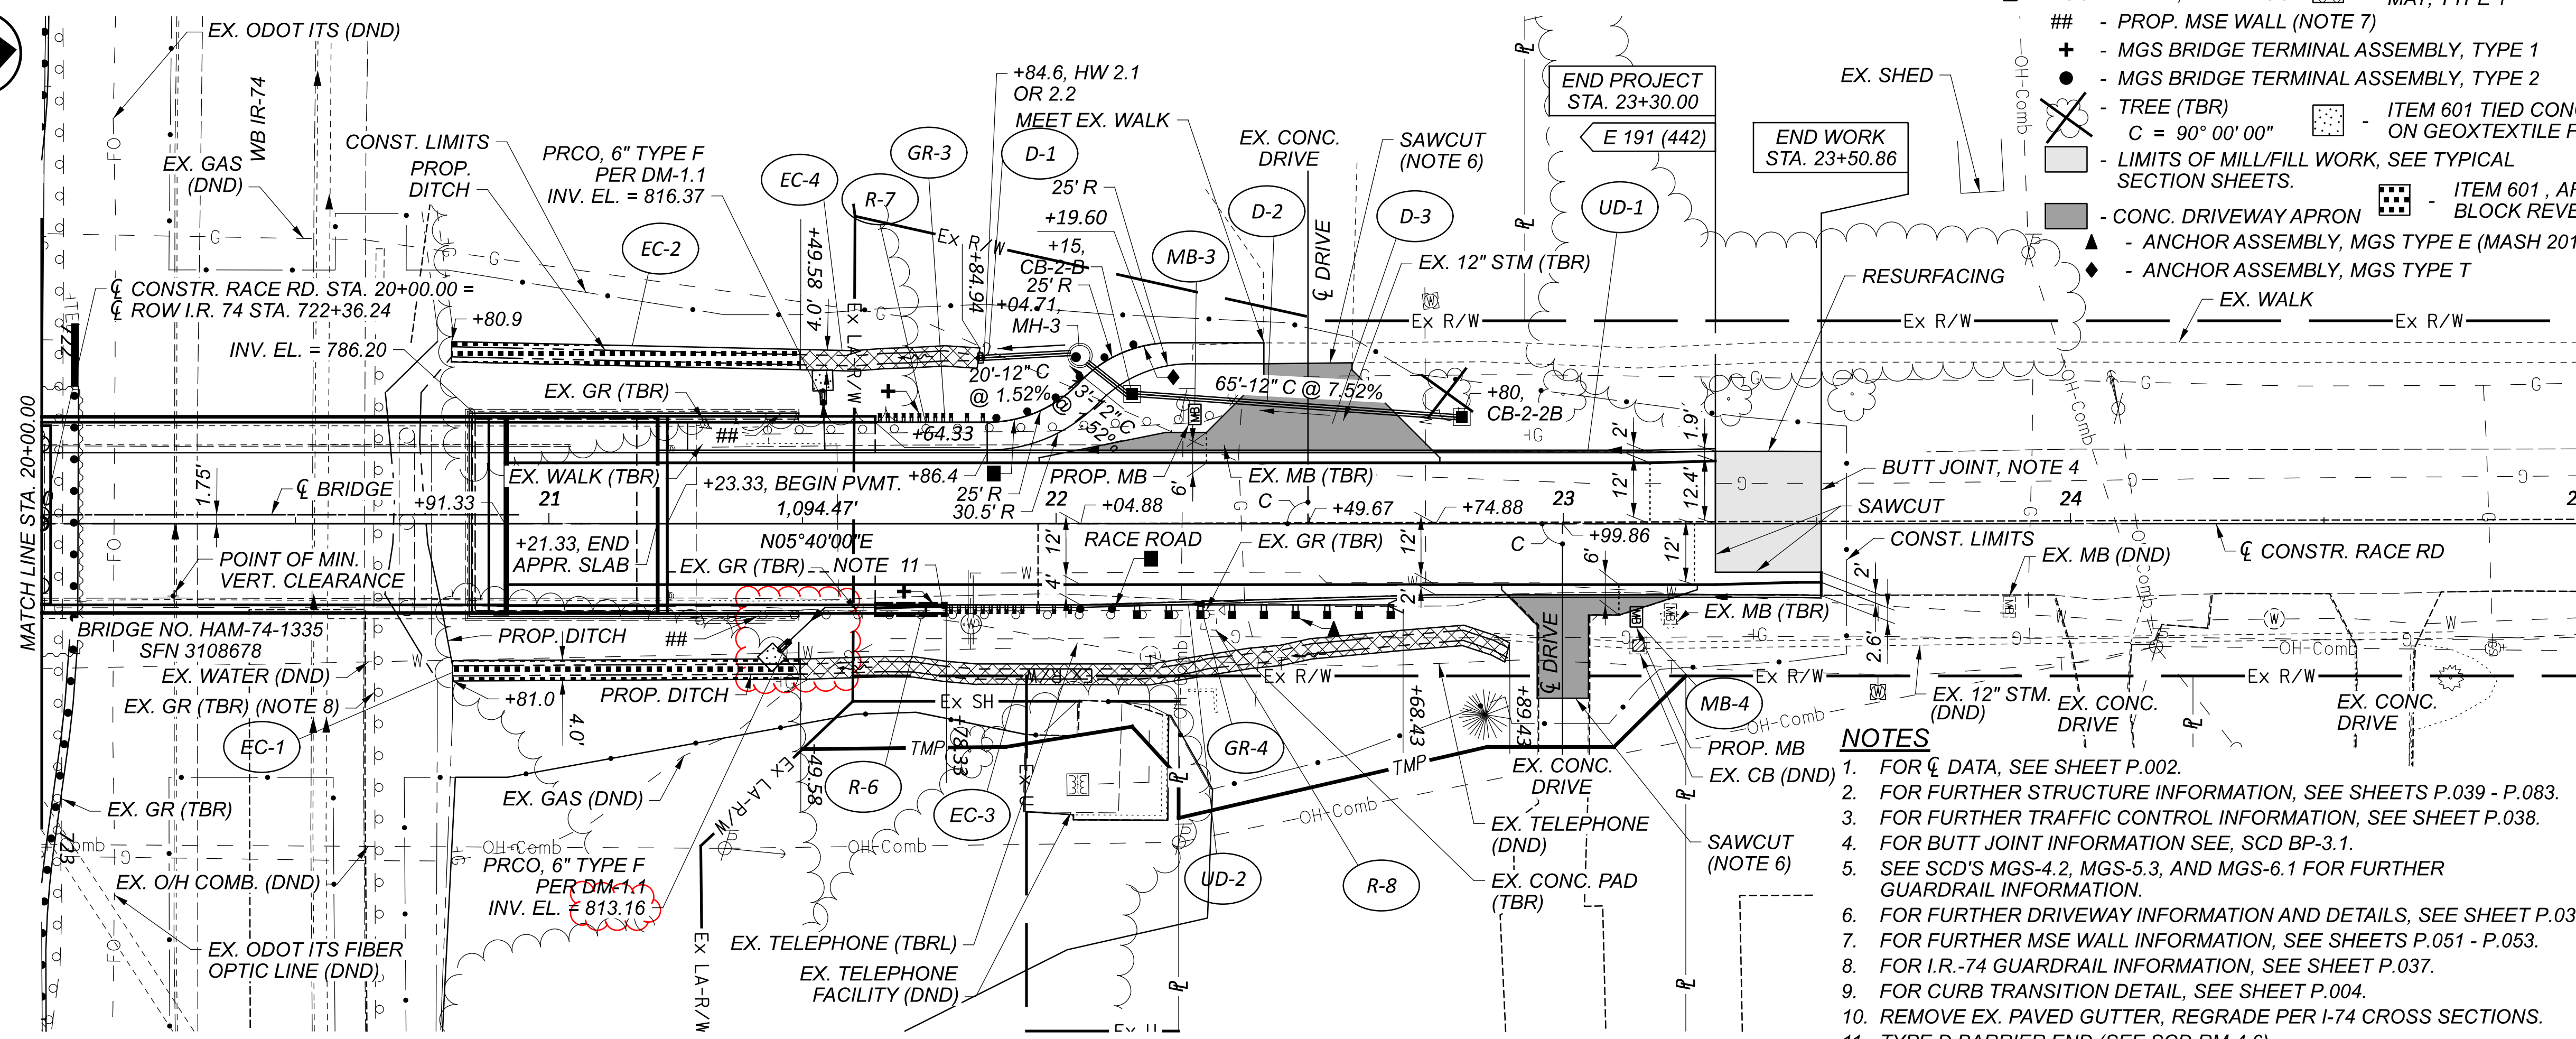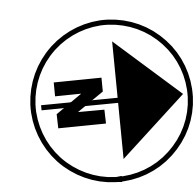


- LEGEND**
- - GUARDRAIL, TYPE MGS
  - ⊗ - ITEM 836, SEEDING AND EROSION CONTROL MAT, TYPE 1
  - ## - PROP. MSE WALL (NOTE 7)
  - + - MGS BRIDGE TERMINAL ASSEMBLY, TYPE 1
  - - MGS BRIDGE TERMINAL ASSEMBLY, TYPE 2
  - ⊗ - TREE (TBR)
  - C = 90° 00' 00"
  - ▨ - LIMITS OF MILL/FILL WORK, SEE TYPICAL SECTION SHEETS.
  - - CONC. DRIVEWAY APRON
  - ▨ - ITEM 601 TIED CONCRETE BLOCK MAT, TYPE 1 ON GEOTEXTILE FABRIC, AS PER SCD DM-1.1
  - ▨ - ITEM 601, ARTICULATING CONCRETE BLOCK REVETMENT SYSTEM, TYPE 1
  - ▲ - ANCHOR ASSEMBLY, MGS TYPE E (MASH 2016)
  - ◆ - ANCHOR ASSEMBLY, MGS TYPE T


- NOTES**
1. FOR  $\phi$  DATA, SEE SHEET P.002.
  2. FOR FURTHER STRUCTURE INFORMATION, SEE SHEETS P.039 - P.083.
  3. FOR FURTHER TRAFFIC CONTROL INFORMATION, SEE SHEET P.038.
  4. FOR BUTT JOINT INFORMATION SEE, SCD BP-3.1.
  5. SEE SCD'S MGS-4.2, MGS-5.3, AND MGS-6.1 FOR FURTHER GUARDRAIL INFORMATION.
  6. FOR FURTHER DRIVEWAY INFORMATION AND DETAILS, SEE SHEET P.036.
  7. FOR FURTHER MSE WALL INFORMATION, SEE SHEETS P.051 - P.053.
  8. FOR I.R.-74 GUARDRAIL INFORMATION, SEE SHEET P.037.
  9. FOR CURB TRANSITION DETAIL, SEE SHEET P.004.
  10. REMOVE EX. PAVED GUTTER, REGRADE PER I-74 CROSS SECTIONS.
  11. TYPE D BARRIER END (SEE SCD RM-4.6).

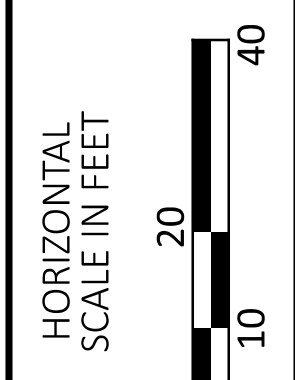


PLAN AND PROFILE  
STA. 20+00 TO END PROJECT

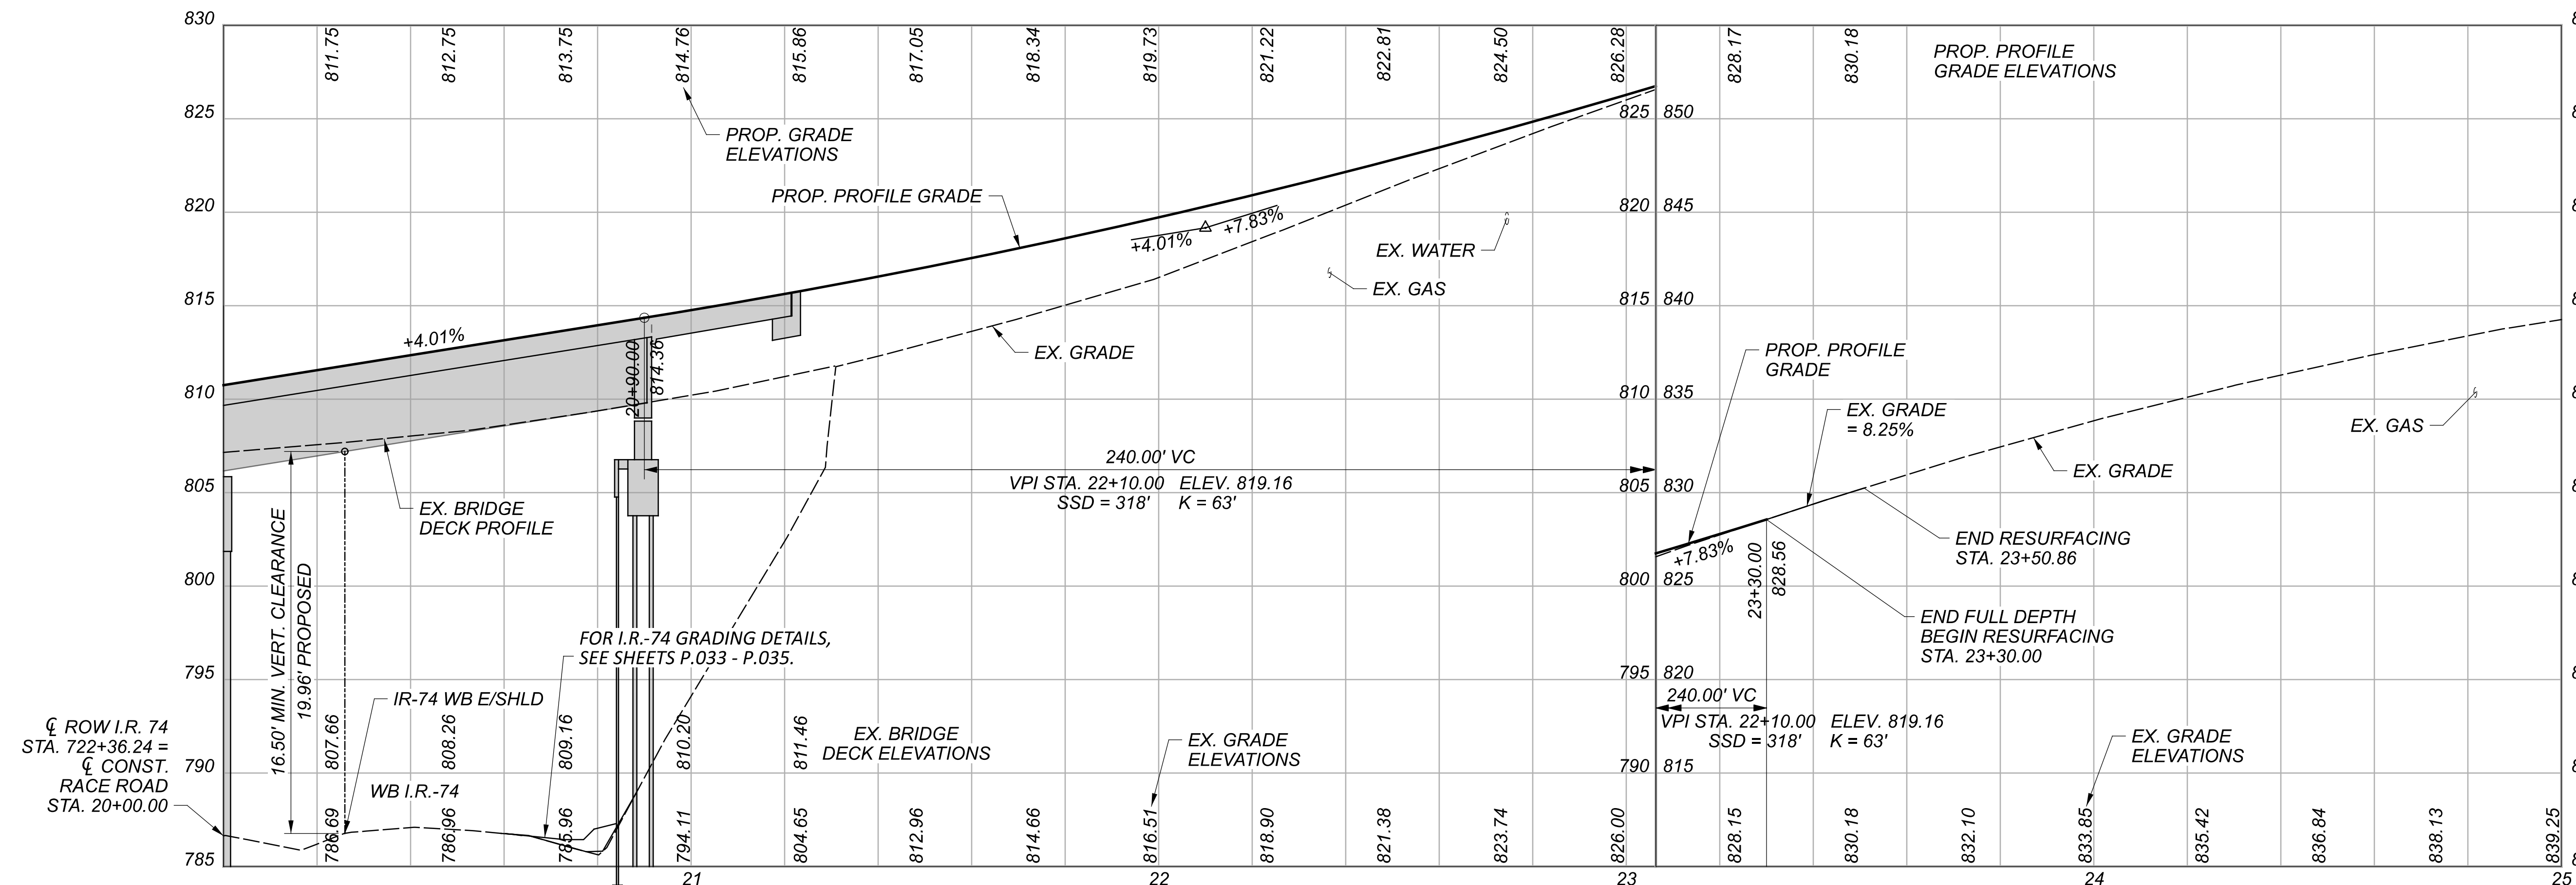

DESIGN AGENCY	fishbeck
DESIGNER	JAL
REVIEWER	JAH 05/01/24
PROJECT ID	110563
SHEET TOTAL	P.023 103

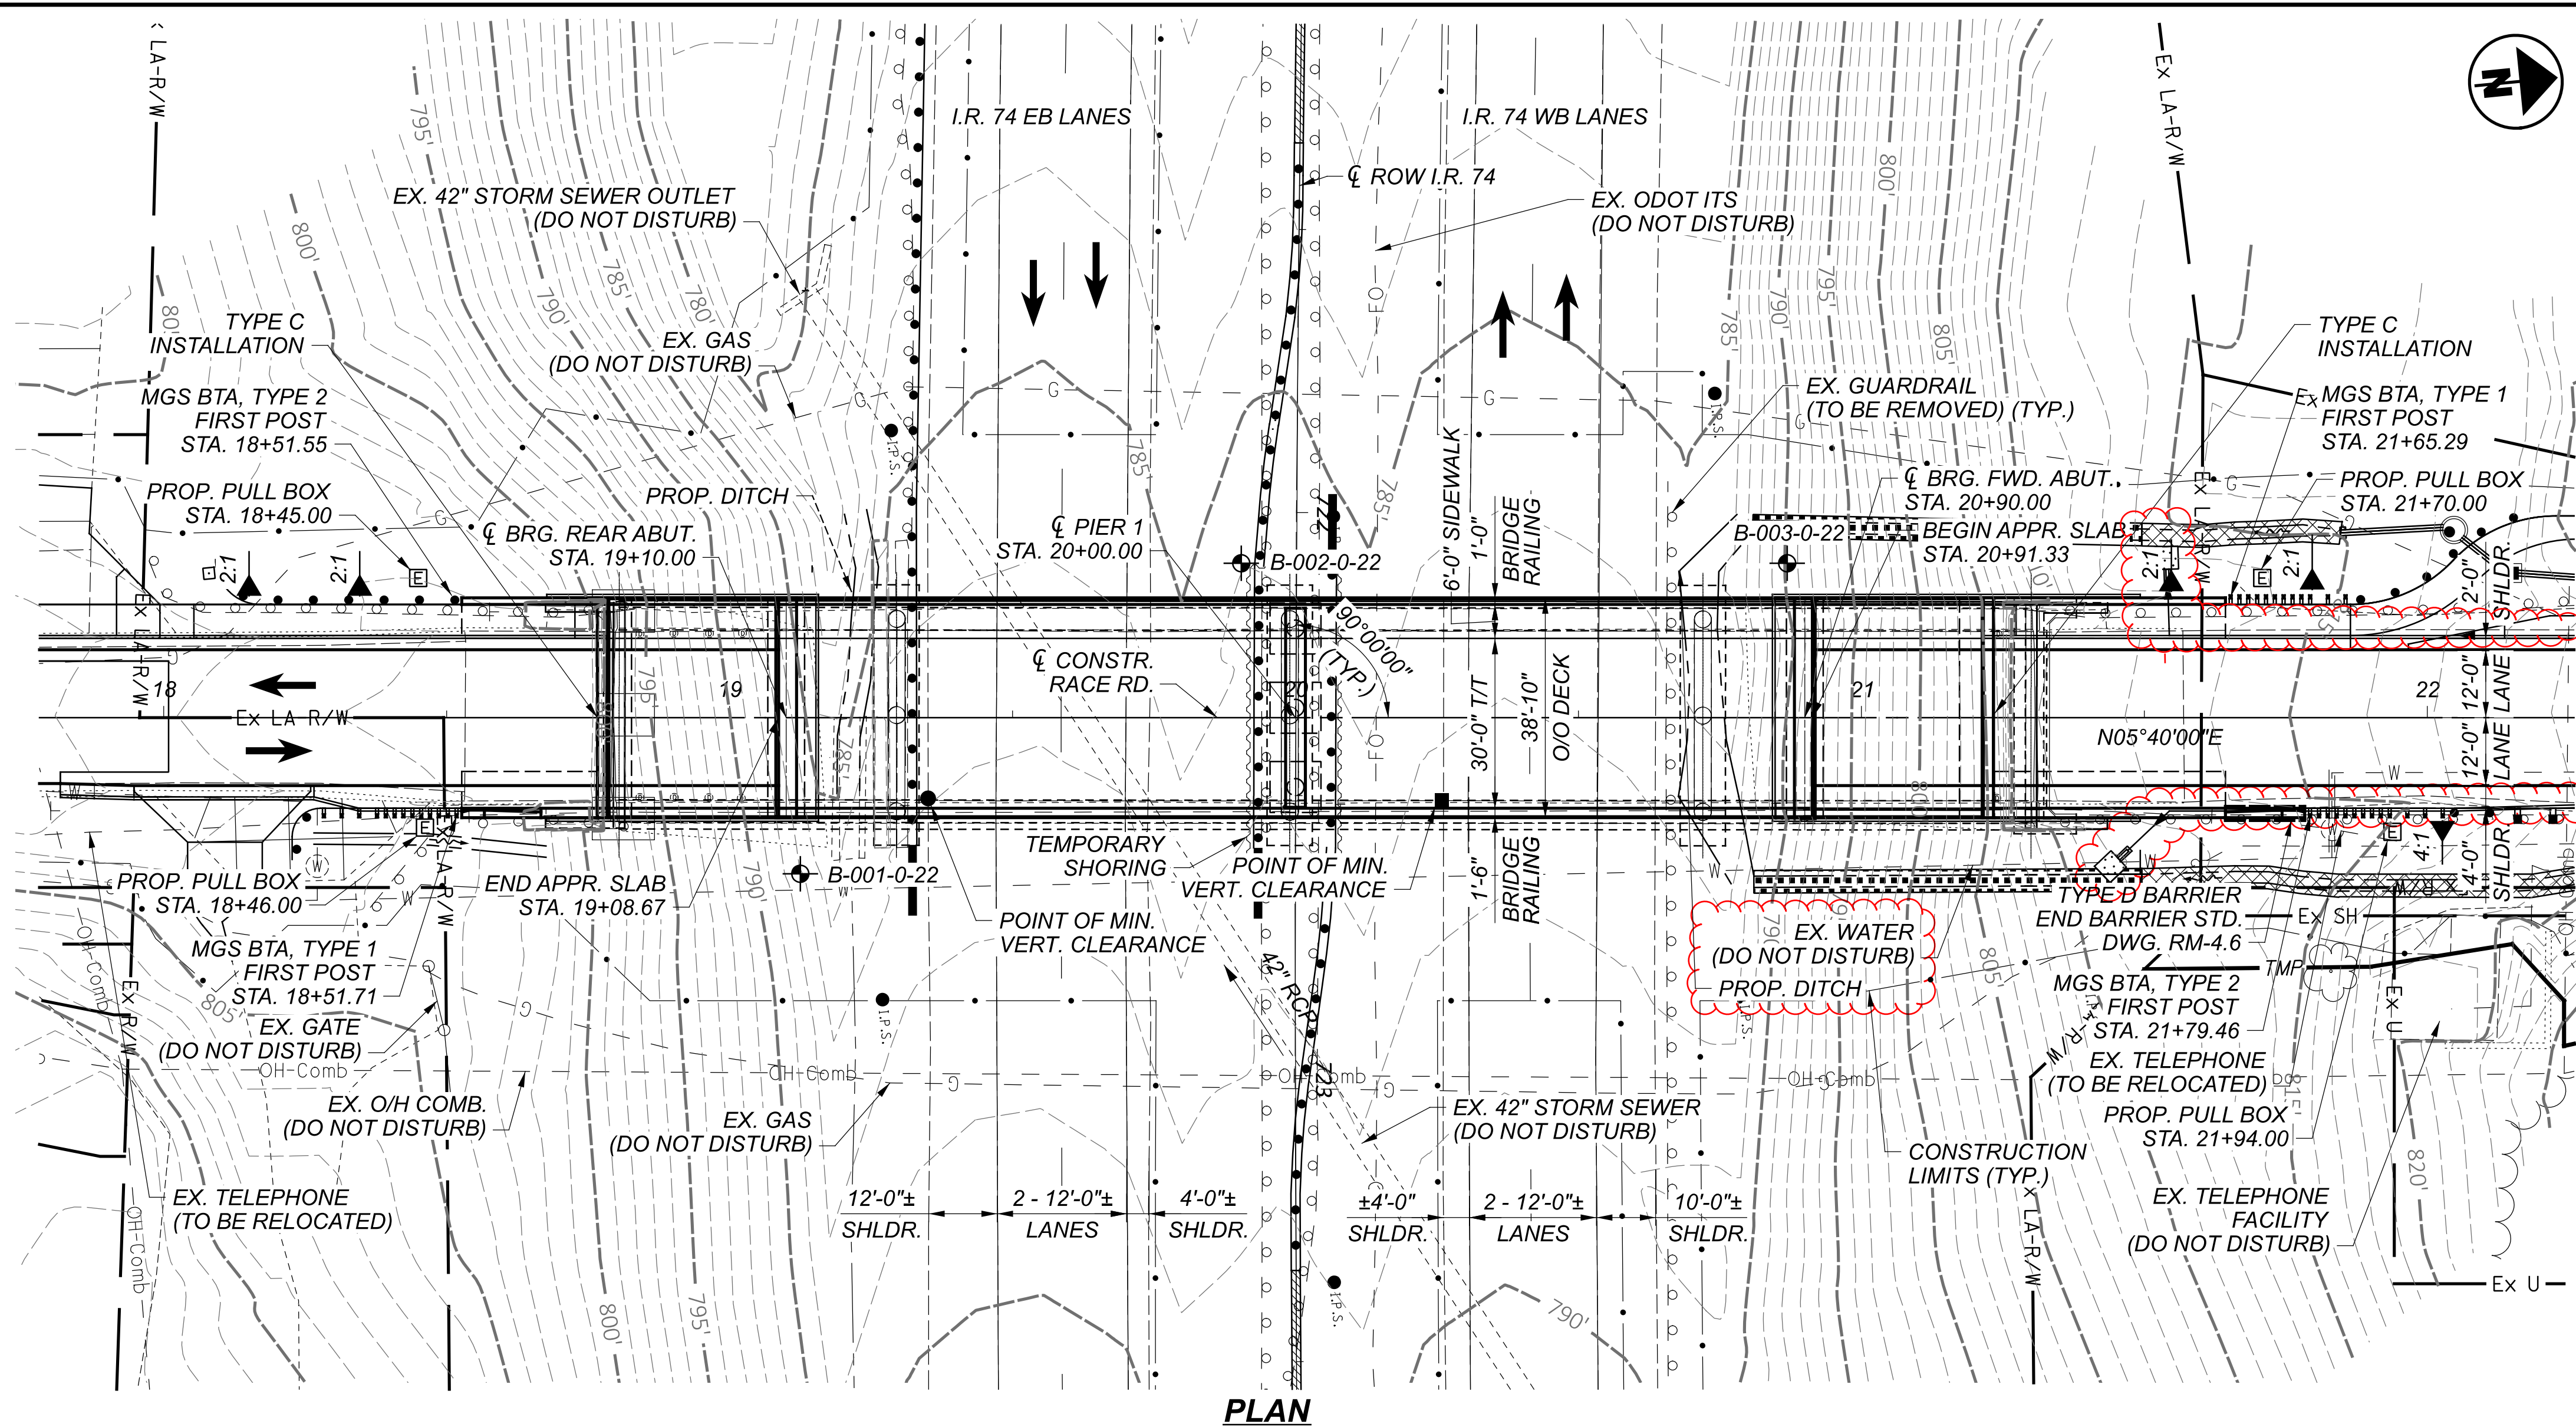

PLAN

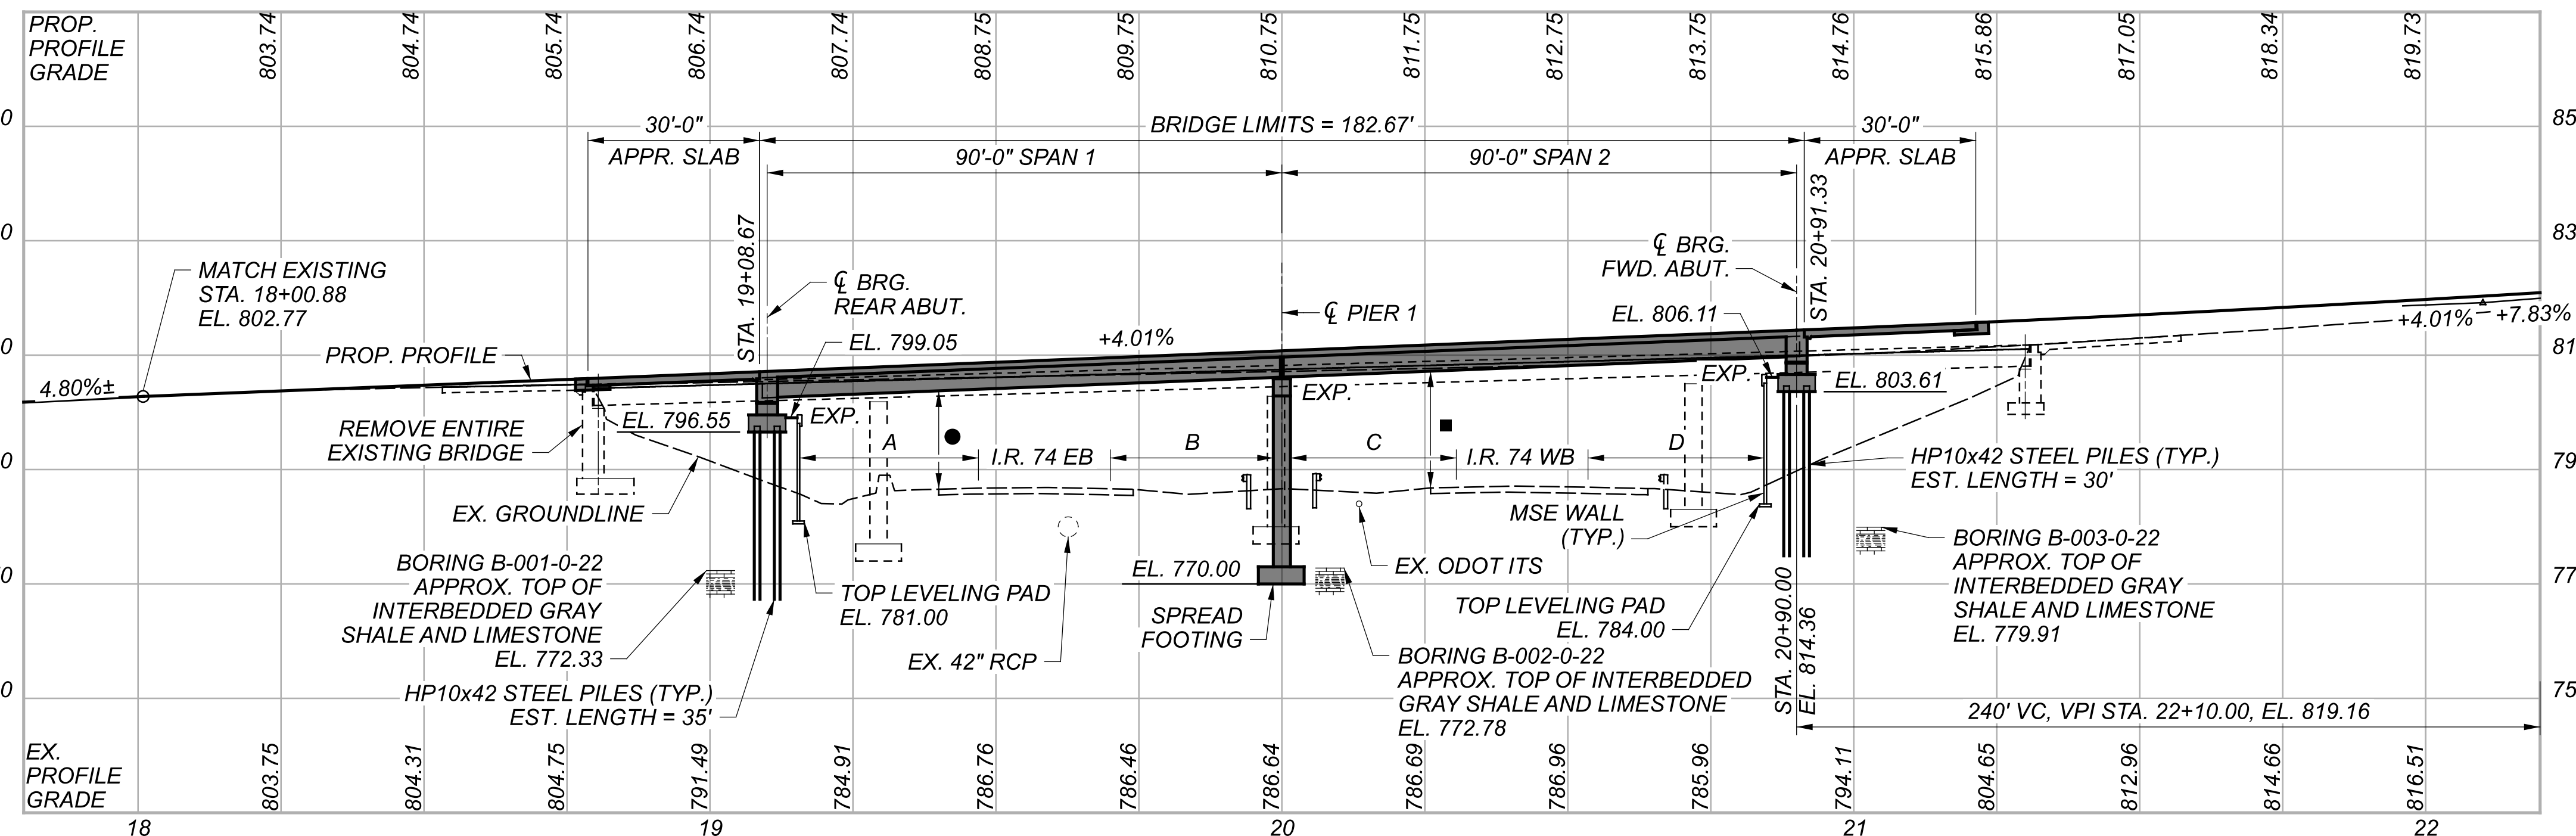

PROFILE ALONG  $\phi$  CONSTRUCTION RACE ROAD

**BENCHMARK DATA**

BM 500 STA. 18+04.17,	EL. 802.675,	OFFSET 19.65' RT.
BM 501 STA. 24+25.28,	EL. 835.668,	OFFSET 31.96' LT.
CP 158 STA. 722+00.64,	EL. 785.512,	OFFSET 6.53' LT.

FOR ADDITIONAL BENCHMARK INFORMATION SEE ROADWAY PLAN SHEET P.002/103.  
 FOR MEDIAN AND SHOULDER GUARDRAIL WORK SEE ROADWAY PLAN SHEET P.037/103.

**NOTES:**

EARTHWORK LIMITS SHOWN ARE APPROXIMATE. ACTUAL SLOPES SHALL CONFORM TO PLAN CROSS SECTIONS.

**DESIGN TRAFFIC:**

2026 ADT = 6,400	2026 ADTT = 64
2046 ADT = 7,600	2046 ADTT = 76
DIRECTIONAL DISTRIBUTION = 0.51	

**LEGEND:**

- $\bullet$  PROJECT BORING LOCATION
- $\bullet$  EASTBOUND I.R. 74  
16'-6" REQUIRED MINIMUM VERTICAL CLEARANCE  
16'-10" ACTUAL MINIMUM VERTICAL CLEARANCE
- $\blacksquare$  WESTBOUND I.R. 74  
16'-6" REQUIRED MINIMUM VERTICAL CLEARANCE  
19'-11 1/2" ACTUAL MINIMUM VERTICAL CLEARANCE
- BTA = BRIDGE TERMINAL ASSEMBLY
- A = MIN. HORIZ. CLEARANCE = 31'-3"  
REQ'D. HORIZ. CLEARANCE = 30'-0"
- B = MIN. HORIZ. CLEARANCE = 28'-6"  
REQ'D. HORIZ. CLEARANCE = 10'-0"
- C = MIN. HORIZ. CLEARANCE = 29'-0"  
REQ'D. HORIZ. CLEARANCE = 10'-0"
- D = MIN. HORIZ. CLEARANCE = 30'-9"  
REQ'D. HORIZ. CLEARANCE = 30'-0"

**EXISTING STRUCTURE**

TYPE: 4-SPAN CONTINUOUS ROLLED STEEL BEAM WITH REINFORCED CONCRETE DECK AND SUBSTRUCTURE

SPANS: 49'-0"±, 69'-6"±, 73'-0"±, 58'-0"± C/C BEARINGS  
 ROADWAY: 30'-0"± T/T CURB WITH 4'-0"± SIDEWALKS  
 LOADING: CF-400 (57)

SKEW: NONE

WEARING SURFACE: 1"± SDC OVERLAY

APPROACH SLABS: 25'± LONG (AS-1-54)

ALIGNMENT: TANGENT

CROWN: 0.016± FT/FT

STRUCTURE FILE NUMBER: 3108678

DATE BUILT: 1969 REHABILITATED: 1992

DISPOSITION: TO BE REPLACED

**PROPOSED STRUCTURE**

TYPE: 2-SPAN PRESTRESSED CONCRETE WIDE FLANGE BEAM COMPOSITE WITH REINFORCED CONCRETE DECK ON SEMI-INTEGRAL ABUTMENTS BEHIND MSE WALLS AND CAP & COLUMN PIER

SPANS: 88'-11", 88'-11" C/C BEARINGS

ROADWAY: 30'-0" T/T, 6'-0" SIDEWALK LEFT SIDE

LOADING: HL93 AND 0.06 KSF FUTURE WEARING SURFACE

SKEW: NONE

WEARING SURFACE: 1" MONOLITHIC CONCRETE

APPROACH SLABS: 30'-0" LONG (AS-1-15 MODIFIED, AS-2-15 TYPE C INSTALLATION)

ALIGNMENT: TANGENT

CROWN: 0.016 FT/FT

DECK AREA: 7,094 SF


COORDINATES: LATITUDE 39°11'11.84" N

LONGITUDE 84°37'40.94" W

SITE PLAN  
 BRIDGE NO. HAM-74-1335  
 RACE ROAD OVER I.R. 74



SFN	3108680
DESIGN AGENCY	fishbeck
DESIGNER/CHECKER	BMV/JPC
REVIEWER	JBD 04/30/24
PROJECT ID	110563
SUBSET	TOTAL
S.01	45
SHEET	TOTAL
P.039	103

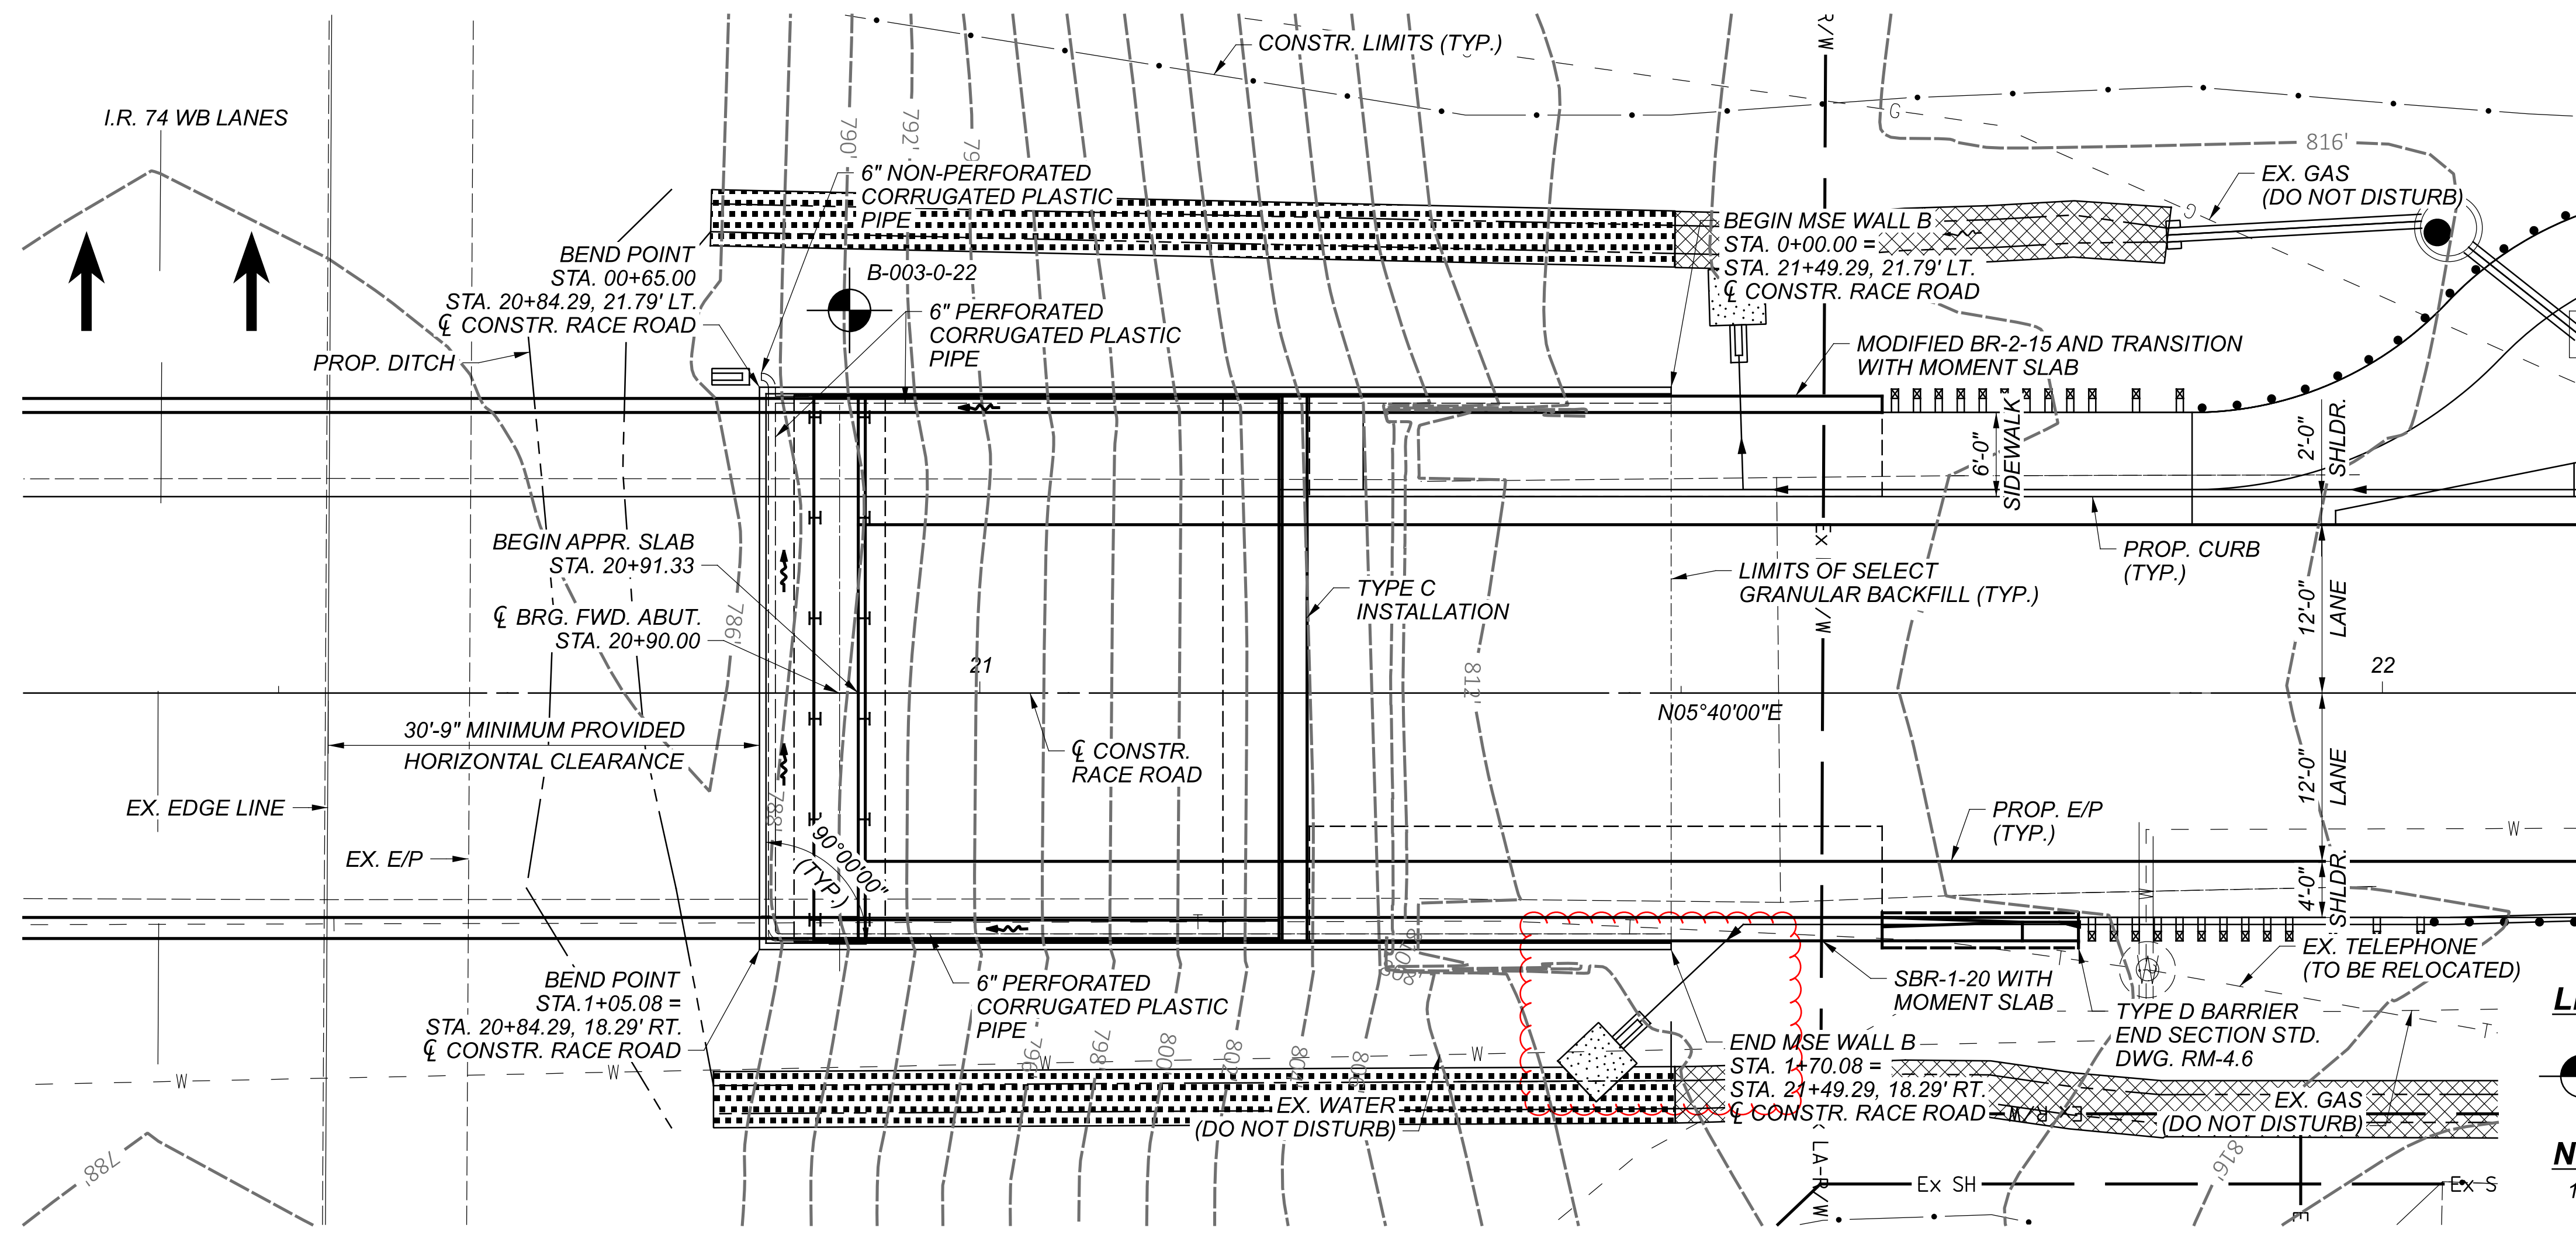


**MSE WALL B PLAN**

**LEGEND:**


PROJECT BORING LOCATION

**NOTES:**

1. ALL STATIONS, OFFSETS, ELEVATIONS AND DIMENSIONS MEASURED ALONG FRONT FACE OF MSE WALL PANEL.
2. FOR SECTIONS B-B, C-C, D-D SEE SHEET S.15/ 45.
3. FOR MOMENT SLAB DETAILS SEE SHEETS S.34/ 45 THRU S.38/ 45.

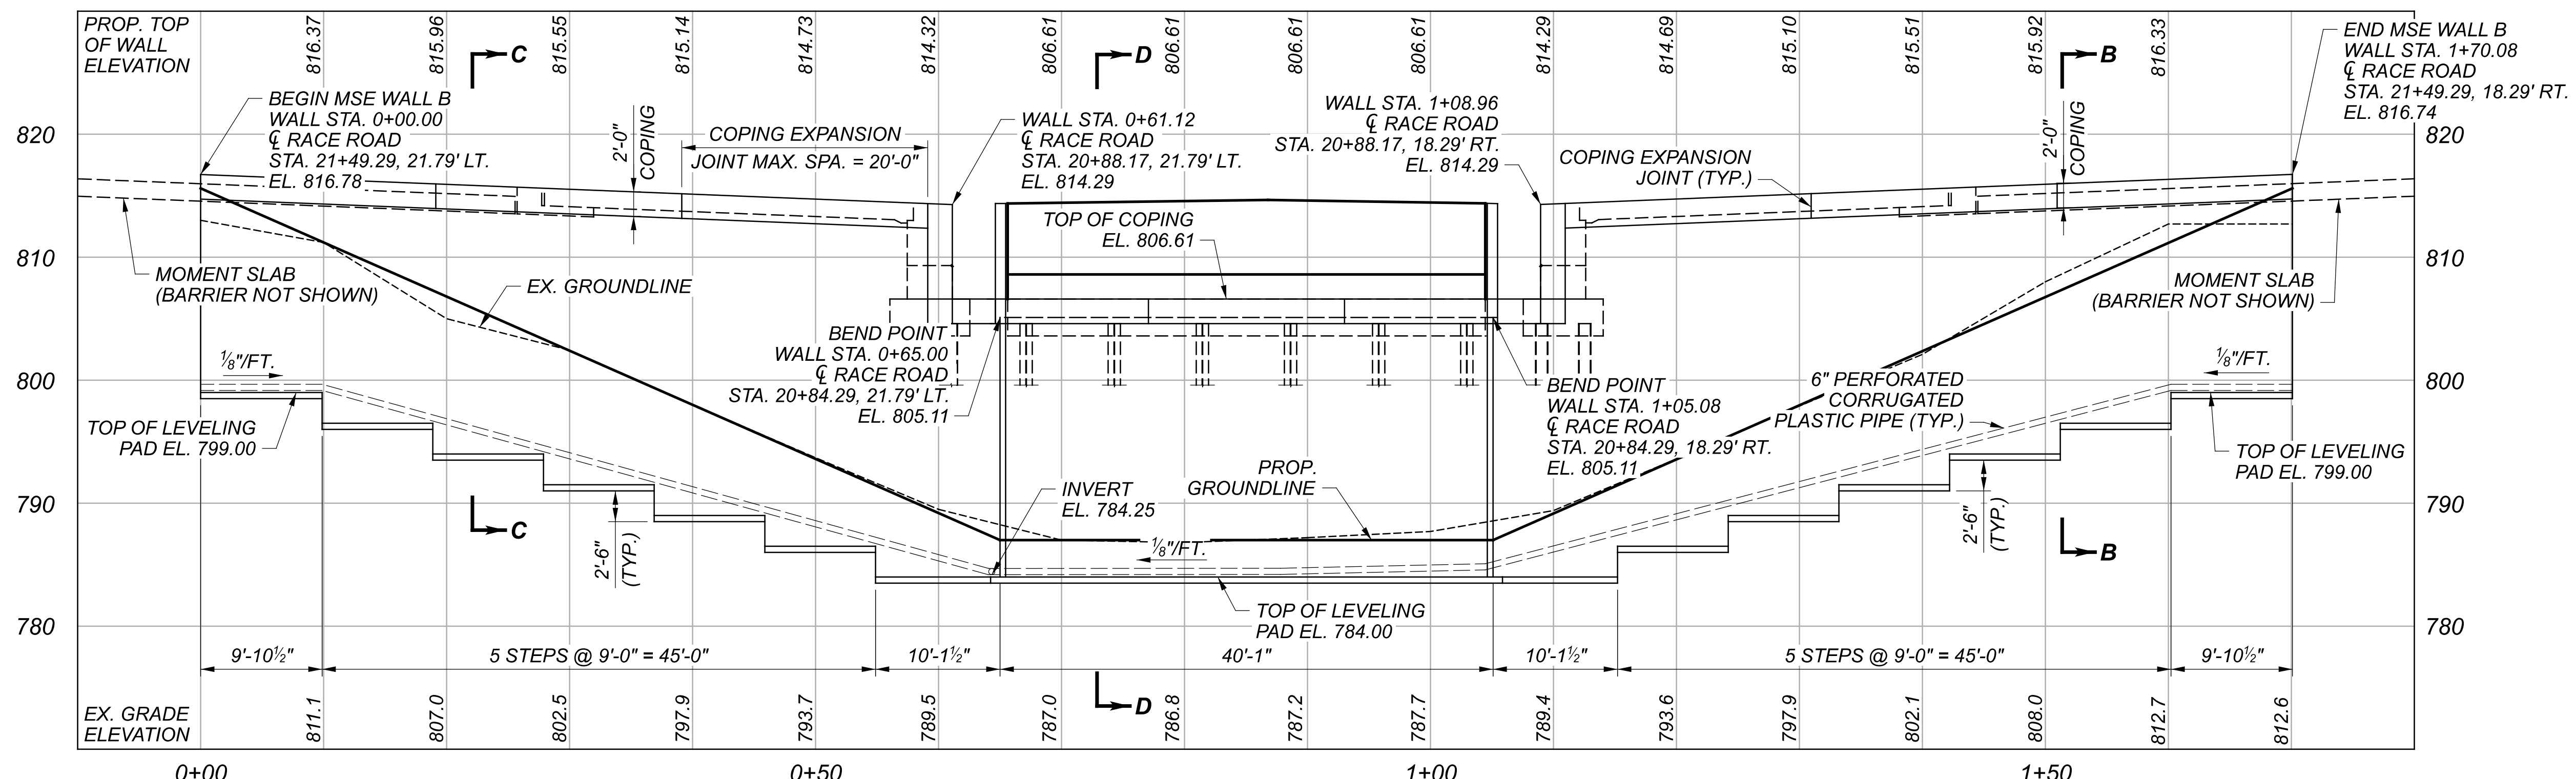

**PROFILE ALONG MSE WALL B**

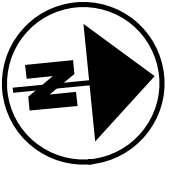

PLAN AND ELEVATION  
 MSE RETAINING WALL B

DESIGN AGENCY	
fishbeck	
DESIGNER	
BMV	
REVIEWER	
JPC 04/30/24	
PROJECT ID	
110563	
SUBSET	TOTAL
S.14	45
SHEET	
P.052	TOTAL
	103