

ш S 4 ΡH S I ш 12 **XTENSION** ST LM AZ T

POINTS: (CONTINUED)	ITEM 614, LAW ENFORCEMENT OFFICER (WITH PATROL CAR) FOR ASSISTANCE DURING CONSTRUCTION OPERATIONS (CONTINUED)	ITEM FOR
ALL BE CREATED BY REMOVING FOUR		(CON
RDRAIL TO CREATE AN OPENING IN THE EXISTING	IN ADDITION TO THE REQUIREMENTS OF C&MS 614 AND THE OMUTCD,	THE
E T ANCHOR ASSEMBLIES PLACED TANGENT	A UNIFORMED LEO WITH AN OFFICIAL PATROL CAR (CAR WITH TOP-	THE
ENT, CONSTRUCTING NEW GUARDRAIL TURN	MOUNTED EMERGENCY FLASHING LIGHTS AND COMPLETE	SER\
LEARING AND GRADING OPERATIONS TO	MARKINGS OF THE APPROPRIATE LAW ENFORCEMENT AGENCY)	AND
ESS THE WORK WEST OF CLOUGH CREEK.	SHALL BE PROVIDED FOR THE FOLLOWING TRAFFIC CONTROL TASKS:	RESF
OT INTERFERE WITH THE OPERATION OF THE		HAVE
	DURING THE ENTIRE ADVANCE PREPARATION AND CLOSURE	AND
	SEQUENCE WHERE COMPLETE BLOCKAGE OF TRAFFIC IS REQUIRED.	TWO
TERMITTENTLY CLOSE THE RAMP DURING THE		ENSU
ATION OF THE GUARDRAIL, THE GRADING FOR	DURING A TRAFFIC SIGNAL INSTALLATION WHEN IMPACTING	TO T
ID THE REESTABLISHING OF THE GUARDRAIL.	THE NORMAL FUNCTION OF THE SIGNAL OR THE FLOW OF	ON T
BE LIMITED TO THE HOURS BETWEEN 9 AM	TRAFFIC, OR WHEN TRAFFIC NEEDS TO BE DIRECTED	
GH FRIDAY. WHEN NO WORK IS BEING PERFORMED		THE
NEATED WITH DRUMS, ALL DETOUR SIGNS	THE SIGNAL DISPLAY (E.G., DIRECTING MOTORISTS THROUGH	THE
IS SIGN SHALL BE TURNED OFF, AND THE RAMP	A RED LIGHT).	REG
FFIC. DRUMS SPACED AT 10' CENTER TO CENTER	A NED LIGHT).	SHIF
THE ACCESS POINT WHEN NOT IN USE.	IN ADDITION TO THE REQUIREMENT OF C&MS 614 AND THE OMUTCD,	FOR
THE ACCESS FOUNT WHEN NOT IN OSE.	A UNIFORMED LEO WITH AN OFFICIAL PATROL CAR (CAR WITH TOP-	REP
E INSTALLED AS FOLLOWS:	MOUNTED EMERGENCY FLASHING LIGHTS AND COMPLETE	SHO
L INSTALLED AST OLLOWS.	MOUNTED EMERGENCY TEASTING EIGHTS AND COMPLETE MARKINGS OF THE APPROPRIATE LAW ENFORCEMENT AGENCY)	LEO
D EXITING SIGN, W8-H6a-48, AND ON	SHOULD BE PROVIDED FOR THE FOLLOWING TRAFFIC CONTROL	PRO
H6aP, INSTALLED 300' IN ADVANCE OF THE	TASKS AS APPROVED BY THE ENGINEER:	THAT
IOAF, INSTALLED SOU IN ADVANCE OF THE	ASKS AS AFFROVED BY THE ENGINEER.	OF H
GN, W20-1-48, INSTALLED 600' IN ADVANCE	FOR LANE CLOSURES: DURING INITIAL SET-UP PERIODS,	OF H
-	TEAR DOWN PERIODS, SUBSTANTIAL SHIFTS OF A CLOSURE	LEOS
· · · · · · · · · · · · · · · · · · ·	POINT OR WHEN NEW LANE CLOSURE ARRANGEMENTS ARE	MAIN
ALL WORK WILL BE PERFORMED DURING	INITIATED FOR LONG-TERM LANE CLOSURES/SHIFTS (FOR	PRIC
E INSTALLATION OF FLASHING WARNING	THE FIRST AND LAST DAY OF MAJOR CHANGES IN TRAFFIC	OFFI
WARNING SIGNS WILL NOT BE REQUIRED.	CONTROL SETUP).	ESTI
WARNING SIGNS WILL NOT DE REGOIRED.		SUM
SHALL BE CONSTRUCTED OFF THE WEST	IN GENERAL, LEOS SHOULD BE POSITIONED IN ADVANCE OF AND	501/11
EARING AND GRADING OPERATIONS SHALL	ON THE SAME SIDE AS THE LANE RESTRICTION (OR AT THE POINT	ITEM
STRUCT A DRIVE TO ACCESS THE WORK	OF ROAD CLOSURE), AND TO MANUALLY CONTROL TRAFFIC	FOR
THE CONTRACTOR SHALL NOT PARK OR	MOVEMENTS THROUGH SIGNALIZED INTERSECTIONS IN WORK	101
QUIPMENT, OR MATERIALS ALONG THE	ZONES.	THE
AR ZONE OF ELSTUN ROAD. DRUMS SPACED	ZONES.	REQ
ALL BE PLACED ACCROSS THE ACCESS POINT	LEOS SHOULD NOT FORGO THEIR TRAFFIC CONTROL	
IALE DE FLACED ACCROSS THE ACCESS FOINT	RESPONSIBILITIES TO APPREHEND MOTORISTS FOR ROUTINE	ANY
S	TRAFFIC VIOLATIONS. HOWEVER, IF A MOTORIST'S ACTIONS	INCU
E INSTALLED AS FOLLOWS:	ARE CONSIDERED TO BE RECKLESS, THEN PURSUIT OF THE	OF A
E INSTALLED AS FOLLOWS.	MOTORIST IS APPROPRIATE.	ITEM
DEVITING SIGN WE HEA AR AND ON	MOTORIST IS AFFROFRIATE.	FOR
D EXITING SIGN, W8-H6a-48, AND ON H6aP, INSTALLED 100' IN ADVANCE OF THE	An	
GN, W20-1-48, INSTALLED 100' IN ADVANCE		
AND EXITING SIGN, W8-6A, FOR EASTBOUND		GIN
STA. 91+00 FOR WESTBOUND ELSTUN ROAD.		MOVAL C A. 72+52.0
ALL WORK WILL BE PERFORMED DURING		ANCHOR
E INSTALLATION OF FLASHING WARNING		MGS TYP


PAYMENT FOR ALL ITEMS ASSOCIATED WITH THE CONSTRUCTION OF THESE ACCESS POINTS, INCLUDING GUARDRAIL WORK, AND OTHER REPAIRS NECESSARY TO RESTORE THE ROADWAY TO PRECONSTRUCTION CONDITION, SHALL BE INCLUDED IN THE LUMP SUM CONTRACT PRICE

ITEM 614, LAW ENFORCEMENT OFFICER (WITH PATROL CAR)

USE OF LAW ENFORCEMENT OFFICERS (LEOS) BY CONTRACTORS OTHER THAN THE USES SPECIFIED BELOW WILL NOT BE PERMITTED AT PROJECT COST. LEOS SHOULD NOT BE USED WHERE THE

INIGS TYPF T

TEMPORARY REMOVAL OF EXISTING GUARDRAIL FOR WEST CONSTRUCTION ACCESS

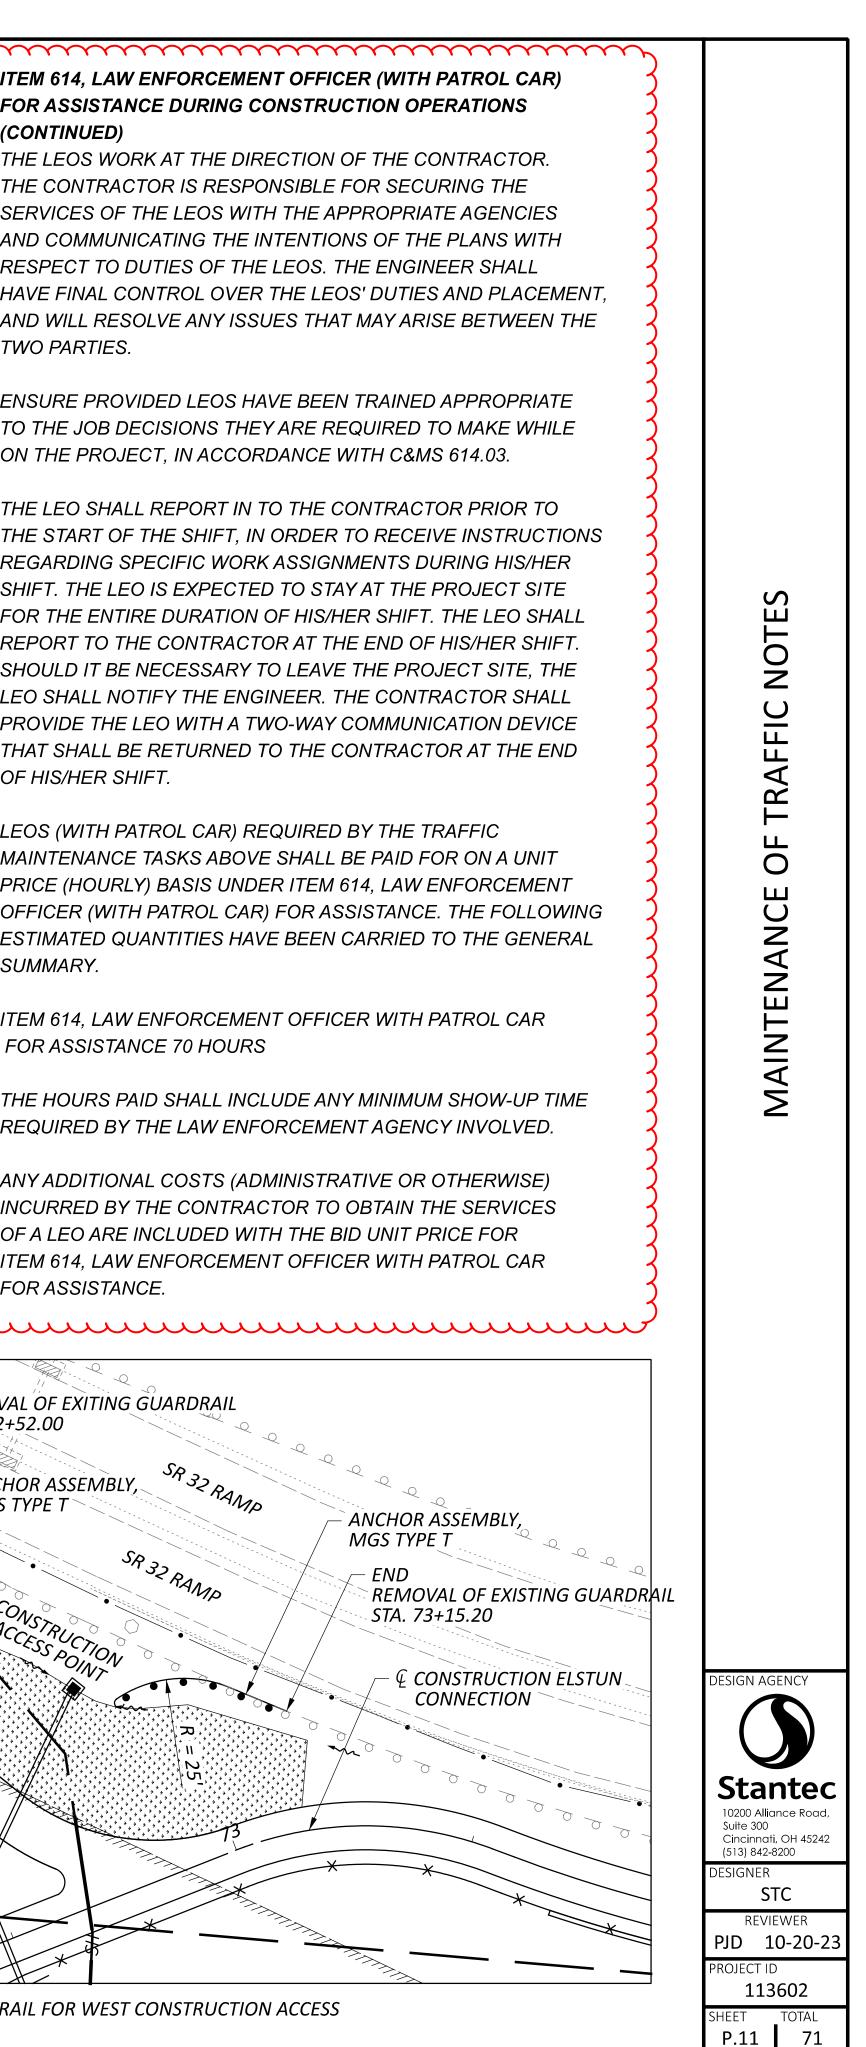

HAM-LMST EXTENSION TO ELSTUN PHASE 2

eU	
Ŝ	
lia	
σ	
I USER:	
Щ	
Š.	
_	
2	
e S	
Ω.	
52	
÷	
~	
ш	
\geq	
\vdash	
4	
8	
2	
/22/2024	
DATE: 1/2	
ΠE:	
F	
à	
_	
<u>.</u>	
34x22 (
2	
¥.	
PERSIZE: (
5	
ř	
Щ	
Ā	
t PAPERSIZE: 34x22 (in.) DATE: 1/22/2024 TIME: 11:25:53	
et B	
ĕ	
ς Ω	
ODEL: SI	
Ш	
2	
\circ	

	SHEET NUM.									
6	7	8	9	10	11	15	16	17	46	47
		25								
									205	
									318	
									235	
									50 235	
									2	
					70 	* * * * *	* * * * *	* * * * *		* * * * *
				2	30					
				LS						

		PA	RT.		ITEM	GRAND		
				ITEM			UNIT	D
	55		01/S>2/28		EXT	TOTAL		
			05	004	400.40	05	FAOL	
			25	661	40040	25	EACH	DECIDUOUS TREE, 1" CALIPER
								RE
	\sim	~~~~~	205	512	10100	205	SY	SEALING OF CONCRETE SURFACES (EPOXY-URETHA
		* * * * *	302	518	21200	302	CY	POROUS BACKFILL WITH GEOTEXTILE FABRIC
			2,012	870	10000	2,012	SF	PREFABRICATED MODULAR RETAINING WALL
			318	870	11000	318	CY	
			235	870	12000	235	FT	6" DRAINAGE PIPE, PERFORATED
			50	870	12100	50	FT	6" DRAINAGE PIPE, NON-PERFORATED
			235	870	12500	235	FT	CONCRETE COPING
			2	870	14000	2	DAY	ON-SITE ASSISTANCE
	LS		LS	503	11101	LS		STRUCTURE OVER 20 F COFFERDAMS AND EXCAVATION BRACING, AS PER PI
	LS		LS	503	21300	LS		UNCLASSIFIED EXCAVATION
	LS		LS	505	11100	LS		PILE DRIVING EQUIPMENT MOBILIZATION
	880		880	507	00100	880	FT	STEEL PILES HP10X42, FURNISHED
	800		800	507	00150	800	FT	STEEL PILES HP10X42, DRIVEN
	0.767		0.767	509	10000	0.767	LB	
	9,767 69		9,767 69	509	42012	9,767 69	CY	EPOXY COATED STEEL REINFORCEMENT CLASS QC1 CONCRETE WITH QC/QA, PIER ABOVE FO
	74		74	511	43512	74	CY	CLASS QC1 CONCRETE WITH QC/QA, ABUTMENT INCL
	171		171	512	10100	171	SY	SEALING OF CONCRETE SURFACES (EPOXY-URETHA
	31		31	518	20000	31	SY	PREFABRICATED GEOCOMPOSITE DRAIN
	\sim	\sim	\sim	$\sim\sim\sim\sim$	\sim	\sim	\sim	POROUS BACKFILL WITH GEOTEXTILE FABRIC
	C_{62}	\dots	$\frac{11}{62}$	518	40000	\mathcal{L}_{62}		6" PERFORATED CORRUGATED PLASTIC PIPE
	80		80	518	40010	80	FT	6" NON-PERFORATED CORRUGATED PLASTIC PIPE, IN
	11		11	524	94804	11	FT	DRILLED SHAFTS, 42" DIAMETER, INTO BEDROCK
	52		52	524	94902	52	FT	DRILLED SHAFTS, 48" DIAMETER, ABOVE BEDROCK
	LS		LS		F2000200	LS		
	LS 1,285		1,285	SPECIAL 601	53000200 32004	1,285	CY	STRUCTURES, MISC: PREFABRICATED BRIDGE ROCK CHANNEL PROTECTION, TYPE A WITH GEOTEX
	2		2	894	10000	2	EACH	THERMAL INTEGRITY PROFILING (TIP) TEST
(\sim	\sim	\sim	\sim	\cdots			HIVIAM MAINT
			70	614	11110	70	HOUR	LAW ENFORCEMENT OFFICER WITH PATROL CAR FOR
۲	\dots	\dots	LS	614 614	12420 18601	LS	SNMT	DETOUR SIGNING PORTABLE CHANGEABLE MESSAGE SIGN, AS PER PL
			30	616	10000	30	MGAL	WATER
			LS	614	11000	LS		MAINTAINING TRAFFIC
			LS LS	623 624	10000 10000	LS LS		CONSTRUCTION LAYOUT STAKES AND SURVEYING MOBILIZATION

DESCRIPTION	SEE	
	SHEET NO.	
LANDSCAPING		
	7	
RETAINING WALLS IANE)		
D FOOT SPAN (HAM-LMST ELSTUN-0.09)		
PLAN	51	
		ſRΥ
OOTINGS		٨٨
CLUDING FOOTING		۲ ا
HANE)		IU:
		AL S
		ER/
INCLUDING SPECIALS		GENERAL SUMMARY
		U
	50-52	
EXTILE FABRIC		
	51	
TENANCE OF TRAFFIC OR ASSISTANCE		
PLAN	10	
INCIDENTALS		
	10	
		DESIGN AGENCY
		Stantec 10200 Alliance Road, Suite 300 Cincinnati, OH 45242
		(513) 842-8200 DESIGNER ZTM
		REVIEWER
		PJD 10-20-23
		113602 Sheet Total
		P.14 71