# DEL: Sheet\_SurvFt PAPERSIZE: 34x22 (in.) DATE: 11/7/2025 TIME: 9:44:27 AM PLTDRV: OHDO

# HAM-50-0376 HAM-50-1903 GREEN DELHI HAM-50-1903

# STATE OF OHIO DEPARTMENT OF TRANSPORTATION

# HAM-US 50-3.76/19.03

CITY OF CINCINNATI
VILLAGE OF CLEVES
MIAMI TOWNSHIP
WHITEWATER TOWNSHIP
HAMILTON COUNTY

### **LOCATION MAP**

LATITUDE: 39°10'11"N LONGITUDE: 84°45'28"W LATITUDE: 39°06'06"N LONGITUDE: 84°32'40"W



HAM-50-0376 L/R HAM-50-1903L

PORTION TO BE IMPROVED	
INTERSTATE HIGHWAY	
FEDERAL ROUTES	
STATE ROUTES	
COUNTY & TOWNSHIP ROADS	
OTHER ROADS	

### **DESIGN DESIGNATION**

CURRENT ADT (2026)	19,500	44,000
DESIGN YEAR ADT (2038)	20,500	46,500
DESIGN HOURLY VOLUME (2038)	2,600	6000
DIRECTIONAL DISTRIBUTION	52.0%	70.0%
TRUCKS (24 HOUR B&C)	6.0%	7.0%
DESIGN SPEED	50	55
LEGAL SPEED	50	40
DESIGN FUNCTIONAL CLASSIFICATION:		
HAM-50-0376 L/R: MINOR ARTERIAL (URBAN)		
HAM-50-1903L: PRINCIPAL ARTERIAL (URBAN)		
NHS PROJECT	YES	

### **DESIGN EXCEPTIONS**

NONE

### ADA DESIGN WAIVERS

NONE REQUIRED

# UNDERGROUND UTILITIES Contact Two Working Days

Before You Dig



OHIO811, 8-1-1, or 1-800-362-2764 (Non members must be called directly)

PLAN PREPARED BY:
ODOT DISTRICT 8 ENGINEERING
505 S. STATE ROUTE 741
LEBANON, OHIO 45036

### **INDEX OF SHEETS:**

HAM-50-1903L

TITLE SHEET	1
GENERAL NOTES	2
MAINTENANCE OF TRAFFIC	3 - 8
GENERAL SUMMARY	9
STRUCTURES GENERAL NOTES	10 - 11
STRUCTURES SUBSUMMARY	12
STRUCTURES OVER 20' SPAN	
HAM-50-0376L	13 - 29
HAM-50-0376R	<i>30 - 35</i>

### FEDERAL PROJECT NUMBER

E250 (741)

### RAILROAD INVOLVEMENT

CENTRAL RAILROAD OF INDIANA (CIND)
CSX TRANSPORTATION

### **PROJECT DESCRIPTION**

FIELD PAINT ALL STRUCTURAL STEEL AND REPAIR DETORIORATED STEEL AT BRIDGE HAM-50-0376L WHICH CARRIES WB US 50 OVER THE GREAT MIAMI RIVER. FIELD PAINT THE BEAM ENDS AT BRIDGE HAM-50-0376R THAT CARRIES EB US 50 OVER THE GREAT MIAMI RIVER. FIELD PAINT ALL STRUCTURAL STEEL AT BRIDGE HAM-50-1903L THAT CARRIES WB US 50 OVER THE MILL CREEK AND A RAILROAD. OTHER MINOR REHAB WORK IS ALSO TO BE INCLUDED.

### EARTH DISTURBED AREAS

PROJECT EARTH DISTURBED AREA: 0.0 ACRES

ESTIMATED CONTRACTOR EARTH DISTURBED AREA: 0.25 ACRES

NOTICE OF INTENT EARTH DISTURBED AREA: N/A (NOI NOT REQUIRED)

### LIMITED ACCESS

THIS IMPROVEMENT IS ESPECIALLY DESIGNED FOR THROUGH TRAFFIC AND HAS BEEN DECLARED A LIMITED ACCESS HIGHWAY OR FREEWAY BY ACTION OF THE DIRECTOR IN ACCORDANCE WITH THE PROVISIONS OF SECTION 5511.02 OF THE OHIO REVISED CODE.

### **2023 SPECIFICATIONS**

THE STANDARD SPECIFICATIONS OF THE STATE OF OHIO, DEPARTMENT OF TRANSPORTATION, INCLUDING SUPPLEMENTAL SPECIFICATIONS LISTED IN THE PLANS, CHANGES LISTED IN THE PROPOSAL, AND THE SUPPLEMENTAL SPECIFICATION 800 VERSION INDICATED ON THE PROPOSAL SHALL GOVERN THIS IMPROVEMENT.

I HEREBY APPROVE THESE PLANS AND DECLARE THAT THE MAKING OF THIS IMPROVEMENT WILL NOT REQUIRE THE CLOSING TO TRAFFIC OF THE HIGHWAY AND THAT PROVISIONS FOR THE MAINTENANCE AND SAFETY OF TRAFFIC WILL BE AS SET FORTH ON THE PLANS AND ESTIMATES.

Douglas A. Gruver, P.E. District 08 Deputy Director

Pamela Boratyn
Director, Department of Transportation

	STANDARD CONSTRUCTION	DRAWINGS	SUPPLEMENTAL SPECIFICATIONS	SPECIAL PROVISIONS	
TC-41.20 10/18/13			800-2023 7/18/25		
TC-42.20 10/18/13			821 4/20/12		
			832 7/19/24		
WT-95.30 7/19/19			844 1/17/25		ENGINEER'S SEAL
MT-95.40 7/18/25			909 1/17/25		2,10,112,13 32,12
MT-95.50 7/21/17					
MT-105.10 1/17/20					TE OF OXY
MT-110.10 7/19/13					X PTE OF OXY
					GARRET T.
					FREEMAN  ★
					E-83489
					RECIETE PED 1
					SONAL ENGLIS
					7771111



SHEET



DESIGNER
GTF

REVIEWER
JDO 07/14/25
PROJECT ID
114515

### UTILITIES

LISTED BELOW ARE ALL UTILITIES LOCATED WITHIN THE PROJECT CONSTRUCTION LIMITS TOGETHER WITH THEIR **RESPECTIVE OWNERS:** 

### HAM-50-0376 L/R

CHEVRON, USA 4800 FOURNACE PLACE BELLAIRE, TX 77401 (877) 596-2800

VILLAGE OF CLEVES WATERWORKS 92 E. CLEVES AVENUE CLEVES, OH 45002 (513) 941-3409

DUKE ENERGY 139 E. FOURTH ST., RM 467A CINCINNATI, OHIO 45202 (513) 287-2366

ALTAFIBER 209 W. 7TH STREET FL 1 CINCINNATI, OHIO 45202 (513) 565-2111

**SPRINT** 11370 ENTERPRISE PARK DR. SHARONVILLE, OH 45241 (440) 447-6163

### HAM-50-1903L

SHANE ERHART DUKE ENERGY CORP. (ELECTRIC) 139 EAST 4TH ST, ROOM 467A CINCINNATI, OH 45202 PHONE: 513-508-9609

ANDY MCNICHOLS DUKE ENERGY CORP. (GAS) 139 EAST 4TH ST, ROOM 460A CINCINNATI, OH 45202 PHONE: 513-384-4731

**BRECK COWAN** ALTAFIBER *221 EAST 4TH STREET, BLDG 121-900* CINCINNATI, OHIO 45201 PHONE: 513-565-7187

JOHN LONGSWORTH **CHARTER COMMUNICATIONS** 11252 CORNELL PARK DR CINCINNATI, OH 45242 PHONE: 513-386-5235

DAN LOUIS CINCINNATI WATER WORKS 4747 SPRING GROVE AVE CINCINNATI, OH 45232 PHONE: 513-352-3723

ROB FRANKLIN METROPOLITAN SEWER DISTRICT OF GREATER CINCINNATI 1600 GEST STREET CINCINNATI, OH 45204 PHONE: 513-557-7188

ANDY CARTER CITY OF CINCINNATI TRANSPORTATION AND ENGINEERING 801 PLUM STREET, ROOM 450 CITY HALL CINCINNATI, OHIO 45202 PHONE: 513-378-6190 PAUL BECKER COGNET PHONE: 815-557-8416

CYNTHIA MARTINEZ MCI NETWORK SERVICES, INC./ VERIZON - FIBER OPTIC *5400 DUFF DRIVE* CINCINNATI, OH 45246 757-799-8038

**BRUCE MILLER** LUMEN TECHNOLOGIES 9490 MERIDIAN WAY WEST CHESTER, OH 45069 513-644-8943

### GREATER CINCINNATI WATERWORKS (GCWW) WATERLINE PROTECTION

GREATER CINCINNATI WATER WORKS (GCWW) HAS A WATER MAIN ATTACHED TO BRIDGE No.: HAM-50-1903L, EXTENDING FROM SPAN 3N TO SPAN 7N IN BAY 3. THIS FACILITY IS NOT TO BE DISTURBED DURING SURFACE PREPARATION AND PAINTING OF THE ADJACENT EXISTING STRUCTURAL STEEL. THE CONTRACTOR SHALL TAKE ALL NECESSARY PRECAUTIONS TO PREVENT PAINT, OVERSPRAY, OR ANY RELATED MATERIALS FROM COMING INTO CONTACT WITH THE GCWW WATER MAIN. THE METHOD OF PROTECTION SHALL BE DETERMINED BY THE CONTRACTOR BUT MUST BE EFFECTIVE IN FULLY SHIELDING THE WATERLINE FROM OVERSPRAY, DEBRIS, AND ANY OTHER POTENTIAL IMPACTS. ALL PROTECTION MEASURES SHALL BE IN PLACE PRIOR TO THE START OF ANY SURFACE PREPARATION OR PAINTING OPERATIONS IN THE VICINITY OF THE WATERLINE. FOR COORDINATION AND INSPECTION, THE CONTRACTOR SHALL CONTACT DAN LOUIS AT GCWW AT (513) 352-3723 PRIOR TO BEGINNING WORK NEAR THE WATER MAIN.

THE COST FOR MATERIAL AND LABOR TO PROVIDE PROTECTION OF UTILITIES AS DESCRIBED ABOVE SHALL BE INCLUDED IN THE COST OF ITEM 514, SURFACE PREPARATION OF EXISTING STRUCTURAL STEEL.

### ITS CONTACT INFORMATION

THERE ARE EXISTING ITS ASSETS NEAR THE PROJECT LIMITS. THERE ARE NO ANTICIPATED IMPACTS TO THESE FACILITIES. PRIOR TO PERFORMING ANY WORK AT THESE LOCATIONS CONTACT CENTRAL OFFICE ITS.

ODOT ITS LAB 1606 WEST BROAD STREET COLUMBUS, OHIO 43223 614-387-4113 CEN.ITS.LAB@DOT.OHIO.GOV

### CLEARING AND GRUBBING

ALTHOUGH THERE ARE NO TREES OR STUMPS SPECIFICALLY MARKED FOR REMOVAL WITHIN THE LIMITS OF THE PROJECT, A LUMP SUM QUANTITY IS INCLUDED IN THE GENERAL SUMMARY FOR ITEM 201, CLEARING AND GRUBBING. ALL PROVISIONS AS SET FORTH IN THE SPECIFICATIONS UNDER THIS ITEM ARE INCLUDED IN THE LUMP SUM PRICE BID FOR ITEM 201, CLEARING AND GRUBBING.

### **SOLE SOURCE AQUIFER**

PROJECT LOCATION HAM-US-50 3.759 L / R IS LOCATED WITHIN THE GREATER MIAMI SOLE SOURCE AQUIFER. USE PROPER CONTAINMENT AND DIKING IN REFUELING AREAS. DO NOT STORE FUELS, TOXIC/HAZARDOUS MATERIALS. AND CHEMICALS NEAR DRAINAGE WAYS, DITCHES, OR STREAMS, MAINTAIN A SPILL KIT ON-SITE THROUGHOUT CONSTRUCTION ACTIVITIES. IMMEDIATELY MITIGATE ANY EVENT, SUCH AS A SPILL OF FUELS, OILS, OR CHEMICALS, THAT COULD THREATEN TO CONTAMINATE THE DRINKING WATER SUPPLY. REPORT ALL SPILLS OR EVENTS TO THE GREATER CINCINNATI WATER WORKS (513) 591-7700. IF THE SPILL IS A REPORTABLE AMOUNT (PER OHIO EPA'S RELEASE REPORTING REQUIREMENTS), CONTACT VILLAGE OF CLEVES FIRE DEPARTMENT (513) 941-3618 OR THE OHIO EPA'S SPILLS HOTLINE 1-800-282-9378 FOR CLEAN-UP OF THE SPILL

### $\sim$ **DEMOLITION DEBRIS**

THE CONTRACTOR SHALL TAKE PRECAUTIONS TO AVOID AND/OR LIMIT DEMOLITION DEBRIS FROM ENTERING WATERWAYS OR FALLING ONTO TRAFFIC LANES. ANY MATERIAL THAT DOES FALL INTO A WATERWAY OR ONTO TRAFFIC LANES SHALL BE IMMEDIATELY REMOVED AT THE CONTRACTOR'S EXPENSE. DAMAGE TO PROPERTY AS A RESULT OF FALLING DEMOLITION DEBRIS SHALL BE REPAIRED AT THE CONTRACTOR'S EXPENSE. WHILE SEALING ANY PORTION OF THE BRIDGE STRUCTURES, AN APPROPRIATE APRON WILL BE UTILIZED TO PREVENT DEBRIS, OVER SPRAY, AND SEALANTS FROM ENTERING INTO THE WATERWAYS OR AFFECTING VEHICULAR/PEDESTRIAN TRAFFIC AND/OR PROTECTED

### **WORK LIMITS**

THE WORK LIMITS SHOWN ON THESE PLANS ARE FOR PHYSICAL CONSTRUCTION ONLY. PROVIDE THE INSTALLATION AND OPERATION OF ALL WORK ZONE TRAFFIC CONTROL AND WORK ZONE TRAFFIC CONTROL DEVICES REQUIRED BY THESE PLANS WHETHER INSIDE OR OUTSIDE THESE WORK LIMITS.

### **CITY OF CINCINNATI NOTES**

### **CONSTRUCTION NOTIFICATION:**

TEN BUSINESS DAYS PRIOR TO THE PRE-CONSTRUCTION MEETING THE PROJECT ENGINEER WILL NOTIFY THE CITY OF CINCINNATI LPA COORDINATOR OF THE PRECONSTRUCTION MEETING'S DATE, TIME, AND LOCATION. CONTACT CITY OF CINCINNATI, DEPARTMENT OF TRANSPORTATION AND ENGINEERING, DIRECTOR'S OFFICE, AT (513) 352-2366, ATTENTION: CHRIS KELLY AT (513) 352-3721 OR BY EMAIL AT CHRÍS.KELLY@CINCINNATI-OH.GOV.

### **PERMITS:**

A CITY OF CINCINNATI DEPARTMENT OF TRANSPORTATION AND ENGINEERING (DOTE) PERMIT IS REQUIRED PRIOR TO THE ODOT CONTRACTOR COMMENCING WORK IN THE CITY OF CINCINNATI'S PUBLIC RIGHT-OF-WAY. PERMIT APPLICATIONS FOR STREET USE, STREET BARRICADE, STREET OPENING, ETC. MAY BE MADE AT ROOM 425, CITY HALL, 801 PLUM STREET CINCINNATI, OHIO 45202.

CITY ISSUED PERMITS MAY REQUIRE MAJOR EVENT WORK RESTRICTIONS ON THE CONTRACTOR'S ACTIVITIES. THE CITY MAINTAINS A LIST OF KNOWN MAJOR EVENTS AT THE FOLLOWING WEBSITE:

### HTTP://CINCINNATI-OH.GOV/POLICE/SPECIAL-EVENTS-REGULATIONS-AUCTIONS/EVENTPERMITS/.

THE CITY OF CINCINNATI RESTRICTS NIGHTTIME CONSTRUCTION WORK BETWEEN THE HOURS OF 11:00 P.M. AND 7:00 A.M. CITY ISSUED PERMITS WILL REQUIRE THE CONTRACTOR TO SECURE THE CITY ENGINEERS APPROVAL FOR NIGHTTIME WORK.

### RAILROAD SECTION

TEMPORARY CONSTRUCTION CLEARANCE - ENSURE ALL FALSEWORK. BRACING OR FORMS HAVE A MINIMUM HORIZONTAL CLEARANCE OF 12 FEET MEASURED PERPENDICULAR TO THE CENTERLINE OF THE NEAREST TRACK AND 23 FEET MEASURED VERTICALLY FROM THE TOP OF RAIL.

ALL WASTE MATERIALS GENERATED BY THIS PROJECT, INCLUDING BUT NOT LIMITED TO WASHING WITH CLEANING SOLVENTS, BLASTING, SCRAPING, BRUSHING AND PAINTING OPERATIONS, SHALL BE THE RESPONSIBILITY OF THE PROJECT SPONSOR OR ITS CONTRACTOR AND SHALL BE CONTAINED, COLLECTED AND PROPERLY DISPOSED OF BY THE PROJECT SPONSOR OR ITS CONTRACTOR. THE PROJECT SPONSOR AND ITS CONTRACTOR AGREE TO FULLY COMPLY WITH ALL FEDERAL, STATE, AND LOCAL ENVIRONMENTAL LAWS, REGULATIONS, STATUTES AND ORDINANCES AT ALL TIMES.

IF CONTRACTOR HAS THE POTENTIAL TO PENETRATE THE DECK DURING THE DECK REHABILITATION WORK, THEN CONTRACTOR WILL BE REQUIRED TO INSTALL FALSEWORK/DEMO SHIELD PROTECTION DIRECTLY OVER THE CSXT RAILROAD SPAN. THE FALSEWORK/DEMO SHIELD PROTECTION WILL BE INSTALLED PRIOR TO THE DECK BEING PENETRATED AND WILL STAY IN PLACE FOR THE DURATION OF THE CONSTRUCTION ACTIVITIES. THE FALSEWORK/DEMO SHIELD SHALL BE DESIGNED AND CONSTRUCTED IN ACCORDANCE TO CSX"S CONSTRUCTION SUBMISSION CRITERIA. IN ADDITION, FILTER FABRIC PROTECTION WILL BE REQUIRED TO PROTECT THE TRACK AND BALLAST DIRECTLY UNDER THE FALSEWORK/DEMO SHIELD PROTECTION.

EMERGENCY ACTION PLAN —SUBMIT AN EMERGENCY ACTION PLAN INDICATING THE LOCATION OF THE SITE, CONTACT NUMBERS, ACCESS TO THE SITE, INSTRUCTIONS FOR EMERGENCY RESPONSE AND LOCATION OF THE NEAREST HOSPITALS. THIS PLAN SHOULD COVER ALL ITEMS REQUIRED IN THE EVENT OF AN EMERGENCY AT THE SITE INCLUDING FIRE SUPPRESSION. COORDINATE THE EMERGENCY ACTION PLAN WITH THE SAFETY RELATED DISCUSSION OF THE MEANS AND METHODS SUBMISSION DISCUSSED ABOVE. THE PLAN SHOULD ALSO INCLUDE A METHOD TO PROVIDE THIS INFORMATION TO EACH PROJECT WORKER FOR EACH DAY ON SITE.

### RAILROAD SECTION (CONTINUED)

BALLAST PROTECTION - CONTRACTOR SHALL INSTALL A NON-WOVEN GEOTEXTILE FABRIC BALLAST PROTECTION SYSTEM TO PREVENT CONSTRUCTION/DEMOLITION DEBRIS AND FINES FROM FOULING THE BALLAST. THE GEOTEXTILE BALLAST PROTECTION SHALL BE INSTALLED AND MAINTAINED BY THE CONTRACTOR TO THE SATISFACTION OF CSX'S CONSTRUCTION REPRESENTATIVE. FABRIC SHOULD EXTEND AT LEAST 15' PAST THE CONSTRUCTION LIMITS IN BOTH DIRECTIONS OF THE TRACK AND COVER ALL RAILROAD BALLAST STONE (FROM FENCE TO FENCE, INCLUDING THE AREAS BETWEEN THE TRACK).

### RAILROAD PROJECT COORDINATION

THE CONTRACTOR SHALL PERFORM ONGOING COORDINATION OF THEIR DESIGN AND CONSTRUCTION ACTIVITIES WITH THE RAILROAD(S) THROUGHOUT THE PROJECT. THE CONTRACTOR SHALL PROVIDE A CURRENT SCHEDULE ON A MONTHLY BASIS INCLUDING ANTICIPATED DATES OF THE FOLLOWING ITEMS:

- CONSTRUCTION SUBMITTALS REQUIRING RAIL REVIEW AND APPROVAL PRIOR TO BEGINNING CONSTRUCTION (PER THE RAIL AGREEMENT(S)).
- CONSTRUCTION START AND END DATES FOR WORK THAT MAY CREATE AN IMPACT TO THE RAILFACILITY/ OPERATIONS.
- ANTICIPATED DATES AND DURATION FOR FLAGGERS.
- ANY OTHER MILESTONES THAT MAY IMPACT RAIL FACILITIES OR OPERATIONS.

### **MEANS AND METHODS**

THE CONTRACTOR SHALL DEVELOP A DETAILED SUBMISSION INDICATING THE PROGRESSION OF WORK WITH SPECIFIC TIMES WHEN TASKS WILL BE PERFORMED FOR WORK ACTIVITIES THAT ARE ON OR IN THE VICINITY OF THE RAILROAD PROPERTY. THIS SUBMISSION MAY REQUIRE A WALKTHROUGH AT WHICH TIME THE RAILROAD AND/OR THEIR REPRESENTATIVE WILL BE PRESENT. WORK WILL NOT BE PERMITTED TO COMMENCE UNTIL THE CONTRACTOR HAS PROVIDED THE RAILROADS WITH A SATISFACTORY PLAN THAT THE PROJECT WILL BE UNDERTAKEN WITHOUT SCHEDULING, PERFORMANCE, OR SAFETY RELATED ISSUES. PROVIDE A LISTING OF THE ANTICIPATED EQUIPMENT TO BE USED, THE LOCATION OF ALL EQUIPMENT TO BE USED AND ENSURE A CONTINGENCY PLAN OF ACTION IS IN PLACE SHOULD A PRIMARY PIECE OF EQUIPMENT MALFUNCTIONS. ALL WORK IN THE VICINITY OF THE RAILROAD PROPERTY THAT HAS THE POTENTIAL OF AFFECTING TRAIN OPERATIONS MUST BE SUBMITTED AND APPROVED BY THE RAILROAD PRIOR TO WORK BEING PERFORMED. THIS SUBMISSION WILL ALSO INCLUDE A DETAILED NARRATIVE DISCUSSING THE COORDINATION OF PROJECT SAFETY ISSUES BETWEEN THE CONTRACTOR AND THE RAILROAD AND/OR THEIR REPRESENTATIVE. THE NARRATIVE SHALL ADDRESS PROJECT LEVEL COORDINATION AND DAY TO DAY, SPECIFIC WORK OPERATIONS INCLUDING CRANE AND EQUIPMENT OPERATIONS, ERECTIONS PLANS AND TEMPORARY WORKS.

UP TO THIRTY (30) CALENDAR DAYS WILL BE REQUIRED TO REVIEW ALL CONSTRUCTION SUBMISSIONS. UP TO AN ADDITIONAL THIRTY (30) CALENDAR DAYS WILL BE REQUIRED TO REVIEW ANY SUBSEQUENT SUBMISSIONS RETURNED NOT APPROVED.

### CONSTRUCTION SCHEDULE

SUBMIT A DETAILED CONSTRUCTION SCHEDULE FOR THE DURATION OF THE PROJECT CLEARLY INDICATING THE TIME PERIODS WHILE WORKING ON AND AROUND THE RAILROADS RIGHT-OF-WAY. AS THE WORK PROGRESSES, THIS SCHEDULE SHALL BE UPDATED MONTHLY AND RESUBMITTED AS NECESSARY TO REFLECT CHANGES IN WORK SEQUENCE, DURATION AND METHOD, ETC.



ESIGN AGENCY

**NOTES** 

**ENERAL** 

(7)

ESIGNER GTF

REVIEWER JDO 07/14/25 ROJECT ID

### ITEM 614, MAINTAINING TRAFFIC

A MINIMUM OF 1 LANE OF TRAFFIC IN EACH DIRECTION SHALL BE MAINTAINED AT ALL TIMES BY USE OF THE EXISTING PAVEMENT AND THE COMPLETED PAVEMENT.

NO WORK SHALL BE PERFORMED AND ALL EXISTING LANES SHALL BE OPEN TO TRAFFIC DURING THE FOLLOWING DESIGNATED HOLIDAYS OR SPECIAL EVENTS:

NEW YEAR'S (OBSERVED)ELECTION DAY (NOV)MEMORIAL DAYTHANKSGIVINGFOURTH OF JULY (OBSERVED)CHRISTMAS (OBSERVED)LABOR DAY

THE PERIOD OF TIME THAT THE LANES ARE TO BE OPEN DEPENDS ON THE DAY OF THE WEEK ON WHICH THE HOLIDAY OR SPECIAL EVENT FALLS. THE FOLLOWING SCHEDULE SHALL BE USED TO DETERMINE THIS PERIOD:

DAY OF HOLIDAY TIME ALL LANES

OR SPECIAL EVENT MUST BE OPEN TO TRAFFIC

SUNDAY 12:00N FRIDAY THROUGH 6:00 AM MONDAY

MONDAY 12:00N FRIDAY THROUGH 6:00 AM TUESDAY

TUESDAY 12:00N MONDAY THROUGH 6:00 AM WEDNESDAY

TUESDAY (GEN./REG. ELECTION)

5:00 AM TUESDAY THROUGH 12:00 AM WEDNESDAY WEDNESDAY 12:00N TUESDAY THROUGH 6:00 AM THURSDAY THURSDAY 12:00N WEDNESDAY THROUGH 6:00 AM FRIDAY THURSDAY (THANKSGIVING ONLY)

6:00 AM WEDNESDAY THROUGH 6:00 AM MONDAY FRIDAY 12:00N THURSDAY THROUGH 6:00 AM MONDAY SATURDAY 12:00N FRIDAY THROUGH 6:00 AM MONDAY

SHOULD THE CONTRACTOR FAIL TO MEET ANY OF THESE REQUIREMENTS, THE CONTRACTOR SHALL BE ASSESSED A DISINCENTIVE PER THE C&MS TABLE 108.07-1

LENGTH AND DURATION OF LANE CLOSURES AND RESTRICTIONS SHALL
BE AT THE APPROVAL OF THE ENGINEER. IT IS THE INTENT TO MINIMIZE
THE IMPACT TO THE TRAVELING PUBLIC. LANE CLOSURES OR
RESTRICTIONS OVER SEGMENTS OF THE PROJECT IN WHICH NO WORK
IS ANTICIPATED WITHIN A REASONABLE TIME FRAME, AS DETERMINED
BY THE ENGINEER, SHALL NOT BE PERMITTED. THE LEVEL OF
UTILIZATION OF MAINTENANCE OF TRAFFIC DEVICES SHALL BE
COMMENSURATE WITH THE WORK IN PROGRESS.

TRAFFIC SHALL BE MAINTAINED AT ALL INTERSECTIONS AND DRIVES AT ALL TIMES AND SHALL BE CONTROLLED WITH FLAGGERS AND TRAFFIC CONTRAOL DEVICES AS REQUIRED AND SHALL BE SUBJECT TO APPROVAL BY THE ENGINEER.

ALL WORK AND TRAFFIC CONTROL DEVICES SHALL BE IN ACCORDANCE WITH C&MS 614 AND OTHER APPLICABLE PORTIONS OF THE SPECIFICATIONS, AS WELL AS THE OHIO MANUAL OF UNIFORM TRAFFIC CONTROL DEVICES. PAYMENT FOR ALL LABOR, EQUIPMENT AND MATERIALS SHALL BE INCLUDED IN THE LUMP SUM CONTRACT PRICE FOR ITEM 614, MAINTAINING TRAFFIC, UNLESS SEPARATELY ITEMIZED IN THE PLAN.

### VERTICAL CLEARANCE

ANY WORK (FALSEWORK, TRAFFIC PROTECTION, CONTAINMENT, ETC.) OVER LIVE TRAFFIC BY THE CONTRACTOR THAT REDUCES THE EXISTING VERTICAL CLEARANCE IS PROHIBITED UNLESS 30 DAYS ADVANCED NOTICE IS PROVIDED WITH NEW PROPOSED VERTICAL CLEARANCES. THE CONTRACTOR SHALL PROVIDE FIELD MEASUREMENTS BEFORE ALLOWING TRAFFIC UNDERNEATH. IF ANY WORK IS TO OCCUR BELOW ~14'-6", THEN SIGNS ON THE STRUCTURE AND ADVANCE WARNING SIGNS SHALL BE INSTALLED A MINIMUM OF 2 WEEKS PRIOR TO PERFORMING SUCH WORK. SIGNING SHALL BE IN ACCORDANCE WITH THE "OHIO MANUAL OF UNIFORM TRAFFIC CONTROL DEVICES" (OMUTCD) AND THE OHIO "TRAFFIC ENGINEERING MANUAL" (TEM). NO WORK OVER TRAFFIC SHALL OCCUR WITH A VERTICAL CLEARANCE LESS THAN 14'-0". LOWERING THE VERTICAL CLEARANCE DURING CONSTRUCTION IS CONSIDERED THE CONTRACTOR'S MEANS AND METHODS OF ACCOMPLISHING THE WORK, AND THEREFORE THE STATE IS NOT RESPONSIBLE FOR ANY DAMAGE FROM VEHICULAR IMPACTS "THAT MAY RESULT AS PER 107.10."

### **SEQUENCE OF CONSTRUCTION - HAM-50-0376L**

### PHASE 1

- \* CLOSE THE RIGHT LANE OF WESTBOUND US 50 BETWEEN COOPER AVENUE AND SR 128.
- \* MAINTAIN THRU TRAFFIC IN THE LEFT LANE OF WESTBOUND US 50 AND BOTH LANES OF EASTBOUND US 50.
- \* PERFORM STRUCTURAL REPAIRS IN THE RIGHT LANE OF WESTBOUND US 50.

### PHASE 2

- \* CLOSE THE LEFT LANE OF WESTBOUND US 50 BETWEEN COOPER AVENUE AND SR 128 AND CLOSE THE LEFT LANE OF EASTBOUND US 50 BETWEEN 1000'` WEST OF SR 128 AND 100'` EAST OF THE NORTHWEST END POST OF THE HAM-50-0376R BRIDGE.
- \* MAINTAIN THRU TRAFFIC IN THE RIGHT LANE OF WESTBOUND US 50 AND EASTBOUND US 50.
- \* PERFORM STRUCTURAL REPAIRS IN THE LEFT LANE OF WESTBOUND US 50.

### **NOTIFICATION OF TRAFFIC RESTRICTIONS**

THROUGHOUT THE DURATION OF THE PROJECT, THE CONTRACTOR SHALL NOTIFY THE PROJECT ENGINEER IN WRITING OF ALL TRAFFIC RESTRICTIONS AND UPCOMING MAINTENANCE OF TRAFFIC CHANGES. THE CONTRACTOR SHALL ENSURE THE WRITTEN NOTIFICATION IS SUBMITTED IN A TIMELY MANNER TO ALLOW THE PROJECT ENGINEER TO MEET THE REQUIRED TIME FRAMES SET FORTH IN THE TABLE BELOW TO INFORM THE LISTED CONTACTS.

THIS NOTIFICATION SHALL BE RECEIVED BY THE PROJECT ENGINEER PRIOR TO THE PHYSICAL SETUP OF ANY APPLICABLE SIGNS OR MESSAGE BOARDS. INFORMATION SHOULD INCLUDE, BUT IS NOT LIMITED TO, ALL CONSTRUCTION ACTIVITIES THAT IMPACT OR INTERFERE WITH TRAFFIC AND SHALL LIST THE SPECIFIC LOCATION, TYPE OF WORK, ROAD STATUS, DATE AND TIME OF RESTRICTION, DURATION OF RESTRICTION, NUMBER OF LANES MAINTAINED, NUMBER OF LANES CLOSED, MINIMUM VERTICAL CLEARANCE, MINIMUM WIDTH OF DRIVABLE PAVEMENT, DETOUR ROUTES, IF APPLICABLE, AND ANY OTHER INFORMATION REQUESTED BY THE PROJECT ENGINEER.

NOTIFICATION TIME TABLE								
ITEM	DURATION OF	NOTICE DUE TO						
ITEIVI	CLOSURE	LISTED CONTACTS						
	>= 2 WEEKS	21 CALENDAR DAYS						
	>- 2 VVEENS	PRIOR TO CLOSURE						
RAMP & ROAD	> 12 HOURS &	14 CALENDAR DAYS						
CLOSURES	< 2 WEEKS	PRIOR TO CLOSURE						
	< 12 HOURS	4 BUSINESS DAYS						
	< 12 HOUNS	PRIOR TO CLOSURE						
	>= 2 WEEKS	14 CALENDAR DAYS						
LANE CLOSURES &	>- 2 VVEEKS	PRIOR TO CLOSURE						
RESTRICTIONS	< 2 WEEKS	5 BUSINESS DAYS						
	< 2 WEEKS	PRIOR TO CLOSURE						
START OF CONSTRUCTION & TRAFFIC PATTERN CHANGES	N/A	14 CALENDAR DAYS PRIOR TO IMPLEMENTATION						

ANY UNFORESEEN CONDITIONS NOT SPECIFIED IN THE PLANS REQUIRING TRAFFIC RESTRICTIONS SHALL ALSO BE REPORTED TO THE PROJECT ENGINEER USING THE NOTIFICATION TIME TABLE.

CONTACT THE FOLLOWING:
-DISTRICT PUBLIC INFORMATION OFFICER BY EMAIL AT DOT.D08.PIO@DOT.OHIO.GOV
-DISTRICT PERMIT SECTION BY EMAIL AT D08.PERMITS@DOT.OHIO.GOV

-CENTRAL OFFICE SPECIAL HAUL PERMITS SECTION BY EMAIL AT HAULING.PERMITS@DOT.OHIO.GOV

### HAM-50-1903L PEDESTRAIN & BICYCLE TRAFFIC

PEDESTRIAN AND BIKE TRAFFIC ON THE OHIO RIVER TRAIL, THE MULTI-USE PATH UNDER THE BRIDGE, SHALL BE MAINTAINED AT ALL TIMES DURING CONSTRUCTION. THE CONTRACTOR MUST IMPLEMENT SAFETY MEASURES TO PROTECT USERS AND PREVENT FALLING DEBRIS DURING CONSTRUCTION.

## ITEM 614, LAW ENFORCEMENT OFFICER (WITH PATROL CAR) FOR ASSISTANCE DURING CONSTRUCTION OPERATIONS

USE OF LAW ENFORCEMENT OFFICERS (LEOS) BY CONTRACTORS
OTHER THAN THE USES SPECIFIED BELOW SHALL NOT BE
PERMITTED AT PROJECT COST NOR TIME COMPENSATION.
LEOS SHOULD NOT BE USED WHERE THE OMUTCD INTENDS THAT
FLAGGERS BE USED.

IN ADDITION TO THE REQUIREMENTS OF C&MS 614 AND THE OMUTCD, A UNIFORMED LEO WITH AN OFFICIAL PATROL CAR (CAR WITH TOP-MOUNTED EMERGENCY FLASHING LIGHTS AND COMPLETE MARKINGS OF THE APPROPRIATE LAW ENFORCEMENT AGENCY) SHALL BE PROVIDED FOR THE FOLLOWING TRAFFIC CONTROL TASKS:

- DURING THE ENTIRE ADVANCE PREPARATION AND CLOSURE SEQUENCE WHERE COMPLETE BLOCKAGE OF TRAFFIC IS REQUIRED.
- DURING A TRAFFIC SIGNAL INSTALLATION WHEN IMPACTING THE NORMAL FUNCTION OF THE SIGNAL OR THE FLOW OF TRAFFIC, OR WHEN TRAFFIC NEEDS TO BE DIRECTED THROUGH AN ENERGIZED TRAFFIC SIGNAL CONTRARY TO THE SIGNAL DISPLAY (E.G., DIRECTING MOTORISTS THROUGH A RED LIGHT).

IN ADDITION TO THE REQUIREMENT OF C&MS 614 AND THE OMUTCD,
A UNIFORMED LEO WITH AN OFFICIAL PATROL CAR (CAR WITH TOPMOUNTED EMERGENCY FLASHING LIGHTS AND COMPLETE MARKINGS OF
THE APPROPRIATE LAW ENFORCEMENT AGENCY) SHOULD BE PROVIDED
FOR THE FOLLOWING TRAFFIC CONTROL TASKS AS APPROVED
BY THE ENGINEER:

• FOR LANE CLOSURES THAT MEET ALL OF THE CRITERIA LISTED BELOW: DURING INITIAL SET-UP PERIODS, TEAR DOWN PERIODS, SUBSTANTIAL SHIFTS OF A CLOSURE POINT OR WHEN NEW LANE CLOSURE ARRANGEMENTS ARE INITIATED FOR LONG-TERM LANE CLOSURES/SHIFTS (FOR THE FIRST AND LAST DAY OF MAJOR CHANGES IN TRAFFIC CONTROL SETUP).

### o CRITERIA

- ON A MULTI-LANE DIVIDED INTERSTATE, OTHER FREEWAY OR EXPRESSWAY; AND,
- AN AUTHORIZED SPEED LIMIT OF 45 MPH OR GREATER THAT IS IN EFFECT AT THE TIME OF THE OPERATION; AND,
- AADT OF 50,000 (OR AADT OF 30,000 WITH 25% OR HIGHER PERCENT TRUCKS)

IN GENERAL, LEOS SHOULD BE POSITIONED IN ADVANCE OF AND ON THE SAME SIDE AS THE LANE RESTRICTION (OR AT THE POINT OF ROAD CLOSURE), AND TO MANUALLY CONTROL TRAFFIC MOVEMENTS THROUGH SIGNALIZED INTERSECTIONS AND/OR IN CONTRARY TO OTHER TRAFFIC CONTROL DEVICES IN WORK ZONES.

LEOS SHOULD NOT FORGO THEIR TRAFFIC CONTROL RESPONSIBILITIES TO
APPREHEND MOTORISTS FOR ROUTINE TRAFFIC VIOLATIONS. HOWEVER,
IF A MOTORISTâ??S ACTIONS ARE CONSIDERED TO BE RECKLESS, THEN PURSUIT OF THE MOTORIST IS APPROPRIATE.

THE LEOS WORK AT THE DIRECTION OF THE CONTRACTOR.

THE CONTRACTOR IS RESPONSIBLE FOR SECURING THE SERVICES

OF THE LEOS WITH THE APPROPRIATE AGENCIES AND COMMUNICATING

THE INTENTIONS OF THE PLANS WITH RESPECT TO DUTIES OF THE LEOS.

THE ENGINEER SHALL HAVE FINAL CONTROL OVER THE LEOSâ?? DUTIES AND PLACEMENT, AND WILL RESOLVE ANY ISSUES THAT MAY ARISE BETWEEN THE TWO PARTIES.

## ITEM 614, LAW ENFORCEMENT OFFICER (WITH PATROL CAR) FOR ASSISTANCE DURING CONSTRUCTION OPERATIONS (CONTINUED)

manner ma

ENSURE PROVIDED LEOS HAVE BEEN TRAINED APPROPRIATE TO THE JOB DECISIONS THEY ARE REQUIRED TO MAKE WHILE ON THE PROJECT, IN ACCORDANCE WITH C&MS 614.03.THE LEO SHALL REPORT IN TO THE CONTRACTOR PRIOR TO THE START OF THE SHIFT, IN ORDER TO RECEIVE INSTRUCTIONS REGARDING SPECIFIC WORK ASSIGNMENTS DURING HIS/HER SHIFT. THE LEO IS EXPECTED TO STAY AT THE PROJECT SITE FOR THE ENTIRE DURATION OF HIS/HER SHIFT. THE LEO SHALL REPORT TO THE CONTRACTOR AT THE END OF HIS/HER SHIFT. SHOULD IT BE NECESSARY TO LEAVE THE PROJECT SITE, THE LEO SHALL NOTIFY THE ENGINEER. THE CONTRACTOR SHALL PROVIDE THE LEOWITH A TWO-WAY COMMUNICATION DEVICE THAT SHALL BE RETURNED TO THE CONTRACTOR AT THE END OF HIS/HER SHIFT.

LEOS (WITH PATROL CAR) REQUIRED BY THE TRAFFIC MAINTENANCE TASKS ABOVE SHALL BE PAID FOR ON A UNIT PRICE (HOURLY) BASIS UNDER ITEM 614, LAW ENFORCEMENT OFFICER (WITH PATROL CAR) FOR ASSISTANCE. THE FOLLOWING ESTIMATED QUANTITIES HAVE BEEN CARRIED TO THE GENERAL SUMMARY.

ITEM 614, LAW ENFORCEMENT OFFICER WITH PATROL CAR FOR ASSISTANCE 200 HOURS

THE HOURS PAID SHALL INCLUDE ANY MINIMUM SHOW-UP TIME REQUIRED
BY THE LAW ENFORCEMENT AGENCY INVOLVED.ANY ADDITIONAL COSTS
(ADMINISTRATIVE OR OTHERWISE) INCURRED BY THE CONTRACTOR TO OBTAIN
THE SERVICES OF AN LEO ARE INCLUDED WITH THE BID UNIT PRICE FOR
ITEM 614, LAW ENFORCEMENT OFFICER WITH PATROL CAR FOR ASSISTANCE.

### PERMITTED LANE CLOSURE SCHEDULE (PLCS)

LANE CLOSURE(S) SHALL CONFORM TO THE PLCS. PUBLISHED
PLCS INFORMATION CAN BE FOUND ON THE ODOT WEBSITE AT:
HTTPS://WWW.TRANSPORTATION.OHIO.GOV/WPS/PORTAL/GOV/
ODOT/WORKING/DATA-TOOLS/RESOURCES/PERMITTED-LANECLOSURE

THE MONTHLY PUBLISHED SCHEDULES REQUIRED TO BE USED, FOR EACH PLCS SEGMENT WITHIN THE PROJECT AREA, ARE THOSE THAT COMPRISE THE CONSECUTIVE 12-MONTH PERIOD BEGINNING 15 MONTHS PRIOR TO THE MONTH AND YEAR OF SALE AND ENDING 4 MONTHS PRIOR TO THE MONTH AND YEAR OF SALE. THESE SAME 12 MONTHS APPLY FOR THE LIFE OF THE PROJECT AND SHALL BE APPLIED TO EACH RESPECTIVE MONTH OF CONSTRUCTION (MONTH OF LANE CLOSURE(S) SHALL MATCH MONTH OF PLCS USED). LANE CLOSURE(S) IN PLACE FOR MULTIPLE MONTHS SHALL ALWAYS COMPLY WITH THE CURRENT RESPECTIVE MONTH.

(FOR EXAMPLE: IF THE SALE DATE FOR THE PROJECT WAS MARCH OF 2021, THE MONTHLY PUBLISHED SCHEDULES FOR EACH APPLICABLE PLCS SEGMENT WOULD BE DECEMBER 2019 TO NOVEMBER 2020.

MORE RESTRICTIVE CHANGES TO THE ALLOWABLE LANE CLOSURE HOURS ARE AT THE DISCRETION OF THE ENGINEER IN ORDER TO COMPLY WITH THE TRAFFIC MANAGEMENT IN WORK ZONES POLICY (21-008(P)) AND STANDARD PROCEDURE (123-001(SP)).

LESS RESTRICTIVE CHANGES TO THE ALLOWABLE LANE CLOSURE HOURS ARE SUBJECT TO THE TRAFFIC MANAGEMENT IN WORK ZONES POLICY (21-008(P)) AND STANDARD PROCEDURE (123-001(SP)) AND SHALL NOT BE IMPLEMENTED UNTIL, AND UNLESS, APPROVED BY THE PROPER ODOT AUTHORITY.

ALLOWABLE LANE CLOSURE HOURS FOR FACILITIES NOT COVERED BY THE PLCS, IF ANY, SHALL BE AS SPECIFIED ELSEWHERE IN THE PLANS.


DESIGN AGENCY

NOTES

**TRAFFIC** 

OF

**MAINTENANCE** 

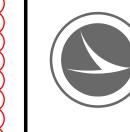

DESIGNER
GTF

REVIEWER
SRK 07/14/25

ROJECT ID

114515

HEET \_ TOTAL

TOTAL **3 52** 



FROM

197+50

207+00

211+00

197+50

207+00

1

2

2

7

TO

207+00

210+50

216+00

207+00

210+50

TOTALS CARRIED TO GENERAL SUMMARY


LT

LT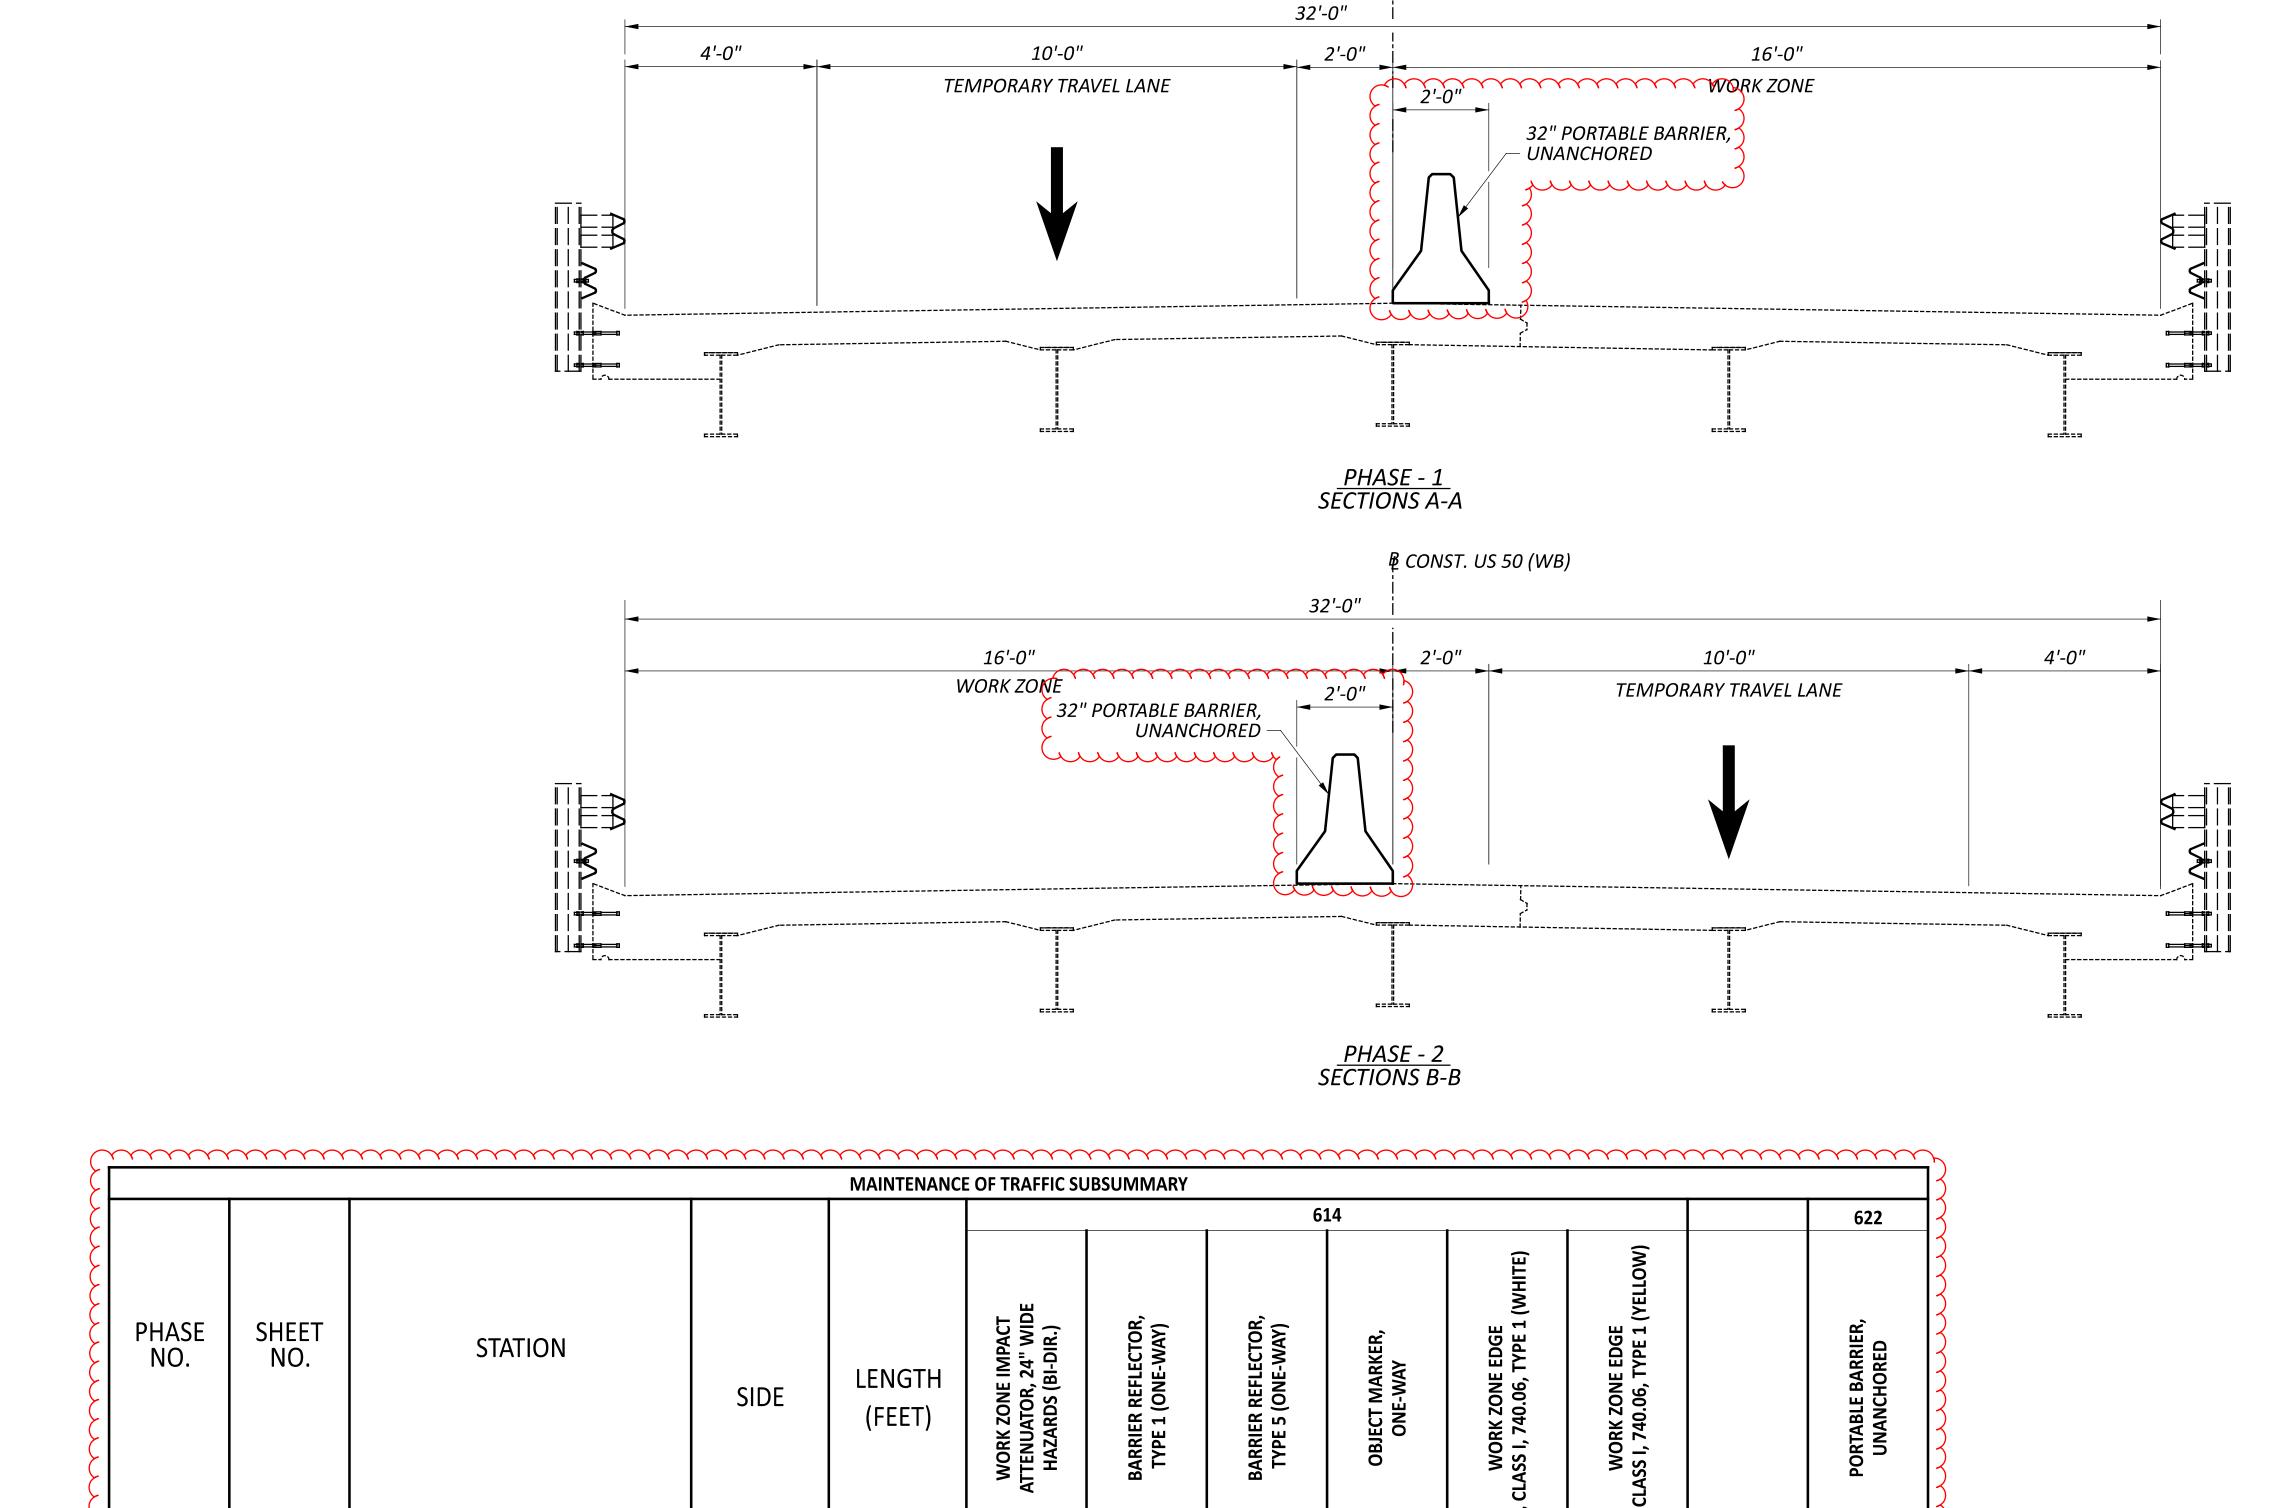

**EACH** 

11

19

63

**EACH** 

19

19

7

52

MILE

0.18

0.07

MILE

0.18

0.07

0.50

FT

900

260

900

260

2,320

**EACH** 

19

19

**52** 

**EACH** 

1

1

950

350

500

950

350


及 CONST. US 50 (WB)






DESIGNER
GTF

REVIEWER
SRK 07/14/25
PROJECT ID
114515
SHEET TOTAL

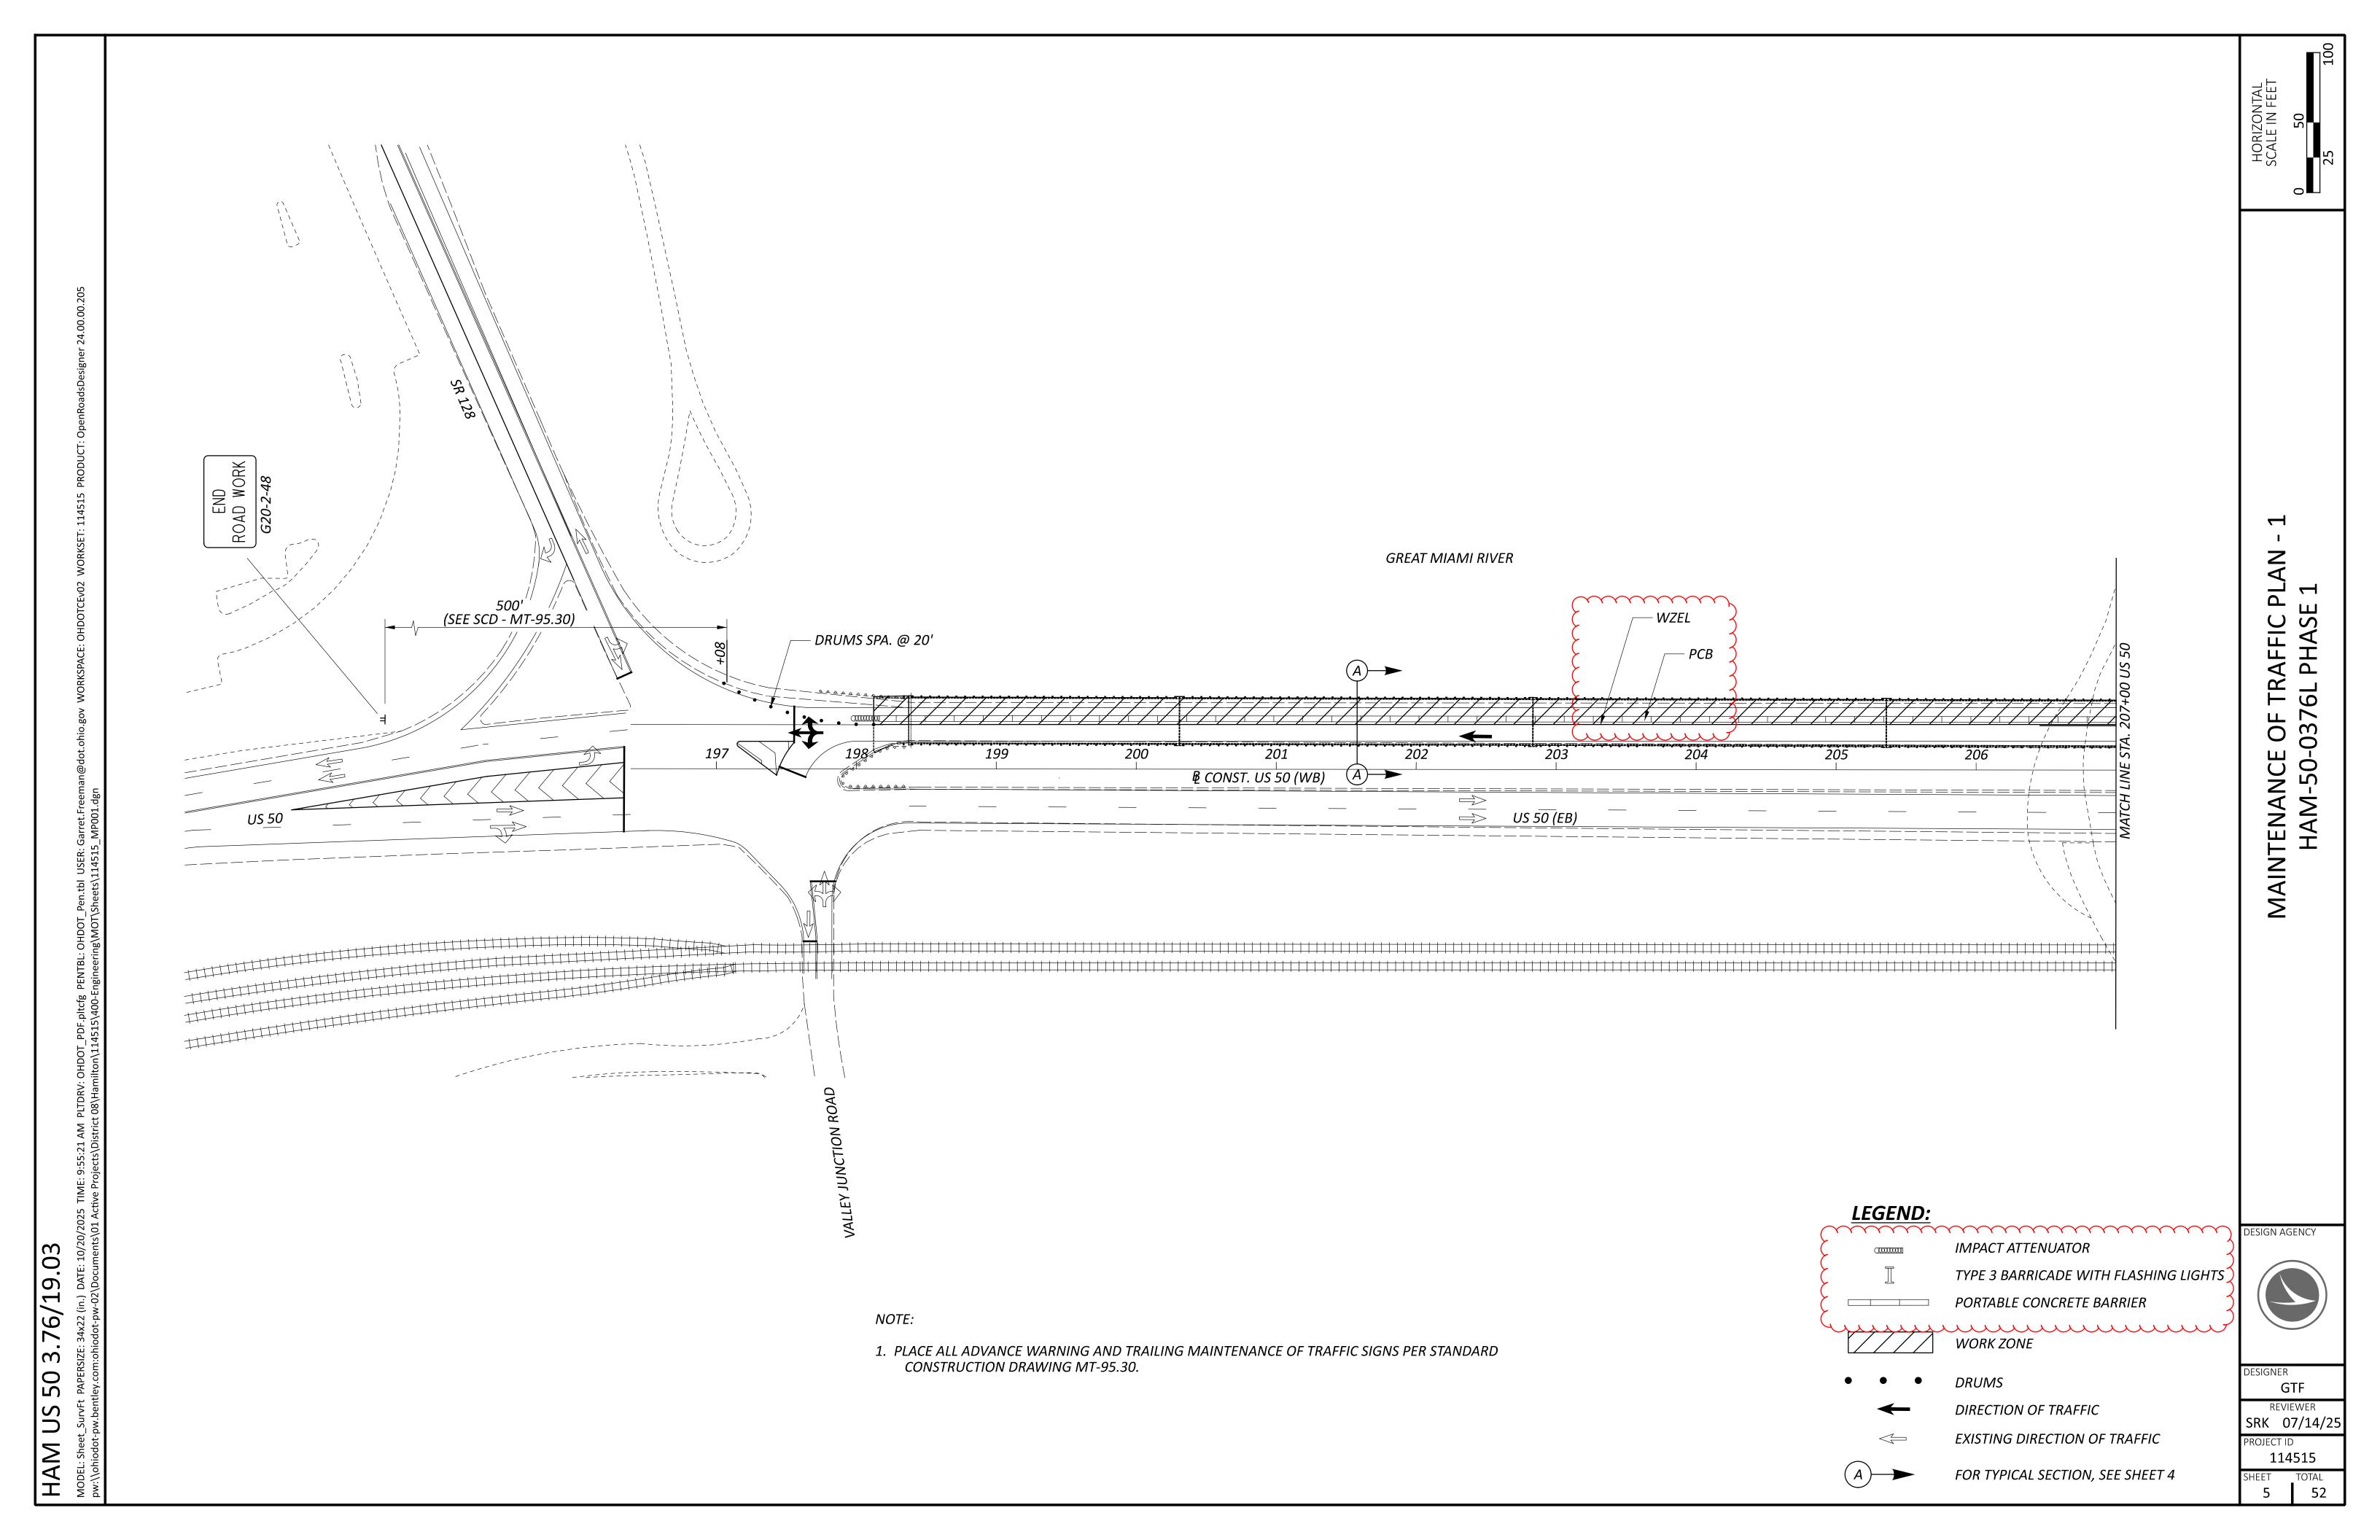

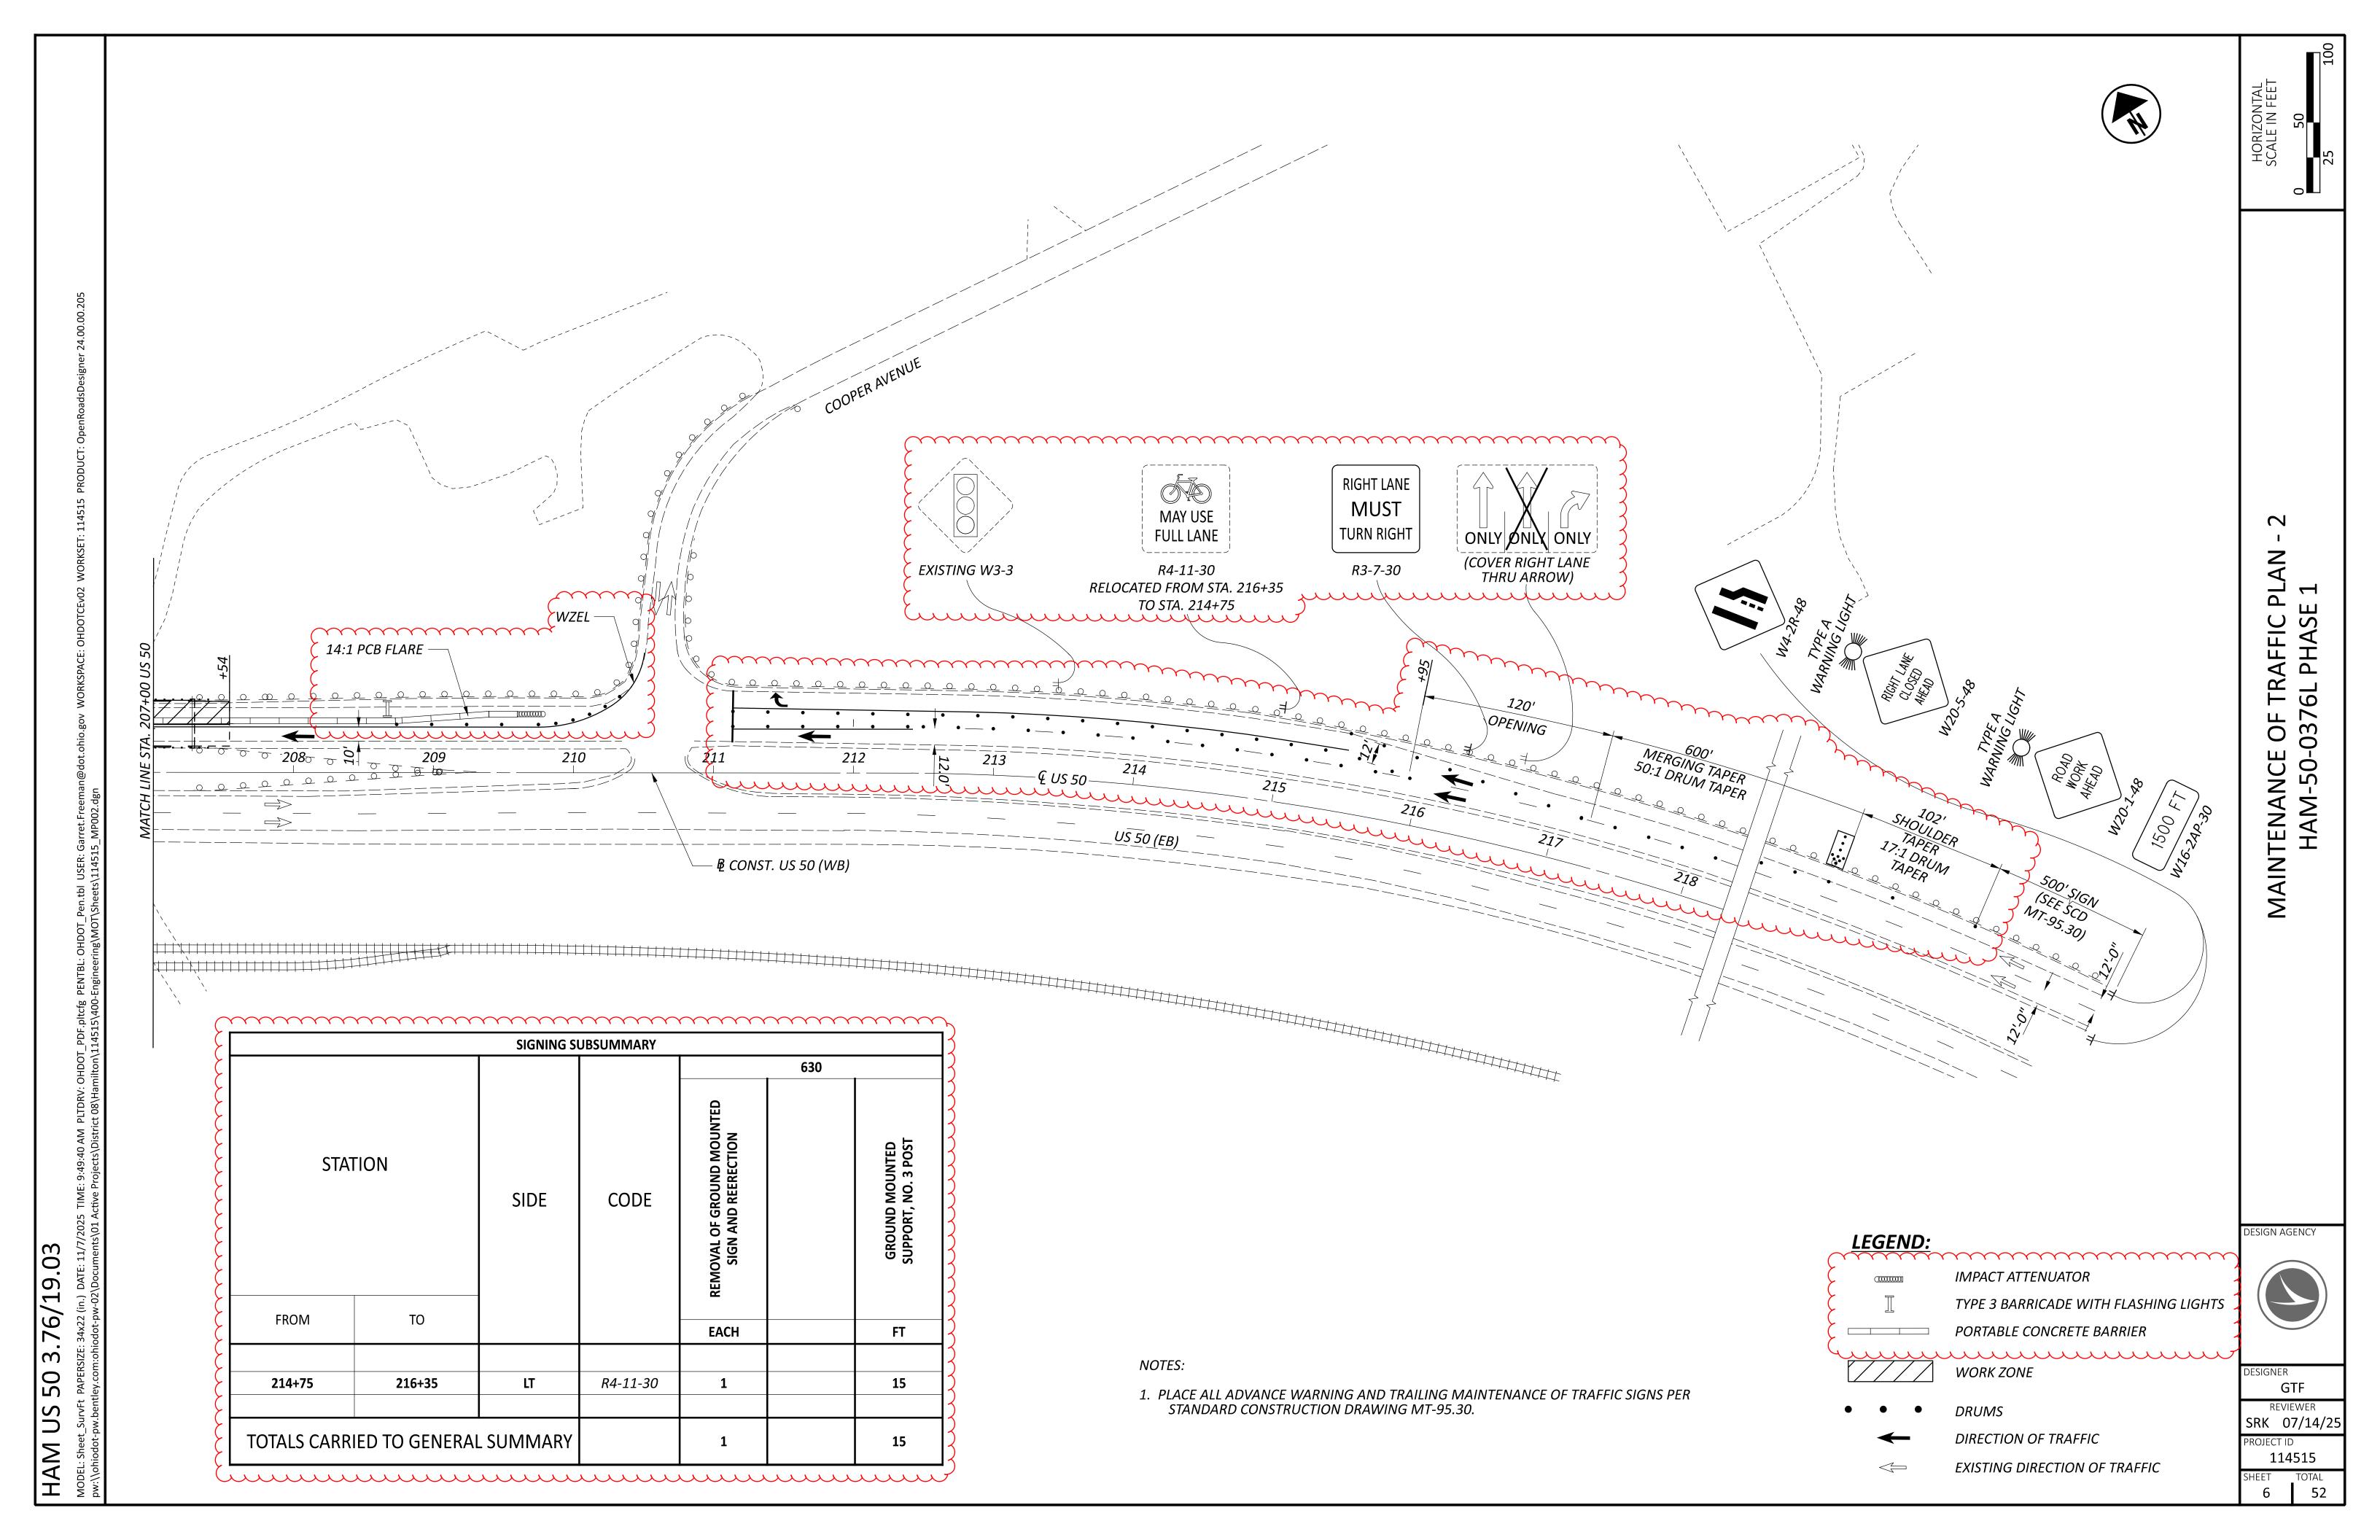


MAINTENANCE OF TRAFFIC PLAN - 1 HAM-50-0376L PHASE 2

DESIGN AGENCY

designer **GTF** 

REVIEWER
SRK 07/14/25
PROJECT ID
114515

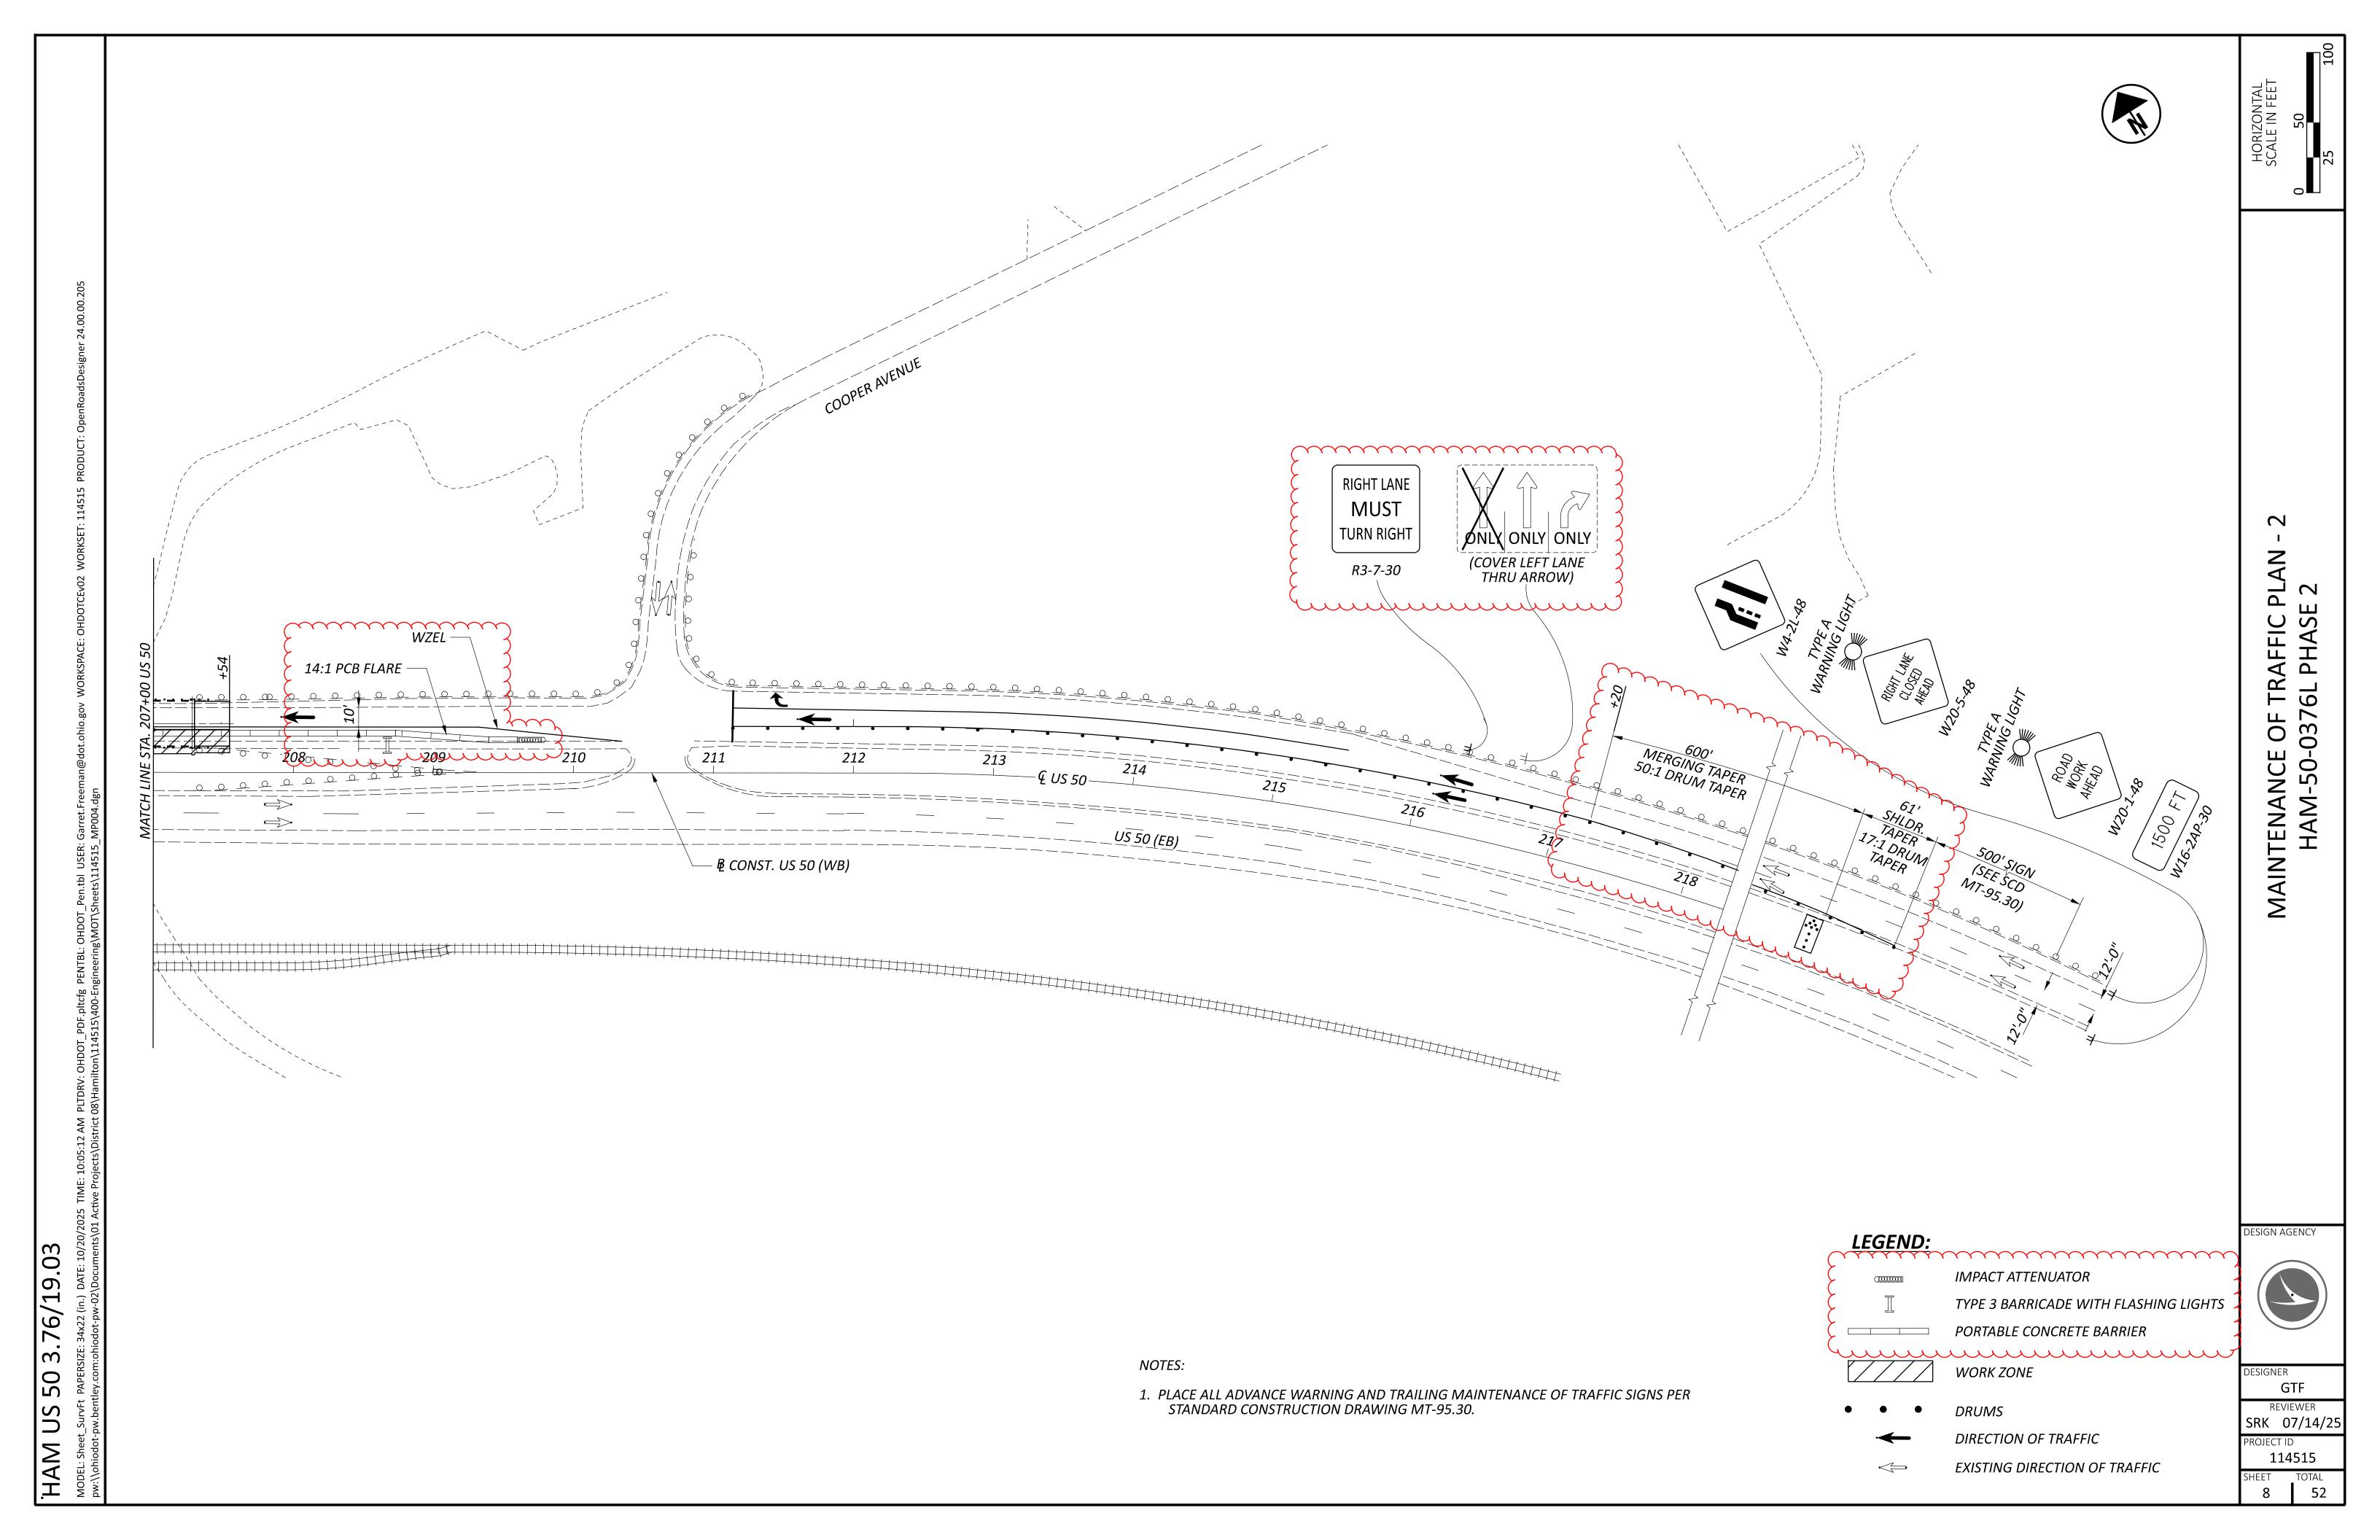

SHEET NUMBER				SHEET NUMBER							RT.	ITEM	ITEM	GRAND	UNIT	DESCRIPTION	SEE SHEET	
4	6									01/NHS	02/NHS	11211	EXT	TOTAL			NO.	
																ROADWAY		1
										LUMP		201	11000	LS		CLEARING AND GRUBBING	2	-
																EROSION CONTROL		
										5,000		832	30000	5,000	EACH	EROSION CONTROL		-
	$\sim$		$\sim$	m		· · · · · · · · · · · · · · · · · · ·		<b>~~~</b>	m		· · · · · · · · · · · · · · · · · · ·	~~~	$\sim$		· · · · · · · · · · · · · · · · · · ·	TRAFFIC CONTROL		7
	15									15		630	03100	15		GROUND MOUNTED SUPPORT, NO. 3 POST		] \
	1				Luu					1		630	85100	1	EACH	REMOVAL OF GROUND MOUNTED SIGN AND REERECTION		<u>ک</u> ر
																STRUCTURE OVER 20 FOOT SPAN (HAM-50-0376L)		-
																SEE SHEET 12		
																STRUCTURE OVER 20 FOOT SPAN (HAM-50-0376R)		-
																SEE SHEET 12		1
																		1
																STRUCTURE OVER 20 FOOT SPAN (HAM-50-1903L) SEE SHEET 12		-
																JEE SHEET 12		
~~~	~~~	~~~	~~~	······	******	~~~	~~~	~~~	·····	~~~	~~~~		12204	m		MAINTENANCE OF TRAFFIC	<u> </u>	
52							1			52		614 614	12384 13310	52		WORK ZONE IMPACT ATTENUATOR, 24" WIDE HAZARDS, (BIDIRECTIONAL) BARRIER REFLECTOR, TYPE 1 (ONE-WAY)	$\frac{1}{2}$	_
63										63		614	13318	63	EACH	BARRIER REFLECTOR, TYPE 5 (ONE-WAY)	<del></del>	1
52 0.5										52 0.5		614 614	13350 22210	52 0.5		OBJECT MARKER, ONE WAY WORK ZONE EDGE LINE, CLASS I, 6", 740.06, TYPE I	}	-
0.5										0.5		014	22210	0.5	IVIILE	WORK ZONE EDGE LINE, CLASS I, 6 , 740.06, TYPE I	<u>)</u>	-
2,320										2,320		622	41100	2,320		PORTABLE BARRIER, UNANCHORED	3	_
										200		<u> </u>		2000	HOUR	LAW ENFORCEMENT OPFICER WITH PATROL CAR FOR ASSISTANCE, AS PER PLAN	3	_
																INCIDENTALS		
										LUMP	LUMP	614	11000	LS		MAINTAINING TRAFFIC		
										LUMP LUMP	LUMP LUMP	623 624	10000 10000	LS LS		CONSTRUCTION LAYOUT STAKES AND SURVEYING MOBILIZATION		-
																		_
																		1
																		_
<u> </u>																		_
																		_
																		_
																		_
																		_
																		-
																		_
																		_
																		_
						1												-
						<u> </u>												-
																		DESIG
						1												-
						<u> </u>	<u> </u>											] (/
																		] \
						1												-
		_				1												DESIG
									•			_	_			·		
																		<u> </u>
																		CAF
																		CAH PROJE

SS 844 DATED 01-17-2025

### **DESIGN SPECIFICATIONS**

THE PROPOSED WORK CONFORMS TO THE 10th EDITION OF THE "LRFD BRIDGE DESIGN SPECIFICATIONS" ADOPTED BY THE AMERICAN ASSOCIATION OF STATE HIGHWAY AND TRANSPOR-TATION OFFICIALS, 2020 AND THE ODOT BRIDGE DESIGN MANUAL, 2020. 

 $\sim$ 

### **DESIGN LOADING**

HS20-44, CASE II AND THE ALTERNATE MILITARY LOADING, NO FUTURE WEARING SURFACE.

### DESIGN DATA (NEW MATERIAL)

STRUCTURAL STEEL - ASTM A709 GRADE 50, YIELD STRENGTH 50,000

STEEL TUBING - ASTM A500 GRADE B, YIELD STRENGTH 46,000 PSI

### **EXISTING STRUCTURE VERIFICATION**

DETAILS AND DIMENSIONS SHOWN ON THESE PLANS PERTAINING TO THE EXISTING STRUCTURE HAVE BEEN OBTAINED FROM PLANS OF THE EXISTING STRUCTURE AND FROM FIELD OBSERVATIONS AND MEASUREMENTS. CONSEQUENTLY, THEY ARE INDICATIVE OF THE EXISTING STRUCTURE AND THE PROPOSED WORK BUT THEY SHALL BE CONSIDERED TENTATIVE AND APPROXIMATE. THE CONTRACTOR IS REFERRED TO CMS SECTIONS 102.05, 105.02 AND 513.04.

BASE CONTRACT BID PRICES UPON A RECOGNITION OF THE UNCERTAINTIES DESCRIBED ABOVE AND UPON A PREBID EXAMINATION OF THE EXISTING STRUCTURE. HOWEVER, THE DEPARTMENT WILL PAY FOR ALL PROJECT WORK BASED UPON ACTUAL DETAILS AND DIMENSIONS THAT HAVE BEEN VERIFIED IN THE FIELD.

### CONSTRUCTION PROCEDURES

THE CONTRACTOR SHALL SUBMIT ALL PROPOSED REMOVAL AND REPLACEMENT PROCEDURES TO THE ENGINEER FOR APPROVAL. THE PROCEDURES SHALL INCLUDE PROPOSED METHODS, ORDER OF OPERATION, AND EQUIPMENT. ALL SUBMITTALS SHALL BE SEALED BY A PROFESSIONAL ENGINEER REGISTERED IN THE STATE OF OHIO AND BE SUBMITTED A MINIMUM OF FOUR (4) WEEKS PRIOR TO INTENDED DATE FOR COMMENCEMENT OF WORK. ALL COSTS FOR THIS WORK SHALL BE INCLUDED WITH THE APPROPRIATE BID ITEMS.

THE CONTRACTOR SHALL NOT ORDER MATERIALS OR PERFORM WORK LISTED IN THE GENERAL SUMMARY FOR ITEMS DESIGNATED BY PLAN NOTE TO BE USED "AS DIRECTED BY THE ENGINEER" UNLESS AUTHORIZED BY THE ENGINEER.

### RIVET REMOVAL PROCEDURE

THE PROCEDURE FOR RIVET REMOVAL AND PREPARATION OF THE EXISTING HOLES FOR NEW BOLTS SHALL BE AS FOLLOWS:

RIVET REMOVAL - EXISTING RIVETS SHALL BE REMOVED BY FIRST SAW CUTTING OR CHISELING HEADS OFF AND THEN REMOVING THE REMAINDER OF THE RIVET BY CHISELING OR OTHER MECHANICAL METHOD APPROVED BY THE ENGINEER. AT NO TIME SHALL THERMAL CUTTING, AIR CARBON ARC, OR GOUGING BE ALLOWED. CARE SHALL BE TAKEN TO ENSURE THAT THE REMOVAL OF THE EXISTING FASTENERS CAUSES NO DAMAGE TO THE CONNECTED ELEMENTS THAT ARE TO REMAIN. THE CONTRACTOR SHALL SUBMIT FOR APPROVAL A METHOD OF REPAIR TO THE ENGINEER FOR ANY EXISTING ELEMENTS DAMAGED DURING RIVET REMOVAL. ALL REPAIRS TO DAMAGED STEEL SHALL BE MADE AT NO ADDITIONAL COST TO THE PROJECT.

REAMING - OPEN RIVET HOLES THAT WILL RECEIVE NEW HIGH STRENGTH BOLTS SHALL BE PROPERLY SIZED TO A DIAMETER THAT IS ONE-SIXTEENTH INCH (2") LARGER THAN THE NEW BOLTS. IN THE EVENT THAT THE EXISTING RIVET HOLE IS NOT ADEQUATE TO ACCEPT THE NEW SPECIFIED BOLT, THE HOLE SHALL BE DRILLED OR REAMED AS REQUIRED TO PROVIDE A PROPER SIZED HOLE.

### ITEM 513 - STRUCTURAL STEEL, MISC.: LACING BAR REPAIRS

### **DESCRIPTION:**

THIS WORK INCLUDES ALL ACCESS, LABOR, MATERIALS, AND EQUIPMENT NECESSARY TO REPLACE LACING BARS AS SHOWN IN THE PLANS AND SHALL CONFORM TO THE REQUIREMENTS OF CMS 513 SUPPLEMENTED WITH THE FOLLOWING INFORMATION. EXISTING RIVETS ARE TO BE REMOVED PER THE RIVET REMOVAL PROCEDURE.

NO MORE THAN THREE PASTENERS (ONE LACING BAR) SHALL BE REMOVED AT ONE TIME.

THE CONTRACTOR SHALL PERFORM ALL WORK IN A MANNER THAT WILL NOT GOUGE, CUT, OR DAMAGE THE EXISTING STEEL TO REMAIN. IF EXISTING STEEL TO REMAIN IS DAMAGED DURING REMOVAL OR INSTALLATION OF THE RETROFIT, THE CONTRACTOR SHALL REPLACE THE DAMAGED AREA AT NO COST TO THE DEPARTMENT AND TO THE SATISFACTION OF THE ENGINEER. THE CONTRACTOR IS TO FIELD VERIFY ALL MEMBER DIMENSIONS, RIVET/BOLT LAYOUTS, AND LACING BARS TO BE RETROFITTED PRIOR TO PERFORMING THE WORK.

STEEL MEMBERS TO BE FABRICATED UNDER THIS ITEM WILL NOT REQUIRE SHOP DRAWINGS PRIOR TO FABRICATION. THE CONTRACTOR SHALL MAKE NECESSARY MEASUREMENTS AND PREPARE SKETCHES, DRAWINGS, TABLES, ETC. THE ENGINEER SHALL HAVE AUTHORITY AND RESPONSIBILITY FOR ENSURING THAT THE FABRICATED STEEL IS ACCEPTABLE. MILL TEST REPORTS AND SHIPPING DOCUMENTS SHALL BE SUBMITTED TO THE ENGINEER FOR REVIEW AND APPROVAL PRIOR TO INCORPORATING STEEL ITEMS INTO THE WORK, AS REQUIRED BY CMS *501.06.* 

### MEASUREMENT AND PAYMENT:

PAYMENT SHALL INCLUDE FULL COMPENSATION FOR ALL MATERIAL, TOOLS, EQUIPMENT, LABOR, AND ACCESS NECESSARY TO COMPLETE THE REPAIRS. PAYMENT FOR CUTTING, GRINDING, DRILLING, AND BOLTING AS PART OF THE REPAIR SHALL BE CONSIDERED INCIDENTAL TO THESE ITEMS.

ANY LABOR AND/OR MATERIALS AND EQUIPMENT INCIDENTAL TO STEEL WORK NOT SPECIFICALLY PAID FOR UNDER ANY OTHER ITEM SHALL BE INCLUDED AND PAID FOR UNDER THE FOLLOWING CONTRACT ITEM (PAY ITEM):

DESCRIPTION

STRUCTURAL STEEL, MISC.: LACING BAR REPAIRS EACH

### ITEM 513 - STRUCTURAL STEEL, MISC.: RIVET REPLACEMENT

### **DESCRIPTION:**

THIS WORK INCLUDES FURNISHING ALL ACCESS, LABOR, MATERIALS, AND EQUIPMENT NECESSARY TO REPLACE RIVETS WITH HIGH STRENGTH BOLTS AS SHOWN IN THE PLANS. COMPLETED AND IN PLACE WORK SHALL CONFORM TO THE REQUIREMENTS OF CMS 513 SUPPLEMENTED WITH THE FOLLOWING ADDITIONAL INFORMATION.

THE CONTRACTOR SHALL REMOVE NO MORE THAN ONE RIVET AT ANY TIME FOLLOWING THE RIVET REMOVAL PROCEDURE UNLESS REPLACING LACES, WHICH WILL HAVE A MAXIMUM RIVET REMOVAL LIMIT OF 3 RIVETS. 

### MATERIAL:

NEW BOLTS SHALL BE GALVANIZED (PER CMS 711.02) ASTM A325 AND MATCH EXISTING RIVET SIZES. NEW MATERIAL SHALL BE CERTIFIED PER CMS 501.06.

### **SEQUENCE OF CONSTRUCTION:**

LIMIT REMOVAL AND CONSTRUCTION OPERATIONS TO ONE GUSSET PLATE ON EITHER THE NORTH OR SOUTH TRUSS AT ANY GIVEN TIME. THIS WORK MAY OCCUR SIMULTANEOUSLY WITH STEEL REPAIRS IN OTHER SPANS.

PERFORM RIVET REPLACEMENT WITH BOLTS AS FOLLOWS:

- A. ABRASIVE BLAST AREA ENCOMPASSING GUSSET PLATE CONNECTION *IN ACCORDANCE WITH CMS 514.13.C.*
- B. REMOVE A SINGLE RIVET PER RIVET REMOVAL PROCEDURE.
- C. IN THE OPEN RIVET HOLE, INSTALL A NEW BOLT WITH SUFFICIENT GRIP LENGTH TO ACCOMMODATE ALL BEARING SURFACES.
- D. PROPERLY TENSION NEW BOLT.
- E. REPEAT "B" THROUGH "D" UNTIL ALL SPECIFIED RIVETS ARE REPLACED.
- F. THE ENGINEER SHALL INSPECT NEW BOLT TENSION WITH A CALIBRATED TORQUE WRENCH PRIOR TO FIELD PAINTING.
- G. FIELD PAINT EXPOSED STEEL PER CMS 514.

### **MEASUREMENT AND PAYMENT:**

PAYMENT FOR SURFACE PREPARATION AND PAINTING SHALL BE INCLUDED FOR PAYMENT WITH ITEM 514.

PAYMENT SHALL INCLUDE FULL COMPENSATION FOR ALL MATERIAL, TOOLS, EQUIPMENT, LABOR, AND ACCESS NECESSARY TO COMPLETE THE REPAIRS. PAYMENT FOR REAMING, GRINDING, AND BOLTING AS PART OF THE REPAIR SHALL BE CONSIDERED INCIDENTAL TO THESE ITEMS. THE UNIT "EACH" REFERS TO A SINGLE GUSSET PLATE AT A PANEL POINT LOCATION.

ANY LABOR AND/OR MATERIALS AND EQUIPMENT INCIDENTAL TO STEEL WORK NOT SPECIFICALLY PAID FOR UNDER ANY OTHER ITEM SHALL BE INCLUDED AND PAID FOR UNDER THE FOLLOWING CONTRACT ITEM (PAY ITEM):

DESCRIPTION ITEM UNIT

*513 EACH* STRUCTURAL STEEL, MISC.: RIVET REPLACEMENT

### STRUCTURAL STEEL, MISC.: BEARING ANCHOR BOLT

### **DESCRIPTION:**

THE INTENT OF THE ANCHOR BOLT ITEM IS TO RE-TIGHTEN BEARING ANCHOR BOLT NUTS THAT HAVE BACKED OFF FROM THEIR ORIGINAL POSITIONS. THE LOCATIONS WHERE THIS WORK IS TO BE PERFORMED ARE AT PIER 3 UNDER BOTH THE NORTH AND SOUTH TRUSS.

 $\sim$ 

PAYMENT SHALL INCLUDE FULL COMPENSATION FOR ALL MATERIAL, TOOLS, EQUIPMENT, LABOR, AND ACCESS NECESSARY TO COMPLETE THE REPAIRS. ANY LABOR AND/OR MATERIALS AND EQUIPMENT INCIDENTAL TO COMPLETION OF THE WORK AS STATED ABOVE SHALL BE INCLUDED AND PAID FOR UNDER THE FOLLOWING CONTRACT ITEM (PAY ITEM):

ITEM UNIT DESCRIPTION

EACH STRUCTURAL STEEL, MISC.: RIVET REPLACEMENT 

### ITEM 513 - STRUCTURAL STEEL, MISC.: GUSSET/COVER PLATE HOLE

### **DESCRIPTION:**

THIS WORK INCLUDES FURNISHING ALL ACCESS, LABOR, MATERIALS, AND EQUIPMENT NECESSARY TO REPAIR HOLES IN GUSSET PLATES WITH A NEW STEEL PLATE ADHERED TO THE EXISTING GUSSET PLATE USING A METAL POLYMER MATERIAL. COMPLETED AND IN PLACE WORK SHALL CONFORM TO THE REQUIREMENTS OF CMS 513 SUPPLEMENTED WITH THE FOLLOWING ADDITIONAL INFORMATION.

### <u>MATERIAL:</u>

THE MATERAILS USED TO COMPLETE THE WORK SHALL BE AS FOLLOWS OR AN APPROVED EQUAL MATERIAL APPROVED BY THE ENGINEER. METAL POLYMER MATERIAL MANUFACTURER INFORMATION:

**DEVCON** 

https://itwperformancepolymers.com/

DIAMANT MM1018 https://diamant-polymer.com

RESIMETAL

https://resimacsolutions.com/product/101-metal-repair-paste/

### **SEQUENCE OF CONSTRUCTION:**

LIMIT REMOVAL AND CONSTRUCTION OPERATIONS TO ONE GUSSET/COVER PLATE ON EITHER THE NORTH OR SOUTH TRUSS AT ANY GIVEN TIME. THIS WORK MAY OCCUR SIMULTANEOUSLY WITH STEEL REPAIRS IN OTHER SPANS.

PERFORM RIVET REPLACEMENT WITH BOLTS AS FOLLOWS:

- A. ABRASIVE BLAST AREA ENCOMPASSING NEW STEEL PLATE CONNECTION IN ACCORDANCE WITH CMS 514.13.C.
- B. INSTALL A MINIMUM OF 1/4" THICK LAYER OF METAL POLYMER OR AS RECOMMENDED BY THE MANUFACTURER
- C. INSTALL 1/2" THICK UNCOATED STEEL PLATE CENTERED OVER THE HOLE IN THE GUSSET/ COVER PLATE.
- D. SEAL PERIMETER WITH MINIMUM 1/2"
- DEVCON/MM1018/RESIMETAL WEDGE E. COVER TOP SURFACE WITH MINIMUM 1/16"COAT OF DEVCON/MM1018/RESIMETAL. G. FIELD PAINT EXPOSED STEEL PER CMS 514.

### **MEASUREMENT AND PAYMENT:**

PAYMENT FOR SURFACE PREPARATION AND PAINTING SHALL BE INCLUDED FOR PAYMENT WITH ITEM 514.

PAYMENT SHALL INCLUDE FULL COMPENSATION FOR ALL MATERIAL, TOOLS, EQUIPMENT, LABOR, AND ACCESS NECESSARY TO COMPLETE THE REPAIRS. THE UNIT "EACH" REFERS TO A SINGLE HOLE IN A PLATE AT THE SPECIFIED LOCATION.

ANY LABOR AND/OR MATERIALS AND EQUIPMENT INCIDENTAL TO STEEL WORK NOT SPECIFICALLY PAID FOR UNDER ANY OTHER ITEM SHALL BE INCLUDED AND PAID FOR UNDER THE FOLLOWING CONTRACT ITEM (PAY ITEM):

> DESCRIPTION UNIT

STRUCTURAL STEEL, MISC.: GUSSET/COVER PLATE

**HOLE REPAIRS** 

ESIGN AGENCY

 $\vdash$ 

OTE

**ENERAL** 

**(** 

STRUCTURE

ESIGNER

GTF REVIEWER CAH 07/14/25

114515 10 52

ROJECT ID

ITEM 514 - SURFACE PREPARATION OF EXISTING STRUCTURAL STEEL, AS PER PLAN

ITEM 514 - FIELD PAINTING OF EXISTING STRUCTURAL STEEL, PRIME COAT, AS PER PLAN

ITEM 514 - FIELD PAINTING STRUCTURAL STEEL, INTERMEDIATE COAT, AS PER PLAN

ITEM 514 - FIELD PAINTING STRUCTURAL STEEL, FINISH COAT, AS PER **PLAN** 

THIS ITEM INCLUDES THE SURFACE PREPARATION AND COATING OF THE EXISTING STEEL MEMBERS TO REMAIN TO THE LIMITS DESCRIBED OR SHOWN IN THE PLANS. THIS WORK SHALL BEGIN AFTER THE REMOVALS UNDER ITEM 202 AND 513 ARE FINISHED AT A REPAIR LOCATION, AND BEFORE THE PLACEMENT OF THE NEW MEMBERS.

THE COLOR OF THE FINISH COAT FOR ALL STRUCTURAL STEEL IS TO MATCH THE EXISTING AND THE CONTRACTOR SHALL PROVIDE SAMPLES TO THE ENGINEER FOR APPROVAL PRIOR TO APPLICATION.

IN ADDITION TO THE AREAS SHOWN ON THE PLANS, A QUANTITY OF 500 SF HAS BEEN ADDED TO THE ESTIMATED QUANTITIES FOR PURPOSES OF ESTABLISHING A UNIT BID PRICE. THIS QUANTITY SHALL BE USED TO PAINT AREAS SUCH AS THE TRUSS CHORD MEMBERS, FLOORBEAM ENDS, LATERAL BRACING MEMBERS, ETC. AT THE DISCRETION OF THE ENGINEER.

THE REQUIREMENTS OF CMS 514 SHALL APPLY WITH THE FOLLOWING **ADDITIONS/MODIFICATIONS:** 

### 514.13.C - ABRASIVE BLASTING (QCP #3):

PORTIONS OF THE INSIDE OF THE TRUSS MEMBERS ARE IDENTIFIED AS BEING POSSIBLY INACCESSIBLE. THE CONTRACTOR SHALL MAKE A REASONABLE EFFORT TO CLEAN STEEL SURFACES IN THESE AREAS, AND IN ALL OTHER AREAS DETERMINED BY THE ENGINEER AS BEING INACCESSIBLE, ACCORDING TO SSPC-SP 6 (COMMERCIAL BLAST CLEANING) AND AS SHOWN ON THE PICTORIAL SURFACE PREPARATION STANDARDS FOR PAINTING STEEL SURFACES IN SSPC-VIS 1.

ALL OTHER ACCESSIBLE STEEL SURFACES SHALL BE BLASTED TO SSPC-SP 10 AS PER CMS 514.13.C.

IN ADDITION, THIS WORK WILL INCLUDE THE REPAIR OF PACK-RUSTED AREAS OF THE EXISTING STEEL AS DIRECTED BY THE ENGINEER. PACK RUSTED AREAS ARE DEFINED AS THOSE LOCATIONS WHERE IMPACTED RUST HAS PRODUCED A GAP BETWEEN ADJACENT STEEL PLATES MORE THAN ¼". PACK RUST SHALL BE REMOVED FROM THE JOINTS RUSTED APART MORE THAN 1/4" BY CHIPPING, HAMMERING, PUNCHING, CHISELING OR BY OTHER SUITABLE MEANS, TO A DEPTH OF AT LEAST EQUAL TO THE WIDTH OF THE GAP. ALL JOINTS SHALL THEN BE VACUUMED WITH A COMMERCIAL VACUUM CLEANER HAVING A NOZZLE OPENING OF 1" TO 1½" OR AIR BLOWN SUCH THAT ALL DUST AND DEBRIS ARE REMOVED TO THE SATISFACTION OF THE ENGINEER.

### 514.13.D - CONTAINMENT/WASTE DISPOSAL (QCP#4):

THE CONTRACTOR SHALL INSTALL AND MAINTAIN CONTAINMENT SYSTEMS SURROUNDING THE WORK FOR THE PURPOSE OF CONTROLLING EMISSIONS OF DUST AND DEBRIS IN ACCORDANCE WITH THE REQUIREMENTS OF CMS 514. WORKING PLATFORMS AND CONTAINMENT MATERIALS THAT ARE USED SHALL BE FIRM AND STABLE, AND PLATFORMS SHALL BE DESIGNED TO SUPPORT THE WORKERS, INSPECTORS, SPENT SURFACE PREPARATION MEDIA (E.G. ABRASIVES) AND EQUIPMENT DURING ALL PHASES OF SURFACE PREPARATION AND PAINTING. PLATFORMS, CABLES AND OTHER SUPPORTING STRUCTURES SHALL BE DESIGNED IN ACCORDANCE WITH THE APPLICABLE REQUIREMENTS OF THE OHIO INDUSTRIAL COMMISSION AND OSHA. INSPECTION ACCESS SHALL BE IN ACCORDANCE WITH THE REQUIREMENTS OF CMS 514.10.

ITEM 514 - SURFACE PREPARATION OF EXISTING STRUCTURAL STEEL, AS PER PLAN (CONTINUED)

ITEM 514 - FIELD PAINTING OF EXISTING STRUCTURAL STEEL, PRIME COAT, AS PER PLAN (CONTINUED)

ITEM 514 - FIELD PAINTING STRUCTURAL STEEL, INTERMEDIATE COAT, AS PER PLAN (CONTINUED)

ITEM 514 - FIELD PAINTING STRUCTURAL STEEL, FINISH COAT, AS PER PLAN (CONTINUED)

IF THE CONTAINMENT IS PROPOSED TO BE ATTACHED TO THE STRUCTURE, THE CONTAINMENT SHALL BE ATTACHED BY BOLTING, CLAMPING OR SIMILAR MEANS. WELDING ONTO OR DRILLING INTO THE STRUCTURE IS PROHIBITED. THE CONTRACTOR SHALL PROVIDE DRAWINGS SHOWING THE CONTAINMENT SYSTEM AND INDICATING THE METHOD(S) OF SUPPORTING THE WORKING PLATFORMS AND CONTAINMENT MATERIALS.

IN THE EVENT OF SUSTAINED WINDS OF 40 MPH OR GREATER, THE CONTAINMENT SHALL BE DROPPED AND ALL MATERIALS AND EQUIPMENT SHALL BE SECURED TO AVOID OVERSTRESSING AND/OR DAMAGING THE BRIDGE STRUCTURE.

THE CONTRACTOR SHALL SUBMIT CALCULATIONS AND DRAWINGS SIGNED, SEALED, AND DATED BY AN OHIO REGISTERED PROFESSIONAL ENGINEER IN THE EMPLOY OF THE CONTRACTOR, ASSURING THE STRUCTURAL INTEGRITY OF THE BRIDGE UNDER LIVE AND DEAD LOADS IMPOSED, INCLUDING THE DESIGN WIND LOADING. DESIGN SHALL BE IN ACCORDANCE WITH APPLICABLE PROVISIONS OF THE MOST CURRENT VERSION OF AASHTO'S "STANDARD SPECIFICATIONS FOR HIGHWAY BRIDGES" AND ODOT'S BRIDGE DESIGN MANUAL. THE CONTAINMENT SUBMITTAL SHALL INCLUDE CALCULATIONS THAT ASSURE STRUCTURAL INTEGRITY OF THE BRIDGE WHEN IT SUPPORTS THE CONTAINMENT.

THE CONTRACTOR IS NOTIFIED THAT THE EXISTING PAINT SYSTEM MAY CONTAIN LEAD, AND CMS 514.13.D.1 MAY APPLY.

### 514.17 COATING APPLICATION:

IN ADDITION TO THE REQUIREMENTS OF CMS 514, A STRIPE COATING OF THE PRIME COAT SHALL BE APPLIED TO ALL WELDS. CREVICES. RIVET HEADS, NUTS, BOLT HEADS, BOLT THREADS AND OTHER SURFACE IRREGULARITIES. ALSO, THE AREAS SPECIFIED UNDER THIS CONTRACT FOR SURFACE PREPARATION PER SSPC-SP 2 (HAND TOOL CLEANING), SSPC-SP 3 (POWER TOOL CLEANING) OR SSPC-SP 11 (POWER TOOL CLEANING TO BARE METAL) SHALL HAVE THE EDGES OF THE PREPARED AREAS STRIPE COATED WITH THE PRIME COAT. THE STRIPE COATING SHALL BE APPLIED TO THE SPECIFIED SURFACES BEFORE THE APPLICATION OF THE FULL PRIME COAT OVER THE SAME AREAS AND ADJACENT PREPARED SURFACES. STRIPING SHALL EXTEND A MINIMUM OF 1" FROM THE EDGES REQUIRING STRIPE COATING. THE STRIPE COATING SHALL SET TO TOUCH BEFORE APPLICATION OF THE FULL PRIME COAT OVER THE SAME AREA; HOWEVER, THE STRIPE COATING SHALL NOT BE PERMITTED TO DRY FOR A PERIOD LONG ENOUGH TO ALLOW RUSTING OF THE ADJACENT UNPRIMED STEEL SURFACES BEFORE THE FULL PRIME COAT CAN BE APPLIED TO THE AREA.

THE CONTRACTOR SHALL THOROUGHLY COAT ALL SURFACES RECEIVING A STRIPE COATING, PAYING PARTICULAR ATTENTION TO HARD-TO-REACH AREAS AND IRREGULAR SURFACES, SUCH AS LACING BARS, BOLT HEADS, LAP SPLICES, GUSSET PLATES, PINS, ETC. WHEN STRIPE COATING MULTI-PLANED SURFACE CONFIGURATIONS, SUCH AS ON NUTS AND BOLT THREADS, THE CONTRACTOR SHALL APPLY THE STRIPE COATING FROM MULTIPLE DIRECTIONS TO ENSURE COMPLETE COVERAGE OF ALL SURFACES, CREVICES, CORNERS AND SHARP EDGES.

ITEM 514 - SURFACE PREPARATION OF EXISTING STRUCTURAL STEEL. AS PER PLAN (CONTINUED)

ITEM 514 - FIELD PAINTING OF EXISTING STRUCTURAL STEEL, PRIME COAT, AS PER PLAN (CONTINUED)

ITEM 514 - FIELD PAINTING STRUCTURAL STEEL, INTERMEDIATE COAT, AS PER PLAN (CONTINUED)

ITEM 514 - FIELD PAINTING STRUCTURAL STEEL, FINISH COAT, AS PER PLAN (CONTINUED)

### DEVCON PLASTIC PUTTY OR DIAMANT MM1018P

PRIOR TO THE PRIMER COAT HAS BEEN APPLIED. THE CONTRACTOR SHALL FILL ALL GAPS OR CREVICES GREATER THAN 1/8" REMOVED BY ABRASIVE BLASTING WITH DEVCON PLASTIC PUTTY OR DIAMANT MM1018P IN LIEU OF CAULKING PER CMS 514.19. THE STEEL SURFACE SHALL BE FREE OF CONTAMINANTS WHEN THE DEVCON PLASTIC PUTTY OR DIAMANT MM1018P IS APPLIED.

THE DEVCON PLASTIC PUTTY OR DIAMANT MM1018P SHALL BE APPLIED EVENLY TO THE JOINTS AND GAPS. VOIDS SHALL BE COMPLETELY FILLED ,BE APPLIED BY TROWEL OR CAULKING GUN AND SPREAD SMOOTHLY USING HEAVY PRESSURE TO DISPLACE AIR BUBBLES. EXCESS MATERIAL SHALL BE REMOVED IMMEDIATELY. ALL PROCEDURES SHALL CONFORM TO THE REQUIREMENTS OF THE MANUFACTURER'S WRITTEN SPECIFICATIONS AND TO THE SATISFACTION OF THE ENGINEER.

### **MEASUREMENT AND PAYMENT:**

THE ACCEPTED QUANTITIES FOR THE COMPLETED WORK AS DESCRIBED WILL BE MEASURED AND PAID FOR USING THE FOLLOWING CONTRACT ITEMS (PAY ITEMS):

ITEM (	UNIT )	
514	LS	
514	LS	
514	E LS	
	UU	

**DESCRIPTION** SURFACE PREPARATION OF EXISTING STRUCTURAL STEEL, AS PER PLAN FIELD PAINTING OF EXISTING STRUCTURAL STEEL,

PRIME COAT, AS PER PLAN FIELD PAINTING STRUCTURAL STEEL, INTERMEDIATE COAT, AS PER PLAN FIELD PAINTING STRUCTURAL STEEL. FINISH COAT, AS PER PLAN

### ITEM 519, PATCHING CONCRETE STRUCTURES, AS PER PLAN

THE QUANTITY GIVEN IN THE ESTIMATE QUANTITY TABLE HAS BEEN ESTIMATED FROM FIELD INSPECTION AND ORIGINAL PLANS. IT IS POSSIBLE THAT ADDITIONAL AREAS REQUIRING PATCHING MAY HAVE DEVELOPED SINCE THE MOST RECENT INSPECTION OF THE STURCUTRE. THEREFORE, THE CONTRACTOR SHALL SOUND THE SURROUNDING PERIMETER OF THE AREA TO BE PATCHED AND PATCH NEW AREAS APPROVED BY THE ENGINEER THAT HAVE NOT BEEN DETAILED IN THE PLANS. PAYMENT SHALL BE MADE PER SQ. FT. AT THE PRICE BID FOR THE ACTUAL AREA PATCHED AND SHALL INCLUDE ALL COST FOR LABOR. MATERIALS AND EQUIPMENT.

 $\sim$ 

PRIOR TO THE SURFACE CLEANING SPECIFIED IN C&MS 519.04 AND WITHIN 24 HOURS OF PLACING PATCHING MATERIAL, BLAST CLEAN ALL SURFACES TO BE PATCHED INCLUDING THE EXPOSED STEEL REINFORCEMENT. ACCEPTABLE METHODS INCLUDE HIGH-PRESSURE WATER BLASTING WITH OR WITHOUT ABRASIVES IN THE WATER, ABRASIVE BLASTING WITH CONTAINMENT, OR VACUUM ABRASIVE BLASTING.

REMOVE THE FORMS WITHIN 24 HOURS AFTER PLACING CONCRETE AND FINISH ALL EXPOSED SURFACES BY RUBBING TO MATCH THE SURROUNDING SURFACE. APPLY MEMBRANE CURING ACCORDING TO C&MS 511.14, METHOD B, IMMEDIATELY AFTER RUBBING THE SURFACES.

ITEM 517 - RAILING, MISC.: 3.5" O.D. ALUMINUM TUBE WITH ANCHOR ITEM 517 - RAILING, MISC.: 4.5" O.D. ALUMINUM TUBE WITH ANCHOR

### **DESCRIPTION:**

THIS WORK CONSISTS OF REMOVAL AND REPLACEMENT OF THE EXISTING ALUMINUM TUBE RAILING IN THE LOCATIONS AS DIRECTED BY THE ENGINEER. THE PROVISIONS OF ITEM 202 SHALL APPLY EXCEPT AS SPECIFIED BY THE FOLLOWING NOTES. PERFORM WORK CAREFULLY DURING REMOVAL TO PROTECT PORTIONS OF THE BRIDGE RAILING TO BE SALVAGED AND INCORPORATED INTO THE NEW STRUCTURE.

NO HAZARD SHALL BE LEFT UNPROTECTED EXCEPT FOR THE ACTUAL TIME NECESSARY TO REMOVE THE EXISTING RAIL AND INSTALL THE NEW RAIL IN A CONTINUOUS OPERATION. NO RAIL SHALL BE REMOVED UNTIL THE REPLACEMENT MATERIAL IS ON SITE AND READY FOR INSTALLATION. FAILURE TO COMPLY WITH THIS REQUIREMENT SHALL BE DEEMED SUFFICIENT CAUSE TO ORDER WORK SUSPENDED UNTIL SUCH TIME AS THE ENGINEER IS ASSURED OF COMPLIANCE.

THE CONTRACTOR SHALL TAKE PRECAUTIONS NOT TO DAMAGE THE EXISTING GALVANIZED COATING ON THE PORTIONS TO REMAIN. THE CONTRACTOR SHALL REPAIR ANY DAMAGED TO THE GALVANIZED COATING PER CMS 711.02 AND TO THE ENGINEER'S SATISFACTION. THIS SHALL BE CONSIDERED INCIDENTAL TO THIS PAYMENT ITEM.

THE CONTRACTOR SHALL MAINTAIN AT LEAST ONE THROUGH LANE IN EACH DIRECTION OF TRAFFIC AT THE WORK OPERATION AREA AT ALL TIMES. FOR ADDITIONAL INFORMATION REGARDING THE MAINTENANCE OF TRAFFIC, REFER TO ITEM 614 ON SHEET 3.

### **MEASUREMENT AND PAYMENT:**

THE ACCEPTED QUANTITIES FOR THE COMPLETED WORK AS DESCRIBED WILL BE PAID FOR USING THE FOLLOWING CONTRACT ITEM (PAY ITEM):

### ITEM UNIT DESCRIPTION

517 FT ITEM 517 - RAILING, MISC.: 3.5" O.D. ALUMINUM TUBE WITH ANCHOR 517 FT ITEM 517 - RAILING, MISC.: 4.5" O.D. ALUMINUM TUBE WITH ANCHOR

### **ABBREVIATIONS:**

MIN. - MINIMUM

N.F. - NEAR FACE

NO./# - NUMBER

MISC. - MISCELLANEOUS

**MOT - MAINTENANCE OF TRAFFIC** 

N.P.C.P.P. - NON-PERFORATED

CORRUGATED

PLASTIC PIPE

THE FOLLOWING ABBREVIATIONS HAVE BEEN USED THROUGHOUT THESE PLANS TO INDICATE THE DESIGNATIONS CONTAINED IN THE LEGEND BELOW:

ABUT. - ABUTMENT O/O - OUT TO OUT APPR. - APPROACH P.C.P.P - PERFORATED CORRUGATED BTM. - BOTTOM PLASTIC PIPE BRG. - BEARING P.E.J.F. - PREFORMED EXPANSION BRGS. - BEARINGS JOINT FILLER PG - PROFILE GRADE - CENTERLINE PGL - PROFILE GRADE LINE C/C - CENTER TO CENTER CIP - CAST-IN-PLACE PROP. - PROPOSED PT - POINT OF TANGENCY C.J. - CONSTRUCTION JOINT PVC - POINT OF VERTICAL CURVATURE CLR. - CLEARANCE PVI - POINT OF VERTICAL INTERSECTION CMS - CONSTRUCTION AND MATERIAL SPECIFICATIONS PVT - POINT OF VERTICAL TANGENCY CONC. - CONCRETE R. - RADIUS CONSTR. - CONSTRUCTION R.A. - REAR ABUTMENT CONTR. - CONTRACTION RF - RIGHT FORWARD CU YD - CUBIC YARD RT. - RIGHT DIA. - DIAMETER R/W - RIGHT OF WAY E.F. - EACH FACE SAN. - SANITARY ELEV., EL. - ELEVATION SER. - SERIES EQ. - EQUAL SHT. - SHEET EX. - EXISTING S.O. - SERIES OF EXP. - EXPANSION SPA. - SPACES OR SPACING F.A. - FORWARD ABUTMENT SR - STATE ROUTE STA. - STATION F.F. - FAR FACE STD. - STANDARD F.S. - FIELD SPLICE STM. - STORM FT/FT - FOOT PER FOOT FTG. - FOOTING STR. - STRAIGHT FWD. - FORWARD TBM - TEMPORARY BENCH MARK GALV. = GALVANIZED TEMP. - TEMPORARY GEN. - GENERAL T.O.S. - TOE OF SLOPE LF - LEFT FORWARD T/PARAPET - TOE OF PARAPET T/T - TOE TO TOE LT. - LEFT TYP. - TYPICAL MAX. - MAXIMUM

U.G. - UNDERGROUND

VC - VERTICAL CURVE

VAR. - VARIES

VERT. - VERTICAL

W/O - WITHOUT

ESIGN AGENCY

2

OTE

**ENERAL** 

**5** 

STRUCTURE

ESIGNER GTF

REVIEWER CAH 07/14/25 ROJECT ID

114515 **1·1** 52

HAM US 50 3.76/19.03	MODEL: Sheet_SurvFt PAPERSIZE: 34x22 (in.) DALE: 11/6/2025 TIME: 3:24:45 PM PLIDRV: OHDOT_
----------------------	--------------------------------------------------------------------------------------------

			ESTIMATED QUANTITIES - STRUCTURE No.: HAM-50-0376L (SFN: 3102521) (01/NHS FUNDING SPLIT)				
ITEM	EXTENSION	TOTAL UNIT	DESCRIPTION	ABUT.	PIERS SUPER.	GEN.	SHEET
512	10600	123 FT	CONCRETE REPAIR BY EPOXY INJECTION		123		
512	73500	3139 SY	TREATING CONCRETE BRIDGE DECKS WITH GRAVITY FED RESIN		3139		
513	95030	32 EACH	STRUCTURAL STEEL, MISC.: LACING BAR REPAIRS		32		10
513	95030	66 EACH	STRUCTURAL STEEL, MISC.: RIVET REPLACEMENT		66		10
513	95030	2 EACH	STRUCTURAL STEEL, MISC.: BEARING ANCHOR BOLT		2		10
513	95030	2 EACH	STRUCTURAL STEEL, MISC.: GUSSET/COVER PLATE HOLE REPAIRS		2		10
514	00101	<u>Eccents</u>	SURFACE PREPARATION OF EXISTING STRUCTURAL STEEL, AS PER PLAN	****	LUMP	~~~	777
514	00201		FIELD PAINTING OF EXISTING STRUCTURAL STEEL, PRIME COAT, AS PER PLAN		LUMP		11
514	00301	LS LS	FIELD PAINTING STRUCTURAL STEEL, INTERMEDIATE COAT, AS PER PLAN		LUMP		11
514	00401	LS LS	FIELD PAINTING STRUCTURAL STEEL, FINISH COAT, AS PER PLAN		LUMP		11
514	00504	400 MNHR	GRINDING FINS, TEARS, SLIVERS ON EXISTING STRUCTURAL STEEL		400		
514	10000	86 EACH	FINAL INSPECTION REPAIR		86		
519	11101	2592 SF	PATCHING CONCRETE STRUCTURE, AS PER PLAN PATCHING CONCRETE BRIDGE DECK - TYPE C	604	1,988		1:
519	12304	1 SY	PATCHING CONCRETE BRIDGE DECK - TYPE C		1		
644	00104	0.32 MILE	EDGE LINE, 6"			0.32	2
644	00204	0.16 MILE	LANE LINE, 6"			0.16	5
844	20000	3216 EACH	GÁLVANIC ÁNODE PROTECTIÓN	718	2498	~~~~	
		,		كنك			Luci de la constante de la con


			ESTIMATED QUANTITIES - STRUCTURE No.: HAM-50-0376R (SFN: 3102548) (02/NHS FUNDING SPLIT)		
ΓΕΜ Ε)	XTENSION	TOTAL UNIT	DESCRIPTION ABUT. PIERS	SUPER. GEN.	SHEET
511	34410	CY CY	CLASS QC2 CONCRETE, SUPERSTRUCTURE	3	
512	73500	2983 SY	TREATING CONCRETE BRIDGE DECKS WITH GRAVITY FED RESIN	2983	
514	00050	4157 SF	SURFACE PREPARATION OF EXISTING STRUCTURAL STEEL	4,157	
514	00056	4157 SF	FIELD PAINTING OF EXISTING STRUCTURAL STEEL, PRIME COAT	4,157	
514	00060	4157 SF	FIELD PAINTING STRUCTURAL STEEL, INTERMEDIATE COAT	4,157	
514	00066	4157 SF	FIELD PAINTING STRUCTURAL STEEL, FINISH COAT	4,157	
514	00504	3 MNHR	GRINDING FINS, TEARS, SLIVERS ON EXISTING STRUCTURAL STEEL	3	
514	10000	5 EACH	FINAL INSPECTION REPAIR	5	
517	76302	29 FT	RAILING, MISC.: 3.5" O.D. ALUMINUM TUBE WITH ANCHOR	29	~~
517	76302	897 FT	RAILING, MISC.: 4.5" O.D. ALUMINUM TUBE WITH ANCHOR	897	
519	11101	96 SF	PATCHING CONCRETE STRUCTURE, AS PER PLAN	96	
519	12304	25 SY	PATCHING CONCRETE BRIDGE DECK - TYPE C	25	
644	00104	0.32 MILE	EDGE LINE, 6"	0.32	
644	00204	0.16 MILE	LANE LINE, 6"	0.16	

ГЕМ	<b>EXTENSION</b>	TOTAL UNIT	DESCRIPTION	ABUT. F	PIERS	SUPER.	GEN.	SHEET
512	10100	6149 SY	SEALING OF CONCRETE SURFACES (EPOXY-URETHANE)	189	2,019	3,941		
512	74000	6149 SY	REMOVAL OF EXISTING COATINGS FROM CONCRETE SURFACES	189	2,019	3,941		
514	1 00050	137916 SF	SURFACE PREPARATION OF EXISTING STRUCTURAL STEEL		2,839	135,077		
514	00056	137916 SF	FIELD PAINTING OF EXISTING STRUCTURAL STEEL, PRIME COAT		2,839	135,077		
514	00060	137916 SF	FIELD PAINTING STRUCTURAL STEEL, INTERMEDIATE COAT		2,839	135,077		
514	00066	137916 SF	FIELD PAINTING STRUCTURAL STEEL, FINISH COAT		2,839	135,077		
514	1 00504	118 MNHR	GRINDING FINS, TEARS, SLIVERS ON EXISTING STRUCTURAL STEEL		3	115		
514	10000	27 EACH	FINAL INSPECTION REPAIR		2	25		
519		467 SF	PATCHING CONCRETE STRUCTURE, AS PER PLAN			467		
844	20000	1145 EACH	GALVANIC ANODE PROTECTION	116	1029	$\gamma\gamma\gamma\gamma$		


DESIGN AGENCY




DESIGNER GTF REVIEWER CAH 7-14-25 PROJECT ID 114515

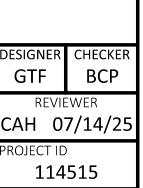

CAH 07/14/2!

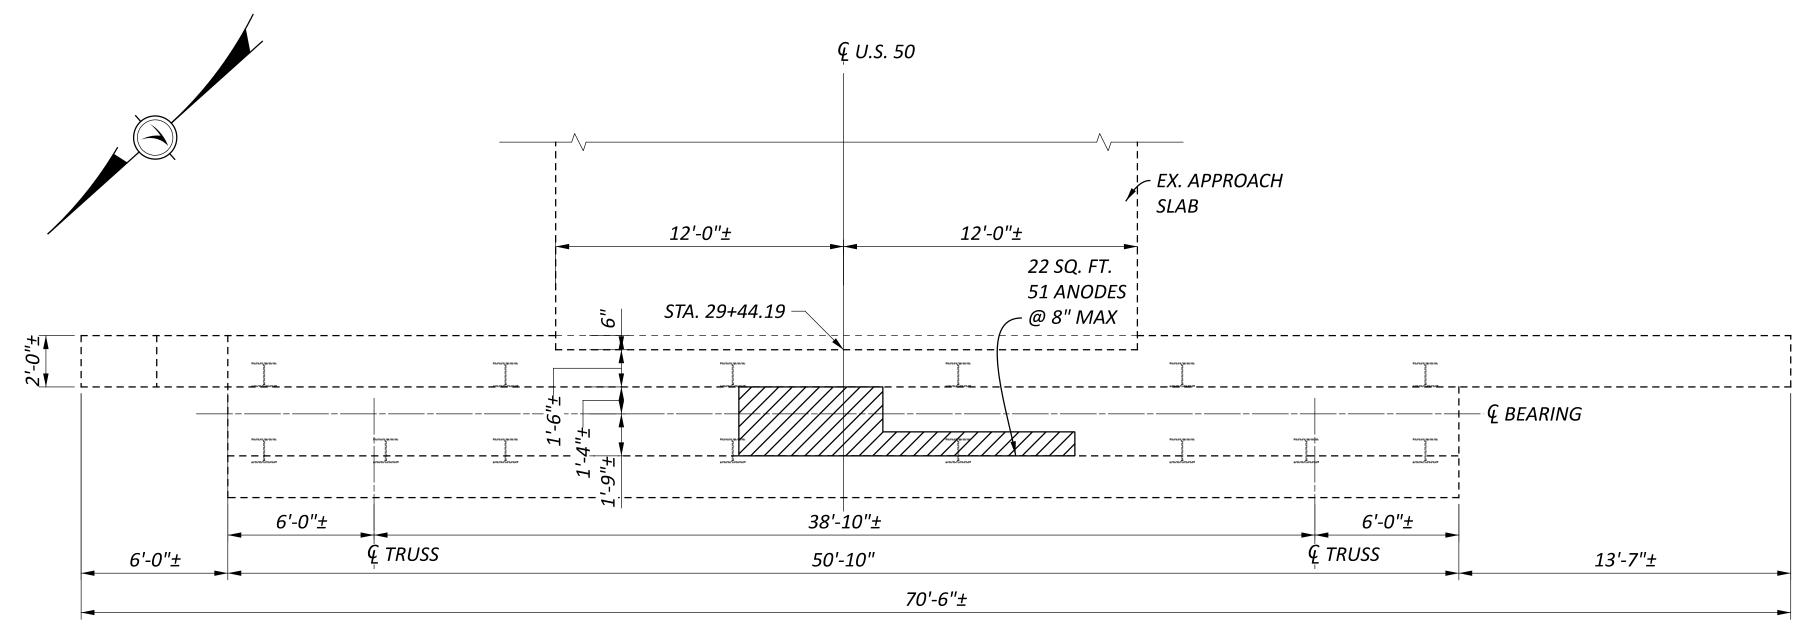

### **FORWARD ABUTMENT PLAN**

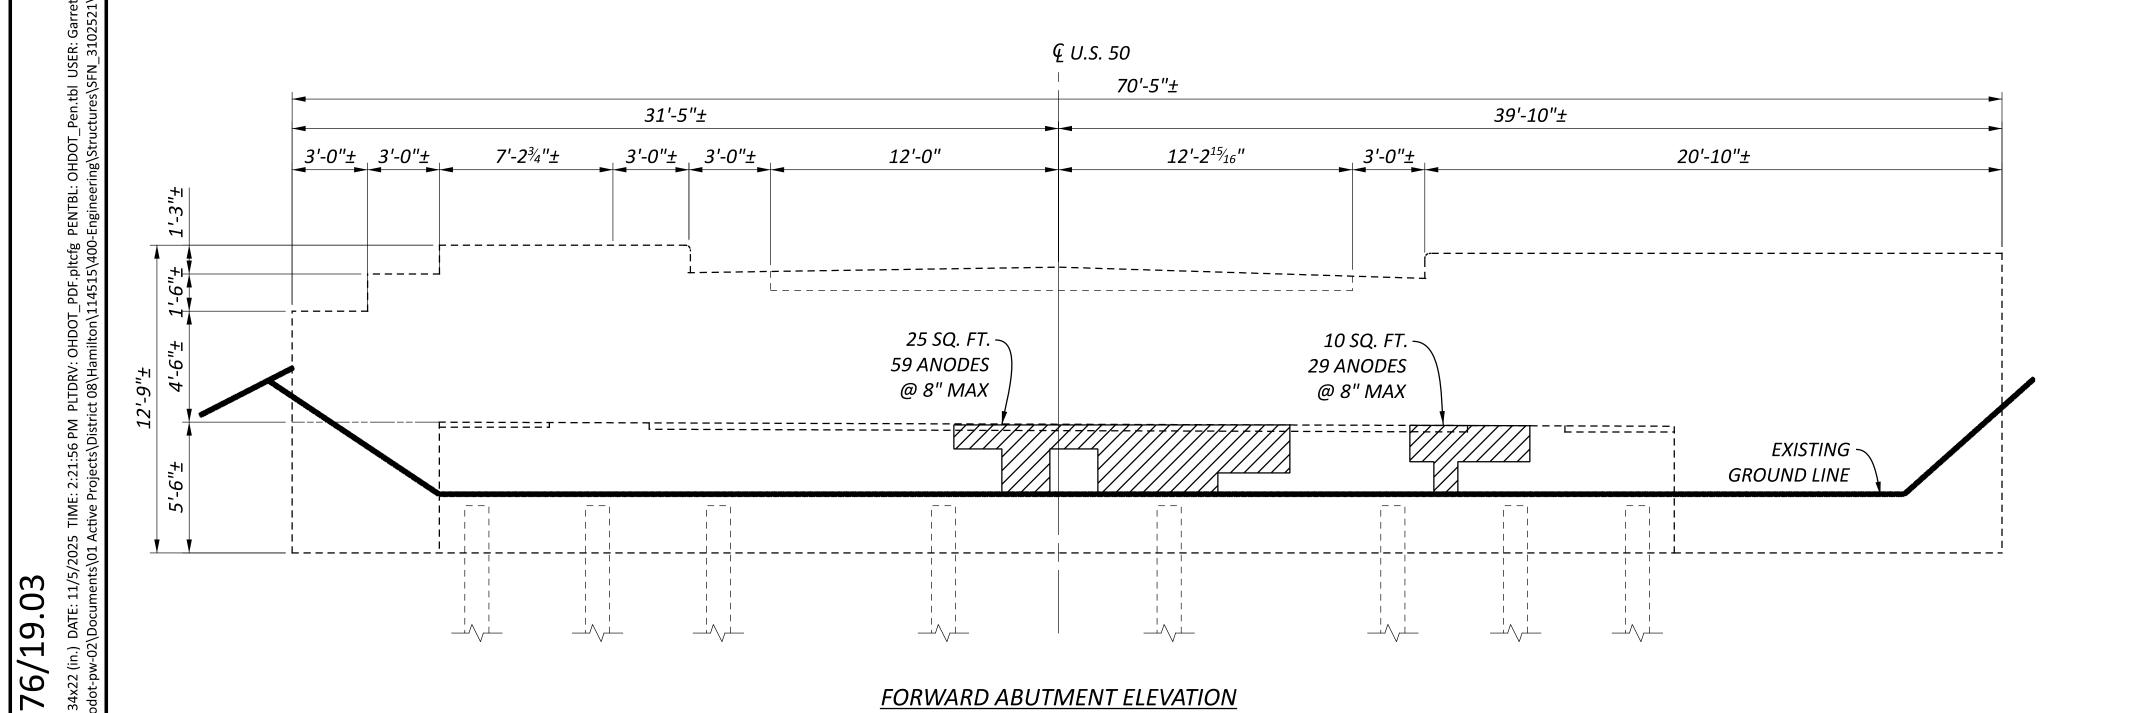

**FORWARD ABUTMENT ELEVATION** 

50

# SUMMARY OF REPAIR AREAS

PHYSICAL INVENTORY OF MEASURED QUANTITIES OF DETERIORATION WAS PERFORMED IN AUGUST OF 2023. EXACT DIMENSIONS AND LOCATIONS OF REPAIRS SHALL BE DETERMINED BY THE ENGINEER IN THE FIELD FOR FINAL PAY QUANTITIES.

TYPE	MEASURED QUANTITIES	ESTIMATING FACTOR*	ESTIMATEL QUANTITIE
FWD. ABUT. PATCHING	57 SQ. FT.	1.5	86 SQ. FT.
FWD. ABUT. ANODES	139	1.5	209

\* - ESTIMATED QUANTITIES HAVE BEEN INCREASED BY 50% OVER MEASURED QUANTITIES TO ALLOW FOR ADDITIONAL DETERIORATION.

### <u>LEGEND</u>

- AREA TO BE REPAIRED WITH ITEM 519 -PATCHING CONCRETE STRUCTURE, AS PER PLAN

### **NOTES**

1. ALL DIMENSIONS ARE ±.

- 2. ALL ESTIMATED AREAS ARE GIVEN AS WIDTH x HEIGHT.
- 3. REPAIR CONCRETE SHALL BE HYDRAULIC CEMENT-BASED MATERIAL WITH A ELECTRICAL RESISTIVITY LESS THAN 50,000 OHM-CM ACCORDING TO ASTM C 1760. DO NOT USE NON- CONDUCTIVE REPAIR MATERIALS SUCH AS MAGNESIUM AMMONIUM PHOSPHATE CONCRETE AND EPOXY MORTARS OR BONDING AGENTS. CONCRETE MIXES CONTAINING HIGH LEVELS OF SUPPLEMENTARY CEMENTITIOUS MATERIALS SUCH AS SILICA FUME, GROUND-GRANULATED BLAST FURNACE SLAG, LATEX, FLY ASH OR METAKAOLIN MAY NOT MEET THE RESISTIVITY REQUIREMENT THE GALVANIC ANODE SIZE AND SPACING IS BASED ON ACHIEVING A CURRENT DENSITY FOR THE EXTREMELY · HIGH CORROSION RISK CATEGORY WITH A 30 YEAR INSTALLATION. SUPPLY ANODES WITH A MINIMUM CORE OF 210 GRAMS OF ZINC. SEE THIS SHEET FOR DISTRIBUTION.

PHYSICAL INVENTORY OF MEASURED QUANTITIES OF DETERIORATION WAS PERFORMED IN AUGUST OF 2023.

MEASURED QUANTITIES	ESTIMATING FACTOR*	ESTIMATED QUANTITIES
345 SQ. FT.	1.5	518 SQ. FT.
339	1.5	509
1	QUANTITIES  345 SQ. FT.	QUANTITIES FACTOR*  345 SQ. FT. 1.5

\* - ESTIMATED QUANTITIES HAVE BEEN INCREASED BY 50% OVER MEASURED QUANTITIES TO ALLOW FOR ADDITIONAL

- 3. REPAIR CONCRETE SHALL BE HYDRAULIC CEMENT-BASED MATERIAL WITH A ELECTRICAL RESISTIVITY LESS THAN 50,000 OHM-CM ACCORDING TO ASTM C 1760. DO NOT USE NON- CONDUCTIVE REPAIR MATERIALS SUCH AS MAGNESIUM AMMONIUM PHOSPHATE CONCRETE AND EPOXY MORTARS OR BONDING AGENTS. CONCRETE MIXES CONTAINING HIGH LEVELS OF SUPPLEMENTARY CEMENTITIOUS MATERIALS SUCH AS SILICA FUME, GROUND-GRANULATED BLAST FURNACE SLAG, LATEX, FLY ASH OR METAKAQLIN MAY NOT MEET THE RESISTIVITY REQUIREMENT. THE GALVANIC ANODE SIZE AND SPACING IS BASED ON ACHIEVING A CURRENT DENSITY FOR THE EXTREMELY  $\succ$  HIGH CORROSION RISK CATEGORY WITH A 30 YEAR INSTALLATION.

3102521

DETAIL

**FORWARD** 

GREAT

OVER


50

WESTBOUND

9280-



CAH 07/14/2! 114515

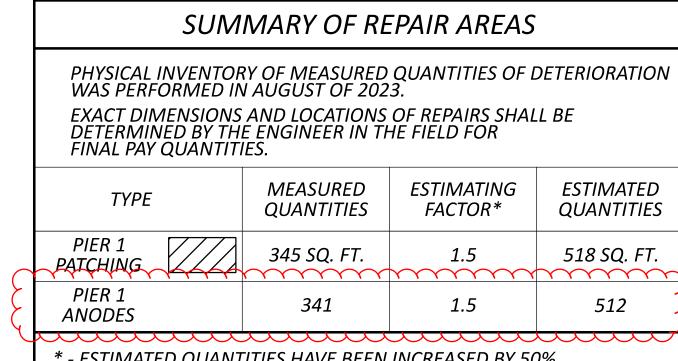


\* - ESTIMATED QUANTITIES HAVE BEEN INCREASED BY 50% OVER MEASURED QUANTITIES TO ALLOW FOR ADDITIONAL DETERIORATION.

### **LEGEND**

- AREA TO BE REPAIRED WITH ITEM 519 -PATCHING CONCRETE STRUCTURE, AS PER PLAN

### **NOTES**

- 1. ALL DIMENSIONS ARE ±.
- 2. ALL ESTIMATED AREAS ARE GIVEN AS WIDTH x HEIGHT.
- WITH A ELECTRICAL RESISTIVITY LESS THAN 50,000 OHM-CM ACCORDING TO ASTM C 1760. DO NOT USE NON- CONDUCTIVE REPAIR MATERIALS SUCH AS MAGNESIUM AMMONIUM PHOSPHATE CONCRETE AND EPOXY MORTARS OR BONDING AGENTS. CONCRETE MIXES CONTAINING HIGH LEVELS OF SUPPLEMENTARY CEMENTITIOUS MATERIALS SUCH AS SILICA FUME, GROUND-GRANULATED BLAST FURNACE SLAG, LATEX, FLY ASH OR METAKAOLIN MAY NOT MEET THE RESISTIVITY REQUIREMENT. THE GALVANIC ANODE SIZE AND SPACING IS BASED ON ACHIEVING A CURRENT DENSITY FOR THE EXTREMELY HIGH CORROSION RISK CATEGORY WITH A 30 YEAR INSTALLATION. SUPPLY ANODES WITH A MINIMUM CORE OF 210 GRAMS OF ZINC. SEE THIS SHEET FOR DISTRIBUTION.

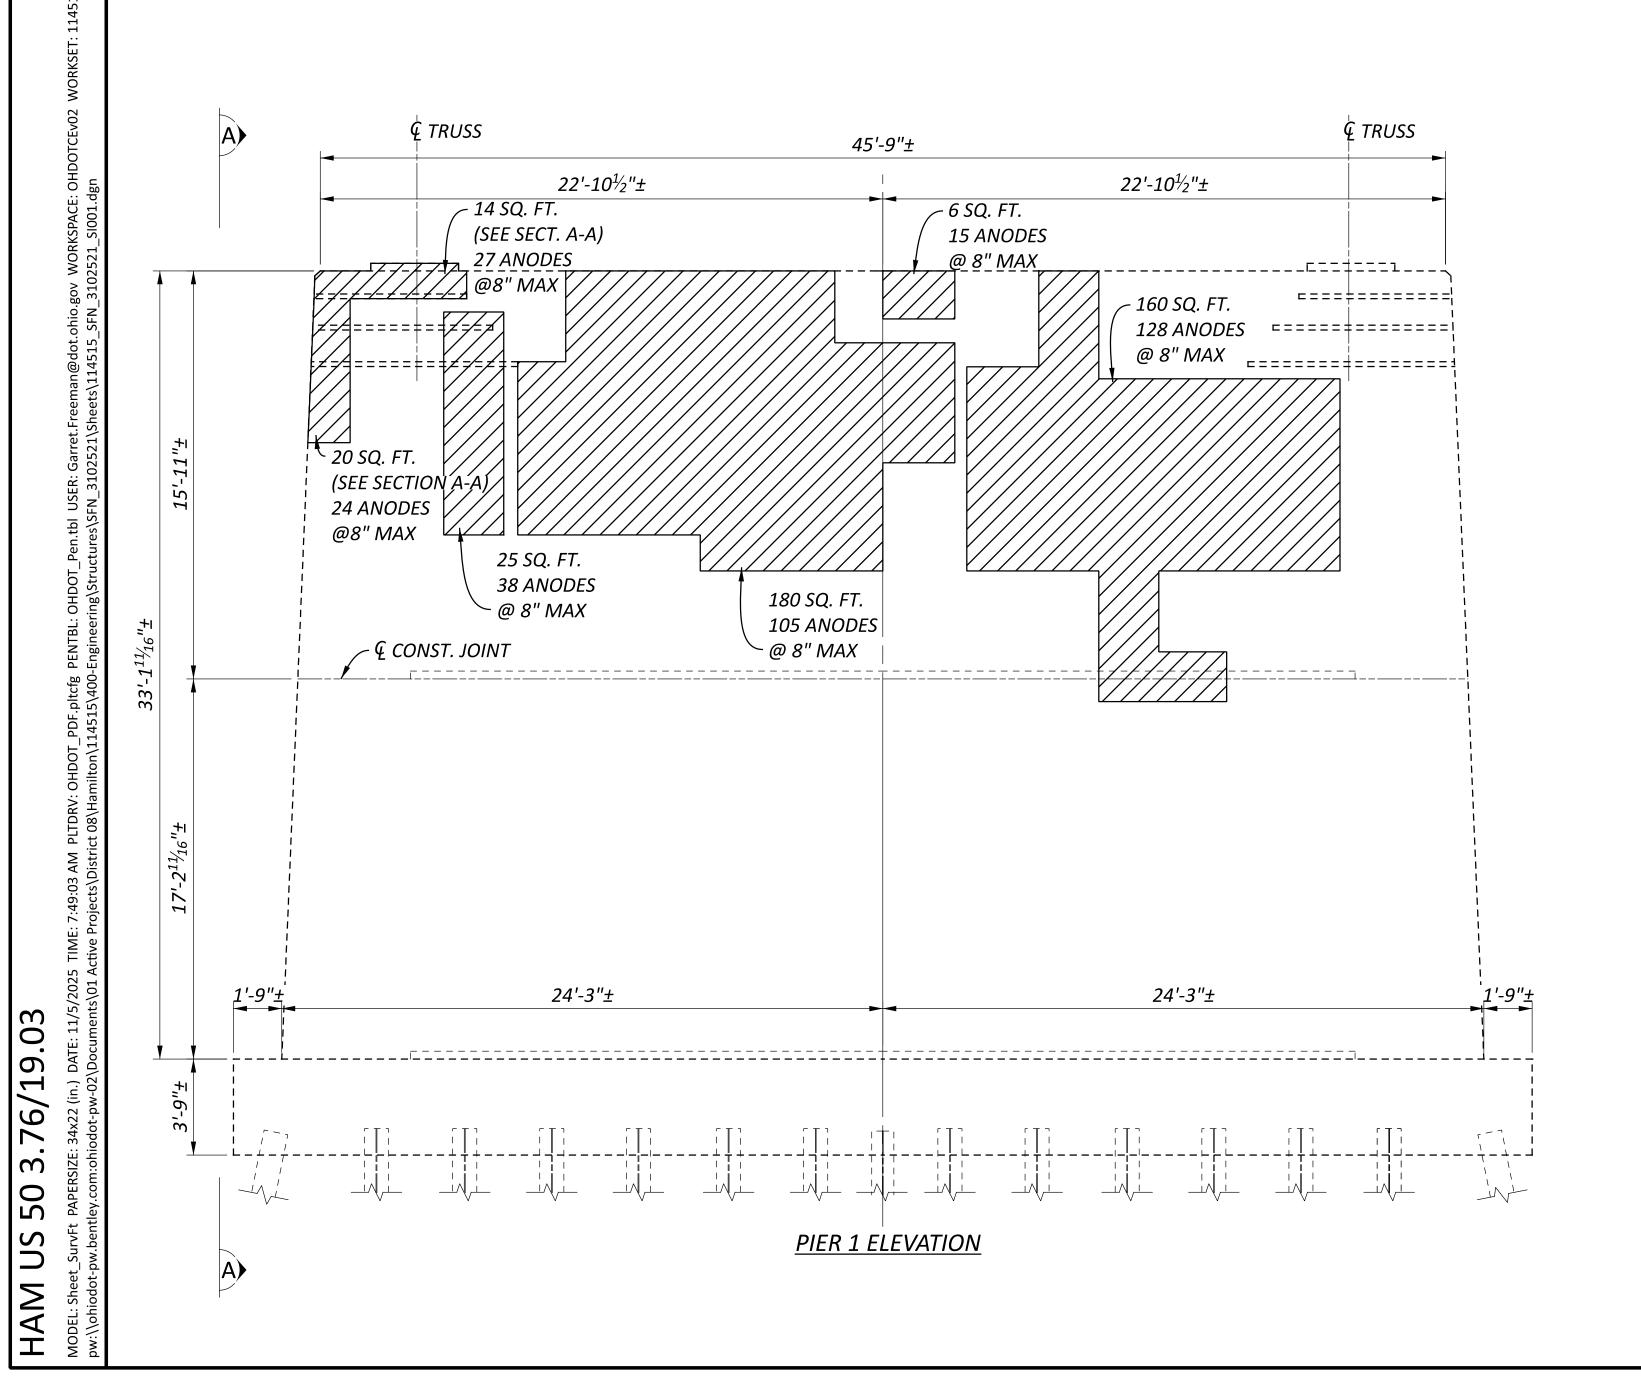

€ U.S. 50

PIER 1 PLAN

19'-5"±

₹ BRG.

19'-5"±

TRUSS

 $1'-4\frac{1}{2}"\pm$ 

14 SQ. FT.

(SEE ELEVATION)


3'-5<sup>1</sup>/<sub>2</sub>"±

₹ TRUSS

1'-4<sup>1</sup>/<sub>2</sub>"±

4 PIER 1

STA. 22+43.78±

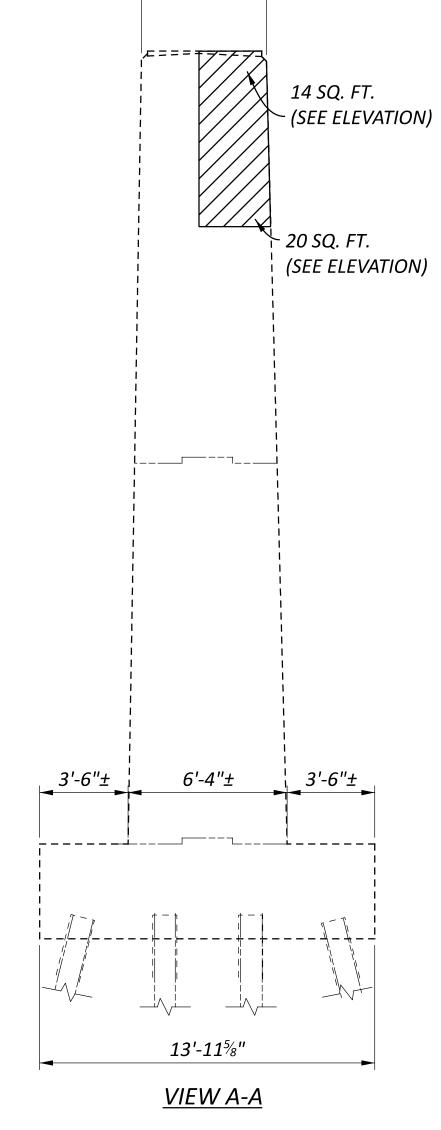


5'-0"±

3102521 ESIGN AGENCY



	_
DESIGNER	CHECKER
GTF	ВСР
REVI	EWER
CAH 0	7/14/25
PROJECT II	)
114	515
SUBSET	TOTAL
5	17
SHEET	TOTAL
17	52

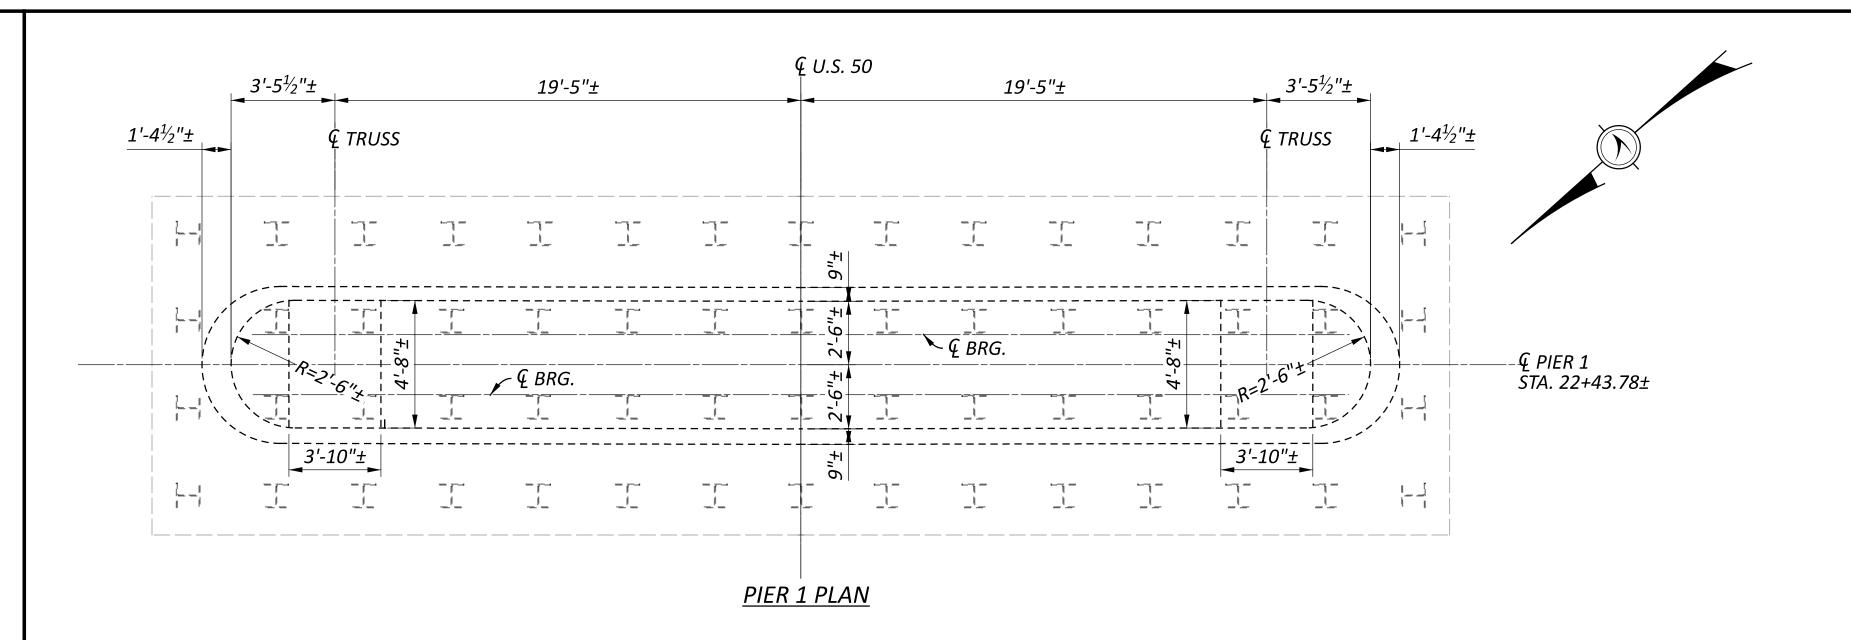

### ₡ TRUSS **E** TRUSS 45′-9"± 22'-10<sup>1</sup>/<sub>2</sub>"± 22'-10<sup>1</sup>/<sub>2</sub>"± <u>|----</u> 15 ANODES !======== |c============= 105 SQ. FT. 94 ANODES @ 8" MAX ∠ 9 FT. 77 ANODES @ 8" MAX @ 8" MAX *E CONST. JOINT* 12 SQ. FT. 28 ANODES 18 ANODES @ 8" MAX @ 8" MAX 1'-9"± 24'-3"± 24′-3″± **PIER 1 ELEVATION**

3.76/19.03

50

### SUMMARY OF REPAIR AREAS

PHYSICAL INVENTORY OF MEASURED QUANTITIES OF DETERIORATION WAS PERFORMED IN AUGUST OF 2023. EXACT DIMENSIONS AND LOCATIONS OF REPAIRS SHALL BE DETERMINED BY THE ENGINEER IN THE FIELD FOR FINAL PAY QUANTITIES. **MEASURED ESTIMATING ESTIMATED** TYPE **QUANTITIES** FACTOR\* **QUANTITIES** 187 SQ. FT. 280 SQ. FT. 1.5 **PATCHING** PIER 1 15 FT. **EPOXY** 1.5 23 FT. ~~~

\* - ESTIMATED QUANTITIES HAVE BEEN INCREASED BY 50% OVER MEASURED QUANTITIES TO ALLOW FOR ADDITIONAL DETERIORATION.

1.5

### <u>LEGEND</u>

LINJECTION

PIER 1

**ANODES** 

- AREA TO BE REPAIRED WITH ITEM 519 -PATCHING CONCRETE STRUCTURE, AS PER PLAN

### **NOTES**

5'-0"±

/c========

3'-6"±

6'-4"±

13'-4"±

VIEW A-A


¦ 3'-6"±

- 1. ALL DIMENSIONS ARE ±.
- 2. ALL ESTIMATED AREAS ARE GIVEN AS WIDTH x HEIGHT.
- 3. REPAIR CONCRETE SHALL BE HYDRAULIC CEMENT-BASED MATERIAL WITH A ELECTRICAL RESISTIVITY LESS THAN 50,000 OHM-CM ACCORDING TO ASTM C 1760. DO NOT USE NON- CONDUCTIVE REPAIR MATERIALS SUCH AS MAGNESIUM AMMONIUM PHOSPHATE CONCRETE AND EPOXY MORTARS OR BONDING AGENTS. CONCRETE MIXES CONTAINING HIGH LEVELS OF SUPPLEMENTARY CEMENTITIOUS MATERIALS SUCH AS SILICA FUME, GROUND-GRANULATED BLAST FURNACE SLAG, LATEX, FLY ASH OR METAKAOLIN MAY NOT MEET THE RESISTIVITY REQUIREMENT. THE GALVANIC ANODE SIZE AND SPACING IS BASED ON ACHIEVING A CURRENT DENSITY FOR THE EXTREMELY HIGH CORROSION RISK CATEGORY WITH A 30 YEAR INSTALLATION. SUPPLY ANODES WITH A MINIMUM CORE OF 210 GRAMS OF ZINC. SEE THIS SHEET FOR DISTRIBUTION.

3102521
DESIGN AGENCY



DESIGNER	CHECKER				
GTF	ВСР				
REVIE	EWER				
CAH 0	7/14/25				
PROJECT ID					
114515					
SUBSET	TOTAL				
6	17				

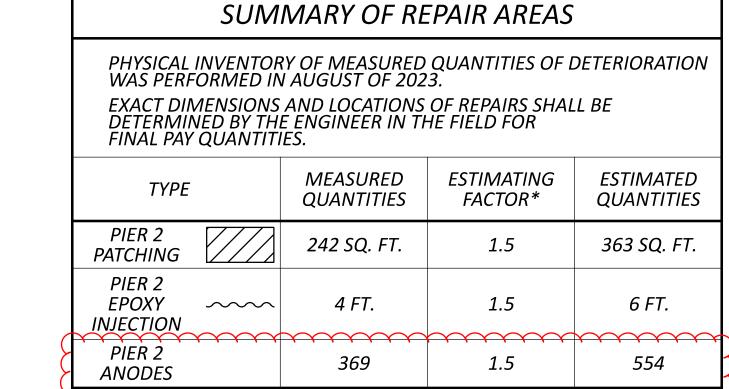

\* - ESTIMATED QUANTITIES HAVE BEEN INCREASED BY 50% OVER MEASURED QUANTITIES TO ALLOW FOR ADDITIONAL


LEGEND

DETERIORATION.

- AREA TO BE REPAIRED WITH ITEM 519 -PATCHING CONCRETE STRUCTURE, AS PER PLAN

### **NOTES**

- 1. ALL DIMENSIONS ARE ±.
- 2. ALL ESTIMATED AREAS ARE GIVEN AS WIDTH x HEIGHT.
- 3. REPAIR CONCRETE SHALL BE HYDRAULIC CEMENT-BASED MATERIAL WITH A ELECTRICAL RESISTIVITY LESS THAN 50,000 OHM-CM ACCORDING TO ASTM C 1760. DO NOT USE NON- CONDUCTIVE REPAIR MATERIALS SUCH AS MAGNESIUM AMMONIUM PHOSPHATE CONCRETE AND EPOXY MORTARS OR BONDING AGENTS. CONCRETE MIXES CONTAINING HIGH LEVELS OF SUPPLEMENTARY CEMENTITIOUS MATERIALS SUCH AS SILICA FUME, GROUND-GRANULATED BLAST FURNACE SLAG, LATEX, FLY ASH OR METAKAOLIN MAY NOT MEET THE RESISTIVITY REQUIREMENT THE GALVANIC ANODE SIZE AND SPACING IS BASED ON ACHIEVING A CURRENT DENSITY FOR THE EXTREMELY HIGH CORROSION RISK CATEGORY WITH A 30 YEAR INSTALLATION. SUPPLY ANODES WITH A MINIMUM CORE OF 210 GRAMS OF ZINC. SEE THIS SHEET FOR DISTRIBUTION.

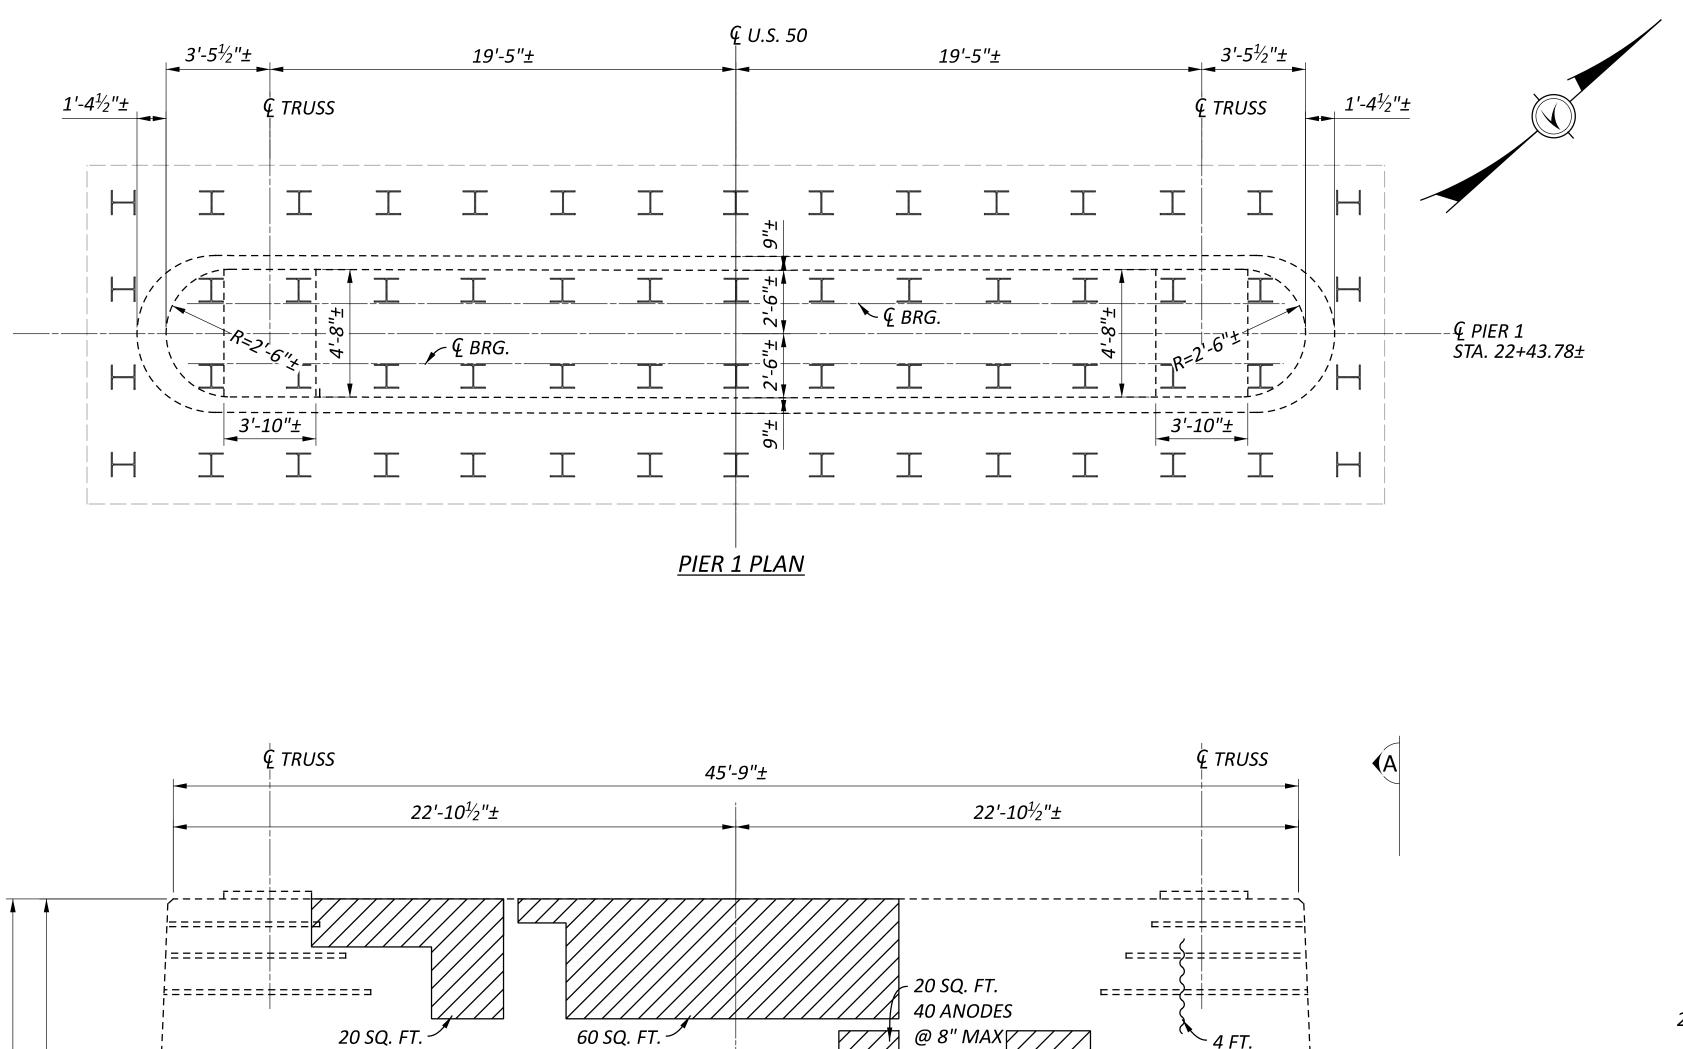

12 SQ. FT.

25 ANODES

@ 8" MAX

24′-3″±

50 SQ. FT.

67 ANODES

@ 8" MAX

**42 ANODES** 

∙ **Ç** CONST. JOINT

1'-9"±

3.76/19.03

50

30 ANODES @ 8" MAX

@ 8" MAX

35 SQ. FT.

@ 8" MAX ~

*41 ANODES* 

24′-3″±

56 ANODES


@ 8" MAX

15 SQ. FT.

41 ANODES


@ 8" MAX

**PIER 1 ELEVATION** 

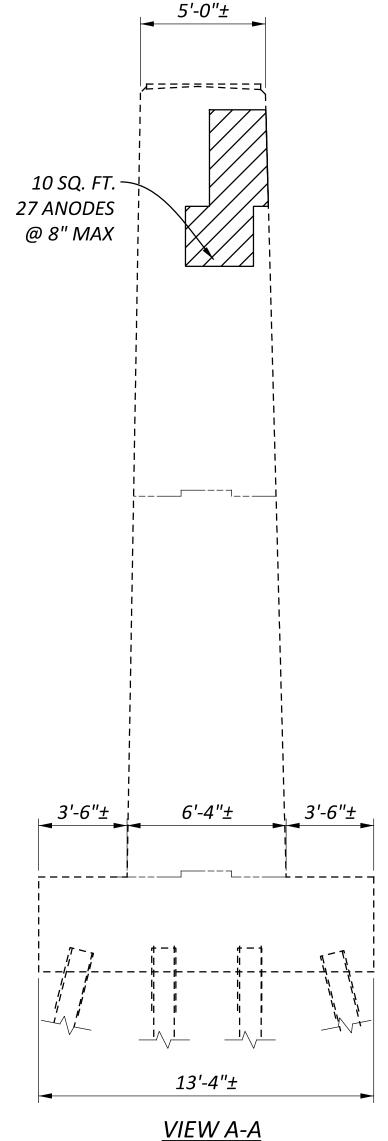



DESIGNER	CHECKER
GTF	BCP
REVIE	WER
CAH 0	7/14/25
PROJECT ID	
114	515
SUBSET	TOTAL
7	17
CLIEFT	TOTAL

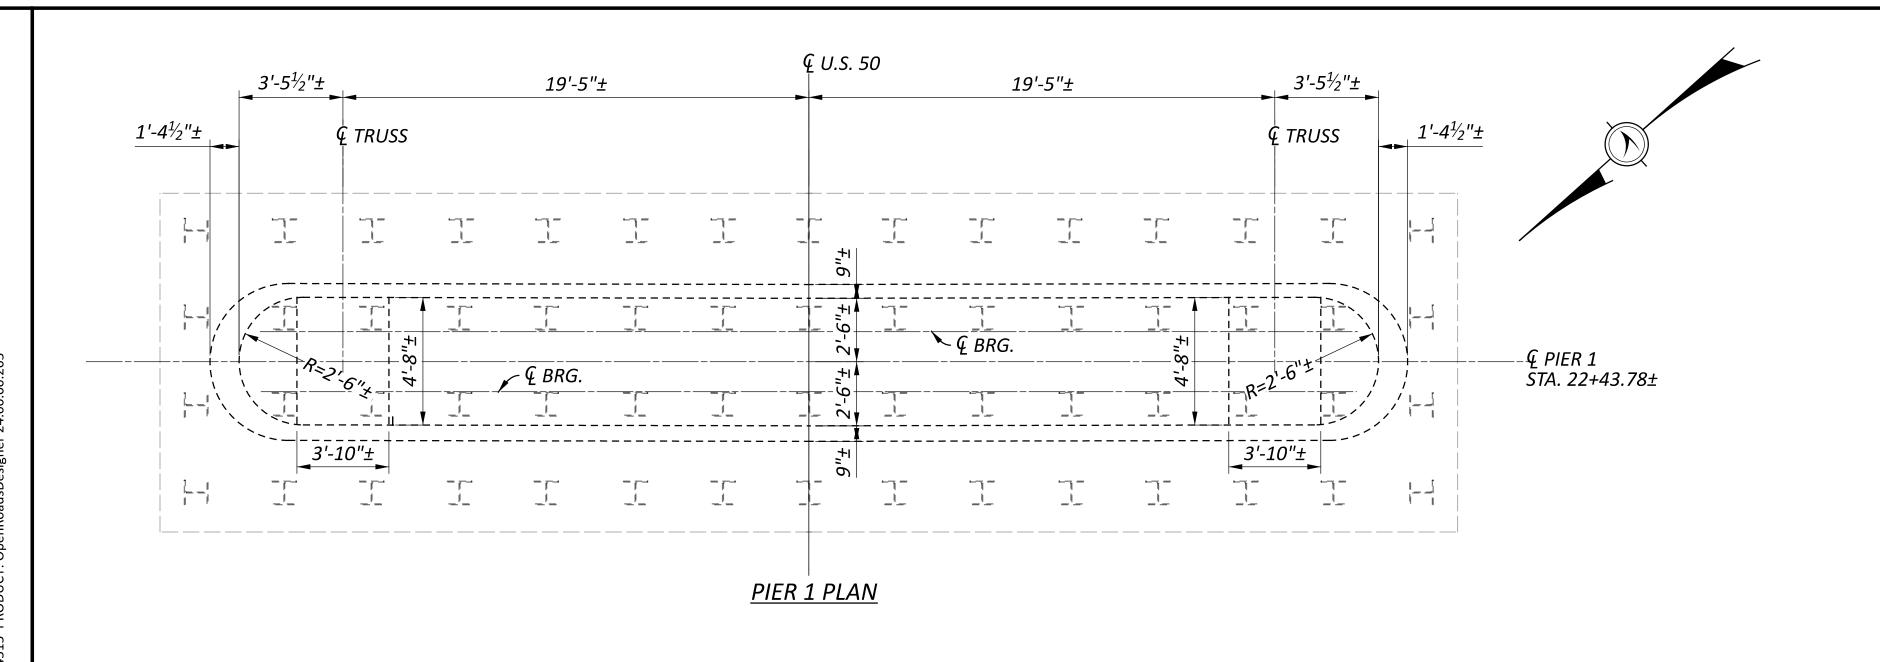

### ₡ TRUSS **E** TRUSS 45′-9"± 22'-10<sup>1</sup>/<sub>2</sub>"± 22'-10<sup>1</sup>/<sub>2</sub>"± - 100 SQ. FT. |========= ========== 83 ANODES ·-----@ 8" MAX 15 ANODES 6 FT. < ~ € CONST. 3 SQ. FT. ~ JOINT 35 SQ. FT. *39 ANODES 56 ANODES* @ 8" MAX @ 8" MAX 18 ANODES @ 8" MAX 1'-9"± 24′-3″± 24′-3″± **PIER 1 ELEVATION**

.76/19.03

50

# /c======== 3'-6"± 6'-4"± ¦ 3′-6″± 13'-4"± VIEW A-A

### SUMMARY OF REPAIR AREAS

PHYSICAL INVENTORY OF MEASURED QUANTITIES OF DETERIORATION WAS PERFORMED IN AUGUST OF 2023.

EXACT DIMENSIONS AND LOCATIONS OF REPAIRS SHALL BE DETERMINED BY THE ENGINEER IN THE FIELD FOR FINAL PAY QUANTITIES.

TYPE		MEASURED QUANTITIES	ESTIMATING FACTOR*	ESTIMATED QUANTITIES
PIER 2 PATCHING		188 SQ. FT.	1.5	282 SQ. FT.
PIER 2 EPOXY INJECTION	~~~	6 FT.	1.5	9 FT.
PIER 2 ANO	DES	212	1.5	318

\* - ESTIMATED QUANTITIES HAVE BEEN INCREASED BY 50% OVER MEASURED QUANTITIES TO ALLOW FOR ADDITIONAL DETERIORATION.

### **LEGEND**

- AREA TO BE REPAIRED WITH ITEM 519 PATCHING CONCRETE STRUCTURE, AS PER PLAN

### **NOTES**

- 1. ALL DIMENSIONS ARE ±.
- 2. ALL ESTIMATED AREAS ARE GIVEN AS WIDTH x HEIGHT.
- 3. REPAIR CONCRETE SHALL BE HYDRAULIC CEMENT-BASED MATERIAL WITH A ELECTRICAL RESISTIVITY LESS THAN 50,000 OHM-CM ACCORDING TO ASTM C 1760. DO NOT USE NON- CONDUCTIVE REPAIR MATERIALS SUCH AS MAGNESIUM AMMONIUM PHOSPHATE CONCRETE AND EPOXY MORTARS OR BONDING AGENTS. CONCRETE MIXES CONTAINING HIGH LEVELS OF SUPPLEMENTARY CEMENTITIOUS MATERIALS SUCH AS SILICA FUME, GROUND-GRANULATED BLAST FURNACE SLAG, LATEX, FLY ASH OR METAKAQLIN MAY NOT MEET THE RESISTIVITY BEQUIREMENT. THE GALVANIC ANODE SIZE AND SPACING IS BASED ON ACHIEVING A CURRENT DENSITY FOR THE EXTREMELY HIGH CORROSION RISK CATEGORY WITH A 30 YEAR INSTALLATION. SUPPLY ANODES WITH A MINIMUM CORE OF 210 GRAMS OF ZINC. SEE THIS SHEET FOR DISTRIBUTION.

3102521
DESIGN AGENCY



DESIGNER	CHECKER				
GTF	ВСР				
REVIE	WER				
CAH 0	7/14/25				
PROJECT ID					
114515					
SUBSET	TOTAL				
8	17				



FINAL PAY QUANTITIES.						
TYPE	MEASURED QUANTITIES	ESTIMATING FACTOR*	ESTIMATED QUANTITIES			
PIER 3 PATCHING	103 SQ. FT.	1.5	155 SQ. FT.			
PIER 3 EPOXY ~~~ INJECTION	37 FT.	1.5	56 FT.			
PIER 3 ANODES	126	1.5	189			


\* - ESTIMATED QUANTITIES HAVE BEEN INCREASED BY 50% OVER MEASURED QUANTITIES TO ALLOW FOR ADDITIONAL DETERIORATION.

### <u>LEGEND</u>

- AREA TO BE REPAIRED WITH ITEM 519 -PATCHING CONCRETE STRUCTURE, AS PER PLAN

### **NOTES**

- 1. ALL DIMENSIONS ARE ±.
- 2. ALL ESTIMATED AREAS ARE GIVEN AS WIDTH x HEIGHT.
- 3. REPAIR CONCRETE SHALL BE HYDRAULIC CEMENT-BASED MATERIAL WITH A ELECTRICAL RESISTIVITY LESS THAN 50,000 OHM-CM ACCORDING TO ASTM C 1760. DO NOT USE NON- CONDUCTIVE REPAIR MATERIALS SUCH AS MAGNESIUM AMMONIUM PHOSPHATE CONCRETE AND EPOXY MORTARS OR BONDING AGENTS. CONCRETE MIXES CONTAINING HIGH LEVELS OF SUPPLEMENTARY CEMENTITIOUS MATERIALS SUCH AS SILICA FUME, GROUND-GRANULATED BLAST FURNACE SLAG, LATEX, FLY ASH OR METAKAOLIN MAY NOT MEET THE RESISTIVITY REQUIREMENT. THE GALVANIC ANODE SIZE AND SPACING IS BASED ON ACHIEVING A CURRENT DENSITY FOR THE EXTREMELY HIGH CORROSION RISK CATEGORY WITH A 30 YEAR INSTALLATION. SUPPLY ANODES WITH A MINIMUM CORE OF 210 GRAMS OF ZINC. SEE THIS SHEET FOR DISTRIBUTION.

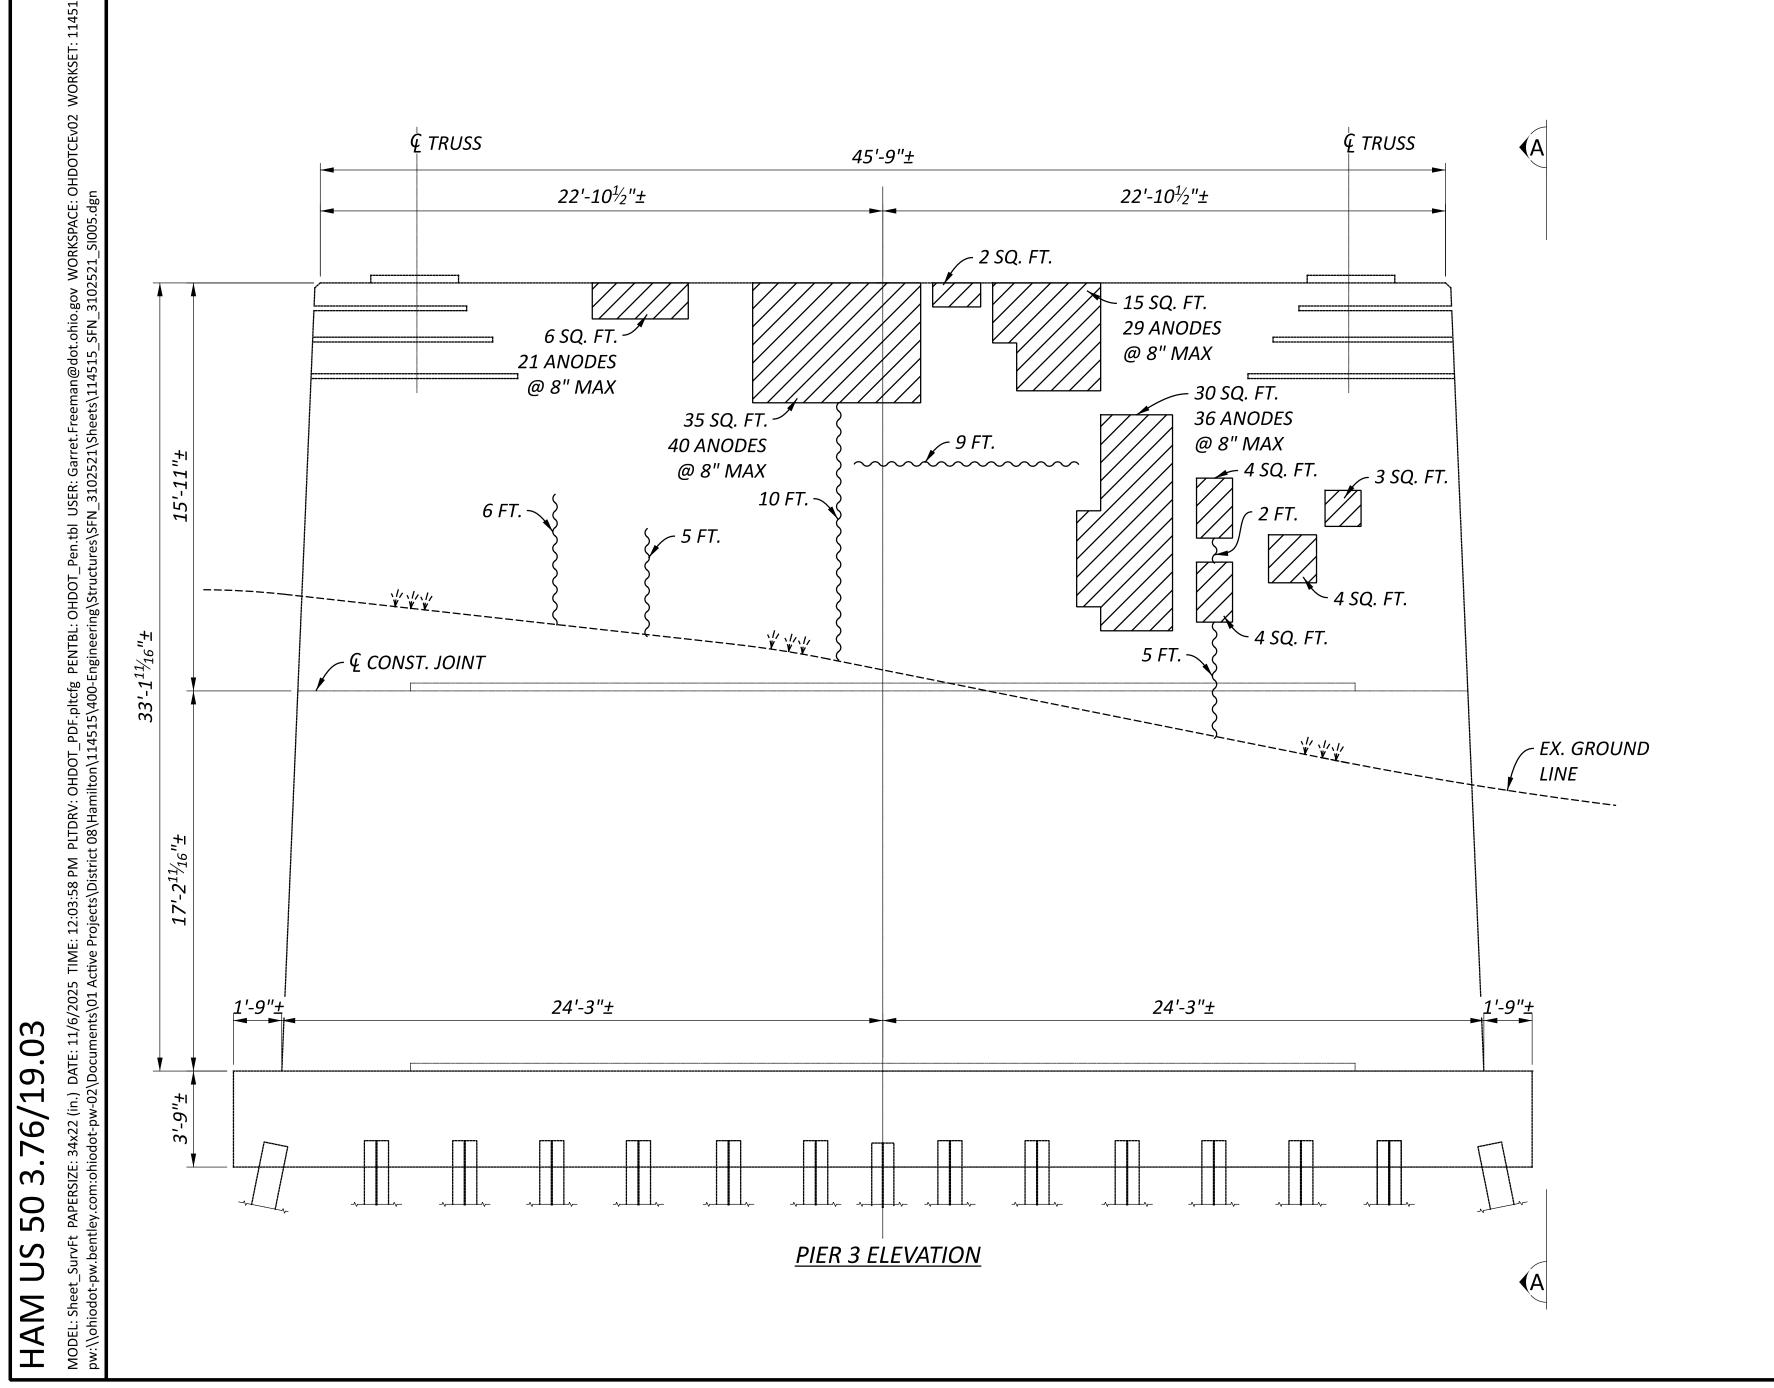

€ U.S. 50

PIER 3 PLAN

19'-5"±

F BRG.

19'-5"±

3'-5<sup>1</sup>/<sub>2</sub>"±

**Q** TRUSS

3'-10"±

 $1'-4\frac{1}{2}"\pm$ 

₽ PIER 1


STA. 22+43.78±

3'-5½"±

**E** TRUSS

3'-10"±

1'-4<sup>1</sup>/<sub>2</sub>"±

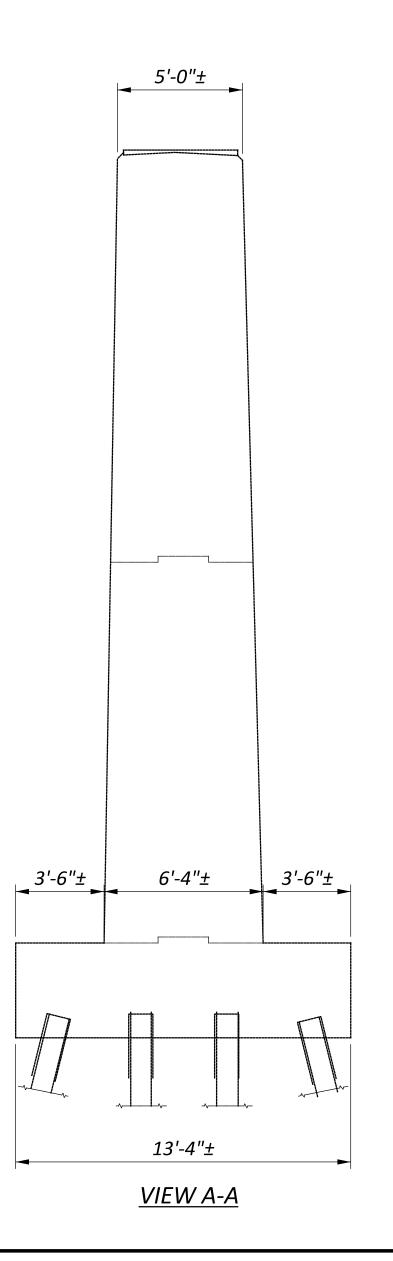



DESIGNER	CHECKER
GTF	ВСР
REVIE	WER
CAH 0	7/14/25
PROJECT ID	)
114	515
SUBSET	TOTAL
	17


**ESTIMATED** 

**QUANTITIES** 

390 SQ. FT.

29 FT.

539

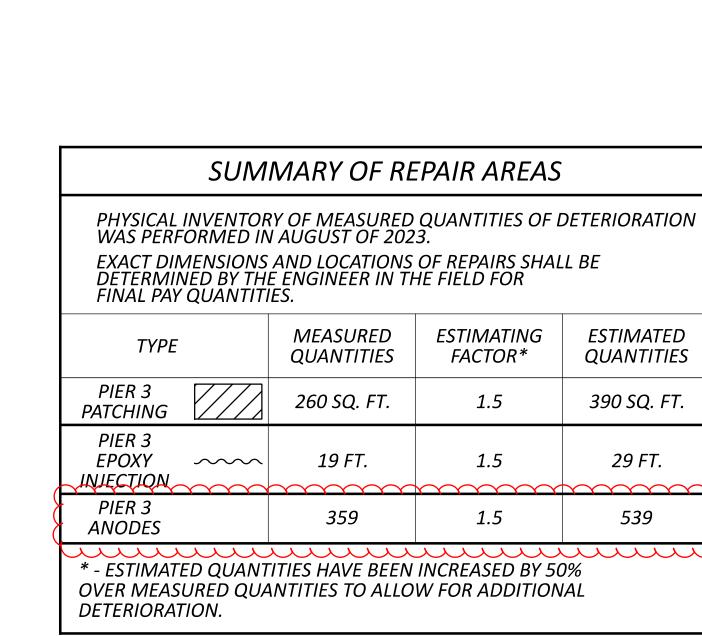


### **LEGEND**

- AREA TO BE REPAIRED WITH ITEM 519 -PATCHING CONCRETE STRUCTURE, AS PER PLAN

### **NOTES**

- 1. ALL DIMENSIONS ARE ±.
- 2. ALL ESTIMATED AREAS ARE GIVEN AS WIDTH x HEIGHT.
- 3. REPAIR CONCRETE SHALL BE HYDRAULIC CEMENT-BASED MATERIAL WITH A ELECTRICAL RESISTIVITY LESS THAN 50,000 OHM-CM ACCORDING TO ASTM C 1760. DO NOT USE NON- CONDUCTIVE REPAIR MATERIALS SUCH AS MAGNESIUM AMMONIUM PHOSPHATE CONCRETE AND EPOXY MORTARS OR BONDING AGENTS. CONCRETE MIXES CONTAINING HIGH LEVELS OF SUPPLEMENTARY CEMENTITIOUS MATERIALS SUCH AS SILICA FUME, GROUND-GRANULATED BLAST FURNACE SLAG, LATEX, FLY REQUIREMENT THE GALVANIC ANODE SIZE AND SPACING IS BASED. ON ACHIEVING A CURRENT DENSITY FOR THE EXTREMELY HIGH CORROSION RISK CATEGORY WITH A 30 YEAR INSTALLATION. SUPPLY ANODES WITH A MINIMUM CORE OF 210 GRAMS OF ZINC. SEE THIS SHEET FOR DISTRIBUTION.

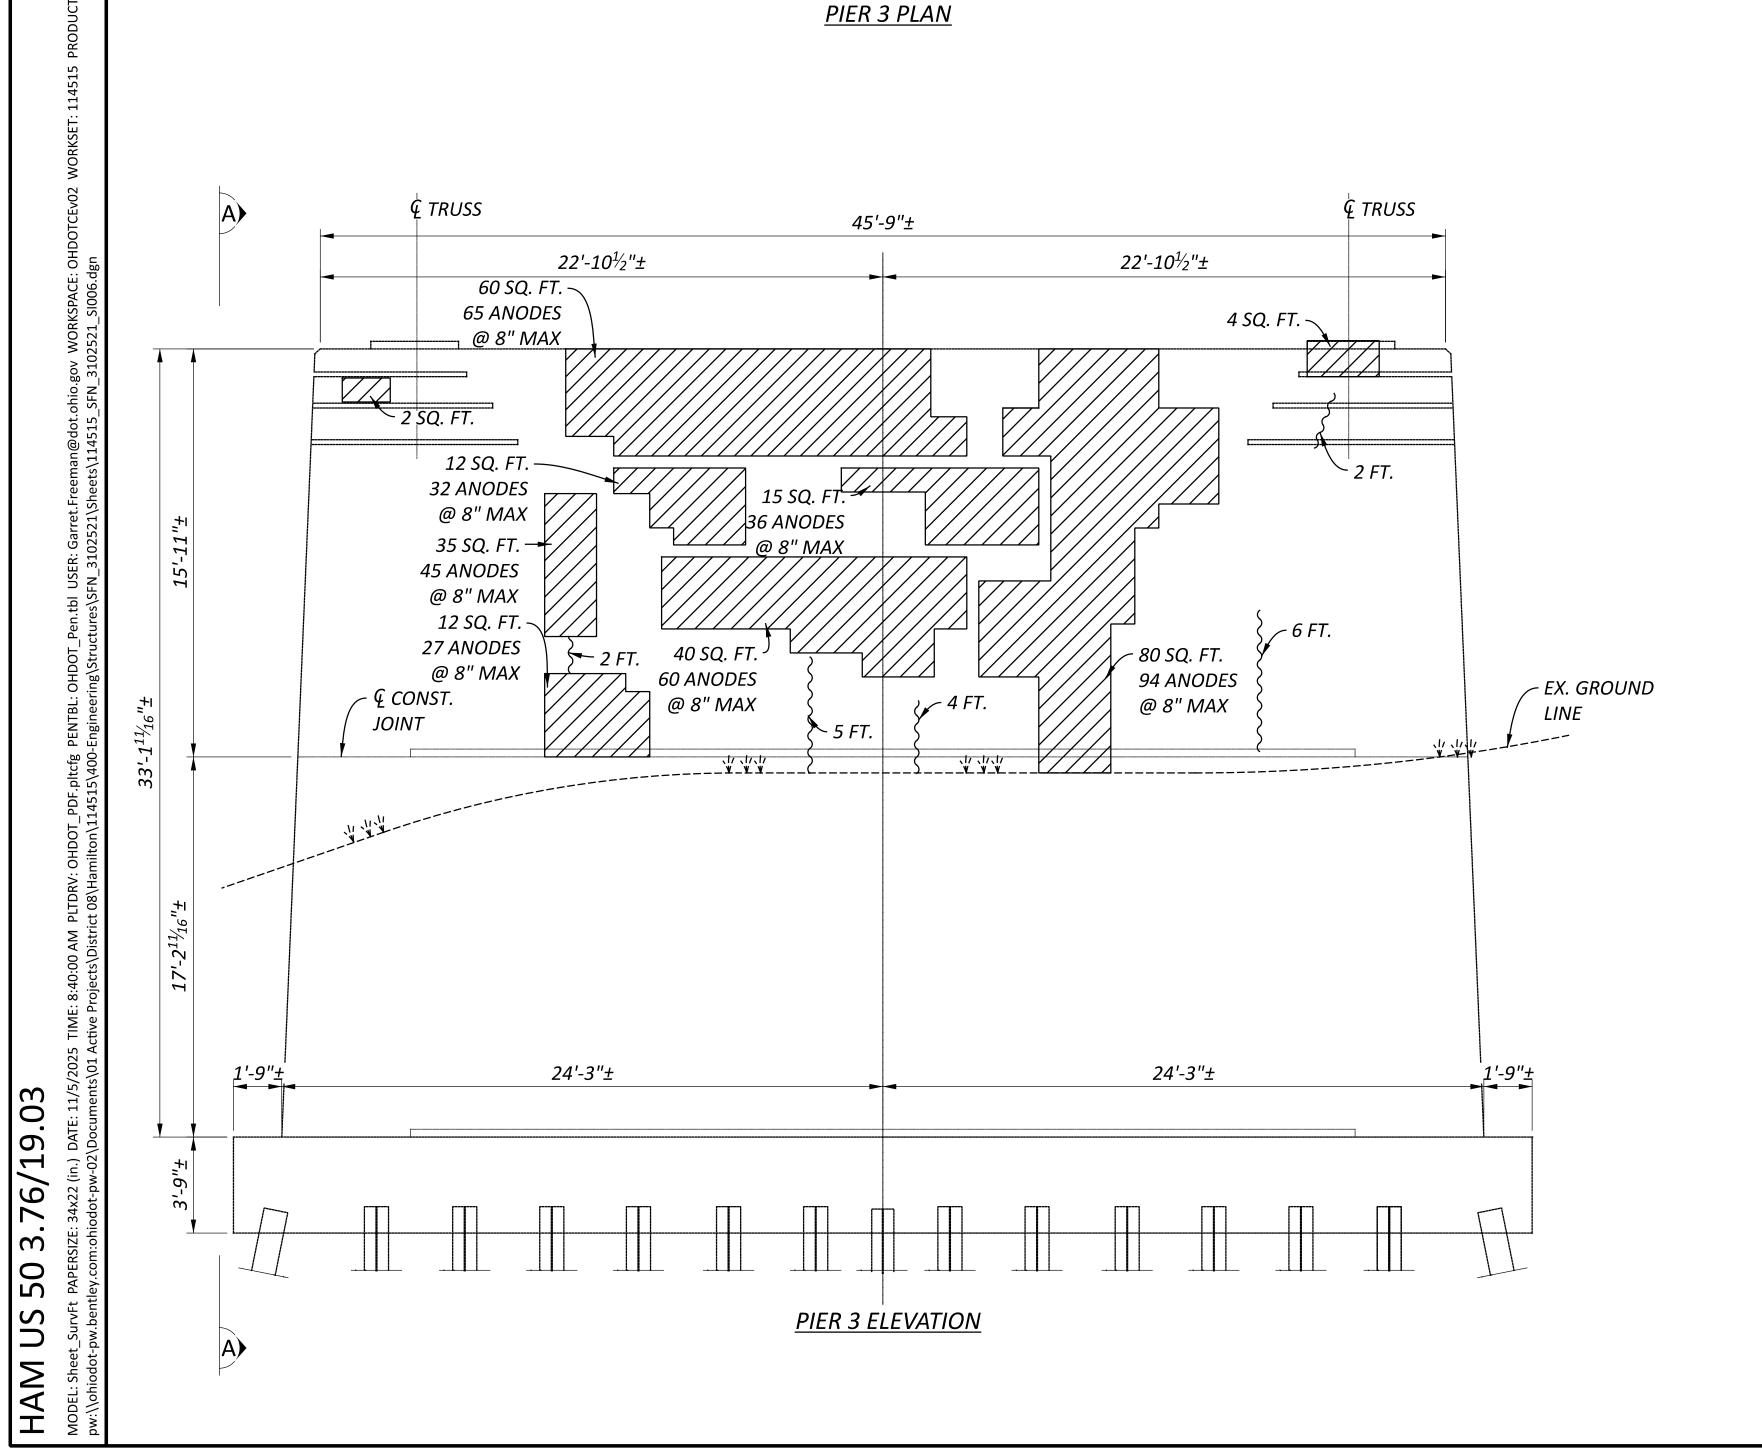

€ U.S. 50

19'-5"±

₹ BRG.

19'-5"±

 $3'-5\frac{1}{2}"\pm$ 

**Q** TRUSS

3'-10"±

 $1'-4\frac{1}{2}"\pm$ 

4 PIER 1


STA. 22+43.78±

3'-5<sup>1</sup>/<sub>2</sub>"±

**E** TRUSS

3'-10"±

1'-4<sup>1</sup>/<sub>2</sub>"±

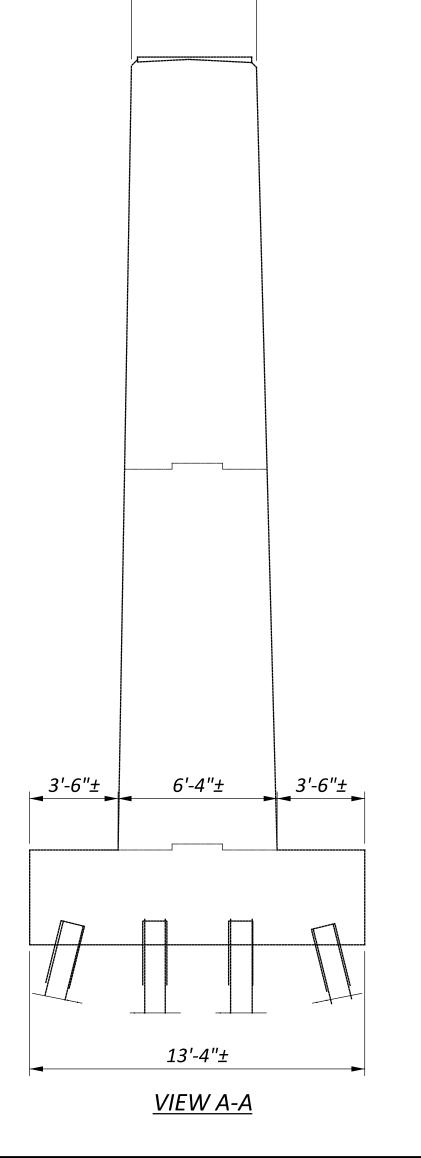

5'-0"±

3102521 ESIGN AGENCY



DESIGNER	CHECKER
GTF	BCP
REVIE	WER
CAH 0	7/14/25
PROJECT ID	)
11/	515
114	J1J

**SWAY BRACING** 

Member	SIZE	QUANTITY	PERIMETER (FT)	LENGTH (FT)	SURFACE AREA (SQ FT)
HORIZONTAL	W8x28	2	3.4	37.0	251.6
DIACONAL	DIACONAL MONTO	1	3.0	22.5	126 5
DIAGONAL W8x17	VVOX17	2	3.0	11.5	136.5
				TOTAL PER BRACE	388
				NO. OF BRACES (EA.)	24

PORTAL BRACING

I ONIAL DINAGINO					
Member	SIZE	QUANTITY	PERIMETER (FT)	LENGTH (FT)	SURFACE AREA (SQ FT)
HORIZONTAL	W8x28	2	3.4	37.0	251.6
DIACONAL	14/0:47	4	3.0	8.5	150.0
DIAGONAL	W8x17	2	3.0	8.0	150.0
				TOTAL PER BRACE	402
				NO. OF BRACES (EA.)	8
				TOTAL + 10%	3534

**LATERAL BRACING** 

Member	SIZE	QUANTITY	PERIMETER (FT)	LENGTH (FT)	SURFACE AREA (SQ FT)
DIAGONAL	ST8 x WF18	2	3.0	22.5	269.4
DIAGONAL	SIOX WF10	1	3.0	44.9	209.4
				TOTAL PER LATERAL	269
				NO. OF LATERAL (EA.)	28
				TOTAL + 10%	8298

TRUSS (SPAN 1 OR 4)

Member	SIZE	QUANTITY	PERIMETER (FT)	LENGTH (FT)	SURFACE AREA (SQ FT)	
	2 C15x50 1- f2 21 x <sup>9</sup> / <sub>16</sub> W/ LACING BARS	2	6.9	36.8		
TOD CHORD		2	6.9	24.5		
TOP CHORD		2	6.9	24.0	15206	
		2	6.9	23.9	1528.6	
TOP CHORD DIAPHRAGM @ PANEL PTS.	4 L-4 x 3½ x 3/8 1/2 P2	7	3.1	-		
BOTTOM CHORD	P 15 x 3/4	16	2.6	23.9		
BOT. CHORD INT. DIAPHRAGM	4 L-3 x 3½ x 3/8 1/2 PL	48	2.9	-		
BOT. CHORD DIAPHRAGM @ SPLICE	4 L-3 x 3½ x 3/8 1/2 PL	16	2.9	-	1213.1	
BOT. CHORD DIAPHRAGM @ PANEL PTS.	4 L-4 x 3½ x 3/8 ½ P2	7	3.1	-		
HORIZONTAL	W12x36	4	4.2	12.0	198.6	
	W12x36	3	4.2	35.0		
VERTICAL	W12x40	2	4.5	28.0	1077.4	
	W12x65	2	5.9	33.3		
DIAGONAL	W12x36	2	4.2	42.4		
	W12x36	4	4.2	21.2	1512.0	
	W12x53	2	5.2	41.0	1312.0	
	W12x58	2	5.2	36.8		
				TOTAL PER TRUSS	5530	
				NO. OF TRUSSES (EA.)	4	
				TOTAL + 10%	24331	

TRUSS (SPAN 2 OR 3)

10246

TOTAL + 10%

Member	SIZE	QUANTITY	PERIMETER (FT)	LENGTH (FT)	SURFACE AREA (SQ FT)	
TOD CHORD	2 C18x51.9 1 ½ 22 x <sup>5</sup> / <sub>8</sub> W/ LACING BARS	2	7.7	37.5		
		2	7.7	25.9		
TOP CHORD		2	7.7	25.3	2157.5	
		4	7.7	25.0	2137.3	
TOP CHORD DIAPHRAGM @ PANEL PTS.	4 L-4 x 3½ x ¾ ½ P2	9	3.1	-		
BOTTOM CHORD	2 PLY 18 x 3/4	20	3.3	25.0		
BOT. CHORD INT. DIAPHRAGM	4 L-3 x 3½ x 3/8 ½ P2	60	2.9	-	1886.5	
BOT. CHORD DIAPHRAGM @ SPLICE	4 L-3 x 3½ x 3/8 1/2 P2	20	2.9	-		
BOT. CHORD DIAPHRAGM @ PANEL PTS.	4 L-4 x 3½ x 3/8 1/2 P2	9	3.1	-		
HORIZONTAL	W12x36	8	4.2	12.5	415.1	
	W12x36	5	4.2	40.0		
VERTICAL	W12x40	2	4.5	28.0	1488.4	
	W12x65	2	5.9	34.7		
	W12x36	2	4.2	47.2		
DIAGONAL	W12x36	4	4.2	23.6		
	W12x45	2	4.5	46.0	2084.2	
	W12x53	2	5.2	42.7		
	W12x65	2	5.9	37.5		
				TOTAL PER TRUSS	8032	
				NO. OF TRUSSES (EA.)	4	
				TOTAL + 10%	35339	

FLOOR (SPAN 1 OR 2)

Member	SIZE	QUANTITY	PERIMETER (FT)	LENGTH (FT)	SURFACE AREA (SQ FT)
FLOOD DEAM	W36x260	7	11.3	37.8	3837.6
FLOOR BEAM	W36x280	2	11.3	37.8	
STRINGER	W21x62	40	6.1	23.9	5806.7
CROSSFRAME	<i>L-3x3x</i> 15/16	7	1.0	21,2	143.5
				TOTAL PER SPAN	9788
				NO. OF SPAN (EA.)	
			(	TOTAL + 10%	21533

FLOOR (SPAN 2 OR 3)

Member	SIZE	QUANTITY	PERIMETER (FT)	LENGTH (FT)	SURFACE AREA (SQ FT)
	W36x280	9	11.3	37.8	4710.6
FLOOR BEAM	W36x300	2	11.4	37.8	
STRINGER	W21x62	50	6.1	23.9	7258.3
CROSSFRAME	<i>L-3x3x</i> 15/16	9	1.0	21.2	184.5
			>	TOTAL PER SPAN	12153
				NO. OF SPAN (EA.)	

26737


3102521


FIELD PAINTING OF STRUCTURAL STEEL - 6
HAM-50-0376 L
ESTBOUND US 50 OVER GREAT MIAMI RIVER

WESTBOUND



DESIGNER GTF	CHECKER BCP
REVIE	WER 7/14/25
PROJECT ID	
SUBSET 16	TOTAL <b>17</b>
SHEET <b>28</b>	TOTAL <b>52</b>

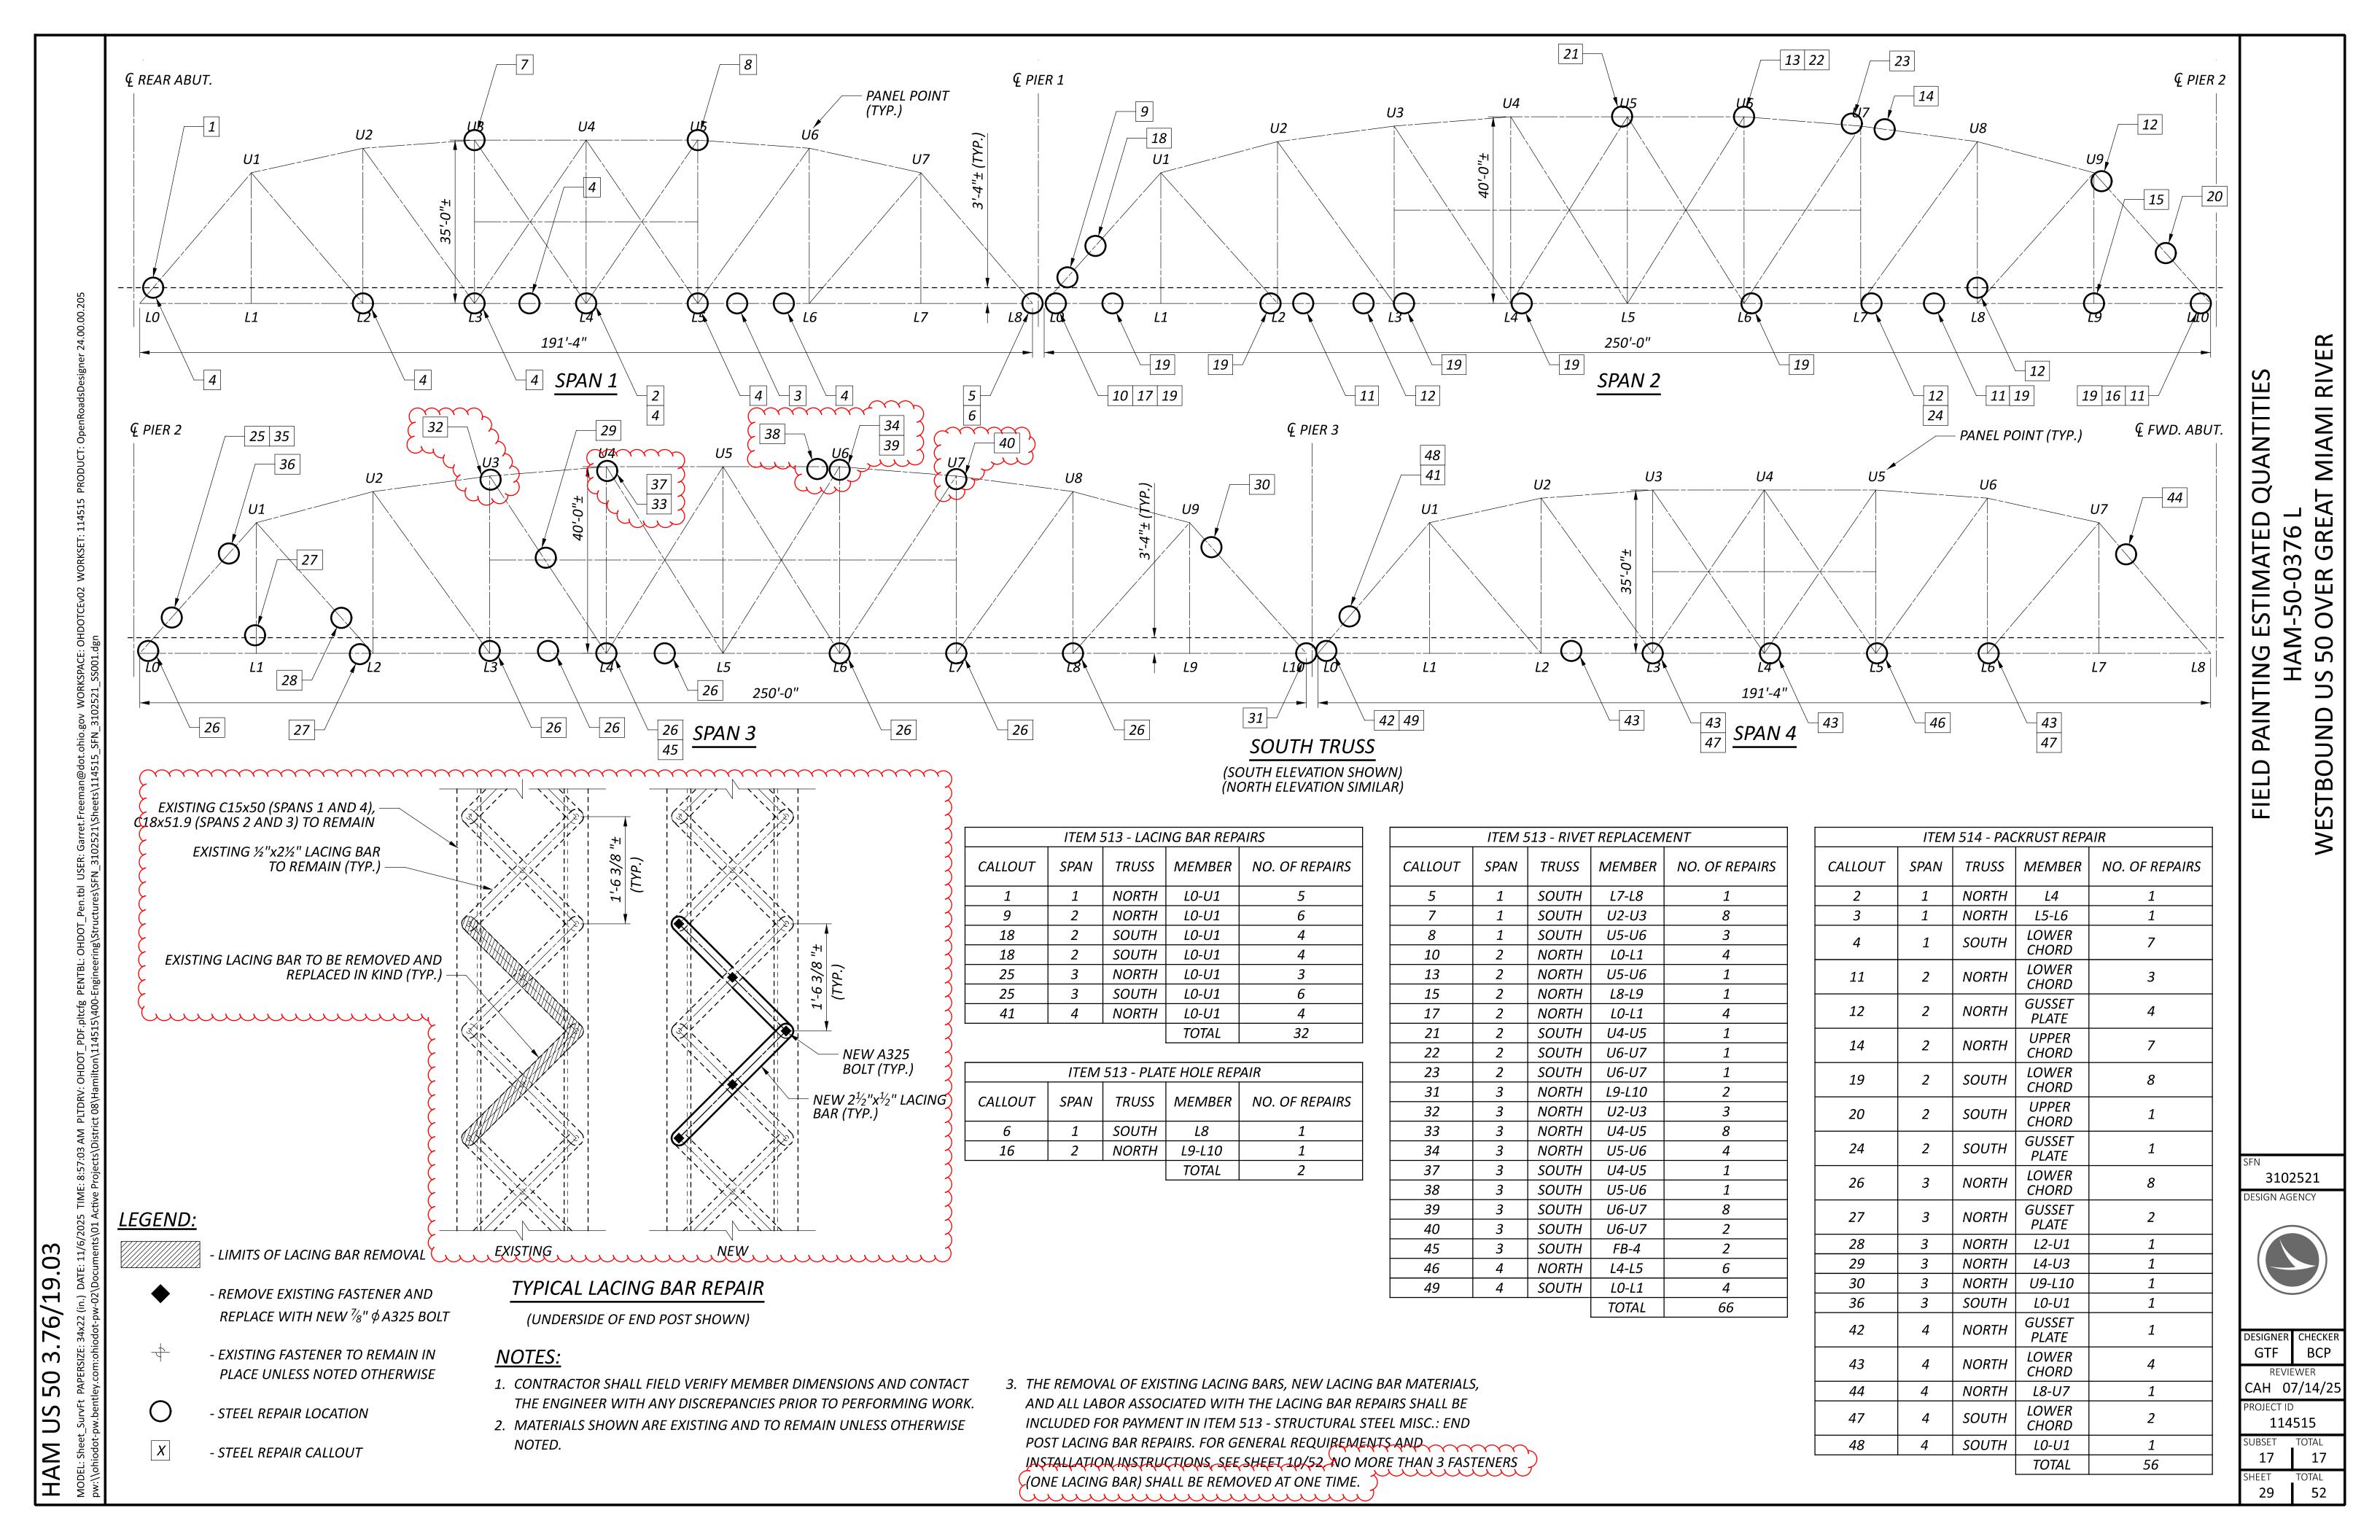

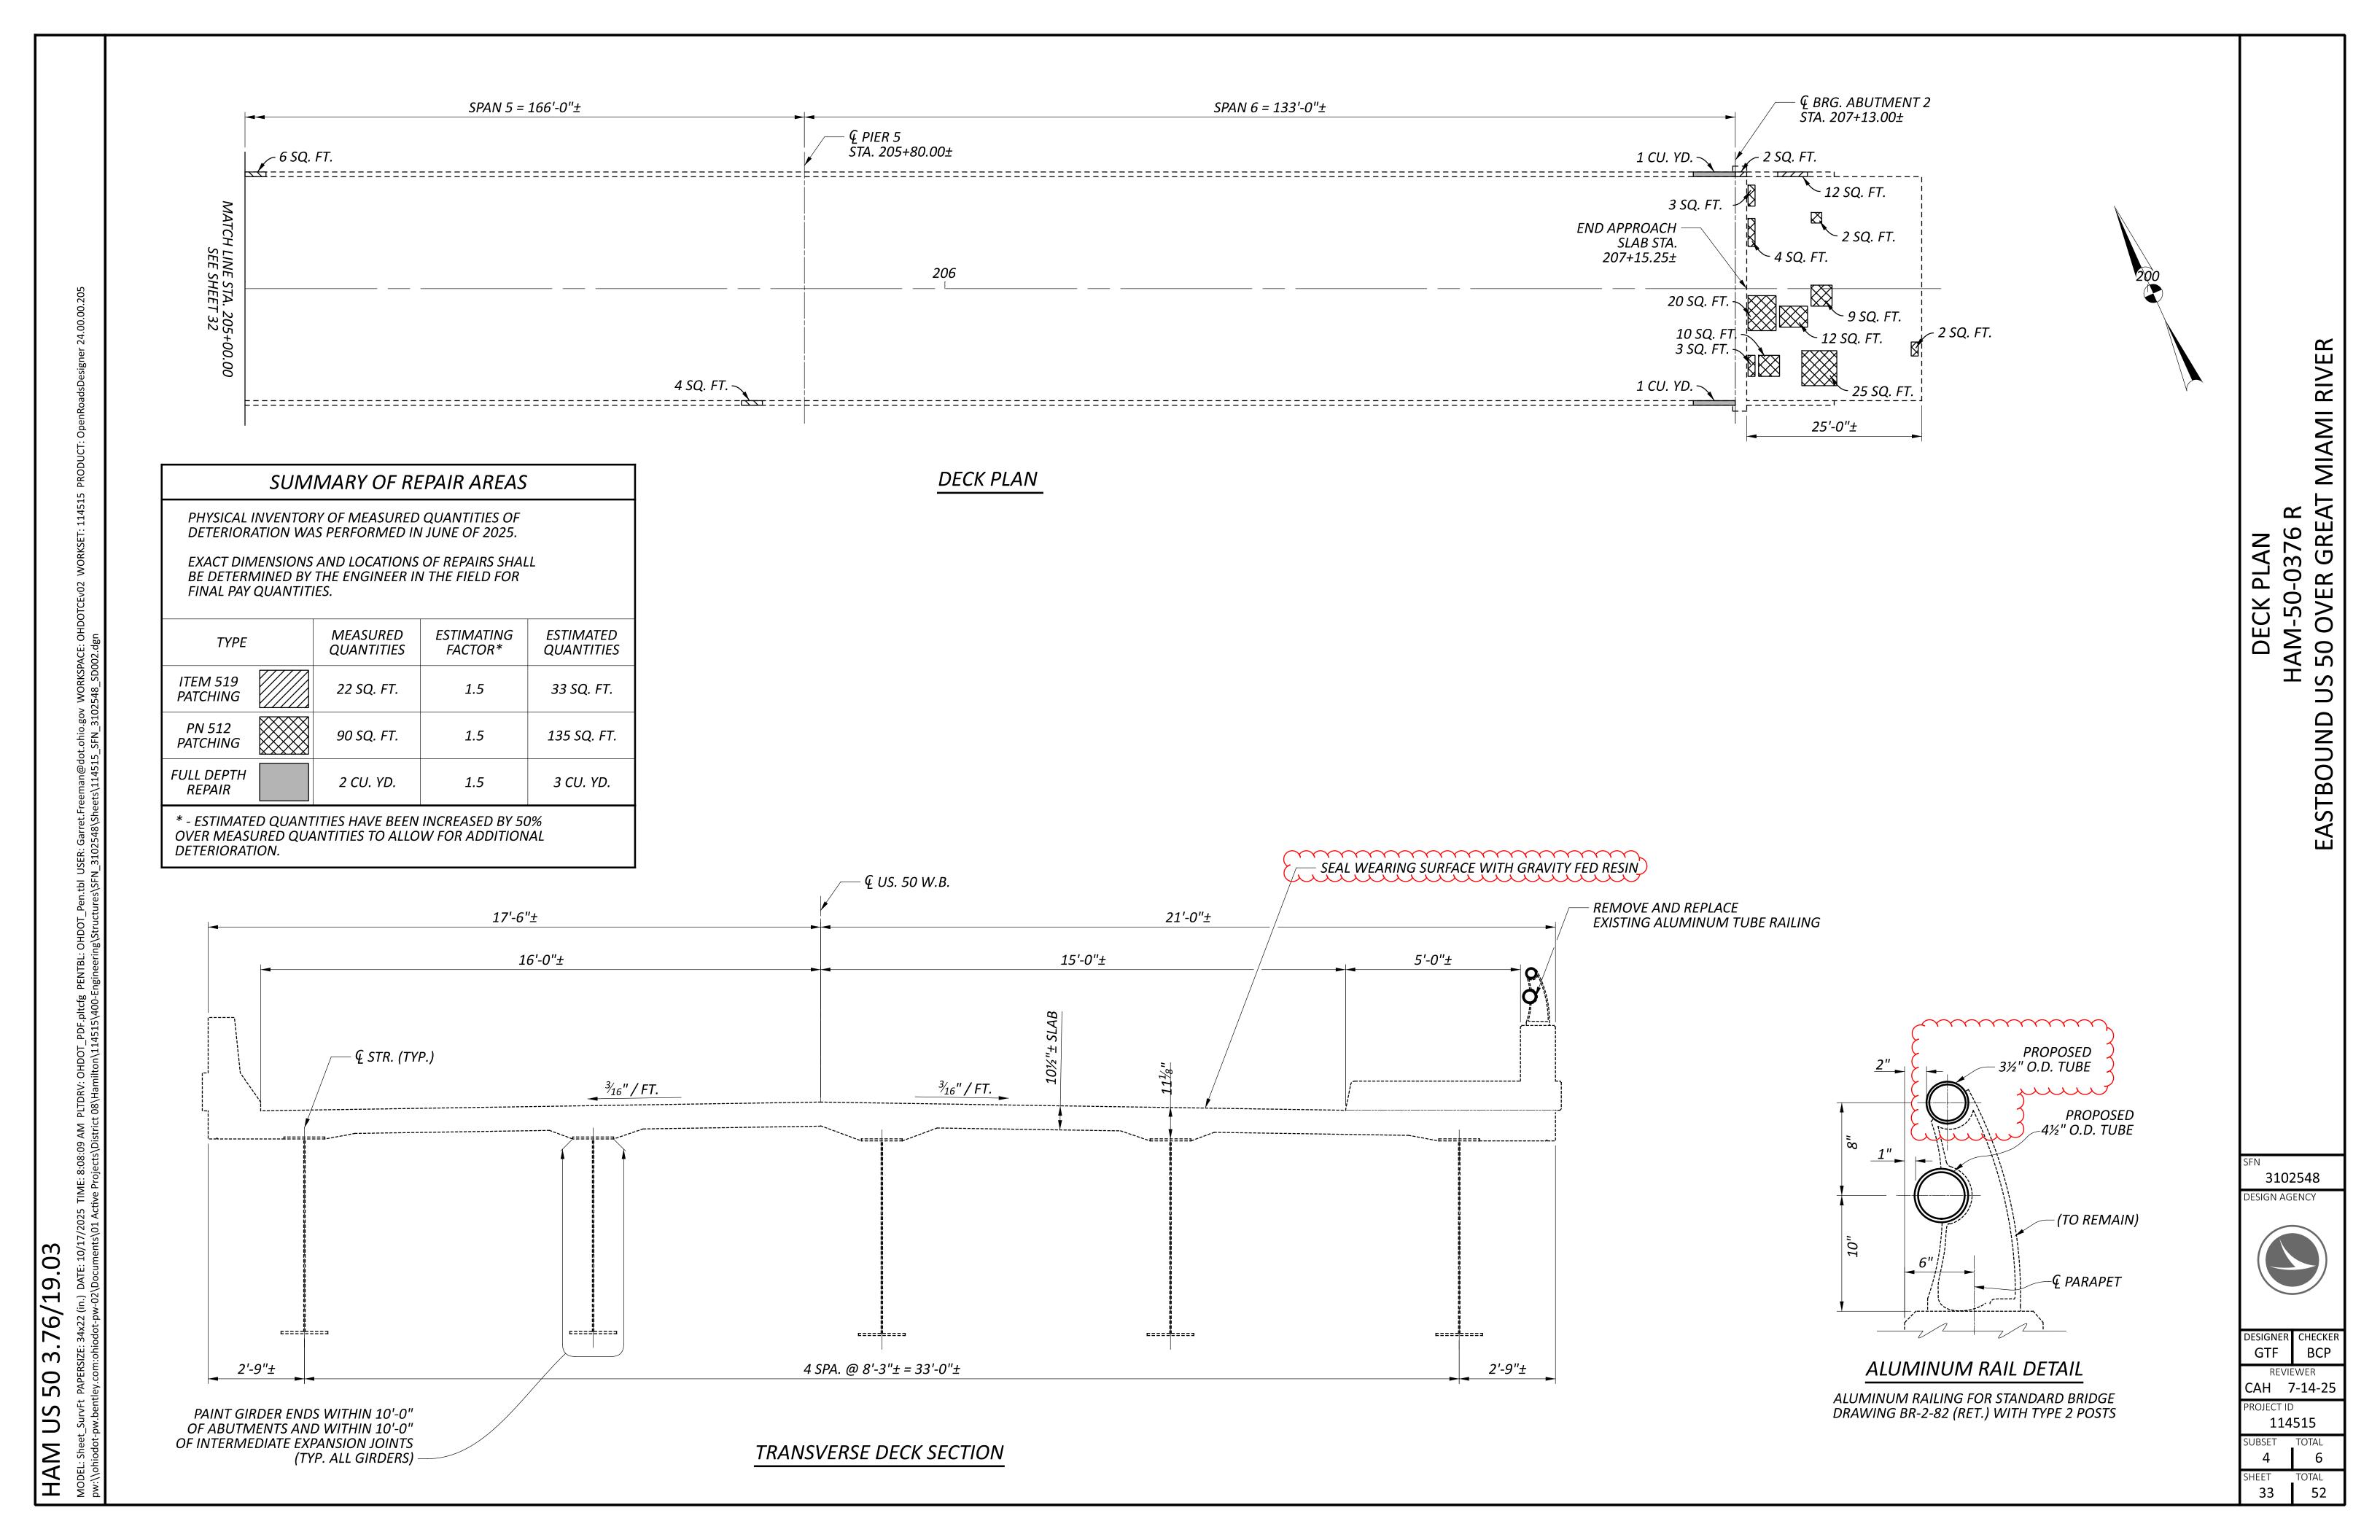

**NOTES** 

1. ALL DIMENSIONS ARE ±.

5 SQ. FT. \ 18 ANODES @ 8" MAX

2. ALL ESTIMATED AREAS ARE GIVEN AS WIDTH x HEIGHT.

3. REPAIR CONCRETE SHALL BE HYDRAULIC CEMENT-BASED MATERIAL

ACCORDING TO ASTM C 1760. DO NOT USE NON- CONDUCTIVE

WITH A ELECTRICAL RESISTIVITY LESS THAN 50,000 OHM-CM

PHOSPHATE CONCRETE AND EPOXY MORTARS OR BONDING

SUPPLEMENTARY CEMENTITIOUS MATERIALS SUCH AS SILICA

FUME, GROUND GRANULATED BLAST FURNACE SLAG, LATEX, FLY

ASH OR METAKAOLIN MAY NOT MEET THE RESISTIVITY REQUIREMENT. THE GALVANIC ANODE SIZE AND SPACING IS BASED

AGENTS. CONCRETE MIXES CONTAINING HIGH LEVELS OF


ON ACHIEVING A CURRENT DENSITY FOR THE EXTREMELY


4. SEAL ENTIRE EXPOSED SURFACE AREA OF ABUTMENT AND WING


WALLS, EXCEPT FOR TOP HORIZONTAL SURFACE OF CAP, WITH

EPOXY-URETHANE. SEE TYPICAL SEALING DETAILS.

REPAIR MATERIALS SUCH AS MAGNESIUM AMMONIUM

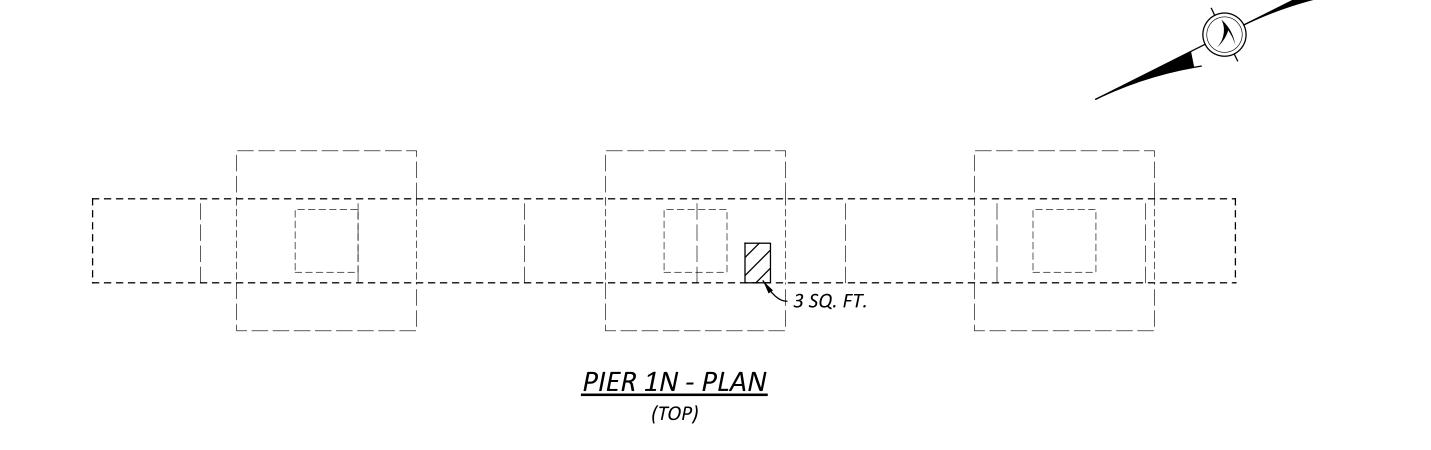

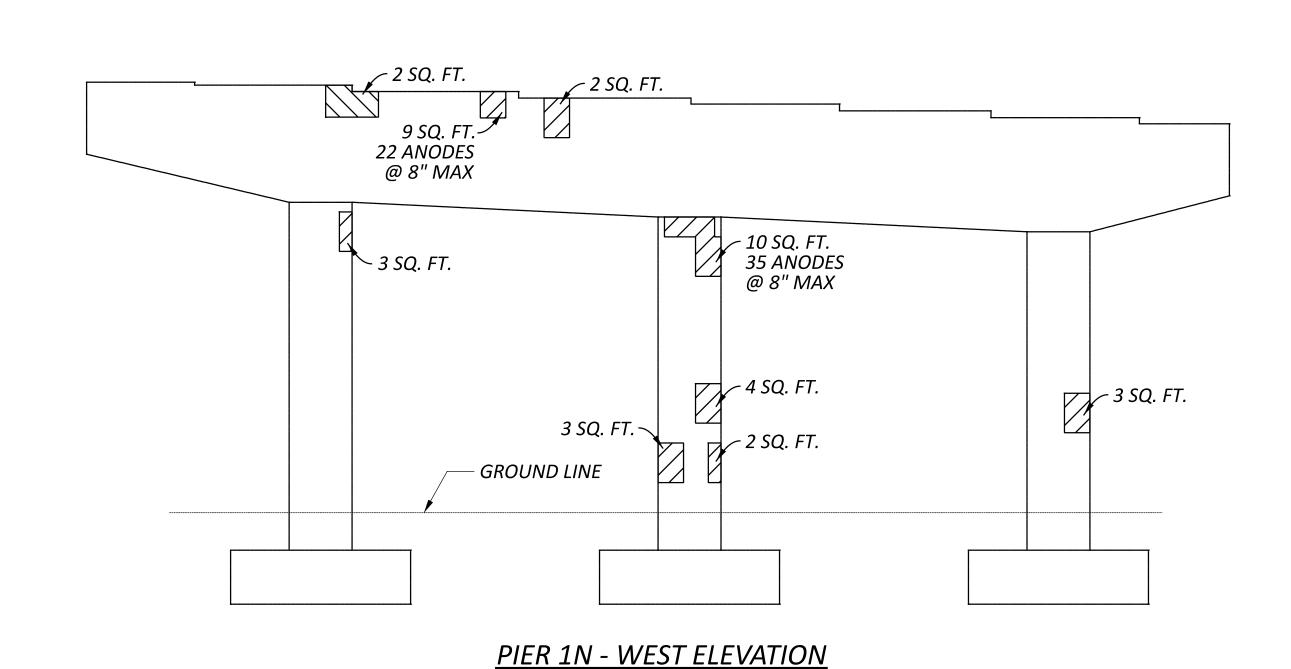

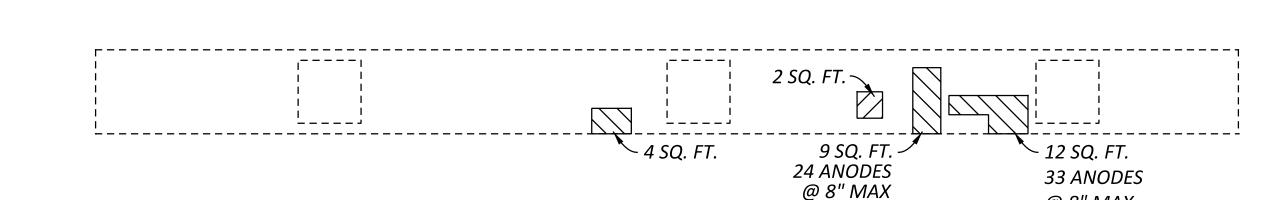

(LOOKING EAST)

PIER 1N - PLAN (BOTTOM)

@ 8" MAX

# SUMMARY OF REPAIR AREAS PHYSICAL INVENTORY OF MEASURED QUANTITIES OF DETERIORATION WAS PERFORMED IN JUNE OF 2025. EXACT DIMENSIONS AND LOCATIONS OF REPAIRS SHALL BE DETERMINED BY THE ENGINEER IN THE FIELD FOR FINAL PAY QUANTITIES.

2 SQ. FT.

- GROUND LINE

TYPE	MEASURED QUANTITIES	ESTIMATING FACTOR*	ESTIMATED QUANTITIES		
PIER 1N PATCHING	94 SQ. FT.	1.5	141 SQ. FT.		
PIER 1N ANODES	155	1.5	233		

\* - ESTIMATED QUANTITIES HAVE BEEN INCREASED BY 50% OVER MEASURED QUANTITIES TO ALLOW FOR ADDITIONAL DETERIORATION.

### **LEGEND**

### HIGH CORROSION RISK CATEGORY WITH A 30 YEAR INSTALLATION. SUPPLY ANODES WITH A MINIMUM CORE OF 210 GRAMS OF ZINC. SEE THIS SHEET FOR DISTRIBUTION.

10 SQ. FT. 23 ANODES @ 8" MAX


4 SQ. FT.

<u>PIER 1N - EAST ELEVATION</u>

(LOOKING WEST)



3102807 ESIGN AGENCY

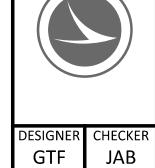

REVIEWER

CAH 7-14-25

114515

ROJECT ID

HORIZONTAL SURFACE OF CAP, WITH EPOXY-URETHANE. SEE TYPICAL SEALING DETAILS.

19.0

/9/

3

50

DRIVE

**PRIVATE** 

CREEK

CSX RR,

CIND RR,

OVER

50

WESTBOUN

17

SUMMARY OF REPAIR AREAS

PHYSICAL INVENTORY OF MEASURED QUANTITIES OF DETERIORATION WAS PERFORMED IN JUNE OF 2025.

EXACT DIMENSIONS AND LOCATIONS OF REPAIRS SHALL BE DETERMINED BY THE ENGINEER IN THE FIELD FOR FINAL PAY QUANTITIES. FSTIMATING FSTIMATED MFASURFD

TYPE	QUANTITIES	FACTOR*	QUANTITIES
PIER 4N PATCHING	7 SQ. FT.	1.5	11 SQ. FT.
PIER 7N PATCHING	55 SQ. FT.	1.5	83 SQ. FT.
SS844 PATCHING		1.5	
PIER 7N ANODES	268	1.5	402
PIER 4N ANODES	22	1.5	33


\* - ESTIMATED QUANTITIES HAVE BEEN INCREASED BY 50% OVER MEASURED QUANTITIES TO ALLOW FOR ADDITIONAL DETERIORATION.

### **LEGEND**


- AREA TO BE REPAIRED WITH ITEM 519 -PATCHING CONCRETE STRUCTURE, AS PER PLAN

### **NOTES**

- 1. ALL DIMENSIONS ARE ±.
- 2. ALL ESTIMATED AREAS ARE GIVEN AS WIDTH x HEIGHT.
- 3. REPAIR CONCRETE SHALL BE HYDRAULIC CEMENT-BASED MATERIAL WITH A ELECTRICAL RESISTIVITY LESS THAN 50,000 OHM-CM ACCORDING TO ASTM C 1760. DO NOT USE NON- CONDUCTIVE REPAIR MATERIALS SUCH AS MAGNESIUM AMMONIUM PHOSPHATE CONCRETE AND EPOXY MORTARS OR BONDING AGENTS. CONCRETE MIXES CONTAINING HIGH LEVELS OF SUPPLEMENTARY CEMENTITIOUS MATERIALS SUCH AS SILICA FUME, GROUND GRANULATED BLAST FURNACE SLAG, LATEX, FLY ASH OR METAKAQLIN MAX NOT MEET THE RESISTIVITY REQUIREMENT. THE GALVANIC ANODE SIZE AND SPACING IS BASED ON ACHIEVING A CURRENT DENSITY FOR THE EXTREMELY HIGH CORROSION RISK CATEGORY WITH A 30 YEAR INSTALLATION. SUPPLY ANODES WITH A MINIMUM CORE OF 210 GRAMS OF ZINC. SEE THIS SHEET FOR DISTRIBUTION.
- 4. SEAL ENTIRE EXPOSED SURFACE AREA OF ABUTMENT AND WING WALLS, EXCEPT FOR TOP HORIZONTAL SURFACE OF CAP, WITH EPOXY-URETHANE. SEE TYPICAL SEALING DETAILS.

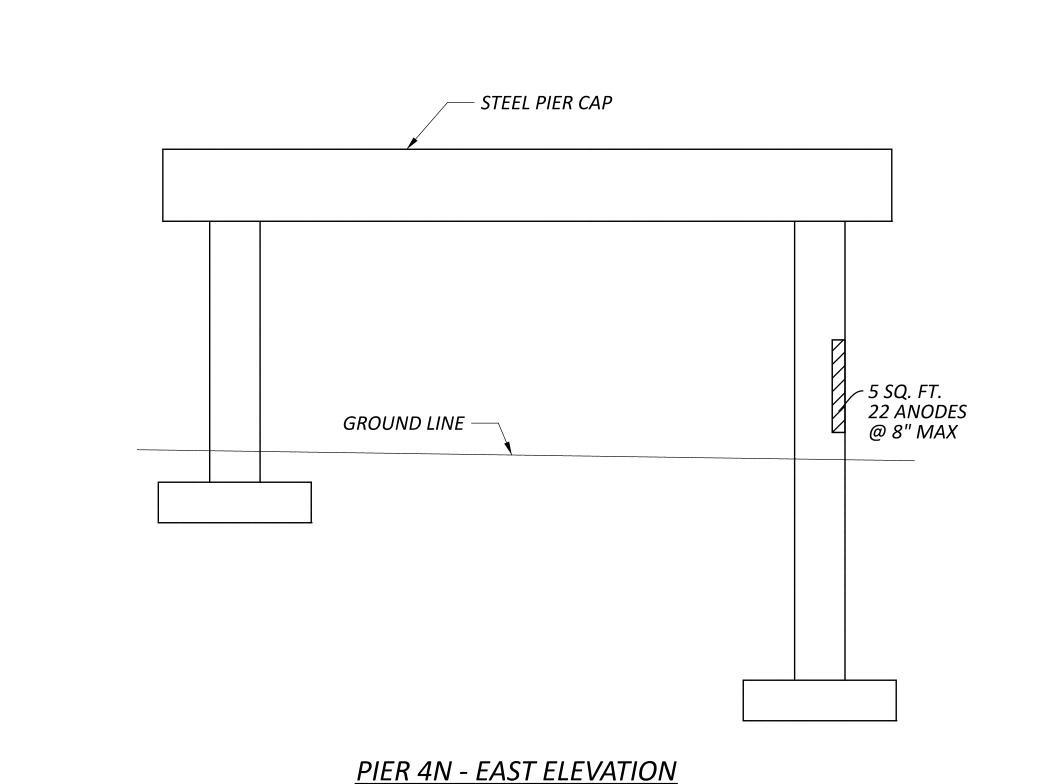

(LOOKING WEST)

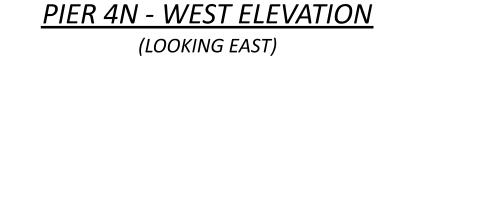


- STEEL PIER CAP

GROUND LINE -


2 SQ. FT.

3.76/19.03

50

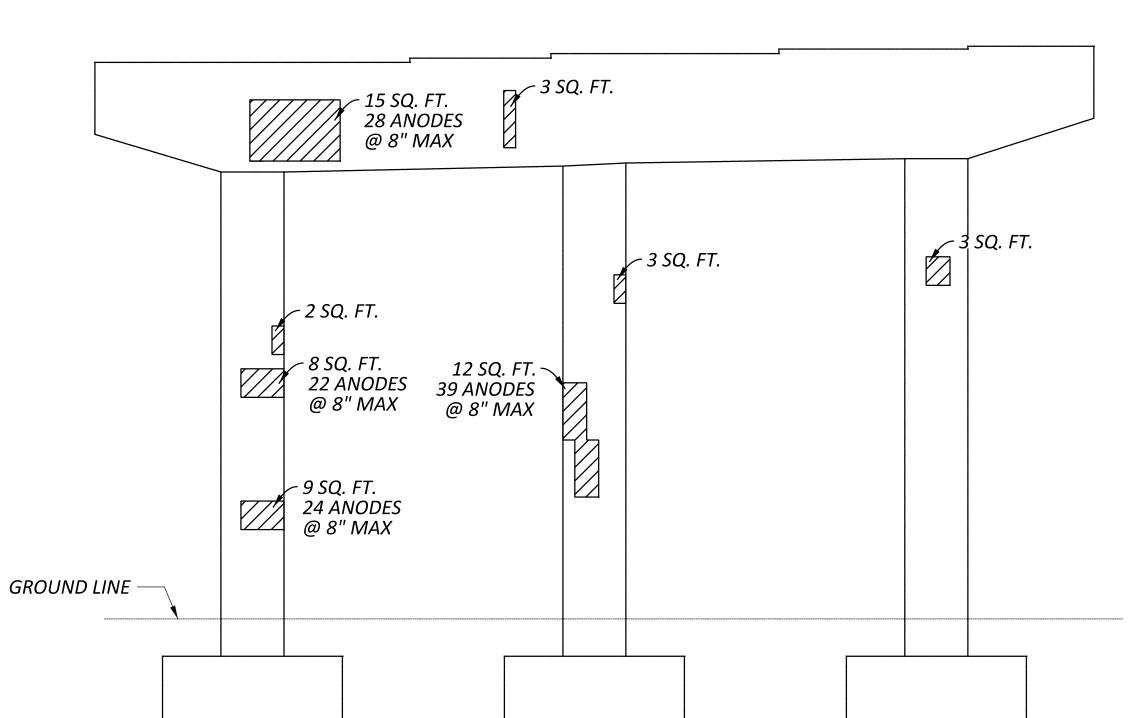

**PIER 7N - WEST ELEVATION** (LOOKING EAST)

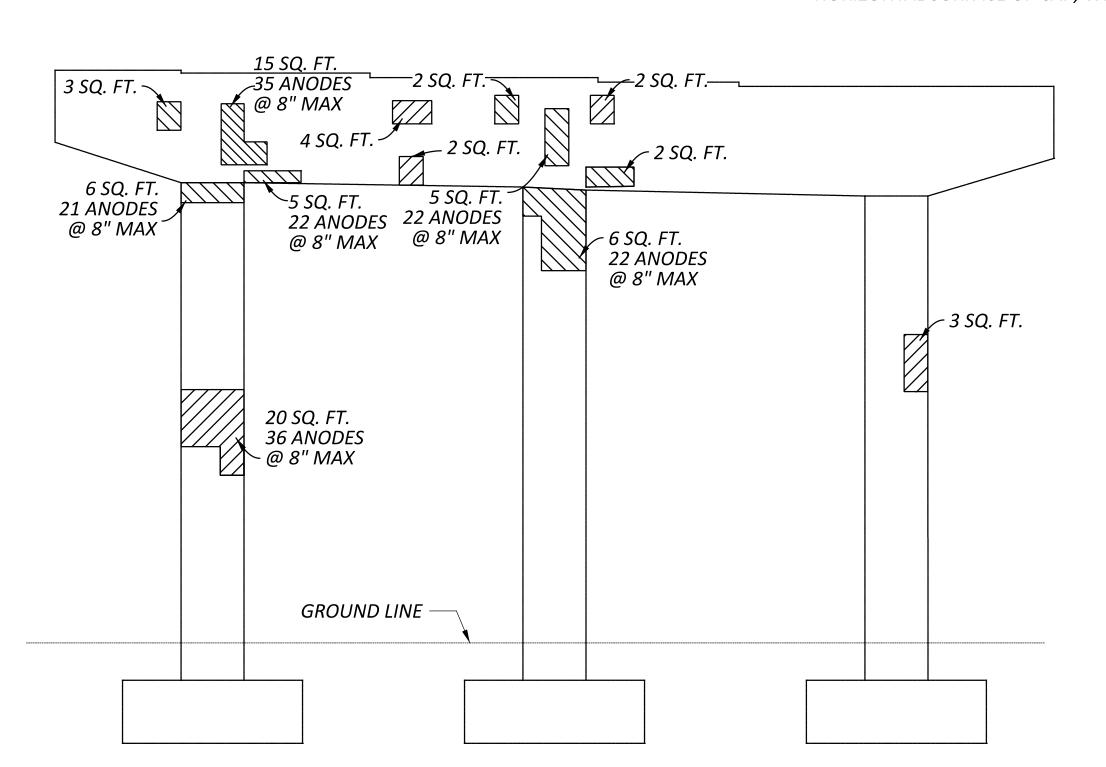

**PIER 7N - EAST ELEVATION** 

(LOOKING WEST)

3102807 ESIGN AGENCY




DESIGNER CHECKER GTF JAB REVIEWER CAH 7-14-25 114515



GROUND LINE 2 SQ. FT.

PIER 8N - WEST ELEVATION

(LOOKING EAST)

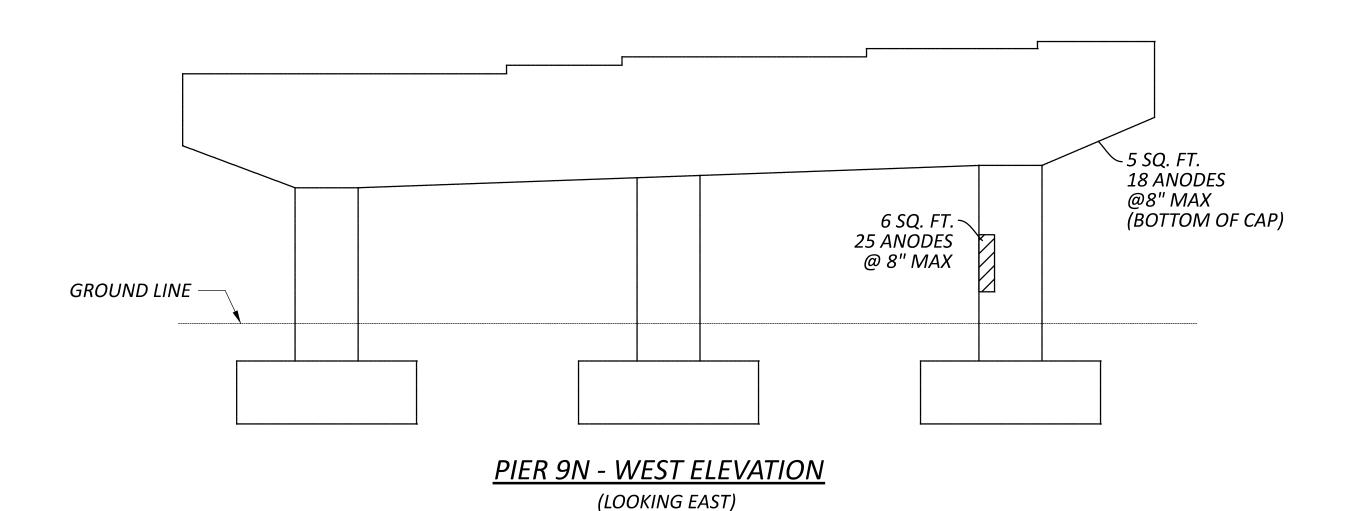

### SUMMARY OF REPAIR AREAS PHYSICAL INVENTORY OF MEASURED QUANTITIES OF DETERIORATION WAS PERFORMED IN JUNE OF 2025. EXACT DIMENSIONS AND LOCATIONS OF REPAIRS SHALL BE DETERMINED BY THE ENGINEER IN THE FIELD FOR FINAL PAY QUANTITIES. MEASURED **ESTIMATING ESTIMATED** TYPE FACTOR\* **QUANTITIES QUANTITIES** 2 SQ. FT. 3 SQ. FT. PIER 9N PATCHING 11 SQ. FT. 18 SQ. FT. 1.5 **ANODES** \* - ESTIMATED QUANTITIES HAVE BEEN INCREASED BY 50% OVER MEASURED QUANTITIES TO ALLOW FOR ADDITIONAL


**LEGEND** 

DETERIORATION.

- AREA TO BE REPAIRED WITH ITEM 519 -PATCHING CONCRETE STRUCTURE, AS PER PLAN


### **NOTES**


- 1. ALL DIMENSIONS ARE ±.
- 2. ALL ESTIMATED AREAS ARE GIVEN AS WIDTH x HEIGHT.
- 3. REPAIR CONCRETE SHALL BE HYDRAULIC CEMENT-BASED MATERIAL WITH A ELECTRICAL RESISTIVITY LESS THAN 50,000 OHM-CM ACCORDING TO ASTM C 1760. DO NOT USE NON- CONDUCTIVE REPAIR MATERIALS SUCH AS MAGNESIUM AMMONIUM PHOSPHATE CONCRETE AND EPOXY MORTARS OR BONDING AGENTS. CONCRETE MIXES CONTAINING HIGH LEVELS OF SUPPLEMENTARY CEMENTITIOUS MATERIALS SUCH AS SILICA FUME, GROUND GRANULATED BLAST FURNACE SLAG, LATEX, FLY ASH OR METAKAOLIN MAY NOT MEET THE RESISTIVITY REQUIREMENT. THE GALVANIC ANODE SIZE AND SPACING IS BASED ON ACHIEVING A CURRENT DENSITY FOR THE EXTREMELY HIGH CORROSION RISK CATEGORY WITH A 30 YEAR INSTALLATION. SUPPLY ANODES WITH A MINIMUM CORE OF 210 GRAMS OF ZINC. SEE THIS SHEET FOR DISTRIBUTION.
- 4. SEAL ENTIRE EXPOSED SURFACE AREA OF ABUTMENT AND WING WALLS, EXCEPT FOR TOP HORIZONTAL SURFACE OF CAP, WITH EPOXY-URETHANE. SEE TYPICAL SEALING DETAILS.

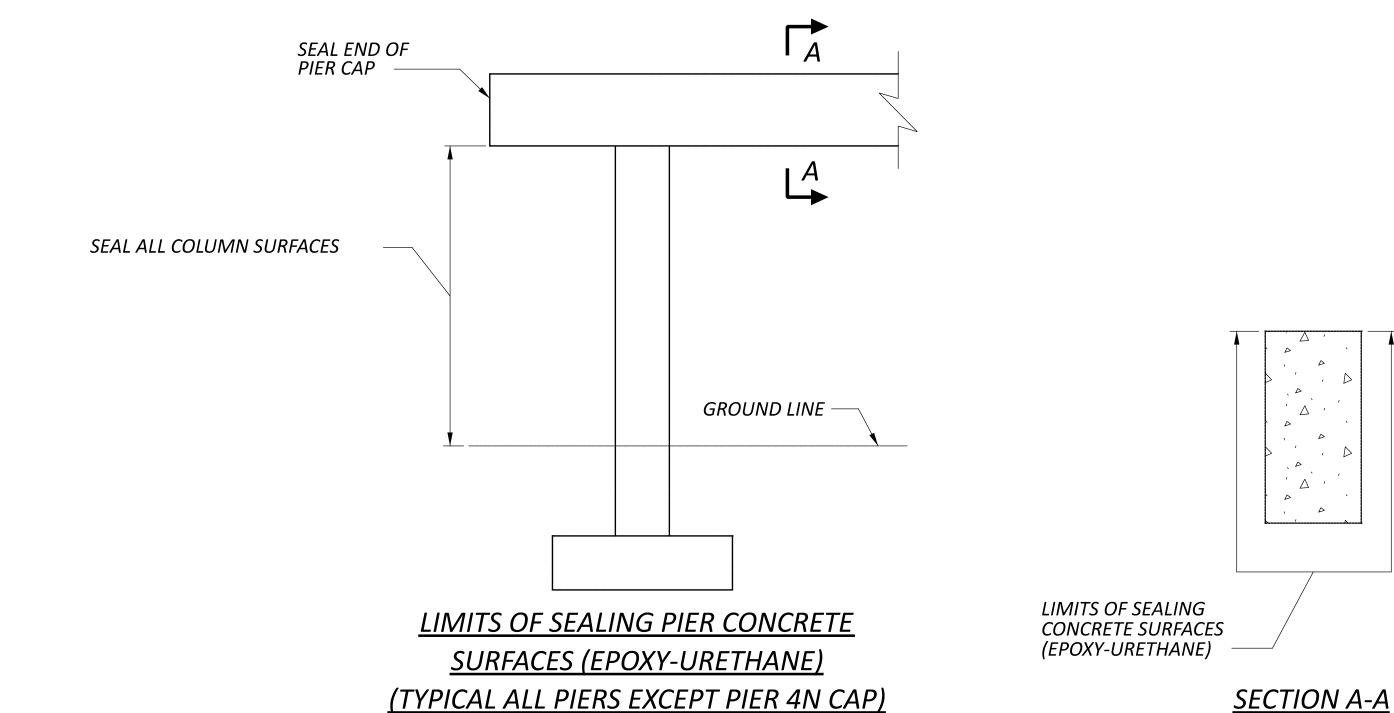



SFN
3102807
DESIGN AGENCY



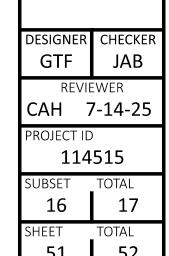

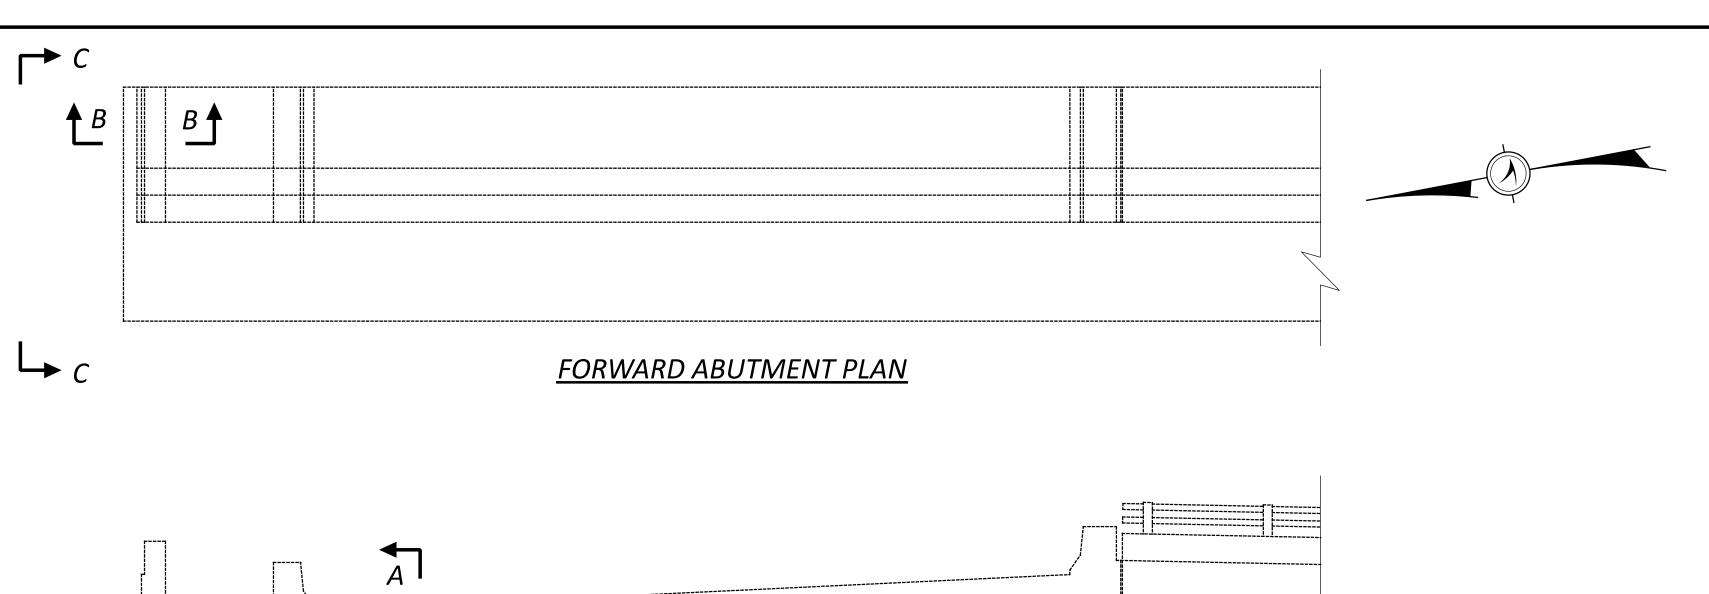

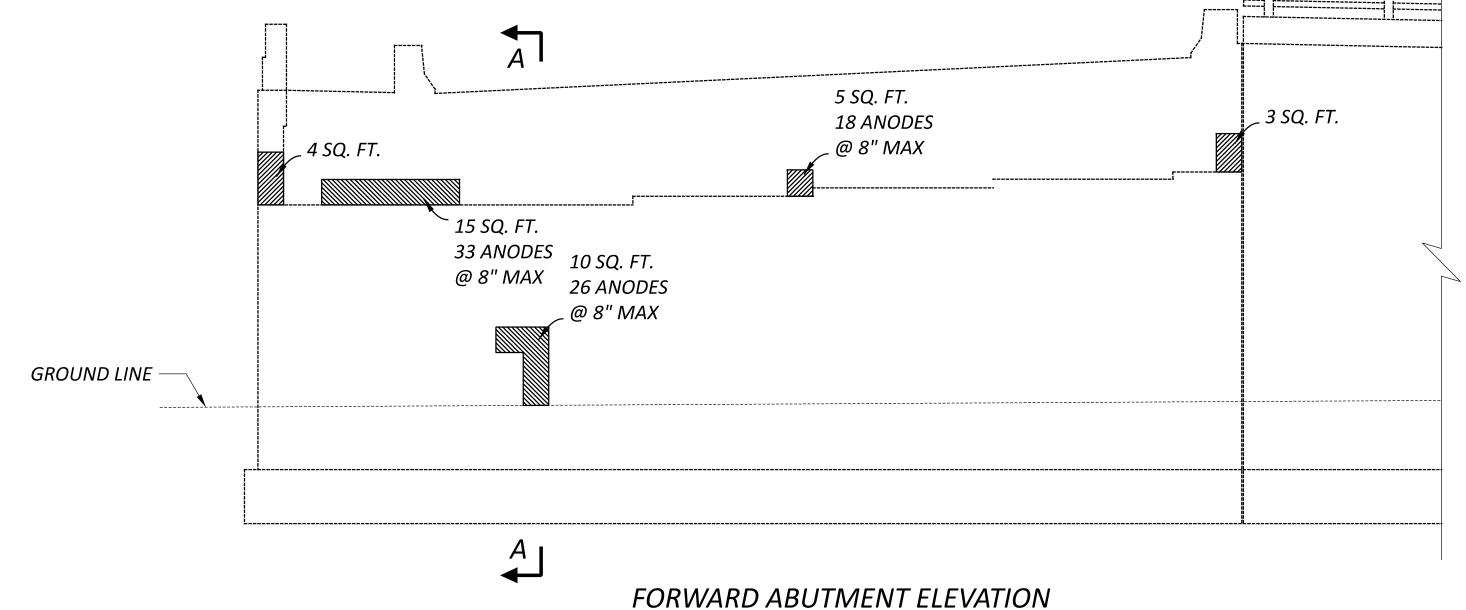

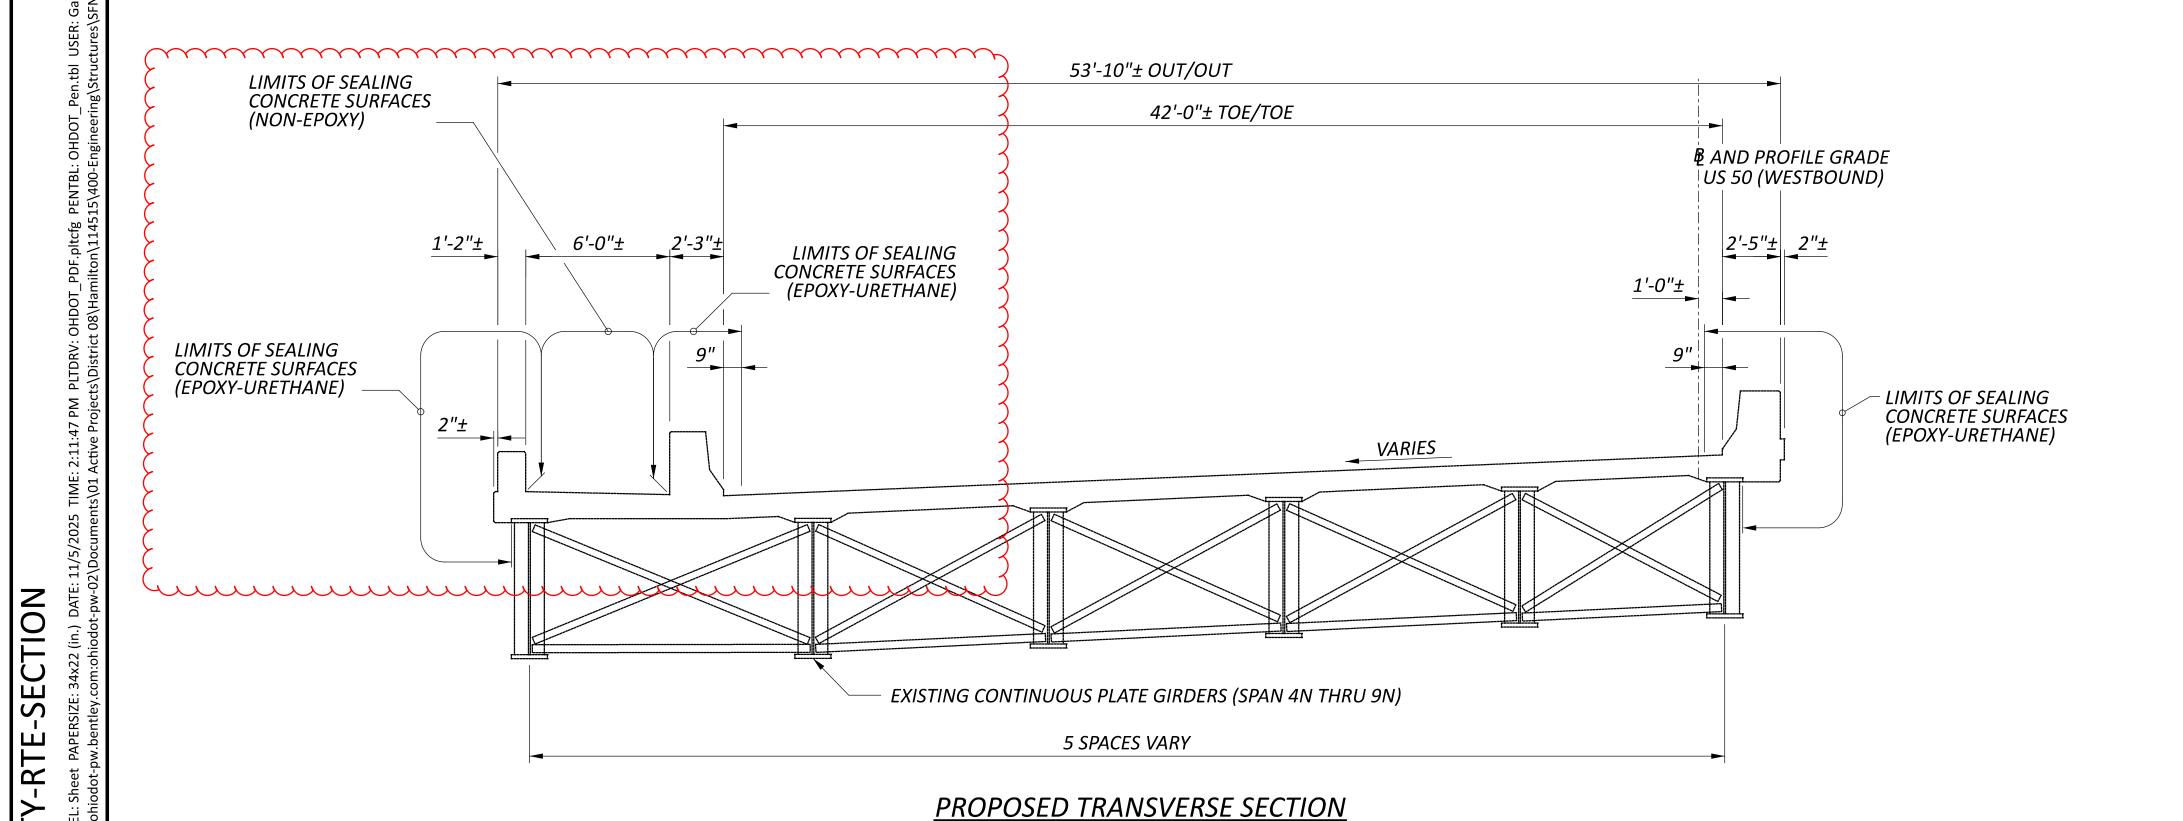

(WESTBOUND STA. 5+70± TO STA. 13+10±, LOOKING EAST)

### SUMMARY OF REPAIR AREAS PHYSICAL INVENTORY OF MEASURED QUANTITIES OF DETERIORATION WAS PERFORMED IN JUNE OF 2025. EXACT DIMENSIONS AND LOCATIONS OF REPAIRS SHALL BE DETERMINED BY THE ENGINEER IN THE FIELD FOR FINAL PAY QUANTITIES. MEASURED **ESTIMATING** ESTIMATED TYPE **QUANTITIES** FACTOR\* **QUANTITIES** FOR. ABUT. 37 SQ. FT. 56 SQ. FT. FOR. ABUT. **ANODES**

\* - ESTIMATED QUANTITIES HAVE BEEN INCREASED BY 50% OVER MEASURED QUANTITIES TO ALLOW FOR ADDITIONAL DETERIORATION.

### **LEGEND**

- AREA TO BE REPAIRED WITH ITEM 519 -PATCHING CONCRETE STRUCTURE, AS PER PLAN

### NOTES

- 1. ALL DIMENSIONS ARE ±.
- 2. ALL ESTIMATED AREAS ARE GIVEN AS WIDTH x HEIGHT.
- 3. REPAIR CONCRETE SHALL BE HYDRAULIC CEMENT-BASED MATERIAL WITH A ELECTRICAL RESISTIVITY LESS THAN 50,000 OHM-CM ACCORDING TO ASTM C 1760. DO NOT USE NON- CONDUCTIVE REPAIR MATERIALS SUCH AS MAGNESIUM AMMONIUM PHOSPHATE CONCRETE AND EPOXY MORTARS OR BONDING AGENTS. CONCRETE MIXES CONTAINING HIGH LEVELS OF SUPPLEMENTARY CEMENTITIOUS MATERIALS SUCH AS SILICA FUME, GROUND GRANULATED BLAST FURNACE SLAG, LATEX, FLY ASH OR METAKAOLIN MAY NOT MEET THE RESISTIVITY REQUIREMENT. THE GALVANIC ANODE SIZE AND SPACING IS BASED ON ACHIEVING A CURRENT DENSITY FOR THE EXTREMELY HIGH CORROSION RISK CATEGORY WITH A 30 YEAR INSTALLATION. SUPPLY ANODES WITH A MINIMUM CORE OF 210 GRAMS OF ZINC. SEE THIS SHEET FOR DISTRIBUTION.
- 4. SEAL ENTIRE EXPOSED SURFACE AREA OF ABUTMENT AND WING WALLS, EXCEPT FOR TOP HORIZONTAL SURFACE OF CAP, WITH EPOXY-URETHANE. SEE TYPICAL SEALING DETAILS.

3102807
DESIGN AGENCY



DESIGNER CHECKER
GTF JAB

REVIEWER
CAH 7-14-25

PROJECT ID
114515

SUBSET TOTAL
17 17

SHEET TOTAL
52 52