

SHEET NUM.

PART.

ITEM

ITEM

GRAND

UNIT

DESCRIPTION

SEE SHEET NO.

01/IMS/44

EXT

TOTAL

ROADWAY

LS	201	11000	LS	
1	202	20010	1	EACH
96	202	35100	96	FT
1	202	58500	1	EACH
693	SPECIAL	20270000	693	FT
4,030	203	10000	4,030	CY
1,420	203	20000	1,420	CY

CLEARING AND GRUBBING	2
HEADWALL REMOVED	
PIPE REMOVED, 24" AND UNDER	
CATCH BASIN ABANDONED	
FILL AND PLUG EXISTING CONDUIT, 30" CMP	2
EXCAVATION	
EMBANKMENT	

EROSION CONTROL

835	659	00300	835	CY
7,500	659	10000	7,500	SY
1.01	659	20000	1.01	TON
1.05	659	31000	1.05	ACRE
41.5	659	35000	41.5	MGAL

TOPSOIL	
SEEDING AND MULCHING	
COMMERCIAL FERTILIZER	
LIME	
WATER	

894	670	00710	894	SY
5,000	832	30000	5,000	EACH

DITCH EROSION PROTECTION MAT, TYPE A	
EROSION CONTROL	

DRAINAGE

0.39	602	20000	0.39	CY
132	611	11200	132	FT

CONCRETE MASONRY	
24" CONDUIT, TYPE F, 707.33	

INCIDENTALS

LS	614	11000	LS	
LS	623	10000	LS	
LS	624	10000	LS	

MAINTAINING TRAFFIC	
CONSTRUCTION LAYOUT STAKES AND SURVEYING	
MOBILIZATION	

GENERAL SUMMARY

DESIGN AGENCY




DESIGNER
MLB

REVIEWER
TRB

PROJECT ID
116308




SHEET TOTAL
03 | 11

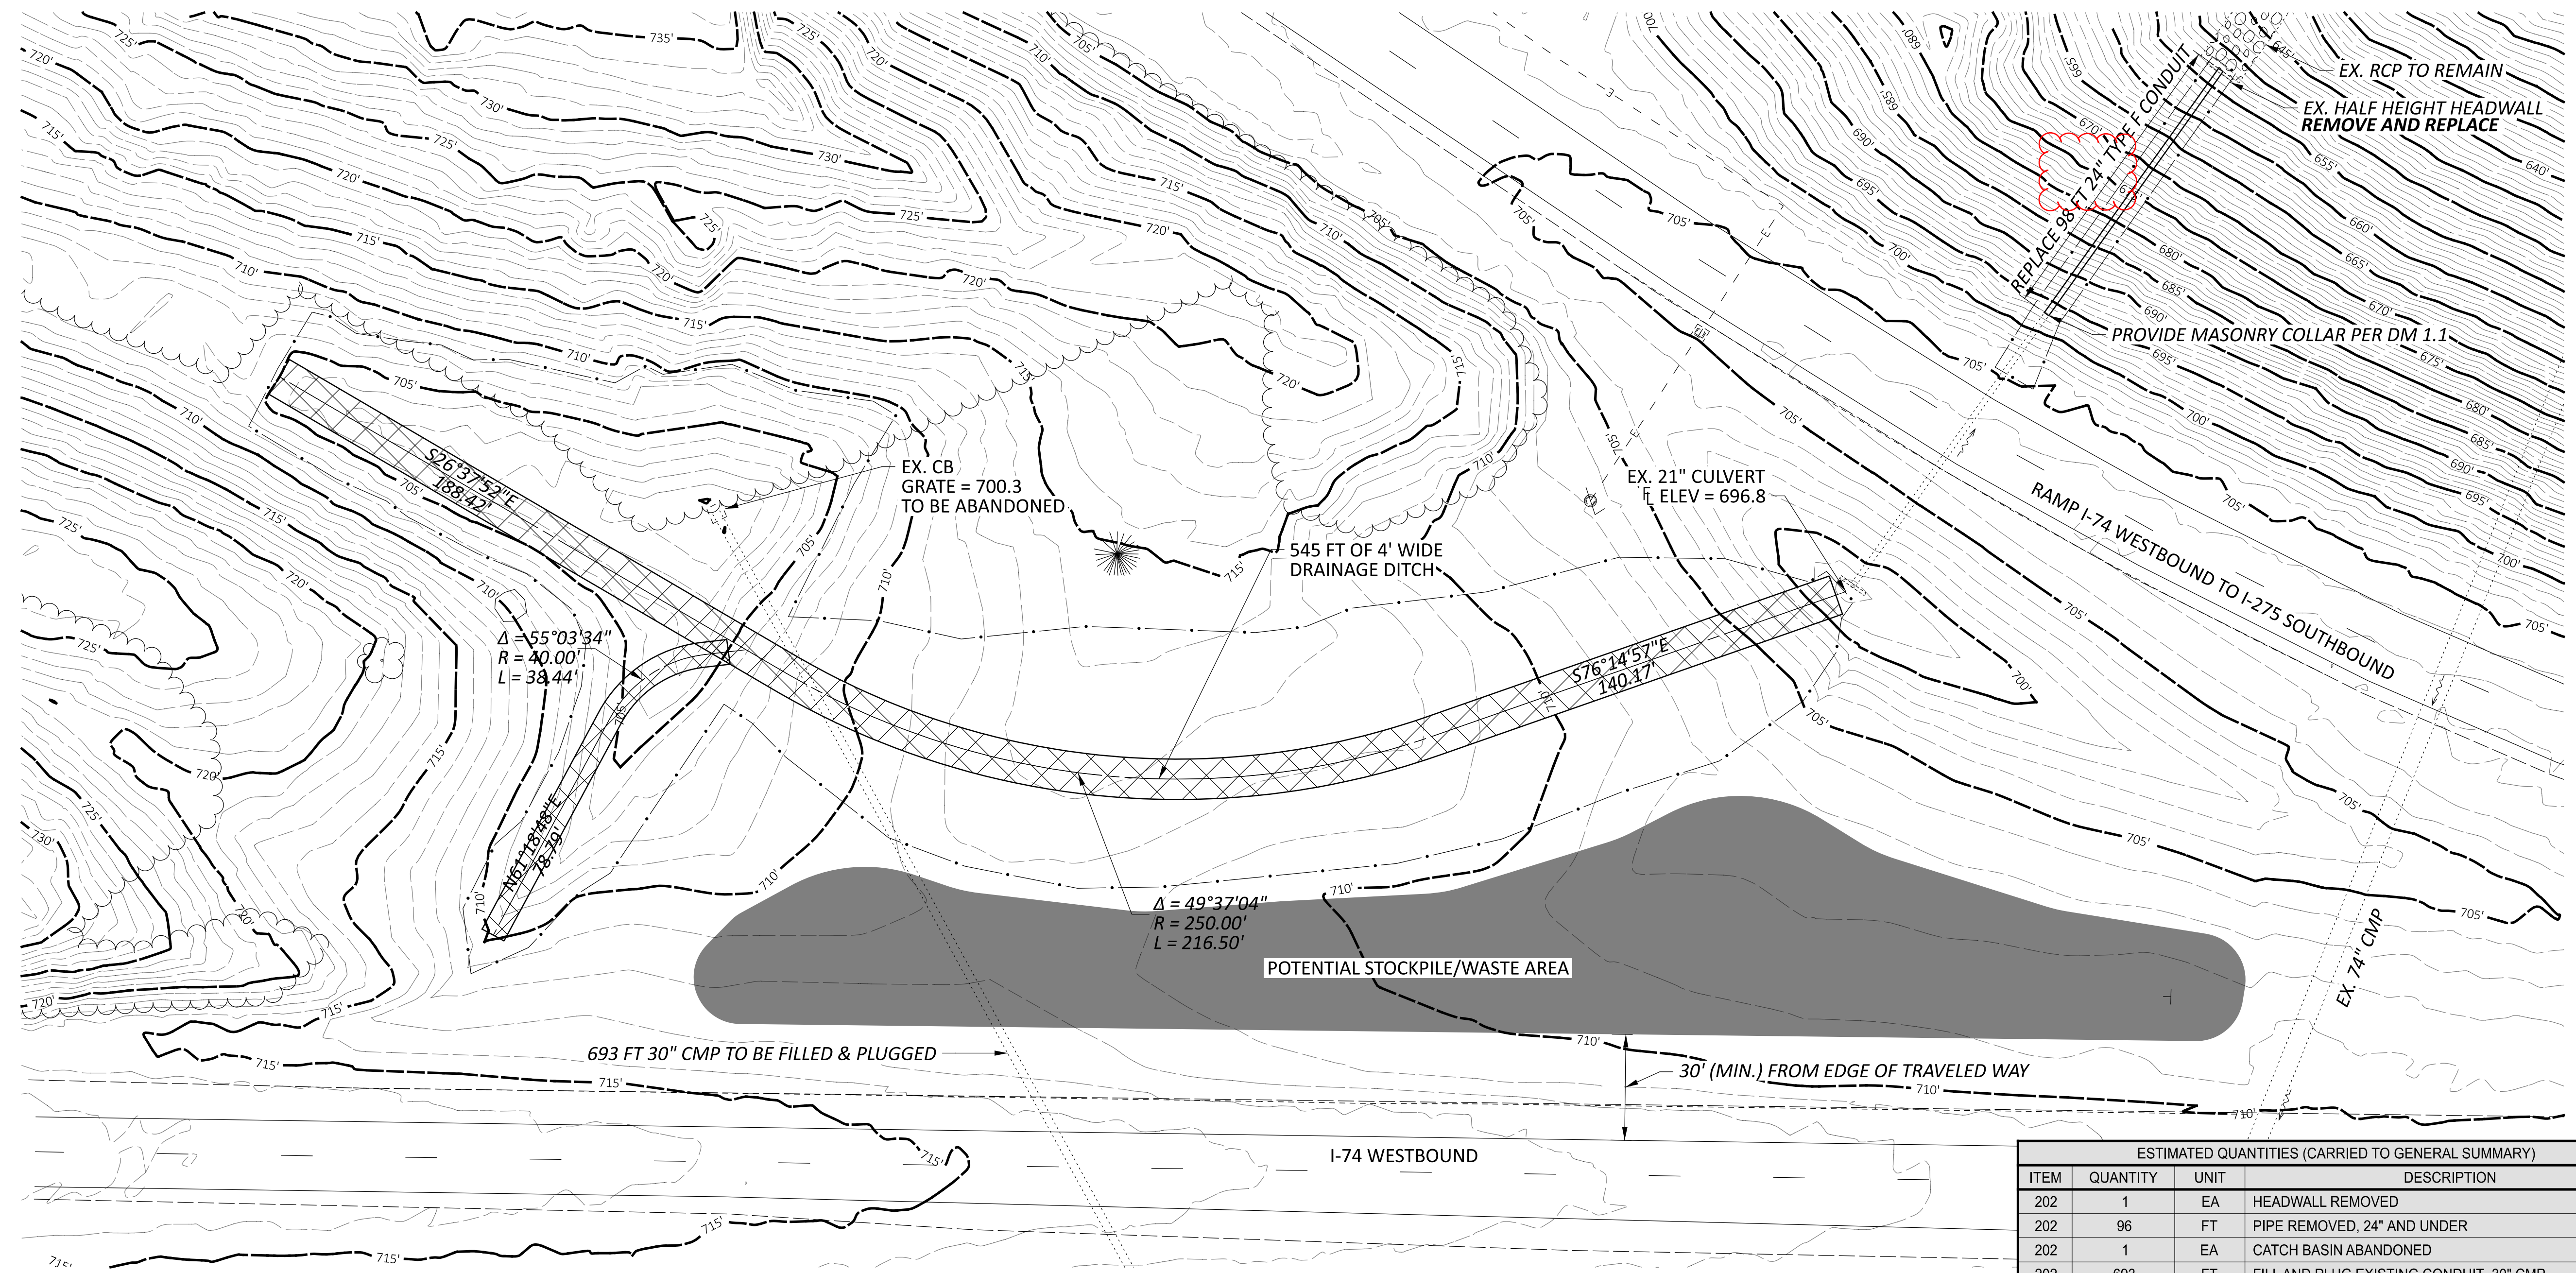

DITCH EROSION CONTROL MAT

CONSTRUCTION LAYOUT STAKES AND SURVEYING
 IF CONTRACTOR UTILIZED POTENTIAL STOCKPILE AREA TO WASTE EXCESS SOIL, CONTRACTOR SHALL PROVIDE PRE AND POST PROJECT SURVEY OF STOCKPILE AREA.

ESTIMATED QUANTITIES (CARRIED TO GENERAL SUMMARY)			
ITEM	QUANTITY	UNIT	DESCRIPTION
202	1	EA	HEADWALL REMOVED
202	96	FT	PIPE REMOVED, 24" AND UNDER
202	1	EA	CATCH BASIN ABANDONED
202	693	FT	FILL AND PLUG EXISTING CONDUIT, 30" CMP
203	4030	CY	EXCAVATION
203	1420	CY	EMBANKMENT
602	6.39	GY	CONCRETE MASONRY
611	98	FT	24" CONDUIT, 707.33
670	894	SY	DITCH EROSION PROTECTION MAT, TYPE A

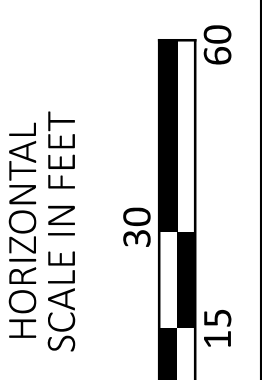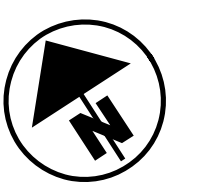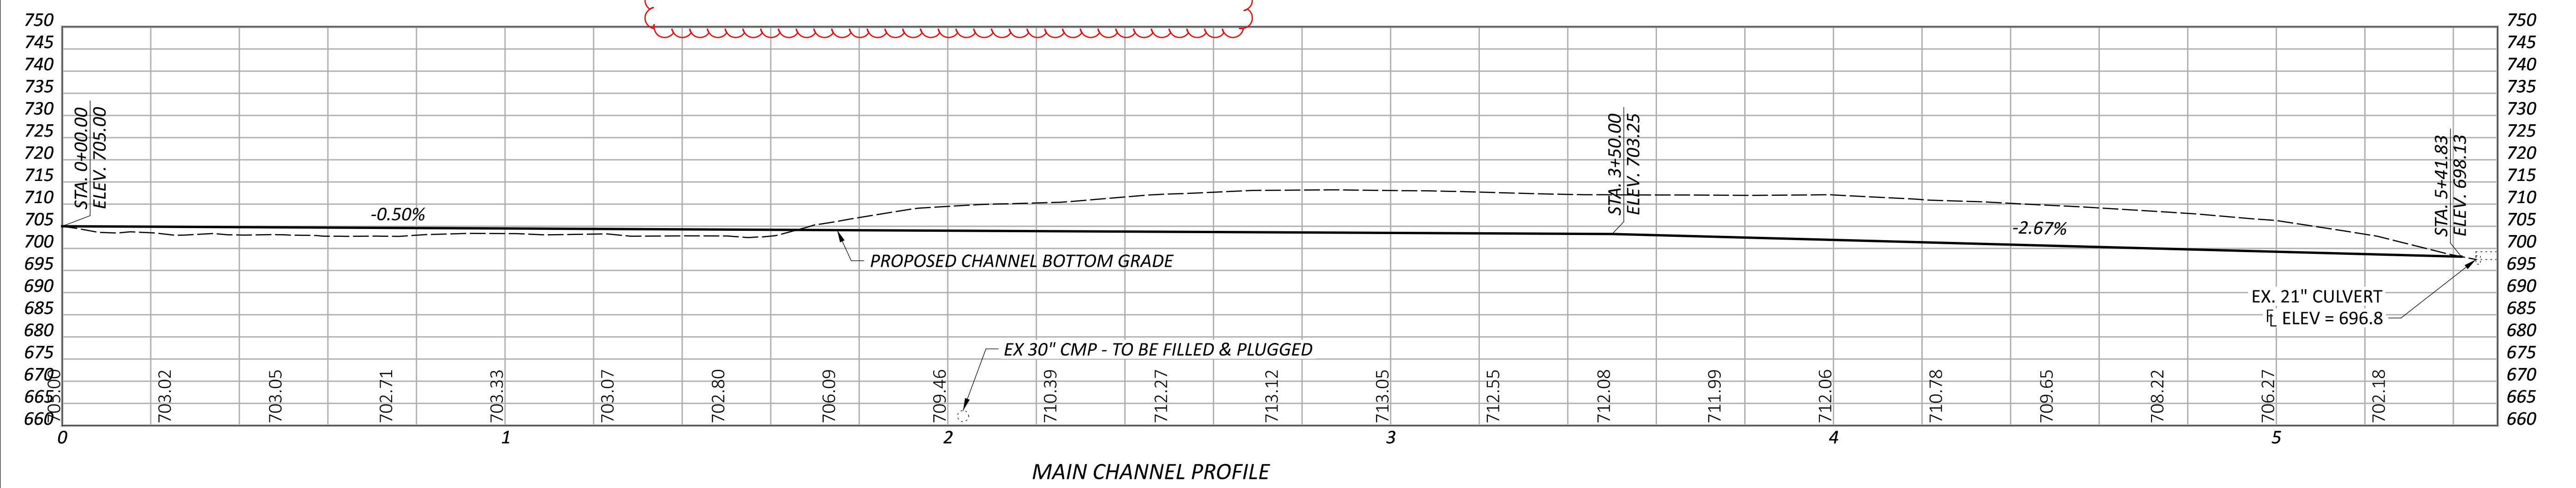

INFELD GRADING PLAN & PROFILE


DESIGN AGENCY




DESIGNER: **MLB**
 REVIEWER: **TRB**
 PROJECT ID: **116308**
 SHEET: **05** TOTAL: **11**

HAM-275-7.50 INFIELD GRADING

MODEL: Sheet PAPER: 34x22 (in.) DATE: 1/20/2023 TIME: 9:05:05 AM USER: mbailey5
 pw:\ohiodot-pw.bentley.com\ohiodot-pw-02\Documents\01 Active Projects\District 08\Hamilton\116308\400-Engineering\Drainage\Sheets\116308_DP004.dgn

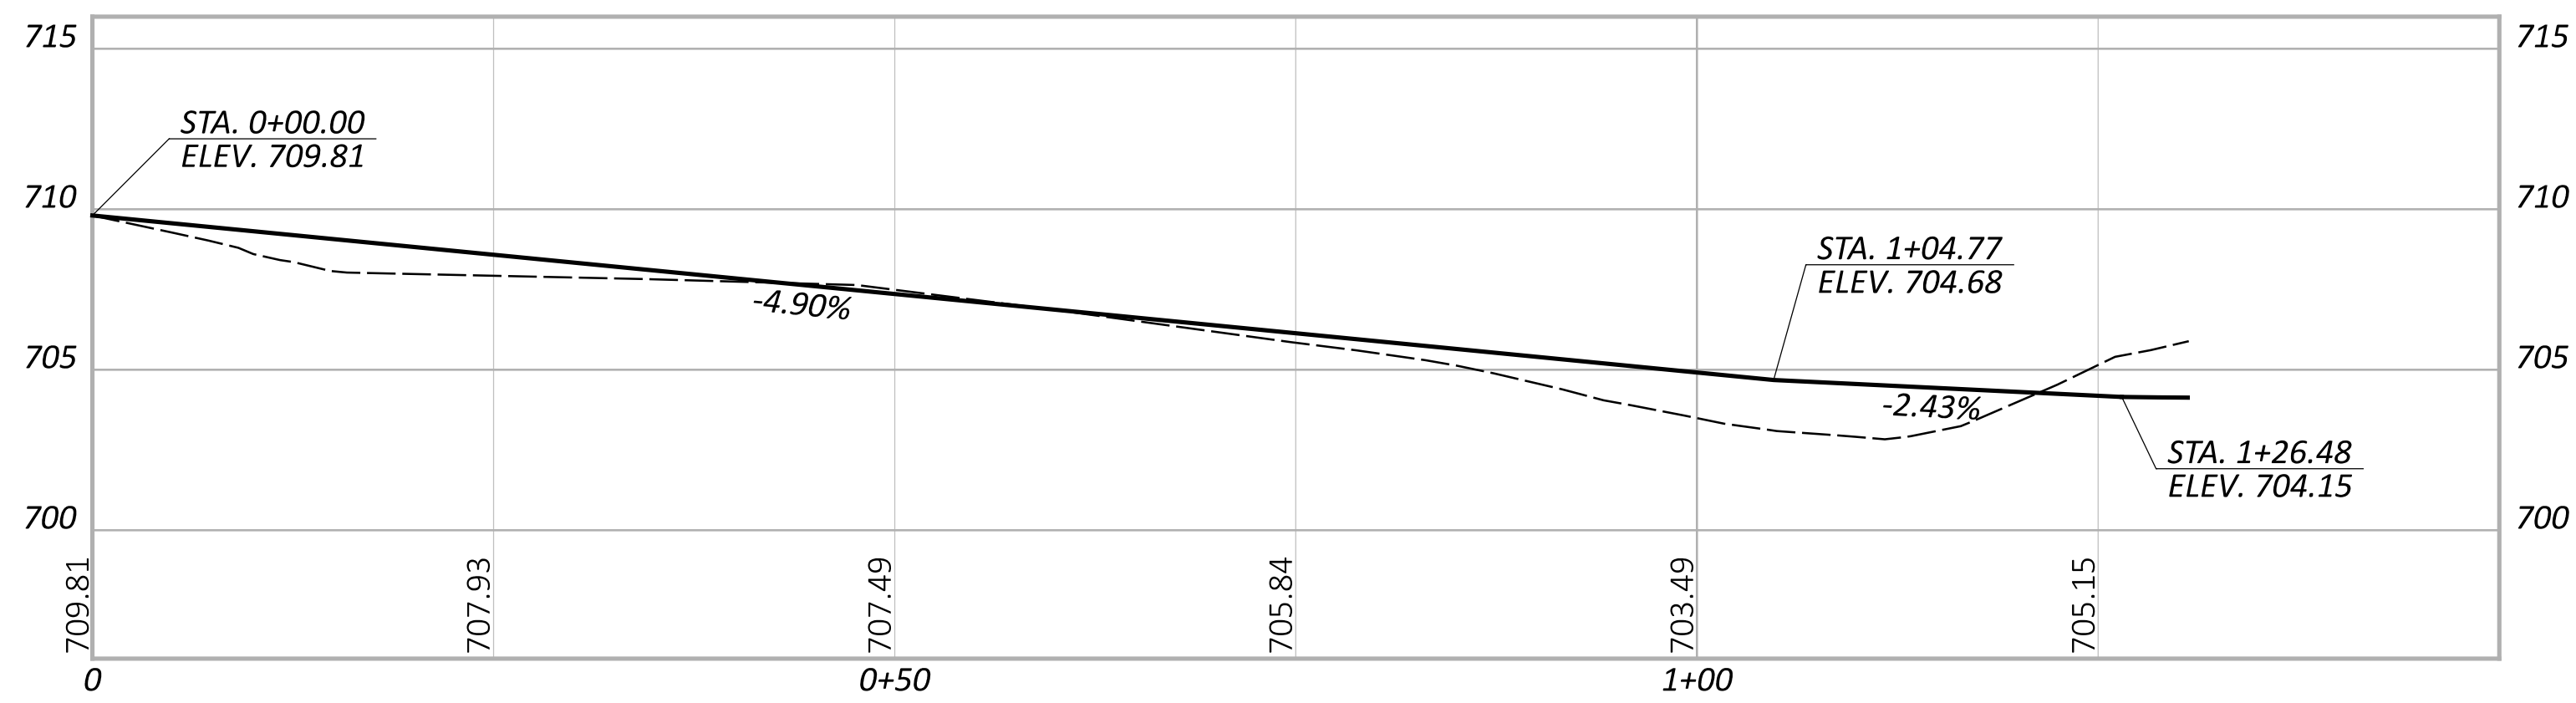

SIDE CHANNEL PROFILE
 SCALE: 1"=10'H, 1"=5'V

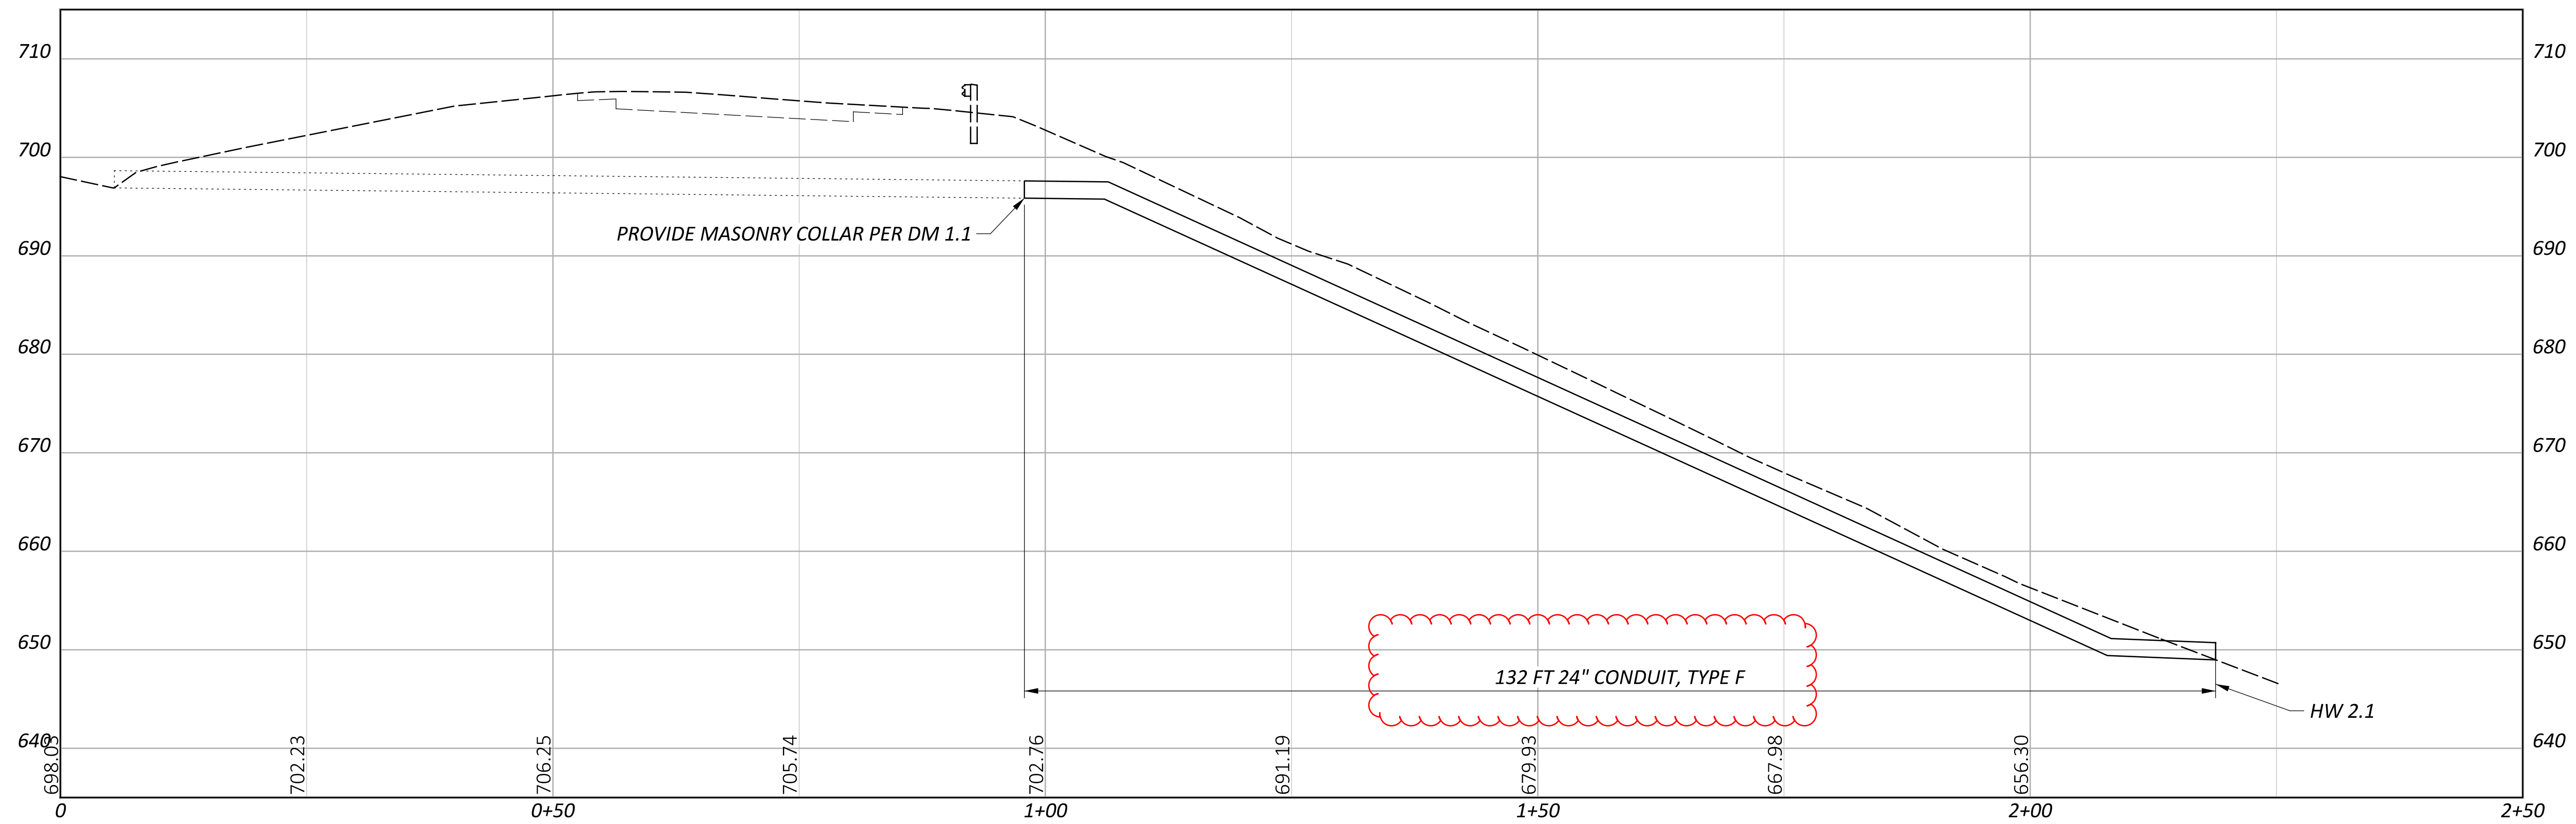

24" CULVERT PROFILE
 SCALE: 1"=10'H



INFIELD GRADING PLAN & PROFILE & DETAILS

DESIGN AGENCY



DESIGNER

MLB

REVIEWER

TRB

PROJECT ID

116308

SHEET

06

TOTAL

11