





10200 Alliance Road, Cincinnati, OH 45242
P: 513-842-8200 F: 513-842-8250

DESCRIPTION
Sanitary

PERSONNEL
Kleiner
Hensley

JOB NO. 173620162
SHEET NO. 1-2
DATE 6-20-23
WEATHER Cloudy
TEMP. 75 °F

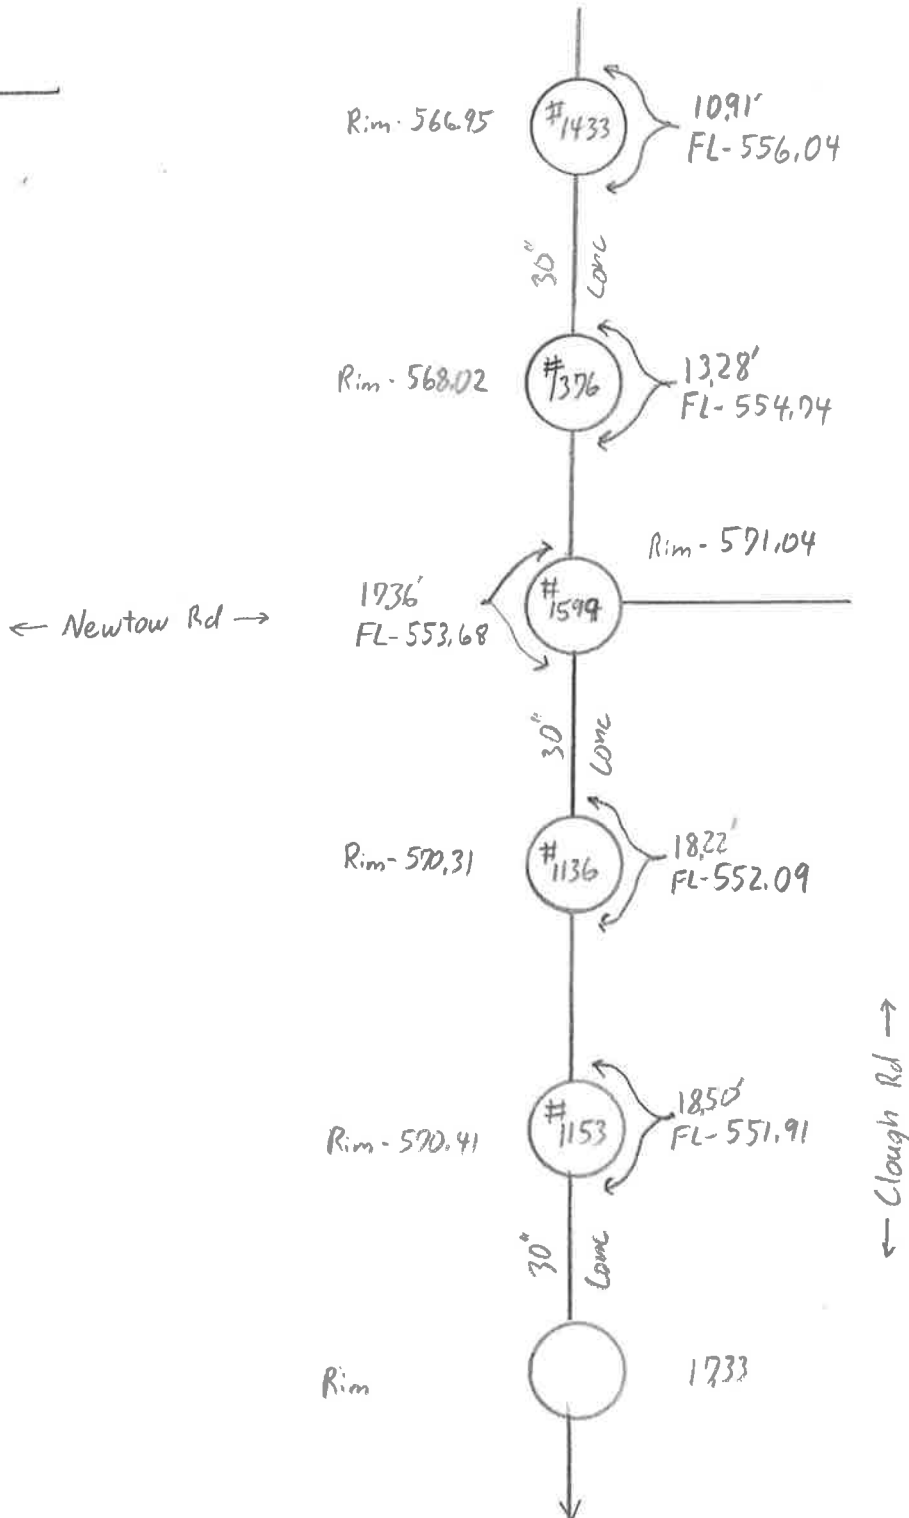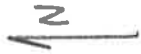



10200 Alliance Road, Cincinnati, OH 45242
P: 513-842-8200 F: 513-842-8250

DESCRIPTION
Storm

PERSONNEL
Kleiner
Hansley

JOB NO. 173620162
SHEET NO. 2-2
DATE 6-20-23
WEATHER Cloudy
TEMP. 75 °F

