

J:\pre-int\06-386\_HAM-75\HAM\00000\roadway\sheets\00000G\Y101.dgn 2021-01-09 4:26:46 PM william.croxton\ODOT\cadd\_PDF\_plt\cfig OD0TV8i\_Pen-ME.tbi IBI Group

**PROPOSED LEGEND**

- 1 ITEM 442 - (1.5") ASPHALT CONCRETE SURFACE COURSE, 12.5 MM, TYPE A (442), AS PER PLAN
- 2A ITEM 442 - (1.75") ASPHALT CONCRETE INTERMEDIATE COURSE, 19 MM, TYPE A (446), PG64-28
- 2B ITEM 442 - (VAR. DEPTH, 2" AVG) ASPHALT CONCRETE INTERMEDIATE COURSE, 19 MM, TYPE A (446), AS PER PLAN (0" MIN, 4" MAX)
- 3 ITEM 302 - 11" ASPHALT CONCRETE BASE, PG64-22 (PLACED IN TWO 5.5" LIFTS WITH 6" EDGE COURSE)
- 4 ITEM 407 - NON-TRACKING TACK COAT (APPLIED @ AVG 0.055 GAL/SY FOR NEW ASPHALT) (APPLIED @ AVG 0.085 GAL/SY FOR MILLED ASPHALT SURFACE)
- 5 ITEM 304 - (8") AGGREGATE BASE
- 6 CHEMICALLY STABILIZED SUBGRADE:  
 ITEM 204 - PROOF ROLLING (APPLIED @ 1 HR/2000 SY FOR RECONSTRUCTION) (APPLIED @ 1 HR/3000 SY FOR NEW CONSTRUCTION)  
 ITEM 206 - CEMENT (APPLIED @ 5% PER 115 LB/CF SOIL)  
 ITEM 206 - CEMENT STABILIZED SUBGRADE, 14 INCHES DEEP  
 ITEM 206 - CURING COAT  
 ITEM 206 - MIXTURE DESIGN FOR CHEMICALLY STABILIZED SOILS (SPECIFIED ON PROJECTS > 40,000 SY, SEE SUPPLEMENT 1120)
- 7 ITEM 442 - (1.5") ASPHALT CONCRETE SURFACE COURSE, 12.5 MM, TYPE A (442)
- 8A ITEM 442 - (1.75") ASPHALT CONCRETE INTERMEDIATE COURSE, 19MM, TYPE A (448), PG64-28
- 8B ITEM 442 - (VAR. DEPTH, 2" AVG) 1.75" ASPHALT CONCRETE INTERMEDIATE COURSE, 19MM, TYPE A (448), AS PER PLAN (0" MIN, 4" MAX)
- 9A ITEM 301 - ASPHALT CONCRETE BASE, PG64-22 (10" SHARON ROAD (PLACED IN TWO 5" LIFTS), 6" CHESTER ROAD)
- 9B ITEM 301 - (VAR. DEPTH, 2" AVG) ASPHALT CONCRETE BASE, PG64-22, AS PER PLAN (4" MIN, SHARON ROAD & CHESTER ROAD)
- 10 ITEM 204 - SUBGRADE COMPACTION  
 ITEM 204 - PROOF ROLLING (APPLIED @ 1 HR/2000 SY FOR RECONSTRUCTION) (APPLIED @ 1 HR/3000 SY FOR NEW CONSTRUCTION)
- 11 ITEM 605 - 6" BASE PIPE UNDERDRAINS (18" DEPTH)
- 12 ITEM 605 - 6" SHALLOW PIPE UNDERDRAINS (24" OR 30" DEPTH)
- 13 ITEM 659 - SEEDING AND MULCHING
- 14 ITEM 622 - CONCRETE BARRIER, SINGLE SLOPE, TYPE D
- 15 UNDERCUT AND REPLACE:  
 ITEM 204 - EXCAVATION OF SUBGRADE, 18 INCHES DEEP  
 ITEM 204 - GRANULAR MATERIAL, TYPE C  
 ITEM 204 - GEOTEXTILE FABRIC
- 16 ITEM 606 - GUARDRAIL, TYPE MGS
- 17 ITEM 452 - 13.5" NON-REINFORCED CONCRETE PAVEMENT, CLASS CQ1
- 18 ITEM 609 - COMBINATION CURB AND GUTTER, TYPE 2
- 19 ITEM 609 - COMBINATION CURB AND GUTTER, TYPE 2, AS PER PLAN (13.25" THICK)
- 20 ITEM 608 - 4" CONCRETE WALK
- 21 ITEM 526 - REINFORCED CONCRETE APPROACH SLABS (T=17")
- 23 ITEM 254 - PAVEMENT PLANING, ASPHALT CONCRETE (1"-3.25") (1" MIN, 3.25" MAX)
- 24 ITEM 252 - FULL DEPTH PAVEMENT SAWING
- 25 ITEM 601 - PAVED GUTTER, TYPE 4

**NOTES**


1. STATION EQUATION FOR I-75 MAINLINE SPLIT  
 STA. 358+82.52 @ CONST. I-75 SB BK.=  
 STA. 359+17.48 @ CONST. I-75 NB BK.=  
 STA. 359+00.00 @ CONST. I-75 AH.

2. THE PAVED SHOULDER WIDTHS IDENTIFIED WITH "#" INDICATES THE PAVED WIDTH IS EQUAL TO THE GRADED SHOULDER WIDTH.


3. THE EXISTING PAVEMENT BUILDUP (COMPOSITION AND DEPTHS) ARE BASED ON EXISTING PLAN INFORMATION AND AVERAGE RESULTS OF BORING LOCATIONS PER SUBSURFACE INVESTIGATION REPORT BY RESOURCE INTERNATIONAL DATED OCTOBER 2016

**EXISTING LEGEND**

- A EXISTING ASPHALT CONCRETE (3"± I-75 MAINLINE, 3"± RAMPS, 4" SHARON ROAD, 3" CHESTER ROAD)
- B EXISTING REINFORCED CONCRETE PAVEMENT (9" RAMPS, 9" SHARON ROAD, 10" I-75 MAINLINE)
- C EXISTING SUBBASE (VARIES 6-8", 6" TYP.)
- D EXISTING 3" WATERPROOFED BITUMINOUS BASE COURSE, TYPE B
- E EXISTING 5" STABILIZED CRUSHED AGGREGATE SHOULDERS
- F EXISTING CONCRETE CURB AND GUTTER
- G EXISTING CONCRETE WALK
- H 6"-10" ASPHALT CONCRETE BASE
- I EXISTING 12" BITUMINOUS 301 BASE
- J EXISTING 6" BITUMINOUS 301 BASE
- K EXISTING 5" BITUMINOUS 301 BASE
- L FUTURE EXISTING ITEM 442 - 1.5" ASPHALT CONCRETE SURFACE COURSE, 12.5 MM, TYPE A (446) (SEE HAM-75-12.60, PID 82288)
- M FUTURE EXISTING ITEM 442 - 1.75" ASPHALT CONCRETE INTERMEDIATE COURSE, 19 MM, TYPE A (446) (SEE HAM-75-12.60, PID 82288)
- N FUTURE EXISTING ITEM 302 - 13" ASPHALT CONCRETE BASE, PG64-22 (SEE HAM-75-12.60, PID 82288)
- O FUTURE EXISTING ITEM 304 - 6" AGGREGATE BASE (SEE HAM-75-12.60, PID 82288)
- P FUTURE EXISTING ITEM 622 - CONCRETE BARRIER, SINGLE SLOPE, TYPE B1 (STA. 324+00 TO STA. 327+00 @ CONST. I-75 SB) OR TYPE C1 (STA. 327+00 TO STA. 329+34.11 @ CONST. I-75 SB) (SEE HAM-75-12.60, PID 82288)
- Q EXISTING NON-REINFORCED CONCRETE PAVEMENT (13.5" RAMP C, RAMP G)

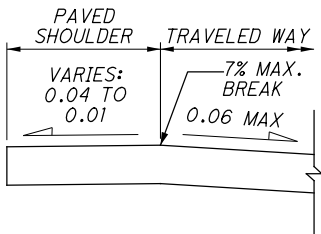


PAVED SHOULDER (3' TO 10' WIDTH) CROSS SLOPE DETAILS FOR HIGH SIDE OF SUPERELEVATED SECTION

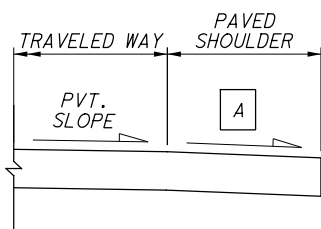


PAVED SHOULDER CROSS SLOPE DETAILS FOR LOW SIDE OF SUPERELEVATED SECTION


A 0.040 OR SAME SLOPE AS RATE OF SUPERELEVATION, WHICHEVER IS GREATER

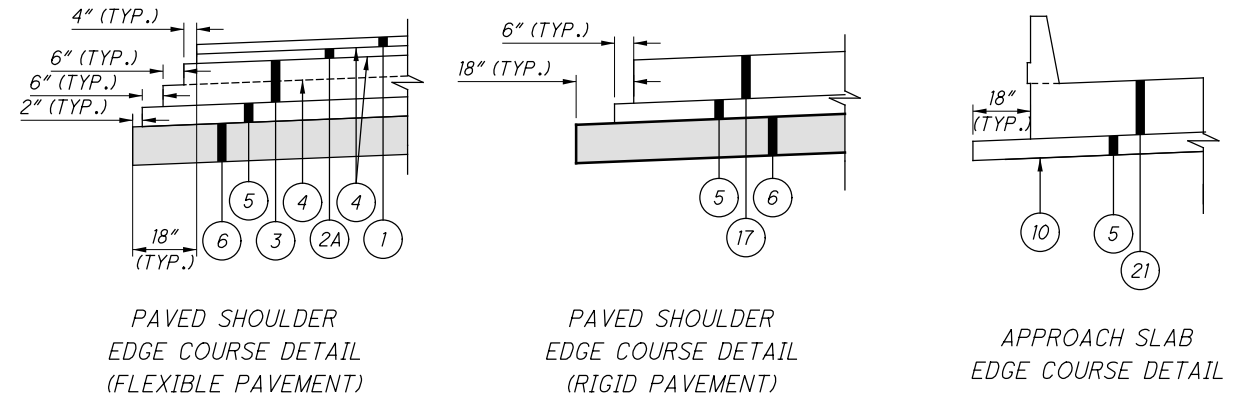


PAVED SHOULDER EDGE COURSE DETAIL (FLEXIBLE PAVEMENT)      PAVED SHOULDER EDGE COURSE DETAIL (RIGID PAVEMENT)      APPROACH SLAB EDGE COURSE DETAIL

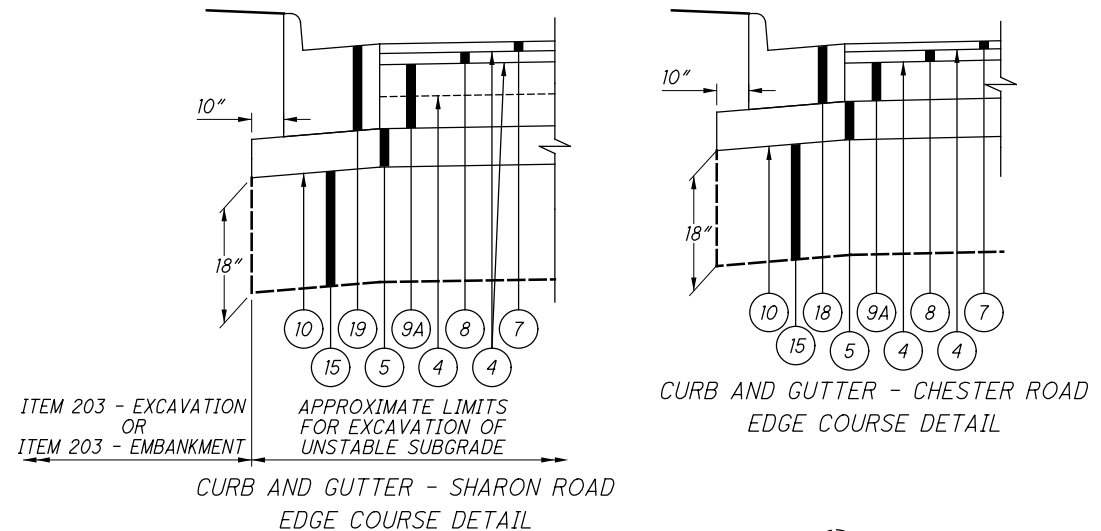

ITEM 203 - EXCAVATION OR ITEM 203 - EMBANKMENT      APPROXIMATE LIMITS FOR EXCAVATION OF UNSTABLE SUBGRADE      CURB AND GUTTER - SHARON ROAD EDGE COURSE DETAIL      CURB AND GUTTER - CHESTER ROAD EDGE COURSE DETAIL

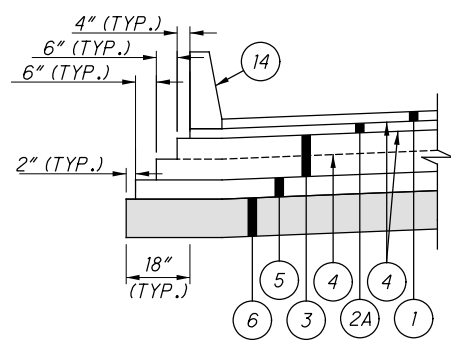


PAVED SHOULDER AND SINGLE SLOPE BARRIER, TYPE D EDGE COURSE DETAIL  
 DETAIL APPLIES:  
 STA. 325+00, LT. TO STA. 342+00, LT. (I-75 SB)

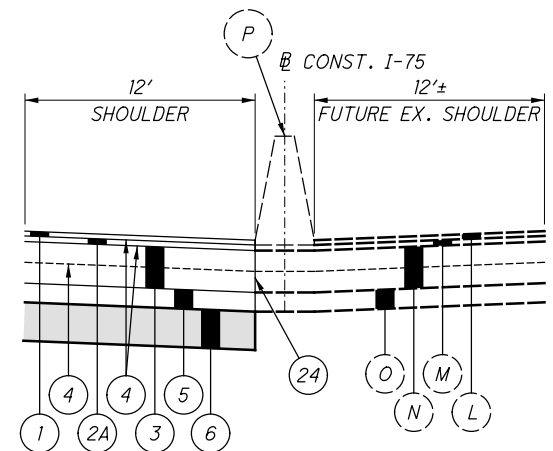


FUTURE EXISTING MEDIAN CONCRETE BARRIER DETAIL  
 DETAIL APPLIES:  
 STA. 324+00 TO STA. 329+34.11

- 1 5-20-2020 - ADDED BINDER TYPE (PG64-28) FOR ITEM 442E10101 AND ITEM 442E20201
- 2 1-15-2021 - UPDATED EX. PVT DEPTHS AND EARTHWORK EQ ON CROSS SECTIONS
- 3 1-15-2021 - ADDED ITEM 202-WEARING COURSE REMOVED REMOVED ITEM 202-PAVEMENT REMOVED, APP USE ITEM 202-PAVEMENT REMOVED, COMBINE INTO SINGLE PAY ITEM


j:\pre-int\06\06-386\_HAM-75\HAM\00000\roadway\sheets\00000GY102.dgn 2021-01-09 4:33:54 PM e\_william.crofton\ODOTcadd\_PDF.plcfig ODOTV81\_Pen-ME.tbl IBI Group

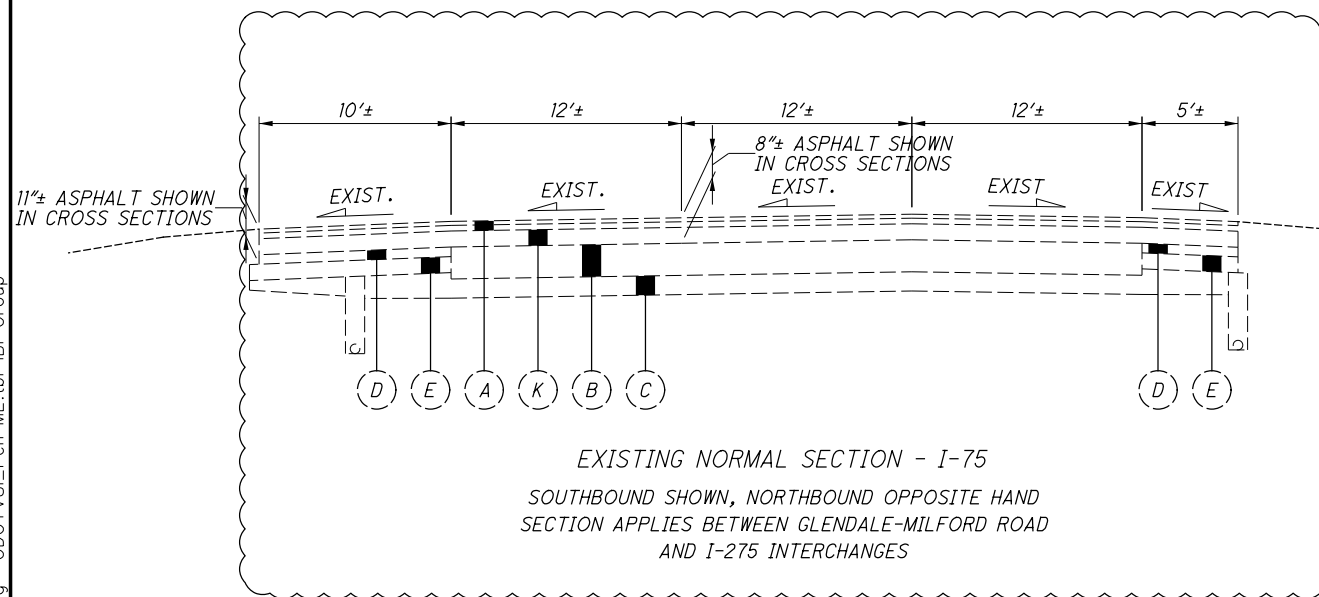


EXISTING NORMAL SECTION - I-75  
 SOUTHBOUND SHOWN, NORTHBOUND OPPOSITE HAND  
 SECTION APPLIES BETWEEN GLENDALE-MILFORD ROAD  
 AND I-275 INTERCHANGES

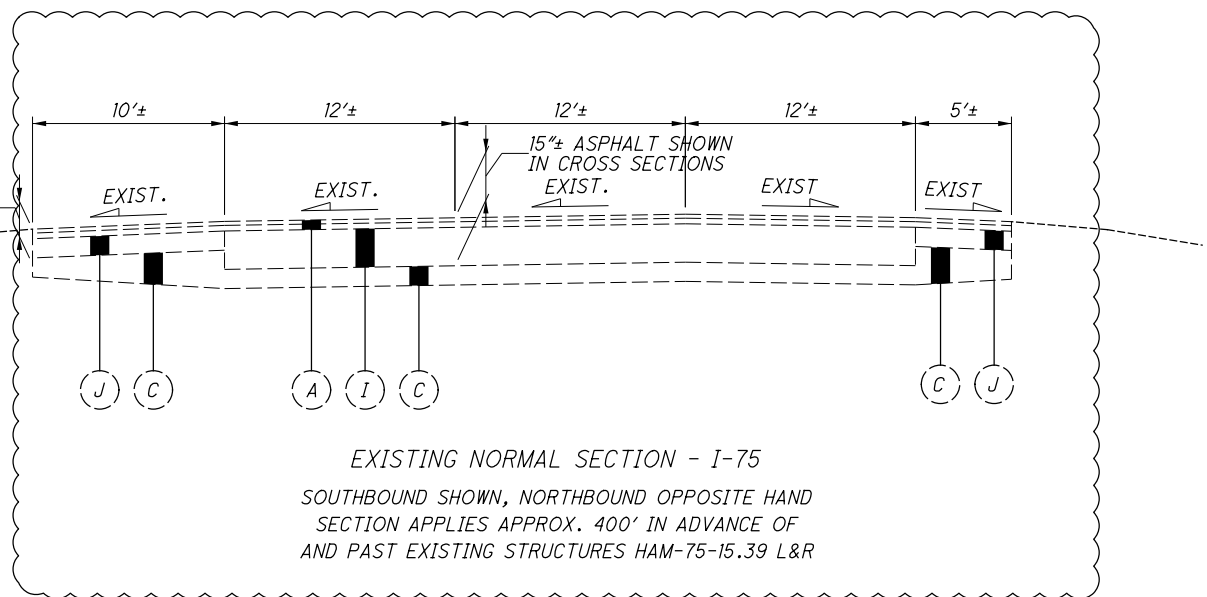


EXISTING NORMAL SECTION - I-75  
 SOUTHBOUND SHOWN, NORTHBOUND OPPOSITE HAND  
 SECTION APPLIES APPROX. 400' IN ADVANCE OF  
 AND PAST EXISTING STRUCTURES HAM-75-15.39 L&R

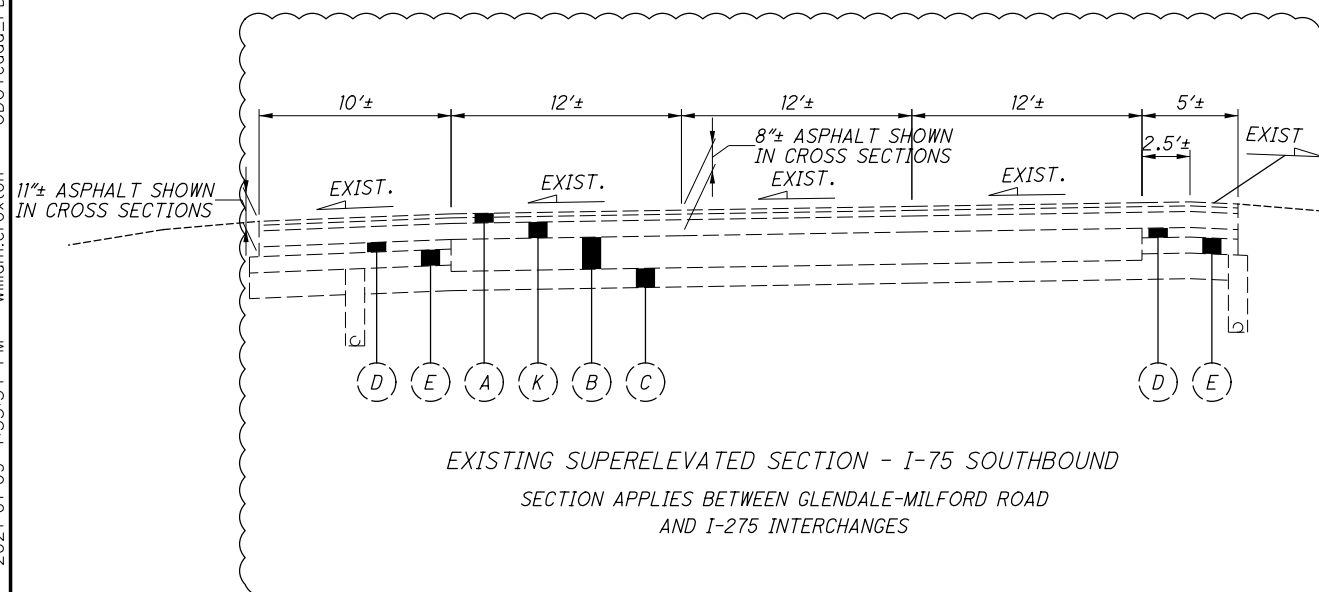


EXISTING SUPERELEVATED SECTION - I-75 SOUTHBOUND  
 SECTION APPLIES BETWEEN GLENDALE-MILFORD ROAD  
 AND I-275 INTERCHANGES

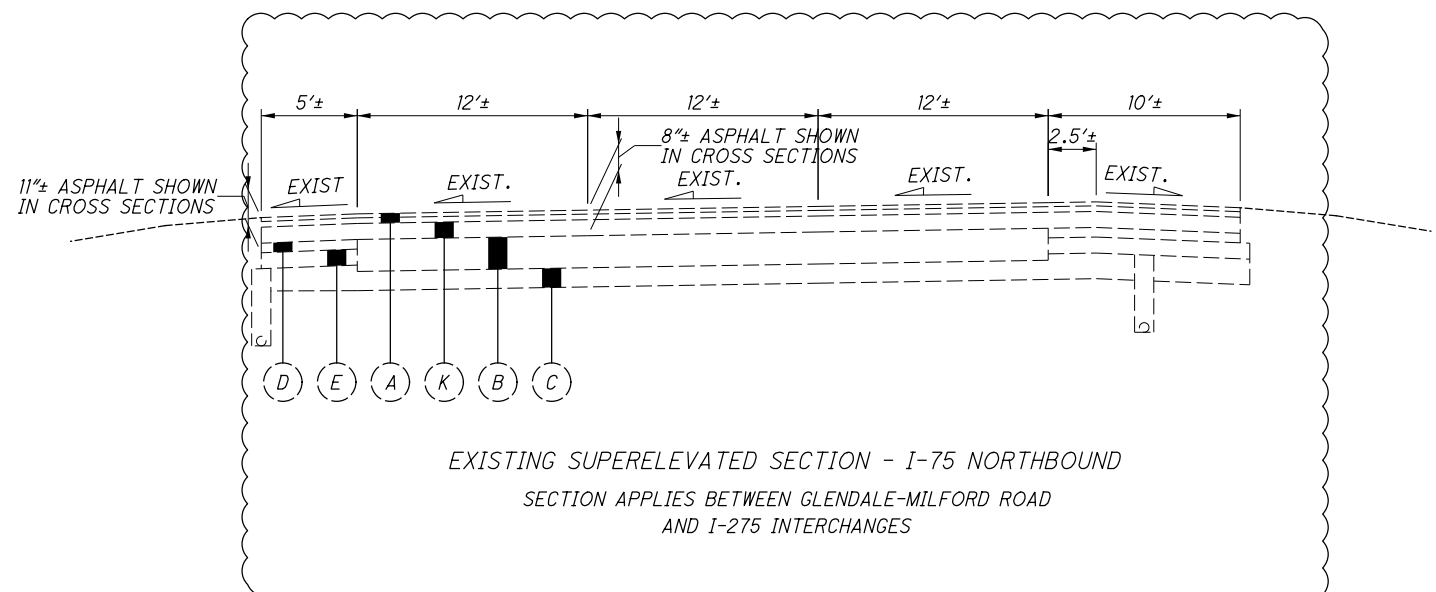

EXISTING SUPERELEVATED SECTION - I-75 NORTHBOUND  
 SECTION APPLIES BETWEEN GLENDALE-MILFORD ROAD  
 AND I-275 INTERCHANGES

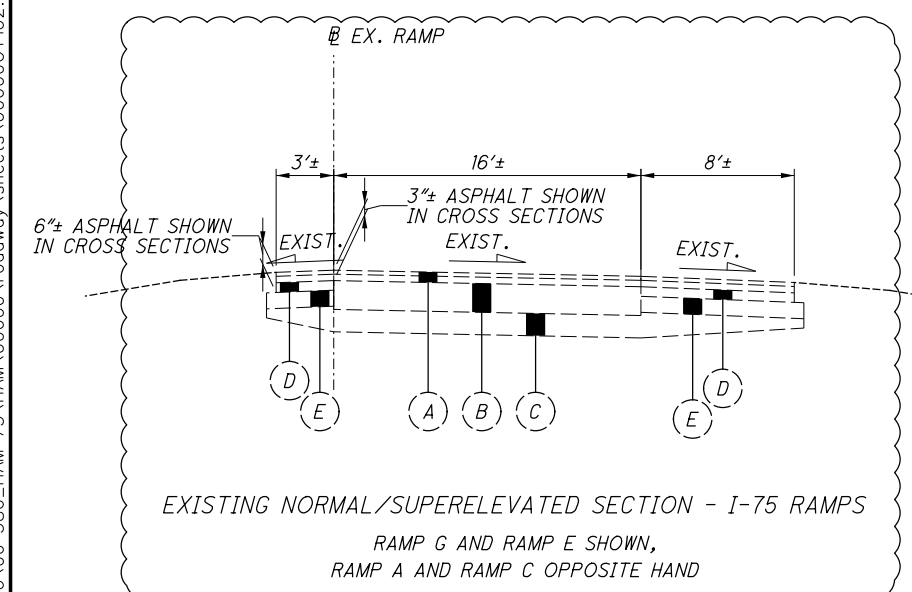

EXISTING NORMAL/SUPERELEVATED SECTION - I-75 RAMPS  
 RAMP G AND RAMP E SHOWN,  
 RAMP A AND RAMP C OPPOSITE HAND

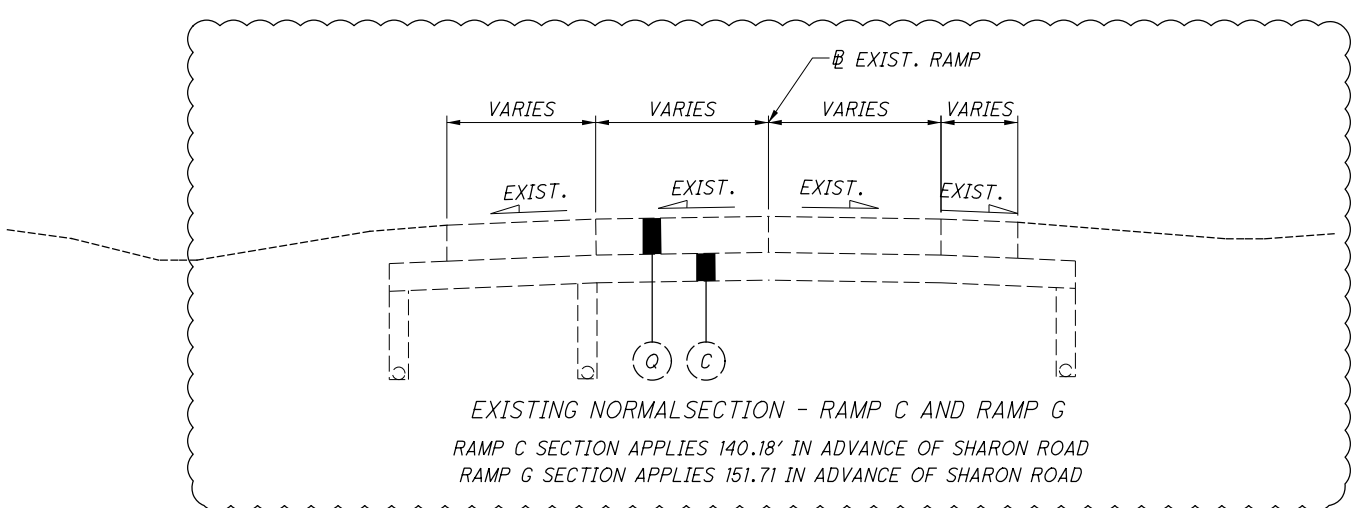

EXISTING NORMAL SECTION - RAMP C AND RAMP G  
 RAMP C SECTION APPLIES 140.18' IN ADVANCE OF SHARON ROAD  
 RAMP G SECTION APPLIES 151.71 IN ADVANCE OF SHARON ROAD

1 1-15-2021 - UPDATED EX. PVT DEPTHS AND EARTHWORK EQ ON CROSS SECTIONS  
 1 1-15-2021 - ADDED ITEM 202-WEARING COURSE REMOVED  
 REMOVED ITEM 202-PAVEMENT REMOVED, APP  
 USE ITEM 202-PAVEMENT REMOVED, COMBINE INTO SINGLE PAY ITEM

J:\pre-int\06\06-386\_HAM-75\HAM\00000\roadway\sheets\00000GN002.dgn 2021-01-09 3:03:55 PM william.croxton" ODOT\cadd\_PDF\_plt\cfig\_ODOTV8i\_Pen.tbl IBI Group

**ITEM 201-CLEARING AND GRUBBING:**

ALTHOUGH THERE ARE NO TREES OR STUMPS SPECIFICALLY MARKED FOR REMOVAL WITHIN THE LIMITS OF THE PROJECT, A LUMP SUM QUANTITY IS INCLUDED IN THE GENERAL SUMMARY FOR ITEM 201-CLEARING AND GRUBBING. ALL PROVISIONS AS SET FORTH IN THE SPECIFICATIONS UNDER THIS ITEM ARE INCLUDED IN THE LUMP SUM PRICE BID FOR ITEM 201-CLEARING AND GRUBBING.

**ITEM SPECIAL-FILL AND PLUG EXISTING CONDUIT**

THIS ITEM SHALL CONSIST OF THE CONSTRUCTION OF BULKHEADS IN AN EXISTING 12" DIAMETER CONDUIT AND FILLING THE AREA THUS SEALED OFF WITH ITEM 613, SAND OR OTHER MATERIAL APPROVED BY THE ENGINEER.

BULKHEADS SHALL BE LOCATED AT THE LIMITS OF THE AREA TO BE FILLED AS INDICATED ON THE PLANS. THE BULKHEADS SHALL CONSIST OF BRICK OR CONCRETE MASONRY WITH A MINIMUM THICKNESS OF 12 INCHES.

THE FILL MATERIAL SHALL BE PUMPED INTO PLACE, OR PLACED BY OTHER MEANS APPROVED BY THE ENGINEER, SO THAT, AFTER SETTLEMENT, AT LEAST 90 PERCENT OF THE CROSS- SECTIONAL AREA OF THE CONDUIT, FOR ITS ENTIRE LENGTH, SHALL BE FILLED. THE LENGTH OF FILLED AND PLUGGED CONDUIT TO BE PAID FOR SHALL BE THE ACTUAL NUMBER OF FEET (MEASURED ALONG THE CENTERLINE OF EACH CONDUIT FROM OUTER FACE TO OUTER FACE OF BULKHEADS) FILLED AND PLUGGED AS DESCRIBED ABOVE.

IN LIEU OF FILLING AND PLUGGING THE EXISTING CONDUIT, THE PIPE MAY BE CRUSHED AND BACKFILLED IN ACCORDANCE WITH THE PROVISIONS OF 203, OR IT MAY BE REMOVED. THE LENGTH, MEASURED AS PROVIDED ABOVE, SHALL BE PAID FOR AT THE CONTRACT PRICE PER FOOT FOR, ITEM SPECIAL, FILL AND PLUG EXISTING CONDUIT.

**ITEM 204- EMBANKMENT, AS PER PLAN:**

THE REQUIREMENTS OF ITEM 204 WILL APPLY; DEVIATIONS FROM THESE ARE AS FOLLOWS:

THE CONTRACTOR SHALL REPLACE UNSUITABLE SUBGRADE WITH NEW EMBANKMENT WITH A PLASTICITY INDEX OF 20 OR LESS. APPROXIMATE LIMITS FOR EXCAVATION OF UNSUITABLE SUBGRADE ARE SHOWN AND LABELED ON THE CROSS SECTIONS AS UNSUITABLE SUBGRADE ALONG I-75 SOUTHBOUND FROM APPROXIMATELY STA. 325+00 TO STA. 351+00. THE USE OF EXISTING SHALE BEDROCK AS A REPLACEMENT MATERIAL FOR UNSUITABLE SUBGRADE IS NOT PERMITTED.

**ITEM 606-ANCHOR ASSEMBLY, MGS TYPE B:**

THIS ITEM SHALL CONSIST OF FURNISHING AND INSTALLING ANY OF THE GUARDRAIL END TERMINALS FOR TYPE MGS GUARDRAIL AS LISTED ON ROADWAY ENGINEERING'S WEB PAGE UNDER ROADSIDE SAFETY DEVICES FOR APPROVED GUARDRAIL END TREATMENTS. INSTALLATION SHALL BE AT THE LOCATIONS SPECIFIED IN THE PLANS, IN ACCORDANCE WITH THE MANUFACTURER'S SPECIFICATIONS.

REFER TO THE MANUFACTURER'S INSTRUCTIONS REGARDING THE INSTALLATION OF, AND THE GRADING AROUND, THE FOUNDATION TUBES AND GROUND STRUT. THE TOP OF ANY FOUNDATION TUBE SHOULD BE LESS THAN 4 INCHES ABOVE THE GROUND. THE PLACEMENT OF THE FOUNDATION TUBES SHOULD BE AN APPROPRIATE DEPTH BELOW THE LEVEL LINE IN ORDER TO MAINTAIN THE FINISHED GUARDRAIL HEIGHT OF 31 INCHES FROM THE EDGE OF THE SHOULDER.

ON-SITE GRADING IS REQUIRED IF THE TOP OF THE FOUNDATION TUBES OR TOP OF THE GROUND STRUT DOES PROJECT MORE THAN 4 INCHES ABOVE THE GROUND LINE.

THE FACE OF THE TYPE B IMPACT HEAD SHALL BE COVERED WITH TYPE G REFLECTIVE SHEETING, PER CMS 730.19.

PAYMENT FOR THE ABOVE WORK SHALL BE MADE AT THE UNIT PRICE BID FOR ITEM 606, ANCHOR ASSEMBLY, MGS TYPE B, EACH, AND SHALL INCLUDE ALL LABOR, TOOLS, EQUIPMENT AND MATERIALS NECESSARY TO CONSTRUCT A COMPLETE AND FUNCTIONAL ANCHOR ASSEMBLY SYSTEM, INCLUDING REFLECTIVE SHEETING AND ALL RELATED HARDWARE, GRADING, EMBANKMENT AND EXCAVATION NOT SEPARATELY SPECIFIED, AS REQUIRED BY THE MANUFACTURER.

**ITEM 606- ANCHOR ASSEMBLY, MGS TYPE E:**

THIS ITEM SHALL CONSIST OF FURNISHING AND INSTALLING ANY OF THE GUARDRAIL END TERMINALS FOR TYPE MGS GUARDRAIL AS LISTED ON ROADWAY ENGINEERING'S WEB PAGE UNDER ROADSIDE SAFETY DEVICES FOR APPROVED GUARDRAIL END TREATMENTS. INSTALLATION SHALL BE AT THE LOCATIONS SPECIFIED IN THE PLANS, IN ACCORDANCE WITH THE MANUFACTURER'S SPECIFICATIONS.

THE FACE OF THE TYPE E IMPACT HEAD SHALL BE COVERED WITH A SHEET OF TYPE G REFLECTIVE SHEETING, PER CMS 730.19.

REFER TO THE MANUFACTURER'S INSTRUCTIONS REGARDING THE INSTALLATION OF, AND THE GRADING AROUND THE FOUNDATION TUBES AND GROUND STRUT. THE TOP OF ANY FOUNDATION TUBE SHOULD BE LESS THAN 4 INCHES ABOVE THE GROUND. THE PLACEMENT OF THE FOUNDATION TUBES SHOULD BE AN APPROPRIATE DEPTH BELOW THE LEVEL LINE IN ORDER TO MAINTAIN THE FINISHED GUARDRAIL HEIGHT OF 31 INCHES FROM THE EDGE OF THE SHOULDER.

ON-SITE GRADING IS REQUIRED IF THE TOP OF THE FOUNDATION TUBES OR TOP OF THE GROUND STRUT DOES PROJECT MORE THAN 4 INCHES ABOVE THE GROUND LINE.

PAYMENT FOR THE ABOVE WORK SHALL BE MADE AT THE UNIT PRICE BID FOR ITEM 606, ANCHOR ASSEMBLY, MGS TYPE E, EACH, AND SHALL INCLUDE ALL LABOR, TOOLS, EQUIPMENT AND MATERIALS NECESSARY TO CONSTRUCT A COMPLETE AND FUNCTIONAL ANCHOR ASSEMBLY SYSTEM, INCLUDING ALL RELATED TRANSITIONS, REFLECTIVE SHEETING, HARDWARE, GRADING, EMBANKMENT AND EXCAVATION NOT SEPARATELY SPECIFIED, AS REQUIRED BY THE MANUFACTURER.

**ITEM 606-IMPACT ATTENUATOR, TYPE 3 (UNIDIRECTIONAL) (DS=70 MPH, W=90 INCHES)**

THIS ITEM SHALL CONSIST OF FURNISHING AND INSTALLING ANY OF THE TYPE 3 IMPACT ATTENUATORS AS LISTED ON THE OFFICE OF ROADWAY ENGINEERING'S WEB PAGE (REFER TO THE POSTED SHOP DRAWINGS FOR THE MOST CURRENT APPROVED PRODUCT MODELS). WHEN BI- DIRECTIONAL DESIGNS ARE SPECIFIED, THE CONTRACTOR SHALL SUPPLY APPROPRIATE TRANSITIONS. THE FACE OF THE IMPACT HEAD SHALL BE COVERED WITH TYPE G REFLECTIVE SHEETING, PER CMS 730.19.

PAYMENT FOR THE ABOVE WORK SHALL BE MADE AT THE UNIT PRICE BID FOR ITEM 606, IMPACT ATTENUATOR, TYPE 3 (SPEED (IN MPH), HAZARD WIDTH (IN INCHES)), (UNIDIRECTIONAL OR BIDIRECTIONAL), EACH, AND SHALL INCLUDE ALL LABOR, TOOLS, EQUIPMENT AND MATERIALS NECESSARY TO CONSTRUCT A COMPLETE AND FUNCTIONAL IMPACT ATTENUATOR SYSTEM, INCLUDING ALL RELATED BACKUPS/BACKSTOPS, TRANSITIONS, HARDWARE AND GRADING, NOT SEPARATELY SPECIFIED, AS REQUIRED BY THE MANUFACTURER. INSTALLATION SHALL BE AT THE LOCATIONS SPECIFIED IN THE PLANS, IN ACCORDANCE WITH THE MANUFACTURER'S SPECIFICATIONS.

**ITEM 607-FENCE MISC.: TEMPORARY CONSTRUCTION FENCE**

THIS ITEM SHALL CONSIST OF FURNISHING AND INSTALLING TEMPORARY CONSTRUCTION FENCE ALONG THE PRINCETON CITY SCHOOL DISTRICT PROPERTY TO IMPROVE SAFETY DURING CONSTRUCTION ALONG I-75 AT LOCATIONS IN WHICH LIMITED ACCESS FENCE IS TO BE REMOVED. BEFORE ANY FENCE WORK, THE CONTRACTOR SHALL CONTACT THE SCHOOL DISTRICT FOR PERMISSION TO ACCESS THE PROPERTY AND TO MUTUALLY DETERMINE APPROPRIATE LOCATION TO CONSTRUCT TEMPORARY CONSTRUCTION FENCE ON PRIVATE PROPERTY.

THE FOLLOWING ESTIMATED QUANTITIES HAVE BEEN CARRIED TO THE GENERAL SUMMARY FOR USE AS DIRECTED BY THE ENGINEER:

ITEM 607 - FENCE MISC.: TEMPORARY CONSTRUCTION FENCE 2000 FT

**ITEM 622-CONCRETE BARRIER, END SECTION, TYPE D, AS PER PLAN**

IN ADDITION TO THE REQUIREMENTS OF CMS 622, THE CONCRETE BARRIER SHALL BE CONSTRUCTED AS SHOWN ON SHEET 444 OF 708. ALL LABOR, EQUIPMENT, MATERIALS, AND INCIDENTALS NECESSARY TO PERFORM THE REQUIRED WORK SHALL BE INCLUDED IN THE CONTRACT BID PRICE PER EACH FOR ITEM 622 - CONCRETE BARRIER, END SECTION, TYPE D.

**ITEM 622-CONCRETE BARRIER, END ANCHORAGE, REINFORCED, TYPE D AS PER PLAN**

IN ADDITION TO THE REQUIREMENTS OF CMS 622, THE CONCRETE BARRIER SHALL BE CONSTRUCTED AS SHOWN ON SHEET 444 OF 708. ALL LABOR, EQUIPMENT, MATERIALS, AND INCIDENTALS NECESSARY TO PERFORM THE REQUIRED WORK SHALL BE INCLUDED IN THE CONTRACT BID PRICE PER EACH FOR ITEM 622 - CONCRETE BARRIER, END ANCHORAGE, REINFORCED, TYPE D, AS PER PLAN.

**ITEM 623-MONUMENT ASSEMBLY, ITEM 623-RIGHT OF WAY ASSEMBLY**

CONSTRUCT MONUMENT ASSEMBLIES IN ACCORDANCE WITH THE DETAILS SHOWN ON THE ODOT SCD RM-1.1 AND AT THE LOCATIONS SHOWN IN THE RIGHT OF WAY PLANS ON SHEETS 692-693.

THE FOLLOWING ESTIMATED QUANTITIES HAVE BEEN CARRIED TO THE GENERAL SUMMARY:

ITEM 623 - MONUMENT ASSEMBLY 4 EACH  
ITEM 623 - RIGHT OF WAY MONUMENT 2 EACH

**ITEM SPECIAL, MISC.: BOLLARD REMOVED AND RESET**

IN ADDITION TO THE REQUIREMENTS OF SCD RM-5.1, THE EXISTING BOLLARDS SHALL BE REMOVED AND RESET AT LOCATIONS SHOWN IN THE PLANS. THE BOLLARDS SHALL BE RESET INTO THE EXISTING ASPHALT CONCRETE DRIVEWAY PAVEMENT AT A DISTANCE OF 1-FOOT BEYOND THE LIMITS OF PROPOSED ASPHALT CONCRETE DRIVEWAY PAVEMENT. THE CENTER BOLLARD SHALL BE CONSTRUCTED AT CENTER OF EXISTING DRIVEWAY. THE OUTER BOLLARDS SHALL BE CONSTRUCTED AT 6-FOOT SPACING FROM CENTER BOLLARD. ALL LABOR, EQUIPMENT, MATERIALS, AND INCIDENTALS NECESSARY TO PERFORM THE REQUIRED WORK SHALL BE INCLUDED IN THE CONTRACT BID PRICE PER EACH FOR ITEM SPECIAL, MISC.: BOLLARD REMOVED AND RESET.

1-15-2021 - ADDED ITEM 202-WEARING COURSE REMOVED  
REMOVED ITEM 202-PAVEMENT REMOVED, APP  
USE ITEM 202-PAVEMENT REMOVED, COMBINE INTO SINGLE PAY ITEM

CALCULATED  
WLC  
CHECKED  
JDH

GENERAL NOTES (2 OF 4)

HAM-75-14.61

22  
708

**PAVEMENT RESTORATION FOR PIPE INSTALLATIONS AND/OR REMOVALS:**

THIS ITEM SHALL CONSIST OF RESTORATION OF ASPHALT PAVEMENT AREAS FOLLOWING INSTALLATION AND/OR REMOVAL OF PIPES OUTSIDE OF PAVEMENT LIMITS ALREADY ITEMIZED IN THE ROADWAY PLANS.

AREAS INCLUDED IN THIS ESTIMATION ARE AS FOLLOWS:

SHARON RD.: 11 SY  
CHESTER RD.: 27 SY


THE FOLLOWING ESTIMATED QUANTITIES HAVE BEEN CARRIED TO THE GENERAL SUMMARY FOR USE AS DIRECTED BY THE ENGINEER:

ITEM 204-SUBGRADE COMPACTION	38 SY
ITEM 204-PROOF ROLLING	1 HR
(38 SY) X (1/3000) = 0.13 HR	
ITEM 302-ASPHALT CONCRETE BASE, PG64-22	7 CY
(38 SY) X (6") X (1/12) X (1/3) = 6.3 CY	
ITEM 304-AGGREGATE BASE	7 CY
(38 SY) X (6") X (1/12) X (1/3) = 6.3 CY	
ITEM 407-NON-TRACKING TACK COAT	5 GAL
(38 SY) X 0.055 (2) = 4.18 GAL	
*ITEM 442-ASPHALT CONCRETE SURFACE COURSE, 12.5 MM, TYPE A, (448)	2 CY
(38 SY) X (1.5") X (1/12) X (1/3) = 1.6 CY	
*ITEM 442-ASPHALT CONCRETE INTERMEDIATE COURSE, 19MM, TYPE A (448)	2 CY
(38 SY) X (1.75") X (1/12) X (1/3) = 1.8 CY	

\* FOR AREAS WITHIN PAVEMENT PLANING & RESURFACING AREAS, ITEM 302 MAY BE INSTALLED TO EXISTING SURFACE IN PLACE OF ITEM 442 ITEMS.

THE ABOVE QUANTITIES ARE BASED ON THE PAVEMENT REPLACEMENT DETAIL BELOW AND A PAVEMENT RESTORATION WIDTH THAT INCLUDES THE TRENCH WIDTH PLUS TWO FEET ON EACH SIDE OF THE TRENCH.

PROVIDE ANY MATERIALS USED OUTSIDE THE LIMITS STATED ABOVE AT NO ADDITIONAL COST.

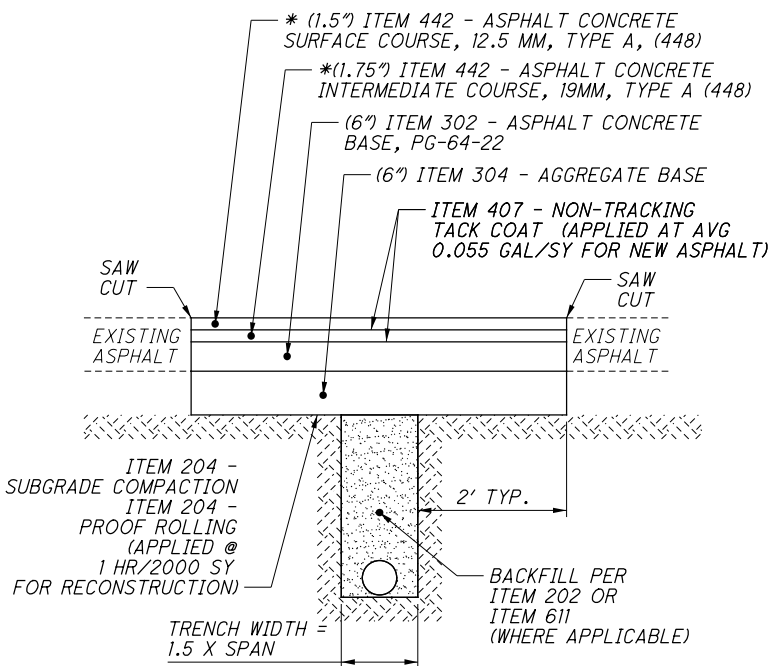

PAVEMENT REPLACEMENT DETAIL (NOT TO SCALE)

**CONTRACTION AND/OR EXPANSION JOINTS:**

ALTHOUGH SPECIFIC LOCATIONS OF CERTAIN CONTRACTION AND EXPANSION JOINTS HAVE BEEN DETAILED ON THIS PLAN, NO WAIVER OF THE SPECIFICATIONS IS INTENDED. IN ALL CASES, THE PROVISION OF EXPANSION JOINTS AT ALL MAJOR STRUCTURES INCLUDING THE MAXIMUM SPACING BETWEEN CONTRACTION JOINTS IS IN ACCORDANCE WITH STANDARD CONSTRUCTION DRAWING BP-2.2 AND THE SPECIFICATIONS.

**CONTRACTION JOINTS IN CONCRETE PAVEMENT OR BASE WIDENING:** WHERE NEW CONCRETE IS PLACED ADJACENT TO EXISTING CONCRETE, PROVIDE CONTRACTION JOINTS IN THE NEW CONCRETE TO FORM CONTINUOUS JOINTS WITH THOSE IN THE EXISTING CONCRETE.

THE MAXIMUM DISTANCE BETWEEN THE JOINTS IN THE NEW CONCRETE ARE IN ACCORDANCE WITH STANDARD CONSTRUCTION DRAWING BP-2.2, IF NECESSARY, ADDITIONAL JOINTS MAY BE PROVIDED IN THE NEW CONCRETE AT APPROXIMATELY EQUAL INTERVALS BETWEEN EXISTING JOINTS THAT EXCEED THE MAXIMUM SPACING.

**PART-WIDTH CONSTRUCTION:**

BECAUSE OF THE NECESSITY TO BUILD THIS PROJECT UNDER TRAFFIC AND TO CONSTRUCT THE FULL PAVEMENT WIDTH IN STAGES, EXERCISE CARE TO PREVENT THE CONSTRUCTION OF A BUTT JOINT IN THE BASE COURSES. LAP LONGITUDINAL JOINTS AS SHOWN ON STANDARD CONSTRUCTION DRAWING BP-3.1.

**ITEM 301 - ASPHALT CONCRETE BASE, PG64-22, AS PER PLAN**

THIS ITEM SHALL CONSIST OF A VARIABLE DEPTH ASPHALT CONCRETE BASE WEDGE COURSE (4" MIN) IN BETWEEN THE SALVAGED PLANED PAVEMENT SURFACE COURSE (1" MIN) AND STANDARD DEPTH INTERMEDIATE COURSE TO ACCOUNT FOR DIFFERENCES IN EXISTING/PROPOSED PAVEMENT CROSS SLOPES AND TO MEET THE PROPOSED PROFILE GRADE ELEVATIONS WITHIN THE PLANING & RESURFACING, (1" MIN, 3.25" MAX) WITH WEDGE COURSE SECTIONS BASED ON A 1-INCH MINIMUM PLANING DEPTH AS SPECIFIED IN THE PLANS. AN AVERAGE DEPTH OF 2-INCHES SHALL BE USED FOR PAVEMENT CALCULATIONS BASED ON ACTUAL CROSS SECTIONS.

ALL REQUIREMENTS OF ITEM 301 ARE APPLICABLE.

**ITEM 442 - ASPHALT CONCRETE SURFACE COURSE, 12.5 MM, TYPE A (447), AS PER PLAN**

PLACE THE MAINLINE PAVEMENT SURFACE COURSE WITH A SINGLE COLD LONGITUDINAL JOINT LOCATED BETWEEN LANES 2 AND 3. WHERE THE NUMBER OF MAINLINE LANES EXCEEDS FOUR (4) LANES, AN ADDITIONAL COLD JOINT IS PERMITTED.

PLEASE NOTE: SHOULDERS ARE NOT MAINLINE LANES AND SHALL HAVE A HOT JOINT TO THE ADJOINING LANE PER SPECIFICATION. NO OTHER COLD JOINTS ARE PERMITTED IN THE SURFACE COURSE OF MAINLINE PAVEMENT UNLESS APPROVED BY THE ENGINEER.

**ITEM 442 - ASPHALT CONCRETE INTERMEDIATE COURSE, 19 MM, TYPE A (446), AS PER PLAN, PG64-28**

THIS ITEM SHALL CONSIST OF A VARIABLE DEPTH INTERMEDIATE WEDGE COURSE (0" MIN, 4" MAX) IN BETWEEN THE SALVAGED PLANED PAVEMENT SURFACE COURSE (1" MIN) AND STANDARD DEPTH INTERMEDIATE COURSE TO ACCOUNT FOR DIFFERENCES IN EXISTING/PROFILE GRADE ELEVATIONS WITHIN THE PLANING & RESURFACING, (1" MIN, 3.25" MAX) WITH WEDGE COURSE SECTIONS BASED ON A 1-INCH MINIMUM PLANING DEPTH AS SPECIFIED IN THE PLANS. AN AVERAGE DEPTH OF 2-INCHES SHALL BE USED FOR PAVEMENT CALCULATIONS BASED ON ACTUAL CROSS SECTIONS.

ALL REQUIREMENTS OF ITEM 442 ARE APPLICABLE.

**ITEM 442 - ASPHALT CONCRETE INTERMEDIATE COURSE, 19 MM, TYPE A (448), AS PER PLAN, PG64-28**

THIS ITEM SHALL CONSIST OF A VARIABLE DEPTH INTERMEDIATE WEDGE COURSE (0" MIN, 4" MAX) IN BETWEEN THE SALVAGED PLANED PAVEMENT SURFACE COURSE (1" MIN) AND STANDARD DEPTH INTERMEDIATE COURSE TO ACCOUNT FOR DIFFERENCES IN EXISTING/PROFILE GRADE ELEVATIONS WITHIN THE PLANING & RESURFACING, (1" MIN, 3.25" MAX) WITH WEDGE COURSE SECTIONS BASED ON A 1-INCH MINIMUM PLANING DEPTH AS SPECIFIED IN THE PLANS. AN AVERAGE DEPTH OF 2-INCHES SHALL BE USED FOR PAVEMENT CALCULATIONS BASED ON ACTUAL CROSS SECTIONS.

ALL REQUIREMENTS OF ITEM 442 ARE APPLICABLE.

**ITEM 609 - COMBINATION CURB AND GUTTER, TYPE 2, AS PER PLAN**

THE REQUIREMENTS OF ITEM 609 AND STANDARD CONSTRUCTION DRAWING BP-5.1 WILL APPLY; DEVIATIONS FROM THESE ARE AS FOLLOWS:

THE GUTTER PLATE THICKNESS SHALL BE 13.25 INCHES TO MATCH PROPOSED ASPHALT BUILDUP DEPTH OF ITEM 442 AND ITEM 301 ALONG SHARON RD.

**ITEM 618 - RUMBLE STRIPS, SHOULDER (ASPHALT CONCRETE) AS PER PLAN**

RUMBLE STRIPS SHALL BE PLACED ALONG I-75 PER SCD BP-9.1; HOWEVER, THEY SHALL BE PLACED 5' FROM THE EDGE OF PAVEMENT FOR BOTH THE INSIDE AND OUTSIDE SHOULDERS. WHEN TRANSITIONING FROM A NORMAL SHOULDER WIDTH TO AN EXISTING SHOULDER WIDTH, THE OFFSET DISTANCE SHALL VARY FROM 5' TO THE MIDPOINT OF THE EXISTING SHOULDER WIDTH.

**ITEM SPECIAL - SANITARY SEWER, MSD SANITARY SEWER PROTECTION**

THE CONTRACTOR SHALL BE REQUIRED TO PROTECT ALL MSD SANITARY SEWER FACILITIES LOCATED WITHIN THE PROJECT CONSTRUCTION LIMITS. SPECIAL CARE MUST BE TAKEN TO ASSURE NO HARM TO THE MSD SEWER SYSTEM OCCURS DURING CONSTRUCTION ACTIVITIES INCLUDING EXCAVATION, DRILLING, OR EXCESSIVE WEIGHTS OVER THE SYSTEM.

IN ADDITION, THE CONTRACTOR SHALL BE REQUIRED TO VIDEO INSPECT ALL SANITARY SEWER FACILITIES BOTH PRE AND POST CONSTRUCTION. THE CONTRACTOR SHALL CONTACT WASTEWATER COLLECTION (WWC) DIVISION OF MSD (513-352-4204) AND REQUEST ADVANCE NOTIFICATION/COORDINATION OF AT LEAST 7 DAYS PRIOR TO ANY VIDEO WORK. ONE (1) COPY OF THE VIDEO INSPECTION SHALL BE PROVIDED TO THE PROJECT ENGINEER AND MSD FOR REVIEW. IF DAMAGE IS FOUND IN THE PRE-CONSTRUCTION VIDEO, THE CONTRACTOR SHALL DOCUMENT THE DAMAGE AND PROVIDE THE DOCUMENTATION TO THE PROJECT ENGINEER. IF DAMAGE IS FOUND IN THE POST-CONSTRUCTION VIDEO, THEN REPAIRS TO THE SATISFACTION OF THE DEPARTMENT AND MSD SHALL BE PERFORMED BY THE CONTRACTOR AT CONTRACTOR EXPENSE.

ALL LABOR, MATERIAL AND INCIDENTALS FOR THE ABOVE WORK SHALL BE PAID FOR BY LUMP SUM, ITEM SPECIAL - SANITARY SEWER, MSD SANITARY SEWER PROTECTION.

THE FOLLOWING ESTIMATED QUANTITIES HAVE BEEN CARRIED TO THE GENERAL SUMMARY:

ITEM SPECIAL-SANITARY SEWER, LS  
MSD SANITARY SEWER PROTECTION

**WATERWAY PERMITS:**

ALL NECESSARY 404/401 WATERWAY PERMITS WILL BE ACQUIRED PRIOR TO ANY CONSTRUCTION ACTIVITY. PER THE NOVEMBER 9, 2007 COMMENTS RECEIVED FROM ODNR, NO IN-STREAM WORK WILL OCCUR BETWEEN APRIL 15 AND JUNE 30.

**ENDANGERED BAT HABITAT REMOVAL:**

(THIS PROJECT IS LOCATED WITHIN THE KNOWN HABITAT RANGES OF THE FEDERALLY LISTED AND PROTECTED INDIANA BAT AND NORTHERN LONG-EARED BAT. NO TREES SHALL BE REMOVED UNDER THIS PROJECT FROM APRIL 1 THROUGH SEPTEMBER 30. ALL NECESSARY TREE REMOVAL SHALL OCCUR FROM OCTOBER 1 THROUGH MARCH 31. THIS REQUIREMENT IS NECESSARY TO AVOID AND MINIMIZE IMPACTS TO THESE SPECIES AS REQUIRED BY THE ENDANGERED SPECIES ACT.)

**WETLANDS**

WETLANDS AVOIDANCE - UNDER NO CIRCUMSTANCES SHALL THE CONTRACTOR IMPACT THE WETLANDS (WETLANDS ID A AND B) INDICATED ON THE SCHEMATIC PLAN. NO EXCAVATION, GRADING OR FILLING OPERATIONS SHALL BE PERFORMED IN THESE WETLANDS. UNDER NO CIRCUMSTANCES SHALL THE CONTRACTOR STORE CONSTRUCTION EQUIPMENT AND/OR MATERIALS IN THESE WETLANDS. TEMPORARY CONSTRUCTION FENCE AND FILTER FABRIC FENCE SHALL BE INSTALLED BY THE CONTRACTOR TO PROTECT THE BOUNDARY OF THESE WETLAND PRIOR TO THE START OF ANY CONSTRUCTION ACTIVITIES WITHIN THESE LIMITS AND ADJACENT AREA AND MAINTAINED BY THE CONTRACTOR THROUGHOUT PROJECT CONSTRUCTION. BEST MANAGEMENT PRACTICES AND PRACTICES FOR SOIL EROSION CONTROL SHALL BE FULLY COMPLIED WITH, AS WELL AS, ALL OF THE REGULATIONS AND CONDITIONS ASSOCIATED WITH THE REQUIRED SWPPP AND NPDES PERMIT.

1 5-20-2020 - ADDED BINDER TYPE (PG64-28) FOR ITEM 442E10101 AND ITEM 442E20201

2 1-15-2021 - UPDATED BAT NOTE

J:\pre-int\06-386\_HAM-75-HAM\00000\roadway\sheets\00000GN004.dgn 2021-01-09 3:12:54 PM e:\william.croxtone\ODOT\cadd\_PDF\ptcfcg\_ODOTV81\_Pen.tbl IBI Group



j:\pre-int\06-386\_HAM-75\_HAM\00000\mot\sheets\00000m001.dgn 2021-01-06 12:12:12 PM brian.sedzior\ODOTV8i\_PDF\_Half.pltcfq ODOTV8i\_Pen.tbl IBI Group

**ITEM 614 - MAINTAINING TRAFFIC**

**IR-75 AND RAMPS**

MAINTAIN THE SAME NUMBER OF LANES AS CURRENTLY EXISTS IN EACH DIRECTION AND RAMPS AT ALL TIMES, EXCEPT IN ACCORDANCE WITH THE UNAUTHORIZED LANE USE TABLE (SEE SHEET 34), BY USE OF THE EXISTING PAVEMENT, COMPLETED PAVEMENT, ITEM 615 PAVEMENT FOR MAINTAINING TRAFFIC AND ITEM 615 ROADS FOR MAINTAINING TRAFFIC.

**SHARON RD**

A MINIMUM OF 2 LANES OF TRAFFIC IN EACH DIRECTION SHALL BE MAINTAINED AT ALL TIMES BY UTILIZING A COMBINATION OF EXISTING PAVEMENT, THE COMPLETED PAVEMENT, ITEM 615 PAVEMENT FOR MAINTAINING TRAFFIC, ITEM 615 ROADS FOR MAINTAINING TRAFFIC, AND TEMPORARY SURFACES USING ITEMS 410, AND 614.

**CHESTER RD**

A MINIMUM OF 1 LANES OF TRAFFIC IN EACH DIRECTION SHALL BE MAINTAINED AT ALL TIMES, EXCEPT FOR A PERIOD WHEN TRAFFIC MAY BE MAINTAINED USING A FLAGGER OPERATION AS DETAILED IN SCD MT-97.10.

NO WORK SHALL BE PERFORMED ON I-75 AND A MINIMUM OF THREE LANES OF TRAFFIC IN EACH DIRECTION ON I-75 SHALL BE OPEN TO TRAFFIC ALONG WITH NO WORK ON THE RAMPS, SHARON ROAD, AND CHESTER ROAD DURING THE FOLLOWING DESIGNATED HOLIDAYS OR EVENTS:

CHRISTMAS	FOURTH OF JULY
NEW YEARS	LABOR DAY
MEMORIAL DAY	THANKSGIVING
EASTER	

THE PERIOD OF TIME THAT THE LANES ARE TO BE OPEN DEPENDS ON THE DAY OF THE WEEK ON WHICH THE HOLIDAY OR EVENT FALLS. THE FOLLOWING SCHEDULE SHALL BE USED TO DETERMINE THIS PERIOD:

DAY OF HOLIDAY OR EVENT	TIME ALL LANES MUST BE OPEN TO TRAFFIC
SUNDAY	6:00 AM FRIDAY THROUGH 9:00 PM MONDAY
MONDAY	6:00 AM FRIDAY THROUGH 9:00 PM TUESDAY
TUESDAY	6:00 AM MONDAY THROUGH 9:00 PM WEDNESDAY
WEDNESDAY	6:00 AM TUESDAY THROUGH 9:00 PM THURSDAY
THURSDAY	6:00 AM WEDNESDAY THROUGH 9:00 PM FRIDAY (THANKSGIVING ONLY)
FRIDAY	6:00 AM WEDNESDAY THROUGH 9:00 PM MONDAY
SATURDAY	6:00 AM THURSDAY THROUGH 9:00 PM MONDAY

SHOULD THE CONTRACTOR FAIL TO MEET ANY OF THESE REQUIREMENTS, THE CONTRACTOR SHALL BE ASSESSED A DISINCENTIVE IN THE AMOUNT SHOWN IN THE UNAUTHORIZED LANE USE TABLE ON SHEET 34 WHEN THE ABOVE DESCRIBED LANE CLOSURE RESTRICTIONS ARE VIOLATED.

LENGTH AND DURATION OF LANE CLOSURES AND RESTRICTIONS SHALL BE AT THE APPROVAL OF THE ENGINEER. IT IS THE INTENT TO MINIMIZE THE IMPACT TO THE TRAVELING PUBLIC. LANE CLOSURES OR RESTRICTIONS OVER SEGMENTS OF THE PROJECT IN WHICH NO WORK IS ANTICIPATED WITHIN A REASONABLE TIME FRAME, AS DETERMINED BY THE ENGINEER, SHALL NOT BE PERMITTED. THE LEVEL OF UTILIZATION OF MAINTENANCE OF TRAFFIC DEVICES SHALL BE COMMENSURATE WITH THE WORK IN PROGRESS.

NOTICE OF CLOSURE SIGNS (W20-H13) SHALL BE ERECTED BY THE CONTRACTOR PRIOR TO THE SCHEDULED ROAD OR RAMP CLOSURE IN ACCORDANCE WITH THE NOTICE OF CLOSURE TIME TABLE BELOW. AT THE APPROVAL OF THE ENGINEER, PORTABLE CHANGEABLE MESSAGE SIGNS MAY BE USED IN LIEU OF THE STANDARD FLATSHEET SIGN FOR CLOSURE DURATIONS OF LESS THAN 1 WEEK.

THE SIGNS SHALL BE ERECTED ON THE RIGHT-HAND SIDE OF THE ROAD/RAMP FACING TRAFFIC. THEY SHALL BE PLACED SO AS NOT TO INTERFERE WITH THE VISIBILITY OF ANY OTHER TRAFFIC CONTROL SIGNS. ON ROADWAYS, THEY SHOULD BE ERECTED AT OR NEAR THE POINT OF CLOSURE. THE SIGNS MAY BE ERECTED ANYWHERE ON RAMPS AS LONG AS THEY ARE VISIBLE TO THE MOTORISTS USING THE RAMP. ON ENTRANCE RAMPS, THE SIGN SHALL BE ERECTED WELL IN ADVANCE OF THE MERGE AREA TO AVOID DISTRACTING MOTORISTS.

**NOTICE OF CLOSURE SIGN TIME TABLE**

ITEM	DURATION OF CLOSURE	SIGN DISPLAYED TO PUBLIC
RAMP & ROAD CLOSURES	>= 2 WEEKS	14 CALENDAR DAYS PRIOR TO CLOSURE
	> 12 HOURS & < 2 WEEKS	7 CALENDAR DAYS PRIOR TO CLOSURE
	< 12 HOURS	2 BUSINESS DAYS PRIOR TO CLOSURE

THE SIGN SHALL DISPLAY THE DATE OF THE CLOSURE IN MMM-DD FORMAT AND THE NUMBER OF DAYS OF THE CLOSURE. THE LAST LINE OF THE W20-H13 SIGN LISTS A PHONE NUMBER WHICH A MOTORIST MAY CALL FOR ADDITIONAL INFORMATION. THIS IS TO BE A SPECIFIC OFFICE WITHIN THE DISTRICT RATHER THAN THE GENERAL SWITCHBOARD NUMBER.

THE CONTRACTOR SHALL PROVIDE, ERECT AND MAINTAIN STANDARD 48 X 30 INCH ROAD CLOSED SIGNS, SIGN SUPPORTS, BARRICADES AND LIGHTS, AS DETAILED IN SCD MT-101.60 AT THE FOLLOWING LOCATIONS DURING PERIODS IN WHICH THE AFFECTED ROADS ARE CLOSED TO TRAFFIC.

SHARON ROAD AT CURB RETURN TO I-75 SB EXIT RAMP  
 SHARON ROAD AT CURB RETURN TO I-75 SB ENTRANCE RAMP  
 SHARON ROAD AT CURB RETURN TO I-75 NB EXIT RAMP  
 SHARON ROAD AT CURB RETURN TO I-75 SB ENTRANCE RAMP  
 CHESTER ROAD STA. 95+00 AND STA. 96+50

THE FOLLOWING ESTIMATED QUANTITIES HAVE BEEN INCLUDED IN THE GENERAL SUMMARY FOR USE AS DETERMINED BY THE ENGINEER FOR THE MAINTENANCE OF TRAFFIC.

ITEM 410, TRAFFIC COMPACTED SURFACE, TYPE A OR B	100 CU YD
ITEM 614, ASPHALT CONCRETE FOR MAINTAINING TRAFFIC	100 CU YD
ITEM 616, WATER	50 M GAL

ALL WORK AND TRAFFIC CONTROL DEVICES SHALL BE IN ACCORDANCE WITH CMS 614 AND OTHER APPLICABLE PORTIONS OF THE SPECIFICATIONS, AS WELL AS THE OHIO MANUAL OF UNIFORM TRAFFIC CONTROL DEVICES. PAYMENT FOR ALL LABOR, EQUIPMENT AND MATERIALS SHALL BE INCLUDED IN THE LUMP SUM CONTRACT PRICE FOR ITEM 614, MAINTAINING TRAFFIC, UNLESS SEPARATELY ITEMIZED IN THE PLAN.

**TRENCH FOR WIDENING**

TRENCH EXCAVATION FOR BASE WIDENING SHALL BE ONLY ON ONE SIDE OF THE PAVEMENT AT A TIME. THE OPEN TRENCH SHALL BE ADEQUATELY MAINTAINED AND PROTECTED WITH DRUMS OR BARRICADES AT ALL TIMES. PLACEMENT OF PROPOSED SUBBASE AND BASE MATERIAL SHALL FOLLOW AS CLOSELY AS POSSIBLE BEHIND EXCAVATION OPERATIONS. THE LENGTH OF WIDENING TRENCH WHICH IS OPEN AT ANY ONE TIME SHALL BE HELD TO A MINIMUM AND SHALL AT ALL TIMES BE SUBJECT TO APPROVAL OF THE ENGINEER.

**OVERNIGHT TRENCH CLOSING**

THE BASE WIDENING SHALL BE COMPLETED TO A DEPTH OF NO MORE THAN 5 INCHES BELOW THE EXISTING PAVEMENT BY THE END OF EACH WORK DAY. NO TRENCH SHALL BE LEFT OPEN OVERNIGHT EXCEPT FOR A SHORT LENGTH (25 FEET OR LESS) OF A WORK SECTION AT THE END OF THE TRENCH. IN CASE WORK MUST BE SUSPENDED BECAUSE OF INCLEMENT WEATHER OR OTHER REASONS, THE TRENCH FOR THE UN-COMPLETED BASE WIDENING SHALL BE BACKFILLED AT THE DIRECTION OF THE ENGINEER.

**DRUM REQUIREMENTS**

IN ADDITION TO THE REQUIREMENTS OF THE PLANS, SPECIFICATION AND PROPOSAL, DRUMS FURNISHED BY THE CONTRACTOR SHALL BE NEW AND UNUSED AT THE TIME OF ARRIVAL ON THE PROJECT. ANY DRUMS BROUGHT ON THE PROJECT, WHICH HAVE PREVIOUSLY BEEN USED ELSEWHERE, SHALL NOT BE ACCEPTED.

PAYMENT FOR DRUMS SHALL BE INCLUDED IN THE LUMP SUM PRICE BID FOR MAINTAINING TRAFFIC UNLESS SEPARATELY ITEMIZED.

**DUST CONTROL**

THE CONTRACTOR SHALL FURNISH AND APPLY WATER FOR DUST CONTROL AS DIRECTED BY THE ENGINEER. THE FOLLOWING ESTIMATED QUANTITIES HAVE BEEN INCLUDED FOR DUST CONTROL PURPOSES:

ITEM 616, WATER	2,500 M GAL
-----------------	-------------

**ITEM 614 - REPLACEMENT DRUM**

DRUMS FURNISHED BY THE CONTRACTOR IN ACCORDANCE WITH THE REQUIREMENTS OF THE PLANS, SPECIFICATIONS AND PROPOSAL WHICH BECOME DAMAGED BY TRAFFIC FOR REASONS BEYOND THE CONTROL OF THE CONTRACTOR SHALL BE REPLACED IN KIND WHEN ORDERED BY THE ENGINEER. REPLACEMENT DRUMS SHALL BE NEW.

PAYMENT FOR THE NEW DRUMS SHALL BE MADE AT THE CONTRACT PRICE PER EACH FOR ITEM 614, REPLACEMENT DRUM, AND SHALL INCLUDE THE COST OF REMOVING AND DISPOSING OF THE DAMAGED DRUM, AND PROVIDING AND MAINTAINING THE REPLACEMENT DRUM IN ACCORDANCE WITH THE CONTRACT REQUIREMENTS FOR THE ORIGINAL DRUM.

AN ESTIMATED QUANTITY OF 100 EACH HAS BEEN PROVIDED IN THE GENERAL SUMMARY.

**EARTHWORK FOR MAINTAINING TRAFFIC**

THE FOLLOWING QUANTITIES HAVE BEEN INCLUDED IN THE PLAN FOR INFORMATION ONLY:

EXCAVATION FOR MAINTAINING TRAFFIC	5,000 CU YD
EMBANKMENT FOR MAINTAINING TRAFFIC	5,000 CU YD

WHEN UNDERCUTS ARE NECESSARY FOR MAINLINE PAVEMENT OR EMBANKMENT CONSTRUCTION, EVALUATE THE NEED FOR TEMPORARY ROAD UNDERCUTS IF WITHIN A CLOSE PROXIMITY TO THE MAINLINE UNDERCUTS.

PAYMENT FOR ALL LABOR, EQUIPMENT AND MATERIALS SHALL BE INCLUDED IN THE LUMP SUM CONTRACT PRICE FOR ITEM 614, MAINTAINING TRAFFIC.

**ITEM 614 - REPLACEMENT SIGN**

FLATSHEET SIGNS FURNISHED BY THE CONTRACTOR IN ACCORDANCE WITH THE REQUIREMENTS OF THE PLANS, SPECIFICATIONS AND PROPOSAL WHICH BECOME DAMAGED BY TRAFFIC FOR REASONS BEYOND THE CONTROL OF THE CONTRACTOR SHALL BE REPLACED IN KIND WHEN ORDERED BY THE ENGINEER. REPLACEMENT SIGNS SHALL BE NEW. OTHER MATERIALS MAY BE IN USED, BUT GOOD CONDITION SUBJECT TO APPROVAL BY THE ENGINEER.

PAYMENT FOR THE NEW SIGNS SHALL BE MADE AT THE CONTRACT PRICE PER EACH FOR ITEM 614, REPLACEMENT SIGN, AND SHALL INCLUDE THE COST OF REMOVING AND DISPOSING OF DAMAGED SIGNS, HARDWARE AND SUPPORTS, AND PROVIDING THE NECESSARY REPLACEMENT HARDWARE, SUPPORTS, ETC.

AN ESTIMATED QUANTITY OF 20 EACH HAS BEEN PROVIDED IN THE GENERAL SUMMARY.

**ITEM 618 - RUMBLE STRIPS, SHOULDER (ASPHALT CONCRETE), AS PER PLAN**

THE CONTRACTOR SHALL MILL 2" DEEP BY 4' WIDE OF THE EXISTING ASPHALT SHOULDER IN ORDER TO ELIMINATE THE EXISTING EDGE LINE AND RUMBLE STRIPS ALONG I-75 IN THE AREA WHERE TRAFFIC IS SHIFTED. NEXT THE CONTRACTOR SHALL PLACE ITEM 407, TACK COAT, APPLIED AT 0.1 GAL/SY, AND 2" OF ITEM 448 ASPHALT CONCRETE SURFACE COURSE, TYPE 1, PG64-28. ALL COST ASSOCIATED WITH THIS WORK SHALL BE INCLUDED IN THE UNIT PRICE BID PER MILE OF ITEM 618, RUMBLE STRIPS, SHOULDER (ASPHALT CONCRETE), AS PER PLAN.

AN ESTIMATED QUANTITY OF 2.65 MILE HAS BEEN CARRIED TO THE GENERAL SUMMARY.

**ITEM 615 - PAVEMENT FOR MAINTAINING TRAFFIC, CLASS A, AS PER PLAN:**

THE TEMPORARY PAVEMENT BUILD-UP SHALL BE CONSTRUCTED AS SPECIFIED PER CMS 615 FOR CLASS A FLEXIBLE PAVEMENT WITH THE EXCEPTION THAT A SINGLE LAYER OF 2" OF ITEM 448, TYPE 2, PG64-22 PLACED ABOVE 8" ITEM 302 AND 6" ITEM 304.

**ITEM 614 - PORTABLE CHANGEABLE MESSAGE SIGN, AS PER PLAN**

THE CONTRACTOR SHALL FURNISH, INSTALL, MAINTAIN AND REMOVE, WHEN NO LONGER NEEDED, A CHANGEABLE MESSAGE SIGN. THE SIGN SHALL BE OF A TYPE SHOWN ON A LIST OF APPROVED PCMS UNITS AVAILABLE ON THE (OFFICE OF MATERIALS MANAGEMENT WEB PAGE). THE LIST CONTAINS CLASS A AND B UNITS WITH MINIMUM LEGIBILITY DISTANCES OF 650 FEET AND 475 FEET, RESPECTIVELY.

EACH SIGN SHALL BE TRAILER-MOUNTED AND EQUIPPED WITH A FUNCTIONAL DIMMING MECHANISM, TO DIM THE SIGN DURING DARKNESS, AND A TAMPER AND VANDAL PROOF ENCLOSURE. EACH SIGN SHALL BE PROVIDED WITH APPROPRIATE TRAINING AND OPERATION INSTRUCTIONS TO ENABLE ON-SITE PERSONNEL TO OPERATE AND TROUBLESHOOT THE UNIT. THE SIGN SHALL ALSO BE CAPABLE OF BEING POWERED BY AN ELECTRICAL SERVICE DROP FROM A LOCAL UTILITY COMPANY. THE PCMS SHALL BE DELINEATED IN ACCORDANCE WITH C&MS 614.03.

THE PROBABLE PCMS LOCATIONS AND WORK LIMITS FOR THOSE LOCATIONS ARE SHOWN ON SHEET(S) OF THE PLAN. PLACEMENT, OPERATION, MAINTENANCE AND ALL ACTIVATION OF THE SIGNS BY THE CONTRACTOR SHALL BE AS DIRECTED BY THE ENGINEER. THE PCMS SHALL BE LOCATED IN A HIGHLY VISIBLE POSITION YET PROTECTED FROM TRAFFIC. THE CONTRACTOR SHALL, AT THE DIRECTION OF THE ENGINEER, RELOCATE THE PCMS TO IMPROVE VISIBILITY OR ACCOMMODATE CHANGED CONDITIONS. WHEN NOT IN USE, THE PCMS SHALL BE TURNED OFF. ADDITIONALLY, WHEN NOT IN USE FOR EXTENDED PERIODS OF TIME, THE PCMS SHALL BE TURNED AWAY FROM ALL TRAFFIC.

THE PROBABLE PCMS LOCATIONS AND WORK LIMITS ARE LISTED BELOW:

NORTHBOUND - I-75 1000 FT ADVANCE OF NORTHBOUND OFF RAMP TO RONALD REAGAN HIGHWAY.  
SOUTHBOUND - 1000 FT IN ADVANCE OF I-275

**SOUTHBOUND OF RAMP**

DMS LOCATION - I-75 300 FT IN ADVANCE OF SHARON RD OVERPASS.

TWO 'CLASS A' PCMS AT THE SHARON ROAD OVERPASS SHALL HAVE THE ABILITY FOR THE ODOT TRAFFIC MANAGEMENT CENTER (TMC) TO ACCESS REMOTELY AND UPDATE THE MESSAGE WHILE THE EXISTING DMS IS REMOVED AND REPLACED. THESE PCMS SHALL BE SETUP AND OPERATIONAL THRU THE TMC IN PRE-PHASE 1 AS SHOWN ON SHEET 32 PRIOR TO DEACTIVATION AND REMOVAL OF THE EXISTING DMS. THE PCMS WILL BE ACTIVE UNTIL THE PROPOSED DMS IS INSTALLED AND OPERATIONAL, HOWEVER, THE USE OF THESE PCMS SHALL NOT EXCEED 6 MONTHS.

IF THE CONTRACTOR DEACTIVATES THE EXISTING DMS PRIOR TO BOTH PCMS BEING OPERATIONAL, THEN A DISINCENTIVE OF \$500 PER DAY PER PCMS SIGN SHALL BE APPLIED UNTIL BOTH SIGNS ARE OPERATIONAL. IN ADDITION, THIS DISINCENTIVE PER SIGN SHALL ALSO APPLY FOR EACH DAY THAT THE PCMS ARE IN USE PAST 6 MONTHS.

THE ENGINEER SHALL BE PROVIDED ACCESS TO EACH SIGN UNIT AND SHALL BE PROVIDED WITH APPROPRIATE TRAINING AND OPERATION INSTRUCTIONS TO ENABLE ODOT PERSONNEL TO OPERATE AND TROUBLESHOOT THE UNIT, AND TO REVISE SIGN MESSAGES, IF NECESSARY.

THE CONTRACTOR SHALL IMPLEMENT A SYSTEM WHEREBY CHANGEABLE MESSAGES WILL BE IMPLEMENTED WITHIN 4 HOURS FOLLOWING TELEPHONE NOTIFICATION FROM THE PROJECT ENGINEER TO A DESIGNATED PHONE.

ALL MESSAGES TO BE DISPLAYED ON THE SIGN WILL BE PROVIDED BY THE ENGINEER. A LIST OF ALL REQUIRED PRE-PROGRAMMED MESSAGES WILL BE GIVEN TO THE CONTRACTOR AT THE PROJECT PRECONSTRUCTION CONFERENCE. THE SIGN SHALL HAVE THE CAPABILITY TO STORE UP TO 99 MESSAGES. MESSAGE MEMORY OR PRE-PROGRAMMED DISPLAYS

SHALL NOT BE LOST AS A RESULT OF POWER FAILURES TO THE ON-BOARD COMPUTER. THE SIGN LEGEND SHALL BE CAPABLE OF BEING CHANGED IN THE FIELD. THREE-LINE PRESENTATION FORMATS WITH UP TO SIX MESSAGE PHASES SHALL BE SUPPORTED. PCMS FORMAT SHALL PERMIT THE COMPLETE MESSAGE FOR EACH PHASE TO BE READ AT LEAST TWICE. THE PCMS SHALL CONTAIN AN ACCURATE CLOCK AND PROGRAMMING LOGIC WHICH WILL ALLOW THE SIGN TO BE ACTIVATED, DEACTIVATED OR MESSAGES CHANGED AUTOMATICALLY AT DIFFERENT TIMES OF THE DAY FOR DIFFERENT DAYS OF THE WEEK.

THE PCMS SHALL CONTAIN A CELLULAR TELEPHONE DATA LINK WHICH WILL (IN ACTIVE CELLULAR PHONE AREAS) ALLOW REMOTE SIGN ACTIVATION, MESSAGE CHANGES, MESSAGE ADDITIONS AND REVISIONS TO TIME OF DAY PROGRAMS. THE SYSTEM SHALL ALSO PERMIT VERIFICATION OF CURRENT AND PROGRAMMED MESSAGES. ONE REMOTE DATA INPUT DEVICE (LAPTOP COMPUTER PLUS MODEM OR EQUIVALENT) SHALL BE FURNISHED FOR USE BY THE DISTRICT TRAFFIC ENGINEER, OR EQUIVALENT, AND SHALL BE INSURED AGAINST THEFT.

THE PCMS UNIT SHALL BE MAINTAINED IN GOOD WORKING ORDER BY THE CONTRACTOR IN ACCORDANCE WITH THE PROVISIONS OF C&MS 614.07. THE CONTRACTOR SHALL, PRIOR TO ACTIVATING THE UNIT, MAKE ARRANGEMENTS, WITH AN AUTHORIZED SERVICE AGENT FOR THE PCMS, TO ASSURE PROMPT SERVICE IN THE EVENT OF FAILURE. ANY FAILURE SHALL NOT RESULT IN THE SIGN BEING OUT OF SERVICE FOR MORE THAN 12 HOURS, INCLUDING WEEKENDS. FAILURE TO COMPLY MAY RESULT IN AN ORDER TO STOP WORK AND OPEN ALL TRAFFIC LANES AND/OR IN THE DEPARTMENT TAKING APPROPRIATE ACTION TO SAFELY CONTROL TRAFFIC. THE ENTIRE COST TO CONTROL TRAFFIC, ACCRUED BY THE DEPARTMENT DUE TO THE CONTRACTOR'S NONCOMPLIANCE, WILL BE DEDUCTED FROM MONEYS DUE, OR TO BECOME DUE THE CONTRACTOR ON HIS CONTRACT.

THE CONTRACTOR SHALL BE RESPONSIBLE FOR 24-HOUR-PER-DAY OPERATION AND MAINTENANCE OF THESE SIGNS ON THE PROJECT FOR THE DURATION OF THE PHASES WHEN THE PLAN REQUIRES THEIR USE.

PAYMENT FOR THE ABOVE DESCRIBED ITEM SHALL BE AT THE CONTRACT UNIT PRICE. PAYMENT SHALL INCLUDE ALL LABOR, MATERIALS, EQUIPMENT, FUELS, LUBRICATING OILS, SOFTWARE, HARDWARE AND INCIDENTALS TO PERFORM THE ABOVE DESCRIBED WORK.

ITEM 614, PORTABLE CHANGEABLE MESSAGE SIGN, AS PER PLAN

54 SIGN MONTH

**SHORT DURATION CLOSING OF THE HIGHWAY**

THE FOLLOWING NOTES SHALL APPLY TO ALL WORK ON I-75.

1. FIVE CALENDAR DAYS PRIOR TO IMPLEMENTING THE SHORT DURATION CLOSING OF THE HIGHWAY THE CONTRACTOR SHALL PLACE A PORTABLE CHANGEABLE MESSAGE SIGN AT THE STRUCTURE IN THE DIRECTION THE ROAD IS TO BE CLOSED WITH THE MESSAGE:

I-75 12M  
CLOSES TO  
\*DATE\* 4AM

2. CLOSURES WILL ONLY BE PERMITTED FOR REMOVAL AND ERECTION OF THE STRUCTURAL BEAMS AND SIGN TRUSSES, TO PROTECT TRAFFIC DURING DEMOLITION OPERATIONS AS CALLED FOR IN C&MS 501.05, FOR OVERHEAD UTILITY WIRE CROSSING, AND FOR TRAFFIC SWITCHES. CLOSURES WILL BE PERMITTED DURING THE HOURS SPECIFIED IN THE PERMITTED LANE CLOSURE AND UNAUTHORIZED LANE USE TABLE, ON SHEET 34. THE MAXIMUM DURATION OF THE CLOSURE SHALL NOT EXCEED 15 MINUTES SUBJECT TO A DISINCENTIVE IN THE AMOUNT SPECIFIED IN THE PERMITTED LANE CLOSURE AND UNAUTHORIZED LANE USE TABLE, ON SHEET 34. UNLESS OTHERWISE DIRECTED BY THE ENGINEER, ONLY ONE (1) BEAM SHALL BE REMOVED OR SET PER CLOSING. TRAFFIC SHALL BE COMPLETELY CLEARED BEFORE THE NEXT CLOSING.

3. THE CONTRACTOR SHALL IMPLEMENT THE TRAFFIC CONTROL CONTAINED IN STANDARD CONSTRUCTION DRAWING MT-99.60. IN THE EVENT THE CLOSURE OCCURS IN CLOSE PROXIMITY TO SYSTEM-SYSTEM INTERCHANGE, TRAFFIC CONTROL SHALL EXTEND ONTO ANY ENTERING DIVIDED HIGHWAY ACCORDING TO THE LIMITS PROVIDED IN MT-99.60.

4. THE CONTRACTOR SHALL FURNISH AND INSTALL TWO (2) WATCH FOR STOPPED TRAFFIC SIGNS (W3-H7-48) 1500 FEET UPSTREAM FROM THE ANTICIPATED BACKUP ON I-75. THE CONTRACTOR SHALL INSTALL ADDITIONAL WATCH FOR STOPPED TRAFFIC SIGNS EVERY 2000 FEET UPSTREAM FROM THE WATCH FOR STOPPED TRAFFIC SIGNS ON I-75 IF TRAFFIC BACKUPS REACH THE FIRST SET OF SIGNS. THE NEED FOR THESE SIGNS SHALL BE CONSTANTLY MONITORED BY THE CONTRACTOR. ALL WATCH FOR STOPPED TRAFFIC AND PREPARE TO STOP SIGNS SHALL BE EQUIPPED WITH TYPE B WARNING LIGHTS.

6. IN THE EVENT OF AN INCLEMENT WEATHER FORECAST (RAIN OR SNOW FORECAST AT 50% OR GREATER THE DAY THE EVENT WILL OCCUR IS DEFINED AS AN INCLEMENT FORECAST) THE CLOSURE SHALL NOT TAKE PLACE. THE CONTRACTOR WILL MAKE THE DETERMINATION BASED UPON THE WEATHER FORECAST PREDICTED BY THE NATIONAL WEATHER SERVICE.

**SPECIAL - WORK ZONE GUARDRAIL**

THIS WORK AND MATERIALS SHALL COMPLY WITH ITEM 606 FOR PERMANENT GUARDRAIL, EXCEPT THAT USED TYPE 5 RAILS AND POSTS MAY BE USED IF IN GOOD CONDITION AND APPROVED BY THE ENGINEER. FOR EXISTING GUARDRAIL RUNS WHICH REQUIRE AN EXTENSION, THE EXISTING END TERMINAL ASSEMBLY SHALL BE REMOVED AND RESET TO THE NEW LOCATION, AS SHOWN ON THE PLANS. NEW RUNS, FOR BRIDGE PARAPET PROTECTION, SHALL HAVE THE APPROPRIATE BRIDGE TERMINAL ASSEMBLIES INSTALLED. UPON COMPLETION OF THE PHASE WHICH REQUIRES THE TEMPORARY GUARDRAIL, ALL WORK ZONE GUARDRAIL SHALL BE REMOVED AND THE POST HOLES BACKFILLED (UNLESS PERMANENT GRADING TO BE PERFORMED LATER WOULD REPAIR THE HOLES), ALL TERMINAL ASSEMBLIES REMOVED, AND END TERMINAL ASSEMBLIES RESET TO THEIR ORIGINAL LOCATIONS.

ALL COSTS RESULTING FROM THE ABOVE REQUIREMENTS SHALL BE CONSIDERED TO BE INCLUDED IN THE LUMP SUM PRICE BID FOR ITEM 614, MAINTAINING TRAFFIC.

**ITEM 614 - WORK ZONE IMPACT ATTENUATOR FOR 24" WIDE HAZARDS (UNIDIRECTIONAL OR BIDIRECTIONAL)**

THIS ITEM SHALL CONSIST OF FURNISHING AND INSTALLING A NON-GATING IMPACT ATTENUATOR. FURNISH AN IMPACT ATTENUATOR FROM THE OFFICE OF ROADWAY ENGINEERING APPROVED LIST FOR WORK ZONE IMPACT ATTENUATORS. THE APPROVED LIST IS AVAILABLE AT THE "ROADWAY STANDARDS: PROPRIETARY ROADSIDE SAFETY DEVICES" WEB PAGE ON THE OFFICE OF ROADWAY ENGINEERING WEBSITE.

INSTALLATION SHALL BE AT THE LOCATIONS SPECIFIED IN THE PLANS IN ACCORDANCE WITH THE MANUFACTURER'S SPECIFICATIONS.

THE CONTRACTOR SHALL REPAIR OR REPLACE A DAMAGED UNIT WITHIN 24 HOURS OF A DAMAGING IMPACT.

WHEN BIDIRECTIONAL DESIGNS ARE SPECIFIED, THE CONTRACTOR SHALL SUPPLY APPROPRIATE TRANSITIONS.

WHEN GATING IMPACT ATTENUATORS ARE DESIRED, THE CONTRACTOR SHALL SUBMIT DOCUMENTATION TO THE ENGINEER FOR ACCEPTANCE.

THE COST FOR THE ADDITIONAL BARRIER REQUIRED FOR A GATING IMPACT ATTENUATOR SHALL BE INCLUDED IN THE COST OF THE GATING IMPACT ATTENUATOR.

PAYMENT FOR THE ABOVE WORK SHALL BE MADE AT THE UNIT PRICE BID AND SHALL INCLUDE ALL LABOR, TOOLS, EQUIPMENT AND MATERIALS NECESSARY TO CONSTRUCT AND MAINTAIN A COMPLETE AND FUNCTIONAL IMPACT ATTENUATOR SYSTEM, INCLUDING ALL RELATED BACKUPS, TRANSITIONS, LEVELING PADS, HARDWARE AND GRADING, NOT SEPARATELY SPECIFIED, AS REQUIRED BY THE MANUFACTURER.

**ITEM 614 - MAINTAINING TRAFFIC, MISC.: MAINTENANCE OF MAJOR GUIDE SIGNS**

THE CONTRACTOR SHALL MAINTAIN THE SAME NUMBER OF GUIDE SIGNS AS CURRENTLY EXIST FOR EACH FREEWAY EXIT/ENTRANCE WHICH IS TO REMAIN OPEN DURING EACH PHASE OF CONSTRUCTION IN ORDER TO ALLOW MOTORIST TO FIND THEIR DESTINATIONS SAFELY. ERECTION/DISMANTLING OF THE OVERHEAD SIGN SUPPORTS WHICH WILL BE AFFECTED BY THE PROPOSED CONSTRUCTION SHALL BE COMPLETED PRIOR TO THAT PHASE OF CONSTRUCTION. NO MORE THAN ONE SIGN FOR ANY EXIT OR ENTRANCE RAMP MAY BE REMOVED AT ANY TIME. IN INSTANCES WHERE THE COPY ON THE REPLACEMENT SIGN IS SUBSTANTIALLY DIFFERENT FROM THE COPY ON THE EXISTING SIGNS FOR A PARTICULAR EXIT OR ENTRANCE RAMP, ALL OF THE SIGNS IN THE SEQUENCE FOR THAT RAMP SHALL BE CHANGED WITHIN ONE CALENDAR DAY. IN SOME CASES IT SHALL BE NECESSARY TO SUPPLY AND INSTALL TEMPORARY SUPPORTS. THE CONTRACTOR SHALL BE RESPONSIBLE TO DESIGN, INSTALL, PROVIDE POSITIVE PROTECTION, AND REMOVE THE TEMPORARY SUPPORTS AS NEEDED IN ACCORDANCE WITH MT-105.10.

PAYMENT FOR ALL THE MATERIALS, INSTALLATION AND WORK DESCRIBED ABOVE SHALL BE INCLUDED IN THE UNIT PRICE PER EACH FOR ITEM 614, MAINTAINING TRAFFIC, MISC.; MAINTENANCE OF MAJOR GUIDE SIGNS.

\\10.120.112.5\ibishare\pre-int\06\06-386\_HAM-75\HAM-00000\mot\sheets\00000mn002.dgn Sheet 2021-01-25 11:58:17 AM william.croxton

CALCULATED  
STC  
CHECKED  
JDH

MAINTENANCE OF TRAFFIC GENERAL NOTES

HAM-75-14.61

26  
708

j:\pre-int\06-106-386\_HAM-75\_HAM\00000\mot\sheets\00000mm008.dgn 2021-01-19 4:39:45 PM brion.sedzior ODOTV81\_PDF\_Half.pltcfg ODOTV81\_Pen.tbl IBI Group

**MAINTENANCE OF TRAFFIC SEQUENCE**

A MINIMUM OF THREE LANES OF TRAFFIC SHALL BE MAINTAINED AT ALL TIMES ON I-75 BOTH NORTHBOUND AND SOUTHBOUND. ALL LANES WILL BE 11' TYPICAL WITH 2' SHOULDERS, 2' PORTABLE CONCRETE BARRIERS AND 1' BUFFERS UNLESS OTHERWISE NOTED ON THE PLANS. 11' MINIMUM LANE WIDTH WILL BE MAINTAINED ON THE RAMPS AT ALL TIMES, EXCEPT AS NOTED ON THE PLANS. BELOW IS THE CONSTRUCTION SEQUENCE FOR THE PROJECT:

**PRE-PHASE 1**

**TEMPORARY PAVEMENT PLACEMENT**

PCMS SHALL BE SET UP 300 FT IN ADVANCE OF SHARON RD OVERPASS TO PREPARE FOR THE REMOVAL OF THE DMS SIGN AND TRUSS SUPPORT. THE CONTRACTOR SHALL COORDINATE WITH CENTRAL OFFICE (BRYAN COMER AT (614) 378-1253) TO OBTAIN A MODEM TO USE WITH THE PORTABLE CHANGEABLE MESSAGE SIGN.



PLACE TEMPORARY PAVEMENT ALONG THE WEST SIDE OF I-75 SOUTHBOUND FROM STA. 350+60 TO STA. 366+63 AND STA. 368+55 TO STA. 375+71 CLOSING THE SHOULDER.

PLACE TEMPORARY PAVEMENT ALONG THE EAST SIDE OF I-75 NORTHBOUND FROM STA. 352+85 TO STA. 366+12 AND STA. 367+90 TO STA. 375+95 CLOSING THE SHOULDER.

TWO LANES OF TRAFFIC ON I-75 SB OR NB SHALL BE MAINTAINED AS PER THE UNAUTHORIZED LANE USE TABLE DURING THE PLACEMENT OF TEMPORARY PAVEMENT.

PLACE TEMPORARY PAVEMENT ALONG THE EAST SIDE OF THE EXISTING RAMP G PAVEMENT FROM STA. 360+42 AND STA. 366+50.

ONE LANE OF TRAFFIC ON RAMP G SHALL BE MAINTAINED AS PER THE UNAUTHORIZED LANE USE TABLE DURING THE PLACEMENT OF TEMPORARY PAVEMENT.

PLACE TEMPORARY PAVEMENT ALONG THE EAST SIDE OF THE EXISTING RAMP C PAVEMENT FROM STA. 368+50 AND STA. 373+34.

ONE LANE OF TRAFFIC ON RAMP C SHALL BE MAINTAINED AS PER THE UNAUTHORIZED LANE USE TABLE DURING THE PLACEMENT OF TEMPORARY PAVEMENT.

**PHASE 1**

**TEMPORARY PAVEMENT PLACEMENT  
I-75 NORTHBOUND AND SOUTHBOUND BRIDGE OVER  
SHARON ROAD PARTIAL DEMOLITION  
I-75 NORTHBOUND AND SOUTHBOUND BRIDGE OVER  
SHARON ROAD PARTIAL CONSTRUCTION  
RAMP G CONSTRUCTION  
RAMP C CONSTRUCTION  
SHARON ROAD WIDENING  
CHESTER ROAD WIDENING (COMPLETED IN PHASE 1)**

RESTRIPE THE I-75 NORTHBOUND AND SOUTHBOUND LANES TO SHIFT TRAFFIC TO THE OUTSIDE OF THE NORTHBOUND AND SOUTHBOUND BRIDGES OVER SHARON ROAD.

REMOVE THE EXISTING BRIDGE DECK ON THE MEDIAN PORTION OF THE I-75 NORTHBOUND AND SOUTHBOUND BRIDGES OVER SHARON ROAD.

USING SHORT TERM CLOSURES OF SHARON ROAD, REMOVE THE MEDIAN EXISTING BEAMS OF THE I-75 NORTHBOUND AND SOUTHBOUND BRIDGES OVER SHARON ROAD (THE EXISTING BRIDGE PIERS AND CAPS WILL REMAIN INTACT AT THIS TIME).

INSTALL TEMPORARY SHEETING, SHOWN IN THE PLANS, ALONG THE MEDIAN EDGE OF THE I-75 NORTHBOUND AND SOUTHBOUND TEMPORARY ALIGNMENT.

BASED ON CONDITION III OF STANDARD CONSTRUCTION DRAWING (SCD) MT-101.90, PLACE DRUMS ALONG THE TOP OF THE CURB ALONG THE SOUTH SIDE OF SHARON ROAD FROM RAMP A TO RAMP G AND DEMOLISH THE MEDIAN PORTION OF THE EXISTING APPROACH SLAB AND CONCRETE APRON OF THE I-75 NORTHBOUND AND SOUTHBOUND BRIDGES.

CLOSE THE OUTSIDE LANE OF EASTBOUND SHARON ROAD AND CONSTRUCT THE TEMPORARY SIDEWALK ALONG THE SOUTHERN EDGE OF SHARON ROAD, DEMOLISH ENOUGH OF THE EXISTING BRIDGE PIERS AND CAPS TO ACCOMMODATE THE INSTALLATION OF THE PROPOSED BRIDGE BEAMS (THE REMAINING PORTION OF THE EXISTING BRIDGE PIERS CAN REMAIN IN PLACE) AND PLACE THE REMAINING PORTION OF TEMPORARY PAVEMENT FOR RAMP G FROM STA. 366+50 TO SHARON ROAD.

DETOUR PEDESTRIAN TRAFFIC TO THE TEMPORARY SIDEWALK CONSTRUCTED ON THE SOUTH SIDE OF SHARON ROAD.

BASED ON CONDITION III OF SCD 101.90, PLACE DRUMS ON THE TOP OF THE CURB ALONG THE NORTH SIDE OF SHARON ROAD FROM RAMP C TO RAMP E AND DEMOLISH THE MEDIAN PORTION OF THE EXISTING APPROACH SLAB AND CONCRETE APRON OF THE I-75 NORTHBOUND AND SOUTHBOUND BRIDGES.

CLOSE THE OUTSIDE LANE OF WESTBOUND SHARON ROAD AND DEMOLISH ENOUGH OF THE EXISTING BRIDGE PIERS AND CAPS TO ACCOMMODATE THE INSTALLATION OF THE PROPOSED BRIDGE BEAMS (THE REMAINING PORTION OF THE EXISTING BRIDGE PIERS CAN REMAIN IN PLACE) AND PLACE THE REMAINING PORTION OF TEMPORARY PAVEMENT FOR RAMP C FROM STA. 368+50 TO SHARON ROAD.

RESTRIPE RAMP G TRAFFIC TO SHIFT TRAFFIC ONTO THE TEMPORARY PAVEMENT AT SHARON ROAD AND ADJUST SIGNAL HEADS.

RESTRIPE RAMP C TRAFFIC TO SHIFT TRAFFIC ONTO THE TEMPORARY PAVEMENT AT SHARON ROAD AND INSTALL TEMPORARY SIGNALS AT THE FAR SIDE OF THE INTERSECTION.

BASED ON CONDITION III OF SCD 101.90, PLACE DRUMS ON THE TOP OF THE CURB ALONG THE NORTH SIDE OF SHARON ROAD FROM RAMP C TO RAMP E AND CONSTRUCT THE MEDIAN BRIDGE PIERS AND THE MEDIAN PORTIONS ABUTMENT WALLS ALONG THE NORTH SIDE OF SHARON ROAD OF THE I-75 NORTHBOUND AND SOUTHBOUND STRUCTURES (HAM-75-1539 LT AND RT). PEDESTRIAN DETOURING PEDESTRIAN TRAFFIC TO THE SOUTH SIDE OF SHARON ROAD.

BASED ON CONDITION III OF SCD 101.90, PLACE DRUMS ON THE TOP OF THE CURB ALONG THE SOUTH SIDE OF SHARON ROAD FROM RAMP A TO RAMP G AND CONSTRUCT THE MEDIAN BRIDGE PIERS AND THE MEDIAN PORTIONS ABUTMENT WALLS ALONG THE NORTH SIDE OF SHARON ROAD OF THE I-75 NORTHBOUND AND SOUTHBOUND STRUCTURES (HAM-75-1539 LT AND RT). PEDESTRIAN TRAFFIC WILL BE SHIFTED BACK TO THE NORTH SIDE OF SHARON ROAD.

USING SHORT TERM CLOSURES OF SHARON ROAD, PLACE THE PROPOSED BRIDGE BEAMS FOR THE HAM-75-1539 LT AND RT STRUCTURES.

CONSTRUCT THE PROPOSED MEDIAN LANES OF I-75 NORTHBOUND AND SOUTHBOUND OVER SHARON ROAD, HAM-75-1539 LT AND RT, INCLUDING THE APPROACH SLABS AND THE BRIDGE DECKS.



1-19-2021 - ADDED PCMS TO PRE-PHASE

PLACE TEMPORARY PAVEMENT ALONG THE MEDIAN SIDE OF THE I-75 SOUTHBOUND PAVEMENT FROM STA. 325+00 TO STA. 344+19 AND ON THE MEDIAN SIDE OF I-75 NORTHBOUND PAVEMENT FROM STA. 337+05 TO STA. 350+71.

PLACE TEMPORARY PAVEMENT ALONG THE WEST SIDE OF RAMP A FROM STA. 346+16 TO STA. 366+76.

CONSTRUCT A PARTIAL SEGMENT OF RAMP G FROM STA. 353+00 TO STA. 366+71, INCLUDING TEMPORARY PAVEMENT ALONG THE INSIDE EDGE OF PAVEMENT FROM STA. 362+00 TO STA. 366+68, AND INSTALL DRAINAGE PIPE AT STA. 358+10 USING JACK AND BORE TO INSTALL PIPE UNDER THE EXISTING RAMP G PAVEMENT.

CONSTRUCT DRAINAGE DITCH ALONG THE WEST SIDE OF RAMP G FROM STA. 359+00 TO STA. 365+00.

CONSTRUCT A PARTIAL SEGMENT OF RAMP C FROM STA. 368+13 TO STA. 381+00.

CONSTRUCT/INSTALL DRAINAGE DITCHES AND COMPONENTS ALONG THE WEST SIDE OF RAMP C FROM STA. 369+00 TO STA. 384+00.

PLACE TEMPORARY PAVEMENT ALONG THE EAST SIDE OF RAMP E FROM STA. 367+65 TO STA. 380+20.

PLACE TEMPORARY PAVEMENT ALONG THE WEST SIDE OF I-75 SOUTHBOUND PAVEMENT FROM STA. 381+00 TO STA. 409+50.

PLACE TEMPORARY PAVEMENT ALONG THE EAST SIDE OF I-75 NORTHBOUND PAVEMENT FROM STA. 384+50 TO STA. 414+61.

WIDEN THE NORTH SIDE OF SHARON ROAD PAVEMENT FROM STA. 10+75 TO STA. 16+00.

RESTRIPE SHARON ROAD WEST OF CHESTER ROAD TO SHIFT TRAFFIC TO THE NORTH SIDE OF SHARON ROAD.

RESTRIPE CHESTER ROAD TO THE EAST SIDE OF CHESTER ROAD.

PLACE TEMPORARY CONCRETE BARRIER AT THE SOUTHWEST CORNER OF THE SHARON ROAD AND CHESTER ROAD INTERSECTION AND DRUMS ALONG THE WESTERN TRAVEL LANE OF CHESTER ROAD.

WIDEN THE WEST EDGE OF THE CHESTER ROAD, CONSTRUCT ASSOCIATED DRAINAGE AND COMPLETE RECONSTRUCTION OF THE CURB ALONG SHARON ROAD.

DUE TO LACK OF PAVEMENT WIDTH, CHESTER ROAD WIDENING FROM STA. 94+94.95 TO STA. 96+50 SHALL BE COMPLETED WITH A FLAGGER OPERATION FOLLOWING STANDARD CONSTRUCTION DRAWING MT-97.10.

THE REALIGNMENT AND LENGTHENING OF THE STORM SEWER PIPE AT STA. 99+36 SHALL BE COMPLETED WITH A FLAGGER OPERATION FOLLOWING STANDARD CONSTRUCTION DRAWING MT-97.10.

**PHASE 2**

**I-75 NORTHBOUND AND SOUTHBOUND MEDIAN  
PAVEMENT CONSTRUCTION  
RAMP A, G, C, & E CONSTRUCTION**

RESTRIPE THE I-75 NORTHBOUND AND SOUTHBOUND LANES TO SHIFT TRAFFIC TO THE OUTSIDE PAVEMENT AND INSTALL PORTABLE CONCRETE BARRIER ALONG THE I-75 MAINLINE.

PERFORM REPAIRS ON THE EAST PARAPET OF THE HAM-75-1642 L STRUCTURE USING OVERNIGHT LANE CLOSURES ON KEMPER ROAD.

RESTRIPE RAMP A TO THE OUTSIDE PAVEMENT AND INSTALL PORTABLE CONCRETE BARRIER ALONG THE TEMPORARY RAMP A ALIGNMENT.

RESTRIPE RAMP G TO THE PROPOSED PAVEMENT AND INSTALL PORTABLE CONCRETE BARRIER ALONG THE TEMPORARY RAMP G ALIGNMENT.

RESTRIPE RAMP C TO THE PROPOSED PAVEMENT AND INSTALL PORTABLE CONCRETE BARRIER ALONG THE TEMPORARY RAMP C ALIGNMENT.

CONSTRUCT THE INSIDE LANES OF I-75 NORTHBOUND FROM STA. 337+06 TO STA. 420+00.

CONSTRUCT THE INSIDE LANES OF I-75 SOUTHBOUND FROM STA. 325+00 TO STA. 420+00.

CONSTRUCT TURNAROUNDS IN THE MEDIAN OF I-75 AT STA. 336+50 AND STA. 392+75.

CONSTRUCT TEMPORARY PAVEMENT ALONG THE NEWLY CONSTRUCTED I-75 NORTHBOUND PAVEMENT FROM STA. 390+00 TO STA. 392+23 AND STA. 392+75 TO STA. 417+00.

CONSTRUCT DRAINAGE ALONG THE MEDIAN OF I-75, INCLUDING DRAINAGE DITCH, STRUCTURES AND PIPES. USE JACK AND BORE TO PLACE DRAINAGE PIPE UNDER THE I-75 SOUTHBOUND PAVEMENT AT STA. 392+90 AND STA. 400+00.

PLACE TEMPORARY PAVEMENT AT TRAFFIC ISLAND AT RAMP A AND SHARON ROAD INTERSECTION.

CONSTRUCT EAST SIDE OF RAMP A FROM STA. 352+25 TO STA. 366+50.

CONSTRUCT DRAINAGE DITCH ALONG THE EAST SHOULDER OF RAMP A FROM STA. 364+15 TO STA. 367+02.

CONSTRUCT REMAINING SECTION OF RAMP G FROM STA. 362+00 TO STA. 366+71 AND REMOVE THE EXISTING AND TEMPORARY RAMP G PAVEMENT AND CONSTRUCT TEMPORARY PAVEMENT FOR RIGHT TURN MOVEMENT.

CONSTRUCT DRAINAGE DITCH ALONG THE EAST SIDE OF RAMP G FROM STA. 363+00 TO STA. 365+22 AND DRAINAGE PIPES.

SHIFT RAMP G RIGHT TURN MOVEMENT TO TEMPORARY PAVEMENT AND CONSTRUCT THE REMAINING SECTION OF THE RAMP G/ SHARON ROAD INTERSECTION.

SHIFT THE RAMP G RIGHT TURN MOVEMENT ONTO THE PROPOSED RAMP PAVEMENT, REMOVE THE TEMPORARY PAVEMENT AND CONSTRUCT TEMPORARY ASPHALT WALK ALONG THE SOUTH SIDE OF SHARON RD EAST OF RAMP G.

SHIFT PEDESTRIAN TRAFFIC TO THE SOUTH SIDE OF SHARON ROAD.

PLACE TEMPORARY PAVEMENT AT TRAFFIC ISLAND AT RAMP E AND SHARON ROAD INTERSECTION.

RESTRIPE RAMP E TO THE OUTSIDE PAVEMENT AND INSTALL PORTABLE CONCRETE BARRIER ALONG THE TEMPORARY RAMP E ALIGNMENT.

CONSTRUCT THE WEST SIDE OF RAMP E FROM STA. 366+66 TO STA. 376+32.

CONSTRUCT THE EAST SIDE OF RAMP C FROM STA. 368+34 TO STA. 372+00.

REMOVE EXISTING RAMP C PAVEMENT AND TEMPORARY PAVEMENT.

CONSTRUCT DRAINAGE ALONG THE EAST SIDE OF RAMP C FROM STA. 369+00 TO STA. 375+00, INCLUDING DRAINAGE DITCH, STRUCTURES AND PIPES.


CALCULATED  
STC  
CHECKED  
JDH

MAINTENANCE OF TRAFFIC SEQUENCE OF CONSTRUCTION

HAM-75-14.61

32  
708

J:\pre-int\06\06-386\_HAM-75\HAM\00000\mot\sheets\00000mp\108\_ph01.dgn 2021-01-19 4:05:39 PM brian.sedzic\ OD0TV8i\_PDF\_Half.plt\cfdg OD0TV8i\_Pen-ME.tbi IBI Group

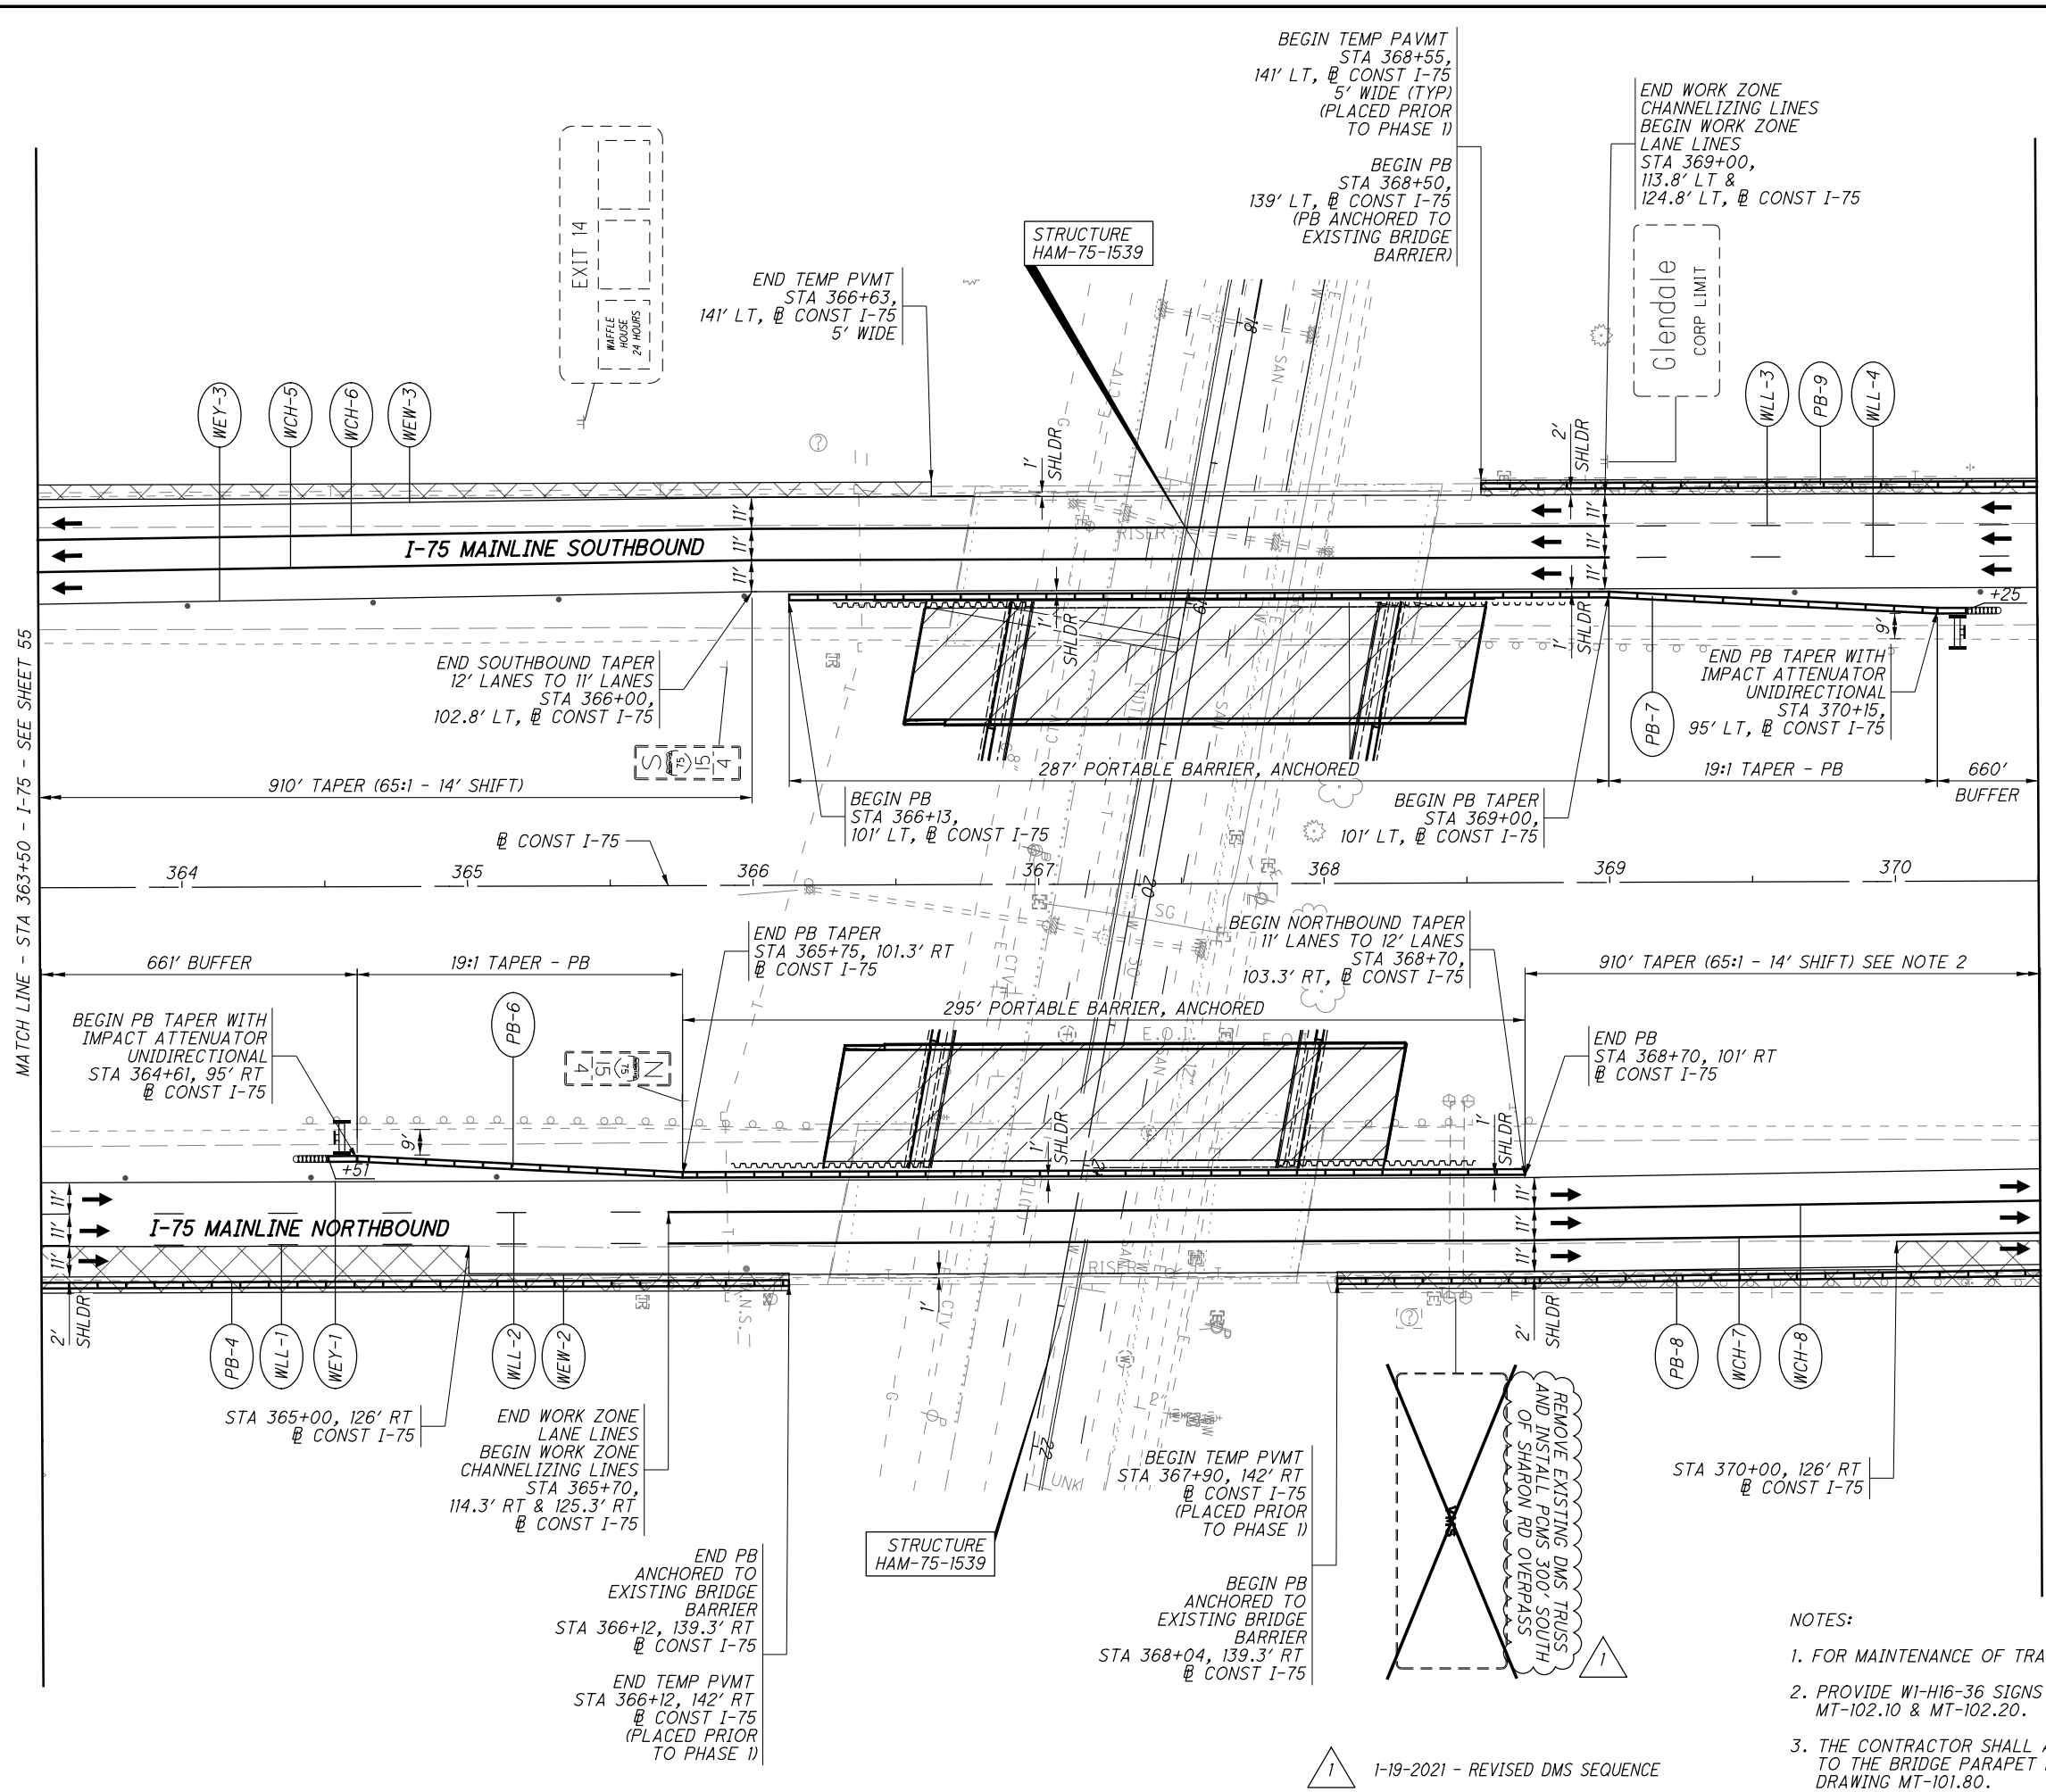

MATCH LINE - STA 363+50 - I-75 - SEE SHEET 55

MATCH LINE - STA 370+50 - I-75 - SEE SHEET 57

BEGIN TEMP PVMT  
STA 368+55,  
141' LT, @ CONST I-75  
5' WIDE (TYP)  
(PLACED PRIOR  
TO PHASE I)

BEGIN PB  
STA 368+50,  
139' LT, @ CONST I-75  
(PB ANCHORED TO  
EXISTING BRIDGE  
BARRIER)

END WORK ZONE  
CHANNELIZING LINES  
BEGIN WORK ZONE  
LANE LINES  
STA 369+00,  
113.8' LT &  
124.8' LT, @ CONST I-75

END TEMP PVMT  
STA 366+63,  
141' LT, @ CONST I-75  
5' WIDE

END SOUTHBOUND TAPER  
12' LANES TO 11' LANES  
STA 366+00,  
102.8' LT, @ CONST I-75

END PB TAPER WITH  
IMPACT ATTENUATOR  
UNIDIRECTIONAL  
STA 370+15,  
95' LT, @ CONST I-75

BEGIN PB  
STA 366+13,  
101' LT, @ CONST I-75

BEGIN PB TAPER  
STA 369+00,  
101' LT, @ CONST I-75

BEGIN PB TAPER WITH  
IMPACT ATTENUATOR  
UNIDIRECTIONAL  
STA 364+61, 95' RT  
@ CONST I-75

END PB TAPER  
STA 365+75, 101.3' RT  
@ CONST I-75

BEGIN NORTHBOUND TAPER  
11' LANES TO 12' LANES  
STA 368+70,  
103.3' RT, @ CONST I-75

END PB  
STA 368+70, 101' RT  
@ CONST I-75

STA 365+00, 126' RT  
@ CONST I-75

END WORK ZONE  
LANE LINES  
BEGIN WORK ZONE  
CHANNELIZING LINES  
STA 365+70,  
114.3' RT & 125.3' RT  
@ CONST I-75

END PB  
ANCHORED TO  
EXISTING BRIDGE  
BARRIER  
STA 366+12, 139.3' RT  
@ CONST I-75

END TEMP PVMT  
STA 366+12, 142' RT  
@ CONST I-75  
(PLACED PRIOR  
TO PHASE I)

BEGIN TEMP PVMT  
STA 367+90, 142' RT  
@ CONST I-75  
(PLACED PRIOR  
TO PHASE I)

BEGIN PB  
ANCHORED TO  
EXISTING BRIDGE  
BARRIER  
STA 368+04, 139.3' RT  
@ CONST I-75


STA 370+00, 126' RT  
@ CONST I-75

REMOVE EXISTING DMS TRUSS  
AND INSTALL PCMS 300' SOUTH  
OF SHARON RD OVERPASS

NOTES:

- FOR MAINTENANCE OF TRAFFIC LEGEND SEE SHEET 49.
- PROVIDE W1-H16-36 SIGNS WITHIN LANE SHIFT PER MT-102.10 & MT-102.20.
- THE CONTRACTOR SHALL ANCHOR THE PORTABLE BARRIER TO THE BRIDGE PARAPET PER STANDARD CONSTRUCTION DRAWING MT-101.80.

1-19-2021 - REVISED DMS SEQUENCE

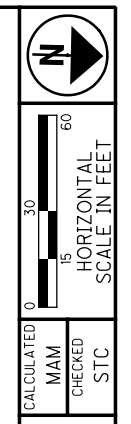

MAINTENANCE OF TRAFFIC PLAN - PHASE 1  
STA 363+50 TO STA 370+50


HAM-75-14.61

56  
708





J:\pre-int\06\06-386\_HAM-75\HAM\00000\mot\sheet\00000mp104\_ph02.dgn 2021-01-06 10:28:55 AM brian.sedzoi\ ODOTV81\_PDF\_Half\_pltcfgr ODOTV81\_Pen-ME.tbi IBI Group

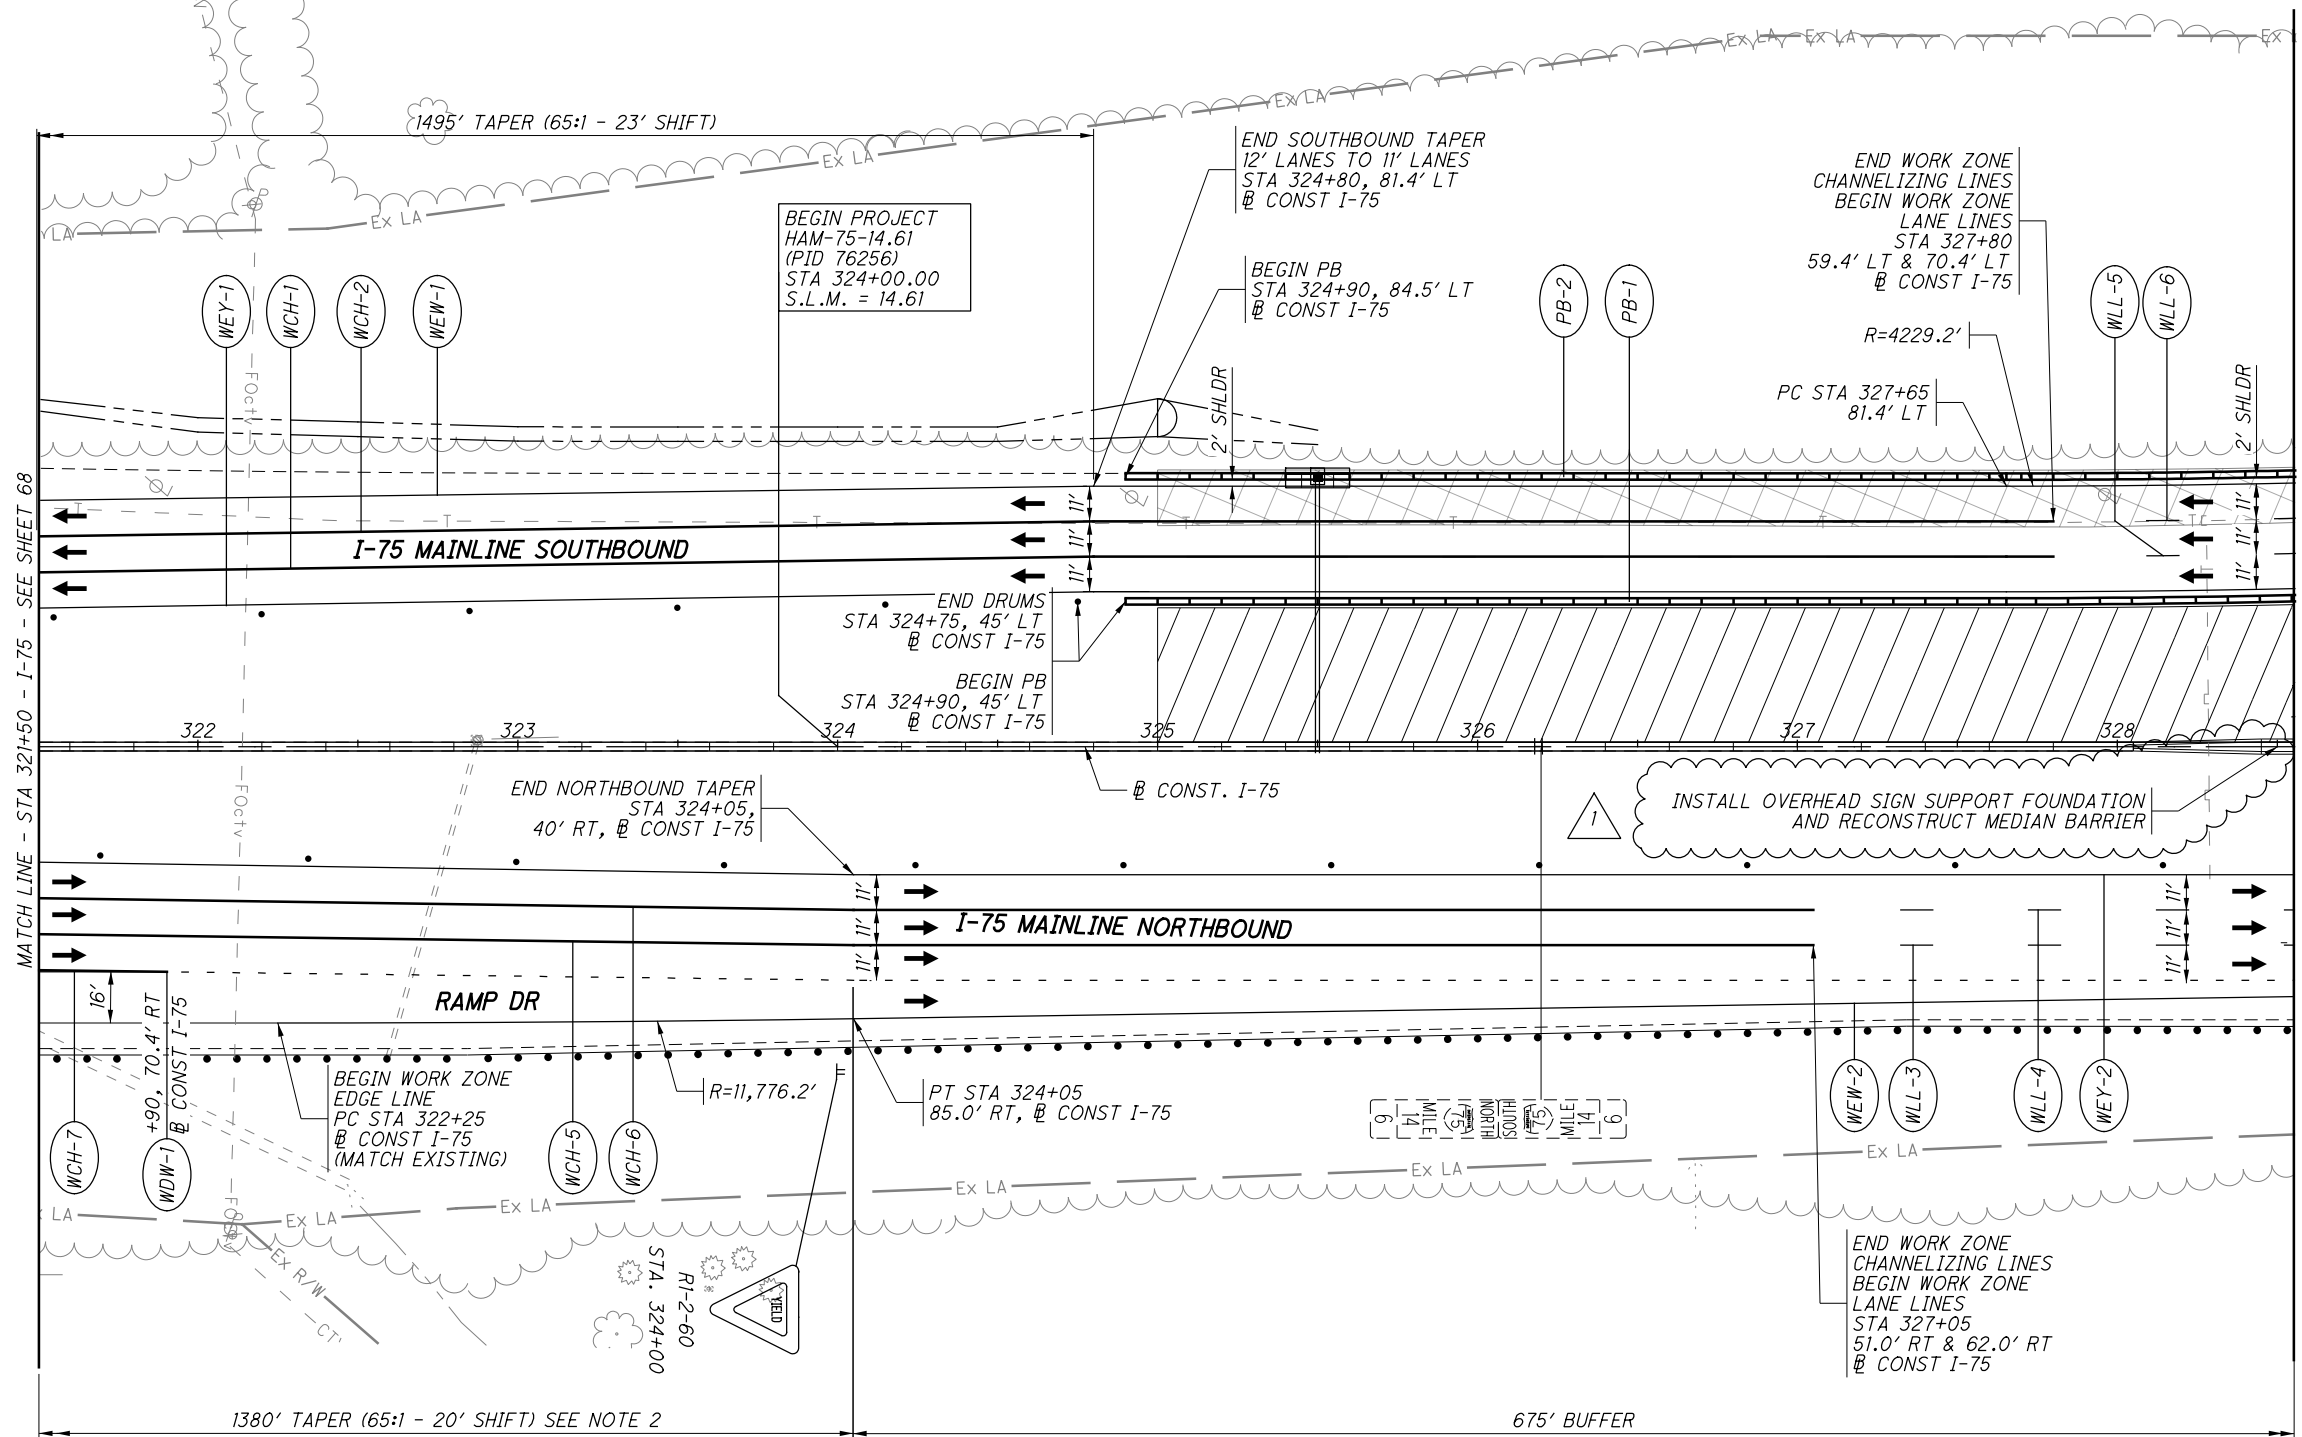

- NOTES:
- FOR MAINTENANCE OF TRAFFIC LEGEND SEE SHEET 49.
  - PROVIDE W1-H16-36 SIGNS WITHIN LANE SHIFT PER MT-102.10 & MT-102.20.



**MAINTENANCE OF TRAFFIC PLAN - PHASE 2**  
**STA 321+50 TO STA 328+50**

**HAM-75-14.61**









SHEET NUM.					PART.					ITEM	ITEM EXT	GRAND TOTAL	UNIT	DESCRIPTION	SEE SHEET NO.
565	566				01/IMS/PV	02/NHS/OT	03/IMS/OT	04/IMS/BR	05/IMS/BR						
														TRAFFIC SURVEILLANCE	
						345				625	25400	345	FT	CONDUIT, 2", 725.04	
	726					726				625	25408	726	FT	CONDUIT, 2", 725.051	
	437					1,113				625	25500	1,113	FT	CONDUIT, 3", 725.04	
	1,271					1,271				625	25504	1,271	FT	CONDUIT, 3", 725.051	
16,846	3,992					20,838				625	25750	20,838	FT	CONDUIT, 4", MULTICELL, 725.20 , EPC-40	562
	1,098	100				1,198				625	25752	1,198	FT	CONDUIT, 4", MULTICELL, 725.20 , EPC-80	562
	1,196	145				1,341				625	25901	1,341	FT	CONDUIT, JACKED OR DRILLED, AS PER PLAN ,3" OR 4"	562
8,578	4,343					12,921				625	29010	12,921	FT	TRENCH, 30" DEEP	
	1	9				10				625	30700	10	EACH	PULL BOX, 725.08, 18"	
	29	9				38				625	30710	38	EACH	PULL BOX, 725.08, 32"	
	6					6				625	31510	6	EACH	PULL BOX REMOVED	
		6				6				625	32000	6	EACH	GROUND ROD	
	5					5				625	32001	5	EACH	GROUND ROD, AS PER PLAN	563
	4	2				6				625	34001	6	EACH	POWER SERVICE, AS PER PLAN	563
8,578	4,343					12,921				625	36000	12,921	FT	PLASTIC CAUTION TAPE	
	1					1				630	70021	1	EACH	OVERHEAD SIGN SUPPORT, DMS TRUSS, 115', AS PER PLAN	563
	1					1				630	70051	1	EACH	CATWALK, DMS TRUSS, AS PER PLAN	563
	2					2				630	70080	2	EACH	OVERHEAD SIGN SUPPORT FOUNDATION, DMS TRUSS	
	8					8				632	04905	8	EACH	VEHICULAR SIGNAL HEAD, (LED), 2-SECTION, 12" LENS, 1-WAY, POLYCARBONATE, AS PER PLAN	564
	8					8				632	25000	8	EACH	COVERING OF VEHICULAR SIGNAL HEAD	
	8					8				632	26500	8	EACH	DETECTOR LOOP	
	8					8				632	27004	8	EACH	LOOP DETECTOR UNIT	
	2,625					2,625				632	40500	2,625	FT	SIGNAL CABLE, 5 CONDUCTOR, NO. 14 AWG	
	2					2				632	64010	2	EACH	SIGNAL SUPPORT FOUNDATION	
	2,751					2,751				632	65300	2,751	FT	LOOP DETECTOR LEAD-IN CABLE, 2 CONDUCTOR, NO. 14 AWG	
594	2,559					3,153				632	68200	3,153	FT	POWER CABLE, 2 CONDUCTOR, NO. 6 AWG	
LS	LS					LS				632	90300	LS		SIGNALIZATION, MISC.: REMOVAL OF ITS EQUIPMENT	564
	2					2				632	90400	2	EACH	SIGNALIZATION, MISC.: RAMP METER SIGN	564
	2					2				632	90400	2	EACH	SIGNALIZATION, MISC.: SIGNAL SUPPORT, TYPE TC-81.22, DESIGN 12	564
	2					2				632	90400	2	EACH	SIGNALIZATION, MISC.: SIGNAL SUPPORT, MECHANICAL DAMPER FOR TC-81.22 MAST ARM (GREATER THAN 39' IN LENGTH)	564
	2	2				4				633	67100	4	EACH	CABINET FOUNDATION	
		2				2				633	67200	2	EACH	CONTROLLER WORK PAD	
	3					3				633	67201	3	EACH	CONTROLLER WORK PAD, AS PER PLAN	563
	2	2				4				633	74000	4	EACH	UNINTERRUPTIBLE POWER SUPPLY (UPS)	
12,449	909					13,358				804	15010	13,358	FT	FIBER OPTIC CABLE, 24 FIBER	
	5	2				7				804	34022	7	EACH	FIBER TERMINATION PANEL, 24 FIBER	
	1					1				809	60000	1	EACH	CCTV IP-CAMERA SYSTEM, DOME-TYPE	
	1					1				809	61000	1	EACH	CCTV CONCRETE POLE WITH LOWERING UNIT, 70 FEET	
	1					1				809	63000	1	EACH	DYNAMIC MESSAGE SIGN (DMS), FULL-SIZE WALK-IN	
	2					2				809	65000	2	EACH	ITS CABINET - GROUND MOUNTED	
		2				2				809	65030	2	EACH	ITS CABINET - RAMP METER	
	3					3				809	65990	3	EACH	ITS DEVICE, MISC.: EX. CABINET WORK	563
		2				2				809	67000	2	EACH	RAMP METER SYSTEM	
		2				2				809	68900	2	EACH	SIDE-FIRED RADAR DETECTOR	
	2	2				4				809	69123	4	EACH	ATC V6.24 CONTROLLER, AS PER PLAN	561
	LS					LS				809	70000	LS		MAINTAINING ITS DURING CONSTRUCTION	

j:\pre-int\06\06-386\_HAM-75\HAM\00000\roadway\sheets\00000GG005.dgn 2021-01-20 12:10:41 PM william.croxtor" ODOTcadd\_PDF.plt:fg ODOTV81\_Pen.tbl IBI Group

CALCULATED WLC CHECKED JDH  
**GENERAL SUMMARY (5 OF 10)**  
**HAM-75-14.61**  
 196  
 708

SHEET NUM.						PART.					ITEM	ITEM EXT	GRAND TOTAL	UNIT	DESCRIPTION	SEE SHEET NO.
204	476	479	480	484	548	01/IMS/PV	02/NHS/OT	03/IMS/OT	04/IMS/BR	05/IMS/BR						
				1,693			1,693				621	00100	1,693	EACH	TRAFFIC CONTROL	
				1,524			1,524				621	54000	1,524	EACH	RAISED PAVEMENT MARKER REMOVED	
		8	22				30				625	32000	30	EACH	GROUND ROD	
28	2						28				626	00102	28	EACH	BARRIER REFLECTOR, TYPE 1, ONE-WAY	
8							8				626	00102	8	EACH	BARRIER REFLECTOR, TYPE 1, BI-DIRECTIONAL	
139							139				626	00110	139	EACH	BARRIER REFLECTOR, TYPE 2, ONE-WAY	
27							27				626	00110	27	EACH	BARRIER REFLECTOR, TYPE 2, BI-DIRECTIONAL	
		1,374			45		1,419				630	03100	1,419	FT	GROUND MOUNTED SUPPORT, NO. 3 POST	
		99.9					99.9				630	06400	99.9	FT	GROUND MOUNTED STRUCTURAL BEAM SUPPORT, S4X7.7	
		348.7					348.7				630	07500	348.7	FT	GROUND MOUNTED STRUCTURAL BEAM SUPPORT, W10X22	
		172.6					172.6				630	07600	172.6	FT	GROUND MOUNTED STRUCTURAL BEAM SUPPORT, W10X12	
		120					120				630	08004	120	FT	ONE WAY SUPPORT, NO. 3 POST	
		18					18				630	08600	18	EACH	SIGN POST REFLECTOR	
		14					14				630	09000	14	EACH	BREAKAWAY STRUCTURAL BEAM CONNECTION	
			2				2				630	20800	2	EACH	OVERHEAD SIGN SUPPORT, TYPE TC-12.30, DESIGN 8	
			2				2				630	74500	2	EACH	OVERHEAD SIGN SUPPORT, MISC.: TYPE TC-16.22 DESIGN 13	512
			2				2				630	74500	2	EACH	OVERHEAD SIGN SUPPORT, MISC.: TYPE TC-17.11 DESIGN 8	496
			1				1				630	74500	1	EACH	OVERHEAD SIGN SUPPORT, MISC.: TYPE TC-17.11 DESIGN 10	512
			2				2				630	74500	2	EACH	OVERHEAD SIGN SUPPORT, MISC.: TYPE TC-12.31 DESIGN 6	512
			4				4				630	74500	4	EACH	OVERHEAD SIGN SUPPORT, MISC.: TYPE TC-12.31 DESIGN 12	496
			6				6				630	74500	6	EACH	OVERHEAD SIGN SUPPORT, MISC.: TYPE TC-15.116 DESIGN 2	496
			1				1				630	74500	1	EACH	OVERHEAD SIGN SUPPORT, MISC.: TYPE TC-15.116 DESIGN 3	496
		3			11		14				630	79100	14	EACH	SIGN HANGER ASSEMBLY, MAST ARM	
					2		2				630	79500	2	EACH	SIGN SUPPORT ASSEMBLY, POLE MOUNTED	
		1,087.7			115		1,202.7				630	80100	1,202.7	SF	SIGN, FLAT SHEET	
		549					549				630	80200	549	SF	SIGN, GROUND MOUNTED EXTRUSHEET	
			3,429.5				3,429.5				630	80224	3,429.5	SF	SIGN, OVERHEAD EXTRUSHEET	
		1					1				630	81020	1	EACH	CONCRETE MEDIAN BARRIER SIGN BRACKET	
									2		630	84010	1	EACH	CONCRETE BARRIER MEDIAN OVERHEAD SIGN SUPPORT FOUNDATION, TYPE TC-21.50	
		28					28				630	84500	28	EACH	GROUND MOUNTED STRUCTURAL BEAM SUPPORT FOUNDATION	
		2	19				21				630	84510	21	EACH	RIGID OVERHEAD SIGN SUPPORT FOUNDATION	
		6					6				630	84520	6	EACH	SPAN WIRE SIGN SUPPORT FOUNDATION	
130							130				630	84900	130	EACH	REMOVAL OF GROUND MOUNTED SIGN AND DISPOSAL	
6							6				630	85400	6	EACH	REMOVAL OF GROUND MOUNTED MAJOR SIGN AND DISPOSAL	
7							7				630	85600	7	EACH	REMOVAL OF GROUND MOUNTED MAJOR SIGN AND REERECTION	
112							112				630	86002	112	EACH	REMOVAL OF GROUND MOUNTED POST SUPPORT AND DISPOSAL	
43							43				630	86102	43	EACH	REMOVAL OF GROUND MOUNTED STRUCTURAL BEAM SUPPORT AND DISPOSAL	
2							2				630	86310	2	EACH	REMOVAL OF STRUCTURE MOUNTED SIGN AND DISPOSAL	
					1		1				630	87100	1	EACH	REMOVAL OF OVERHEAD MOUNTED SIGN AND REERECTION	
41					1		42				630	87400	42	EACH	REMOVAL OF OVERHEAD MOUNTED SIGN AND DISPOSAL	
4							4				630	87500	4	EACH	REMOVAL OF POLE MOUNTED SIGN AND DISPOSAL	
5							5				630	89706	5	EACH	REMOVAL OF OVERHEAD SIGN SUPPORT AND DISPOSAL, TYPE TC-12.30	
5							5				630	89802	5	EACH	REMOVAL OF OVERHEAD SIGN SUPPORT AND DISPOSAL, TYPE TC-7.65	
4							4				630	89810	4	EACH	REMOVAL OF OVERHEAD SIGN SUPPORT AND DISPOSAL, TYPE TC-17.10	
1							1				630	89812	1	EACH	REMOVAL OF WOOD POLE AND DISPOSAL	
											631	94406	1	EACH	REMOVAL OF SIGNS WIRED	
					2		2				631	97700	2	EACH	SIGN LIGHTING MISC.: REMOVE AND REERECT ILLUMINATED SIGN	545
				0.1			0.1				644	00100	0.1	MILE	EDGE LINE, 4"	
				12.74			12.74				644	00104	12.74	MILE	EDGE LINE, 6"	
				0.71			0.71				644	00200	0.71	MILE	LANE LINE, 4"	
				17			17				644	00204	17	MILE	LANE LINE, 6"	
				1			1				644	00300	1	MILE	CENTER LINE	
				6,531			6,531				644	00400	6,531	FT	CHANNELIZING LINE, 8"	
				18,756			18,756				644	00404	18,756	FT	CHANNELIZING LINE, 12"	
				392			392				644	00500	392	FT	STOP LINE	
				630			630				644	00600	630	FT	CROSSWALK LINE	
				735			735				644	00700	735	FT	TRANSVERSE/DIAGONAL LINE	
				887			887				644	00720	887	FT	CHEVRON MARKING	
				640			640				644	00900	640	SF	ISLAND MARKING	
				2			2				644	01120	2	EACH	SCHOOL SYMBOL MARKING, 120"	
				86			86				644	01300	86	EACH	LANE ARROW	
				620			620				644	01500	620	FT	DOTTED LINE, 4"	
				9,705			9,705				644	01510	9,705	FT	DOTTED LINE, 6"	
				3.72			3.72				644	30030	3.72	MILE	REMOVAL OF PAVEMENT MARKING	

1-15-2021 - UPDATED SIGN SUPPORT FOUNDATION DUE TO PID 82288 CONSTRUCTION

**GENERAL SUMMARY (6 OF 10)**

**HAM-75-14.61**

CALCULATED  
WLC  
CHECKED  
JDH

j:\pre-int\06-386\_HAM-75\_HAM\00000\roadway\sheets\00000GG006.dgn 2021-01-19 4:13:11 PM e william.croxtor ODOTcadd\_PDF.plt cfb ODOTV81\_Pen.tbl IBI Group

SHEET NUM.					PART.					ITEM	ITEM EXT	GRAND TOTAL	UNIT	DESCRIPTION	SEE SHEET NO.
647	680	684B			01/IMS/PV	02/NHS/OT	03/IMS/OT	04/IMS/BR	05/IMS/BR						
STRUCTURE OVER 20 FOOT SPAN (HAM-75-15.39R,SFN 3110966)															
LS								LS	LS	202	11003	LS		STRUCTURE REMOVED, OVER 20 FOOT SPAN, AS PER PLAN	645
288								84	204	202	22900	288	SY	APPROACH SLAB REMOVED	
4								1	3	SPECIAL	20365000	4	EACH	SETTLEMENT PLATFORM	646
LS								LS	LS	503	11101	LS		COFFERDAMS AND EXCAVATION BRACING, AS PER PLAN	645
LS								LS	LS	505	11100	LS		PILE DRIVING EQUIPMENT MOBILIZATION	
4,680								1,357	3,323	507	00600	4,680	FT	14" CAST-IN-PLACE REINFORCED CONCRETE PILES, DRIVEN	
5,040								1,462	3,578	507	00650	5,040	FT	14" CAST-IN-PLACE REINFORCED CONCRETE PILES, FURNISHED	
135,203								39,209	95,994	509	10000	135,203	LB	EPOXY COATED REINFORCING STEEL	
648								188	460	509	30040	648	FT	NO. 6 GFRP DEFORMED BARS	
2								1	1	511	33500	2	EACH	SEMI-INTEGRAL DIAPHRAGM GUIDE	
78								23	55	511	34462	78	CY	CLASS QC SCC CONCRETE WITH QC/QA, BRIDGE DECK (PARAPET)	
252								73	179	511	43512	252	CY	CLASS QC1 CONCRETE WITH QC/QA, ABUTMENT INCLUDING FOOTING	
546								158	388	511	53014	546	CY	CLASS QC3 CONCRETE, MISC.: WITH QC/QA, BRIDGE DECK	645
1,222								354	868	512	10100	1,222	SY	SEALING OF CONCRETE SURFACES (EPOXY-URETHANE)	
61								18	43	512	10300	61	SY	SEALING CONCRETE BRIDGE DECKS WITH HMWM RESIN	
13								4	9	512	33000	13	SY	TYPE 2 WATERPROOFING	
8								2	6	515	15130	8	EACH	DRAPED STRAND PRESTRESSED CONCRETE BRIDGE I-BEAM MEMBERS, LEVEL 3, TYPE WF72-49 (134'-8" LONG)	
21								6	15	515	20000	21	EACH	INTERMEDIATE DIAPHRAGMS	
163								47	116	516	13600	163	SF	1" PREFORMED EXPANSION JOINT FILLER	
85								25	60	516	13900	85	SF	2" PREFORMED EXPANSION JOINT FILLER	
203								59	144	516	14020	203	FT	SEMI-INTEGRAL ABUTMENT EXPANSION JOINT SEAL	
16								5	11	516	44201	16	EACH	ELASTOMERIC BEARING WITH INTERNAL LAMINATES AND LOAD PLATE (NEOPRENE), AS PER PLAN:	659
														16"x24"x 3.398" WITH 17"x25"x1.5" LOAD PLATES	
131								38	93	518	21200	131	CY	POROUS BACKFILL WITH GEOTEXTILE FABRIC	
252								73	179	518	40000	252	FT	6" PERFORATED CORRUGATED PLASTIC PIPE	
51								15	36	518	40012	51	FT	6" NON-PERFORATED CORRUGATED PLASTIC PIPE	
4								1	3	523	20000	4	EACH	DYNAMIC LOAD TESTING	
4								1	3	523	20500	4	EACH	RESTRIKE	
558								162	396	526	30000	558	SY	REINFORCED CONCRETE APPROACH SLABS (T=17")	
164								48	116	526	90010	164	FT	TYPE A INSTALLATION	
9								3	6	601	21050	9	SY	TIED CONCRETE BLOCK MAT, TYPE 1	
467								135	332	625	25604	467	FT	CONDUIT, 4", 725.051	
2								1	1	625	29921	2	EACH	STRUCTURE JUNCTION BOX, AS PER PLAN	646
2								1	1	625	30700	2	EACH	PULL BOX, 725.08, 18"	
LS								LS	LS	SPECIAL	69098400	LS		TEMPORARY SURCHARGE	646
68								20	48	846	00110	68	CF	POLYMER MODIFIED ASPHALT EXPANSION JOINT SYSTEM	
STRUCTURE 20 FOOT SPAN AND UNDER (HAM-75-15.57,SFN 3110982)															
LS								LS		202	11200	LS		PORTIONS OF STRUCTURE REMOVED	
48								48		202	35200	48	FT	PIPE REMOVED, OVER 24"	
LS								LS		503	11100	LS		COFFERDAMS AND EXCAVATION BRACING	
LS								LS		503	21300	LS		UNCLASSIFIED EXCAVATION	
10,553								10,553		509	10000	10,553	LB	EPOXY COATED REINFORCING STEEL	
113								113		511	46210	113	CY	CLASS QC1 CONCRETE, RETAINING/WINGWALL INCLUDING FOOTING	
120								120		512	10100	120	SY	SEALING OF CONCRETE SURFACES (EPOXY-URETHANE)	
LS								LS		518	21230	LS		POROUS BACKFILL WITH GEOTEXTILE FABRIC	
75								75		601	11000	75	SY	RIPRAP, TYPE D	
106								106		601	32104	106	CY	ROCK CHANNEL PROTECTION, TYPE B WITH GEOTEXTILE FABRIC	
48								48		611	30000	48	FT	96" CONDUIT, TYPE A, 706.02	
40								40		843	50001	40	SF	PATCHING CONCRETE STRUCTURES WITH TROWELABLE MORTAR, AS PER PLAN	680
STRUCTURE REPAIR (HAM-75-16.42L,SFN 3111040)															
		28						28		202	30701	28	FT	CONCRETE BARRIER REMOVED, AS PER PLAN	684B
		368						368		509	10000	368	LB	EPOXY COATED REINFORCING STEEL	
		16						16		510	10000	16	EACH	DOWEL HOLES WITH NONSHRINK, NONMETALLIC GROUT	
		3						3		511	53014	3	CY	CLASS QC3 CONCRETE, MISC.:QC3 CONCRETE, SUPERSTRUCTURE, AS PER PLAN	684B
		30						30		512	10100	30	SY	SEALING OF CONCRETE SURFACES (EPOXY-URETHANE)	

j:\pre-int\06-386\_HAM-75\_HAM\00000\roadway\sheets\00000GG009.dgn 2021-01-19 4:57:15 PM william.croxton' ODOT\cadd\_PDF\_plt\cfig ODOTV86\_Pen.tbl IBI Group

CALCULATED WLC CHECKED JDH  
 GENERAL SUMMARY (9 OF 10)  
 HAM-75-14.61  
 200  
 708







J:\pre-int\06-386\_HAM-75\_HAM\00000\roadway\sheets\00000G5002.dgn 2021-01-19 4:25:35 PM william.croxton' ODOT.cadd\_PDF.pltcfgr ODOTV81\_Pen.tbl IBI Group

SHEET NO.	203	203	204	204	659	SHEET NO.	203	203	659	SHEET NO.	203	203	659	SHEET NO.	203	203	204	204	659	
	EXCAVATION CY	EMBANKMENT CY	EXCAVATION OF SUBGRADE, 18 INCHES DEEP CY	EMBANKMENT, AS PER PLAN CY	SEEDING AND MULCHING SY		EXCAVATION CY	EMBANKMENT CY	SEEDING AND MULCHING SY		EXCAVATION CY	EMBANKMENT CY	SEEDING AND MULCHING SY		EXCAVATION CY	EMBANKMENT CY	EXCAVATION OF SUBGRADE, 18 INCHES DEEP CY	GRANULAR MATERIAL, TYPE C CY	SEEDING AND MULCHING SY	
I-75 SB						I-75 NB				RAMP C				SHARON ROAD						
251	0	0	0	0	0	312	825	6	803	358	599	17	328	390	29	23	30	30	165	
252	296	2	243	243	39	313	2187	9	1733	359	2418	30	1049	391	166	26	120	120	198	
253	341	15	723	729	217	314	1947	20	1828	360	2694	207	850	392	582	30	270	270	361	
254	367	7	715	730	267	315	1552	210	2561	361	1280	651	689	393	1194	14	321	321	435	
255	338	4	738	756	201	316	1168	129	1445	362	894	1286	778	394	985	70	477	478	456	
256	302	39	716	753	389	317	972	110	1250	363	572	1960	689	395	212	555	278	299	562	
257	129	68	457	498	223	318	1047	118	1431	364	368	2074	690	396	326	209	341	343	515	
258	82	70	328	345	209	319	1371	80	1877	365	221	2200	672	397	363	25	350	350	317	
259	81	107	378	398	296	320	1731	380	3977	366	104	2188	533	398	630	19	349	351	340	
260	187	81	485	499	438	321	1077	1431	3093	367	73	2230	523	399	703	12	351	351	0	
261	219	72	479	509	489	322	837	520	1795	368	48	1626	354	400	624	119	351	351	98	
262	225	90	455	532	584	323	357	145	780					401	316	248	333	333	550	
263	251	83	432	541	677	324	759	803	2143	RAMP A				402	365	67	474	474	211	
264	275	96	377	543	712	325	265	1850	2005		177	36	495	403	205	65	291	293	295	
265	293	52	251	382	697	326	232	5953	2238		142	133	815	404	108	30	140	140	161	
266	345	74	337	449	833	327	859	4784	1513		332	363	1400	405	111	27	119	119	188	
267	374	100	500	556	783	328	1216	7186	2373		509	354	1534	406	0	0	0	0	0	
268	613	169	771	826	1145	329	832	4479	2240		649	211	1172							
269	835	90	818	835	1299	330	890	1352	2555		982	125	1145	SHARON ROAD SUBTOTAL	6,919	1,539	4,595	4,623	4,852	
270	940	67	843	852	1366	331	671	735	1407		1408	68	1305							
271	1055	118	826	835	1621	332	1344	1053	2355		1588	45	1455							
272	1070	172	864	872	1662	333	1798	1346	2778											
273	1720	160	1180	1183	2154	334	526	817	1363	RAMP G				CHESTER ROAD						
274	1619	17		1394	335	335	1552	2193	2782		39	409	536	407	35	27	60	63	151	
275	1453	133		2065	336	336	1865	3214	2699		47	1390	1165	408	22	4	48	51	30	
276	1049	408		2443	337	337	1333	1635	2346		10	1478	845	409	48	26	97	102	122	
277	609	329		1187	338	338	859	1160	1652		39	2247	1389	410	125	14	199	202	109	
278	740	1079		1840	339	339	877	1127	2654		168	1533	1528							
279	612	2052		1971	340	340	738	1524	1994		386	1206	1332	CHESTER ROAD SUBTOTAL	230	71	404	418	412	
280	579	6010		2495	341	341	1010	1269	2455		774	617	1279							
281	767	4561		1309	342	342	909	1047	2220											
282	1057	6044		1954	343	343	1226	1481	2972	RAMP E										
283	646	3507		3084	344	344	1061	1545	3271		356	134	211							
284	3485	1324		3850	345	345	1137	1824	2645		47	220	728							
285	1972	568		2205	346	346	1380	1773	3138		151	353	1217							
286	887	856		1796	347	347	1373	2617	3388		267	277	1156							
287	766	1270		1767	348	348	1574	2677	2594		151	144	494							
288	453	1963		988	349	349	799	1420	1317		186	165	459							
289	898	4050		2361	350	350	1373	1763	2018											
290	1100	2738		2400	351	351	1052	1353	1312											
291	1340	2071		2133	352	352	787	1672	1689											
292	528	860		1346	353	353	778	1880	1788											
293	617	356		1940	354	354	621	1599	1638											
294	507	913		1749	355	355	248	1304	1421											
295	977	723		1911	356	356	226	1107	1659											
296	1214	321		1880	357	357	104	463	2300											
297	1417	502		2484																
298	898	997		2195																
299	701	1380		2321																
300	633	1310		2423																
301	570	1329		2378																
302	620	1260		2423																
303	358	531		1222																
304	493	651		1528																
305	404	613		1278																
306	489	862		1367																
307	491	954		1406																
308	325	949		1439																
309	193	918		1457																
310	188	845		1548																
311	92	402		1033																
I-75 SB SUBTOTAL	42,085	57,392	12,916	13,866	88,871	I-75 NB SUBTOTAL	47,345	71,163	97,495	RAMPS SUBTOTAL	17,679	25,977	28,815	SHARON ROAD SUBTOTAL	6,919	1,539	4,595	4,623	4,852	
														CHESTER ROAD SUBTOTAL	230	71	404	418	412	
														TOTALS CARRIED TO GEN SUM	114,258	156,142	17,915	13,866	5,041	220,445

1 1-15-2021 - UPDATED EX. PVT DEPTHS AND EARTHWORK EQ ON CROSS SECTIONS

GRAND TOTAL						
	203	203	204	204	204	659
	EXCAVATION	EMBANKMENT	EXCAVATION OF SUBGRADE, 18 INCHES DEEP	EMBANKMENT, AS PER PLAN	GRANULAR MATERIAL, TYPE C	SEEDING AND MULCHING
	CY	CY	CY	CY	CY	SY
I-75 SB	42,085	57,392	12,916	13,866		88,871
I-75 NB	47,345	71,163				97,495
RAMPS	17,679	25,977				28,815
SHARON ROAD	6,919	1,539	4,595		4,623	4,852
CHESTER ROAD	230	71	404		418	412
TOTALS CARRIED TO GEN SUM	114,258	156,142	17,915	13,866	5,041	220,445

CALCULATED WLC CHECKED JDH  
**SUBSUMMARY - EARTHWORK**  
**HAM-75-14.61**  
 203  
708









J:\pre-int\06-386\_HAM-75\HAM\00000\roadway\sheets\00000G5008.dgn 2021-01-14 11:15:16 AM william.croxton\ ODOTcadd\_PDF.plt cfg ODOTV8i\_Pen.tbl IBI Group

STATION RANGE		ROUTE	SIDE	L=LENGTH (FT)	W=WIDTH (FT)	A=LXW=AREA (SF)	202	202	202	204	204	204	204	206	206	206	206	254	301	301	301	302	304	407	407	442	442	442	442	442	452	618			
							PAVEMENT REMOVED	PAVEMENT REMOVED, ASPHALT	WEARING COURSE REMOVED	SUBGRADE COMPACTION	PROOF ROLLING (APPLIED AT 1 HR/2000 SY FOR RECONSTRUCTION)	PROOF ROLLING (APPLIED AT 1 HR/3000 SY FOR NEW CONSTRUCTION)	GEOTEXTILE FABRIC	CEMENT (APPLIED AT 5% PER 15 LB/CF SOIL)	CURING COAT	CEMENT STABILIZED SUBGRADE, 14 INCHES DEEP	MIXTURE DESIGN FOR CHEMICALLY STABILIZED SOILS	PAVEMENT PLANING, ASPHALT CONCRETE, (1"-3.25")	(6") ASPHALT CONCRETE BASE, PG64-22	(10") ASPHALT CONCRETE BASE, PG64-22	(VAR. DEPTH, 2" AVG) ASPHALT CONCRETE BASE, PG64-22, AS PER PLAN	(11") ASPHALT CONCRETE BASE, PG64-22	(8") AGGREGATE BASE	NON-TRACKING TACK COAT (APPLIED AT AVG 0.055 GAL/SY FOR NEW ASPHALT)	NON-TRACKING TACK COAT (APPLIED AT AVG 0.085 GAL/SY FOR MILLED ASPHALT SURFACE)	(1.75") ASPHALT CONCRETE INTERMEDIATE COURSE, 19MM, TYPE A (446)	(VAR. DEPTH, 2" AVG) ASPHALT CONCRETE INTERMEDIATE COURSE, 19MM, TYPE A (446), AS PER PLAN	(1.5") ASPHALT CONCRETE SURFACE COURSE, 12.5MM, TYPE A (447), AS PER PLAN	(1.5") ASPHALT CONCRETE SURFACE COURSE, 12.5MM, TYPE A (448)	(1.75") ASPHALT CONCRETE INTERMEDIATE COURSE, 19MM, TYPE A (448)	(VAR. DEPTH, 2" AVG) ASPHALT CONCRETE INTERMEDIATE COURSE, 19MM, TYPE A (448), AS PER PLAN	13.5" NON-REINFORCED CONCRETE PAVEMENT, CLASS OCl	RUMBLE STRIPS, SHOULDER (ASPHALT CONCRETE), AS PER PLAN		
							SY	SY	SY	SY	HR	HR	SY	TON	SY	SY	LS	SY	CY	CY	CY	CY	CY	GAL	GAL	CY	CY	CY	CY	CY	CY	MI			
I-75 NB																																			
337+12.25	TO	366+32.20	MAIN FD	RT		116405.75	12933.97																												
367+95.36	TO	412+00.00	MAIN FD	RT		176473.36	19608.15																												
337+12.25	TO	366+36.18	INS SHLDR FD	RT		15464.50		1718.28	1718.28																										
367+99.13	TO	412+00.00	INS SHLDR FD	RT		25094.34		2788.26	2788.26																										
337+12.25	TO	349+84.11	OUT SHLDR FD	RT		14211.36		1579.04	1579.04																										
353+02.66	TO	366+27.51	OUT SHLDR FD	RT		15141.22		1682.36	1682.36																										
367+91.00	TO	375+90.95	OUT SHLDR FD	RT		8882.35		986.93	986.93																										
383+17.52	TO	412+00.00	OUT SHLDR FD	RT		30999.27		3444.36	3444.36																										
337+12.25	TO	359+17.48	MAIN FD	RT	2205.23	48.00	105851.04				3.92		355.04	11761.23	11761.23	LS																			
359+00.00	TO	366+24.08	MAIN FD	RT	724.08	48.00	34755.84				1.29		116.58	3861.76	3861.76	LS																			
368+20.31	TO	409+85.00	MAIN FD	RT	4164.69	48.00	199905.12				7.40		670.52	22211.68	22211.68	LS																			
409+85.00	TO	412+00.00	MAIN FD	RT	215.00	48.00	10320.00				0.38		34.62	1146.67	1146.67	LS																			
412+00.00	TO	420+00.00	MAIN P&R	RT			4107.00											4567.44																	
337+12.25	TO	347+62.45	AUX. LANE FD	RT	1050.20	12.00	12602.40				0.47		42.27	1400.27	1400.27	LS																			
394+39.26	TO	408+22.55	AUX. LANE FD	RT	1383.29	12.00	16599.48				0.61		55.68	1844.39	1844.39	LS																			
347+62.45	TO	356+71.18	DECEL/GORE FD	RT			21807.00				0.81		73.14	2423.00	2423.00	LS																			
408+22.55	TO	412+00.00	DECEL/GORE FD	RT			4981.00				0.18		16.71	553.44	553.44	LS																			
376+27.58	TO	380+19.26	ACCEL/GORE FD	RT			17785.00				0.66		59.65	1976.11	1976.11	LS																			
380+19.26	TO	387+89.26	ACCEL/GORE FD	RT	770.00	25.00	19250.00				0.71		64.57	2138.89	2138.89	LS																			
387+89.26	TO	394+39.26	ACCEL/GORE FD	RT	650.00	18.50	12025.00				0.45		40.33	1336.11	1336.11	LS																			
366+42.63	TO	366+72.63	REAR APP SL FD	RT	30.00	85.00	2550.00				0.09																								
366+42.63	TO	366+72.63	INS SHLDR 18" EC	RT	30.00	1.50	45.00				0.00																								
368+08.85	TO	368+38.85	FWD APP SL FD	RT	30.00	85.00	2550.00				0.09																								
368+08.85	TO	368+38.85	OUT SHLDR 18" EC	RT	30.00	1.50	45.00				0.00																								
337+12.25	TO	345+50.00	INS SHLDR FD	RT	837.75	12.00	10053.00				0.37		33.72	1117.00	1117.00	LS																			
345+50.00	TO	359+17.48	INS SHLDR FD	RT	1367.48	16.00	21879.68				0.81		73.39	2431.08	2431.08	LS																			
337+12.25	TO	359+17.48	INS SHLDR FD 4" EC	RT	2205.23	0.33	735.08																												
337+12.25	TO	359+17.48	INS SHLDR FD 10" EC	RT	2205.23	0.83	1837.69																												
337+12.25	TO	359+17.48	INS SHLDR FD 16" EC	RT	2205.23	1.33	2940.31																												
337+12.25	TO	359+17.48	INS SHLDR FD 18" EC	RT	2205.23	1.50	3307.85				0.12		11.10	367.54	367.54	LS																			
359+00.00	TO	364+15.00	INS SHLDR FD	RT	515.00	16.00	8240.00				0.31		27.64	915.56	915.56	LS																			
364+15.00	TO	364+25.00	INS SHLDR FD	RT	10.00	17.09	170.85				0.01		0.57	18.98	18.98	LS																			
364+25.00	TO	366+30.22	INS SHLDR FD	RT	205.22	18.17	3728.85				0.14		12.51	414.32	414.32	LS																			
359+00.00	TO	366+30.22	INS SHLDR FD 4" EC	RT	730.22	0.33	243.41																												
359+00.00	TO	366+30.22	INS SHLDR FD 10" EC	RT	730.22	0.83	608.52																												
359+00.00	TO	366+30.22	INS SHLDR FD 16" EC	RT	730.22	1.33	973.63																												
359+00.00	TO	366+30.22	INS SHLDR FD 18" EC	RT	730.22	1.50	1095.33				0.04		3.67	121.70	121.70	LS																			
368+26.44	TO	370+50.00	INS SHLDR FD	RT	223.56	18.17	4062.09				0.15		13.62	451.34	451.34	LS																			
370+50.00	TO	371+04.65	INS SHLDR FD	RT	54.65	17.09	933.70				0.03		3.13	103.74	103.74	LS																			
371+04.65	TO	383+75.00	INS SHLDR FD	RT	1270.35	16.00	20325.60				0.75		68.18	2258.40	2258.40	LS																			
383+75.00	TO	392+02.39	INS SHLDR FD	RT	827.39	12.00	9928.68				0.37		33.30	1103.19	1103.19	LS																			
392+04.03	TO	412+00.00	INS SHLDR FD	RT	1905.97	12.00	22871.64				0.85		76.72	2541.29	2541.29	LS																			
368+26.44	TO	412+00.00	INS SHLDR FD 4" EC	RT	4373.56	0.33	1457.85																												
368+26.44	TO	412+00.00	INS SHLDR FD 10" EC	RT	4373.56	0.83	3644.63	</																											



STATION RANGE		ROUTE	SIDE	L=LENGTH (FT)	W=WIDTH (FT)	A=LxW=AREA (SF)	202	202	202	204	204	204	204	206	206	206	206	254	301	301	301	302	304	407	407	442	442	442	442	442	452	618			
							PAVEMENT REMOVED	PAVEMENT REMOVED, ASPHALT	WEARING COURSE REMOVED	SUBGRADE COMPACTION	PROOF ROLLING (APPLIED AT 1 HR/2000 SY FOR RECONSTRUCTION)	PROOF ROLLING (APPLIED AT 1 HR/3000 SY FOR NEW CONSTRUCTION)	GEOTEXTILE FABRIC	CEMENT (APPLIED AT 5% PER 115 LB/CF SOIL)	CURING COAT	CEMENT STABILIZED SUBGRADE, 14 INCHES DEEP	MIXTURE DESIGN FOR CHEMICALLY STABILIZED SOILS	PAVEMENT PLANING, ASPHALT CONCRETE, (1"-3.25")	(6") ASPHALT CONCRETE BASE, PG64-22	(10") ASPHALT CONCRETE BASE, PG64-22	(VAR. DEPTH, 2" AVG) ASPHALT CONCRETE BASE, PG64-22, AS PER PLAN	(11") ASPHALT CONCRETE BASE, PG64-22	(8") AGGREGATE BASE	NON-TRACKING TACK COAT (APPLIED AT AVG 0.055 GAL/SY FOR NEW ASPHALT)	NON-TRACKING TACK COAT (APPLIED AT AVG 0.085 GAL/SY FOR MILLED ASPHALT SURFACE)	(1.75") ASPHALT CONCRETE INTERMEDIATE COURSE, 19MM, TYPE A (446)	(VAR. DEPTH, 2" AVG) ASPHALT CONCRETE INTERMEDIATE COURSE, 19MM, TYPE A (446), AS PER PLAN	(1.5") ASPHALT CONCRETE SURFACE COURSE, 12.5MM, TYPE A (447), AS PER PLAN	(1.5") ASPHALT CONCRETE SURFACE COURSE, 12.5MM, TYPE A (448)	(1.75") ASPHALT CONCRETE INTERMEDIATE COURSE, 19MM, TYPE A (448)	(VAR. DEPTH, 2" AVG) ASPHALT CONCRETE INTERMEDIATE COURSE, 19MM, TYPE A (448), AS PER PLAN	13.5" NON-REINFORCED CONCRETE PAVEMENT, CLASS OCI	RUMBLE STRIPS, SHOULDER (ASPHALT CONCRETE), AS PER PLAN		
							SY	SY	SY	SY	HR	HR	SY	TON	SY	SY	LS	SY	CY	CY	CY	CY	CY	GAL	GAL	CY	CY	CY	CY	CY	SY	MILE			
RAMP A																																			
343+23.26	TO	367+57.83	MAIN	LT/RT		44695.05	4966.12																												
343+22.75	TO	367+49.13	INS SHLDR	RT		14448.93																													
343+22.96	TO	367+72.87	OUT SHLDR	LT/RT		25039.86																													
366+30.31	TO	367+57.86	MEDIAN SHLDR	LT/RT		1006.60																													
352+30.24	TO	367+51.17	MAIN/SHLDR FD	LT/RT		59870.00																													
352+30.24	TO	367+51.17	INS SHLDR 6" EC	RT	1520.93	0.50	760.47																												
352+30.24	TO	367+51.17	OUT SHLDR 6" EC	LT	1520.93	0.50	760.47																												
352+30.24	TO	367+51.17	INS SHLDR 18" EC	RT	1520.93	1.50	2281.40																												
352+30.24	TO	367+51.17	OUT SHLDR 18" EC	LT	1520.93	1.50	2281.40																												
RAMP C																																			
368+11.82	TO	379+41.35	MAIN	LT/RT		20790.61	2310.07																												
368+13.62	TO	379+41.72	INS SHLDR	RT		8076.01																													
368+15.05	TO	379+40.88	OUT SHLDR	LT/RT		10980.47																													
368+34.09	TO	380+22.92	MAIN/SHLDR FD	LT/RT		54305.00																													
368+34.09	TO	380+22.92	INS SHLDR 6" EC	RT	1188.83	0.50	594.42																												
368+34.09	TO	380+22.92	OUT SHLDR 6" EC	LT	1188.83	0.50	594.42																												
368+34.09	TO	380+22.92	INS SHLDR 18" EC	RT	1188.83	1.50	1783.25																												
368+34.09	TO	380+22.92	OUT SHLDR 18" EC	LT	1188.83	1.50	1783.25																												
RAMP E																																			
366+72.45	TO	383+17.33	MAIN	LT/RT		30014.08	3334.90																												
366+71.64	TO	383+17.00	INS SHLDR	LT		13115.14																													
367+11.17	TO	383+17.52	OUT SHLDR	LT/RT		14247.02																													
366+72.51	TO	367+44.44	MEDIAN SHLDR	RT		760.85																													
366+93.35	TO	376+29.48	MAIN/SHLDR FD	LT/RT		44585.00																													
366+93.35	TO	376+29.48	INS SHLDR 6" EC	RT	936.13	0.50	468.07																												
366+93.35	TO	376+29.48	OUT SHLDR 6" EC	LT	936.13	0.50	468.07																												
366+93.35	TO	376+29.48	INS SHLDR 18" EC	RT	936.13	1.50	1404.20																												
366+93.35	TO	376+29.48	OUT SHLDR 18" EC	LT	936.13	1.50	1404.20																												
RAMP G																																			
349+84.59	TO	366+80.08	MAIN	LT/RT		36983.83	4109.31																												
349+84.96	TO	366+80.21	INS SHLDR	LT/RT		8373.01																													
349+84.31	TO	366+70.34	OUT SHLDR	RT		14879.29																													
356+70.22	TO	366+71.35	MAIN/SHLDR FD	LT/RT		44585.00																													
356+70.22	TO	366+71.35	INS SHLDR 6" EC	RT	1001.13	0.50	500.56																												
356+70.22	TO	366+71.35	OUT SHLDR 6" EC	LT	1001.13	0.50	500.56																												
356+70.22	TO	366+71.35	INS SHLDR 18" EC	RT	1001.13	1.50	1501.70																												
356+70.22	TO	366+71.35	OUT SHLDR 18" EC	LT	1001.13	1.50	1501.70																												
P&R=PLANING & RESURFACING, FD=FULL DEPTH, WID=WIDENING, EC=EDGE COURSE																																			
TOTALS CARRIED TO SHEET 212							14,721	12,326	27,048	0	0	9	0	729	24,143	24,143	LS	0	0	0	0	0	0	5,136	0	0	0	0	0	0	0	0	0	22,594	0.00

CALCULATED  
WLC  
CHECKED  
JDH

SUBSUMMARY - PAVEMENT (5 OF 6)

J:\pre-int\06-386\_HAM-75\_HAM\00000\roadway\sheets\00000G5010.dgn 2021-01-14 11:15:17 AM william.croxton\ODOTcadd\_PDF.plt ODOTV81\_Pen.tbl IBI Group

J:\pre-int\06-386\_HAM-75-HAM\00000\roadway\sheets\00000G5011.dgn 2021-01-20 9:09:07 AM william.croxton' ODOT\cadd\_PDF\plctfg ODOTV8i\_Pen.tbl IBI Group

STATION RANGE	ROUTE	SIDE	L=LENGTH (FT)	W=WIDTH (FT)	A=LxW=AREA (SF)	202	202	202	204	204	204	204	206	206	206	206	254	301	301	301	302	304	407	407	442	442	442	442	442	452	618			
						SY	SY	SY	SY	HR	HR	SY	TON	SY	SY	LS	SY	CY	CY	CY	CY	CY	GAL	GAL	CY	CY	CY	CY	CY	CY	CY	OC1	MILE	
SHARON ROAD																																		
10+75.00 TO 28+51.86	MAIN	LT			8631.09	959.01		959.01																										
9+10.00 TO 28+24.63	MAIN	RT			7023.18	780.35		780.35																										
10+75.00 TO 14+00.00	MAIN P&R	LT	325.00	30.00	9750.00												1083.33		60.19			178.75	92.08											
14+00.00 TO 15+00.00	MAIN P&R	LT	100.00	24.00	2400.00														14.81			44.00	22.67											
15+00.00 TO 28+22.95	MAIN P&R	LT	1322.95	25.00	33073.75												3674.86		204.16			606.35	312.36											
28+22.95 TO 29+16.67	MAIN P&R	LT			2348.00												260.89		14.49			43.05	22.18											
9+10.00 TO 13+00.00	MAIN P&R	RT	390.00	21.50	8385.00												931.67		51.76			153.73	79.19											
13+00.00 TO 16+75.00	MAIN P&R	RT	375.00	22.75	8531.25												947.92		52.66			156.41	80.57											
16+75.00 TO 24+50.00	MAIN P&R	RT	775.00	24.00	18600.00												2066.67		114.81			341.00	175.67											
24+50.00 TO 28+00.00	MAIN P&R	RT	350.00	28.00	9800.00												1088.89		60.49			179.67	92.56											
10+75.00 TO 15+79.22	MAIN FD WID	LT			10813.00				1201.44	0.60		1201.44							333.73			266.99	198.24											
10+75.00 TO 15+79.22	C&G 40* EC	LT	504.22	3.33	1680.73				186.75	0.09		186.75										41.50												
15+79.22 TO 23+97.11	MAIN FD WID	LT	817.89	24.00	19629.36				2181.04	1.09		2181.04										484.68	359.87											
15+79.22 TO 23+97.11	C&G 40* EC	LT	817.89	3.33	2726.30				302.92	0.15		302.92										67.32												
23+97.11 TO 28+51.86	MAIN FD WID	LT			10011.00				1112.33	0.56		1112.33										308.98												
23+97.11 TO 28+51.86	C&G 40* EC	LT	454.75	3.33	1515.83				168.43	0.08		168.43										37.43												
9+10.00 TO 16+75.00	MAIN FD WID	RT			18861.00				2095.67	1.05		2095.67										582.13												
9+10.00 TO 16+75.00	C&G 40* EC	RT	765.00	3.33	2550.00				283.33	0.14		283.33										62.96												
16+75.00 TO 24+50.00	MAIN FD WID	RT	775.00	11.00	8525.00				947.22	0.47		947.22										263.12												
16+75.00 TO 24+50.00	C&G 40* EC	RT	775.00	3.33	2583.33				287.04	0.14		287.04										63.79												
24+50.00 TO 28+24.63	MAIN FD WID	RT			2655.00				295.00	0.15		295.00										81.94												
24+50.00 TO 28+24.63	C&G 40* EC	RT	374.63	3.33	1248.77				138.75	0.07		138.75										65.56	48.68											
TOTALS CARRIED TO SHEET 212						1,740	0	1,740	9,200	5	0	9,200	0	0	0	LS	10,321	0	2,176	574	0	2,045	2,996	878	0	0	0	757	883	574	0	0.00		
CHESTER ROAD																																		
94+94.95 TO 99+90.70	MAIN P&R	LT/RT			14965.00																													
94+94.95 TO 99+90.70	MAIN FD	LT			5233.00				581.44	0.29		581.44																						
94+94.95 TO 99+90.70	C&G 40* EC	LT	495.75	3.33	1652.50				183.61	0.09		183.61																						
P&R=PLANING & RESURFACING, FD=FULL DEPTH, WID=WIDENING, EC=EDGE COURSE																																		
TOTALS CARRIED TO SHEET 212						0	0	0	766	1	0	766	0	0	0	LS	1,663	97	0	93	0	171	371	142	0	0	0	94	110	93	0	0.00		
1	1-15-2021 - ADDED ITEM 202-WEARING COURSE REMOVED REMOVED ITEM 202-PAVEMENT REMOVED, APP USE ITEM 202-PAVEMENT REMOVED, COMBINE INTO SINGLE PAY ITEM					202	202	202	204	204	204	204	206	206	206	206	254	301	301	301	302	304	407	407	442	442	442	442	442	442	452	618		
2	1-15-2021 - REVISED QUANTITY FOR ITEM 618- RUMBLE STRIPS, SHOULDER (ASPHALT CONCRETE)					PAVEMENT REMOVED	PAVEMENT REMOVED, ASPHALT	WEARING COURSE REMOVED	SUBGRADE COMPACTION	PROOF ROLLING (APPLIED AT 1 HR/2000 SY FOR RECONSTRUCTION)	PROOF ROLLING (APPLIED AT 1 HR/3000 SY FOR NEW CONSTRUCTION)	GEOTEXTILE FABRIC	CEMENT (APPLIED AT 5% PER 115 LB/CF SOIL)	CURING COAT	CEMENT STABILIZED SUBGRADE, 14 INCHES DEEP	MIXTURE DESIGN FOR CHEMICALLY STABILIZED SOILS	PAVEMENT PLANING, ASPHALT CONCRETE, (1"-3.25")	(6") ASPHALT CONCRETE BASE, PG64-22	(10") ASPHALT CONCRETE BASE, PG64-22	(VAR. DEPTH, 2" AVG) ASPHALT CONCRETE BASE, PG64-22, AS PER PLAN	(11") ASPHALT CONCRETE BASE, PG64-22	(8") AGGREGATE BASE	NON-TRACKING TACK COAT (APPLIED AT AVG 0.055 GAL/SY FOR NEW ASPHALT)	NON-TRACKING TACK COAT (APPLIED AT AVG 0.085 GAL/SY FOR MILLED ASPHALT SURFACE)	(1.75") ASPHALT CONCRETE INTERMEDIATE COURSE, 19MM, TYPE A (446)	(VAR. DEPTH, 2" AVG) ASPHALT CONCRETE INTERMEDIATE COURSE, 19MM, TYPE A (446), AS PER PLAN	(1.5") ASPHALT CONCRETE SURFACE COURSE, 12.5MM, TYPE A (447), AS PER PLAN	(1.5") ASPHALT CONCRETE SURFACE COURSE, 12.5MM, TYPE A (448)	(1.75") ASPHALT CONCRETE INTERMEDIATE COURSE, 19MM, TYPE A (448)	(VAR. DEPTH, 2" AVG) ASPHALT CONCRETE INTERMEDIATE COURSE, 19MM, TYPE A (448), AS PER PLAN	13.5" NON-REINFORCED CONCRETE PAVEMENT, CLASS OC1	RUMBLE STRIPS, SHOULDER (ASPHALT CONCRETE), AS PER PLAN		
208	I-75 SB				39,199	14,918	54,116	577	0	32	0	2,717	89,973	89,973	LS	2,895	0	0	0	26,906	20,045	14,686	247	4,362	161	3,740	0	0	0	0	3.53			
210	I-75 NB				32,543	12,200	44,742	577	0	27	0	2,337	77,382	77,382	LS	4,568	0	0	0	23,126	17,256	12,847	389	3,850	254	3,252	0	0	0	0	3.05			
211	RAMPS				14,721	12,326	27,046	0	0	9	0	729	24,143	24,143	LS	0	0	0	0	0	5,136	0	0	0	0	0	0	0	0	0	22,594	0.00		
212	SHARON ROAD				1,740	0	1,740	9,200	5	0	9,200	0	0	0	LS	10,321	0	2,176	574	0	2,045	2,996	878	0	0	0	757	883	574	0	0.00			
212	CHESTER ROAD				0	0	0	766	1	0	766	0	0	0	LS	1,663	97	0	93	0	171	371	142	0	0	0	94	110	93	0	0.00			
TOTALS CARRIED TO GENERAL SUMMARY						88,203	39,444	127,644	11,120	74	0	9,966	5,783	191,498	191,498	LS	19,447	2,273	667	50,032	44,653		32,556		8,212	415	6,992	851	993	667	22,594	6.58		
FUNDING SPLITS																																		
01/MS/PV:																																		
	I-75 MAINLINE MULTI-LANE 71%				50937	19254	70189	819	42	0	3588	118822	118822	LS	5299	0	0	35523	26484		20000		5831	295	4964	0	0	0	0	4.67				
02/NHS/OT:																																		
	I-75 MAINLINE MAJOR NEW 29%				20805	7864	28669	335	17	0	1466	48533	48533	LS	2164	0	0	14509	10817		8169		2381	120	2028	0	0	0	0	1.91				
	ALL OTHERS MAJOR NEW FUNDING				16,461	12,326	28,786	9,966	15	0	9,966	729	24,143	24,143	LS	11,984	2,273	667	0	7,352		4,387	0	0	0	851	993	667	22,594	0.00				
	SUBTOTAL				37,266	20,190	57,455	10,301	32	0	9,966	2,195	72,676	72,676	LS	14,148	2,273	667	14,509	18,169		12,556		2,381	120	2,028	851	993	667	22,594	1.91			



--- HAM-75-12.60 (PID 82288)  
 --- ORIGINAL HAM-75  
 \*\* DENOTES ITEM CONSTRUCTED DURING  
 HAM-75-12.60 (PID 82288)

BEGIN PROJECT  
 HAM-75-14.61  
 (PID 76256)  
 STA 324+00.00  
 SLM=14.61  
 E040(822)

BEGIN WORK  
 @ CONST. I-75 SB  
 STA 316+00.00

STA. 323+39.12  
 BEGIN SPEED CHANGE  
 LANE FOR RAMP Q

STA. 324+00.00, @ CONST. I-75 SB  
 MATCH INTO HAM-75-12.60 (PID 82288)  
 BEGIN PLANING AND RESURFACING

STA. 324+30.61, @ CONST. I-75 SB  
 END PLANING AND RESURFACING  
 BEGIN FULL DEPTH PAVEMENT

BEGIN CONCRETE BARRIER, END ANCHORAGE, REINFORCED, TYPE D  
 STA. 325+00.00, 72.00' LT @ CONST. I-75 SB  
 END CONCRETE BARRIER, END ANCHORAGE, REINFORCED, TYPE D  
 BEGIN CONCRETE BARRIER, SINGLE SLOPE, TYPE D  
 STA. 325+15.00, 72.00' LT @ CONST. I-75 SB  
 CONCRETE BARRIER, SINGLE SLOPE, TYPE D (10')  
 END CONCRETE BARRIER, SINGLE SLOPE, TYPE D  
 BEGIN CONCRETE BARRIER, END ANCHORAGE, REINFORCED, TYPE D  
 STA. 325+25.00, 72.00' LT @ CONST. I-75 SB  
 END CONCRETE BARRIER, SINGLE SLOPE, TYPE D  
 END ANCHORAGE, REINFORCED, TYPE D  
 STA. 325+40.00, 72.00' LT @ CONST. I-75 SB  
 BEGIN PAVED GUTTER, TYPE 4  
 STA. 325+50.00, 81.00' LT @ CONST. I-75 SB  
 BEGIN END ANCHORAGE, REINFORCED, TYPE D  
 STA. 325+60.00, 72.00' LT @ CONST. I-75 SB  
 END END ANCHORAGE, REINFORCED, TYPE D  
 BEGIN CONCRETE BARRIER, SINGLE SLOPE, TYPE D  
 STA. 325+75.00, 72.00' LT @ CONST. I-75 SB

CONCRETE BARRIER,  
 SINGLE SLOPE, TYPE D (760')

\*\* EX. CONCRETE BARRIER,  
 TYPE C1  
 (DND)

PAVED GUTTER,  
 TYPE 4

CONST  
 LIMITS  
 ITS

EX. GUARDRAIL  
 (TBR)  
 @ CONST. I-75 SB

EX. OVERHEAD  
 CANTILEVER SIGN  
 (TBR)

STA 333+19.29, 60.00' LT.  
 @ CONST. I-75 SB  
 END SPEED CHANGE LANE FOR RAMP A  
 END 100' SHOULDER TAPER (50:1)  
 END 650' SPEED CHANGE LANE FOR  
 RAMP A TAPER (62.5:1)  
 BEGIN AUXILIARY LANE FOR MAINLINE

STA 334+19.29, 72.00' LT.  
 @ CONST. I-75 SB  
 BEGIN 100' SHOULDER  
 TAPER (50:1)

CONCRETE BARRIER,  
 SINGLE SLOPE, TYPE D (820')

END GUARDRAIL, TYPE MGS  
 BEGIN AA, MGS TYPE B  
 STA. 334+80.30, 18.55' RT.  
 @ CONST. I-75 SB

END AA, MGS TYPE B  
 STA. 335+17.44, 23.50' RT.  
 @ CONST. I-75 SB

\*\* EX. CONCRETE BARRIER,  
 TYPE B1  
 (DND)

\*\* EX. FENCE  
 (DND)

\*\* EX. DITCH  
 (DND)

\*\* EX. DITCH  
 (TBR)


\*\* EX. CATCH BASIN  
 (TBR)

EX. MANHOLE \*\*  
 (DND)

\*\* EX. CATCH  
 BASIN (DND)

END GUARDRAIL, TYPE MGS  
 BEGIN AA, MGS TYPE B  
 STA. 335+17.44, 23.50' RT.  
 @ CONST. I-75 SB

NOTES:  
 1.) SEE CROSS SECTION  
 SHEETS FOR  
 ADDITIONAL UTILITY  
 INFORMATION.  
 2.) SEE SHEETS  
 450A-450D FOR  
 BMP DETAILS.

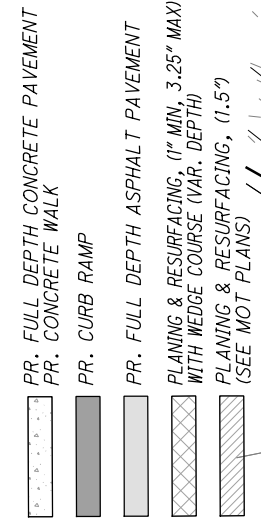

BEGIN GUARDRAIL, TYPE MGS  
 MATCH EXISTING  
 STA. 327+50.54, 74.00' RT.  
 @ CONST. I-75 NB


120' CONCRETE  
 BARRIER  
 REPLACEMENT FOR NEW  
 OVERHEAD SIGN  
 SUPPORT FOUNDATION

END GUARDRAIL, TYPE MGS  
 MATCH EXISTING  
 STA. 331+77.00, 74' RT.  
 @ CONST. I-75 NB

1-STY METAL  
 BLDG.

\$=CONCRETE BARRIER AND  
 INLET (20' LENGTH) INCLUDED  
 WITH ITEM 611

1-15-2021 - UPDATED SIGN SUPPORT FOUNDATION  
 DUE TO PID 82288 CONSTRUCTION

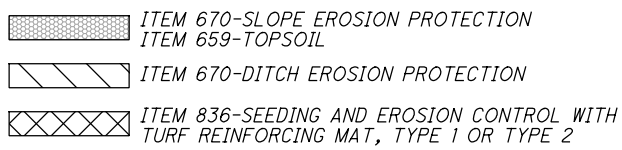

**CURVE 2**  
 @ CONST. I-75 SB  
 P.I. STA 336+05.55  
 $\Delta = 22^\circ 07' 38''$  (LT)  
 $D_c = 1^\circ 20' 00''$   
 $R = 4,297.18'$   
 $T = 840.24'$   
 $L = 1,659.54'$   
 $E = 81.38'$   
 $C = 1,649.25'$   
 $C.B. = N 9^\circ 28' 36'' E$   
 $e_{max} = 0.043$

**CURVE 3**  
 @ CONST. I-75  
 P.I. STA 337+74.35  
 $\Delta = 22^\circ 07' 38''$  (LT)  
 $D_c = 1^\circ 20' 00''$   
 $R = 4,297.18'$   
 $T = 840.24'$   
 $L = 1,659.54'$   
 $E = 81.38'$   
 $C = 1,649.25'$   
 $C.B. = N 9^\circ 28' 36'' E$   
 $e_{max} = N.C.$

**CURVE 4**  
 @ CONST. I-75 NB  
 P.I. STA 339+43.15  
 $\Delta = 22^\circ 07' 38''$  (LT)  
 $D_c = 1^\circ 20' 00''$   
 $R = 4,297.18'$   
 $T = 840.24'$   
 $L = 1,659.54'$   
 $E = 81.38'$   
 $C = 1,649.25'$   
 $C.B. = N 9^\circ 28' 36'' E$   
 $e_{max} = 0.043$




PLAN - I-75 SB / NB  
 STA 323+00 TO STA 335+50

HAM-75-14.61

216  
 708

j:\pre-int\06-386\_HAM-75\HAM\00000\roadway\sheets\00000GP100.dgn 2021-01-19 3:54:11 PM e:\william.croxtor\ODOTcadd\_PDF.plt\cgt ODOTV81\_Pen-ME.tbl IBI Group

j:\pre-int\06\06-386\_HAM-75\HAM\00000\roadway\sheets\00000X5100\_SB.dgn 2021-01-20 10:30:24 AM william.croxton' ODOTcadd\_PDF.pltcfg ODOTV8i\_Pen-ME.tbl IBI Group

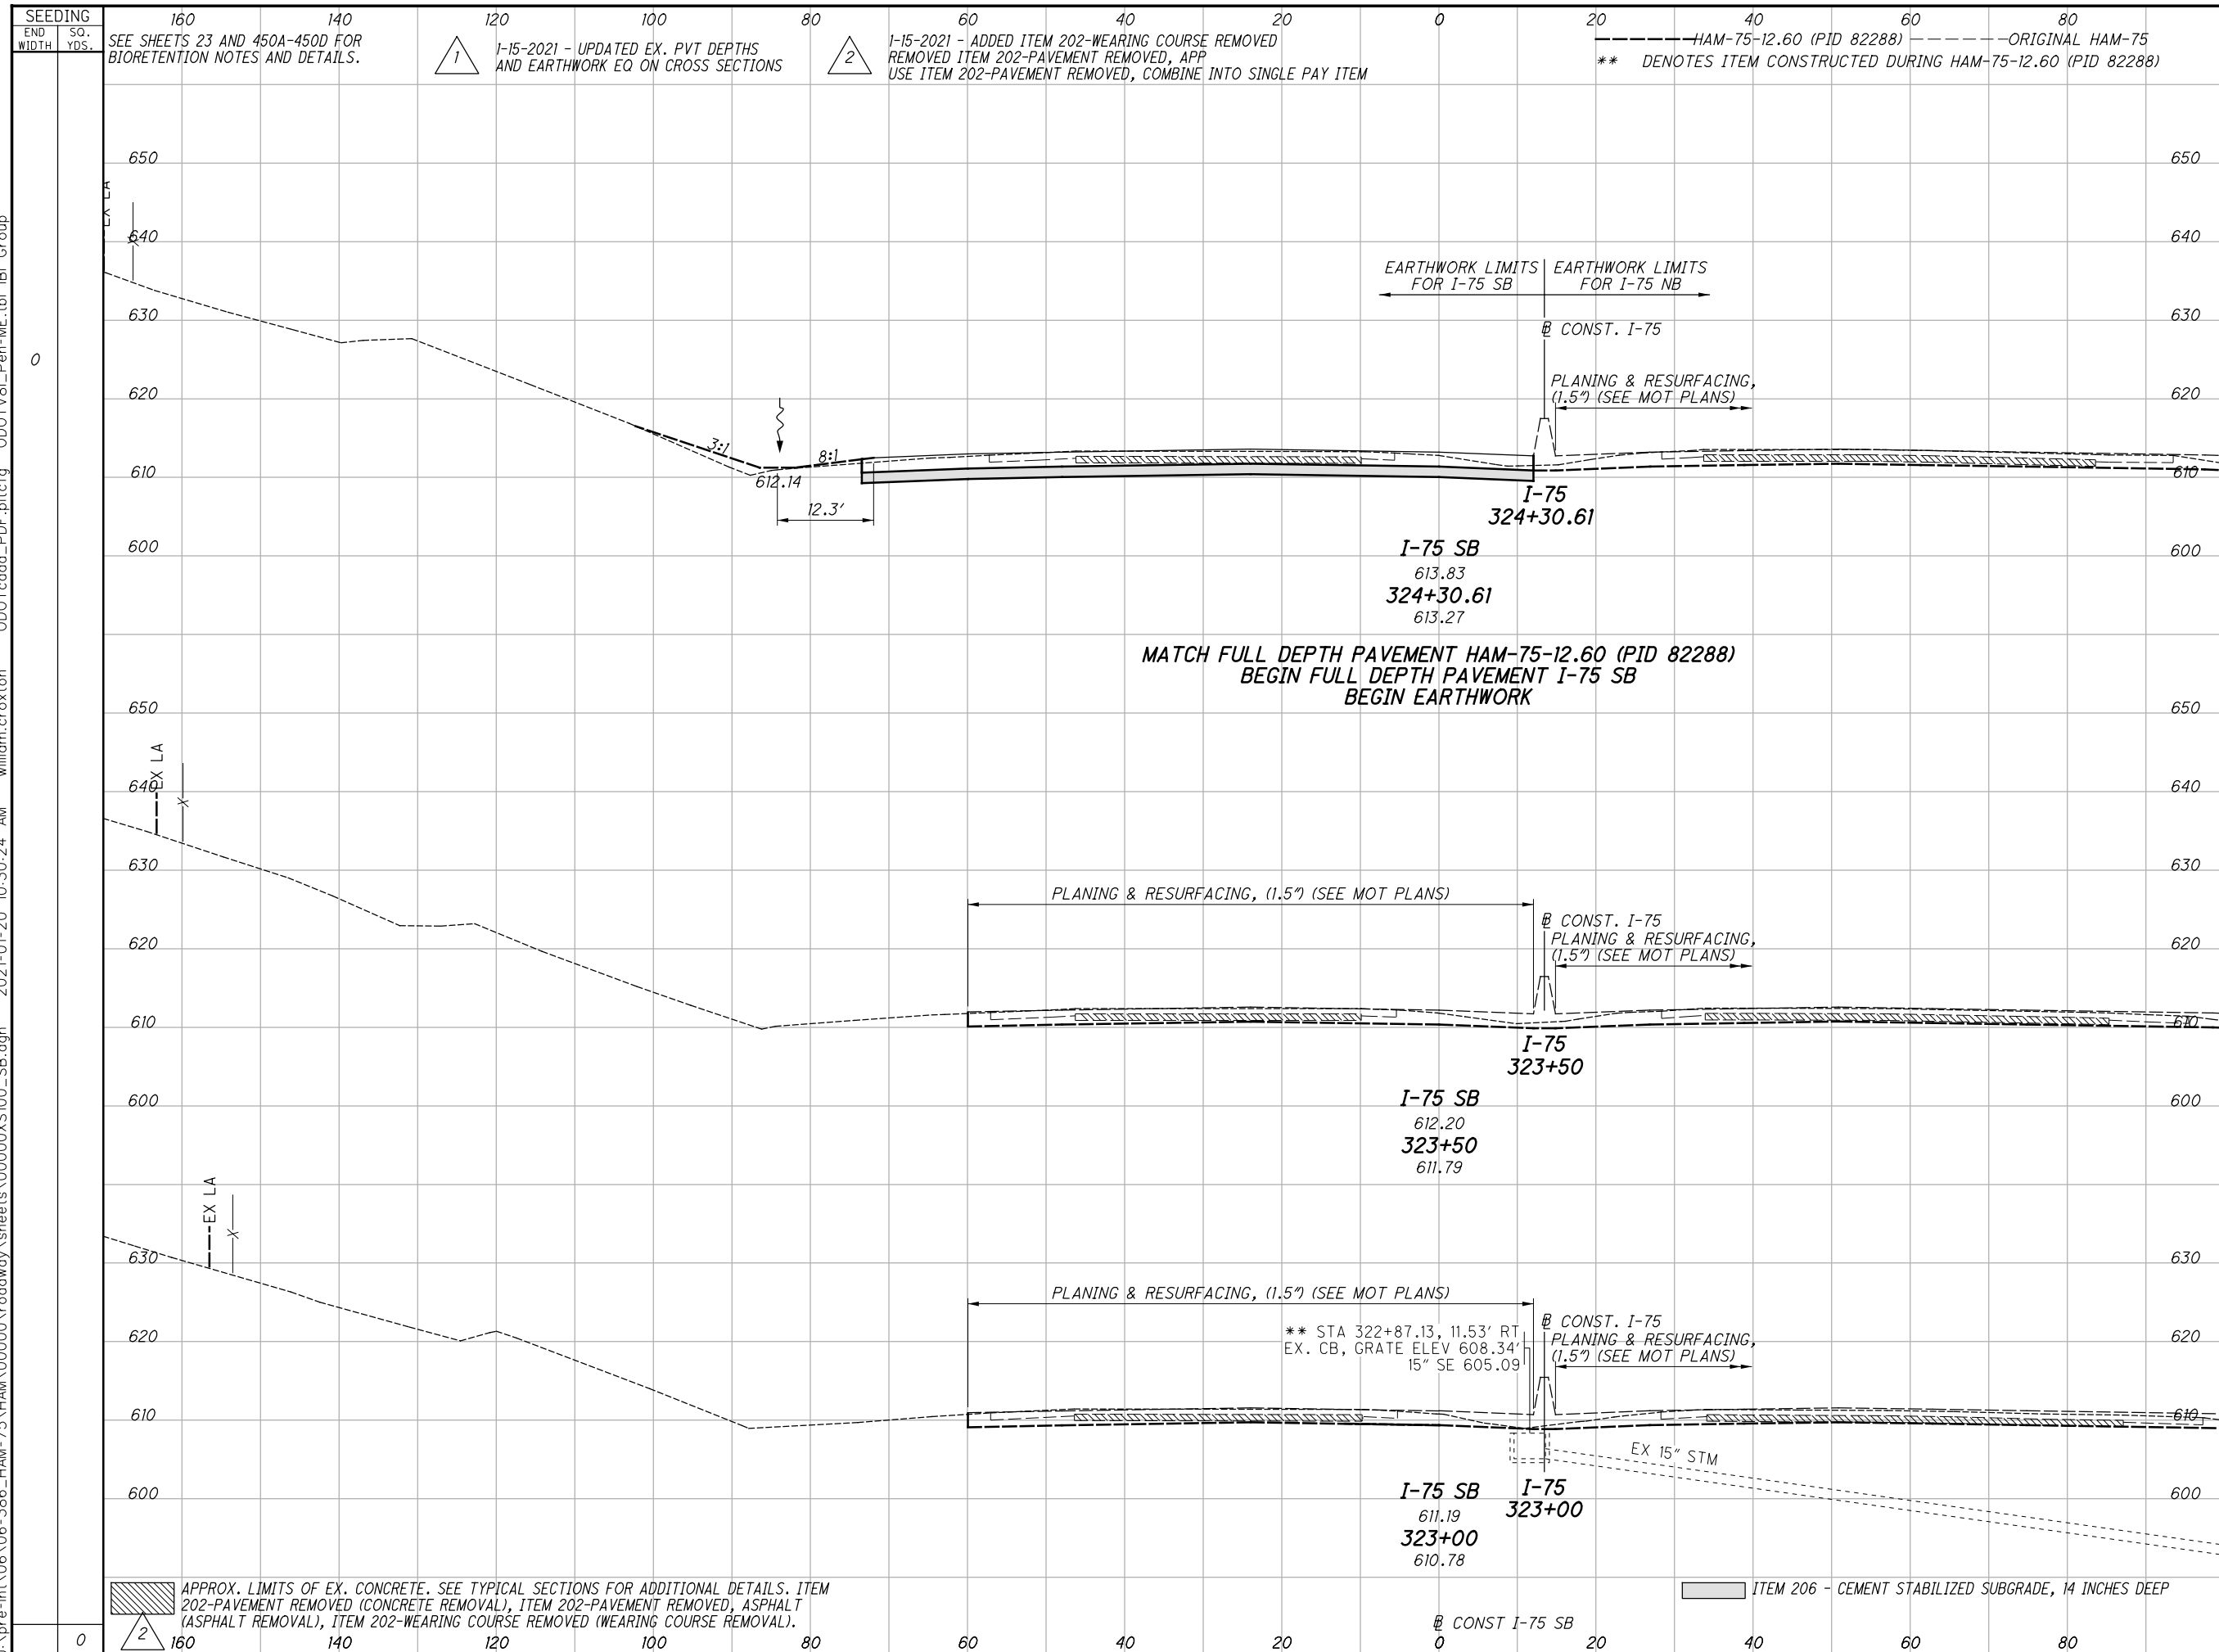

APPROX. LIMITS OF EX. CONCRETE. SEE TYPICAL SECTIONS FOR ADDITIONAL DETAILS. ITEM 202-PAVEMENT REMOVED (CONCRETE REMOVAL), ITEM 202-PAVEMENT REMOVED, ASPHALT (ASPHALT REMOVAL), ITEM 202-WEARING COURSE REMOVED (WEARING COURSE REMOVAL).

ITEM 206 - CEMENT STABILIZED SUBGRADE, 14 INCHES DEEP

SEEDING		END AREA		VOLUME		CALCULATED	
END WIDTH	SO. YDS.	CUT	FILL	CUT	FILL	WLC	CHECKED
0	0	0	0	0	0	0	0

\* QUANTITIES FOR EXCAVATION OF SUBGRADE, 18 INCHES DEEP AND EMBANKMENT, AS PER PLAN

**CROSS SECTIONS I-75 SB**  
**STA. 323+00 TO STA. 324+30.61**

**HAM-75-14.61**

251  
708


1-15-2021 - UPDATED EX. PVT DEPTHS AND EARTHWORK EQ ON CROSS SECTIONS

1-15-2021 - ADDED ITEM 202-WEARING COURSE REMOVED REMOVED ITEM 202-PAVEMENT REMOVED, APP USE ITEM 202-PAVEMENT REMOVED, COMBINE INTO SINGLE PAY ITEM

HAM-75-12.60 (PID 82288) ORIGINAL HAM-75  
 \*\* DENOTES ITEM CONSTRUCTED DURING HAM-75-12.60 (PID 82288)




j:\pre-int\06\06-386\_HAM-75\HAM\00000\roadway\sheets\00000X5100\_SB.dgn 2021-01-20 10:30:25 AM william.croxton' ODOTcadd\_PDF.pltcfgr ODOTV8i\_Pen-ME.tbl IBI Group

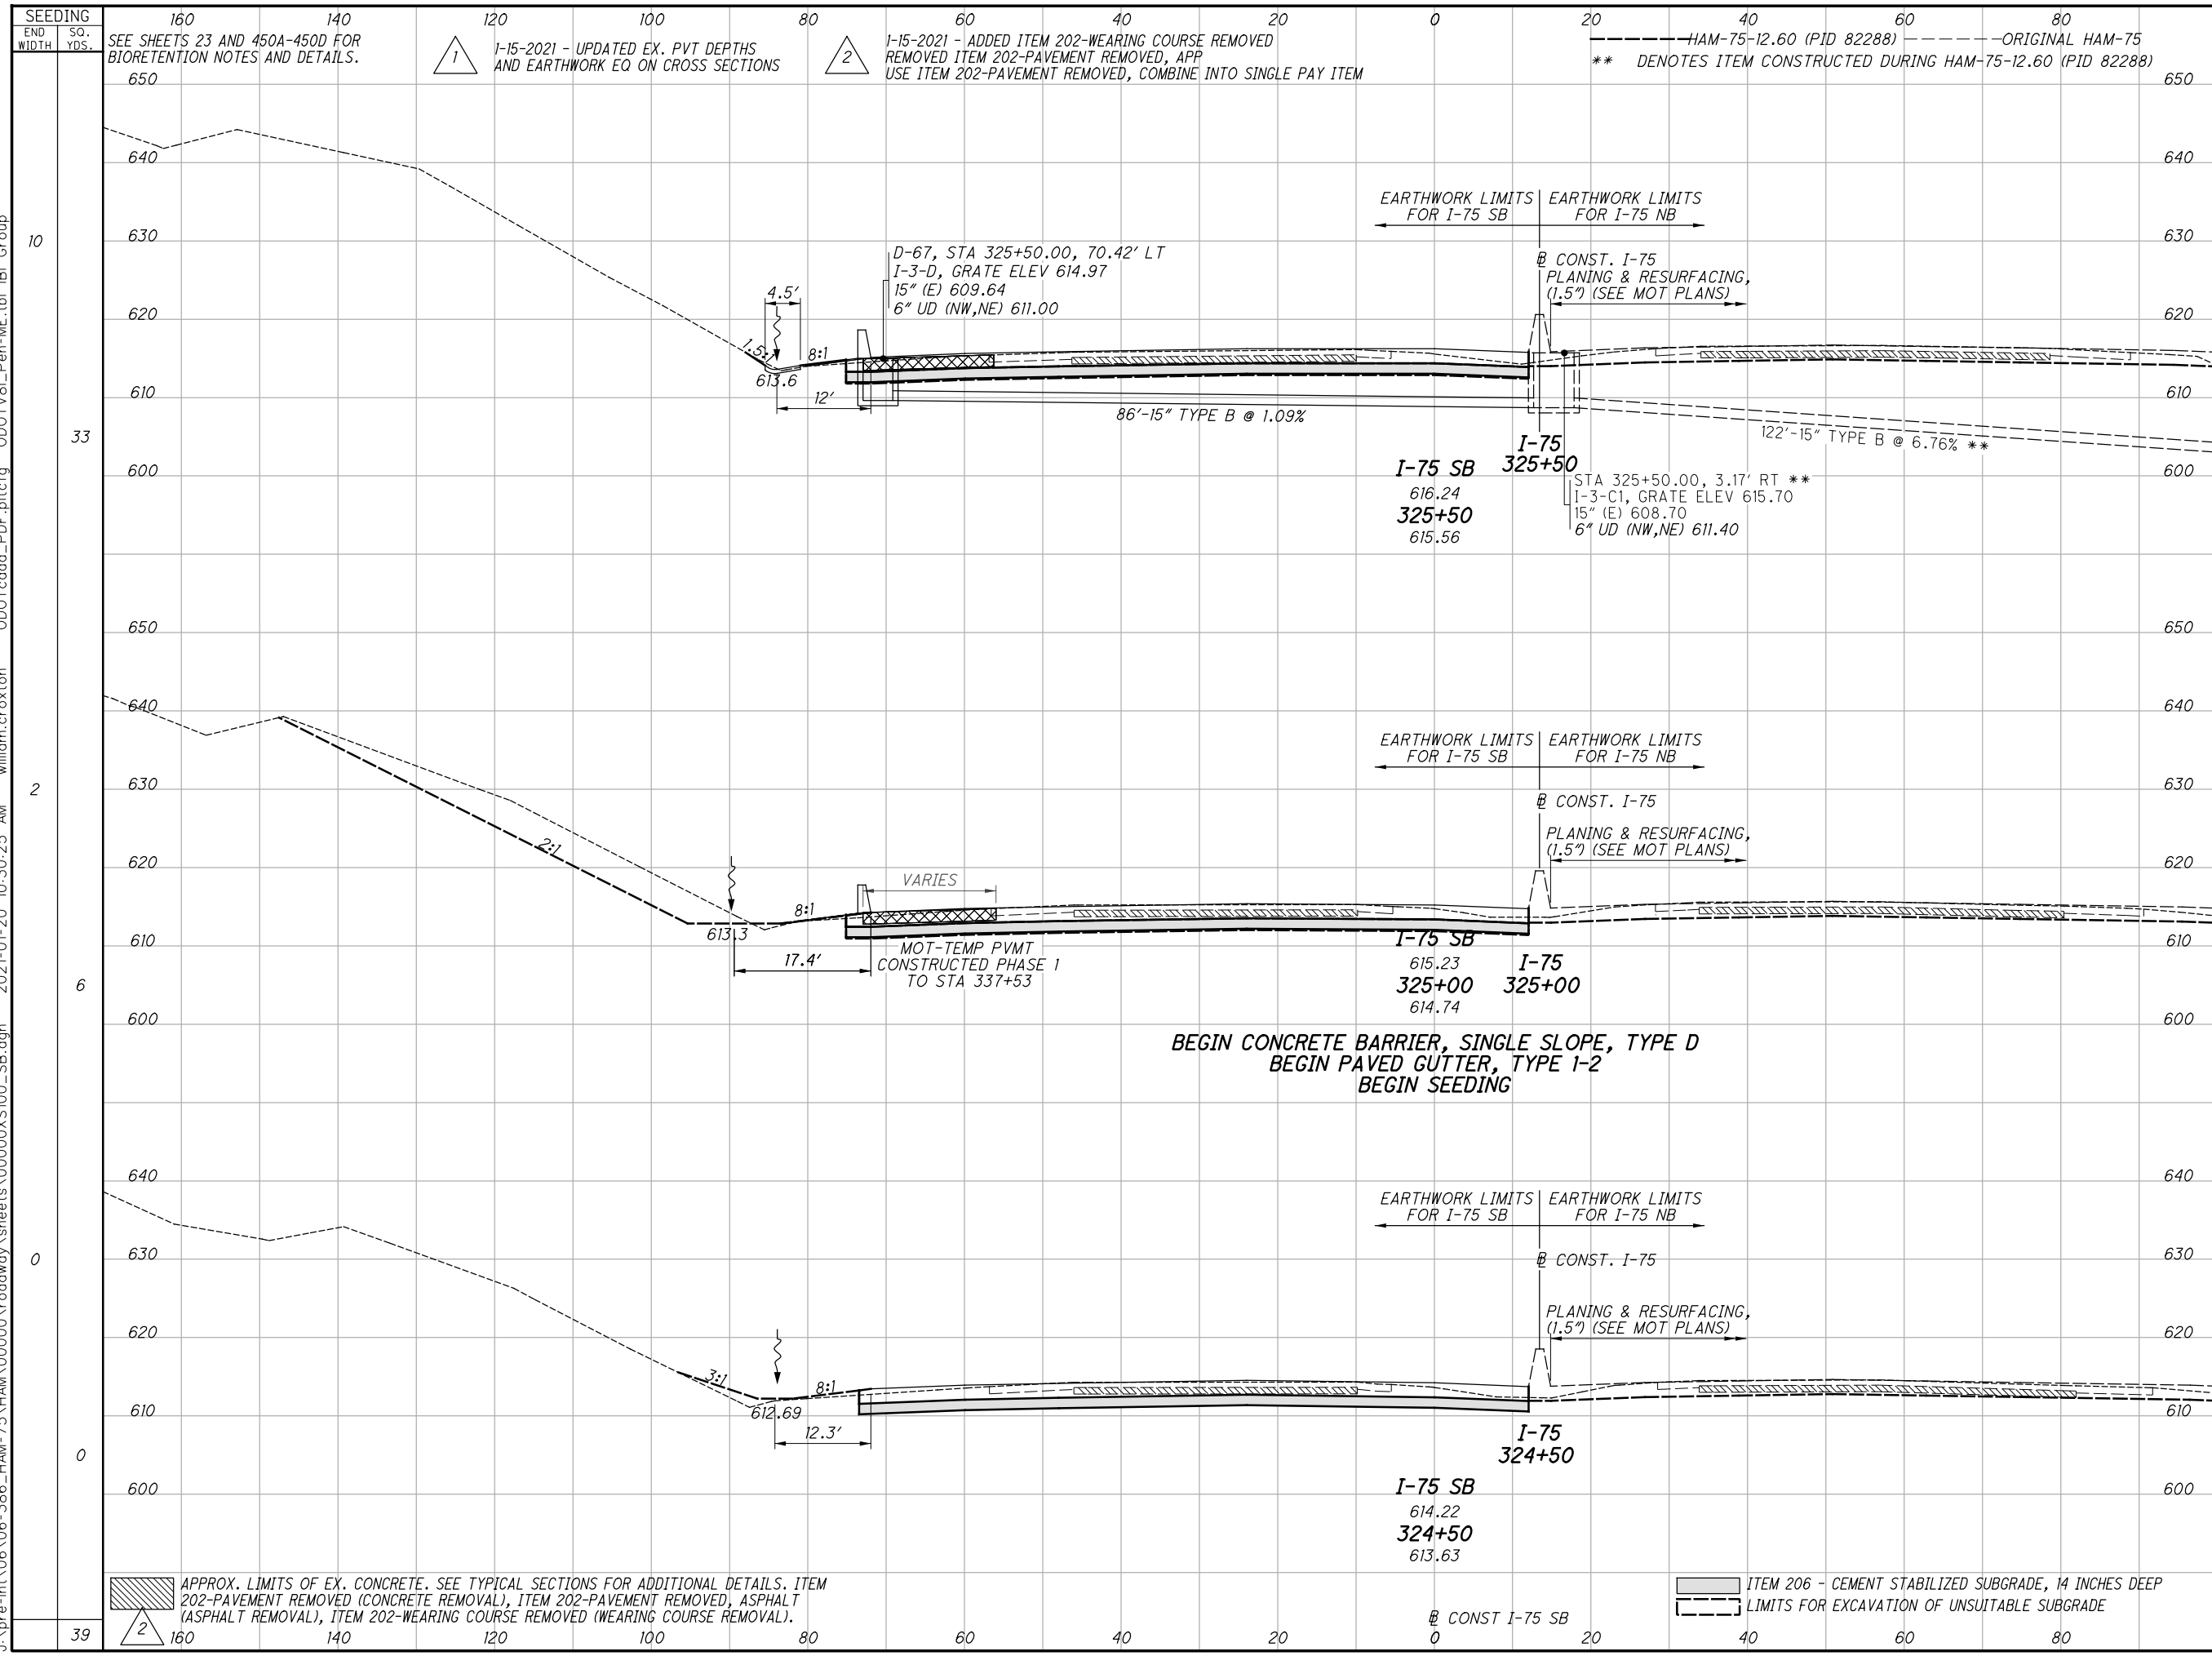

END AREA	VOLUME	CALCULATED	CHECKED
CUT	FILL	WLC	JDH
63	2		
131*	131*		
73	0		
131*	131*		
61	0		
131*	131*		
296	2		
243*	243*		
252	708		

j:\pre-int\06\06-386\_HAM-75\HAM\00000\roadway\sheets\00000X5100\_SB.dgn 2021-01-20 10:30:27 AM william.croxton' ODOTcadd\_PDF.pltcfgr ODOTV8i\_Pen-ME.tbl IBI Group

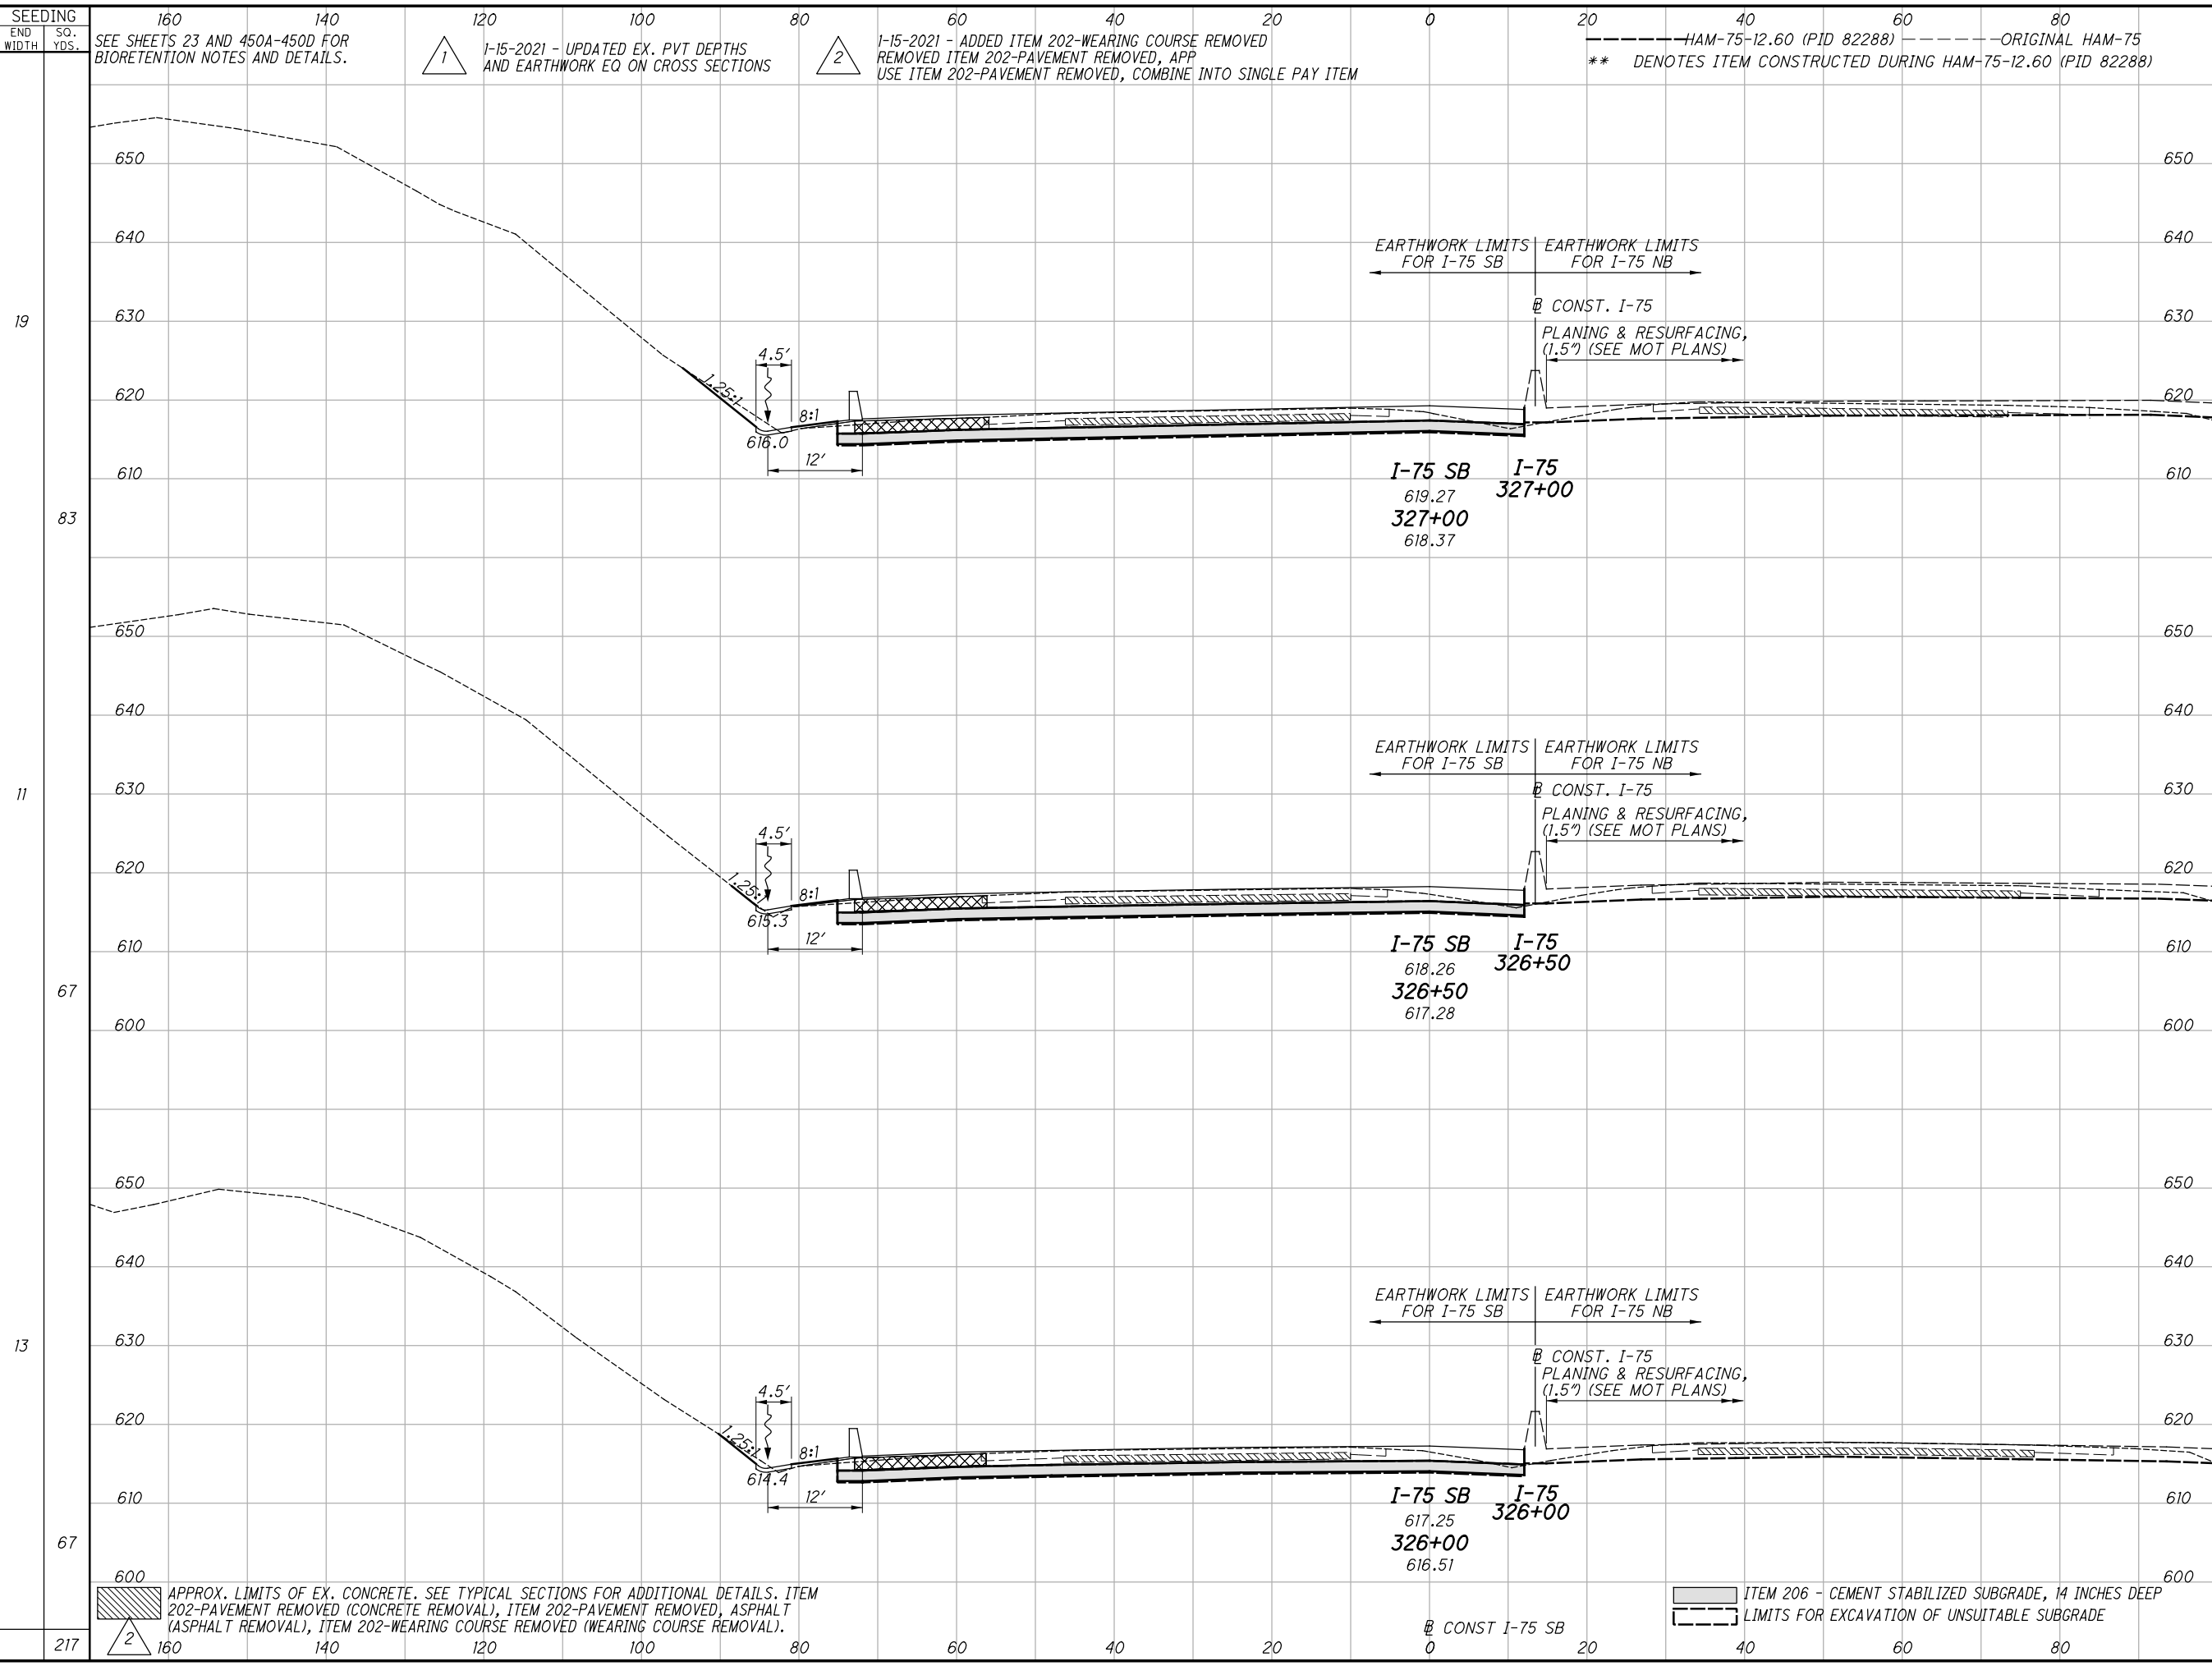

END AREA	VOLUME		CALCULATED	CHECKED	JDH
	CUT	FILL			
66	129*	3			
58	130*	2			
61	130*	3			
115	240*	5			
111	241*	5			
115	242*	5			
341	723*	15			

CROSS SECTIONS I-75 SB  
STA. 326+00 TO STA. 327+00

HAM-75-14.61

253  
708

SEEDING  
END WIDTH SO. YDS.

SEE SHEETS 23 AND 450A-450D FOR BIORETENTION NOTES AND DETAILS.

1-15-2021 - UPDATED EX. PVT DEPTHS AND EARTHWORK EQ ON CROSS SECTIONS

1-15-2021 - ADDED ITEM 202-WEARING COURSE REMOVED REMOVED ITEM 202-PAVEMENT REMOVED, APP USE ITEM 202-PAVEMENT REMOVED, COMBINE INTO SINGLE PAY ITEM

HAM-75-12.60 (PID 82288) ORIGINAL HAM-75  
\*\* DENOTES ITEM CONSTRUCTED DURING HAM-75-12.60 (PID 82288)


\* QUANTITIES FOR EXCAVATION OF SUBGRADE, 18 INCHES DEEP AND EMBANKMENT, AS PER PLAN

APPROX. LIMITS OF EX. CONCRETE. SEE TYPICAL SECTIONS FOR ADDITIONAL DETAILS. ITEM 202-PAVEMENT REMOVED (CONCRETE REMOVAL), ITEM 202-PAVEMENT REMOVED, ASPHALT (ASPHALT REMOVAL), ITEM 202-WEARING COURSE REMOVED (WEARING COURSE REMOVAL).

ITEM 206 - CEMENT STABILIZED SUBGRADE, 14 INCHES DEEP  
LIMITS FOR EXCAVATION OF UNSUITABLE SUBGRADE



j:\pre-int\06\06-386\_HAM-75\HAM\00000\roadway\sheets\00000X5100\_SB.dgn 2021-01-20 10:30:28 AM william.croxton' ODOTcadd\_PDF.pltcfgr ODOTV8i\_Pen-ME.tbl IBI Group

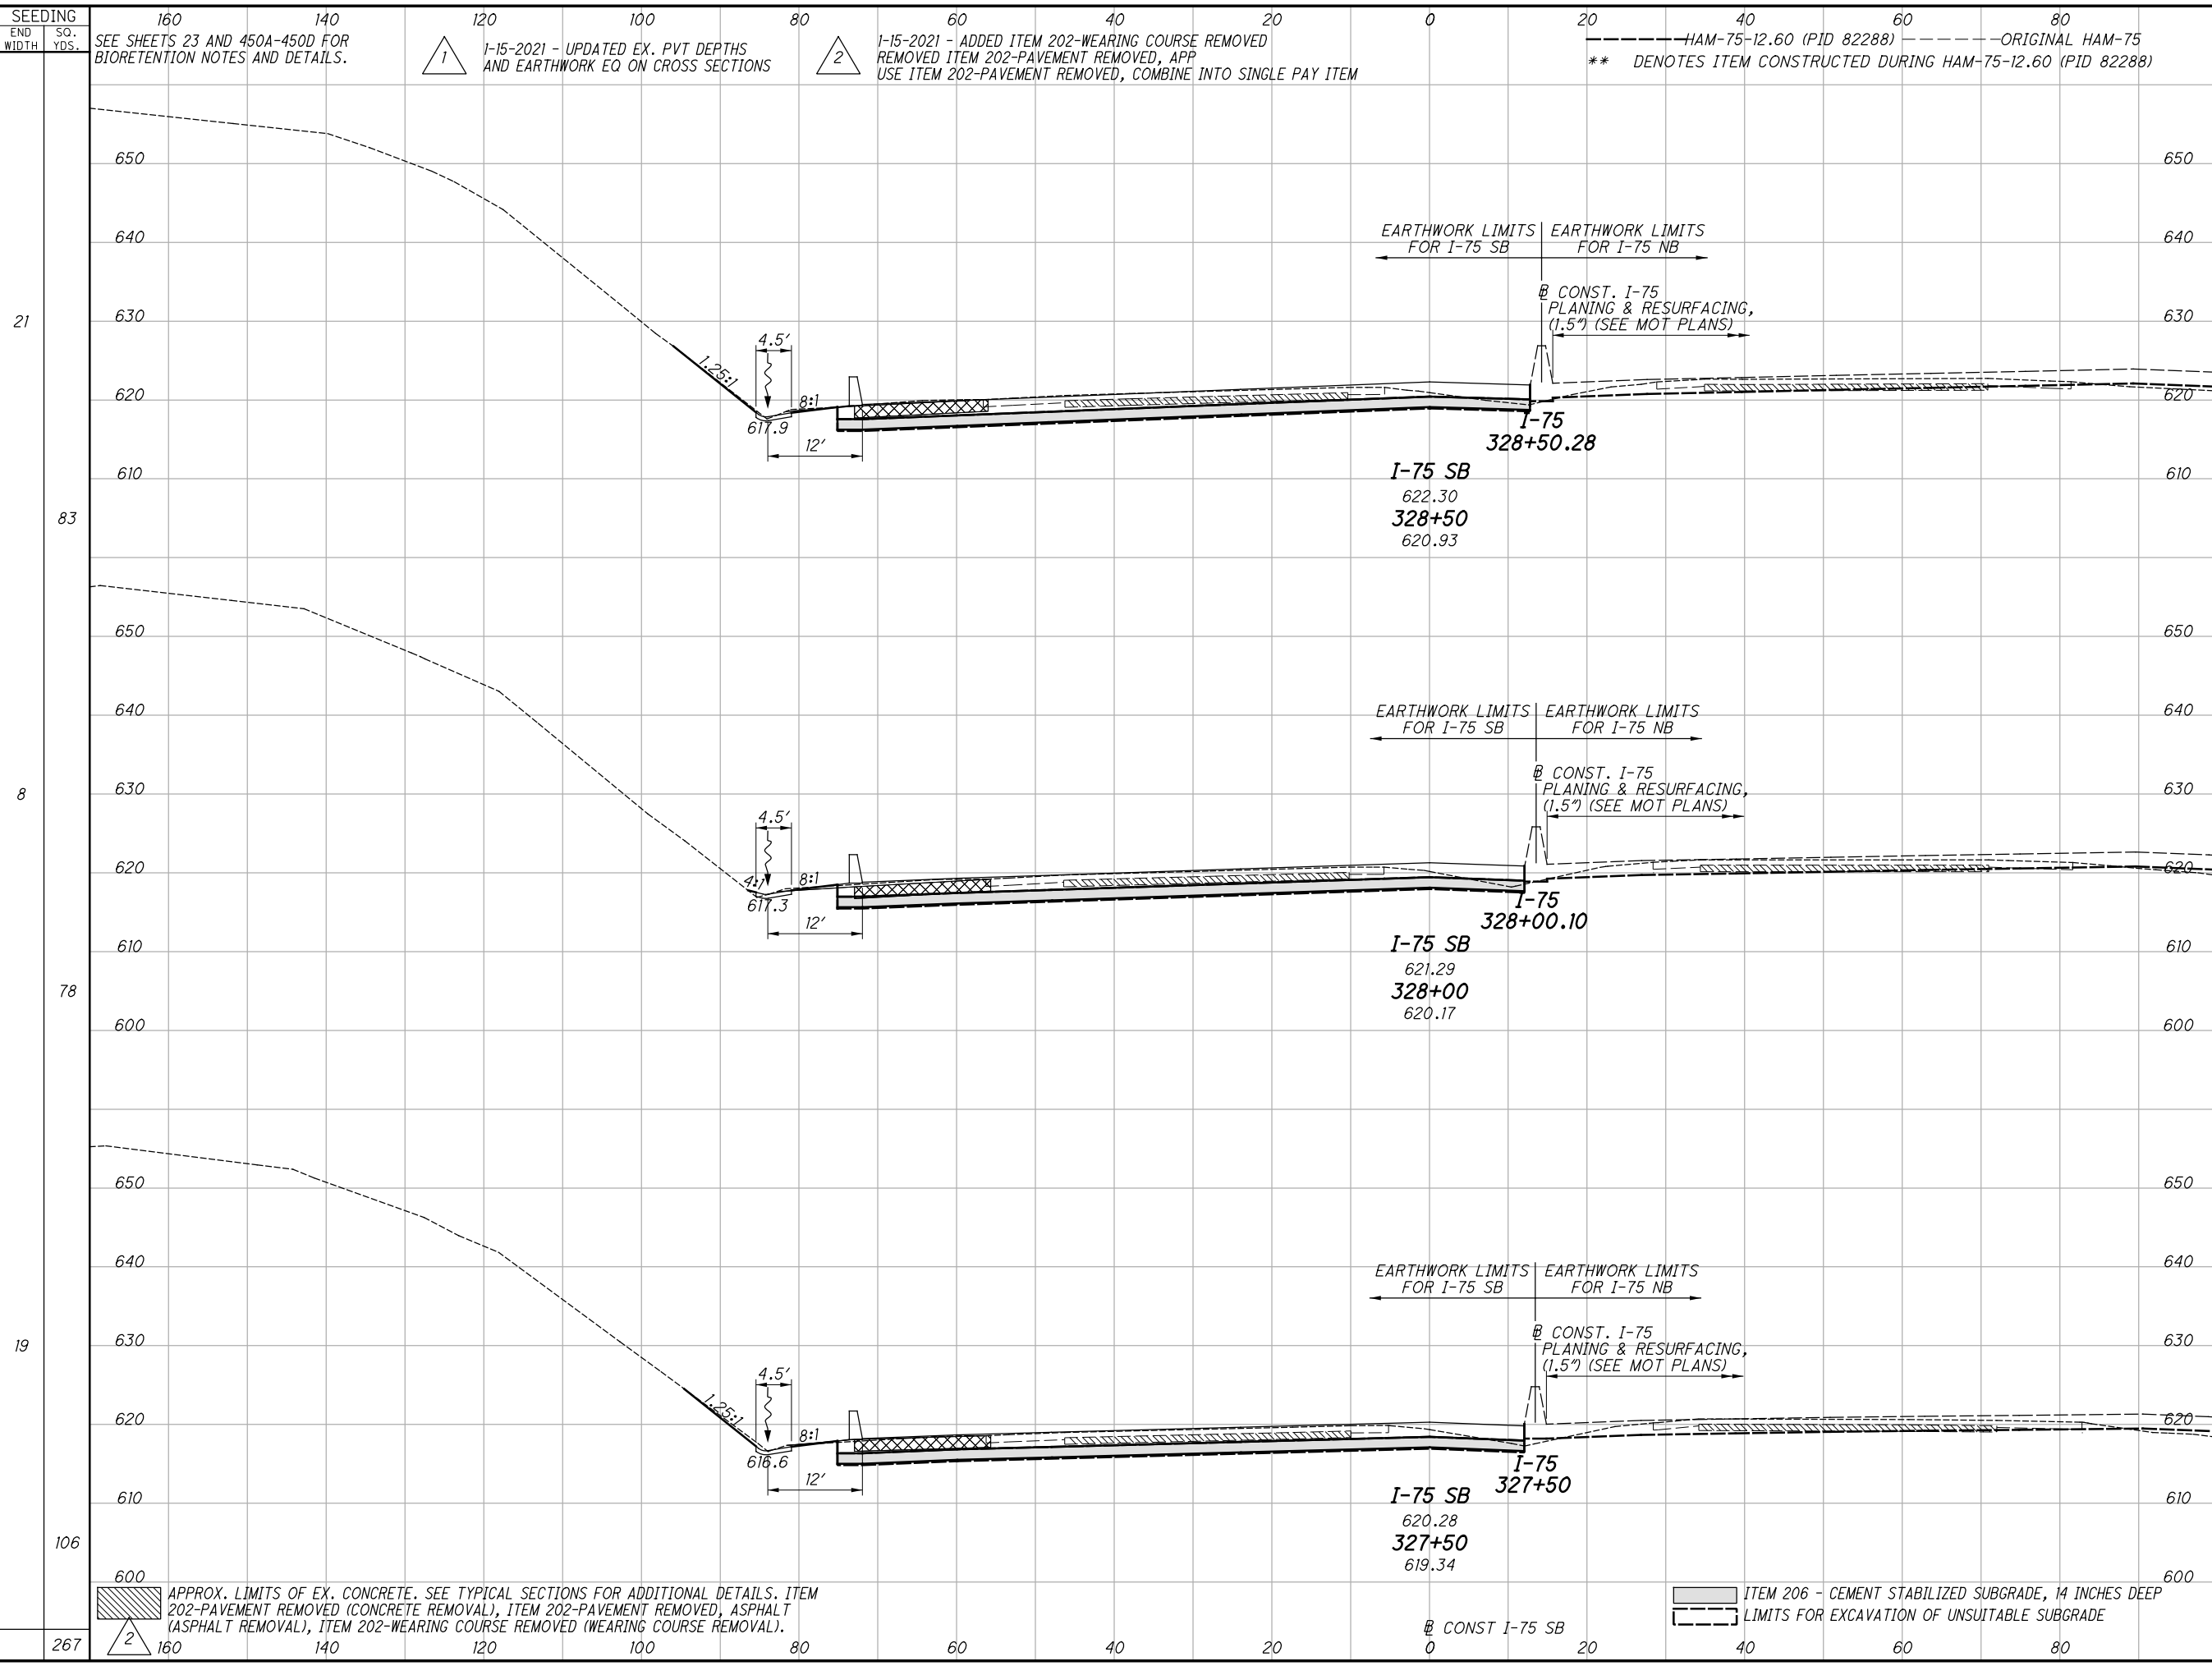

END AREA	VOLUME		CALCULATED	CHECKED	JDH
	CUT	FILL			
70 129*	0	132*			
62 128*	1	131*	123 238*	1	244*
67 129*	1	131*	120 238*	2	243*
60 129*	4	243*	124 239*	4	243*
	367 715*	7 730*			

**CROSS SECTIONS I-75 SB**  
**STA. 327+50 TO STA. 328+50**  
**HAM-75-14.61**

254  
 708

SEEDING  
 END WIDTH SO. YDS.  
 SEE SHEETS 23 AND 450A-450D FOR BIORETENTION NOTES AND DETAILS.


1-15-2021 - UPDATED EX. PVT DEPTHS AND EARTHWORK EQ ON CROSS SECTIONS  
 1-15-2021 - ADDED ITEM 202-WEARING COURSE REMOVED REMOVED ITEM 202-PAVEMENT REMOVED, APP USE ITEM 202-PAVEMENT REMOVED, COMBINE INTO SINGLE PAY ITEM

HAM-75-12.60 (PID 82288) ORIGINAL HAM-75  
 \*\* DENOTES ITEM CONSTRUCTED DURING HAM-75-12.60 (PID 82288)

\* QUANTITIES FOR EXCAVATION OF SUBGRADE, 18 INCHES DEEP AND EMBANKMENT, AS PER PLAN

APPROX. LIMITS OF EX. CONCRETE. SEE TYPICAL SECTIONS FOR ADDITIONAL DETAILS. ITEM 202-PAVEMENT REMOVED (CONCRETE REMOVAL), ITEM 202-PAVEMENT REMOVED, ASPHALT (ASPHALT REMOVAL), ITEM 202-WEARING COURSE REMOVED (WEARING COURSE REMOVAL).

ITEM 206 - CEMENT STABILIZED SUBGRADE, 14 INCHES DEEP  
 LIMITS FOR EXCAVATION OF UNSUITABLE SUBGRADE

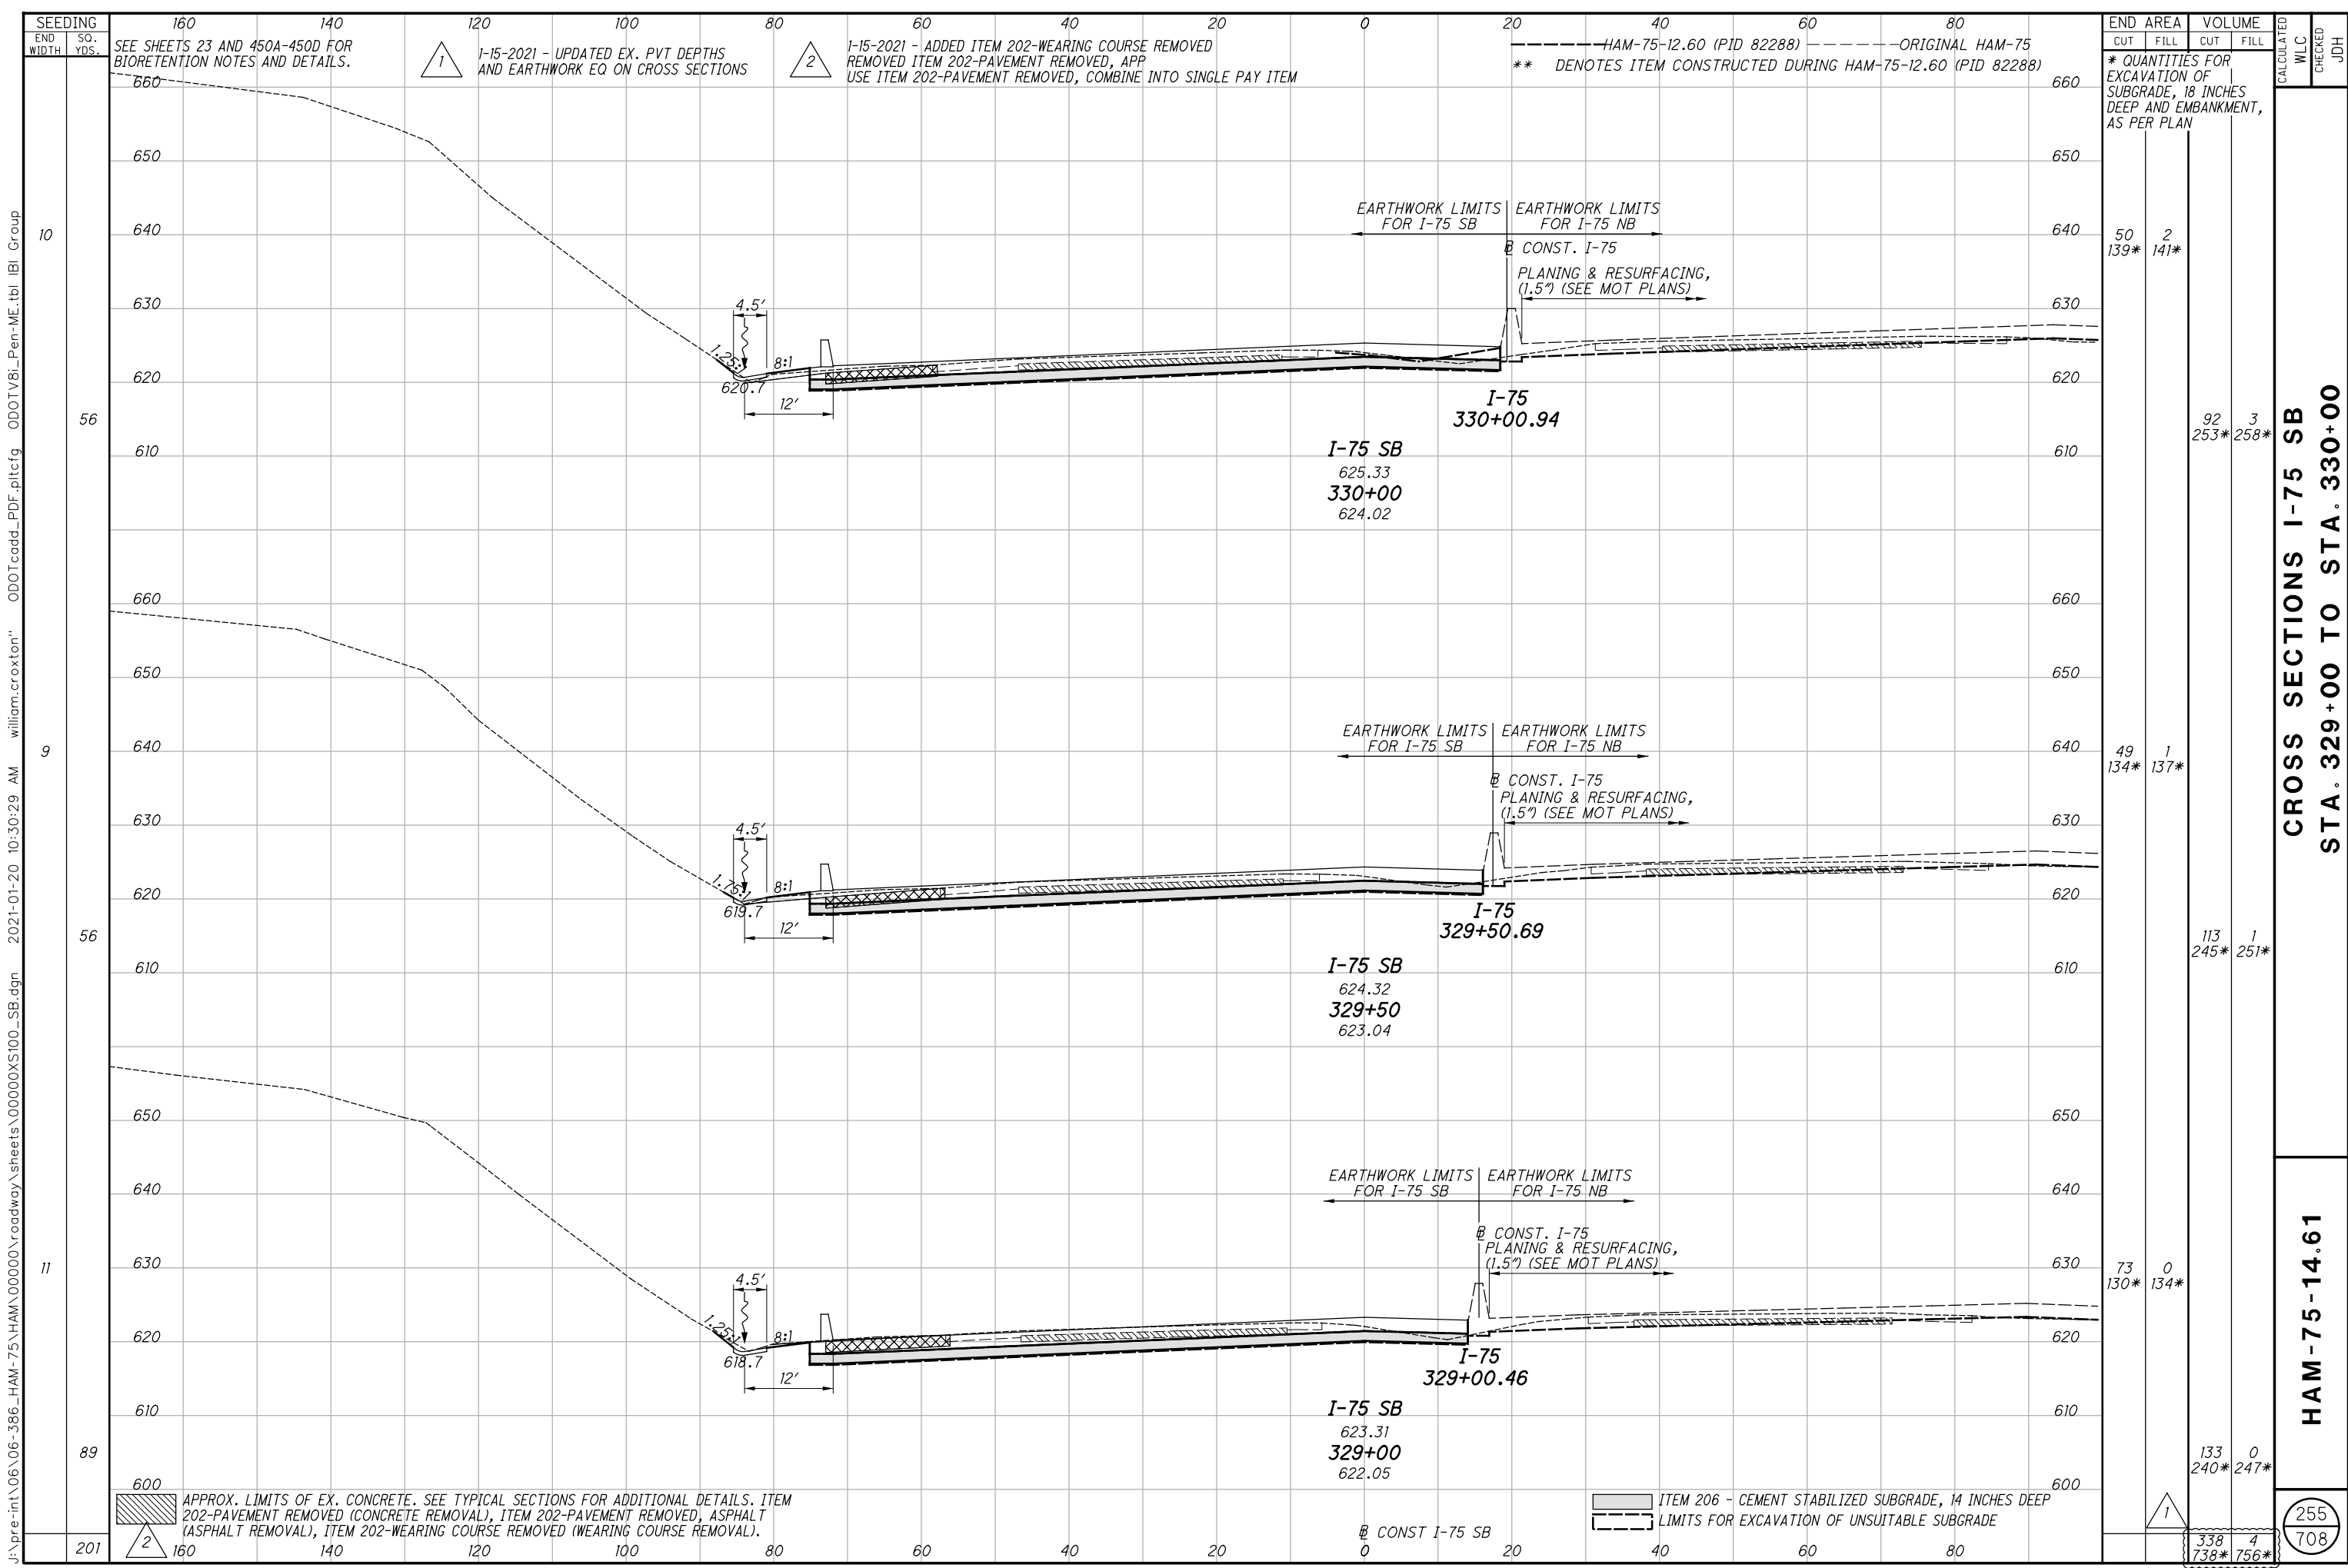

END AREA		VOLUME		CALCULATED WLC	CHECKED	JDH
CUT	FILL	CUT	FILL			
50	2	92	3			
139*	141*	253*	258*			
49	1	113	1			
134*	137*	245*	251*			
73	0	133	0			
130*	134*	240*	247*			
		338	4			
		738*	756*			


CROSS SECTIONS I-75 SB  
STA. 329+00 TO STA. 330+00

HAM-75-14.61

255  
708

j:\pre-int\06\06-386\_HAM-75\_HAM\00000\roadway\sheets\00000X5100\_SB.dgn 2021-01-20 10:30:29 AM william.croxton ODOTcadd\_PDF.pltcfgr ODOTV8i\_Pen-ME.tbl IBI Group

j:\pre-int\06\06-386\_HAM-75\HAM\00000\roadway\sheets\00000X5100\_SB.dgn 2021-01-20 10:30:30 AM william.croxton' ODOTcadd\_PDF.pltcfgr ODOTV8i\_Pen-ME.tbl IBI Group

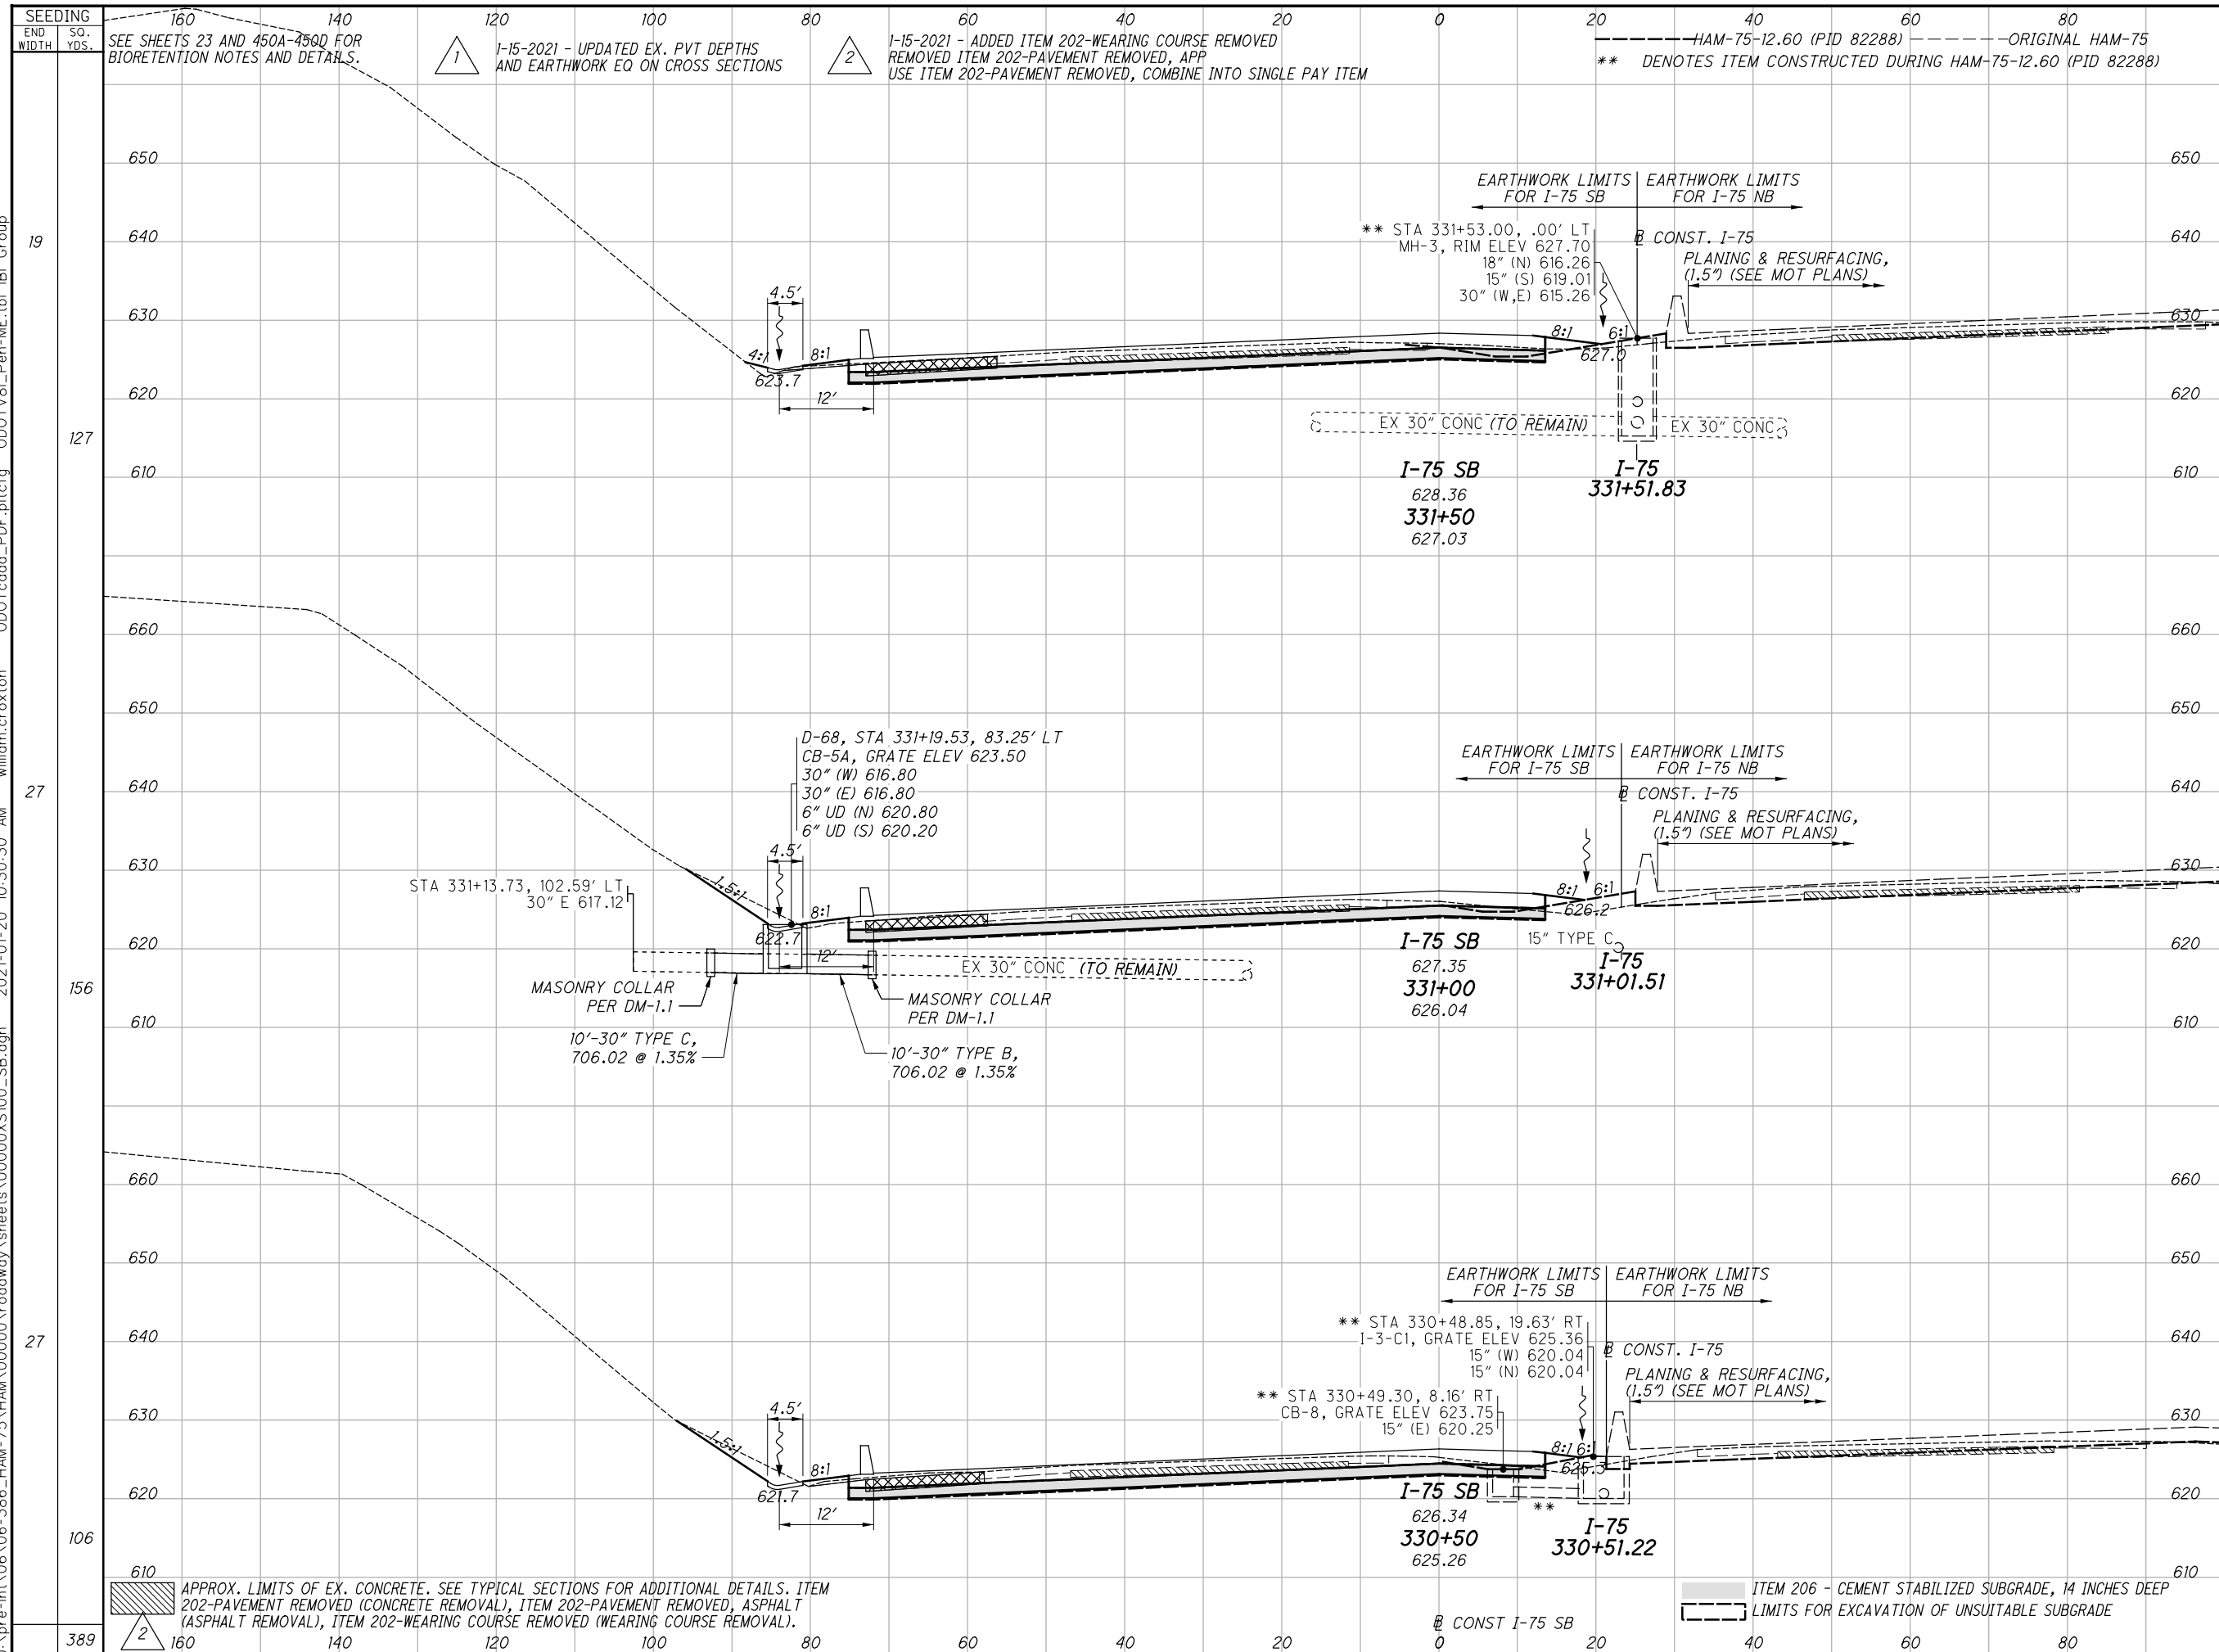

END AREA	VOLUME		CALCULATED	CHECKED	JDH
	CUT	FILL			
34	120*	12	134*		
54	127*	7	134*		
66	129*	6	134*		
82	229*	18	249*		
108	249*	8	255*		
112	238*	13	249*		
302	716*	39	753*		

**CROSS SECTIONS I-75 SB  
 STA. 330+50 TO STA. 331+50**

**HAM-75-14.61**

256  
 708

SEE SHEETS 23 AND 450A-450D FOR BIORETENTION NOTES AND DETAILS.

I-15-2021 - UPDATED EX. PVT DEPTHS AND EARTHWORK EQ ON CROSS SECTIONS  
 I-15-2021 - ADDED ITEM 202-WEARING COURSE REMOVED, REMOVED ITEM 202-PAVEMENT REMOVED, APP USE ITEM 202-PAVEMENT REMOVED, COMBINE INTO SINGLE PAY ITEM

HAM-75-12.60 (PID 82288) --- ORIGINAL HAM-75  
 \*\* DENOTES ITEM CONSTRUCTED DURING HAM-75-12.60 (PID 82288)

\* QUANTITIES FOR EXCAVATION OF SUBGRADE, 18 INCHES DEEP AND EMBANKMENT, AS PER PLAN


APPROX. LIMITS OF EX. CONCRETE. SEE TYPICAL SECTIONS FOR ADDITIONAL DETAILS. ITEM 202-PAVEMENT REMOVED (CONCRETE REMOVAL), ITEM 202-PAVEMENT REMOVED, ASPHALT (ASPHALT REMOVAL), ITEM 202-WEARING COURSE REMOVED (WEARING COURSE REMOVAL).

ITEM 206 - CEMENT STABILIZED SUBGRADE, 14 INCHES DEEP  
 LIMITS FOR EXCAVATION OF UNSUITABLE SUBGRADE





j:\pre-int\06\06-386\_HAM-75\HAM\00000\roadway\sheets\00000X5100\_SB.dgn 2021-01-20 10:30:32 AM william.croxton ODOTcadd\_PDF.pltcfgr ODOTV8i\_Pen-ME.tbl IBI Group

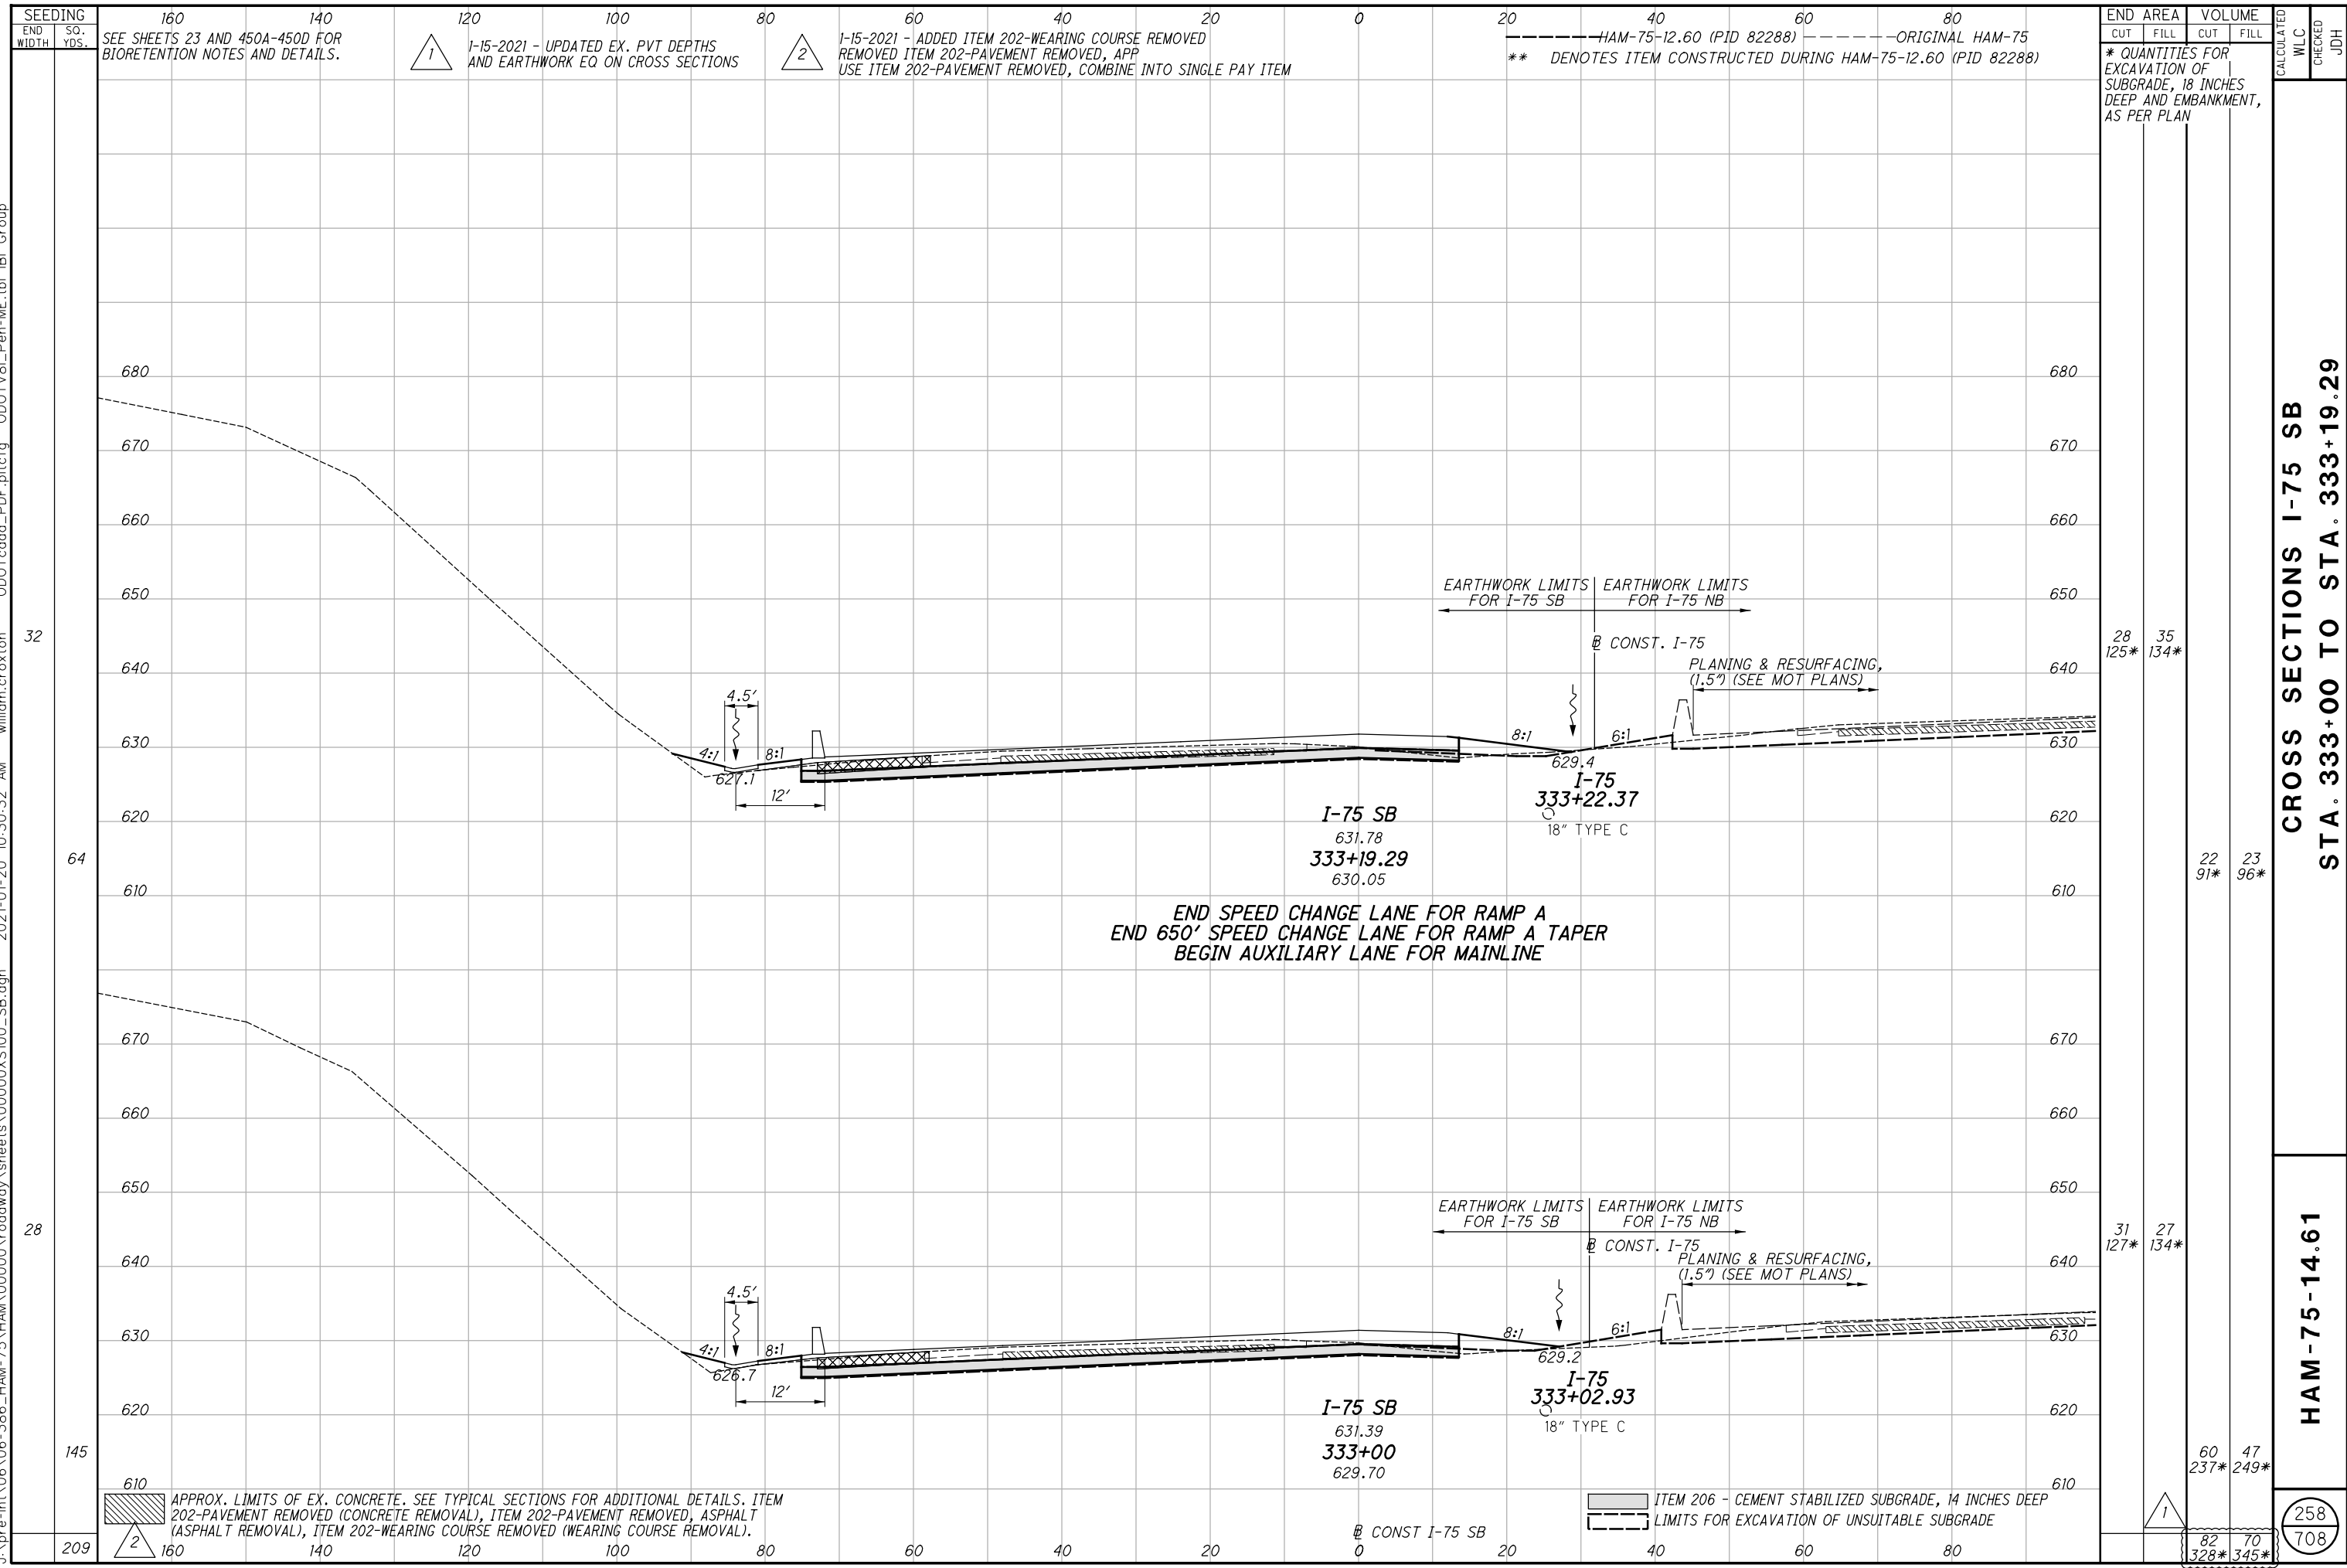

SEEDING  
END WIDTH SO. YDS.

1-15-2021 - UPDATED EX. PVT DEPTHS AND EARTHWORK EQ ON CROSS SECTIONS

1-15-2021 - ADDED ITEM 202-WEARING COURSE REMOVED REMOVED ITEM 202-PAVEMENT REMOVED, APP USE ITEM 202-PAVEMENT REMOVED, COMBINE INTO SINGLE PAY ITEM

HAM-75-12.60 (PID 82288) ORIGINAL HAM-75  
\*\* DENOTES ITEM CONSTRUCTED DURING HAM-75-12.60 (PID 82288)

END AREA		VOLUME		CALCULATED WLC	CHECKED JDH
CUT	FILL	CUT	FILL		
28	125*	35	134*		
64		22	91*	23	96*
28	127*	27	134*		
145		60	237*	47	249*
209		82	328*	70	345*

APPROX. LIMITS OF EX. CONCRETE. SEE TYPICAL SECTIONS FOR ADDITIONAL DETAILS. ITEM 202-PAVEMENT REMOVED (CONCRETE REMOVAL), ITEM 202-PAVEMENT REMOVED, ASPHALT (ASPHALT REMOVAL), ITEM 202-WEARING COURSE REMOVED (WEARING COURSE REMOVAL).

ITEM 206 - CEMENT STABILIZED SUBGRADE, 14 INCHES DEEP  
LIMITS FOR EXCAVATION OF UNSUITABLE SUBGRADE

CROSS SECTIONS I-75 SB  
 STA. 333+00 TO STA. 333+19.29  
 HAM-75-14.61

258  
708

j:\pre-int\06\06-386\_HAM-75\HAM\00000\roadway\sheets\00000X5100\_SB.dgn 2021-01-20 10:30:33 AM william.croxton' ODOTcadd\_PDF.pltcfgr ODOTV8i\_Pen-ME.tbl IBI Group

SEEDING	160		140		120		100		80		60		40		20		0		20		40		60		80		
	END WIDTH	SO. YDS.	END WIDTH	SO. YDS.	END WIDTH	SO. YDS.	END WIDTH	SO. YDS.	END WIDTH	SO. YDS.	END WIDTH	SO. YDS.	END WIDTH	SO. YDS.	END WIDTH	SO. YDS.	END WIDTH	SO. YDS.	END WIDTH	SO. YDS.	END WIDTH	SO. YDS.	END WIDTH	SO. YDS.	END WIDTH	SO. YDS.	
33																											
184																											
32																											
112																											
296																											

SEE SHEETS 23 AND 450A-450D FOR BIORETENTION NOTES AND DETAILS.

1-15-2021 - UPDATED EX. PVT DEPTHS AND EARTHWORK EQ ON CROSS SECTIONS

1-15-2021 - ADDED ITEM 202-WEARING COURSE REMOVED REMOVED ITEM 202-PAVEMENT REMOVED, APP USE ITEM 202-PAVEMENT REMOVED, COMBINE INTO SINGLE PAY ITEM

HAM-75-12.60 (PID 82288) ORIGINAL HAM-75  
 \*\* DENOTES ITEM CONSTRUCTED DURING HAM-75-12.60 (PID 82288)


END AREA	VOLUME		CALCULATED	CHECKED	JDH
	CUT	FILL			
28	130*	30			
50	236*	64			
25	124*	39			
31	142*	43			
81	378*	107			

\* QUANTITIES FOR EXCAVATION OF SUBGRADE, 18 INCHES DEEP AND EMBANKMENT, AS PER PLAN

CROSS SECTIONS I-75 SB  
 STA. 333+50 TO STA. 334+00

HAM-75-14.61


259  
 708

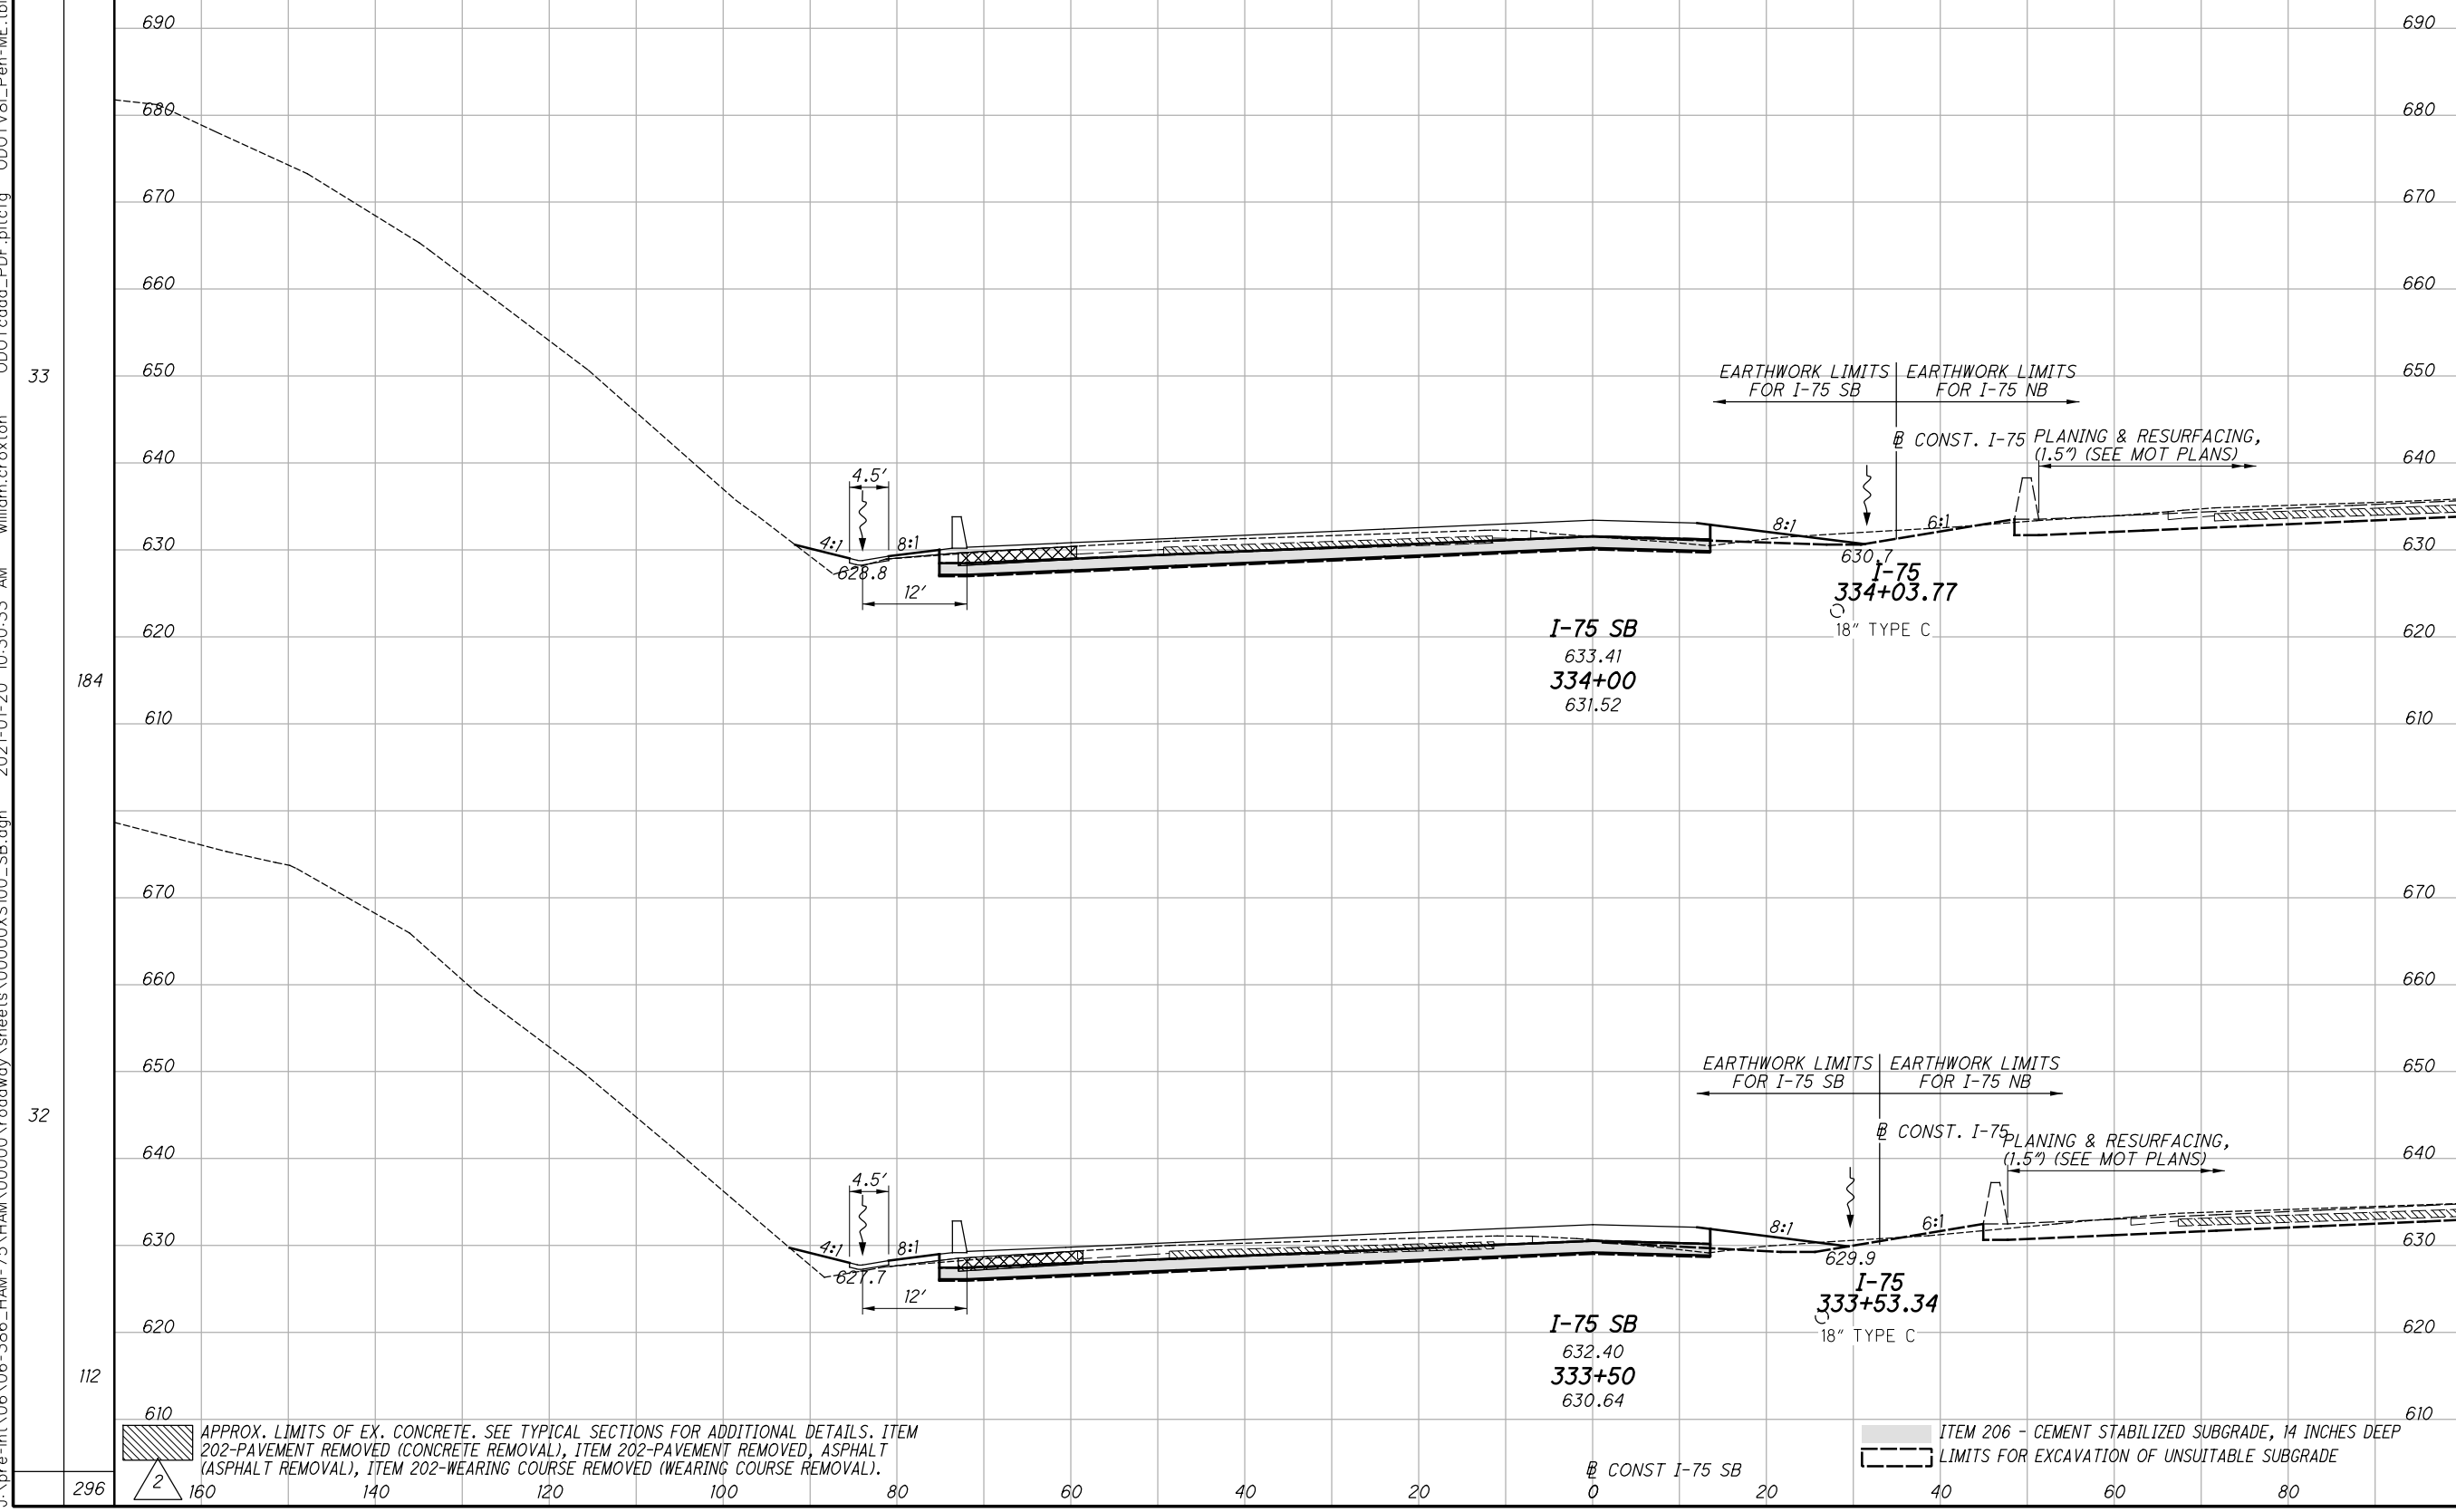

APPROX. LIMITS OF EX. CONCRETE. SEE TYPICAL SECTIONS FOR ADDITIONAL DETAILS. ITEM 202-PAVEMENT REMOVED (CONCRETE REMOVAL), ITEM 202-PAVEMENT REMOVED, ASPHALT (ASPHALT REMOVAL), ITEM 202-WEARING COURSE REMOVED (WEARING COURSE REMOVAL).

ITEM 206 - CEMENT STABILIZED SUBGRADE, 14 INCHES DEEP  
 LIMITS FOR EXCAVATION OF UNSUITABLE SUBGRADE

j:\pre-int\06\06-386\_HAM-75\HAM\00000\roadway\sheets\00000X5100\_SB.dgn 2021-01-20 10:30:34 AM william.croxton' ODOTcadd\_PDF.pltcfgr ODOTV8i\_Pen-ME.tbl IBI Group

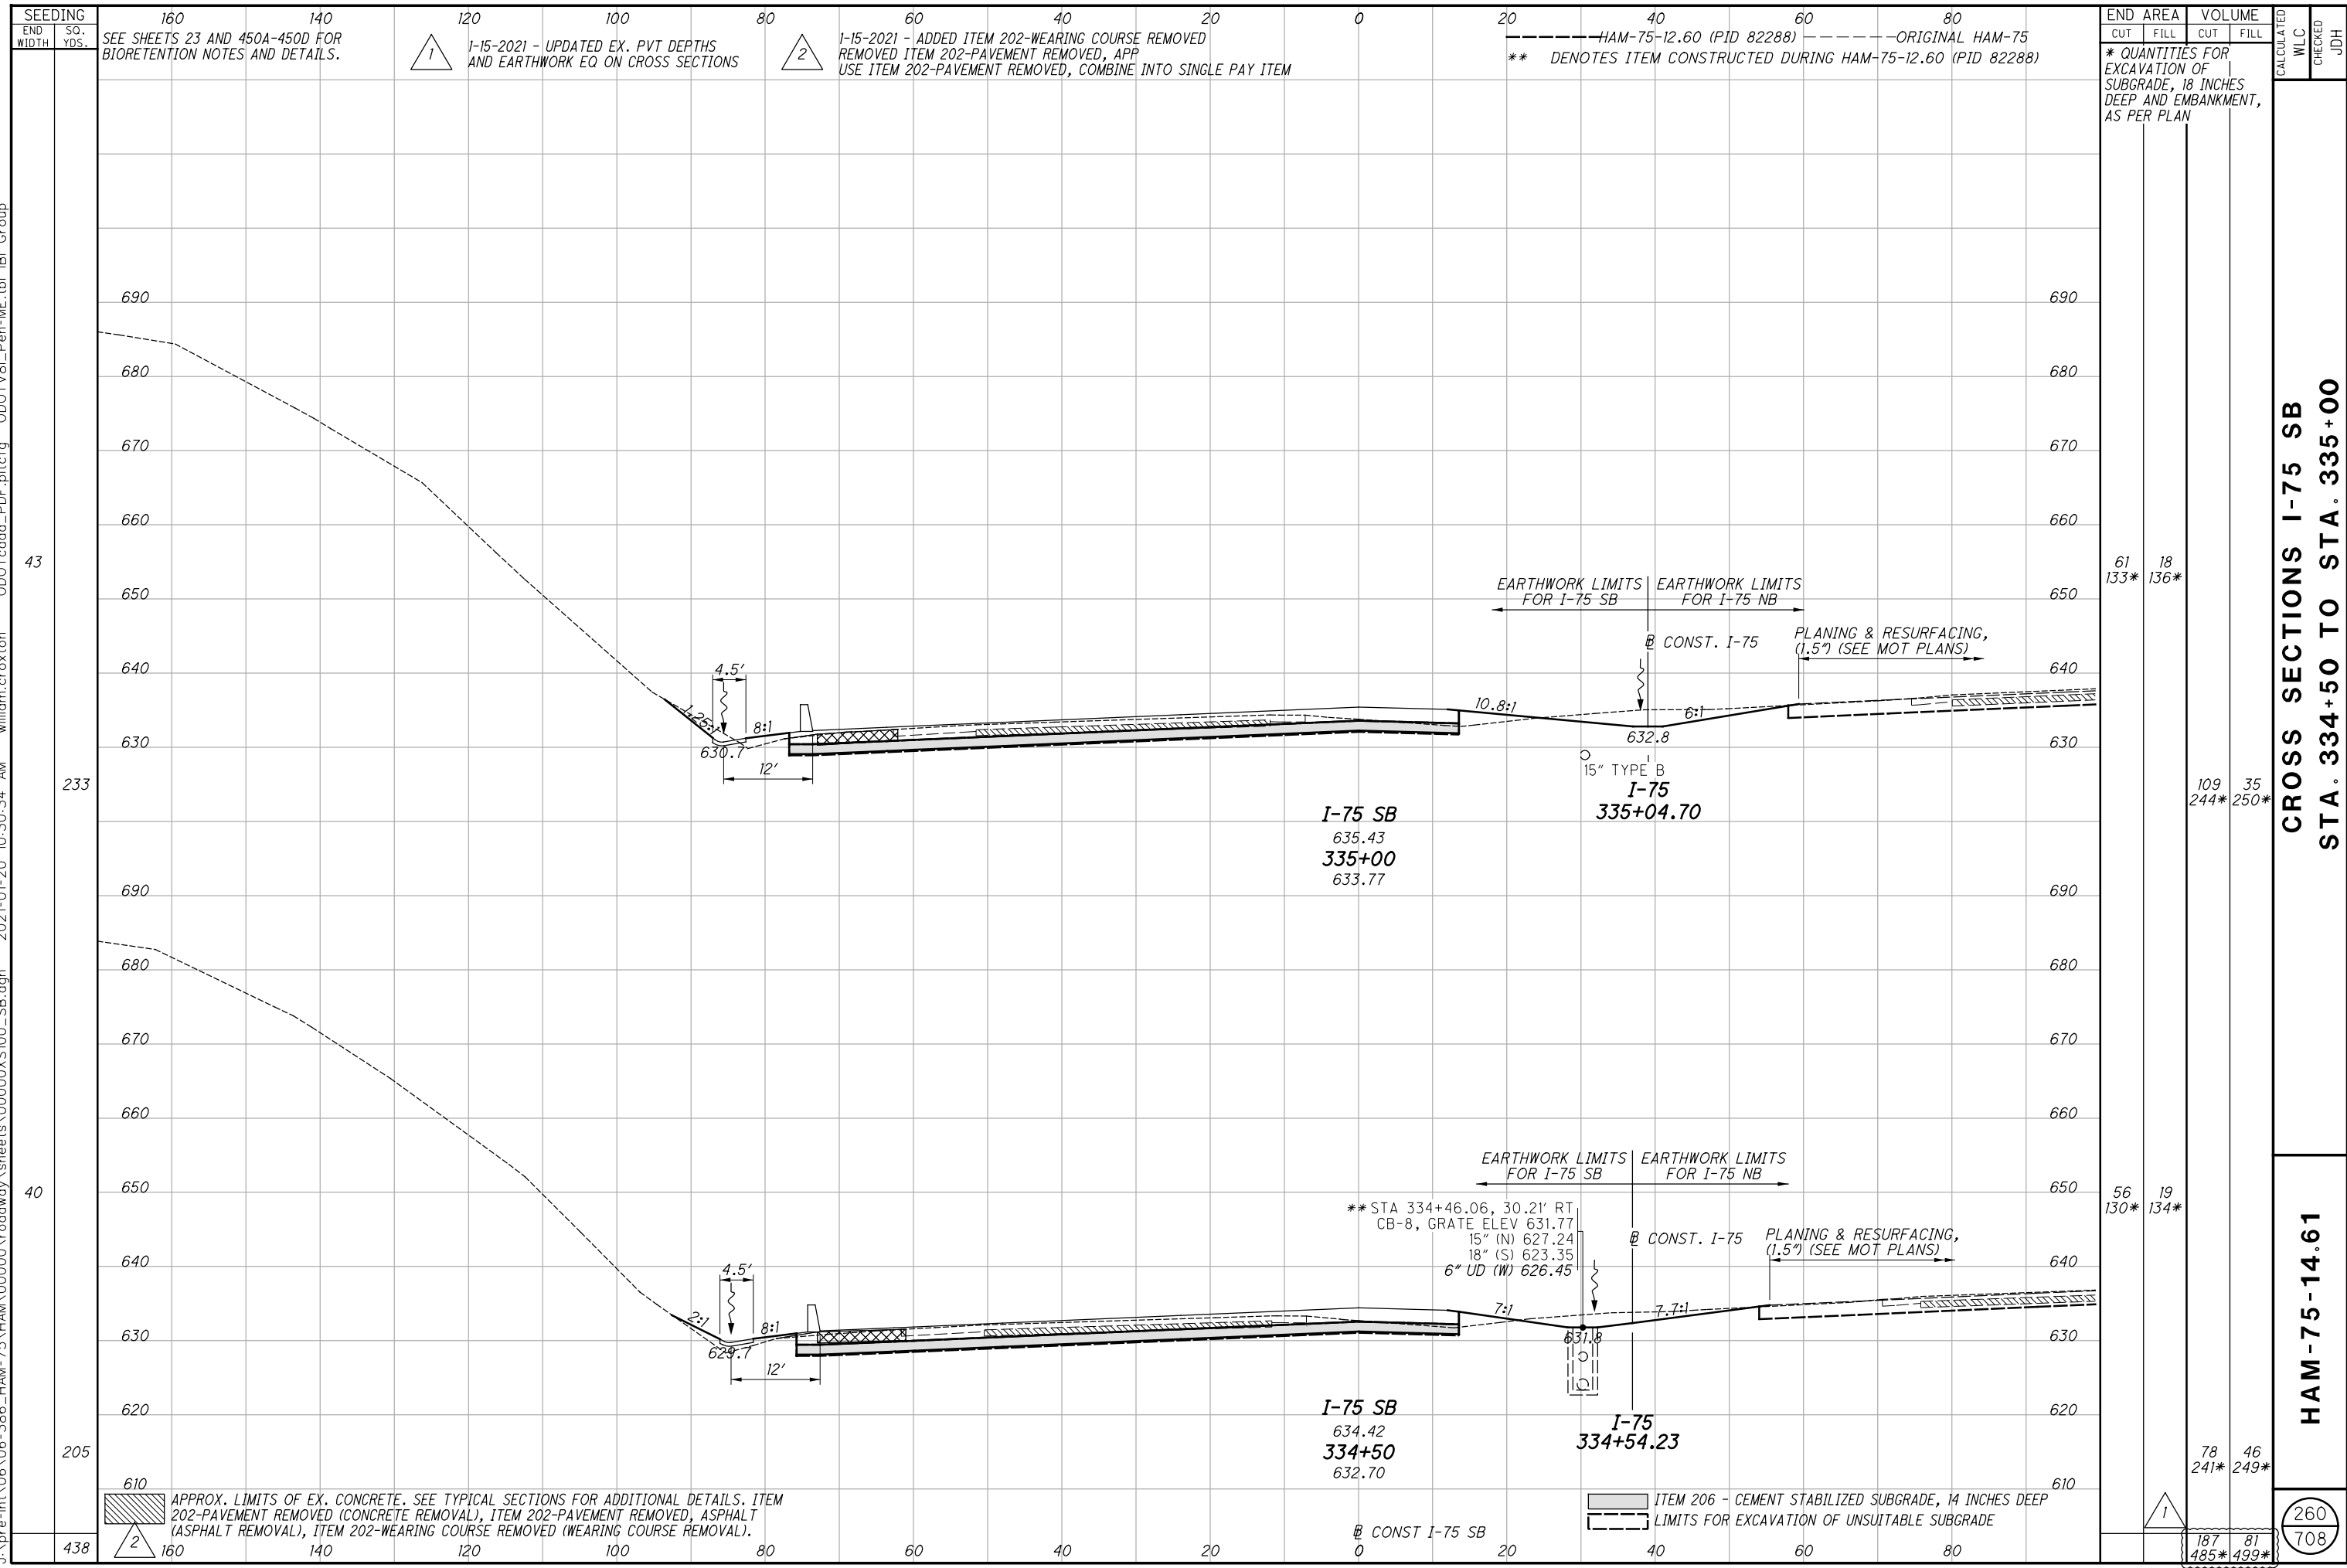

SEEDING  
END SO. WIDTH YDS.

1-15-2021 - UPDATED EX. PVT DEPTHS AND EARTHWORK EQ ON CROSS SECTIONS

1-15-2021 - ADDED ITEM 202-WEARING COURSE REMOVED REMOVED ITEM 202-PAVEMENT REMOVED, APP USE ITEM 202-PAVEMENT REMOVED, COMBINE INTO SINGLE PAY ITEM

HAM-75-12.60 (PID 82288) ORIGINAL HAM-75  
\*\* DENOTES ITEM CONSTRUCTED DURING HAM-75-12.60 (PID 82288)

END AREA		VOLUME		CALCULATED WLC	CHECKED JDH
CUT	FILL	CUT	FILL		
61	18	109	35		
133*	136*	244*	250*		
56	19	78	46		
130*	134*	241*	249*		
		187	81		
		485*	499*		

APPROX. LIMITS OF EX. CONCRETE. SEE TYPICAL SECTIONS FOR ADDITIONAL DETAILS. ITEM 202-PAVEMENT REMOVED (CONCRETE REMOVAL), ITEM 202-PAVEMENT REMOVED, ASPHALT (ASPHALT REMOVAL), ITEM 202-WEARING COURSE REMOVED (WEARING COURSE REMOVAL).

ITEM 206 - CEMENT STABILIZED SUBGRADE, 14 INCHES DEEP  
LIMITS FOR EXCAVATION OF UNSUITABLE SUBGRADE


CROSS SECTIONS I-75 SB  
 STA. 334+50 TO STA. 335+00

HAM-75-14.61

260  
708



j:\pre-int\06\06-386\_HAM-75\HAM\00000\roadway\sheets\00000X5100\_SB.dgn 2021-01-20 10:30:36 AM william.croxton' ODOTcadd\_PDF.pltcfgr ODOTV8i\_Pen-ME.tbl IBI Group

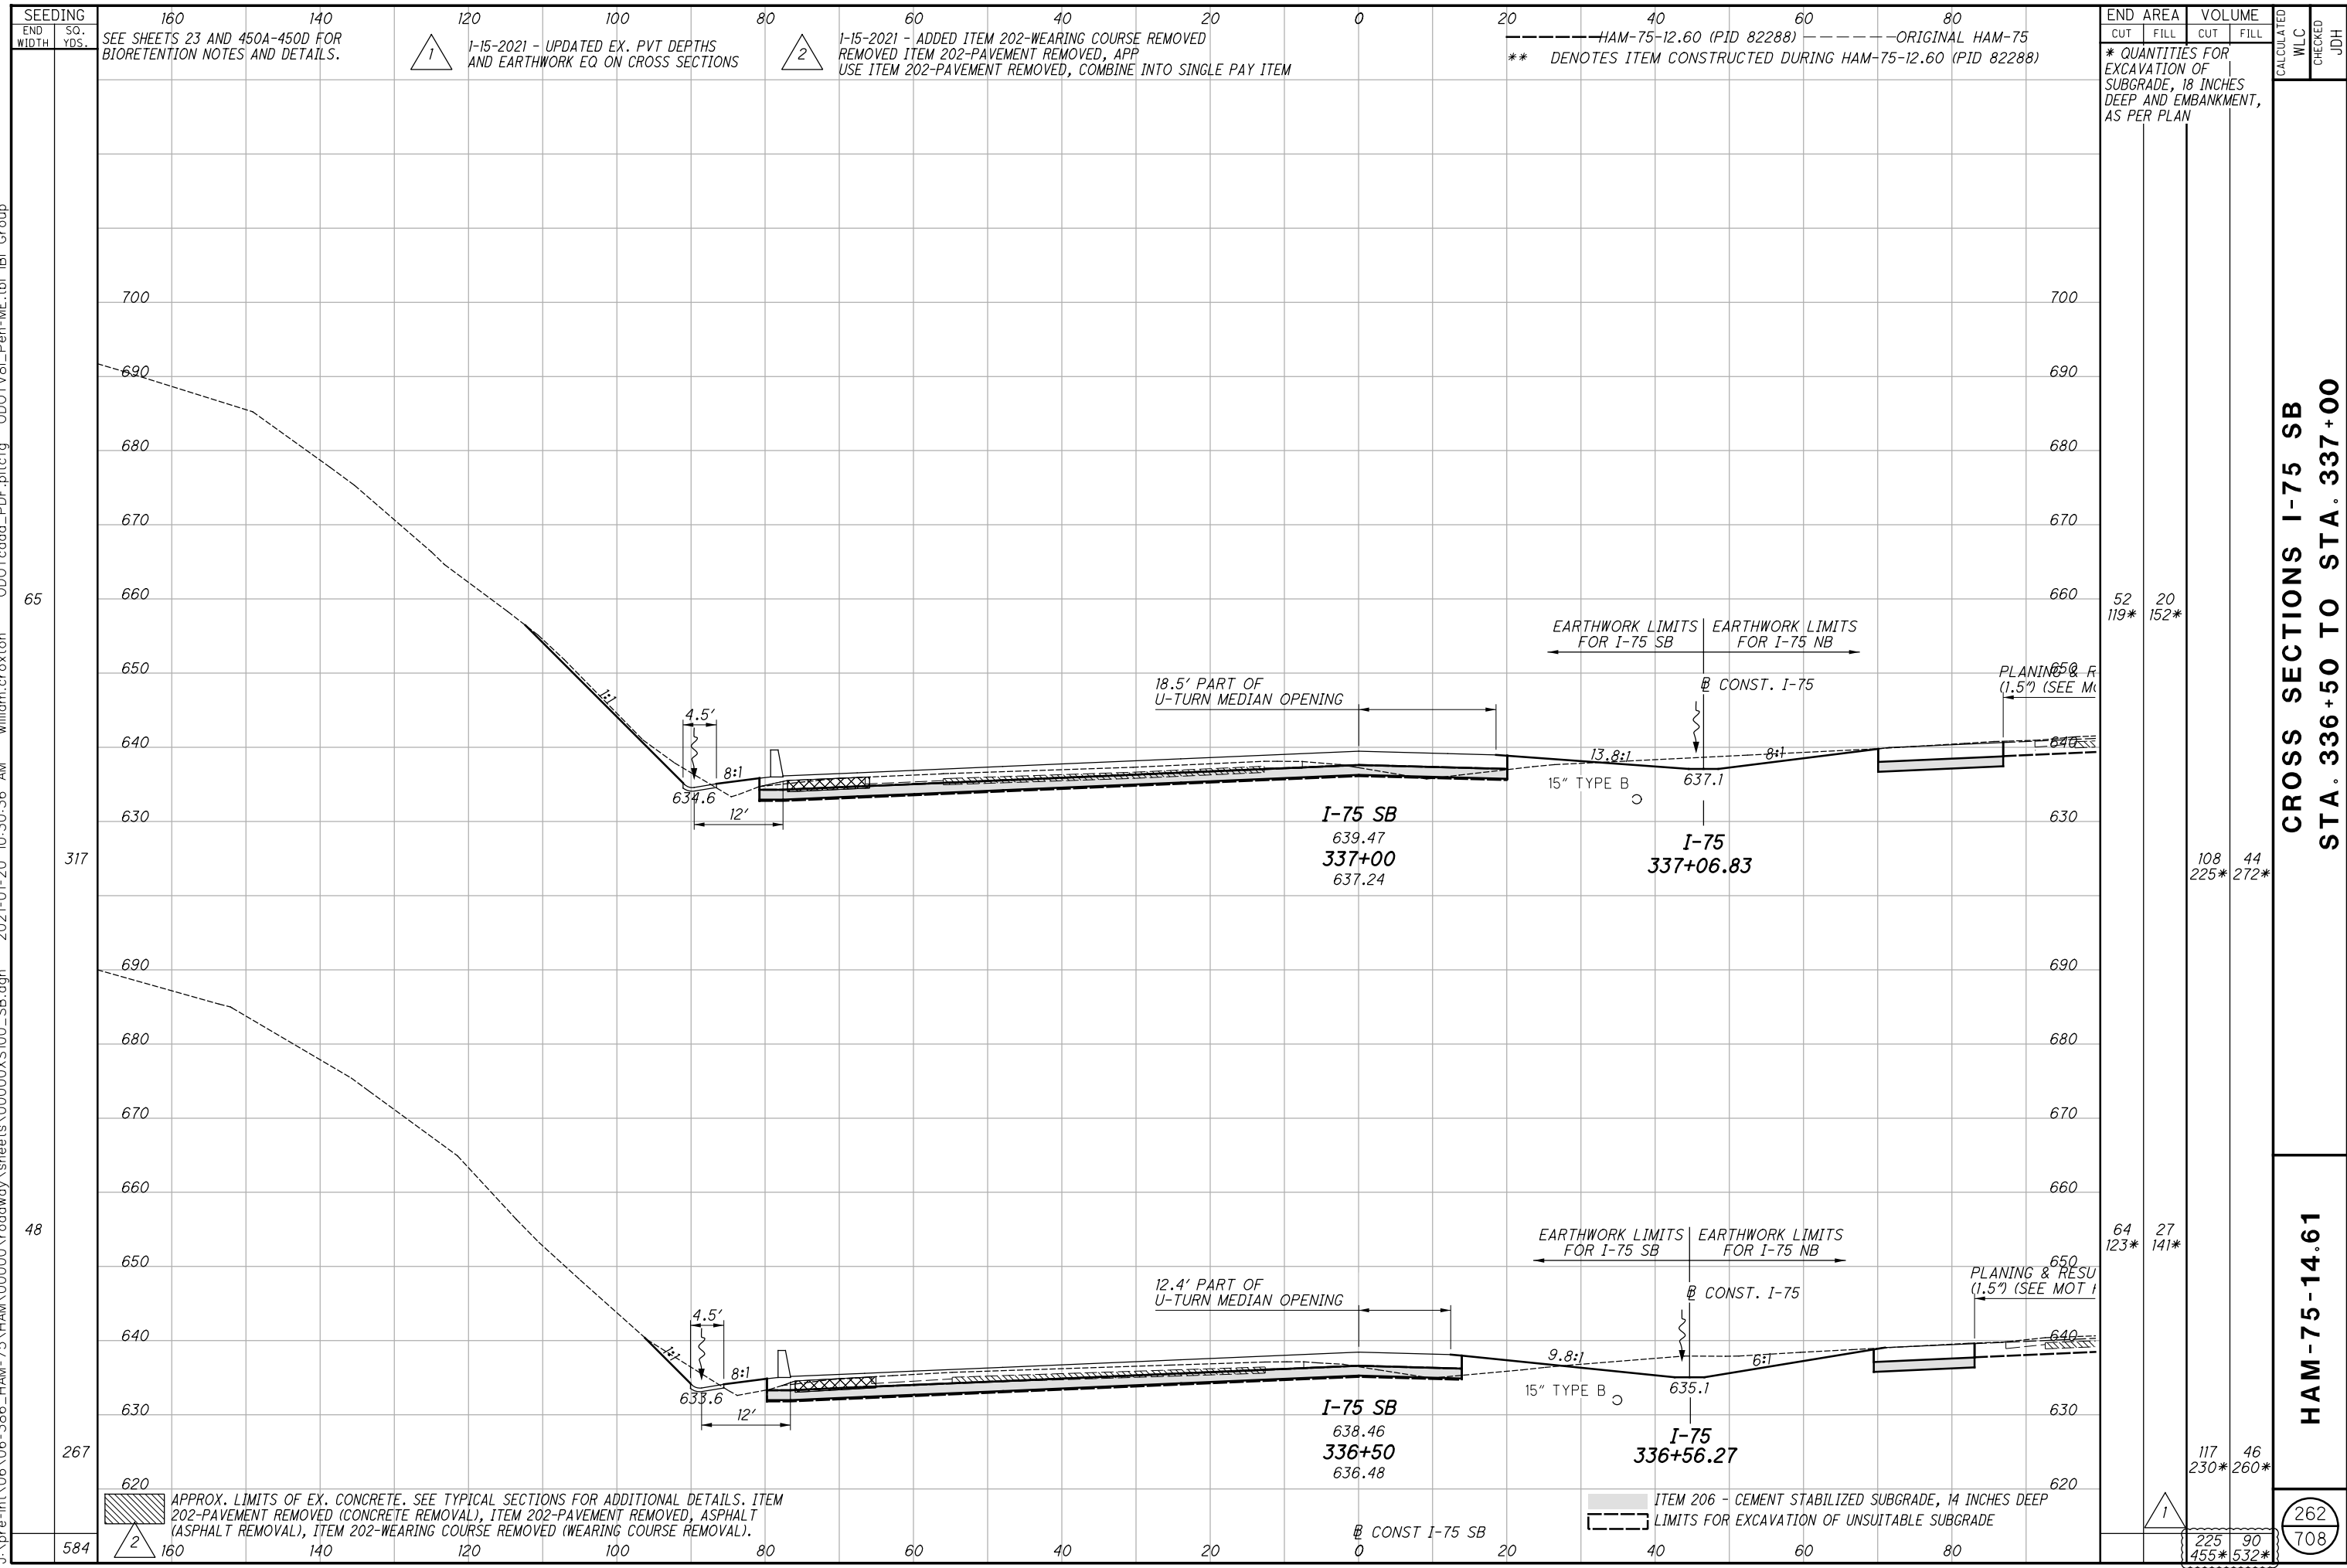

SEEDING  
END SO. WIDTH YDS.

1-15-2021 - UPDATED EX. PVT DEPTHS AND EARTHWORK EQ ON CROSS SECTIONS

1-15-2021 - ADDED ITEM 202-WEARING COURSE REMOVED REMOVED ITEM 202-PAVEMENT REMOVED, APP USE ITEM 202-PAVEMENT REMOVED, COMBINE INTO SINGLE PAY ITEM

HAM-75-12.60 (PID 82288) ORIGINAL HAM-75  
\*\* DENOTES ITEM CONSTRUCTED DURING HAM-75-12.60 (PID 82288)

END AREA		VOLUME		CALCULATED	WLC	CHECKED	JDH
CUT	FILL	CUT	FILL				
52	119*	20	152*				
108	225*	44	272*				
64	123*	27	141*				
117	230*	46	260*				
225	455*	90	532*				

APPROX. LIMITS OF EX. CONCRETE. SEE TYPICAL SECTIONS FOR ADDITIONAL DETAILS. ITEM 202-PAVEMENT REMOVED (CONCRETE REMOVAL), ITEM 202-PAVEMENT REMOVED, ASPHALT (ASPHALT REMOVAL), ITEM 202-WEARING COURSE REMOVED (WEARING COURSE REMOVAL).

ITEM 206 - CEMENT STABILIZED SUBGRADE, 14 INCHES DEEP  
LIMITS FOR EXCAVATION OF UNSUITABLE SUBGRADE

CROSS SECTIONS I-75 SB  
STA. 336+50 TO STA. 337+00  
HAM-75-14.61

262  
708

j:\pre-int\06\06-386\_HAM-75\HAM\00000\roadway\sheets\00000X5100\_SB.dgn 2021-01-20 10:30:37 AM william.croxton' ODOTcadd\_PDF\_pltcfg ODOTV8i\_Pen-ME.tbl IBI Group

SEEDING	160		140		120		100		80		60		40		20		0		20		40		60		80	
	END WIDTH	SO. YDS.	END WIDTH	SO. YDS.	END WIDTH	SO. YDS.	END WIDTH	SO. YDS.	END WIDTH	SO. YDS.	END WIDTH	SO. YDS.	END WIDTH	SO. YDS.	END WIDTH	SO. YDS.	END WIDTH	SO. YDS.	END WIDTH	SO. YDS.	END WIDTH	SO. YDS.	END WIDTH	SO. YDS.	END WIDTH	SO. YDS.

SEE SHEETS 23 AND 450A-450D FOR BIORETENTION NOTES AND DETAILS.

1-15-2021 - UPDATED EX. PVT DEPTHS AND EARTHWORK EQ ON CROSS SECTIONS


1-15-2021 - ADDED ITEM 202-WEARING COURSE REMOVED REMOVED ITEM 202-PAVEMENT REMOVED, APP USE ITEM 202-PAVEMENT REMOVED, COMBINE INTO SINGLE PAY ITEM

HAM-75-12.60 (PID 82288) ORIGINAL HAM-75  
 \*\* DENOTES ITEM CONSTRUCTED DURING HAM-75-12.60 (PID 82288)

END AREA		VOLUME	
CUT	FILL	CUT	FILL

\* QUANTITIES FOR EXCAVATION OF SUBGRADE, 18 INCHES DEEP AND EMBANKMENT, AS PER PLAN

CALCULATED WLC CHECKED JDH

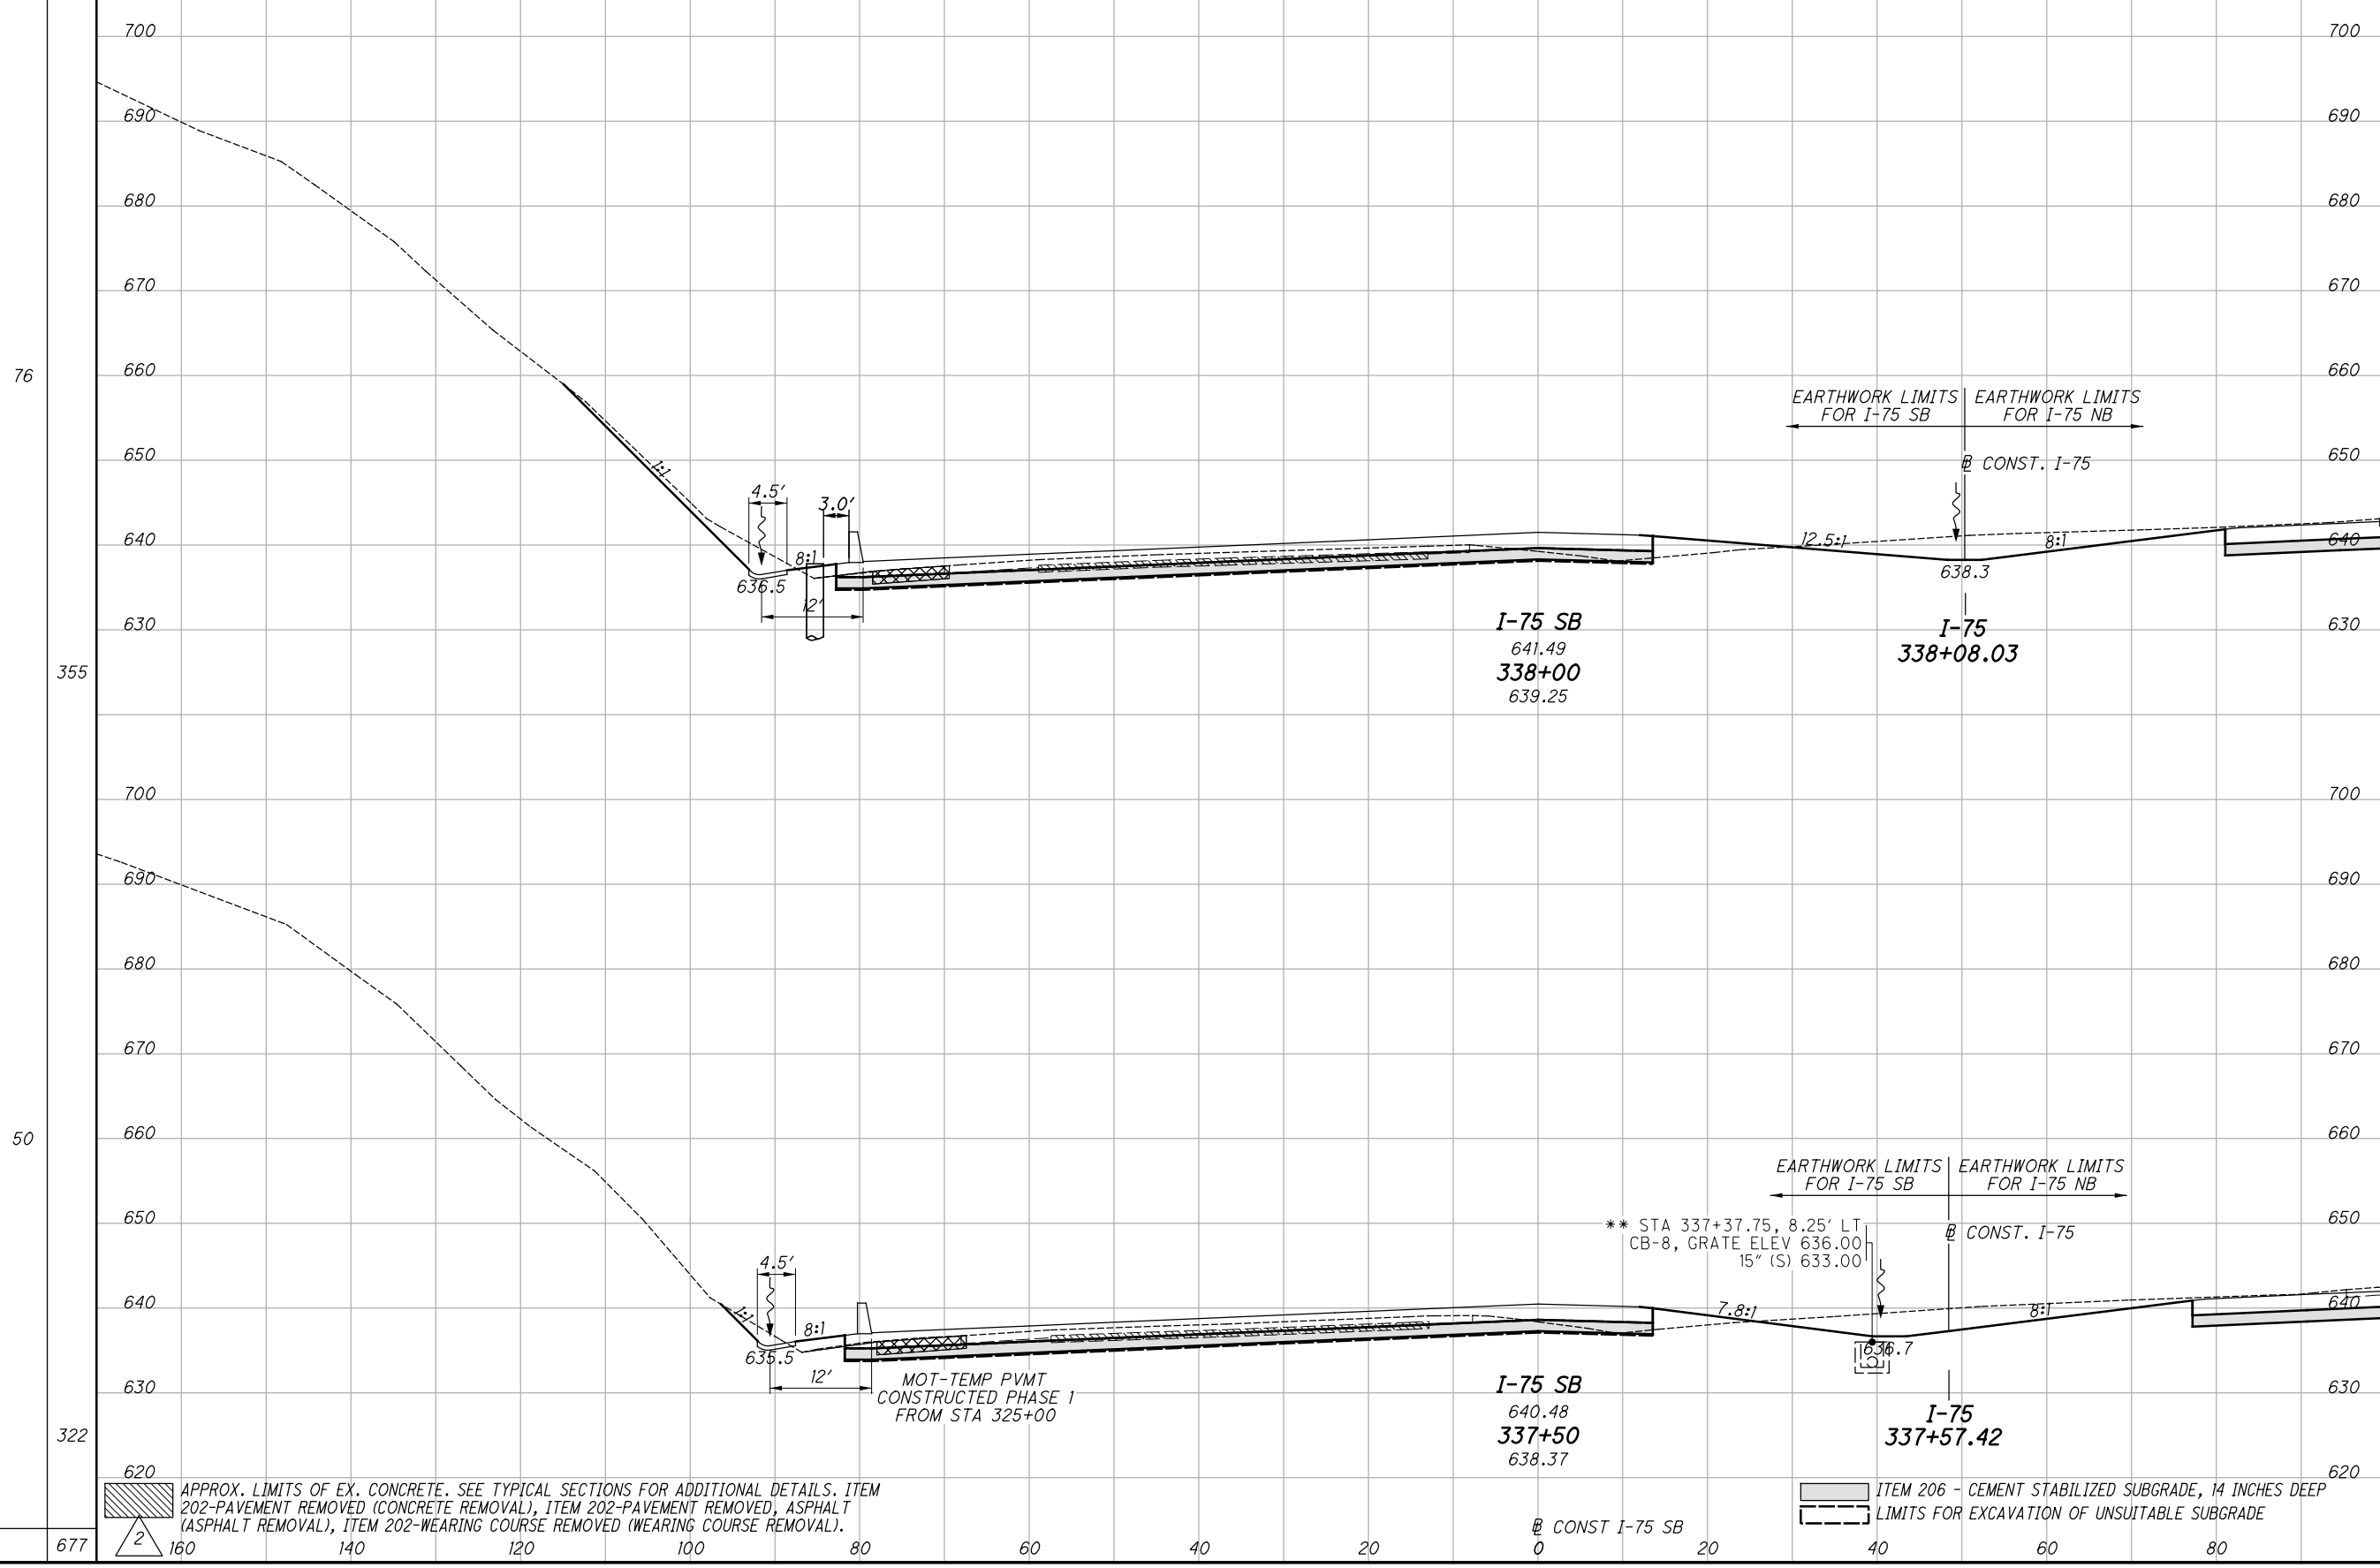

78	25
113*	145*
138	44
213*	267*

70	22
117*	143*
113	39
219*	274*

CROSS SECTIONS I-75 SB  
 STA. 337+50 TO STA. 338+00

HAM-75-14.61

263  
 708

APPROX. LIMITS OF EX. CONCRETE. SEE TYPICAL SECTIONS FOR ADDITIONAL DETAILS. ITEM 202-PAVEMENT REMOVED (CONCRETE REMOVAL), ITEM 202-PAVEMENT REMOVED, ASPHALT (ASPHALT REMOVAL), ITEM 202-WEARING COURSE REMOVED (WEARING COURSE REMOVAL).



ITEM 206 - CEMENT STABILIZED SUBGRADE, 14 INCHES DEEP  
 LIMITS FOR EXCAVATION OF UNSUITABLE SUBGRADE

251	83
432*	541*



j:\pre-int\06\06-386\_HAM-75\_HAM\00000\roadway\sheets\00000X5100\_SB.dgn 2021-01-20 10:30:39 AM william.croxton ODOTcadd\_PDF.pltcfgr ODOTV8i\_Pen-ME.tbl IBI Group

SEEDING	160		140		120		100		80		60		40		20		0		20		40		60		80	
	END WIDTH	SO. YDS.																								

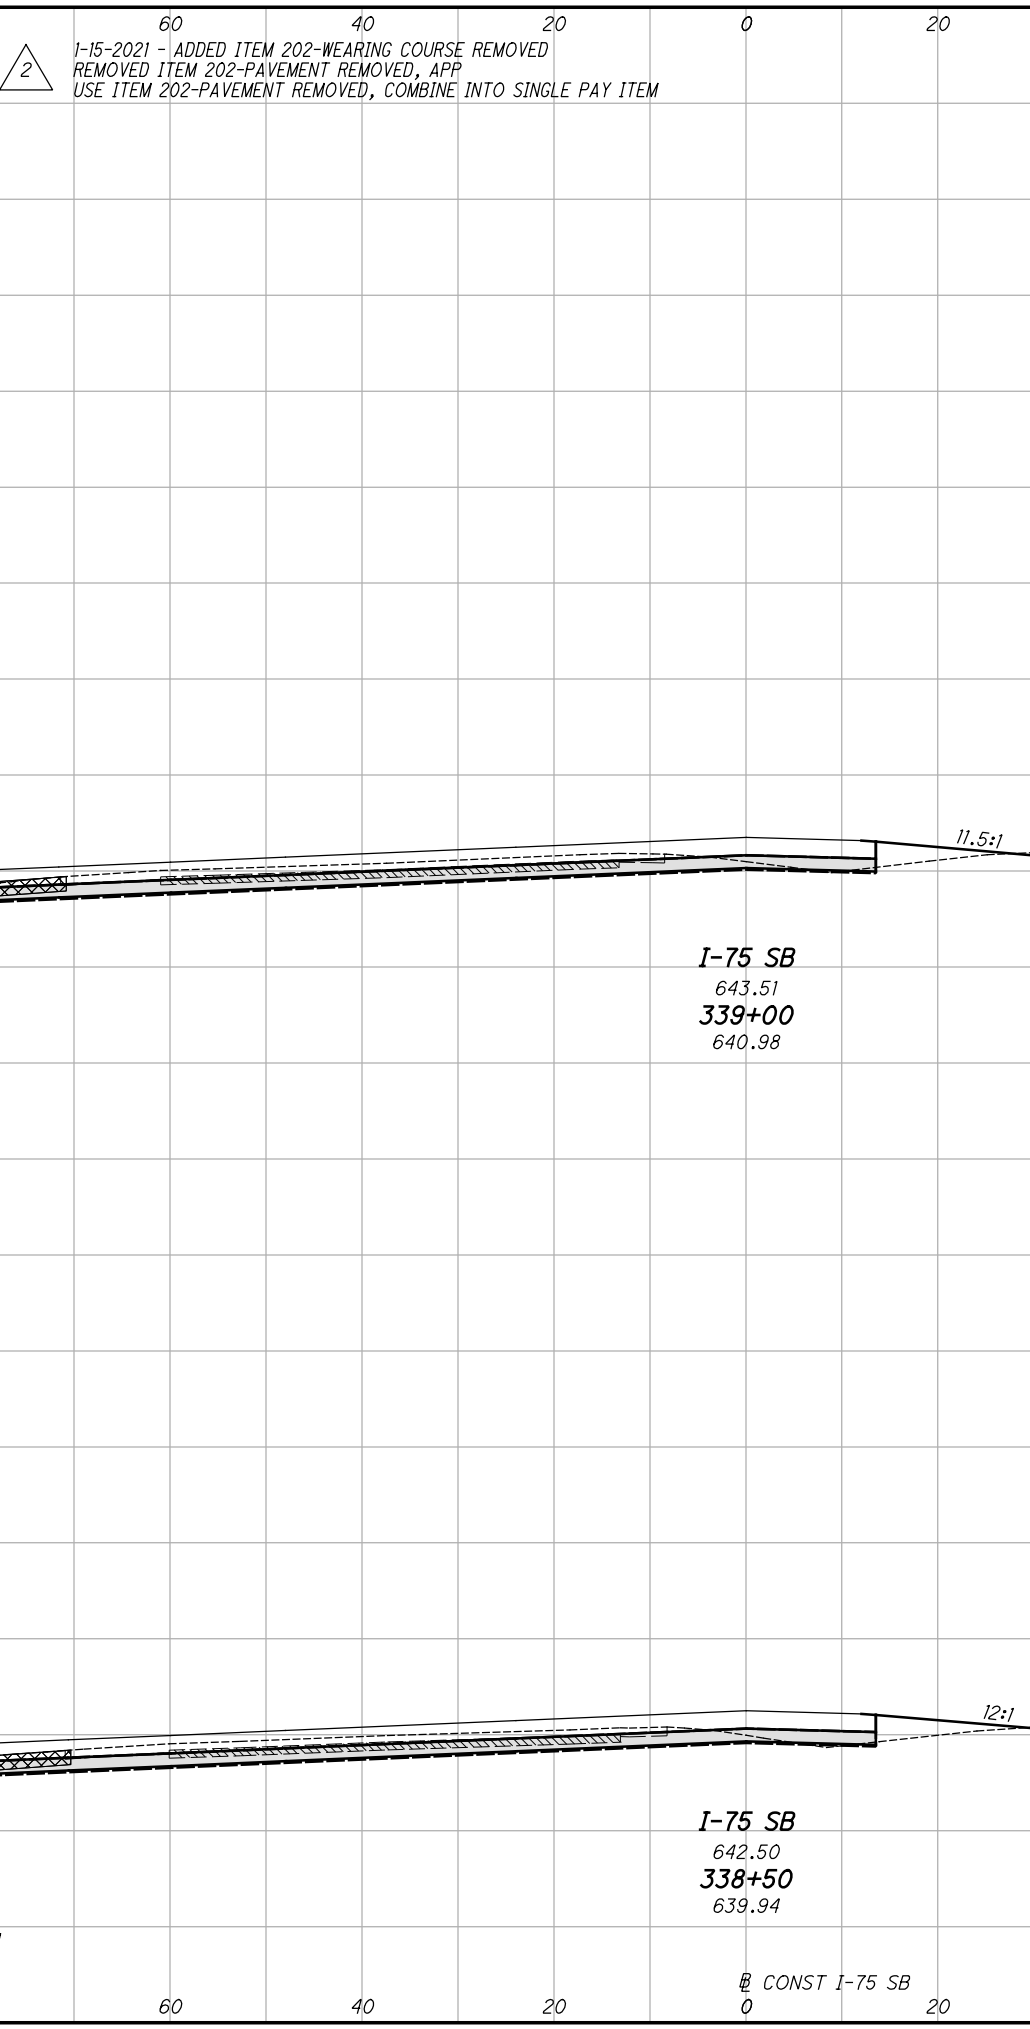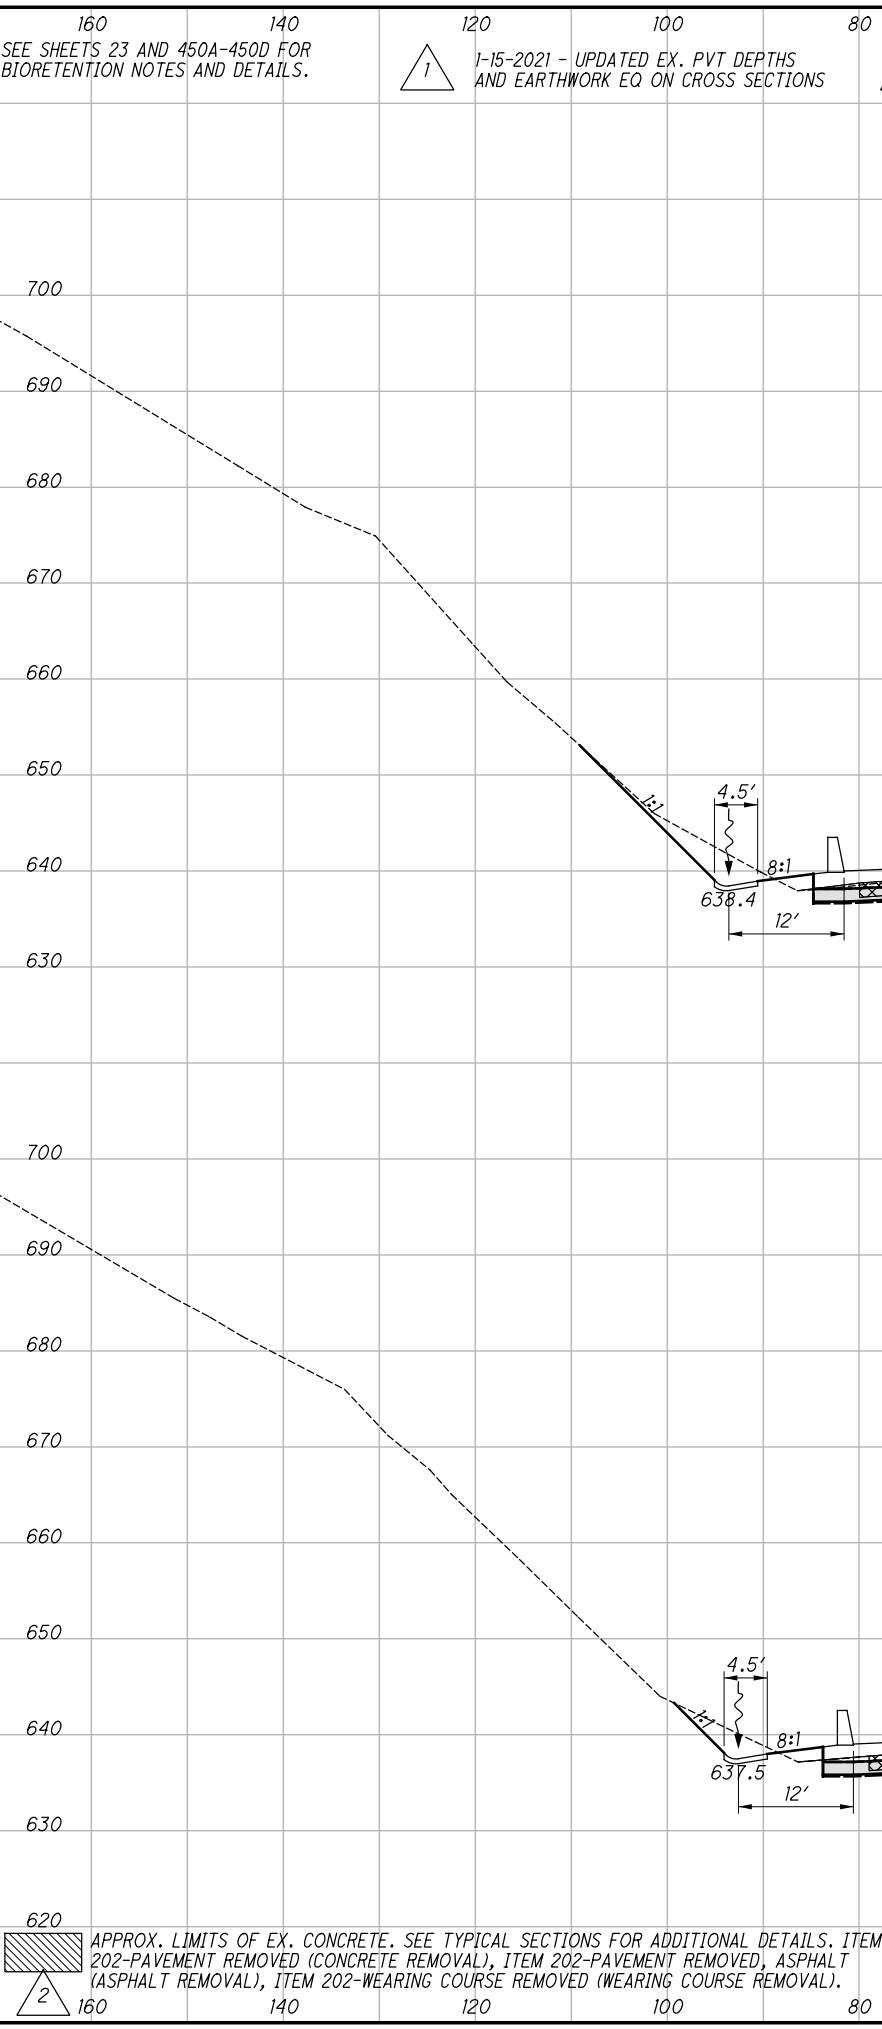

END AREA	VOLUME		CALCULATED	CHECKED	JDH
	CUT	FILL			
84	99*	23	148*		
140	182*	47	273*		
67	97*	27	146*		
135	195*	49	270		
275	377*	96	543*		

**CROSS SECTIONS I-75 SB**  
**STA. 338+50 TO STA. 339+00**

**HAM-75-14.61**

264  
708

APPROX. LIMITS OF EX. CONCRETE. SEE TYPICAL SECTIONS FOR ADDITIONAL DETAILS. ITEM 202-PAVEMENT REMOVED (CONCRETE REMOVAL), ITEM 202-PAVEMENT REMOVED, ASPHALT (ASPHALT REMOVAL), ITEM 202-WEARING COURSE REMOVED (WEARING COURSE REMOVAL).

ITEM 206 - CEMENT STABILIZED SUBGRADE, 14 INCHES DEEP  
 LIMITS FOR EXCAVATION OF UNSUITABLE SUBGRADE

1-15-2021 - UPDATED EX. PVT DEPTHS AND EARTHWORK EQ ON CROSS SECTIONS  
 1-15-2021 - ADDED ITEM 202-WEARING COURSE REMOVED REMOVED ITEM 202-PAVEMENT REMOVED, APP USE ITEM 202-PAVEMENT REMOVED, COMBINE INTO SINGLE PAY ITEM

j:\pre-int\06\06-386\_HAM-75\_HAM\00000\roadway\sheets\00000X5100\_SB.dgn 2021-01-20 10:30:40 AM william.croxton' ODOTcadd\_PDF\_pltcfg ODOTV8i\_Pen-ME.tbl IBI Group

SEEDING	160		140		120		100		80		60		40		20		0		20		40		60		80		
	END WIDTH	SO. YDS.	END WIDTH	SO. YDS.	END WIDTH	SO. YDS.	END WIDTH	SO. YDS.	END WIDTH	SO. YDS.	END WIDTH	SO. YDS.	END WIDTH	SO. YDS.	END WIDTH	SO. YDS.	END WIDTH	SO. YDS.	END WIDTH	SO. YDS.	END WIDTH	SO. YDS.	END WIDTH	SO. YDS.	END WIDTH	SO. YDS.	
107																											
225																											
101																											
472																											
697																											

SEE SHEETS 23 AND 450A-450D FOR BIORETENTION NOTES AND DETAILS.

1-15-2021 - UPDATED EX. PVT DEPTHS AND EARTHWORK EQ ON CROSS SECTIONS

1-15-2021 - ADDED ITEM 202-WEARING COURSE REMOVED REMOVED ITEM 202-PAVEMENT REMOVED, APP USE ITEM 202-PAVEMENT REMOVED, COMBINE INTO SINGLE PAY ITEM


END AREA	VOLUME		CALCULATED WLC	CHECKED	JDH
	CUT	FILL			
142	95*	21	150*		
97	69*	14	107*		
127	97*	18	149*		
196	182*	38	275*		
293	251*	52	382*		

\* QUANTITIES FOR EXCAVATION OF SUBGRADE, 18 INCHES DEEP AND EMBANKMENT, AS PER PLAN

CROSS SECTIONS I-75 SB STA. 339+50 TO STA. 339+69.29

HAM-75-14.61

265  
708


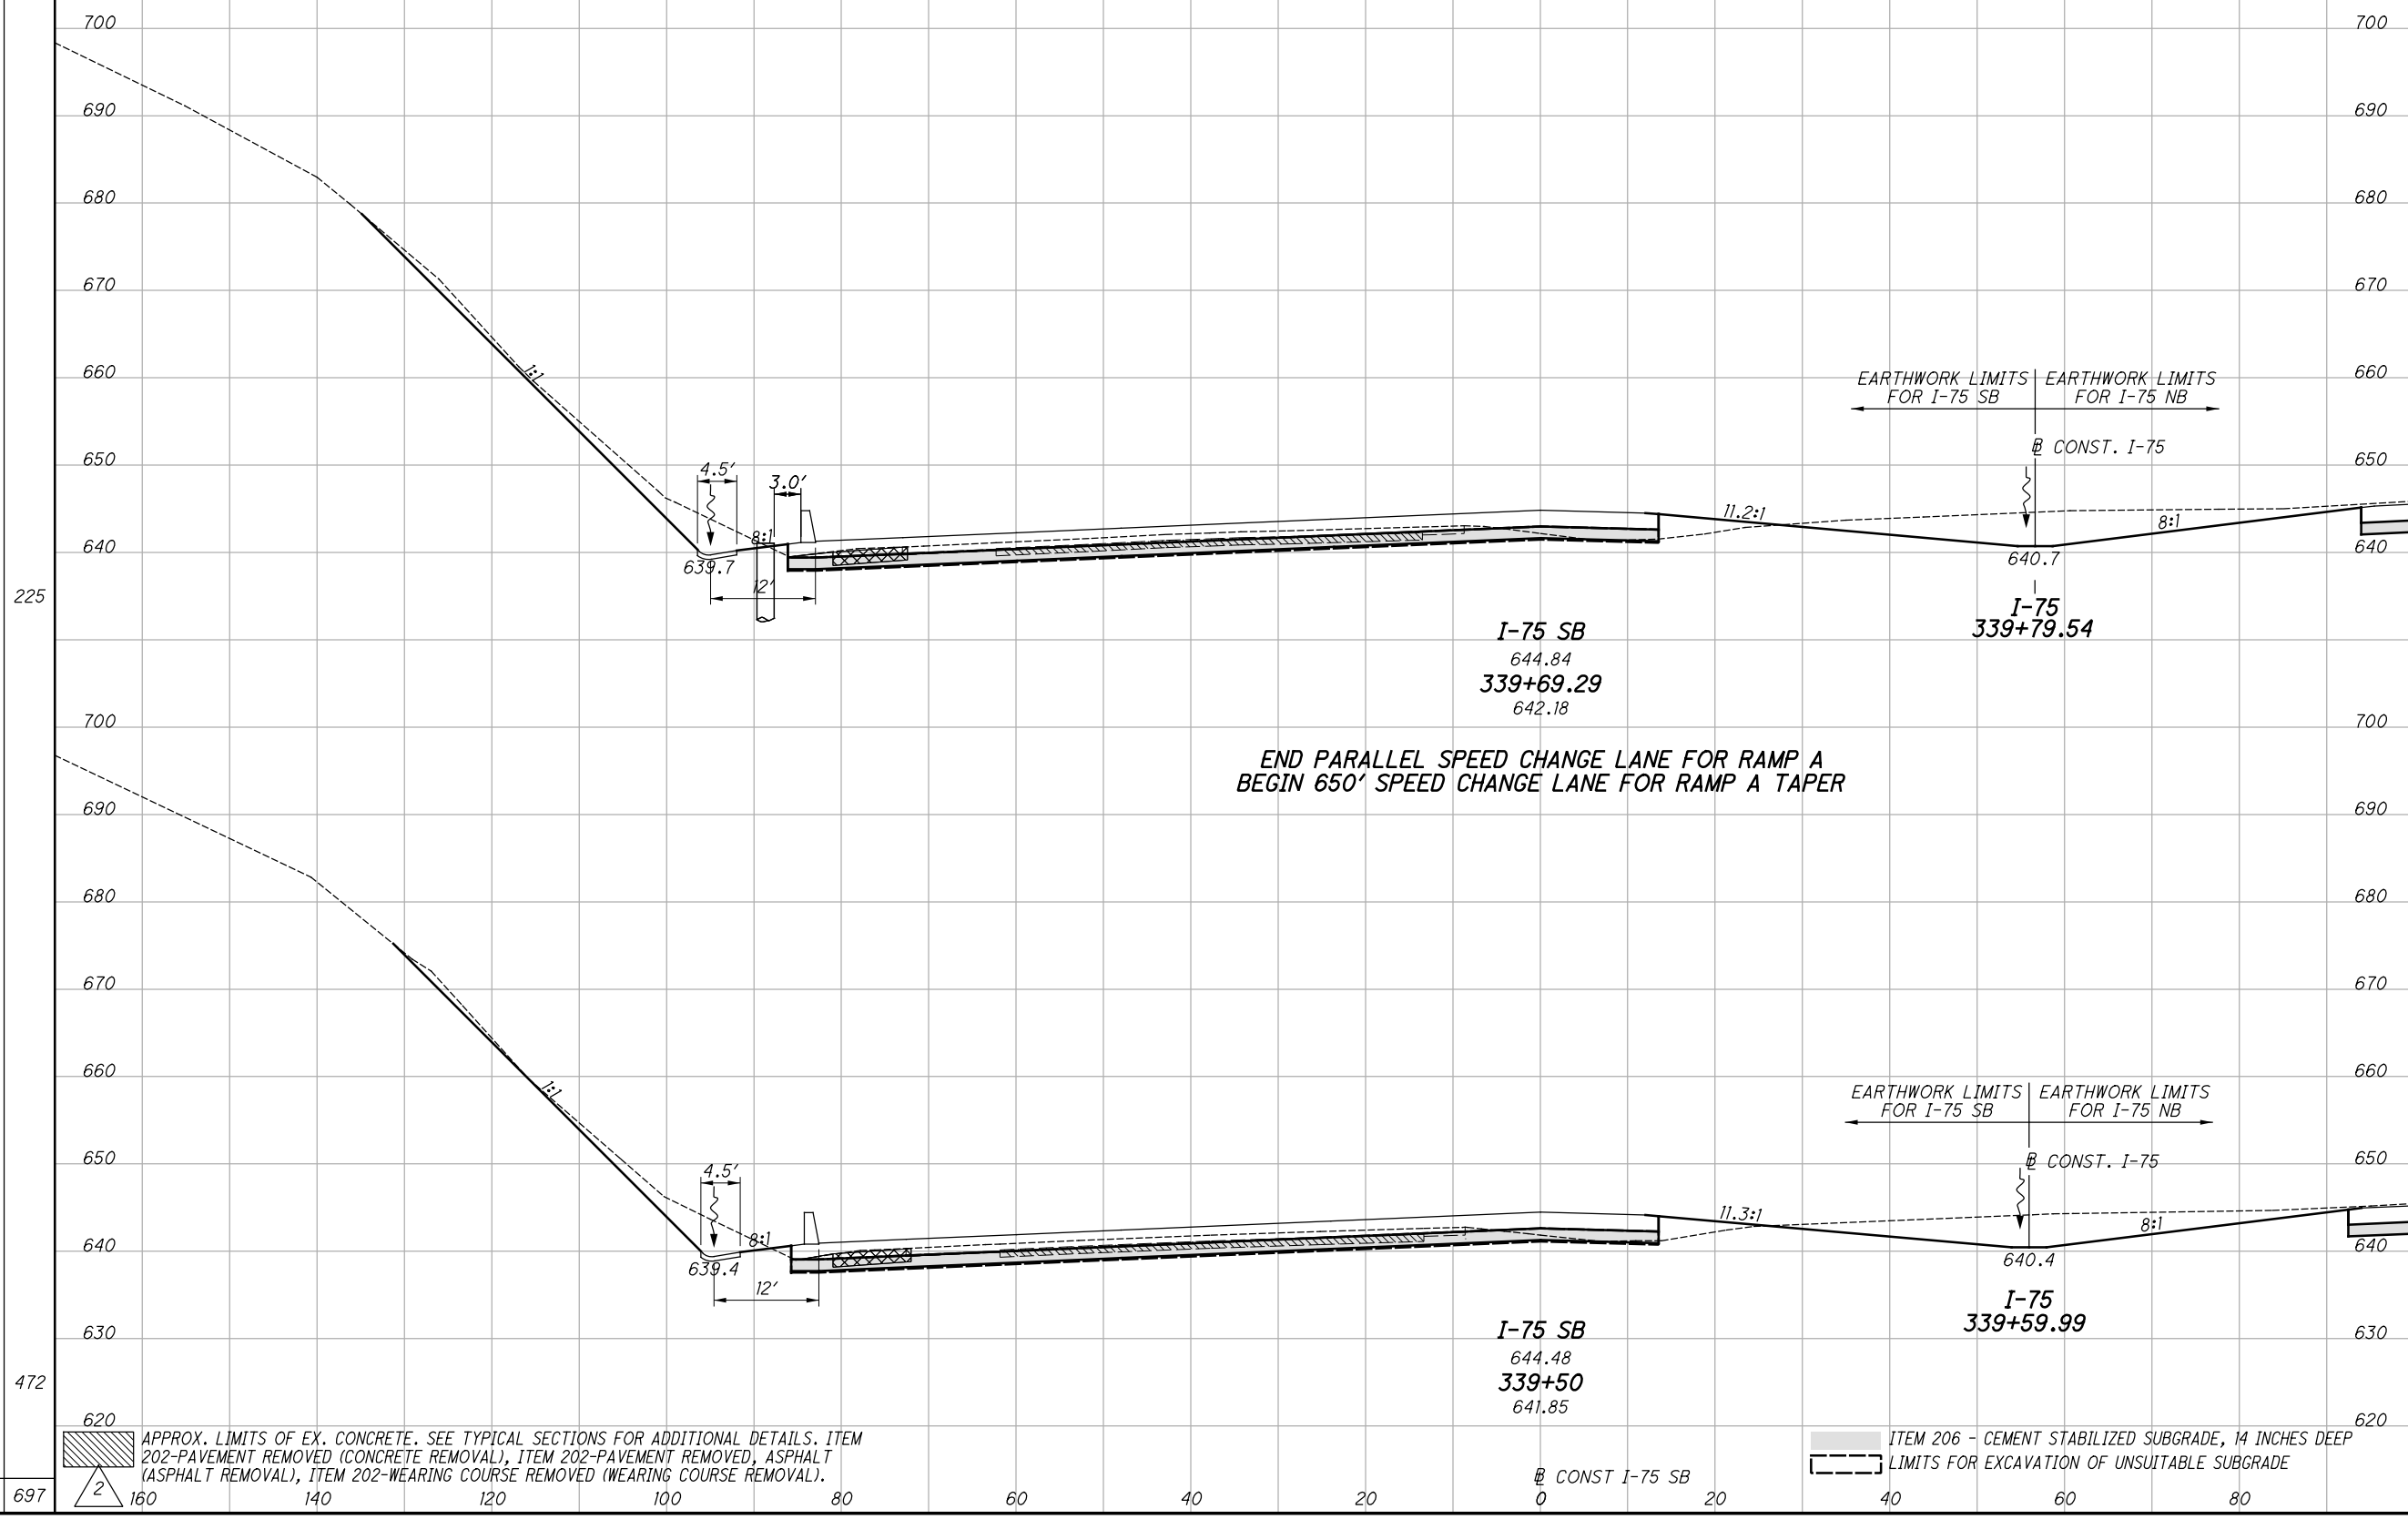


APPROX. LIMITS OF EX. CONCRETE. SEE TYPICAL SECTIONS FOR ADDITIONAL DETAILS. ITEM 202-PAVEMENT REMOVED (CONCRETE REMOVAL), ITEM 202-PAVEMENT REMOVED, ASPHALT (ASPHALT REMOVAL), ITEM 202-WEARING COURSE REMOVED (WEARING COURSE REMOVAL).

ITEM 206 - CEMENT STABILIZED SUBGRADE, 14 INCHES DEEP  
LIMITS FOR EXCAVATION OF UNSUITABLE SUBGRADE

j:\pre-int\06\06-386\_HAM-75\HAM\00000\roadway\sheets\00000X5100\_SB.dgn 2021-01-20 10:30:41 AM william.croxton\ ODOTcadd\_PDF.plt\cfig ODOTV8i\_Pen-ME.tbi IBI\_Group

SEEDING	160		140		120		100		80		60		40		20		0		20		40		60		80	
	END WIDTH	SO. YDS.																								

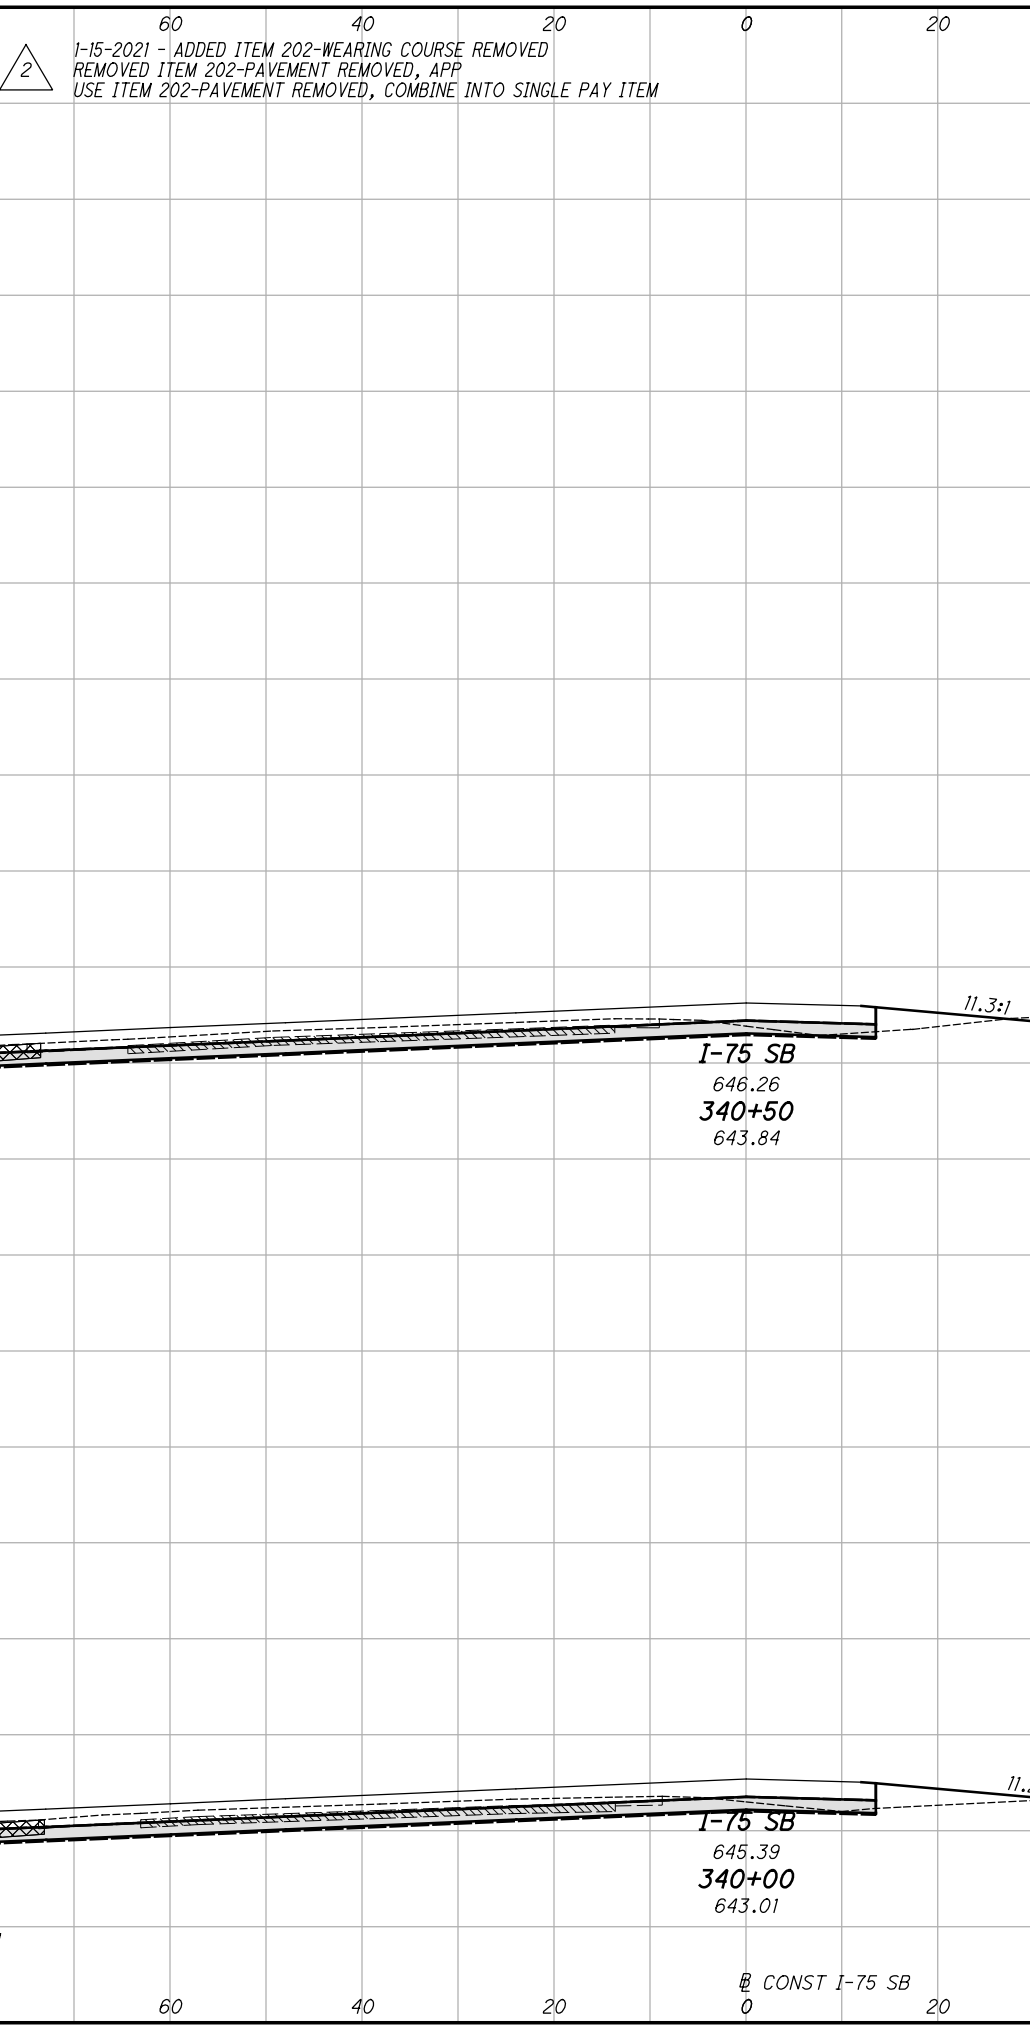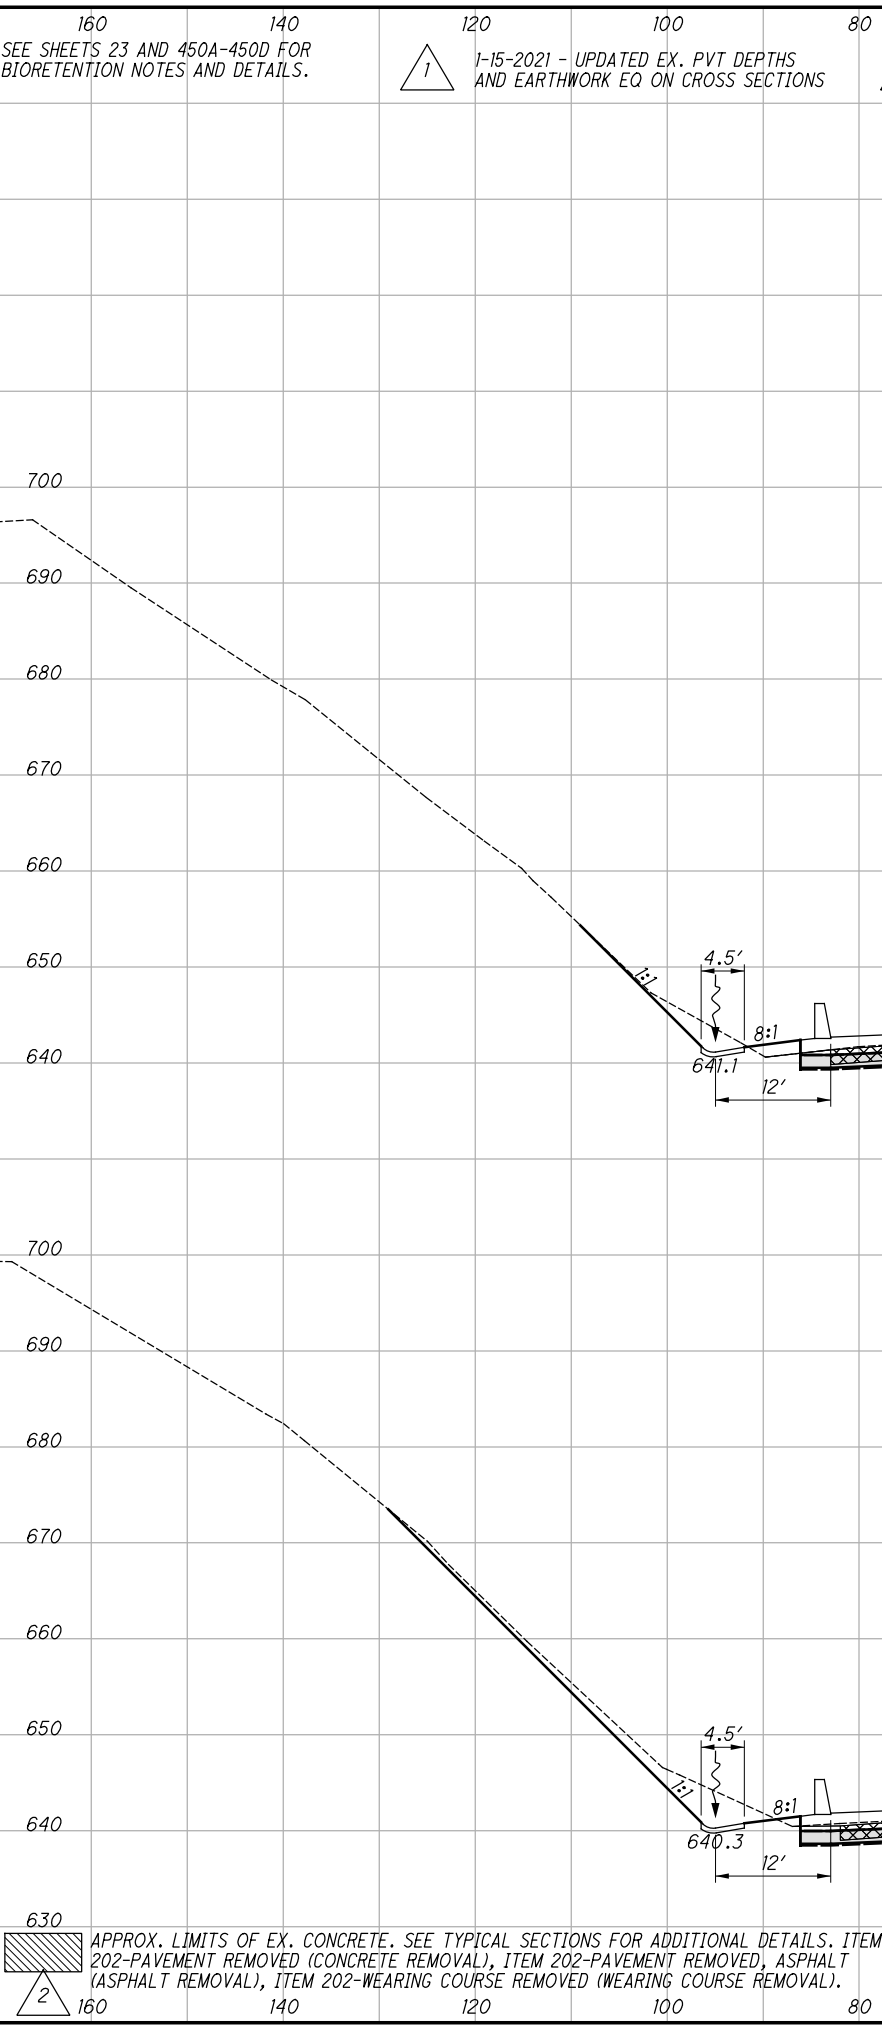

END AREA	VOLUME	
	CUT	FILL
98	135*	24
115	105*	26
198	223*	47

CALCULATED	WLC	CHECKED	JDH
		337*449*	

APPROX. LIMITS OF EX. CONCRETE. SEE TYPICAL SECTIONS FOR ADDITIONAL DETAILS. ITEM 202-PAVEMENT REMOVED (CONCRETE REMOVAL), ITEM 202-PAVEMENT REMOVED, ASPHALT (ASPHALT REMOVAL), ITEM 202-WEARING COURSE REMOVED (WEARING COURSE REMOVAL).


ITEM 206 - CEMENT STABILIZED SUBGRADE, 14 INCHES DEEP  
LIMITS FOR EXCAVATION OF UNSUITABLE SUBGRADE

CROSS SECTIONS I-75 SB  
STA. 340+00 TO STA. 340+50  
HAM-75-14.61

\* QUANTITIES FOR EXCAVATION OF SUBGRADE, 18 INCHES DEEP AND EMBANKMENT, AS PER PLAN



j:\pre-int\06\06-386\_HAM-75\HAM\00000\roadway\sheets\00000X5100\_SB.dgn 2021-01-20 10:30:43 AM william.croxton' ODOTcadd\_PDF.pltcfgr ODOTV8i\_Pen-ME.tbl IBI Group

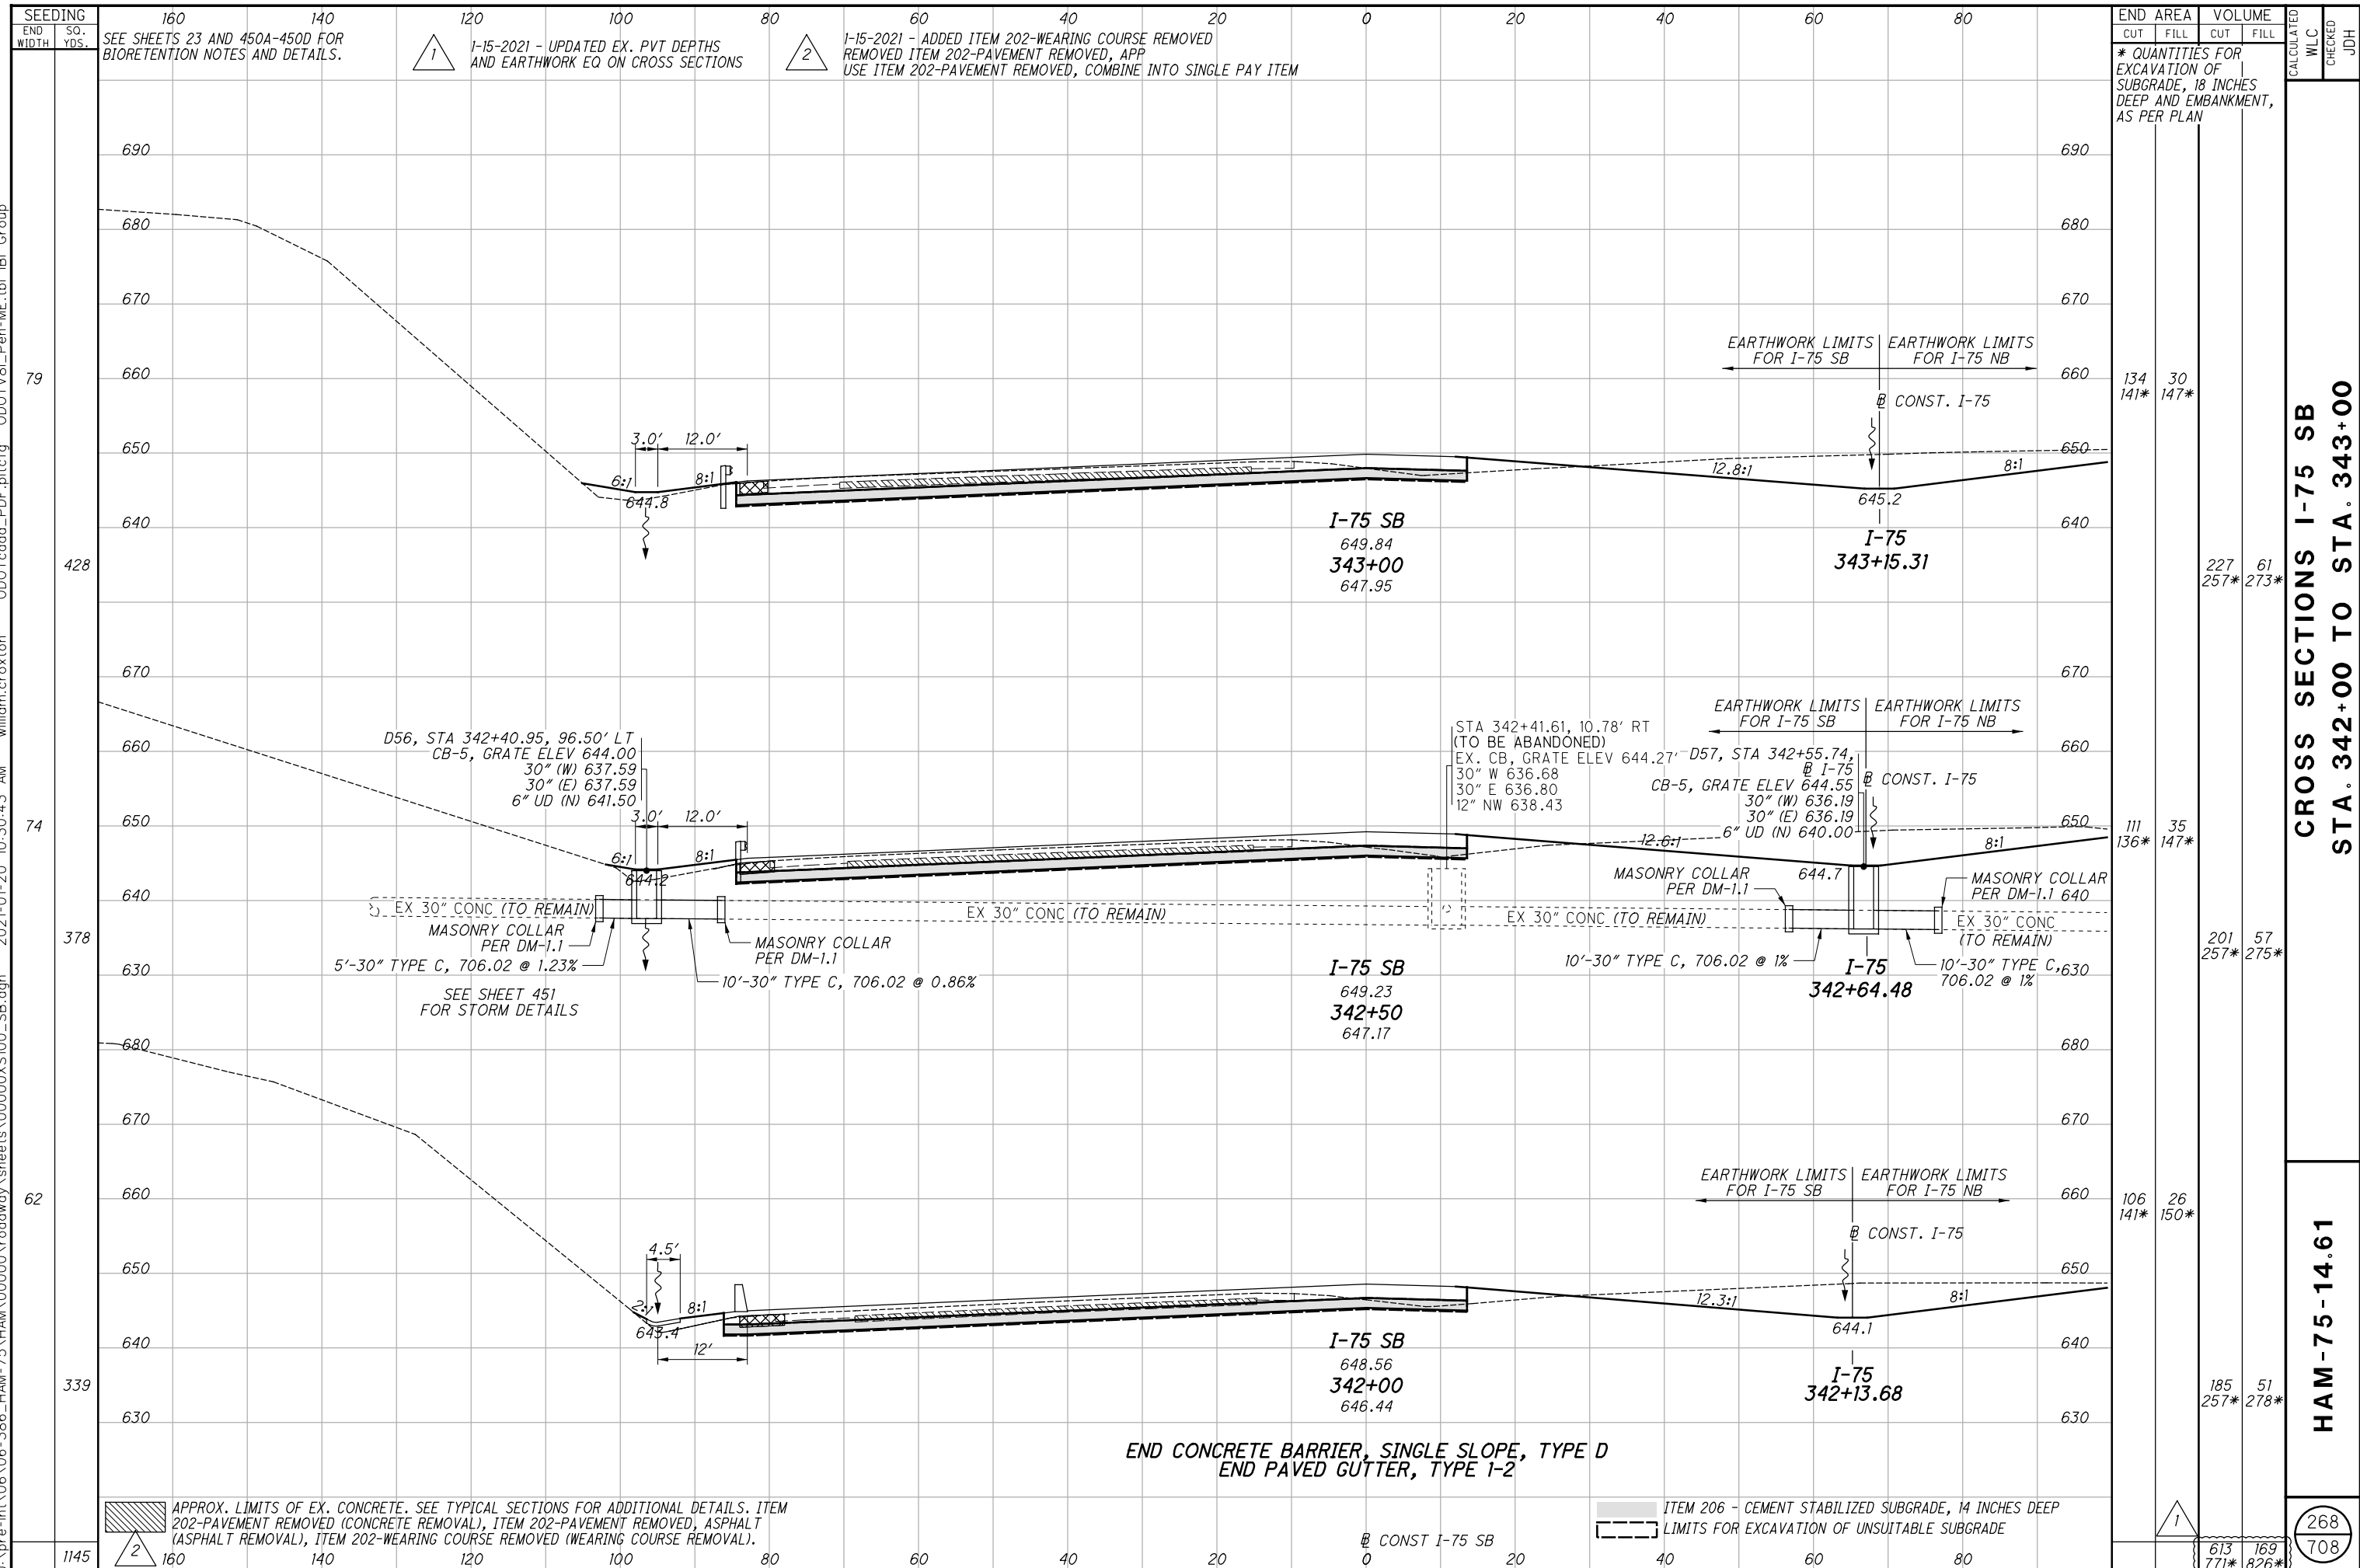

SEEDING		END AREA		VOLUME		CALCULATED	
END WIDTH	SO. YDS.	CUT	FILL	CUT	FILL	WLC	CHECKED
160	140	134	30	141*	147*		JDH
140	120	227	61	257*	273*		
120	100	111	35	136*	147*		
100	80	201	57	257*	275*		
80	60	106	26	141*	150*		
60	40	185	51	257*	278*		
40	20						
20	0						
0	20						
20	40						
40	60						
60	80						
80							
1145		613	169	771*	826*		

**CROSS SECTIONS I-75 SB  
 STA. 342+00 TO STA. 343+00**

**HAM-75-14.61**

268  
 708

APPROX. LIMITS OF EX. CONCRETE. SEE TYPICAL SECTIONS FOR ADDITIONAL DETAILS. ITEM 202-PAVEMENT REMOVED (CONCRETE REMOVAL), ITEM 202-PAVEMENT REMOVED, ASPHALT (ASPHALT REMOVAL), ITEM 202-WEARING COURSE REMOVED (WEARING COURSE REMOVAL).

ITEM 206 - CEMENT STABILIZED SUBGRADE, 14 INCHES DEEP  
 LIMITS FOR EXCAVATION OF UNSUITABLE SUBGRADE

END CONCRETE BARRIER, SINGLE SLOPE, TYPE D  
 END PAVED GUTTER, TYPE 1-2

\* QUANTITIES FOR EXCAVATION OF SUBGRADE, 18 INCHES DEEP AND EMBANKMENT, AS PER PLAN


1-15-2021 - UPDATED EX. PVT DEPTHS AND EARTHWORK EQ ON CROSS SECTIONS

1-15-2021 - ADDED ITEM 202-WEARING COURSE REMOVED REMOVED ITEM 202-PAVEMENT REMOVED, APP USE ITEM 202-PAVEMENT REMOVED, COMBINE INTO SINGLE PAY ITEM

SEE SHEETS 23 AND 450A-450D FOR BIORETENTION NOTES AND DETAILS.

1  
 2

j:\pre-int\06\06-386\_HAM-75\HAM\00000\roadway\sheets\00000X5100\_SB.dgn 2021-01-20 10:30:44 AM william.croxton' ODOTcadd\_PDF.pltcfgr ODOTV8i\_Pen-ME.tbl IBI Group

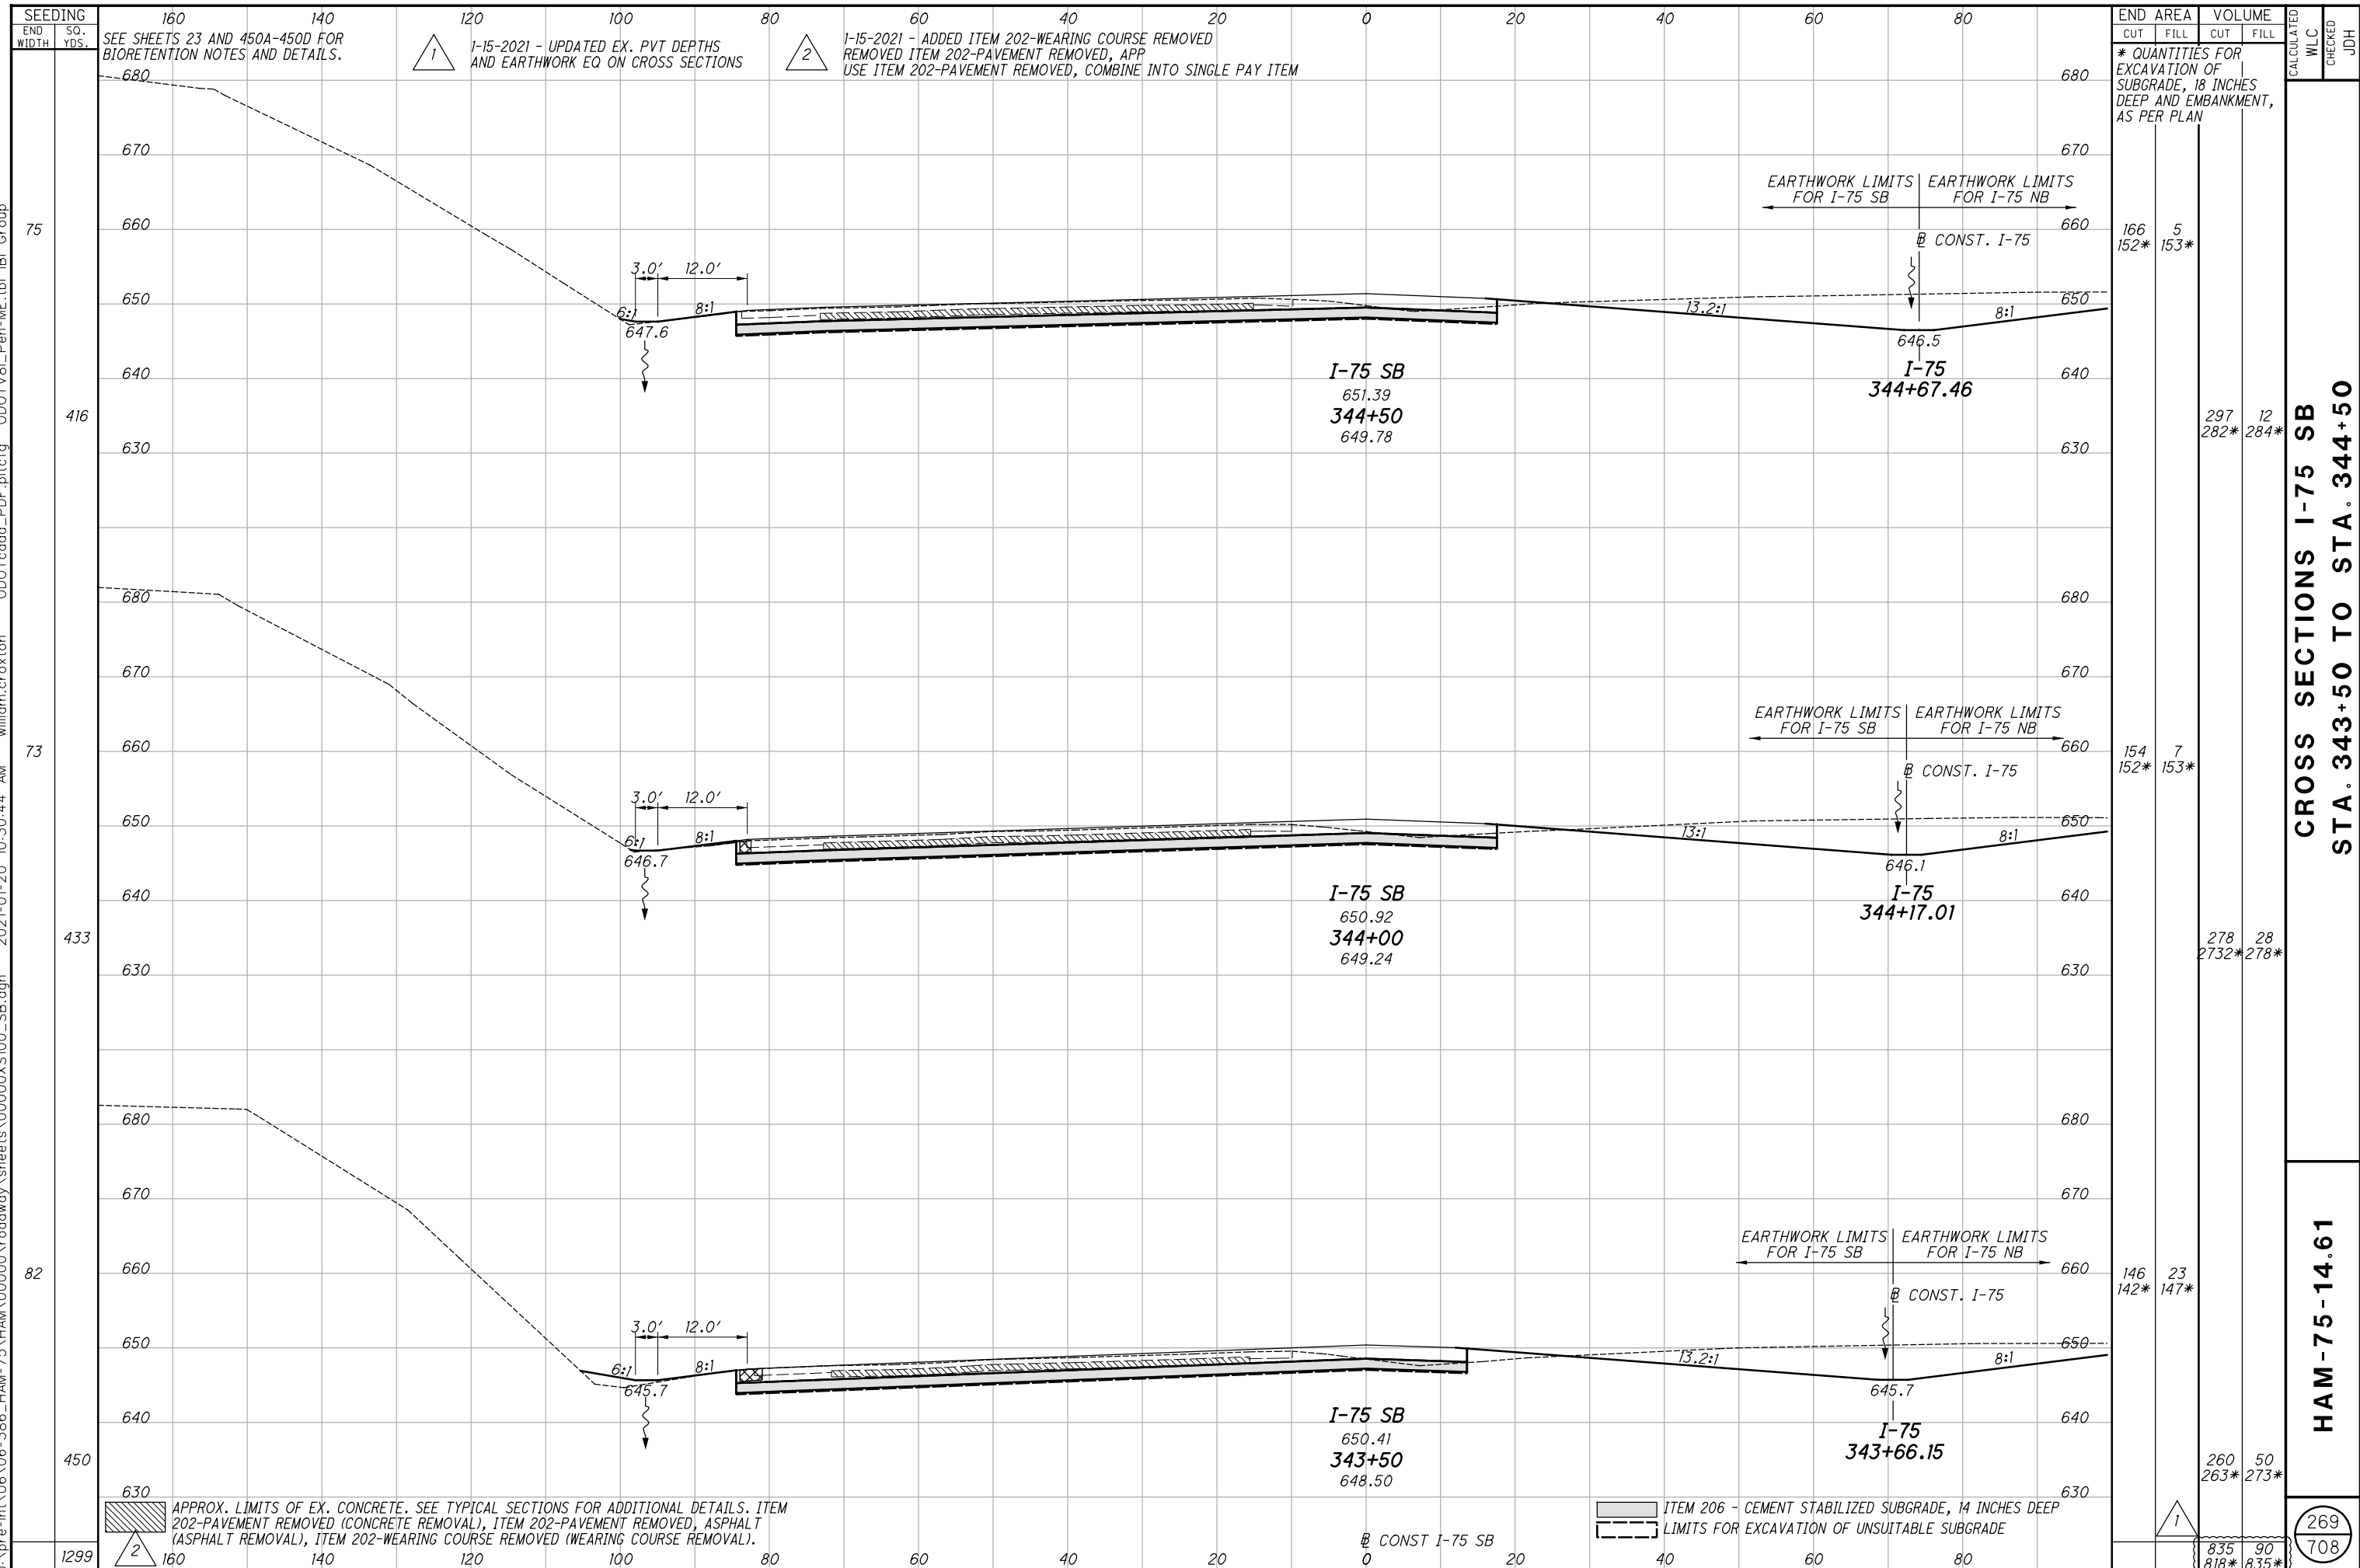

END AREA	VOLUME		CALCULATED	CHECKED	JDH
	CUT	FILL			
166	5				
152*	153*				
297	12				
282*	284*				
154	7				
152*	153*				
278	28				
2732*	278*				
146	23				
142*	147*				
260	50				
263*	273*				
835	90				
818*	835*				

**CROSS SECTIONS I-75 SB  
 STA. 343+50 TO STA. 344+50**

**HAM-75-14.61**

269  
 708

SEE SHEETS 23 AND 450A-450D FOR BIORETENTION NOTES AND DETAILS.

1-15-2021 - UPDATED EX. PVT DEPTHS AND EARTHWORK EQ ON CROSS SECTIONS  
 1-15-2021 - ADDED ITEM 202-WEARING COURSE REMOVED  
 REMOVED ITEM 202-PAVEMENT REMOVED, APP  
 USE ITEM 202-PAVEMENT REMOVED, COMBINE INTO SINGLE PAY ITEM


\* QUANTITIES FOR EXCAVATION OF SUBGRADE, 18 INCHES DEEP AND EMBANKMENT, AS PER PLAN

APPROX. LIMITS OF EX. CONCRETE. SEE TYPICAL SECTIONS FOR ADDITIONAL DETAILS. ITEM 202-PAVEMENT REMOVED (CONCRETE REMOVAL), ITEM 202-PAVEMENT REMOVED, ASPHALT (ASPHALT REMOVAL), ITEM 202-WEARING COURSE REMOVED (WEARING COURSE REMOVAL).

ITEM 206 - CEMENT STABILIZED SUBGRADE, 14 INCHES DEEP  
 LIMITS FOR EXCAVATION OF UNSUITABLE SUBGRADE



j:\pre-int\06\06-386\_HAM-75\_HAM\00000\roadway\sheets\00000X5100\_SB.dgn 2021-01-20 10:30:45 AM william.croxton' ODOTcadd\_PDF.pltcfg ODOTV8i\_Pen-ME.tbl IBI Group

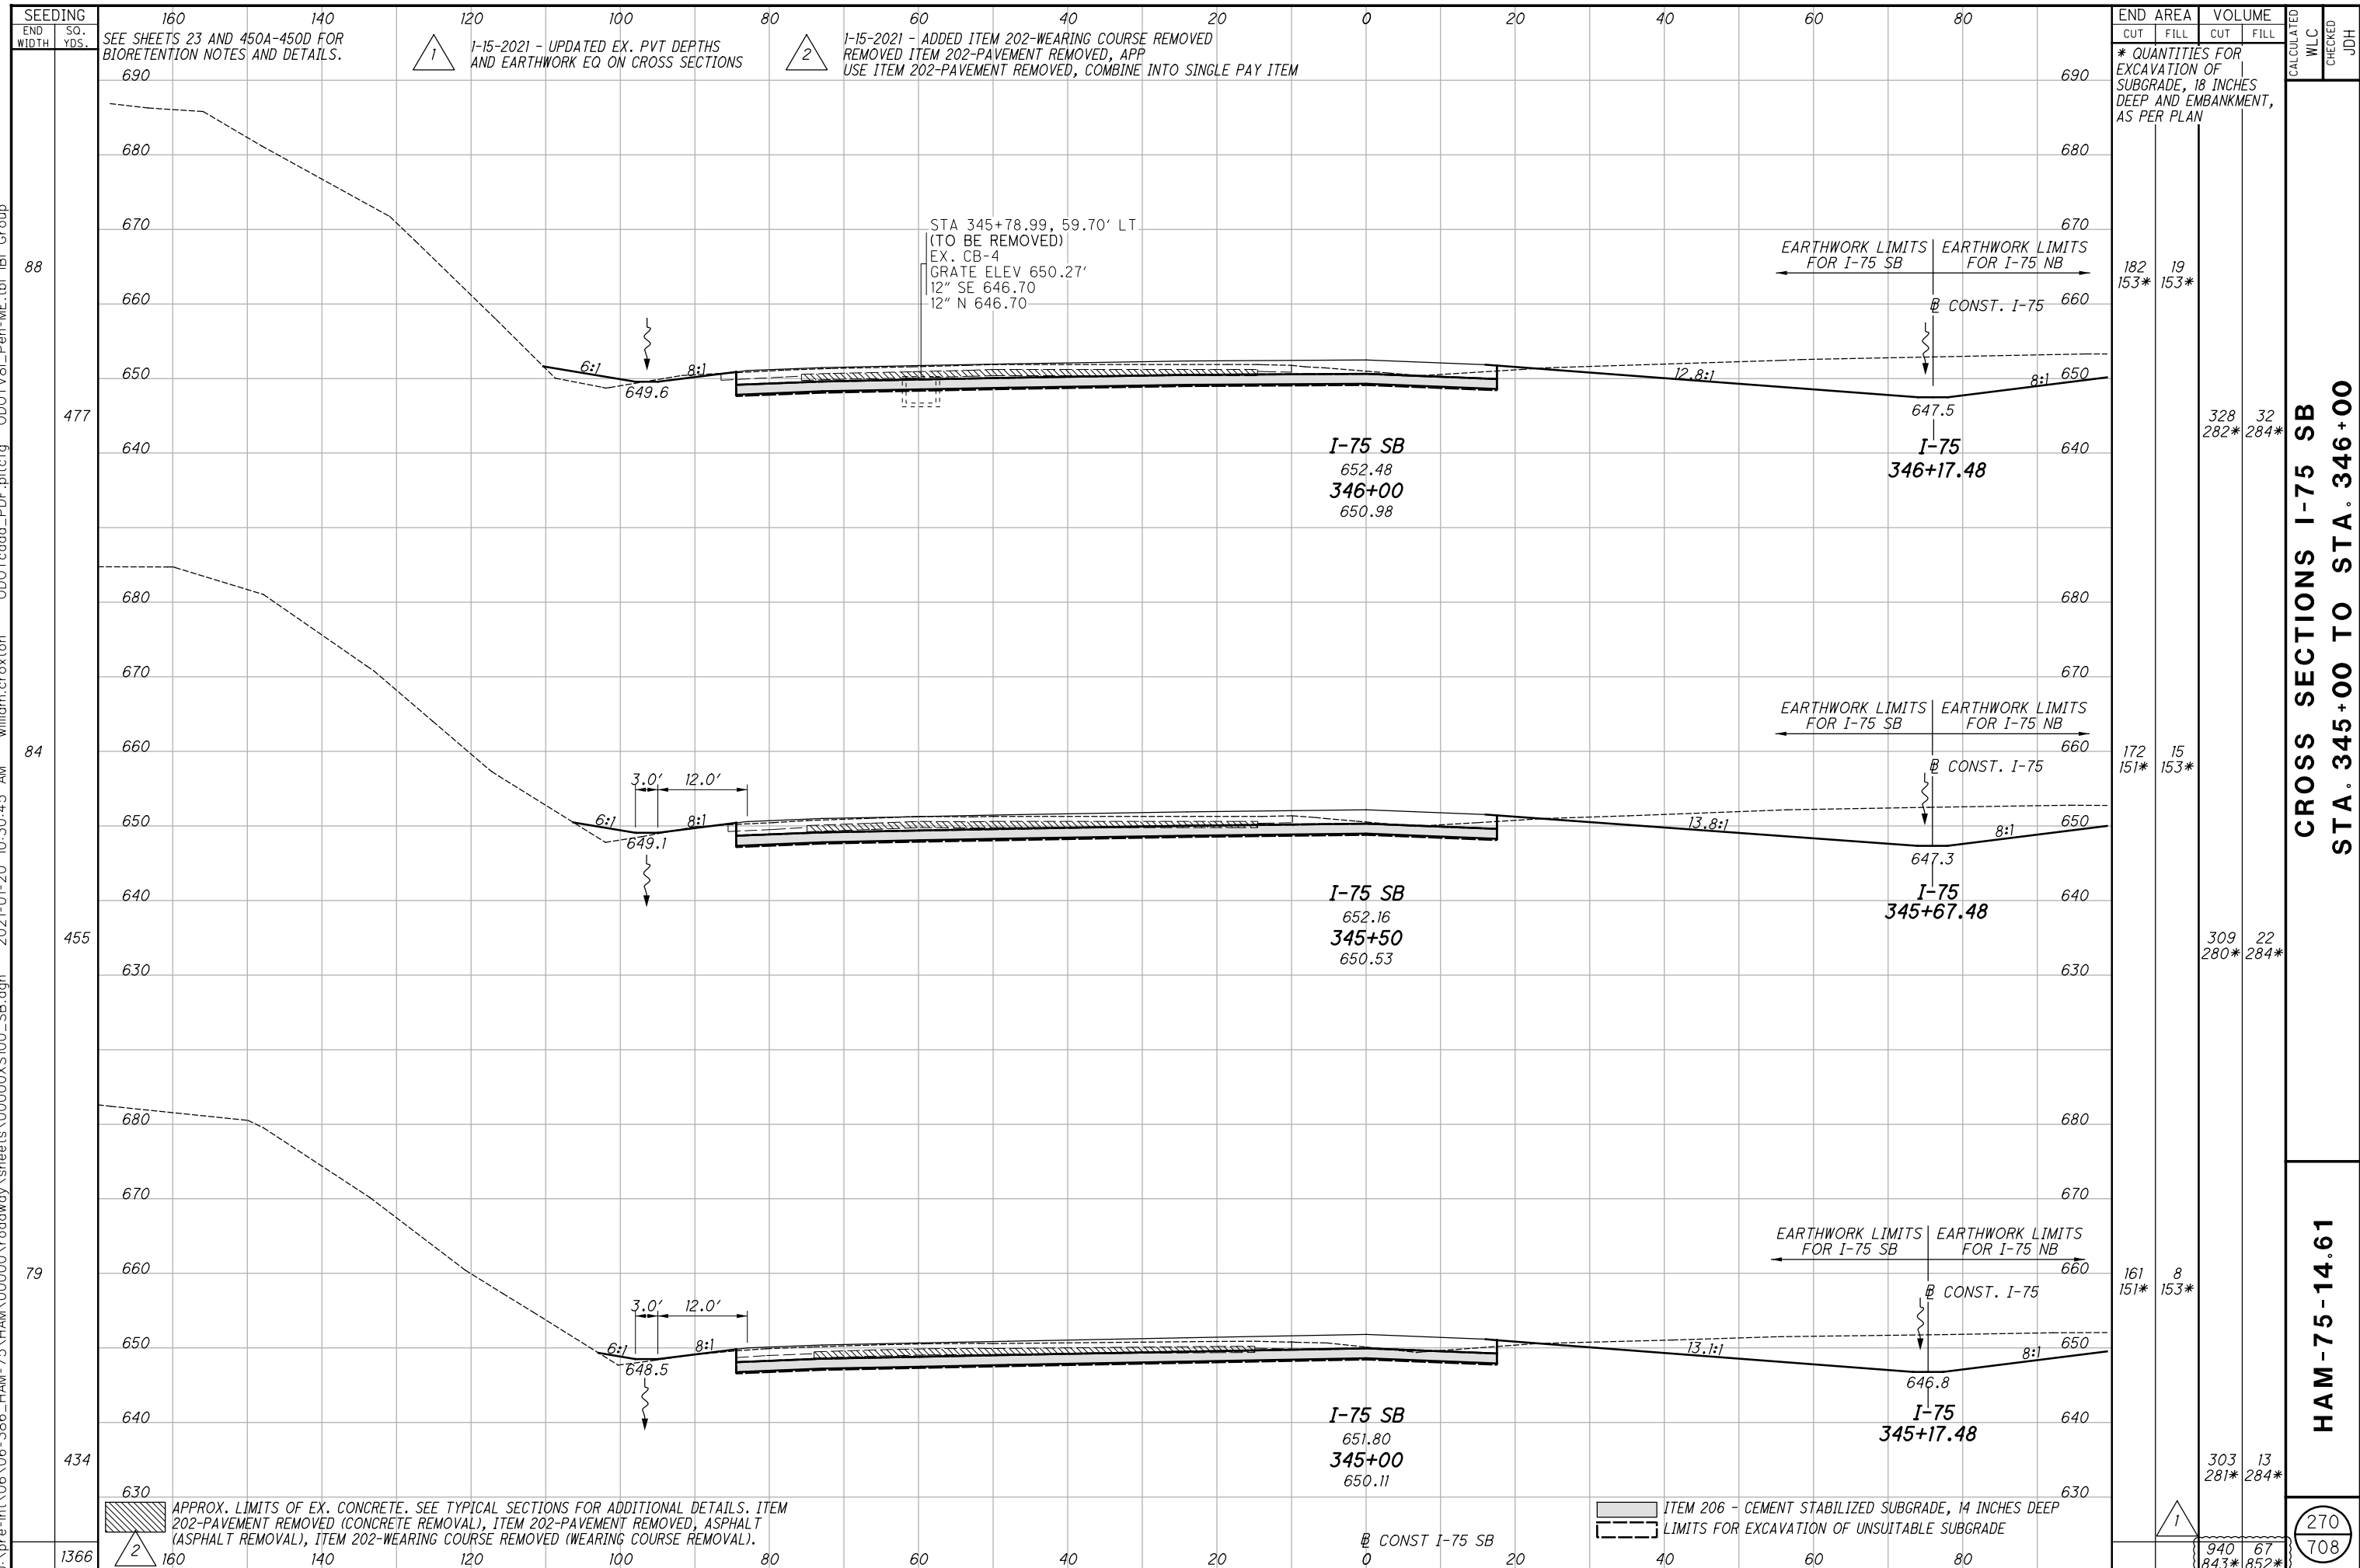

SEEDING	160		140		120		100		80		60		40		20		0		20		40		60		80	
	END WIDTH	SO. YDS.	END WIDTH	SO. YDS.	END WIDTH	SO. YDS.	END WIDTH	SO. YDS.	END WIDTH	SO. YDS.	END WIDTH	SO. YDS.	END WIDTH	SO. YDS.	END WIDTH	SO. YDS.	END WIDTH	SO. YDS.	END WIDTH	SO. YDS.	END WIDTH	SO. YDS.	END WIDTH	SO. YDS.	END WIDTH	SO. YDS.
1366	160	140	120	100	80	60	40	20	0	20	40	60	80	160	140	120	100	80	60	40	20	0	20	40	60	80

SEE SHEETS 23 AND 450A-450D FOR BIORETENTION NOTES AND DETAILS.

1-15-2021 - UPDATED EX. PVT DEPTHS AND EARTHWORK EQ ON CROSS SECTIONS

1-15-2021 - ADDED ITEM 202-WEARING COURSE REMOVED  
 REMOVED ITEM 202-PAVEMENT REMOVED, APP  
 USE ITEM 202-PAVEMENT REMOVED, COMBINE INTO SINGLE PAY ITEM

STA 345+78.99, 59.70' LT  
 (TO BE REMOVED)  
 EX. CB-4  
 GRATE ELEV 650.27'  
 12" SE 646.70  
 12" N 646.70

APPROX. LIMITS OF EX. CONCRETE. SEE TYPICAL SECTIONS FOR ADDITIONAL DETAILS. ITEM 202-PAVEMENT REMOVED (CONCRETE REMOVAL), ITEM 202-PAVEMENT REMOVED, ASPHALT (ASPHALT REMOVAL), ITEM 202-WEARING COURSE REMOVED (WEARING COURSE REMOVAL).

ITEM 206 - CEMENT STABILIZED SUBGRADE, 14 INCHES DEEP

LIMITS FOR EXCAVATION OF UNSUITABLE SUBGRADE

EARTHWORK LIMITS FOR I-75 SB

EARTHWORK LIMITS FOR I-75 NB

CONST. I-75

END AREA	VOLUME	
	CUT	FILL
182	19	153*
172	15	153*
161	8	153*
328	32	284*
309	22	284*
303	13	284*

\* QUANTITIES FOR EXCAVATION OF SUBGRADE, 18 INCHES DEEP AND EMBANKMENT, AS PER PLAN


**CROSS SECTIONS I-75 SB**


**STA. 345+00 TO STA. 346+00**

**HAM-75-14.61**

270  
708

j:\pre-int\06\06-386\_HAM-75\_HAM\00000\roadway\sheets\00000X5100\_SB.dgn 2021-01-20 10:30:46 AM william.croxton' ODOTcadd\_PDF.pltcfgr ODOTV8i\_Pen-ME.tbl IBI Group

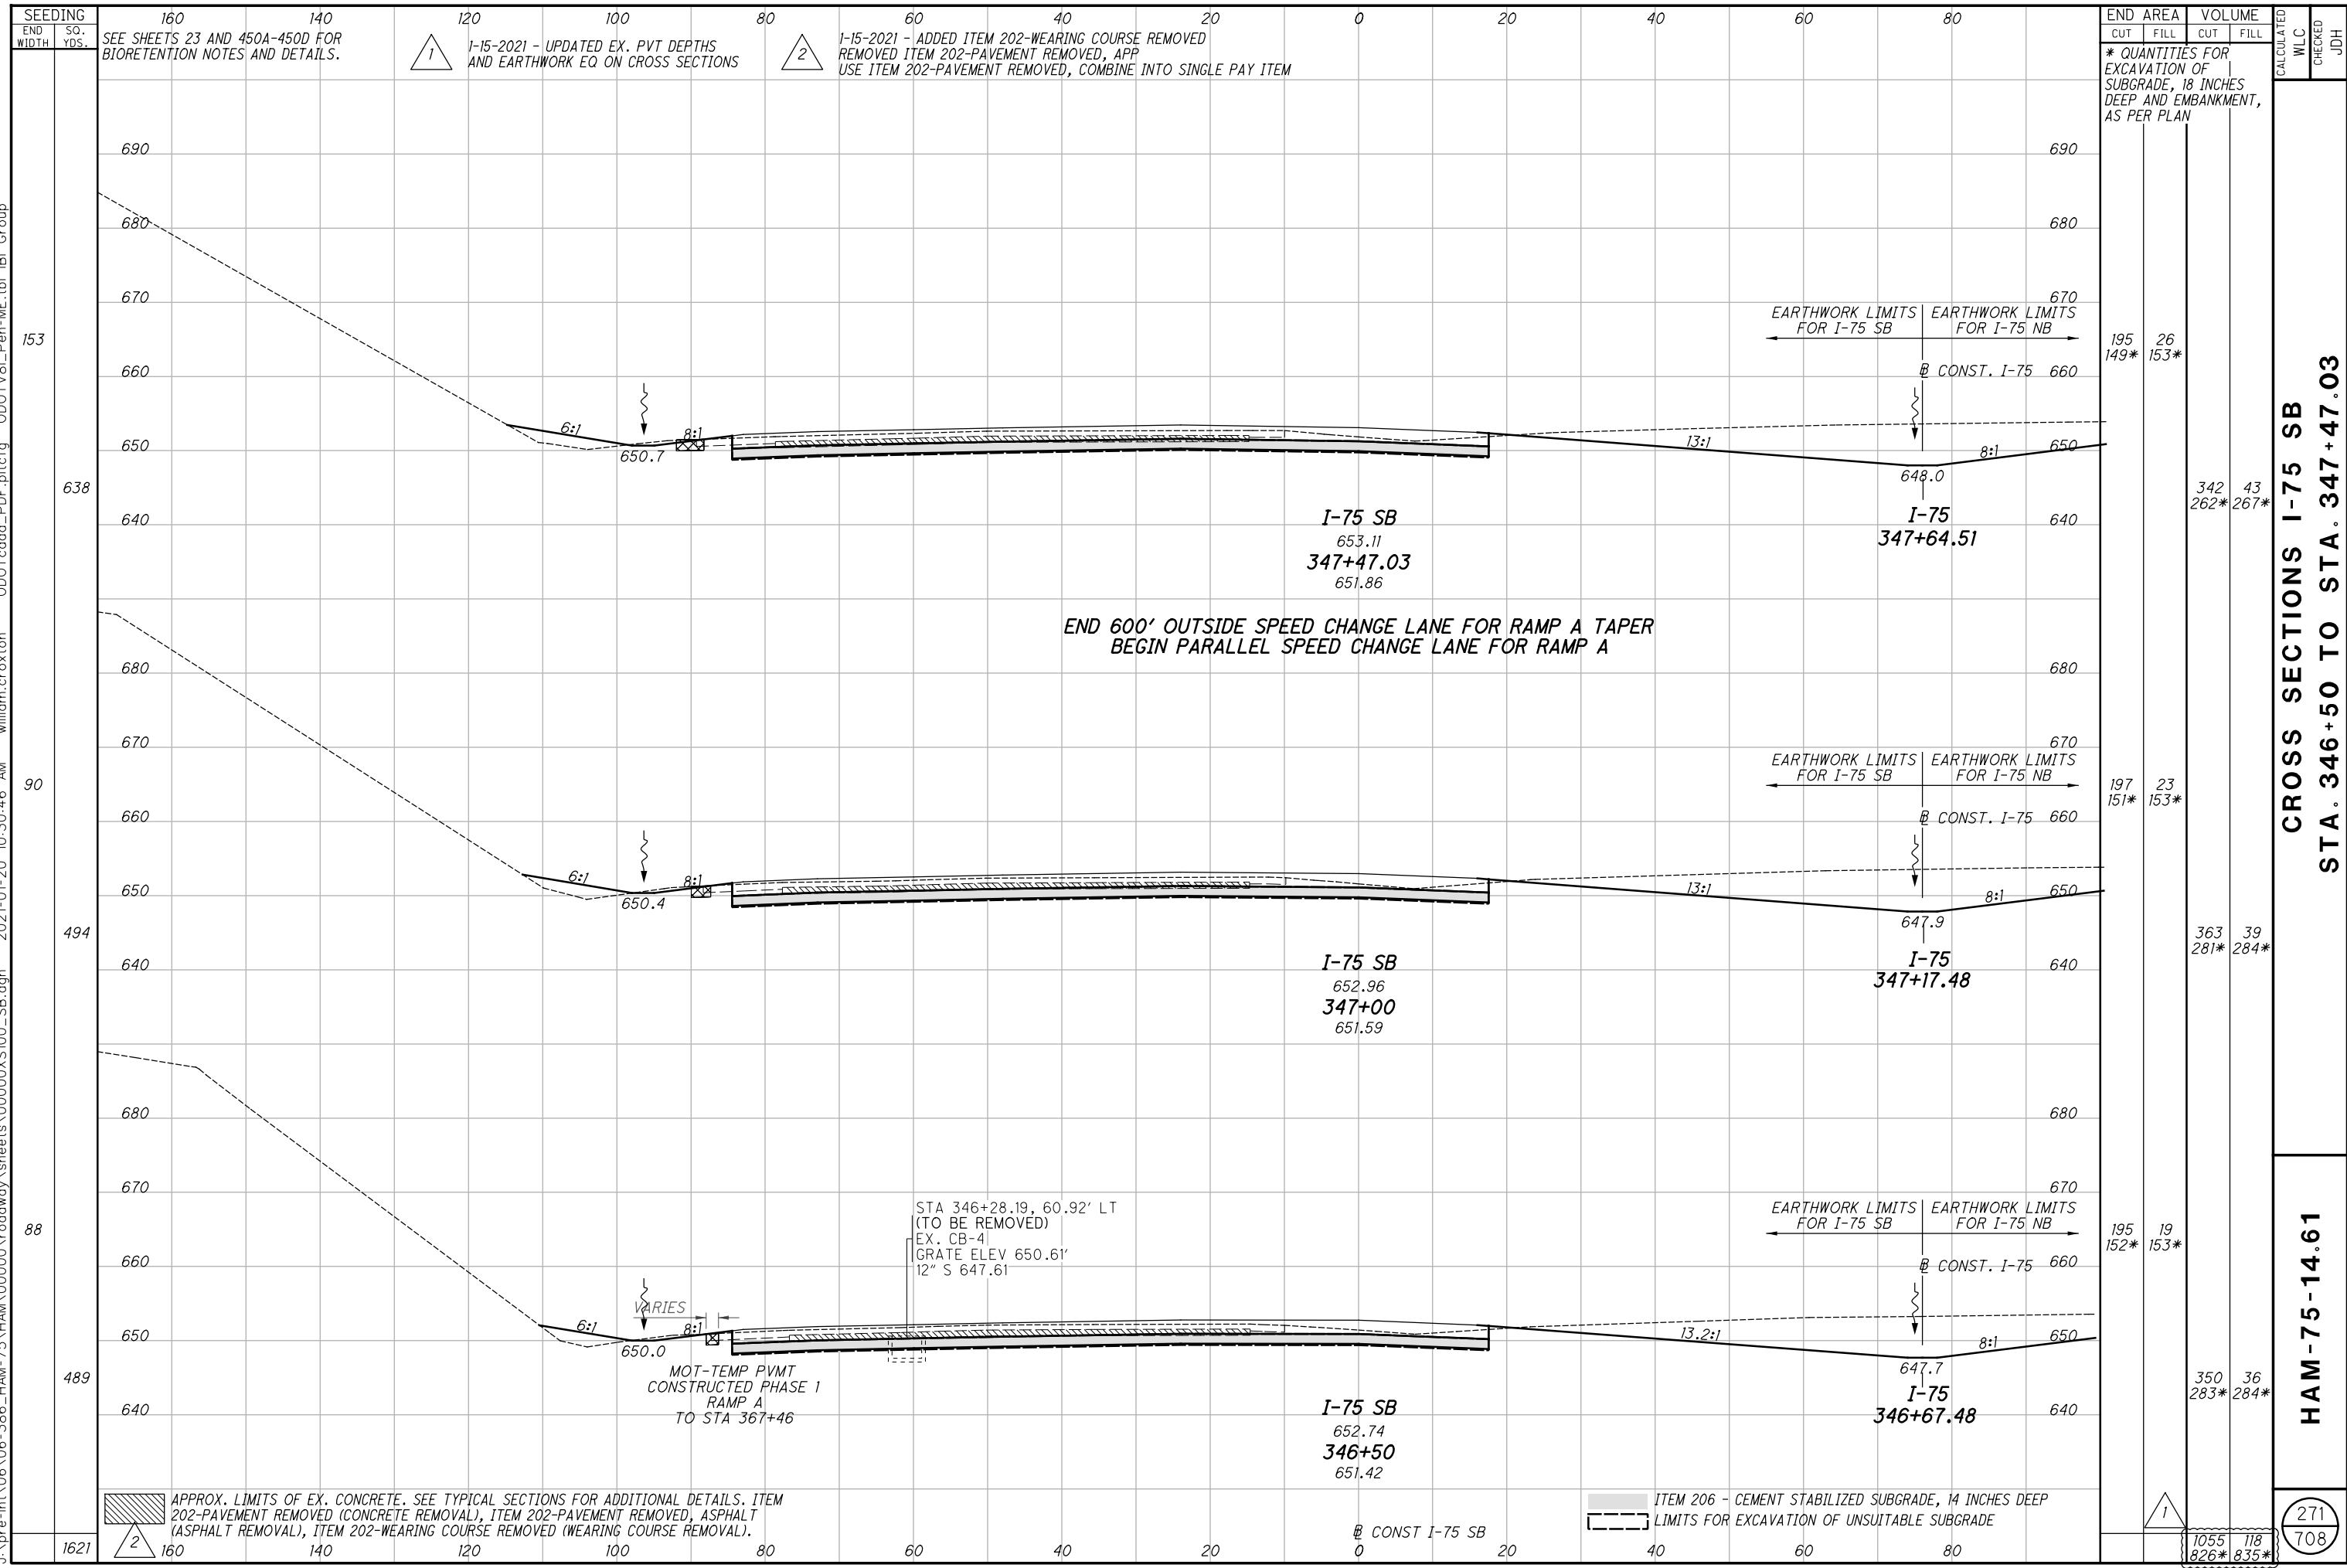

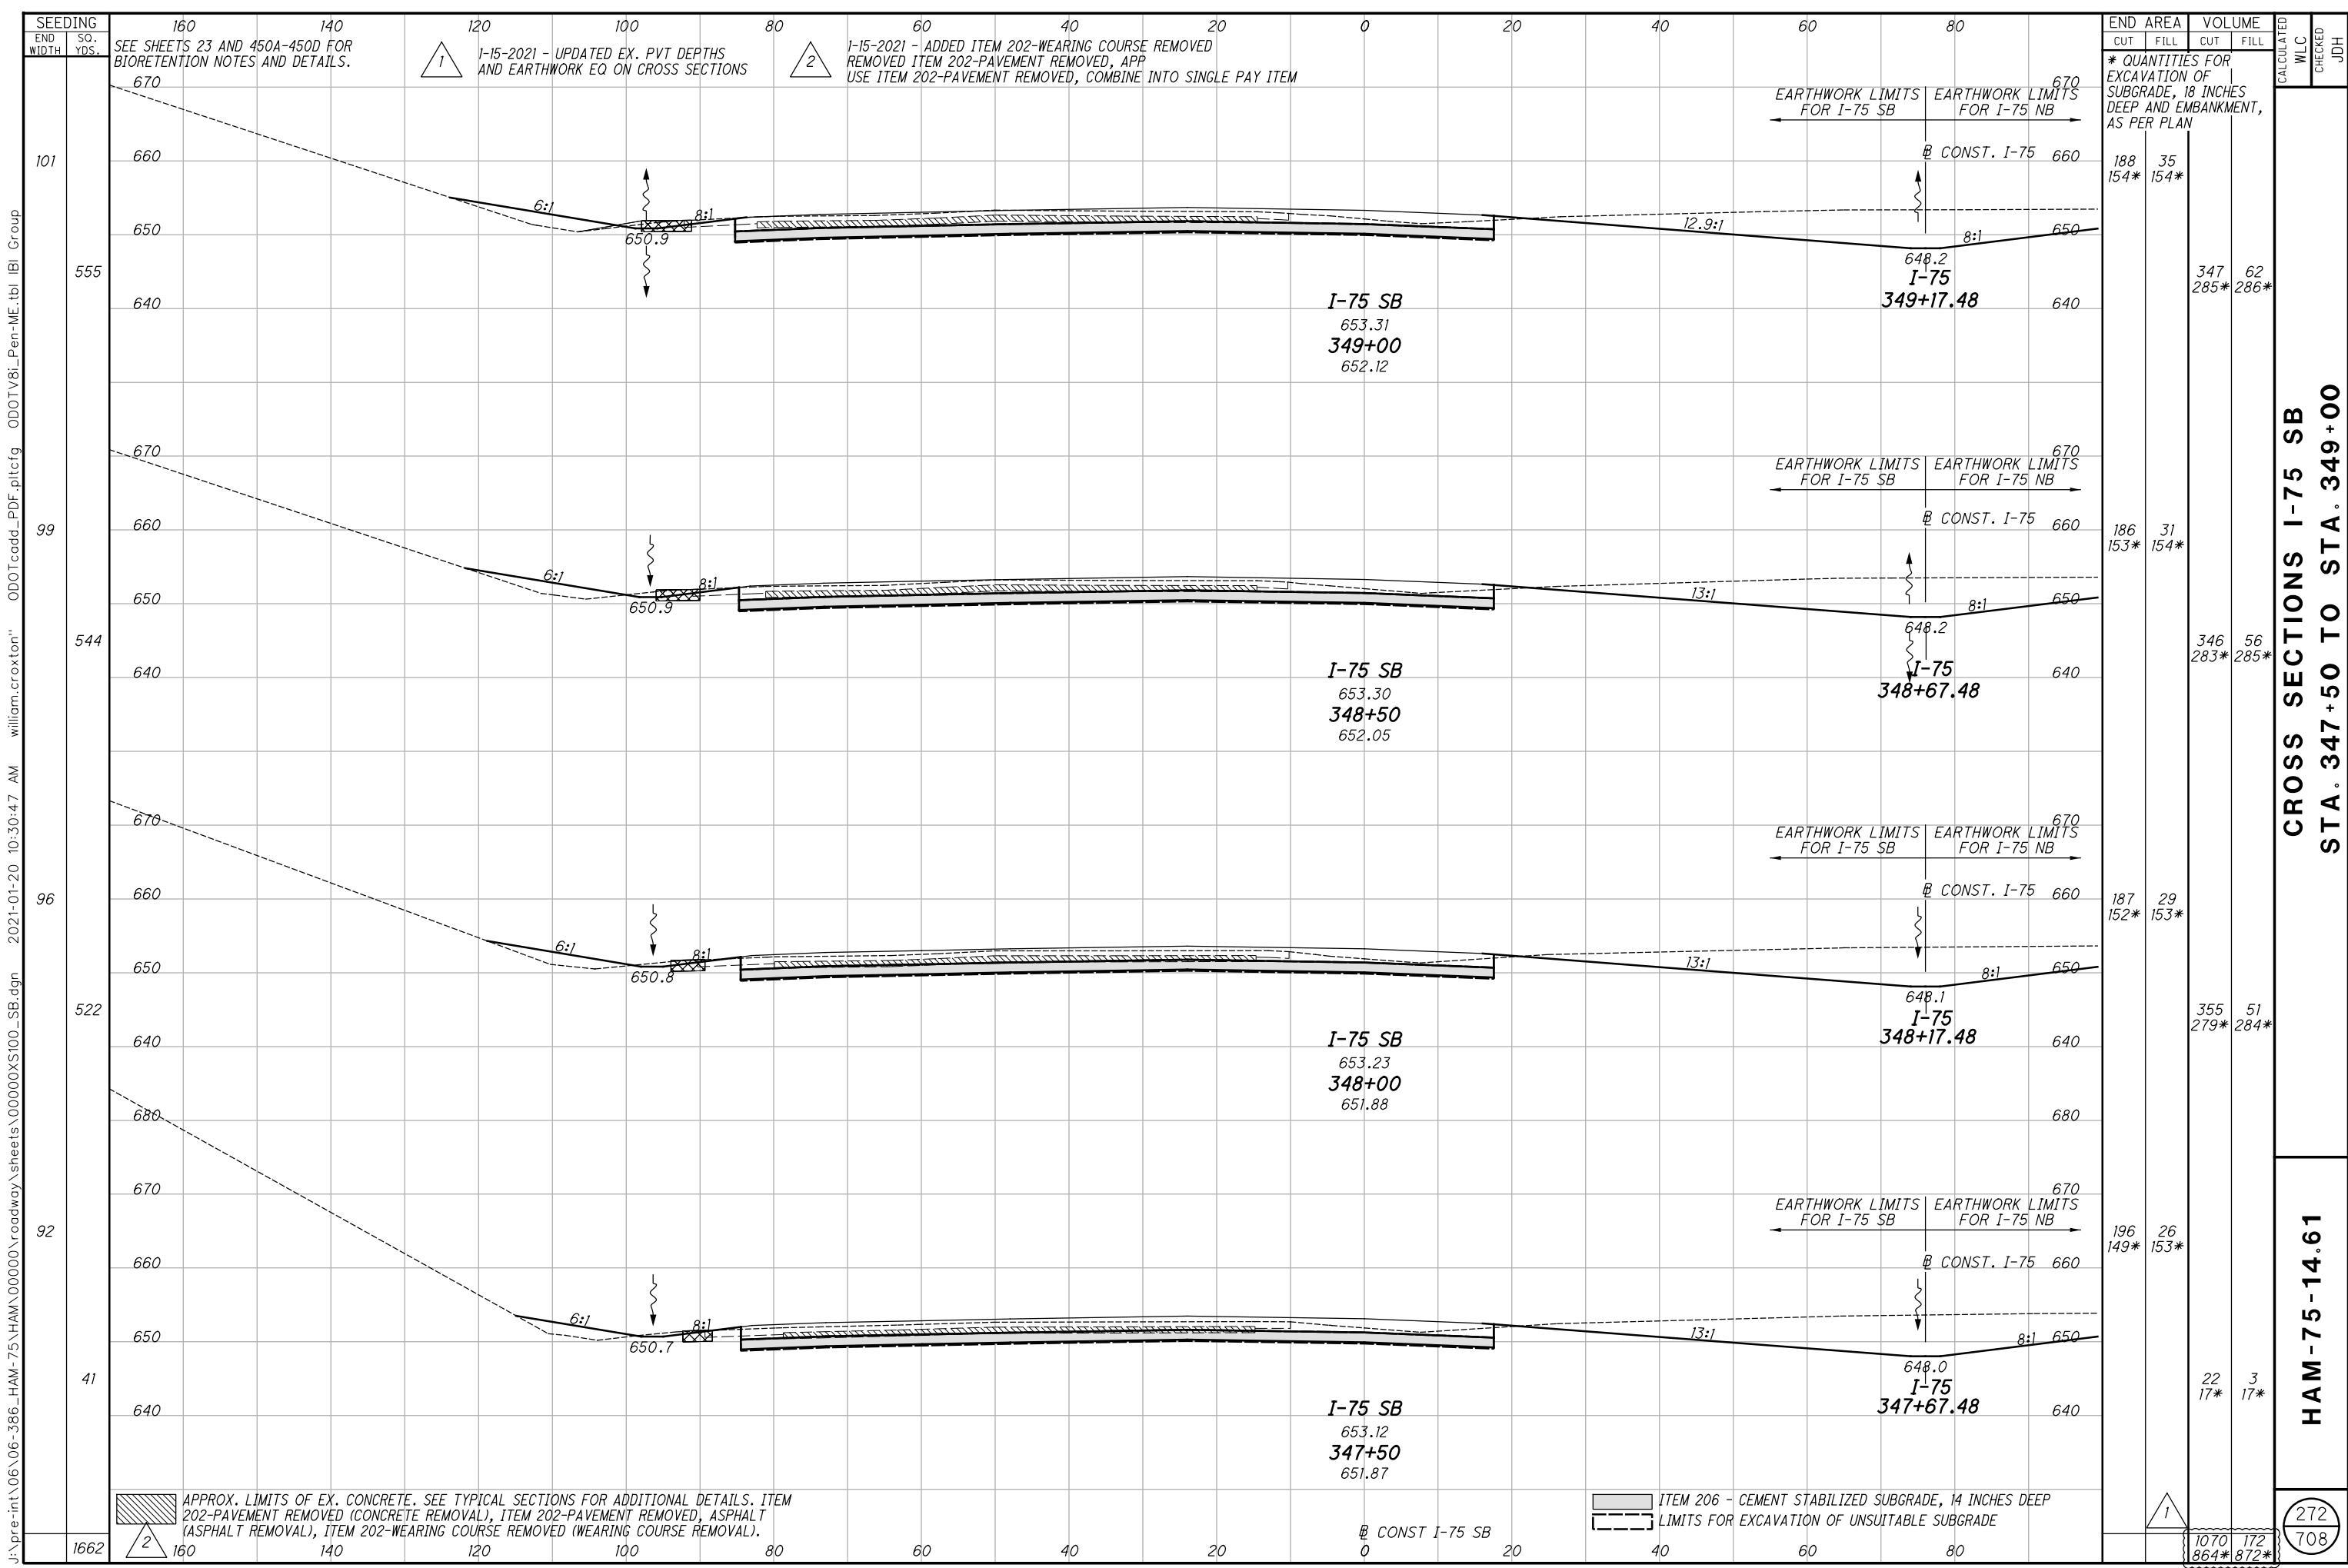

SEEDING  
END SO. WIDTH YDS.

160 140 120 100 80 60 40 20 0 20 40 60 80

101 555 99 544 96 522 92 41

1662 160 140 120 100 80 60 40 20 0 20 40 60 80

SEE SHEETS 23 AND 450A-450D FOR BIORETENTION NOTES AND DETAILS.

1-15-2021 - UPDATED EX. PVT DEPTHS AND EARTHWORK EQ ON CROSS SECTIONS

1-15-2021 - ADDED ITEM 202-WEARING COURSE REMOVED REMOVED ITEM 202-PAVEMENT REMOVED, APP USE ITEM 202-PAVEMENT REMOVED, COMBINE INTO SINGLE PAY ITEM

END AREA		VOLUME		CALCULATED WLC	CHECKED JDH
CUT	FILL	CUT	FILL		
188	35	347	62	272	708
154*	154*	285*	286*		
186	31	346	56		
153*	154*	283*	285*		
187	29	355	51	272	708
152*	153*	279*	284*		
196	26	22	3		
149*	153*	17*	17*		

APPROX. LIMITS OF EX. CONCRETE. SEE TYPICAL SECTIONS FOR ADDITIONAL DETAILS. ITEM 202-PAVEMENT REMOVED (CONCRETE REMOVAL), ITEM 202-PAVEMENT REMOVED, ASPHALT (ASPHALT REMOVAL), ITEM 202-WEARING COURSE REMOVED (WEARING COURSE REMOVAL).


ITEM 206 - CEMENT STABILIZED SUBGRADE, 14 INCHES DEEP  
LIMITS FOR EXCAVATION OF UNSUITABLE SUBGRADE

CROSS SECTIONS I-75 SB  
STA. 347+50 TO STA. 349+00

HAM-75-14.61

272  
708

j:\pre-int\06\06-386\_HAM-75\_HAM\00000\roadway\sheets\00000X5100\_SB.dgn 2021-01-20 10:30:47 AM william.croxton' ODOTcadd\_PDF.pltcfgr ODOTV8i\_Pen-ME.tbl IBI Group

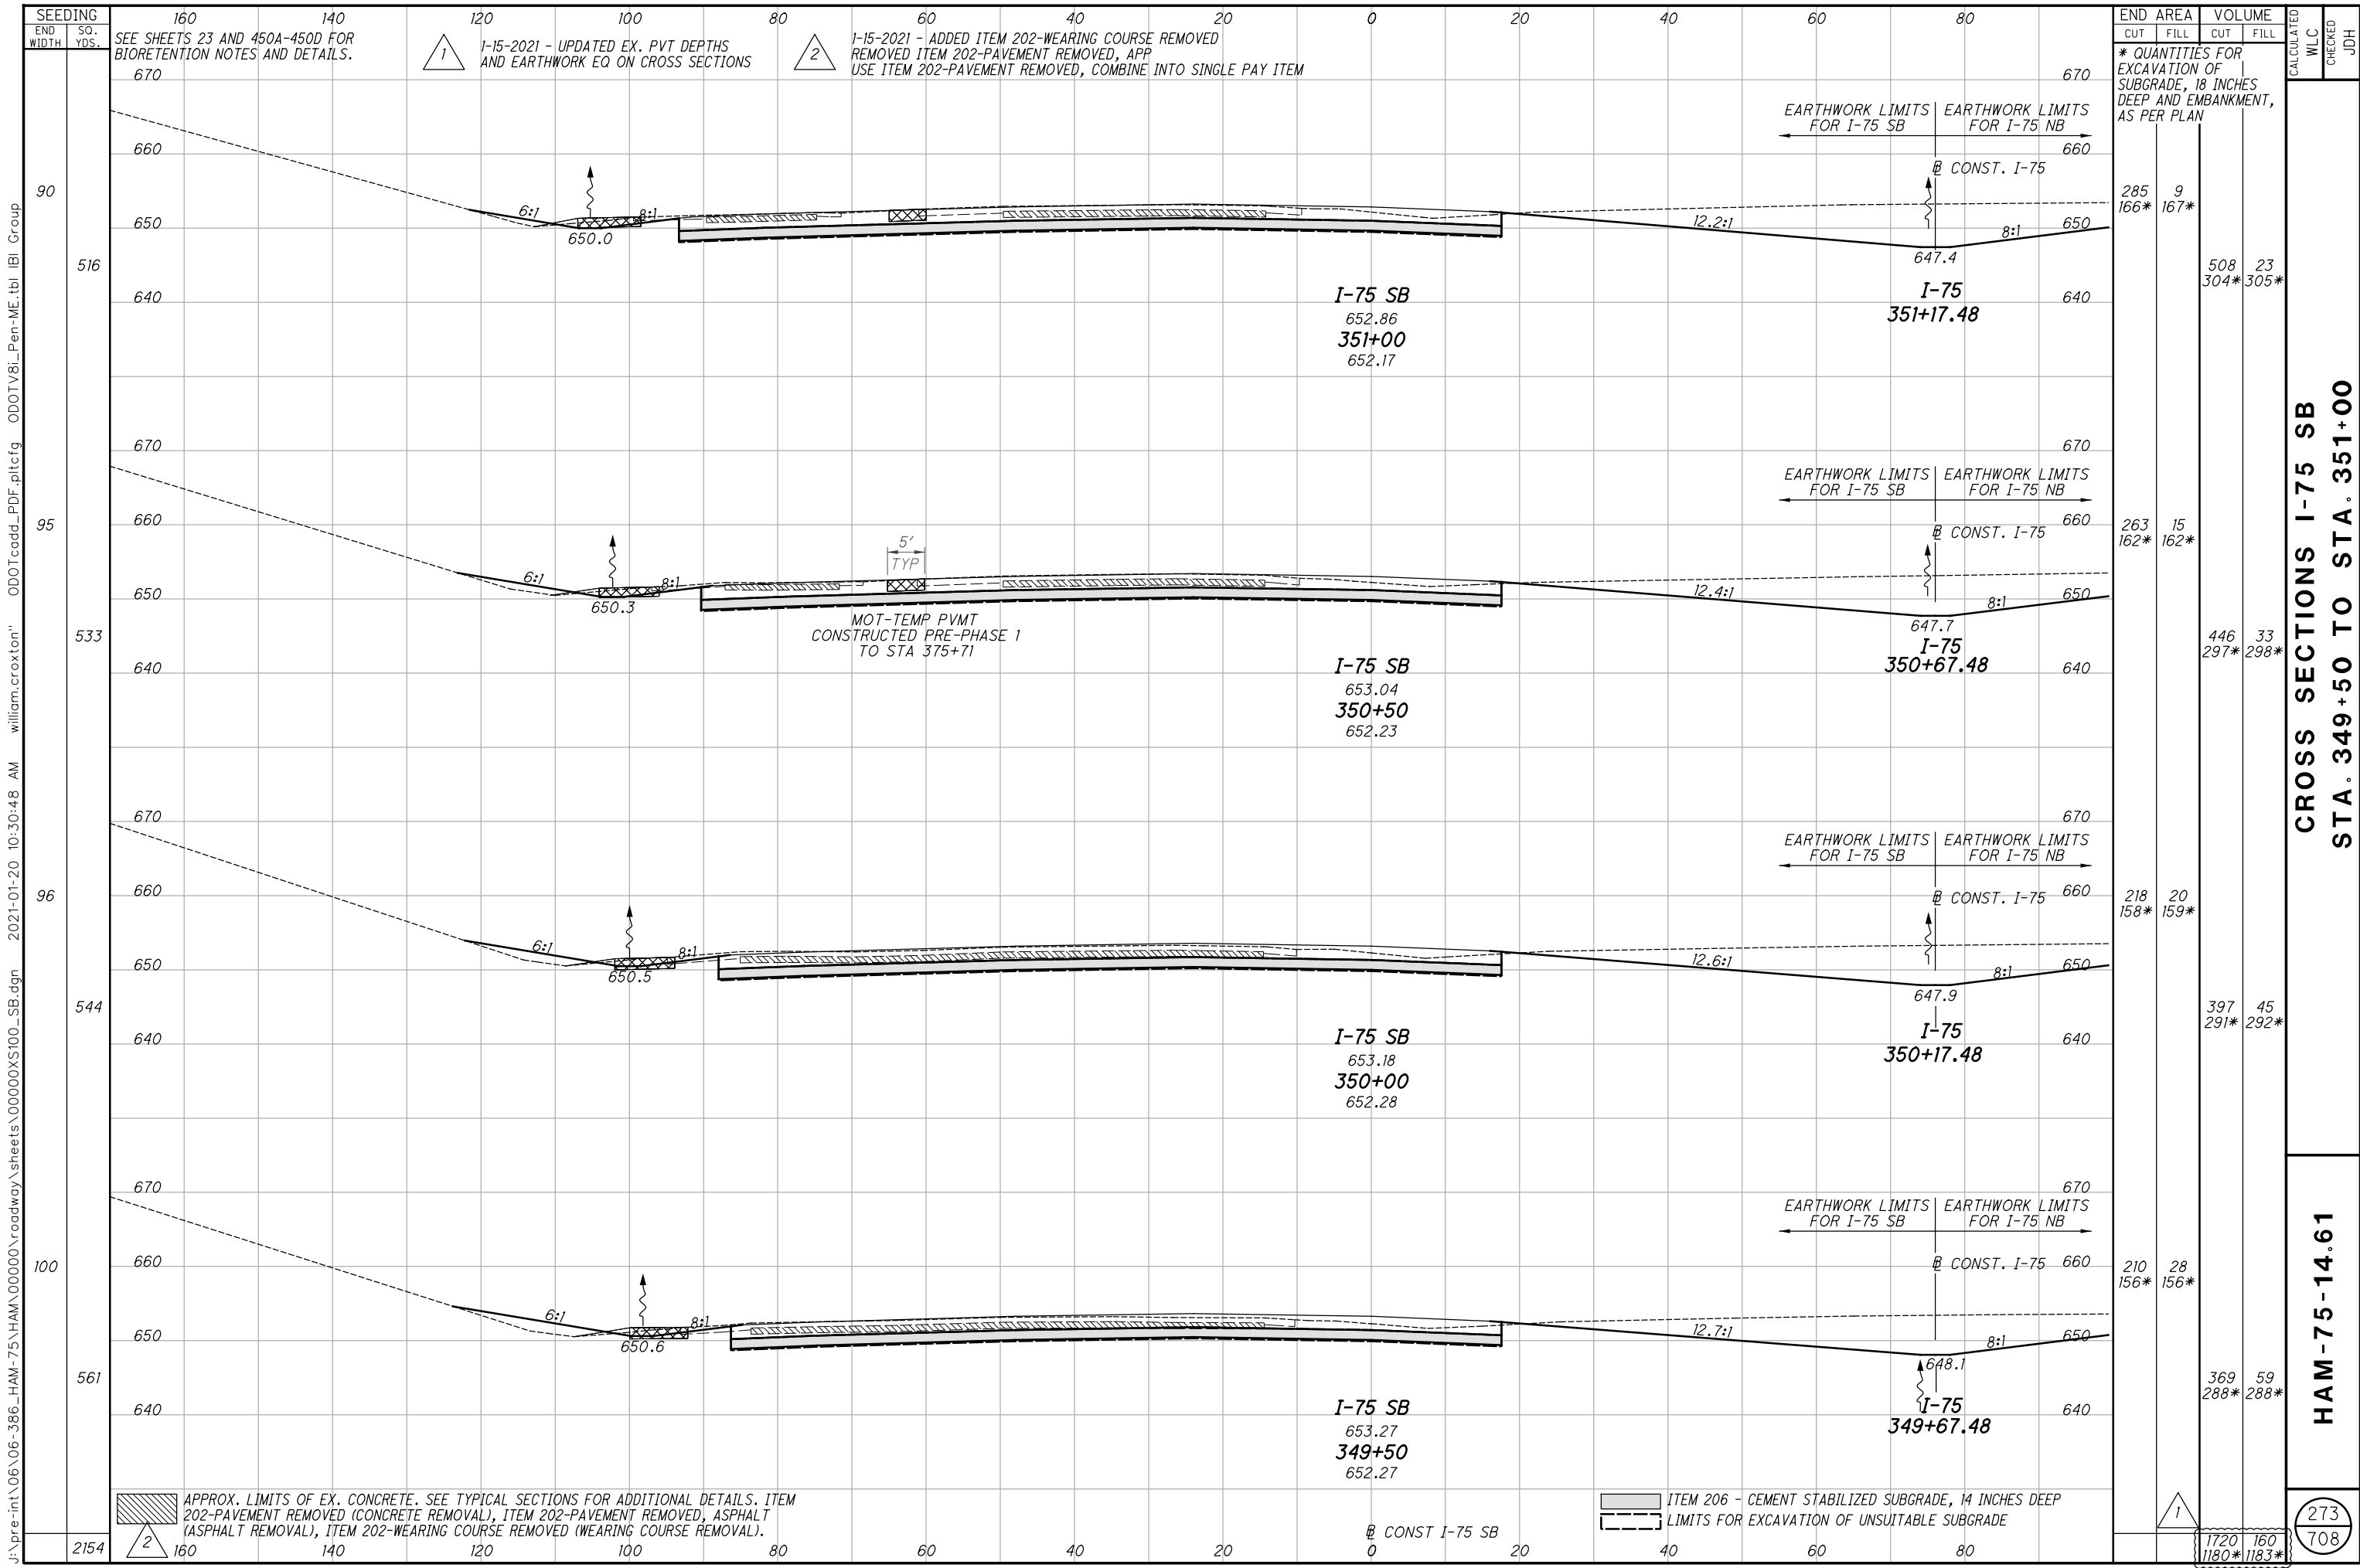

SEE SHEETS 23 AND 450A-450D FOR BIORETENTION NOTES AND DETAILS.

1-15-2021 - UPDATED EX. PVT DEPTHS AND EARTHWORK EQ ON CROSS SECTIONS

1-15-2021 - ADDED ITEM 202-WEARING COURSE REMOVED REMOVED ITEM 202-PAVEMENT REMOVED, APP USE ITEM 202-PAVEMENT REMOVED, COMBINE INTO SINGLE PAY ITEM

SEEDING		END AREA		VOLUME		CALCULATED	
END WIDTH	SO. YDS.	CUT	FILL	CUT	FILL	WLC	CHECKED
160	140	285	9	508	23		
		166*	167*	304*	305*		
140	120	263	15	446	33		
		162*	162*	297*	298*		
120	100	218	20	397	45		
		158*	159*	291*	292*		
100	80	210	28	369	59		
		156*	156*	288*	288*		
80	60						
60	40						
40	20						
20	0						
0	20						
20	40						
40	60						
60	80						
80							
2154		1720		160		708	
		1180*		1183*			

CROSS SECTIONS I-75 SB STA. 349+50 TO STA. 351+00


HAM-75-14.61

273  
708

APPROX. LIMITS OF EX. CONCRETE. SEE TYPICAL SECTIONS FOR ADDITIONAL DETAILS. ITEM 202-PAVEMENT REMOVED (CONCRETE REMOVAL), ITEM 202-PAVEMENT REMOVED, ASPHALT (ASPHALT REMOVAL), ITEM 202-WEARING COURSE REMOVED (WEARING COURSE REMOVAL).

ITEM 206 - CEMENT STABILIZED SUBGRADE, 14 INCHES DEEP  
LIMITS FOR EXCAVATION OF UNSUITABLE SUBGRADE

j:\pre-int\06\06-386\_HAM-75\_HAM\00000\roadway\sheets\00000X5100\_SB.dgn 2021-01-20 10:30:48 AM william.croxton' ODOTcadd\_PDF.pltcfgr ODOTV8i\_Pen-ME.tbl IBI Group

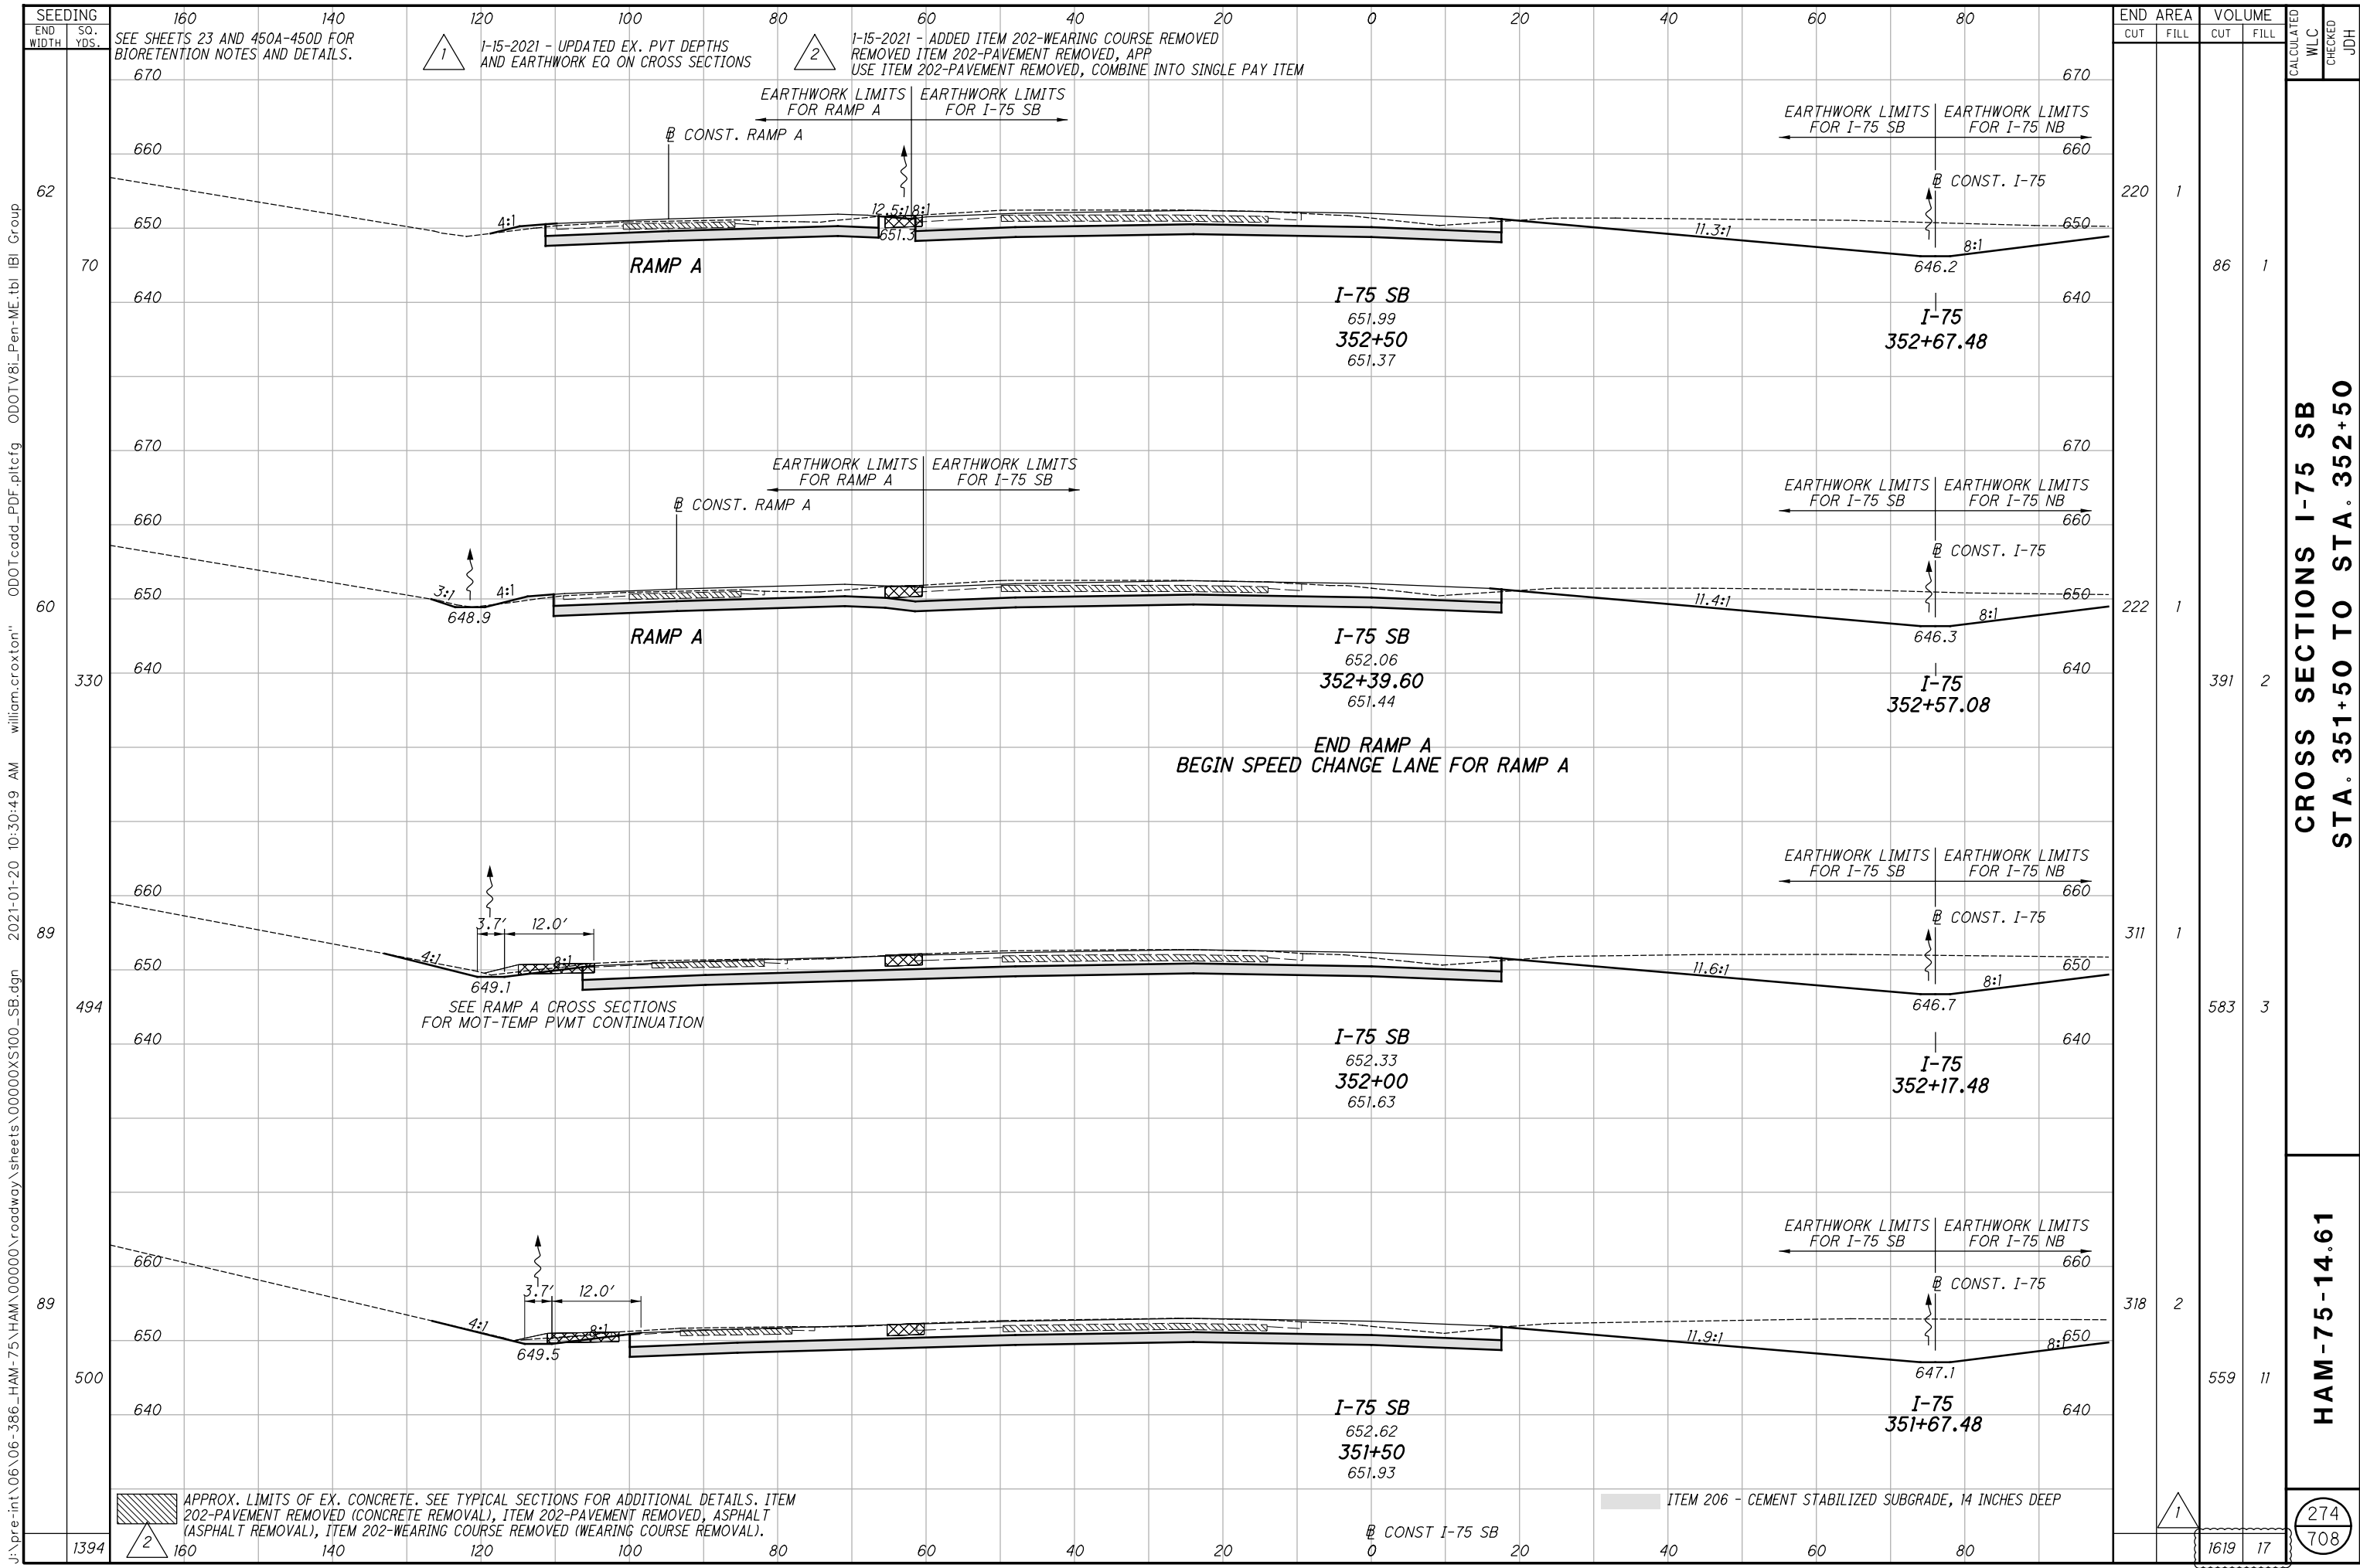


**CROSS SECTIONS I-75 SB**  
**STA. 351+50 TO STA. 352+50**

**HAM-75-14.61**

CALCULATED WLC 274  
 CHECKED JDH 708

SEEDING END WIDTH SO. YDS.  
 SEE SHEETS 23 AND 450A-450D FOR BIORETENTION NOTES AND DETAILS.  
 1-15-2021 - UPDATED EX. PVT DEPTHS AND EARTHWORK EQ ON CROSS SECTIONS  
 1-15-2021 - ADDED ITEM 202-WEARING COURSE REMOVED REMOVED ITEM 202-PAVEMENT REMOVED, APP USE ITEM 202-PAVEMENT REMOVED, COMBINE INTO SINGLE PAY ITEM  
 ODOTV8i\_Pen-ME.tbl IBI Group  
 ODOTcadd\_PDF\_pltcfgr william.croxton  
 2021-01-20 10:30:49 AM  
 j:\pre-int\06\06-386\_HAM-75\_HAM\00000\roadway\sheets\00000X5100\_SB.dgn  
 2021-01-20 10:30:49 AM  
 1394

APPROX. LIMITS OF EX. CONCRETE. SEE TYPICAL SECTIONS FOR ADDITIONAL DETAILS. ITEM 202-PAVEMENT REMOVED (CONCRETE REMOVAL), ITEM 202-PAVEMENT REMOVED, ASPHALT (ASPHALT REMOVAL), ITEM 202-WEARING COURSE REMOVED (WEARING COURSE REMOVAL).  
 ITEM 206 - CEMENT STABILIZED SUBGRADE, 14 INCHES DEEP  
 CONST I-75 SB

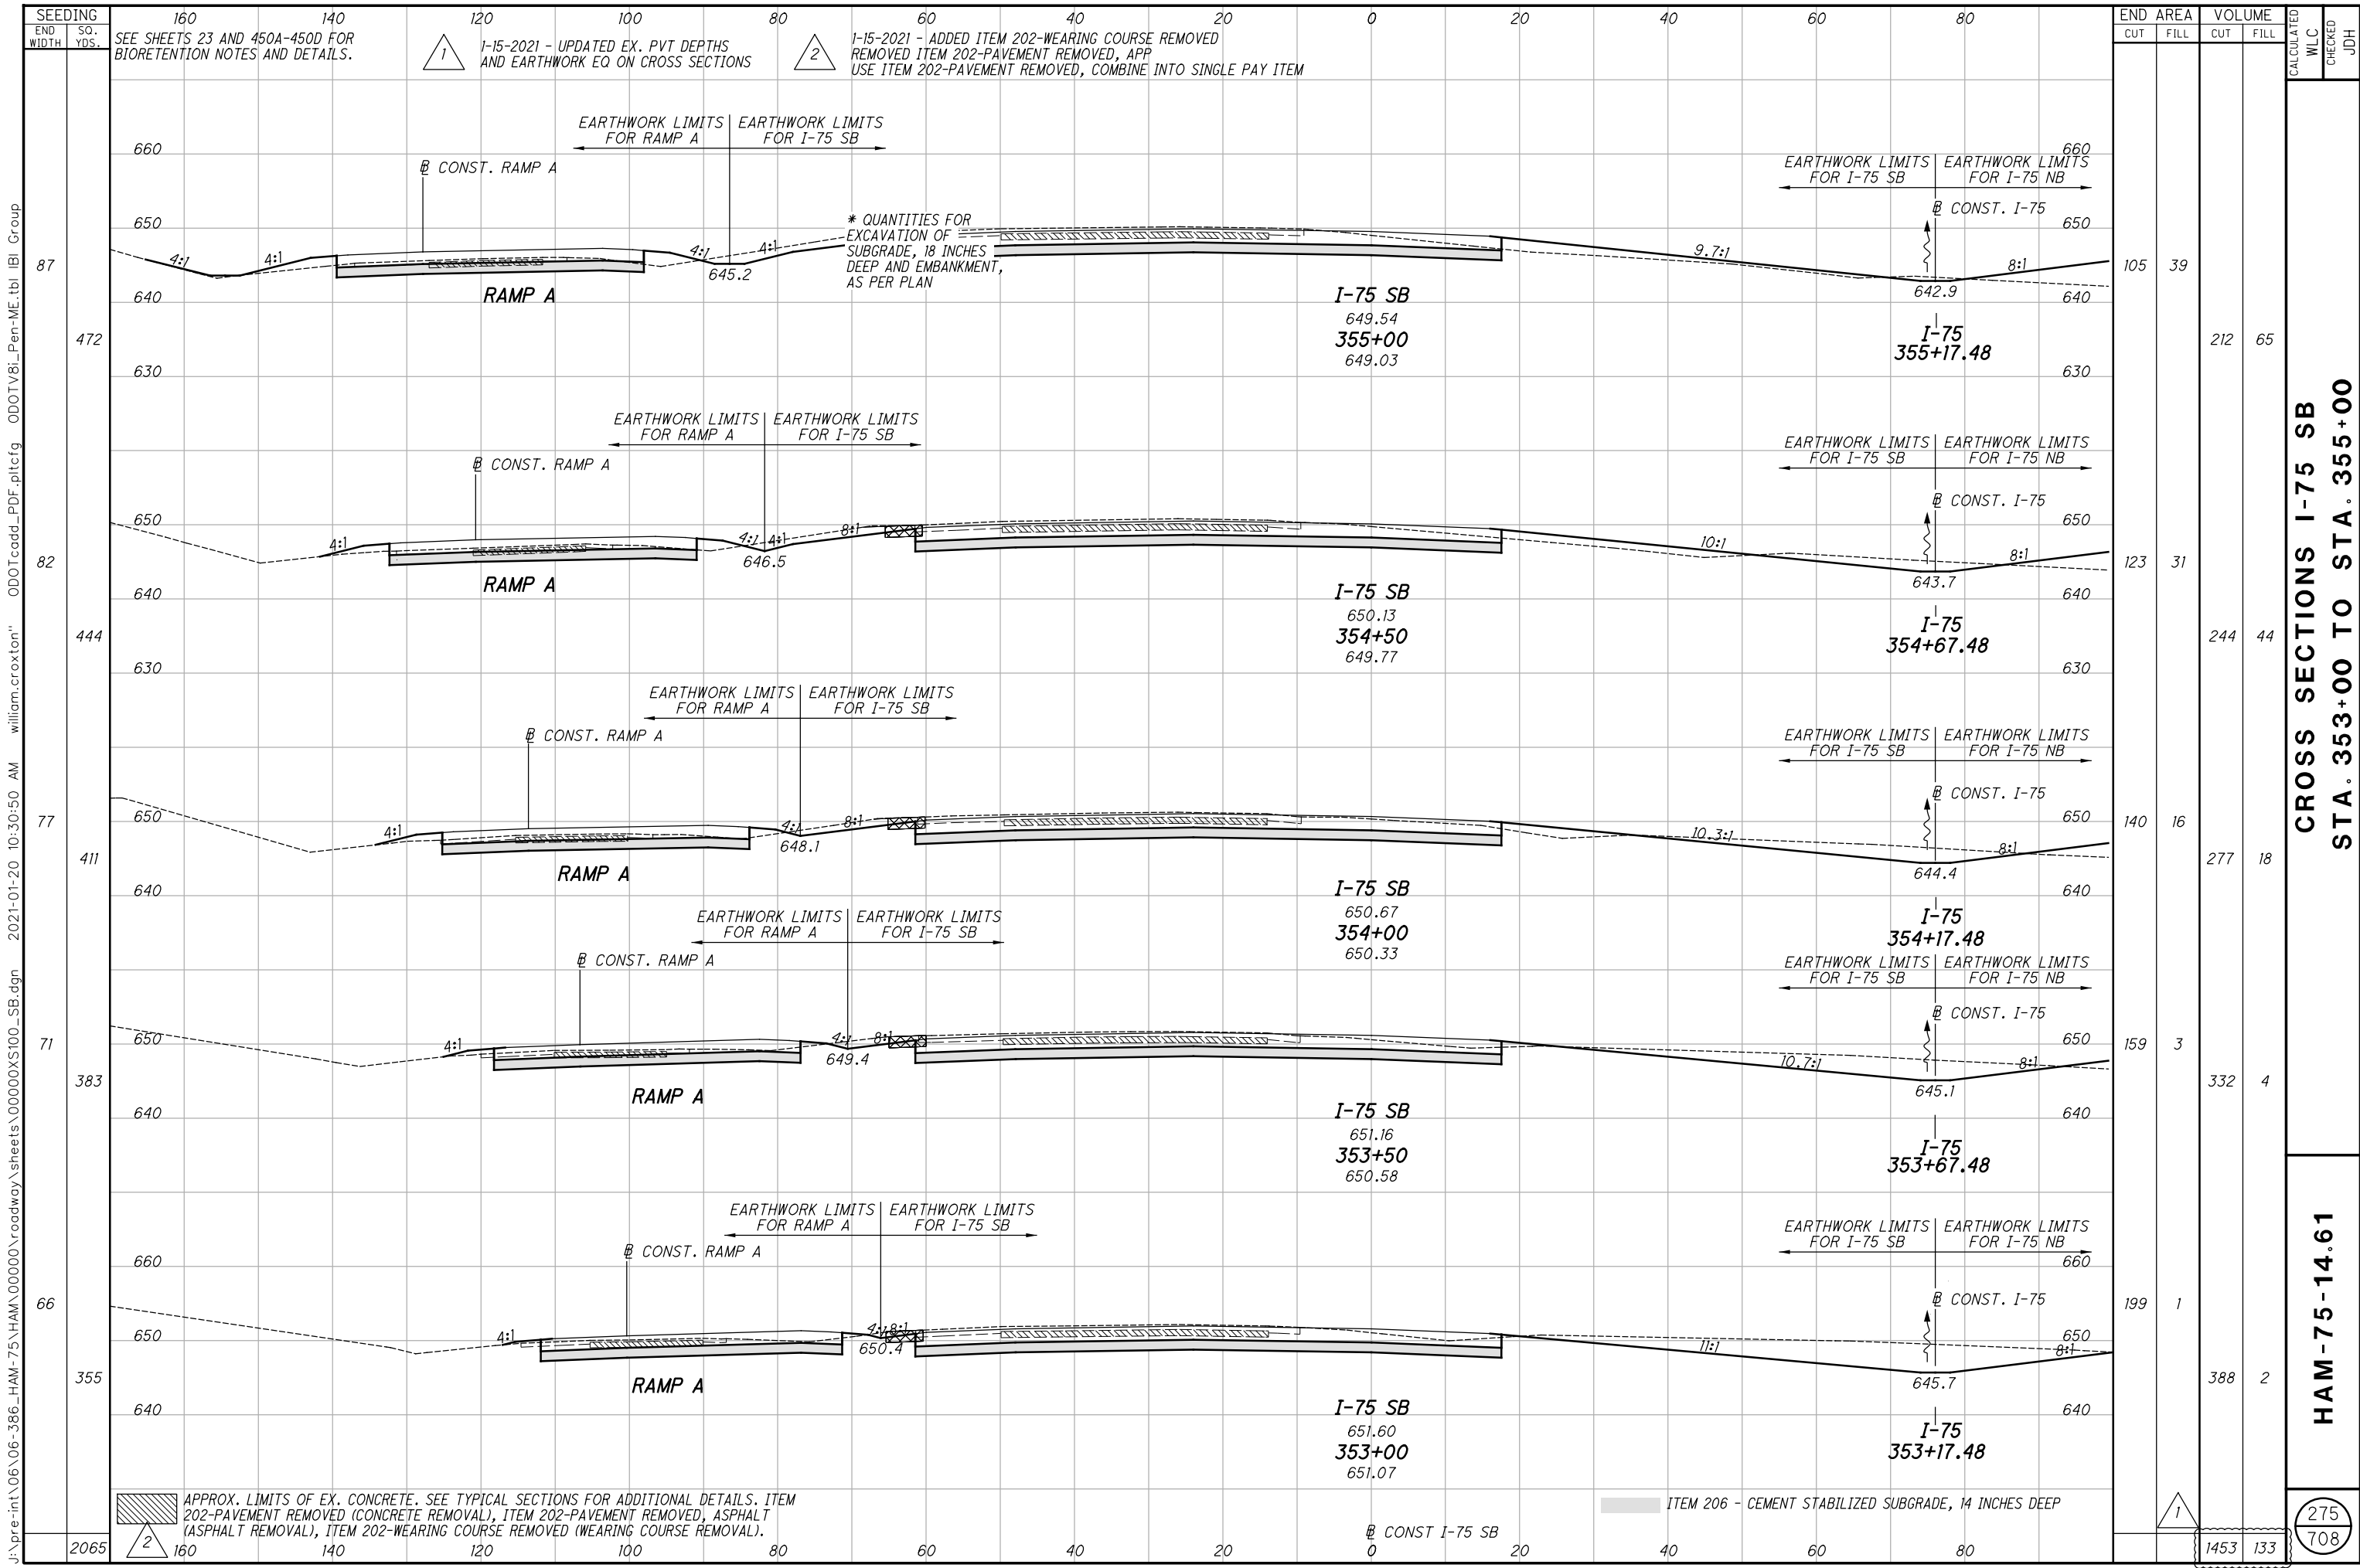

END STA	AREA		VOLUME		CALCULATED WLC	CHECKED	JDH
	CUT	FILL	CUT	FILL			
353+00	105	39	212	65			
354+00	123	31	244	44			
354+50	140	16	277	18			
355+00	159	3	332	4			
355+61	199	1	388	2			
<b>TOTAL</b>	<b>1453</b>	<b>133</b>	<b>275</b>	<b>708</b>			


**CROSS SECTIONS I-75 SB**  
**STA. 353+00 TO STA. 355+00**

**HAM-75-14.61**

j:\pre-int\06\06-386\_HAM-75\_HAM\00000\roadway\sheets\00000X5100\_SB.dgn 2021-01-20 10:30:50 AM william.croxton ODOT\cad\_PDF\_pltcfg ODOTVBI\_Pen-ME.tbl IBI Group



j:\pre-int\06\06-386\_HAM-75\_HAM\00000\roadway\sheets\000005100\_SB.dgn 2021-01-20 10:30:51 AM william.croxton ODOTcadd\_PDF.plt cfig ODOTV8i\_Pen-ME.tbl IBI Group

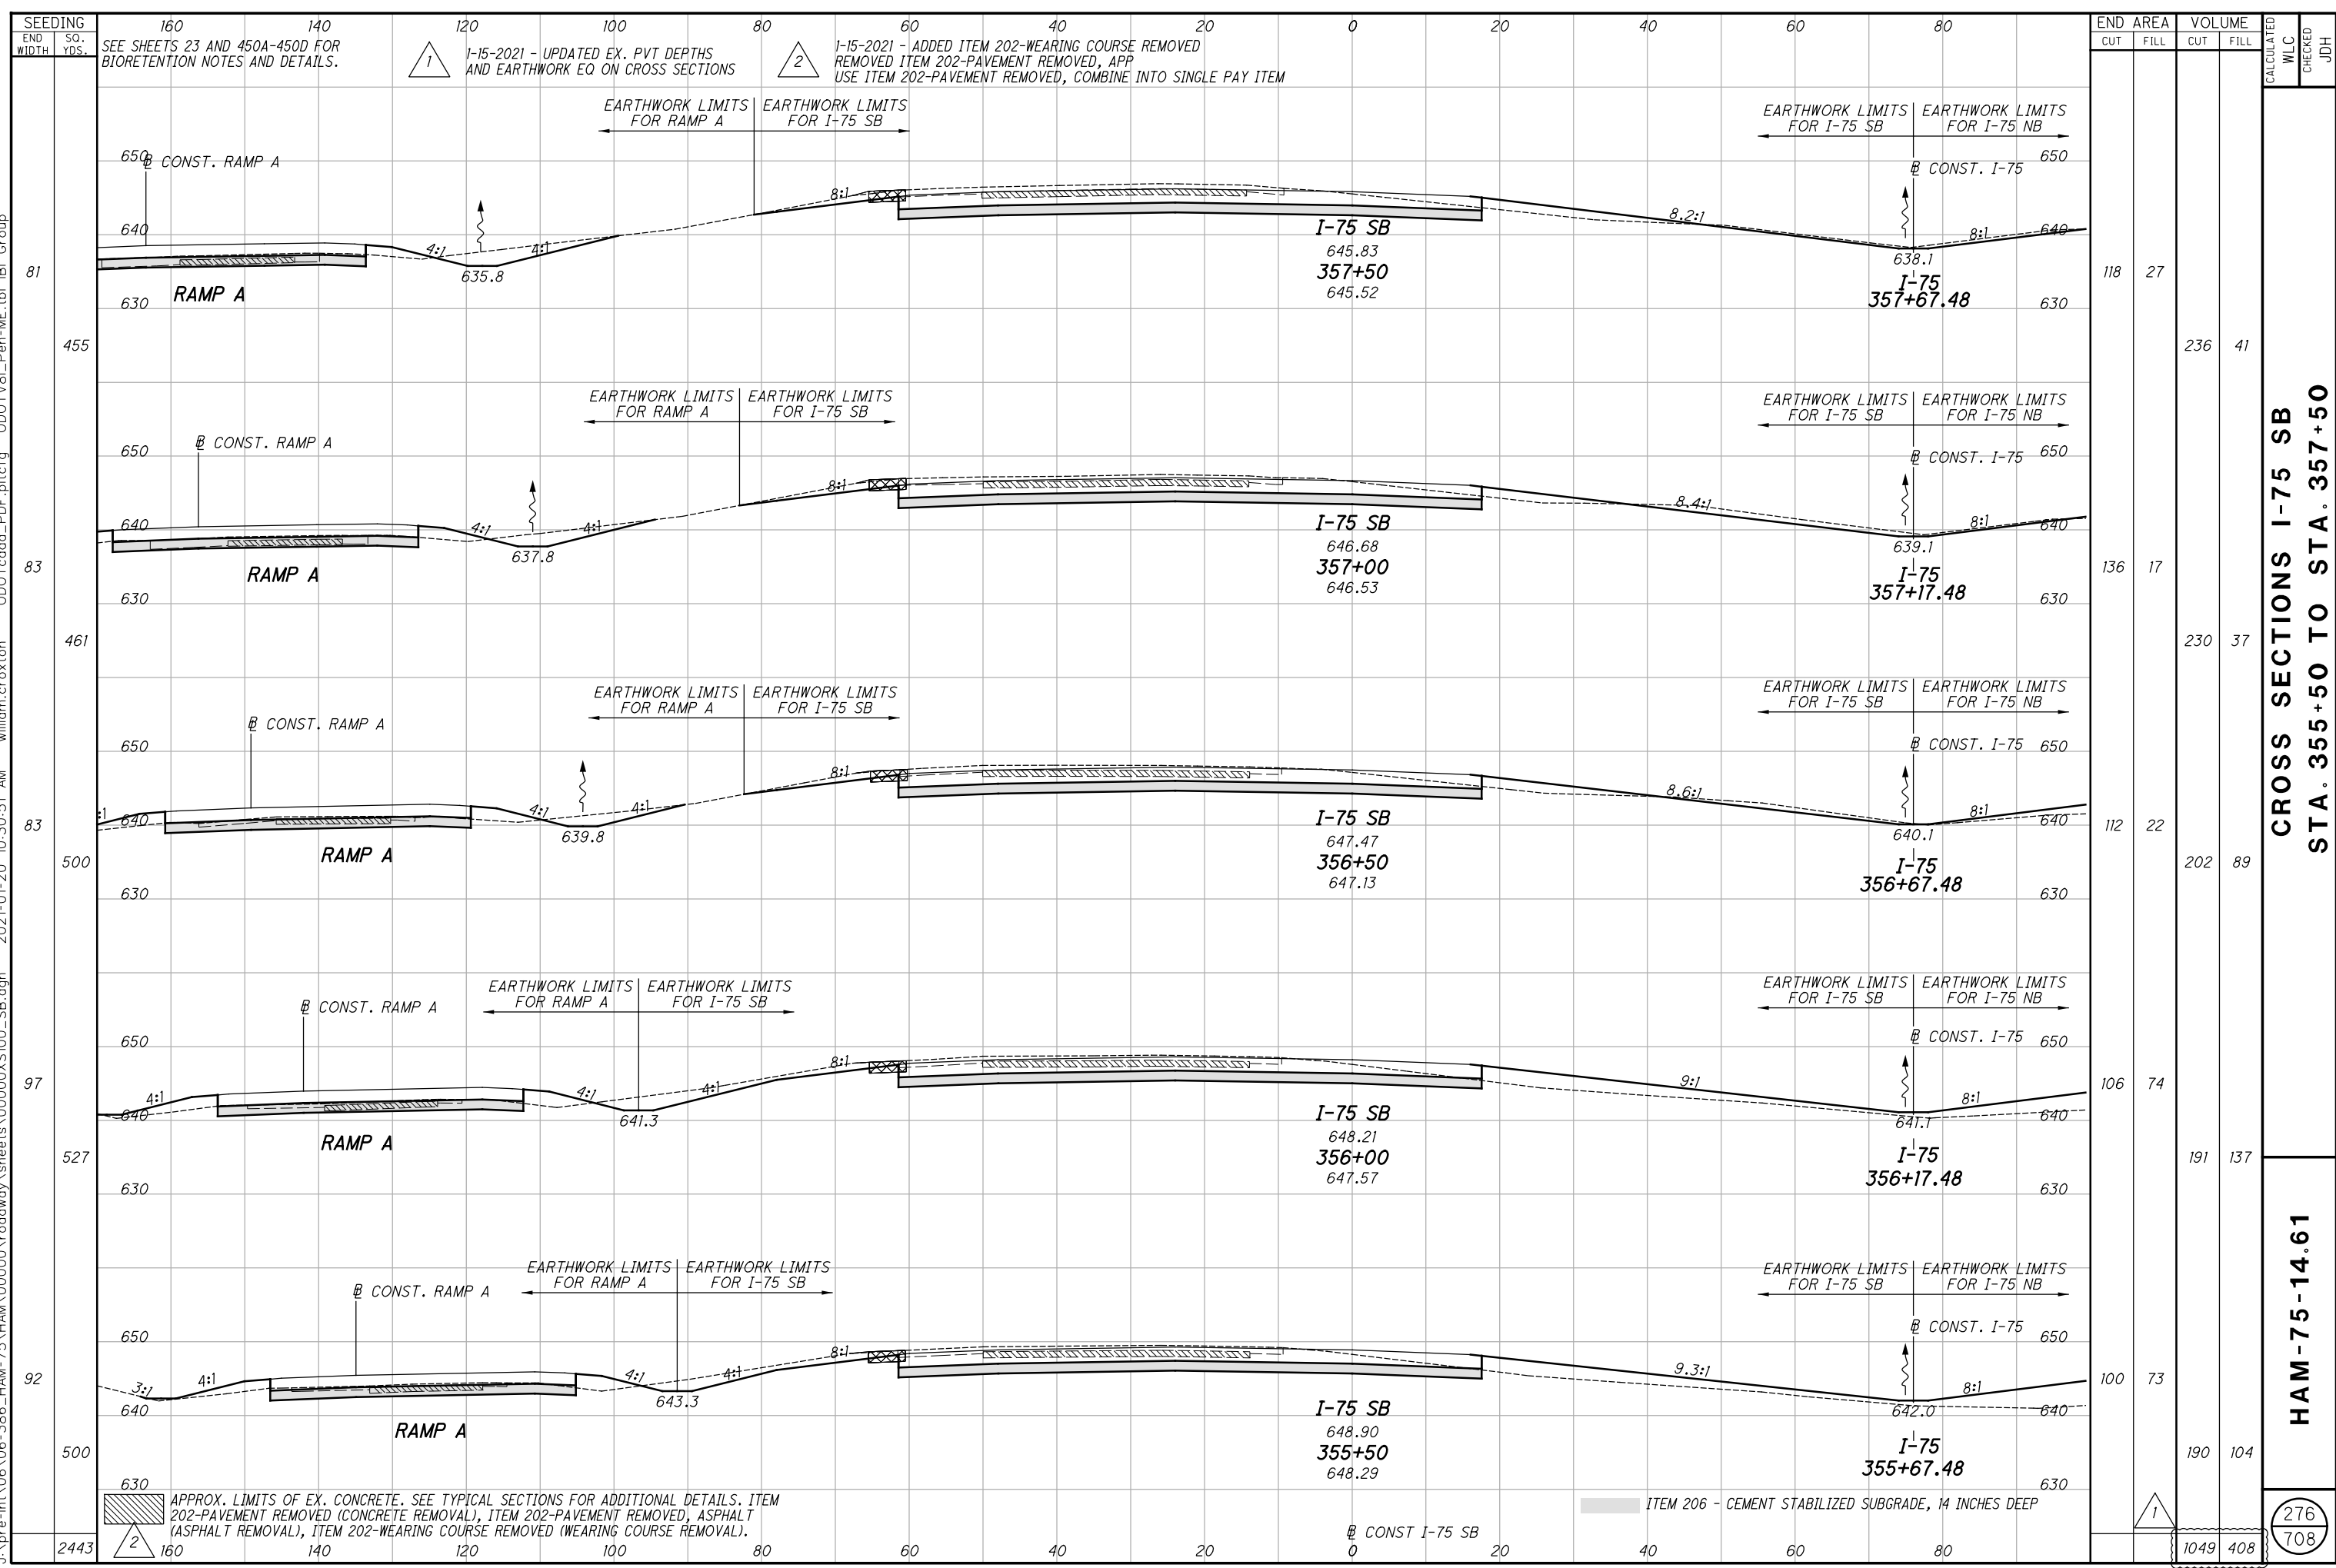


CROSS SECTIONS I-75 SB  
STA. 355+50 TO STA. 357+50

HAM-75-14.61


276  
708

END AREA	VOLUME	CALCULATED	WLC	CHECKED	JDH
118	27				
136	17				
112	22				
106	74				
100	73				
1049	408				

j:\pre-int\06\06-386\_HAM-75\HAM-75\HAM\00000\roadway\sheets\00000X5100\_SB.dgn 2021-01-20 10:30:52 AM william.croxton' ODOTV8i\_Pen-ME.tbl IBI Group

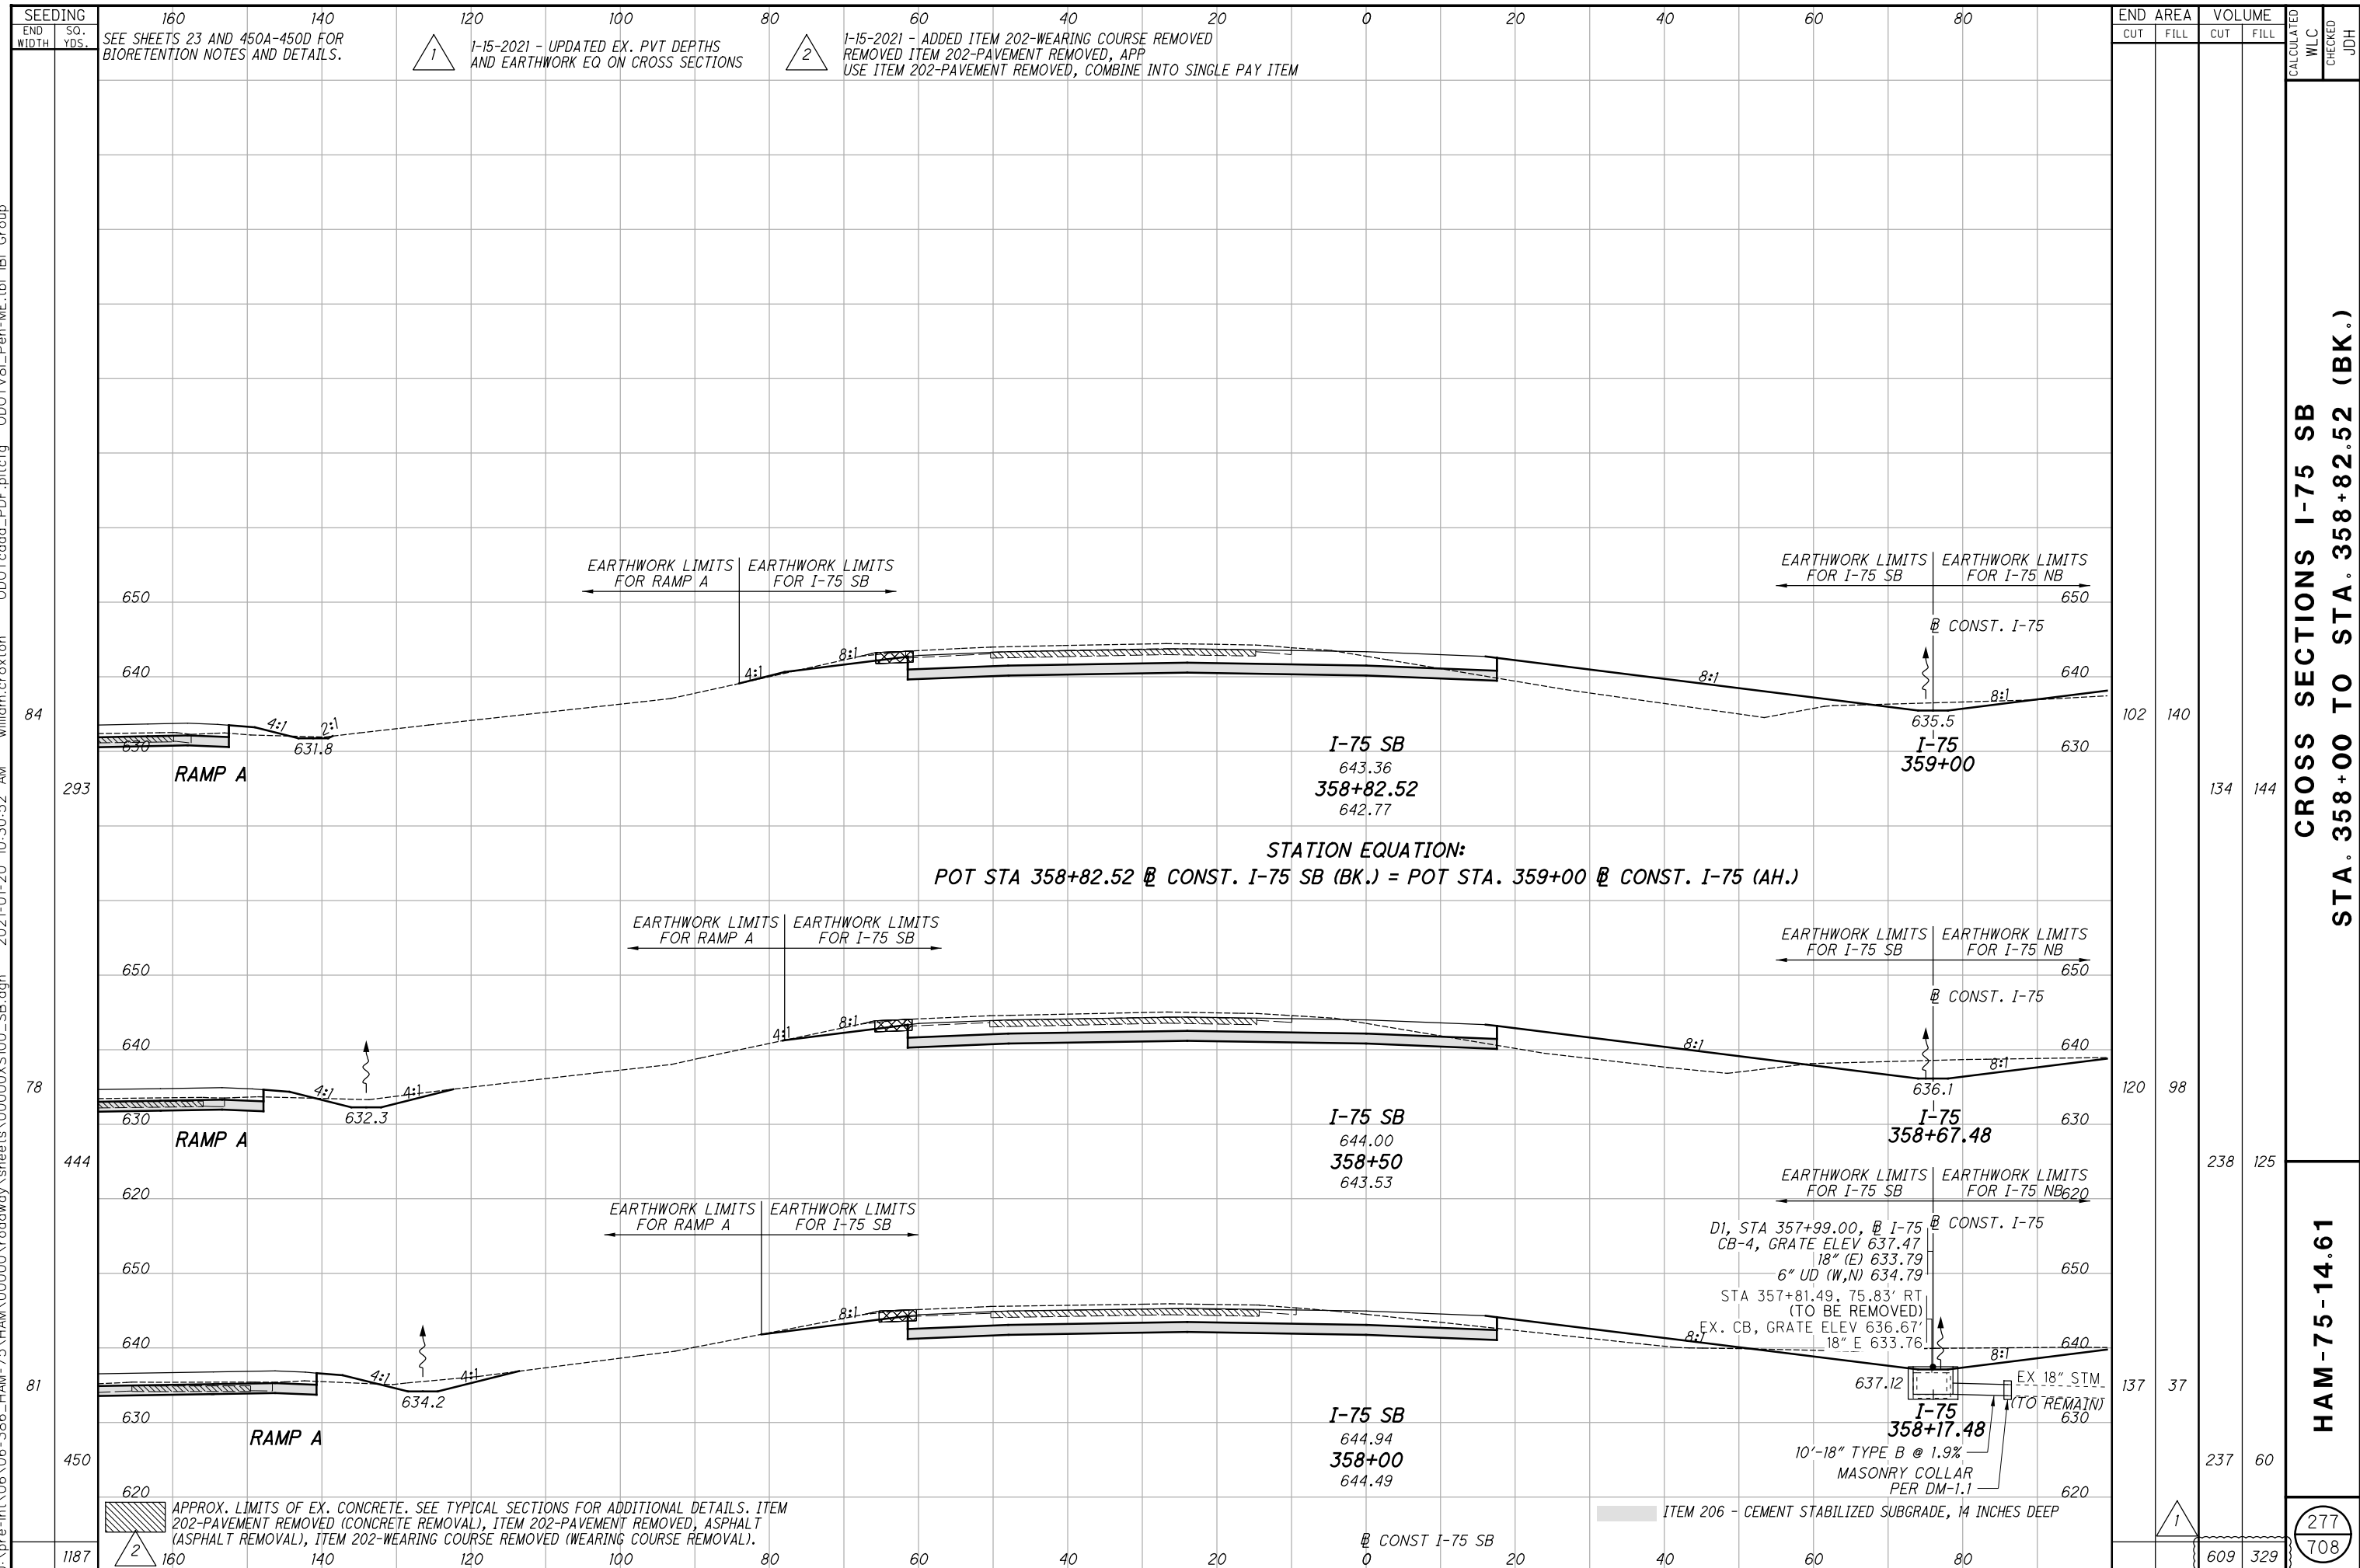

j:\pre-int\06\06-386\_HAM-75\HAM\00000\roadway\sheets\00000X5101\_SB.dgn 2021-01-20 10:30:55 AM william.croxton ODOT\81\_Pen-ME.tbl IBI Group

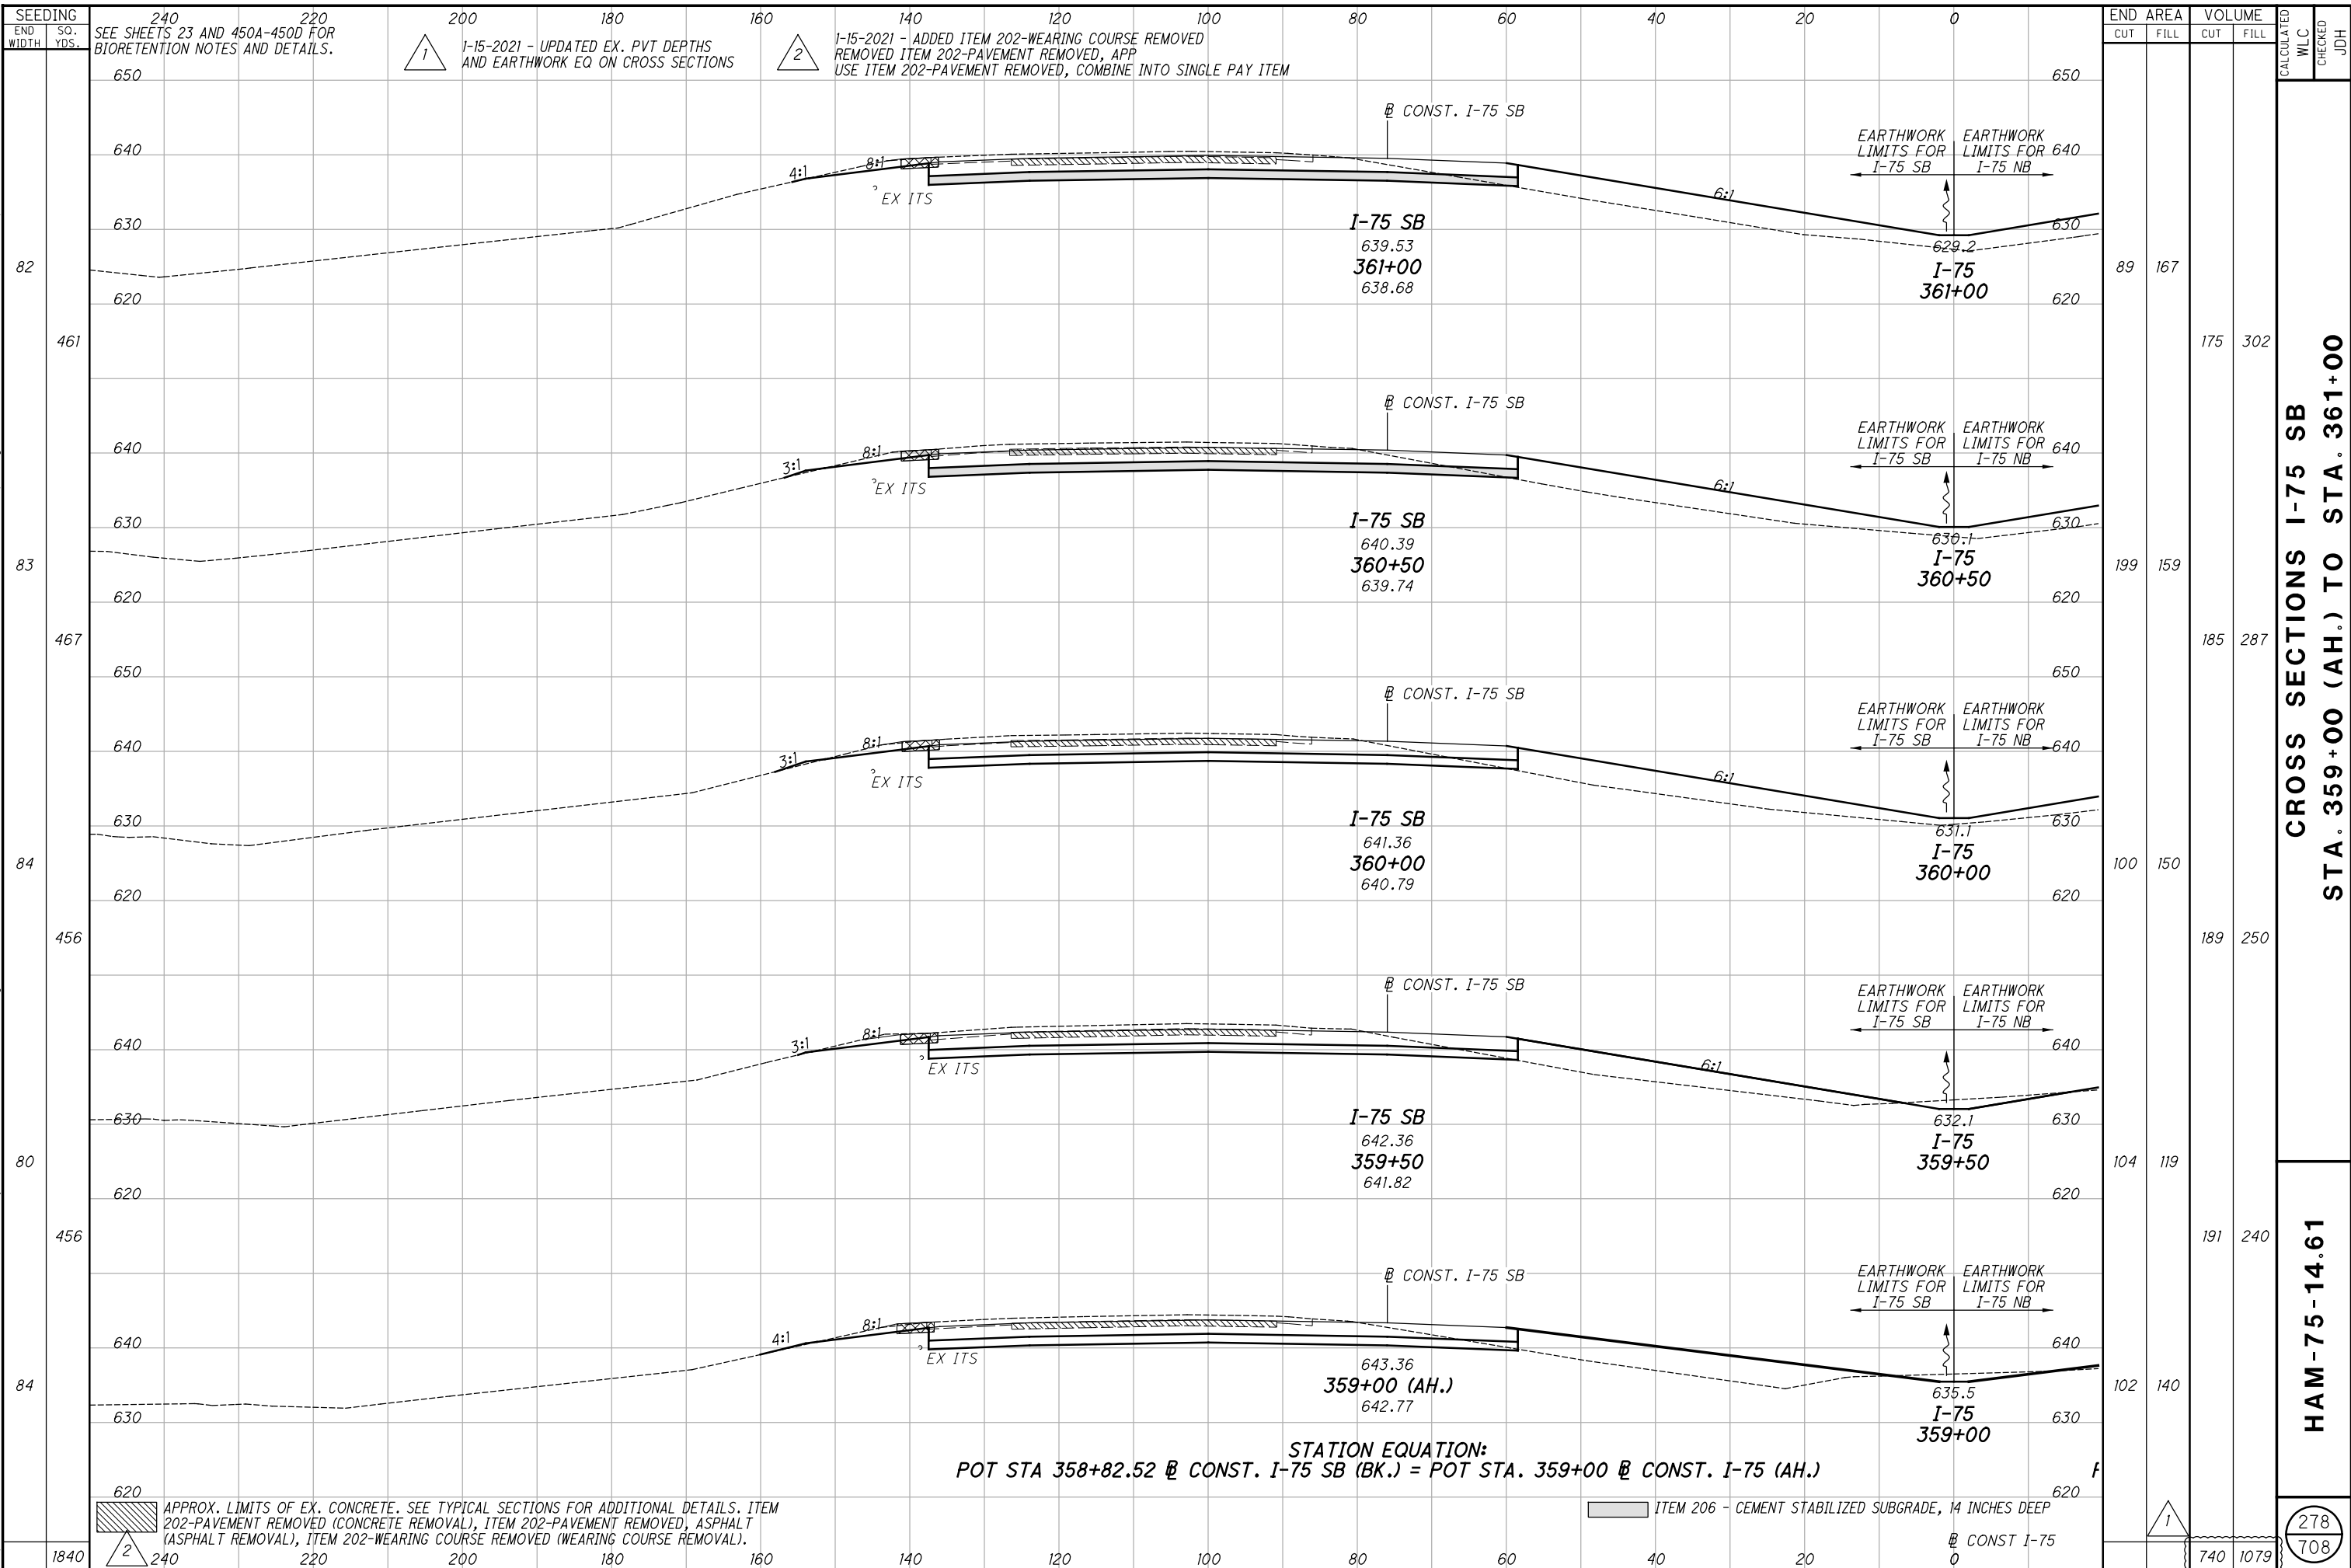

END STA	AREA		VOLUME		CALCULATED WLC	CHECKED	JDH
	CUT	FILL	CUT	FILL			
361+00	89	167	175	302			
360+50	199	159	185	287			
360+00	100	150	189	250			
359+50	104	119	191	240			
359+00	102	140					
TOTAL			740	1079			

CROSS SECTIONS I-75 SB STA. 359+00 (AH.) TO STA. 361+00

HAM-75-14.61

278  
708


SEEDING 240 220  
END SO. SEE SHEETS 23 AND 450A-450D FOR BIOTENTION NOTES AND DETAILS.  
WIDTH YDS.

1-15-2021 - UPDATED EX. PVT DEPTHS AND EARTHWORK EQ ON CROSS SECTIONS  
1-15-2021 - ADDED ITEM 202-WEARING COURSE REMOVED REMOVED ITEM 202-PAVEMENT REMOVED, APP USE ITEM 202-PAVEMENT REMOVED, COMBINE INTO SINGLE PAY ITEM


STATION EQUATION:  
POT STA 358+82.52 @ CONST. I-75 SB (BK.) = POT STA. 359+00 @ CONST. I-75 (AH.)

APPROX. LIMITS OF EX. CONCRETE. SEE TYPICAL SECTIONS FOR ADDITIONAL DETAILS. ITEM 202-PAVEMENT REMOVED (CONCRETE REMOVAL), ITEM 202-PAVEMENT REMOVED, ASPHALT (ASPHALT REMOVAL), ITEM 202-WEARING COURSE REMOVED (WEARING COURSE REMOVAL).  
ITEM 206 - CEMENT STABILIZED SUBGRADE, 14 INCHES DEEP  
CONST I-75

j:\pre-int\06\06-386\_HAM-75\_HAM\00000\roadway\sheets\00000XS101\_SB.dgn 2021-01-20 10:30:56 AM william.croxton ODOTcadd\_PDF.plt cfbg ODOTV8i\_Pen-ME.tbl IBI Group

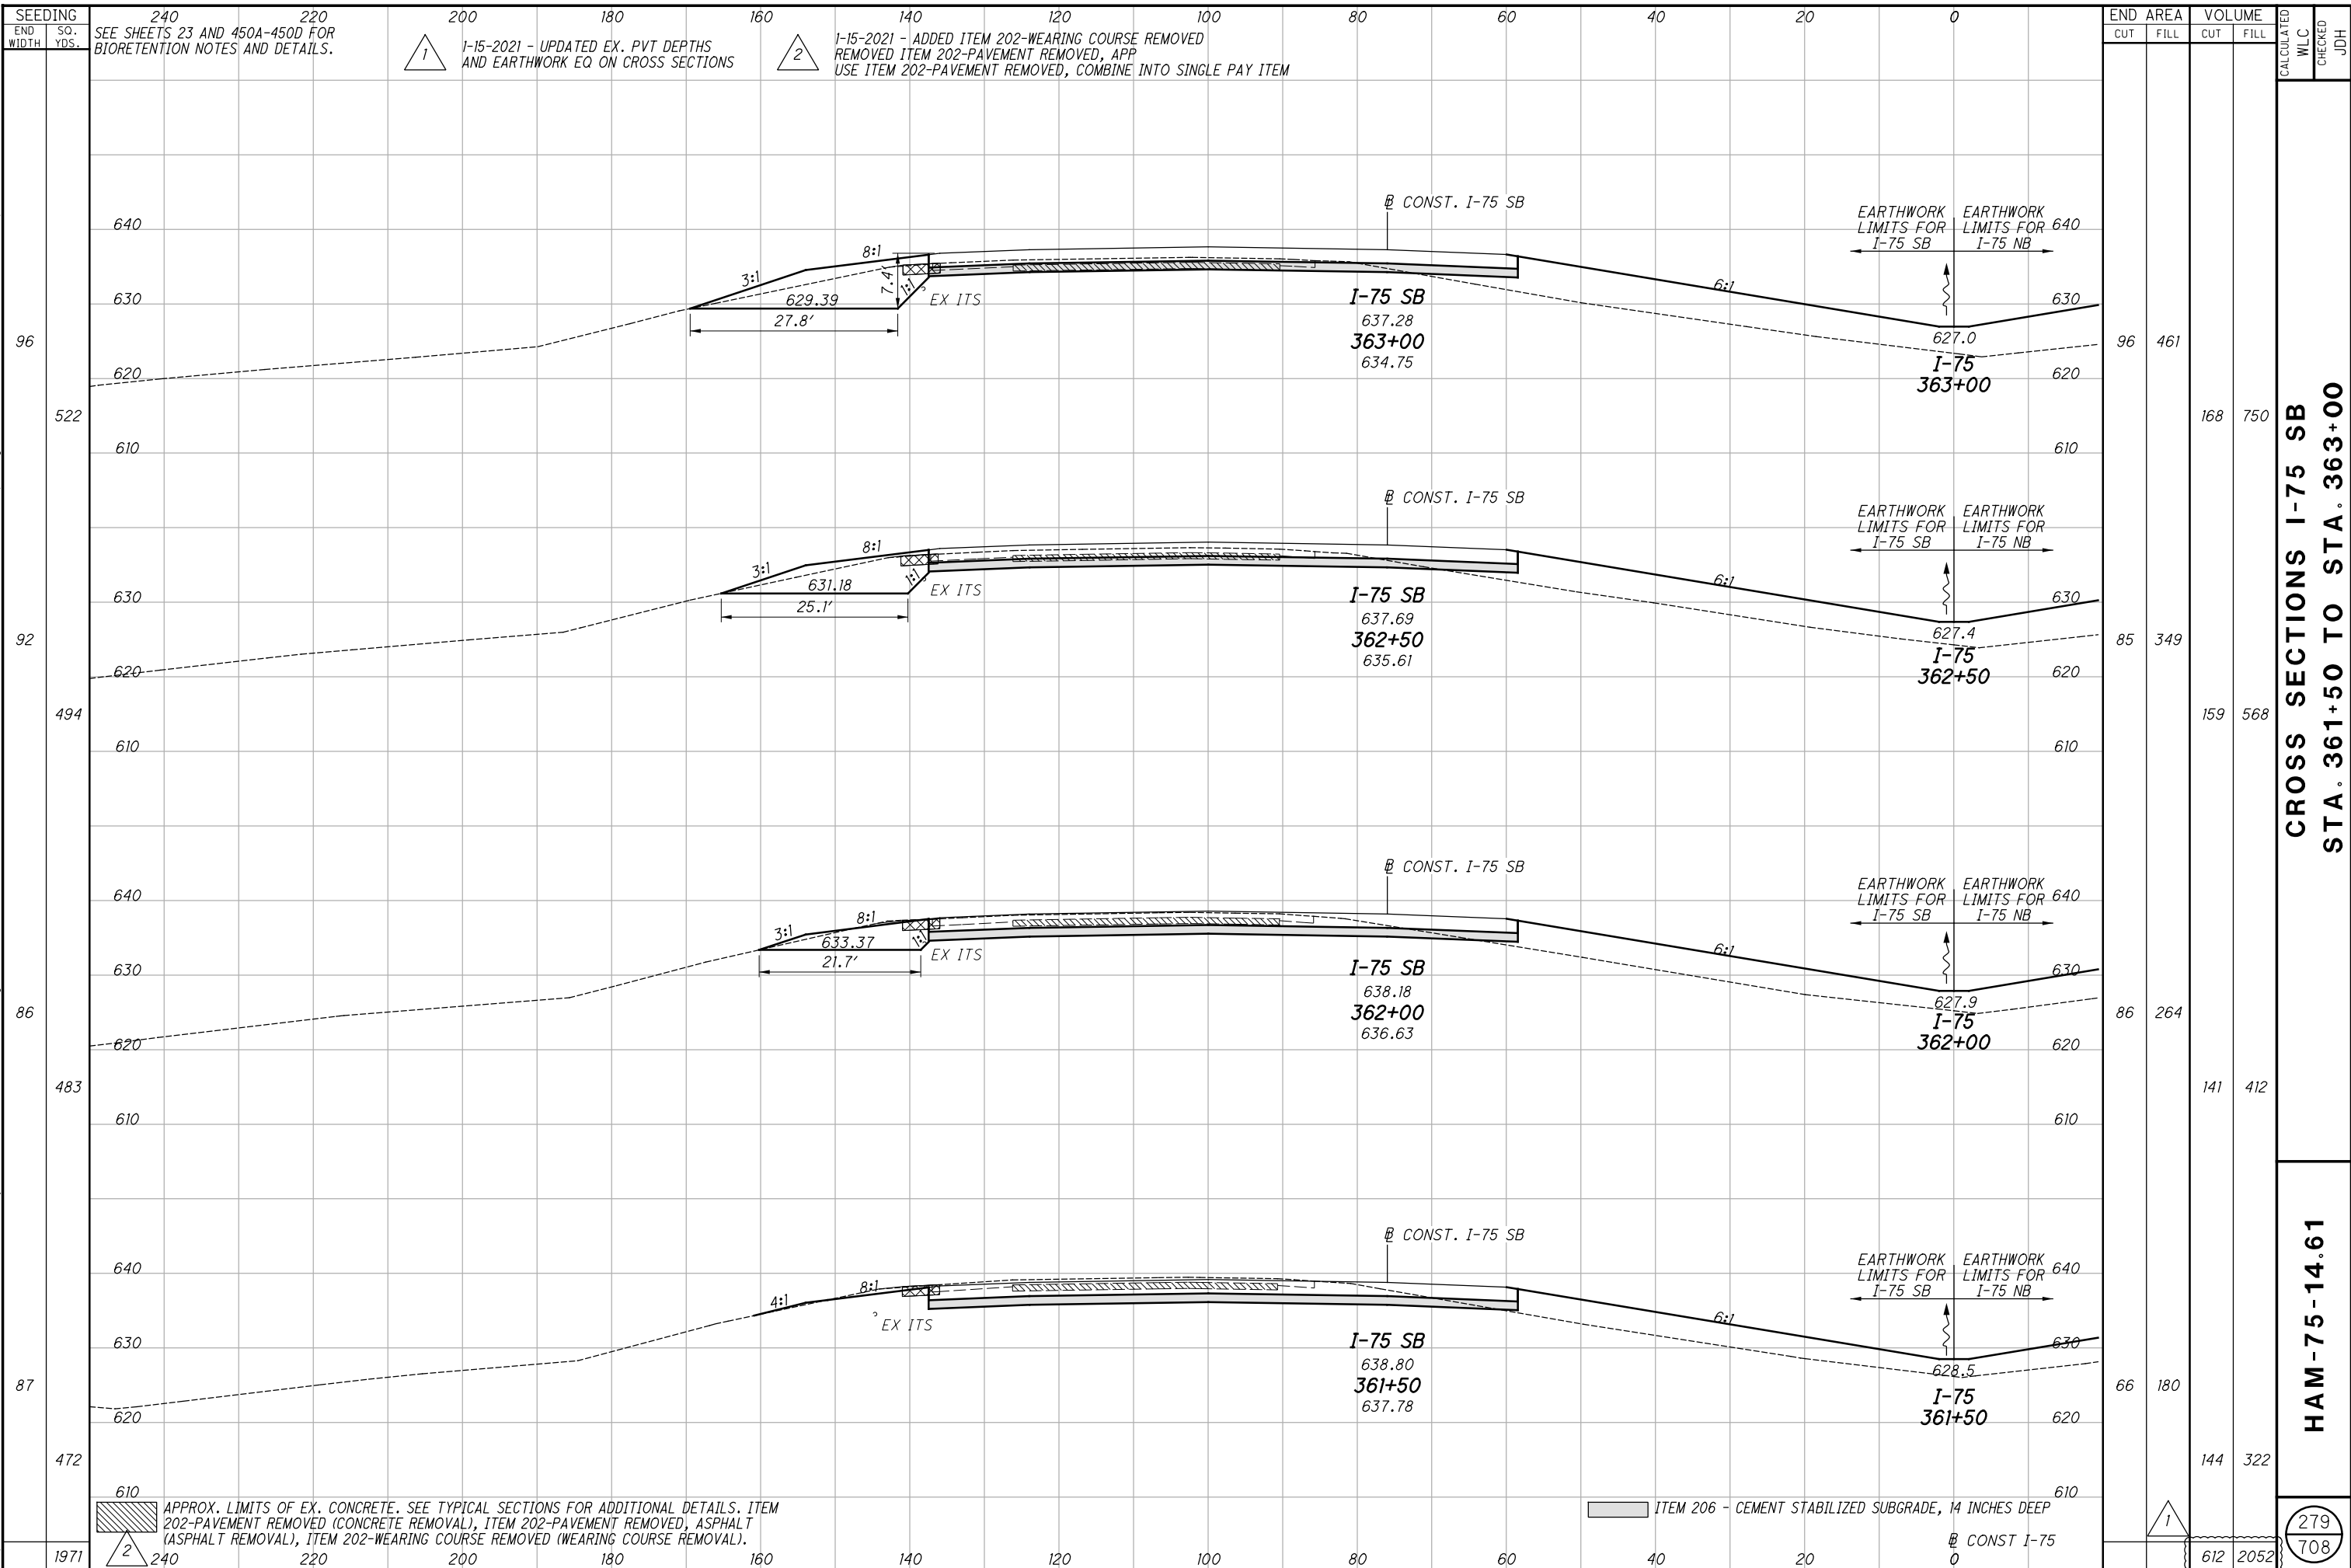

j:\pre-int\06\06-386\_HAM-75\_HAM\00000\roadway\sheets\00000XS101\_SB.dgn 2021-01-20 10:30:57 AM william.croxton ODOT\cadd\_PDF.plt\cfig ODOTV8i\_Pen-ME.tbl IBI Group

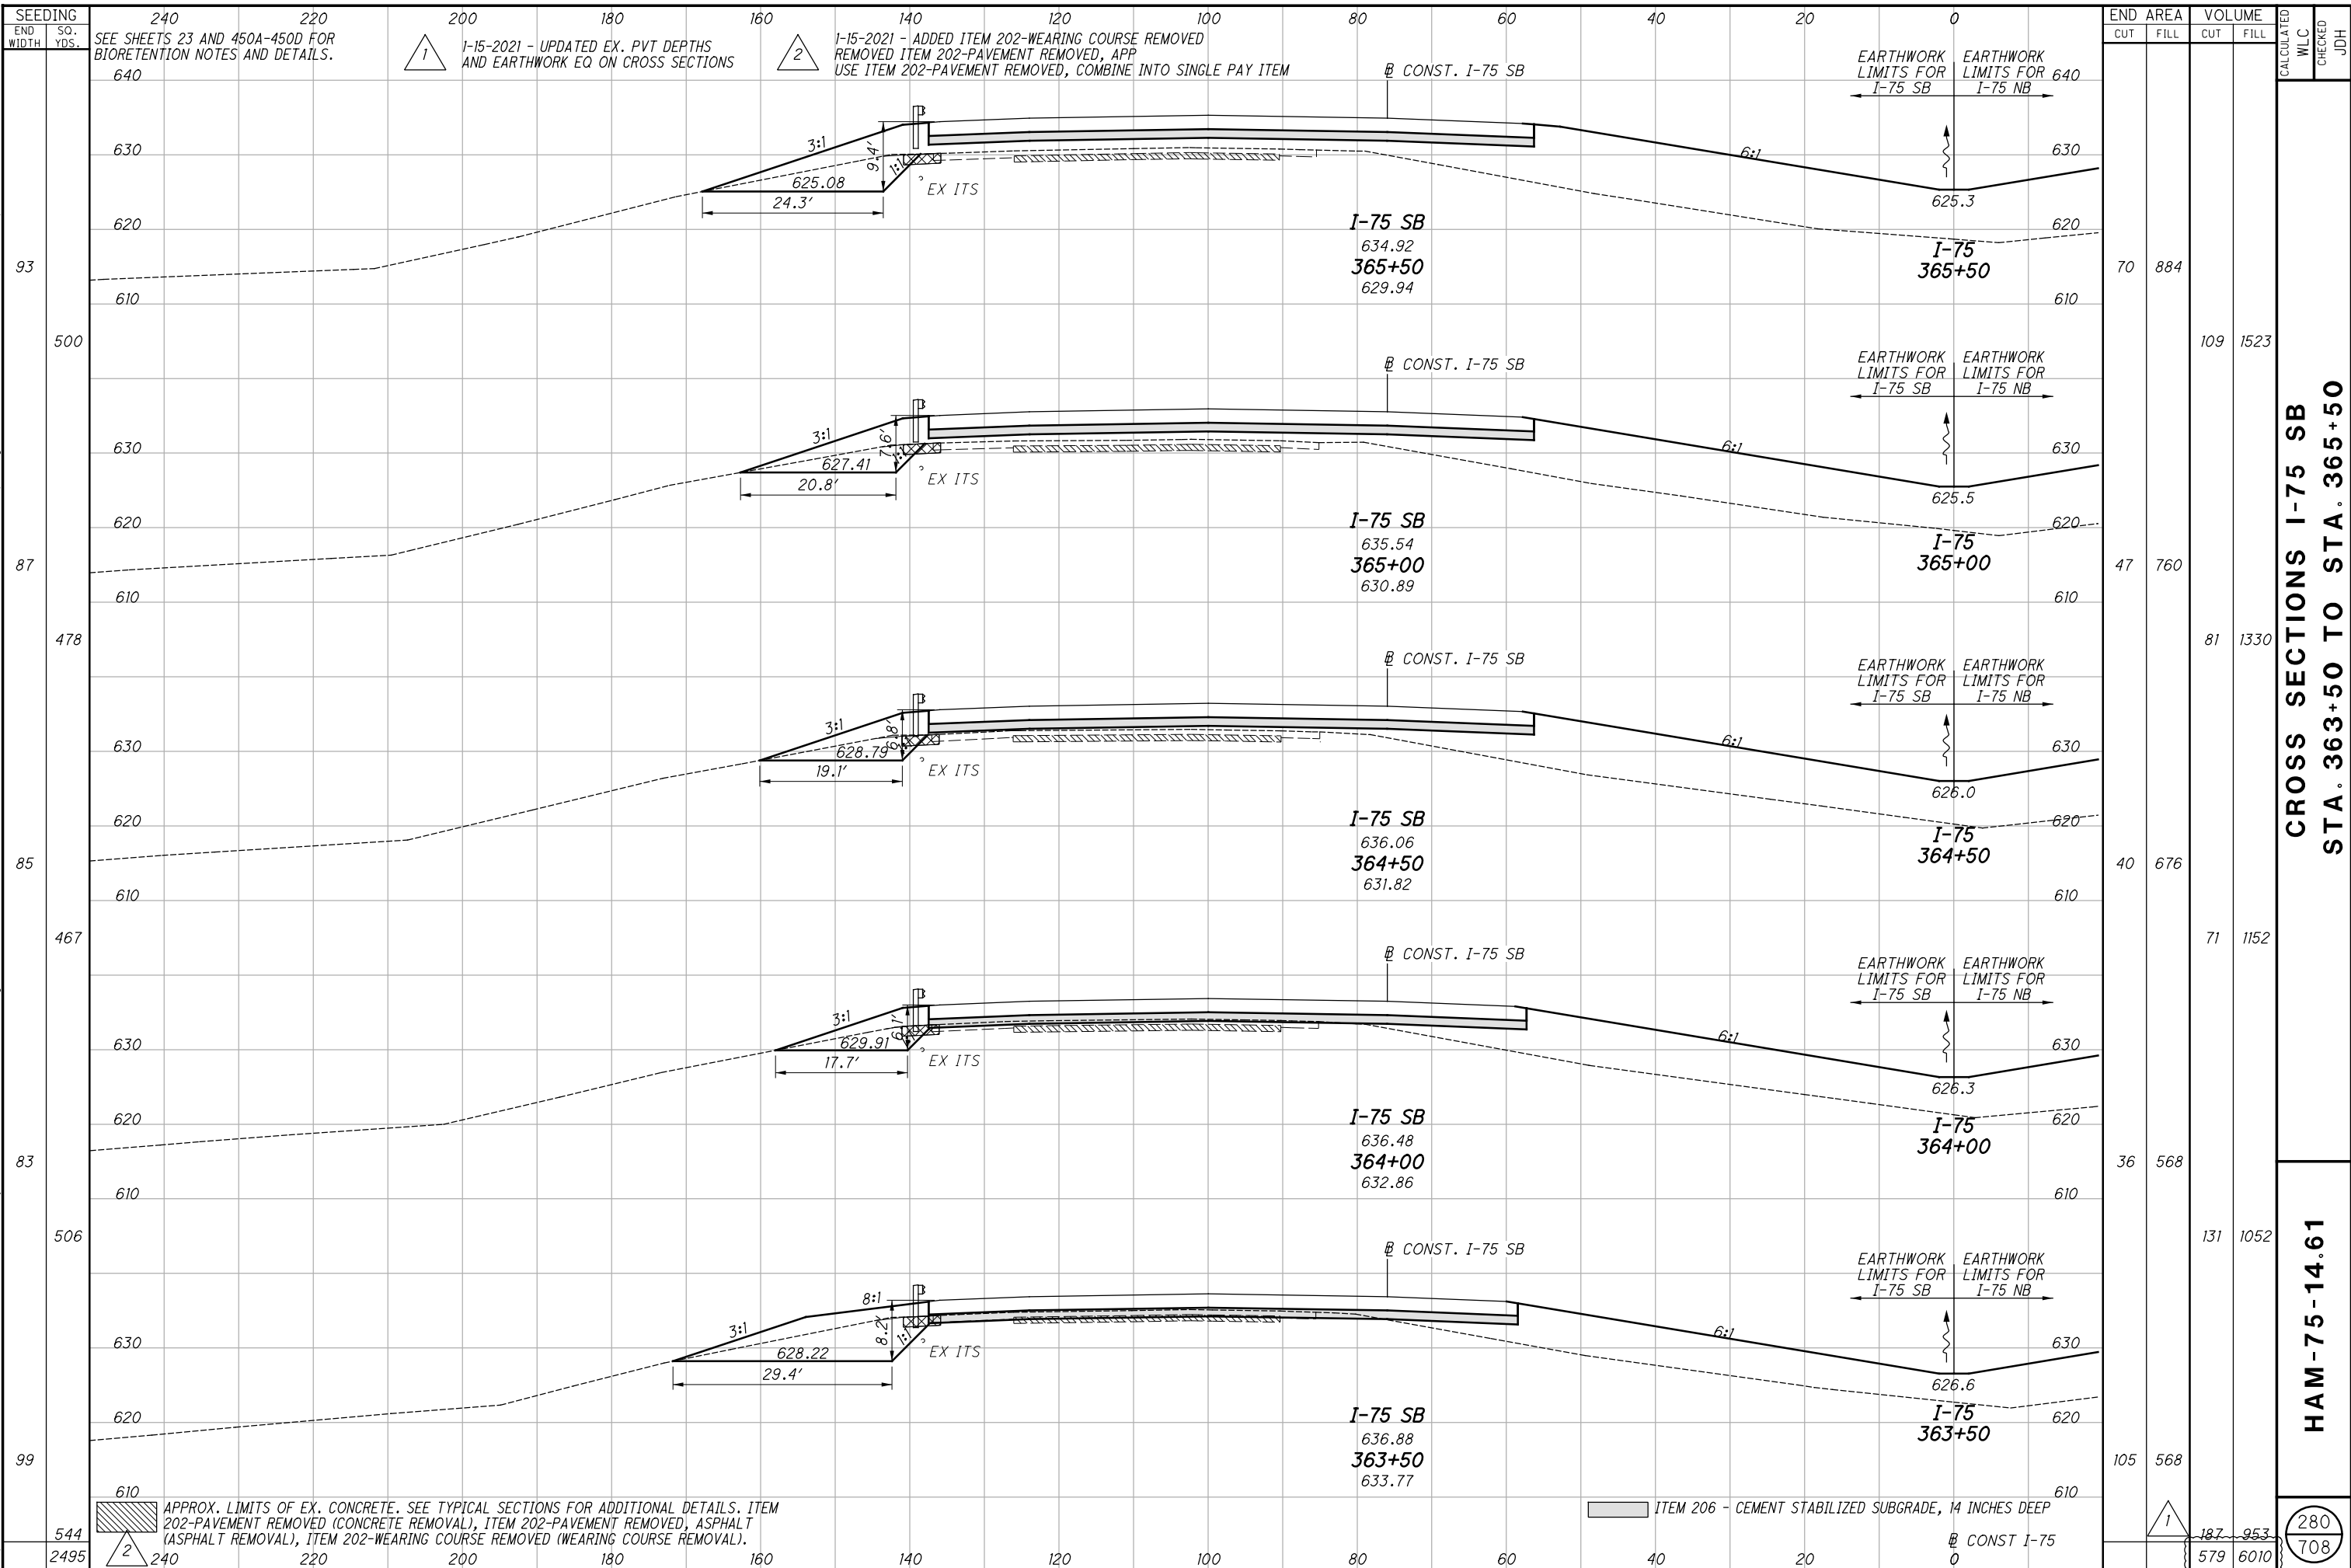

SEEDING  
END SO. WIDTH YDS.

240 220 200 180 160 140 120 100 80 60 40 20 0  
 SEE SHEETS 23 AND 450A-450D FOR BIORETENTION NOTES AND DETAILS.  
 1-15-2021 - UPDATED EX. PVT DEPTHS AND EARTHWORK EQ ON CROSS SECTIONS  
 2 1-15-2021 - ADDED ITEM 202-WEARING COURSE REMOVED REMOVED ITEM 202-PAVEMENT REMOVED, APP USE ITEM 202-PAVEMENT REMOVED, COMBINE INTO SINGLE PAY ITEM

END STA	AREA CUT	AREA FILL	VOLUME		CALCULATED WLC	CHECKED	JDH
			CUT	FILL			
70	884						
47	760						
40	676						
36	568						
105	568						
187	953						
579	6010						

CROSS SECTIONS I-75 SB  
 STA. 363+50 TO STA. 365+50

HAM-75-14.61


280  
 708

APPROX. LIMITS OF EX. CONCRETE. SEE TYPICAL SECTIONS FOR ADDITIONAL DETAILS. ITEM 202-PAVEMENT REMOVED (CONCRETE REMOVAL), ITEM 202-PAVEMENT REMOVED, ASPHALT (ASPHALT REMOVAL), ITEM 202-WEARING COURSE REMOVED (WEARING COURSE REMOVAL).

ITEM 206 - CEMENT STABILIZED SUBGRADE, 14 INCHES DEEP

CONST I-75

j:\pre-int\06\06-386\_HAM-75\HAM-75\roadway\sheets\00000X5101\_SB.dgn 2021-01-20 10:30:58 AM william.croxton ODOT\cadd\_PDF.plt\cfig ODOTV8i\_Pen-ME.tbl IBI Group

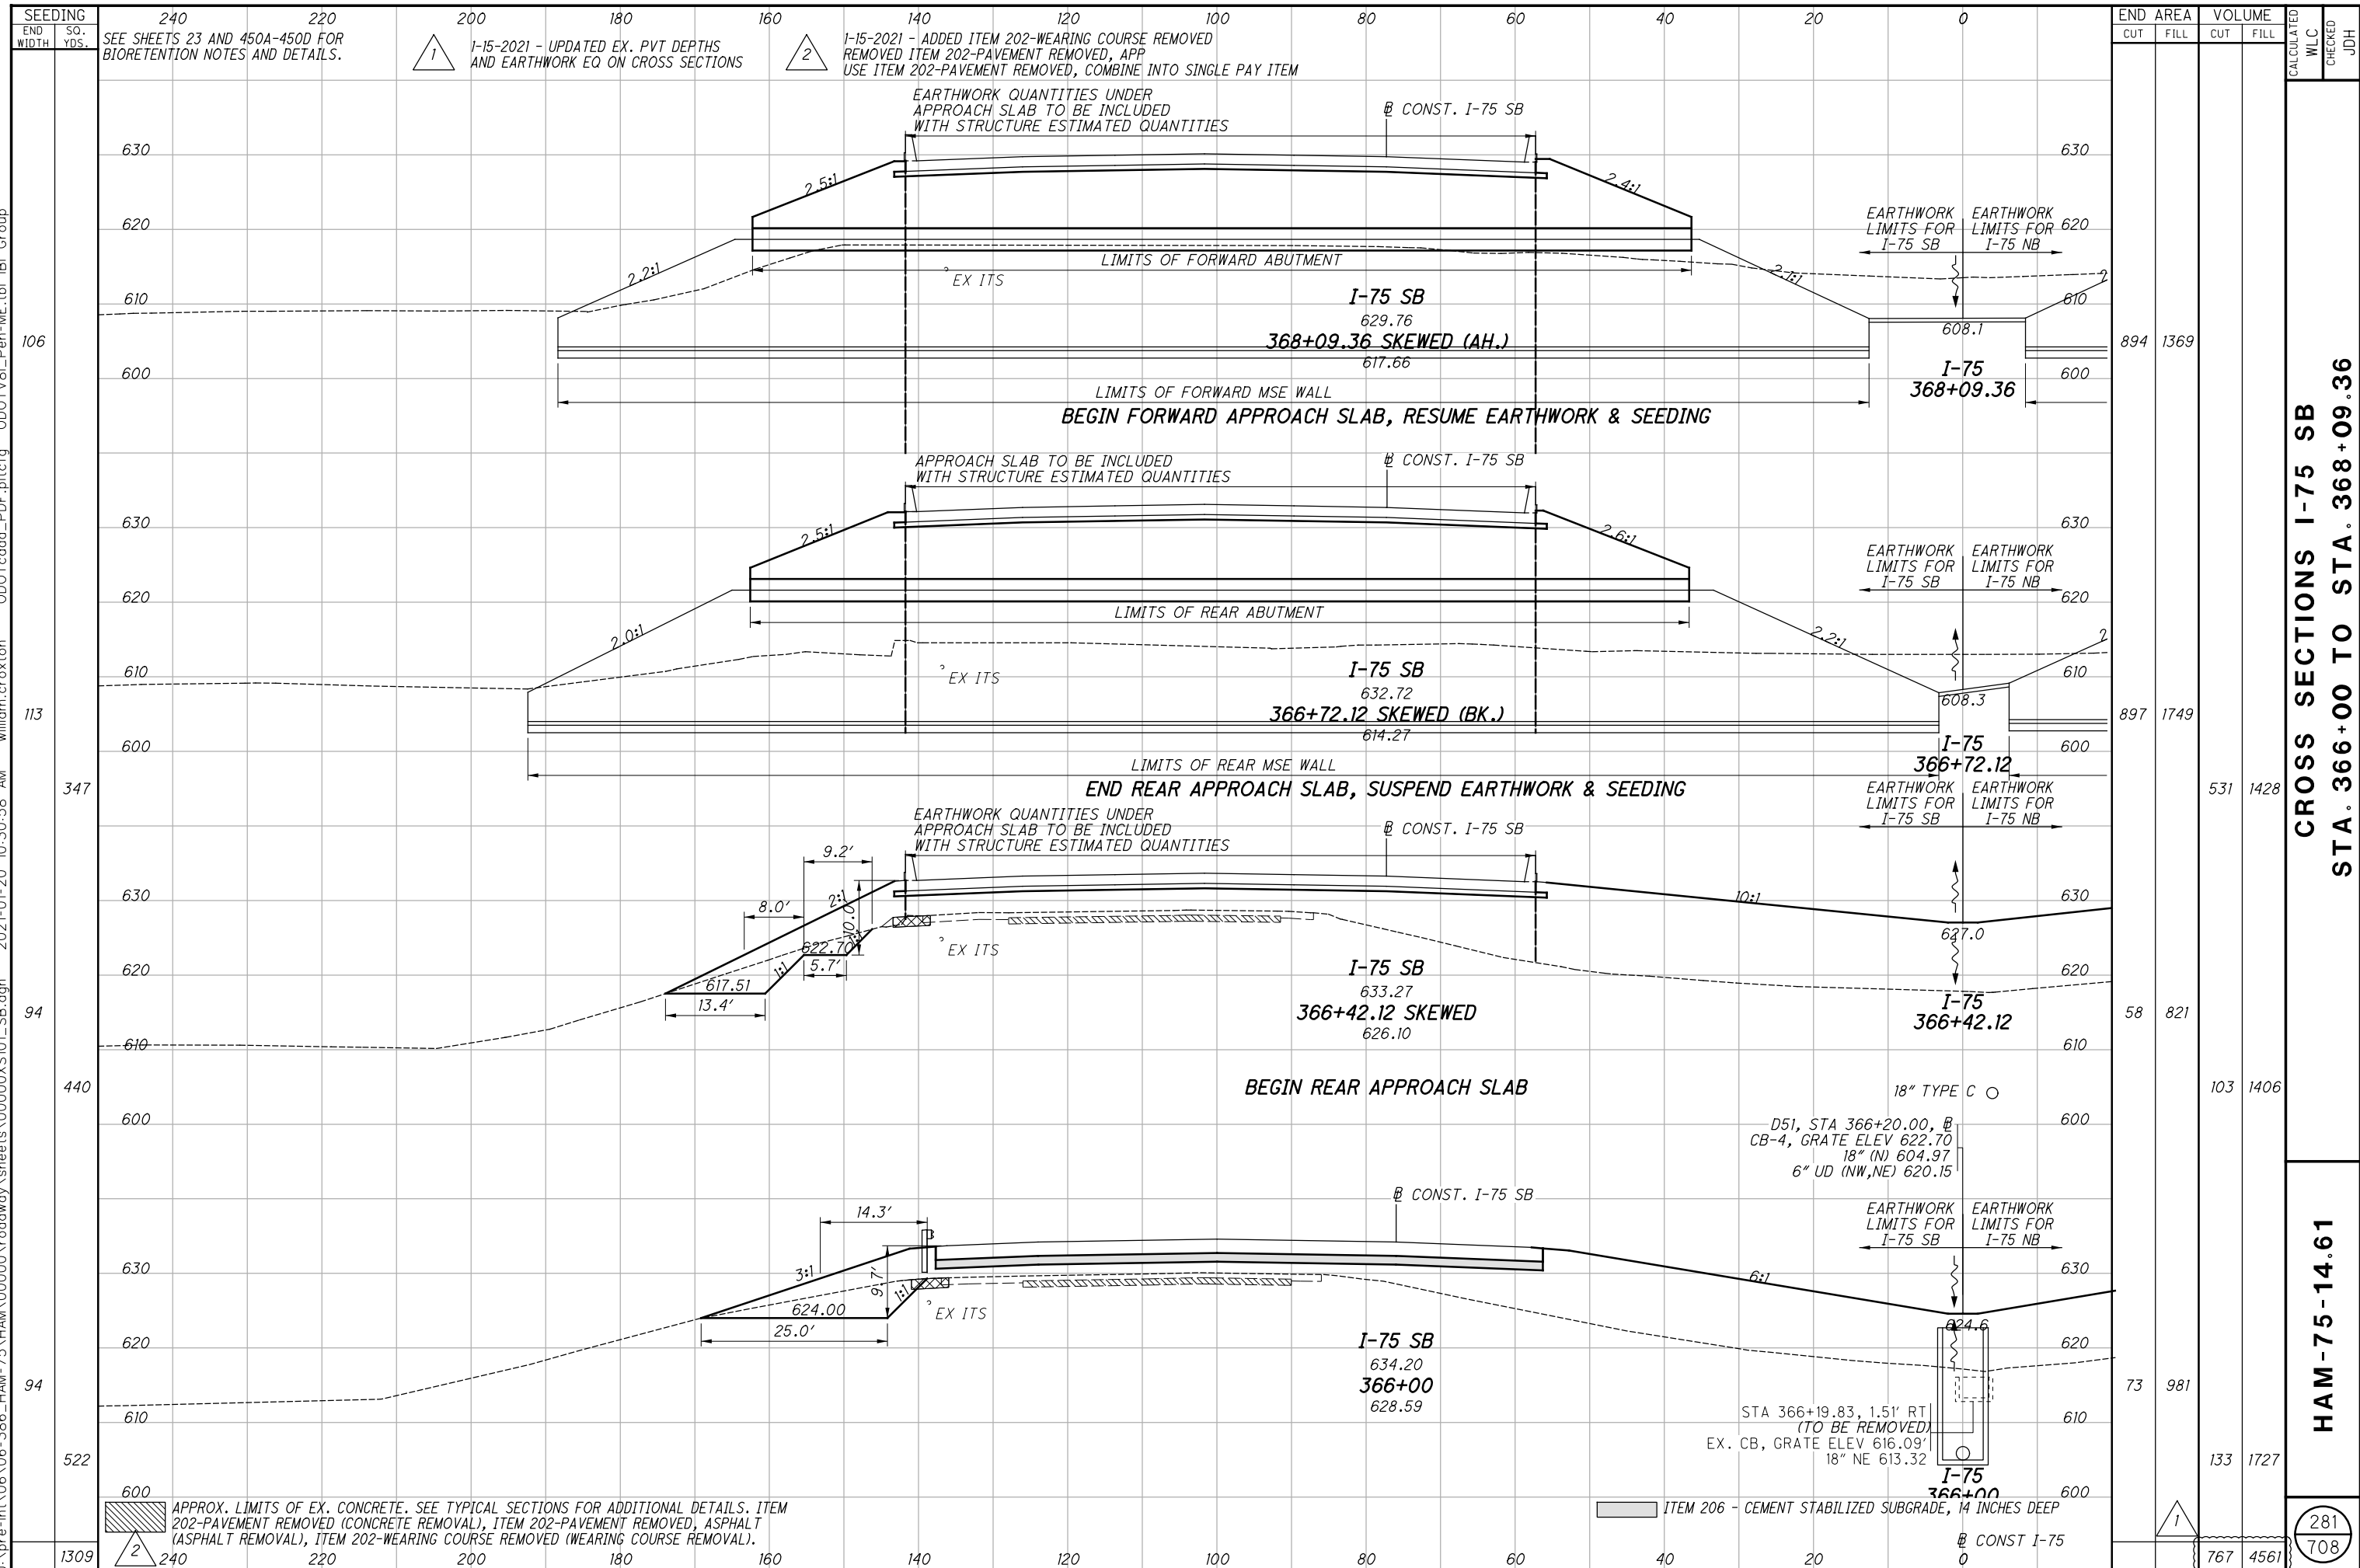

END STA	AREA		VOLUME		CALCULATED WLC	CHECKED	JDH
	CUT	FILL	CUT	FILL			
368+09.36	894	1369					
366+72.12	897	1749					
366+42.12	58	821					
366+00	73	981					
366+00	767	4561					

CROSS SECTIONS I-75 SB  
STA. 366+00 TO STA. 368+09.36

HAM-75-14.61


281  
708

SEEDING  
END WIDTH SO. YDS.  
240 220 200 180 160 140 120 100 80 60 40 20 0

SEE SHEETS 23 AND 450A-450D FOR BIORETENTION NOTES AND DETAILS.  
1-15-2021 - UPDATED EX. PVT DEPTHS AND EARTHWORK EQ ON CROSS SECTIONS  
1-15-2021 - ADDED ITEM 202-WEARING COURSE REMOVED REMOVED ITEM 202-PAVEMENT REMOVED, APP USE ITEM 202-PAVEMENT REMOVED, COMBINE INTO SINGLE PAY ITEM

APPROX. LIMITS OF EX. CONCRETE. SEE TYPICAL SECTIONS FOR ADDITIONAL DETAILS. ITEM 202-PAVEMENT REMOVED (CONCRETE REMOVAL), ITEM 202-PAVEMENT REMOVED, ASPHALT (ASPHALT REMOVAL), ITEM 202-WEARING COURSE REMOVED (WEARING COURSE REMOVAL).  
ITEM 206 - CEMENT STABILIZED SUBGRADE, 14 INCHES DEEP

j:\pre-int\06\06-386\_HAM-75\_HAM\00000\roadway\sheets\00000X5101\_S1B.dgn 2021-01-20 10:30:59 AM william.croxton ODOTcadd\_PDF.plt cfbg ODOTV8i\_Pen-ME.tbl IBI Group

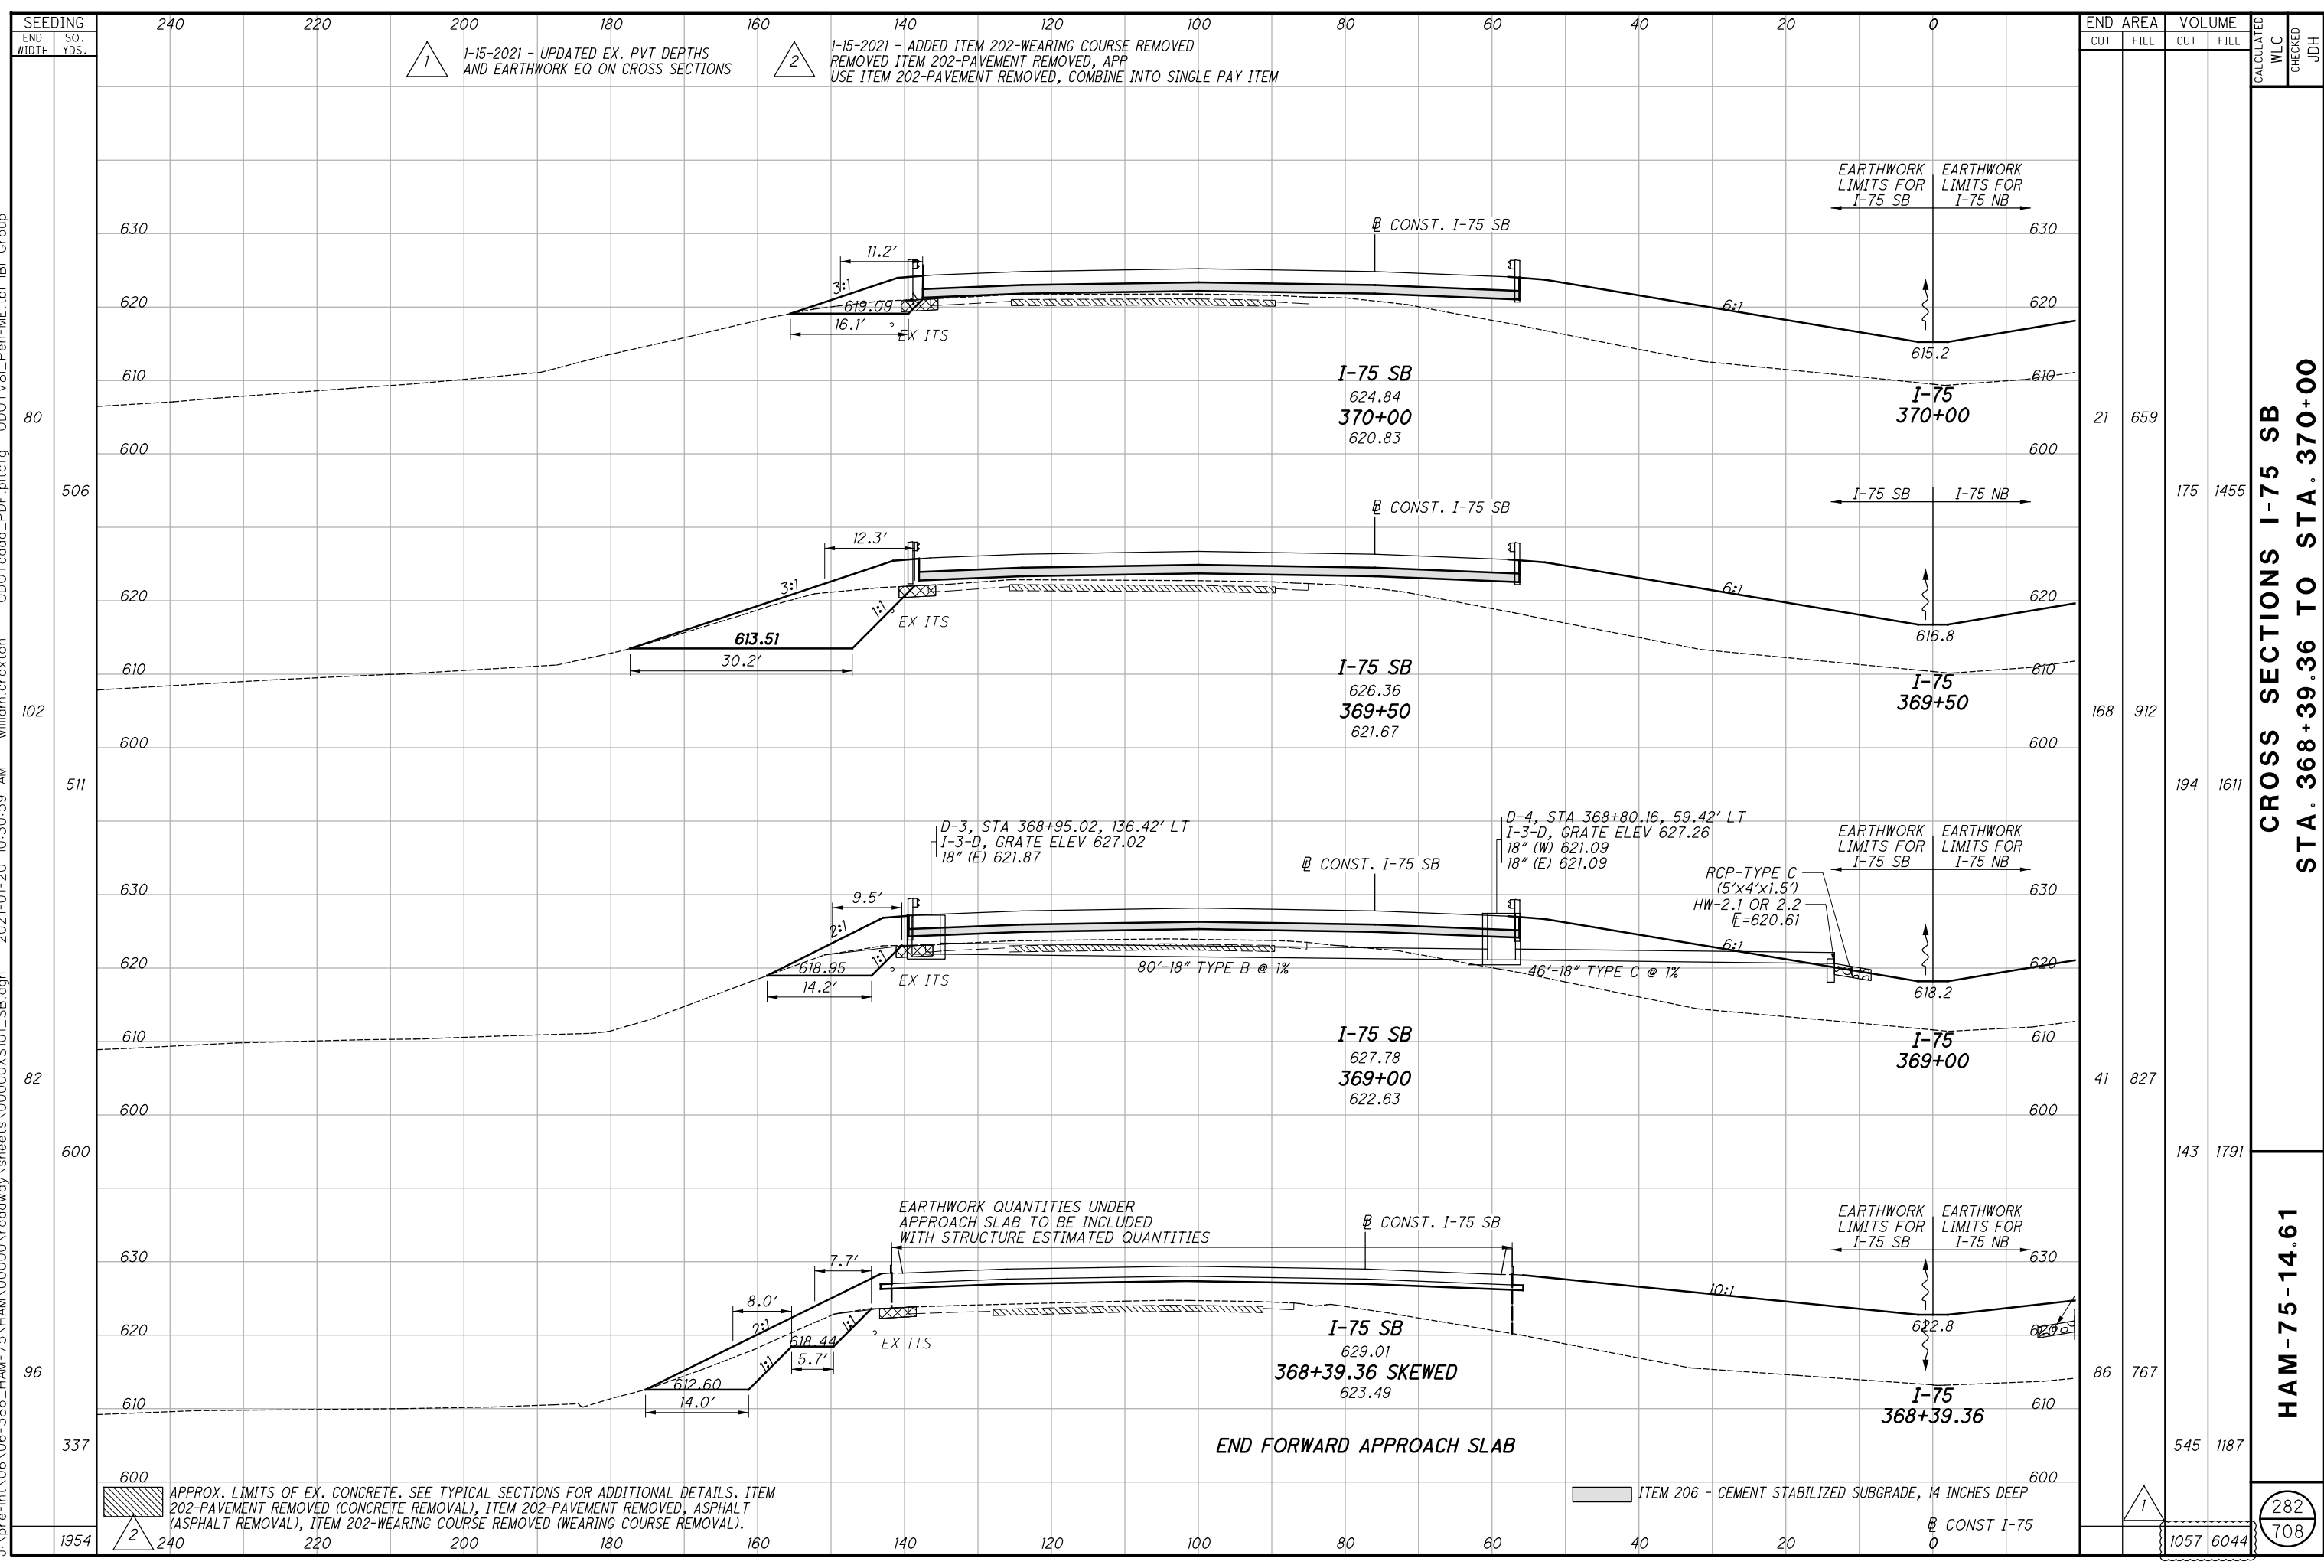

1-15-2021 - UPDATED EX. PVT DEPTHS AND EARTHWORK EQ ON CROSS SECTIONS  
 1-15-2021 - ADDED ITEM 202-WEARING COURSE REMOVED REMOVED ITEM 202-PAVEMENT REMOVED, APP USE ITEM 202-PAVEMENT REMOVED, COMBINE INTO SINGLE PAY ITEM

END AREA	VOLUME		CALCULATED WLC	CHECKED	JDH
	CUT	FILL			
21	659				
168	912				
41	827				
86	767				
1057	6044				
175	1455				
194	1611				
143	1791				
545	1187				

CROSS SECTIONS I-75 SB  
 STA. 368+39.36 TO STA. 370+00


HAM-75-14.61

282  
 708

APPROX. LIMITS OF EX. CONCRETE. SEE TYPICAL SECTIONS FOR ADDITIONAL DETAILS. ITEM 202-PAVEMENT REMOVED (CONCRETE REMOVAL), ITEM 202-PAVEMENT REMOVED, ASPHALT (ASPHALT REMOVAL), ITEM 202-WEARING COURSE REMOVED (WEARING COURSE REMOVAL).  
 ITEM 206 - CEMENT STABILIZED SUBGRADE, 14 INCHES DEEP  
 CONST I-75

END FORWARD APPROACH SLAB



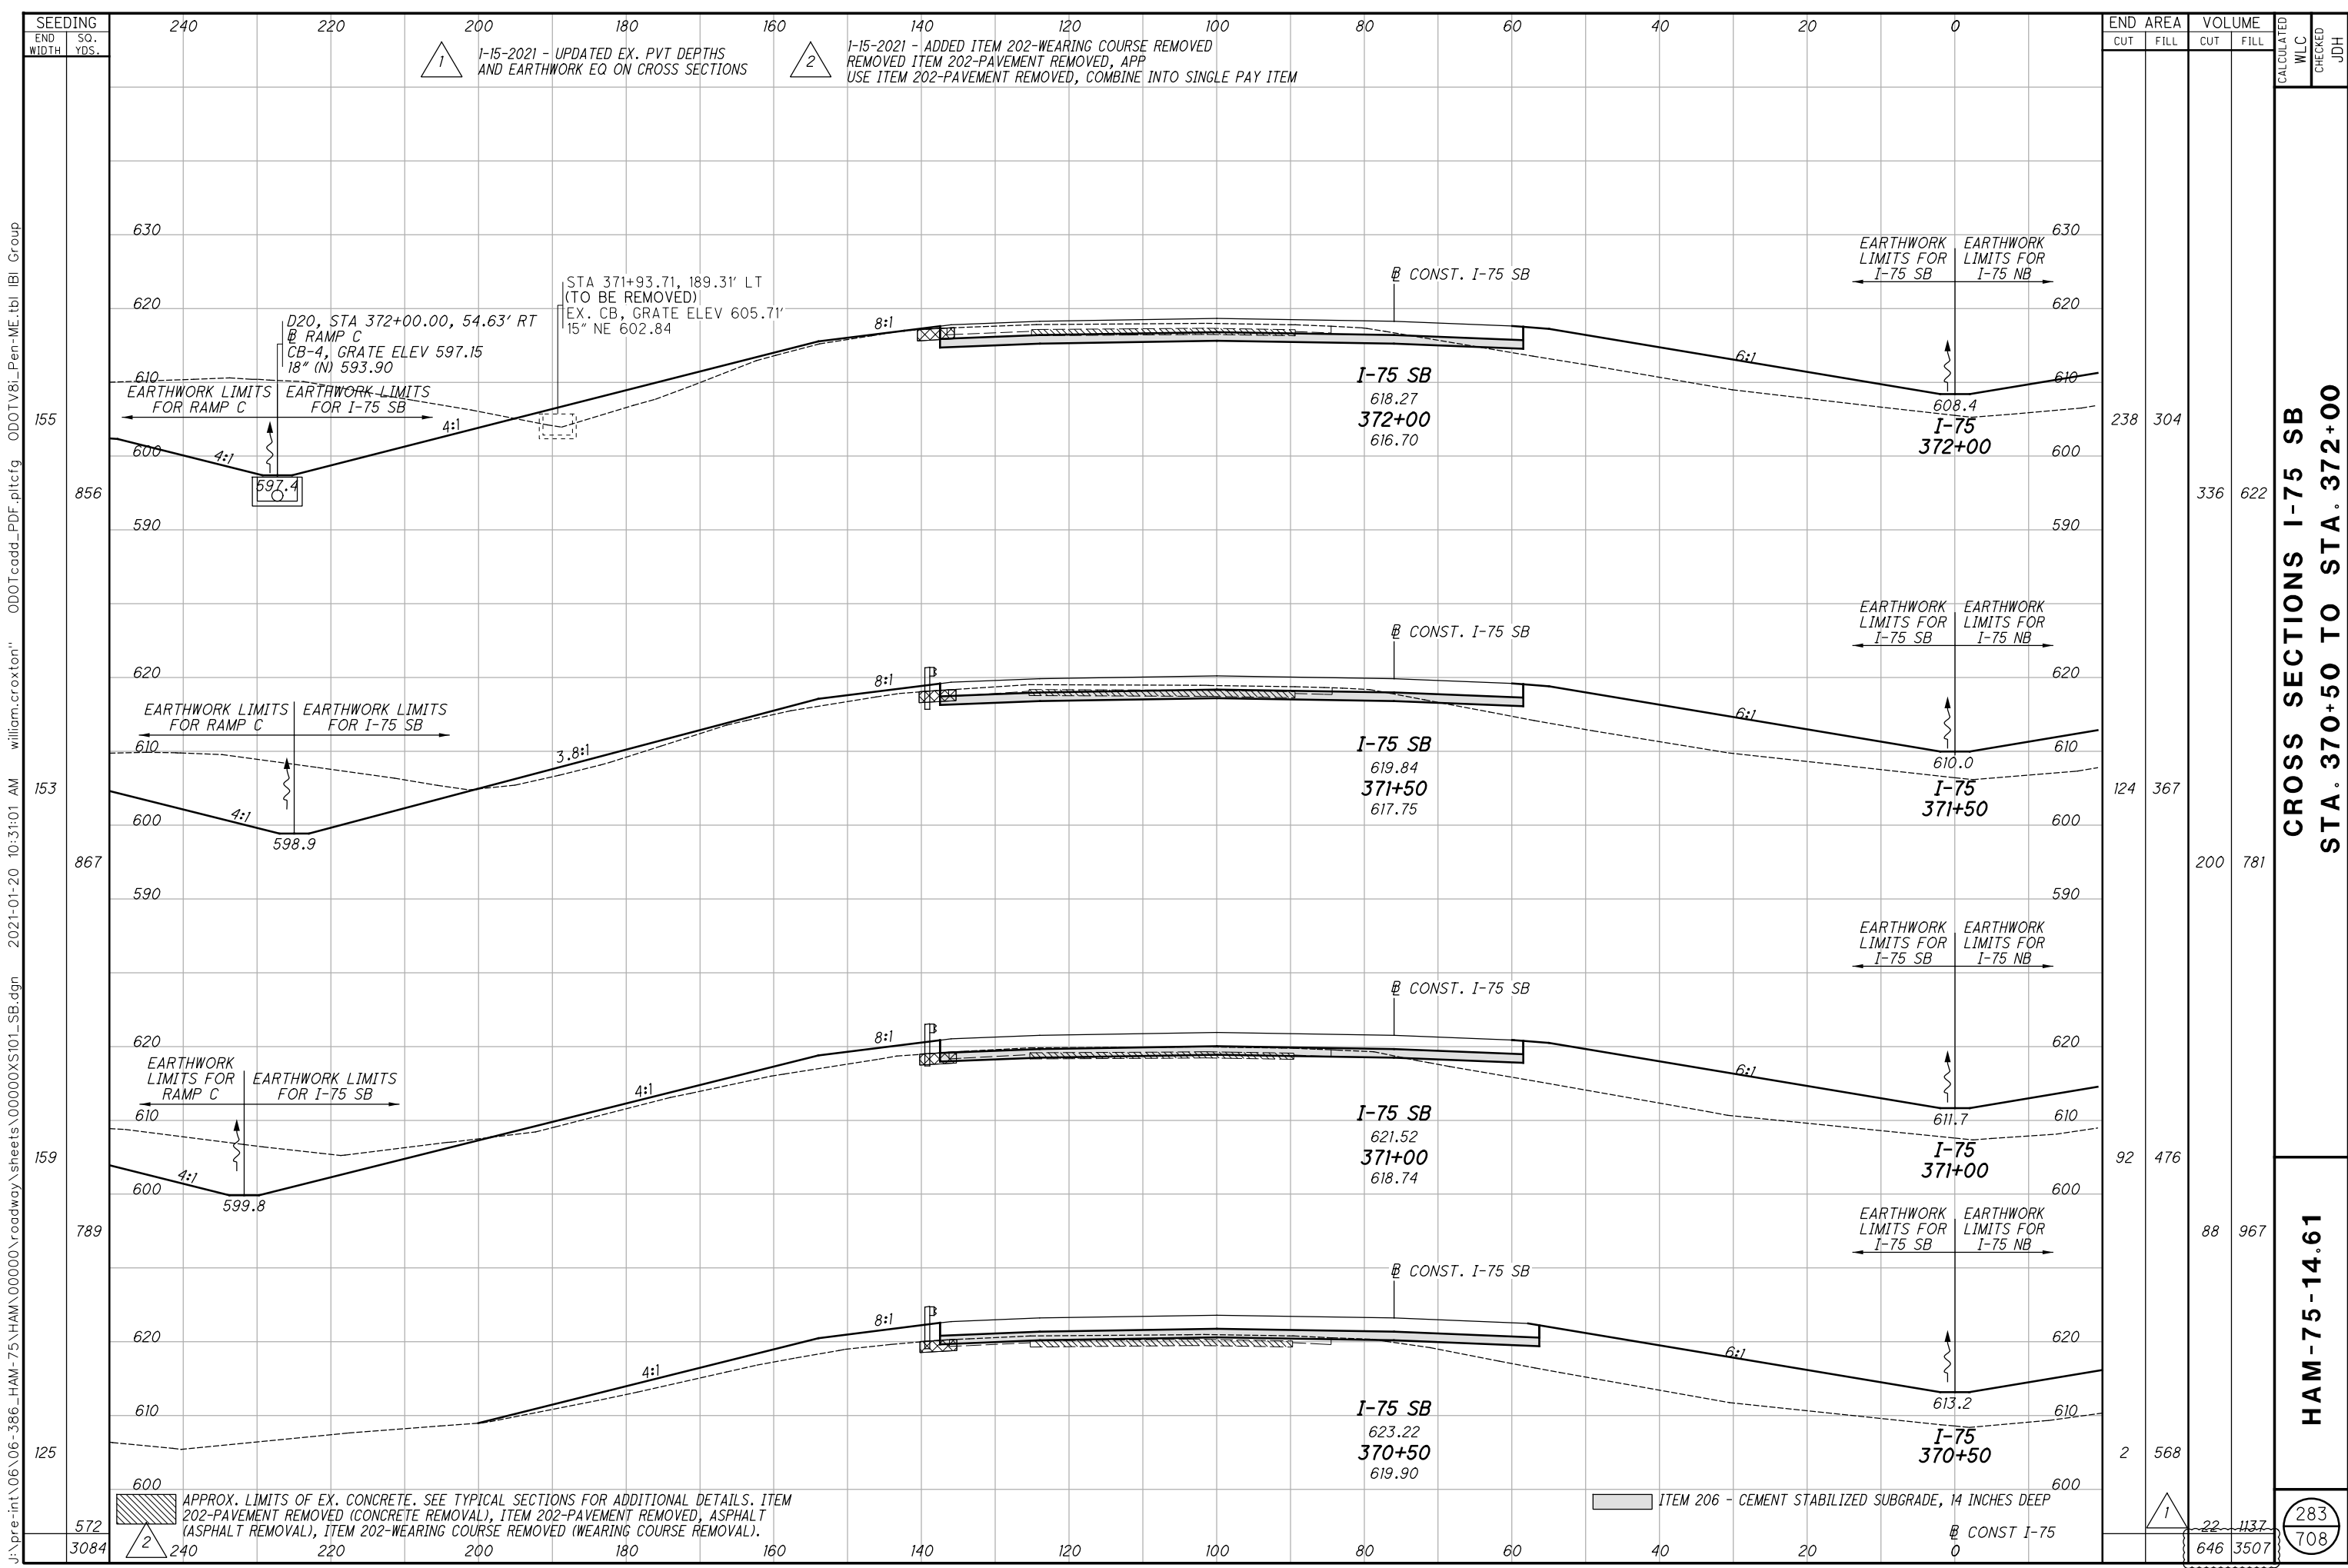

j:\pre-int\06-386\_HAM-75\_HAM\00000\roadway\sheets\00000\5101\_SB.dgn 2021-01-20 10:31:01 AM william.croxton' ODOTcadd\_PDF.pltcfg ODOTV8i\_Pen-ME.tbl IBI Group

1-15-2021 - UPDATED EX. PVT DEPTHS AND EARTHWORK EQ ON CROSS SECTIONS  
 1-15-2021 - ADDED ITEM 202-WEARING COURSE REMOVED REMOVED ITEM 202-PAVEMENT REMOVED, APP USE ITEM 202-PAVEMENT REMOVED, COMBINE INTO SINGLE PAY ITEM

END STA	AREA		VOLUME		CALCULATED WLC	CHECKED JDH
	CUT	FILL	CUT	FILL		
372+00	238	304	336	622		
371+50	124	367	200	781		
371+00	92	476	88	967		
370+50	2	568	22	1137		
3084	646	3507			283	708

**CROSS SECTIONS I-75 SB  
 STA. 370+50 TO STA. 372+00**


**HAM-75-14.61**

APPROX. LIMITS OF EX. CONCRETE. SEE TYPICAL SECTIONS FOR ADDITIONAL DETAILS. ITEM 202-PAVEMENT REMOVED (CONCRETE REMOVAL), ITEM 202-PAVEMENT REMOVED, ASPHALT (ASPHALT REMOVAL), ITEM 202-WEARING COURSE REMOVED (WEARING COURSE REMOVAL).

ITEM 206 - CEMENT STABILIZED SUBGRADE, 14 INCHES DEEP

CONST I-75

j:\pre-int\06\06-386\_HAM-75\_HAM-75\HAM-75\roadway\sheets\00000X5101\_SB.dgn 2021-01-20 10:31:02 AM william.croxton  
 ODOT\cadd\_PDF.plt\cfig ODOTV81\_Pen-ME.tbl IBI Group

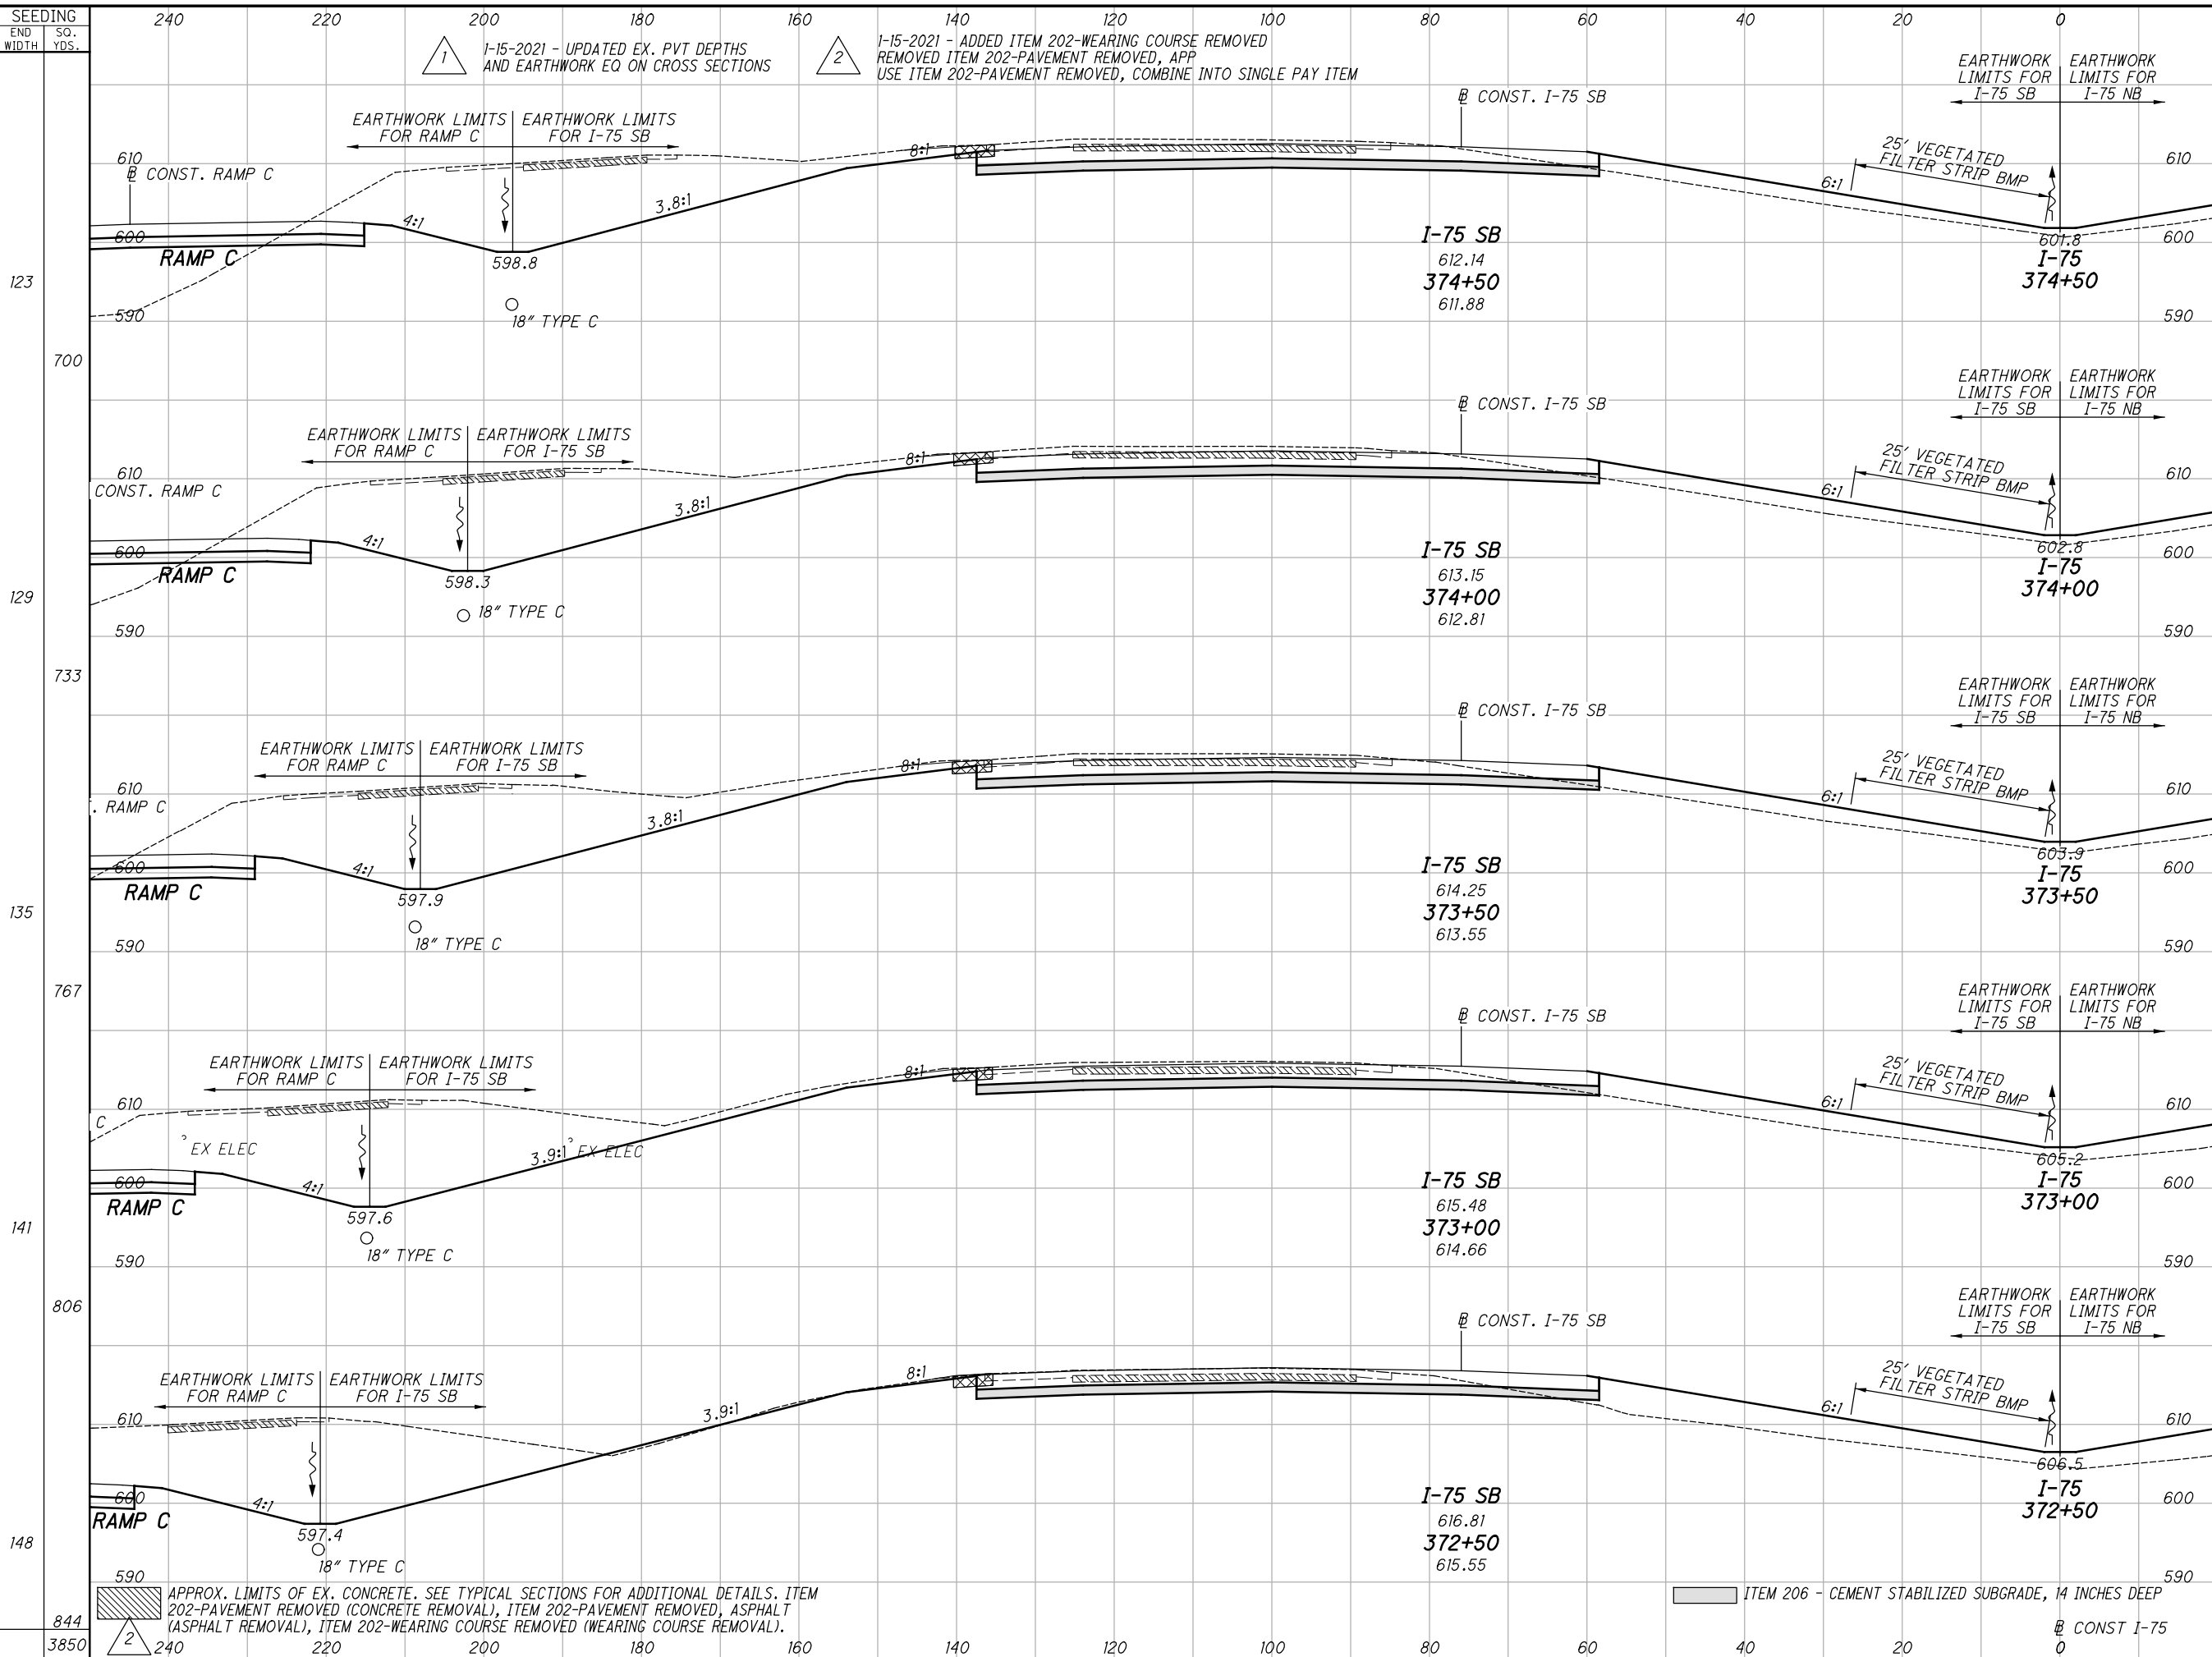

END STA	END AREA		VOLUME		CALCULATED WLC	CHECKED	JDH
	CUT	FILL	CUT	FILL			
374+50	389	90	759	175			
374+00	430	99	802	193			
373+50	436	109	770	219			
373+00	395	127	650	287			
372+50	306	182	504	450			
3850	3485	1324					

**CROSS SECTIONS I-75 SB  
 STA. 372+50 TO STA. 374+50**

**HAM-75-14.61**


284  
 708

APPROX. LIMITS OF EX. CONCRETE. SEE TYPICAL SECTIONS FOR ADDITIONAL DETAILS. ITEM 202-PAVEMENT REMOVED (CONCRETE REMOVAL), ITEM 202-PAVEMENT REMOVED, ASPHALT (ASPHALT REMOVAL), ITEM 202-WEARING COURSE REMOVED (WEARING COURSE REMOVAL).

ITEM 206 - CEMENT STABILIZED SUBGRADE, 14 INCHES DEEP

1-15-2021 - UPDATED EX. PVT DEPTHS AND EARTHWORK EQ ON CROSS SECTIONS  
 1-15-2021 - ADDED ITEM 202-WEARING COURSE REMOVED REMOVED ITEM 202-PAVEMENT REMOVED, APP USE ITEM 202-PAVEMENT REMOVED, COMBINE INTO SINGLE PAY ITEM

j:\pre-int\06\06-386\_HAM-75\HAM\00000\roadway\sheets\00000X5101\_SB.dgn 2021-01-20 10:31:03 AM william.croxton ODOTcadd\_PDF.pltcfgr ODOTV81\_Pen-ME.tbl IBI Group

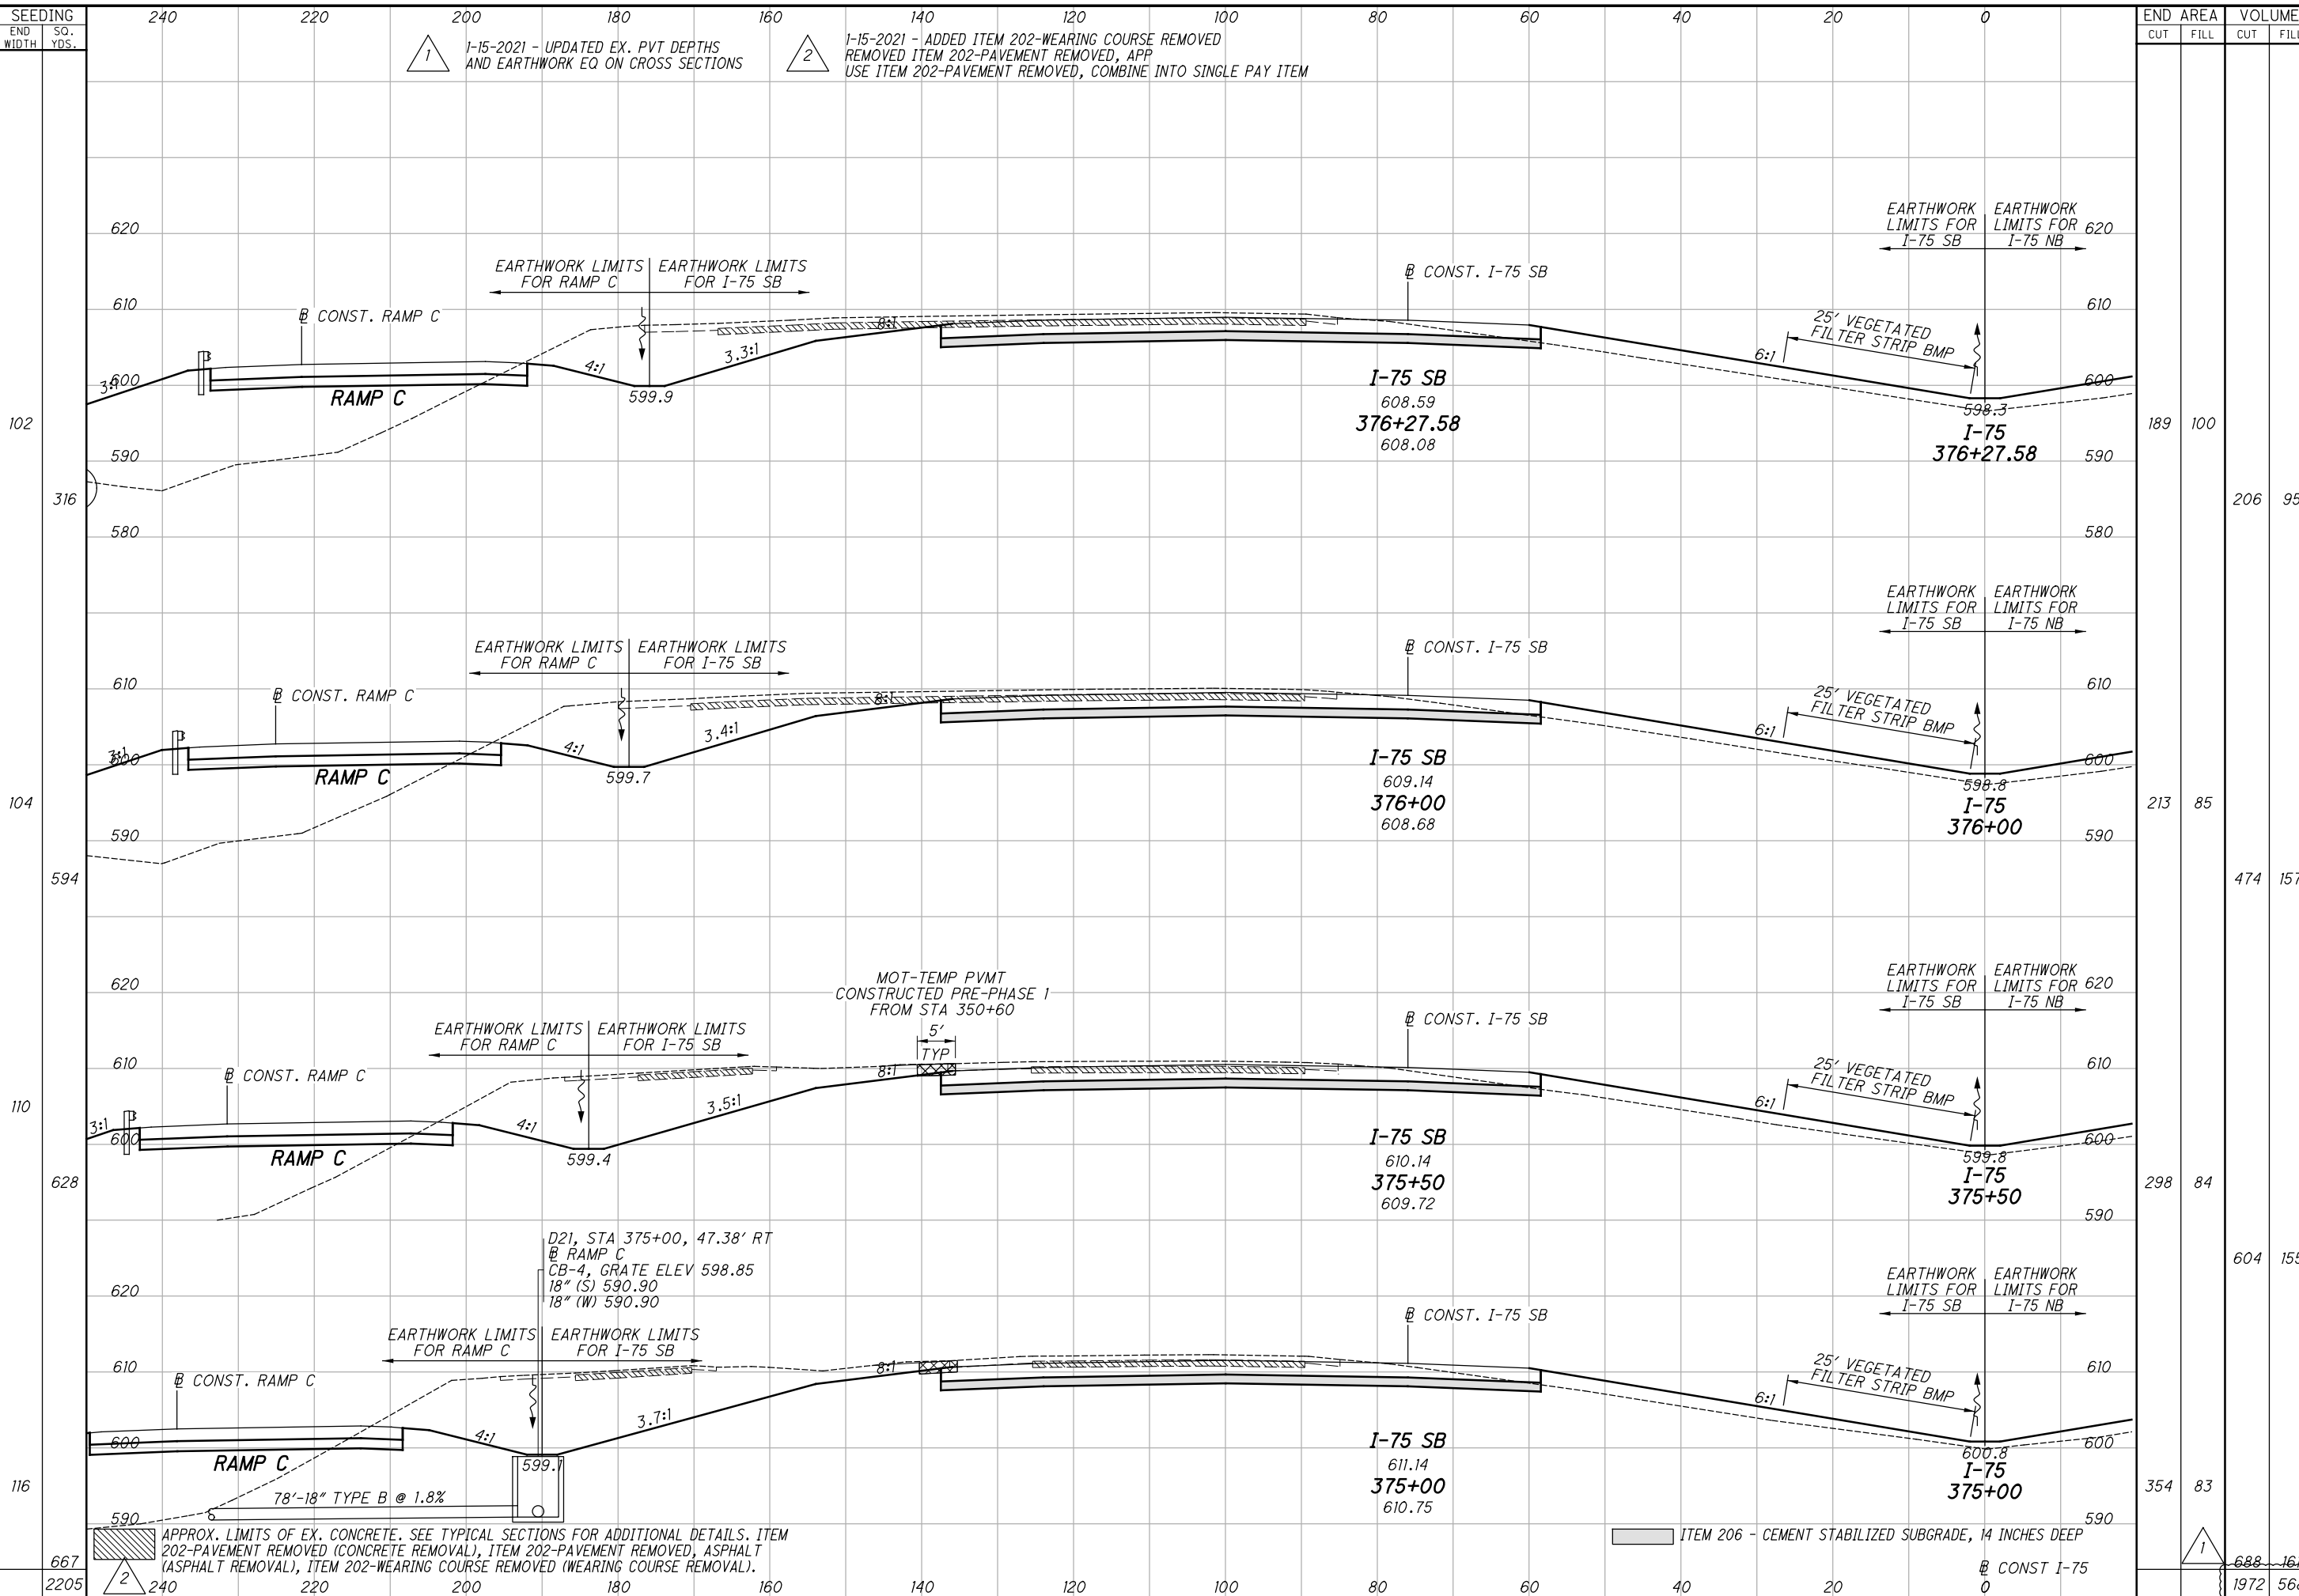


END AREA	VOLUME		CALCULATED WLC	CHECKED	JDH
	CUT	FILL			
189	100				
213	85				
298	84				
354	83				
688	161				
1972	568				

**CROSS SECTIONS I-75 SB**  
**STA. 375+00 TO STA. 376+27.58**

**HAM-75-14.61**

**285**  
**708**

j:\pre-int\06\06-386\_HAM-75\_HAM\00000\roadway\sheets\00000X5101\_SB.dgn 2021-01-20 10:31:04 AM william.croxtan ODOTV81\_Pen-ME.tbl IBI Group

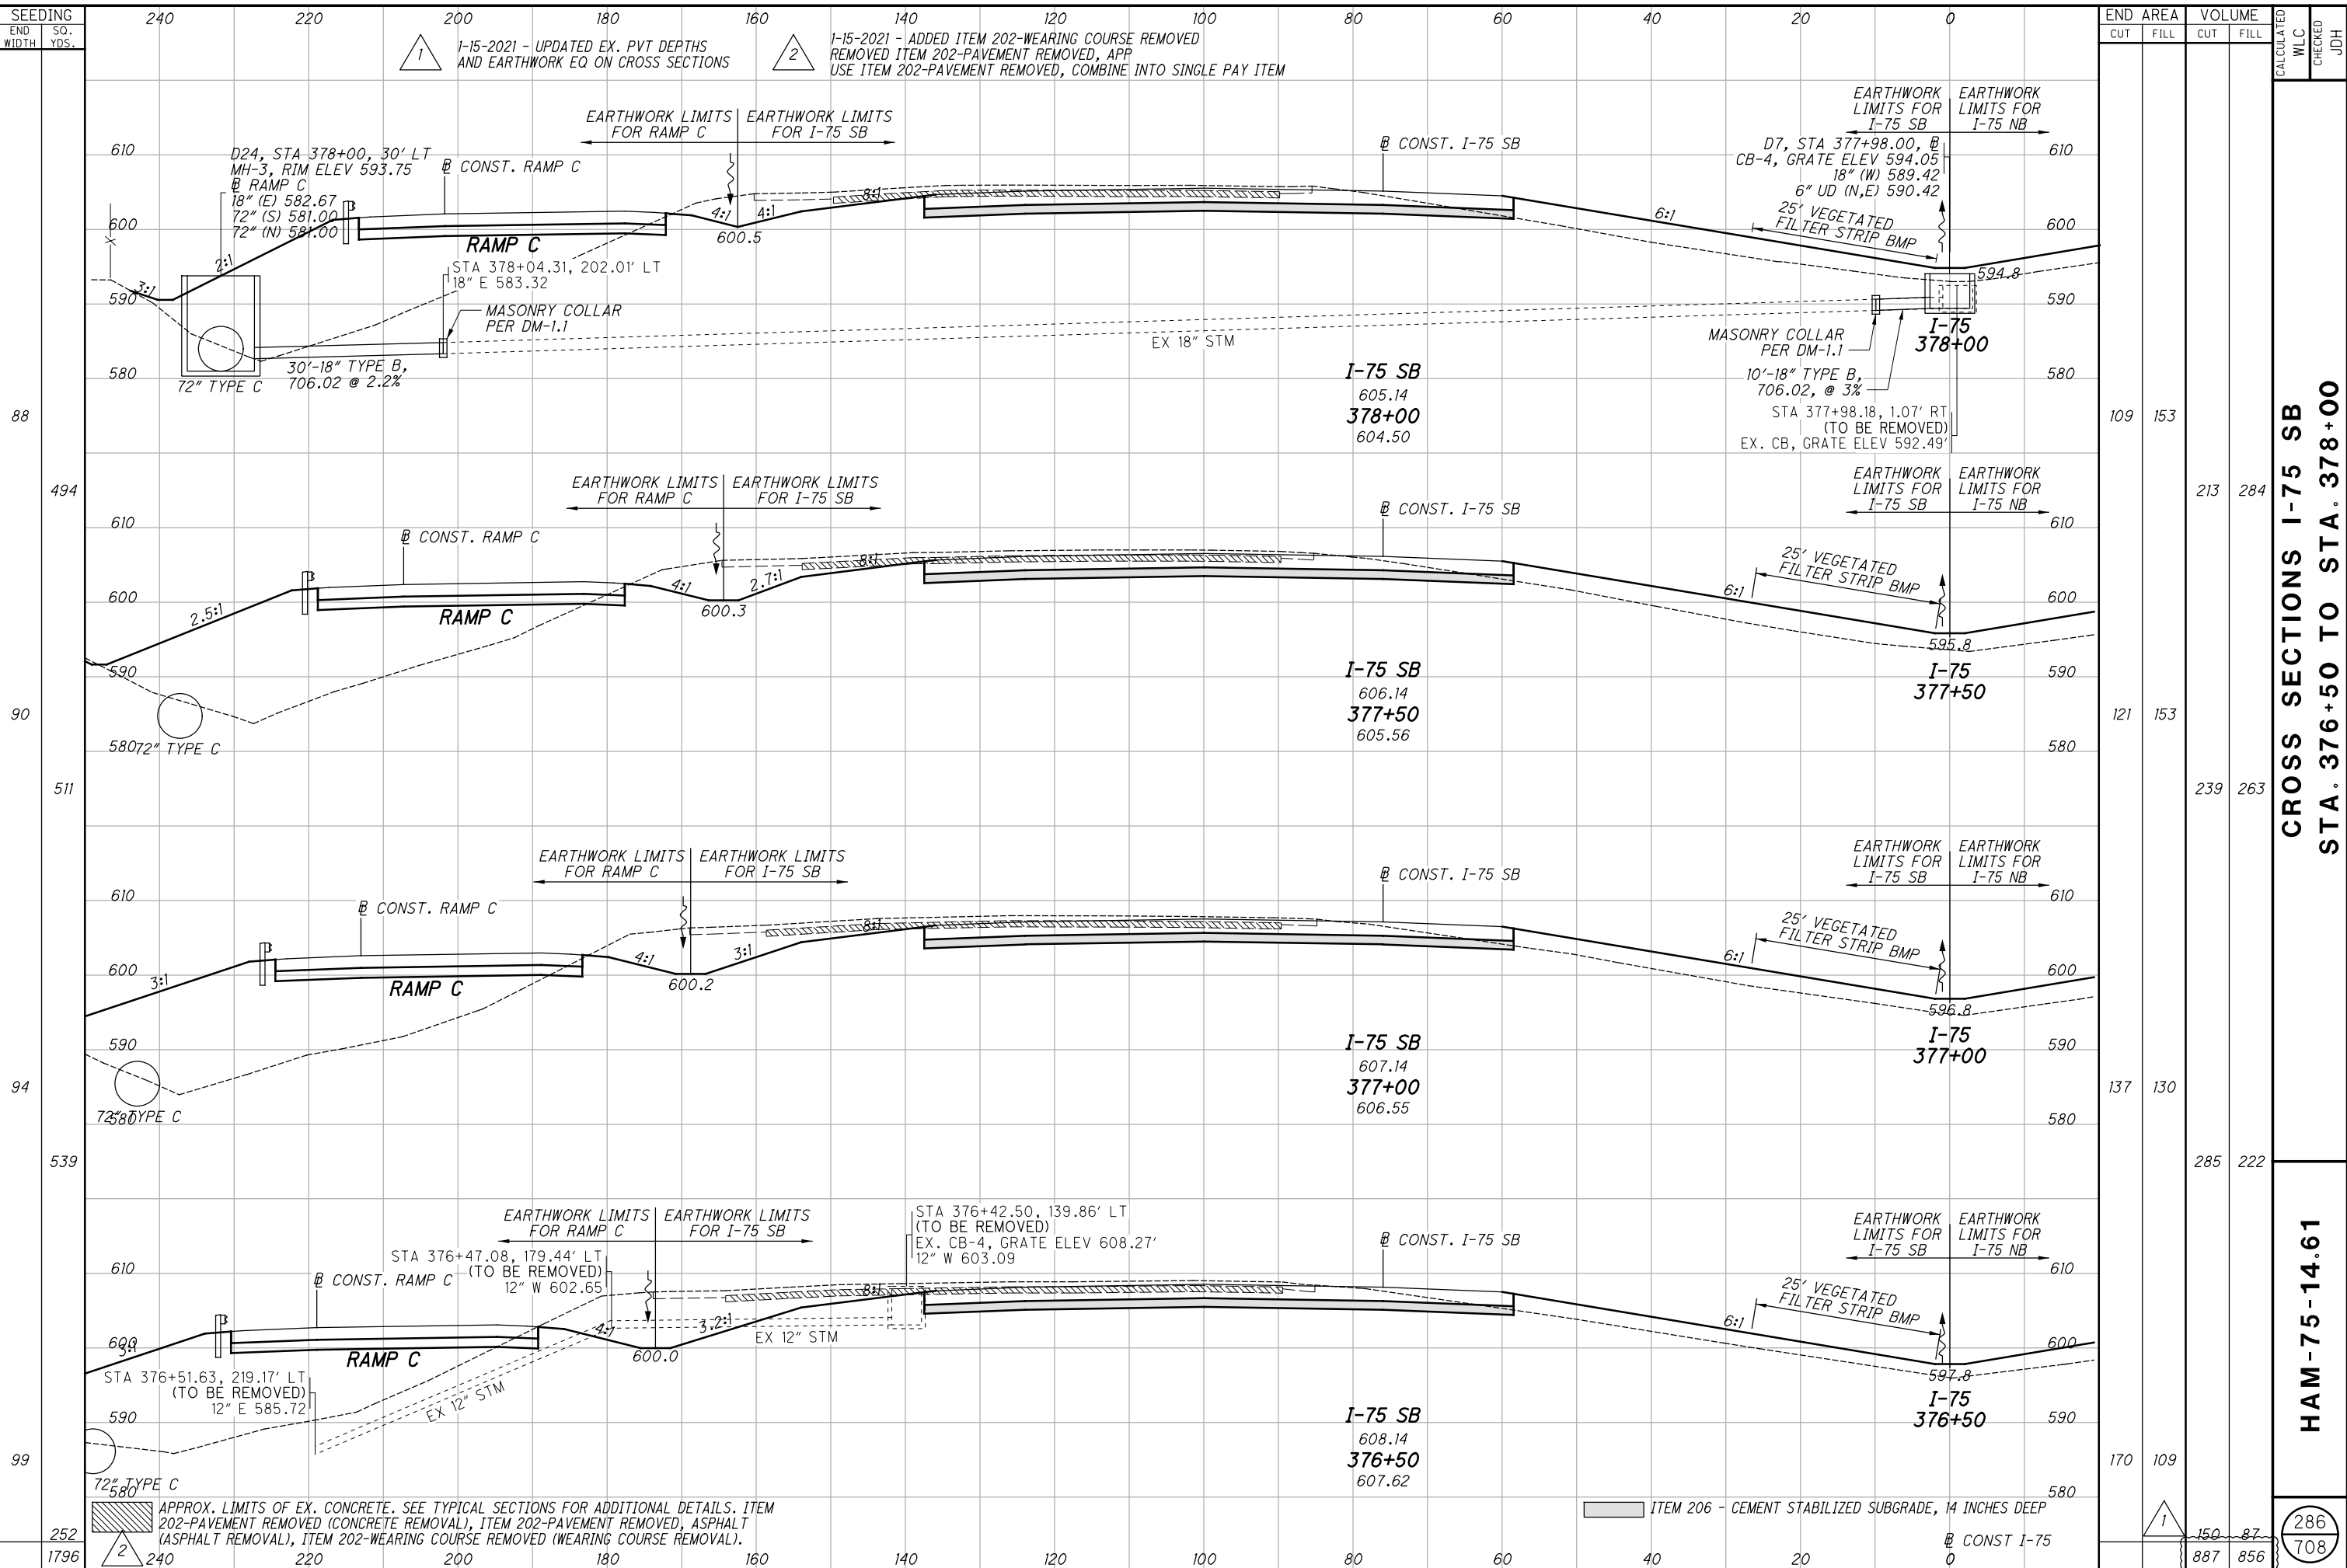

**CROSS SECTIONS I-75 SB  
STA. 376+50 TO STA. 378+00**


**HAM-75-14.61**

286  
708

STATION	END AREA		VOLUME	
	CUT	FILL	CUT	FILL
378+00	109	153	213	284
377+50	121	153	239	263
377+00	137	130	285	222
376+50	170	109	150	87
TOTAL	537	545	1177	856



J:\pre-int\06\06-386\_HAM-75\HAM\00000\roadway\sheets\00000X5101\_SB.dgn 2021-01-20 10:31:07 AM william.croxton ODOTcadd\_PDF.pltcfgr ODOTV81\_Pen-ME.tbl IBI Group

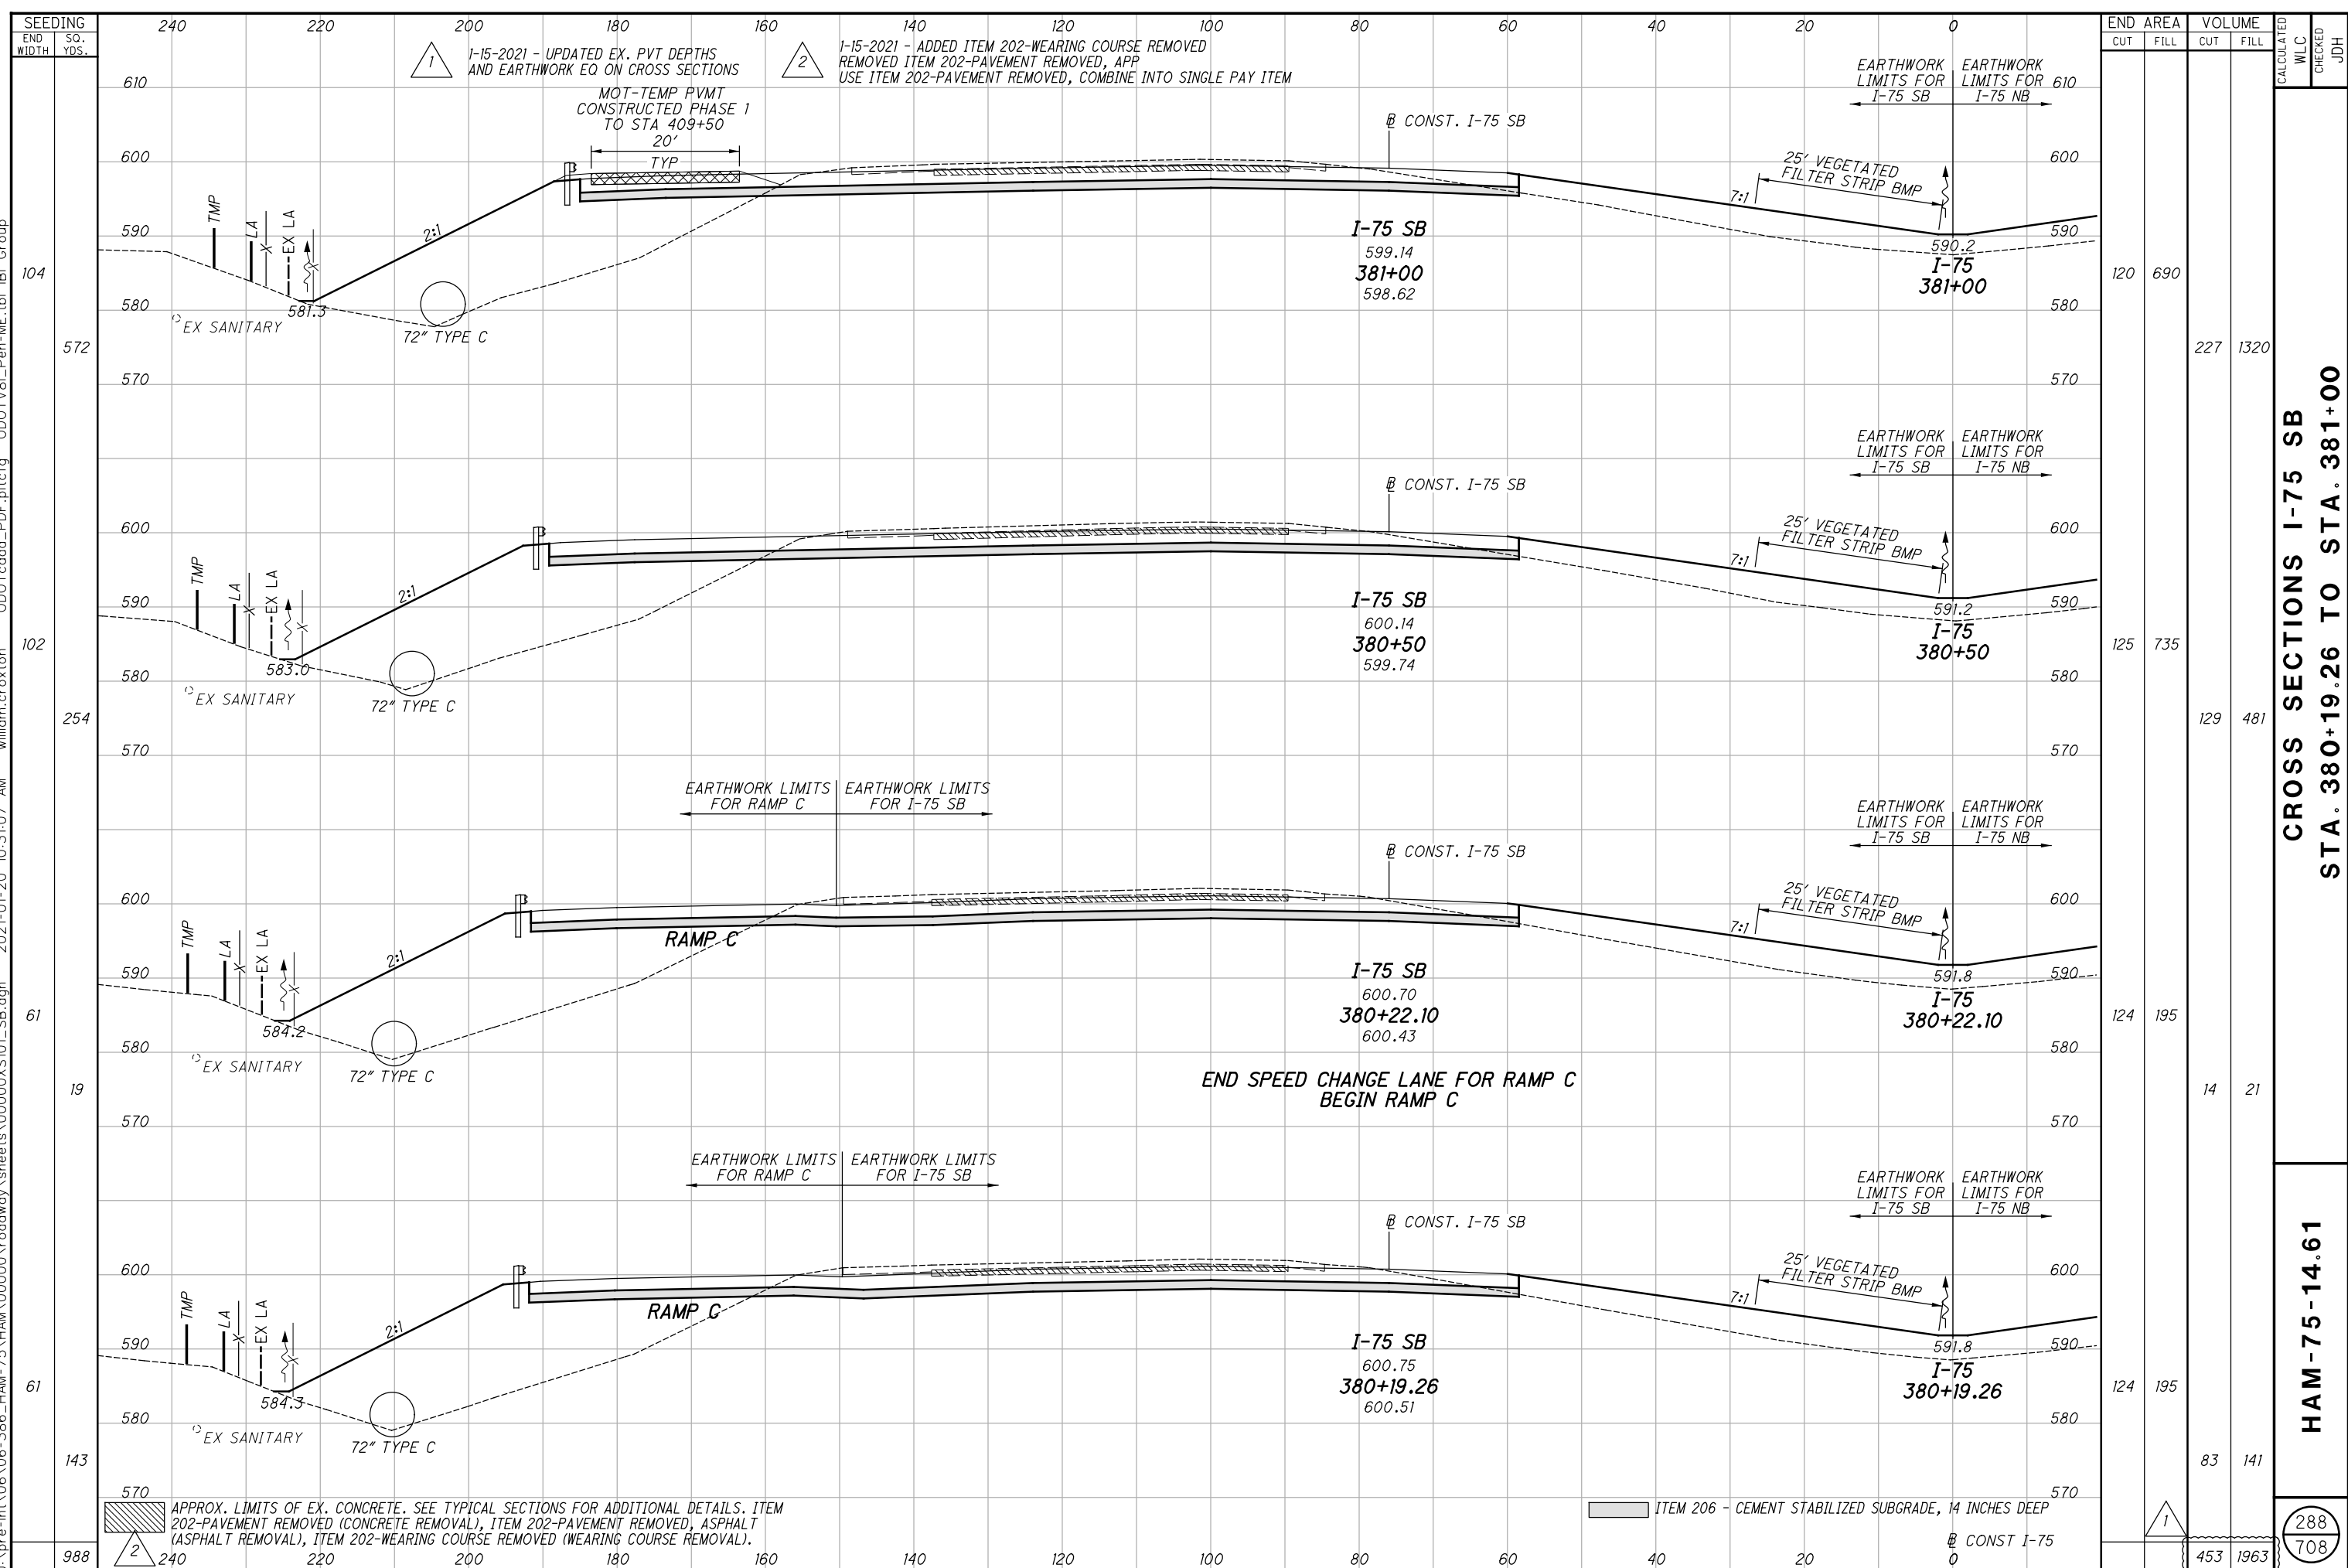

CROSS SECTIONS I-75 SB  
STA. 380+19.26 TO STA. 381+00

HAM-75-14.61

288  
708

1-15-2021 - UPDATED EX. PVT DEPTHS AND EARTHWORK EQ ON CROSS SECTIONS  
1-15-2021 - ADDED ITEM 202-WEARING COURSE REMOVED REMOVED ITEM 202-PAVEMENT REMOVED, APP USE ITEM 202-PAVEMENT REMOVED, COMBINE INTO SINGLE PAY ITEM

MOT-TEMP PVMT CONSTRUCTED PHASE I TO STA 409+50  
TYP  
20'

CONST. I-75 SB

EARTHWORK LIMITS FOR I-75 SB  
EARTHWORK LIMITS FOR I-75 NB

25' VEGETATED FILTER STRIP BMP  
7:1

I-75 SB  
599.14  
381+00  
598.62

I-75  
381+00

I-75 SB  
600.14  
380+50  
599.74

I-75  
380+50

I-75 SB  
600.70  
380+22.10  
600.43

I-75  
380+22.10

END SPEED CHANGE LANE FOR RAMP C  
BEGIN RAMP C

I-75 SB  
600.75  
380+19.26  
600.51


I-75  
380+19.26

APPROX. LIMITS OF EX. CONCRETE. SEE TYPICAL SECTIONS FOR ADDITIONAL DETAILS. ITEM 202-PAVEMENT REMOVED (CONCRETE REMOVAL), ITEM 202-PAVEMENT REMOVED, ASPHALT (ASPHALT REMOVAL), ITEM 202-WEARING COURSE REMOVED (WEARING COURSE REMOVAL).

ITEM 206 - CEMENT STABILIZED SUBGRADE, 14 INCHES DEEP

CONST I-75

J:\pre-int\06\06-386\_HAM-75\HAM\00000\roadway\sheets\00000X5101\_SB.dgn 2021-01-20 10:31:08 AM william.croxton ODOTcadd\_PDF.pltcfgr ODOTV81\_Pen-ME.tbl IBI Group

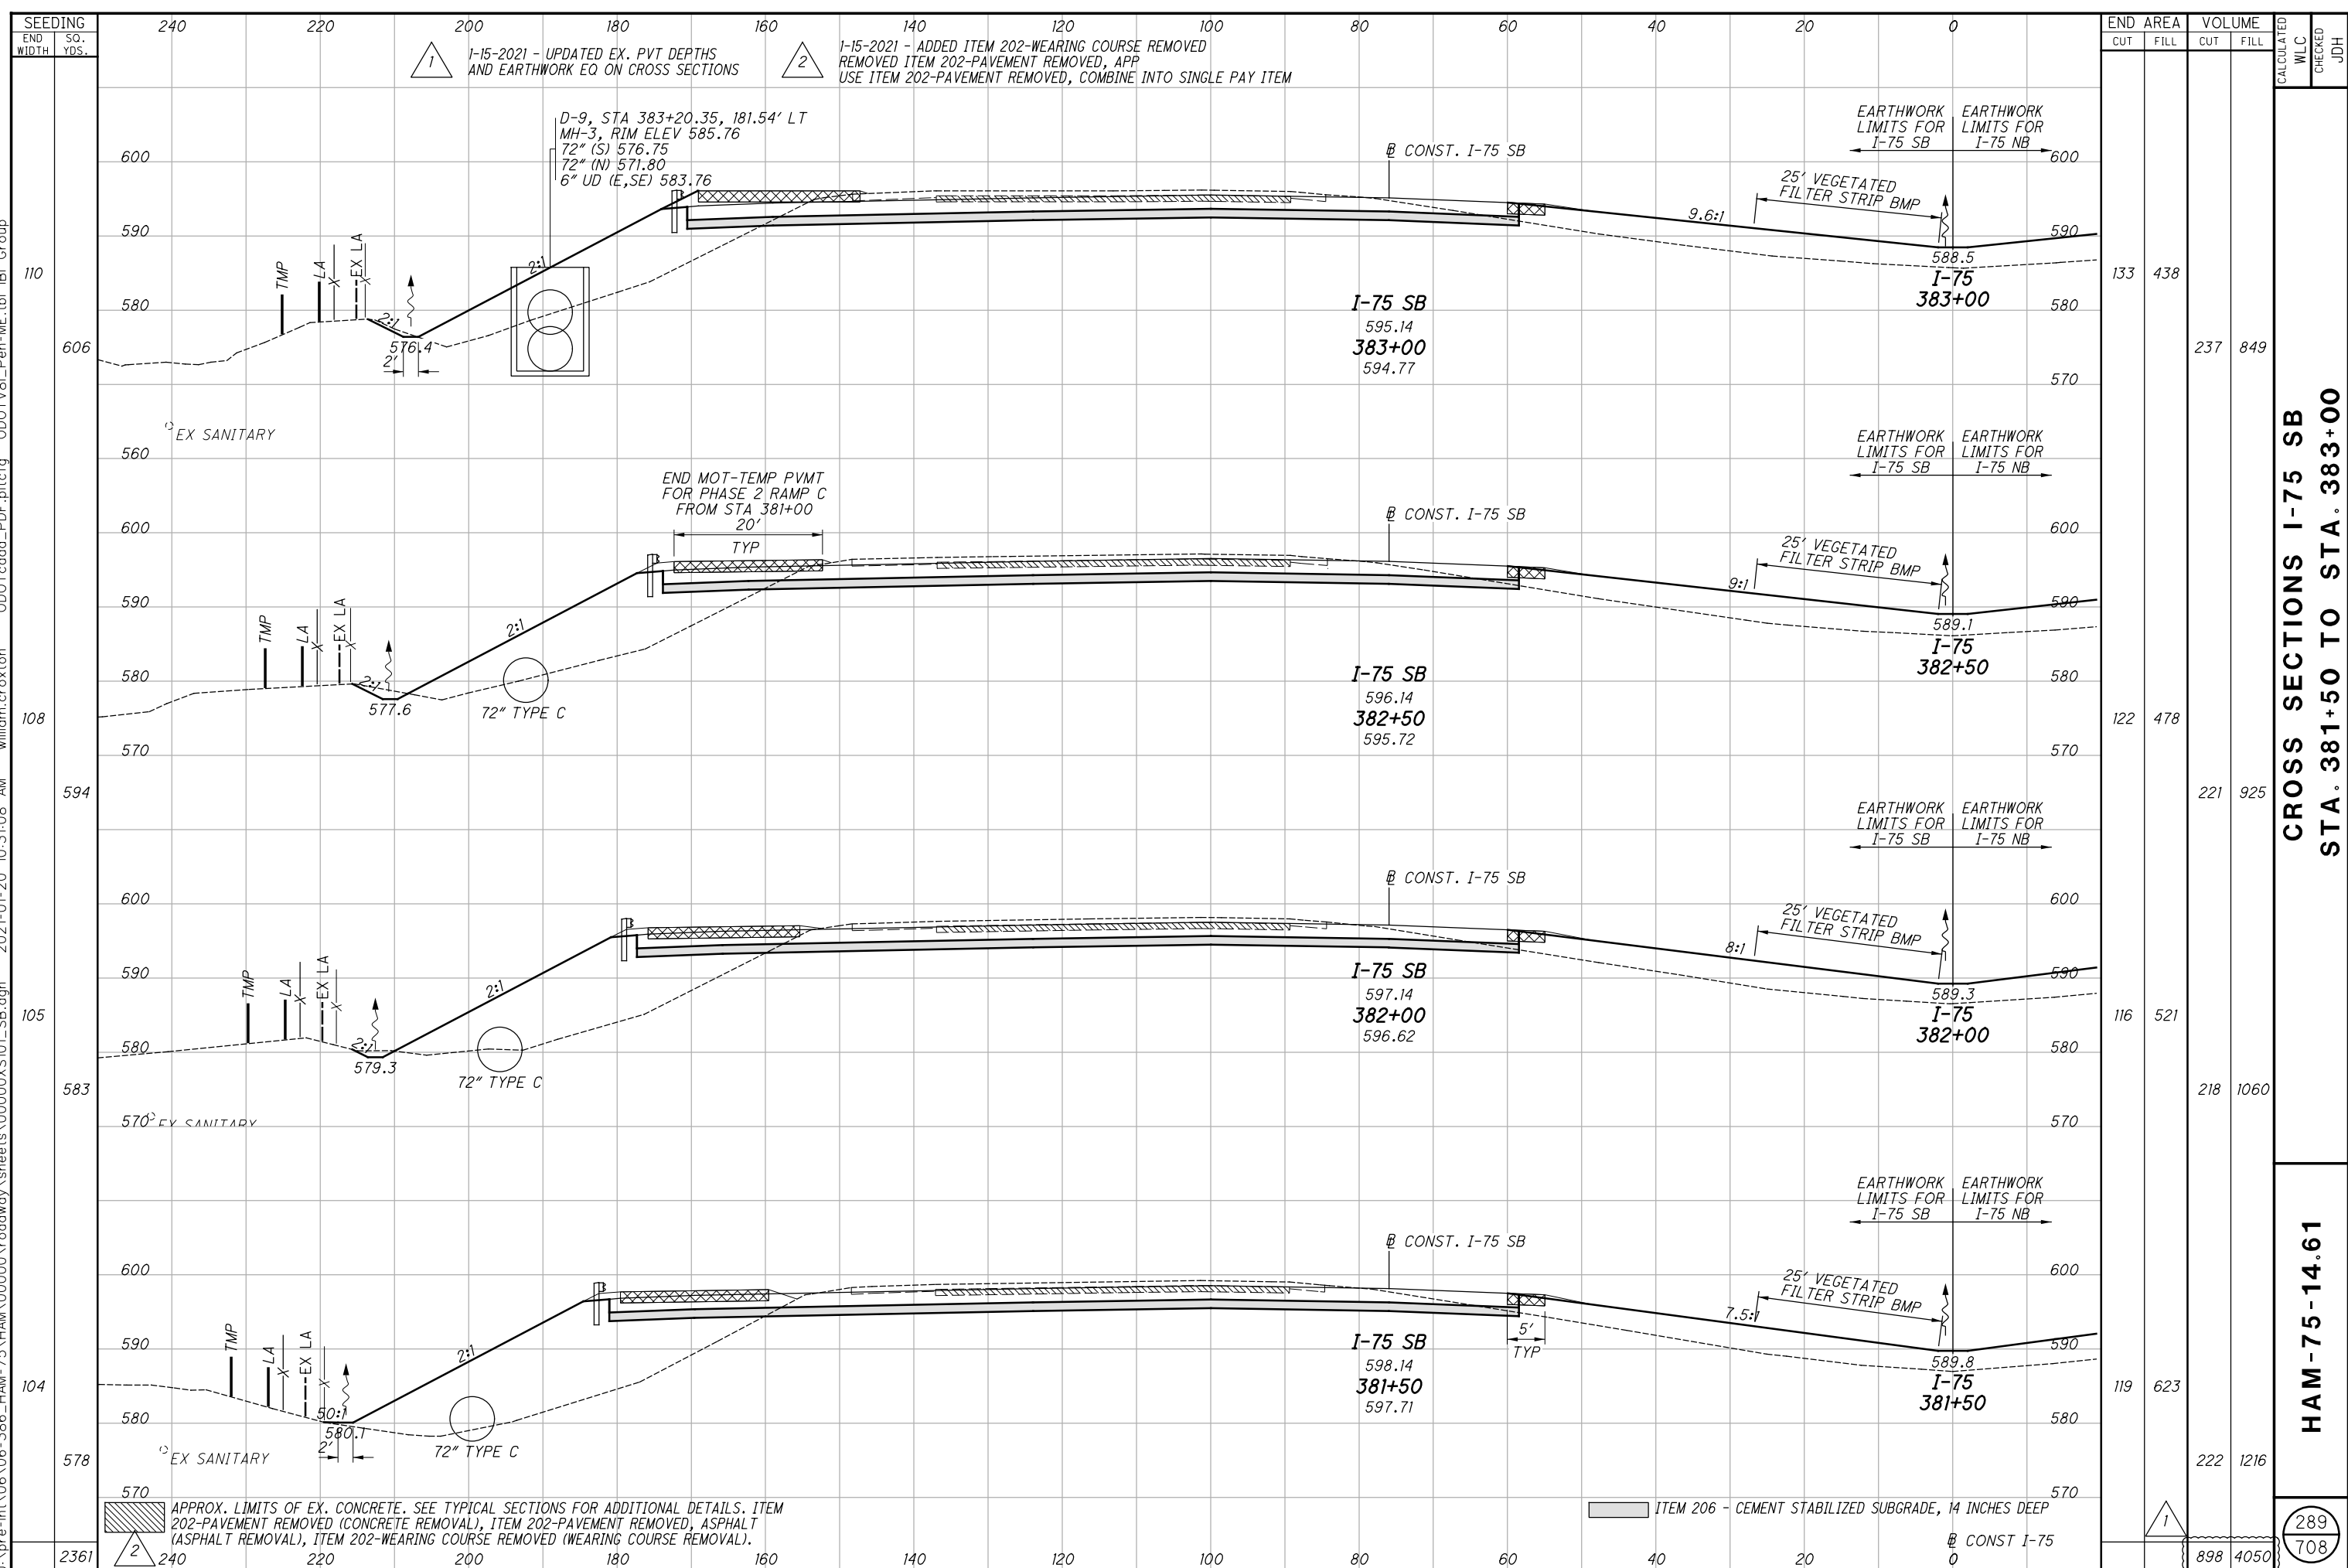

1-15-2021 - UPDATED EX. PVT DEPTHS AND EARTHWORK EQ ON CROSS SECTIONS  
 1-15-2021 - ADDED ITEM 202-WEARING COURSE REMOVED REMOVED ITEM 202-PAVEMENT REMOVED, APP USE ITEM 202-PAVEMENT REMOVED, COMBINE INTO SINGLE PAY ITEM

D-9, STA 383+20.35, 181.54' LT  
 MH-3, RIM ELEV 585.76  
 72" (S) 576.75  
 72" (N) 571.80  
 6" UD (E,SE) 583.76

END MOT-TEMP PVMT FOR PHASE 2 RAMP C FROM STA 381+00  
 20'  
 TYP

APPROX. LIMITS OF EX. CONCRETE. SEE TYPICAL SECTIONS FOR ADDITIONAL DETAILS. ITEM 202-PAVEMENT REMOVED (CONCRETE REMOVAL), ITEM 202-PAVEMENT REMOVED, ASPHALT (ASPHALT REMOVAL), ITEM 202-WEARING COURSE REMOVED (WEARING COURSE REMOVAL).

ITEM 206 - CEMENT STABILIZED SUBGRADE, 14 INCHES DEEP  
 CONST I-75

END STA	AREA		VOLUME		CALCULATED WLC	CHECKED JDH
	CUT	FILL	CUT	FILL		
383+00	133	438	237	849		
382+50	122	478	221	925		
382+00	116	521	218	1060		
381+50	119	623	222	1216		
TOTAL	490	2060	900	4050	289	708


CROSS SECTIONS I-75 SB  
 STA. 381+50 TO STA. 383+00

HAM-75-14.61

289  
708



J:\pre-int\06\06-386\_HAM-75\HAM\00000\roadway\sheets\000005\01\_SB.dgn 2021-01-20 10:31:09 AM william.croxton ODOTVBI\_Pen-ME.tbl IBI Group

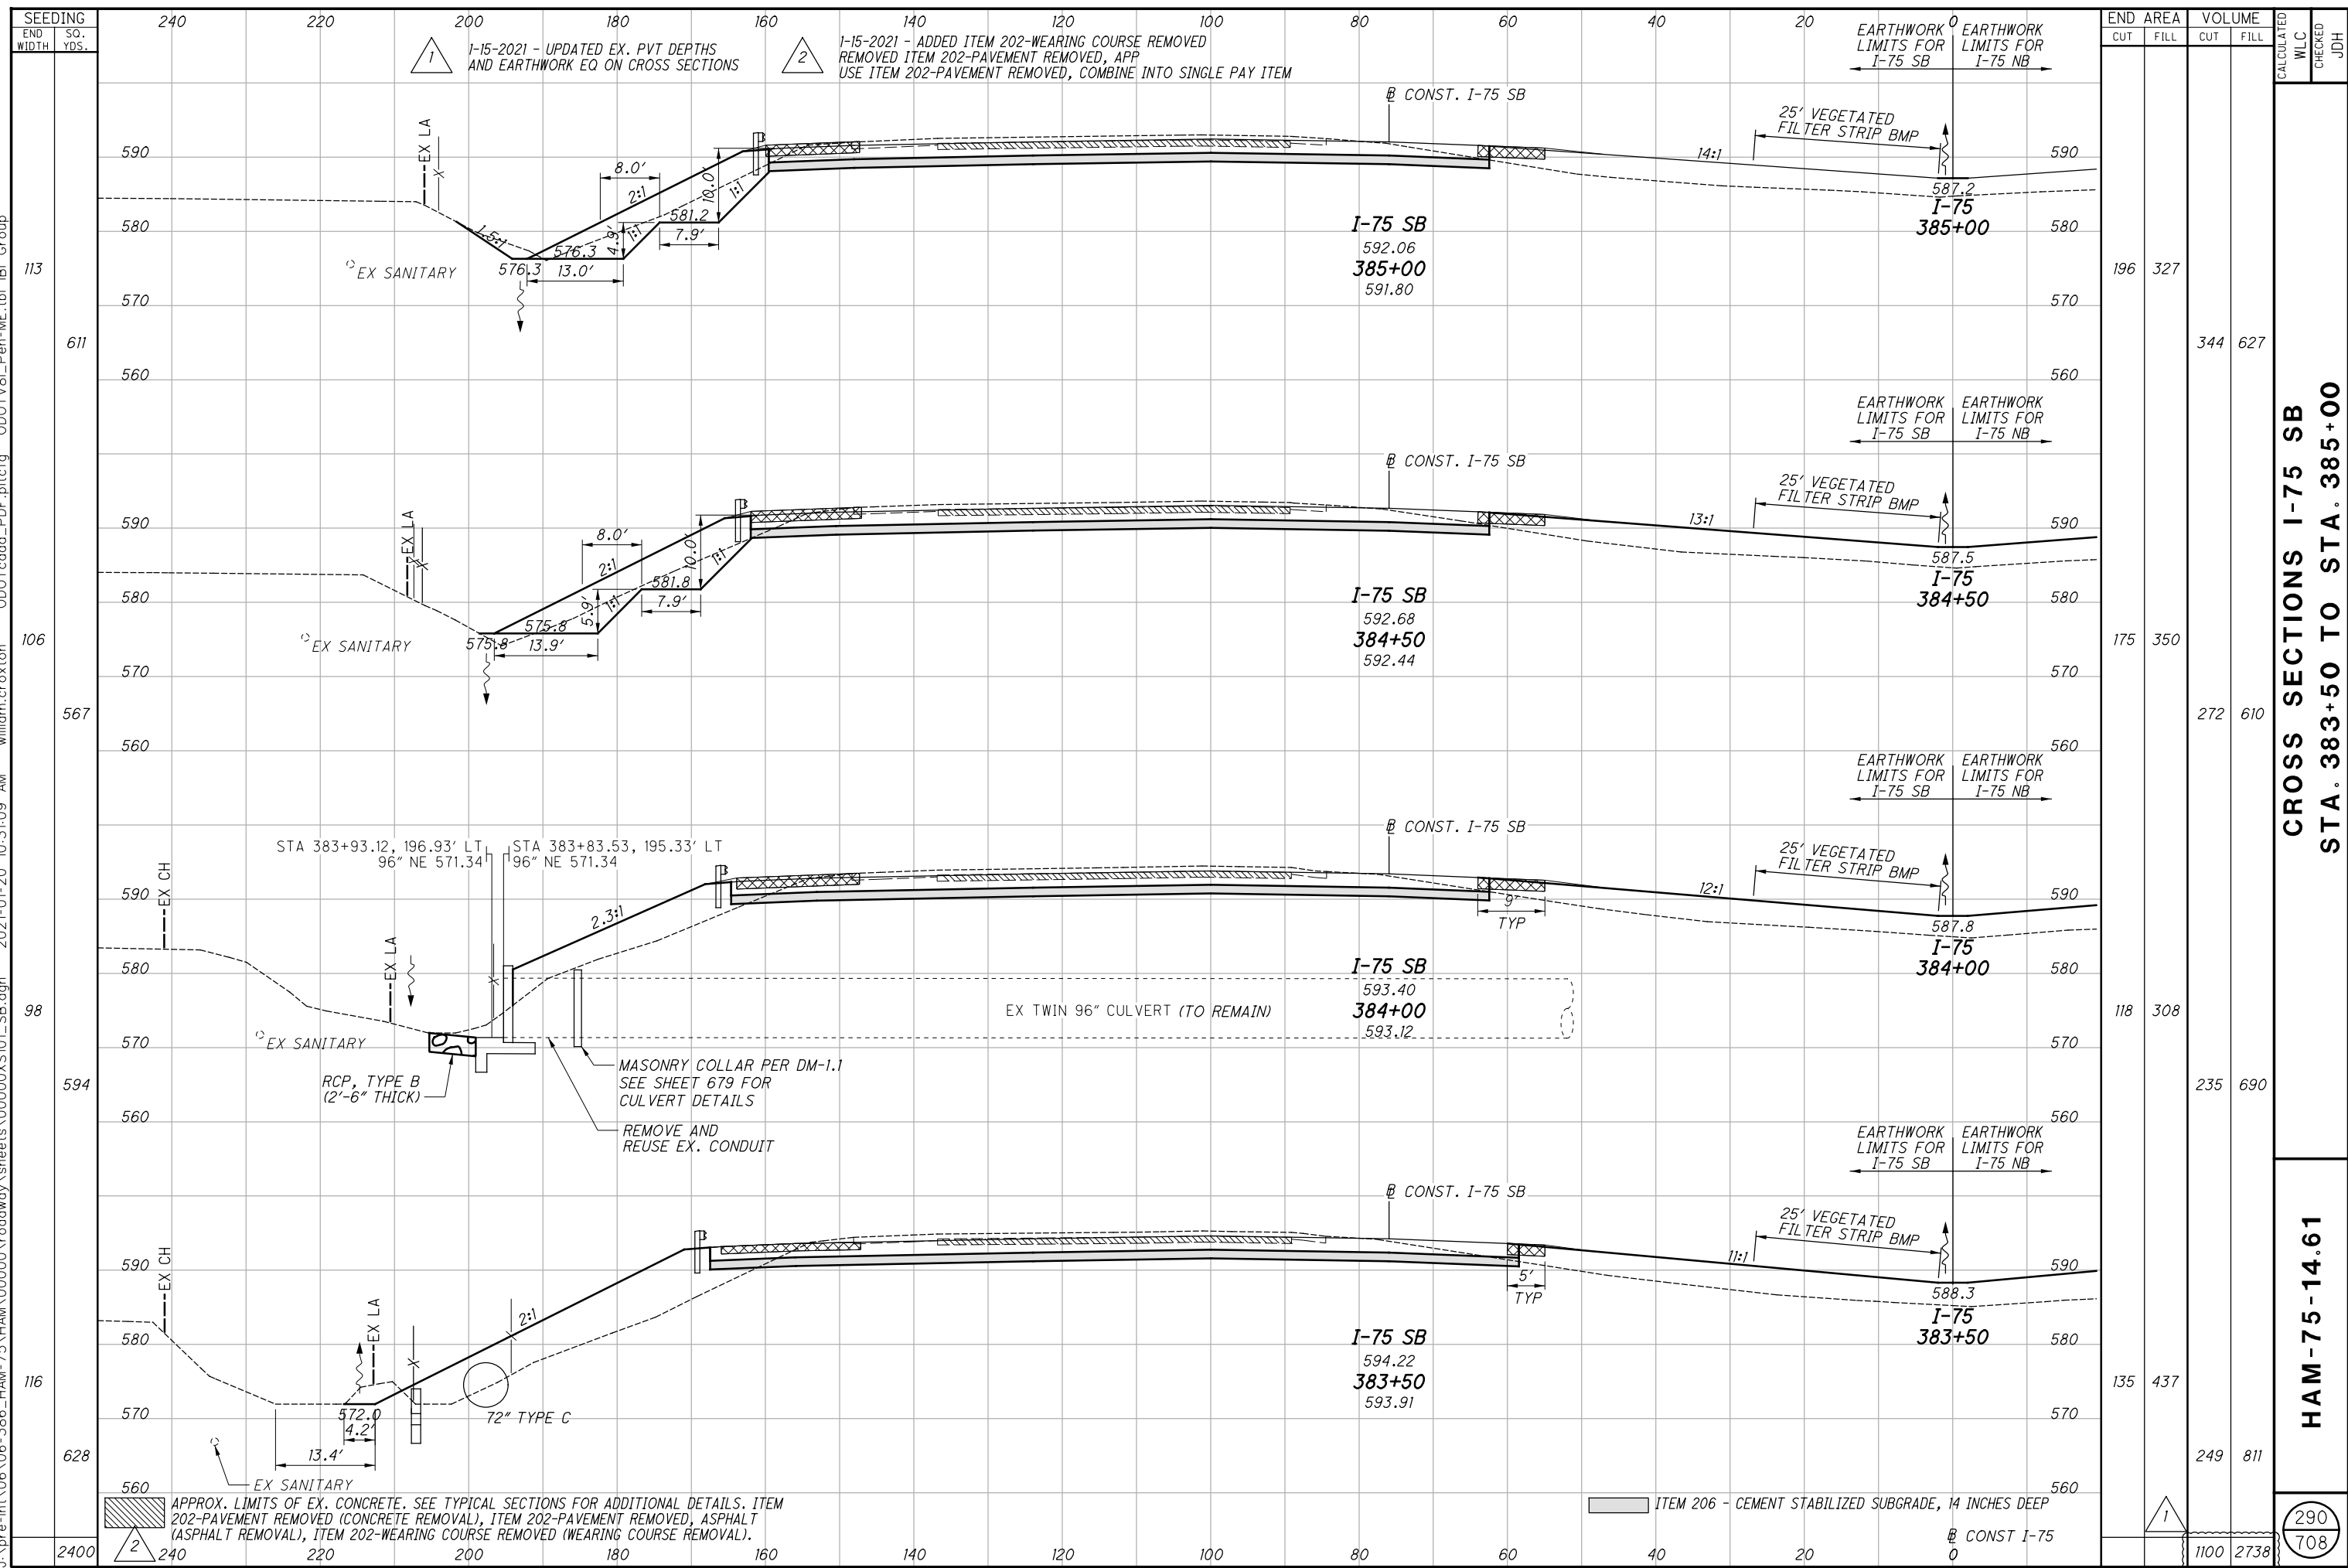


END AREA	VOLUME	CALCULATED	WLC	CHECKED	JDH
196	327				
	344				
175	350				
	272				
118	308				
	235				
135	437				
	249				
	1100				
	2738				

CROSS SECTIONS I-75 SB  
STA. 383+50 TO STA. 385+00

HAM-75-14.61

290  
708

j:\pre-int\06\06-386\_HAM-75\HAM\00000\roadway\sheets\00000X5101\_SB.dgn 2021-01-20 10:31:10 AM william.croxton' ODOT\cadd\_PDF\plctfg ODOTV8i\_Pen-ME.tbl |BI Group

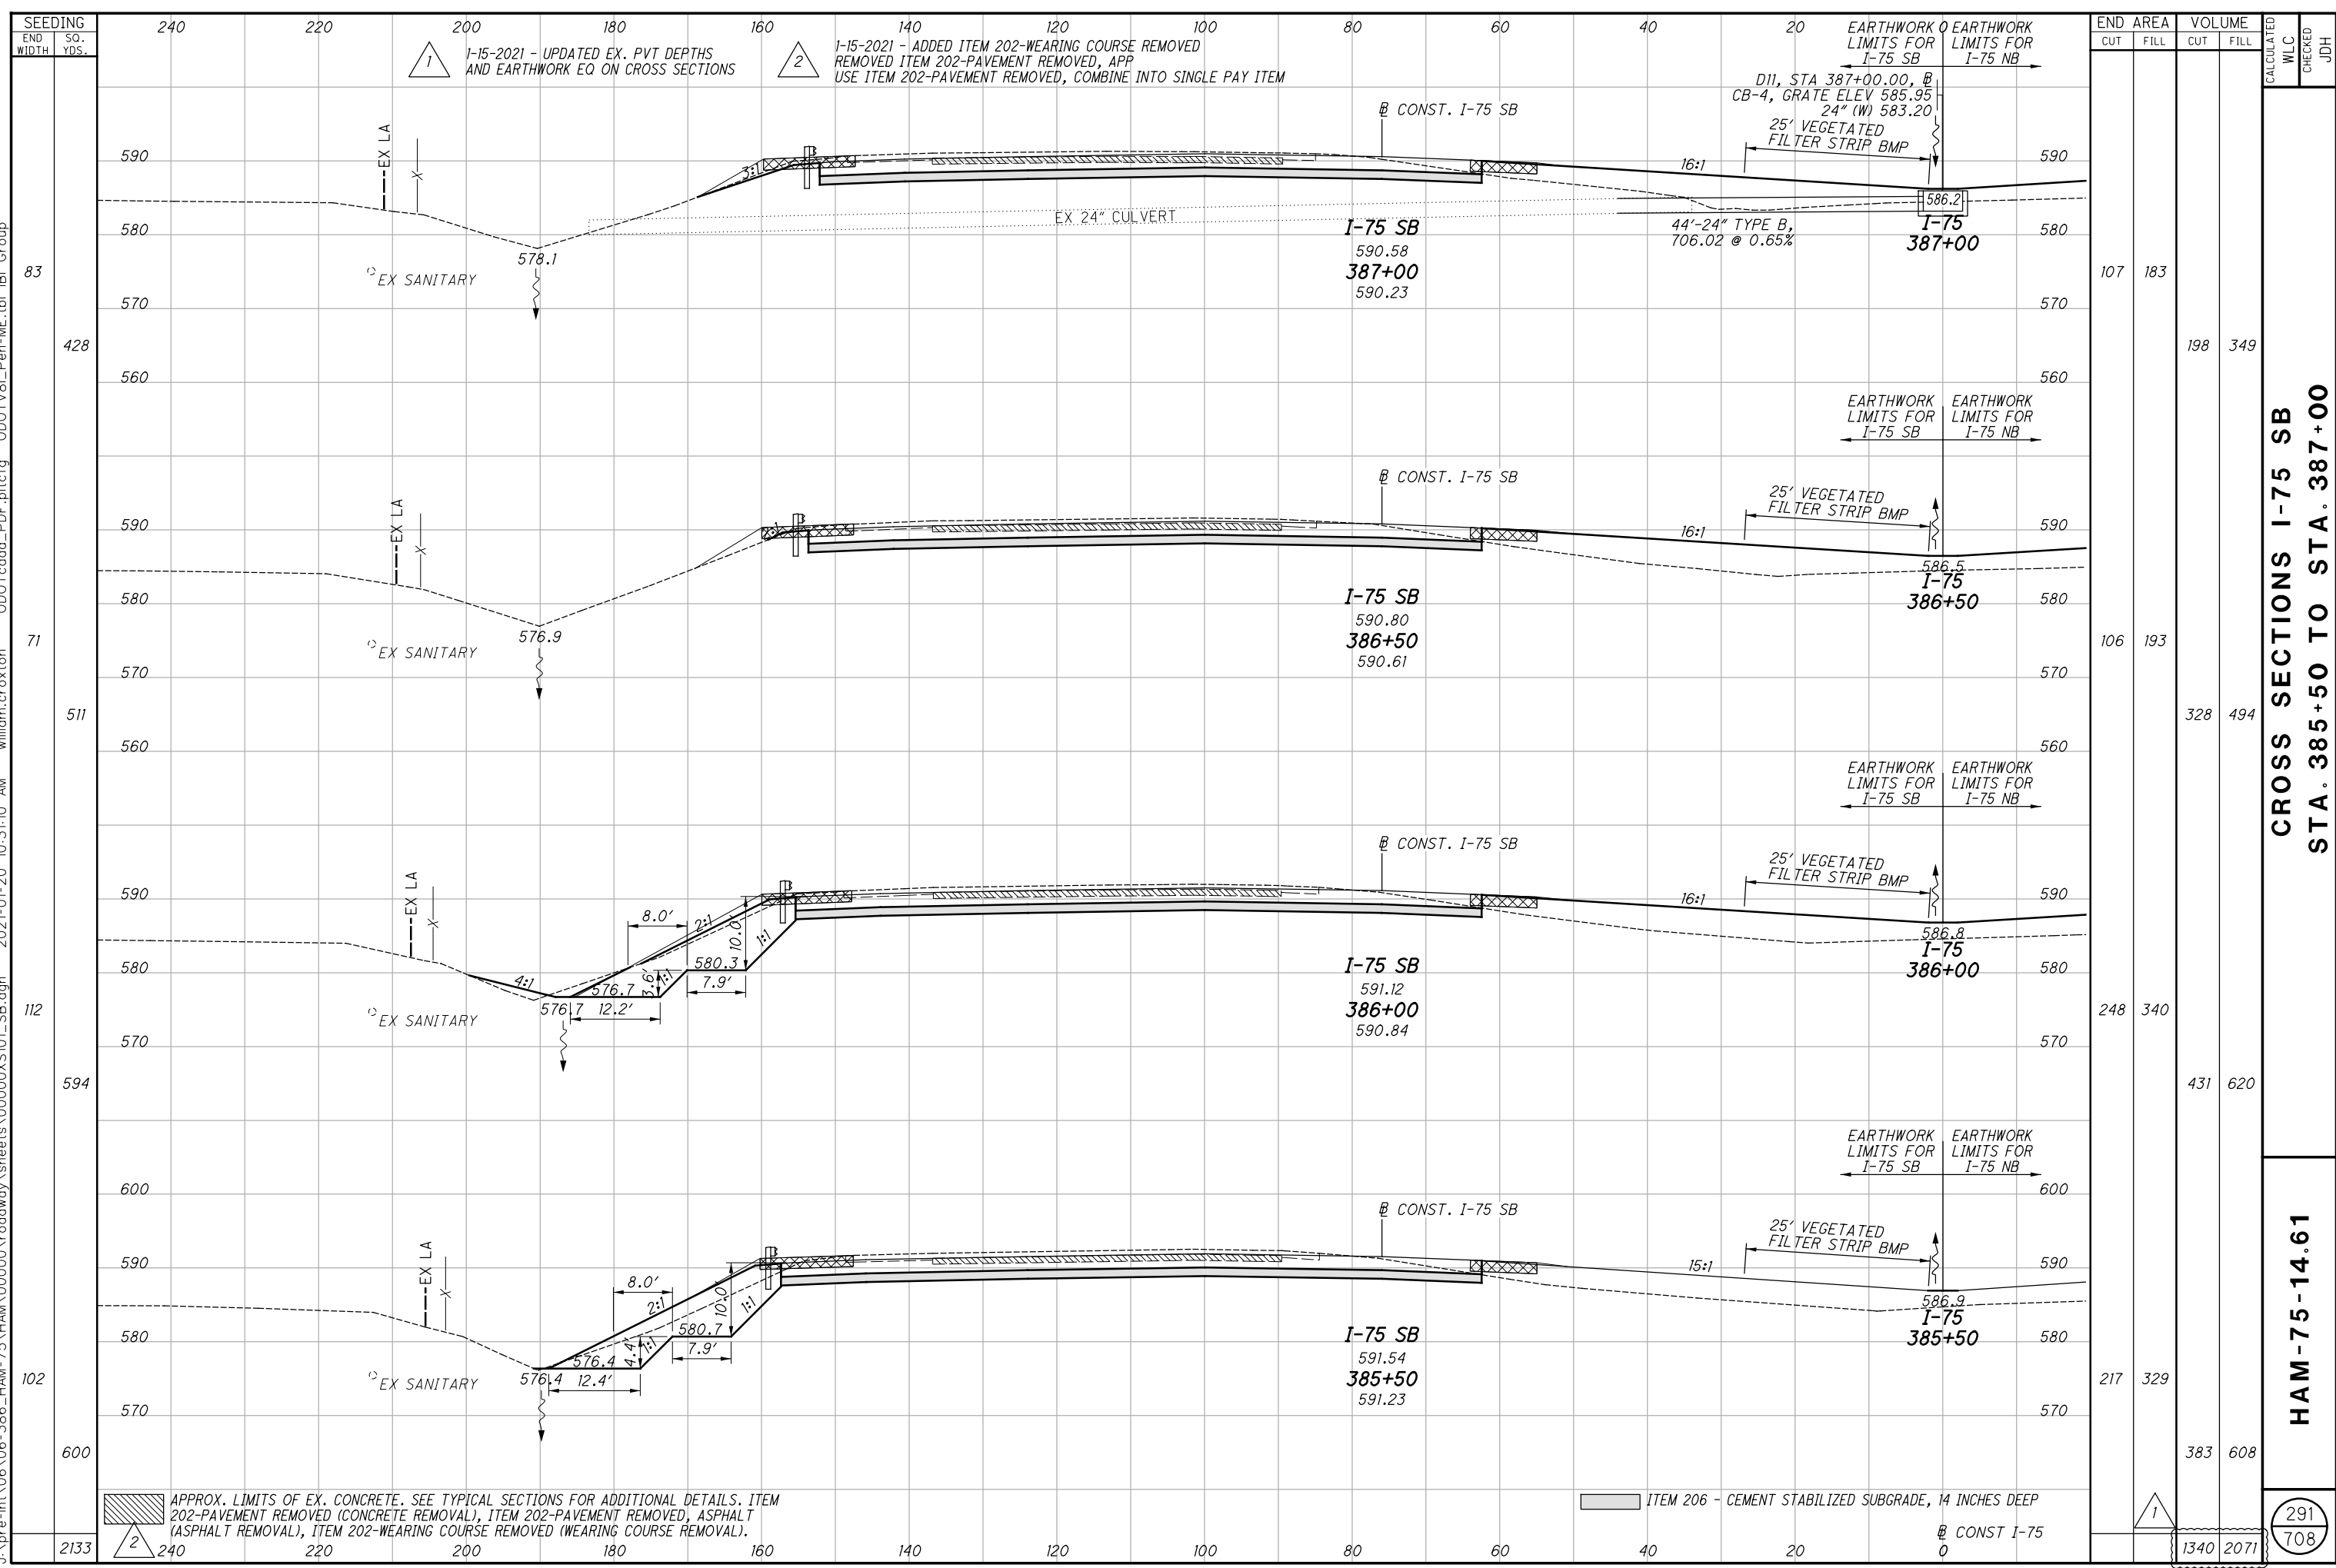

END AREA	VOLUME		CALCULATED WLC	CHECKED	JDH
	CUT	FILL			
107	183	198			
106	193	328			
248	340	431			
217	329	383			
		1340			
		2071			

**CROSS SECTIONS I-75 SB  
 STA. 385+50 TO STA. 387+00**

**HAM-75-14.61**

291  
 708

APPROX. LIMITS OF EX. CONCRETE. SEE TYPICAL SECTIONS FOR ADDITIONAL DETAILS. ITEM 202-PAVEMENT REMOVED (CONCRETE REMOVAL), ITEM 202-PAVEMENT REMOVED, ASPHALT (ASPHALT REMOVAL), ITEM 202-WEARING COURSE REMOVED (WEARING COURSE REMOVAL).

ITEM 206 - CEMENT STABILIZED SUBGRADE, 14 INCHES DEEP  
 CONST I-75

1-15-2021 - UPDATED EX. PVT DEPTHS AND EARTHWORK EQ ON CROSS SECTIONS

1-15-2021 - ADDED ITEM 202-WEARING COURSE REMOVED REMOVED ITEM 202-PAVEMENT REMOVED, APP USE ITEM 202-PAVEMENT REMOVED, COMBINE INTO SINGLE PAY ITEM

D11, STA 387+00.00, @ CB-4, GRATE ELEV 585.95 24" (W) 583.20  
 25' VEGETATED FILTER STRIP BMP

EARTHWORK LIMITS FOR I-75 SB  
 EARTHWORK LIMITS FOR I-75 NB


EARTHWORK LIMITS FOR I-75 SB  
 EARTHWORK LIMITS FOR I-75 NB

EARTHWORK LIMITS FOR I-75 SB  
 EARTHWORK LIMITS FOR I-75 NB

25' VEGETATED FILTER STRIP BMP

CONST I-75

j:\pre-int\06\06-386\_HAM-75\_HAM\00000\roadway\sheets\00000XS101\_SB.dgn 2021-01-20 10:31:11 AM william.croxton ODOT\cadd\_PDF.pltcf ODOTV8i\_Pen-ME.tbl IBI Group

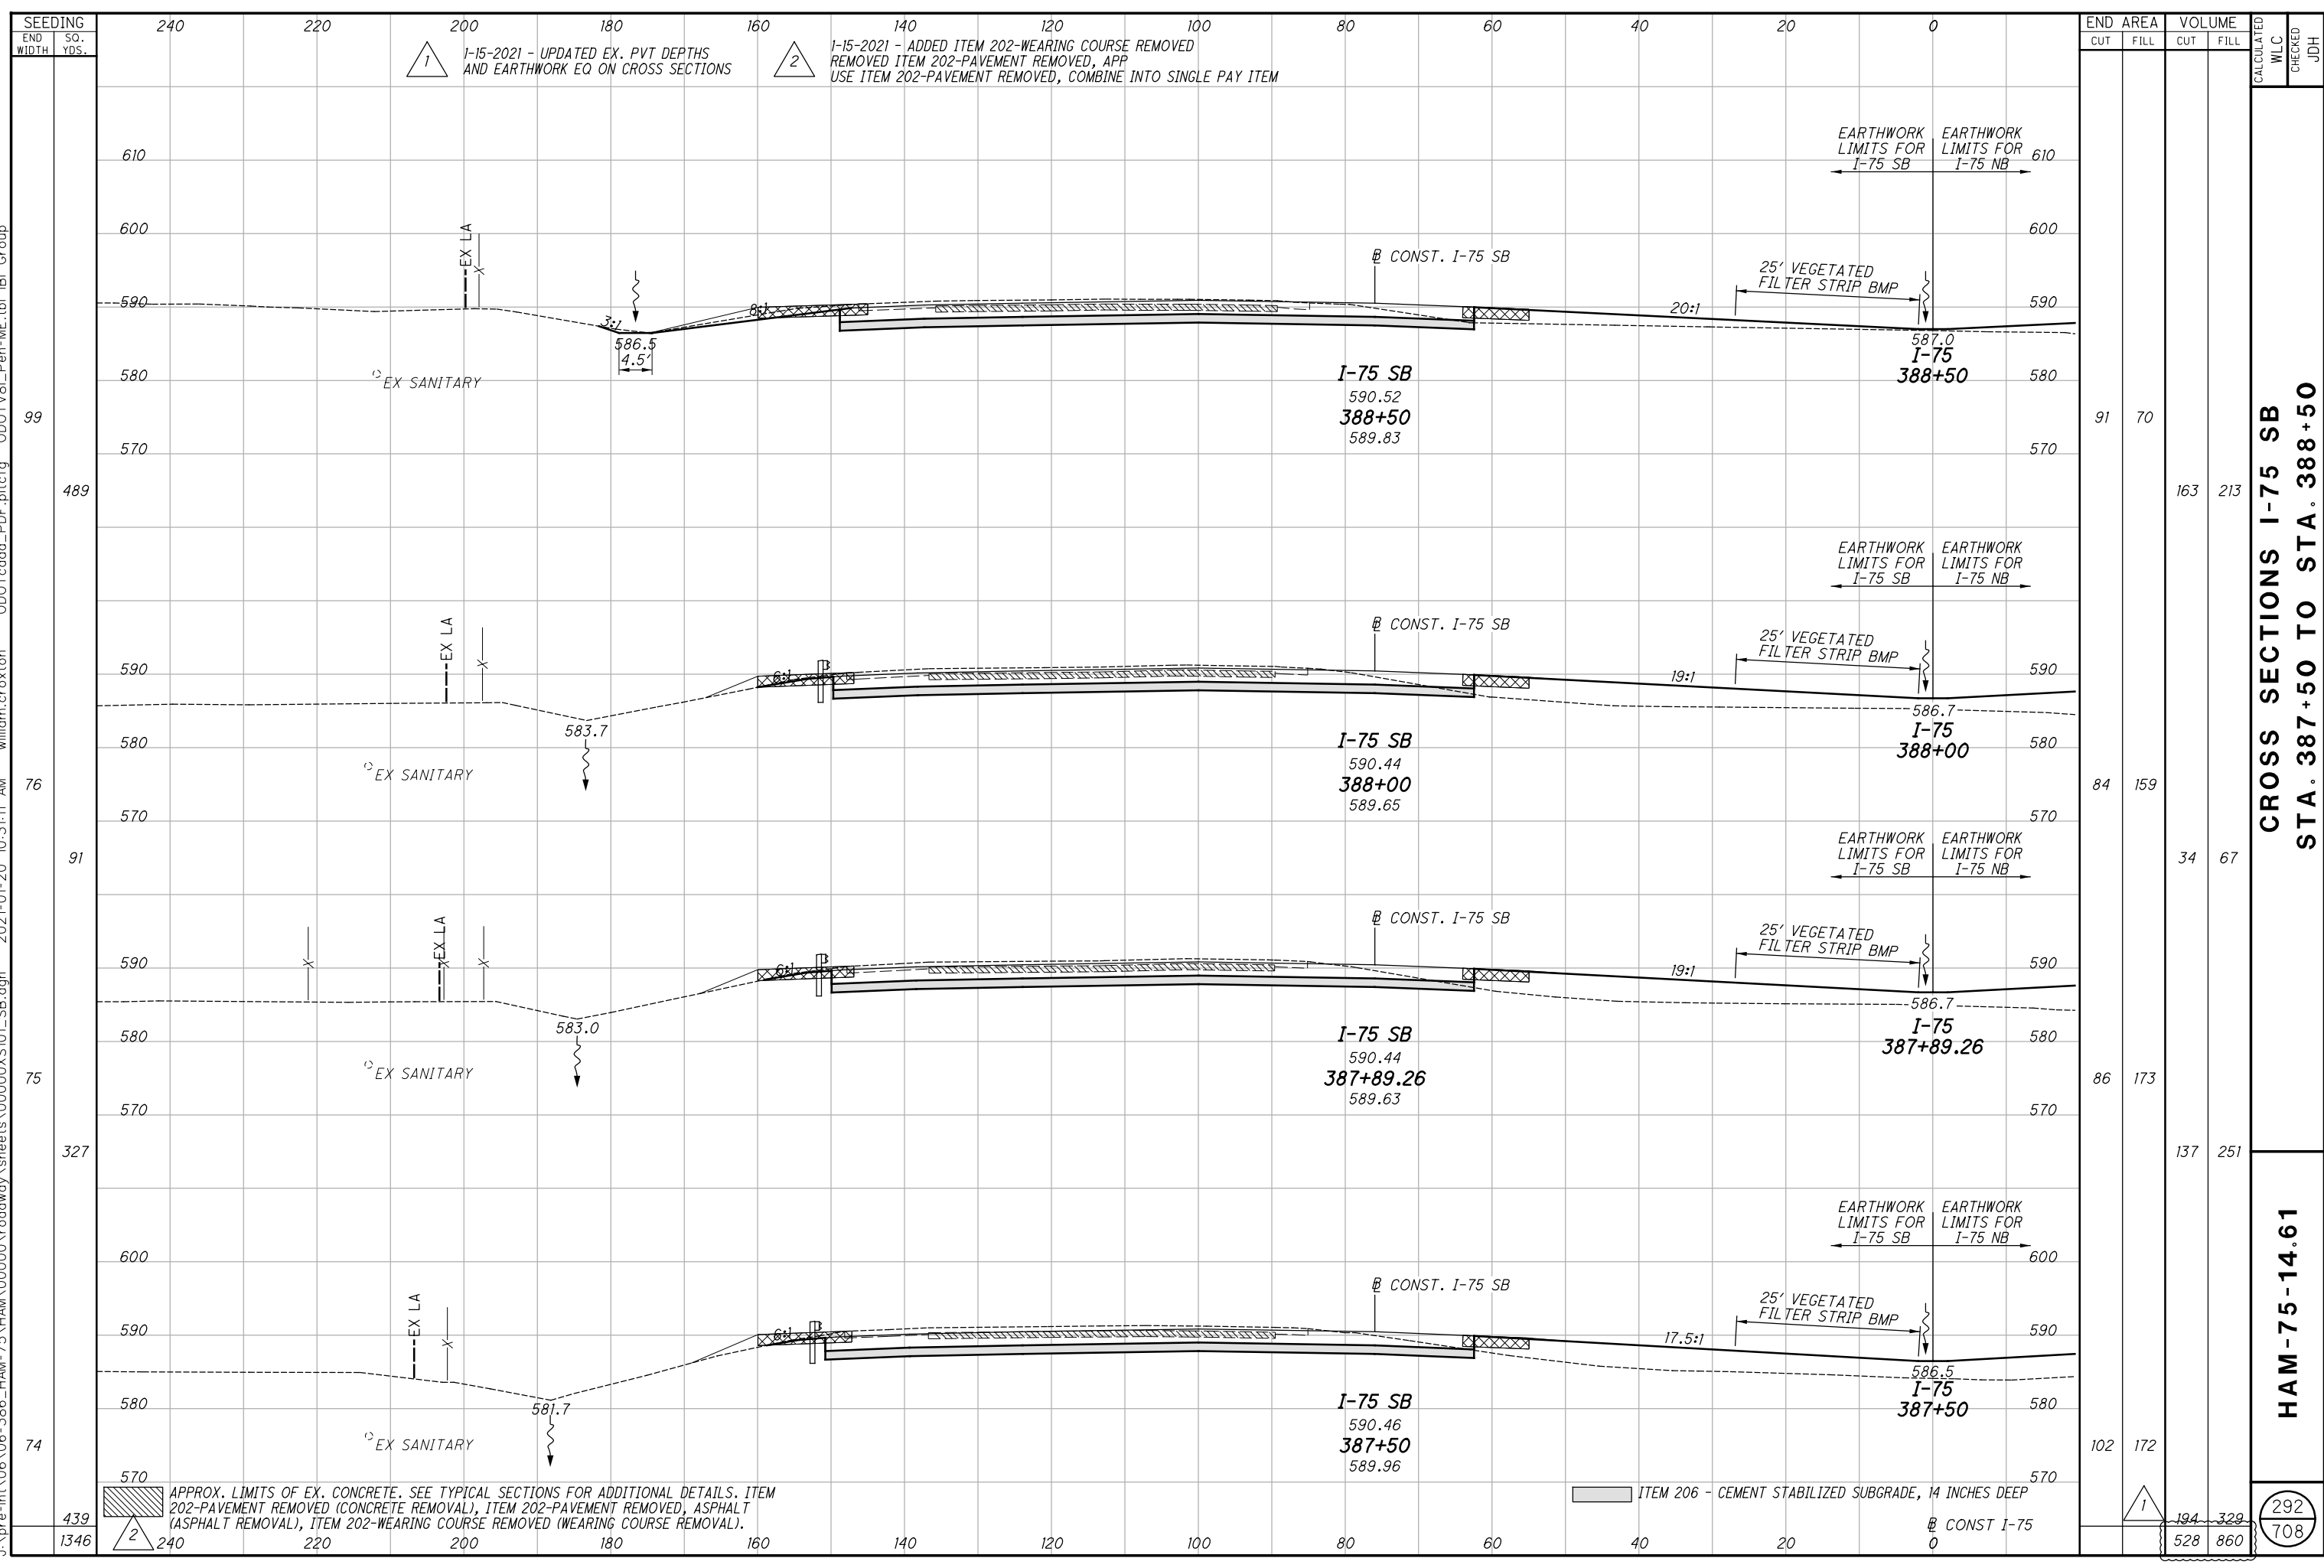

1-15-2021 - UPDATED EX. PVT DEPTHS AND EARTHWORK EQ ON CROSS SECTIONS  
 1-15-2021 - ADDED ITEM 202-WEARING COURSE REMOVED REMOVED ITEM 202-PAVEMENT REMOVED, APP USE ITEM 202-PAVEMENT REMOVED, COMBINE INTO SINGLE PAY ITEM

SEEDING		END AREA		VOLUME		CALCULATED	
END WIDTH	SO. YDS.	CUT	FILL	CUT	FILL	WLC	CHECKED
99	489	91	70	163	213		
76	91	84	159	34	67		
75	327	86	173	137	251		
74	439	102	172	194	329	292	708
1346	240	528	860				


**CROSS SECTIONS I-75 SB  
 STA. 387+50 TO STA. 388+50**

**HAM-75-14.61**

APPROX. LIMITS OF EX. CONCRETE. SEE TYPICAL SECTIONS FOR ADDITIONAL DETAILS. ITEM 202-PAVEMENT REMOVED (CONCRETE REMOVAL), ITEM 202-PAVEMENT REMOVED, ASPHALT (ASPHALT REMOVAL), ITEM 202-WEARING COURSE REMOVED (WEARING COURSE REMOVAL).

ITEM 206 - CEMENT STABILIZED SUBGRADE, 14 INCHES DEEP  
 CONST I-75

j:\pre-int\06\06-386\_HAM-75\HAM\00000\roadway\sheets\00000X5101\_SB.dgn 2021-01-20 10:31:13 AM william.croxton ODOT\cadd\_PDF\plcfig ODOTV81\_Pen-ME.tbl IBI Group

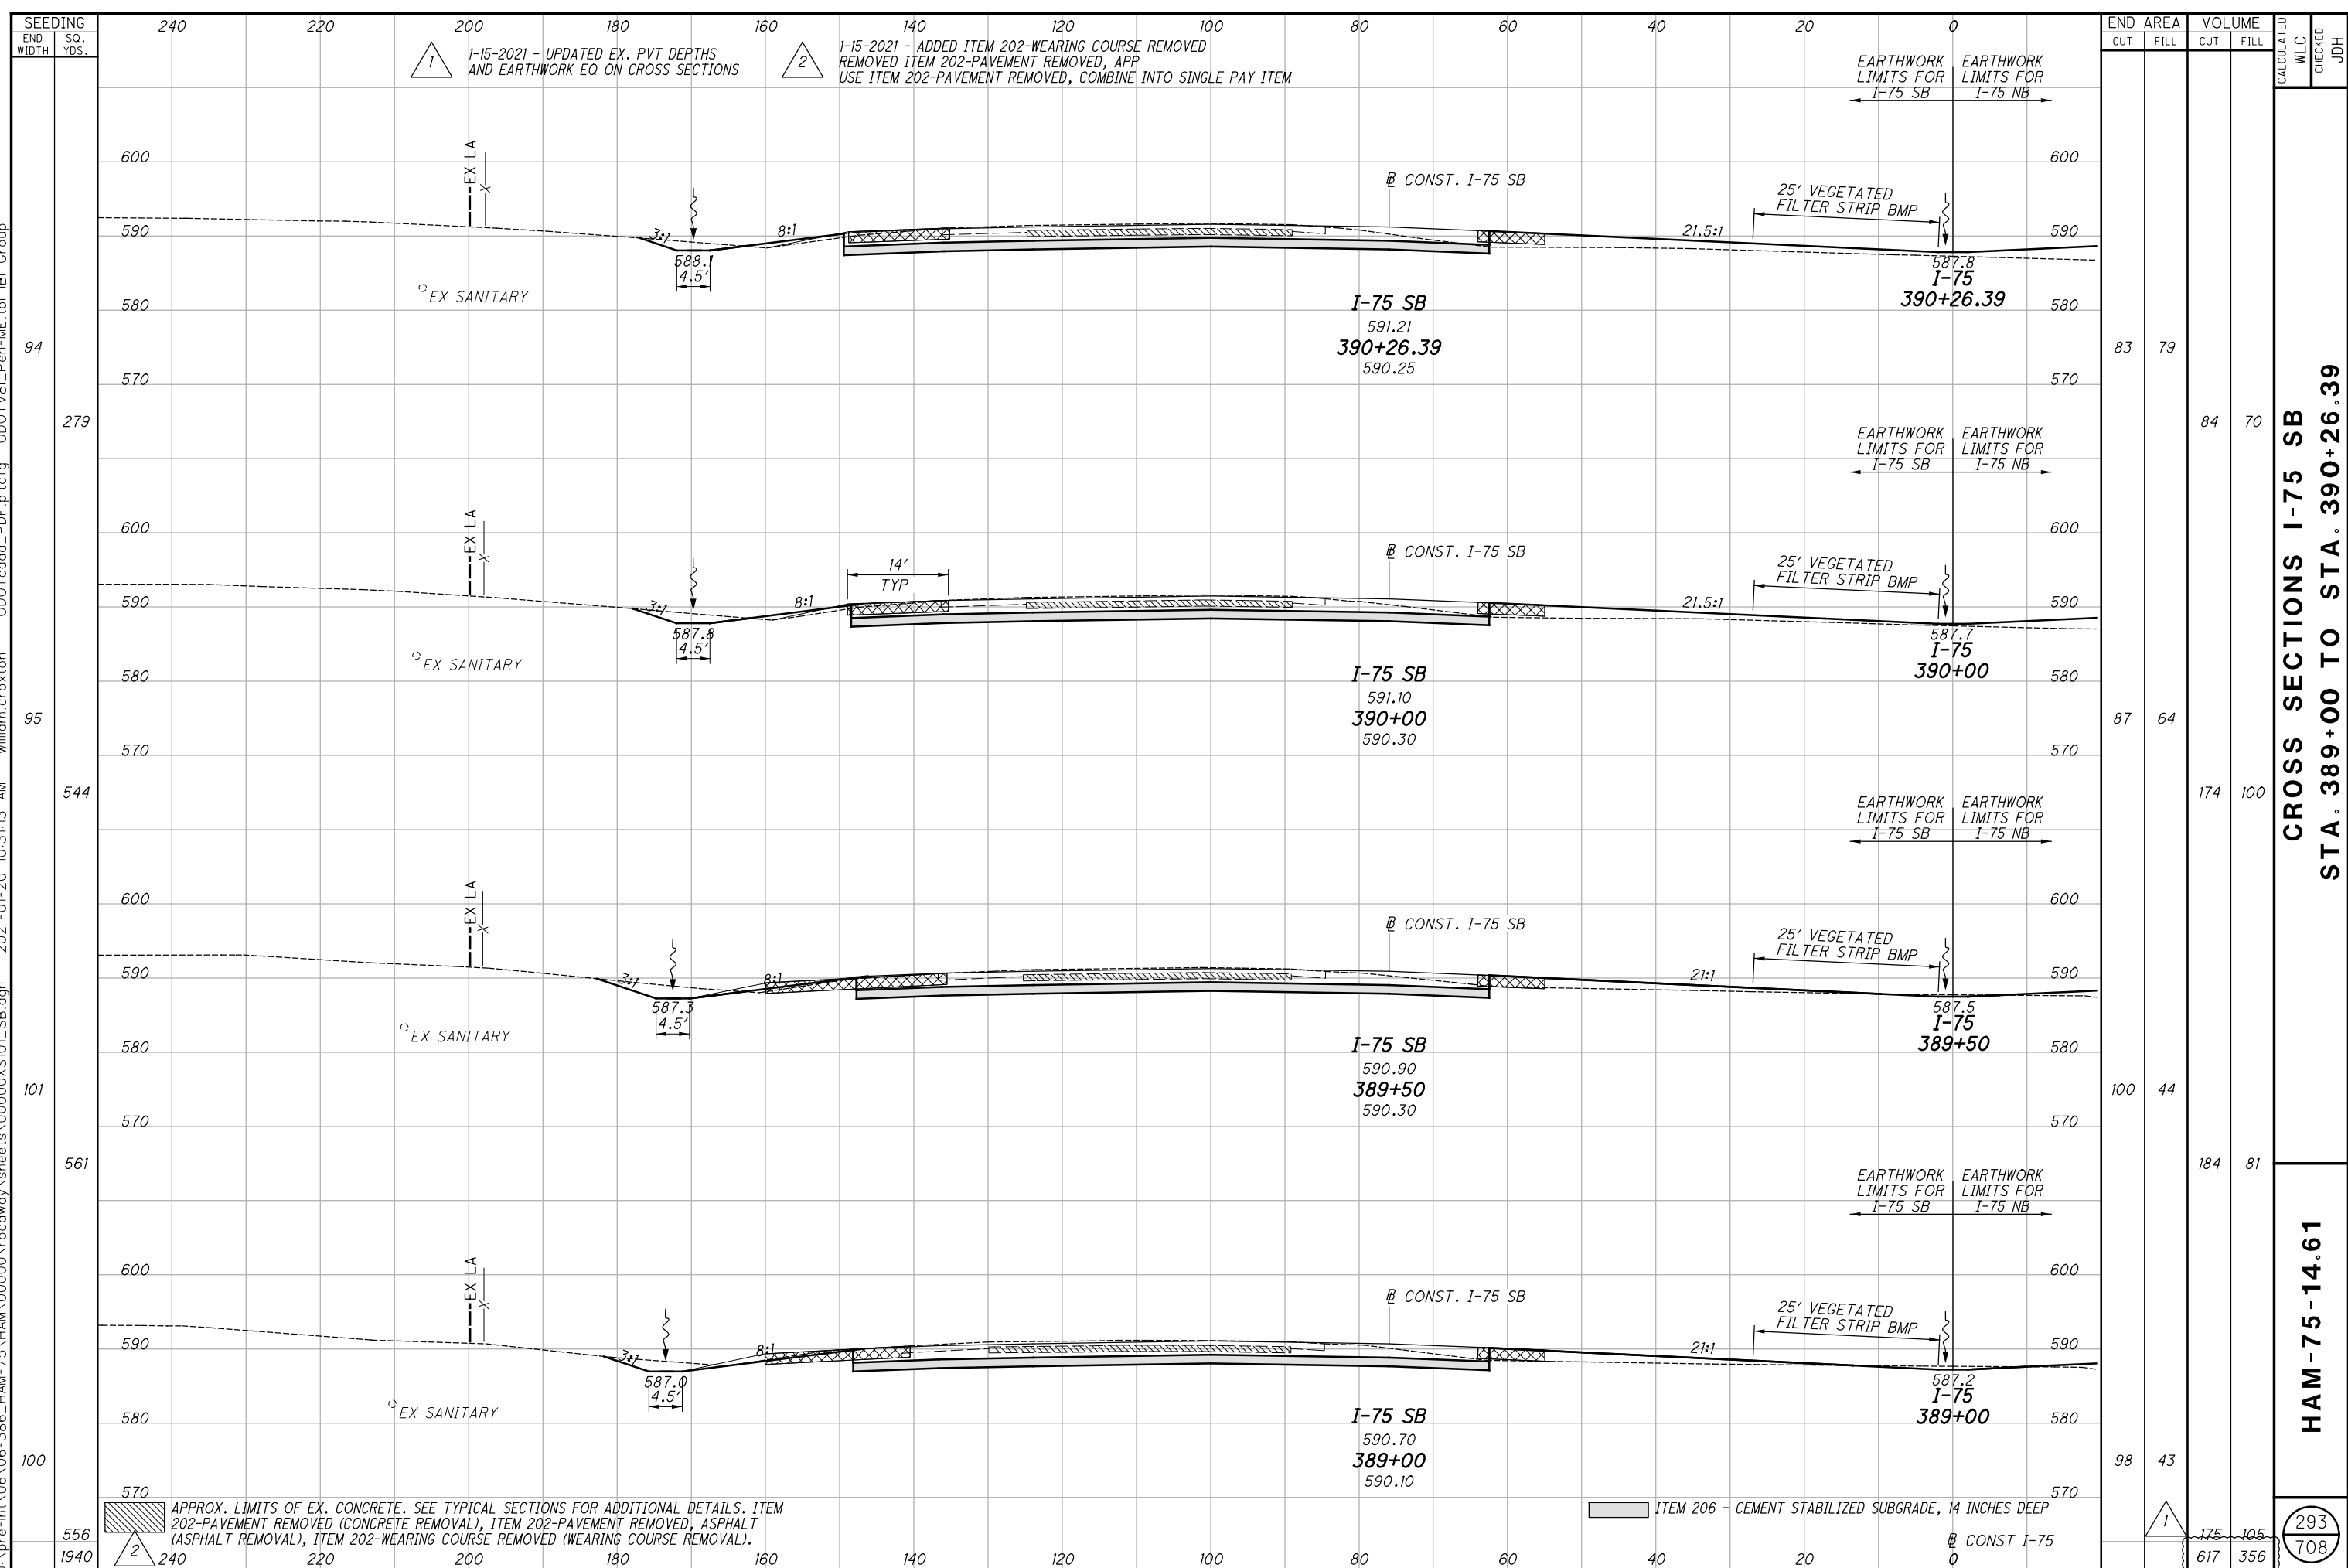

1-15-2021 - UPDATED EX. PVT DEPTHS AND EARTHWORK EQ ON CROSS SECTIONS  
 1-15-2021 - ADDED ITEM 202-WEARING COURSE REMOVED REMOVED ITEM 202-PAVEMENT REMOVED, APP USE ITEM 202-PAVEMENT REMOVED, COMBINE INTO SINGLE PAY ITEM

EARTHWORK LIMITS FOR I-75 SB  
 EARTHWORK LIMITS FOR I-75 NB

END STA	AREA		VOLUME		CALCULATED WLC	CHECKED	JDH
	CUT	FILL	CUT	FILL			
390+26.39	83	79	84	70			
390+00	87	64	174	100			
389+50	100	44	184	81			
389+00	98	43	175	105	293	708	

**CROSS SECTIONS I-75 SB  
 STA. 389+00 TO STA. 390+26.39**


**HAM-75-14.61**

APPROX. LIMITS OF EX. CONCRETE. SEE TYPICAL SECTIONS FOR ADDITIONAL DETAILS. ITEM 202-PAVEMENT REMOVED (CONCRETE REMOVAL), ITEM 202-PAVEMENT REMOVED, ASPHALT (ASPHALT REMOVAL), ITEM 202-WEARING COURSE REMOVED (WEARING COURSE REMOVAL).

ITEM 206 - CEMENT STABILIZED SUBGRADE, 14 INCHES DEEP

CONST I-75

j:\pre-int\06\06-386\_HAM-75\_HAM\00000\roadway\sheets\00000X5101\_SB.dgn 2021-01-20 10:31:14 AM william.croxton' ODOT\cadd\_PDF\_pltcfgr ODOTV8i\_Pen-ME.tbl IBI Group

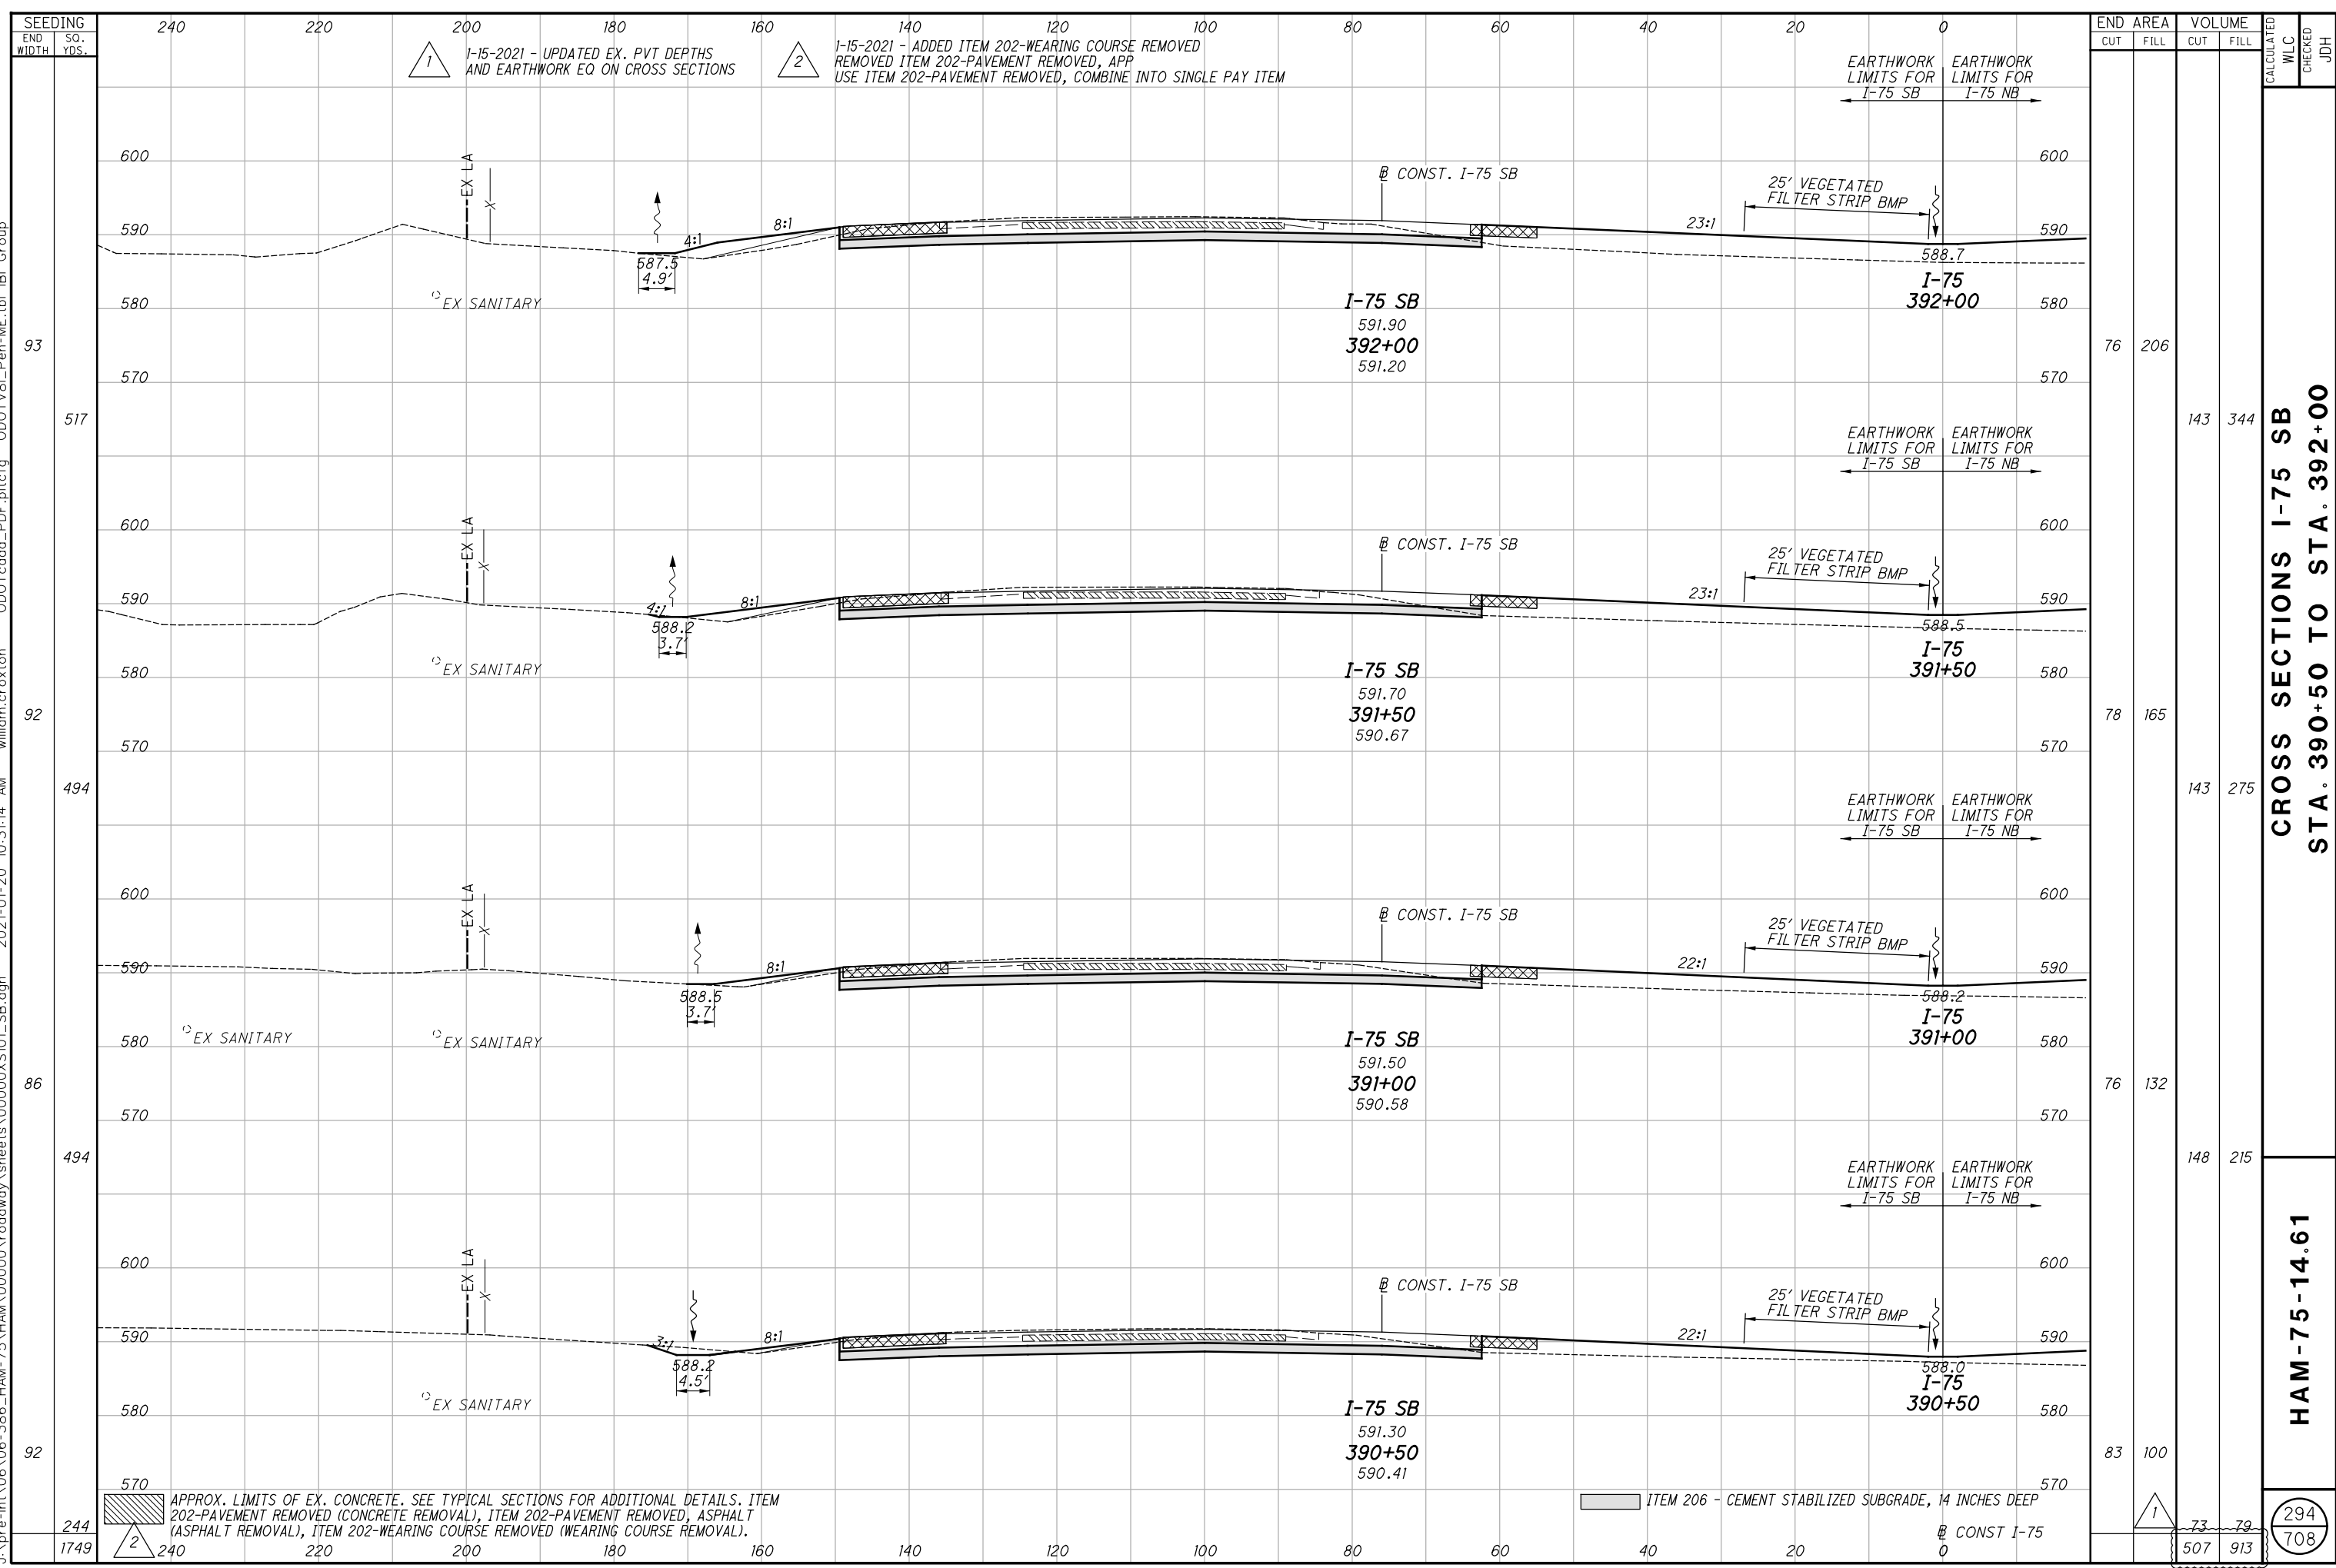

1-15-2021 - UPDATED EX. PVT DEPTHS AND EARTHWORK EQ ON CROSS SECTIONS  
 1-15-2021 - ADDED ITEM 202-WEARING COURSE REMOVED REMOVED ITEM 202-PAVEMENT REMOVED, APP USE ITEM 202-PAVEMENT REMOVED, COMBINE INTO SINGLE PAY ITEM

EARTHWORK LIMITS FOR I-75 SB  
 EARTHWORK LIMITS FOR I-75 NB

END STA	AREA		VOLUME		CALCULATED WLC	CHECKED	JDH
	CUT	FILL	CUT	FILL			
392+00	76	206	143	344			
391+50	78	165	143	275			
391+00	76	132	148	215			
390+50	83	100	73	79			
390+00			507	913			

**CROSS SECTIONS I-75 SB  
 STA. 390+50 TO STA. 392+00**

**HAM-75-14.61**


294  
 708

APPROX. LIMITS OF EX. CONCRETE. SEE TYPICAL SECTIONS FOR ADDITIONAL DETAILS. ITEM 202-PAVEMENT REMOVED (CONCRETE REMOVAL), ITEM 202-PAVEMENT REMOVED, ASPHALT (ASPHALT REMOVAL), ITEM 202-WEARING COURSE REMOVED (WEARING COURSE REMOVAL).

ITEM 206 - CEMENT STABILIZED SUBGRADE, 14 INCHES DEEP

CONST I-75

j:\pre-int\06\06-386\_HAM-75\_HAM\00000\roadway\sheets\00000X5101\_SB.dgn 2021-01-20 10:31:15 AM william.croxton ODOT\cadd\_PDF\_plt\cfig ODOTV8i\_Pen-ME.tbl IBI Group

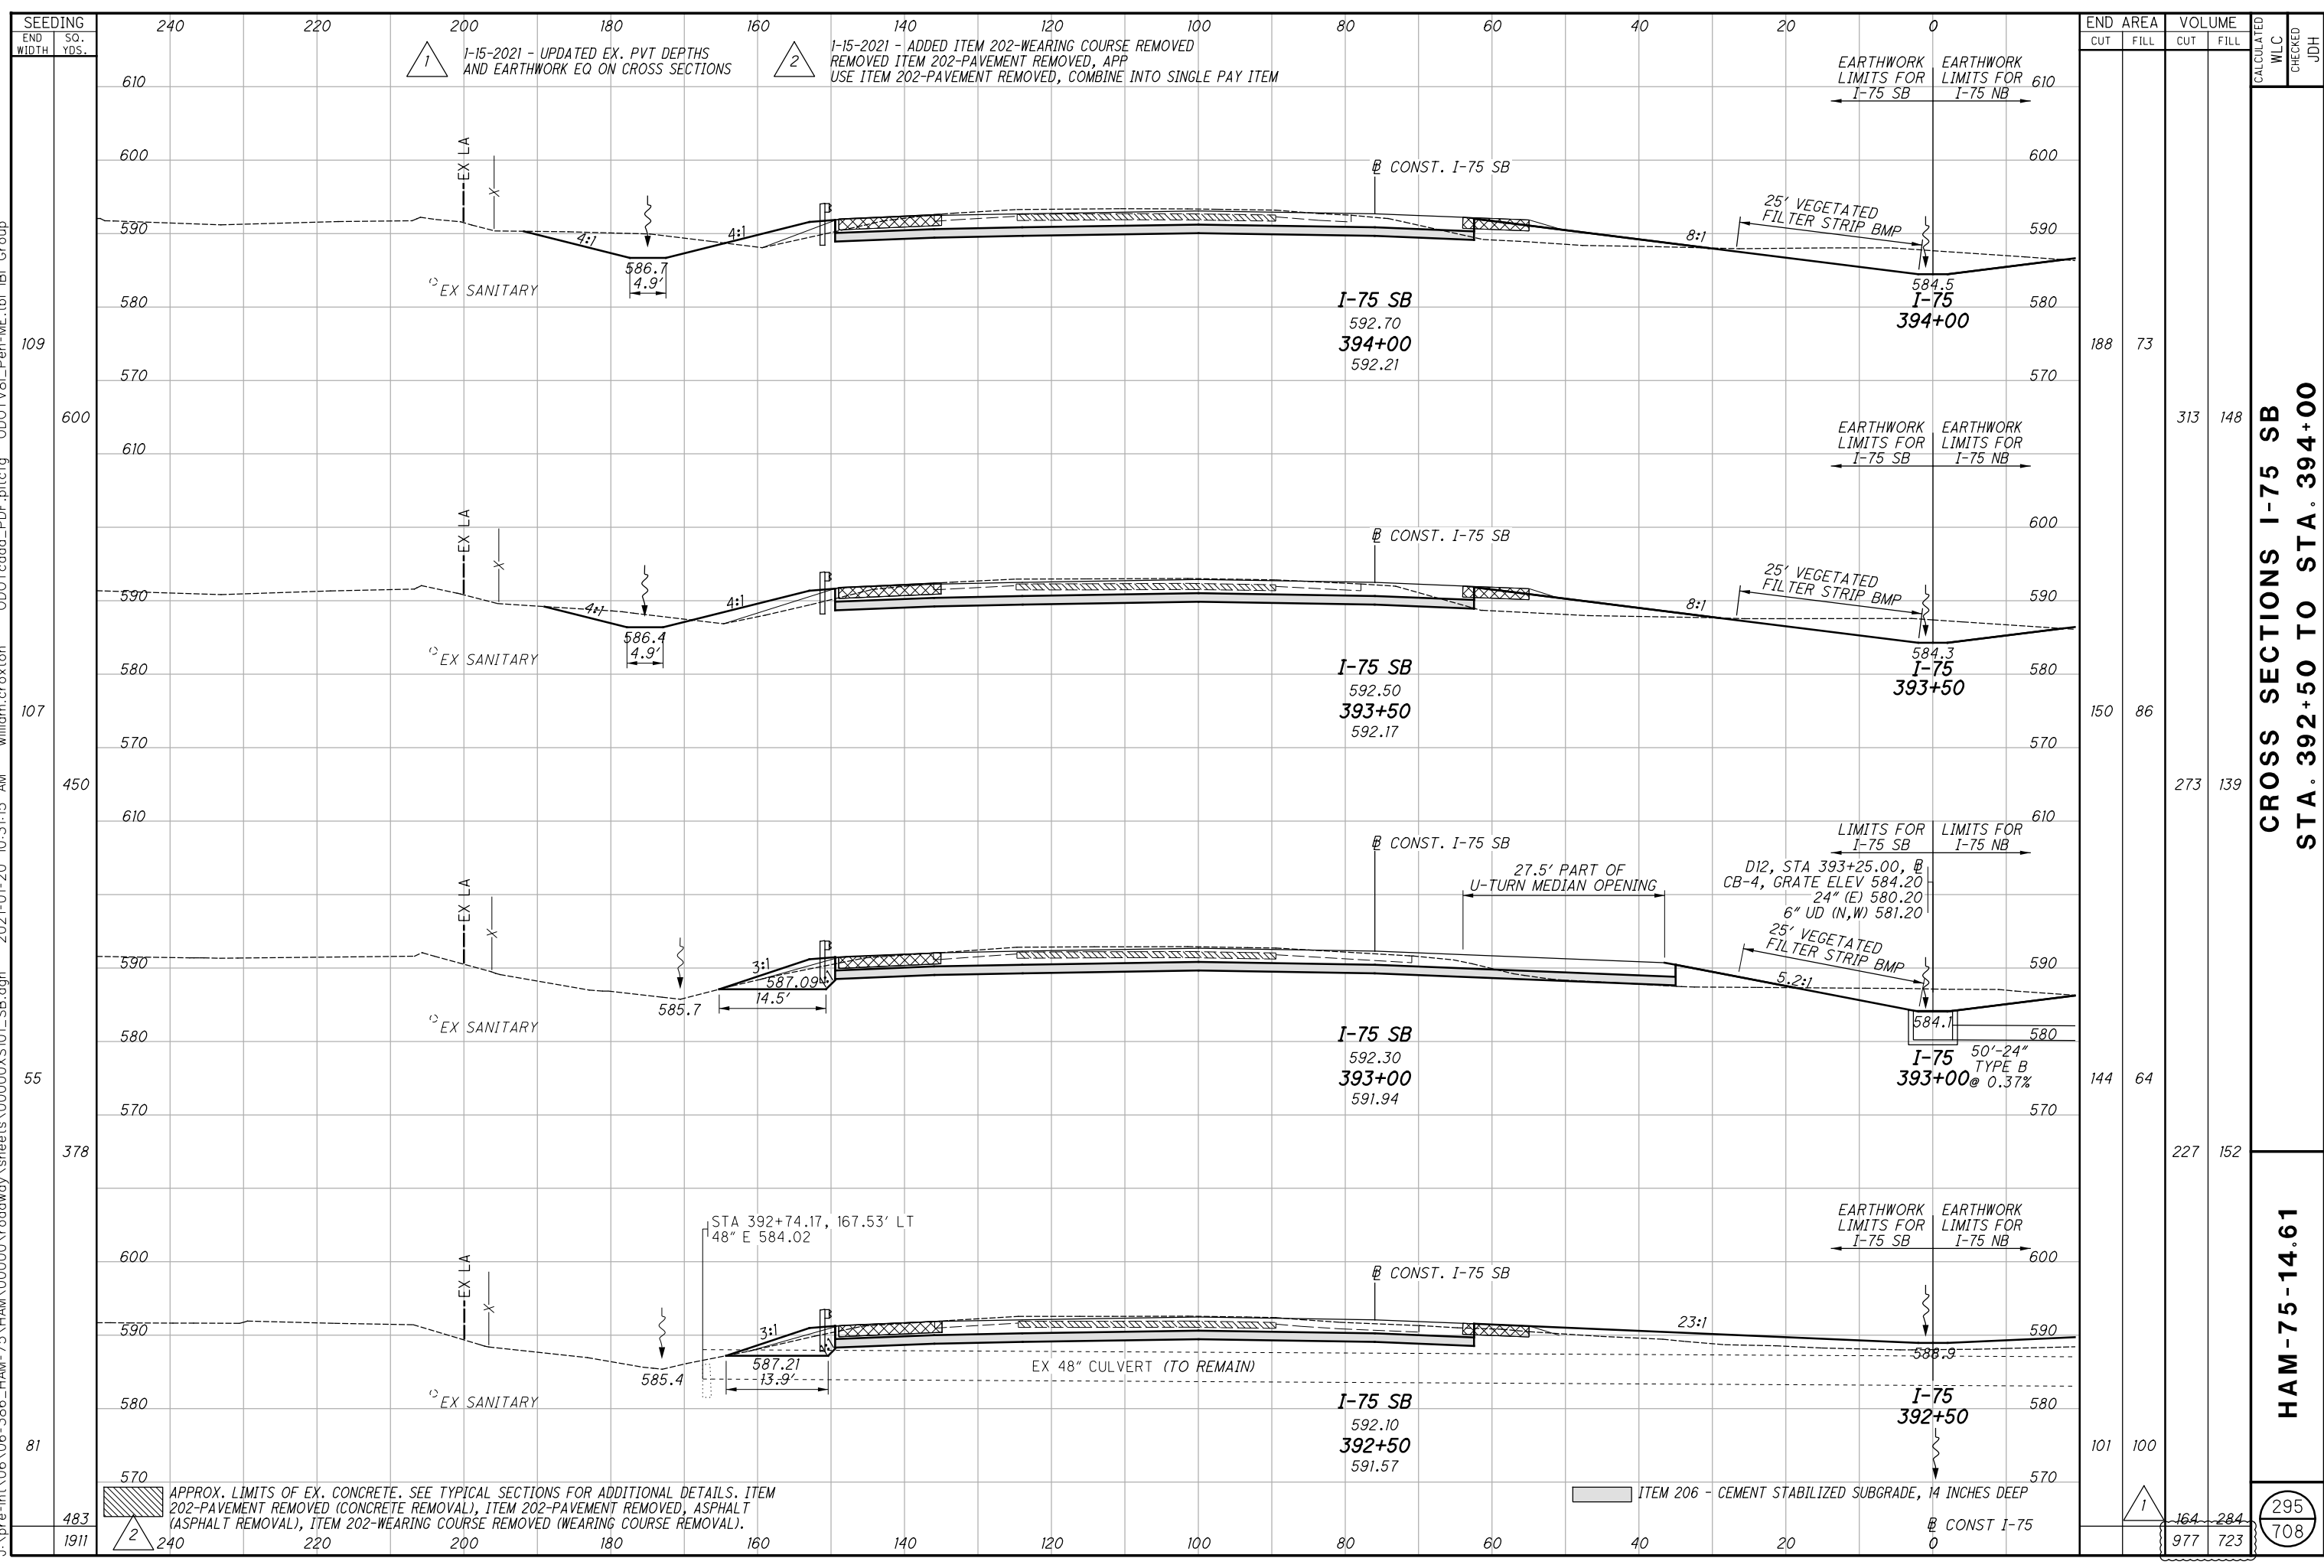

SEEDING: END WIDTH SO. YDS. 240 220 200 180 160 140 120 100 80 60 40 20 0 188 150 144 101  
 END AREA: CUT FILL CUT FILL  
 VOLUME: CUT FILL  
 CALCULATED WLC CHECKED JDH

1-15-2021 - UPDATED EX. PVT DEPTHS AND EARTHWORK EQ ON CROSS SECTIONS  
 1-15-2021 - ADDED ITEM 202-WEARING COURSE REMOVED REMOVED ITEM 202-PAVEMENT REMOVED, APP USE ITEM 202-PAVEMENT REMOVED, COMBINE INTO SINGLE PAY ITEM

EARTHWORK LIMITS FOR I-75 SB  
 EARTHWORK LIMITS FOR I-75 NB

I-75 SB  
 592.70  
 394+00  
 592.21

I-75 SB  
 592.50  
 393+50  
 592.17

I-75 SB  
 592.30  
 393+00  
 591.94

I-75 SB  
 592.10  
 392+50  
 591.57

27.5' PART OF U-TURN MEDIAN OPENING  
 D12, STA 393+25.00, @ CB-4, GRATE ELEV 584.20  
 24" (E) 580.20  
 6" UD (N,W) 581.20

APPROX. LIMITS OF EX. CONCRETE. SEE TYPICAL SECTIONS FOR ADDITIONAL DETAILS. ITEM 202-PAVEMENT REMOVED (CONCRETE REMOVAL), ITEM 202-PAVEMENT REMOVED, ASPHALT (ASPHALT REMOVAL), ITEM 202-WEARING COURSE REMOVED (WEARING COURSE REMOVAL).


ITEM 206 - CEMENT STABILIZED SUBGRADE, 14 INCHES DEEP

CROSS SECTIONS I-75 SB  
 STA. 392+50 TO STA. 394+00

HAM-75-14.61


295  
 708

j:\pre-int\06\06-386\_HAM-75\_HAM\00000\roadway\sheets\00000XS101\_SB.dgn 2021-01-20 10:31:16 AM william.croxton' ODOT\cadd\_PDF\_pltcfg ODOTV8i\_Pen-ME.tbl IBI Group

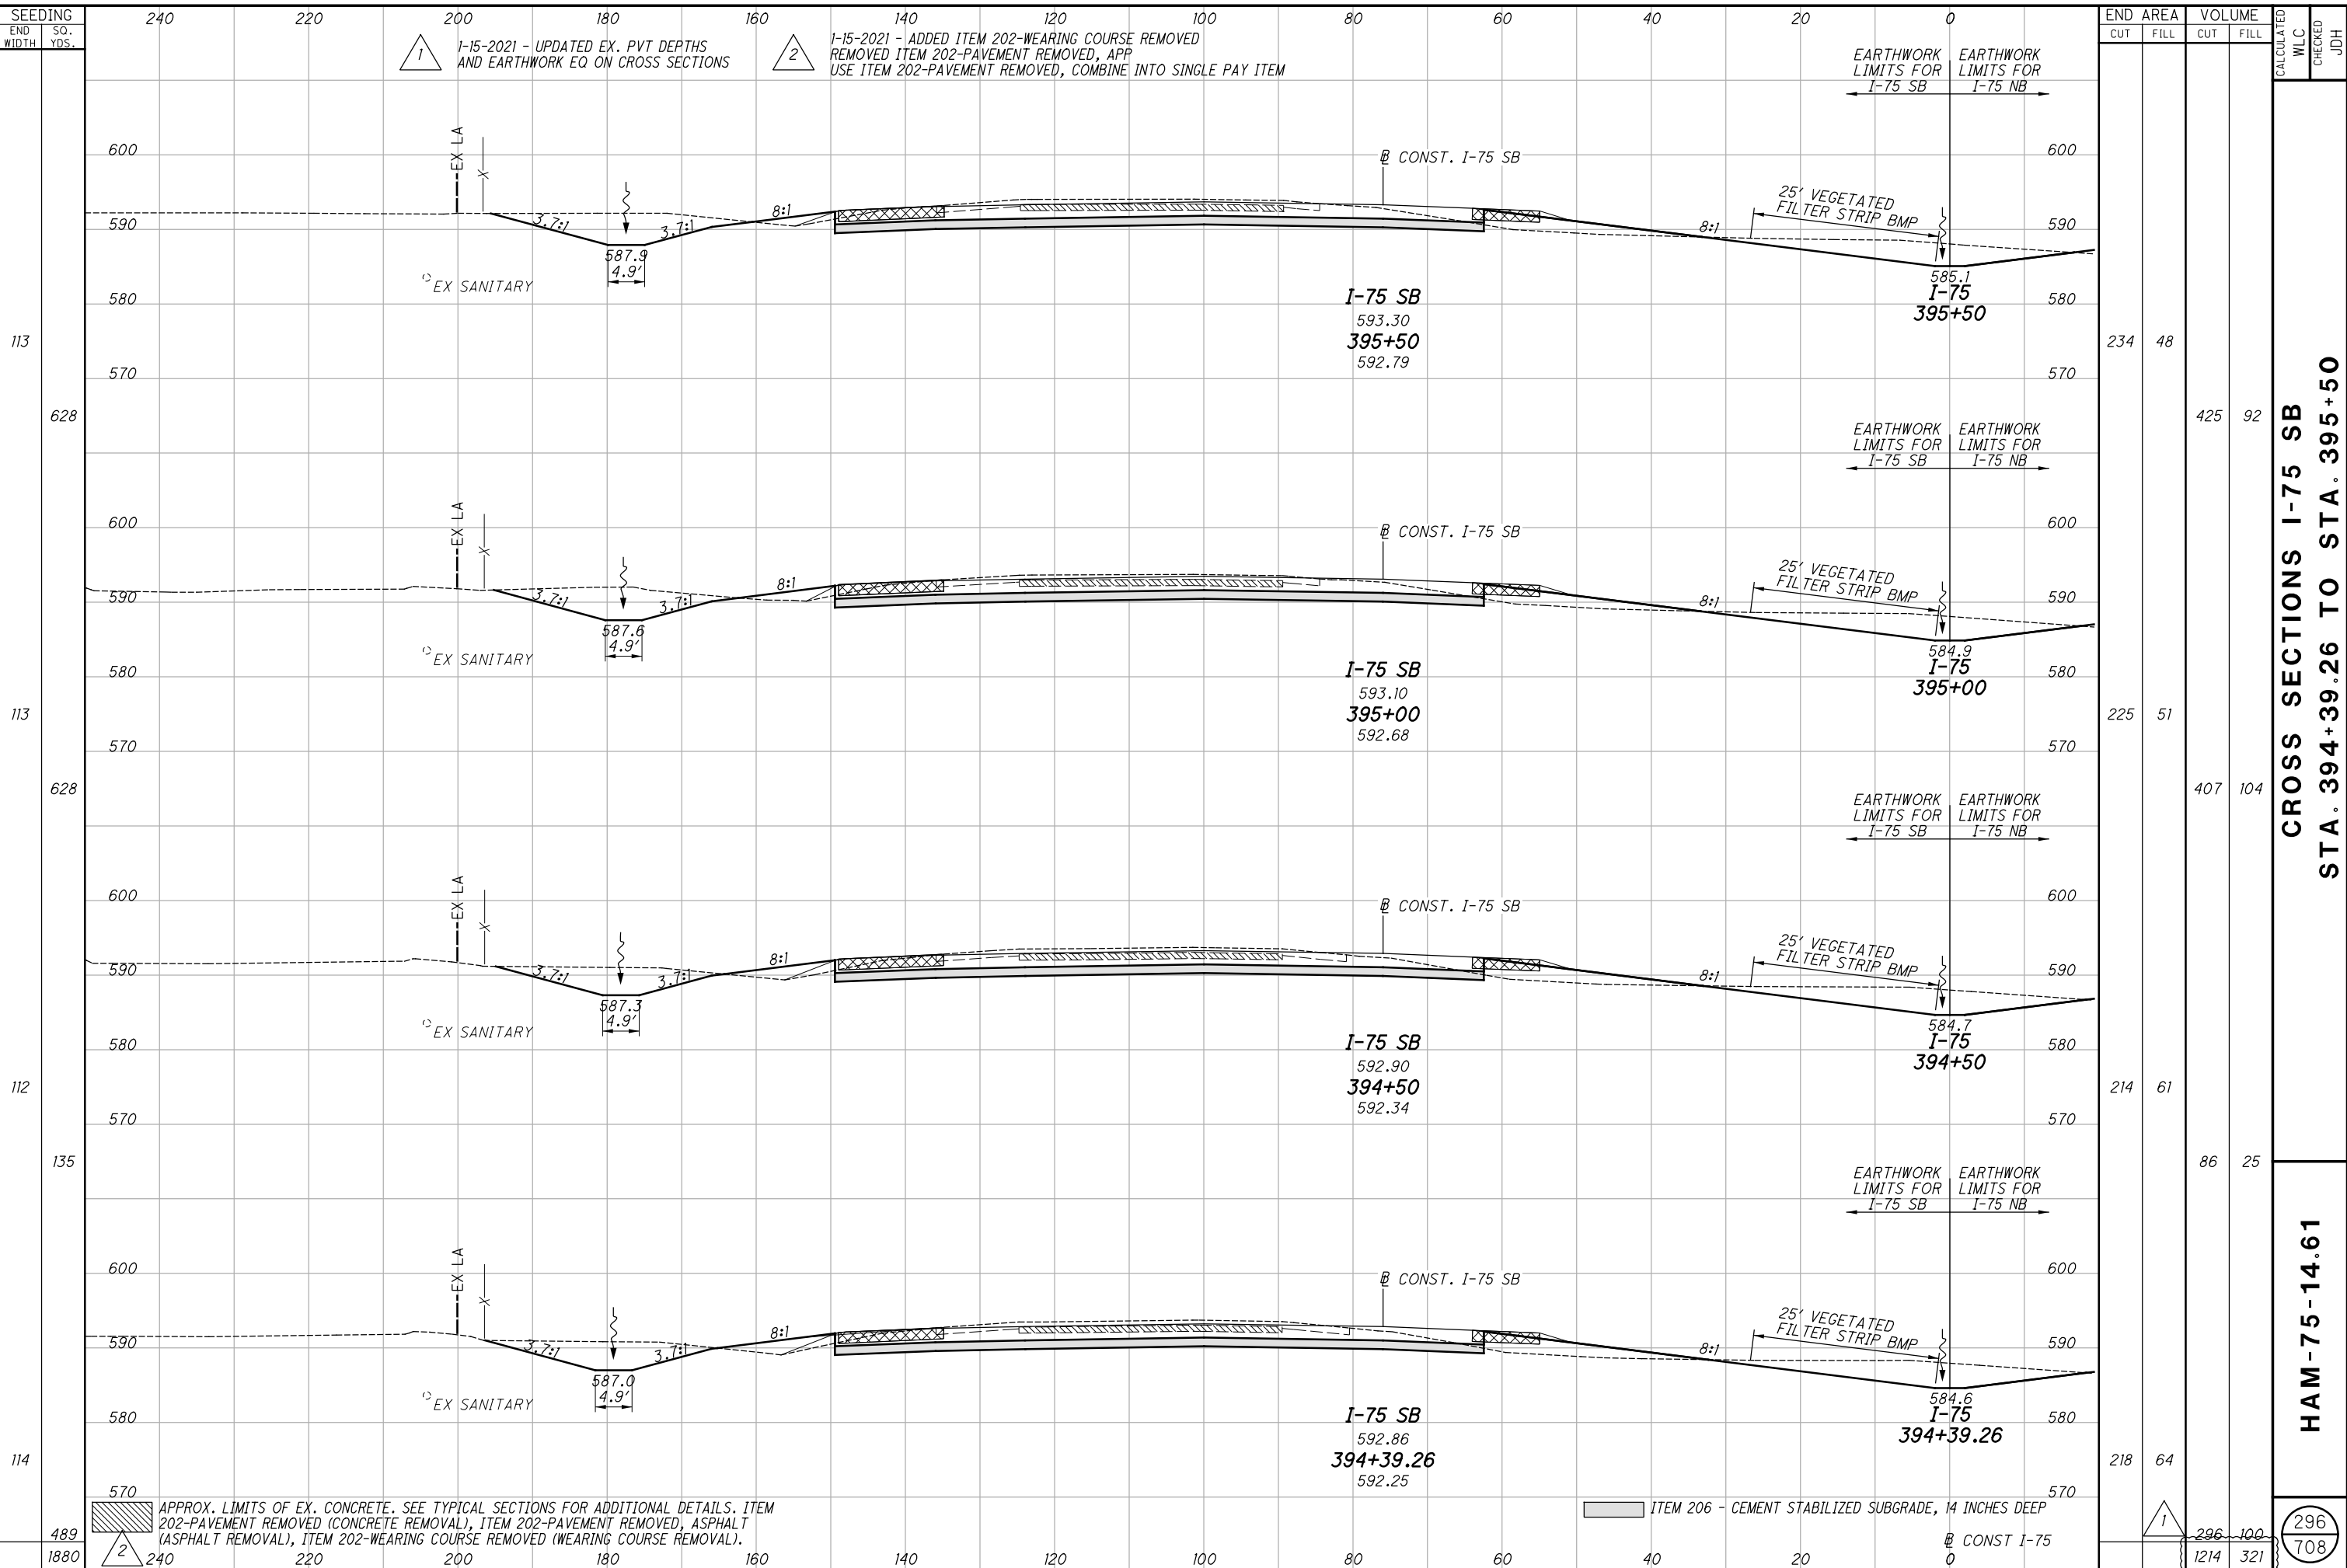

296  
 708

j:\pre-int\06\06-386\_HAM-75\HAM\00000\roadway\sheets\00000XS101\_SB.dgn 2021-01-20 10:31:17 AM william.croxton' ODOTV86\_PDF.pltcfg ODOTV86\_Pen\_ME.tbl IBI Group

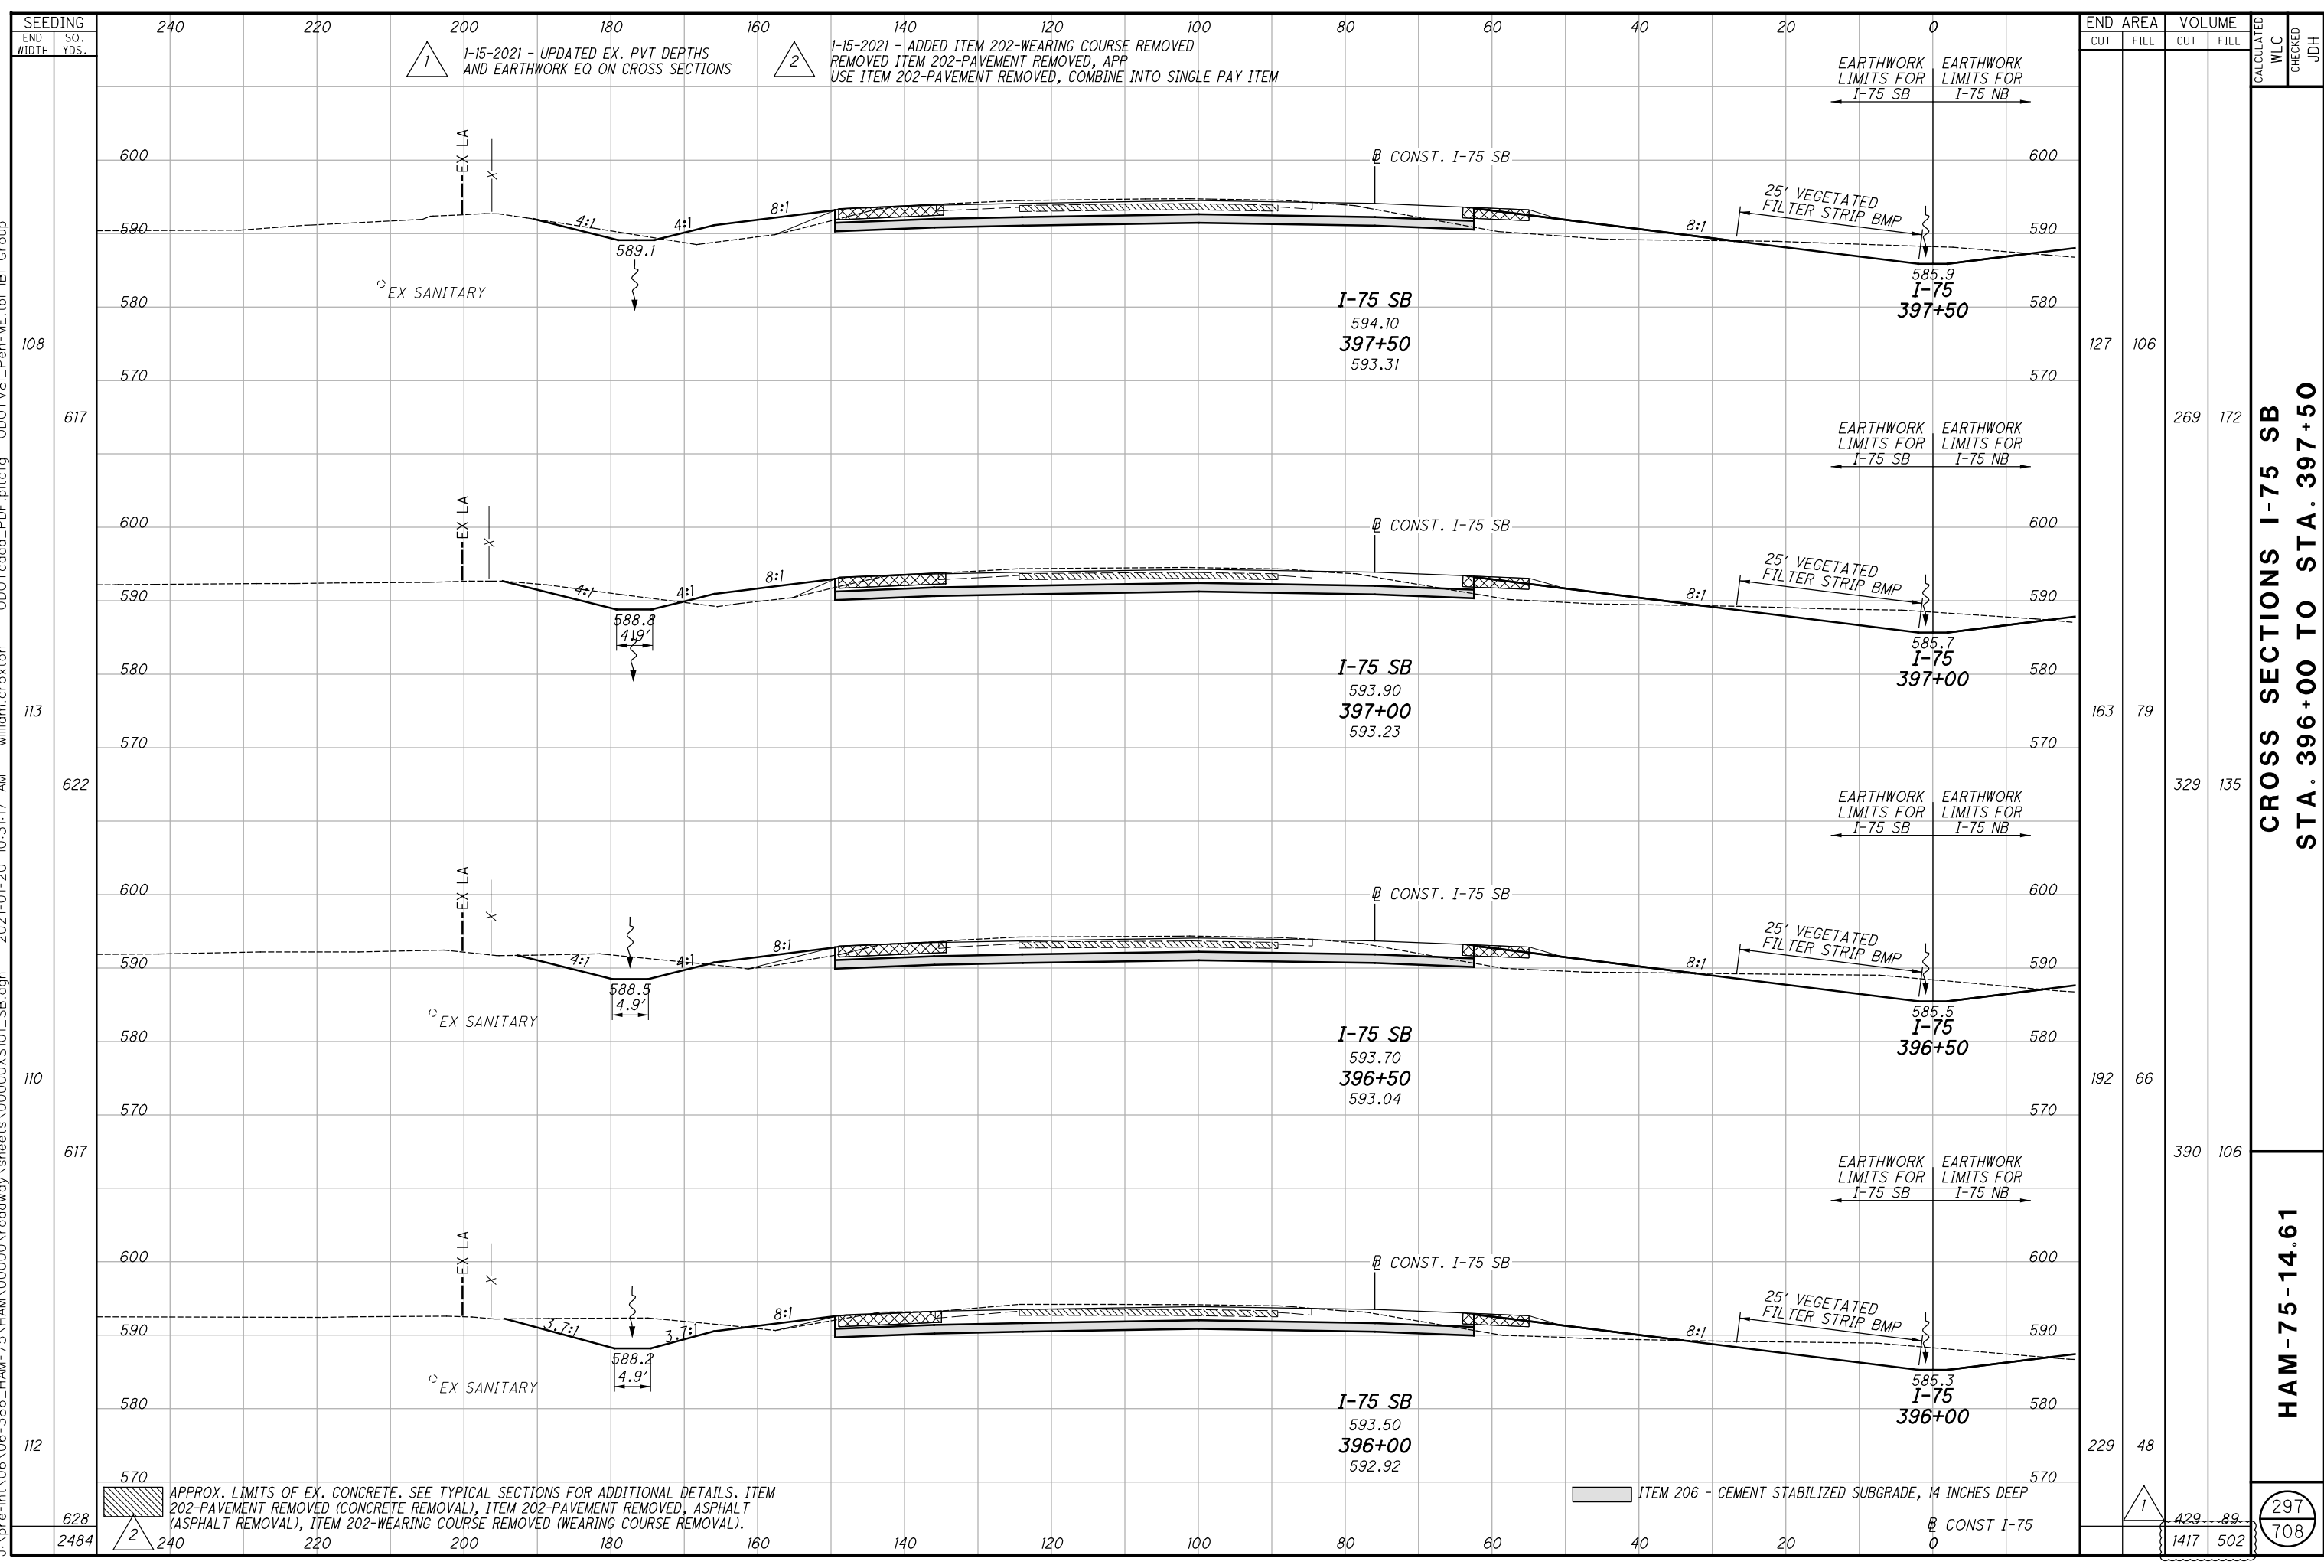


END AREA	VOLUME		CALCULATED WLC	CHECKED JDH
	CUT	FILL		
127	106			
163	79	269	172	
192	66	329	135	
229	48	390	106	
429	89	1417	502	297
				708

**CROSS SECTIONS I-75 SB**  
**STA. 396+00 TO STA. 397+50**


**HAM-75-14.61**



j:\pre-int\06\06-386\_HAM-75\HAM\00000\roadway\sheets\00000XS101\_SB.dgn 2021-01-20 10:31:19 AM william.croxton' ODOTcadd\_PDF.pltcfg ODOTV8i\_Pen-ME.tbl IBI Group

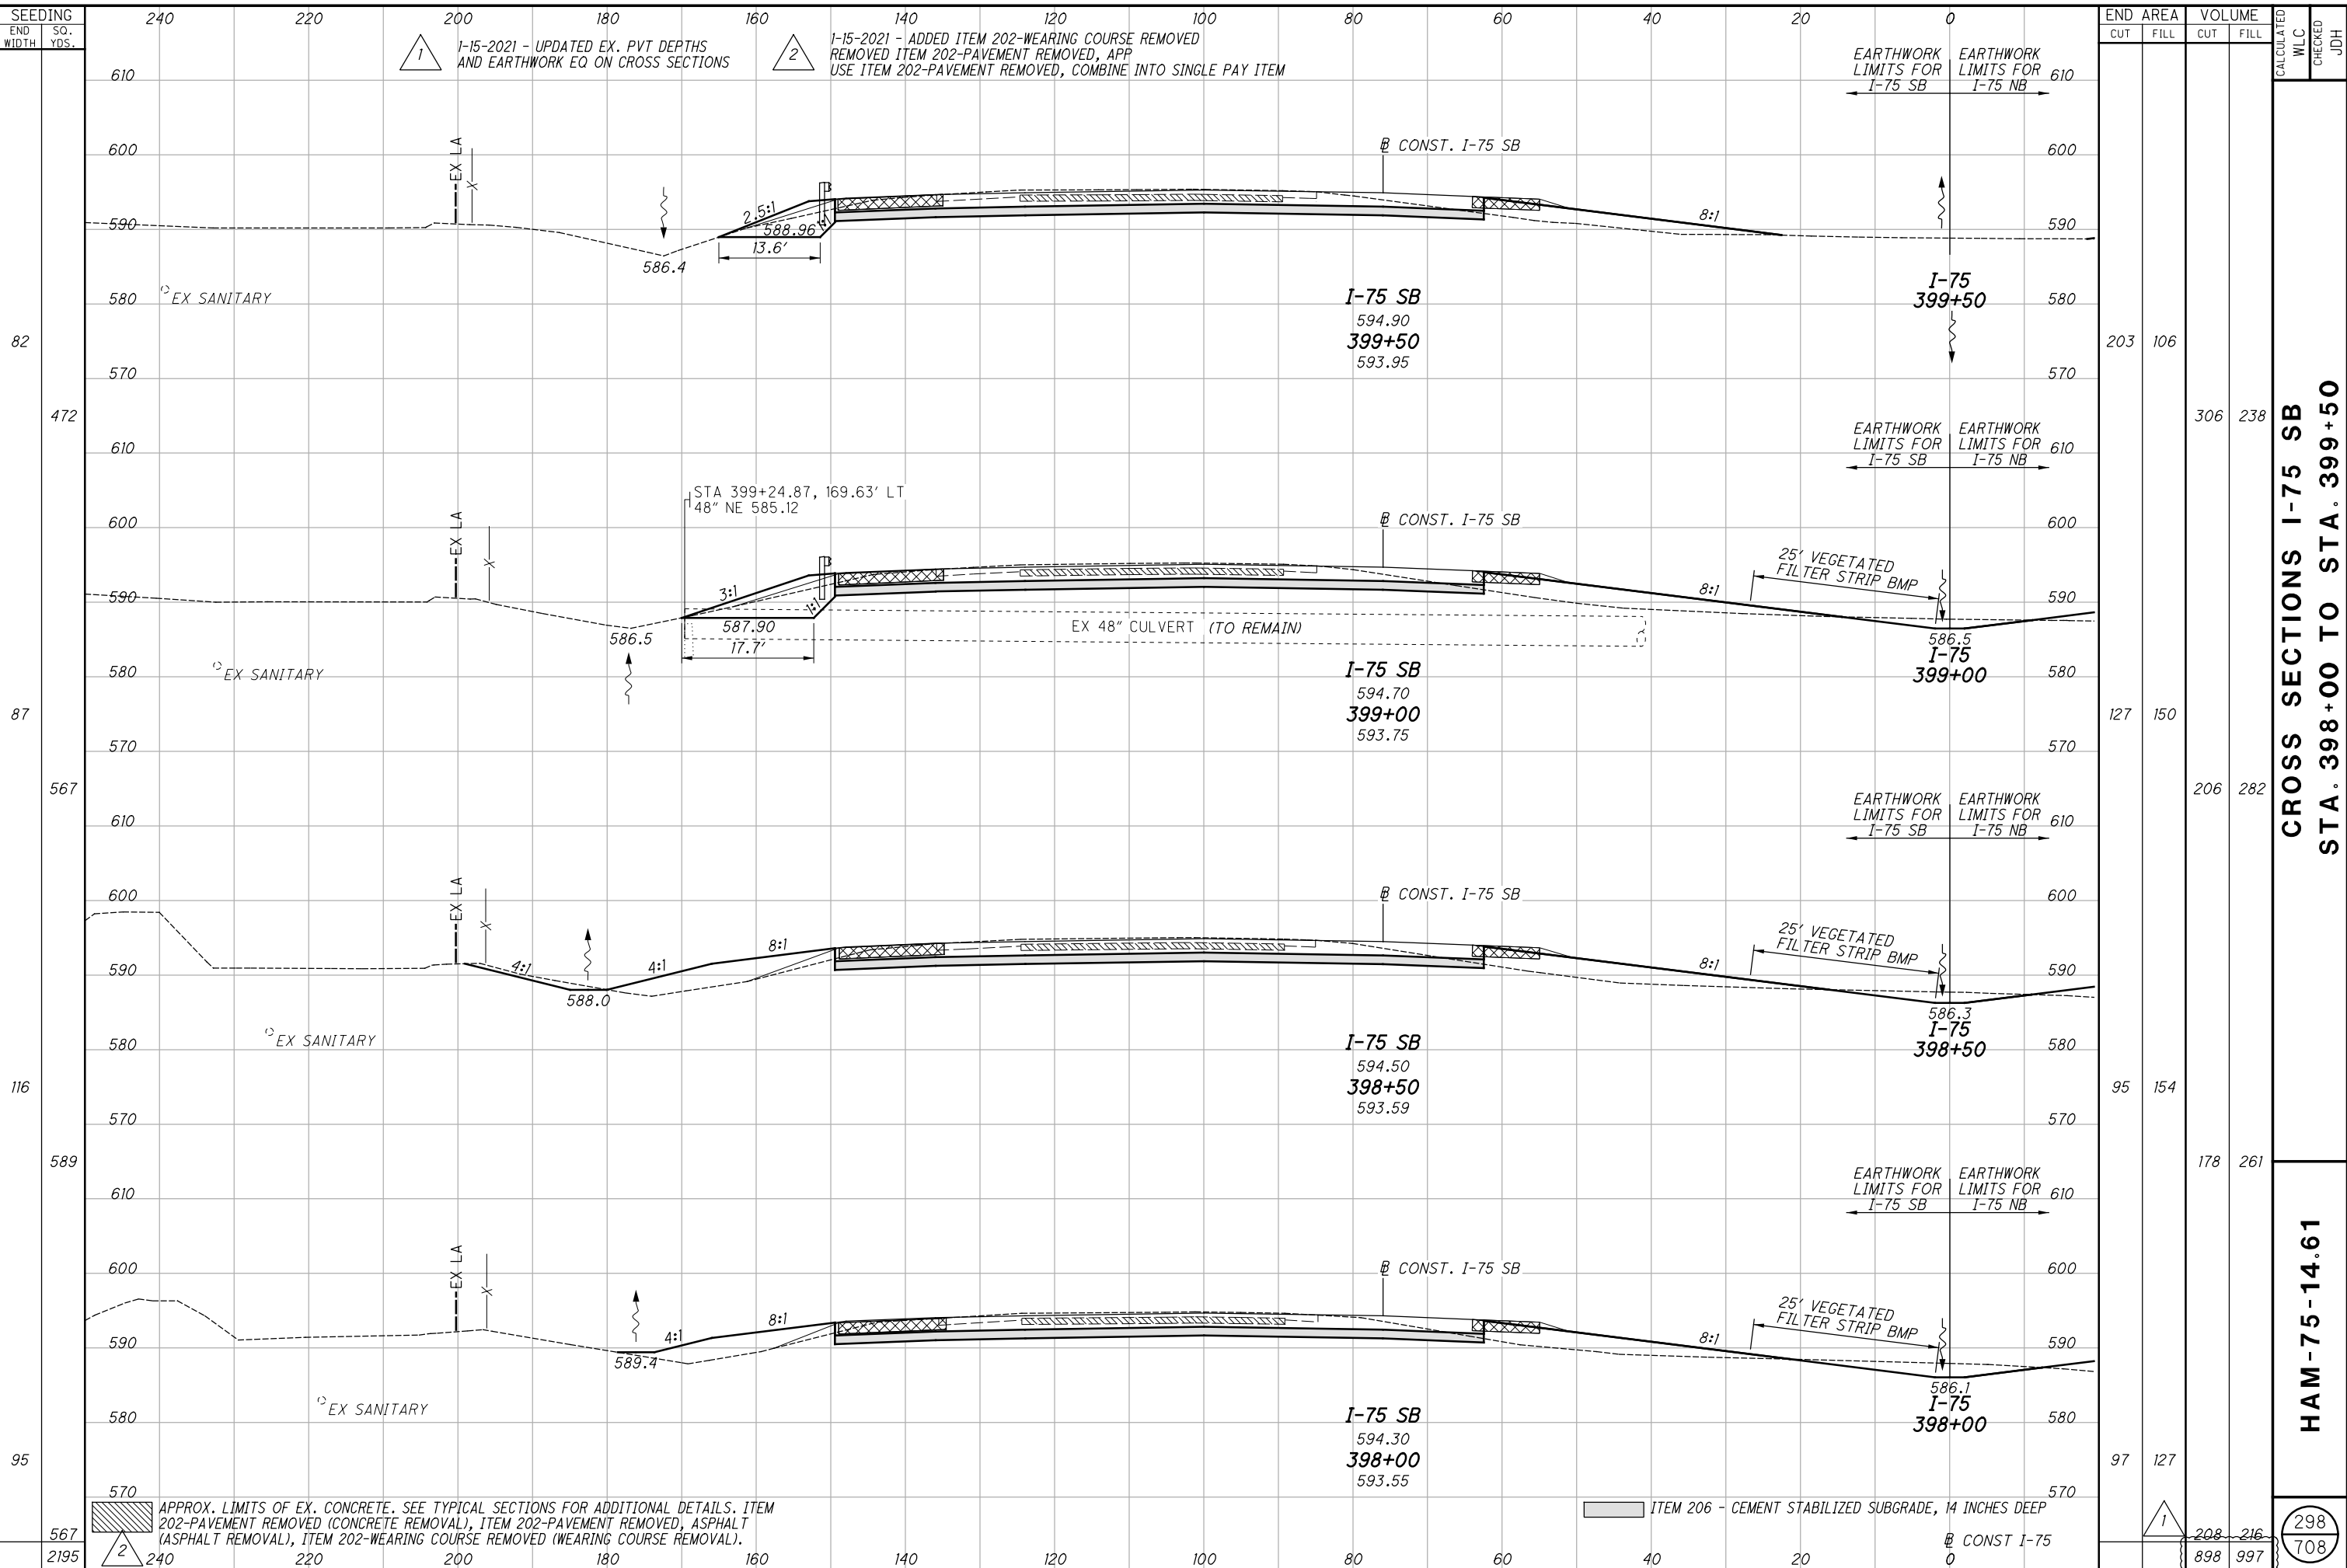

j:\pre-int\06\06-386\_HAM-75\_HAM\00000\roadway\sheets\00000X5101\_SB.dgn 2021-01-20 10:31:20 AM william.croxton ODOTcadd\_PDF.pltcfgr ODOTV81\_Pen-ME.tbl IBI Group

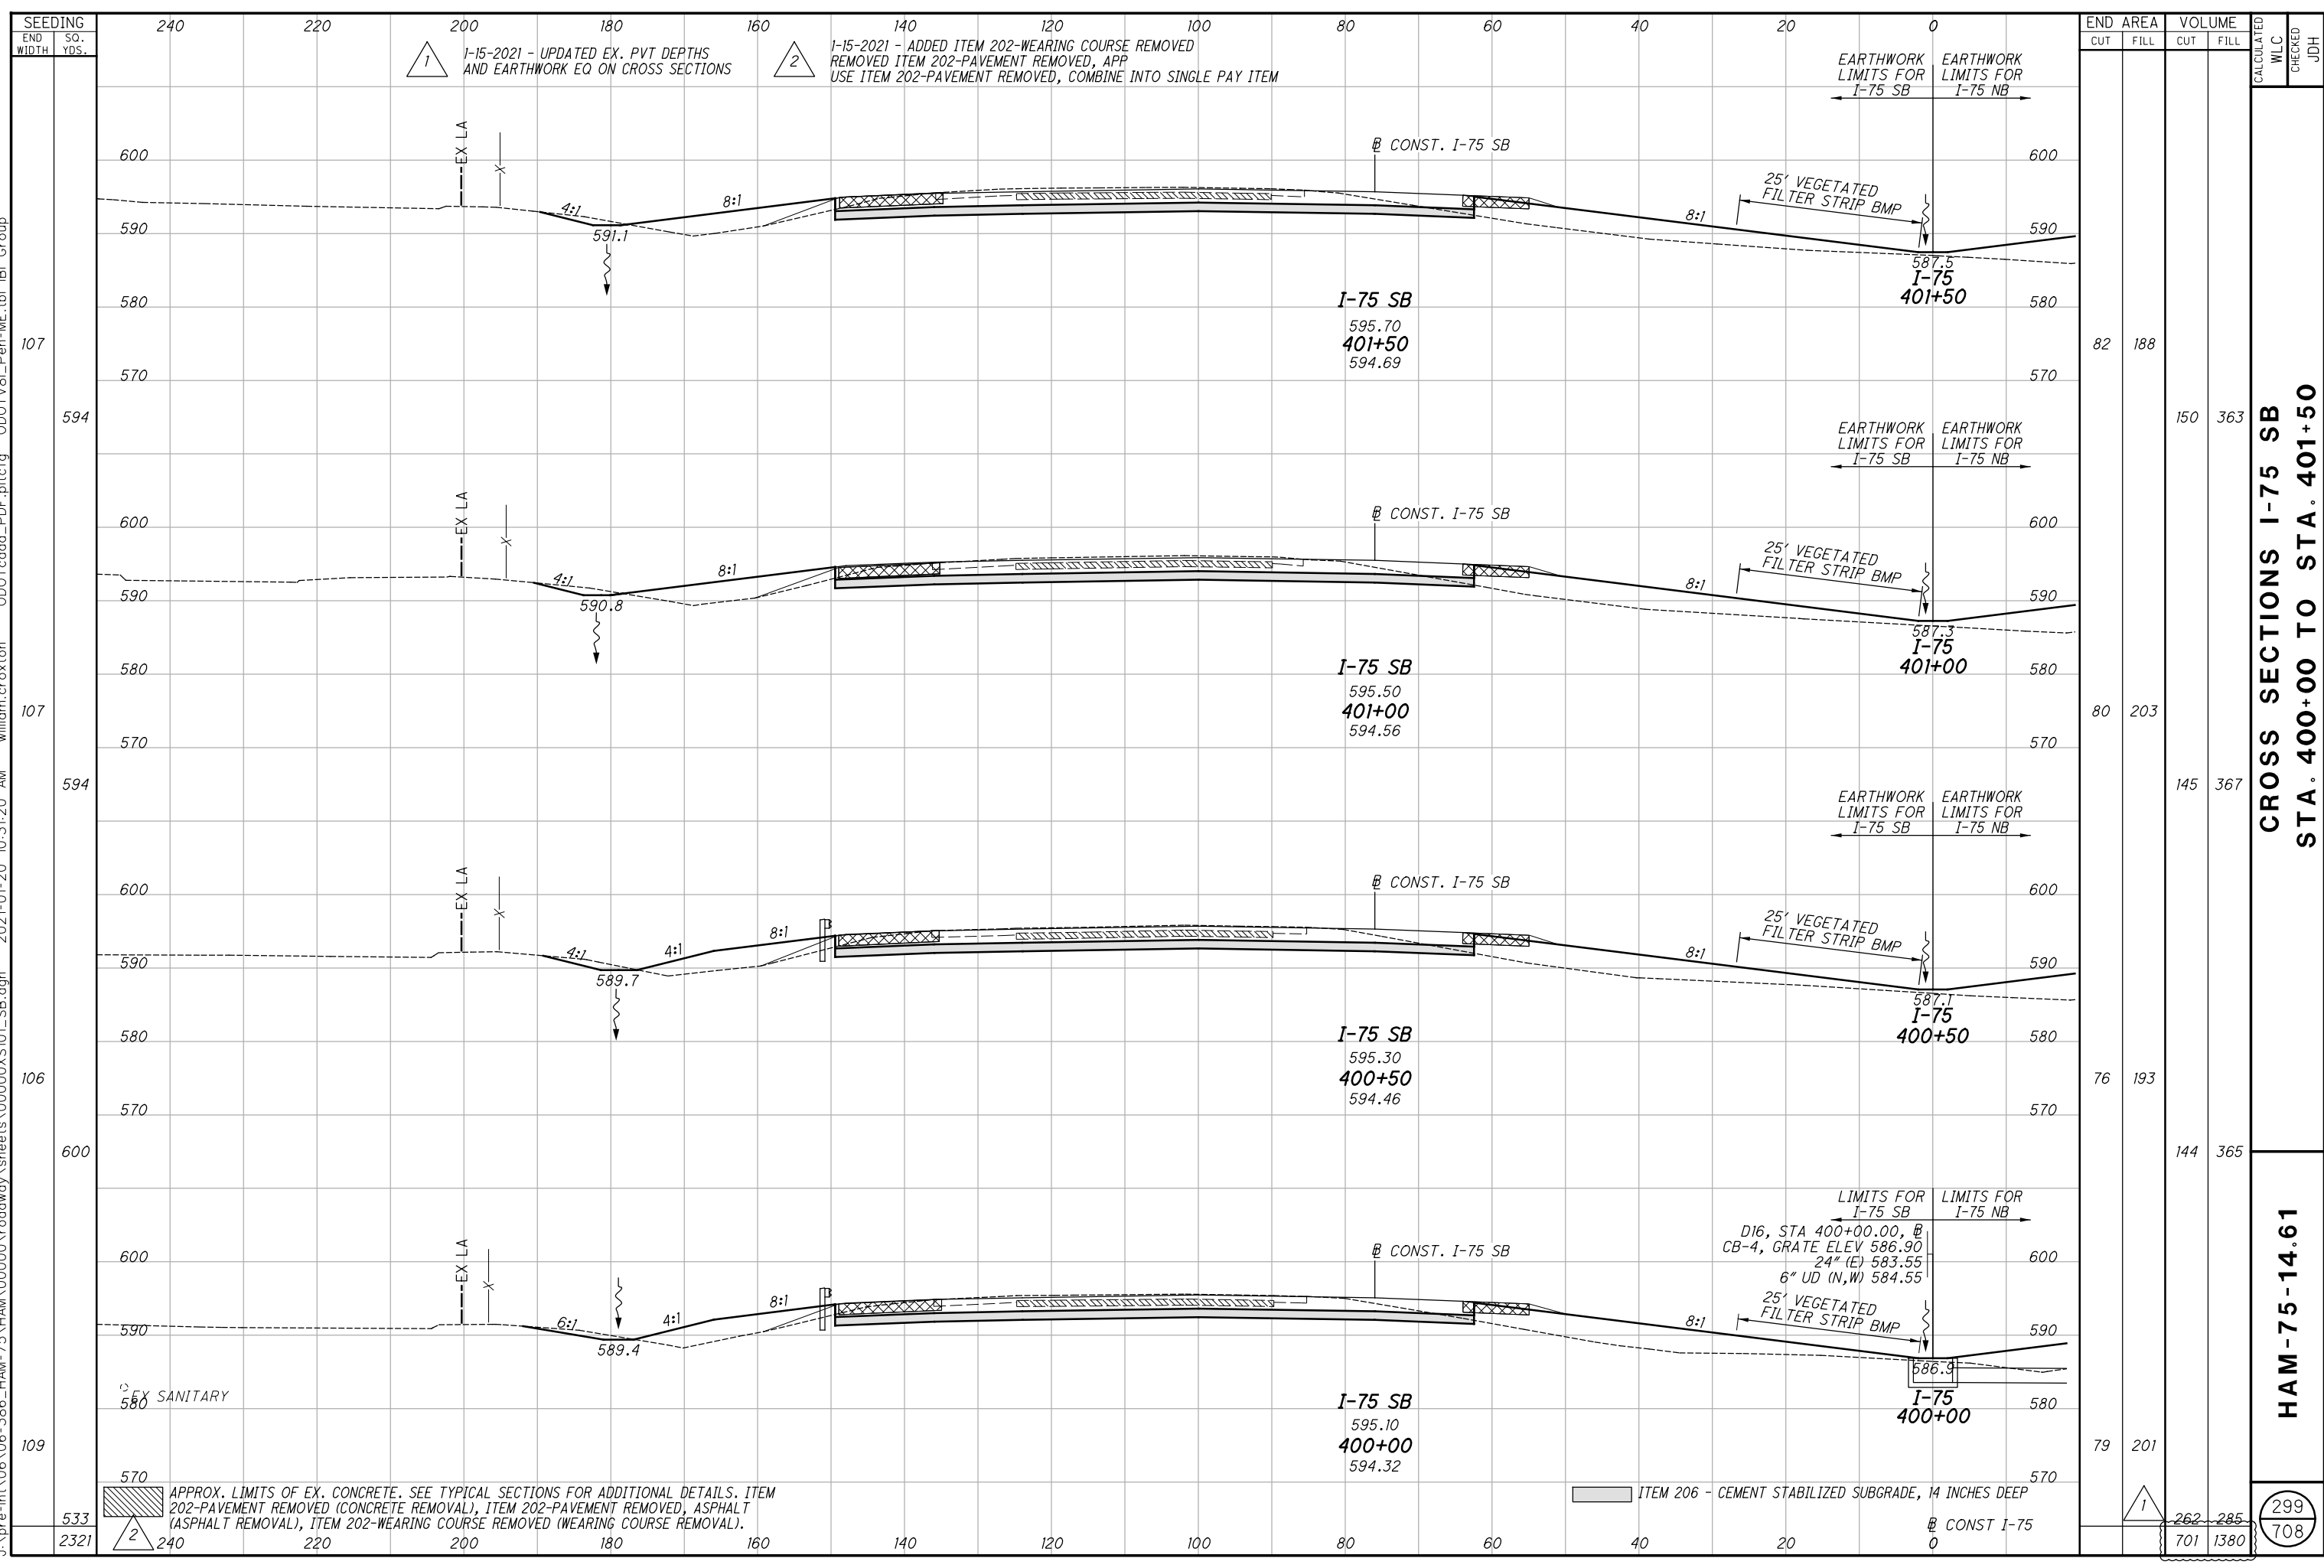

**CROSS SECTIONS I-75 SB  
STA. 400+00 TO STA. 401+50**

**HAM-75-14.61**

1-15-2021 - UPDATED EX. PVT DEPTHS AND EARTHWORK EQ ON CROSS SECTIONS  
 1-15-2021 - ADDED ITEM 202-WEARING COURSE REMOVED REMOVED ITEM 202-PAVEMENT REMOVED, APP USE ITEM 202-PAVEMENT REMOVED, COMBINE INTO SINGLE PAY ITEM

APPROX. LIMITS OF EX. CONCRETE. SEE TYPICAL SECTIONS FOR ADDITIONAL DETAILS. ITEM 202-PAVEMENT REMOVED (CONCRETE REMOVAL), ITEM 202-PAVEMENT REMOVED, ASPHALT (ASPHALT REMOVAL), ITEM 202-WEARING COURSE REMOVED (WEARING COURSE REMOVAL).

ITEM 206 - CEMENT STABILIZED SUBGRADE, 14 INCHES DEEP

LIMITS FOR I-75 SB  
 D16, STA 400+00.00, @  
 CB-4, GRATE ELEV 586.90  
 24" (E) 583.55  
 6" UD (N,W) 584.55

SEEDING

END WIDTH SO. YDS.


CUT FILL

CUT FILL


CALCULATED WLC CHECKED JDH

299  
708

j:\pre-int\06\06-386\_HAM-75\HAM-75\HAM-00000\roadway\sheets\00000XS101\_SB.dgn 2021-01-20 10:31:21 AM william.croxton' ODOT\cadd\_PDF\_plt\cfig ODOTV81\_Pen-ME.tbl IBI Group

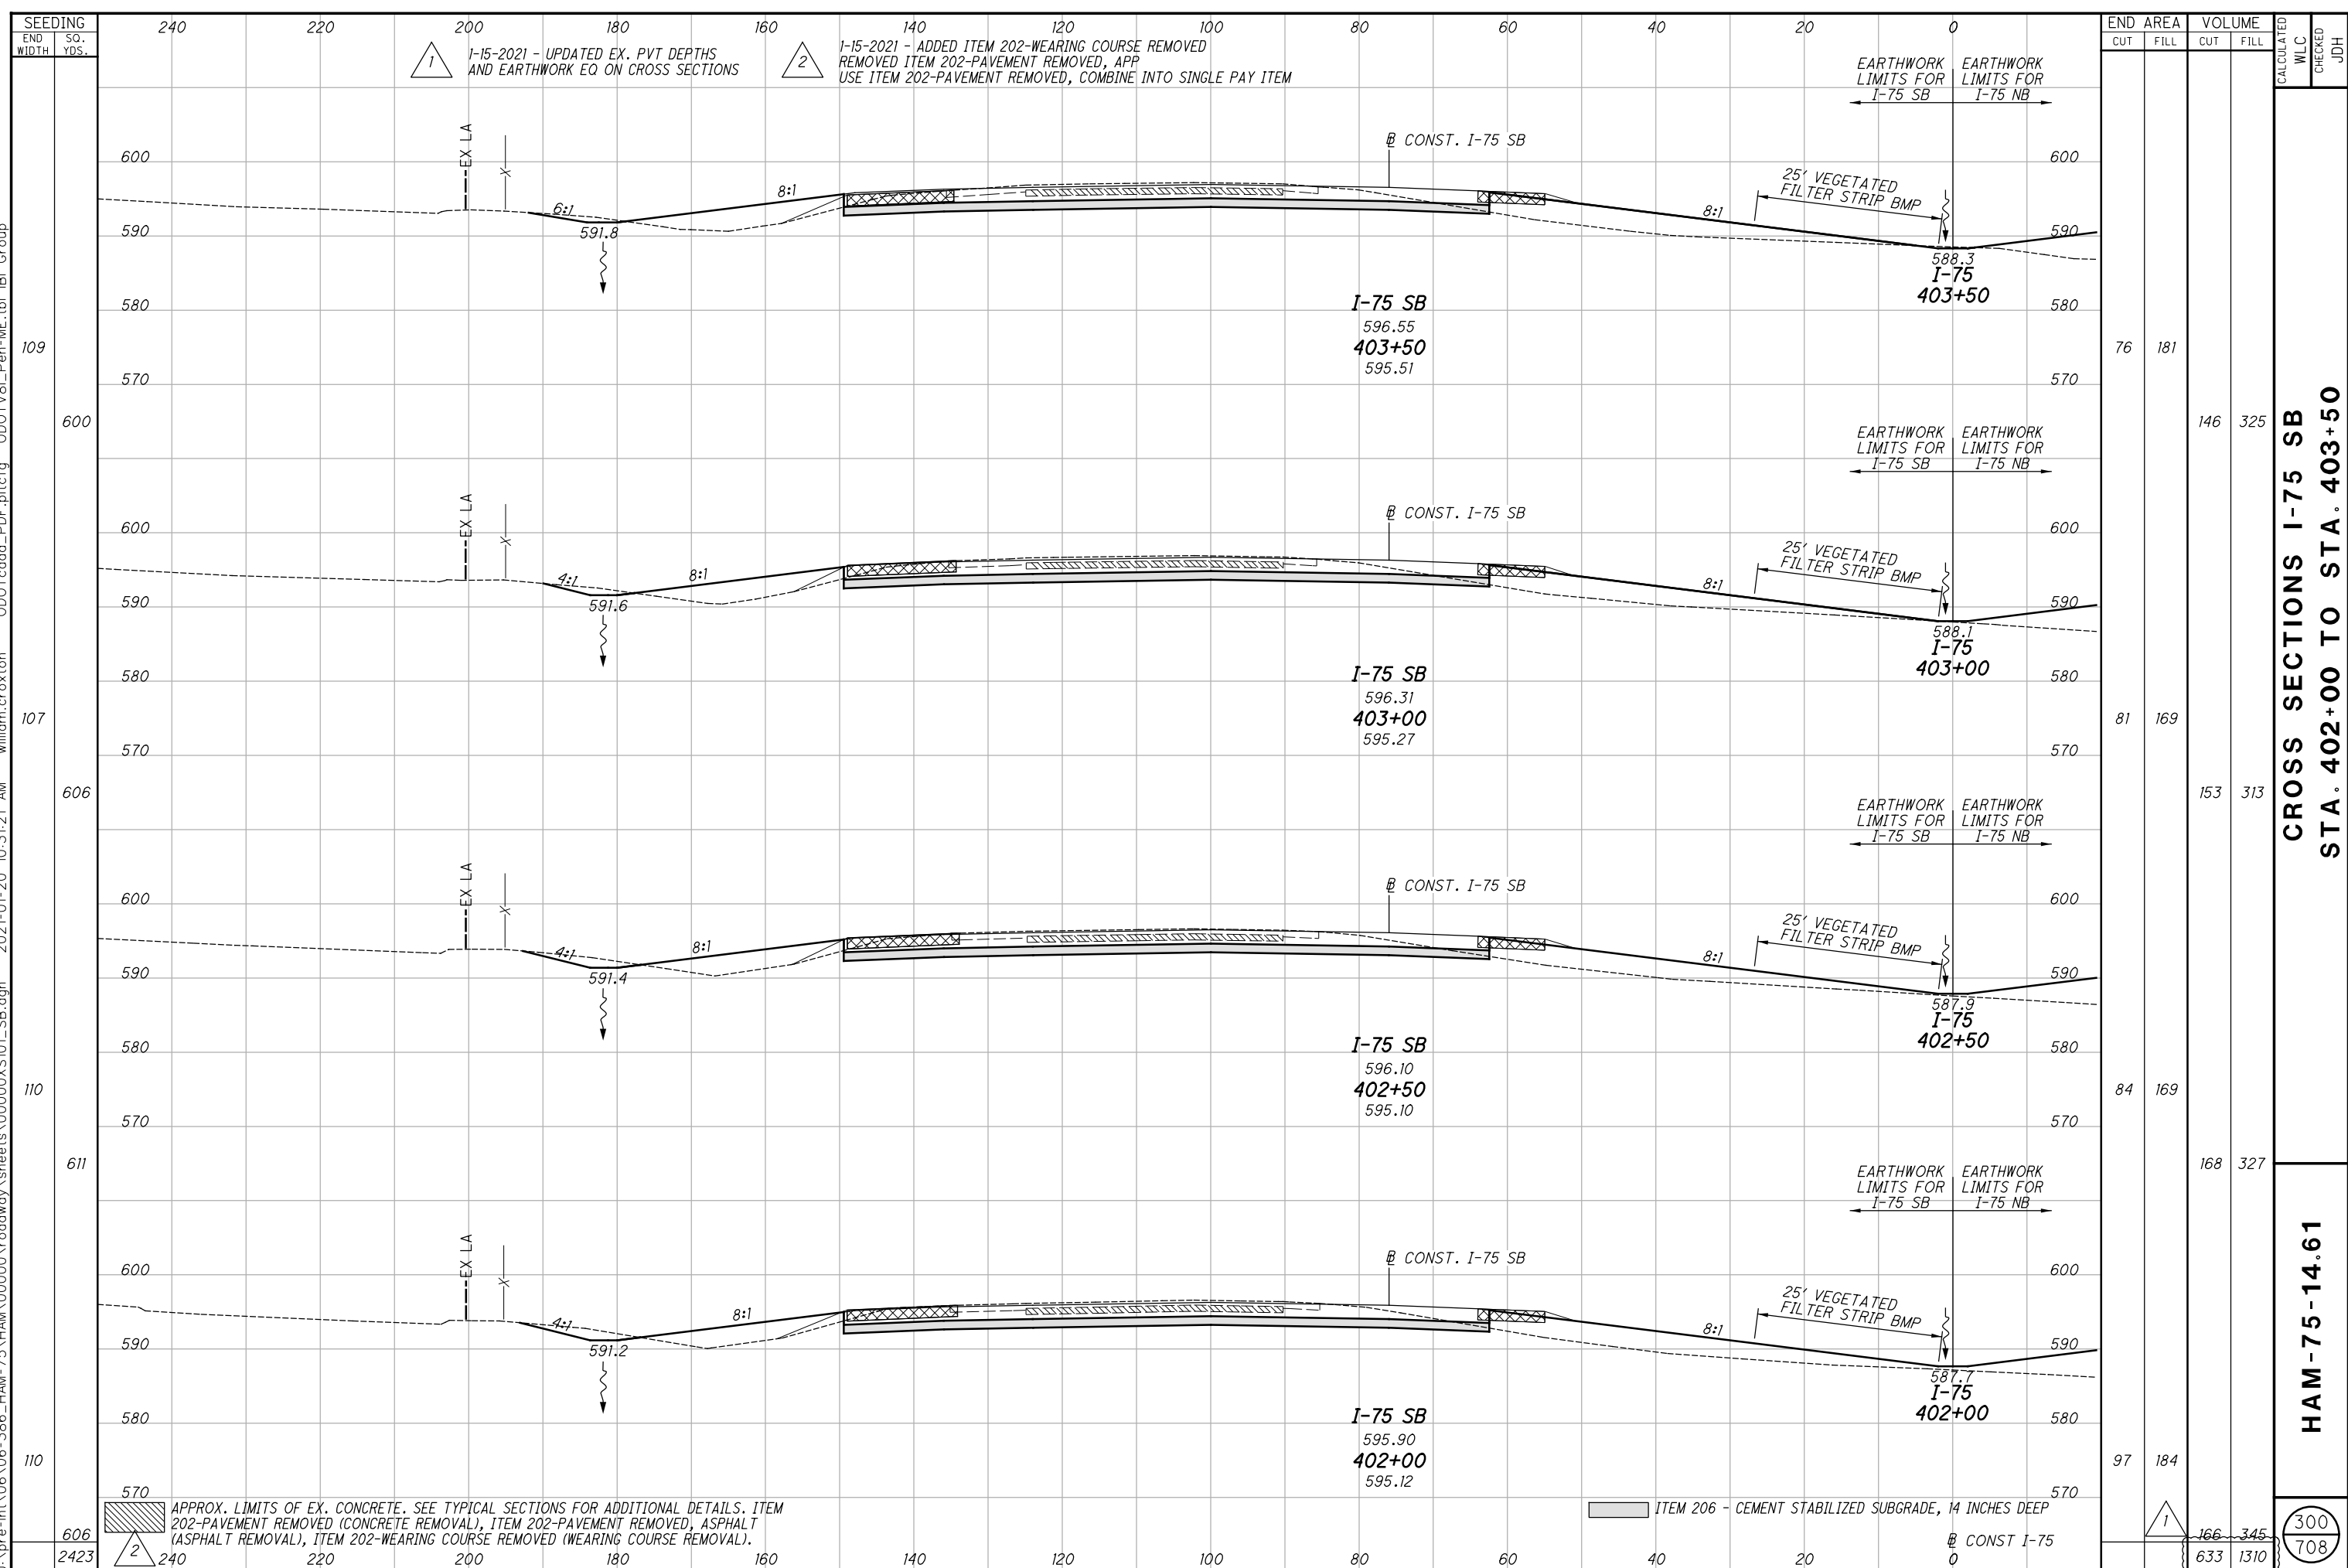

j:\pre-int\06\06-386\_HAM-75\HAM\00000\roadway\sheets\00000X5101\_SB.dgn 2021-01-20 10:31:22 AM william.croxton ODOTcadd\_PDF.pltcfgr ODOTV81\_Pen-ME.tbl IBI Group

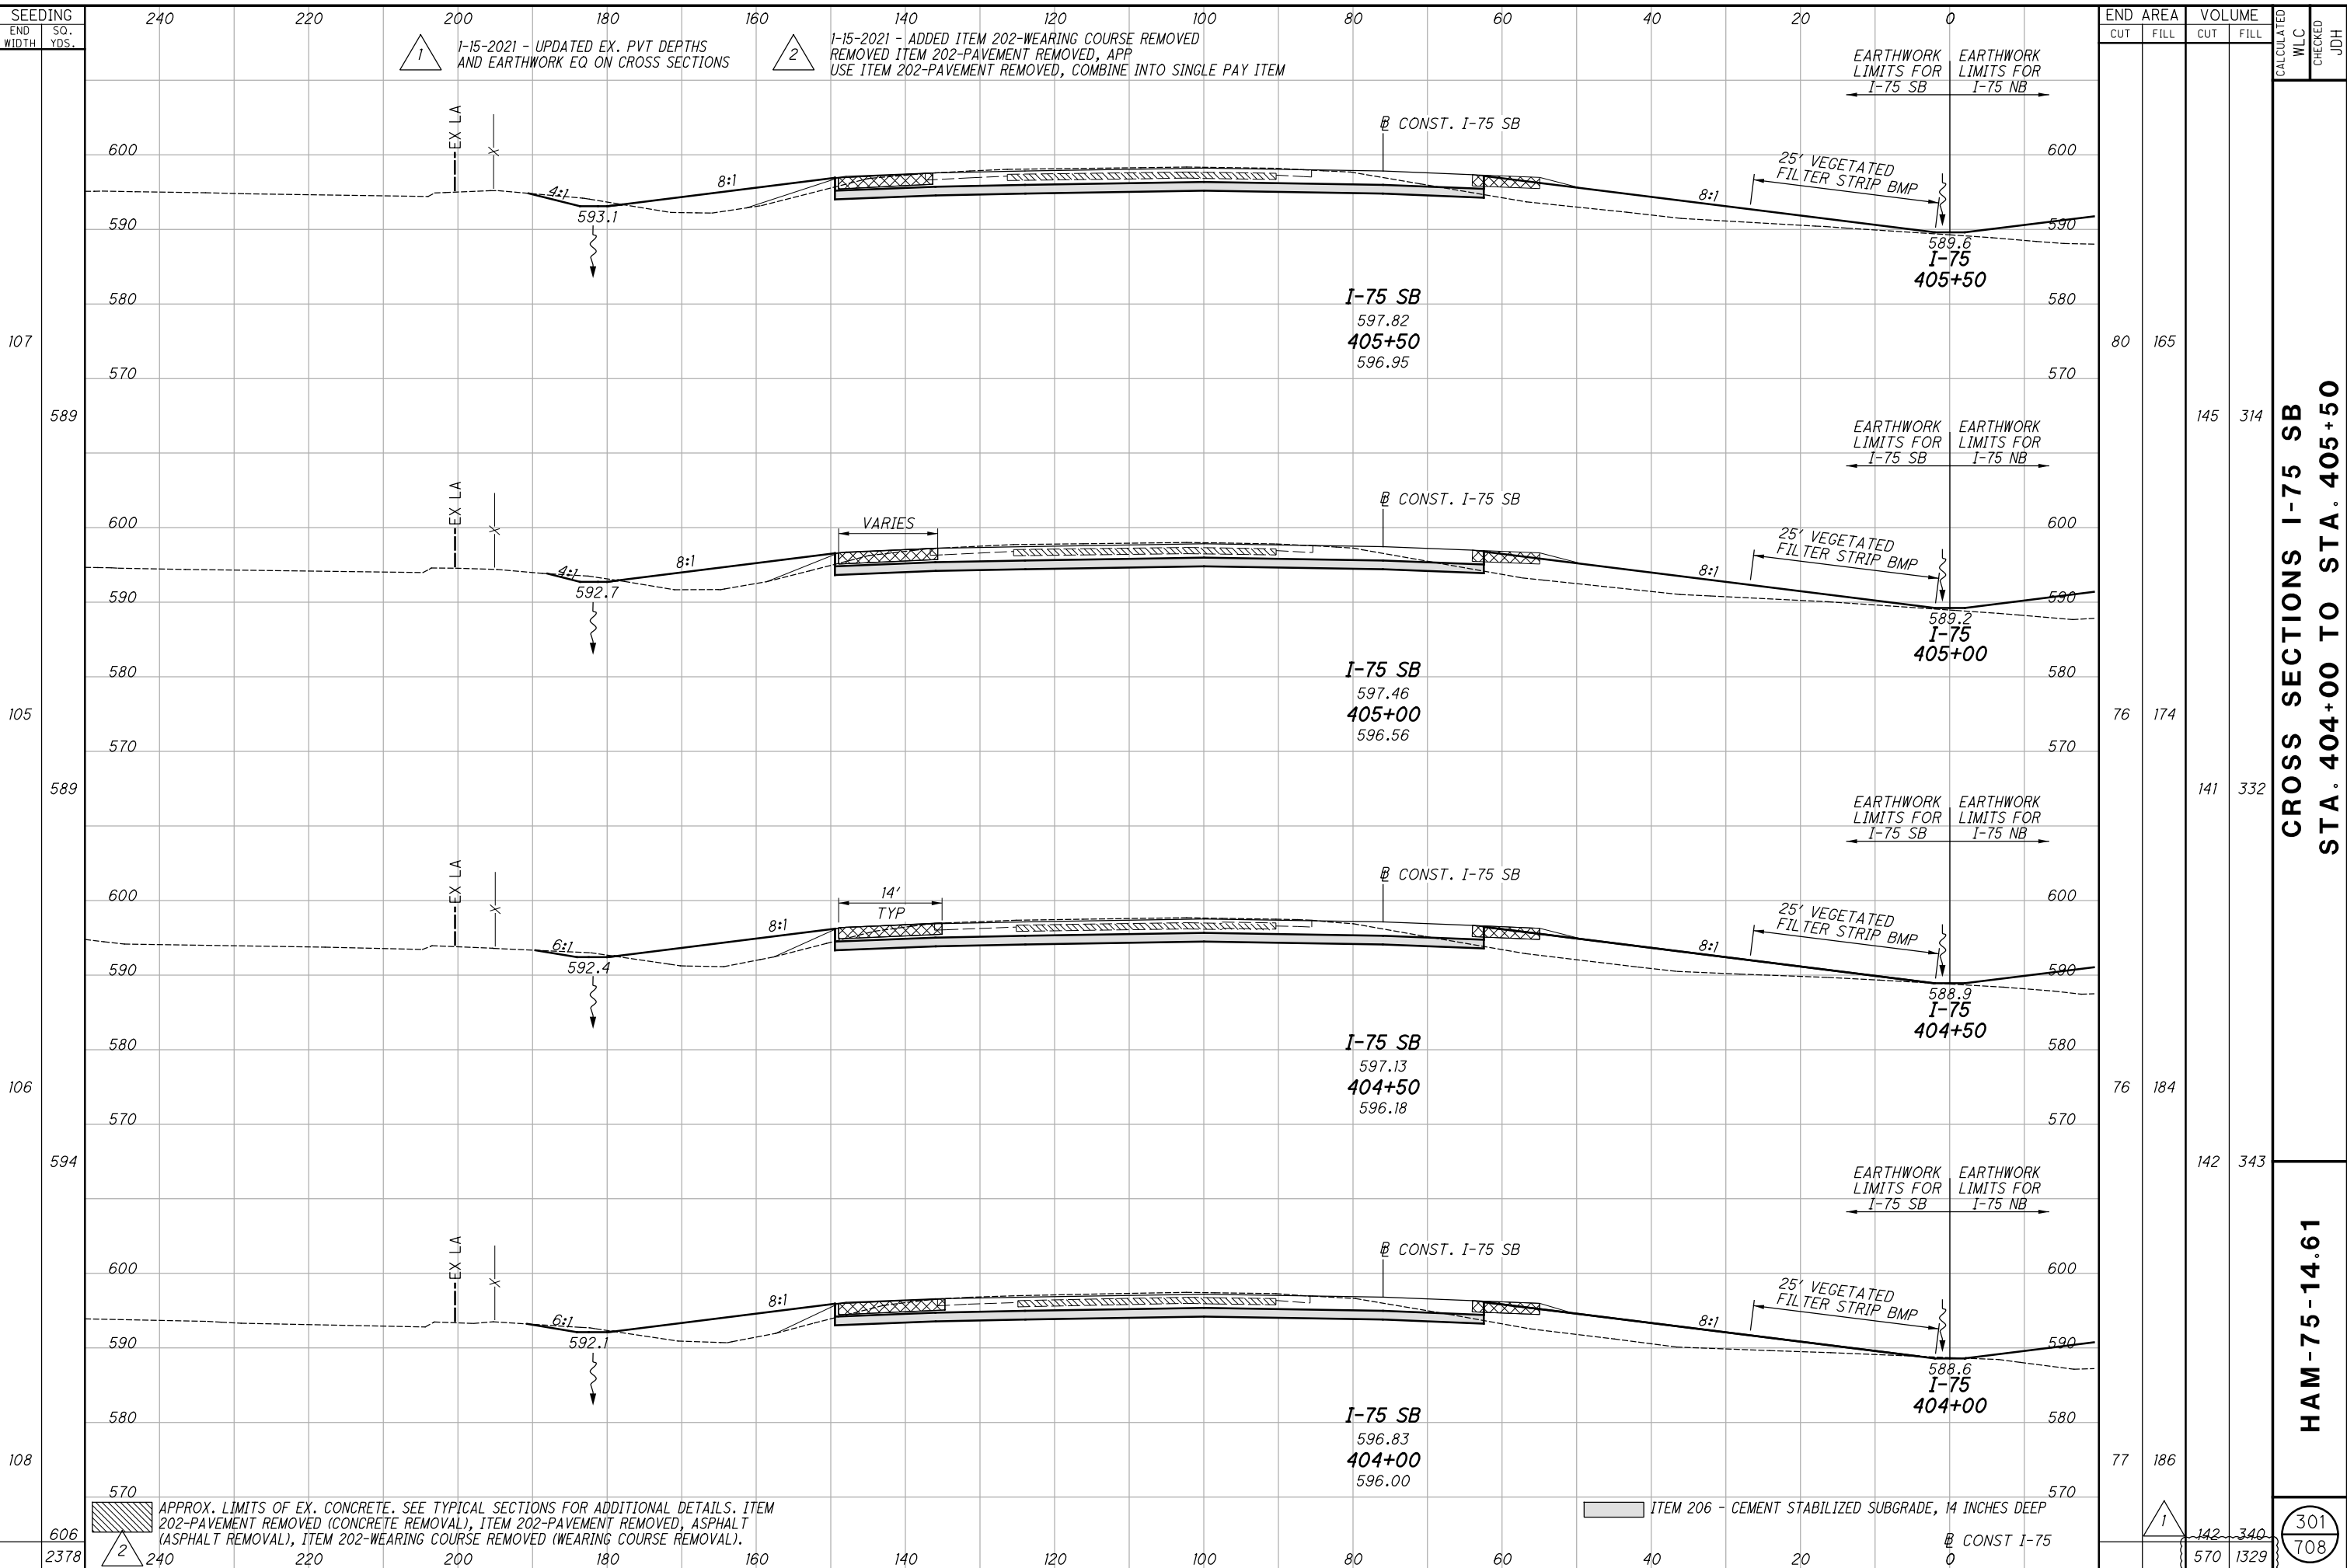

END STA	END AREA		VOLUME		CALCULATED WLC	CHECKED	JDH
	CUT	FILL	CUT	FILL			
405+50	80	165	145	314			
405+00	76	174	141	332			
404+50	76	184	142	343			
404+00	77	186	142	340			
404+00			570	1329	301	708	

CROSS SECTIONS I-75 SB  
STA. 404+00 TO STA. 405+50

HAM-75-14.61


301  
708

APPROX. LIMITS OF EX. CONCRETE. SEE TYPICAL SECTIONS FOR ADDITIONAL DETAILS. ITEM 202-PAVEMENT REMOVED (CONCRETE REMOVAL), ITEM 202-PAVEMENT REMOVED, ASPHALT (ASPHALT REMOVAL), ITEM 202-WEARING COURSE REMOVED (WEARING COURSE REMOVAL).

ITEM 206 - CEMENT STABILIZED SUBGRADE, 14 INCHES DEEP

CONST I-75

j:\pre-int\06\06-386\_HAM-75\HAM\00000\roadway\sheets\00000X5101\_SB.dgn 2021-01-20 10:31:23 AM william.croxton ODOT\cadd\_PDF.plt\cfig ODOTV81\_Pen-ME.tbl IBI Group

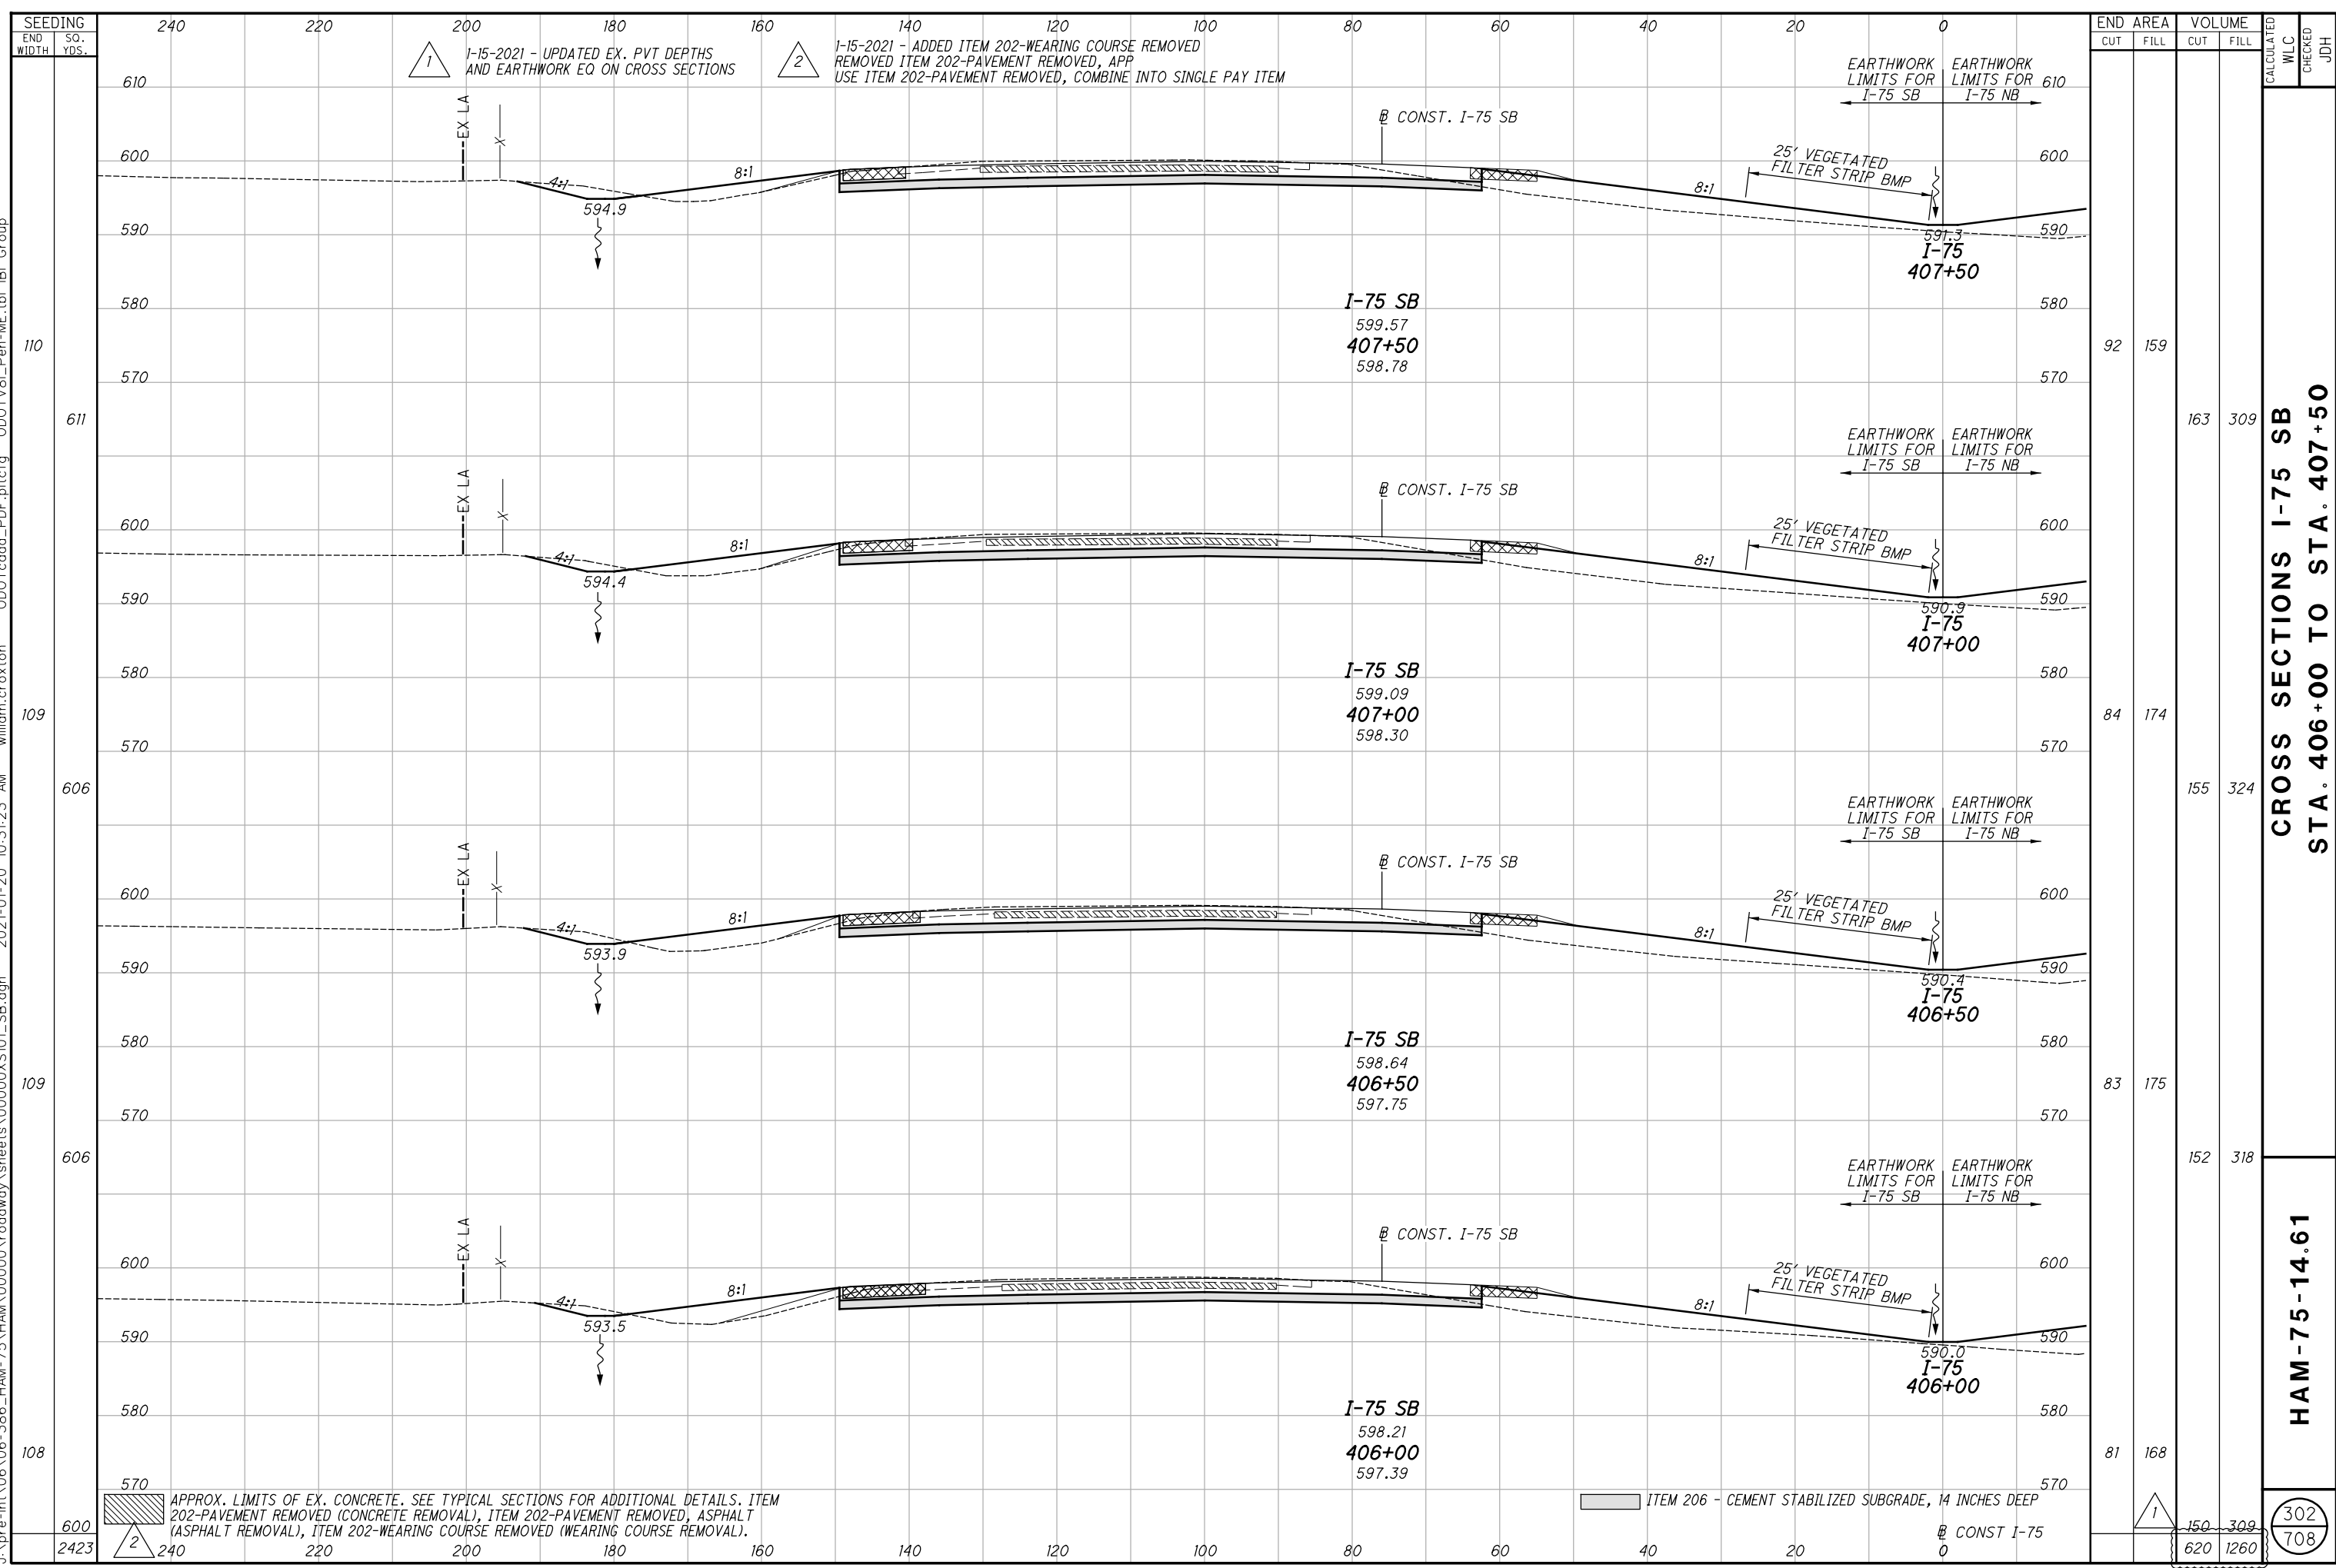

CROSS SECTIONS I-75 SB  
STA. 406+00 TO STA. 407+50

HAM-75-14.61

302  
708

APPROX. LIMITS OF EX. CONCRETE. SEE TYPICAL SECTIONS FOR ADDITIONAL DETAILS. ITEM 202-PAVEMENT REMOVED (CONCRETE REMOVAL), ITEM 202-PAVEMENT REMOVED, ASPHALT (ASPHALT REMOVAL), ITEM 202-WEARING COURSE REMOVED (WEARING COURSE REMOVAL).


ITEM 206 - CEMENT STABILIZED SUBGRADE, 14 INCHES DEEP

CONST I-75

1-15-2021 - UPDATED EX. PVT DEPTHS AND EARTHWORK EQ ON CROSS SECTIONS

1-15-2021 - ADDED ITEM 202-WEARING COURSE REMOVED REMOVED ITEM 202-PAVEMENT REMOVED, APP USE ITEM 202-PAVEMENT REMOVED, COMBINE INTO SINGLE PAY ITEM

j:\pre-int\06\06-386\_HAM-75\HAM\00000\roadway\sheets\00000X5101\_SB.dgn 2021-01-20 10:31:24 AM william.croxton' ODOTcadd\_PDF.pltcfgr ODOTV81\_Pen-ME.tbl IBI Group

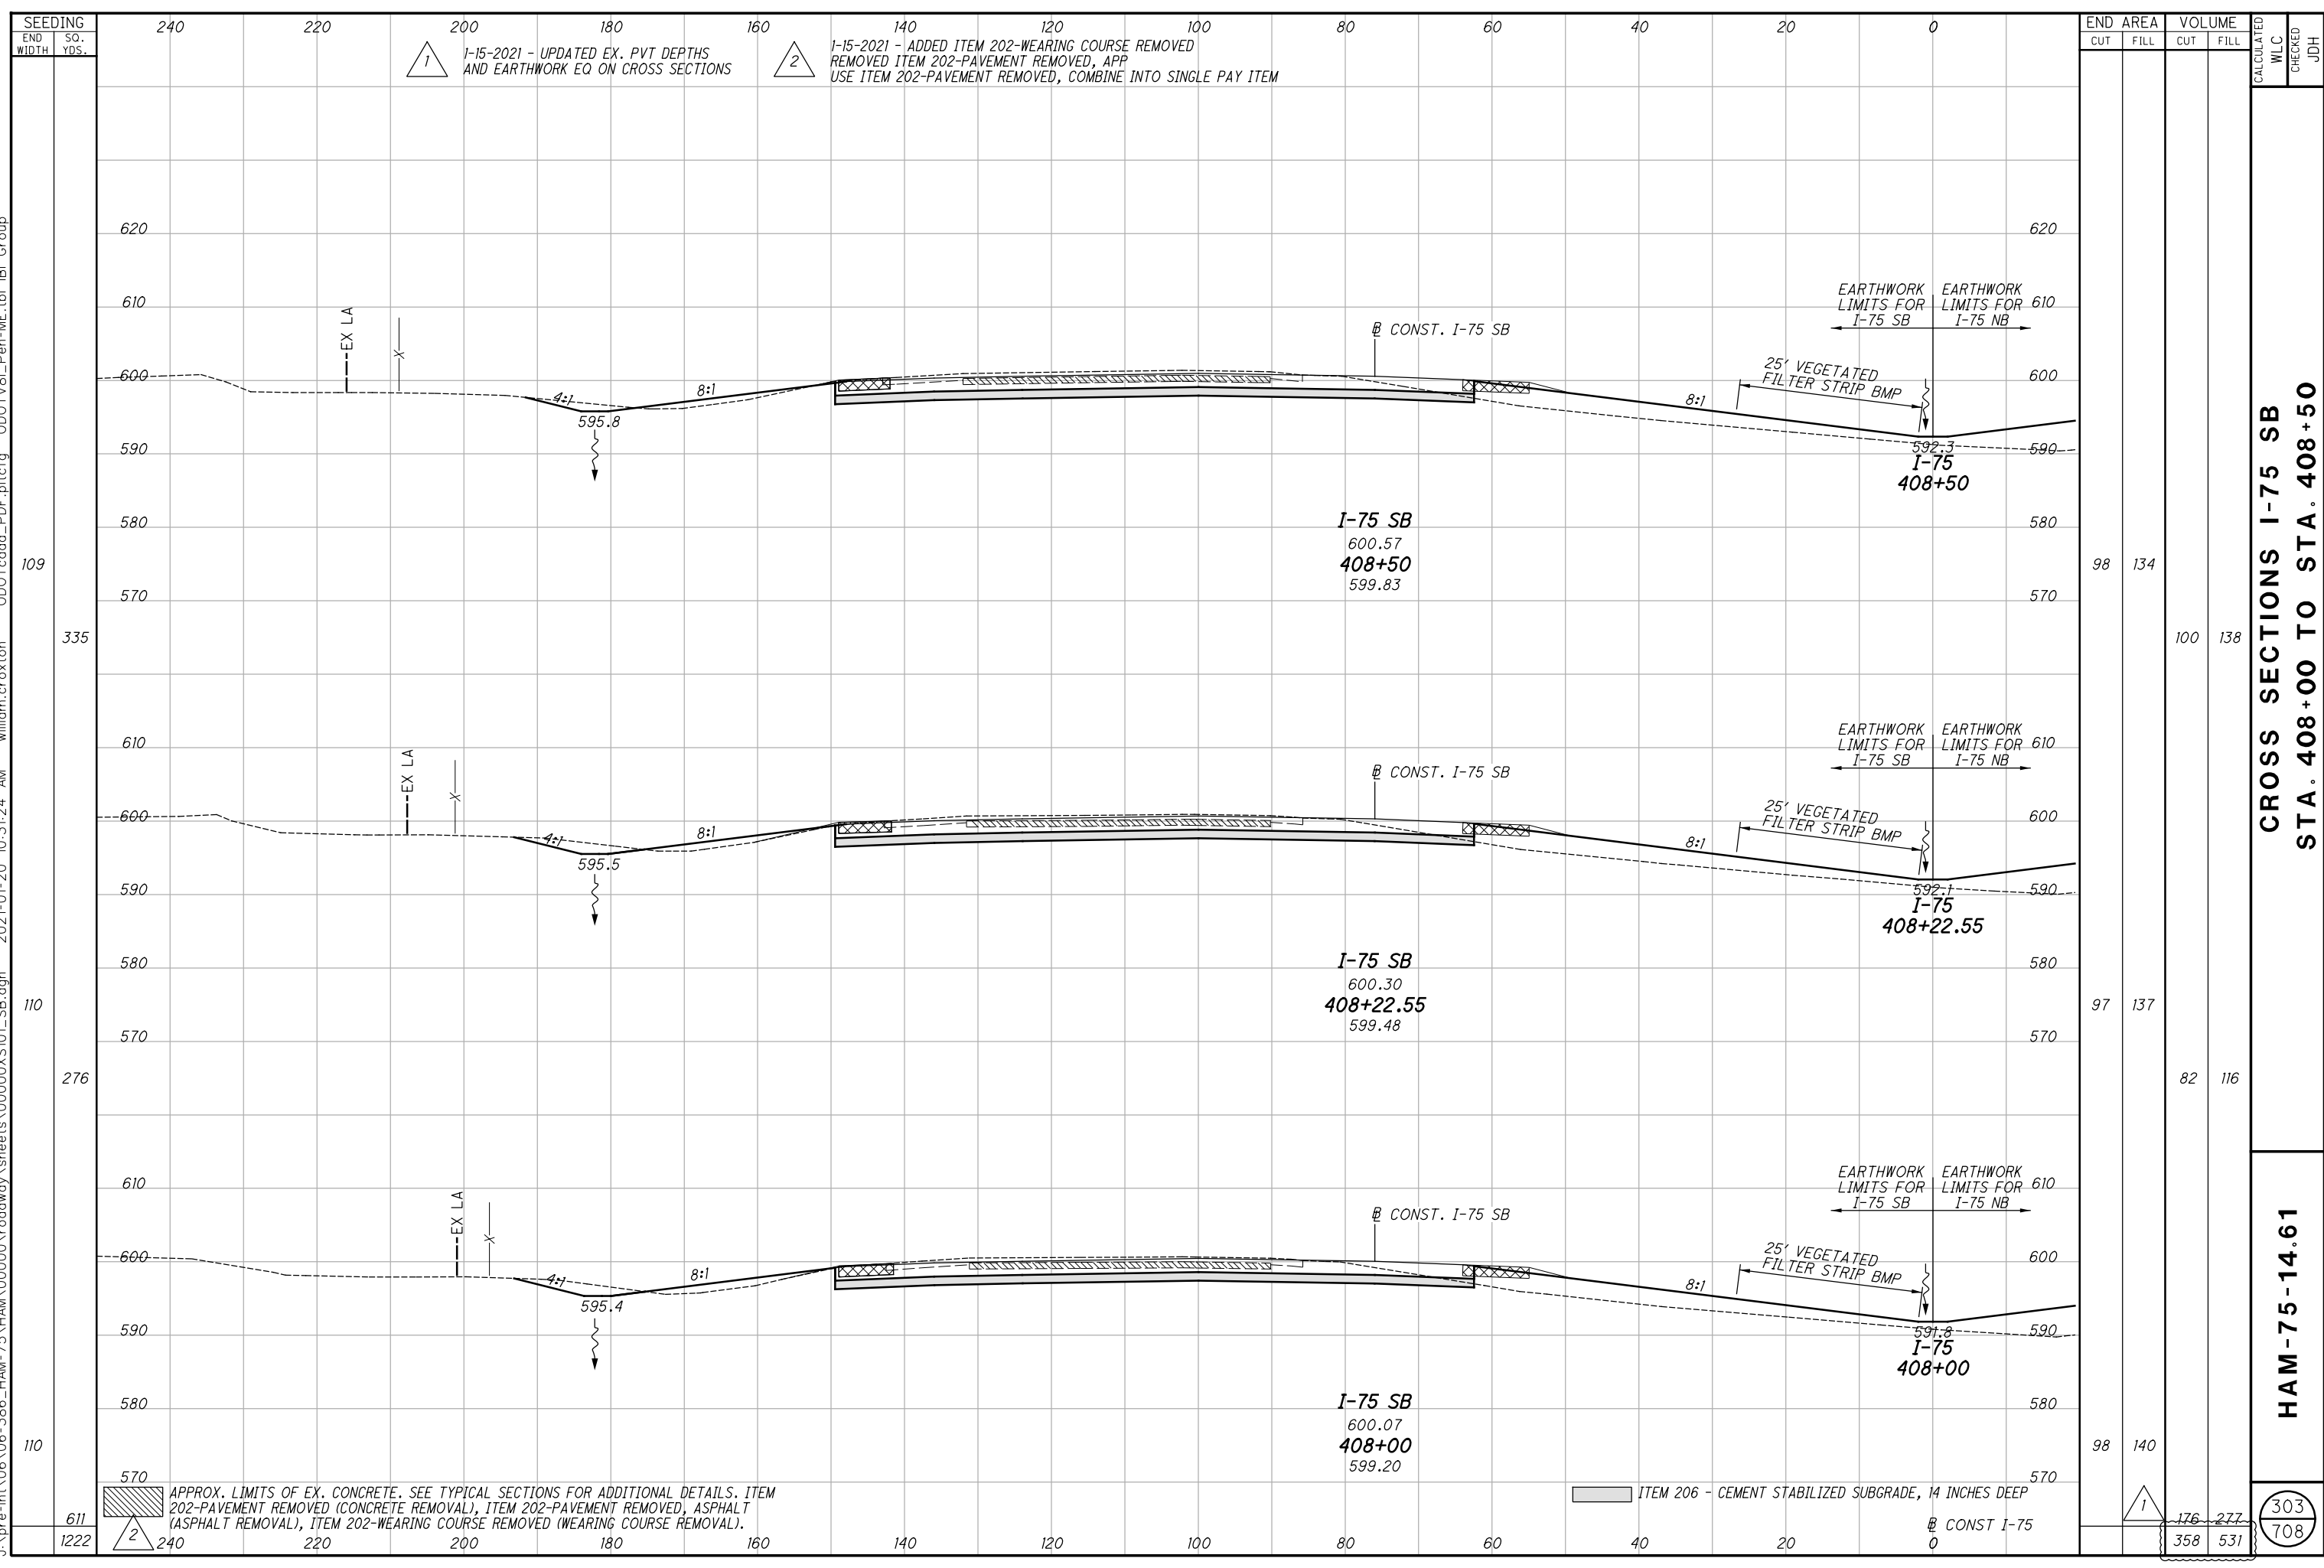

END AREA	VOLUME		CALCULATED WLC	CHECKED	JDH
	CUT	FILL			
98	134	100	138		
97	137	82	116		
98	140	176	277		
		358	531		

CROSS SECTIONS I-75 SB  
STA. 408+00 TO STA. 408+50

HAM-75-14.61

303  
708

1-15-2021 - UPDATED EX. PVT DEPTHS AND EARTHWORK EQ ON CROSS SECTIONS


2-1-15-2021 - ADDED ITEM 202-WEARING COURSE REMOVED REMOVED ITEM 202-PAVEMENT REMOVED, APP USE ITEM 202-PAVEMENT REMOVED, COMBINE INTO SINGLE PAY ITEM

APPROX. LIMITS OF EX. CONCRETE. SEE TYPICAL SECTIONS FOR ADDITIONAL DETAILS. ITEM 202-PAVEMENT REMOVED (CONCRETE REMOVAL), ITEM 202-PAVEMENT REMOVED, ASPHALT (ASPHALT REMOVAL), ITEM 202-WEARING COURSE REMOVED (WEARING COURSE REMOVAL).

ITEM 206 - CEMENT STABILIZED SUBGRADE, 14 INCHES DEEP

CONST I-75

j:\pre-int\06\06-386\_HAM-75\HAM\00000\roadway\sheets\00000X5101\_SB.dgn 2021-01-20 10:31:26 AM william.croxton' ODOTcodd\_PDF.pltcfgr ODOTV81\_Pen-ME.tbl IBI Group

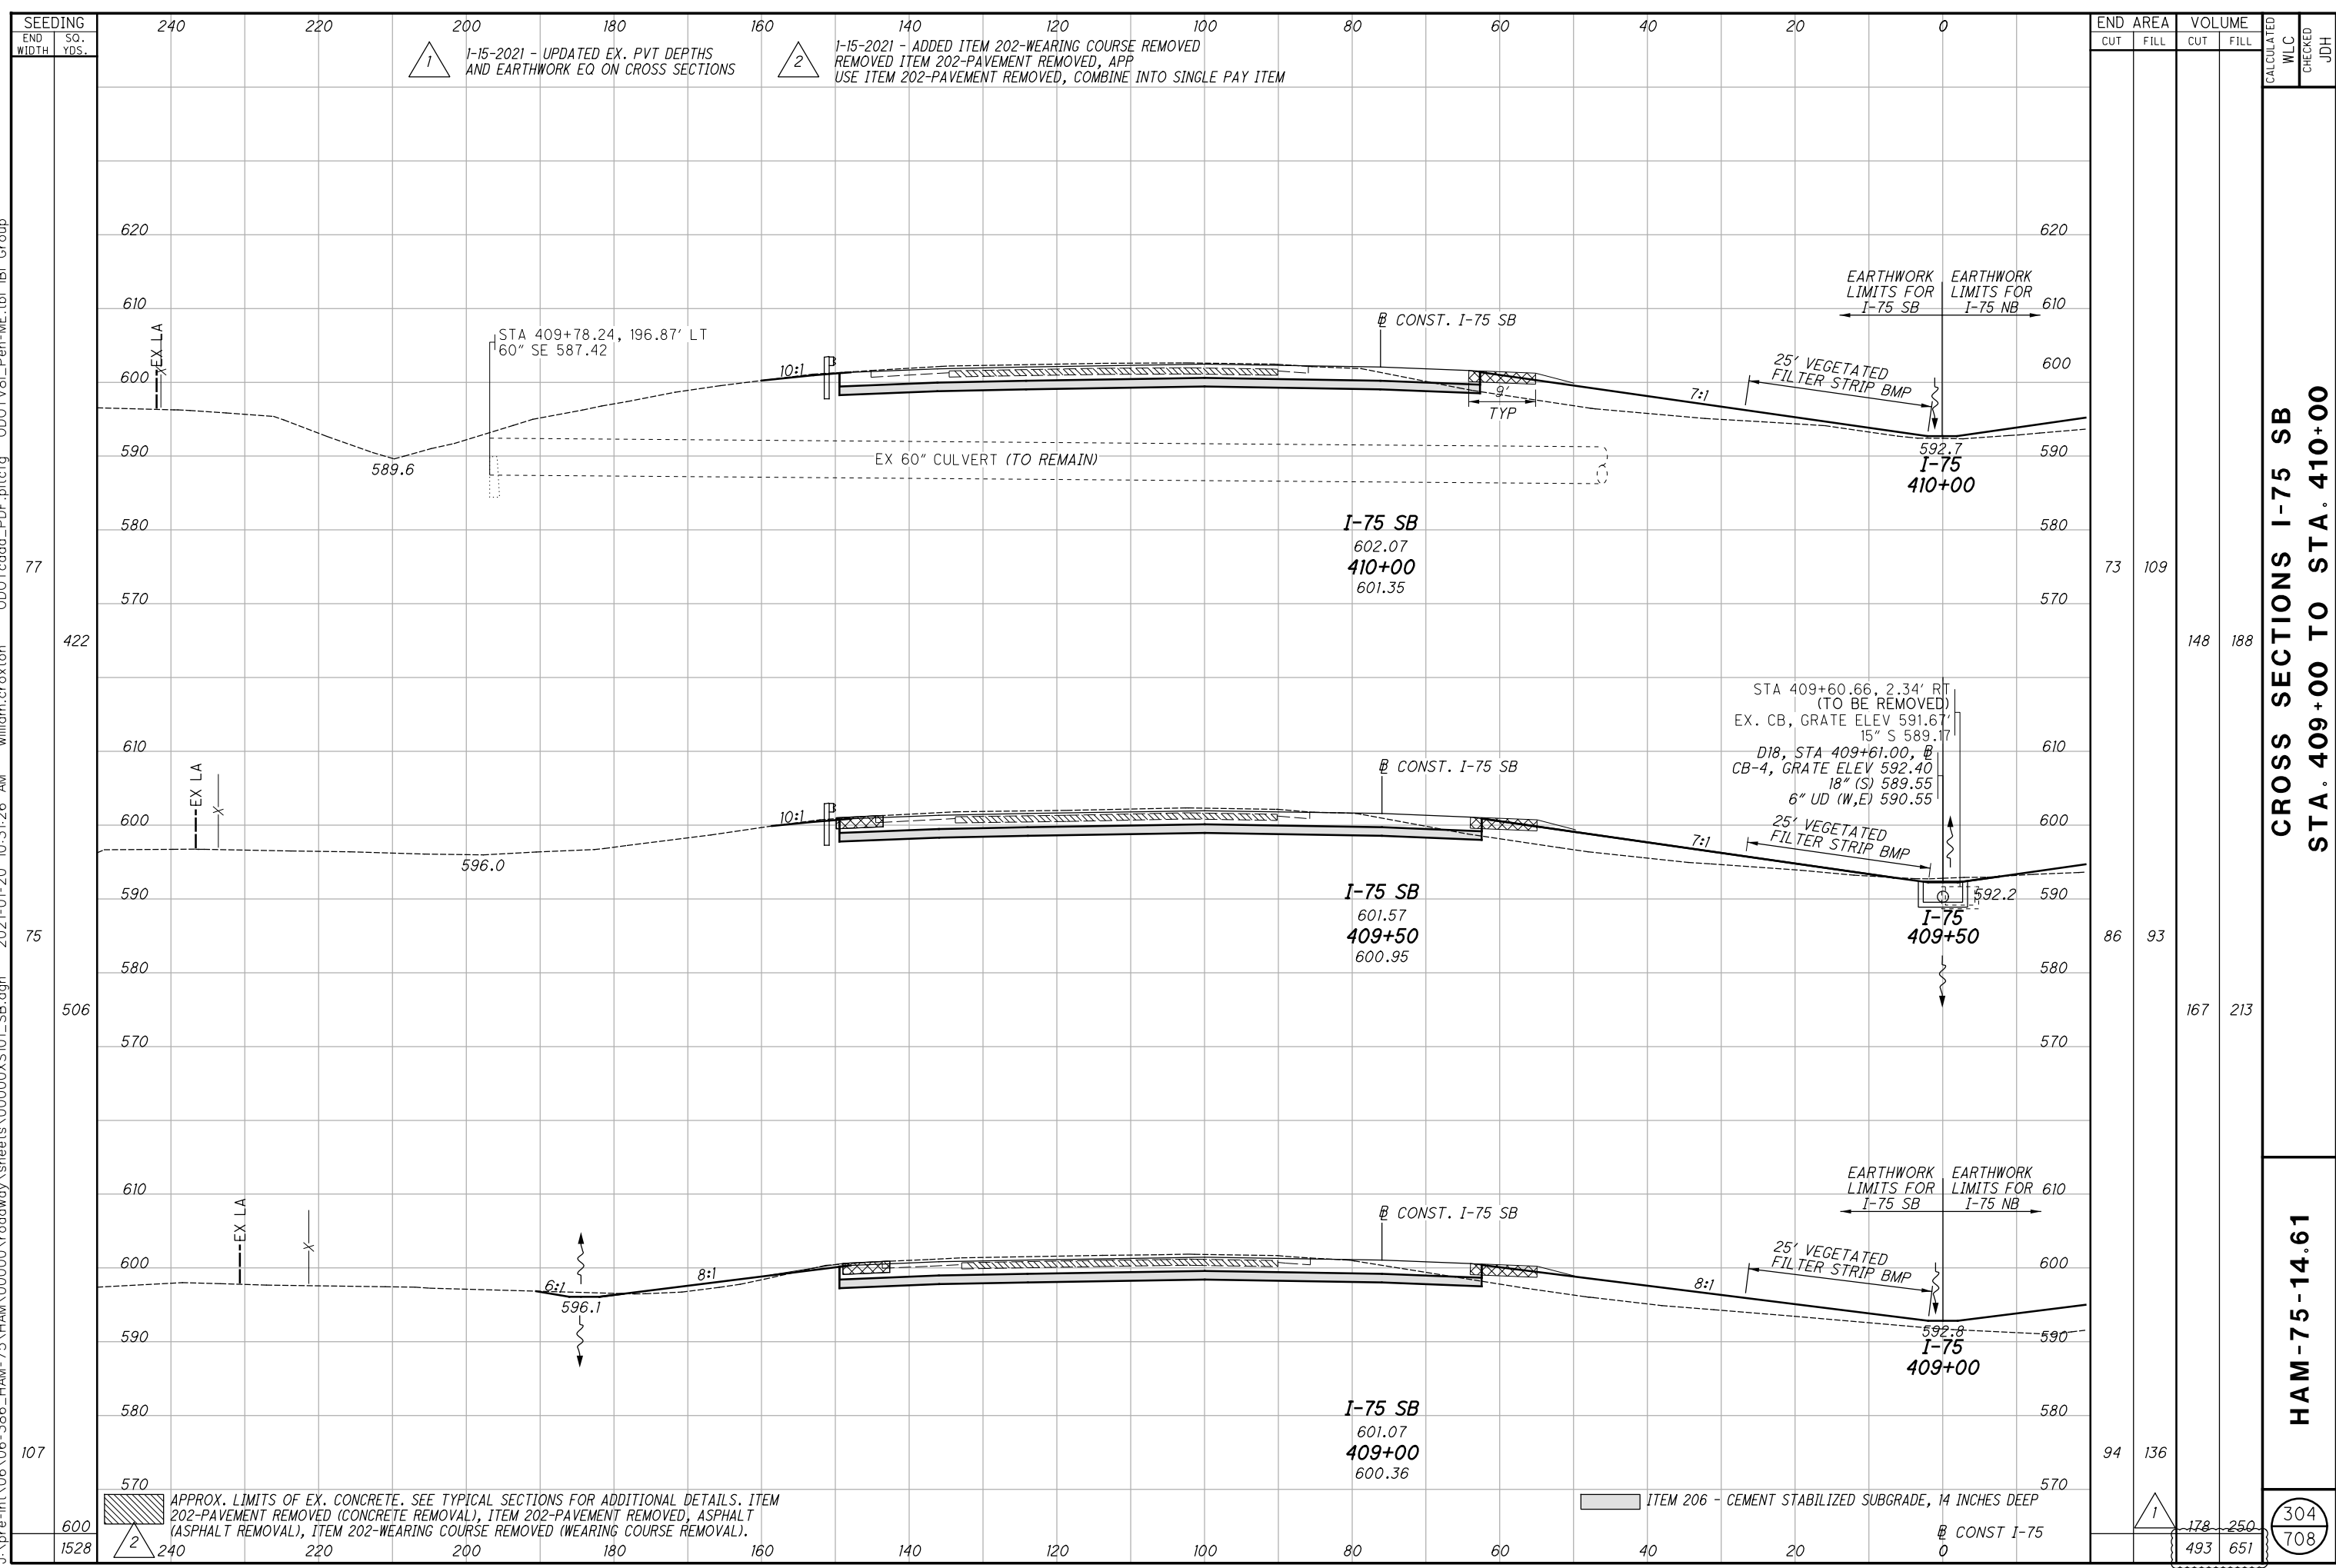

1-15-2021 - UPDATED EX. PVT DEPTHS AND EARTHWORK EQ ON CROSS SECTIONS

2-1-15-2021 - ADDED ITEM 202-WEARING COURSE REMOVED REMOVED ITEM 202-PAVEMENT REMOVED, APP USE ITEM 202-PAVEMENT REMOVED, COMBINE INTO SINGLE PAY ITEM

APPROX. LIMITS OF EX. CONCRETE. SEE TYPICAL SECTIONS FOR ADDITIONAL DETAILS. ITEM 202-PAVEMENT REMOVED (CONCRETE REMOVAL), ITEM 202-PAVEMENT REMOVED, ASPHALT (ASPHALT REMOVAL), ITEM 202-WEARING COURSE REMOVED (WEARING COURSE REMOVAL).


ITEM 206 - CEMENT STABILIZED SUBGRADE, 14 INCHES DEEP

CROSS SECTIONS I-75 SB  
STA. 409+00 TO STA. 410+00

HAM-75-14.61


304  
708

j:\pre-int\06\06-386\_HAM-75\_HAM\00000\roadway\sheets\00000X5101\_SB.dgn 2021-01-20 10:31:27 AM william.croxton ODOTcadd\_PDF.pltcfgr ODOTV81\_Pen-ME.tbl IBI Group

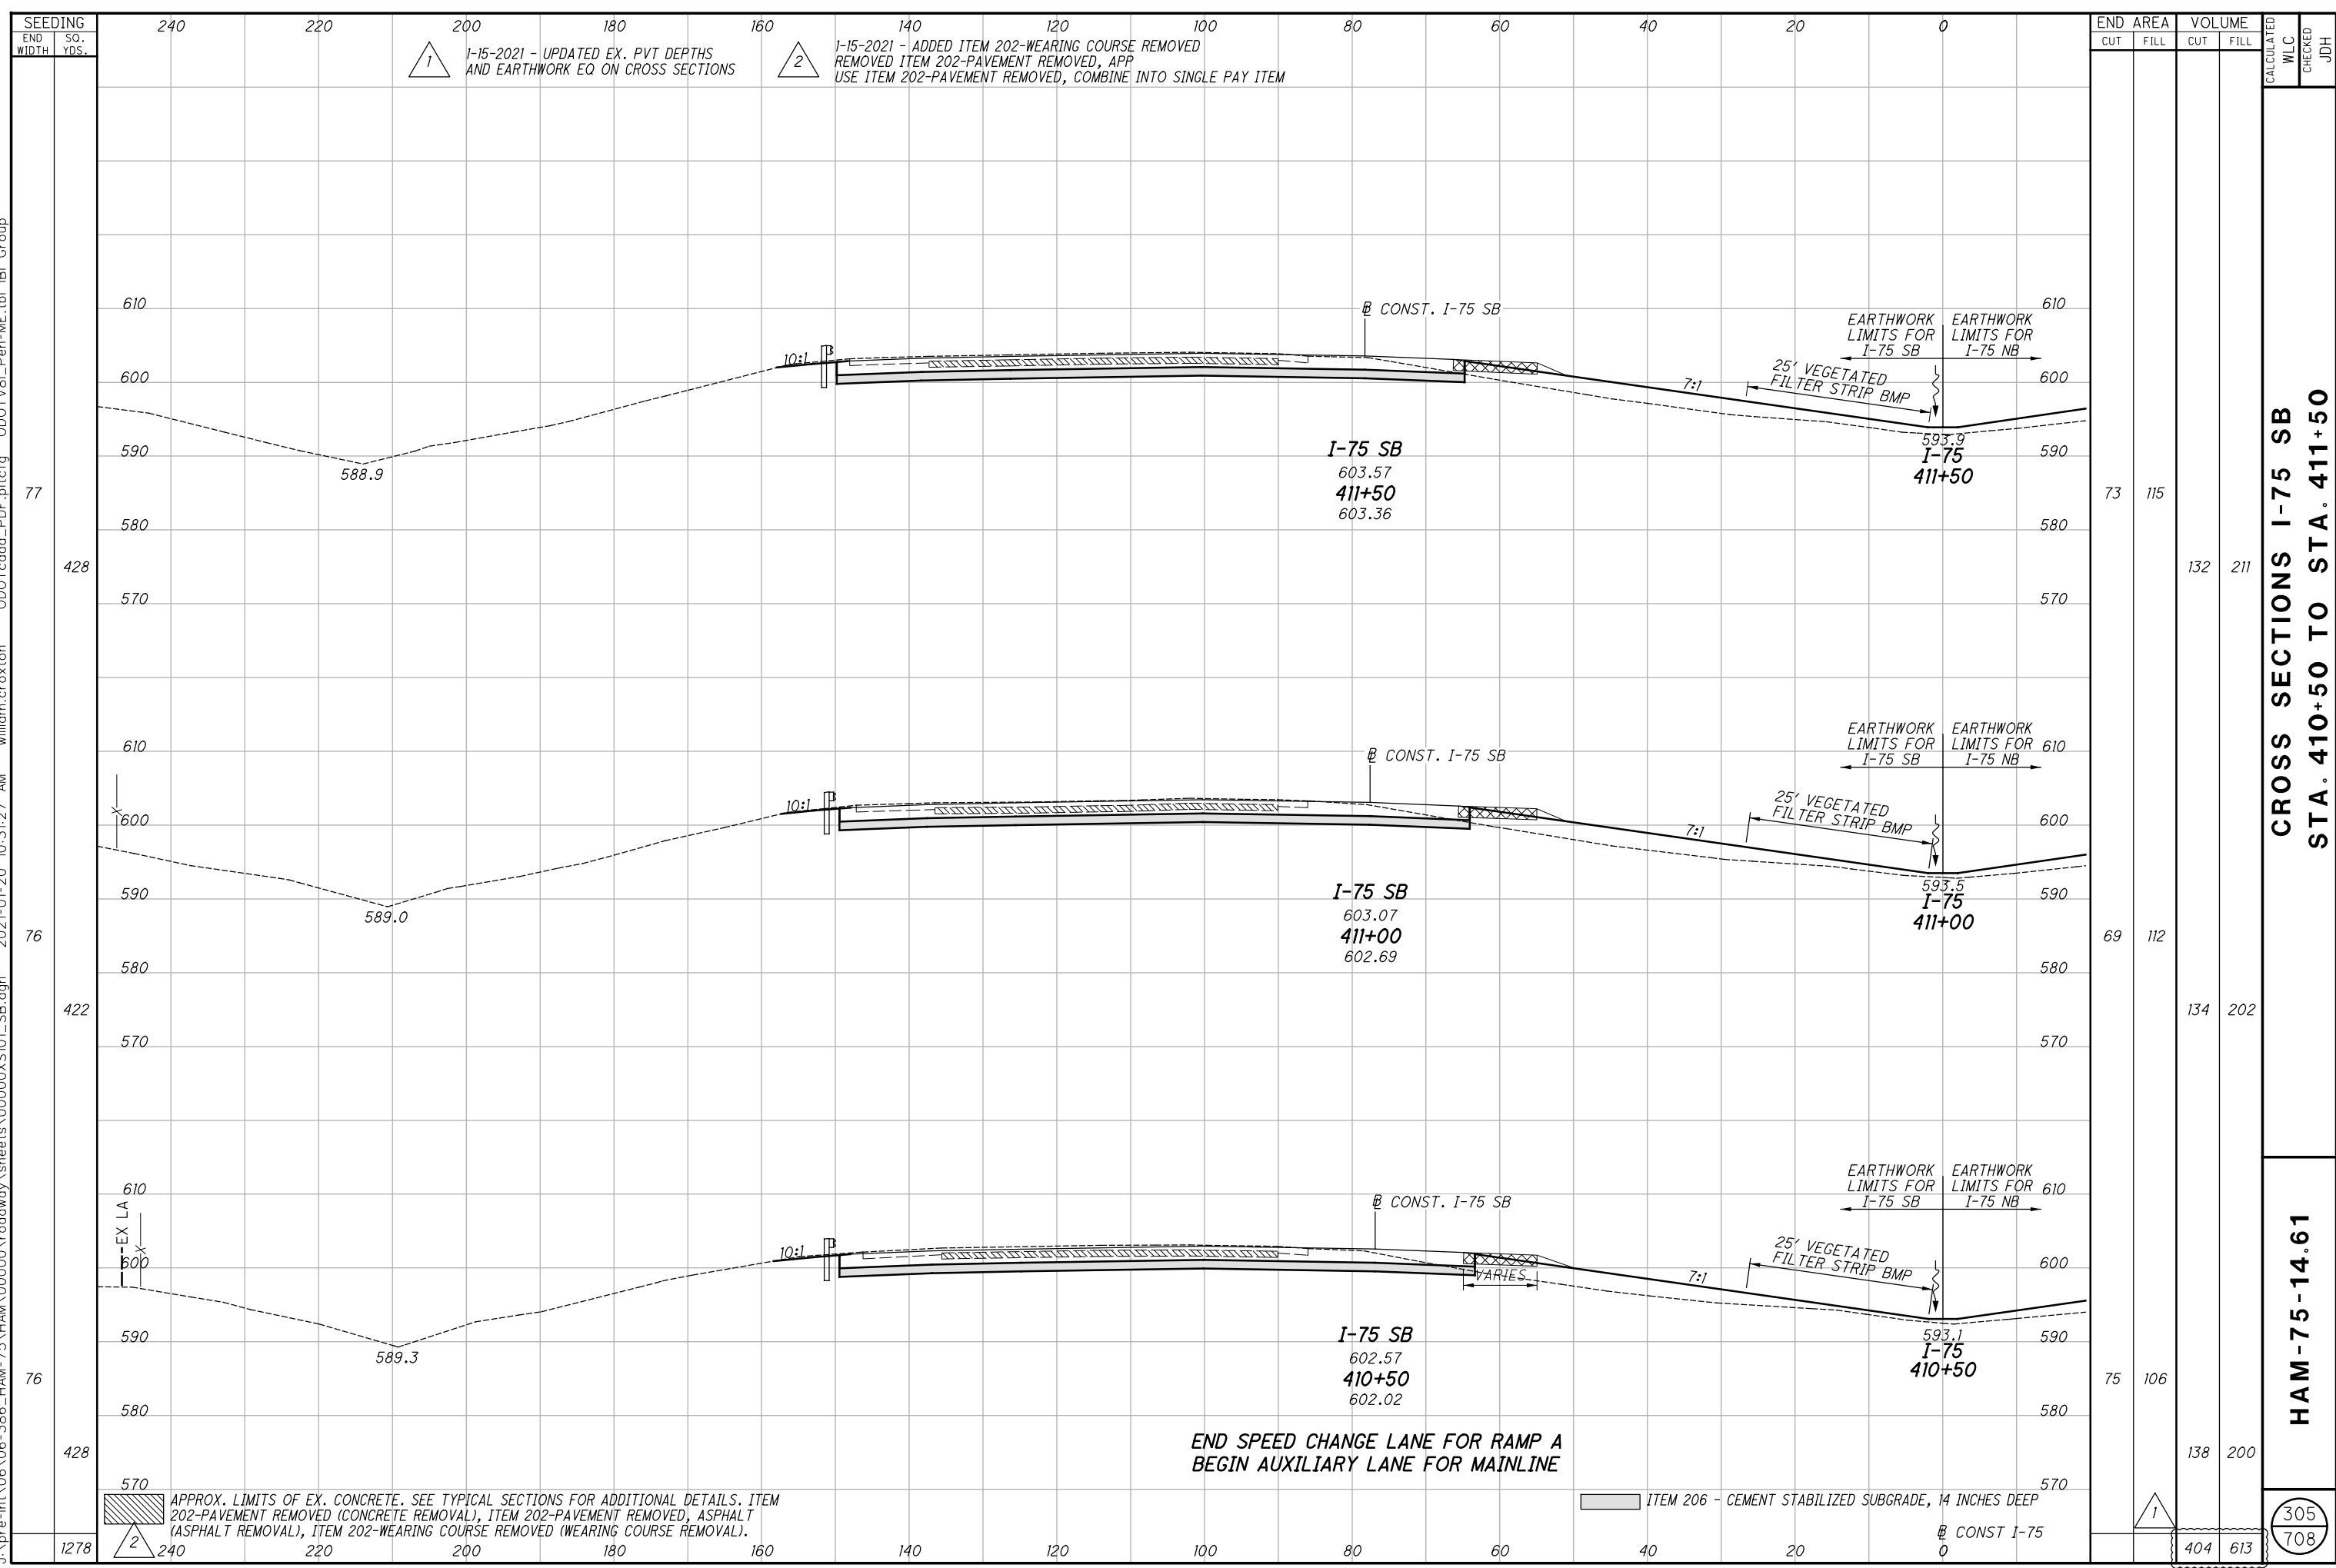



j:\pre-int\06\06-386\_HAM-75\HAM\00000\roadway\sheets\00000X5101\_SB.dgn 2021-01-20 10:31:28 AM william.croxton ODOTcadd\_PDF.pltcfgr ODOTV81\_Pen-ME.tbl IBI Group

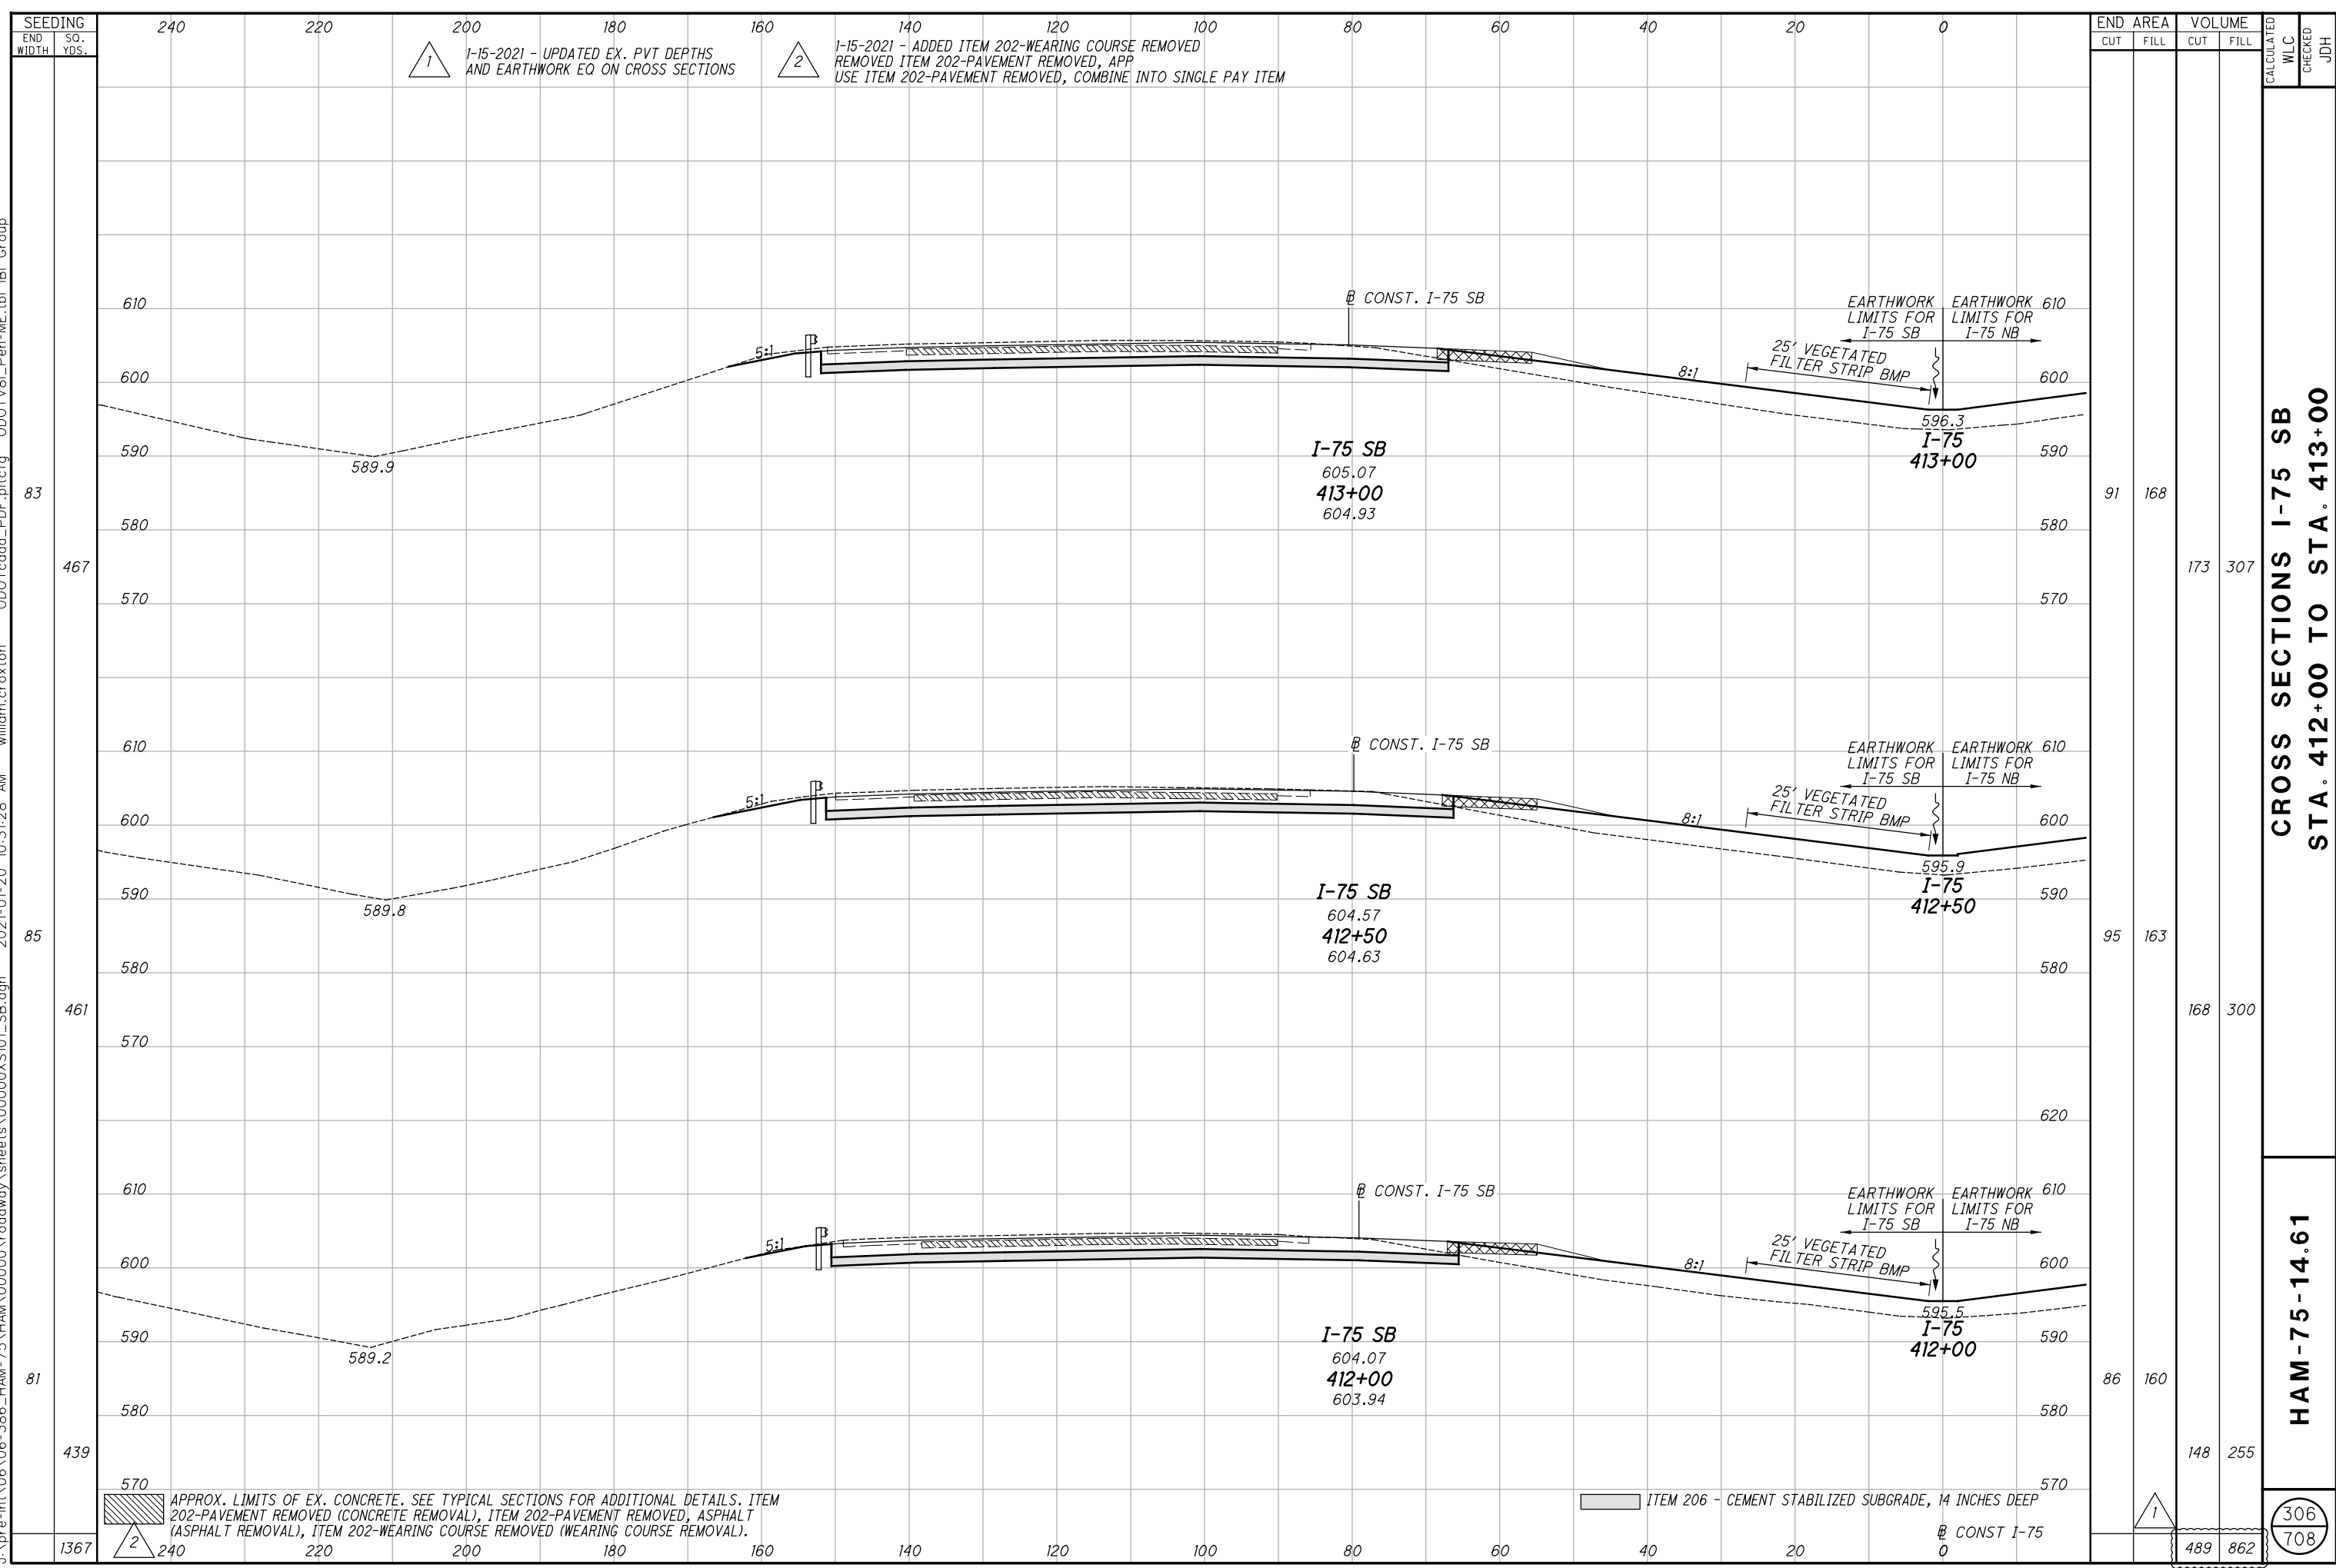

1-15-2021 - UPDATED EX. PVT DEPTHS AND EARTHWORK EQ ON CROSS SECTIONS



1-15-2021 - ADDED ITEM 202-WEARING COURSE REMOVED REMOVED ITEM 202-PAVEMENT REMOVED, APP USE ITEM 202-PAVEMENT REMOVED, COMBINE INTO SINGLE PAY ITEM

APPROX. LIMITS OF EX. CONCRETE. SEE TYPICAL SECTIONS FOR ADDITIONAL DETAILS. ITEM 202-PAVEMENT REMOVED (CONCRETE REMOVAL), ITEM 202-PAVEMENT REMOVED, ASPHALT (ASPHALT REMOVAL), ITEM 202-WEARING COURSE REMOVED (WEARING COURSE REMOVAL).

ITEM 206 - CEMENT STABILIZED SUBGRADE, 14 INCHES DEEP

CONST I-75


END AREA		VOLUME		CALCULATED WLC	CHECKED	JDH
CUT	FILL	CUT	FILL			
91	168	173	307			
95	163	168	300			
86	160	148	255			
		489	862			

CROSS SECTIONS I-75 SB  
STA. 412+00 TO STA. 413+00

HAM-75-14.61

306  
708

j:\pre-int\06\06-386\_HAM-75\HAM-75\HAM-75\roadway\sheets\00000X5101\_SB.dgn 2021-01-20 10:31:29 AM william.croxton' ODOTcodd\_PDF.pltcfgr ODOTV81\_Pen-ME.tbl IBI Group

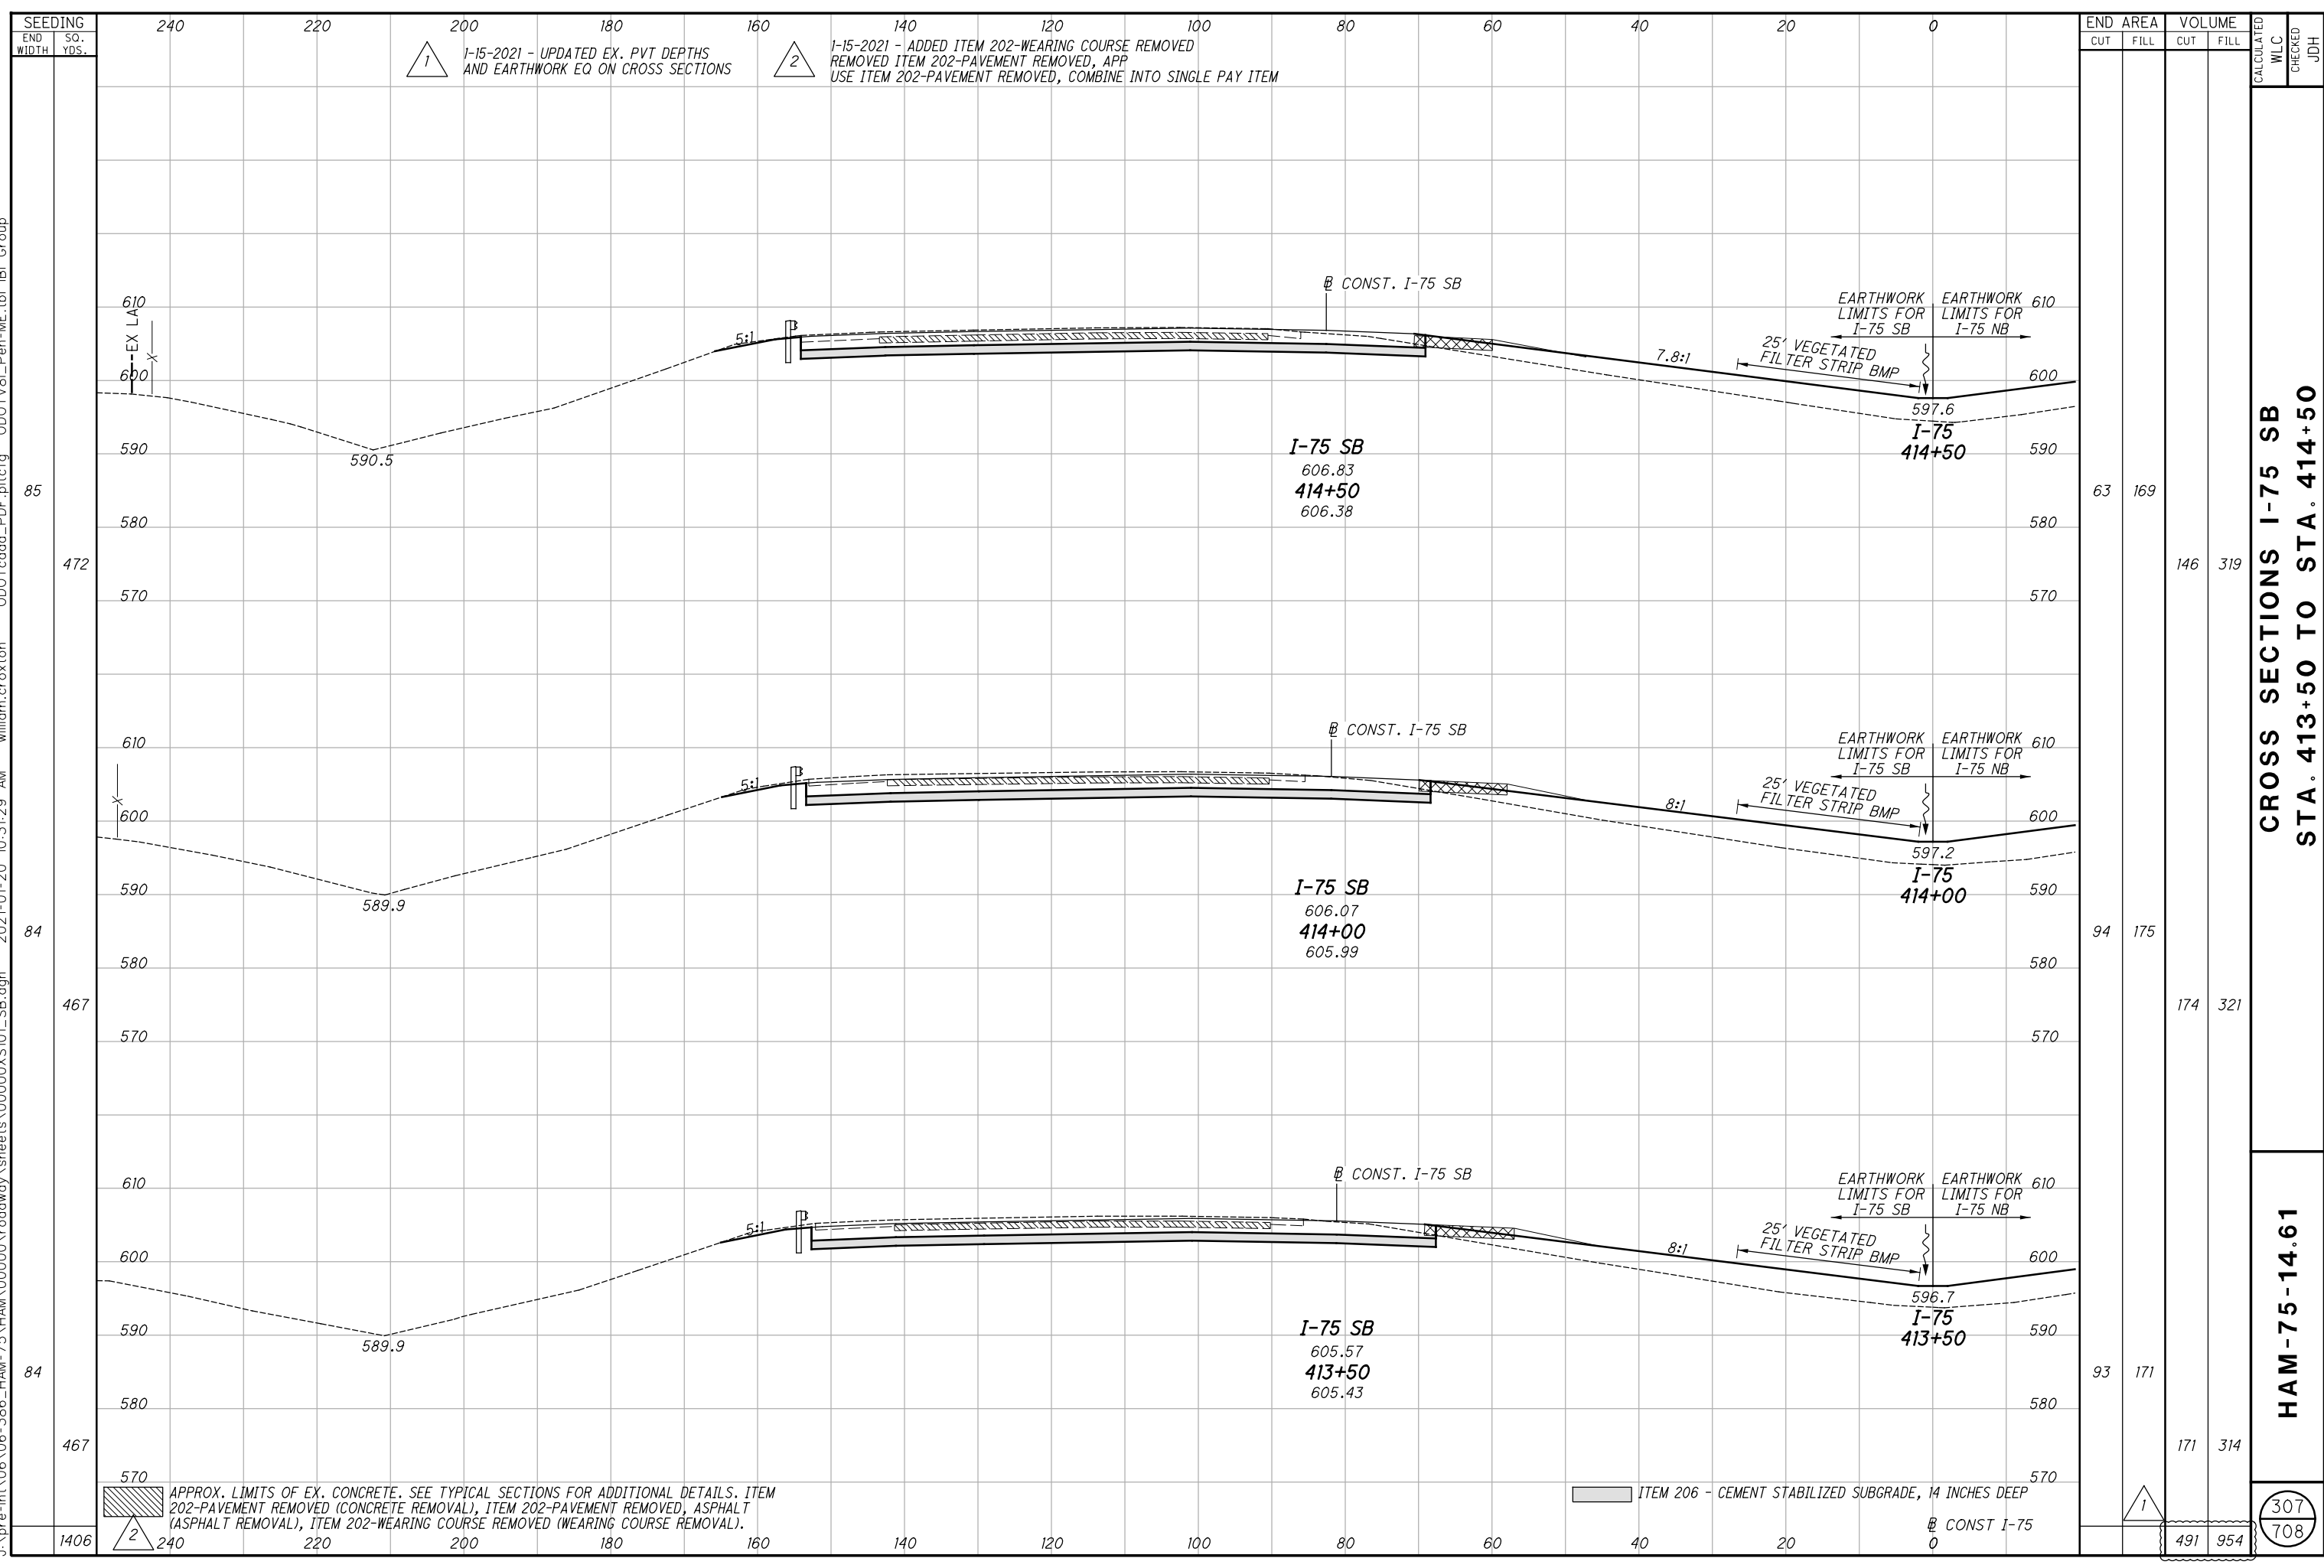

CROSS SECTIONS I-75 SB  
STA. 413+50 TO STA. 414+50

HAM-75-14.61

307  
708

1-15-2021 - UPDATED EX. PVT DEPTHS AND EARTHWORK EQ ON CROSS SECTIONS


2-1-15-2021 - ADDED ITEM 202-WEARING COURSE REMOVED REMOVED ITEM 202-PAVEMENT REMOVED, APP USE ITEM 202-PAVEMENT REMOVED, COMBINE INTO SINGLE PAY ITEM

APPROX. LIMITS OF EX. CONCRETE. SEE TYPICAL SECTIONS FOR ADDITIONAL DETAILS. ITEM 202-PAVEMENT REMOVED (CONCRETE REMOVAL), ITEM 202-PAVEMENT REMOVED, ASPHALT (ASPHALT REMOVAL), ITEM 202-WEARING COURSE REMOVED (WEARING COURSE REMOVAL).

ITEM 206 - CEMENT STABILIZED SUBGRADE, 14 INCHES DEEP

CONST I-75

j:\pre-int\06\06-386\_HAM-75\HAM\00000\roadway\sheets\00000X5101\_SB.dgn 2021-01-20 10:31:30 AM william.croxton ODOTcadd\_PDF.pltcfgr ODOTV81\_Pen-ME.tbl IBI Group

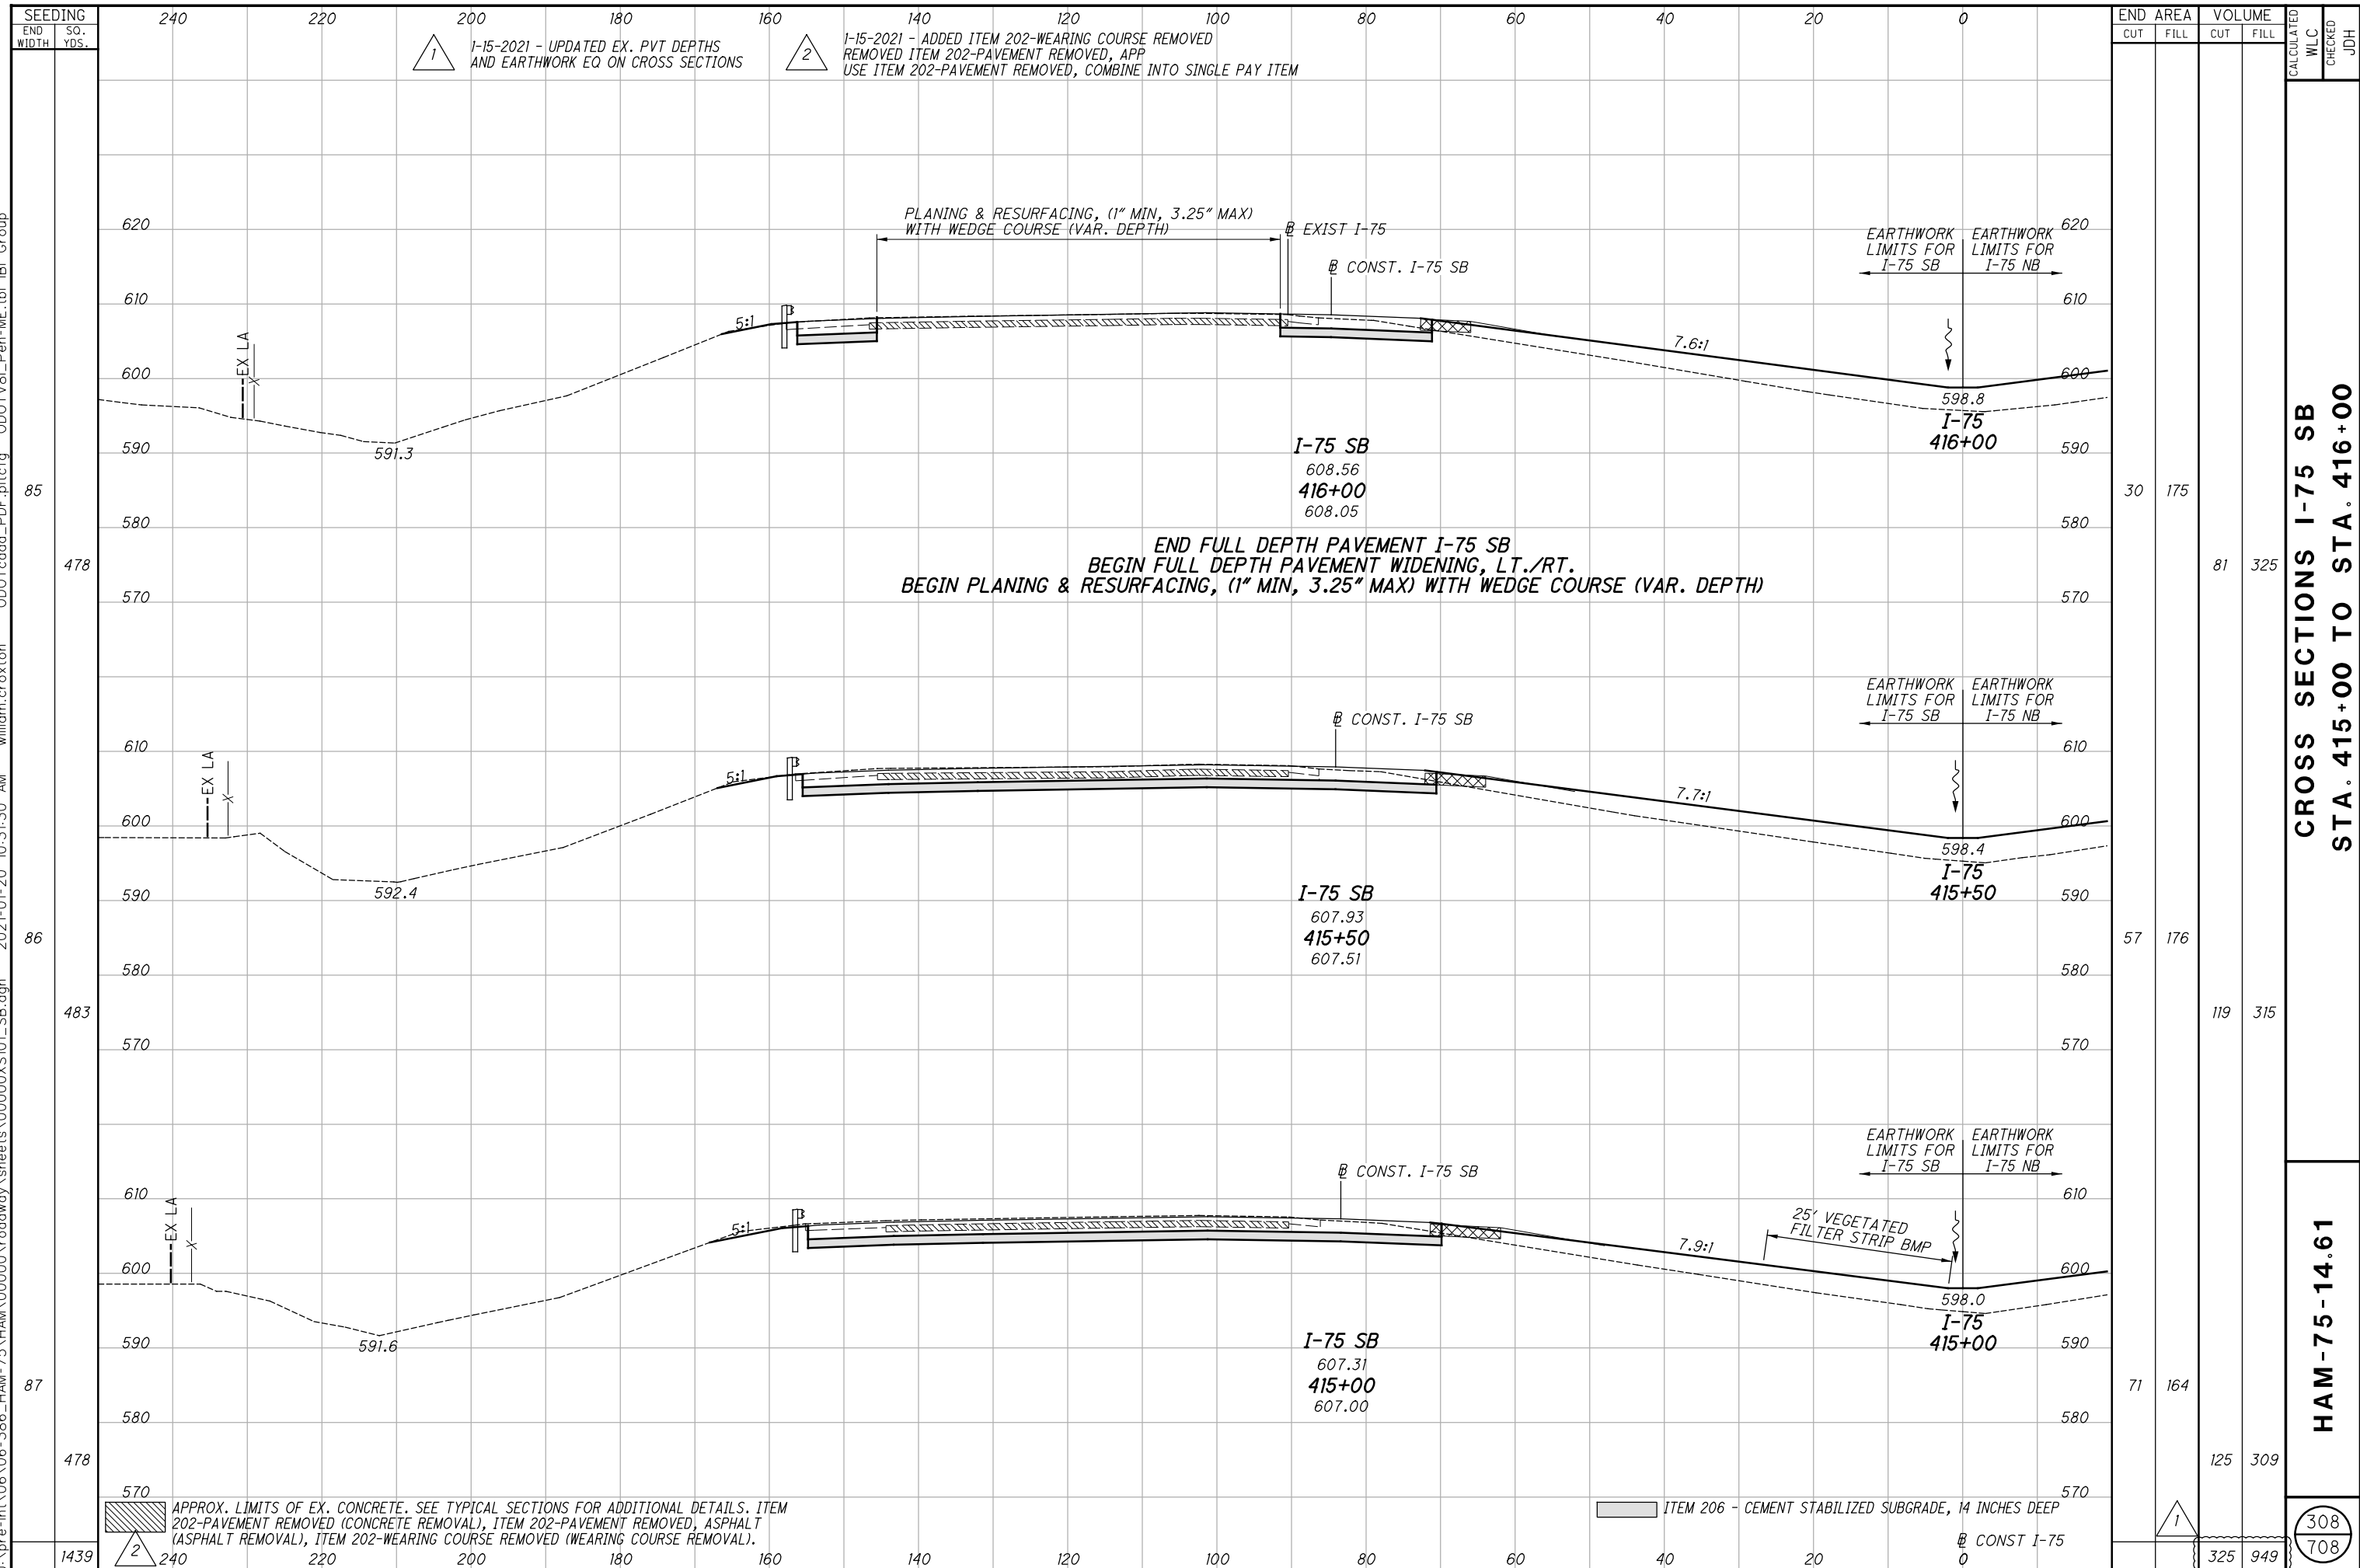

1-15-2021 - UPDATED EX. PVT DEPTHS AND EARTHWORK EQ ON CROSS SECTIONS  
 1-15-2021 - ADDED ITEM 202-WEARING COURSE REMOVED REMOVED ITEM 202-PAVEMENT REMOVED, APP USE ITEM 202-PAVEMENT REMOVED, COMBINE INTO SINGLE PAY ITEM

PLANING & RESURFACING, (1" MIN, 3.25" MAX) WITH WEDGE COURSE (VAR. DEPTH)  
 END FULL DEPTH PAVEMENT I-75 SB  
 BEGIN FULL DEPTH PAVEMENT WIDENING, LT./RT.  
 BEGIN PLANING & RESURFACING, (1" MIN, 3.25" MAX) WITH WEDGE COURSE (VAR. DEPTH)

APPROX. LIMITS OF EX. CONCRETE. SEE TYPICAL SECTIONS FOR ADDITIONAL DETAILS. ITEM 202-PAVEMENT REMOVED (CONCRETE REMOVAL), ITEM 202-PAVEMENT REMOVED, ASPHALT (ASPHALT REMOVAL), ITEM 202-WEARING COURSE REMOVED (WEARING COURSE REMOVAL).  
 ITEM 206 - CEMENT STABILIZED SUBGRADE, 14 INCHES DEEP


END AREA	VOLUME		CALCULATED WLC	CHECKED	JDH
	CUT	FILL			
30	175				
81	325				
57	176				
119	315				
71	164				
125	309				
325	949				

CROSS SECTIONS I-75 SB  
 STA. 415+00 TO STA. 416+00

HAM-75-14.61

308  
 708

j:\pre-int\06\06-386\_HAM-75\HAM\00000\roadway\sheets\00000X5101\_SB.dgn 2021-01-20 10:31:31 AM william.croxton' ODOTcadd\_PDF.pltcfgr ODOTV8i\_Pen-ME.tbl |BI Group

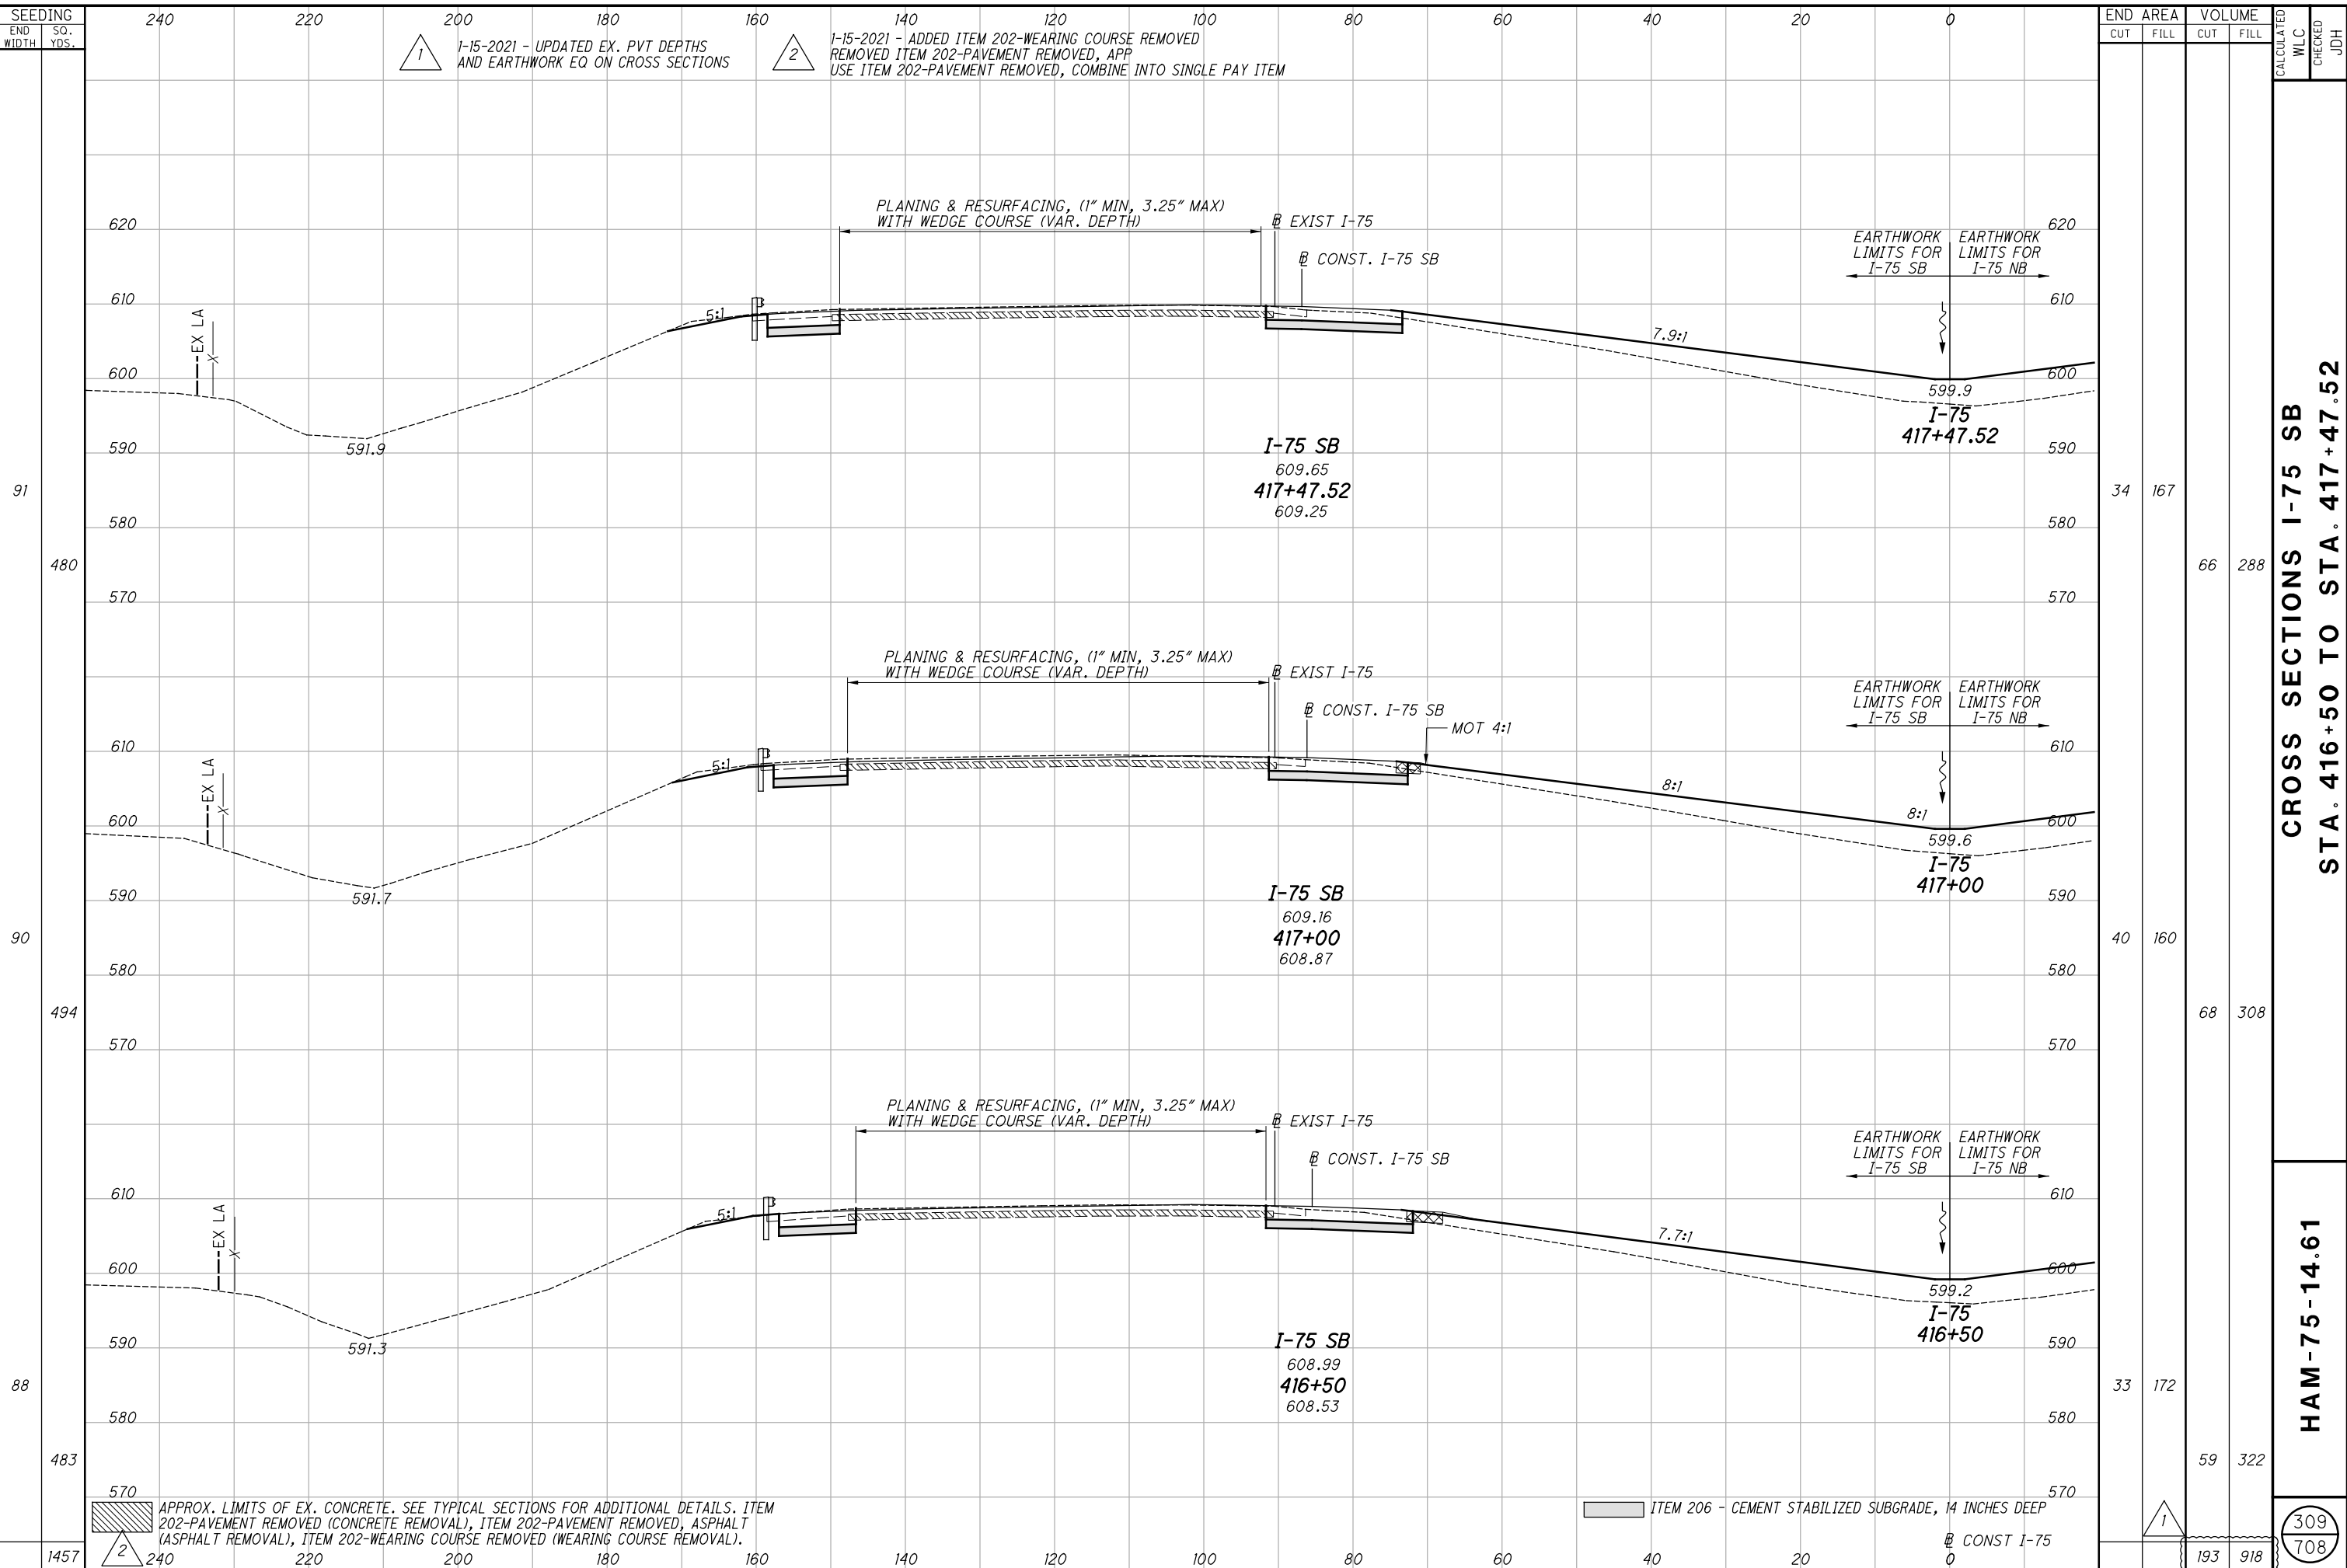

SEEDING		END AREA		VOLUME		CALCULATED	
END WIDTH	SO. YDS.	CUT	FILL	CUT	FILL	WLC	CHECKED
91	480	34	167	66	288		
90	494	40	160	68	308		
88	483	33	172	59	322		
1457	240	193	918			309	708

CROSS SECTIONS I-75 SB  
STA. 416+50 TO STA. 417+47.52

HAM-75-14.61


1-15-2021 - UPDATED EX. PVT DEPTHS AND EARTHWORK EQ ON CROSS SECTIONS  
1-15-2021 - ADDED ITEM 202-WEARING COURSE REMOVED REMOVED ITEM 202-PAVEMENT REMOVED, APP USE ITEM 202-PAVEMENT REMOVED, COMBINE INTO SINGLE PAY ITEM

APPROX. LIMITS OF EX. CONCRETE. SEE TYPICAL SECTIONS FOR ADDITIONAL DETAILS. ITEM 202-PAVEMENT REMOVED (CONCRETE REMOVAL), ITEM 202-PAVEMENT REMOVED, ASPHALT (ASPHALT REMOVAL), ITEM 202-WEARING COURSE REMOVED (WEARING COURSE REMOVAL).

ITEM 206 - CEMENT STABILIZED SUBGRADE, 14 INCHES DEEP

CONST I-75

j:\pre-int\06\06-386\_HAM-75\HAM-75\HAM-00000\roadway\sheets\00000X5101\_SB.dgn 2021-01-20 10:31:33 AM william.croxton ODOT\cadd\_PDF.plt\cfig ODOTV81\_Pen-ME.tbl IBI Group

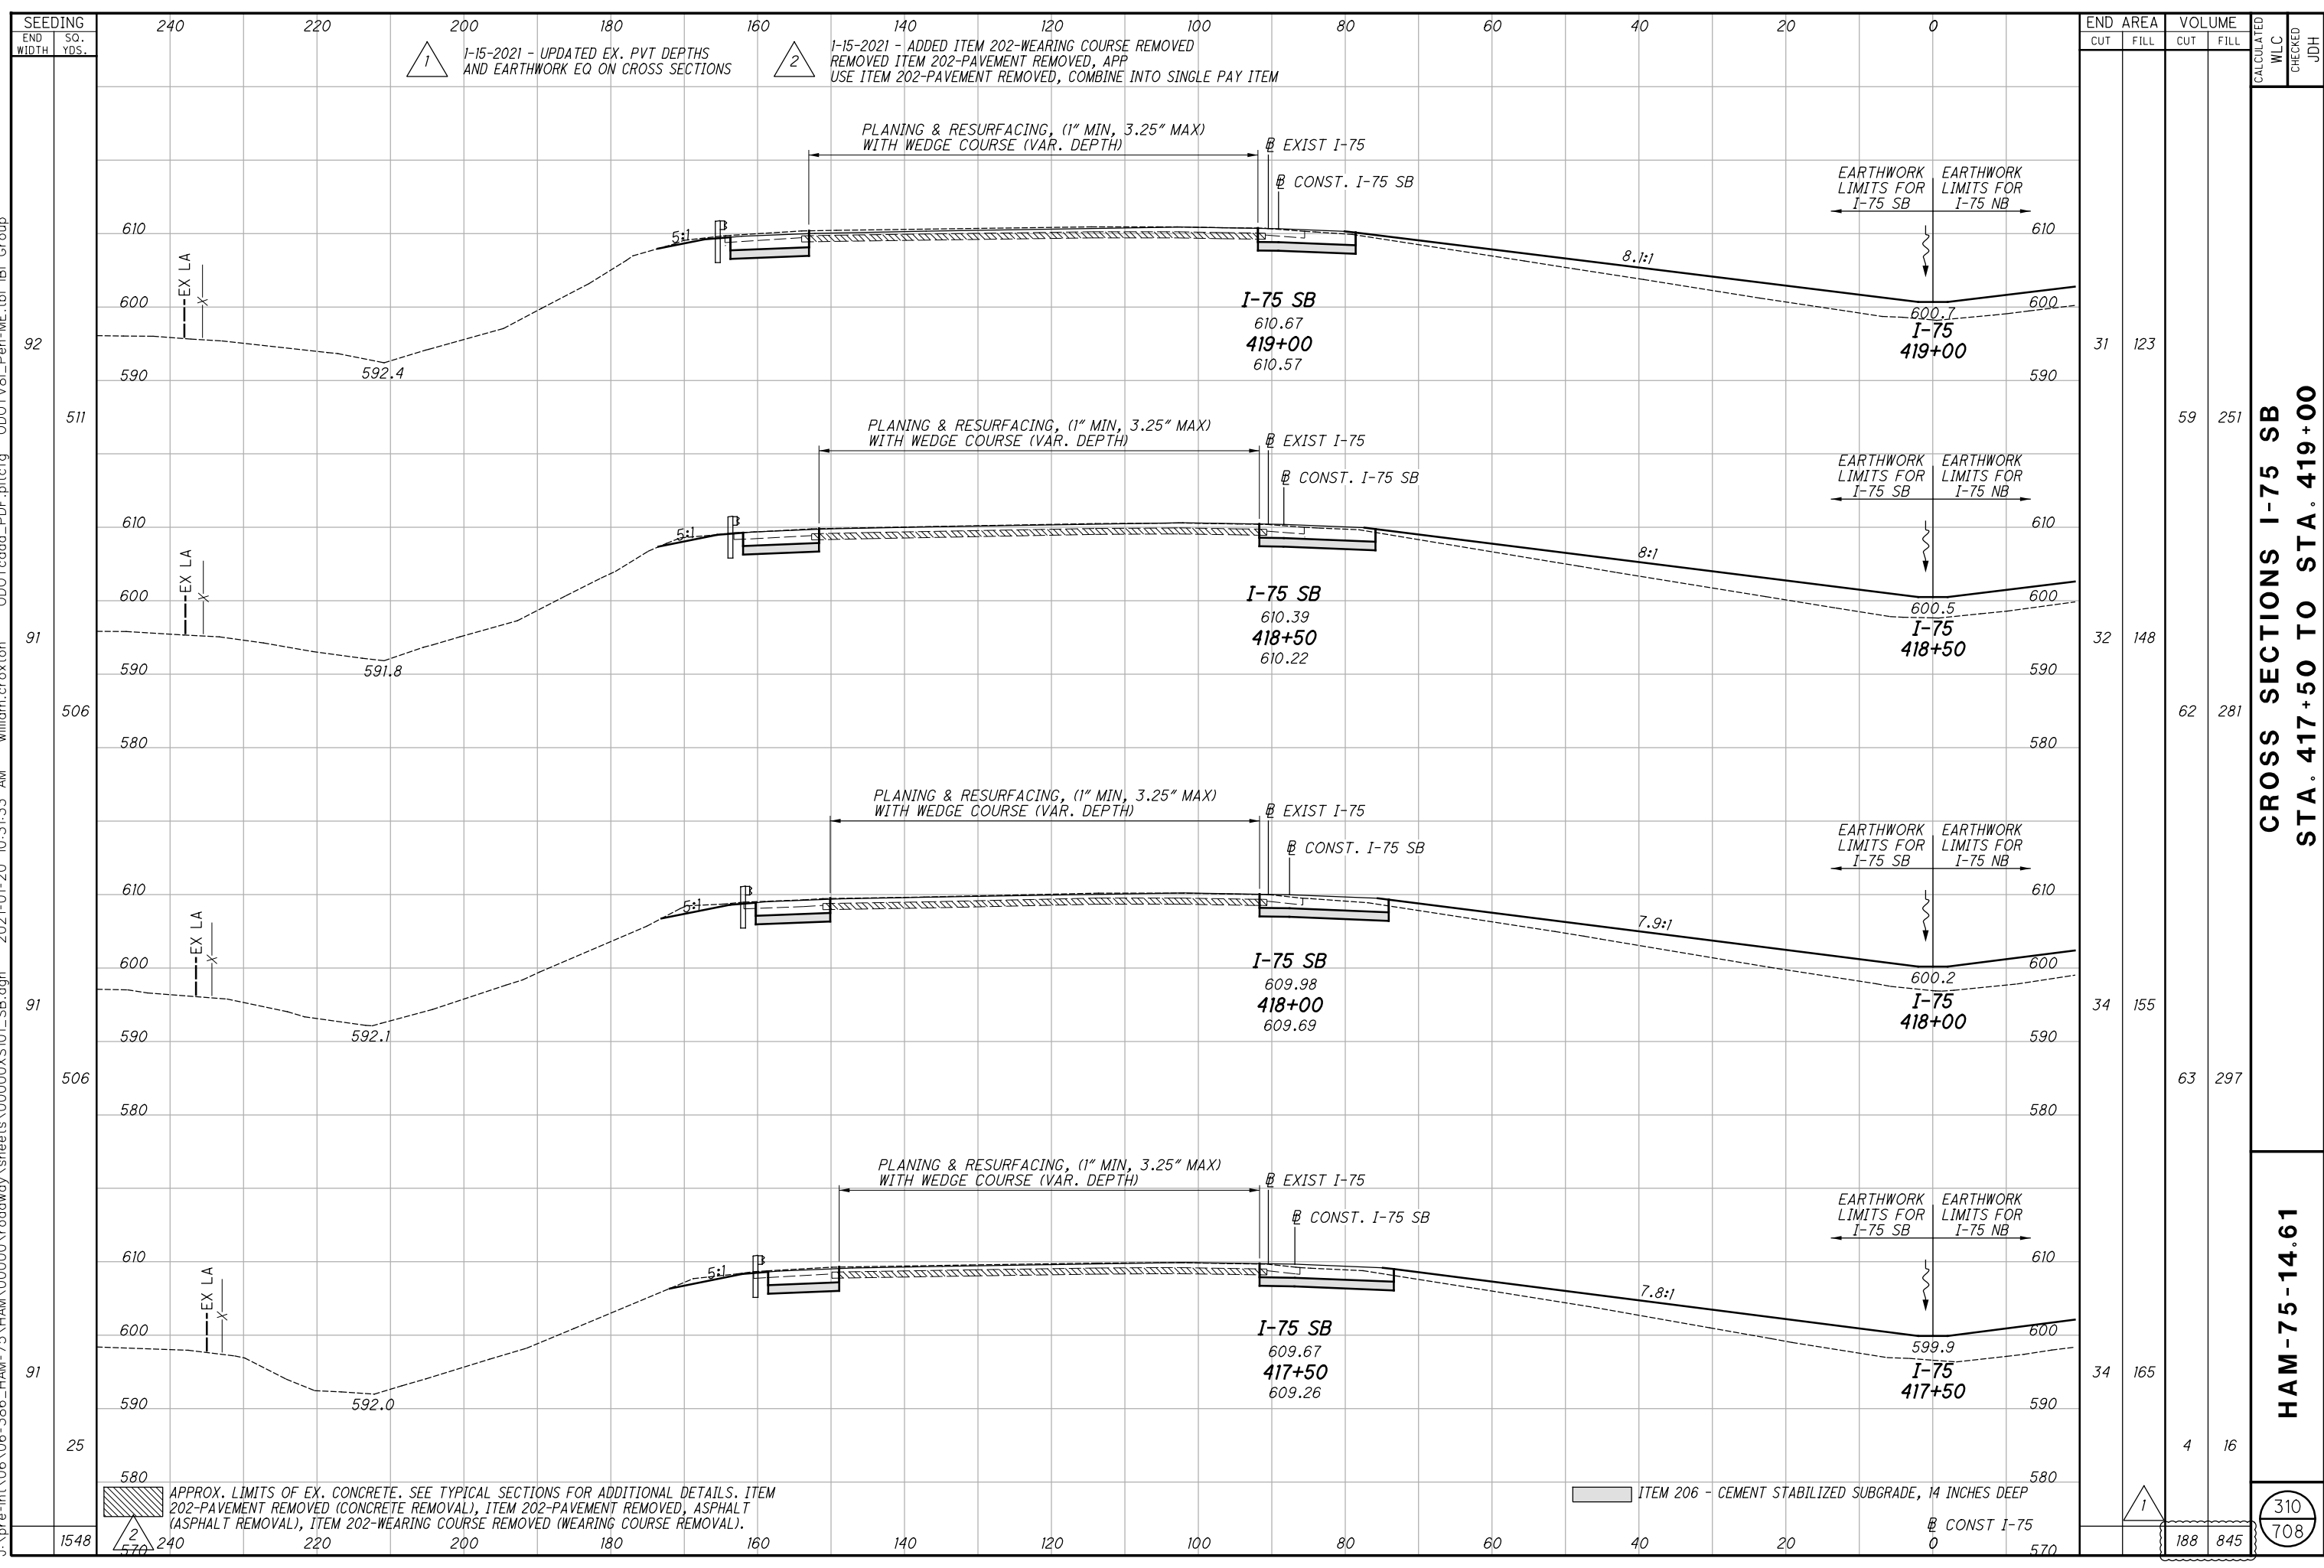

CROSS SECTIONS I-75 SB  
STA. 417+50 TO STA. 419+00

HAM-75-14.61

310  
708

1-15-2021 - UPDATED EX. PVT DEPTHS AND EARTHWORK EQ ON CROSS SECTIONS

2-1-15-2021 - ADDED ITEM 202-WEARING COURSE REMOVED REMOVED ITEM 202-PAVEMENT REMOVED, APP USE ITEM 202-PAVEMENT REMOVED, COMBINE INTO SINGLE PAY ITEM

PLANING & RESURFACING, (1" MIN, 3.25" MAX) WITH WEDGE COURSE (VAR. DEPTH)

EARTHWORK LIMITS FOR I-75 SB


EARTHWORK LIMITS FOR I-75 NB

APPROX. LIMITS OF EX. CONCRETE. SEE TYPICAL SECTIONS FOR ADDITIONAL DETAILS. ITEM 202-PAVEMENT REMOVED (CONCRETE REMOVAL), ITEM 202-PAVEMENT REMOVED, ASPHALT (ASPHALT REMOVAL), ITEM 202-WEARING COURSE REMOVED (WEARING COURSE REMOVAL).

ITEM 206 - CEMENT STABILIZED SUBGRADE, 14 INCHES DEEP

CONST I-75

j:\pre-int\06\06-386\_HAM-75\HAM\00000\roadway\sheets\00000\5101\_SB.dgn 2021-01-20 10:31:34 AM william.croxton ODOTcadd\_PDF.pltcfgr ODOTV81\_Pen-ME.tbl IBI Group

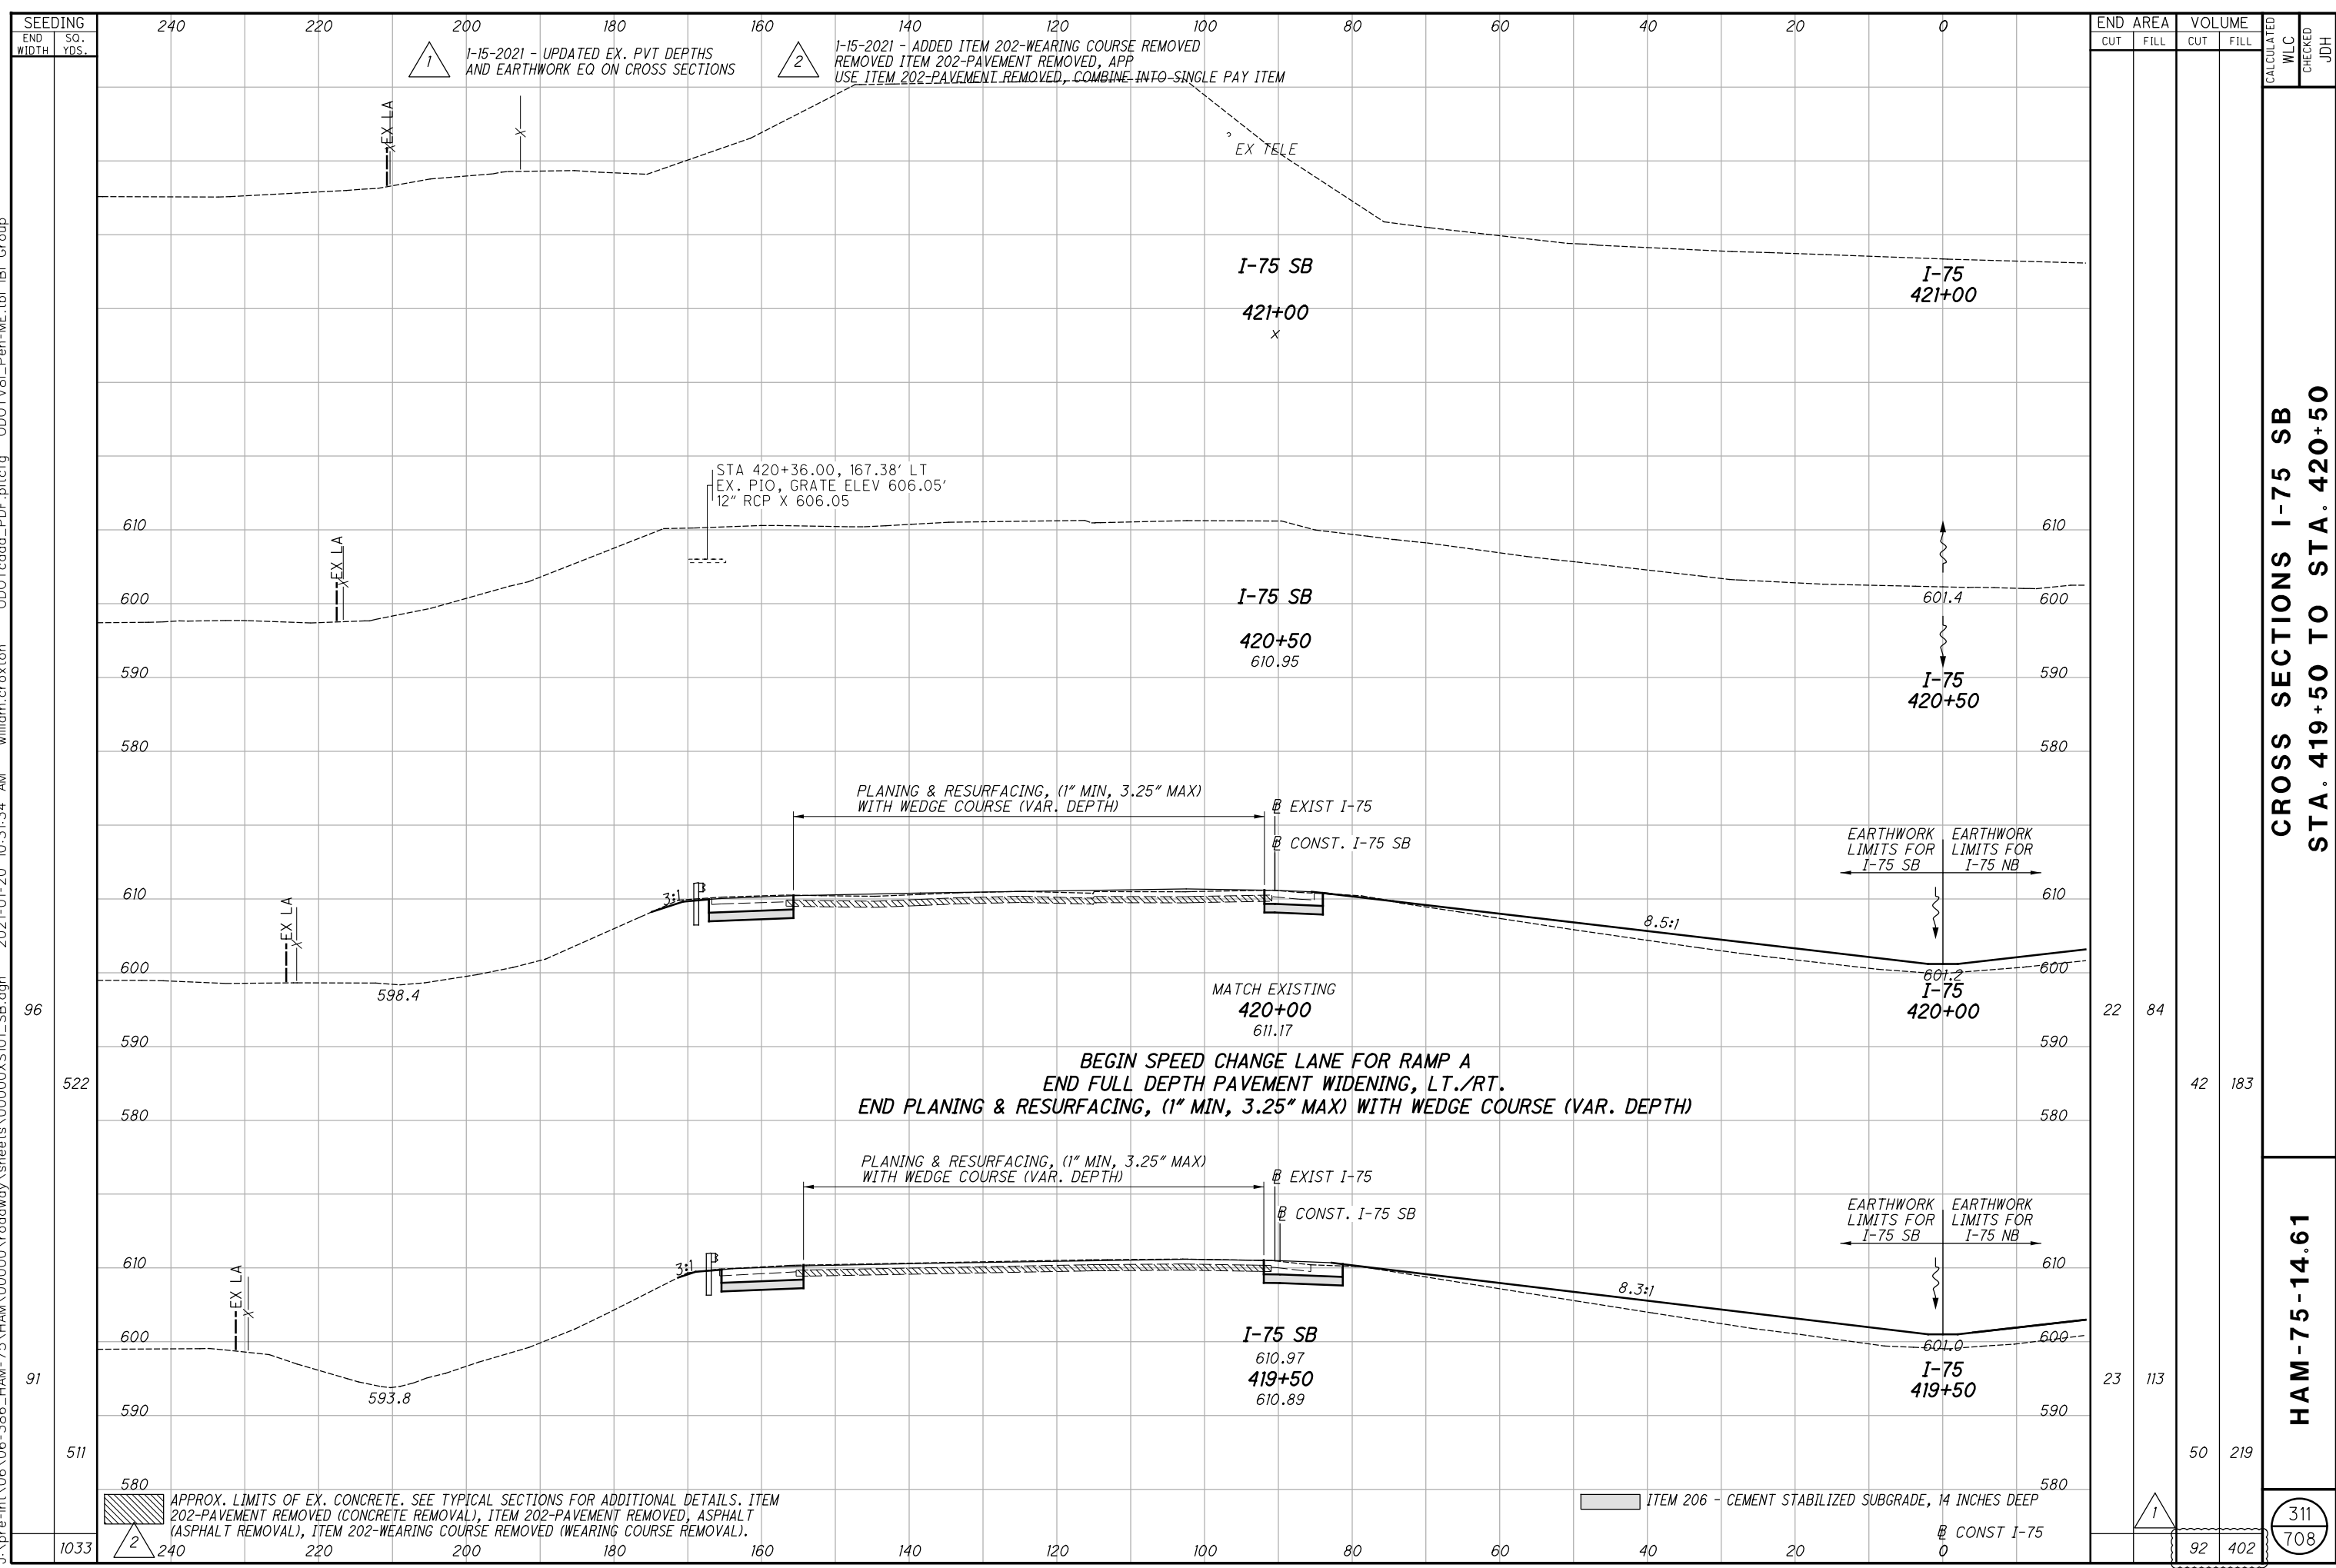

SEEDING  
END SO. WIDTH YDS.

END AREA  
CUT FILL

STATION	END AREA		VOLUME	
	CUT	FILL	CUT	FILL
419+50	23	113	50	219
420+00	22	84	42	183
421+00				
TOTAL	92	402		

CROSS SECTIONS I-75 SB  
STA. 419+50 TO STA. 420+50

HAM-75-14.61


311  
708

APPROX. LIMITS OF EX. CONCRETE. SEE TYPICAL SECTIONS FOR ADDITIONAL DETAILS. ITEM 202-PAVEMENT REMOVED (CONCRETE REMOVAL), ITEM 202-PAVEMENT REMOVED, ASPHALT (ASPHALT REMOVAL), ITEM 202-WEARING COURSE REMOVED (WEARING COURSE REMOVAL).

ITEM 206 - CEMENT STABILIZED SUBGRADE, 14 INCHES DEEP

CONST I-75

j:\pre-int\06\06-386\_HAM-75\HAM-75\HAM-75\roadway\sheets\000005\102\_NB.dgn 2021-01-20 11:25:51 AM william.croxton ODOT\cadd\_PDF.plt\cfig ODOTV81\_Pen-ME.tbl IBI Group

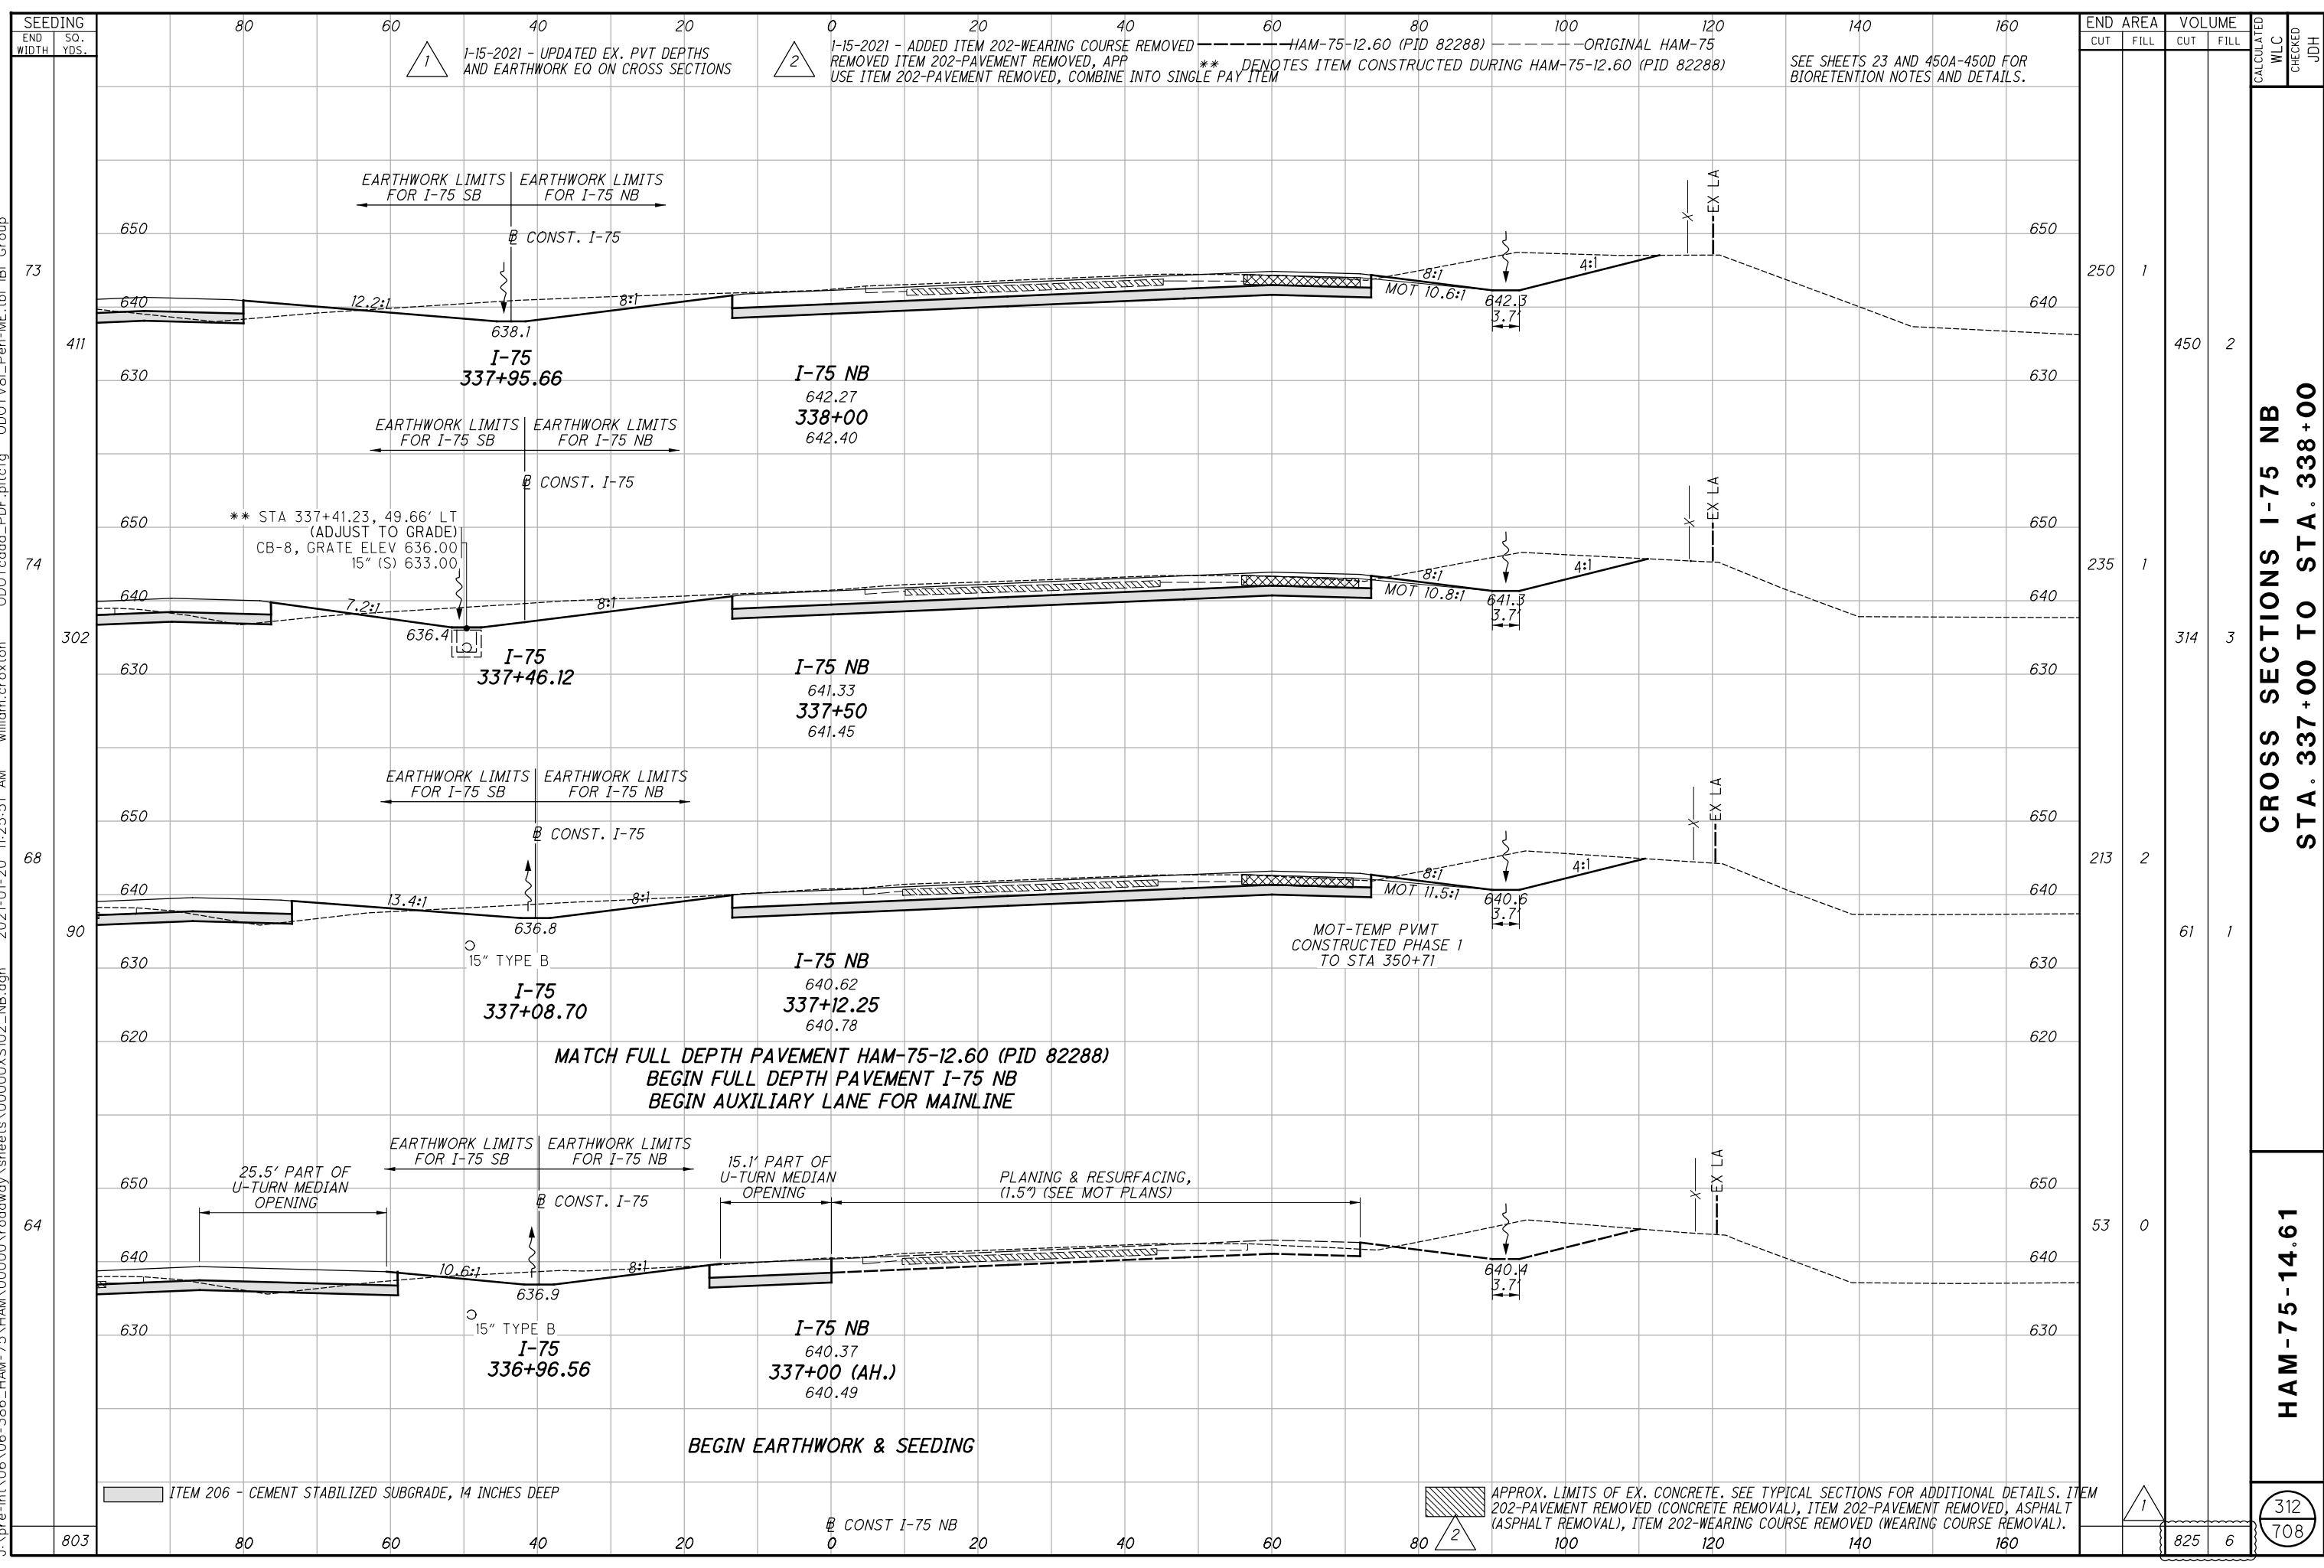

END STA	END AREA		VOLUME		CALCULATED WLC	CHECKED	JDH
	CUT	FILL	CUT	FILL			
337+00	250	1	450	2			
337+50	235	1	314	3			
337+71	213	2	61	1			
336+96.56	53	0					
338+00	825	6					

CROSS SECTIONS I-75 NB  
STA. 337+00 TO STA. 338+00

HAM-75-14.61

312  
708

1-15-2021 - UPDATED EX. PVT DEPTHS AND EARTHWORK EQ ON CROSS SECTIONS  
 1-15-2021 - ADDED ITEM 202-WEARING COURSE REMOVED, APP REMOVED ITEM 202-PAVEMENT REMOVED, USE ITEM 202-PAVEMENT REMOVED, COMBINE INTO SINGLE PAY ITEM  
 HAM-75-12.60 (PID 82288) ORIGINAL HAM-75  
 \*\* DENOTES ITEM CONSTRUCTED DURING HAM-75-12.60 (PID 82288)  
 SEE SHEETS 23 AND 450A-450D FOR BIORETENTION NOTES AND DETAILS.

EARTHWORK LIMITS FOR I-75 SB | EARTHWORK LIMITS FOR I-75 NB

EARTHWORK LIMITS FOR I-75 SB | EARTHWORK LIMITS FOR I-75 NB

EARTHWORK LIMITS FOR I-75 SB | EARTHWORK LIMITS FOR I-75 NB

EARTHWORK LIMITS FOR I-75 SB | EARTHWORK LIMITS FOR I-75 NB

MATCH FULL DEPTH PAVEMENT HAM-75-12.60 (PID 82288)  
 BEGIN FULL DEPTH PAVEMENT I-75 NB  
 BEGIN AUXILIARY LANE FOR MAINLINE

25.5' PART OF U-TURN MEDIAN OPENING

15.1' PART OF U-TURN MEDIAN OPENING

PLANING & RESURFACING, (1.5") (SEE MOT PLANS)


BEGIN EARTHWORK & SEEDING

ITEM 206 - CEMENT STABILIZED SUBGRADE, 14 INCHES DEEP

APPROX. LIMITS OF EX. CONCRETE. SEE TYPICAL SECTIONS FOR ADDITIONAL DETAILS. ITEM 202-PAVEMENT REMOVED (CONCRETE REMOVAL), ITEM 202-PAVEMENT REMOVED, ASPHALT (ASPHALT REMOVAL), ITEM 202-WEARING COURSE REMOVED (WEARING COURSE REMOVAL).

CONST I-75 NB

j:\pre-int\06\06-386\_HAM-75\_HAM\00000\roadway\sheets\00000X5102\_NB.dgn 2021-01-20 11:25:52 AM william.croxton ODOT\cadd\_PDF.plt c:\odot\8i\_Pen-ME.tbl IBI Group

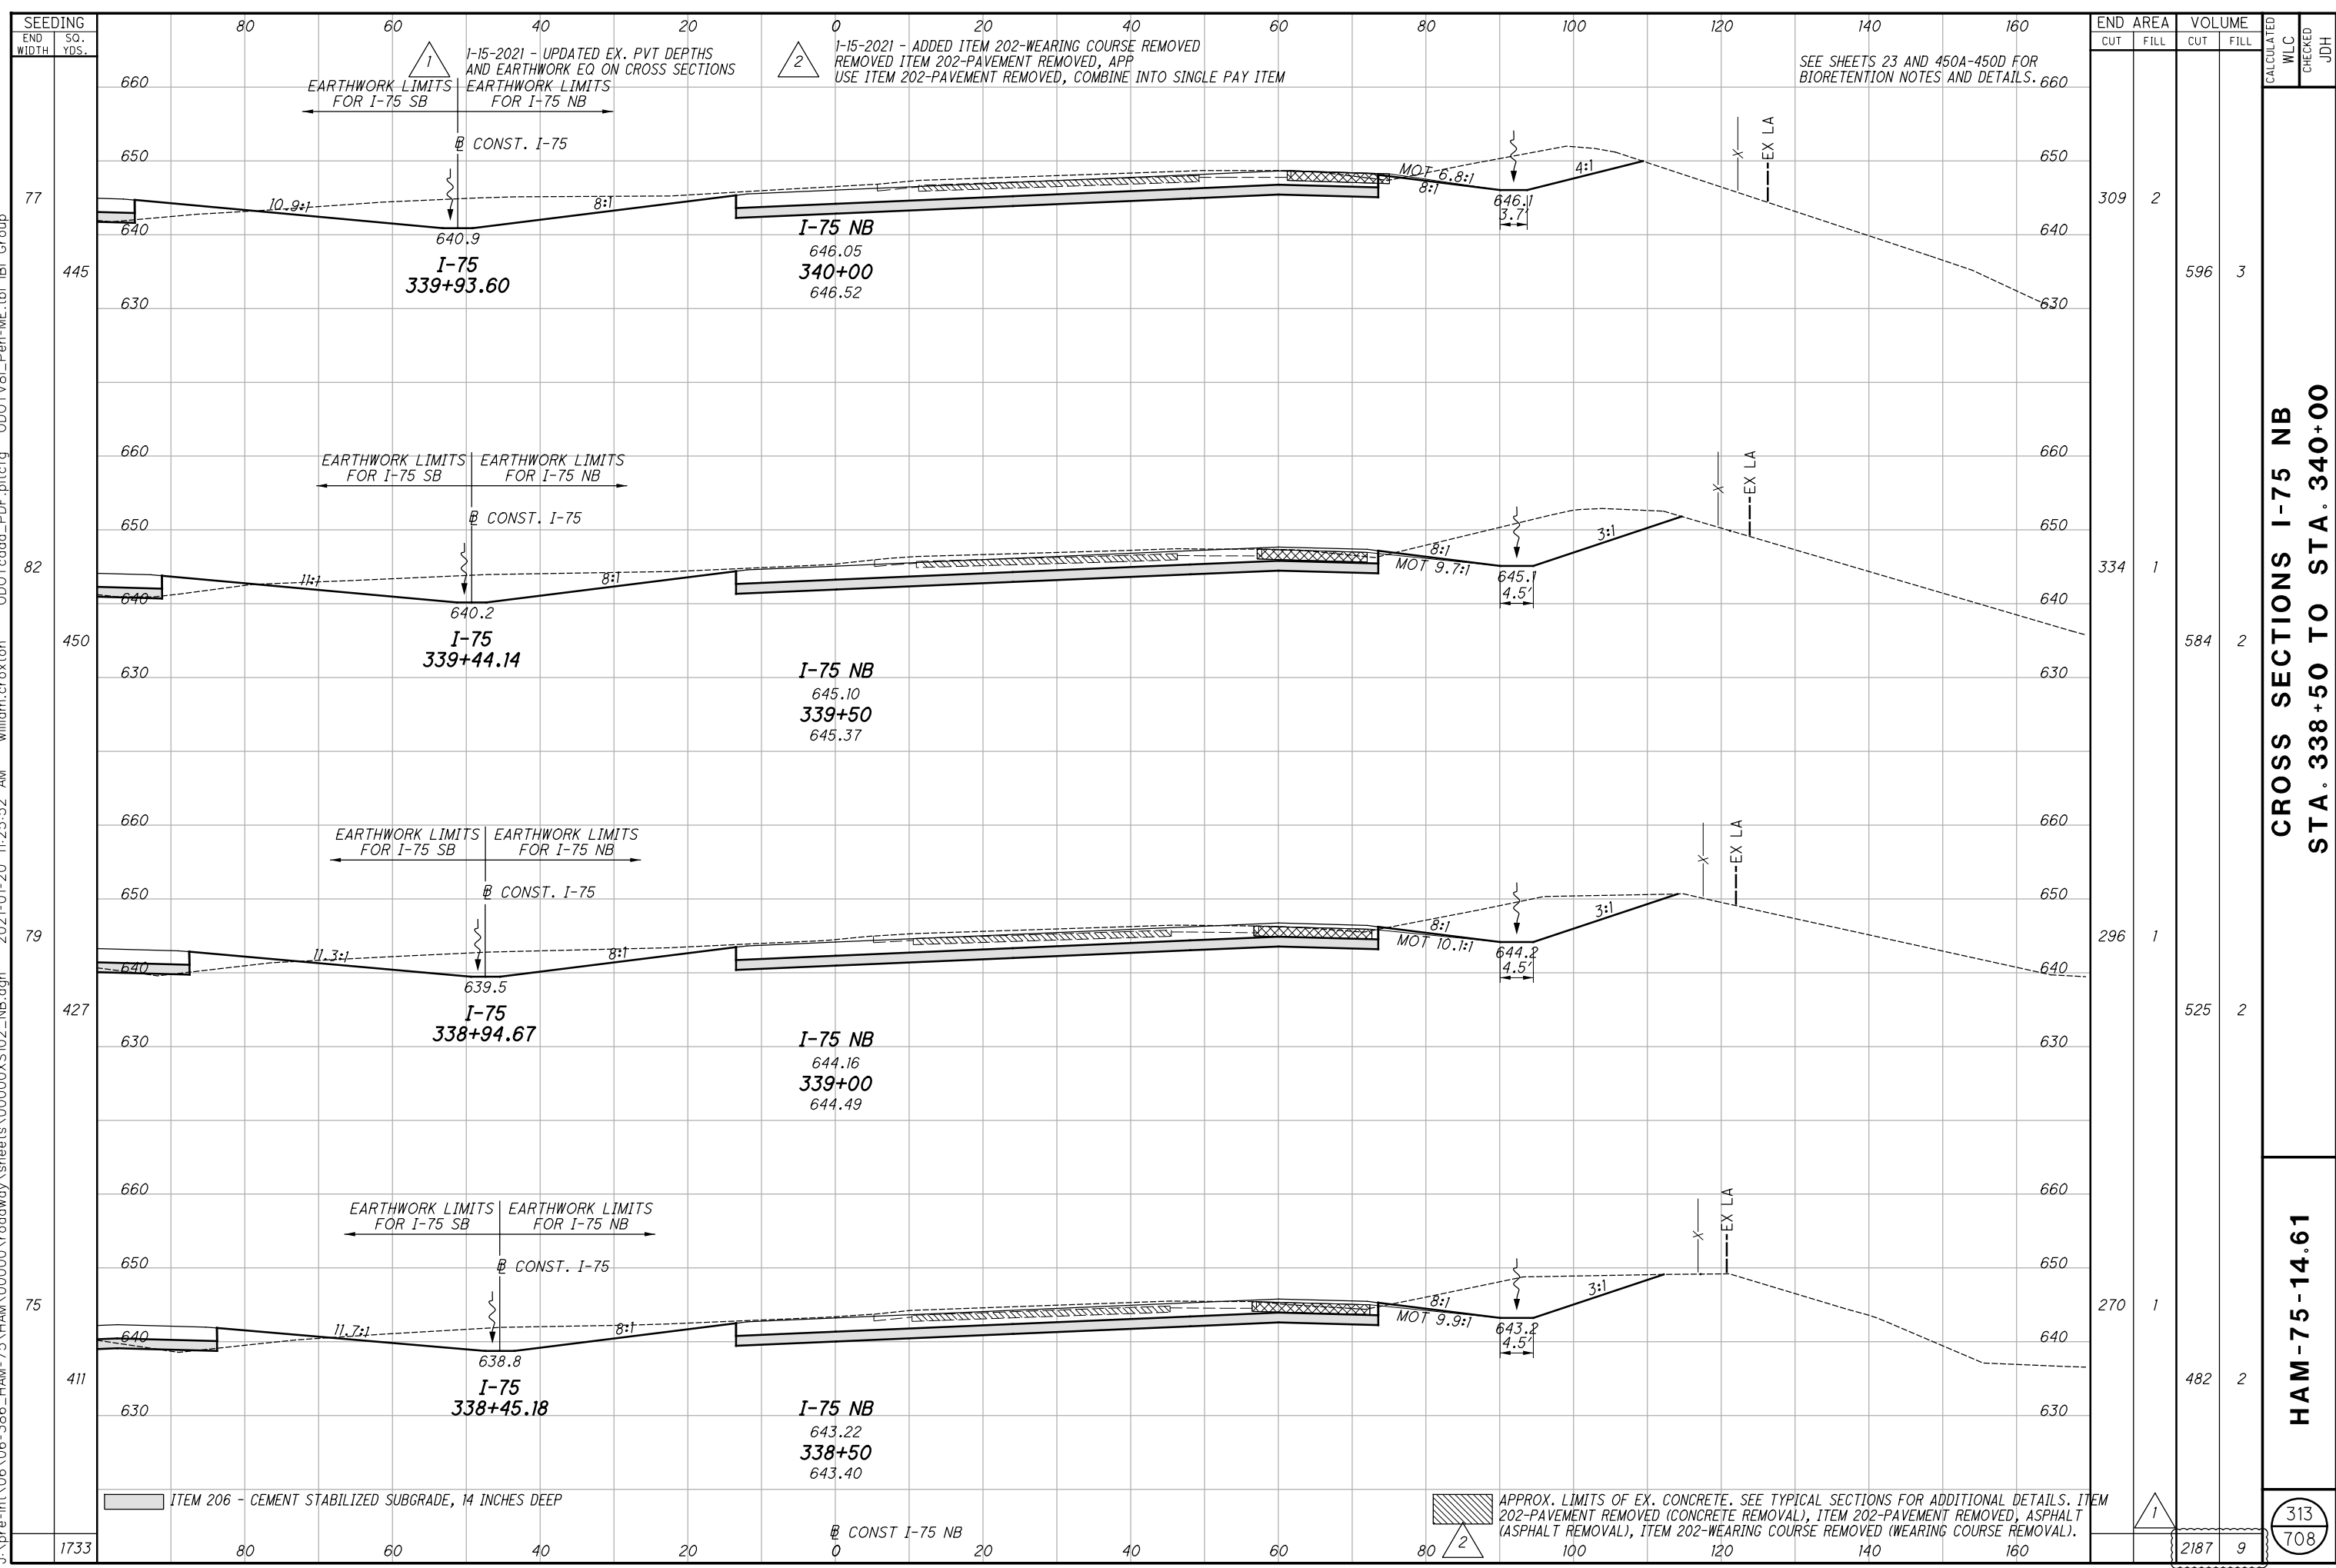


**CROSS SECTIONS I-75 NB  
STA. 338+50 TO STA. 340+00**

**HAM-75-14.61**

313  
708



j:\pre-int\06\06-386\_HAM-75\HAM-75\00000\roadway\sheets\00000X5102\_NB.dgn 2021-01-20 11:25:52 AM william.croxton ODOT\cadd\_PDF.plt cfig ODOT\8i\_Pen-ME.tbl IBI Group

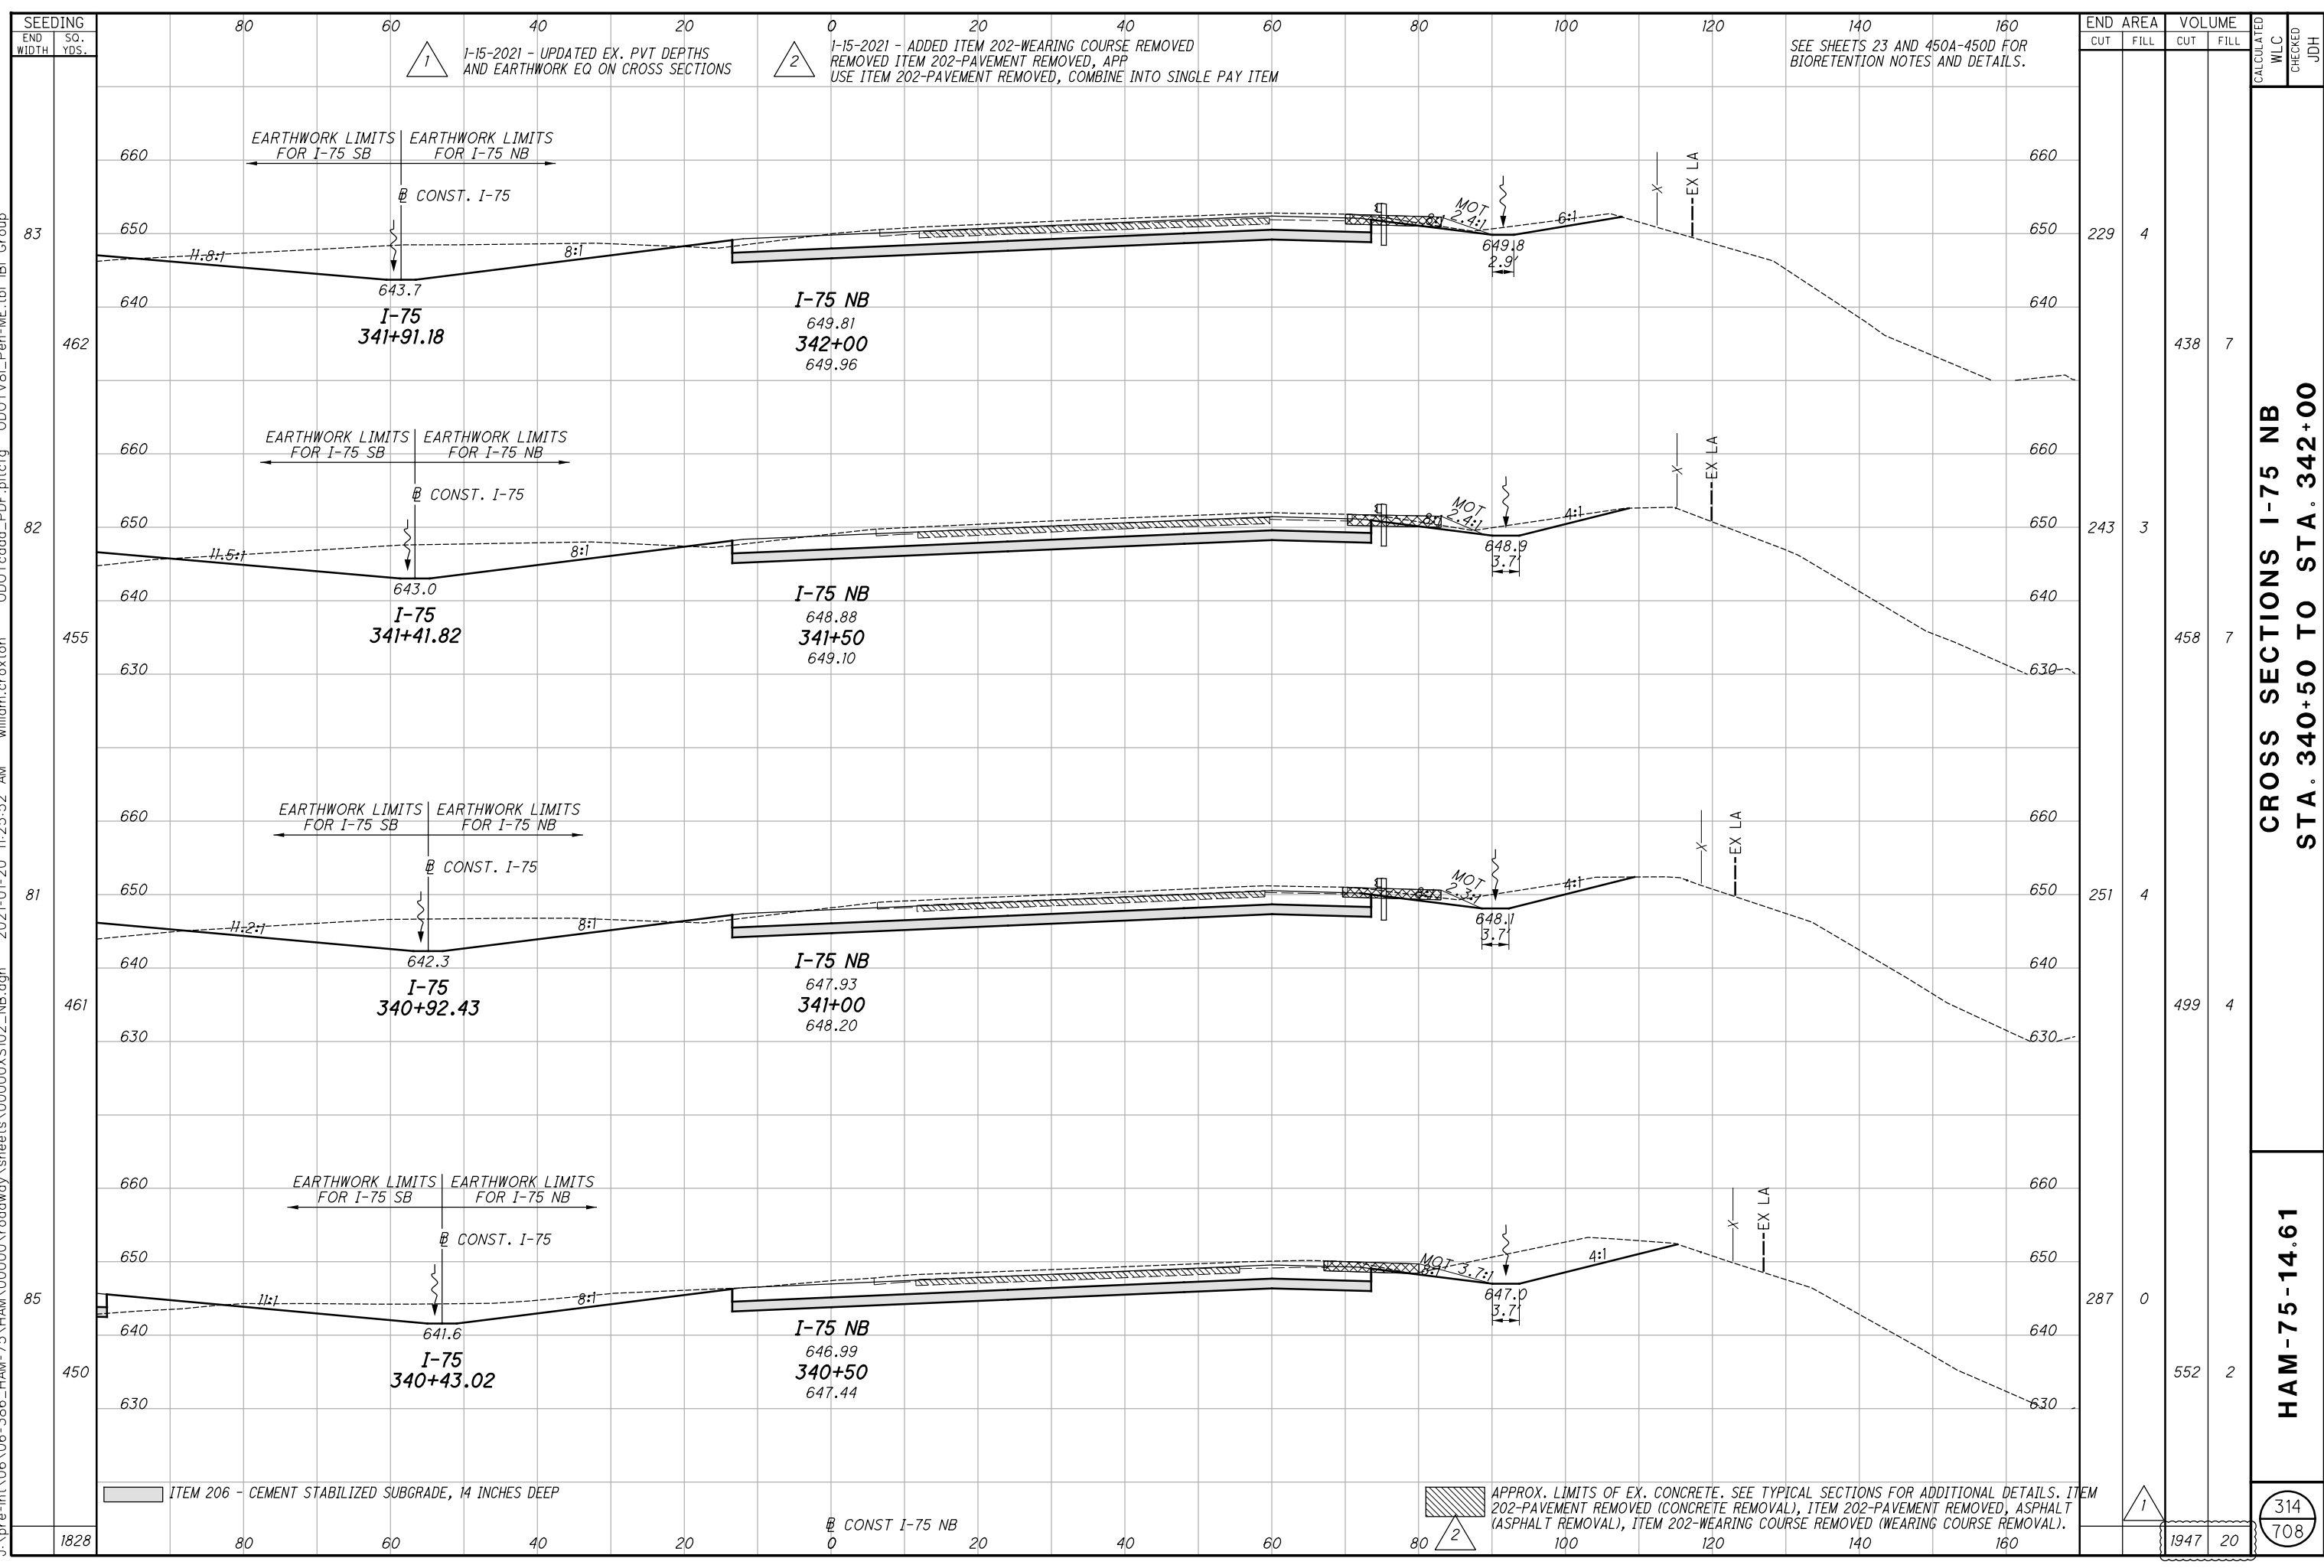


CROSS SECTIONS I-75 NB  
STA. 340+50 TO STA. 342+00

HAM-75-14.61

314  
708

CALCULATED WLC  
CHECKED JDH

j:\pre-int\06\06-386\_HAM-75\_HAM\00000\roadway\sheets\00000X5102\_NB.dgn 2021-01-20 11:25:52 AM william.croxton\ODOTV8i\_Pen-NE.tbl IBI Group

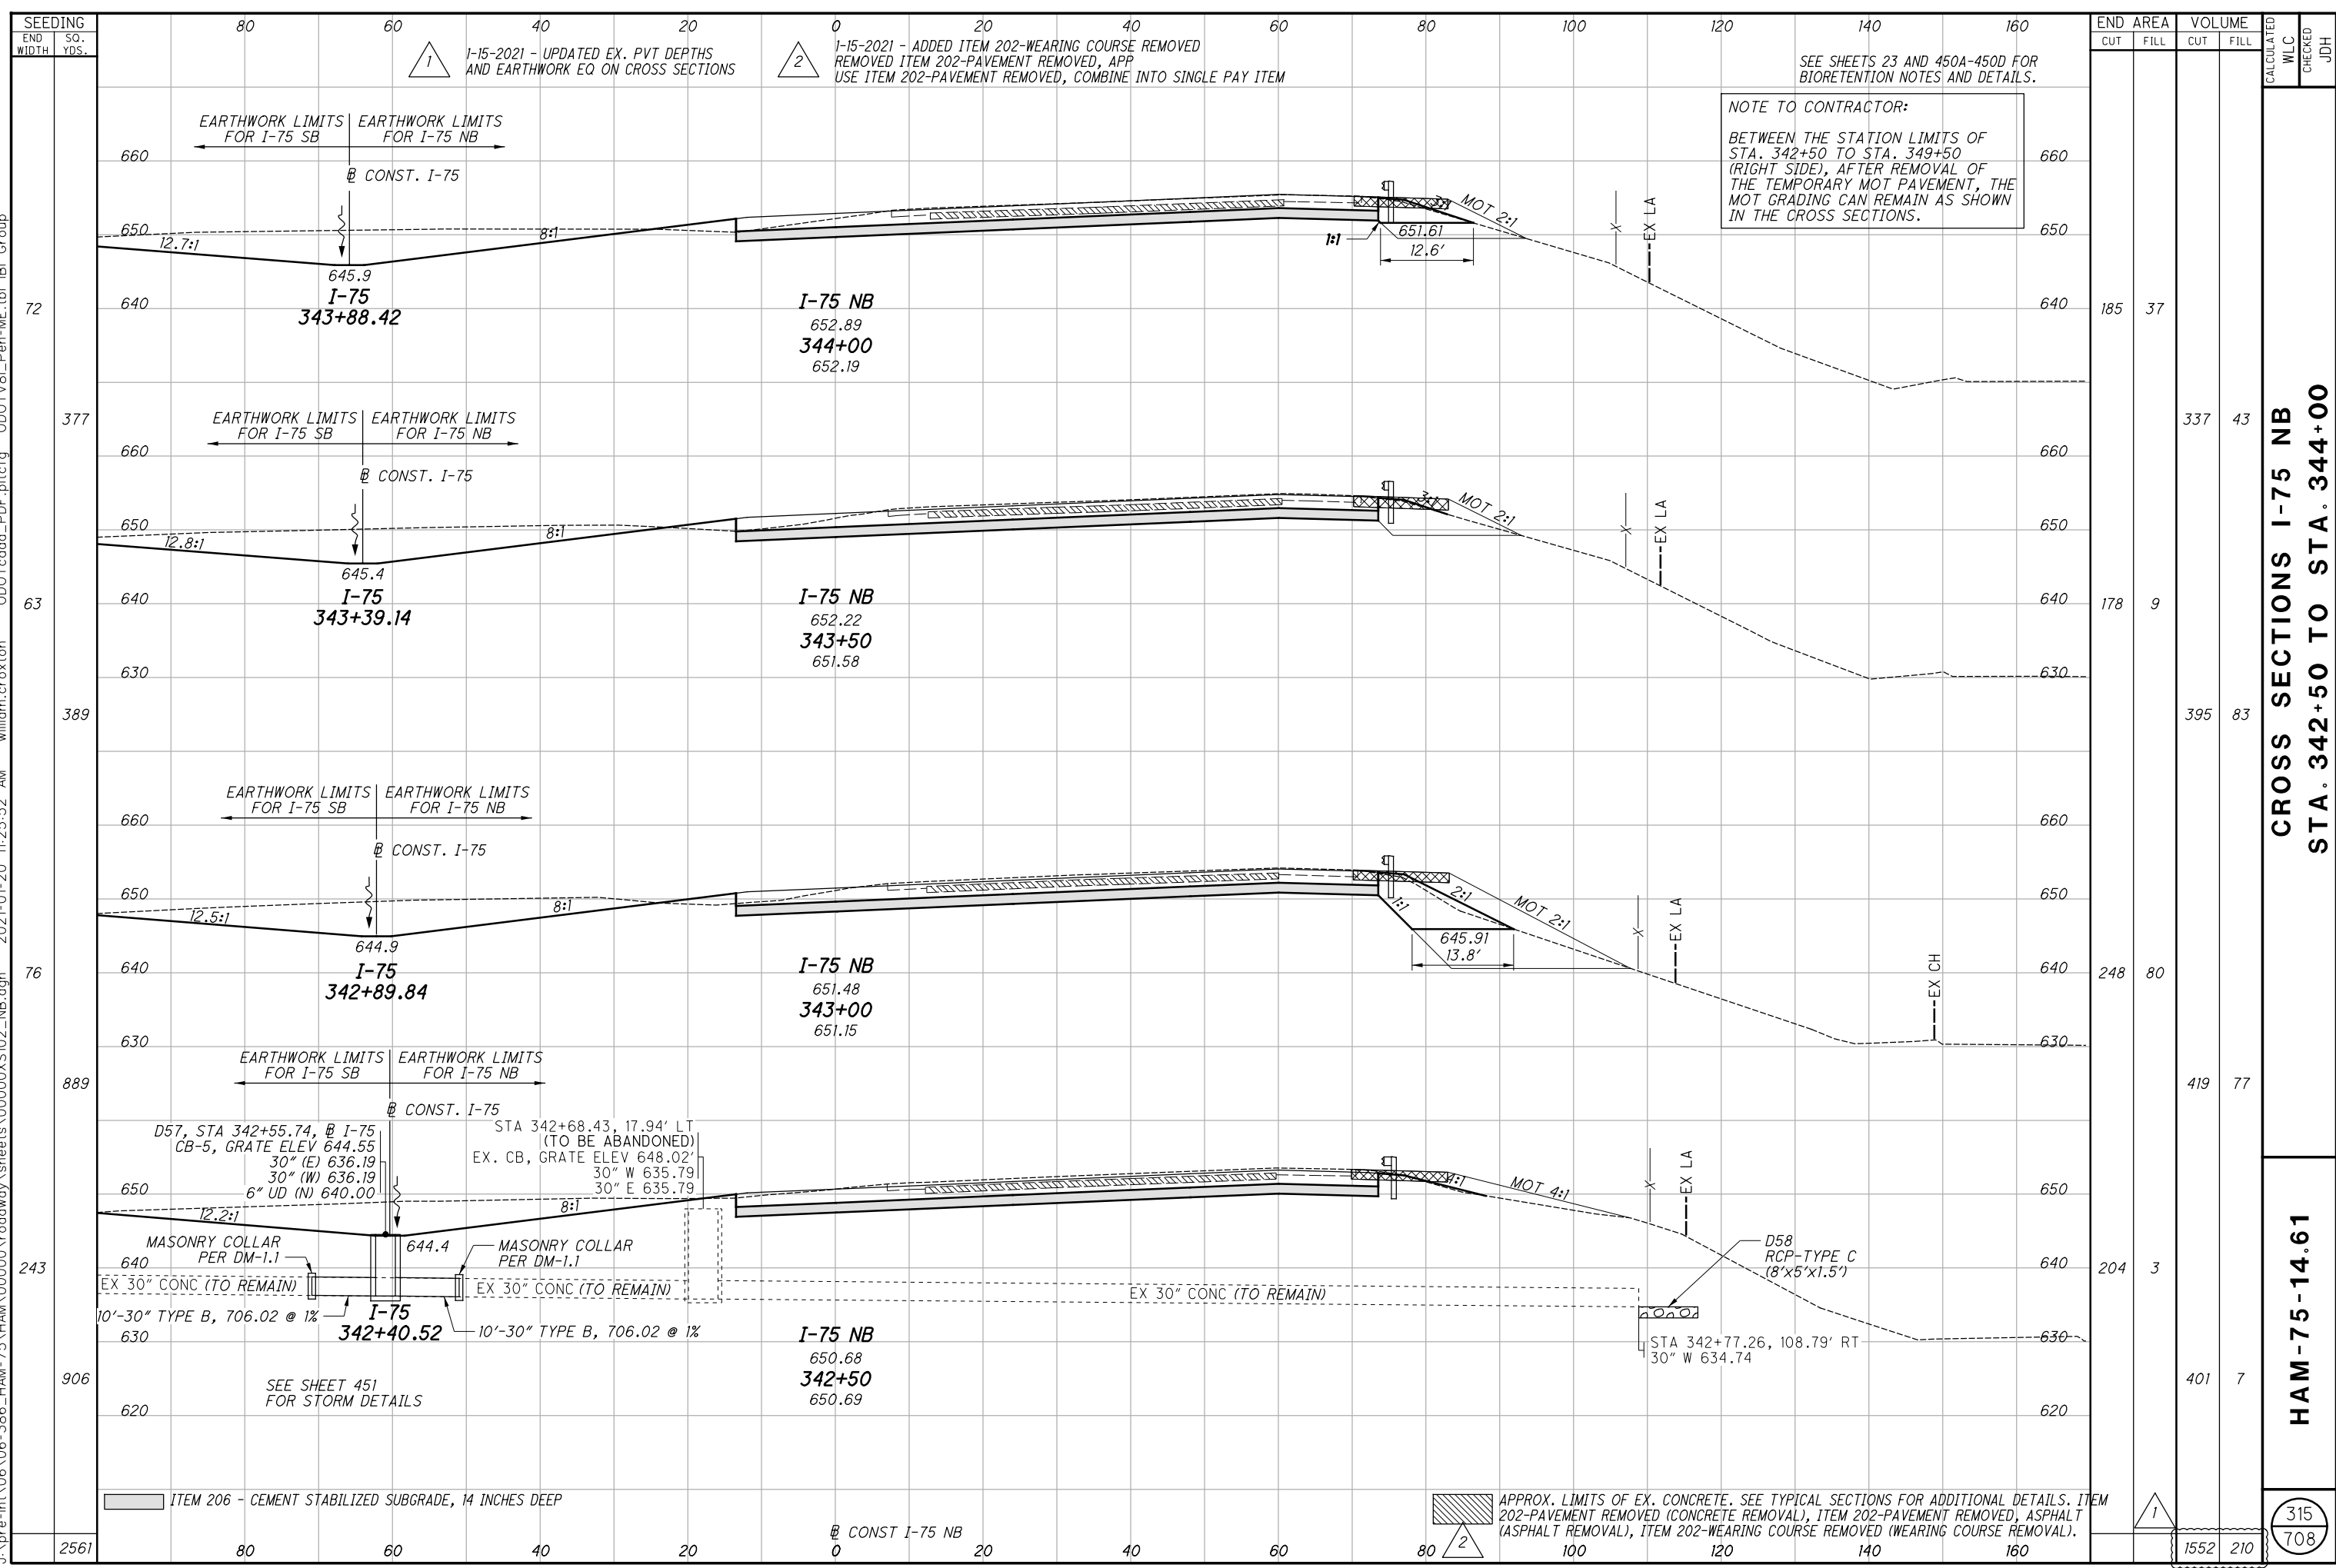


**CROSS SECTIONS I-75 NB  
STA. 342+50 TO STA. 344+00**

**HAM-75-14.61**

315  
708

STATION	END AREA		VOLUME		CALCULATED WLC	CHECKED JDH
	CUT	FILL	CUT	FILL		
343+88.42	185	37				
343+39.14	178	9				
342+89.84	248	80				
342+40.52	204	3				
<b>TOTAL</b>	<b>1552</b>	<b>210</b>				

j:\pre-int\06\06-386\_HAM-75\_HAM\00000\roadway\sheets\00000X5102\_NB.dgn 2021-01-20 11:25:53 AM william.croxton\ODOT\cadd\_PDF.plt\cfig\_ODOTV8i\_Pen-ME.tbi IBI Group

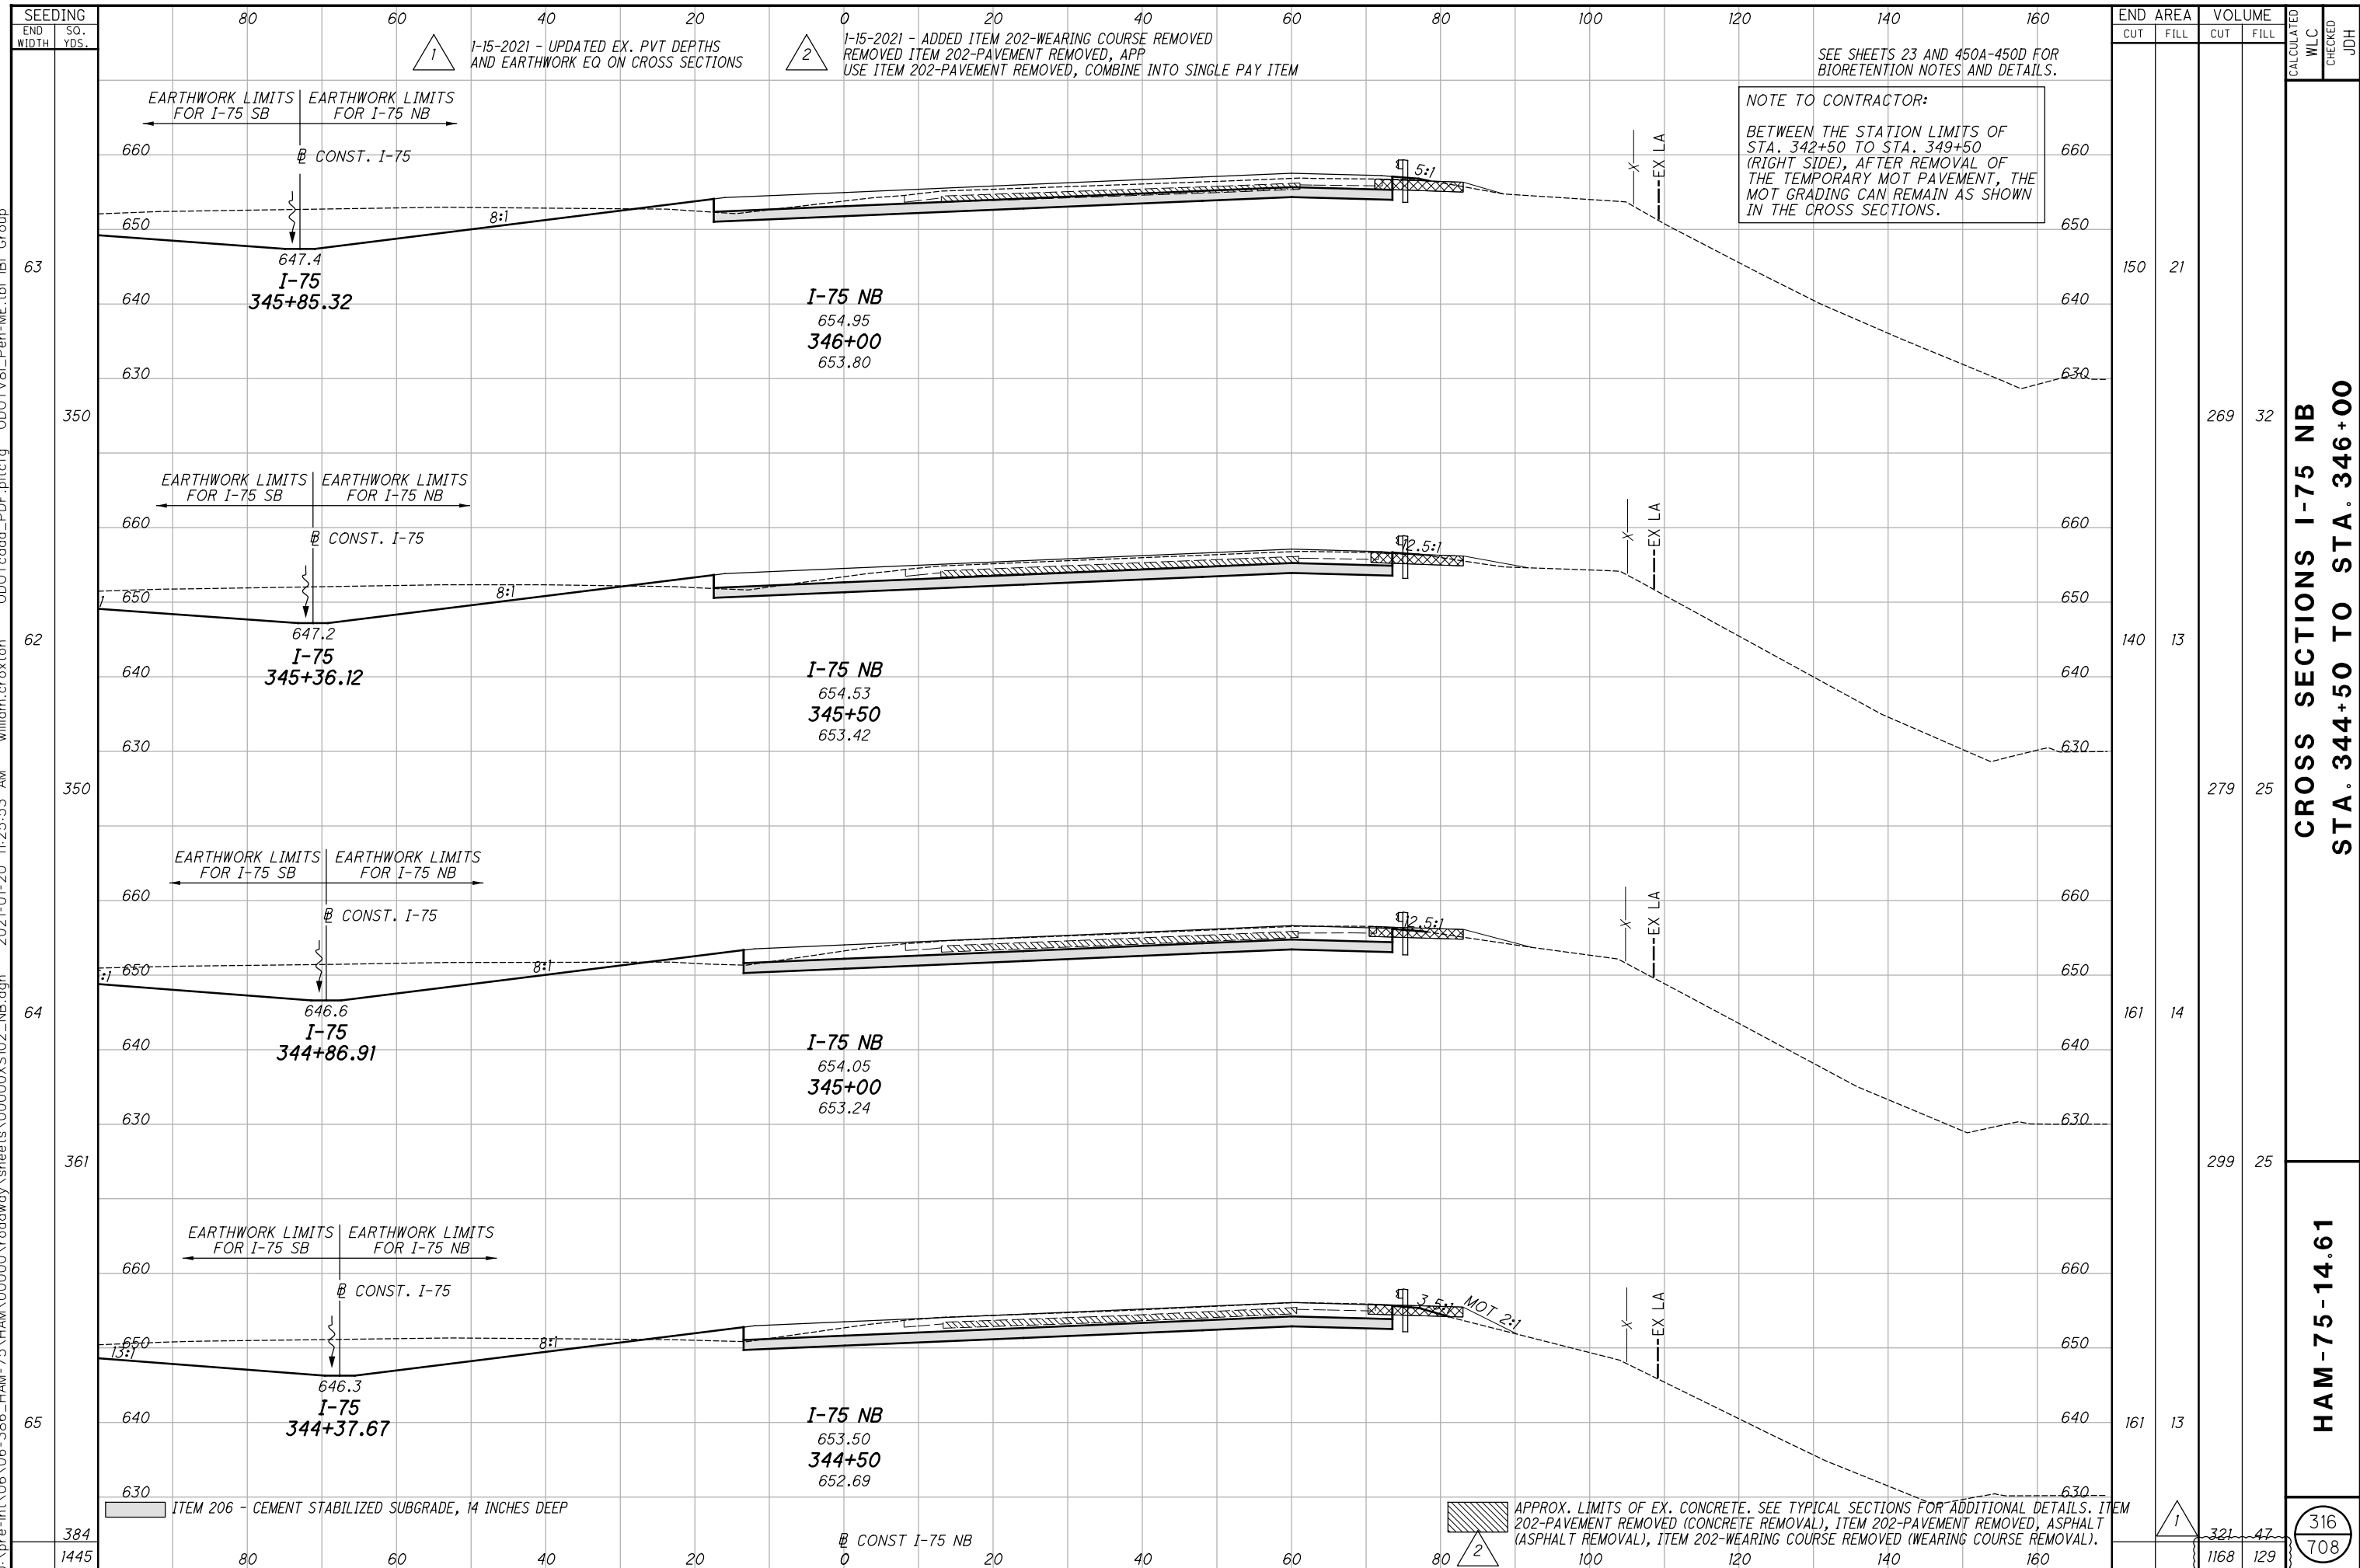

END AREA	VOLUME		CALCULATED WLC	CHECKED JDH
	CUT	FILL		
150	21			
140	13			
161	14			
161	13			
321	47		316	708
1168	129			


**CROSS SECTIONS I-75 NB  
 STA. 344+50 TO STA. 346+00**

**HAM-75-14.61**

1-15-2021 - UPDATED EX. PVT DEPTHS AND EARTHWORK EQ ON CROSS SECTIONS  
 1-15-2021 - ADDED ITEM 202-WEARING COURSE REMOVED REMOVED ITEM 202-PAVEMENT REMOVED, APP USE ITEM 202-PAVEMENT REMOVED, COMBINE INTO SINGLE PAY ITEM


ITEM 206 - CEMENT STABILIZED SUBGRADE, 14 INCHES DEEP

APPROX. LIMITS OF EX. CONCRETE. SEE TYPICAL SECTIONS FOR ADDITIONAL DETAILS. ITEM 202-PAVEMENT REMOVED (CONCRETE REMOVAL), ITEM 202-PAVEMENT REMOVED, ASPHALT (ASPHALT REMOVAL), ITEM 202-WEARING COURSE REMOVED (WEARING COURSE REMOVAL).

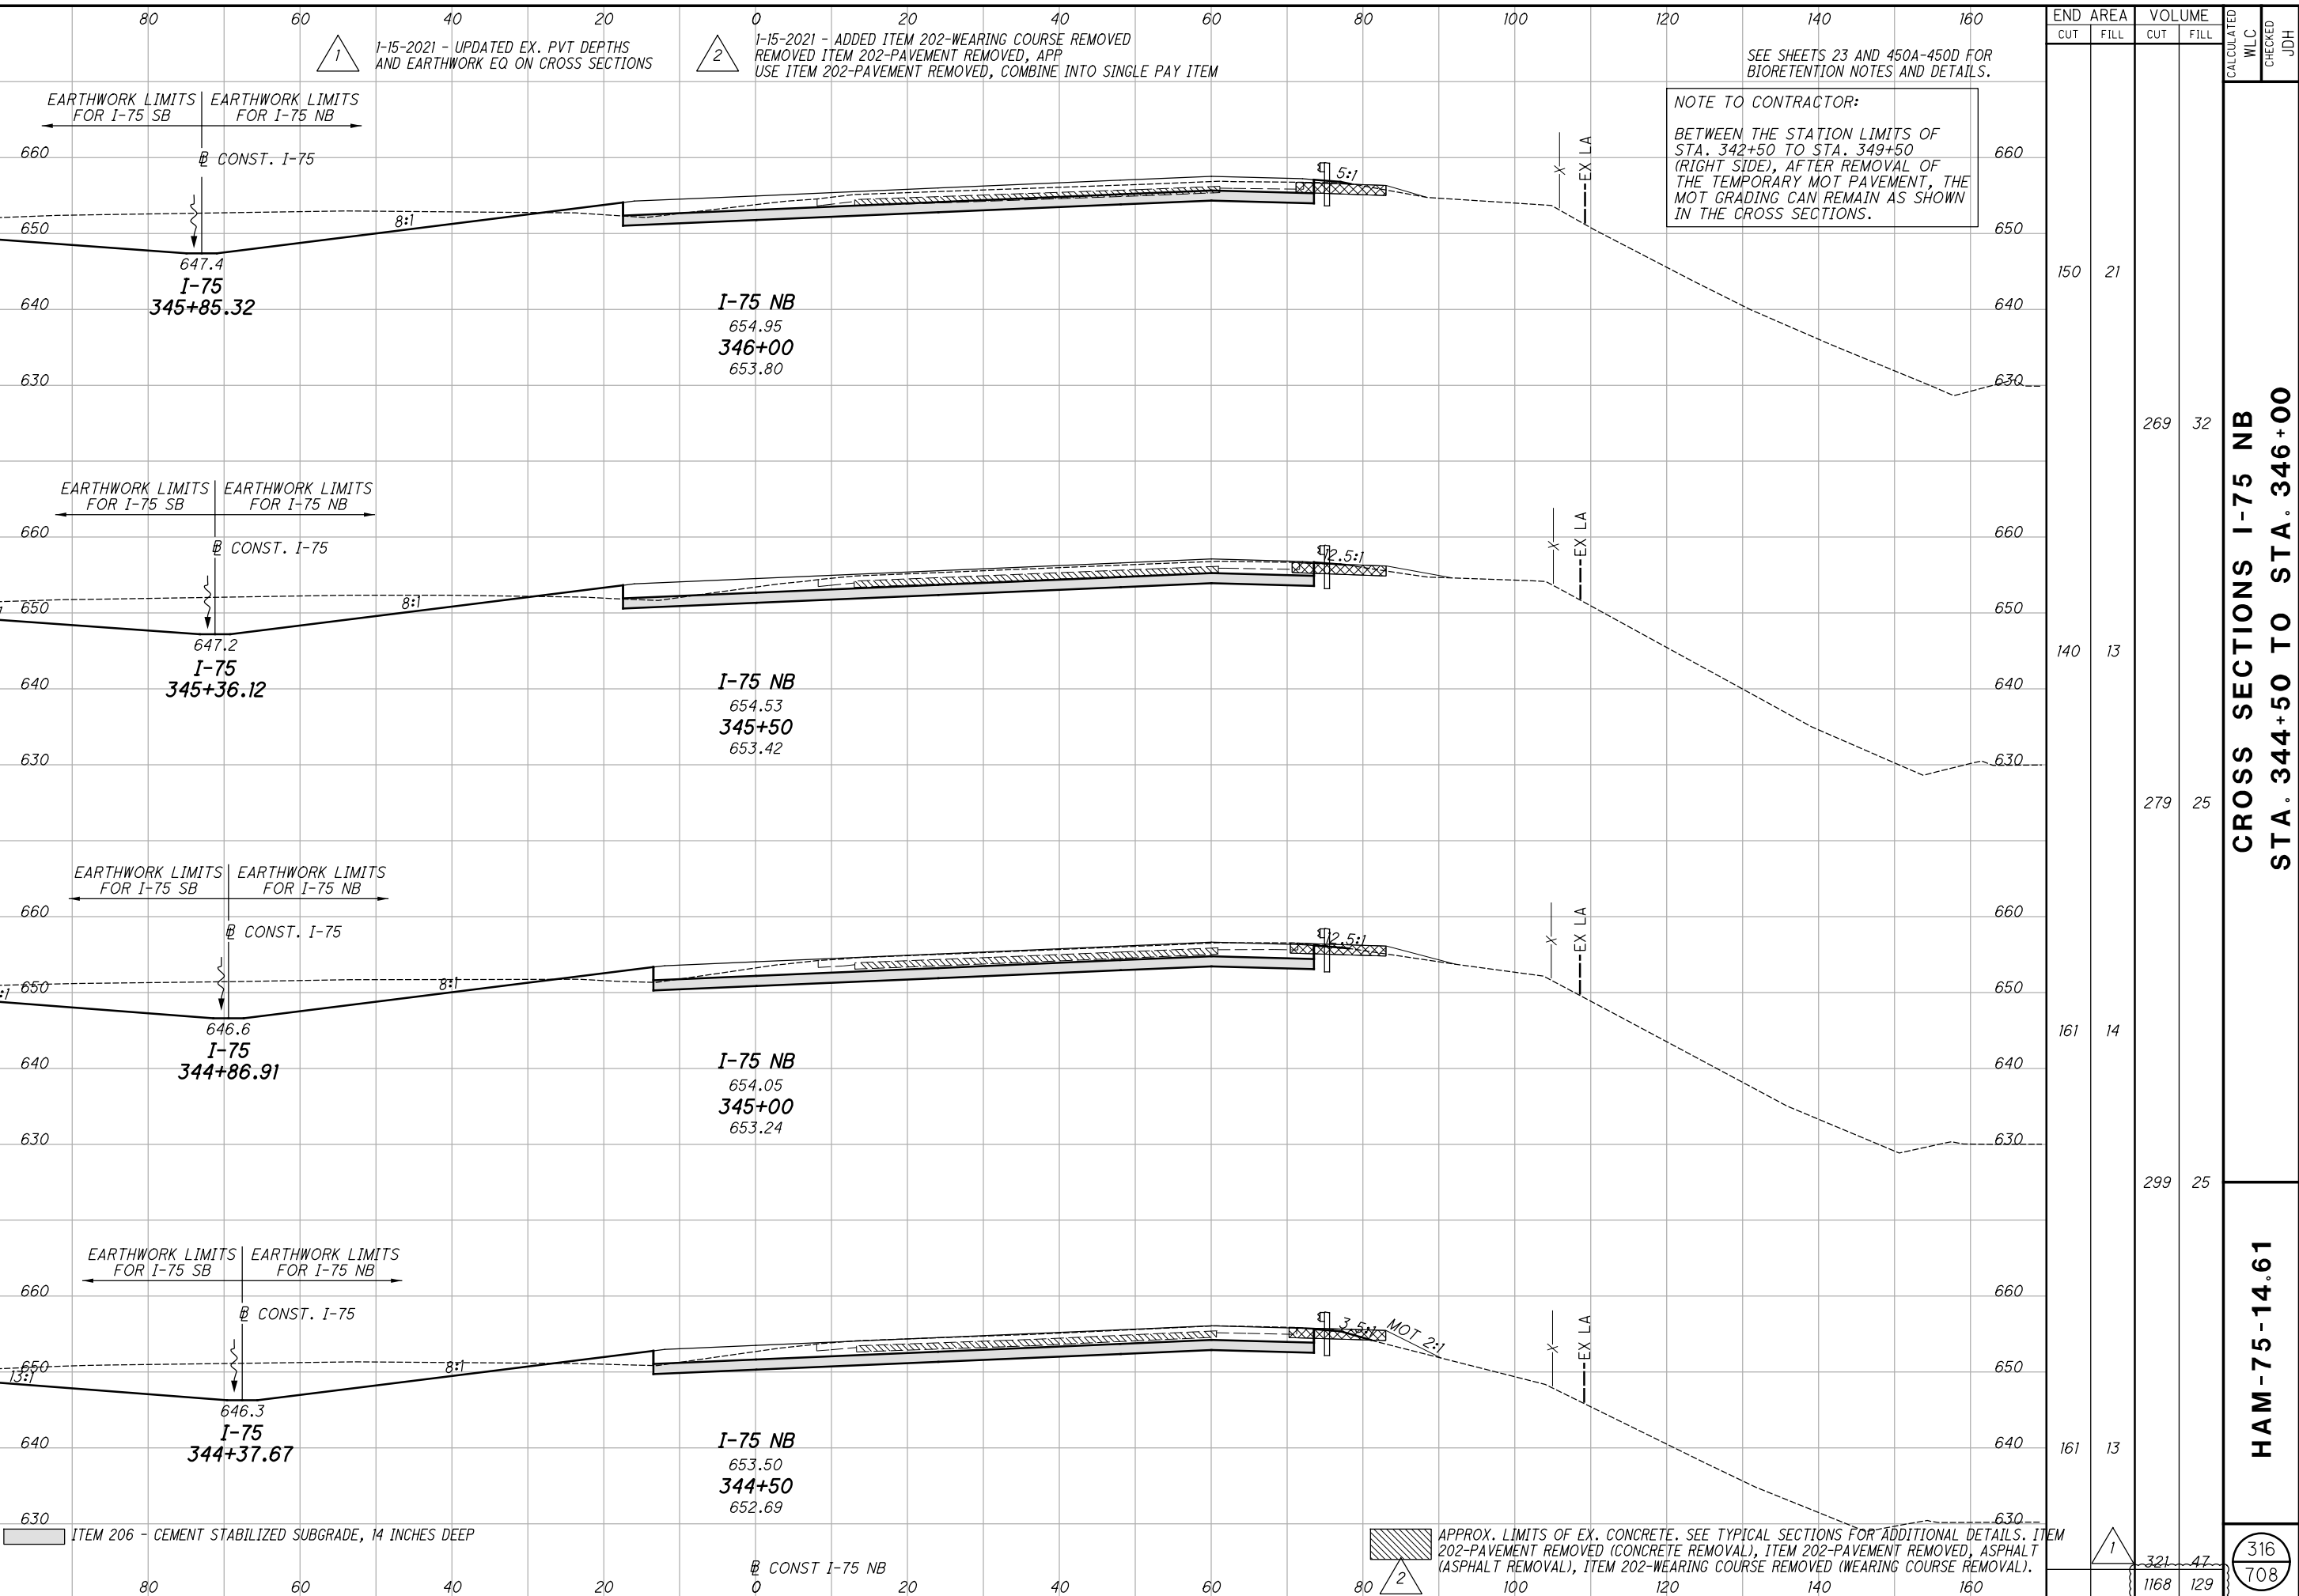

80 60 40 20 0 20 40 60 80 100 120 140 160

j:\pre-int\06\06-386\_HAM-75\HAM\00000\roadway\sheets\00000X5102\_NB.dgn 2021-01-20 11:25:53 AM william.croxton ODOT\cadd\_PDF.plt\cfig ODOTV8i\_Pen-ME.tbi IBI Group

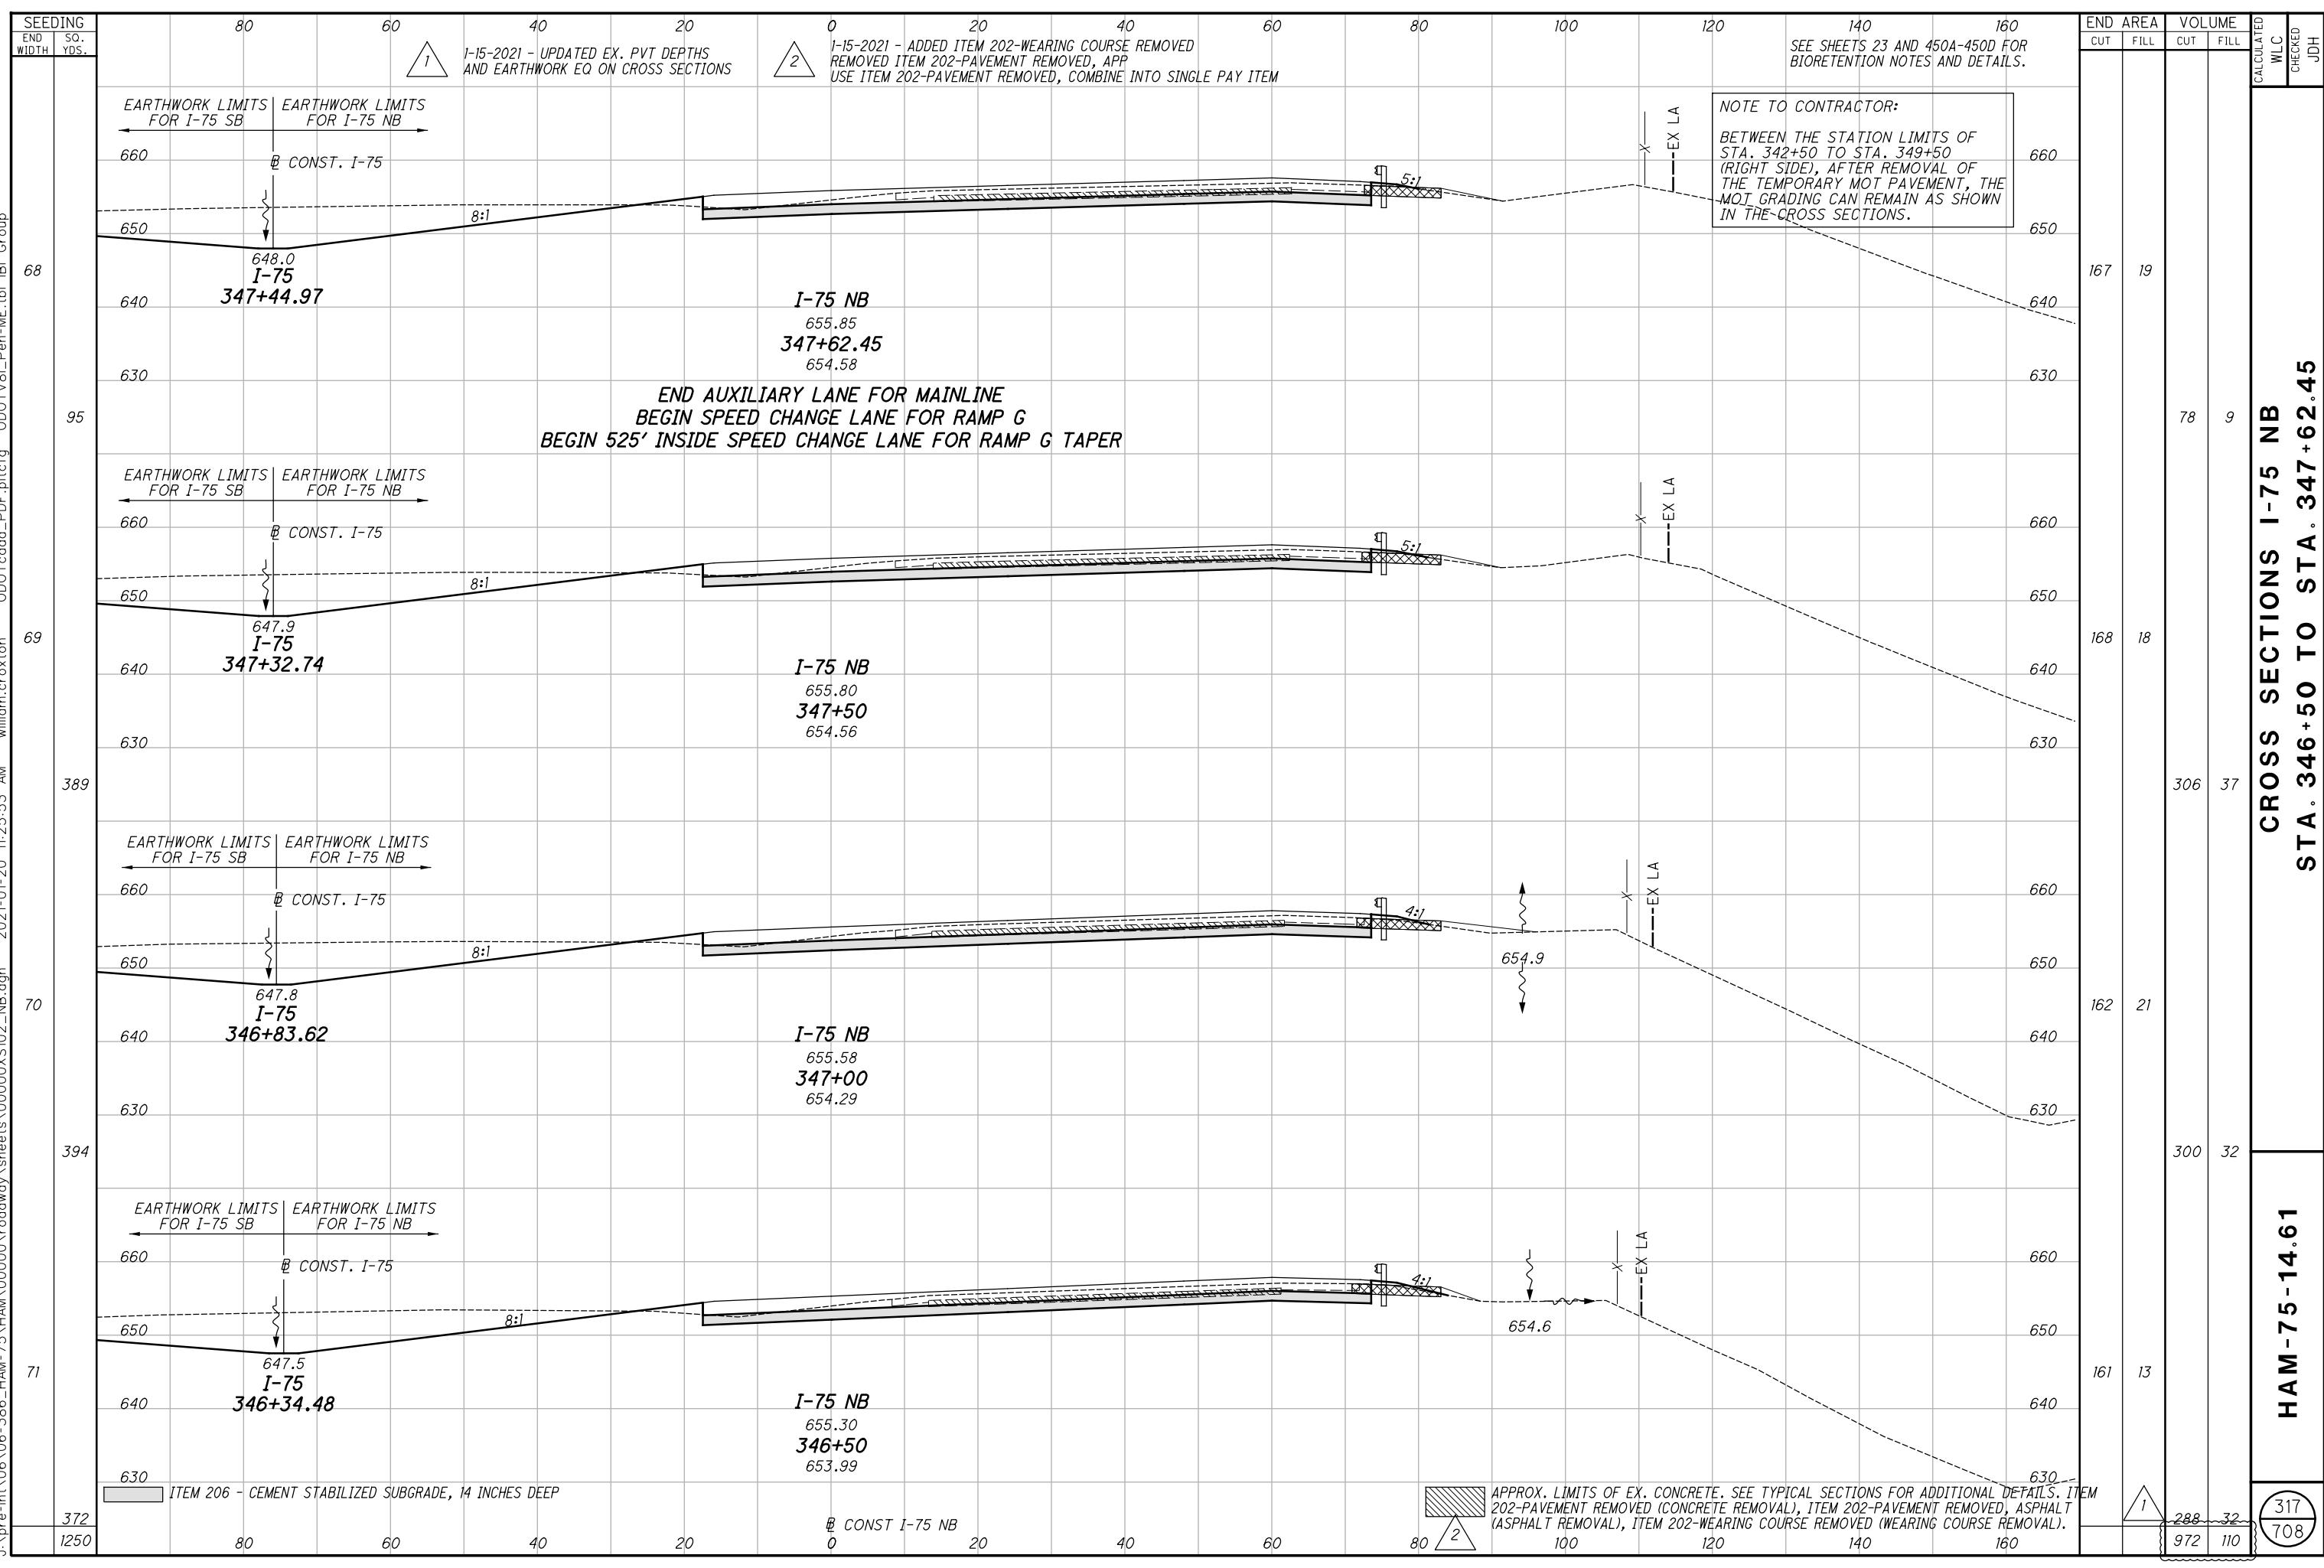

1-15-2021 - UPDATED EX. PVT DEPTHS AND EARTHWORK EQ ON CROSS SECTIONS  
 1-15-2021 - ADDED ITEM 202-WEARING COURSE REMOVED REMOVED ITEM 202-PAVEMENT REMOVED, APP USE ITEM 202-PAVEMENT REMOVED, COMBINE INTO SINGLE PAY ITEM

SEE SHEETS 23 AND 450A-450D FOR BIORETENTION NOTES AND DETAILS.

END AUXILIARY LANE FOR MAINLINE  
 BEGIN SPEED CHANGE LANE FOR RAMP G  
 BEGIN 525' INSIDE SPEED CHANGE LANE FOR RAMP G TAPER

EARTHWORK LIMITS FOR I-75 SB

CONST. I-75

648.0  
 I-75  
 347+44.97

I-75 NB  
 655.85  
 347+62.45  
 654.58

EARTHWORK LIMITS FOR I-75 SB

CONST. I-75

647.9  
 I-75  
 347+32.74

I-75 NB  
 655.80  
 347+50  
 654.56

EARTHWORK LIMITS FOR I-75 SB

CONST. I-75

647.8  
 I-75  
 346+83.62

I-75 NB  
 655.58  
 347+00  
 654.29

EARTHWORK LIMITS FOR I-75 SB

CONST. I-75

647.5  
 I-75  
 346+34.48

I-75 NB  
 655.30  
 346+50  
 653.99

ITEM 206 - CEMENT STABILIZED SUBGRADE, 14 INCHES DEEP


APPROX. LIMITS OF EX. CONCRETE. SEE TYPICAL SECTIONS FOR ADDITIONAL DETAILS. ITEM 202-PAVEMENT REMOVED (CONCRETE REMOVAL), ITEM 202-PAVEMENT REMOVED, ASPHALT (ASPHALT REMOVAL), ITEM 202-WEARING COURSE REMOVED (WEARING COURSE REMOVAL).

END AREA	VOLUME		CALCULATED WLC	CHECKED	JDH
	CUT	FILL			
167	19				
168	18	78	9		
162	21	306	37		
161	13	300	32		
288	32	972	110	317	708

CROSS SECTIONS I-75 NB  
 STA. 346+50 TO STA. 347+62.45

HAM-75-14.61

j:\pre-int\06\06-386\_HAM-75\_HAM\00000\roadway\sheets\00000X5102\_NB.dgn 2021-01-20 11:25:54 AM william.croxton ODOTcadd\_PDF.pltcfgr ODOTV8i\_Pen-ME.tbl IBI Group

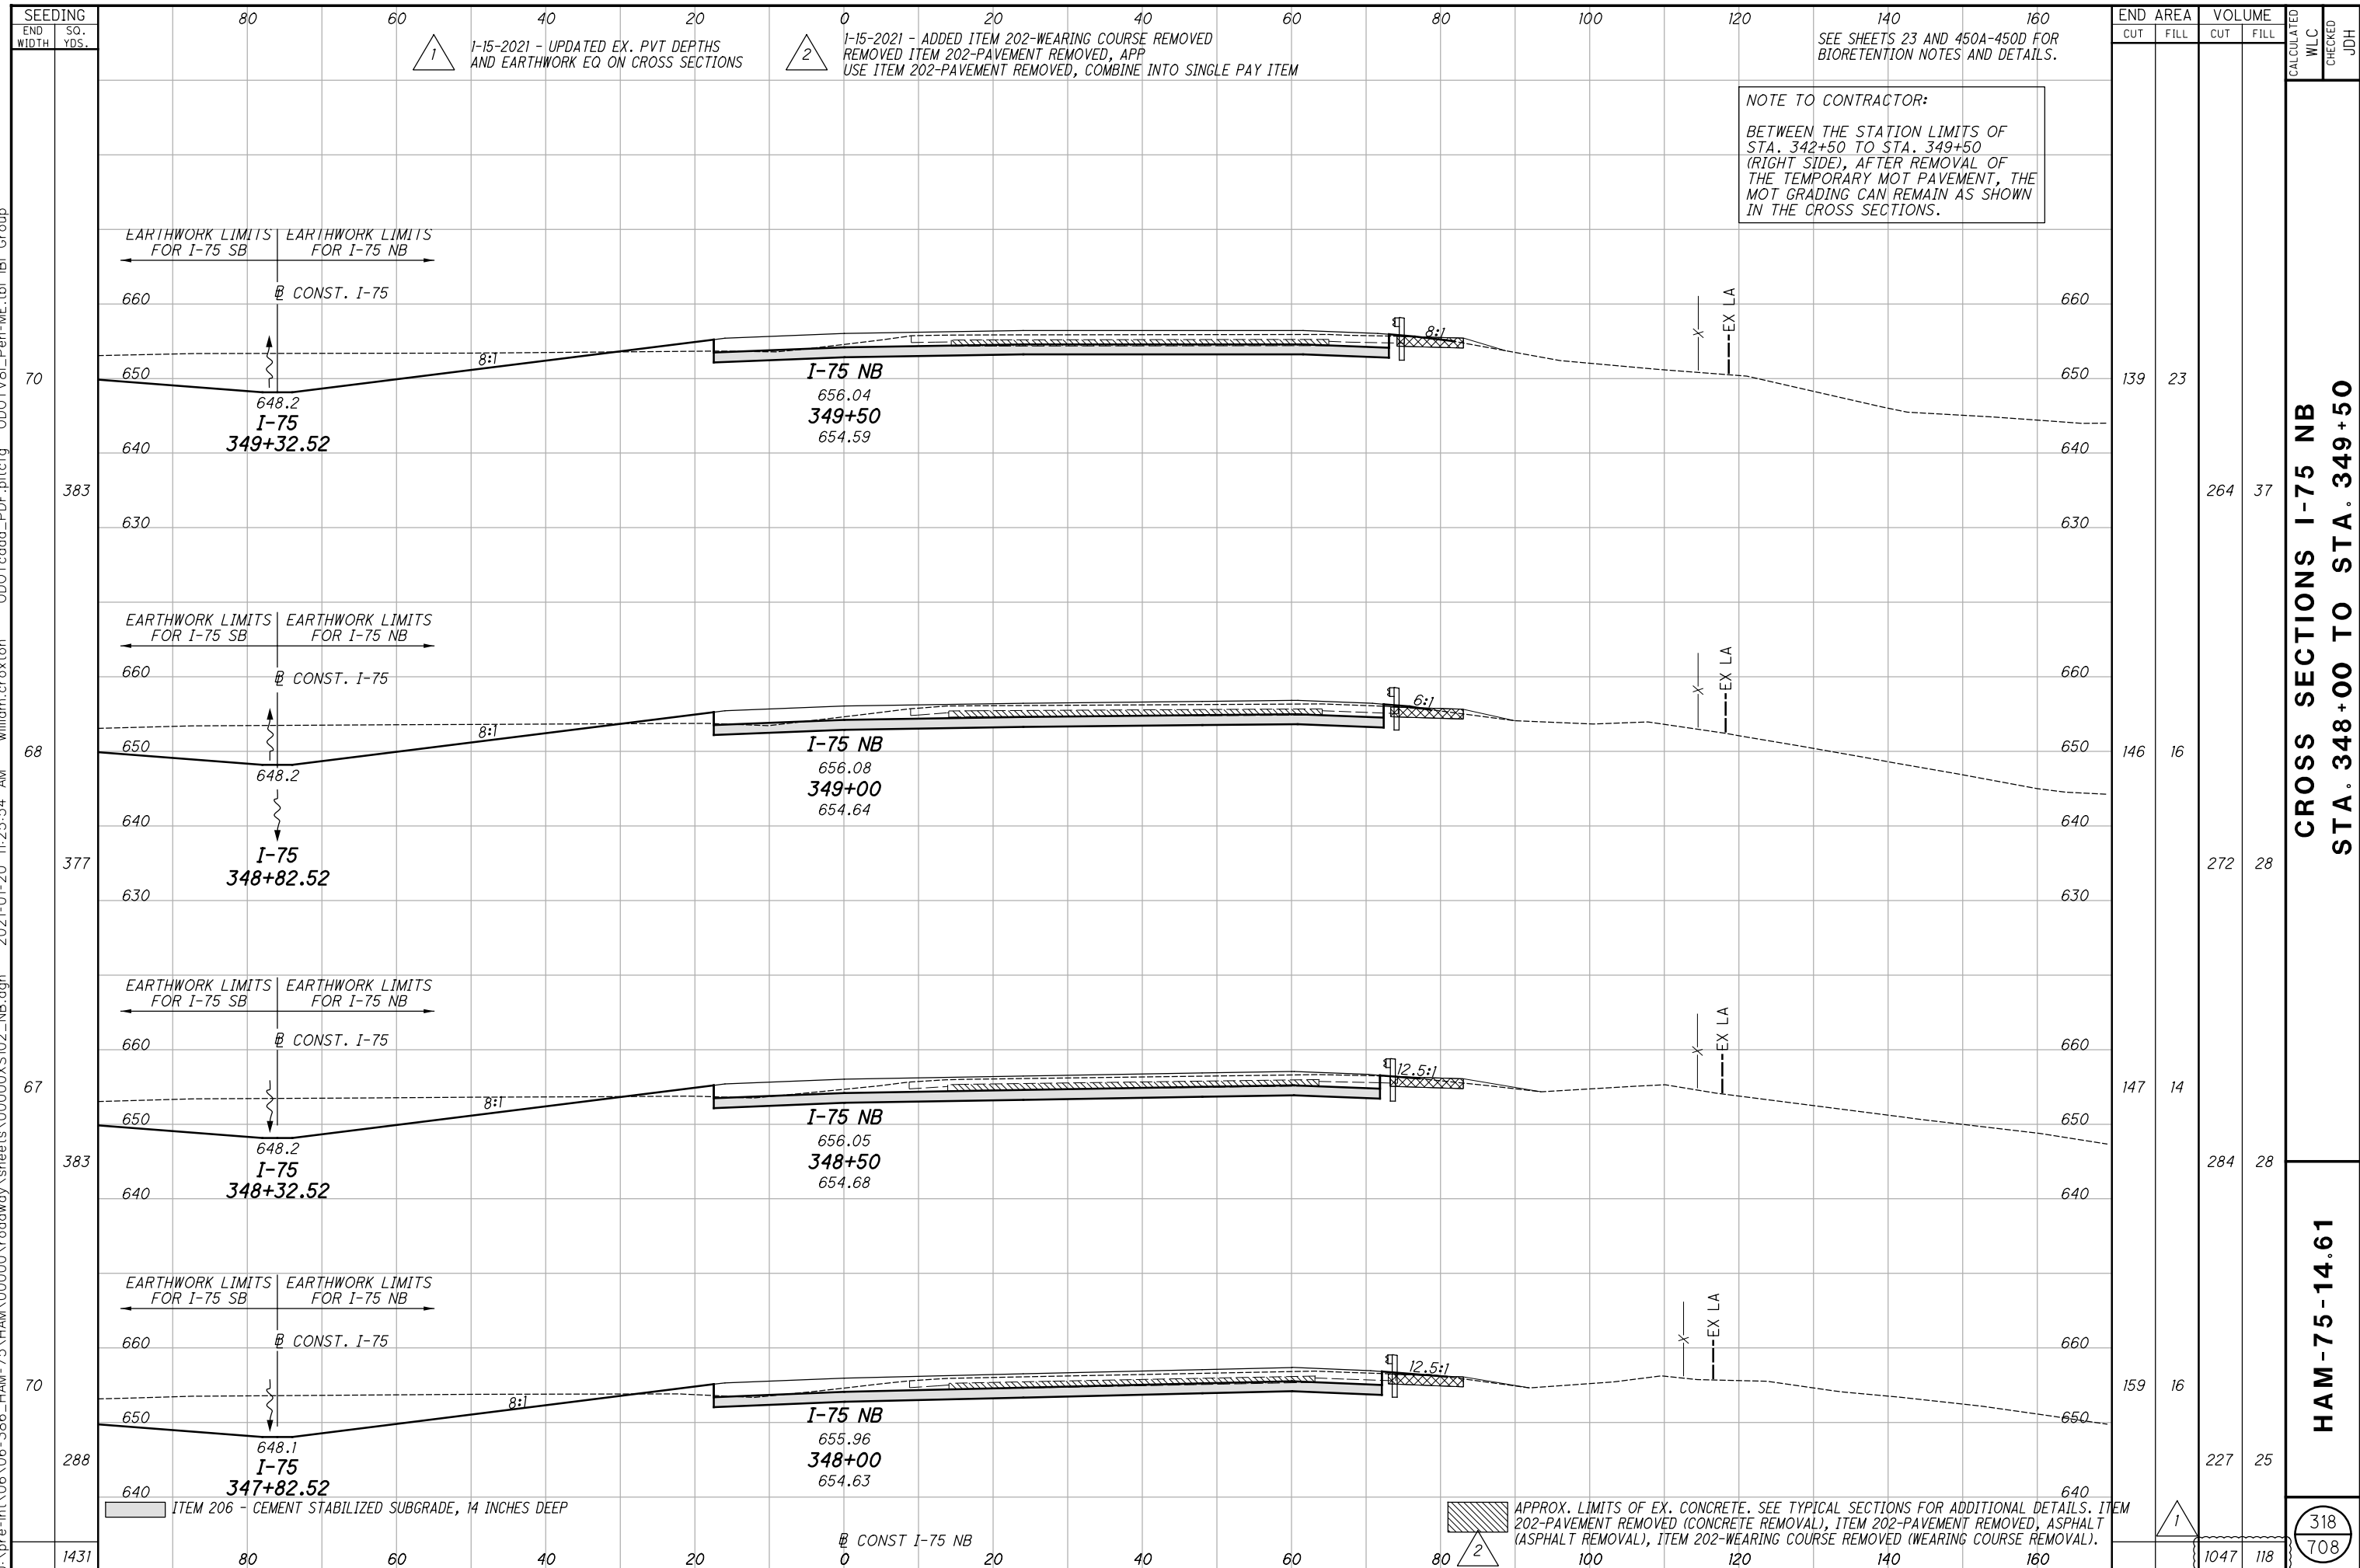

1-15-2021 - UPDATED EX. PVT DEPTHS AND EARTHWORK EQ ON CROSS SECTIONS  
 1-15-2021 - ADDED ITEM 202-WEARING COURSE REMOVED REMOVED ITEM 202-PAVEMENT REMOVED, APP USE ITEM 202-PAVEMENT REMOVED, COMBINE INTO SINGLE PAY ITEM

**NOTE TO CONTRACTOR:**  
 BETWEEN THE STATION LIMITS OF STA. 342+50 TO STA. 349+50 (RIGHT SIDE), AFTER REMOVAL OF THE TEMPORARY MOT PAVEMENT, THE MOT GRADING CAN REMAIN AS SHOWN IN THE CROSS SECTIONS.

END AREA	VOLUME		CALCULATED WLC	CHECKED	JDH
	CUT	FILL			
139	23				
146	16				
147	14				
159	16				
1047	118				

**CROSS SECTIONS I-75 NB  
 STA. 348+00 TO STA. 349+50**

**HAM-75-14.61**


318  
708

APPROX. LIMITS OF EX. CONCRETE. SEE TYPICAL SECTIONS FOR ADDITIONAL DETAILS. ITEM 202-PAVEMENT REMOVED (CONCRETE REMOVAL), ITEM 202-PAVEMENT REMOVED, ASPHALT (ASPHALT REMOVAL), ITEM 202-WEARING COURSE REMOVED (WEARING COURSE REMOVAL).

ITEM 206 - CEMENT STABILIZED SUBGRADE, 14 INCHES DEEP

CONST I-75 NB

j:\pre-int\06\06-386\_HAM-75\HAM-75\HAM-75\roadway\sheets\00000X5102\_NB.dgn 2021-01-20 11:25:54 AM william.croxton ODOT\cadd\_PDF.plt cfg ODOTV8i\_Pen-ME.tbl IBI Group

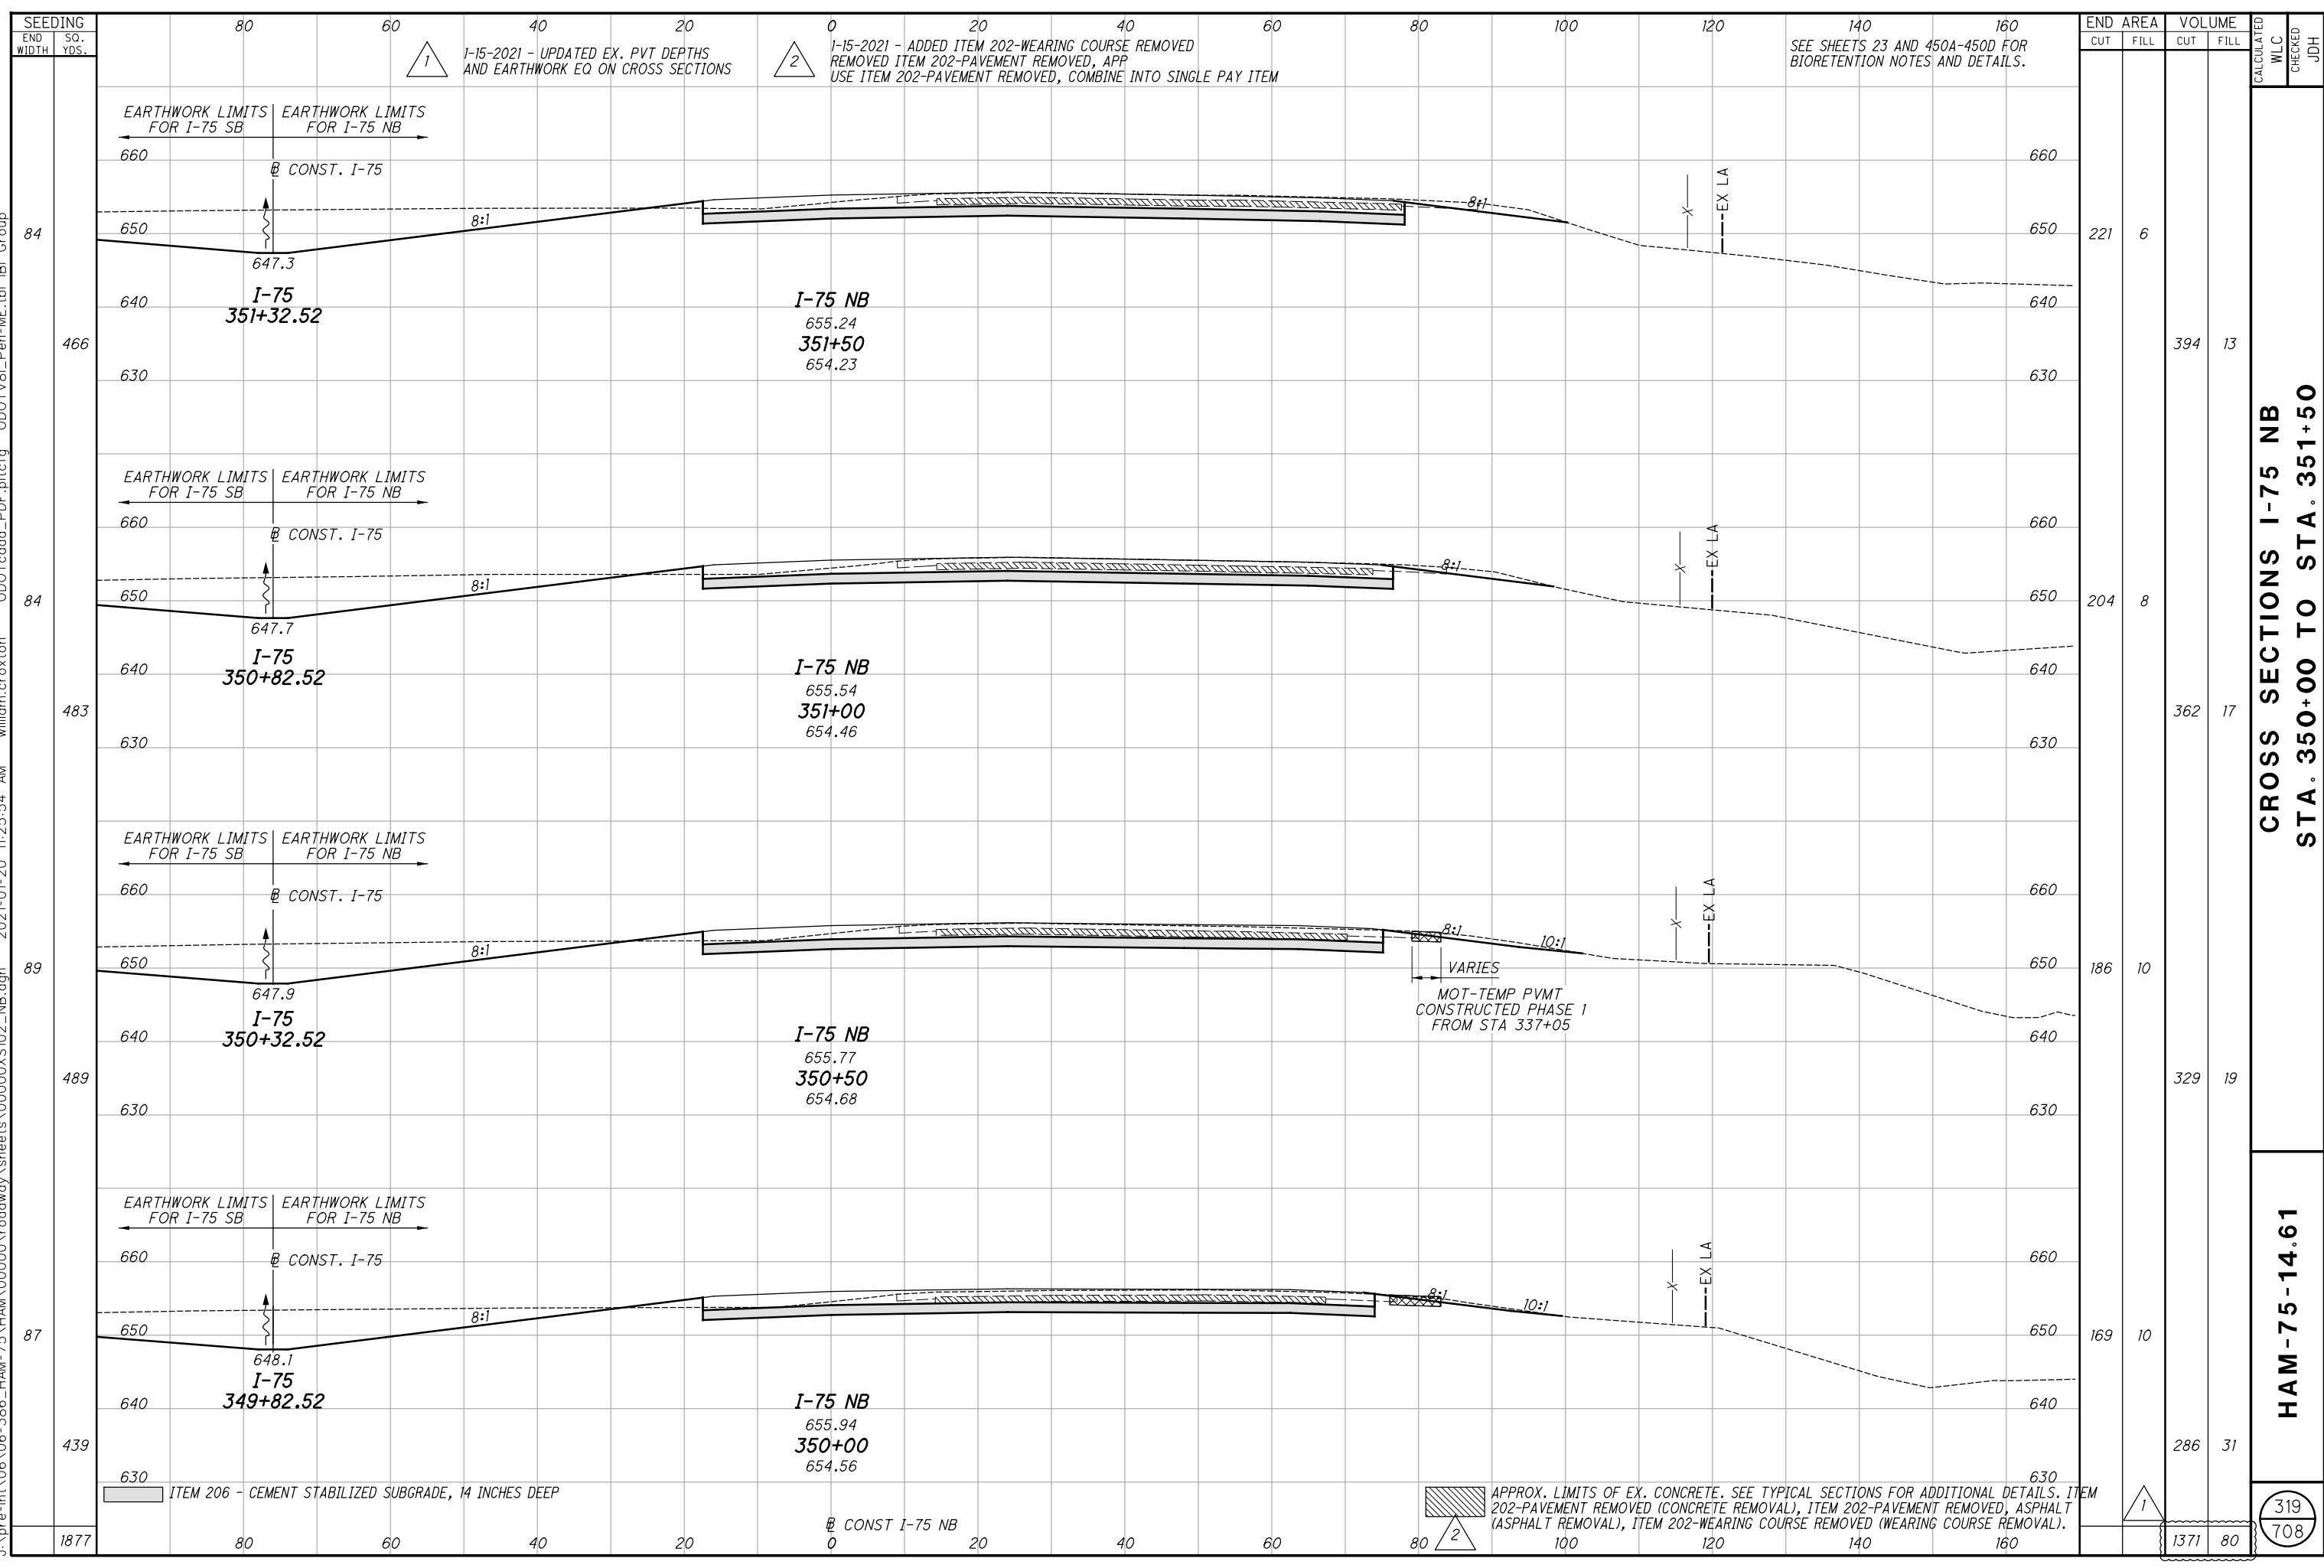


**CROSS SECTIONS I-75 NB  
STA. 350+00 TO STA. 351+50**


**HAM-75-14.61**

**319**  
**708**

j:\pre-int\06\06-386\_HAM-75\HAM-75\HAM-75\roadway\sheets\000005102\_NB.dgn 2021-01-20 11:25:55 AM william.croxton ODOTcadd\_PDF.plt cfbg ODOTV8i\_Pen-ME.tbl IBI Group

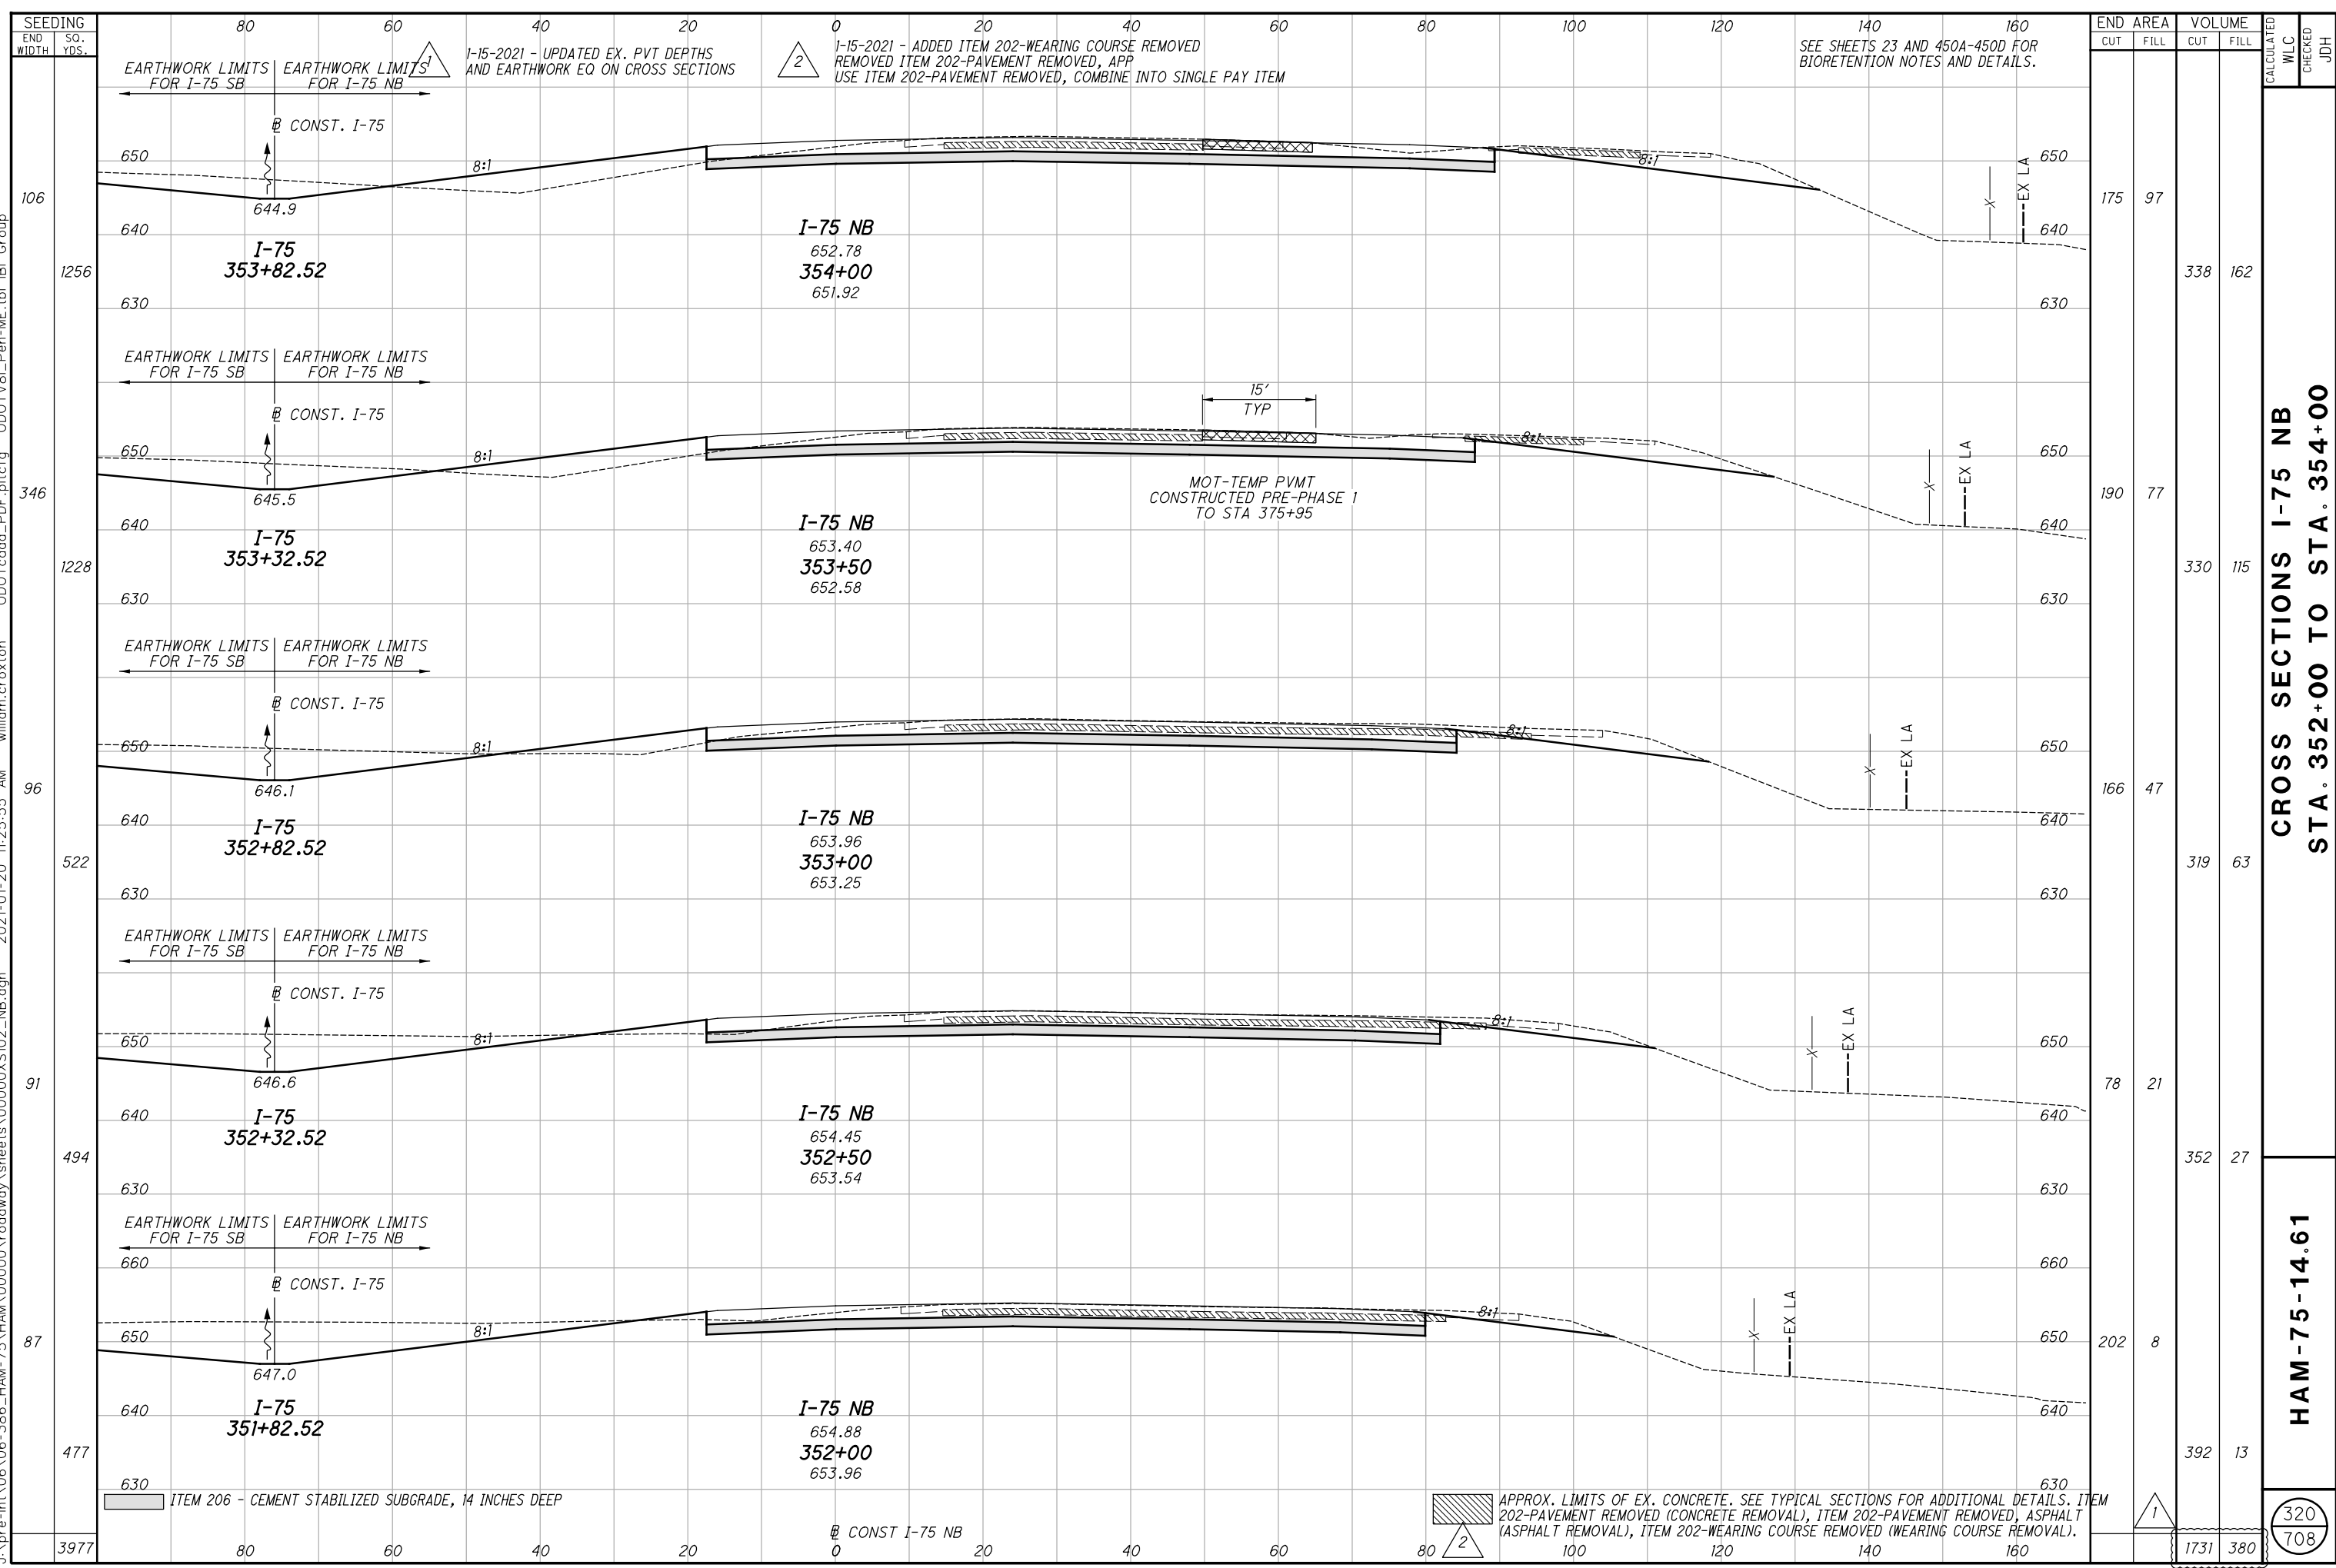


j:\pre-int\06\06-386\_HAM-75\_HAM\00000\roadway\sheets\00000X5102\_NB.dgn 2021-01-20 11:25:55 AM william.croxton ODOTcadd\_PDF.plt cfbg ODOTV8i\_Pen-ME.tbi IBI Group

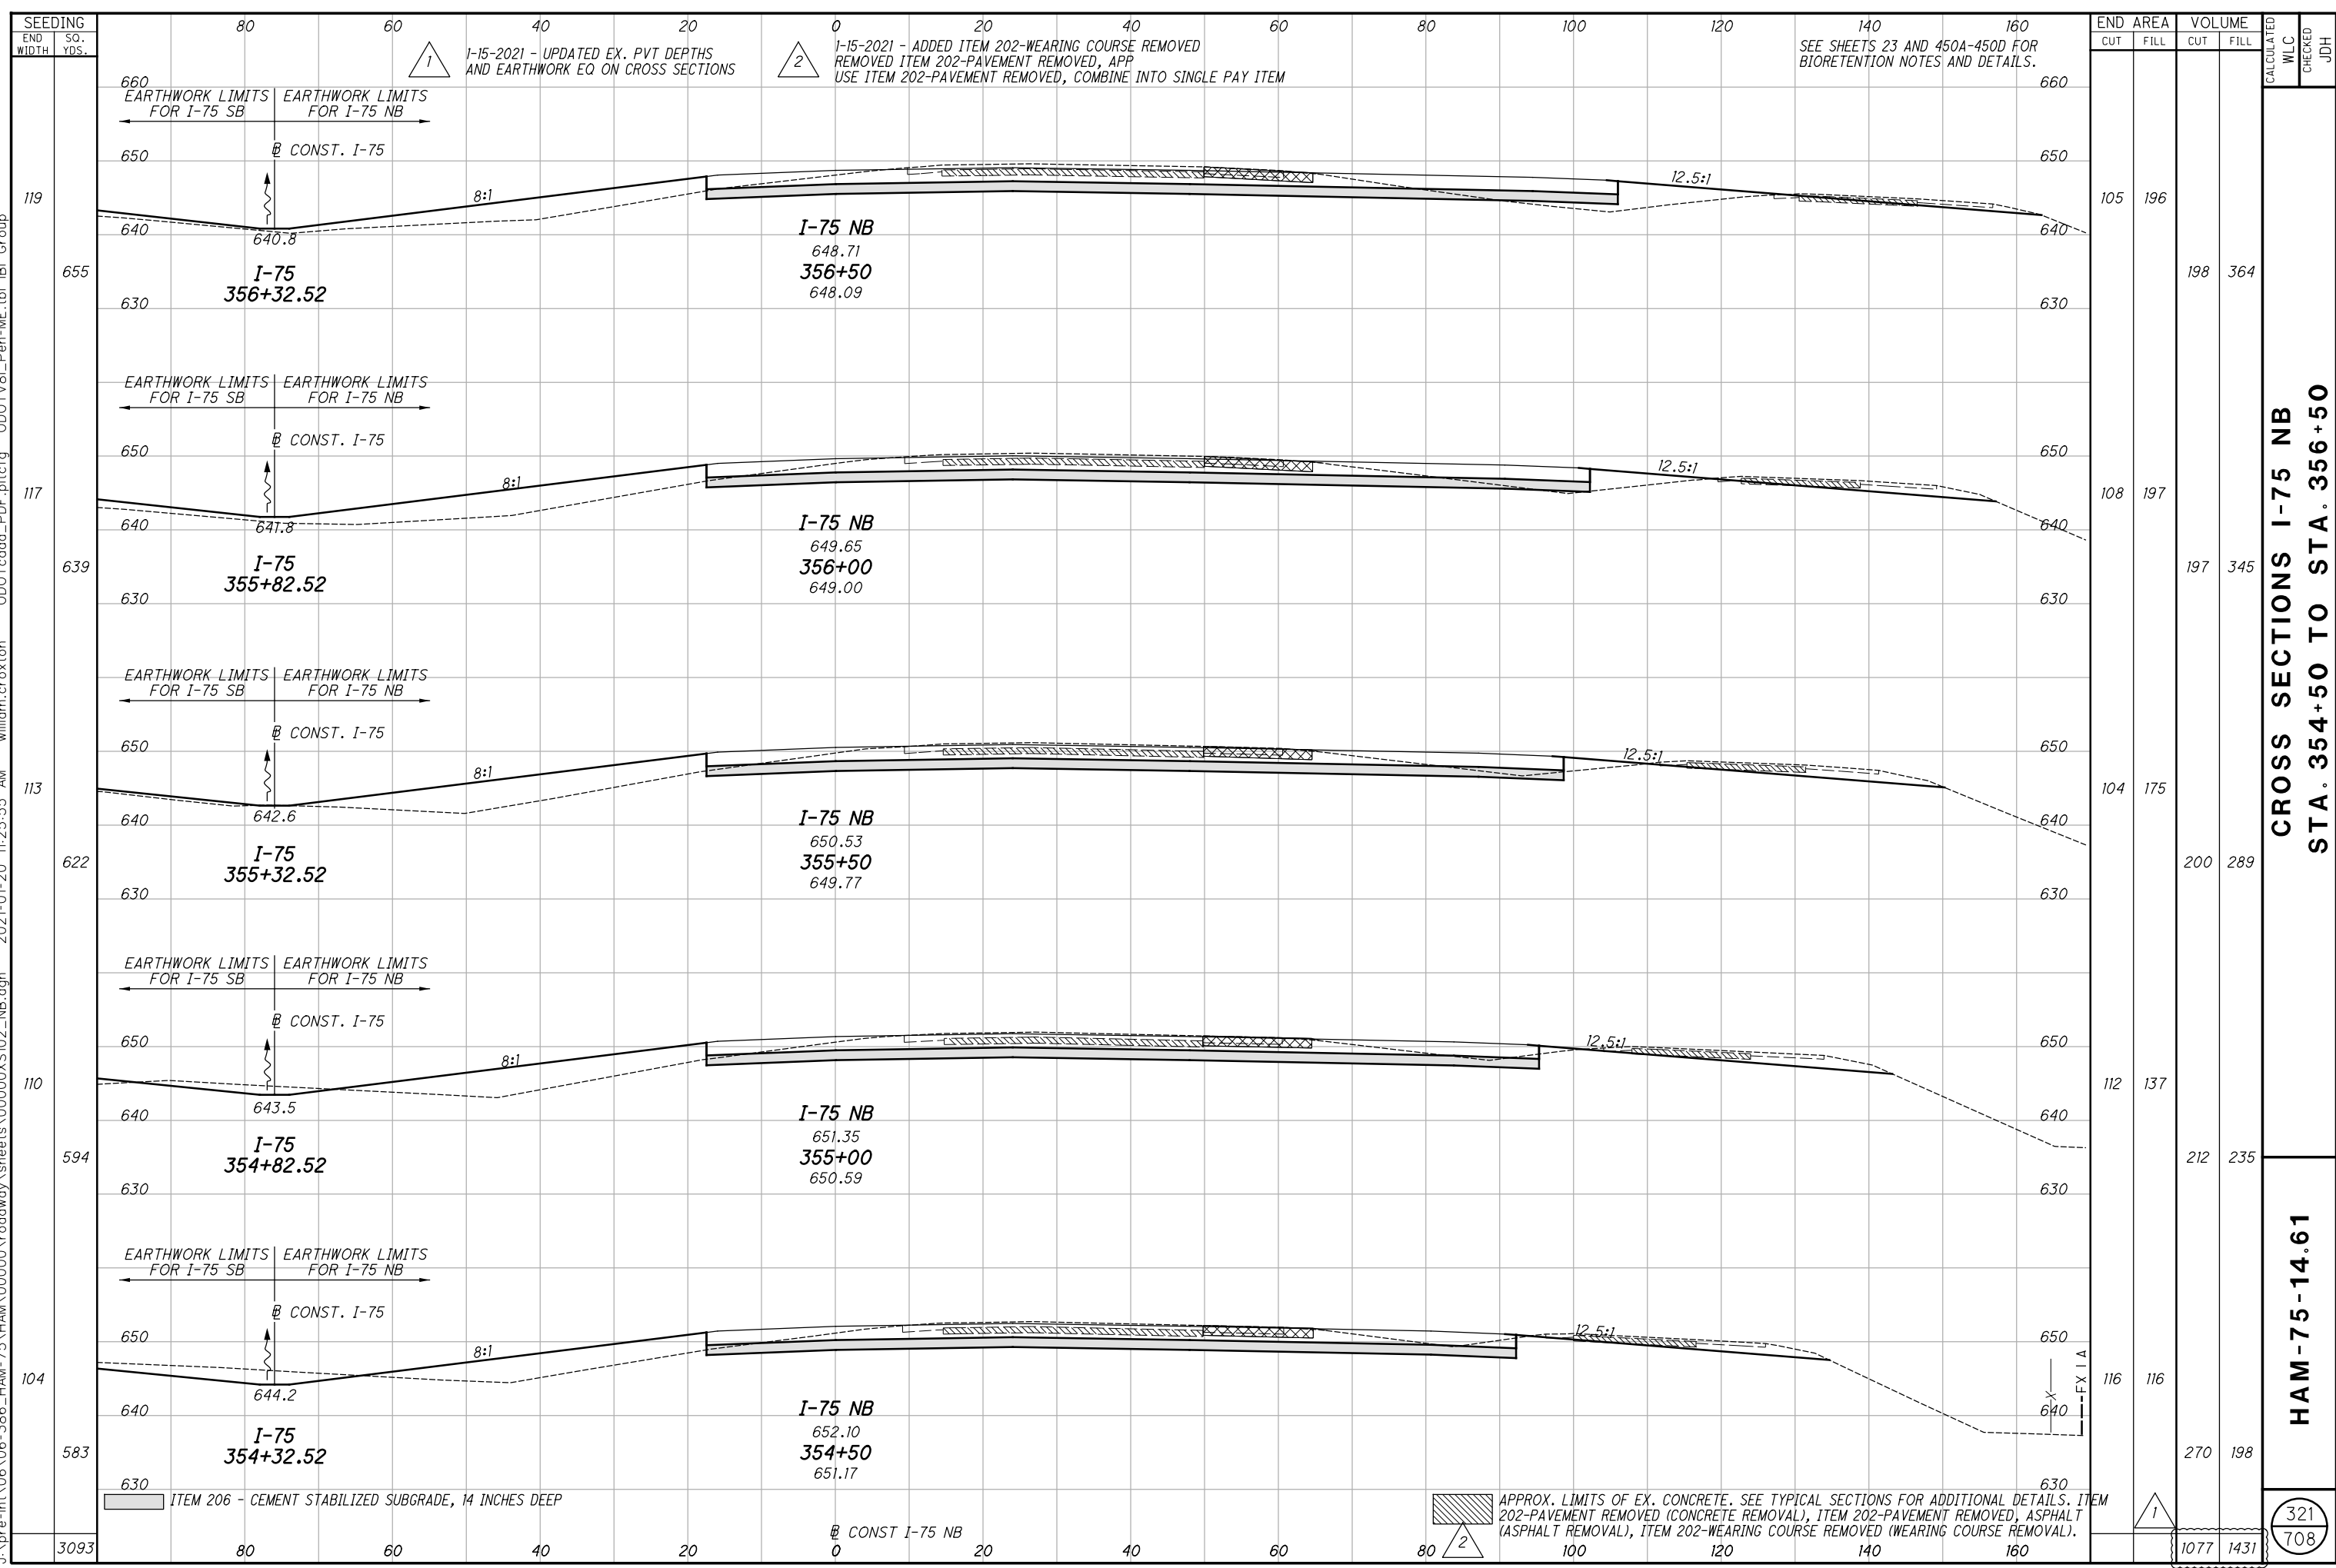



j:\pre-int\06\06-386\_HAM-75\HAM\00000\roadway\sheets\00000X5102\_NB.dgn 2021-01-20 11:25:56 AM william.croxton ODOT\cadd\_PDF.plt cfbg ODOTV81\_Pen-ME.tbl IBI Group

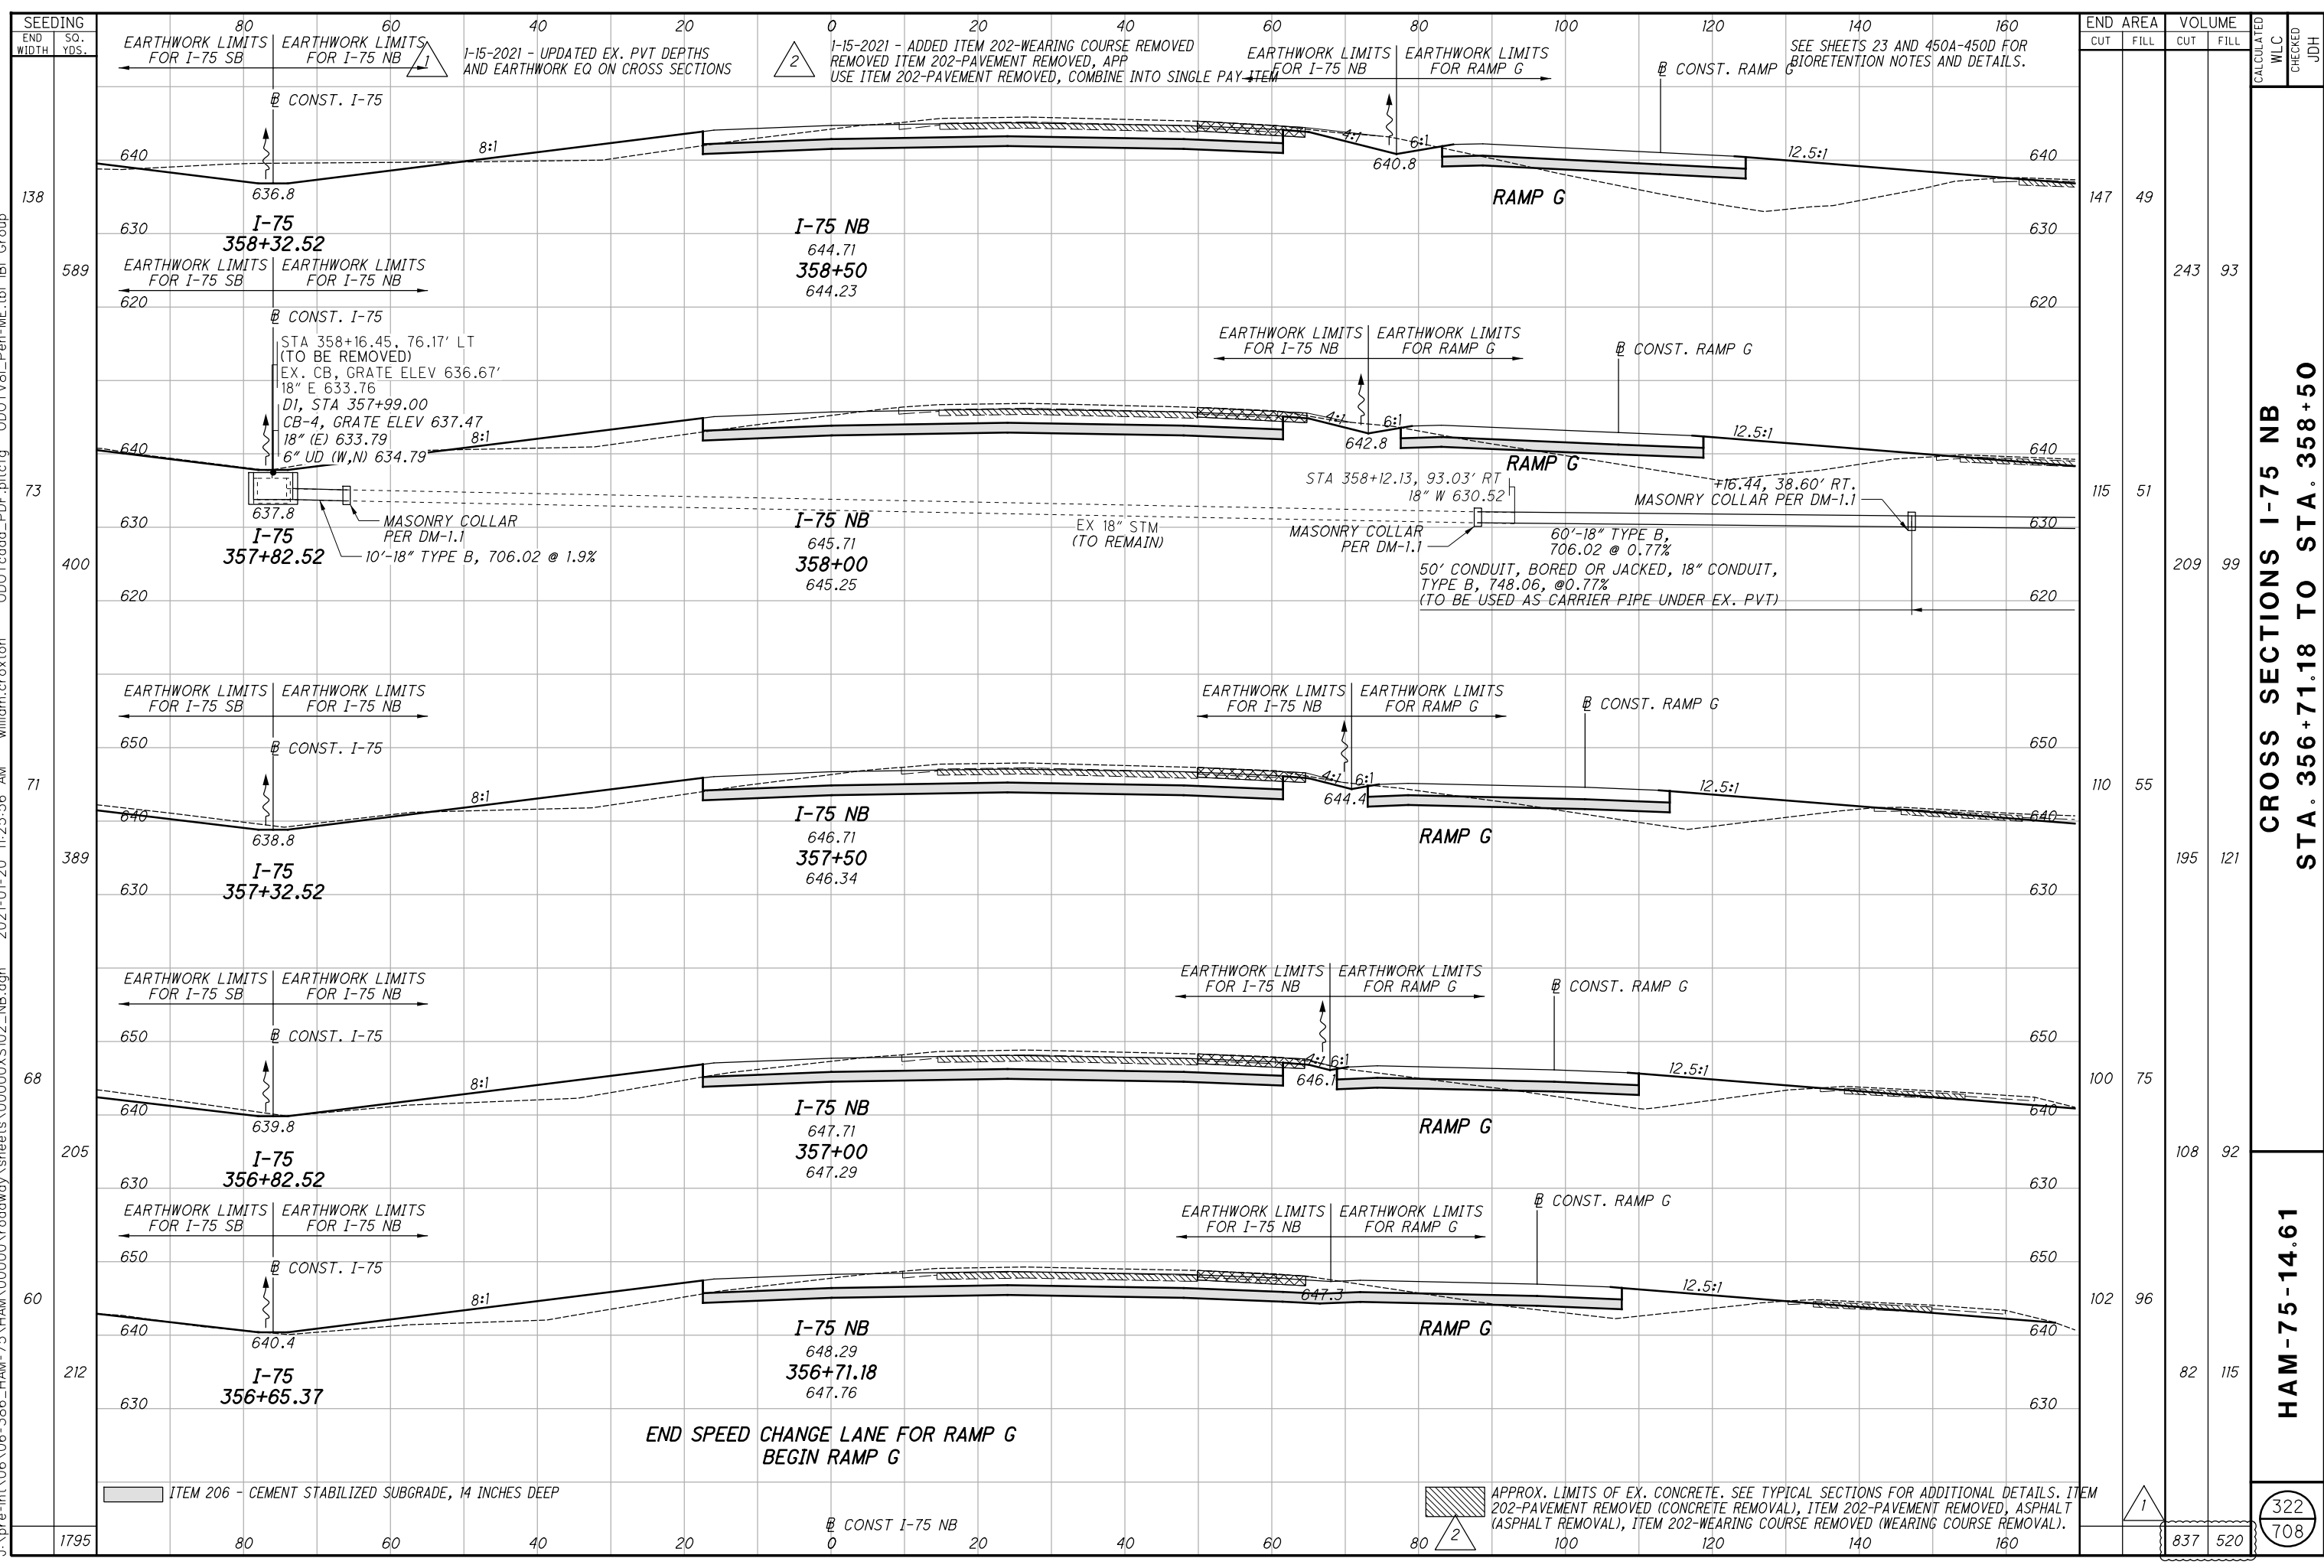

CROSS SECTIONS I-75 NB  
STA. 356+71.18 TO STA. 358+50

HAM-75-14.61


322  
708

END SPEED CHANGE LANE FOR RAMP G  
BEGIN RAMP G


ITEM 206 - CEMENT STABILIZED SUBGRADE, 14 INCHES DEEP

APPROX. LIMITS OF EX. CONCRETE. SEE TYPICAL SECTIONS FOR ADDITIONAL DETAILS. ITEM 202-PAVEMENT REMOVED (CONCRETE REMOVAL), ITEM 202-PAVEMENT REMOVED, ASPHALT (ASPHALT REMOVAL), ITEM 202-WEARING COURSE REMOVED (WEARING COURSE REMOVAL).


j:\pre-int\06\06-386\_HAM-75\_HAM\00000\roadway\sheets\00000X5102\_NB.dgn 2021-01-20 11:25:56 AM william.croxton\ODOTcadd\_PDF.plt c:\odotv8i\_Pen-ME.tbl IBI\_Group

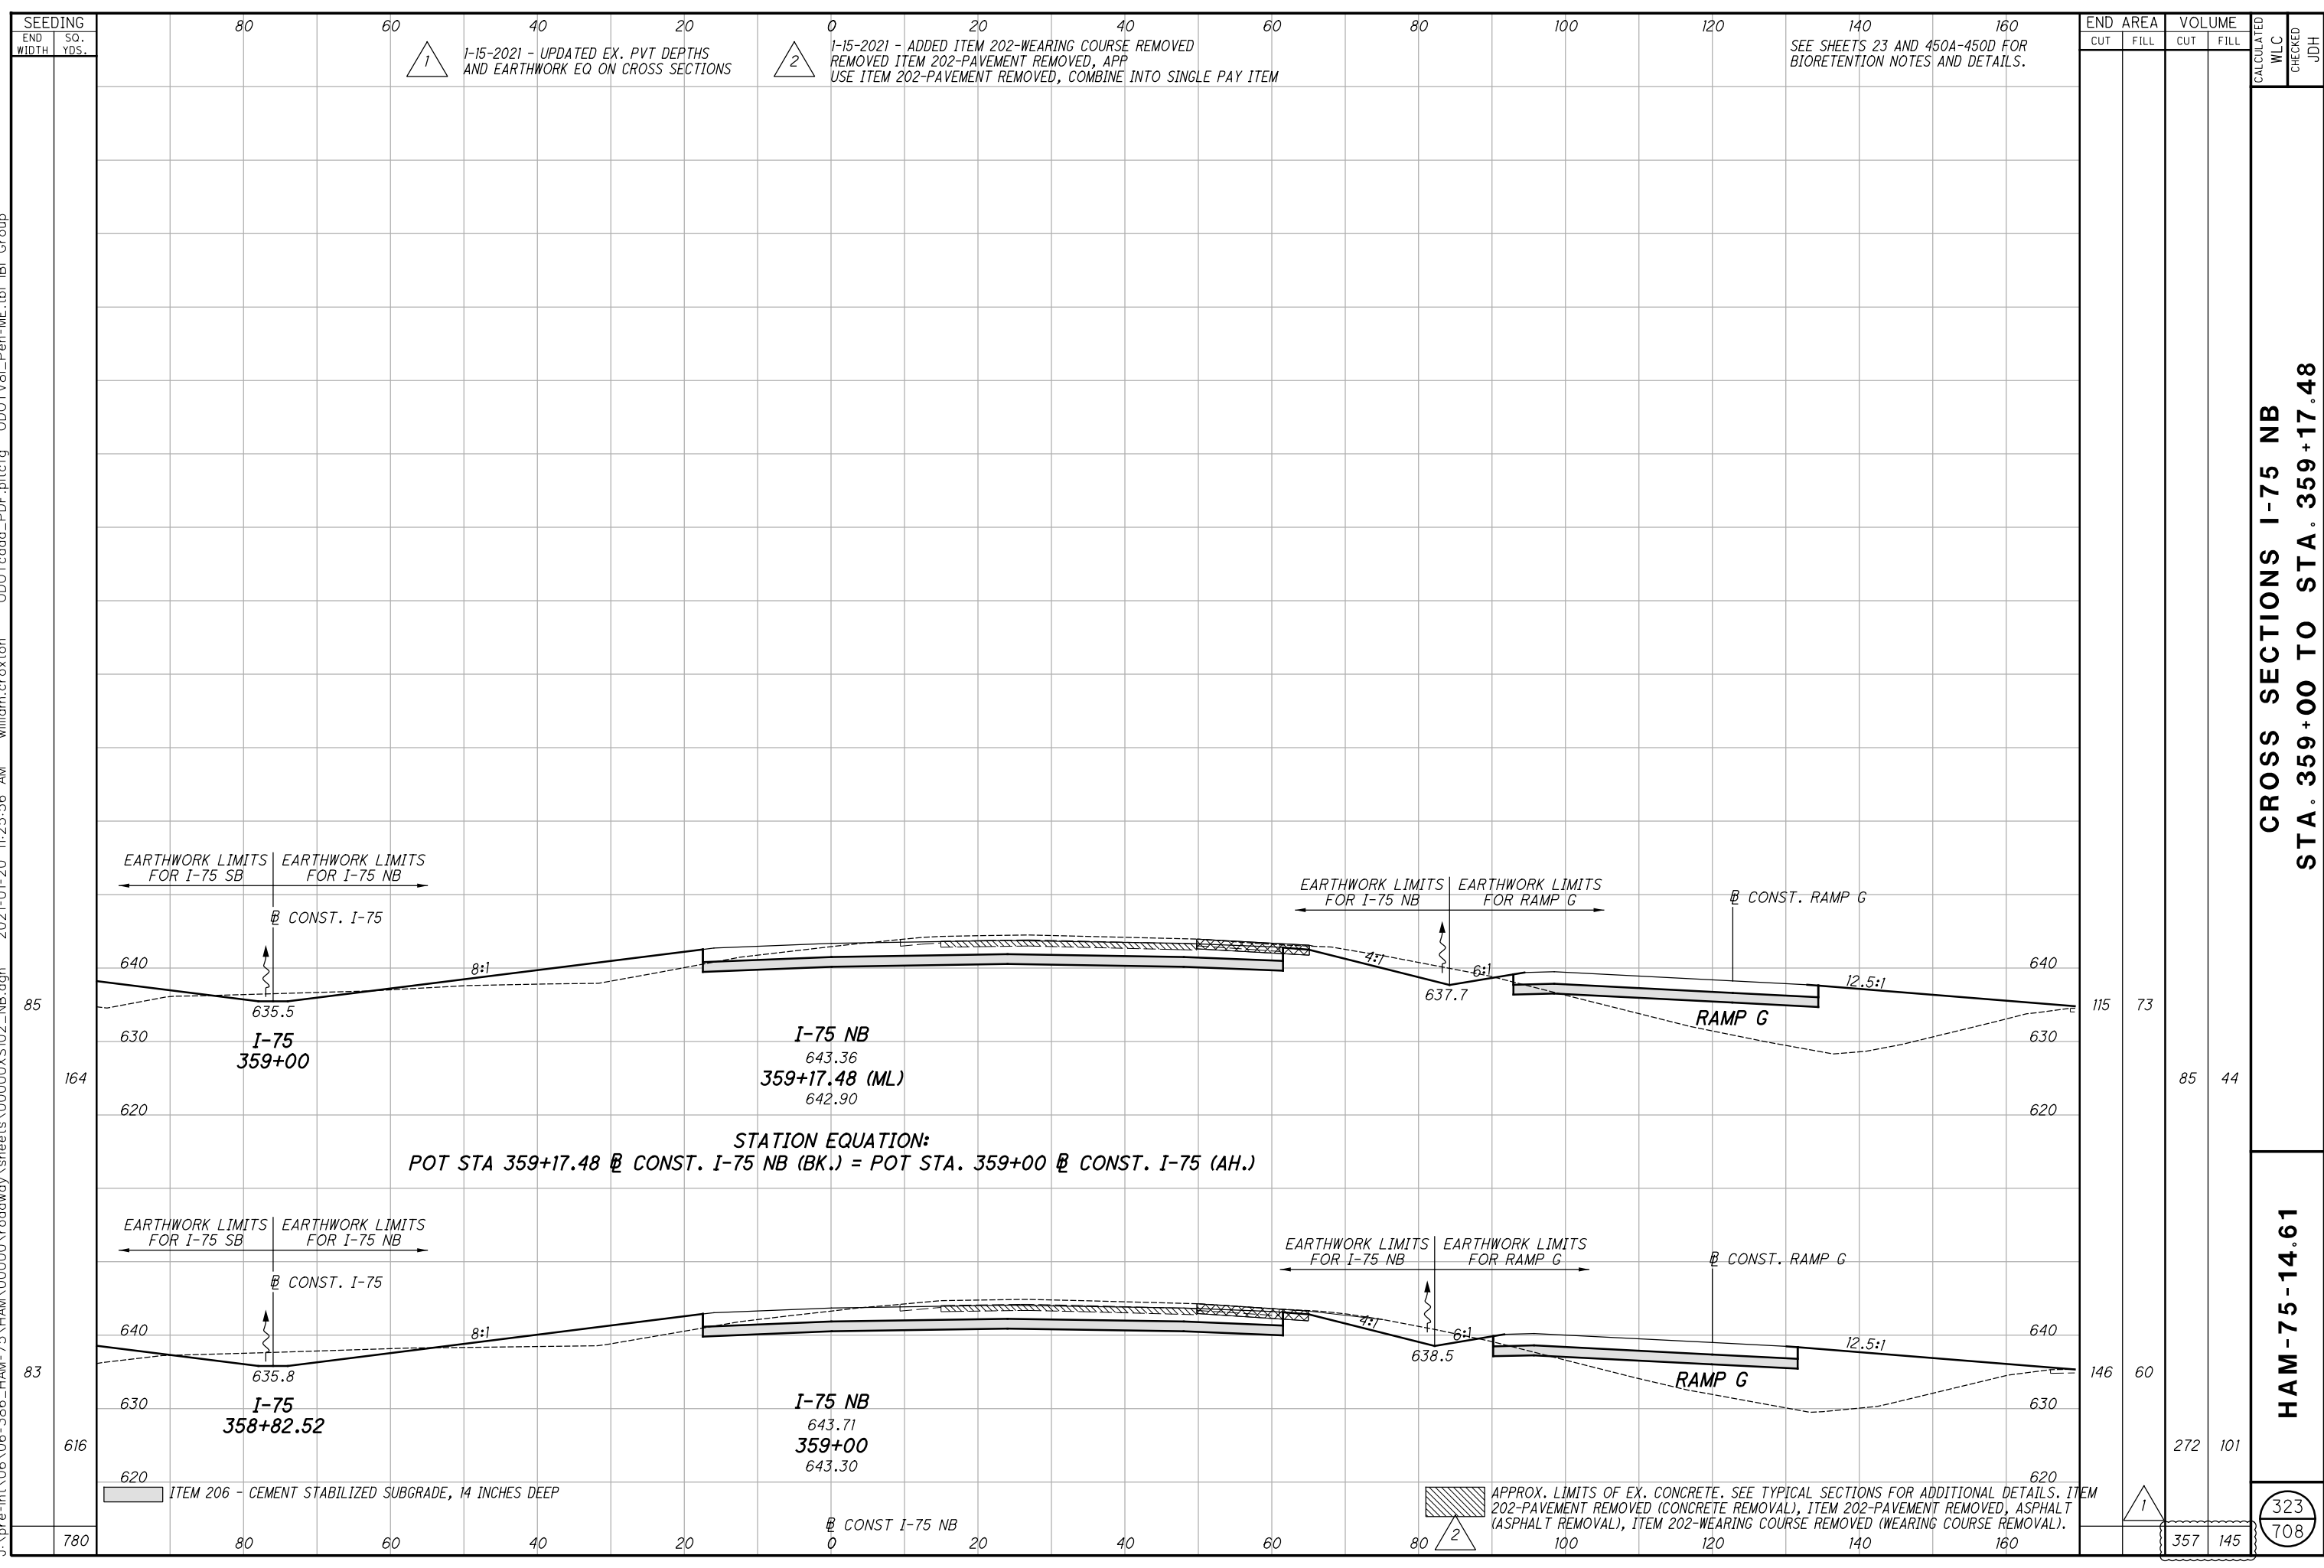

j:\pre-int\06\06-386\_HAM-75\HAM-75\HAM-75\roadway\sheets\00000X5103\_NB.dgn 2021-01-20 11:25:58 AM william.croxton\ODOT\cadd\_PDF.plt\cfig\_ODOTV8i\_Pen-ME.tbl IBI Group

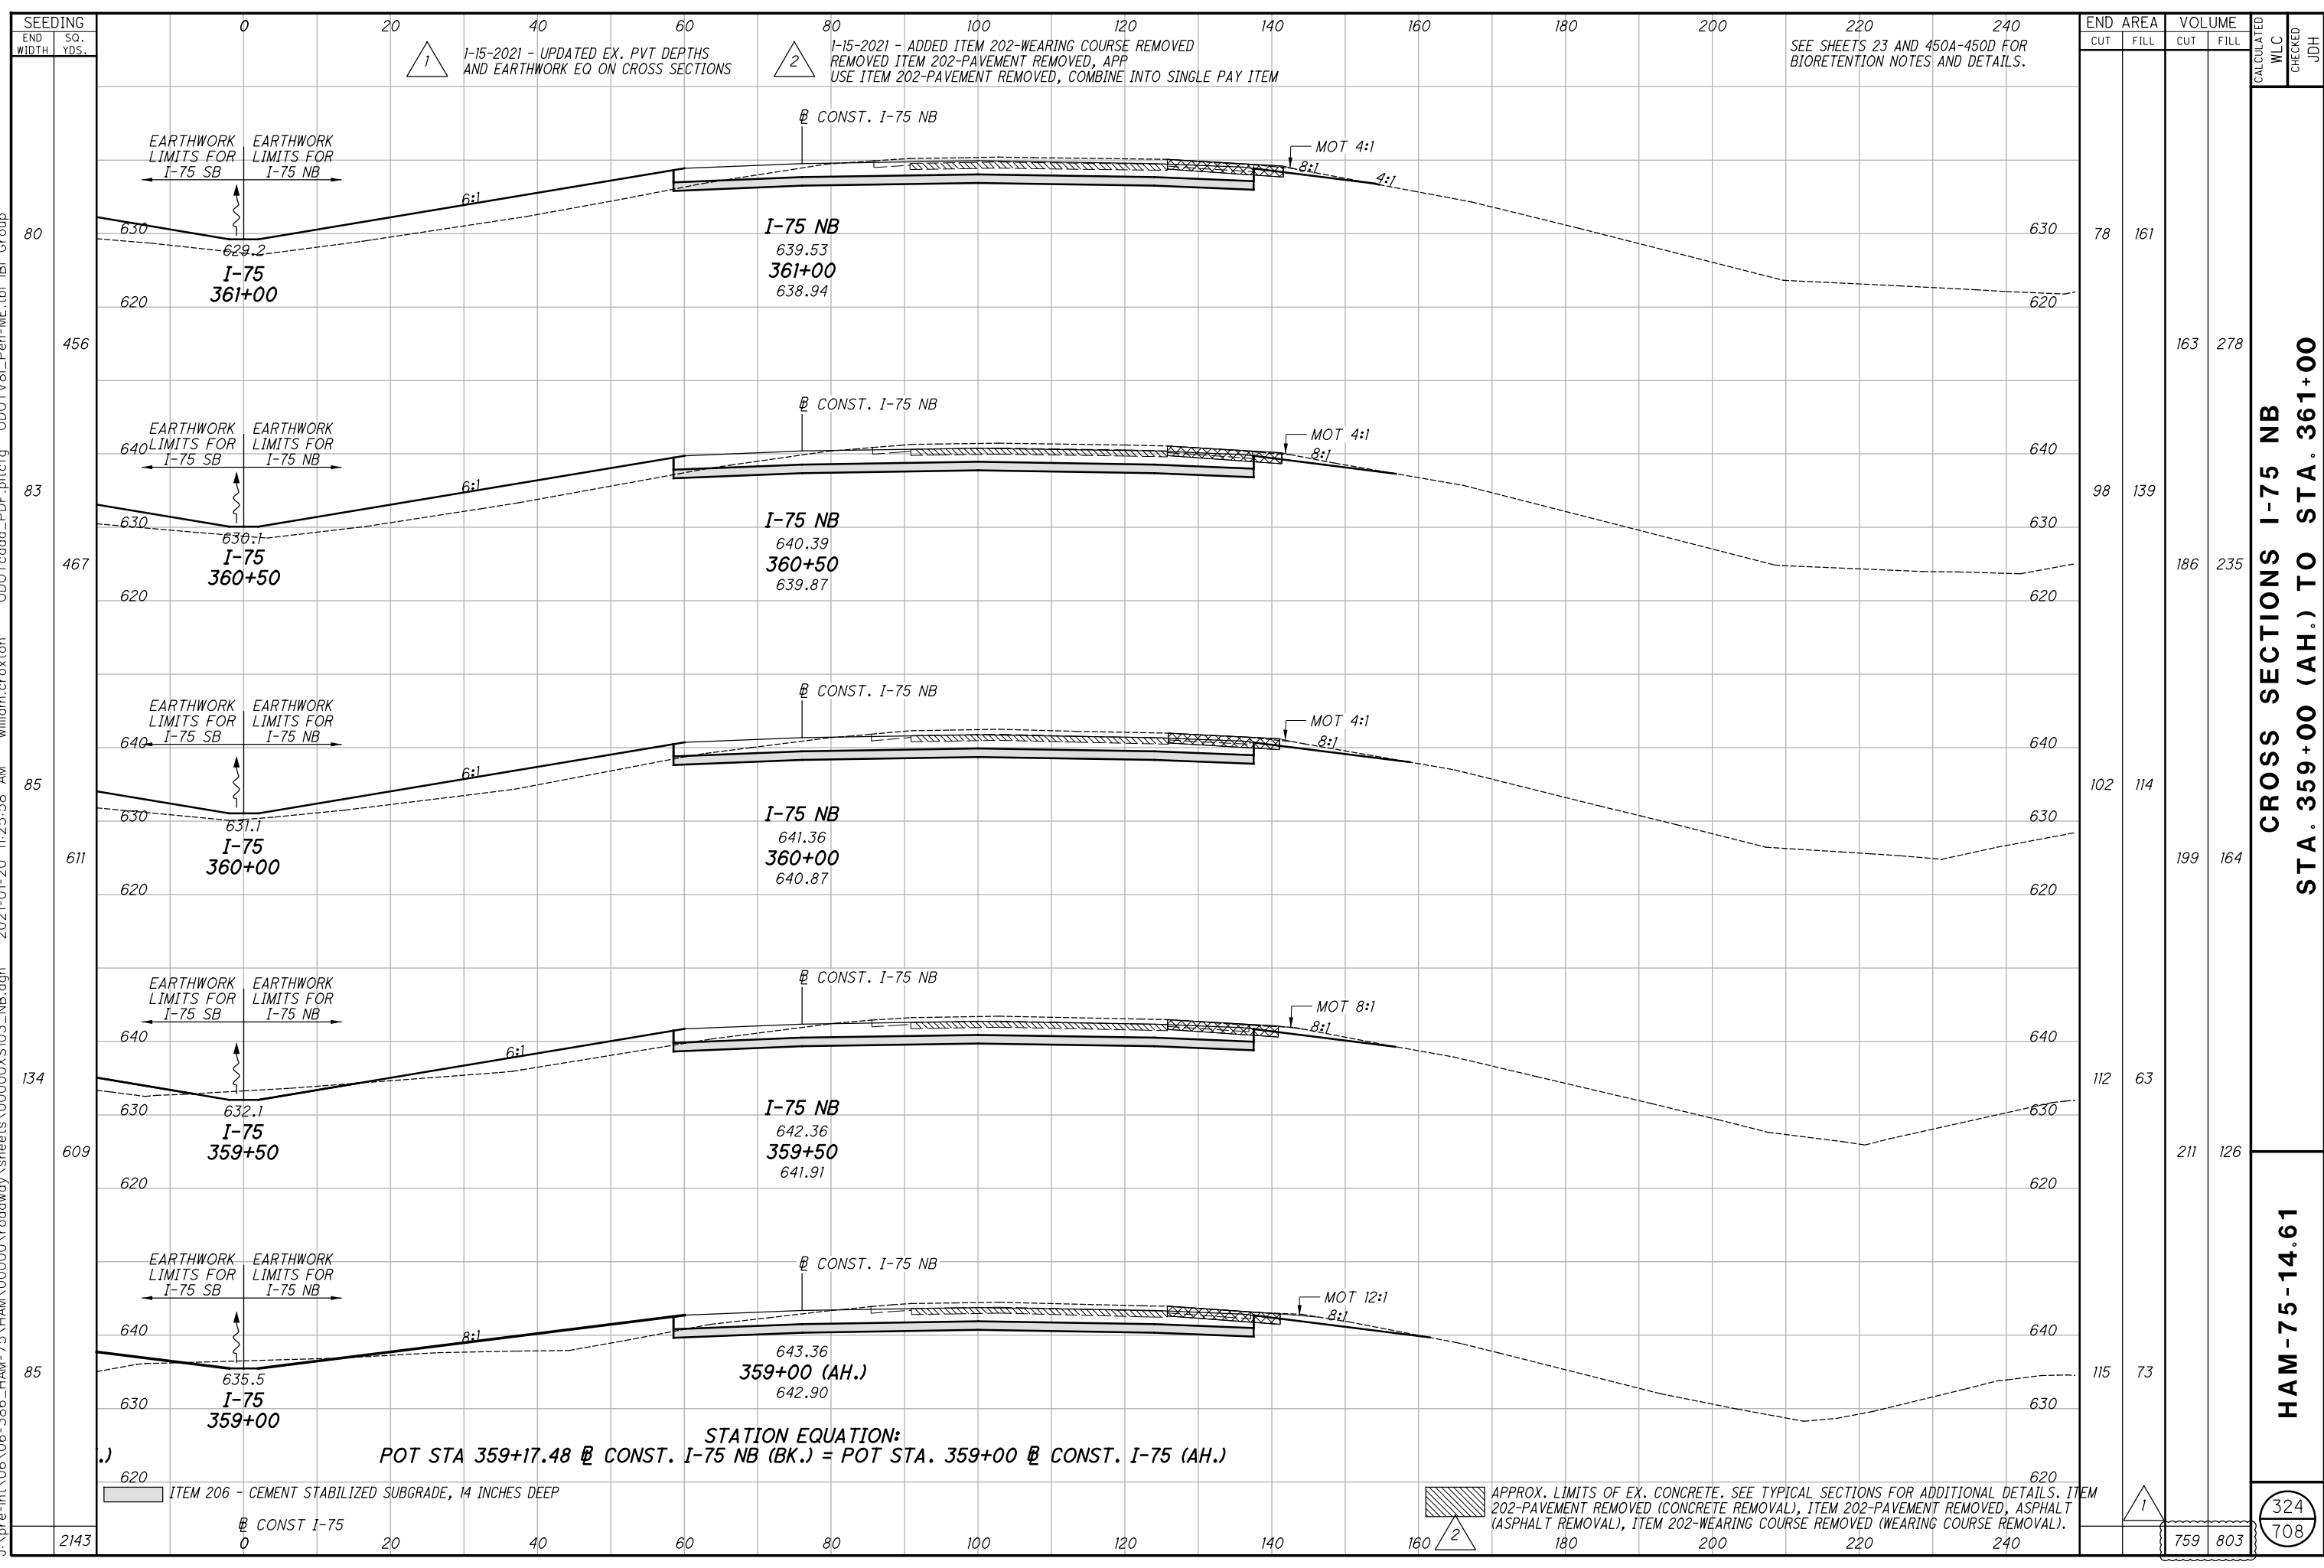

j:\pre-int\06\06-386\_HAM-75\HAM\00000\roadway\sheets\00000X5103\_NB.dgn 2021-01-20 11:25:59 AM william.croxton\ ODOT\cadd\_PDF.plt\cfig ODOTV8I\_Pen-ME.tbl |BI Group

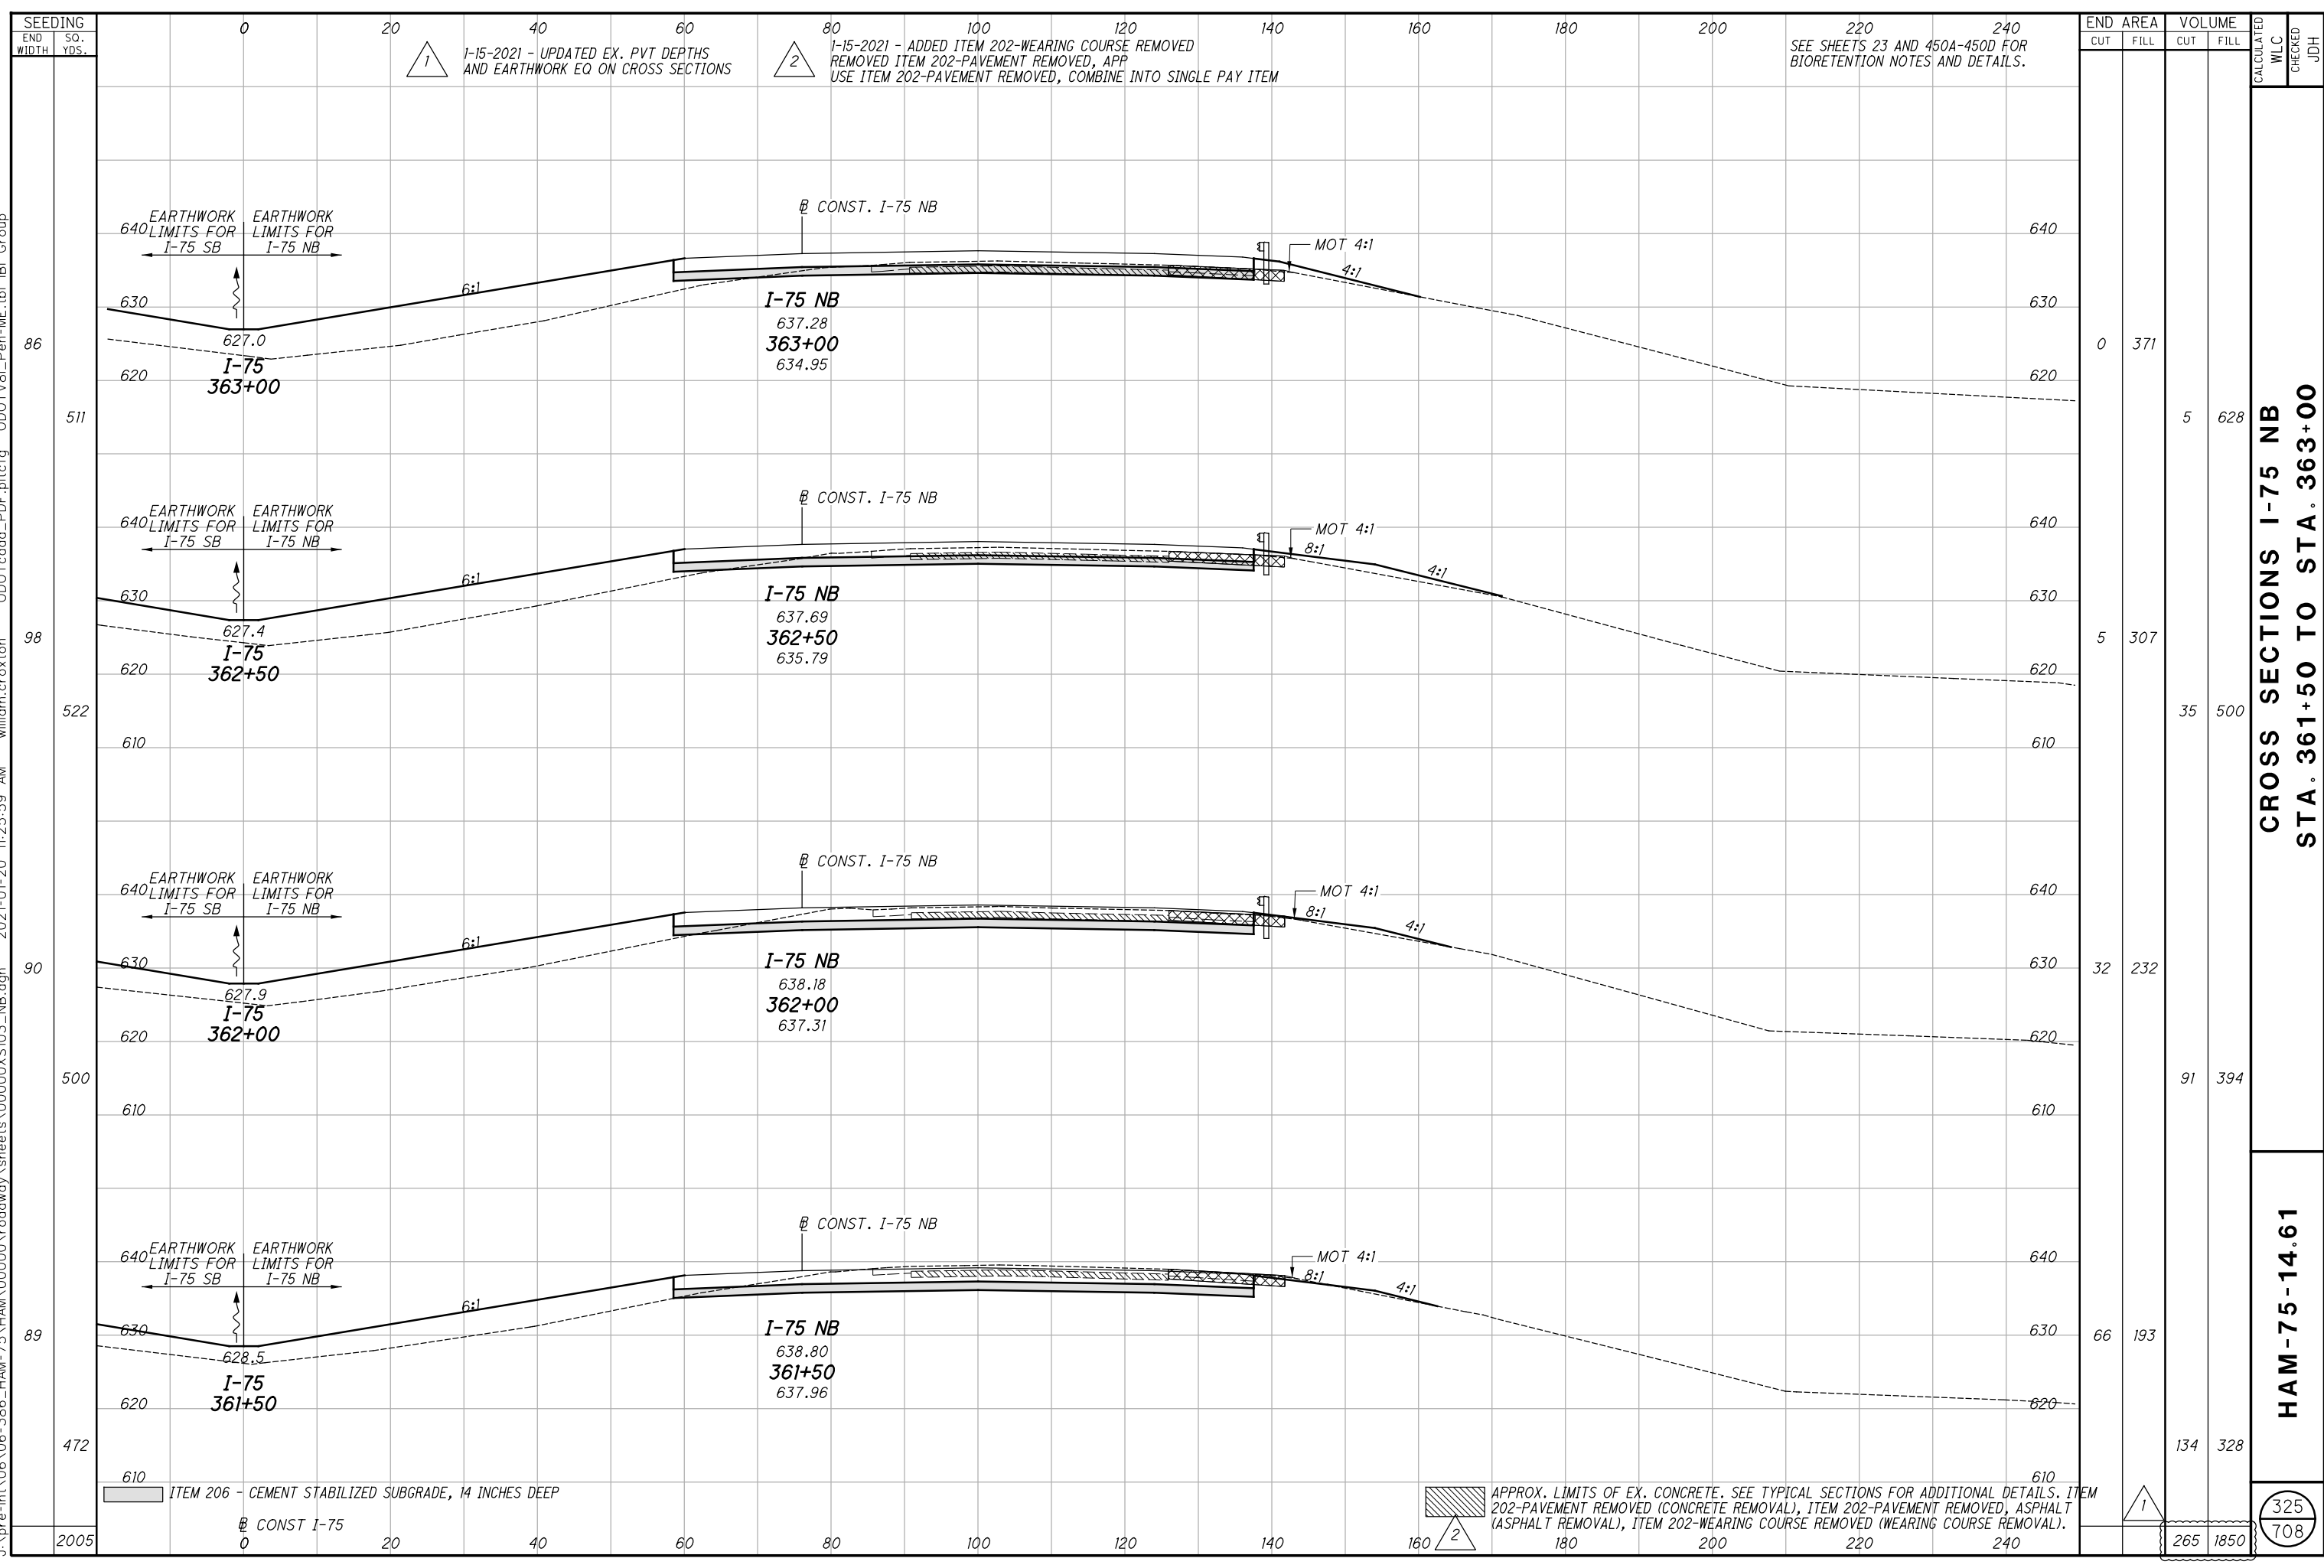

1

1-15-2021 - UPDATED EX. PVT DEPTHS AND EARTHWORK EQ ON CROSS SECTIONS

2

1-15-2021 - ADDED ITEM 202-WEARING COURSE REMOVED REMOVED ITEM 202-PAVEMENT REMOVED, APP USE ITEM 202-PAVEMENT REMOVED, COMBINE INTO SINGLE PAY ITEM

SEE SHEETS 23 AND 450A-450D FOR BIORETENTION NOTES AND DETAILS.

END AREA	VOLUME		CALCULATED WLC	CHECKED	JDH
	CUT	FILL			
0	371				
5	307	628			
35	500				
32	232				
91	394				
66	193				
134	328				
265	1850				

CROSS SECTIONS I-75 NB  
STA. 361+50 TO STA. 363+00

HAM-75-14.61

325  
708


ITEM 206 - CEMENT STABILIZED SUBGRADE, 14 INCHES DEEP

APPROX. LIMITS OF EX. CONCRETE. SEE TYPICAL SECTIONS FOR ADDITIONAL DETAILS. ITEM 202-PAVEMENT REMOVED (CONCRETE REMOVAL), ITEM 202-PAVEMENT REMOVED, ASPHALT (ASPHALT REMOVAL), ITEM 202-WEARING COURSE REMOVED (WEARING COURSE REMOVAL).

1

2

j:\pre-int\06\06-386\_HAM-75\_HAM\00000\roadway\sheets\00000X5103\_NB.dgn 2021-01-20 11:26:01 AM william.croxton ODOTV81\_Pen-ME.tbl IBI Group

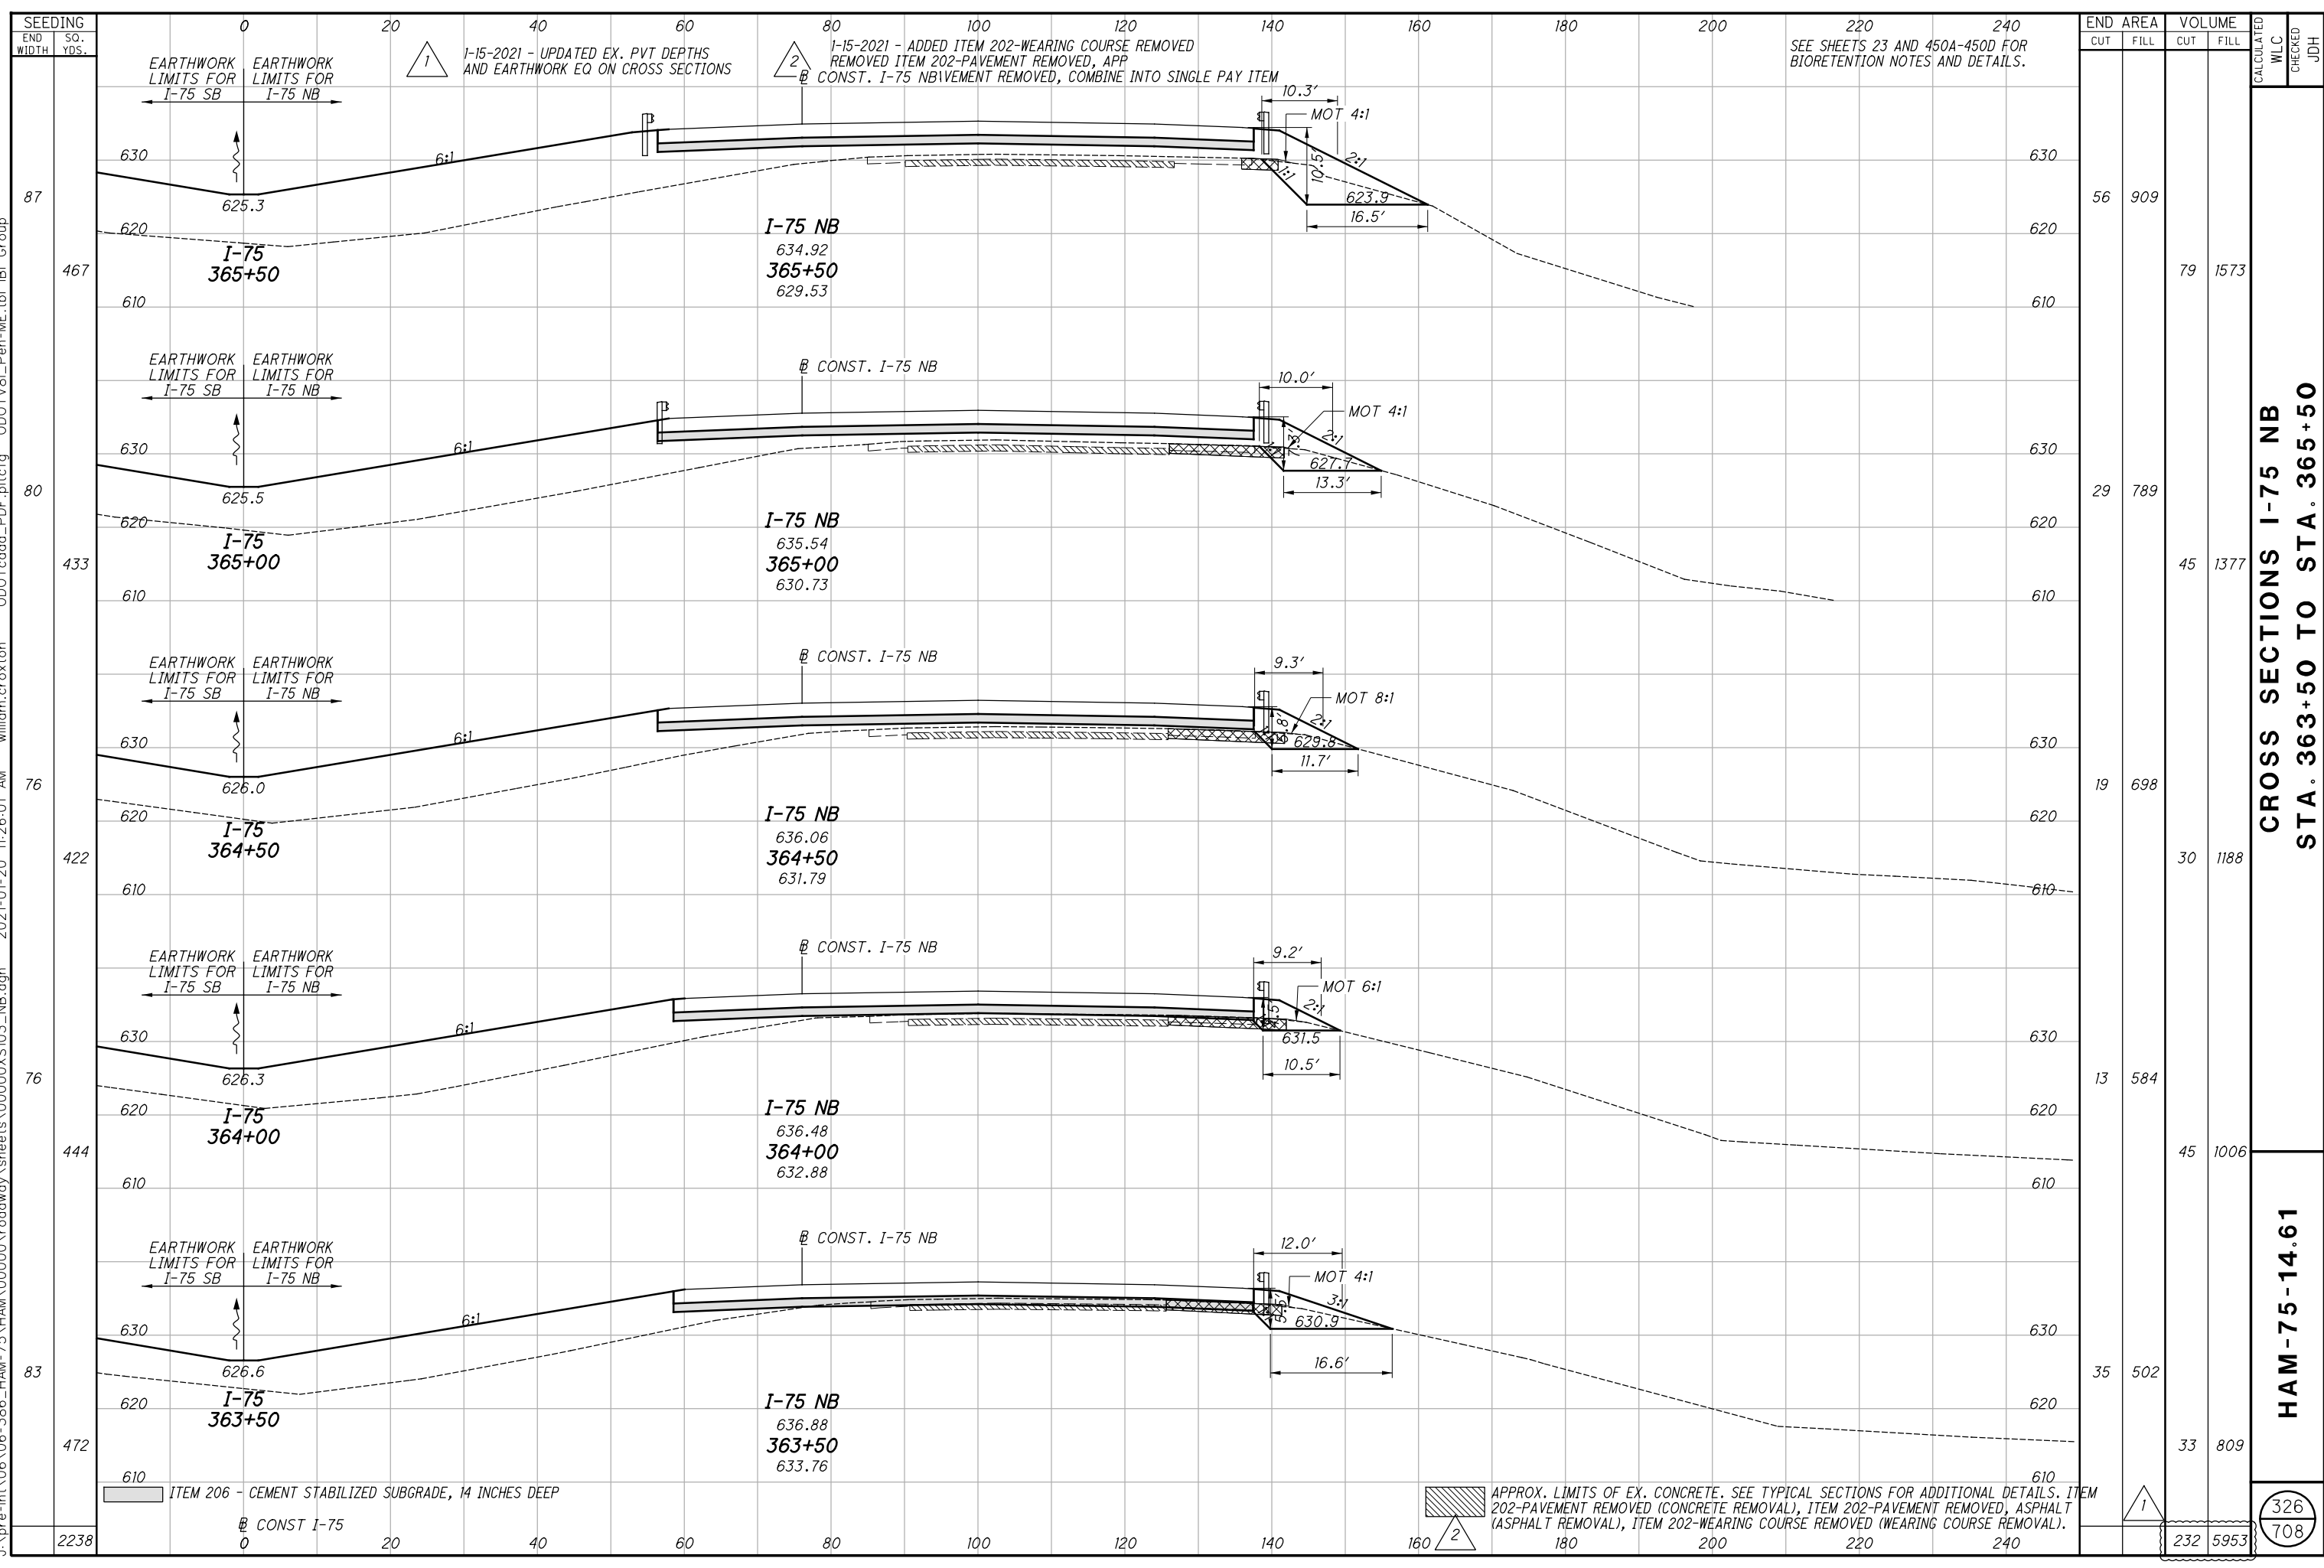


**CROSS SECTIONS I-75 NB  
STA. 363+50 TO STA. 365+50**

**HAM-75-14.61**

END STA.	END AREA		VOLUME		CALCULATED WLC	CHECKED	JDH
	CUT	FILL	CUT	FILL			
363+50	35	502	33	809			
364+00	13	584	45	1006			
364+50	19	698	30	1188			
365+00	29	789	45	1377			
365+50	56	909	79	1573			
<b>TOTAL</b>	<b>232</b>	<b>5953</b>	<b>232</b>	<b>5953</b>			

326  
708

J:\pre-int\06\06-386\_HAM-75\HAM\00000\roadway\sheets\00000X5103\_NB.dgn 2021-01-20 11:26:02 AM william.croxton ODOTcadd\_PDF.plt c:\odot\cadd\Pen-ME.tbl IBI Group

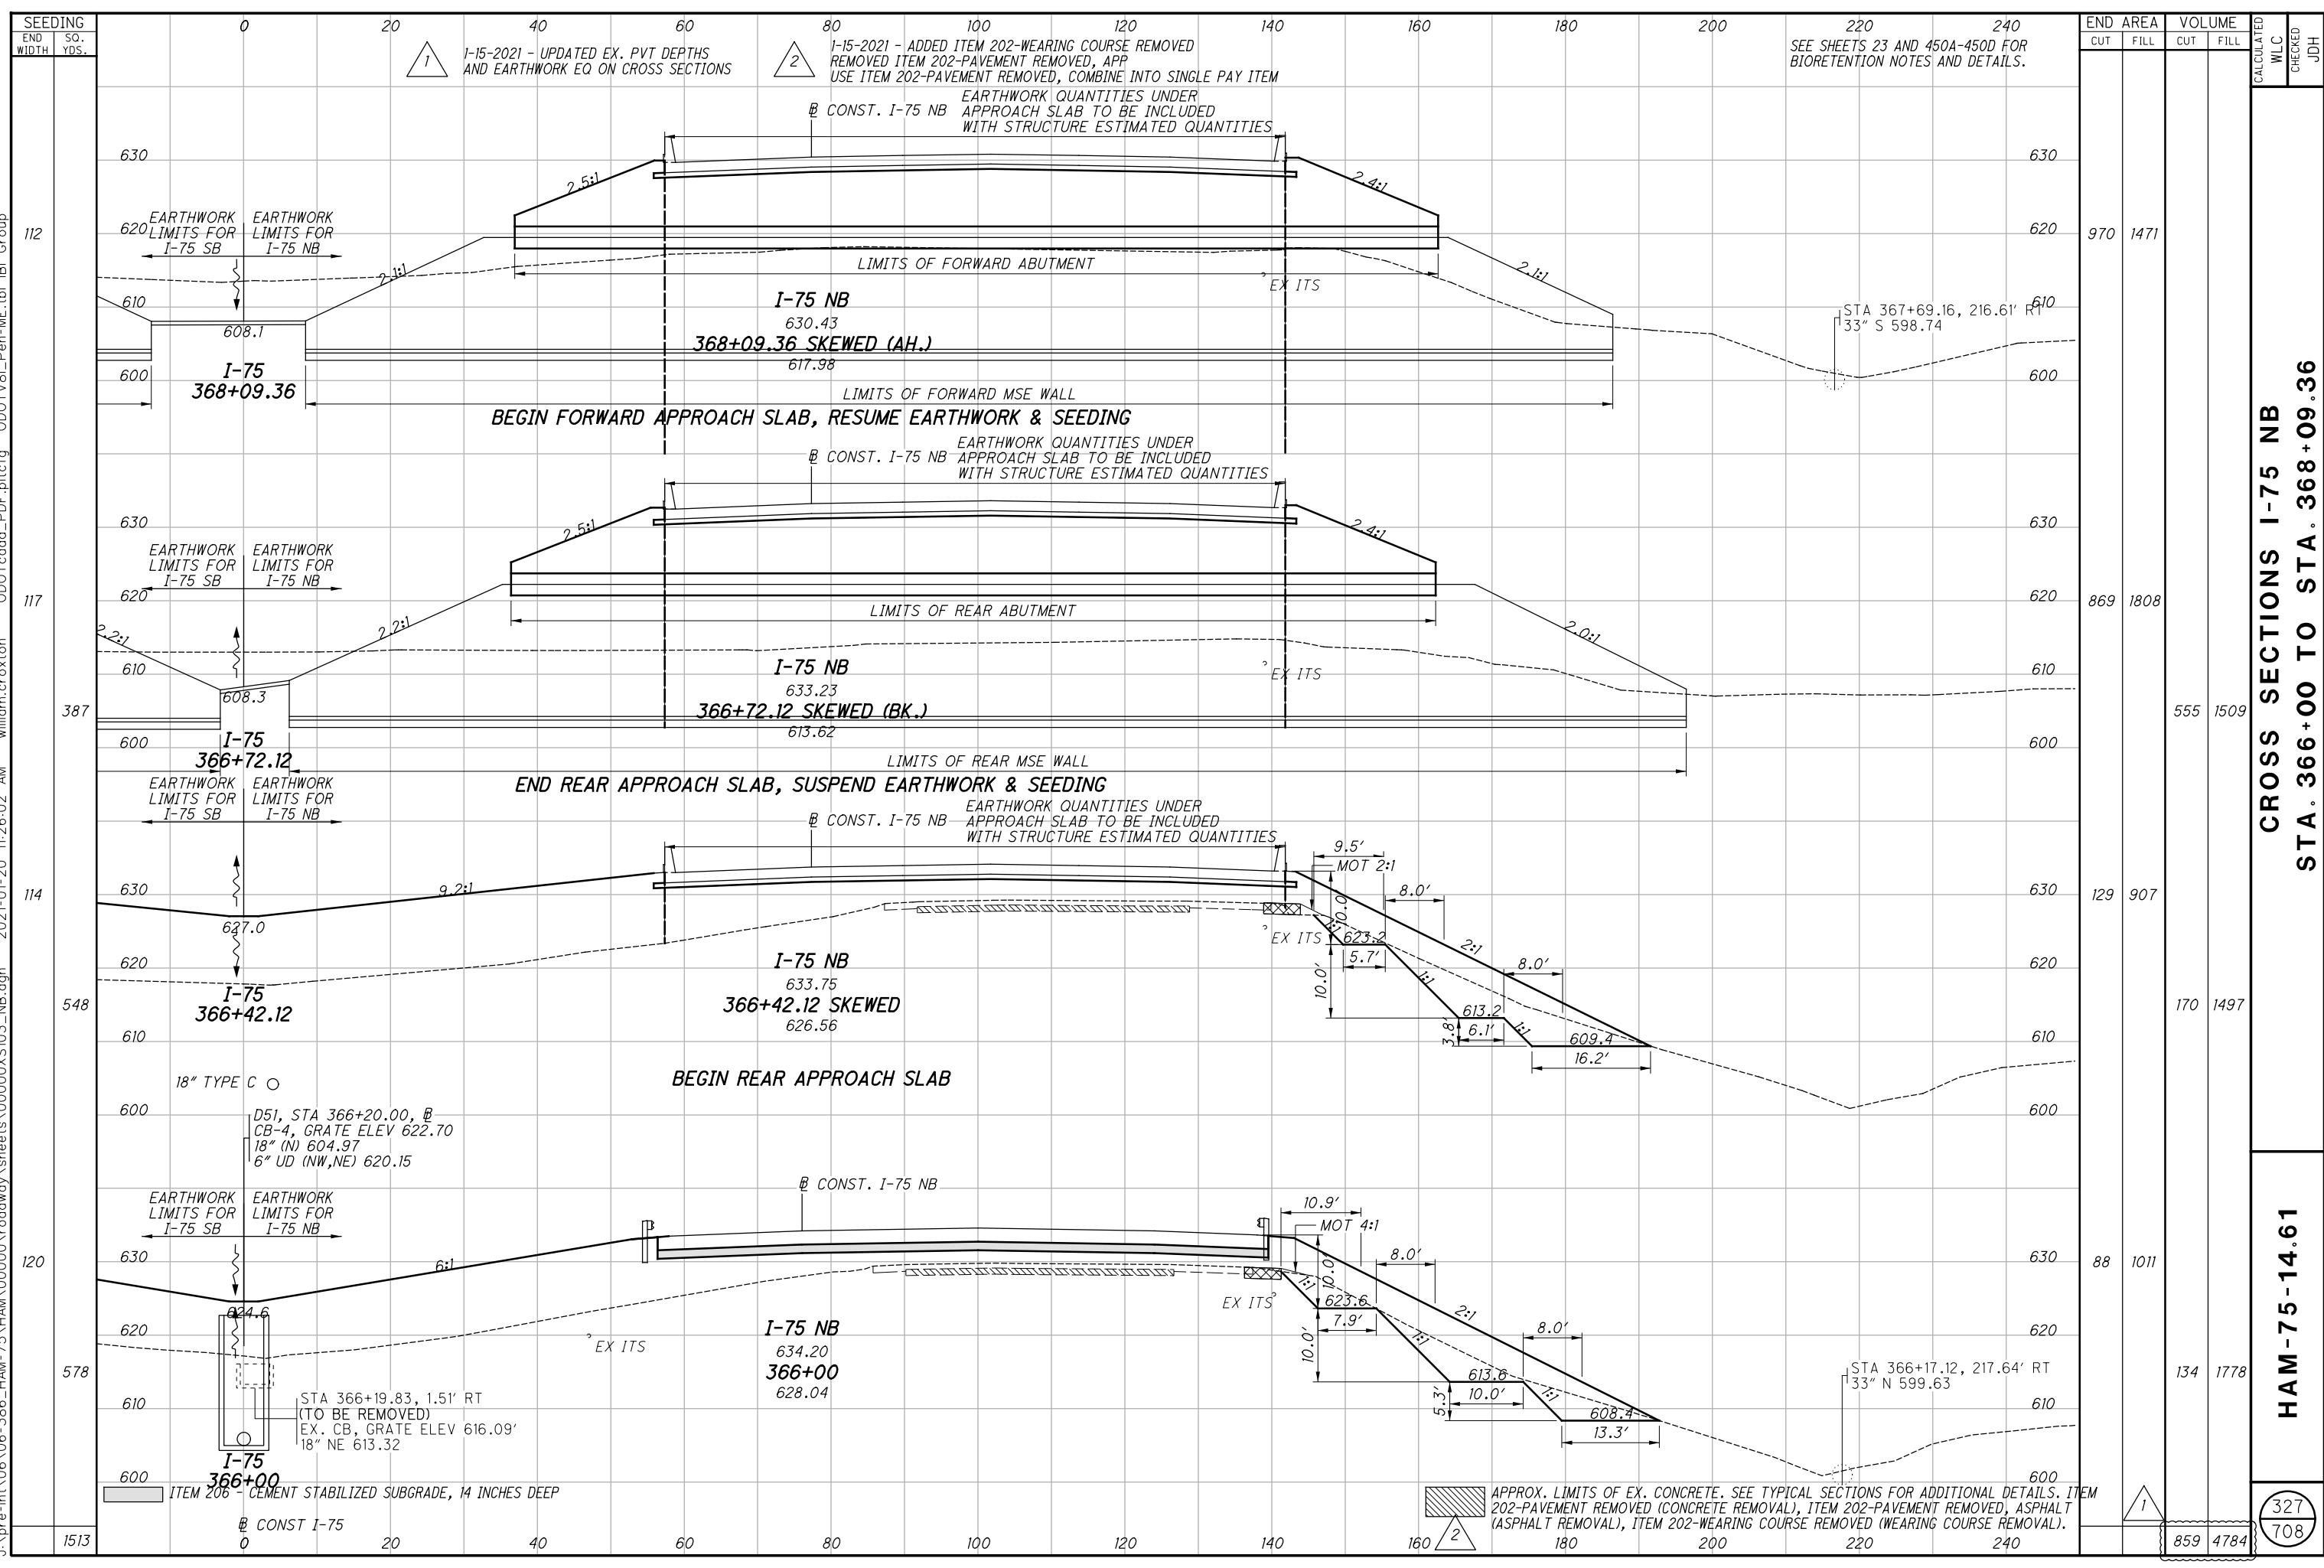


END STA	AREA		VOLUME		CALCULATED WLC	CHECKED	JDH
	CUT	FILL	CUT	FILL			
112	970	1471					
117	869	1808					
387			555	1509			
114	129	907					
548			170	1497			
120	88	1011					
578			134	1778			
1513			859	4784			

CROSS SECTIONS I-75 NB  
STA. 366+00 TO STA. 368+09.36

HAM-75-14.61

327  
708

j:\pre-int\06\06-386\_HAM-75\_HAM\00000\roadway\sheets\00000X5103\_NB.dgn 2021-01-20 11:26:03 AM william.croxton\ODOTcadd\_PDF.pltcfgr ODOTV81\_Pen-ME.tbl IBI Group

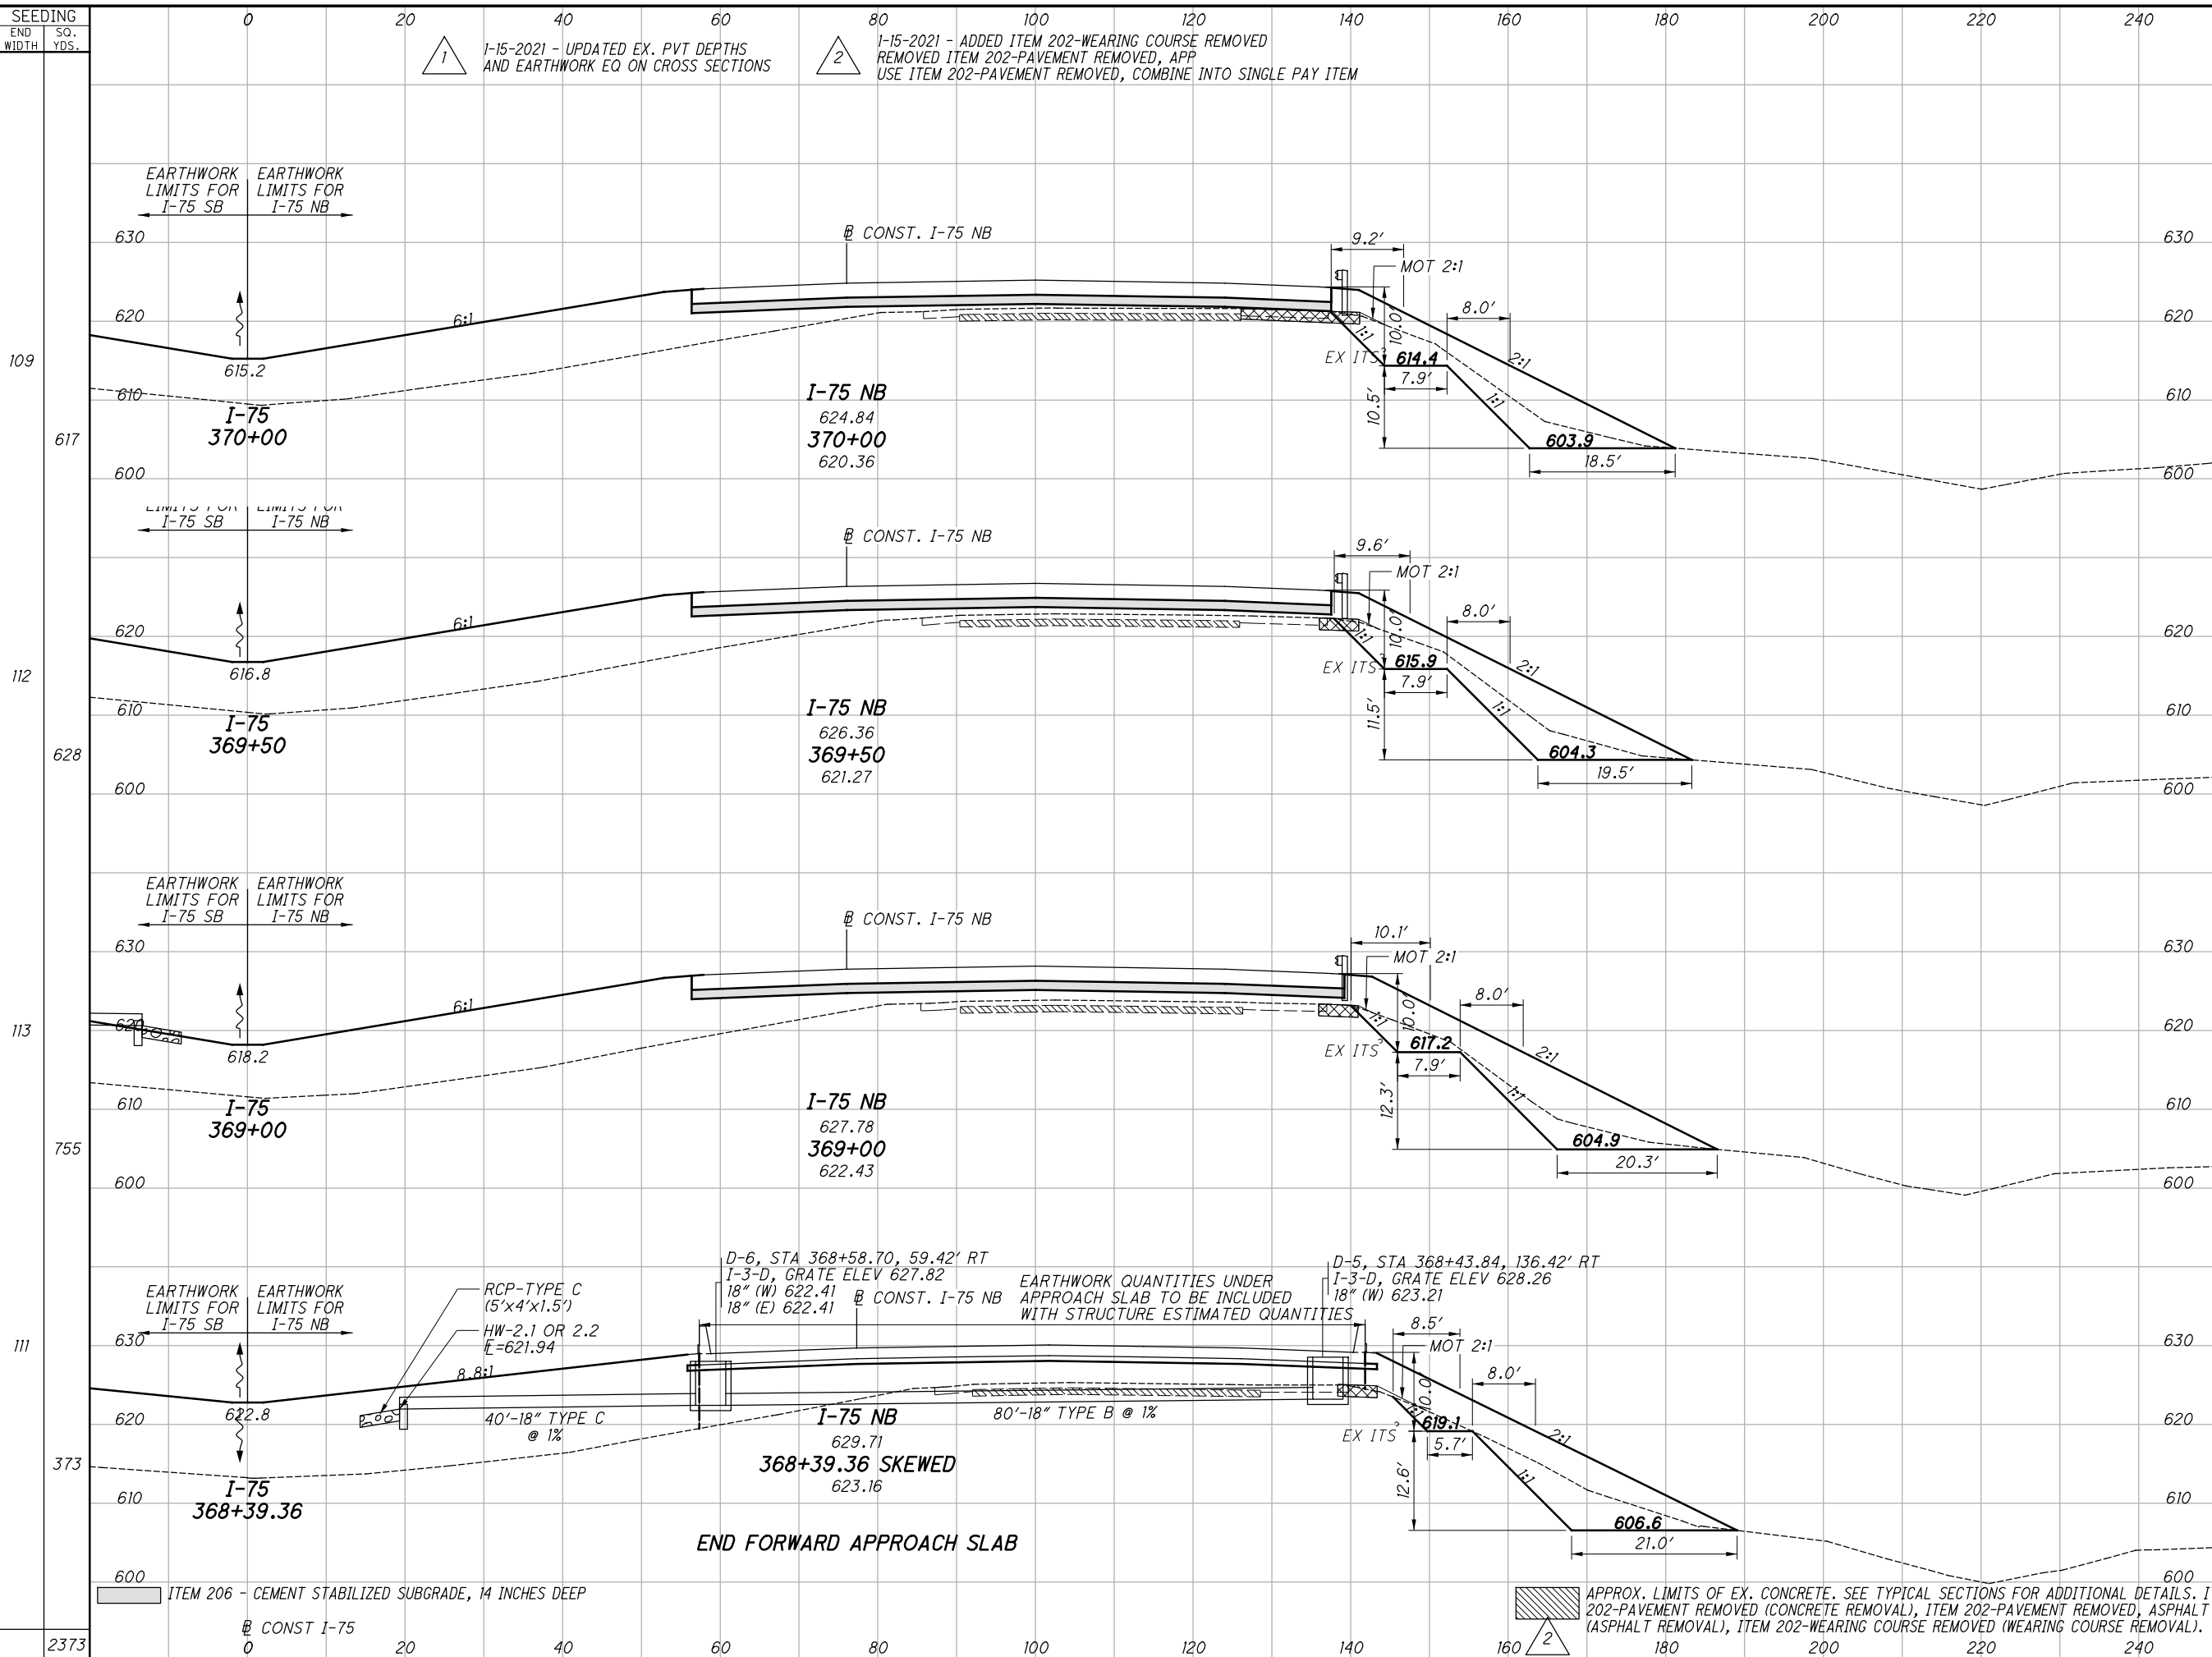

END STA	END AREA		VOLUME		CALCULATED WLC	CHECKED	JDH
	CUT	FILL	CUT	FILL			
109	114	884	213	1729			
112	115	983	188	1890			
113	87	1058	217	2233			
111	106	930	598	1334			
2373	1216	7186	328	708			

CROSS SECTIONS I-75 NB  
STA. 368+39.36 TO STA. 370+00

HAM-75-14.61

328  
708

1-15-2021 - UPDATED EX. PVT DEPTHS AND EARTHWORK EQ ON CROSS SECTIONS  
1-15-2021 - ADDED ITEM 202-WEARING COURSE REMOVED REMOVED ITEM 202-PAVEMENT REMOVED, APP USE ITEM 202-PAVEMENT REMOVED, COMBINE INTO SINGLE PAY ITEM

\* QUANTITIES FOR EXCAVATION OF SUBGRADE, 16 INCHES DEEP AND GRANULAR MATERIAL, TYPE B

EARTHWORK LIMITS FOR I-75 SB  
EARTHWORK LIMITS FOR I-75 NB

EARTHWORK LIMITS FOR I-75 SB  
EARTHWORK LIMITS FOR I-75 NB

EARTHWORK LIMITS FOR I-75 SB  
EARTHWORK LIMITS FOR I-75 NB


EARTHWORK LIMITS FOR I-75 SB  
EARTHWORK LIMITS FOR I-75 NB

ITEM 206 - CEMENT STABILIZED SUBGRADE, 14 INCHES DEEP

END FORWARD APPROACH SLAB

APPROX. LIMITS OF EX. CONCRETE. SEE TYPICAL SECTIONS FOR ADDITIONAL DETAILS. ITEM 202-PAVEMENT REMOVED (CONCRETE REMOVAL), ITEM 202-PAVEMENT REMOVED, ASPHALT (ASPHALT REMOVAL), ITEM 202-WEARING COURSE REMOVED (WEARING COURSE REMOVAL).

j:\pre-int\06\06-386\_HAM-75\HAM\00000\roadway\sheets\00000X5\03\_NB.dgn 2021-01-20 11:26:04 AM william.croxton\ODOTcadd\_PDF.plt\cfig\_ODOTV8i\_Pen-ME.tbl IBI Group

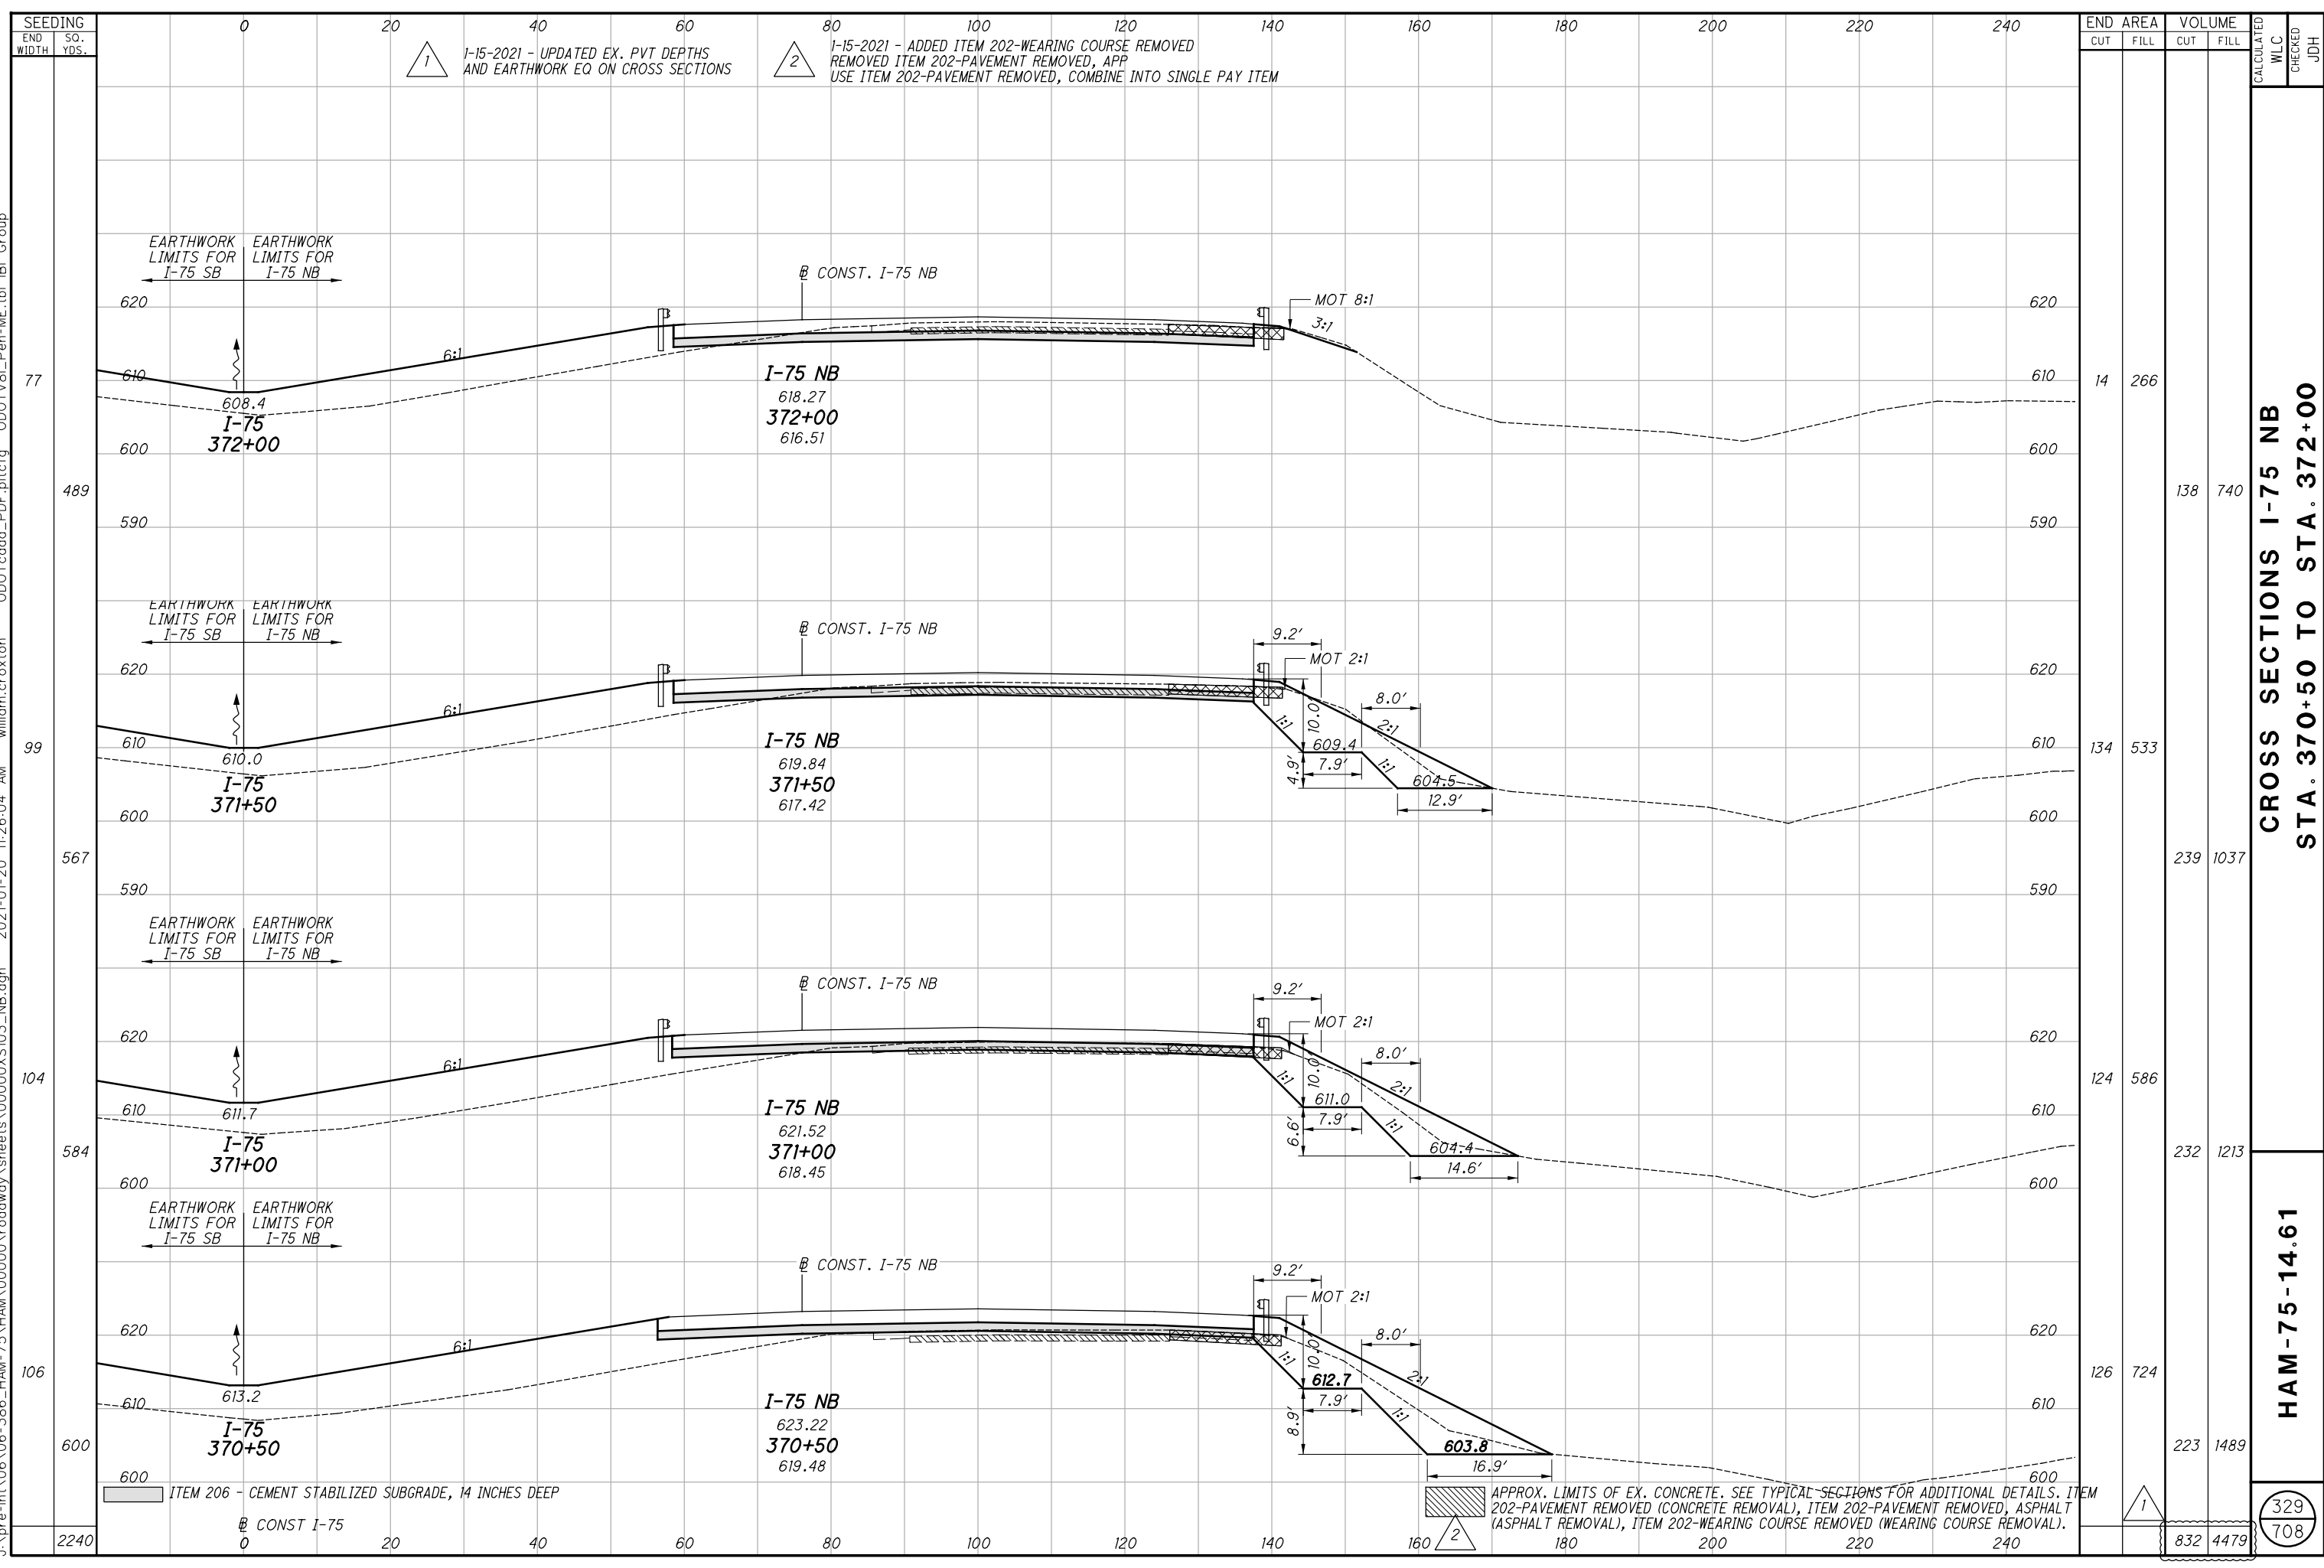


**CROSS SECTIONS I-75 NB  
STA. 370+50 TO STA. 372+00**

**HAM-75-14.61**

329  
708



j:\pre-int\06\06-386\_HAM-75\HAM-75\HAM-00000\roadway\sheets\00000XS103\_NB.dgn 2021-01-20 11:26:05 AM william.croxton ODOTcadd\_PDF.plt c:\odot\ib\IBI\_Group

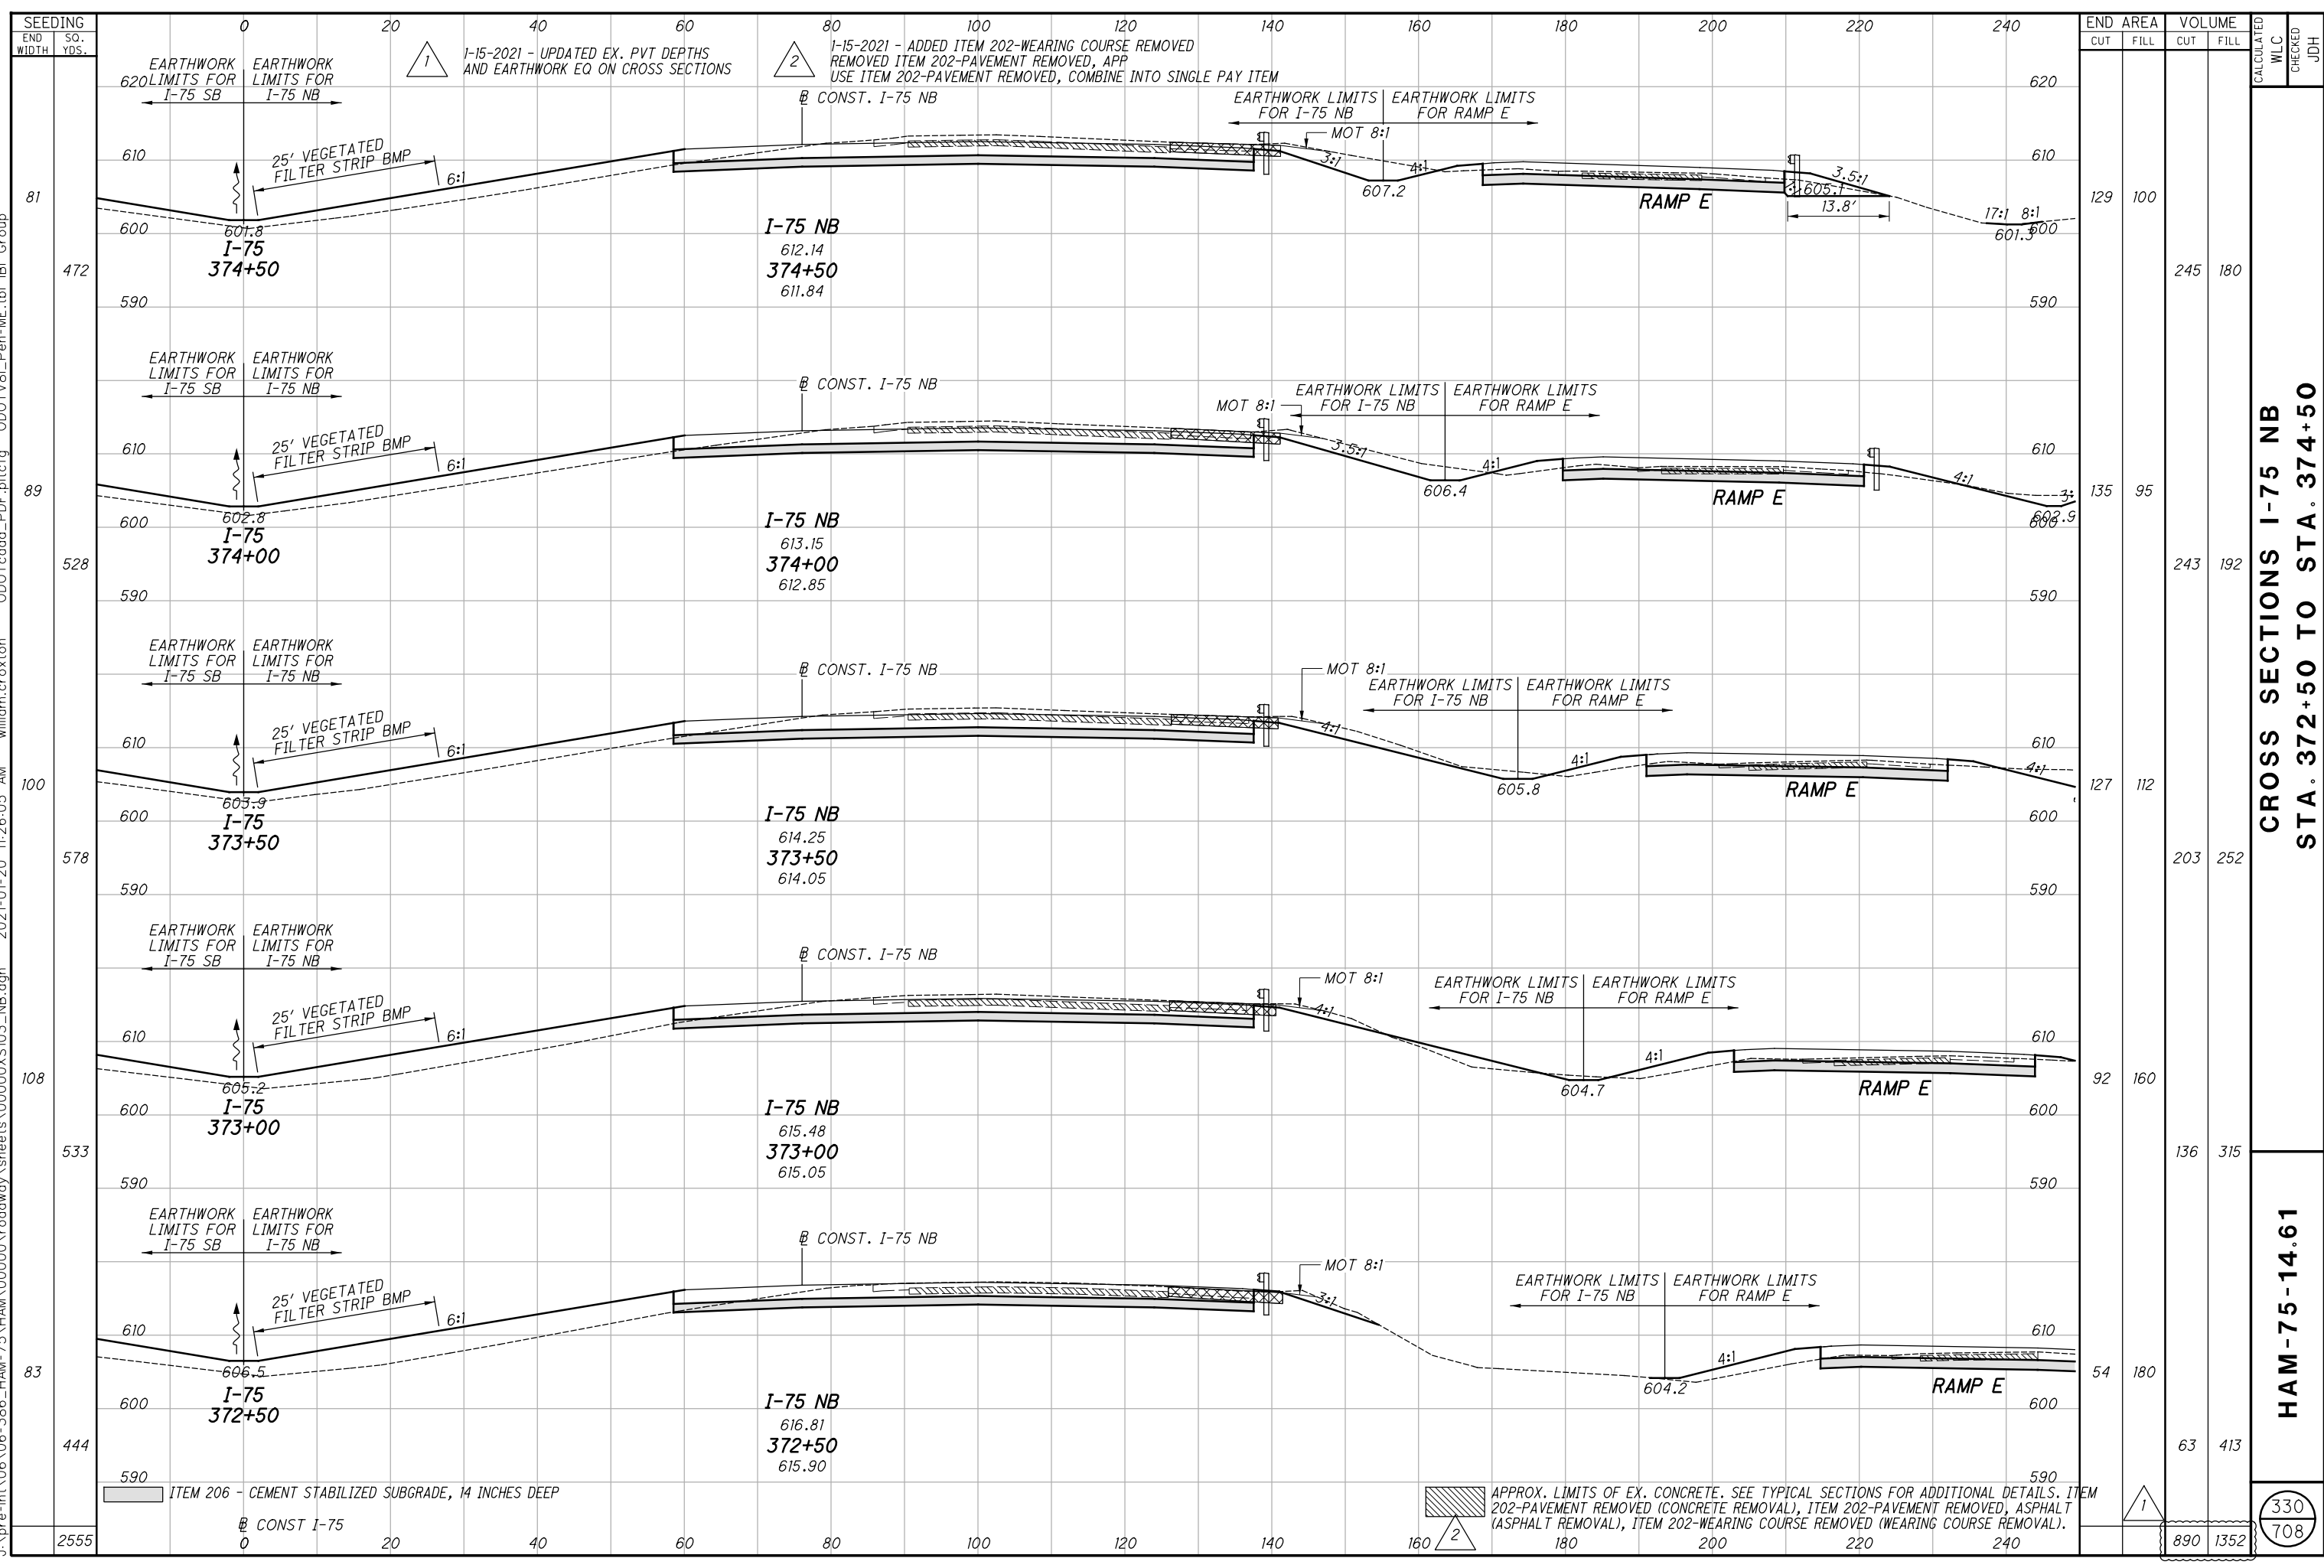


END STA.	AREA		VOLUME		CALCULATED WLC	CHECKED	JDH
	CUT	FILL	CUT	FILL			
374+50	129	100	245	180			
374+00	135	95	243	192			
373+50	127	112	203	252			
373+00	92	160	136	315			
372+50	54	180	63	413			
TOTAL	890	1352	890	1352	330	708	

CROSS SECTIONS I-75 NB  
STA. 372+50 TO STA. 374+50


HAM-75-14.61

330  
708

j:\pre-int\06\06-386\_HAM-75\_HAM\00000\roadway\sheets\000005\03\_NB.dgn 2021-01-20 11:26:06 AM william.croxton ODOTcadd\_PDF.plt c:\odotv8\Pen-ME.tbl IBI Group

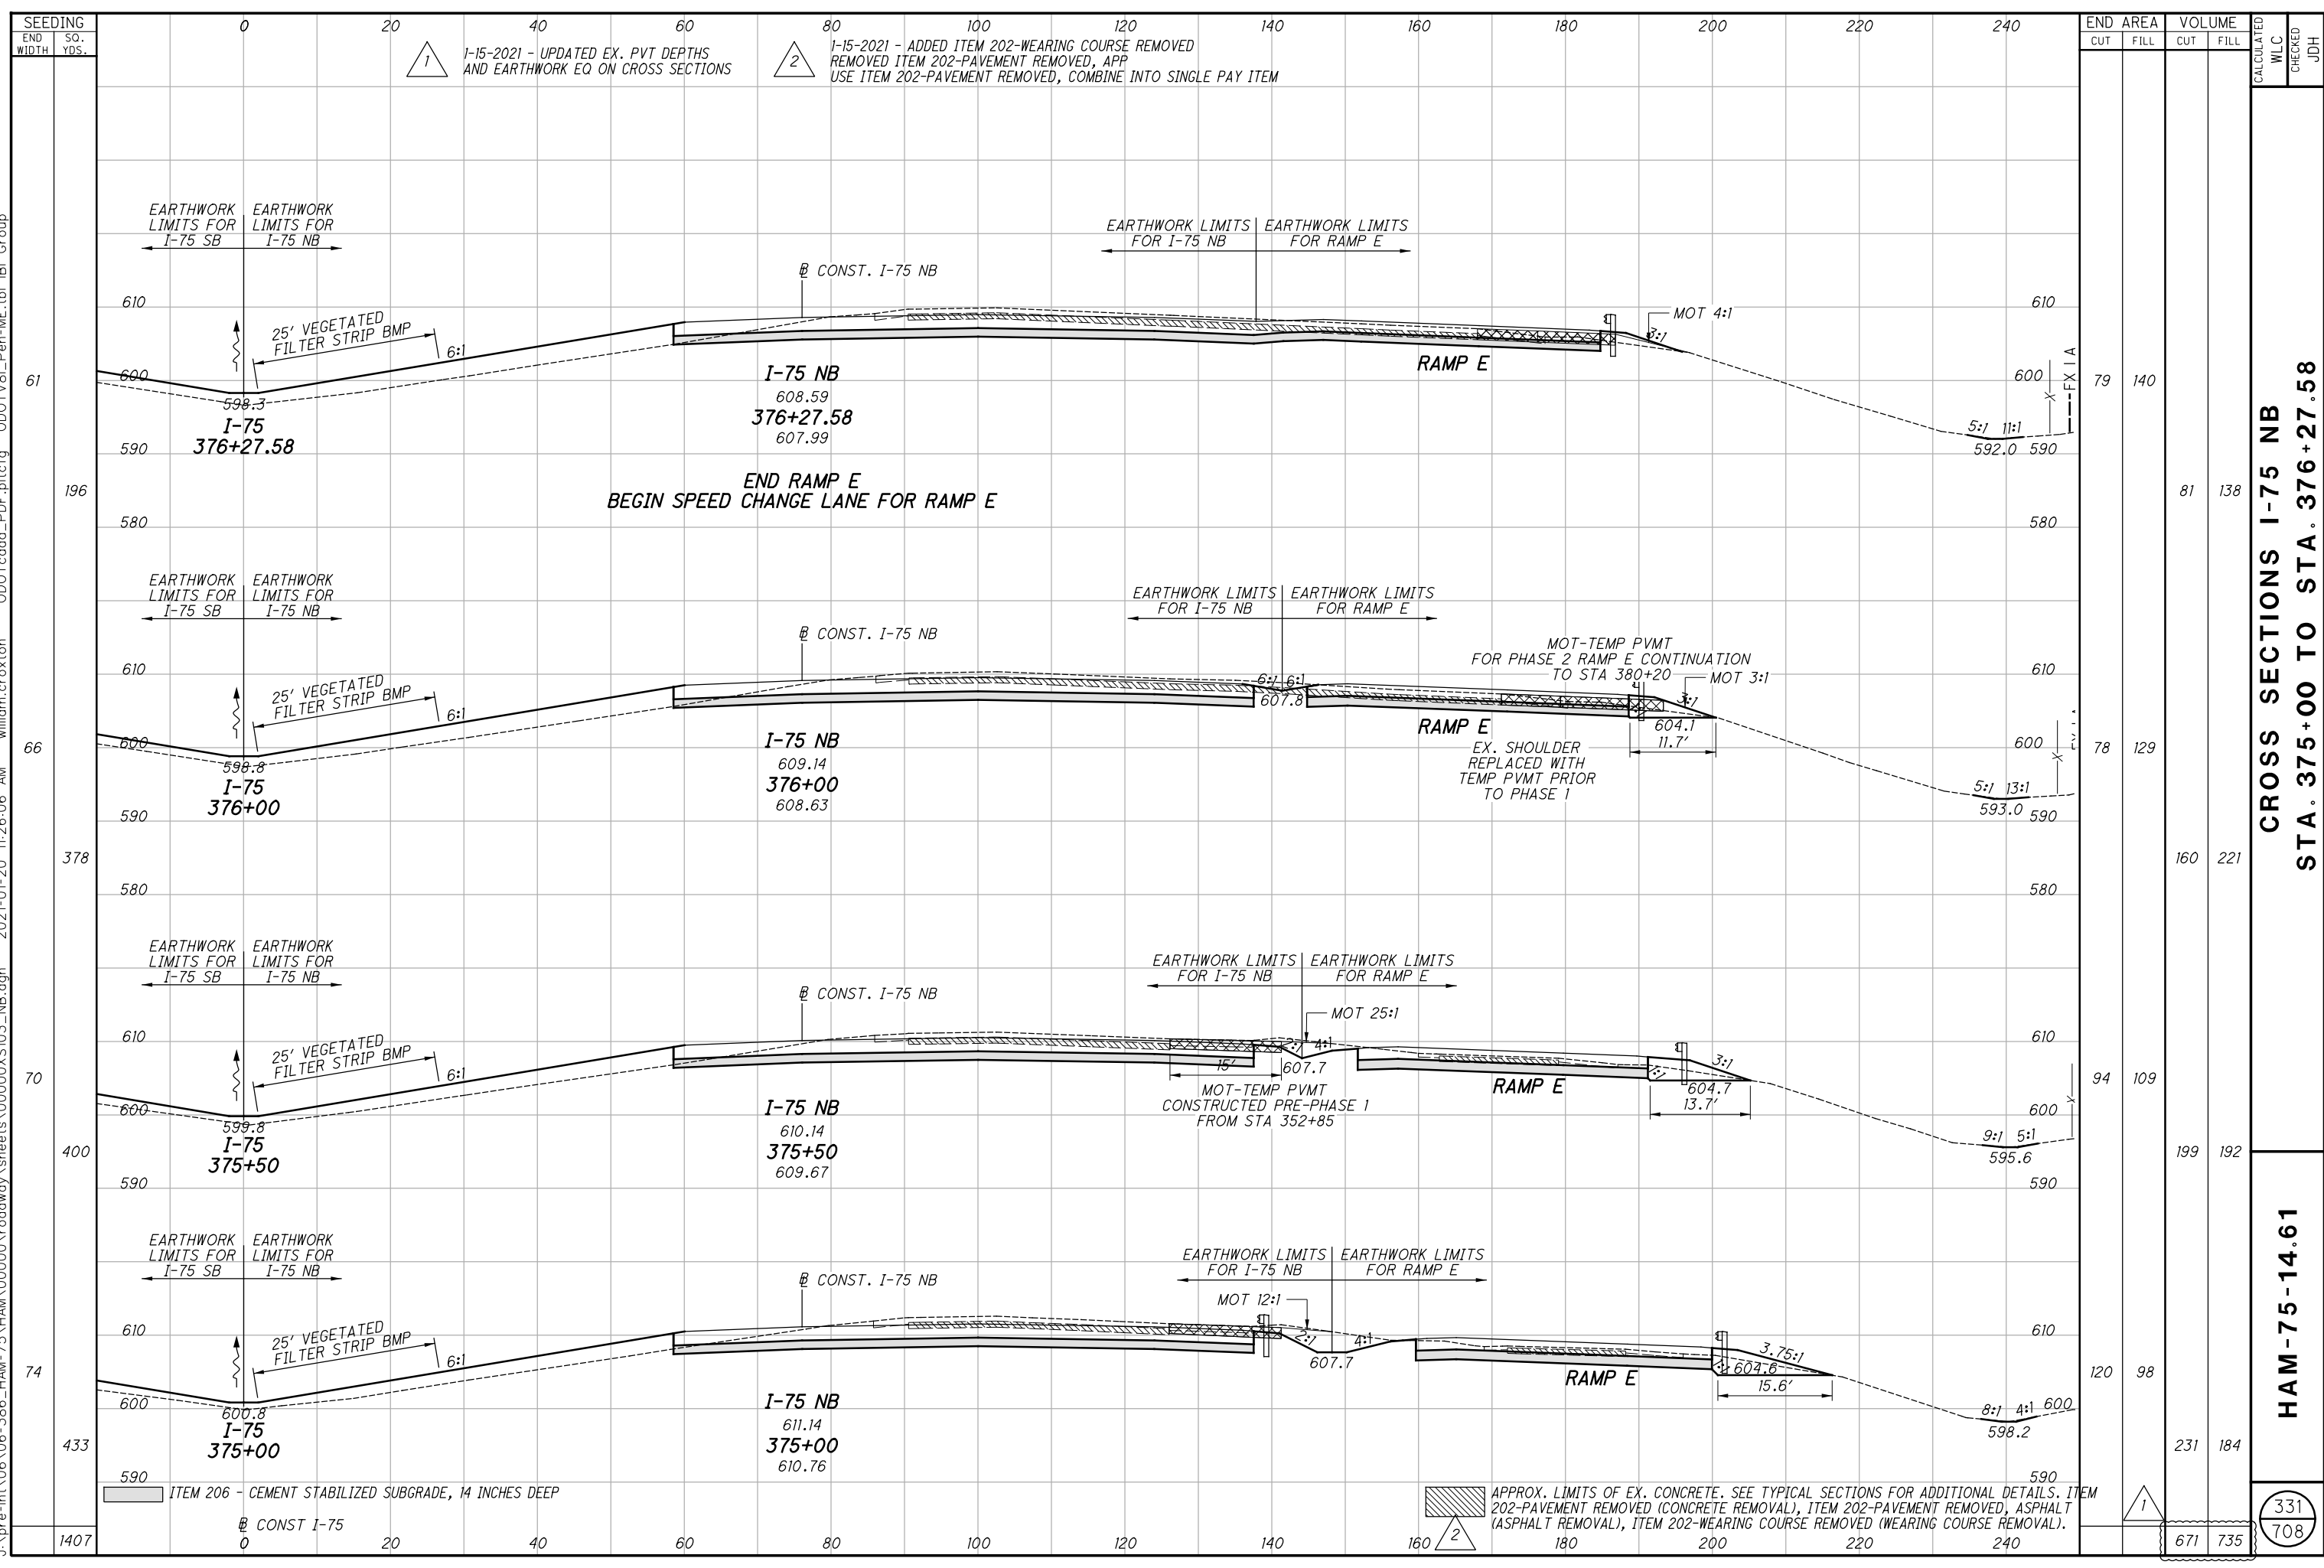

j:\pre-int\06\06-386\_HAM-75\HAM-75\HAM-75\roadway\sheets\00000X5103\_NB.dgn 2021-01-20 11:26:07 AM william.croxton ODOT\cadd\_PDF.plt c:\odot\ib\Group

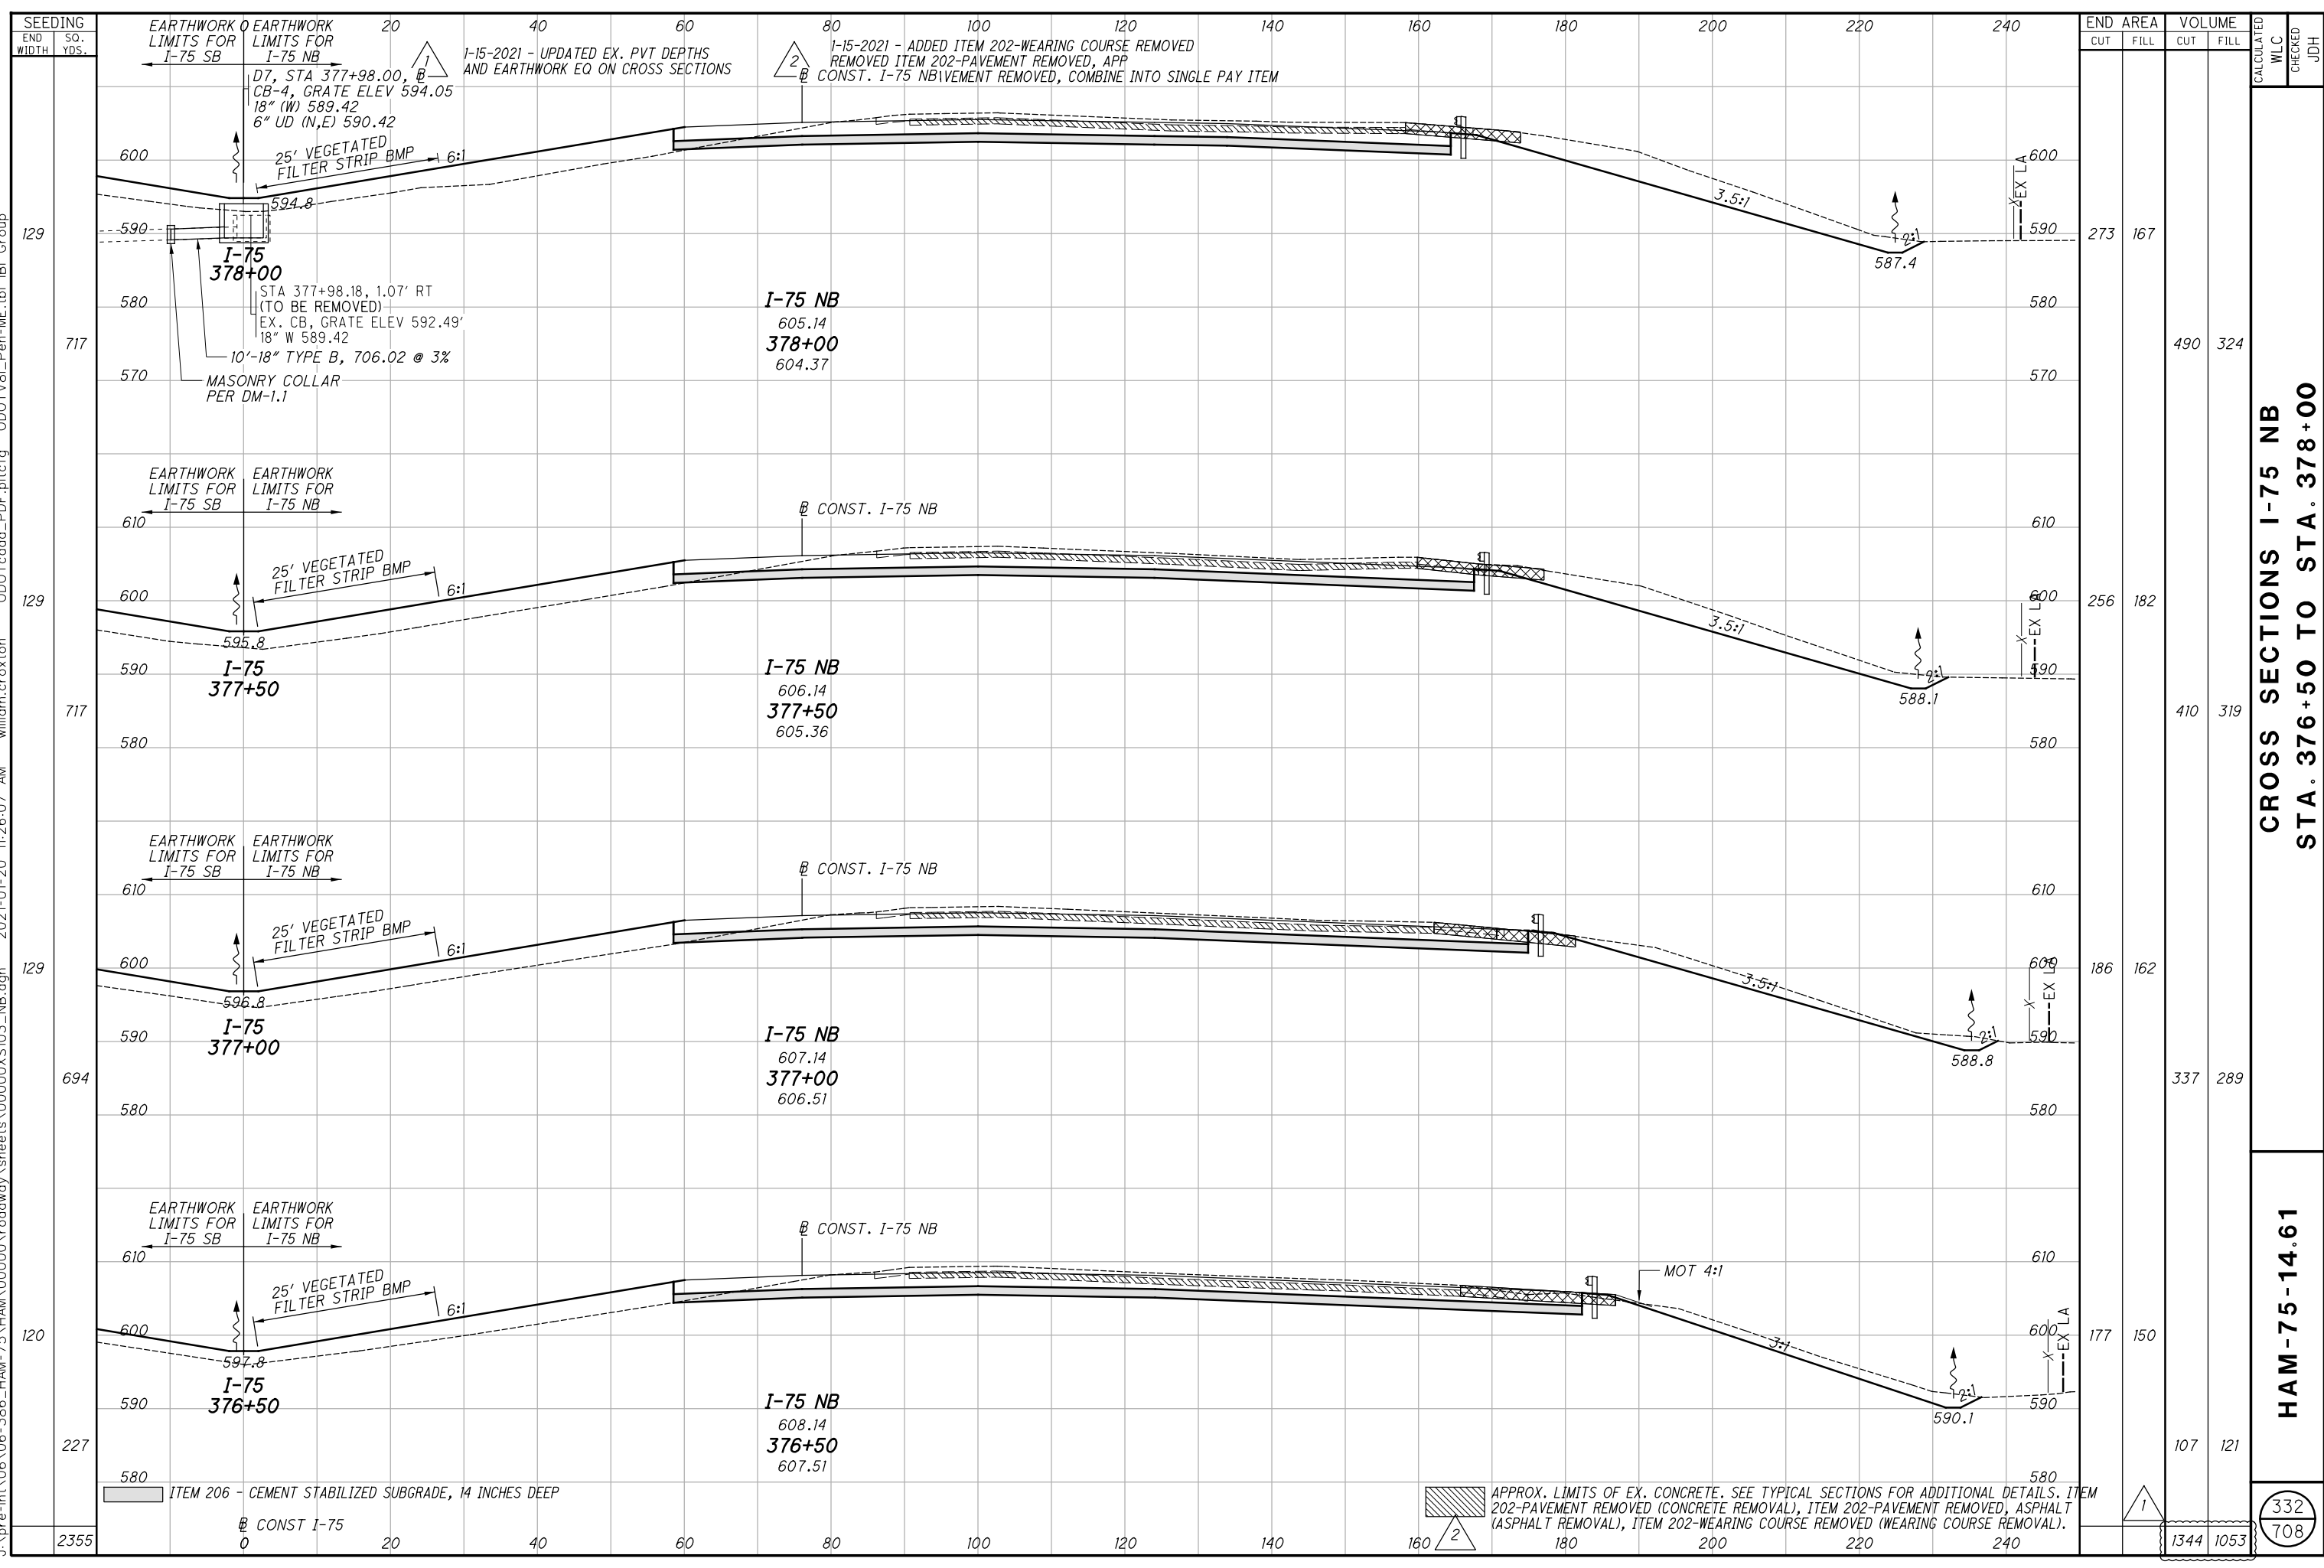


**CROSS SECTIONS I-75 NB  
STA. 376+50 TO STA. 378+00**

**HAM-75-14.61**

332  
708

APPROX. LIMITS OF EX. CONCRETE. SEE TYPICAL SECTIONS FOR ADDITIONAL DETAILS. ITEM 202-PAVEMENT REMOVED (CONCRETE REMOVAL), ITEM 202-PAVEMENT REMOVED, ASPHALT (ASPHALT REMOVAL), ITEM 202-WEARING COURSE REMOVED (WEARING COURSE REMOVAL).

j:\pre-int\06\06-386\_HAM-75\HAM\00000\roadway\sheets\00000X5103\_NB.dgn 2021-01-20 11:26:09 AM william.croxton ODOTcadd\_PDF.plt c:\odotv8i\_Pen-ME.tbl IBI Group

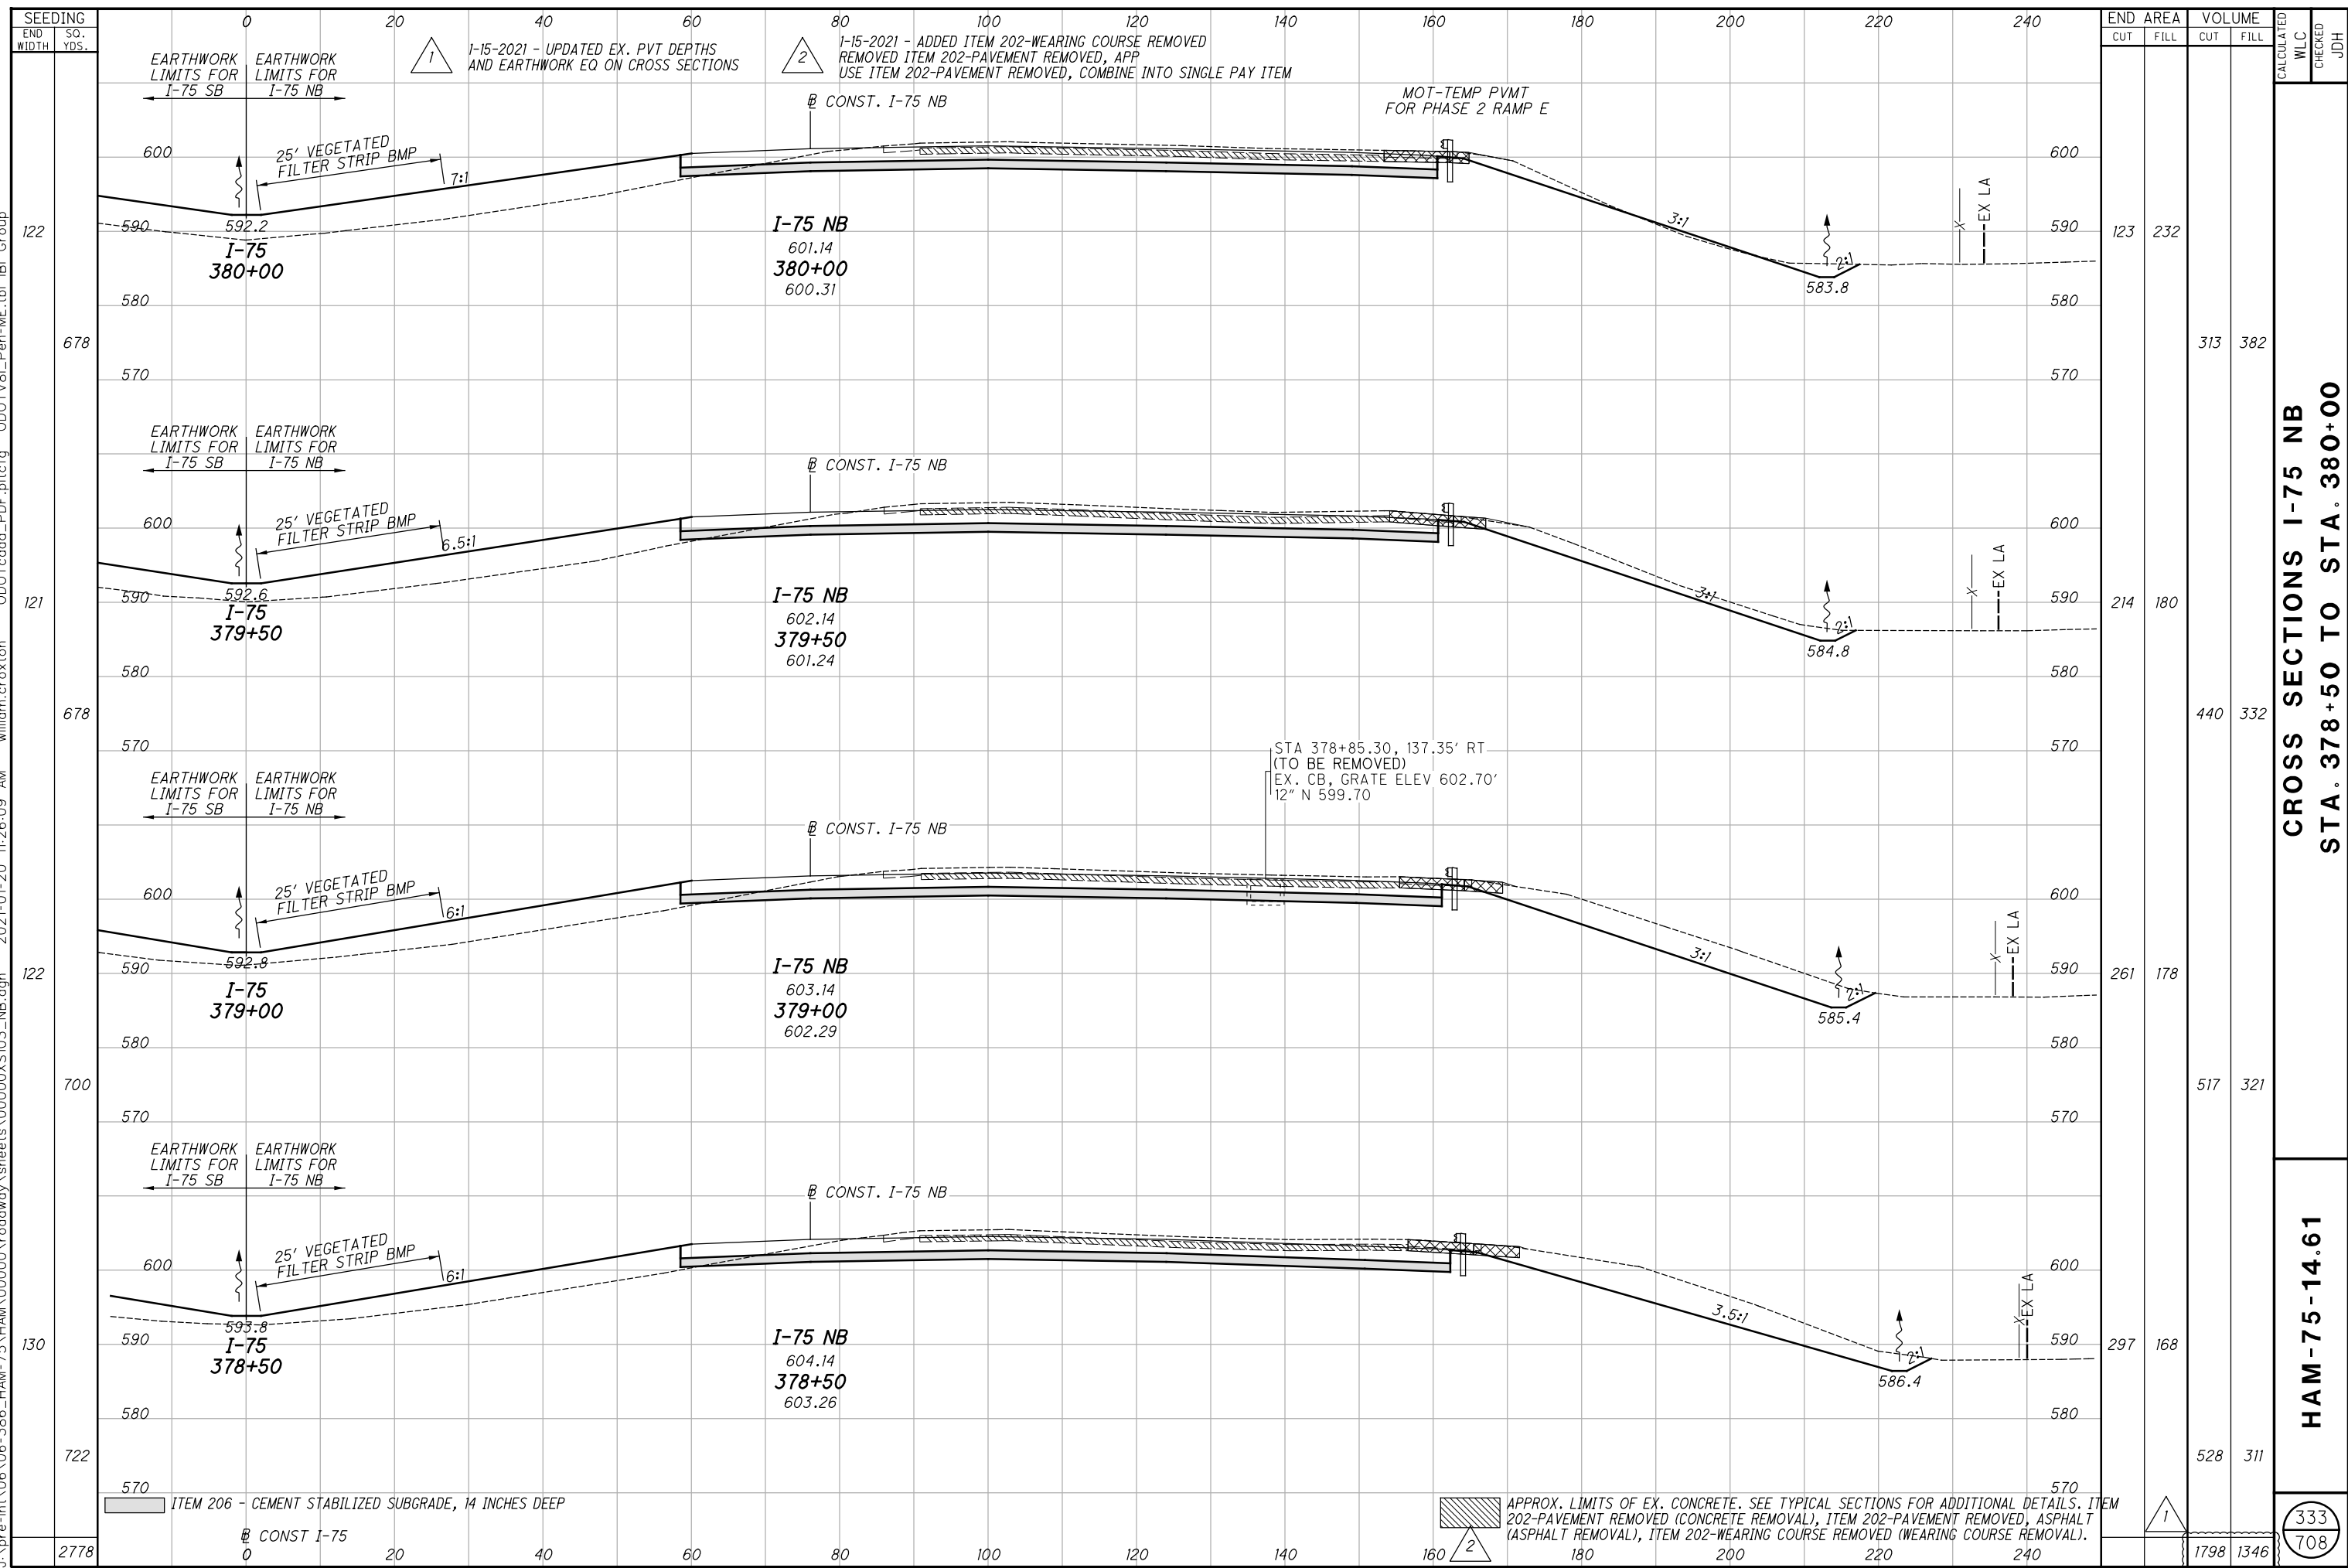

END STA	END AREA		VOLUME		CALCULATED WLC	CHECKED	JDH
	CUT	FILL	CUT	FILL			
378+50	297	168	528	311			
379+00	261	178	517	321			
379+50	214	180	440	332			
380+00	123	232	313	382			
<b>TOTAL</b>	<b>1798</b>	<b>1346</b>	<b>1798</b>	<b>1346</b>			

**CROSS SECTIONS I-75 NB  
STA. 378+50 TO STA. 380+00**


**HAM-75-14.61**

333  
708

APPROX. LIMITS OF EX. CONCRETE. SEE TYPICAL SECTIONS FOR ADDITIONAL DETAILS. ITEM 202-PAVEMENT REMOVED (CONCRETE REMOVAL), ITEM 202-PAVEMENT REMOVED, ASPHALT (ASPHALT REMOVAL), ITEM 202-WEARING COURSE REMOVED (WEARING COURSE REMOVAL).

ITEM 206 - CEMENT STABILIZED SUBGRADE, 14 INCHES DEEP

1-15-2021 - UPDATED EX. PVT DEPTHS AND EARTHWORK EQ ON CROSS SECTIONS  
1-15-2021 - ADDED ITEM 202-WEARING COURSE REMOVED REMOVED ITEM 202-PAVEMENT REMOVED, APP USE ITEM 202-PAVEMENT REMOVED, COMBINE INTO SINGLE PAY ITEM

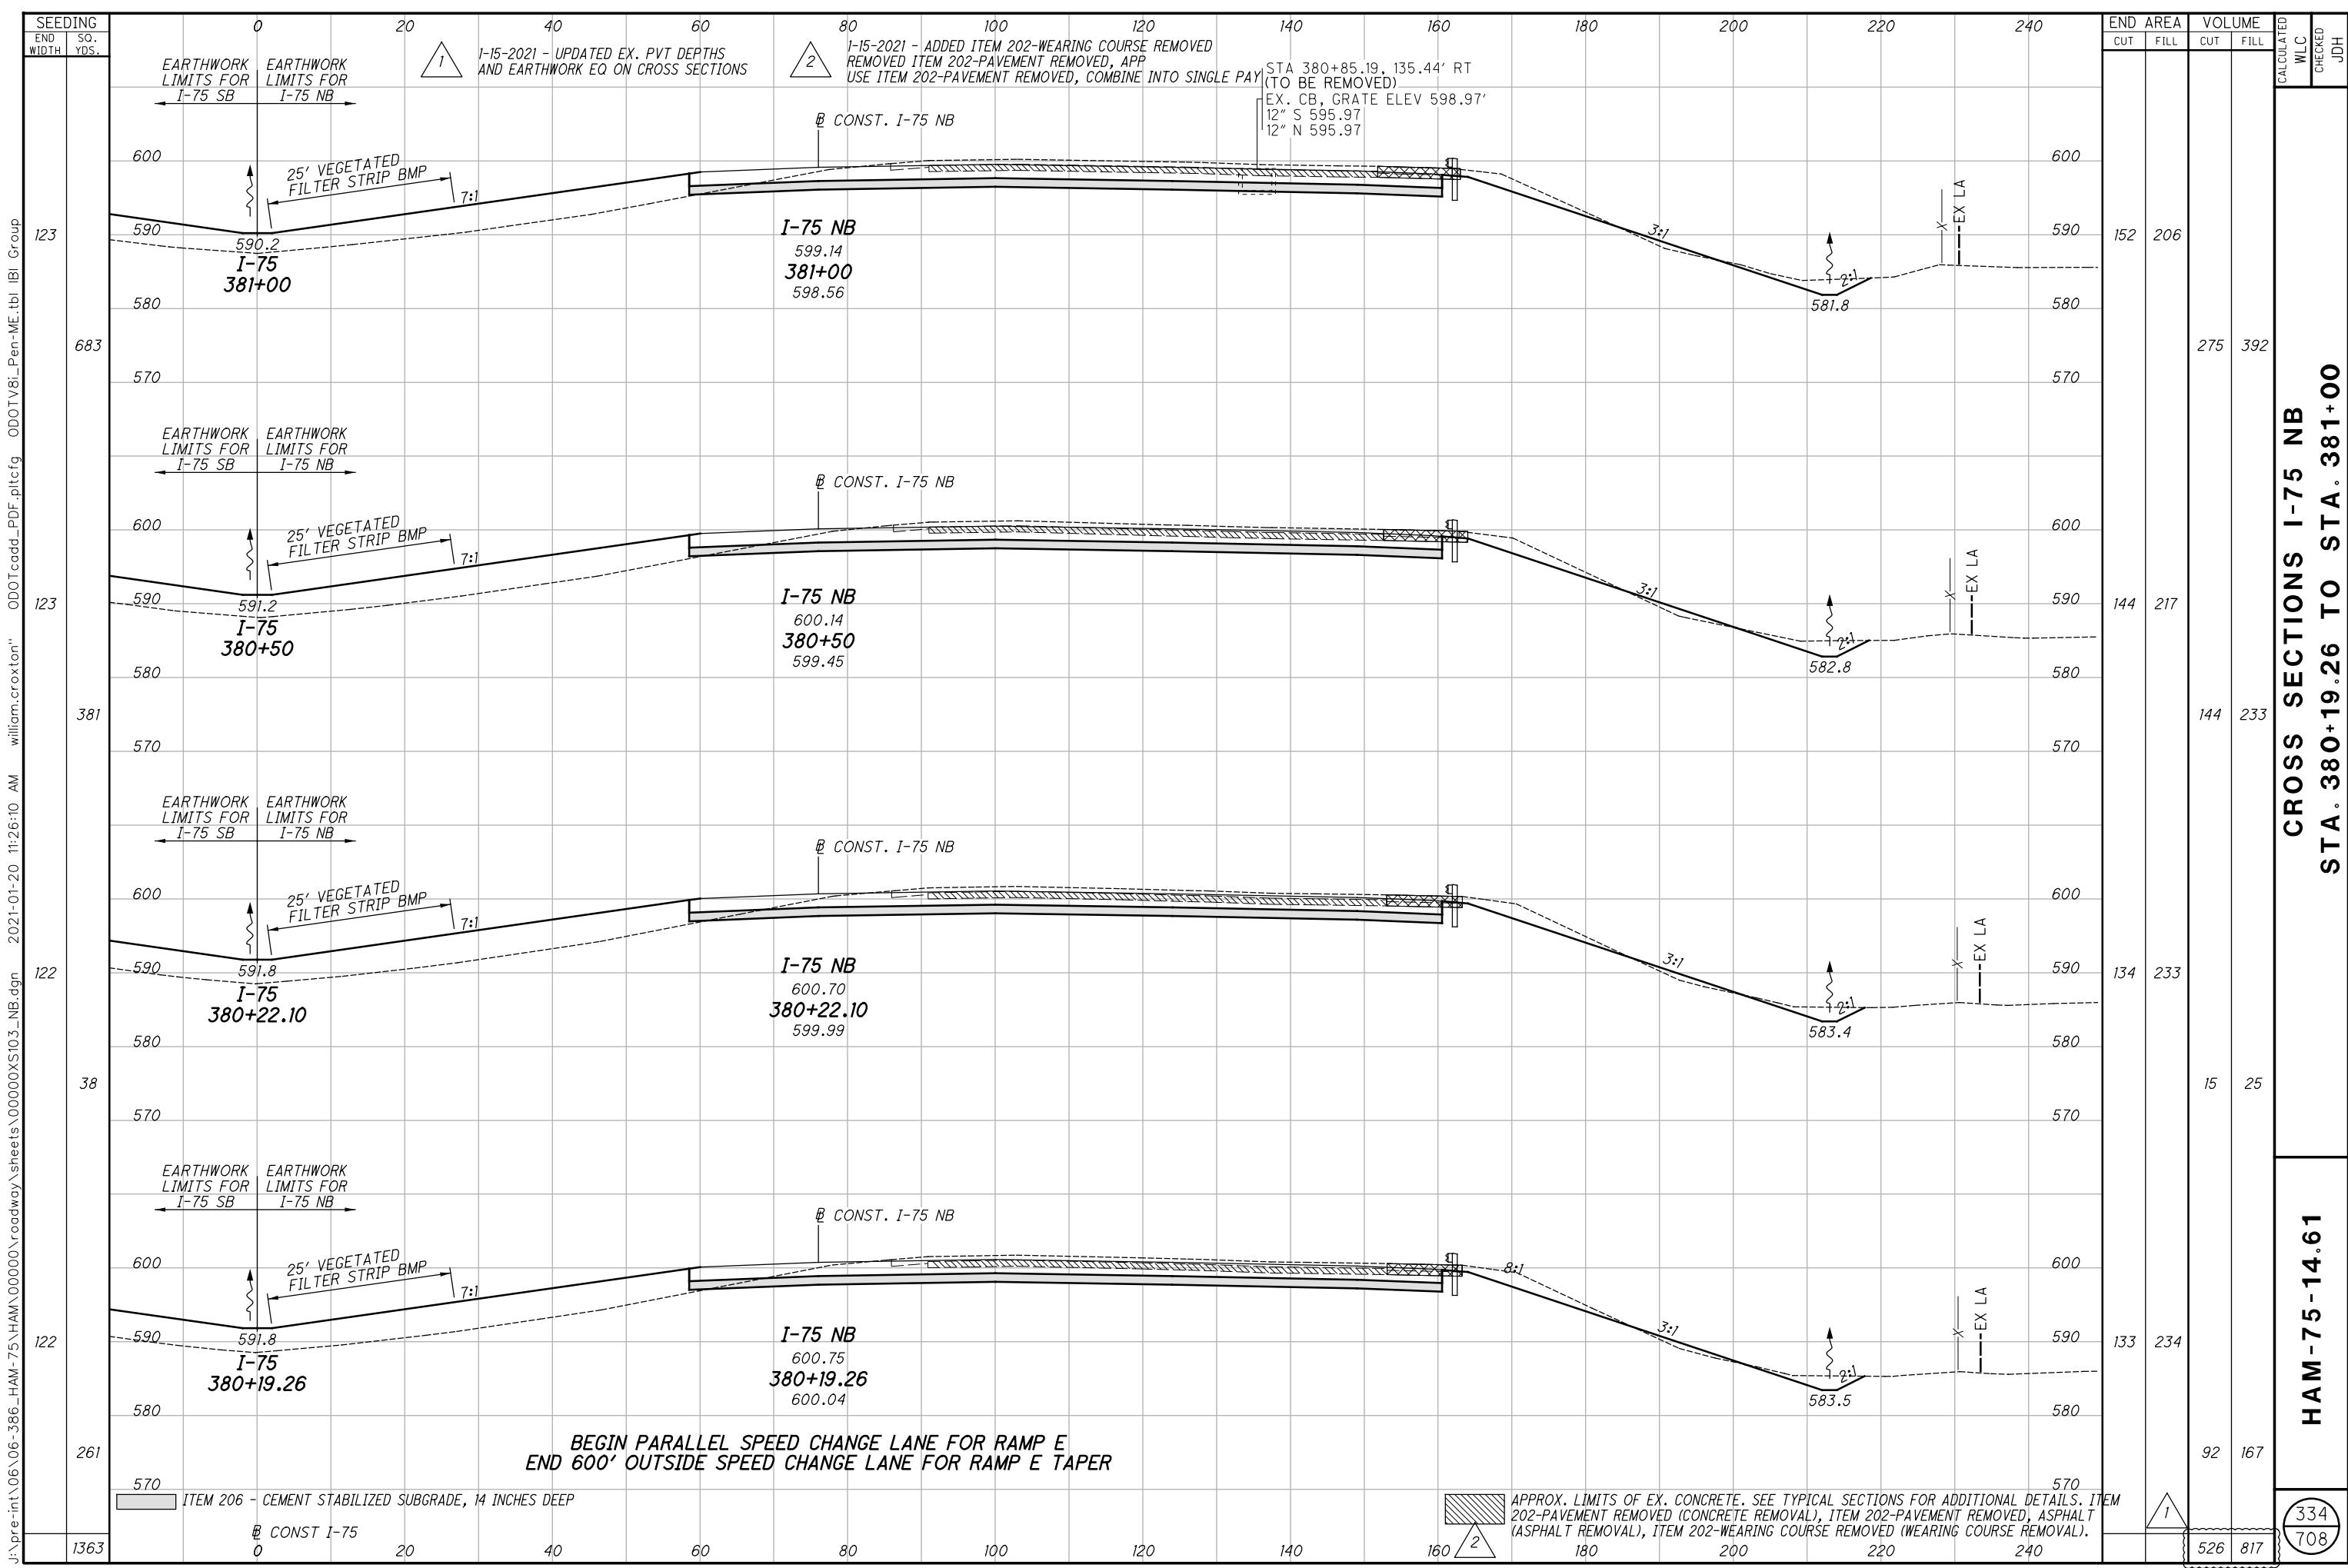

SEEDING  
END WIDTH SO. YDS.

1363 0 20 40 60 80 100 120 140 160 180 200 220 240

123 683 123 381 122 38 122 261 1363

ODOTcadd\_PDF.pltcfgr ODOTV81\_Pen-ME.tbl IBI Group  
william.croxton  
2021-01-20 11:26:10 AM

1-15-2021 - UPDATED EX. PVT DEPTHS AND EARTHWORK EQ ON CROSS SECTIONS

1-15-2021 - ADDED ITEM 202-WEARING COURSE REMOVED REMOVED ITEM 202-PAVEMENT REMOVED, APP USE ITEM 202-PAVEMENT REMOVED, COMBINE INTO SINGLE PAY

STA 380+85.19, 135.44' RT (TO BE REMOVED)  
EX. CB, GRATE ELEV 598.97'  
12" S 595.97  
12" N 595.97

EARTHWORK LIMITS FOR I-75 SB EARTHWORK LIMITS FOR I-75 NB

25' VEGETATED FILTER STRIP BMP 7:1

CONST. I-75 NB

I-75 NB

381+00 599.14 598.56

380+50 600.14 599.45

380+22.10 600.70 599.99

380+19.26 600.75 600.04

ITEM 206 - CEMENT STABILIZED SUBGRADE, 14 INCHES DEEP

BEGIN PARALLEL SPEED CHANGE LANE FOR RAMP E  
END 600' OUTSIDE SPEED CHANGE LANE FOR RAMP E TAPER

APPROX. LIMITS OF EX. CONCRETE. SEE TYPICAL SECTIONS FOR ADDITIONAL DETAILS. ITEM 202-PAVEMENT REMOVED (CONCRETE REMOVAL), ITEM 202-PAVEMENT REMOVED, ASPHALT (ASPHALT REMOVAL), ITEM 202-WEARING COURSE REMOVED (WEARING COURSE REMOVAL).


END AREA	VOLUME	CALCULATED	CHECKED	J.D.H.
152	206			
	275			
144	217			
	144			
134	233			
	15			
133	234			
	92			
	167			
	526			
	817			

CROSS SECTIONS I-75 NB  
STA. 380+19.26 TO STA. 381+00

HAM-75-14.61

334  
708

j:\pre-int\06\06-386\_HAM-75\HAM-75\HAM-75\roadway\sheets\00000X5103\_NB.dgn 2021-01-20 11:26:11 AM william.croxton' ODOT\cadd\_PDF\_pltcfg ODOTV8i\_Pen-ME.tbl IBI Group

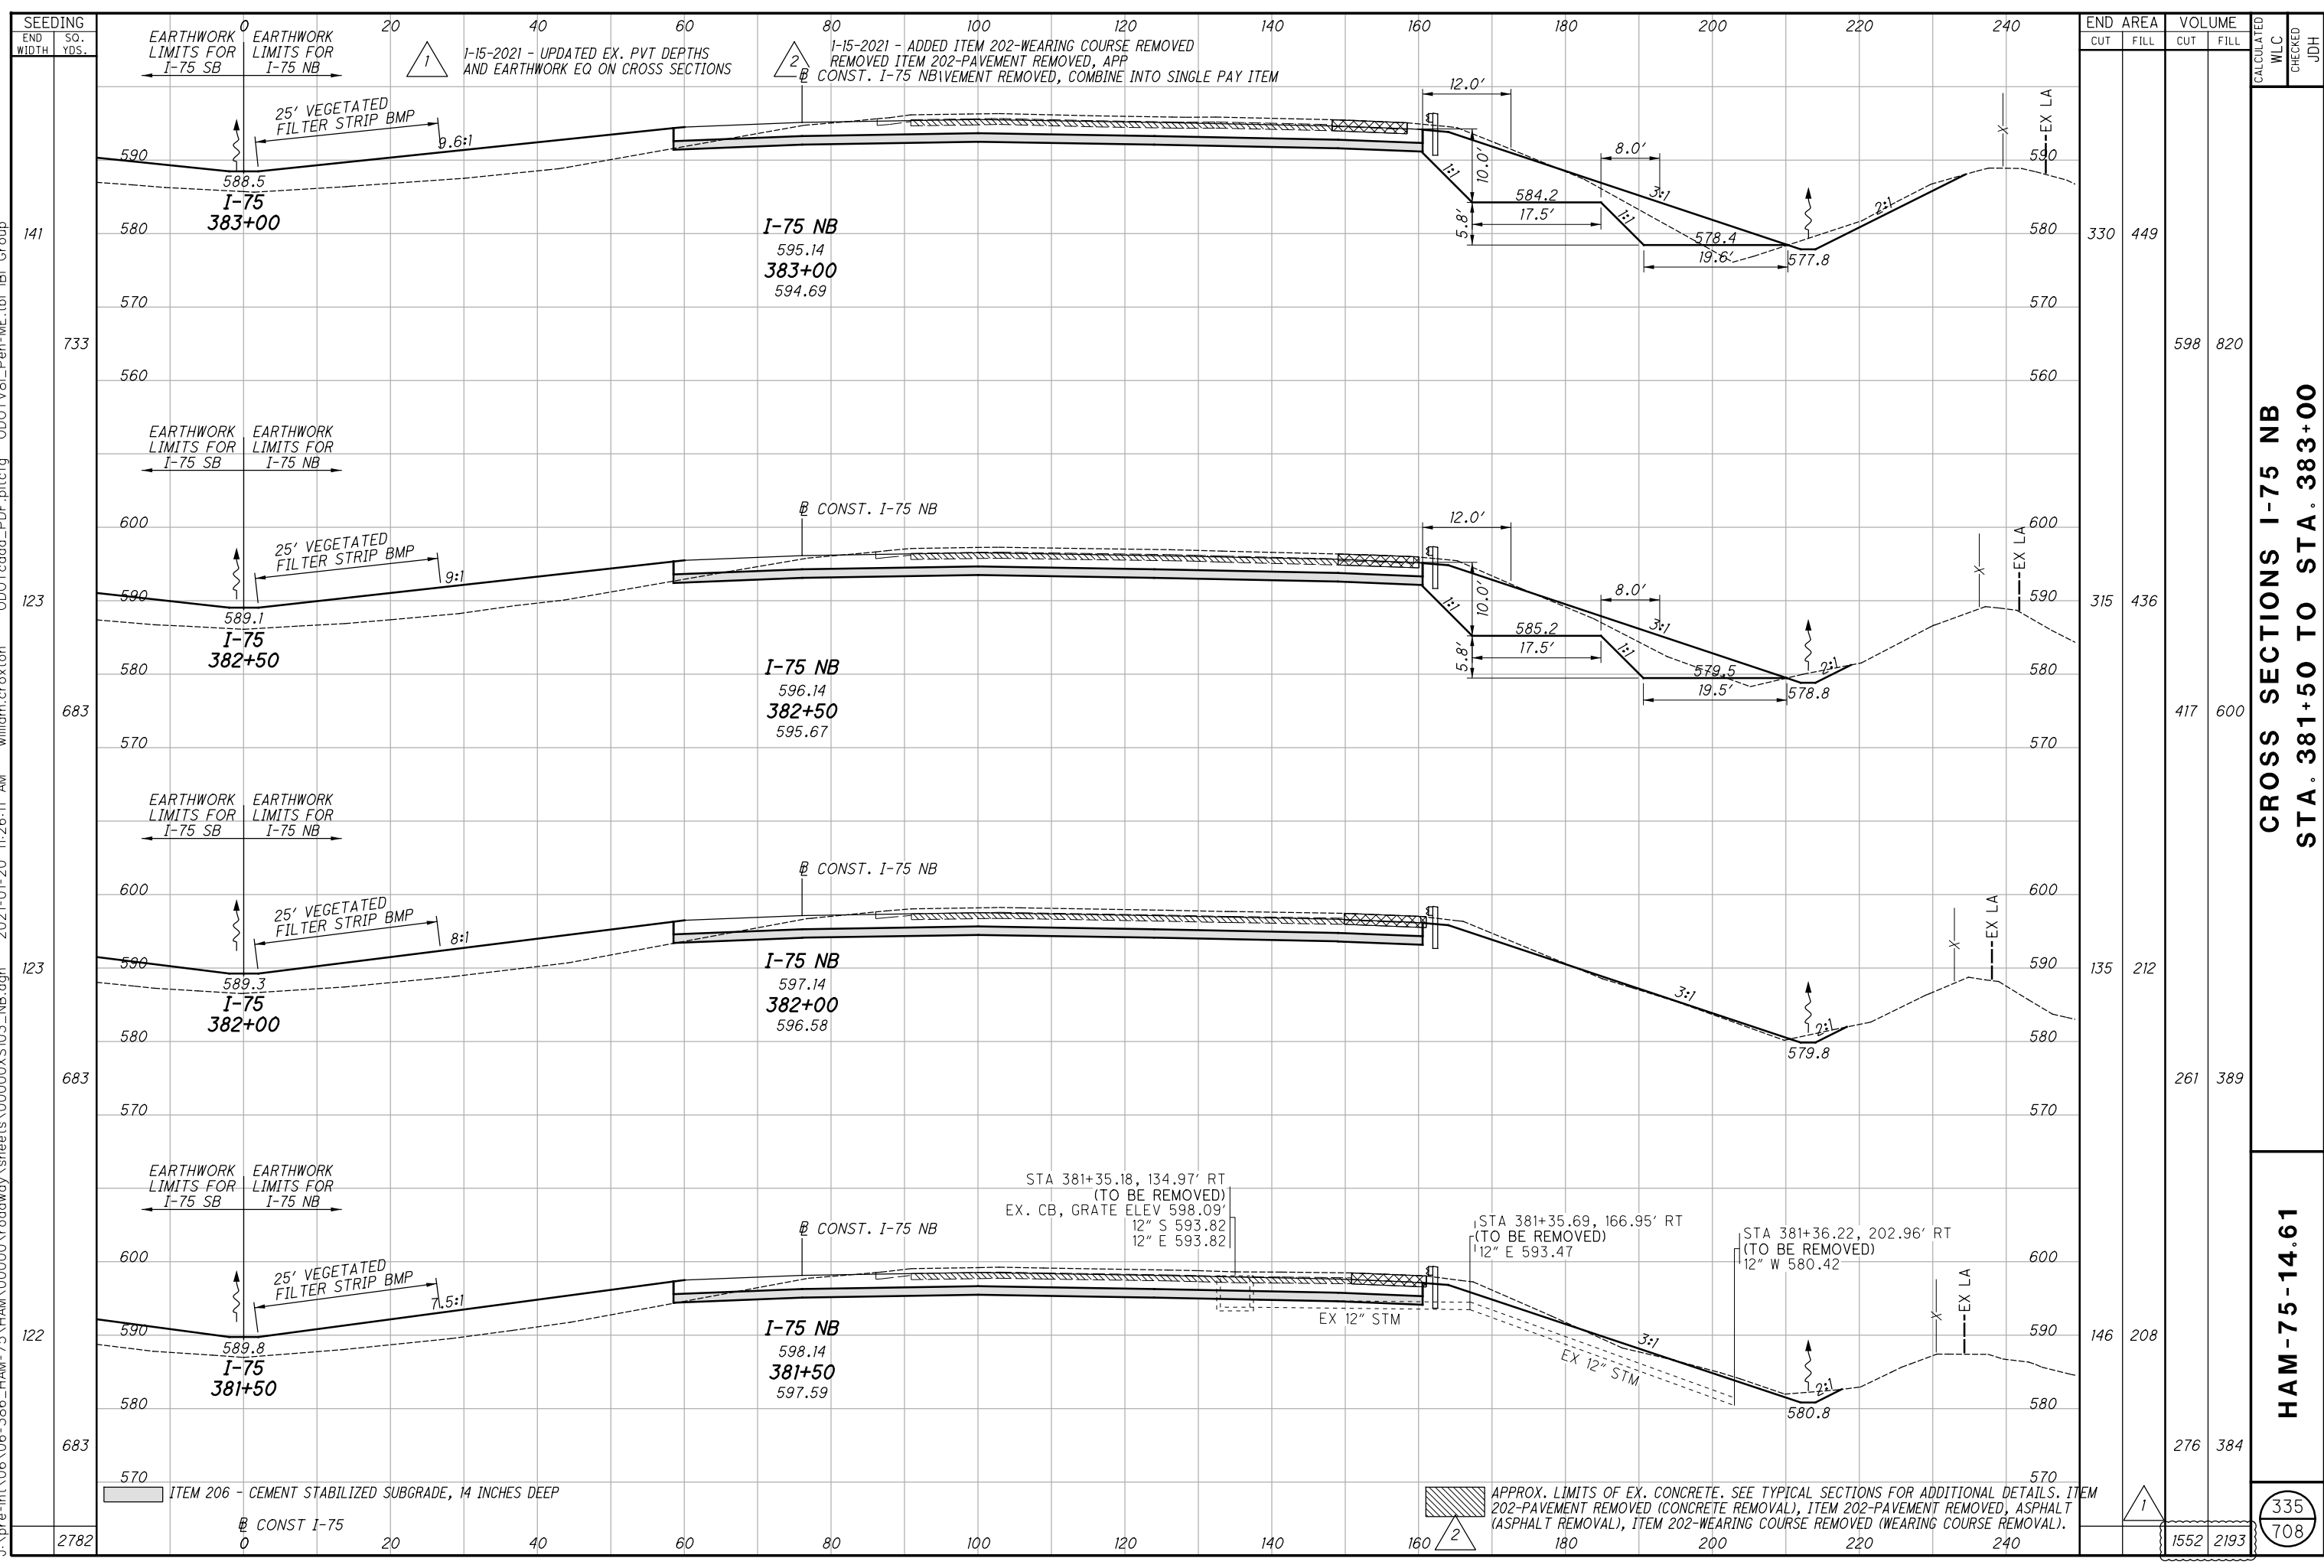


END STA	END AREA		VOLUME		CALCULATED WLC	CHECKED	JDH
	CUT	FILL	CUT	FILL			
383+00	330	449					
382+50	315	436	598	820			
382+00	135	212	417	600			
381+50	146	208	261	389			
TOTAL	1552	2193					

**CROSS SECTIONS I-75 NB  
STA. 381+50 TO STA. 383+00**

**HAM-75-14.61**

335  
708

j:\pre-int\06\06-386\_HAM-75\HAM\00000\roadway\sheets\00000X5103\_NB.dgn 2021-01-20 11:26:12 AM william.croxton ODOTcadd\_PDF.pltcfg ODOTV81\_Pen-ME.tbl IBI Group

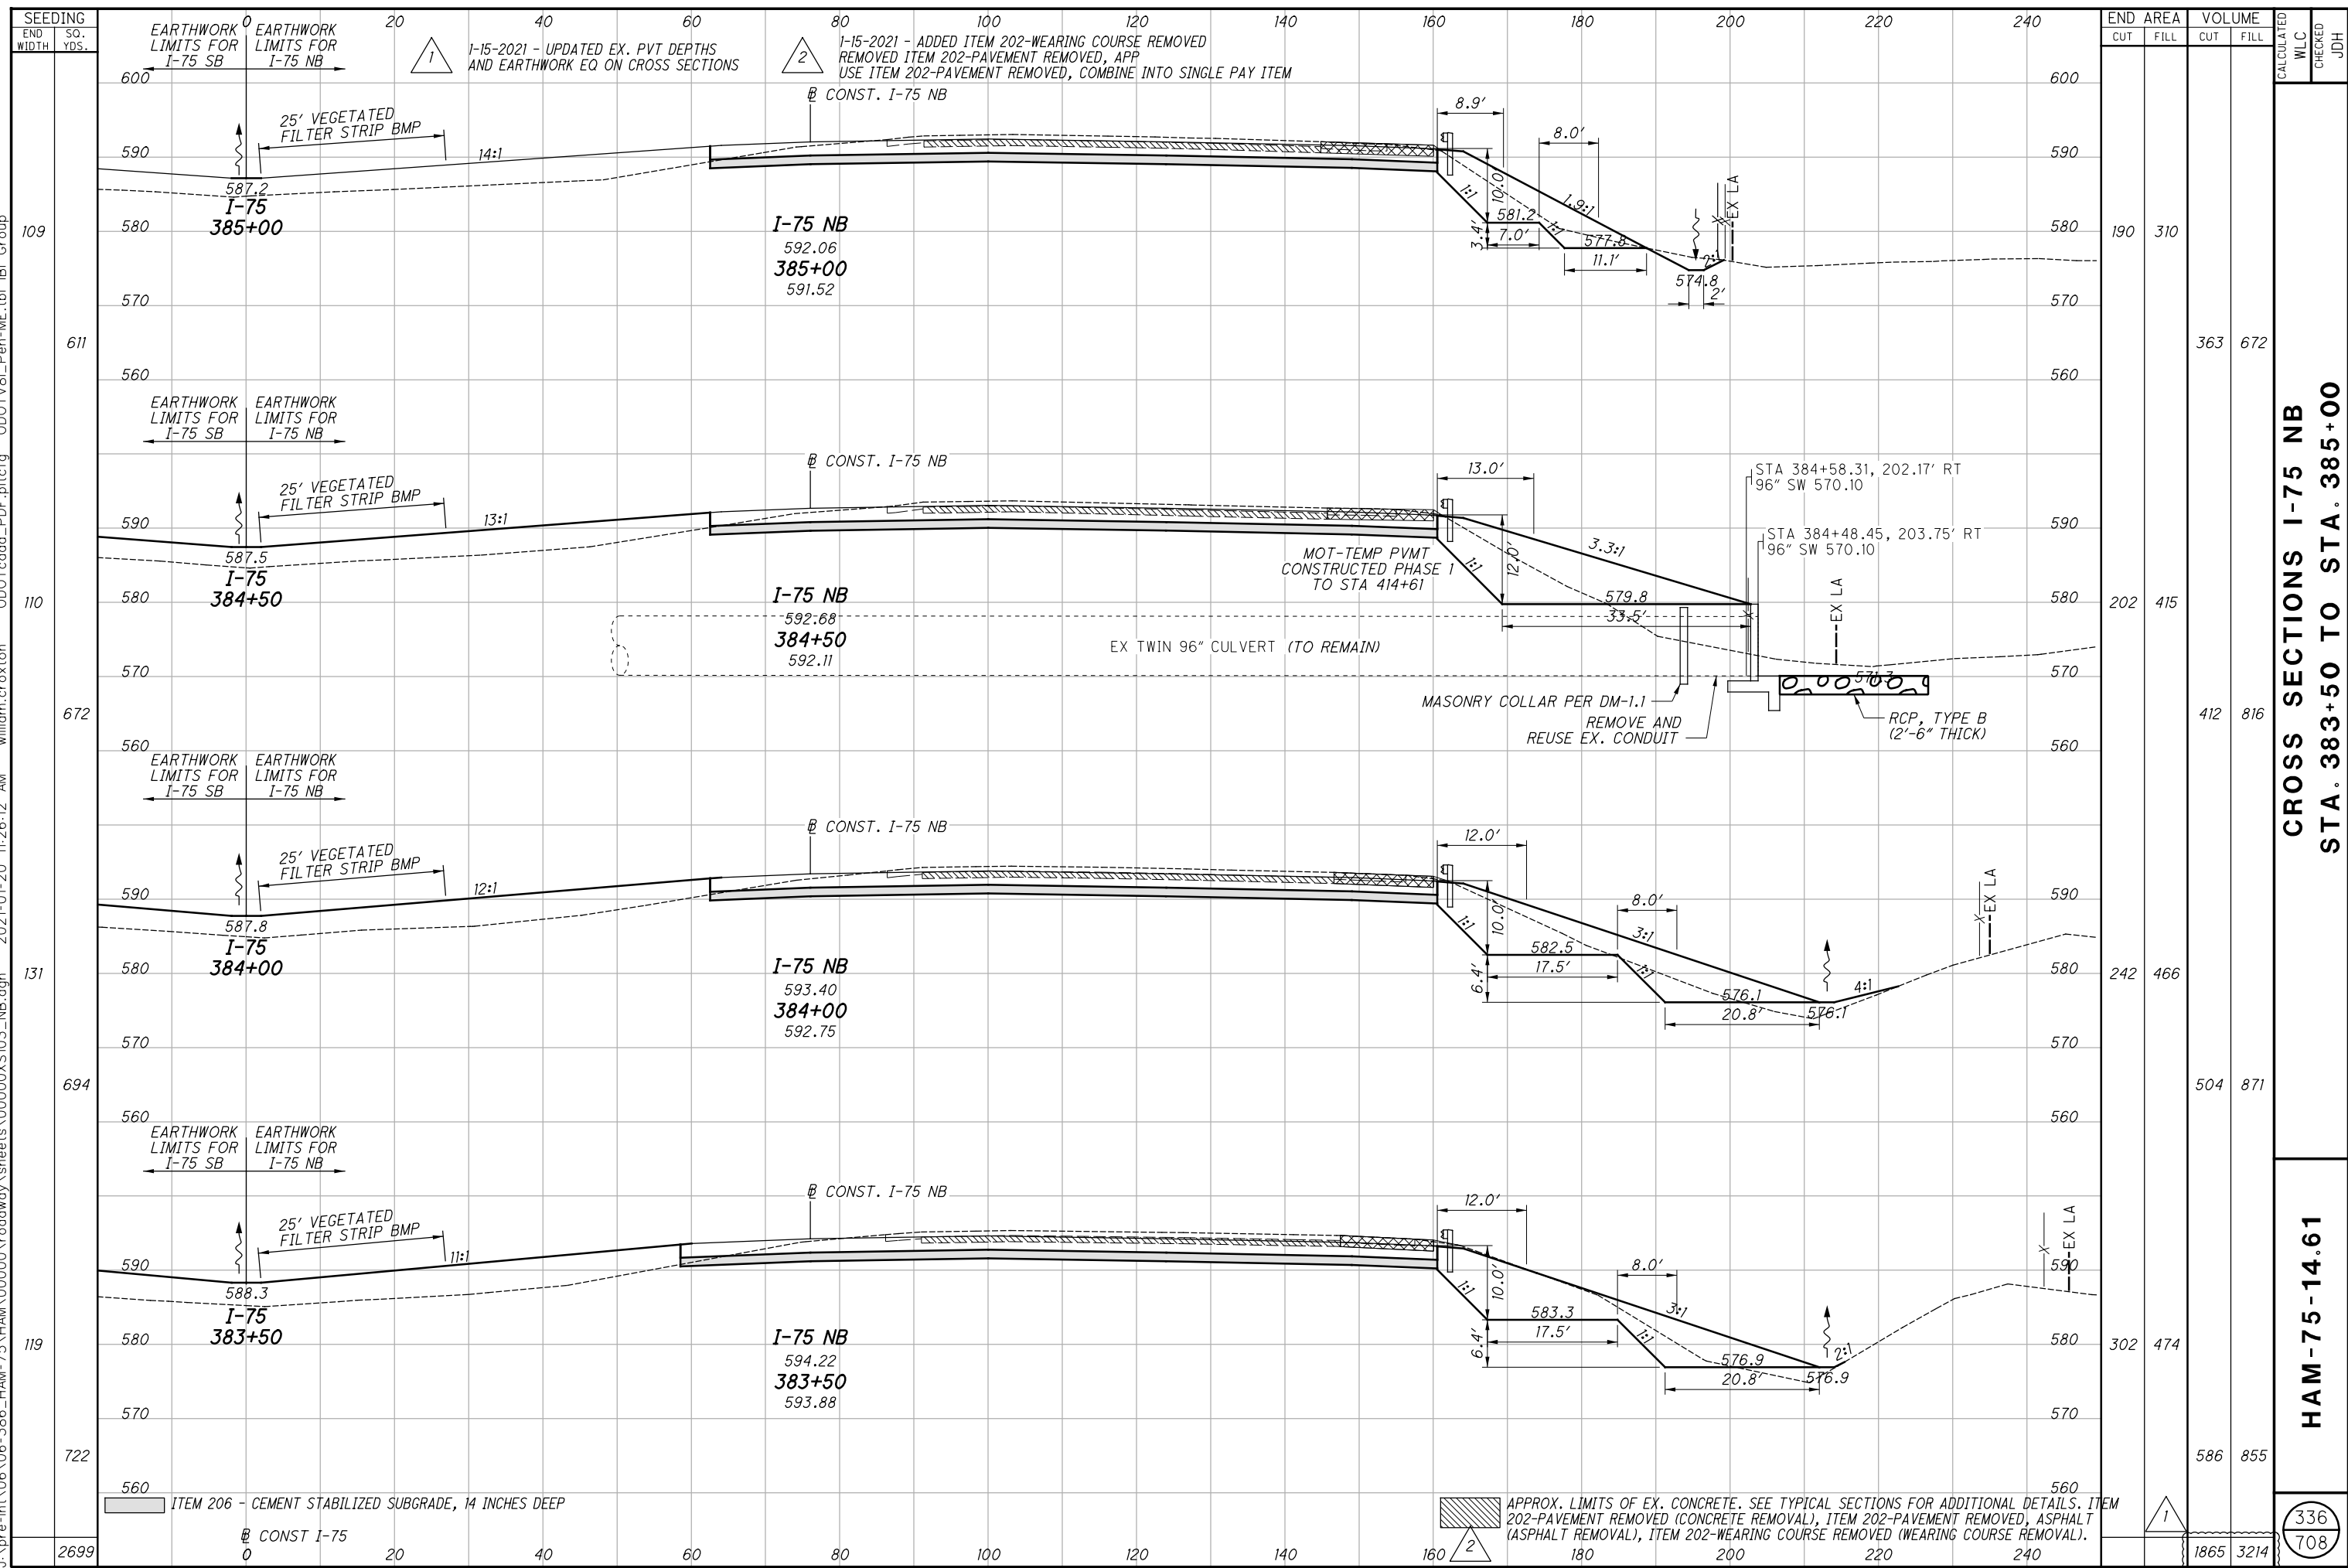

CROSS SECTIONS I-75 NB  
STA. 383+50 TO STA. 385+00

HAM-75-14.61

336  
708

SEEDING  
END WIDTH SO. YDS.

EARTHWORK LIMITS FOR I-75 SB EARTHWORK LIMITS FOR I-75 NB

25' VEGETATED FILTER STRIP BMP

CONST. I-75 NB

1-15-2021 - UPDATED EX. PVT DEPTHS AND EARTHWORK EQ ON CROSS SECTIONS

1-15-2021 - ADDED ITEM 202-WEARING COURSE REMOVED REMOVED ITEM 202-PAVEMENT REMOVED, APP USE ITEM 202-PAVEMENT REMOVED, COMBINE INTO SINGLE PAY ITEM

1-75 NB  
592.06  
385+00  
591.52

1-75 NB  
592.68  
384+50  
592.11

1-75 NB  
593.40  
384+00  
592.75

1-75 NB  
594.22  
383+50  
593.88

ITEM 206 - CEMENT STABILIZED SUBGRADE, 14 INCHES DEEP

APPROX. LIMITS OF EX. CONCRETE. SEE TYPICAL SECTIONS FOR ADDITIONAL DETAILS. ITEM 202-PAVEMENT REMOVED (CONCRETE REMOVAL), ITEM 202-PAVEMENT REMOVED, ASPHALT (ASPHALT REMOVAL), ITEM 202-WEARING COURSE REMOVED (WEARING COURSE REMOVAL).

EX TWIN 96" CULVERT (TO REMAIN)

MASONRY COLLAR PER DM-1.1 REMOVE AND REUSE EX. CONDUIT


RCP, TYPE B (2'-6" THICK)

STA 384+58.31, 202.17' RT 96" SW 570.10

STA 384+48.45, 203.75' RT 96" SW 570.10

EX LA

j:\pre-int\06\06-386\_HAM-75\HAM-75\HAM-75\roadway\sheets\00000X5103\_NB.dgn 2021-01-20 11:26:13 AM william.croxton ODOTV81\_Pen-ME.tbl IBI Group

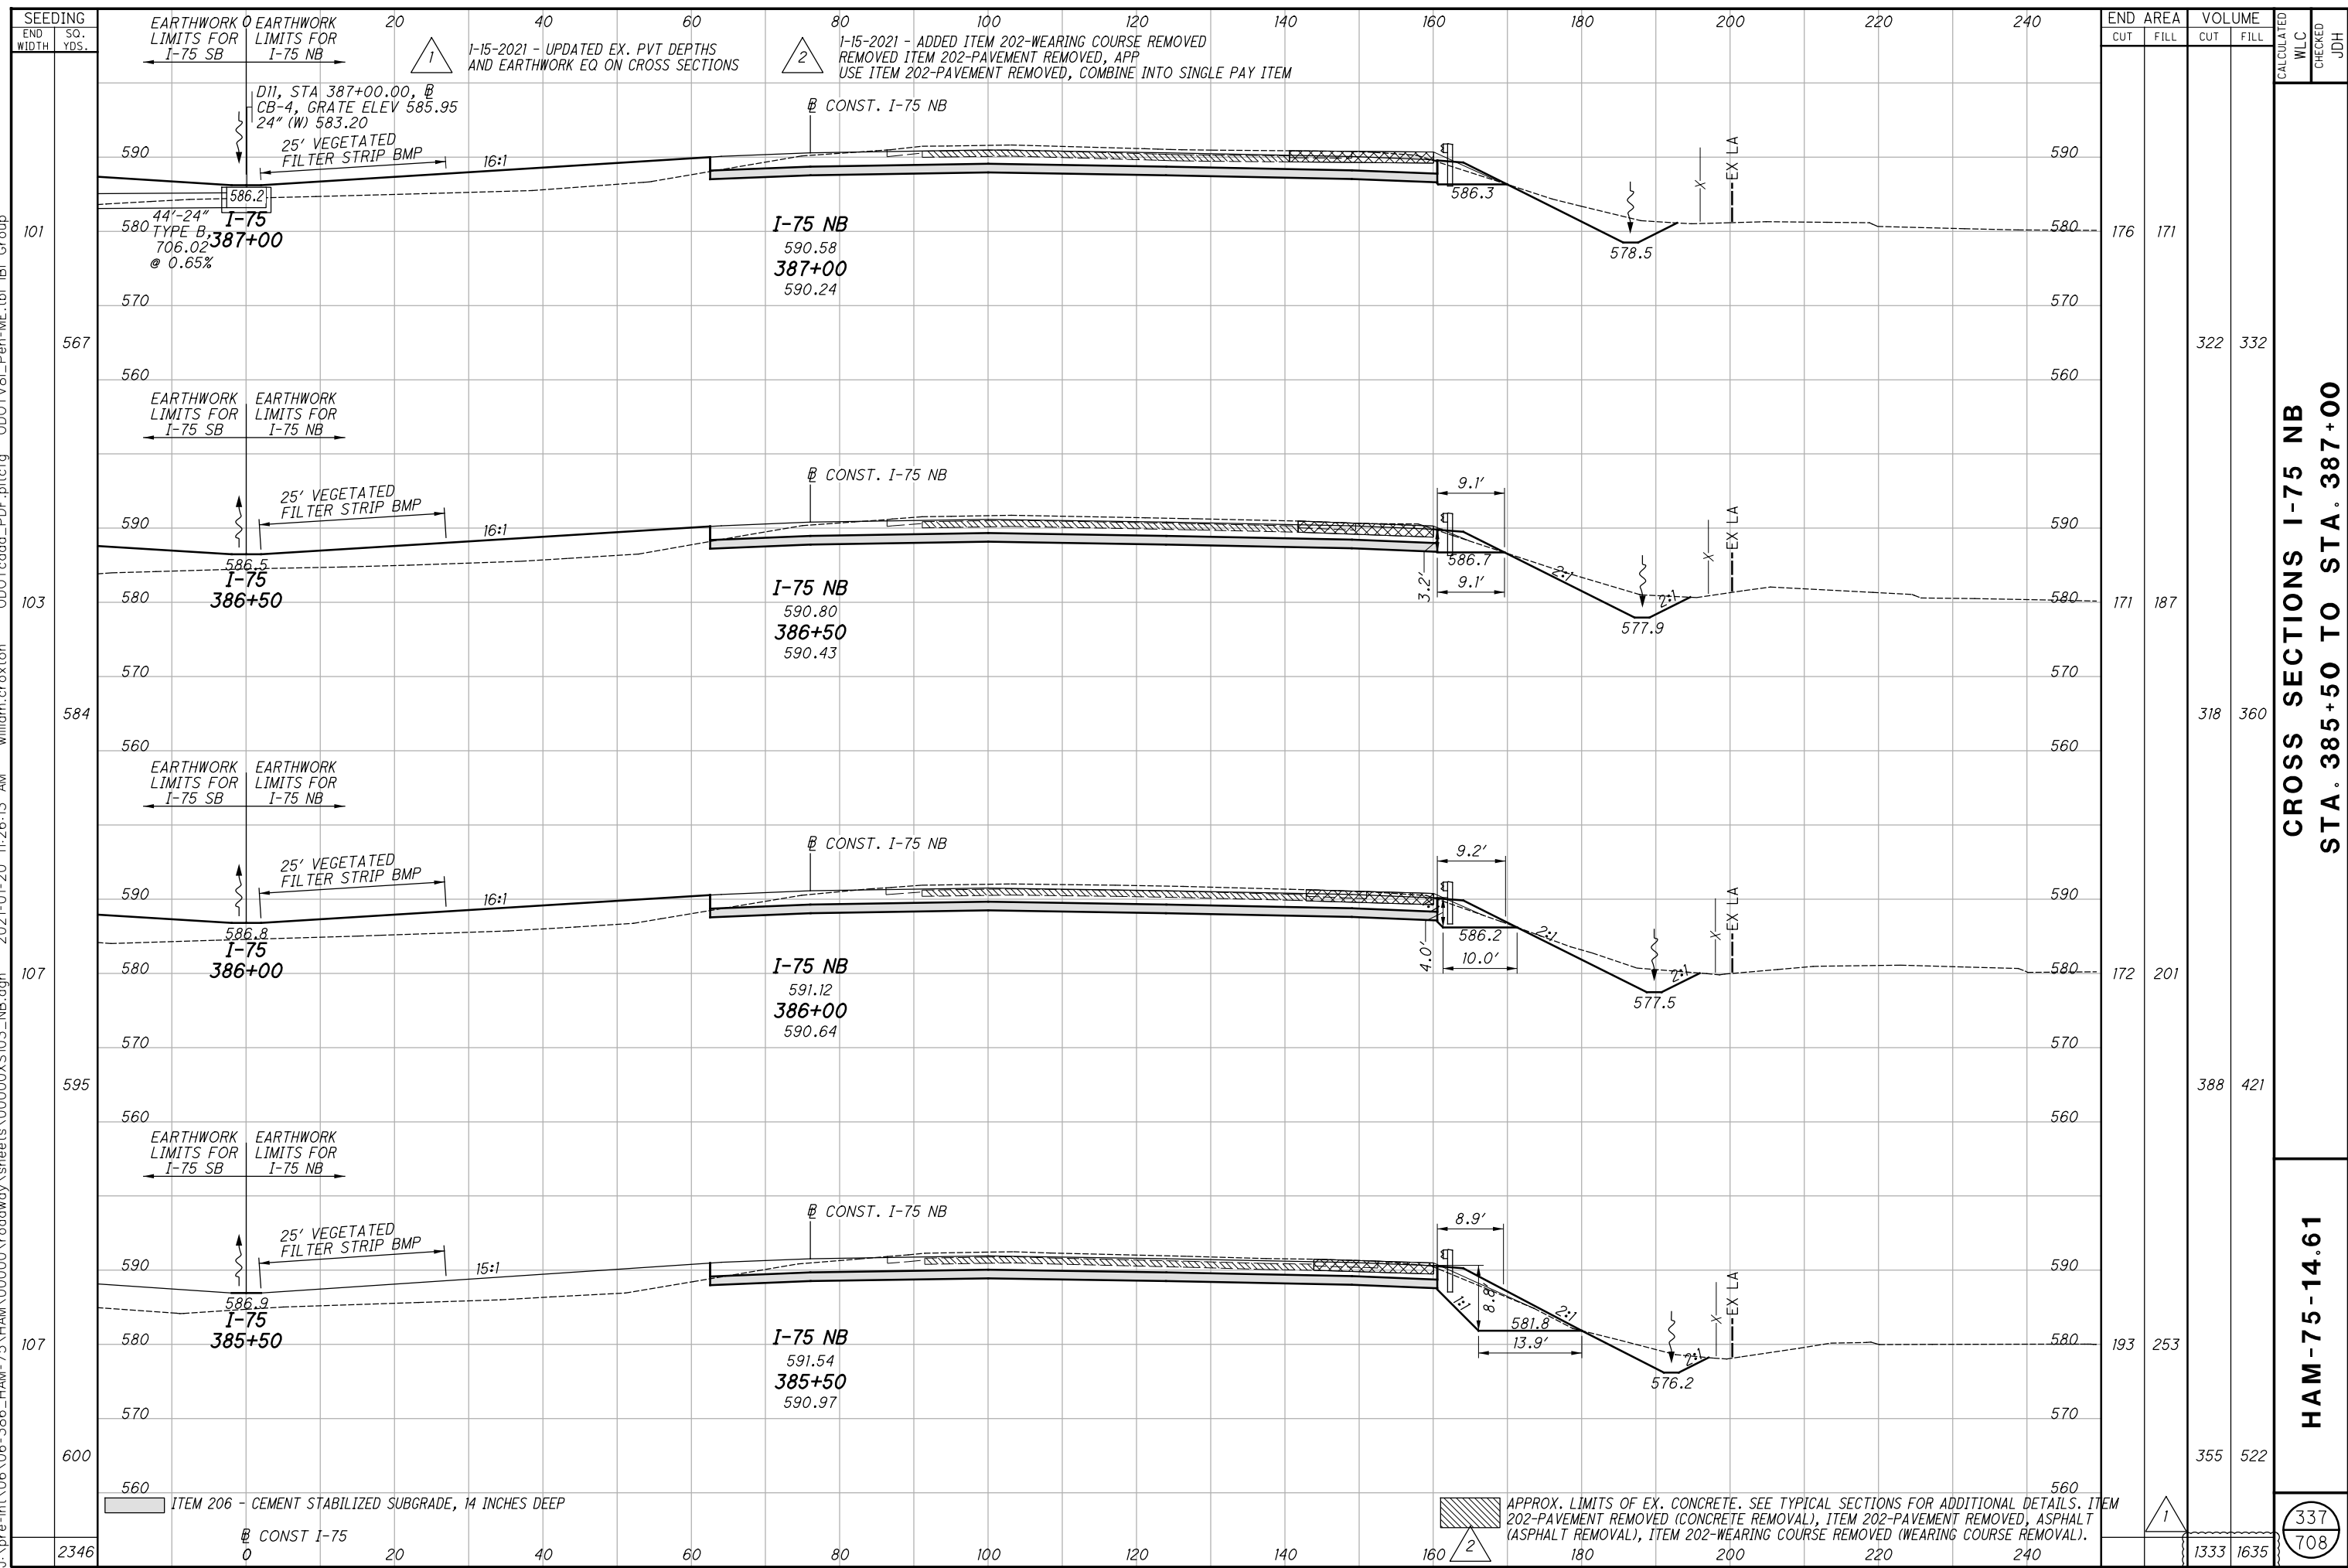


**CROSS SECTIONS I-75 NB  
 STA. 385+50 TO STA. 387+00**

**HAM-75-14.61**

337  
 708



j:\pre-int\06\06-386\_HAM-75\HAM-75\00000\roadway\sheets\00000X5\03\_NB.dgn 2021-01-20 11:26:14 AM william.croxton ODOTcadd\_PDF.pltcfgr \_ODOTV81\_Pen-ME.tbl IBI Group

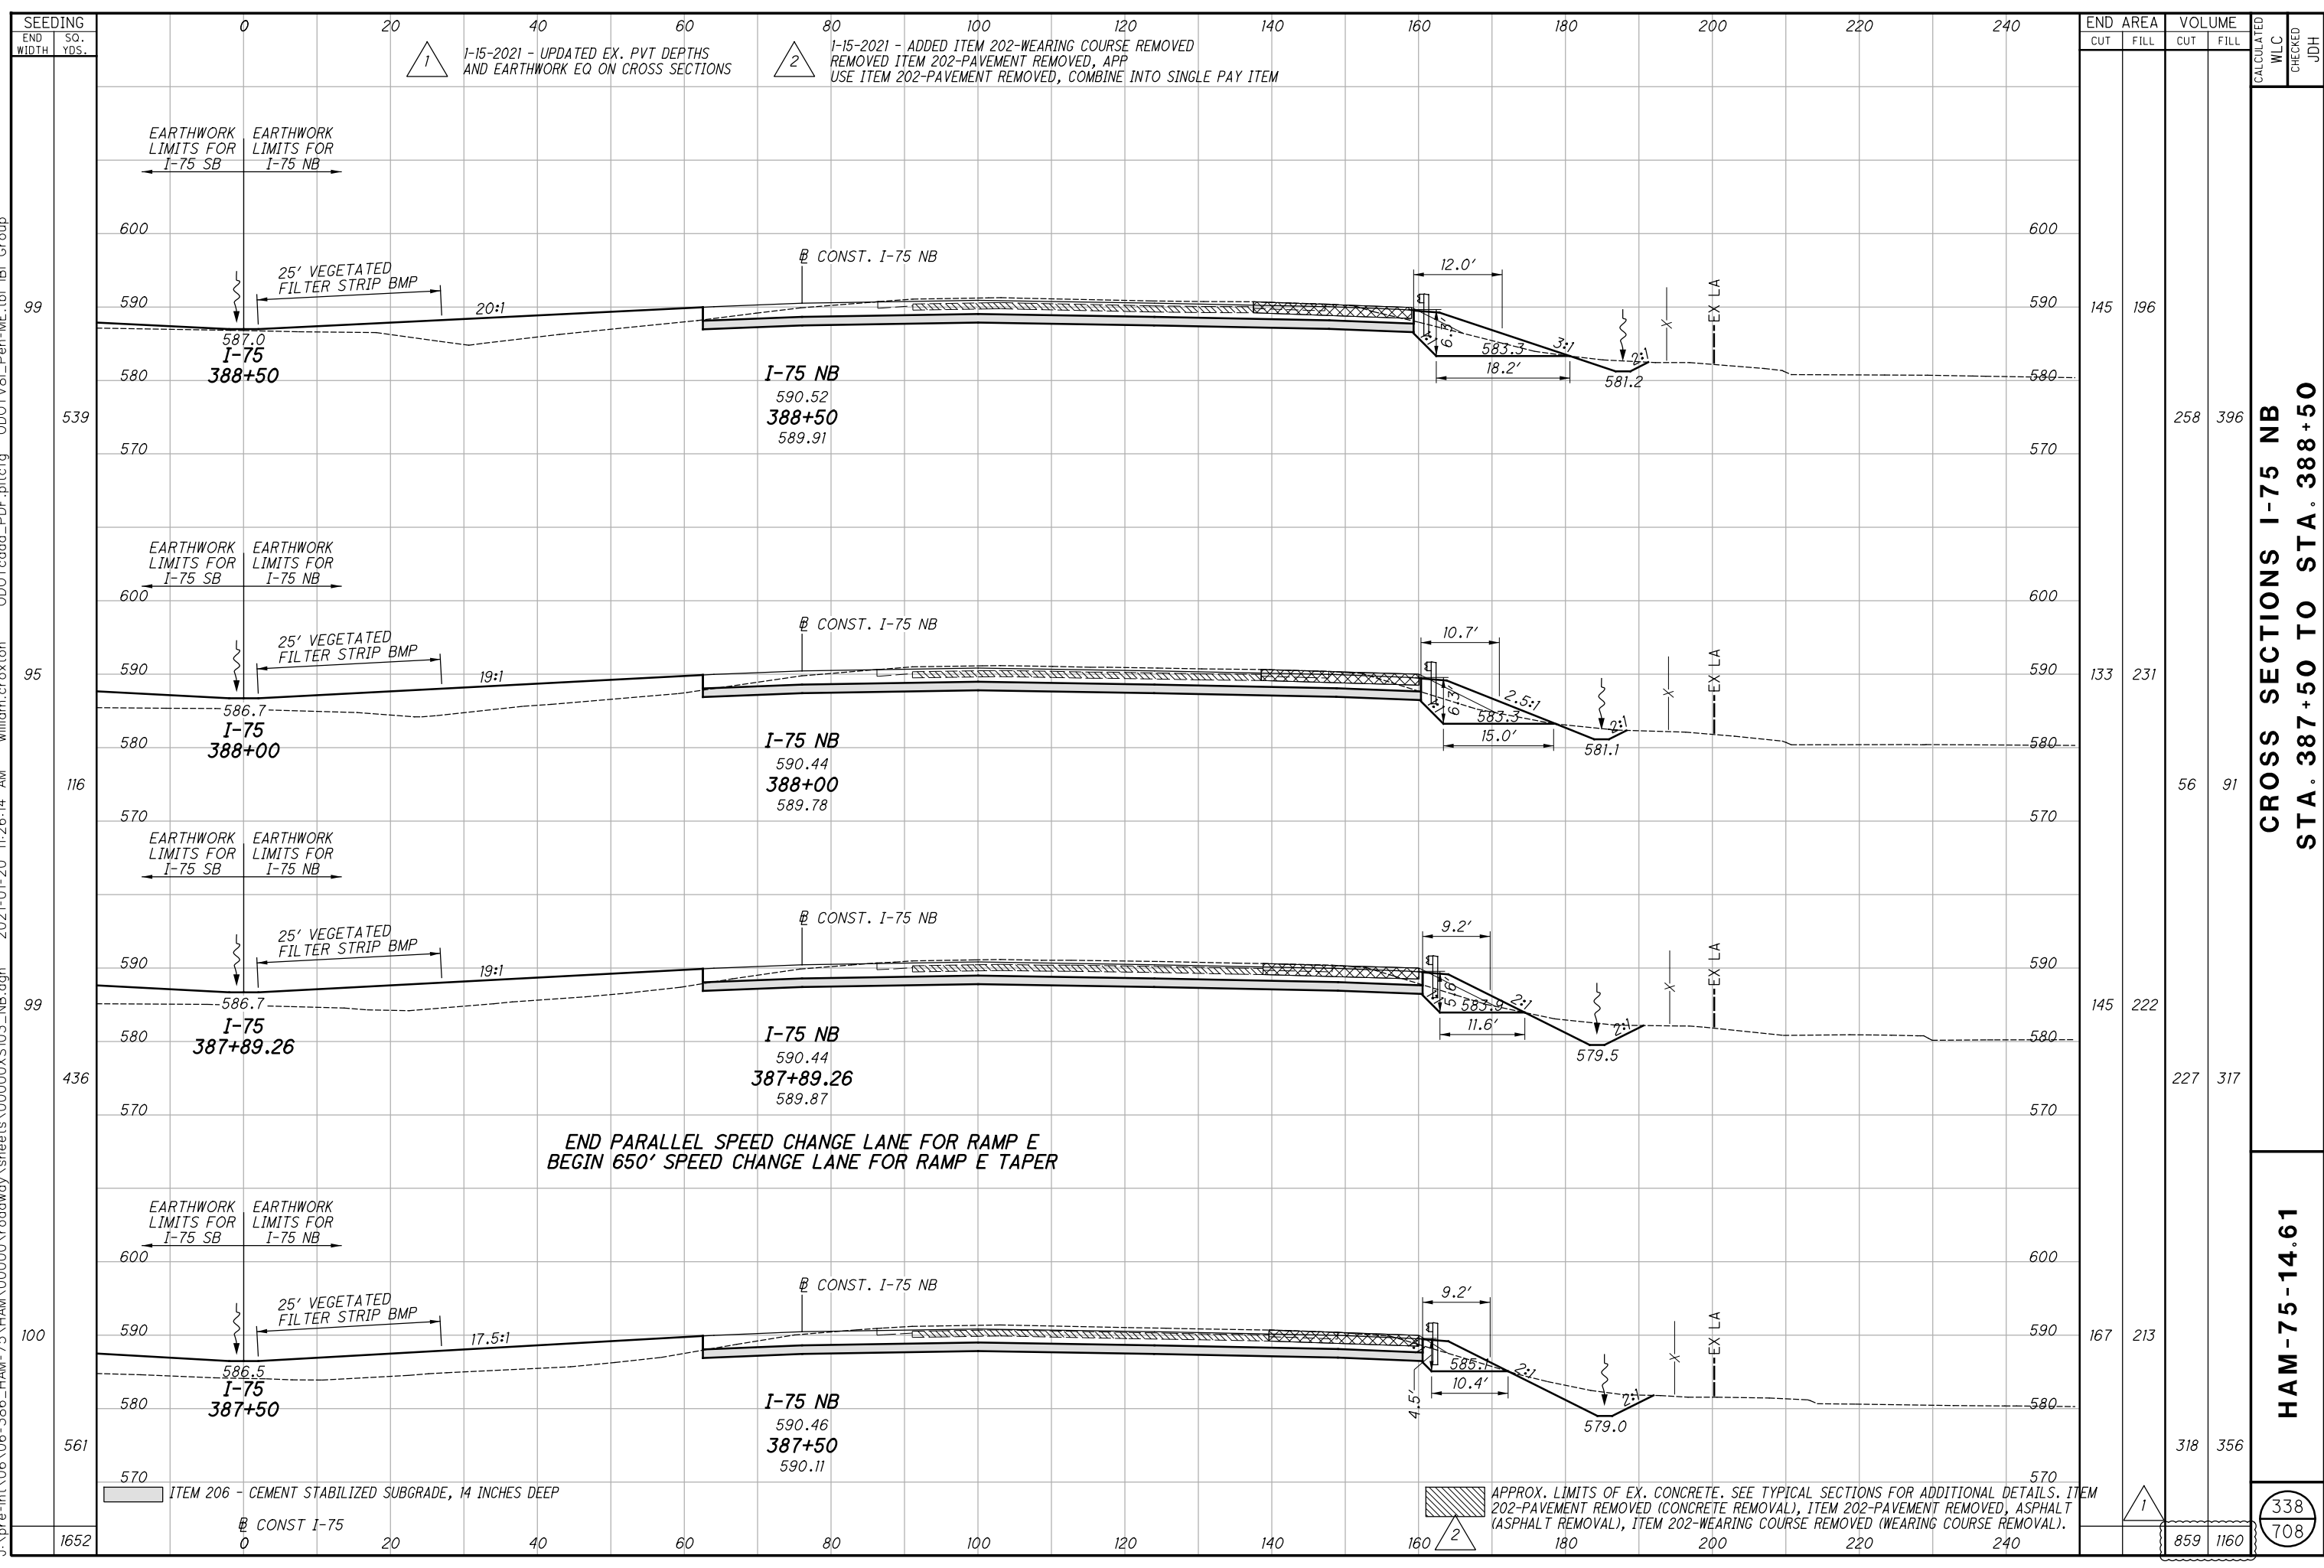


**CROSS SECTIONS I-75 NB  
STA. 387+50 TO STA. 388+50**

**HAM-75-14.61**

338  
708

j:\pre-int\06\06-386\_HAM-75\HAM\00000\roadway\sheets\00000X5103\_NB.dgn 2021-01-20 11:26:16 AM william.croxton ODOTcodd\_PDF.pltcfgr ODOTVBI\_Pen-ME.tbl IBI Group

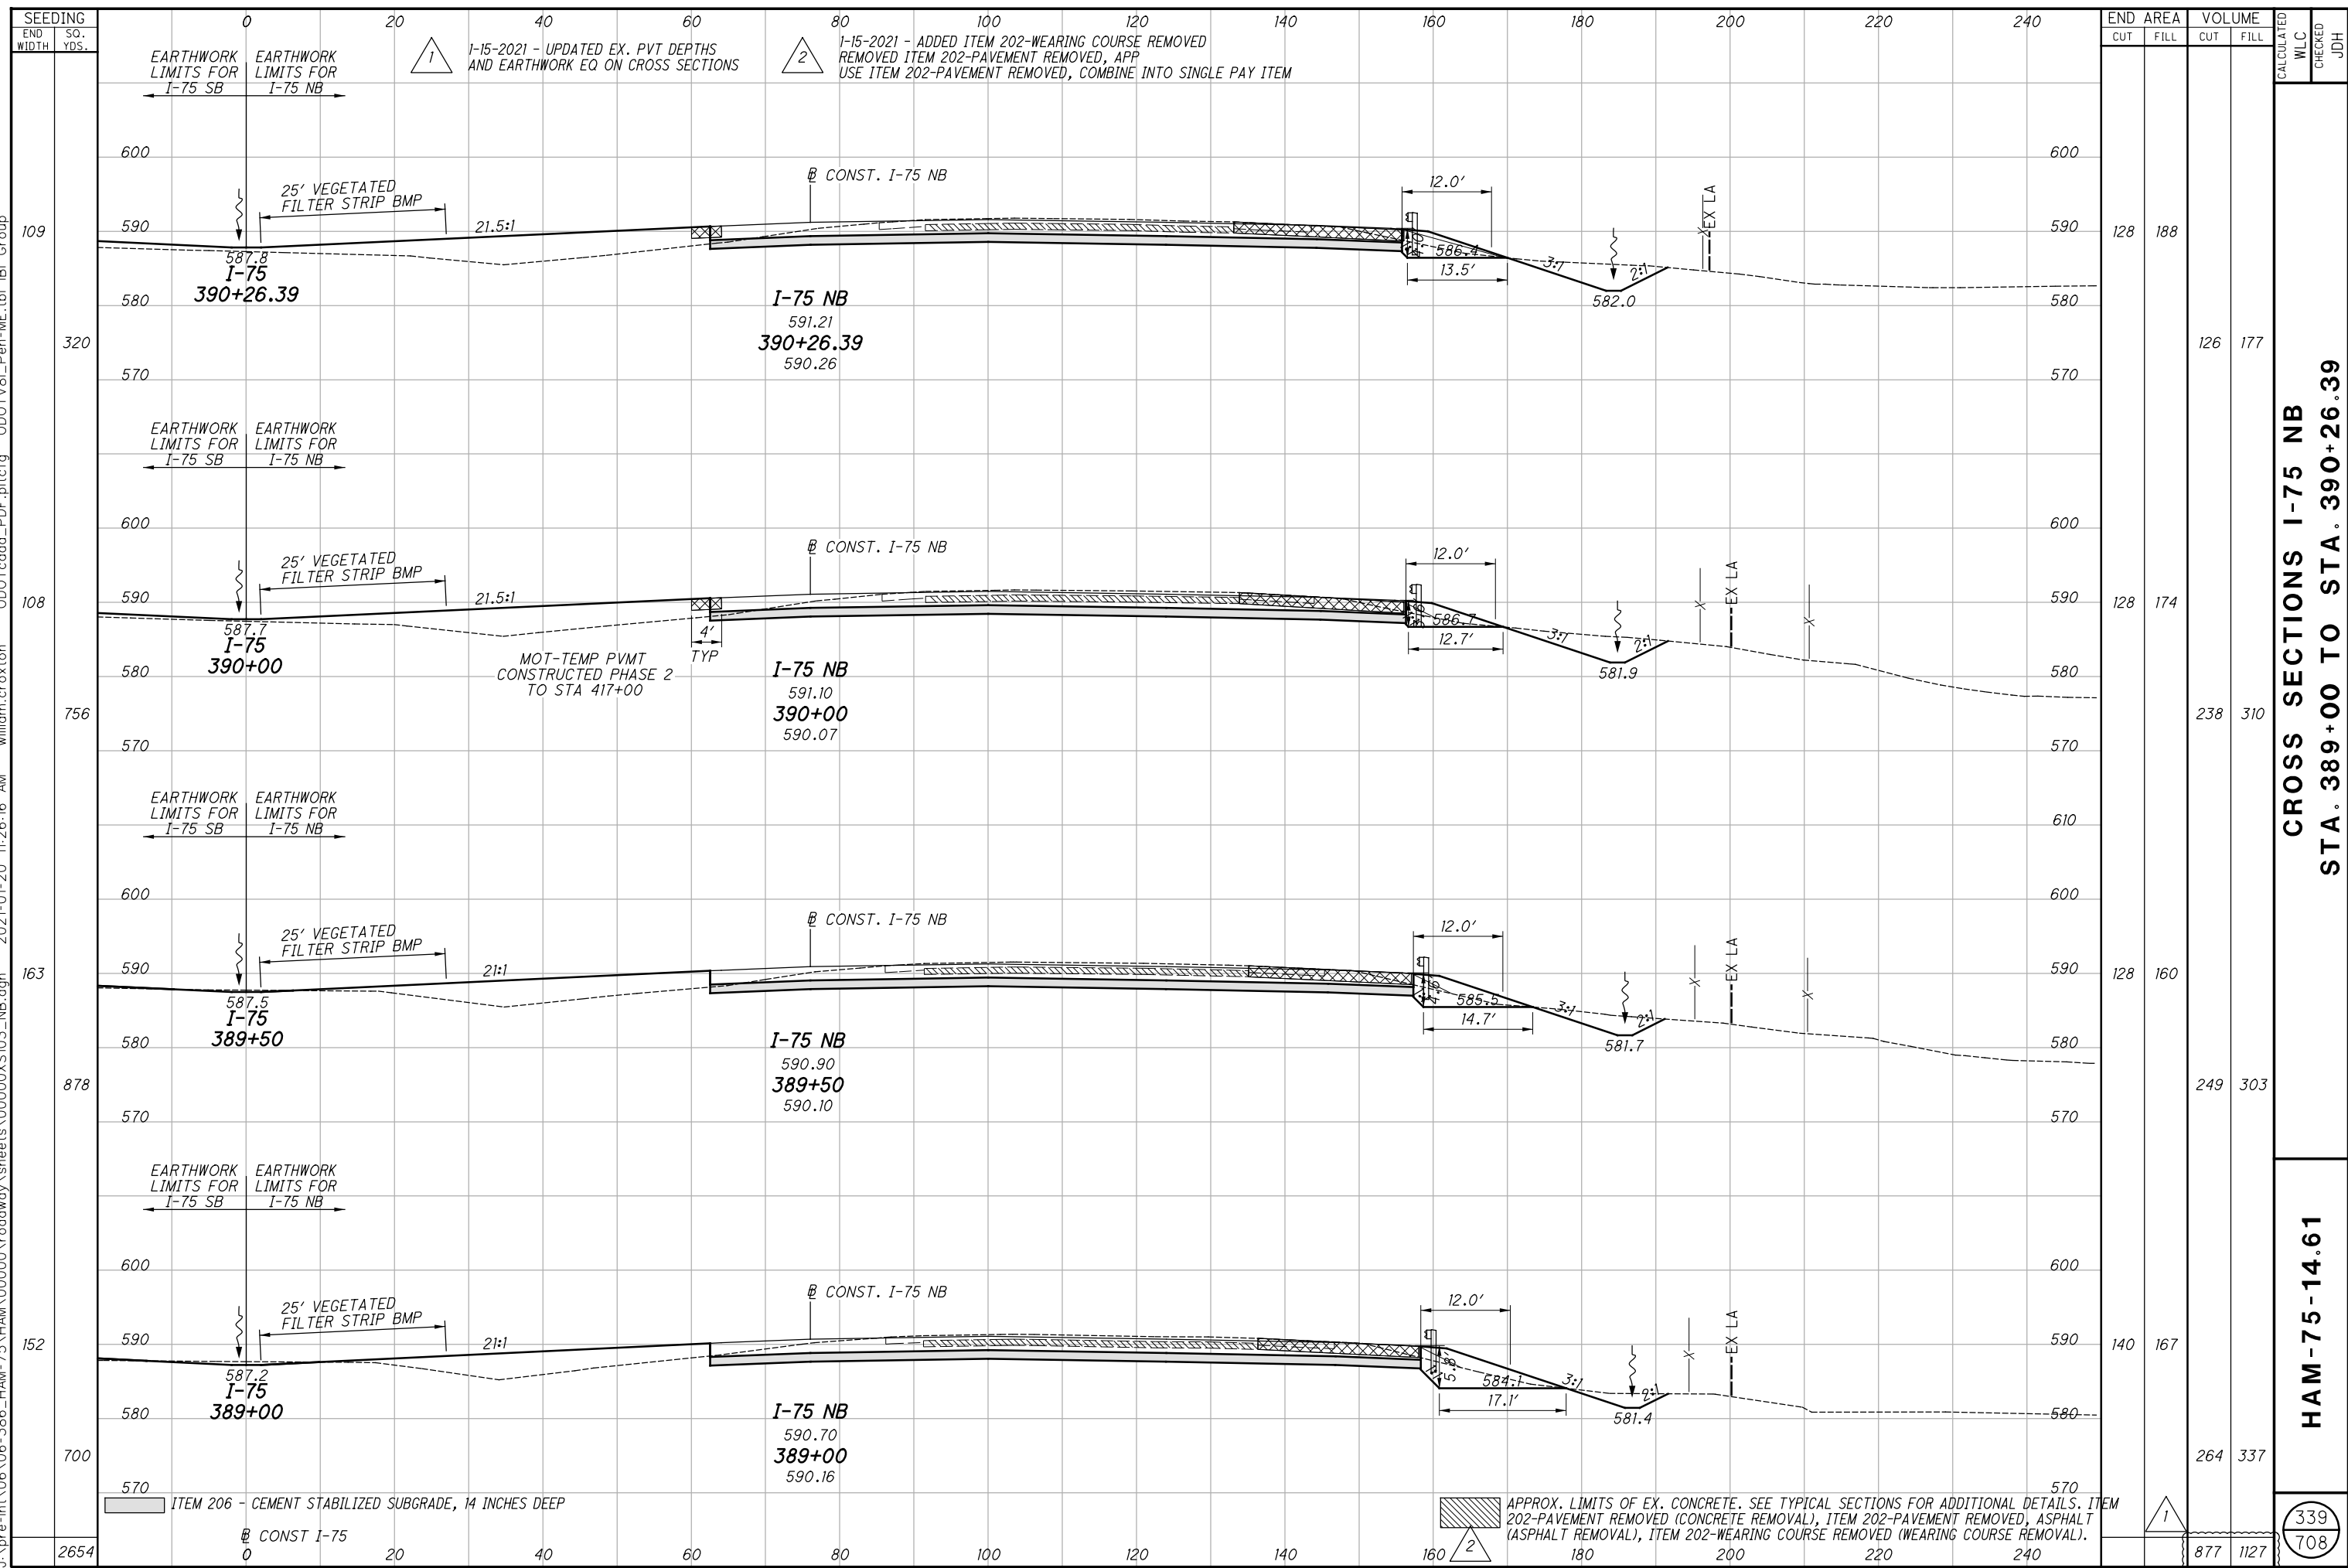

STATION	END AREA		VOLUME		CALCULATED WLC	CHECKED	JDH
	CUT	FILL	CUT	FILL			
390+26.39	128	188	126	177			
390+00	128	174	238	310			
389+50	128	160	249	303			
389+00	140	167	264	337			
<b>TOTAL</b>	<b>877</b>	<b>1127</b>	<b>877</b>	<b>1127</b>			

**CROSS SECTIONS I-75 NB  
STA. 389+00 TO STA. 390+26.39**

**HAM-75-14.61**


339  
708

1-15-2021 - UPDATED EX. PVT DEPTHS AND EARTHWORK EQ ON CROSS SECTIONS  
1-15-2021 - ADDED ITEM 202-WEARING COURSE REMOVED REMOVED ITEM 202-PAVEMENT REMOVED, APP USE ITEM 202-PAVEMENT REMOVED, COMBINE INTO SINGLE PAY ITEM

APPROX. LIMITS OF EX. CONCRETE. SEE TYPICAL SECTIONS FOR ADDITIONAL DETAILS. ITEM 202-PAVEMENT REMOVED (CONCRETE REMOVAL), ITEM 202-PAVEMENT REMOVED, ASPHALT (ASPHALT REMOVAL), ITEM 202-WEARING COURSE REMOVED (WEARING COURSE REMOVAL).

ITEM 206 - CEMENT STABILIZED SUBGRADE, 14 INCHES DEEP

j:\pre-int\06\06-386\_HAM-75\_HAM\00000\roadway\sheets\00000X5103\_NB.dgn 2021-01-20 11:26:17 AM william.croxton ODOTcadd\_PDF.pltcfgr ODOTV81\_Pen-ME.tbl IBI Group

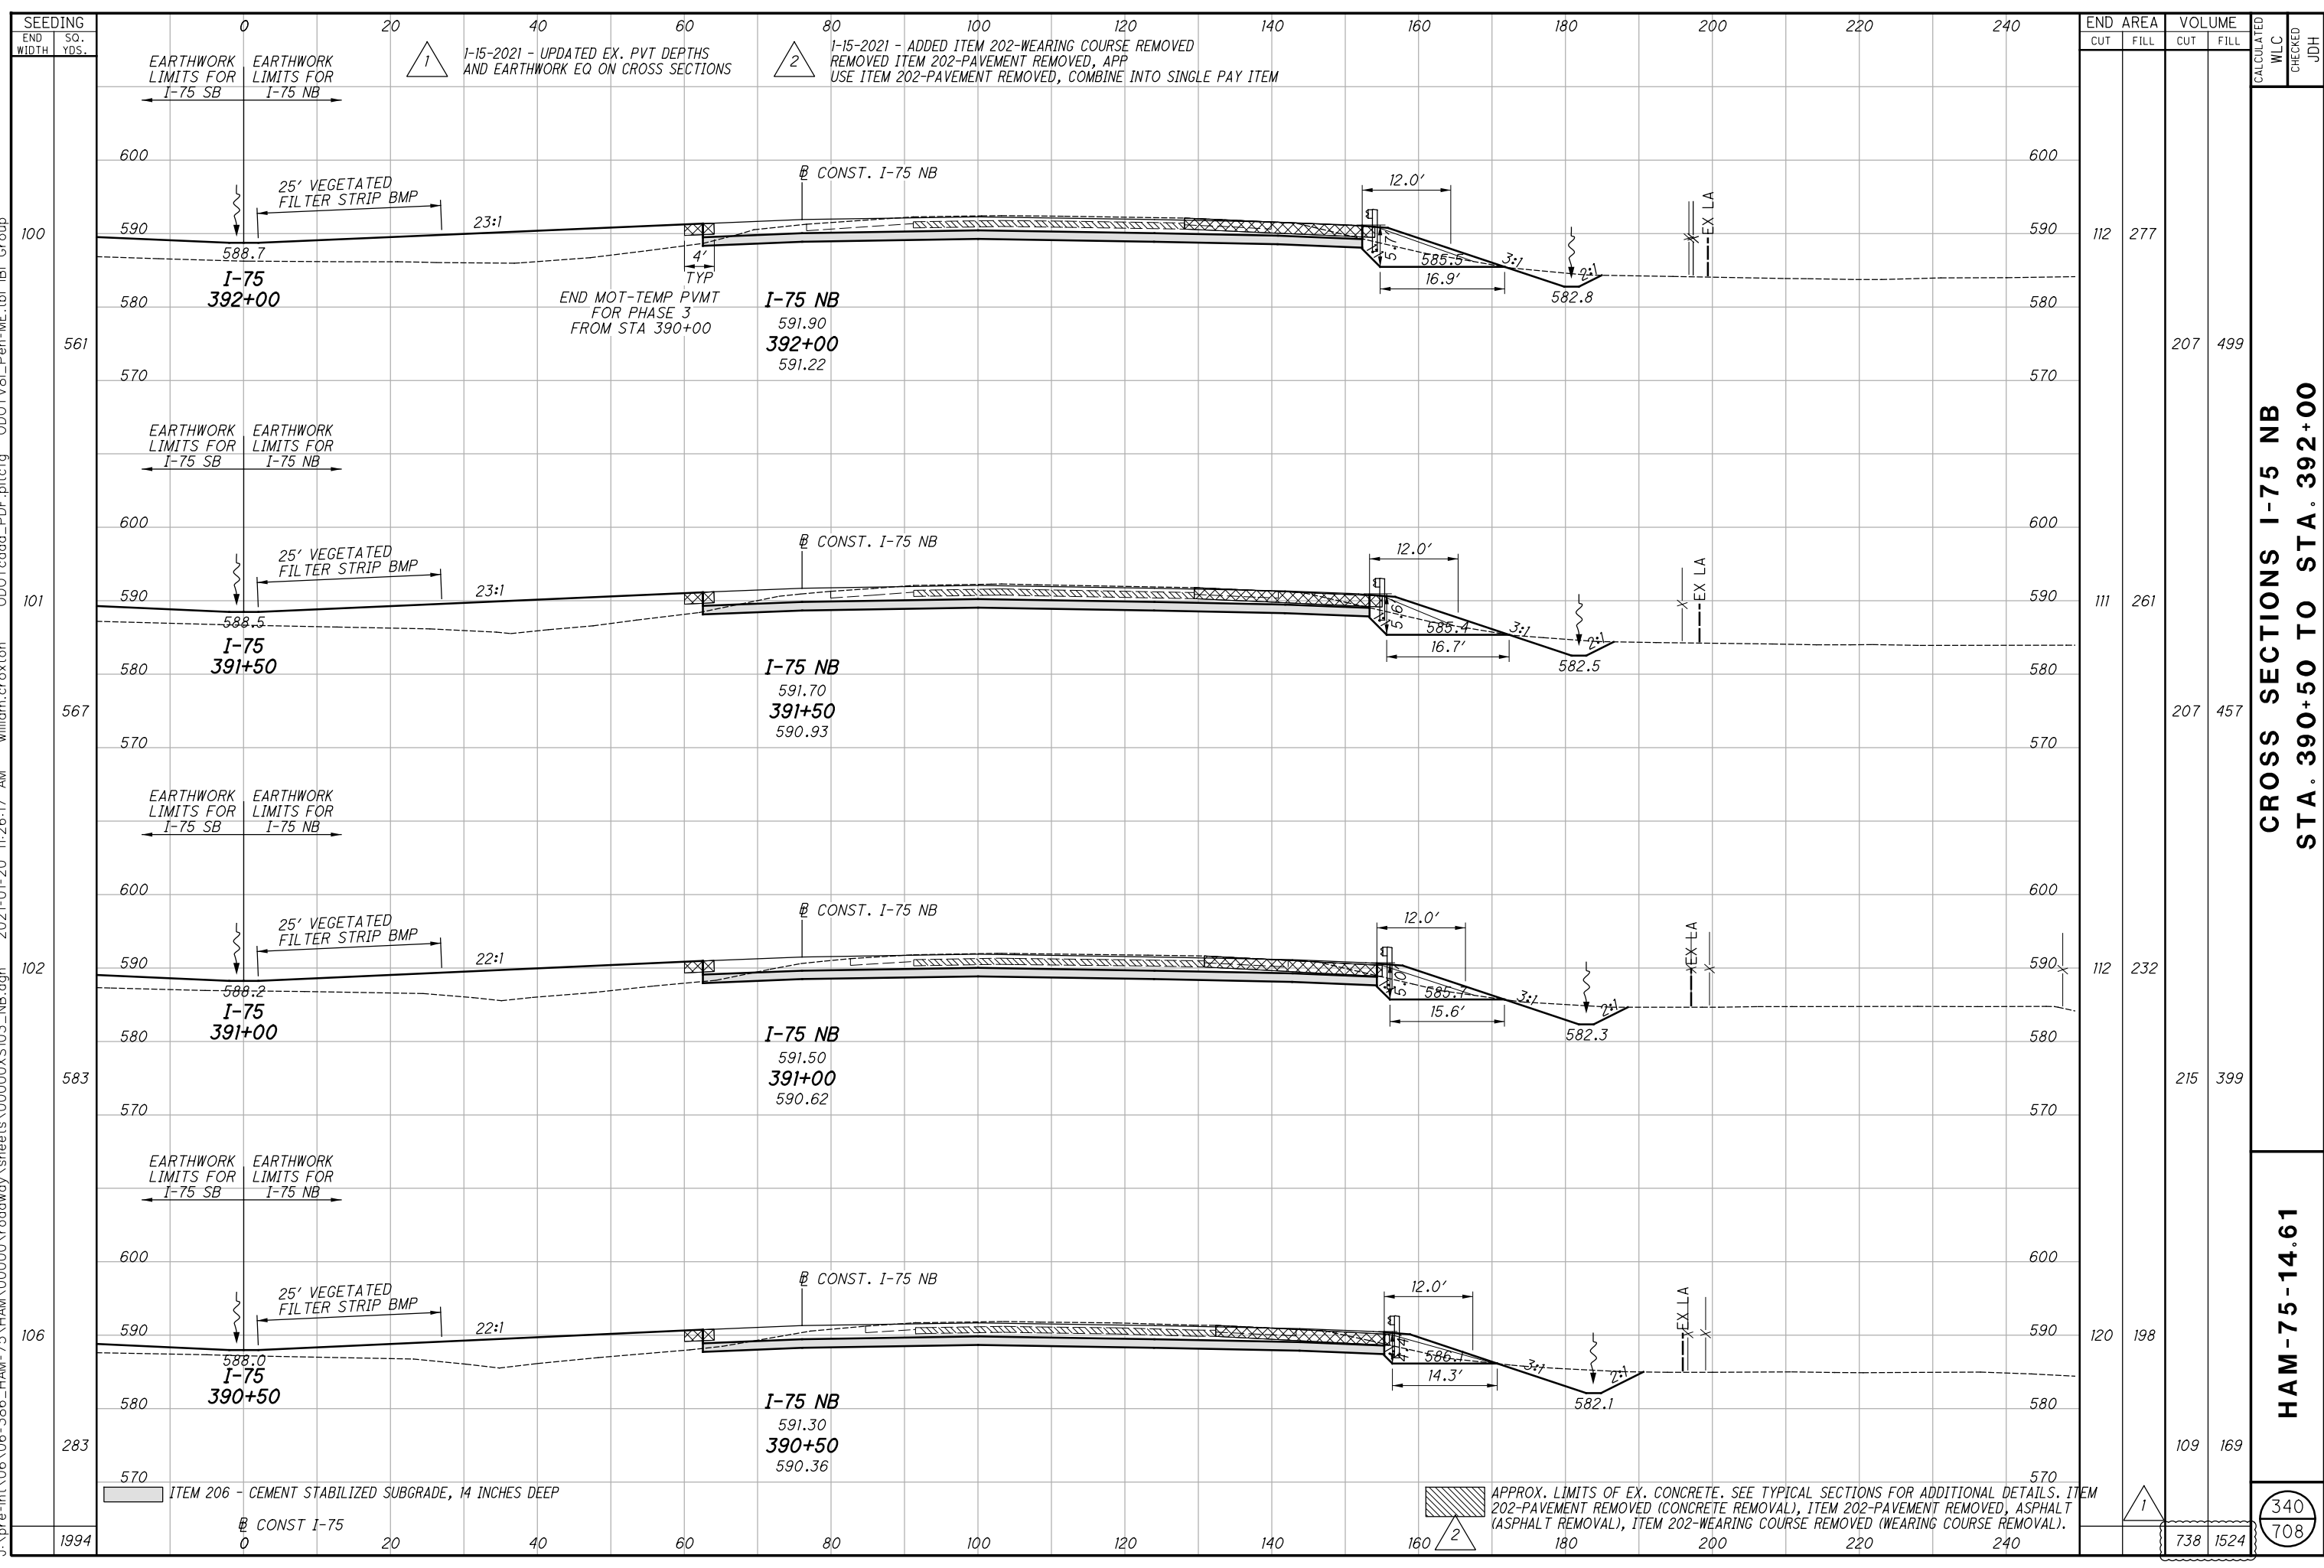

STATION	SEEDING		END AREA		VOLUME		CALCULATED WLC	CHECKED	JDH
	END WIDTH	SO. YDS.	CUT	FILL	CUT	FILL			
392+00			112	277					
391+50			111	261	207	499			
391+00			112	232	207	457			
390+50			120	198	215	399			
390+50			109	169					
TOTAL			738	1524					

CROSS SECTIONS I-75 NB  
STA. 390+50 TO STA. 392+00

HAM-75-14.61

340  
708

APPROX. LIMITS OF EX. CONCRETE. SEE TYPICAL SECTIONS FOR ADDITIONAL DETAILS. ITEM 202-PAVEMENT REMOVED (CONCRETE REMOVAL), ITEM 202-PAVEMENT REMOVED, ASPHALT (ASPHALT REMOVAL), ITEM 202-WEARING COURSE REMOVED (WEARING COURSE REMOVAL).


1-15-2021 - UPDATED EX. PVT DEPTHS AND EARTHWORK EQ ON CROSS SECTIONS  
1-15-2021 - ADDED ITEM 202-WEARING COURSE REMOVED REMOVED ITEM 202-PAVEMENT REMOVED, APP USE ITEM 202-PAVEMENT REMOVED, COMBINE INTO SINGLE PAY ITEM

ITEM 206 - CEMENT STABILIZED SUBGRADE, 14 INCHES DEEP

CONST I-75



j:\pre-int\06\06-386\_HAM-75\HAM\00000\roadway\sheets\00000X5103\_NB.dgn 2021-01-20 11:26:19 AM william.croxton ODOT\cadd\_PDF.plt cfbg ODOTVBI\_Pen-ME.tbl IBI Group

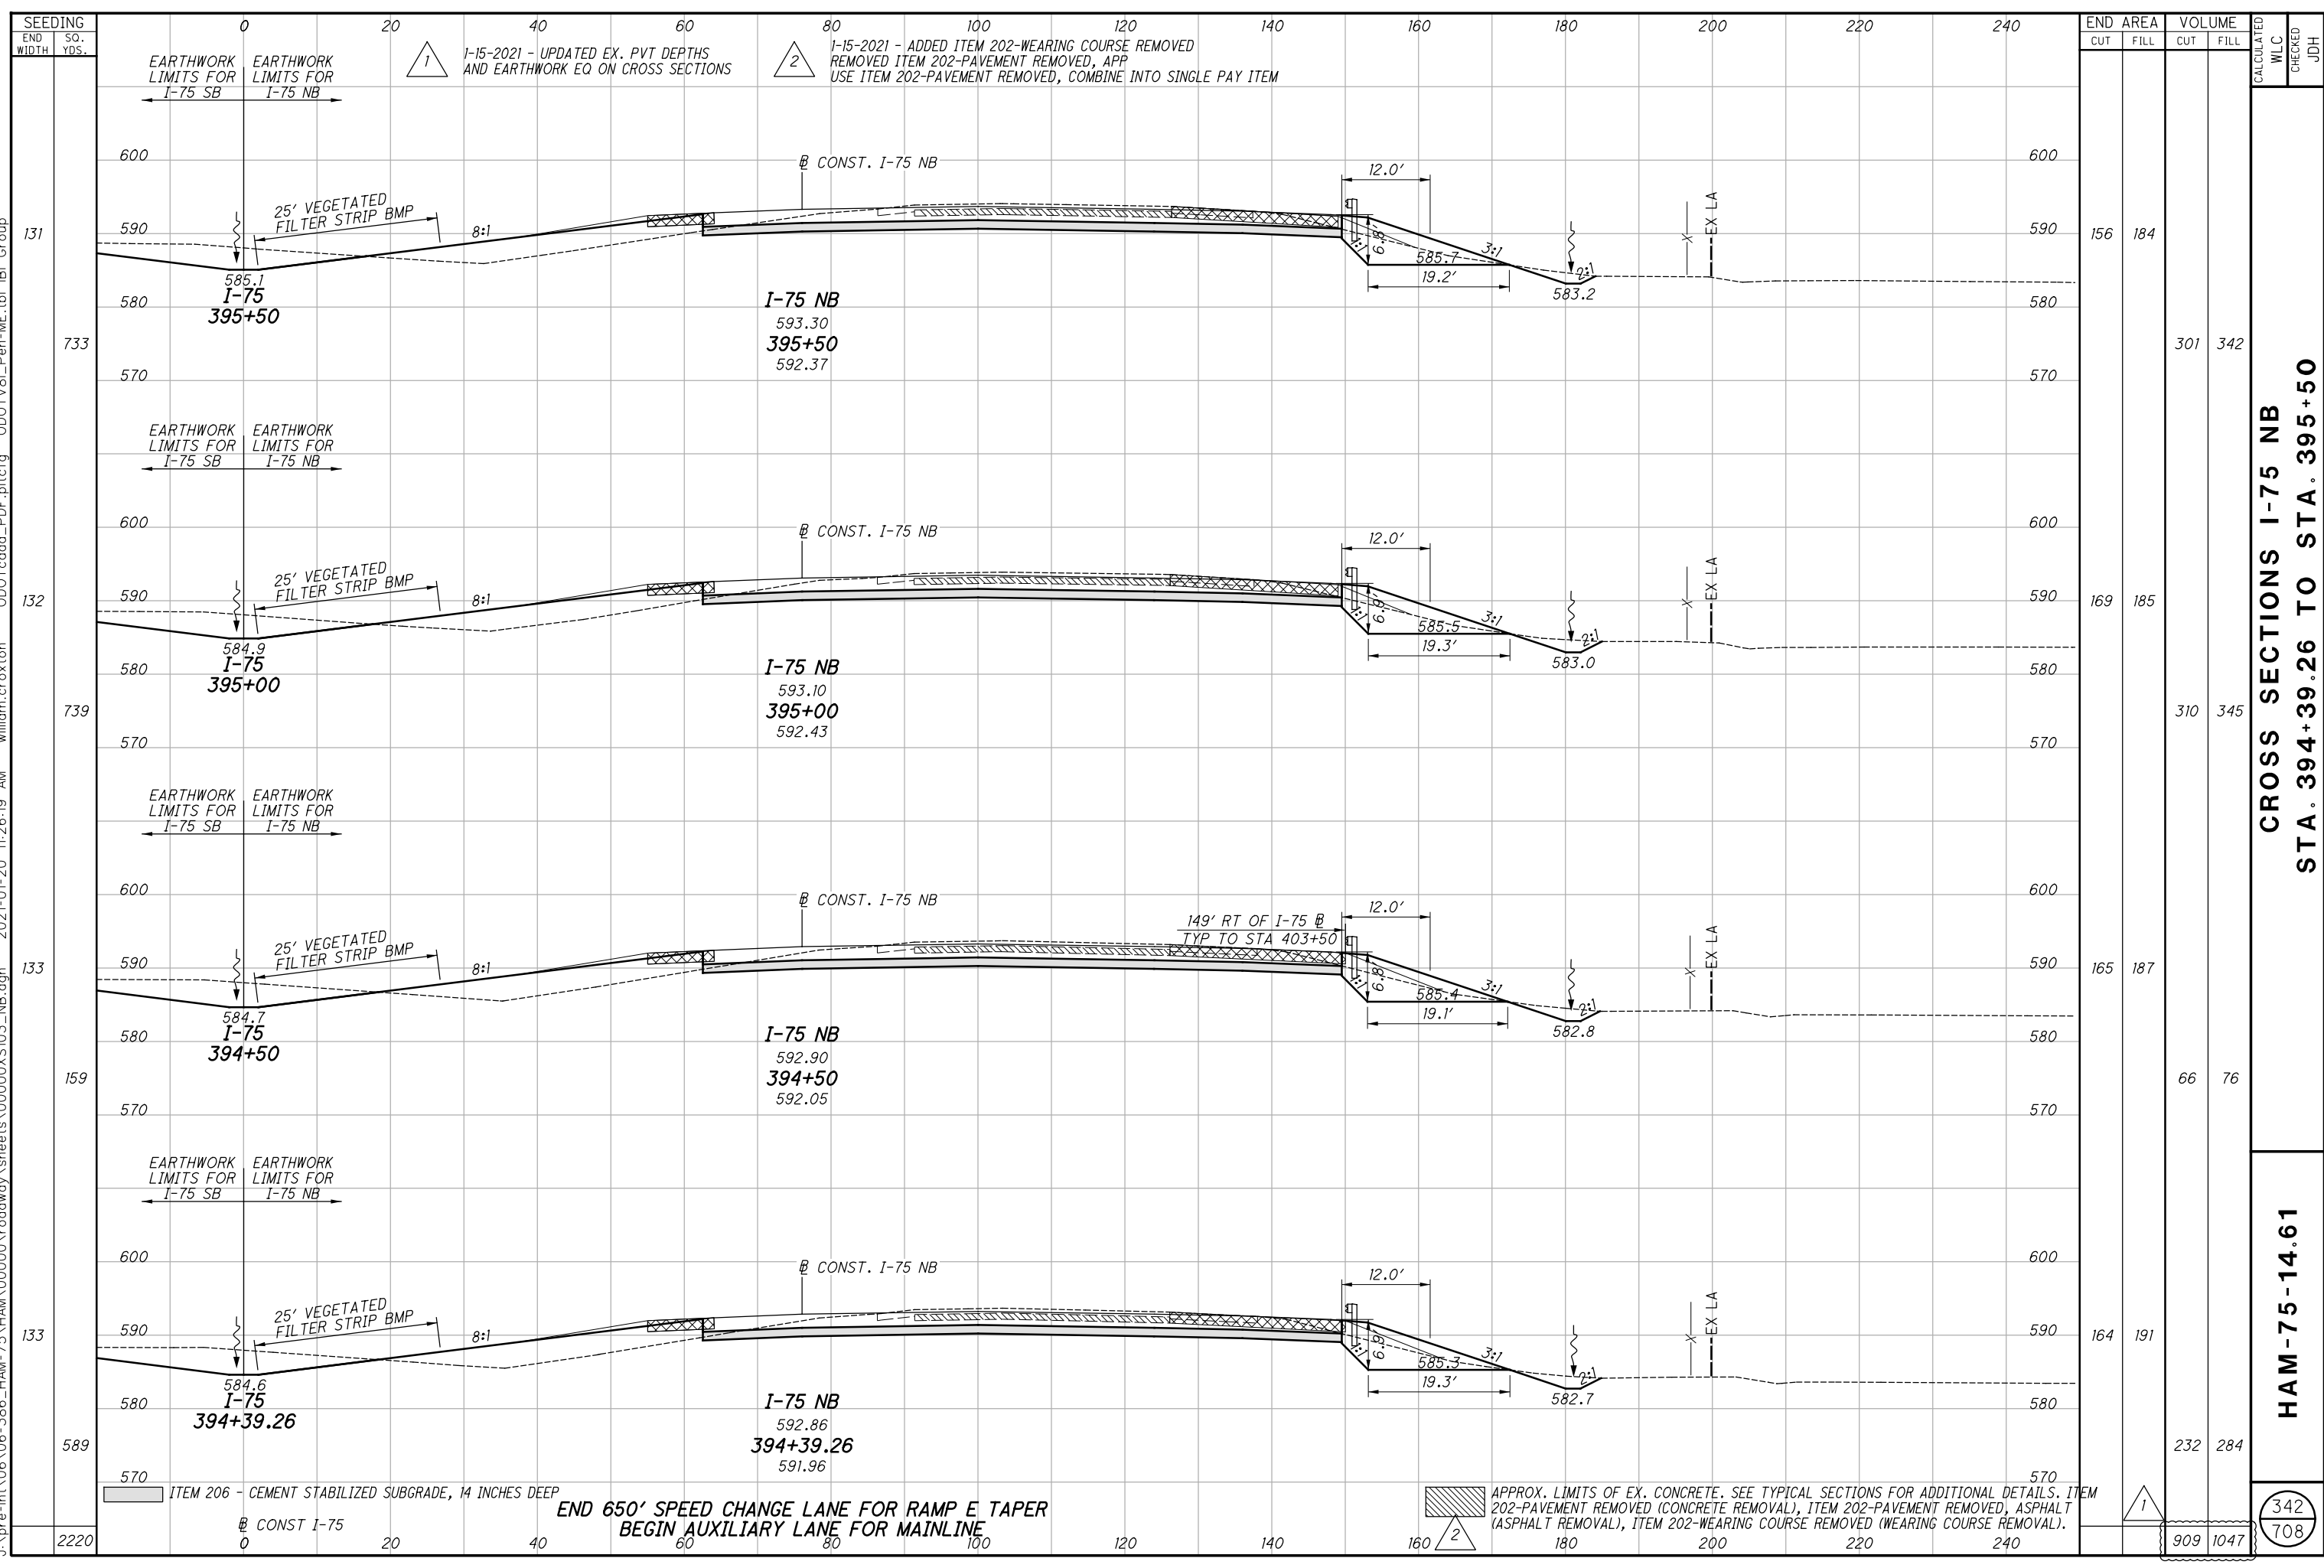

CROSS SECTIONS I-75 NB  
STA. 394+39.26 TO STA. 395+50

HAM-75-14.61

342  
708


SEEDING	END AREA		VOLUME		CALCULATED WLC	CHECKED	JDH
	END WIDTH	SO. YDS.	CUT	FILL			
	131	733	156	184	301	342	
	132	739	169	185	310	345	
	133	159	165	187	66	76	
	133	589	164	191	232	284	
	2220		909	1047	342	708	

ITEM 206 - CEMENT STABILIZED SUBGRADE, 14 INCHES DEEP  
 END 650' SPEED CHANGE LANE FOR RAMP E TAPER BEGIN AUXILIARY LANE FOR MAINLINE  
 APPROX. LIMITS OF EX. CONCRETE. SEE TYPICAL SECTIONS FOR ADDITIONAL DETAILS. ITEM 202-PAVEMENT REMOVED (CONCRETE REMOVAL), ITEM 202-PAVEMENT REMOVED, ASPHALT (ASPHALT REMOVAL), ITEM 202-WEARING COURSE REMOVED (WEARING COURSE REMOVAL).

1-15-2021 - UPDATED EX. PVT DEPTHS AND EARTHWORK EQ ON CROSS SECTIONS  
 1-15-2021 - ADDED ITEM 202-WEARING COURSE REMOVED REMOVED ITEM 202-PAVEMENT REMOVED, APP USE ITEM 202-PAVEMENT REMOVED, COMBINE INTO SINGLE PAY ITEM

EARTHWORK LIMITS FOR I-75 SB  
 EARTHWORK LIMITS FOR I-75 NB  
 25' VEGETATED FILTER STRIP BMP  
 8:1  
 CONST. I-75 NB  
 12.0'  
 3:1  
 EX LA  
 I-75 NB  
 149' RT OF I-75 NB TYP TO STA 403+50  
 19.2'  
 19.3'  
 19.1'  
 19.3'

j:\pre-int\06\06-386\_HAM-75\HAM-75\HAM-75\roadway\sheets\00000X5103\_NB.dgn 2021-01-20 11:26:20 AM william.croxton ODOT\cadd\_PDF.plt c:\odot\cadd\_PDF.plt IBI Group

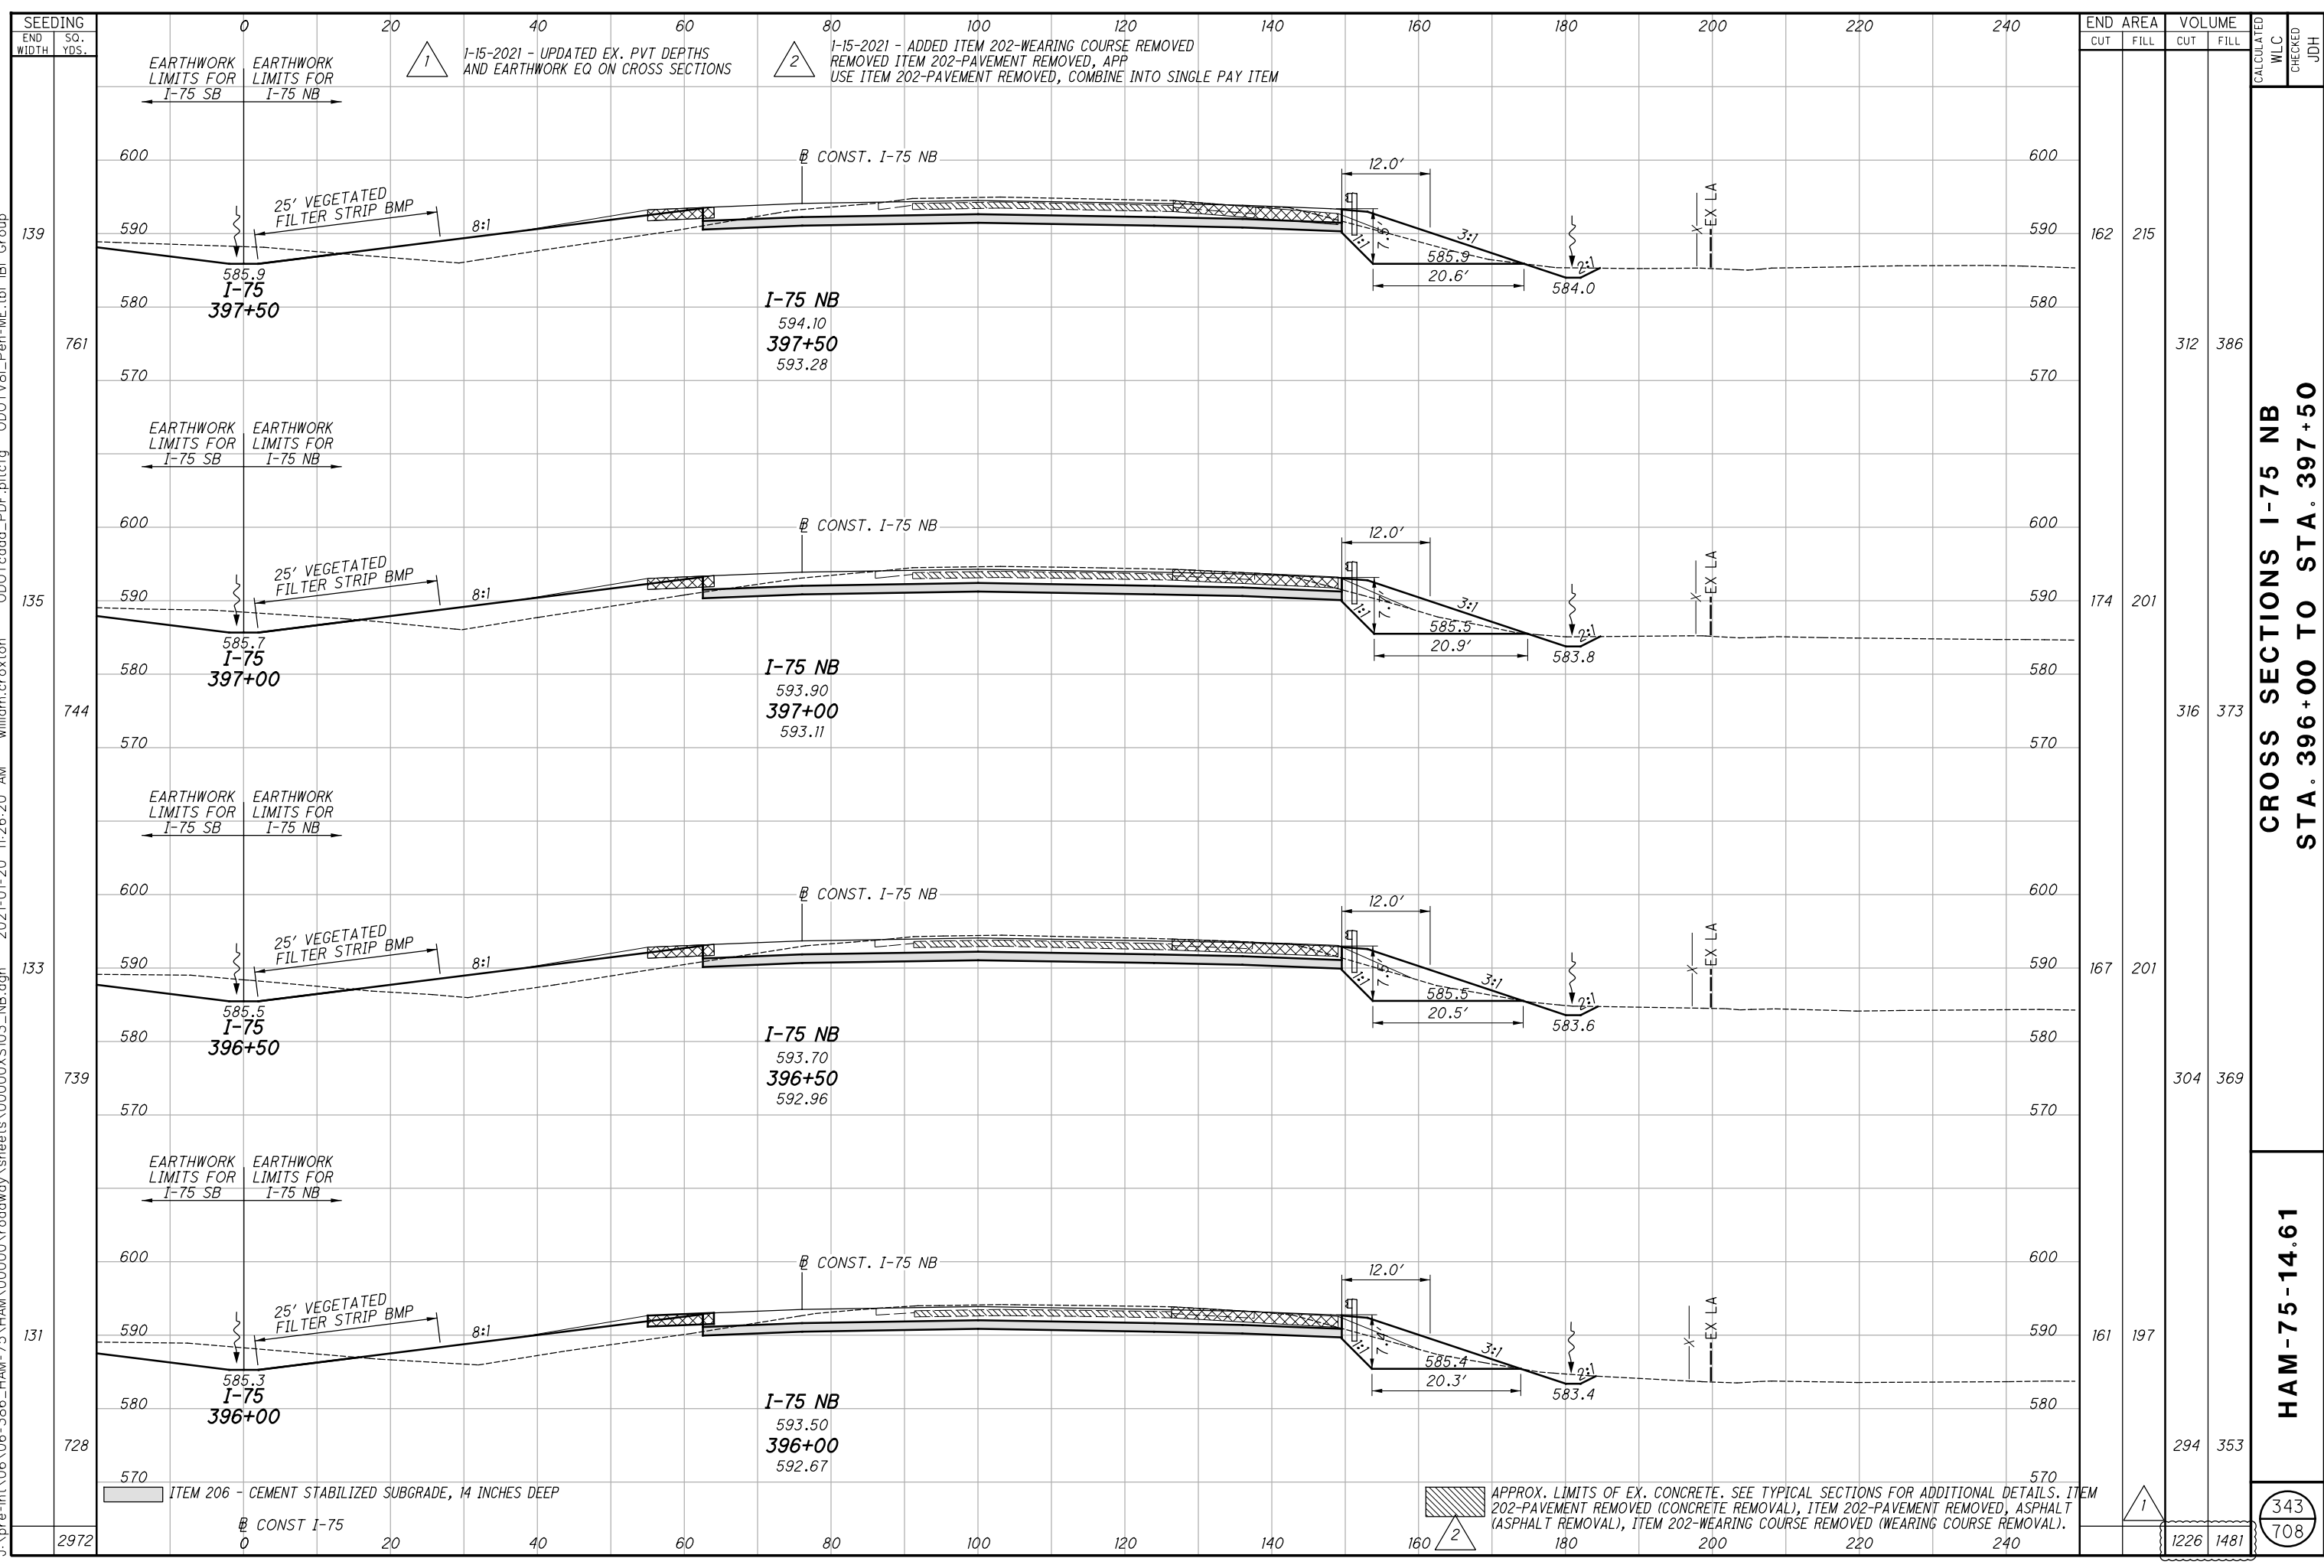

END STA	AREA		VOLUME		CALCULATED WLC	CHECKED	JDH
	CUT	FILL	CUT	FILL			
397+50	162	215	312	386			
397+00	174	201	316	373			
396+50	167	201	304	369			
396+00	161	197	294	353			
TOTAL	1226	1481					

**CROSS SECTIONS I-75 NB  
STA. 396+00 TO STA. 397+50**

**HAM-75-14.61**

343  
708

SEEDING  
END WIDTH SO. YDS.

1-15-2021 - UPDATED EX. PVT DEPTHS AND EARTHWORK EQ ON CROSS SECTIONS

1-15-2021 - ADDED ITEM 202-WEARING COURSE REMOVED REMOVED ITEM 202-PAVEMENT REMOVED, APP USE ITEM 202-PAVEMENT REMOVED, COMBINE INTO SINGLE PAY ITEM

EARTHWORK LIMITS FOR I-75 SB

EARTHWORK LIMITS FOR I-75 NB

EARTHWORK LIMITS FOR I-75 SB

EARTHWORK LIMITS FOR I-75 NB


EARTHWORK LIMITS FOR I-75 SB

EARTHWORK LIMITS FOR I-75 NB

ITEM 206 - CEMENT STABILIZED SUBGRADE, 14 INCHES DEEP

APPROX. LIMITS OF EX. CONCRETE. SEE TYPICAL SECTIONS FOR ADDITIONAL DETAILS. ITEM 202-PAVEMENT REMOVED (CONCRETE REMOVAL), ITEM 202-PAVEMENT REMOVED, ASPHALT (ASPHALT REMOVAL), ITEM 202-WEARING COURSE REMOVED (WEARING COURSE REMOVAL).

j:\pre-int\06\06-386\_HAM-75\_HAM\00000\roadway\sheets\00000X5103\_NB.dgn 2021-01-20 11:26:22 AM william.croxton ODOTcadd\_PDF.plt c:\odot\ib\Group

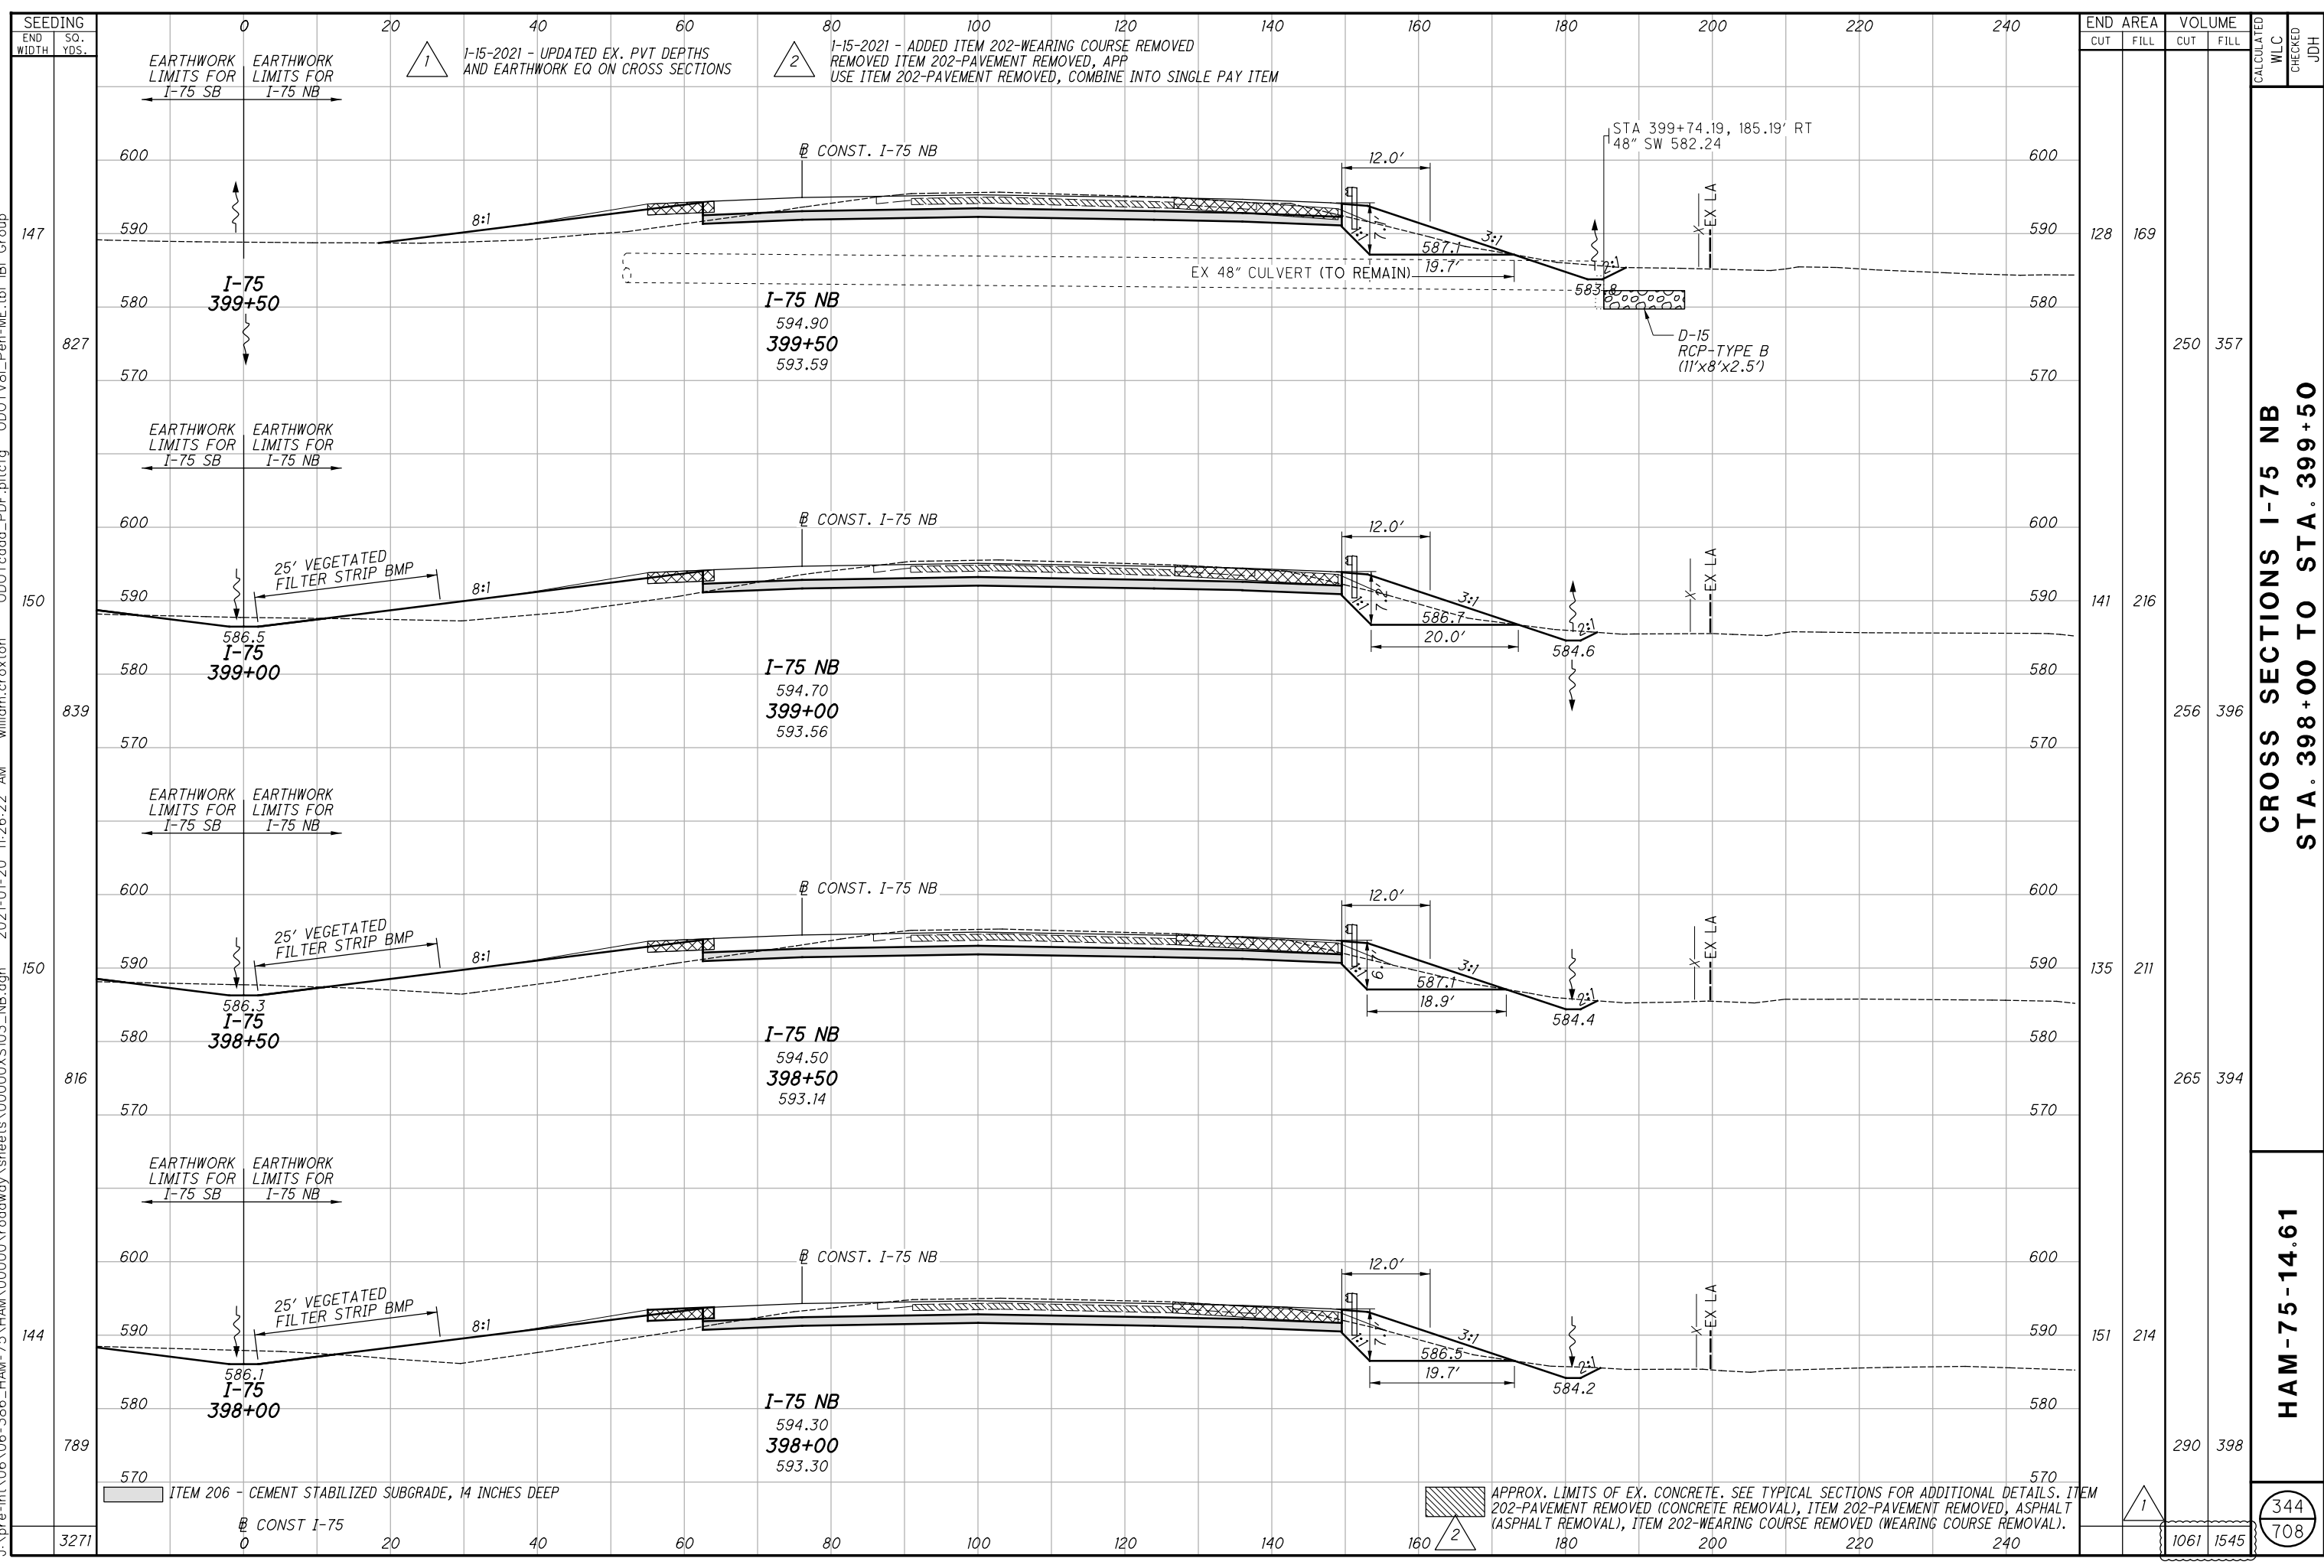


**CROSS SECTIONS I-75 NB  
STA. 398+00 TO STA. 399+50**

**HAM-75-14.61**


344  
708

j:\pre-int\06\06-386\_HAM-75\HAM-75\HAM-00000\roadway\sheets\00000X5103\_NB.dgn 2021-01-20 11:26:23 AM william.croxton ODOTcadd\_PDF.plt c:\odot\ib\Group

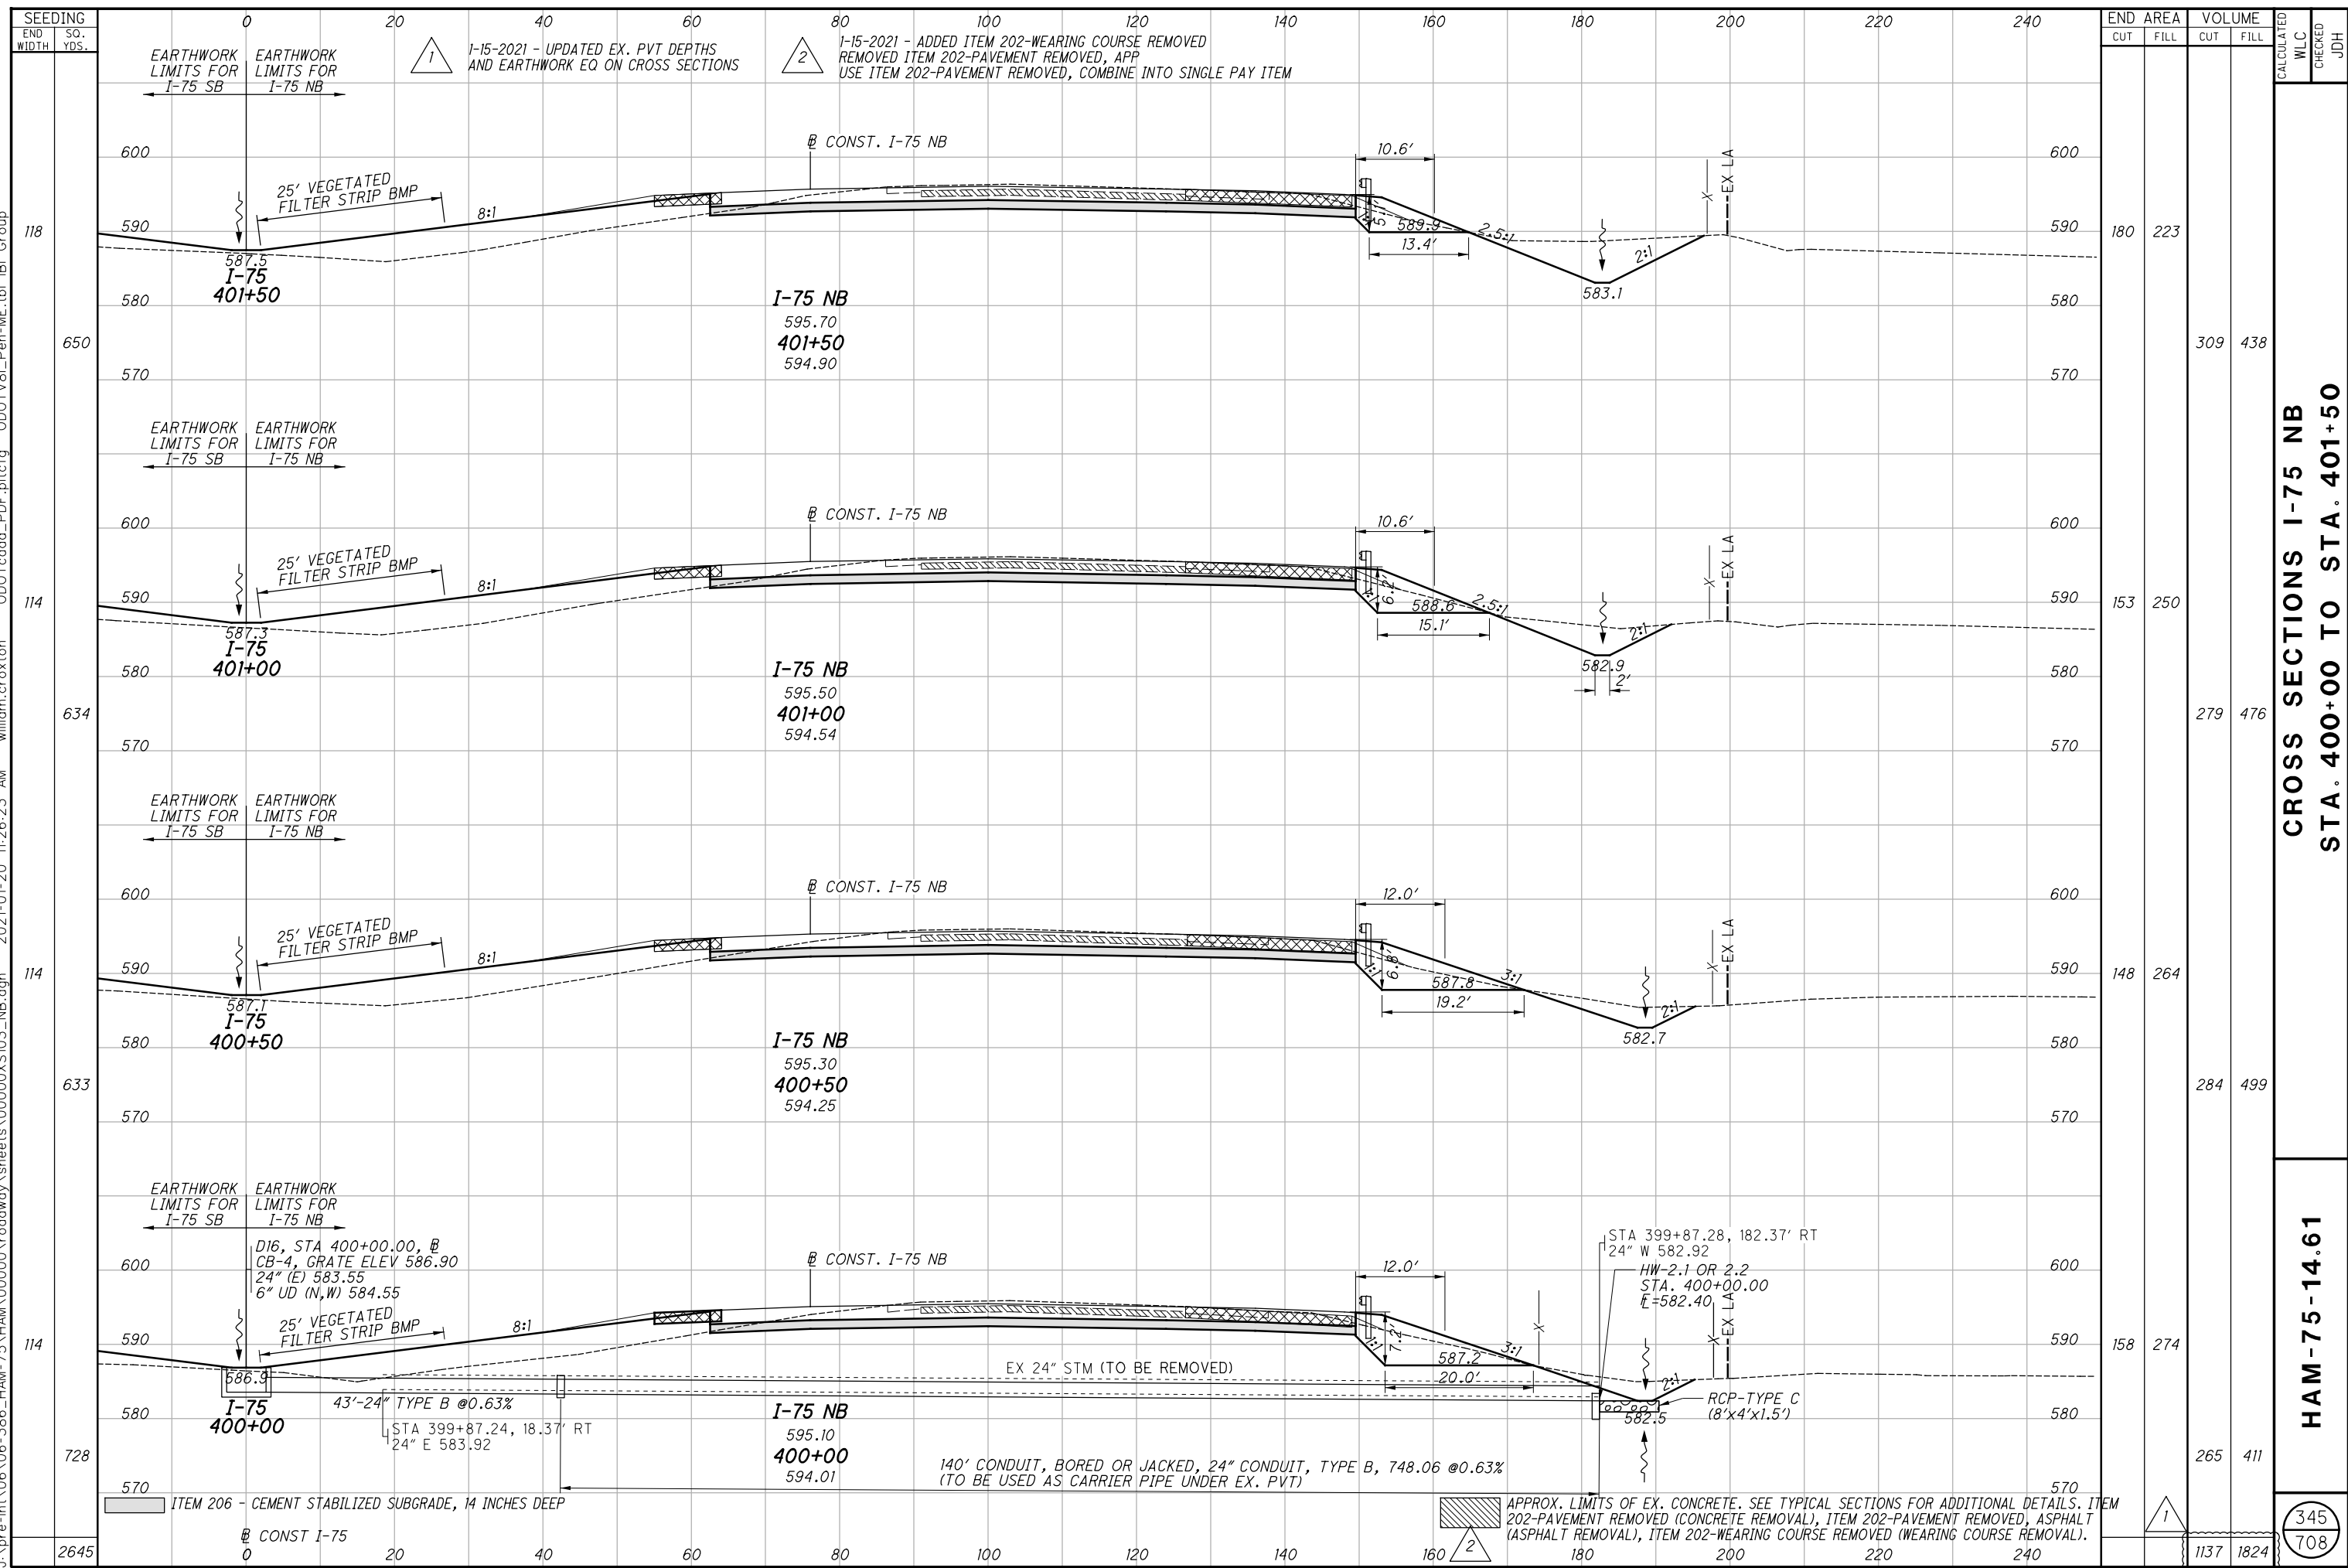



j:\pre-int\06\06-386\_HAM-75\HAM\00000\roadway\sheets\00000X5103\_NB.dgn 2021-01-20 11:26:24 AM william.croxton ODOT\cadd\_PDF.plt cfig ODOTV8i\_Pen-ME.tbl IBI Group

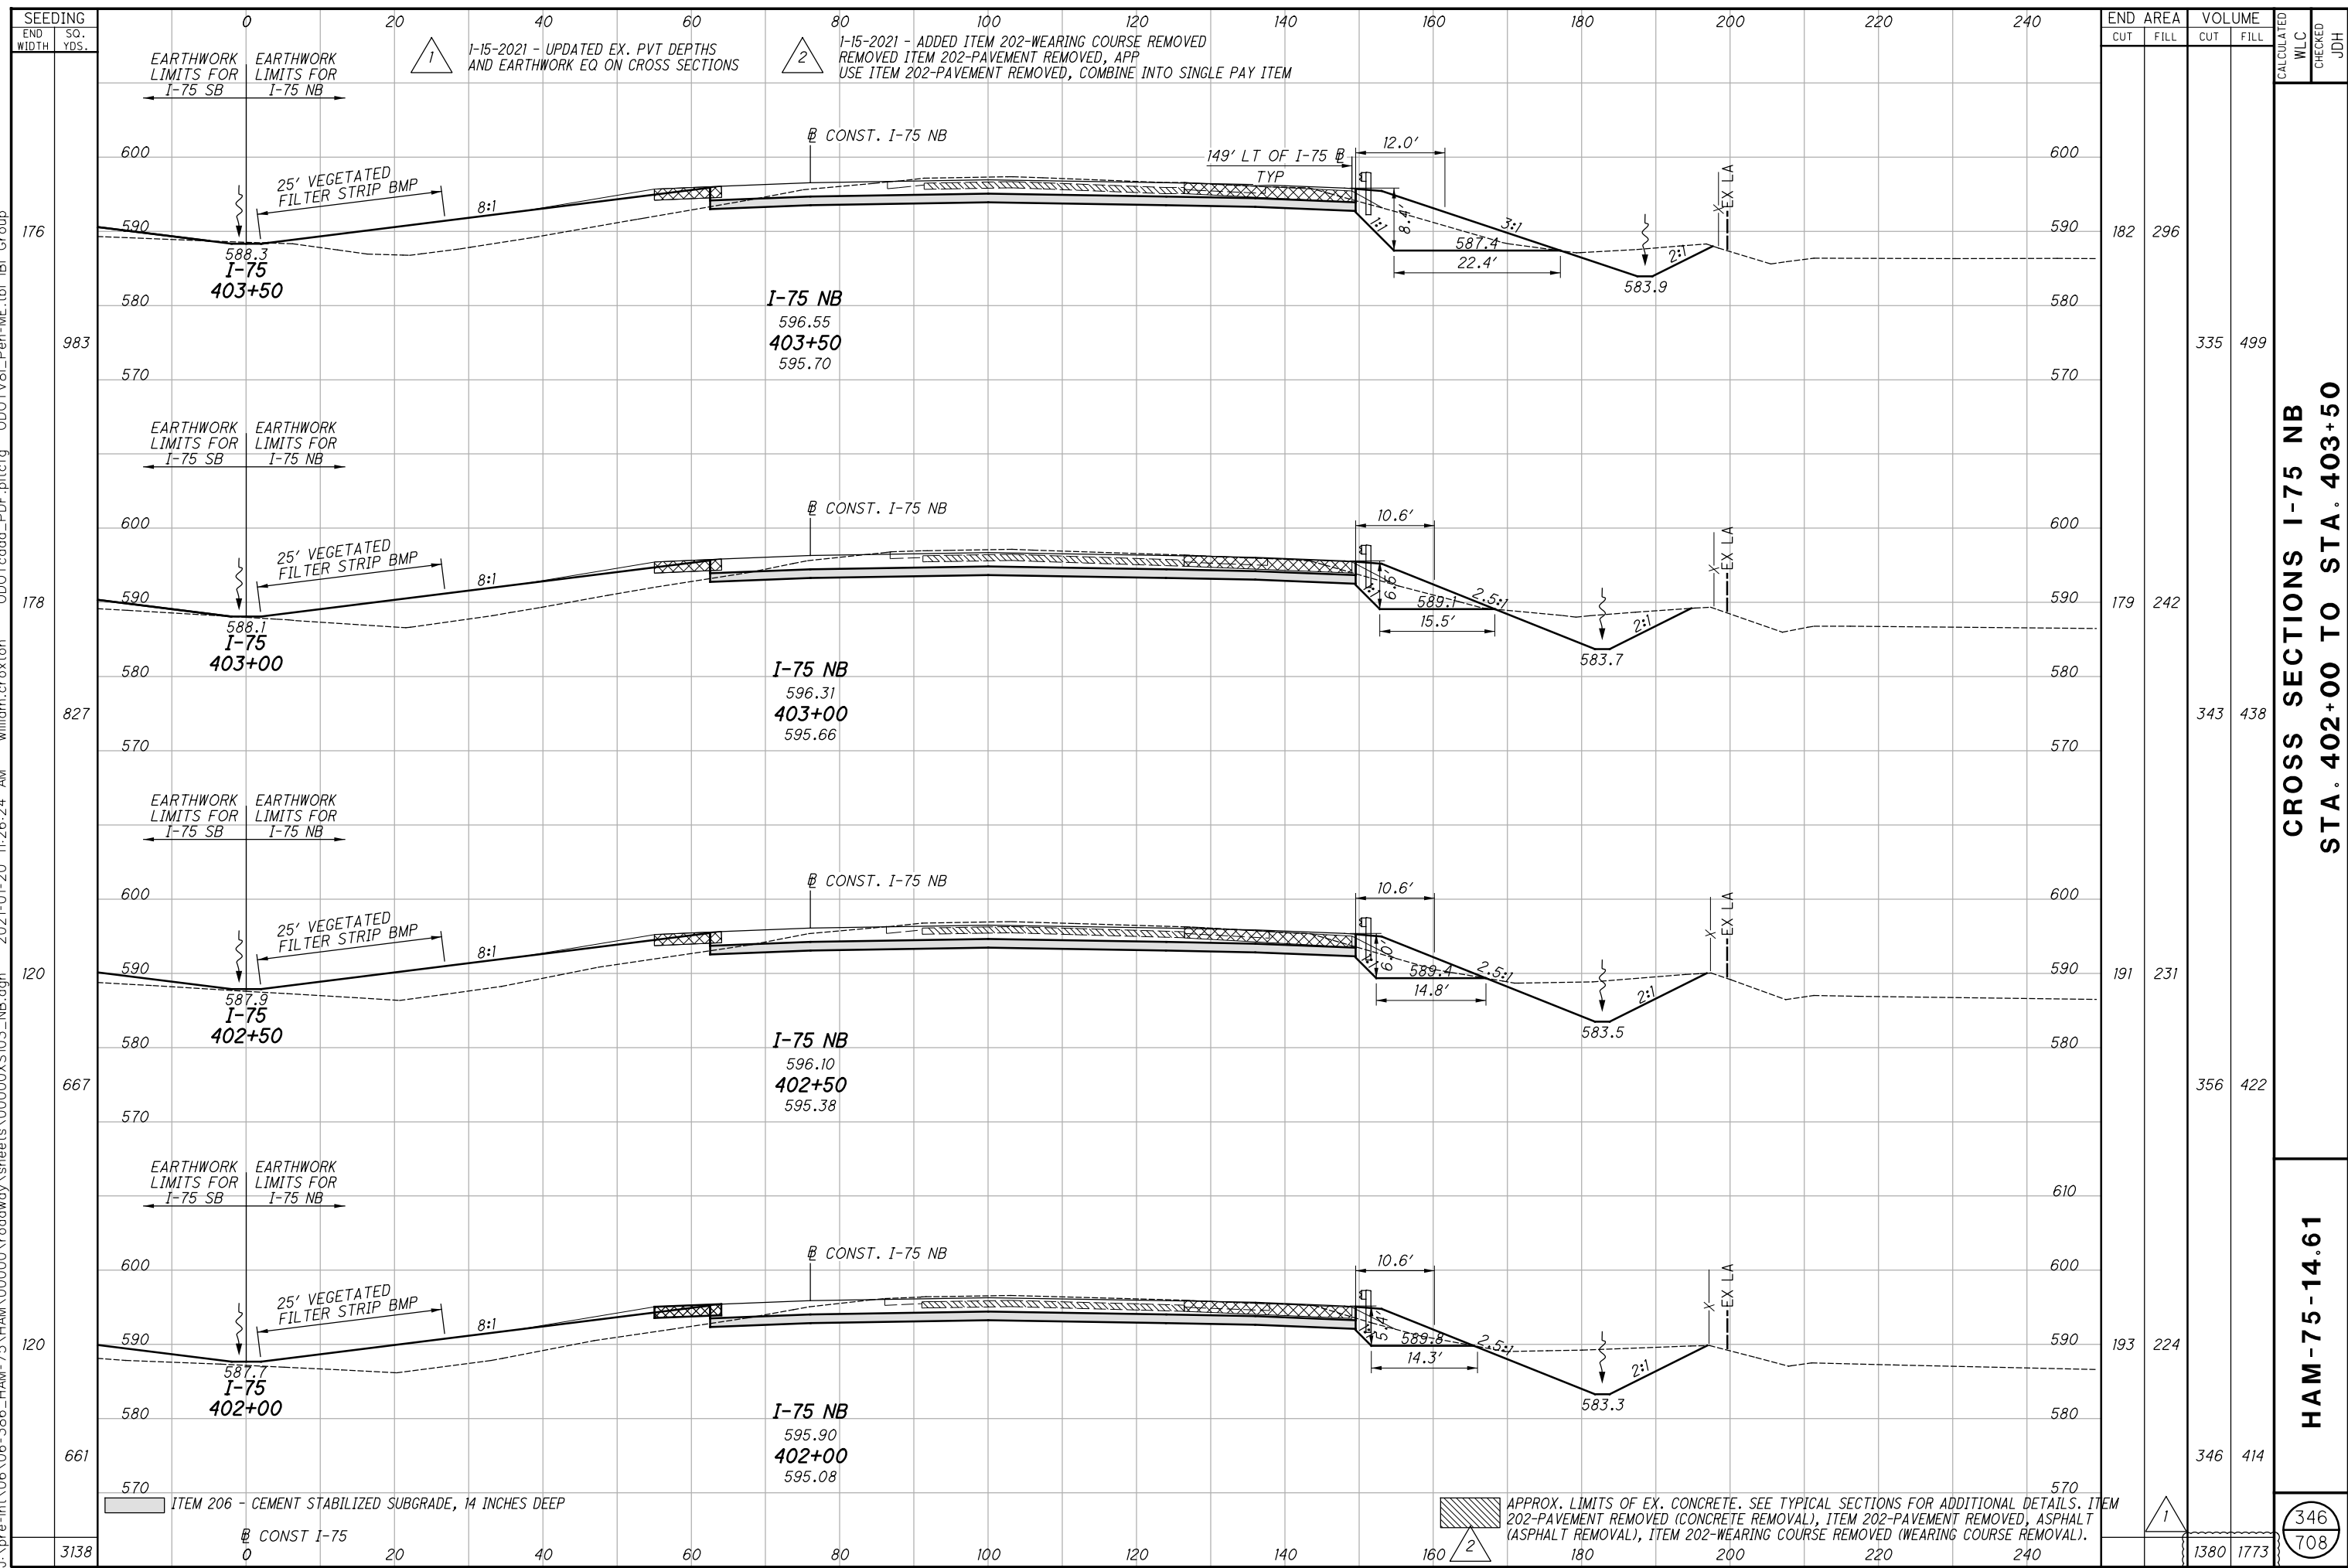


**CROSS SECTIONS I-75 NB STA. 402+00 TO STA. 403+50**


**HAM-75-14.61**

**346**  
**708**

j:\pre-int\06\06-386\_HAM-75\HAM\00000\roadway\sheets\00000X5103\_NB.dgn 2021-01-20 11:26:25 AM william.croxton\ ODOTV81\_Pen-ME.tbl IBI Group

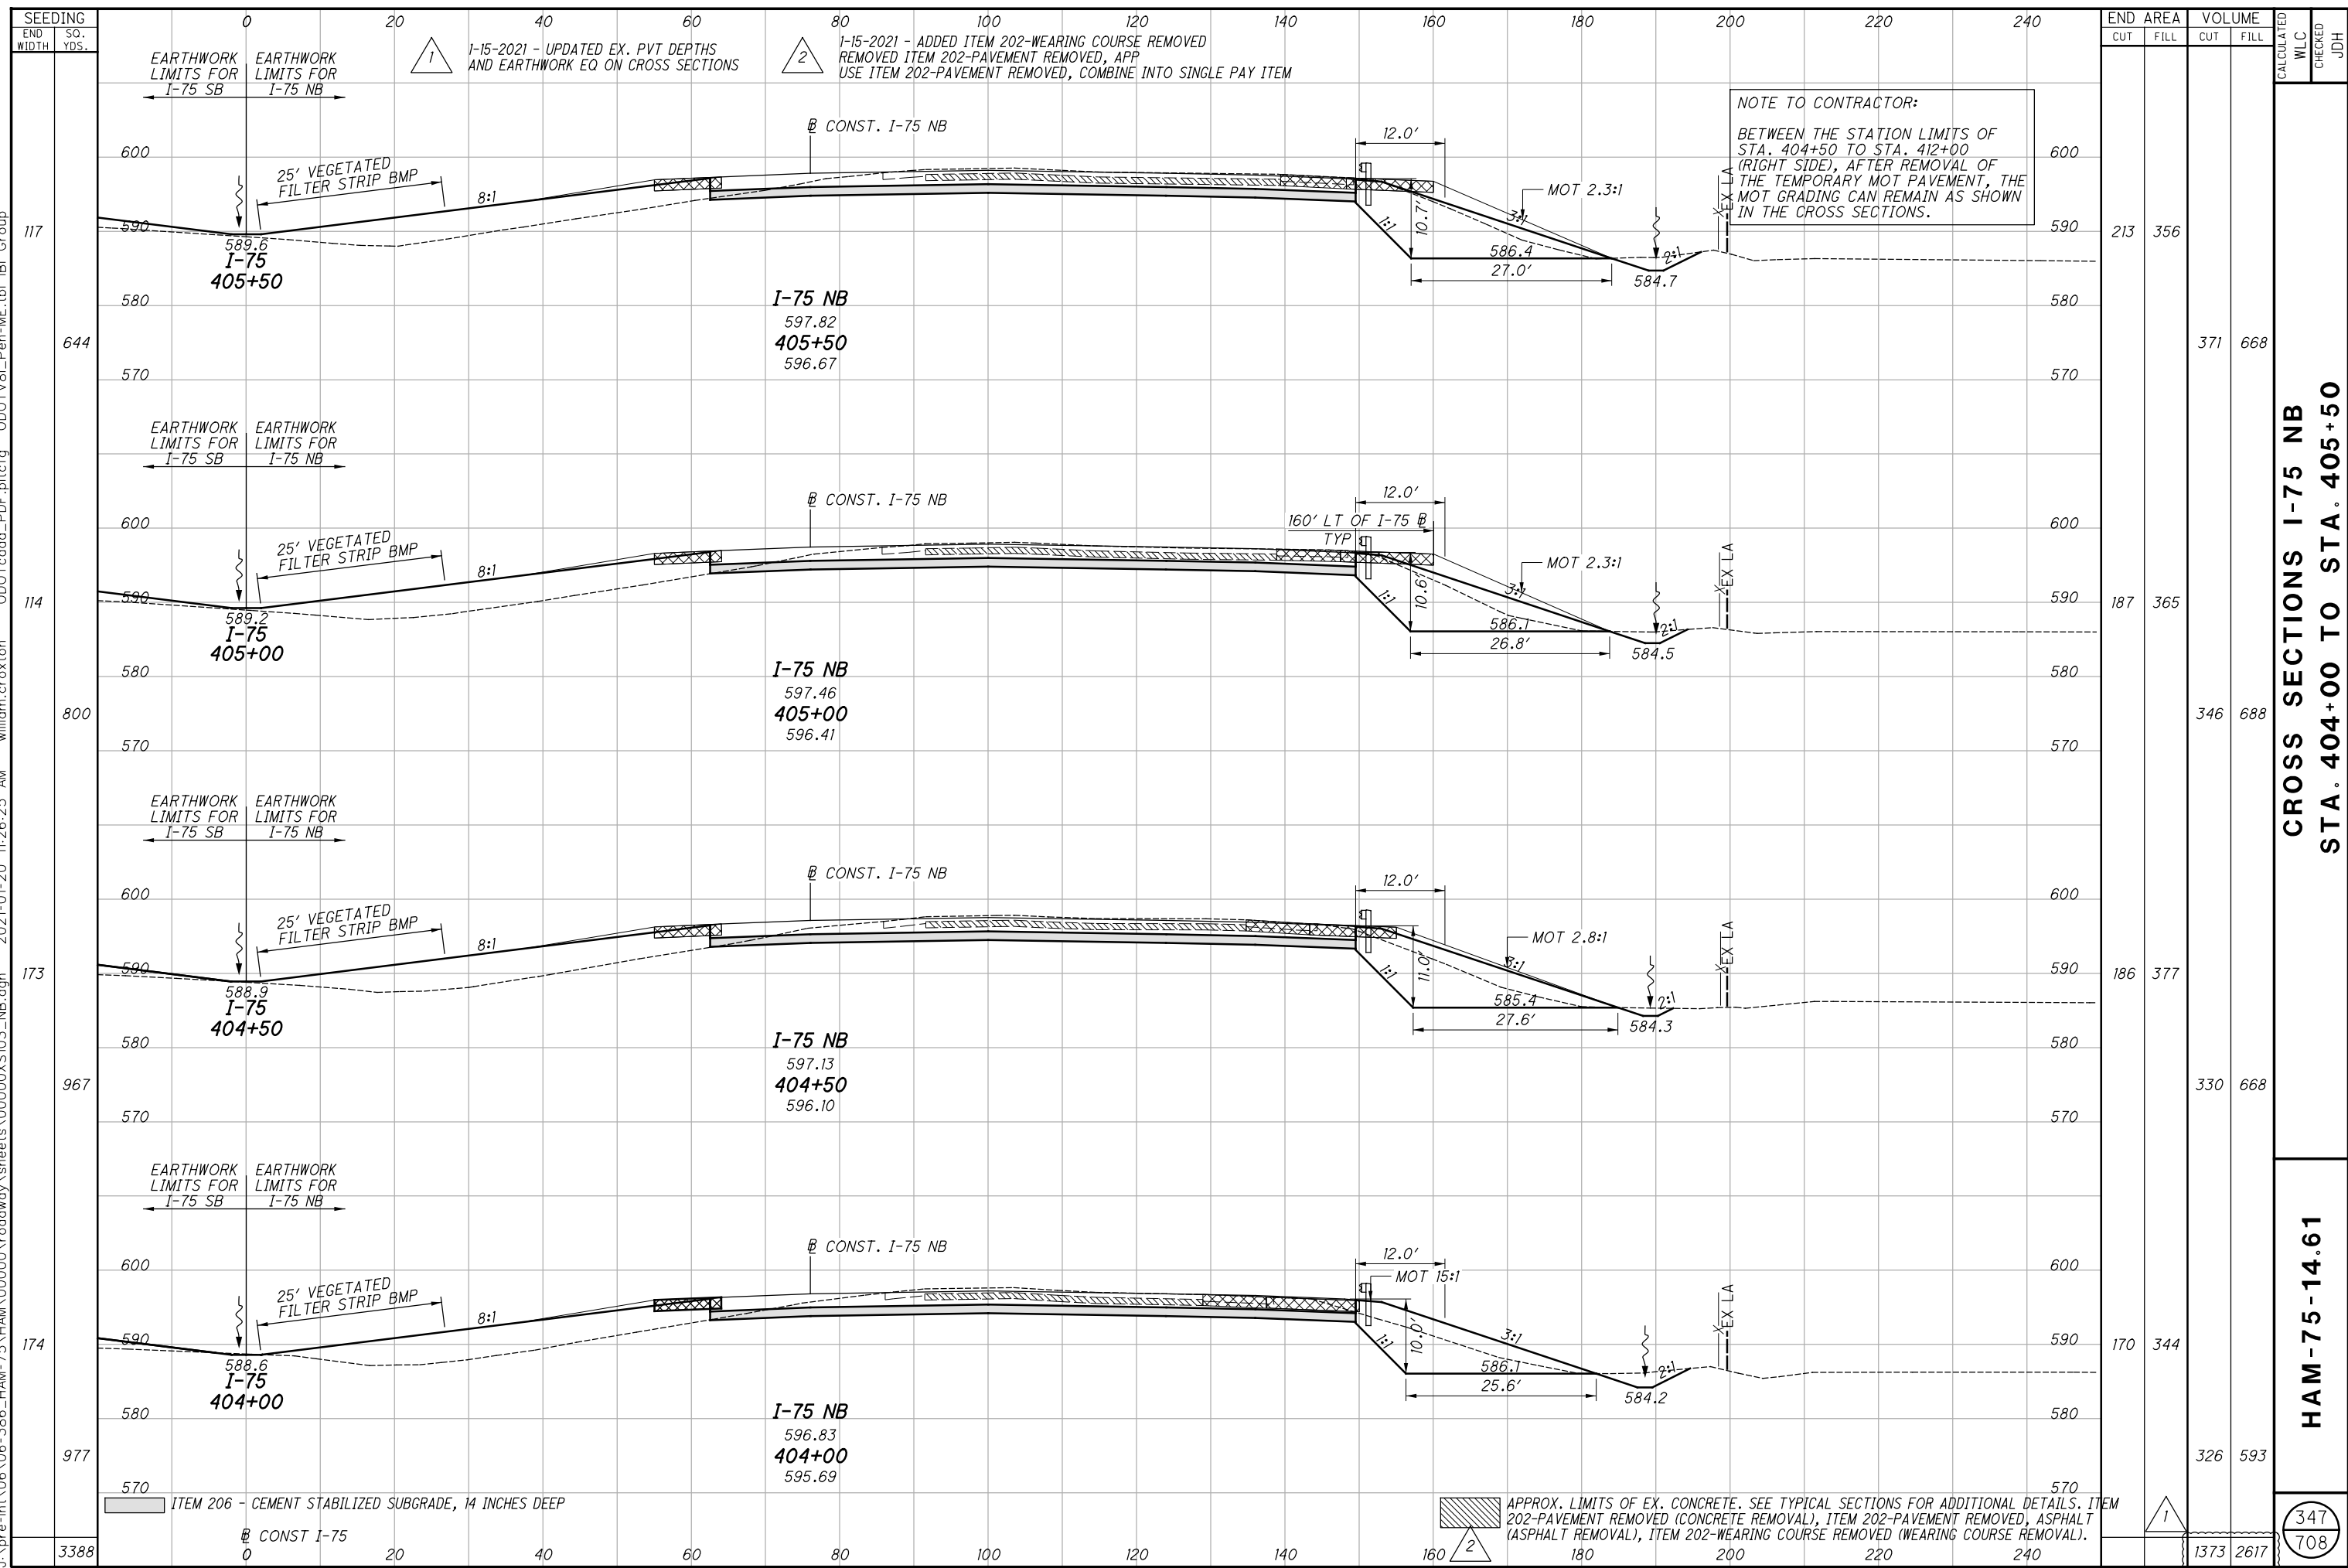

j:\pre-int\06\06-386\_HAM-75\HAM-75\HAM-75\roadway\sheets\00000X5103\_NB.dgn 2021-01-20 11:26:27 AM william.croxton ODOTV8i\_Pen-NE.tbl IBI Group

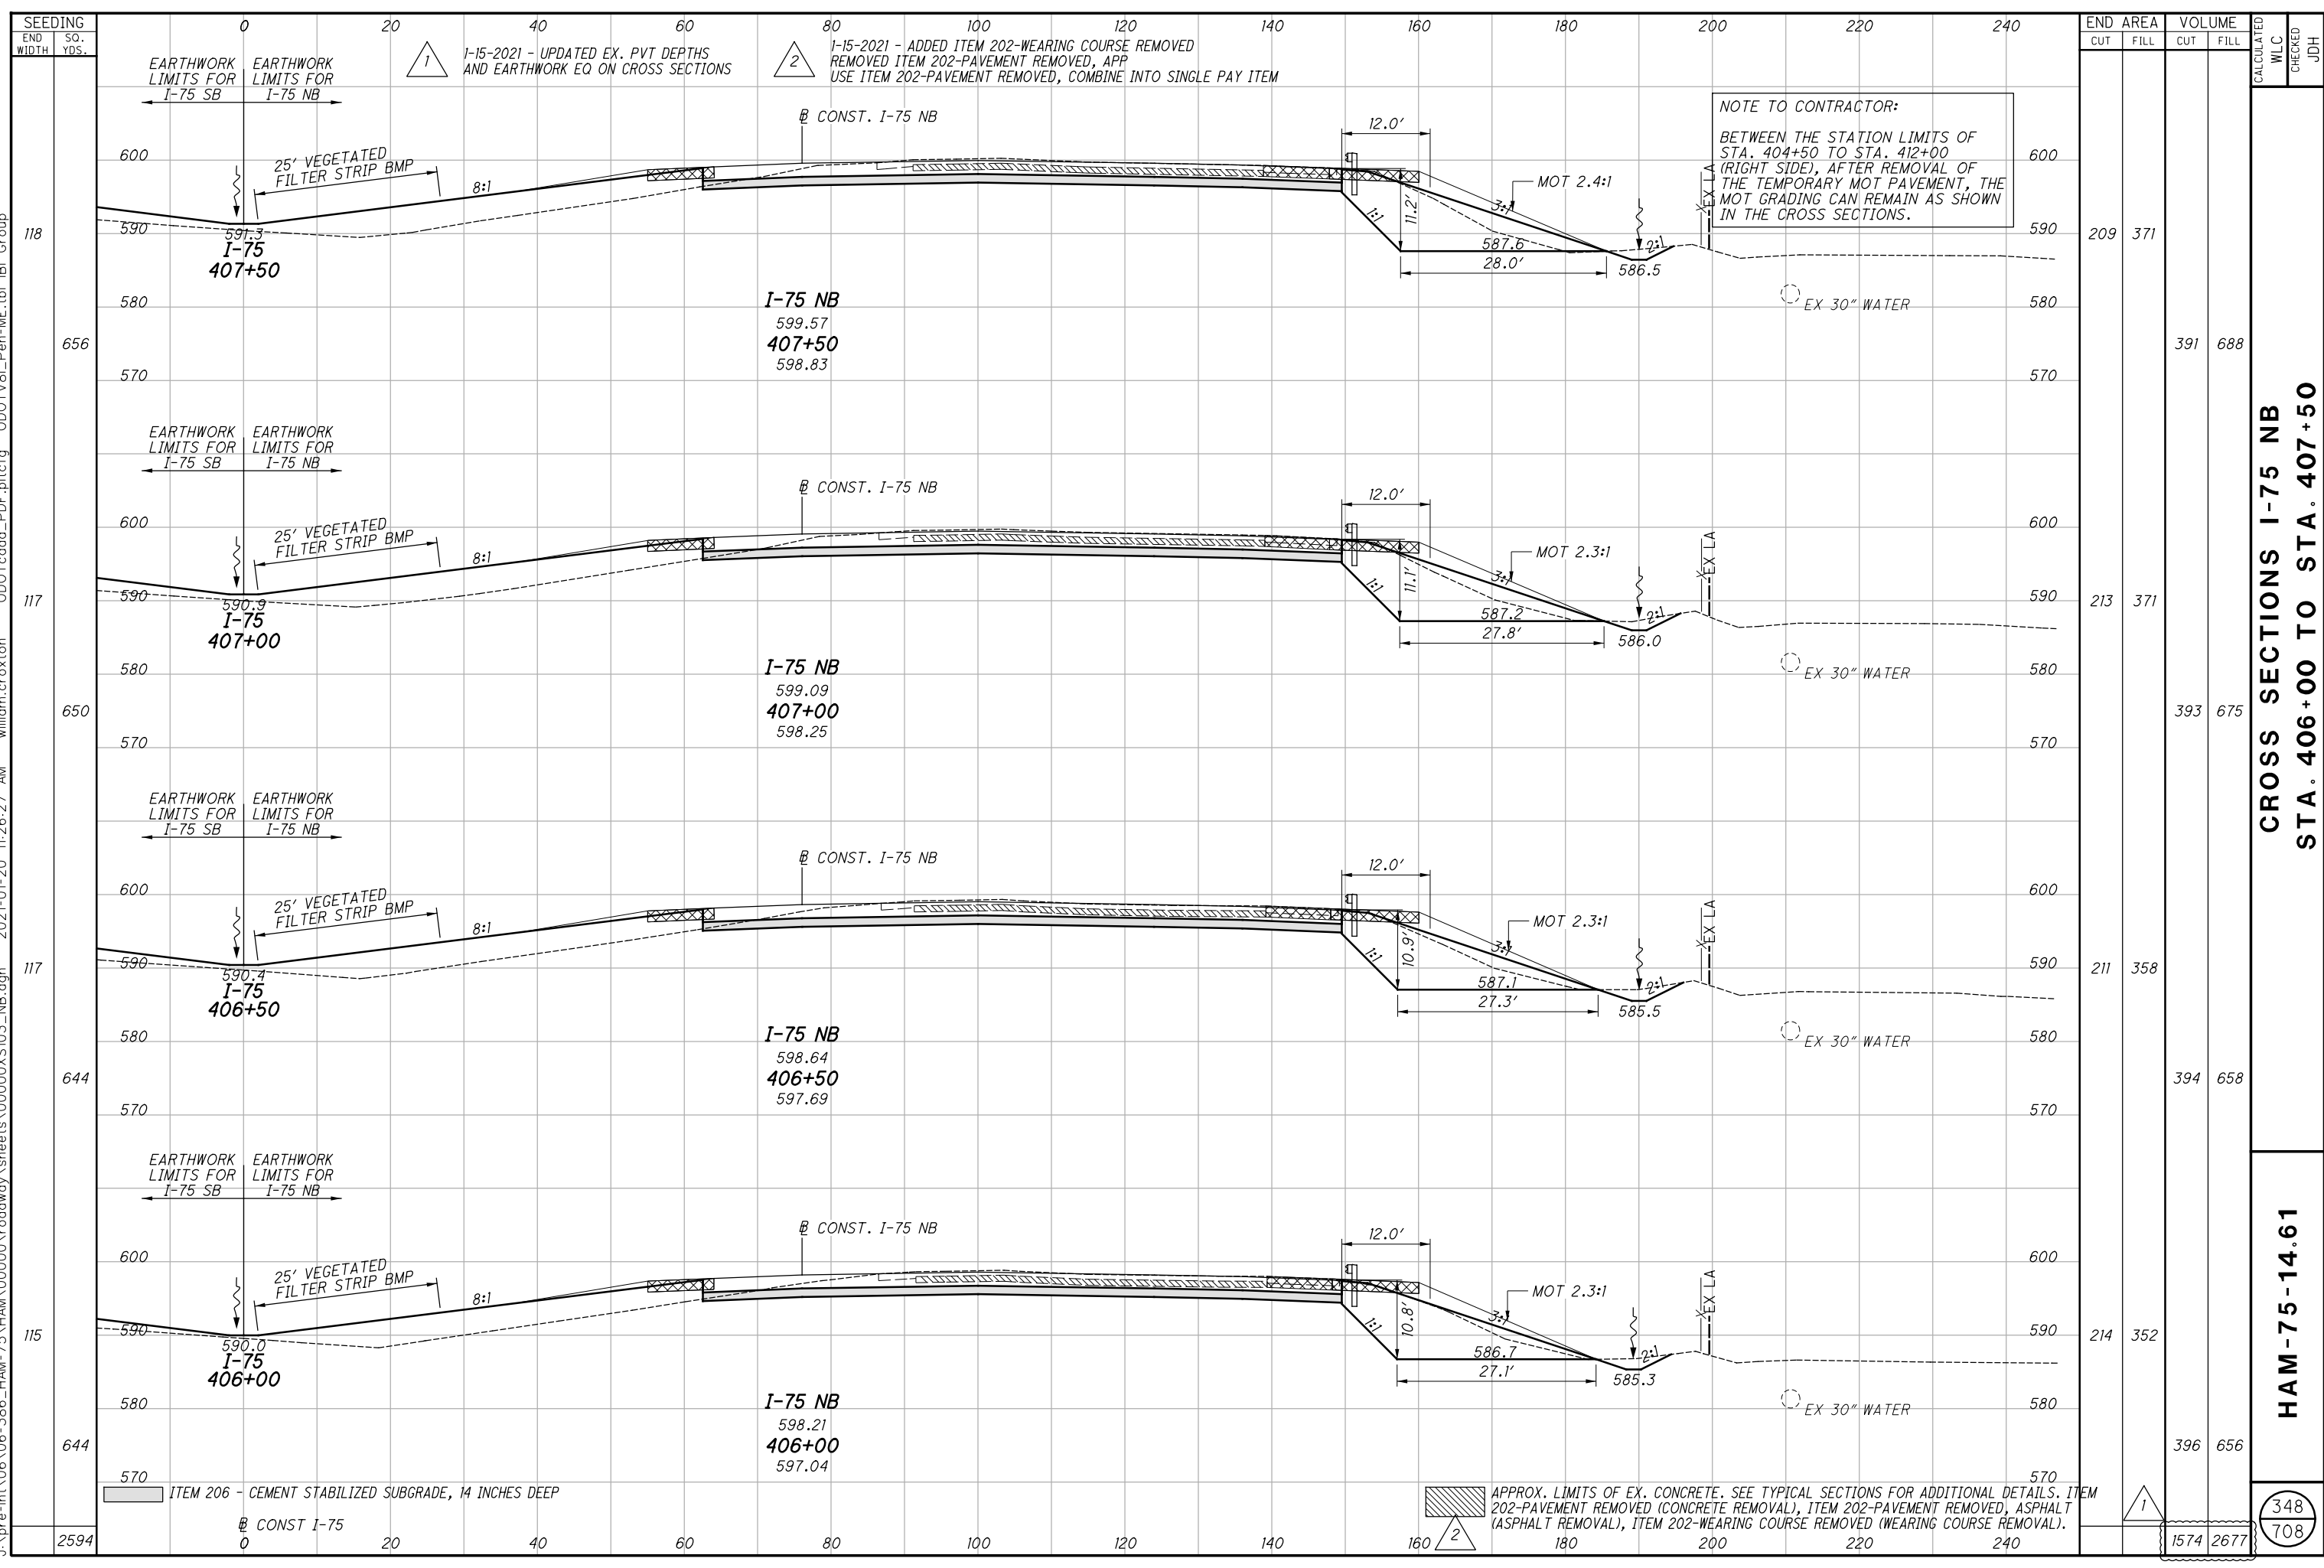


**CROSS SECTIONS I-75 NB  
STA. 406+00 TO STA. 407+50**

**HAM-75-14.61**

CALCULATED WLC CHECKED JDH  
348  
708

j:\pre-int\06\06-386\_HAM-75\_HAM\00000\roadway\sheets\00000X5103\_NB.dgn 2021-01-20 11:26:28 AM william.croxton ODOTcadd\_PDF.plt c:\odot\81\_Pen-ME.tbl IBI Group

SEEDING	END SO. YDS.	
	WIDTH	
	1317	
	661	
	118	
	296	
	117	
	360	
	117	

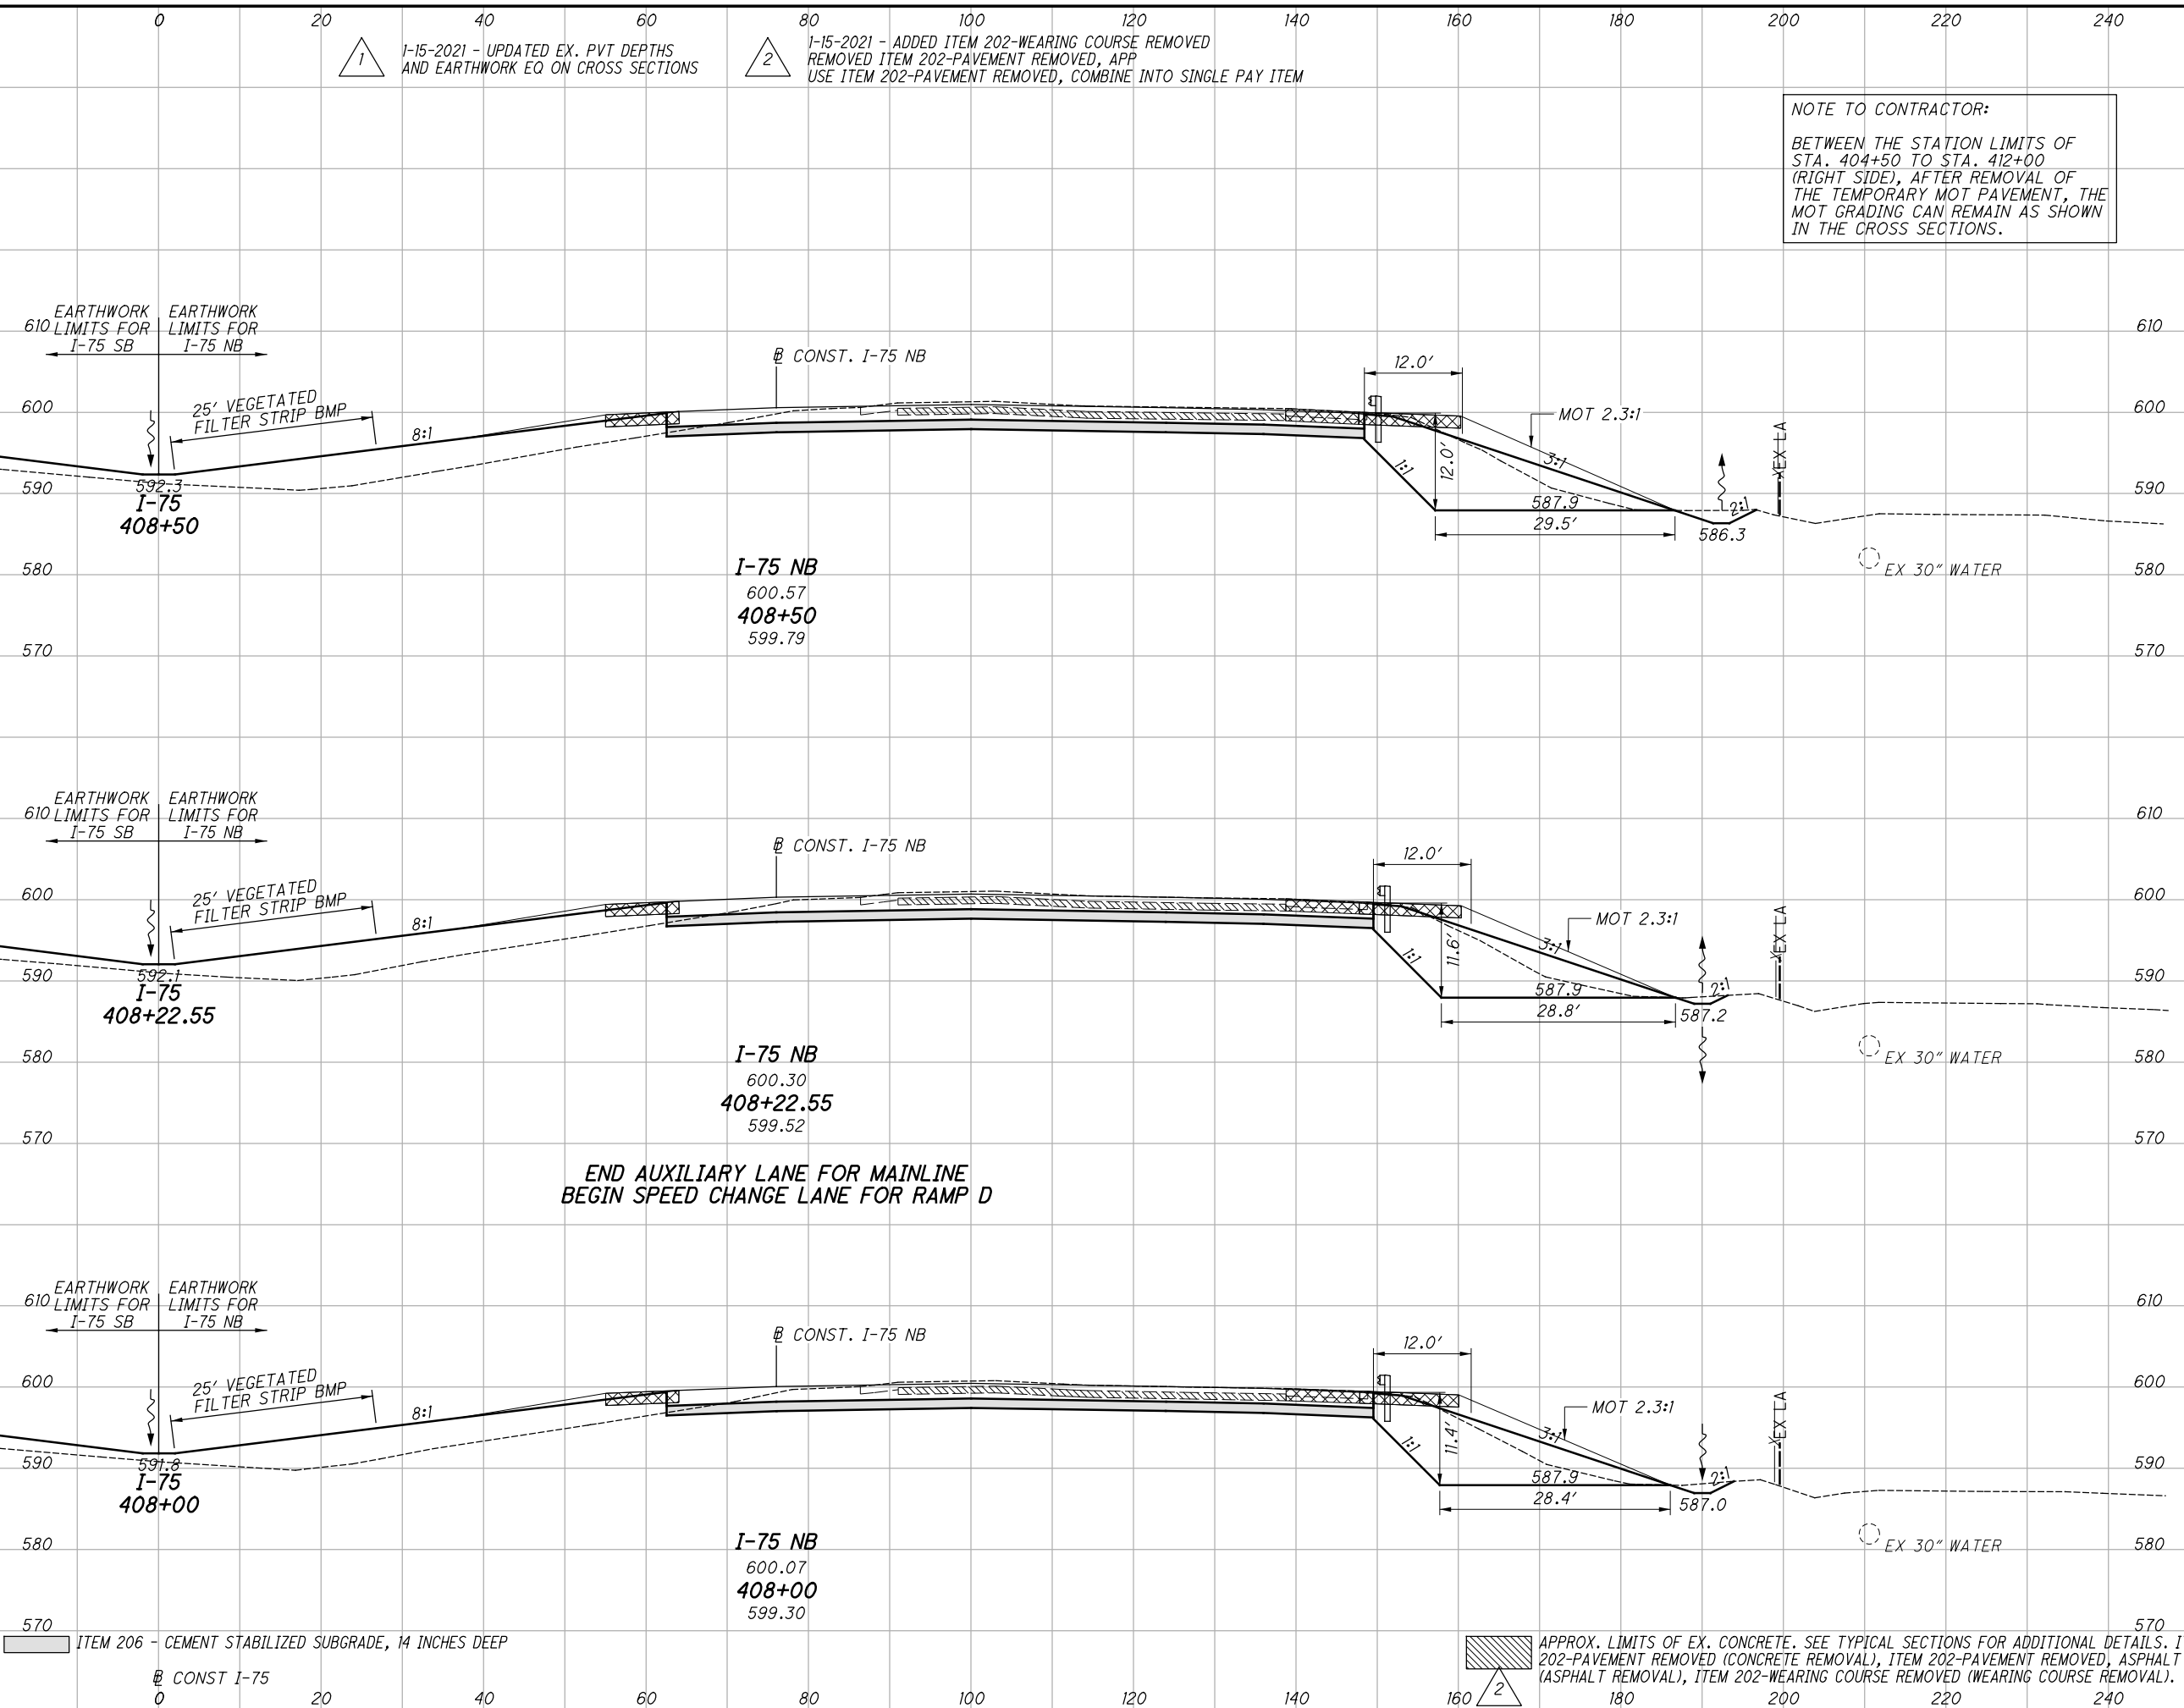

1-15-2021 - UPDATED EX. PVT DEPTHS AND EARTHWORK EQ ON CROSS SECTIONS

2 1-15-2021 - ADDED ITEM 202-WEARING COURSE REMOVED REMOVED ITEM 202-PAVEMENT REMOVED, APP USE ITEM 202-PAVEMENT REMOVED, COMBINE INTO SINGLE PAY ITEM

NOTE TO CONTRACTOR:  
 BETWEEN THE STATION LIMITS OF STA. 404+50 TO STA. 412+00 (RIGHT SIDE), AFTER REMOVAL OF THE TEMPORARY MOT PAVEMENT, THE MOT GRADING CAN REMAIN AS SHOWN IN THE CROSS SECTIONS.

END AREA	VOLUME	
	CUT	FILL
241	398	
213	386	
212	383	
390	699	
799	1420	

CROSS SECTIONS I-75 NB  
 STA. 408+00 TO STA. 408+50


HAM-75-14.61

349  
708

ITEM 206 - CEMENT STABILIZED SUBGRADE, 14 INCHES DEEP

APPROX. LIMITS OF EX. CONCRETE. SEE TYPICAL SECTIONS FOR ADDITIONAL DETAILS. ITEM 202-PAVEMENT REMOVED (CONCRETE REMOVAL), ITEM 202-PAVEMENT REMOVED, ASPHALT (ASPHALT REMOVAL), ITEM 202-WEARING COURSE REMOVED (WEARING COURSE REMOVAL).

J:\pre-int\06\06-386\_HAM-75\HAM-75\HAM-75\roadway\sheets\000005\03\_NB.dgn 2021-01-20 11:26:29 AM william.croxton ODOTcadd\_PDF.plt cfbg ODOTV8i\_Pen-ME.tbl IBI Group

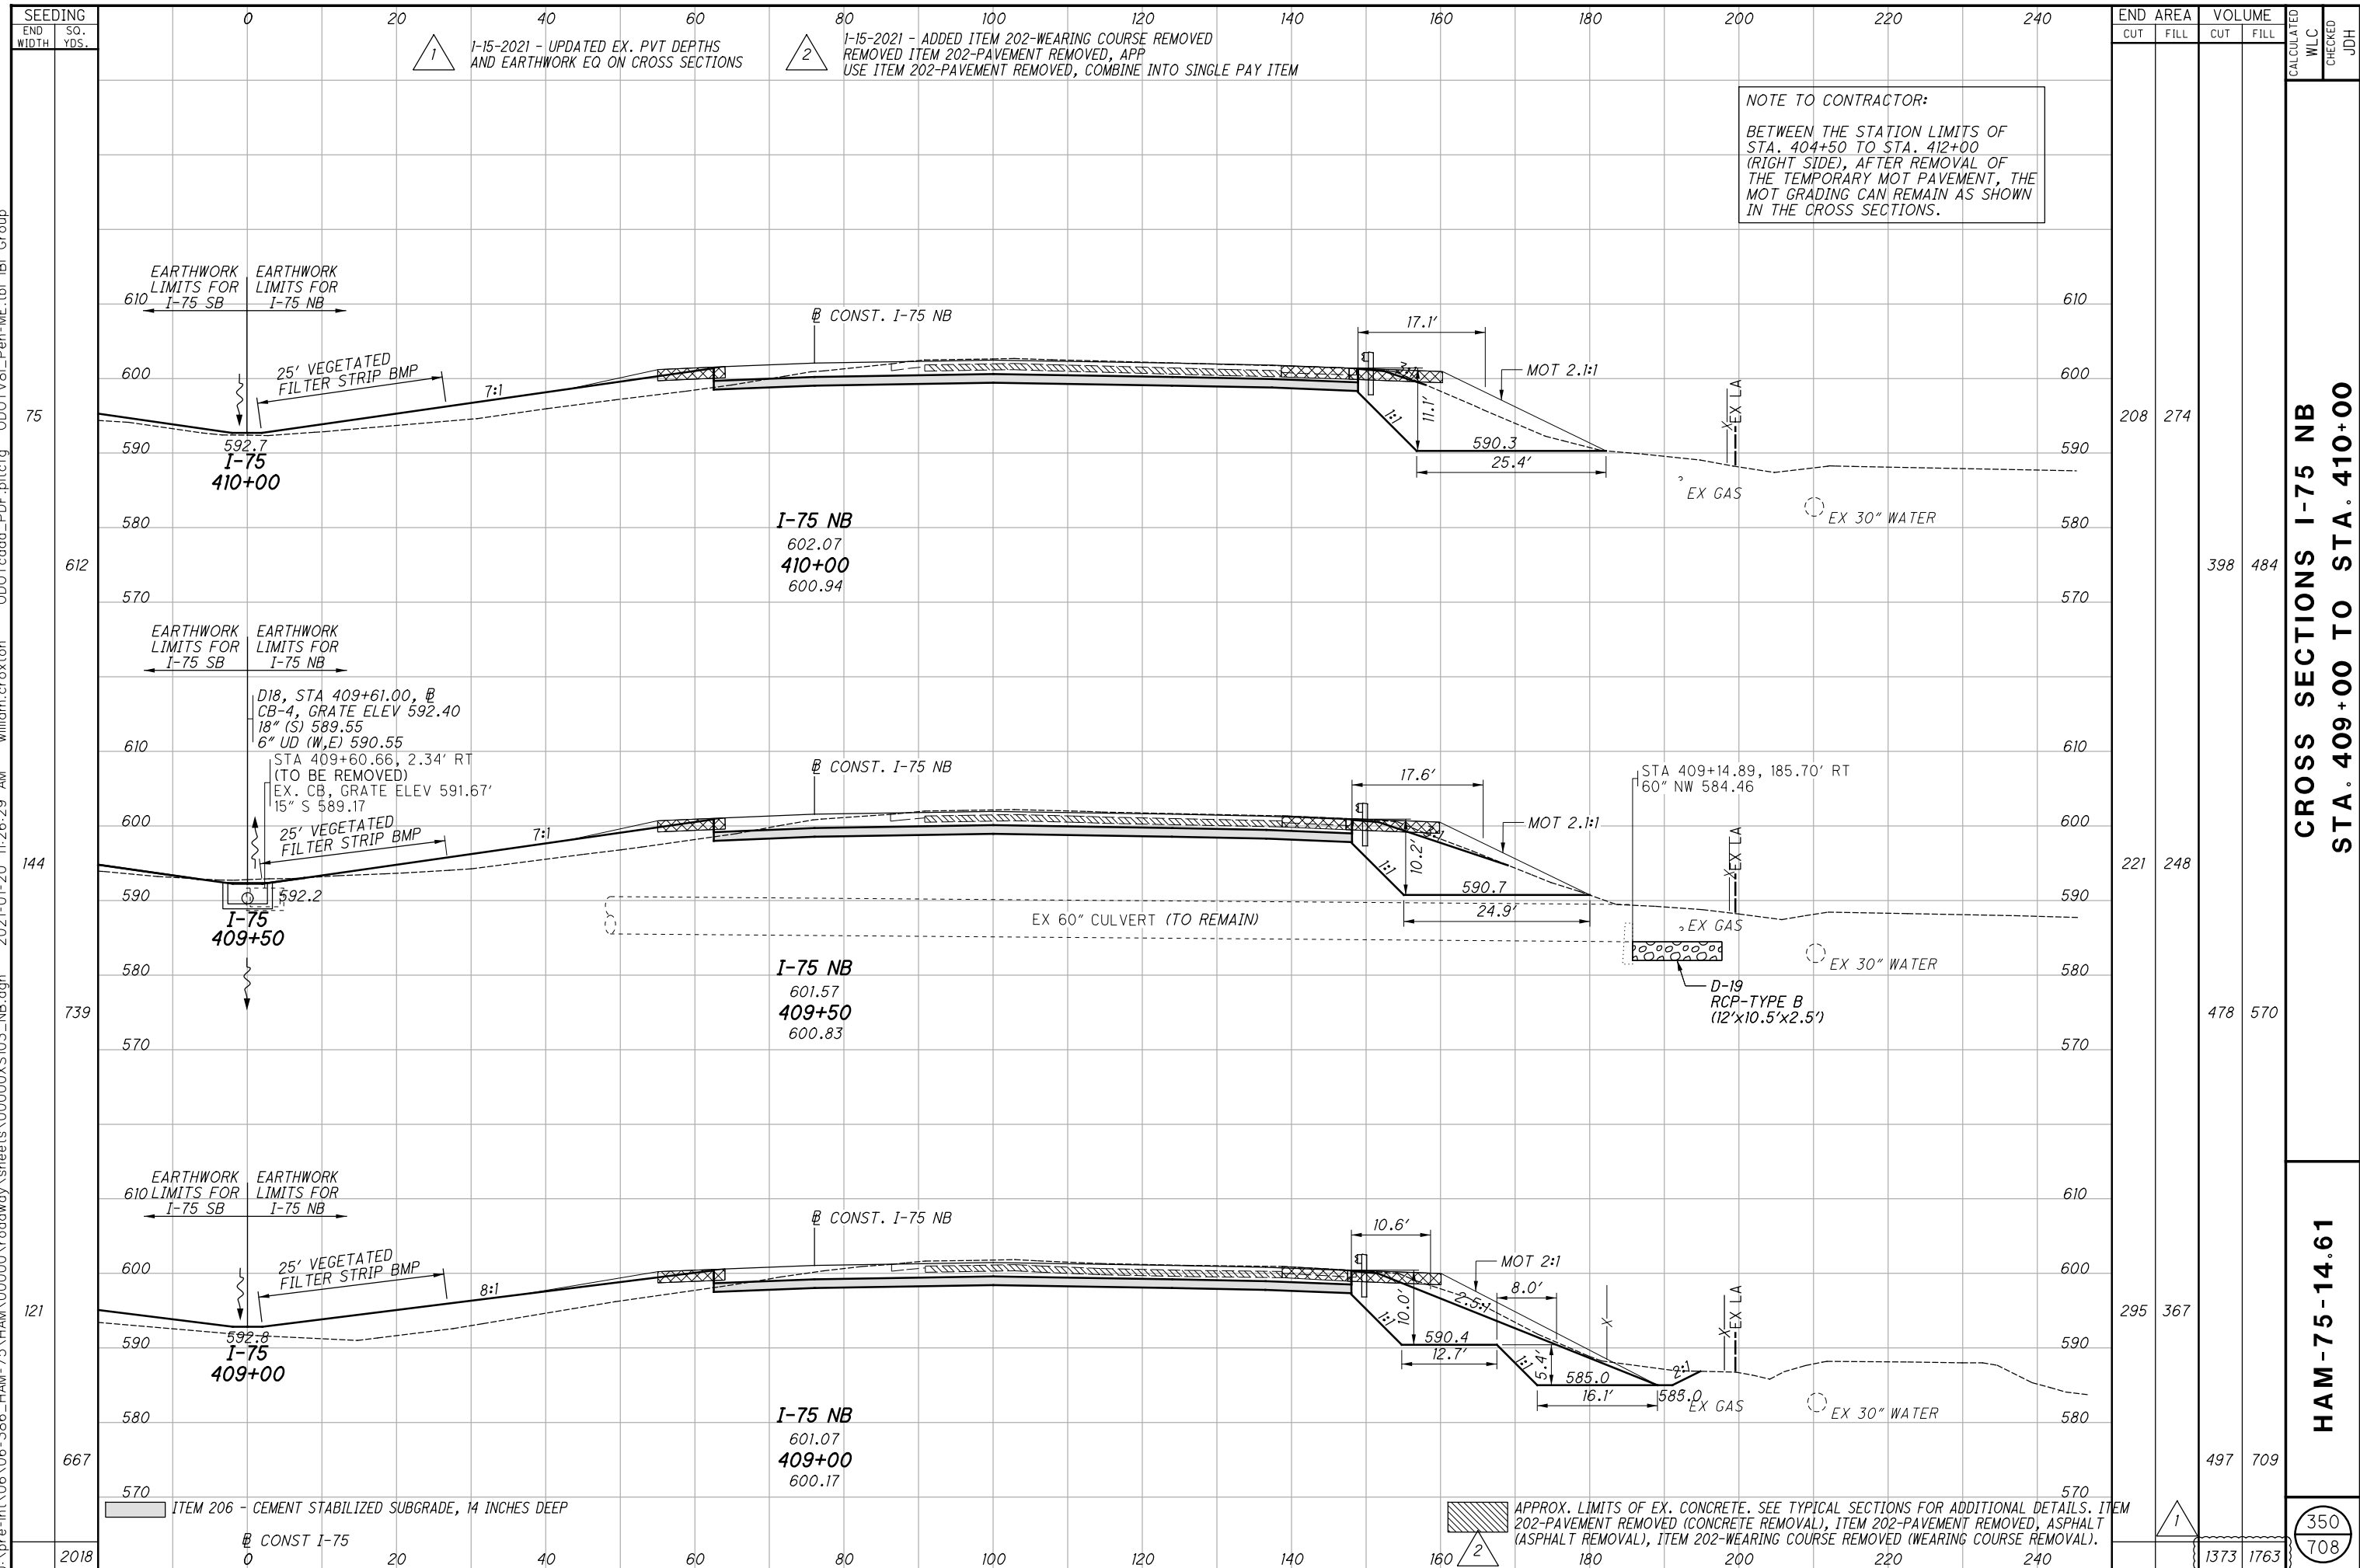

1-15-2021 - UPDATED EX. PVT DEPTHS AND EARTHWORK EQ ON CROSS SECTIONS

2 1-15-2021 - ADDED ITEM 202-WEARING COURSE REMOVED REMOVED ITEM 202-PAVEMENT REMOVED, APP USE ITEM 202-PAVEMENT REMOVED, COMBINE INTO SINGLE PAY ITEM

**NOTE TO CONTRACTOR:**  
 BETWEEN THE STATION LIMITS OF STA. 404+50 TO STA. 412+00 (RIGHT SIDE), AFTER REMOVAL OF THE TEMPORARY MOT PAVEMENT, THE MOT GRADING CAN REMAIN AS SHOWN IN THE CROSS SECTIONS.

END STA	AREA		VOLUME		CALCULATED WLC	CHECKED JDH
	CUT	FILL	CUT	FILL		
410+00	208	274				
409+50	221	248				
409+00	295	367				
TOTAL	724	889				

**CROSS SECTIONS I-75 NB  
 STA. 409+00 TO STA. 410+00**


**HAM-75-14.61**

350  
708

ITEM 206 - CEMENT STABILIZED SUBGRADE, 14 INCHES DEEP

APPROX. LIMITS OF EX. CONCRETE. SEE TYPICAL SECTIONS FOR ADDITIONAL DETAILS. ITEM 202-PAVEMENT REMOVED (CONCRETE REMOVAL), ITEM 202-PAVEMENT REMOVED, ASPHALT (ASPHALT REMOVAL), ITEM 202-WEARING COURSE REMOVED (WEARING COURSE REMOVAL).

j:\pre-int\06\06-386\_HAM-75\HAM\00000\roadway\sheets\00000X5103\_NB.dgn 2021-01-20 11:26:30 AM william.croxton ODOTcadd\_PDF.plt cfbg ODOTV81\_Pen-ME.tbl IBI Group

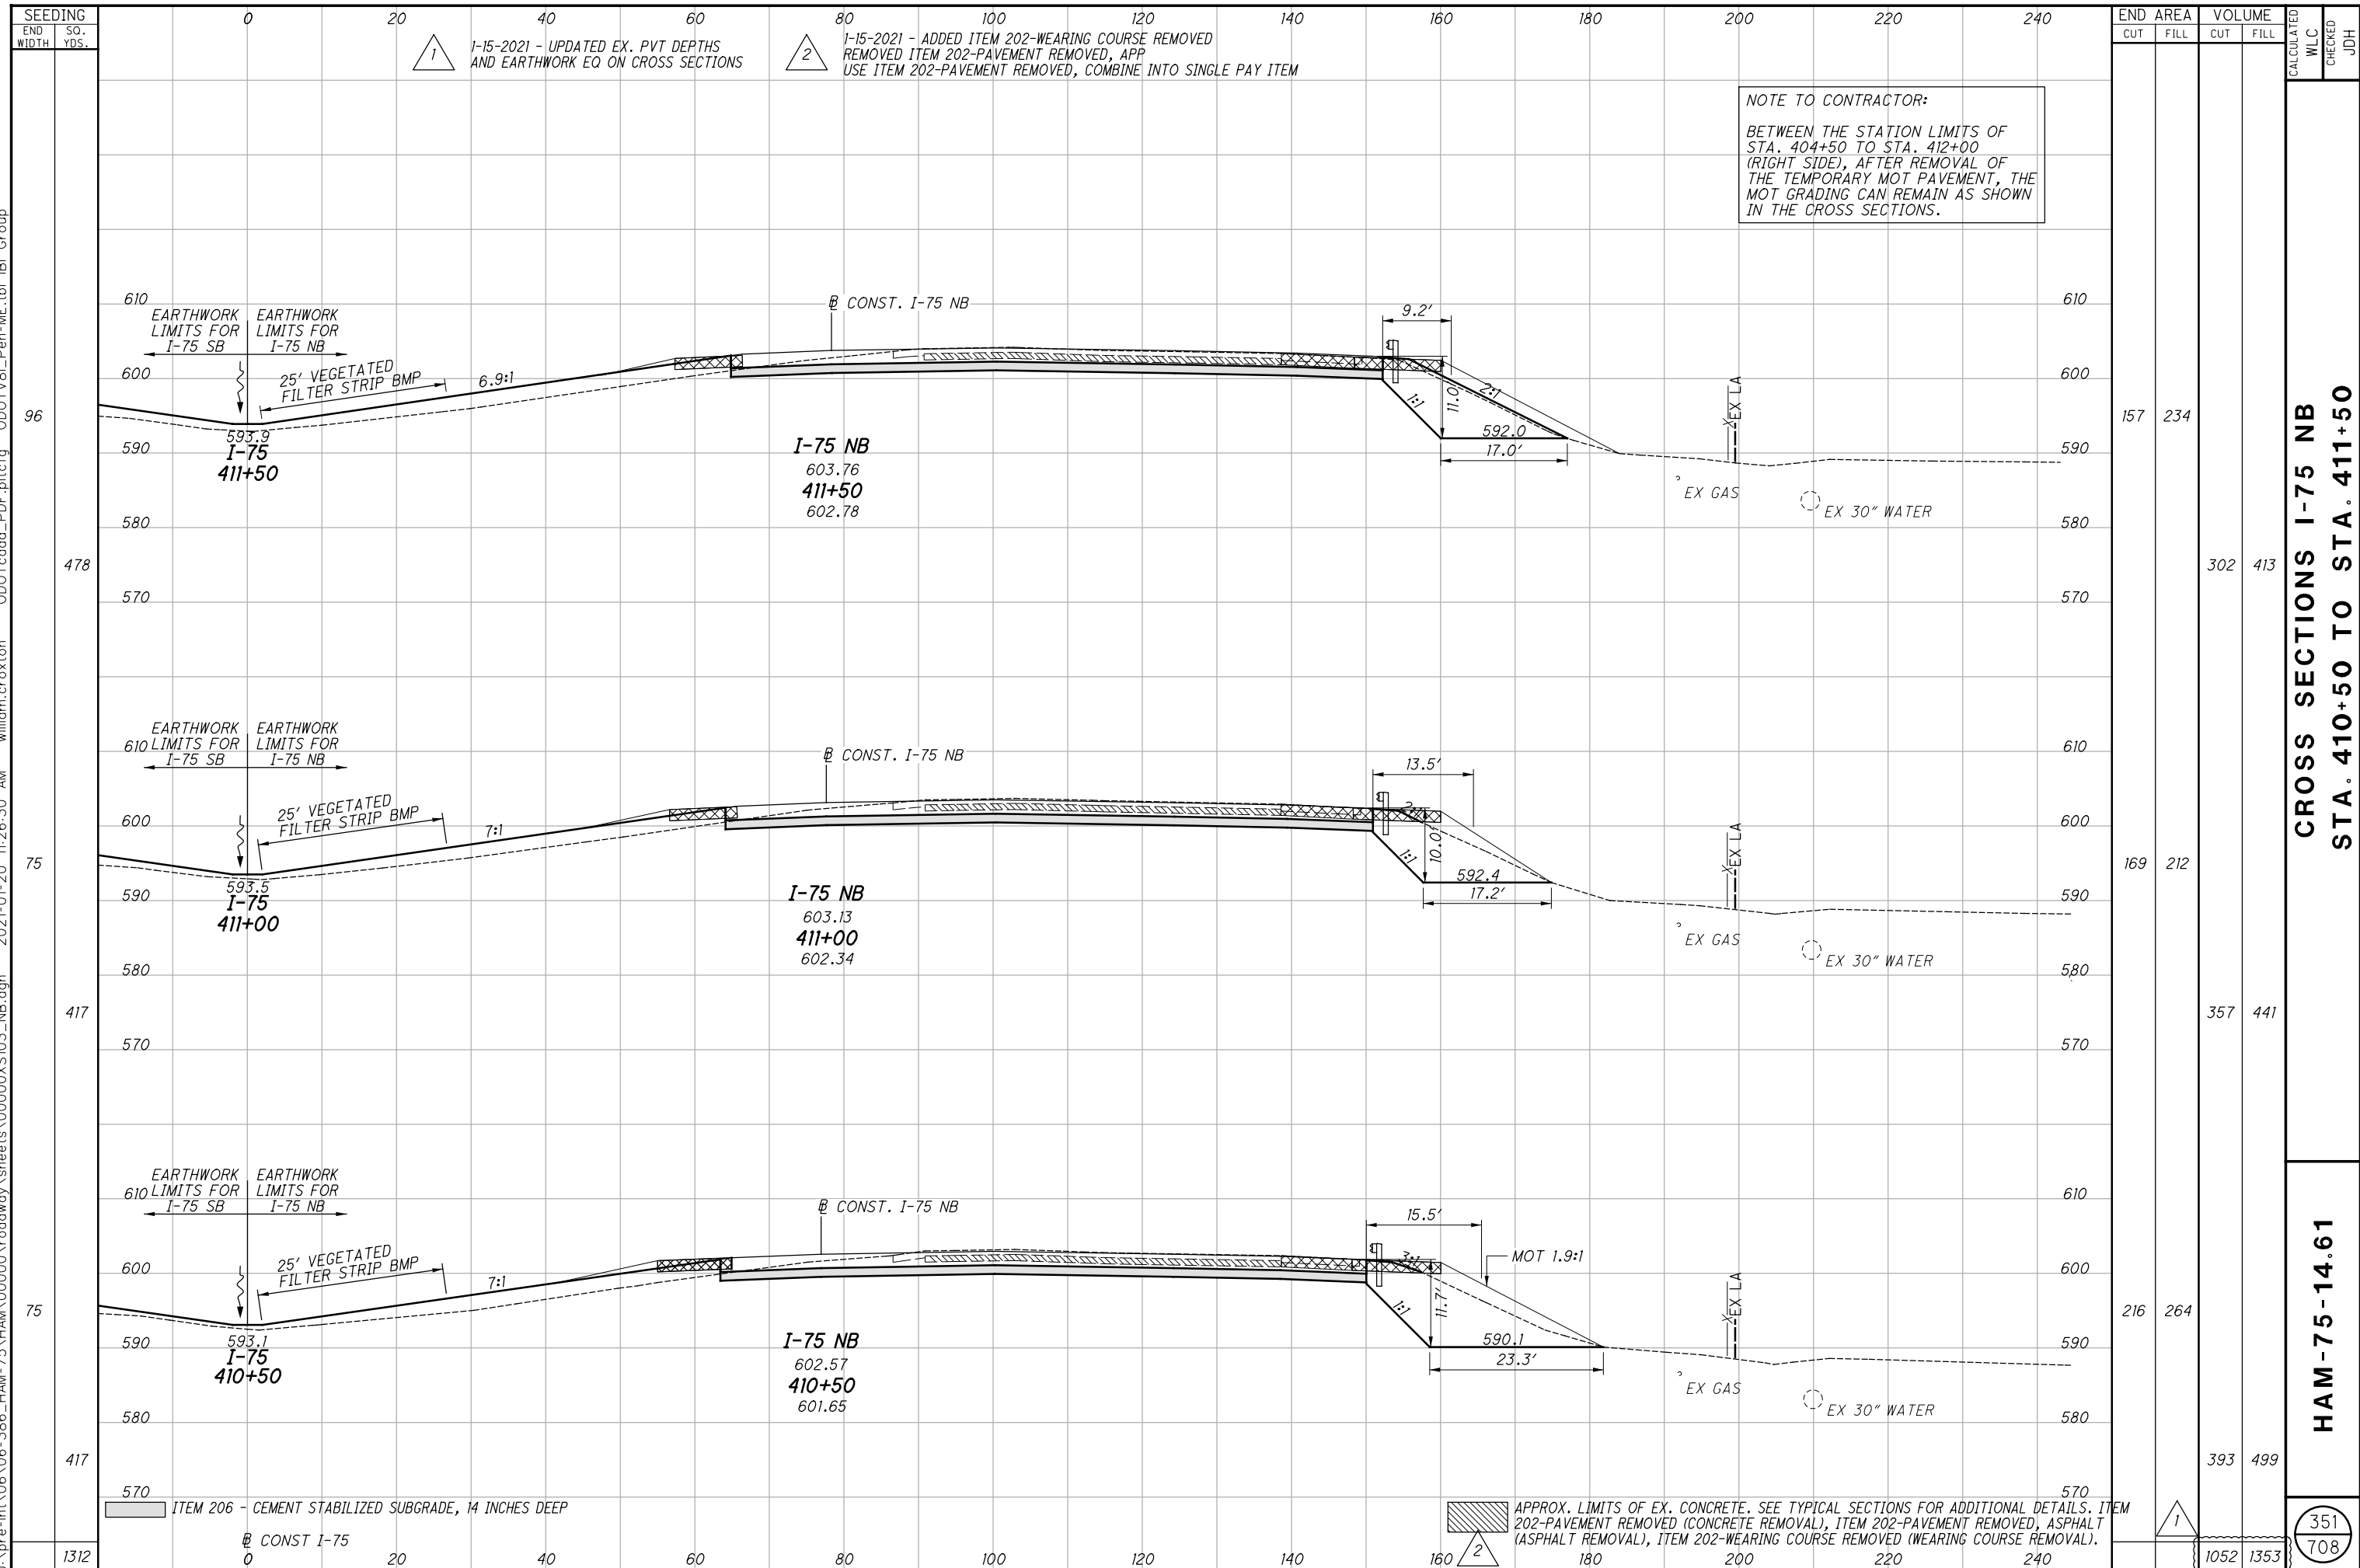


**CROSS SECTIONS I-75 NB  
STA. 410+50 TO STA. 411+50**

**HAM-75-14.61**

CALCULATED WLC 351  
CHECKED JDH 708

j:\pre-int\06\06-386\_HAM-75\HAM-75\HAM-75\roadway\sheets\00000X5103\_NB.dgn 2021-01-20 11:26:31 AM william.croxton' ODOTcadd\_PDF.pltcfgr ODOTV81\_Pen-ME.tbl IBI Group

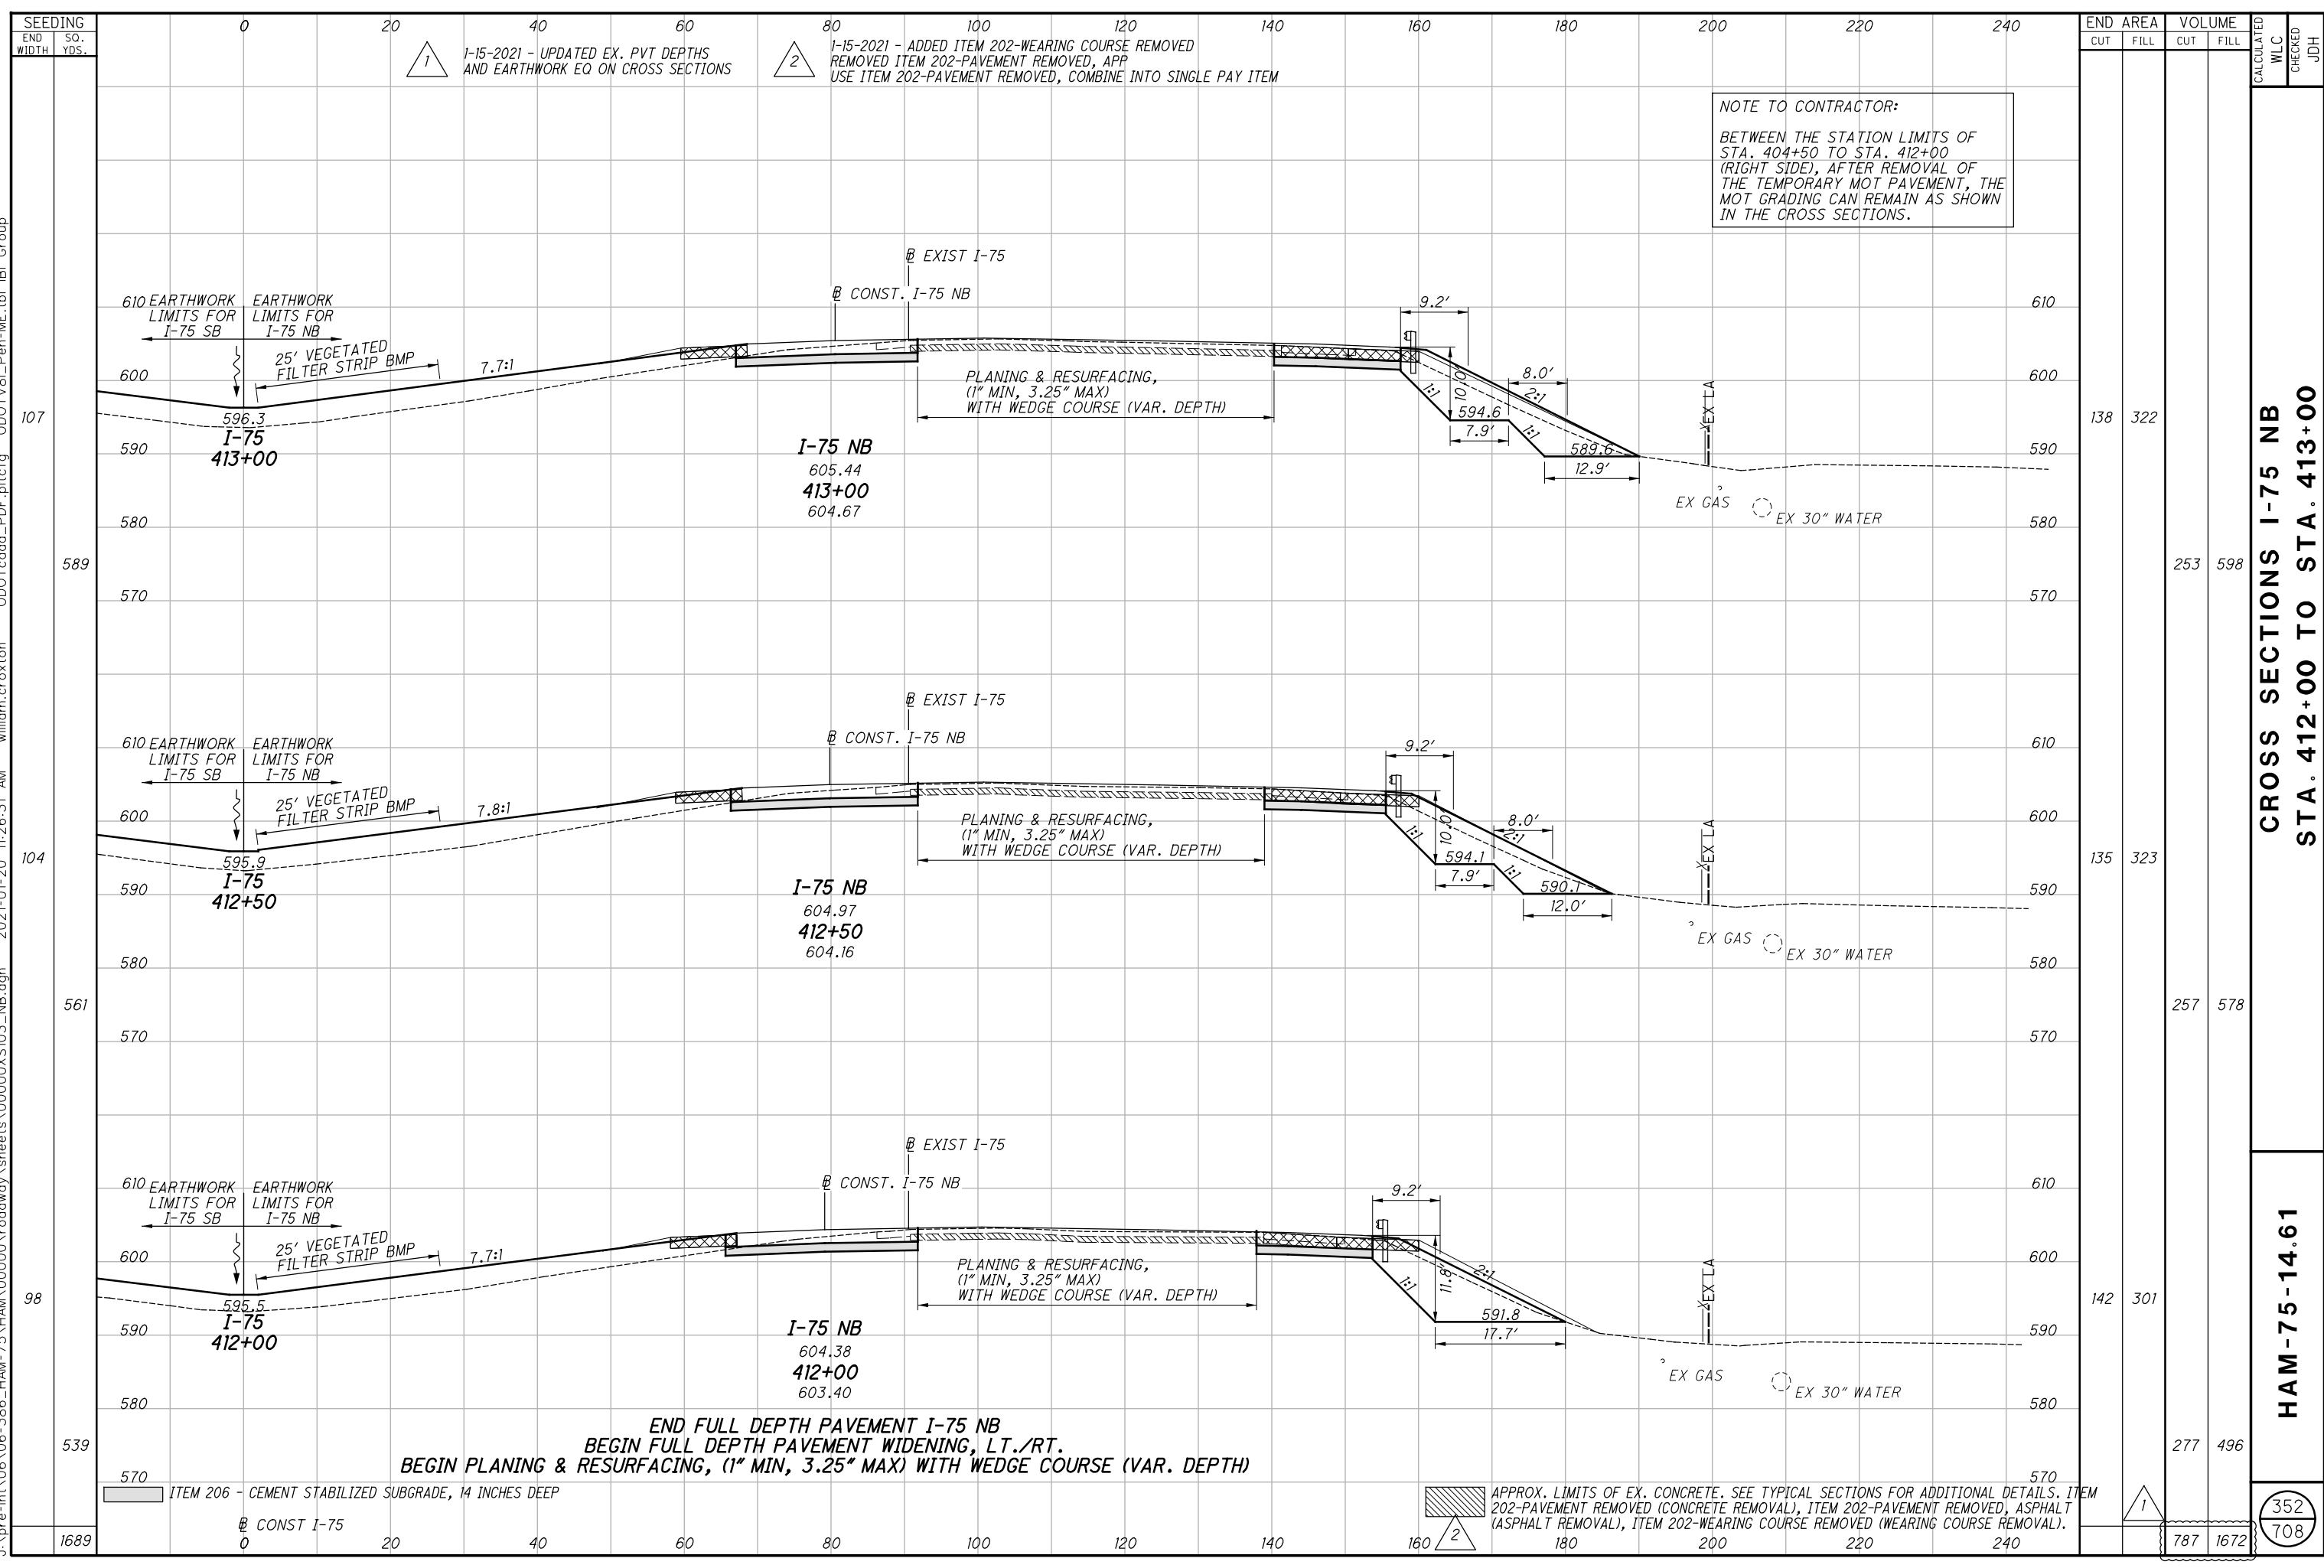

END FULL DEPTH PAVEMENT I-75 NB  
 BEGIN FULL DEPTH PAVEMENT WIDENING, LT./RT.  
 BEGIN PLANING & RESURFACING, (1" MIN, 3.25" MAX) WITH WEDGE COURSE (VAR. DEPTH)

**NOTE TO CONTRACTOR:**  
 BETWEEN THE STATION LIMITS OF STA. 404+50 TO STA. 412+00 (RIGHT SIDE), AFTER REMOVAL OF THE TEMPORARY MOT PAVEMENT, THE MOT GRADING CAN REMAIN AS SHOWN IN THE CROSS SECTIONS.

ITEM 206 - CEMENT STABILIZED SUBGRADE, 14 INCHES DEEP

APPROX. LIMITS OF EX. CONCRETE. SEE TYPICAL SECTIONS FOR ADDITIONAL DETAILS. ITEM 202-PAVEMENT REMOVED (CONCRETE REMOVAL), ITEM 202-PAVEMENT REMOVED, ASPHALT (ASPHALT REMOVAL), ITEM 202-WEARING COURSE REMOVED (WEARING COURSE REMOVAL).


END STA.	END AREA		VOLUME		CALCULATED WLC	CHECKED	JDH
	CUT	FILL	CUT	FILL			
413+00	138	322					
412+50	135	323					
412+00	142	301					
TOTAL	415	946	277	496			

**CROSS SECTIONS I-75 NB  
 STA. 412+00 TO STA. 413+00**

**HAM-75-14.61**

352  
 708

j:\pre-int\06\06-386\_HAM-75\HAM-75\00000\roadway\sheets\00000X5103\_NB.dgn 2021-01-20 11:26:32 AM william.croxton ODOTcadd\_PDF.plt cfb ODOTV8i\_Pen-ME.tbl IBI Group

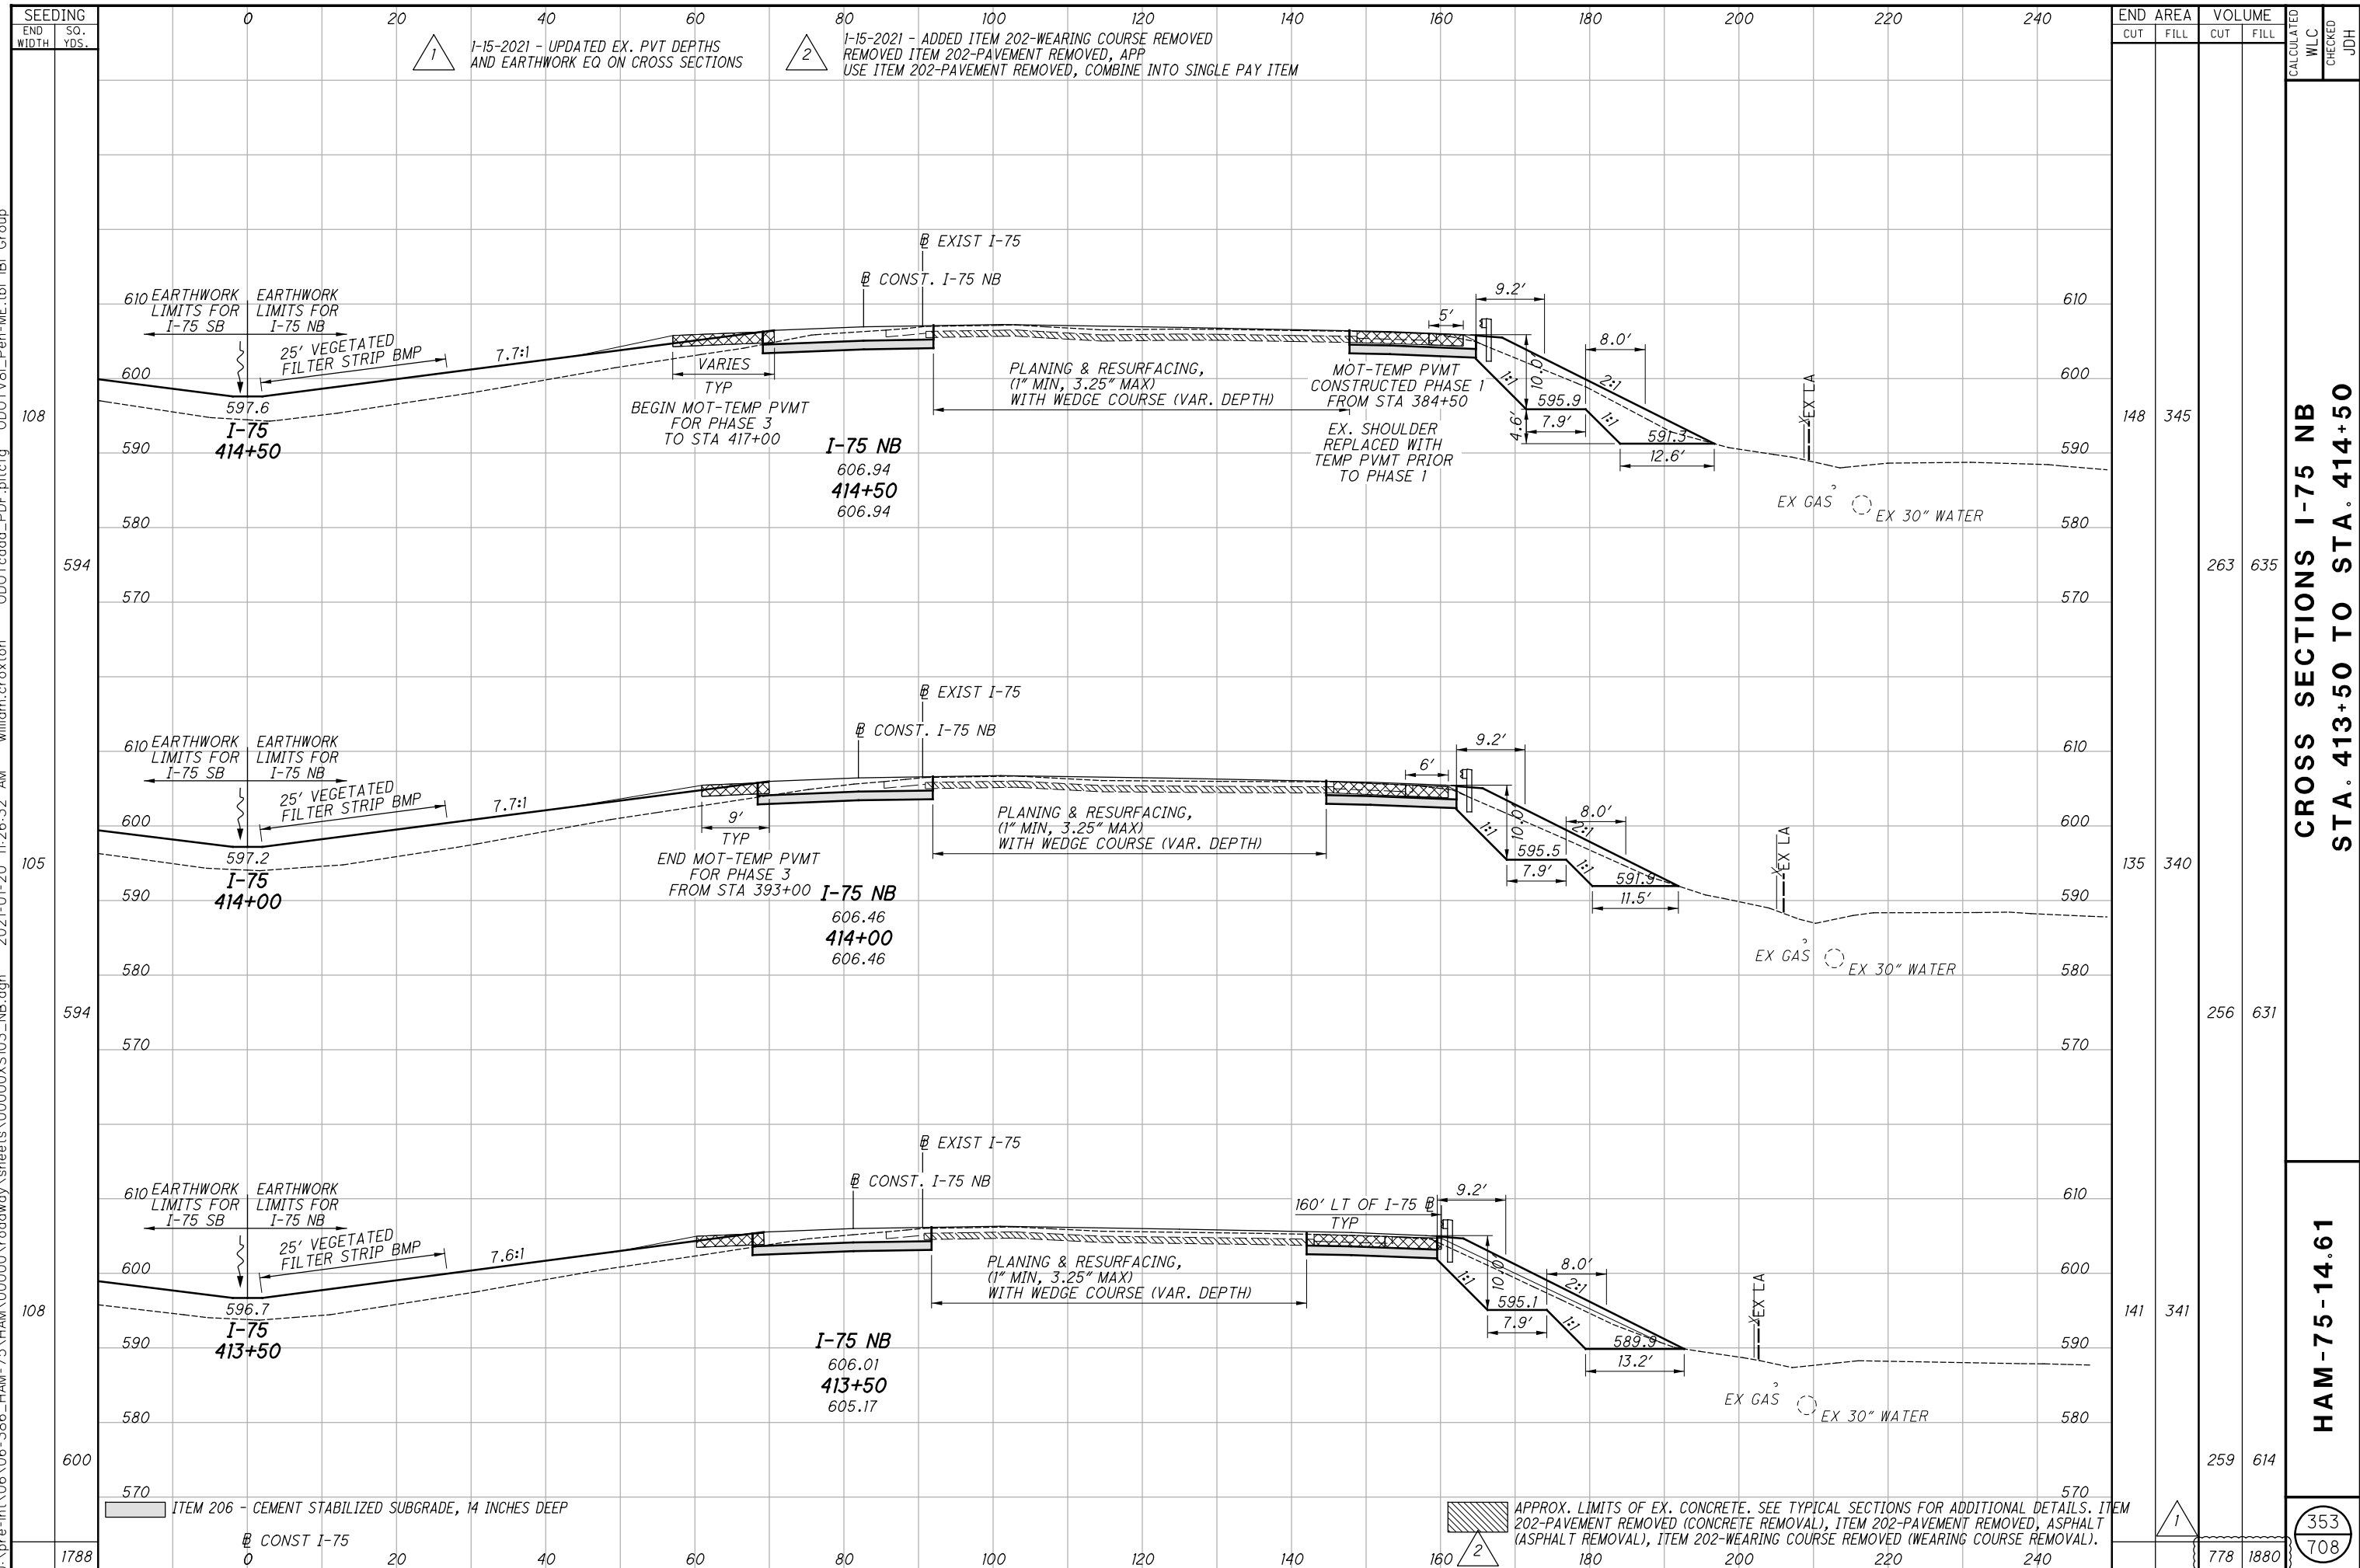

1-15-2021 - UPDATED EX. PVT DEPTHS AND EARTHWORK EQ ON CROSS SECTIONS

2 1-15-2021 - ADDED ITEM 202-WEARING COURSE REMOVED REMOVED ITEM 202-PAVEMENT REMOVED, APP USE ITEM 202-PAVEMENT REMOVED, COMBINE INTO SINGLE PAY ITEM

END AREA	VOLUME	CALCULATED WLC	CHECKED	JDH
148	345			
135	340	263	635	
141	341	256	631	
1788	778	259	614	1880

CROSS SECTIONS I-75 NB  
STA. 413+50 TO STA. 414+50

HAM-75-14.61


353  
708

ITEM 206 - CEMENT STABILIZED SUBGRADE, 14 INCHES DEEP

APPROX. LIMITS OF EX. CONCRETE. SEE TYPICAL SECTIONS FOR ADDITIONAL DETAILS. ITEM 202-PAVEMENT REMOVED (CONCRETE REMOVAL), ITEM 202-PAVEMENT REMOVED, ASPHALT (ASPHALT REMOVAL), ITEM 202-WEARING COURSE REMOVED (WEARING COURSE REMOVAL).



j:\pre-int\06\06-386\_HAM-75\HAM-75\00000\roadway\sheets\00000X5103\_NB.dgn 2021-01-20 11:26:34 AM william.croxton ODOTcadd\_PDF.plt cfig ODOTV8i\_Pen-ME.tbl IBI Group

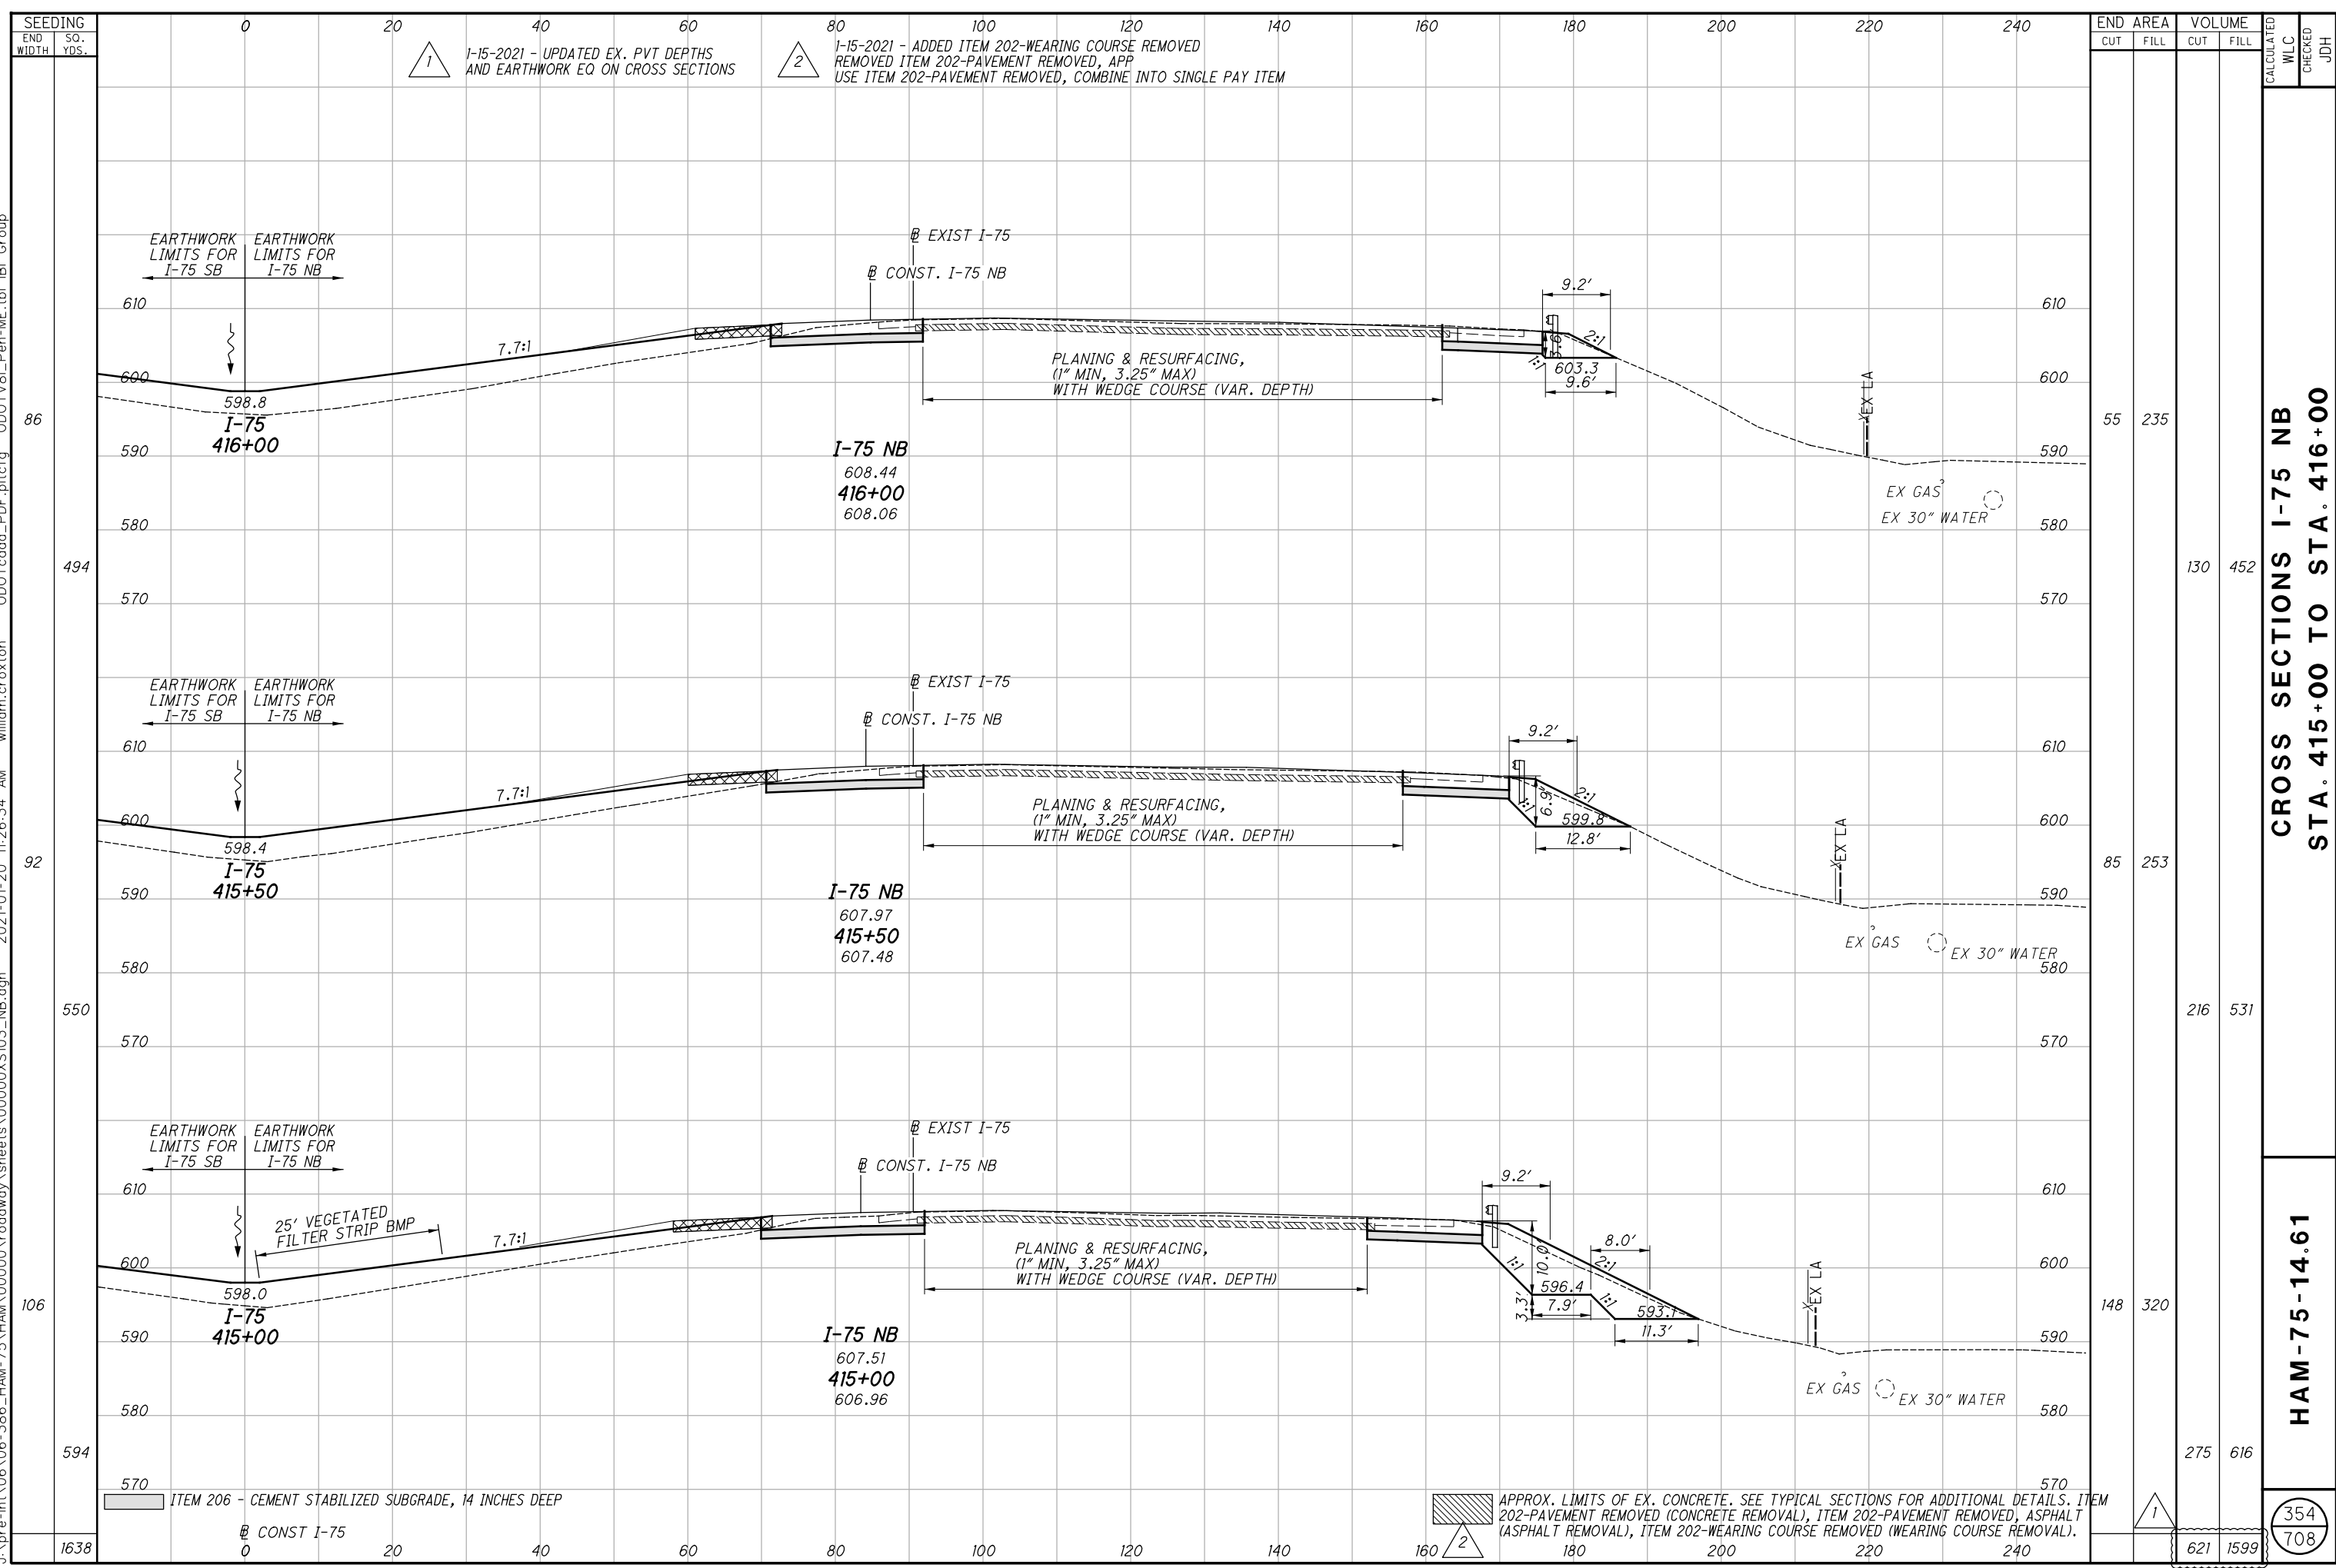


CROSS SECTIONS I-75 NB  
STA. 415+00 TO STA. 416+00

HAM-75-14.61

354  
708

STATION	END AREA		VOLUME	
	CUT	FILL	CUT	FILL
416+00	55	235		
415+50	85	253		
415+00	148	320		
TOTAL	288	808	288	808

j:\pre-int\06\06-386\_HAM-75\HAM-75\00000\roadway\sheets\00000X5103\_NB.dgn 2021-01-20 11:26:35 AM william.croxton ODOTcadd\_PDF.plt c:\odot\81\_Pen-ME.tbl IBI\_Group

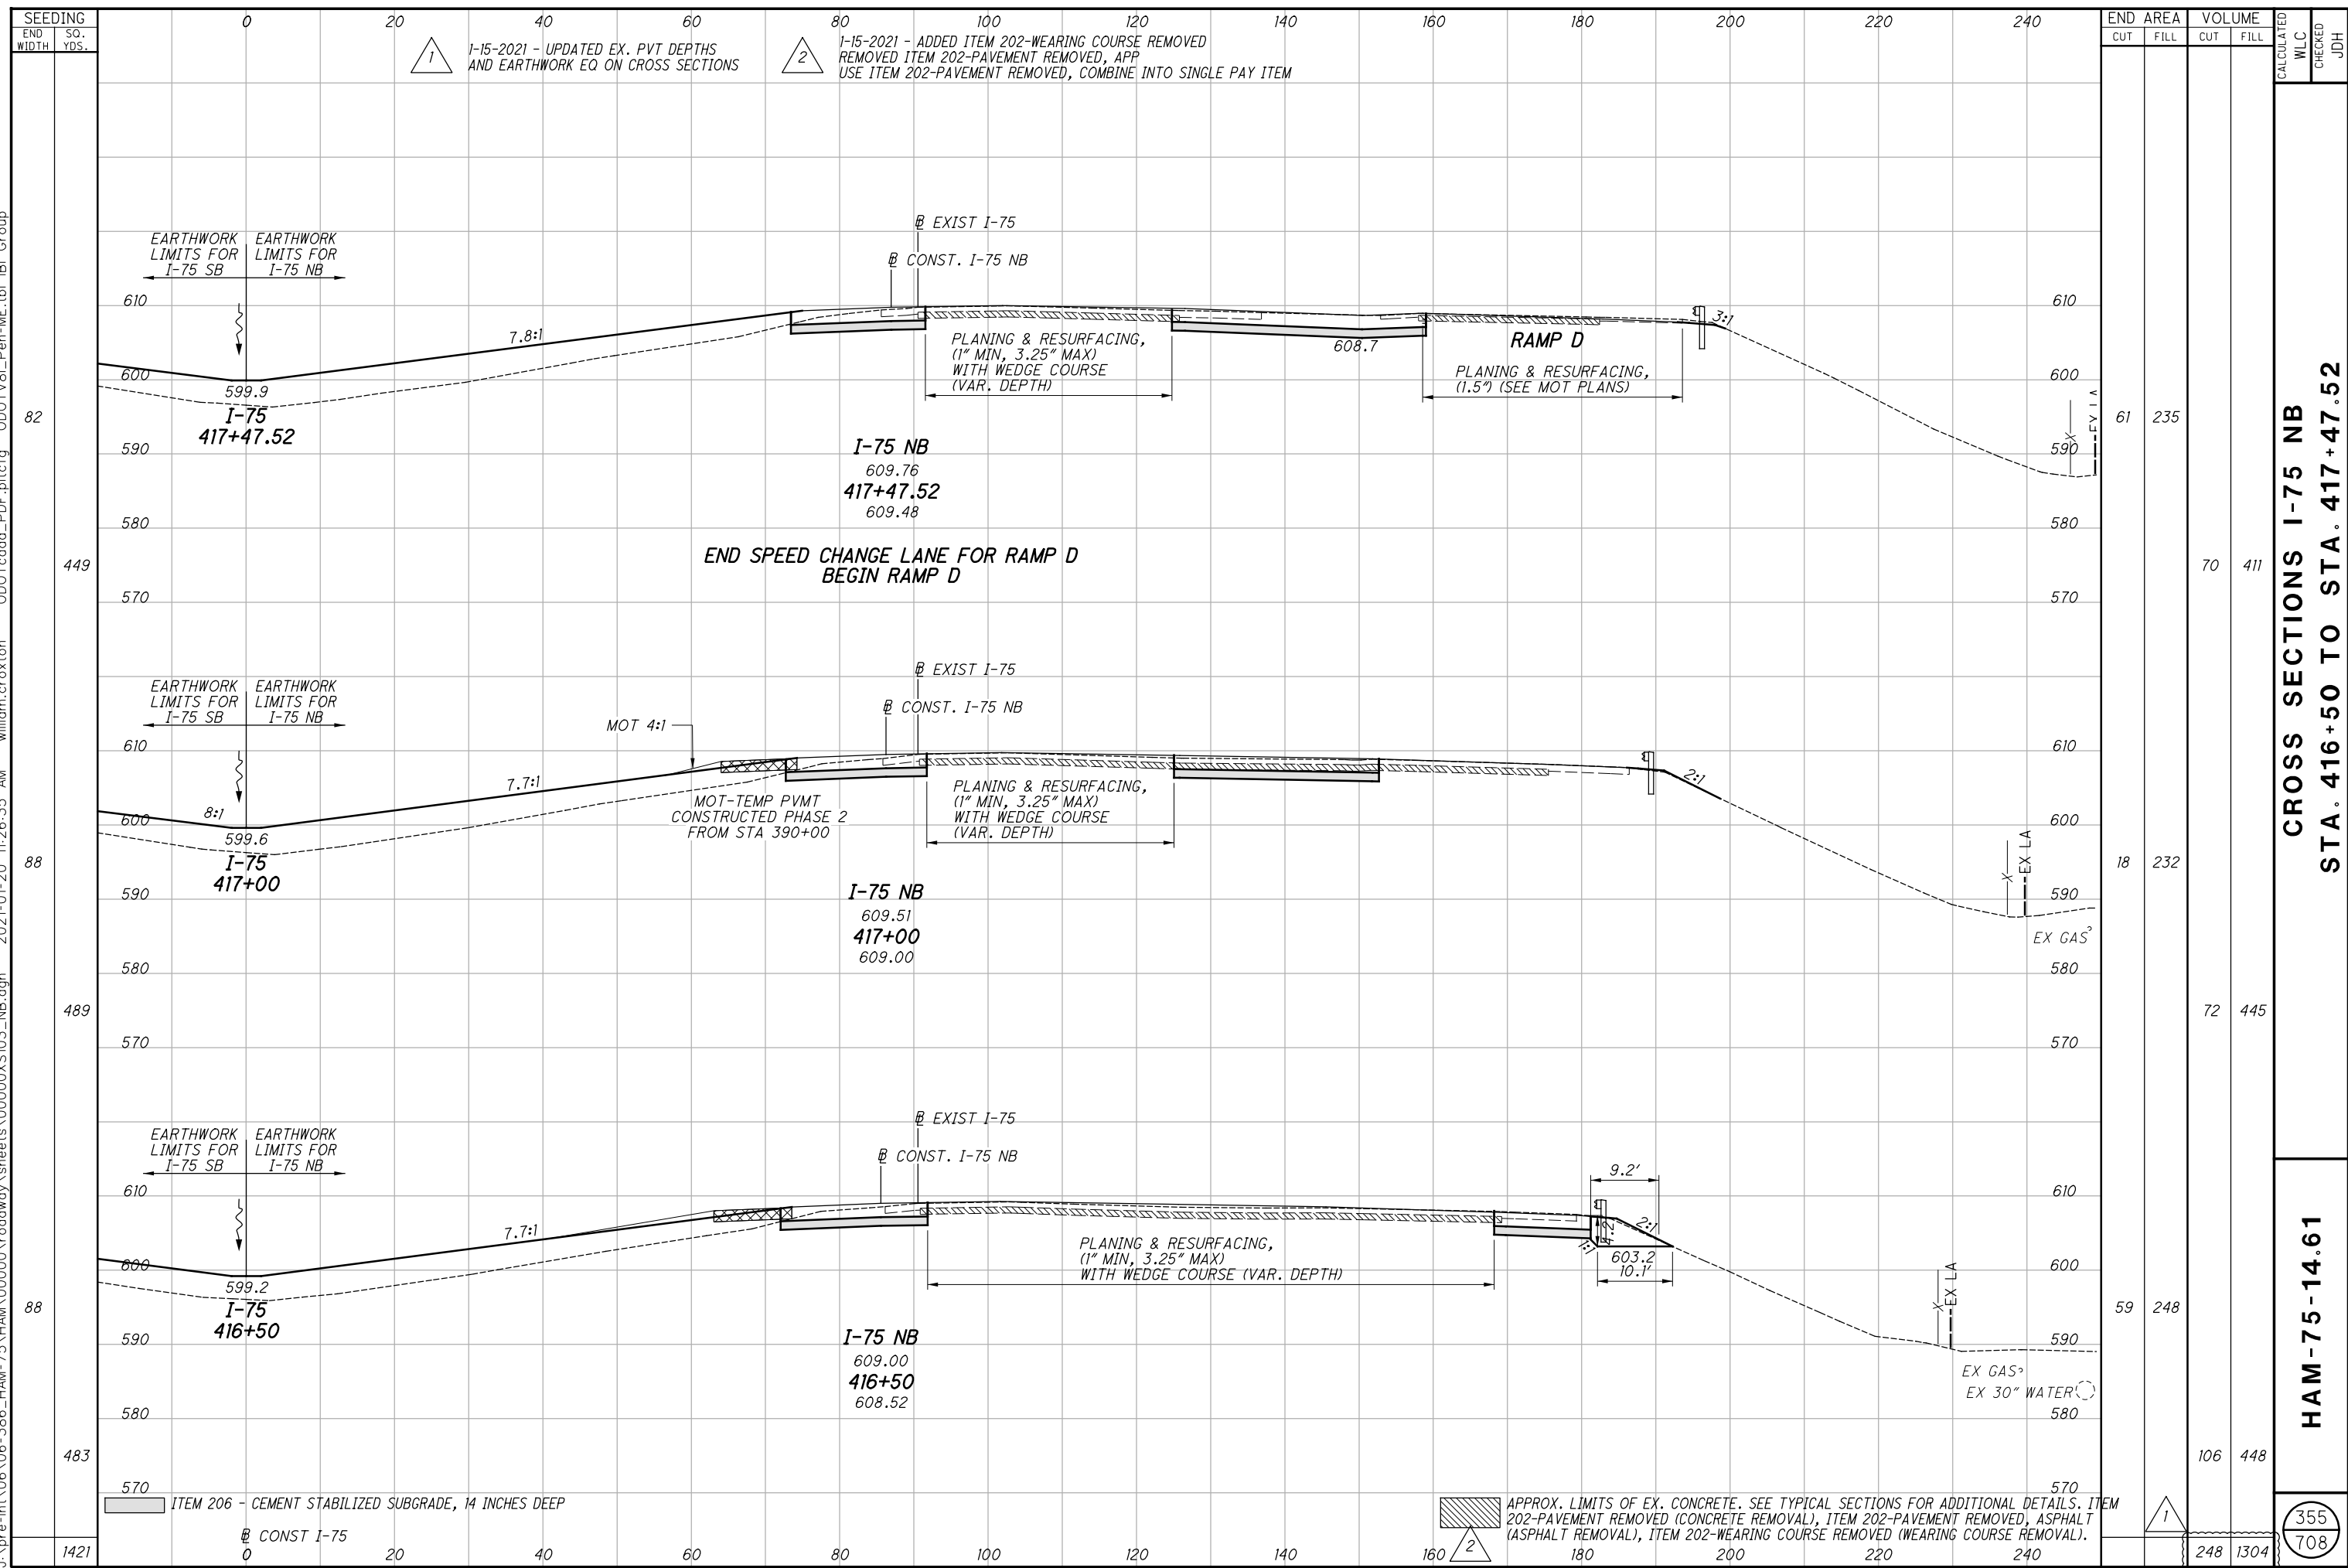

1-15-2021 - UPDATED EX. PVT DEPTHS AND EARTHWORK EQ ON CROSS SECTIONS

2 1-15-2021 - ADDED ITEM 202-WEARING COURSE REMOVED REMOVED ITEM 202-PAVEMENT REMOVED, APP USE ITEM 202-PAVEMENT REMOVED, COMBINE INTO SINGLE PAY ITEM

END AREA	VOLUME		CALCULATED WLC	CHECKED JDH
	CUT	FILL		
61	235			
18	232			
59	248			
106	448			
248	1304			

CROSS SECTIONS I-75 NB  
STA. 416+50 TO STA. 417+47.52


HAM-75-14.61

355  
708

ITEM 206 - CEMENT STABILIZED SUBGRADE, 14 INCHES DEEP

APPROX. LIMITS OF EX. CONCRETE. SEE TYPICAL SECTIONS FOR ADDITIONAL DETAILS. ITEM 202-PAVEMENT REMOVED (CONCRETE REMOVAL), ITEM 202-PAVEMENT REMOVED, ASPHALT (ASPHALT REMOVAL), ITEM 202-WEARING COURSE REMOVED (WEARING COURSE REMOVAL).

j:\pre-int\06\06-386\_HAM-75\_HAM\00000\roadway\sheets\00000X5103\_NB.dgn 2021-01-20 11:26:36 AM william.croxton ODOTcadd\_PDF.plt cfb ODOTV81\_Pen-ME.tbl IBI Group

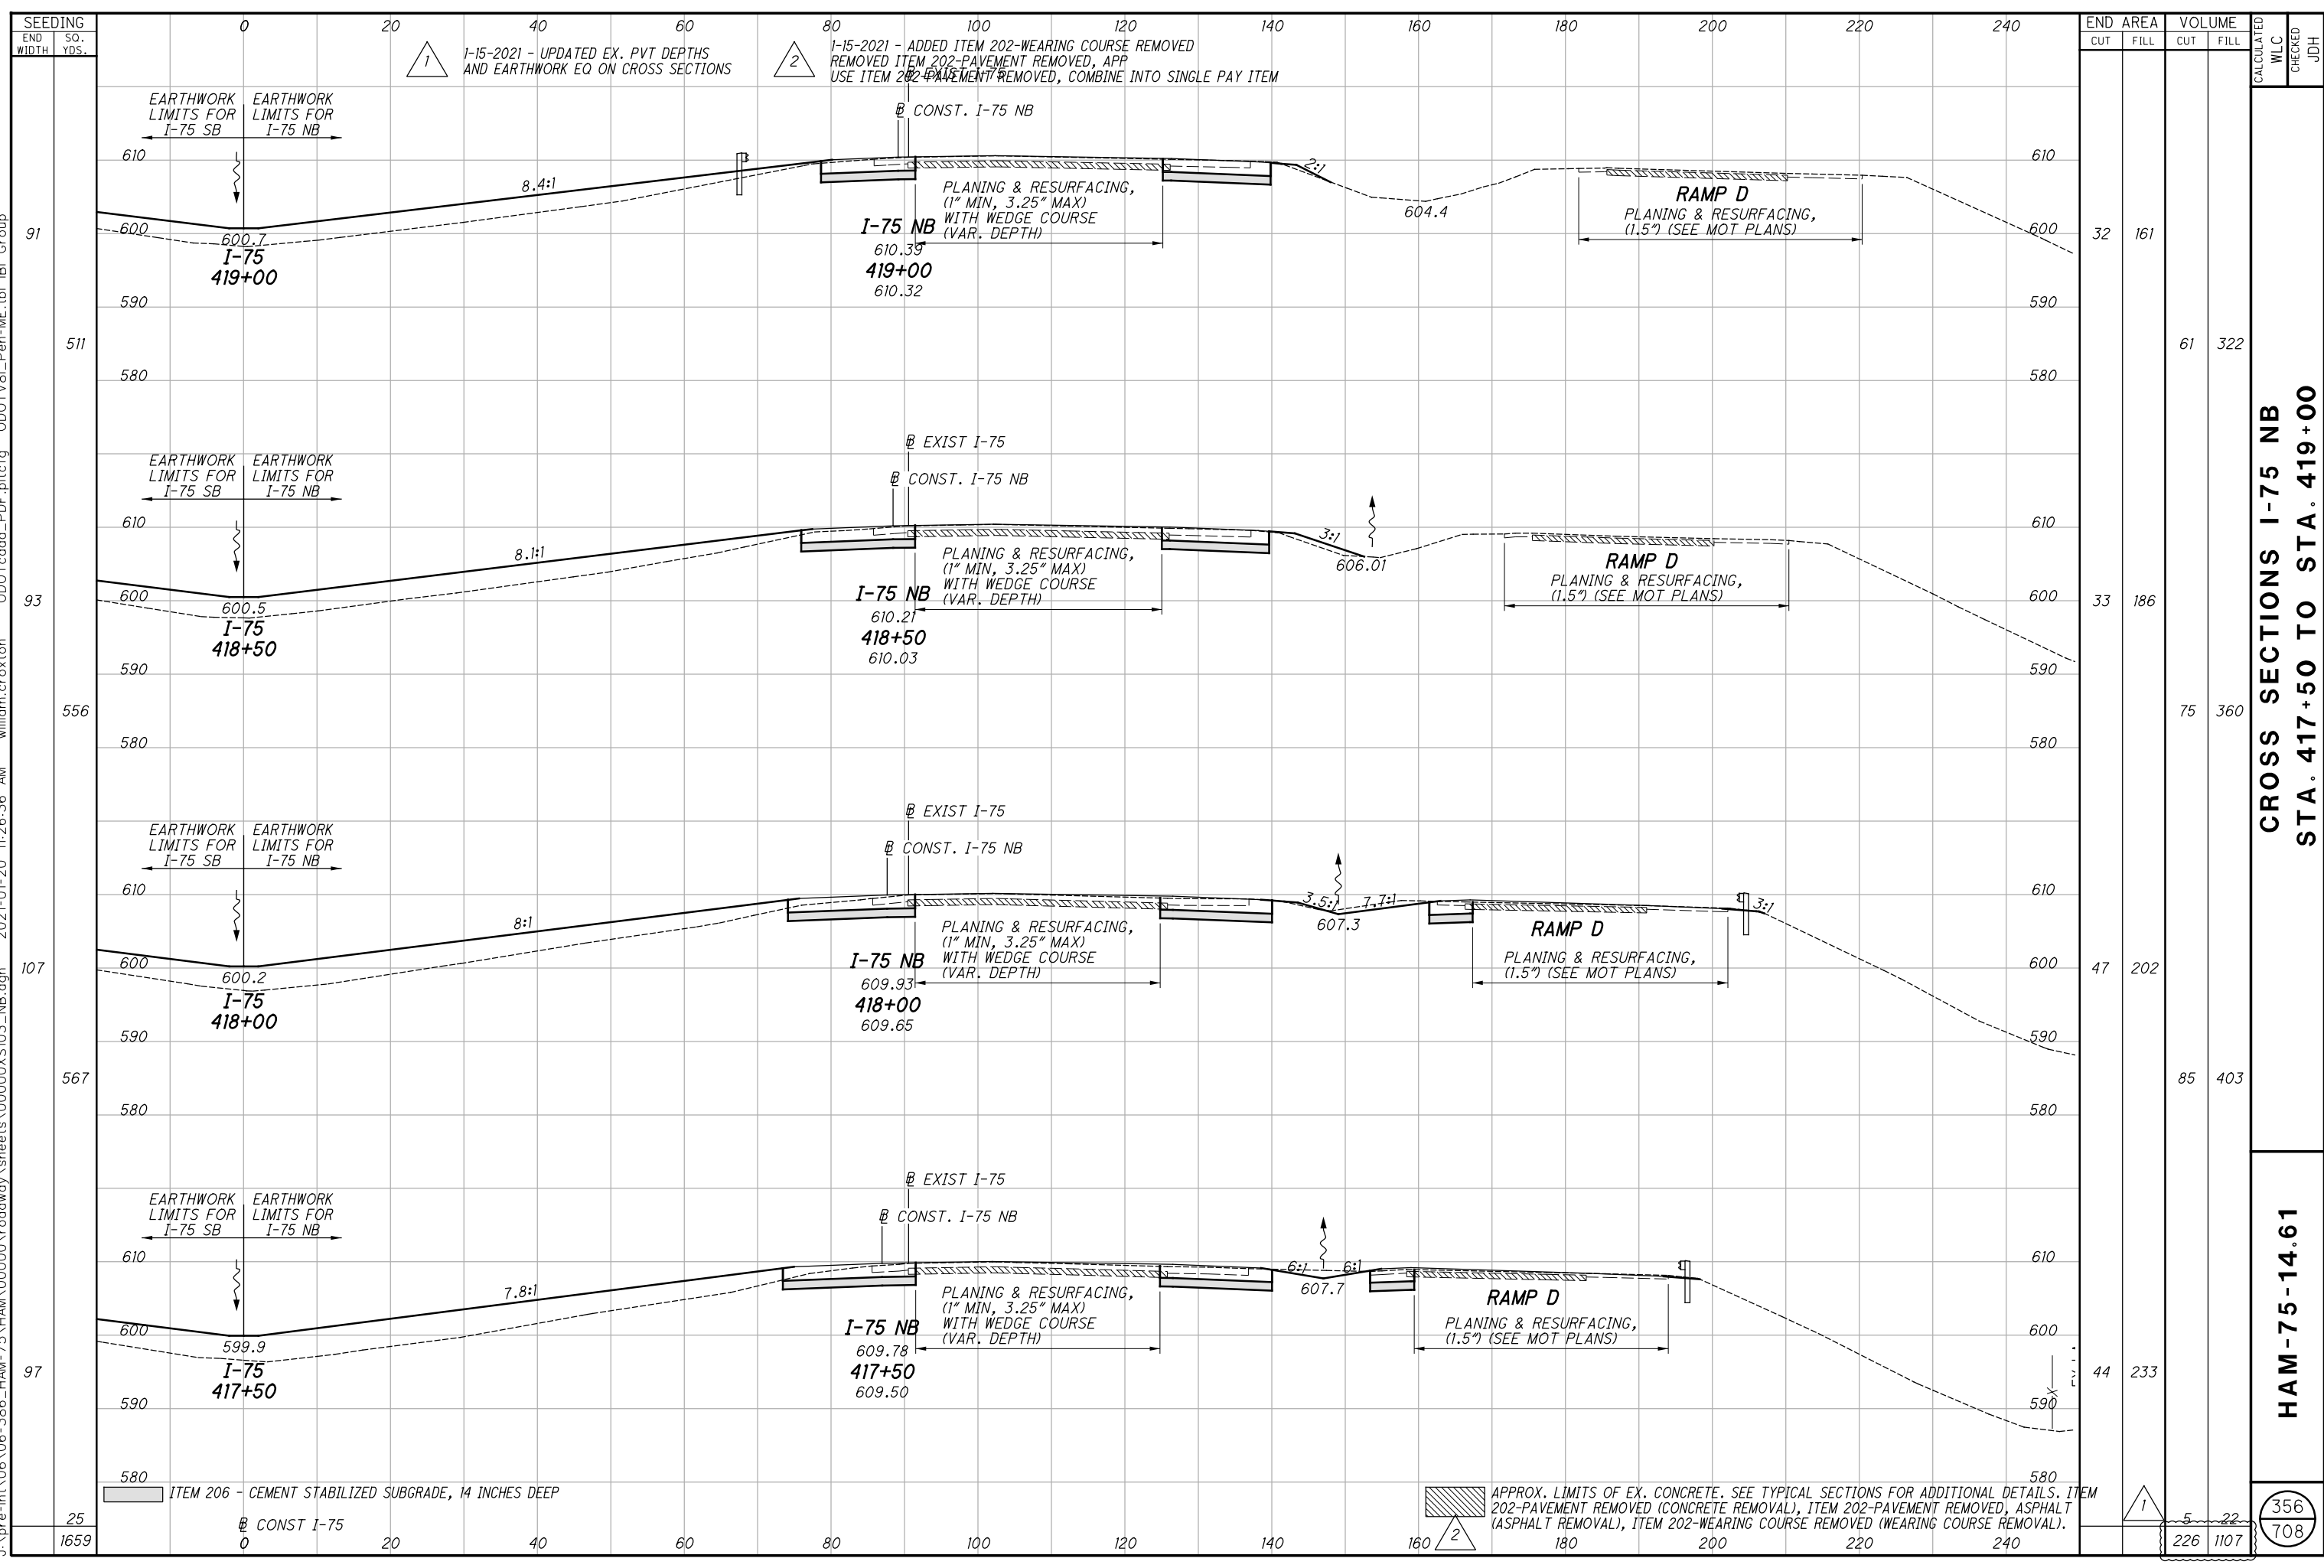


END STA	AREA		VOLUME		CALCULATED WLC	CHECKED	JDH
	CUT	FILL	CUT	FILL			
91	32	161					
511		61		322			
93	33	186					
556		75		360			
107	47	202					
567		85		403			
97	44	233					
25		5		22			
1659		226		1107			

CROSS SECTIONS I-75 NB  
STA. 417+50 TO STA. 419+00

HAM-75-14.61

356  
708


j:\pre-int\06\06-386\_HAM-75\_HAM\00000\roadway\sheets\00000X5103\_NB.dgn 2021-01-20 11:26:37 AM william.croxton\ ODOTcadd\_PDF.plt c:\odot\8i\_Pen-ME.tbl |BI\_Group

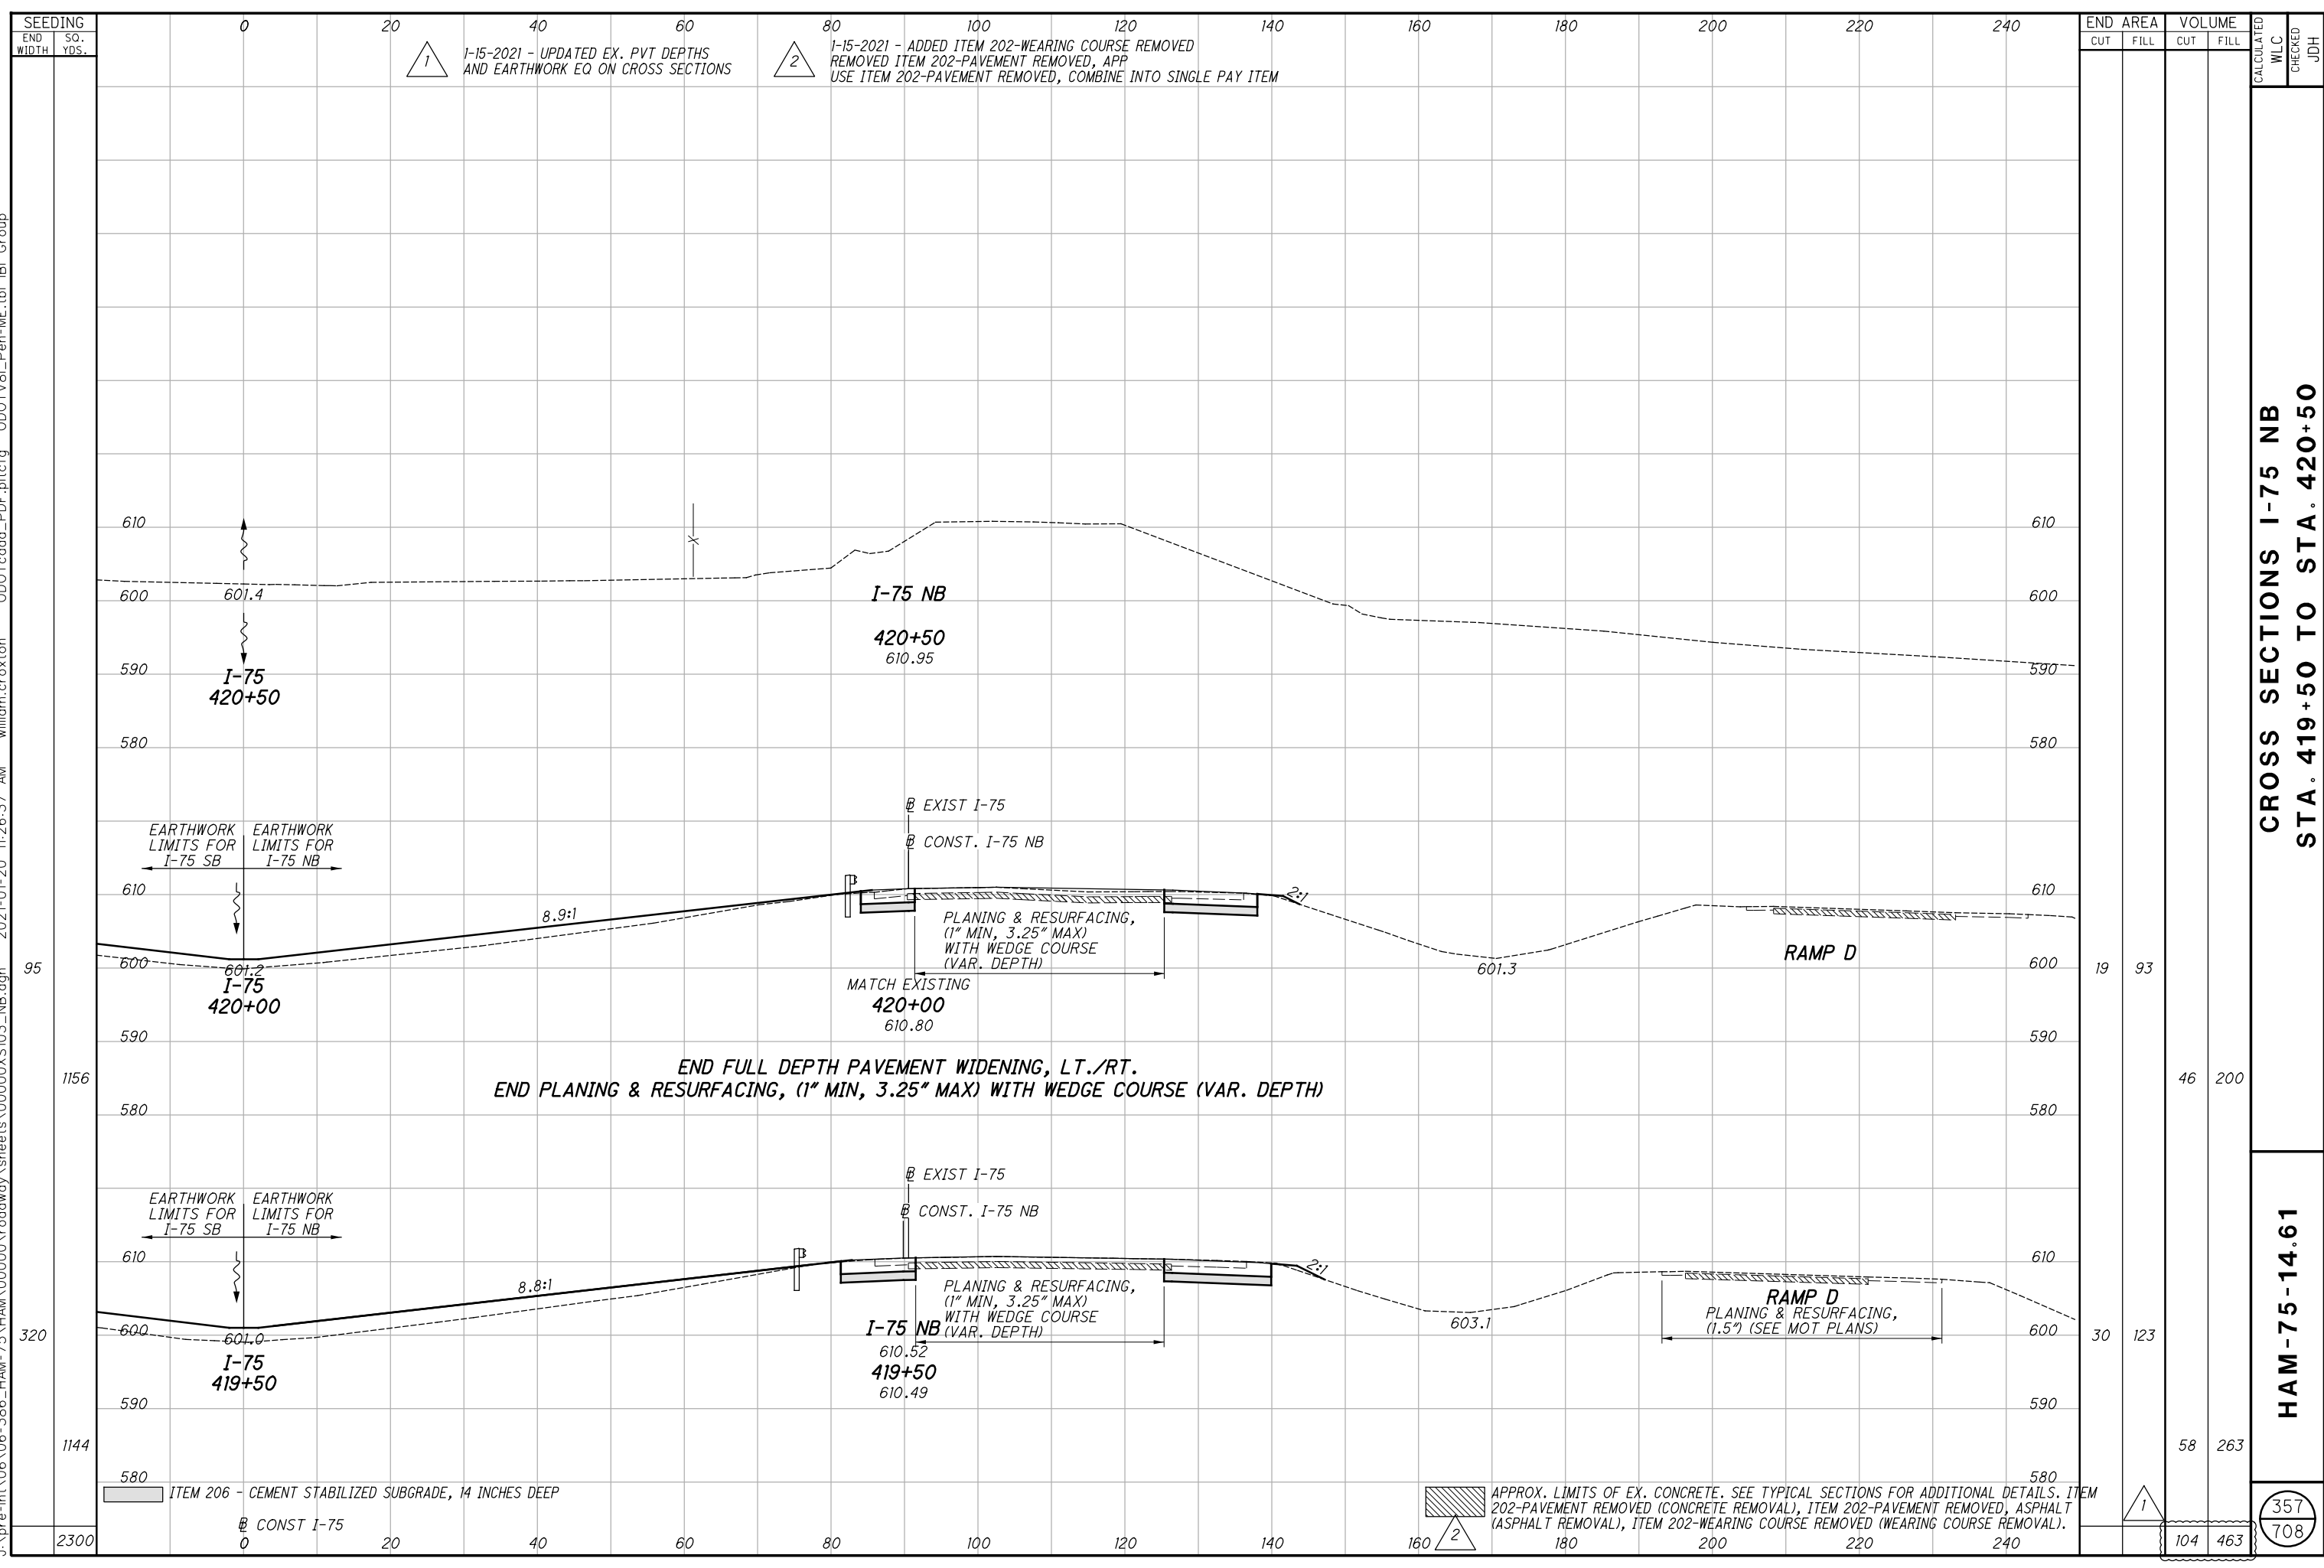

ITEM 206 - CEMENT STABILIZED SUBGRADE, 14 INCHES DEEP

APPROX. LIMITS OF EX. CONCRETE. SEE TYPICAL SECTIONS FOR ADDITIONAL DETAILS. ITEM 202-PAVEMENT REMOVED (CONCRETE REMOVAL), ITEM 202-PAVEMENT REMOVED, ASPHALT (ASPHALT REMOVAL), ITEM 202-WEARING COURSE REMOVED (WEARING COURSE REMOVAL).

j:\pre-int\06\06-386\_HAM-75\HAM\00000\roadway\sheets\00000X5200.dgn 2021-01-18 2:51:07 PM william.croxton\ODOTcadd\_PDF.pltcfgr ODOTV8i\_Pen-ME.tbl IBI Group

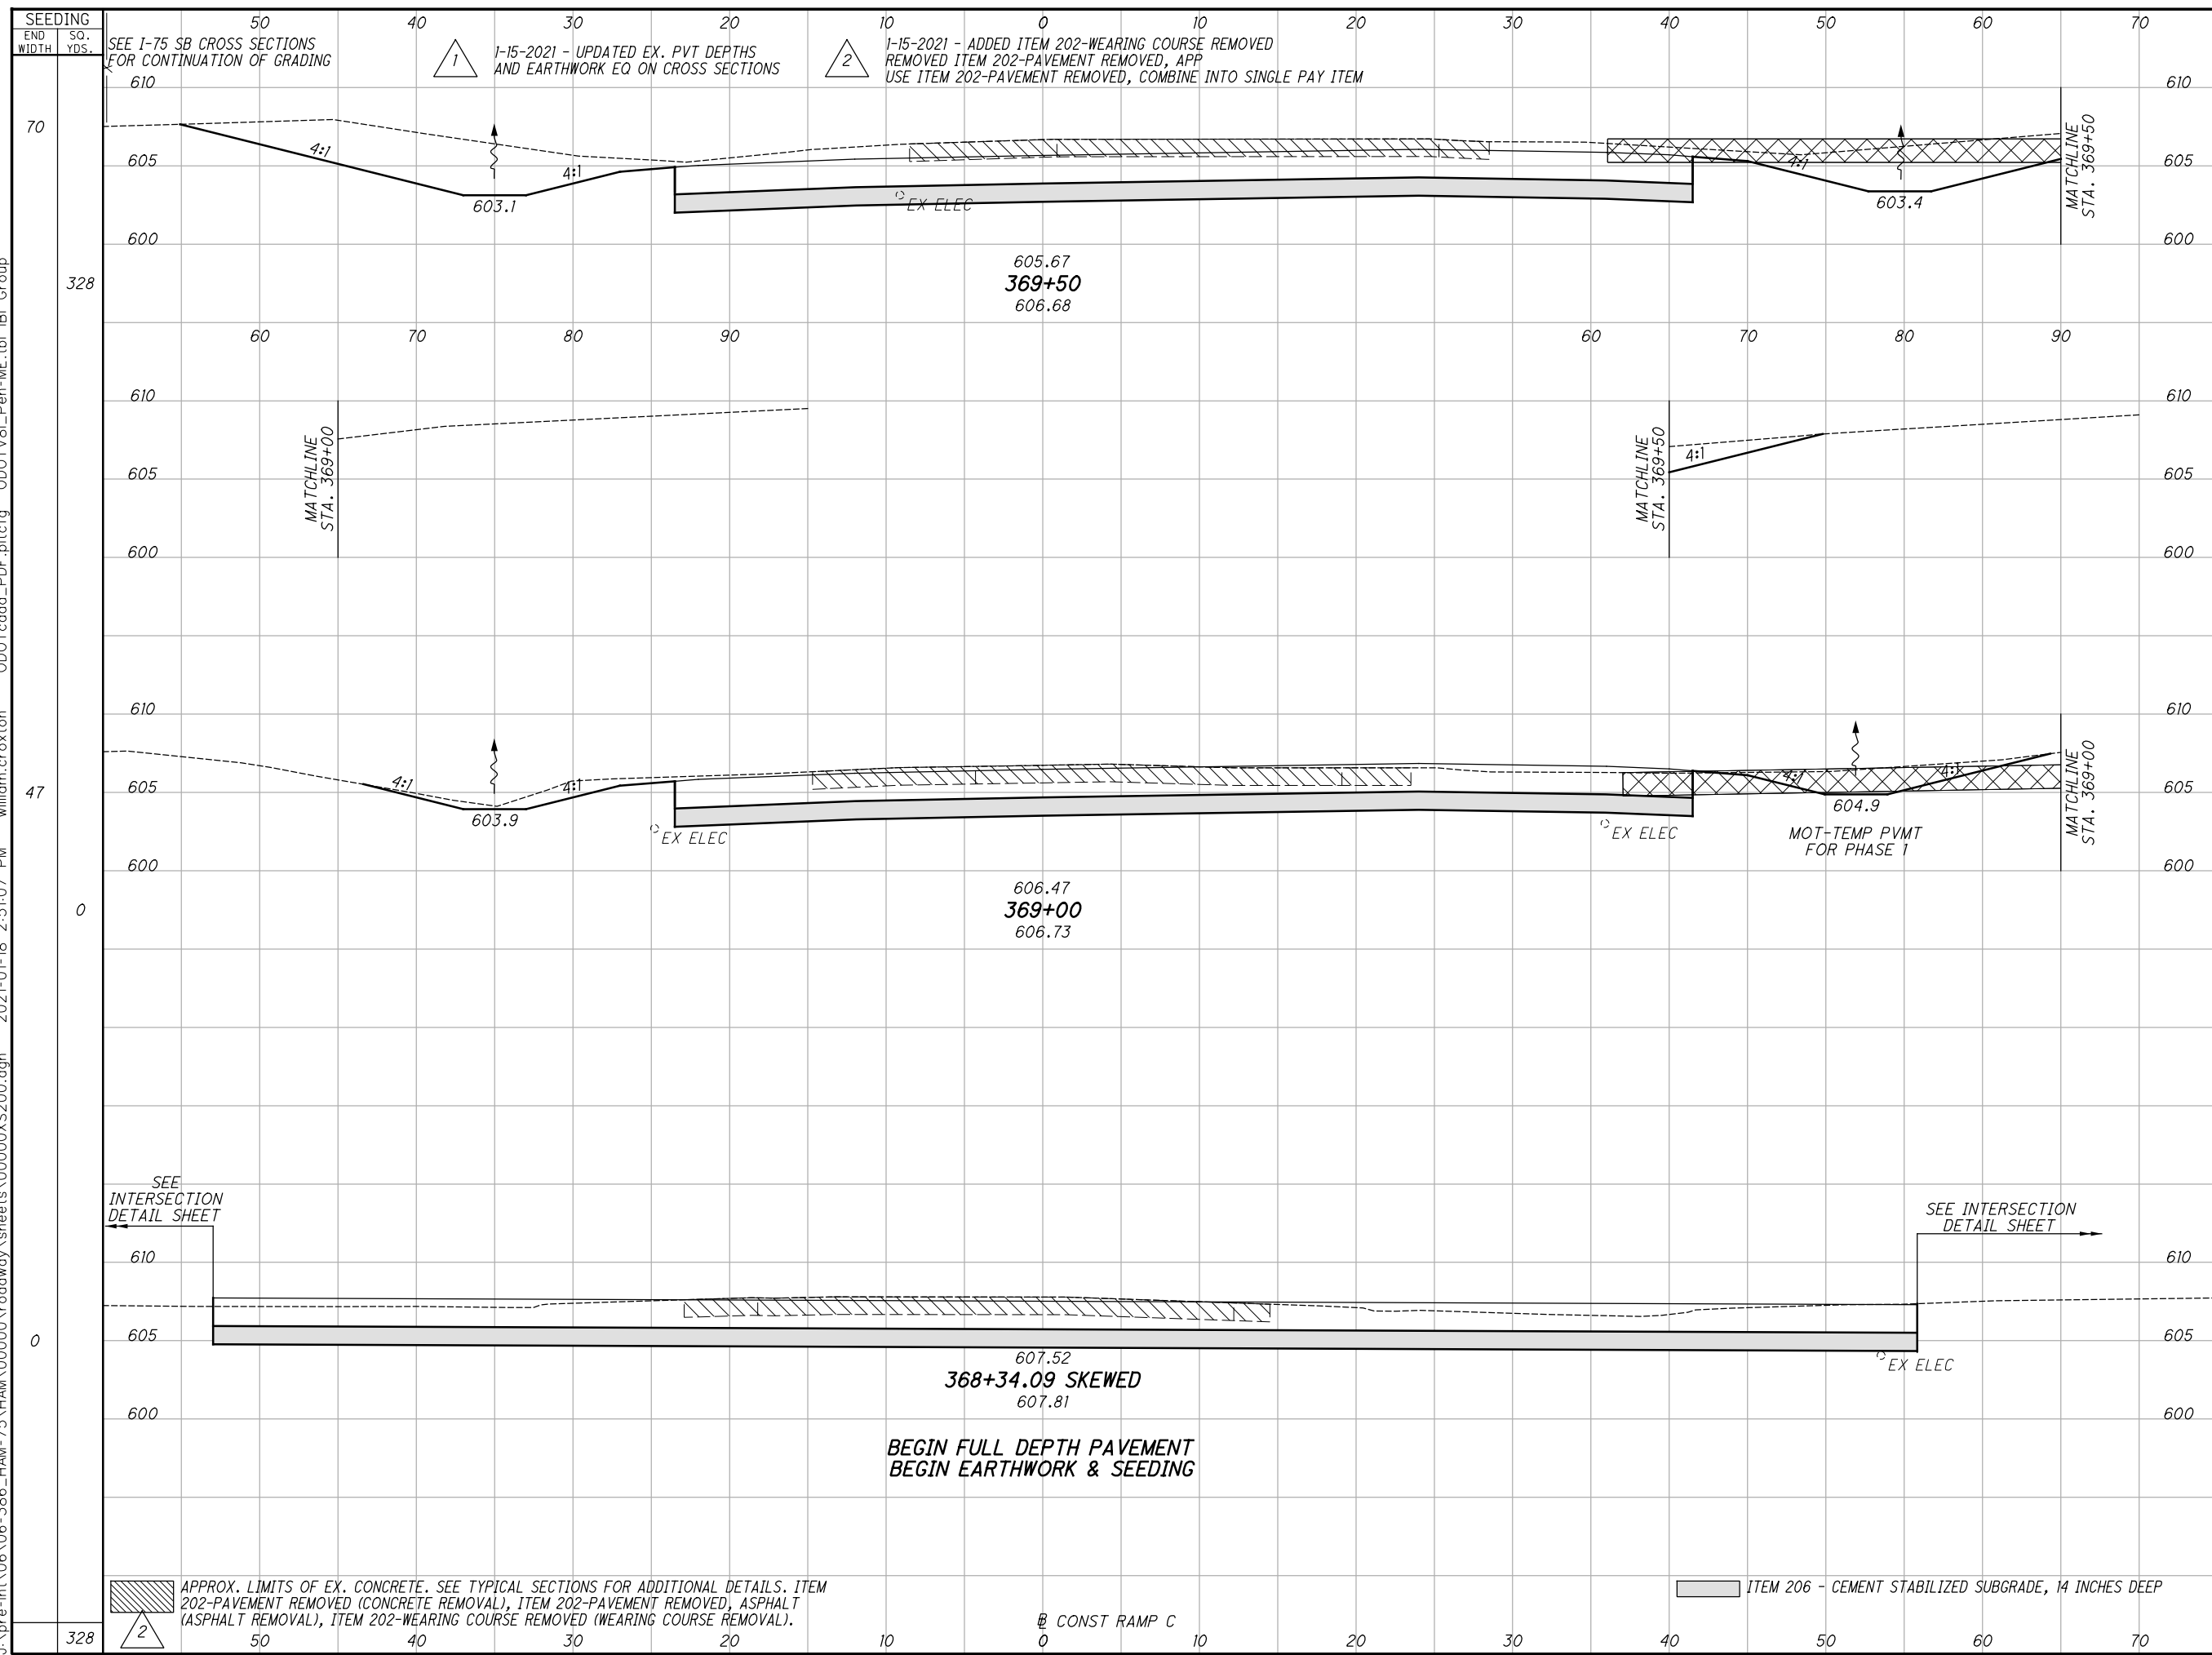


END STA	AREA		VOLUME		CALCULATED WLC	CHECKED JDH
	CUT	FILL	CUT	FILL		
369+50	241	5	317	10		
369+00	101	5	282	7		
368+34.09	130	0				
TOTAL	472	10	600	17		

**CROSS SECTIONS RAMP C**  
**STA. 368+34.09 TO STA. 369+50**

**HAM-75-14.61**


358  
708

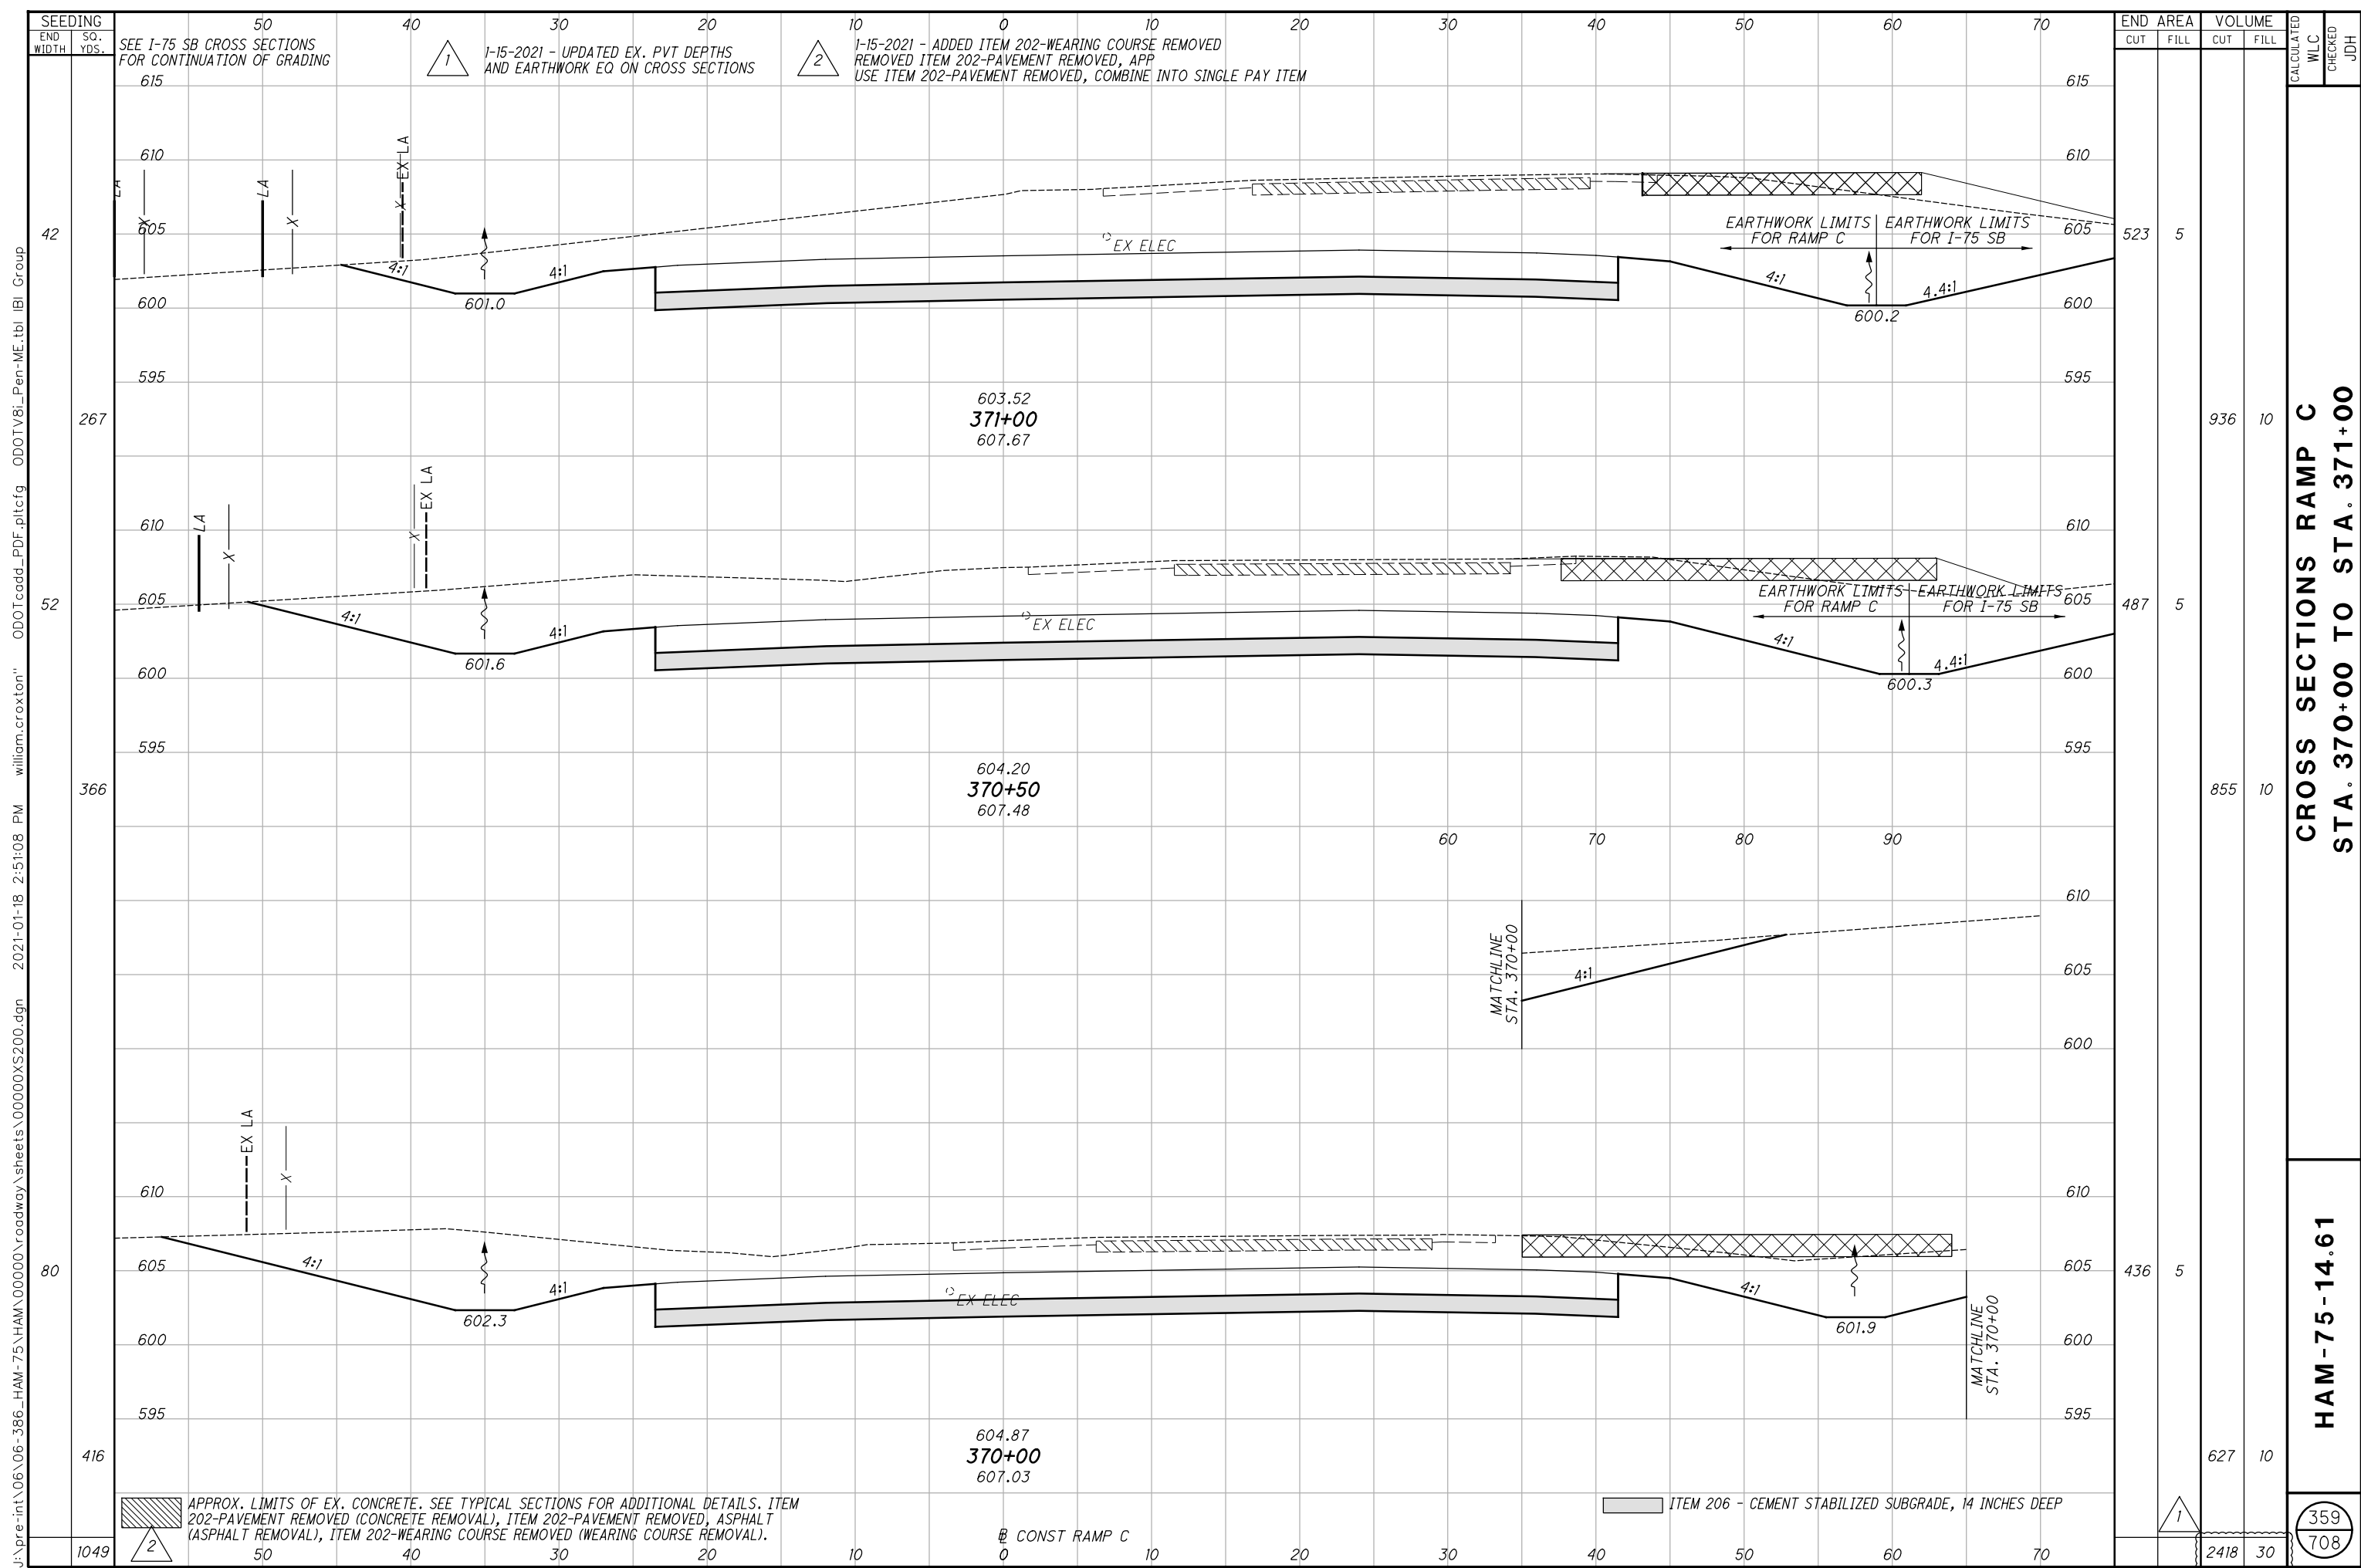

j:\pre-int\06\06-386\_HAM-75\_HAM\00000\roadway\sheets\00000X5200.dgn 2021-01-18 2:51:08 PM william.croxton ODOTcadd\_PDF.pltcfgr ODOTV8i\_Pen-ME.tbl IBI Group

359  
708

j:\pre-int\06\06-386\_HAM-75\HAM\00000\roadway\sheets\00000X5200.dgn 2021-01-18 2:51:08 PM william.croxton" ODOTcadd\_PDF.pltcfgr ODOTV8i\_Pen-ME.tbl IBI Group

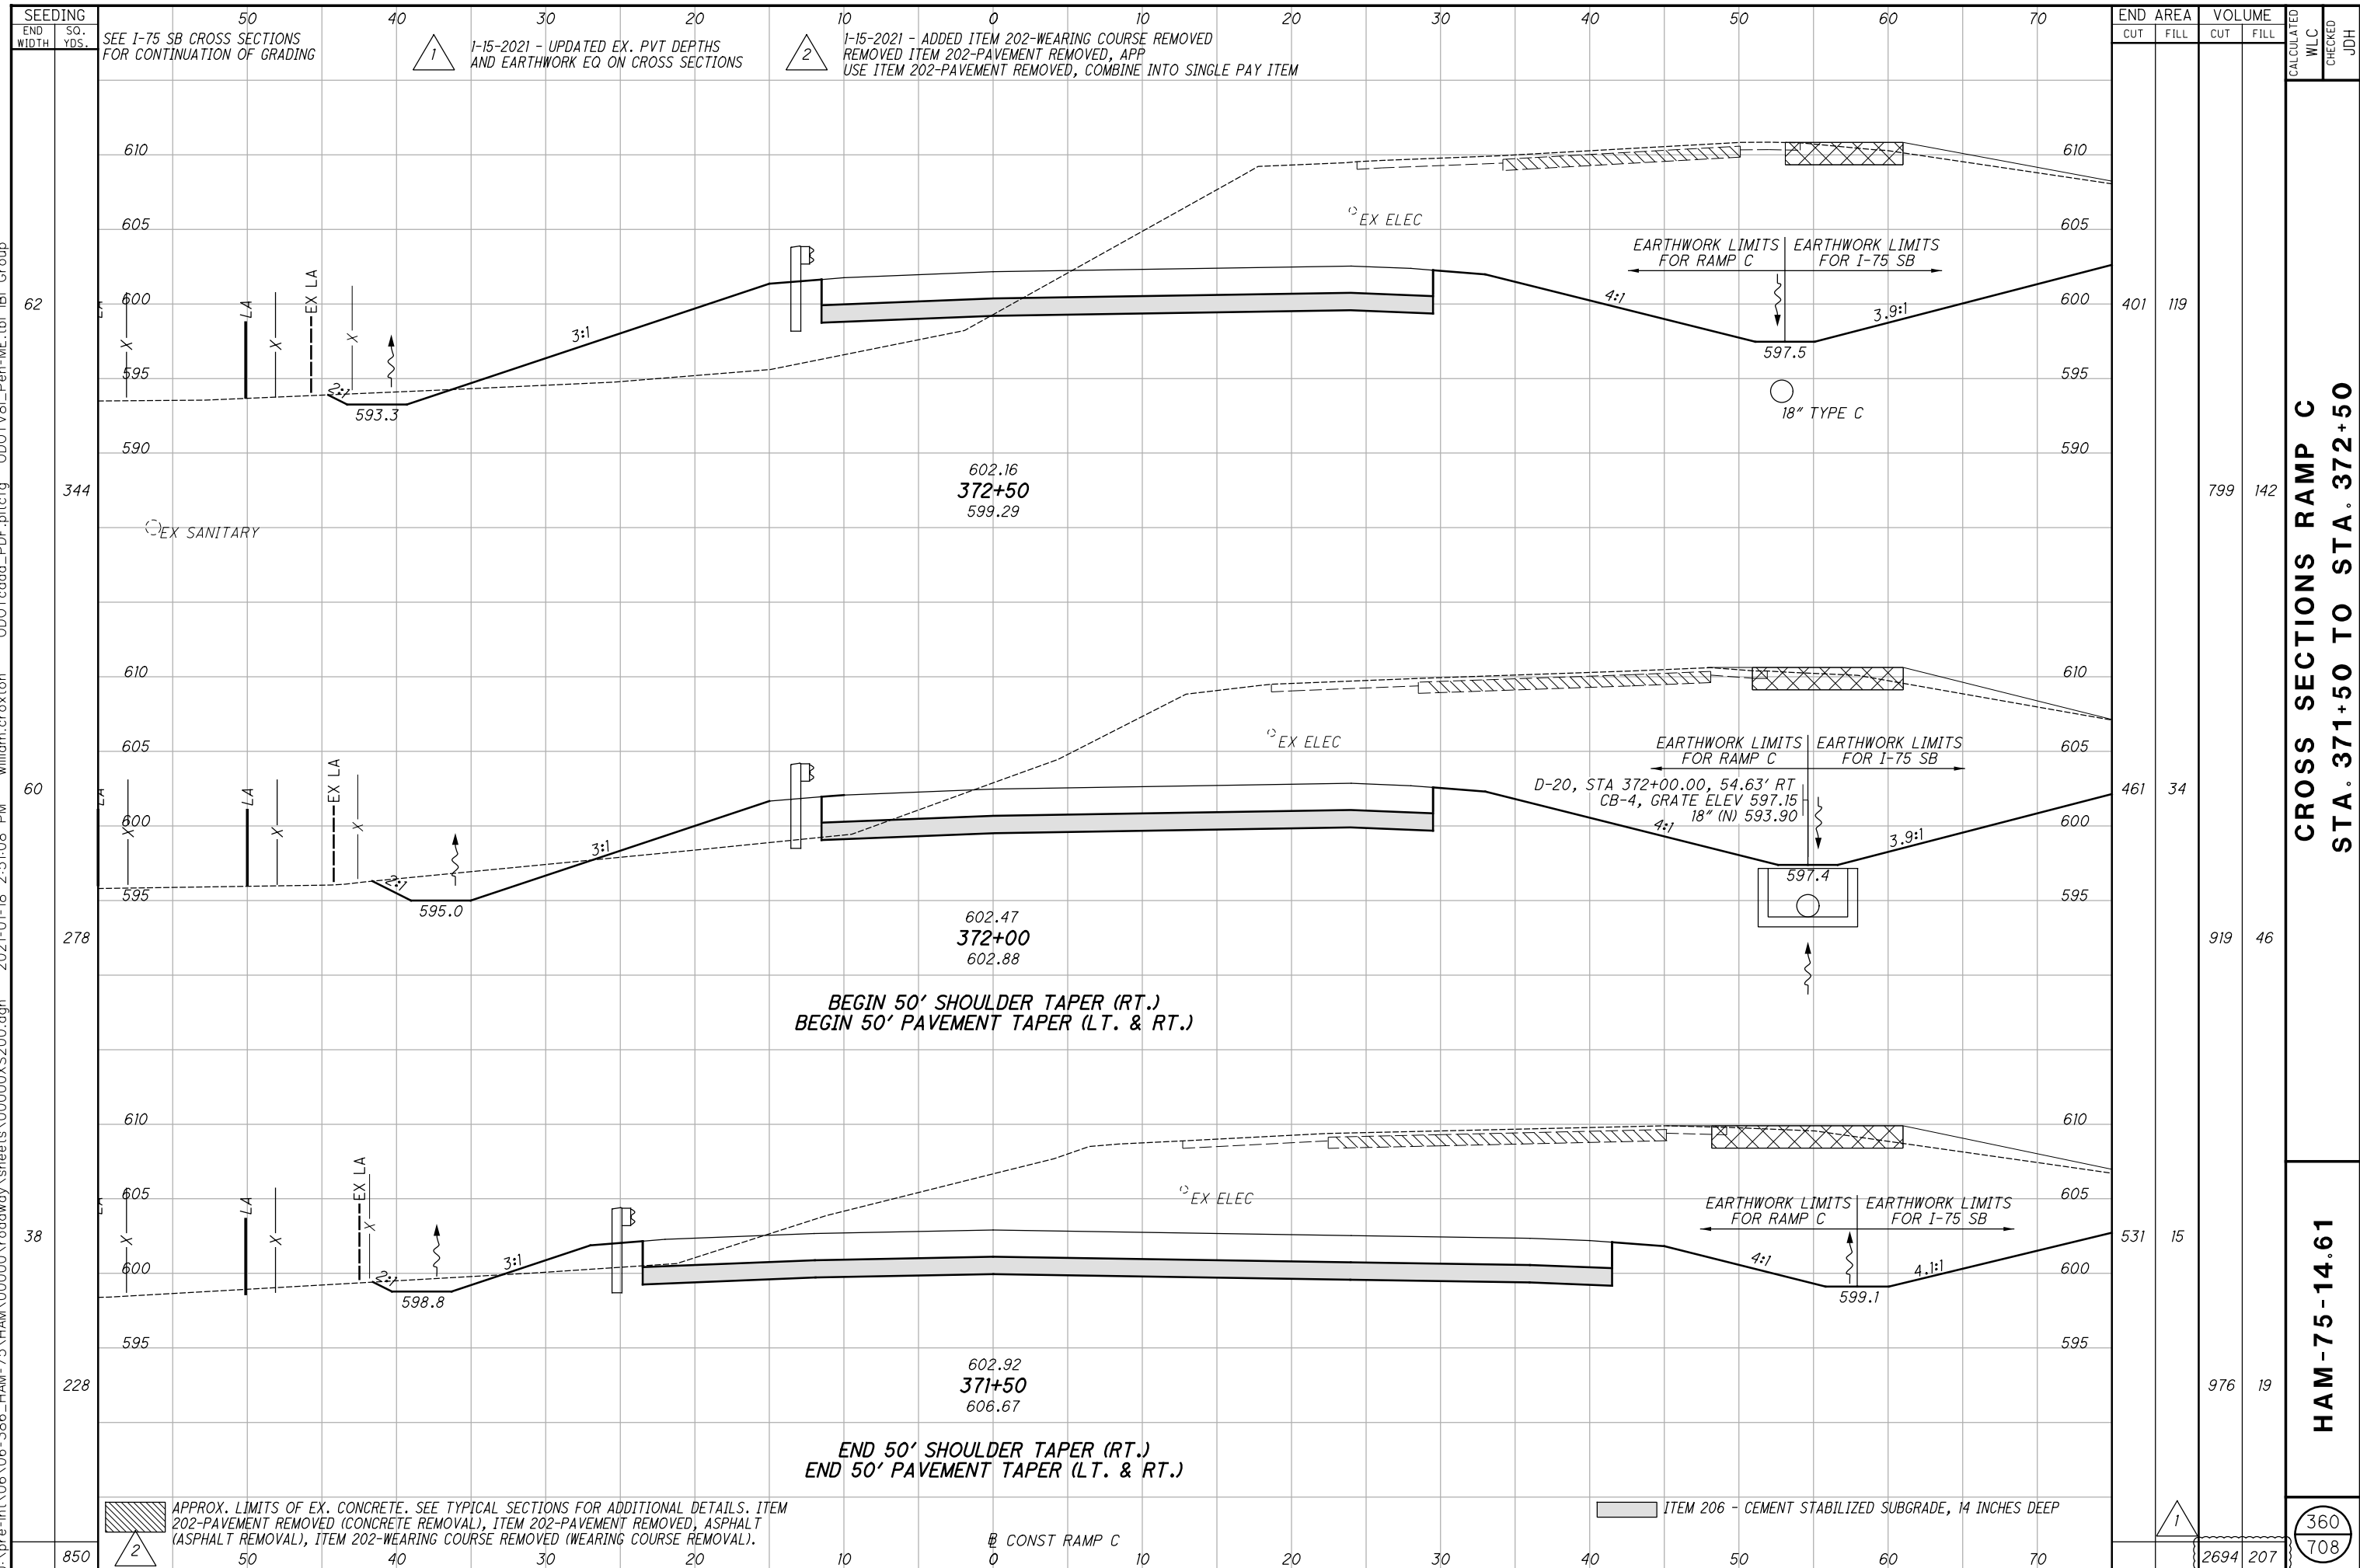

SEEDING	END AREA		VOLUME		CALCULATED	WLC	CHECKED	JDH
	CUT	FILL	CUT	FILL				
50	401	119	799	142				
40	461	34	919	46				
30	531	15	976	19				
20								
10								
0								
10								
20								
30								
40								
50								
60								
70								
80								
850			2694	207				

CROSS SECTIONS RAMP C  
STA. 371+50 TO STA. 372+50

HAM-75-14.61

360  
708

SEE I-75 SB CROSS SECTIONS FOR CONTINUATION OF GRADING

1-15-2021 - UPDATED EX. PVT DEPTHS AND EARTHWORK EQ ON CROSS SECTIONS

1-15-2021 - ADDED ITEM 202-WEARING COURSE REMOVED REMOVED ITEM 202-PAVEMENT REMOVED, APP USE ITEM 202-PAVEMENT REMOVED, COMBINE INTO SINGLE PAY ITEM

APPROX. LIMITS OF EX. CONCRETE. SEE TYPICAL SECTIONS FOR ADDITIONAL DETAILS. ITEM 202-PAVEMENT REMOVED (CONCRETE REMOVAL), ITEM 202-PAVEMENT REMOVED, ASPHALT (ASPHALT REMOVAL), ITEM 202-WEARING COURSE REMOVED (WEARING COURSE REMOVAL).


CONST RAMP C

ITEM 206 - CEMENT STABILIZED SUBGRADE, 14 INCHES DEEP


BEGIN 50' SHOULDER TAPER (RT.)  
BEGIN 50' PAVEMENT TAPER (LT. & RT.)

END 50' SHOULDER TAPER (RT.)  
END 50' PAVEMENT TAPER (LT. & RT.)

D-20, STA 372+00.00, 54.63' RT  
CB-4, GRATE ELEV 597.15  
18" (N) 593.90

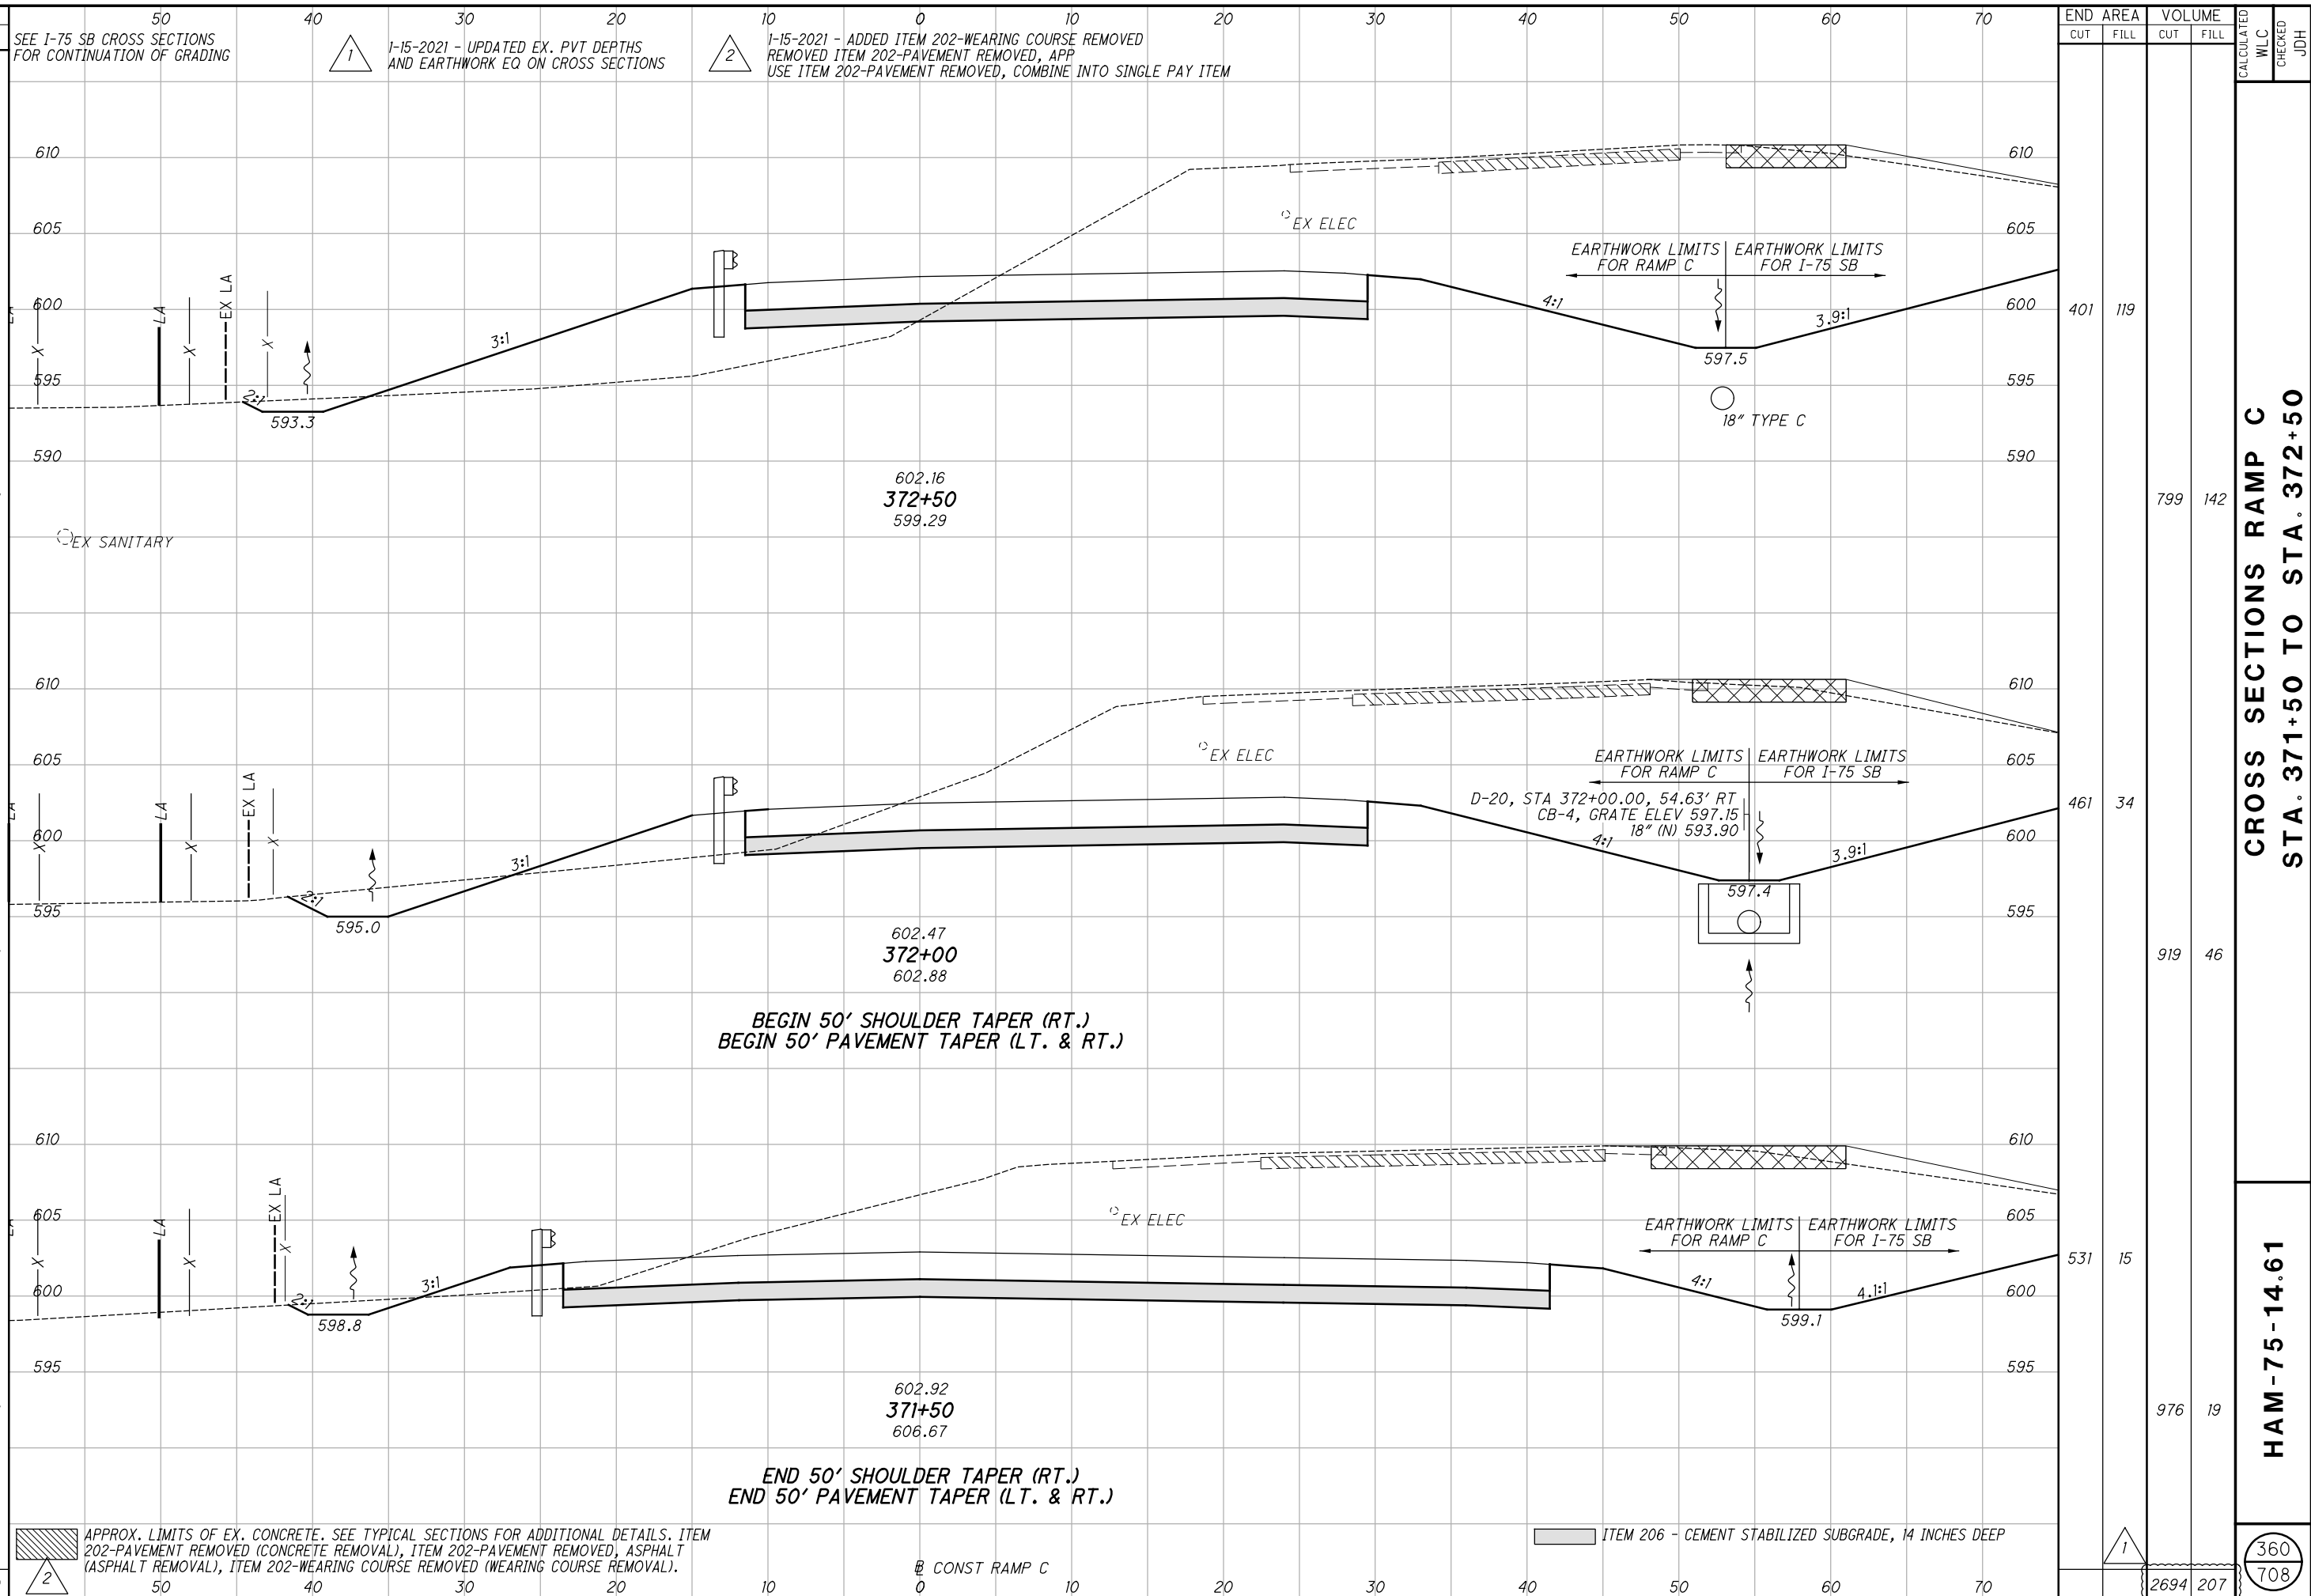

j:\pre-int\06\06-386\_HAM-75\HAM\00000\roadway\sheets\00000X5200.dgn 2021-01-18 2:51:08 PM william.croxton' ODOTcadd\_PDF.pltcfgr ODOTV8i\_Pen-ME.tbl IBI Group

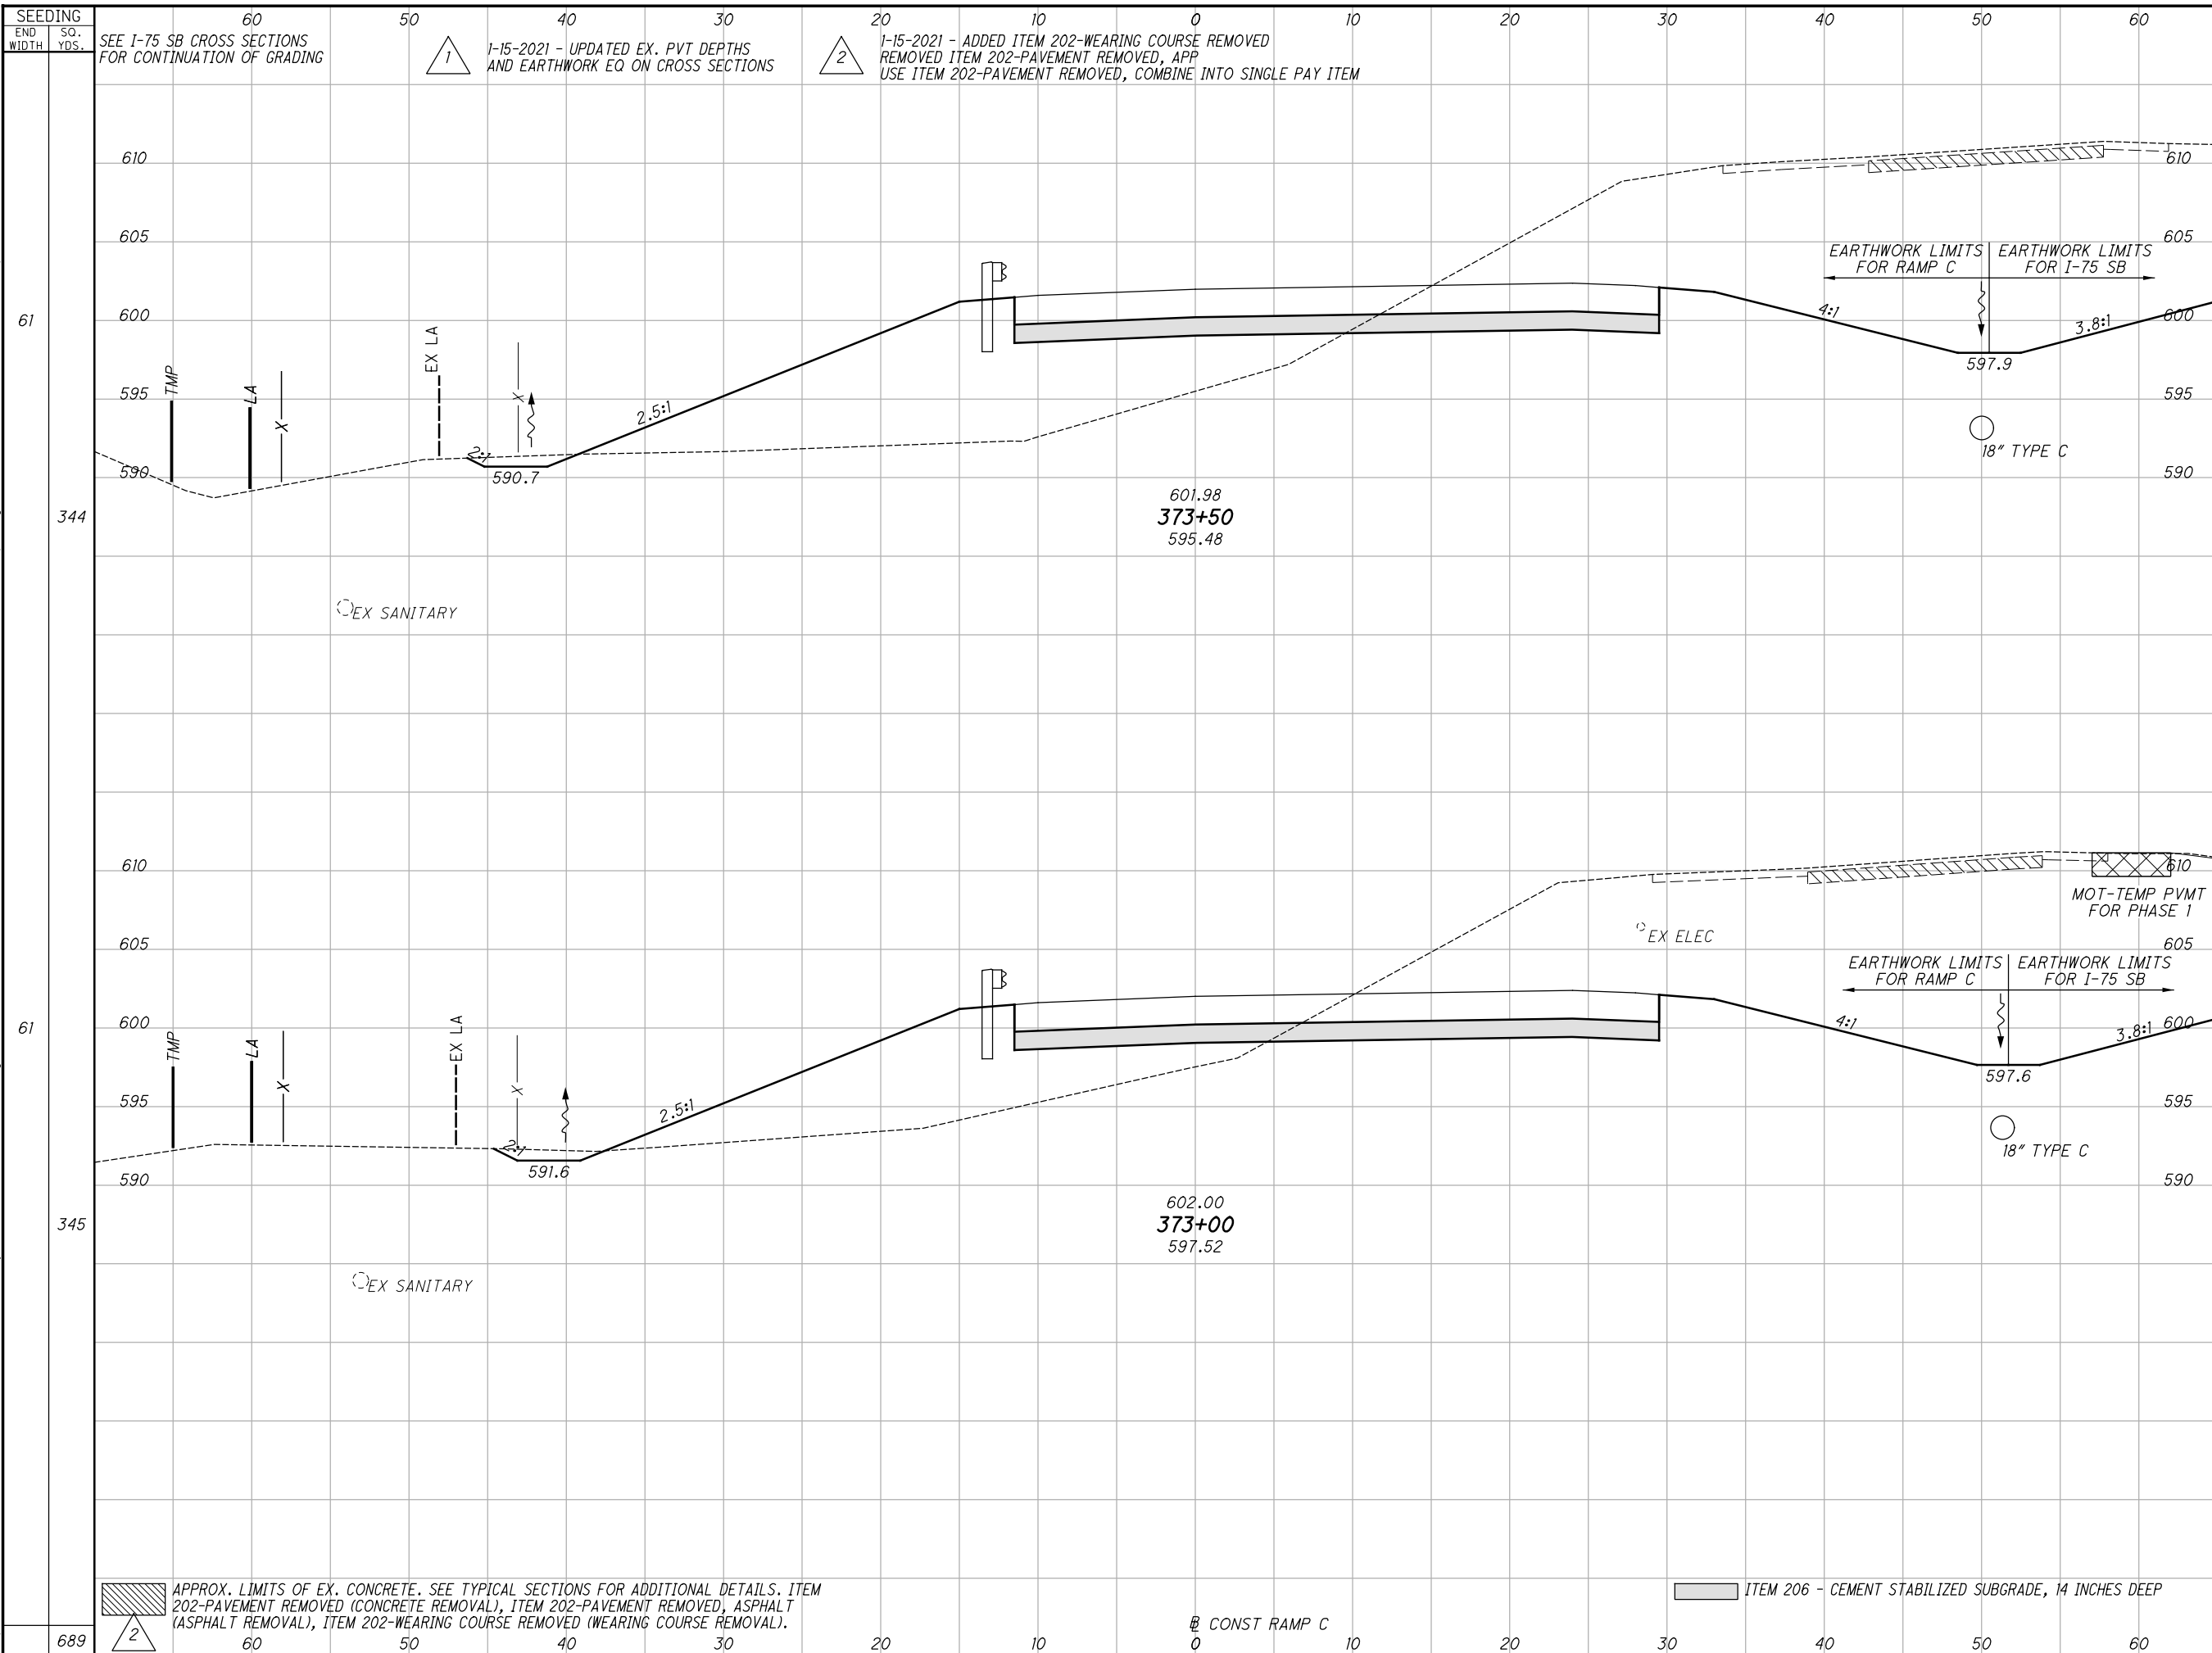

END AREA	VOLUME	CALCULATED	WLC	CHECKED	JDH
289	249				
346	167				
1280	651				

CROSS SECTIONS RAMP C  
STA. 373+00 TO STA. 373+50

HAM-75-14.61

361  
708

SEEDING  
END WIDTH SO. YDS.

SEE I-75 SB CROSS SECTIONS FOR CONTINUATION OF GRADING

1-15-2021 - UPDATED EX. PVT DEPTHS AND EARTHWORK EQ ON CROSS SECTIONS

1-15-2021 - ADDED ITEM 202-WEARING COURSE REMOVED REMOVED ITEM 202-PAVEMENT REMOVED, APP USE ITEM 202-PAVEMENT REMOVED, COMBINE INTO SINGLE PAY ITEM


APPROX. LIMITS OF EX. CONCRETE. SEE TYPICAL SECTIONS FOR ADDITIONAL DETAILS. ITEM 202-PAVEMENT REMOVED (CONCRETE REMOVAL), ITEM 202-PAVEMENT REMOVED, ASPHALT (ASPHALT REMOVAL), ITEM 202-WEARING COURSE REMOVED (WEARING COURSE REMOVAL).

ITEM 206 - CEMENT STABILIZED SUBGRADE, 14 INCHES DEEP

CONST RAMP C



j:\pre-int\06\06-386\_HAM-75\HAM\00000\roadway\sheets\00000X5200.dgn 2021-01-18 2:51:09 PM william.croxton' ODOTcadd\_PDF.pltcfgr ODOTV8i\_Pen-ME.tbl IBI Group

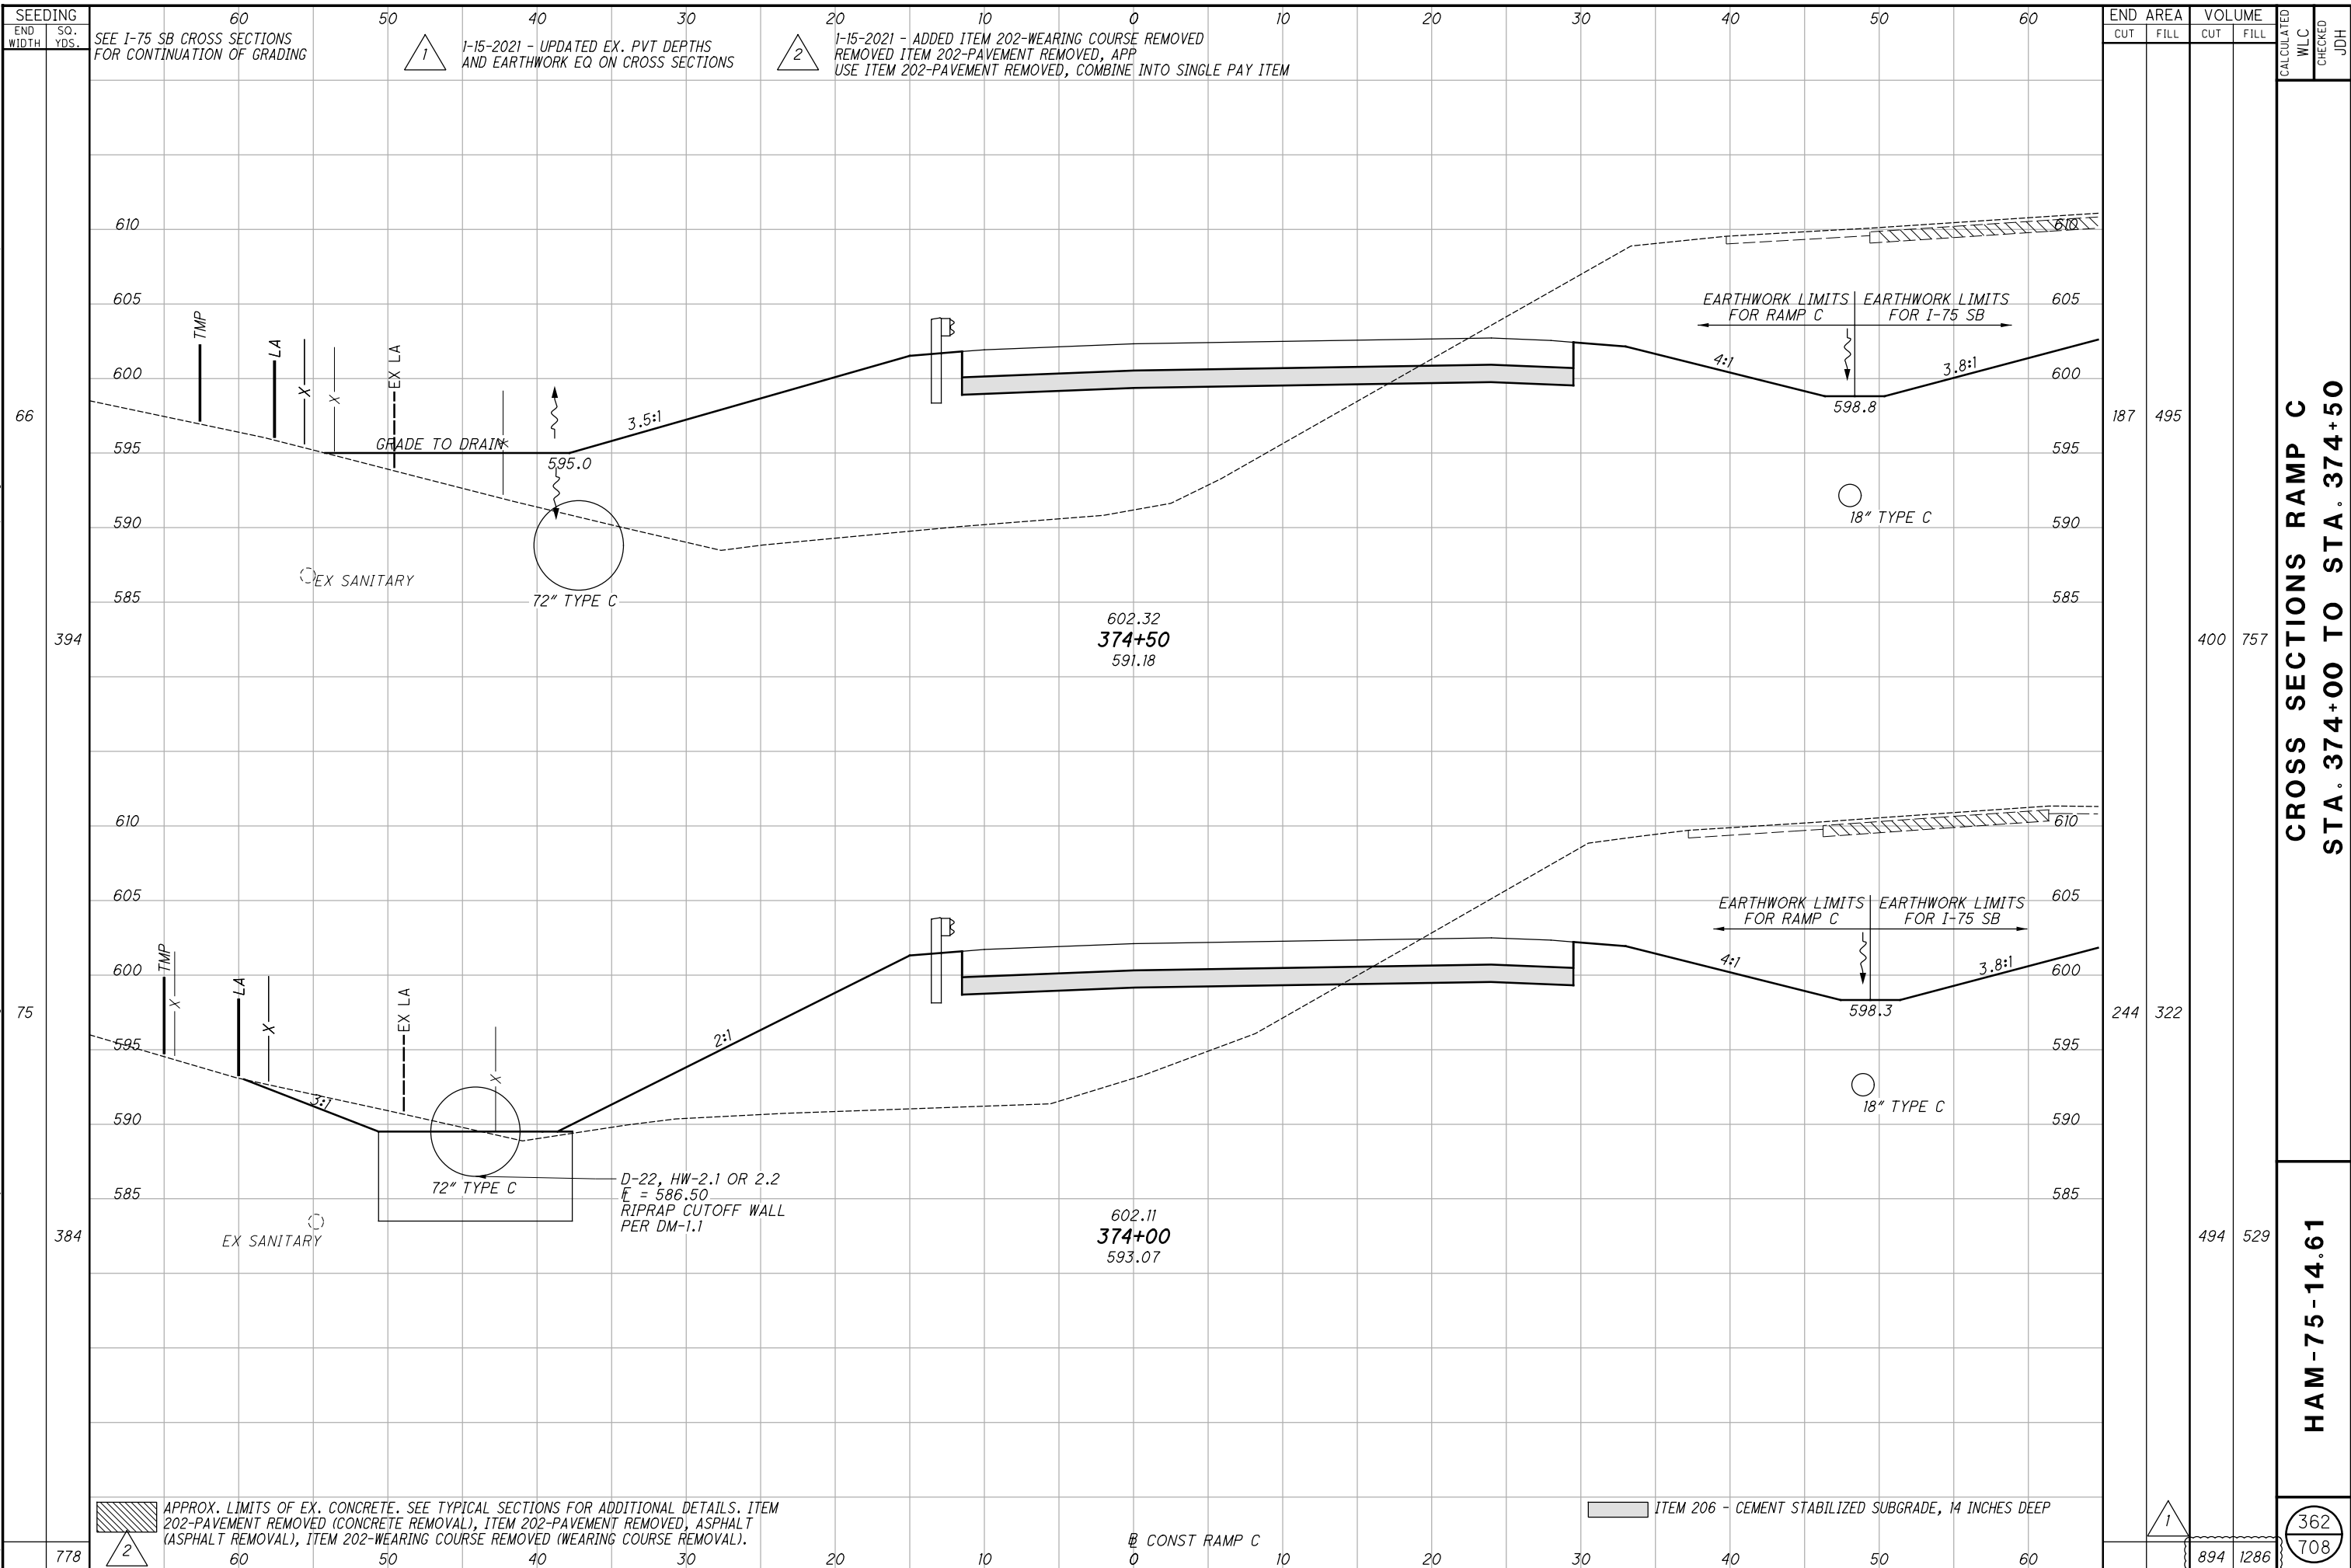

66

394

75

384

778

187 495

400 757


244 322

494 529

894 1286

362  
708

j:\pre-int\06\06-386\_HAM-75\HAM\00000\roadway\sheets\00000X5200.dgn 2021-01-18 2:51:09 PM william.croxton' ODOTcadd\_PDF.pltcfgr ODOTV8i\_Pen-ME.tbl IBI Group

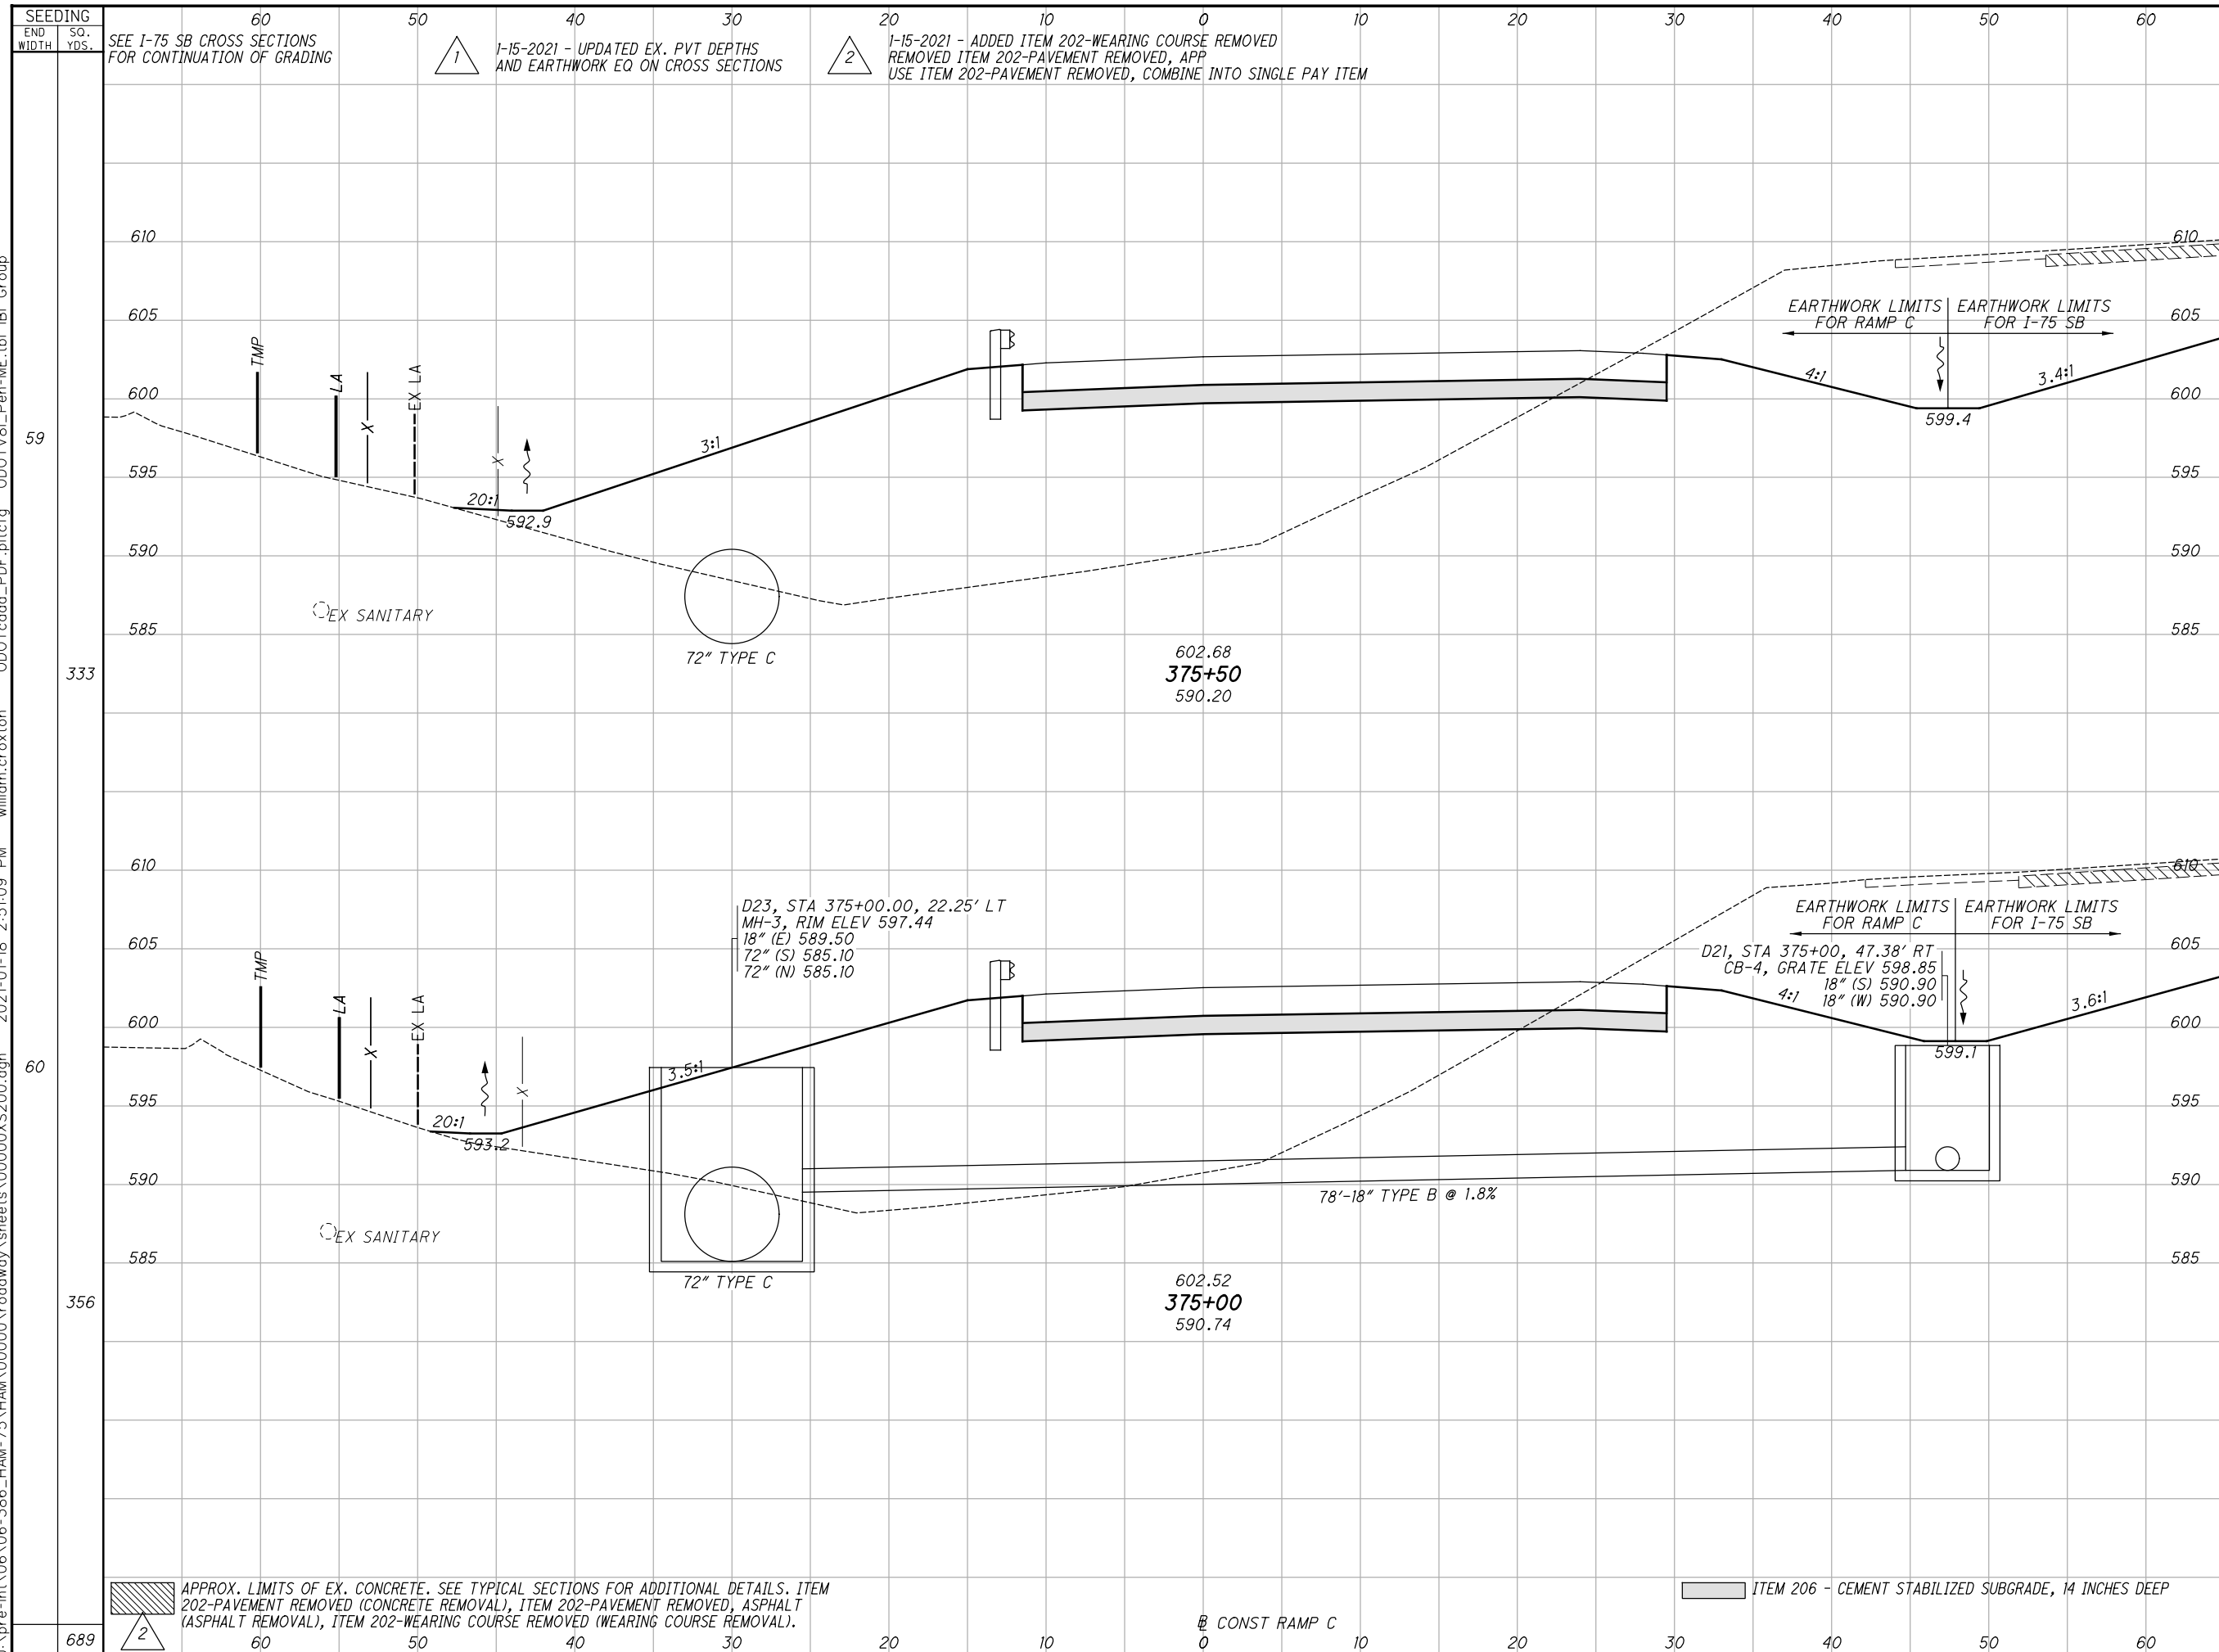

END AREA	VOLUME	CALCULATED	CHECKED	J.D.H.
122	573			
256	1016			
154	524			
316	944			
572	1960			

**CROSS SECTIONS RAMP C  
STA. 375+00 TO STA. 375+50**

**HAM-75-14.61**

363  
708

SEEDING  
END WIDTH SO. YDS.  
SEE I-75 SB CROSS SECTIONS FOR CONTINUATION OF GRADING

60 50 40 30 20 10 0 10 20 30 40 50 60

1-15-2021 - UPDATED EX. PVT DEPTHS AND EARTHWORK EQ ON CROSS SECTIONS


2 1-15-2021 - ADDED ITEM 202-WEARING COURSE REMOVED REMOVED ITEM 202-PAVEMENT REMOVED, APP USE ITEM 202-PAVEMENT REMOVED, COMBINE INTO SINGLE PAY ITEM

APPROX. LIMITS OF EX. CONCRETE. SEE TYPICAL SECTIONS FOR ADDITIONAL DETAILS. ITEM 202-PAVEMENT REMOVED (CONCRETE REMOVAL), ITEM 202-PAVEMENT REMOVED, ASPHALT (ASPHALT REMOVAL), ITEM 202-WEARING COURSE REMOVED (WEARING COURSE REMOVAL).

ITEM 206 - CEMENT STABILIZED SUBGRADE, 14 INCHES DEEP

CONST RAMP C

j:\pre-int\06\06-386\_HAM-75\HAM\00000\roadway\sheets\00000X5200.dgn 2021-01-18 2:51:09 PM william.croxton' ODOTcadd\_PDF.pltcfgr ODOTV8i\_Pen-ME.tbl IBI Group

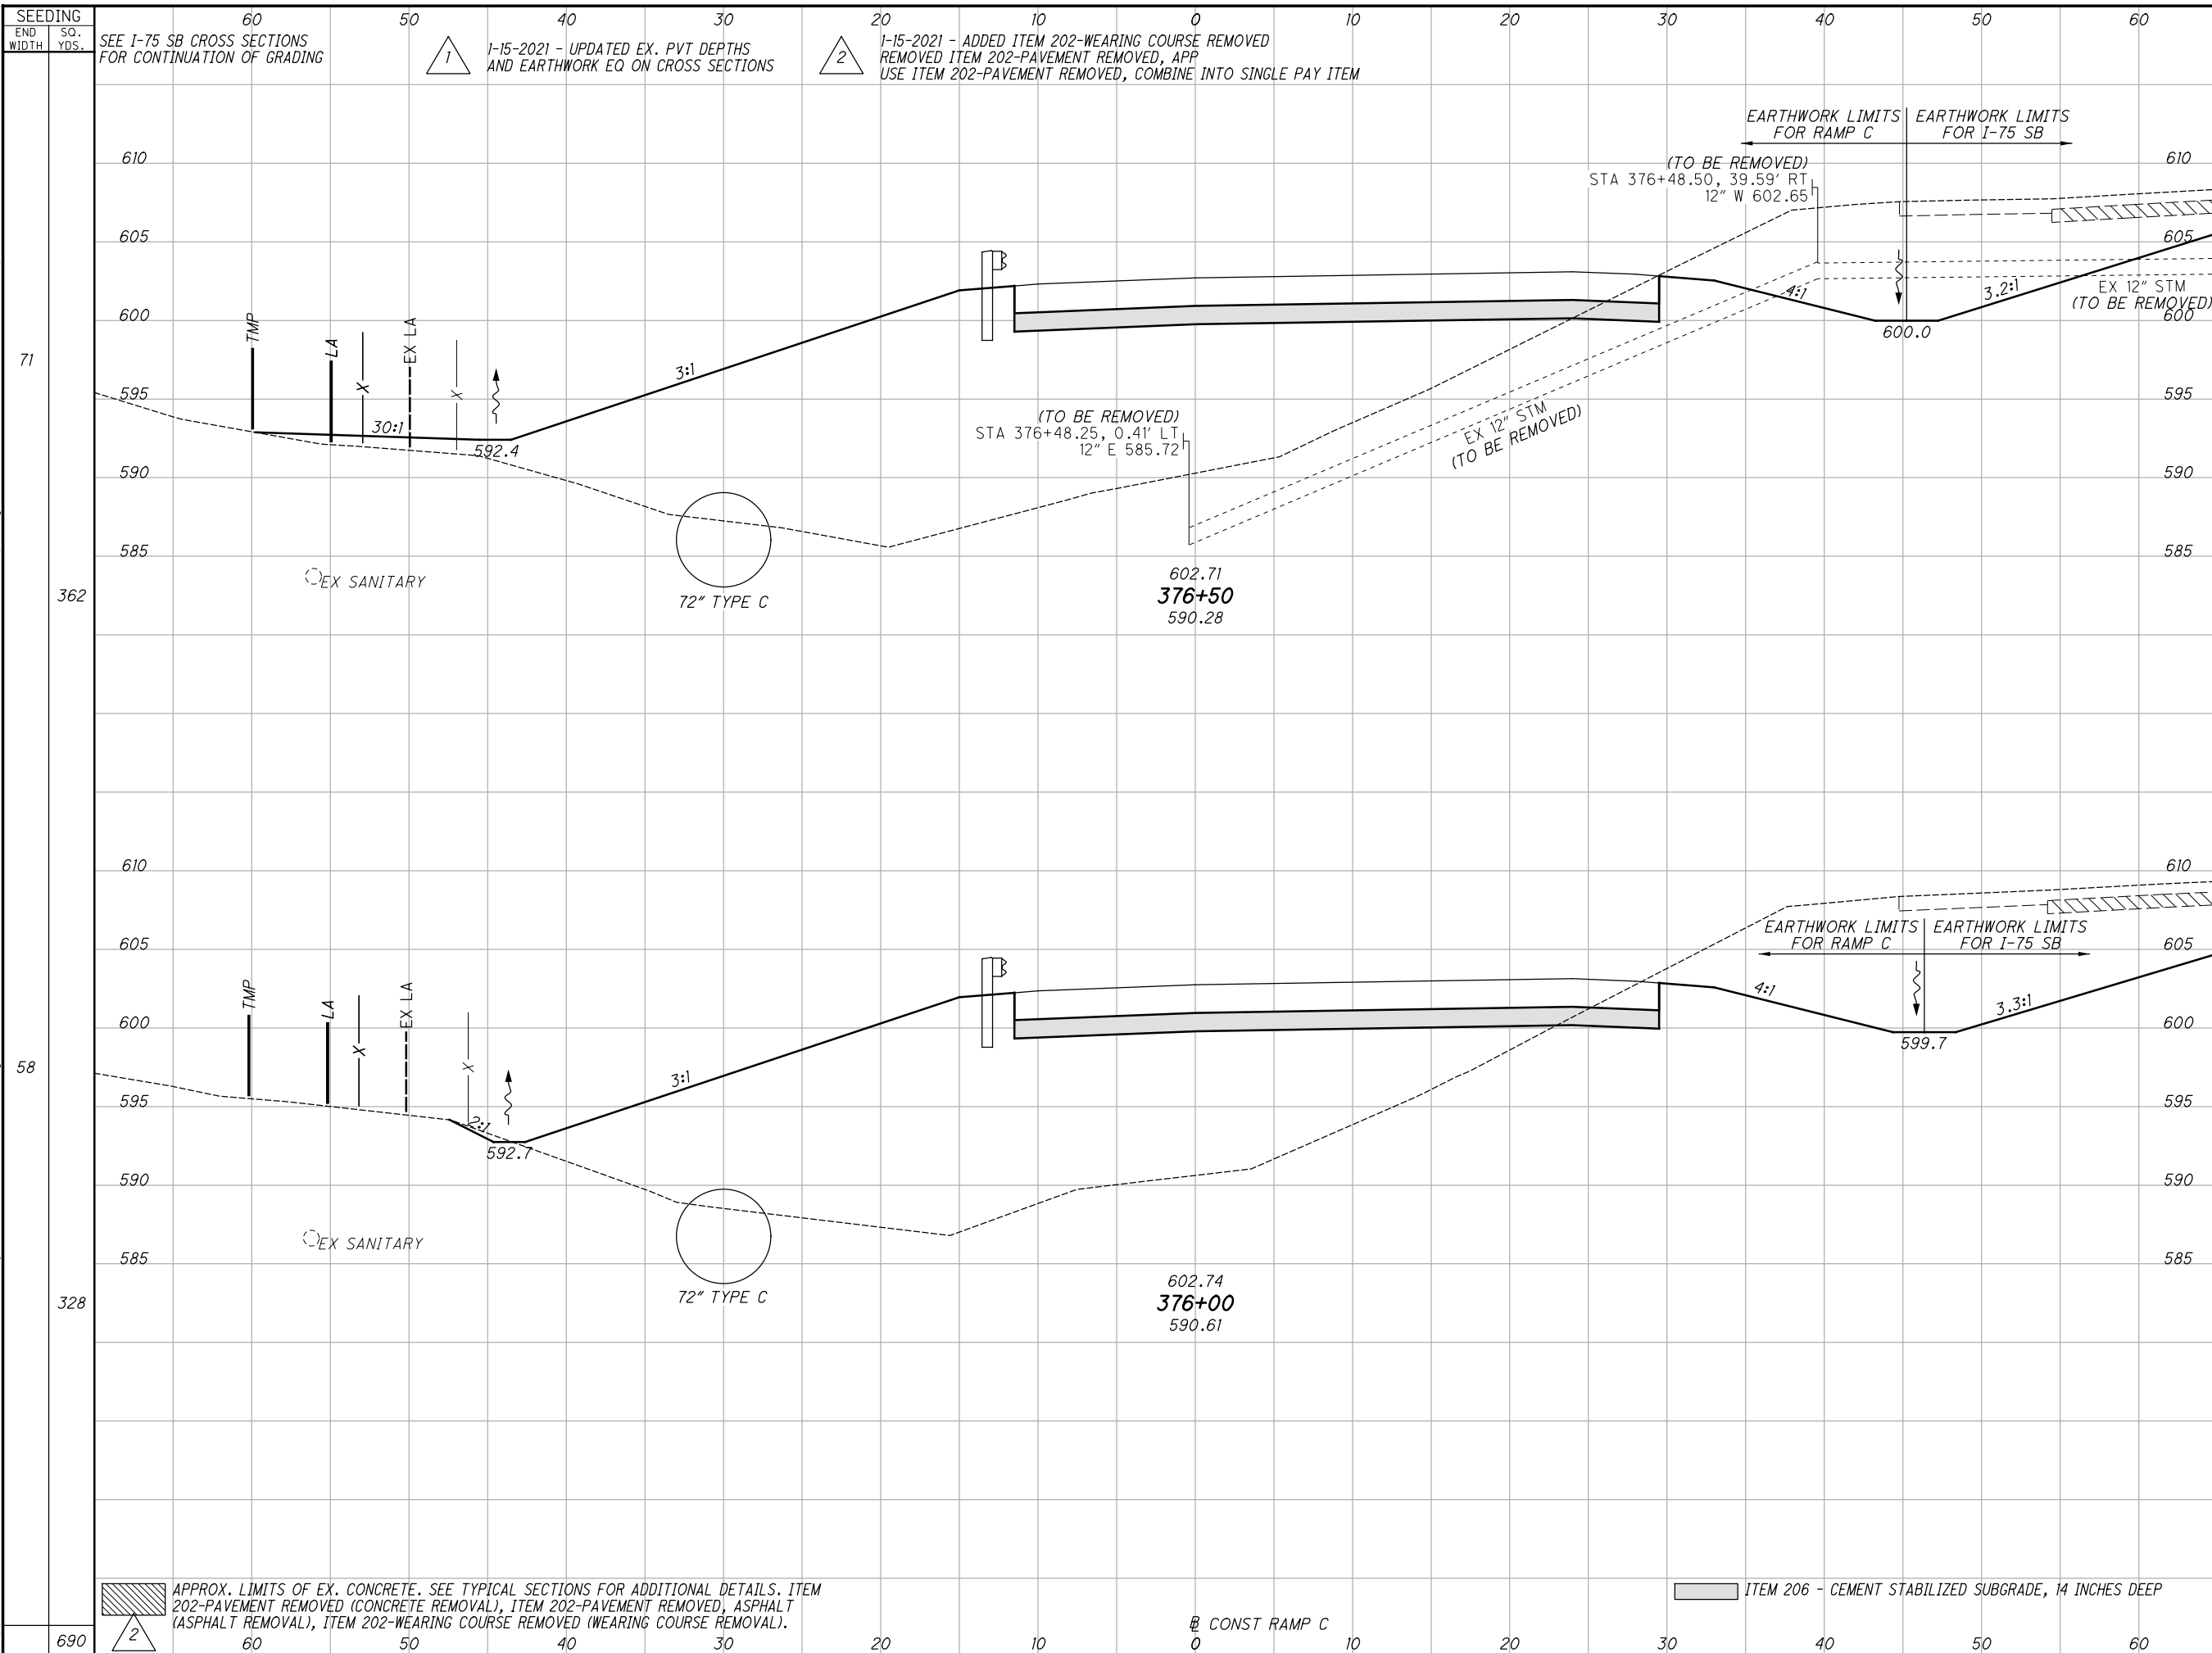

APPROX. LIMITS OF EX. CONCRETE. SEE TYPICAL SECTIONS FOR ADDITIONAL DETAILS. ITEM 202-PAVEMENT REMOVED (CONCRETE REMOVAL), ITEM 202-PAVEMENT REMOVED, ASPHALT (ASPHALT REMOVAL), ITEM 202-WEARING COURSE REMOVED (WEARING COURSE REMOVAL).  
 CONST RAMP C  
 ITEM 206 - CEMENT STABILIZED SUBGRADE, 14 INCHES DEEP


END AREA	VOLUME		CALCULATED WLC	CHECKED JDH
	CUT	FILL		
76	534			
163	1019			
99	566			
205	1055			
368	2074			

**CROSS SECTIONS RAMP C  
 STA. 376+00 TO STA. 376+50**

**HAM-75-14.61**

364  
708

j:\pre-int\06\06-386\_HAM-75\_HAM\00000\roadway\sheets\00000X5200.dgn 2021-01-18 2:51:10 PM william.croxton\ODOTcadd\_PDF.pltcfgr ODOTV8i\_Pen-ME.tbl IBI\_Group

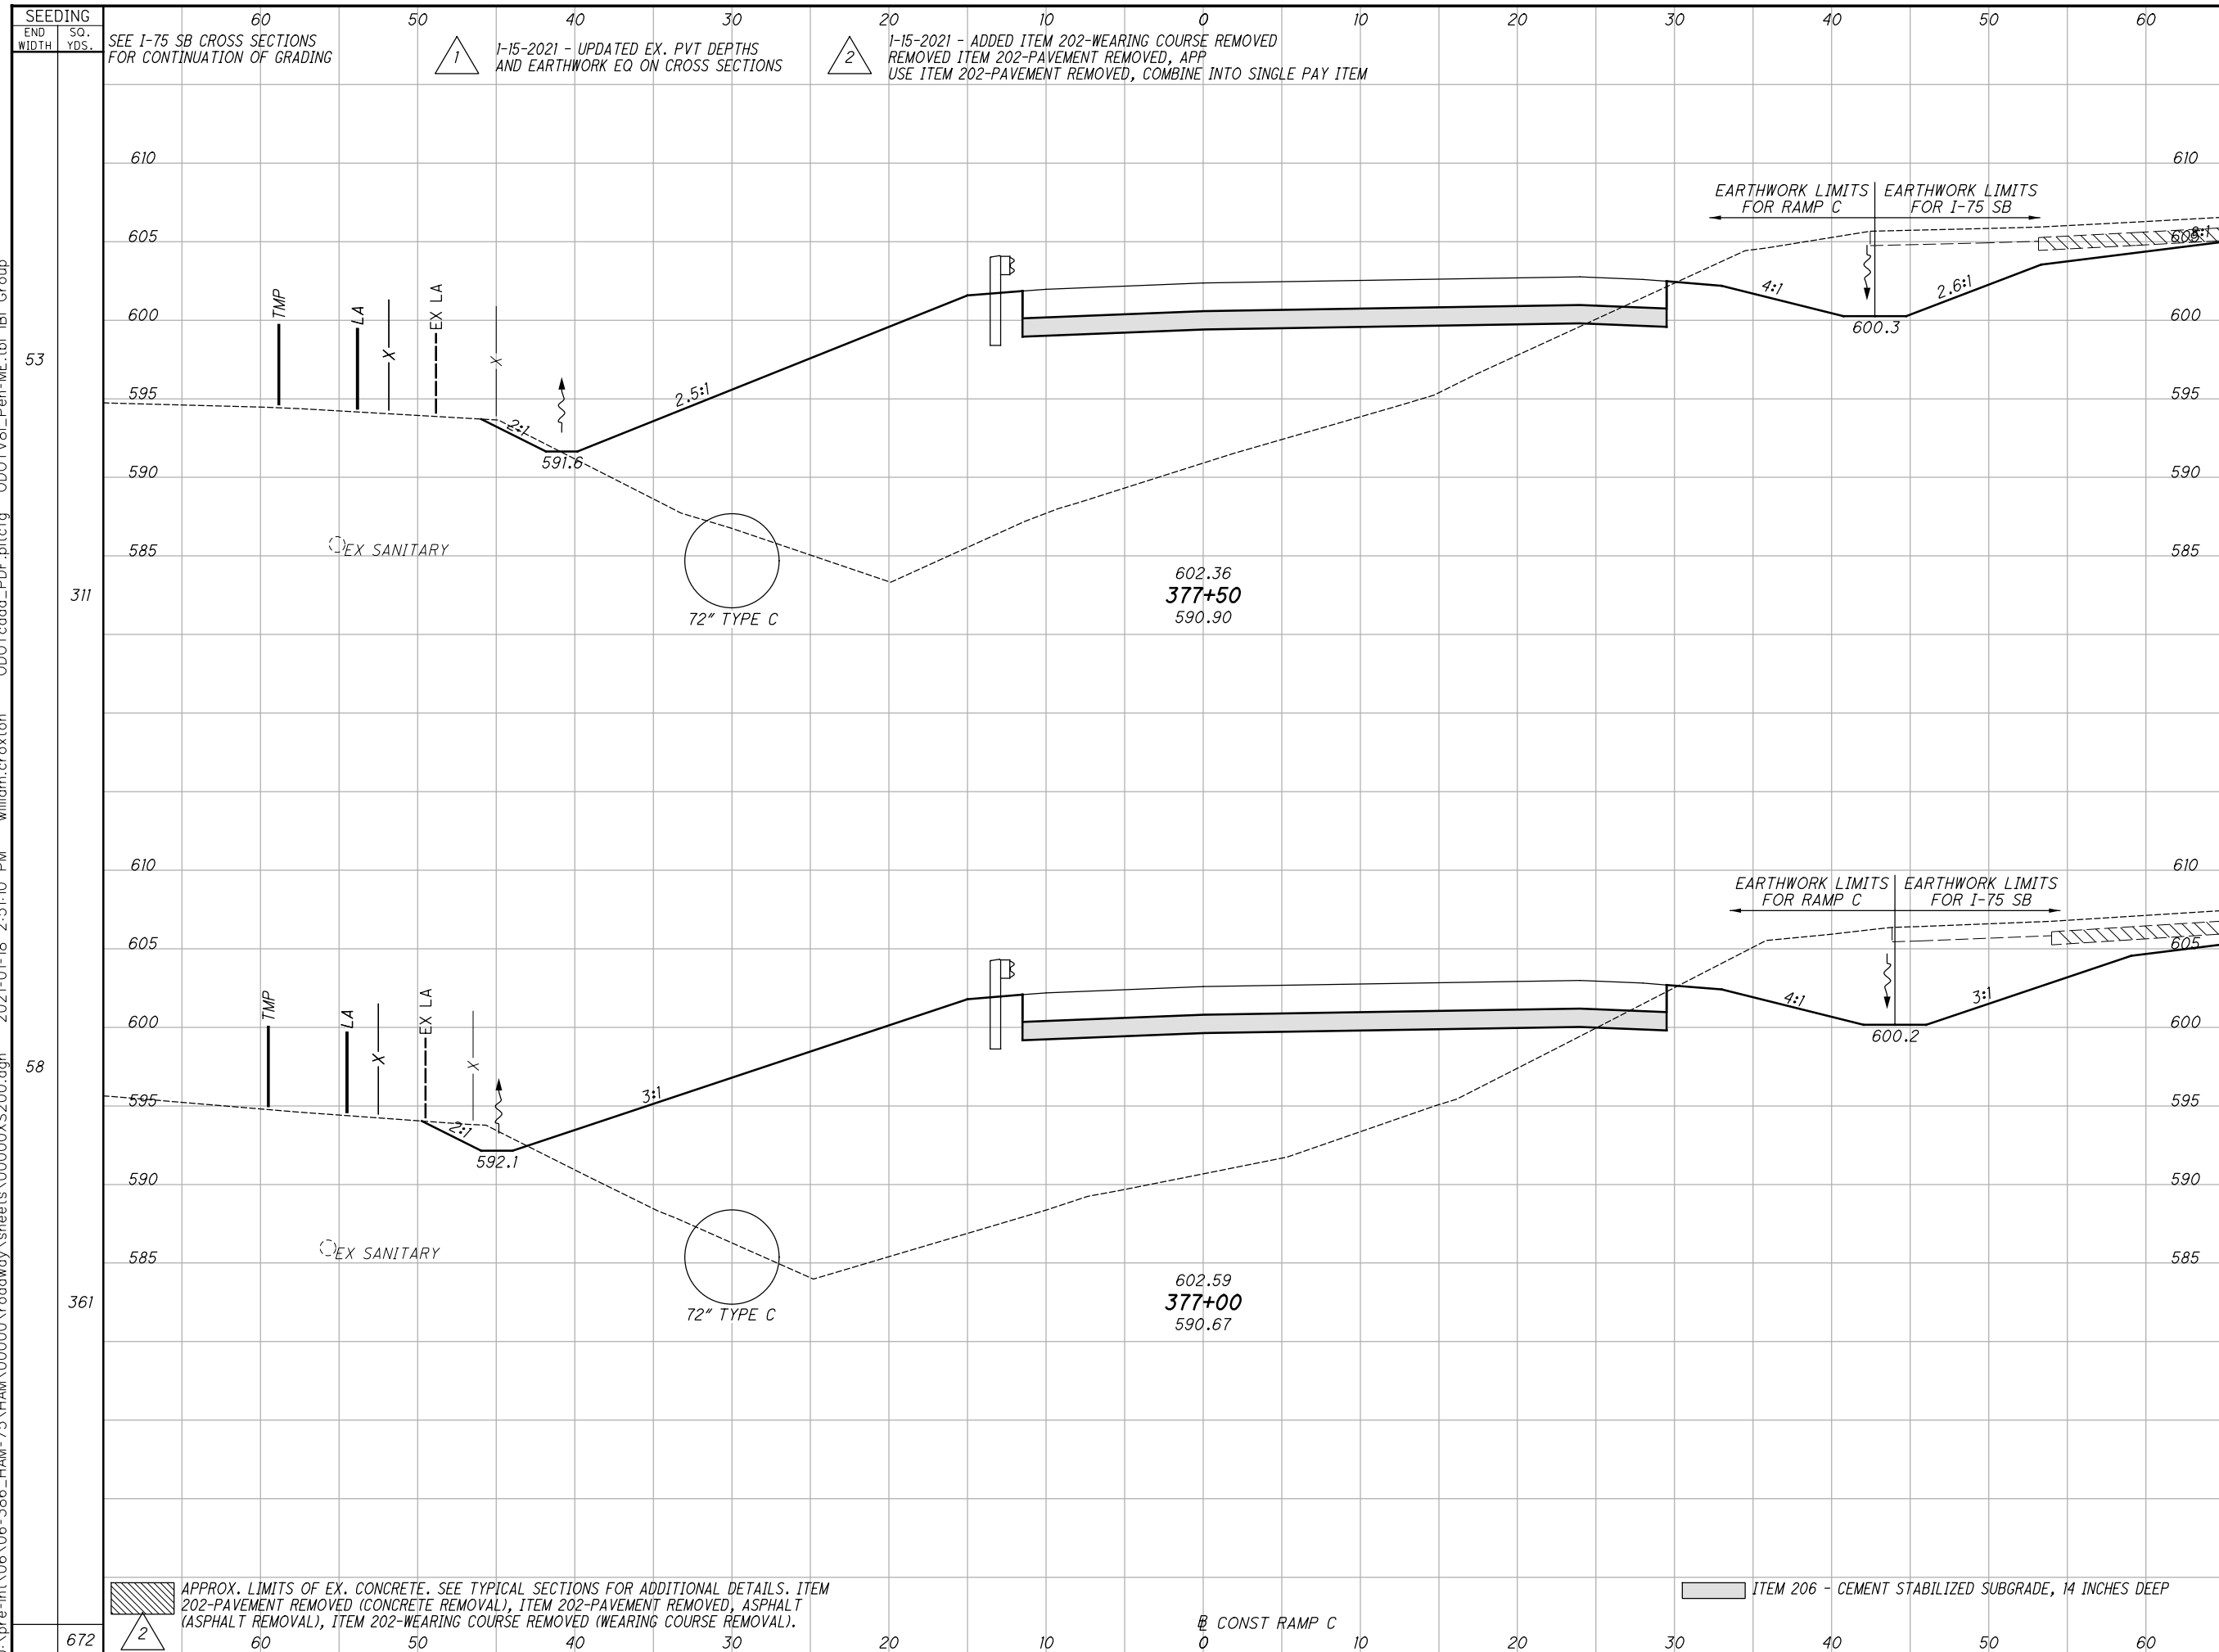

END AREA	VOLUME		CALCULATED W/LC	CHECKED JDH
	CUT	FILL		
44	589			
96	1125			
59	626			
125	1075			
221	2200			

**CROSS SECTIONS RAMP C  
STA. 377+00 TO STA. 377+50**

**HAM-75-14.61**


365  
708

SEEDING  
END WIDTH SO. YDS.  
60 50 40 30 20 10 0 10 20 30 40 50 60

SEE I-75 SB CROSS SECTIONS FOR CONTINUATION OF GRADING  
1-15-2021 - UPDATED EX. PVT DEPTHS AND EARTHWORK EQ ON CROSS SECTIONS  
1-15-2021 - ADDED ITEM 202-WEARING COURSE REMOVED REMOVED ITEM 202-PAVEMENT REMOVED, APP USE ITEM 202-PAVEMENT REMOVED, COMBINE INTO SINGLE PAY ITEM

APPROX. LIMITS OF EX. CONCRETE. SEE TYPICAL SECTIONS FOR ADDITIONAL DETAILS. ITEM 202-PAVEMENT REMOVED (CONCRETE REMOVAL), ITEM 202-PAVEMENT REMOVED, ASPHALT (ASPHALT REMOVAL), ITEM 202-WEARING COURSE REMOVED (WEARING COURSE REMOVAL).  
ITEM 206 - CEMENT STABILIZED SUBGRADE, 14 INCHES DEEP  
CONST RAMP C

j:\pre-int\06\06-386\_HAM-75\HAM\00000\roadway\sheets\00000X5200.dgn 2021-01-18 2:51:10 PM william.croxton\ODOT\cadd\_PDF.plt\cadd\_ODOTV8i\_Pen-ME.tbl IBI\_Group

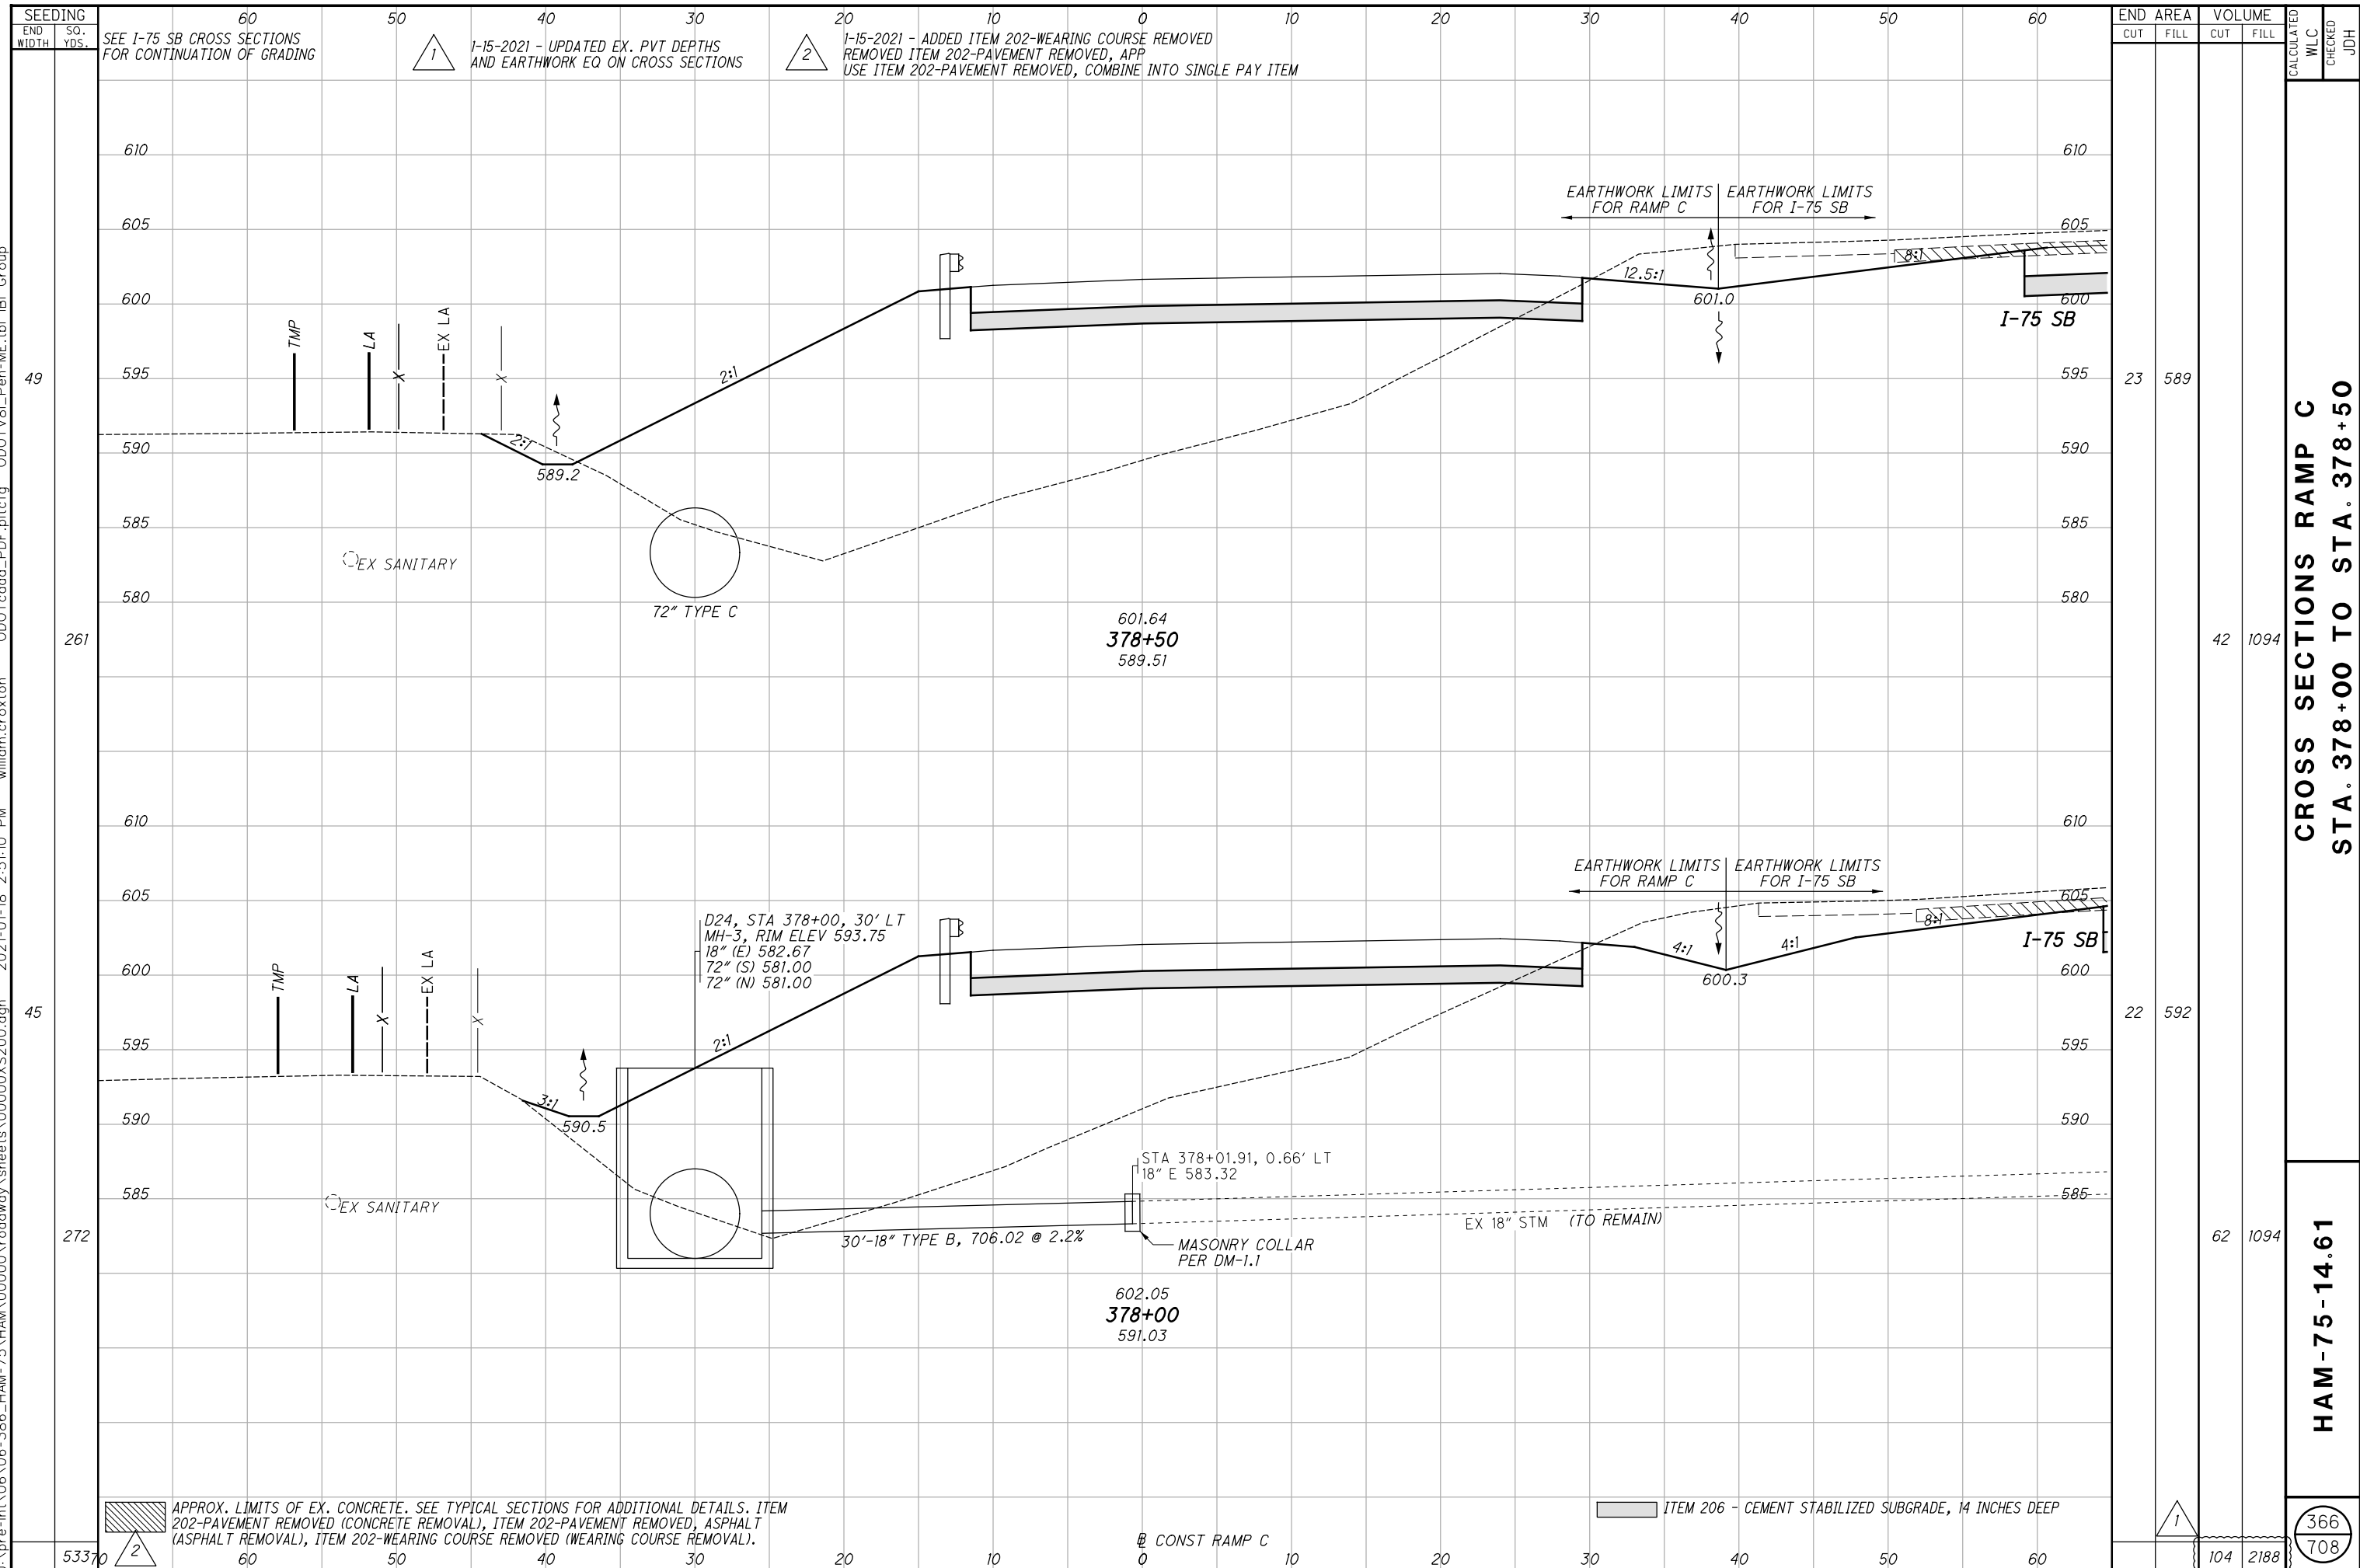

APPROX. LIMITS OF EX. CONCRETE. SEE TYPICAL SECTIONS FOR ADDITIONAL DETAILS. ITEM 202-PAVEMENT REMOVED (CONCRETE REMOVAL), ITEM 202-PAVEMENT REMOVED, ASPHALT (ASPHALT REMOVAL), ITEM 202-WEARING COURSE REMOVED (WEARING COURSE REMOVAL).

ITEM 206 - CEMENT STABILIZED SUBGRADE, 14 INCHES DEEP

CONST RAMP C

END AREA	VOLUME		CALCULATED WLC	CHECKED JDH
	CUT	FILL		
23	589			
42	1094			
22	592			
62	1094			
104	2188			

CROSS SECTIONS RAMP C  
STA. 378+00 TO STA. 378+50

HAM-75-14.61


366  
708

SEEDING  
END WIDTH SO. YDS.  
60 50 40 30 20 10 0 10 20 30 40 50 60  
SEE I-75 SB CROSS SECTIONS FOR CONTINUATION OF GRADING  
1-15-2021 - UPDATED EX. PVT DEPTHS AND EARTHWORK EQ ON CROSS SECTIONS  
1-15-2021 - ADDED ITEM 202-WEARING COURSE REMOVED REMOVED ITEM 202-PAVEMENT REMOVED, APP USE ITEM 202-PAVEMENT REMOVED, COMBINE INTO SINGLE PAY ITEM

53370

104 2188

j:\pre-int\06\06-386\_HAM-75\_HAM\00000\roadway\sheets\00000X5200.dgn 2021-01-18 2:51:10 PM william.croxton ODOTcadd\_PDF.pltcf ODOTV8i\_Pen-ME.tbl IBI\_Group

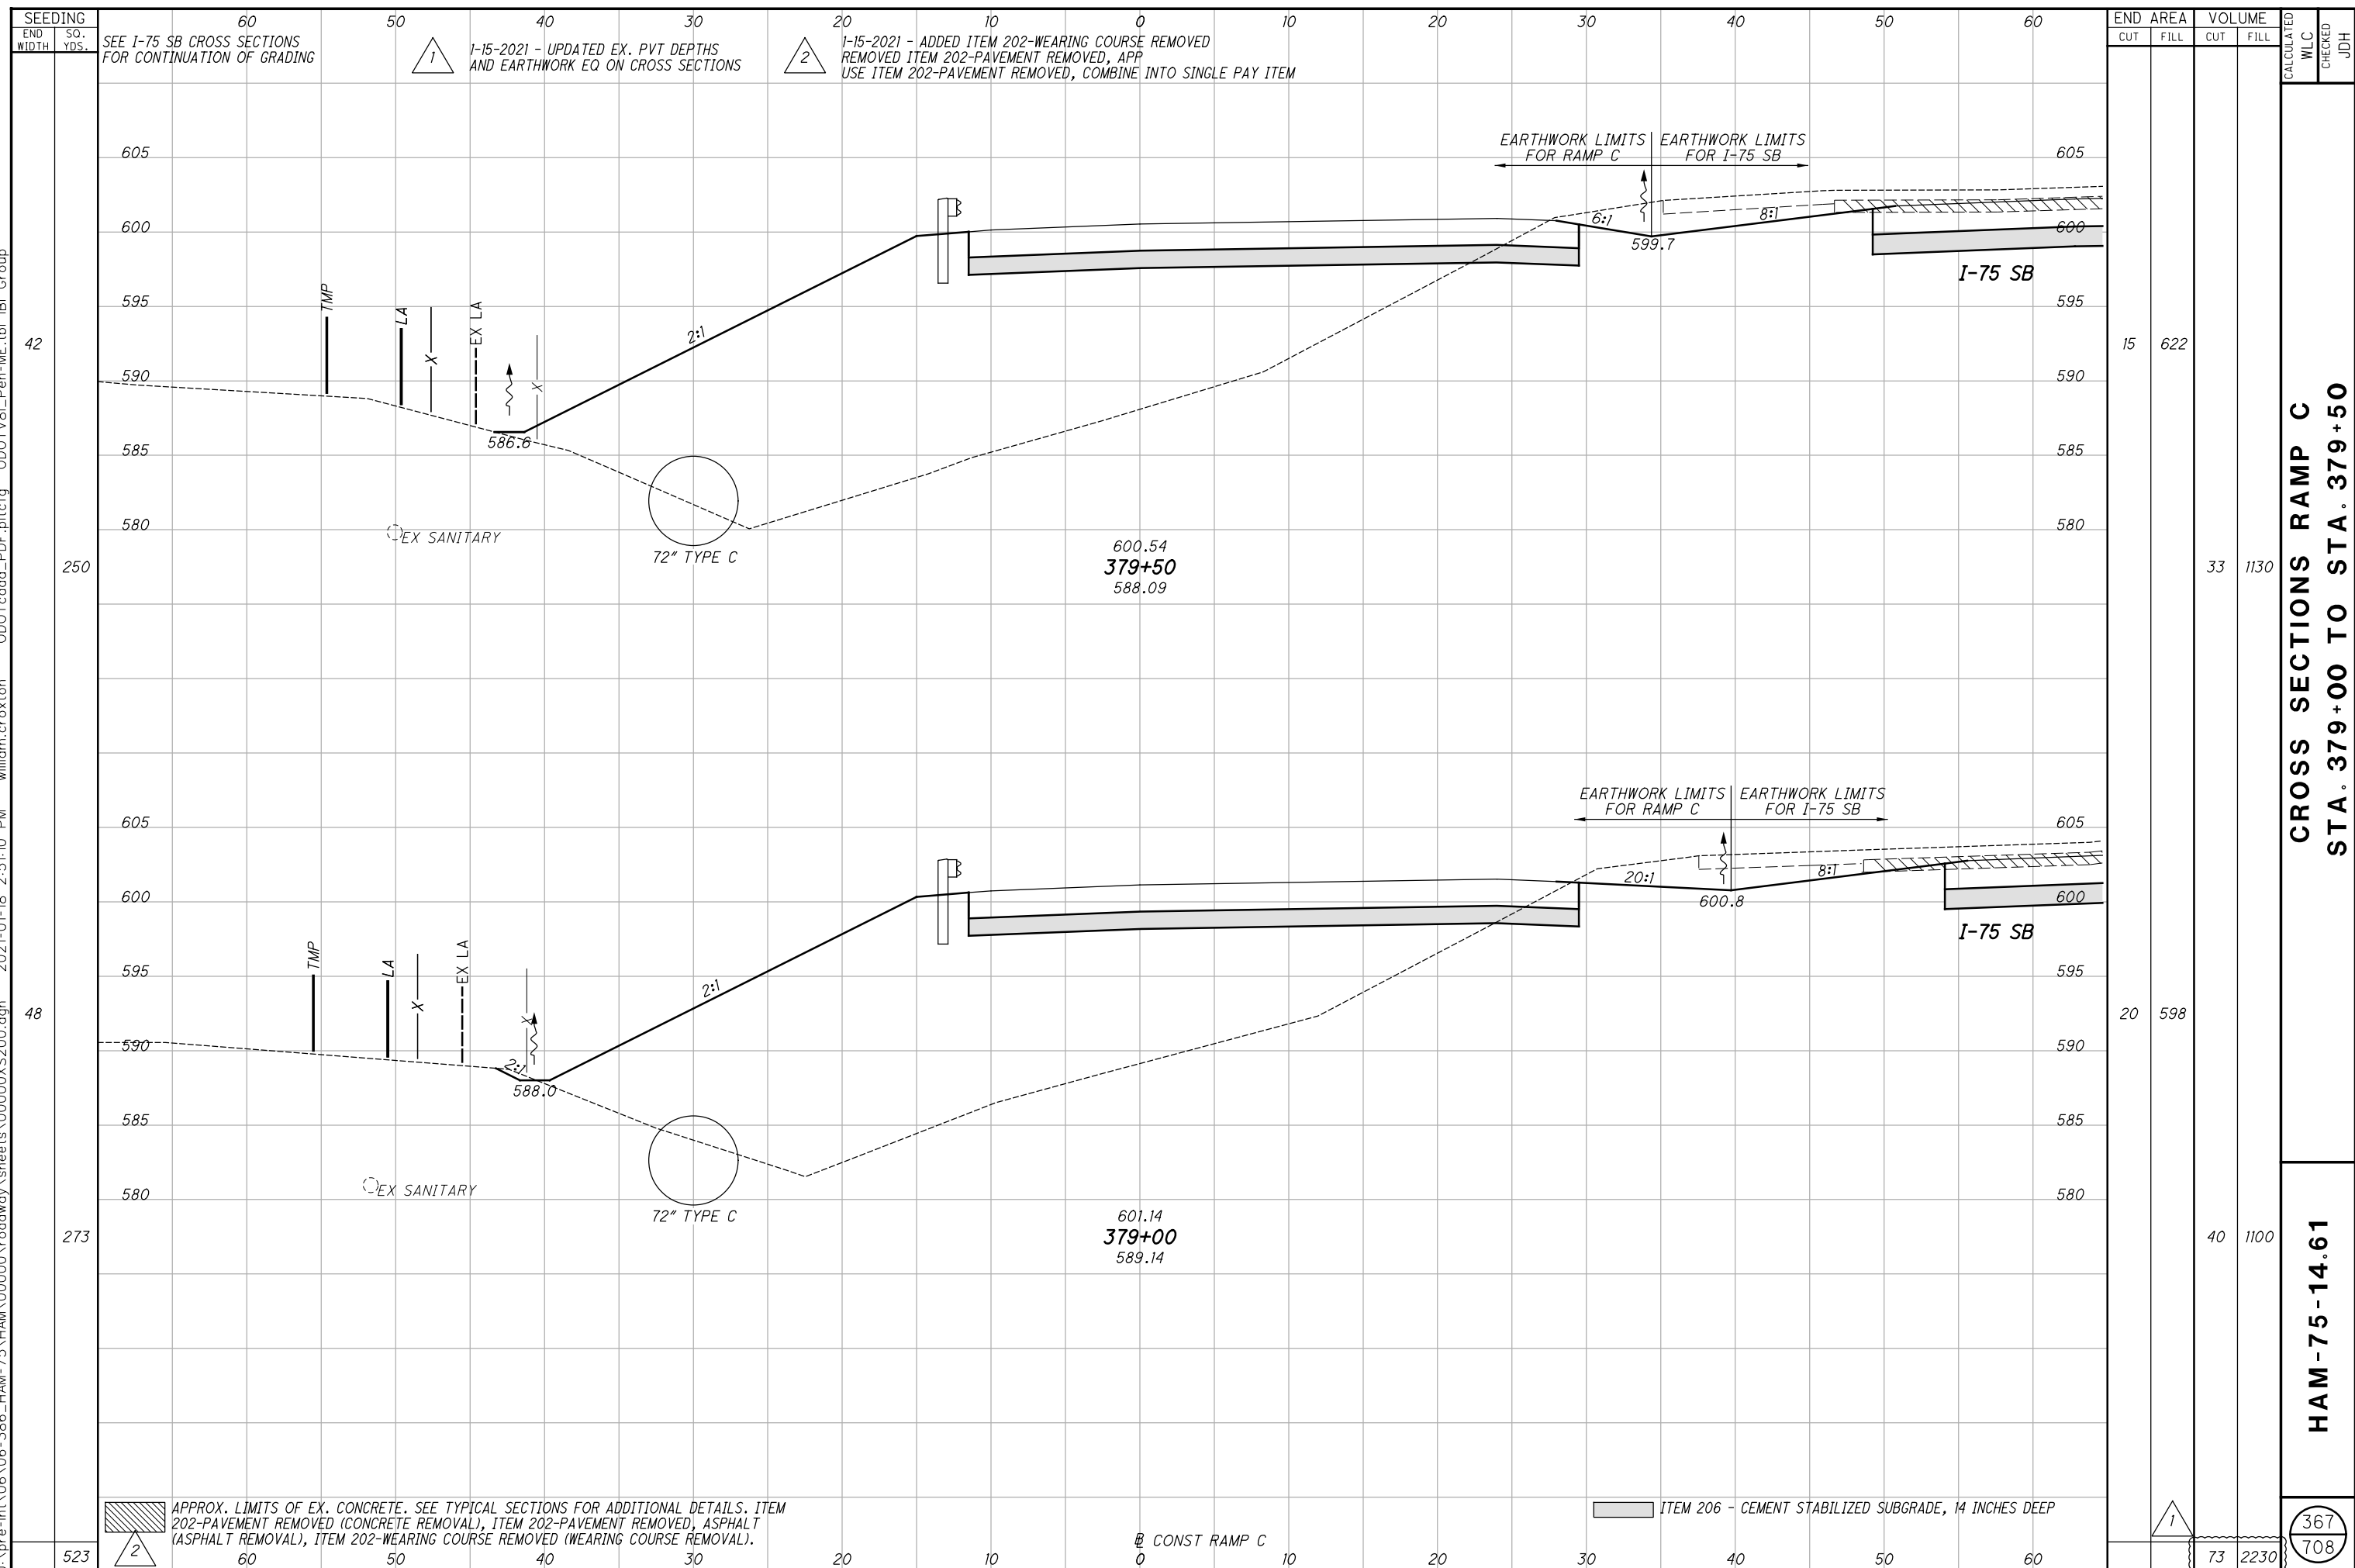

APPROX. LIMITS OF EX. CONCRETE. SEE TYPICAL SECTIONS FOR ADDITIONAL DETAILS. ITEM 202-PAVEMENT REMOVED (CONCRETE REMOVAL), ITEM 202-PAVEMENT REMOVED, ASPHALT (ASPHALT REMOVAL), ITEM 202-WEARING COURSE REMOVED (WEARING COURSE REMOVAL).

ITEM 206 - CEMENT STABILIZED SUBGRADE, 14 INCHES DEEP

CONST RAMP C


END AREA	VOLUME		CALCULATED WLC	CHECKED	JDH
	CUT	FILL			
15	622				
33	1130				
20	598				
40	1100				
73	2230				

CROSS SECTIONS RAMP C  
STA. 379+00 TO STA. 379+50

HAM-75-14.61

367  
708


j:\pre-int\06\06-386\_HAM-75\_HAM\00000\roadway\sheets\00000X5200.dgn 2021-01-18 2:51:11 PM william.croxton\ ODOTcadd\_PDF.pltcfgr ODOTV81\_Pen-ME.tbl IBI Group

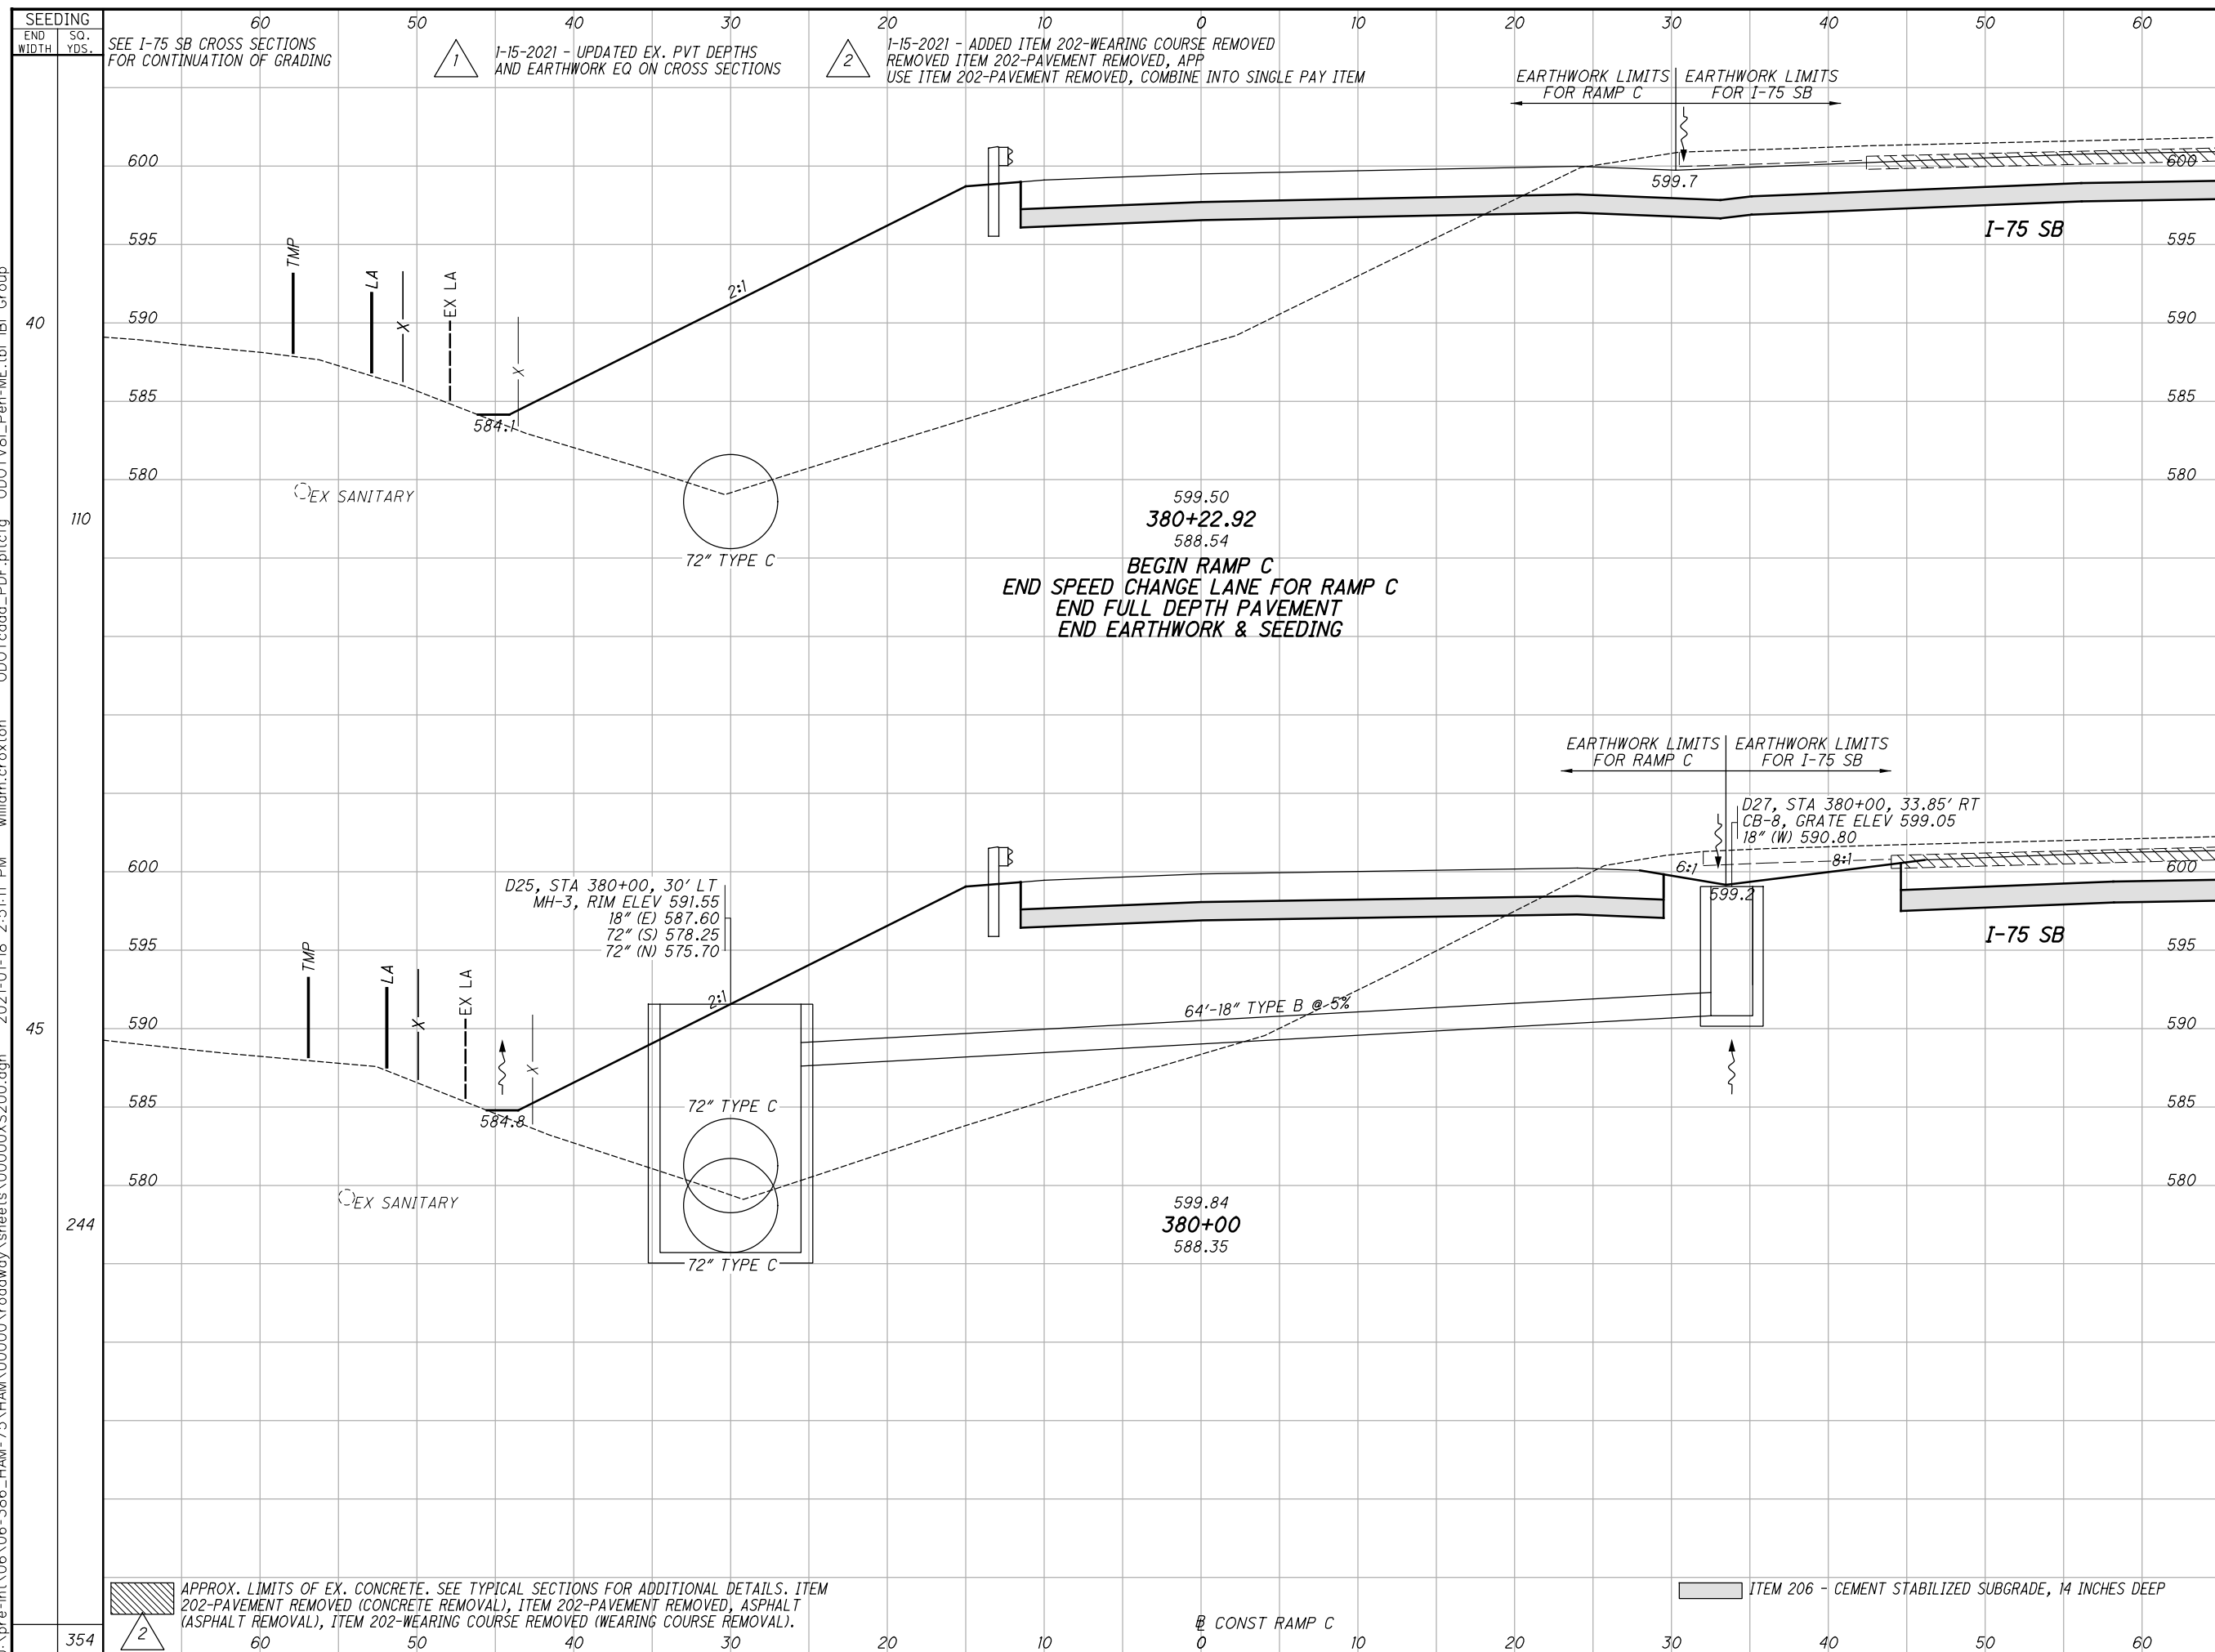

END AREA		VOLUME		CALCULATED WLC	CHECKED JDH
CUT	FILL	CUT	FILL		
18	569	16	496		
19	598	32	1130		
48	1626			368	708

**CROSS SECTIONS RAMP C**  
**STA. 380+00 TO STA. 380+22.92**  
**HAM-75-14.61**

j:\pre-int\06\06-386\_HAM-75\HAM\00000\roadway\sheets\00000X5300.dgn 2021-01-18 2:51:27 PM william.croxton' ODOTcadd\_PDF.pltcfgr ODOTV8i\_Pen-ME.tbl IBI Group

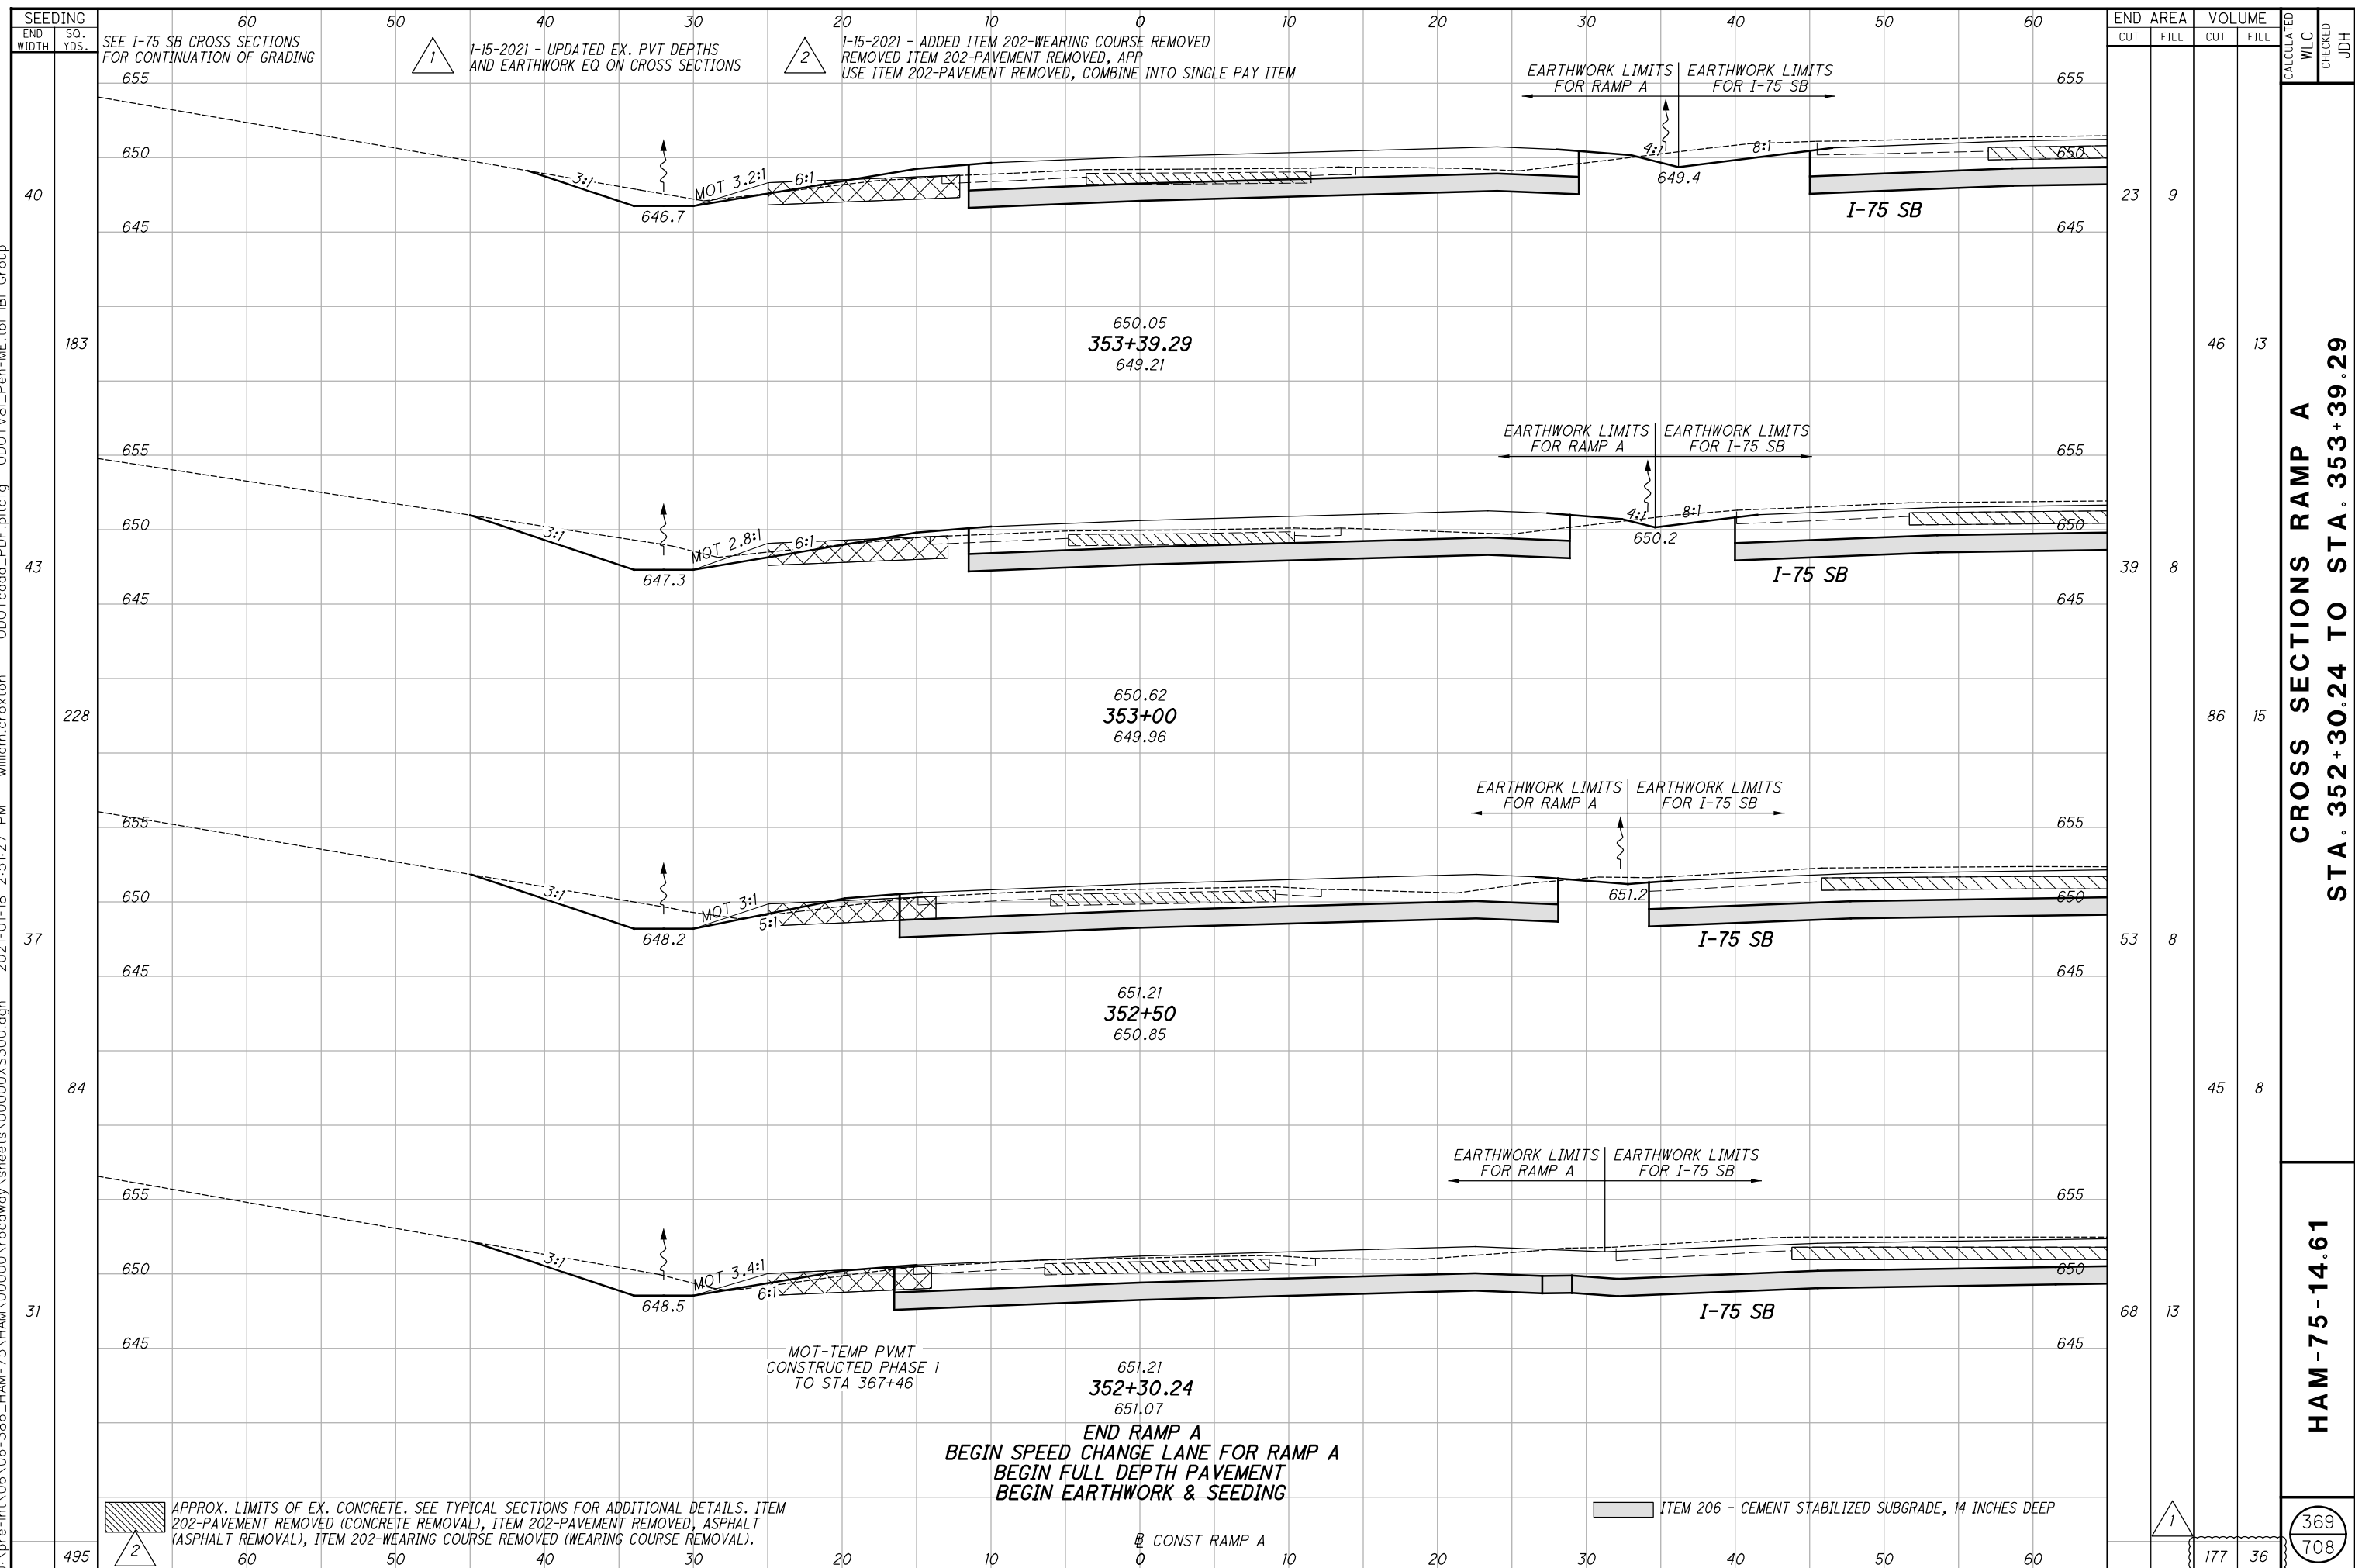

CROSS SECTIONS RAMP A  
STA. 352+30.24 TO STA. 353+39.29

HAM-75-14.61

APPROX. LIMITS OF EX. CONCRETE. SEE TYPICAL SECTIONS FOR ADDITIONAL DETAILS. ITEM 202-PAVEMENT REMOVED (CONCRETE REMOVAL), ITEM 202-PAVEMENT REMOVED, ASPHALT (ASPHALT REMOVAL), ITEM 202-WEARING COURSE REMOVED (WEARING COURSE REMOVAL).

END RAMP A  
BEGIN CHANGE LANE FOR RAMP A  
BEGIN FULL DEPTH PAVEMENT  
BEGIN EARTHWORK & SEEDING


ITEM 206 - CEMENT STABILIZED SUBGRADE, 14 INCHES DEEP



369  
708



j:\pre-int\06\06-386\_HAM-75\_HAM\00000\roadway\sheets\00000X5300.dgn 2021-01-18 2:51:27 PM william.croxton\ODOTV86\_PDF.pltcfgr ODOTV86\_Pen-ME.tbl IBI Group

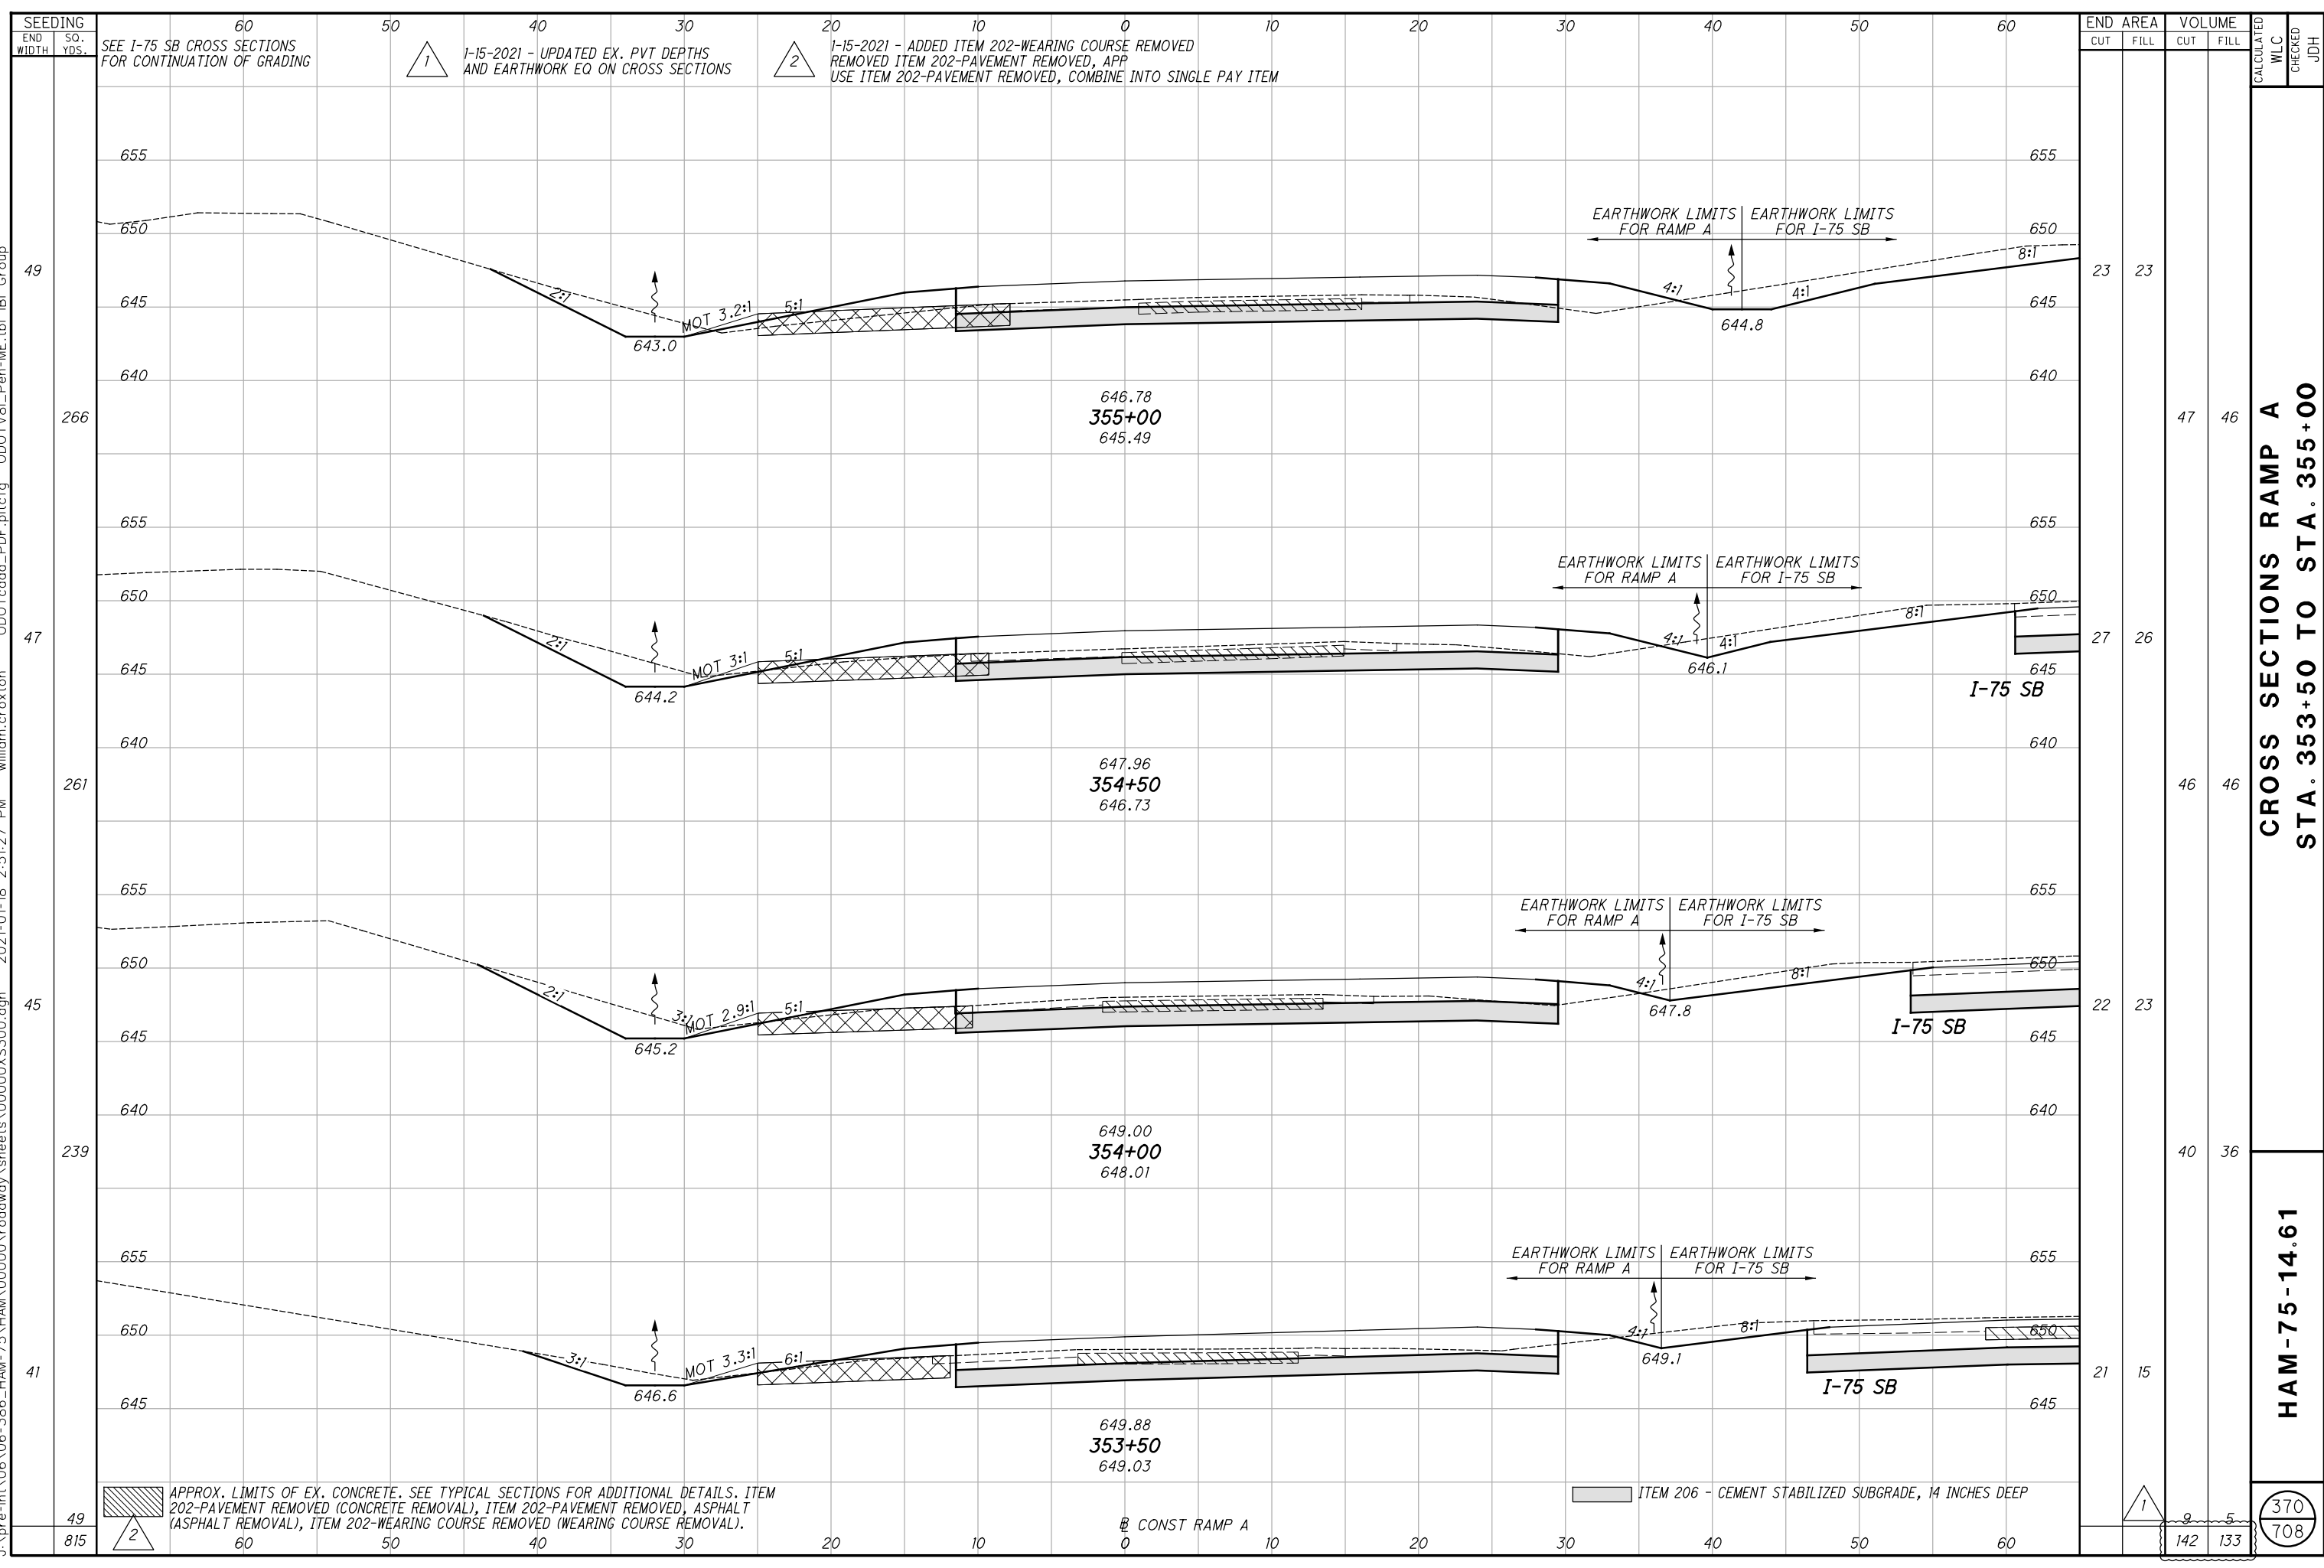

APPROX. LIMITS OF EX. CONCRETE. SEE TYPICAL SECTIONS FOR ADDITIONAL DETAILS. ITEM 202-PAVEMENT REMOVED (CONCRETE REMOVAL), ITEM 202-PAVEMENT REMOVED, ASPHALT (ASPHALT REMOVAL), ITEM 202-WEARING COURSE REMOVED (WEARING COURSE REMOVAL).

ITEM 206 - CEMENT STABILIZED SUBGRADE, 14 INCHES DEEP

CONST RAMP A

END AREA	VOLUME		CALCULATED WLC	CHECKED JDH
	CUT	FILL		
23	23			
27	26			
22	23			
21	15			
9	5		370	708
142	133			

CROSS SECTIONS RAMP A  
STA. 353+50 TO STA. 355+00

HAM-75-14.61


j:\pre-int\06\06-386\_HAM-75\_HAM\00000\roadway\sheets\00000X5300.dgn 2021-01-18 2:51:28 PM william.croxton'

SEEDING	END SO.		60	50	40	30	20	10	0	10	20	30	40	50	60	END AREA		VOLUME		CALCULATED	WLC	CHECKED	JDH
	WIDTH	YDS.														CUT	FILL	CUT	FILL				
																	56	58					
																			102	100			
																			90	100			
																			43	58			
																			79	98			
																			42	47			
																			61	65			
																			332	363			

SEE I-75 SB CROSS SECTIONS FOR CONTINUATION OF GRADING

1-15-2021 - UPDATED EX. PVT DEPTHS AND EARTHWORK EQ ON CROSS SECTIONS

1-15-2021 - ADDED ITEM 202-WEARING COURSE REMOVED REMOVED ITEM 202-PAVEMENT REMOVED, APP USE ITEM 202-PAVEMENT REMOVED, COMBINE INTO SINGLE PAY ITEM

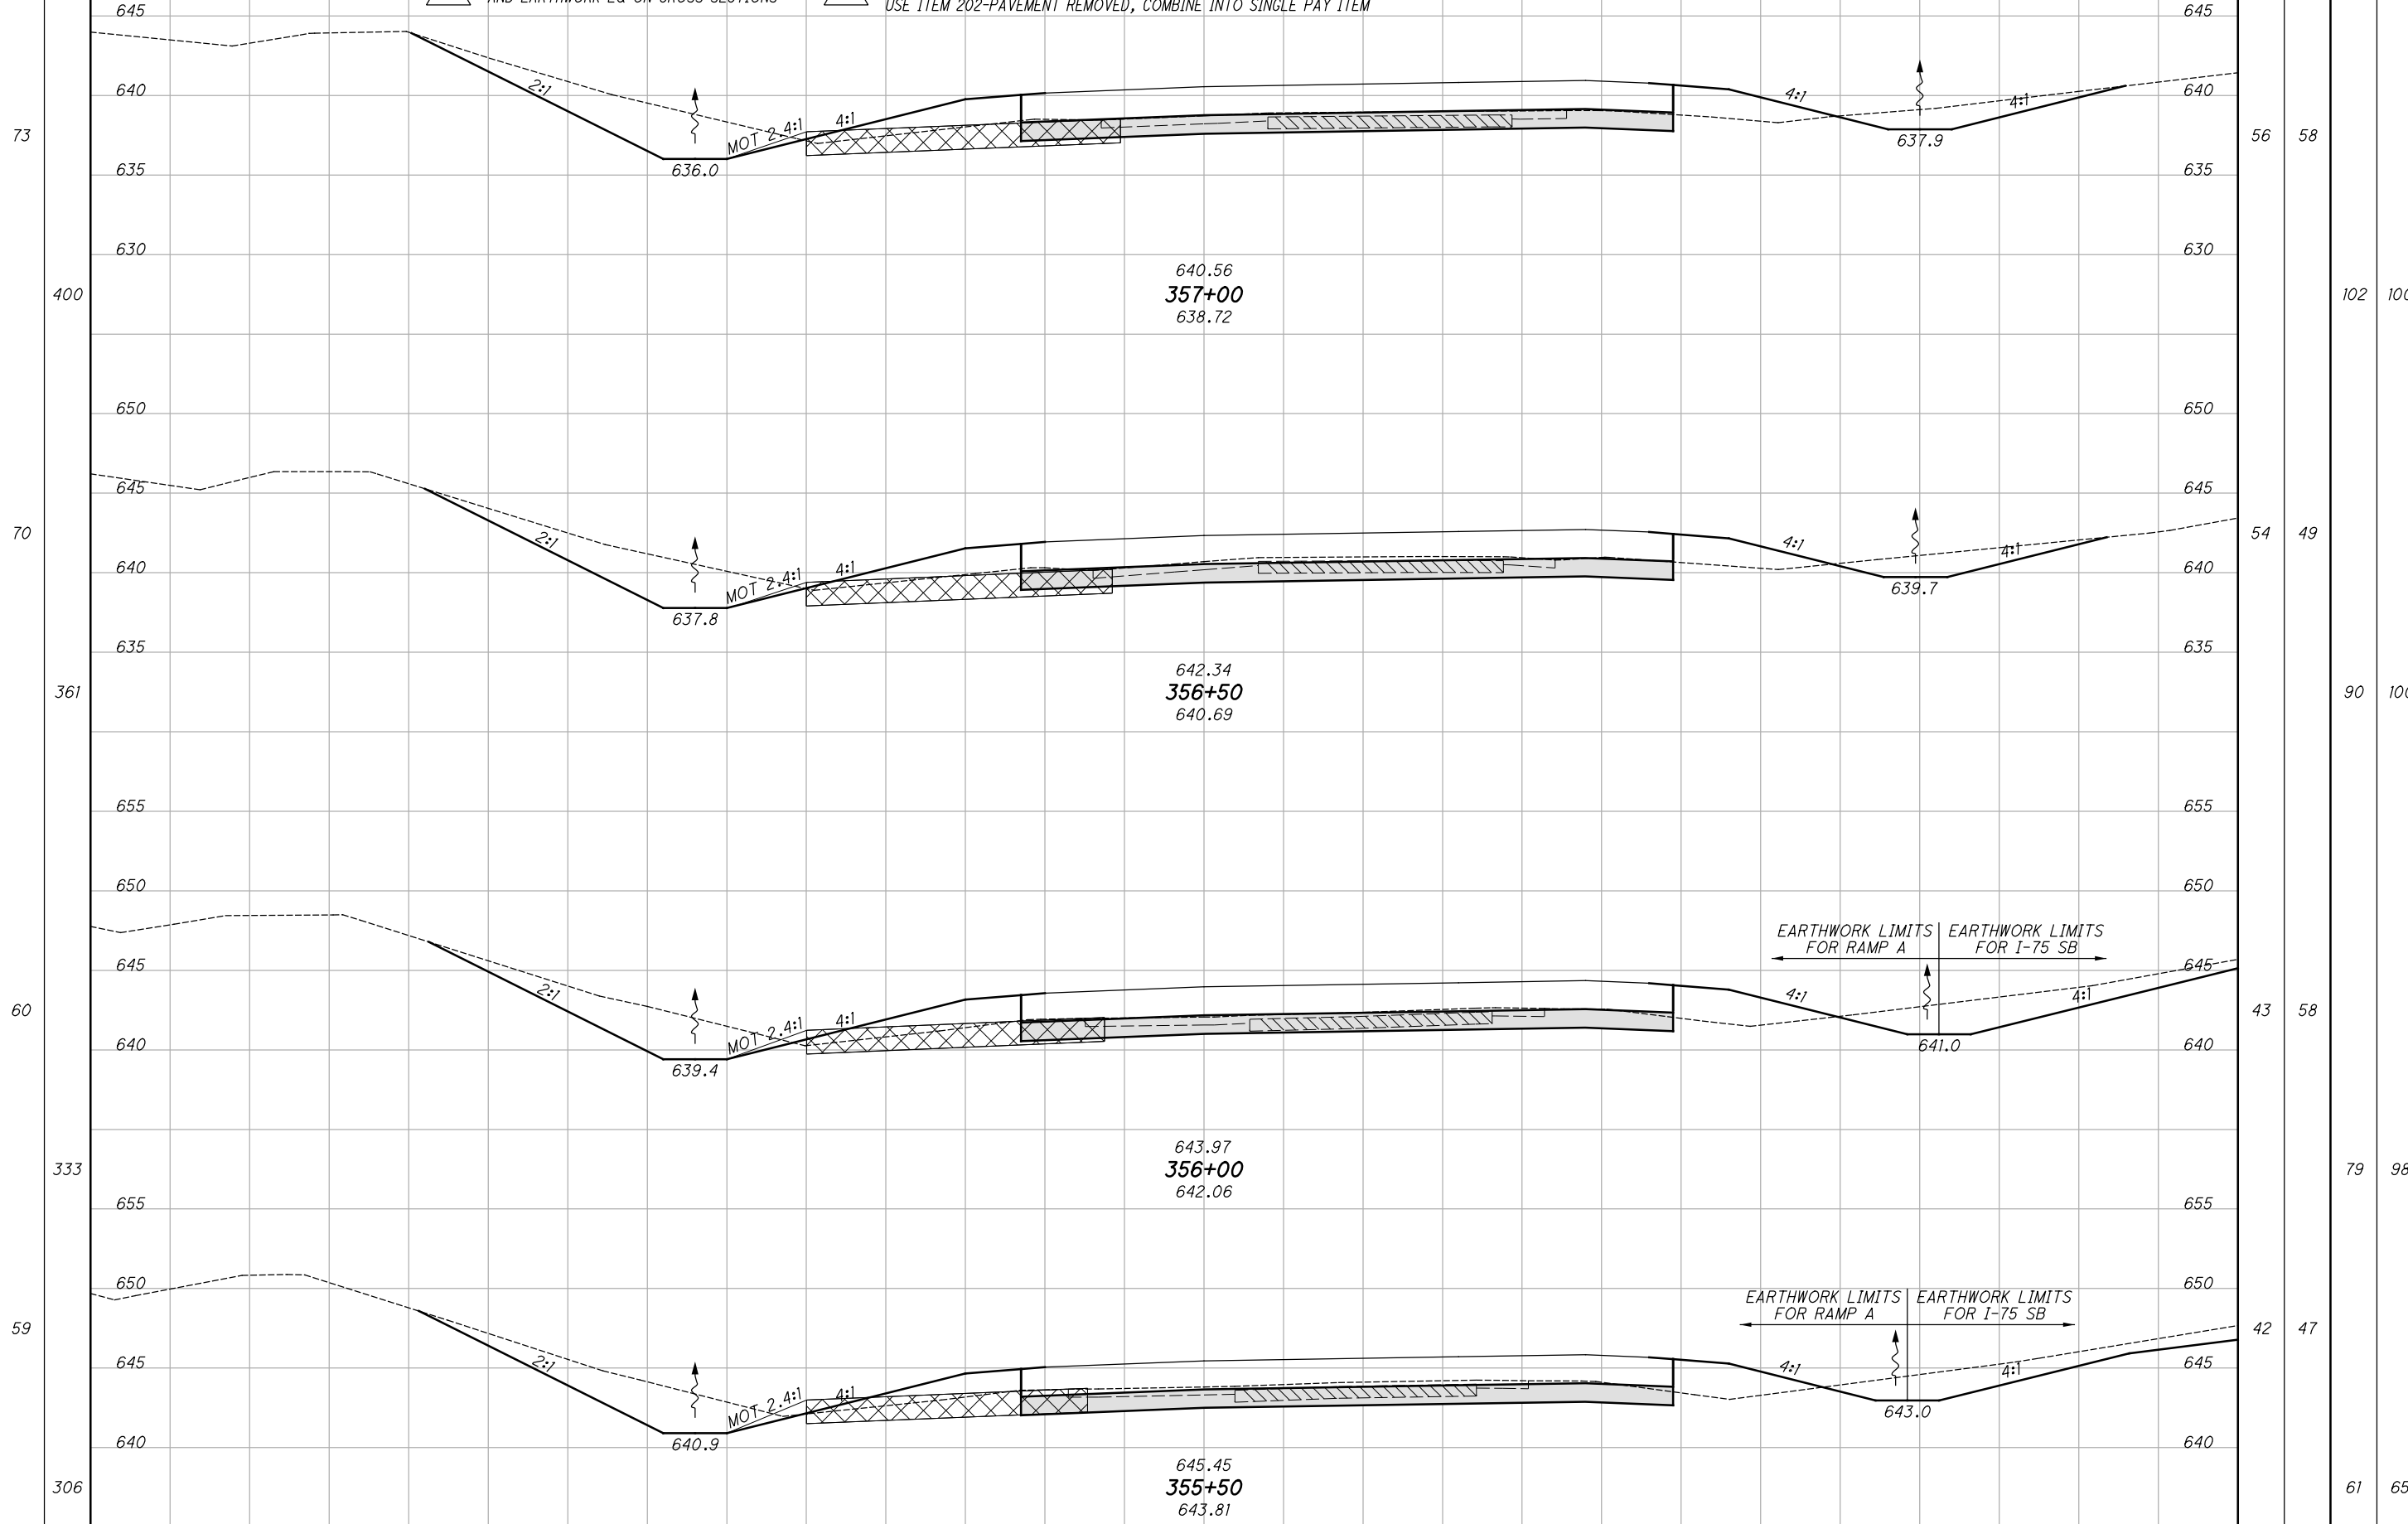

APPROX. LIMITS OF EX. CONCRETE. SEE TYPICAL SECTIONS FOR ADDITIONAL DETAILS. ITEM 202-PAVEMENT REMOVED (CONCRETE REMOVAL), ITEM 202-PAVEMENT REMOVED, ASPHALT (ASPHALT REMOVAL), ITEM 202-WEARING COURSE REMOVED (WEARING COURSE REMOVAL).

ITEM 206 - CEMENT STABILIZED SUBGRADE, 14 INCHES DEEP


CONST RAMP A

CROSS SECTIONS RAMP A  
STA. 355+50 TO STA. 357+00

HAM-75-14.61

371  
708

j:\pre-int\06\06-386\_HAM-75\_HAM\00000\roadway\sheets\00000X5300.dgn 2021-01-18 2:51:28 PM william.croxton' ODOTcadd\_PDF.pltcfgr ODOTV8i\_Pen-ME.tbl IBI Group

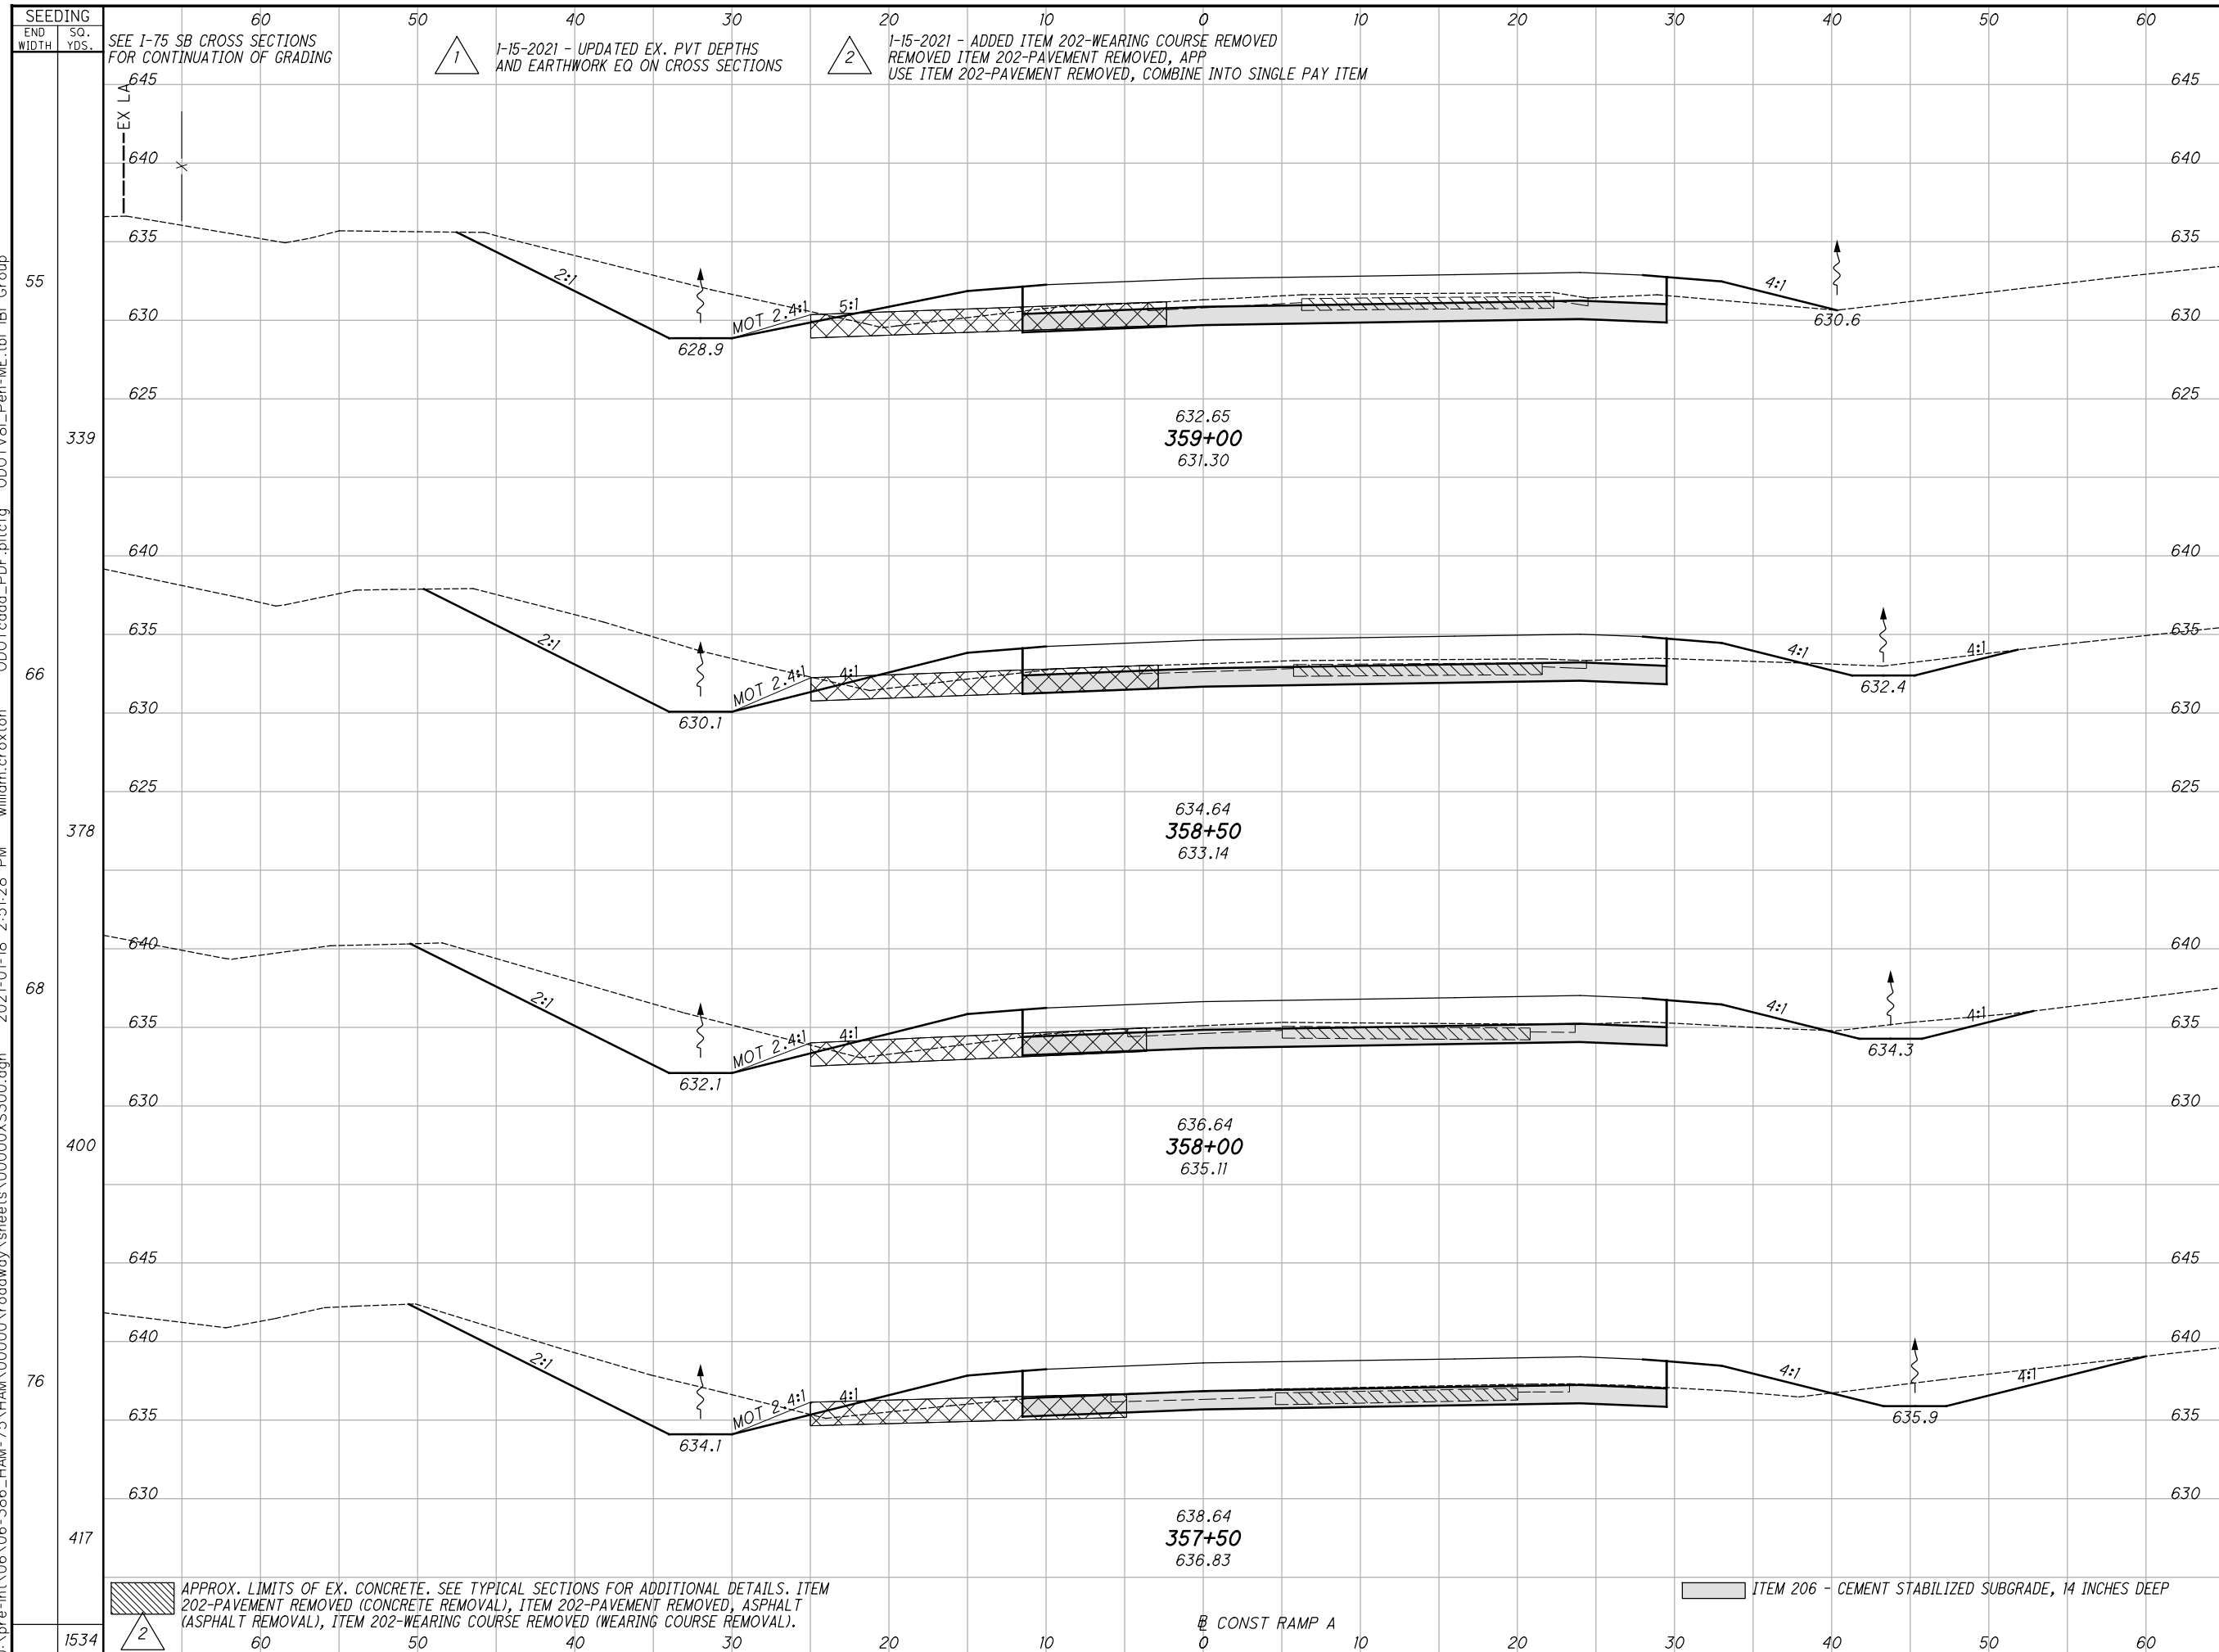


END AREA	VOLUME	CALCULATED	WLC	CHECKED	JDH
56	36				
78	40	125	71		
72	48	139	82		
68	55	130	96		
509	354	115	105		

**CROSS SECTIONS RAMP A  
STA. 357+50 TO STA. 359+00**

**HAM-75-14.61**

372  
708

j:\pre-int\06\06-386\_HAM-75\_HAM\00000\roadway\sheets\00000X5300.dgn 2021-01-18 2:51:28 PM william.croxton' ODOTcadd\_PDF.pltcfgr ODOTV8i\_Pen-ME.tbl IBI Group

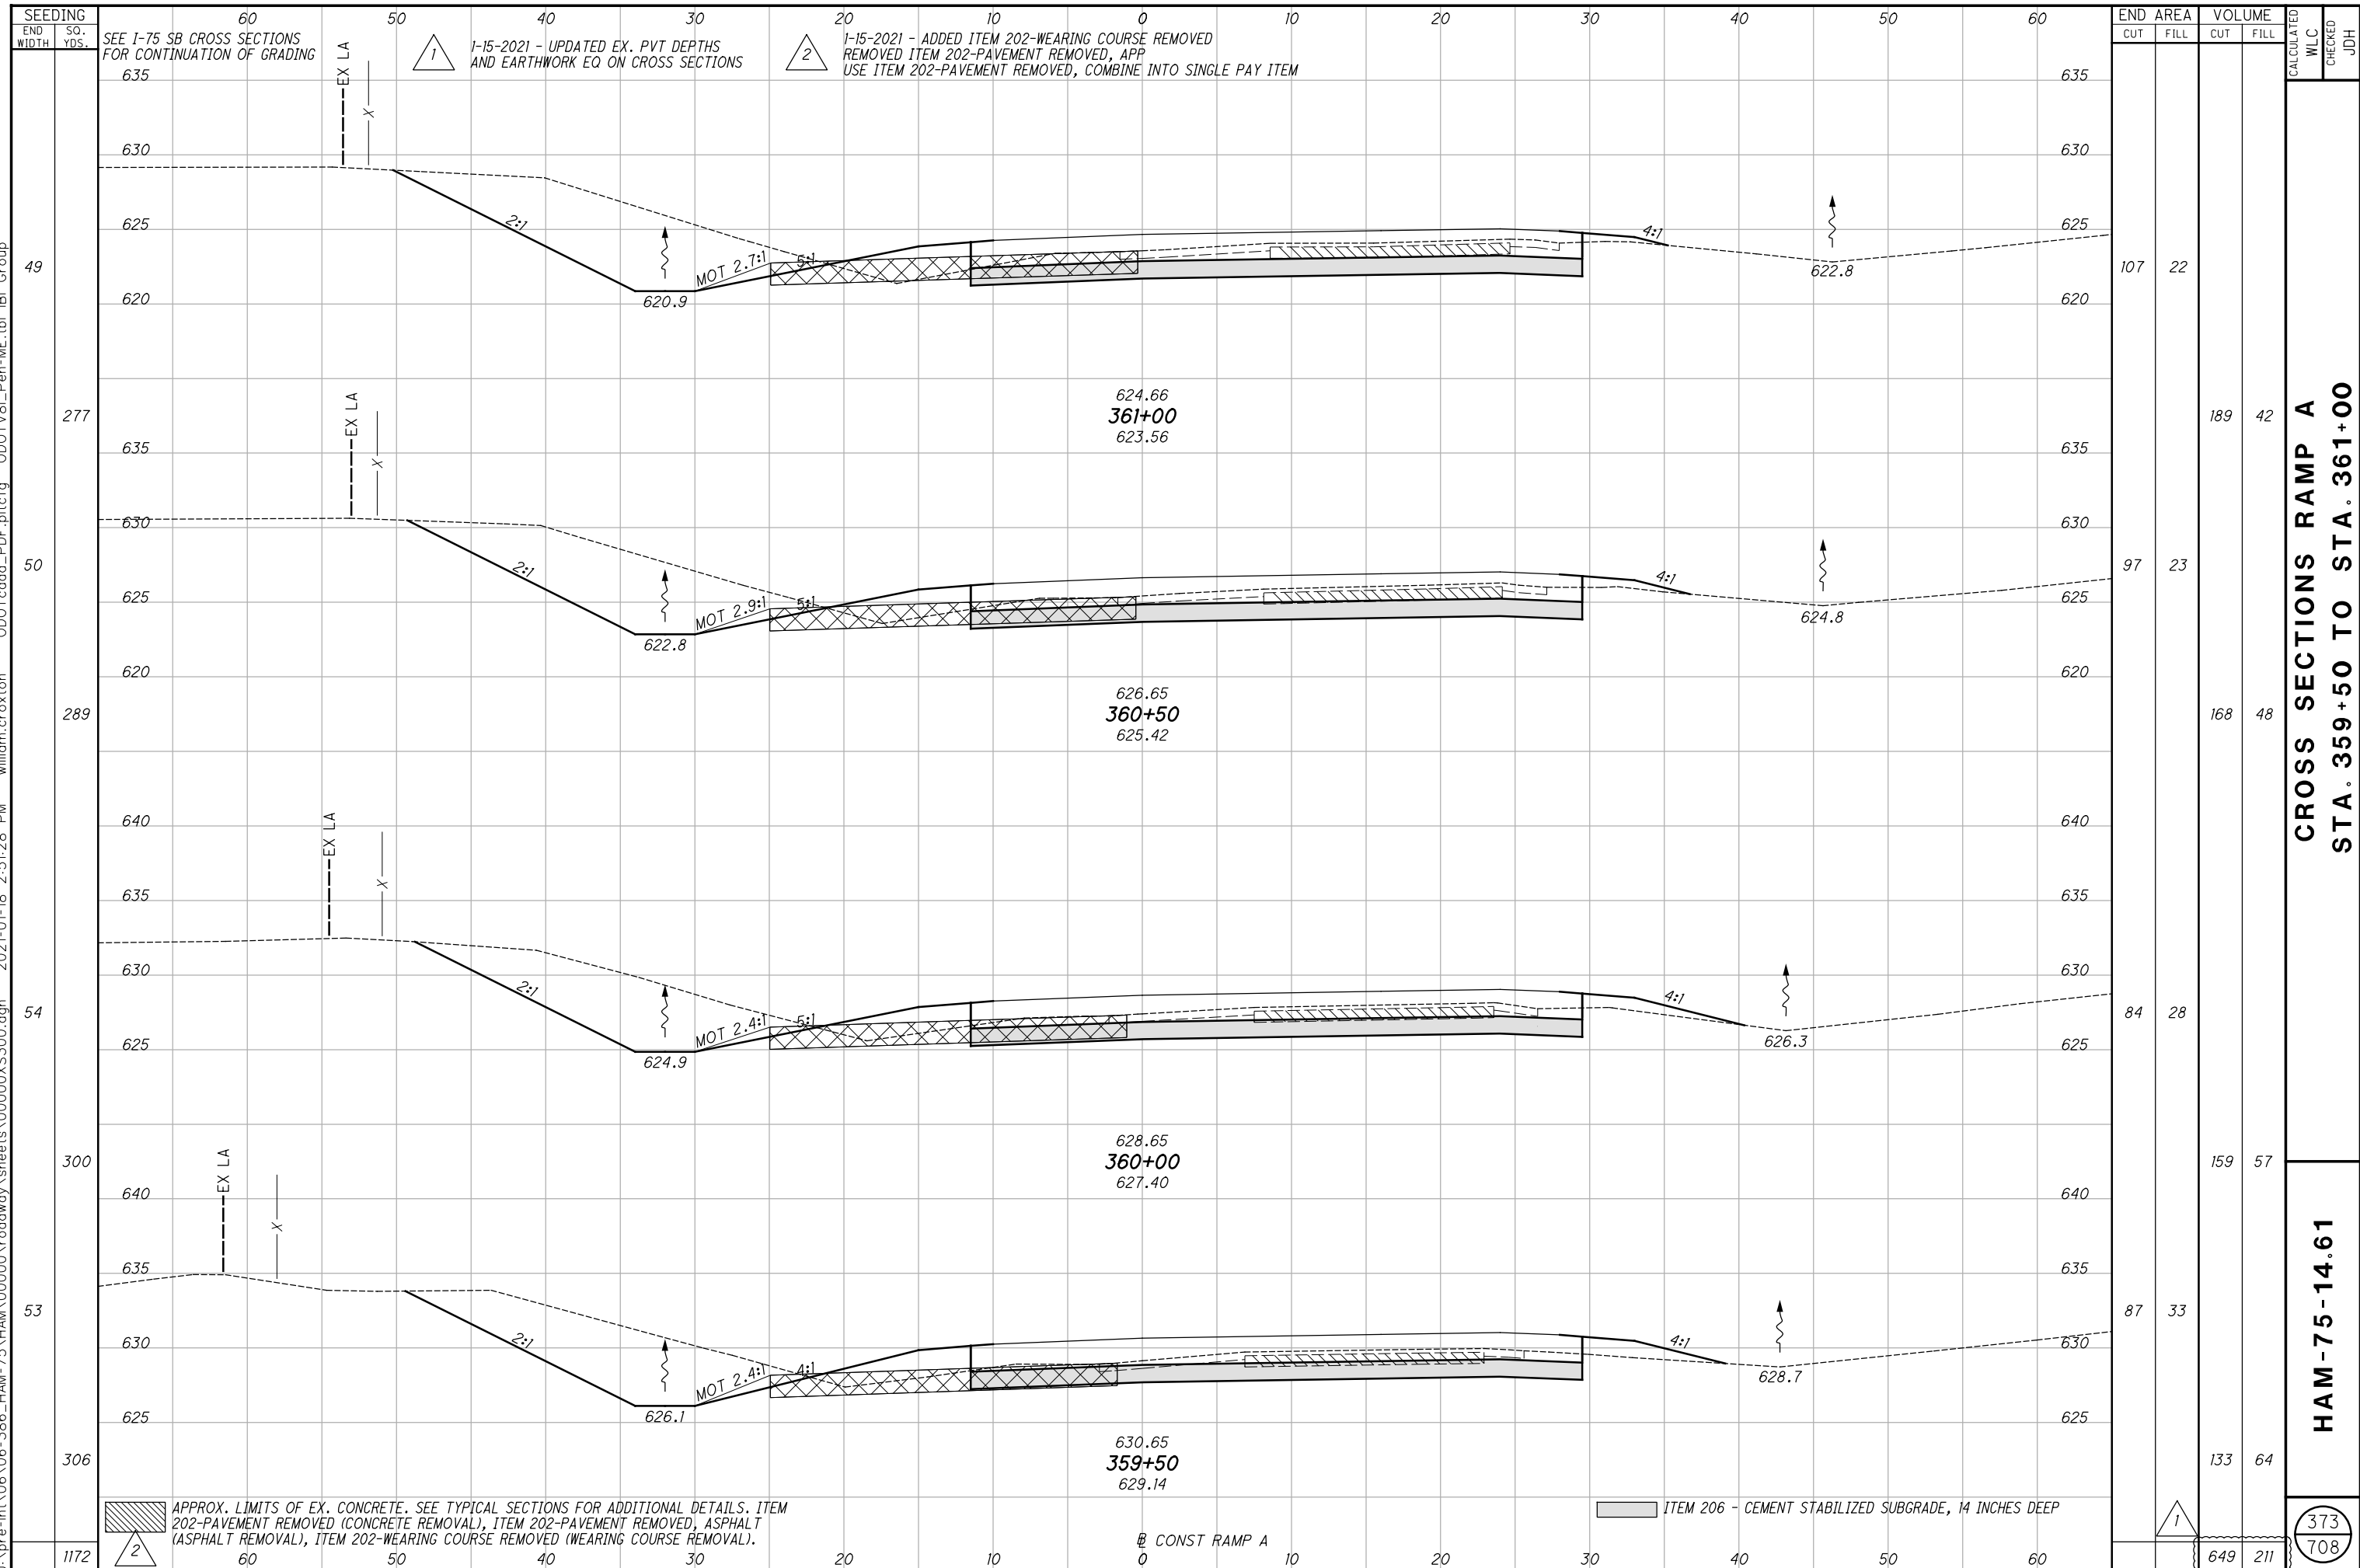


**CROSS SECTIONS RAMP A**  
**STA. 359+50 TO STA. 361+00**

**HAM-75-14.61**

373  
708

STATION	END AREA		VOLUME	
	CUT	FILL	CUT	FILL
361+00	107	22	189	42
360+50	97	23	168	48
360+00	84	28	159	57
359+50	87	33	133	64
<b>TOTAL</b>	<b>649</b>	<b>211</b>	<b>649</b>	<b>211</b>

j:\pre-int\06\06-386\_HAM-75\_HAM\00000\roadway\sheets\00000X5300.dgn 2021-01-18 2:51:29 PM william.croxton' ODOTcadd\_PDF.pltcfgr ODOTV8i\_Pen-ME.tbl IBI Group

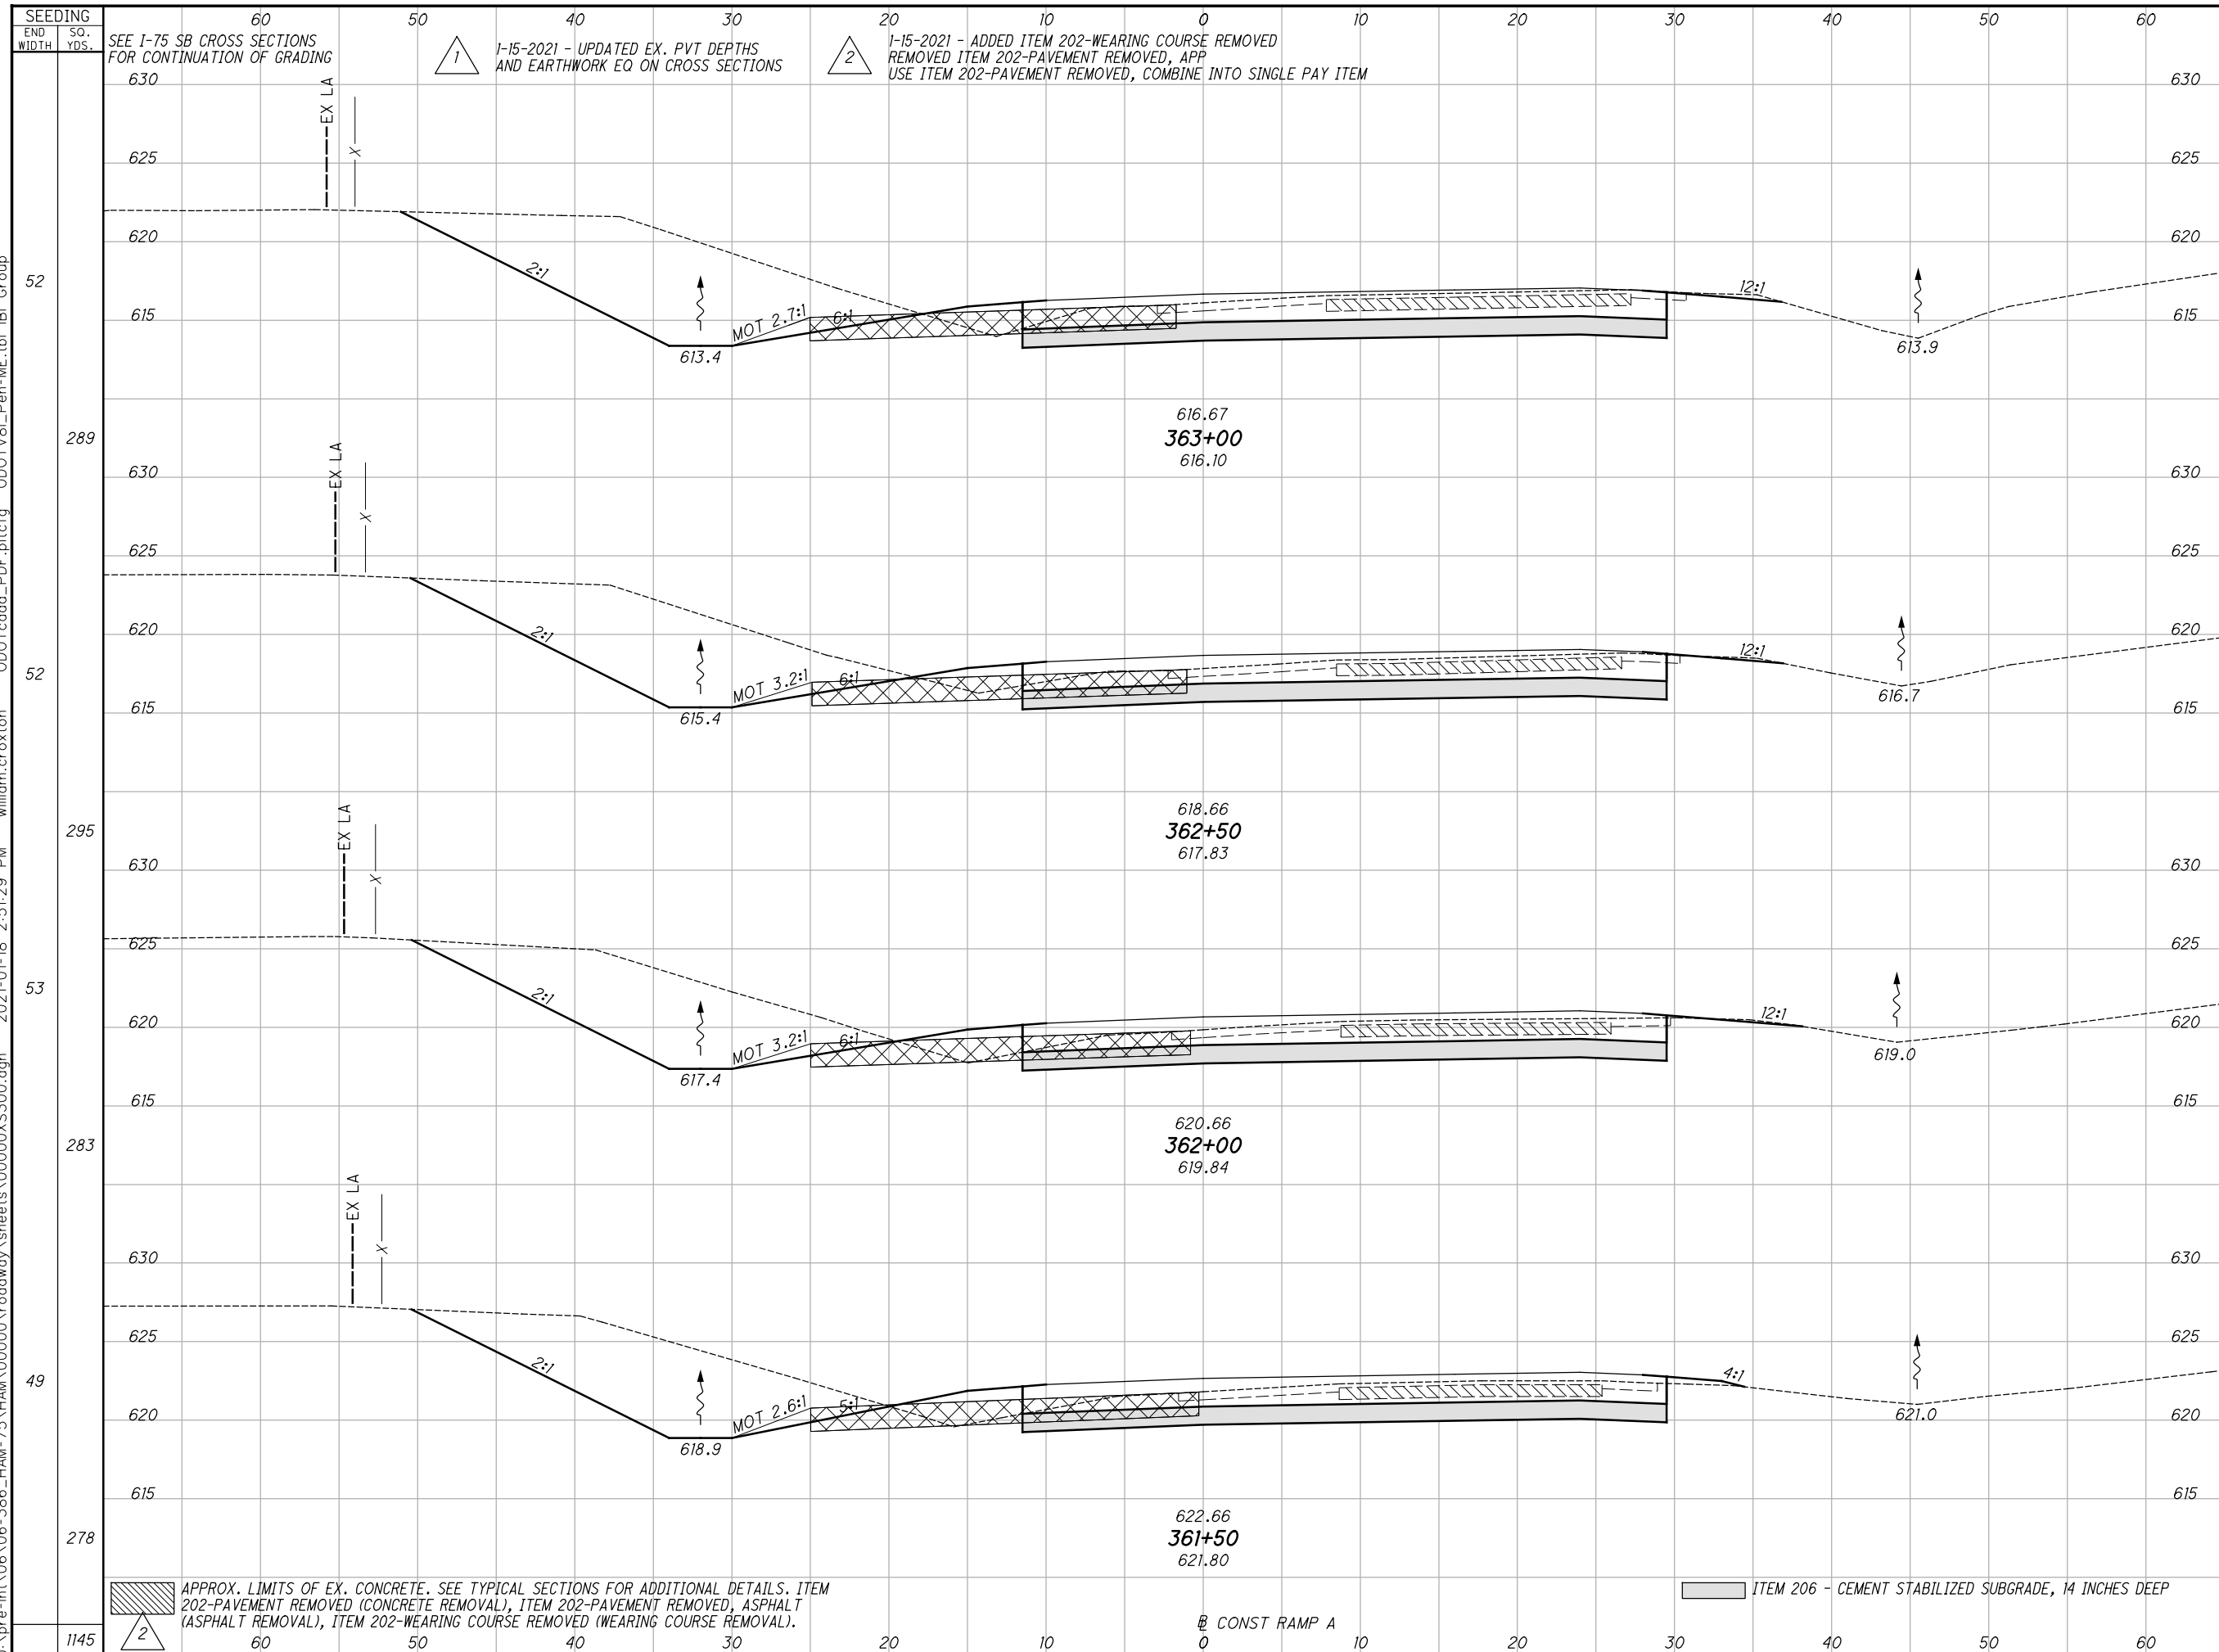


END AREA	VOLUME	CALCULATED	WLC	CHECKED	JDH
163	13				
281	25				
140	13				
249	28				
128	17				
236	34				
126	19				
216	38				
982	125				

**CROSS SECTIONS RAMP A  
STA. 361+50 TO STA. 363+00**

**HAM-75-14.61**

374  
708

j:\pre-int\06\06-386\_HAM-75\_HAM\00000\roadway\sheets\00000X5300.dgn 2021-01-18 2:51:29 PM william.croxton' ODOTcadd\_PDF.pltcfg ODOTV8i\_Pen-ME.tbl IBI Group

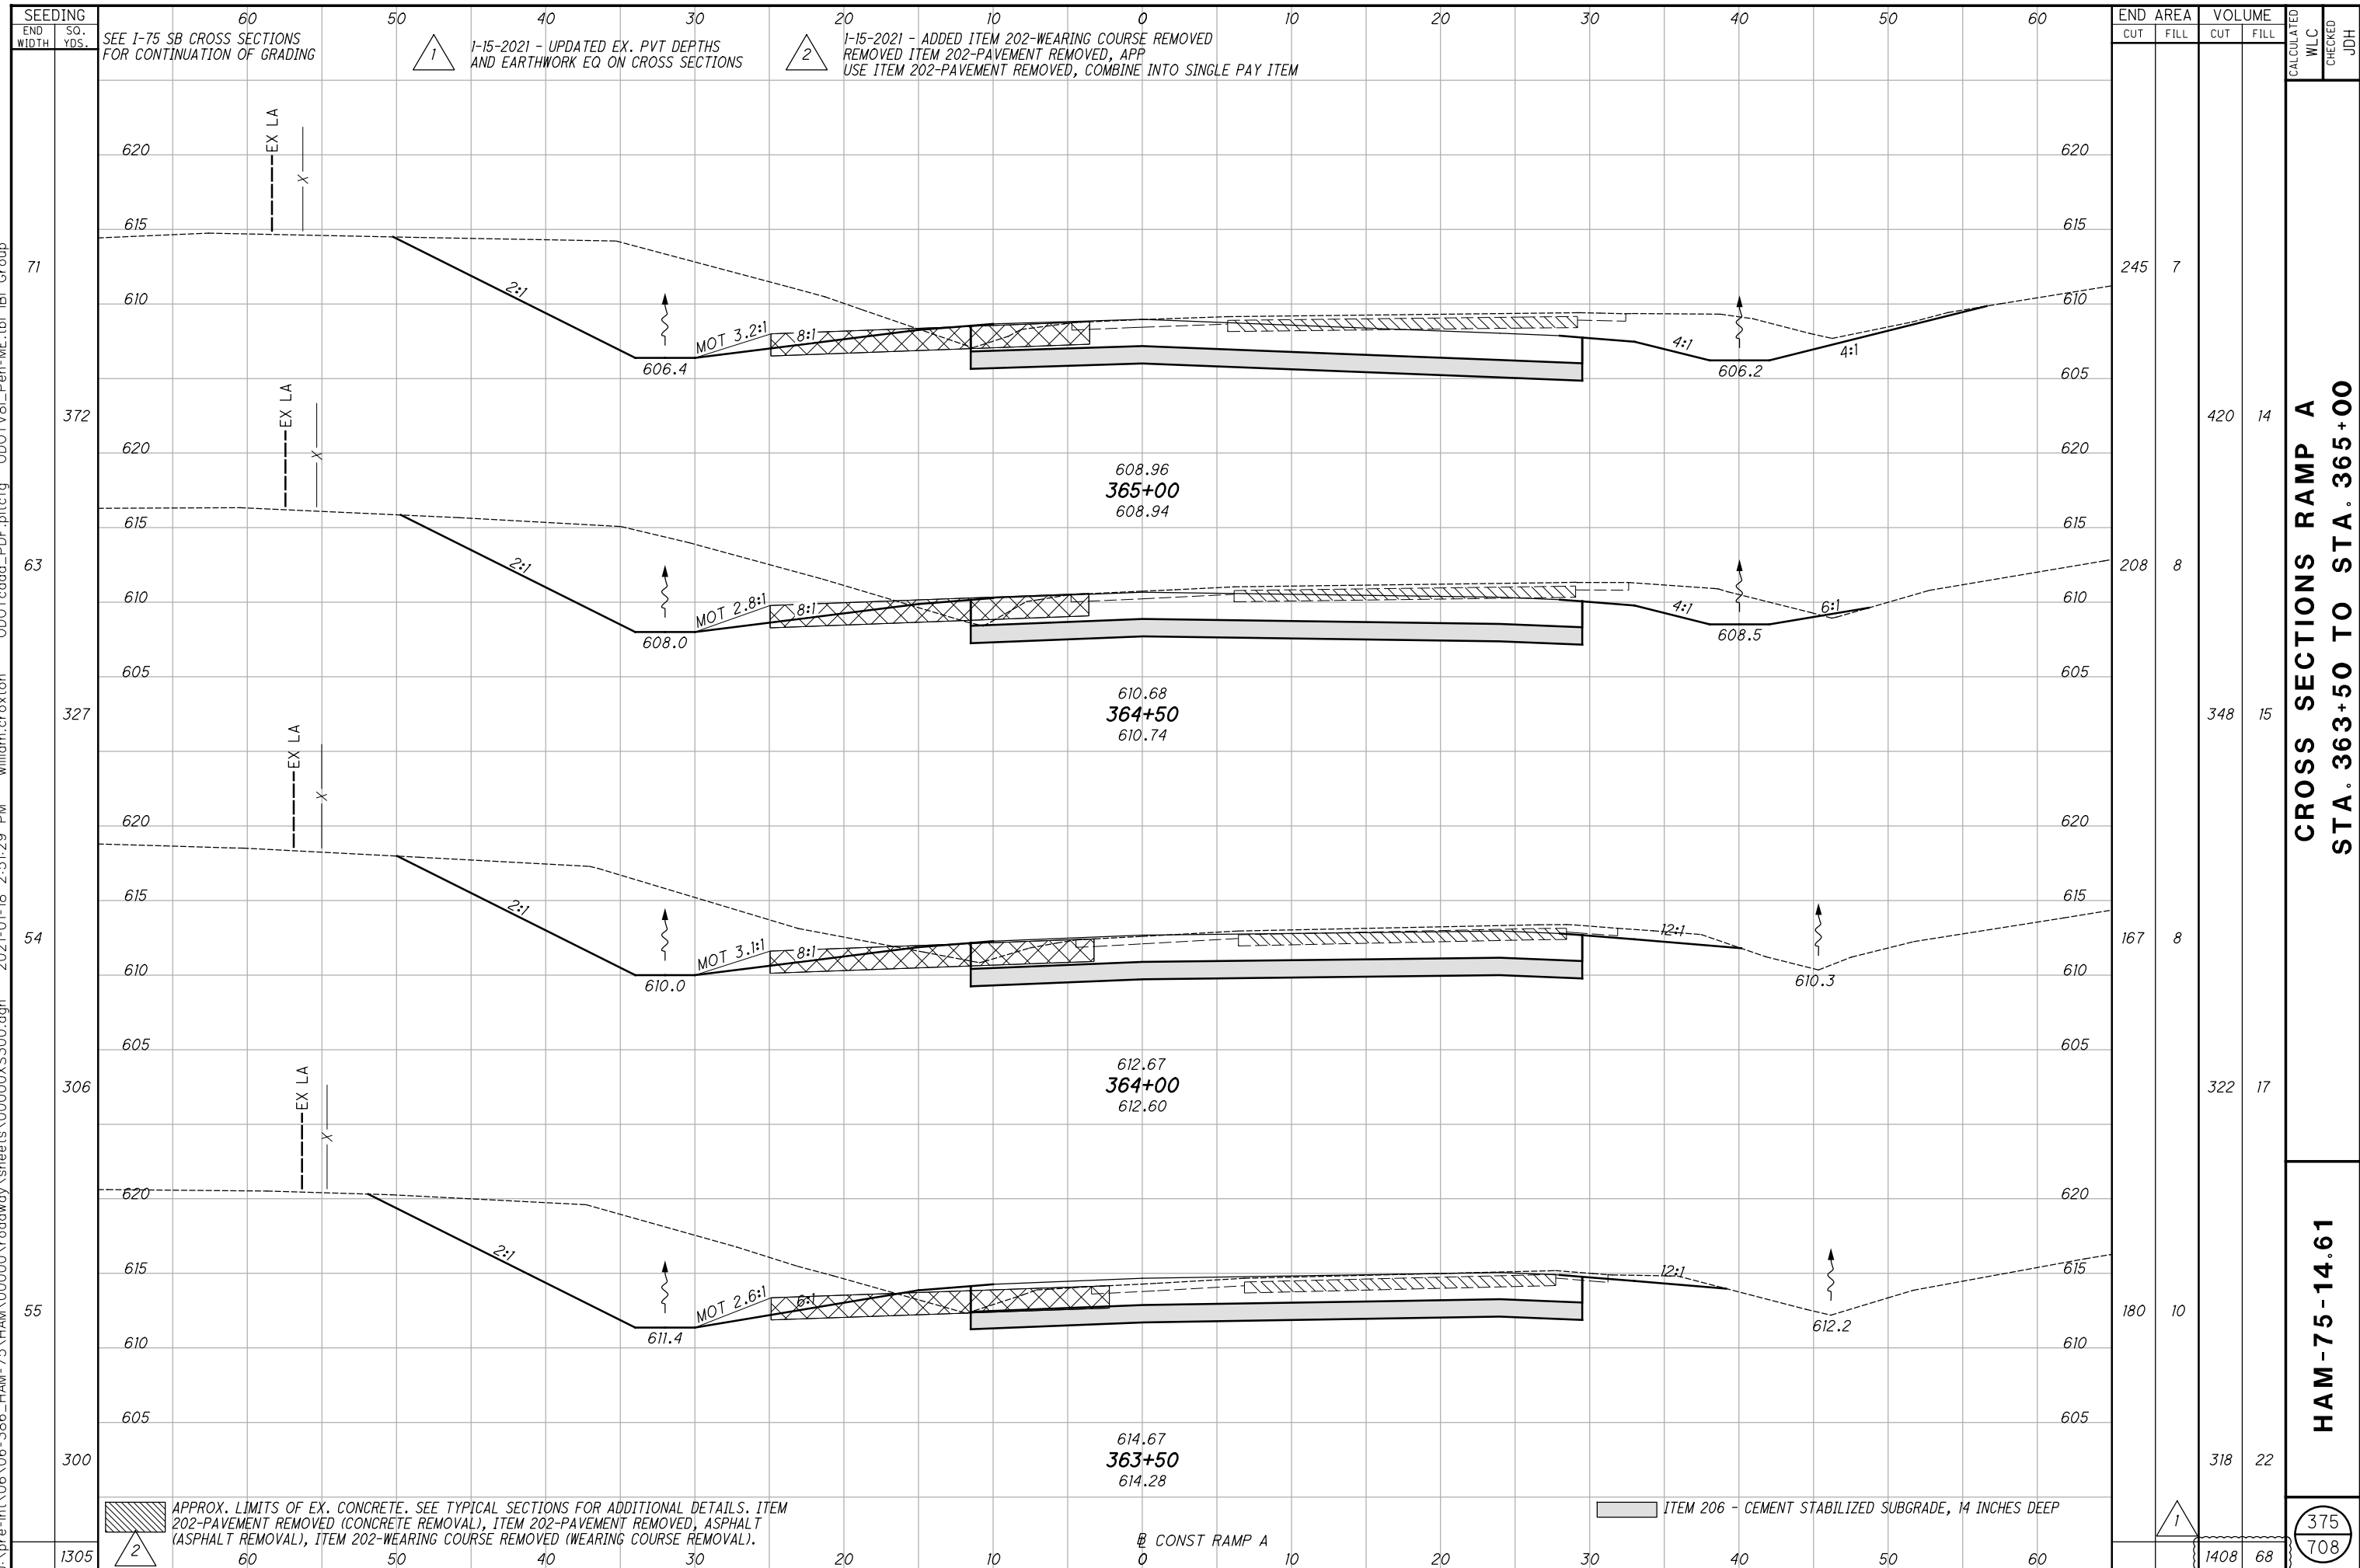

SEEDING  
END WIDTH SO. YDS.  
SEE I-75 SB CROSS SECTIONS FOR CONTINUATION OF GRADING

60 50 40 30 20 10 0 10 20 30 40 50 60

1-15-2021 - UPDATED EX. PVT DEPTHS AND EARTHWORK EQ ON CROSS SECTIONS

1-15-2021 - ADDED ITEM 202-WEARING COURSE REMOVED REMOVED ITEM 202-PAVEMENT REMOVED, APP USE ITEM 202-PAVEMENT REMOVED, COMBINE INTO SINGLE PAY ITEM

EX LA

MOT 3.2:1

MOT 2.8:1

MOT 3.1:1

MOT 2.6:1

606.4

608.0

610.0

611.4

606.2

608.5

610.3

612.2

608.96  
365+00  
608.94

610.68  
364+50  
610.74

612.67  
364+00  
612.60

614.67  
363+50  
614.28

ITEM 206 - CEMENT STABILIZED SUBGRADE, 14 INCHES DEEP

CONST RAMP A


END AREA		VOLUME		CALCULATED WLC	CHECKED JDH
CUT	FILL	CUT	FILL		
245	7	420	14		
208	8	348	15		
167	8	322	17		
180	10	318	22		
1408	68				

**CROSS SECTIONS RAMP A  
STA. 363+50 TO STA. 365+00**

**HAM-75-14.61**

375  
708

j:\pre-int\06\06-386\_HAM-75\_HAM\00000\roadway\sheets\00000X5300.dgn 2021-01-18 2:51:29 PM william.croxton' ODOTcadd\_PDF.pltcfg ODOTV8i\_Pen-ME.tbl IBI Group

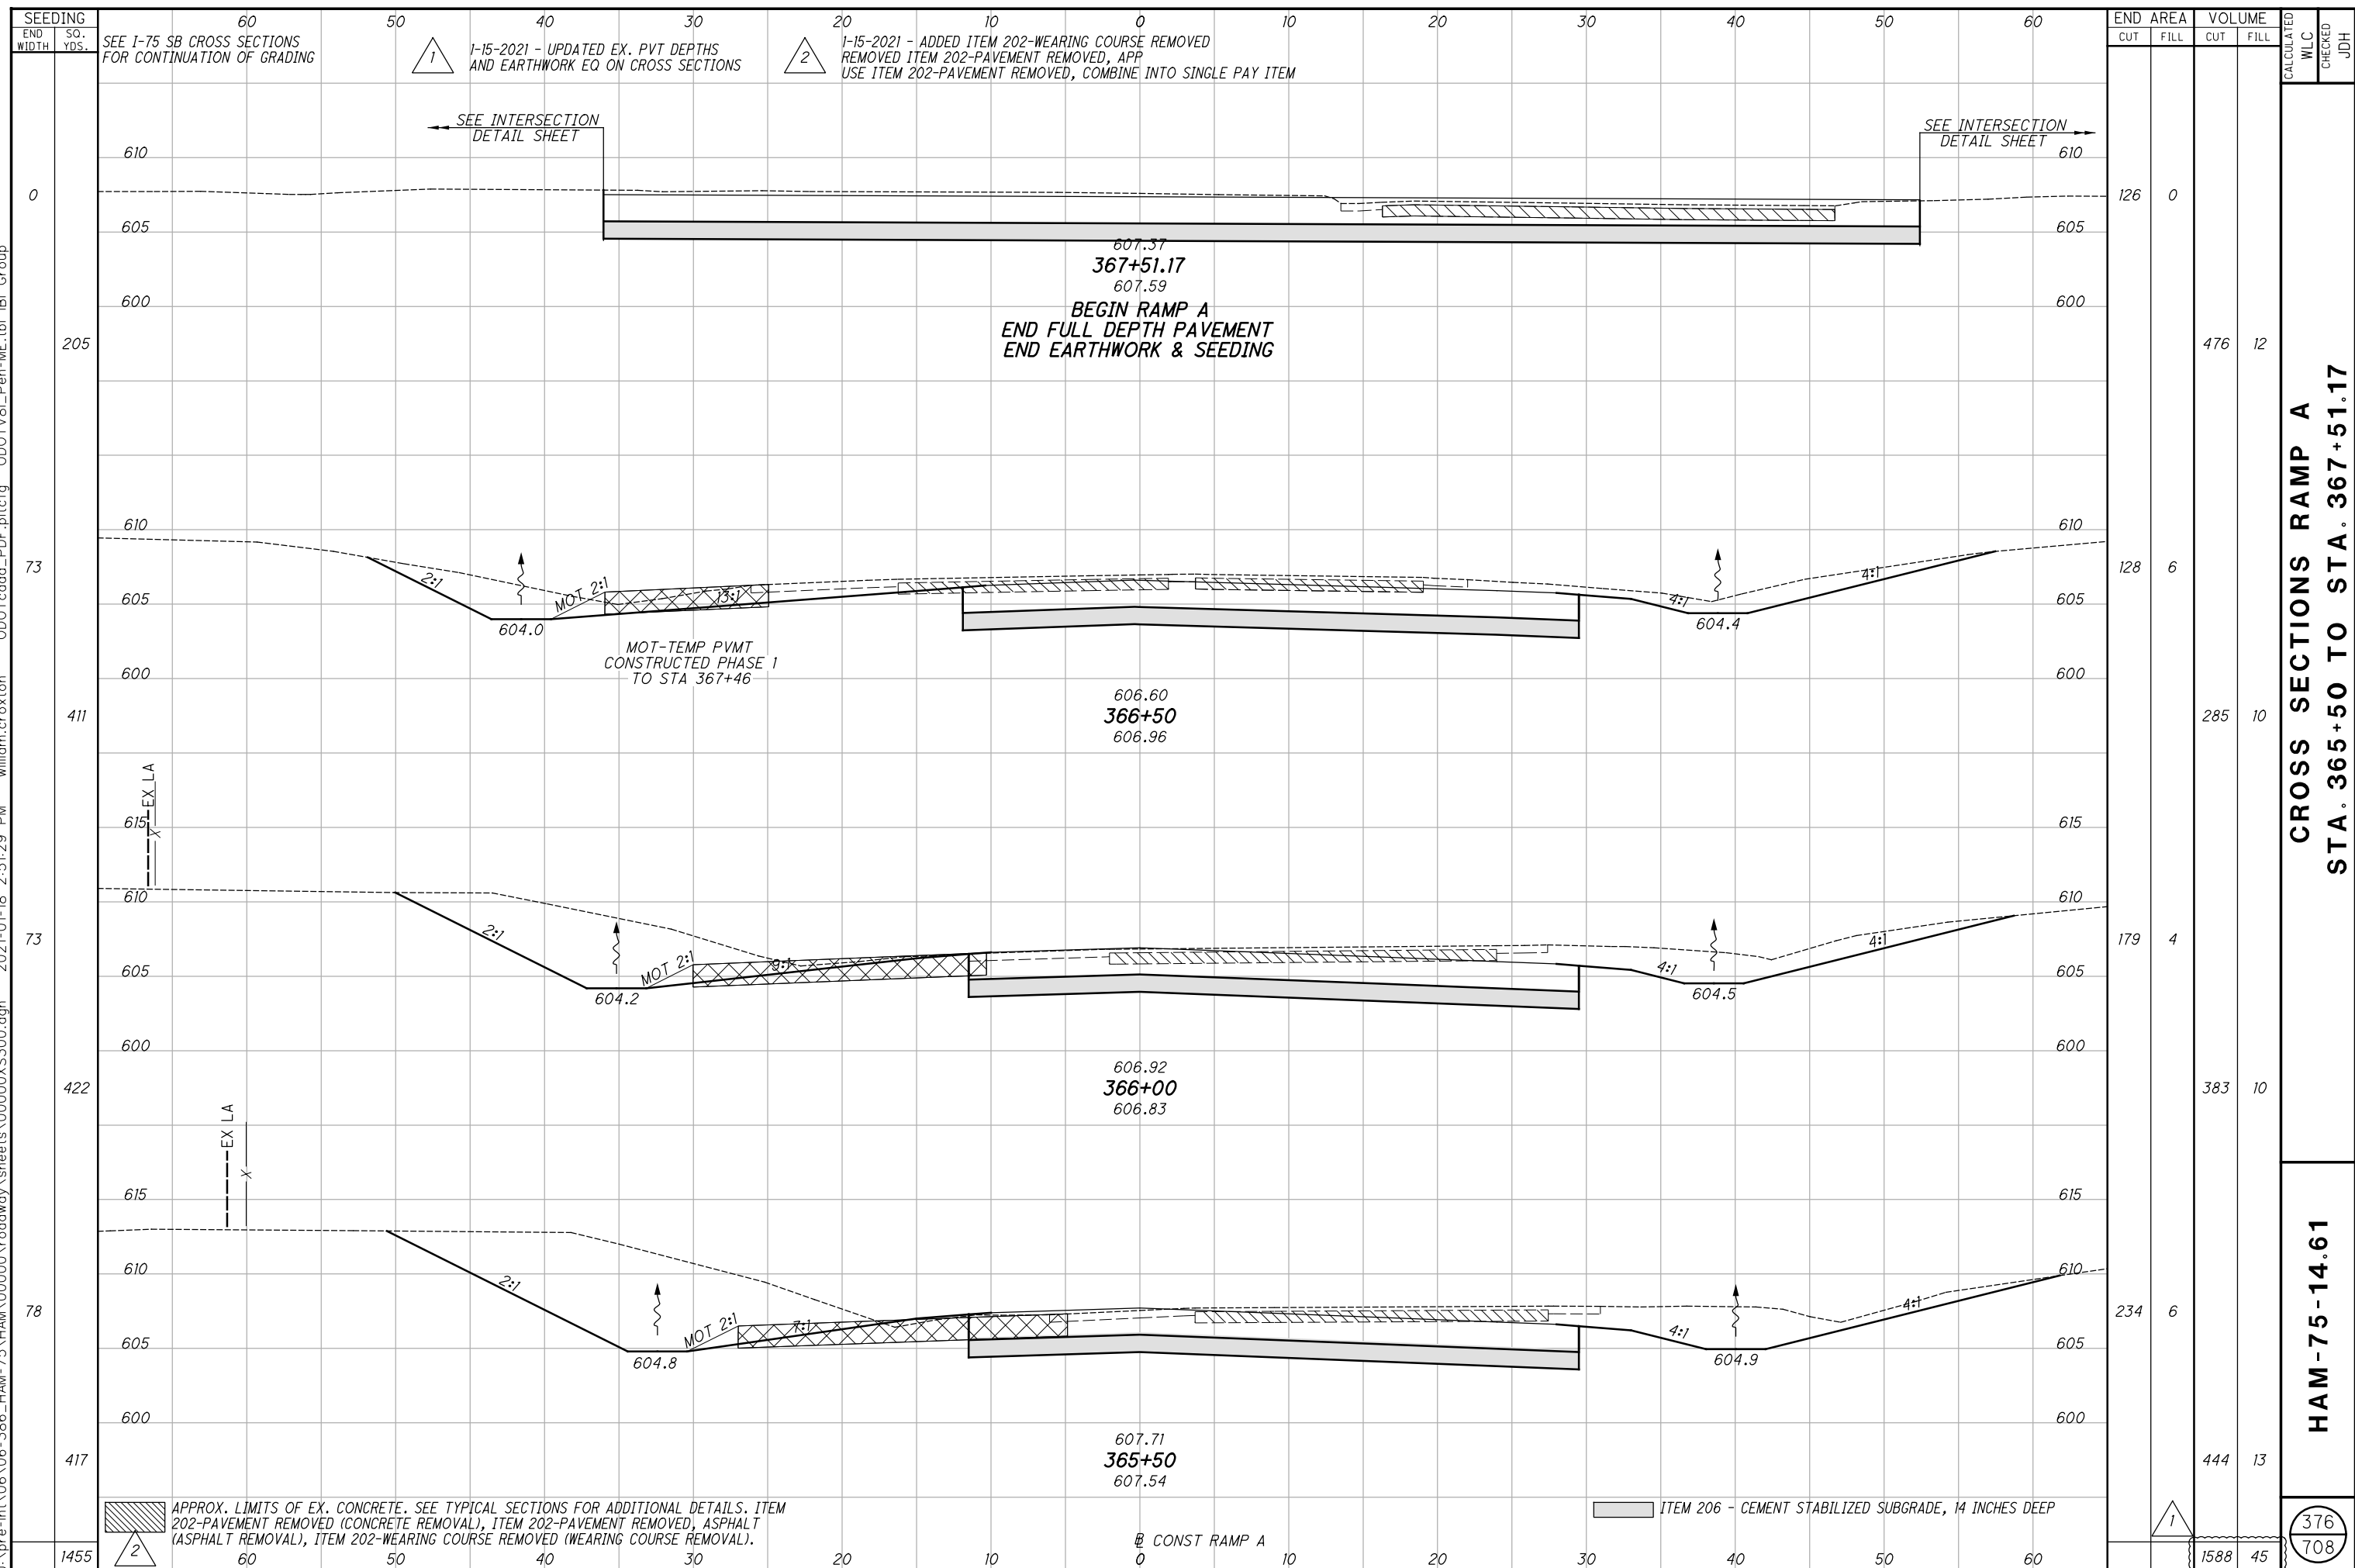

SEEDING		END AREA		VOLUME		CALCULATED	
END WIDTH	SO. YDS.	CUT	FILL	CUT	FILL	WLC	CHECKED
60		126	0				
205				476	12		
73		128	6				
411				285	10		
73		179	4				
422				383	10		
78		234	6				
417				444	13		
1455				1588	45		

**CROSS SECTIONS RAMP A  
STA. 365+50 TO STA. 367+51.17**

**HAM-75-14.61**

376  
708

SEE I-75 SB CROSS SECTIONS FOR CONTINUATION OF GRADING

1-15-2021 - UPDATED EX. PVT DEPTHS AND EARTHWORK EQ ON CROSS SECTIONS

1-15-2021 - ADDED ITEM 202-WEARING COURSE REMOVED REMOVED ITEM 202-PAVEMENT REMOVED, APP USE ITEM 202-PAVEMENT REMOVED, COMBINE INTO SINGLE PAY ITEM

SEE INTERSECTION DETAIL SHEET

SEE INTERSECTION DETAIL SHEET

607.37  
367+51.17  
607.59  
**BEGIN RAMP A**  
END FULL DEPTH PAVEMENT  
END EARTHWORK & SEEDING


MOT-TEMP PVMT  
CONSTRUCTED PHASE 1  
TO STA 367+46

APPROX. LIMITS OF EX. CONCRETE. SEE TYPICAL SECTIONS FOR ADDITIONAL DETAILS. ITEM 202-PAVEMENT REMOVED (CONCRETE REMOVAL), ITEM 202-PAVEMENT REMOVED, ASPHALT (ASPHALT REMOVAL), ITEM 202-WEARING COURSE REMOVED (WEARING COURSE REMOVAL).

ITEM 206 - CEMENT STABILIZED SUBGRADE, 14 INCHES DEEP

CONST RAMP A

j:\pre-int\06\06-386\_HAM-75\HAM\00000\roadway\sheets\00000XS400.dgn 2021-01-18 2:51:40 PM william.croxton ODOTcadd\_PDF.plt cfig ODOTV8i\_Pen-ME.tbl IBI Group

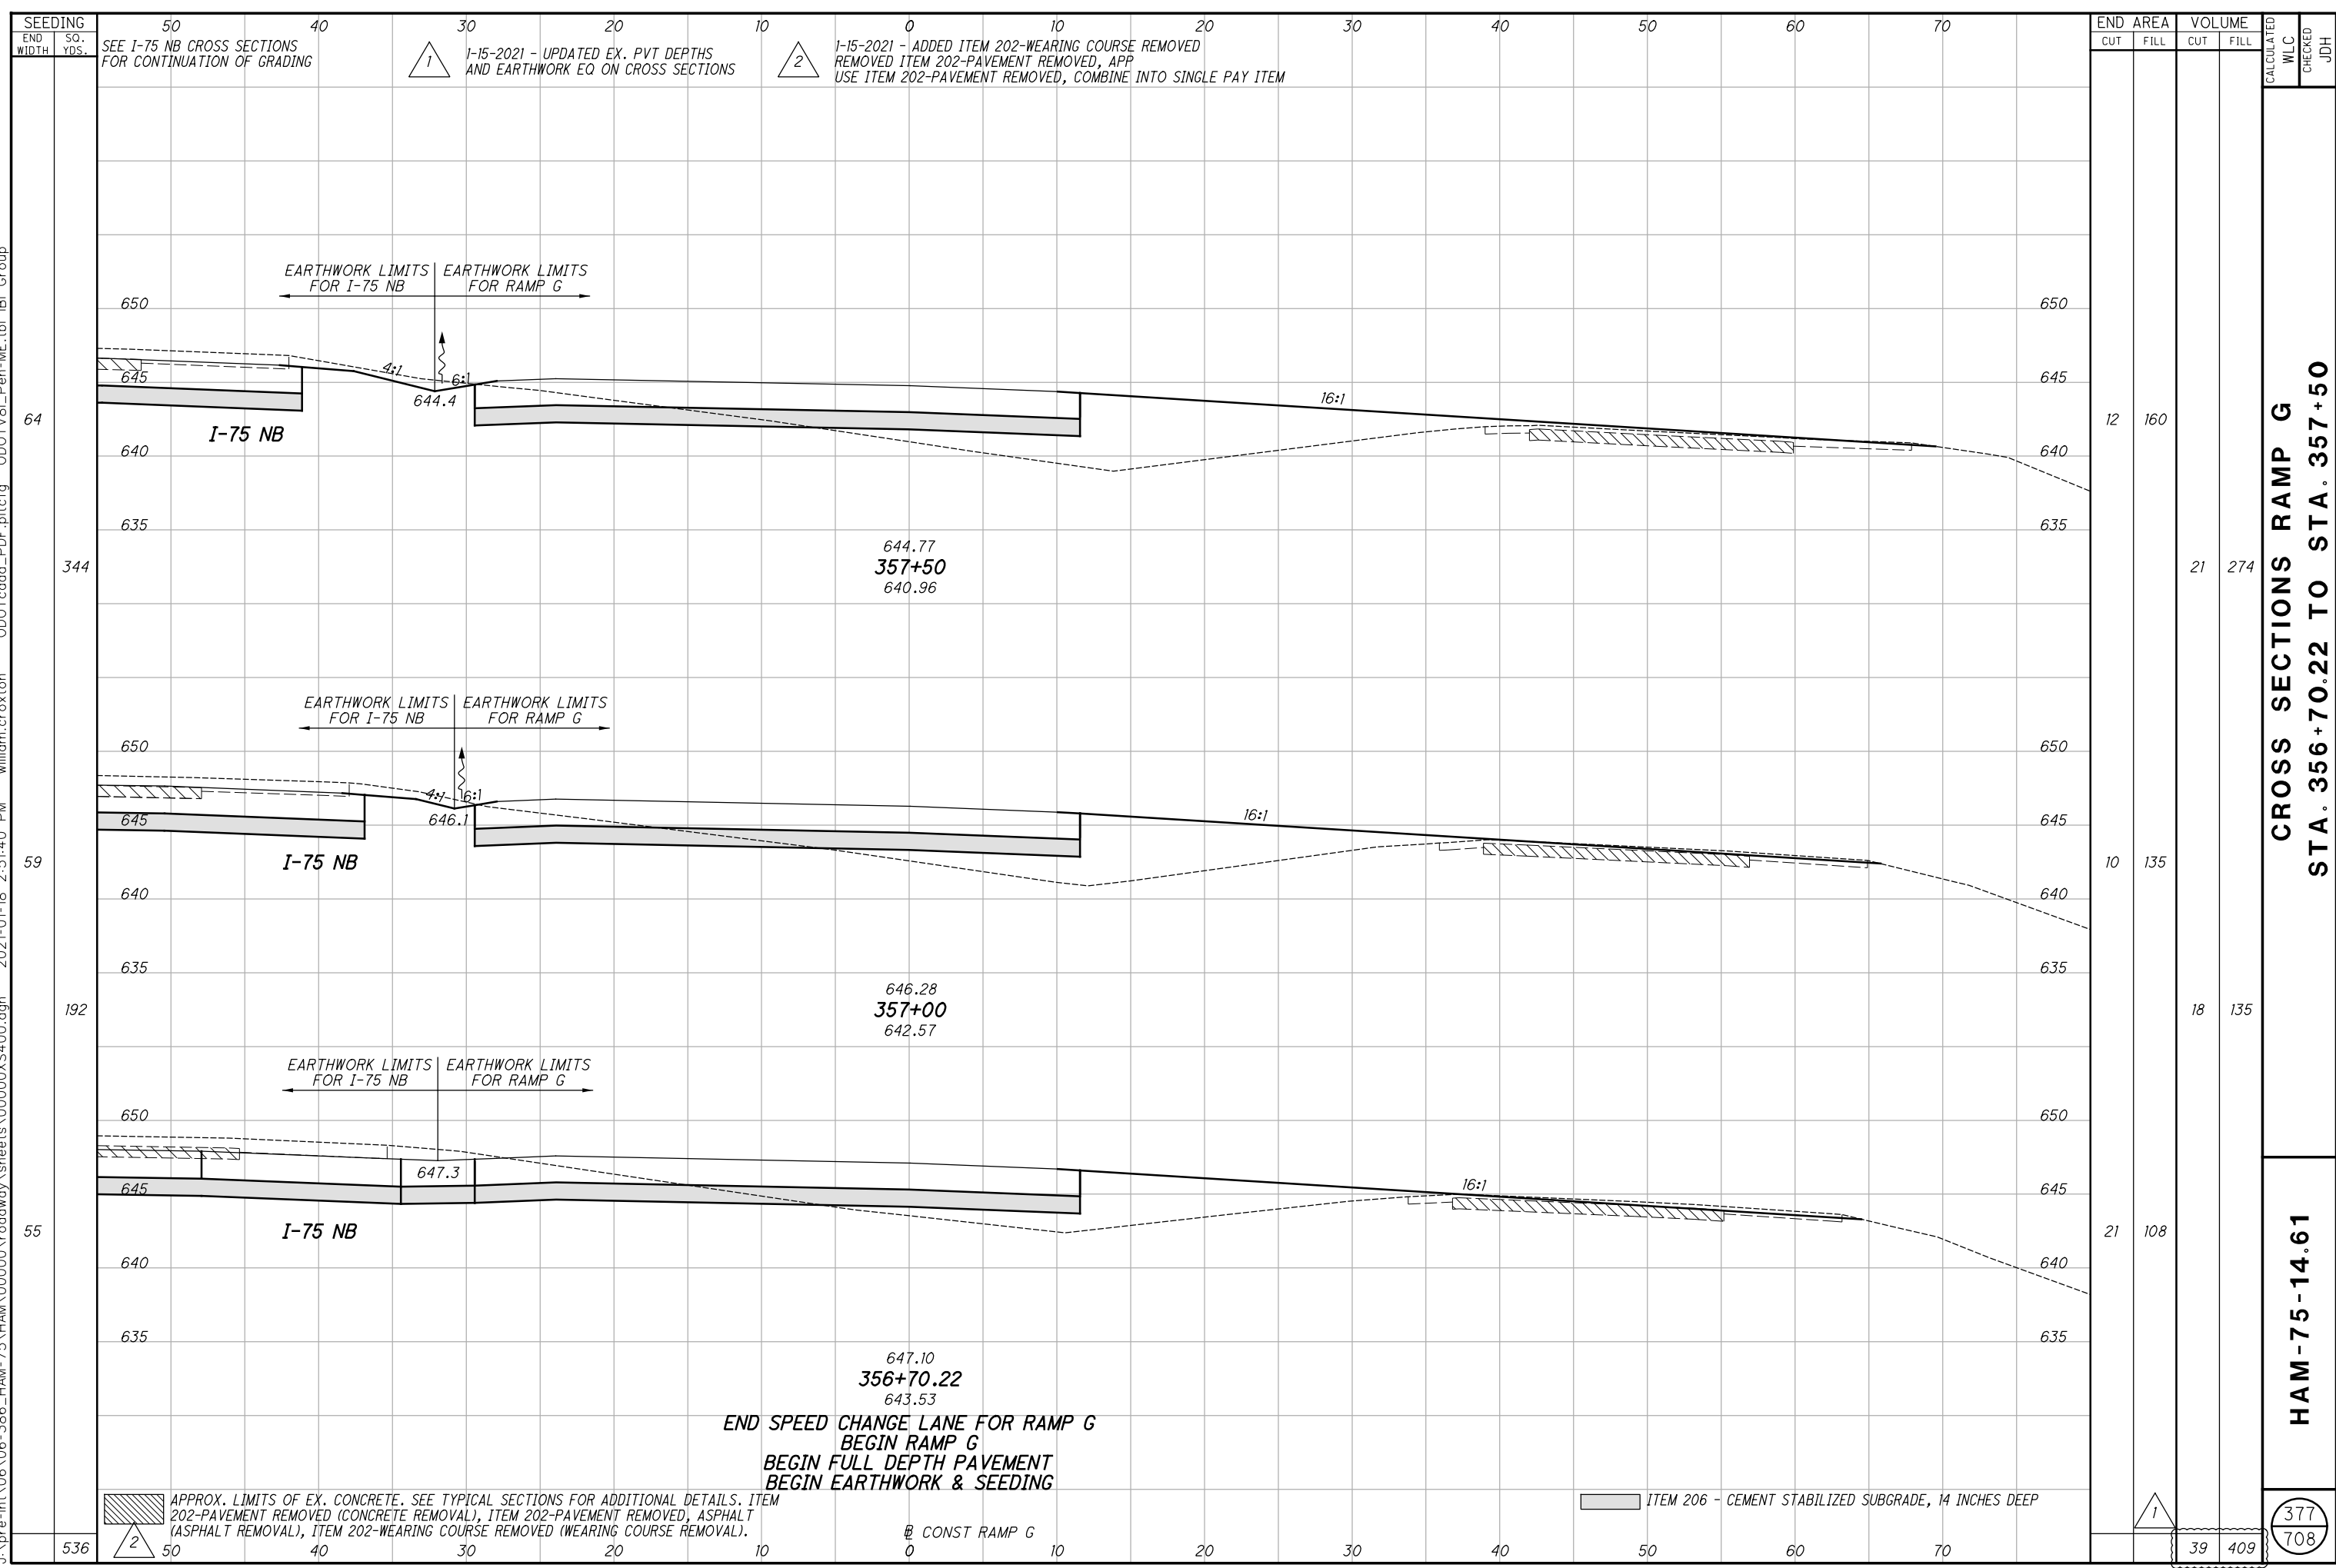

SEEDING  
END WIDTH SO. YDS.

SEE I-75 NB CROSS SECTIONS FOR CONTINUATION OF GRADING

1-15-2021 - UPDATED EX. PVT DEPTHS AND EARTHWORK EQ ON CROSS SECTIONS

2 1-15-2021 - ADDED ITEM 202-WEARING COURSE REMOVED REMOVED ITEM 202-PAVEMENT REMOVED, APP USE ITEM 202-PAVEMENT REMOVED, COMBINE INTO SINGLE PAY ITEM

EARTHWORK LIMITS FOR I-75 NB

EARTHWORK LIMITS FOR RAMP G

650 645 640 635

I-75 NB

4:1 6:1 16:1

644.4

644.77  
357+50  
640.96

650 645 640 635

I-75 NB

4:1 6:1 16:1

646.1

646.28  
357+00  
642.57

650 645 640 635

I-75 NB

4:1 6:1 16:1

647.3

647.10  
356+70.22  
643.53

END SPEED CHANGE LANE FOR RAMP G  
BEGIN RAMP G  
BEGIN FULL DEPTH PAVEMENT  
BEGIN EARTHWORK & SEEDING

APPROX. LIMITS OF EX. CONCRETE. SEE TYPICAL SECTIONS FOR ADDITIONAL DETAILS. ITEM 202-PAVEMENT REMOVED (CONCRETE REMOVAL), ITEM 202-PAVEMENT REMOVED, ASPHALT (ASPHALT REMOVAL), ITEM 202-WEARING COURSE REMOVED (WEARING COURSE REMOVAL).

CONST RAMP G

ITEM 206 - CEMENT STABILIZED SUBGRADE, 14 INCHES DEEP

END AREA	VOLUME		CALCULATED WLC	CHECKED JDH
	CUT	FILL		
12	160			
21	274			
10	135			
18	135			
21	108			
39	409			


CROSS SECTIONS RAMP G  
STA. 356+70.22 TO STA. 357+50

HAM-75-14.61

377  
708



j:\pre-int\06-386\_HAM-75\_HAM\00000\roadway\sheets\00000XS400.dgn 2021-01-18 2:51:40 PM william.croxton'

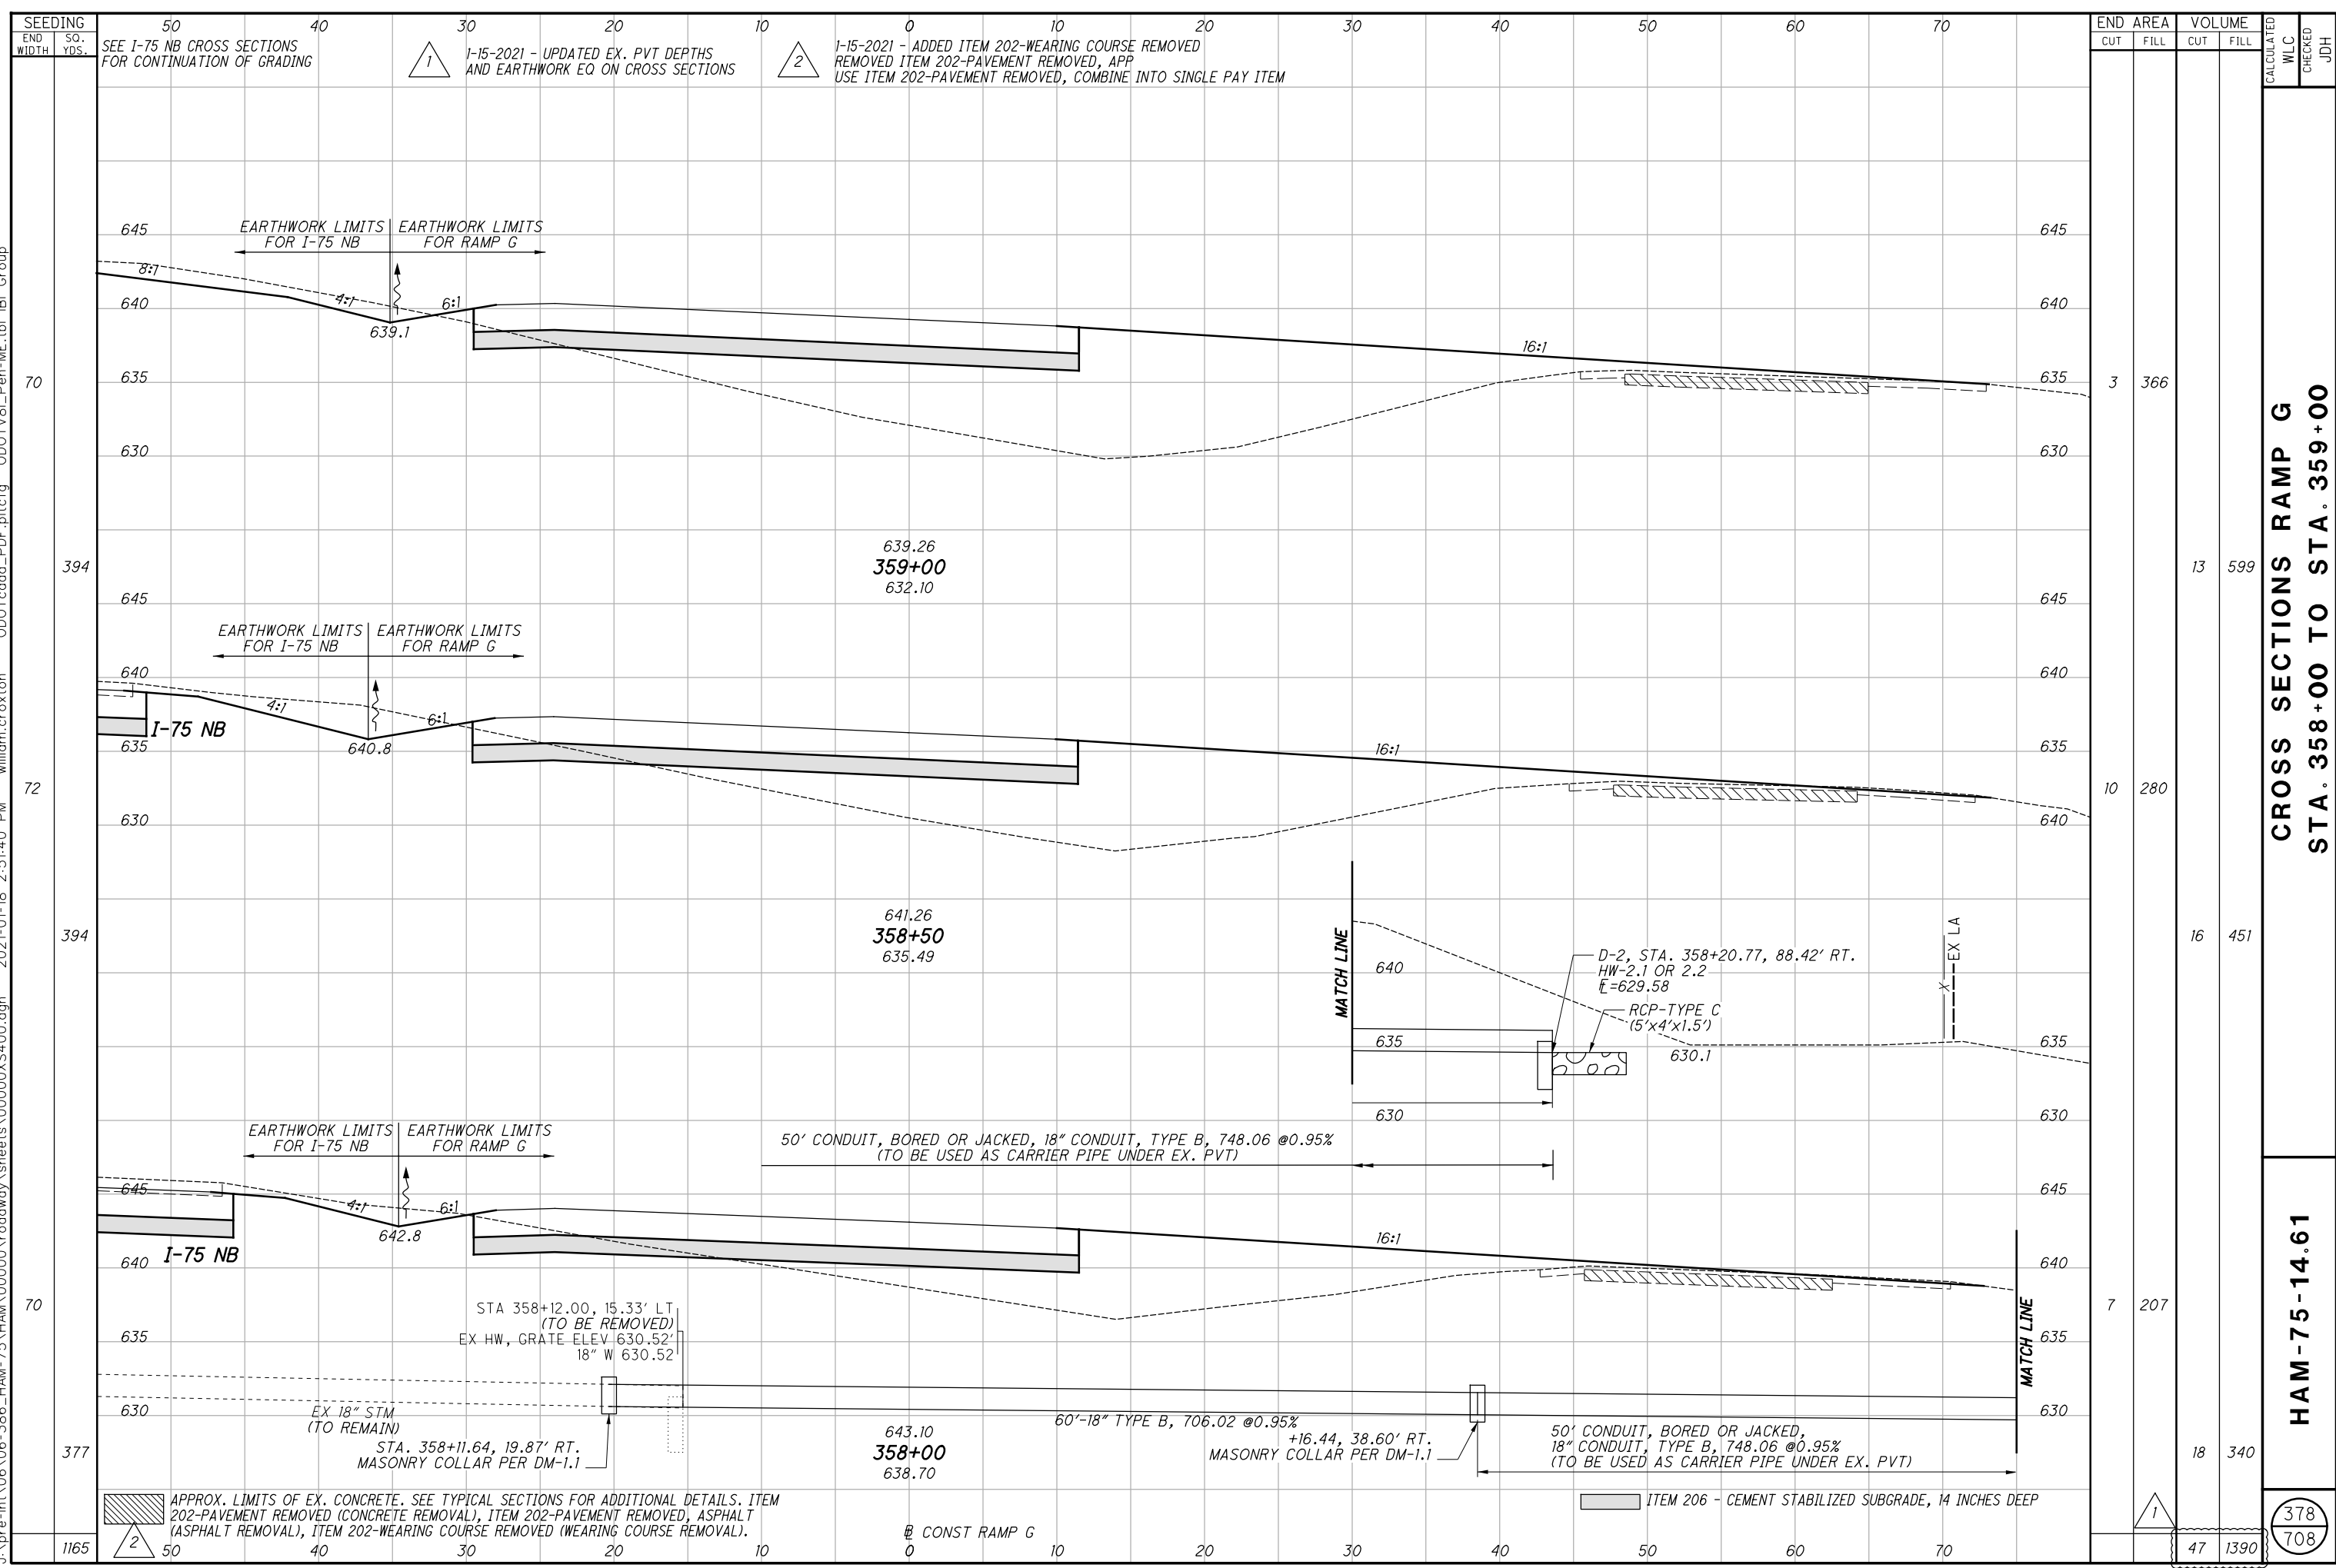


**CROSS SECTIONS RAMP G  
STA. 358+00 TO STA. 359+00**

**HAM-75-14.61**

378  
708

j:\pre-int\06\06-386\_HAM-75\HAM\00000\roadway\sheets\00000XS400.dgn 2021-01-18 2:51:40 PM william.croxton" ODOTcadd\_PDF\_pltcfgr ODOTV8i\_Pen-ME.tbl IBI Group

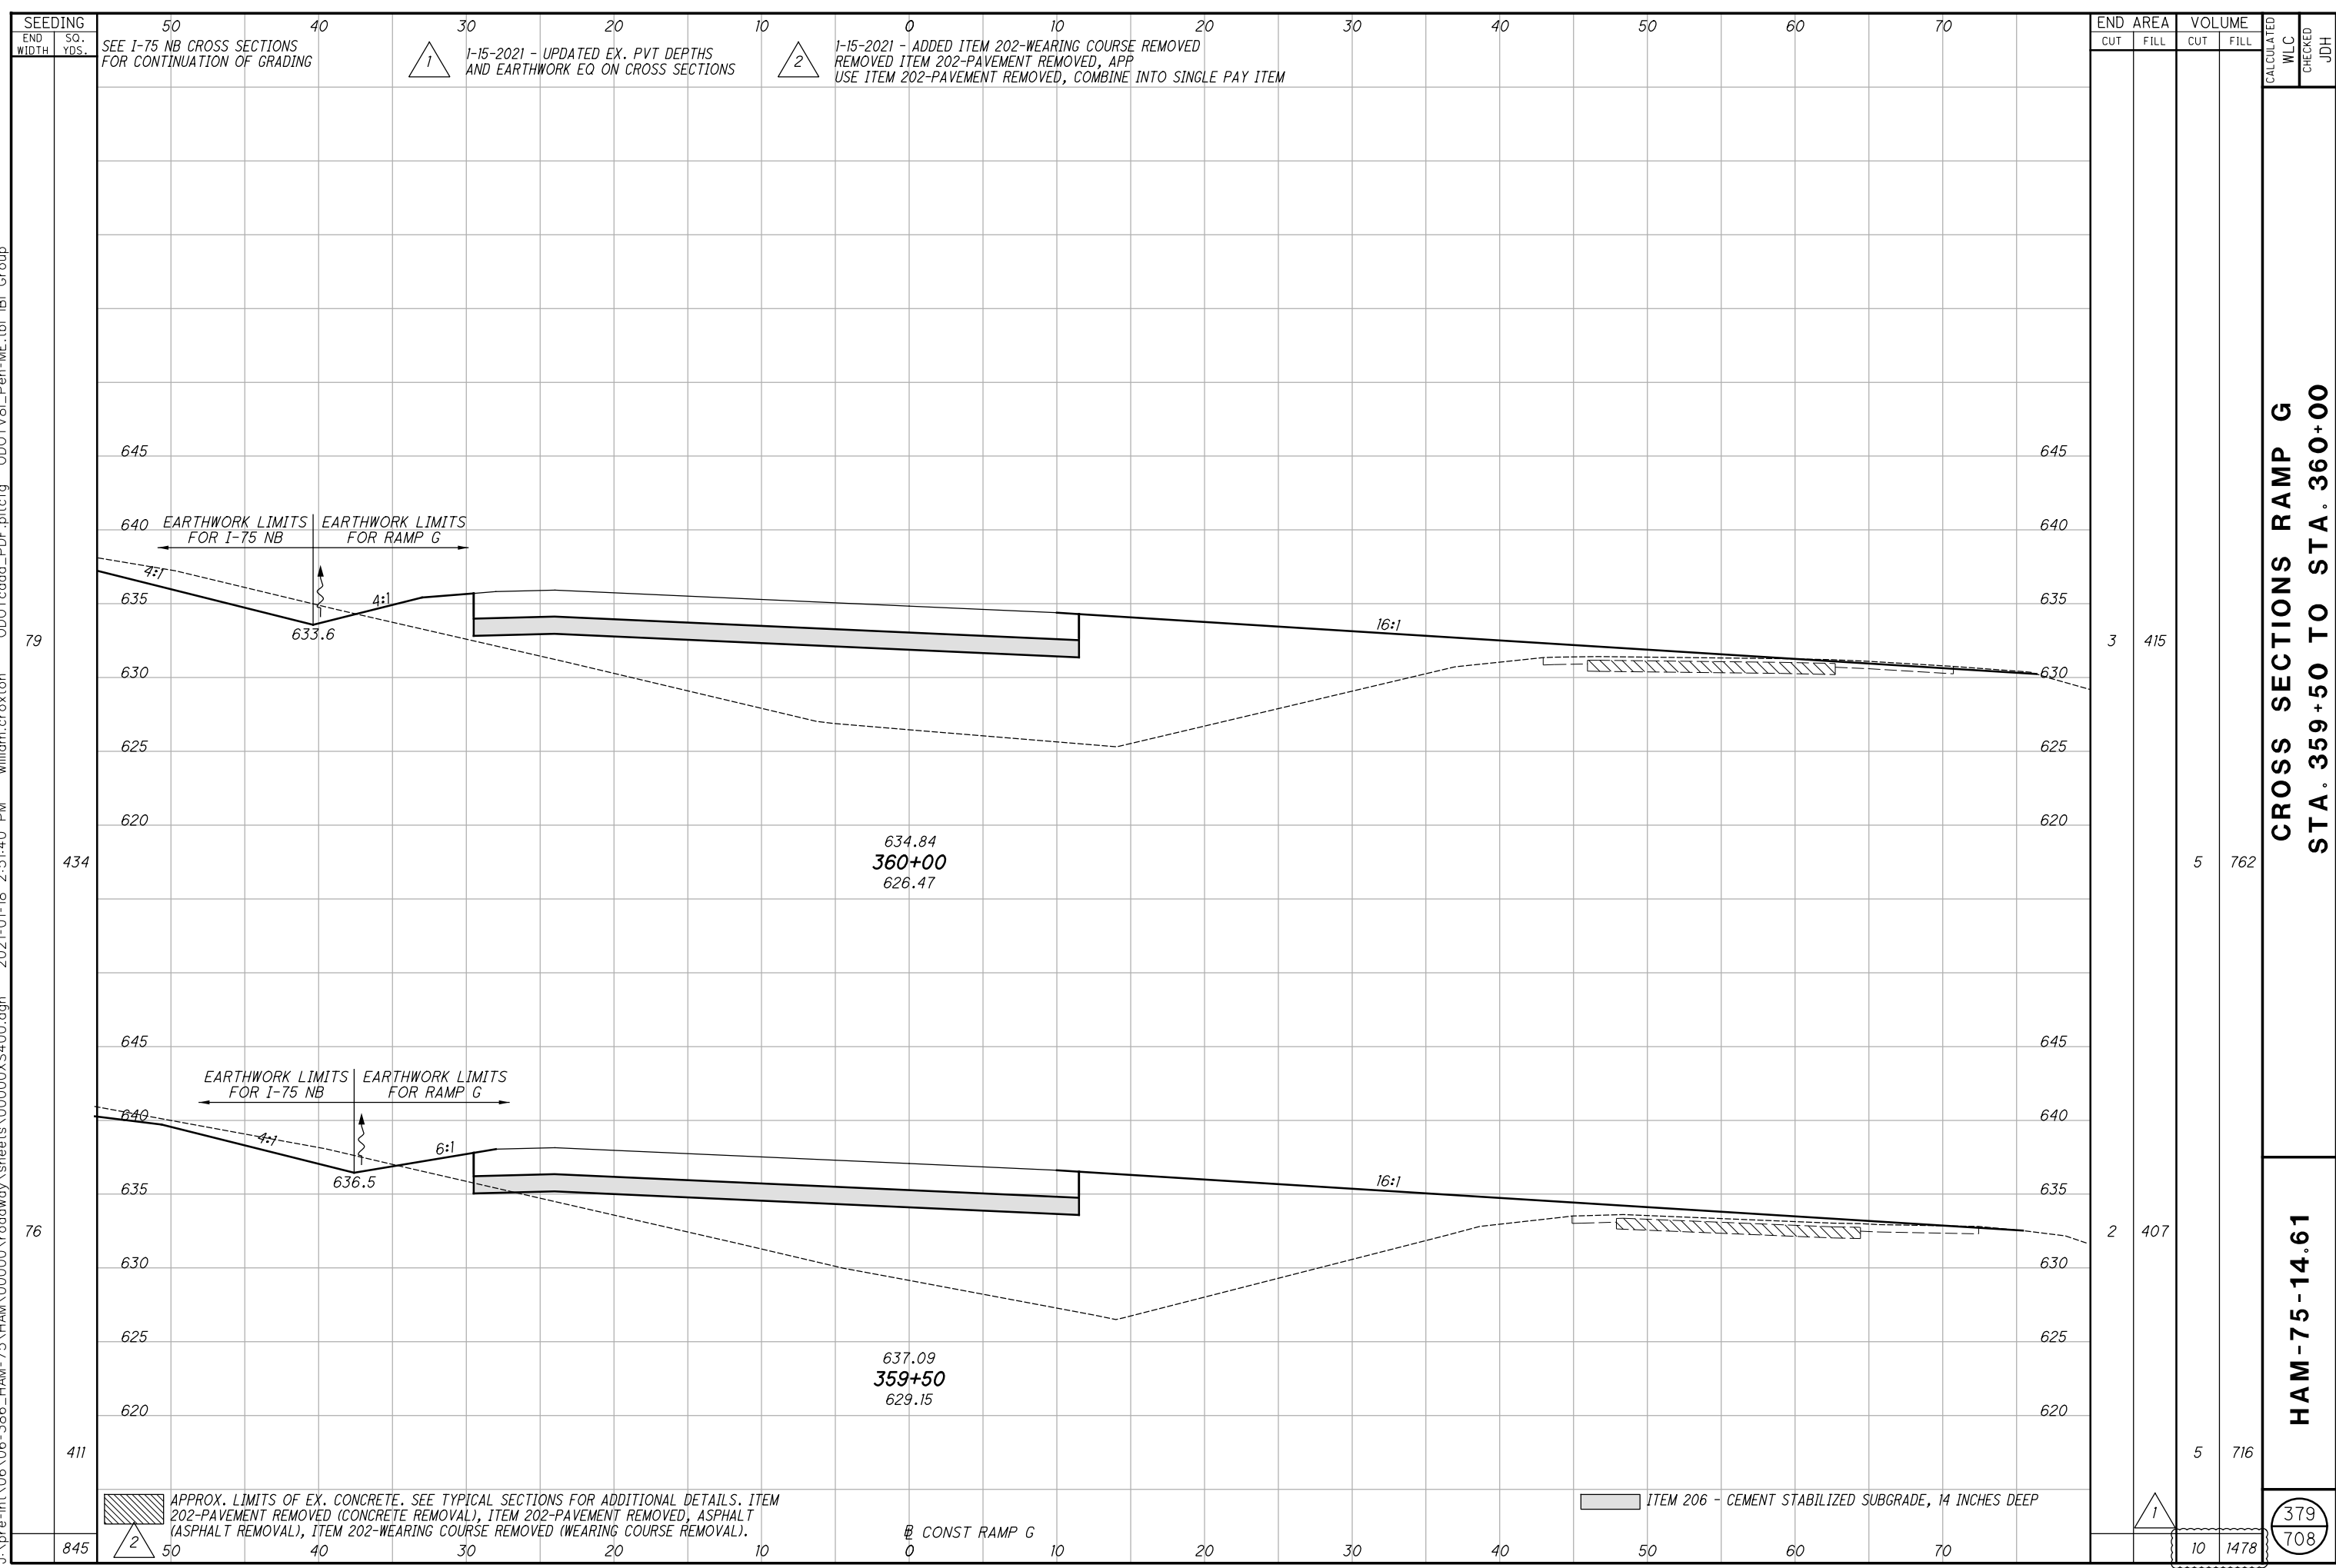

CROSS SECTIONS RAMP G  
STA. 359+50 TO STA. 360+00

HAM-75-14.61

379  
708

1-15-2021 - UPDATED EX. PVT DEPTHS AND EARTHWORK EQ ON CROSS SECTIONS


2 1-15-2021 - ADDED ITEM 202-WEARING COURSE REMOVED REMOVED ITEM 202-PAVEMENT REMOVED, APP USE ITEM 202-PAVEMENT REMOVED, COMBINE INTO SINGLE PAY ITEM

SEE I-75 NB CROSS SECTIONS FOR CONTINUATION OF GRADING

APPROX. LIMITS OF EX. CONCRETE. SEE TYPICAL SECTIONS FOR ADDITIONAL DETAILS. ITEM 202-PAVEMENT REMOVED (CONCRETE REMOVAL), ITEM 202-PAVEMENT REMOVED, ASPHALT (ASPHALT REMOVAL), ITEM 202-WEARING COURSE REMOVED (WEARING COURSE REMOVAL).

ITEM 206 - CEMENT STABILIZED SUBGRADE, 14 INCHES DEEP

CONST RAMP G

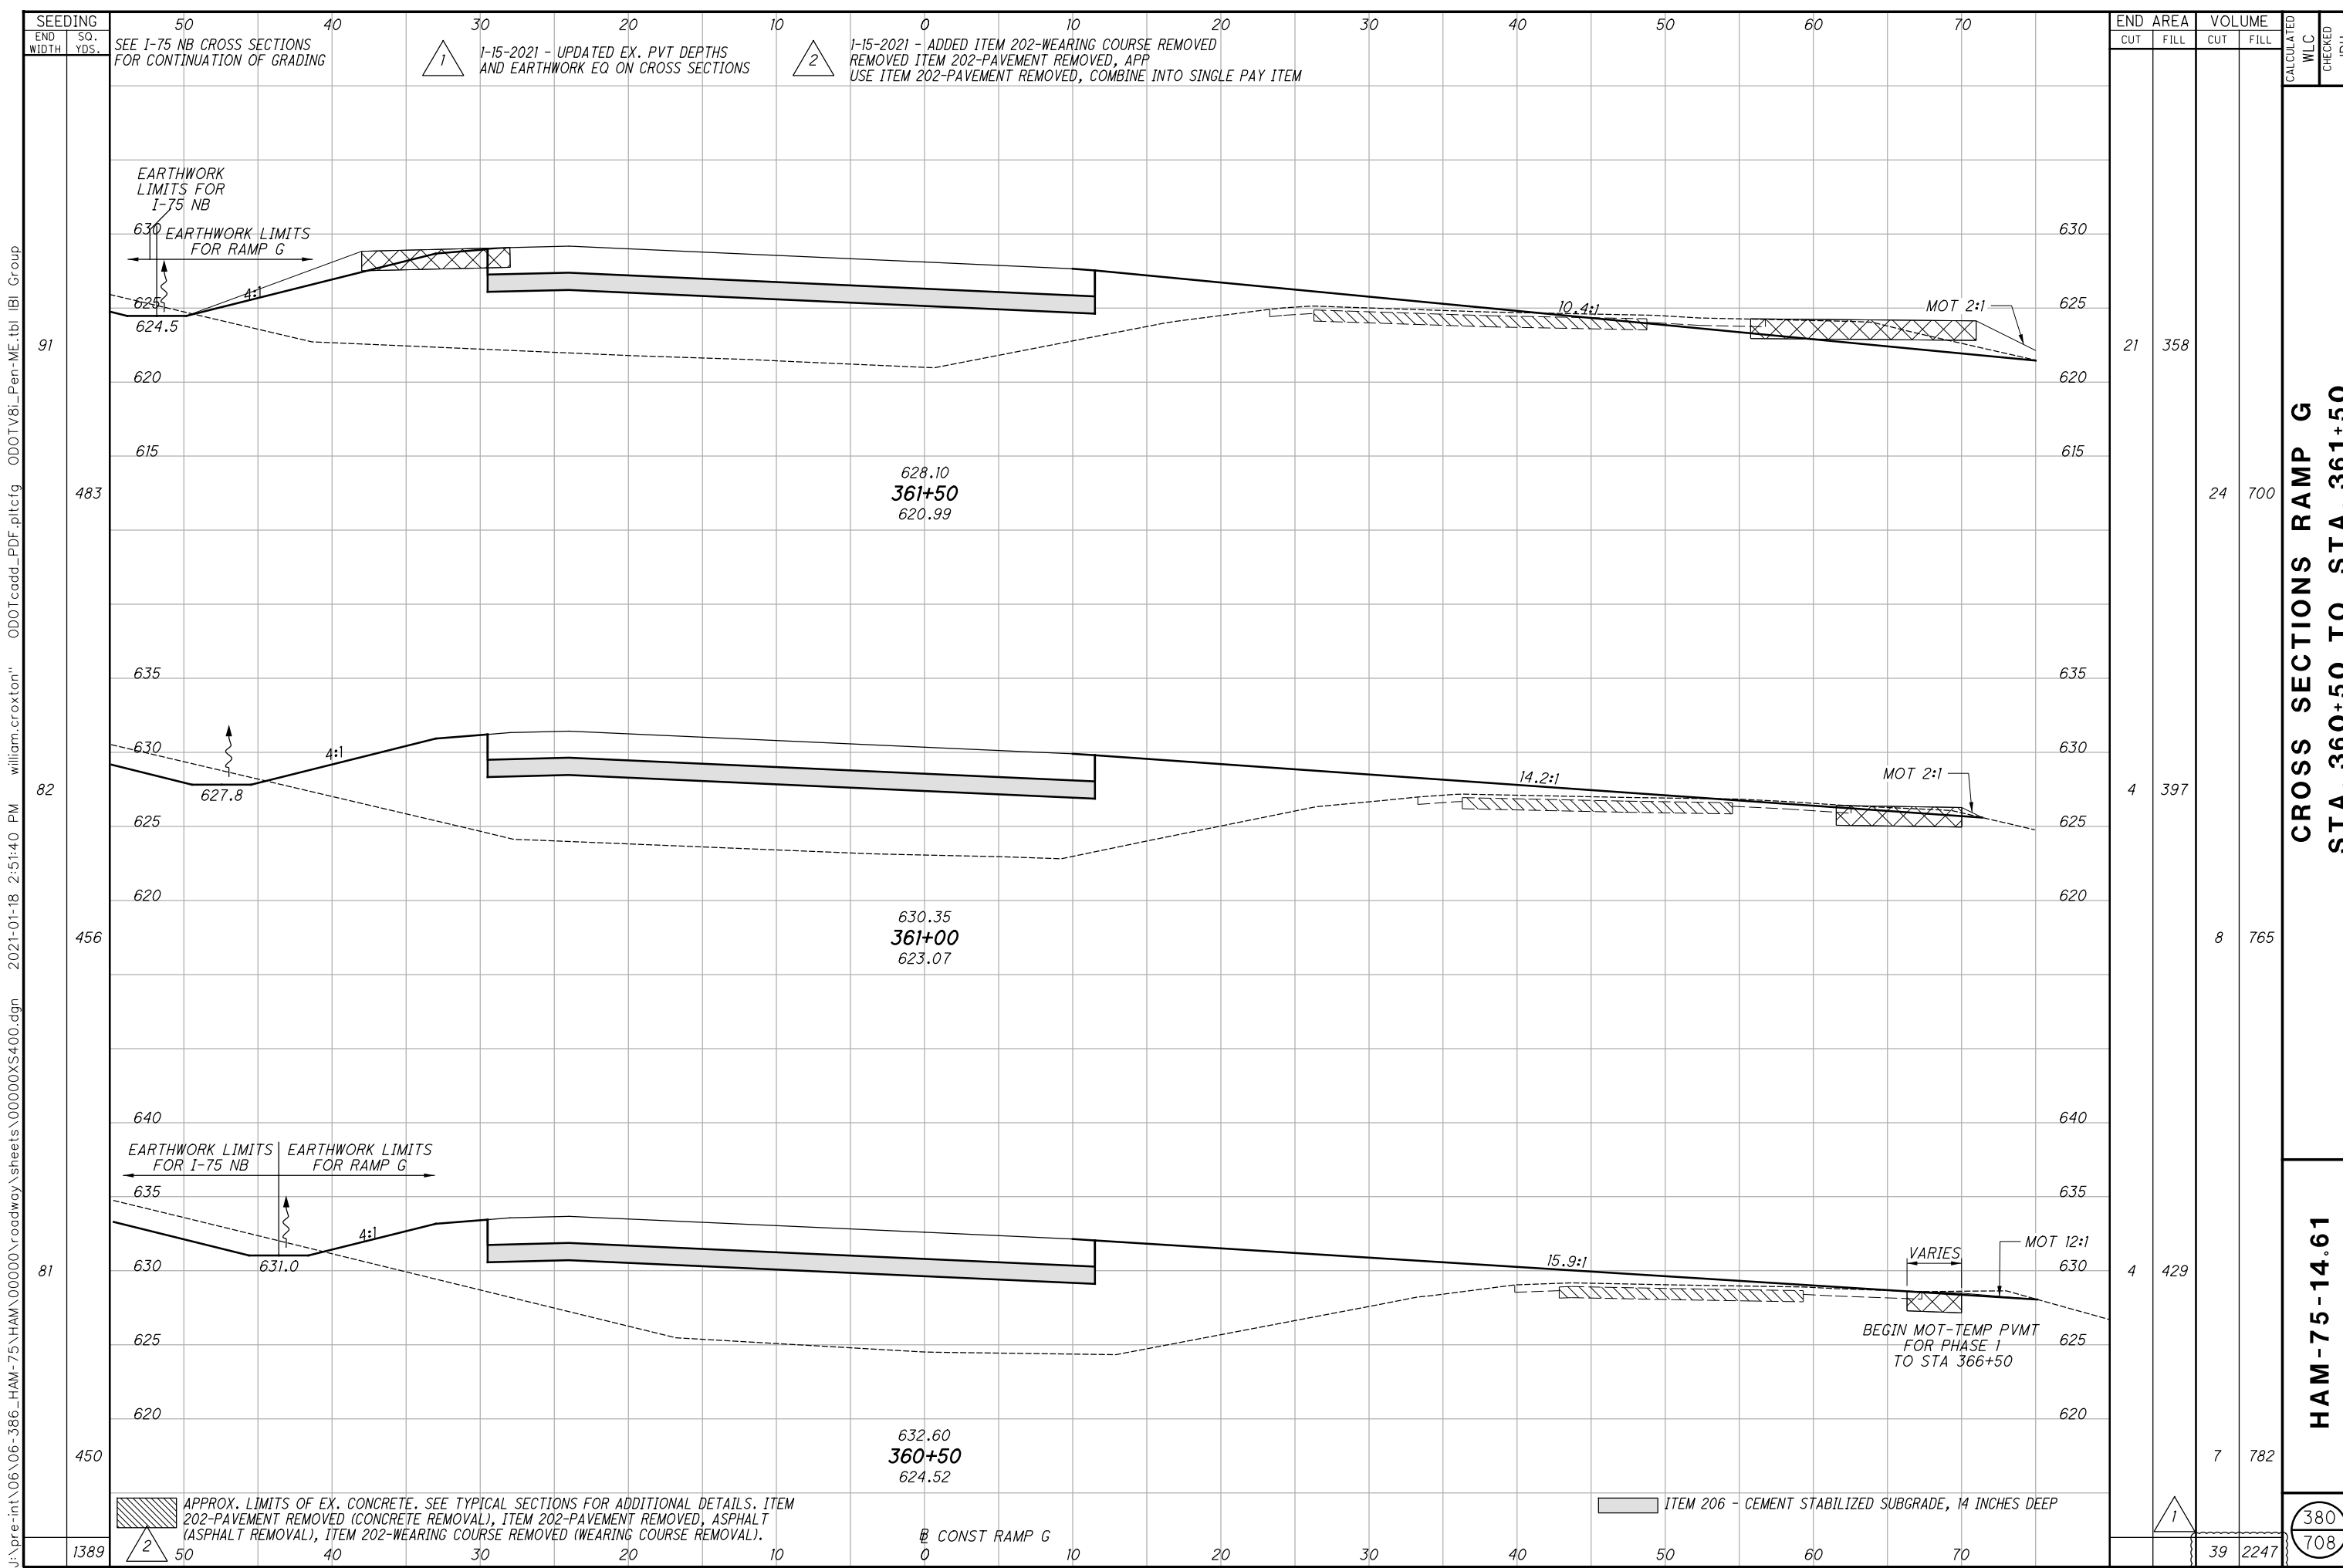

SEEDING  
END WIDTH SO. YDS.

SEE I-75 NB CROSS SECTIONS FOR CONTINUATION OF GRADING

EARTHWORK LIMITS FOR I-75 NB

EARTHWORK LIMITS FOR RAMP G

1-15-2021 - UPDATED EX. PVT DEPTHS AND EARTHWORK EQ ON CROSS SECTIONS

1-15-2021 - ADDED ITEM 202-WEARING COURSE REMOVED REMOVED ITEM 202-PAVEMENT REMOVED, APP USE ITEM 202-PAVEMENT REMOVED, COMBINE INTO SINGLE PAY ITEM

630  
625  
620  
615

635  
630  
625  
620

640  
635  
630  
625  
620

APPROX. LIMITS OF EX. CONCRETE. SEE TYPICAL SECTIONS FOR ADDITIONAL DETAILS. ITEM 202-PAVEMENT REMOVED (CONCRETE REMOVAL), ITEM 202-PAVEMENT REMOVED, ASPHALT (ASPHALT REMOVAL), ITEM 202-WEARING COURSE REMOVED (WEARING COURSE REMOVAL).

ITEM 206 - CEMENT STABILIZED SUBGRADE, 14 INCHES DEEP

CONST RAMP G


END CUT	AREA FILL	VOLUME		CALCULATED WLC	CHECKED JDH
		CUT	FILL		
21	358				
24	700				
4	397				
8	765				
4	429				
7	782				
39	2247				

CROSS SECTIONS RAMP G  
STA. 360+50 TO STA. 361+50

HAM-75-14.61

380  
708

j:\pre-int\06\06-386\_HAM-75\HAM\00000\roadway\sheets\00000XS400.dgn 2021-01-18 2:51:41 PM william.croxton\ ODOTcadd\_PDF.pltcf ODOT\81\_Pen-ME.tbl IBI\_Group

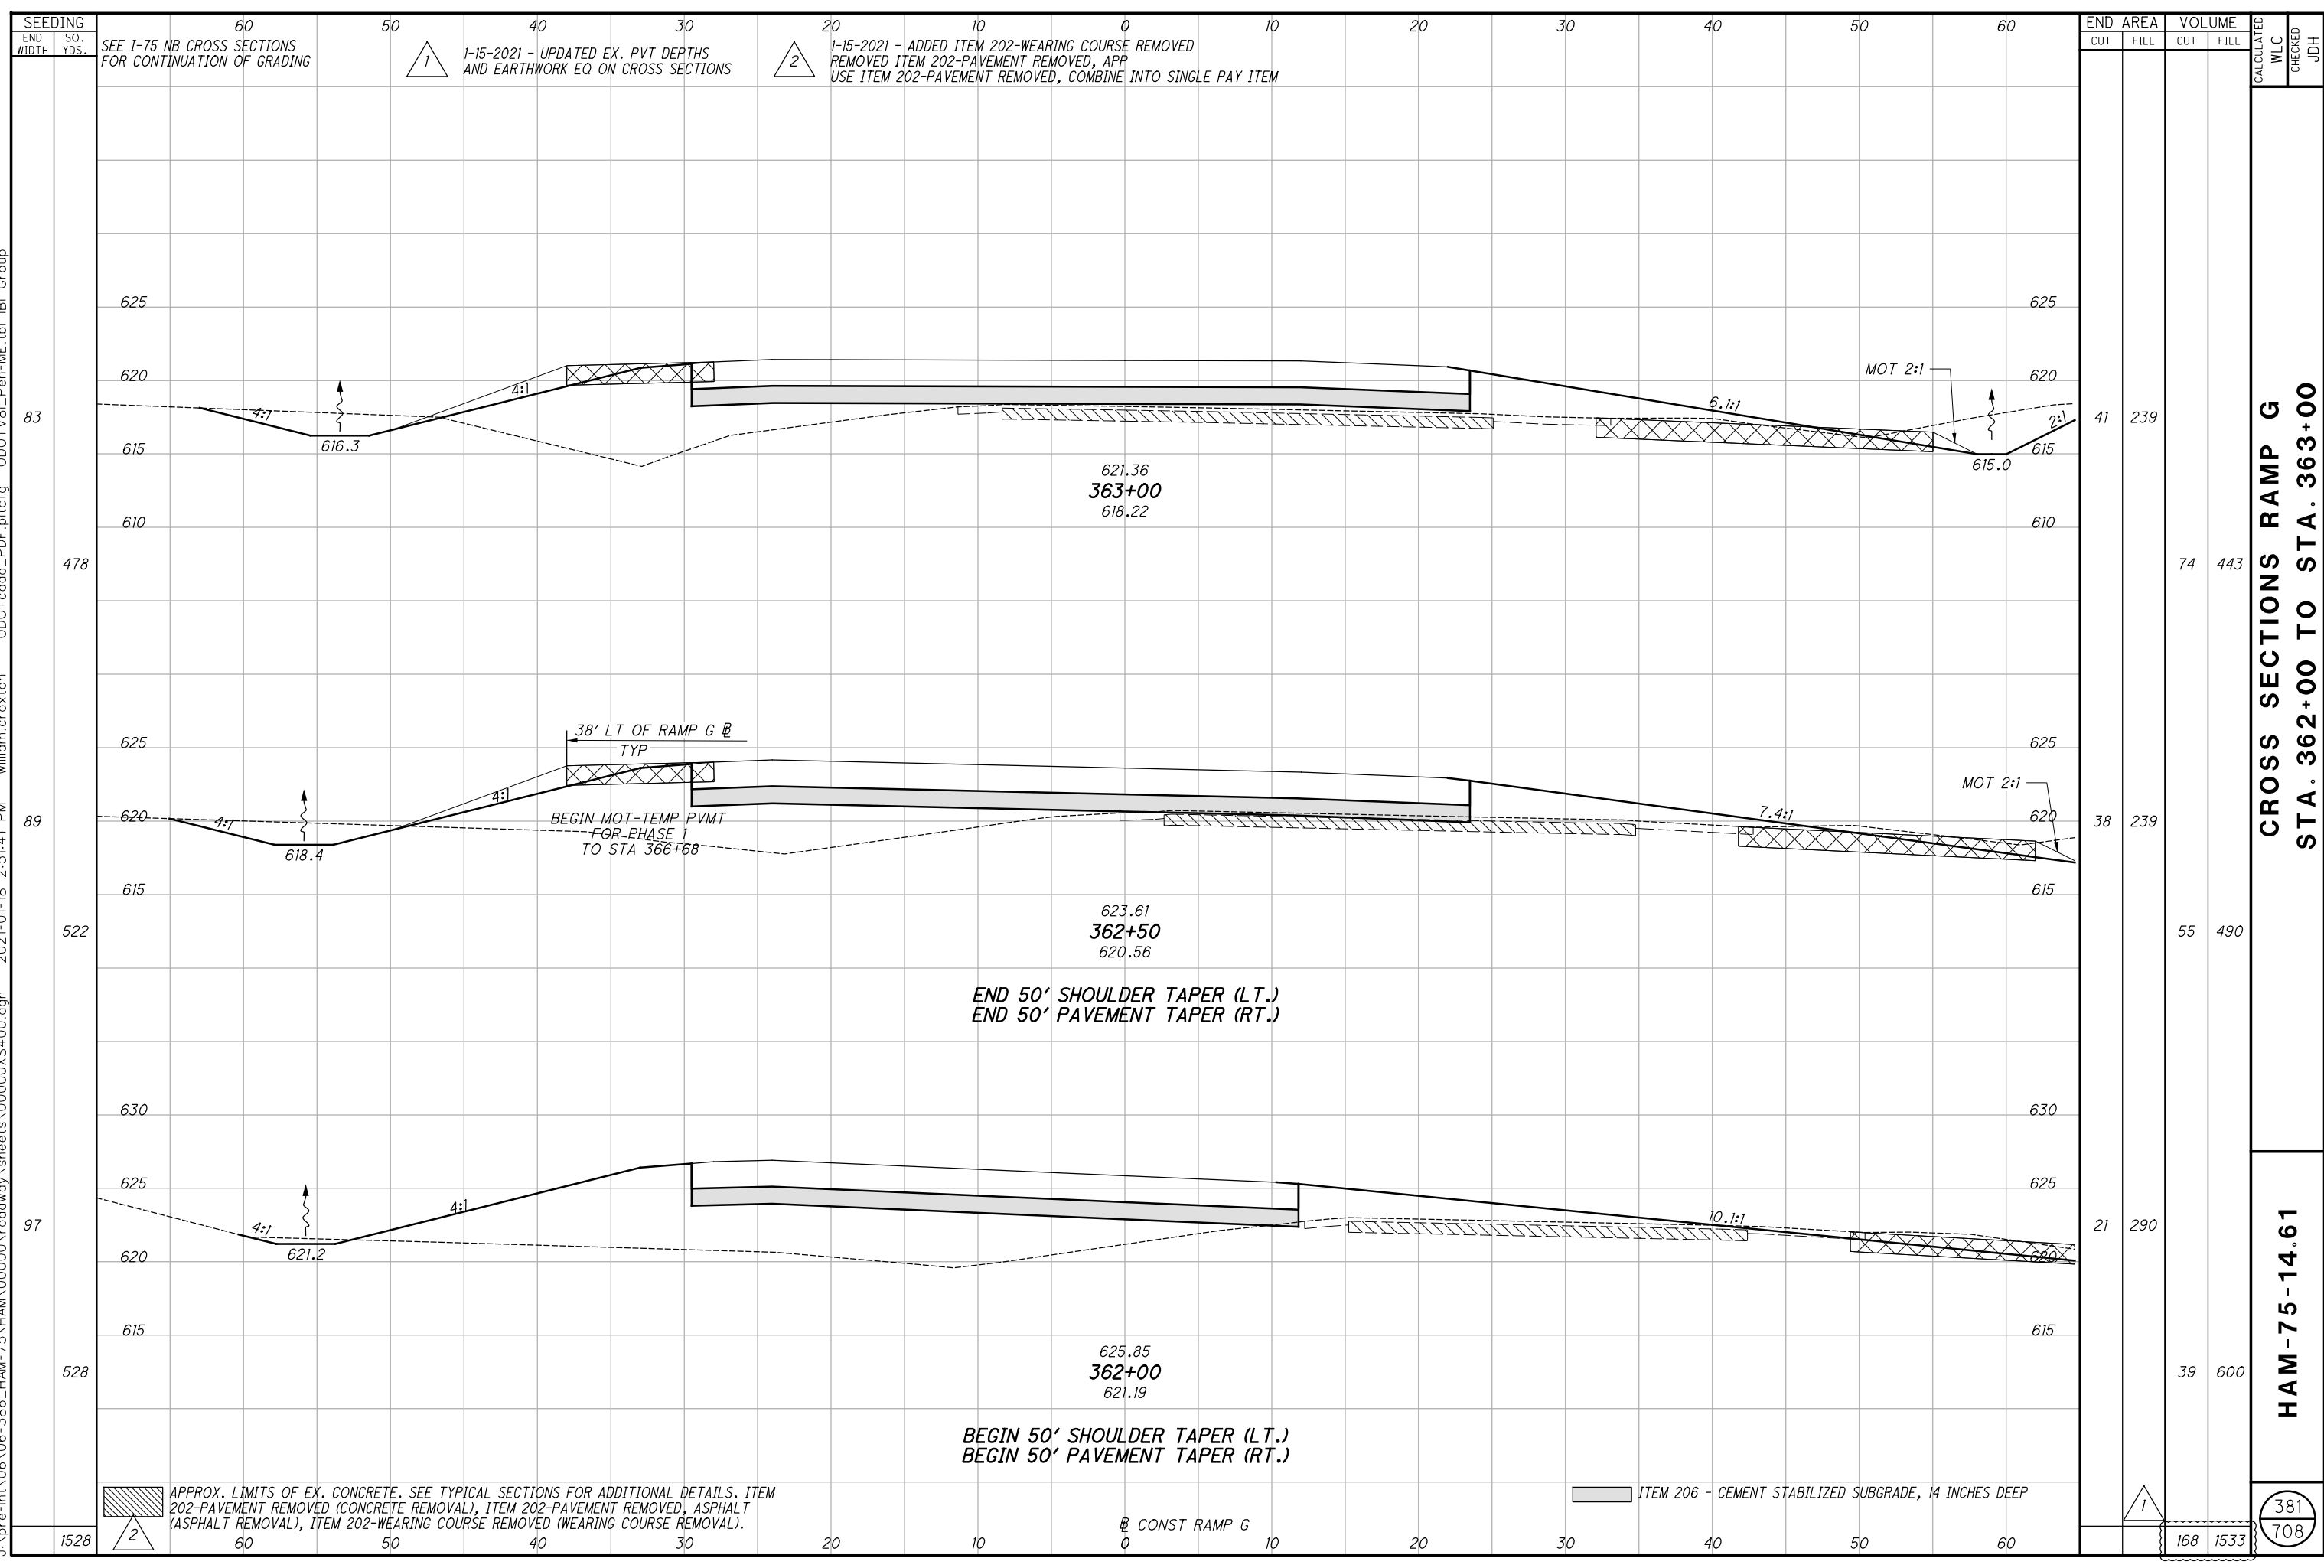

SEEDING  
END WIDTH SO. YDS.  
60 50 40 30 20 10 0 10 20 30 40 50 60

SEE I-75 NB CROSS SECTIONS FOR CONTINUATION OF GRADING

1-15-2021 - UPDATED EX. PVT DEPTHS AND EARTHWORK EQ ON CROSS SECTIONS

2 1-15-2021 - ADDED ITEM 202-WEARING COURSE REMOVED REMOVED ITEM 202-PAVEMENT REMOVED, APP USE ITEM 202-PAVEMENT REMOVED, COMBINE INTO SINGLE PAY ITEM

END AREA	VOLUME		CALCULATED WLC	CHECKED JDH
	CUT	FILL		
41	239			
	74	443		
38	239			
	55	490		
21	290			
	39	600		
	168	1533		

CROSS SECTIONS RAMP G  
STA. 362+00 TO STA. 363+00

HAM-75-14.61


381  
708

APPROX. LIMITS OF EX. CONCRETE. SEE TYPICAL SECTIONS FOR ADDITIONAL DETAILS. ITEM 202-PAVEMENT REMOVED (CONCRETE REMOVAL), ITEM 202-PAVEMENT REMOVED, ASPHALT (ASPHALT REMOVAL), ITEM 202-WEARING COURSE REMOVED (WEARING COURSE REMOVAL).

ITEM 206 - CEMENT STABILIZED SUBGRADE, 14 INCHES DEEP

CONST RAMP G

j:\pre-int\06\06-386\_HAM-75\_HAM\00000\roadway\sheets\00000XS400.dgn 2021-01-18 2:51:41 PM william.croxton' ODOTcadd\_PDF.pltcfgr ODOTV8i\_Pen-ME.tbl IBI\_Group

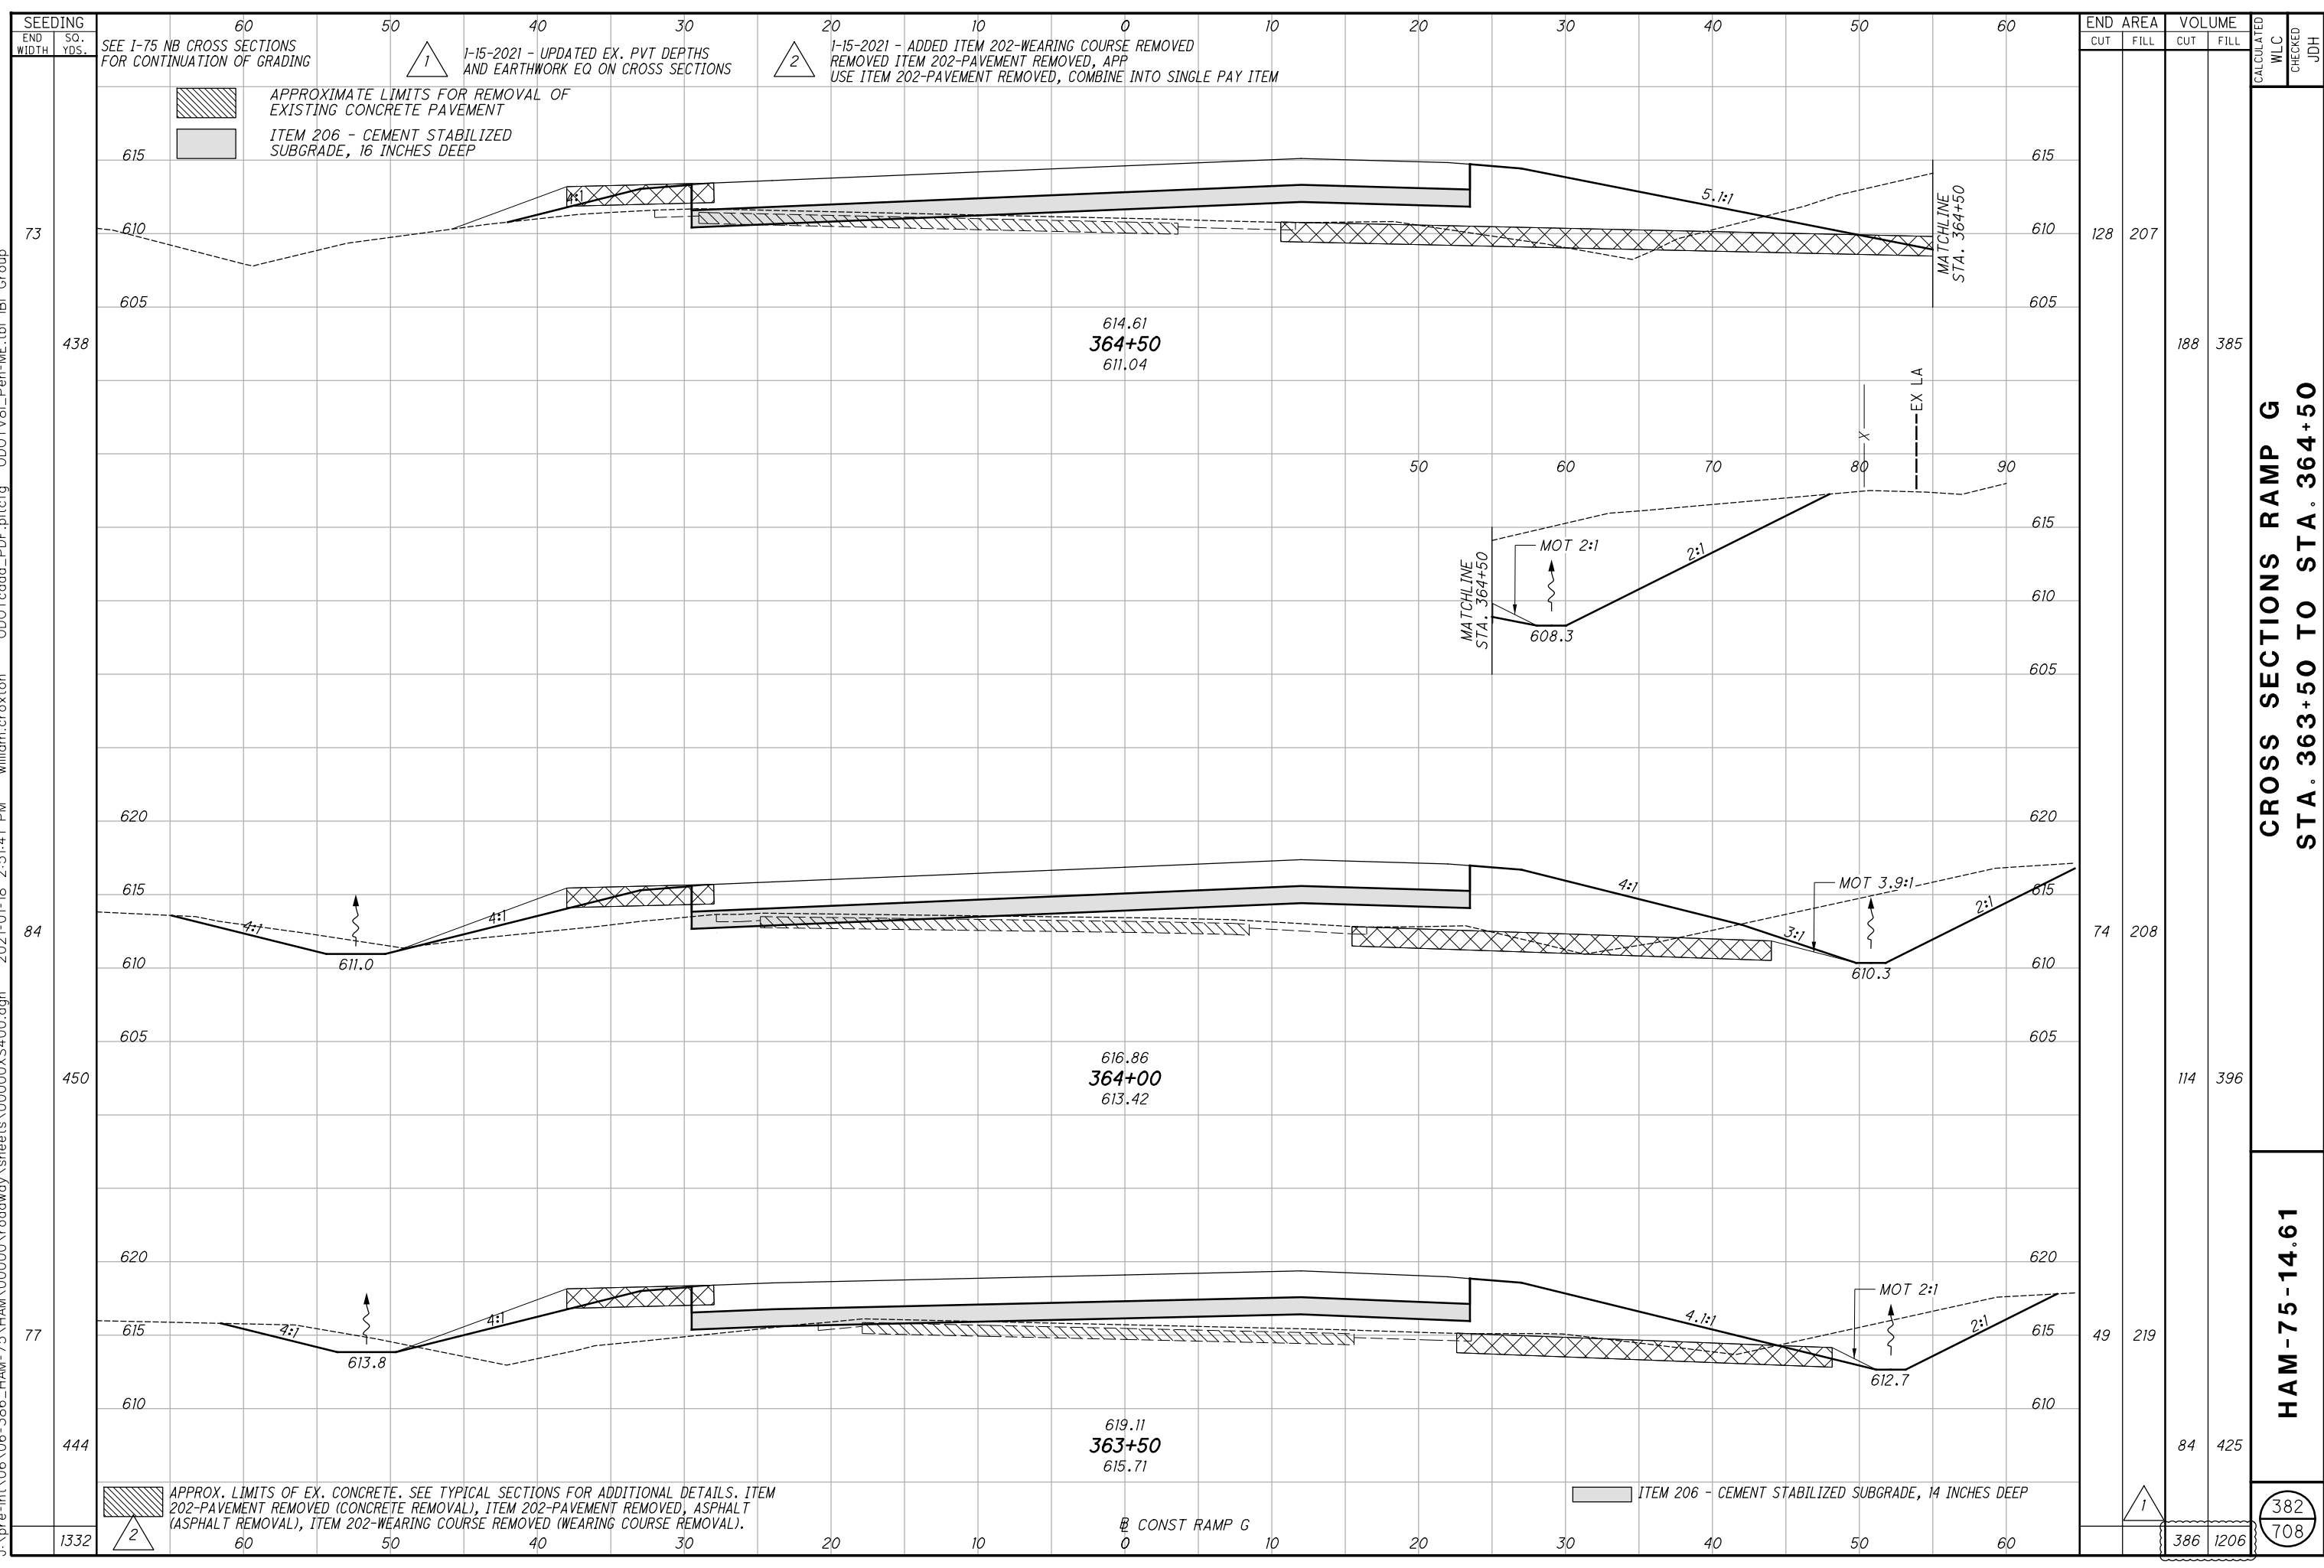


**CROSS SECTIONS RAMP G  
STA. 363+50 TO STA. 364+50**

**HAM-75-14.61**

382  
708



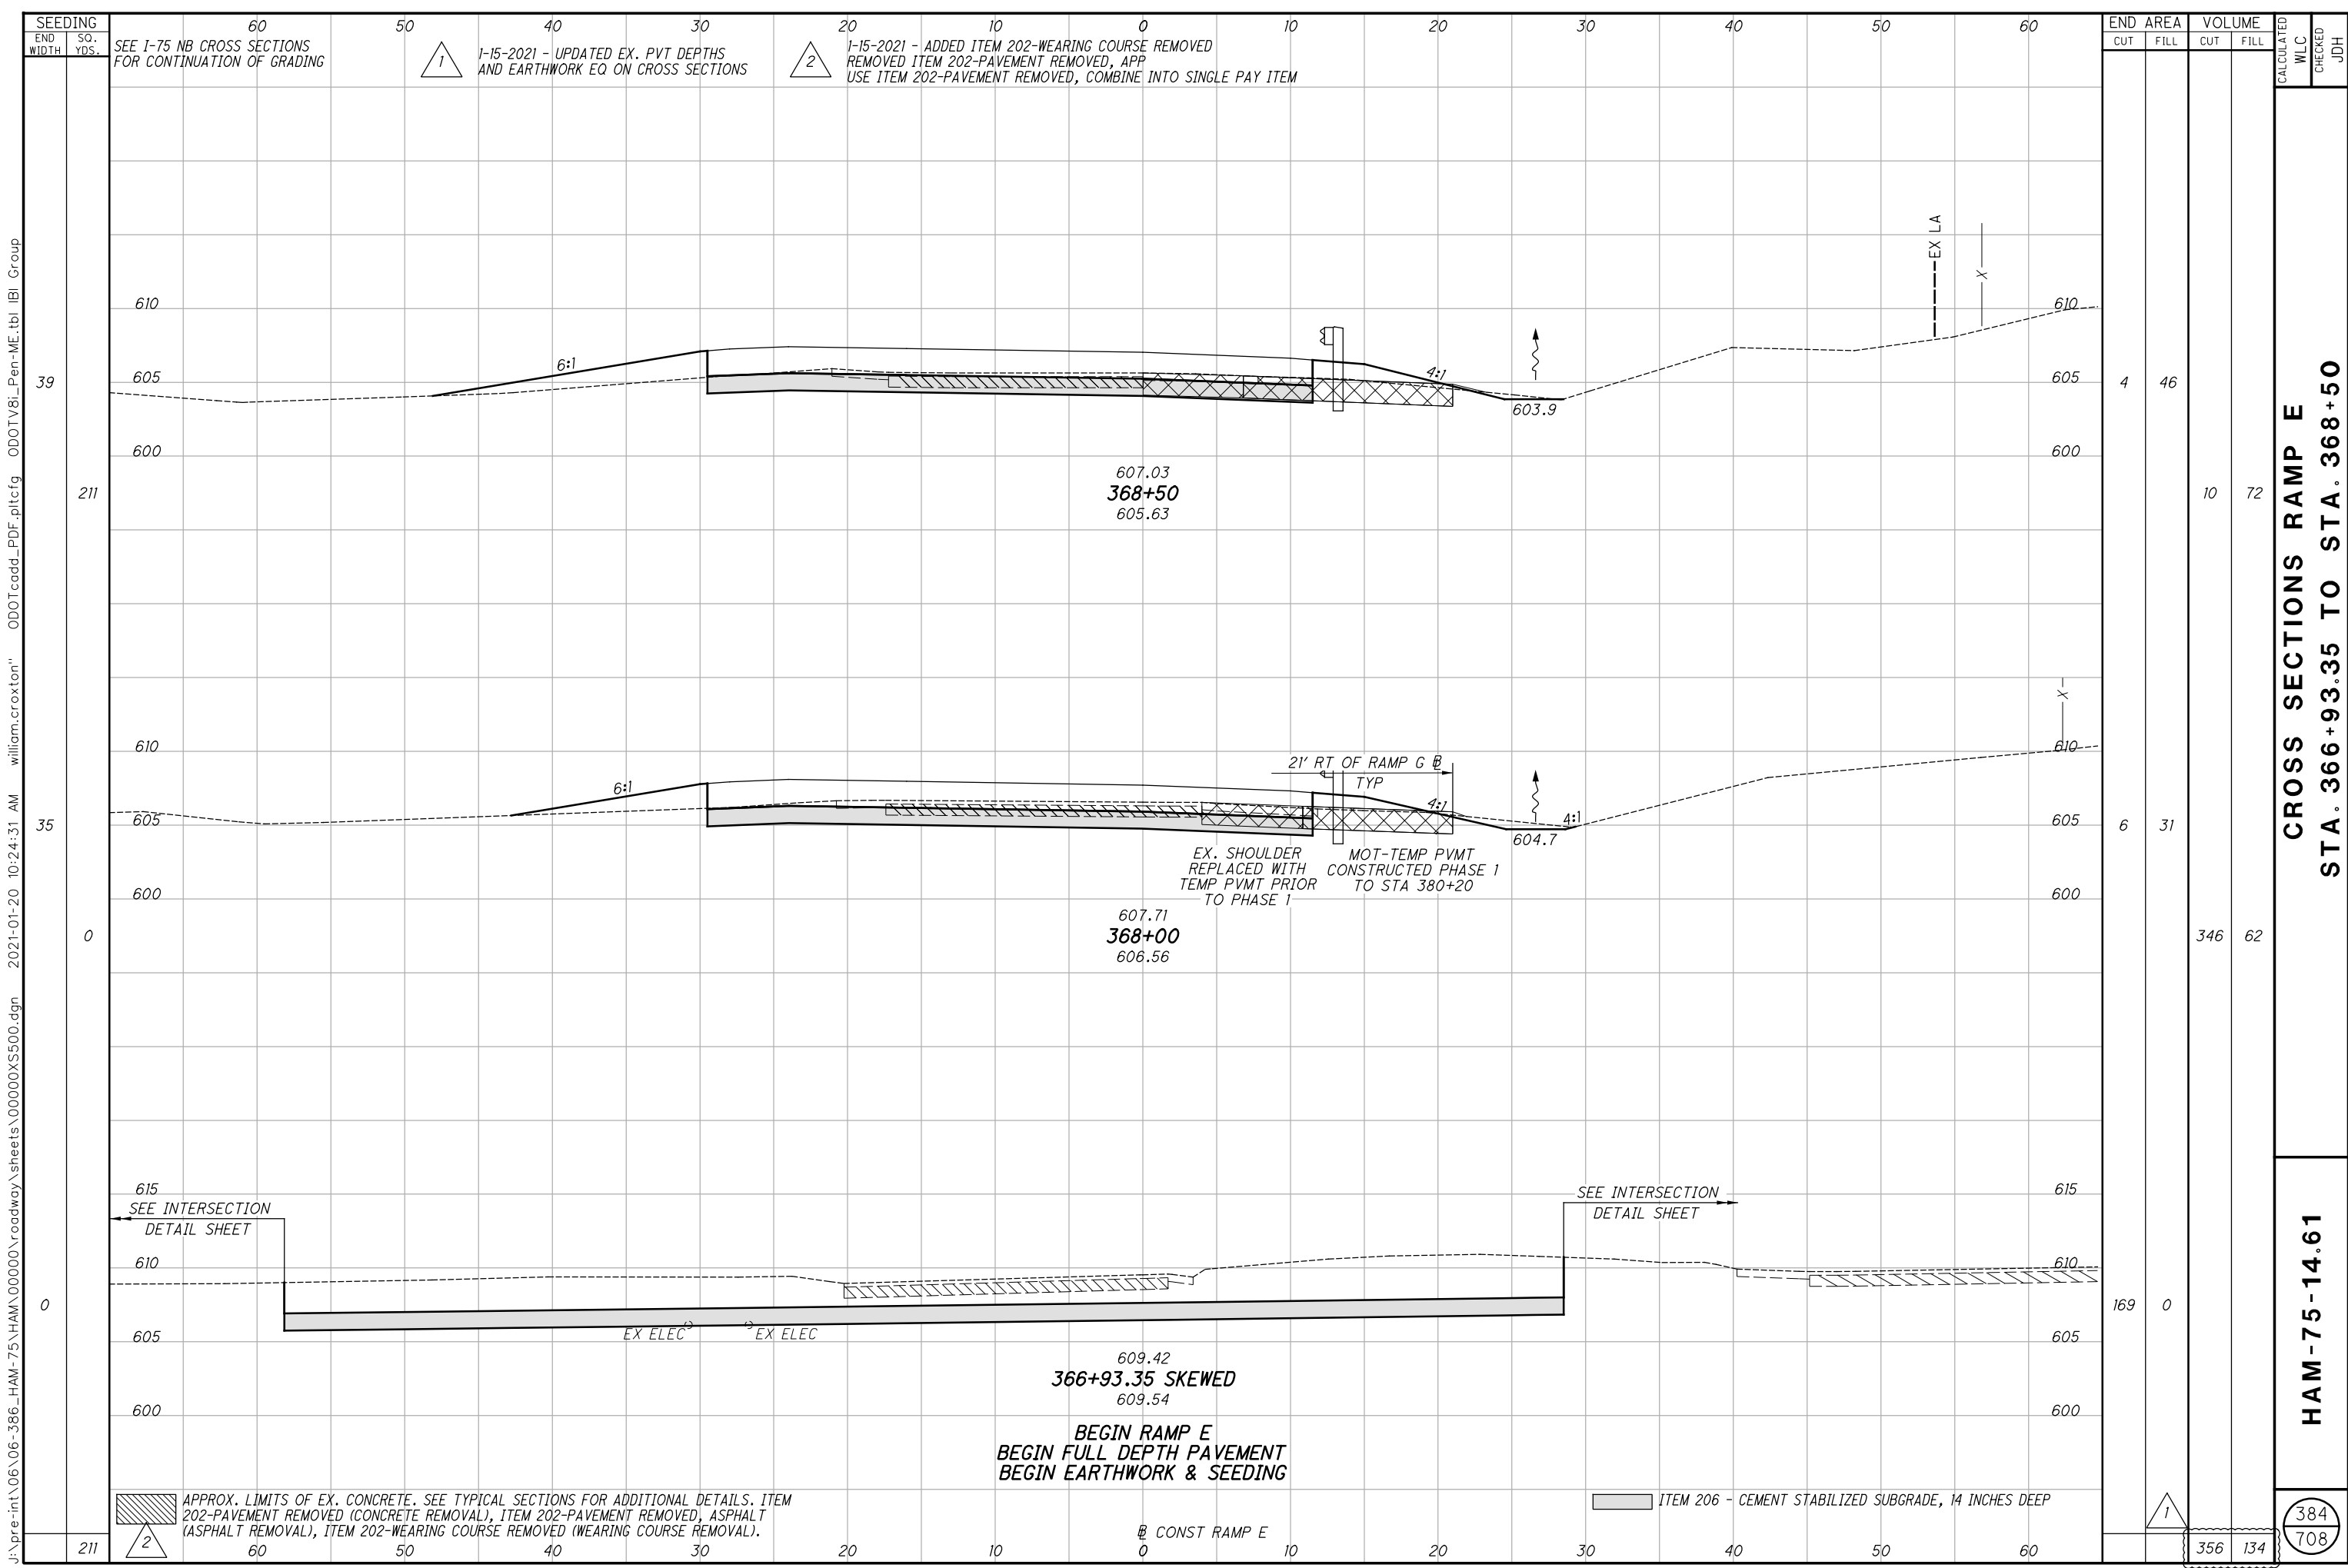

SEEDING  
END WIDTH SO. YDS.

SEE I-75 NB CROSS SECTIONS FOR CONTINUATION OF GRADING

1-15-2021 - UPDATED EX. PVT DEPTHS AND EARTHWORK EQ ON CROSS SECTIONS

1-15-2021 - ADDED ITEM 202-WEARING COURSE REMOVED REMOVED ITEM 202-PAVEMENT REMOVED, APP USE ITEM 202-PAVEMENT REMOVED, COMBINE INTO SINGLE PAY ITEM

211 39 211 35 0 0

60 50 40 30 20 10 0 10 20 30 40 50 60

610 605 600 610 605 600 615 610 605 600

607.03  
368+50  
605.63

607.71  
368+00  
606.56

609.42  
366+93.35 SKEWED  
609.54

6:1 4:1 4:1

EX LA

21' RT OF RAMP G @ TYP

EX SHOULDER REPLACED WITH TEMP PVMT PRIOR TO PHASE 1

MOT-TEMP PVMT CONSTRUCTED PHASE 1 TO STA 380+20

EX ELEC

SEE INTERSECTION DETAIL SHEET

SEE INTERSECTION DETAIL SHEET

APPROX. LIMITS OF EX. CONCRETE. SEE TYPICAL SECTIONS FOR ADDITIONAL DETAILS. ITEM 202-PAVEMENT REMOVED (CONCRETE REMOVAL), ITEM 202-PAVEMENT REMOVED, ASPHALT (ASPHALT REMOVAL), ITEM 202-WEARING COURSE REMOVED (WEARING COURSE REMOVAL).

ITEM 206 - CEMENT STABILIZED SUBGRADE, 14 INCHES DEEP

CONST RAMP E

END AREA		VOLUME		CALCULATED WLC	CHECKED	JDH
CUT	FILL	CUT	FILL			
4	46	10	72			
6	31	346	62			
169	0					
		356	134			


**CROSS SECTIONS RAMP E**  
**STA. 366+93.35 TO STA. 368+50**

**HAM-75-14.61**

384  
708

j:\pre-int\06\06-386\_HAM-75\_HAM\00000\roadway\sheets\00000X5500.dgn 2021-01-20 10:24:31 AM william.croxton" ODOTcadd\_PDF.pltcf ODOTV8i\_Pen-ME.tbl IBI Group

j:\pre-int\06\06-386\_HAM-75\_HAM\00000\roadway\sheets\00000X5500.dgn 2021-01-20 10:24:32 AM william.croxton" ODOTcadd\_PDF.pltcfgr ODOTV8i\_Pen-ME.tbl IBI Group

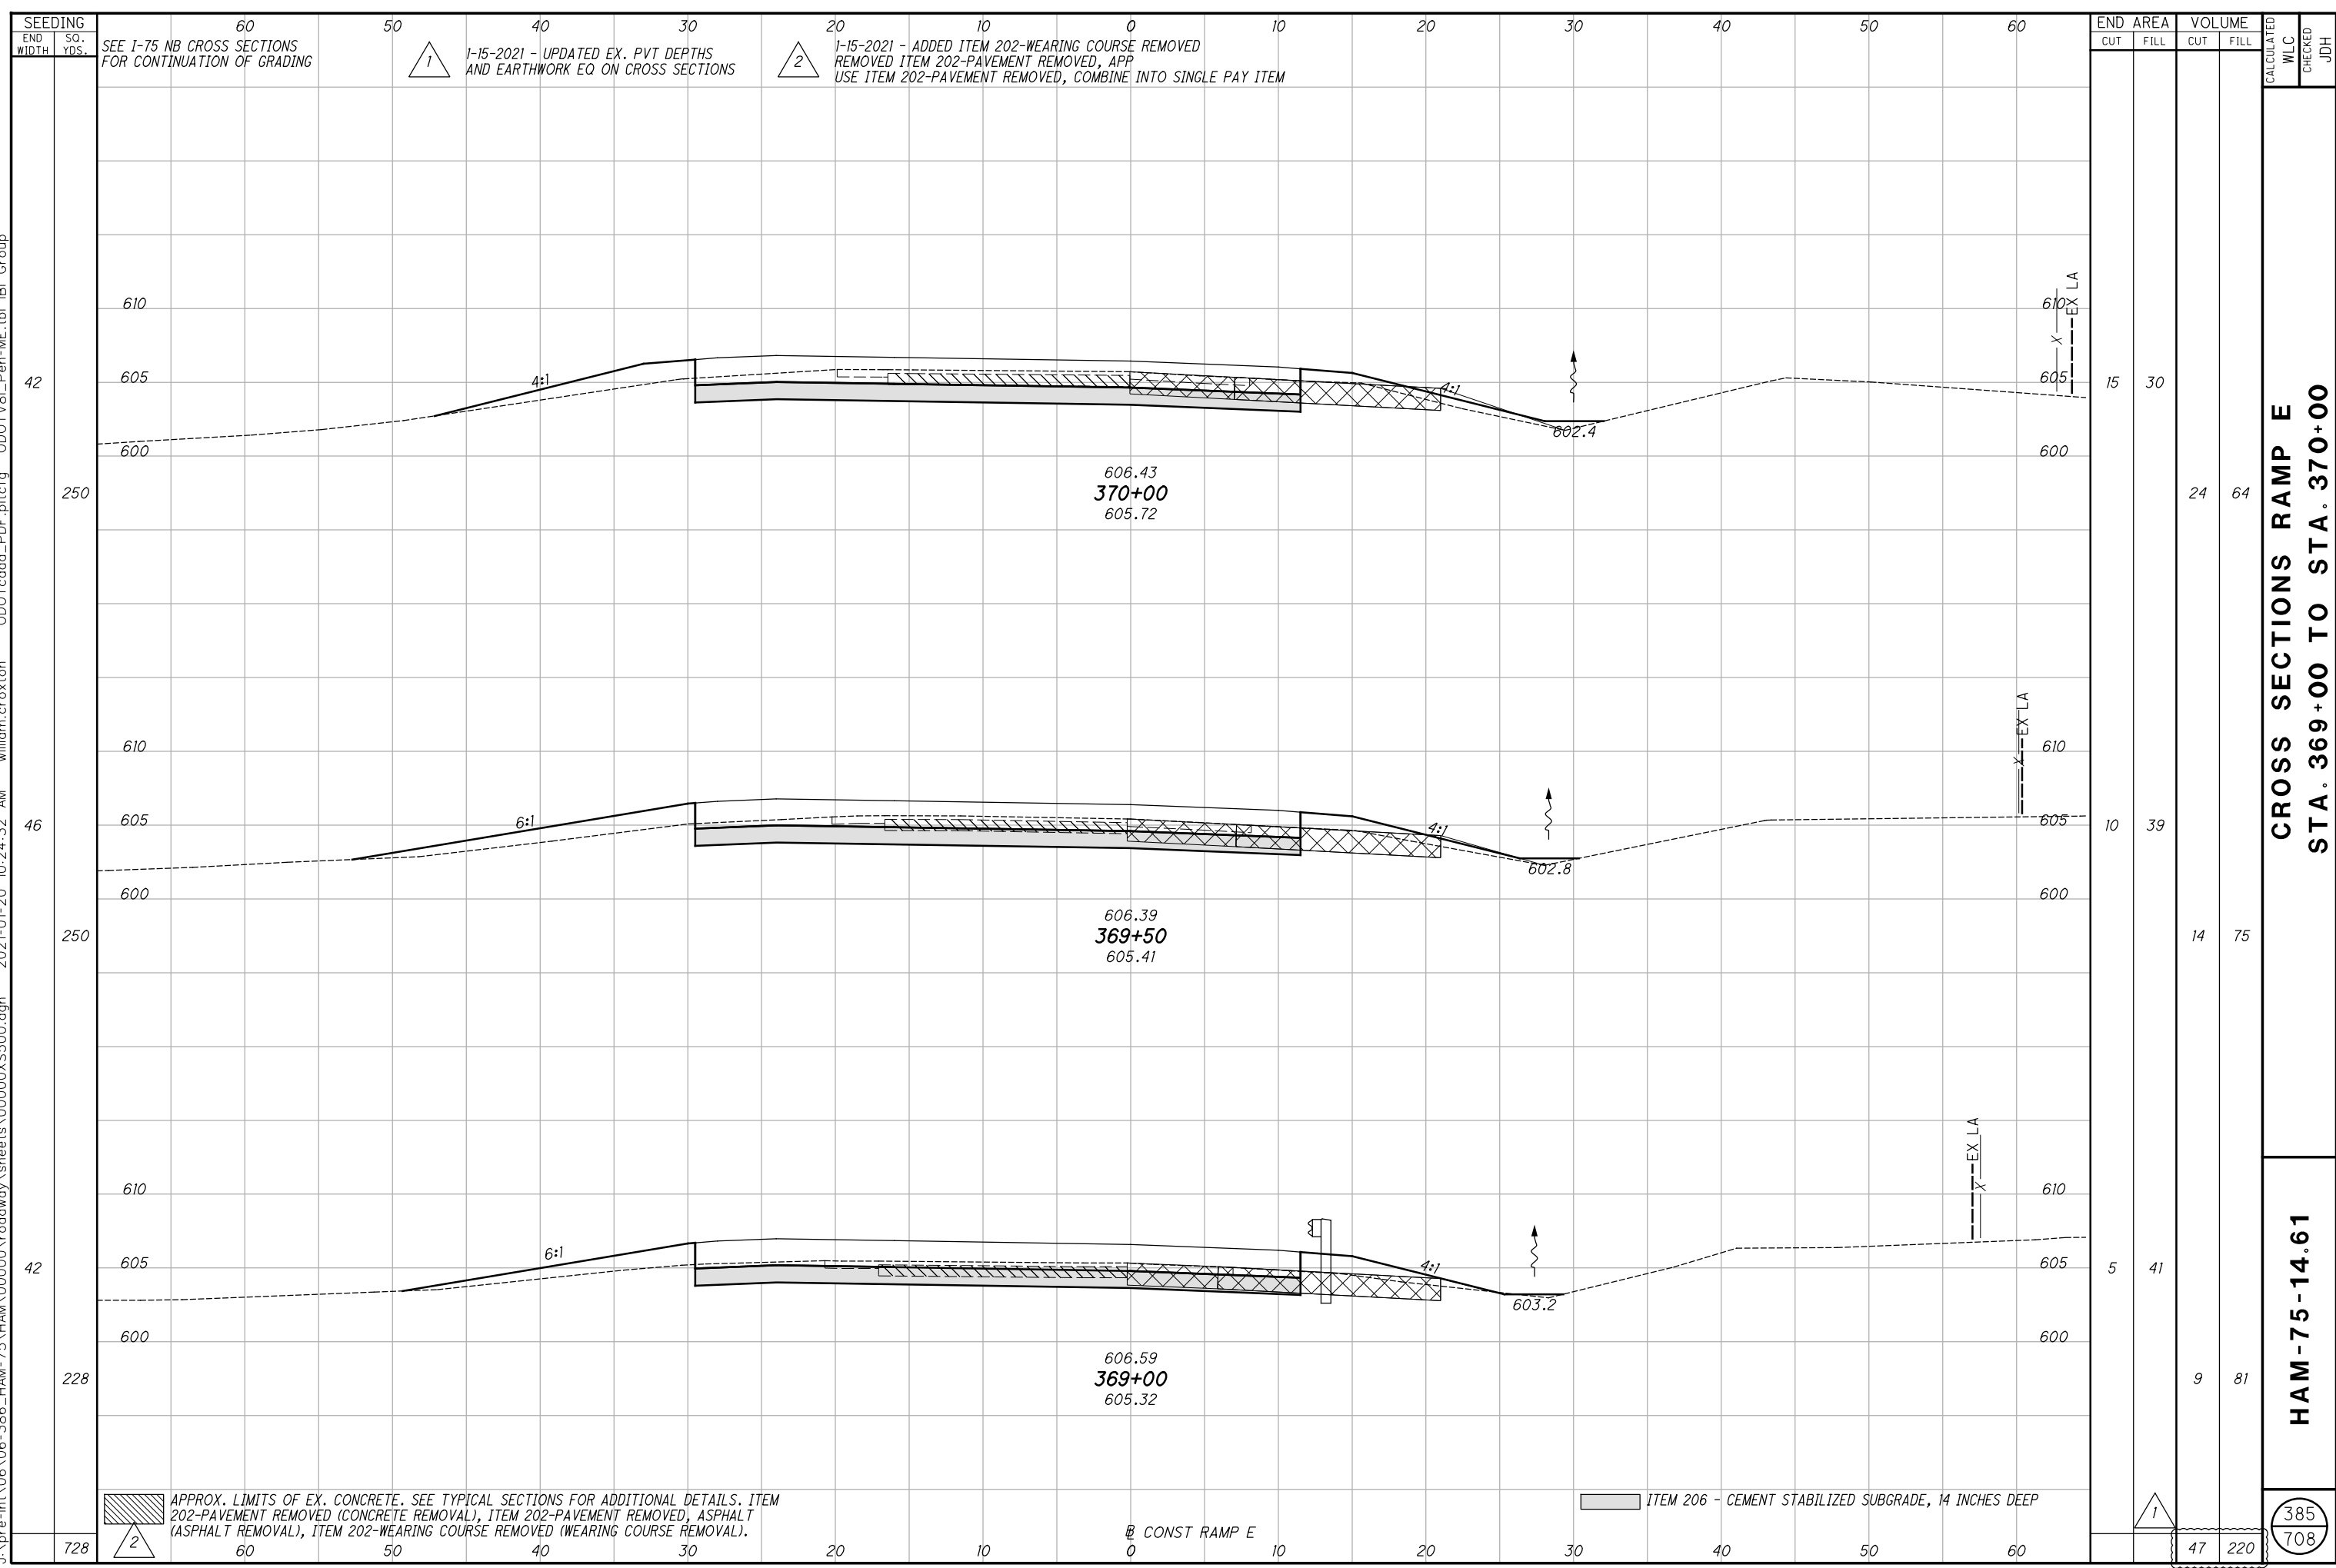

SEE I-75 NB CROSS SECTIONS FOR CONTINUATION OF GRADING

1-15-2021 - UPDATED EX. PVT DEPTHS AND EARTHWORK EQ ON CROSS SECTIONS

1-15-2021 - ADDED ITEM 202-WEARING COURSE REMOVED REMOVED ITEM 202-PAVEMENT REMOVED, APP USE ITEM 202-PAVEMENT REMOVED, COMBINE INTO SINGLE PAY ITEM

APPROX. LIMITS OF EX. CONCRETE. SEE TYPICAL SECTIONS FOR ADDITIONAL DETAILS. ITEM 202-PAVEMENT REMOVED (CONCRETE REMOVAL), ITEM 202-PAVEMENT REMOVED, ASPHALT (ASPHALT REMOVAL), ITEM 202-WEARING COURSE REMOVED (WEARING COURSE REMOVAL).

ITEM 206 - CEMENT STABILIZED SUBGRADE, 14 INCHES DEEP

CONST RAMP E


END AREA	VOLUME		CALCULATED WLC	CHECKED JDH
	CUT	FILL		
15	30			
24	64			
10	39			
14	75			
5	41			
9	81			
47	220			

CROSS SECTIONS RAMP E  
STA. 369+00 TO STA. 370+00

HAM-75-14.61

385  
708



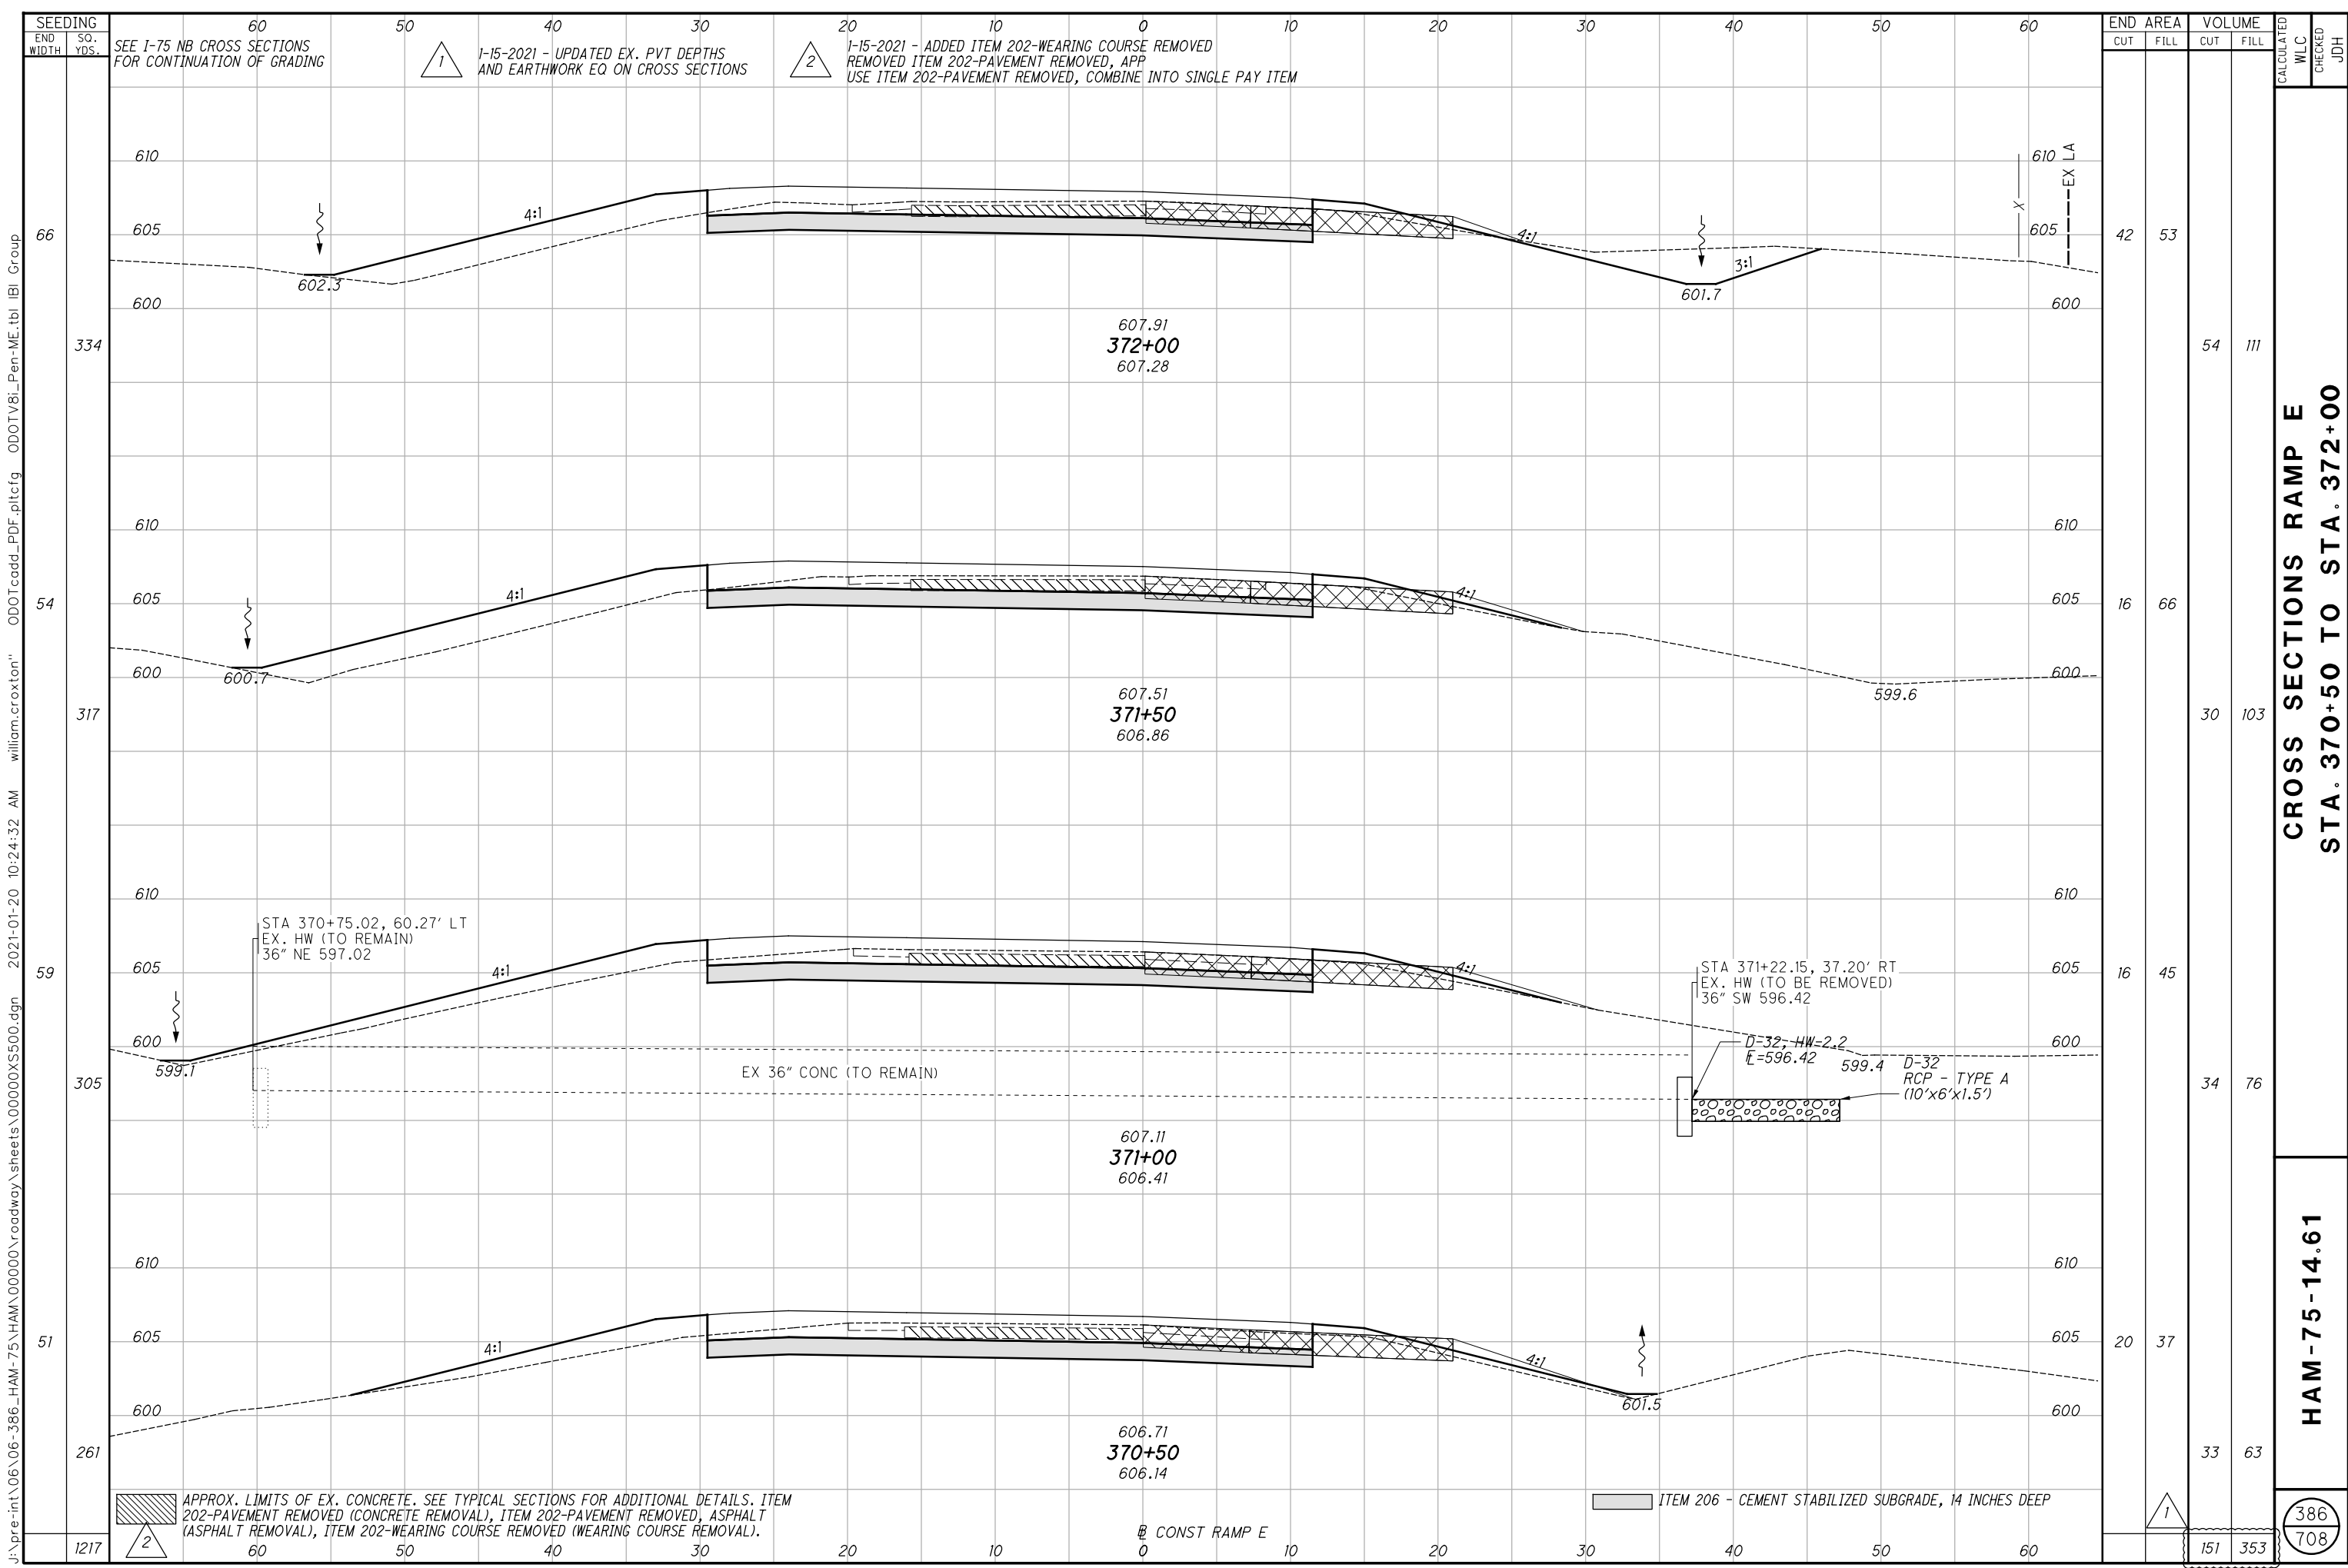

SEEDING  
END WIDTH SO. YDS.

SEE I-75 NB CROSS SECTIONS FOR CONTINUATION OF GRADING

1-15-2021 - UPDATED EX. PVT DEPTHS AND EARTHWORK EQ ON CROSS SECTIONS

1-15-2021 - ADDED ITEM 202-WEARING COURSE REMOVED REMOVED ITEM 202-PAVEMENT REMOVED, APP USE ITEM 202-PAVEMENT REMOVED, COMBINE INTO SINGLE PAY ITEM

ODOTV86\_Pen-ME.tbl IBI Group  
ODOTcadd\_PDF.pltcfgr william.croxton  
2021-01-20 10:24:32 AM

1217

STATION	END AREA		VOLUME	
	CUT	FILL	CUT	FILL
372+00	42	53	54	111
371+50	16	66	30	103
371+00	16	45	34	76
370+50	20	37	33	63
TOTAL	151	353		

APPROX. LIMITS OF EX. CONCRETE. SEE TYPICAL SECTIONS FOR ADDITIONAL DETAILS. ITEM 202-PAVEMENT REMOVED (CONCRETE REMOVAL), ITEM 202-PAVEMENT REMOVED, ASPHALT (ASPHALT REMOVAL), ITEM 202-WEARING COURSE REMOVED (WEARING COURSE REMOVAL).


ITEM 206 - CEMENT STABILIZED SUBGRADE, 14 INCHES DEEP

CONST RAMP E

386  
708

**CROSS SECTIONS RAMP E  
STA. 370+50 TO STA. 372+00**

**HAM-75-14.61**

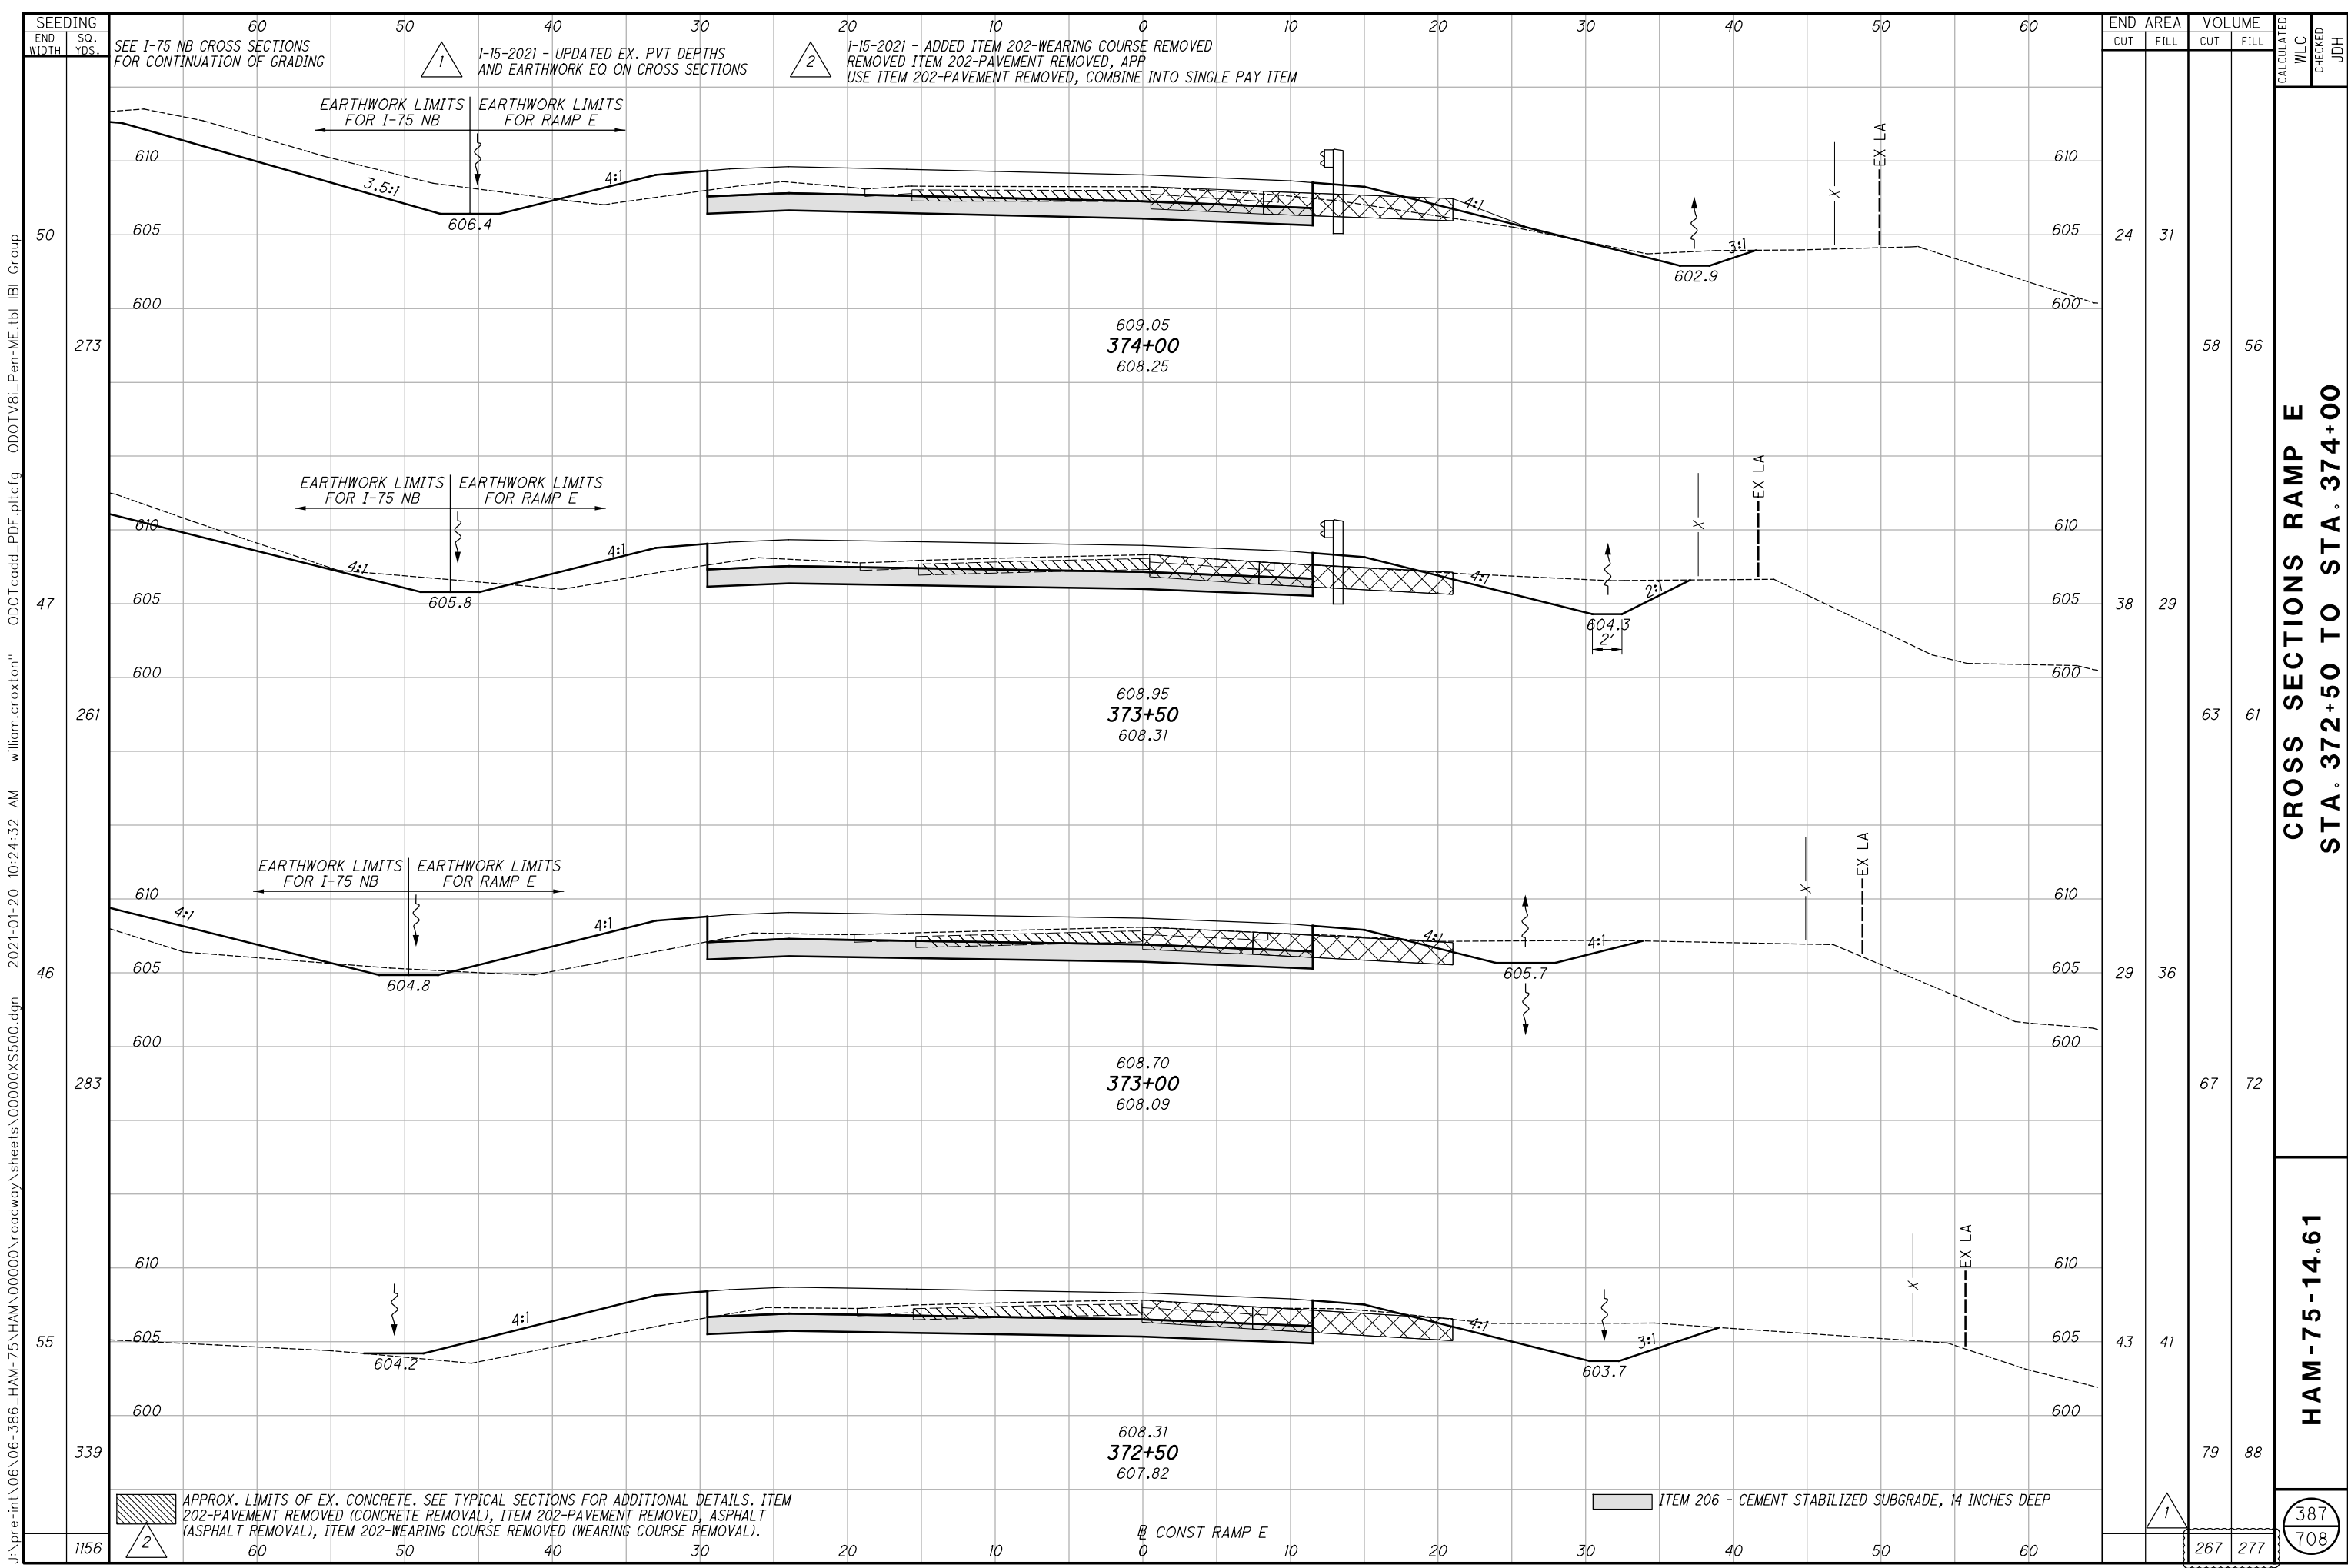

j:\pre-int\06\06-386\_HAM-75\_HAM\00000\roadway\sheets\00000X5500.dgn 2021-01-20 10:24:32 AM william.croxton ODOTcadd\_PDF.plt cfig ODOTV8i\_Pen-ME.tbl IBI Group

SEEDING	END SO. YDS.	
	WIDTH	
	60	50
	50	40
	40	30
	30	20
	20	10
	10	0
	0	10
	10	20
	20	30
	990	1000

END AREA	VOLUME		CALCULATED WLC	CHECKED JDH
	CUT	FILL		
24	31	58	56	
38	29	63	61	
29	36	67	72	
43	41	79	88	
		267	277	

**CROSS SECTIONS RAMP E**  
**STA. 372+50 TO STA. 374+00**


**HAM-75-14.61**

387  
 708

APPROX. LIMITS OF EX. CONCRETE. SEE TYPICAL SECTIONS FOR ADDITIONAL DETAILS. ITEM 202-PAVEMENT REMOVED (CONCRETE REMOVAL), ITEM 202-PAVEMENT REMOVED, ASPHALT (ASPHALT REMOVAL), ITEM 202-WEARING COURSE REMOVED (WEARING COURSE REMOVAL).

ITEM 206 - CEMENT STABILIZED SUBGRADE, 14 INCHES DEEP

CONST RAMP E

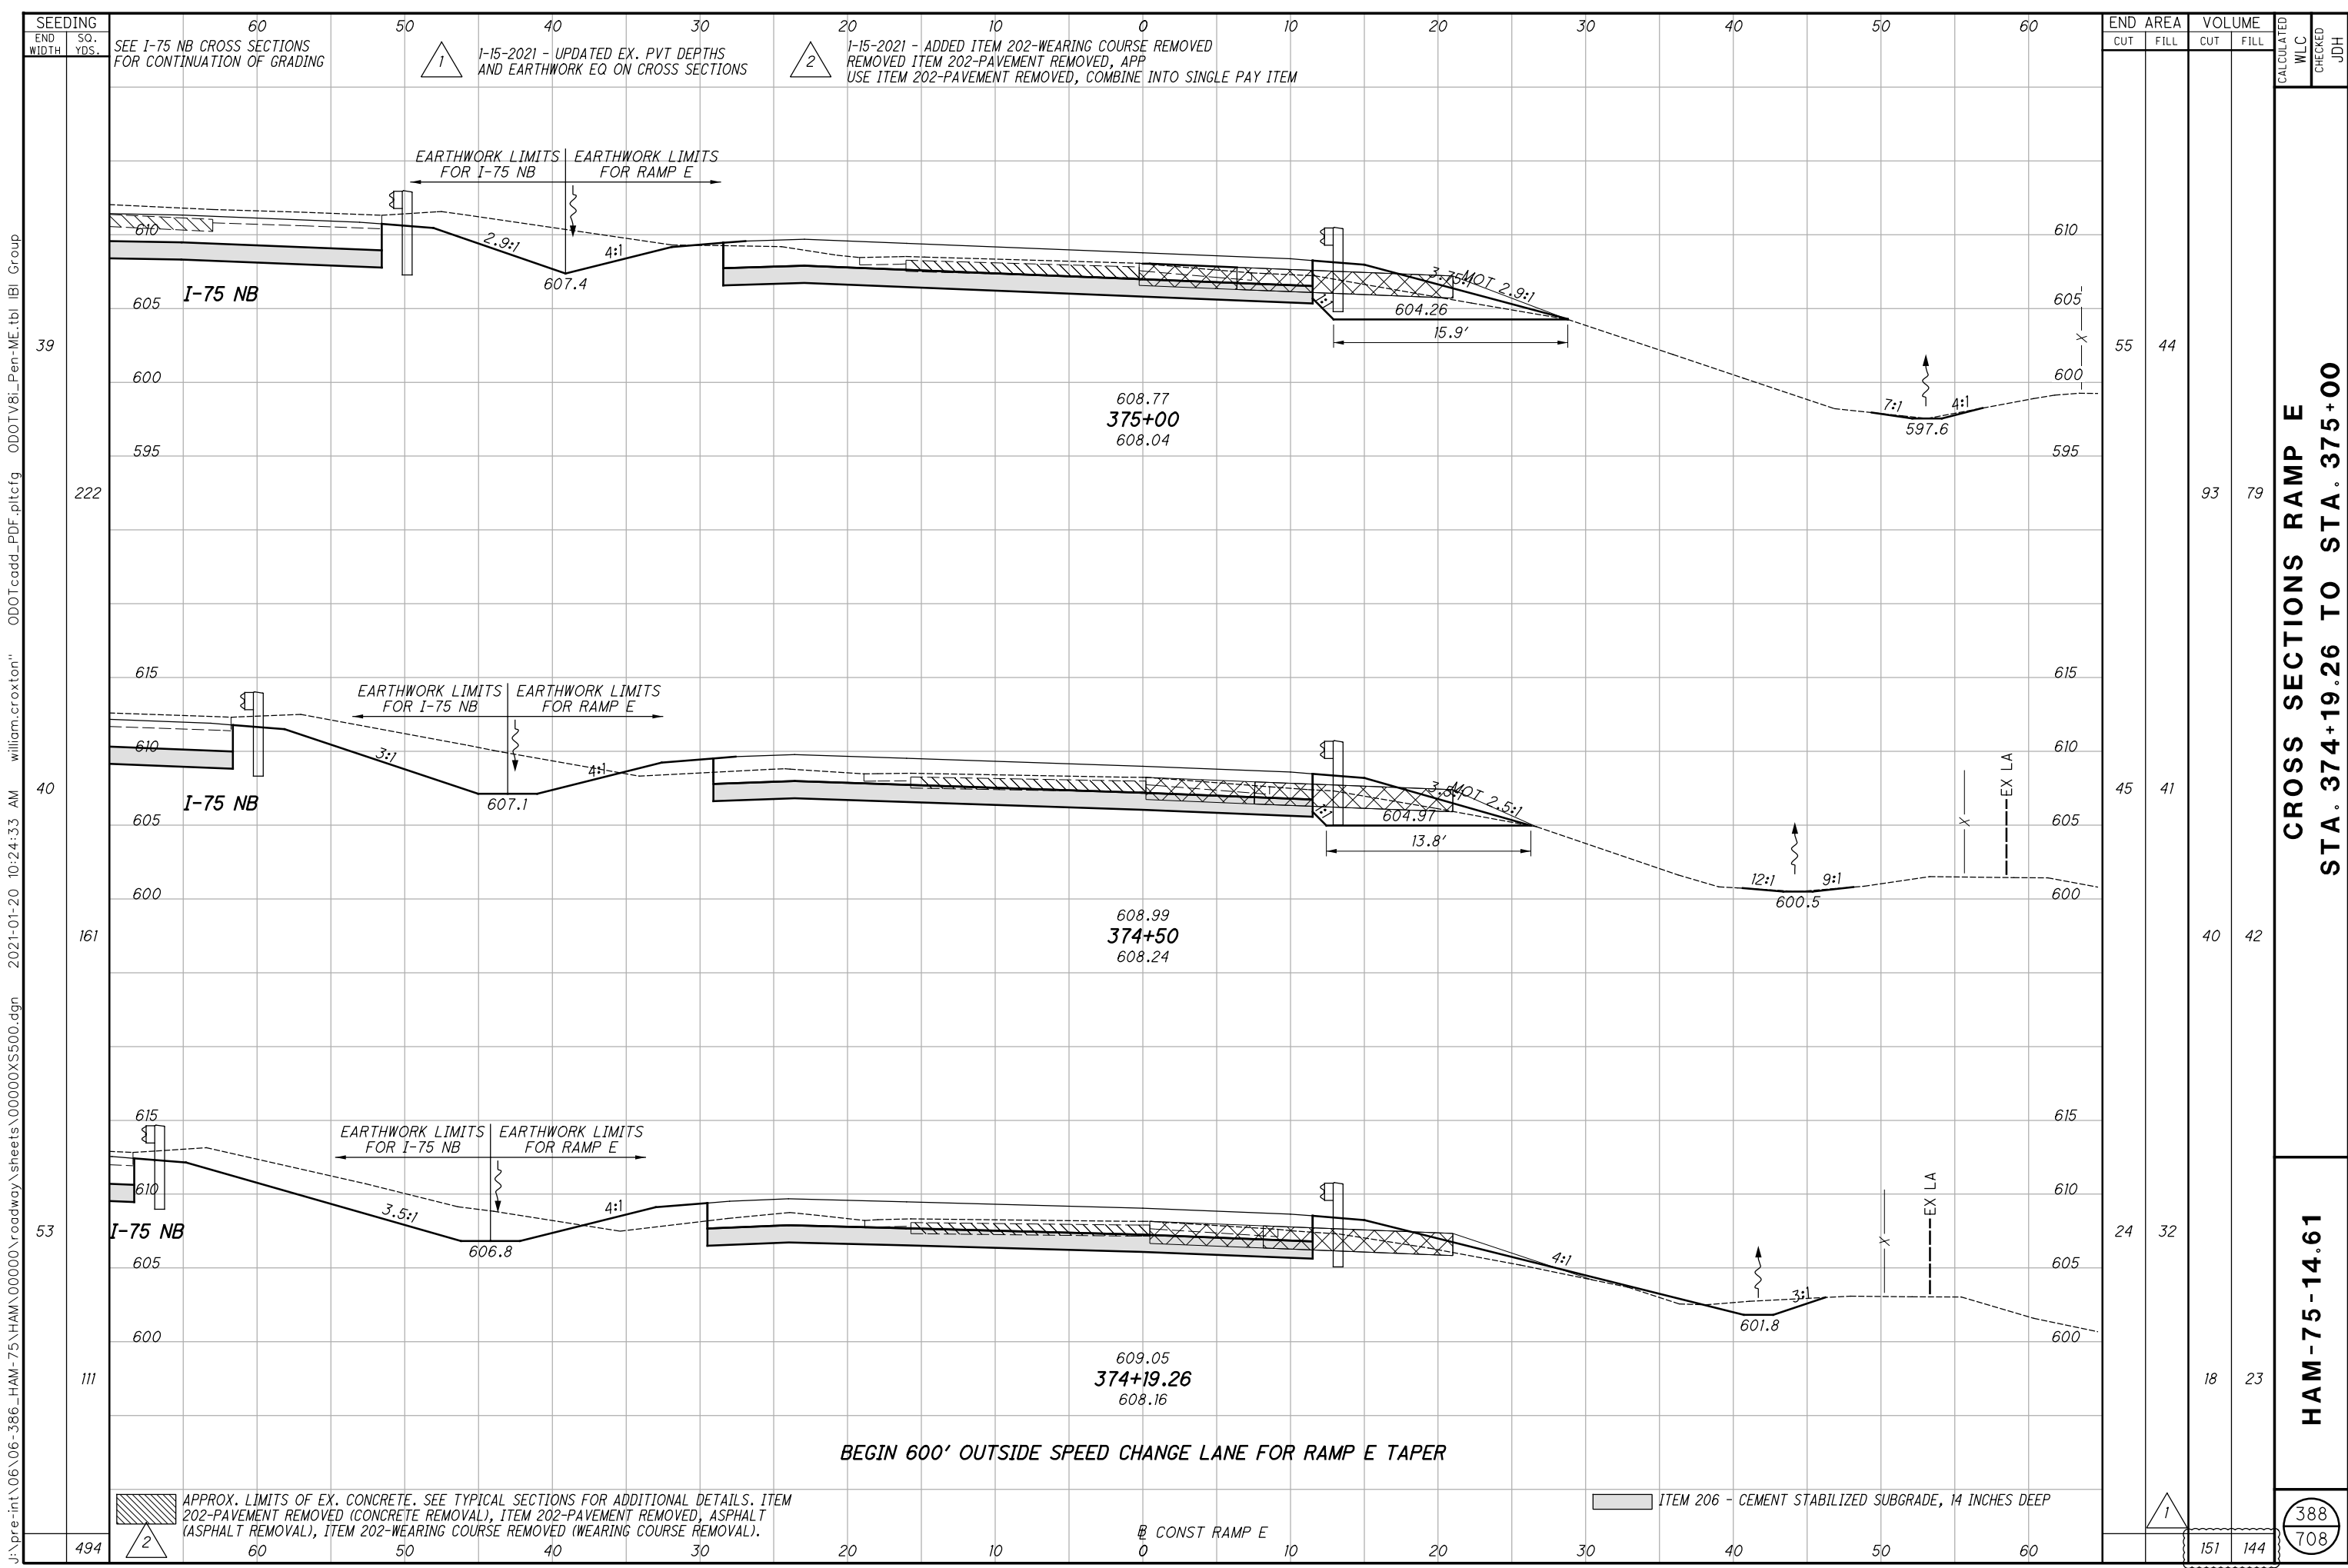


END CUT	AREA FILL	VOLUME		CALCULATED WLC	CHECKED JDH
		CUT	FILL		
55	44	93	79		
45	41	40	42		
24	32	18	23		
151	144			388	708

**CROSS SECTIONS RAMP E**  
**STA. 374+19.26 TO STA. 375+00**

**HAM-75-14.61**

j:\pre-int\06\06-386\_HAM-75\_HAM\00000\roadway\sheets\00000X5500.dgn 2021-01-20 10:24:33 AM william.croxton" ODOTcadd\_PDF.pltcfgr ODOTV8i\_Pen-ME.tbl IBI Group

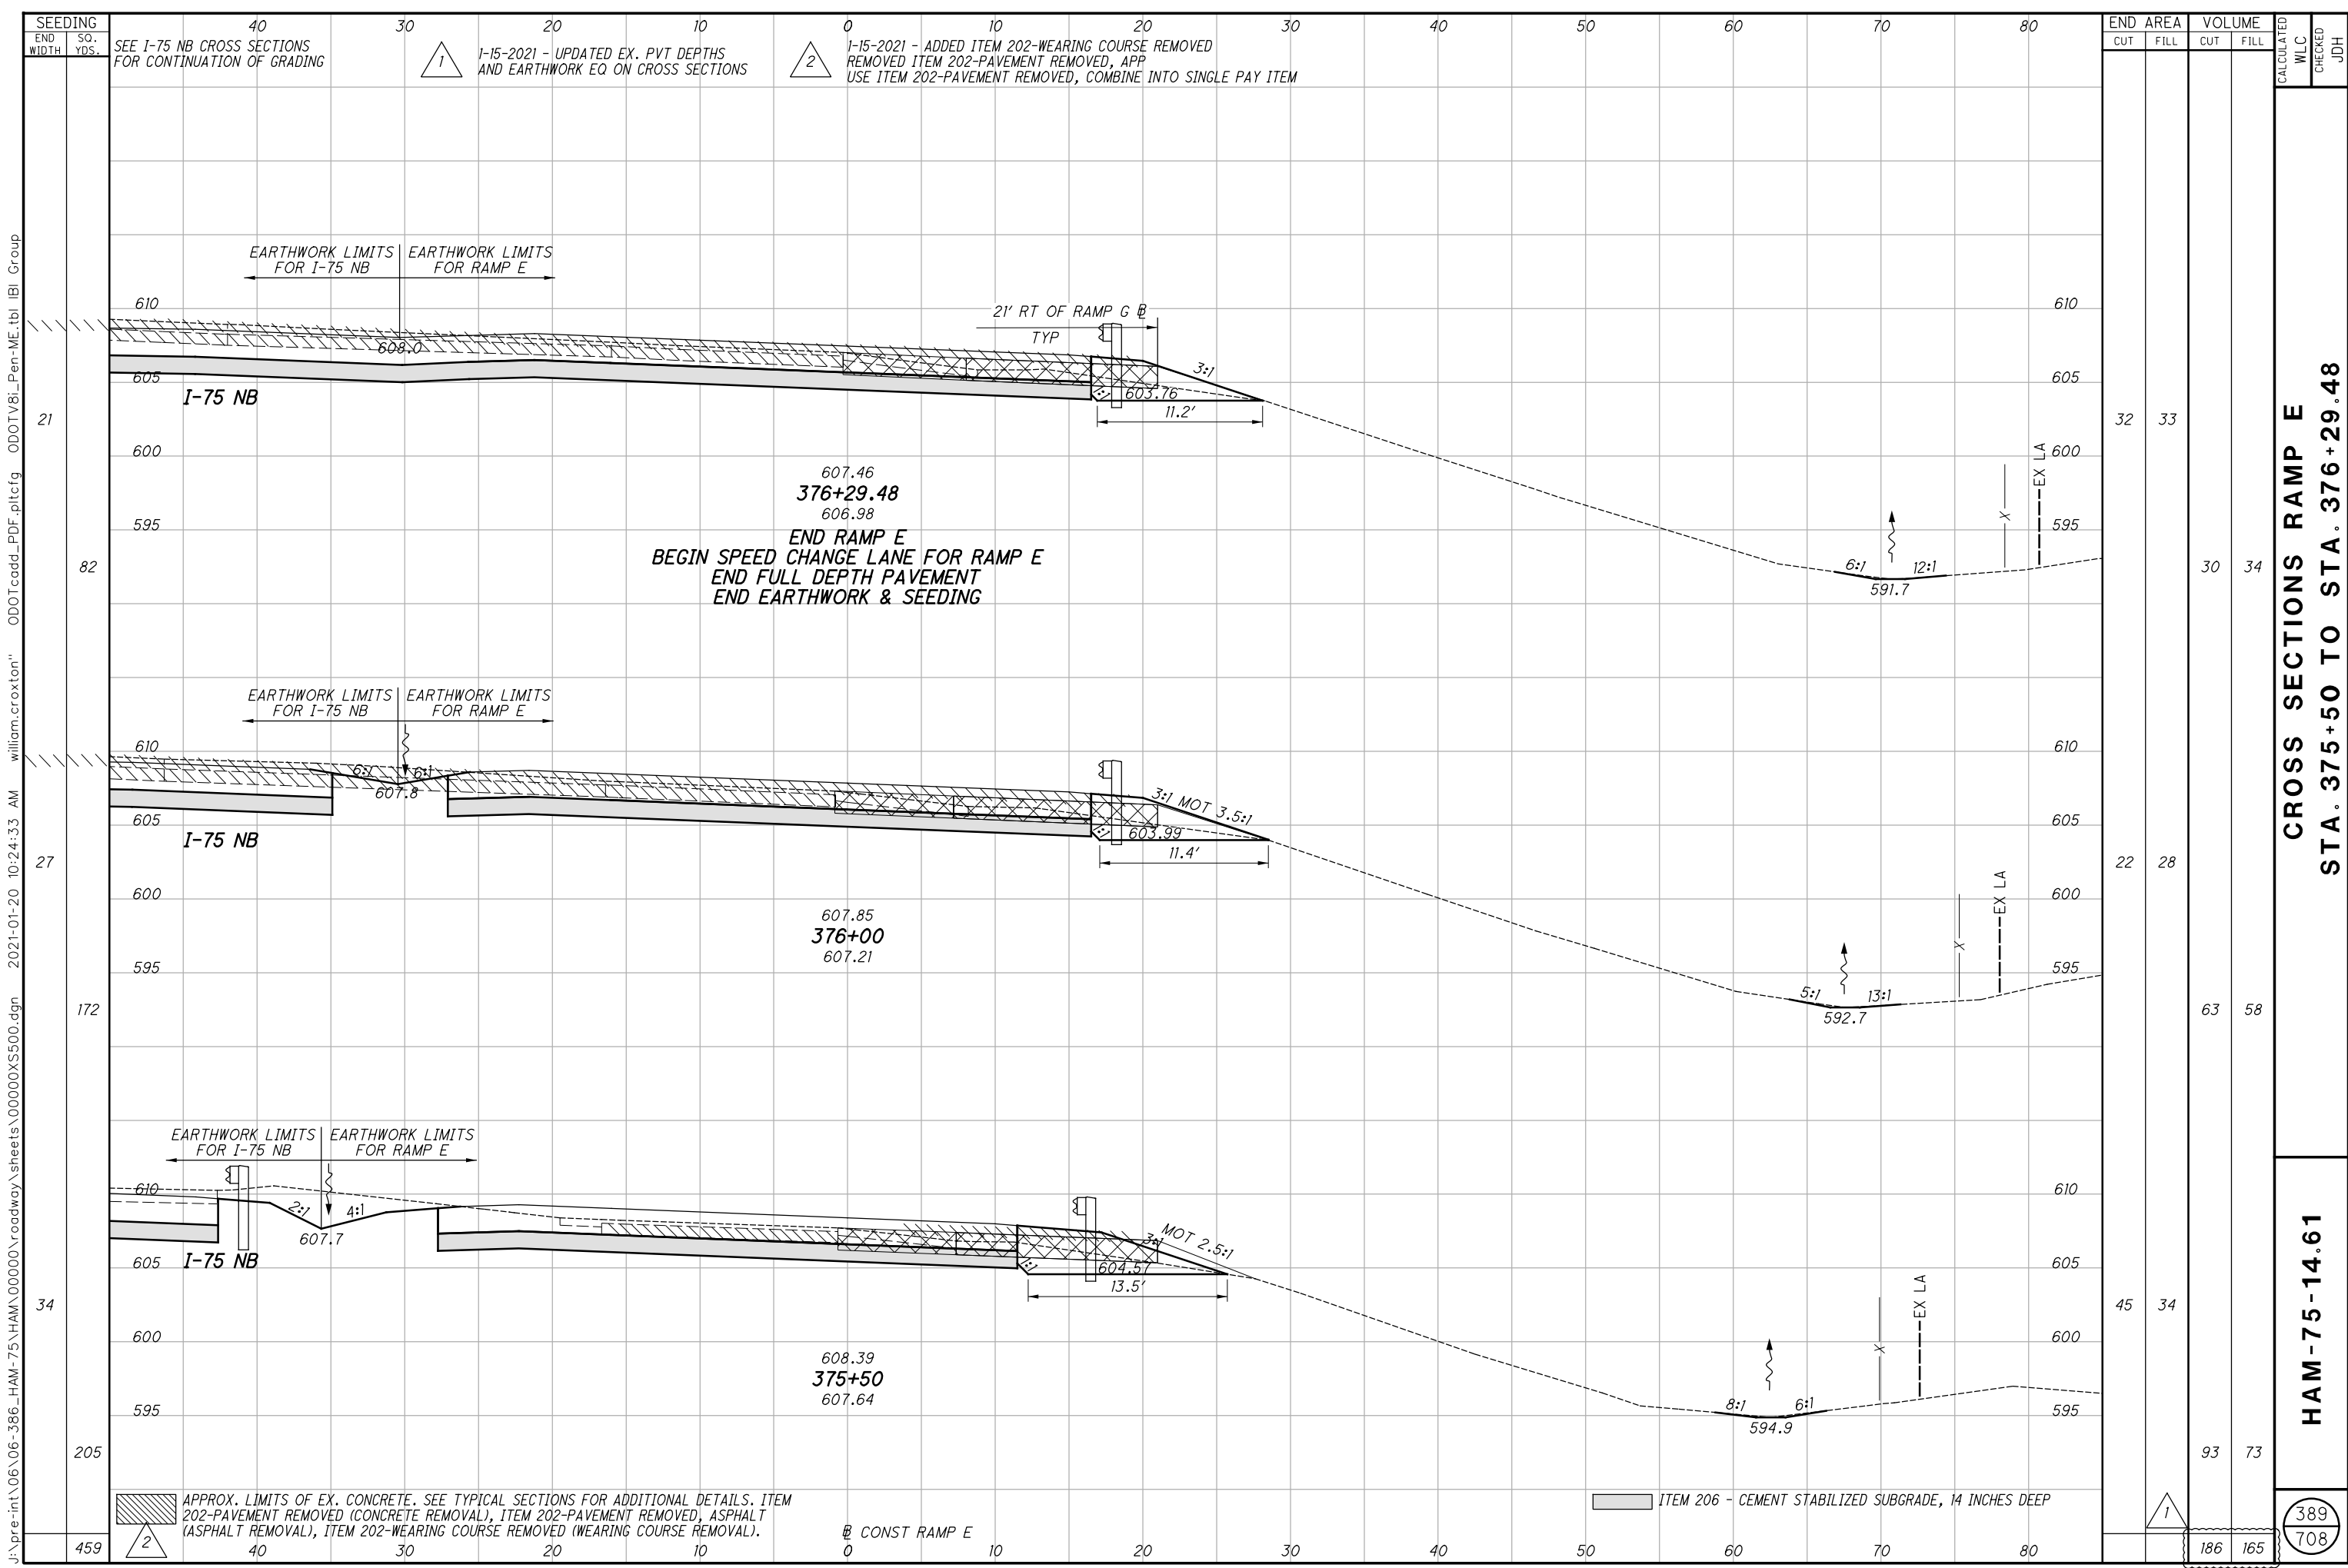

END AREA		VOLUME		CALCULATED WLC	CHECKED JDH
CUT	FILL	CUT	FILL		
32	33				
22	28				
45	34				
186	165				


**CROSS SECTIONS RAMP E**  
**STA. 375+50 TO STA. 376+29.48**

**HAM-75-14.61**

389  
708

j:\pre-int\06\06-386\_HAM-75\_HAM\00000\roadway\sheets\00000X5500.dgn 2021-01-20 10:24:33 AM william.croxton ODOTV86\_Pen-ME.tbl IBI Group

j:\pre-int\06\06-386\_HAM-75\HAM\00000\roadway\sheets\00000X5700.dgn 2021-01-18 2:52:07 PM william.croxtton' ODOT\cadd\_PDF.plt\cfig ODOTV81\_Pen-ME.tbl IBI Group

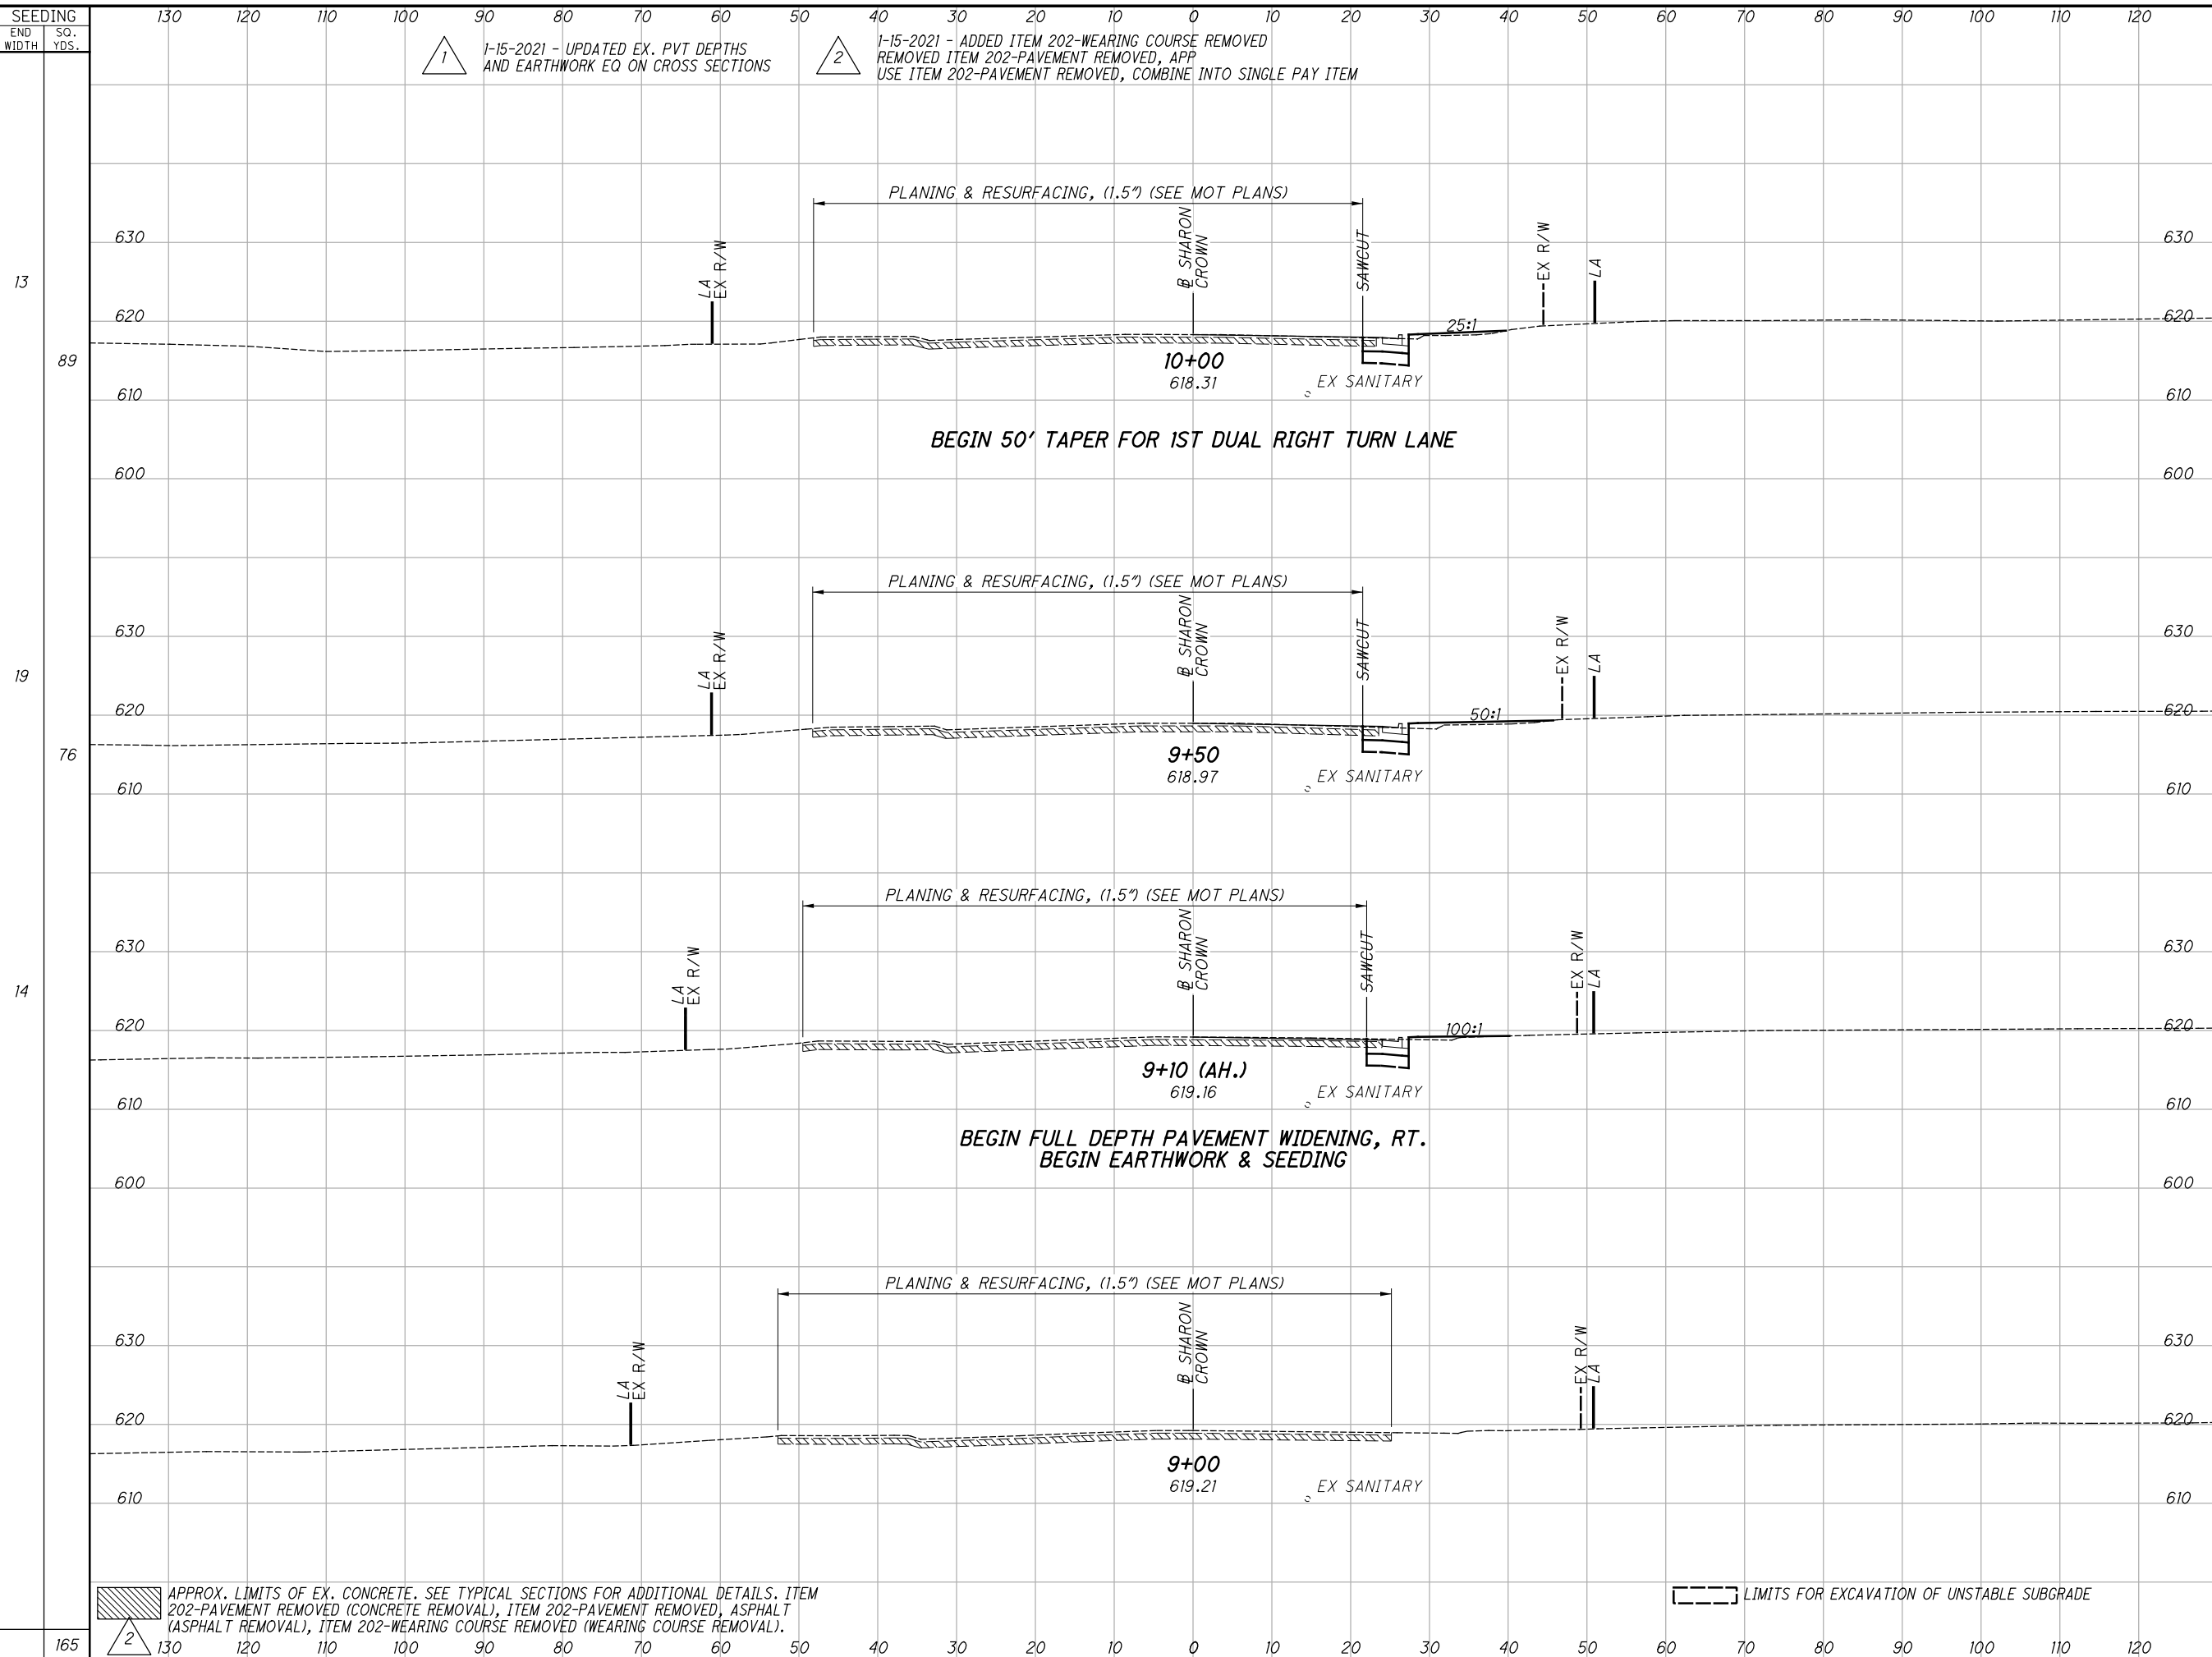

SEEDING		END AREA		VOLUME		CALCULATED WLC	CHECKED JDH
END WIDTH	SO. YDS.	CUT	FILL	CUT	FILL		
13	89	9 9*	5 9*	16 17*	13 17*		
19	76	8 9*	9 9*	13 13*	10 13*		
14		9 8*	4 8*				
165							

\* QUANTITIES FOR EXCAVATION OF SUBGRADE, 18 INCHES DEEP AND GRANULAR MATERIAL, TYPE C

**CROSS SECTIONS - SHARON ROAD**  
**STA. 9+00 TO STA. 10+00**


**HAM-75-14.61**

390  
708

APPROX. LIMITS OF EX. CONCRETE. SEE TYPICAL SECTIONS FOR ADDITIONAL DETAILS. ITEM 202-PAVEMENT REMOVED (CONCRETE REMOVAL), ITEM 202-PAVEMENT REMOVED, ASPHALT (ASPHALT REMOVAL), ITEM 202-WEARING COURSE REMOVED (WEARING COURSE REMOVAL).

LIMITS FOR EXCAVATION OF UNSTABLE SUBGRADE

j:\pre-int\06\06-386\_HAM-75\HAM\00000\roadway\sheets\00000X5700.dgn 2021-01-18 2:52:07 PM william.croxton' ODOTcadd\_PDF.pltcfgr ODOTV81\_Pen-ME.tbl IBI Group

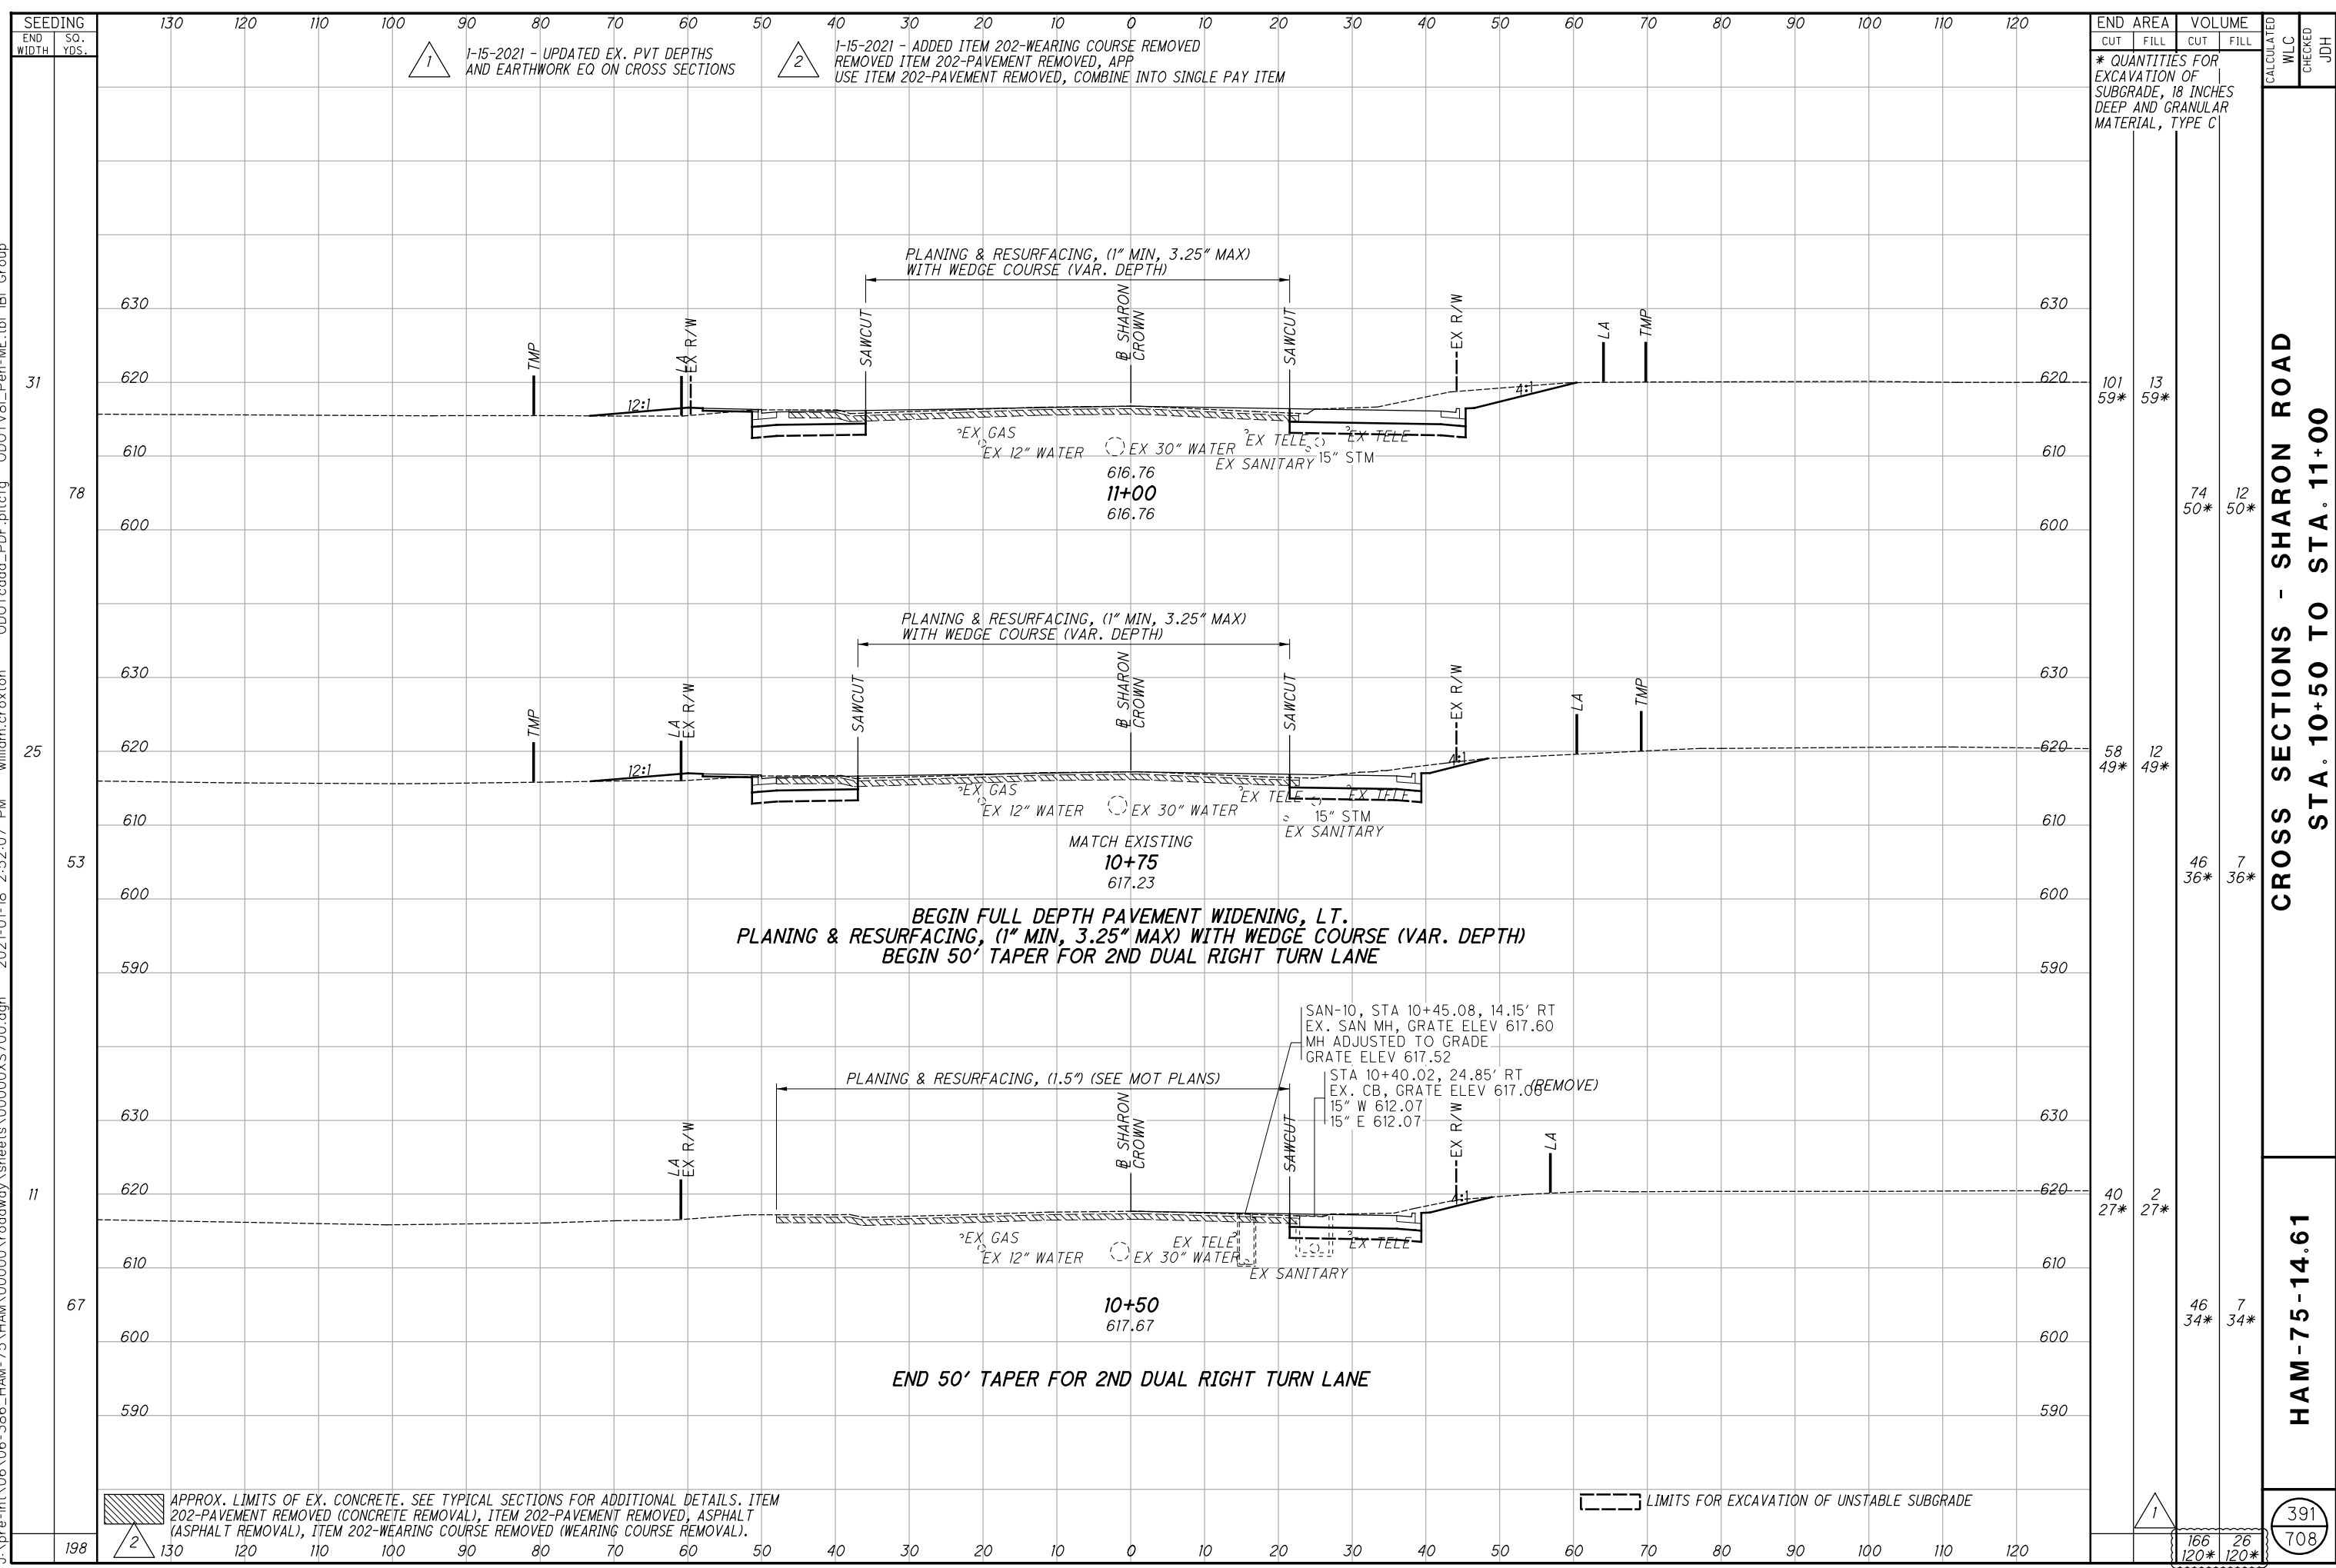

1

1-15-2021 - UPDATED EX. PVT DEPTHS AND EARTHWORK EQ ON CROSS SECTIONS

2

1-15-2021 - ADDED ITEM 202-WEARING COURSE REMOVED REMOVED ITEM 202-PAVEMENT REMOVED, APP USE ITEM 202-PAVEMENT REMOVED, COMBINE INTO SINGLE PAY ITEM

END AREA	VOLUME		CALCULATED	CHECKED	JDH
	CUT	FILL			
101	13				
59*	59*				
58	12				
49*	49*				
40	2				
27*	27*				
166	26				
120*	120*				

CROSS SECTIONS - SHARON ROAD  
STA. 10+50 TO STA. 11+00


HAM-75-14.61

391  
708

APPROX. LIMITS OF EX. CONCRETE. SEE TYPICAL SECTIONS FOR ADDITIONAL DETAILS. ITEM 202-PAVEMENT REMOVED (CONCRETE REMOVAL), ITEM 202-PAVEMENT REMOVED, ASPHALT (ASPHALT REMOVAL), ITEM 202-WEARING COURSE REMOVED (WEARING COURSE REMOVAL).

LIMITS FOR EXCAVATION OF UNSTABLE SUBGRADE

j:\pre-int\06\06-386\_HAM-75\HAM\00000\roadway\sheets\00000X5700.dgn 2021-01-18 2:52:08 PM william.croxton' ODOTcadd\_PDF.pltcfgr ODOTV81\_Pen-ME.tbl IBI Group

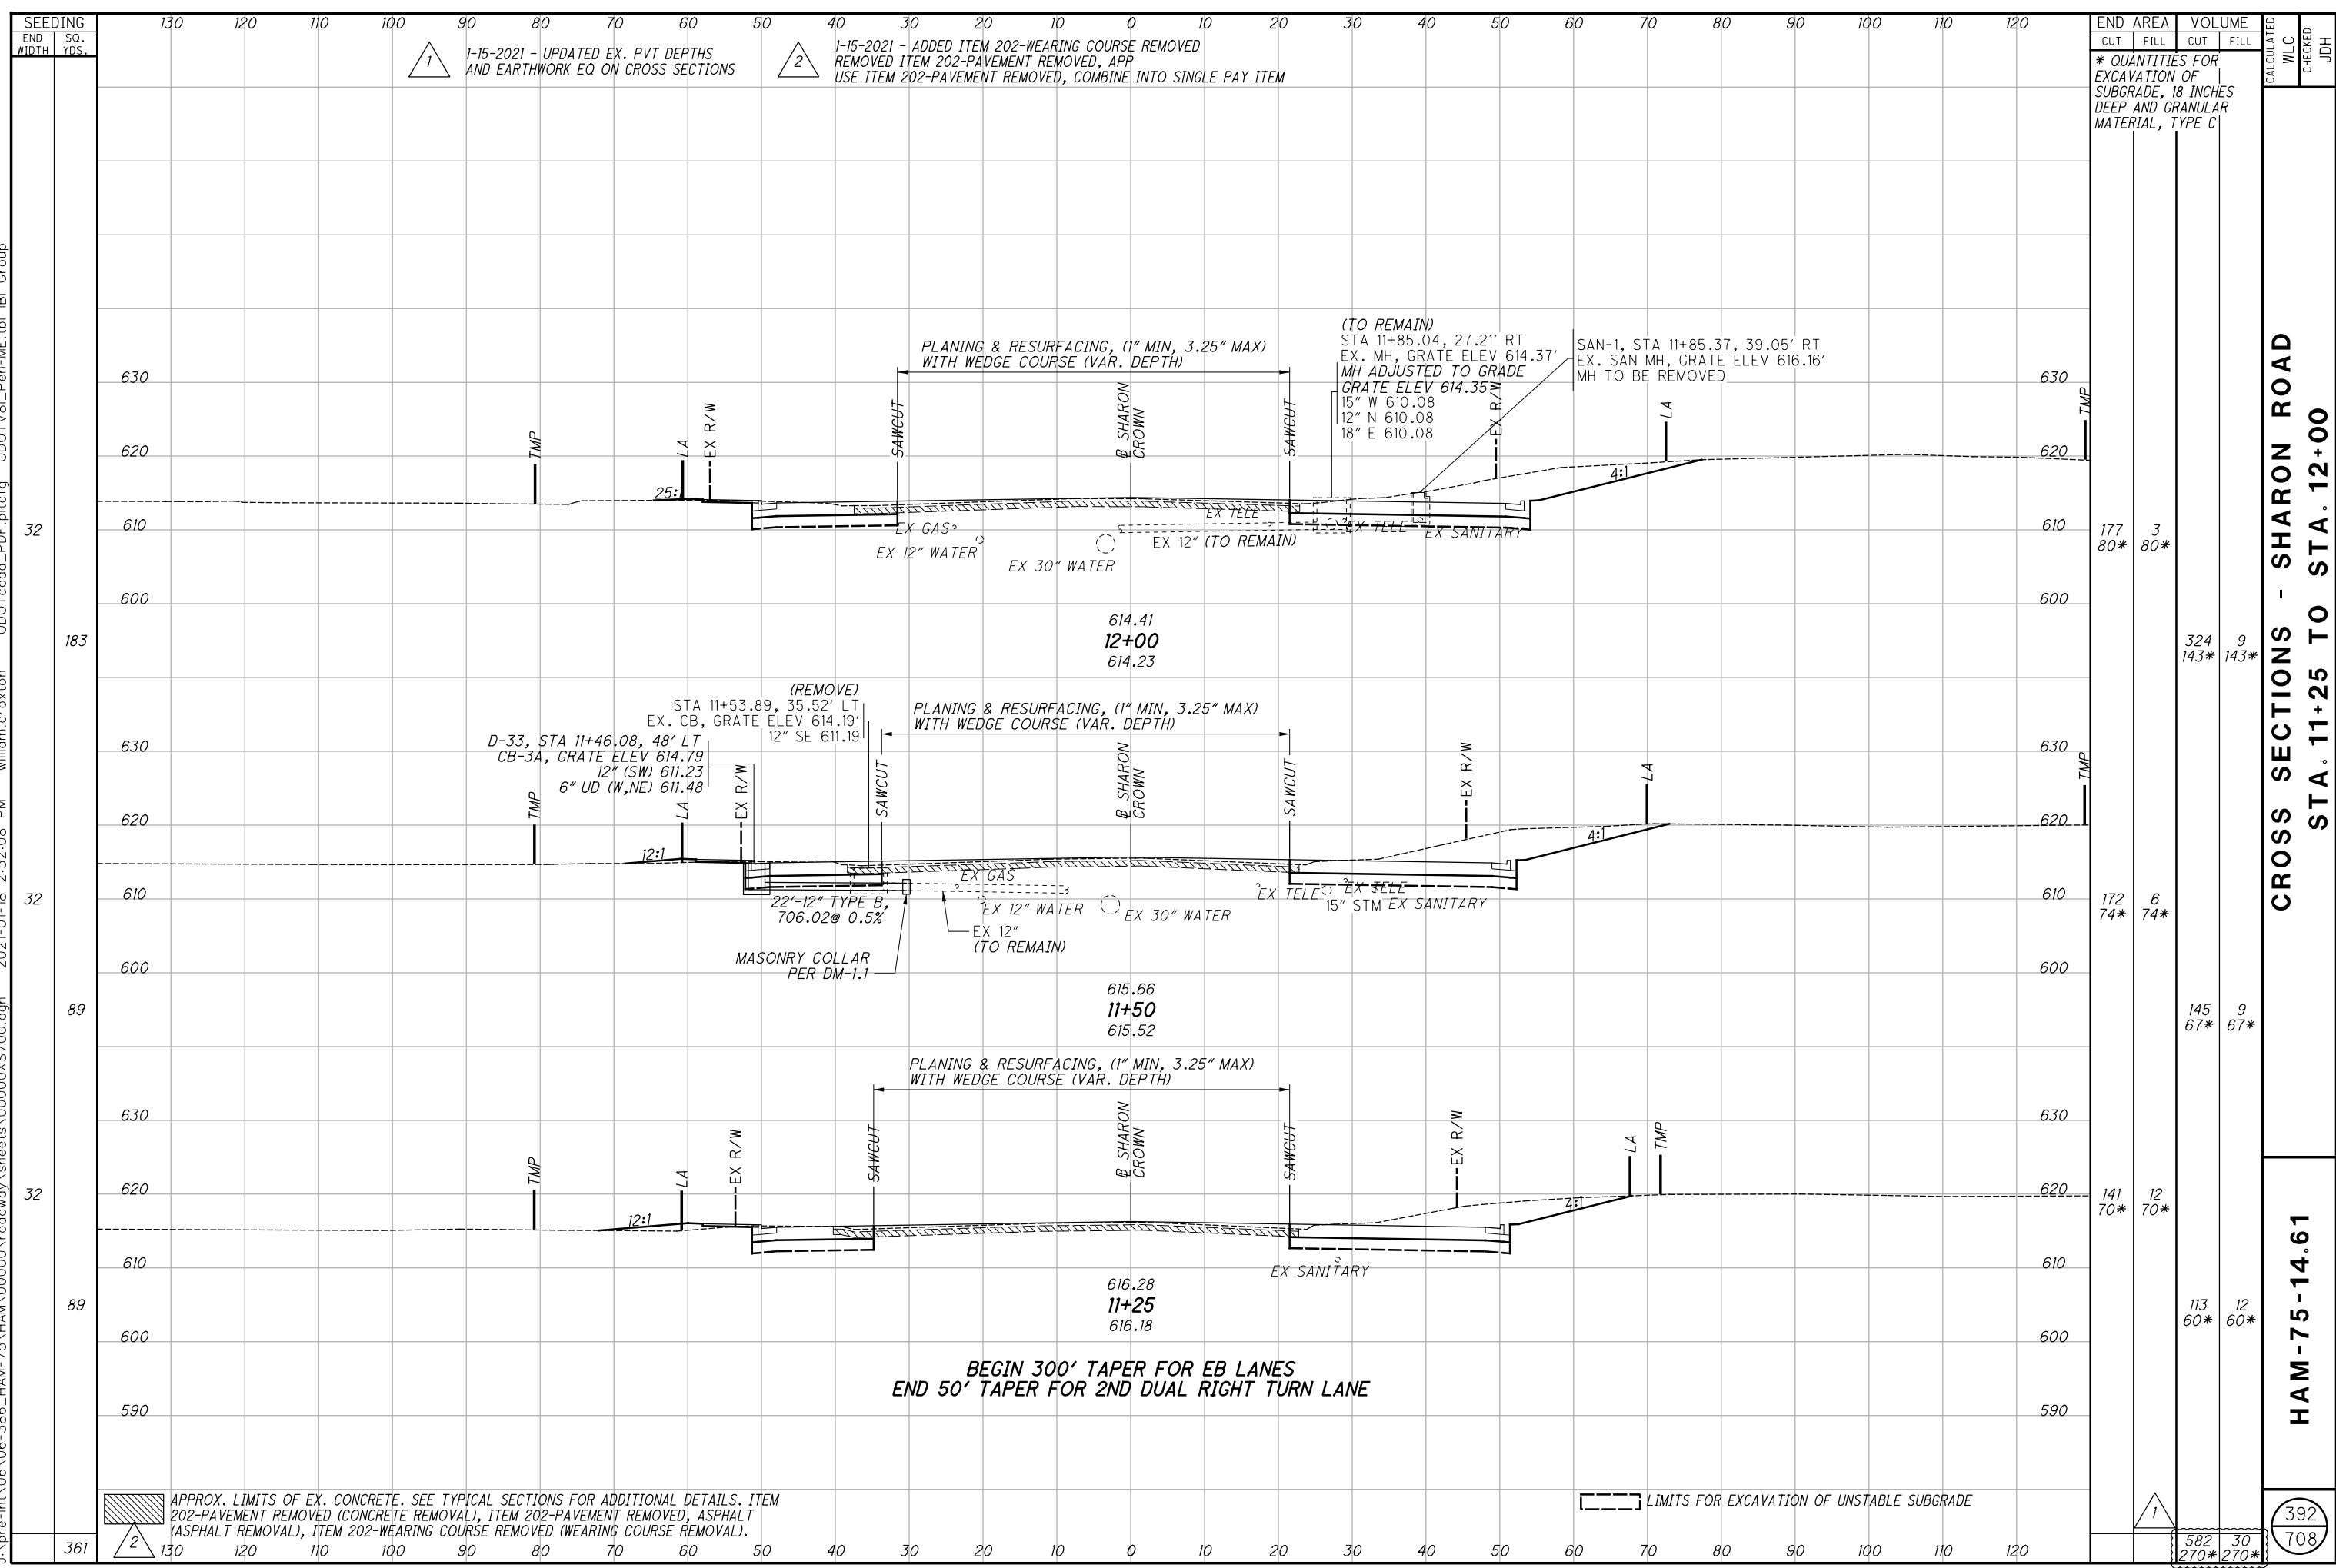

1-15-2021 - UPDATED EX. PVT DEPTHS AND EARTHWORK EQ ON CROSS SECTIONS  
 1-15-2021 - ADDED ITEM 202-WEARING COURSE REMOVED REMOVED ITEM 202-PAVEMENT REMOVED, APP USE ITEM 202-PAVEMENT REMOVED, COMBINE INTO SINGLE PAY ITEM


END AREA	VOLUME		CALCULATED	CHECKED	JDH
	CUT	FILL			
177	3	80*			
324	9	143*			
172	6	74*			
145	9	67*			
141	12	70*			
113	12	60*			
582	30	270*			

**CROSS SECTIONS - SHARON ROAD**  
**STA. 11+25 TO STA. 12+00**  
**HAM-75-14.61**

392 / 708

APPROX. LIMITS OF EX. CONCRETE. SEE TYPICAL SECTIONS FOR ADDITIONAL DETAILS. ITEM 202-PAVEMENT REMOVED (CONCRETE REMOVAL), ITEM 202-PAVEMENT REMOVED, ASPHALT (ASPHALT REMOVAL), ITEM 202-WEARING COURSE REMOVED (WEARING COURSE REMOVAL).  
 LIMITS FOR EXCAVATION OF UNSTABLE SUBGRADE

j:\pre-int\06\06-386\_HAM-75\HAM\00000\roadway\sheets\00000X5700.dgn 2021-01-18 2:52:08 PM william.croxton' ODOT\cadd\_PDF.plt\cfig ODOTV81\_Pen-ME.tbl IBI Group

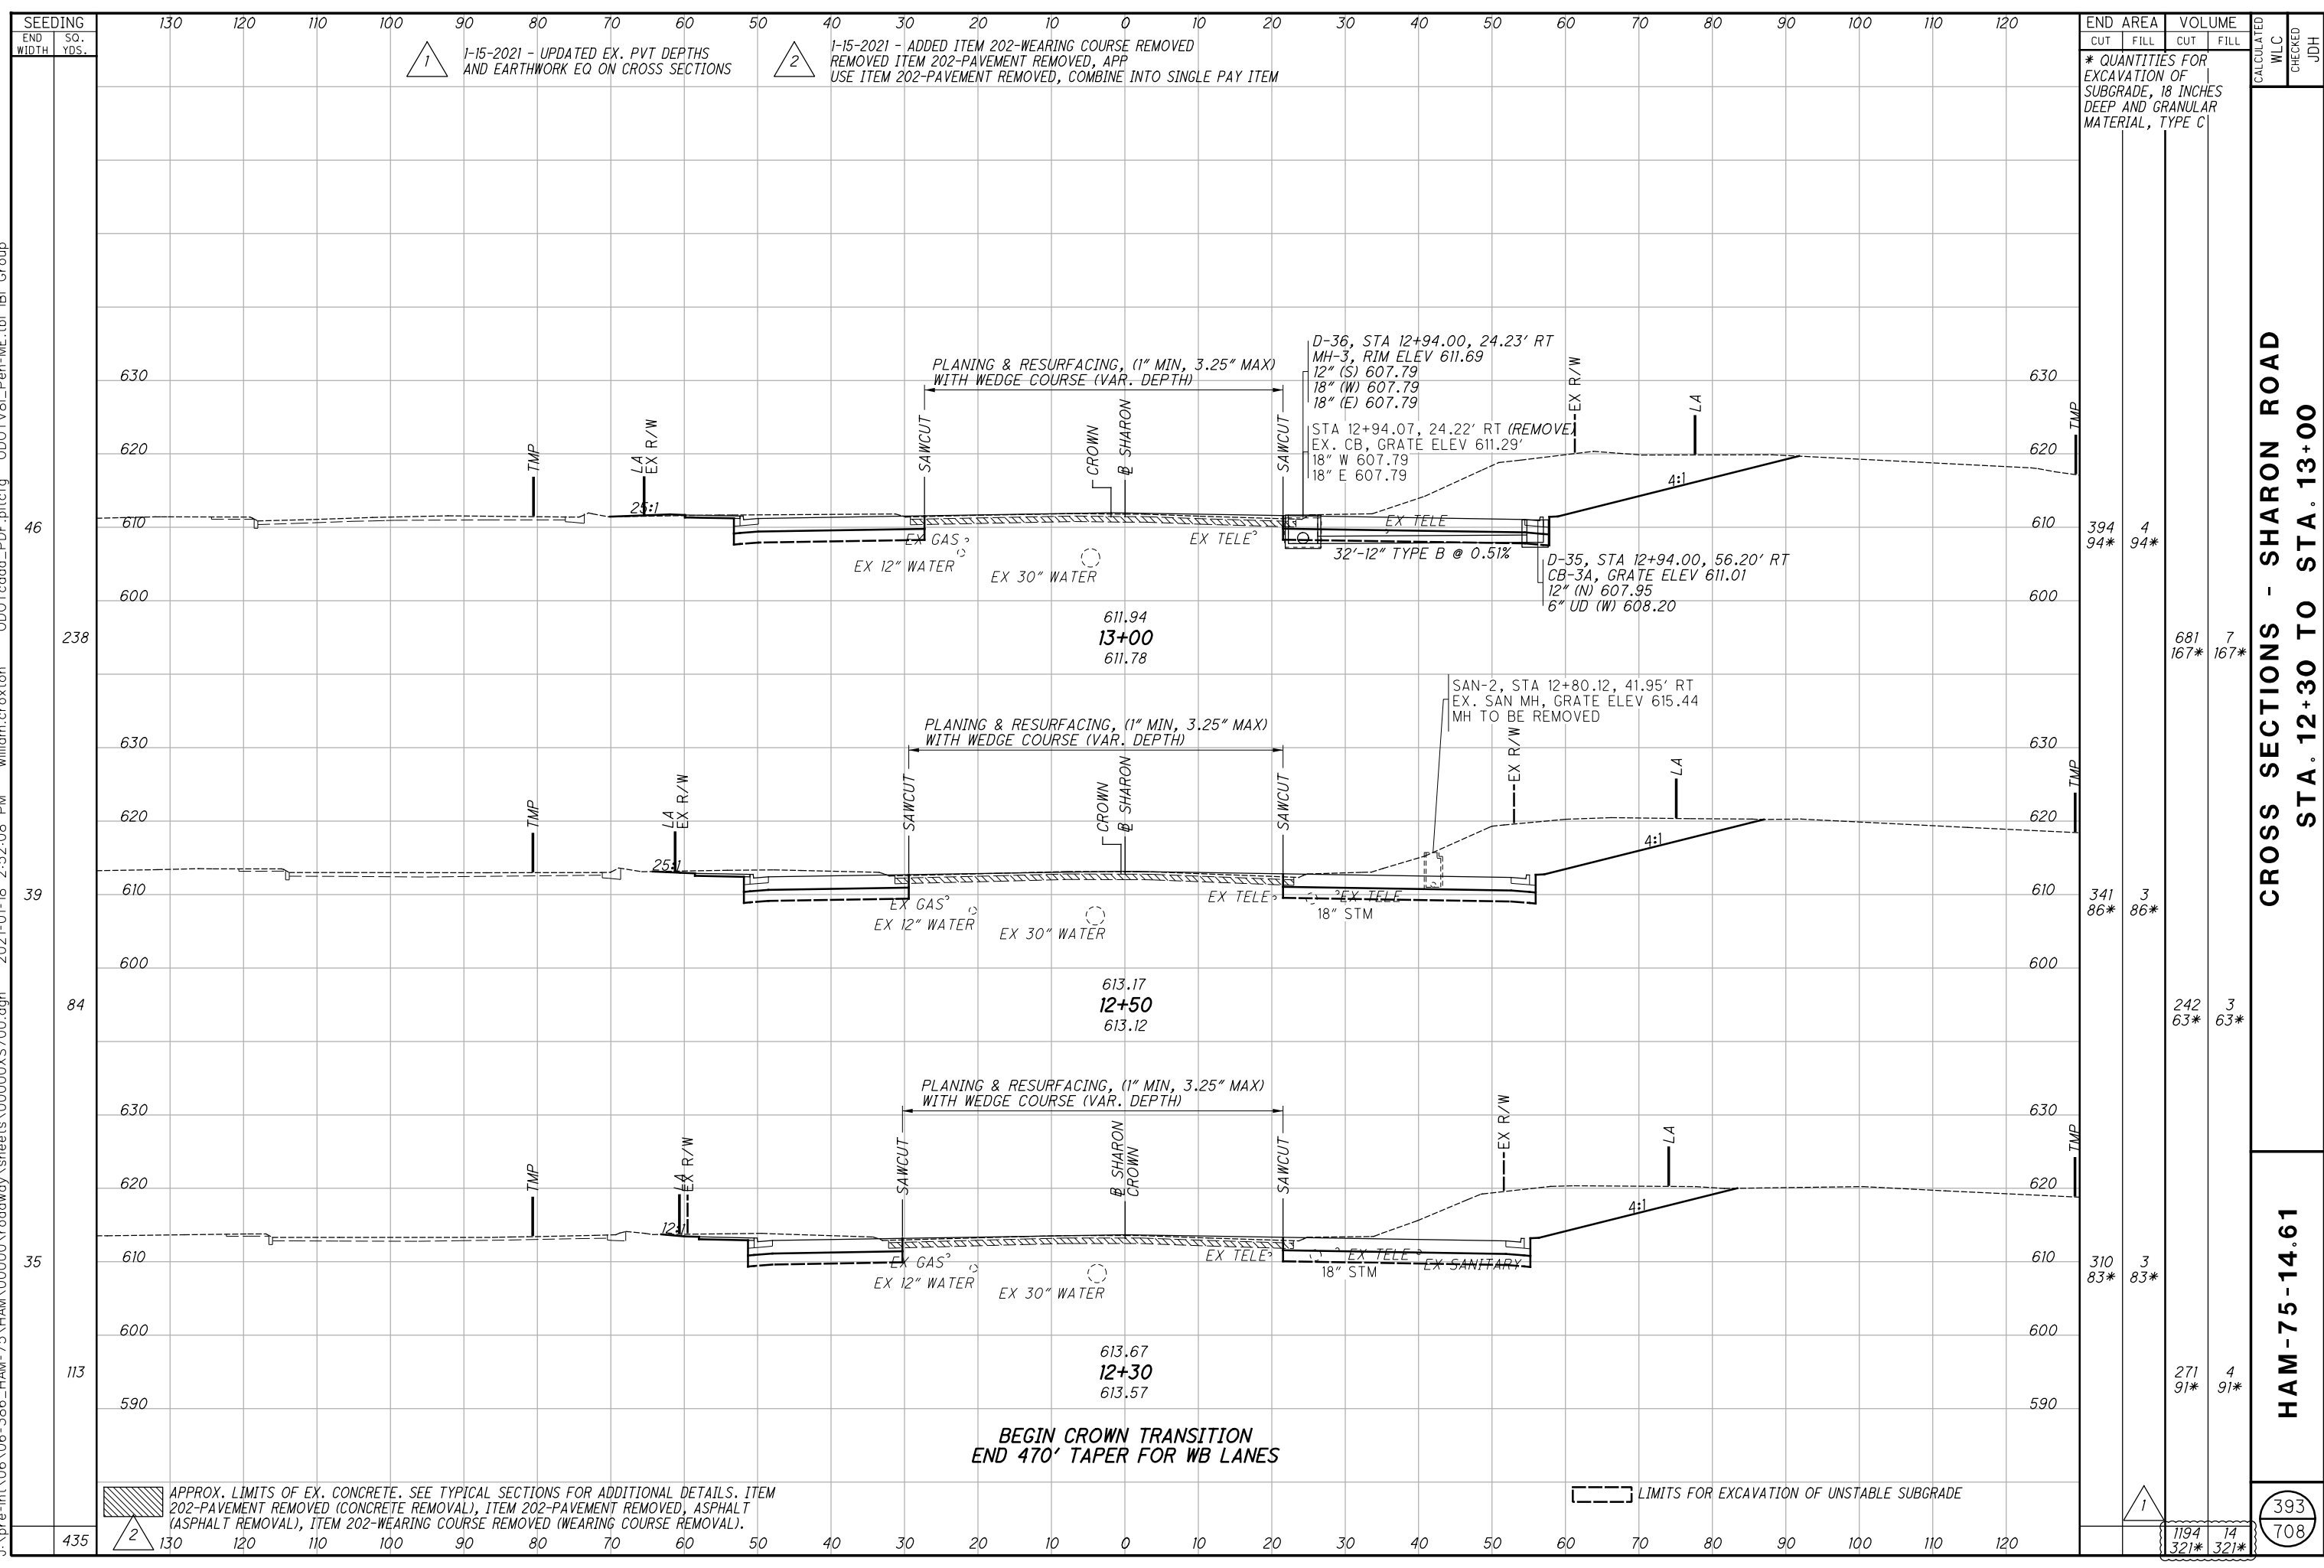

1-15-2021 - UPDATED EX. PVT DEPTHS AND EARTHWORK EQ ON CROSS SECTIONS



1-15-2021 - ADDED ITEM 202-WEARING COURSE REMOVED REMOVED ITEM 202-PAVEMENT REMOVED, APP USE ITEM 202-PAVEMENT REMOVED, COMBINE INTO SINGLE PAY ITEM

END AREA	VOLUME		CALCULATED	CHECKED	JDH
	CUT	FILL			
394	4	94*			
681	7	167*			
341	3	86*			
242	3	63*			
310	3	83*			
271	4	91*			
393	14	708			

**CROSS SECTIONS - SHARON ROAD  
STA. 12+30 TO STA. 13+00**

**HAM-75-14.61**

APPROX. LIMITS OF EX. CONCRETE. SEE TYPICAL SECTIONS FOR ADDITIONAL DETAILS. ITEM 202-PAVEMENT REMOVED (CONCRETE REMOVAL), ITEM 202-PAVEMENT REMOVED, ASPHALT (ASPHALT REMOVAL), ITEM 202-WEARING COURSE REMOVED (WEARING COURSE REMOVAL).

LIMITS FOR EXCAVATION OF UNSTABLE SUBGRADE


BEGIN CROWN TRANSITION  
END 470' TAPER FOR WB LANES



393  
708



j:\pre-int\06\06-386\_HAM-75\HAM\00000\roadway\sheets\00000X5700.dgn 2021-01-18 2:52:09 PM william.croxton\ ODOTcadd\_PDF.pltcfgr ODOTV81\_Pen-ME.tbl IBI Group

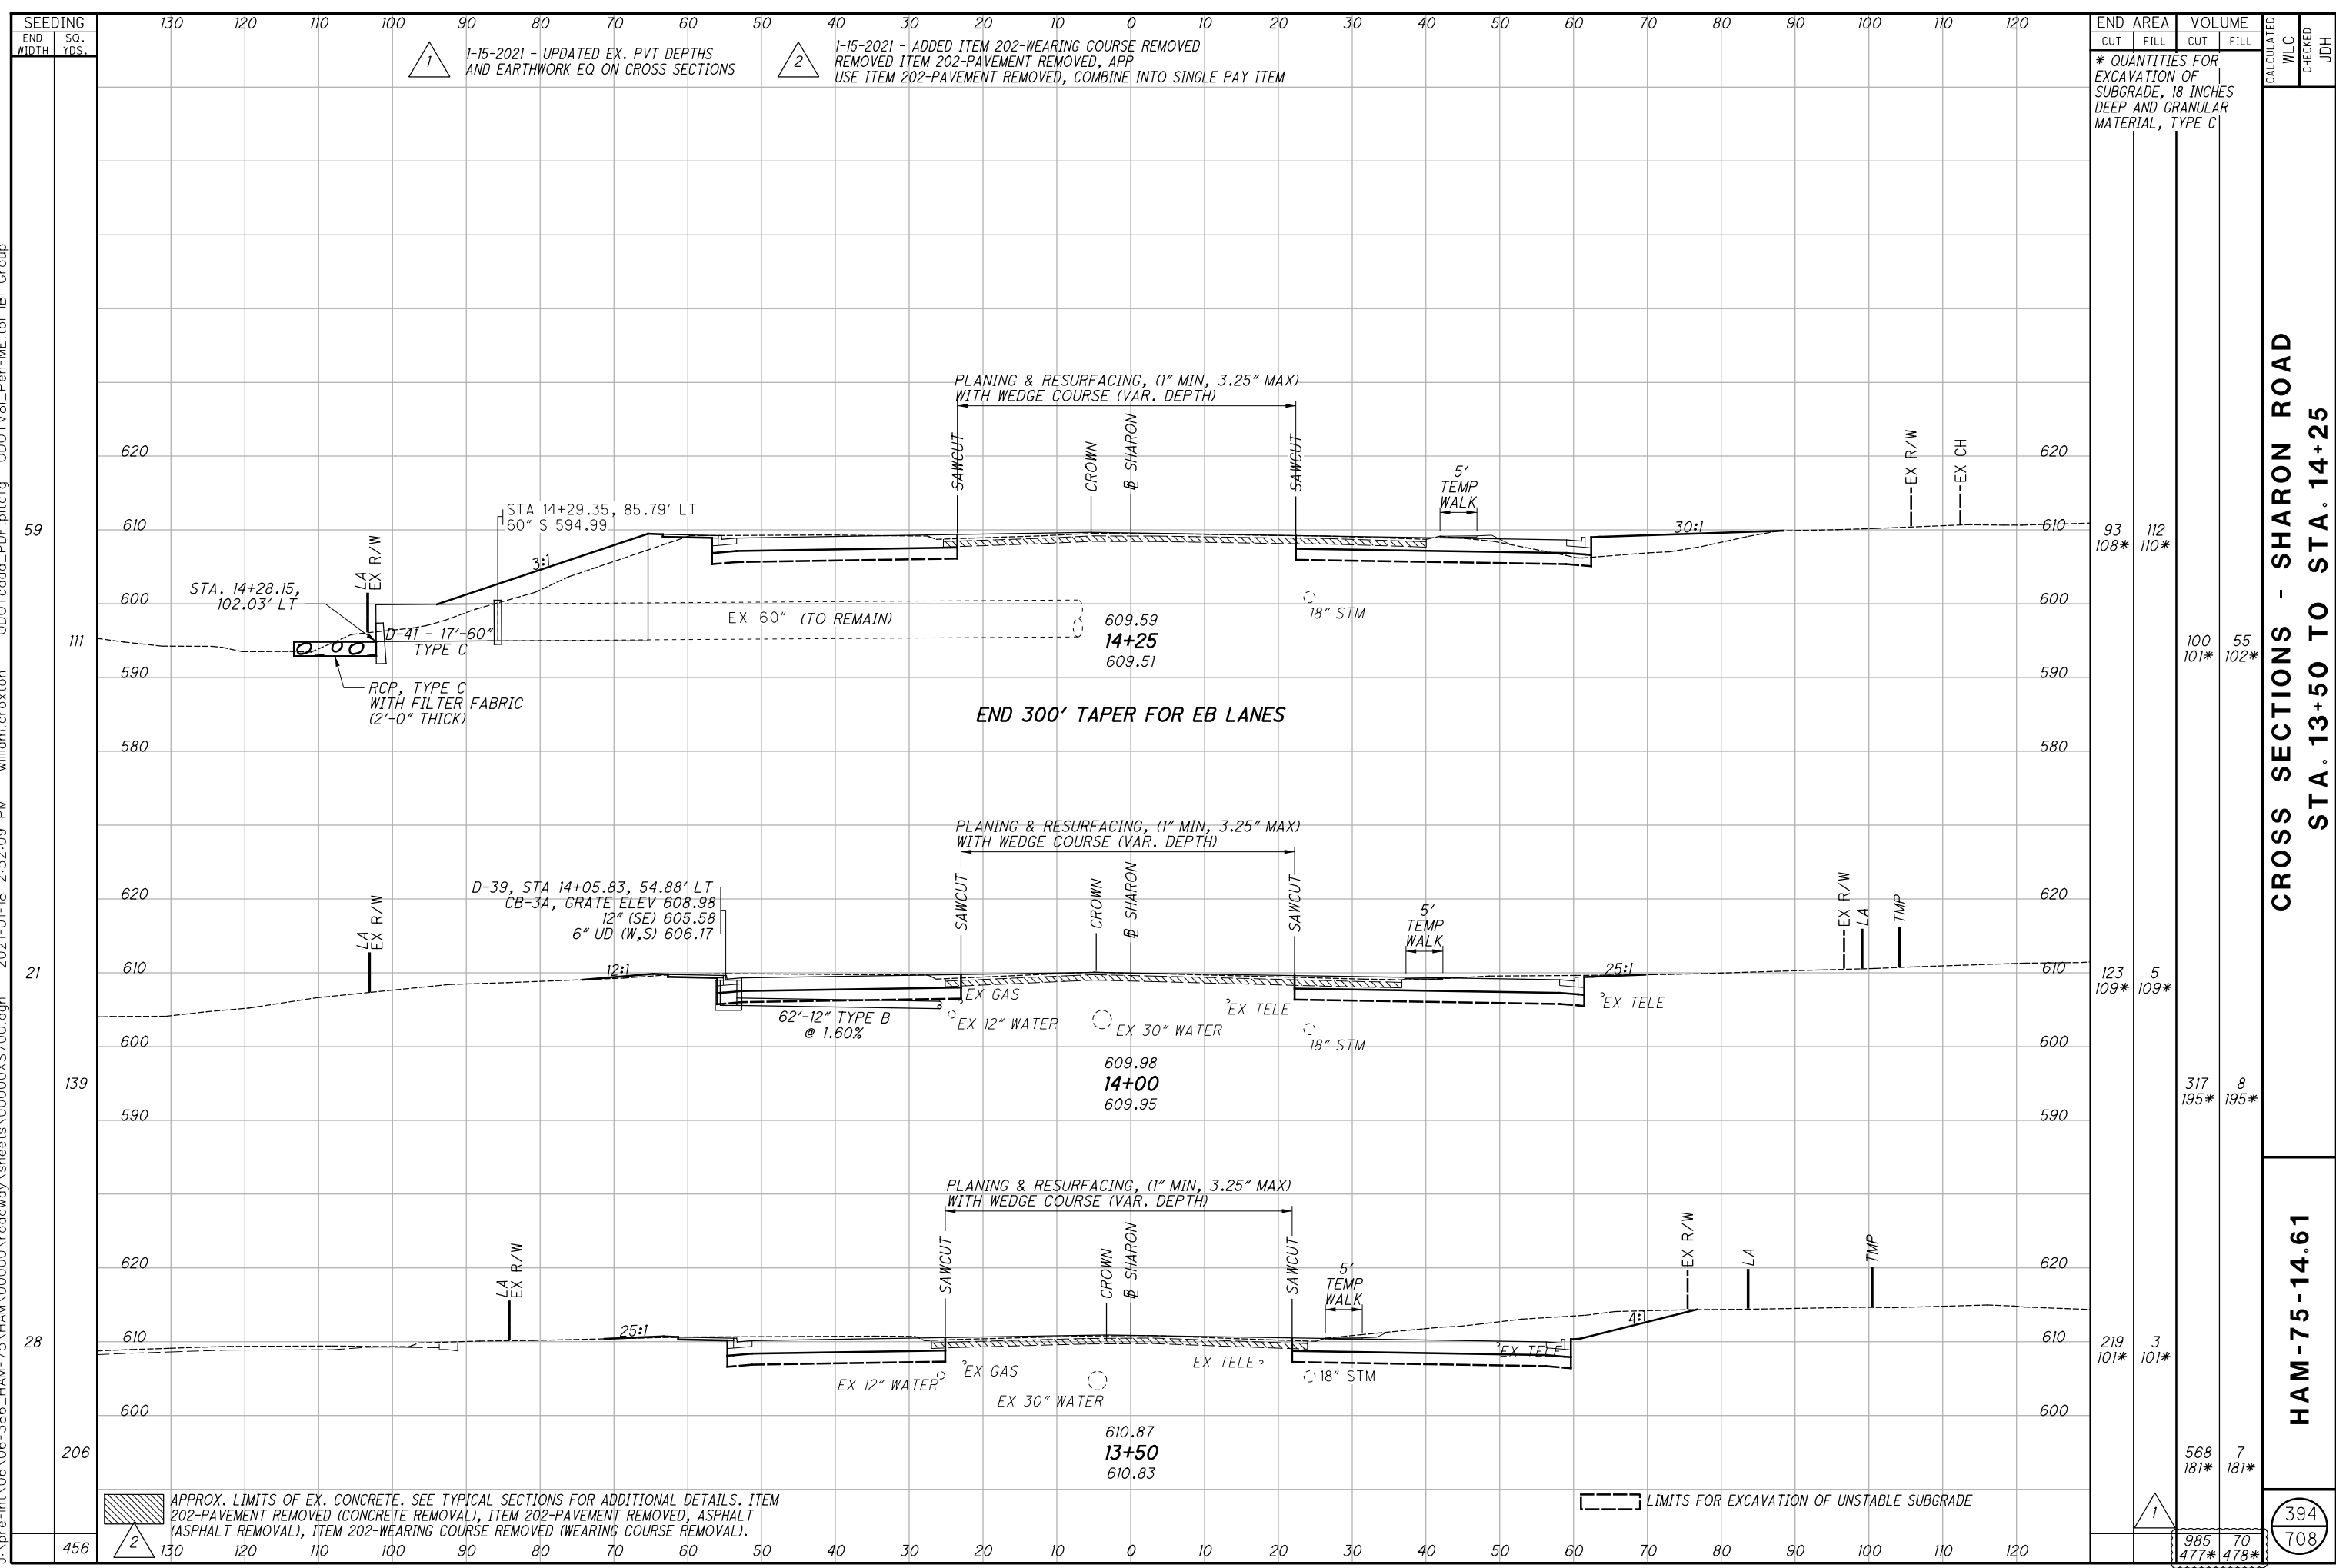

SEEDING		END AREA		VOLUME		CALCULATED	
END WIDTH	SO. YDS.	CUT	FILL	CUT	FILL	WLC	CHECKED
130	120	93	112	100	55		
110	100	108*	110*	101*	102*		
90	80						
70	60						
50	40						
30	20						
10	0						
10	20						
30	40						
50	60						
70	80						
90	100						
110	120						
		123	5	109*	109*		
		317	8	195*	195*		
		219	3	101*	101*		
		568	7	181*	181*		
		985	70	477*	478*		

**CROSS SECTIONS - SHARON ROAD**  
**STA. 13+50 TO STA. 14+25**

**HAM-75-14.61**

394  
 708

APPROX. LIMITS OF EX. CONCRETE. SEE TYPICAL SECTIONS FOR ADDITIONAL DETAILS. ITEM 202-PAVEMENT REMOVED (CONCRETE REMOVAL), ITEM 202-PAVEMENT REMOVED, ASPHALT (ASPHALT REMOVAL), ITEM 202-WEARING COURSE REMOVED (WEARING COURSE REMOVAL).


LIMITS FOR EXCAVATION OF UNSTABLE SUBGRADE

1-15-2021 - UPDATED EX. PVT DEPTHS AND EARTHWORK EQ ON CROSS SECTIONS

1-15-2021 - ADDED ITEM 202-WEARING COURSE REMOVED REMOVED ITEM 202-PAVEMENT REMOVED, APP USE ITEM 202-PAVEMENT REMOVED, COMBINE INTO SINGLE PAY ITEM

\* QUANTITIES FOR EXCAVATION OF SUBGRADE, 18 INCHES DEEP AND GRANULAR MATERIAL, TYPE C

j:\pre-int\06\06-386\_HAM-75\HAM\00000\roadway\sheets\00000X5700.dgn 2021-01-18 2:52:09 PM william.croxton' ODOTcadd\_PDF.pltcfgr ODOTV81\_Pen-ME.tbl IBI Group

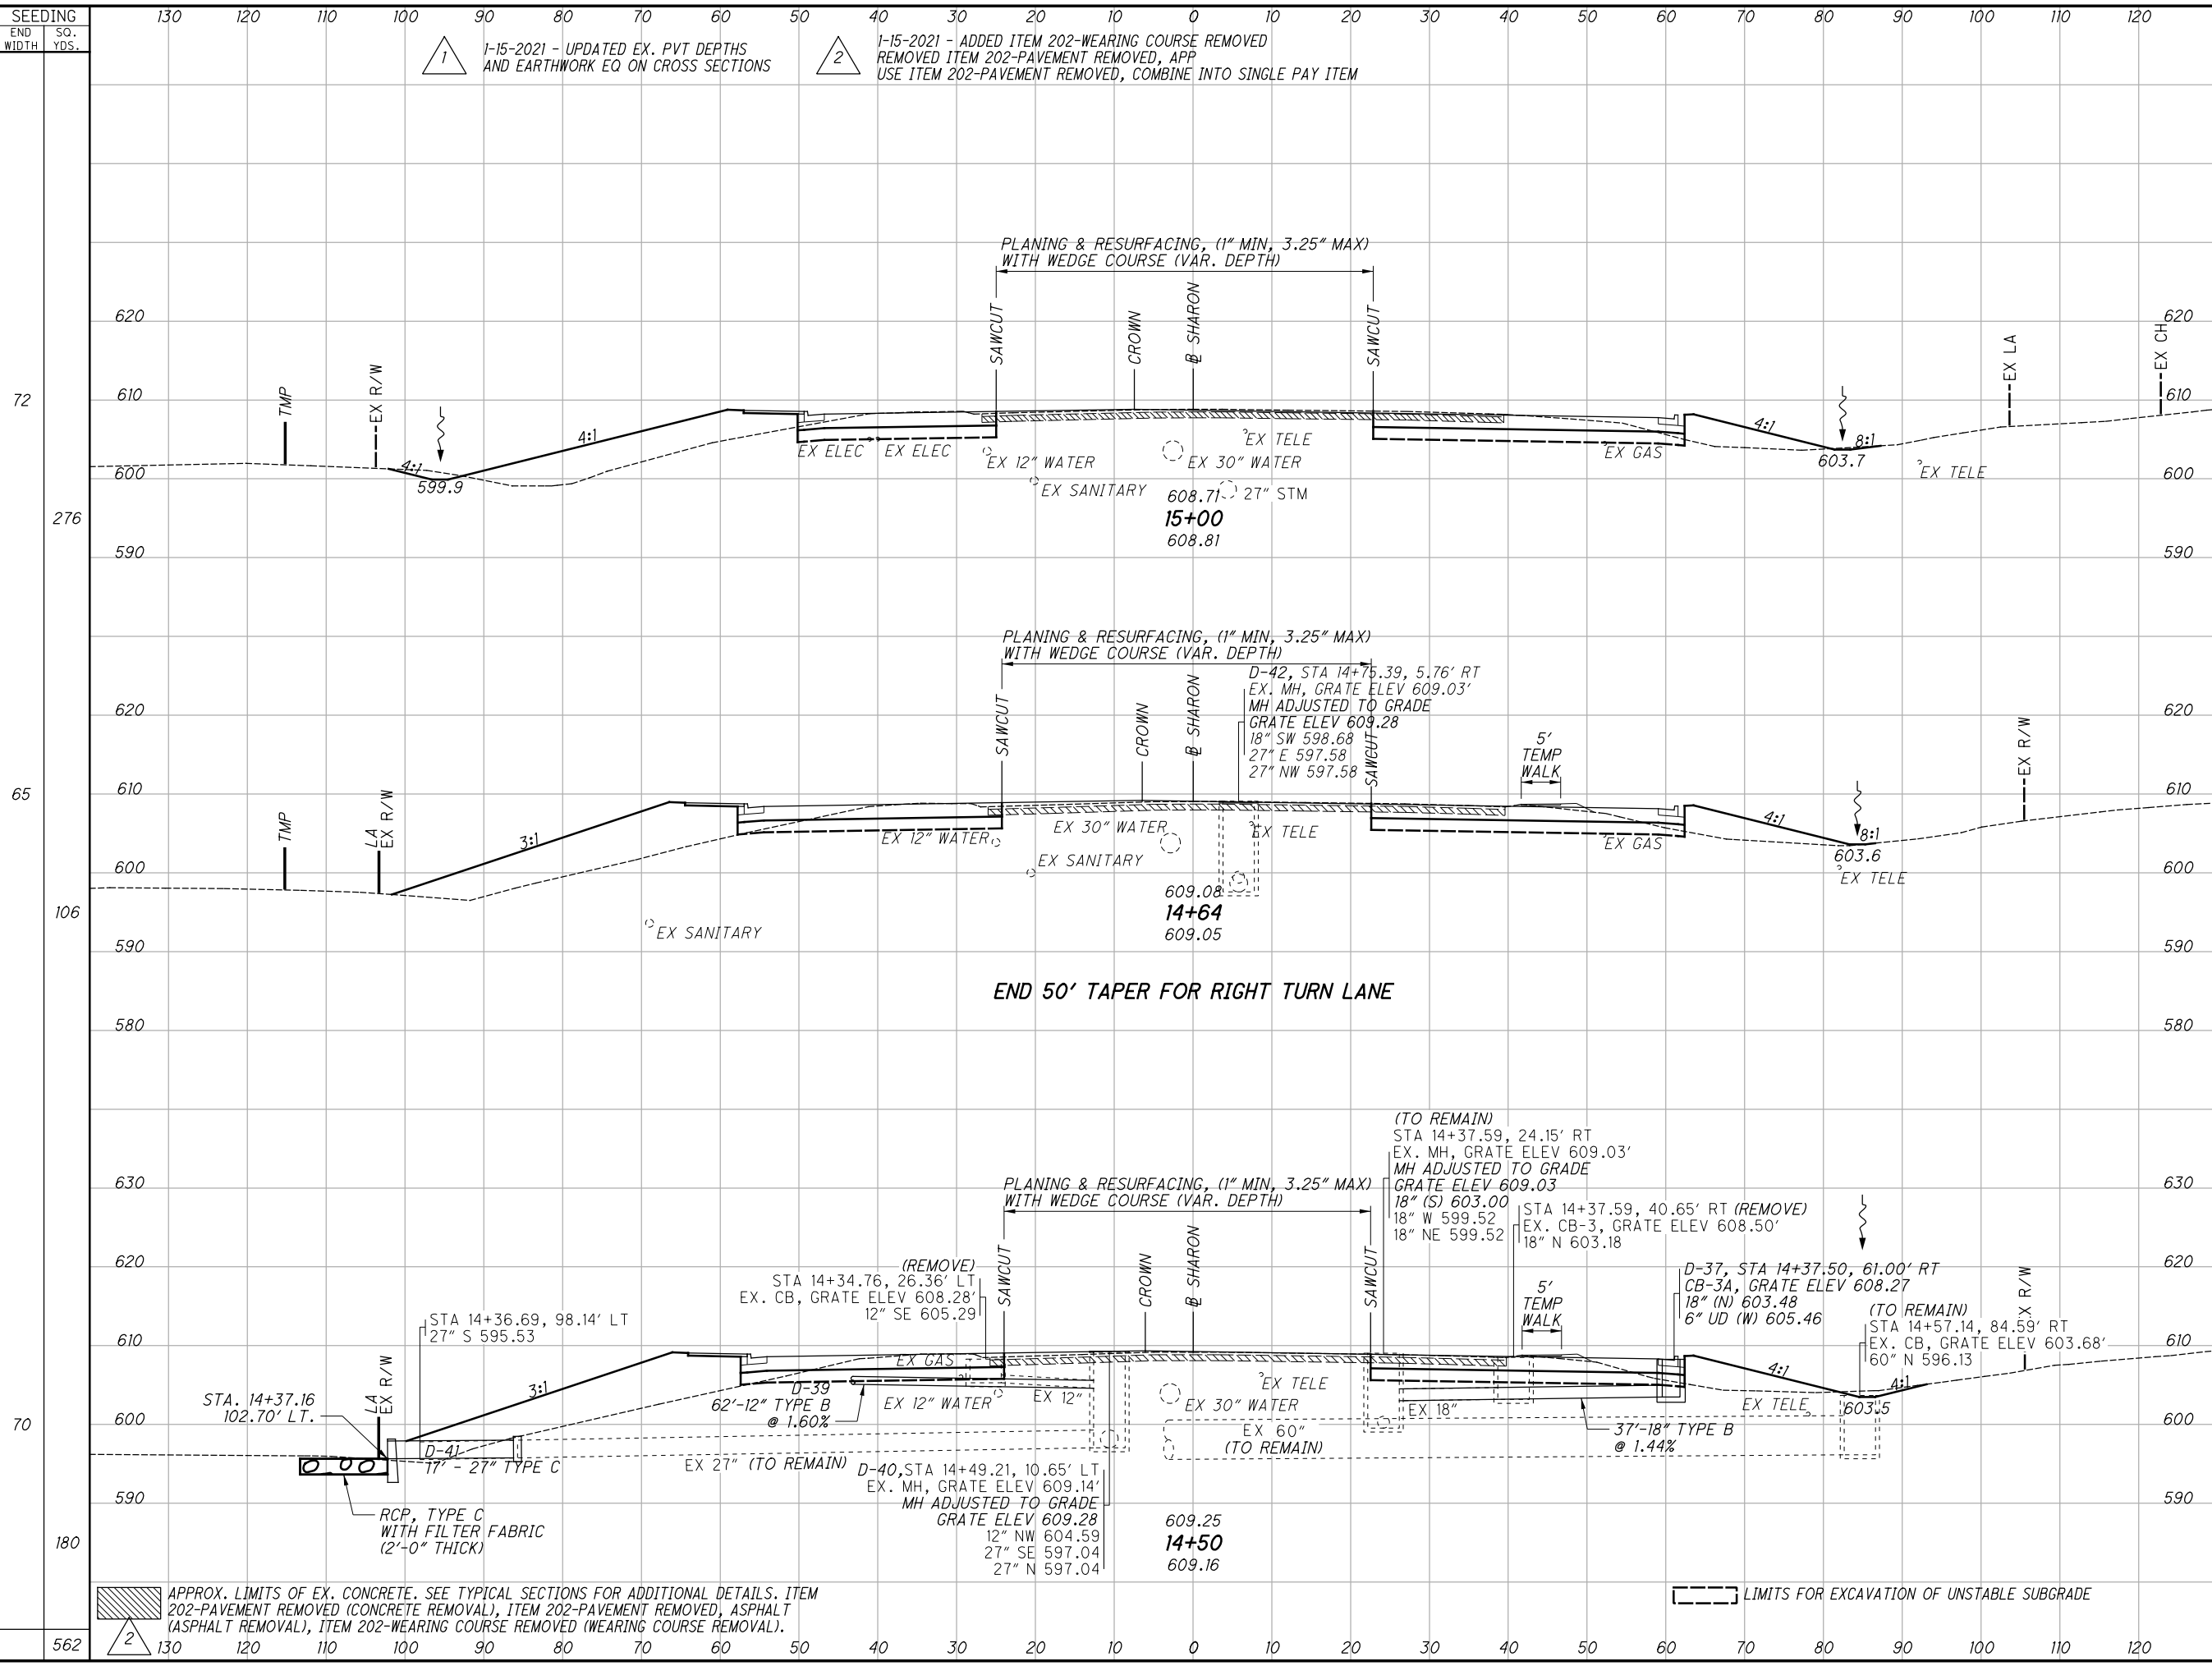

END AREA	VOLUME		CALCULATED	CHECKED	JDH
	CUT	FILL			
81 96*	181 98*	100 130*	280	139*	
68 99*	238 110*	36 52*	120	58*	
70 98*	222 110*	76 96*	155	102*	
		212 278*	555	299*	

**CROSS SECTIONS - SHARON ROAD**  
**STA. 14+50 TO STA. 15+00**


**HAM-75-14.61**

395  
708

APPROX. LIMITS OF EX. CONCRETE. SEE TYPICAL SECTIONS FOR ADDITIONAL DETAILS. ITEM 202-PAVEMENT REMOVED (CONCRETE REMOVAL), ITEM 202-PAVEMENT REMOVED, ASPHALT (ASPHALT REMOVAL), ITEM 202-WEARING COURSE REMOVED (WEARING COURSE REMOVAL).

LIMITS FOR EXCAVATION OF UNSTABLE SUBGRADE

j:\pre-int\06\06-386\_HAM-75\_HAM\00000\roadway\sheets\00000X5700.dgn 2021-01-18 2:52:10 PM william.croxton' ODOTcadd\_PDF.plt:fig ODOTV8i\_Pen-ME.tbl IBI Group

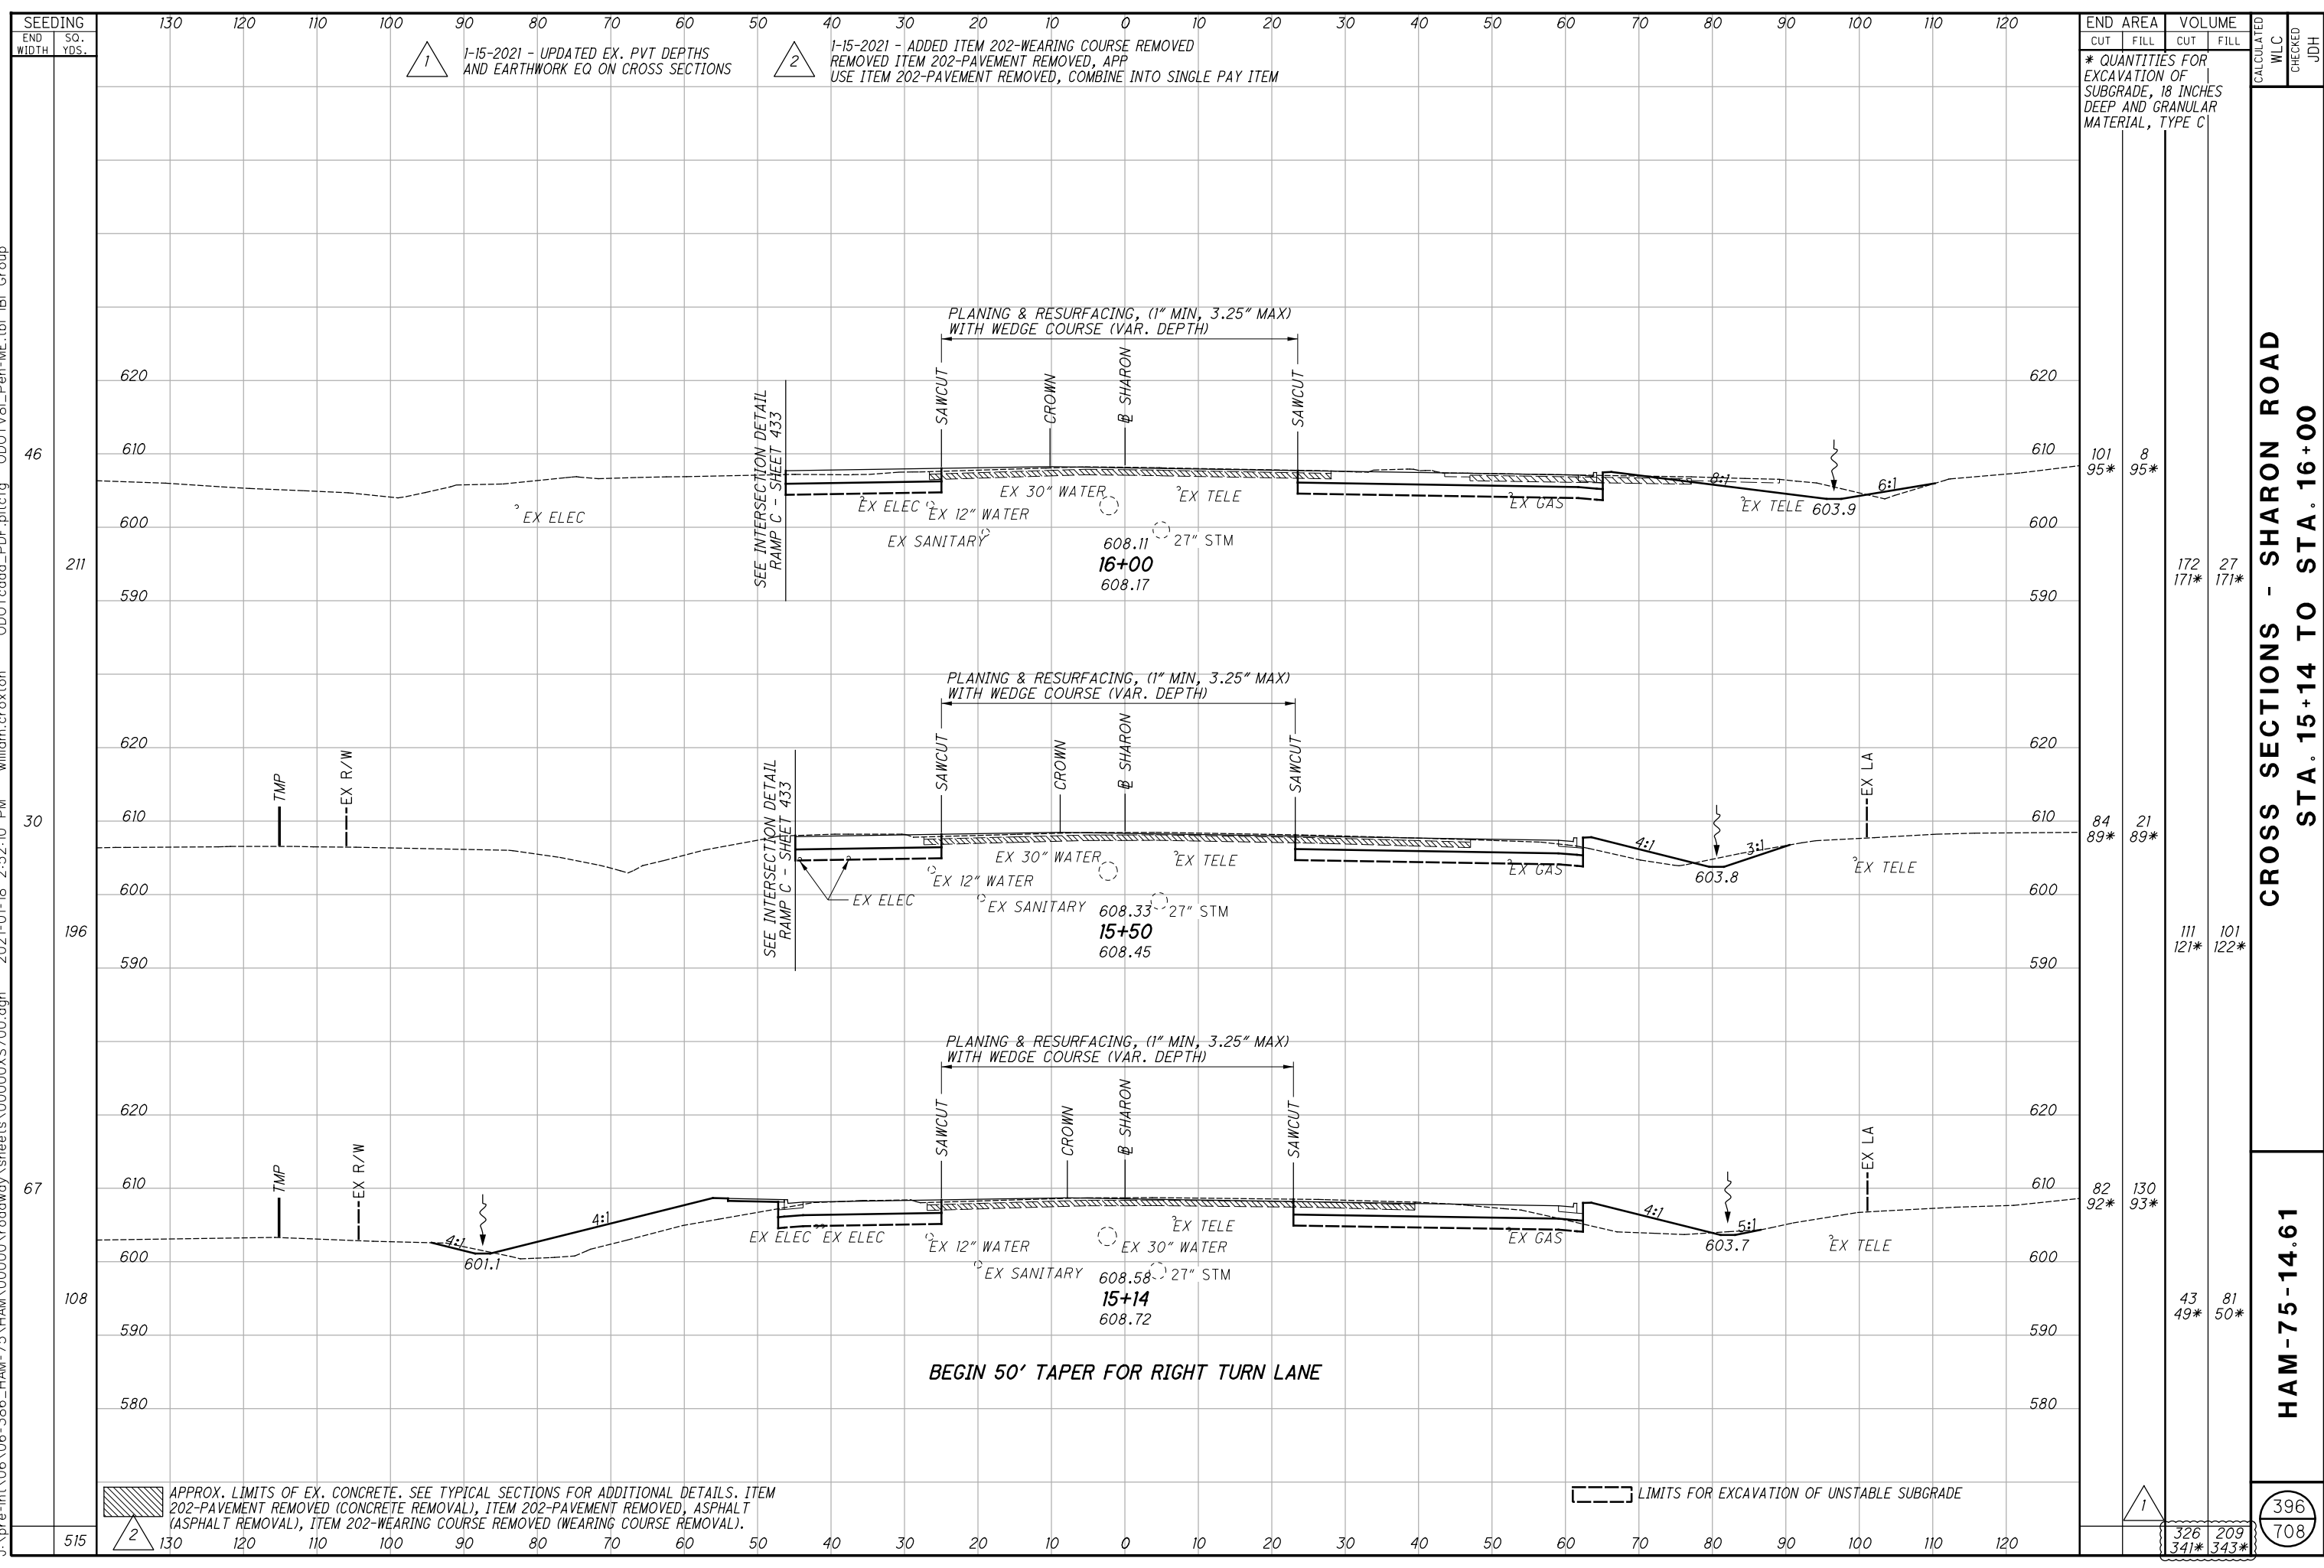

1-15-2021 - UPDATED EX. PVT DEPTHS AND EARTHWORK EQ ON CROSS SECTIONS

1-15-2021 - ADDED ITEM 202-WEARING COURSE REMOVED REMOVED ITEM 202-PAVEMENT REMOVED, APP USE ITEM 202-PAVEMENT REMOVED, COMBINE INTO SINGLE PAY ITEM

END AREA	VOLUME		CALCULATED	CHECKED	JDH
	CUT	FILL			
101 95*	8	95*	172	27	171*
84 89*	21	89*	111	101	122*
82 92*	130	93*	43	81	50*
		326		209	708
		341*		343*	

CROSS SECTIONS - SHARON ROAD  
STA. 15+14 TO STA. 16+00

HAM-75-14.61


396  
708

APPROX. LIMITS OF EX. CONCRETE. SEE TYPICAL SECTIONS FOR ADDITIONAL DETAILS. ITEM 202-PAVEMENT REMOVED (CONCRETE REMOVAL), ITEM 202-PAVEMENT REMOVED, ASPHALT (ASPHALT REMOVAL), ITEM 202-WEARING COURSE REMOVED (WEARING COURSE REMOVAL).


LIMITS FOR EXCAVATION OF UNSTABLE SUBGRADE

BEGIN 50' TAPER FOR RIGHT TURN LANE

j:\pre-int\06\06-386\_HAM-75\HAM\00000\roadway\sheets\00000X5700.dgn 2021-01-18 2:52:10 PM william.croxton' ODOTcadd\_PDF.pltcfgr ODOTV8i\_Pen-ME.tbl IBI Group

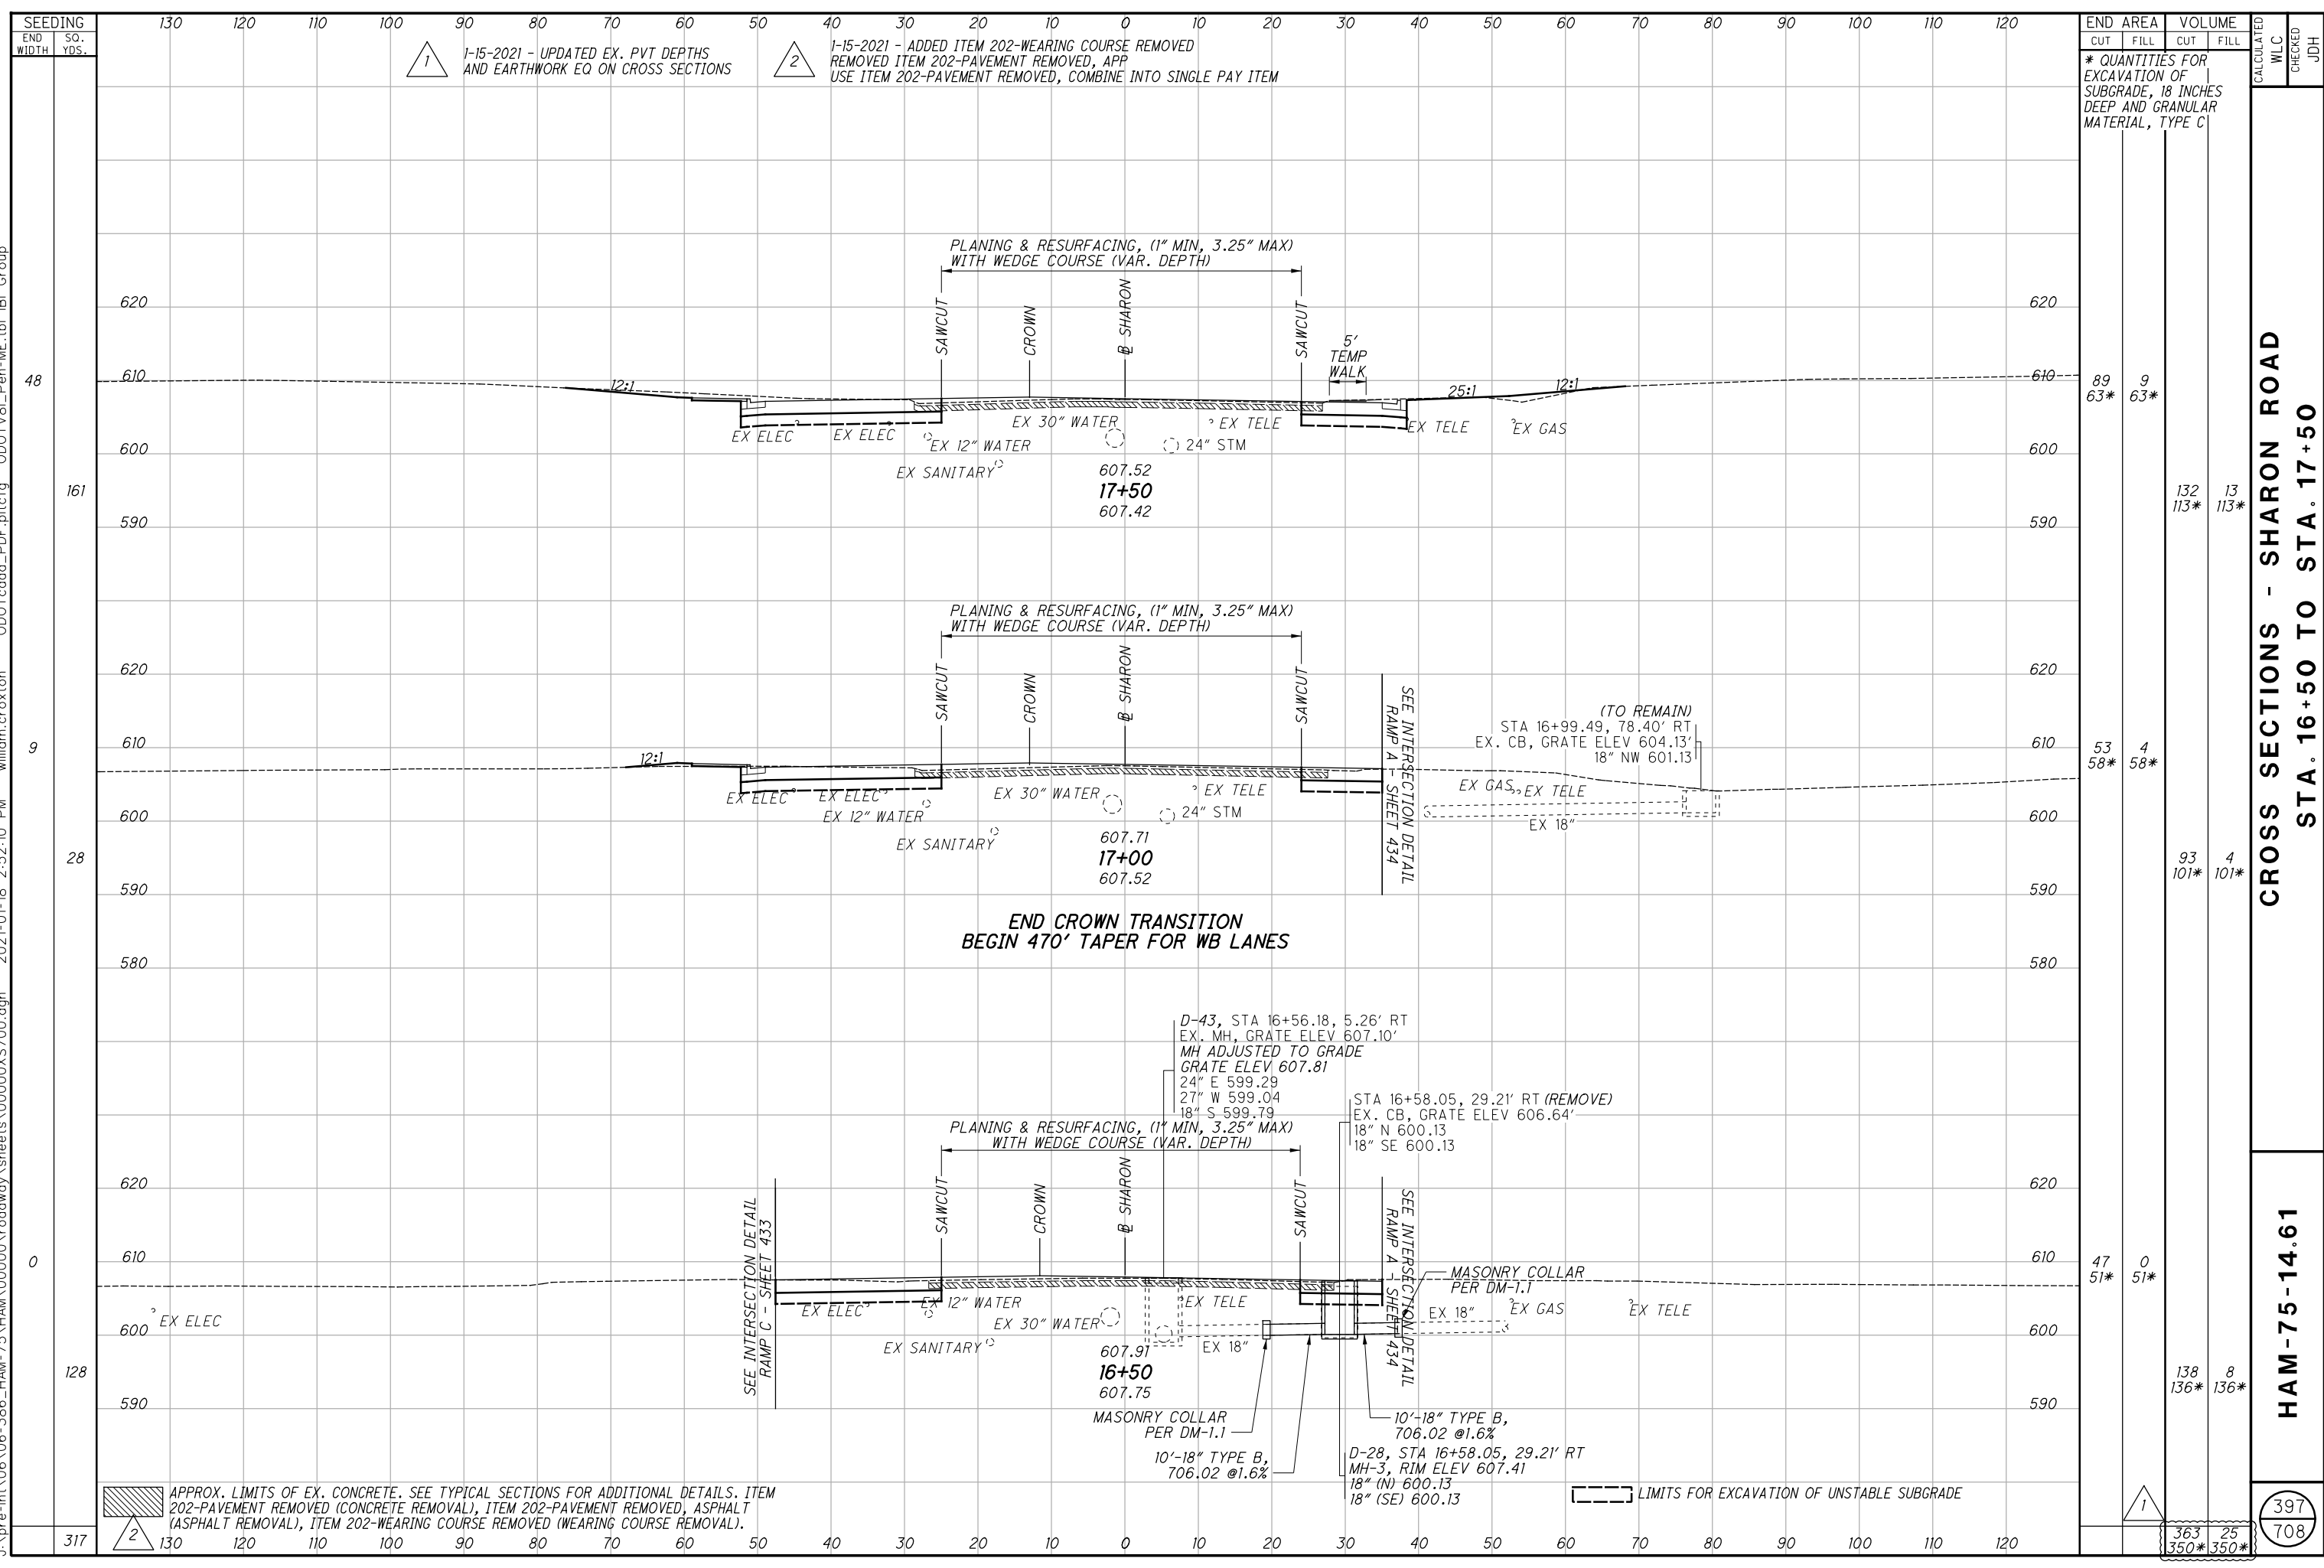

J:\pre-int\06-386\_HAM-75\HAM\00000\roadway\sheets\00000X5700.dgn 2021-01-18 2:52:11 PM william.croxton ODOTcadd\_PDF.pltcf ODOTV8i\_Pen-ME.tbl IBI Group

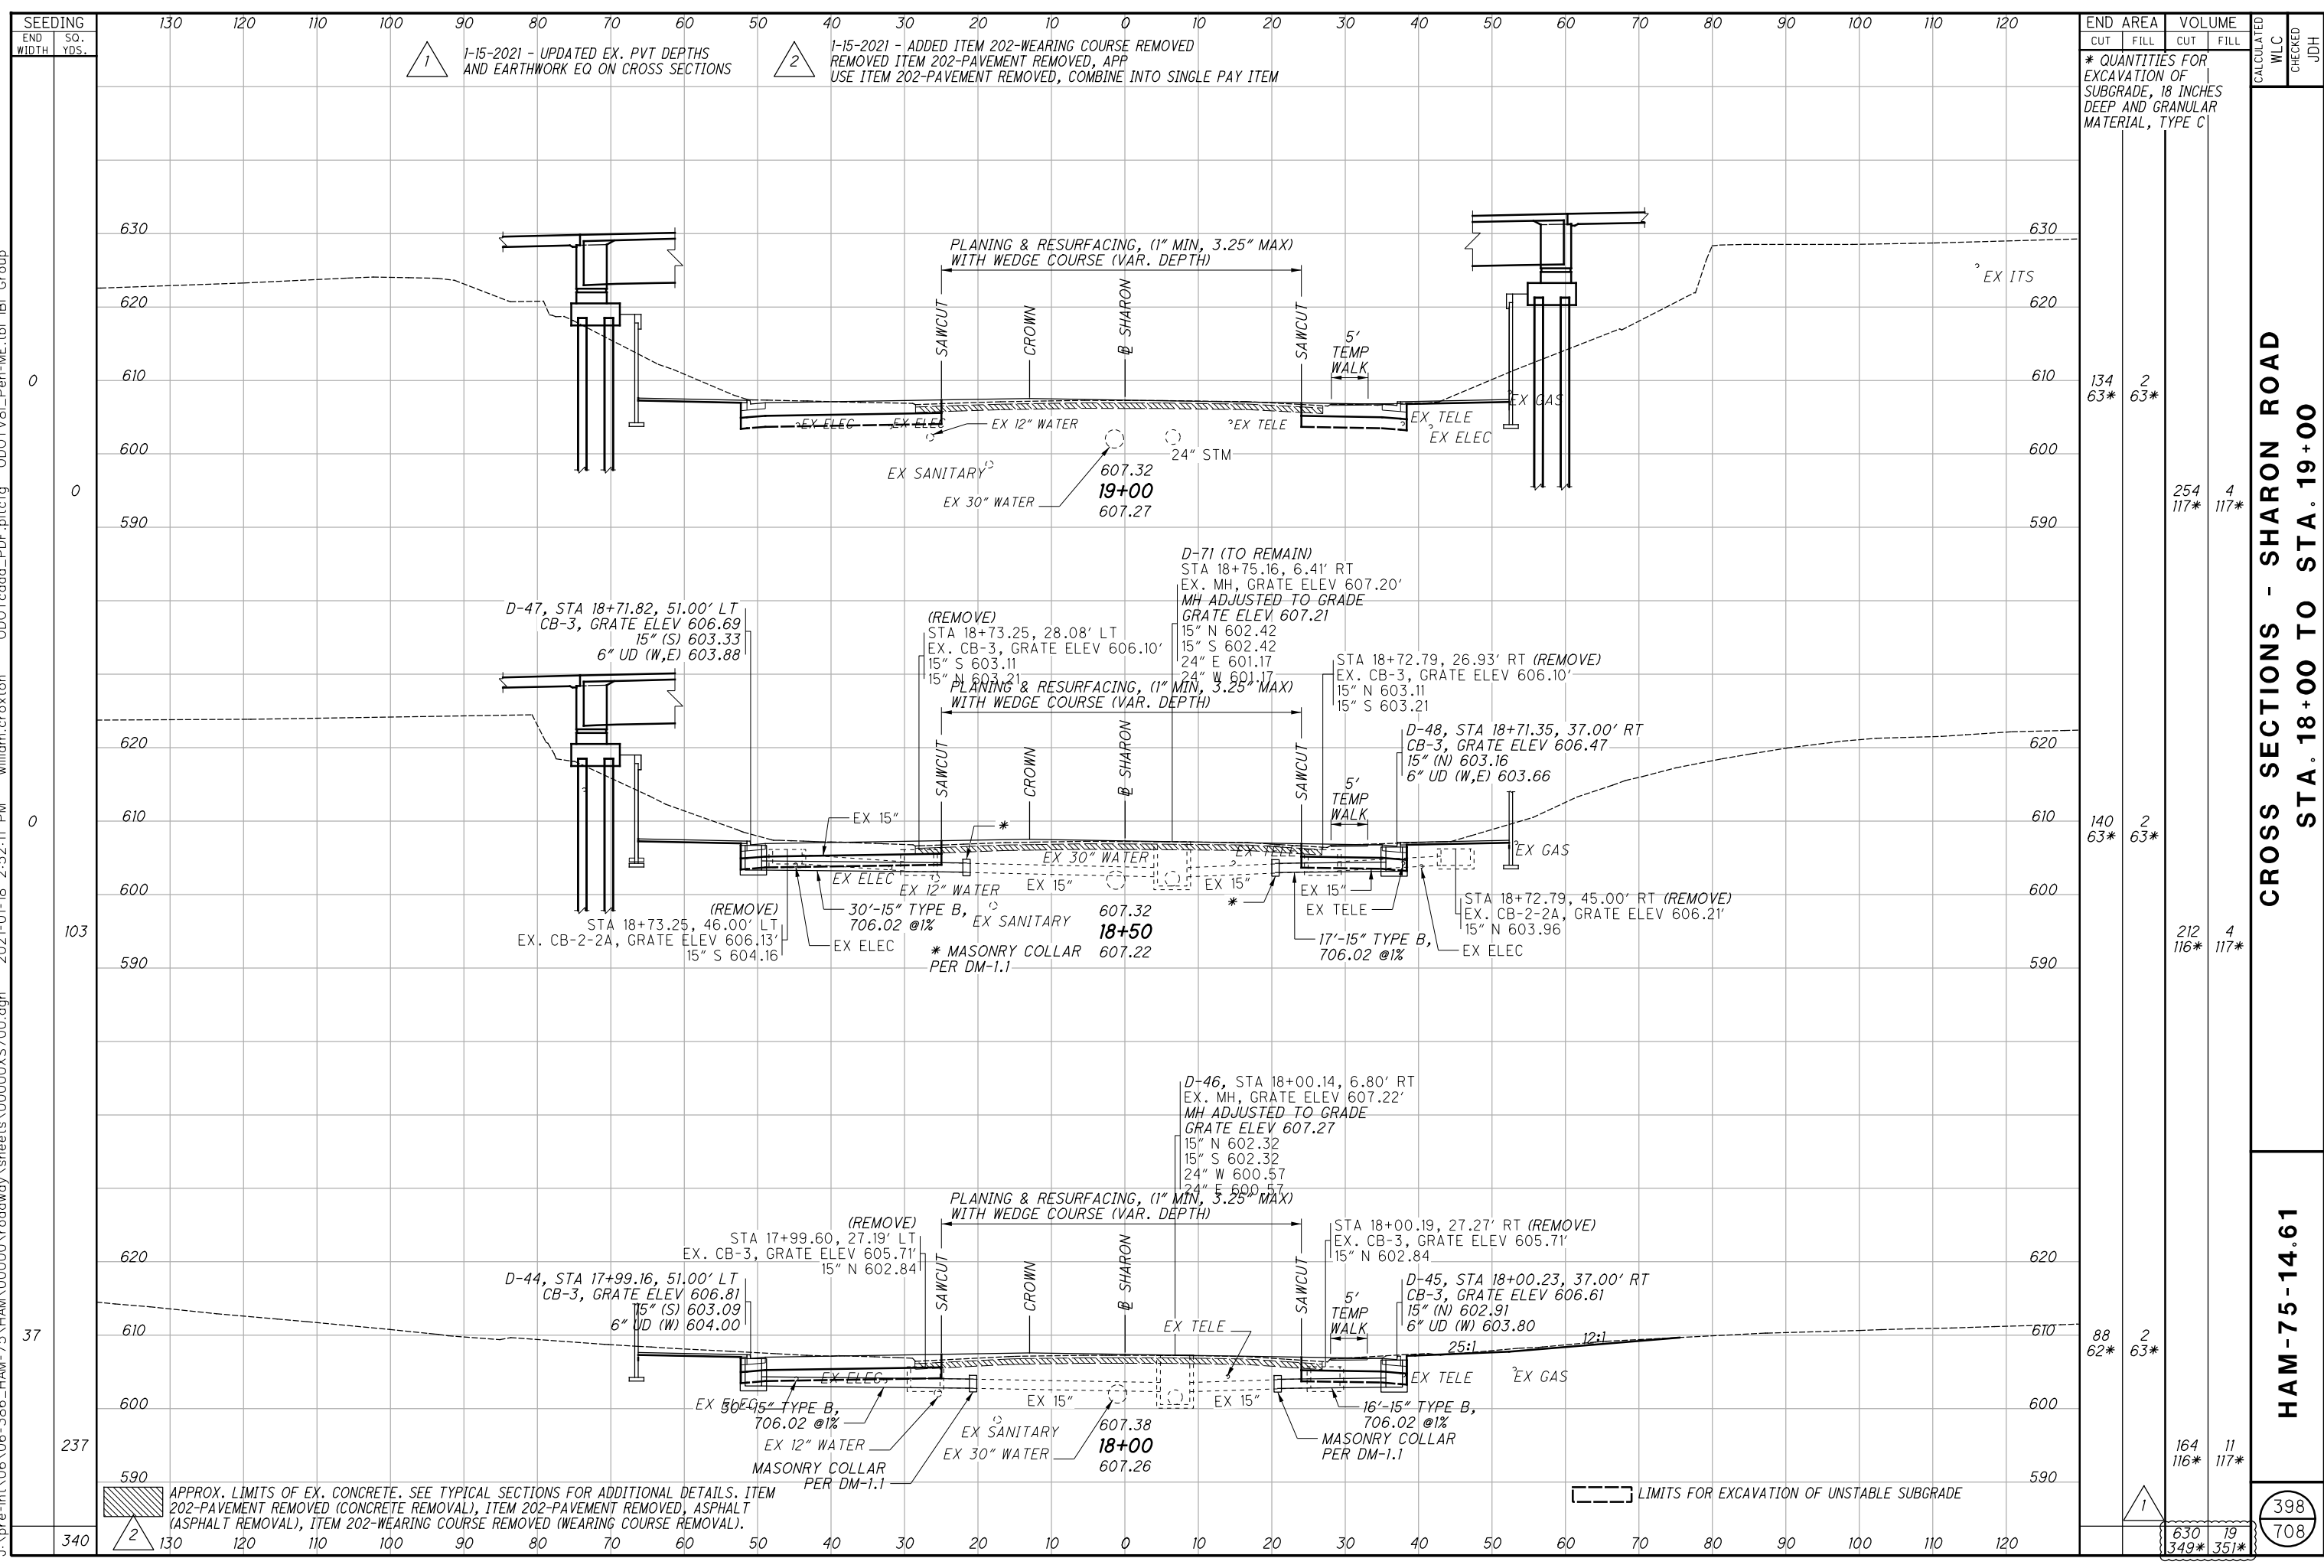


END AREA	VOLUME		CALCULATED	CHECKED	JDH
	CUT	FILL			
134	2	63*	254	4	117*
140	2	63*	212	4	117*
88	2	63*	164	11	117*
* QUANTITIES FOR EXCAVATION OF SUBGRADE, 18 INCHES DEEP AND GRANULAR MATERIAL, TYPE C					
APPROX. LIMITS OF EX. CONCRETE. SEE TYPICAL SECTIONS FOR ADDITIONAL DETAILS. ITEM 202-PAVEMENT REMOVED (CONCRETE REMOVAL), ITEM 202-PAVEMENT REMOVED, ASPHALT (ASPHALT REMOVAL), ITEM 202-WEARING COURSE REMOVED (WEARING COURSE REMOVAL).					
LIMITS FOR EXCAVATION OF UNSTABLE SUBGRADE					
398 708					

CROSS SECTIONS - SHARON ROAD  
STA. 18+00 TO STA. 19+00

HAM-75-14.61

398  
708

j:\pre-int\06\06-386\_HAM-75\_HAM\00000\roadway\sheets\00000X5700.dgn 2021-01-18 2:52:11 PM william.croxton ODOT\cadd\_PDF.plt\cfdg ODOTV8i\_Pen-ME.tbl IBI Group

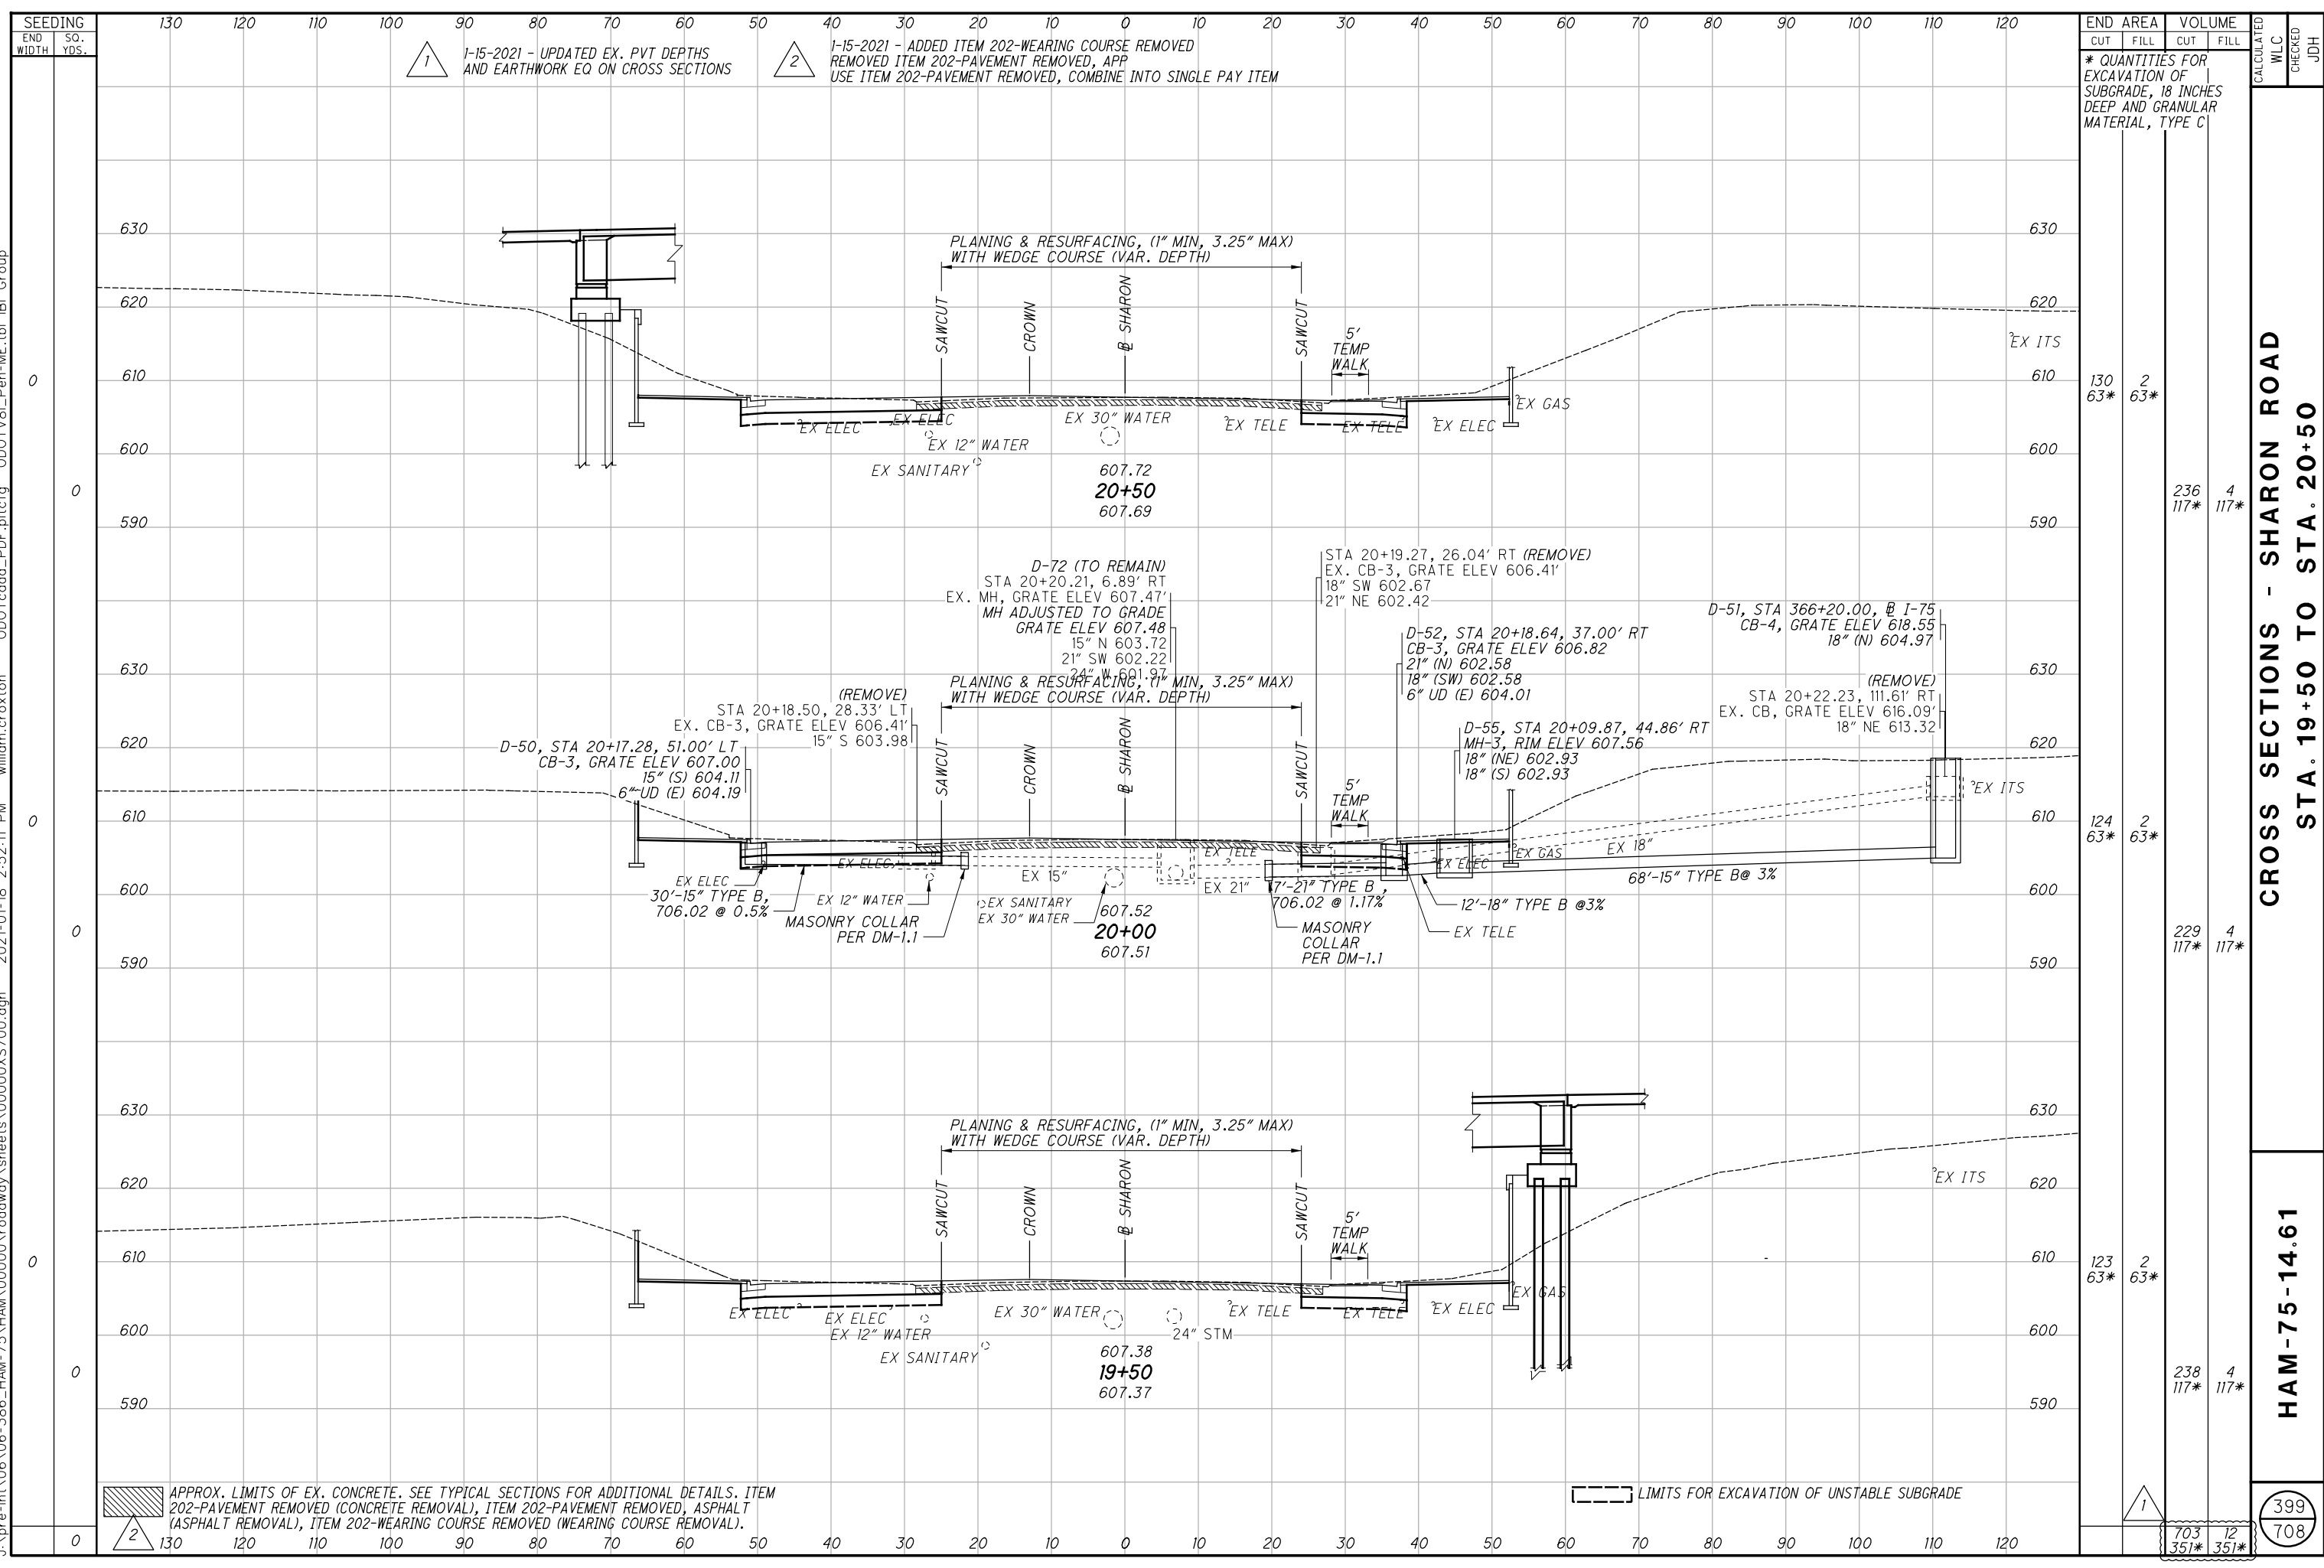

1-15-2021 - UPDATED EX. PVT DEPTHS AND EARTHWORK EQ ON CROSS SECTIONS  
 1-15-2021 - ADDED ITEM 202-WEARING COURSE REMOVED REMOVED ITEM 202-PAVEMENT REMOVED, APP USE ITEM 202-PAVEMENT REMOVED, COMBINE INTO SINGLE PAY ITEM

END AREA	VOLUME		CALCULATED	CHECKED	JDH
	CUT	FILL			
130 63*	2 63*		236 117*	4 117*	
124 63*	2 63*		229 117*	4 117*	
123 63*	2 63*		238 117*	4 117*	

\* QUANTITIES FOR EXCAVATION OF SUBGRADE, 18 INCHES DEEP AND GRANULAR MATERIAL, TYPE C


**CROSS SECTIONS - SHARON ROAD**  
**STA. 19+50 TO STA. 20+50**

**HAM-75-14.61**

APPROX. LIMITS OF EX. CONCRETE. SEE TYPICAL SECTIONS FOR ADDITIONAL DETAILS. ITEM 202-PAVEMENT REMOVED (CONCRETE REMOVAL), ITEM 202-PAVEMENT REMOVED, ASPHALT (ASPHALT REMOVAL), ITEM 202-WEARING COURSE REMOVED (WEARING COURSE REMOVAL).

399  
 708

j:\pre-int\06\06-386\_HAM-75\_HAM\00000\roadway\sheets\00000X5700.dgn 2021-01-18 2:52:12 PM william.croxton' ODOTcadd\_PDF.pltcfgr ODOTV8i\_Pen-ME.tbl IBI Group

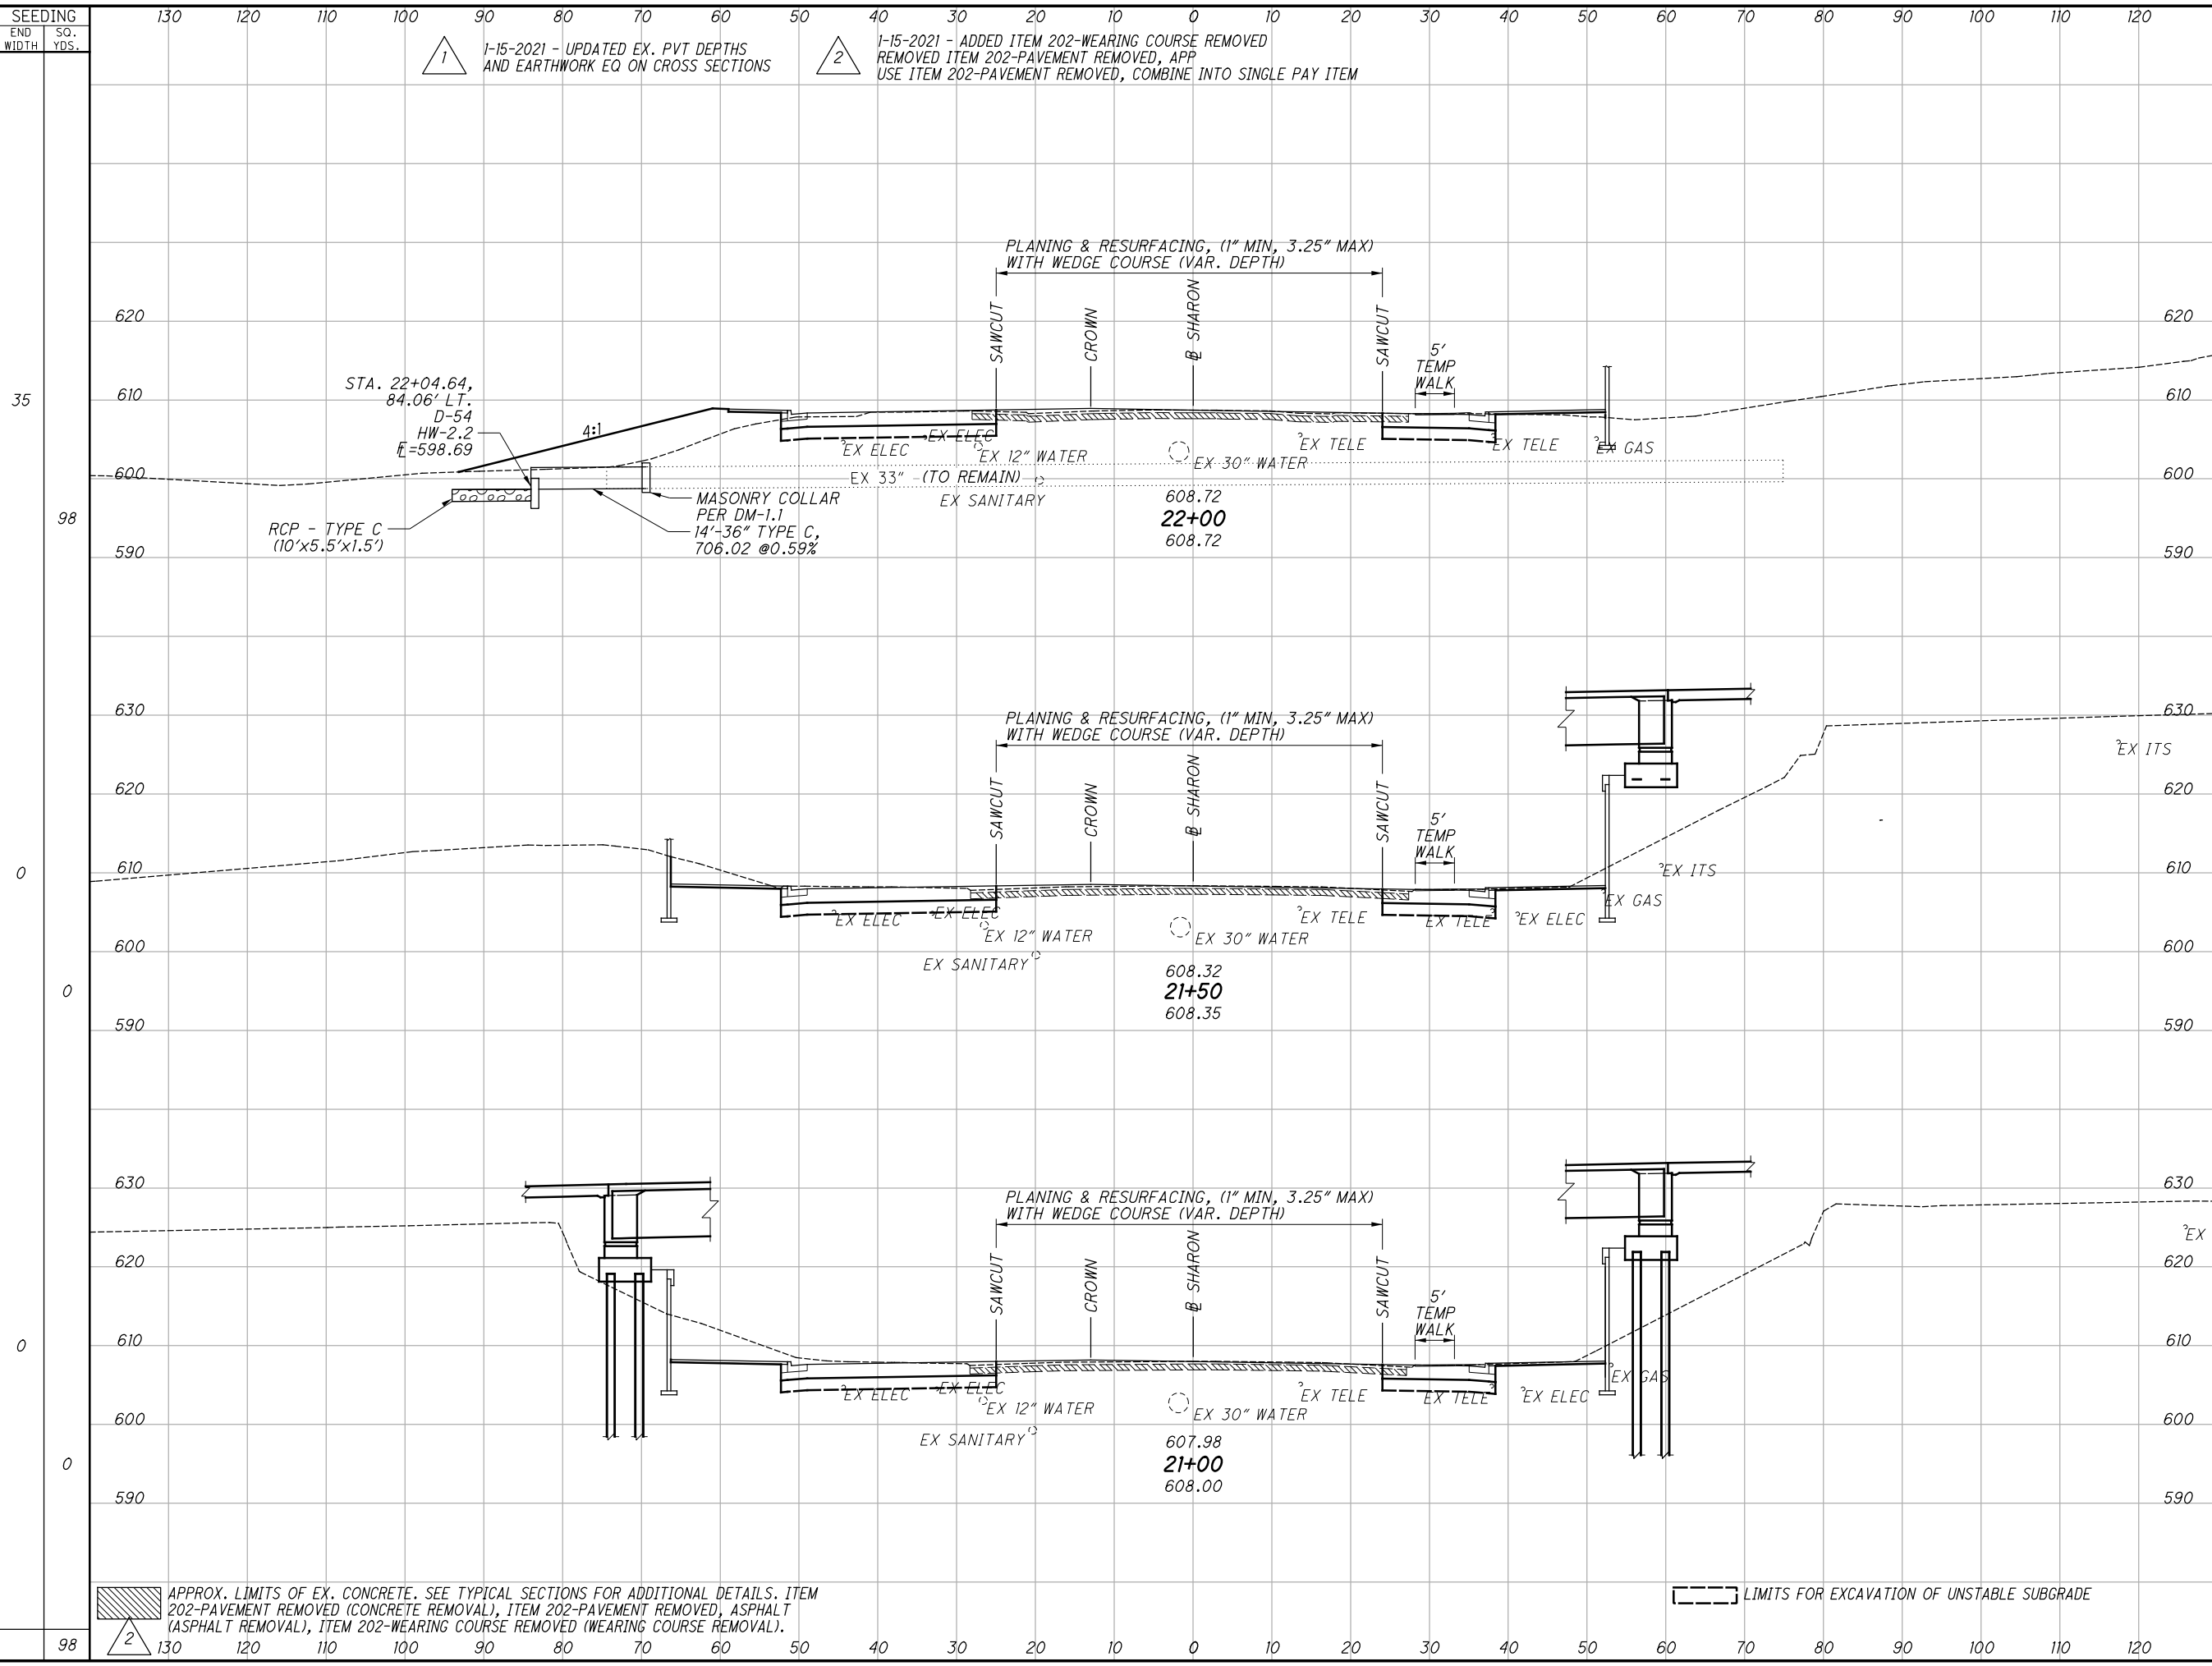

SEEDING		END AREA		VOLUME		CALCULATED	
END WIDTH	SO. YDS.	CUT	FILL	CUT	FILL	WLC	CHECKED
		62	117	155	111		
		63*	63*	117*	117*		
		105	2	223	4		
		63*	63*	117*	117*		
		135	2	246	4		
		63*	63*	117*	117*		
		624	119	351*	351*		
		708					

**CROSS SECTIONS - SHARON ROAD**  
**STA. 21+00 TO STA. 22+00**

**HAM-75-14.61**


400  
708

APPROX. LIMITS OF EX. CONCRETE. SEE TYPICAL SECTIONS FOR ADDITIONAL DETAILS. ITEM 202-PAVEMENT REMOVED (CONCRETE REMOVAL), ITEM 202-PAVEMENT REMOVED, ASPHALT (ASPHALT REMOVAL), ITEM 202-WEARING COURSE REMOVED (WEARING COURSE REMOVAL).  
 LIMITS FOR EXCAVATION OF UNSTABLE SUBGRADE

\* QUANTITIES FOR EXCAVATION OF SUBGRADE, 18 INCHES DEEP AND GRANULAR MATERIAL, TYPE C

1-15-2021 - UPDATED EX. PVT DEPTHS AND EARTHWORK EQ ON CROSS SECTIONS  
 1-15-2021 - ADDED ITEM 202-WEARING COURSE REMOVED, REMOVED ITEM 202-PAVEMENT REMOVED, APP USE ITEM 202-PAVEMENT REMOVED, COMBINE INTO SINGLE PAY ITEM

j:\pre-int\06\06-386\_HAM-75\HAM\00000\roadway\sheets\00000X5700.dgn 2021-01-18 2:52:13 PM william.croxton' ODOTcadd\_PDF.pltcfgr ODOTV8i\_Pen-ME.tbl IBI Group

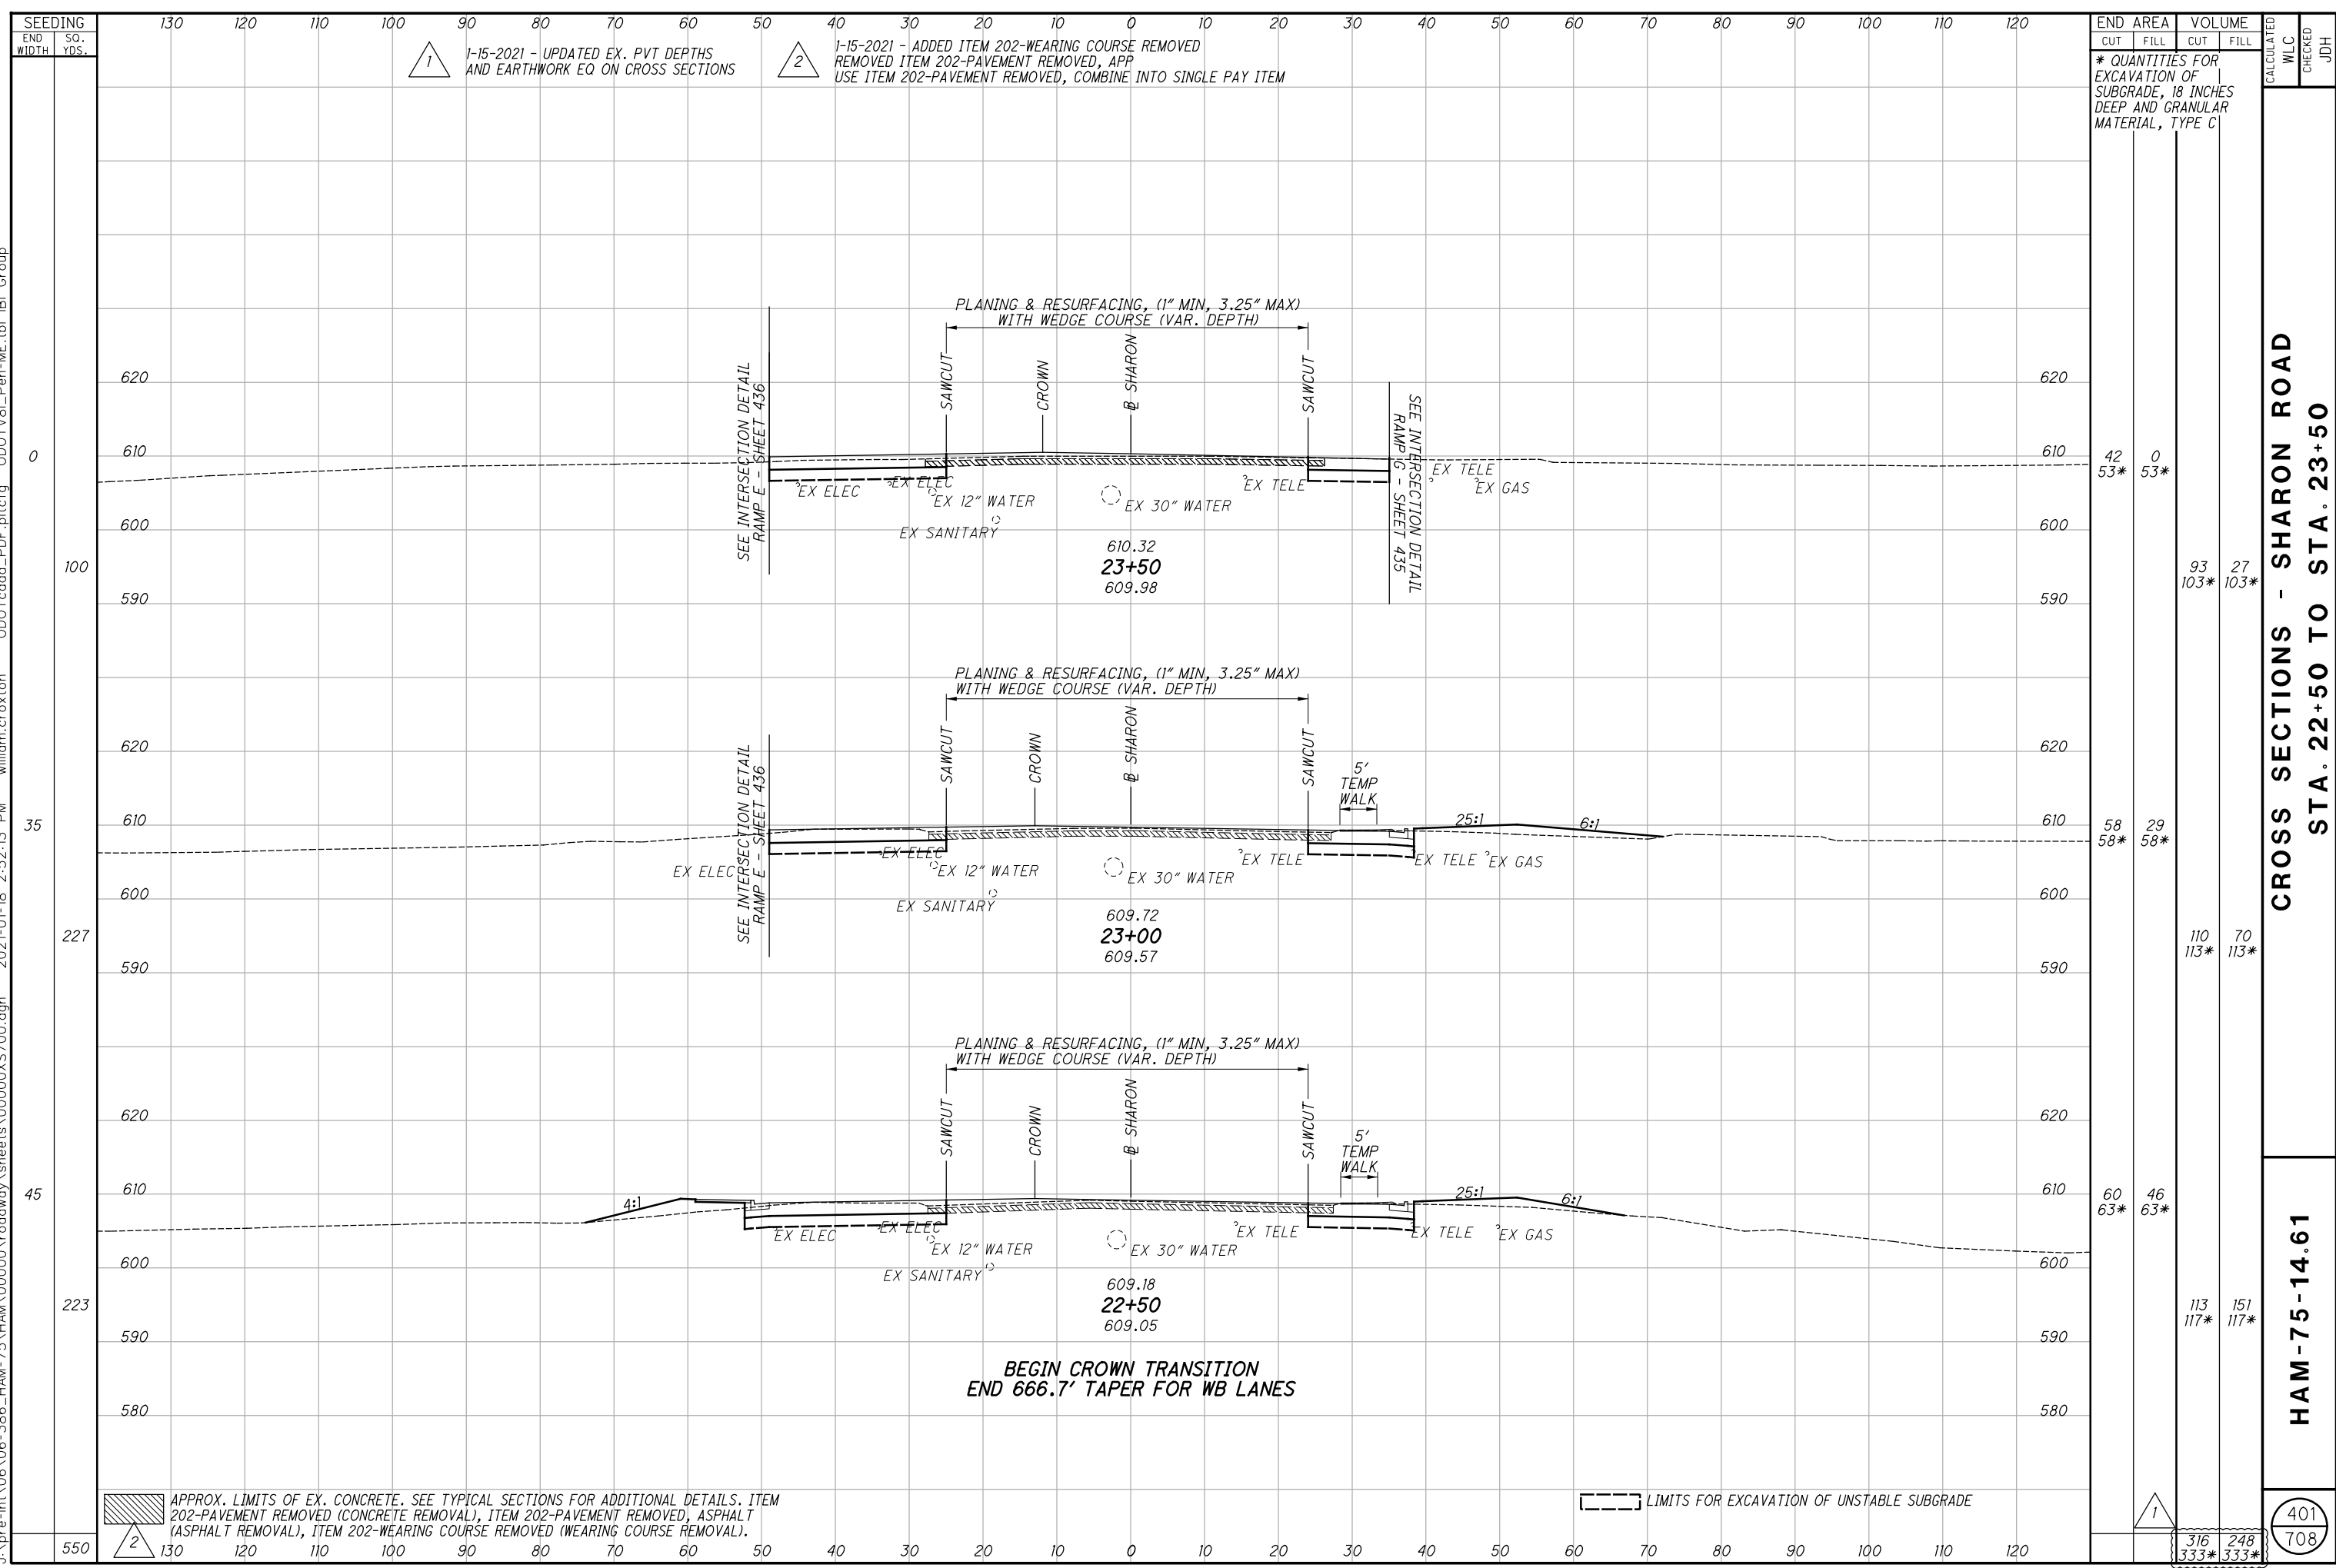

1-15-2021 - UPDATED EX. PVT DEPTHS AND EARTHWORK EQ ON CROSS SECTIONS

2-1-15-2021 - ADDED ITEM 202-WEARING COURSE REMOVED REMOVED ITEM 202-PAVEMENT REMOVED, APP USE ITEM 202-PAVEMENT REMOVED, COMBINE INTO SINGLE PAY ITEM

END AREA	VOLUME		CALCULATED WLC	CHECKED JDH
	CUT	FILL		
42	0	53*	93	27
53*	53*		103*	103*
58	29	58*	110	70
58*	58*		113*	113*
60	46	63*	113	151
63*	63*		117*	117*
		316		248
		333*		333*

**CROSS SECTIONS - SHARON ROAD**  
**STA. 22+50 TO STA. 23+50**

**HAM-75-14.61**

401  
708


APPROX. LIMITS OF EX. CONCRETE. SEE TYPICAL SECTIONS FOR ADDITIONAL DETAILS. ITEM 202-PAVEMENT REMOVED (CONCRETE REMOVAL), ITEM 202-PAVEMENT REMOVED, ASPHALT (ASPHALT REMOVAL), ITEM 202-WEARING COURSE REMOVED (WEARING COURSE REMOVAL).

LIMITS FOR EXCAVATION OF UNSTABLE SUBGRADE

BEGIN CROWN TRANSITION  
END 666.7' TAPER FOR WB LANES



j:\pre-int\06\06-386\_HAM-75\HAM\00000\roadway\sheets\00000X5700.dgn 2021-01-18 2:52:13 PM william.croxton' ODOTcadd\_PDF.pltcfgr ODOTV86\_Pen-ME.tbl IBI Group

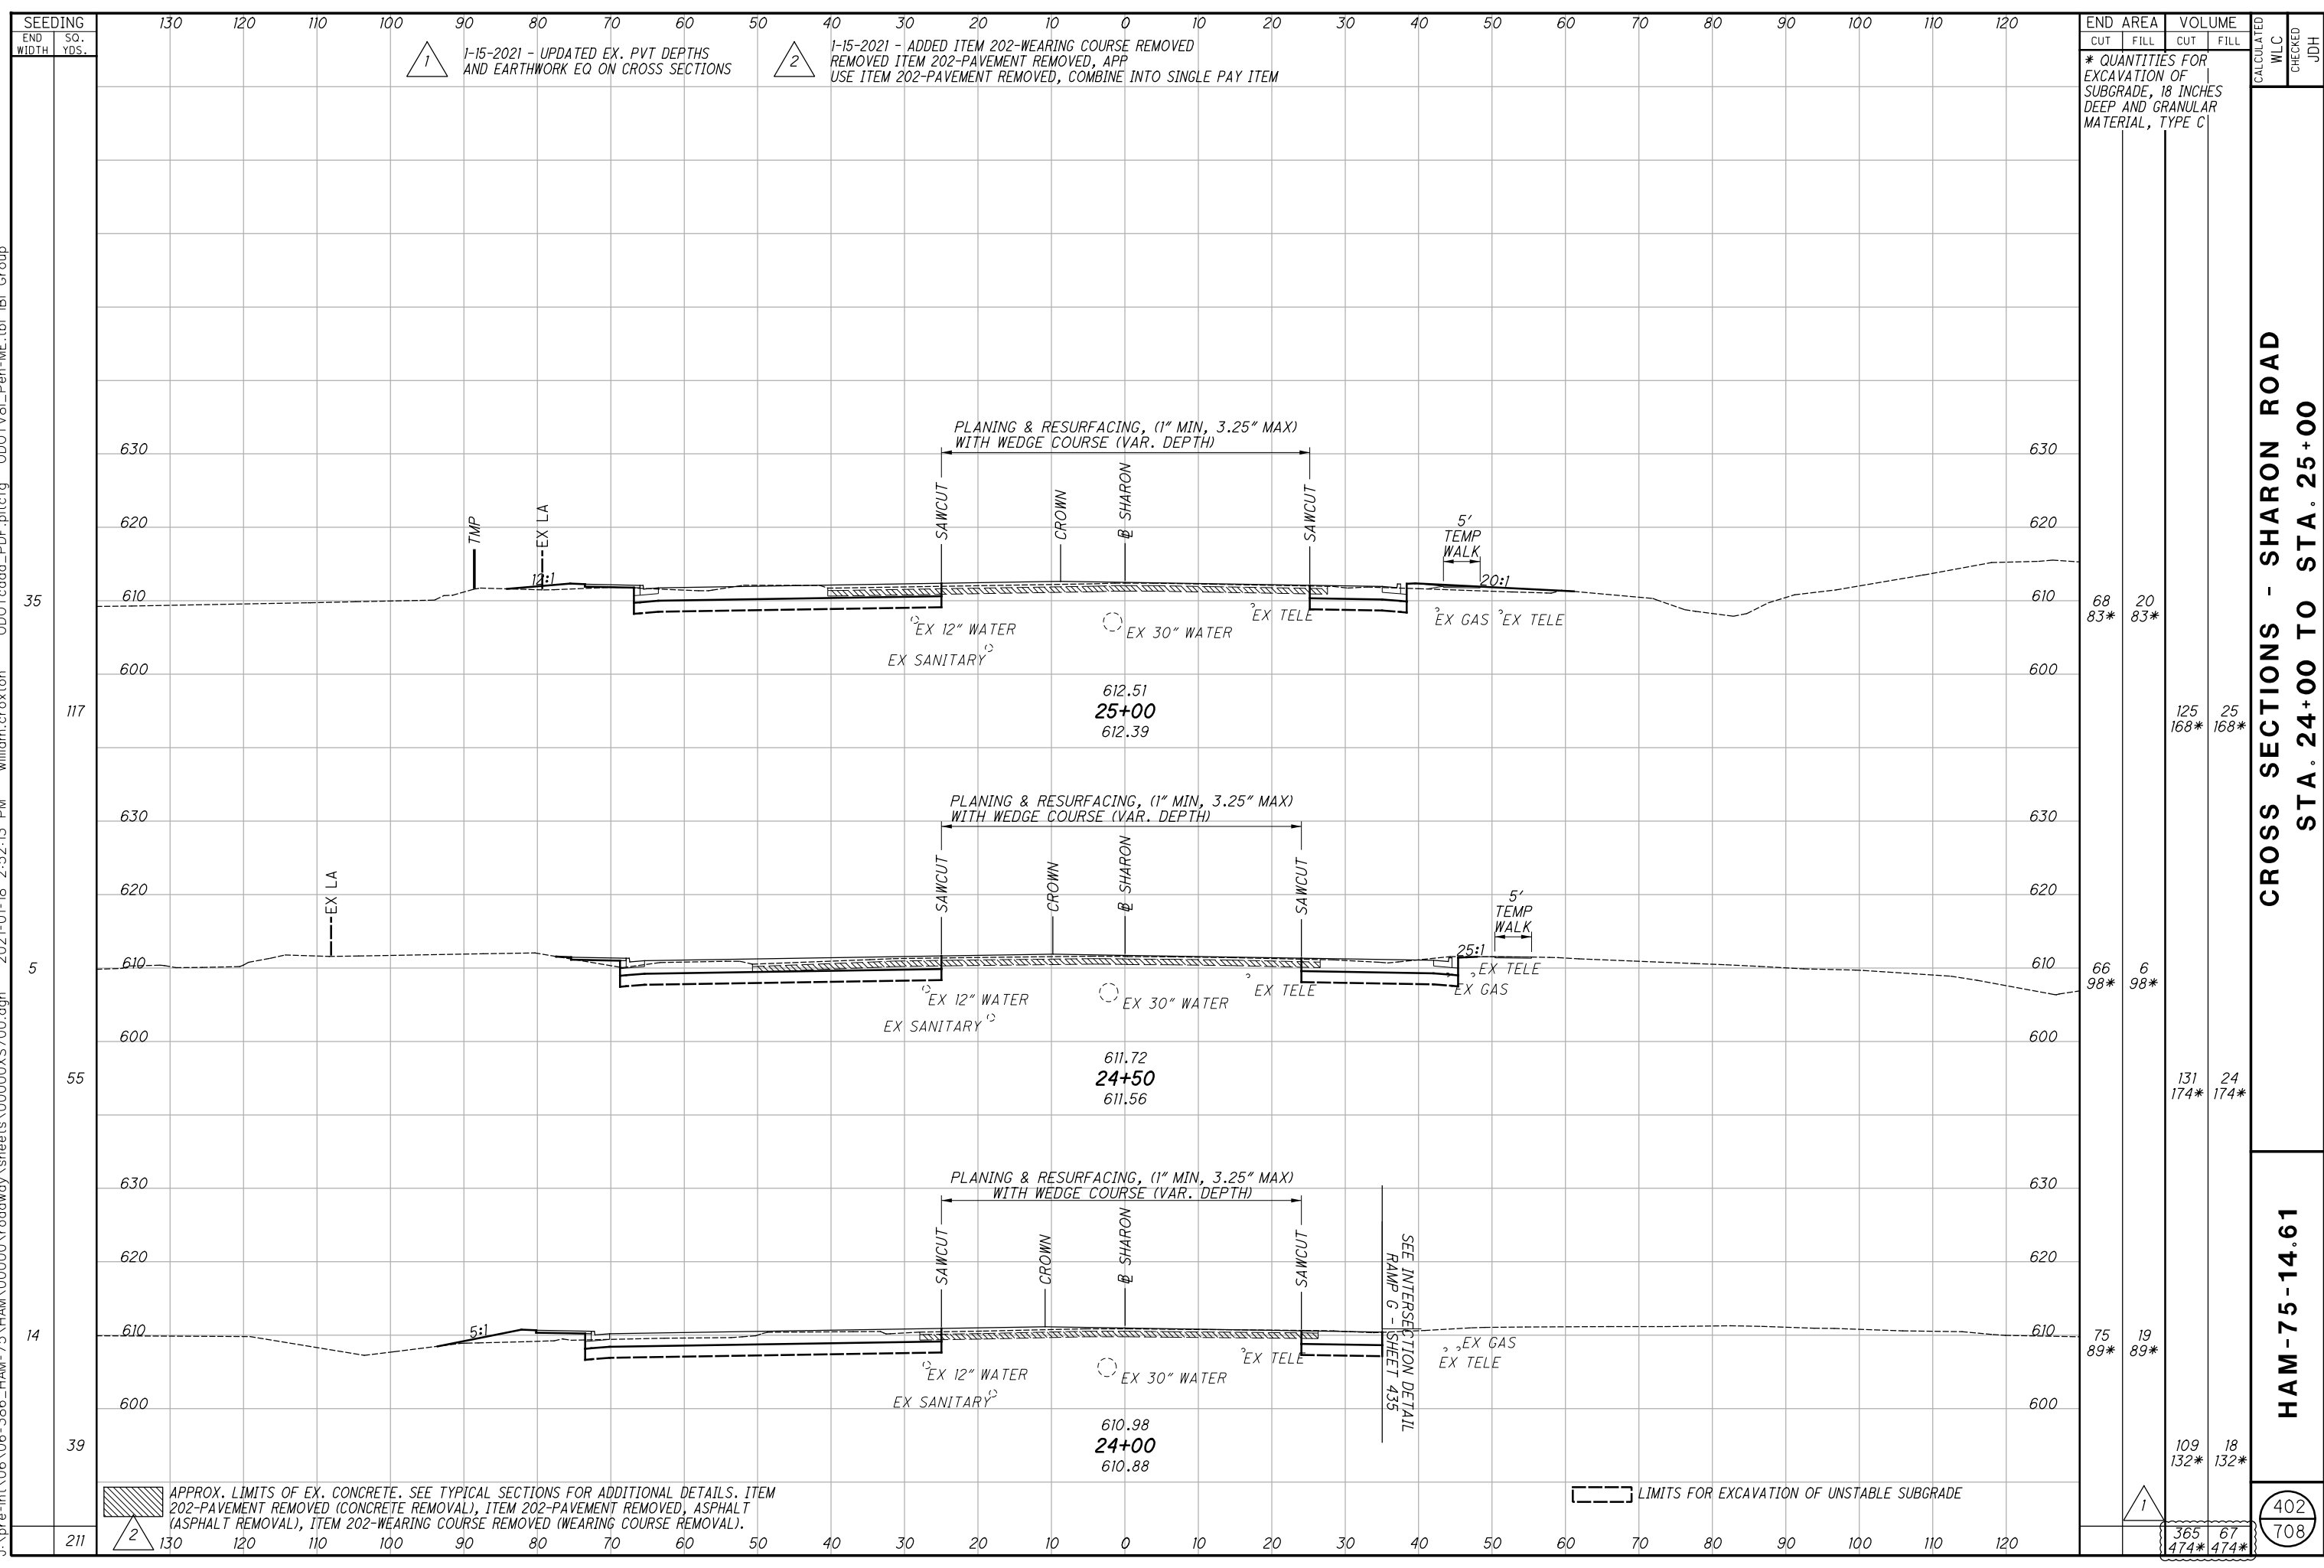

1-15-2021 - UPDATED EX. PVT DEPTHS AND EARTHWORK EQ ON CROSS SECTIONS

2-1-15-2021 - ADDED ITEM 202-WEARING COURSE REMOVED REMOVED ITEM 202-PAVEMENT REMOVED, APP USE ITEM 202-PAVEMENT REMOVED, COMBINE INTO SINGLE PAY ITEM

END AREA		VOLUME		CALCULATED WLC	CHECKED JDH
CUT	FILL	CUT	FILL		
68	20	83*	83*		
66	6	98*	98*		
75	19	89*	89*		
125	25	168*	168*		
109	18	132*	132*		
365	67	474*	474*		

CROSS SECTIONS - SHARON ROAD  
STA. 24+00 TO STA. 25+00


HAM-75-14.61

402  
708

APPROX. LIMITS OF EX. CONCRETE. SEE TYPICAL SECTIONS FOR ADDITIONAL DETAILS. ITEM 202-PAVEMENT REMOVED (CONCRETE REMOVAL), ITEM 202-PAVEMENT REMOVED, ASPHALT (ASPHALT REMOVAL), ITEM 202-WEARING COURSE REMOVED (WEARING COURSE REMOVAL).

LIMITS FOR EXCAVATION OF UNSTABLE SUBGRADE

j:\pre-int\06\06-386\_HAM-75\HAM\00000\roadway\sheets\00000X5700.dgn 2021-01-18 2:52:14 PM william.croxton' ODOTcadd\_PDF\_pltfcg ODOTV8i\_Pen-ME.tbl IBI Group

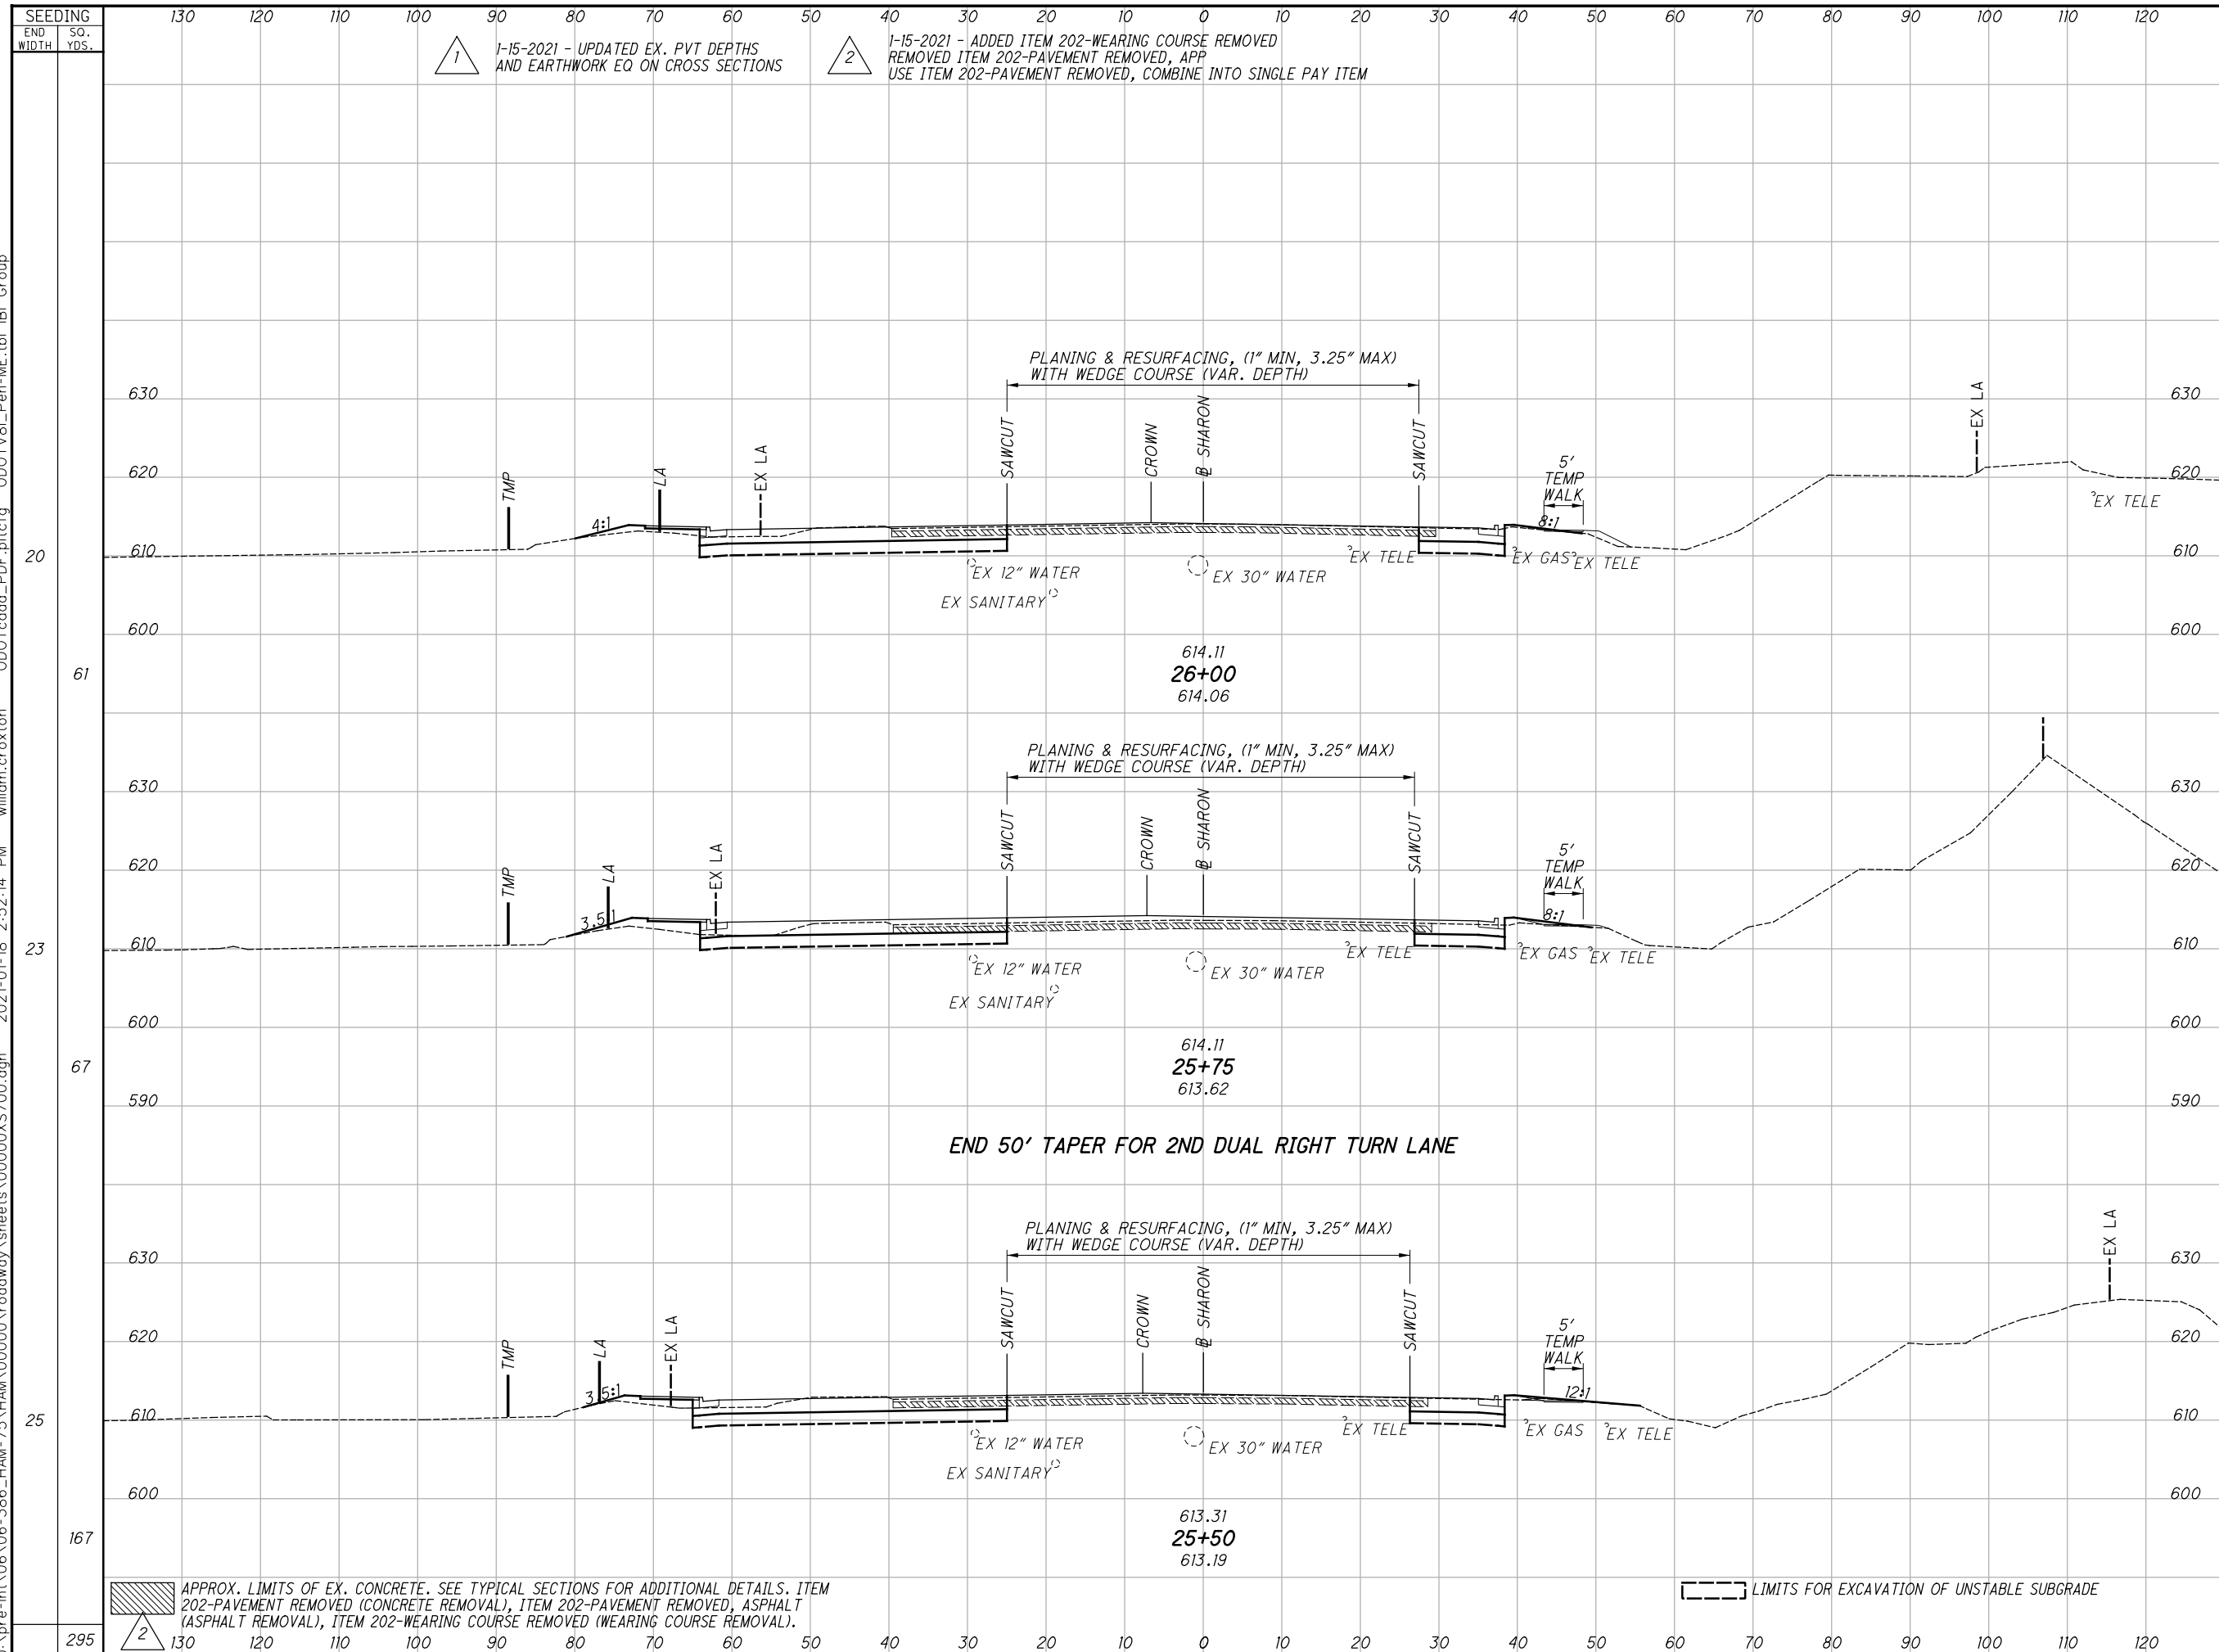

END AREA	VOLUME		CALCULATED WLC	CHECKED JDH
	CUT	FILL		
56	12	76*	42	16
34	21	74*	44	17
60	14	79*	119	32
			205	65
			291*	293*

**CROSS SECTIONS - SHARON ROAD  
STA. 25+50 TO STA. 26+00**

**HAM-75-14.61**

403  
708


1-15-2021 - UPDATED EX. PVT DEPTHS AND EARTHWORK EQ ON CROSS SECTIONS  
 1-15-2021 - ADDED ITEM 202-WEARING COURSE REMOVED REMOVED ITEM 202-PAVEMENT REMOVED, APP USE ITEM 202-PAVEMENT REMOVED, COMBINE INTO SINGLE PAY ITEM

\* QUANTITIES FOR EXCAVATION OF SUBGRADE, 18 INCHES DEEP AND GRANULAR MATERIAL, TYPE C

APPROX. LIMITS OF EX. CONCRETE. SEE TYPICAL SECTIONS FOR ADDITIONAL DETAILS. ITEM 202-PAVEMENT REMOVED (CONCRETE REMOVAL), ITEM 202-PAVEMENT REMOVED, ASPHALT (ASPHALT REMOVAL), ITEM 202-WEARING COURSE REMOVED (WEARING COURSE REMOVAL).

LIMITS FOR EXCAVATION OF UNSTABLE SUBGRADE

j:\pre-int\06\06-386\_HAM-75\HAM\00000\roadway\sheets\00000X5700.dgn 2021-01-18 2:52:14 PM william.croxton' ODOT\cadd\_PDF\_plt\cfig ODOTV8i\_Pen-ME.tbl IBI Group

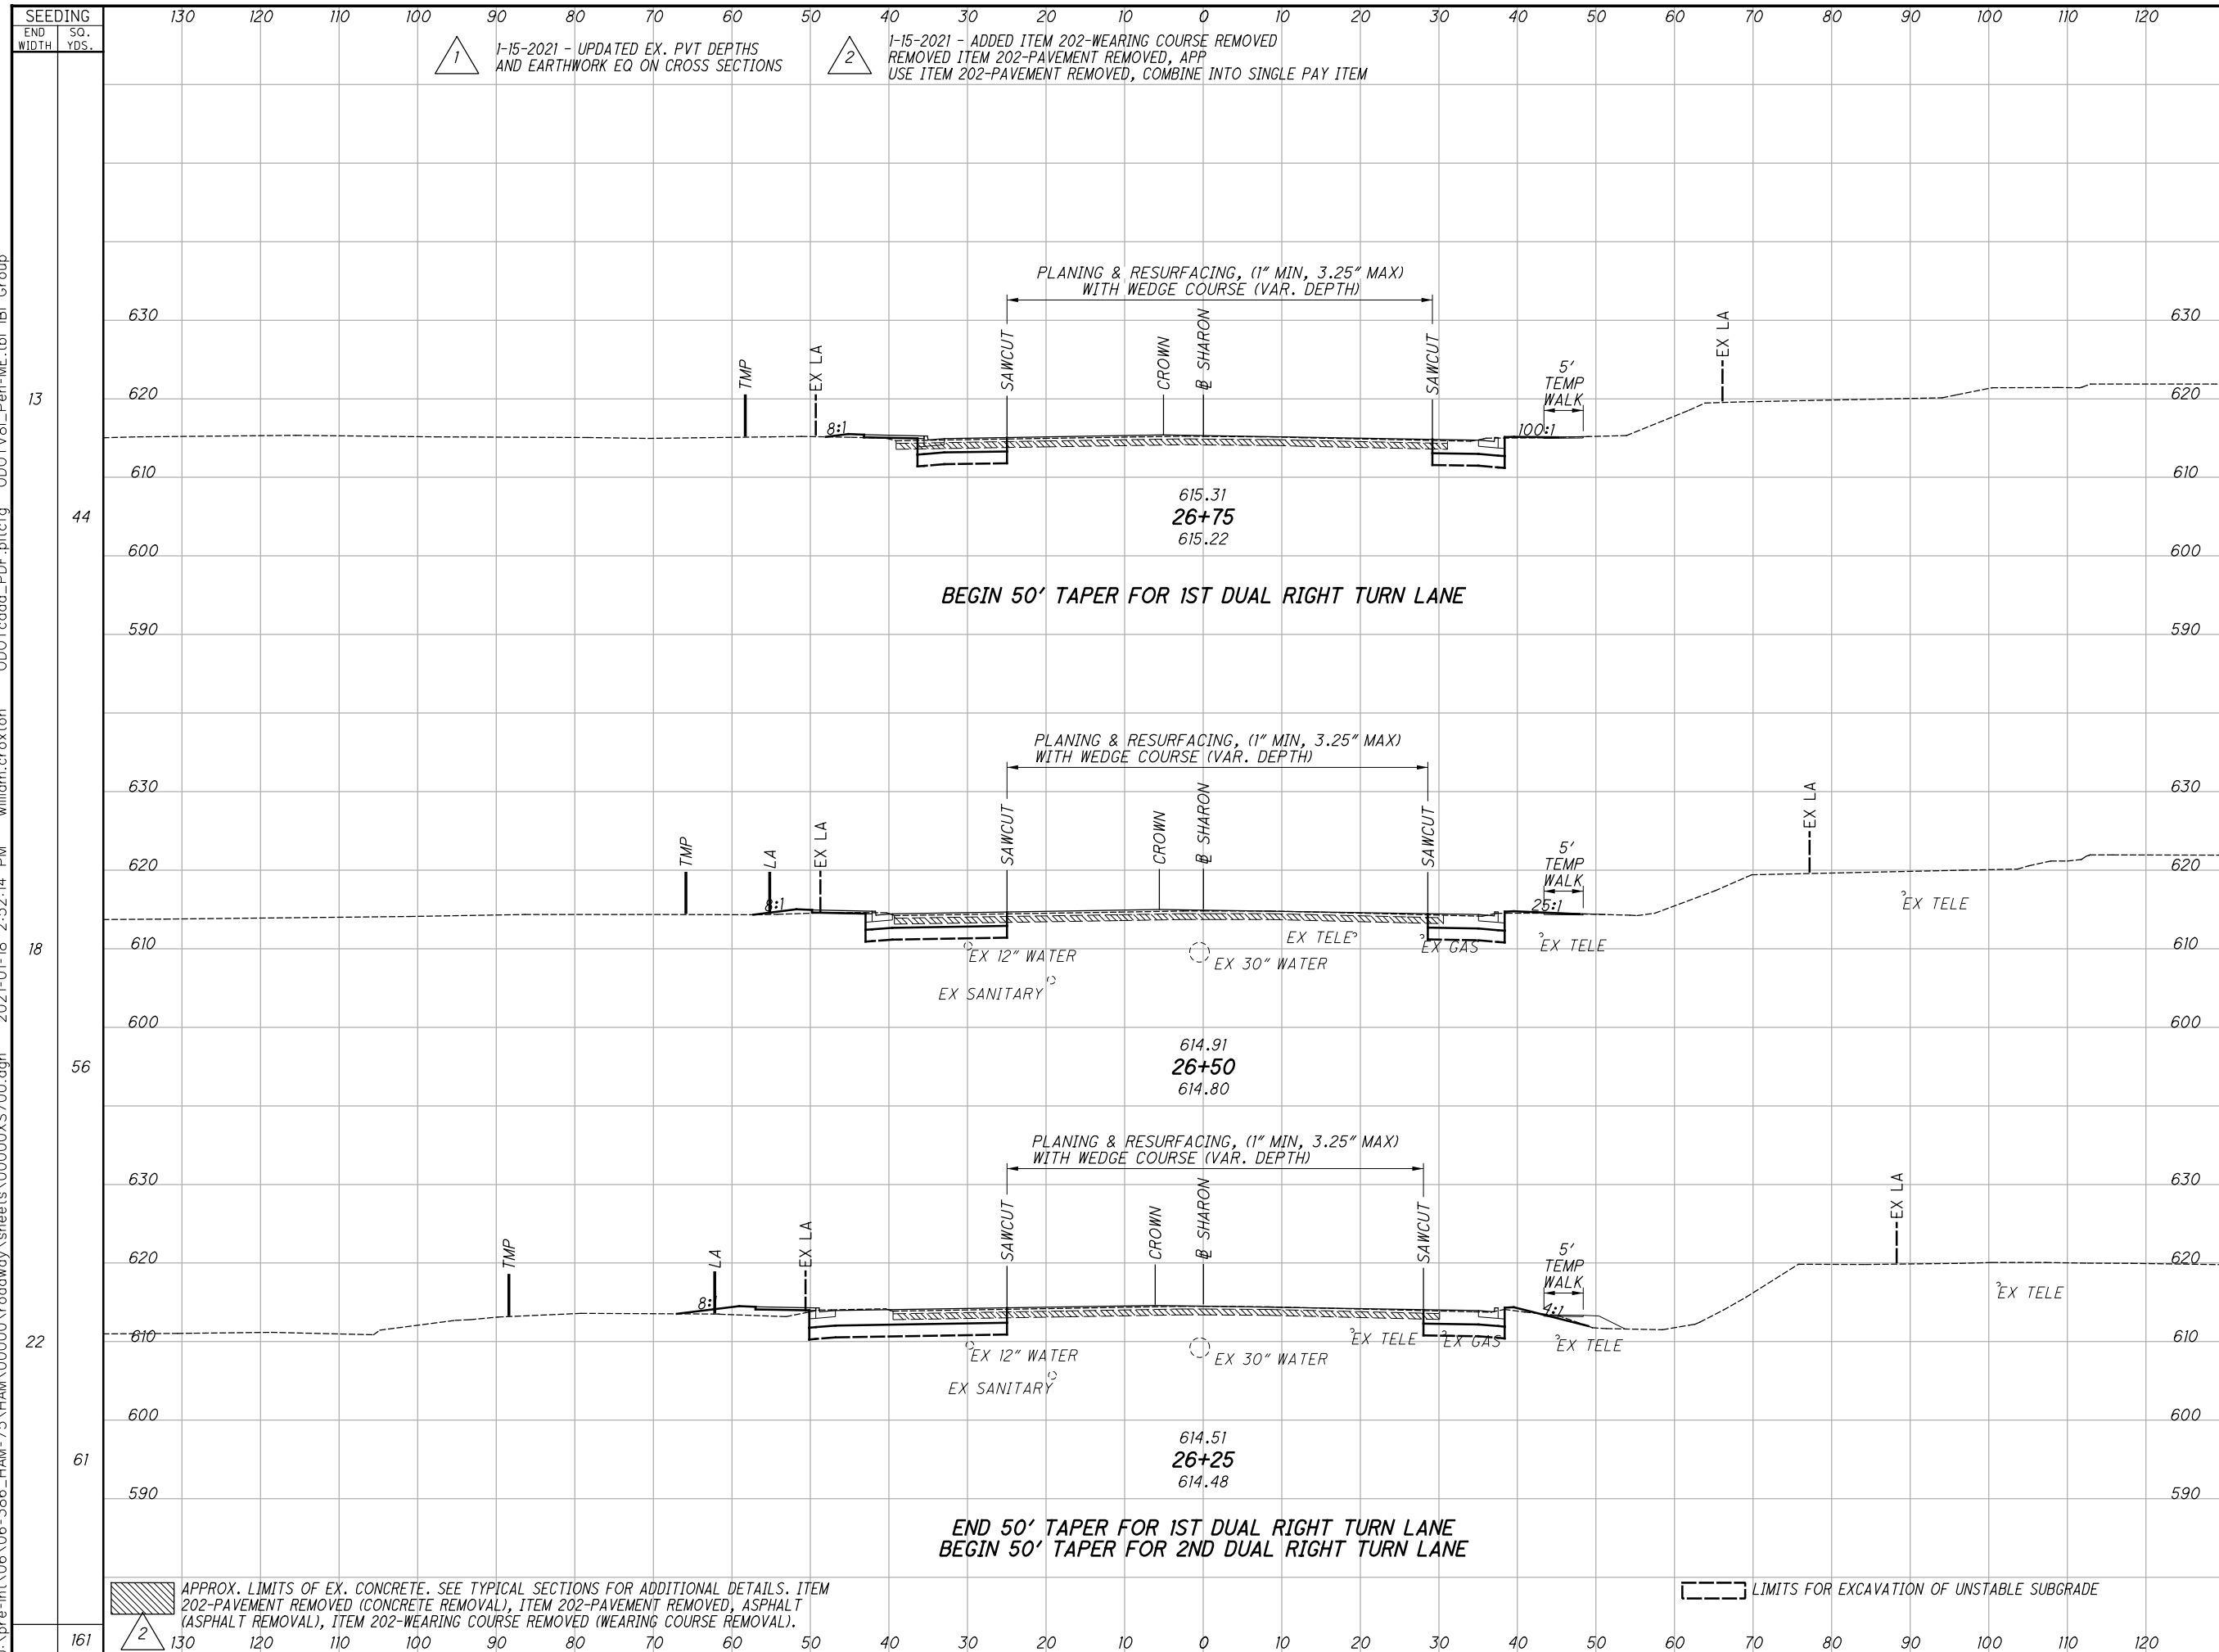

END AREA	VOLUME		CALCULATED	CHECKED	JDH
	CUT	FILL			
21	31*	9	31*		
24	34*	7	34*		
29	42*	6	42*		
36	45*	10	45*		
47	54*	15	54*		
48	61*	13	61*		
108	140*	30	140*		

\* QUANTITIES FOR EXCAVATION OF SUBGRADE, 18 INCHES DEEP AND GRANULAR MATERIAL, TYPE C

**CROSS SECTIONS - SHARON ROAD**  
**STA. 26+25 TO STA. 26+75**  
**HAM-75-14.61**  
 404  
 708


APPROX. LIMITS OF EX. CONCRETE. SEE TYPICAL SECTIONS FOR ADDITIONAL DETAILS. ITEM 202-PAVEMENT REMOVED (CONCRETE REMOVAL), ITEM 202-PAVEMENT REMOVED, ASPHALT (ASPHALT REMOVAL), ITEM 202-WEARING COURSE REMOVED (WEARING COURSE REMOVAL).

LIMITS FOR EXCAVATION OF UNSTABLE SUBGRADE

1-15-2021 - UPDATED EX. PVT DEPTHS AND EARTHWORK EQ ON CROSS SECTIONS

2-1-15-2021 - ADDED ITEM 202-WEARING COURSE REMOVED REMOVED ITEM 202-PAVEMENT REMOVED, APP USE ITEM 202-PAVEMENT REMOVED, COMBINE INTO SINGLE PAY ITEM

j:\pre-int\06\06-386\_HAM-75\HAM\00000\roadway\sheets\00000X5700.dgn 2021-01-18 2:52:15 PM william.croxton' ODOTcadd\_PDF.pltcfgr ODOTV8i\_Pen-ME.tbl IBI Group

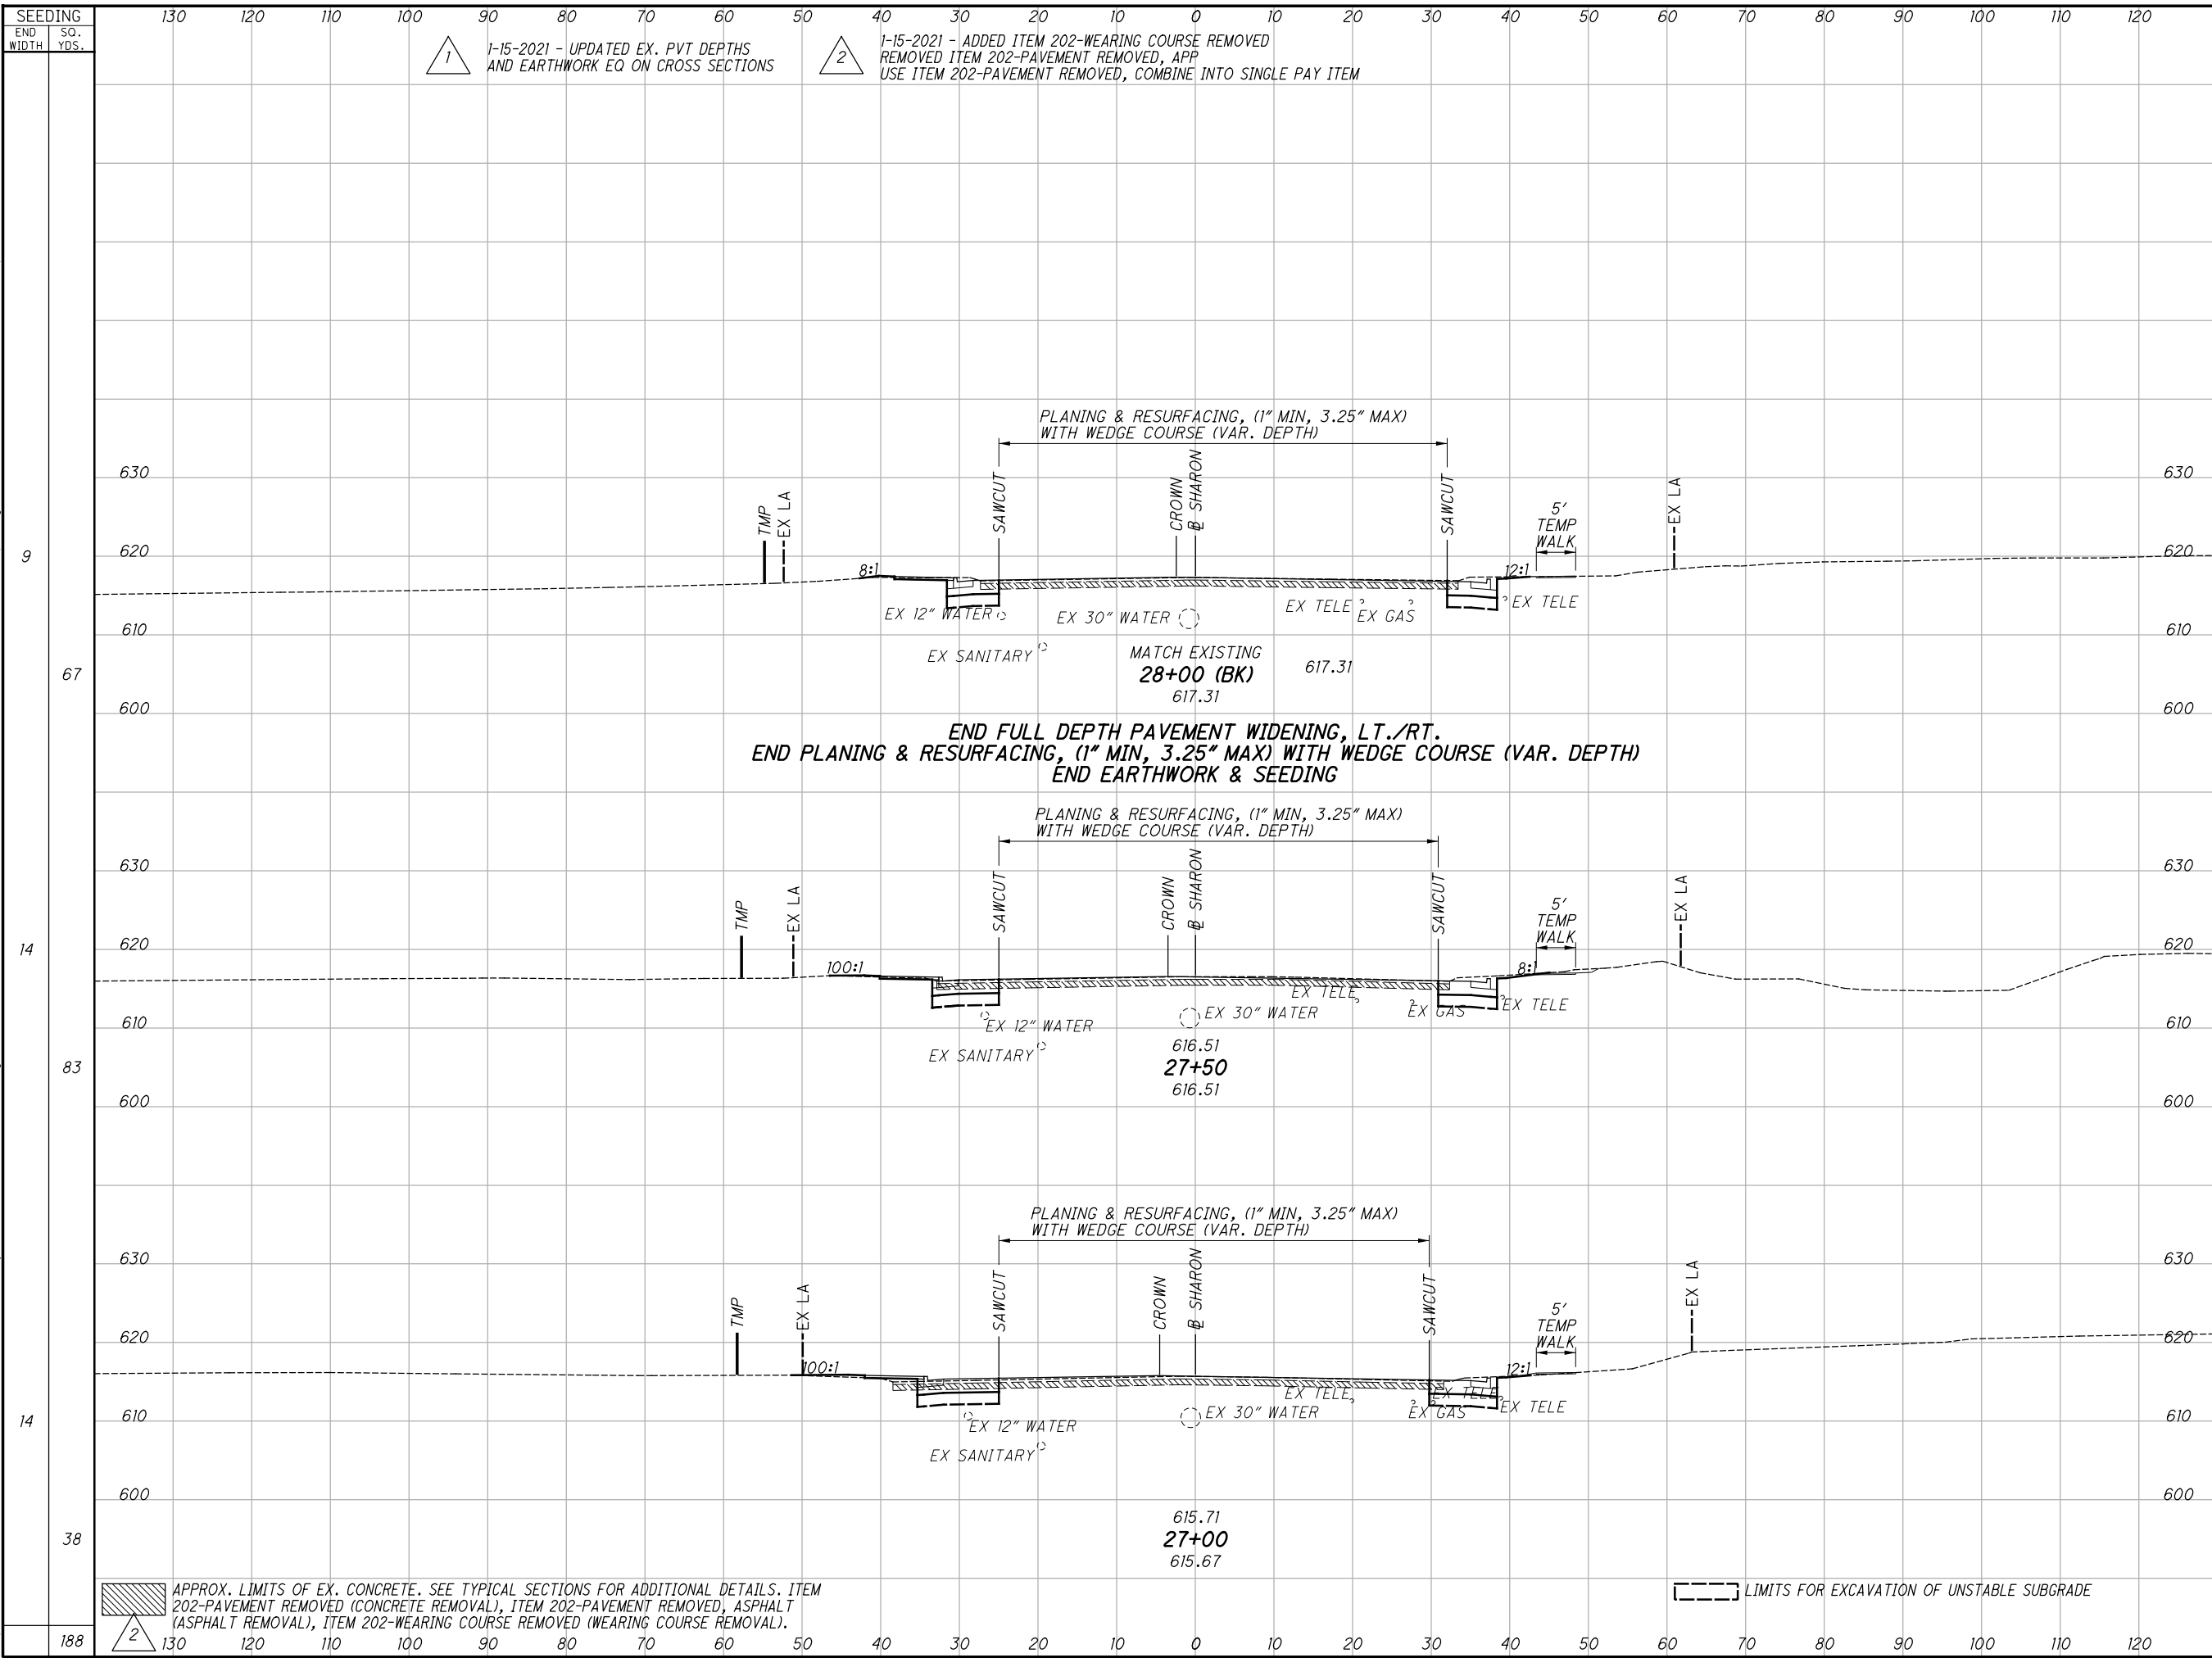

1

1-15-2021 - UPDATED EX. PVT DEPTHS AND EARTHWORK EQ ON CROSS SECTIONS

2

1-15-2021 - ADDED ITEM 202-WEARING COURSE REMOVED REMOVED ITEM 202-PAVEMENT REMOVED, APP USE ITEM 202-PAVEMENT REMOVED, COMBINE INTO SINGLE PAY ITEM

SEEDING		END AREA		VOLUME		CALCULATED	
END WIDTH	SO. YDS.	CUT	FILL	CUT	FILL	WLC	CHECKED
		27	3	24	3	43	12
		20*	20*	24*	24*	50*	50*
		22	9	20	9	111	27
		29*	29*	28*	28*	119*	119*
		* QUANTITIES FOR EXCAVATION OF SUBGRADE, 18 INCHES DEEP AND GRANULAR MATERIAL, TYPE C					
						405	
						708	

CROSS SECTIONS - SHARON ROAD  
STA. 27+00 TO STA. 28+00


HAM-75-14.61

405  
708

APPROX. LIMITS OF EX. CONCRETE. SEE TYPICAL SECTIONS FOR ADDITIONAL DETAILS. ITEM 202-PAVEMENT REMOVED (CONCRETE REMOVAL), ITEM 202-PAVEMENT REMOVED, ASPHALT (ASPHALT REMOVAL), ITEM 202-WEARING COURSE REMOVED (WEARING COURSE REMOVAL).

LIMITS FOR EXCAVATION OF UNSTABLE SUBGRADE

j:\pre-int\06\06-386\_HAM-75\HAM\00000\roadway\sheets\00000X5700.dgn 2021-01-18 2:52:15 PM william.croxton' ODOTcadd\_PDF.pltcfgr ODOTV8i\_Pen-ME.tbl IBI Group

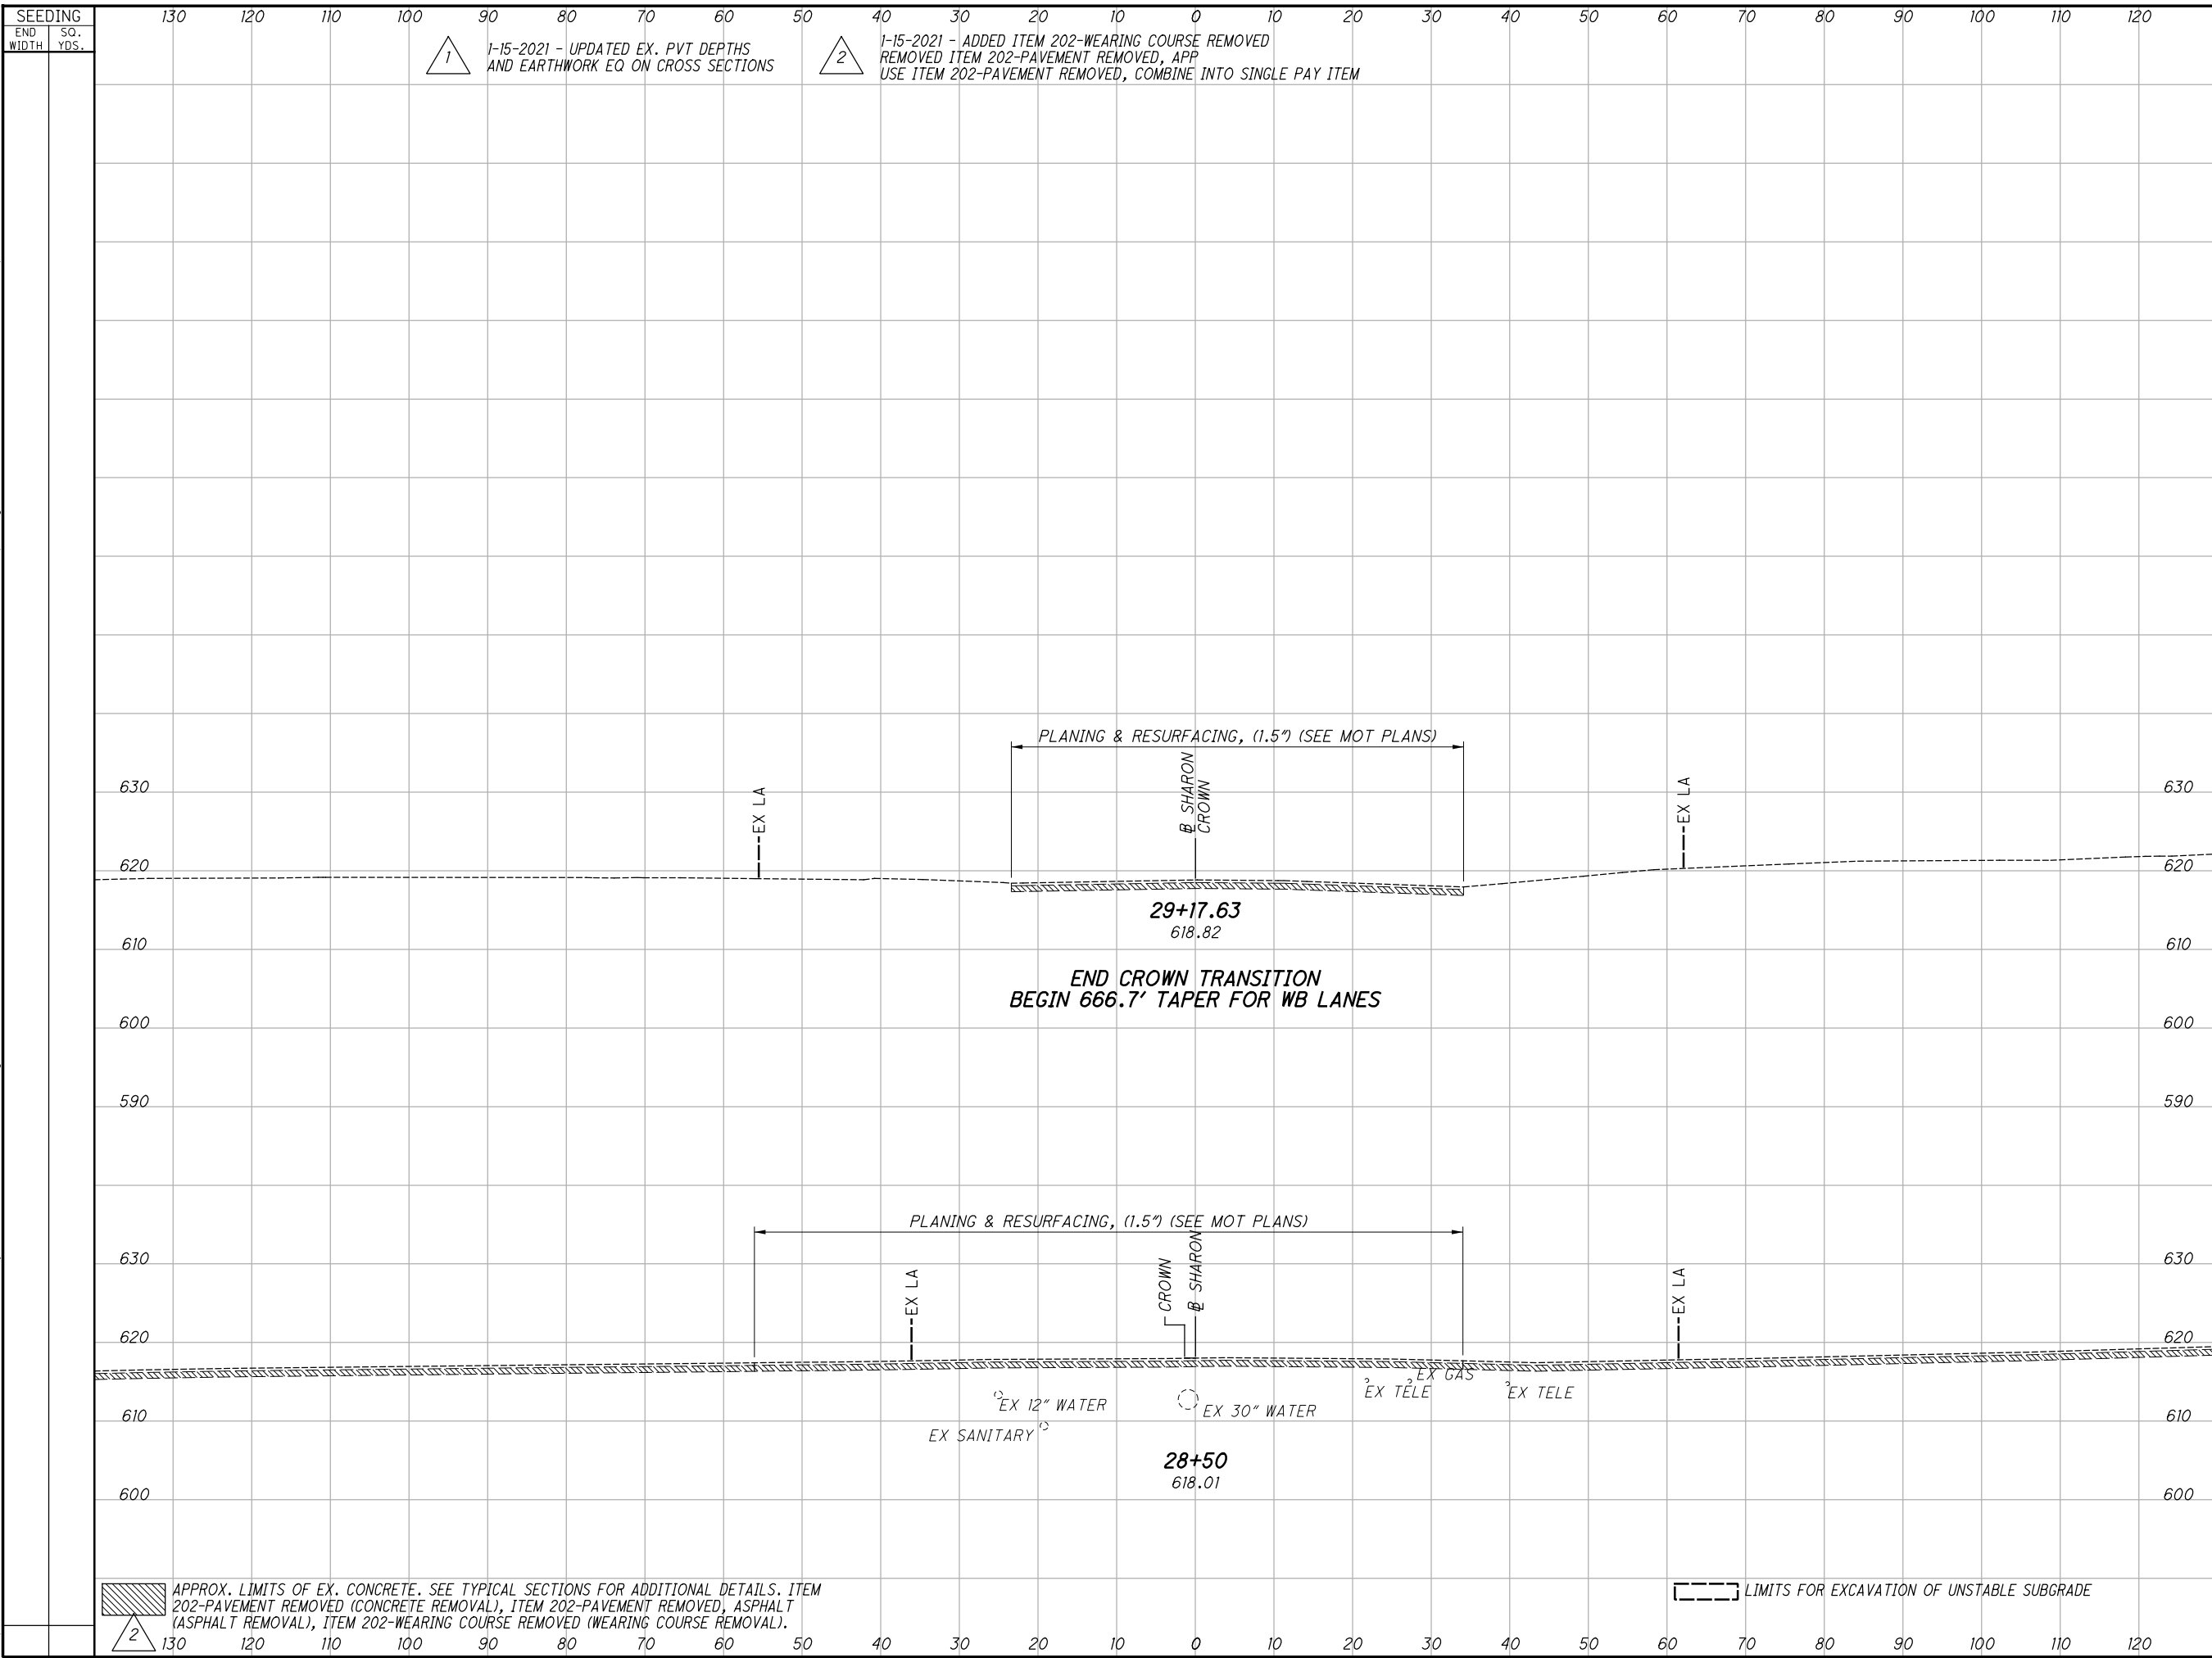

1

1-15-2021 - UPDATED EX. PVT DEPTHS AND EARTHWORK EQ ON CROSS SECTIONS

2

1-15-2021 - ADDED ITEM 202-WEARING COURSE REMOVED REMOVED ITEM 202-PAVEMENT REMOVED, APP USE ITEM 202-PAVEMENT REMOVED, COMBINE INTO SINGLE PAY ITEM


SEEDING		END AREA		VOLUME		CALCULATED	
END WIDTH	SO. YDS.	CUT	FILL	CUT	FILL	WLC	CHECKED
							JDH
* QUANTITIES FOR EXCAVATION OF SUBGRADE, 18 INCHES DEEP AND GRANULAR MATERIAL, TYPE C							
<b>CROSS SECTIONS - SHARON ROAD</b>							
<b>STA. 28+50 TO STA. 29+17.63</b>							
<b>HAM-75-14.61</b>							
						406	708

APPROX. LIMITS OF EX. CONCRETE. SEE TYPICAL SECTIONS FOR ADDITIONAL DETAILS. ITEM 202-PAVEMENT REMOVED (CONCRETE REMOVAL), ITEM 202-PAVEMENT REMOVED, ASPHALT (ASPHALT REMOVAL), ITEM 202-WEARING COURSE REMOVED (WEARING COURSE REMOVAL).

LIMITS FOR EXCAVATION OF UNSTABLE SUBGRADE

1

j:\pre-int\06\06-386\_HAM-75\HAM\00000\roadway\sheets\00000XS800.dgn 2021-01-18 2:52:26 PM william.croxton' ODOTcadd\_PDF.pltcfgr ODOTV81\_Pen-ME.tbl IBI Group

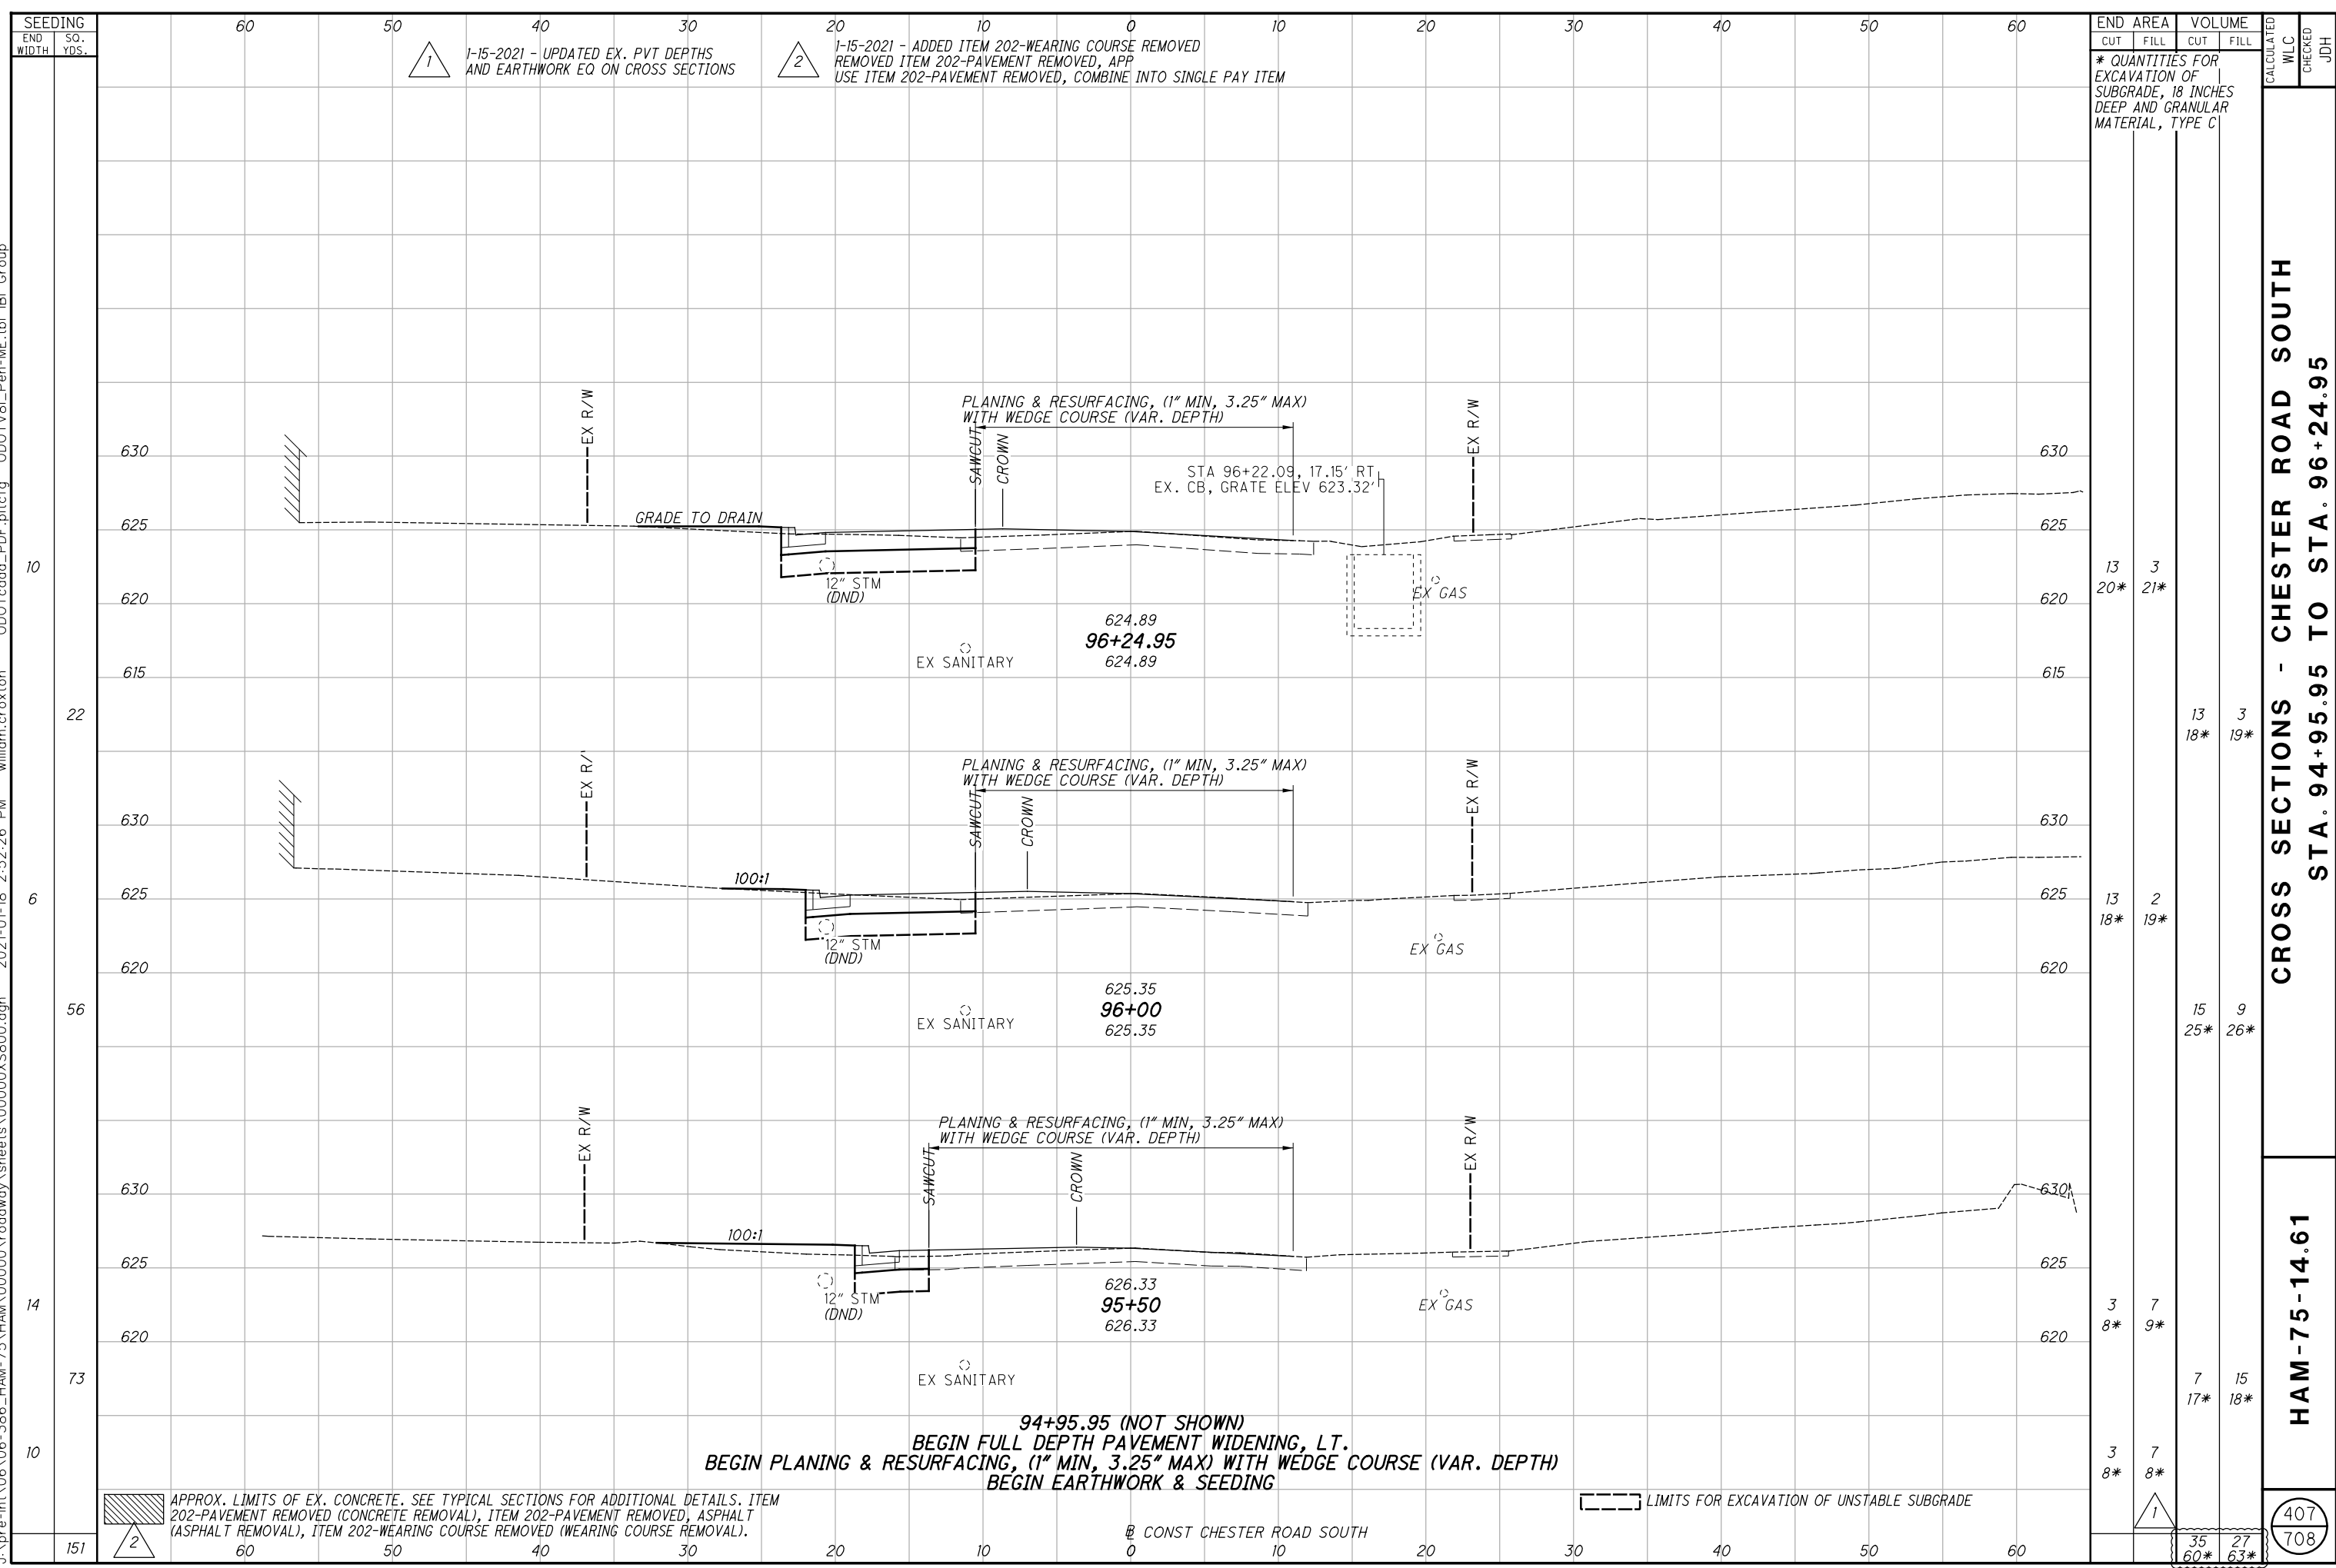

1-15-2021 - UPDATED EX. PVT DEPTHS AND EARTHWORK EQ ON CROSS SECTIONS

2 1-15-2021 - ADDED ITEM 202-WEARING COURSE REMOVED REMOVED ITEM 202-PAVEMENT REMOVED, APP USE ITEM 202-PAVEMENT REMOVED, COMBINE INTO SINGLE PAY ITEM

SEEDING		END AREA		VOLUME		CALCULATED	
END WIDTH	SO. YDS.	CUT	FILL	CUT	FILL	WLC	CHECKED
* QUANTITIES FOR EXCAVATION OF SUBGRADE, 18 INCHES DEEP AND GRANULAR MATERIAL, TYPE C							
13	3	20*	21*	13	3		
13	3	18*	19*	15	9		
3	7	8*	9*	7	15		
3	7	8*	8*	35	27		
				60*	63*		

**CROSS SECTIONS - CHESTER ROAD SOUTH**  
**STA. 94+95.95 TO STA. 96+24.95**

**HAM-75-14.61**

407  
708


APPROX. LIMITS OF EX. CONCRETE. SEE TYPICAL SECTIONS FOR ADDITIONAL DETAILS. ITEM 202-PAVEMENT REMOVED (CONCRETE REMOVAL), ITEM 202-PAVEMENT REMOVED, ASPHALT (ASPHALT REMOVAL), ITEM 202-WEARING COURSE REMOVED (WEARING COURSE REMOVAL).

LIMITS FOR EXCAVATION OF UNSTABLE SUBGRADE

94+95.95 (NOT SHOWN)  
 BEGIN FULL DEPTH PAVEMENT WIDENING, LT.  
 BEGIN PLANING & RESURFACING, (1" MIN, 3.25" MAX) WITH WEDGE COURSE (VAR. DEPTH)  
 BEGIN EARTHWORK & SEEDING

CONST CHESTER ROAD SOUTH

j:\pre-int\06\06-386\_HAM-75\HAM\00000\roadway\sheets\00000XS800.dgn 2021-01-18 2:52:26 PM william.croxton' ODOTcadd\_PDF.pltcfgr ODOTV81\_Pen-ME.tbl IBI Group

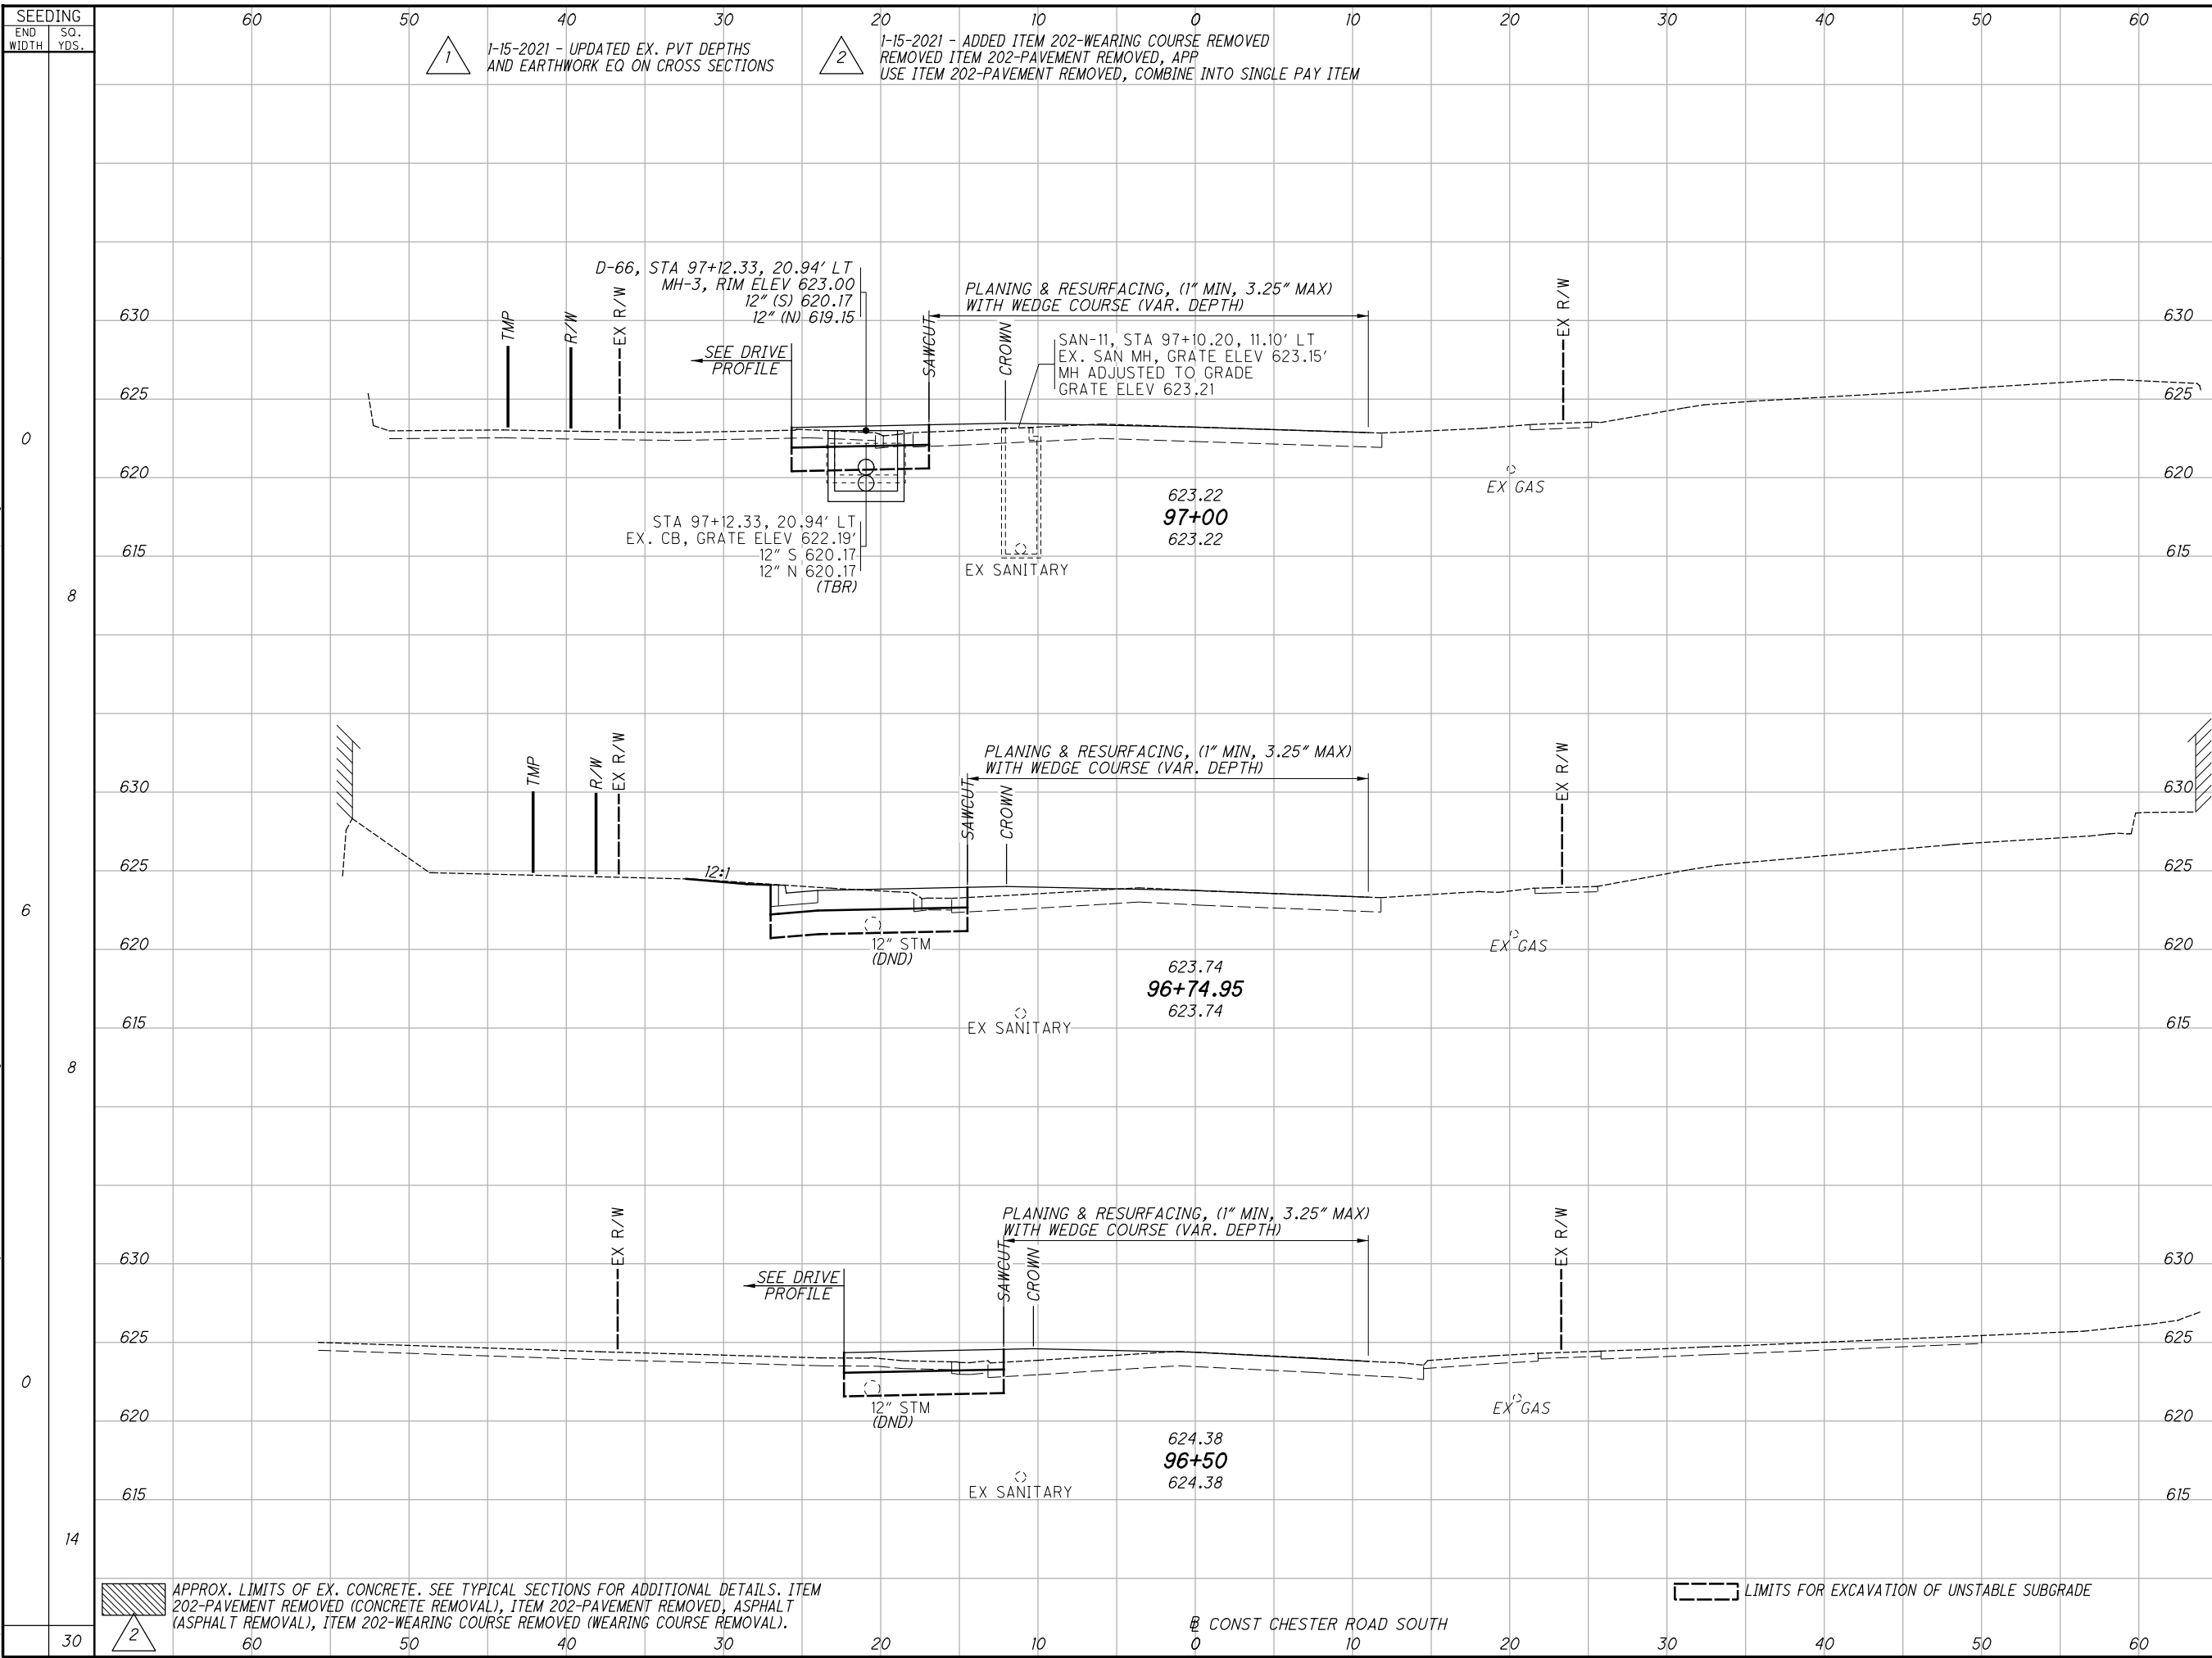

END AREA	VOLUME		CALCULATED	CHECKED	JDH
	CUT	FILL			
* QUANTITIES FOR EXCAVATION OF SUBGRADE, 18 INCHES DEEP AND GRANULAR MATERIAL, TYPE C					
3	0				
13*	14*				
8					
15*	16*				
6					
13	1				
18*	19*				
8					
7	1				
16*	17*				
0					
2	0				
15*	16*				
14					
7	2				
17*	18*				
30					
22	4				
48*	51*				

**CROSS SECTIONS - CHESTER ROAD SOUTH  
STA. 96+50 TO STA. 97+00**

**HAM-75-14.61**

408  
708

APPROX. LIMITS OF EX. CONCRETE. SEE TYPICAL SECTIONS FOR ADDITIONAL DETAILS. ITEM 202-PAVEMENT REMOVED (CONCRETE REMOVAL), ITEM 202-PAVEMENT REMOVED, ASPHALT (ASPHALT REMOVAL), ITEM 202-WEARING COURSE REMOVED (WEARING COURSE REMOVAL).

LIMITS FOR EXCAVATION OF UNSTABLE SUBGRADE

CONST CHESTER ROAD SOUTH

j:\pre-int\06\06-386\_HAM-75\HAM\00000\roadway\sheets\00000XS800.dgn 2021-01-18 2:52:27 PM william.croxtton' ODOT\cadd\_PDF.plt\cfig ODOTV81\_Pen-ME.tbl IBI Group


SEEDING	END WIDTH	SO. YDS.	60		50		40		30		20		10		0		10		20		30		40		50		60	
			CUT	FILL	CUT	FILL	CUT	FILL	CUT	FILL	CUT	FILL	CUT	FILL	CUT	FILL	CUT	FILL	CUT	FILL	CUT	FILL	CUT	FILL	CUT	FILL	CUT	FILL

1 1-15-2021 - UPDATED EX. PVT DEPTHS AND EARTHWORK EQ ON CROSS SECTIONS  
2 1-15-2021 - ADDED ITEM 202-WEARING COURSE REMOVED REMOVED ITEM 202-PAVEMENT REMOVED, APP USE ITEM 202-PAVEMENT REMOVED, COMBINE INTO SINGLE PAY ITEM

END AREA		VOLUME		CALCULATED WLC	CHECKED JDH
CUT	FILL	CUT	FILL		
* QUANTITIES FOR EXCAVATION OF SUBGRADE, 18 INCHES DEEP AND GRANULAR MATERIAL, TYPE C					
12	4	23*	25*		
18	12	38*	41*		
7	8	18*	19*		
17	11	32*	33*		
11	3	16*	16*		
13	3	27*	28*		
48	26	97*	102*		

**CROSS SECTIONS - CHESTER ROAD SOUTH**  
**STA. 97+50 TO STA. 98+50**  
**HAM-75-14.61**


409  
708

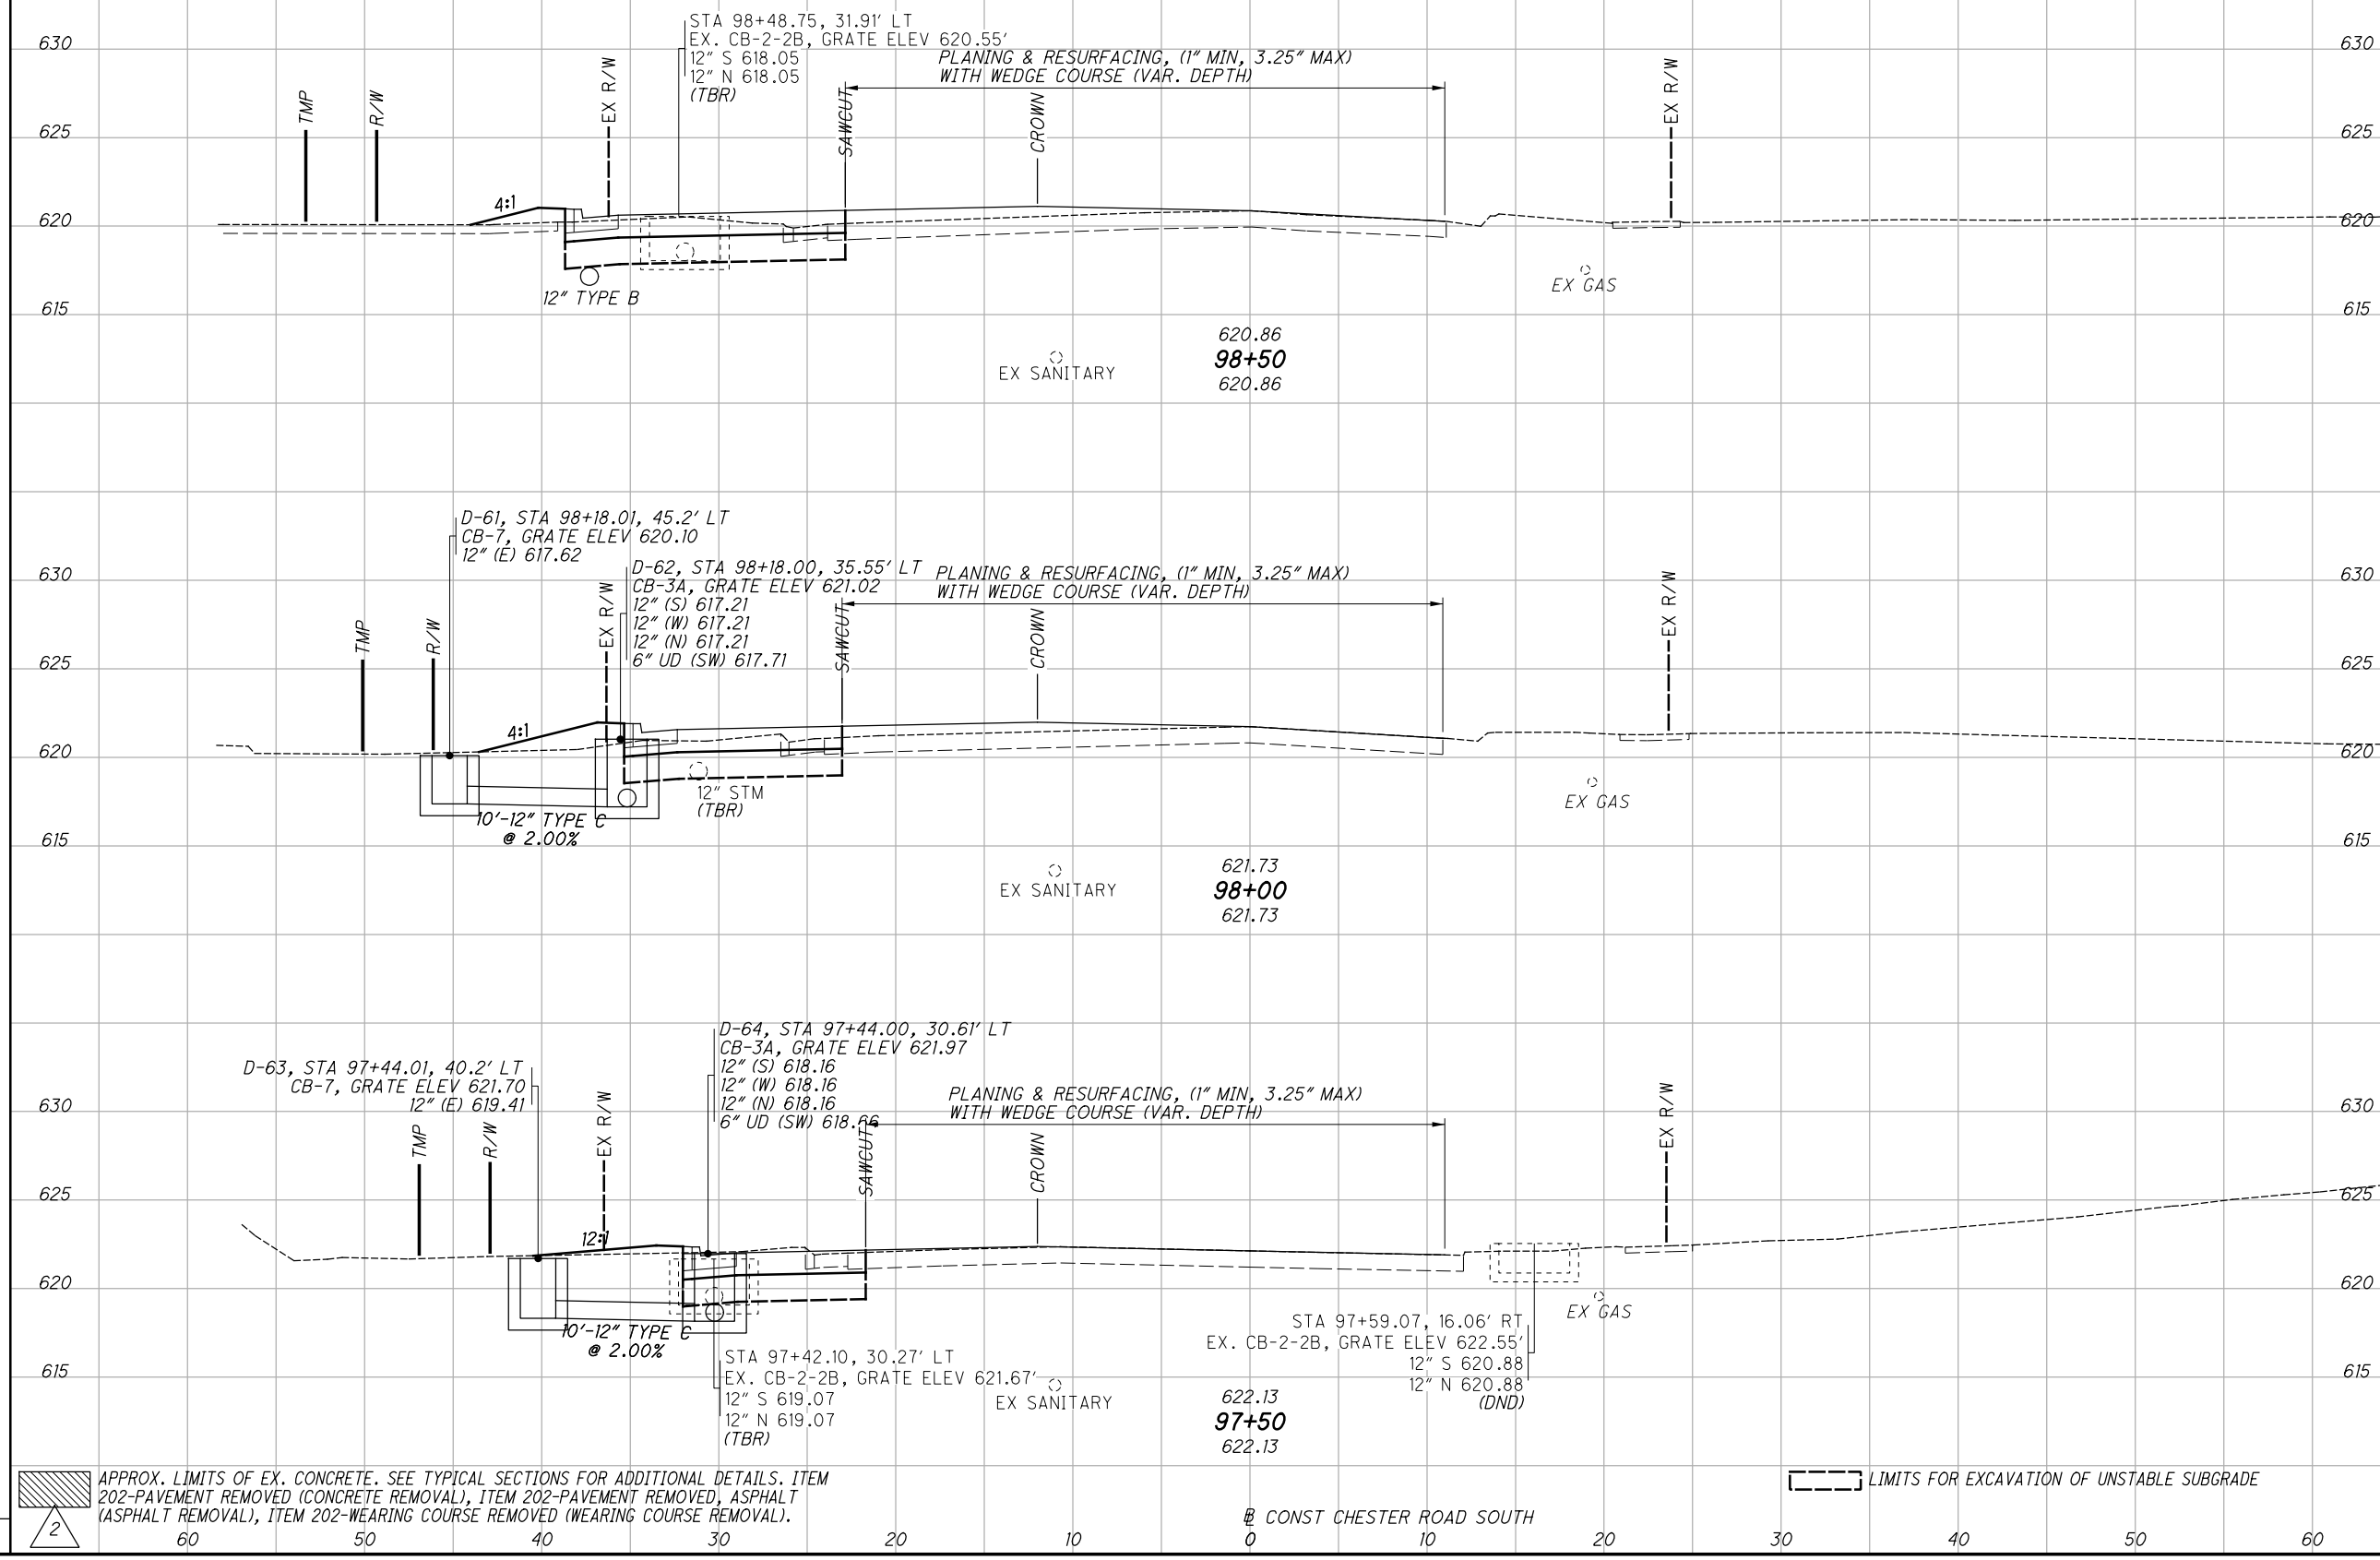

1 APPROX. LIMITS OF EX. CONCRETE. SEE TYPICAL SECTIONS FOR ADDITIONAL DETAILS. ITEM 202-PAVEMENT REMOVED (CONCRETE REMOVAL), ITEM 202-PAVEMENT REMOVED, ASPHALT (ASPHALT REMOVAL), ITEM 202-WEARING COURSE REMOVED (WEARING COURSE REMOVAL).  
2 LIMITS FOR EXCAVATION OF UNSTABLE SUBGRADE  
 CONST CHESTER ROAD SOUTH



j:\pre-int\06\06-386\_HAM-75\_HAM\00000\roadway\sheets\00000XS800.dgn 2021-01-18 2:52:27 PM william.croxtton' ODOTcadd\_PDF.plt cfig ODOTV81\_Pen-ME.tbl IBI Group

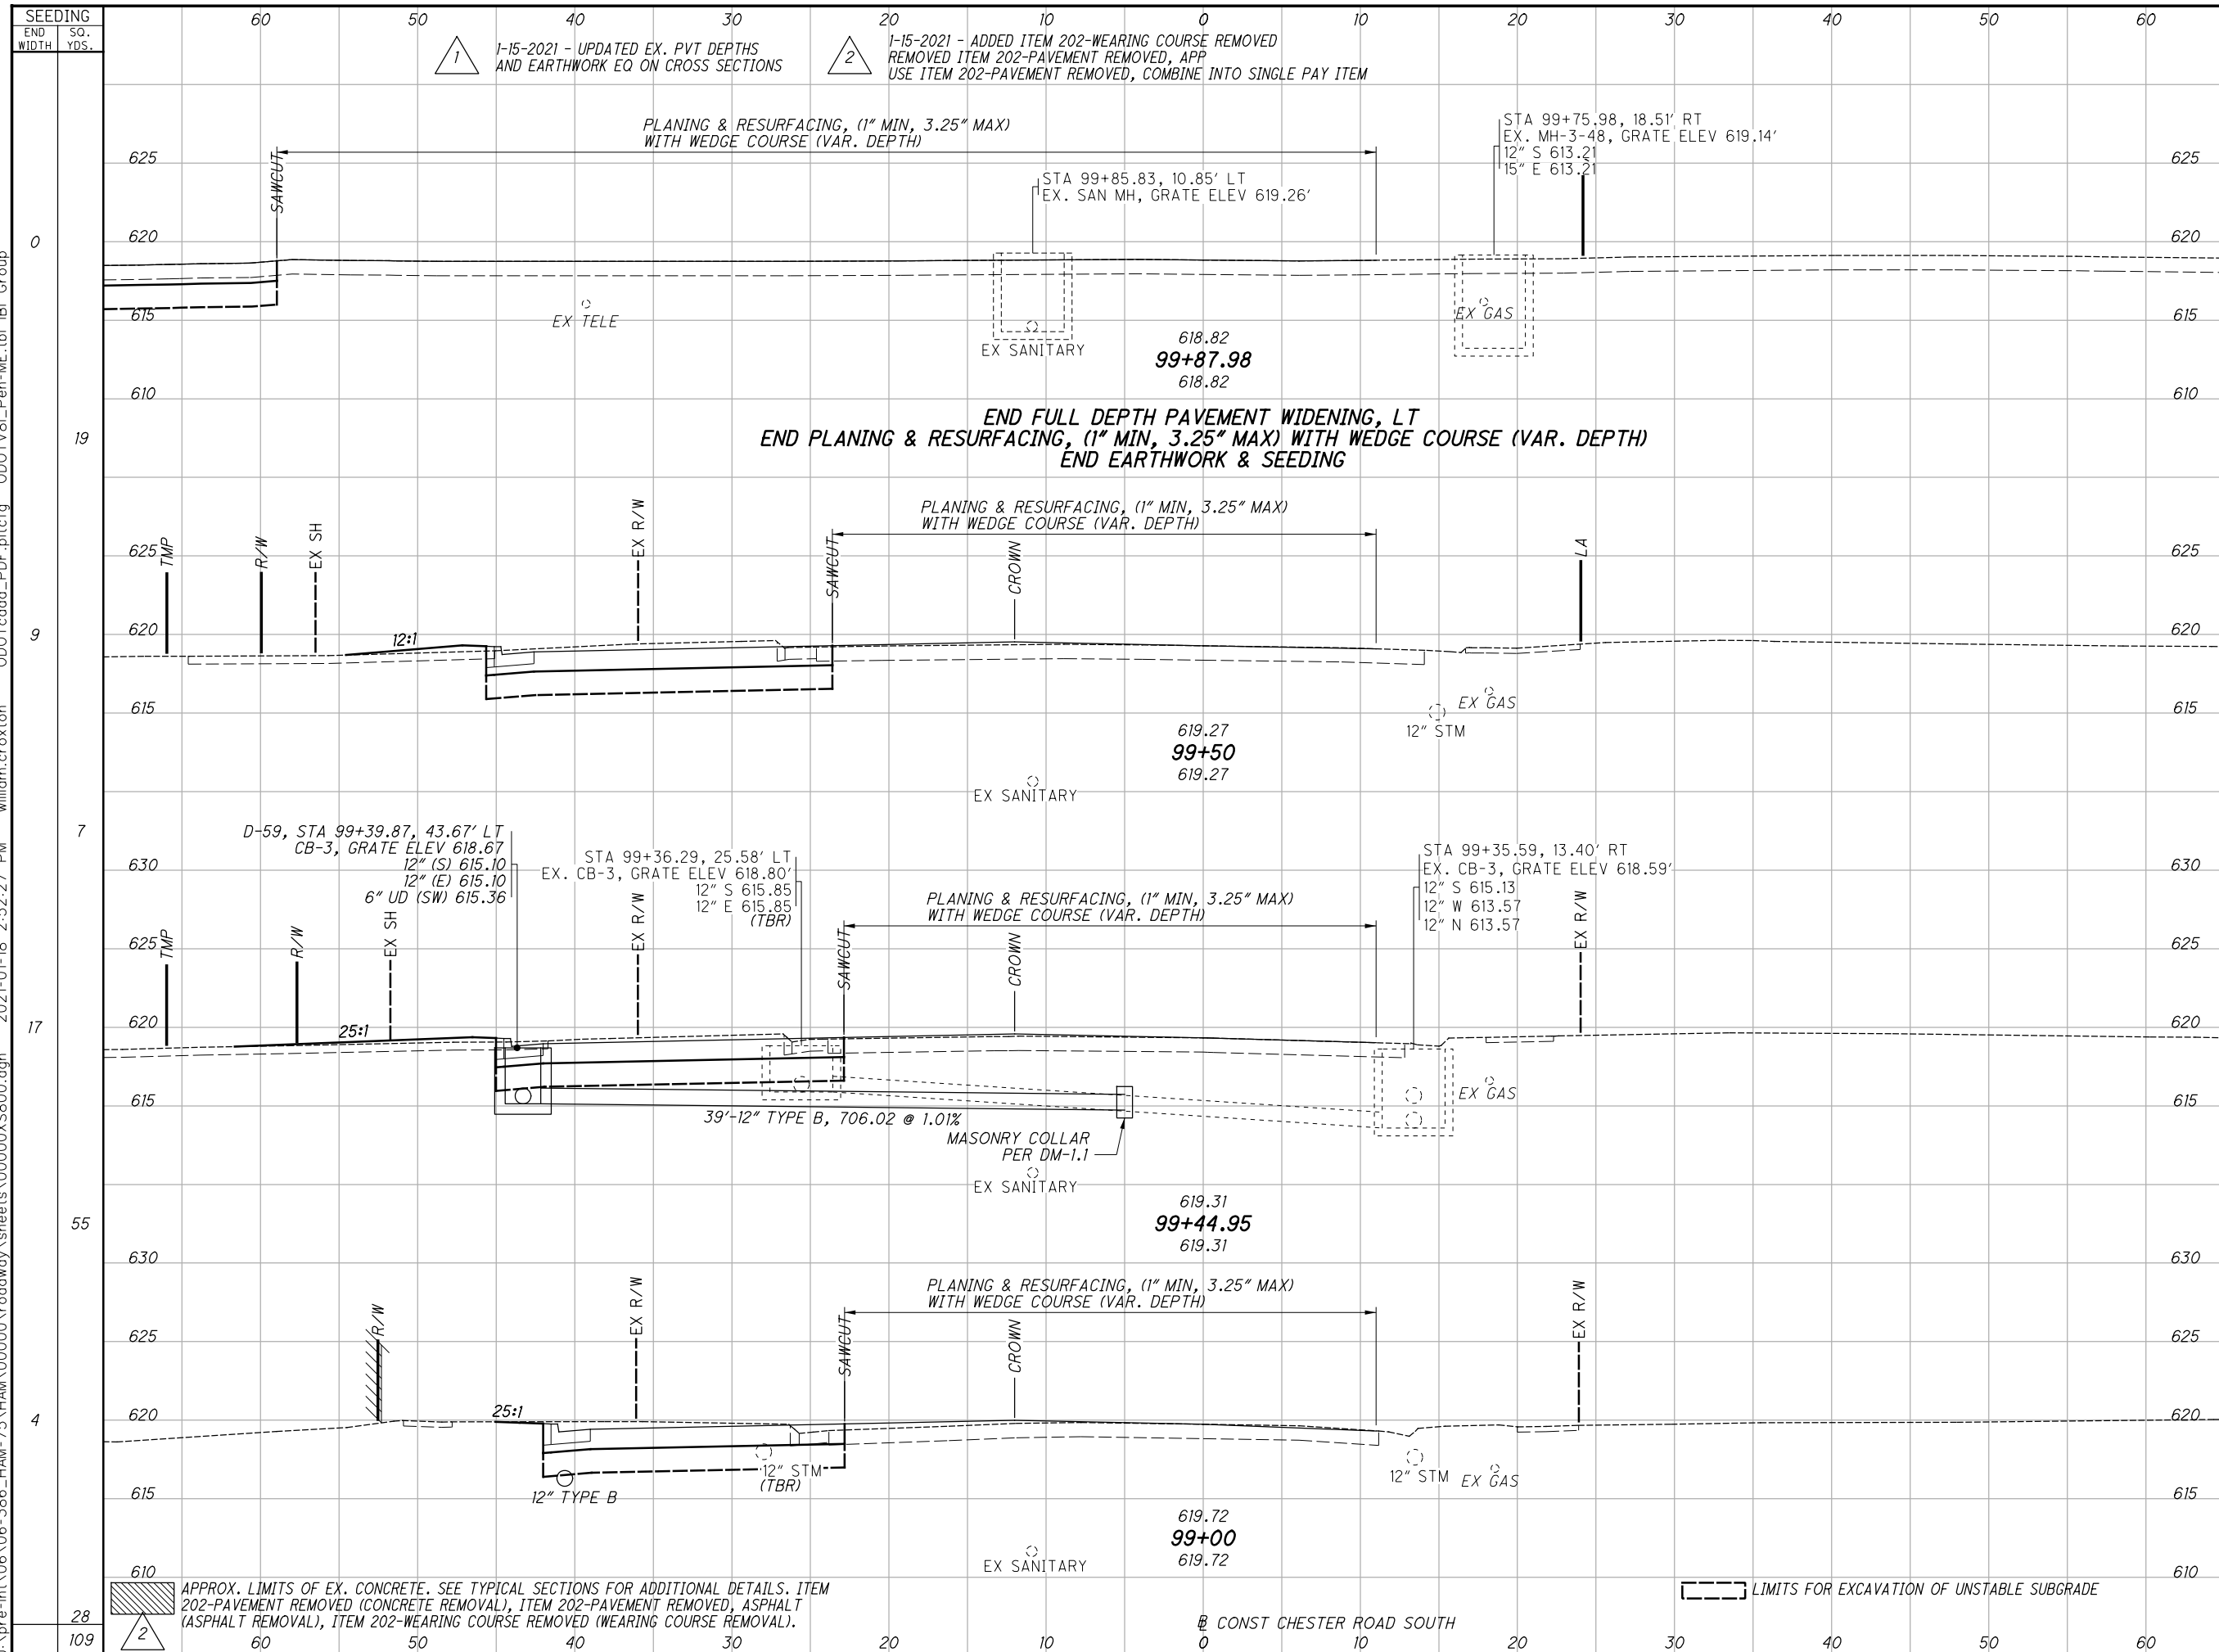

STATION	END AREA		VOLUME		CALCULATED	CHECKED	JDH
	CUT	FILL	CUT	FILL			
99+87.98	23	0	95*	95*			
99+50	31	3	34*	34*			
99+44.95	27	4	33*	33*			
99+00	26	1	29*	30*			
TOTAL	107	8	135*	135*			

**CROSS SECTIONS - CHESTER ROAD SOUTH**  
**STA. 99+00 TO STA. 99+87.98**

**HAM-75-14.61**

410  
 708

APPROX. LIMITS OF EX. CONCRETE. SEE TYPICAL SECTIONS FOR ADDITIONAL DETAILS. ITEM 202-PAVEMENT REMOVED (CONCRETE REMOVAL), ITEM 202-PAVEMENT REMOVED, ASPHALT (ASPHALT REMOVAL), ITEM 202-WEARING COURSE REMOVED (WEARING COURSE REMOVAL).

--- LIMITS FOR EXCAVATION OF UNSTABLE SUBGRADE

@ CONST CHESTER ROAD SOUTH



1-15-2021 - UPDATED EX. PVT DEPTHS AND EARTHWORK EQ ON CROSS SECTIONS



1-15-2021 - ADDED ITEM 202-WEARING COURSE REMOVED REMOVED ITEM 202-PAVEMENT REMOVED, APP USE ITEM 202-PAVEMENT REMOVED, COMBINE INTO SINGLE PAY ITEM


\* QUANTITIES FOR EXCAVATION OF SUBGRADE, 18 INCHES DEEP AND GRANULAR MATERIAL, TYPE C

J:\pre-int\06-386\_HAM-75\HAM\00000\traffic\sheets\00000ts103.dgn 2021-01-08 2:23:29 PM brian.sedzia\ODOTV81\_PDF\_Half.pltcfgr ODOTV81\_Pen-ME.tbl IB Group


SHEET NO.	REF. NO.	LOCATION	STATION	SIDE	CODE	SIZE (FEET)	625		630					SIGN, OVERHEAD EXTRUSHEET	CONCRETE BARRIER MEDIUM OVERHEAD SIGN SUPPORT FOUNDATION, TYPE TC-21.50	RIGID OVERHEAD SIGN SUPPORT FOUNDATION	1	1-5-2021 - UPDATED SIGN SUPPORT FOUNDATION DUE TO PID 82288 CONSTRUCTION
							GROUND ROD	OVERHEAD SIGN SUPPORT, TYPE TC-12.30, DESIGN 8	OVERHEAD SIGN SUPPORT, MISC.: TYPE TC-12.31 DESIGN 6	OVERHEAD SIGN SUPPORT, MISC.: TYPE TC-12.31 DESIGN 12	OVERHEAD SIGN SUPPORT, MISC.: TYPE TC-15.116 DESIGN 2	OVERHEAD SIGN SUPPORT, MISC.: TYPE TC-15.116 DESIGN 3	EACH					
496	S-1	I-75 MAINLINE (SB)	208+50	RT	GUIDE SIGN	16 X 5	1	1						80.0				
496	S-2	I-75 MAINLINE (SB)	231+00	RT	GUIDE SIGN	16 X 5	1	1						80.0				
497	S-121	I-75 MAINLINE	317+75	LT	GUIDE SIGN	14 X 10								140.0				
499	S-4	I-75 MAINLINE	328+50	RT	GUIDE SIGN	19 X 13	2				1		247.0	1	1			
499	S-7	I-75 MAINLINE	334+00	LT	EI-H5P	7 X 2.5							17.5					
					GUIDE SIGN	15 X 8	2			1	120.0		2					
					EI-H5P	9 X 2.5					22.5							
					GUIDE SIGN	15 X 11					165.0							
500	S-24	I-75 MAINLINE	353+00	RT	GUIDE SIGN	12 X 10	2				1	120.0			2			
					GUIDE SIGN	18 X 11					198.0							
					EI-H5P	7 X 2.5					17.5							
501	S-35	I-75 MAINLINE	361+00	RT	GUIDE SIGN	18 X 12	1			1	216.0			1				
					EI-H5P	7 X 2.5					17.5							
502	S-43	I-75 MAINLINE	371+00	LT	GUIDE SIGN	17 X 10	1			1	170.0			1				
					EI-H5P	12 X 2.5					30.0							
503	S-58	I-75 MAINLINE	385+00	LT	GUIDE SIGN	14 X 10	2				1	140.0		2				
					GUIDE SIGN	18 X 11					198.0							
503	S-59	I-75 MAINLINE	388+00	RT	EI-H5P	7 X 2.5						17.5						
					GUIDE SIGN	23 X 15	2			1	345.0		2					
504	S-68	I-75 MAINLINE	396+00	RT	GUIDE SIGN	16 X 5	1			1	80.0			1				
505	S-77	I-75 MAINLINE	406+00	RT	GUIDE SIGN	16 X 5	1			1	80.0			1				
505	S-78	I-75 MAINLINE	409+00	LT	GUIDE SIGN	19 X 13	2				1	247.0		2				
					EI-H5P	7 X 2.5					17.5							
					GUIDE SIGN	12 X 10	2				120.0		2					
506	S-81	I-75 MAINLINE	414+00	RT	GUIDE SIGN	18 X 13						234.0						
					EI-H5P	7 X 2.5					17.5							
					GUIDE SIGN	10 X 7	1			1	70.0		1					
514	S-105	SHARON RD	16+00	RT	GUIDE SIGN	10 X 7						70.0						
					GUIDE SIGN	10 X 7					70.0							
516	S-112	SHARON RD	23+07	LT	GUIDE SIGN	8 X 7	1				1	56.0		1				
					GUIDE SIGN	8 X 7					56.0							
<b>TOTALS CARRIED TO GENERAL SUMMARY</b>							22	2	2	4	6	1	3429.5	1	19			

CALCULATED	BSS	CHECKED	JDH
<b>SIGNING SUBSUMMARY</b>			
<b>HAM-75-14.61</b>			
(480 / 708)			

J:\pre-int\06\06-386\_HAM-75\HAM\00000\traffic\sheets\00000td002.dgn 2021-01-05 5:07:20 PM brion.sezior\ODOTV8i\_PDF\_Hof.pltcfgr ODOTV8i\_PDF\_Hof.pltcfgr ODOTV8i\_PDF\_Hof.pltcfgr IBI Group

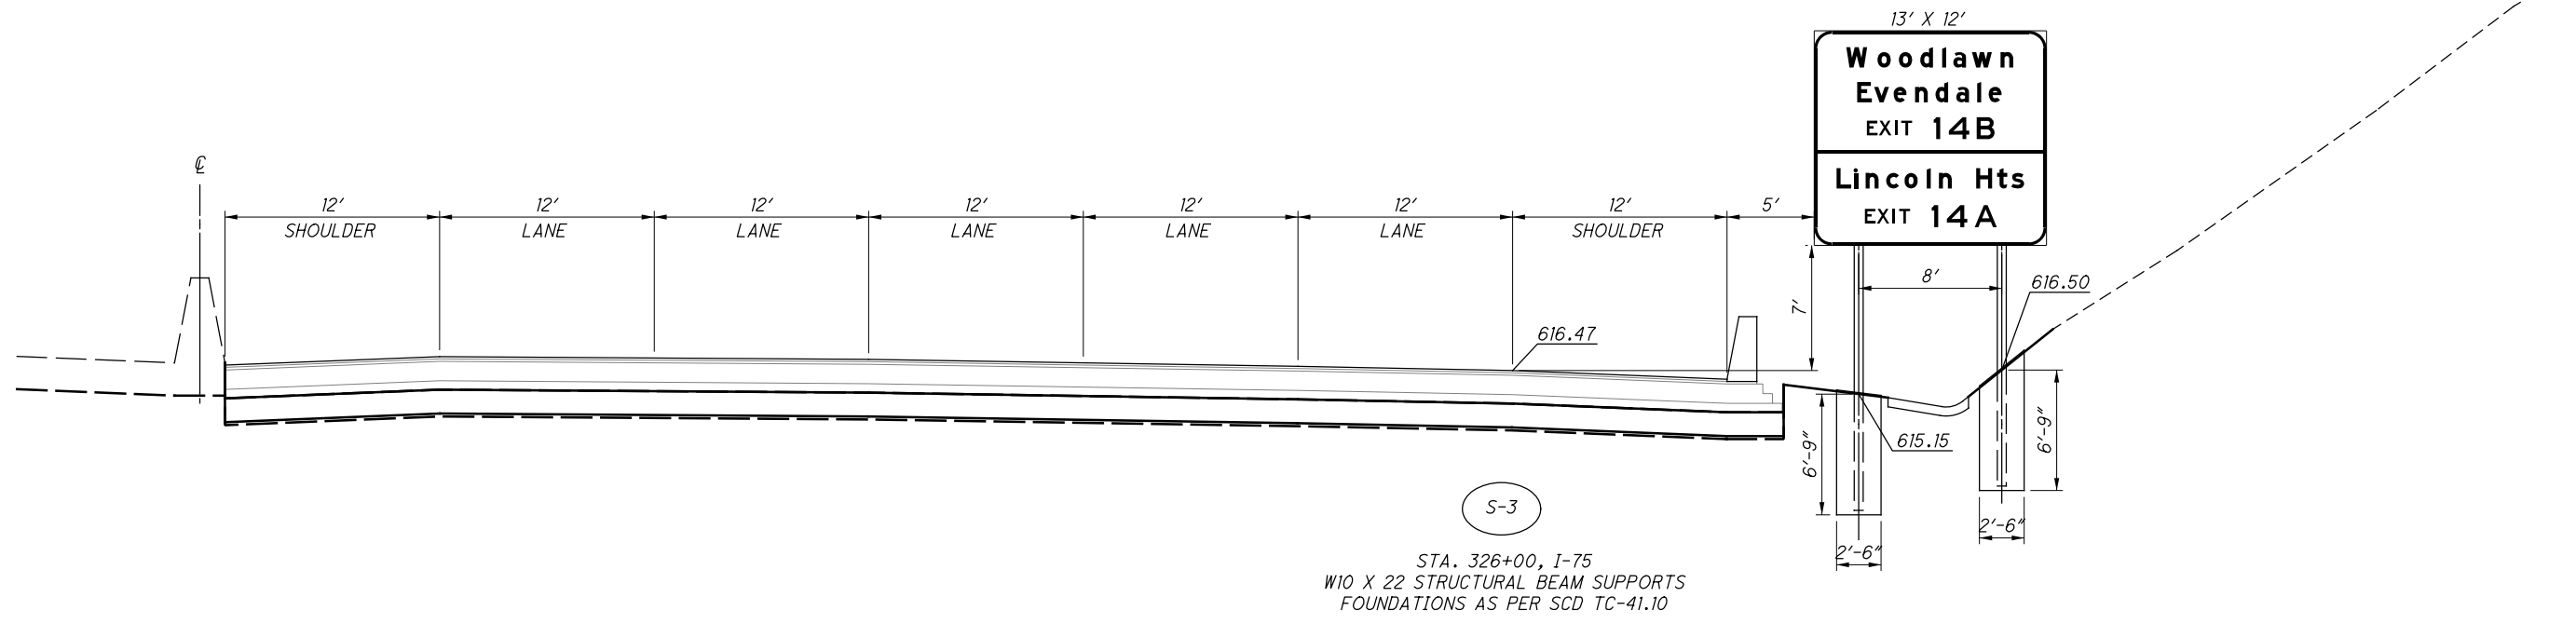

S-3  
 STA. 326+00, I-75  
 W10 X 22 STRUCTURAL BEAM SUPPORTS  
 FOUNDATIONS AS PER SCD TC-41.10

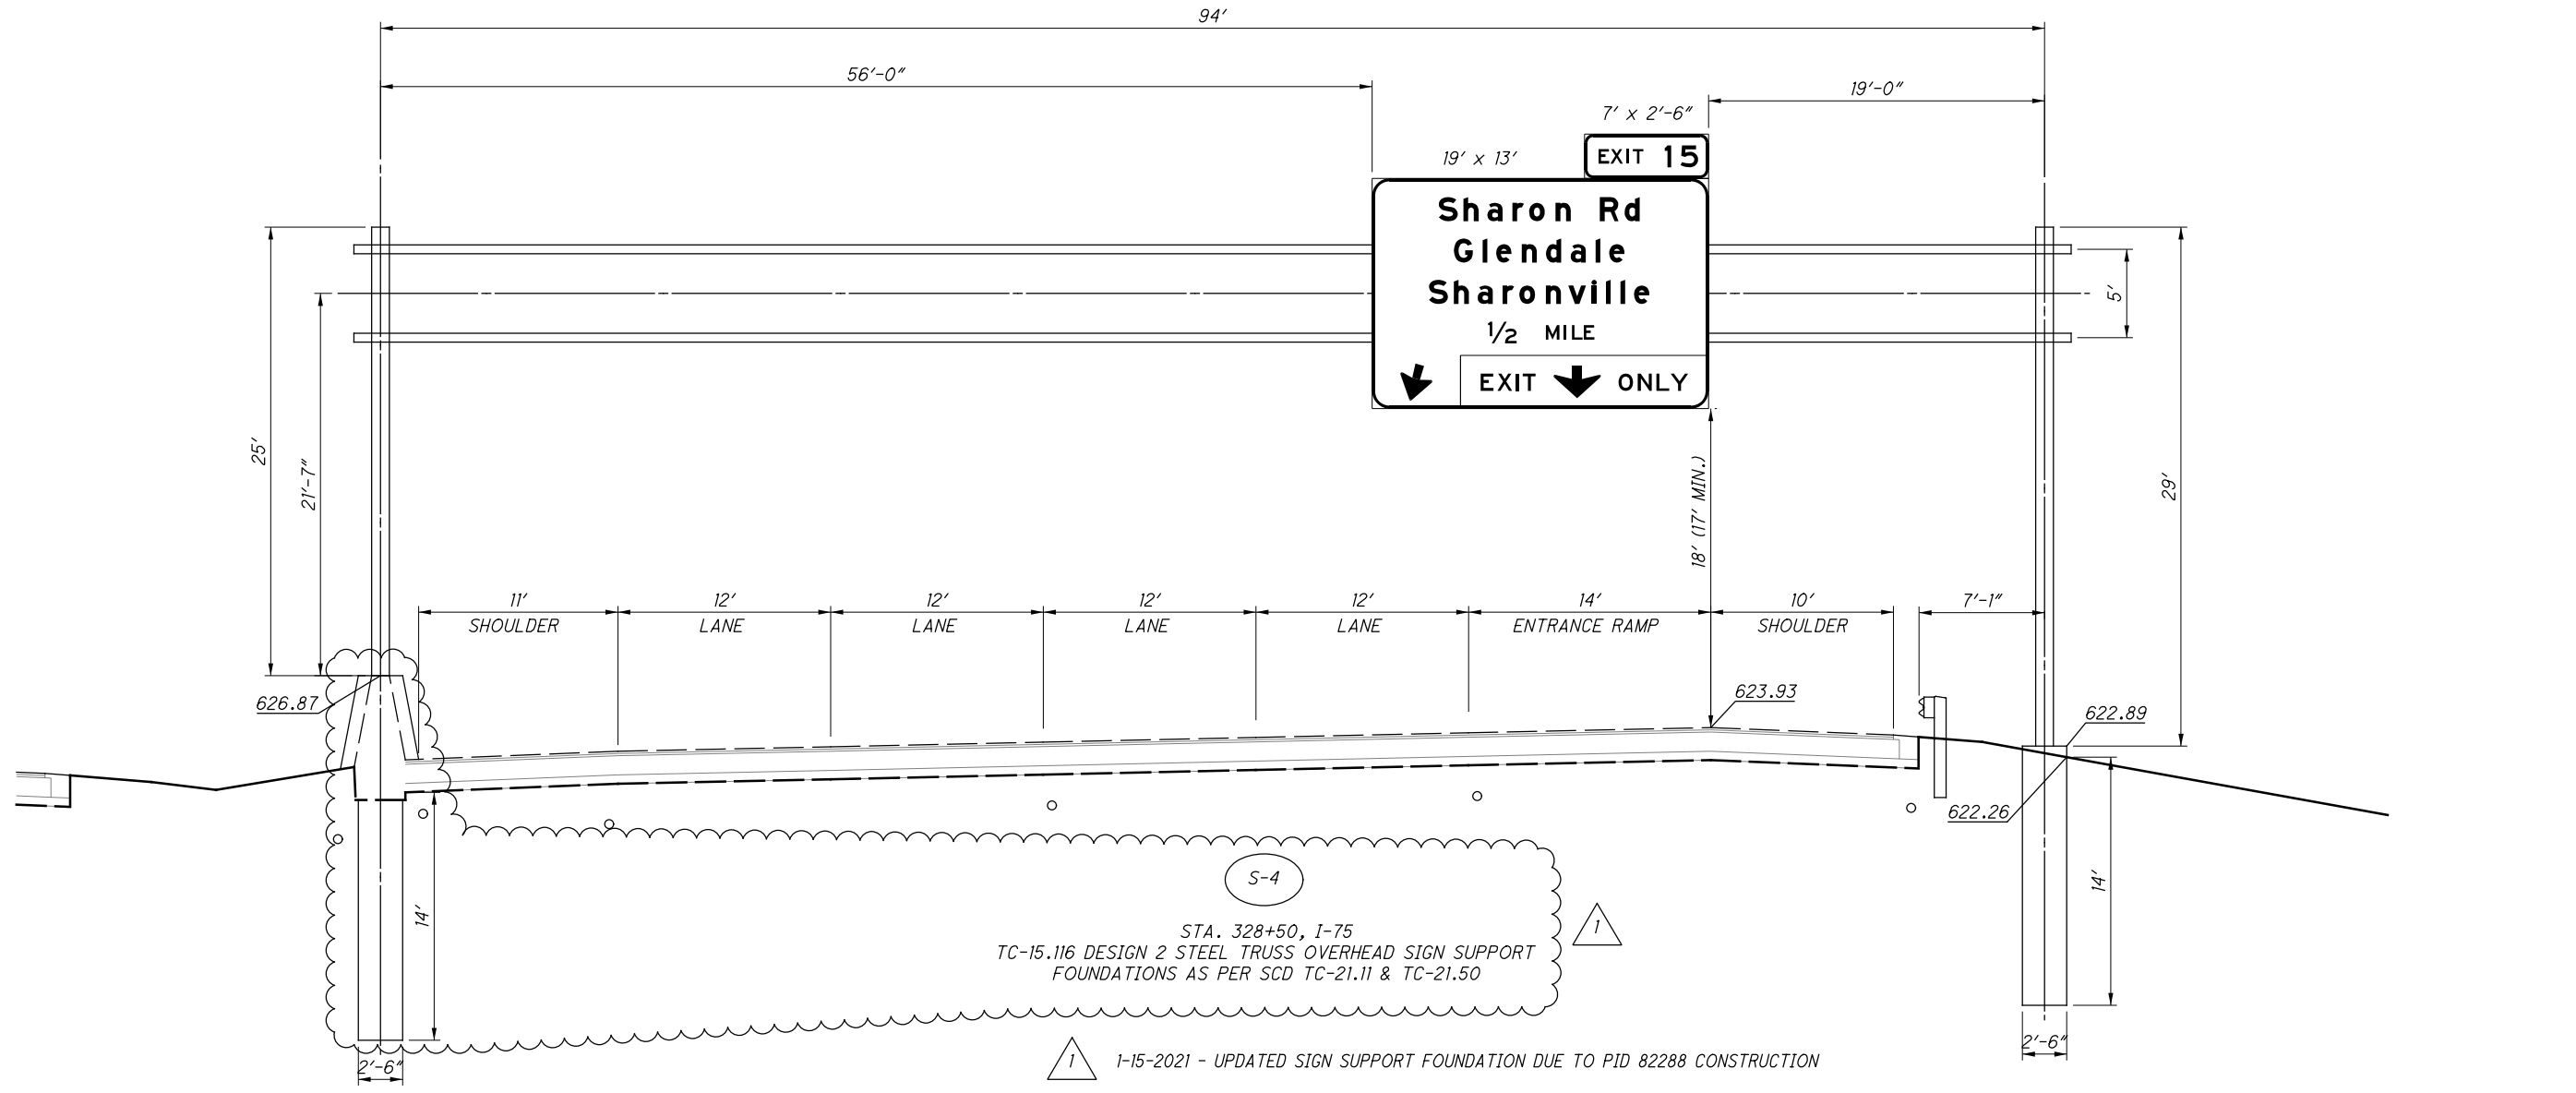

S-4  
 STA. 328+50, I-75  
 TC-15.116 DESIGN 2 STEEL TRUSS OVERHEAD SIGN SUPPORT  
 FOUNDATIONS AS PER SCD TC-21.11 & TC-21.50  
 1-15-2021 - UPDATED SIGN SUPPORT FOUNDATION DUE TO PID 82288 CONSTRUCTION

J:\pre-int\06\06-386\_HAM-75\_HAM\00000\signals\sheets\00000CM001.dgn\_Sheet 2021-01-19 2:44:51 PM william.croxton

**PULL BOX COVERS**

PULL BOX COVERS SHALL BE INSTALLED PER SECTION 725 OF THE CMS. THE WORD "TRAFFIC" SHALL BE CAST ON THE SURFACE OF THE PULL BOX COVER. COVERS ARE INCIDENTAL TO THE PULL BOXES.

**UTILITIES**

FOR LOCATING INFORMATION AND CONTACT INFORMATION REFER TO THE UTILITIES NOTE LOCATED IN THE GENERAL NOTES OF THIS PLAN SET.

**MAINTAINING ITS DURING CONSTRUCTION**

THE CONTRACTOR SHALL MAINTAIN ALL PREEXISTING OR NEWLY INSTALLED PERMANENT ITS/TRAFFIC DEVICES AND INFRASTRUCTURE DURING CONSTRUCTION ACCORDING TO ODOT SUPPLEMENTAL SPECIFICATION 809.

**DYNAMIC MESSAGE SIGN INSTALLATIONS**



THE CONTRACTOR SHALL CONSTRUCT THE DMS TRUSS SUPPORT AND RELOCATE THE EXISTING ITS DEVICES SUCH THAT IT LIMITS THE AMOUNT OF ITS DOWN TIME. WHILE THE ITS EQUIPMENT IS OUT OF SERVICE, THE CONTRACTOR SHALL UTILIZE A PORTABLE CHANGEABLE MESSAGE SIGN TO DISPLAY THE INFORMATION RELAYED ON THE EXISTING DMS SIGN. THE CONTRACTOR SHALL COORDINATE WITH CENTRAL OFFICE (BRYAN COMER AT (614) 378-1253) TO OBTAIN A MODEM TO USE WITH THE PORTABLE CHANGEABLE MESSAGE SIGN. THE WORK ASSOCIATED WITH INSTALLING AND FURNISHING THE PORTABLE CHANGEABLE MESSAGE SIGN SHALL BE PAID FOR UNDER ITEM 614 - PORTABLE CHANGEABLE MESSAGE SIGN, AS PER PLAN.

THE DISINCENTIVES ASSOCIATED WITH SUPPLEMENTAL SPECIFICATION 809.14 SHALL NOT BE ENFORCED, FOR THIS DMS SIGN ONLY, DURING THE 6 MONTHS THE PCMS SIGN IS ACTIVE, DUE TO THE LENGTH OF TIME THE DMS WILL BE OUT OF SERVICE.

**CCTV INSTALLATIONS**

THE CONTRACTOR SHALL FURNISH AND INSTALL THIS ITEM ACCORDING TO ODOT SUPPLEMENTAL SPECIFICATION 809, AS WELL AS ANY STANDARD CONSTRUCTION DRAWINGS NOTED ON THE PLANS.

**ITEM 809 - ATC V6.24 CONTROLLER, AS PER PLAN**

THE CONTROLLER UNIT SHALL BE FURNISHED AND INSTALLED PER SUPPLEMENTAL SPECIFICATION 809 AND BE LISTED ON THE TRAFFIC AUTHORIZED PRODUCTS (TAP) LIST.

THE CONTROLLER SHALL BE AN ECONOLITE COBALT AND COMPATIBLE WITH THE CABINET TYPE BEING INSTALLED.



1-19-2021 - ADDED SUPPLEMENTAL NOTES FOR PCMS, APP  
ADDED 6 MONTHS TO ITEM 614-PCSM, APP

CALCULATED  
MAM  
CHECKED  
PCG

TRAFFIC SURVEILLANCE GENERAL NOTES

HAM-75-14.61

561

708



TRAFFIC SURVEILLANCE - EQUIPMENT LEGEND


- ⋯ EXISTING LOOP DETECTORS
- + - EXISTING TRAFFIC SURVEILLANCE (TS) CONDUIT
- ⊗ EXISTING TRAFFIC SURVEILLANCE (TS) PULL BOX TO BE REMOVED
- /// PROPOSED LIGHTING
- T — TRAFFIC SURVEILLANCE CONDUIT
- DETECTION AREA
- 📷 CCTV CAMERA
- ▲ POWER SOURCE
- ⊖ (PB-1) TRAFFIC SURVEILLANCE PULL BOX
- ⊖ (MJB-1) TRAFFIC SURVEILLANCE MEDIAN JUNCTION BOX
- ⊖ ELECTRIC PULL BOX
- ⊖ ITS CABINET

REMOVAL QUANTITIES	
ITEM 625-PULL BOX REMOVED	0 EACH

N

0 50 100  
HORIZONTAL SCALE IN FEET

CALCULATED JAW CHECKED PCG

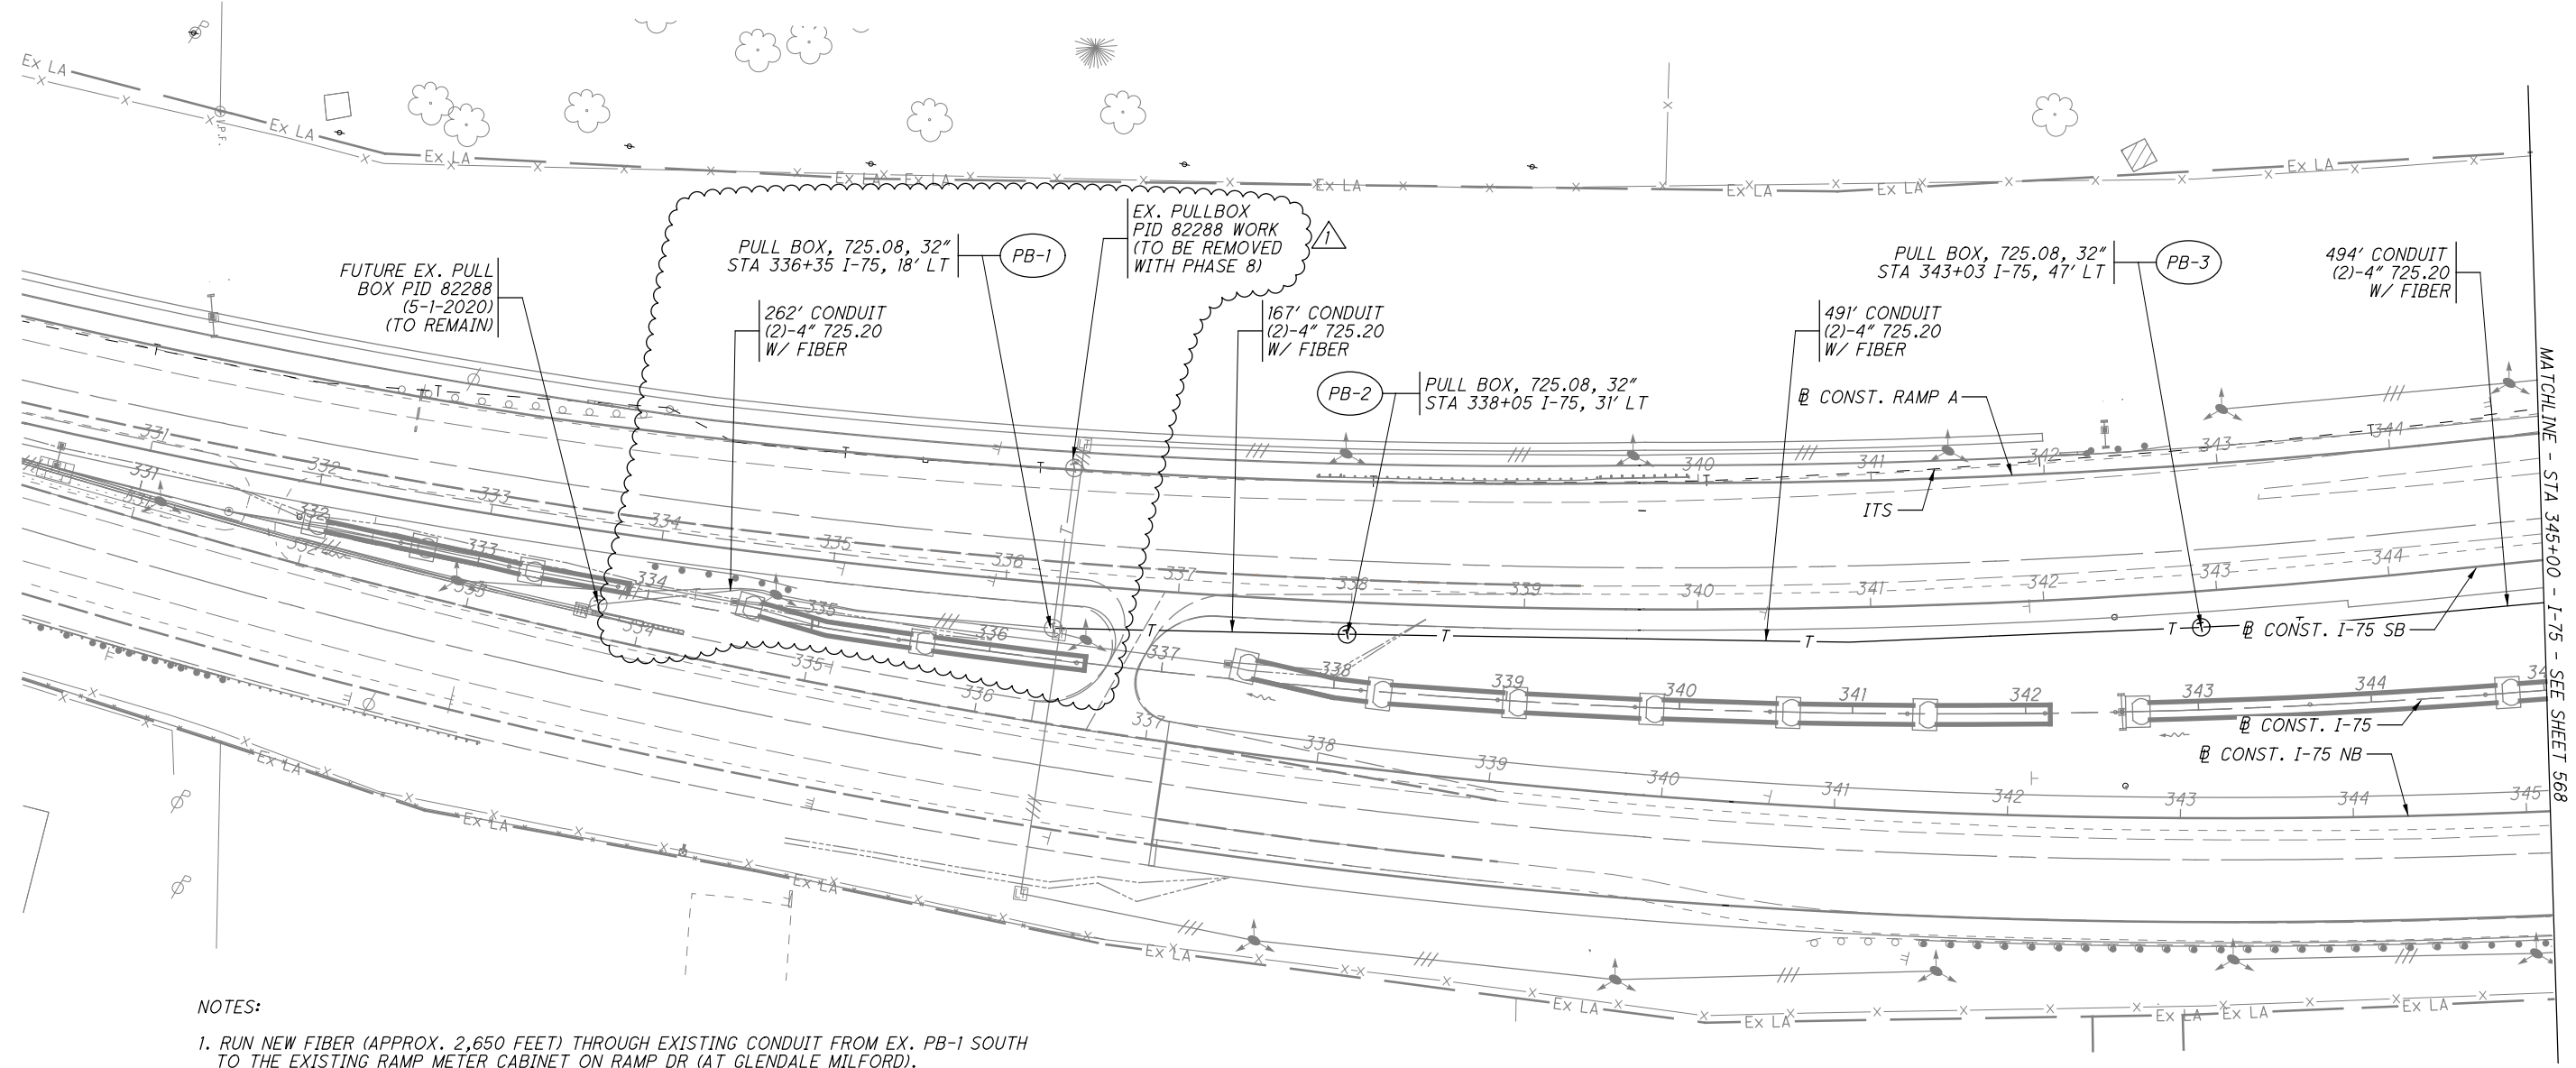

- NOTES:
1. RUN NEW FIBER (APPROX. 2,650 FEET) THROUGH EXISTING CONDUIT FROM EX. PB-1 SOUTH TO THE EXISTING RAMP METER CABINET ON RAMP DR (AT GLENDALE MILFORD).
  2. NO SPLICES IN THE FIBER BETWEEN THE EXISTING RAMP METER CABINET ON RAMP DR (AT GLENDALE-MILFORD) AND THE PROPOSED RAMP METER CABINET ON RAMP A (AT SHARON RD).

- NOTES:
1. EXISTING TRAFFIC SURVEILLANCE EQUIPMENT LOCATIONS ARE APPROXIMATE.
  2. EXISTING TRAFFIC SURVEILLANCE SYSTEM SHALL BE KEPT FULLY FUNCTIONAL THROUGHOUT CONSTRUCTION.

⚠ 1-15-2021 - UPDATED WORK LIMITS DUE TO PID 82288 CONSTRUCTION

TRAFFIC SURVEILLANCE - I-75 SB / NB  
STA 330+00 TO STA 345+00

HAM-75-14.61

567  
708

j:\pre-int\06\06-386\_HAM-75\_HAM\00000\signals\sheets\00000CM101.dgn 2021-01-11 4:37:58 PM jason.watt ODOTV81\_PDF\_Half.plt cfg ODOTV81\_Pen-ME.tbl IBI Group

j:\pre-int\06-386\_HAM-75\_HAM\00000\lighting\sheets\00000LN001.dgn 2021-01-14 10:20:53 AM jason.watt' ODOTcadd\_PDF.pltcfgr ODOTV81\_Pen-ME.tbl IBI Group

**ITEM 625 - POWER SERVICE, AS PER PLAN**

IN ADDITION TO THE REQUIREMENTS OF THE SPECIFICATIONS, THE FOLLOWING IS ADDED.

THE POWER SUPPLYING AGENCY FOR THIS PROJECT IS:

DUKE ENERGY  
139 E. 4TH STREET 467A  
CINCINNATI, OH 45202  
513-287-3674  
AARON WRIGHT

THE ENGINEER SHALL ENSURE THAT EACH POWER SERVICE ELECTRICAL ENERGY ACCOUNT IS IN THE NAME OF AND THAT THE BILLING ADDRESS IS TO THE MAINTAINING AGENCY NOTED IN THE PLANS. THIS SHALL BE DONE NOT ONLY FOR EACH NEW POWER SERVICE ESTABLISHED BY THIS PROJECT BUT ALSO FOR EACH EXISTING POWER SERVICE, SINCE THERE MAY BE A REASSIGNMENT OF THE RESPONSIBILITY FOR AN EXISTING SERVICE AS A RESULT OF THE WORK PERFORMED BY THIS PROJECT.

PAYMENT WILL BE MADE AT THE UNIT BID PRICE FOR EACH C&MS ITEM 625, "POWER SERVICE, AS PER PLAN" WHICH SHALL BE FULL COMPENSATION FOR ALL LABOR, MATERIALS AND INCIDENTALS REQUIRED TO COMPLETE THIS ITEM IN A SATISFACTORY AND WORKMANLIKE MANNER.

**ITEM 625 - DISCONNECT CIRCUIT, AS PER PLAN**

THIS ITEM OF WORK SHALL CONSIST OF THE DISCONNECTION OF AN EXISTING LIGHT CIRCUIT AT A PULL BOX OR TRANSFORMER BASE.

DISCONNECTION AT A PULL BOX SHALL INVOLVE CUTTING THE EXISTING CIRCUIT AND REMOVING ALL SPLICE KITS. ANY CABLE THAT IS TO BE ABANDONED SHALL BE TERMINATED FROM THE PULL BOX SO THAT NO CABLE IS LEFT IN THE BOX.

DISCONNECTION AT A TRANSFORMER BASE SHALL INVOLVE CUTTING THE EXISTING CIRCUIT AND REMOVING ALL CONNECTOR KITS. ALL DUCT-CABLE NOT TO BE REUSED SHALL BE REMOVED FROM THE TRANSFORMER BASE AND THE EXISTING CONDUIT IN THE FOUNDATION SHALL BE CLEANED OF ALL CABLE AND DEBRIS SO THAT THE NEW DUCT-CABLE CAN BE INSTALLED. ALL EXISTING CABLE TO REMAIN ACTIVE SHALL BE CUT IN A MANNER SO THAT THERE IS SUFFICIENT CABLE LEFT FOR RECONNECTION.

THOSE WIRES THAT ARE TO REMAIN ON ACTIVE CIRCUITS SHALL HAVE A WATER-RESISTANT SEAL AT THE CUT END. THE WATER-RESISTANT SEAL SHALL BE ACCOMPLISHED BY PLUGGING THE DEACTIVATED PORT OF AN EXISTING CONNECTOR KIT OR BY INSTALLING A CABLE SPLICE KIT ON THE CUT END OF THE CABLE.

PAYMENT SHALL BE MADE AT THE UNIT BID PRICE PER EACH UNDER C&MS ITEM 625, DISCONNECT CIRCUIT, AS PER PLAN AT EACH LOCATION WHERE DISCONNECTION IS REQUIRED WHICH SHALL BE FULL COMPENSATION FOR ALL LABOR, MATERIALS AND INCIDENTALS REQUIRED TO COMPLETE THIS ITEM IN A SATISFACTORY AND WORKMANLIKE MANNER.

AN ESTIMATED QUANTITY OF 100 EACH HAS BEEN CARRIED TO THE GENERAL SUMMARY FOR THIS PURPOSE.

**ITEM 625 - HIGH VOLTAGE TEST**

A HIGH VOLTAGE TEST, AS DESCRIBED IN 625.19, SHALL BE PERFORMED ON ALL DISTRIBUTION CABLE AND DUCT CABLE SYSTEMS TO BE INSTALLED ON THIS PROJECT.

**LAMPS**

ALL LAMPS SHALL BE SOLID STATE (LED) AS LISTED IN THE ODOT OFFICE OF ROADWAY ENGINEERING APPROVED LIST SUPPLEMENTAL SPECIFICATION 813: LUMINAIRE, SOLID STATE (LED), OR APPROVED EQUAL.

**PADLOCKS AND KEYS**

PADLOCKS FURNISHED SHALL BE EITHER BRASS OR BRONZE, EQUAL TO MASTER NO. 4BKA OR WILSON BOHANNAN 660A, AND SHALL BE KEYED IN ACCORDANCE WITH C&MS 631.06. PAYMENT SHALL BE INCLUDED IN THE BID FOR THE ITEM(S) BEING LOCKED.

**ITEM 625 - LUMINAIRE, LOW MAST, SOLID STATE (LED), AS PER PLAN**

LUMINAIRES FOR LOW-MAST SOLID STATE (LED) LIGHTING UNITS WITH SYMMETRIC DISTRIBUTION TYPE V 400W HPS EQUIVALENT SHALL BE HOLOPHANE "HMLD-II", CHM "CONDOR LED2", OR GE "EVOLVE HM", OR EQUAL AS APPROVED BY THE ENGINEER.

IN ADDITION, OTHER LUMINAIRES WILL BE CONSIDERED IF THE DESIGNED INTENSITY AND UNIFORMITY ARE PROVIDED USING THE DESIGNED POLE LOCATIONS AND THE DESIGNED NUMBER AND TYPE OF FIXTURES PER POLE AND APPROVED BY ODOT.

**ITEM 625 - LUMINAIRE, CONVENTIONAL, SOLID STATE (LED), AS PER PLAN**

LUMINAIRES FOR CONVENTIONAL SOLID STATE (LED) LIGHTING UNITS WITH ASSYMMETRIC DISTRIBUTION TYPE III, SHALL BE EQUIVALENT TO 250W HPS.

THE CONVENTIONAL SOLID STATE (LED) LUMINAIRES SHALL BE LISTED IN THE ODOT OFFICE OF ROADWAY ENGINEERING APPROVED LIST SUPPLEMENTAL SPECIFICATION 813: LUMINAIRE, SOLID STATE (LED), OR APPROVED EQUAL.

**ITEM 625 - LUMINAIRE, UNDERPASS, SOLID STATE (LED), AS PER PLAN**

LUMINAIRES FOR UNDERPASS SOLID STATE (LED) LIGHTING UNITS SHALL BE GE "EVOLVE EWS3", HOLOPHANE "TUNNELPASS", OR EATON/COOPER "GALLEON GWC", OR EQUAL AS APPROVED BY THE ENGINEER.

LUMINAIRES SHALL BE 150 WATT HPS EQUIVALENT WITH ASSYMMETRIC DISTRIBUTION TYPE III.

IN ADDITION, OTHER LUMINAIRES WILL BE CONSIDERED IF THE DESIGNED INTENSITY AND UNIFORMITY ARE PROVIDED USING THE DESIGNED POLE LOCATIONS AND THE DESIGNED NUMBER AND TYPE OF FIXTURES PER POLE AND APPROVED BY ODOT.

**ITEM 625 - SPECIAL - MAINTAIN EXISTING LIGHTING**

EXISTING ROADWAYS WHICH ARE TO REMAIN OPEN TO TRAFFIC DURING CONSTRUCTION OF THIS PROJECT AND WHICH ARE LIGHTED SHALL HAVE THE LIGHTING MAINTAINED AS DESCRIBED HEREIN.

BEFORE ANY WORK IS STARTED IN THE IMMEDIATE VICINITY OF THE EXISTING LIGHTING CIRCUITS, REPRESENTATIVES OF ODOT, THE MAINTAINING AGENCY AND THE CONTRACTOR SHALL MAKE A VISUAL INSPECTION OF THE EXISTING ROADWAY LIGHTING CIRCUITS TO BE MAINTAINED. DURING THIS INSPECTION, A WRITTEN RECORD OF THE CONDITION OF EXISTING LIGHTING SHALL BE MADE BY ODOT'S REPRESENTATIVE. THIS WRITTEN REPORT SHALL NOTE INDIVIDUAL LUMINAIRES WHICH ARE NOT IN WORKING ORDER, INDIVIDUAL POLES WHICH ARE STANDING, AND INDIVIDUAL CIRCUITS WHICH ARE NOT IN WORKING ORDER. THE COMPLETED REPORT SHALL BE SIGNED BY THE REPRESENTATIVES OF ODOT, THE MAINTAINING AGENCY AND THE CONTRACTOR.

IF, AS A RESULT OF THIS INSPECTION, IT IS DETERMINED THAT THE CONDITION OF THE EXISTING SYSTEM IS BELOW THAT REQUIRED FOR THE SAFETY OF THE TRAVELING PUBLIC, THEN THE MAINTAINING AGENCY SHALL MAKE THE REPAIRS NECESSARY TO RETURN THE SYSTEM TO AN ACCEPTABLE CONDITION. FOLLOWING THESE REPAIRS, THE SYSTEM SHALL AGAIN BE INSPECTED AND A REPORT SHALL BE MADE AND SIGNED AS OUTLINED HEREIN.

WHEN THE EXISTING SYSTEM IS IN AN ACCEPTABLE CONDITION, IT SHALL BE TURNED OVER TO THE CONTRACTOR WHO SHALL THEN BE REQUIRED TO MAINTAIN THE EXISTING LIGHTING TO THE CONDITION OUTLINED IN THIS REPORT WITH THE EXCEPTION OF KNOCKDOWNS DUE TO TRAFFIC ACCIDENTS.

REPLACEMENT OF KNOCKED DOWN UNITS SHALL BE DONE ONLY WHEN THE ENGINEER HAS DETERMINED THAT THE REPLACEMENT OF THE KNOCKED DOWN UNIT IS NECESSARY AND SHALL BE PAID SEPARATELY ON A UNIT BASIS.

BETTERMENTS SHALL BE COVERED IN ITEMS OF WORK PERTAINING TO THE CONSTRUCTION OF PERMANENT IMPROVEMENT.

WHEN THE SEQUENCE OF CONSTRUCTION ACTIVITIES REQUIRES, OR SHOULD THE CONTRACTOR DESIRE, THE REMOVAL OF THE EXISTING LIGHTING BEFORE THE NEW LIGHTING IS OPERATIONAL, THE CONTRACTOR SHALL BE RESPONSIBLE FOR PROVIDING TEMPORARY LIGHTING OF THIS PORTION OF THE ROADWAY.

PRIOR TO INSTALLING SUCH LIGHTING, THE CONTRACTOR SHALL PREPARE AND SUBMIT FOUR SETS OF THE TEMPORARY LIGHTING PLAN TO THE ENGINEER FOR REVIEW AND APPROVAL.

THIS PLAN SHALL SHOW LOCATIONS OF POLES, LENGTHS OF BRACKET ARMS, STYLES OF LUMINAIRES, MOUNTING HEIGHTS, WIRING METHODS AND OTHER PERTINENT INFORMATION. THE TEMPORARY LIGHTING SHALL PROVIDE AN AVERAGE INITIAL INTENSITY OF 1.2 FOOTCANDLES WITH AN AVERAGE TO MINIMUM UNIFORMITY NOT TO EXCEED 3:1. MOUNTING HEIGHT OF TEMPORARY LUMINAIRES SHALL NOT BE LESS THAN 30 FEET, AND THE MINIMUM OVERHEAD CONDUCTOR CLEARANCE SHALL BE 20 FEET. TEMPORARY OVERHEAD CONSTRUCTION SHALL NOT BE LESS THAN GRADE "A" FOR STRENGTH REQUIREMENTS AS DEFINED BY THE NATIONAL ELECTRIC SAFETY CODE. WOOD POLES WITH OVERHEAD WIRING MAY BE USED. HOWEVER, TEMPORARY LIGHTING SHALL MEET FEDERAL AND STATE SAFETY CRITERIA. IF BREAKAWAY POLES ARE USED TO MEET THESE CRITERIA, THEN UNDERGROUND WIRING SHALL BE USED. RECONDITIONED OR USED MATERIALS MAY BE FURNISHED FOR TEMPORARY LIGHTING.

ALL MATERIALS NECESSARY TO COMPLETE THE TEMPORARY LIGHTING SHALL BE FURNISHED AND INSTALLED BY THE CONTRACTOR. WHEN NO LONGER NEEDED, THE TEMPORARY LIGHTING INSTALLATION SHALL BE REMOVED AND PROPERLY DISPOSED OF BY THE CONTRACTOR.

THE MAINTAINING AGENCY WILL PAY FOR ELECTRICAL ENERGY CONSUMED BY EXISTING POWER SERVICES AND BY PROPOSED PERMANENT POWER SERVICES AFTER ACCEPTANCE OF THE LIGHTING WORK. THE CONTRACTOR WILL PAY FOR ELECTRICAL ENERGY, INSTALLATION, REMOVAL AND MAINTENANCE OF ANY TEMPORARY POWER SERVICES.

LIGHTING SHALL BE MAINTAINED AT ALL TIMES THROUGH THE USE OF THE EXISTING LIGHTING, TEMPORARY LIGHTING, OR THE COMPLETED LIGHTING. ANY LIGHTING OUTAGE SHALL BE REPAIRED AND RESTORED WITHIN 24 HOURS OF NOTIFICATION. A DISINCENTIVE SHALL BE ASSESSED IN THE AMOUNT OF \$1,000 FOR EACH DAY LIGHTING IS NOT MAINTAINED BEYOND THE SPECIFIED LIMIT.

THE LUMP SUM PRICE BID FOR ITEM SPECIAL "MAINTAIN EXISTING LIGHTING" SHALL INCLUDE PAYMENT FOR ALL LABOR, EQUIPMENT, MATERIALS AND INCIDENTALS NECESSARY TO MAINTAIN THE EXISTING LIGHTING AS SPECIFIED HEREIN.

THE PRICE BID FOR ITEM SPECIAL, MAINTAIN EXISTING LIGHTING SHALL BE FULL PAYMENT FOR THE REPLACEMENT OF AN EXISTING LIGHTING UNIT WHICH HAS BEEN KNOCKED DOWN AFTER THE AFOREMENTIONED INSPECTION AND SHALL INCLUDE ALL LABOR, EQUIPMENT, MATERIALS AND INCIDENTALS NECESSARY TO PROVIDE A REPLACEMENT FOR SUCH UNIT.

**ITEM 625 - STRUCTURE GROUNDING SYSTEM**

THIS ITEM OF WORK SHALL CONSIST OF PROVIDING GROUND RODS AND GROUNDING CONDUCTOR RISER CABLES EMBEDDED IN THE PIERS TO THE STRUCTURE SUPPORT BEAMS AND PROVIDING GROUNDING CONNECTIONS FOR CONDUITS EMBEDDED IN THE STRUCTURES AT SHARON ROAD. IN ADDITION, PROVIDE BONDING JUMPERS AROUND STRUCTURE SUPPORT BEAM SPLICES AND HINGES AND ACROSS EXPANSION JOINTS. BOND PARALLEL BRIDGE SECTION TOGETHER.

PAYMENT WILL BE MADE AT THE UNIT PRICE BID FOR EACH ITEM 625, STRUCTURE GROUNDING SYSTEM AND SHALL BE FULL COMPENSATION FOR ALL LABOR, MATERIALS, AND INCIDENTALS REQUIRED TO COMPLETE THE WORK. AN ESTIMATED QUANTITY OF 2 EACH HAS BEEN CARRIED TO THE GENERAL SUMMARY.

**LIGHT POLE, LOW MAST, AS PER PLAN**

LIGHT POLES AND FIXTURES SHALL BE FURNISHED BY THE DEPARTMENT FOR CONTRACTOR INSTALLATION. POLES AND LIGHT FIXTURES ARE STORED IN THE VILLAGE OF EVENDALE MAINTENANCE FACILITY AT 1433 GLENDALE MILFORD ROAD (1/2 MILE WEST OF I-75). CONTRACTOR SHALL PICK THE LIGHT POLES AND FIXTURES UP AT THE LOCATION FOR INSTALLATION.



j:\pre-int\06-386\_HAM-75\_HAM\00000\lighting\sheets\00000LS001.dgn 2021-01-14 10:21:05 AM jason.watt' ODOTcadd\_PDF\_pltcfgr ODOTV8i\_Pen.tbl IBI Group

SHEET NO.	LOCATION	LENGTH IN FEET	625																															
			CONNECTION, FUSED PULL APART	CONNECTION, UNFUSED PERMANENT	LIGHT POLE, LOW MAST, AS PER PLAN	LIGHT POLE, CONVENTIONAL, AT20B40	LIGHT POLE, LOW MAST, ATLM50	LIGHT POLE FOUNDATION, 24" X 10' DEEP	NO. 4 AWG 2400 VOLT DISTRIBUTION CABLE	NO. 10 AWG POLE AND BRACKET CABLE	1-1/2" DUCT CABLE WITH THREE NO. 4 AWG 2400 VOLT CABLES	CONDUIT, 3", 725.04	CONDUIT, JACKED OR DRILLED, 725.04, 3"	LUMINAIRE, CONVENTIONAL, SOLID STATE (LED), AS PER PLAN, 250 W HPS EQUIVALENT, 480V, ASYMMETRIC	LUMINAIRE, LOW MAST, SOLID STATE (LED), AS PER PLAN, 400W, 480V, SYMMETRIC	LUMINAIRE, UNDERPASS, SOLID STATE (LED), AS PER PLAN, 150W HPS EQUIVALENT, 480V, ASYMMETRIC	TRENCH	JUNCTION BOX	PULL BOX, 725.08, 18"	PULL BOX REMOVED	GROUND ROD	POWER SERVICE, AS PER PLAN	PLASTIC CAUTION TAPE	SERVICE TO UNDERPASS LIGHTING	HIGH VOLTAGE TEST	SPECIAL - MAINTAIN EXISTING LIGHTING	LIGHT TOWER REMOVED	LIGHT POLE REMOVED	LIGHT POLE FOUNDATION REMOVED	POWER SERVICE REMOVED	LUMINAIRE SUPPORT REMOVED	LIGHT TOWER FOUNDATION REMOVED		
EACH	EACH	EACH	EACH	EACH	EACH	EACH	FT	FT	FT	FT	FT	EACH	EACH	EACH	FT	EACH	EACH	EACH	EACH	EACH	FT	EACH	LUMP	LUMP	EACH	EACH	EACH	EACH	EACH	EACH	EACH			
587	EX. PB TO CB-12, CB-13	360	4			2		300	360						360						360						2	2		2				
587	PB TO PB SB CROSSING 336+33	120								120																								
587	CB14, CB-15, CB-16	500	6	3		3		450	500						500			1	1							2	2		2					
587	AA-11	168	2			1		150	168					1	168											4	4							
587	AA-10	169	2			1		150	169					1	169																			
587	AA-9	170	2			1		150	170					1	170																			
587	AB-13	169	2			1		150	169					1	169																			
587	AB-12	165	2			1		150	165					1	165																			
587	AB-11	186	2			1		150	186					1	186																			
588	AA-8	170	2			1		150	169.5					1	169.5											2	2	2			2			
588	AA-7	110	2			1		150	109.5					1	109.5																			
588	AA-6	170	2			1		150	170					1	170																			
588	AA-5	169	2			1		150	169					1	169																			
588	AA-4	142	2			1		150	142					1	142																			
588	AB-10	169	2			1		150	169					1	169																			
588	AB-9	168	2			1		150	168					1	168																			
588	AB-8	168	2			1		150	168					1	168																			
588	AB-7	169	2			1		150	169					1	169																			
588	AB-6	165	2			1		150	165					1	165																			
588	AA-21	179	2			1		150	179					1	179																			
588	AA-20	188	2			1		150	188					1	188																			
588	AA-19	213	2			1		150	213					1	213																			
588	AB-15	184	2			1		150	184					1	184																			
588	AB-14	4	2			1		150	4					1	4																			
588	PBA-5	62		3				186			62							1																
588	PBA-4	116		3				348			116							1																
588	AA-23	181	2			1		150	181					1	181																			
588	AA-22	4	2			1		150	4					1	4																			
588	PBA-3	181		3				543			181							1																
588	AA-13	167	2			1		150	167					1	167																			
588	AA-12	4	2			1		150	4					1	4																			
588	PBA-2	84		3				252			84							1																
588	PBA-1	551		3					1102						551			1																
589	AA-3	169	2			1		150	338					1	169											7			1			7		
589	AA-2	168	2			1		150	335					1	167.5																			
589	AA-1	175	2			1		150	349					1	174.5																			
589	AA-24	26	2			1		150	52					1	26																			
589	CONTROL CENTER 'A'	10							10						10						1													
589	AA-18	170	2			1		150	170					1	170																			
589	AA-17	169	2			1		150	169					1	169																			
589	AA-16	169	2			1		150	169					1	169																			
589	AA-15	169	2			1		150	169					1	169																			
589	AA-14	168	2			1		150	168					1	168																			
589	AB-5	156	2			1		150	156					1	156																			
589	AB-4	148	2			1		150	148					1	148																			
589	AB-3	152	2			1		150	152					1	152																			
589	AB-2	467	2			1		150	467					1	467																			
589	AB-1	29	2			1		150	29					1	29																			
589	AB-18	167	2			1		150	167					1	167																			
589	AB-17	164	2			1		150	164					1	164																			
589	AB-16	437	2			1		150	437					1	437																			

TOTALS CARRIED TO SHEET 586

94	15	3	0	42	47	1329	7050	9361	120	443	0	42	0	8273	0	6	1	48	1	8273	0	LUMP	LUMP	9	10	10	1	4	9
----	----	---	---	----	----	------	------	------	-----	-----	---	----	---	------	---	---	---	----	---	------	---	------	------	---	----	----	---	---	---


CALCULATED  
 JAW  
 CHECKED  
 PCG  
**HAM - 75 - 14.61**





**LEGEND**

- LIGHT POLE, STATION, OFFSET, TRANSFORMER BASE  
CONVENTIONAL, SOLID STATE (LED), 20' ARM, 40' MOUNTING HEIGHT
- (A) POLE IDENTIFICATION NO.  
(B) CONTROL CENTER NO.  
(I) POLE NO. WITHIN CIRCUIT
- LUMINAIRE, UNDERPASS, SOLID STATE (LED)
- PROPOSED CONTROL CENTER/ POWER SERVICE
- PROPOSED LOW MAST SYMMETRIC LUMINAIRE,  
TRANSFORMER BASE, LOW MAST, SOLID STATE (LED), 50' MOUNTING HT.
- PULL BOX, IDENTIFICATION NO. W/OFFSET
- JUNCTION BOX, TYPE 1, IDENTIFICATION NO.
- INDICATES CIRCUIT & NO. OF  
SINGLE CONDUCTORS IN  
1-1/2" DUCT/DISTRIBUTION  
CABLE IN 24" DEEP TRENCH/BARRIER  
UNDER PAVEMENT PLACE 3" CONDUIT, 725.04
- EXISTING LIGHT POLE TO BE REMOVED
- EXISTING LIGHT POLE
- EXISTING PULL BOX WITH IDENTIFICATION NUMBER
- EXISTING CABLE TO REMAIN IN PLACE

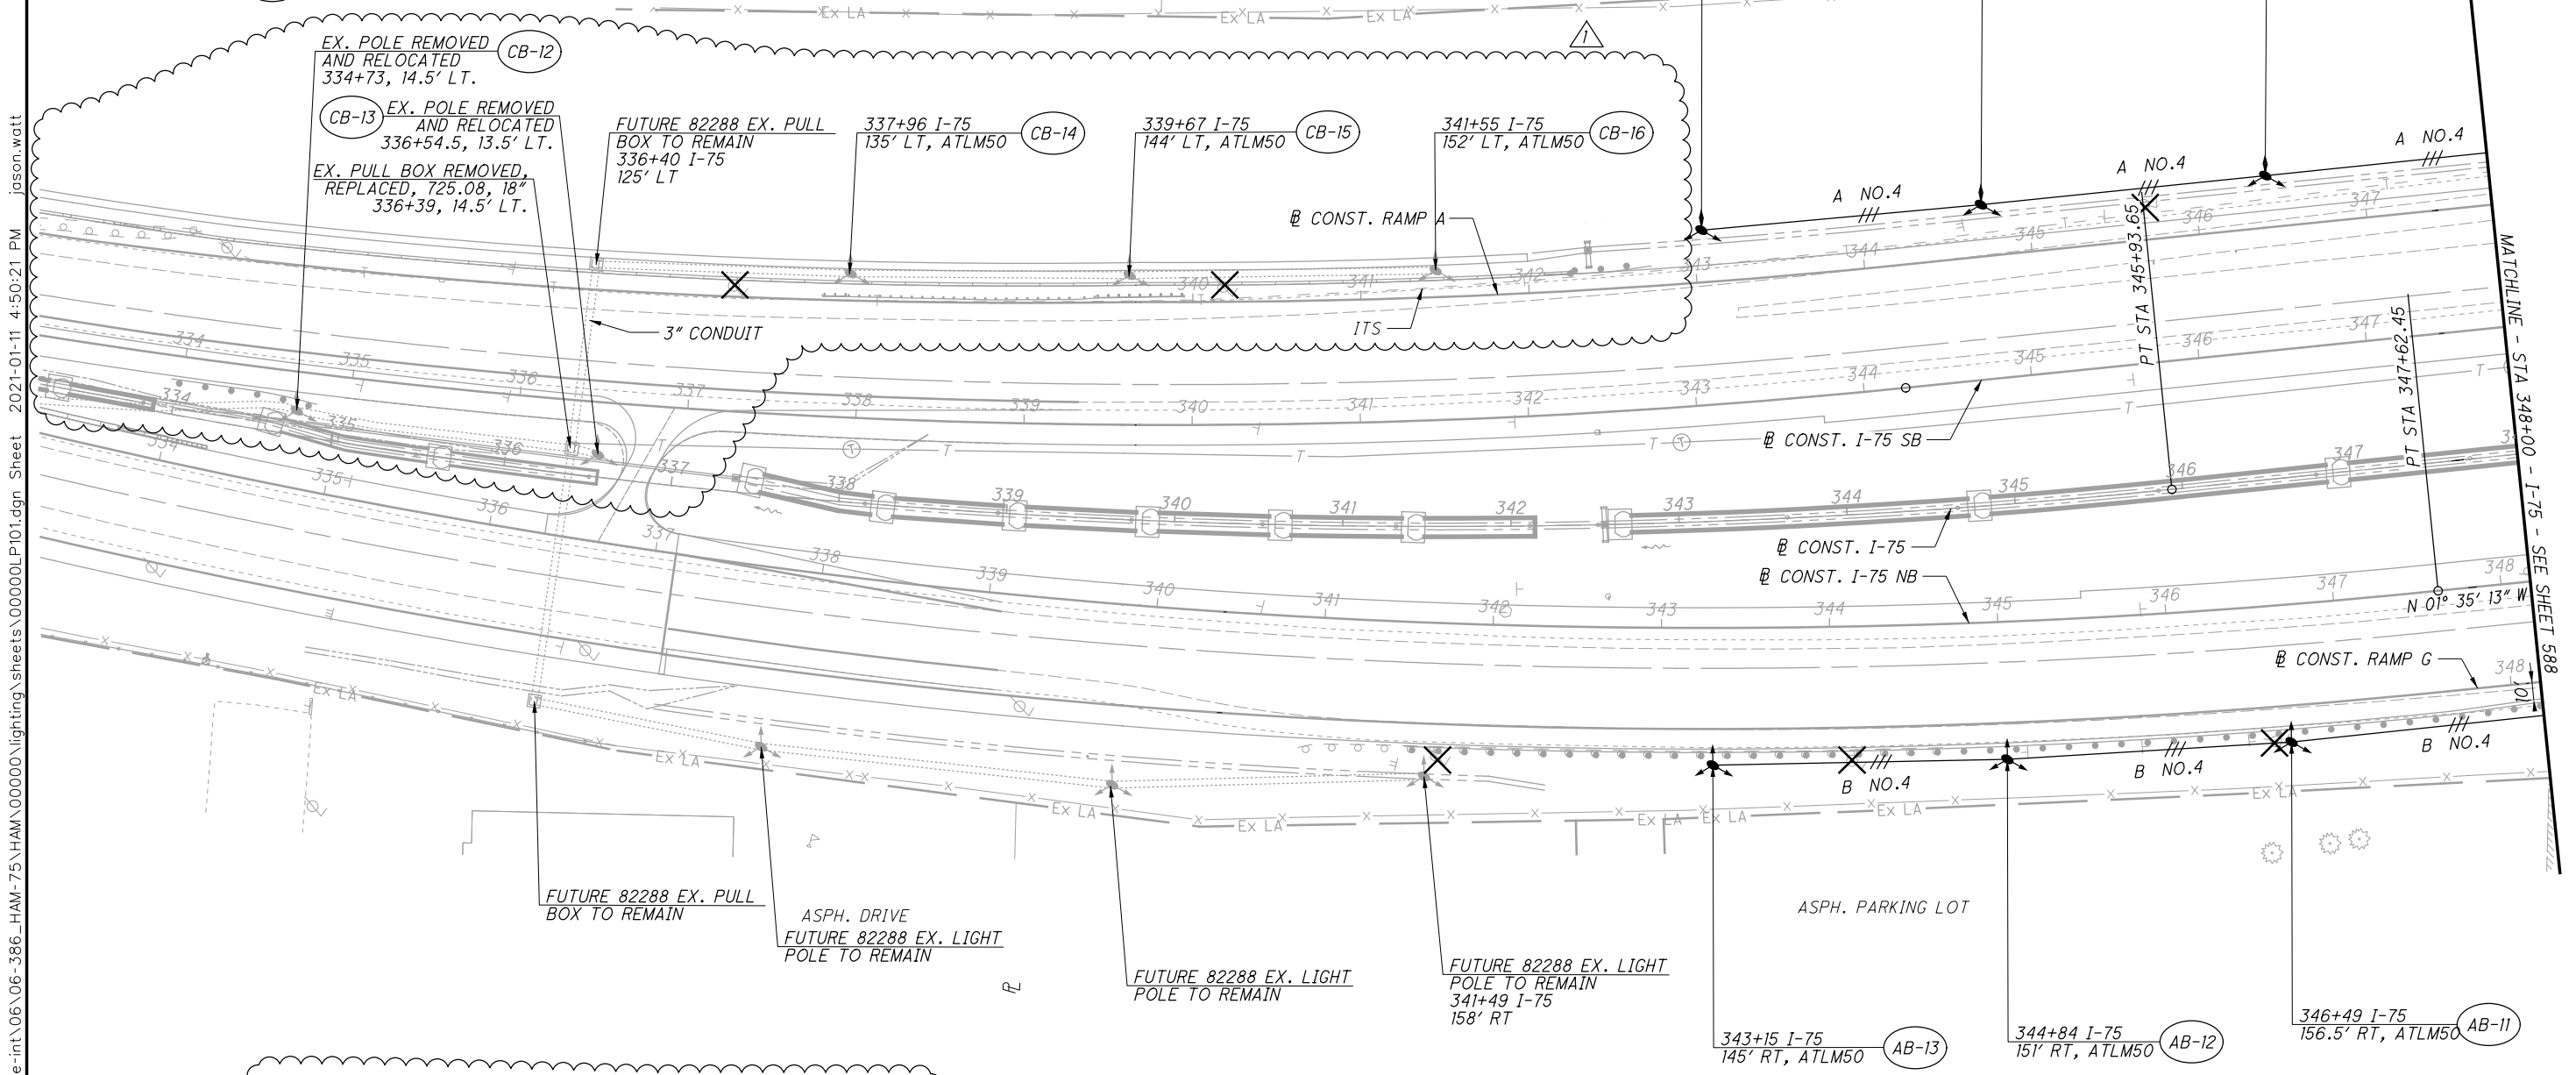

**REMOVAL QUANTITIES:**

ITEM 625 - LIGHT POLE REMOVED	6 EACH
ITEM 625 - LIGHT TOWER REMOVED	0 EACH
ITEM 625 - LIGHT POLE FOUNDATION REMOVED	6 EACH
ITEM 625 - LIGHT TOWER FOUNDATION REMOVED	0 EACH
ITEM 625 - POWER SERVICE REMOVED	0 EACH

1-15-2021 - UPDATED WORK LIMITS DUE TO PID 82288 CONSTRUCTION

\\useeast.ibigroup.com\j\cn\pre-int\06\06-386\_HAM-75\_HAM\00000\lighting\_sheets\00000\P101.dgn\_Sheet 2021-01-11 4:50:21 PM jason.watt

**STANDARD DRAWINGS AND SUPPLEMENTAL SPECIFICATIONS**

REFER TO THE FOLLOWING STANDARD BRIDGE DRAWING(S):

- AS-1-15 DATED/REVISED 7-17-15
- AS-2-15 DATED/REVISED 1-18-19
- PCB-91 DATED/REVISED 1-18-13
- PSID-1-13 DATED/REVISED 7-20-18
- SBR-1-13 DATED/REVISED 7-20-18
- SICD-1-96 DATED/REVISED 7-18-14
- SICD-2-14 DATED/REVISED 7-18-14

AND TO THE FOLLOWING SUPPLEMENTAL SPECIFICATIONS:

- 840 DATED 4-17-20
- 846 DATED 4-17-15
- 866 DATED 4-21-17
- 867 DATED 1-18-19
- 878 DATED 1-17-20

**DESIGN SPECIFICATIONS**

DESIGN SPECIFICATIONS: THIS STRUCTURE CONFORMS TO THE 8TH EDITION OF THE "LRFD BRIDGE DESIGN SPECIFICATIONS" ADOPTED BY THE AMERICAN ASSOCIATION OF STATE HIGHWAY AND TRANSPORTATION OFFICIALS, 2017 AND THE ODOT BRIDGE DESIGN MANUAL, 2020.

**LOAD MODIFIER FOR OPERATIONAL IMPORTANCE**

OPERATIONAL IMPORTANCE: A LOAD MODIFIER OF 1.00 HAS BEEN ASSUMED FOR THE DESIGN OF THIS STRUCTURE IN ACCORDANCE WITH THE AASHTO LRFD BRIDGE DESIGN SPECIFICATIONS, ARTICLE 1.3.5 AND THE ODOT BRIDGE DESIGN MANUAL, 2007.

**DESIGN LOADING**

DESIGN LOADING: HL-13

FUTURE WEARING SURFACE (FWS) OF 0.060 KIPS/SQ.FT.

**DESIGN DATA**

- CONCRETE CLASS QC3 - COMPRESSIVE STRENGTH 4.5 KSI (BRIDGE DECK, DIAPHRAGM, APPROACH SLAB)
- CONCRETE CLASS CQ SCC - COMPRESSIVE STRENGTH 4.5 KSI (PARAPETS)
- CONCRETE CLASS QC1 - COMPRESSIVE STRENGTH 4.0 KSI (SUBSTRUCTURE)
- REINFORCING STEEL - MINIMUM YIELD STRENGTH 60 KSI
- STEEL PIPE PILES - GRADE A 252 - GRADE 3 - YIELD STRENGTH 45 KSI
- STRUCTURAL STEEL - ASTM A709 GRADE 50 - YIELD STRENGTH 50 KSI

CONCRETE FOR PRESTRESSED BEAMS: COMPRESSIVE STRENGTH (FINAL) - 9.5 KSI COMPRESSIVE STRENGTH (RELEASE) - 7 KSI

WELDED WIRE FABRIC: YIELD STRENGTH - 70 KSI

PRESTRESSING STRAND: AREA = 0.217 IN<sup>2</sup> ULTIMATE STRENGTH = 270 KSI INITIAL STRESS = 202.5 KSI (LOW RELAXATION STRANDS)

**DECK PROTECTION METHOD**

EPOXY COATED REINFORCING STEEL

2.5" CONCRETE COVER

**MONOLITHIC WEARING SURFACE**

MONOLITHIC WEARING SURFACE IS ASSUMED, FOR DESIGN PURPOSES, TO BE 1 INCH THICK.

**EXISTING STRUCTURE PLANS:**

CONSTRUCTION PLANS FOR EXISTING BRIDGE ARE ON FILE AT THE DEPARTMENT OF TRANSPORTATION, DISTRICT 8 OFFICE, 505 SOUTH STATE ROUTE 741, LEBANON, OHIO AND ARE AVAILABLE FOR REFERENCE.

**PILE DRIVING CONSTRAINTS**

PRIOR TO DRIVING ABUTMENT PILES TO THE ULTIMATE BEARING VALUE (UBV), CONSTRUCT THE MSE WALL AND THE BRIDGE APPROACH EMBANKMENT UP TO THE BOTTOM OF THE FOOTINGS. PROVIDE A SURCHARGE FROM THE BOTTOM OF THE ABUTMENT FOOTING TO THE BOTTOM OF THE SUBGRADE FOR A MINIMUM DISTANCE OF 100 FEET BEHIND THE ABUTMENT. SURCHARGE LOADS SHALL REMAIN UNTIL THE REQUIRED SETTLEMENT HAS OCCURRED AND AS DIRECTED BY THE ENGINEER. COMPLETE THE MSE WALL CONSTRUCTION IMMEDIATELY FOLLOWING THE SURCHARGE REMOVAL.

THE CONTRACTOR MAY PRE-DRIVE ABUTMENT PILES BEFORE CONSTRUCTING MSE WALLS. PRE-DRIVING CONSISTS OF INSTALLING THE ABUTMENT PILES INTO THE SOIL ONLY AS FAR AS NECESSARY SO THAT THE PILE WILL REMAIN VERTICAL DURING MSE WALL CONSTRUCTION. IF PRE-DRIVING PILES, INSTALL PILE SLEEVES AROUND PILES BEFORE CONSTRUCTING THE MSE WALL. AT LEAST THREE FEET OF PILE MUST EXTEND ABOVE THE TOP OF THE PILE SLEEVE TO MEET THE REQUIREMENTS OF CMS 507.09 REGARDING SPLICES. DO NOT DRIVE ABUTMENT PILES TO THE UBV UNTIL AFTER THE ABOVE REQUIRED MSE WALL AND EMBANKMENT HAVE BEEN CONSTRUCTED AND THE SPECIFIED WAITING PERIOD HAS ELAPSED.

IF NOT PRE-DRIVING ABUTMENT PILES, INSTALL THE ABUTMENT PILES THROUGH PILE SLEEVES AFTER THE ABOVE REQUIRED MSE WALL AND EMBANKMENT HAVE BEEN CONSTRUCTED AND THE SPECIFIED WAITING PERIOD HAS ELAPSED.

ABUTMENT PILE DRIVING TO THE UBV (FOR PILES DRIVEN AFTER MSE CONSTRUCTION) OR PILE REDRIVING (FOR PILES PRE-DRIVEN BEFORE MSE CONSTRUCTION) MAY NOT BEGIN UNTIL A MINIMUM 30 DAY CALENDAR DAY WAITING PERIOD HAS ELAPSED AFTER THE COMPLETION OF EMBANKMENT AND SURCHARGE CONSTRUCTION. THE WAITING PERIOD BEGINS ONCE THE APPROACH EMBANKMENT HAS REACHED THE PROPOSED SUBGRADE ELEVATION. THE WAITING PERIOD WILL BE EVALUATED ON A PER READING BASIS AND MAY BE EXTENDED OR TERMINATED BY THE DEPARTMENT BASED ON THE SETTLEMENT PLATFORM READINGS. CONSECUTIVE SETTLEMENT READINGS SHOULD BE RECORDED AT LEAST ONE WEEK AFTER EMBANKMENT CONSTRUCTION IS COMPLETE. TERMINATION OF THE SETTLEMENT MONITORING WILL BE EVALUATED AFTER THE 30 DAY WAITING PERIOD, PROVIDED THE SETTLEMENT PLATFORMS HAVE INDICATED 1/8" OR LESS OF SETTLEMENT FOR EACH OF THE LAST TWO WEEKS OF READING.

AFTER THE SPECIFIED WAITING PERIOD HAS ELAPSED, DRIVE PILES TO THE UBV. IN ORDER TO REMOVE ANY NEGATIVE SKIN FRICTION THAT HAS DEVELOPED DURING THE WAITING PERIOD, DRIVE EACH ABUTMENT PILE A DISTANCE OF AT LEAST 0.5 INCH.

**PROPRIETARY RETAINING WALL DATA**

THE PROPRIETARY WALL SUPPLIER SHALL DESIGN THE INTERNAL STABILITY OF A MECHANICALLY STABILIZED EARTH (MSE) WALL IN ACCORDANCE WITH SS840 TO SUPPORT THE ABUTMENT. THE DESIGN FOR INTERNAL STABILITY SHALL INCLUDE A NOMINAL (I.E. UNFACTORED) HORIZONTAL STRIP LOAD DUE TO FRICTION (FR) FROM THE SUPERSTRUCTURE OF 6.0 K/FT APPLIED PERPENDICULAR TO THE FACE OF WALL AT THE BASE OF THE CONCRETE FOOTING. THIS STRIP LOAD DOES NOT INCLUDE EARTH PRESSURE LOADS FROM THE ABUTMENT BACKFILL. HOWEVER, THE PROPRIETARY WALL SUPPLIER SHALL INCLUDE EARTH PRESSURE LOADS FROM THE ABUTMENT BACKFILL IN THE DESIGN CALCULATIONS.

**DECK PLACEMENT DESIGN ASSUMPTIONS:**

THE FOLLOWING ASSUMPTIONS OF CONSTRUCTION MEANS AND METHODS WERE MADE FOR THE ANALYSIS AND DESIGN OF THE SUPERSTRUCTURE. THE CONTRACTOR IS RESPONSIBLE FOR THE DESIGN OF THE FALSEWORK SUPPORT SYSTEM WITHIN THESE PARAMETERS AND WILL ASSUME RESPONSIBILITY FOR SUPERSTRUCTURE ANALYSIS FOR DEVIATION FROM THESE DESIGN ASSUMPTIONS.

AN EIGHT WHEEL FINISHING MACHINE WITH A MAXIMUM WHEEL LOAD OF 1.08 KIPS.

A MINIMUM OUT-TO-OUT WHEEL SPACING AT EACH END OF THE MACHINE OF 103".

A MAXIMUM SPACING OF OVERHANG FALSEWORK BRACKETS OF 48 IN.

A MAXIMUM DISTANCE FROM THE CENTERLINE OF THE FASCIA GIRDER TO THE FACE OF THE SAFETY HANDRAIL OF 65".

**PILES DRIVEN TO TIP ELEVATION FOR PILE/SOIL SETUP**

THE ULTIMATE BEARING VALUE IS 330 KIPS PER PILE FOR THE ABUTMENT PILES. PART OF THE ULTIMATE BEARING VALUE WILL BE ACHIEVED THROUGH PILE/SOIL SETUP, WHICH IS A TIME-DEPENDENT INCREASE IN RESISTANCE THAT OCCURS IN SOME SOILS.

NOTIFY THE ENGINEER AT LEAST 5 DAYS BEFORE DRIVING PILES SO THAT THE ENGINEER CAN NOTIFY THE DISTRICT GEOTECHNICAL ENGINEER, THE OFFICE OF CONSTRUCTION ADMINISTRATION, AND THE OFFICE OF STRUCTURAL ENGINEERING. DRIVE THE FIRST TWO PILES IN EACH SUBSTRUCTURE TO THE TIP ELEVATION GIVEN BELOW FOR THE SUBSTRUCTURE. DRIVE THE THIRD AND FORTH PILES TO 75% AND 85% OF THE LENGTH OF THE FIRST TWO PILES. PERFORM DYNAMIC LOAD TESTING ON ALL FOUR PILES WHILE DRIVING. AFTER DRIVING THE FOUR PILES, CEASE ALL DRIVING OPERATIONS AT THE SUBSTRUCTURE FOR A MINIMUM OF 7 DAYS. INCLUDE THE WAITING PERIOD AS A SEPARATE ACTIVITY IN THE PROGRESS SCHEDULE. AFTER THE WAITING PERIOD, PERFORM PILE RESTRIKES ON THE FOUR PILES (TWO RESTRIKE ITEMS). SUBMIT ALL TEST RESULTS TO THE ENGINEER. THE ENGINEER WILL REVIEW THE TEST RESULTS AND ESTABLISH DRIVING CRITERIA FOR THE PILING IN THE SUBSTRUCTURE WITH ASSISTANCE OF THE DISTRICT GEOTECHNICAL ENGINEER, THE OFFICE OF CONSTRUCTION ADMINISTRATION, AND THE OFFICE OF STRUCTURAL ENGINEERING.

IF THE DYNAMIC LOAD TESTING INDICATES A PILE HAS ACHIEVED THE ULTIMATE BEARING VALUE ABOVE THE TIP ELEVATION DURING THE INITIAL DRIVING (BEFORE THE WAITING PERIOD), STOP DRIVING AND NOTIFY THE ENGINEER. IF THE RESTRIKE TEST RESULTS ON THE FOUR PILES INDICATE THAT A PILE DID NOT ACHIEVE THE REQUIRED ULTIMATE BEARING VALUE, DRIVE THE PILE TO THE ESTABLISHED DRIVING CRITERIA.

REAR ABUTMENT PILES:  
36 PILES 75 FEET LONG, ORDER LENGTH TIP ELEVATION, 558.00 FEET  
2 DYNAMIC LOAD TESTING ITEMS  
2 RESTRIKES

FORWARD ABUTMENT PILES:  
36 PILES 65 FEET LONG, ORDER LENGTH TIP ELEVATION, 550.30 FEET  
2 DYNAMIC LOAD TESTING ITEMS  
2 RESTRIKES

**ITEM 503. COFFERDAMS AND EXCAVATION BRACING, AS PER PLAN:**

THE DESIGN SHOWN ON THE PLANS FOR TEMPORARY SUPPORT OF EXCAVATION IS ONE REPRESENTATIVE DESIGN THAT MAY BE USED TO CONSTRUCT THE PROJECT. THE CONTRACTOR MAY CONSTRUCT THE DESIGN SHOWN ON THE PLANS OR PREPARE AN ALTERNATE DESIGN TO SUPPORT THE SIDES OF EXCAVATIONS. IF CONSTRUCTING AN ALTERNATE DESIGN FOR TEMPORARY SUPPORT OF EXCAVATION, PREPARE AND PROVIDE PLANS IN ACCORDANCE WITH CMS 501.05. THE DEPARTMENT WILL PAY FOR THE TEMPORARY SUPPORT OF EXCAVATION AT THE CONTRACT LUMP SUM PRICE FOR COFFERDAMS AND EXCAVATION BRACING. NO ADDITIONAL PAYMENT WILL BE MADE FOR PROVIDING AN ALTERNATE DESIGN.

**ITEM 202 - STRUCTURE REMOVED, OVER 20 FOOT SPAN, AS PER PLAN**

THE EXISTING STRUCTURE SHALL BE REMOVED IN ACCORDANCE WITH ITEM 202 EXCEPT THAT THE EXISTING ABUTMENTS SHALL BE REMOVED IN THEIR ENTIRETY.

**ITEM 511 CLASS QC3 CONCRETE, MISC.: WITH QC/QA, BRIDGE DECK**

THIS ITEM MODIFIES THE STANDARD 511 CONCRETE FOR STRUCTURES SPECIFICATION TO INCLUDE MACRO-SYNTHETIC INTO THE SUPERSTRUCTURE CONCRETE. THIS ITEM SHALL CONFORM TO CMS 511 WITH THE FOLLOWING CONDITIONS AND REVISIONS:

PROVIDE MATERIALS CONFORMING TO 511.02 EXCEPT AS MODIFIED BELOW:

PORTLAND CEMENT CONCRETE 499.03, CLASS QC 3 MEETING A DESIGN STRENGTH OF 4,500 PSI, WITH MACRO-SYNTHETIC FIBERS WITH MODIFICATION PER 511.02 FIBERS FOR CONCRETE: ASTM C 1116, TYPE III CORROSION INHIBITOR: 515.15

THE CLASS QC3 CONCRETE FOR THE SUPERSTRUCTURE SHALL MEET THE FOLLOWING CRITERIA: WATER/CEMENT RATIO = 0.40 MAXIMUM; MINIMUM 4 LBS/CY MACRO-SYNTHETIC FIBERS (1.5 IN. MIN. TO 2.5 IN. MAX.) MEETING ASTM C1116 TYPE III SHALL BE ADDED TO THE MIX.

MIX SHALL INCLUDE A MIGRATING CORROSION INHIBITOR AS MANUFACTURED BY AN APPROVED SUPPLIER LISTED ON ODOT'S QUALIFIED APPROVED SUPPLIERS, ITEM 515.15. THE DOSAGE RATE LISTED ON THE ODOT QUALIFIED APPROVED SUPPLIERS LIST WILL APPLY.

**ITEM 511 CLASS QC3 CONCRETE, MISC.: WITH QC/QA, BRIDGE DECK, AS PER PLAN CONTINUED**

THE MACRO-SYNTHETIC FIBERS SHALL BE INCORPORATED INTO THE MIX IN SUCH A WAY THAT NO 'BALLING' OCCURS. UPON INSPECTION OF THE MIX AT THE TIME OF PLACEMENT, IF ANY 'BALLING' OCCURS, THE ENGINEER SHALL REJECT THE REMAINDER OF THE LOAD AT ANY TIME DURING THE POUR. IT IS IMPORTANT TO FOLLOW INDUSTRY STANDARDS AND ASTM SPECIFICATIONS ON THE PREMIXING OF THE CEMENT, AGGREGATE, AND MACRO-SYNTHETIC FIBERS PRIOR TO THE ADDITION OF WATER AND ADMIXTURES. PROVIDE MACRO-SYNTHETIC FIBERS THAT ARE MONOFILAMENT FIBERS MADE FROM VIRGIN POLYPROPYLENE, POLYETHYLENE, OR CO-POLYMERS THAT ARE INERT TO ALKALI ATTACK. ENSURE THE MACRO-SYNTHETIC FIBERS HAVE A MINIMUM TENSILE STRENGTH OF 70 KSI, A MINIMUM MODULUS OF ELASTICITY OF 800 KSI, A MINIMUM FILAMENT DIAMETER OF 0.012 INCHES, AND ASPECT RATIO BETWEEN 60 AND 100, AND ARE BETWEEN 1.0 AND 2.5 INCHES IN LENGTH. STORE THE MACRO-SYNTHETIC FIBERS ACCORDING TO THE MANUFACTURER'S RECOMMENDATION AND KEEP THE MATERIAL FREE FROM DUST, DIRT AND MOISTURE. PLACING THE BAG THAT THE FIBERS COME IN INTO THE CONCRETE MIX IS NOT PERMITTED.

USE A MINIMUM DOSAGE RATE OF MACRO-SYNTHETIC FIBERS OF 4.0 LBS/CY OF CONCRETE. DETERMINE THE FINAL PROPOSED DOSAGE RATE THROUGH MIX TESTING. ENSURE THE FIBER REINFORCED CONCRETE MEETS OR EXCEEDS A MINIMUM EQUIVALENT FLEXURAL STRENGTH RATIO OF 25% ACCORDING TO ASTM C 1609. ENSURE THE FINAL PROPOSED MIX IS WORKABLE AND ABLE TO BE PRODUCED SUCH THAT BALLING OR CLUMPING OF THE FIBERS IS NOT A PROBLEM AS DETERMINED BY THE ENGINEER. UTILIZE A LABORATORY REGULARLY INSPECTED BY THE CEMENT AND CONCRETE REFERENCE LABORATORY (CCRL) OF THE NATIONAL INSTITUTE OF STANDARDS AND TECHNOLOGY, OR OTHER APPROVED REFERENCE LABORATORY, TO PERFORM THE TESTING. BEFORE USE, SUBMIT DOCUMENTATION TO THE PROJECT ENGINEER CERTIFYING BOTH THE MACRO-SYNTHETIC FIBERS AND THE MIX MEET OR EXCEED THE REQUIRED PROPERTIES. SAMPLING WILL BE ALLOWED FOR TESTING PURPOSES. A DEMONSTRATION OF THE MIX PRODUCTION OR TRIAL MIX, MAY BE REQUIRED BY THE ENGINEER PRIOR TO PLACING ANY OF THE MIX ON THE PROJECT.

THE BATCH WEIGHTS SHALL BE CORRECTED TO COMPENSATE FOR THE MOISTURE CONTAINED IN THE AGGREGATE AT THE TIME OF USE. A CHEMICAL ADMIXTURE (705.12, TYPE A OR D) SHALL BE USED. THE TRANSIT MIXER CHARGE SHALL BE LIMITED TO 3/4 OF ITS RATED CAPACITY OR 6 CUBIC YARDS, WHICHEVER IS SMALLER. THE FIRST THREE TRANSIT MIXER LOADS ARE REQUIRED TO BE AT THE MINIMUM YARDAGE LISTED ABOVE TO SHOW PROOF OF THE SUCCESSFUL BATCHING OPERATION. AFTER CONSISTENCY IN THE DELIVERED MATERIAL HAS BEEN ESTABLISHED, THE CONCRETE SUPPLIER MAY INCREASE THE BATCH DELIVERED QUANTITIES AS LONG AS THE QUALITY REMAINS ACCEPTABLE TO THE ENGINEER. THE ENGINEER CAN REDUCE THE BATCH LOAD SIZE AT ANY TIME AS NEEDED TO CORRECT/IMPROVE CONCRETE QUALITY.

CONCRETE SUPPLIERS SHOULD RECOGNIZE THAT THE CORROSION INHIBITOR AND ADMIXTURES MAY HAVE AN EFFECT ON STRENGTH, ENTRAINED AIR CONTENT, WORKABILITY, ETC. OF THEIR CONCRETE MIXES. THE CORROSION INHIBITOR IS SUGGESTED TO BE A MCI PRODUCT BY CORTEC OR AN APPROVED EQUAL FROM THE QUALIFIED PRODUCTS LIST. THE CONCRETE SUPPLIER'S CHOICE OF ONE OF THESE CORROSION INHIBITORS DOES NOT ALLEVIATE MEETING DESIGN REQUIREMENTS. PLEASE BE ADVISED THAT SOME PRODUCTS ON THE LIST EFFECT THE DELIVERED MIX PROPERTIES GREATLY WHILE OTHER PRODUCTS DO NOT.

APPROACH SLABS, DIAPHRAGMS, AND BRIDGE RAILING CONCRETE (WHEN APPLICABLE) ARE TO USE THE SAME MIX DESIGN AS THE BRIDGE DECK. THE CONTRACTOR SHOULD BE ADVISED THAT CONCRETE RETARDING AGENTS MAY NEED TO BE ADDED TO OFFSET THE EFFECTS OF THE MIGRATING CORROSION INHIBITOR SELECTED. USE SELF-COMPACTING CONCRETE ON DECORATIVE RAILING SIMILAR TO TEXAS RAILING AND MACRO-SYNTHETIC CONCRETE PER THIS SPECIFICATION ON TRADITIONAL CONCRETE RAILING WHEN APPLICABLE.

THE CONTRACTOR SHALL PROVIDE TRADITIONAL BRIDGE DECK FORMS CONFORMING TO CMS 508. PERMANENT STAY-IN-PLACE (SIP) FORMS ARE NOT ALLOWED. THE PLACING OF THE DECK AND THE APPROACH SLABS IN THE SAME CONCRETE POUR IS NOT PERMITTED.

DESIGN AGENCY	DATE	DESIGNED	DRAWN	REVIEWED	DATE	DESIGN AGENCY
THO WIRMANOVA PLACE SUITE 480 COLUMBUS, OHIO 43215	4/24/20	RLC	RLC	MJZ	4/24/20	wsj
GENERAL NOTES	STRUCTURE FILE NUMBER	CHECKED	REVISED	STRUCTURE FILE NUMBER	3110966	
BRIDGE NO. HAM-75-1539R		SAP				
1-75 NB OVER SHARON RD.						
HAM-75-14.61						
PID No. 76256						
3/36						
645						
708						

**GENERAL NOTES**

**DESIGN SPECIFICATIONS:**

THIS STRUCTURE CONFORMS TO THE "LRFD BRIDGE DESIGN SPECIFICATIONS" ADOPTED BY THE AMERICAN ASSOCIATION OF STATE HIGHWAY AND TRANSPORTATION OFFICIALS, 5TH EDITION, INCLUDING THE 2010 INTERIM SPECIFICATIONS AND THE ODOT BRIDGE DESIGN MANUAL, 2007 EDITION.

**DESIGN DATA:**

THE FOLLOWING DESIGN DATA IS ASSUMED:

CONCRETE CLASS QC1 - COMPRESSIVE STRENGTH 4000 PSI (FOOTING, WINGWALL AND FORESLOPE WALL)

REINFORCING STEEL - ASTM A615, A616, OR A617 GRADE 60 MINIMUM YIELD STRENGTH 60,000 PSI (ALL REINFORCING SHALL BE EPOXY COATED)

**POROUS BACKFILL WITH FILTER FABRIC:**

1'-6" THICK SHALL BE PLACED BEHIND THE WINGWALLS ONLY AND SHALL EXTEND TO 12" BELOW THE EMBANKMENT SURFACE. GEOTEXTILE FABRIC SHALL BE PLACED BETWEEN THE POROUS BACKFILL AND REPLACED EXCAVATION ADJACENT TO THE STRUCTURE. IT SHALL TURN UNDER THE BOTTOM OF THE POROUS AND RETURN 6" ABOVE THE TOP ELEVATION OF THE WEEP HOLE. WEEP HOLES SHALL BE PLACED 6" TO 12" ABOVE THE NORMAL WATER ELEVATION OR GROUND LINE AND SHALL HAVE A MAXIMUM SPACING OF 10'-0". A MINIMUM OF ONE WEEP HOLE SHALL BE PROVIDED PER WINGWALL.

**EXISTING STRUCTURE VERIFICATION:**

DETAILS AND DIMENSIONS SHOWN ON THESE PLANS PERTAINING TO THE EXISTING STRUCTURE HAVE BEEN OBTAINED FROM PLANS OF THE EXISTING STRUCTURE AND FROM FIELD OBSERVATIONS AND MEASUREMENTS. CONSEQUENTLY, THEY ARE INDICATIVE OF THE EXISTING STRUCTURE AND THE PROPOSED WORK BUT THEY SHALL BE CONSIDERED TENTATIVE AND APPROXIMATE. THE CONTRACTOR IS REFERRED TO CMS SECTIONS 102.05 AND 105.02.

CONTRACT BID PRICES SHALL BE BASED UPON A RECOGNITION OF THE UNCERTAINTIES DESCRIBED ABOVE AND UPON PREBID EXAMINATION OF THE EXISTING STRUCTURE BY THE CONTRACTOR. HOWEVER, ALL PROJECT WORK SHALL BE BASED UPON ACTUAL DETAILS AND DIMENSIONS WHICH HAVE BEEN VERIFIED BY THE CONTRACTOR IN THE FIELD.

**ITEM 843 - PATCHING CONCRETE STRUCTURES WITH TROWELABLE MORTAR, AS PER PLAN:**

AN ESTIMATED QUANTITY FOR THIS ITEM HAS BEEN PROVIDED TO BE USED AS DIRECTED BY THE ENGINEER FOR PATCHING SPALLED AREAS ON THE EXISTING CONDUITS.

**FOUNDATION BEARING RESISTANCE**

FOUNDATION BEARING RESISTANCE: WINGWALL FOOTINGS, AS DESIGNED, PRODUCE A MAXIMUM SERVICE LOAD PRESSURE OF 1.68 KIPS PER SQUARE FOOT AND A MAXIMUM STRENGTH LOAD PRESSURE OF 2.36 KIPS PER SQUARE FOOT. THE FACTORED BEARING RESISTANCE IS 5.5 KIPS PER SQUARE FOOT.


**ABBREVIATIONS:**

THE FOLLOWING ABBREVIATIONS ARE USED THROUGHOUT THESE PLANS:

- B = BASELINE
- C = CENTERLINE
- CIP = CAST IN PLACE
- CMS = CONSTRUCTION AND MATERIAL SPECIFICATIONS
- EF = EACH FACE
- EL = ELEVATION
- EX = EXISTING
- FF = FAR FACE
- NF = NEAR FACE
- PEJF = PREFORMED EXPANSION JOINT FILLER
- TYP = TYPICAL

**SEALING OF FORESLOPE WALL AND WINGWALLS:**

ALL EXPOSED FORESLOPE WALL AND WINGWALL CONCRETE SHALL BE SEALED WITH EPOXY-URETHANE SEALER. THE LIMITS SHALL BE AS SHOWN IN THE DIAGRAMS BELOW. PAYMENT FOR THE EPOXY-URETHANE SEALER SHALL BE PER ITEM 512, SEALING OF CONCRETE SURFACES.

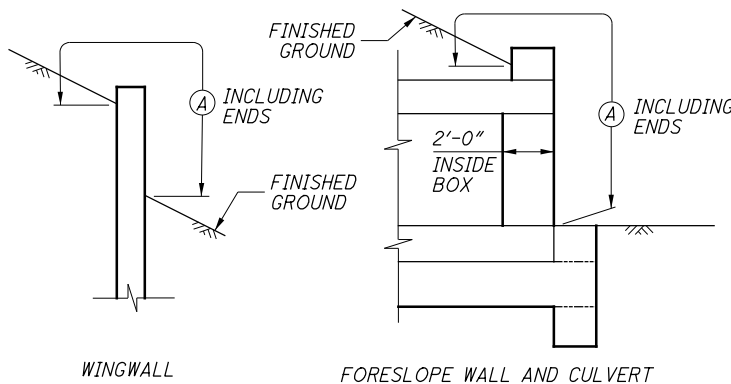

LIMITS OF ITEM 512 - SEALING CONCRETE SURFACES

(A) - SEAL ENTIRE CONCRETE SURFACE AREA

ESTIMATED QUANTITIES				
ITEM	ITEM EXT	TOTAL	UNIT	DESCRIPTION
202	11200	LS		PORTIONS OF STRUCTURE REMOVED
<del>202</del>	<del>35200</del>	<del>48</del>	<del>FT</del>	<del>PIPE REMOVED, OVER 24"</del>
503	11100	LS		COFFERDAMS AND EXCAVATION BRACING
503	21300	LS		UNCLASSIFIED EXCAVATION
509	10000	10553	LB	EPOXY COATED REINFORCING STEEL
511	46210	113	CY	CLASS QC1 CONCRETE, RETAINING/WINGWALL INCLUDING FOOTING
512	10100	120	SY	SEALING OF CONCRETE SURFACES (EPOXY-URETHANE)
518	21230	LS		POROUS BACKFILL WITH GEOTEXTILE FABRIC
601	11000	75	SY	RIPRAP, TYPE D
601	32104	106	CY	ROCK CHANNEL PROTECTION, TYPE B WITH GEOTEXTILE FABRIC
611	30000	48	FT	96" CONDUIT, TYPE A 706.02
843	50001	40	SF	PATCHING CONCRETE STRUCTURES WITH TROWELABLE MORTAR, AS PER PLAN
TOTALS CARRIED TO GENERAL SUMMARY				

\\10.120.112.5\ibishare\pre-int\06\06-386\_HAM-75\HAM\00000\structures\HAM075\_1557\00000\CO02A.dgn 2021-01-19 1:15:55 PM Shirwan.Saeed



DESIGNED	DESIGNED	DATE	DESIGN AGENCY
SJF	JDH	02/03/16	IBI GROUP
CHECKED	STRUCTURE FILE NUMBER	310982	1557
SRB			Westerville, OH 43081 USA Phone: 614-818-9900 Fax: 614-818-9901

**GENERAL NOTES & QUANTITIES**

HAM-75-14.61  
PID No. 76256