

ITEM 614, MAINTAINING TRAFFIC (I-71)

ALL WORK ALONG I-71, RED BANK EXPRESSWAY AND RAMPS NOT DETAILED TO BE DONE IN THE PHASING DESCRIBED BELOW SHALL ADHERE TO THE PERMITTED LANE CLOSURE TIMES AND UNAUTHORIZED LANE USE AND LANE VALUE CONTRACT TABLES ON SHEET 28 .

SEE SHEETS 127 - 133 FOR DETOURS FOR NOTED RAMP CLOSURES. SEE PART 2 FOR MAINTENANCE OF TRAFFIC PLANS FOR THE AUXILIARY LANE ADDITION AND RAMP CONSTRUCTION BETWEEN KENNEDY AVE AND RED BANK ROAD.

PART 2

PRIOR TO PHASES 1 THRU 4 BELOW, THE AUXILIARY LANE ALONG N.B. I-71 BETWEEN KENNEDY AVENUE/RIDGE ROAD AND THE OFF-RAMP TO RED BANK ROAD SHALL BE COMPLETE (EXCEPT THE PAVEMENT SURFACE COURSE) AND OPEN TO TRAFFIC. SEE PART 2 PLANS FOR MAINTENANCE OF TRAFFIC PHASING AND DETAILS.

PHASE 1A

UTILIZING S.C.D. MT-95.45, CONSTRUCT THE MEDIAN CROSSOVERS FOR USE IN PHASE 1 THRU 4 BY REMOVING THE CONCRETE BARRIER AND DITCH, REMOVING, ADDING AND ADJUSTING DRAINAGE, REMOVAL OF LIGHTING ETC. PLACE PAVEMENT FOR M.O.T. IN BOTH CROSSOVER LOCATIONS. PORTABLE BARRIER PER S.C.D. MT-95.45. SHALL REMAIN IN PLACE UNTIL SUCH TIME THAT THE CROSSOVERS ARE UTILIZED.

CONSTRUCT FULL DEPTH MEDIAN SHOULDER REPLACEMENT AND OUTSIDE SHOULDER REPLACEMENT ON THE NORTH BOUND LANES FOR USE IN PHASES 1&2. LANE AND RAMP CLOSURES ON I-71 SHALL BE PER THE PERMITTED LANE CLOSURE TIMES NOTE. CLOSE LEFT AND RIGHT LANES AS PER S.C.D. 95.30. USE SCD'S MT-98.10, MT-98.11, MT- 98.20 AND MT-98.22 AS APPROPRIATE FOR WORK NEAR RAMPS.

PHASE 1

SEE SHEETS 39 - 40 , 43 & 49 - 59 FOR PHASE DETAILS. SHIFT ONE LANE OF SOUTHBOUND I-71 IN A CONTRAFLOW ARRANGEMENT ON THE NORTHBOUND PAVEMENT. SHIFT THE REMAINING 2 LANES OF SOUTHBOUND I-71 TO THE INSIDE OF BRIDGE HAM-71-0970L AND BRIDGE HAM-71-1068L. ON BRIDGE HAM-71-0970L PERFORM HYDRO-DEMOLITION AND DECK OVERLAY ON THE OUTSIDE OF THE DECK. CLOSE RAMP A (RED BANK ROAD TO SB I-71) TO COMPLETE THE WORK ON THE OUTSIDE. ON BRIDGE HAM-71-1068L REMOVE AND REPLACE THE DECK ON THE OUTSIDE. PERFORM SUBSTRUCTURE REHABILITATION ON THE OUTSIDE. SHIFT THE REMAINING 2 LANES OF SOUTHBOUND I-71 TO THE MEDIAN IN THE PAVEMENT LOWERING AREA IN THE RED BANK ROAD INTERCHANGE AND CONSTRUCT THE OUTSIDE PORTION OF THE FULL DEPTH PAVEMENT REPLACEMENT. PERFORM FULL DEPTH JOINT REPAIRS ON THE SOUTHBOUND LANES ON THE CLOSED MEDIAN LANE, AND IN THE CENTER LANE USING LANE CLOSURES OR LANE SHIFTS.

PHASE 2

SEE SHEETS 41 - 43 & 60 - 68 FOR PHASE DETAILS. SEE SHEETS 58 - 59 FOR LEAD IN SIGNAGE DETAILS. MAINTAINING THE CONTRAFLOW ARRANGEMENT FROM PHASE 1. SHIFT THE REMAINING 2 LANES OF SOUTHBOUND I-71 TO THE PORTIONS OF BRIDGE HAM-71-0970L AND BRIDGE HAM-71-1068L CONSTRUCTED IN PHASE 1. ON BRIDGE HAM-71-0970L PERFORM HYDRO-DEMOLITION AND DECK OVERLAY ON THE INSIDE (MEDIAN) OF THE DECK. ON BRIDGE HAM-71-1068L REMOVE AND REPLACE THE DECK ON THE INSIDE (MEDIAN). PERFORM SUBSTRUCTURE REHABILITATION ON THE INSIDE.

IN THE LOWERING AREA IN THE RED BANK ROAD INTERCHANGE SHIFT 2 LANES OF SOUTHBOUND I-71 TO THE FULL DEPTH PAVEMENT CONSTRUCTED IN PHASE 1 AND CONSTRUCT INSIDE (MEDIAN) PORTION OF THE FULL DEPTH PAVEMENT REPLACEMENT.

CONTINUE FULL DEPTH JOINT REPAIRS ON THE SOUTHBOUND LANES ON THE OUTSIDE LANES, AND IN THE CENTER LANE USING LANE CLOSURES OR SHIFTS. CONSTRUCT FULL DEPTH MEDIAN SHOULDER REPLACEMENT AND OUTSIDE SHOULDER REPLACEMENT ON THE SOUTHBOUND LANES FOR USE IN PHASES 3&4.

PHASE 3

SEE SHEETS 44 - 45 , 48 & 69 - 79 FOR PHASE DETAILS. SHIFT THE ADD LEFT LANE FROM SR 562 TO NORTH BOUND I-71 IN A CONTRAFLOW ARRANGEMENT ON THE SOUTHBOUND PAVEMENT. TRAFFIC ON THE NORTHBOUND THRU LANES SOUTH OF THE INTERCHANGE WILL NOT BE ALLOWED ACCESS TO THE CONTRAFLOW LANE. SHIFT THE REMAINING 2 LANES OF NORTHBOUND I-71 TO THE INSIDE OF BRIDGE HAM-71-0970R AND THE OUTSIDE OF BRIDGE HAM-71-1068R. CLOSE RAMP B (NB I-71 TO RED BANK ROAD). ON BRIDGE HAM-71-0970R PERFORM HYDRO-DEMOLITION AND DECK OVERLAY ON THE OUTSIDE OF THE DECK. ON BRIDGE HAM-71-1068L REMOVE AND REPLACE THE DECK ON THE INSIDE (MEDIAN). PERFORM SUBSTRUCTURE REHABILITATION ON THE INSIDE. PERFORM FULL DEPTH JOINT REPAIRS ON THE NORTHBOUND LANES ON THE CLOSED MEDIAN LANE, AND IN THE CENTER LANE USING LANE CLOSURES OR LANE SHIFTS.

PHASE 4

SEE SHEETS 46 - 48 , & 80 - 88 FOR PHASE DETAILS, SEE SHEETS 78 - 79 FOR LEAD IN SIGNAGE DETAILS. MAINTAINING THE CONTRAFLOW ARRANGEMENT FROM PHASE 3. SHIFT THE REMAINING 2 LANES OF SOUTHBOUND I-71 TO THE PORTIONS OF BRIDGE HAM-71-0970R AND BRIDGE HAM-71-1068R CONSTRUCTED DURING PHASE 3. CLOSE RAMP F (NB I-71 TO STEWART ROAD). ON BRIDGE HAM-71-0970R PERFORM HYDRO-DEMOLITION AND DECK OVERLAY ON THE INSIDE (MEDIAN) OF THE DECK. ON BRIDGE HAM-71-1068R REMOVE AND REPLACE THE DECK ON THE OUTSIDE. PERFORM SUBSTRUCTURE REHABILITATION ON THE OUTSIDE. CONTINUE FULL DEPTH JOINT REPAIRS ON THE NORTHBOUND LANES ON THE OUTSIDE LANES, AND IN THE CENTER LANE USING LANE CLOSURES OR SHIFTS.

PHASE 5

RE-CONSTRUCT WHAT WAS REMOVED FOR THE MEDIAN CROSSOVERS; (MEDIAN CONCRETE BARRIER, DRAINAGE INLETS, ETC.) RECONSTRUCT SHOULDER WHERE MODIFIED CROSS SLOPE WAS UTILIZED. PLACE PORTABLE BARRIER ALONG THE MEDIAN EDGE LINE PER S.C.D. MT-95.45 THAT SHALL REMAIN IN PLACE UNTIL SUCH TIME MEDIAN BARRIER IS REBUILT. LANE CLOSURES ON I-71 SHALL BE PER THE PERMITTED LANE CLOSURE NOTE AND PERTINENT S.C.D.'S

SINGLE AND DOUBLE LANE CLOSURES AT THE SR 562 AND SR 126 INTERCHANGES.

WHEN WORK REQUIRES SHORT TERM SINGLE AND DOUBLE LANE CLOSURES PER THE LVCT THAT IMPACT THE SR 562 AND SR 126 INTERCHANGES AT THE PROJECT LIMITS, THE CONTRACTOR SHALL USE THE LANE CLOSURE DETAILS ON SHEETS 89 - 110 . LANE CLOSURE SETUPS NOT DETAILED ON THESE SHEETS SHALL FOLLOW THE PERTINENT SCDs.

HAM-71-0991; RAMP C (S.B. I-71 TO S.B. RED BANK ROAD)

CLOSE RAMP C PER LVCT FOR 2 SEPARATE WEEKENDS TO PERFORM THE BRIDGE DECK OVERLAY ON HAM-71-0991, JOINT REPAIRS AND PAVEMENT OVERLAY ON THE RAMP. SEE SHEETS 129 - 130 FOR DETOUR. SEE SHEET 131 FOR AUXILIARY LANE CLOSURE DETAILS.

HAM-71-0992; RAMP A (N.B. RED BANK ROAD TO I-71 S.B.)

CLOSE RAMP A PER LVCT TO PERFORM THE BRIDGE DECK OVERLAY ON HAM-71-0992, JOINT REPAIRS AND PAVEMENT OVERLAY ON THE RAMP AND COMPLETE THE OUTSIDE OF HAM-71-0970L WITHIN THE SAME CLOSURE PERIOD. SEE SHEET 127 FOR DETOUR. SEE SHEET 114 FOR MODIFICATIONS AND PHASE DETAILS ON STEWART ROAD TO BE UTILIZED DURING THE DETOUR PERIOD.

RAMP B (N.B. I-71 TO S.B. RED BANK ROAD)

CLOSE RAMP B PER LVCT TO COMPLETE THE OUTSIDE OF HAM-71-0970R AND TO PERFORM JOINT REPAIRS AND PAVEMENT OVERLAY ON THE RAMP WITHIN THE SAME CLOSURE PERIOD. SEE SHEET 128 FOR DETOUR. SEE SHEET 114 FOR MODIFICATIONS AND PHASE DETAILS ON STEWART ROAD TO BE UTILIZED DURING THE DETOUR PERIOD.

RAMP F (N.B. I-71 TO STEWART ROAD)

CLOSE RAMP F PER LVCT TO COMPLETE THE OUTSIDE OF BRIDGE HAM-71-1068R AND TO PERFORM PAVEMENT OVERLAY ON THE RAMP WITHIN THE SAME CLOSURE PERIOD. SEE SHEETS 132 - 133 FOR DETOUR.

BRIDGE HAM-71-0875 (KENNEDY AVENUE)

MAINTAIN 1 LANE IN EACH DIRECTION PER THE LVCT, EXCEPT THE RIGHT LANE CAN BE CLOSED WITH PORTABLE BARRIER TO REPAIR BACK WALL AS SHOWN ON SHEET 111

HAM-71-0970 L/R (OVER RED BANK ROAD)

BRIDGE PAINTING IN PHASES 2 & 3 WILL REQUIRE MAINTAINING TWO-WAY TRAFFIC IN A SINGLE LANE USING A TEMPORARY SIGNAL (SEE PHASE DETAILS ON SHEETS 112 - 113). THE DURATION OF PHASES 2 & 3 SHALL BE 45 CALENDAR DAYS TOTAL. FLAGGING IS PERMITTED FROM 9AM TO 3PM FOR PHASES 1 & 4 .

HAM-71-1068 L/R (OVER STEWART ROAD)

MAINTAIN 1 LANE IN EACH DIRECTION FOR BRIDGE PAINTING AND OVERHEAD WORK PER PHASE DETAILS ON SHEETS 115 - 116 . 15 MINUTE SHORT DURATION COMPLETE CLOSURES ON STEWART ROAD ARE PERMITTED FROM 10PM TO 5AM DURING DECK REMOVAL.

HAM-71-1149 (EUCLID ROAD)

MAINTAIN TRAFFIC USING FLAGGERS BETWEEN 9AM-3PM.

HAM-71-1181 (KENWOOD ROAD)

PER THE TIMES PERMITTED IN THE LVCT, SETUP LANE CLOSURES PER SHEETS 117 - 126 FOR PHASE DETAILS. MAINTAIN A MINIMUM OF ONE OPEN SIDEWALK AT ALL TIMES, AND DETOUR PEDESTRIANS FROM THE CLOSED SIDEWALK AS SHOWN ON THE PHASE DETAILS.

HAM-71-1277 (GALBRAITH ROAD)

MAINTAIN PEDESTRIAN TRAFFIC AT ALL TIMES AND MAINTAIN 1 LANE OF VEHICULAR TRAFFIC IN EACH DIRECTION DURING NON WORKING TIMES. MAINTAIN 2-WAY TRAFFIC IN ONE LANE USING FLAGGERS AS PER THE LVCT.

ITEM 614, MAINTAINING TRAFFIC (NOTICE OF CLOSURE SIGN)

NOTICE OF CLOSURE SIGNS (W20-H13),SHALL BE ERECTED BY THE CONTRACTOR PRIOR TO THE SCHEDULED ROAD OR RAMP CLOSURE IN ACCORDANCE WITH THE NOTICE OF CLOSURE TIME TABLE BELOW. [AT THE APPROVAL OF THE ENGINEER, PORTABLE CHANGABLE MESSAGE SIGNS MAY BE USED IN LIEU OF THE STANDARD FLATSHEET SIGN FOR CLOSURE DURATIONS OF LESS THAN 1 WEEK.

THE SIGNS SHALL BE ERECTED ON THE RIGHT-HAND SIDE OF THE ROAD/RAMP FACING TRAFFIC. THEY SHALL BE PLACED SO AS NOT TO INTERFERE WITH THE VISIBILITY OF ANY OTHER TRAFFIC CONTROL SIGNS. ON ROADWAYS, THEY SHOULD BE ERECTED AT OR NEAR THE POINT OF CLOSURE. THE SIGNS MAY BE ERECTED ANYWHERE ON RAMPS AS LONG AS THEY ARE VISIBLE TO THE MOTORISTS USING THE RAMP. ON ENTRANCE RAMPS, THE SIGN SHALL BE ERECTED WELL IN ADVANCE OF THE MERGE AREA TO AVOID DISTRACTING MOTORISTS.

NOTICE OF CLOSURE SIGN TIME TABLE		
ITEM	DURATION OF CLOSURE	SIGN DISPLAYED TO PUBLIC
RAMP & ROAD	>=2 WEEKS	14 CALENDAR DAYS PRIOR TO CLOSURE
	> 12 HOURS & < 2 WEEKS	7 CALENDAR DAYS PRIOR TO CLOSURE
	CLOSURES < 12 HOURS	2 BUSINESS DAYS PRIOR TO CLOSURE

THE SIGN SHALL DISPLAY THE DATE OF THE CLOSURE IN MMM-DD FORMAT AND THE NUMBER OF DAYS OF THE CLOSURE. THE LAST LINE OF THE W20-H13 SIGN LISTS A PHONE NUMBER WHICH A MOTORIST MAY CALL FOR ADDITIONAL INFORMATION. THIS IS TO BE A SPECIFIC OFFICE WITHIN THE DISTRICT RATHER THAN THE GENERAL SWITCHBOARD NUMBER.

LANES OPEN DURING HOLIDAYS OR SPECIAL EVENTS (I-71 & RAMPS)

NO WORK SHALL BE PERFORMED AND ALL EXISTING LANES SHALL BE OPEN TO TRAFFIC DURING THE FOLLOWING DESIGNATED HOLIDAYS OR EVENTS:

CHRISTMAS	FOURTH OF JULY
NEW YEARS	LABOR DAY
MEMORIAL DAY	THANKSGIVING
EASTER	

THE PERIOD OF TIME THAT THE LANES ARE TO BE OPEN DEPENDS ON THE DAY OF THE WEEK ON WHICH THE HOLIDAY OR EVENT FALLS. THE FOLLOWING SCHEDULE SHALL BE USED TO DETERMINE THIS PERIOD:

DAY OF HOLIDAY OR EVENT	TIME ALL LANES MUST BE OPEN TO TRAFFIC
SUNDAY	12:00N FRIDAY THROUGH 6:00 AM MONDAY
MONDAY	12:00N FRIDAY THROUGH 6:00 AM TUESDAY
TUESDAY	12:00N MONDAY THROUGH 6:00 AM WEDNESDAY
WEDNESDAY	12:00N TUESDAY THROUGH 6:00 AM THURSDAY
THURSDAY	12:00N WEDNESDAY THROUGH 6:00 AM FRIDAY
THURSDAY (THANKSGIVING ONLY)	6:00 AM WEDNESDAY THROUGH 6:00 AM MONDAY
FRIDAY	12:00N THURSDAY THROUGH 6:00 AM MONDAY
SATURDAY	12:00N FRIDAY THROUGH 6:00 AM MONDAY

SHOULD THE CONTRACTOR FAIL TO MEET ANY OF THESE REQUIREMENTS, THE CONTRACTOR SHALL BE ASSESSED A DISINCENTIVE IN THE AMOUNT OF \$125 FOR EACH MINUTE THE ABOVE DESCRIBED LANE CLOSURE RESTRICTIONS ARE VIOLATED.

PERMITTED LANE CLOSURE TIMES AND UNAUTHORIZED LANE USE TABLE

LOCATION	NO. OF EXISTING THRU LANES PER DIRECTION	1 LANE CLOSED		2 LANES CLOSED		15 MINUTE SHORT DURATION COMPLETE CLOSURES	COMPLETE CLOSURE	TIME UNIT	DISINCENTIVE PER LANE PER TIME UNIT
		WEEKDAY	WEEKEND	WEEKDAY	WEEKEND	ANY DAY	ANY DAY		
I-71	3	8 PM - 6 AM	7 PM - 7 AM	11 PM - 5 AM	10 PM - 6 AM	12 M - 4 AM	NONE	15 MINUTES	\$1,875
ALL RAMPS	VAR.	9 PM - 6 AM	7 PM - 6 AM	NONE	NONE	12 M - 4 AM	10 PM - 5 AM	15 MINUTES	\$1,200
KENNEDY AVE	2	9 AM - 3 PM & 8 PM - 6 AM	7 AM - 4 PM	NONE	NONE	NONE	NONE	15 MINUTES	\$750
OLD RED BANK RD	1	9 AM - 3 PM	7 AM - 7 PM	NONE	NONE	NONE	NONE	15 MINUTES	\$750
EUCLID RD	1	7 AM - 7 PM	7 AM - 7 PM	NONE	NONE	NONE	NONE	15 MINUTES	\$750
KENWOOD AVE	2	9 AM - 3 PM AND 7 PM - 6 AM	9 AM - 3 PM AND 7 PM - 6 AM	NONE	NONE	NONE	NONE	15 MINUTES	\$750
GALBRAITH RD	1	9 AM - 3 PM AND 7 PM - 7 AM (1 LANE IN EACH DIR.)	9 AM - 3 PM AND 7 PM - 7 AM (1 LANE IN EACH DIR.)	8PM - 6 AM (1-LANE, 2-WAY TRAFFIC)	8PM - 7 AM (1-LANE, 2-WAY TRAFFIC)	NONE	NONE	15 MINUTES	\$750
STEWART RD	2	AT ALL TIMES	AT ALL TIMES	NONE	NONE	10 PM - 5 AM	NONE	15 MINUTES	\$750

NOTES

- 1) NO SHORT-TERM INTERSTATE SHOULDER CLOSURES BETWEEN THE HOURS OF 6 AM TO 9 AM AND 3 PM TO 7 PM, MONDAY THROUGH FRIDAY.
- 2) NO CLOSURES 2 HOURS BEFORE TO 2 HOURS AFTER EVENTS AT GREAT AMERICAN BALL PARK, PAUL BROWN STADIUM, OR US BANK ARENA. THIS RESTRICTION ALSO APPLIES TO ANY OTHER LOCAL VENUE GENERATING AN EVENT ATTENDANCE OF 20,000+.
- 3) RAMP J/I-71 LANE CLOSURES: SHORT TERM LANE CLOSURES WITH RAMP J AS AN ADD LANE, SHEETS 99-96, IS CONSIDERED 1 LANE CLOSED. SHORT TERM LANE CLOSURES WITH RAMP J AS A MERGE, SHEETS 100-101, IS CONSIDERED 2 LANES CLOSED.
- 4) SHORT TERM PARTIAL-WIDTH RAMP CLOSURE, MAINTAINING 1-11' LANE, IS PERMITTED DURING THE TIMES FOR 1 LANE CLOSED. MAINTAIN THE EXISTING DECISION SIGHT DISTANCE ON MERGE RAMPS.
- 5) A MAXIMUM OF 1 RAMP MAY BE CLOSED AT ANY TIME.

LANE VALUE CONTRACT TABLE

DESCRIPTION OF CRITICAL LANE/RAMP TO BE MAINTAINED	RESTRICTED TIME PERIOD	TIME UNIT	DISINCENTIVE PER TIME UNIT
RAMP A - RED BANK TO I-71 SB	30 DAYS	1 DAY	\$2,500
RAMP B - I-71 NB TO RED BANK	30 DAYS	1 DAY	\$2,500
RAMP C - I-71 SB TO RED BANK	MONDAY 6 AM TO FRIDAY 9 PM	15 MINUTES	\$1,200
RAMP F - I-71 NB TO STEWART	45 DAYS	1 DAY	\$2,500

NOTES

- 1) RAMP C IS PERMITTED TO BE CLOSED A MAXIMUM OF 2 WEEKENDS. A WEEKEND CLOSURE IS DEFINED AS BEGINNING AT 9 PM ON FRIDAY AND ENDING AT 6 AM ON MONDAY.

WORK ZONE MARKINGS

THE CONTRACTOR SHALL PLACE THE ASPHALT INTERMEDIATE COURSE AND ALL WORK ZONE PAVEMENT MARKINGS, INCLUDING WORK ZONE EDGE LINE, UPON COMPLETION OF THE PAVEMENT PLANING PRIOR TO OPENING THE ROADWAY TO TRAFFIC. THE CONTRACTOR SHALL PLACE ALL WORK ZONE PAVEMENT MARKINGS OR PERMANENT MARKINGS UPON COMPLETION OF THE ASPHALT SURFACE COURSE PRIOR TO OPENING THE ROADWAY TO TRAFFIC.

PERMITTED LANE CLOSURE TIMES

SHORT TERM LANE CLOSURES ARE THOSE WHICH ARE PERMITTED BY THE PERMITTED LANE CLOSURE NOTE. THESE TIMES SHALL NOT BE REVISED WITHOUT PRIOR APPROVAL FROM THE DISTRICT 8 WORK ZONE TRAFFIC CONTROL MANAGER. SHORT TERM LANE CLOSURES SHALL ONLY BE IMPLEMENTED WHEN WORK IS BEING CONTINUOUSLY PERFORMED IN THE LANE. THE CLOSURE SHALL BE REMOVED AS SOON AS POSSIBLE AFTER WORK HAS STOPPED. PERMITTED LANE CLOSURES SHALL ONLY BE ALLOWED DURING THE TIMES SPECIFIED IN THE LANE VALUE CONTRACT TABLE AND THE MAINTAINING TRAFFIC (CITY STREETS) NOTE INCLUDED IN THESE PLANS. NO LANE OR SHOULDER CLOSURE SHALL BE IN PLACE WHEN NO WORK IS BEING PERFORMED.

LANE CLOSURE/REDUCTION REQUIRED

LENGTH AND DURATION OF LANE CLOSURES AND RESTRICTIONS SHALL BE AT THE APPROVAL OF THE ENGINEER. IT IS THE INTENT TO MINIMIZE THE IMPACT TO THE TRAVELING PUBLIC. LANE CLOSURES OR RESTRICTIONS OVER SEGMENTS OF THE PROJECT IN WHICH NO WORK IS ANTICIPATED WITHIN A REASONABLE TIME FRAME, AS DETERMINED BY THE ENGINEER, SHALL NOT BE PERMITTED. THE LEVEL OF UTILIZATION OF MAINTENANCE OF TRAFFIC DEVICES SHALL BE COMMENSURATE WITH THE WORK IN PROGRESS.

ITEM 614, REPLACEMENT DRUM

DRUMS FURNISHED BY THE CONTRACTOR IN ACCORDANCE WITH THE REQUIREMENTS OF THE PLANS, SPECIFICATIONS AND PROPOSAL WHICH BECOME DAMAGED BY TRAFFIC FOR REASONS BEYOND THE CONTROL OF THE CONTRACTOR SHALL BE REPLACED IN KIND WHEN ORDERED BY THE ENGINEER. REPLACEMENT DRUMS SHALL BE NEW.

PAYMENT FOR THE NEW DRUMS SHALL BE MADE AT THE CONTRACT PRICE PER EACH FOR ITEM 614, REPLACEMENT DRUM, AND SHALL INCLUDE THE COST OF REMOVING AND DISPOSING OF THE DAMAGED DRUM, AND PROVIDING AND MAINTAINING THE REPLACEMENT DRUM IN ACCORDANCE WITH THE CONTRACT REQUIREMENTS FOR THE ORIGINAL DRUM.

AN ESTIMATED QUANTITY OF 100 EACH HAS BEEN PROVIDED IN THE GENERAL SUMMARY.

DRUM REQUIREMENTS

IN ADDITION TO THE REQUIREMENTS OF THE PLANS, SPECIFICATION AND PROPOSAL, DRUMS FURNISHED BY THE CONTRACTOR SHALL BE NEW AND UNUSED AT THE TIME OF ARRIVAL ON THE PROJECT. ANY DRUMS BROUGHT ON THE PROJECT, WHICH HAVE PREVIOUSLY BEEN USED ELSEWHERE, WILL NOT BE ACCEPTED.

PAYMENT FOR DRUMS SHALL BE INCLUDED IN THE LUMP SUM PRICE BID FOR MAINTAINING TRAFFIC UNLESS SEPARATELY ITEMIZED.

ADVANCE WARNING SIGNS

THE ROAD WORK NEXT XX MILES (G20-1) SIGN AND END ROAD WORK (G20-2) SIGN SHALL BE INSTALLED AT THE PROJECT LIMITS IN ADVANCE OF THE TTC ZONE. THE DISTANCE DISPLAYED ON THE ROAD WORK NEXT XX MILES SIGN SHALL BE STATED TO THE NEAREST WHOLE MILE.

ITEM 614, REPLACEMENT SIGN

FLATSHEET SIGNS FURNISHED BY THE CONTRACTOR IN ACCORDANCE WITH THE REQUIREMENTS OF THE PLANS, SPECIFICATIONS AND PROPOSAL WHICH BECOME DAMAGED BY TRAFFIC FOR REASONS BEYOND THE CONTROL OF THE CONTRACTOR SHALL BE REPLACED IN KIND WHEN ORDERED BY THE ENGINEER. REPLACEMENT SIGNS SHALL BE NEW. OTHER MATERIALS MAY BE IN USED, BUT GOOD, CONDITION SUBJECT TO APPROVAL BY THE ENGINEER.

PAYMENT FOR THE NEW SIGNS SHALL BE MADE AT THE CONTRACT PRICE PER EACH FOR ITEM 614, REPLACEMENT SIGN, AND SHALL INCLUDE THE COST OF REMOVING AND DISPOSING OF DAMAGED SIGNS, HARDWARE AND SUPPORTS, AND PROVIDING THE NECESSARY REPLACEMENT HARDWARE, SUPPORTS, ETC.

AN ESTIMATED QUANTITY OF 10 EACH HAS BEEN PROVIDED IN THE GENERAL SUMMARY.

ROAD CLOSED SIGN

THE CONTRACTOR SHALL PROVIDE, ERECT AND MAINTAIN STANDARD 48 X 30 INCH ROAD CLOSED SIGNS, SIGN SUPPORTS, BARRICADES AND LIGHTS, AS DETAILED IN SCD MT-101.60 AT THE FOLLOWING LOCATIONS DURING PERIODS IN WHICH THE AFFECTED ROADS ARE CLOSED TO TRAFFIC.

- RAMP A: @ RAMP GORE AT SPLIT WITH RAMP D TO NB I-71
- RAMP B: ON RAMP DECELERATION LANE PRIOR TO BRIDGE
- RAMP C: @ RAMP GORE AT I-71 SB
- RAMP F: ON RAMP DECELERATION LANE PRIOR TO BRIDGE

ALL WORK AND TRAFFIC CONTROL DEVICES SHALL BE IN ACCORDANCE WITH C&MS 614 AND OTHER APPLICABLE PORTIONS OF THE SPECIFICATIONS, AS WELL AS THE OHIO MANUAL OF UNIFORM TRAFFIC CONTROL DEVICES. PAYMENT FOR ALL LABOR, EQUIPMENT AND MATERIALS SHALL BE INCLUDED IN THE LUMP SUM CONTRACT PRICE FOR ITEM 614, MAINTAINING TRAFFIC, UNLESS SEPARATELY ITEMIZED IN THE PLAN.

TEMPORARY PAVEMENT WEDGE

TEMPORARY PAVEMENT WEDGES SHALL BE PROVIDED AT ALL TIMES WHERE TRAFFIC IS REQUIRED TO TRAVEL FROM OR ONTO A PAVEMENT SURFACE OF A DIFFERENT ELEVATION. THE MINIMUM SLOPE OF THE TEMPORARY PAVEMENT WEDGE SHALL BE 3:1 ALONG LONGITUDINAL JOINTS AND 120:1 AT TRANSVERSE JOINTS. THESE WEDGES SHALL BE REMOVED PRIOR TO PLACING THE SPECIFIED PAVEMENT COURSE. PAYMENT FOR ALL WORK, MATERIALS, ETC. ASSOCIATED WITH THIS ITEM SHALL BE PAID FOR UNDER ITEM 614 MAINTAINING TRAFFIC LUMP SUM.

SHORT DURATION CLOSING OF THE HIGHWAY

THE FOLLOWING NOTES SHALL APPLY TO ALL WORK ON I-71 AND STEWART ROAD.

1. FIVE CALENDAR DAYS PRIOR TO IMPLEMENTING THE SHORT DURATION CLOSING OF THE HIGHWAY THE CONTRACTOR SHALL PLACE A PORTABLE CHANGEABLE MESSAGE SIGN AT THE STRUCTURE IN THE DIRECTION THE ROAD IS TO BE CLOSED WITH THE MESSAGE:

(I-71 or STEWART) 12 AM
CLOSES TO
DATE 4 AM

2. CLOSURES WILL ONLY BE PERMITTED FOR REMOVAL AND ERECTION OF THE STRUCTURAL BEAMS AND SIGN TRUSSES, TO PROTECT TRAFFIC DURING DEMOLITION OPERATIONS AS CALLED FOR IN C&MS 501.05, FOR OVERHEAD UTILITY WIRE CROSSING, AND FOR TRAFFIC SWITCHES. CLOSURES WILL BE PERMITTED DURING THE HOURS SPECIFIED IN THE PERMITTED LANE CLOSURE AND UNAUTHORIZED LANE USE TABLE, ON SHEET __. THE MAXIMUM DURATION OF THE CLOSURE SHALL NOT EXCEED 15 MINUTES SUBJECT TO A DISINCENTIVE IN THE AMOUNT SPECIFIED IN THE PERMITTED LANE CLOSURE AND UNAUTHORIZED LANE USE TABLE, ON SHEET __. UNLESS OTHERWISE DIRECTED BY THE ENGINEER, ONLY ONE (1) BEAM SHALL BE REMOVED OR SET PER CLOSING. TRAFFIC SHALL BE COMPLETELY CLEARED BEFORE THE NEXT CLOSING.

3. THE CONTRACTOR SHALL IMPLEMENT THE TRAFFIC CONTROL CONTAINED IN STANDARD CONSTRUCTION DRAWING MT-99.60. IN THE EVENT THE CLOSURE OCCURS IN CLOSE PROXIMITY TO SYSTEM-SYSTEM INTERCHANGE, TRAFFIC CONTROL SHALL EXTEND ONTO ANY ENTERING DIVIDED HIGHWAY ACCORDING TO THE LIMITS PROVIDED IN MT-99.60.

4. THE CONTRACTOR SHALL FURNISH AND INSTALL TWO (2) WATCH FOR STOPPED TRAFFIC SIGNS (W3-H7-48) 1500 FEET UPSTREAM FROM THE ANTICIPATED BACKUP ON I-71. THE CONTRACTOR SHALL INSTALL ADDITIONAL WATCH FOR STOPPED TRAFFIC SIGNS EVERY 2000 FEET UPSTREAM FROM THE WATCH FOR STOPPED TRAFFIC SIGNS ON I-71 IF TRAFFIC BACKUPS REACH THE FIRST SET OF SIGNS. THE NEED FOR THESE SIGNS SHALL BE CONSTANTLY MONITORED BY THE CONTRACTOR. ALL WATCH FOR STOPPED TRAFFIC AND PREPARE TO STOP SIGNS SHALL BE EQUIPPED WITH TYPE B WARNING LIGHTS.

5. IN THE EVENT OF AN INCLEMENT WEATHER FORECAST (RAIN OR SNOW FORECAST AT 50% OR GREATER THE DAY THE EVENT WILL OCCUR IS DEFINED AS AN INCLEMENT FORECAST) THE CLOSURE SHALL NOT TAKE PLACE. THE CONTRACTOR WILL MAKE THE DETERMINATION BASED UPON THE WEATHER FORECAST PREDICTED BY THE NATIONAL WEATHER SERVICE.

6. ALTHOUGH THE PLANS CONTAIN BID ITEMS FOR LEOS AND PCMS, THEIR USE FOR THE SHORT DURATION CLOSING OF THE HIGHWAY, INCLUDING LEOS DESCRIBED IN MT-99.60 NOTE 5, IS CONSIDERED INCIDENTAL TO ITEM 614 MAINTAINING TRAFFIC IN ORDER TO LIMIT THE FREQUENCY OF CLOSURES TO THE MINIMUM NEEDED TO PERFORM THE WORK.

O:\ODOT\HAM\91826_HAM-71-8.42\Design\MOT\Sheets\91826_MN401.dgn_Sheet 3/1/2018 9:33:28 AM dan-f

P:\PR54704\HAM\91826\Design\Roadway\Sheets\91826_GG009.dgn Sheet 3/2/2018 2:33:47 PM chen

SHEET NUM.										PART.			ITEM	ITEM EXT	GRAND TOTAL	UNIT	DESCRIPTION	SEE SHEET NO.
										01/IMS/PV	02/TMS/B R	03/						
STRUCTURE OVER 20 FOOT SPAN (HAM-71-1068L)																		
												LS	201	11001	LS		CLEARING AND GRUBBING, AS PER PLAN	339
												LS	202	11203	LS		PORTIONS OF STRUCTURE REMOVED, OVER 20 FOOT SPAN, AS PER PLAN	339
												296	202	22900	296	SY	APPROACH SLAB REMOVED	
												12	202	98100	12	EACH	REMOVAL MISC.: SCUPPER AND DOWNSPOUT REMOVAL (EACH)	369
												LS	503	11100	LS		COFFERDAMS AND EXCAVATION BRACING	
												83	503	21100	83	CY	UNCLASSIFIED EXCAVATION	
												154,359	509	10000	154,359	LB	EPOXY COATED REINFORCING STEEL	
												306	510	10001	306	EACH	DOWEL HOLES WITH NONSHRINK, NONMETALLIC GROUT, AS PER PLAN	339
												467	511	34447	467	CY	CLASS QC2 CONCRETE WITH QC/QA, BRIDGE DECK, AS PER PLAN	343
												128	511	34449	128	CY	CLASS QC2 CONCRETE, BRIDGE DECK (PARAPET), AS PER PLAN	343
												71	511	44110	71	CY	CLASS QC1 CONCRETE, ABUTMENT NOT INCLUDING FOOTING	
												LS	511	81200	LS		CONCRETE, MISC.: SURVEYING EXISTING BRIDGE	410
												1,553	512	10100	1,553	SY	SEALING OF CONCRETE SURFACES (EPOXY-URETHANE)	
												120	SPECIAL	51271500	120	SY	URETHANE TOP COAT SEALER	341
												1,553	512	74000	1,553	SY	REMOVAL OF EXISTING COATINGS FROM CONCRETE SURFACES	
												4,053	513	20000	4,053	EACH	WELDED STUD SHEAR CONNECTORS	
												250	513	95030	250	EACH	STRUCTURAL STEEL, MISC.: WELDING CROSSFRAME STIFFENERS	392
												80	513	95030	80	EACH	STRUCTURAL STEEL, MISC.: DRILLING STRUCTURAL STEEL, GRINDING, AND NDT	339
												160	513	95030	160	EACH	STRUCTURAL STEEL, MISC.: PENCIL ABRASIVE BLASTING, GRINDING, AND NDT	340
												6	513	95030	6	EACH	STRUCTURAL STEEL, MISC.: INTERMEDIATE CROSSFRAME	392
												3	513	95030	3	EACH	STRUCTURAL STEEL, MISC.: REMOVE EXISTING INTERMEDIATE CROSSFRAME	390
												2	513	95030	2	EACH	STRUCTURAL STEEL, MISC.: FIELD WELD CRACK REPAIR	390A
												1	513	95030	1	EACH	STRUCTURAL STEEL, MISC.: BEARING STIFFENER REPAIR	390A
												413	514	20001	413	SF	FIELD PAINTING OF DAMAGED STRUCTURAL STEEL, AS PER PLAN	340
												146	516	11210	146	FT	STRUCTURAL EXPANSION JOINT INCLUDING ELASTOMERIC STRIP SEAL	
												140	516	14020	140	FT	SEMI-INTEGRAL ABUTMENT EXPANSION JOINT SEAL	
												7	516	44201	7	EACH	ELASTOMERIC BEARING WITH INTERNAL LAMINATES AND LOAD PLATE (NEOPRENE), AS PER PLAN, 11 1/2"x1'-2"x3.22"	340
												7	516	44401	7	EACH	ELASTOMERIC BEARING WITH INTERNAL LAMINATES AND LOAD PLATE (NEOPRENE), AS PER PLAN, 11 1/2"x1'-1"x5.04"	340
												LS	516	47000	LS		JACKING AND TEMPORARY SUPPORT OF SUPERSTRUCTURE	
												LS	518	21230	LS		POROUS BACKFILL WITH GEOTEXTILE FABRIC	
												1,647	SPECIAL	51900100	1,647	SF	COMPOSITE FIBER WRAP SYSTEM	
												12	519	11101	12	SF	PATCHING CONCRETE STRUCTURE, AS PER PLAN	340
												296	526	25001	296	SY	REINFORCED CONCRETE APPROACH SLABS (T=15"), AS PER PLAN	343
												141	526	90010	141	FT	TYPE A INSTALLATION	
												40	SPECIAL	53000500	40	HOUR	STRUCTURES: STRUCTURE INSPECTION AND MECHANIZED ACCESS	340
												502	607	39900	502	FT	VANDAL PROTECTION FENCE, 6' STRAIGHT, COATED FABRIC	
												502	607	39900	502	FT	TEMPORARY FENCE	
STRUCTURE OVER 20 FOOT SPAN (HAM-71-1068L) ALT. BID 1																		
												482	514	00050	482	SF	SURFACE PREPARATION OF EXISTING STRUCTURAL STEEL	
												482	514	00056	482	SF	FIELD PAINTING OF EXISTING STRUCTURAL STEEL, PRIME COAT	
												482	514	00060	482	SF	FIELD PAINTING STRUCTURAL STEEL, INTERMEDIATE COAT	
												482	514	00066	482	SF	FIELD PAINTING STRUCTURAL STEEL, FINISH COAT	
												1	514	00504	1	MNHR	GRINDING FINS, TEARS, SLIVERS ON EXISTING STRUCTURAL STEEL	
												1	514	10000	1	EACH	FINAL INSPECTION REPAIR	
STRUCTURE OVER 20 FOOT SPAN (HAM-71-1068L) ALT. BID 2																		
												24,625	514	00050	24,625	SF	SURFACE PREPARATION OF EXISTING STRUCTURAL STEEL	
												24,625	514	00056	24,625	SF	FIELD PAINTING OF EXISTING STRUCTURAL STEEL, PRIME COAT	
												24,625	514	00060	24,625	SF	FIELD PAINTING STRUCTURAL STEEL, INTERMEDIATE COAT	
												24,625	514	00066	24,625	SF	FIELD PAINTING STRUCTURAL STEEL, FINISH COAT	
												50	514	00504	50	MNHR	GRINDING FINS, TEARS, SLIVERS ON EXISTING STRUCTURAL STEEL	
												18	514	10000	18	EACH	FINAL INSPECTION REPAIR	

GENERAL SUMMARY

HAM-IR71-8.42

▲ - REVISED 03/02/2018
 ▲ - REVISED 02/26/2018
 ▲ - REVISED 02/21/2018
 ▲ - REVISED 01/23/2018

P:\PR54704\HAM\91826\Design\Roadway\Sheets\91826_GG010.dgn Sheet 3/2/2018 2:32:11 PM chen

SHEET NUM.										PART.			ITEM	ITEM EXT	GRAND TOTAL	UNIT	DESCRIPTION	SEE SHEET NO.
										01/IMS/PV	02/TMS/BR	03/						
STRUCTURE OVER 20 FOOT SPAN (HAM-71-1068R)																		
												LS	201	11001	LS		CLEARING AND GRUBBING, AS PER PLAN	339
												LS	202	11203	LS		PORTIONS OF STRUCTURE REMOVED, OVER 20 FOOT SPAN, AS PER PLAN	339
												454	202	22900	454	SY	APPROACH SLAB REMOVED	
												LS	202	98000	LS		REMOVAL MISC.: SIGN TRUSS SUPPORT BRACKETS	389
												20	202	98100	20	EACH	REMOVAL MISC.: SCUPPER AND DOWNSPOUT REMOVAL (EACH)	368
												LS	503	11100	LS		COFFERDAMS AND EXCAVATION BRACING	
												126	503	21100	126	CY	UNCLASSIFIED EXCAVATION	
												235,915	509	10000	235,915	LB	EPOXY COATED REINFORCING STEEL	
												294	510	10001	294	EACH	DOWEL HOLES WITH NONSHRINK, NONMETALLIC GROUT, AS PER PLAN	339
												763	511	34447	763	CY	CLASS QC2 CONCRETE WITH QC/QA, BRIDGE DECK, AS PER PLAN	343
												140	511	34449	140	CY	CLASS QC2 CONCRETE, BRIDGE DECK (PARAPET), AS PER PLAN	343
												105	511	44110	105	CY	CLASS QC1 CONCRETE, ABUTMENT NOT INCLUDING FOOTING	
												LS	511	81200	LS		CONCRETE, MISC.: SURVEYING EXISTING BRIDGE	409
												1,875	512	10100	1,875	SY	SEALING OF CONCRETE SURFACES (EPOXY-URETHANE)	
												105	SPECIAL	51271500	105	SY	URETHANE TOP COAT SEALER	341
												1,875	512	74000	1,875	SY	REMOVAL OF EXISTING COATINGS FROM CONCRETE SURFACES	
												6,867	513	20000	6,867	EACH	WELDED STUD SHEAR CONNECTORS	
												466	513	95030	466	EACH	STRUCTURAL STEEL, MISC.: WELDING CROSSFRAME STIFFENERS	392
												10	513	95030	10	EACH	STRUCTURAL STEEL, MISC.: INTERMEDIATE CROSSFRAME	392
												621	514	20001	621	SF	FIELD PAINTING OF DAMAGED STRUCTURAL STEEL, AS PER PLAN	340
												219	516	11210	219	FT	STRUCTURAL EXPANSION JOINT INCLUDING ELASTOMERIC STRIP SEAL	
												213	516	14020	213	FT	SEMI-INTEGRAL ABUTMENT EXPANSION JOINT SEAL	
												11	516	44201	11	EACH	ELASTOMERIC BEARING WITH INTERNAL LAMINATES AND LOAD PLATE (NEOPRENE), AS PER PLAN, 1'-0"x1'-2"x3.25"	340
												11	516	44201	11	EACH	ELASTOMERIC BEARING WITH INTERNAL LAMINATES AND LOAD PLATE (NEOPRENE), AS PER PLAN, 11 1/2"x1'-2"x3.22"	340
												LS	516	47000	LS		JACKING AND TEMPORARY SUPPORT OF SUPERSTRUCTURE	
												LS	518	21230	LS		POROUS BACKFILL WITH GEOTEXTILE FABRIC	
												1,997	SPECIAL	51900100	1,997	SF	COMPOSITE FIBER WRAP SYSTEM	341
												64	519	11101	64	SF	PATCHING CONCRETE STRUCTURE, AS PER PLAN	340
												454	526	25001	454	SY	REINFORCED CONCRETE APPROACH SLABS (T=15"), AS PER PLAN	343
												215	526	90010	215	FT	TYPE A INSTALLATION	
												556	607	79900	556	FT	VANDAL PROTECTION FENCE, 6' STRAIGHT, COATED FABRIC	
												556	607	79900	556	FT	TEMPORARY FENCE	
STRUCTURE OVER 20 FOOT SPAN (HAM-71-1068R) ALT. BID 1																		
												450	514	00050	450	SF	SURFACE PREPARATION OF EXISTING STRUCTURAL STEEL	
												450	514	00056	450	SF	FIELD PAINTING OF EXISTING STRUCTURAL STEEL, PRIME COAT	
												450	514	00060	450	SF	FIELD PAINTING STRUCTURAL STEEL, INTERMEDIATE COAT	
												450	514	00066	450	SF	FIELD PAINTING STRUCTURAL STEEL, FINISH COAT	
												1	514	00504	1	MNHR	GRINDING FINS, TEARS, SLIVERS ON EXISTING STRUCTURAL STEEL	
												1	514	10000	1	EACH	FINAL INSPECTION REPAIR	
STRUCTURE OVER 20 FOOT SPAN (HAM-71-1068R) ALT. BID 2																		
												41,195	514	00050	41,195	SF	SURFACE PREPARATION OF EXISTING STRUCTURAL STEEL	
												41,195	514	00056	41,195	SF	FIELD PAINTING OF EXISTING STRUCTURAL STEEL, PRIME COAT	
												41,195	514	00060	41,195	SF	FIELD PAINTING STRUCTURAL STEEL, INTERMEDIATE COAT	
												41,195	514	00066	41,195	SF	FIELD PAINTING STRUCTURAL STEEL, FINISH COAT	
												200	514	00504	200	MNHR	GRINDING FINS, TEARS, SLIVERS ON EXISTING STRUCTURAL STEEL	
												31	514	10000	31	EACH	FINAL INSPECTION REPAIR	

GENERAL SUMMARY

HAM-IR71-8.42

- REVISED 03/02/2018
 - REVISED 02/26/2018
 - REVISED 02/23/2018
 - REVISED 02/21/2018
 - REVISED 01/29/2018

P:\PR54704\HAM\91826\Design\Roadway\Sheets\91826_GG012.dgn Sheet 2/28/2018 8:57:08 AM chen

SHEET NUM.										PART.			ITEM	ITEM EXT	GRAND TOTAL	UNIT	DESCRIPTION	SEE SHEET NO.	
										01/IMS/PV	02/IMS/B R	03/							
																	STRUCTURE OVER 20 FOOT SPAN (HAM-71-1277L)		
											LS		201	11001	LS			CLEARING AND GRUBBING, AS PER PLAN	339
											LS		202	11203	LS			PORTIONS OF STRUCTURE REMOVED, OVER 20 FOOT SPAN, AS PER PLAN	339
											LS		202	98000	LS			REMOVAL MISC.:EXPANSION JOINT REMOVAL	441
											3		257	10000	3	SY		DIAMOND GRINDING PORTLAND CEMENT CONCRETE PAVEMENT	
											16		510	10001	16	EACH		DOWEL HOLES WITH NONSHRINK, NONMETALLIC GROUT, AS PER PLAN	339
											935		512	10400	935	SY		TREATING OF CONCRETE BRIDGE DECK WITH SRS	
											1,581		514	00050	1,581	SF		SURFACE PREPARATION OF EXISTING STRUCTURAL STEEL	
											1,581		514	00056	1,581	SF		FIELD PAINTING OF EXISTING STRUCTURAL STEEL, PRIME COAT	
											1,581		514	00060	1,581	SF		FIELD PAINTING STRUCTURAL STEEL, INTERMEDIATE COAT	
											1,581		514	00066	1,581	SF		FIELD PAINTING STRUCTURAL STEEL, FINISH COAT	
											3		514	00504	3	MNHR		GRINDING FINS, TEARS, SLIVERS ON EXISTING STRUCTURAL STEEL	
											1		514	10000	1	EACH		FINAL INSPECTION REPAIR	
											115		516	10011	115	FT		ARMORLESS PREFORMED JOINT SEAL, AS PER PLAN	441
											2		516	44101	2	EACH		ELASTOMERIC BEARING WITH INTERNAL LAMINATES AND LOAD PLATE (NEOPRENE), AS PER PLAN, 8"x1'-0"x2.51"	340
											6		516	44101	6	EACH		ELASTOMERIC BEARING WITH INTERNAL LAMINATES AND LOAD PLATE (NEOPRENE), AS PER PLAN, 8"x1'-0"x2.51" WITH HP POST	340
											2		516	44101	2	EACH		ELASTOMERIC BEARING WITH INTERNAL LAMINATES AND LOAD PLATE (NEOPRENE), AS PER PLAN, 8"x1'-0"x2.53"	340
											6		516	44101	6	EACH		ELASTOMERIC BEARING WITH INTERNAL LAMINATES AND LOAD PLATE (NEOPRENE), AS PER PLAN, 8"x1'-0"x2.53" WITH HP POST	340
											LS		516	47000	LS			JACKING AND TEMPORARY SUPPORT OF SUPERSTRUCTURE	
											130		519	11101	130	SF		PATCHING CONCRETE STRUCTURE, AS PER PLAN	340
											LS		SPECIAL	60610900	LS			NOISE BARRIER REPAIR LOOSE OR MISSING SOUNDWALL SHIMS AND WOODEN MEMBERS	340
																		STRUCTURE OVER 20 FOOT SPAN (HAM-71-1277R)	
											LS		201	11001	LS			CLEARING AND GRUBBING, AS PER PLAN	339
											LS		202	11203	LS			PORTIONS OF STRUCTURE REMOVED, OVER 20 FOOT SPAN, AS PER PLAN	339
											LS		202	98000	LS			REMOVAL MISC.:EXPANSION JOINT REMOVAL	441
											3		257	10000	3	SY		DIAMOND GRINDING PORTLAND CEMENT CONCRETE PAVEMENT	
											18		510	10001	18	EACH		DOWEL HOLES WITH NONSHRINK, NONMETALLIC GROUT, AS PER PLAN	339
											1,074		512	10400	1,074	SY		TREATING OF CONCRETE BRIDGE DECK WITH SRS	
											1,775		514	00050	1,775	SF		SURFACE PREPARATION OF EXISTING STRUCTURAL STEEL	
											1,775		514	00056	1,775	SF		FIELD PAINTING OF EXISTING STRUCTURAL STEEL, PRIME COAT	
											1,775		514	00060	1,775	SF		FIELD PAINTING STRUCTURAL STEEL, INTERMEDIATE COAT	
											1,775		514	00066	1,775	SF		FIELD PAINTING STRUCTURAL STEEL, FINISH COAT	
											3		514	00504	3	MNHR		GRINDING FINS, TEARS, SLIVERS ON EXISTING STRUCTURAL STEEL	
											1		514	10000	1	EACH		FINAL INSPECTION REPAIR	
											131		516	10011	131	FT		ARMORLESS PREFORMED JOINT SEAL, AS PER PLAN	441
											2		516	44101	2	EACH		ELASTOMERIC BEARING WITH INTERNAL LAMINATES AND LOAD PLATE (NEOPRENE), AS PER PLAN, 8"x1'-0"x2.51"	340
											7		516	44101	7	EACH		ELASTOMERIC BEARING WITH INTERNAL LAMINATES AND LOAD PLATE (NEOPRENE), AS PER PLAN, 8"x1'-0"x2.51" WITH HP POST	340
											2		516	44101	2	EACH		ELASTOMERIC BEARING WITH INTERNAL LAMINATES AND LOAD PLATE (NEOPRENE), AS PER PLAN, 8"x1'-0"x2.53"	340
											7		516	44101	7	EACH		ELASTOMERIC BEARING WITH INTERNAL LAMINATES AND LOAD PLATE (NEOPRENE), AS PER PLAN, 8"x1'-0"x2.53" WITH HP POST	340
											LS		516	47000	LS			JACKING AND TEMPORARY SUPPORT OF SUPERSTRUCTURE	
											60		519	11101	60	SF		PATCHING CONCRETE STRUCTURE, AS PER PLAN	340

GENERAL SUMMARY

HAM-IR71-8.42

- REVISED 02/28/2018

166
441

WRONG WAY DETECTION SYSTEM NOTES

THESE SPECIFICATIONS, TOGETHER WITH THE ACCOMPANYING PLANS ARE INTENDED TO DESCRIBE THE TYPE, SIZE AND LOCATION OF THE PRODUCTS AND MATERIALS TO BE PROVIDED AND INSTALLED UNDER THE VARIOUS BID ITEMS RELATED TO THE WRONG WAY DETECTION SYSTEM. THE CONTRACTOR SHALL FURNISH AND INSTALL ALL DEVICES AND RELATED MATERIALS IN COMPLIANCE WITH THESE PLANS AND SPECIFICATIONS, AS WELL AS:

- OHIO MANUAL OF UNIFORM TRAFFIC CONTROL DEVICES (OMUTCD)
- 2016 OHIO DEPARTMENT OF TRANSPORTATION CONSTRUCTION AND MATERIAL SPECIFICATIONS
- STANDARD CONSTRUCTION DRAWINGS ISSUED BY THE OHIO DEPARTMENT OF TRANSPORTATION

THESE SPECIFICATIONS SET FORTH THE MINIMUM REQUIREMENTS OF THE WRONG WAY DETECTION SYSTEM AND THE ITEMS REFERRED HEREIN.

GROUNDING AND BONDING

THE REQUIREMENTS OF THE CONSTRUCTION AND MATERIAL SPECIFICATIONS (C&MS) AND THE TC SERIES OF STANDARD CONSTRUCTION DRAWINGS ARE MODIFIED AS FOLLOWS:

1. ALL METALLIC PARTS CONTAINING ELECTRICAL CONDUCTORS SHALL BE PERMANENTLY JOINED TO FORM AN EFFECTIVE GROUND FAULT CURRENT PATH BACK TO THE GROUNDED CONDUCTOR IN THE POWER SERVICE DISCONNECT SWITCH.
 - A. PROVIDE AN EQUIPMENT GROUNDING CONDUCTOR IN METALLIC CONDUITS (725.04) IN ADDITION TO THE CONDUCTORS SPECIFIED AND BOND THE CONDUIT TO THIS GROUNDING CONDUCTOR.
 - B. WHEN AN EQUIPMENT GROUNDING CONDUCTOR IS REQUIRED IN PLASTIC CONDUIT (725.05), THE INSTALLATION SHALL INCLUDE A SEPARATE EQUIPMENT GROUNDING CONDUCTOR IN ADDITION TO THE CONDUCTORS SPECIFIED.
 - C. IF MULTIPLE CONDUIT RUNS BEGIN AND END AT THE SAME POINTS, ONLY ONE EQUIPMENT GROUNDING CONDUCTOR IS REQUIRED.
2. CONDUITS.
 - A. THE 725.04 CONDUIT SHALL HAVE GROUNDING BUSHINGS INSTALLED AT ALL TERMINATION POINTS. THE BUSHING MATERIAL SHALL BE COMPATIBLE WITH GALVANIZED STEEL CONDUIT AND THE GROUNDING LUG MATERIAL SHALL BE COMPATIBLE FOR USE WITH COPPER WIRE. THREADED OR COMPRESSION TYPE BUSHINGS MAY BE USED.
 - B. THE 725.05 CONDUIT SHALL HAVE THE INSIDE AND OUTSIDE DIAMETERS OF THE CONDUIT DEBURRED AT ALL TERMINATION POINTS.
 - C. BOTH ENDS OF METALLIC CONDUIT SHALL BE BONDED TO THE EQUIPMENT GROUNDING CONDUCTOR.
 - D. METALLIC CONDUIT MAY BE BONDED TO METALLIC BOXES THROUGH THE USE OF CONDUIT FITTINGS UL APPROVED FOR THIS TYPE OF CONNECTION, WITH THE BOX BONDED TO THE EQUIPMENT GROUNDING CONDUCTOR.
3. WIRE FOR GROUNDING AND BONDING.
 - A. USE INSULATED, COPPER WIRE FOR THE EQUIPMENT GROUNDING CONDUCTOR. BONDING JUMPERS IN BOXES AND ENCLOSURES MAY BE BARE OR INSULATED COPPER WIRE. WIRE SIZE SHALL BE AS FOLLOWS:
 - I. USE 4 AWG BETWEEN THE POWER SERVICE AND SUPPORTS, POLES, PEDESTALS, CONTROLLER OR FLASHER CABINETS.
 - II. THE INSULATION SHALL BE GREEN OR GREEN WITH YELLOW STRIPE(S). FOR 4 AWG OR LARGER, INSULATION MAY ALSO BE BLACK WITH GREEN TAPE/LABELS INSTALLED AT ALL ACCESS POINTS.
4. GROUND ROD.
 - A. A 3/4 INCH SCHEDULE 40 PVC CONDUIT WILL BE USED IN FOUNDATIONS AND CONCRETE WALLS FOR THE GROUNDING CONDUCTOR (GROUND WIRE) RACEWAY TO THE GROUND ROD. SHOULD METALLIC CONDUIT BE USED, BOTH ENDS OF THE CONDUIT SHALL BE BONDED TO THE GROUNDING CONDUCTOR.
 - B. THE TYPICAL GROUNDING CONDUCTOR (GROUND WIRE) SHALL BE 4 AWG INSULATED, COPPER.

5. POWER SERVICE AND DISCONNECT SWITCH.
 - A. AT THE POWER SERVICE LOCATION, THE GROUNDING CONDUCTOR (GROUND WIRE) FROM THE DISCONNECT SWITCH NEUTRAL (AC-) BAR TO THE GROUND ROD SHALL BE A CONTINUOUS, UNSPLICED CONDUCTOR. IF SPLICED, IT SHALL BE AN EXOTHERMIC WELD BUTT SPLICE.
 - B. THE SERVICE NEUTRAL (AC-) SHALL ONLY BE CONNECTED TO GROUND AT THE PRIMARY POWER SERVICE DISCONNECT SWITCH.
 - I. NEMA CONTROLLER CABINETS: IF A POWER SERVICE DISCONNECT SWITCH IS LOCATED BEFORE THE CONTROLLER CABINET, THE NEUTRAL (AC-) AND THE GROUNDING BARS IN THE CONTROLLER CABINET SHALL NOT BE CONNECTED TOGETHER AS SHOWN IN NEMA TS-2, FIGURE 5-4.
 - II. IF SECONDARY DISCONNECT SWITCHES ARE CONNECTED AFTER THE PRIMARY DISCONNECT SWITCH, THE NEUTRAL (AC-) SHALL ONLY BE GROUNDED AT THE PRIMARY SWITCH. EQUIPMENT GROUNDING CONDUCTORS SHALL BE BROUGHT TO THE PRIMARY SWITCH, BUT SHALL BE GROUNDED AT BOTH SECONDARY AND PRIMARY SWITCHES.

6. PAYMENT ALL MATERIALS AND WORK REQUIRED TO COMPLETE THE EFFECTIVE GROUND FAULT CURRENT PATH SYSTEM ARE INCIDENTAL TO THE CONDUCTORS INSTALLED BY CONTRACT.

**ITEM 625 TRENCH, AS PER PLAN
ITEM 625 CONDUIT, JACKED OR DRILLED, 725.04, 2", AS PER PLAN**



TRENCH, JACKING, DRILLING OR DIRECTIONALLY BORING THROUGH ROCK AS REQUIRED SHALL BE CONSIDERED INCIDENTAL TO THIS ITEM OF WORK.

PAYMENT SHALL BE PER ITEM 632.

ITEM 630 - SIGN SUPPORT ASSEMBLY, BARRIER MOUNTED, AS PER PLAN

EACH SIGN SUPPORT ASSEMBLY SHALL MEET THE REQUIREMENTS OF 630 AND CONFORM TO THE DIMENSIONS OF THE DETAILS WITHIN.

ALL WORK AND MATERIALS SHALL BE IN ACCORDANCE WITH STANDARD SPECIFICATIONS. PAYMENT FOR THIS ITEM SHALL BE MADE AT THE CONTRACT PRICE BID PER EACH.

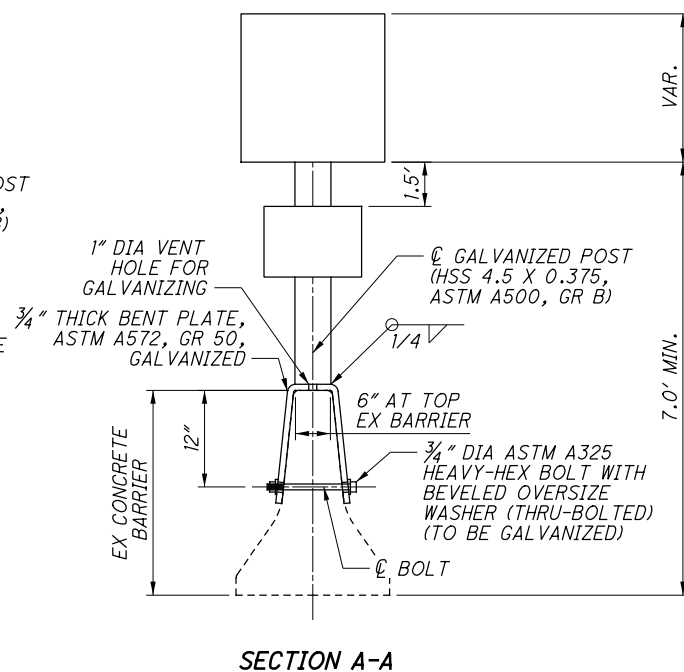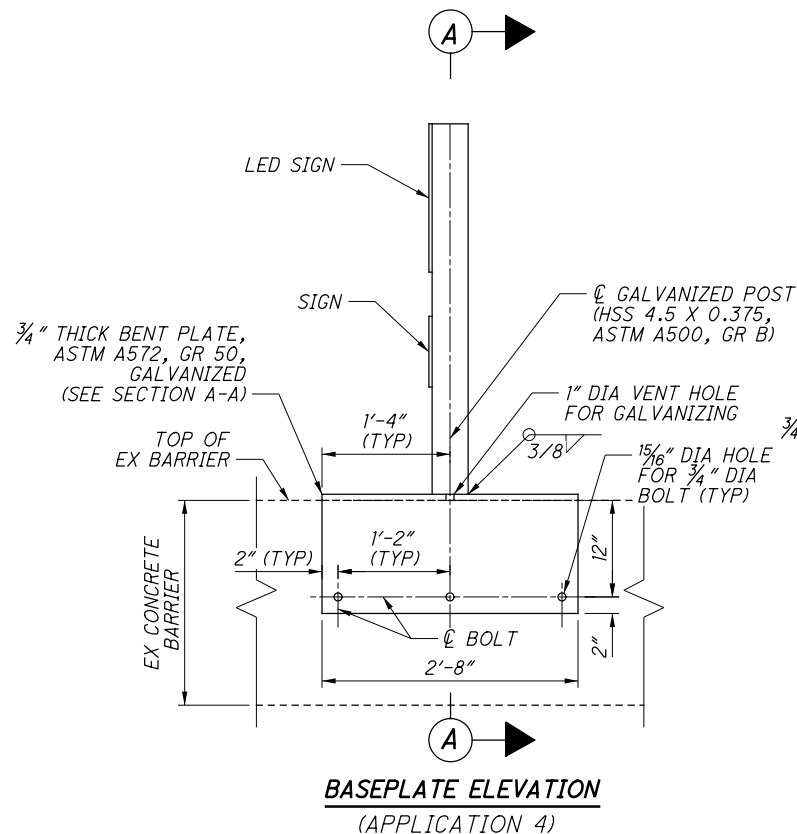

ITEM 630 SIGNING MISC.: WRONG WAY DETECTION SYSTEM

THIS ITEM OF WORK SHALL CONSIST OF FURNISHING AND INSTALLING A COMPLETE WRONG WAY DETECTION SYSTEM. THE SYSTEM SHALL DETECT THE PRESENCE OF VEHICLES TRAVELING IN THE WRONG DIRECTION ON AN EXIT RAMP. WHEN A VEHICLE TRAVELING IN THE WRONG DIRECTION IS DETECTED, WHITE LED WARNING LIGHTS IN THE SIGN SYSTEM SHALL BE ACTIVATED, A CAMERA SHALL RECORD THE EVENT AND AFTER A SECOND DETECTOR CONFIRMS THAT THE VEHICLE CONTINUED TO TRAVEL IN THE WRONG DIRECTION, ELECTRONIC NOTIFICATION SHALL BE SENT.

ALL ELEMENTS OF THE WRONG WAY SYSTEM SHALL BE PROVIDED AS A COMPLETE SYSTEM BY A SINGLE VENDOR/MANUFACTURE.

ALL ELEMENTS OF THE WRONG WAY DETECTION SYSTEM SHALL BE CONSIDERED INCIDENTAL TO THIS ITEM OF WORK UNLESS SEPARATELY ITEMIZED. THE FOLLOWING LIST REPRESENTS AN OUTLINE OF COMPONENTS TO BE INCLUDED WITH THE SYSTEM. ITEMS NOT SPECIFICALLY LISTED BELOW, BUT REQUIRED TO PROVIDE FOR A FULLY FUNCTIONING WRONG WAY DETECTION SYSTEM SHALL ALSO BE INCLUDED:

- VEHICLE DUAL DIRECTION DETECTOR UNITS.
 - NUMBER OF UNITS FURNISHED PER SITE SHALL BE AS REQUIRED TO MEET THE FUNCTIONALITY REQUIREMENTS OF THE SYSTEM AND DETECT ALL WRONG WAY VEHICLES.
 - DETECTION HARDWARE SHALL BE POWERED BY 120VAC. ULTRA-LOW POWERED RADAR UNITS WITH PROGRAMMABLE OUTPUTS.
 - SHALL BE CAPABLE OF DETECTING INCOMING OR OUTGOING TARGETS TRAVELING BETWEEN 5 AND 100 MPH.
 - SHALL BE SEALED FROM WATER INTRUSION.
 - SHALL INCLUDE SELF-TESTING, STATUS LED LIGHTS AND SELF-PROTECTION FROM REVERSE POLARITY.
 - SHALL UTILIZE RS232 SERIAL COMMUNICATION FOR PROGRAMMING.
- (1)-CONFORMATION CAMERA.
 - WIDE ANGLE HDTV (1080P) OUTDOOR RATED WITH CROSS-LINK ANALYSIS.
 - SHALL HAVE PROGRAMMABLE EVENT BASED LOGIC THAT INTEGRATES WITH THE WRONG WAY LOGIC CONTROLLER.
 - IP66 RATED, NEMA 4X
 - PROVIDE FOR A MINIMUM OF ONE INPUT AND ONE OUTPUT.
 - PROVIDE FOR ADJUSTABLE IMAGE SETTINGS.
- USE A 1X4" PROGRESSIVE SCAN RGB CMOS.
 - (1)-AN ILLUMINATOR SHALL BE FURNISHED AND INSTALLED WHERE AMBIENT LIGHTING CONDITIONS DON'T PROVIDE SUFFICIENT LIGHT LEVELS TO OPERATE CAMERAS IN COLOR MODE.
- 4G LTE CELLULAR MODEM
 - WITH 2 YEARS OF MONITORING SERVICE. THE SYSTEM SHALL INCLUDE SYSTEM MONITORING, NOTIFICATIONS, AND UPDATES VIA A CELLULAR SERVICE, HOSTED/PROVIDED BY THE MANUFACTURE FOR A PERIOD OF 2 YEARS FOLLOWING THE ORIGINAL PROJECT COMPLETION DATE.
 - 4G LTE CELLULAR GATEWAY WITH INTEGRAL FIVE PORT 10/100 ETHERNET SWITCH WITH EXTERNAL OMNI-DIRECTION ANTENNA.
 - INCLUDE INTEGRAL RS232 PORT.
 - SHALL BE CAPABLE OF OVER THE AIR FIRMWARE UPDATED AND REMOTE MANAGEMENT.
 - SHALL BE CAPABLE OF IPSEC VPN
- (4)-WIRELESS RADIO COMMUNICATION UNITS. RADIO CONTROL SHALL OPERATE ON A 900 MHZ FREQUENCY HOPPING SPREAD SPECTRUM NETWORK, WI-FI OR APPROVED EQUAL. RADIOS SHALL INTEGRATE COMMUNICATION OF SIGN CONTROL CIRCUIT TO ACTIVATE SIGNS. THE RADIO SHALL BE SYNCHRONIZED SO ALL OF THE REMOTE INDICATIONS WILL TURN ON WITHIN 120 MSEC OF EACH OTHER AND REMAIN SYNCHRONIZED THROUGH-OUT THE DURATION OF THE FLASHING CYCLE.
- LOOP DETECTOR MONITORING CARD
 - NUMBER OF CARDS FURNISHED SHALL BE SUFFICIENT TO ACCOMMODATE THE PROPOSED LOOP DETECTION NEEDS.
 - SHALL WORK WITH STANDARD NEMA/170/2070 CARD RACKS.
 - SHALL UTILIZE TIA232 SERIAL COMMUNICATION FOR PROGRAMMING.
 - SHALL INCLUDE SELF-TESTING AND LED STATUS LIGHTS.
 - PROVIDE FOR A MINIMUM OF 4 FREQUENCY SETTINGS.
- (1) - WRONG WAY LOGIC CONTROLLER WITH INTEGRATED TEST FUNCTIONS.
 - SHALL ANALYZE INPUTS FROM MULTIPLE SENSORS AND CAMERAS.
 - PROVIDE FOR PROGRAMMABLE OUTPUTS.
 - SHALL CONTAIN DRIVE RELAYS

J:\20151750\HAM-71-1.51\000T\HAM_91826\Design\Traffic\Sheets\91826_TN001.dgn 3/1/2018 9:41:38 AM brieder

- SHALL INCLUDE LED STATUS LIGHTS AND ON-SITE TESTING.
- PROVIDE FOR MICRO USB INTERFACE
- (1) - PROGRAMMABLE SIGN CONTROLLER
- PROVIDE FOR A MINIMUM OF TWO INPUTS AND OUTPUTS
- PROGRAMMABLE INCLUDING FLASH PATTERN, DURATION AND LED INTENSITY.
- INTEGRATE WITH WIRELESS RADIOS.
- INCLUDE REAL TIME CLOCK WITH ON-BOARD BATTERY.
- PROVIDE FOR DATA LOGGING.
- PROVIDE FOR RS232 SERIAL INTERFACE
- POLE MOUNTED CONTROL CABINET(S), WITH CONTROL EQUIPMENT.
- (2) - WRONG WAY SIGNS R5-1A (48"x36"), 120V AC/SOLAR POWERED, WHITE LED, PERIMETER BLINKING.
- (4) - WRONG WAY SIGNS R5-1A (42"x30"), SIGN FLAT SHEET.
- (2) - DO NOT ENTER SIGNS R5-1 (48"x48"), 120VAC/SOLAR POWERED, WHITE LED, PERIMETER BLINKING.
- SOLAR PANELS MOUNTED TO AN ALUMINUM PLATE AND BRACKET AT AN ANGLE OF 45 DEGREES- 60 DEGREES TO PROVIDE MAXIMUM OUTPUT.
- BATTERIES FOR LED SIGNS WITH WRITTEN TWO YEAR FULL REPLACEMENT WARRANTY.
- THE SYSTEM SHALL OPERATE UNDER THE FOLLOWING CONDITIONS:
 - SHALL COMPLY WITH PART 15 OF FCC.
 - SHALL OPERATE FROM -4 DEGREES F TO 122 DEGREES F.
 - PROGRAMMABLE FROM A WINDOWS BASED PC
- (8)-HOURS OF ONSITE TRAINING.

ALL LED, PERIMETER EDGE LIT BLINKING SIGNS SHALL BE WIRELESSLY CONTROLLED AND SYNCHRONIZED VIA THE USE OF WIRELESS RADIOS. EACH SIGN SHALL BE A COMPLETE ASSEMBLY, CONSISTING OF BUT NOT LIMITED TO, SIGNAGE, SIGN MOUNTING HARDWARE, INDICATIONS AND ELECTRICAL COMPONENTS (WIRING, SOLID-STATE CIRCUIT BOARDS, ETC.). EACH SIGN SHALL BE SUPPLIED WITH ALL REQUIRED HARDWARE TO INSTALL ASSEMBLY. ALL EXPOSED HARDWARE SHALL BE ANTI-VANDAL. ASSURE ALL SIGNS MEETS THE REQUIREMENTS OF C&MS 630. THE CONTROL CIRCUIT SHALL BE SEALED WATERTIGHT TO ELIMINATE DIRT CONTAMINATION AND ALLOW FOR SAFE HANDLING IN ALL WEATHER CONDITIONS.

SEE SOLAR POWERED LED SIGN REQUIREMENTS AND ELECTRICAL REQUIREMENTS FOR SOLAR-POWERED DEVICES FOR ADDITIONAL REQUIREMENTS.

WARRANTY
 WARRANTY SHALL BE TWO YEARS FROM THE DATE OF FINAL ACCEPTANCE.

MEASUREMENT
 THE DEPARTMENT WILL MEASURE THIS ITEM COMPLETE IN PLACE, INCLUDING ALL MATERIALS, TESTING, LABOR AND SOFTWARE FOR A FULLY FUNCTIONAL SYSTEM.

PAYMENT
 PAYMENT WILL BE AT THE CONTRACT UNIT PRICE PER EACH FOR ITEM 630 SIGNING MISC.: WRONG WAY DETECTION SYSTEM AND INCLUDE ALL MATERIALS AND LABOR TO FURNISH AND INSTALL A COMPLETE SYSTEM AT ONE EXIT RAMP. ALL ELEMENTS OF THE SYSTEM SHALL BE CONSIDERED INCIDENTAL TO THIS ITEM OF WORK UNLESS SEPARATELY ITEMIZED.

ITEM 632 POWER SERVICE, AS PER PLAN

POWER FOR THE PROPOSED WRONG WAY DETECTION SYSTEM SHALL BE OBTAINED FROM EITHER AN EXISTING ODOT OWNED CABINET OR DIRECTLY FROM DUKE ENERGY AS SPECIFIED IN THE PLAN.

WHEN POWER IS OBTAINED DIRECTLY FROM DUKE ENERGY, A WOOD POLE, METER AND DISCONNECT SWITCH SHALL BE FURNISHED AND INSTALLED AS PART OF THIS ITEM OF WORK. POWER SUPPLIED SHALL BE 120 VOLTS, SINGLE PHASE. THE CONTRACTOR SHALL COORDINATE WITH DUKE ENERGY TO ESTABLISH POWER SERVICE A MINIMUM OF SIX WEEKS PRIOR TO THE NEED FOR POWER AT (888) 700-3853.

WHEN POWER IS OBTAINED FROM AN EXISTING ODOT OWNED CABINET, A NEW 15 AMP CIRCUIT BREAKER SHALL BE FURNISHED AND INSTALLED AS PART OF THIS ITEM OF WORK. ALL CABINET WIRING MODIFICATIONS AND MISCELLANEOUS HARDWARE NEEDED TO ADD THE CIRCUIT BREAKER SHALL CONSIDERED INCIDENTAL TO THIS ITEM OF WORK. POWER SUPPLIED SHALL BE 120 VOLTS, SINGLE PHASE. A DISCONNECT SWITCH SHALL ALSO BE FURNISHED AND INSTALLED AS INDICATED.

REFERENCE IS MADE TO THE REQUIREMENTS OF ODOT STANDARD DRAWING ITS-15.11.

PAYMENT SHALL BE PER ITEM 632.

ITEM 632 PEDESTAL FOUNDATION, AS PER PLAN

AT APPLICATION 6 THE TOP OF THE PROPOSED FOUNDATION SHALL BE AT THE SAME ELEVATION AS THE EXISTING BARRIER WALL. HOWEVER, THE FOUNDATION DEPTH SHALL BE MEASURED FROM THE LOWER ELEVATION SIDE AS ILLUSTRATED ON THE DETAIL. ALL AFFECTED REINFORCING STEEL SHALL BE LENGTHENED TO CORRESPOND TO THE INCREASED FOUNDATION LENGTH.

ALL ROCK EXCAVATION REQUIRED TO PROVIDE THE REQUIRED FOUNDATION DEPTH AS SPECIFIED IN ODOT STANDARD DRAWING TC-21.20 SHALL BE CONSIDERED INCIDENTAL TO THIS ITEM OF WORK.

ITEM 632 PEDESTAL, MISC.: PEDESTAL, 15', TRANSFORMER BASE

THE PEDESTAL SHALL BE PER ITEM 632 AND THE DETAILS FURNISHED WITHIN.

PAYMENT SHALL BE PER ITEM 632.

ITEM 661 PLANTING, MISC.: RESTORATION OF DISTURBED LANDSCAPED AREA

UNDER THIS ITEM OF WORK THE CONTRACTOR SHALL DOCUMENT THE EXISTING CONDITIONS AND EXISTING VEGETATION PRIOR TO DISTURBING THE EXISTING LANDSCAPED AREA (FLOWER BED) FOR CONDUIT INSTALLATION. AFTER THE INSTALLATION OF POWER CONDUIT, THE AREA SHALL BE FULLY RESTORED TO PRE-CONSTRUCTION CONDITIONS.

PAYMENT SHALL BE PER ITEM 661 AND BE PER SQUARE FEET OF RESTORED AREA.

SOLAR POWERED LED SIGN REQUIREMENTS

THIS SPECIFICATION DESCRIBES THE MINIMUM ACCEPTABLE DESIGN AND PERFORMANCE REQUIREMENTS FOR LED ENHANCED SIGNS. THE SIGN SHALL BE SELF-POWERED BY SOLAR PANELS AND BATTERIES WITH NO EXTERNAL ELECTRICAL POWER INSTALLATION. THE LED ENHANCED SIGN SHALL BE MUTCD COMPLIANT.

THE FOLLOWING CRITERIA SHALL BE MET:

1. THE NEW UNIT SHALL ATTACH SECURELY TO THE PROPOSED SIGN SUPPORT USING A TAMPER RESISTANT FASTENING SYSTEM. SPECIAL TOOLS NEEDED FOR THE TAMPER RESISTANT FASTENING SYSTEM SHALL BE SUPPLIED WITH EACH SIGN.
2. EACH SIGN UNIT SHALL BE IDENTIFIED WITH THE MANUFACTURER'S NAME, DATE OF MANUFACTURE, AND SERIAL NUMBER ON THE BACK SIDE.
3. THE SIGN UNIT SHALL BE VISIBLE AT A MINIMUM OF 1/4 MI. DURING ALL CONDITIONS.
4. THE SIGN UNIT SHALL INCORPORATE CIRCUITRY TO ENSURE THAT IT HAS BRIGHTNESS ADJUSTMENT DURING DAY, DUSK, AND AT NIGHT (DIMMABLE).
5. THE LENS OF THE LED UNIT SHALL BE CAPABLE OF WITHSTANDING ULTRAVIOLET LIGHT (DIRECT SUNLIGHT) EXPOSURE FOR A MINIMUM TIME PERIOD OF FIVE YEARS WITHOUT EXHIBITING EVIDENCE OF DETERIORATION.
6. THE LENSES SHALL WITHSTAND A 3 FOOT DROP TEST ONTO A HARD SURFACE AND SHALL BE A MINIMUM OF 1/4 INCH THICK AND FREE OF BUBBLES AND IMPERFECTIONS. THE LENSES SHALL BE SMOOTH ON THE OUTSIDE, WITH NO EXTERNAL FACETS TO PREVENT DIRT AND DEBRIS BUILD-UP.
7. IF LENSES ARE TINTED, THEY SHALL MATCH THE WAVELENGTH (CHROMATICITY) OF THE LED.
8. THE INDIVIDUAL LED LIGHT SOURCES SHALL BE WIRED SO THAT A CATASTROPHIC FAILURE OF ONE LED LIGHT SOURCE WILL NOT RESULT IN THE LOSS OF MORE THAN ONE LED LIGHT SOURCE IN THE SIGN UNIT.
9. LED UNITS AND ASSOCIATED ON-BOARD CIRCUITRY SHALL CONFORM TO THE REQUIREMENTS IN FEDERAL COMMUNICATIONS COMMISSION (FCC) TITLE 47, SUB PART B, SECTION 15 REGULATIONS CONCERNING THE EMISSION OF ELECTRONIC NOISE.
10. LED'S SHALL BE RATED FOR USE IN THE AMBIENT OPERATING TEMPERATURE RANGE OF -40°F TO +166°F. (-40°C TO +74°C)
11. THE LED'S WIRING SHALL BE SEALED WATERTIGHT TO ELIMINATE DIRT CONTAMINATION AND ALLOW FOR SAFE HANDLING IN ALL WEATHER CONDITIONS. THE LED'S SHALL BE SEALED AGAINST DUST AND MOISTURE INTRUSION AS PER THE REQUIREMENTS OF NEMA STANDARD 250-1991 FOR TYPE 4 ENCLOSURES AND TO PROTECT ALL INTERNAL LED AND ELECTRICAL COMPONENTS.
12. THE SIGN LED'S SHALL DISPLAY A MINIMUM OF 500,000 MCD FOR DAYTIME VISIBILITY.

SOLAR REQUIREMENTS
 SEE "GENERAL ELECTRICAL REQUIREMENTS FOR SOLAR-POWERED DEVICES".

REQUIRED DOCUMENTATION
 EACH SIGN UNIT SHALL BE PROVIDED WITH THE FOLLOWING DOCUMENTATION EITHER IN HARD COPY OR AS A PDF.

1. ONE SCHEMATIC DIAGRAM SHALL BE PROVIDED FOR THE SIGN UNIT ALONG WITH ANY NECESSARY INSTALLATION INSTRUCTIONS.
2. THE LED MANUFACTURERS NAME, BRAND, AND MODEL NUMBER.


WARRANTY

1. THE LED ENHANCED SIGNAL AHEAD SIGN UNIT SHALL BE REPAIRED OR REPLACED BY THE MANUFACTURER IF IT EXHIBITS A FAILURE DUE TO WORKMANSHIP OR MATERIAL DEFECTS WITHIN 2 YEARS OF FIELD OPERATION.
2. THE MANUFACTURER SHALL PROVIDE A WRITTEN WARRANTY AGAINST DEFECTS IN MATERIALS, WORKMANSHIP, AND LUMINOUS INTENSITY FOR THE LED ENHANCED SIGN UNIT FOR A PERIOD OF 2 YEARS AFTER INSTALLATION. A REPLACEMENT LED ENHANCED SIGN UNIT SHALL BE PROVIDED WITHIN 10 DAYS AFTER RECEIPT OF FAILED UNIT AT NO COST, EXCEPT THE COST OF SHIPPING THE FAILED UNIT.

ELECTRICAL REQUIREMENTS FOR SOLAR-POWERED DEVICES

- RUN REQUIREMENTS OF THIS DEVICE SHALL INCLUDE 4 HOURS PER DAY FOR 14 DAYS UNDER AUTONOMY OPERATION.
- UTILIZE ENVIRONMENTALLY-SEALED, HIGH-EFFICIENCY LED LIGHT SOURCES FOR THIS SOLAR-POWERED APPLICATION.
- HOUSE THE SOLAR POWER SUPPLY CONTROLLER AND BATTERY IN ONE OR TWO STAINLESS STEEL OR ALUMINUM ENCLOSURES WITH A MINIMUM NEMA 3 OR 3X RATING.
- IF THE EXTERIOR SIZE OF THE ENCLOSURE NECESSARY TO MEET THE REQUIREMENTS BELOW IS LESS THAN 1000 CUBIC INCHES, A SINGLE POLYMER ENCLOSURE RATED NEMA 4 AND LISTED AS SUNLIGHT-RESISTANT MAY BE INSTALLED, WITH APPROVAL OF THE ENGINEER.
- SEAL ENCLOSURE CONDUIT ENTRIES TO PREVENT INSECT AND/OR RODENT ENTRY.
- PROVIDE METAL ENCLOSURES WITH AN EXTERIOR OF BARE OR POWDER-COATED ALUMINUM, OR STAINLESS STEEL.
- PROVIDE A LOCKING ENCLOSURE USING 2 LOCKS PER PADLOCK PER C&MS 631.06.
- SEPARATE THE CONTROL ELECTRONICS AND BATTERY, IF CONTAINED WITHIN A SINGLE ENCLOSURE, TO PREVENT DAMAGE TO THE CONTROL ELECTRONICS IF THE BATTERY ENVELOPE IS COMPROMISED. CONTROL EQUIPMENT SHALL BE LOCATED IN A NEMA 4X ENCLOSURE.
- PROVIDE SEALED GEL-CELL OR AGM (ABSORBED GLASS MAT) LEAD-ACID BATTERIES FOR ALL INSTALLATIONS WITH INSTANTANEOUS LOAD REQUIREMENTS OF 4 WATTS OR ABOVE, REGARDLESS OF DUTY CYCLE. FOR INSTALLATIONS WITH INSTANTANEOUS LOAD REQUIREMENTS OF LESS THAN 4 WATTS, RECHARGEABLE NICD, LI-ION, OR NIMH BATTERIES MAY BE USED INSTEAD OF AGM OR GEL-CELL, IF APPROVED BY THE ENGINEER.
- PROVIDE SIGNED COPIES FROM THE SOLAR PANEL AND/OR CONTROLLER MANUFACTURER OF ALL CALCULATIONS USED TO SIZE THE SOLAR PANEL AND BATTERIES.
- INCLUDE IN THESE CALCULATIONS THE INSOLATION VALUE USED AND ITS REFERENCE SOURCE, THE SOLAR PANEL EFFICIENCY, CHARGER/CONTROLLER EFFICIENCY, INVERTER EFFICIENCY, PROPOSED LED LAMP AND/OR EQUIPMENT LOAD, AND A FIGURE REPRESENTING ANTICIPATED MISCELLANEOUS LOSSES.
- SHOW CALCULATIONS DOCUMENTING A RESERVE CAPACITY OF TWO WEEKS OPERATION UNDER CONTINUOUS WORST-CASE (MINIMUM) INSOLATION FIGURES (USUALLY DECEMBER) FOR THE PROPOSED GEOGRAPHIC LOCATION, USING A PANEL ELEVATION ANGLE APPROPRIATE TO THE SITE, AT A SUSTAINED TEMPERATURE OF 25 DEGREES FAHRENHEIT (-4 DEGREES CELSIUS).
- DELIVER A COPY OF THE CALCULATIONS TO THE ENGINEER AND ANOTHER COPY TO THE OFFICE OF ROADWAY ENGINEERING FOR APPROVAL.
- PROVIDE DOCUMENTATION SHOWING THAT THE SOLAR PANEL MANUFACTURER TESTED THE PANEL ACCORDING TO IEC61215 OR EQUIVALENT APPROVED STANDARD.
- PROVIDE DOCUMENTATION SHOWING THAT SOLAR PANEL MOUNTING IS RATED FOR 90 MPH DESIGN WIND AND DESIGNED TO RESIST VANDALISM.
- ENSURE NEC GROUNDING AND BONDING REQUIREMENTS ARE MET IF VOLTAGES OVER 50V AC OR DC ARE PRESENT.


ENGINEERS SEAL:




SIGNED: *Jason R. Smallwood*
 DATE: 10-30-2017
 SHEETS: 318A-318O

STANDARD CONSTRUCTION DRAWINGS					SUPPLEMENTAL SPECIFICATIONS	
HL-20.11	4/21/17	TC-41.20	10/18/13	TC-73.20	7/21/17	800-2016 7/21/17
HL-30.11	7/21/17	TC-41.30	10/18/13	TC-82.10	7/17/15	809 7/21/17
HL-30.22	1/17/14	TC-41.40	10/18/13	TC-83.20	7/21/17	
		TC-42.20	10/18/13			
MT-95.45	7/21/17	TC-52.20	7/21/17	ITS-15.11	7/17/15	
MT-98.28	1/20/17	TC-65.10	1/17/14			
		TC-65.11	7/21/17			


J:\20151750\HAM-71-1.5\000T\HAM\91826\Design\Traffic\Sheets\91826_ID002.dgn 3/1/2018 9:41:41 AM brieder

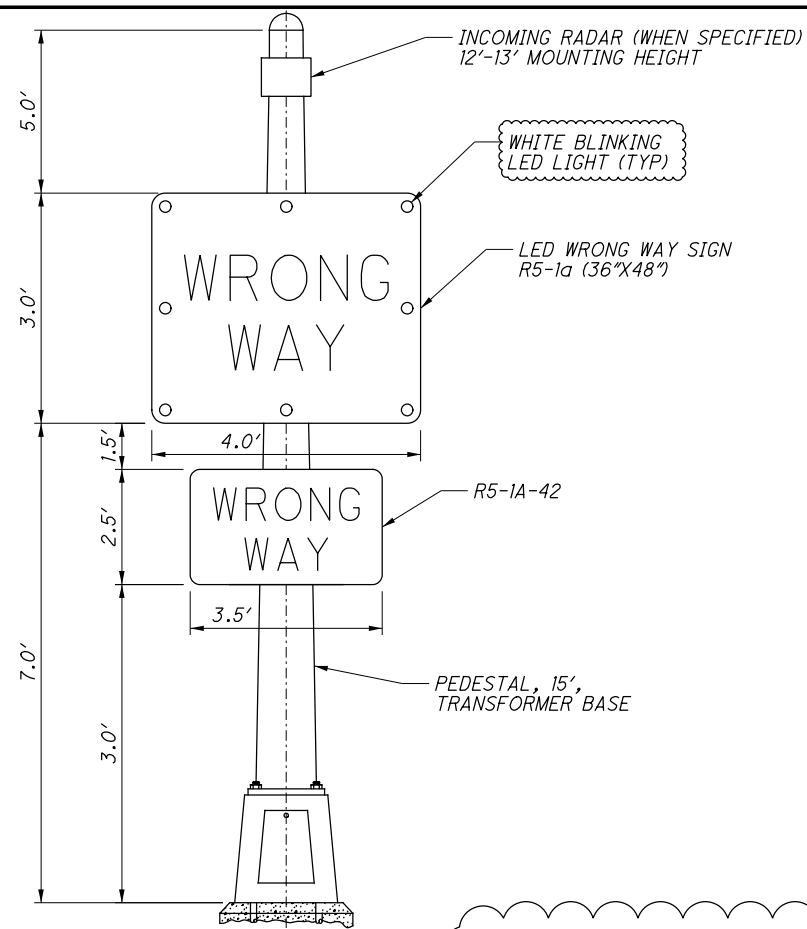


APPLICATION 1
NOT TO SCALE

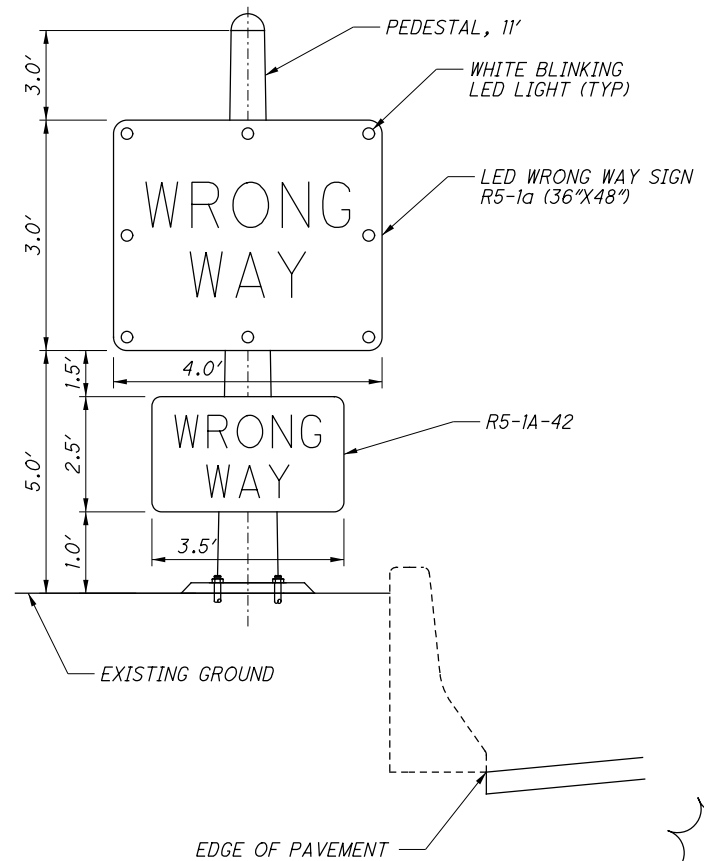

APPLICATION 2
NOT TO SCALE

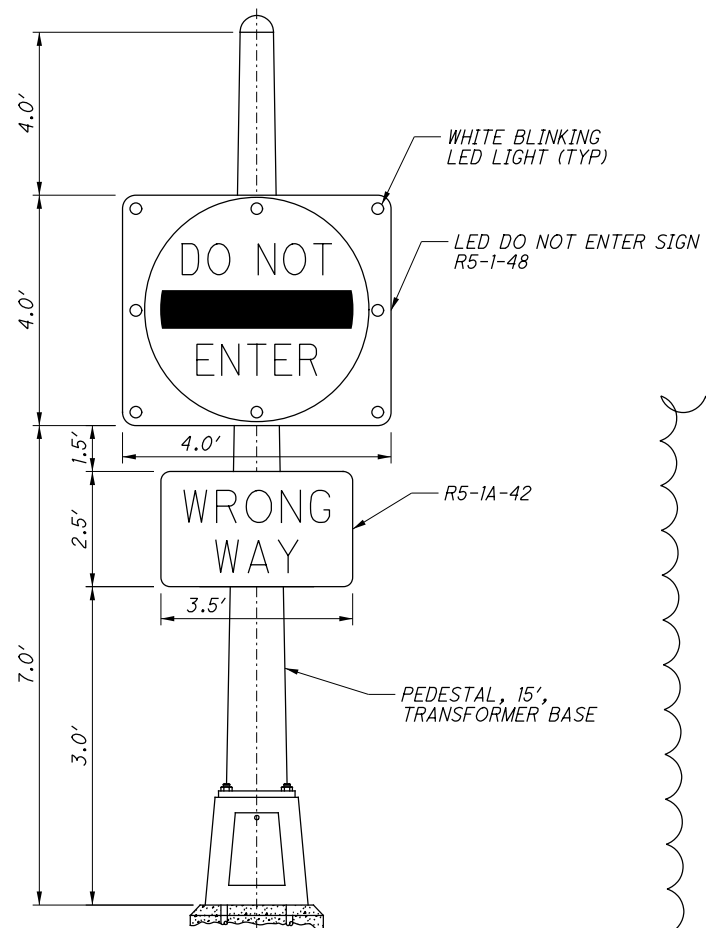

APPLICATION 3
NOT TO SCALE

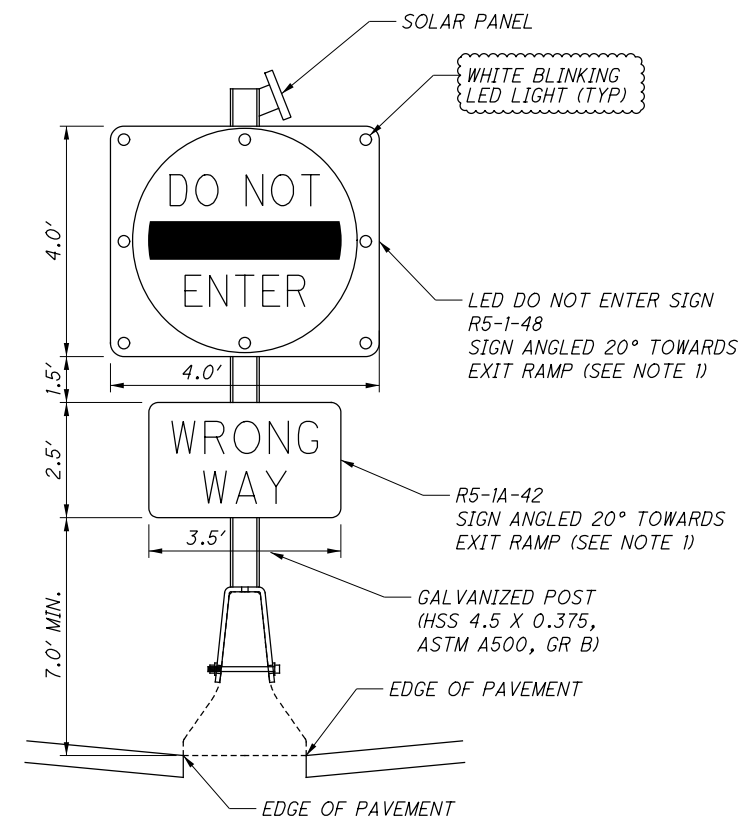

APPLICATION 4
NOT TO SCALE

NOTE:
1. ROTATION ANGLE SHALL BE FIELD APPROVED BY THE ENGINEER.


CALCULATED
BER
CHECKED
JDS

TRAFFIC CONTROL DETAILS

HAM-71-8.42


318F
441

J:\20151750\HAM-71-1.5\000T\HAM\91826\Design\Traffic\Sheets\91826_ID004.dgn 3/1/2018 9:41:41 AM brieder

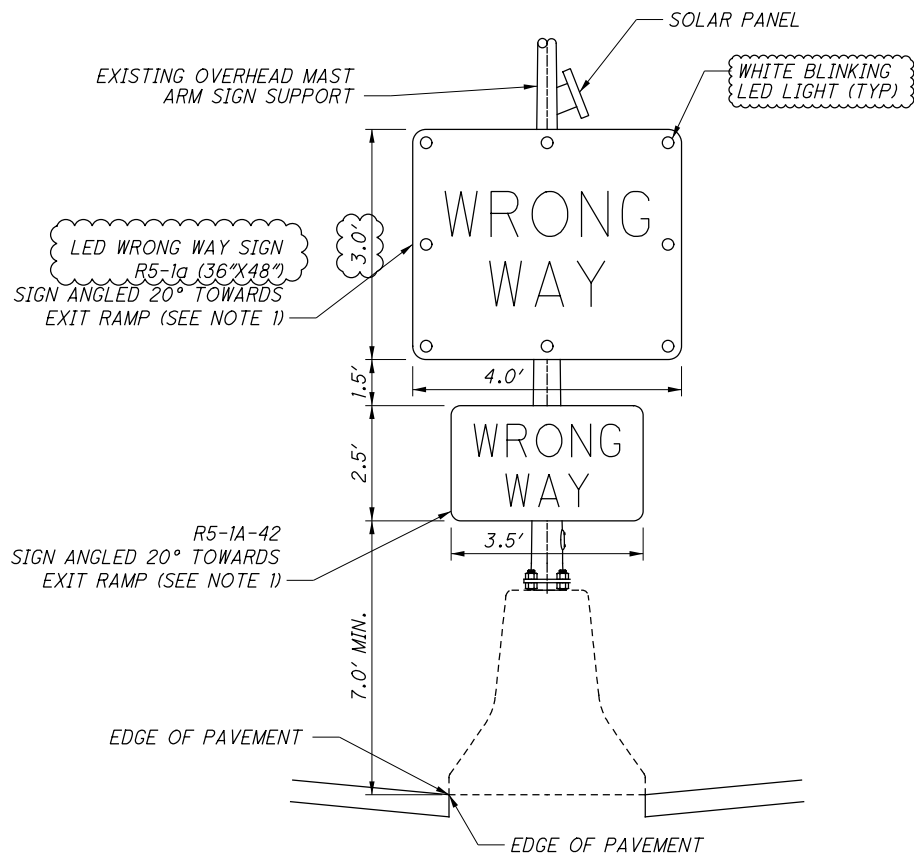

APPLICATION 5
NOT TO SCALE

NOTE:
1. ROTATION ANGLE SHALL BE FIELD
APPROVED BY THE ENGINEER.

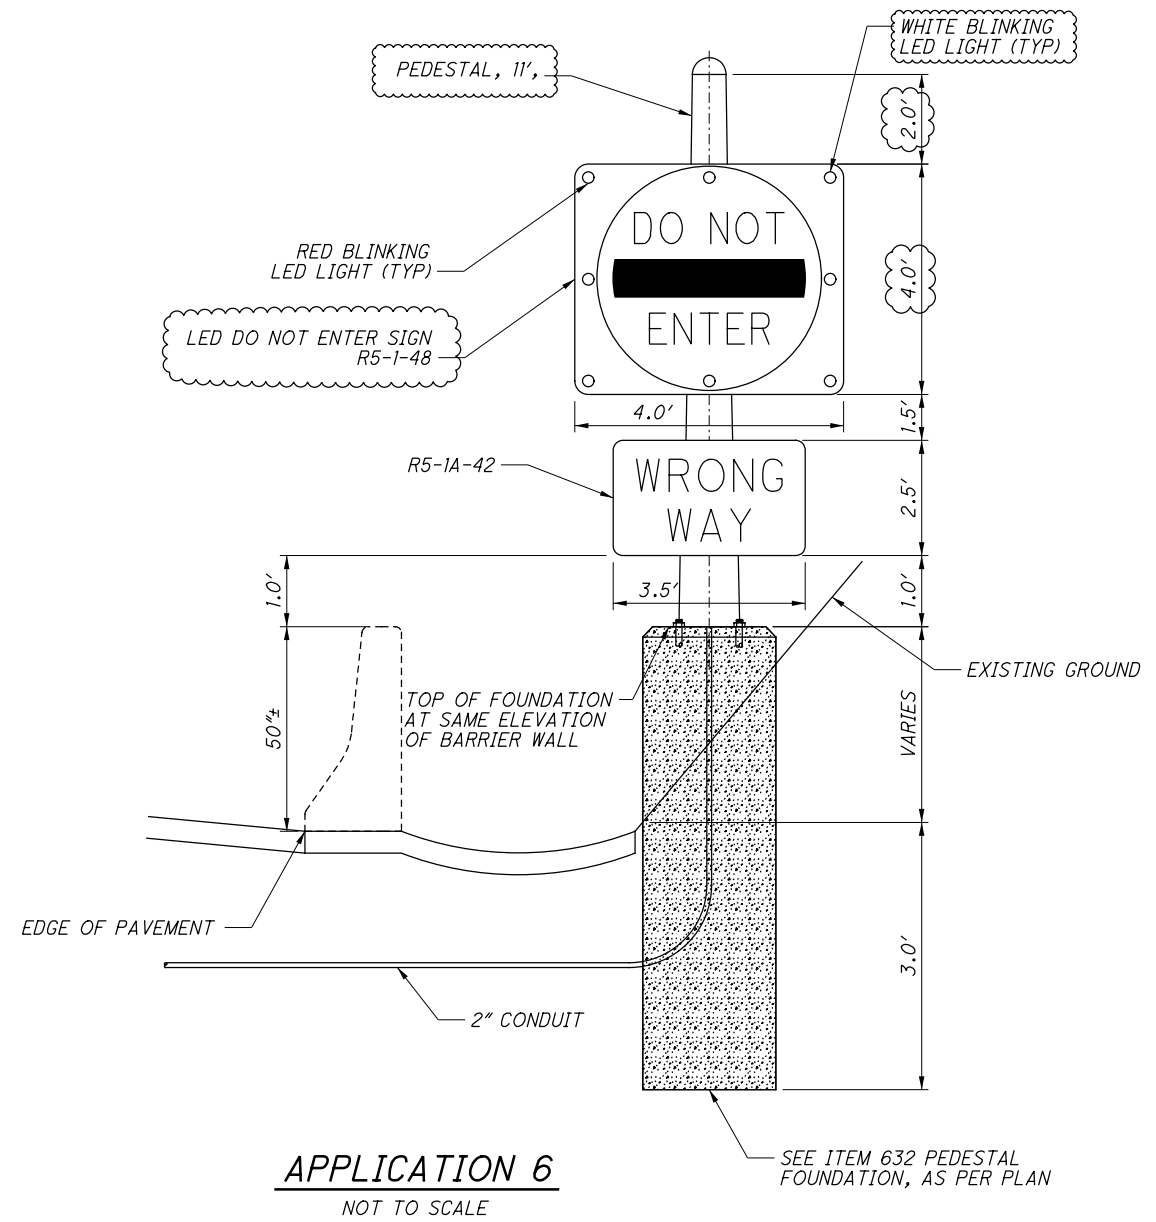

APPLICATION 6
NOT TO SCALE

SEE ITEM 632 PEDESTAL
FOUNDATION, AS PER PLAN

CALCULATED
BER
CHECKED
JDS

TRAFFIC CONTROL DETAILS

HAM-71-8.42

ESTIMATED QUANTITIES

INTERSECTION						ITEM	EXTENSION	GRAND TOTAL	UNIT	DESCRIPTION	SEE SHEET
LOCATION 1 IR-71 NB AT RIDGE RD	LOCATION 2 IR-71 SB AT HIGHLAND AVE	LOCATION 3 IR-71 NB AT STEWART RD	LOCATION 4 IR-71 NB AT KENWOOD RD	LOCATION 5 IR-71 NB AT MONTGOMERY RD	LOCATION 6 IR-71 SB AT MONTGOMERY RD						
				6	6	621	00100	61	EACH	RPM	
				16	16	621	00300	32	EACH	RPM REFLECTOR	
						621	54000	22	EACH	RAISED PAVEMENT MARKER REMOVED	
411	589	507	800	753	791	625	25400	3851	FT	CONDUIT, 2", 725.04	
231						625	25500	231	FT	CONDUIT, 3", 725.04	
	86		70	158	155	625	25902	469	FT	CONDUIT, JACKED OR DRILLED, 725.04, 2"	
		94				625	25903	94	FT	CONDUIT, JACKED OR DRILLED, 725.04, AS PER PLAN, 2"	318B
501	575		786	739	777	625	29000	3378	FT	TRENCH	
		493				625	29001	493	FT	TRENCH, AS PER PLAN	318B
2	4	3	3	2	5	625	30500	19	EACH	PULL BOX, 725.06, SIZE 1.5	
4		1	1	2	1	625	30520	9	EACH	PULL BOX, 725.06, SIZE 7	
1						625	30530	1	EACH	PULL BOX, 725.06, SIZE 18	
3	5	5	5	5	5	625	32000	28	EACH	GROUND ROD	
501	575	493	786	739	777	625	36000	3871	FT	PLASTIC CAUTION TAPE	
						630	03100		FT	GROUND MOUNTED SUPPORT, NO. 3 POST	
						630	08600		EACH	SIGN POST REFLECTOR	
6	8	8	8	8	8	630	79500	46	EACH	SIGN SUPPORT ASSEMBLY, POLE MOUNTED	
1						630	79611	1	EACH	SIGN SUPPORT ASSEMBLY, BARRIER MOUNTED, AS PER PLAN	318B
1	1	1	1	1	1	630	97700	6	EACH	SIGNING, MISC.:SIGNING, MISC.: WRONG WAY DETECTION SYSTEM	318B
						632	26500	22	EACH	DETECTOR LOOP	
2	4	3	4	4	4	632	64020	21	EACH	PEDESTAL FOUNDATION	
		1				632	64021	1	EACH	PEDESTAL FOUNDATION, AS PER PLAN	318C
3034						632	65200	3034	FT	LOOP DETECTOR LEAD-IN CABLE	
269	625	509	731	652	798	632	66000	3584	FT	POWER CABLE, 3 CONDUCTOR, NO. 14 AWG	
230	238	290	320	438	346	632	67300	1862	FT	POWER CABLE, 3 CONDUCTOR, NO. 8 AWG	
102		51				632	69500	153	FT	SERVICE CABLE, 2 CONDUCTOR, NO. 6 AWG	
1	1	1	1	1	1	632	70001	6	EACH	POWER SERVICE, AS PER PLAN	
1		1				632	70400	2	EACH	CONDUIT RISER, 2" DIAMETER	
1		1				632	89300	2	EACH	WOOD POLE, 30'	
		1			1	632	89700	2	EACH	PEDESTAL, 11'	
2	4	3	4	4	3	632	90010	20	EACH	PEDESTAL, MISC.:PEDESTAL, 15', TRANSFORMER BASE	318C
2			2			644	01360	4	EACH	WRONG WAY ARROW	
	440					661	99920	440	SF	PLANTING, MISC.: RESTORATION OF DISTURBED LANDSCAPED AREA	318C

CALCULATED	BER	CHECKED	JDS
SIGNING SUBSUMMARY			
HAM-71-8.42			
318H 441			

J:\20151750\HAM-71-1.51\000T\HAM\91826\Design\Traffic\Sheets\91826_TS001.dgn 3/1/2018 9:41:42 AM brieder



CALCULATED BER CHECKED JDS

TRAFFIC CONTROL PLAN - WRONG WAY SIGNAGE DETAIL - IR-71 NB AT RIDGE ROAD


HAM-71-8.42

(1)-2" CONDUIT (725.04) W/(3)-NO. 14 AWG POWER CABLES IN TRENCH = 76'

APPLICATION 4
BARRIER MOUNTED POST
W/(1)-WIRELESS RADIO
W/(1)-SOLAR POWERED LED DO NOT ENTER SIGN (48"x 48")
W/(1)-WRONG WAY SIGN (42"x 30")
MOUNT BOTH SIGNS AT 20° ANGLE TOWARDS RAMP F (SEE NOTE 2)
X (E) = 1,422,936.995
Y (N) = 430,053.988

APPLICATION 3
PEDESTAL, 15'
W/(1)-WIRELESS RADIO
W/(1)-LED DO NOT ENTER SIGN (48"x 48")
W/(1)-WRONG WAY SIGN (42"x 30")
X (E) = 1,422,942.913
Y (N) = 430,009.928

APPLICATION 5
EXISTING TRAFFIC CONTROL POLE (TO REMAIN)
W/(1)-WIRELESS RADIO
W/(1)-SOLAR POWERED LED WRONG WAY SIGN (48"x 36") (POLE MT'D)
W/(1)-WRONG WAY SIGN (42"x 30") (POLE MT'D)
MOUNT BOTH SIGNS AT 20° ANGLE TOWARDS RAMP F (SEE NOTE 2)
X (E) = 1,423,135.614
Y (N) = 430,081.043

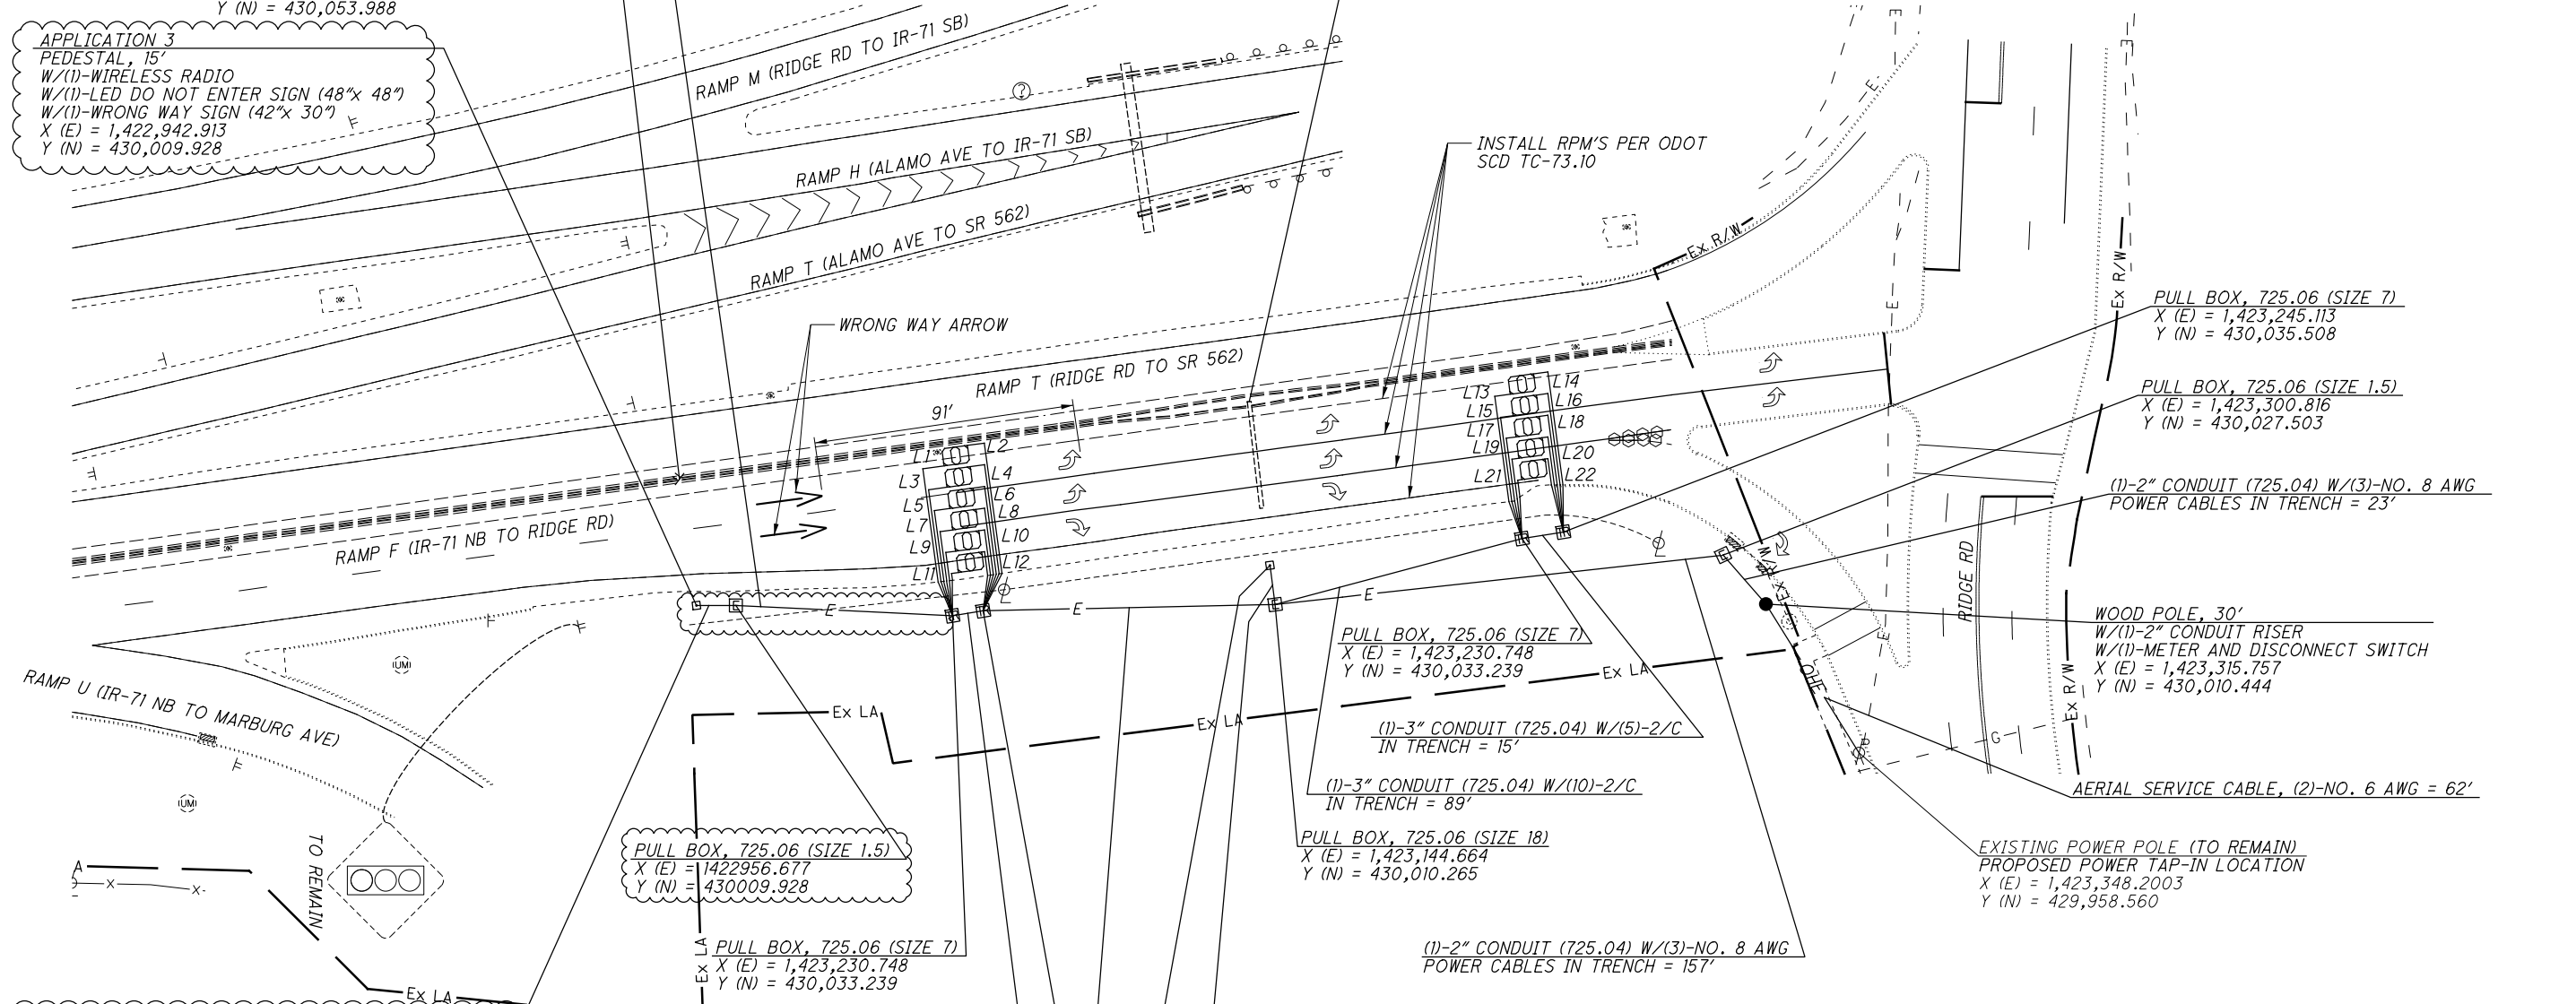

J:\20151750\HAM-71-1.51\000T\HAM\91826\Design\Traffic\Sheets\91826_IP001.dgn 3/1/2018 9:41:44 AM brieder

(1)-2" CONDUIT (725.04) W/(3)-NO. 14 AWG POWER CABLES IN TRENCH = 14'

(1)-3" CONDUIT (725.04) W/(6)-2/C (1)-2" CONDUIT (725.04) W/(3)-NO. 14 AWG POWER CABLES IN TRENCH = 11'

(1)-3" CONDUIT (725.04) W/(12)-2/C (1)-2" CONDUIT (725.04) W/(3)-NO. 14 AWG POWER CABLES IN TRENCH = 102'

APPLICATION 1
PEDESTAL, 15'
W/(1)-POLE MOUNTED CONTROLLER/CABINET
W/(1)-WIRELESS RADIO
W/(1)-CONFIRMATION CAMERA
W/(1)-LED WRONG WAY SIGN (48"x36")
W/(1)-WRONG WAY SIGN (42"x 30")
X (E) = 1,423,142.832
Y (N) = 430,023.906

(1)-2" CONDUIT (725.04) W/(3)-NO. 8 AWG POWER CABLES (1)-2" CONDUIT (725.04) W/(3)-NO. 14 AWG POWER CABLES (1)-3" CONDUIT (725.04) W/(22)-2/C IN TRENCH = 14'

NOTES:
1. REFER TO THE SURVEY PARAMETERS NOTE IN THE GENERAL NOTES FOR PROJECT CONTROL INFORMATION.
2. SIGNS SHALL BE MOUNTED AT A ANGLE OF 20° TO RAMP F. THE FINAL MOUNTING ANGLE SHALL BE APPROVED BY THE SITE ENGINEER FOR MAXIMUM VISABILITY.

PULL BOX, 725.06 (SIZE 7)
X (E) = 1,423,230.748
Y (N) = 430,033.239

(1)-3" CONDUIT (725.04) W/(10)-2/C IN TRENCH = 89'

PULL BOX, 725.06 (SIZE 18)
X (E) = 1,423,144.664
Y (N) = 430,010.265

(1)-2" CONDUIT (725.04) W/(3)-NO. 8 AWG POWER CABLES IN TRENCH = 157'


PULL BOX, 725.06 (SIZE 7)
X (E) = 1,423,245.113
Y (N) = 430,035.508

PULL BOX, 725.06 (SIZE 1.5)
X (E) = 1,423,300.816
Y (N) = 430,027.503

(1)-2" CONDUIT (725.04) W/(3)-NO. 8 AWG POWER CABLES IN TRENCH = 23'

WOOD POLE, 30'
W/(1)-2" CONDUIT RISER
W/(1)-METER AND DISCONNECT SWITCH
X (E) = 1,423,315.757
Y (N) = 430,010.444


EXISTING POWER POLE (TO REMAIN)
PROPOSED POWER TAP-IN LOCATION
X (E) = 1,423,348.2003
Y (N) = 429,958.560

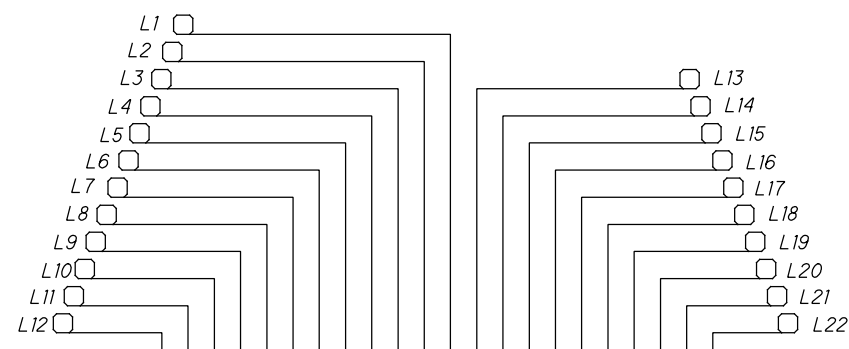

WIRING DIAGRAM LEGEND

- * - (3)-NO. 14 AWG
- M - METER
- DS - DISCONNECT SWITCH

WIRING DIAGRAM

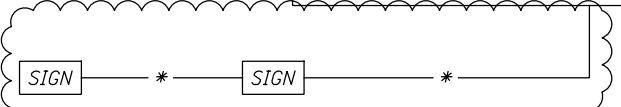



CALCULATED BER CHECKED JDS

A LOCATION OF THE SANITARY SEWER IS BASED ON RECORD PLANS. CONTRACTOR SHALL VERIFY LOCATION AND DEPTH PRIOR TO PLACING THE PEDESTAL. THE PEDESTAL SHALL HAVE A MINIMUM 5 FOOT LATERAL OFFSET FROM THE SANITARY SEWER TO AVOID DISTURBANCE.

(1)-2" CONDUIT (725.04) W/(3)-NO. 14 AWG POWER CABLES JACKED OR DRILLED UNDER PAVEMENT = 46'

APPLICATION 3
PEDESTAL, 15'
W/(1)-WIRELESS RADIO
W/(1)-LED DO NOT ENTER SIGN (48"x48")
W/(1)-WRONG WAY SIGN (42"x 30")
STA. 15+10.0, 14.0' RT.

(1)-2" CONDUIT (725.04) W/(6)-NO. 14 AWG POWER CABLES IN TRENCH = 14'

(1)-2" CONDUIT (725.04) W/(6)-NO. 14 AWG POWER CABLES IN TRENCH = 14'

APPLICATION 1
PEDESTAL, 15'
W/(1)-WIRELESS RADIO
W/(1)-LED WRONG WAY SIGN (48"x36")
W/(1)-WRONG WAY SIGN (42"x 30")
STA. 17+50.0, 14.3' RT.

(1)-2" CONDUIT (725.04) W/(3)-NO. 14 AWG POWER CABLES IN TRENCH = 226'

PULL BOX, 725.06 (SIZE 1.5)
STA. 15+24.8, 15.1' RT.

APPLICATION 6
PEDESTAL, 11'
W/(1)-WIRELESS RADIO
W/(1)-LED DO NOT ENTER SIGN (48"x48")
W/(1)-WRONG WAY SIGN (42"x 30")
STA. 15+10.0 28.6' LT.

APPLICATION 1
PEDESTAL, 15'
W/(1)-POLE MOUNTED CONTROLLER/CABINET
W/(1)-WIRELESS RADIO
W/(1)-CONFIRMATION CAMERA
W/(1)-INCOMING RADAR (MICROWAVE)
W/(1)-OUTGOING RADAR (DOPPLER)
W/(1)-LED WRONG WAY SIGN (48"x36")
W/(1)-WRONG WAY SIGN (42"x 30")
STA. 17+50.0, 32.6' LT.

VEGETATION MAY NEED REMOVED AS DIRECTED BY THE ENGINEER AND SHALL BE PAID FOR BY ITEM 201 CLEARING AND GRUBBING.

PULL BOX, 725.06 (SIZE 1.5)
STA. 17+64.8, 14.4' RT.

(1)-2" CONDUIT (725.04) W/(3)-NO. 14 AWG POWER CABLES JACKED OR DRILLED UNDER PAVEMENT = 48'

WRONG WAY ARROW
SEE TRAFFIC CONTROL PLAN

PULL BOX, 725.06 (SIZE 1.5)
STA. 19+17.2, 121.0' LT.

(1)-2" CONDUIT (725.04) W/(3)-NO. 8 AWG POWER CABLES IN TRENCH = 213'

PULL BOX, 725.06 (SIZE 7)
STA. 17+62.4, 33.8' LT.

(1)-2" CONDUIT (725.04) W/(3)-NO. 8 AWG POWER CABLES IN TRENCH = 12'

(1)-2" CONDUIT (725.04) W/(3)-NO. 14 AWG POWER CABLES
(1)-2" CONDUIT (725.04) W/(3)-NO. 8 AWG POWER CABLES
IN TRENCH = 14'


WOOD POLE, 30'
W/(1)-2" CONDUIT RISER
W/(1)-METER AND DISCONNECT SWITCH
STA. 19+22.7, 129.5' LT.

AERIAL SERVICE CABLE, (2)-NO. 6 AWG = 21'

EXISTING POWER POLE (TO REMAIN)
PROPOSED POWER TAP-IN LOCATION
STA. 19+22.3, 150.0' LT.

WIRING DIAGRAM LEGEND

- * - (3)-NO. 14 AWG
- M - METER
- DS - DISCONNECT SWITCH

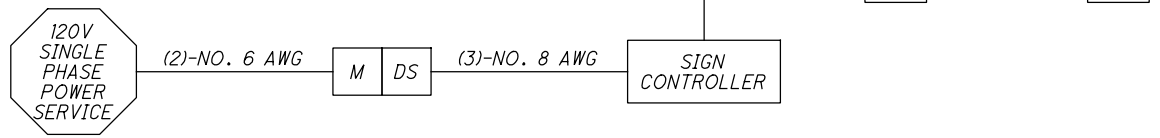

WIRING DIAGRAM

J:\20151750\HAM-71-1.51\0001\HAM-91826\Design\Traffic\Sheets\91826_IP003.dgn 3/1/2018 9:41:46 AM brieder




CALCULATED BER CHECKED JDS

TRAFFIC CONTROL PLAN - WRONG WAY SIGNAGE DETAIL-IR-71 NB AT MONTGOMERY RD

HAM-71-8.42

~~WRONG WAY~~
SEE TRAFFIC CONTROL PLAN
(A)

J:\20151750\HAM-71-1.51\0001\HAM-91826\Design\Traffic\Sheets\91826.TP005.dgn 3/1/2018 9:41:48 AM brieder

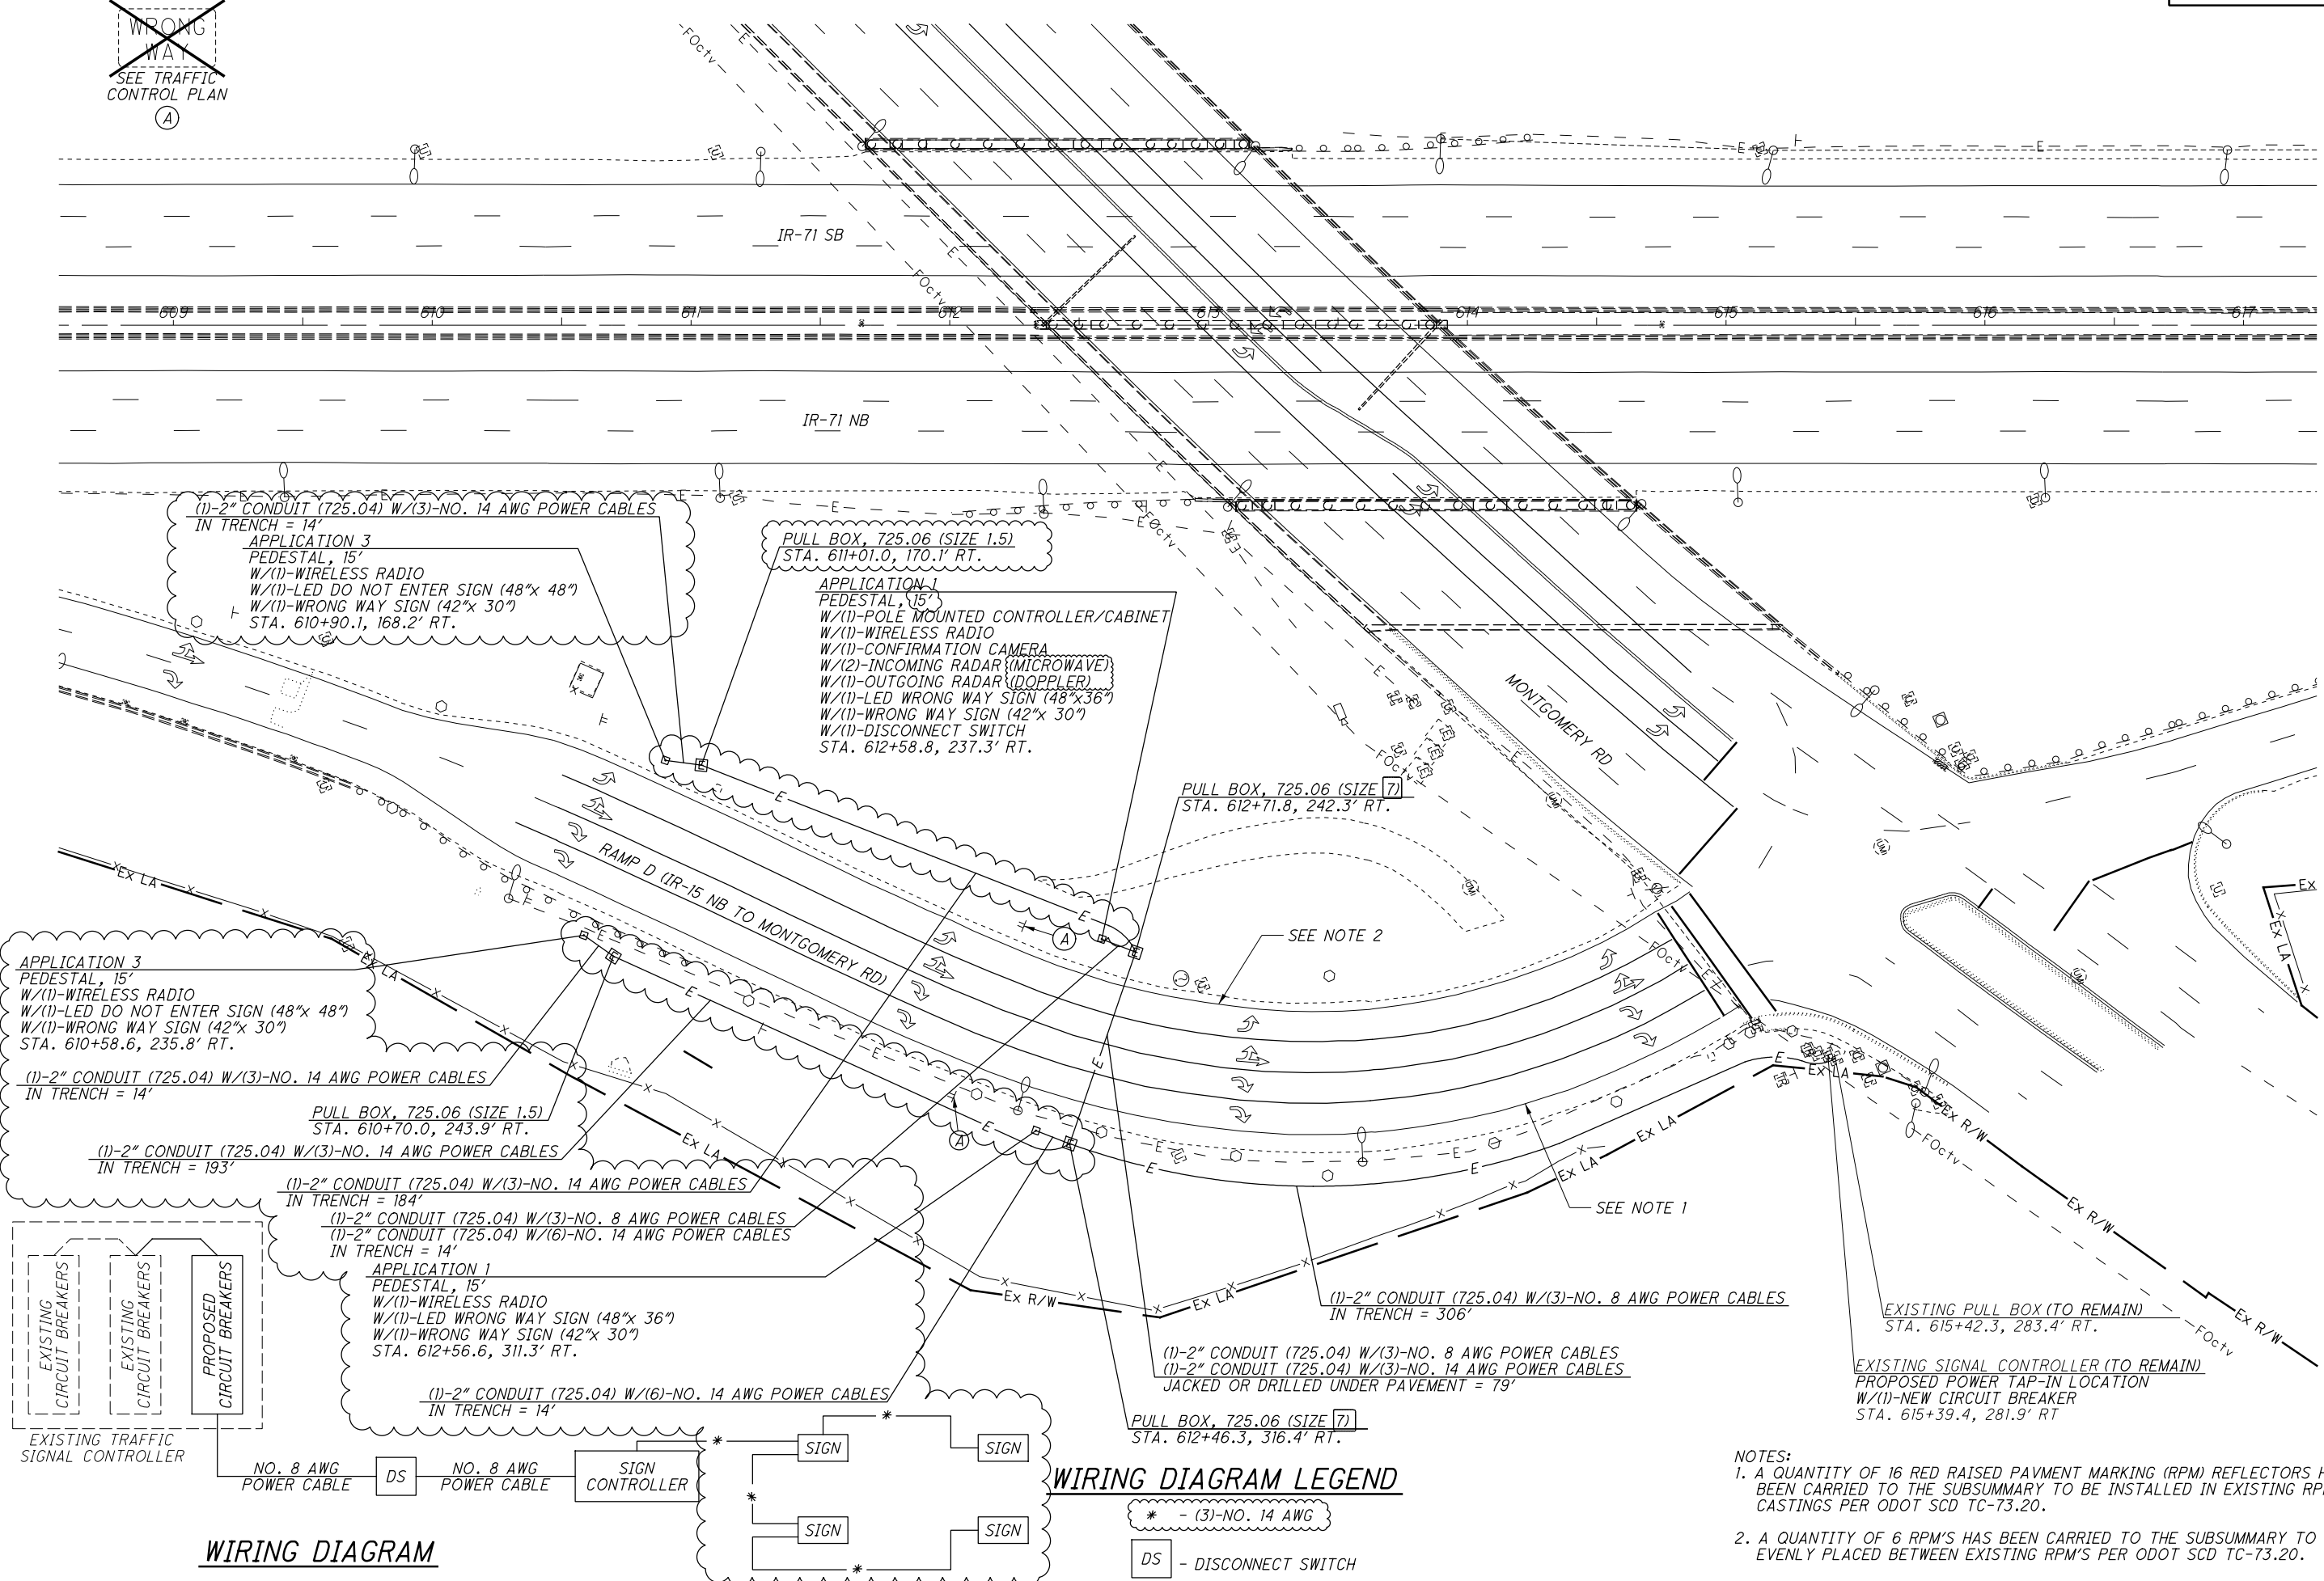

(1)-2" CONDUIT (725.04) W/(3)-NO. 14 AWG POWER CABLES
IN TRENCH = 14'
APPLICATION 3
PEDESTAL, 15'
W/(1)-WIRELESS RADIO
W/(1)-LED DO NOT ENTER SIGN (48"x 48")
W/(1)-WRONG WAY SIGN (42"x 30")
STA. 610+90.1, 168.2' RT.

PULL BOX, 725.06 (SIZE 1.5)
STA. 611+01.0, 170.1' RT.
APPLICATION 1
PEDESTAL, 15'
W/(1)-POLE MOUNTED CONTROLLER/CABINET
W/(1)-WIRELESS RADIO
W/(1)-CONFIRMATION CAMERA
W/(2)-INCOMING RADAR (MICROWAVE)
W/(1)-OUTGOING RADAR (DOPPLER)
W/(1)-LED WRONG WAY SIGN (48"x 36")
W/(1)-WRONG WAY SIGN (42"x 30")
W/(1)-DISCONNECT SWITCH
STA. 612+58.8, 237.3' RT.

PULL BOX, 725.06 (SIZE 7)
STA. 612+71.8, 242.3' RT.

APPLICATION 3
PEDESTAL, 15'
W/(1)-WIRELESS RADIO
W/(1)-LED DO NOT ENTER SIGN (48"x 48")
W/(1)-WRONG WAY SIGN (42"x 30")
STA. 610+58.6, 235.8' RT.

(1)-2" CONDUIT (725.04) W/(3)-NO. 14 AWG POWER CABLES
IN TRENCH = 14'
PULL BOX, 725.06 (SIZE 1.5)
STA. 610+70.0, 243.9' RT.

(1)-2" CONDUIT (725.04) W/(3)-NO. 14 AWG POWER CABLES
IN TRENCH = 193'
(1)-2" CONDUIT (725.04) W/(3)-NO. 8 AWG POWER CABLES
(1)-2" CONDUIT (725.04) W/(6)-NO. 14 AWG POWER CABLES
IN TRENCH = 14'

APPLICATION 1
PEDESTAL, 15'
W/(1)-WIRELESS RADIO
W/(1)-LED WRONG WAY SIGN (48"x 36")
W/(1)-WRONG WAY SIGN (42"x 30")
STA. 612+56.6, 311.3' RT.

(1)-2" CONDUIT (725.04) W/(6)-NO. 14 AWG POWER CABLES
IN TRENCH = 14'


(1)-2" CONDUIT (725.04) W/(3)-NO. 8 AWG POWER CABLES
IN TRENCH = 306'

(1)-2" CONDUIT (725.04) W/(3)-NO. 8 AWG POWER CABLES
(1)-2" CONDUIT (725.04) W/(3)-NO. 14 AWG POWER CABLES
JACKED OR DRILLED UNDER PAVEMENT = 79'

PULL BOX, 725.06 (SIZE 7)
STA. 612+46.3, 316.4' RT.


EXISTING PULL BOX (TO REMAIN)
STA. 615+42.3, 283.4' RT.

EXISTING SIGNAL CONTROLLER (TO REMAIN)
PROPOSED POWER TAP-IN LOCATION
W/(1)-NEW CIRCUIT BREAKER
STA. 615+39.4, 281.9' RT

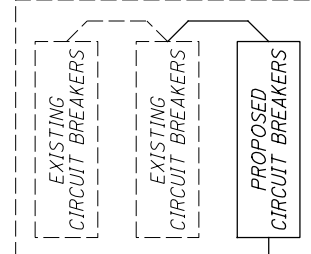

WIRING DIAGRAM

WIRING DIAGRAM LEGEND

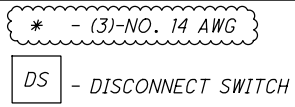

- NOTES:
1. A QUANTITY OF 16 RED RAISED PAVEMENT MARKING (RPM) REFLECTORS HAS BEEN CARRIED TO THE SUBSUMMARY TO BE INSTALLED IN EXISTING RPM CASTINGS PER ODOT SCD TC-73.20.
2. A QUANTITY OF 6 RPM'S HAS BEEN CARRIED TO THE SUBSUMMARY TO BE EVENLY PLACED BETWEEN EXISTING RPM'S PER ODOT SCD TC-73.20.



REPLACE
BACKWALL

VIEW B-B




BRIDGE DECK


APPROACH SLAB

VIEW C-C

ITEM 516 - STRUCTURAL JOINT OR JOINT SEALER, MISC.: CLEAN AND RE-USE EXISTING EXPANSION JOINT ARMOR AND SEAL. CONTRACTOR TO REMOVE EXISTING CONCRETE AROUND THE EXISTING EXPANSION JOINT AS NEEDED TO FINISH THE ABUTMENT RETROFIT, WITHOUT DAMAGING THE JOINT ARMOR AND SEAL. CLEAN THE JOINT AFTER THE WORK IS DONE.

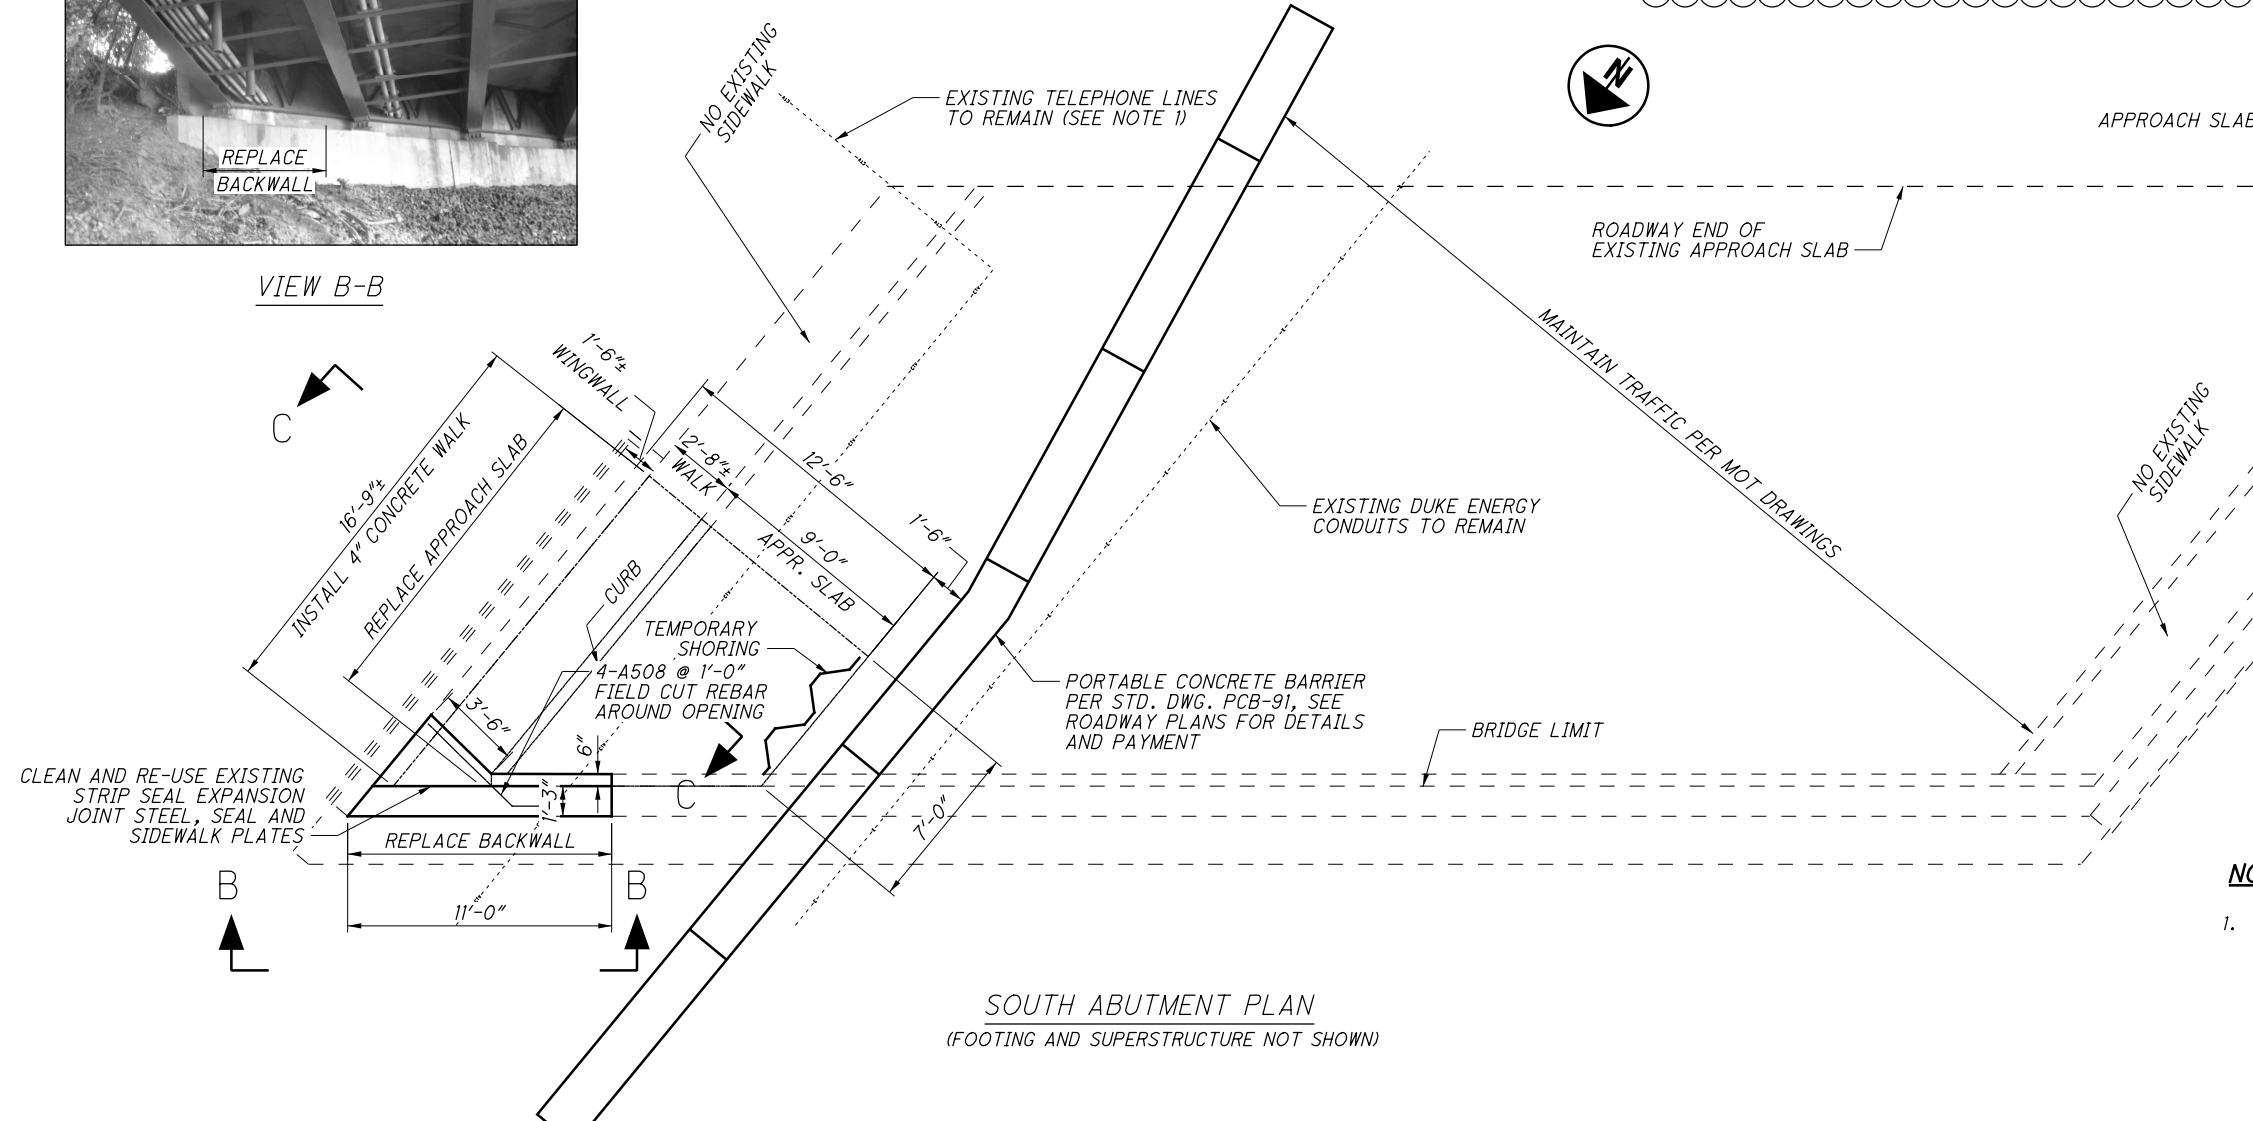

SOUTH ABUTMENT PLAN
(FOOTING AND SUPERSTRUCTURE NOT SHOWN)

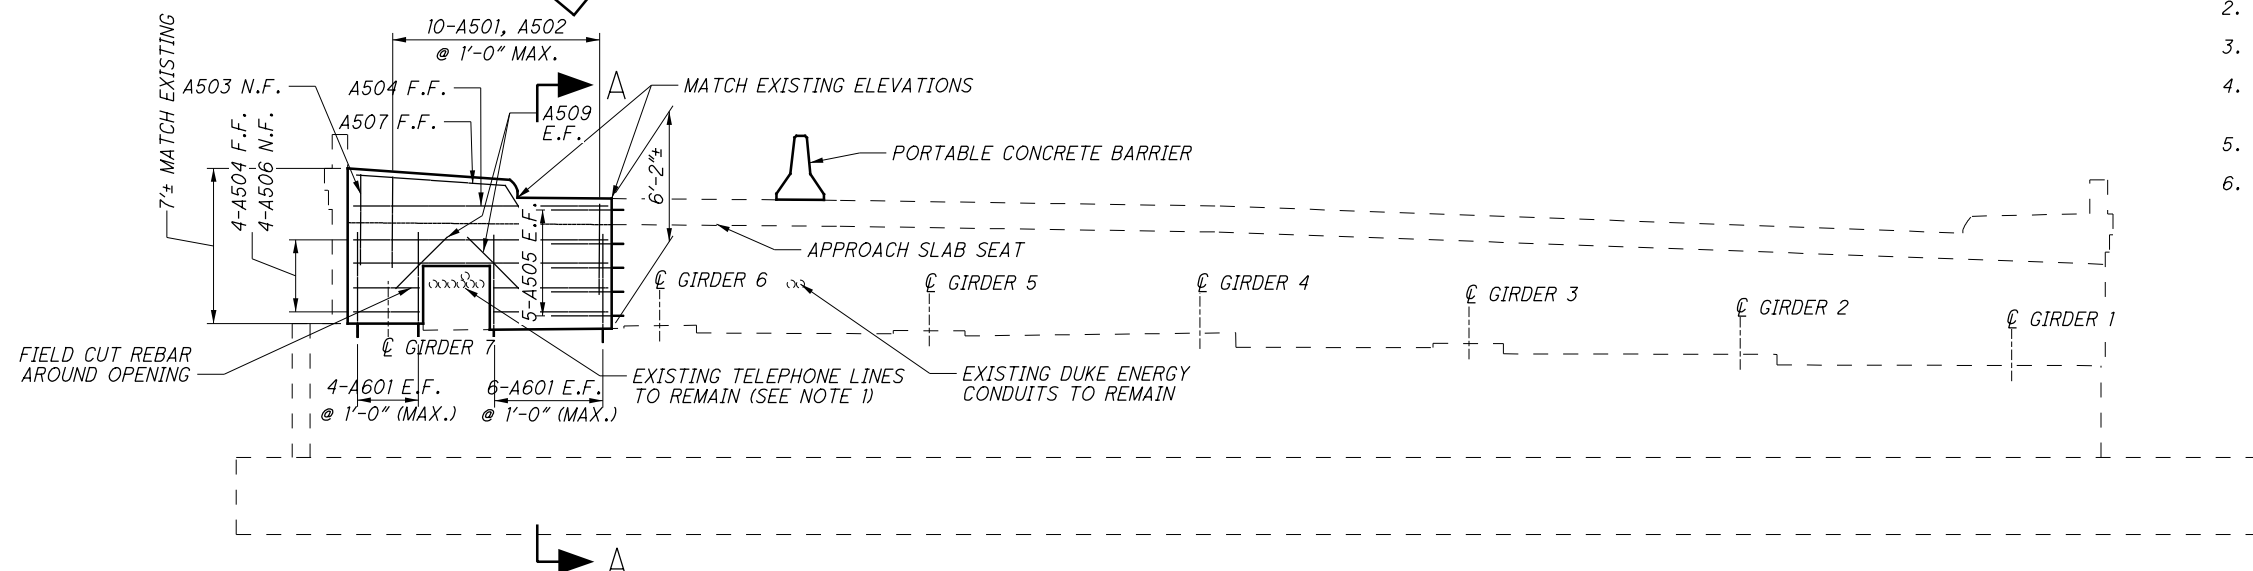

SOUTH ABUTMENT ELEVATION
(PILES NOT SHOWN)

NOTES:

1. EXISTING TELEPHONE CONDUITS MAY CONTAIN ASBESTOS. CONTRACTOR SHALL COORDINATE BACKWALL CONSTRUCTION AND CONDUIT PROTECTION WITH CINCINNATI BELL.



CINCINNATI BELL
221 E. 4TH ST., BLDG. 121-900
CINCINNATI, OH 45201
513-565-7043 (MARK CONNER)
MARK.CONNER@CINBELL.COM
2. FOR SECTION A-A SEE SHEET 6/9.
3. FOR APPROACH SLAB DETAILS SEE SHEET 6/9.
4. CUT OFF EXISTING REINFORCING FLUSH WITH EDGE OF REMOVAL.
5. EPOXY GROUT # 5 BARS 5" MINIMUM INTO EXISTING CONCRETE
6. MIN. LAP LENGTH FOR #5 BAR IS 2'-6".

LEGEND:

E.F. = EACH FACE
F.F. = FAR FACE
N.F. = NEAR FACE


P:\PR54704\HAM\91826\Design\Structures\HAM071_0875C\Sheets\071_0875C_SR001.dgn Sheet 3/2/2018 1:00:02 PM chen

DESIGNED	SJA	CHECKED	XAC
DRAWN	SJA	REVIEWED	DWL
DATE	2/20/2017	STRUCTURE FILE NUMBER	3115283
DESIGN AGENCY	BURGESS & NIPLE		
	306 PLUM ST. CINCINNATI OH		
SOUTH ABUTMENT DETAILS - 1			
HAM-IR71-8.42			
PID No. 91826			
REVISOR 3-2-2018			
5/9			
348			
441			

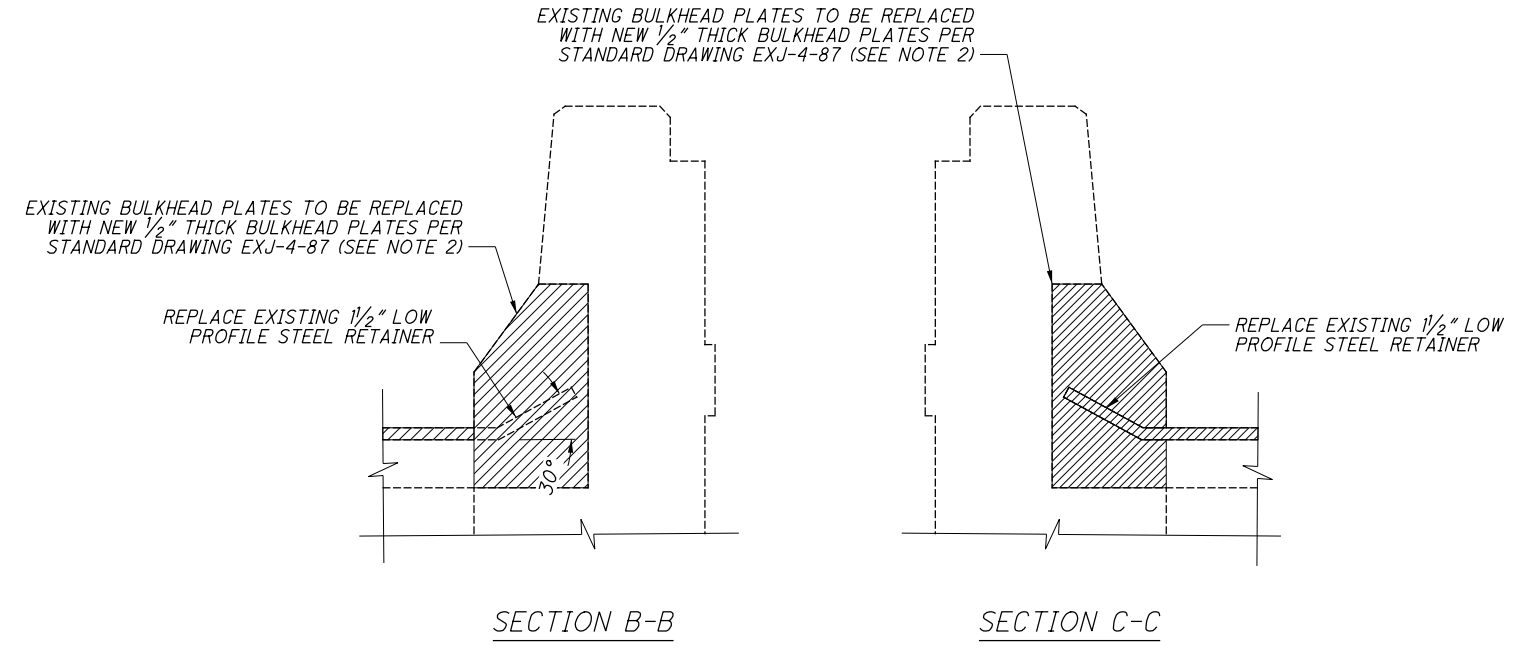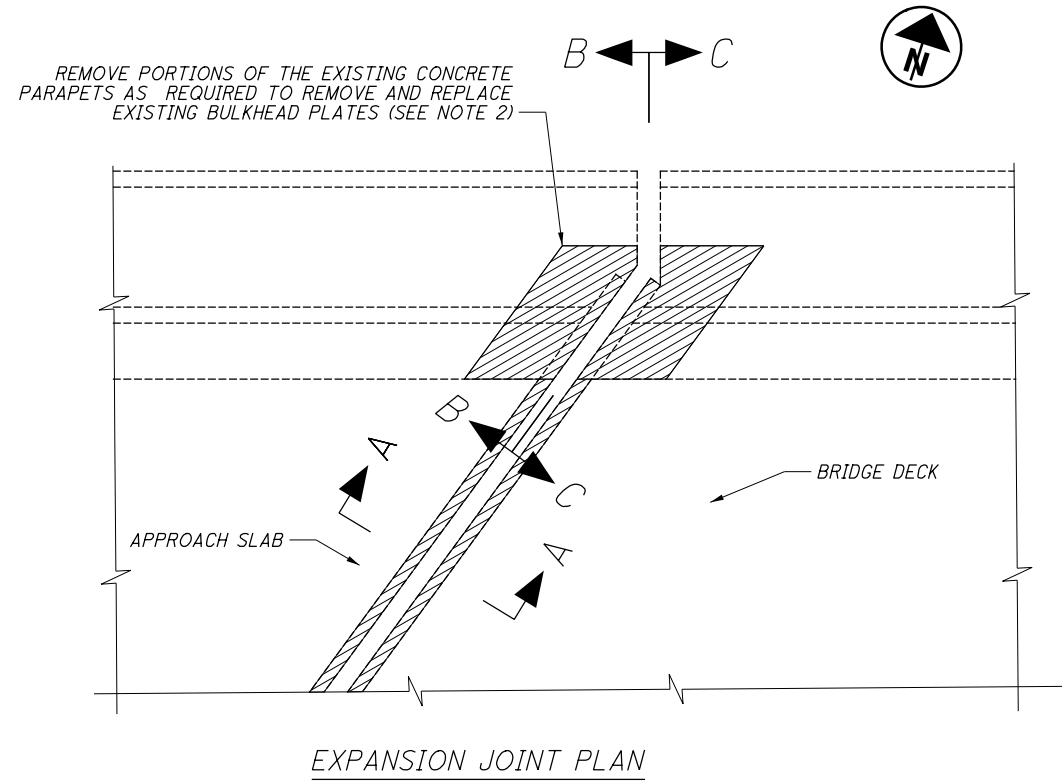

EXPANSION JOINT TABLE - DIMENSION A

TEMPERATURE	REAR ABUT.	FWD. ABUT.
30°	3 1/2"	3 1/4"
40°	3 7/16"	3 3/16"
50°	3 5/16"	3 3/16"
60°	3 1/4"	3 1/8"
70°	3 3/16"	3 1/16"
80°	3 1/16"	3 1/16"
90°	3"	3"

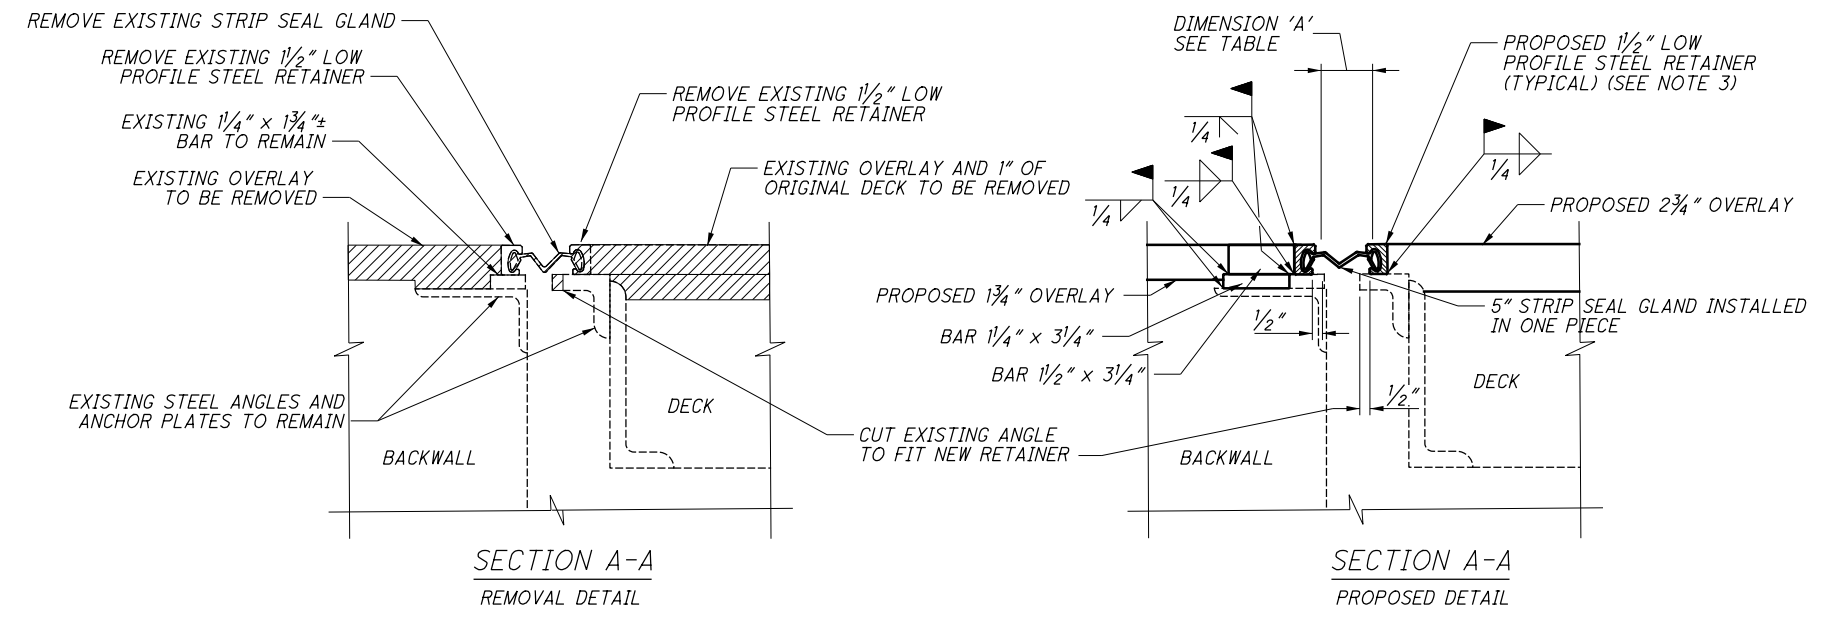

LEGEND:



NOTES:

- CONTRACTOR SHALL REMOVE EXISTING RETAINERS AND DECK ANGLE AND GRIND EXISTING WELDS SMOOTH AND FLUSH WITH SURROUNDING SURFACE. THE COST OF ALL LABOR, EQUIPMENT AND MATERIALS REQUIRED TO REMOVE PORTIONS OF THE EXISTING EXPANSION JOINTS SHALL BE INCLUDED WITH THE UNIT PRICE FOR ITEM 202 - PORTIONS OF STRUCTURE REMOVED, OVER 20 FOOT SPAN, AS PER PLAN.
- CONTRACTOR SHALL REMOVE PORTIONS OF THE EXISTING CONCRETE PARAPETS AS REQUIRED TO REMOVE AND REPLACE EXISTING 1/2" THICK BULKHEAD PLATES AND STRIP SEAL RETAINERS IN THE PARAPETS. REMOVE CONCRETE AS REQUIRED TO PROVIDE 2" CLEAR FROM STUD ANCHORS. BEND AND TRIM EXISTING REINFORCING STEEL TO MAINTAIN 2" CLEAR. THE COST OF ALL LABOR, EQUIPMENT AND MATERIALS REQUIRED TO REMOVE EXISTING CONCRETE AND 1/2" BULKHEAD PLATES SHALL BE INCLUDED WITH ITEM 202 - PORTIONS OF STRUCTURE REMOVED, OVER 20 FT. SPAN, AS PER PAN.
- CONTRACTOR SHALL FIELD CUT, WELD AND BEND PROPOSED STRIP SEAL RETAINERS TO FIT EXISTING JOINTS, EXCEPT FOR THE UPTURNS AT PARAPETS WHICH SHALL BE SHOP FABRICATED. STRIP SEAL JOINTS SHALL BE REMOVED AND REPLACED WITHIN MAINTENANCE OF TRAFFIC PHASING. COST FOR ALL LABOR MATERIALS AND EQUIPMENT FOR INSTALLING THE REPLACEMENT STRIP SEAL JOINTS SHALL BE INCLUDED WITH ITEM 516 - STRUCTURAL EXPANSION JOINT INCLUDING ELASTOMERIC STRIP SEAL, AS PER PLAN.
- FOR ADDITIONAL STRIP SEAL DETAILS AND NOTES SEE STANDARD DRAWING EXJ-4-87.

P:\PR54704\HAM\91826\Design\Structures\HAM071_09701_Sheets\071_09701_SX001.dgn Sheet 2/28/2018 8:28:06 AM chen

DESIGN AGENCY: BURGESS & NIPLE
 312 PLUM ST. CINCINNATI, OH

DATE: 2/20/2017
 STRUCTURE FILE NUMBER: 3115313/3115321

DESIGNED: SJA
 CHECKED: XAC

DRAWN: SJA
 REVISED:

REVIEWED: DWL


EXPANSION JOINT DETAILS
 HAM-71-09701/R
 IR-71 OVER RED BANK ROAD

REVISED 2-28-2018


HAM-IR71-8.42
 PID No. 91826

7/7

359
 441

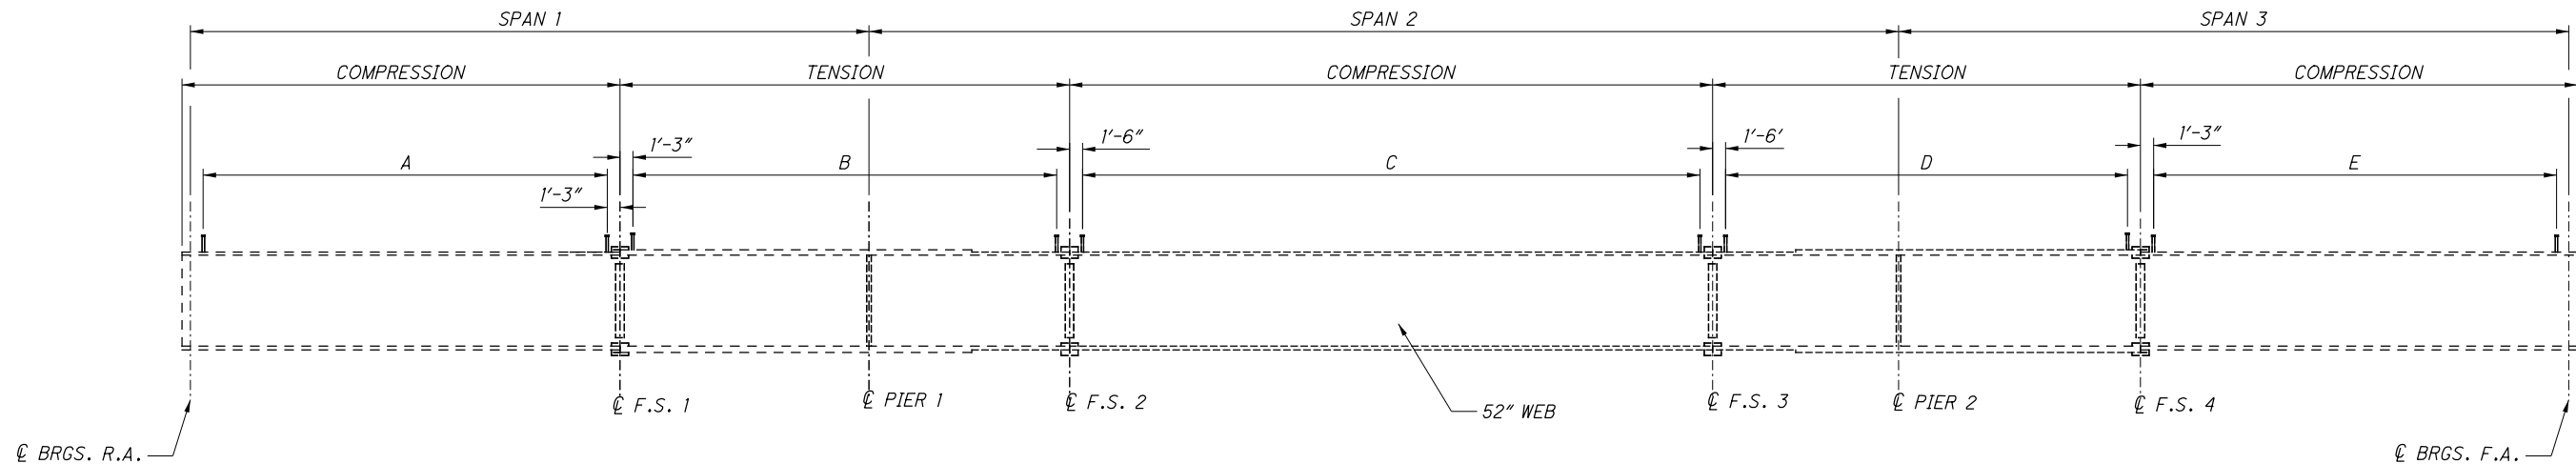

GIRDER ELEVATION - LEFT BRIDGE

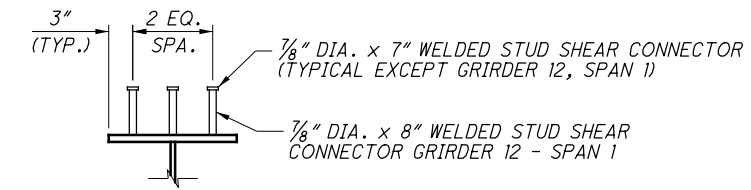

GIRDER SHEAR CONNECTOR DETAIL

LEGEND:
 BRGS. = BEARINGS
 F.S. = FIELD SPLICE
 G# = GIRDER DESIGNATION
 R.A. = REAR ABUTMENT
 F.A. = FORWARD ABUTMENT

NOTES:

1. ALL DIMENSIONS ARE HORIZONTAL AND REQUIRE ADJUSTMENT FOR CAMBER AND FINISHED GRADE.
2. WELD ATTACHMENT OF SUPPORTS FOR CONCRETE DECK FINISHING MACHINE TO AREAS OF THE GIRDER FLANGES DESIGNATED "COMPRESSION". DO NOT WELD ATTACHMENTS TO AREAS DESIGNATED "TENSION". FILLET WELDS TO COMPRESSION FLANGES SHALL BE AT LEAST 1" FROM EDGE OF FLANGE, BE NO MORE THAN 2" LONG, AND BE AT LEAST 5/16".
3. INTERMEDIATE AND CROSSFRAME STIFFENERS NOT SHOWN IN ELEVATION. SEE FRAMING PLAN FOR LOCATIONS.
4. ADJUST SHEAR CONNECTOR SPACING LOCALLY AS REQUIRED TO CLEAR BOLTED FLANGE SPLICES.
5. TEMPORARY DECK SLAB SUPPORTS:

PRIOR TO DECK SLAB REMOVALS, TEMPORARY DECK SLAB SUPPORTS SHALL BE FURNISHED AND INSTALLED AS SHOWN ON THE PLANS. HIGH STRENGTH BOLTS SHALL BE FULLY TIGHTENED.

MATERIALS:
 STEEL SHALL BE ASTM A709, GRADE 50. USED STRUCTURAL STEEL IN GOOD CONDITION MAY BE PROVIDED. HIGH STRENGTH BOLTS SHALL BE NEW 1" DIAMETER ASTM A325.


HARDWOOD WEDGES:
 3-INCH WIDE OF HARDWOOD WEDGES SHALL BE PROVIDED AS PART OF THE TEMPORARY DECK SLAB SUPPORTS. THESE WEDGES SHALL BE INSTALLED TIGHT PRIOR TO PHASE 1 DECK REMOVAL. WEDGES SHALL BE USED IN PAIRS.

TEMPORARY DECK SLAB SUPPORT REMOVAL:
 TEMPORARY DECK SLAB SUPPORT SHALL REMAIN UNTIL THE EXISTING PHASE 2 DECK IS NO LONGER NEEDED TO SUPPORT TRAFFIC.


OPTIONAL DESIGN:
 IN LIEU OF THE TEMPORARY DECK SLAB SUPPORT DESIGN SPECIFIED BY THESE PLANS, THE CONTRACTOR HAS THE OPTION OF PROVIDING ANOTHER SYSTEM, PROVIDED THAT SUCH SYSTEM IS DESIGNED BY A REGISTERED PROFESSIONAL ENGINEER AND IS APPROVED BY THE DIRECTOR PRIOR TO ITS FABRICATION AND INSTALLATION.
 ANY CONTRACTOR ELECTED CHANGES TO THE PLAN DETAILED SHORING WILL BE TREATED AS A VALUE ENGINEERING CHANGE PROPOSAL.

PAYMENT:
 THE COST OF PROVIDING, MAINTAINING AND REMOVING TEMPORARY DECK SLAB SUPPORT SHALL BE INCLUDED IN THE LUMP SUM ITEM 202 - PORTIONS OF STRUCTURE REMOVED FOR PAYMENT.

SHEAR CONNECTOR SPACING					
GIRDER	A	B	C	D	E
G18	42 SPA @ 14" (MAX.) = 49'-0"	20 SPA @ 24" (MAX.) = 39'-9"	36 SPA @ 21" (MAX.) = 63'-1"	24 SPA @ 20" (MAX.) = 39'-0"	47 SPA @ 13" (MAX.) = 50'-4"
G17	42 SPA @ 14" (MAX.) = 49'-0"	30 SPA @ 16" (MAX.) = 39'-9"	49 SPA @ 16" (MAX.) = 64'-3"	30 SPA @ 16" (MAX.) = 36'-6"	44 SPA @ 13" (MAX.) = 50'-10"
G16	42 SPA @ 14" (MAX.) = 49'-0"	30 SPA @ 16" (MAX.) = 39'-9"	49 SPA @ 16" (MAX.) = 64'-3"	30 SPA @ 16" (MAX.) = 39'-6"	44 SPA @ 13" (MAX.) = 50'-10"
G15	42 SPA @ 14" (MAX.) = 49'-0"	30 SPA @ 16" (MAX.) = 39'-9"	49 SPA @ 16" (MAX.) = 64'-3"	30 SPA @ 16" (MAX.) = 39'-6"	44 SPA @ 13" (MAX.) = 50'-10"
G14	42 SPA @ 14" (MAX.) = 49'-0"	30 SPA @ 16" (MAX.) = 39'-9"	49 SPA @ 16" (MAX.) = 64'-3"	30 SPA @ 16" (MAX.) = 39'-6"	44 SPA @ 13" (MAX.) = 50'-10"
G13	42 SPA @ 14" (MAX.) = 49'-0"	30 SPA @ 16" (MAX.) = 39'-9"	49 SPA @ 16" (MAX.) = 64'-3"	30 SPA @ 16" (MAX.) = 39'-6"	44 SPA @ 13" (MAX.) = 50'-10"
G12	43 SPA @ 14" (MAX.) = 50'-3"	21 SPA @ 24" (MAX.) = 40'-10"	37 SPA @ 21" (MAX.) = 64'-3"	24 SPA @ 20" (MAX.) = 39'-6"	47 SPA @ 13" (MAX.) = 50'-10"

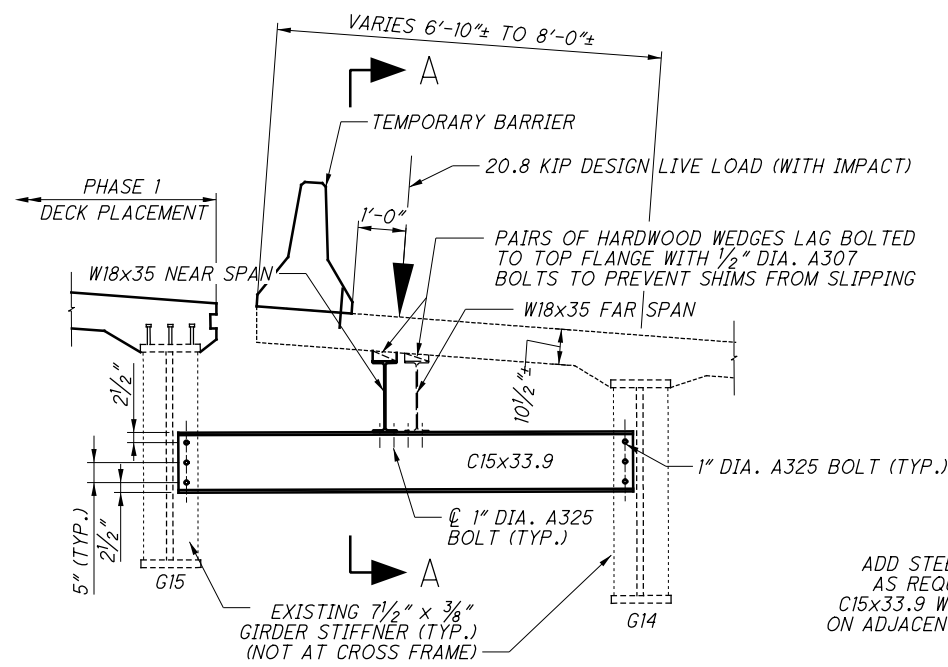

TEMPORARY DECK SLAB SUPPORT DETAIL
 (SEE NOTE 5)

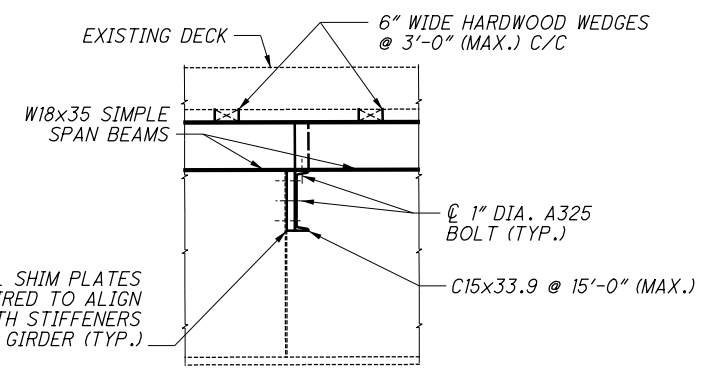

SECTION A-A

P:\PR54704\HAM-91826\Design\Structures\HAM071_1068L_Sheets\071_1068L_SS004.dgn Sheet 3/2/2018 12:13:40 PM chen