

CSX TRANSPORTATION COORDINATION NOTES

REFER TO THE CSX TRANSPORTATION PUBLIC PROJECT INFORMATION MANUAL FOR ADDITIONAL REQUIREMENTS NEEDED FOR WORKING ON/ABOVE/ADJACENT TO CSXT. SPECIFIC SECTIONS THAT PERTAIN TO THIS PROJECT ARE SPECIAL PROVISIONS FOR CONSTRUCTION NEAR CSXT PROPERTY, OVERHEAD BRIDGE CRITERIA, CONSTRUCTION SUBMISSION CRITERIA, AND INSURANCE REQUIREMENTS FOR PUBLIC PROJECTS.

CONTRACTOR ACCESS WILL BE LIMITED TO THE IMMEDIATE PROJECT AREA ONLY. THE CSXT RIGHT-OF-WAY OUTSIDE THE PROJECT AREA MAY NOT BE USED FOR CONTRACTOR ACCESS TO THE PROJECT SITE AND NO TEMPORARY AT-GRADE CROSSINGS WILL BE ALLOWED.

THE CONTRACTOR WILL BE REQUIRED TO ABIDE BY THE PROVISIONS OF THE AGENCY/CSXT AGREEMENT(S). PERIODICALLY, THROUGHOUT THE PROJECT DURATION, THE CONTRACTOR WILL BE REQUIRED TO MEET, DISCUSS AND, IF NECESSARY, TAKE IMMEDIATE ACTION AT THE DISCRETION OF CSXT PERSONNEL AND/OR THEIR AUTHORIZED REPRESENTATIVE, TO COMPLY WITH PROVISIONS OF THAT AGREEMENT AND THESE SPECIFICATIONS.

THE CONTRACTOR MAY NOT USE CSXT RIGHT-OF-WAY FOR STORAGE OF MATERIALS OR EQUIPMENT DURING CONSTRUCTION WITHOUT PRIOR CSXT APPROVAL. THE CSXT RIGHT-OF-WAY MUST ALWAYS REMAIN CLEAR FOR RAILROAD USE. EQUIPMENT MAY NOT BE POSITIONED TO BLOCK THE RAILROAD ACCESS ROAD, TRACK AREA OR ANY PART OF THE CSXT RIGHT-OF-WAY WITHOUT PRIOR CSXT APPROVAL.

CSXT SHALL BE NOTIFIED AT LEAST FIVE (5) DAYS IN ADVANCE OF THE PRE-CONSTRUCTION MEETING.

THE CONTRACTOR SHALL COORDINATE ALL WORK ON, OVER OR ADJACENT TO THE RAILROADS WITHIN THE PROJECT'S LIMITS. THE CONTRACTOR SHALL CONTACT CSX RAILROAD, AT LEAST THIRTY (30) DAYS IN ADVANCE, IN ORDER TO COORDINATE THE NECESSARY WORK. UNDER NO CIRCUMSTANCES SHALL THERE BE ANY WORK WITHIN THE RAILROAD RIGHT-OF-WAY WITHOUT THE PROPER AUTHORIZATION AND/OR FLAG PROTECTION FROM THE RAILROAD.

CSXT REQUIRES THAT THE CONTRACTOR SUBMIT AND RECEIVE ACCEPTANCE OF A COMPREHENSIVE MEANS & METHODS SUBMITTAL (CSXT CONSTRUCTION SUBMISSION CRITERIA, ISSUED APRIL 2022) DETAILING SCOPE WORK WITHIN CSXT TRACKS OR RIGHT-OF-WAY, OR OTHER WORK WHICH PRESENTS THE POTENTIAL TO AFFECT CSXT PROPERTY OR OPERATIONS TO UNDERTAKING THE WORK.

ALL LIFTING EQUIPMENT AND CONNECTION DEVICES SHALL HAVE A CAPACITY FOR 150% OF THE ACTUAL LIFTING LOAD. THE FACTOR OF SAFETY PROVIDED BY THE MANUFACTURER IN THE LIFTING CAPACITY DATA SHALL NOT BE CONSIDERED IN THE 150% REQUIREMENT.

TEMPORARY CONSTRUCTION CLEARANCES (HORIZONTAL & VERTICAL) PROPOSED - FOR EXISTING OR LESS THAN STANDARD CONDITIONS - SHALL BE SUBJECT TO APPROVAL BY CSXT. TYPICALLY REDUCTION IN CONSTRUCTION CLEARANCES ARE NOT PERMITTED.

DURING AND AFTER COMPLETION OF CONSTRUCTION, THE OUTSIDE PARTY OR ITS CONTRACTOR SHALL CLEAR CSXT'S DRAINAGE DITCHES OF ALL DEBRIS TO THE SATISFACTION OF CSXT'S CONSTRUCTION MONITORING REPRESENTATIVE.

A WORK SITE SAFETY PLAN THAT INCLUDES A RECOGNITION TO KEEP ALL PERSONNEL FROM FOULING CSXT RAIL OPERATIONS, A FALL PROTECTION PLAN DESCRIBING THE MEASURES TO BE TAKEN WHEN REQUIRED, AND A FIRE PROTECTION PLAN SHALL BE PRESENTED AND ACCEPTED BY CSXT FOR WORK ON, OVER OR ADJACENT CSXT PROPERTY.

ALL WASTE MATERIALS GENERATED BY THIS PROJECT, INCLUDING WASHING WITH CLEANING SOLVENTS, BLASTING, SCRAPING, BRUSHING AND/OR PAINTING OPERATIONS, SHALL BE THE RESPONSIBILITY OF THE STATE OR ITS CONTRACTOR, AND SHALL BE CONTAINED, COLLECTED AND PROPERLY DISPOSED OF BY THE STATE OR ITS CONTRACTOR. THE STATE AND ITS CONTRACTOR AGREE TO FULLY COMPLY WITH ALL FEDERAL, STATE, AND LOCAL ENVIRONMENTAL LAWS, REGULATIONS, STATUTES AND ORDINANCES AT ALL TIMES.

CSXT MAY REQUIRE FULL TIME RAILROAD FLAGGING FOR ANY PROJECT TASKS THAT MAY HAVE THE POTENTIAL TO FOUL THE TRACK OR CAUSE A HAZARD TO TRAIN MOVEMENTS.

CSXT HAS SOLE AUTHORITY TO DETERMINE THE NEED FOR TRACK PROTECTION REQUIRED TO PROTECT ITS OPERATIONS AND PROPERTY. IN GENERAL, TRACK PROTECTION WILL BE REQUIRED WHENEVER CONTRACTOR OR EQUIPMENT ARE, OR ARE LIKELY TO BE, WORKING WITHIN FIFTY (50) FEET OF TRACK OR OTHER TRACK CLEARANCES AS SPECIFIED BY CSXT.

UPON COMPLETION OF THE WORK ON CSXT PROPERTY, THE CONTRACTOR SHALL REQUEST THE OWNER TO ARRANGE A FINAL INSPECTION OF THE PROJECT WITH THE RAILROAD'S PROJECT ENGINEER OR THEIR AUTHORIZED REPRESENTATIVE.

PERSONAL PROTECTION EQUIPMENT (PPE)

THE CONTRACTOR SHALL FOLLOW ALL REQUIREMENTS OF SECTIONS XXIV AND XXXIV OF THE OHIO DEPARTMENT OF TRANSPORTATION SAFETY & HEALTH STANDARD OPERATING PRECEDURE 220-006 (SP) EFFECTIVE: NOVEMBER 1, 2018 (EXCEPT AS AMENDED BELOW) AND ALL SUBSEQUENT UPDATES POSTED AT THE FOLLOWING WEBSITE:

HTTP://WWW.DOT.STATE.OH.US/POLICY/POLICIESANDSOPS/POLICIES/220-006(SP).PDF

AMENDMENTS TO THE REQUIREMENTS OF THIS DOCUMENTS ARE:


XXIV. HEAD PROTECTION (HARD HATS)

ALL PERSONS WITHIN THE RIGHT-OF-WAY OF ANY HIGHWAY OR ANY OTHER TYPE OF ROADWAY OR CONSTRUCTION SITE WHO ARE EXPOSED TO EITHER TRAFFIC (VEHICLES USING THE HIGHWAY FOR PURPOSES OF TRAVEL) OR CONSTRUCTION EQUIPMENT WITHIN THE WORK AREA, REGARDLESS OF JOB TYPE, SHALL WEAR APPROPRIARE HEAD PROTECTION. ALL HARD HATS MUST MEET OR EXCEED ANSI Z89.1-2009 TYPE 1, CLASS E-G REQUIREMENTS.

XXXIV. SAFETY APPAREL AND VEST (HIGH VISIBILITY)

ALL PERSONS WITHIN THE RIGHT-OF-WAY OF ANY HIGHWAY OR ANY OTHER TYPE OF ROADWAY OR CONSTRUCTION SITE WHO ARE EXPOSED TO EITHER TRAFFIC (VEHICLES USING THE HIGHWAY FOR PURPOSES OF TRAVEL) OR CONSTRUCTION EQUIPMENT WITHIN THE WORK AREA, REGARDLESS OF JOB TYPE, SHALL WEAR A HIGH-VISIBILITY SAFETY VESR THAT MEETS THE PERFORMANCE CLASS II OR CLASS III REQUIREMENTS OF THE ANSI/SEA 107-2015 PUBLICATION ENTITLED "AMERICAN NATIONAL STANDARD FOR HIGH-VISIBILITY SAFETY APPAREL AND ACCESSORIES."

WORKERS MAY WEAR ANSI CLASS II OR ANSI CLAS III APPROVED RAIN SUIT, JACKET OR OTHER APPAREL WITHOUT A SAFETY VEST OVER IT.

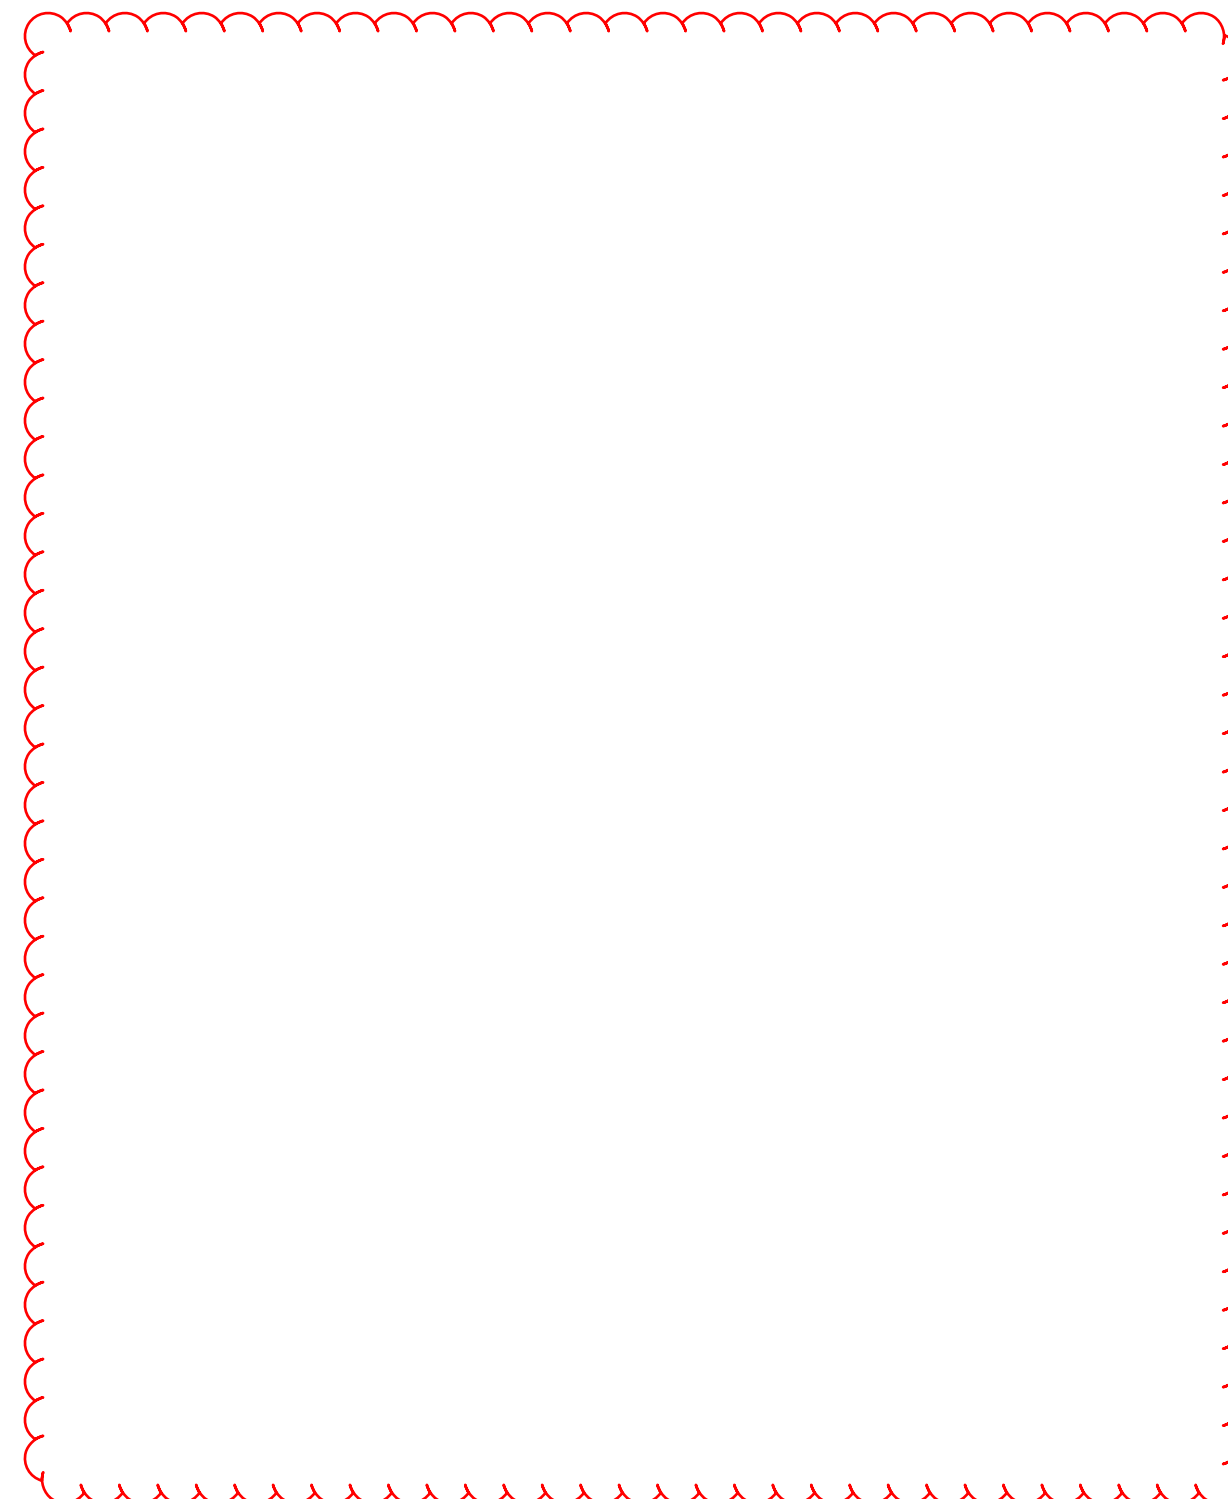

DESIGN AGENCY



DESIGNER

MJL

REVIEWER

KF 05/20/22

PROJECT ID

102375

SHEET TOTAL

34A | 705