

**UTILITIES**

THERE ARE NO UNDERGROUND UTILITIES SHOWN ON THIS PLAN. THE NATURE OF THE WORK REQUIRED BY THIS PROJECT WILL NOT AFFECT ANY KNOWN UNDERGROUND UTILITIES THAT EXIST UNDER OR ADJACENT TO THE WORK AREA.

LISTED BELOW ARE ALL UTILITIES LOCATED WITHIN THE PROJECT CONSTRUCTION LIMITS TOGETHER WITH THEIR RESPECTIVE OWNERS:

AMERICAN ELECTRIC POWER (DISTRIBUTION)  
850 TECH CENTER DRIVE  
GAHANNA, OHIO 43230  
MR. PAUL PAXTON  
614-883-6831

AMERICAN ELECTRIC POWER (TRANSMISSION)  
8600 SMITHS MILL RD.  
NEW ALBANY, OHIO 43054  
MR. MIKE CARR  
380-205-5072

DAYTON POWER & LIGHT COMPANY  
1900 DRYDEN RD  
DAYTON, OHIO 45439  
MR WILLIAM GOURLEY  
937-608-2814

SOUTH CENTRAL POWER COMPANY  
P.O. BOX 250  
LANCASTER, OHI 43130  
MR. ZACHARY REED  
74-689-6150

AT&T OHIO  
7201 FAR HILLS AVE.  
DAYTON, OHIO 45459  
MR. HOWARD LAUDERMILK II  
937-296-3588

FRONTIER COMMUNICATIONS  
241 S. NELSON AVE.  
WILMINGTON, OHIO 45177  
MR. DAVID LONGWORTH  
937-382-0055

HORIZON NETWORK PARTNERS  
1123 GOODALE BLVD. SUITE 550  
COLUMBUS, OHIO 43212  
[hnoc@horizonconnects.com](mailto:hnoc@horizonconnects.com)  
(a representative will be assigned)

CHARTER COMMUNICATIONS  
10920 KENWOOD RD.  
CINCINNATI, OHIO 45242  
MR. JOSEPH ANGEL  
513-233-5705

HIGHLAND COUNTY WATER COMPANY  
P.O. BOX 940  
HILLSBORO, OHIO 45133  
MR. ROB SMITH  
937-393-4281, EXT. 108

WESTERN WATER COMPANY  
1775 SR 28  
GOSHEN, OHIO 45122  
MR. SCOTT KIRK  
513-722-1682

VECTREN ENERGY DELIVERY  
1335 E. DAYTON YELLOW SPRINGS RD  
FAIRBORN, OHIO 45324  
MR. FRED WILLITS III  
937-440-1918

VILLAGE OF LYNCHBURG  
155 MAIN STREET P.O. BOX 402  
LYNCHBURG, OHIO 45142  
937-364-2241

HIGHLAND COUNTY ENGINEER  
138 BOWERS AVE.  
HILLSBORO, OHIO 45133  
MR. CHRIS FAUBER  
937-393-3496

**WORK LIMITS**

THE WORK LIMITS SHOWN ON THESE PLANS ARE FOR PHYSICAL CONSTRUCTION ONLY. PROVIDE THE INSTALLATION AND OPERATION OF ALL WORK ZONE TRAFFIC CONTROL AND WORK ZONE TRAFFIC CONTROL DEVICES REQUIRED BY THESE PLANS WHETHER INSIDE OR OUTSIDE THESE WORK LIMITS.

**WINDOW CONTRACT TABLE**

DESCRIPTION OF CRITICAL WORK	CALENDAR DAYS TO COMPLETE
ALL WORK ON PROJECT	75

**PROFILE AND ALIGNMENT**

PLACE THE PROPOSED PAVEMENT TO FOLLOW THE ALIGNMENT AND PROFILE OF THE EXISTING PAVEMENT. PLACE THE PROPOSED THINLAY ASPHALT CONCRETE, TYPE MEDIUM OVERLAY AS SHOWN ON THE TYPICAL SECTIONS.

**DISPOSAL OF ASPHALT GRINDINGS**

ASPHALT GRINDINGS FROM THIS PROJECT ARE TO BECOME THE PROPERTY OF THE CONTRACTOR.

**PART-WIDTH CONSTRUCTION**

BECAUSE OF THE NECESSITY TO BUILD THIS PROJECT UNDER TRAFFIC AND TO CONSTRUCT THE FULL PAVEMENT WIDTH IN STAGES, EXERCISE CARE TO PREVENT THE CONSTRUCTION OF A BUTT JOINT IN THE BASE COURSES. LAP LONGITUDINAL JOINTS AS SHOWN ON STANDARD CONSTRUCTION DRAWING BP-3.1.

**RPM**

IN ADDITION TO CMS 621.03, RPMs SHALL NOT BE INSTALLED ON BRIDGES OR APPROACH SLABS THAT HAVE A CONCRETE SURFACE. INSTALL RPMs IN ASPHALT CONCRETE BEFORE AND AFTER THE SUPERSTRUCTURE. RPM'S LOCATED IN EXISTING CONCRETE BRIDGE DECKS OR APPROACH SLABS SHALL BE LEFT IN PLACE.

INSTALL NEW RPMs IN ACCORDANCE WITH ODOT STANDARD DRAWINGS TC-65.10 AND TC-65.11.

**617 COMPACTED AGGREGATE**

THE FOLLOWING ESTIMATED QUANTITIES ARE TO BE USED AS DIRECTED BY THE ENGINEER, FOR THE PURPOSE OF BERM REPAIRS.


TOTAL: 250 CY 01/STR/PV

**ITEM 254- PATCHING PLANED SURFACE**

THIS ITEM SHALL BE IN ACCORDANCE WITH SECTION 254 OF THE CONSTRUCTION AND MATERIALS SPECIFICATIONS AND AS DIRECTED BY THE ENGINEER.

ESTIMATED QUANTITIES HAVE BEEN PROVIDED FOR THE FOLLOWING WORK: ITEM 254 PATCHING PLANED SURFACE 22,443 SQ.YD.

**ITEM 251 - PARTIAL DEPTH PAVEMENT REPAIR, AS PER PLAN**

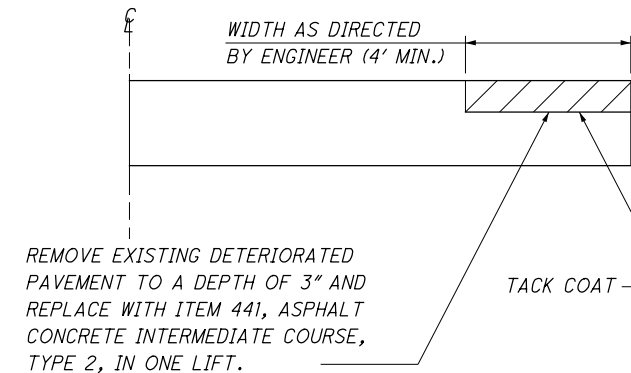

REMOVE EXISTING DETERIORATED PAVEMENT TO A DEPTH OF 3" AND REPLACE WITH ITEM 441, ASPHALT CONCRETE INTERMEDIATE COURSE, TYPE 2, IN ONE LIFT.

THE FOLLOWING ESTIMATED QUANTITIES HAVE BEEN INCLUDED AND CARRIED TO THE GENERAL SUMMARY FOR USE AS DIRECTED BY THE ENGINEER:

ITEM 251 PARTIAL DEPTH PAVEMENT REPAIR (441),AS PER PLAN  
01/STR/PV TOTALS: 500 SY

**SPECIAL NOTE:**

IN LYNCHBURG RAILROAD TIES/CURBS ARE IN PLACE IN CERTAIN LOCATIONS. MILL AND FILL UP TO EXISTING RAILROAD TIES AND LEAVE THEM IN PLACE.

**ITEM 609, CURB, TYPE 4-C, AS PER PLAN**

ESTIMATED QUANTITIES HAVE BEEN INCLUDED FOR USE AT LOCATIONS IDENTIFIED BY THE ENGINEER IN FIELD PREPARATION OF DETERIORATED CURB PER THE REQUIREMENTS OF CMS 609. REPAIR IN KIND IS INTENDED.


SEE SHEET 6 FOR ESTIMATED QUANTITIES.

**ITEM 608, 4" CONCRETE WALK**

ESTIMATED QUANTITIES HAVE BEEN INCLUDED FOR USE AT LOCATIONS IDENTIFIED BY THE ENGINEER FOR THE REPLACEMENT OF DAMAGED WALK.

SEE SHEET 6 FOR ESTIMATED QUANTITIES.

**ITEM 253 - PAVEMENT REPAIR, AS PER PLAN**

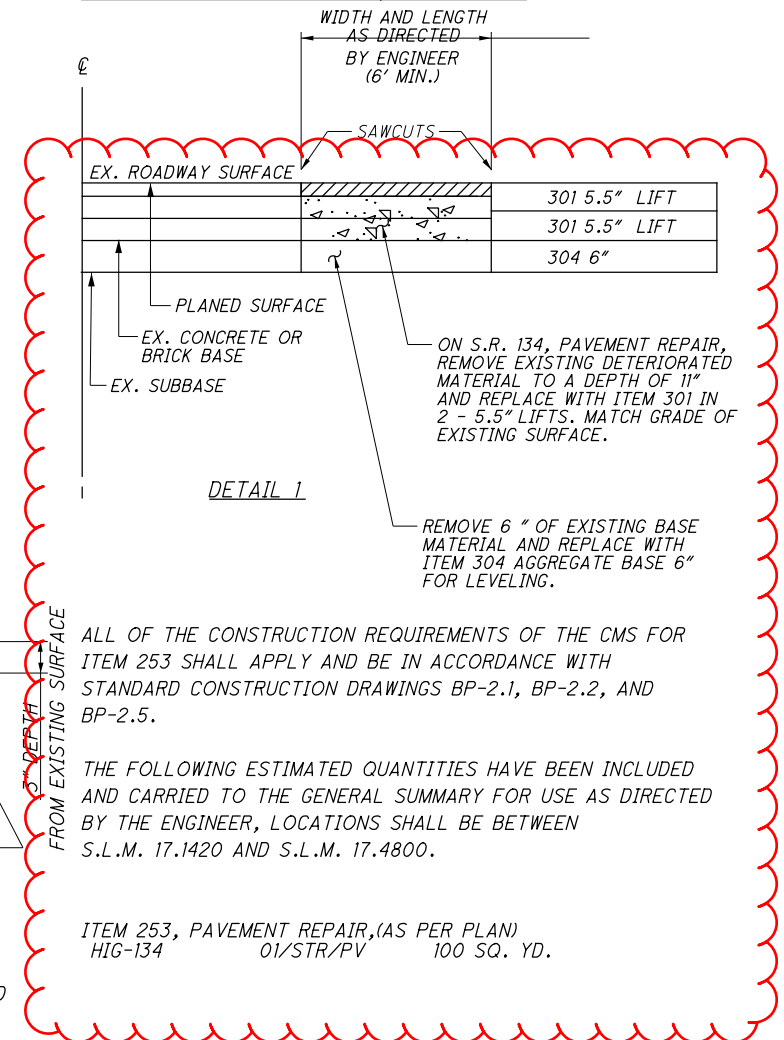

301 5.5" LIFT
301 5.5" LIFT
304 6"

ON S.R. 134, PAVEMENT REPAIR, REMOVE EXISTING DETERIORATED MATERIAL TO A DEPTH OF 11" AND REPLACE WITH ITEM 301 IN 2 - 5.5" LIFTS. MATCH GRADE OF EXISTING SURFACE.

REMOVE 6" OF EXISTING BASE MATERIAL AND REPLACE WITH ITEM 304 AGGREGATE BASE 6" FOR LEVELING.

ALL OF THE CONSTRUCTION REQUIREMENTS OF THE CMS FOR ITEM 253 SHALL APPLY AND BE IN ACCORDANCE WITH STANDARD CONSTRUCTION DRAWINGS BP-2.1, BP-2.2, AND BP-2.5.

THE FOLLOWING ESTIMATED QUANTITIES HAVE BEEN INCLUDED AND CARRIED TO THE GENERAL SUMMARY FOR USE AS DIRECTED BY THE ENGINEER, LOCATIONS SHALL BE BETWEEN S.L.M. 17.1420 AND S.L.M. 17.4800.

ITEM 253, PAVEMENT REPAIR,(AS PER PLAN)  
HIG-134 01/STR/PV 100 SQ. YD.

CALCULATED  
ZDH  
CHECKED  
CLC

GENERAL NOTES

HIG-134-11.24

I:\ProjectData\HIG\10363\_HIG\_134\_1124\Design\Roadway\Sheets\10363\_1\_GN001.dgn Sheet 9/11/2020 10:23:37 AM ewoodbr1

