








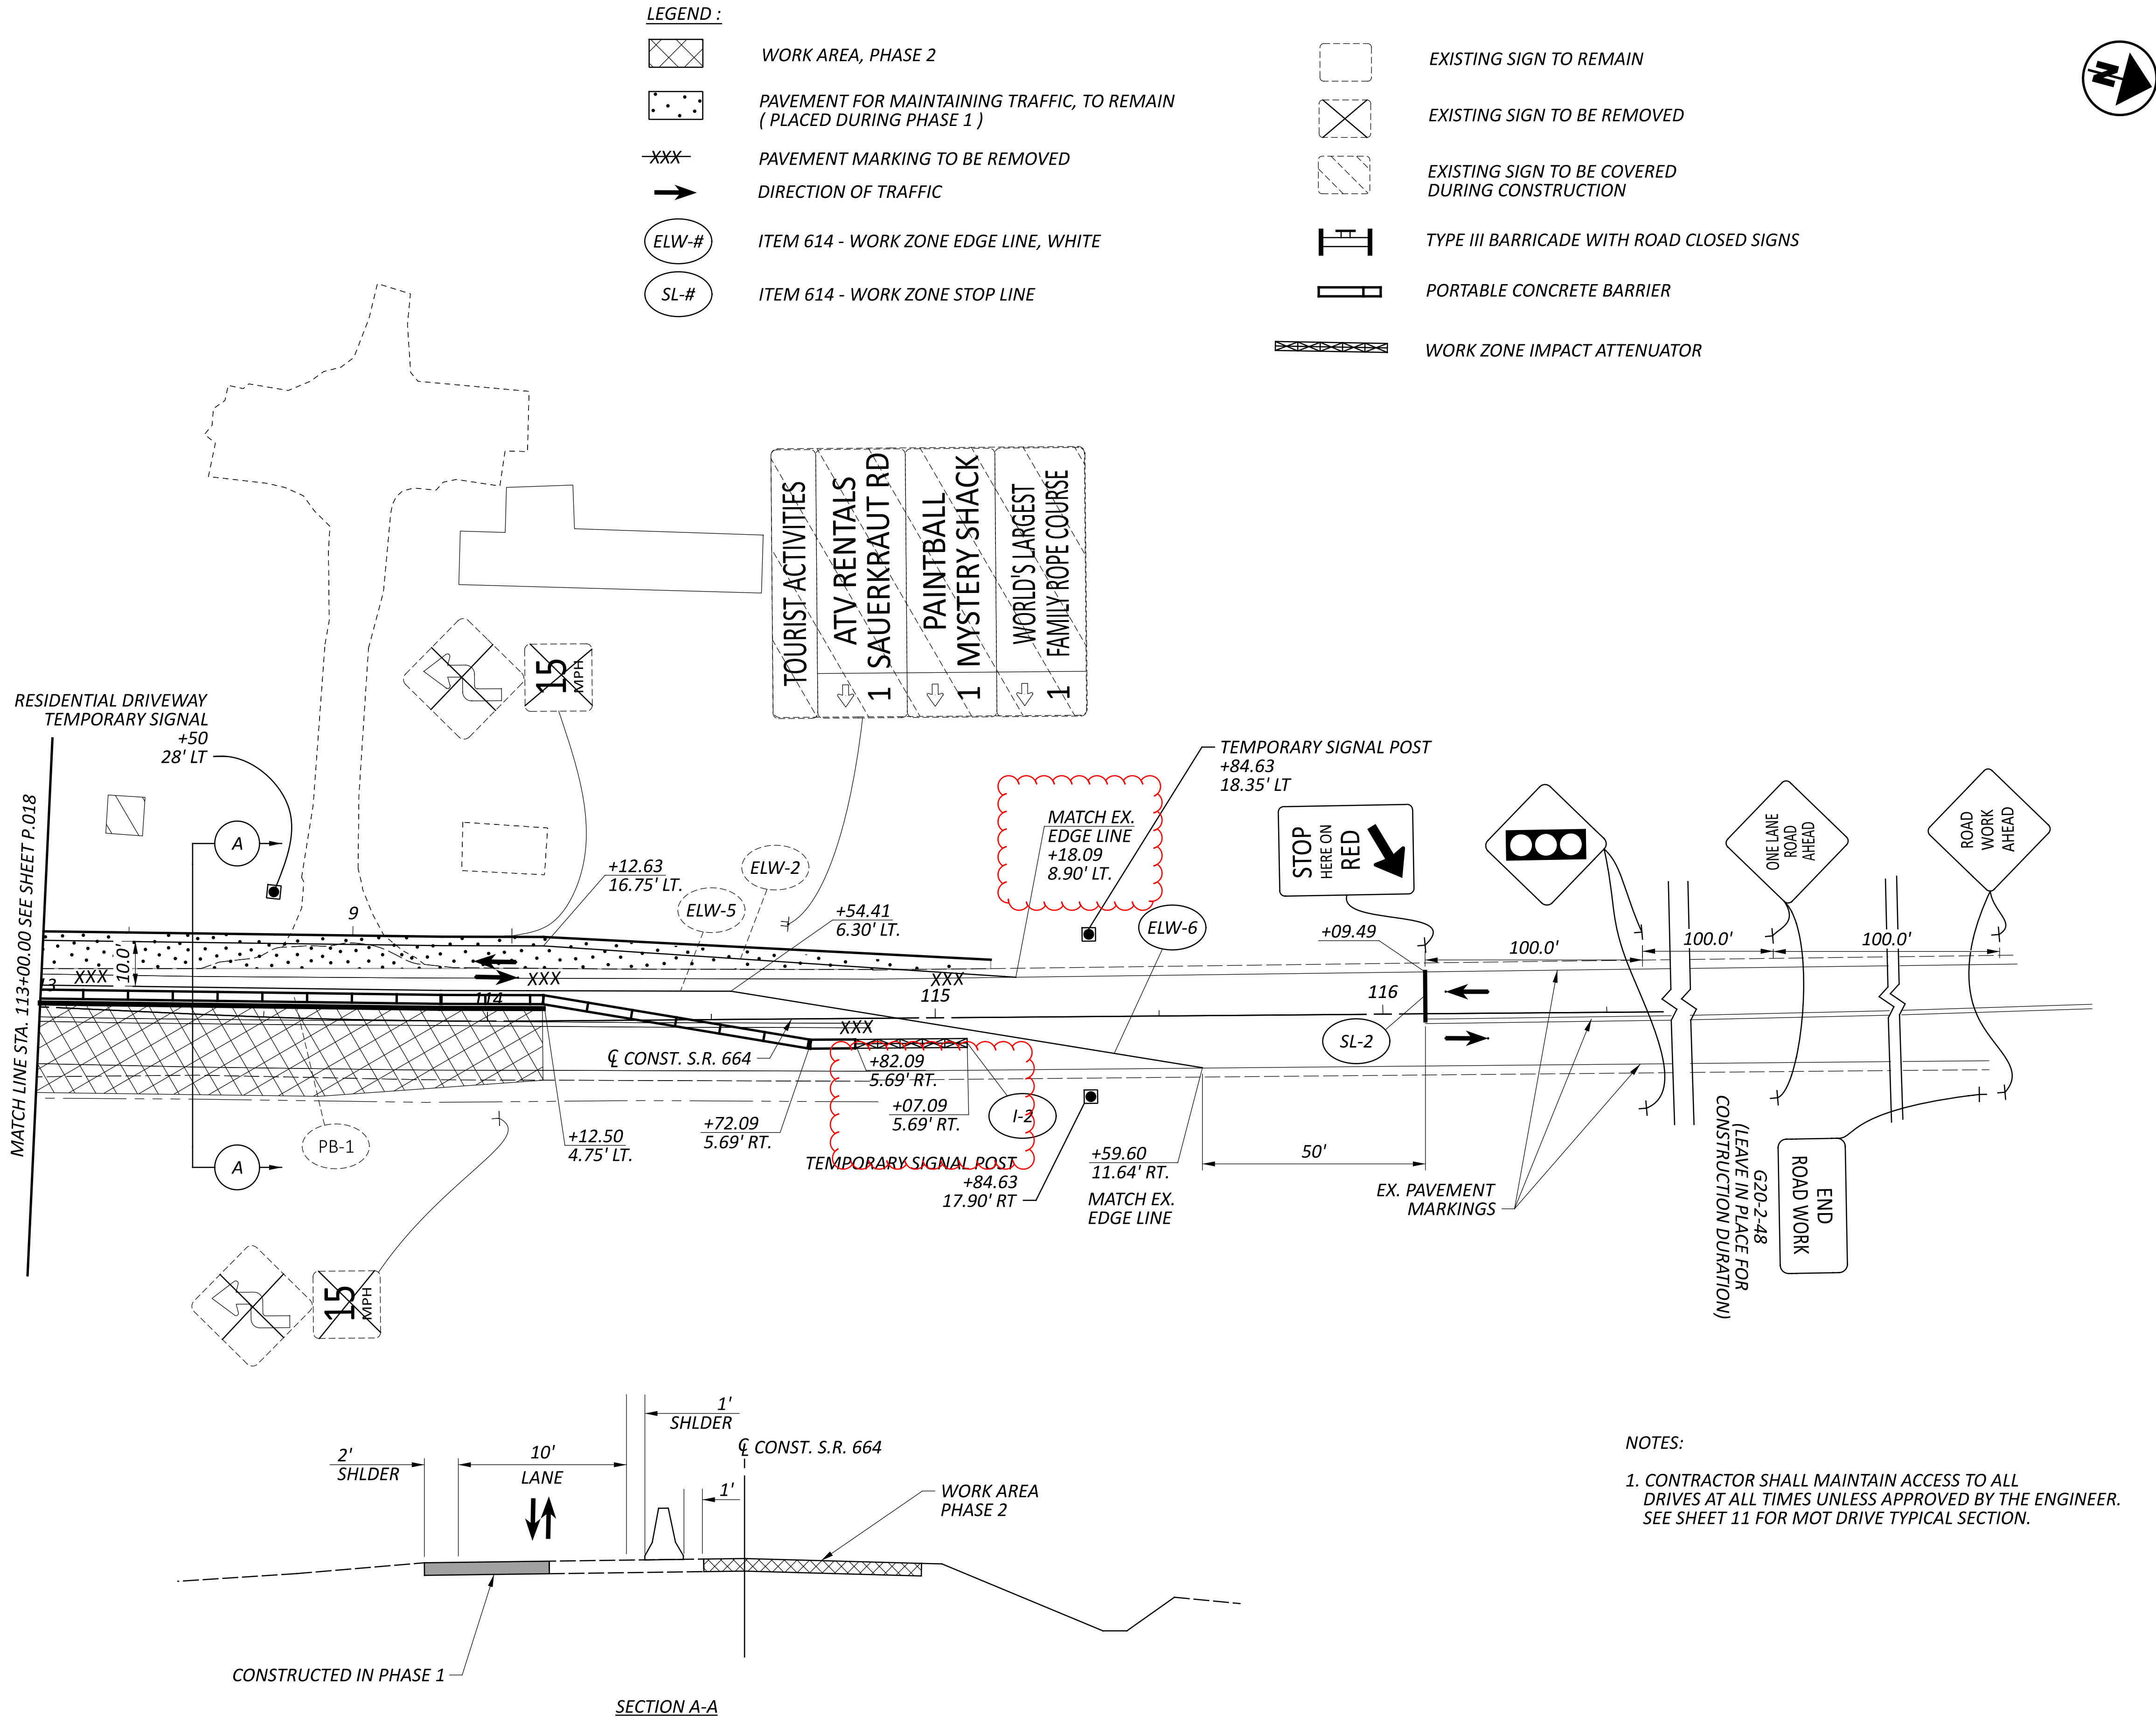

SHEET	TOTAL
P.021	110

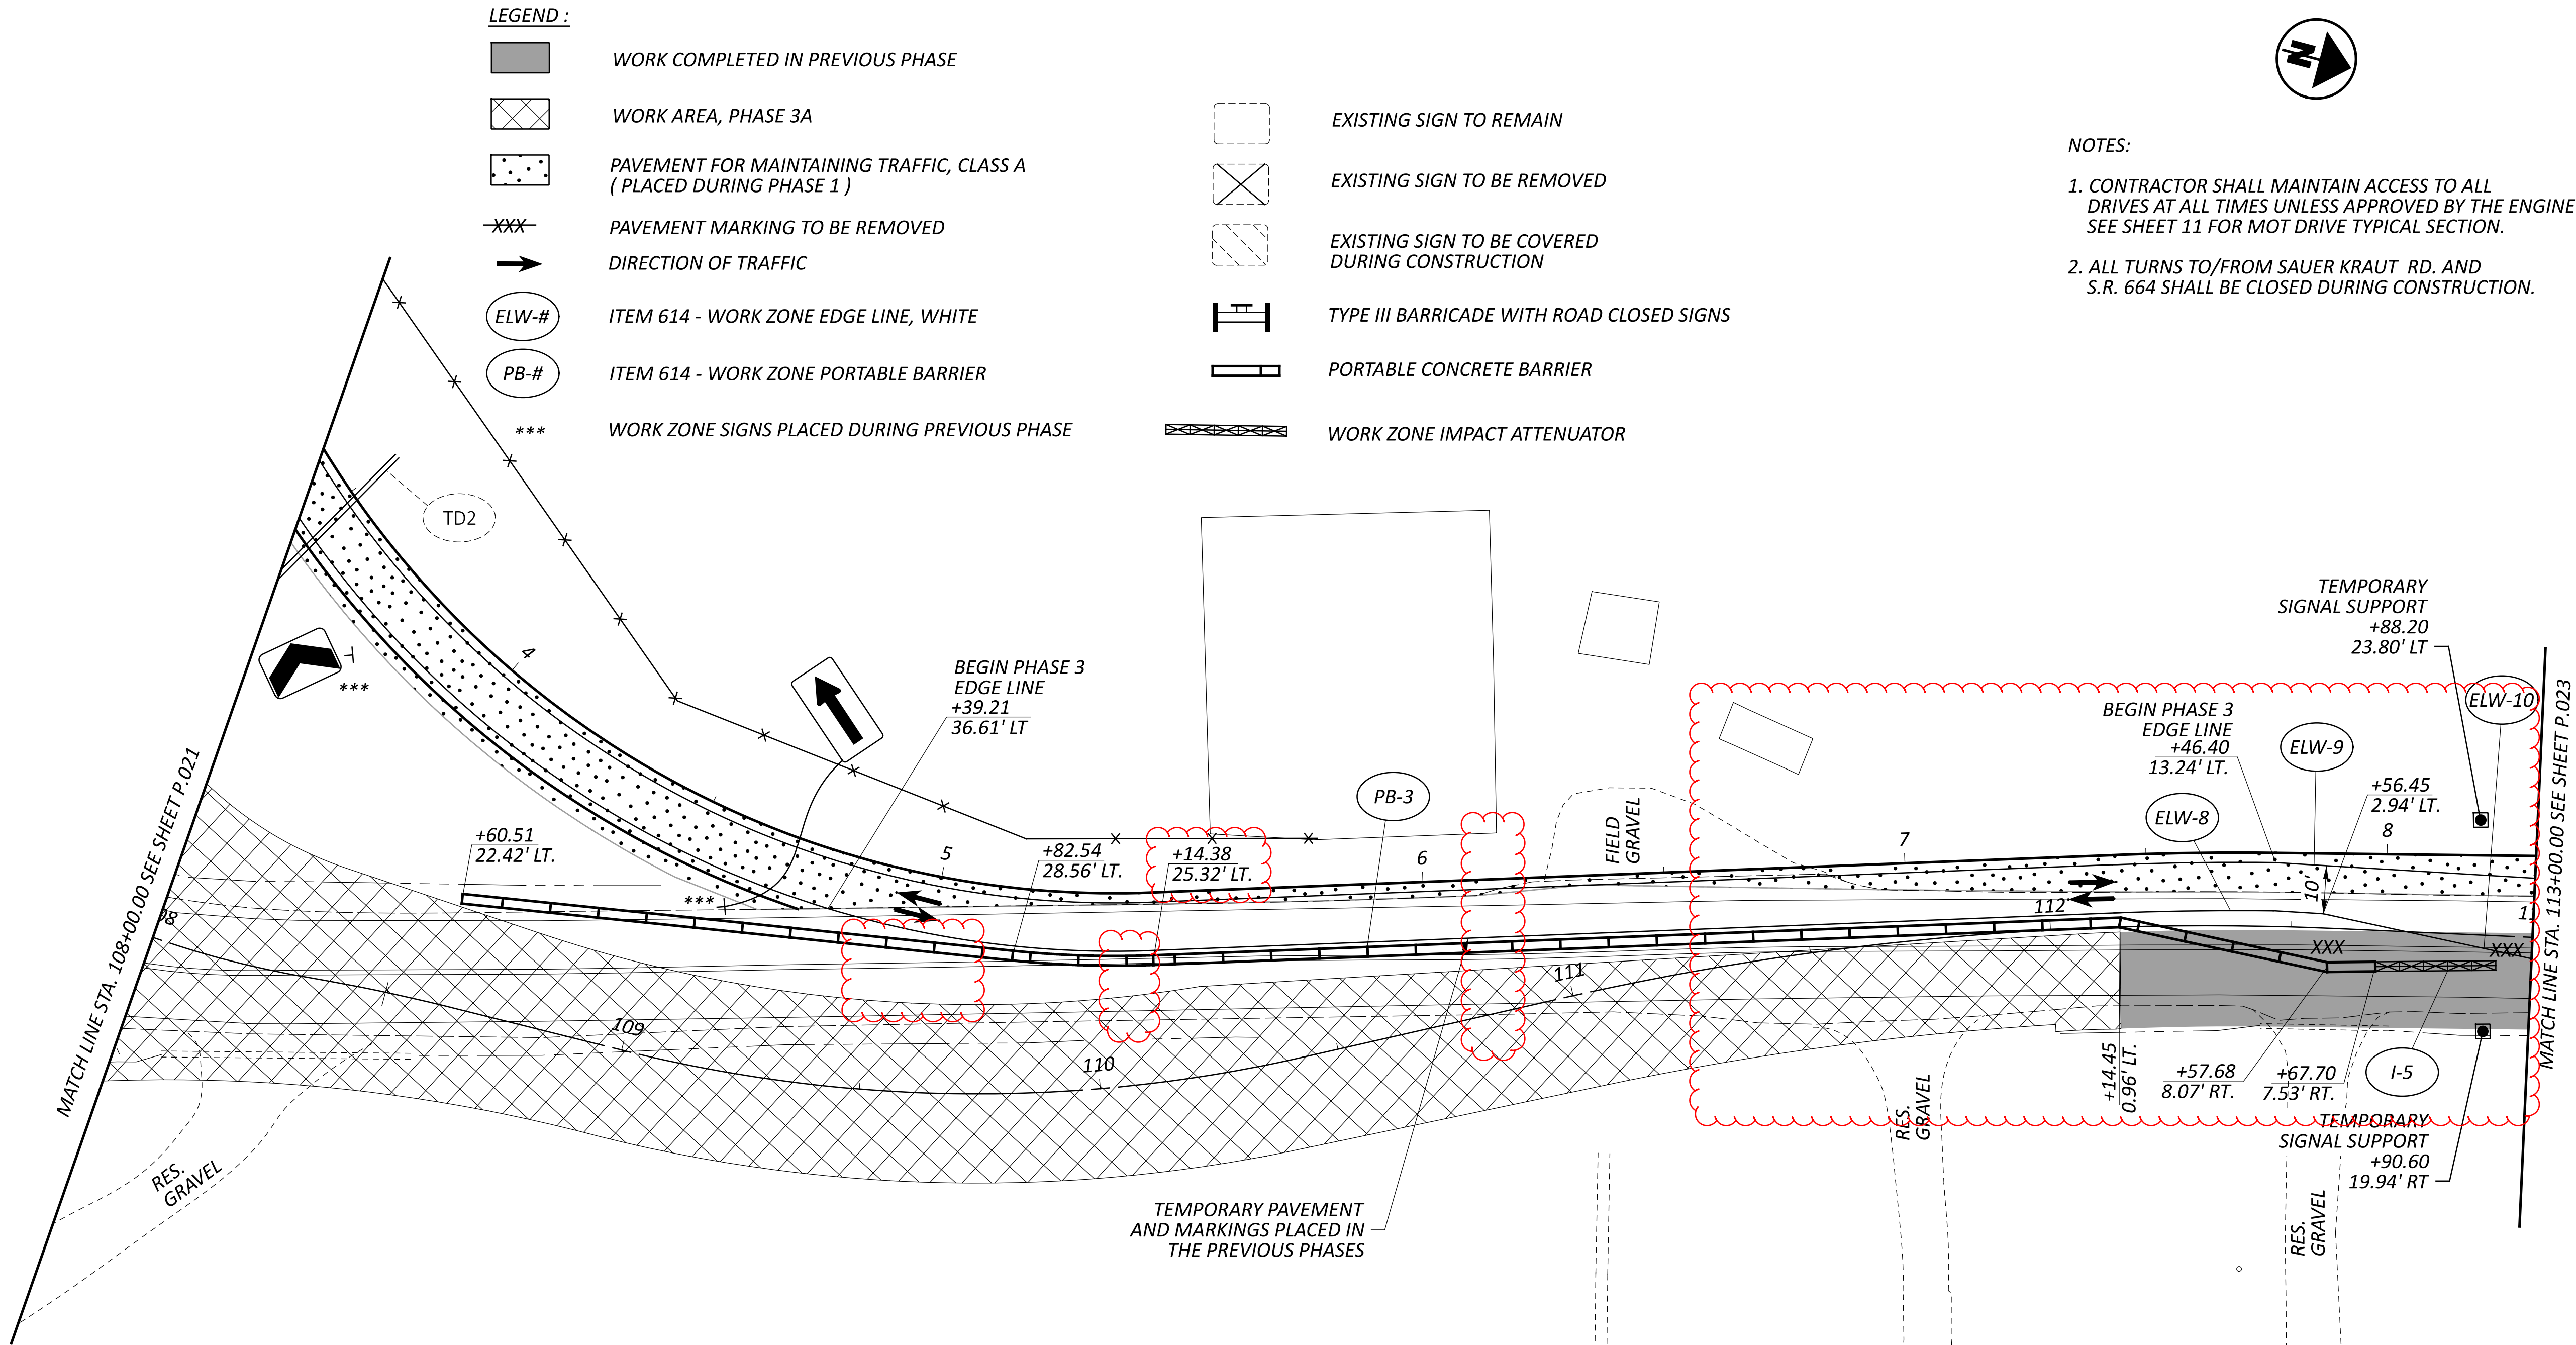

MAINTENANCE OF TRAFFIC - PHASE 3
STA. 108+00.00 TO STA. 113+00.00

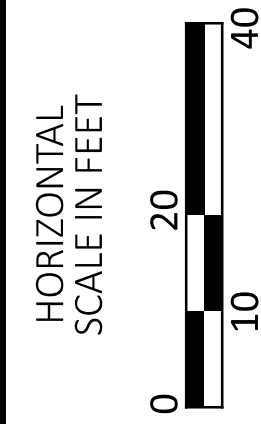

DESIGN AGENCY	
COMPASS INFRASTRUCTURE GROUP	
DESIGNER	AA
REVIEWER	JAH 05/23/25
PROJECT ID	119813
SHEET	P.022
TOTAL	110



HORIZONTAL
SCALE IN FEET

A horizontal scale bar with alternating black and white segments. The segments are labeled 0, 10, 20, and 40, indicating a scale in feet.

1. CONTRACTOR SHALL MAINTAIN ACCESS TO ALL DRIVES AT ALL TIMES UNLESS APPROVED BY THE ENGINEER. SEE SHEET 11 FOR MOT DRIVE TYPICAL SECTION
2. ALL TURNS TO/FROM SAUER KRAUT RD. AND S.R. 664 SHALL BE CLOSED DURING CONSTRUCTION.

119813

SHEET	TOTAL
-------	-------

ITEM 614 - WORK ZONE IMPACT ATTENUATOR

WORK ZONE ITEMS PLACED DURING PREVIOUS PHASE

HORIZONTAL
SCALE IN FEET



A horizontal scale bar with alternating black and white segments. It is marked with '0' at the left end, '10' at the first segment boundary, '20' at the second segment boundary, and '40' at the right end.

DESIGN AGENCY




COMPASS
INFRASTRUCTURE GROUP

DESIGNER


REVIEWER
JAH 05/23/25

PROJECT ID	119813
------------	--------


SHEET	TOTAL
P.025	110

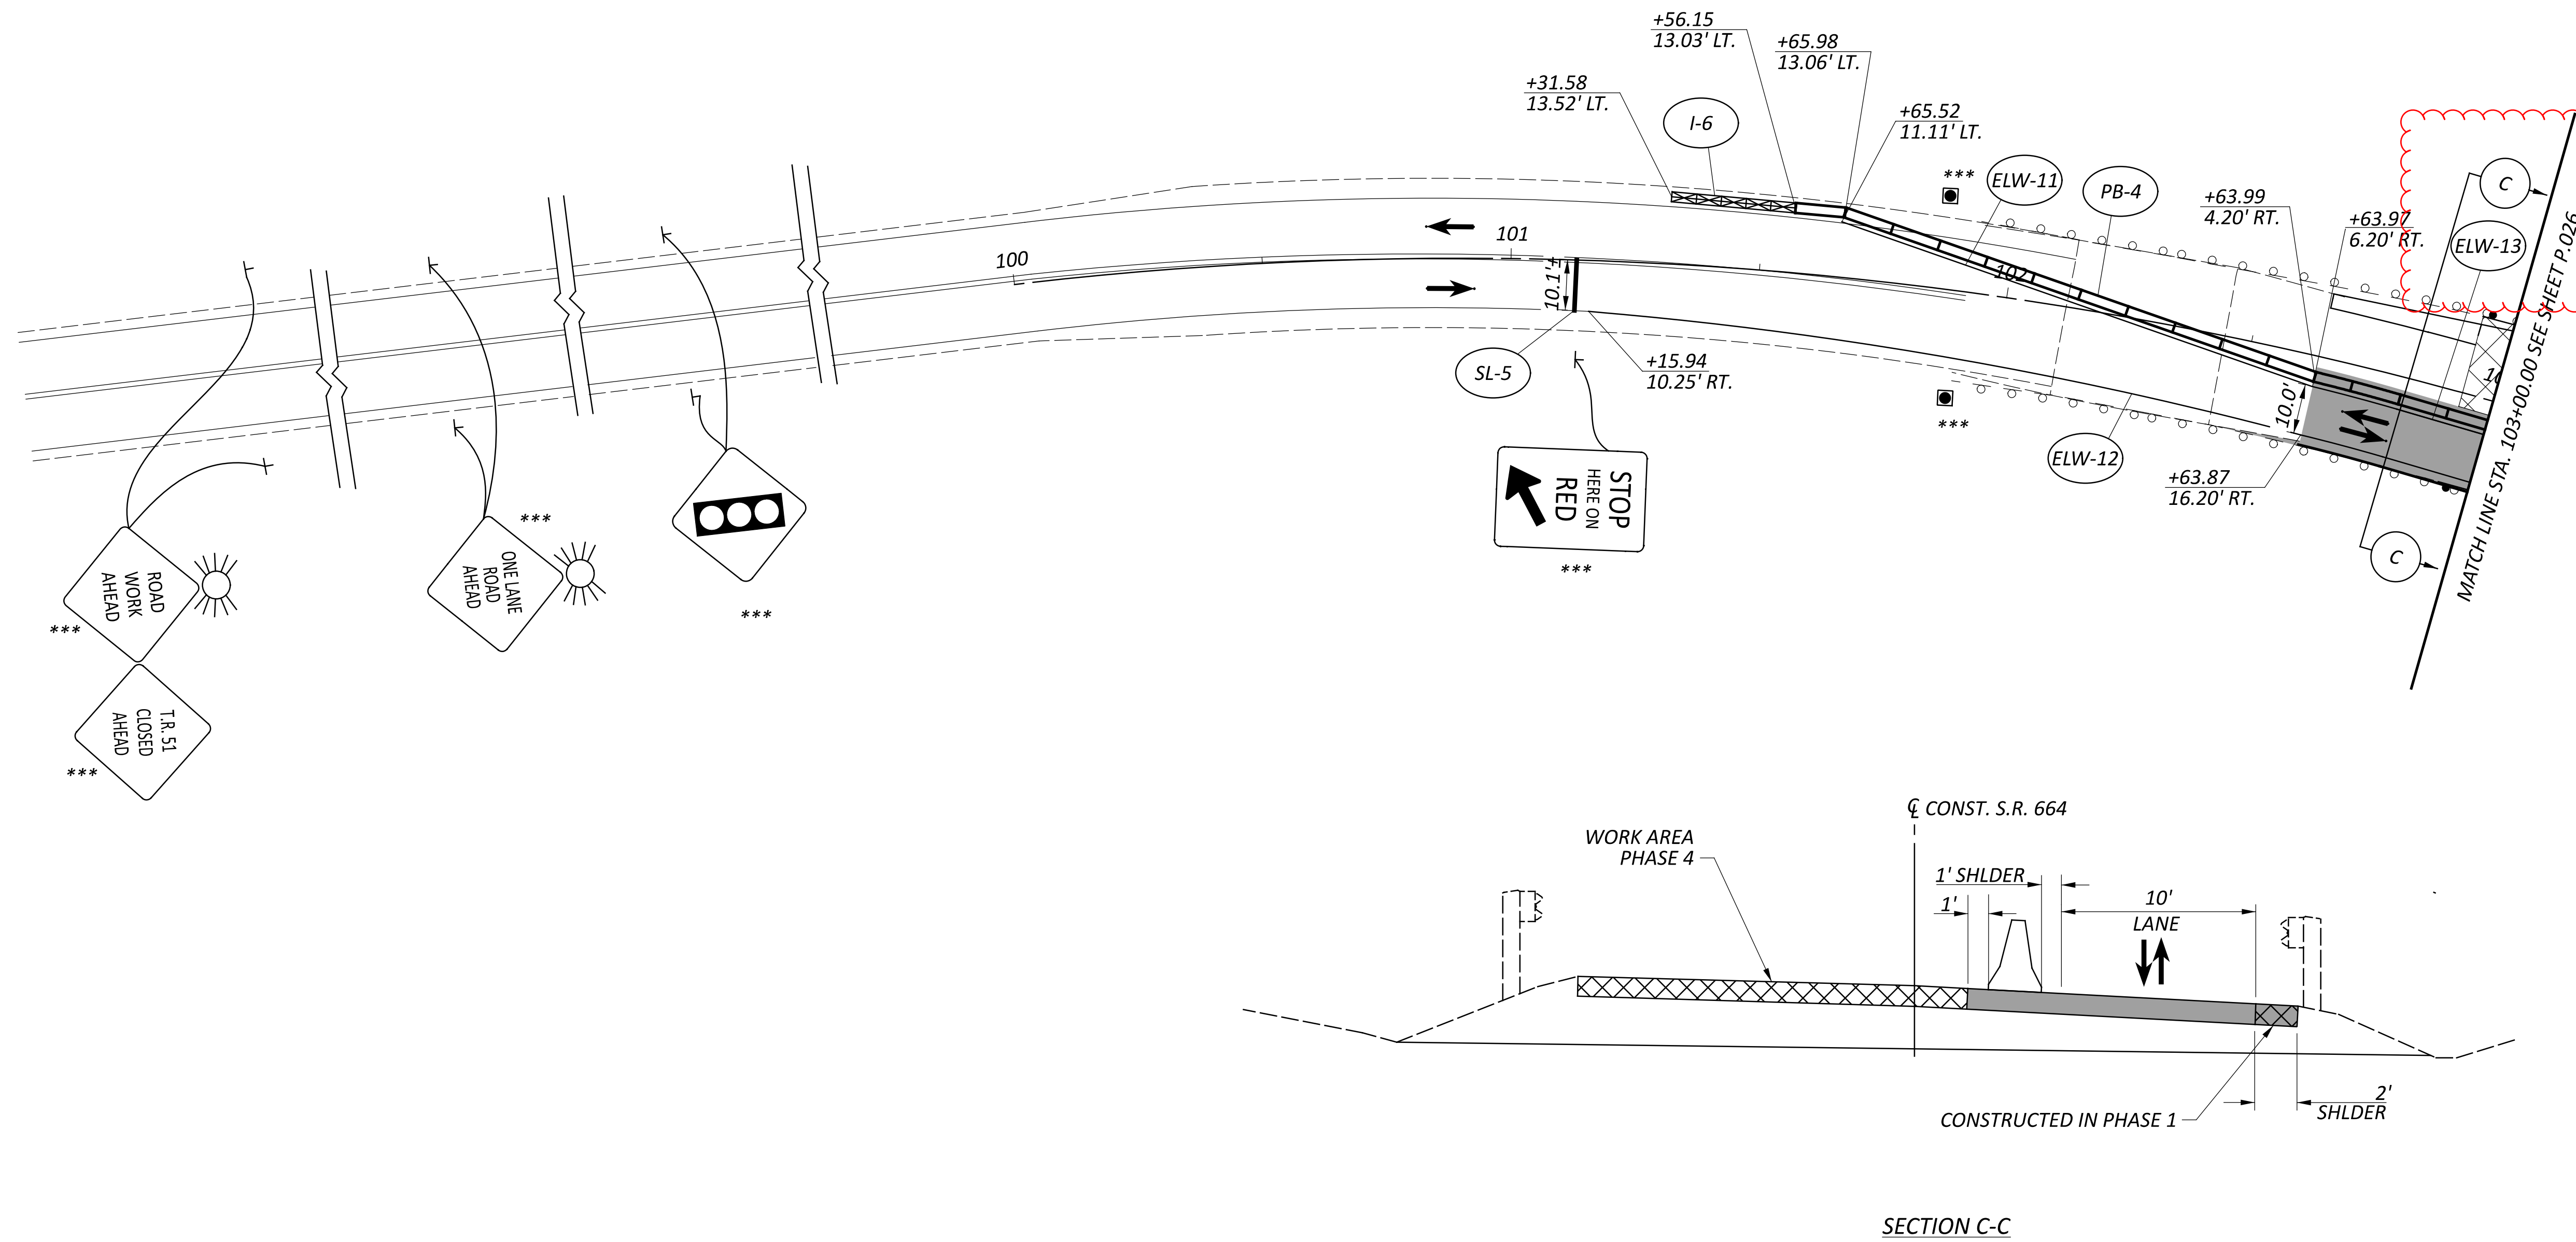

LEGEND :

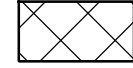


WORK AREA, PHASE 4

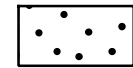


PAVEMENT FOR MAINTAINING TRAFFIC, CLASS A
(PLACED DURING PHASE 1)



WORK COMPLETED IN PREVIOUS PHASE

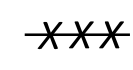


PAVEMENT MARKING TO BE REMOVED

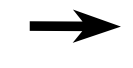

DIRECTION OF TRAFFIC



ITEM 614 - WORK ZONE EDGE LINE, WHITE

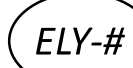


ITEM 614 - WORK ZONE EDGE LINE, YELLOW



ITEM 614 - WORK ZONE STOP LINE




ITEM 614 - WORK ZONE PORTABLE BARRIER

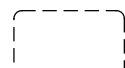


EXISTING SIGN TO REMAIN




EXISTING SIGN TO BE REMOVED

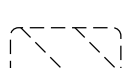

EXISTING SIGN TO BE COVERED
DURING CONSTRUCTION

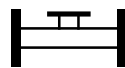

TYPE III BARRICADE WITH ROAD CLOSED SIGNS

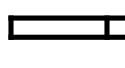

PORTABLE CONCRETE BARRIER




WORK ZONE IMPACT ATTENUATOR



*** WORK ZONE ITEMS PLACED DURING PREVIOUS PHASE

NOTES:

1. CONTRACTOR SHALL MAINTAIN ACCESS TO ALL DRIVES AT ALL TIMES UNLESS APPROVED BY THE ENGINEER. SEE SHEET 11 FOR MOT DRIVE TYPICAL SECTION.
2. ALL PROPOSED SIGNS SHALL BE PLACED AS SHOWN ON THE TRAFFIC CONTROL SHEETS.

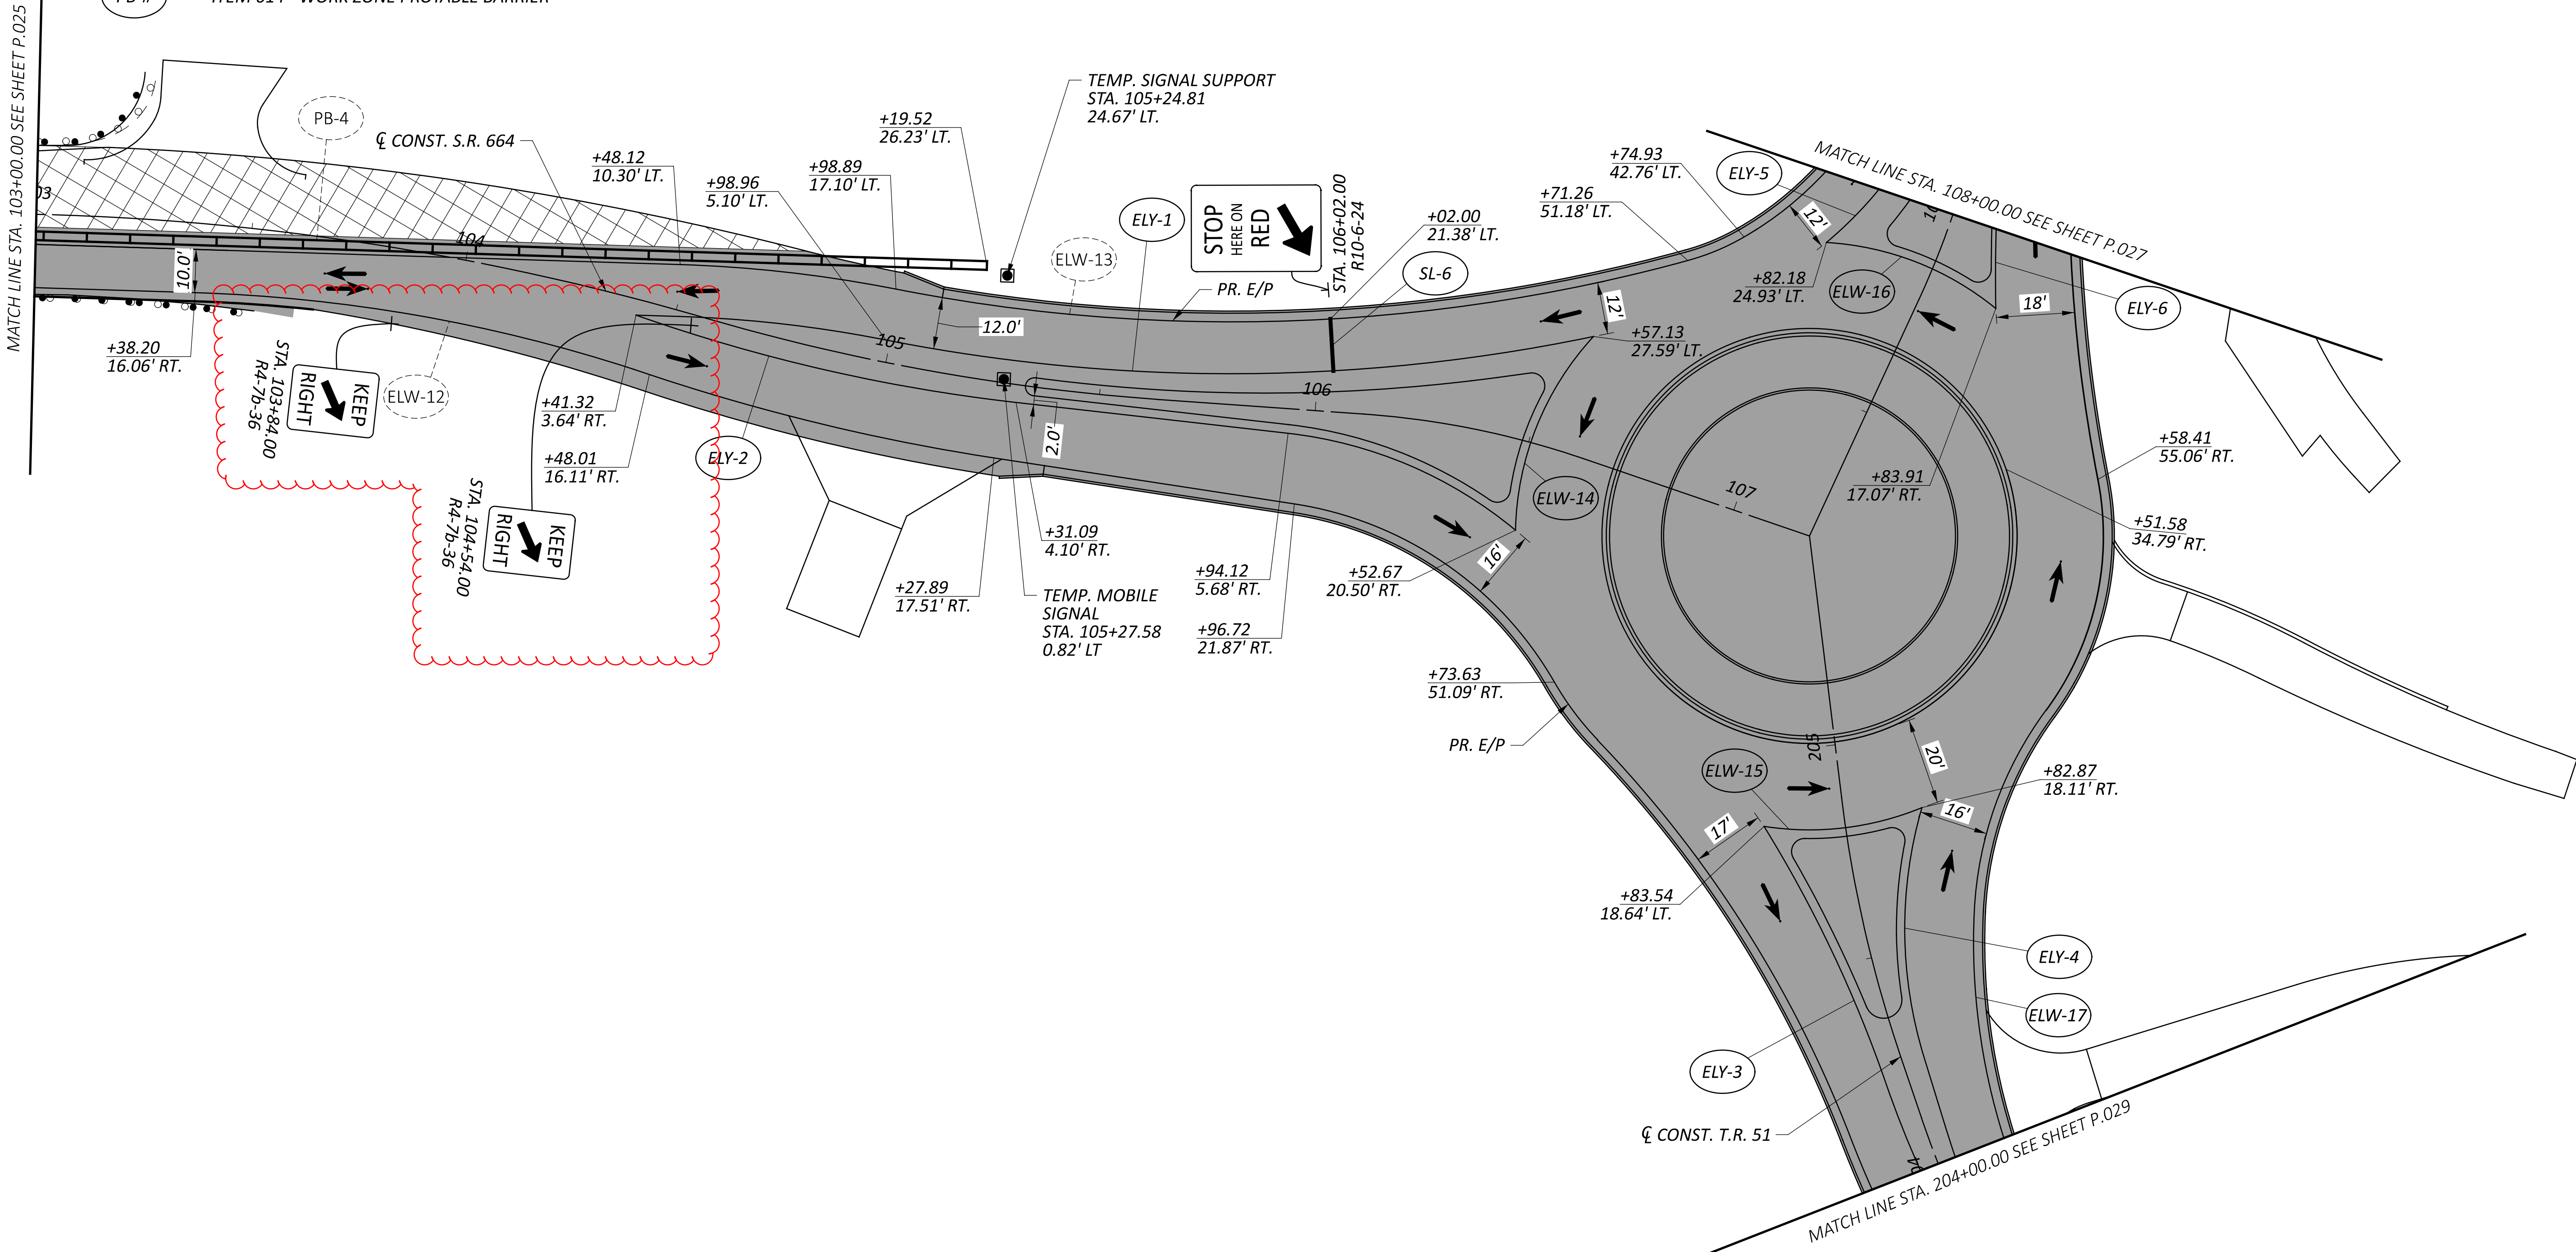

MAINTENANCE OF TRAFFIC - PHASE 4
STA. 103+00.00 TO STA. 108+00.00



DESIGN AGENCY



COMPASS
INFRASTRUCTURE GROUP

DESIGNER

AA

REVIEWER

JAH 05/23/25

PROJECT ID

119813

SHEET

P.026

TOTAL

110