



PAVEMENT SUBSUMMARY

| REFERENCE NO.                    | LOCATION |         |         | PAVEMENT WIDTH |                  |          |          |                  | QUANTITIES          |               |  |  |                      |                        |  |   |   | REMARKS |
|----------------------------------|----------|---------|---------|----------------|------------------|----------|----------|------------------|---------------------|---------------|--|--|----------------------|------------------------|--|---|---|---------|
|                                  | STATION  | STATION | TYPICAL | LENGTH         | LEFT             |          | RIGHT    |                  |                     | 204           |  | 254  | 301                  | 304                    | 407  | 441   | 441   |         |
|                                  |          |         |         |                | OUTSIDE SHOULDER | PAVEMENT | PAVEMENT | OUTSIDE SHOULDER | SUBGRADE COMPACTION | PROOF ROLLING | PAVEMENT PLANING, ASPHALT CONCRETE, 3" (ACTUAL DEPTH VARIABLE) | 7.00" ASPHALT CONCRETE BASE, PG 64-22, (449) | 6.00" AGGREGATE BASE | NON-TRACKING TACK COAT | 1.25" ASPHALT CONCRETE SURFACE COURSE, TYPE 1, PG 64-22, (449) | 1.75" ASPHALT CONCRETE INTERMEDIATE COURSE, TYPE 1, (449) |   |         |
| FT                               | FT       | FT      | FT      | FT             | FT               | FT       | FT       | FT               | SY                  | HOUR          | SY   | CY   | CY                   | GAL                    | CY   | CY  |   |         |
| P-1                              | 103+00   | 105+50  | 1       | 250            | 2                | 12.0     | 12.0     | 2                | 938.88              | 1             | 395.57   | 91.24  | 80.91                | 117.85                 | 29.71  | 41.59   | INCLUDES OVERLAY AND FULL DEPTH PAVEMENT RECONSTRUCTION |         |
| P-2                              | 105+50   | 113+00  | 2, 3    | 750            | 2                | 17.5     | 17.5     | 2                | 3459.40             | 2             |  | 629.46                                       | 547.64               | 353.04                 | 111.44   | 156.02  |   |         |
| P-3                              | 113+00   | 115+65  | 1       | 265            | 2                | 12.0     | 12.0     | 2                | 969.50              | 1             | 332.11   | 108.67                                       | 96.01                | 116.86                 | 30.60  | 42.84   | INCLUDES OVERLAY AND FULL DEPTH PAVEMENT RECONSTRUCTION |         |
| SUBTOTAL                         |          |         |         |                |                  |          |          |                  | 5367.78             | 4             | 727.68   | 829.37                                       | 724.56               | 587.75                 | 171.75   | 240.45  | QUANTITIES CALCULATED BASED ON COMPUTER GENERATED AREAS |         |
| TOTAL CARRIED TO GENERAL SUMMARY |          |         |         |                |                  |          |          |                  | 5368                | 4             | 728  | 830  | 725                  | 588                    | 172  | 241   |   |         |

ITEM 202 PAVEMENT REMOVED, ASPHALT - DELETED

UNDERDRAIN SUBSUMMARY

| REFERENCE NO.                    | SHEET NO. | STATION TO STATION     | SIDE  | ESTIMATED QUANTITIES                             |  |  |   |                                    | BENDS AND BRANCHES (FOR INFORMATION ONLY) |        |        |                   |                   | REMARKS |    |   |
|----------------------------------|-----------|------------------------|-------|--|--|--|---|------------------------------------|---|--------|--------|-------------------|-------------------|---------|----|---|
|                                  |           |                        |       | 601  | 605  |  | 611                                       |                                    | 6" CROSS                                  | 6" WYE | 6" TEE | 6" - 90 DEG. BEND | 6" - 45 DEG. BEND |         |    |   |
|                                  |           |                        |       | TIED CONCRETE BLOCK MAT WITH TYPE 1 UNDERLAYMENT | 6" BASE PIPE UNDERDRAINS WITH GEOTEXTILE FABRIC (18" DEEP) | 6" UNCLASSIFIED UNDERDRAINS WITH GEOTEXTILE FABRIC | 6" CONDUIT, TYPE F FOR UNDERDRAIN OUTLETS | PRECAST REINFORCED CONCRETE OUTLET |   |        |        |                   |                   |         | SY | FT  |
| U-1                              | P.16 - 17 | 103+03.00 TO 105+28.61 | RT    | 2  | 207  | 18   | 16  | 1                                  |   |        | 1      |                   |                   |         |    | UNCLASSIFIED STA. 104+60.00 ELEV 775.28 TO STA. 105+28.55 ELEV 774.94 |
| U-2                              | P.16 - 17 | 104+02.00 TO 105+28.61 | LT/RT |  | 58   | 68   | 18  |                                    |   |        | 1      |                   |                   |         |    | UNCLASSIFIED STA. 105+10.00 ELEV 774.61 TO STA. 105+28.55 ELEV 774.52 |
| U-3                              | P.17      | 105+51.23 TO 107+84.39 | RT    |  | 234  |  | 16  |                                    | 1   |        |        |                   |                   |         |    | TYPE F UNDERDRAIN STA. 105+28.54 TO STA. 105+45.15                    |
| U-4                              | P.17 - 19 | 107+84.39 TO 115+62.00 | RT    |  | 247  | 211  | 22  | 1                                  |   |        | 1      |                   |                   |         |    | UNCLASSIFIED STA. 109+27.28 ELEV 776.17 TO STA. 111+39.76 ELEV 776.17 |
| U-5                              | P.18 - 19 | 112+72.87 TO 115+62.00 | RT    |  | 201  | 77   | 30  | 1                                  |   |        | 1      |                   | 1                 |         |    | UNCLASSIFIED STA. 112+81.59 ELEV 772.21 TO STA. 113+60.00 ELEV 772.21 |
| U-6                              | P.18 - 19 | 113+78.48 TO 115+17.00 | RT/LT |  | 129  | 27   |   |                                    |   |        |        |                   |                   |         |    | UNCLASSIFIED STA. 113+78.48 ELEV 772.23 TO STA. 113+88.29 ELEV 773.54 |
| TOTAL CARRIED TO GENERAL SUMMARY |           |                        |       | 2  | 1076   | 401  | 102                                       | 3                                  |   |        |        |                   |                   |         |    |   |

DESIGN AGENCY



DESIGNER

RCW

REVIEWER


PJD 11/25/24

PROJECT ID


121180

SHEET TOTAL

P.14 43

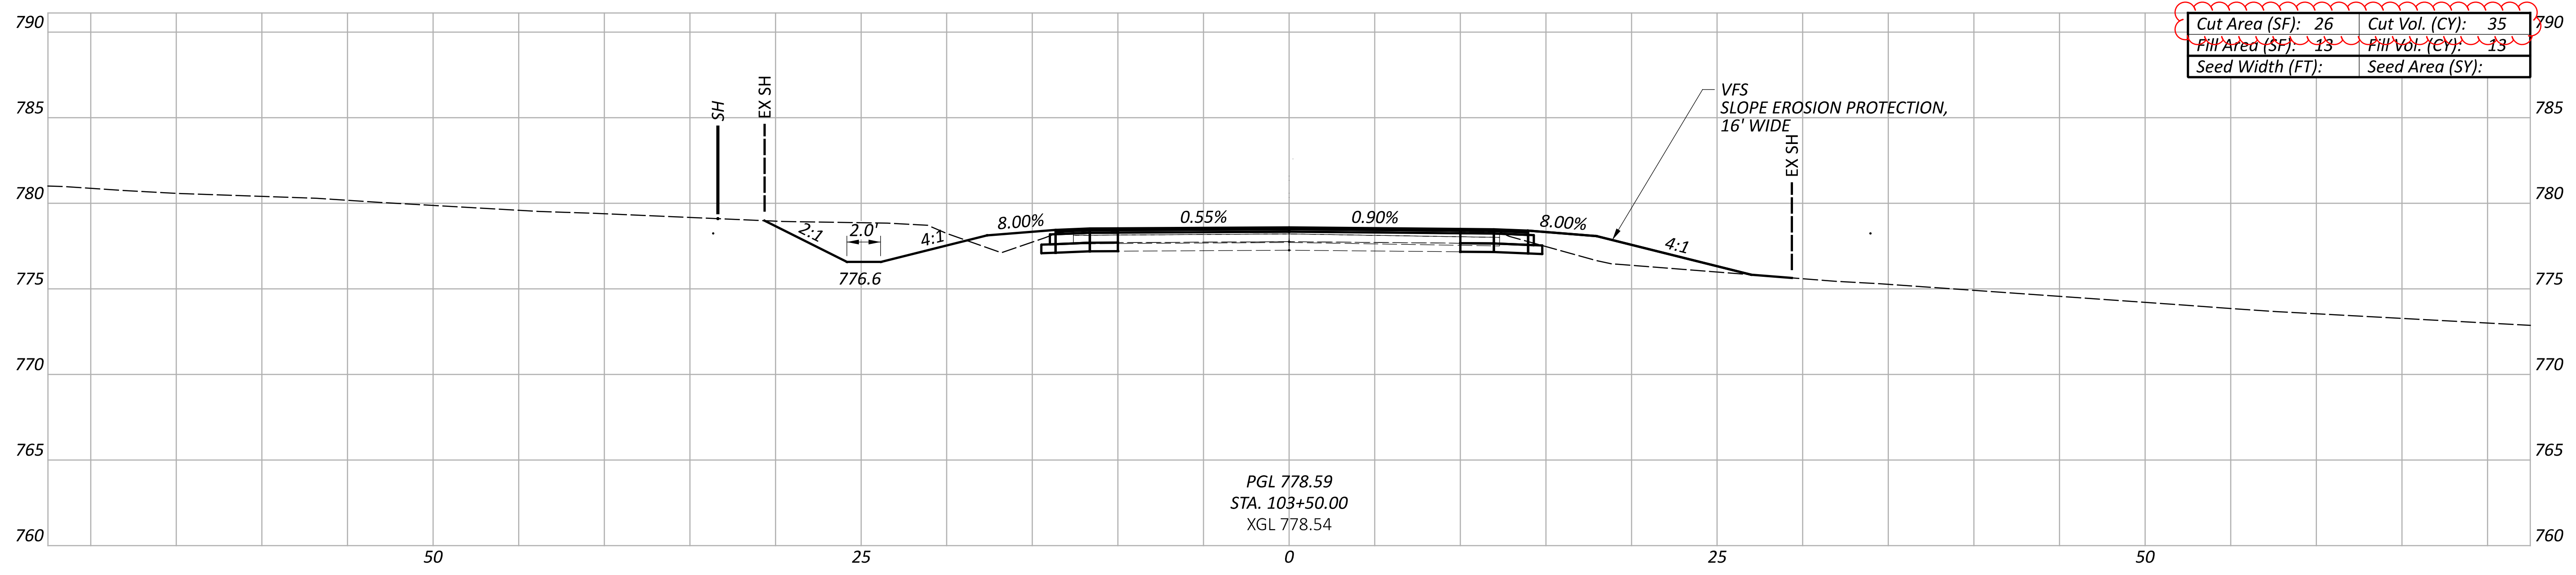

PGL 778.59  
 STA. 103+50.00  
 XGL 778.54

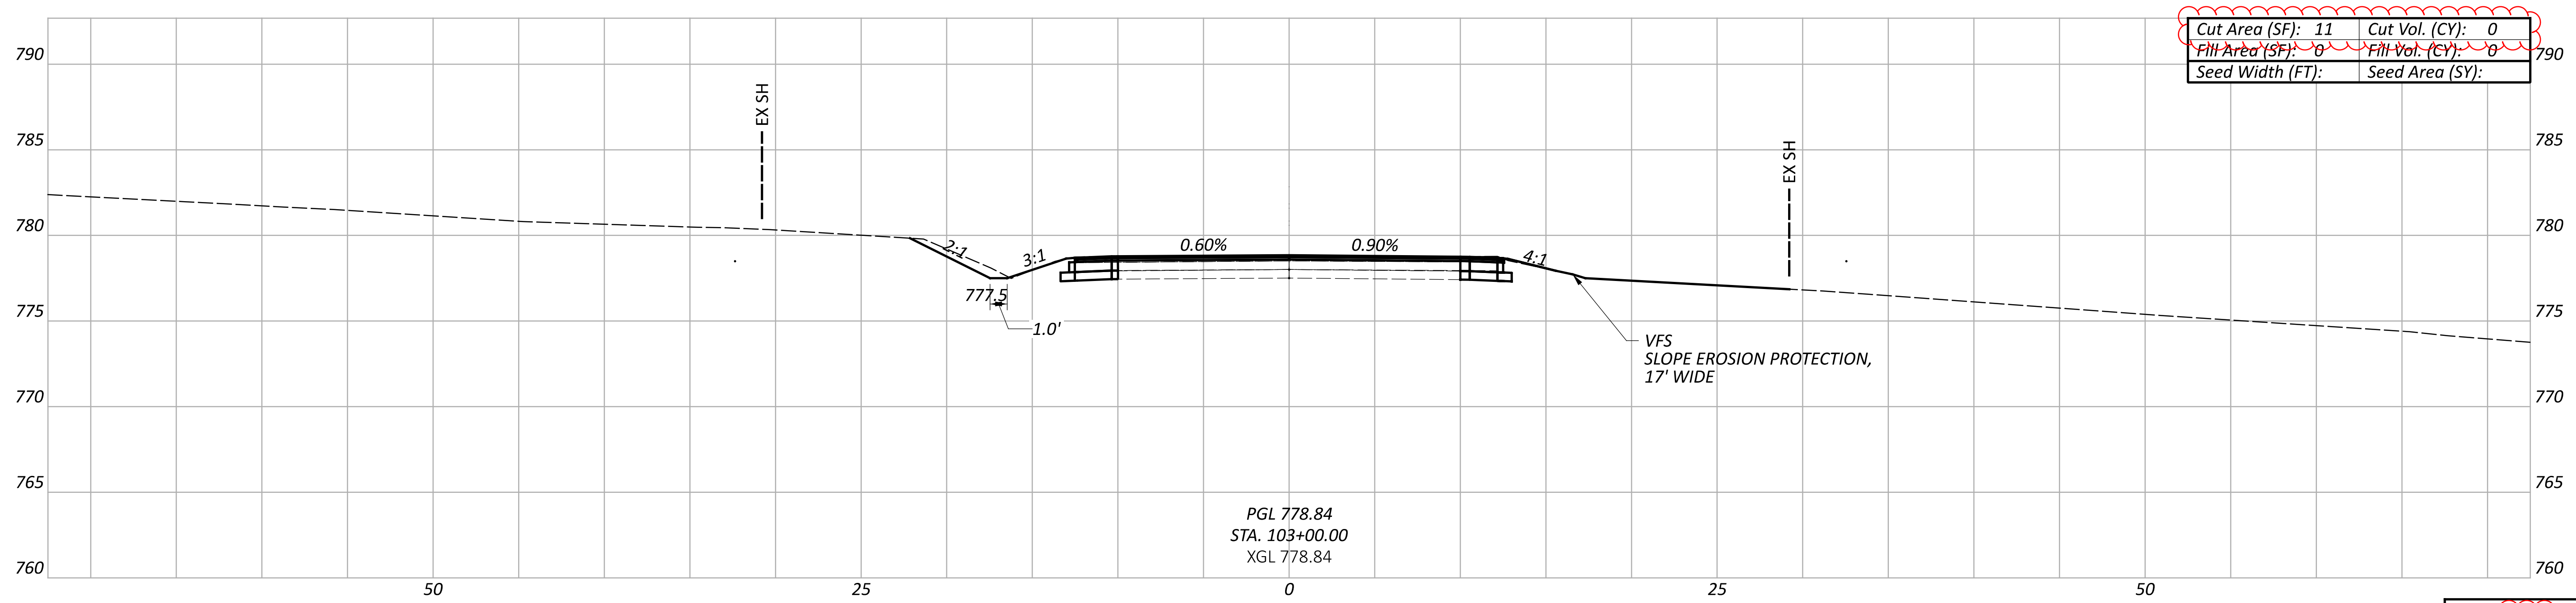

PGL 778.84  
 STA. 103+00.00  
 XGL 778.84

|              |     |      |             |
|--------------|-----|------|-------------|
| Sheet Totals |     |      | 121180      |
| Seeding      | Cut | Fill | SHEET TOTAL |
|              | 35  | 13   | P.20 43     |

CROSS SECTIONS - SR 664  
 STA. 103+00.00 TO STA. 103+50.00

DESIGN AGENCY



DESIGNER




RCW

REVIEWER

PJD 11/25/24

PROJECT ID

121180

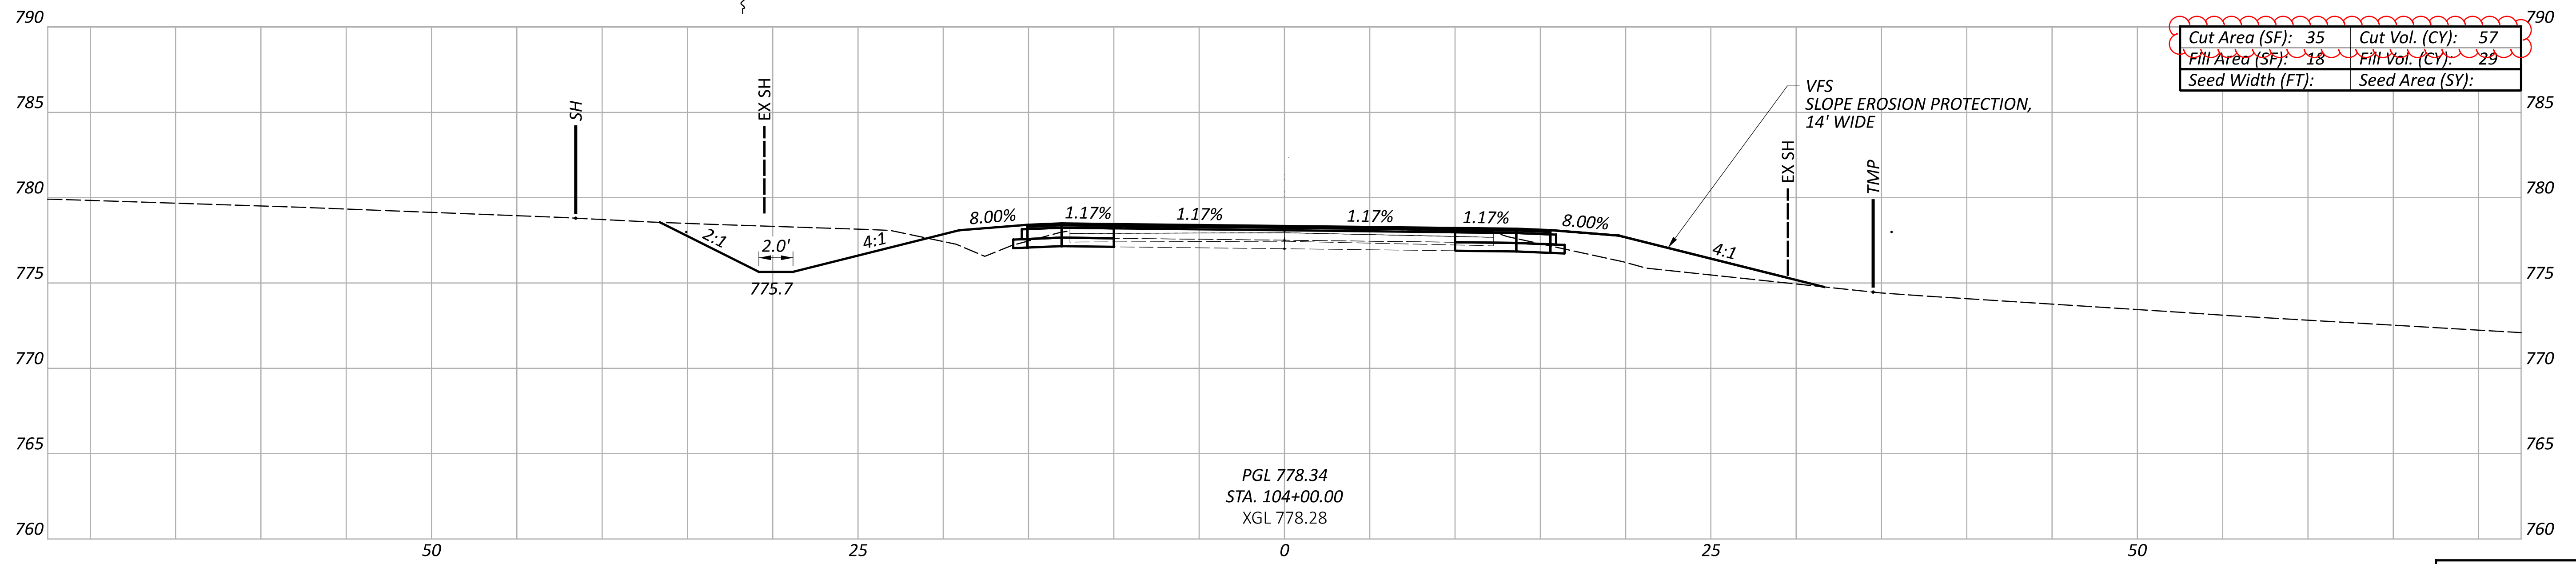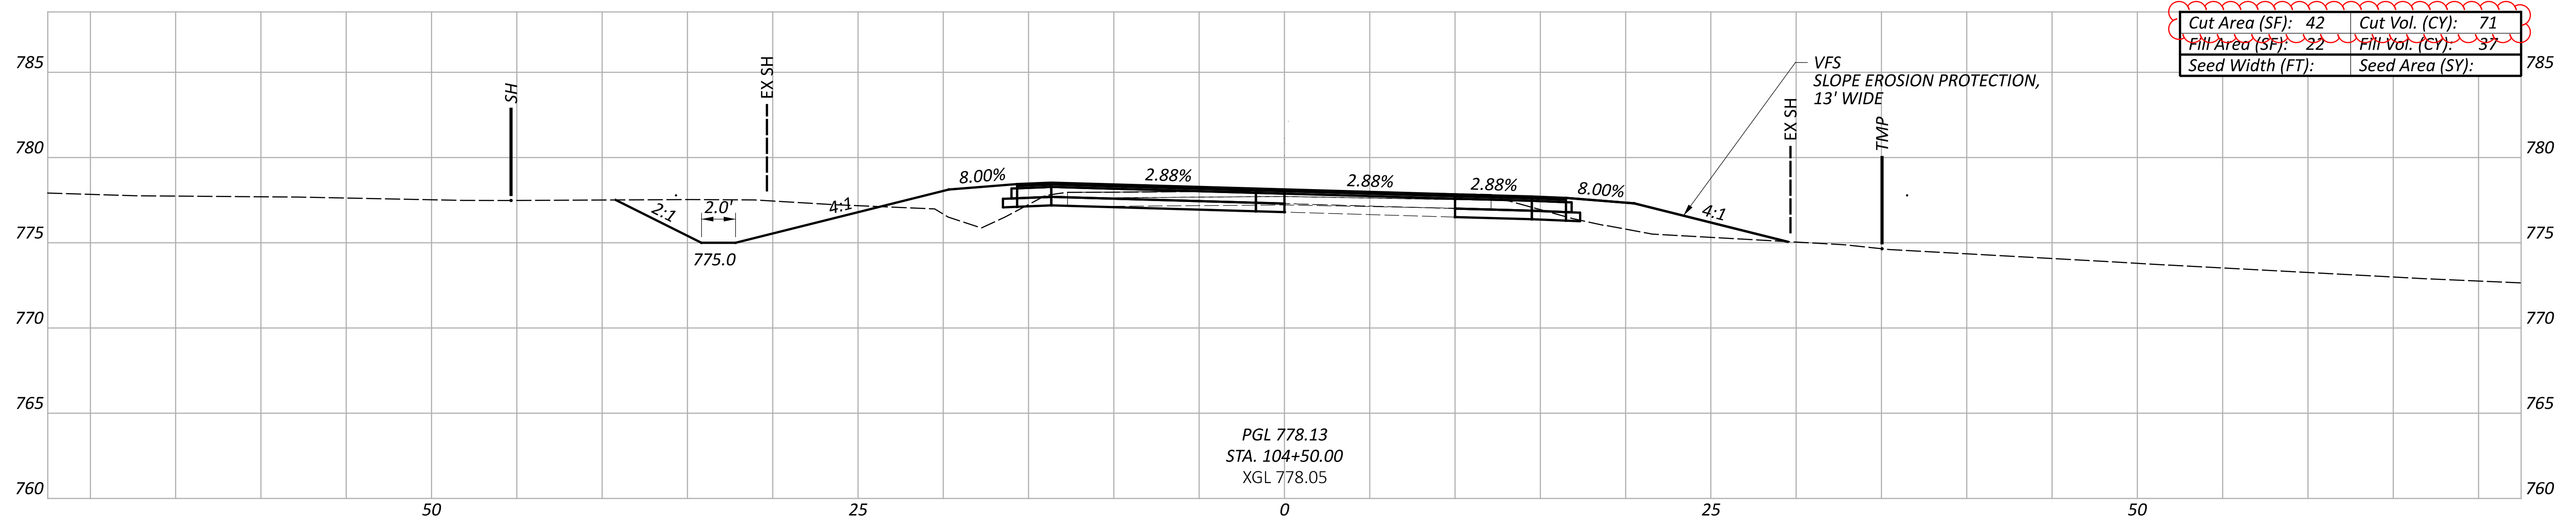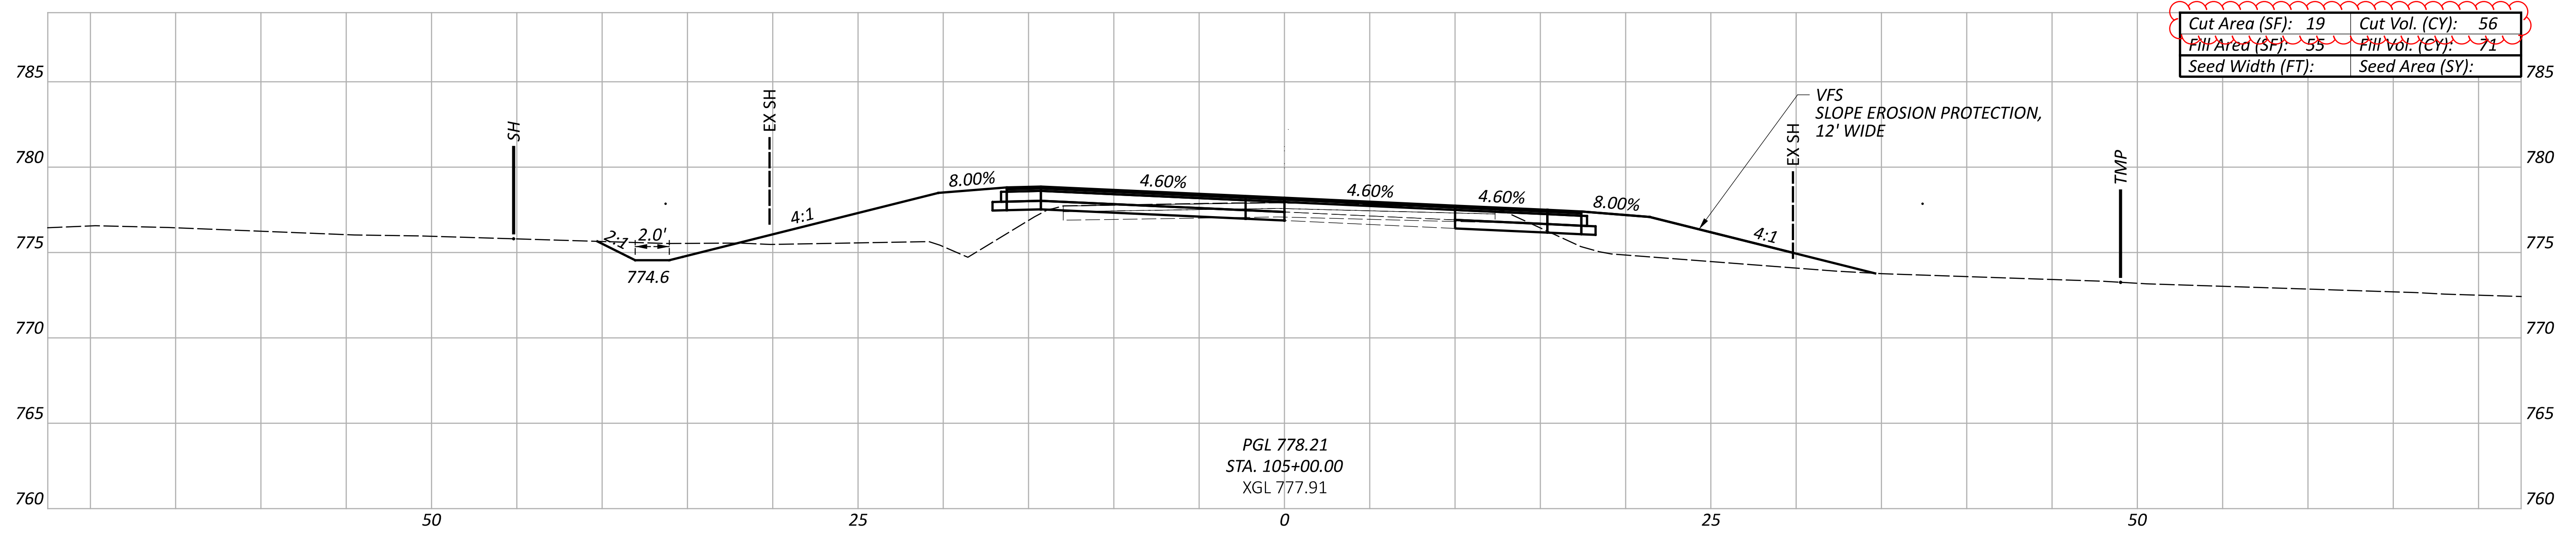

CROSS SECTIONS - SR 664  
 STA. 104+00.00 TO STA. 105+00.00

DESIGN AGENCY



DESIGNER

RCW



REVIEWER

PJD 11/25/24

PROJECT ID

121180

| Sheet Totals |     |      | SHEET TOTAL |    |
|--------------|-----|------|-------------|----|
| Seeding      | Cut | Fill | P.21        | 43 |
| 184          | 137 |      |             |    |

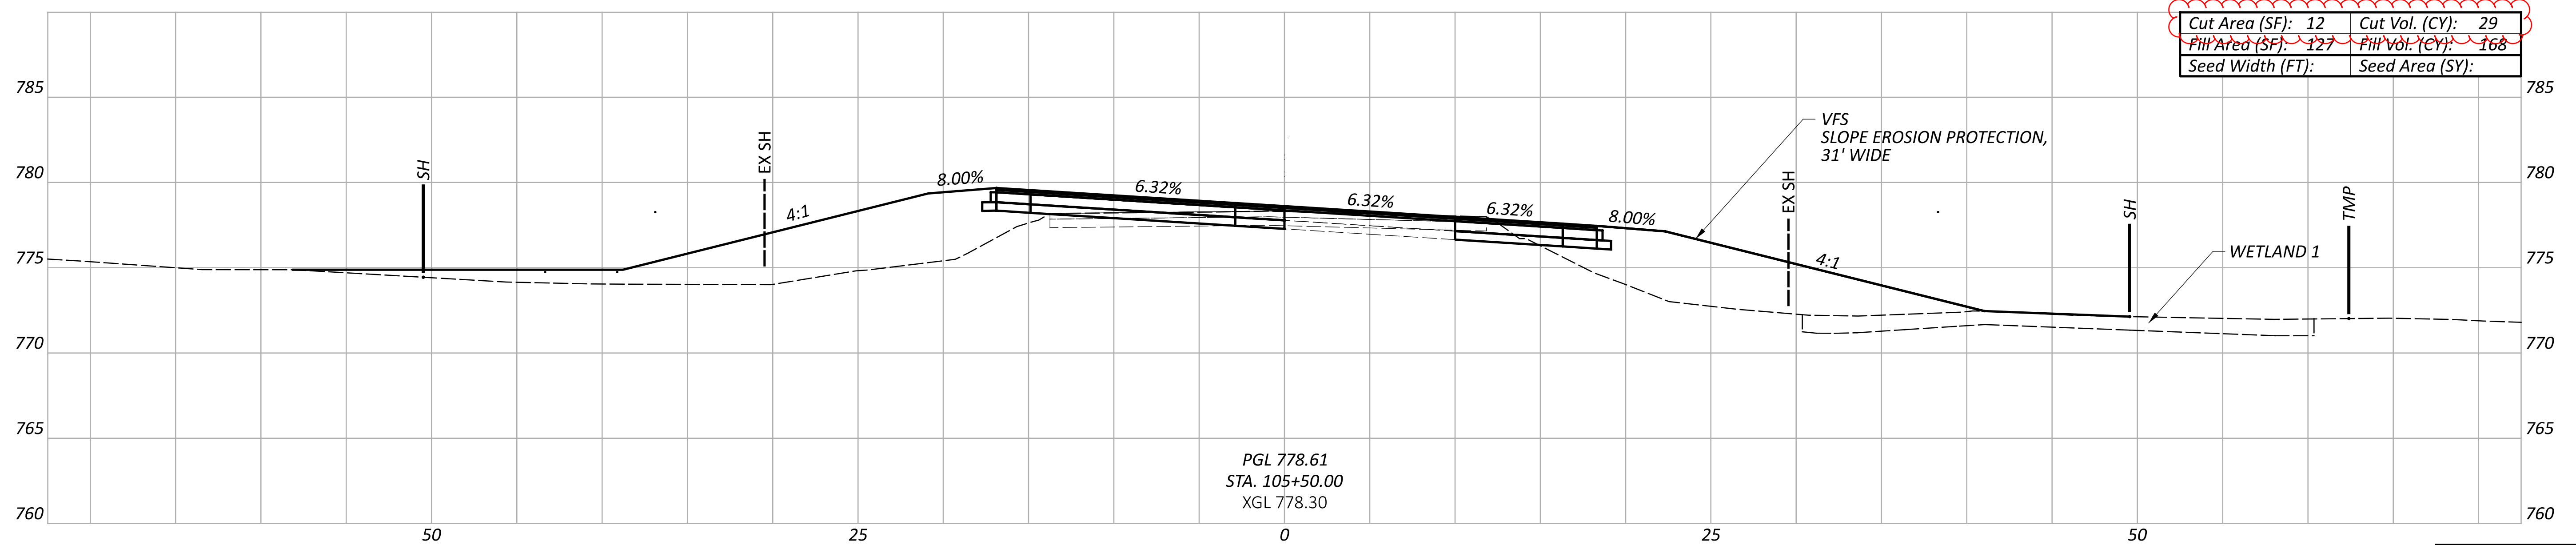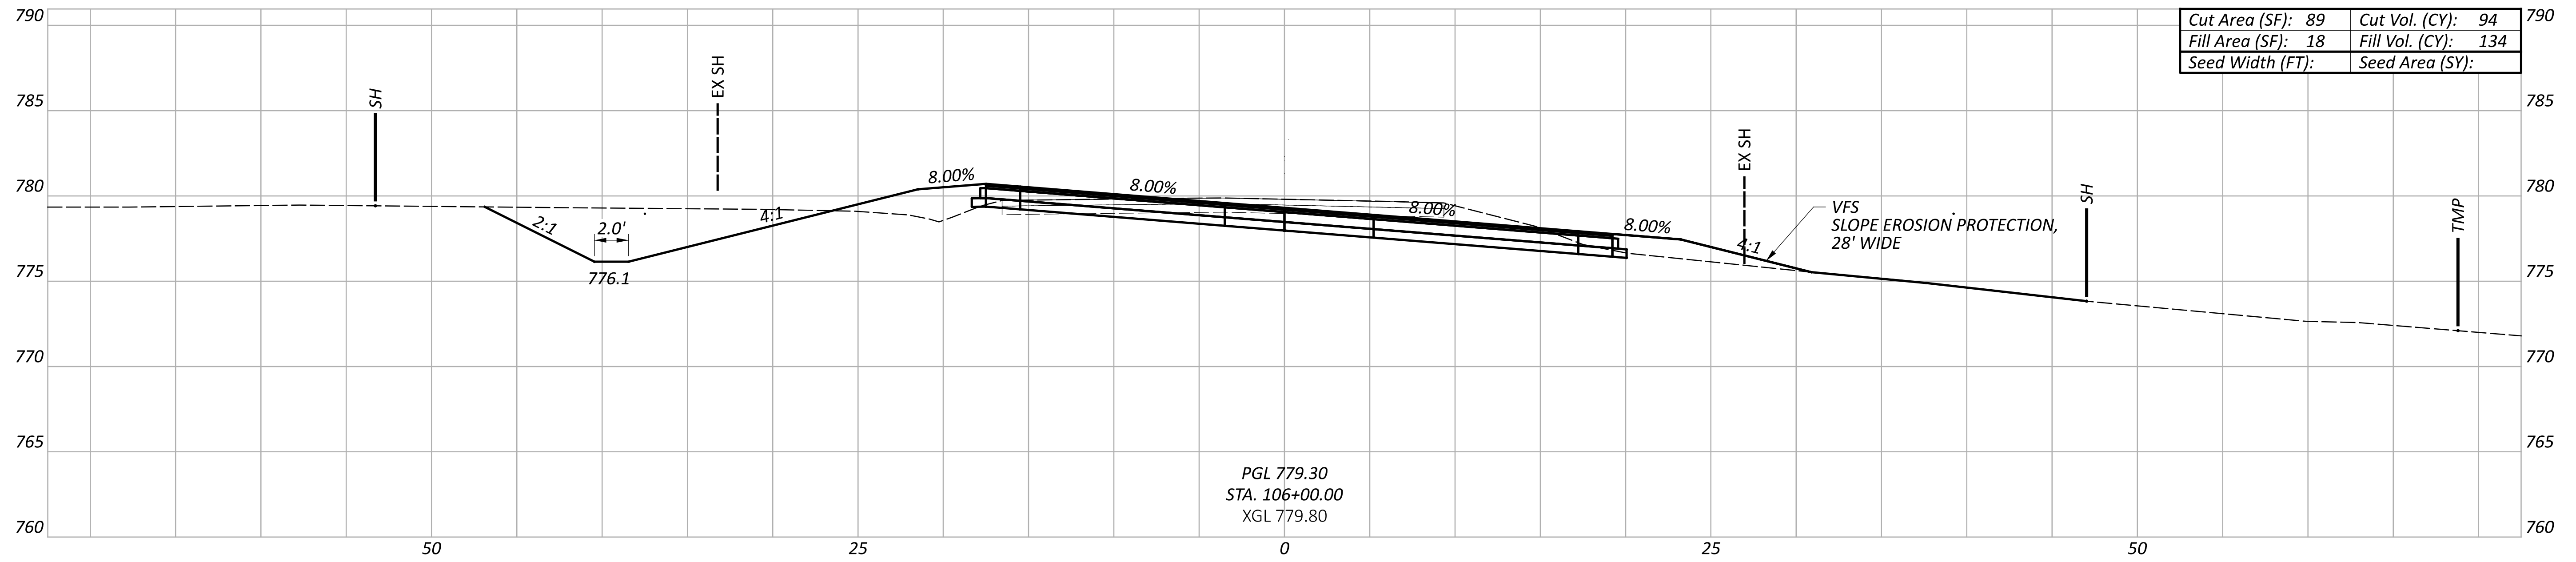

CROSS SECTIONS - SR 664  
 STA. 105+50.00 TO STA. 106+00.00

DESIGN AGENCY



DESIGNER

RCW



REVIEWER

PJD 11/25/24

PROJECT ID


121180



|              |     |      |         |
|--------------|-----|------|---------|
| Sheet Totals |     |      | 121180  |
| Seeding      | Cut | Fill | TOTAL   |
| 123          | 302 |      | P.22 43 |

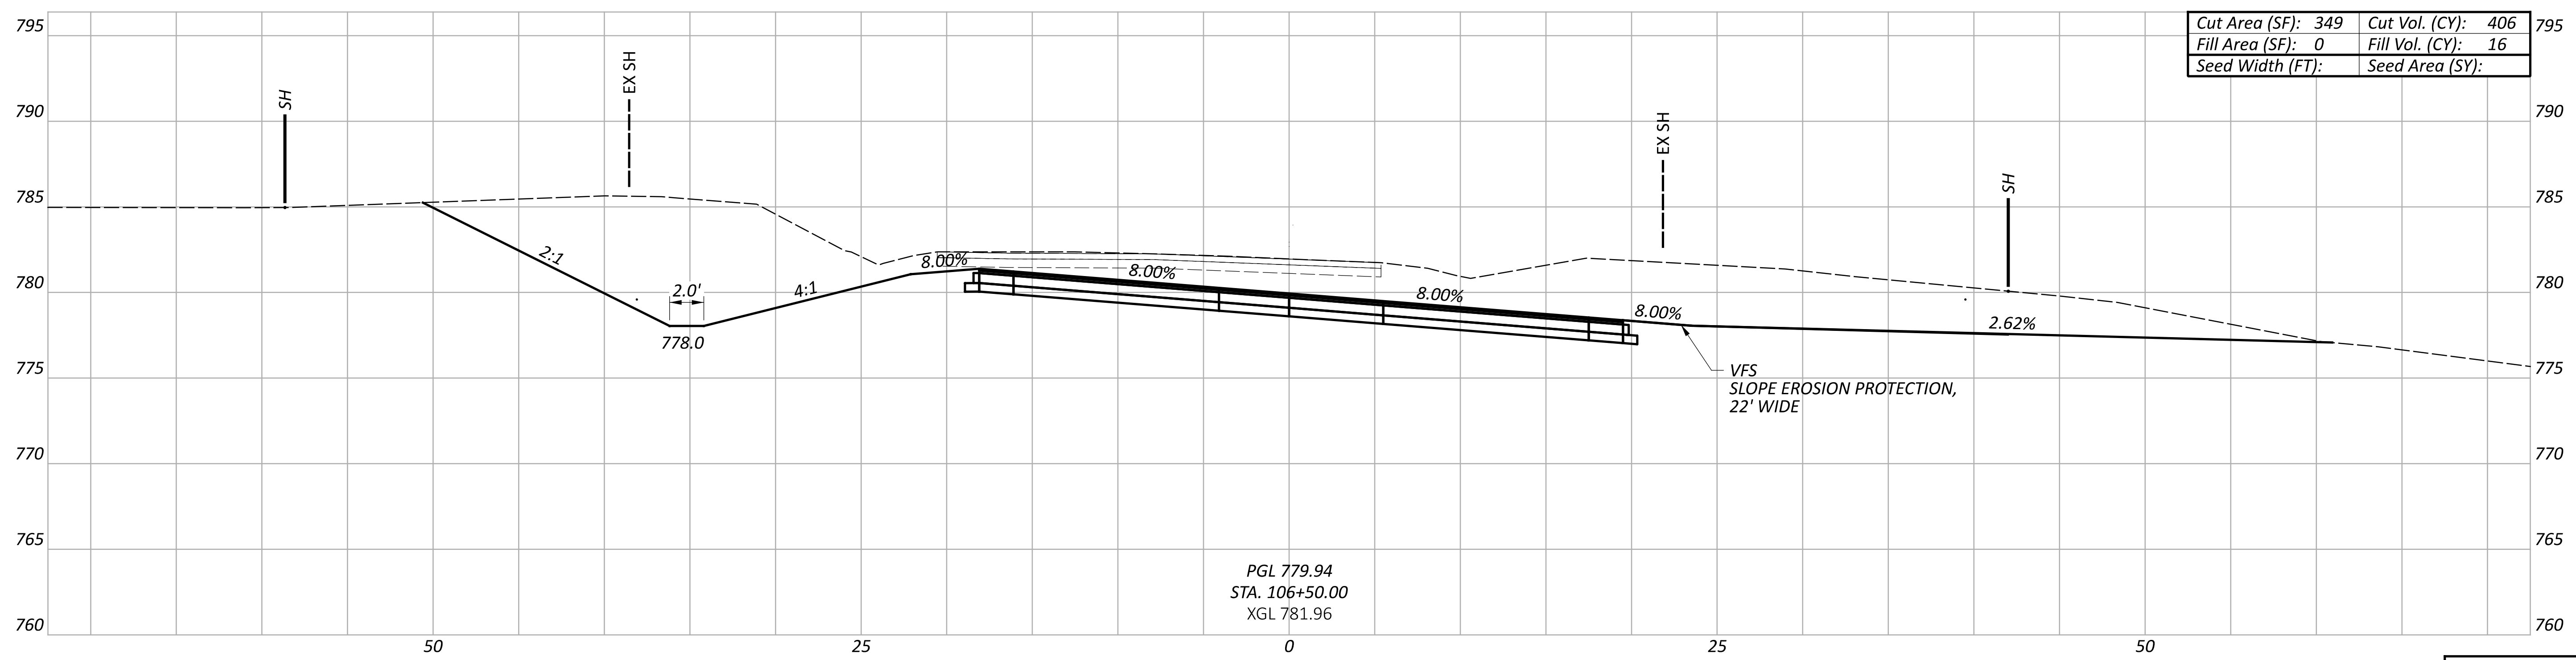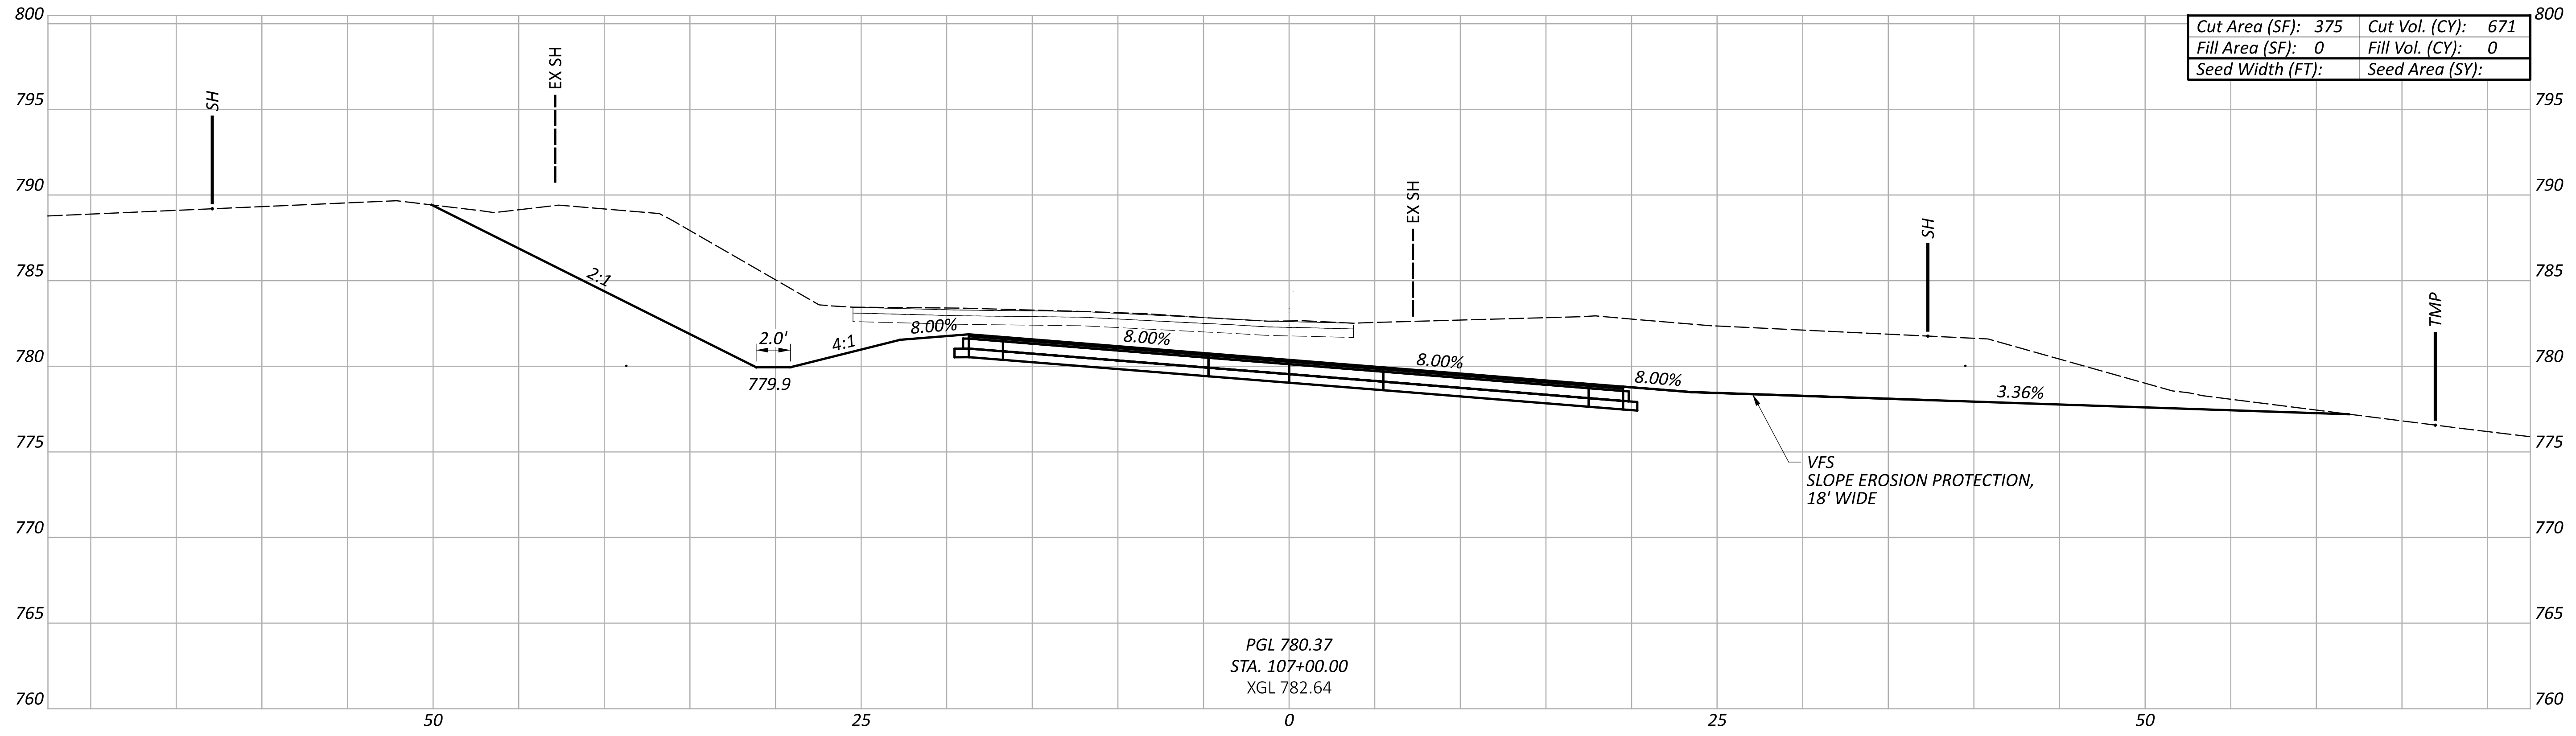

|              |     |      |        |
|--------------|-----|------|--------|
| Sheet Totals |     |      | 121180 |
| Seeding      | Cut | Fill | TOTAL  |
| 1077         | 16  |      | 43     |

CROSS SECTIONS - SR 664  
 STA. 106+50.00 TO STA. 107+00.00

DESIGN AGENCY  
  
 DESIGNER  
 RCW  
 REVIEWER  
 PJD 11/25/24  
 PROJECT ID  
 121180

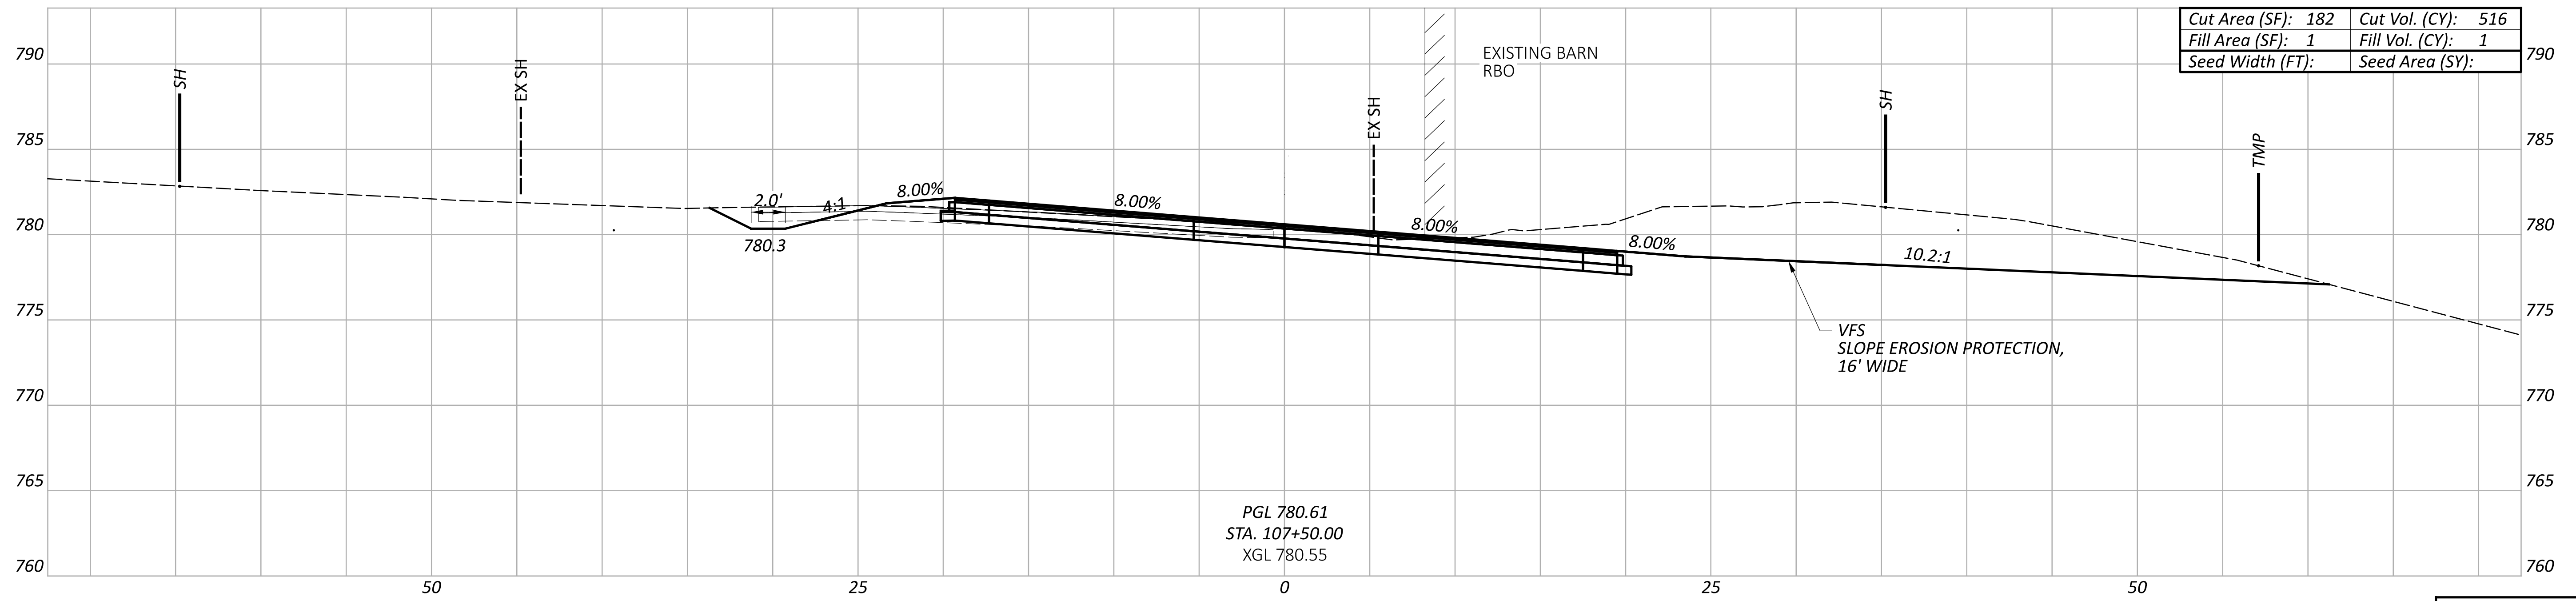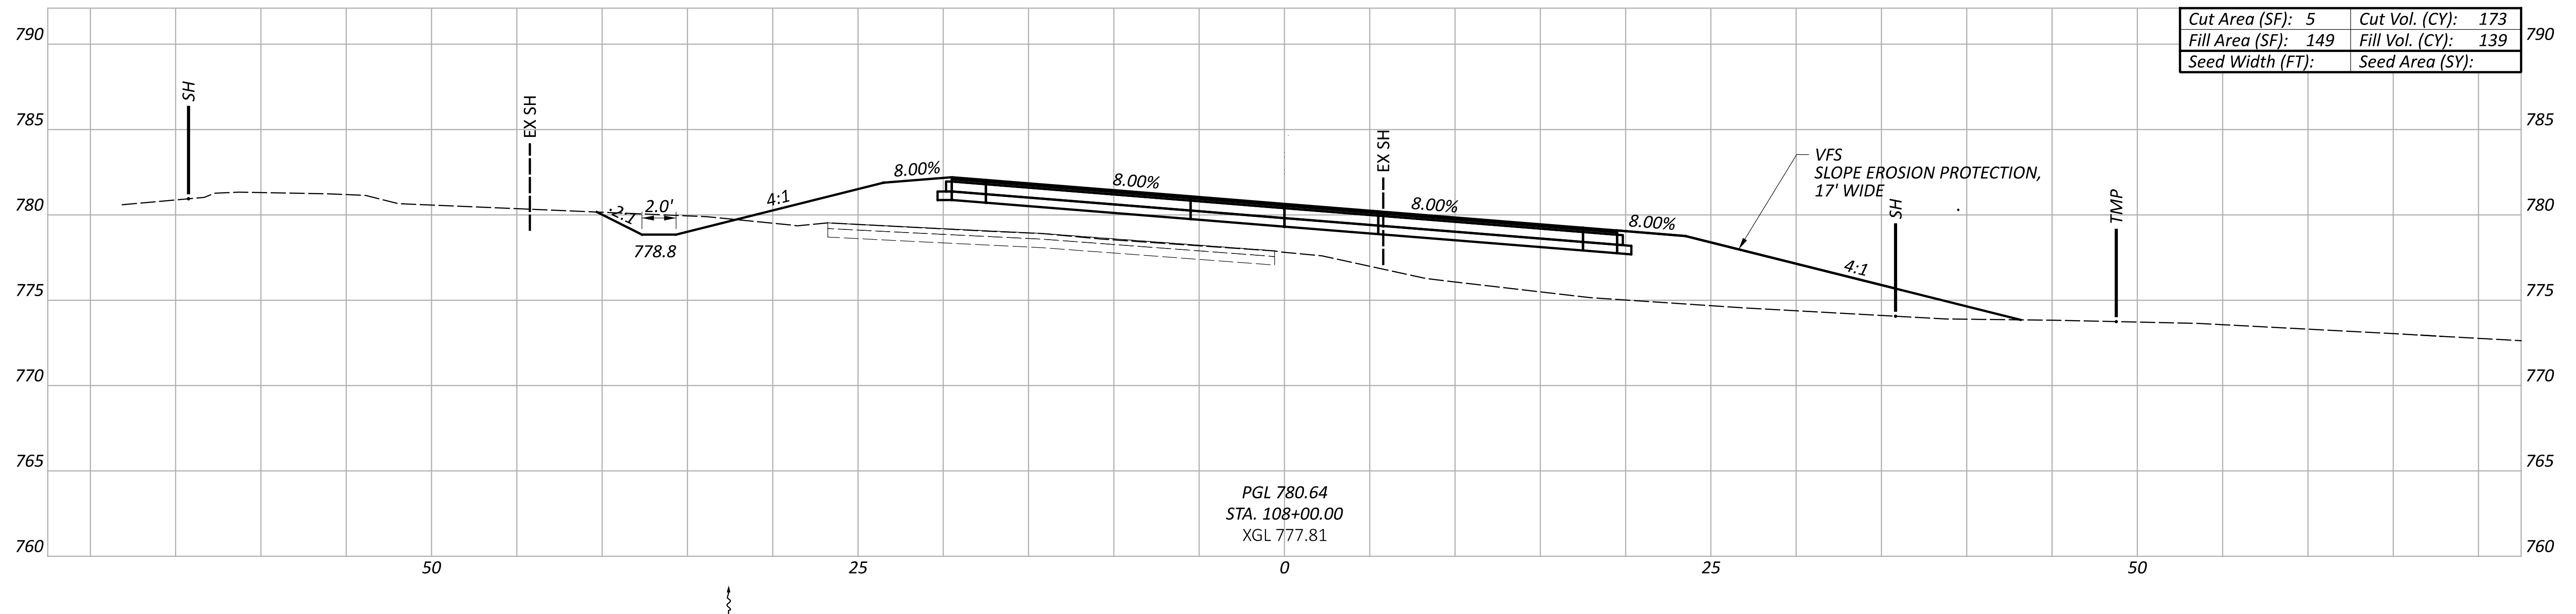

| Sheet Totals |     |      | 121180 |       |
|--------------|-----|------|--------|-------|
| Seeding      | Cut | Fill | SHEET  | TOTAL |
| 689          | 140 |      | P.24   | 43    |



CROSS SECTIONS - SR 664  
STA. 107+50.00 TO STA. 108+00.00

DESIGN AGENCY

DESIGNER  
**RCW**

REVIEWER  
PJD 11/25/24

PROJECT ID  
121180

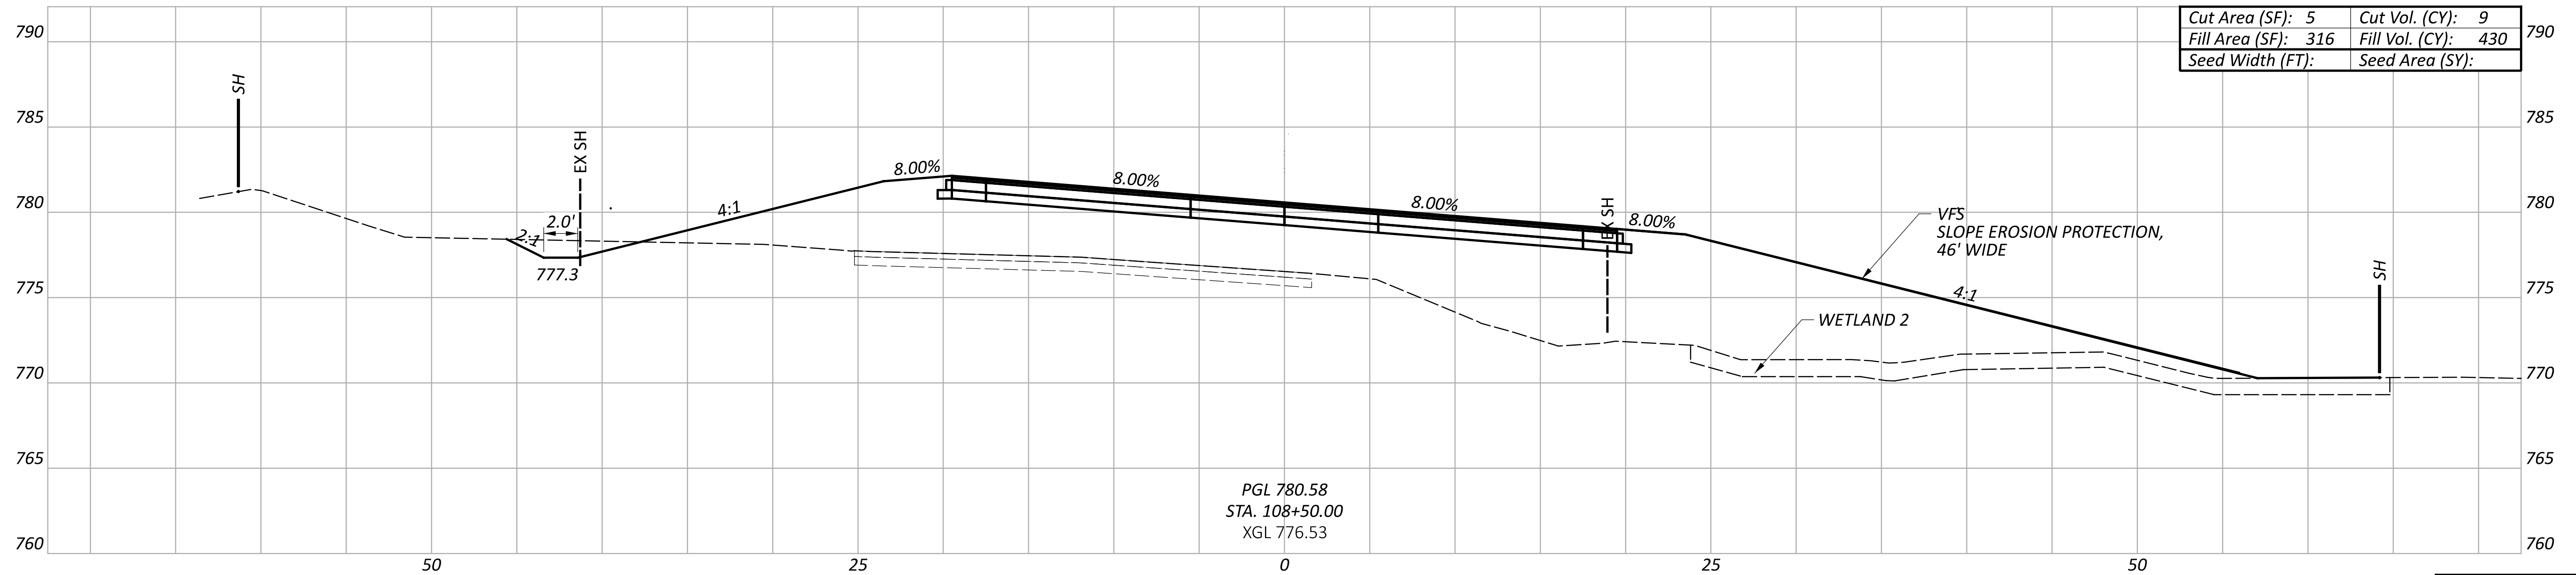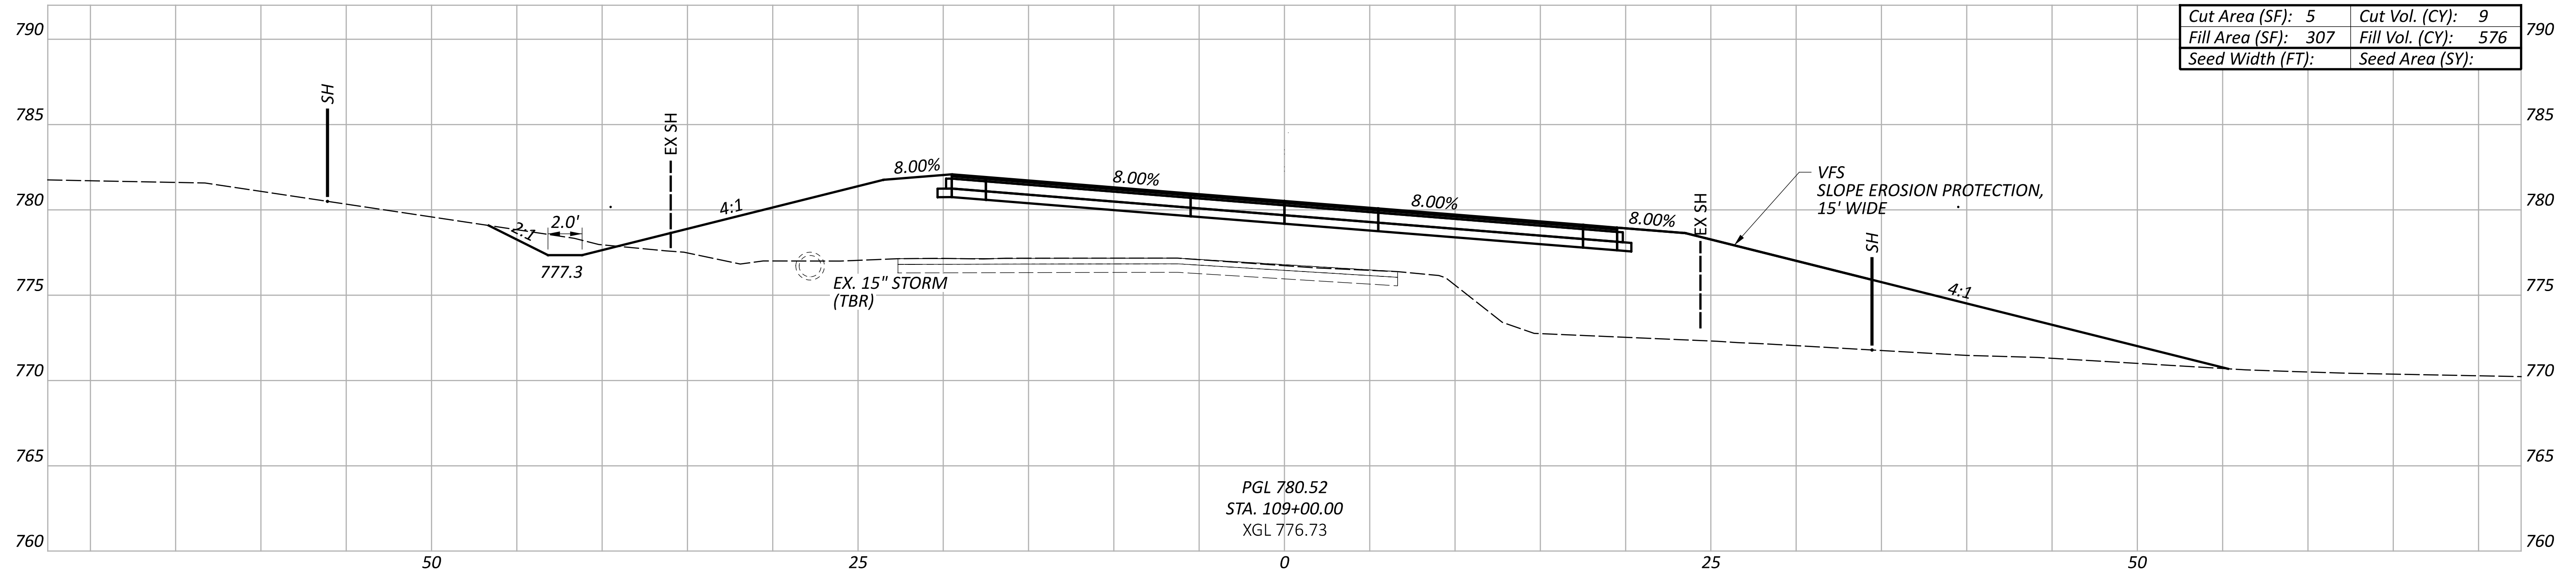

CROSS SECTIONS - SR 664  
 STA. 108+50.00 TO STA. 109+00.00

DESIGN AGENCY



DESIGNER

RCW

REVIEWER



PJD 11/25/24

PROJECT ID

121180

|              |      |      |         |
|--------------|------|------|---------|
| Sheet Totals |      |      | 121180  |
| Seeding      | Cut  | Fill | TOTAL   |
| 18           | 1006 |      | P.25 43 |



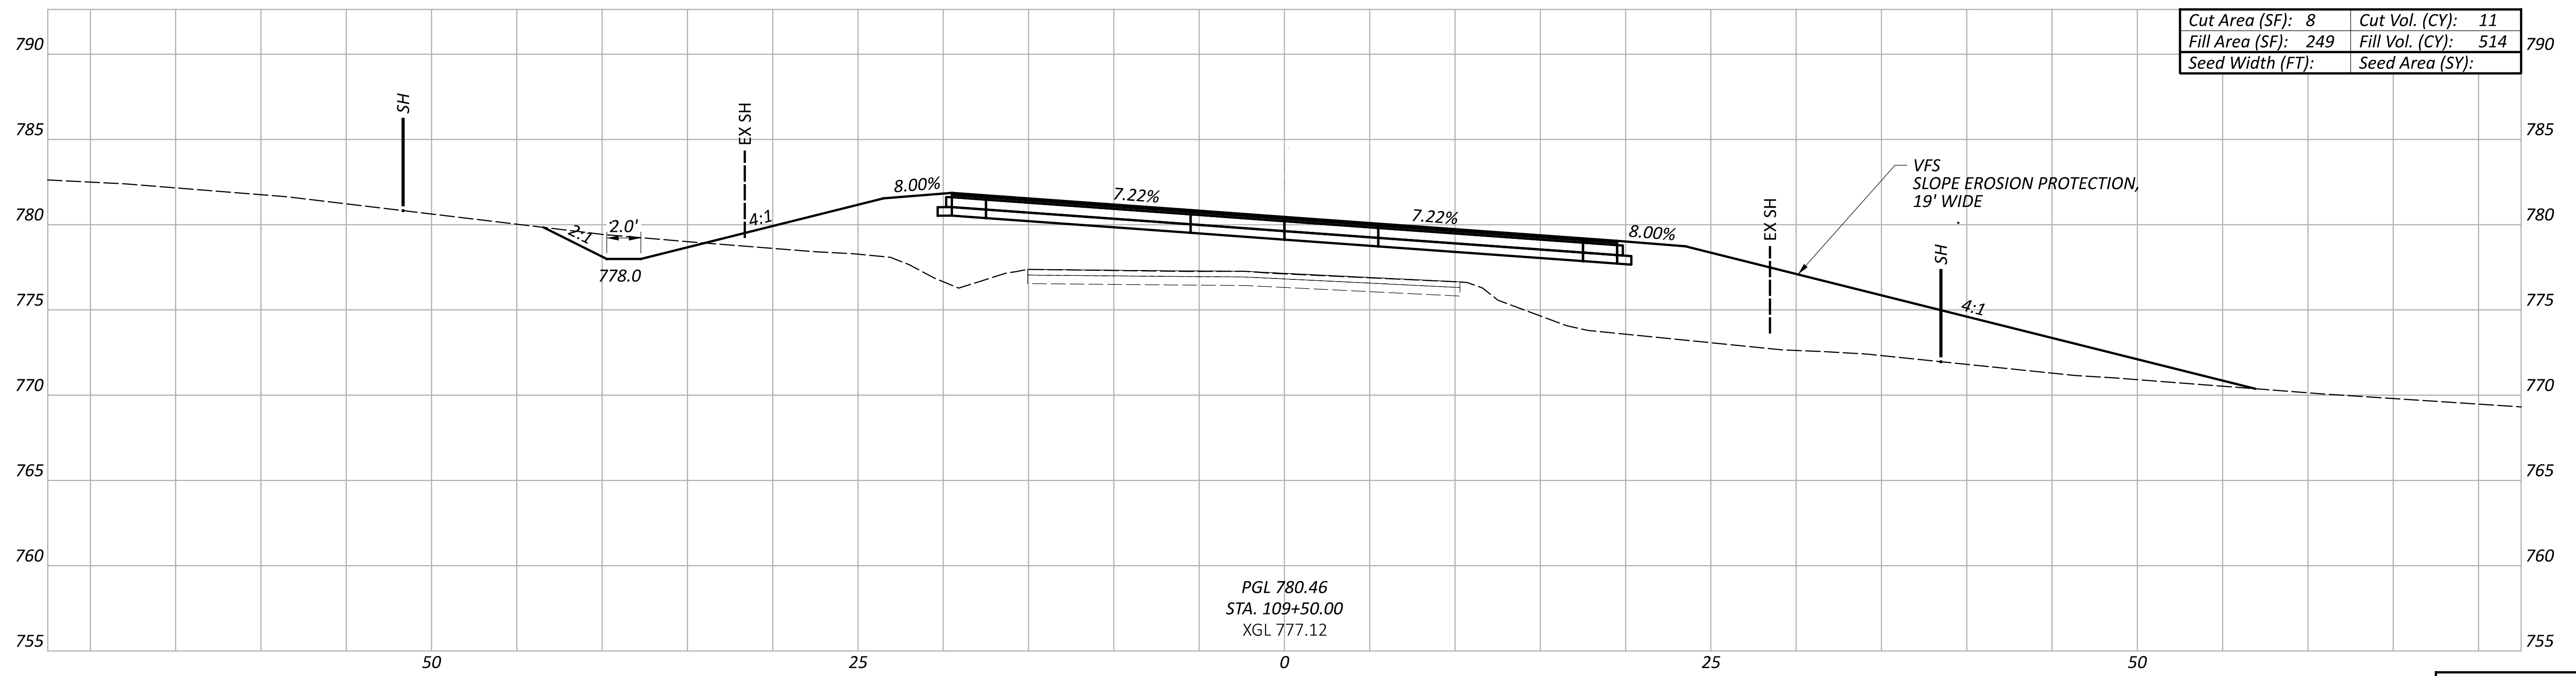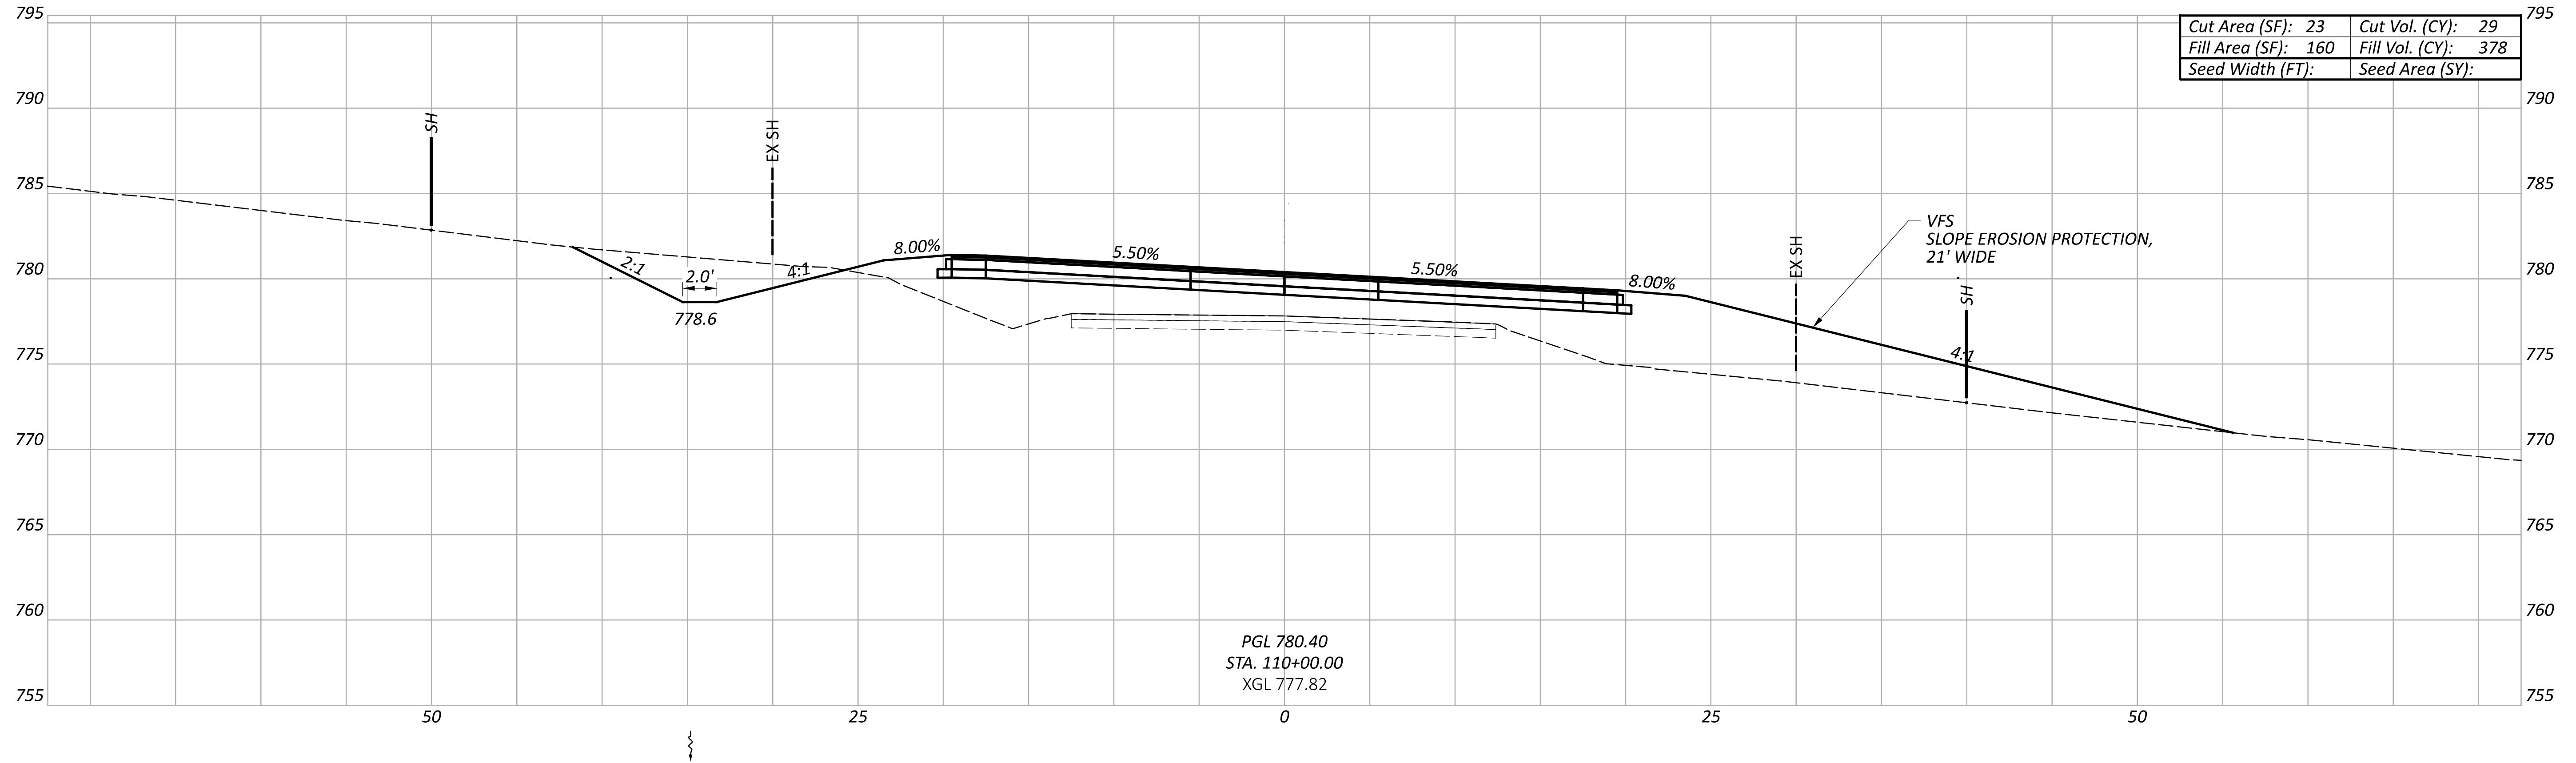

CROSS SECTIONS - SR 664  
 STA. 109+50.00 TO STA. 110+00.00



DESIGN AGENCY



DESIGNER  
 RCW  
 REVIEWER  
 PJD 11/25/24

PROJECT ID  
 121180


| Sheet Totals |     |      | SHEET TOTAL |    |
|--------------|-----|------|-------------|----|
| Seeding      | Cut | Fill | P.26        | 43 |
|              | 40  | 892  |             |    |

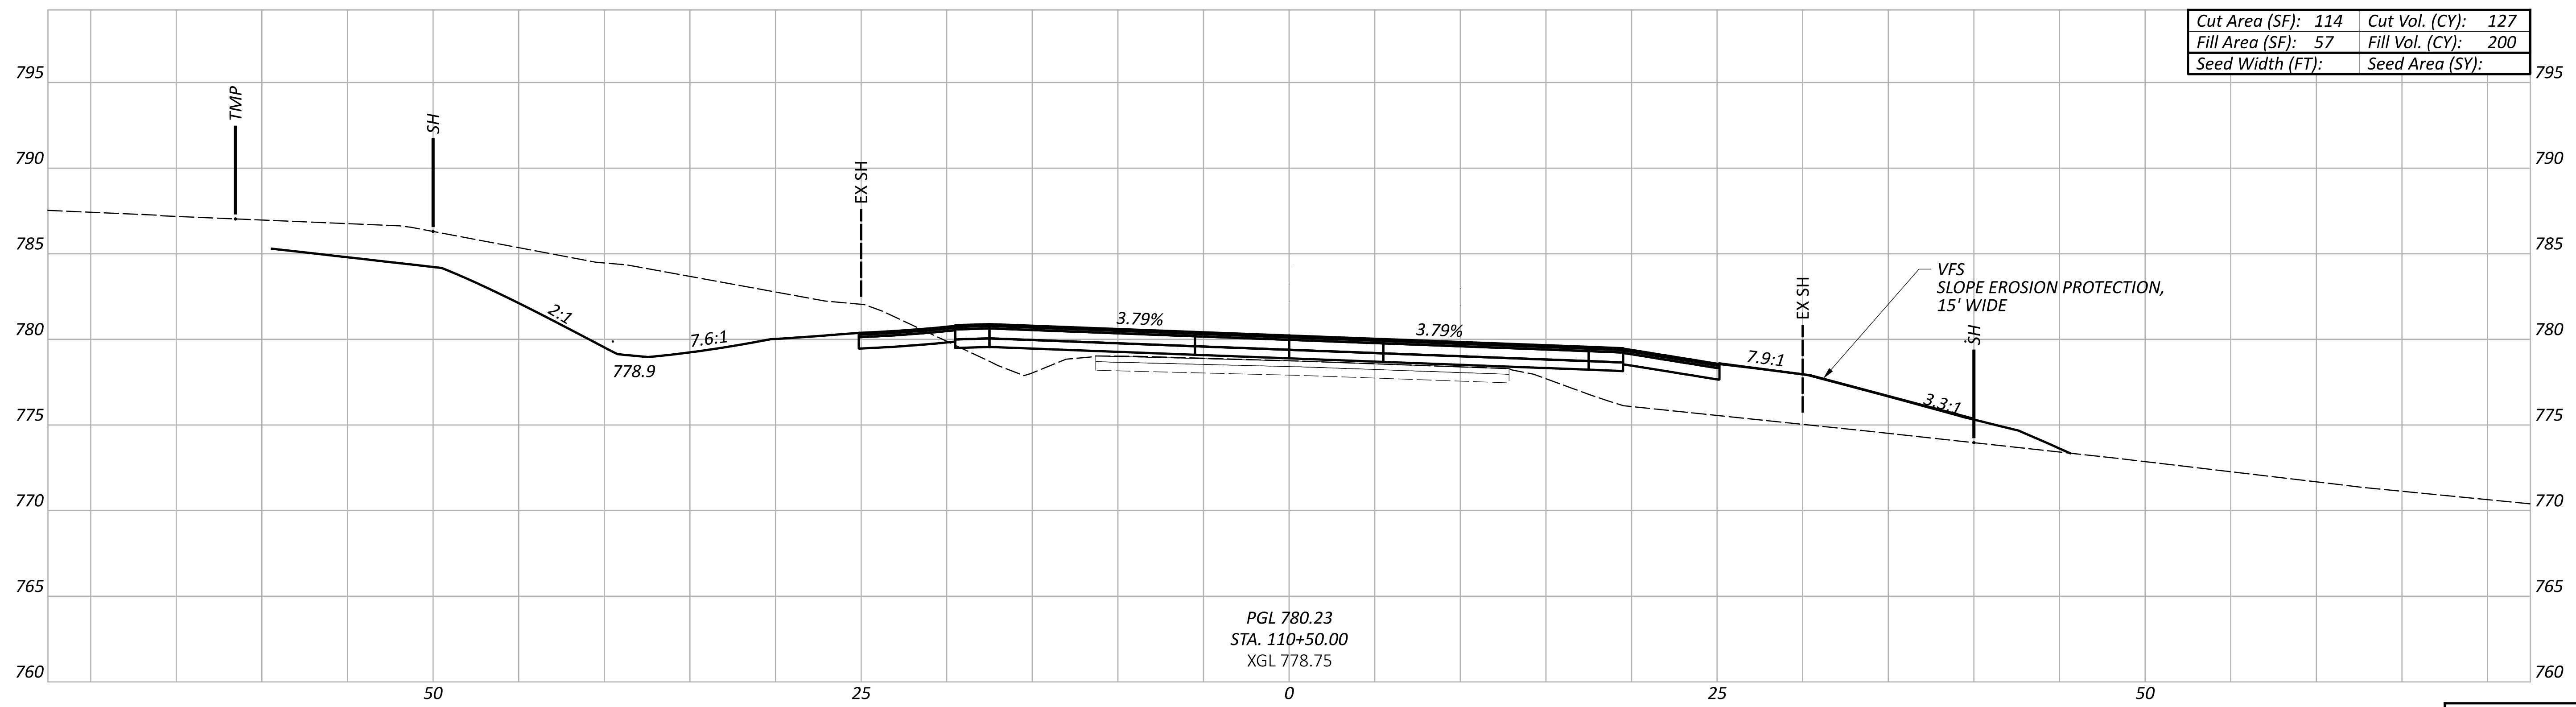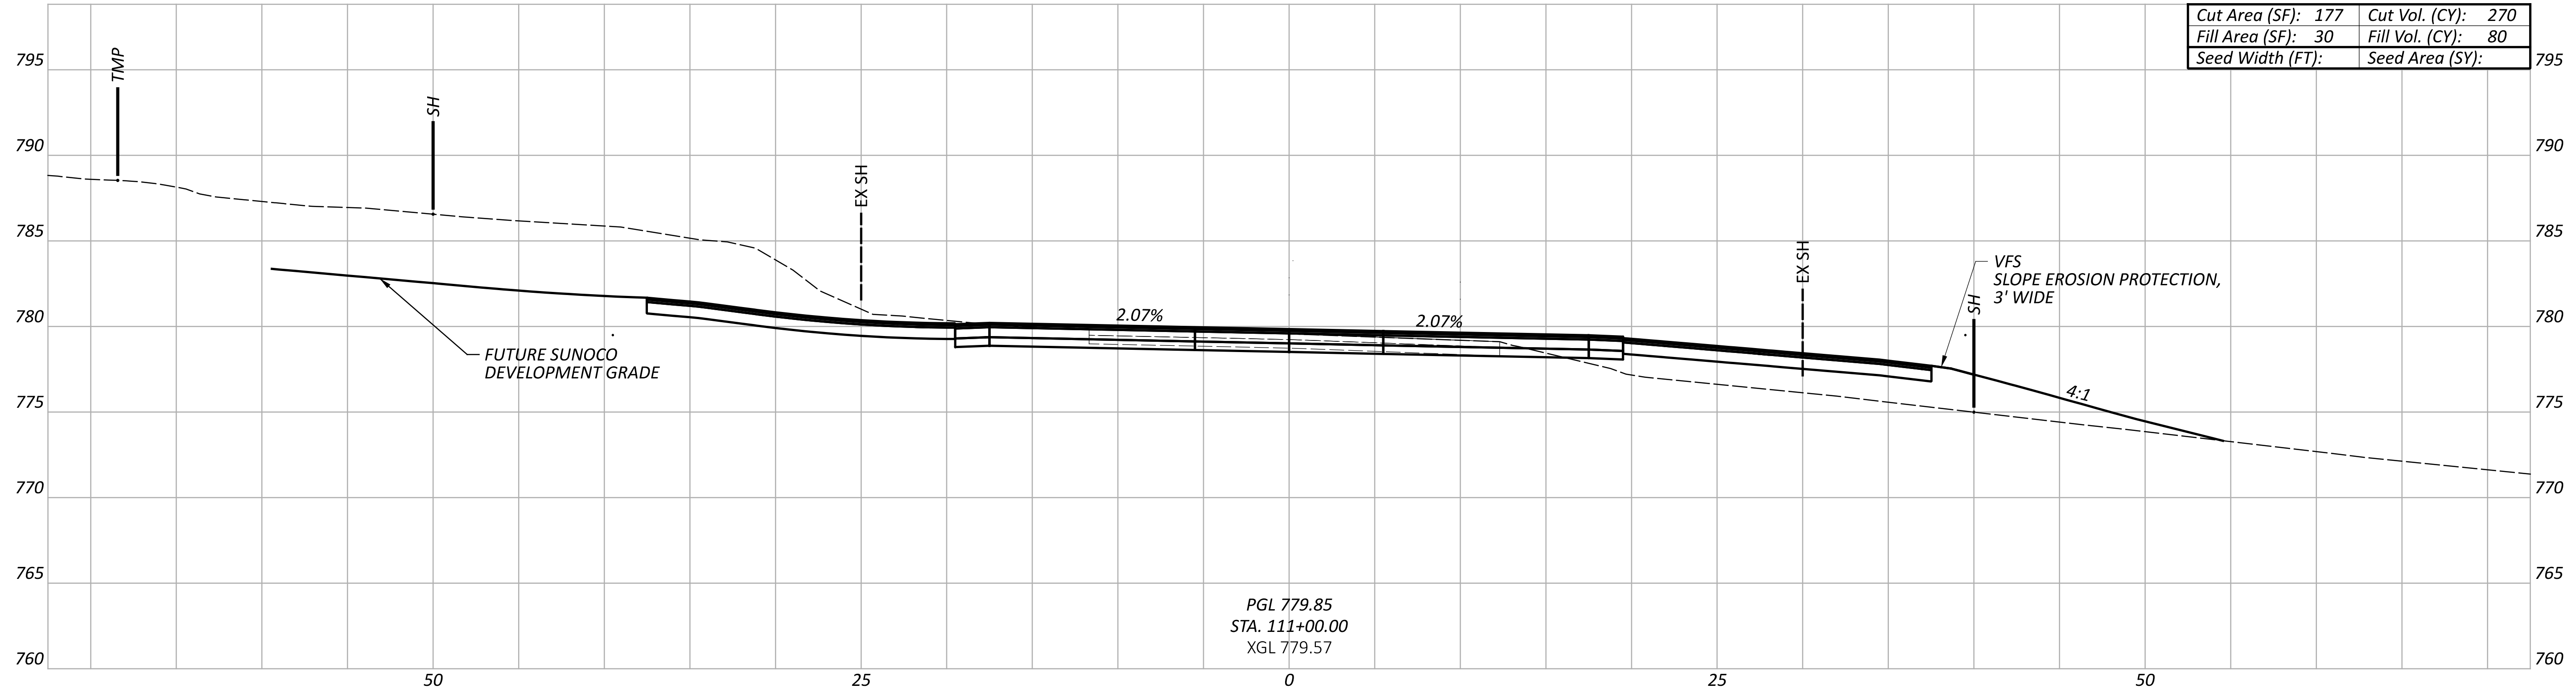



|              |     |      |        |       |
|--------------|-----|------|--------|-------|
| Sheet Totals |     |      | 121180 |       |
| Seeding      | Cut | Fill | SHEET  | TOTAL |
|              | 397 | 280  | P.27   | 43    |

CROSS SECTIONS - SR 664  
 STA. 110+50.00 TO STA. 111+00.00

DESIGN AGENCY



DESIGNER  
 RCW  
 REVIEWER  
 PJD 11/25/24  
 PROJECT ID  
 121180

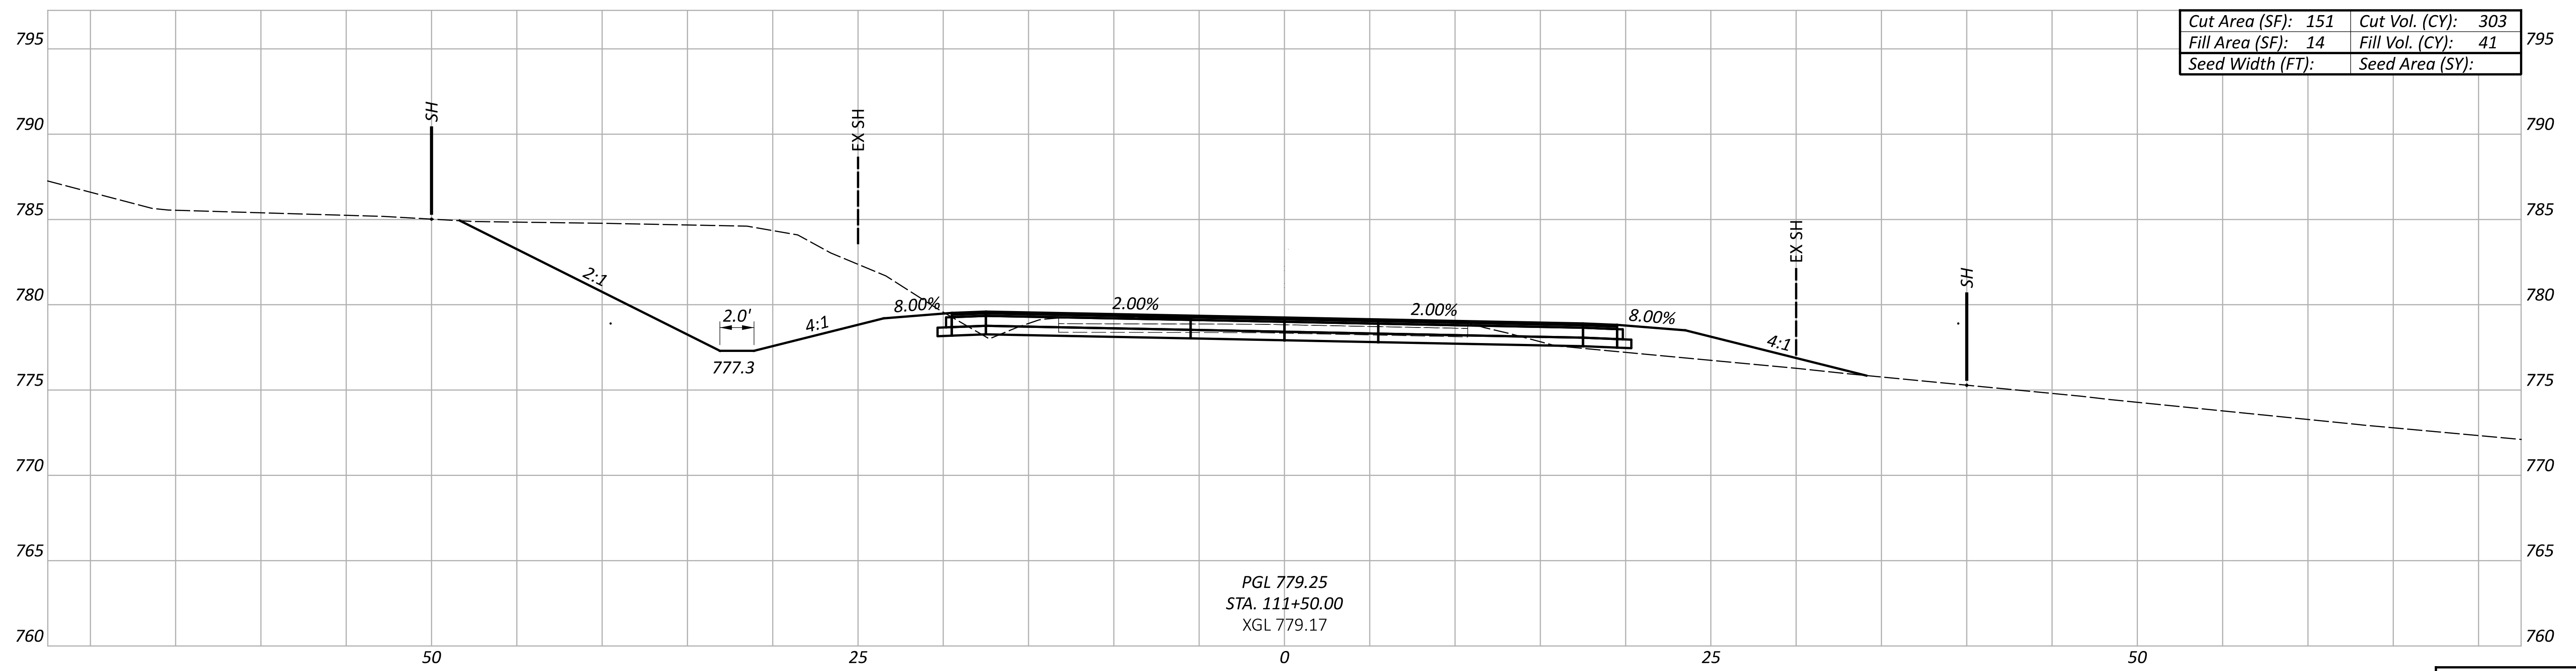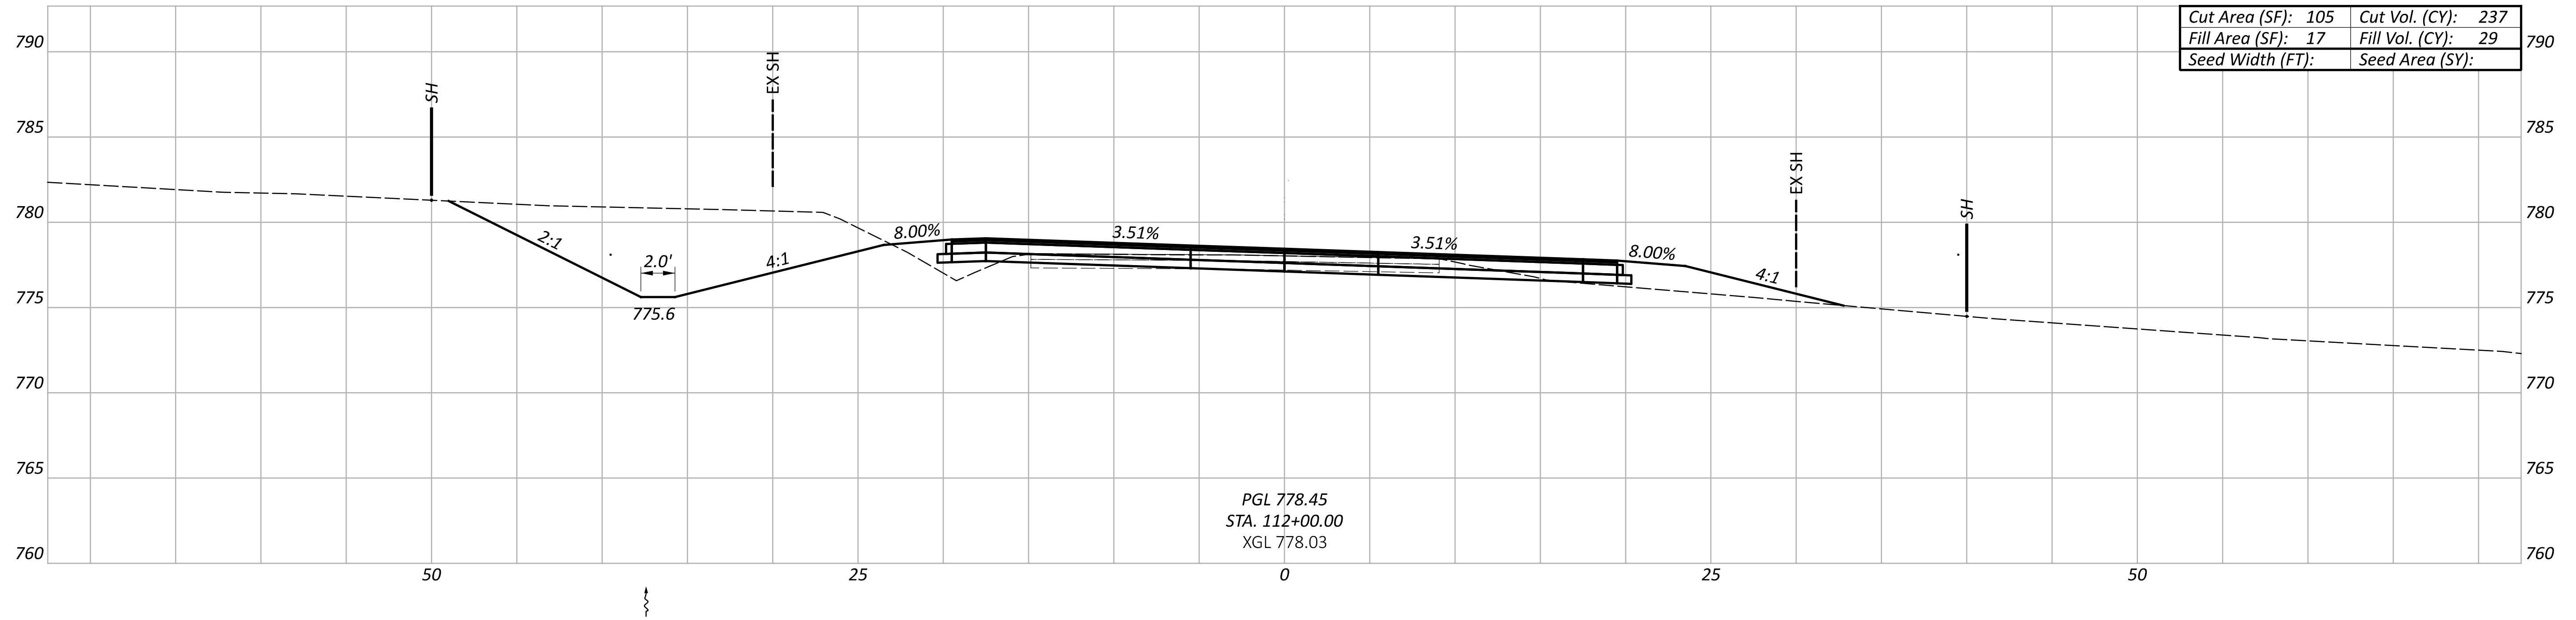

|              |     |      |           |
|--------------|-----|------|-----------|
| Sheet Totals |     |      | 121180    |
| Seeding      | Cut | Fill | TOTAL     |
|              | 540 | 70   | P.28   43 |

DESIGN AGENCY



DESIGNER

RCW

REVIEWER

PJD 11/25/24




PROJECT ID

121180

SHEET

P.28 | 43

CROSS SECTIONS - SR 664  
 STA. 111+50.00 TO STA. 112+00.00

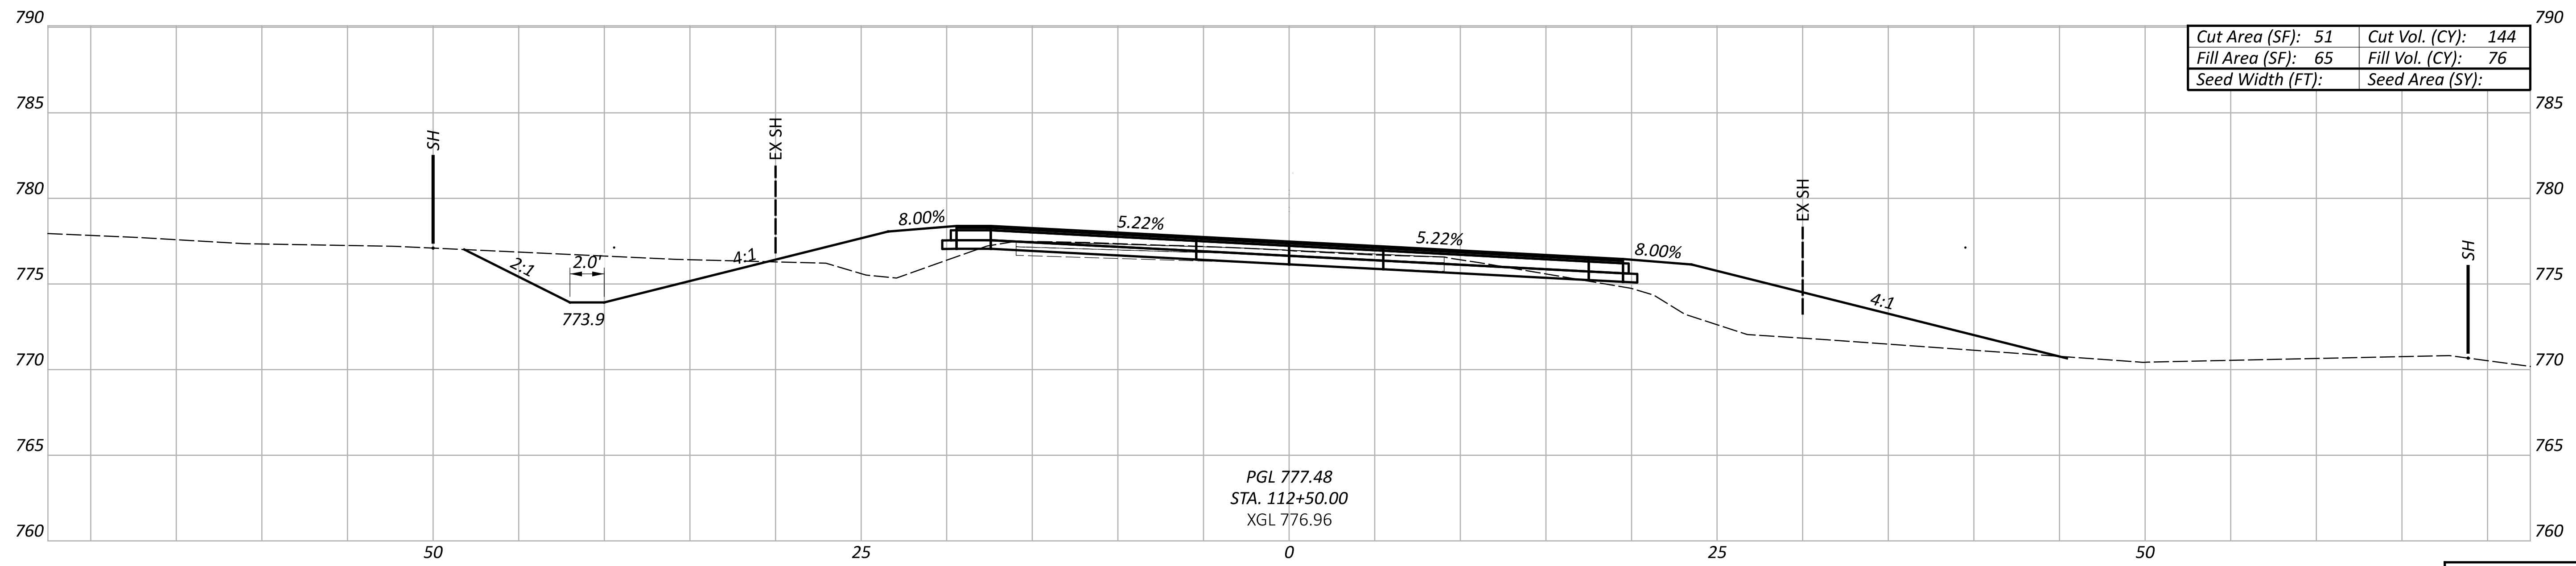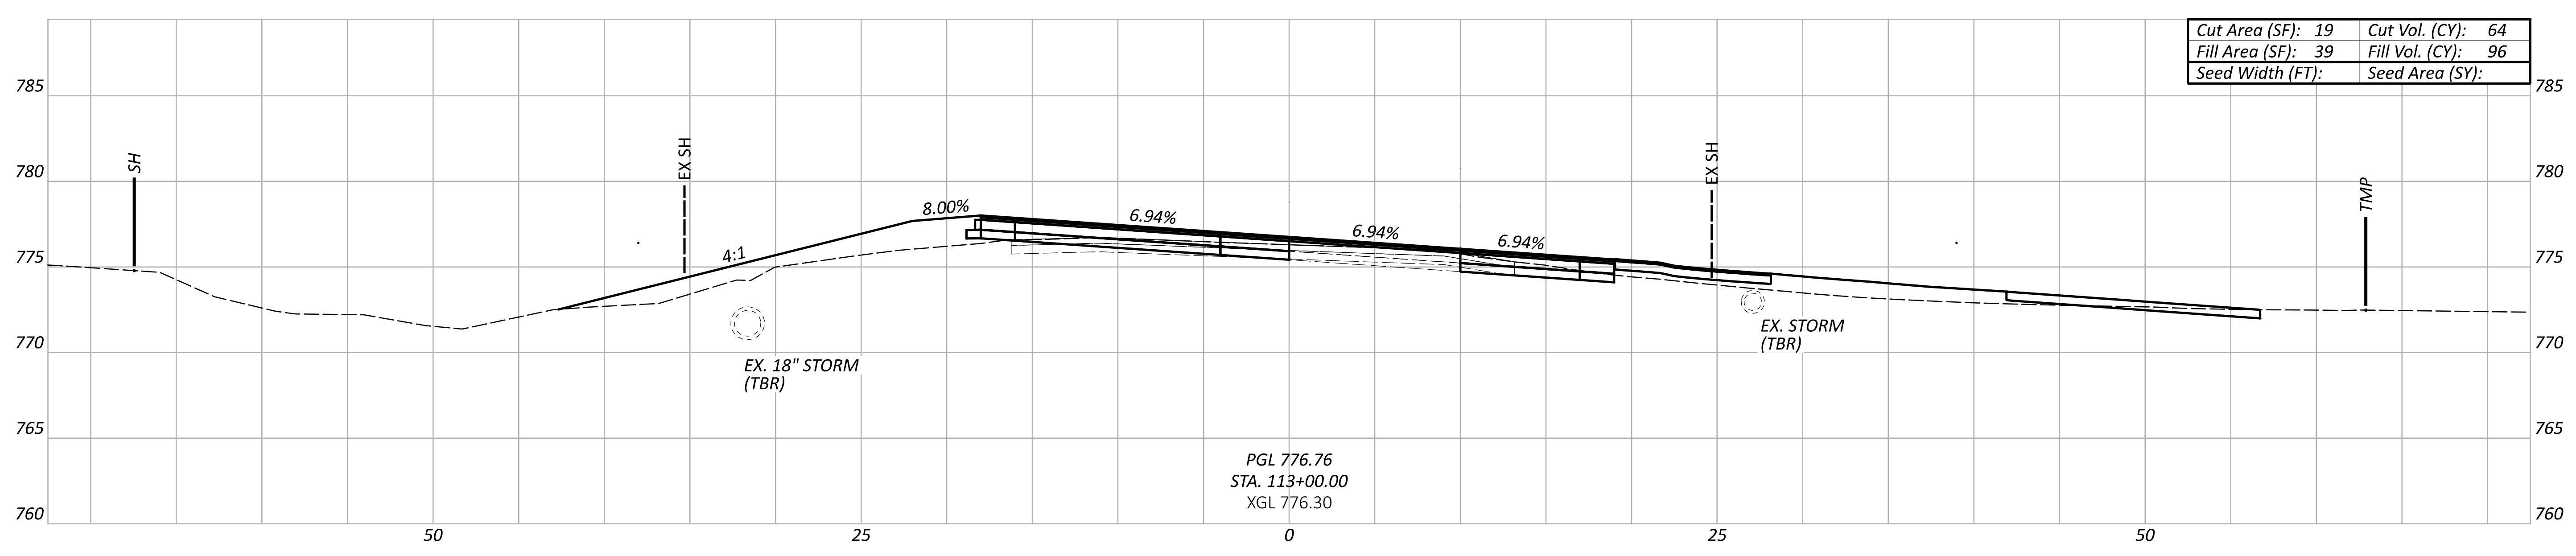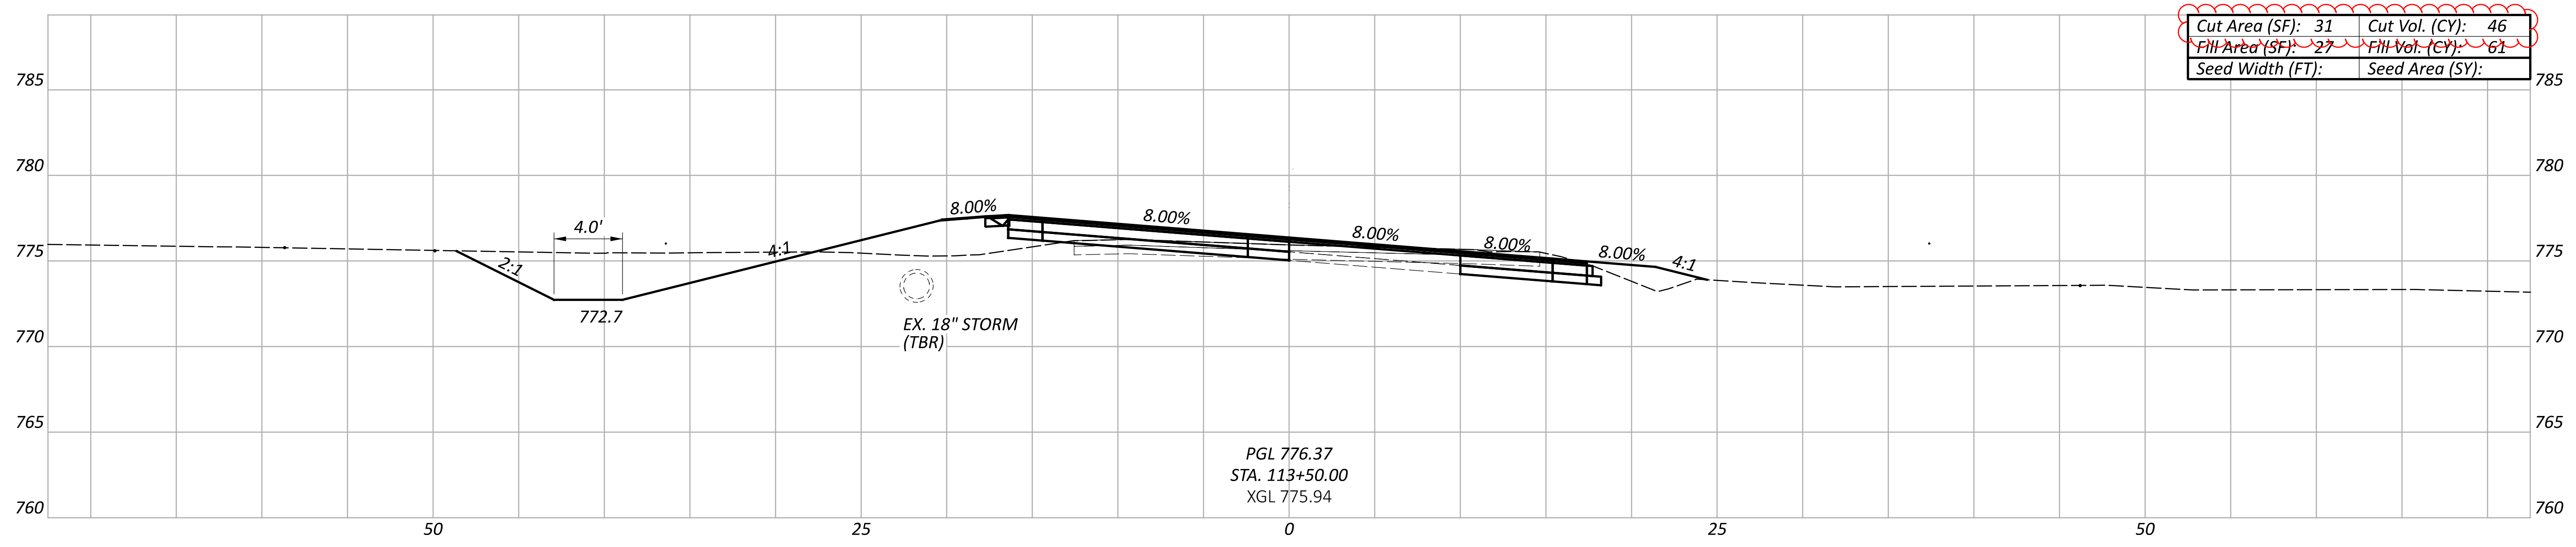

CROSS SECTIONS - SR 664  
 STA. 112+00.00 TO STA. 113+50.00

DESIGN AGENCY



DESIGNER

RCW




REVIEWER

PJD 11/25/24

PROJECT ID

121180

|              |     |      |           |
|--------------|-----|------|-----------|
| Sheet Totals |     |      | 121180    |
| Seeding      | Cut | Fill | TOTAL     |
| 254          | 233 |      | P.29   43 |

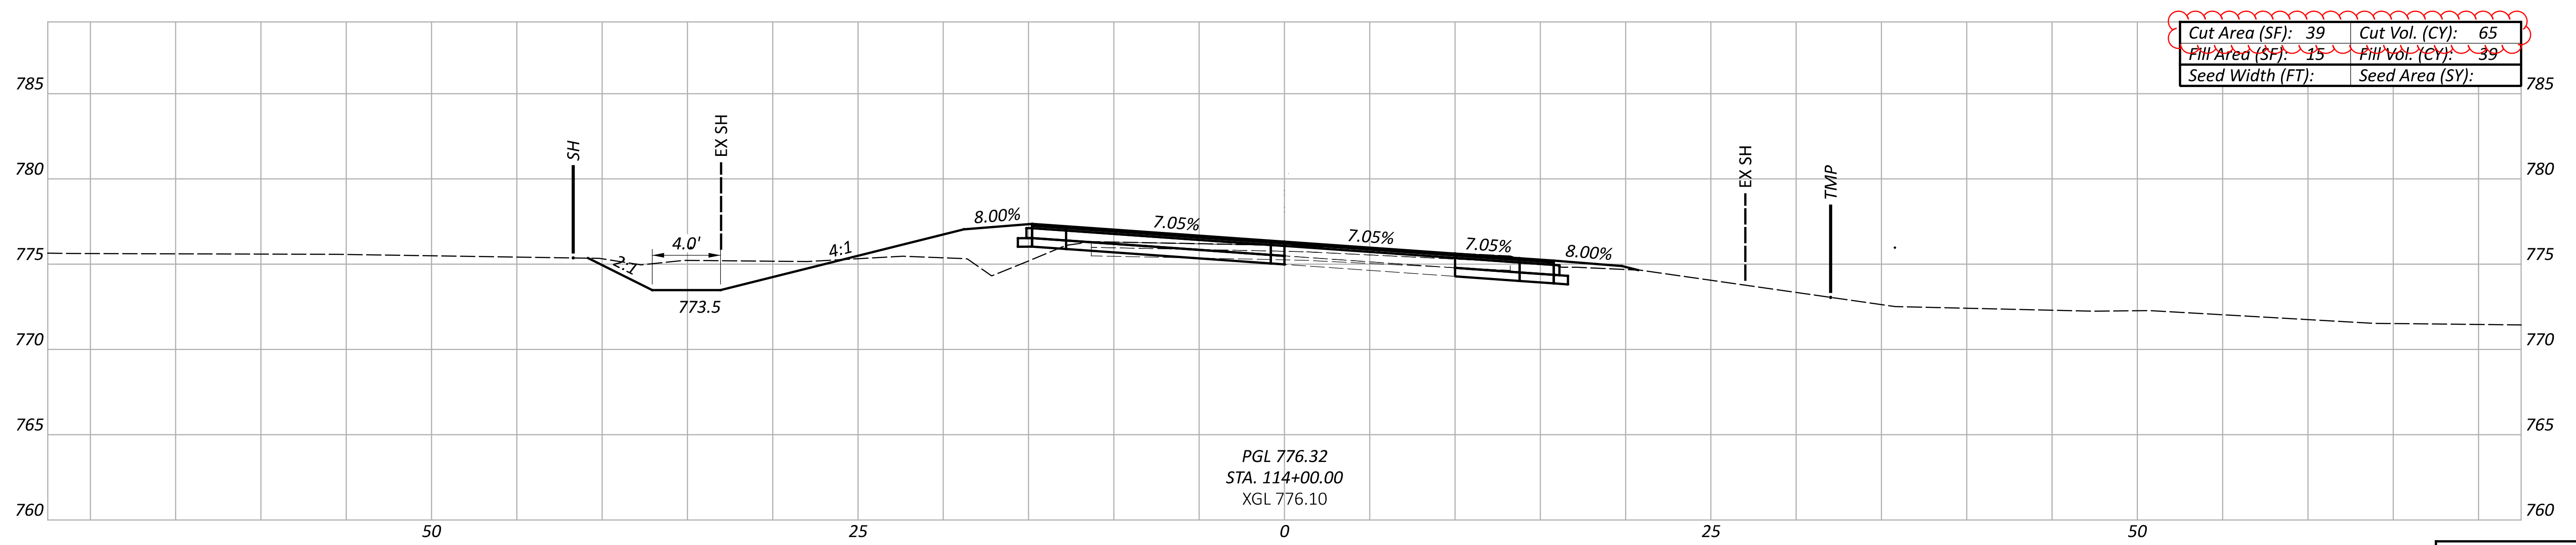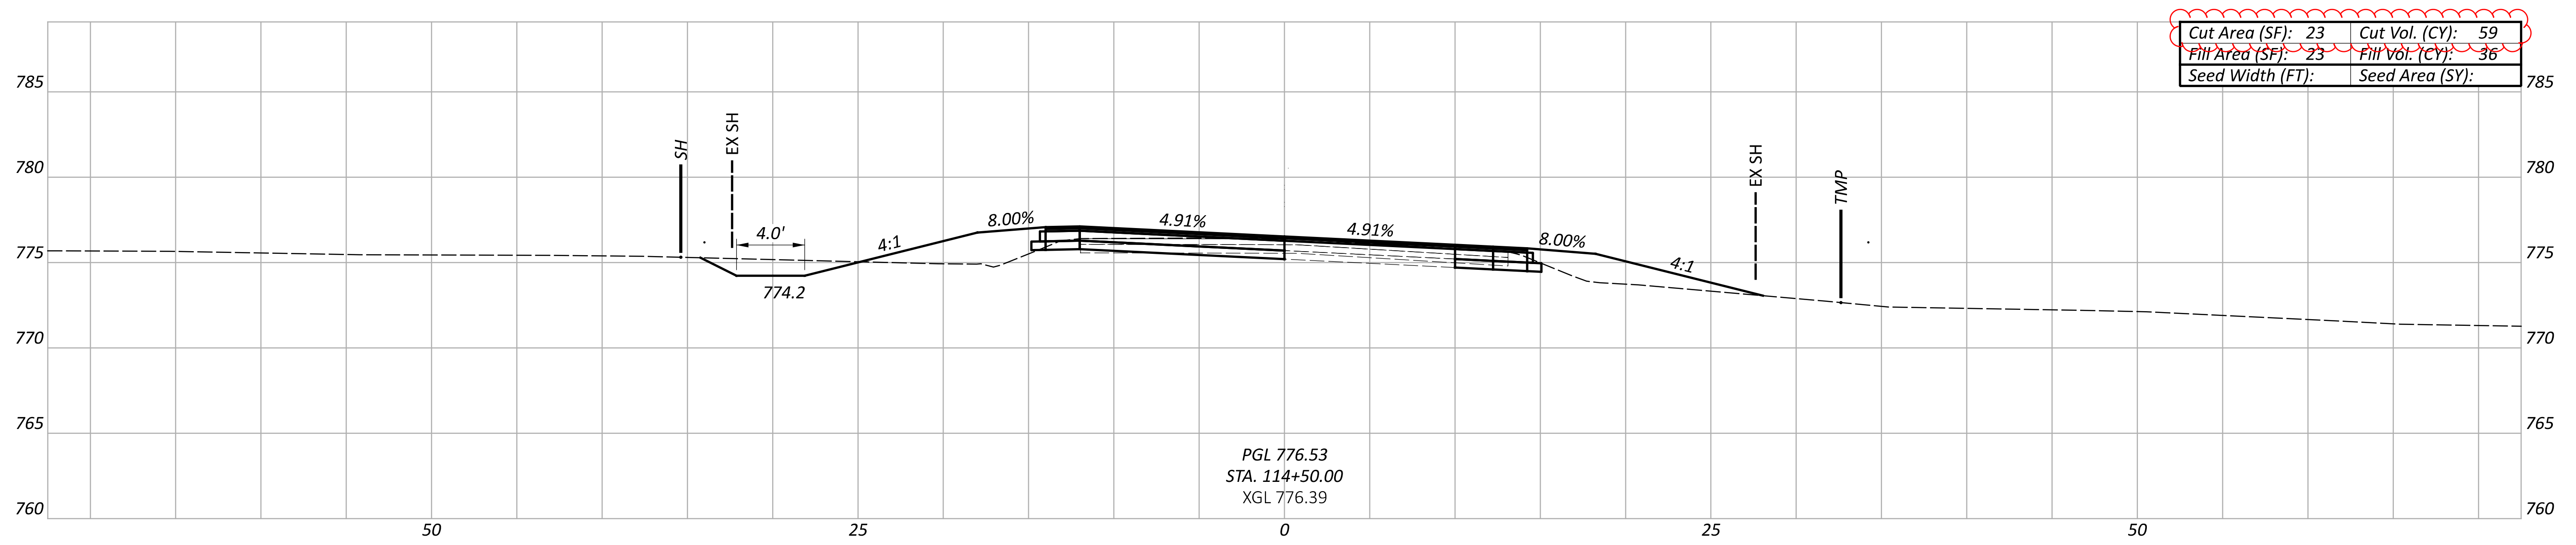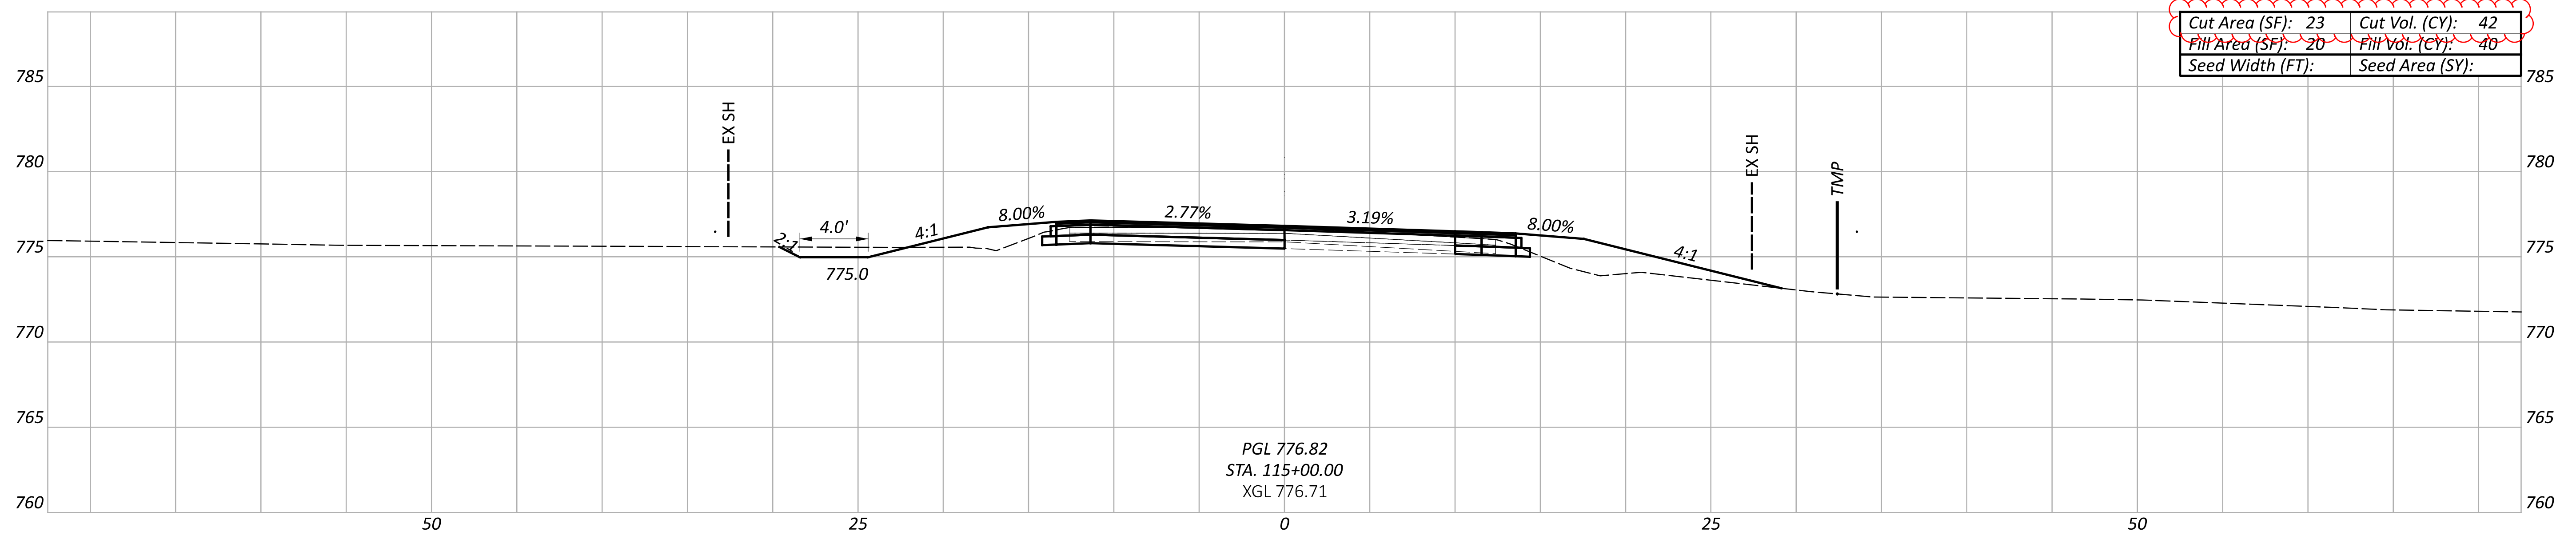

CROSS SECTIONS - SR 664  
STA. 114+00.00 TO STA. 115+00.00

DESIGN AGENCY



DESIGNER

RCW

REVIEWER


PJD 11/25/24

PROJECT ID


121180

| Sheet Totals |     |      | SHEET TOTAL |    |
|--------------|-----|------|-------------|----|
| Seeding      | Cut | Fill | P.30        | 43 |
| 166          | 115 |      |             |    |

| TOTAL ESTIMATED QUANTITIES CARRIED TO GENERAL SUMMARY |            |      |    |
|---|------------|------|----|
| 203   | EXCAVATION | 3567 | CY |
| 203   | EMBANKMENT | 3229 | CY |

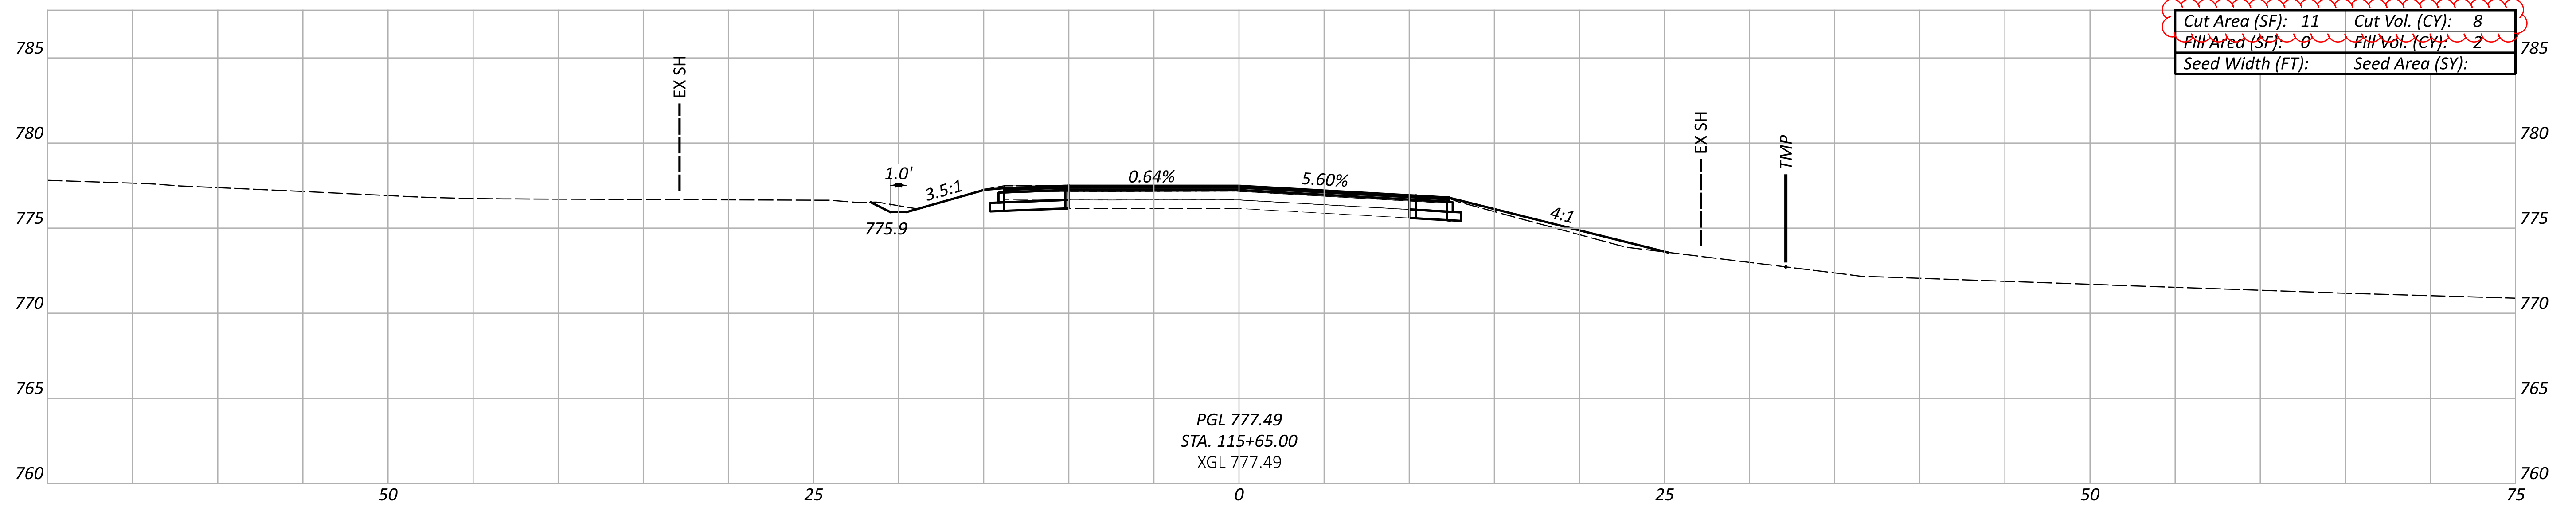

|                   |                   |
|-------------------|-------------------|
| Cut Area (SF): 11 | Cut Vol. (CY): 8  |
| Fill Area (SF): 0 | Fill Vol. (CY): 2 |
| Seed Width (FT):  | Seed Area (SY):   |

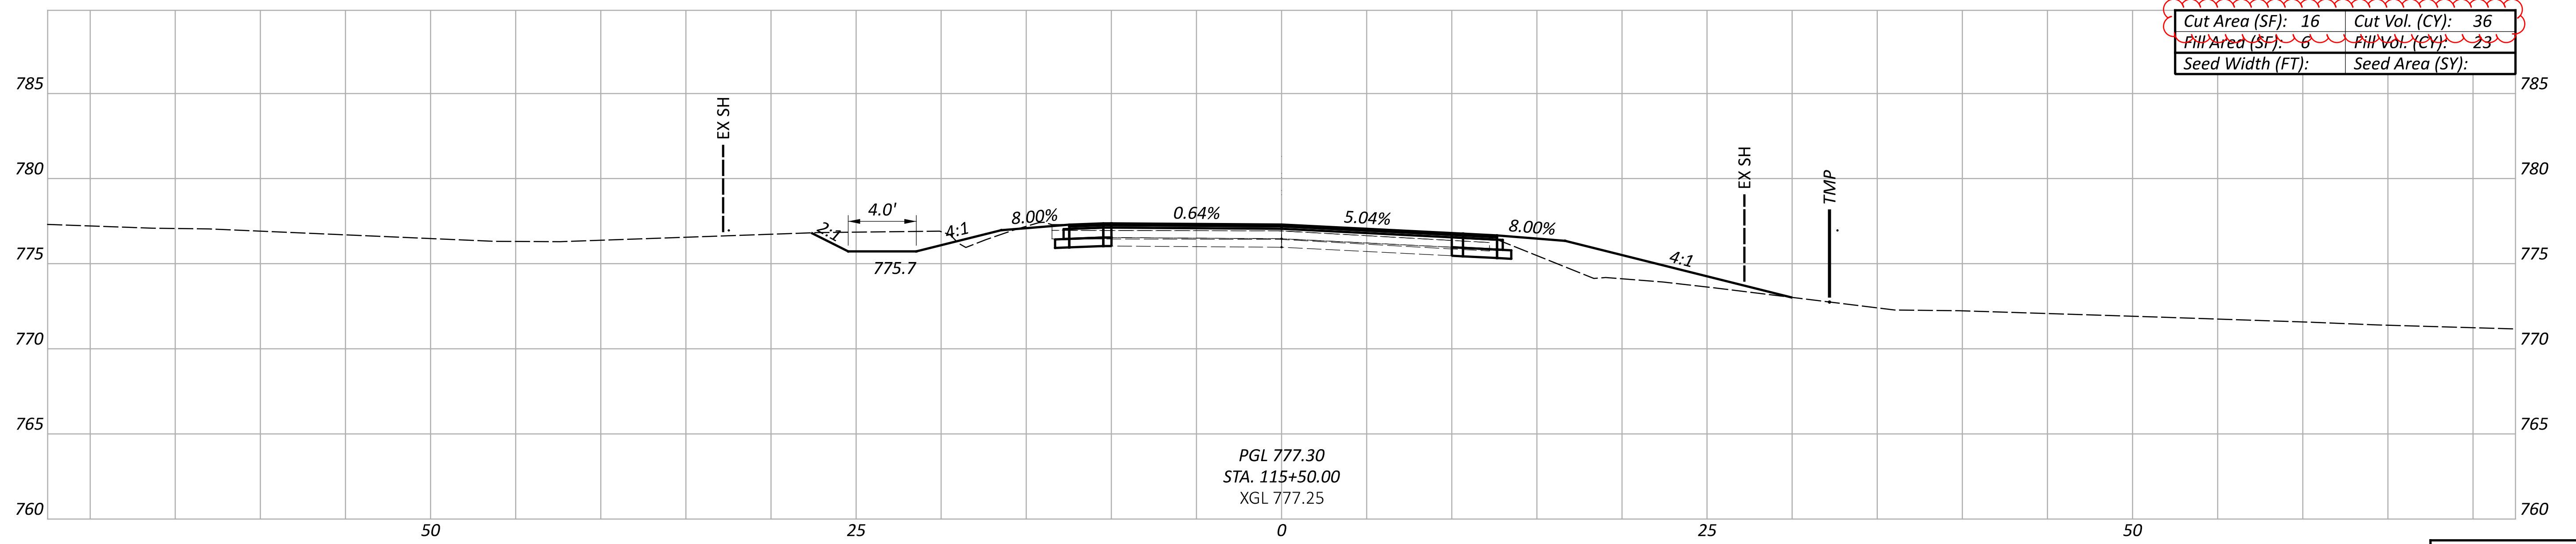

|                   |                    |
|-------------------|--------------------|
| Cut Area (SF): 16 | Cut Vol. (CY): 36  |
| Fill Area (SF): 6 | Fill Vol. (CY): 23 |
| Seed Width (FT):  | Seed Area (SY):    |

CROSS SECTIONS - SR 664  
 STA. 115+50.00 TO STA. 116+00.00

DESIGN AGENCY



DESIGNER

RCW

REVIEWER

PJD 11/25/24

PROJECT ID

121180

|              |     |      |         |
|--------------|-----|------|---------|
| Sheet Totals |     |      | 121180  |
| Seeding      | Cut | Fill | TOTAL   |
| 44           | 25  |      | P.31 43 |