



TYPICAL 1

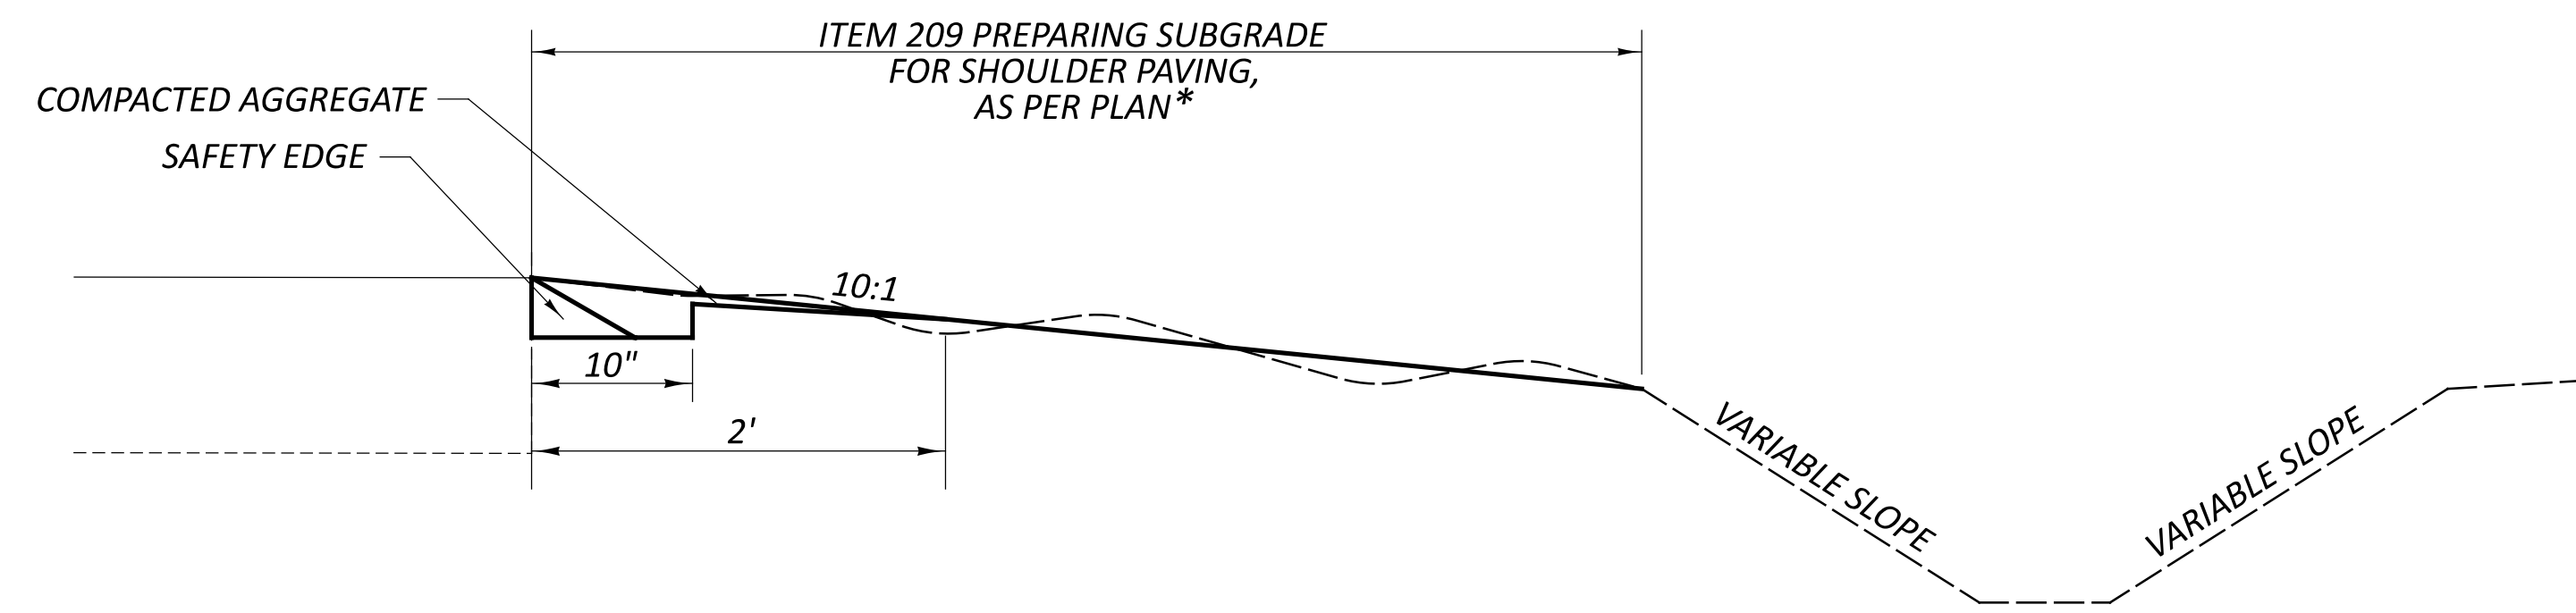

ITEM 209 PREPARING SUBGRADE FOR SHOULDER PAVING, AS PER PLAN

* SEE ITEM 209 PREPARING SUBGRADE FOR SHOULDER PAVING, AS PER PLAN NOTE FOR ADDITIONAL DETAILS

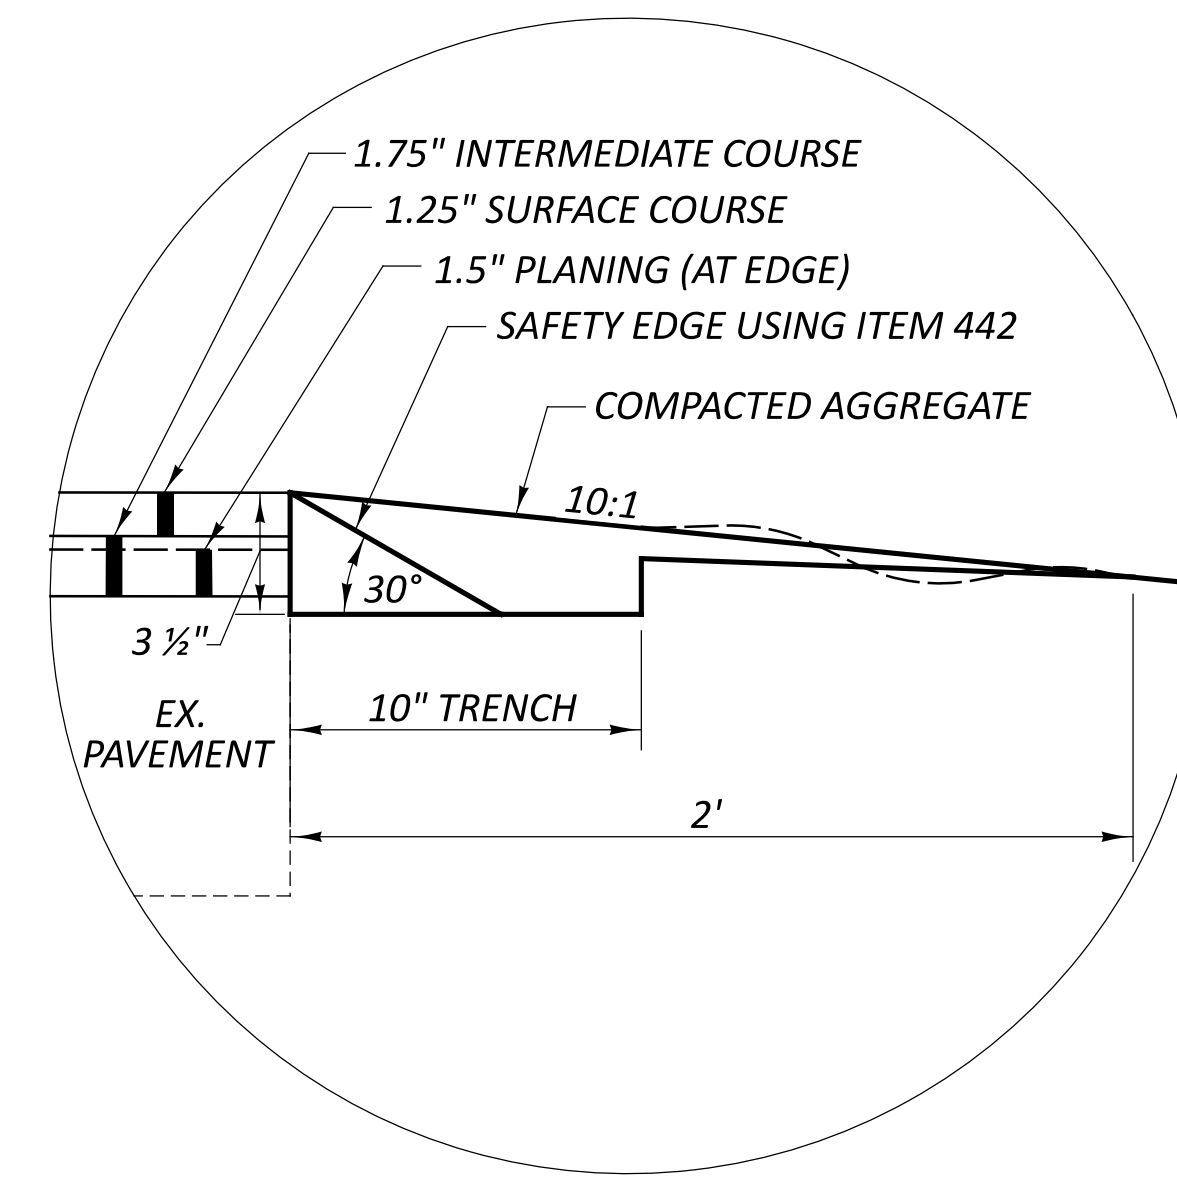

DETAIL A SAFETY EDGE

