Z O

JACKSON CO. TREATMENT SHALL BE 11/2 441 ASPHALT CONCRETE INTERMEDIATE COURSE, TYPE 1, (448). PARTIAL DEPTH PAVEMENT REPAIRS ARE TO BE MADE

EARTH DISTURBED AREAS

PROJECT EARTH DISTURBED AREA:

2019 SPECIFICATIONS

GOVERN THIS IMPROVEMENT.

ON THE CAMPGROUND ROADS.

PROJECT DESCRIPTION

MAINTENANCE PROJECT

ESTIMATED CONTRACTOR EARTH DISTURBED AREA: N/A ACRES MAINTENANCE PROJECT

THE STANDARD SPECIFICATIONS OF THE STATE OF

OHIO. DEPARTMENT OF TRANSPORTATION. INCLUDING SUPPLEMENTAL SPECIFICATIONS LISTED IN THE PLANS AND CHANGES LISTED IN THE PROPOSAL SHALL

THE RESURFACING OF JACKSON LAKE STATE PARK,

NOTICE OF INTENT EARTH DISTURBED AREA: N/A ACRES MAINTENANCE PROJECT

DEPARTMENT OF TRANSPORTATION JAC-JACKON LAKE STATE PARK **JEFFERSON TOWNSHIP** JACKSON COUNTY

STATE OF OHIO

INDEX OF SHEETS:

| TITLE SHEET | 1 |
|------------------------|-------|
| SCHEMATIC PLAN | 2 |
| TYPICAL SECTIONS | 3 |
| GENERAL NOTES | 4 |
| MAINTENANCE OF TRAFFIC | 5 |
| GENERAL SUMMARY | 6 |
| PAVEMENT CALCULATIONS | 7-8 |
| PAVEMENT MARKINGS | 9 |
| GUARDRAIL CALCULATIONS | 10 |
| PLAN DETAIL SHEETS | 11-12 |

| TITLE SHEET | | 1 |
|----------------------|-------|-------|
| SCHEMATIC PLAN | | 2 |
| TYPICAL SECTIONS | | 3 |
| GENERAL NOTES | | 4 |
| MAINTENANCE OF TRAFF | FIC . | 5 |
| GENERAL SUMMARY | | 6 |
| PAVEMENT CALCULATION | VS | 7-8 |
| PAVEMENT MARKINGS | | 9 |
| GUARDRAIL CALCULATIO | NS . | 10 |
| DI ANI DETATI CUEETO | | 11 10 |

DESIGN EXCEPTIONS

PORTION TO BE IMPROVED_.

NONE (ODNR PROJECT)

RM-6.1.



LOCATION MAP


LATITUDE: 38°54′14" LONGITUDE: 82°35′48"

SCALE IN MILES

INTERSTATE HIGHWAY _____

STATE ROUTES _____ COUNTY & TOWNSHIP ROADS._____ OTHER ROADS



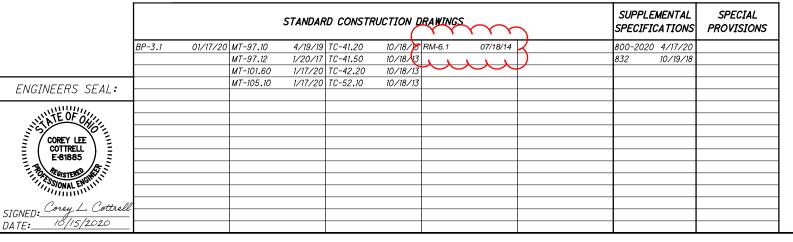

I HEREBY APPROVE THESE PLANS AND DECLARE THAT THE MAKING OF THIS IMPROVEMENT WILL NOT REQUIRE THE CLOSING TO TRAFFIC OF THE HIGHWAY AND THAT PROVISIONS FOR THE MAINTENANCE AND SAFETY OF TRAFFIC WILL BE AS SET FORTH ON THE PLANS AND

| APPROVED Mi | chat Guhashi |
|-----------------|--------------------------|
| DATE 10-15-2020 | DISTRICT DEPUTY DIRECTOR |

| APPROVED | | |
|----------|-------------------------|--|
| DATE | DIRECTOR, DEPARTMENT OF | |
| | TRANSPORTATION | |

 \bigcirc

 \bigcirc

GENERAL

 \bigcirc

QUANTITIES IN THESE PLANS ARE APPROXIMATE FROM FIELD AND AERIAL CADD MEASUREMENTS BUT FINAL WORK AND QUANTITIES WILL BE AS DIRECTED BY THE ENGINEER AND/OR ODNR PERSONNEL.

WINDOW CONTRACT TABLE

| DESCRIPTION OF CRITICAL WORK | CALENDAR DAYS TO COMPLETE |
|------------------------------|---------------------------|
| ALL WORK ON PROJECT | 21 DAYS |

NOTIFICATION

THE OHIO DEPARTMENT OF NATURAL RESOURCES (ODNR) SHALL BE CONTACTED FOURTEEN (14) DAYS PRIOR TO THE PRECONSTRUCTION MEETING. THE LOCAL ODNR CONTACTS

ERIC EVANOO OHIO DEPARTMENT OF NATURAL RESOURCES DIVISION OF ENGINEERING 2045 MORSE RD., BLDG E-3 COLUMBUS, OH 43229 614-265-6957 eric.evanoo@dnr.state.oh.us

OHIO DEPARTMENT OF NATURAL RESOURCES DIVISION OF FORESTRY 360 E. STATE ST. ATHENS, OH 45701 740-272-8519 stephen.rist@dnr.state.oh.us

SPECIAL NOTE:

THERE WILL BE AN INTERIM COMPLETION DATE OF MAY 15TH, 2021.

PROFILE AND ALIGNMENT

PLACE THE PROPOSED PAVEMENT TO FOLLOW THE ALIGNMENT AND PROFILE OF THE EXISTING PAVEMENT. PLACE THE PROPOSED ASPHALT CONCRETE, TYPE 1, (448), PG64-22 OVERLAY AS SHOWN ON THE TYPICAL SECTIONS.

SPECIAL NOTE:

RAILROAD SIGNS ON S.R. 93 S.L.M. 6.69 NORTH OF OAK HILL NEED TO BE REMOVED. THE RAILROAD IS NO LONGER THERE OR OPERATIONAL.

<u>ITEM 448 - ASPHALT CONCRETE INTERMEDIATE</u> COURSE, TYPE 1, PG64-22, AS PER PLAN (SPOT LEVELING)

THIS MATERIAL IS TO BE PLACED AS A SEPARATE LEVELING OPERATION AS DIRECTED BY THE ENGINEER TO CORRECT IRREGULARITIES IN THE EXISTING PAVEMENT CROSS SECTION AND PROFILE PRIOR TO PLACEMENT OF THE SURFACE COURSE. FOR ESTIMATING PURPOSES ONLY, THE PLAN USES A 0.5" DEPTH FOR THIS COURSE.

ESTIMATED QUANTITIES HAVE BEEN PROVIDED FOR THE FOLLOWING WORK:

ITEM 407, TACK COAT FOR INTERMEDIATE COURSE

501 GAL.


ITEM 448, ASPHALT CONCRETE INTERMEDIATE COURSE, TYPE 1, PG64-22, AS PER PLAN

245 CU. YD.

ITEM SPECIAL - CONCRETE PARKING BLOCK ITEM SPECIAL - PARKING BLOCK REMOVED ITEM SPECIAL - PARKING BLOCK REMOVED AND RESET

PARKING BLOCKS SHALL BE AS PER ODOT STANDARD DRAWING RM-6.1. PAYMENT FOR THE ABOVE ITEMS SHALL BE MADE AT THE UNIT PRICE PER EACH, AND SHALL INCLUDE ALL LABOR, TOOLS, EQUIPMENT, MATERIALS AND INCIDENTALS NECESSARY TO PERFORM THE WORK.

ITEM 251 - PARTIAL DEPTH PAVEMENT REPAIR, AS PER PLAN

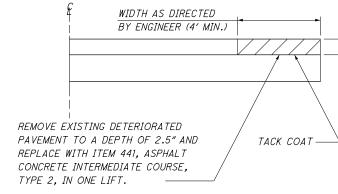

THE FOLLOWING ESTIMATED QUANTITIES HAVE BEEN INCLUDED AND CARRIED TO THE GENERAL SUMMARY FOR USE AS DIRECTED BY THE ENGINEER:

ITEM 251 PARTIAL DEPTH PAVEMENT REPAIR (441), AS PER PLAN

01/STR/PV TOTALS: 2500 SY ഗ 0 Z ⋖ ER Z U G

⋖

| | | | | s | HEET N | UM. | | | | | PAR | • | ITEM | ITEM | GRAND | UNIT | DESCRIPTION | SEE SHEET NO. |
|-------------------|--|--------------|---|---|---------------------------------------|----------|----------|-------|-----|------------|------------|---|------------|----------|----------------|----------|---|---------------------|
| | | 4 | 5 | | | 7 | 8 | 9 | 10 | 01/NF. | √PV | | | EXT | TOTAL | UNIT | DESCRIPTION | NO. |
| | | | | | | | | | | | | | | | | | ROADWAY | |
| - | † | | | | | 2 | | | | 2 | | | 631 | 94490 | 2 | EACH | REMOVAL, MISC.:S.R. 93 N RAILROAD SIGN | 4 |
| | | | | | | | | | | | | | | | | | | |
| | | | | | | | | | 21 | 2 | | | 203 | 40000 | 21 | | BORROW | |
| | | | | | | | | | 150 | 15 |) | | 606 | 13050 | 150 | | GUARDRAIL, TYPE 5A | |
| | | | | | | | | | 2 | 2 | | | 606 | 25000 | 2 | EACH | ANCHOR ASSEMBLY, TYPE A | |
| | | | | | | | | | 4 | 4 | | | 614 | 13314 | 4 | EACH | BARRIER REFLECTOR, TYPE 3, BIDIRECTIONAL | |
| | | _ | | | | | | | | | | | | | | | DAVIDADA | |
| | | 2 500 | | | | | | | 1 | - 2 - | \ <u>\</u> | | 251 | 01001 | - 2 500- | CV | PAVEMENT | |
| | | 2,500 501 | \leftarrow | | + <i>i</i> | 501 | 523 | | | 2,5 1,5 | 25 | | 251 407 | 20000 | 2,500 1,525 | | PARTIAL DEPTH PAVEMENT REPAIR (441), AS PER PLAN NON-TRACKING TACK COAT | 4 |
| | | . 301 |) | | \ \ \ \ \ \ \ \ \ \ \ \ \ \ \ \ \ \ \ | | | | 1 | 50 | | | 441 | 50000 | | | ASPHALT CONCRETE SURFACE COURSE, TYPE 1, (448), PG64-22, 1.5" | |
| | + | 245 | $+ \uparrow$ | | | 245 | 256 | | | 24 | <u> </u> | | 441 | 50000 | 501 245 | CY CY | ASPHALT CONCRETE SONFACE COURSE, TIPE 1, (448), PG64-22, 1.5 ASPHALT CONCRETE INTERMEDIATE COURSE, TYPE 1, (448), AS PER PLAN, (SPOT LEVELING) | 4 |
| \longrightarrow | \vdash | 245 | $\downarrow \downarrow -$ | | | 225 | | | | 22 | | | 452 | 12010 | 225 | | 8" NON-REINFORCED CONCRETE PAVEMENT, CLASS QC 1P | 4 |
| + | + | | | | | 223 | | | | | , | | 702 | 12010 | 223 | 31 | NON NEINI ONCED CONCRETE LAVEMENT, CEASS QC II | |
| | | | | | | 84 | | | | 84 | | | SPECIAL | 20253010 | 84 | EACH | PARKING BLOCK REMOVED AND RESET | |
| | | | | | | 10 | | | | 10 | | | SPECIAL | 20253000 | 10 | | PARKING BLOCK REMOVED AND REPLACED | |
| | † | | | | | 45 | | | 1 1 | 45 | | | 630 | 89812 | 45 | | REMOVAL OF WOOD POLE AND DISPOSAL | |
| | | | | | | 10 | | | | 1 | | | - 000 | 00012 | 10 | EAGII | THE HOUSE TOLE AND SIGN SOME | |
| | | | | | | | | | | | | | | | | | TRAFFIC CONTROL | |
| | | | | | | | | 24 | | 24 | | | 642 | 50010 | 24 | EACH | PAVEMENT MARKING, MISC.: CAMP SITE NUMBERS, 1' STENCILS | |
| | | | | | | | | 5 | | 5 | | | 642 | 01300 | 5 | | LANE ARROW, TYPE 1 | |
| | | | | | | | | 2,054 | | 2,0 | 54 | | 642 | 01200 | 2,054 | | PARKING LOT STALL MARKING, TYPE 1 | |
| | | | | | | | | 1 | | 1 | | | 642 | 01702 | 1 | | HANDICAP SYMBOL MARKING, TYPE 1 | |
| | | | | | | | | | | | | | | | | | | |
| | | | | | | | | | | | | | | | | | MAINTENANCE OF TRAFFIC | |
| | | | 4 | | | | | | | 4 | | | 614 | 12460 | 4 | EACH | WORK ZONE MARKING SIGN | |
| | | | | | | | | | | | | | | | | | | |
| | | | | | | | | | | | | | | | | | INCIDENTALS | |
| | | _ | | | | | | | | LS | | | 614 | 11000 | LS | | MAINTAINING TRAFFIC | |
| | | | | | | | <u> </u> | | 1 | LS | ' | | 624 | 10000 | LS | | MOBILIZATION | |
| | | | | | | | 1 | | 1 | | | | | | | | | |
| | | | | | | | | | | | | | | | | | | |
| \longrightarrow | | | | | | | | | | | | | | | | | | |
| \longrightarrow | | | | | | | | | | | | | | | | | | |
| | | | | | | | | | | | | | | | | | | |
| | | | | | | | | | | | | | | | | | | |
| - | | | | | | | | | | | | | | | | | | |
| | | | | | | | | | | | | | | | | | | |
| | | | | | | | | | | | | | | | | | | |
| | + | | | | | | | | | | | | | | | | | |
| | | | | | | | | | | | | | | | | | | |
| | | | | | | | | | | | | | | | | | | |
| | | | | | | <u> </u> | | | | | | | | | | | | |
| | | | | | | | | | | | | | | | | | | |
| | | | | | | | | | | | | | | | | | | |
