

ITEM 614 - MAINTAINING TRAFFIC


THE CONTRACTOR SHALL MAINTAIN TRAFFIC AT ALL TIMES IN ACCORDANCE WITH THE REQUIREMENTS OF ITEM 614 AND THE MAINTENANCE OF TRAFFIC PLAN.

A MINIMUM OF ONE LANE OF TRAFFIC IN EACH DIRECTION SHALL BE MAINTAINED AT ALL TIMES, EXCEPT FOR A PERIOD NOT TO EXCEED 21 CONSECUTIVE CALENDAR DAYS, WHEN THROUGH TRAFFIC MAY BE DETOURED AS SHOWN ON SHEET 6. A DISINCENTIVE SHALL BE ASSESSED IN THE AMOUNT OF \$7,715 PER DAY FOR EACH CALENDAR DAY THE ROADWAY REMAINS CLOSED TO TRAFFIC BEYOND THE SPECIFIED LIMIT.

THE DETOUR SHALL NOT BEGIN PRIOR TO JUNE 15, 2021. THE DETOUR SHALL END AND S.R. 164 SHALL BE REOPENED TO TRAFFIC ON OR BEFORE JULY 31, 2021.

LENGTH AND DURATION OF LANE CLOSURES AND RESTRICTIONS SHALL BE AT THE APPROVAL OF THE ENGINEER. IT IS THE INTENT TO MINIMIZE THE IMPACT TO THE TRAVELING PUBLIC. LANE CLOSURES OR RESTRICTIONS OVER SEGMENTS OF THE PROJECT IN WHICH NO WORK IS ANTICIPATED WITHIN A REASONABLE TIME FRAME, AS DETERMINED BY THE ENGINEER, SHALL NOT BE PERMITTED. THE LEVEL OF UTILIZATION OF MAINTENANCE OF TRAFFIC DEVICES SHALL BE COMMENSURATE WITH THE WORK IN PROGRESS.

NOTICE OF CLOSURE SIGNS (W20-H13) SHALL BE ERECTED BY THE CONTRACTOR PRIOR TO THE SCHEDULED ROAD CLOSURE IN ACCORDANCE WITH THE NOTICE OF CLOSURE TIME TABLE BELOW.

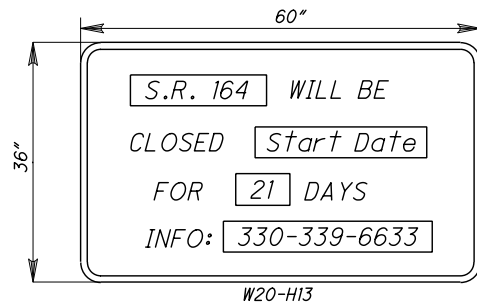

THE SIGNS SHALL BE ERECTED ON THE RIGHT-HAND SIDE OF THE ROAD FACING TRAFFIC. THEY SHALL BE PLACED SO AS NOT TO INTERFERE WITH THE VISIBILITY OF ANY OTHER TRAFFIC CONTROL SIGNS. ON ROADWAYS, THEY SHOULD BE ERECTED AT OR NEAR THE POINT OF CLOSURE.

ITEM	DURATION OF CLOSURE	SIGN DISPLAYED TO PUBLIC
RAMP & ROAD CLOSURES	>= 2 WEEKS	14 CALENDAR DAYS PRIOR TO CLOSURE
	> 12 HOURS & < 2 WEEKS	7 CALENDAR DAYS PRIOR TO CLOSURE
	< 12 HOURS	2 BUSINESS DAYS PRIOR TO CLOSURE

THE SIGN SHALL DISPLAY THE DATE OF THE CLOSURE IN MM-DD FORMAT AND THE NUMBER OF DAYS OF THE CLOSURE. THE LAST LINE OF THE W20-H13 SIGN LISTS A PHONE NUMBER WHICH A MOTORIST MAY CALL FOR ADDITIONAL INFORMATION. THIS IS TO BE A SPECIFIC OFFICE WITHIN THE DISTRICT RATHER THAN THE GENERAL SWITCHBOARD NUMBER.

ITEM 614 - MAINTAINING TRAFFIC (CONT.)

THE FOLLOWING ESTIMATED QUANTITY HAS BEEN INCLUDED IN THE GENERAL SUMMARY FOR USE AS DETERMINED BY THE ENGINEER FOR THE MAINTENANCE OF TRAFFIC:

ITEM 614, ASPHALT CONCRETE
FOR MAINTAINING TRAFFIC 25 CU. YD.

THE CONTRACTOR SHALL PROVIDE, ERECT, AND MAINTAIN STANDARD 48 x 30 INCH ROAD CLOSED SIGNS, SIGN SUPPORTS, BARRICADES, AND LIGHTS, AS DETAILED IN SCD MT-101.60 AND SHOWN ON SHEET 5 DURING PERIODS IN WHICH THE AFFECTED ROAD IS CLOSED TO TRAFFIC.

THE CONTRACTOR SHALL PROVIDE, ERECT, AND MAINTAIN SIGNS AND SIGN SUPPORTS, AS DETAILED IN THE OHIO MANUAL OF UNIFORM TRAFFIC CONTROL DEVICES, AND TYPE III BARRICADES OF THE TYPE SHOWN ON SHEET 5.

ALL WORK AND TRAFFIC CONTROL DEVICES SHALL BE IN ACCORDANCE WITH CMS 614 AND OTHER APPLICABLE PORTIONS OF THE SPECIFICATIONS, AS WELL AS THE OHIO MANUAL OF UNIFORM TRAFFIC CONTROL DEVICES. PAYMENT FOR ALL LABOR, EQUIPMENT AND MATERIALS SHALL BE INCLUDED IN THE LUMP SUM CONTRACT PRICE FOR ITEM 614, MAINTAINING TRAFFIC, UNLESS SEPARATELY ITEMIZED IN THE PLAN.

DUST CONTROL

THE CONTRACTOR SHALL FURNISH AND APPLY WATER FOR DUST CONTROL AS DIRECTED BY THE ENGINEER. THE FOLLOWING ESTIMATED QUANTITIES HAVE BEEN INCLUDED FOR DUST CONTROL PURPOSES:

ITEM 616 - WATER 15 M. GAL

NOTIFICATION OF TRAFFIC RESTRICTIONS

THROUGHOUT THE DURATION OF THE PROJECT, THE CONTRACTOR SHALL NOTIFY THE PROJECT ENGINEER IN WRITING OF ALL TRAFFIC RESTRICTIONS AND UPCOMING MAINTENANCE OF TRAFFIC CHANGES. THE CONTRACTOR SHALL ENSURE THE WRITTEN NOTIFICATION IS SUBMITTED IN A TIMELY MANNER TO ALLOW THE PROJECT ENGINEER TO MEET THE REQUIRED TIME FRAMES SET FORTH IN THE TABLE BELOW TO INFORM THE SPECIAL HAULING PERMITS SECTION (Hauling.Permits@dot.ohio.gov) AND THE DISTRICT PUBLIC INFORMATION OFFICE (PIO). THIS NOTIFICATION SHALL BE RECEIVED BY THE PROJECT ENGINEER PRIOR TO THE PHYSICAL SETUP OF ANY APPLICABLE SIGNS OR MESSAGE BOARDS.

INFORMATION SHOULD INCLUDE, BUT IS NOT LIMITED TO, ALL CONSTRUCTION ACTIVITIES THAT IMPACT OR INTERFERE WITH TRAFFIC AND SHALL LIST THE SPECIFIC LOCATION, TYPE OF WORK, ROAD STATUS, DATE AND TIME OF RESTRICTION, DURATION OF RESTRICTION, NUMBER OF LANES MAINTAINED, NUMBER OF LANES CLOSED, MINIMUM VERTICAL CLEARANCE, MINIMUM WIDTH OF DRIVABLE PAVEMENT, DETOUR ROUTES, IF APPLICABLE, AND ANY OTHER INFORMATION REQUESTED BY THE PROJECT ENGINEER.

ITEM	DURATION OF CLOSURE	NOTICE DUE TO PERMITS & PIO
RAMP & ROAD CLOSURES	>= 2 WEEKS	21 CALENDAR DAYS PRIOR TO CLOSURE
	> 12 HOURS & < 2 WEEKS	14 CALENDAR DAYS PRIOR TO CLOSURE
	<= 12 HOURS	4 BUSINESS DAYS PRIOR TO CLOSURE
LANE CLOSURES & RESTRICTIONS	>= 2 WEEKS	14 CALENDAR DAYS PRIOR TO CLOSURE
	< 2 WEEKS	5 BUSINESS DAYS PRIOR TO CLOSURE
START OF CONSTRUCTION & TRAFFIC PATTERN CHANGES	N/A	14 CALENDAR DAYS PRIOR TO IMPLEMENTATION

ANY UNFORESEEN CONDITIONS NOT SPECIFIED IN THE PLANS REQUIRING TRAFFIC RESTRICTIONS SHALL ALSO BE REPORTED TO THE PROJECT ENGINEER USING THE NOTIFICATION TIME TABLE.

I:\Project+Data\06996\Design\Roadway\Sheets\06996_GN002.dgn_Sheet 23-JUL-2020 2:13PM diorenz

CALCULATED
ADK
CHECKED
DJL


MAINTENANCE OF TRAFFIC GENERAL NOTES

JEF-164-9.40


5
15

DETOUR SIGNING


DETOUR SIGNS SHALL BE ERECTED ALONG THE OFFICIAL DETOUR ROUTE AND SHALL BE ASSEMBLED AS SHOWN. ALL DETOUR SIGNING SHALL BE INSTALLED BEFORE COMMENCING ANY OF THE PROPOSED WORK. PAYMENT FOR ALL LABOR, EQUIPMENT & MATERIALS SHALL BE INCLUDED IN THE LUMP SUM CONTRACT PRICE FOR ITEM 614, DETOUR SIGNING, UNLESS SEPERATELY ITEMIZED IN THE PLAN.

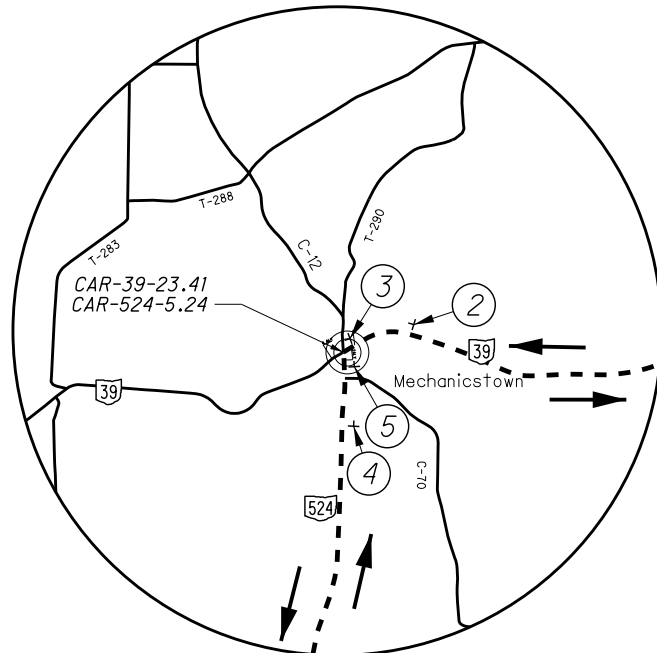


DETAIL 'A'

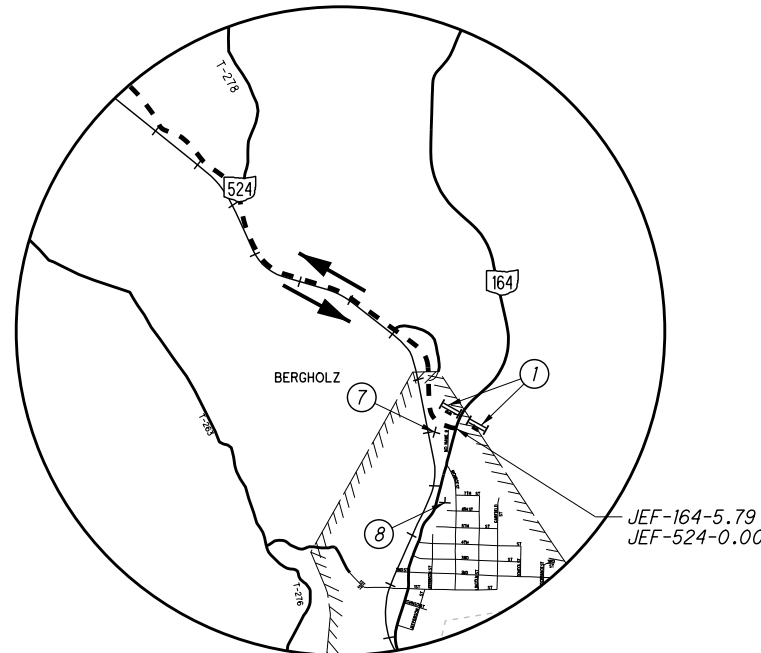

DETAIL 'B'

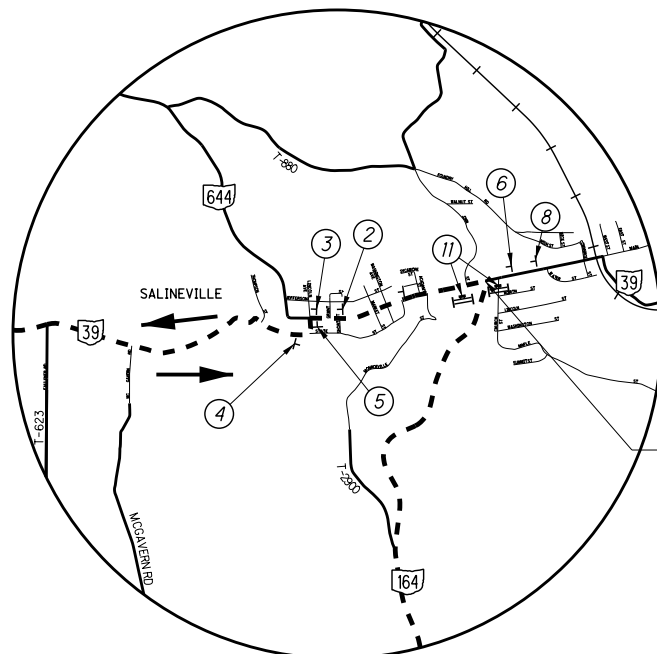

DETAIL 'C'

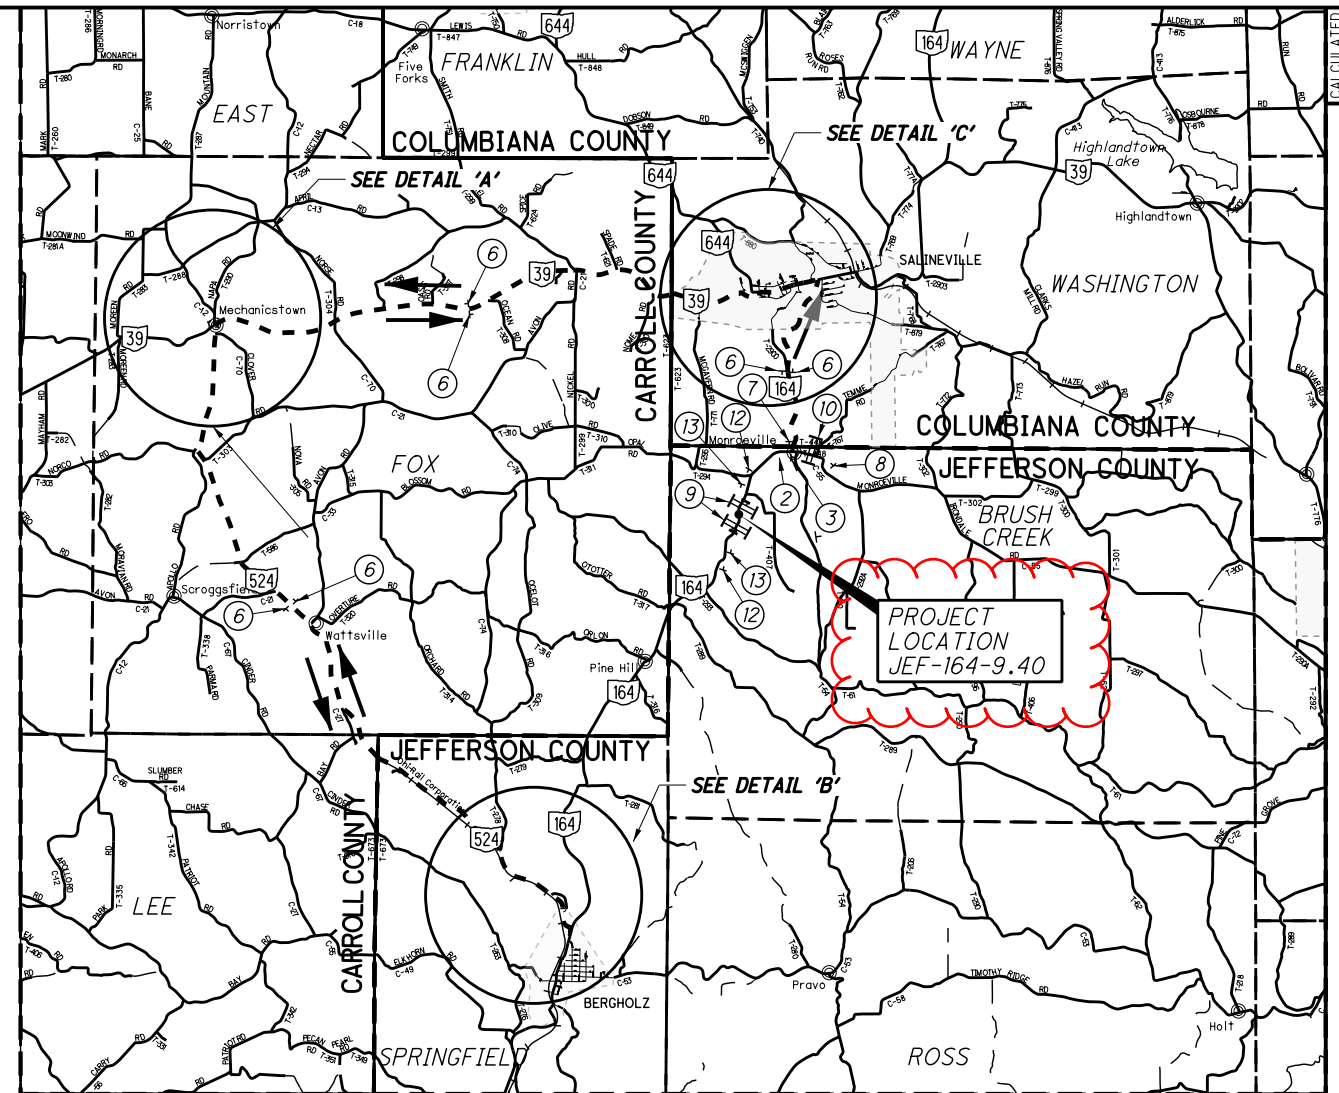

OFFICIAL DETOUR ROUTE

I:\ProjectData\06996\Design\Roadway\Sheets\06996_MD001.dgn Sheet 23-JUL-2020 2:16PM diorenz

NOTE:
 1. FOR ADDITIONAL SIGNING DETAILS, SEE SCD. DWG. MT-101.60
 2. PLACE SIGNS PER SCD TC-42.20

① x2	② x2	③ x2	④ x2	⑤ x2	⑥ x7	⑦ x2	⑧ x3
ROAD CLOSED 3.6 MILES AHEAD LOCAL TRAFFIC ONLY R11-3A-60	DETOUR M4-8-24	DETOUR M4-8-24	DETOUR M4-8-24	DETOUR M4-8-24	DETOUR M4-8-24	END DETOUR M4-8A-24	DETOUR AHEAD W20-2-36
← DETOUR M4-10L-48 ON TYPE 3 BARRICADE	164 MI-5-24-3	164 MI-5-24-3	164 MI-5-24-3	164 MI-5-24-3	164 MI-5-24-3	164 MI-5-24-3	
	↙ M5-1-21	← M6-1-21	↘ M5-1-21	→ M6-1-21	↑ M6-3-21		
⑨ x4	⑩ x2	⑪ x2	⑫ x2	⑬ x2			
TYPE B WARNING LIGHTS	ROAD CLOSED 1.0 MILES AHEAD LOCAL TRAFFIC ONLY R11-3A-60	ROAD CLOSED 3.0 MILES AHEAD LOCAL TRAFFIC ONLY R11-3A-60	TYPE A FLASHING WARNING LIGHTS		ROAD CLOSED 500 FT W20-3-36		
☀ ☀	← DETOUR M4-10R-48 ON TYPE 3 BARRICADE (TWO PER LOCATION)	← DETOUR M4-10R-48 ON TYPE 3 BARRICADE (TWO PER LOCATION)	☀	ROAD CLOSED 1000 FT W20-3-36			
ROAD CLOSED							

DETOUR MAP AND DETAILS

JEF-164-9.40

CALCULATED
MVC
CHECKED
DJL