UTILITIES

LISTED BELOW ARE ALL UTILITIES LOCATED WITHIN THE PROJECT CONSTRUCTION LIMITS TOGETHER WITH THEIR **RESPECTIVE OWNERS**:

JEF-22-13.83

AEP OHIO POWER COMPANY

ATTN: CLARKE SAUNDERS 777 HOPEWELL DRIVE HEATH. OHIO 43056 614-460-4794 CMSAUNDERS@AEP.COM

HORIZON NETWORK PARTNERS

ATTN: JIM LUMP 1123 GOODALE BLVD COLUMBUS. OHIO 43212 740-703-8689 JIM.LUMP@HORIZONCONNECTS.COM

CITY OF STEUBENVILLE

ATTN: THE HONORABLE JERRY BARILLA 115 SOUTH THIRD STREET. STEUBENVILLE, OHIO 43952 740-283-6000 EXT. 1000 MAYOR@CITYOFSTEUBENVILLE.US

<u>JEF-22-14.71</u>

AEP OHIO POWER COMPANY (SEE CONTACT ABOVE)

JEFFERSON COUNTY WATER AND SEWER

ATTN: MIKE EROSHEVICH P.O. BOX 2579 WINTERSVILLE, OHIO 43953 740-283-8577 MEROSHEVICH@JCWATERSEWER.COM

CITY OF STEUBENVILLE (SEE CONTACT ABOVE)

THE LOCATION OF THE UNDERGROUND UTILITIES SHOWN ON THE PLANS ARE AS OBTAINED FROM THE OWNERS AS REQUIRED BY SECTION 153.64 O.R.C.

EXISTING PLANS

THE FOLLOWING EXISTING PLANS ARE AVAILABLE FOR REFERENCE AT THE DISTRICT 11 OFFICE OF THE OHIO DEPARTMENT OF TRANSPORTATION, 2201 REISER AVE. S.E., NEW PHILADELPHIA. OHIO. 44663:

JEF-22-13.24 (1990) JEF-22-13.90 (1990)

IN ADDITION, THE EXISTING PLANS CAN BE FOUND ON THE DEPARTMENT'S WEBSITE AT THE FOLLOWING ADDRESS:

https://ftp.dot.state.oh.us/pub/Contracts/Attach

WORK LIMITS

THE WORK LIMITS SHOWN ON THESE PLANS ARE FOR PHYSICAL CONSTRUCTION ONLY. PROVIDE THE INSTALLATION AND OPERATION OF ALL WORK ZONE TRAFFIC CONTROL AND WORK ZONE TRAFFIC CONTROL DEVICES REQUIRED BY THESE PLANS WHETHER INSIDE OR OUTSIDE THESE WORK LIMITS.

CLEARING AND GRUBBING

ALTHOUGH THERE ARE NO TREES OR STUMPS SPECIFICALLY MARKED FOR REMOVAL WITHIN THE LIMITS OF THE PROJECT, A LUMP SUM QUANTITY IS INCLUDED IN THE GENERAL SUMMARY FOR ITEM 201. CLEARING AND GRUBBING. ALL PROVISIONS AS SET FORTH IN THE SPECIFICATIONS UNDER THIS ITEM ARE INCLUDED IN THE LUMP SUM PRICE BID FOR ITEM 201, CLEARING AND GRUBBING.

SURVEYING PARAMETERS

PRIMARY PROJECT CONTROL MONUMENTS GOVERN ALL POSITIONING ON ODOT PROJECTS. SEE SHEETS P.05 AND P.07 FOR TABLES CONTAINING PROJECT CONTROL INFORMATION.

USE THE FOLLOWING PROJECT CONTROL, VERTICAL POSITIONING. AND HORIZONTAL POSITIONING PARAMETERS FOR ALL SURVEYING:

PROJECT CONTROL

POSITIONING METHOD: ODOT VRS MONUMENT TYPE: TYPE B

VERTICAL POSTIONING

ORTHOMETRIC HEIGHT DATUM: NAVD 88 GEOID: GEOID 18

HORIZONTAL POSITIONING

REFERENCE FRAME: NAD 83 (2011) ELLIPSOID: GRS 1980 MAP PROJECTION: LAMBERT CONFORMAL CONIC COORDINATE SYSTEM: OHIO STATE PLANE, NORTH ZONE COMBINED SCALE FACTOR: 1.00000000 ORIGIN OF COORDINATE SYSTEM: (0,0)

USE THE POSITIONING METHODS AND MONUMENT TYPE USED IN THE ORIGINAL SURVEY TO RESTORE ALL MONUMENTS RELATED TO PRIMARY PROJECT CONTROL THAT ARE DAMAGED OR DESTROYED BY CONSTRUCTION ACTIVITIES. RESTORE THE DAMAGED OR DESTROYED MONUMENTS IN ACCORDANCE WITH CMS 623.

UNITS ARE IN U.S. SURVEY FEET

ENDANGERED BAT HABITAT REMOVAL

THIS PROJECT IS LOCATED WITHIN THE KNOWN HABITAT RANGES OF THE FEDERALLY LISTED AND PROTECTED INDIANA BAT, AND NORTHERN LONG-EARED BAT. NO TREES SHALL BE REMOVED UNDER THIS PROJECT FROM APRIL 1 THROUGH SEPTEMBER 30. ALL NECESSARY TREE REMOVAL SHALL OCCUR FROM OCTOBER 1 THROUGH MARCH 31. THIS REQUIREMENT IS NECESSARY TO AVOID AND MINIMIZE IMPACTS TO THESE SPECIES AS REQUIRED BY THE ENDANGERED SPECIES ACT (ESA). FOR THE PURPOSES OF THIS NOTE, A TREE IS DEFINED AS: A LIVE, DYING, OR DEAD WOODY PLANT, WITH A TRUNK 3 INCHES OR GREATER IN DIAMETER AT A HEIGHT OF 4.5 FEET ABOVE THE GROUND SURFACE. AND WITH A MINIMUM HEIGHT OF 13 FEET.

ITEM SPECIAL - PIPE CLEANOUT OVER 48"

THIS WORK SHALL CONSIST OF REMOVING SEDIMENT AND DEBRIS FROM THE EXISTING DRAINAGE CONDUITS SPECIFIED IN THE PLANS. ALL MATERIAL REMOVED SHALL BE DISPOSED OF AS PER 105.16 AND 105.17. CLEAN OUT TO THE APPROVAL OF THE ENGINEER.

CLEANOUT OF THE PIPE SHALL BE PAID FOR AT THE UNIT BID PRICE PER FOOT FOR ITEM SPECIAL - PIPE CLEANOUT OVER 48". THIS PRICE SHALL INCLUDE THE COST FOR MATERIAL, EQUIPMENT, LABOR, AND ALL INCIDENTALS REQUIRED TO COMPLETE THE CLEANOUT.

 $\overline{}$

4

 $\overline{}$

30.00

 $\overline{}$

 \sim

 \sim

LL Ш

AIRWAY/HIGHWAY CLEARANCE FOR AIRPORTS AND HELIPORTS

THIS PROJECT HAS BEEN IDENTIFIED AS BEING WITHIN THE INFLUENCE AREA OF A PUBLIC USE AIRPORT OR HELIPORT. NO TEMPORARY STRUCTURES OR CONSTRUCTION EQUIPMENT AT MAXIMUM OPERATING HEIGHT SHALL EXCEED A HEIGHT OF 607 FT. IF ANY TEMPORARY STRUCTURES OR CONSTRUCTION EQUIPMENT WILL EXCEED THIS HEIGHT, FURTHER COORDINATION WITH THE FEDERAL AVIATION ADMINISTRATION (FAA), AND ODOT OFFICE OF AVIATION, WILL BE NECESSARY PRIOR TO ERECTING SUCH TEMPORARY STRUCTURES OR OPERATING SUCH EQUIPMENT ON THE PROJECT. THE CONTRACTOR WILL BE REQUIRED TO SUBMIT FORM 7460-1 TO THE FAA. NOTIFY THE ODOT OFFICE OF AVIATION WHEN SUBMITTING FAA FORM 7460-1.

NO TEMPORARY STRUCTURES OR CONSTRUCTION EQUIPMENT SHALL EXCEED THE PERMISSIBLE HEIGHT, UNTIL A COPY OF THE FAA APPROVAL AND THE ODOT OFFICE OF AVIATION PERMIT HAS BEEN FURNISHED TO THE PROJECT ENGINEER.

FEDERAL AVIATION ADMINISTRATION	
SOUTHWEST REGIONAL OFFICE	
OBSTRUCTION EVALUATION GROUP	
10101 HILLWOOD PARKWAY	
FORT WORTH, TX 76177	
FAX: (817) 222-5920	
HTTP://CEAAA.FAA.GOV	
OHIO DEPARTMENT OF TRANSPORTATION	
OFFICE OF AVIATION	
2829 WEST DUBLIN-GRANVILLE ROAD	

ITEM 601 - RIPRAP, TYPE D, AS PER PLAN

OHIO.AIRPORT.PROTECTION@DOT.OHIO.GOV

COLUMBUS, OHIO 43235

THIS WORK SHALL FOLLOW THE SPECIFICATIONS OF ITEM 601 EXCEPT THAT THE PROPOSED CONCRETE RIPRAP SHALL BE REINFORCED WITH No. 3 BARS SPACED AT 24" ON CENTER.

IN ADDITION, THE CONTRACTOR SHALL PROVIDE DOWELING BETWEEN THE EXISTING AND PROPOSED CONCRETE RIPRAP AT THE COLD JOINT AS SHOWN IN THE PLANS. THE DOWELS SHALL BE No. 3 BARS SPACED AT 24" AND SHALL BE EMBEDDED AT A MINIMUM OF 12" INTO THE EXISTING CONCRETE RIPRAP. THE CONTRACTOR SHALL THEN SEAL THE JOINT PER C&MS 516.06.

ALL LABOR, EQUIPMENT, MATERIALS, AND INCIDENTALS NEEDED TO COMPLETE THE ABOVE DESCRIBED WORK SHALL BE INCLUDED IN THE UNIT BID PRICE PER SQUARE YARD FOR ITEM 601 - RIPRAP, TYPE D, AS PER PLAN.


ITEM 503 - COFFERDAMS AND EXCAVATION BRACING

ITEM 503, COFFERDAMS AND EXCAVATION BRACING HAS BEEN **PROVIDED FOR THE FOLLOWING LOCATIONS:**

JEF-22-13.83 JEF-22-14.71

THIS ITEM IS TO BE USED FOR THE NECESSARY COFFERDAMS NEEDED WITH BYPASS PUMPING AT THE LOCATIONS LISTED ABOVE. A LUMP SUM QUANTITY IS INCLUDED IN THE GENERAL SUMMARY FOR ITEM 503, COFFERDAMS AND EXCAVATION BRACING.

mmmm

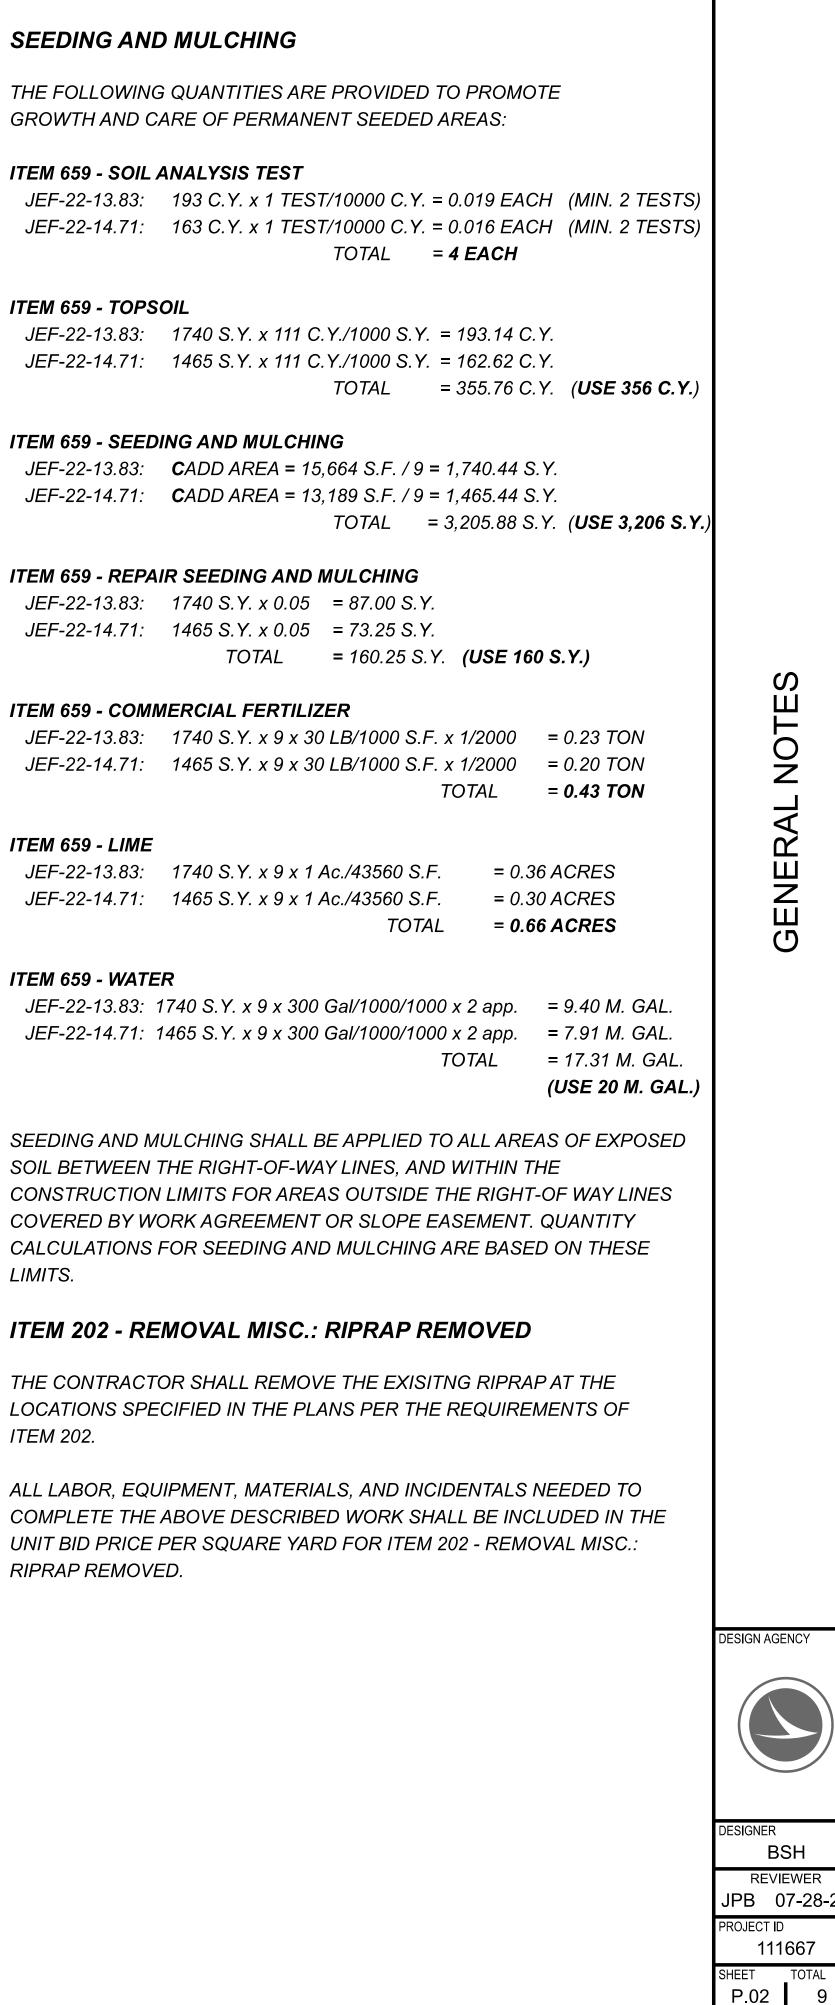

Ш́ Н . O Z ENERAL C

S

DESIGN AGENCY



			•	-		S	HEET NU	М.			•			PAF
	P.02	P.03	P.05	P.07	P.08	P.09								01/NH
_	LS													
_						1								
-					405	18								1
_			31	82	465	331								7
_					38	11								4
_			31	82										1
-														
-						11								
_					38									
_					35	57								9
_	4													
_	356 3,206													3 3,2
_	160													10
-	0.43													0.
_	0.66													0.
_	20													2
_														10,
_														
	\sim	\sim		h		h	h		h	h		h	h	
K	LS													
Ť	\sim					24.6		\sim						24
-														
-						10								1
01.dgn					166									1
7_GG001.					299	341								2
\111667					465	341								8
Sheets														
adway\		50												
ing\Ro; 		50 3												5
gineer		10												1
400-En		25 25												
iic 11667∖-														
bhovar rson\1 ⁻		10												1
JSER: 11\Jeffe		1,030												1,(
5 AM U District														+
8:58.2 ojects\E		LS												
TIME: tive Pro		L3												
/2023 \01 Act														L
: 11/17 uments														
DATE														
2 (in.) ot-pw-C														
: 34x2 ohiodo														
RSIZE														+
H: ☆ I				1	1	1	t			1	1	1		1
t PAPEF v.bentley														-
MODEL: Sheet PAPERSIZE: 34x22 (in.) DATE: 11/17/2023 TIME: 8:58:25 AM USER: bhovanic pw:\\ohiodot-pw.bentley.com:ohiodot-pw-02\Documents\01 Active Projects\District 11\Jefferson\111667\400-Engineering\Roadway\Sheets\														

				PART.		ITEM	GRAND		
				01/NHS/04	ITEM	EXT	TOTAL	UNIT	D
				LS	201	11000	LS		CLEARING AND GRUBBING
				1	202	20010	1	EACH	HEADWALL REMOVED
				18	202	35200	18	FT	PIPE REMOVED, OVER 24"
				796	SPECIAL	20270130	796	FT	PIPE CLEANOUT OVER 48"
				113	202	75000	113	FT	FENCE REMOVED
				49	202	98300	49	SY	REMOVAL MISC.: RIPRAP REMOVED
				113	607	15000	113	FT	FENCE, TYPE 47
									ER
				11	601	11000	11	SY	RIPRAP, TYPE D
				38	601	11001	38	SY	RIPRAP, TYPE D, AS PER PLAN
				92	601	32010	92	CY	ROCK CHANNEL PROTECTION, TYPE A WITH AG
				4	659	00100	4	EACH	SOIL ANALYSIS TEST
				356	659	00300	356	CY	TOPSOIL
				3,206	659	10000	3,206	SY	SEEDING AND MULCHING
				160	659	14000	160	SY	REPAIR SEEDING AND MULCHING
				0.43	659	20000	0.43	TON	COMMERCIAL FERTILIZER
				0.00	050	24000	0.00	4005	
				0.66 20	659 659	31000 35000	0.66 20	ACRE MGAL	LIME WATER
				20	000	00000	20	MOAL	
				10,000	832	30000	10,000	EACH	EROSION CONTROL
3		$\mathbf{\mathbf{x}}$	\sim	\sim				\sim	
				LS	503	11100	LS		COFFERDAMS AND EXCAVATION BRACING
\sim	\sim		\sim	24.6	602	20000	24.6	CY	CONCRETE MASONRY
				24.0	002	20000	24.0	01	
				10	611	28000	10	FT	84" CONDUIT, TYPE A, 707.02
				166	837	10000	166	FT	LINER PIPE, 54" ID 707.33, 707.85
				166 299	837 837	10000 10000	166 299	FT FT	LINER PIPE, 54" ID 707.33, 707.85 LINER PIPE, 60" ID 707.33, 707.85
				166 299 341	837 837 837	10000 10000 10000	166 299 341	FT FT FT	LINER PIPE, 54" ID 707.33, 707.85 LINER PIPE, 60" ID 707.33, 707.85 LINER PIPE, 66" ID 707.85
				166 299	837 837	10000 10000	166 299	FT FT	LINER PIPE, 54" ID 707.33, 707.85 LINER PIPE, 60" ID 707.33, 707.85
				166 299 341	837 837 837	10000 10000 10000	166 299 341	FT FT FT	LINER PIPE, 54" ID 707.33, 707.85 LINER PIPE, 60" ID 707.33, 707.85 LINER PIPE, 66" ID 707.85 BACKFILL FOR LINER PIPE
				166 299 341 806	837 837 837 837	10000 10000 10000 21000	166 299 341 806	FT FT FT FT	LINER PIPE, 54" ID 707.33, 707.85 LINER PIPE, 60" ID 707.33, 707.85 LINER PIPE, 66" ID 707.85 BACKFILL FOR LINER PIPE MAINT
				166 299 341 806 50	837 837 837 837 837 SPECIAL	10000 10000 21000 61412200	166 299 341 806 50	FT FT FT FT	LINER PIPE, 54" ID 707.33, 707.85 LINER PIPE, 60" ID 707.33, 707.85 LINER PIPE, 66" ID 707.85 BACKFILL FOR LINER PIPE MAINT WORK ZONE GUARDRAIL
				166 299 341 806	837 837 837 837 837 SPECIAL 614	10000 10000 21000 61412200 12380	166 299 341 806	FT FT FT FT EACH	LINER PIPE, 54" ID 707.33, 707.85 LINER PIPE, 60" ID 707.33, 707.85 LINER PIPE, 66" ID 707.85 BACKFILL FOR LINER PIPE MAINT WORK ZONE GUARDRAIL WORK ZONE IMPACT ATTENUATOR, 24" WIDE HA
				166 299 341 806 50 3	837 837 837 837 837 SPECIAL	10000 10000 21000 61412200	166 299 341 806 50 3	FT FT FT FT	LINER PIPE, 54" ID 707.33, 707.85 LINER PIPE, 60" ID 707.33, 707.85 LINER PIPE, 66" ID 707.85 BACKFILL FOR LINER PIPE MAINT WORK ZONE GUARDRAIL
				166 299 341 806 50 3 10	837 837 837 837 837 SPECIAL 614 614	10000 10000 21000 21000 61412200 12380 13000	166 299 341 806 50 3 10	FT FT FT FT EACH CY	LINER PIPE, 54" ID 707.33, 707.85 LINER PIPE, 60" ID 707.33, 707.85 LINER PIPE, 66" ID 707.85 BACKFILL FOR LINER PIPE MAINT WORK ZONE GUARDRAIL WORK ZONE IMPACT ATTENUATOR, 24" WIDE HA ASPHALT CONCRETE FOR MAINTAINING TRAFFI
				166 299 341 806 50 3 10 25 25 25	837 837 837 837 837 <i>SPECIAL</i> 614 614 614 614	10000 10000 21000 21000 61412200 12380 13000 13310 13350	166 299 341 806 50 3 10 25 25 25	FT FT FT FT EACH CY EACH EACH	LINER PIPE, 54" ID 707.33, 707.85 LINER PIPE, 60" ID 707.33, 707.85 LINER PIPE, 66" ID 707.85 BACKFILL FOR LINER PIPE MAINT WORK ZONE GUARDRAIL WORK ZONE IMPACT ATTENUATOR, 24" WIDE HA ASPHALT CONCRETE FOR MAINTAINING TRAFFI BARRIER REFLECTOR, TYPE 1 (ONE WAY) OBJECT MARKER, ONE WAY
				166 299 341 806 50 3 10 25	837 837 837 837 837 SPECIAL 614 614 614	10000 10000 21000 21000 61412200 12380 13000 13310	166 299 341 806 50 3 10 25	FT FT FT FT EACH CY EACH	LINER PIPE, 54" ID 707.33, 707.85 LINER PIPE, 60" ID 707.33, 707.85 LINER PIPE, 66" ID 707.85 BACKFILL FOR LINER PIPE MAINT WORK ZONE GUARDRAIL WORK ZONE IMPACT ATTENUATOR, 24" WIDE HA ASPHALT CONCRETE FOR MAINTAINING TRAFFI BARRIER REFLECTOR, TYPE 1 (ONE WAY)
				166 299 341 806 50 3 10 25 25 25	837 837 837 837 837 <i>SPECIAL</i> 614 614 614 614	10000 10000 21000 21000 61412200 12380 13000 13310 13350	166 299 341 806 50 3 10 25 25 25	FT FT FT FT EACH CY EACH EACH	LINER PIPE, 54" ID 707.33, 707.85 LINER PIPE, 60" ID 707.33, 707.85 LINER PIPE, 66" ID 707.85 BACKFILL FOR LINER PIPE MAINT WORK ZONE GUARDRAIL WORK ZONE IMPACT ATTENUATOR, 24" WIDE HA ASPHALT CONCRETE FOR MAINTAINING TRAFFI BARRIER REFLECTOR, TYPE 1 (ONE WAY) OBJECT MARKER, ONE WAY
				166 299 341 806 50 3 10 25 25 25 10	837 837 837 837 837 <i>SPECIAL</i> 614 614 614 614 614	10000 10000 21000 21000 61412200 12380 13000 13310 13350 10000	166 299 341 806 50 3 10 25 25 25 10	FT FT FT FT EACH CY EACH EACH EACH	LINER PIPE, 54" ID 707.33, 707.85 LINER PIPE, 60" ID 707.33, 707.85 LINER PIPE, 66" ID 707.85 BACKFILL FOR LINER PIPE MAINT WORK ZONE GUARDRAIL WORK ZONE IMPACT ATTENUATOR, 24" WIDE HA ASPHALT CONCRETE FOR MAINTAINING TRAFFI BARRIER REFLECTOR, TYPE 1 (ONE WAY) OBJECT MARKER, ONE WAY WATER
				166 299 341 806 50 3 10 25 25 25 10	837 837 837 837 837 <i>SPECIAL</i> 614 614 614 614 614	10000 10000 21000 21000 61412200 12380 13000 13310 13350 10000	166 299 341 806 50 3 10 25 25 25 10	FT FT FT FT EACH CY EACH EACH EACH	LINER PIPE, 54" ID 707.33, 707.85 LINER PIPE, 60" ID 707.33, 707.85 LINER PIPE, 66" ID 707.85 BACKFILL FOR LINER PIPE MAINT WORK ZONE GUARDRAIL WORK ZONE IMPACT ATTENUATOR, 24" WIDE HA ASPHALT CONCRETE FOR MAINTAINING TRAFFI BARRIER REFLECTOR, TYPE 1 (ONE WAY) OBJECT MARKER, ONE WAY WATER
				166 299 341 806 50 3 10 25 25 25 10 10 1,030	837 837 837 837 837 <i>SPECIAL</i> 614 614 614 614 614 614 614	10000 10000 21000 21000 61412200 12380 13000 13310 13350 10000 41100	166 299 341 806 50 3 10 25 25 25 10 10 1,030	FT FT FT FT EACH CY EACH EACH EACH	LINER PIPE, 54" ID 707.33, 707.85 LINER PIPE, 60" ID 707.33, 707.85 LINER PIPE, 66" ID 707.85 BACKFILL FOR LINER PIPE MAINT WORK ZONE GUARDRAIL WORK ZONE GUARDRAIL WORK ZONE IMPACT ATTENUATOR, 24" WIDE HA ASPHALT CONCRETE FOR MAINTAINING TRAFFI BARRIER REFLECTOR, TYPE 1 (ONE WAY) OBJECT MARKER, ONE WAY WATER PORTABLE BARRIER, UNANCHORED
				166 299 341 806 50 3 10 25 25 25 10	837 837 837 837 837 <i>SPECIAL</i> 614 614 614 614 614	10000 10000 21000 21000 61412200 12380 13000 13310 13350 10000	166 299 341 806 50 3 10 25 25 25 10	FT FT FT FT EACH CY EACH EACH EACH	LINER PIPE, 54" ID 707.33, 707.85 LINER PIPE, 60" ID 707.33, 707.85 LINER PIPE, 66" ID 707.85 BACKFILL FOR LINER PIPE MAINT WORK ZONE GUARDRAIL WORK ZONE GUARDRAIL WORK ZONE IMPACT ATTENUATOR, 24" WIDE HA ASPHALT CONCRETE FOR MAINTAINING TRAFFI BARRIER REFLECTOR, TYPE 1 (ONE WAY) OBJECT MARKER, ONE WAY WATER PORTABLE BARRIER, UNANCHORED MAINTAINING TRAFFIC
				166 299 341 806 50 3 10 25 25 25 25 10 10 1,030	837 837 837 837 837 837 837 614 614 614 614 614 614 614 614 614	10000 10000 21000 21000 61412200 12380 13000 13310 13350 10000 41100	166 299 341 806 50 3 10 25 25 25 10 10 1,030	FT FT FT FT EACH CY EACH EACH EACH FT MGAL	LINER PIPE, 54" ID 707.33, 707.85 LINER PIPE, 60" ID 707.33, 707.85 LINER PIPE, 66" ID 707.85 BACKFILL FOR LINER PIPE MAINT WORK ZONE GUARDRAIL WORK ZONE GUARDRAIL WORK ZONE IMPACT ATTENUATOR, 24" WIDE HA ASPHALT CONCRETE FOR MAINTAINING TRAFFI BARRIER REFLECTOR, TYPE 1 (ONE WAY) OBJECT MARKER, ONE WAY WATER PORTABLE BARRIER, UNANCHORED
				166 299 341 806 50 3 10 25 25 25 10 10 1,030 1,030	837 837 837 837 837 837 837 614 614 614 614 614 614 614 614 614 614	10000 10000 21000 21000 61412200 12380 13000 13310 13350 13350 10000 41100 41100	166 299 341 806 50 3 10 25 25 25 25 10 10 1,030	FT FT FT FT EACH CY EACH EACH EACH FT MGAL	LINER PIPE, 54" ID 707.33, 707.85 LINER PIPE, 60" ID 707.33, 707.85 LINER PIPE, 66" ID 707.85 BACKFILL FOR LINER PIPE MAINT WORK ZONE GUARDRAIL WORK ZONE IMPACT ATTENUATOR, 24" WIDE HA ASPHALT CONCRETE FOR MAINTAINING TRAFFI BARRIER REFLECTOR, TYPE 1 (ONE WAY) OBJECT MARKER, ONE WAY WATER PORTABLE BARRIER, UNANCHORED MAINTAINING TRAFFIC FIELD OFFICE, TYPE B
				166 299 341 806 50 3 10 25 25 25 10 10 1,030 1,030	837 837 837 837 837 837 837 837 614 614 614 614 614 614 614 614 614 614	10000 10000 21000 21000 61412200 12380 13300 13310 13350 13350 13350 13350 13350 13000 13310 13350	166 299 341 806 50 3 10 25 25 25 25 10 10 1,030 1,030	FT FT FT FT EACH CY EACH EACH EACH FT MGAL	LINER PIPE, 54" ID 707.33, 707.85 LINER PIPE, 60" ID 707.33, 707.85 LINER PIPE, 66" ID 707.85 BACKFILL FOR LINER PIPE MAINT WORK ZONE GUARDRAIL WORK ZONE IMPACT ATTENUATOR, 24" WIDE HA ASPHALT CONCRETE FOR MAINTAINING TRAFFI BARRIER REFLECTOR, TYPE 1 (ONE WAY) OBJECT MARKER, ONE WAY WATER PORTABLE BARRIER, UNANCHORED MAINTAINING TRAFFIC FIELD OFFICE, TYPE B CONSTRUCTION LAYOUT STAKES AND SURVEYI
				166 299 341 806 50 3 10 25 25 25 10 10 1,030 1,030	837 837 837 837 837 837 837 837 614 614 614 614 614 614 614 614 614 614	10000 10000 21000 21000 61412200 12380 13300 13310 13350 13350 13350 13350 13350 13000 13310 13350	166 299 341 806 50 3 10 25 25 25 25 10 10 1,030 1,030	FT FT FT FT EACH CY EACH EACH EACH FT MGAL	LINER PIPE, 54" ID 707.33, 707.85 LINER PIPE, 60" ID 707.33, 707.85 LINER PIPE, 66" ID 707.85 BACKFILL FOR LINER PIPE MAINT WORK ZONE GUARDRAIL WORK ZONE IMPACT ATTENUATOR, 24" WIDE HA ASPHALT CONCRETE FOR MAINTAINING TRAFFI BARRIER REFLECTOR, TYPE 1 (ONE WAY) OBJECT MARKER, ONE WAY WATER PORTABLE BARRIER, UNANCHORED MAINTAINING TRAFFIC FIELD OFFICE, TYPE B CONSTRUCTION LAYOUT STAKES AND SURVEYI
DESCRIPTION	SEE SHEET NO.	
POADIA/AV		
ROADWAY		
	P.02	
	P.02	
ROSION CONTROL		
RUSION CONTROL		
	P.02	
GGREGATE FILTER		
		SUMMARY
		1AI
		AN VIV
		SI
		٦L
		GENERAL
DRAWNAGE	\sim	Щ
\dots	\cdots	μ
		U U
ITENANCE OF TRAFFIC		
HAZARDS, (UNIDIRECTIONAL)	P.03	
FIC		
INCIDENTALS		
YING		DESIGN AGENCY
		DESIGNER BSH
		REVIEWER
		JPB 04-07-23 PROJECT ID
		111667
		SHEET TOTAL P.04 9