# MAINTAINING DRIVEWAY ACCESS

COMMERCIAL AND HANDICAP PROPERTIES: ACCESS TO ALL COMMERCIAL AND HANDICAP PROPERTY SHALL BE MAINTAINED AT ALL TIMES, AS FOLLOWS:

EOR PROPERTIES WITH MULTIPLE DRIVEWAYS: DRIVEWAY CONSTRUCTION WILL BE SCHEDULED SO THAT AT LEAST ONE ACCESS DRIVEWAY IS OPEN AND CLEAR WHILE THE OTHER DRIVEWAY(S) ARE BEING CONSTRUCTED.

EOR PROPERTIES WITH ONLY ONE ACCESS AND PROPERTIES. WITH ONE WAY DIRECTIONAL DRIVEWAYS: DRIVEWAY CONSTRUCTION SHALL BE SCHEDULED OUTSIDE OF NORMAL BUSINESS HOURS. IF THE PROPERTY CANNOT BE WITHOUT ACCESS TEMPORARILY (SUCH AS OUTSIDE OF NORMAL BUSINESS HOURS OR OVER THE WEEKEND), ACCESS TO THE PROPERTY SHALL BE MAINTAINED AS FOLLOWS:

THE PAVEMENT IN FRONT OF THE DRIVEWAY SHALL BE REMOVED AND TRAFFIC COMPACTED SURFACE FURNISHED, INSTALLED, AND COMPACTED ON TOP OF THE EXPOSED SUBGRADE. THIS WORK SHALL BE PERFORMED IN ONE OPERATION SO THAT THE DISRUPTION TO THE PROPERTY IS KEPT AT AN ABSOLUTE MINIMUM. THE CONTRACTOR WILL MAINTAIN THE RAMP AND REPLACE MATERIAL AS NECESSARY.

THE INSTALLATION OF THE PROPOSED DRIVEWAY AND THE CONCRETE PAVEMENT IN FRONT OF THE DRIVEWAY SHALL BE PERFORMED AS ONE OPERATION UNLESS APPROVED BY THE ENGINEER IN ORDER TO MINIMIZE THE DURATION OF A REQUIRED OUTAGE. IF THE DRIVEWAY IS MORE THAN 20 FEET WIDE, CONSTRUCTION ON THE DRIVEWAY AND PAVEMENT SHALL BE IN TWO (2) PHASES, WITH ONE HALF OF THE DRIVE REMAINING OPEN WHILE THE OTHER HALF IS CLOSED AND BEING CONSTRUCTED. THE CONTRACTOR SHALL PROVIDE ACCESS IMMEDIATELY AFTER ANY MINIMUM REQUIRED TIME TO PERFORM DRIVEWAY RECONSTRUCTION WORK. THE CONTRACTOR SHALL ALSO PROVIDE ACCESS TO THE PROPERTY DURING THE CURE PERIOD.

IN LOCATIONS WHERE A DRIVEWAY TO A PARKING LOT IS CLOSED TO TRAFFIC, THE DRIVE SHALL HAVE PROPER PROTECTION, SUCH AS SIGNS, FENCING, BARRICADES, AND DRUMS, PLACED AND MAINTAINED AROUND IT.

WHERE DIRECTED BY THE ENGINEER, ONE (I) BUSINESS ENTRANCE SIGN (M4-HI5) SIGN SHALL BE PROVIDED, INSTALLED, MAINTAINED, AND SUBSEQUENTLY REMOVED BY THE CONTRACTOR AT AFFECTED COMMERCIAL DRIVEWAYS. THE SIGN SHALL BE 36 INCH X 48 INCH IN SIZE WITH TYPE G OR TYPE H ORANGE RETROREFLECTIVE SHEETING AND BE MOUNTED ON TWO #3 POSTS OR ON TEMPORARY POSTS IN ACCORDANCE WITH ODOT STANDARD CONSTRUCTION DRAWING MT-105.10. THE SIGN SHALL HAVE THE STANDARD M4-HI5 LEGEND, EXCEPT THAT THE ACTUAL BUSINESS NAME SHALL BE SUBSTITUTED FOR THE WORD "RUSINESS."

RESIDENTIAL PROPERTIES: THE CONTRACTOR SHALL MAKE REASONABLE PROVISIONS TO ALLOW RESIDENTIAL ACCESS AT ALL TIME OR OTHERWISE ALLOW RESIDENTS TO PARK SAFELY WITHIN THE PROJECT LIMITS WHEN ACCESS IS NOT POSSIBLE. THE MAXIMUM OUT OF SERVICE TIME FOR ANY RESIDENTIAL DRIVE SHALL BE ONE (1) DAY. RESIDENTIAL ACCESS SHALL BE MAINTAINED USING THE FOLLOWING PROCEDURES, AS DIRECTED BY THE ENGINEER:

AFTER THE EXISTING PAVEMENT AND CURB HAVE BEEN REMOVED, THE CONTRACTOR SHALL IMMEDIATELY MAINTAIN VEHICULAR ACCESS TO THE DRIVEWAY USING ITEM 410, TRAFFIC COMPACTED SURFACE, BETWEEN THE PAVEMENT AND THE DRIVEWAY. STEEL PLATES MAY ALSO BE USED.

WHILE THE CONCRETE PAVEMENT AND CURB IS BEING INSTALLED AND IS CURING, THE CONTRACTOR SHALL PROVIDE PARKING AREAS SAFELY WITHIN THE PROJECT WORK LIMITS OR ALONG ADJACENT SIDE STREETS. DURING THIS TIME, THE EXISTING SIDEWALKS BETWEEN THE SIDE STREETS SHALL REMAIN IN SERVICE FOR ACCESS FROM THE PARKING AREA TO THE PROPERTY.

PRIOR TO THE START OF CONSTRUCTION, THE CONTRACTOR SHALL SUBMIT A PLAN, FOR THE APPROVAL OF THE ENGINEER, WHICH OUTLINES HIS/HER STRATEGY FOR THE MAINTENANCE OF SAFE ACCESS TO COMMERCIAL, HANDICAP AND RESIDENTIAL PROPERTY AND/OR FOR ALLOWING RESIDENTS TO PARK SAFELY WITHIN THE PROJECT LIMITS WHEN ACCESS IS NOT POSSIBLE. CLOSING A DRIVEWAY AND ALLOWING PARKING WITHIN THE PROJECT LIMITS SHALL BE A LAST RESORT.

THE PAYMENT FOR ALL LABOR, EQUIPMENT AND MATERIALS REQUIRED TO MAINTAIN COMMERCIAL, HANDICAP AND RESIDENTIAL ACCESS AND/OR SAFE PARKING AREAS FOR RESIDENTS, INCLUDING TRAFFIC COMPACTED SURFACE AND ASPHALT CONCRETE FOR MAINTAINING TRAFFIC SHALL BE INCLUDED IN THE LUMP SUM CONTRACT PRICE FOR ITEM 614 -MAINTAINING TRAFFIC; EXCEPT FOR THE SEPARATELY ESTIMATED ITEMS/QUANTITIES ADDITIONALLY PROVIDED IN THE PLANS FOR MAINTAINING TRAFFIC (ACCESS).

## EXISTING SIGNS

IN ANY PHASE, WHEN A MAINTENANCE OF TRAFFIC SIGN CONTRADICTS AN EXISTING SIGN, THE EXISTING SIGN SHALL BE COVERED. ALL OTHER SIGNS SHALL BE MAINTAINED DURING CONSTRUCTION AND RELOCATED NEARBY IF NECESSARY.

### LAKETRAN BUS STOPS

LAKETRAN BUS STOPS SHALL BE MAINTAINED DURING ALL PHASES OF CONSTRUCTION. EXISTING BUS STOP SIGNS SHALL BE MOVED TO A NEARBY LOCATION IF NECESSARY. ALL BUS STOP SIGNS SHALL BE MAINTAINED AND RELOCATED AS NECESSARY.

### MAIL BOXES

PER PLAN

MAIL BOXES SHALL BE CAREFULLY RELOCATED AS NECESSARY BY THE CONTRACTOR DURING CONSTRUCTION SO THAT THEY ARE ACCESSIBLE TO MAIL DELIVERY TRUCKS. ANY DAMAGE TO THE MAILBOX SHALL BE THE RESPONSIBILITY OF THE CONTRACTOR. DAMAGED MAILBOXES SHALL BE REPLACED BY THE CONTRACTOR IN KIND.

# ITEM 611 12" CONDUIT, TYPE B, AS PER PLAN

THIS ITEM INCLUDES THE REMOVAL OF THE CONDUIT, OR ABANDONEMENT OF THE CONDUIT IF THE COUDUIT HAS BEEN PLACED UNDER PERMENANT PAVEMENT, AFTER THE MAINTENANCE OF TRAFFIC PHASE IN WHICH IT IS USED HAS BEEN COMPLETED. THE CONDUIT SHALL BE FILLED AND PLUGGED AS PER THE ITEM SPECIAL-FILL AND PLUG EXISTING CONDUIT NOTE SHOWN ON SHEET 17.

# ITEM 611 CATCH BASIN RECONSTRUCTED TO GRADE, AS PER PLAN

WHEN RECONSTRUCTING CATCH BASINS TO GRADE FOR THE PURPOSE OF MAINTAINING TRAFFIC, FOLLOW THE PROCEDURE BELOW.

1. CAREFULLY REMOVE AND CLEAN THE EXISTING CASTINGS. 2. REMOVE EXISTING WALLS OF CATCH BASINS AND INLETS BELOW THE GRATES TO THE DEPTH NECESSARY FOR PLACEMENT OF TEMPORARY PAVEMENT, OR ANY POINTS OF WALL FAILURE. 3. INSTALL A 1-1/4 INCH MINIMUM STEEL ROAD PLATE AS SHOWN IN THE TEMPORARY DRAINAGE DETAIL.

4. WHERE EXISTING BASINS WILL NOT BE REMOVED IN A LATER PHASE OF THE CONTRACT, REMOVE THE ROAD PLATE AND USING THE SALVAGED CASTING, RECONSTRUCT THE STRUCTURE TO THE ORIGINAL PLAN GRADE, CONFORMING AS NEARLY AS PRACTICABLE TO THE EXISTING DIMENSION AND TYPE OF CONSTRUCTION.

#### ITEM 606 - GUARDRAIL, TYPE MGS, AS PER PLAN ITEM 606 - ANCHOR ASSEMBLY, MGS TYPE E, AS PER PLAN (MASH 2016) ITEM 606 - ANCHOR ASSEMBLY, MGS TYPE T, AS

GUARDRAIL AND ANCHOR ASSEMBLIES INSTALLED FOR MAINTAINING TRAFFIC SHALL BE REMOVED AND DISPOSED OF AFTER COMPLETION OF THE PHASE IN WHICH THEY WERE CONSTRUCTED AND USED.

## ITEM 614 - DETOUR SIGNING\_

SIZE AND PLACEMENT OF DETOUR SIGNS (M4-9) SHOULD FOLLOW THE REQUIREMENTS OF THE OMUTCD SECTION 6F.03, SECTION 2A.11 AND TABLE 6F.01.

DETOUR SIGNING SHALL PROVIDE DRIVERS ADEQUATE TIME TO CLEARLY READ THE SIGNS AND MAKE THE PROPER DECISIONS AT EACH REQUIRED TURNING MOVEMENT. THE DESIGNATED DETOUR ROUTE SHALL BE SIGNED IN ACCORDANCE WITH THE REQUIREMENTS BELOW:

1. APPROXIMATELY 1500 FEET PRIOR TO TIP OF THE PAINTED GORE AT AN INTERCHANGE WHEN EXITING A HIGH SPEED (45 MPH OR HIGHER) FACILITY.

2. AT OR NEAR THE EXISTING SIGN IN THE GORE OF AN INTERCHANGE RAMP.

3. AT OR NEAR THE FIRST EXISTING LANE ASSIGNMENT SIGN ON AN INTERCHANGE EXIT RAMP.

4. AT OR NEAR THE EXISTING LANE ASSIGNMENT SIGN OR EXISTING ROUTE MARKER AT THE END OF AN EXIT RAMP.

5. APPROXIMATELY 500 FEET PRIOR TO A REQUIRED TURN AT AN INTERSECTION NOT CONTROLLED BY A STOP SIGN (FOR 45 MPH OR HIGHER ONLY).

6. AT OR NEAR THE EXISTING LANE ASSIGNMENT SIGN OR EXISTING ROUTE MARKER AT AN INTERSECTION.

7. EVERY TWO MILES ALONG A TANGENT SECTION BETWEEN TURNING MOVEMENTS OUTSIDE A CITY.

8. EVERY TWO BLOCKS ALONG A TANGENT SECTION BETWEEN TURNING MOVEMENTS WITHIN A CITY.

9. AT ANY OTHER INTERSECTION OR DECISION POINT WHERE THE DETOUR ROUTE IS CONTRARY TO THE NORMAL, EXPECTED TURNING MANEUVER OR OTHERWISE UNCLEAR.

DETOUR SIGNS SHALL BE PLACED, WHEN POSSIBLE, NEXT TO BUT NOT BLOCKING EXISTING ROUTE MARKERS OR LANE ASSIGNMENT SIGNS. DETOUR SIGNS SHALL NOT OBSCURE OR BE OBSCURED BY OTHER EXISTING OR TEMPORARY SIGNS.

DETOUR SIGNS SHALL BE ERECTED AND/OR UNCOVERED PRIOR TO THE ROAD OR RAMP BEING CLOSED TO TRAFFIC BUT NO EARLIER THAN FOUR HOURS PRIOR TO THE CLOSURE. DETOUR SIGNS SHALL BE COVERED AND/OR REMOVED NO LATER THAN FOUR HOURS FOLLOWING THE ROAD OR RAMP RE-OPENING TO TRAFFIC.

PAYMENT FOR ACCEPTED QUANTITIES WILL BE MADE AT THE CONTRACT UNIT PRICE. PAYMENT SHALL BE FOR ALL MATERIALS, LABOR, INCIDENTALS AND EQUIPMENT FOR FURNISHING, PROPER SIGN PLACEMENT AND SIZING, TIMELY ERECTING AND/OR UNCOVERING OF SIGNS, MAINTAINING SIGNS, AND TIMELY COVERING AND/OR REMOVING SIGNS AND SUPPORTS.

THE FOLLOWING ESTIMATED QUANTITIES HAVE BEEN CARRIED TO THE GENERAL SUMMARY. ITEM 614 - DETOUR SIGNING LUMP SUM

# ITEM 615 PAVEMENT FOR MAINTAINING TRAFFIC, CLASS A, AS PER PLAN


ANY ASPHALT OR CONCRETE CURBS THAT ARE CONSTUCTED ON TOP OF THE TEMPORARY PAVEMENT OR INTEGRAL TO THE TEMPORARY PAVEMENT SHALL BE INCLUDED IN THE UNIT PRICE BID FOR ITEM 615 PAVEMENT FOR MAINTAINING TRAFFIC, CLASS A, AS PER PLAN.

### ITEM 615 PAVEMENT FOR MAINTAINING TRAFFIC, CLASS A, AS PER PLAN, TYPE 1

THE PAVEMENT FOR MAINTAINING TRAFFIC ALONG DERUBERTIS DRIVE AND HUBBARD ROAD (SR 528) SHALL INCLUDE THE REPLACEMENT OF ANY EXISTING DRIVEWAYS AND CONCRETE CURB IMPACTED BY THE INSTALLATION OF THIS PAVEMENT FOR MAINTAINING TRAFFIC. THE PAYMENT FOR ALL LABOR, EQUIPMENT AND MATERIALS REQUIRED TO REPLACE EXISTING DRIVEWAYS AND CONCRETE CURB SHALL BE INCLUDED IN THE CONTRACT PRICE FOR ITEM 615 PAVEMENT FOR MAINTAING TRAFFIC, CLASS A, AS PER PLAN, TYPE 1.

 $\bigcirc$ 

 $\bigcirc$ 

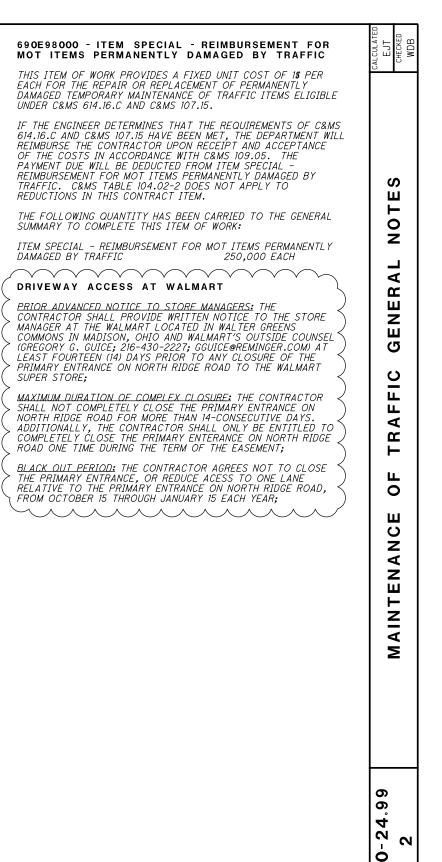

$\overline{(23)}$	
599	

N F

A S

Y

∢

£