

Nov 18, 2025 - 3:14pm
drawing name: H:\2023\231046\DWG\Sheets\C_231046 - TYP SECTIONS_good.dwg Layout: 6 by: tyler.mintus

LEGEND:

- A

EXISTING REINFORCED CONCRETE PAVEMENT (T=10")
- B

EXISTING REINFORCED CONCRETE PAVEMENT (T=7")
- C

EXISTING AGGREGATE BASE (T=6")
- D

EXISTING AGGREGATE BASE (T=4")
- E

STANDARD LONGITUDINAL JOINT
- F

EXISTING INTEGRAL CONCRETE CURB
- G

EXISTING CONCRETE WALK (T=4")
- H

EXISTING 6" UNDERDRAIN

- 1


ITEM 441 - ASPHALT CONCRETE SURFACE COURSE, TYPE 1 (448) PG64-22 (T= 1-1/4")
- 2

ITEM 441 - ASPHALT CONCRETE INTERMEDIATE COURSE, TYPE 2 (448) (T= 1-3/4")
- 3

ITEM 407 - NON-TRACKING TACK COAT
- 4

ITEM 690 - SPECIAL, PAVEMENT REINFORCING FABRIC
- 5

ITEM 872 - VOID REDUCING ASPHALT MEMBRANE (VRAM)

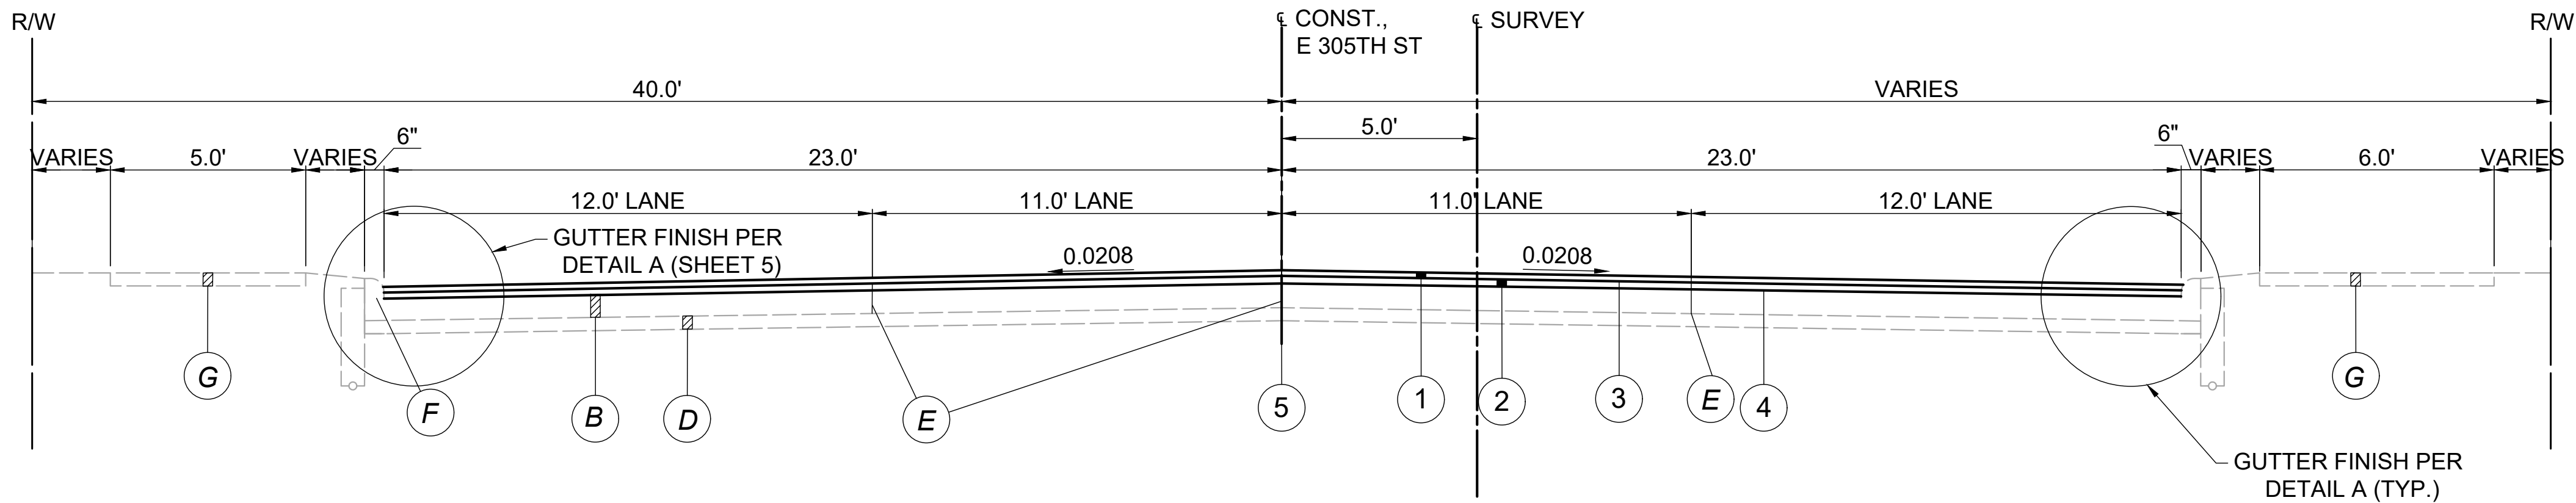

ASPHALT OVERLAY SECTION
STA. 75+39.26 TO STA. 88+71.25
(FAIRWAY BLVD. TO LAKESHORE BLVD.)

NOTE: VRAM TO BE PLACED AT
ALL ADJOINING PAVEMENT
PLACEMENT LANES

CALCULATED

TMK

CHECKED

WDB

TYPICAL SECTIONS - 2

LAK - E 305TH ST.

6
117

[illegible]

