

**LAWRENCE COUNTY**  
**S.H. 681 SEC. A (Pt.) B & C (Pt.)**  
 9.5 Mi. E. of Coalgrove  
 LAW-243-5.03

**PROFILE OF PROPOSED TEMPORARY RUN-AROUND**  
 Stations are projected from proposed &

Notes:  
 Temporary run-around road and bridge are included in this contract.

**CURVE DATA**  
 $\Delta = 22^\circ 30' \text{ Rt.}$   
 $D_c = 14^\circ 00'$   
 $T = 81.41'$   
 $L = 160.71'$   
 $R = 409.26'$

**EXISTING BRIDGE DATA**  
 Type: Steel Truss, Wood Deck, Stone Abutments  
 Span: 42'-0" 39'-0" Clear  
 Roadway: 13' Clear (To be removed)  
 Skew: None  
 Condition: Superstructure - Poor, Substructure - Fair  
 Bridge Limits

**PROPOSED STRUCTURE**  
 Type: Continuous concrete slab with concrete substructure  
 Spans: 28'-35'-28' % brgs.  
 Roadway: 28' w/ guard rails  
 Loading: S-12-40  
 Skew: None  
 Wear Surf: 4" Monolithic Concrete  
 Appr. Slabs: None  
 Alignment: Tangent  
 Superelevation: Variable, on transition 14° curve




DRAINAGE AREA 4 Sq. Mi.

*[Signature]*  
 E. M. W. 10/24/47  
 R. S. P. 10/24/47  
 R. S. P. 10/24/47

STATE OF OHIO  
 DEPARTMENT OF HIGHWAYS  
 BUREAU OF BRIDGES

**SITE PLAN**  
 BRIDGE No LA-243-110  
 OVER LEATHERWOOD CREEK  
 LAWRENCE Co. S.H. 681  
 Sec. C Sta. 570+00.00  
 Scale: Hor. 1"=20'; Vert. 1"=10'

Present Topography	Proposed Work
Surveyed Arthur	Drawn S.E.K.
Designed C.N.A.	Drawn C.N.A.
Checked G.E.S.	Reviewed S.E.K.

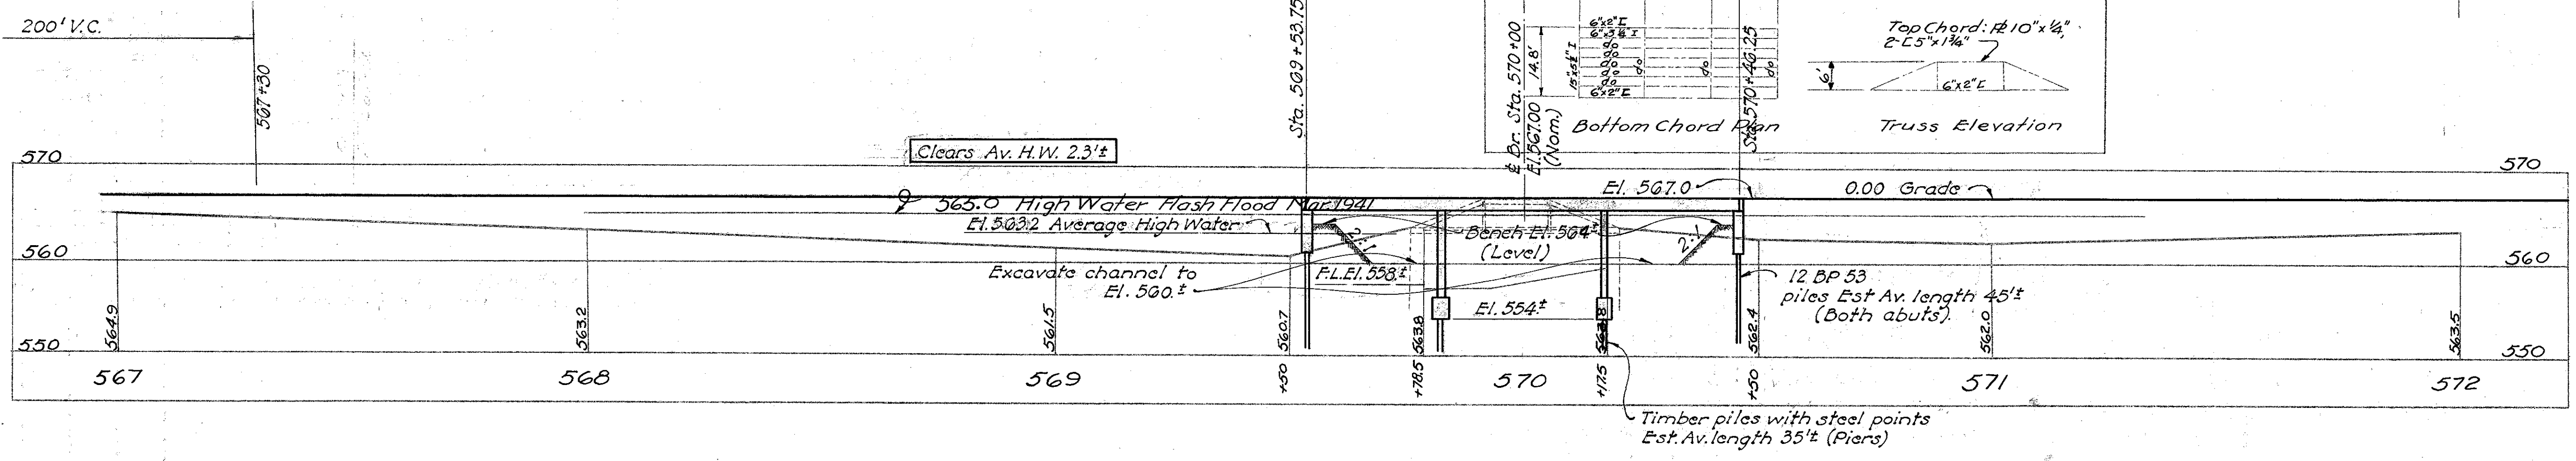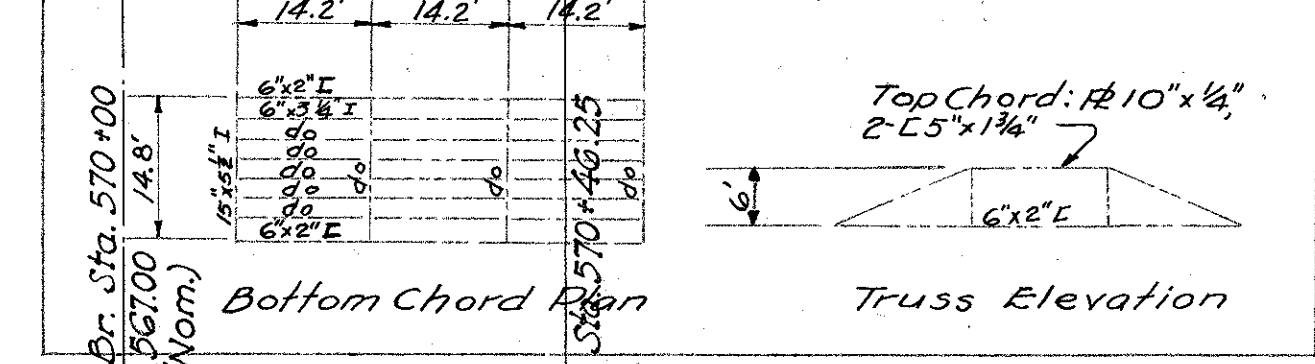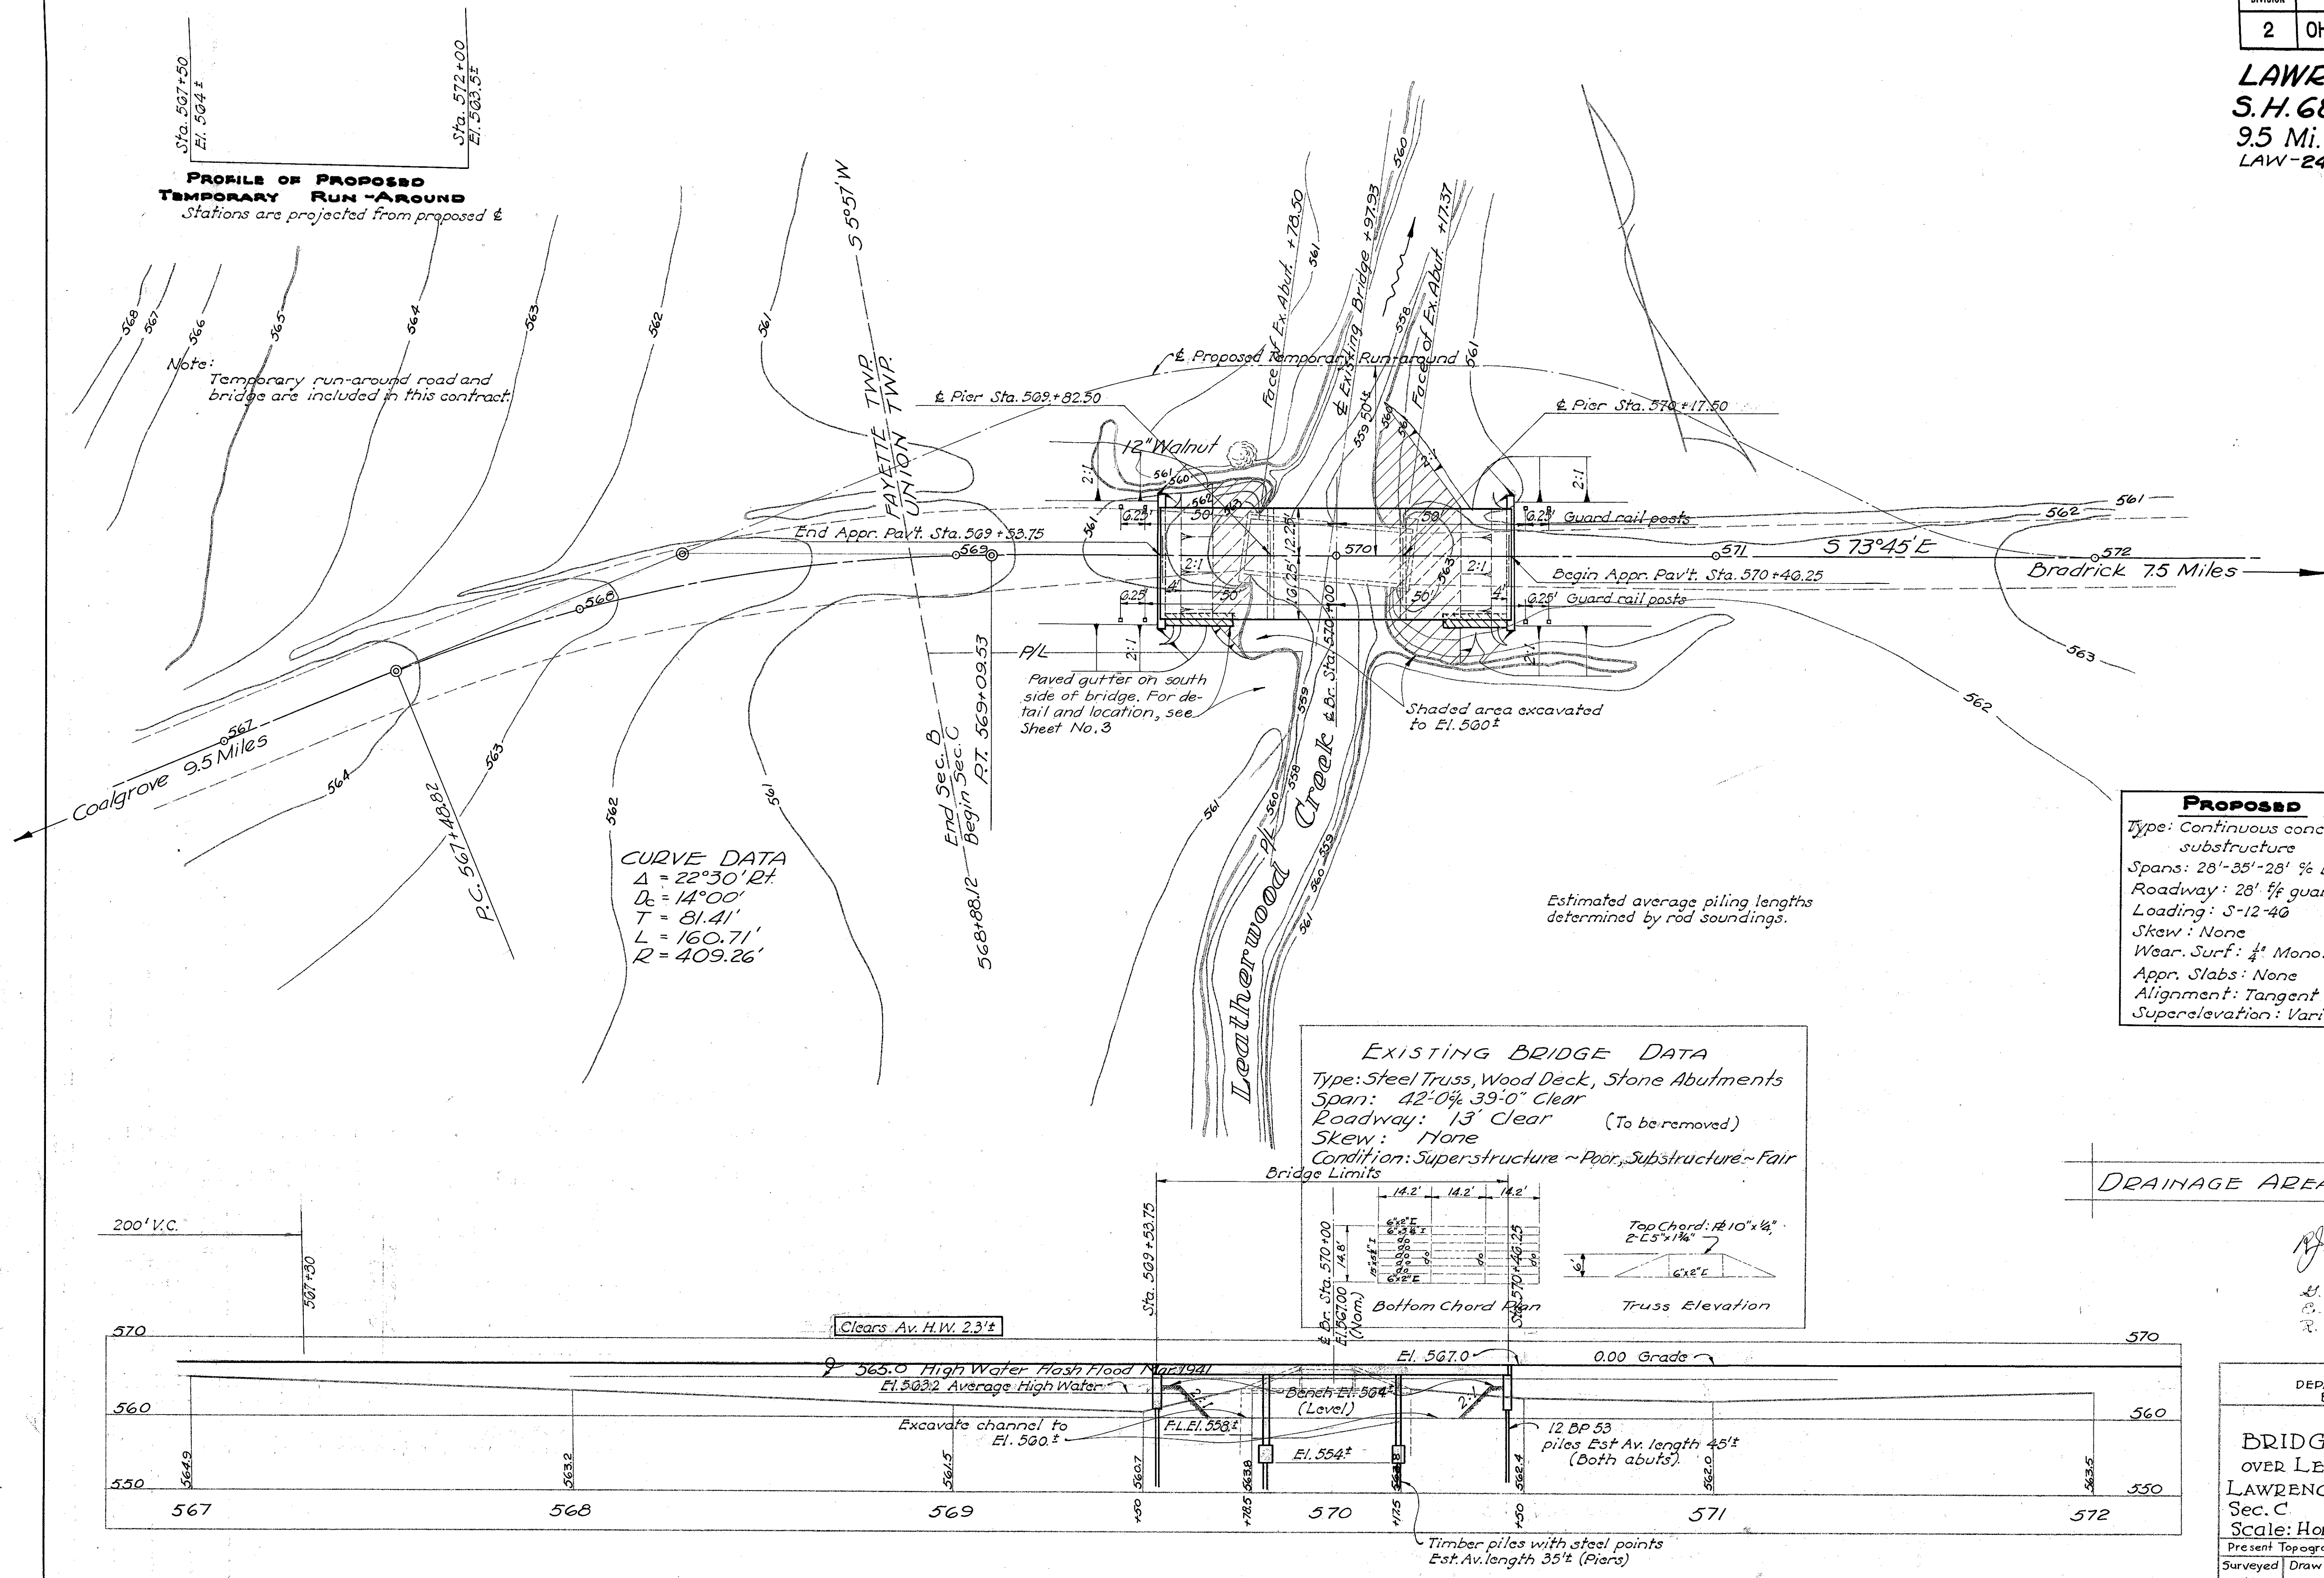


Timber piles with steel points  
 Est. Av. length 35'± (Piers)

Estimated average piling lengths determined by rod soundings.


Paved gutter on south side of bridge. For detail and location, see Sheet No. 3

Shaded area excavated to El. 500±

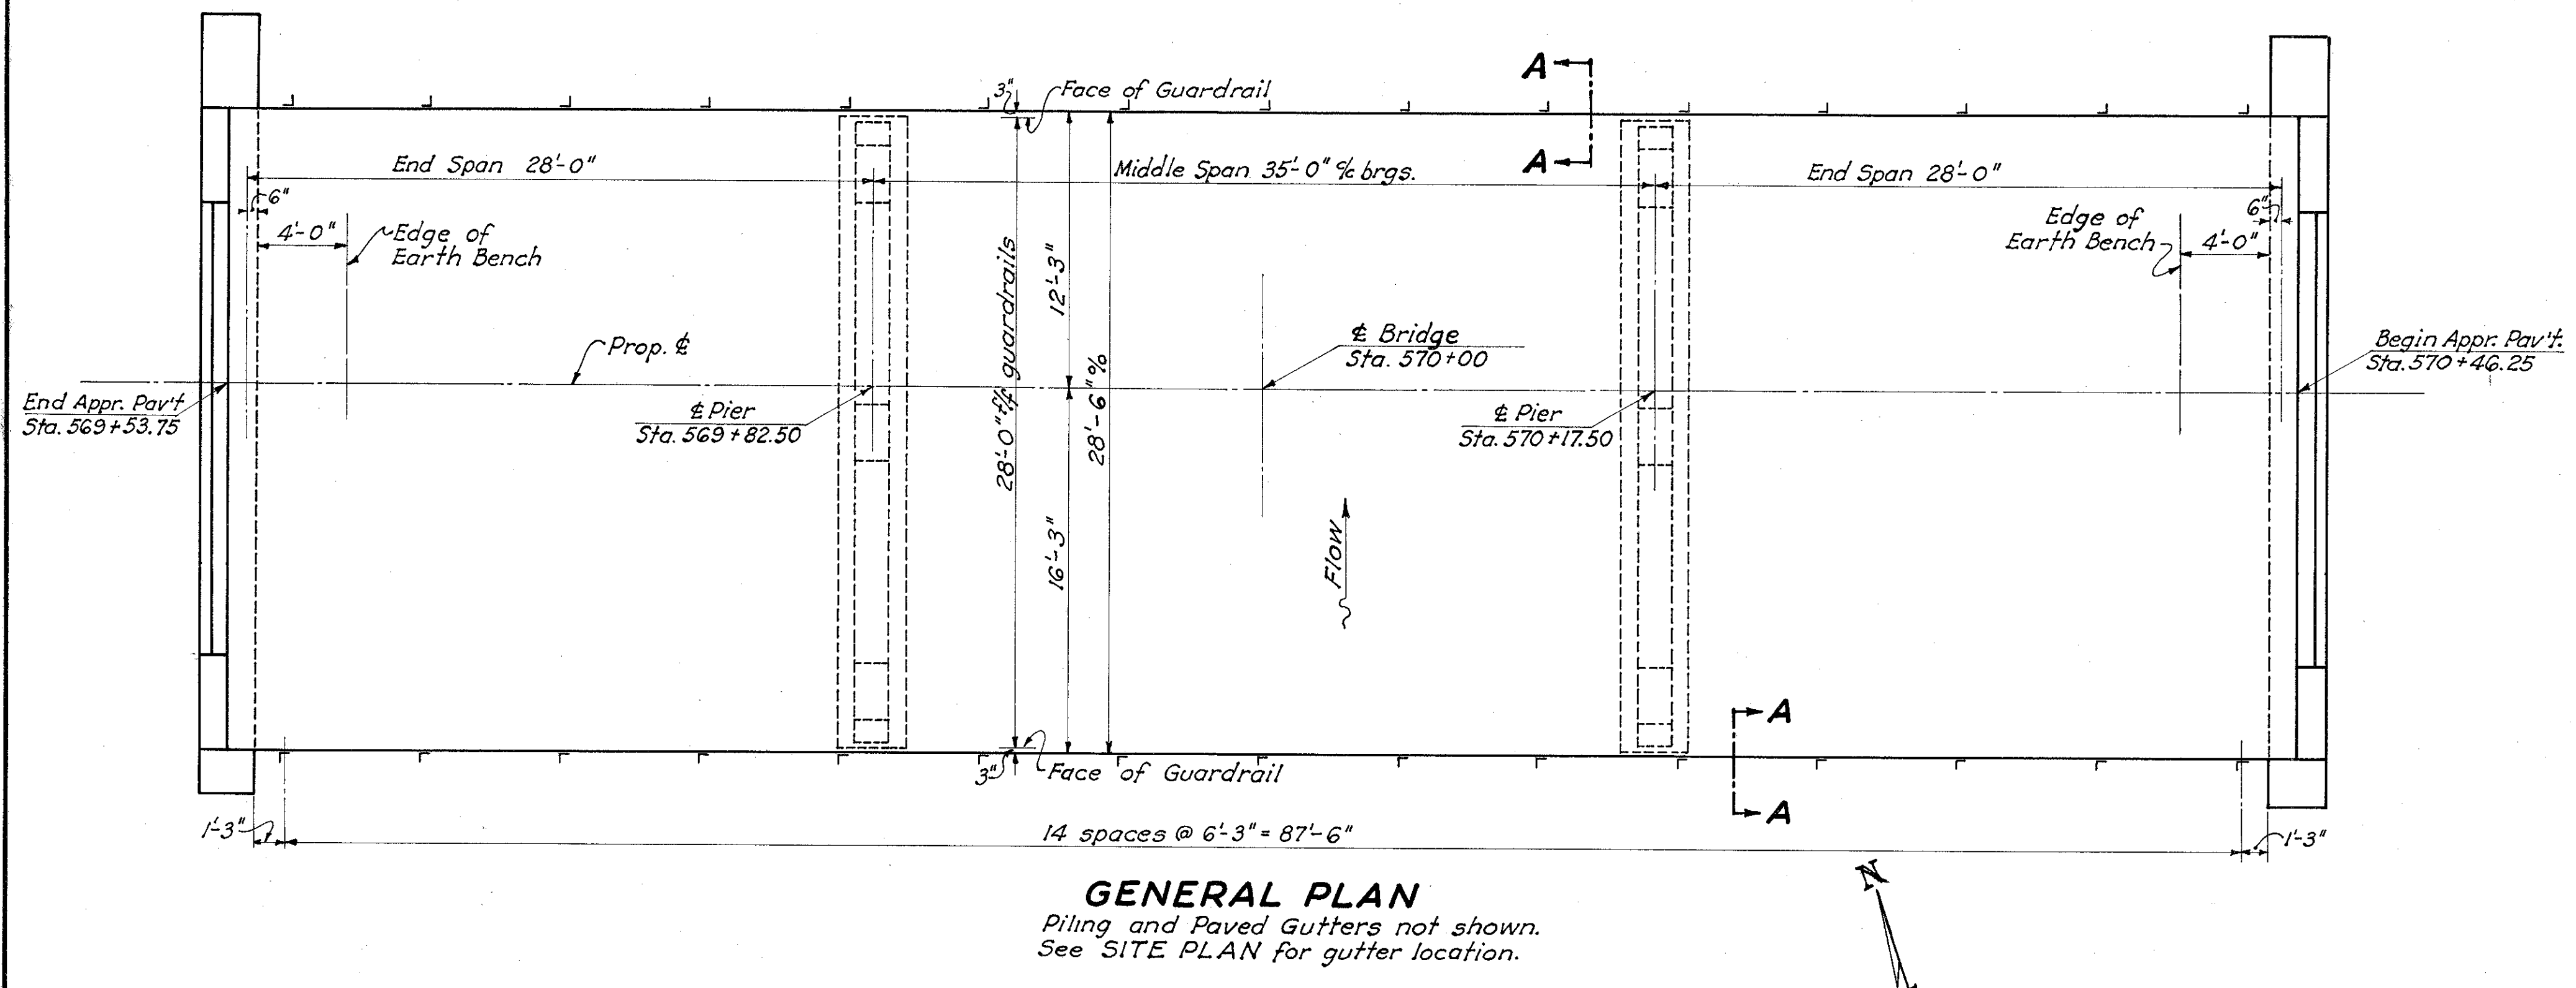

**GENERAL PLAN**  
Piling and Paved Gutters not shown.  
See SITE PLAN for gutter location.


REINFORCING STEEL LIST															
Mark	Size	No.	Length	Weight	Shp.	Bending Diagram				Mark	Size	No.	Length	Weight	Shp.
<b>SUPERSTRUCTURE</b>										<b>PIERS</b>					
A	1"φ	66	33'-0"	7405	Str.					POa	1 1/4"	16	29'-10"	2536	Bt.
B	1"φ	22	24'-0"	1795	Bt.					P9a	1 1/8"	24	27'-6"	2840	Str.
C	1"φ	22	21'-2"	1584	Bt.					b	1 1/8"	48	8'-0"	1652	Bt.
D	1"φ	11	21'-0"	785	Str.					c	1 1/8"	16	8'-9"	602	Str.
E	1"φ	11	17'-6"	655	Str.					d	1 1/8"	16	8'-0"	551	Str.
F	1"φ	58	20'-6"	4043	Str.					e	1 1/8"	16	7'-3"	499	Str.
G	1"φ	28	10'-9"	1023	Str.					<b>REPLACEMENT STEEL</b>					
H	1"φ	28	7'-3"	690	Str.					P4a	5/8"φ	104	7'-7"	822	Bt.
J	3/4"φ	30	20'-9"	935	Str.					P4b	5/8"φ	72	5'-9"	432	Bt.
K	3/4"φ	15	19'-6"	439	Str.					P2a	1/2"φ	202	5'-1"	685	Bt.
L	3/4"φ	87	28'-0"	3659	Str.					<b>ABUTMENTS</b>					
M	3/4"φ	60	28'-0"	2523	Str.					A7a	1"φ	26	33'-9"	2343	Str.
A4a	5/8"φ	128	8'-4"	1112	Bt.					A4a	5/8"φ	128	8'-4"	1112	Bt.
A4b	5/8"φ	40	4'-2"	174	Bt.					A4b	5/8"φ	40	4'-2"	174	Bt.
A4c	5/8"φ	8	4'-10"	40	Bt.					A4c	5/8"φ	8	4'-10"	40	Bt.
A4g	5/8"φ	52	2'-0"	109	Str.					A4g	5/8"φ	52	2'-0"	109	Str.
A4q	5/8"φ	8	3'-11"	32	Str.					A4q	5/8"φ	8	3'-11"	32	Str.
P2a	1/2"φ	8	6'-4"	53	Bt.					P2a	1/2"φ	8	6'-4"	53	Bt.

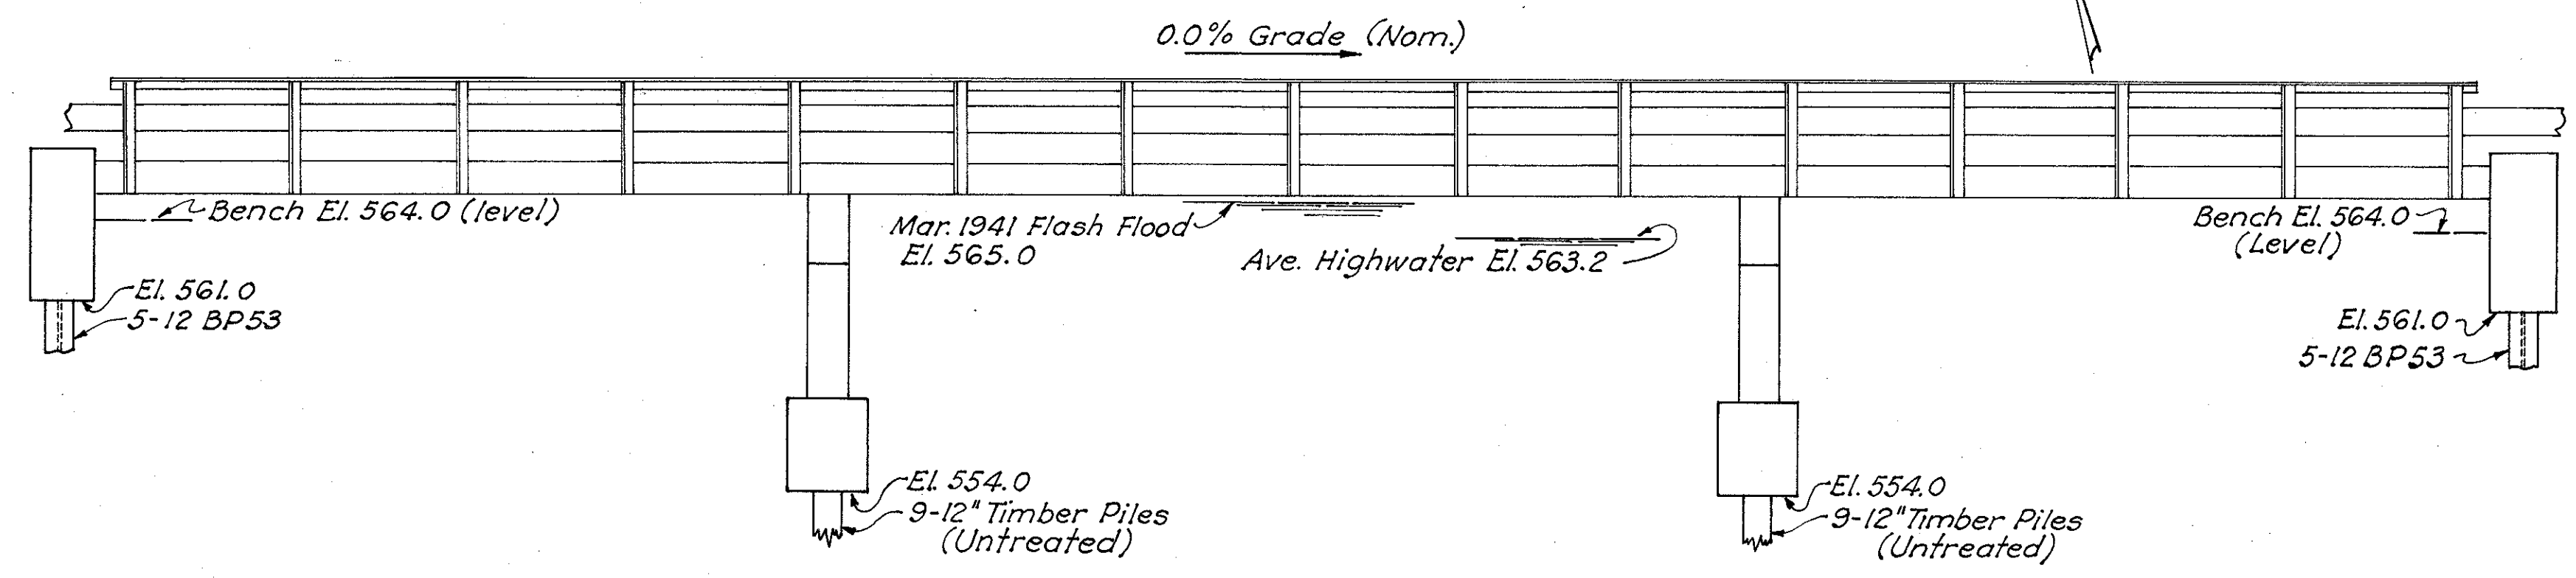

**GENERAL ELEVATION**

**GENERAL NOTES**

- REFERENCE** shall be made to Standard Drawing CS-1-47 dated 9-18-47.
- TEMPORARY RUN-AROUND ROAD AND BRIDGE** are included in this contract. Surface course for approaches to the temporary run-around bridge shall be composed of material as specified in Supplemental Specification T-110, revised 8-3-36. It shall be placed in two or more courses and shall have a final compacted thickness of 6 inches and as much more than this as the Engineer considers necessary. Calcium chloride shall be applied to the extent the Engineer considers necessary, but not less than one ton per 60 cu. yd. of aggregate (measured loose).
- EXISTING SUPERSTRUCTURE** shall be removed and become the property of the contractor.
- EXISTING SUBSTRUCTURE** shall be removed to Elev. 558 and disposed of as directed by the Engineer.
- EXCAVATION** quantity includes the removal of fill material between top of earth bench and bottom of abutment crossbeam.
- PILING** shall be driven to a minimum bearing capacity of 22 tons for steel H and 20 tons for timber.
- REINFORCING STEEL**, Unless otherwise shown, all bars shall be fabricated with dimensions in accordance with the proposed Manual of Standard Practice, American Concrete Institute, 1946, except that a tolerance will be permitted in the diameter of bends equal to the diameter of the bar. No weight allowance will be made for tolerances.
- PAVED GUTTER**: A concrete gutter, 5'-0" wide, 6" thick, depressed 6" at center, shall be placed where shown on "Site Plan", centered under edge of deck. 1/2"φ bars @ 1'-6" ctrs., both directions included in price per lin. ft. See Sheet No. 3

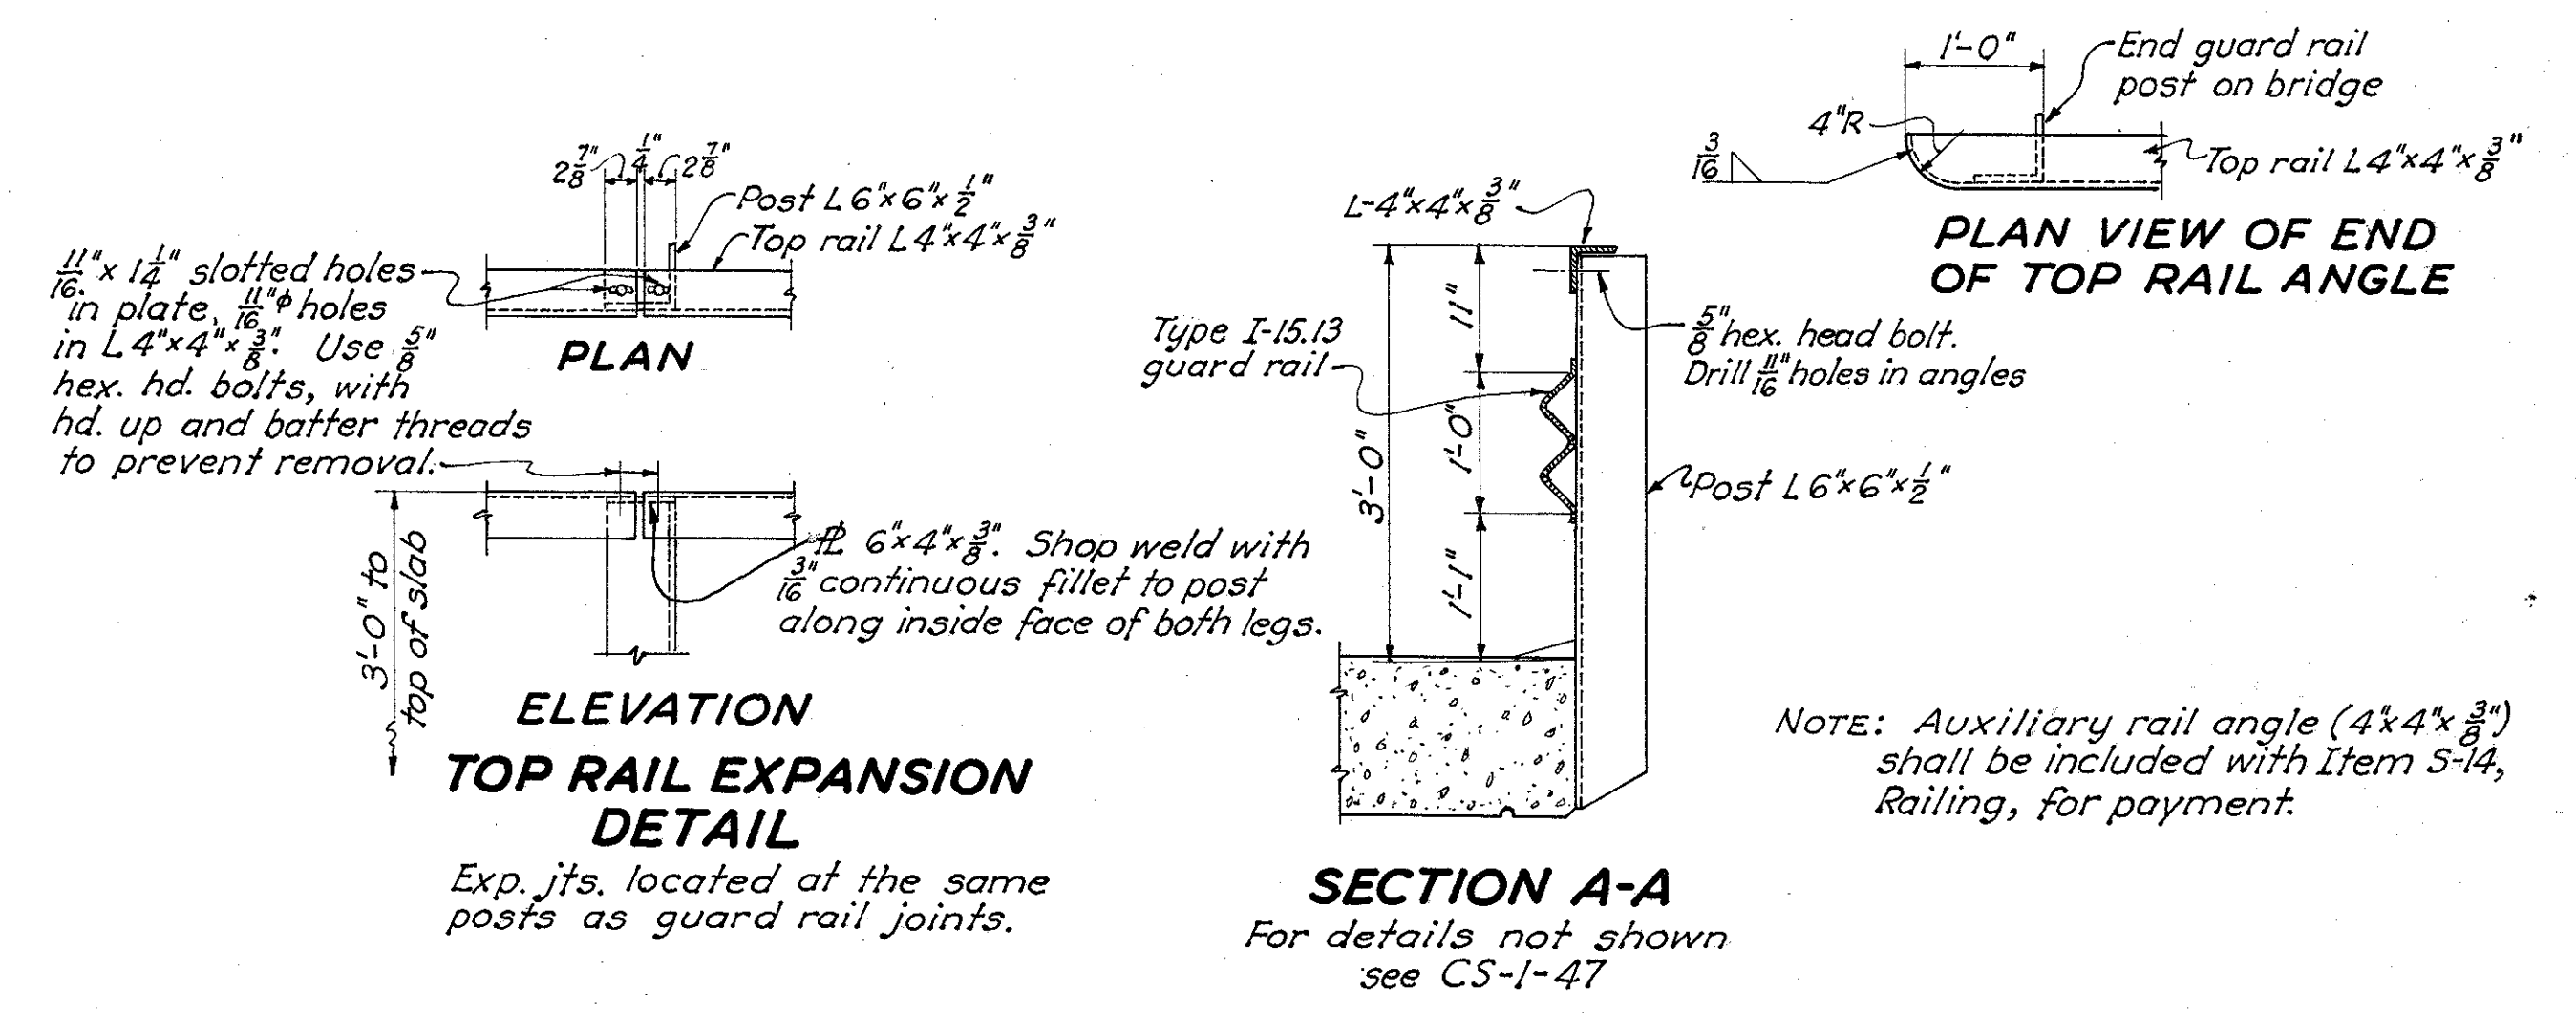


ESTIMATED QUANTITIES									
Item	Total	Unit	Description	Abuts.	Piers	Superstr.	General	As Built	
E-2	Lump	Sum	Cofferdams, cribs and sheeting				Lump	Lump	
E-2	90	Cu. yd.	Unclassified excavation	36	54			90	
E-3	100	Cu. yd.	Channel excavation				100	100	
S-1	116	Cu. yd.	Class "C" concrete, superstructure			116		116	
S-1	34	Cu. yd.	Class "C" concrete, abutments	34				34	
S-1	13	Cu. yd.	Class "C" concrete, pier caps and columns		13			13	
S-1	21	Cu. yd.	Class "C" concrete, pier footings		21			21	
S-4	40,159	Lb.	Reinforcing steel	3,863	10,619	25,536	141	40,159	
S-9	12	Sq. ft.	1/2" Premolded expansion joint filler.			12		12	
S-14	185	Lin. ft.	Railing (Steel beam Type I-15.13 Modified.)			185		185	
S-15	Lump	Sum	Temporary run-around bridge and approaches.				Lump	Lump	
S-16	Lump	Sum	First test pile, timber or steel.				Lump	Lump	
S-18	630	Lin. ft.	Timber piling, untreated.		630			*7-.35.1 594.9	
S-18	450	Lin. ft.	Steel piling, 12" BP @ 53 lb.	450				*7-.2.2 447.8	
S-18	18	Each	Steel pile points.		18			18	
S-24	Lump	Sum	Removal of existing structure				Lump	Lump	
I-14	36	Lin. ft.	Concrete paved gutter				36	*4-.36 0	

STATE OF OHIO  
DEPARTMENT OF HIGHWAYS  
BUREAU OF BRIDGES

**GENERAL PLAN-STEEL LIST  
NOTES & EST. QUANTITIES**


BRIDGE No. LA-243-110  
OVER LEATHERWOOD CREEK  
LAWRENCE CO. S.H. 681  
SECTION C STA. 570+00

DESIGNED	DRAWN	TRACED	CHECKED	REVIEWED	DATE	REVISED
WAK	WAK	J.V.G.	680	ER	1/9/48	

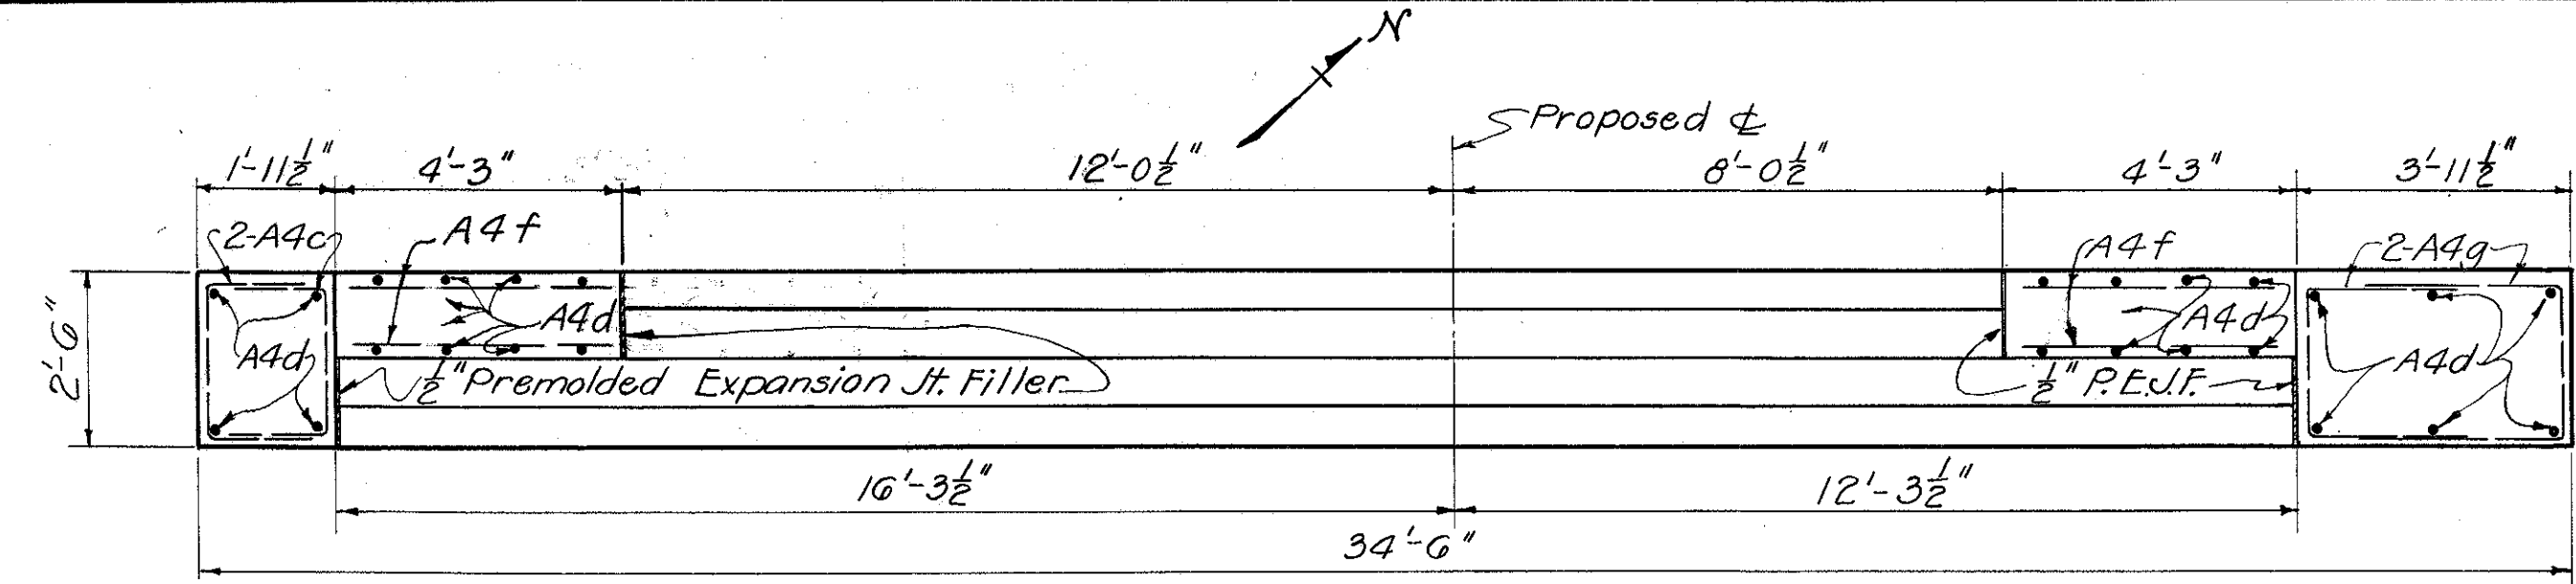


**PLAN - WEST ABUTMENT**  
Piling not shown


NOTE: All earth fill around abutments shall be made full height of earth bench. Excavation shall then be made for abutment cap, after which piling shall be driven. If bottom forms for abutment cap are used, they shall be left in place.

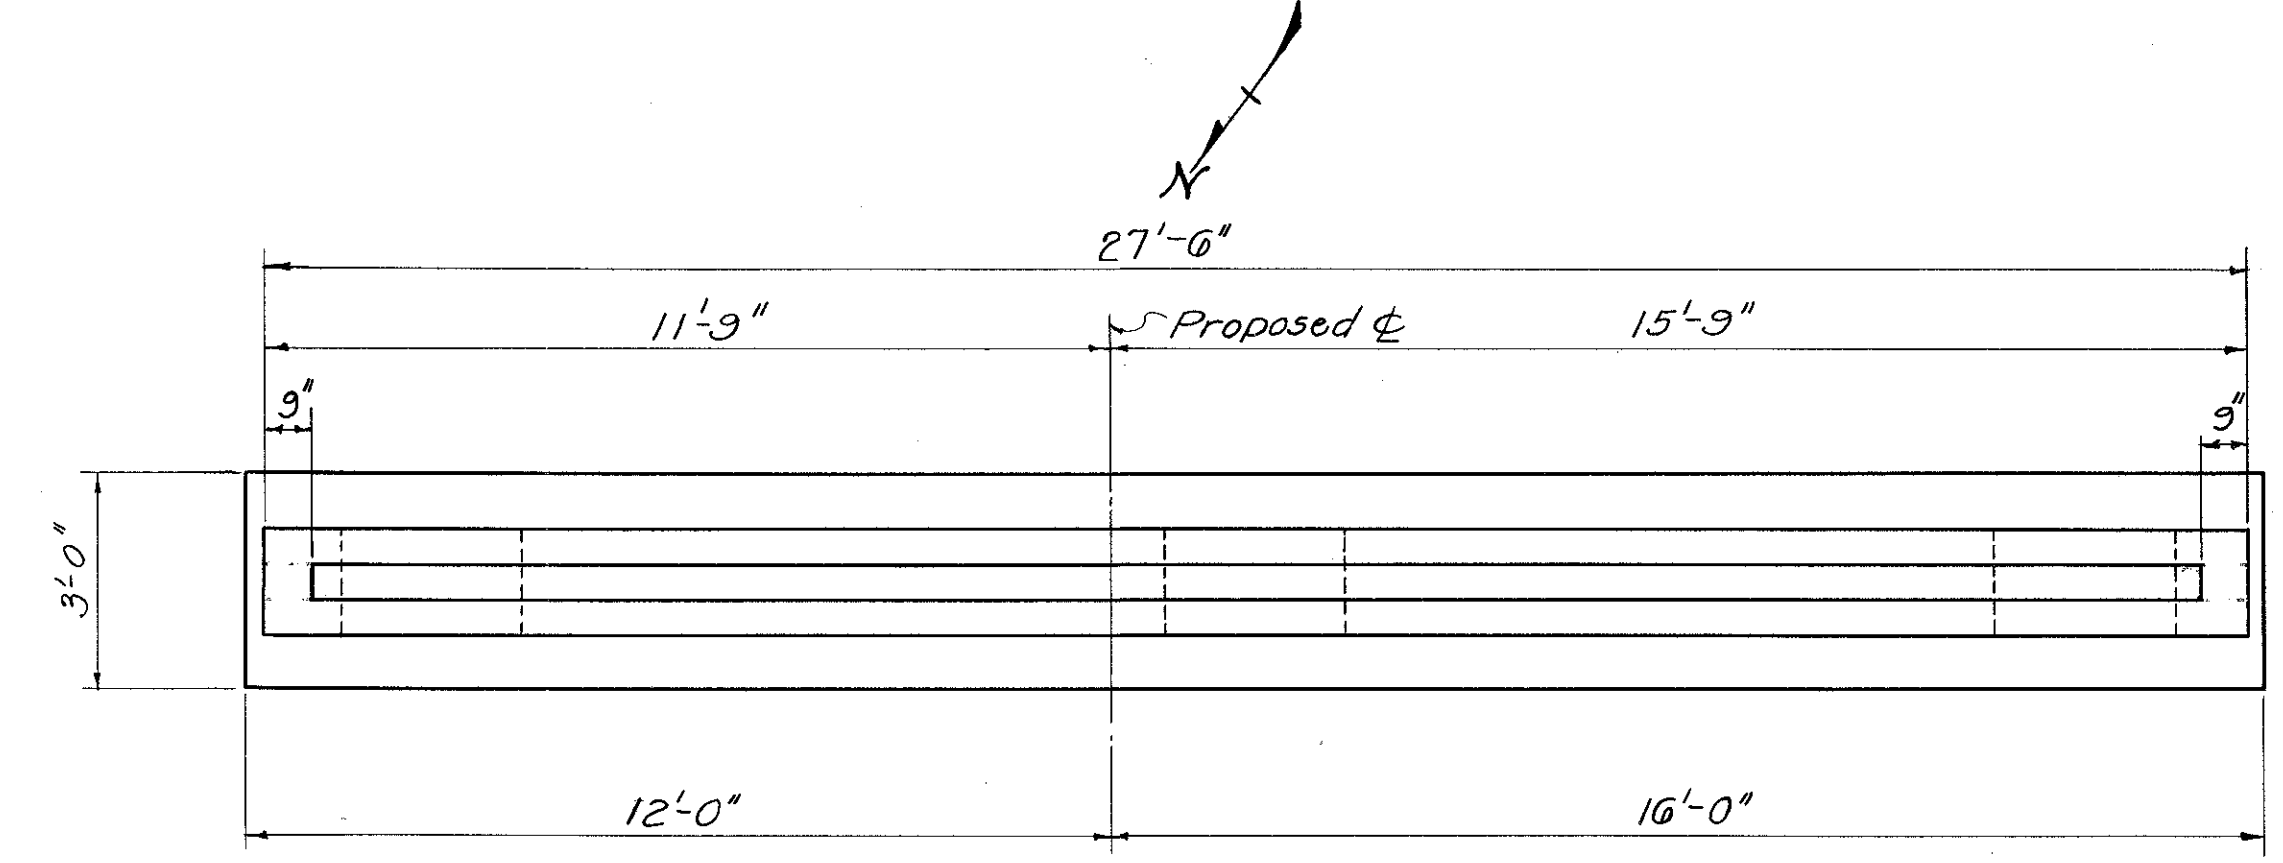

**PLAN - PIERS**  
Piling not shown

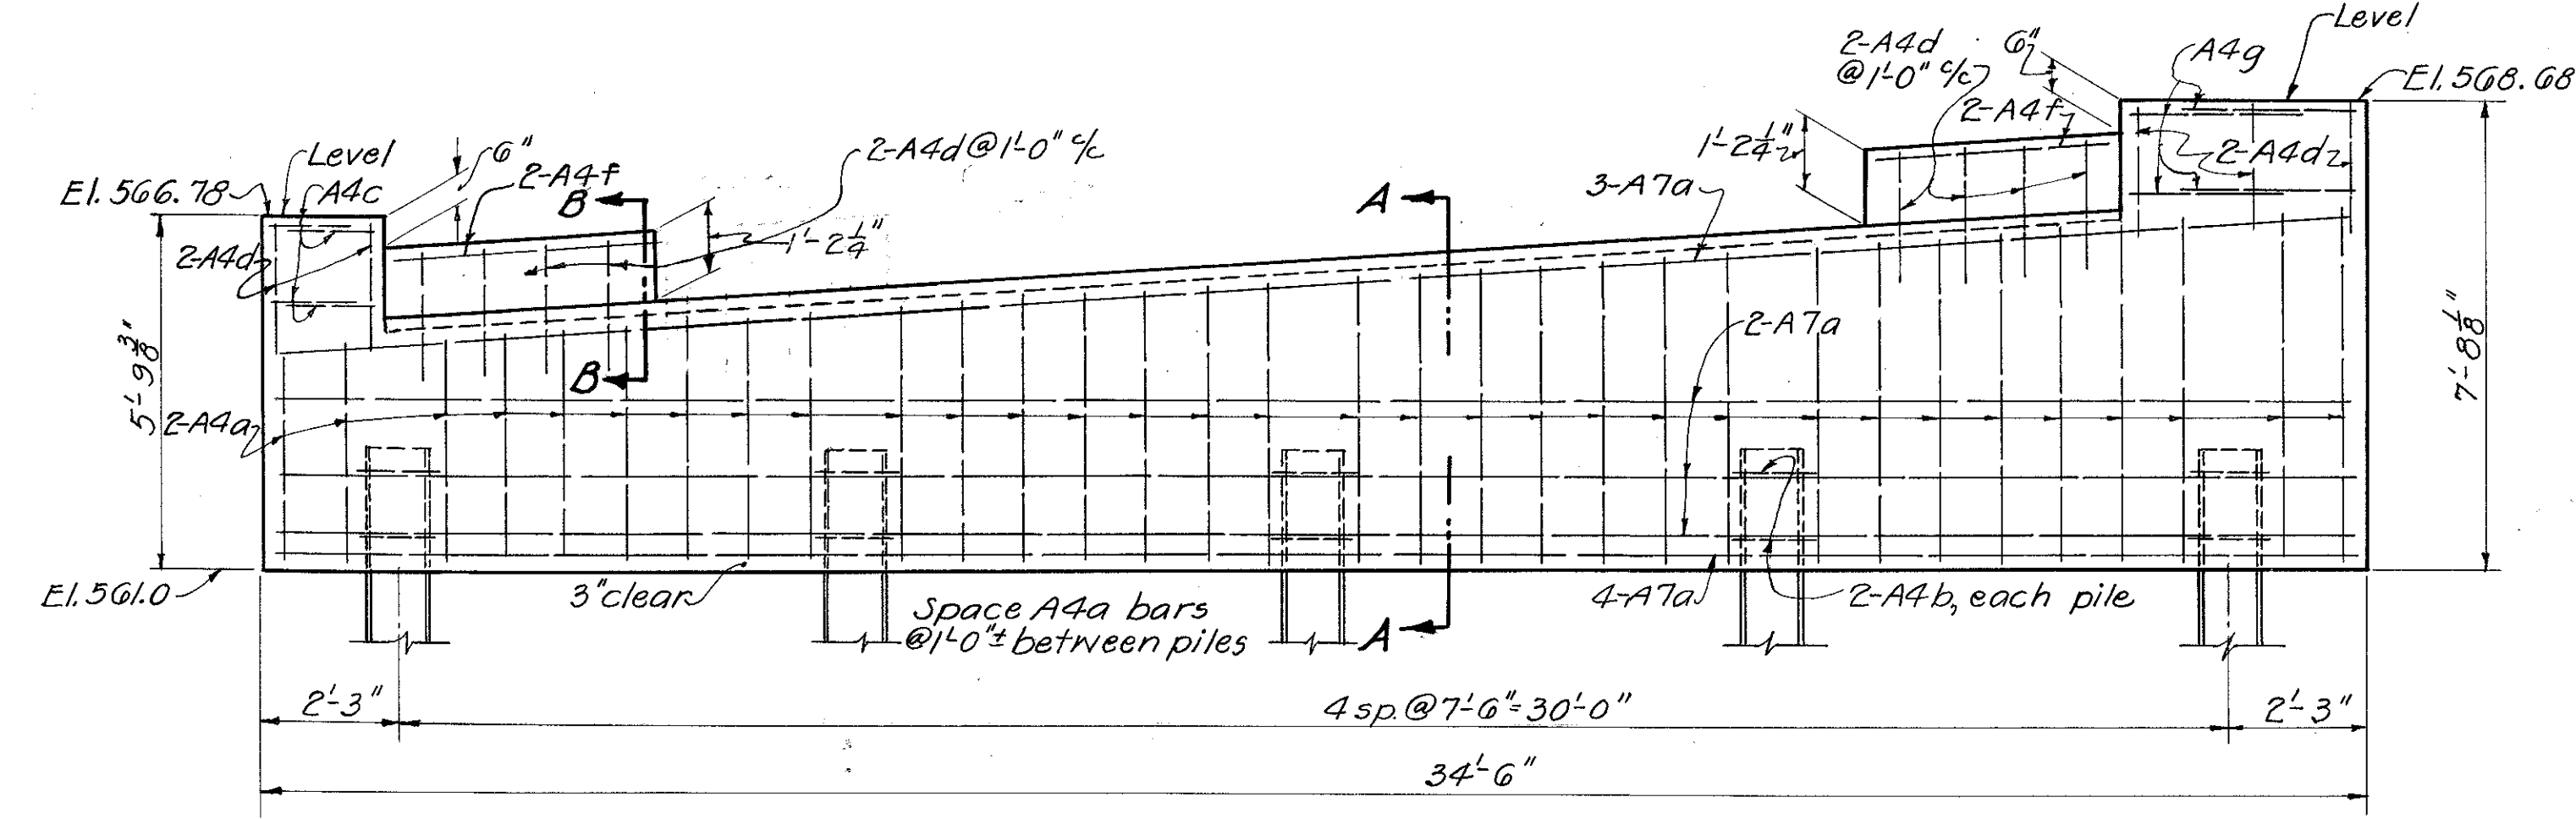


**ELEVATION - WEST ABUTMENT**

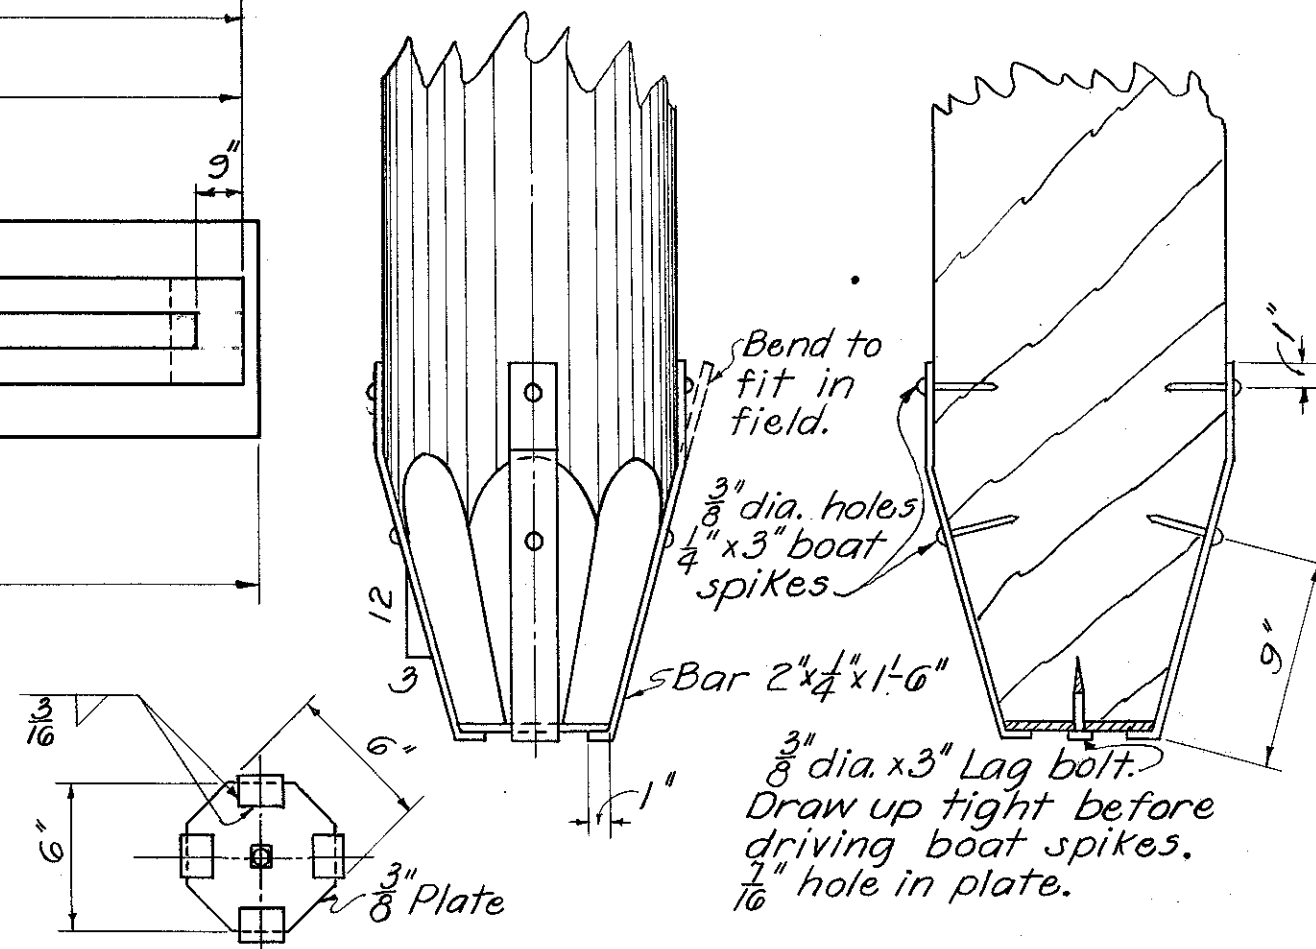


**BOTTOM VIEW**

**STEEL PILE POINT FOR TIMBER PILES**

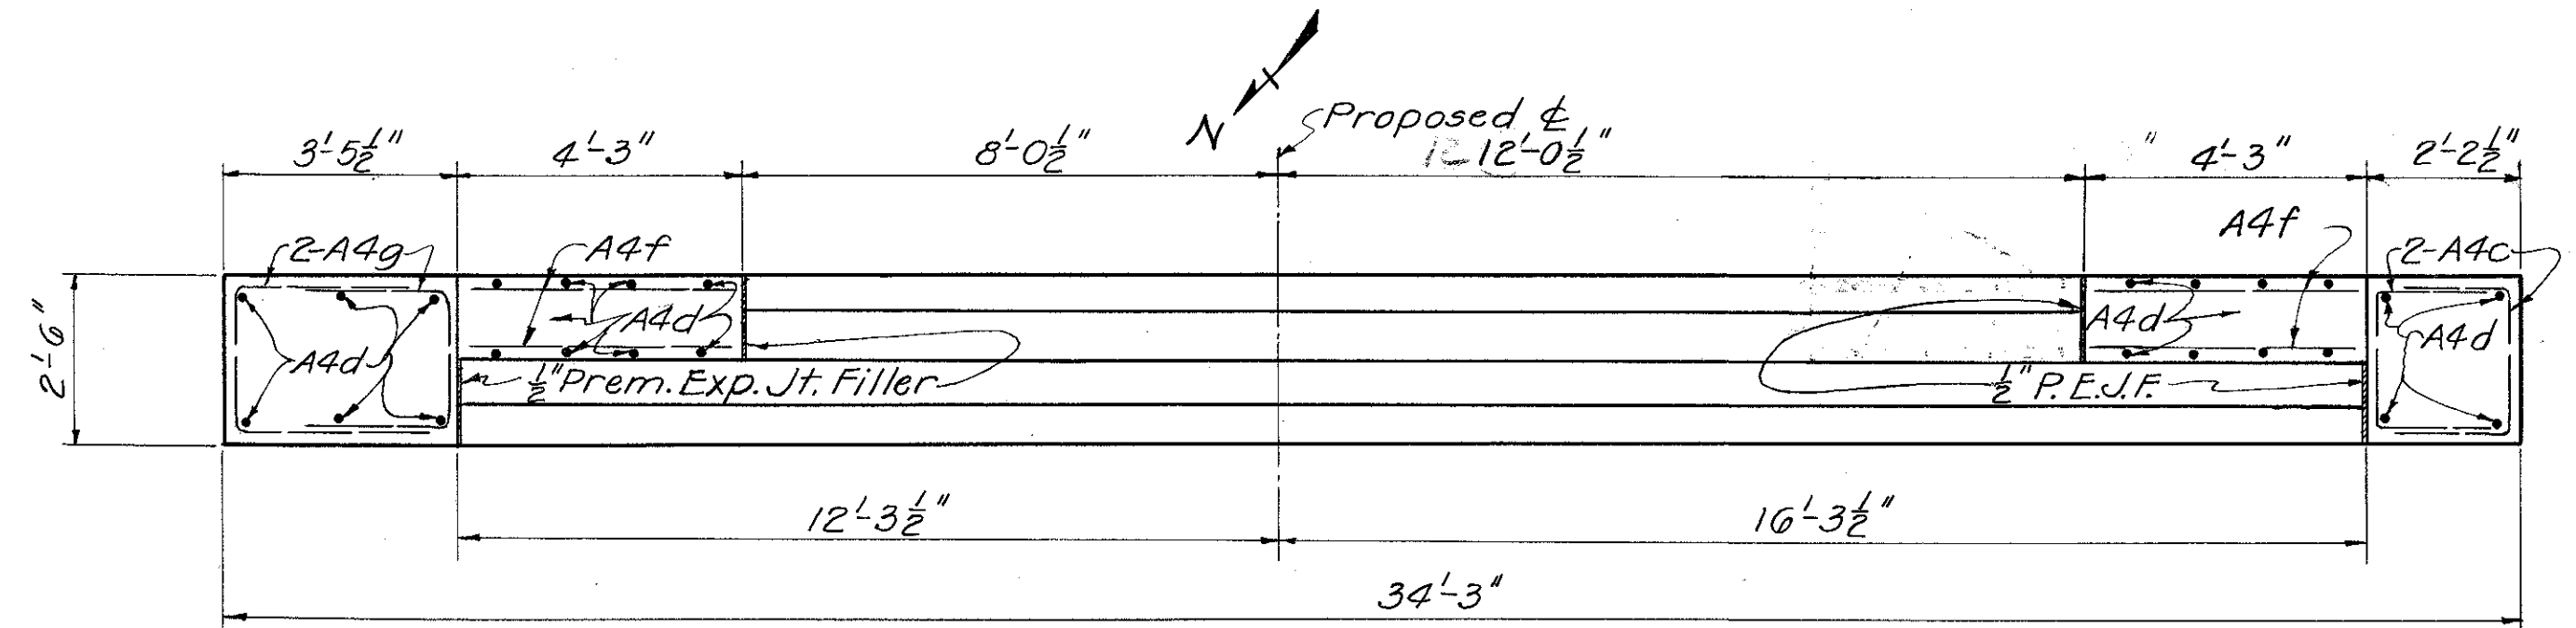


**PLAN - EAST ABUTMENT**  
Piling not shown

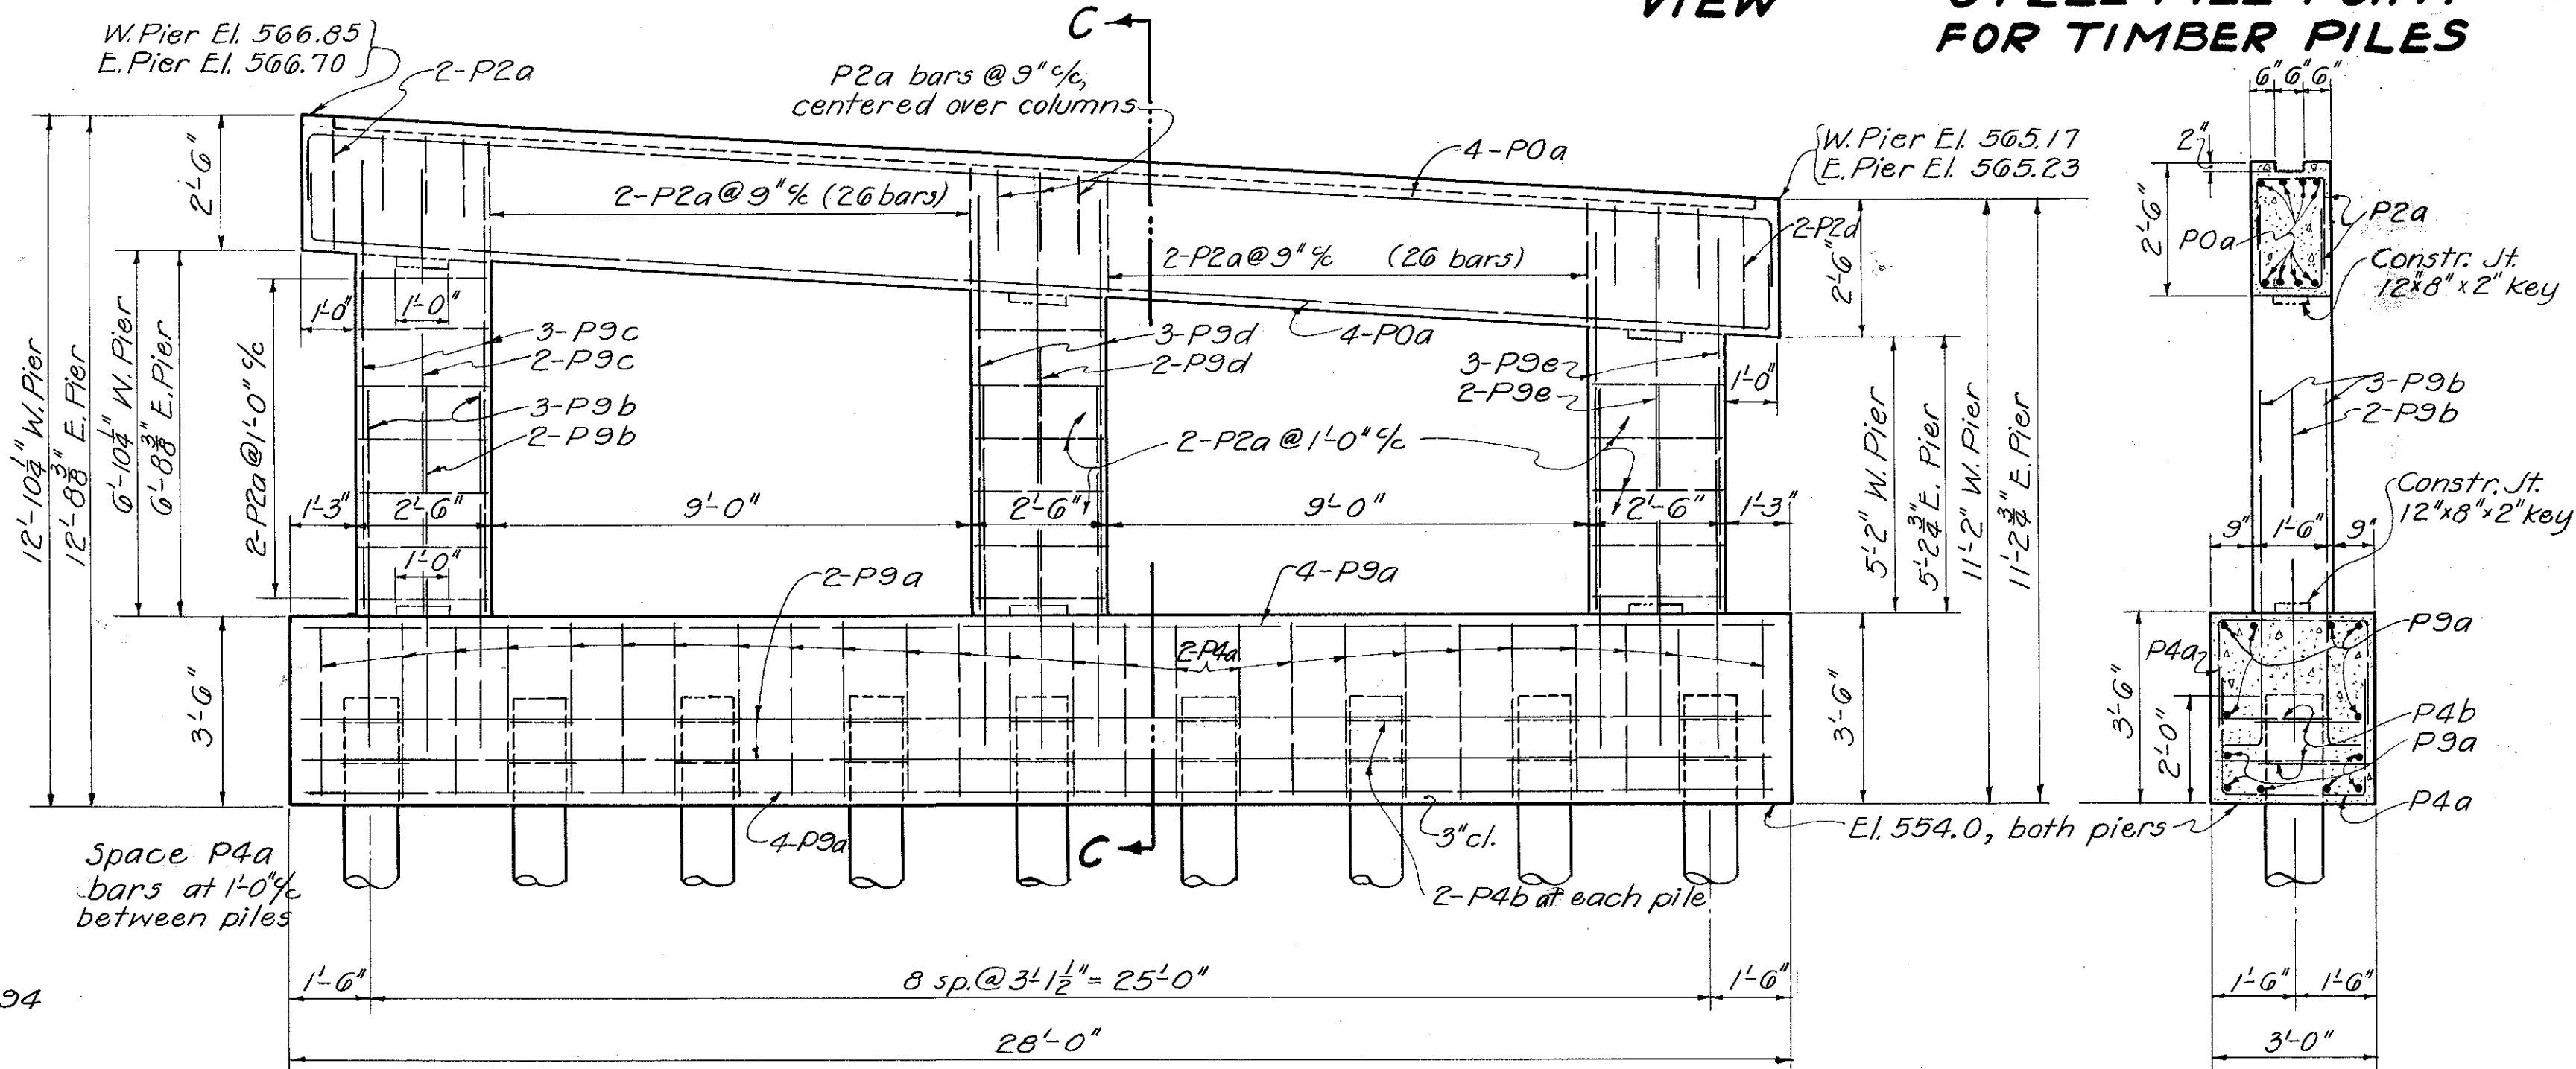


**ELEVATION - PIERS**


**SECTION C-C**

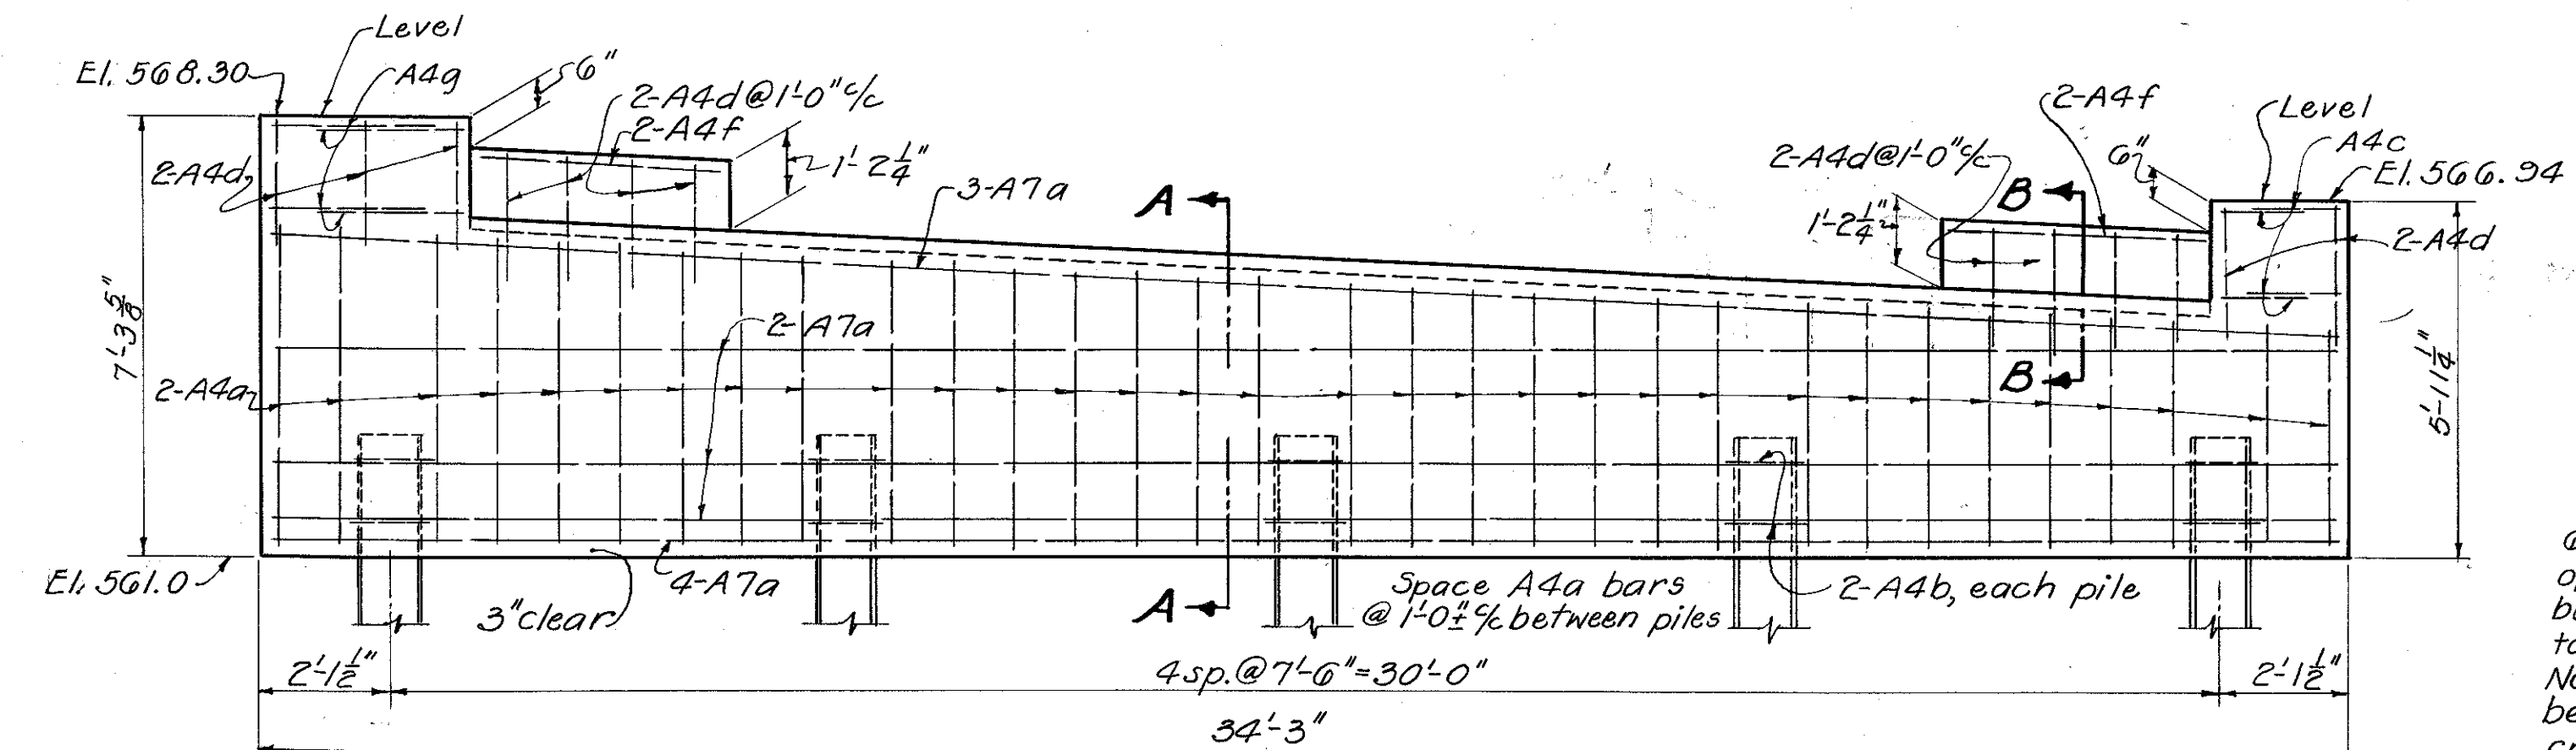

**ELEVATION - EAST ABUTMENT**

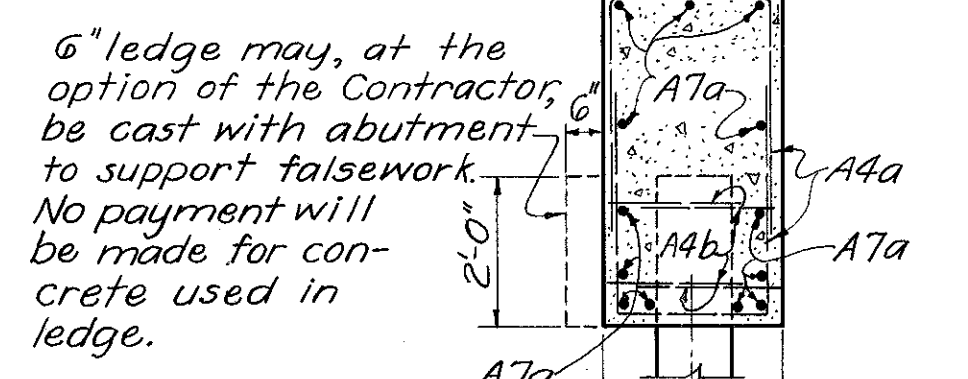

**SECTION A-A**

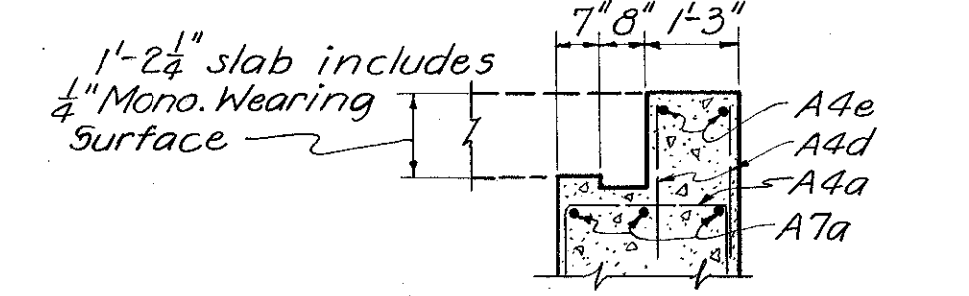

**SECTION B-B**


6" ledge may, at the option of the Contractor, be cast with abutment to support falsework. No payment will be made for concrete used in ledge.

NOTE: All reinforcing steel in piers and abutments shall have a minimum clear distance of 2" unless otherwise shown.


STATE OF OHIO DEPARTMENT OF HIGHWAYS BUREAU OF BRIDGES					
<b>ABUTMENTS AND PIERS</b>					
BRIDGE No. LA-243-110 OVER LEATHERWOOD CR.					
LAWRENCE CO.			S. H. G81 STA. 570+00		
DESIGNED	DRAWN	TRACED	CHECKED	REVIEWED	DATE
WAX	WAX	KET	WAX	WAX	1/9/48

Seeding	
End Width	Sq. Yds.
20	
30	
25	
24	
28	
20	
51	
28	
19	
28	

Total Seeding Channel Rt. & Lt. Sta. 570+00 = 124.59 Yds.

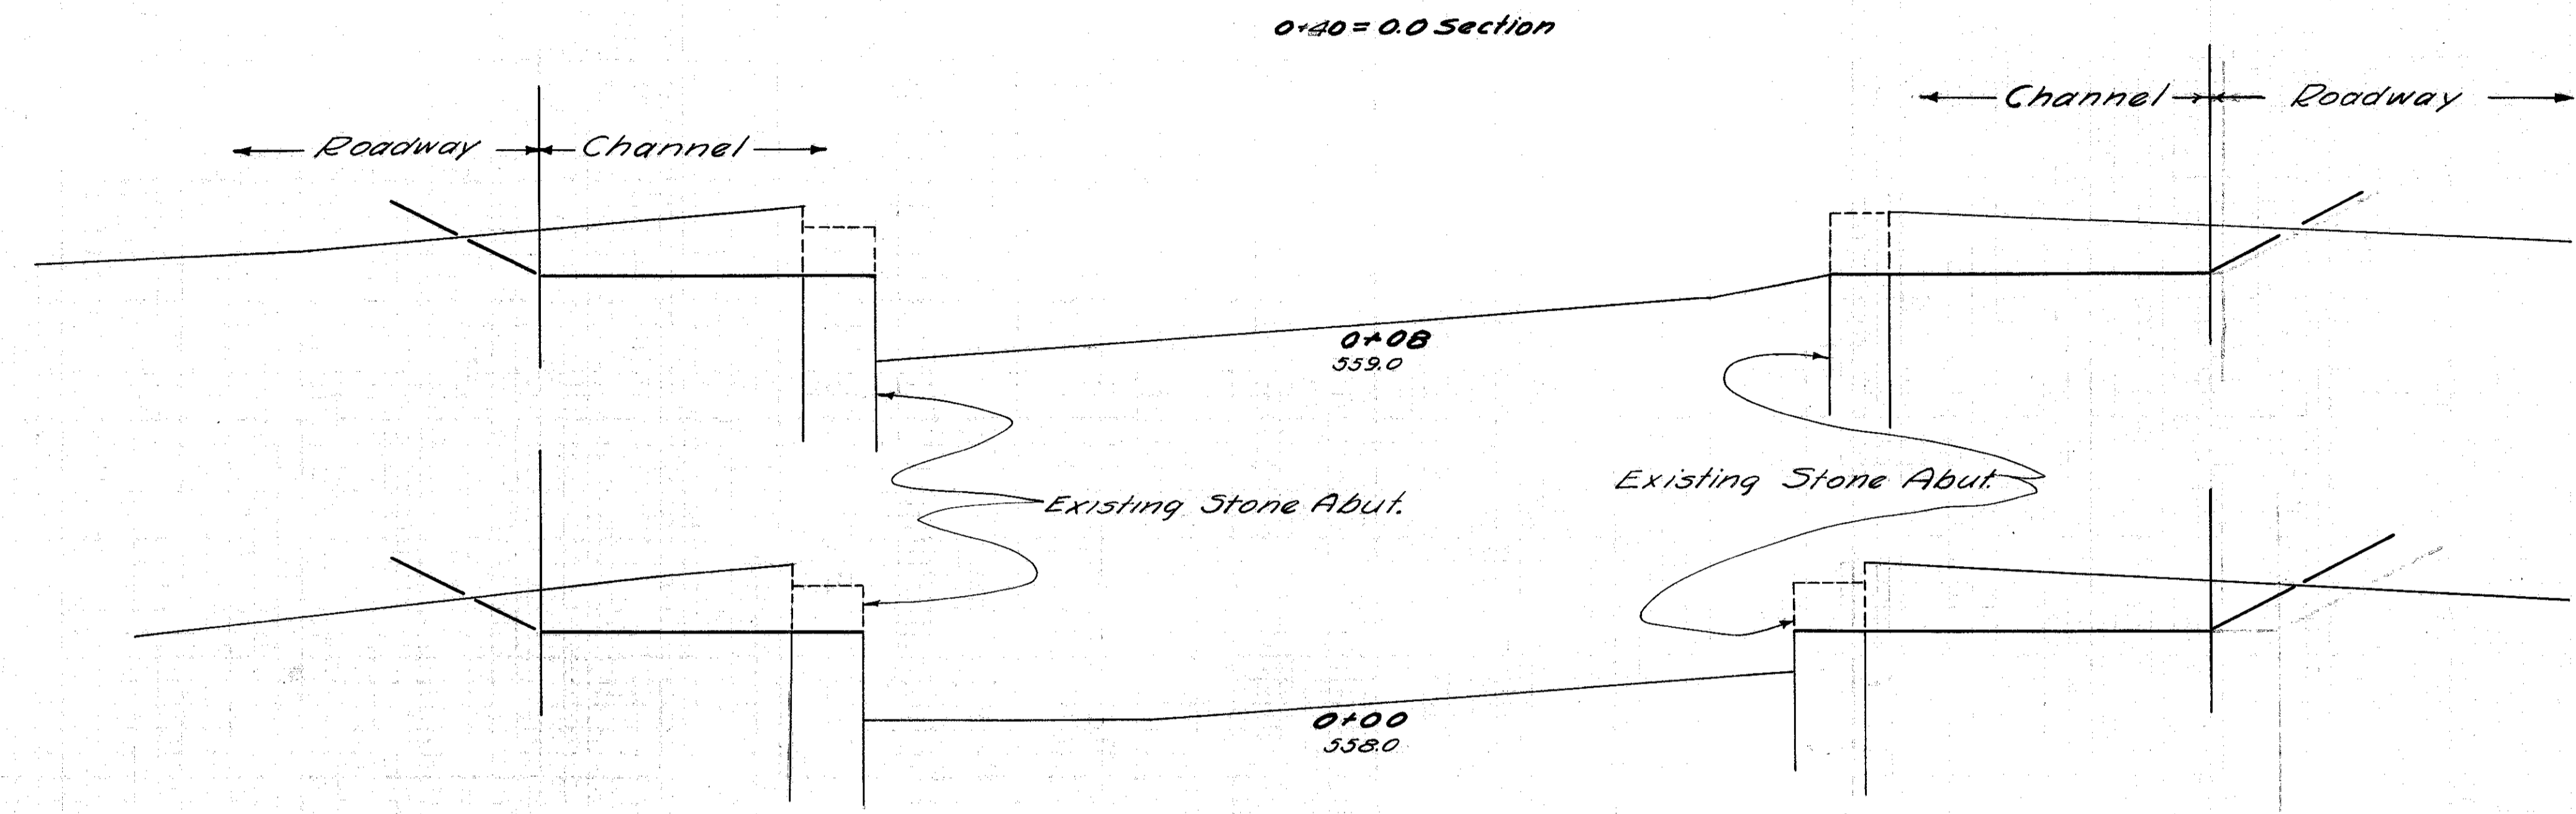

CHANNEL SECTIONS LT. &

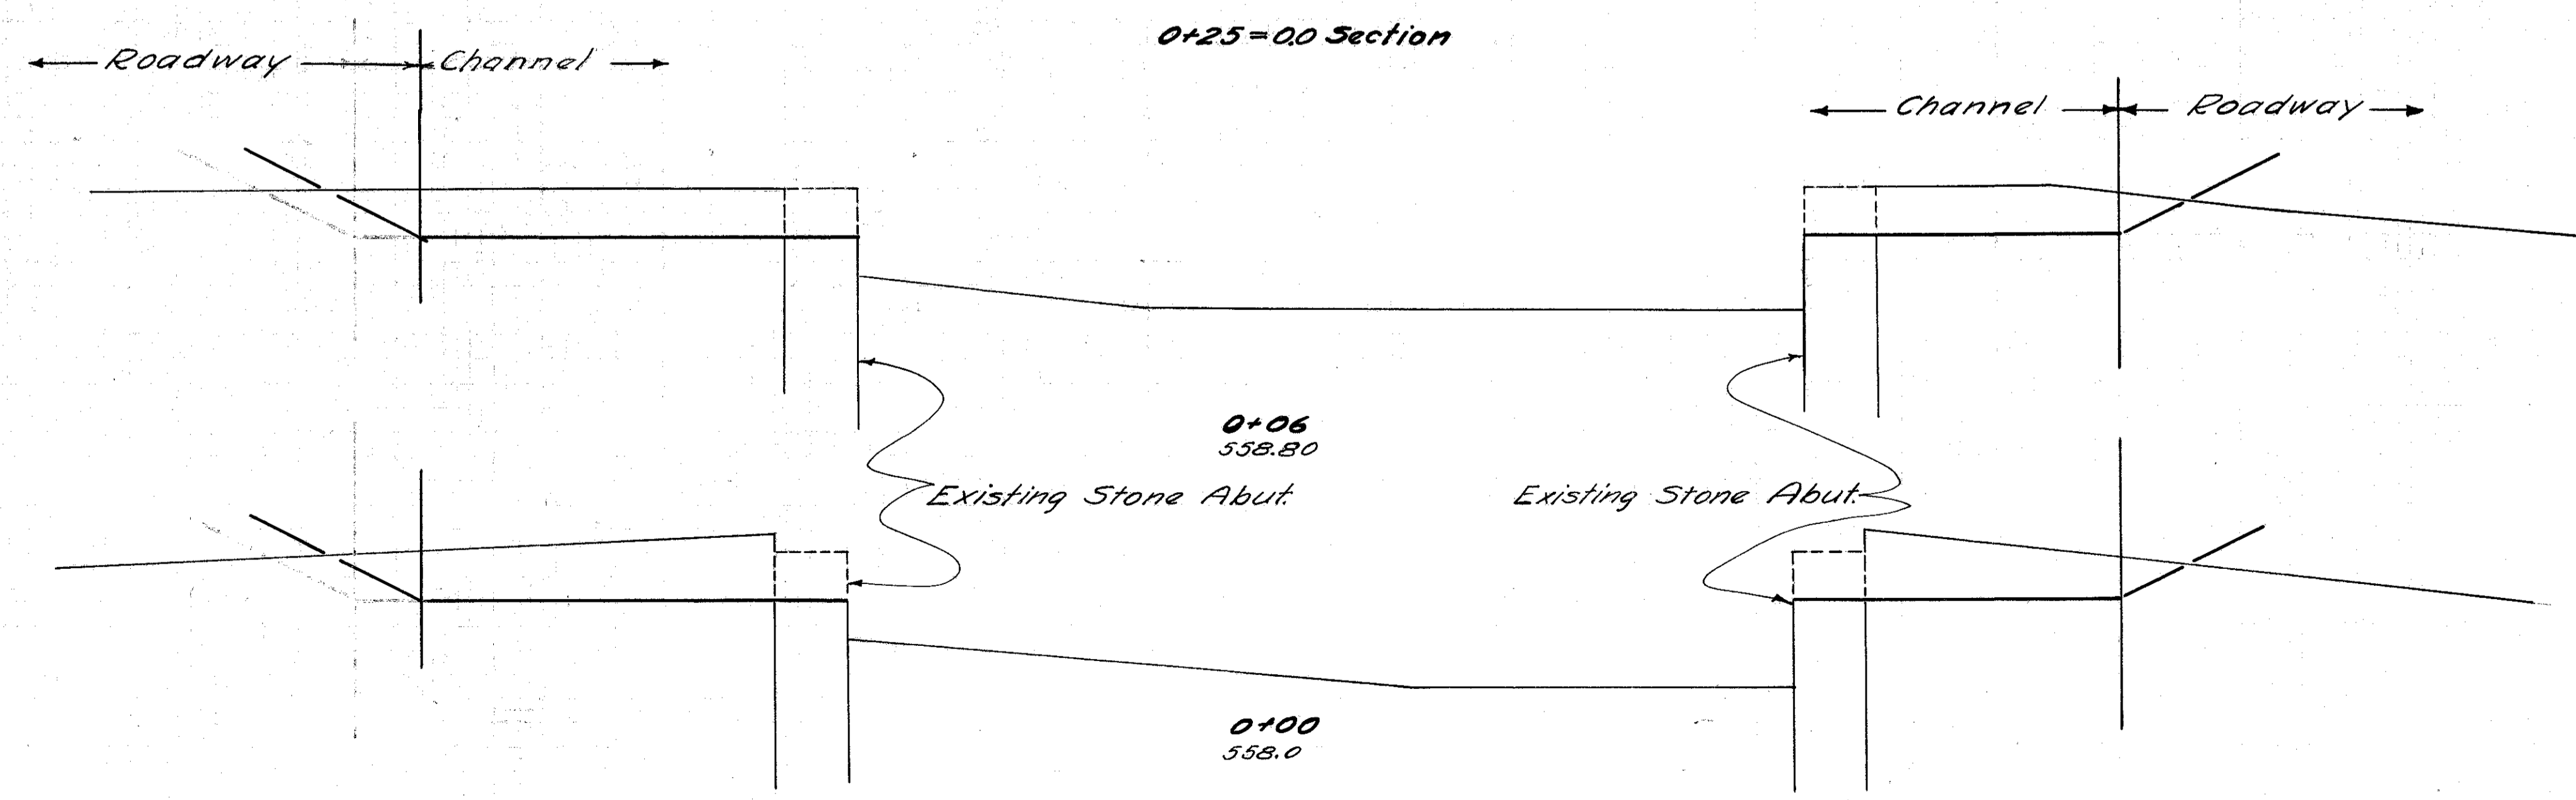

CHANNEL SECTIONS RT. &

End Volume	
Area	Cut
0	
40	
68	
21	
75	
0	
23	
65	
16	
75	

Total Channel Excavation Rt. & Lt. 100 Cu. Yds.

CHANNEL SECTIONS LEATHERWOOD CREEK STA. 570+00