


**ITEM 874 LONGITUDINAL JOINT PREPARATION, AS PER PLAN (PASS 1)**  
**ITEM 874 LONGITUDINAL JOINT PREPARATION, AS PER PLAN (PASS 2)**


This work shall consist of creating lapped pavement layers at the phase construction joint as per the "LONGITUDINAL JOINT PREPARATION Method 1" detail on SCD BP-3.1, except as modified below:

-  ITEM 874 LONGITUDINAL JOINT PREPARATION, AS PER PLAN (PASS 1)
-  ITEM 874 LONGITUDINAL JOINT PREPARATION, AS PER PLAN (PASS 2)

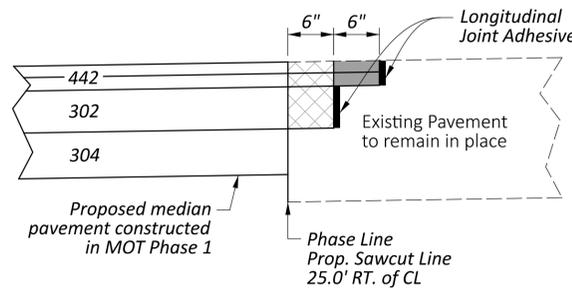

**PHASE 1 LAPPING DETAILS (E.B. / W.B. RESURFACING SECTIONS)**  
 DETAIL APPLIES:  
 STA. 639+65.00 - 653+75.00 = 1410.00 FT.  
 STA. 803+36.00 - 831+70.00 = 2834.00 FT.

- Phase 1 Sequence:**
1. Sawcut and remove existing inside shoulder pavement.
  2. Construct median subgrade to 304 layer.
  3. Trim 6" into existing pavement (874 Pass 1 - max. depth of 8.75").
  4. Construct 302 layer.
  5. Trim 6" into existing pavement. (874 Pass 2 - max depth of 3.25").
  6. Place 442 layers.
- (Note: Detail shown at E.B. sawcut line, but also applies to W.B. sawcut.)

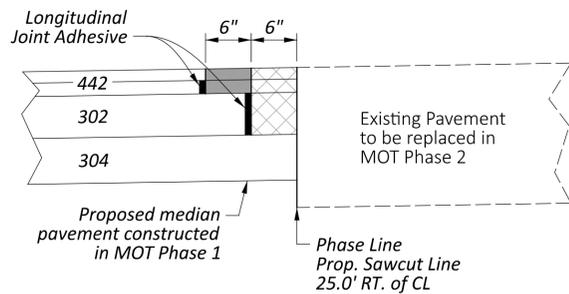

**PHASE 2/3 LAPPING DETAILS (E.B. / W.B. REPLACEMENT SECTION)**  
 DETAIL APPLIES:  
 E.B.: STA. 653+75.00 - 747+61.78 = 9386.78 FT.  
 STA. 750+51.79 - 803+36.00 = 5284.21 FT.  
 TOTAL = 14,670.99  
 W.B.: STA. 653+75.00 - 747+96.78 = 9421.78 FT.  
 STA. 750+81.79 - 803+36.00 = 5254.21 FT.  
 TOTAL = 14,675.99 FT.

- Phase 2 Sequence:**
1. Remove existing E.B. pavement.
  2. Construct E.B. subgrade to 304 layer.
  3. Trim 6" into Phase 1 pavement (874 Pass 1 - 8.75" depth).
  4. Construct E.B. 302 layer.
  5. Trim 6" into Phase 1 pavement. (874 Pass 2 - 3.25" depth).
  6. Place 442 layers.
- (Note: Detail shown at E.B. sawcut line in MOT Phase 2, but also applies to W.B. sawcut in MOT Phase 3.)

**ITEM 206 CEMENT STABILIZED SUBGRADE, 12 INCHES DEEP**

The following quantities have been provided to be used as per Item 206 at the direction of the Project Engineer. The entire project shall utilize cement stabilization unless detailed otherwise.

ITEM 204 PROOF ROLLING	77 HR	
ITEM 206 CEMENT	5915 TON	
ITEM 206 CURING COAT	228,550 SY	
ITEM 206 MIXTURE DESIGN FOR CHEMICALLY STABILIZED SOILS	LS	

Calculation:  
 Proof Rolling@ 1 HR per 3000 SY of stabilized subgrade  
 Plan Split 01/NHS: 104,914 SY ÷ 3000 = 35 HR  
 Plan Split 02/NHS: 123,636 SY ÷ 3000 = 42 HR  
 Total = 35 + 42 = 77 HR

Cement (from Table 600-3, Geotechnical Design Manual)  
 0.75 X 12 inches X 115 X 0.05 = 51.75 lbs per SY  
 Plan Split 01/NHS: (51.75 lb/SY X 104,914 SY) ÷ 2000 lb/ton = 2715 ton  
 Plan Split 02/NHS: (51.75 lb/SY X 123,636 SY) ÷ 2000 lb/ton = 3200 ton  
 Total = 2715 + 3200 = 5915 ton

Curing Coat  
 Plan Split 01/NHS: 104,914 SY (from sheet P.447)  
 Plan Split 02/NHS: 123,636 SY (from sheet P.447)  
 Total = 104,914 + 123,636 = 228,550 SY

**Ditch Undercut Quantities**

The following estimated quantities are provided to accomplish ditch undercuts in the existing median area as shown on the cross sections and as discussed in Section 501 of the Geotechnical Design Manual. This undercut is assumed as 2.0' deep and 16.0' wide for estimating purposes. Actual ditch undercut shall be as directed by the Engineer.

Calculation:  
 Sta. 639+65 to Sta. 647+75 = 810 ft  
 Sta. 648+25 to Sta. 669+40 = 2115 ft  
 Sta. 673+75 to Sta. 694+50 = 2075 ft  
 Sta. 697+65 to Sta. 705+75 = 810 ft  
 Sta. 706+75 to Sta. 726+25 = 1950 ft  
 Sta. 726+75 to Sta. 746+25 = 1950 ft  
 Sta. 752+15 to Sta. 763+75 = 1160 ft  
 Sta. 764+50 to Sta. 800+00 = 3550 ft  
 Sta. 800+50 to Sta. 810+00 = 950 ft  
 Sta. 811+00 to Sta. 812+65 = 165 ft  
 Sta. 813+05 to Sta. 820+60 = 755 ft  
 Sta. 821+10 to Sta. 831+00 = 990 ft  
 Total: 17,280 ft  
 (Deduction: 26 existing median inlets X 25' = 650 ft)  
 Total: 16,630 ft

(16,630 ft X 16 ft wide X 2 ft thick) ÷ 27 = 19,710 CY

The following quantities have been carried to the General Summary to accomplish the work described above:

ITEM 203 EXCAVATION	19,710 CY	(Plan Split 01/NHS)
ITEM 203 EMBANKMENT	19,710 CY	(Plan Split 01/NHS)

**Undercut Contingency Quantities**

In the event any area fails the proof rolling after chemical stabilization, the following quantities have been included in the general summary and may be used for stabilizing the failed areas as directed by the Project Engineer:

ITEM 204 EXCAVATION OF SUBGRADE	3500 CY
ITEM 204 GRANULAR MATERIAL, TYPE B	3500 CY
ITEM 204 GEOTEXTILE FABRIC	5000 SY
ITEM 204 GEOGRID	5000 SY

The above quantities may also be used for stabilizing failed areas in the temporary pavement locations required for the maintenance of traffic.

**Seeding and Mulching**

The following quantities are provided to promote growth and care of permanent seeded areas:

ITEM 659 SOIL ANALYSIS TEST	2 EACH
ITEM 659 SEEDING AND MULCHING, CLASS 2	51,873 SY
50,993 SY (from P.638) + 410 (from P.64) + 240 (from P.66)	
+ 230 (from P.70) = 51,873 SY	

ITEM 659 REPAIR SEEDING AND MUCHING	2594 SY
5% X 51,873 SY = 2594 SY	

ITEM 659 INTER-SEEDING	2594 SY
5% X 51,873 SY = 2594 SY	

ITEM 659 COMMERCIAL FERTILIZER	7 TON
51,873 SY ÷ 7410 = 7 ton	

ITEM 659 LIME	10.7 ACRE
51,873 SY ÷ 4840 = 10.7 acre	

ITEM 659 WATER	295 MGAL
((51,873 + 2594) X 0.0027) X 2 applications = 295 MGAL	

ITEM 659 MOWING	117 MSF
(51,873 SY X 9 SF/SY X 25%) ÷ 1000 = 117 MSF	

Seeding and mulching shall be applied to all areas of exposed soil between the Right-of-Way lines, and within the construction limits for areas outside the Right-of-Way lines covered by work agreement or slope easement. Quantity calculations for seeding and mulching are based on these limits.

**Vegetated Filter Strip**

This plan utilizes vegetated filter strips for post construction storm water treatment. Place either ITEM 660 SODDING or ITEM 659 SEEDING AND MULCHING with a 4-inch lift of topsoil and ITEM 670 SLOPE EROSION PROTECTION to all disturbed areas designated as vegetated filter strips, the edge of shoulder, and the foreslope as specified in the plans. See sheet P.448 for more details.


The following estimated quantities are provided in the general summary for use as directed by the Engineer to improve the proposed BMP locations in the plans:

ITEM 659 TOPSOIL	(600 CY)
ITEM 670 SLOPE EROSION PROTECTION	(5400 SY)

(Quantities based on 20% of plan vegetated filter strip areas.)

**Post Construction Storm Water Treatment**

This plan utilizes structural best management practices (BMP's) for post construction storm water treatment.

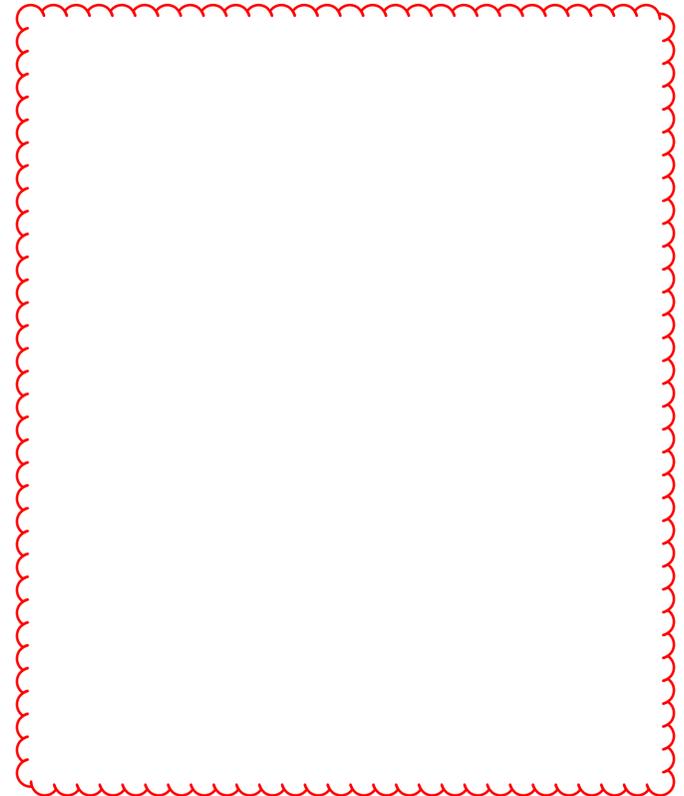

**Endangered Bat Habitat Removal**

This project is located within the known habitat ranges of the federally listed and protected Indiana bat, and Northern Long-Eared Bar. No trees shall be removed under this project from April 1 through September 30. All necessary tree removal shall occur from October 1 through March 31. This requirement is necessary to avoid and minimize impacts to these species as required by the Endangered Species Act (ESA). For the purposes of this note, a tree is defined as: alive, dying, or dead woody plant, with a trunk 3 inches or greater in diameter at a height of 4.5 feet above the ground surface, and with a minimum height of 13 feet.

**Permits - Waterway Permits**

Do not place any temporary or permanent fill within the jurisdictional boundaries of all streams, wetlands, and jurisdictional ditches during construction of this project, including scaffolding or bacing. Do not place any equipment within the jurisdictional boundary of any waterway. If debris enters the waterway during construction, remove the debris immediately using equipment staged outside the jurisdictional boundary.

DESIGN AGENCY	
DESIGNER	BRH
REVIEWER	CMY 09/05/25
PROJECT ID	95445
SHEET	TOTAL
P.20	895

**Maintenance of Traffic Sequence of Operations**

**Alternate Methods**

If the contractor so elects, alternate methods for the maintenance of traffic may be submitted, provided the intent of the below provisions are followed and no additional inconvenience to the traveling public results therefrom. No alternate plan shall be placed into effect until approval has been granted, in writing, by the District Deputy Director.

**Pre-Phase 1 (Miscellaneous Repairs)**

Temporary pavement shall be constructed near the River Road and S.R. 16 E.B. intersection as detailed on sheet P.53.

Pavement repairs shall be performed as per the Pre-Phase 1 Pavement Repair Table on sheet P.29 and as shown on the Pre-Phase 1 plan sheets after approval of these joint locations has been given by the Engineer.

S.R. 37/S.R. 16 shall be resurfaced per the Pre-Phase 1 typical section and Pre-Phase 1 plan sheets. This resurfacing will remove the existing rumble strips on the outside shoulders and provide a new surface for maintained traffic in subsequent MOT phases. In addition to this mainline resurfacing, the ramps at the S.R. 37 & Columbus Rd. interchange shall be resurfaced before Phase 1 MOT may begin.

All proposed bridge work at the LIC-16-1718 (Thornwood Crossing) structure shall be complete before Phase 1 MOT may begin.

Work zone cameras as specified on sheets P.29, P.72, and P.88 shall be installed and functional before Phase 1 MOT may begin.

**Phase 1 (Median Construction)**

Traffic shall be moved to the outside of the existing roadway in both the Eastbound and Westbound directions.

The contractor shall construct the median area per the proposed roadway typical sections except that the proposed surface course shall be replaced with 1.50" of ITEM 442 ASPHALT CONCRETE INTERMEDIATE COURSE, 12.5 MM, TYPE A (448). This temporary surface course will be removed during Phase 4 final resurfacing.

Temporary pavement at the proposed crossover locations as shown on sheets P.54 - P.58 shall be constructed for use in subsequent MOT phases.

All ramps shall remain open during Phase 1.

**Phase 2 (Eastbound Construction)**

Temporary signals at the Columbus Rd. interchange as shown on sheets P.41 - P.42 shall be constructed and operational before any ramps are closed in Phase 2 MOT.

Westbound traffic shall remain in its phase 1 configuration. Eastbound traffic shall be split in contra-flow with the Eastbound passing lane crossing over to the inside shoulder of the Westbound lanes, and the Eastbound driving lane shifting over to the inside shoulder of the Eastbound lanes.

The contractor shall construct the Eastbound area per the proposed roadway typical sections except that the proposed surface course shall be replaced with 1.50" of ITEM 442 ASPHALT CONCRETE INTERMEDIATE COURSE, 12.5 MM, TYPE A (448). This temporary surface course will be removed during Phase 4 final resurfacing.

River Rd. shall be closed to the traveling public during Phase 2, however, EMS access shall be provided **AT ALL TIMES** as shown in the Phase 2 plan sheets. (Access only needed entering River Rd., not exiting from it.)

**Permitted Ramp Closures:**

- Phase 2A - Ramp C, Ramp D, and River Rd. shall be closed
- Phase 2B - Ramps G, Ramp H, and River Rd. shall be closed
- Phase 2C - River Rd. shall be closed

**Phase 3 (Westbound Construction)**

Temporary signals at the Columbus Rd. interchange as shown on sheets P.41 - P.42 shall remain in operation from Phase 2.

Eastbound traffic shall be in its final post-construction configuration. Westbound traffic shall be split in contra-flow with the Westbound passing lane crossing over to the inside shoulder of the Eastbound lanes, and the Westbound driving lane shifting over to the inside shoulder of the Westbound lanes.

The contractor shall construct the Westbound area per the proposed roadway typical sections except that the proposed surface course shall be replaced with 1.50" of ITEM 442 ASPHALT CONCRETE INTERMEDIATE COURSE, 12.5 MM, TYPE A (448). This temporary surface course will be removed during Phase 4 final resurfacing.

**Permitted Ramp Closures:**

- Phase 3A - Ramp A and Ramp B shall be closed
- Phase 3B - Ramp E & F shall be closed
- Phase 3C - All ramps open


**Phase 4 (Final Resurfacing)**

Traffic shall be maintained at all times per SCD MT-95.30.

Construct final resurfacing as per the Phase 4 MOT typical section on sheet P.40.

Install final pavement markings and signs.

All ramps shall be open during Phase 4.

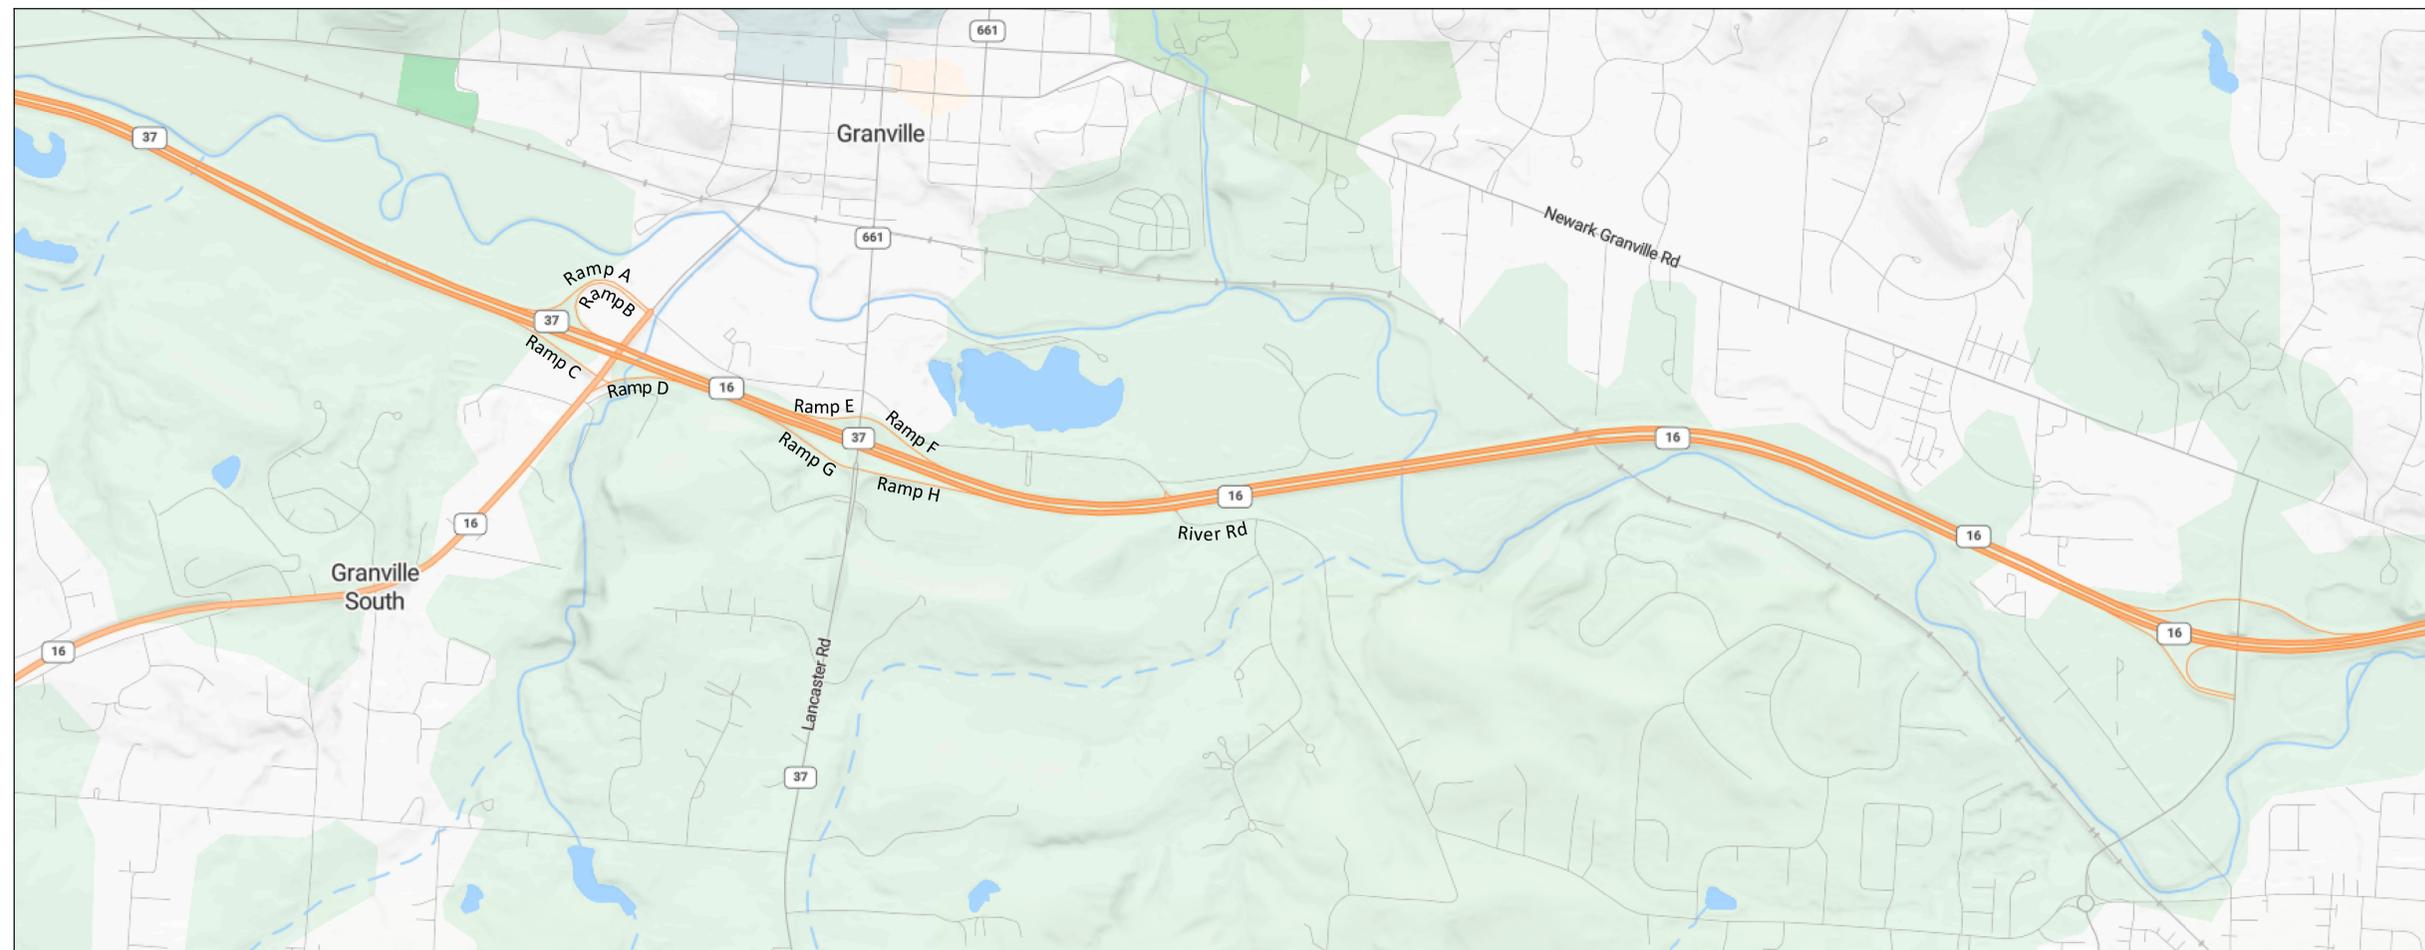

DESIGN AGENCY



DESIGNER

BRH

REVIEWER

CMY 09/05/25

PROJECT ID

95445

SHEET TOTAL

P.24 | 895









**Maintaining ITS Assets During Construction**

The Contractor shall maintain all preexisting or newly installed permanent ITS/Traffic devices and infrastructure during construction according to ODOT Supplemental Specification 809.


**ITEM 809 32" ITS PULL BOX WITH PAD AND STANDARD LID ASSEMBLY, TYPE 2**

This item shall conform to the pull box details provided in SCD ITS-14.11. Payment shall be made at the contract unit price and include all labor, equipment, and materials necessary to furnish and install the pull box.

**General Raceway Details**



Where ITEM 625 CONDUIT, JACKED OR DRILLED, 725.052 (2") or ITEM 809 CONDUIT, 2" DIAMETER, HDPE are specified in the plans, the conduit shall have (4) ITEM 809 MICRO-DUCT INNERDUCT, 14/10 installed inside the conduit as per Supplemental Specification 809 and relevant ITS Standard Construction Drawings. See detail below.

Where lateral offsets are shown in the ITS plans, (2) raceways shall be installed as specified in the plans.

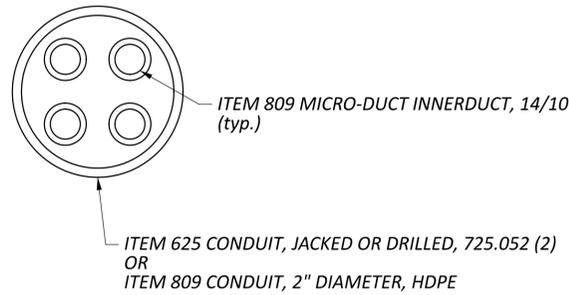

**Median Barrier Raceway Details**

The proposed median Type C1 barrier in the plans, shall only contain (1) 2" ITS raceway, itemized separately. The lighting and spare conduits shown on Standard Construction Drawings ITS-14.50, RM-4.3, and RM-4.4 shall not be installed.

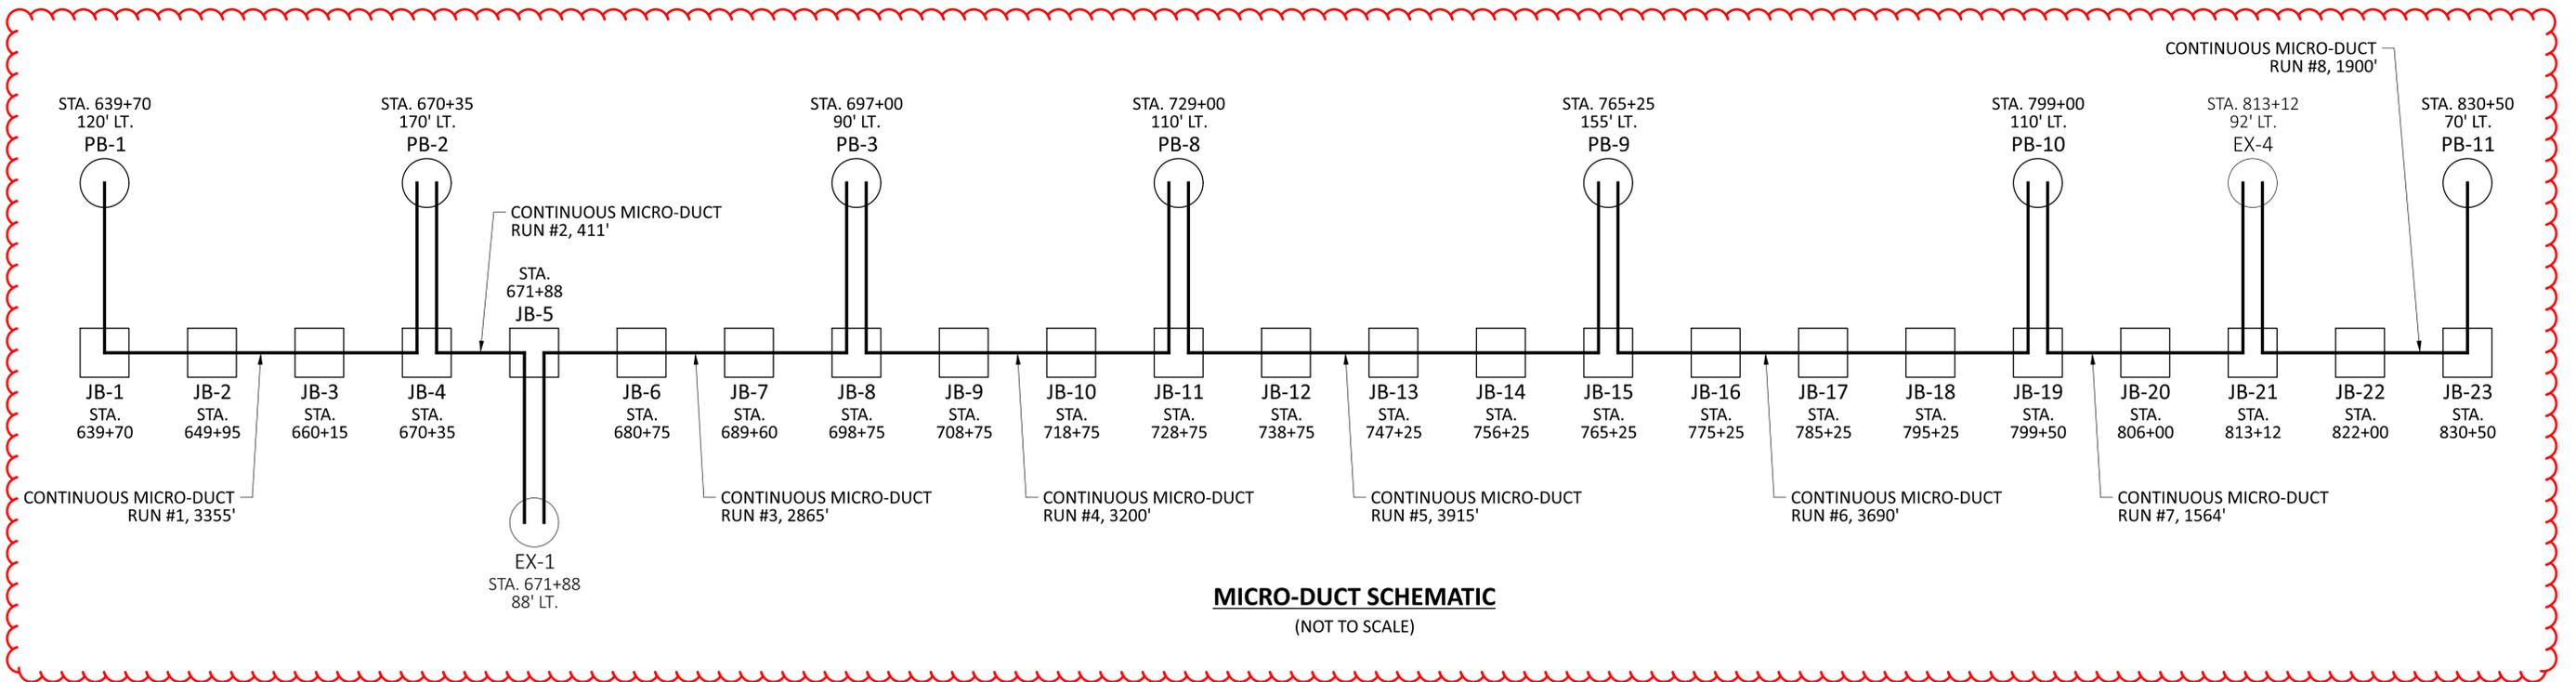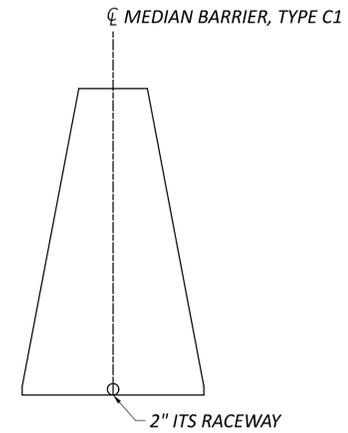

DESIGN AGENCY



DESIGNER  
WAC

REVIEWER  
BRH 09/05/25

PROJECT ID  
95445

SHEET TOTAL  
P.764 895


LIC-16/37-14.24/15.47

MODEL: sheet\_PAPERSCALE.dwg DATE: 12/5/2025 TIME: 8:55:33 AM PLOT: CHDPT\_CDD.dwg USER: Brgn-Hrdw@ca.gov WOPKSET\_06445 PROJECT: C:\ProgramData\Bentley\MapGuide\Projects\95445\TrafficSheets\95445\_TSO03.dgn

SHEET NO.	LOCATION	625	625	809				
		TRENCH, 30" DEEP FT	CONDUIT, JACKED OR DRILLED, 725.052 (2") FT	ITS JUNCTION BOX, 17x24x6 INCHES EACH	32" ITS PULL BOX WITH PAD AND STANDARD LID ASSEMBLY, TYPE 2 EACH	TRACER WIRE FT	MICRO-DUCT INNERDUCT, 14 / 10 FT	CONDUIT, 2" DIAMETER, HDPE FT
	MAINLINE - S.R. 37 / 16 (PLAN SPLIT 01/NHS)							
P.766	END OF WALL TO JB-1			1			20	5
	JB-1 TO PB-1		120		1	120	480	
P.766	PB-1 TO JB-1		120			120	480	
P.766	JB-1 TO JB-2			1			4100	1025
P.766 - P.767	JB-2 TO JB-3			1			4080	1020
P.767 - P.768	JB-3 TO JB-4			1			4080	1020
P.768	JB-4 TO PB-2		170		1	170	680	
P.768	PB-2 TO JB-4		170			170	680	
P.768	JB-4 TO JB-5			1			612	153
P.768	JB-5 TO EX-1		88			88	352	
P.768	EX-1 TO JB-5		88			88	352	
P.768 - P.769	JB-5 TO JB-6			1			3548	887
P.769 - P.770	JB-6 TO JB-7			1			3540	885
P.770	JB-7 TO JB-8			1			3660	915
P.770	JB-8 TO PB-3		90		1	90	360	
P.770	PB-3 TO PB-4	280			1	280		280
P.770	PB-4 TO EX-2		75			75		
P.770	PB-3 TO PB-5		165		1	165		
P.770	PB-5 TO PB-6	140			1	140		140
P.770	PB-6 TO PB-7		38		1	38		
P.770	PB-7 TO EX-3	37				37		37
P.770	PB-3 TO JB-8		90			90	360	
P.770 - P.771	JB-8 TO JB-9			1			4000	1000
P.771 - P.772	JB-9 TO JB-10			1			4000	1000
P.772 - P.773	JB-10 TO JB-11			1			4000	1000
P.773	JB-11 TO PB-8		110		1	110	440	
P.773	PB-8 TO JB-11		110			110	440	
P.773 - P.774	JB-11 TO JB-12			1			4000	1000
P.774	JB-12 TO JB-13			1			3400	850
P.774 - P.775	JB-13 TO JB-14			1			3600	900
P.775 - P.776	JB-14 TO JB-15			1			3600	900
P.776	JB-15 TO PB-9		155		1	155	620	
P.776	PB-9 TO JB-15		155			155	620	
P.776	JB-15 TO JB-16			1			4000	1000
P.777	JB-16 TO JB-17			1			4000	1000
P.777 - P.778	JB-17 TO JB-18			1			4000	1000
P.778	JB-18 TO JB-19			1			1700	425
P.778	JB-19 TO PB-10		110		1	110	440	
P.778	PB-10 TO JB-19		110			110	440	
P.778 - P.779	JB-19 TO JB-20			1			2600	650
P.779 - P.780	JB-20 TO JB-21			1			2848	712
P.780	JB-21 TO EX-4		92			92	368	
P.780	EX-4 TO JB-21		92			92	368	
P.780	JB-21 TO JB-22			1			3552	888
P.780 - P.781	JB-22 TO JB-23			1			3400	850
P.781	JB-23 TO PB-11		70		1	70	280	
P.781	PB-11 TO PB-12	312			1	312		312
P.781	PB-12 TO PB-13		14		1	14		
TOTALS CARRIED TO GENERAL SUMMARY		769	2232	23	13	3001	84,100	19,854


TRAFFIC SURVEILLANCE SUBSUMMARY

DESIGN AGENCY  
  
 DESIGNER  
 WAC  
 REVIEWER  
 BRH 09/05/25  
 PROJECT ID  
 95445  
 SHEET TOTAL  
 P.765 895

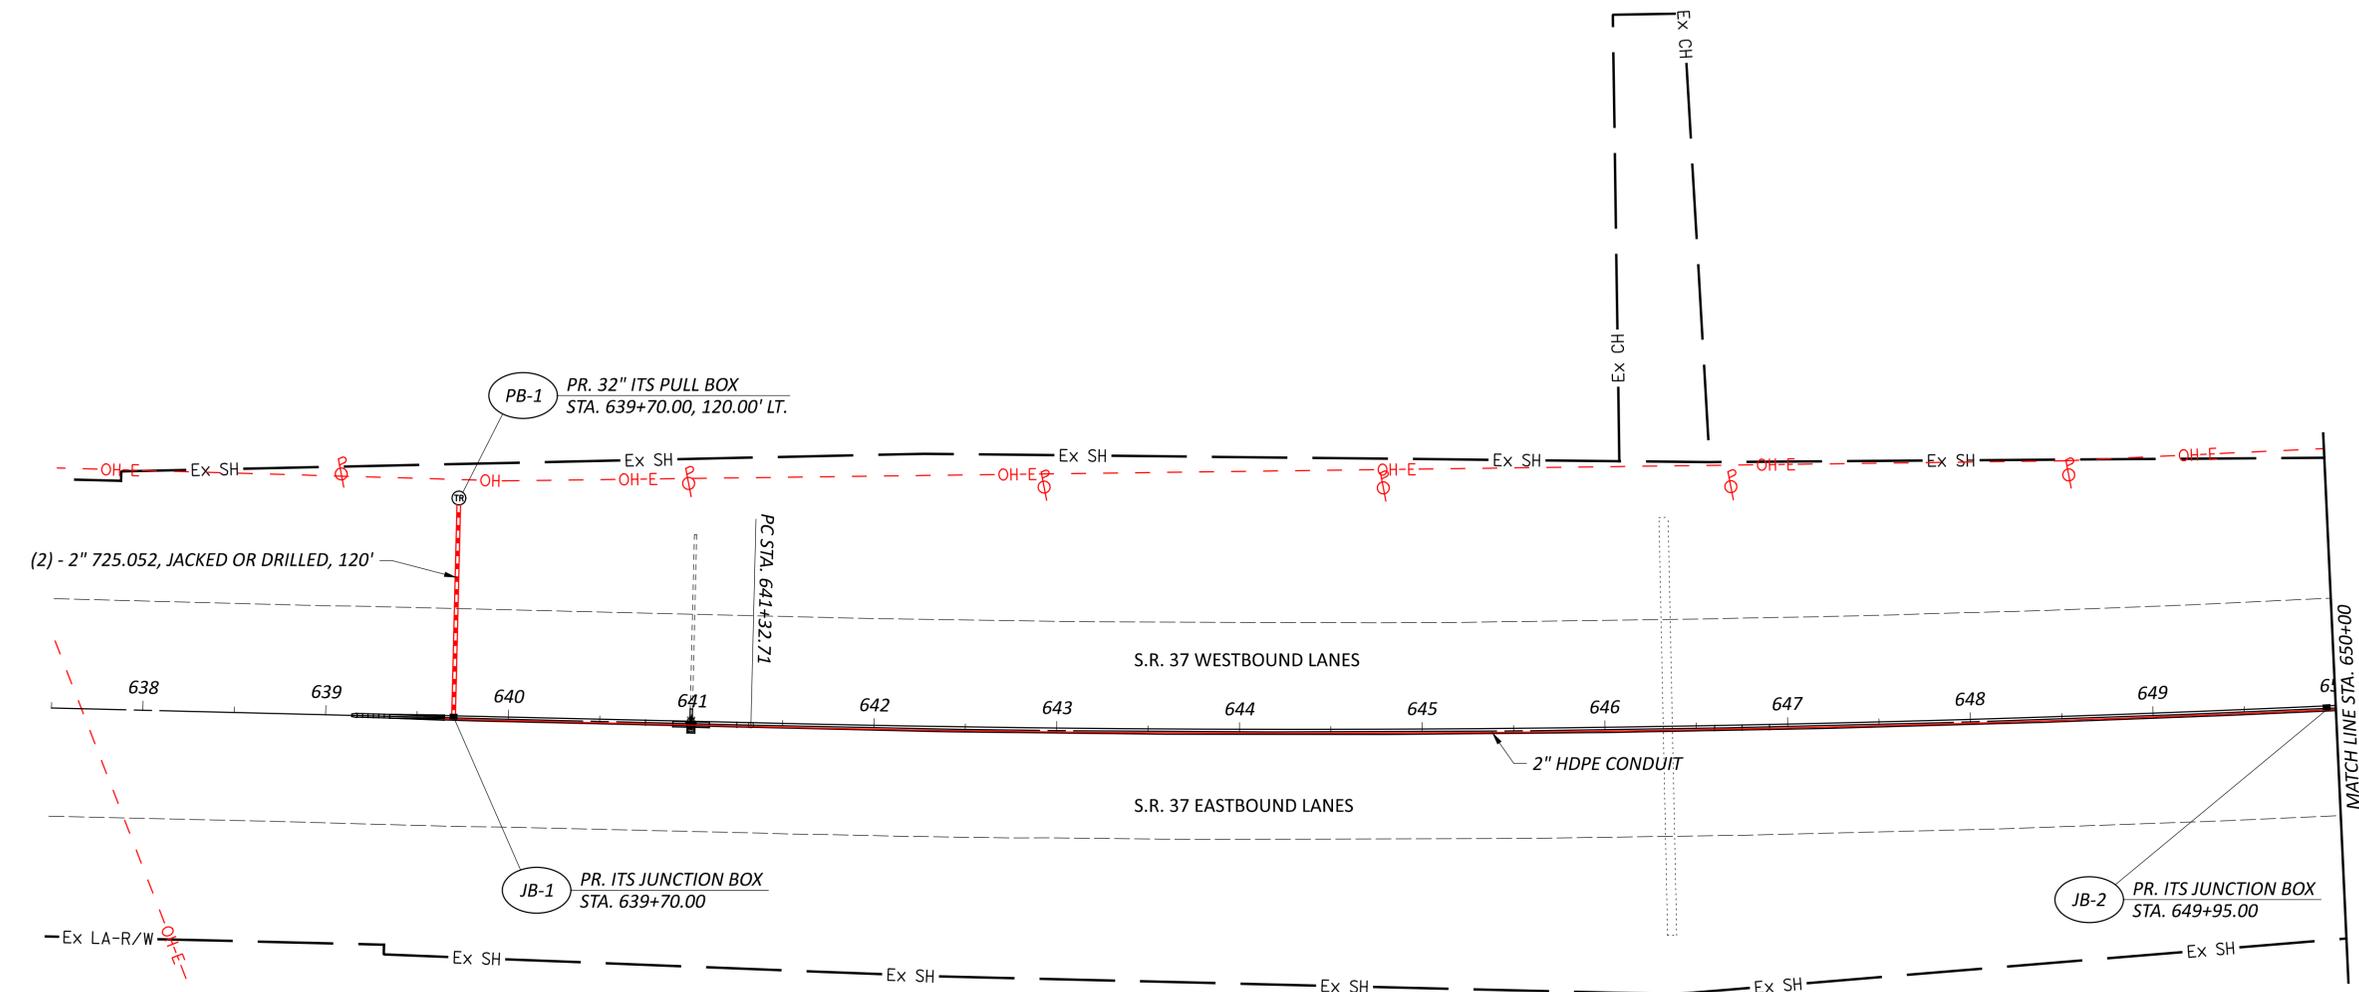

**LEGEND**

- ITS JUNCTION BOX
- CONDUIT, 2" DIAMETER, HDPE
- MICRO-DUCT PATHWAY (x 2), JACKED OR DRILLED
- Ⓢ 32" ITS PULL BOX W/ PAD, TYPE 2

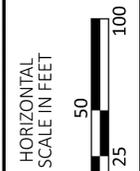

**TRAFFIC SUIVEILLANCE PLAN**  
 STA. 637+50.00 TO STA. 650+00.00

DESIGN AGENCY




DESIGNER  
**WAC**

REVIEWER  
 BRH 09/05/25


PROJECT ID  
 95445

SHEET	TOTAL
P.766	895

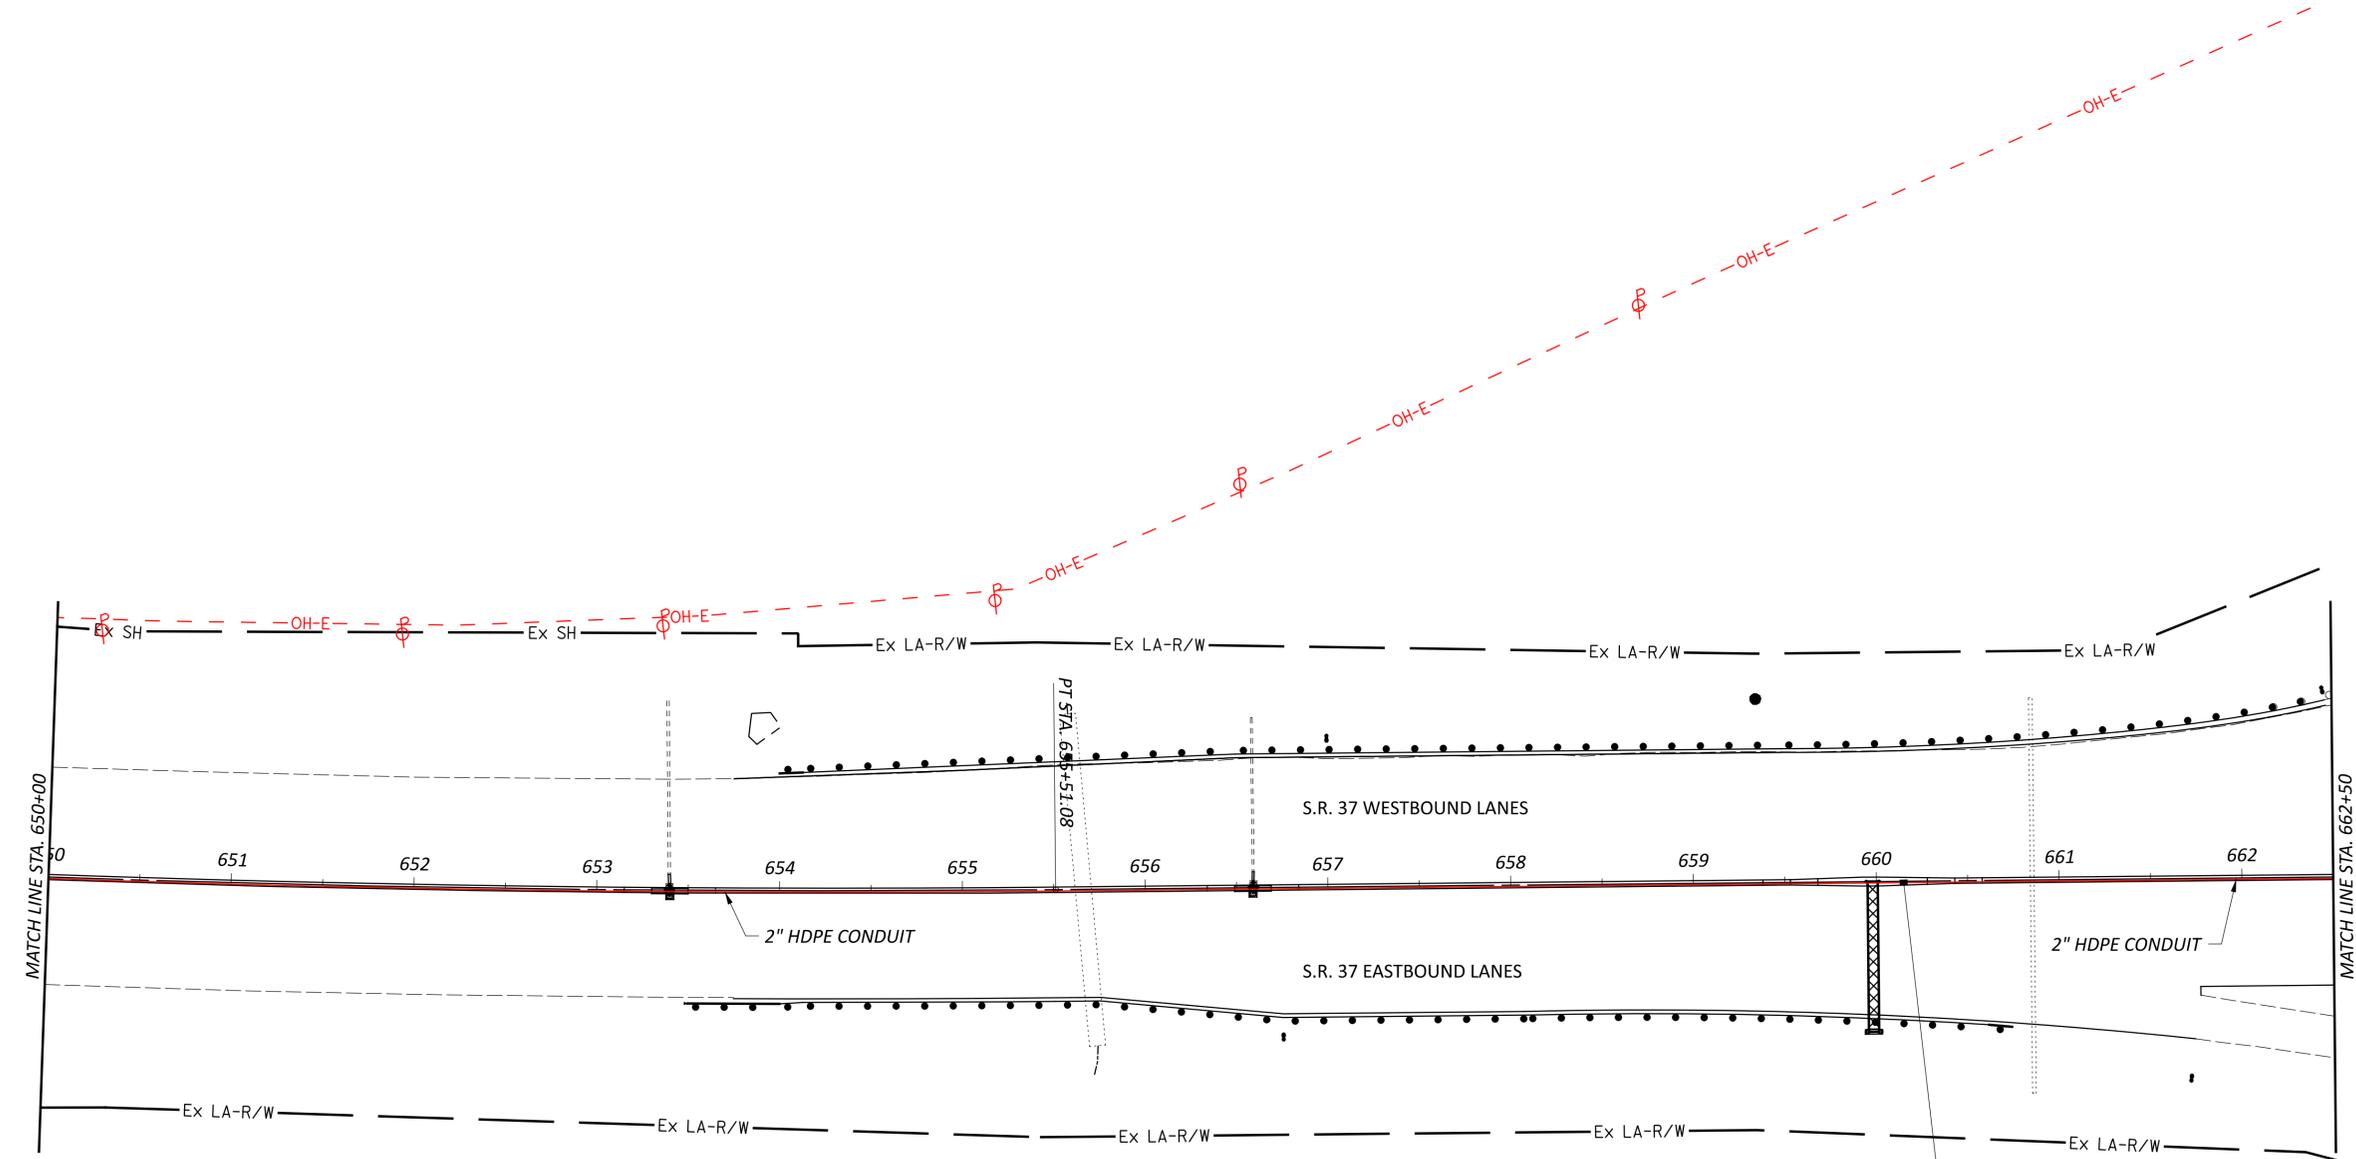

**LEGEND**

- ITS JUNCTION BOX
- CONDUIT, 2" DIAMETER, HDPE
- MICRO-DUCT PATHWAY (x 2), JACKED OR DRILLED
- Ⓜ 32" ITS PULL BOX W/ PAD, TYPE 2

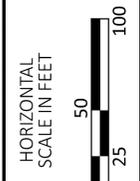

**TRAFFIC SUIVEILLANCE PLAN**  
 STA. 650+00.00 TO STA. 662+50.00

DESIGN AGENCY



DESIGNER  
**WAC**



REVIEWER  
 BRH 09/05/25

PROJECT ID  
 95445

SHEET TOTAL  
 P.767 895

**LEGEND**

- ITS JUNCTION BOX
- CONDUIT, 2" DIAMETER, HDPE
- MICRO-DUCT PATHWAY (x 2), JACKED OR DRILLED
- Ⓜ 32" ITS PULL BOX W/ PAD, TYPE 2

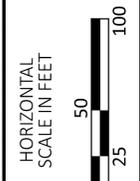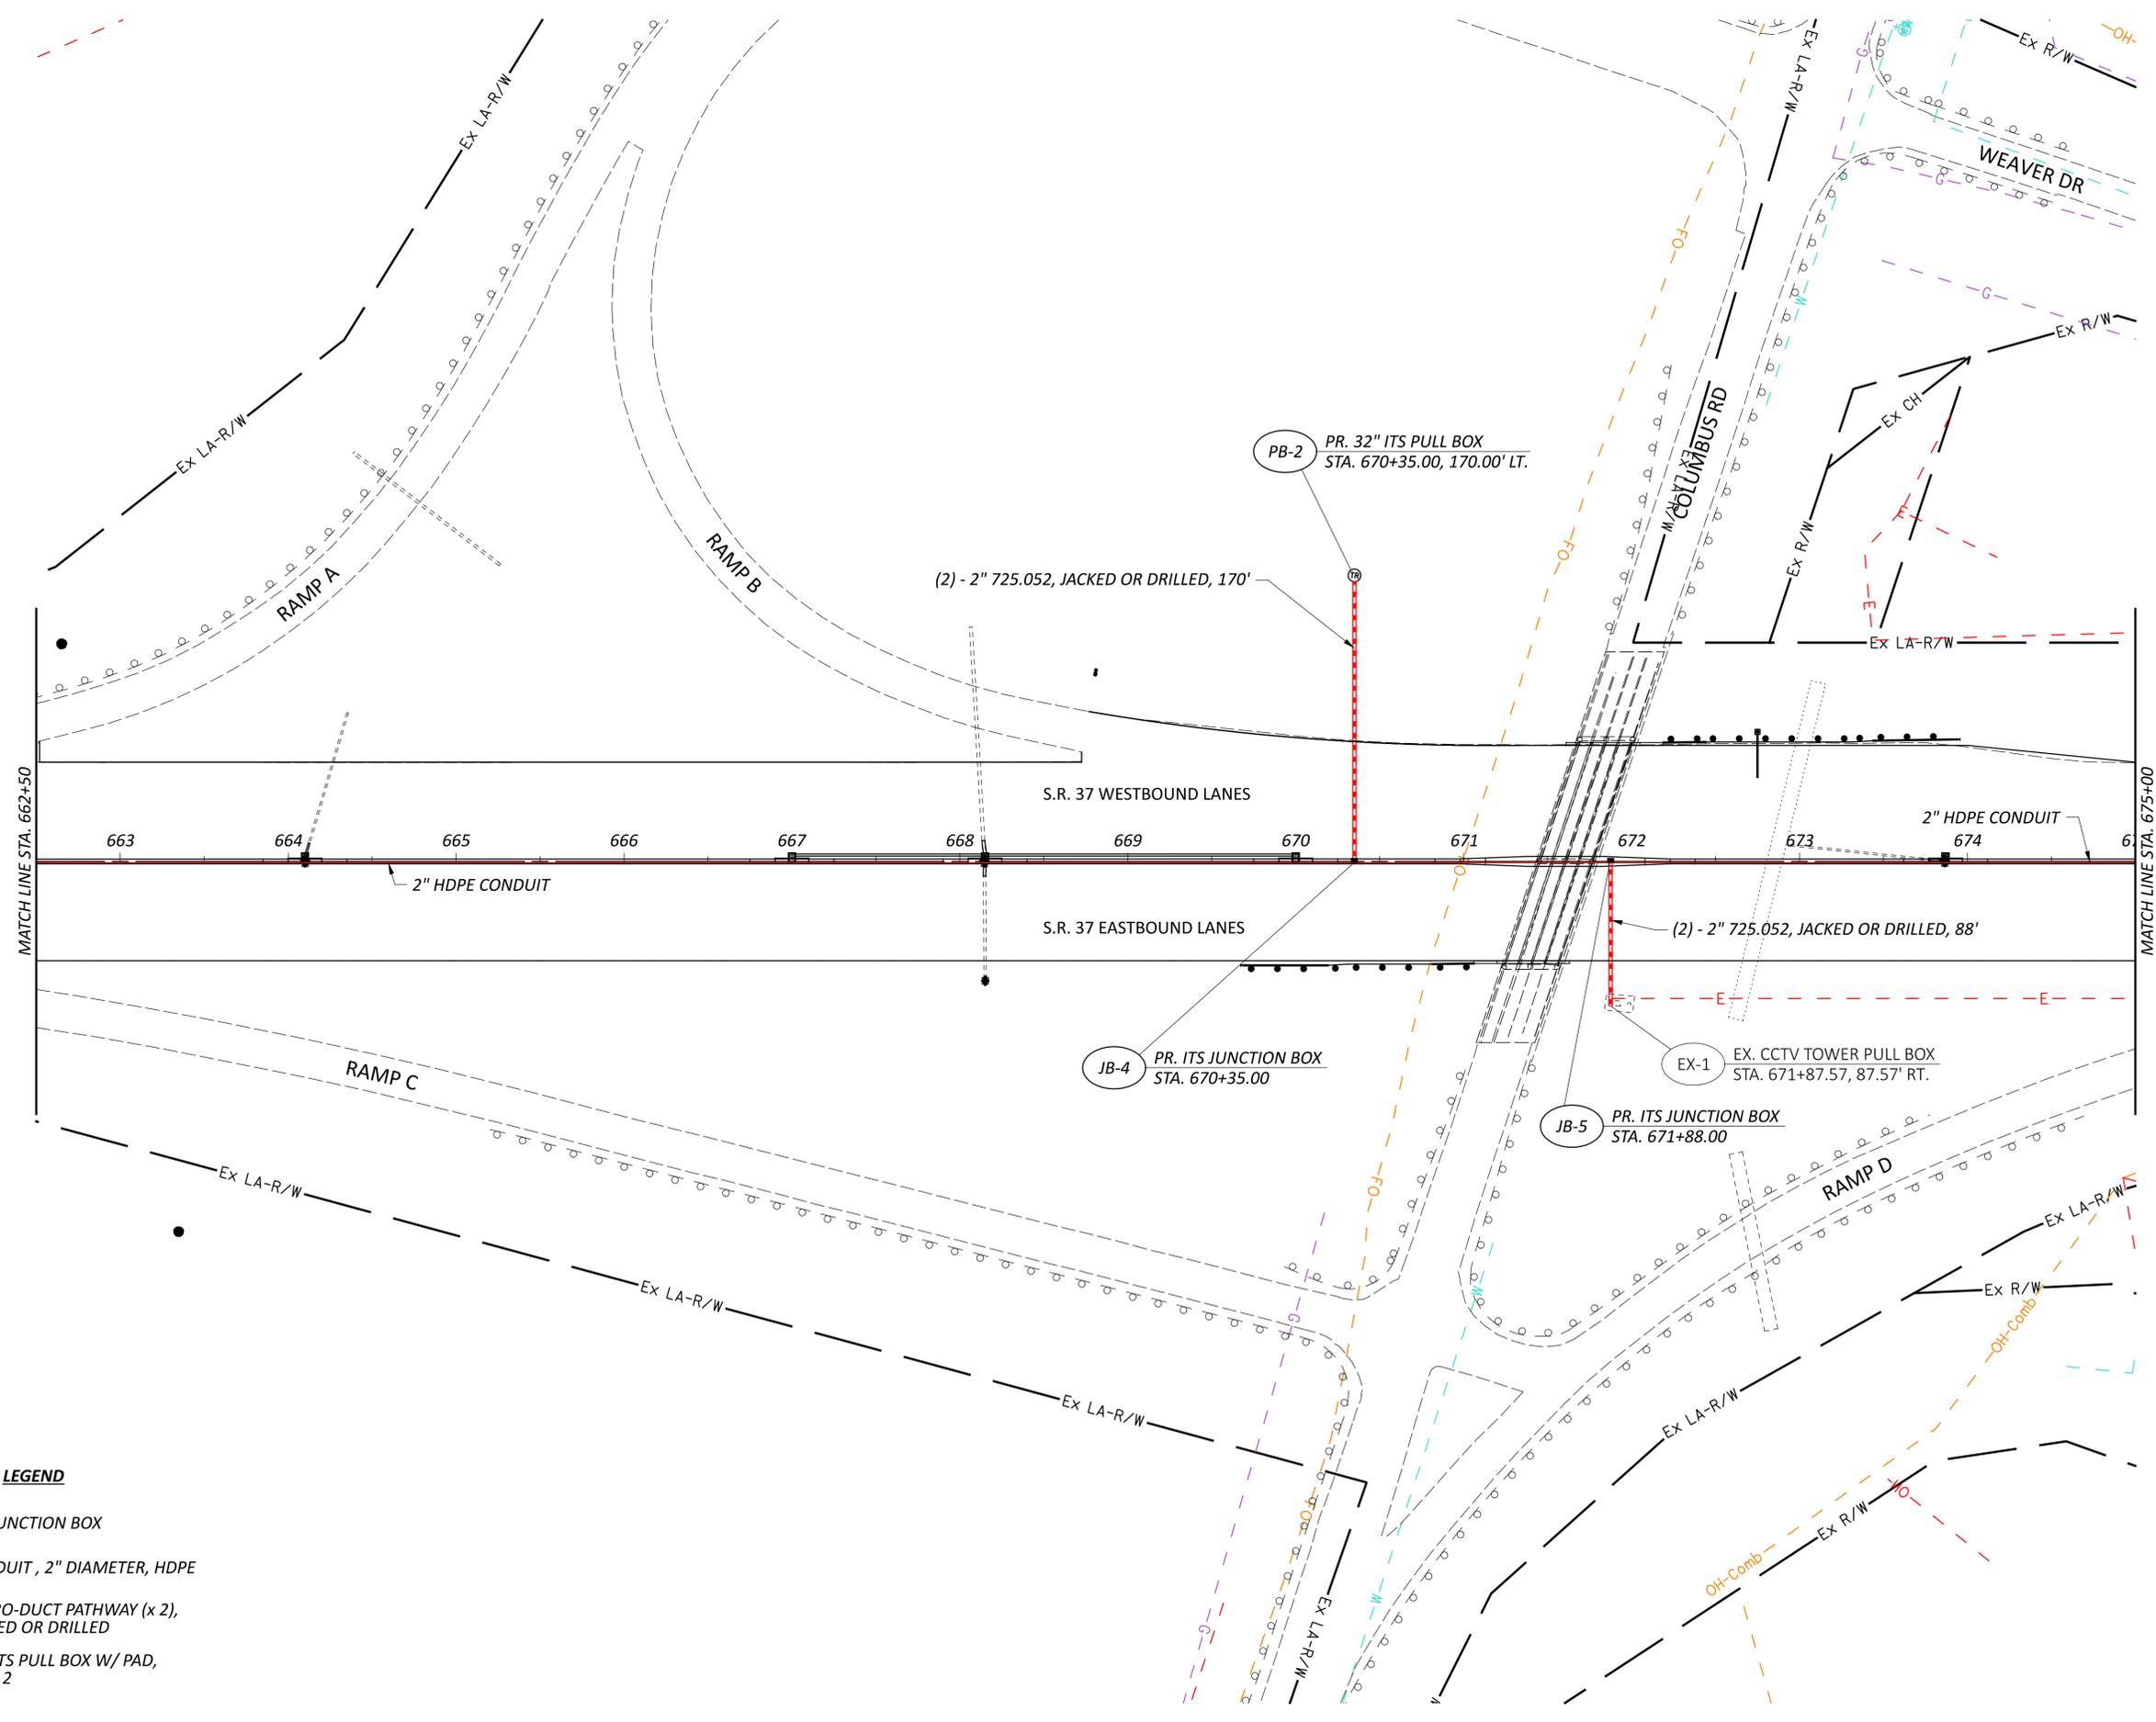

**TRAFFIC SUIVEILLANCE PLAN**  
 STA. 662+50.00 TO STA. 675+00.00

DESIGN AGENCY



DESIGNER

WAC

REVIEWER


BRH 09/05/25

PROJECT ID


95445

SHEET TOTAL

P.768 895

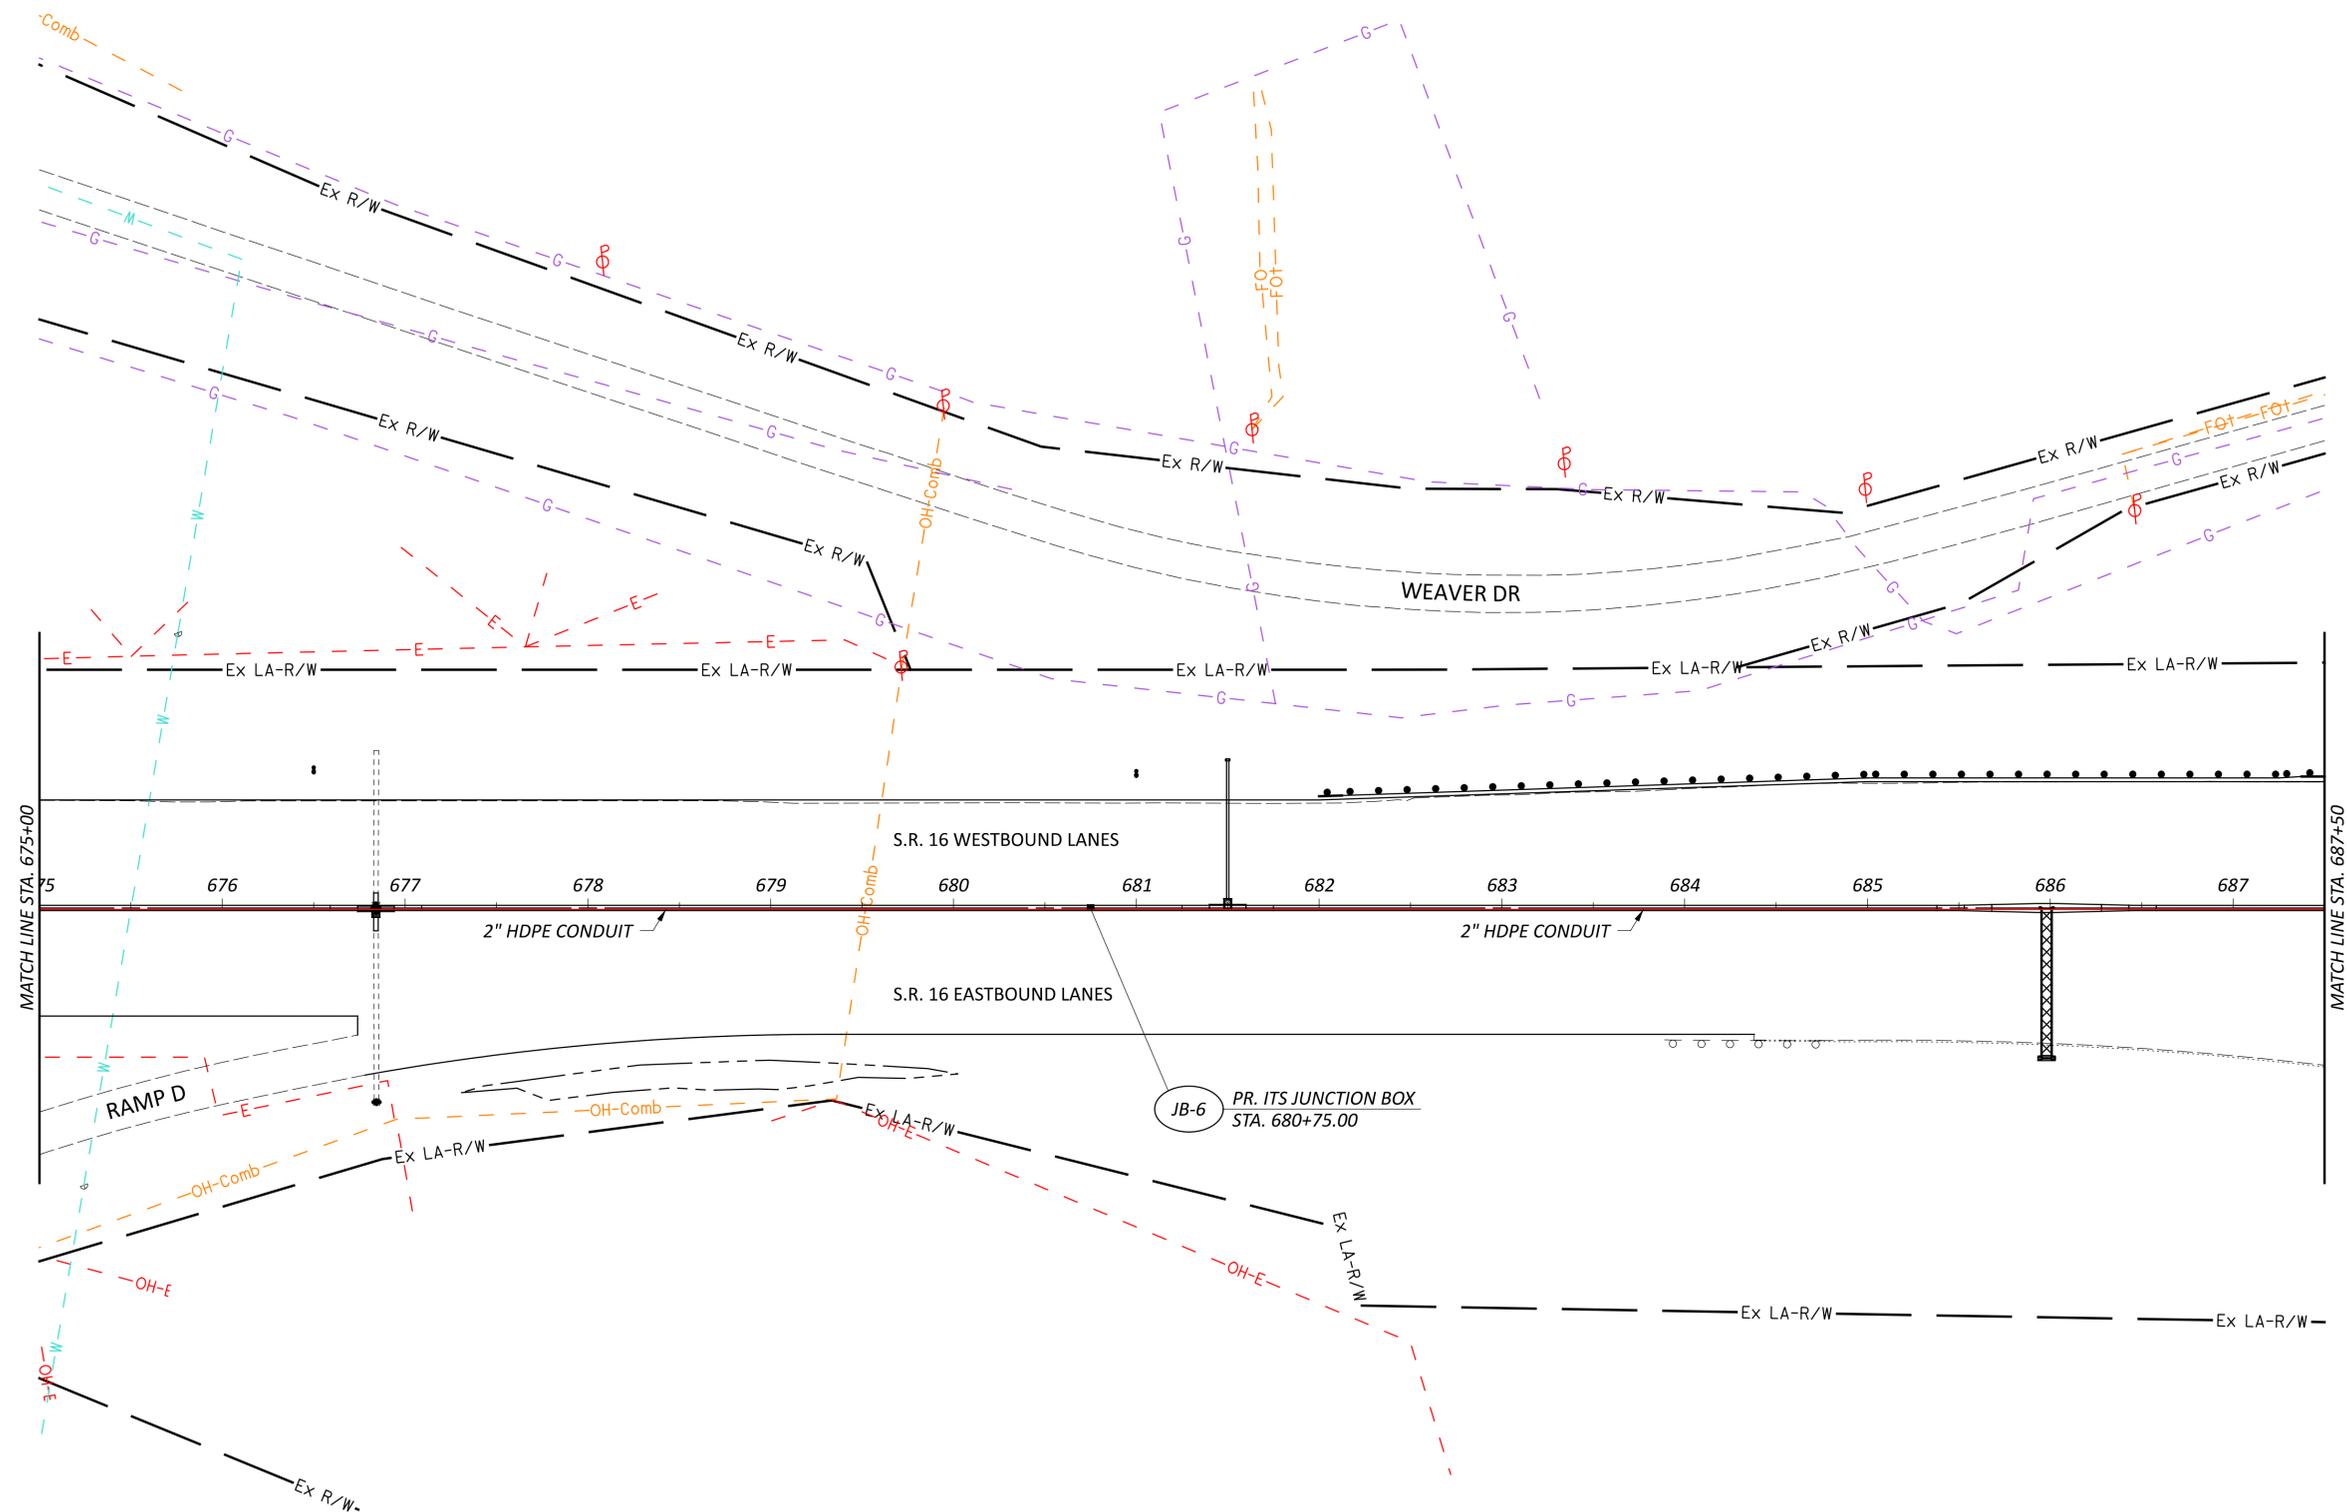


- LEGEND**
- ITS JUNCTION BOX
  - CONDUIT, 2" DIAMETER, HDPE
  - MICRO-DUCT PATHWAY (x 2), JACKED OR DRILLED
  - Ⓜ 32" ITS PULL BOX W/ PAD, TYPE 2

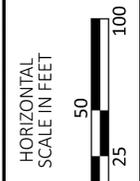


**TRAFFIC SUIVEILLANCE PLAN**  
 STA. 675+00.00 TO STA. 687+50.00

DESIGN AGENCY	
DESIGNER	WAC
REVIEWER	BRH 09/05/25
PROJECT ID	95445
SHEET	TOTAL
P.769	895

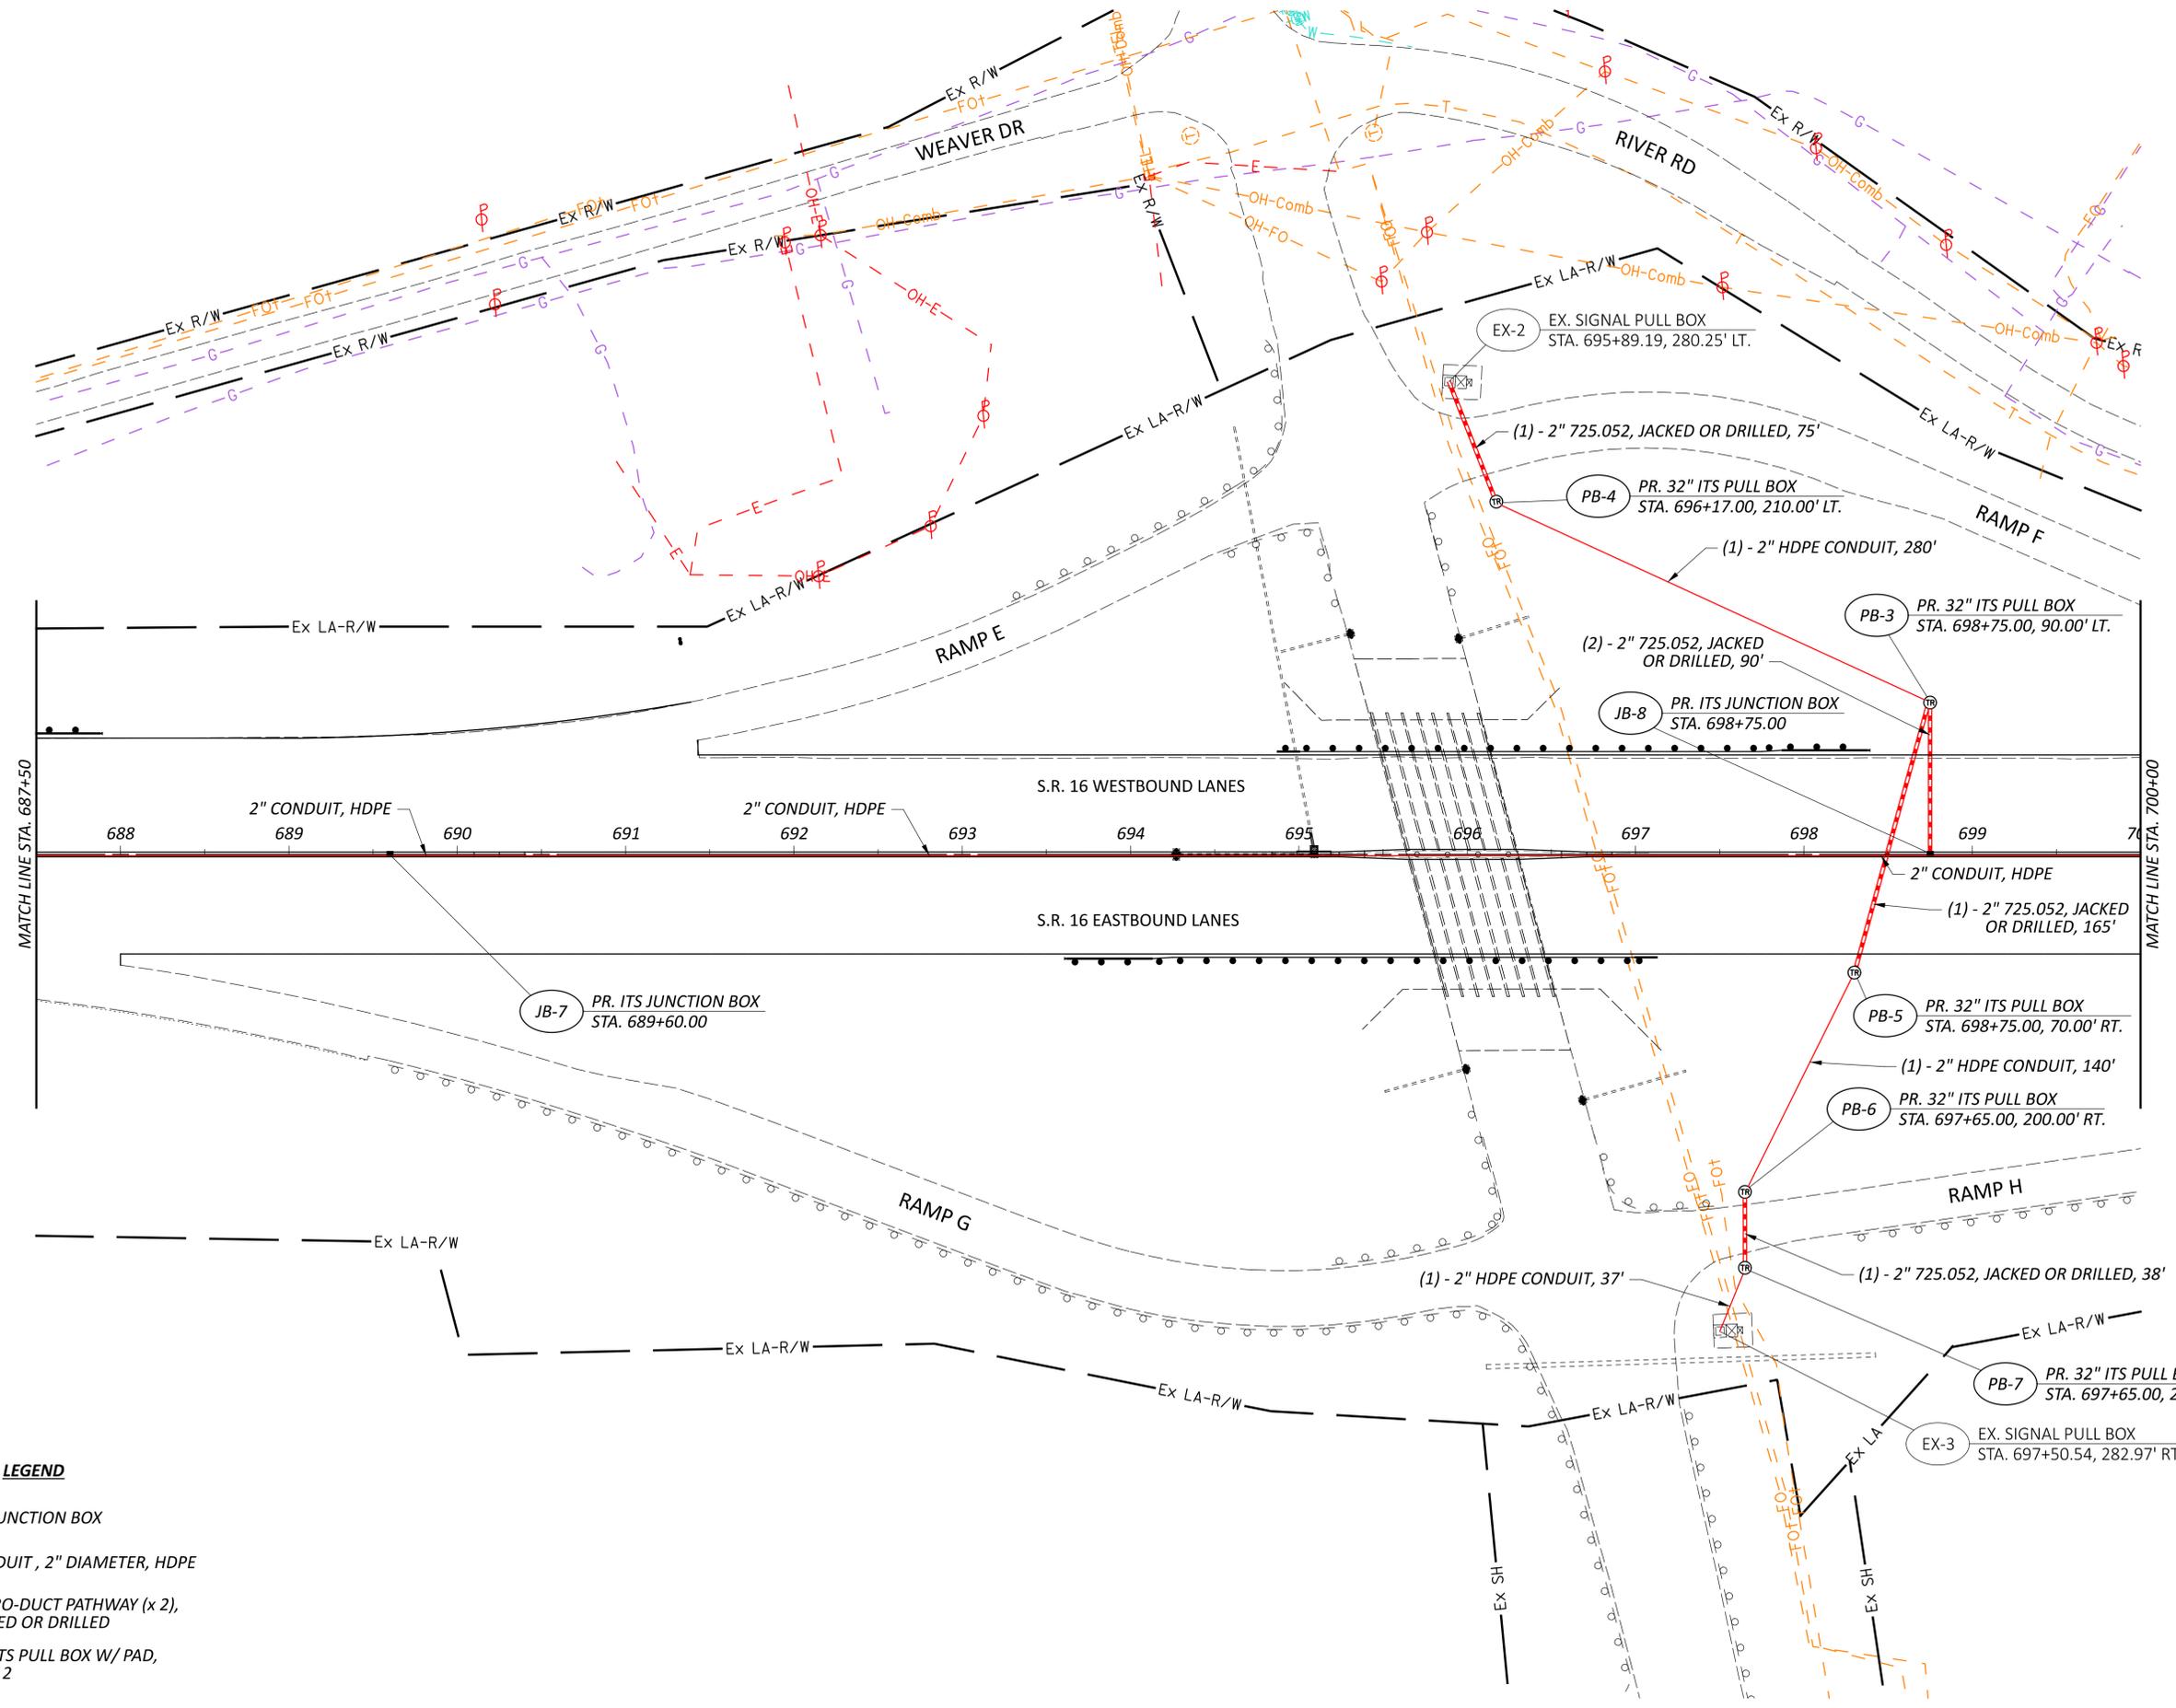

**LEGEND**

- ITS JUNCTION BOX
- CONDUIT, 2" DIAMETER, HDPE
- MICRO-DUCT PATHWAY (x 2), JACKED OR DRILLED
- Ⓜ 32" ITS PULL BOX W/ PAD, TYPE 2

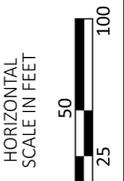

**TRAFFIC SUIVEILLANCE PLAN**  
STA. 687+50.00 TO STA. 700+00.00

DESIGN AGENCY




DESIGNER  
**WAC**

REVIEWER  
BRH 09/05/25


PROJECT ID  
95445

SHEET TOTAL  
P.770 895

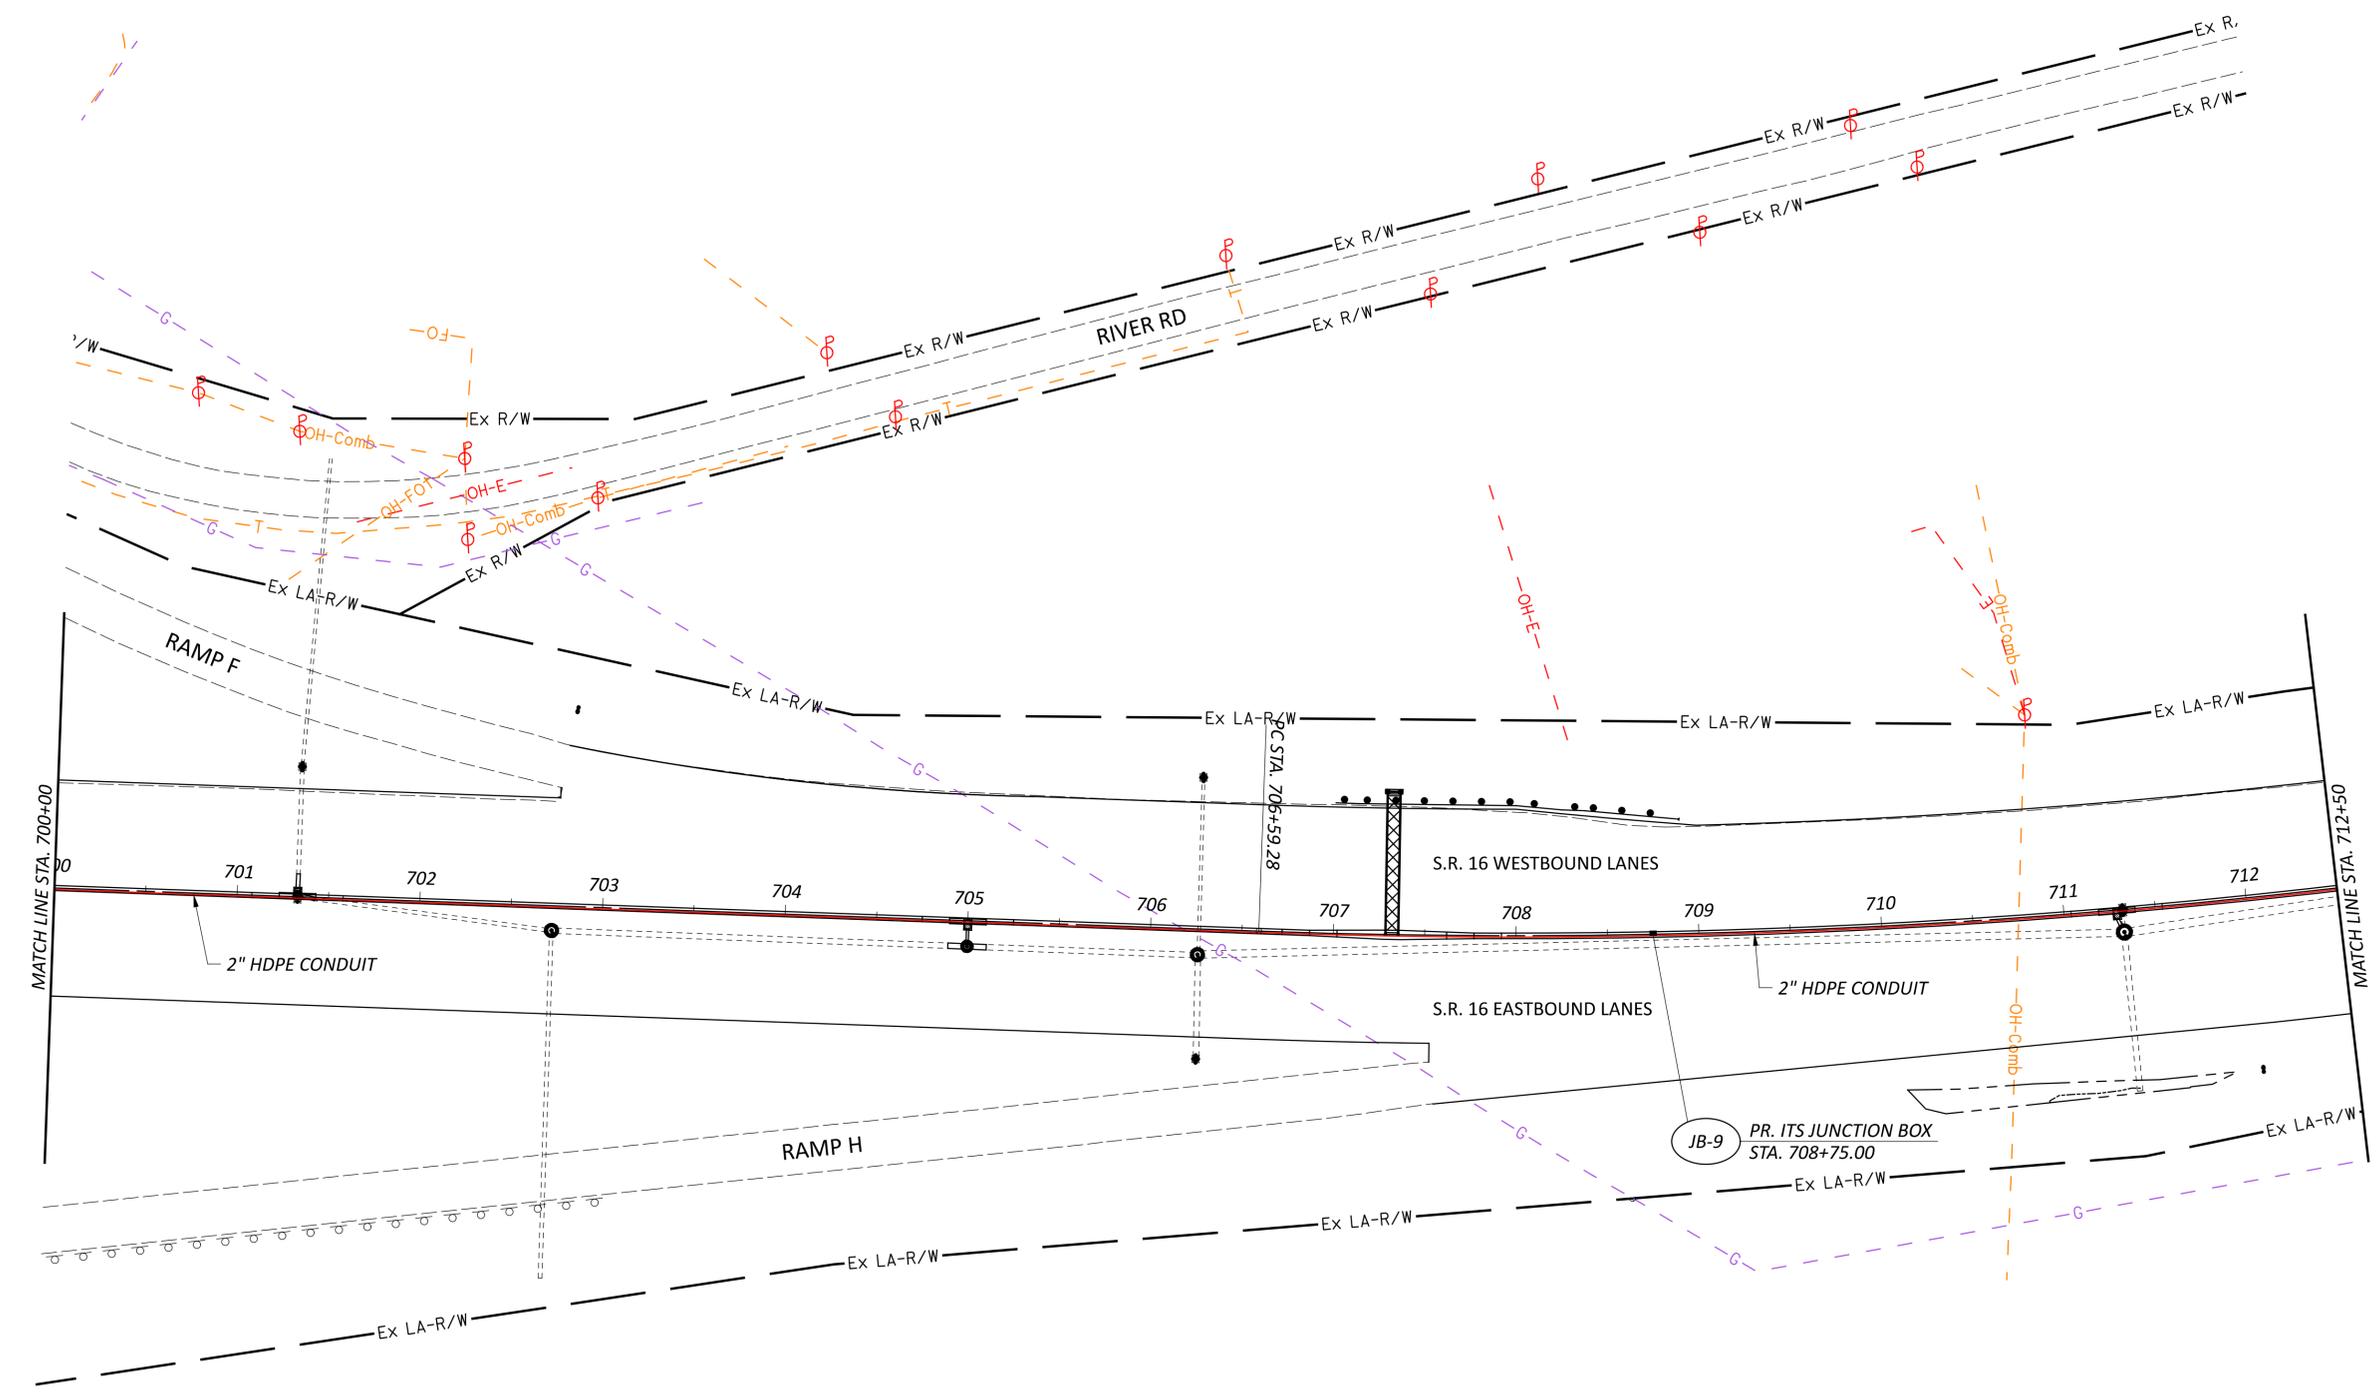

**LEGEND**

- ITS JUNCTION BOX
- CONDUIT, 2" DIAMETER, HDPE
- MICRO-DUCT PATHWAY (x 2), JACKED OR DRILLED
- Ⓜ 32" ITS PULL BOX W/ PAD, TYPE 2

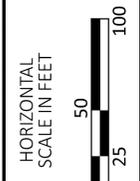

**TRAFFIC SUIVEILLANCE PLAN**  
 STA. 700+00.00 TO STA. 712+50.00

DESIGN AGENCY




DESIGNER  
**WAC**

REVIEWER  
 BRH 09/05/25


PROJECT ID  
 95445

SHEET TOTAL  
 P.771 895

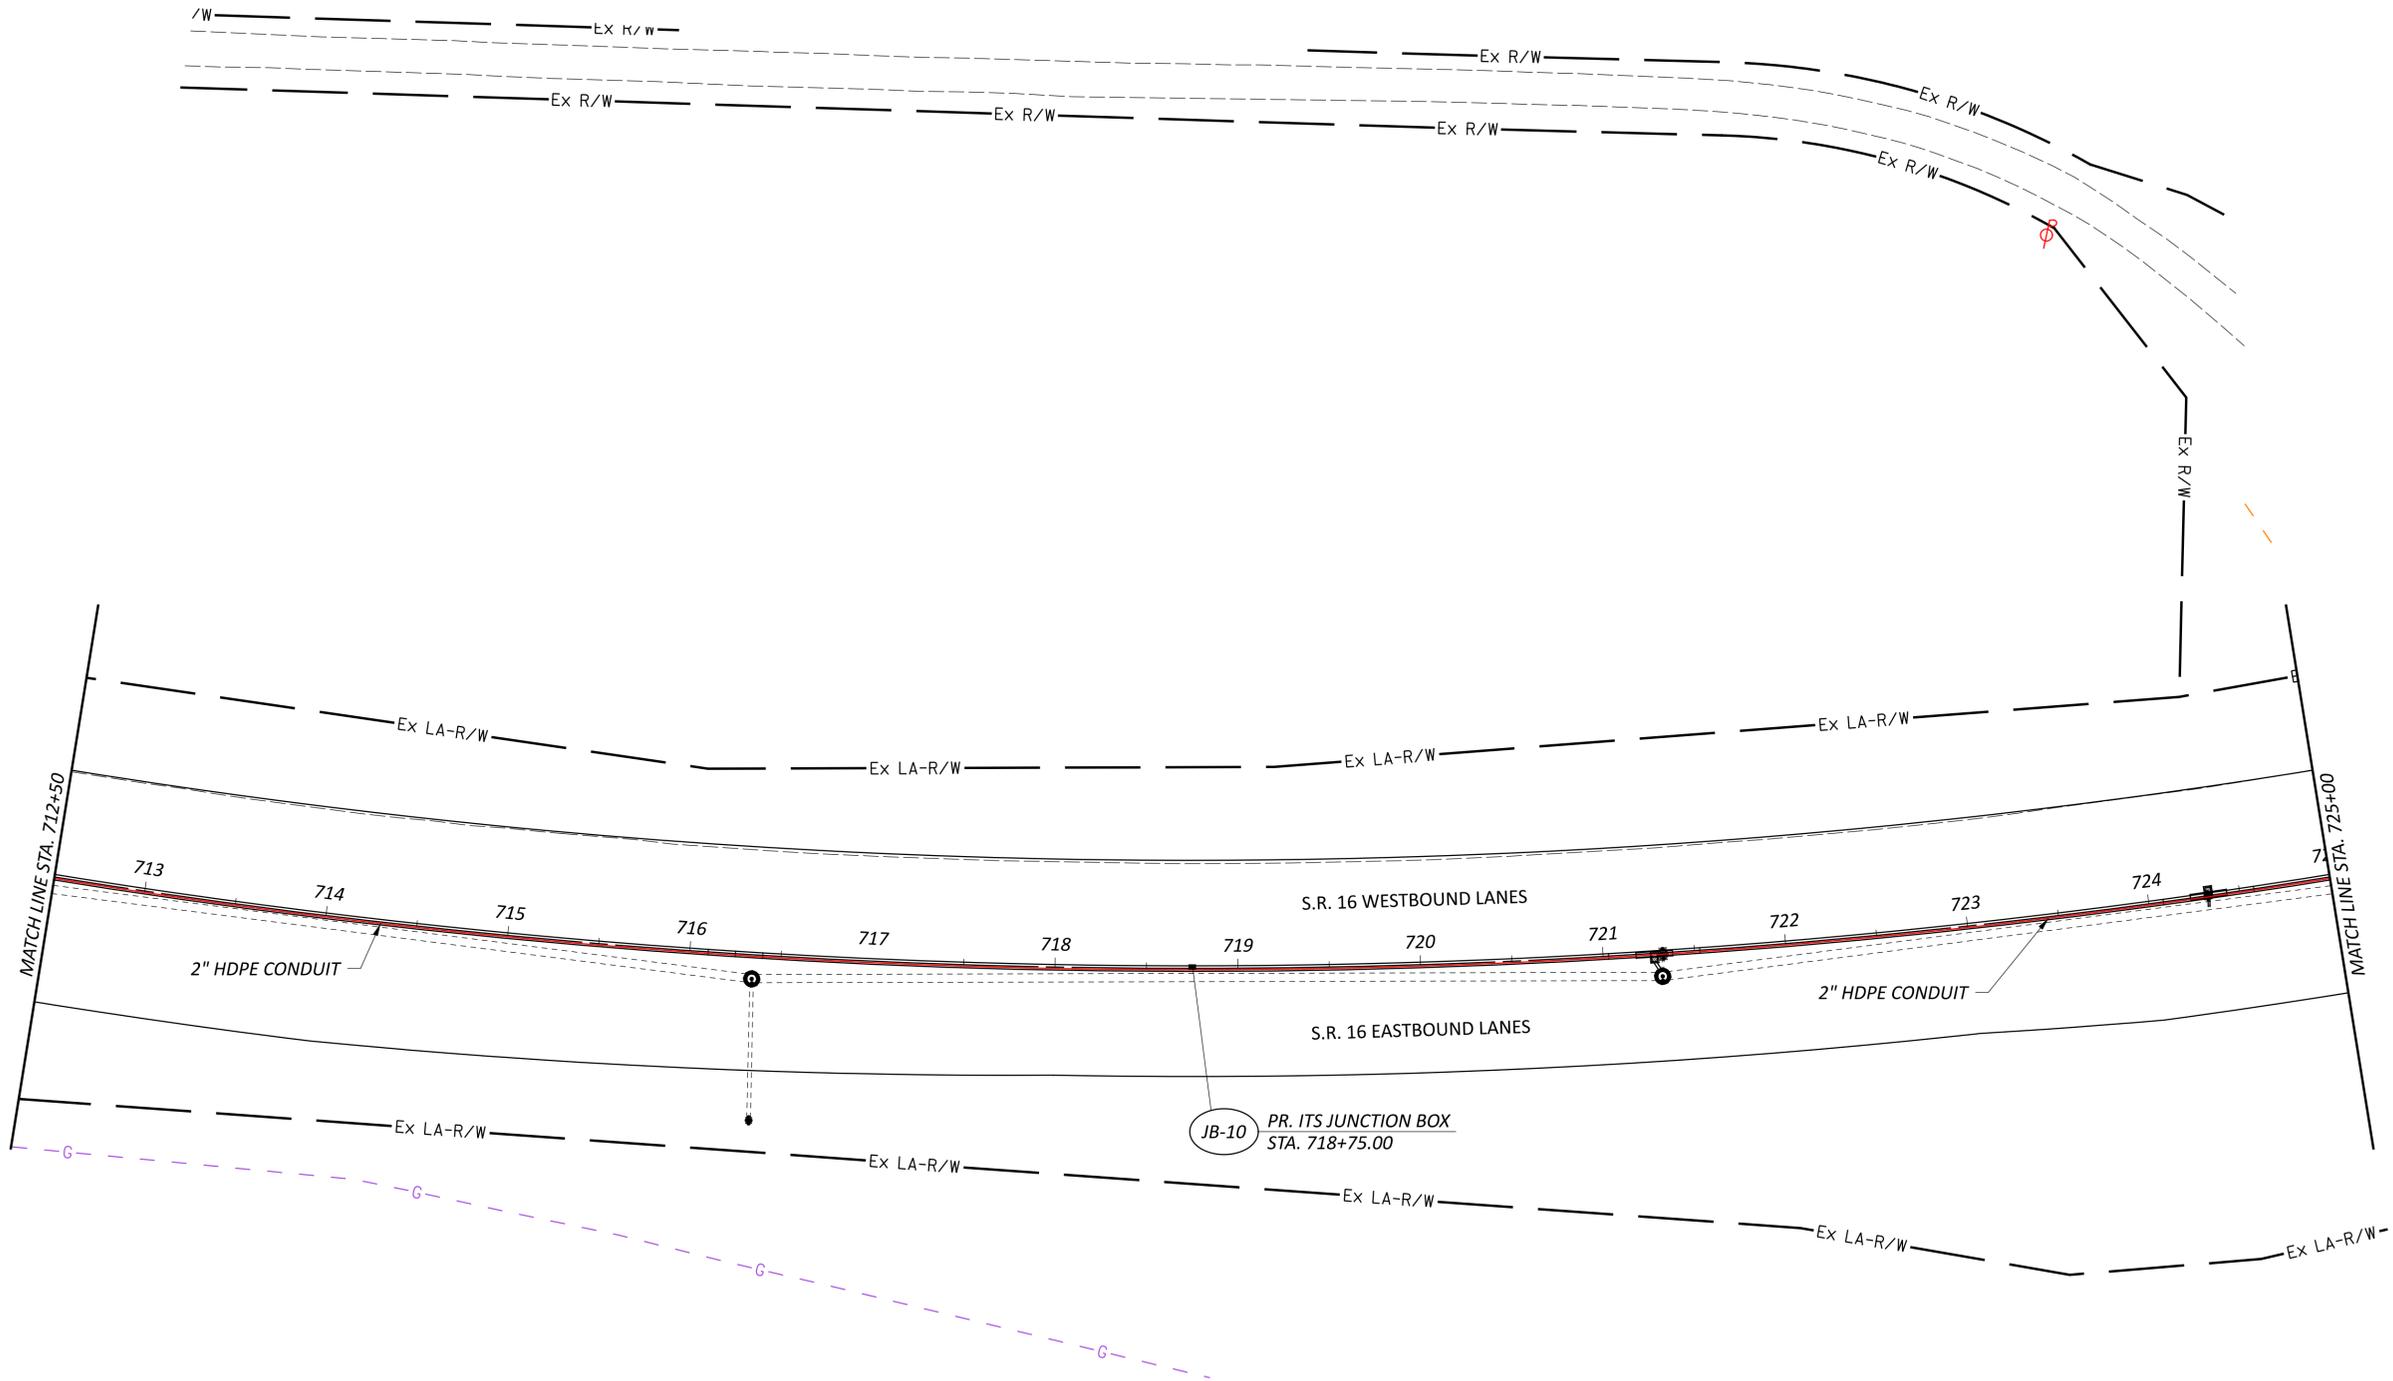

**LEGEND**

- ITS JUNCTION BOX
- CONDUIT, 2" DIAMETER, HDPE
- MICRO-DUCT PATHWAY (x 2), JACKED OR DRILLED
- Ⓜ 32" ITS PULL BOX W/ PAD, TYPE 2

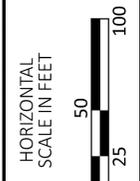

**TRAFFIC SUIVEILLANCE PLAN**  
 STA. 712+50.00 TO STA. 725+00.00

DESIGN AGENCY




DESIGNER  
**WAC**

REVIEWER  
 BRH 09/05/25


PROJECT ID  
 95445

SHEET TOTAL  
 P.772 | 895

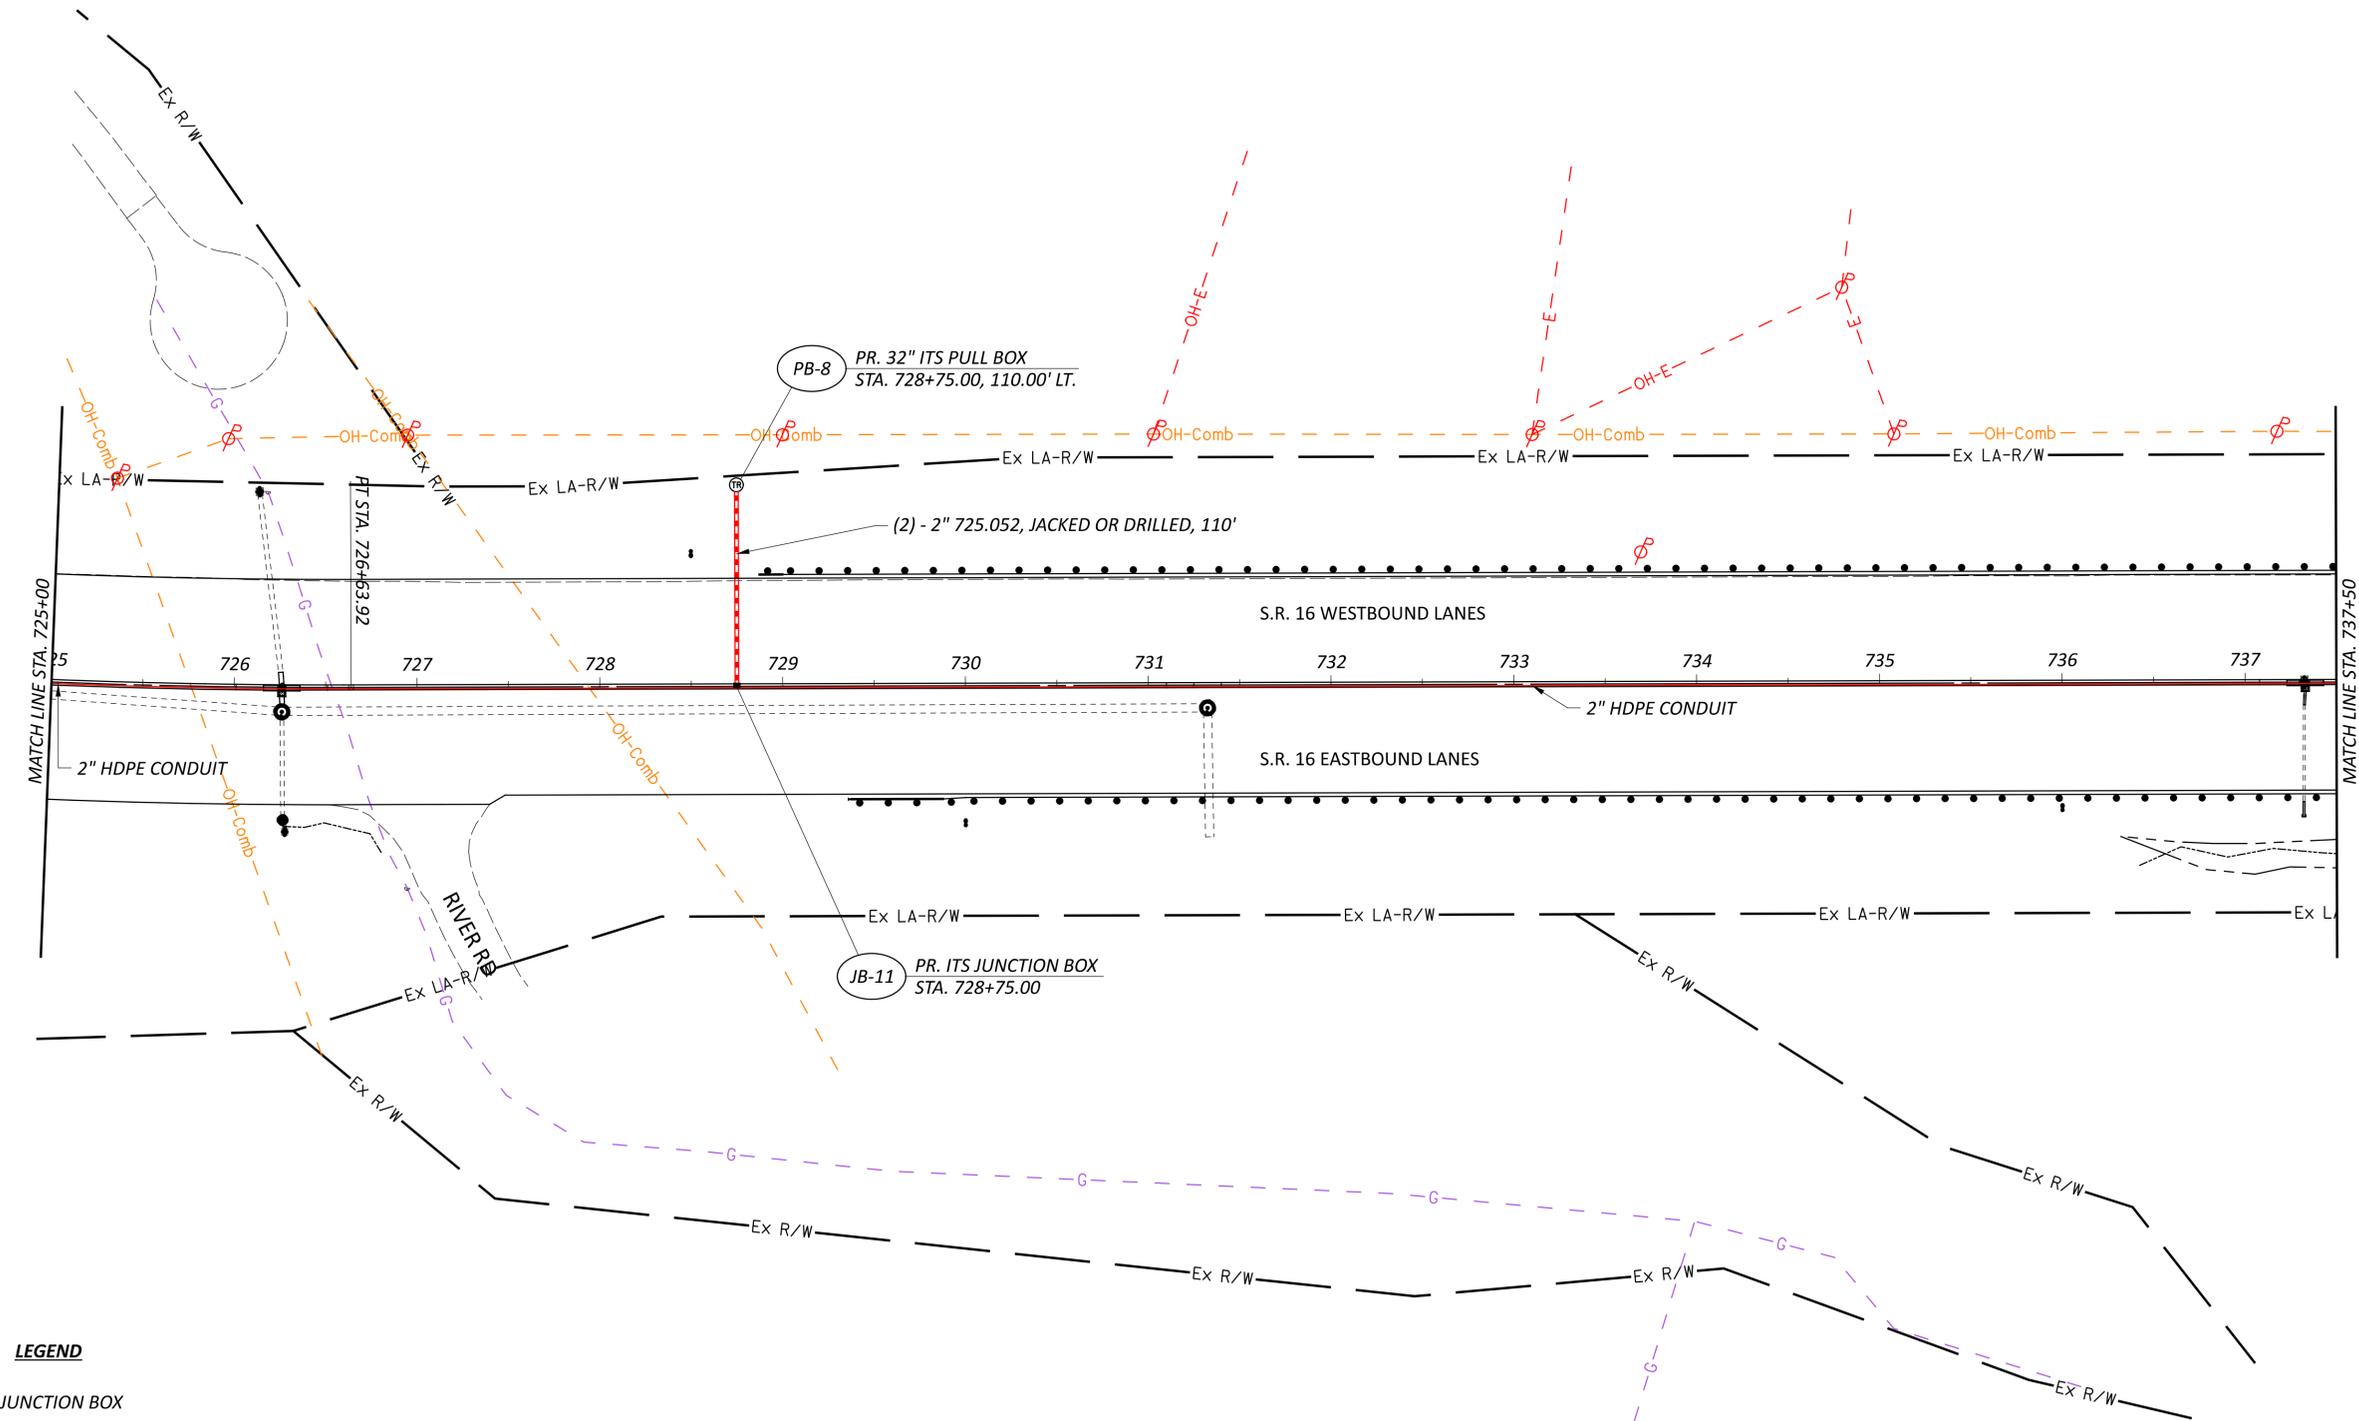

**LEGEND**

- ITS JUNCTION BOX
- CONDUIT, 2" DIAMETER, HDPE
- MICRO-DUCT PATHWAY (x 2), JACKED OR DRILLED
- Ⓢ 32" ITS PULL BOX W/ PAD, TYPE 2

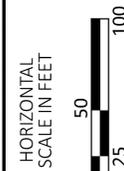

**TRAFFIC SUIVEILLANCE PLAN**  
 STA. 725+00.00 TO STA. 737+50.00

DESIGN AGENCY




DESIGNER  
**WAC**

REVIEWER  
 BRH 09/05/25


PROJECT ID  
 95445

SHEET	TOTAL
P.773	895

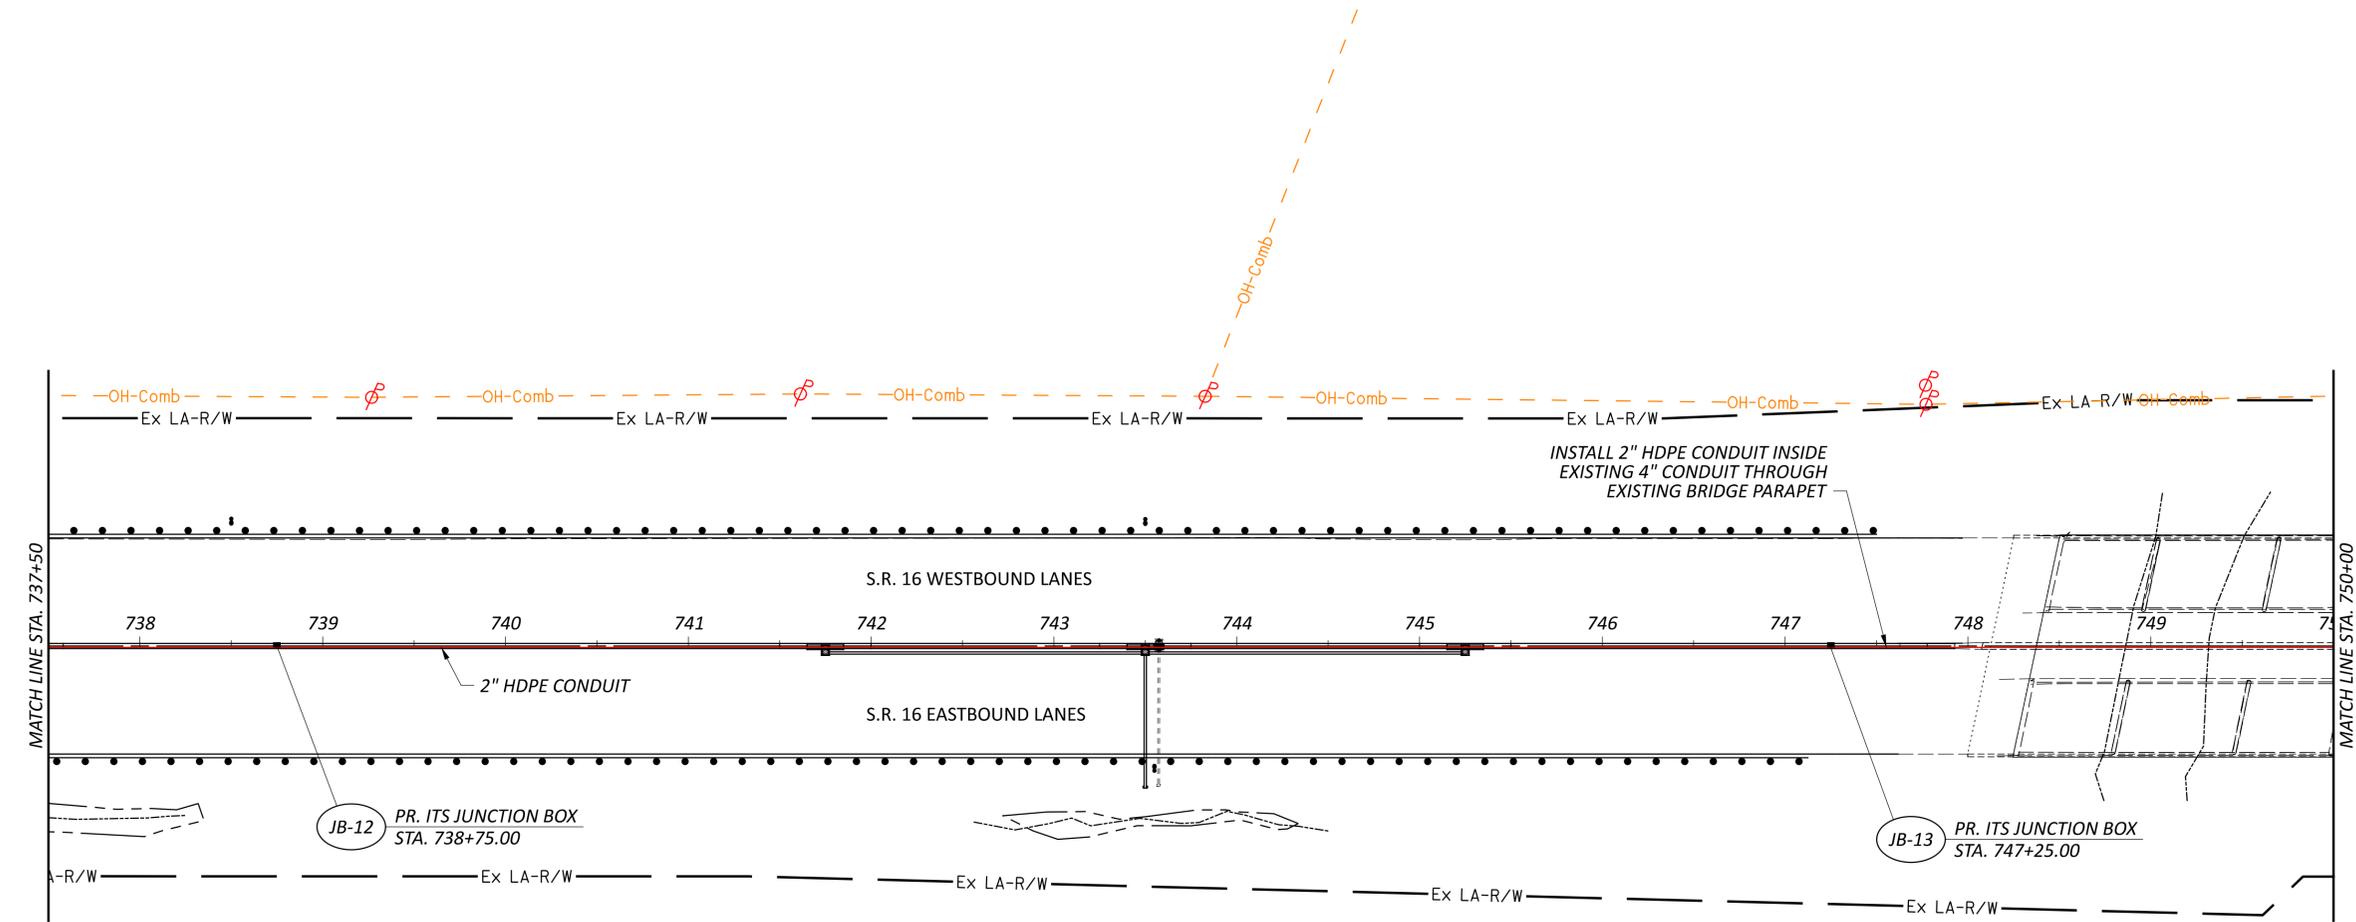

**LEGEND**

- ITS JUNCTION BOX
- CONDUIT, 2" DIAMETER, HDPE
- MICRO-DUCT PATHWAY (x 2), JACKED OR DRILLED
- Ⓜ 32" ITS PULL BOX W/ PAD, TYPE 2

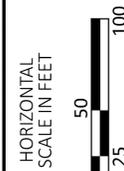

**TRAFFIC SUIVEILLANCE PLAN**  
 STA. 737+50.00 TO STA. 750+00.00

DESIGN AGENCY



DESIGNER

WAC

REVIEWER


BRH 09/05/25

PROJECT ID

95445


SHEET TOTAL

P.774 895

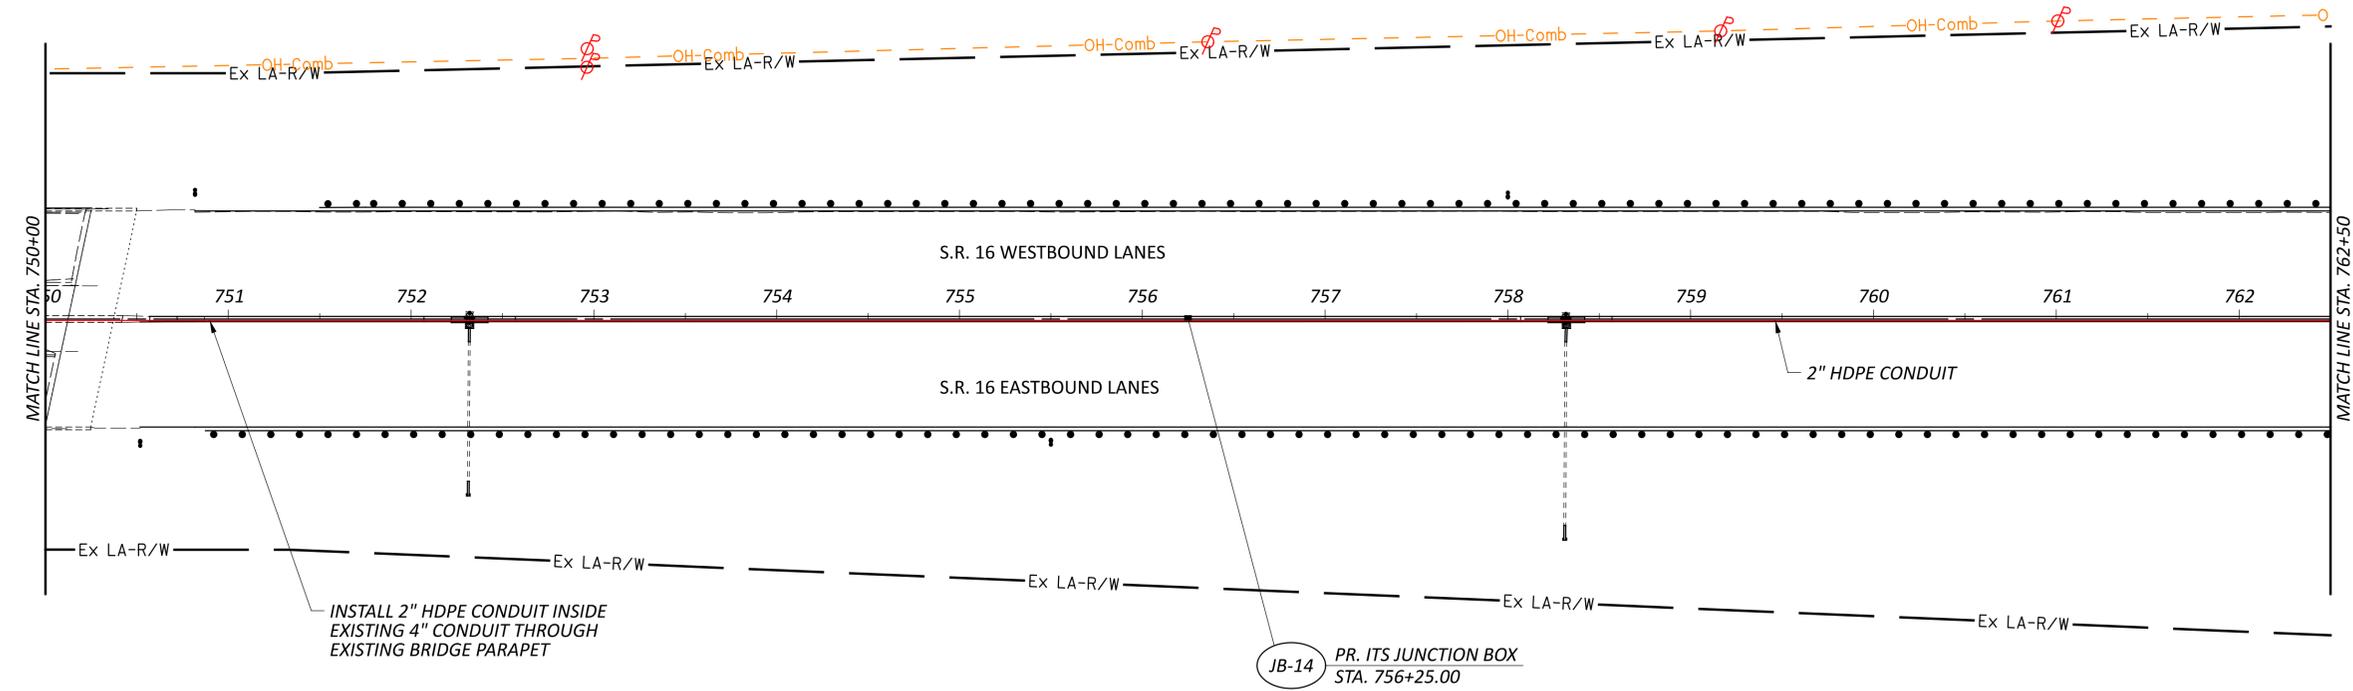

**LEGEND**

- ITS JUNCTION BOX
- CONDUIT, 2" DIAMETER, HDPE
- MICRO-DUCT PATHWAY (x 2), JACKED OR DRILLED
- Ⓜ 32" ITS PULL BOX W/ PAD, TYPE 2

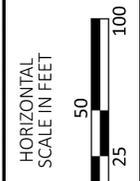

**TRAFFIC SUIVEILLANCE PLAN**  
 STA. 750+00.00 TO STA. 762+50.00

DESIGN AGENCY



DESIGNER

WAC

REVIEWER


BRH 09/05/25

PROJECT ID

95445


SHEET TOTAL

P.775 895

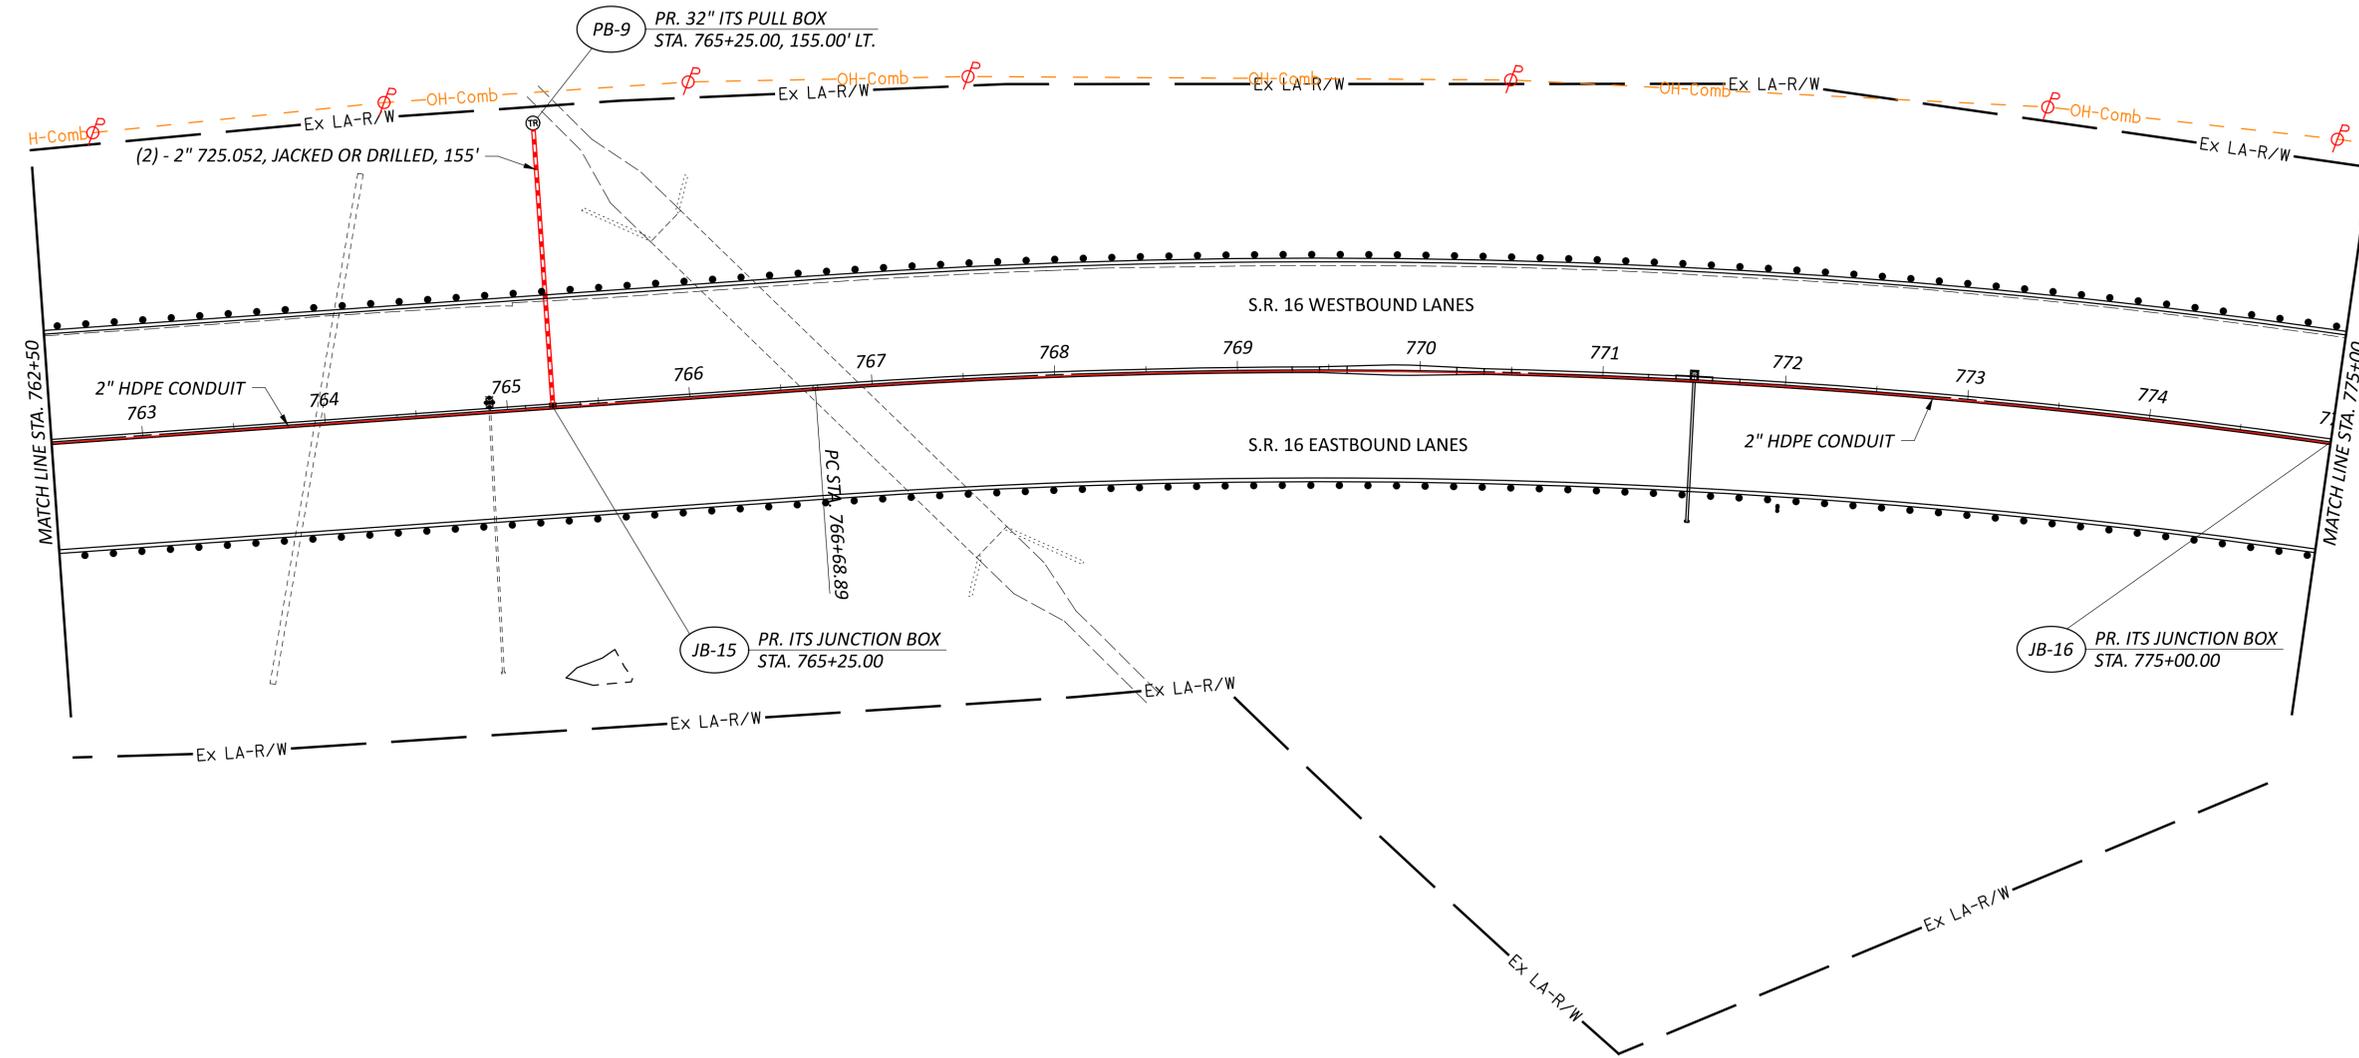

**LEGEND**

- ITS JUNCTION BOX
- CONDUIT, 2" DIAMETER, HDPE
- MICRO-DUCT PATHWAY (x 2), JACKED OR DRILLED
- Ⓜ 32" ITS PULL BOX W/ PAD, TYPE 2

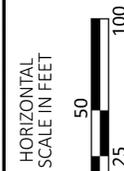

**TRAFFIC SUIVEILLANCE PLAN**  
 STA. 762+50.00 TO STA. 775+00.00

DESIGN AGENCY



DESIGNER

WAC

REVIEWER

BRH 09/05/25

PROJECT ID

95445


SHEET TOTAL

P.776 895



**LEGEND**

- ITS JUNCTION BOX
- CONDUIT, 2" DIAMETER, HDPE
- MICRO-DUCT PATHWAY (x 2), JACKED OR DRILLED
- Ⓜ 32" ITS PULL BOX W/ PAD, TYPE 2

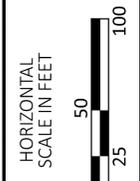

**TRAFFIC SUIVEILLANCE PLAN**  
 STA. 775+00.00 TO STA. 787+50.00

DESIGN AGENCY



DESIGNER

WAC

REVIEWER

BRH 09/05/25

PROJECT ID


95445

SHEET TOTAL

P.777 895

**LEGEND**

- ITS JUNCTION BOX
- CONDUIT, 2" DIAMETER, HDPE
- MICRO-DUCT PATHWAY (x 2), JACKED OR DRILLED
- Ⓜ 32" ITS PULL BOX W/ PAD, TYPE 2

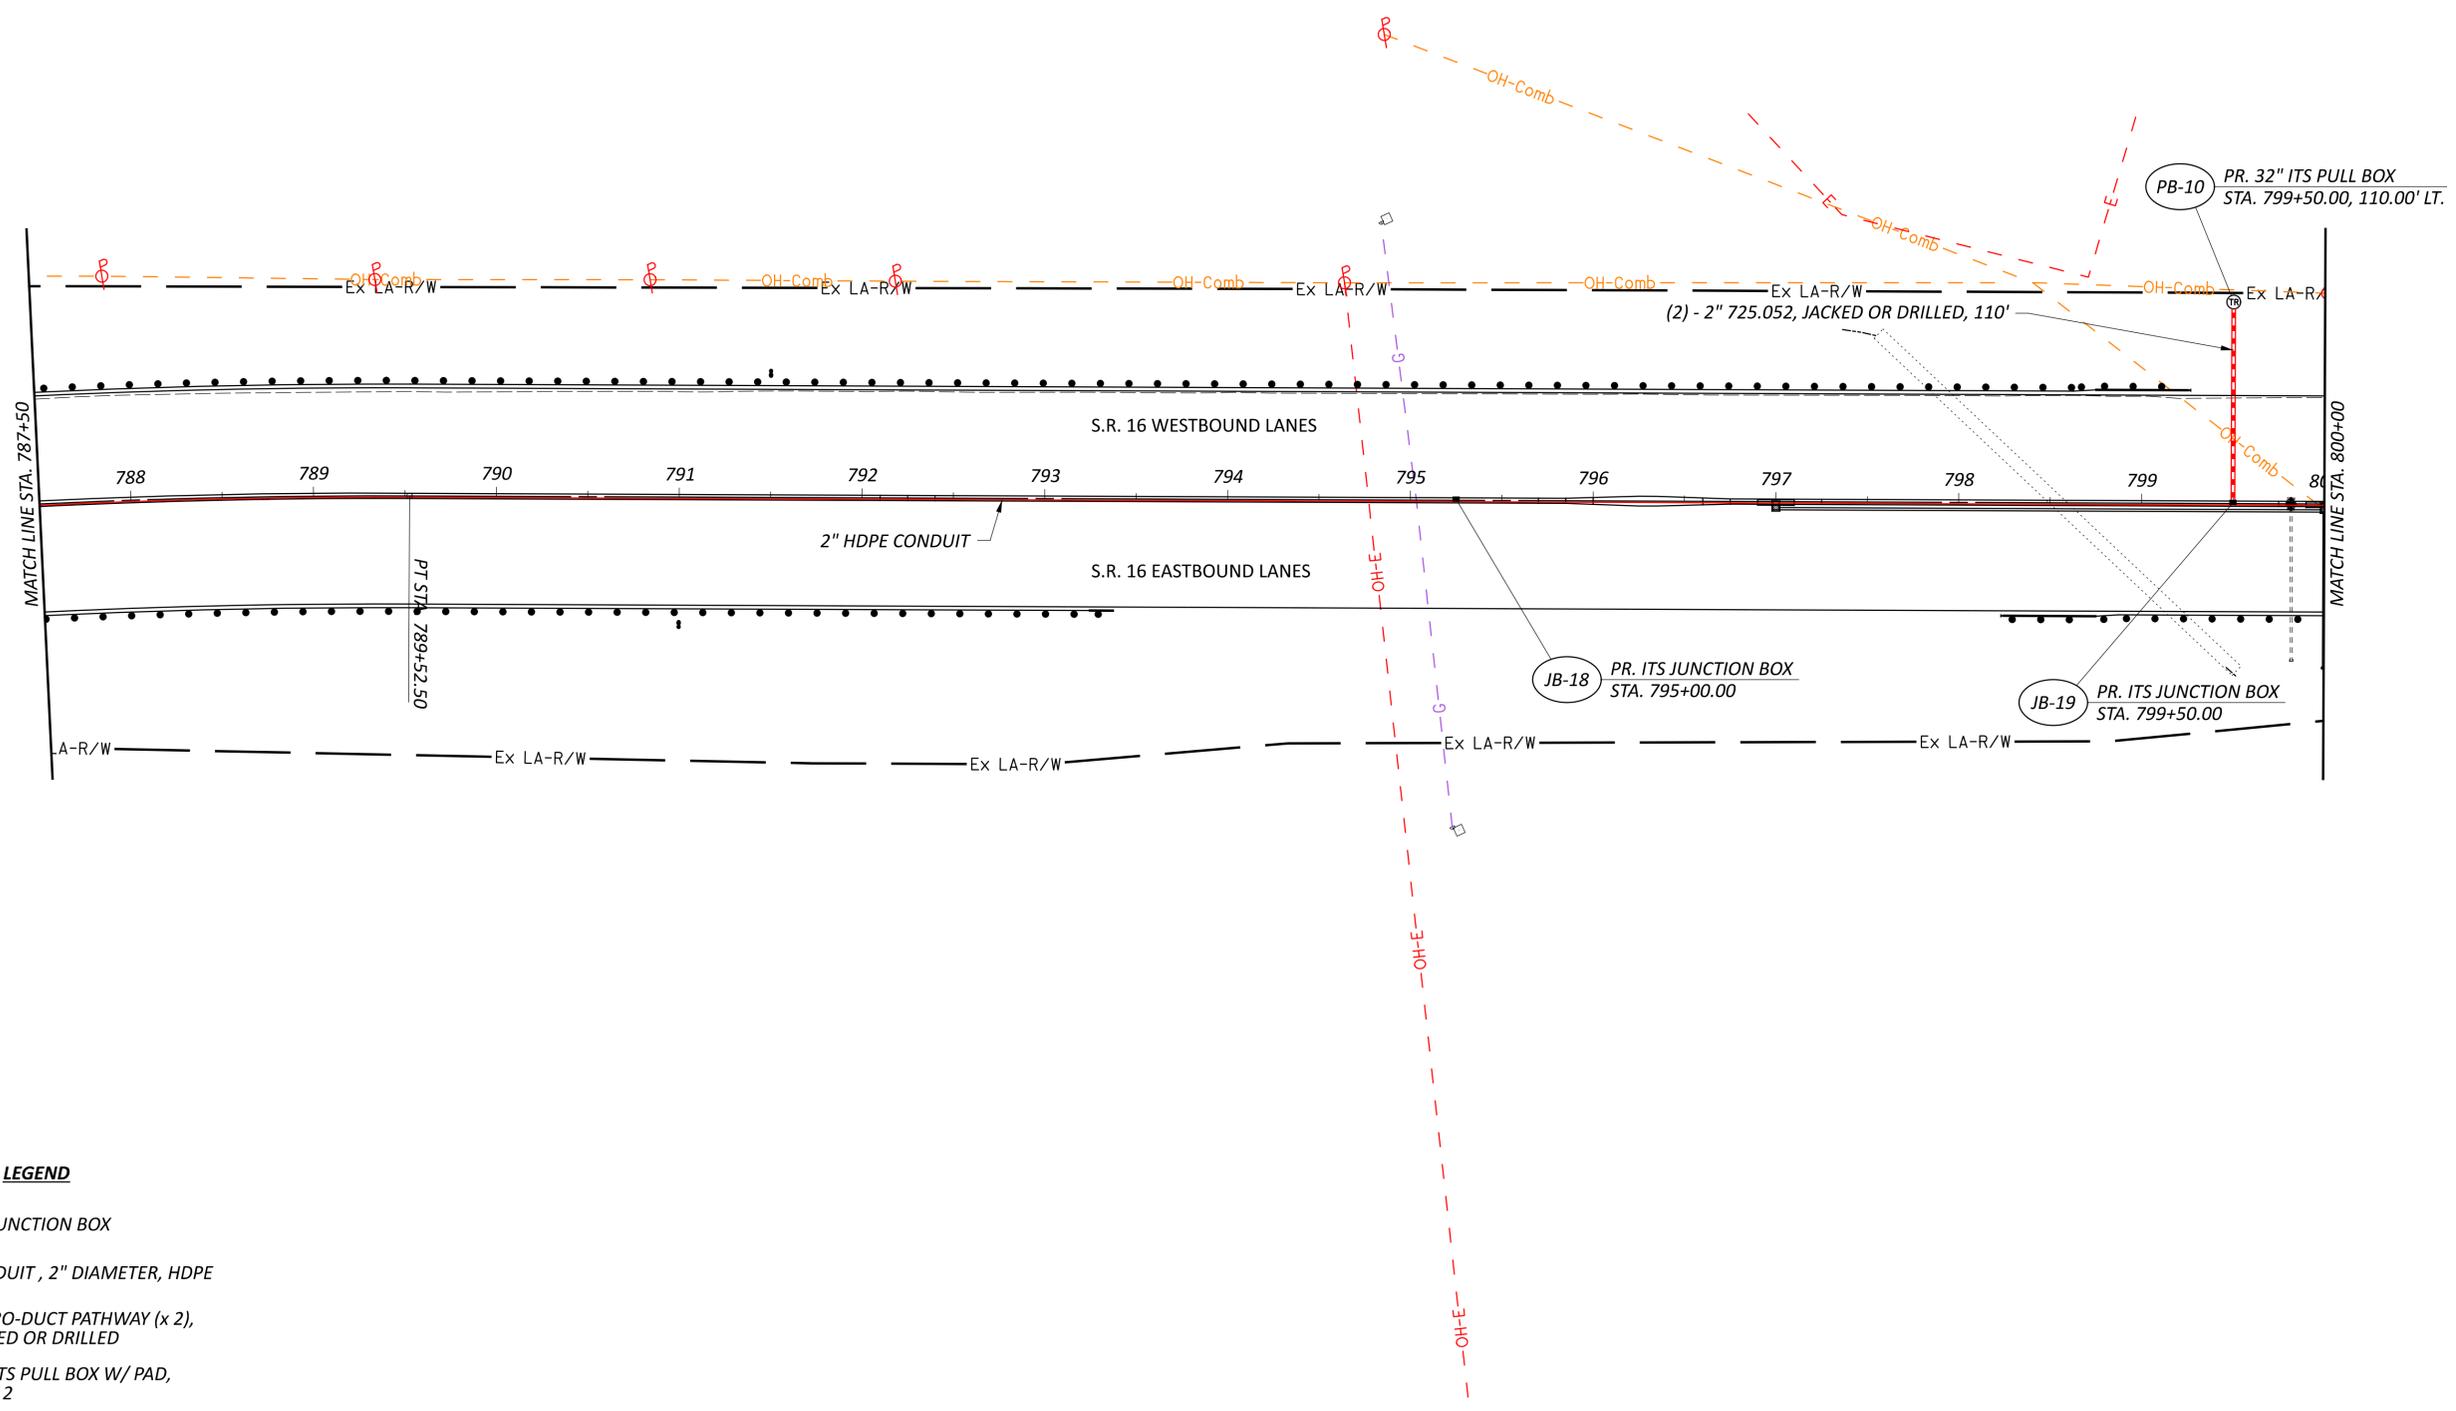

**TRAFFIC SUIVEILLANCE PLAN**  
 STA. 787+50.00 TO STA. 800+00.00

DESIGN AGENCY




DESIGNER  
**WAC**

REVIEWER  
 BRH 09/05/25

PROJECT ID  
 95445

SHEET TOTAL  
 P.778 895

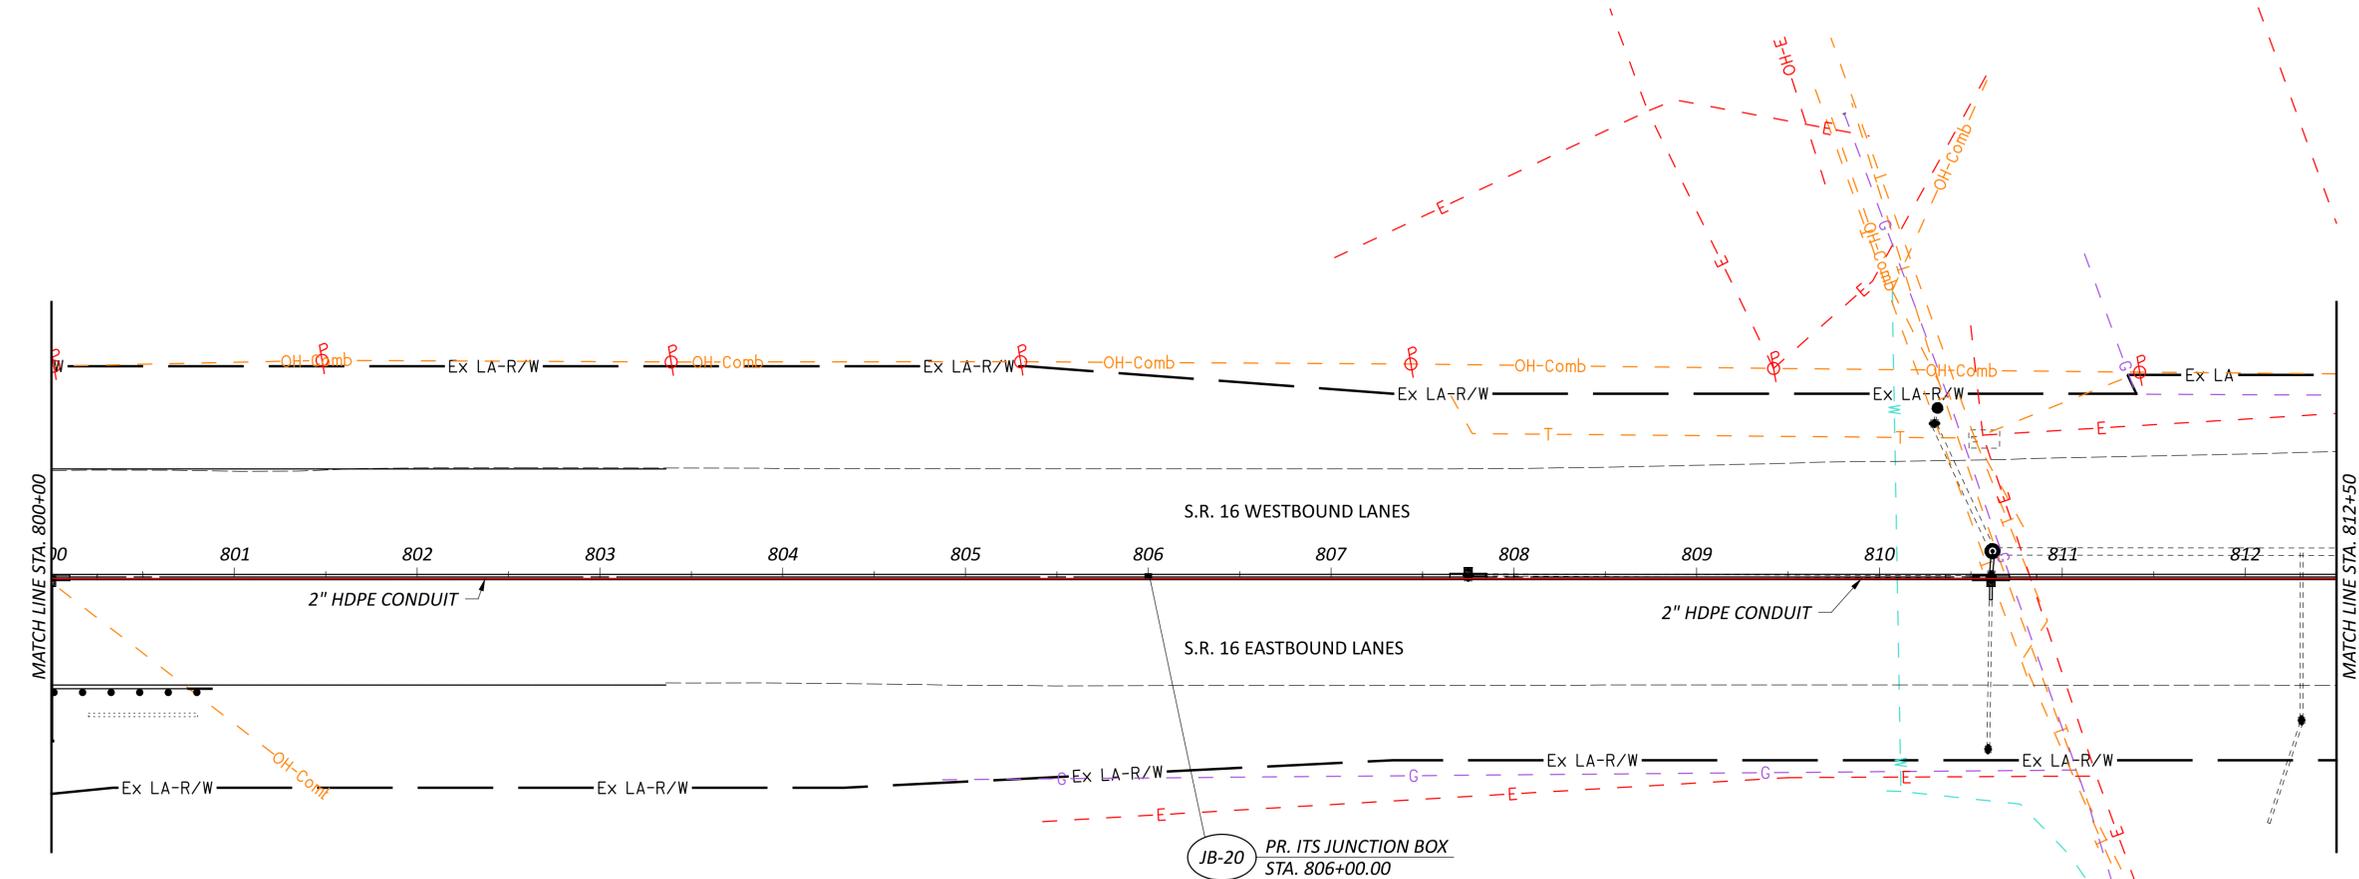

**LEGEND**

- ITS JUNCTION BOX
- CONDUIT, 2" DIAMETER, HDPE
- MICRO-DUCT PATHWAY (x 2), JACKED OR DRILLED
- Ⓢ 32" ITS PULL BOX W/ PAD, TYPE 2



**TRAFFIC SUIVEILLANCE PLAN**  
 STA. 800+00.00 TO STA. 812+50.00

DESIGN AGENCY




DESIGNER  
**WAC**

REVIEWER  
 BRH 09/05/25


PROJECT ID  
 95445

SHEET TOTAL  
 P.779 895

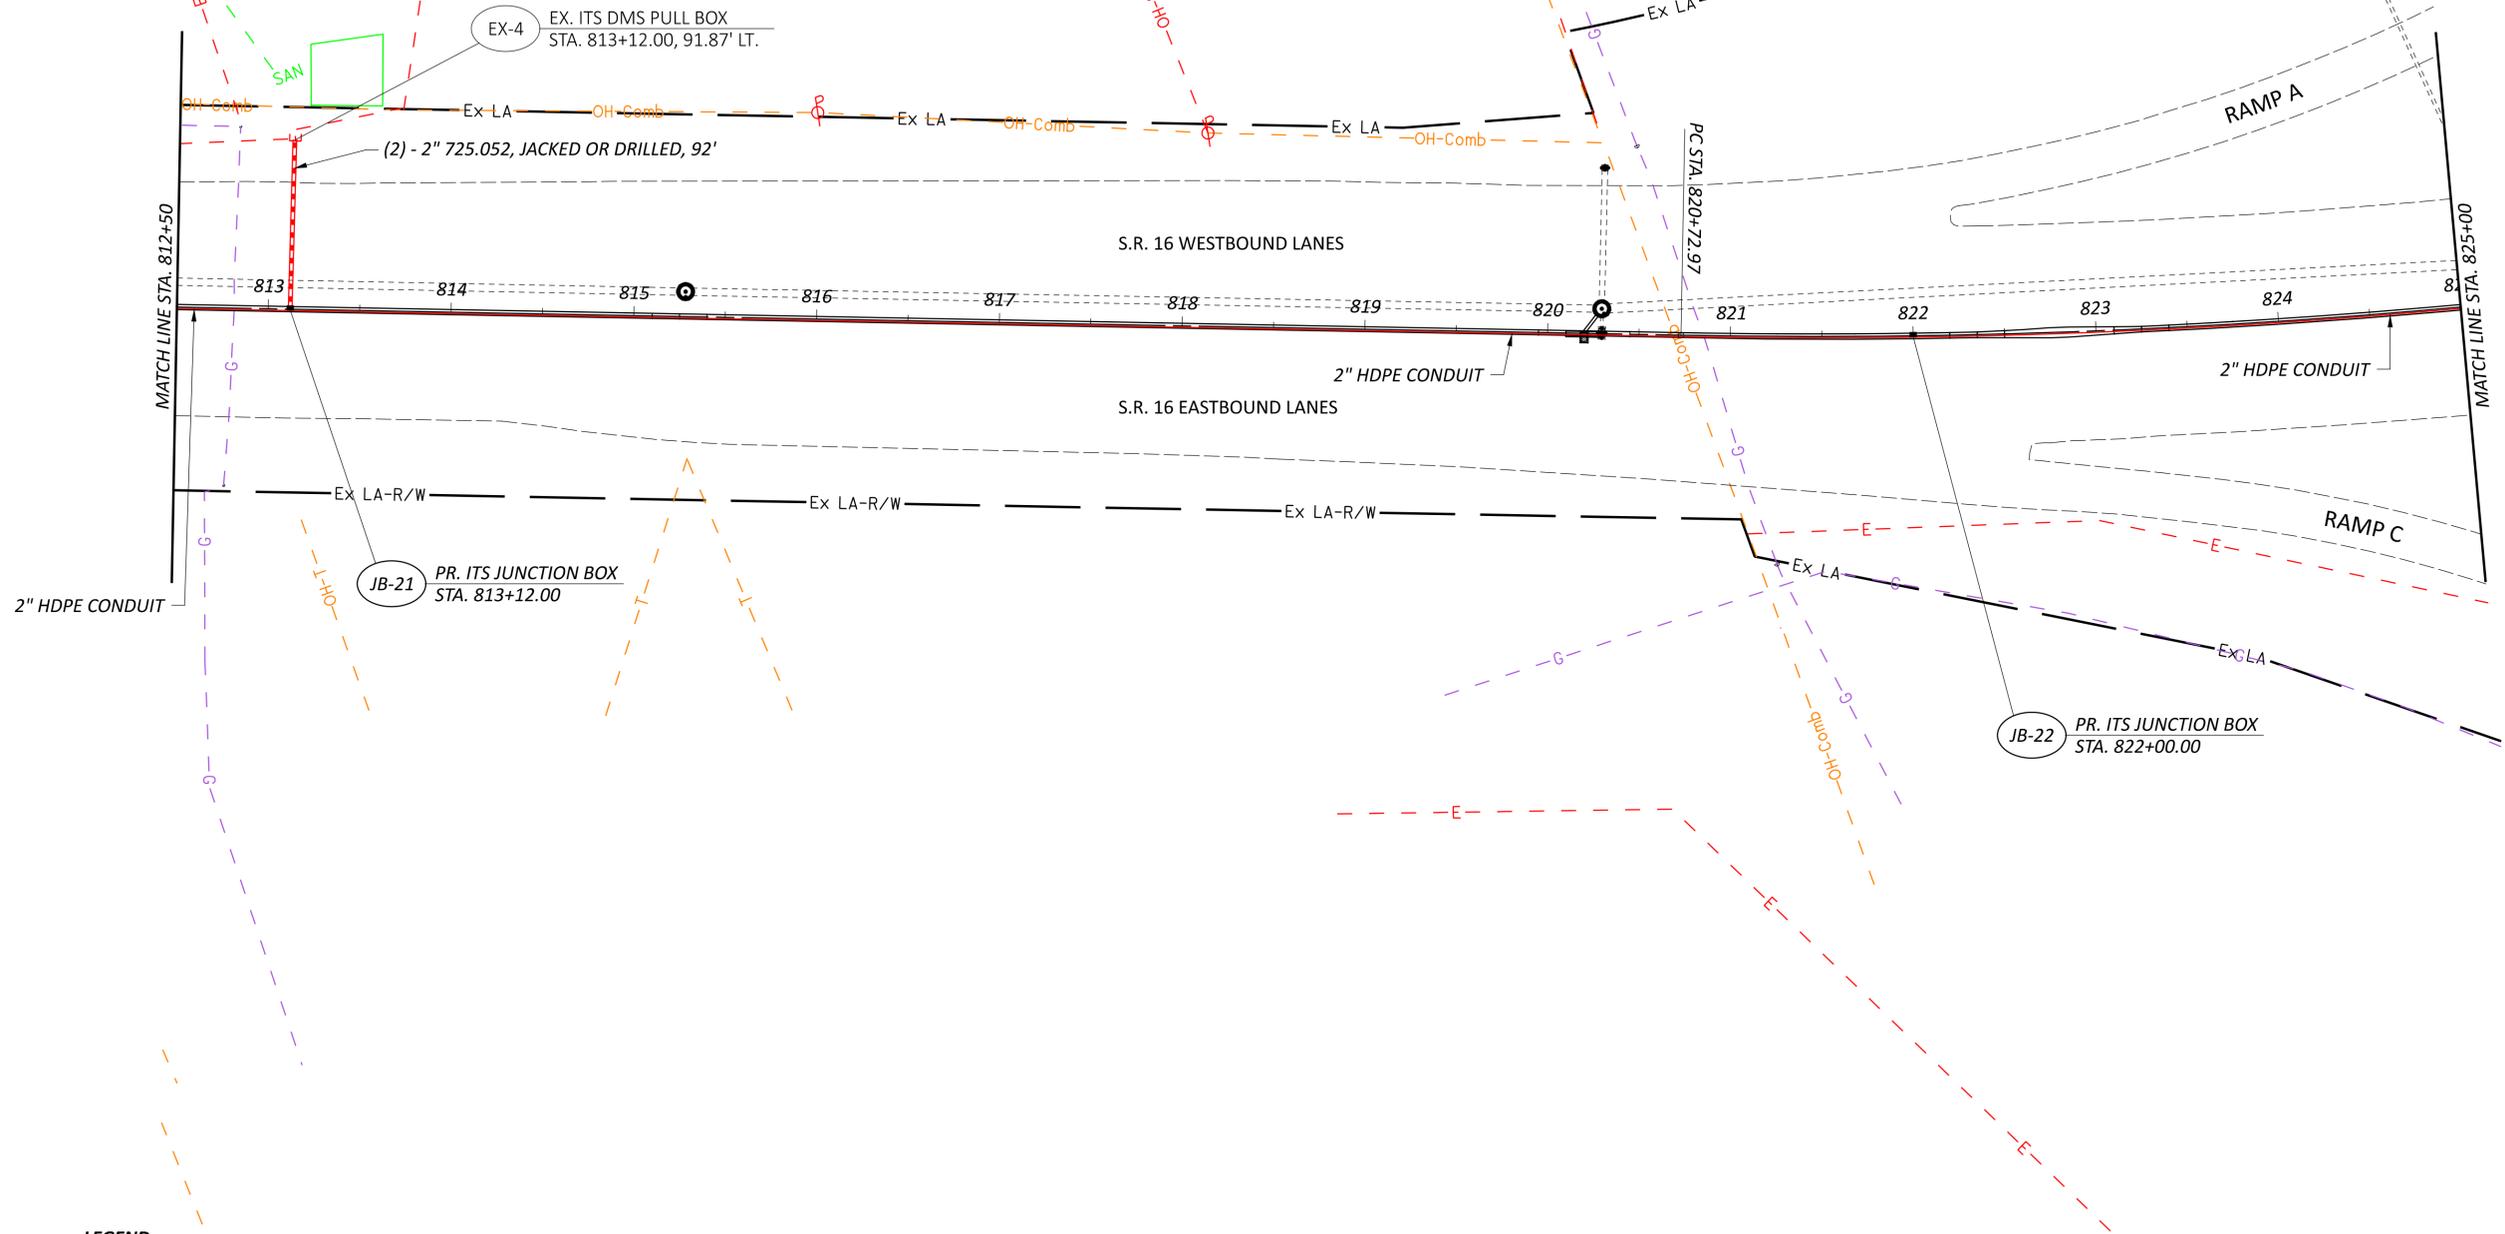

**LEGEND**

- ITS JUNCTION BOX
- CONDUIT, 2" DIAMETER, HDPE
- MICRO-DUCT PATHWAY (x 2), JACKED OR DRILLED
- Ⓢ 32" ITS PULL BOX W/ PAD, TYPE 2

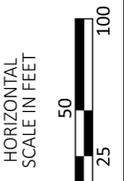

**TRAFFIC SUIVEILLANCE PLAN**  
 STA. 812+50.00 TO STA. 825+00.00

DESIGN AGENCY




DESIGNER  
**WAC**

REVIEWER  
 BRH 09/05/25


PROJECT ID  
 95445

SHEET	TOTAL
P.780	895

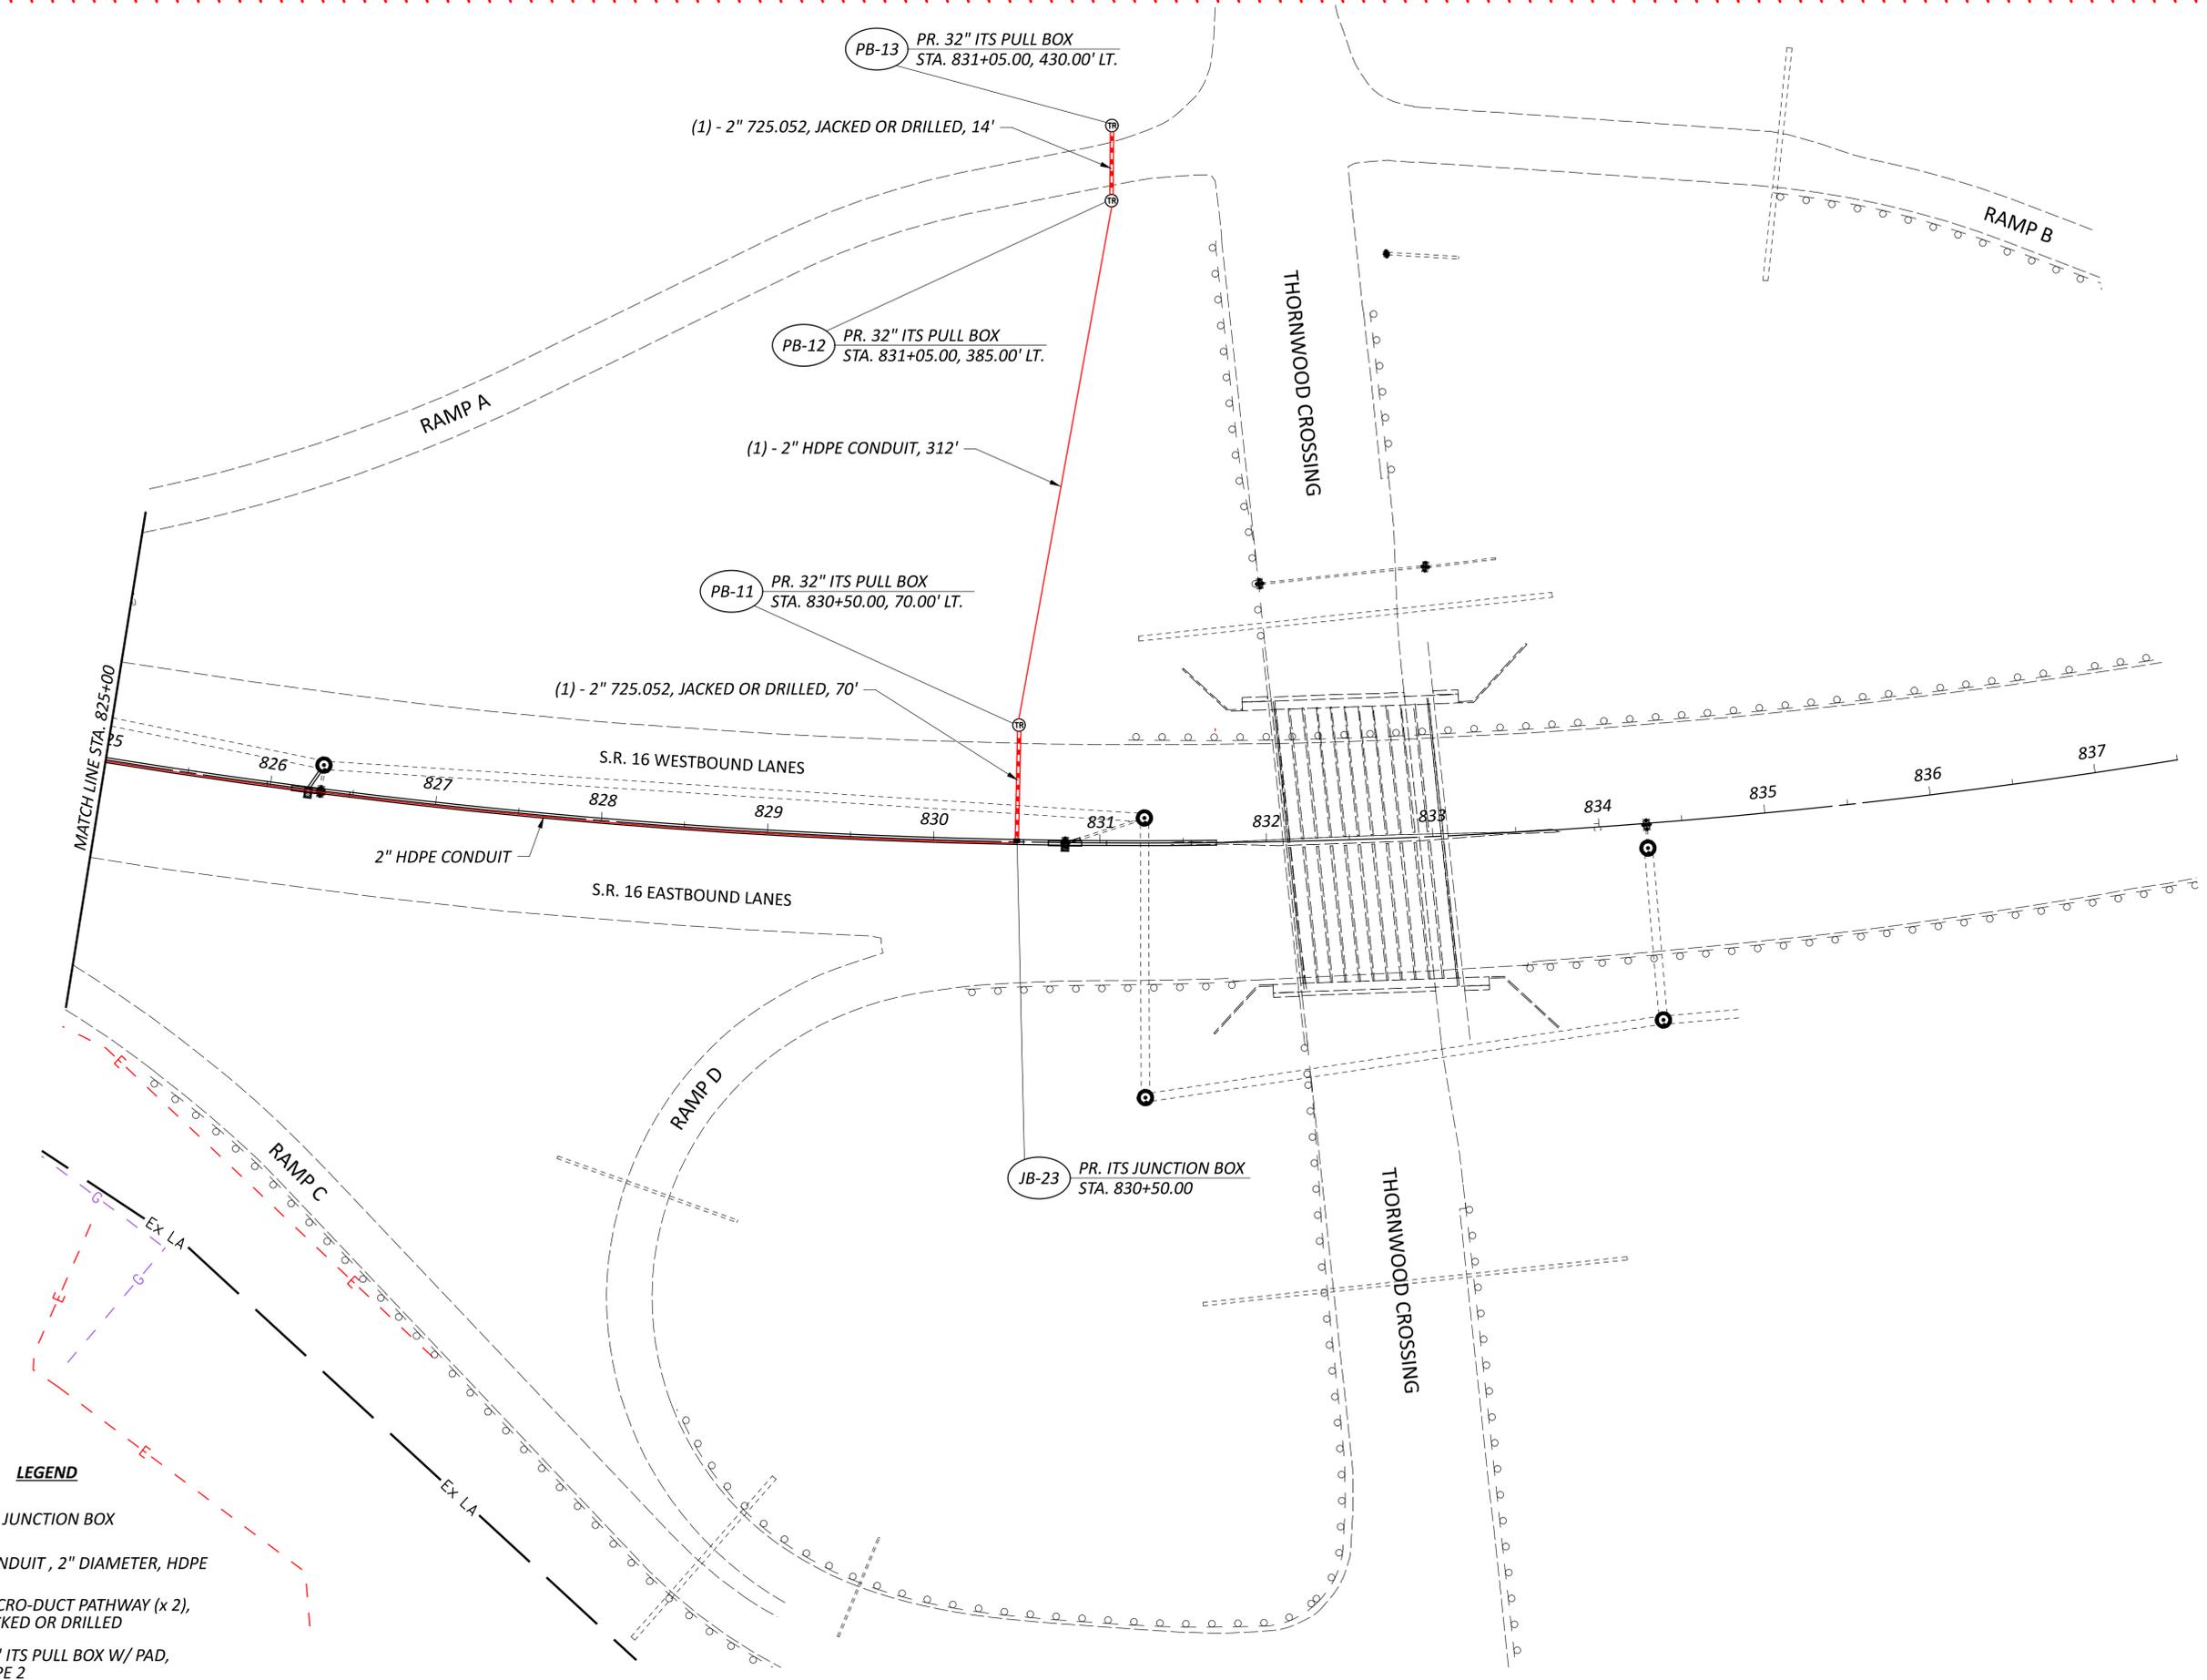

**LEGEND**

- ITS JUNCTION BOX
- CONDUIT, 2" DIAMETER, HDPE
- MICRO-DUCT PATHWAY (x 2), JACKED OR DRILLED
- ⊗ 32" ITS PULL BOX W/ PAD, TYPE 2

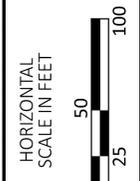

**TRAFFIC SUIVEILLANCE PLAN**  
**STA. 825+00.00 TO STA. 837+50.00**

DESIGN AGENCY




DESIGNER  
**WAC**

REVIEWER  
BRH 09/05/25

PROJECT ID  
95445

SHEET	TOTAL
P.781	895

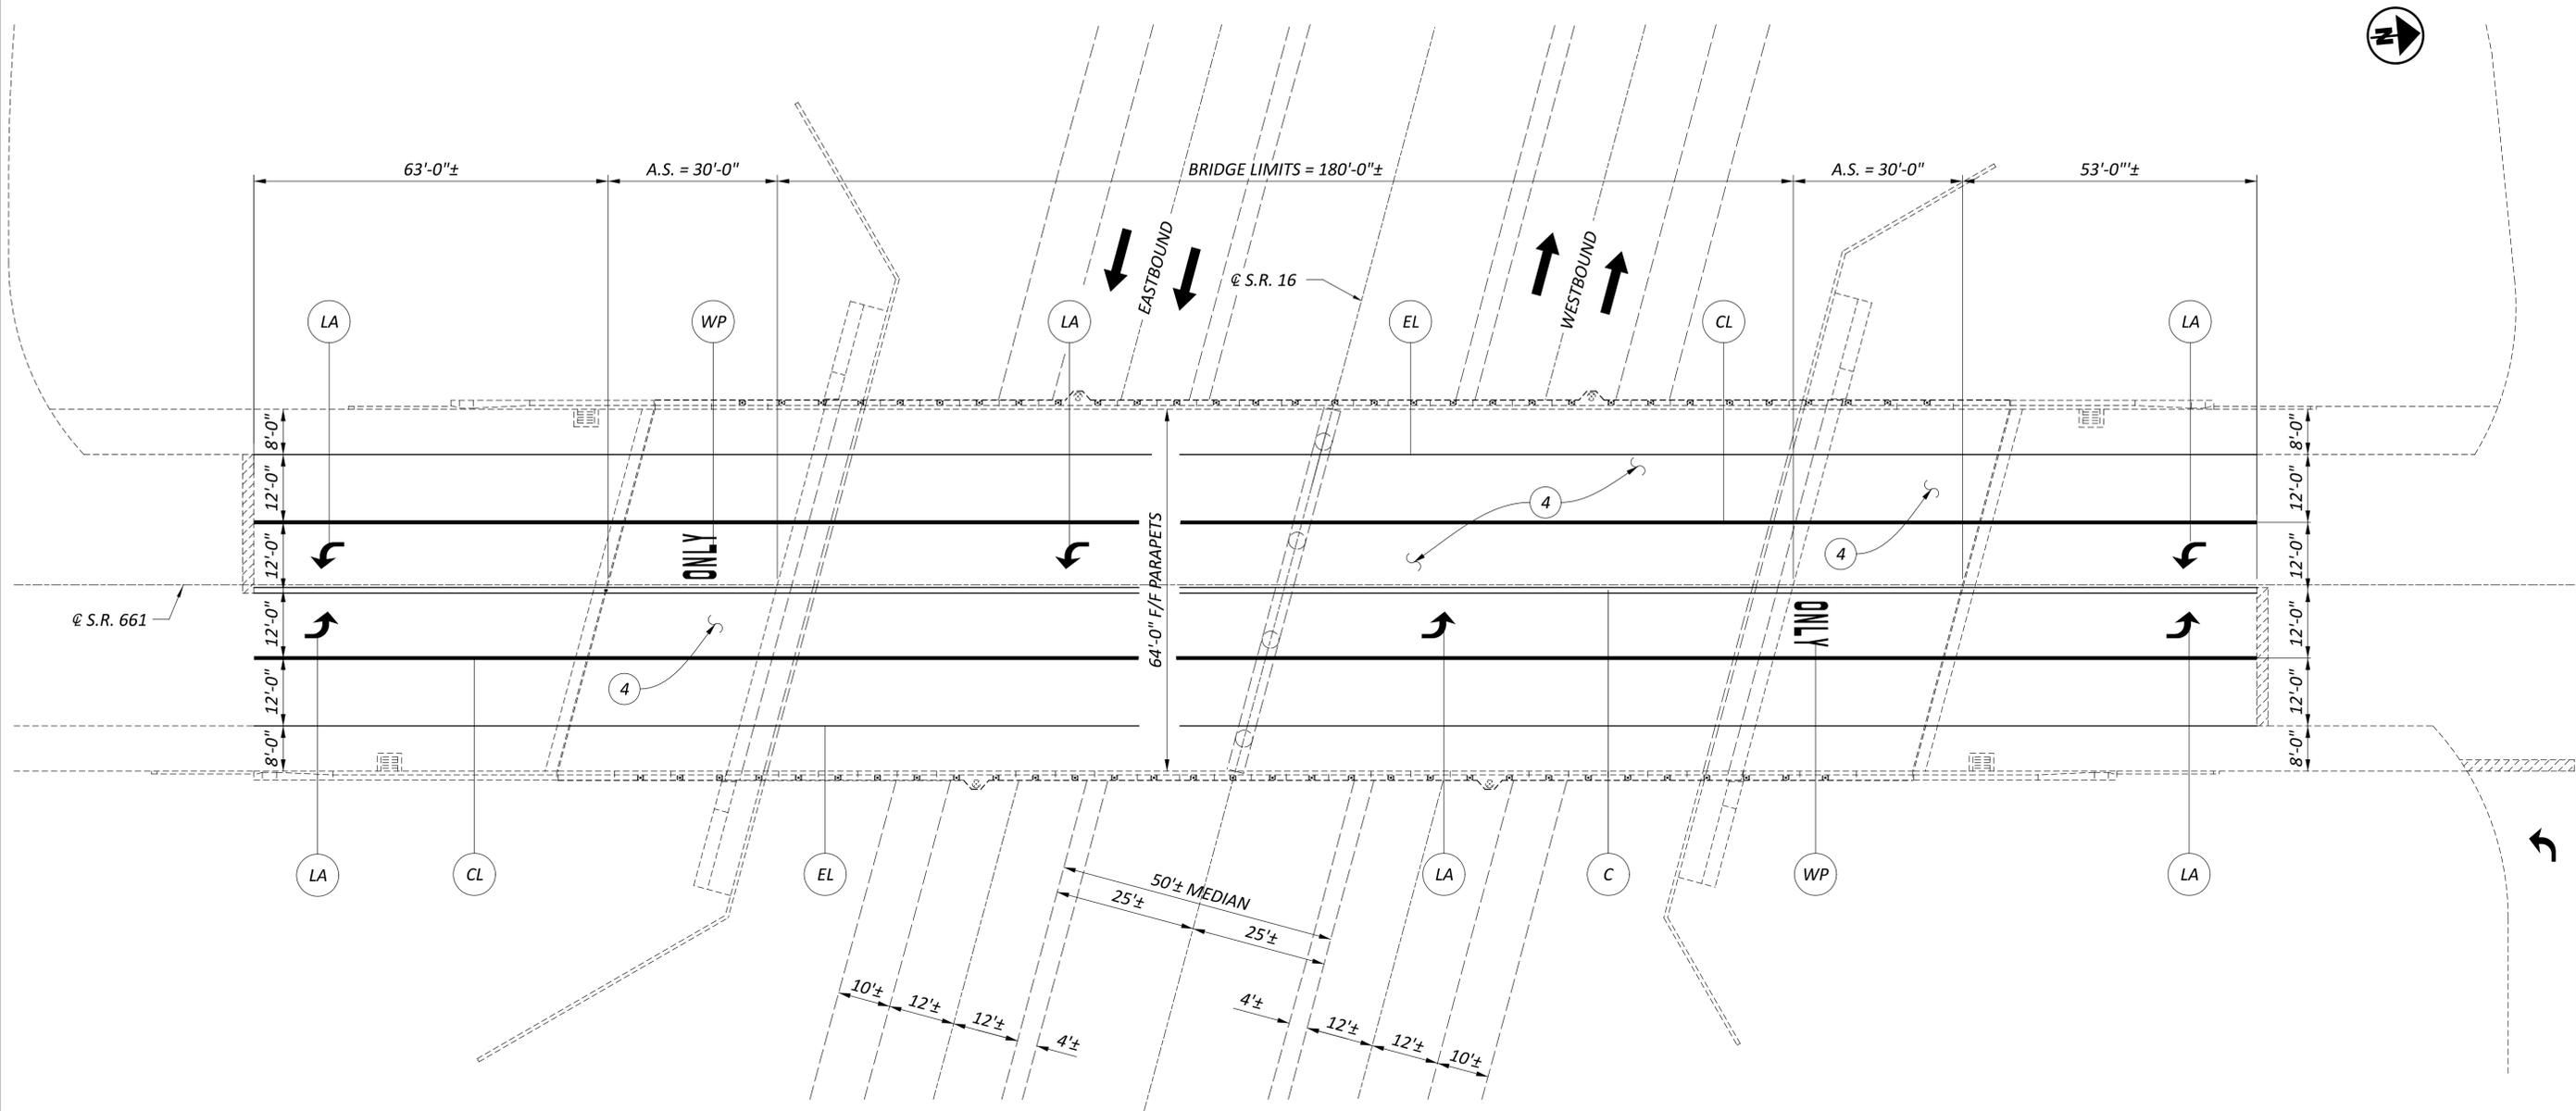

**WORK TYPE LEGEND**

- ① ITEM 202 - PORTIONS OF STRUCTURE REMOVED, AS PER PLAN, SUBSTRUCTURE
- ② ITEM 202 - REMOVAL MISC.: DETERIORATED DECK EDGES
- ③ ITEM 511 - CONCRETE, MISC.: CLASS QC2 WITH ACCELERATING ADMIXTURE, APPROACH SLAB AND BACKWALL REPAIR
- ④ ITEM 512 - SEALING CONCRETE BRIDGE DECKS WITH HMWM RESIN, AS PER PLAN
- ⑤ ITEM 516 - 2" DEEP JOINT SEALER, AS PER PLAN (A)
- ⑥ ITEM 516 - STRUCTURAL JOINT OR JOINT SEALER, MISC.: 3" BEJS EMSEAL
- ⑦ ITEM 519 - PATCHING BRIDGE DECKS, TYPE B

**PAVEMENT MARKING LEGEND**

- EL ITEM 646 - EDGE LINE, 6"
- LL ITEM 646 - LANE LINE, 6"
- C ITEM 646 - CENTERLINE, 6"
- CL ITEM 646 - CHANNELIZING LINE, 8"
- LA ITEM 646 - LANE ARROW
- WP ITEM 646 - WORD ON PAVEMENT, 72"

**EXISTING STRUCTURE (SFN: 4506333)**

TYPE: CONTINUOUS STEEL BEAM WITH REINFORCED CONCRETE DECK, SEMI-INTERGRAL ABUTMENTS AND CAP AND COLUMN PIER.  
 SPANS: 91'-7", 86'-3"  
 ROADWAY: 80'-0" T/T PARAPET  
 LOAD FREQUENCY: HL-93  
 SKEW: 4°33'64"-00"-00" LEFT FORWARD  
 WEARING SURFACE: 1" MONOLITHIC CONCRETE  
 APPROACH SLABS: 30 FEET LONG (AS-1-81)  
 ALIGNMENT: TANGENT  
 CROWN: 0.0156 FT/FT

BRIDGE PLAN  
 BRIDGE NO.: LIC-661-0.034  
 OVER S.R. 16

SFN		4506333
DESIGN AGENCY		
DESIGNER	CHECKER	
TAG	JKS	
REVIEWER		
TAG	09/15/25	
PROJECT ID		95445
SUBSET	TOTAL	0 / 0
SHEET	TOTAL	P.848 / 895