

## LOCATION MAP

LATITUDE: 40°03'51" LONGITUDE: -82°32'21"



PORTION TO BE IMPROVED \_\_\_\_\_  
 INTERSTATE HIGHWAY \_\_\_\_\_  
 FEDERAL ROUTES \_\_\_\_\_  
 STATE ROUTES \_\_\_\_\_  
 COUNTY & TOWNSHIP ROADS \_\_\_\_\_  
 OTHER ROADS \_\_\_\_\_

## DESIGN DESIGNATION

CURRENT ADT (2026) 49,110  
 DESIGN YEAR ADT (2046) 62,700  
 DESIGN HOURLY VOLUME (2048) 7,210  
 DIRECTIONAL DISTRIBUTION 66%  
 TRUCKS (24 HOUR B&C) 9%  
 DESIGN SPEED 60  
 LEGAL SPEED 55  
 DESIGN FUNCTIONAL CLASSIFICATION:  
 PRINCIPAL ARTERIAL FREEWAY  
 NHS PROJECT YES

## DESIGN EXCEPTIONS

NONE

## ADA DESIGN WAIVERS

NONE

UNDERGROUND UTILITIES	
Contact Two Working Days Before You Dig	
 <b>OHIO 811.org</b> Before You Dig	
OHIO 811, 8-1-1, or 1-800-362-2764 (Non members must be called directly)	

PLAN PREPARED BY:  
 ODOT DISTRICT 5 PLANNING AND ENGINEERING  
 9600 JACKSONTOWN ROAD, JACKSONTOWN, OH 43030  
 740-323-4400

# STATE OF OHIO

## DEPARTMENT OF TRANSPORTATION

# LIC-16/37-14.24/15.47

### CITY OF NEWARK VILLAGE OF GRANVILLE GRANVILLE & NEWARK TOWNSHIPS LICKING COUNTY

## FEDERAL PROJECT NUMBER

E161298

## RAILROAD INVOLVEMENT

NONE

## PROJECT DESCRIPTION

FULL DEPTH REPLACEMENT OF EXISTING PAVEMENT ON S.R. 37/S.R. 16.  
 PAVEMENT WIDENING IN THE EXISTING MEDIAN OF S.R. 37/S.R. 16 AND  
 INSTALLATION OF CONCRETE MEDIAN BARRIER WALL.  
 SOME MINOR STRUCTURE WORK AND REPAIRS.

## EARTH DISTURBED AREAS

PROJECT EARTH DISTURBED AREA: 50.0 ACRES  
 ESTIMATED CONTRACTOR EARTH DISTURBED AREA: 1.0 ACRES  
 NOTICE OF INTENT EARTH DISTURBED AREA: 51.0 ACRES


## LIMITED ACCESS

THIS IMPROVEMENT IS ESPECIALLY DESIGNED FOR THROUGH TRAFFIC AND  
 HAS BEEN DECLARED A LIMITED ACCESS HIGHWAY OR FREEWAY BY ACTION  
 OF THE DIRECTOR IN ACCORDANCE WITH THE PROVISIONS OF SECTION  
 5511.02 OF THE OHIO REVISED CODE.

## 2023 SPECIFICATIONS

THE STANDARD SPECIFICATIONS OF THE STATE OF OHIO, DEPARTMENT OF  
 TRANSPORTATION, INCLUDING SUPPLEMENTAL SPECIFICATIONS LISTED IN  
 THE PLANS, CHANGES LISTED IN THE PROPOSAL, AND THE SUPPLEMENTAL  
 SPECIFICATION 800 VERSION INDICATED ON THE PROPOSAL SHALL GOVERN  
 THIS IMPROVEMENT.

I HEREBY APPROVE THESE PLANS AND DECLARE THAT THE MAKING OF THIS  
 IMPROVEMENT WILL NOT REQUIRE THE CLOSING TO TRAFFIC OF THE  
 HIGHWAY EXCEPT AS NOTED ON SHEET 21, AND THAT PROVISIONS FOR  
 THE MAINTENANCE AND SAFETY OF TRAFFIC WILL BE AS SET FORTH ON  
 THE PLANS AND ESTIMATES.


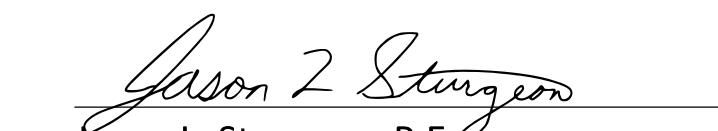
  
 Jason L. Sturgeon, P.E.  
 District 05 Deputy Director

  
 Pamela Boratyn  
 Director, Department of Transportation

## INDEX OF SHEETS:

TITLE SHEET	P.1	PLAN AND PROFILE	P.458 - P.504
<b>SCHEMATIC PLAN</b>		<b>CROSS SECTIONS</b>	P.505 - P.627
PROJECT	P.2	EARTHWORK QUANTITIES	P.628 - P.638
16 INTERCHANGE	P.3	SUPERELEVATION TABLES	P.639 - P.652
37/661 INTERCHANGE	P.4	BARRIER DETAILS	P.653 - P.659
<b>TYPICAL SECTIONS</b>		PAVEMENT DETAILS	P.660 - P.676
EXISTING	P.5 - P.10	VARIABLE PLANNING TABLE	P.677
PROPOSED	P.11 - P.17	DRAINAGE	
<b>GENERAL NOTES</b>	P.18 - P.23	UNDERDRAIN QUANTITIES	P.678 - P.682
<b>MAINTENANCE OF TRAFFIC</b>		UNDERDRAIN DETAILS	P.683 - P.687
MOT NOTES	P.24 - P.29	DRAINAGE QUANTITIES	P.688 - P.693
DETOUR MAPS	P.30 - P.34	DRAINAGE PLAN AND PROFILE	P.694 - P.733
MOT PHASING SCHEMATIC	P.35	DRAINAGE PROFILES	P.734 - P.763
MOT TYPICALS	P.36 - P.40	TRAFFIC SURVEILLANCE	P.764 - P.781
TEMPORARY SIGNALS	P.41 - P.42	TRAFFIC CONTROL	
MOT QUANTITIES	P.43 - P.52	BARRIER DELINEATION	P.782
MOT DETAILS	P.53 - P.58	PAVEMENT MARKINGS	P.783 - P.805
MOT CROSS SECTIONS	P.59 - P.70	SIGNING	P.806 - P.841
MOT PHASE SHEETS	P.71 - P.421	STRUCTURES	P.842 - P.857
<b>GENERAL SUMMARY</b>	P.422 - P.427	SOIL PROFILES	P.858 - P.895
<b>ROADWAY QUANTITIES</b>	P.428 - P.434		
<b>PAVEMENT CALCULATIONS</b>	P.435 - P.447		
<b>PROJECT SITE PLAN</b>	P.448 - P.457		

STANDARD CONSTRUCTION DRAWINGS											SUPPLEMENTAL SPECIFICATIONS	SPECIAL PROVISIONS	
BP-3.1	1/19/24	MGS-1.1	1/17/25	ITS-14.10	1/17/25	MT-98.20	4/19/19	MT-105.10	1/17/20	TC-52.10	10/18/13	800	7/18/25
BP-3.2	1/18/19	MGS-2.1	1/17/25	ITS-14.11	1/17/25	MT-98.21	7/21/23	MT-120.00	7/19/24	TC-52.20	1/15/21	808	7/19/24
BP-9.1	1/18/19	MGS-3.1	1/19/18	ITS-14.50	1/17/25	MT-98.22	1/17/20			TC-61.10	4/21/23	809	1/17/25
		MGS-4.2	1/17/25	ITS-14.60	1/17/25	MT-98.29	1/17/20	TC-12.31	4/15/22	TC-61.30	7/19/24	832	7/19/24
CB-4	7/19/24	MGS-5.2	7/15/16			MT-99.20	4/19/19	TC-15.116	1/19/24	TC-65.10	1/17/14	874	4/17/20
		MGS-5.3	7/15/16	MT-95.30	7/19/19	MT-99.30	1/17/20	TC-21.11	7/16/21	TC-65.11	1/19/24	875	1/17/25
DM-1.1	1/17/25			MT-95.31	7/19/19	MT-100.00	1/19/24	TC-21.21	1/20/23	TC-71.10	4/21/23	902	7/19/19
DM-1.2	1/17/25	RM-1.1	1/20/23	MT-95.32	4/19/19	MT-101.60	1/17/25	TC-21.50	1/17/25	TC-72.20	1/17/25	908	1/17/25
DM-1.3	7/18/14	RM-4.2	4/17/20	MT-95.45	7/21/23	MT-101.70	7/19/24	TC-22.20	1/17/14			909	1/17/25
DM-4.3	1/15/16	RM-4.3	1/17/25	MT-95.50	7/21/17	MT-101.75	7/21/23	TC-41.10	7/19/13				
DM-4.4	1/15/16	RM-4.4	1/17/25	MT-95.70	7/21/23	MT-101.90	7/17/20	TC-41.20	10/18/13				
		RM-4.5	1/17/25	MT-95.73	7/19/24	MT-102.10	7/21/23	TC-41.30	4/21/23				
I-3C, 3C1	1/17/25	RM-4.6	7/19/13	MT-95.82	7/19/13	MT-102.20	4/19/19	TC-42.10	10/18/13				
				MT-97.10	4/19/19	MT-102.30	10/16/15	TC-42.20	10/18/13				
MH-3	7/19/24	HW-2.1	7/15/22	MT-98.10	1/17/20	MT-103.10	1/21/22	TC-51.11	1/15/16				
		HW-2.2	7/20/18	MT-98.11	1/17/20	MT-104.10	1/19/24	TC-51.12	1/15/16				

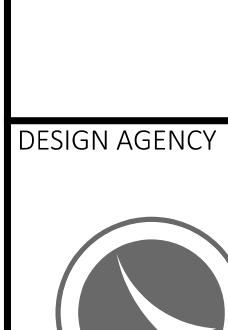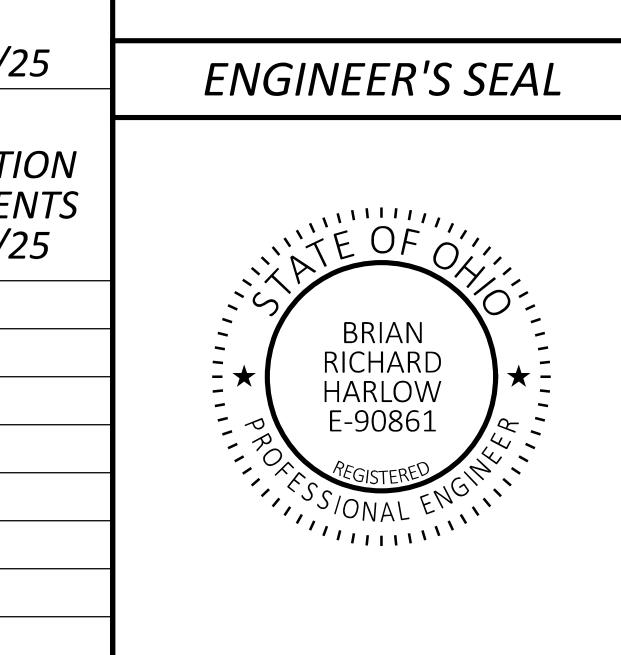

DESIGNER

BRH

REVIEWER

CMY 09/05/25

PROJECT ID

95445

SHEET TOTAL

P.1 895

**Maintenance of Traffic Sequence of Operations****Alternate Methods**

If the contractor so elects, alternate methods for the maintenance of traffic may be submitted, provided the intent of the below provisions are followed and no additional inconvenience to the traveling public results therefrom. No alternate plan shall be placed into effect until approval has been granted, in writing, by the District Deputy Director.

**Pre-Phase 1 (Miscellaneous Repairs)**

Temporary pavement shall be constructed near the River Road and S.R. 16 E.B. intersection as detailed on sheet P.53.

Pavement repairs shall be performed as per the Pre-Phase 1 Pavement Repair Table on sheet P.29 and as shown on the Pre-Phase 1 plan sheets after approval of these joint locations has been given by the Engineer.

Partial depth pavement repairs shall be performed as per the note on sheet P.29 and as directed by the Engineer.

S.R. 37/S.R. 16 shall be resurfaced per the Pre-Phase 1 typical section and Pre-Phase 1 plan sheets. This resurfacing will remove the existing rumble strips on the outside shoulders and provide a new surface for maintained traffic in subsequent MOT phases. In addition to this mainline resurfacing, the ramps at the S.R. 37 & Columbus Rd. interchange shall be resurfaced before Phase 1 MOT may begin.

All proposed bridge work at the LIC-16-1718 (Thornwood Crossing) structure shall be complete before Phase 1 MOT may begin. All proposed bridge work at the LIC-16-1416 (Columbus Road) structure shall be complete before Phase 1 MOT may begin and before temporary signals are installed at the S.R. 16/S.R. 37 interchange.

Work zone cameras as specified on sheets P.29, P.72, and P.88 shall be installed and functional before Phase 1 MOT may begin.

**Phase 1 (Median Construction)**

Traffic shall be moved to the outside of the existing roadway in both the Eastbound and Westbound directions.

The contractor shall construct the median area per the proposed roadway typical sections except that the proposed surface course shall be replaced with 1.50" of ITEM 442 ASPHALT CONCRETE INTERMEDIATE COURSE, 12.5 MM, TYPE A (448). This temporary surface course will be removed during Phase 4 final resurfacing.

Temporary pavement at the proposed crossover locations as shown on sheets P.54 - P.58 shall be constructed for use in subsequent MOT phases.

All ramps shall remain open during Phase 1.

**Phase 2 (Eastbound Construction)**

Temporary signals at the Columbus Rd. interchange as shown on sheets P.41 - P.42 shall be constructed and operational before any ramps are closed in Phase 2 MOT.

Westbound traffic shall remain in its phase 1 configuration. Eastbound traffic shall be split in contra-flow with the Eastbound passing lane crossing over to the inside shoulder of the Westbound lanes, and the Eastbound driving lane shifting over to the inside shoulder of the Eastbound lanes.

The contractor shall construct the Eastbound area per the proposed roadway typical sections except that the proposed surface course shall be replaced with 1.50" of ITEM 442 ASPHALT CONCRETE INTERMEDIATE COURSE, 12.5 MM, TYPE A (448). This temporary surface course will be removed during Phase 4 final resurfacing.

River Rd. shall be closed to the traveling public during Phase 2, however, EMS access shall be provided **AT ALL TIMES** as shown in the Phase 2 plan sheets. (Access only needed entering River Rd., not exiting from it.)

**Permitted Ramp Closures:**

Phase 2A - Ramp C, Ramp D, and River Rd. shall be closed  
Phase 2B - Ramps G, Ramp H, and River Rd. shall be closed  
Phase 2C - River Rd. shall be closed

**Phase 3 (Westbound Construction)**

Temporary signals at the Columbus Rd. interchange as shown on sheets P.41 - P.42 shall remain in operation from Phase 2.

Eastbound traffic shall be in its final post-construction configuration. Westbound traffic shall be split in contra-flow with the Westbound passing lane crossing over to the inside shoulder of the Eastbound lanes, and the Westbound driving lane shifting over to the inside shoulder of the Westbound lanes.

The contractor shall construct the Westbound area per the proposed roadway typical sections except that the proposed surface course shall be replaced with 1.50" of ITEM 442 ASPHALT CONCRETE INTERMEDIATE COURSE, 12.5 MM, TYPE A (448). This temporary surface course will be removed during Phase 4 final resurfacing.

**Permitted Ramp Closures:**

Phase 3A - Ramp A and Ramp B shall be closed  
Phase 3B - Ramp E & F shall be closed  
Phase 3C - All ramps open


**Phase 4 (Final Resurfacing)**

Traffic shall be maintained at all times per SCD MT-95.30.

Construct final resurfacing as per the Phase 4 MOT typical section on sheet P.40.

Install final pavement markings and signs.

All ramps shall be open during Phase 4.

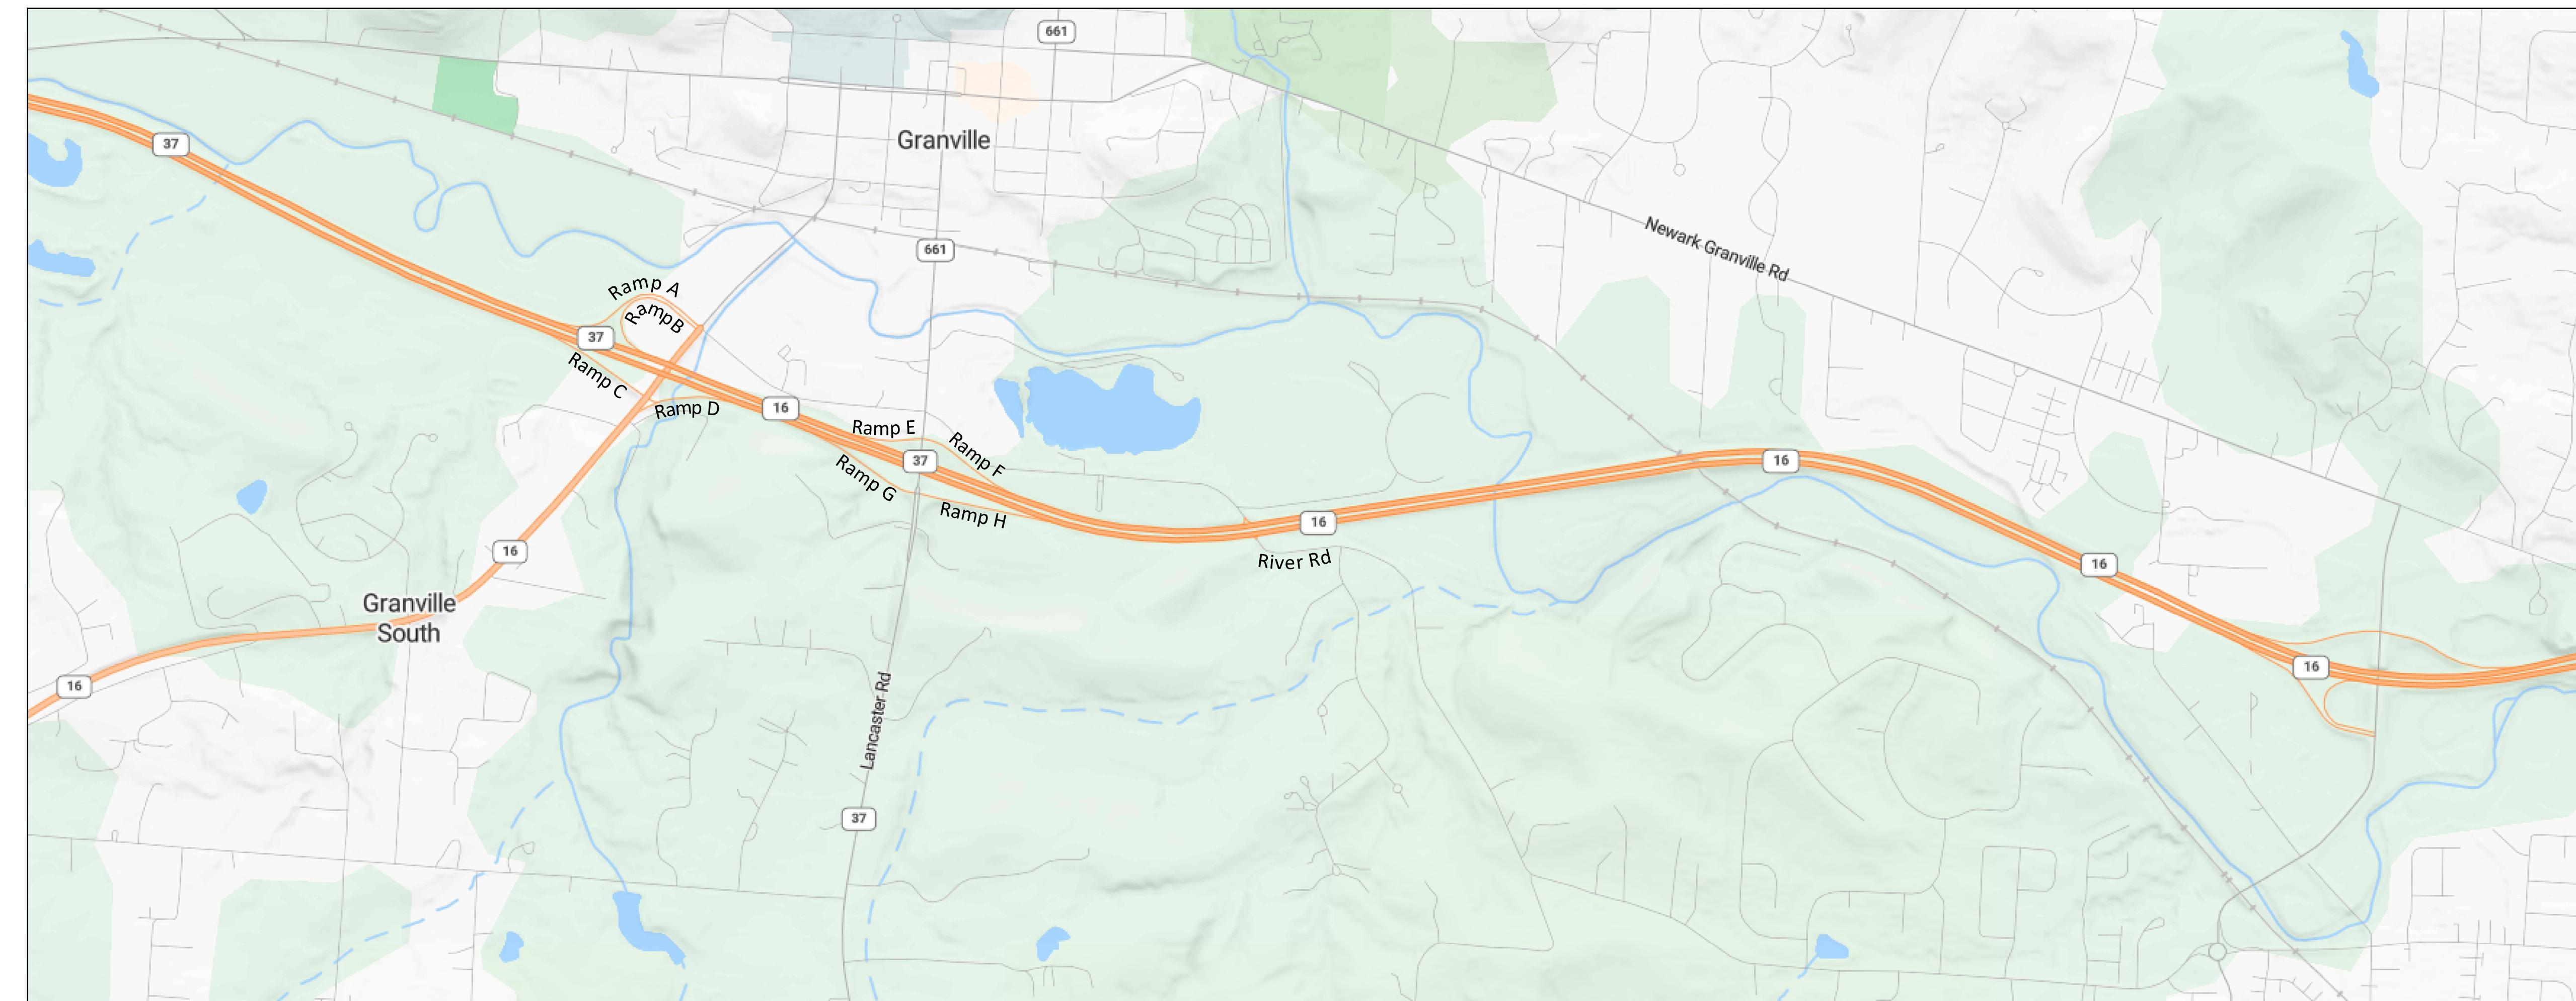

**ITEM 614 MAINTAINING TRAFFIC**

A minimum of two (2) lanes of traffic in each direction shall be maintained at all times by use of existing pavement, the completed pavement, Item 615 Pavement for Maintaining Traffic, Item 615 Roads for Maintaining Traffic, and temporary surfaces using 614, excluding the closure times stated in the lane value contract table below.

**Lane Value Contract Table**

Description of Critical Lane/Ramp to be maintained	Restricted Time Period	Time Unit	Disincentive \$ per time unit
2 Lanes of S.R. 16 / 37 E.B. & W.B.	**	15 Min.	\$2,500
Any Ramps from/to S.R. 16 / 37	**	15 Min.	\$1,250

\*\*See Permitted Lane Closure Times Note

**Lane Closure/Reduction Required**

Length and duration of lane closures and restrictions shall be at the approval of the Engineer. It is the intent to minimize the impact to the traveling public. Lane closures or restrictions over segments of the project in which no work is anticipated within a reasonable time frame, as determined by the Engineer, shall not be permitted. The level of utilization of maintenance of traffic devices shall be commensurate with the work in progress.

Ramp/Lane closures will be permitted for resurfacing and bridge sealing operations under night closure times only, as stated above in the lane value contract table. The Project Engineer shall obtain approval from the District Deputy Director prior to short-term closure of any ramps. Use PCMS to detour ramp traffic adjacent interchanges. Ramp traffic shall be maintained at all other times (except for allowable long-term closures in the incentive/disincentive table below).

The contractor shall provide notice of ramp closures to all traffic at least seven calendar days in advance of closure through the use of portable changeable message signs. The PCMS should be erected as shown in the plans and/or as directed by the engineer. The PCMS should be erected well in advance of the closure area to avoid distracting motorists.

**Incentive/Disincentive Contract Table**

Description or location of critical work	Time (days)	Incentive/Disincentive (\$ per day)	Maximum incentive (\$)
Construct accel./decel. lanes at Ramps C & D	45	\$5,000	\$25,000
Construct accel./decel. lanes at Ramps G & H	45	\$5,000	\$25,000
Construct accel./decel. lanes at Ramps A & B	45	\$5,000	\$25,000
Construct accel./decel. lanes at Ramps E & F	45	\$5,000	\$25,000

Areas that are planed shall not be opened to traffic. All planed areas must be inlaid with a proposed course of asphalt concrete prior to being opened to traffic.

Overnight closures must meet specifications as outlined in the Construction and Maintenance Operations section of the Ohio Manual of Uniform Traffic Control Devices for Streets and Highways. The roadway shall not be opened to traffic without either the permanent or work zone markings in place.

**Lanes Open During Holidays or Special Events**

No work shall be performed and all existing lanes shall be open to traffic during the following designated holidays or special events:

New Year's (observed)	General/Regular Election Day (Nov)
Memorial Day	Thanksgiving
Granville 4th of July Celebration*	Christmas (observed)
Fourth of July (observed)	
Labor Day	

(\*Dates to be determined by Village of Granville)

The period of time that the lanes are to be open depends on the day of the week on which the holiday or special event falls. The following schedule shall be used to determine this period:

Day of holiday or event	Time all lanes must be open to traffic
Sunday	12:00N Friday through 6:00 AM Monday
Monday	12:00N Friday through 6:00 AM Tuesday
Tuesday	12:00N Monday through 6:00 AM Wednesday
Tuesday (Gen./Reg. Election)	5:00 AM Tuesday through 12:00 AM Wednesday
Wednesday	12:00N Tuesday through 6:00 AM Thursday
Thursday	12:00N Wednesday through 6:00 AM Friday
Thursday (Thanksgiving only)	6:00 AM Wednesday through 6:00 AM Monday
Friday	12:00N Thursday through 6:00 AM Monday
Saturday	12:00N Friday through 6:00 AM Monday

**Notice of Closure Signs**

Notice of Closure signs (W20-H13) shall be erected by the Contractor prior to the scheduled road or ramp closure in accordance with the Notice of Closure Time Table below. [At the approval of the Engineer, portable changeable message signs may be used in lieu of the standard flatsheet sign for a closure less than 1 week.]

The signs shall be erected on the right-hand side of the road/ramp facing traffic. They shall be placed so as not to interfere with the visibility of any other traffic control signs. On roadways, they should be erected at or near the point of closure. The signs may be erected anywhere on ramps as long as they are visible to the motorists using the ramp. On entrance ramps, the sign shall be erected well in advance of the merge area to avoid distracting motorists.

**Notice of Closure Sign Time Table**

Item	Duration of Closure	Sign Displayed to Public
Ramp & Road	≥ 2 weeks	14 calendar days prior to closure
Closures	> 12 hours & < 2 weeks	7 calendar days prior to closure
	≤ 12 hours	2 business days prior to closure

The sign shall display the date of the closure in MMM-DD format and the number of days of the closure. The last line of the W20-H13 sign lists a phone number which a motorist may call for additional information. This is to be a specific office within the District rather than the general switchboard number.

**ROAD CLOSED Sign**

The Contractor shall provide, erect and maintain standard 48 x 30 inch ROAD CLOSED signs, sign supports, barricades and lights, as detailed in Traffic SCD MT-101.60 at the following locations during periods in which the affected roads are closed to traffic. See detour plan sheets for locations.

**Signs and Barricades**

The Contractor shall provide, erect and maintain signs and sign supports, as detailed in the Ohio Manual of Uniform Traffic Control Devices, and Type III barricades of the type and location as detailed in the plans. See detour plan sheets for locations.

Lane closures will be accomplished in accordance with the standard drawings listed on the Title Sheet, in consideration of the traffic flow. Lane closures shall only occur during contractor work hours.

The contractor will have on site and in working and or suitable condition; all equipment, tools, laborers, LEO's, traffic control devices, and incidentals necessary to efficiently perform the closure before initializing the lane closure.

All signs shown on the MOT plan sheets (whether relocated existing signs, new temporary signs, or temporary overlays on existing signs) shall be erected as shown in the plans, unless otherwise instructed by the Engineer.

All work and traffic control devices shall be in accordance with CMS 614 and other applicable portions of the specifications, as well as the Ohio Manual of Uniform Traffic Control Devices. Payment for all labor, equipment, and materials shall be included in the lump sum contract price for ITEM 614 MAINTAINING TRAFFIC, unless separately itemized in the plans.

**Notification of Traffic Restrictions**

Throughout the duration of the project, the Contractor shall notify the project engineer in writing of all traffic restrictions and upcoming maintenance of traffic changes. The Contractor shall ensure the written notification is submitted in a timely manner to allow the project engineer to meet the required time frames set forth in the table below to inform the Special Hauling Permits Section (Hauling.Permits@dot.ohio.gov) and the District Public Information Office (PIO). This notification shall be received by the project engineer prior to the physical setup of any applicable signs or message boards.

Information should include, but is not limited to, all construction activities that impact or interfere with traffic and shall list the specific location, type of work, road status, date and time of restriction, duration of restriction, number of lanes maintained, number of lanes closed, minimum vertical clearance, minimum width of drivable pavement, detour routes, if applicable, and any other information requested by the project engineer.

**Notification of Traffic Restrictions Time Table****Item Duration of Closure Sign Displayed to Public**

Ramp & Road	≥ 2 weeks	21 calendar days prior to closure
Closures	> 12 hours & < 2 weeks	14 calendar days prior to closure
	≤ 12 hours	4 business days prior to closure

Lane Closures & Restrictions	≥ 2 weeks	14 calendar days prior to closure
	< 2 weeks	5 business days prior to closure

Start of Construction & Traffic Pattern Changes	N/A	14 calendar days prior to implementation
---	-----	--

Any unforeseen conditions not specified in the plans requiring traffic restrictions shall also be reported to the project engineer using the Notification Time Table.

**MOT for Proposed Bridge Work**

The maintenance of traffic required for the proposed bridge work in the plans shall be as shown on sheets P.843 - P.857 and shall be included in the lump sum bid for ITEM 614 MAINTAINING TRAFFIC.

**Maintaining EMS Access to River Rd.**

The maintenance of traffic plans indicate the Contractor is required to provide access from S.R. 16 Eastbound to River Rd. at all times during the project for emergency vehicles. Access is shown in the plans during Phase 2 (Eastbound construction) when River Rd. will be closed.


If the contractor chooses to change the phasing of the MOT, this access must be maintained for emergency personnel at all times.

This access is only required in one direction, from S.R. 16 Eastbound to River Rd. (i.e. access is not needed from River Rd. to S.R. 16 Eastbound).

Any short-term closures that would prevent an emergency vehicle from getting access to River Rd. from S.R. 16 Eastbound must be approved by:

Casey Curtis (Fire Chief, Granville Township Fire Department)  
500 S. Main Street  
PO BOX 315  
Granville, OH 43023  
740-587-0261 (Station Phone)  
ccurtis@granvilletownship.org

Any signage required to maintain this access (and subsequently to prevent access from non-EMS vehicles) shall be included in the lump sum bid of ITEM 614 MAINTAINING TRAFFIC.

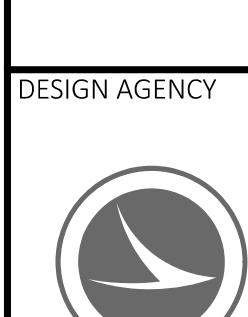

DESIGNER BRH  
REVIEWER CMY 09/05/25  
PROJECT ID 95445  
SHEET TOTAL P.25 895

**ITEM 614 MAINTAINING TRAFFIC, MISC.: SAFETY REPAIRS**

For impact attenuator or guardrail damaged by the motoring public, the contractor shall follow the process outlined in CMS 107.15. If no accident report is available, the contractor shall provide documentation from the various possible responding agencies that no accident report is available. For incidents with an accident report available, but the owner or insurance company is non-responsive, copies of the communication shall be submitted to the project per CMS 107.15B. For both conditions above, the engineer shall determine the safety items that may be repaired and the safety items that shall be replaced.

The work will be as directed by the Engineer and will include all maintenance of traffic costs associated with the activity. The cost for each item shall be \$1.00. The fixed amount shown in the proposal is included (as any other bid items) in the total bid amount. This fixed amount is the Department's estimate of the total cost for the repair or replacement of safety items within the work limits as directed by the Engineer. CMS Table 104.02-2 does not apply to reductions in this contract item. Force account records shall be kept to track and ultimately determine the amount of the pay item used. This item shall include payment for all work, incidentals, and all associated costs for the repair or replacement of damaged safety items as directed by the Engineer.

The following quantity has been provided in the General Summary:

ITEM 614 MAINTAINING TRAFFIC, MISC.: SAFETY REPAIRS 50,000 EACH

**ITEM 251 PARTIAL DEPTH PAVEMENT REPAIR (441), AS PER PLAN**

An estimated quantity for pavement repair has been included in the plan to be used as directed by the Engineer. Repairs shall take place prior to any planing operations.

The intent of this operation is to repair deteriorated transverse joints in the Eastbound pavement area prior to any workzone resurfacing in Pre-Phase 1. However, this item may be used as directed by the Engineer at other locations on the project.

For calculation purposes, the size of the repair shall be as follows:

Transverse Width = 18 feet (12' ex. driving lane + 6' ex. passing lane)

Longitudinal Width = 6 feet (centered over the joint)

Depth of pavement removal shall be 3.00 inches.

After pavement removal has been completed, the face of the repair shall be coated with ITEM 407 TACK COAT. Replacement material shall be 3.00" of ITEM 441 ASPHALT CONCRETE INTERMEDIATE COURSE, TYPE 2, (449), placed, compacted, and tacked.

All excavation, materials, labor, equipment, tools, traffic control, and incidentals needed to complete the work described above shall be paid for under ITEM 251, PARTIAL DEPTH PAVEMENT REPAIR (441), AS PER PLAN.

The following quantity has been provided in the General Summary: ITEM 251 PARTIAL DEPTH PAVEMENT REPAIR (441), AS PER PLAN 60 CY

Assuming 60 joints to be repaired:

6' x 18' x (3" ÷ 12) = 27 CF ÷ 27 = 1.00 CY X 60 joints = 60 CY

**ITEM 253 PAVEMENT REPAIR, AS PER PLAN**

An estimated quantity for pavement repair has been included in the plan to be used as directed by the Engineer. Repairs shall take place prior to any planing operations.

The intent of this operation is to repair deteriorated transverse joints in the Westbound pavement area prior to any workzone resurfacing in Pre-Phase 1. However, this item may be used as directed by the Engineer at other locations on the project.

Depth of excavation shall be 7.00". The minimum width shall be 6 feet, centered over the joint. After excavation has been completed, the face of the repair shall be coated with ITEM 407 TACK COAT. Replacement material shall be 7.00" of ITEM 301 ASPHALT CONCRETE BASE, PG64-22 (placed, compacted, and tacked).

All excavation, materials, labor, equipment, tools, traffic control, and incidentals needed to complete the work described above shall be paid for under ITEM 253, PAVEMENT REPAIR, AS PER PLAN.

The following quantity has been provided in the General Summary: ITEM 253, PAVEMENT REPAIR, AS PER PLAN 132 CY

PRE-PHASE 1 PAVEMENT REPAIR TABLE				
Joint No	Station (CL 37/16)	Width (FT)	Area (SF)	Volume (CY)
1	657 + 98	24	144	3.11
2	660 + 38	24	144	3.11
3	660 + 98	24	144	3.11
4	665 + 18	29	174	3.76
5	676 + 52	29	174	3.76
6	677 + 12	29	174	3.76
7	677 + 72	29	174	3.76
8	678 + 32	29	174	3.76
9	678 + 92	29	174	3.76
10	679 + 52	29	174	3.76
11	680 + 12	29	174	3.76
12	681 + 30	29	174	3.76
13	681 + 90	29	174	3.76
14	683 + 70	24	144	3.11
15	684 + 90	24	144	3.11
16	685 + 50	24	144	3.11
17	686 + 70	24	144	3.11
18	687 + 30	24	144	3.11
19	687 + 90	24	144	3.11
20	689 + 10	24	144	3.11
21	689 + 70	24	144	3.11
22	691 + 40	29	174	3.76
23	700 + 34	29	174	3.76
24	701 + 54	29	174	3.76
25	702 + 14	29	174	3.76
26	703 + 94	24	144	3.11
27	704 + 54	24	144	3.11
28	705 + 74	24	144	3.11
29	706 + 34	24	144	3.11
30	707 + 54	24	144	3.11
31	708 + 14	24	144	3.11
32	708 + 74	29	174	3.76
33	709 + 94	29	174	3.76
34	713 + 44	29	174	3.76
35	721 + 50	29	174	3.76
36	722 + 10	29	174	3.76
37	723 + 80	29	174	3.76
38	725 + 60	29	174	3.76
				TOTAL 132

The joint locations in the table above are for information only, and will be subject to the approval of the engineer before the work begins.

**Temporary Guardrail for MOT**

The following quantities have been carried to the General Summary to provide protection of the temporary workzone camera at the West end of the project. See P.72 for more details.

ITEM 606 GUARDRAIL TYPE MGS, AS PER PLAN 50 FT

ITEM 606 ANCHOR ASSEMBLY, MGS TYPE E, AS PER PLAN 1 EACH

ITEM 606 ANCHOR ASSEMBLY, MGS TYPE T, AS PER PLAN 1 EACH

ITEM 626 BARRIER REFLECTOR, TYPE 2 (ONE-WAY) 4 EACH

**Designated Local Detour Route**

In addition to the official, signed Detour Route, a local detour route has been determined to be the secondary, unsigned Detour Route or "designated local Detour Route." This route is shown on Sheet P.34. During the time that traffic is detoured, the Contractor shall maintain this route in a condition which is reasonably smooth and free from holes, ruts, ridges, bumps, dust, and standing water. Once the detour is removed and traffic returned to its normal pattern, the designated local Detour Route shall be restored to a condition that is equivalent to that which existed prior to its use for this purpose. All such work shall be performed when and as determined by the Engineer.

The following estimated quantities are provided for use as determined by the Engineer to maintain and subsequently restore the designated local Detour Route, and Weaver Drive.

ITEM 254 PAVEMENT PLANNING, ASPHALT CONCRETE (VARIABLE DEPTH - 3" MAX.) 5000 SY

ITEM 301 ASPHALT CONCRETE BASE, PG 64-22 (449) 250 CY

ITEM 304 AGGREGATE BASE 250 CY

ITEM 407 NON-TRACKING TACK COAT 3600 GAL

ITEM 408 PRIME COAT 400 GAL

ITEM 441 ASPHALT CONCRETE SURFACE COURSE, TYPE 1, (449), PG70-22M 50 CY

ITEM 617 COMPACTED AGGREGATE 50 CY

**Temporary Drainage Items**

The following items are provided in the maintenance of traffic plans to establish positive drainage during contra-flow phases. These items shall follow all the provisions of CMS 611, except the requirements of 611.12 and 611.13 may be waived. In addition, the removal of these temporary items shall also be included in their unit price bids. These requirements apply to the following items:

ITEM 611 15" CONDUIT, TYPE B AS PER PLAN

ITEM 611 CATCH BASIN, NO. 4 WITHOUT APRON, AS PER PLAN

ITEM 611 CATCH BASIN, NO. 6, AS PER PLAN

ITEM 611 CATCH BASIN RECONSTRUCTED TO GRADE, AS PER PLAN

Payment for the above items shall include all labor, equipment, tools, and materials required to install, maintain, remove, and/or restore to existing conditions (i.e. existing catch basins) these temporary drainage items.

**ITEM 611 15", SLOTTED DRAIN, TYPE 2, AS PER PLAN**

This item consists of 15 inch diameter slotted drain aluminum coated steel conduit 707.01 with 6 inch trapezoidal galvanized solid bar grate as approved by the Engineer. All costs for labor and materials, including Type 2 bedding, and backfilling as detailed by Standard Construction Drawing DM-1.3 is included in the price bid per FT for ITEM 611 15", SLOTTED DRAIN, TYPE 2, AS PER PLAN.

This item shall also include the removal and disposal of the system by the Contractor at the end of the project.

**Item 614, Maintaining Traffic (Estimated Quantities)**

The following estimated quantities have been included in the General Summary for use as determined by the Engineer for the maintenance of traffic:

ITEM 410 TRAFFIC COMPACTED SURFACE, TYPE A OR B 50 CY

ITEM 614 ASPHALT CONCRETE FOR MAINTAINING TRAFFIC 50 CY

**ITEM 614 MAINTAINING TRAFFIC, MISC.: WORK ZONE CAMERA**

The Contractor shall provide a temporary workzone camera at the locations specified in the plans. The Contractor shall coordinate the work with the Ohio Department of Transportation Office of Intelligent Transportation Systems (ODOT CO ITS). The contractor shall provide the following:

1. 120V Power to the specified camera location
2. A temporary pole with a minimum 40' camera mounting height
3. A pole-mounted cabinet conforming to SS 909.07.B
4. Outdoor ethernet cable conforming to SS 909.10.B
5. A pan-zoom-tilt camera conforming to SS 909.03.A
6. Access to the camera for CO ITS for the duration of the project

CO ITS will provide the Contractor with a modem for installation.

This item shall also include the removal of the above work upon completion of the project. All items shall become the property of the Contractor except that the pole-mounted Cabinet and the PTZ camera shall be delivered to:


Brian Bosch (District 5 Traffic Engineer)  
9600 Jackstown Road  
Jackstown, OH 43030  
740.323.5182  
Brian.Bosch@dot.ohio.gov

See sheets P.72 and P.88 for proposed camera locations.

Payment for the above work shall be at the contract unit price and include all labor, equipment, materials, tools, and incidentals to coordinate, erect, maintain, remove, and deliver salvaged items for each temporary workzone camera location.

The following quantities have been provided in the General Summary:

ITEM 614 MAINTAINING TRAFFIC, MISC.: WORKZONE CAMERA 2 EACH

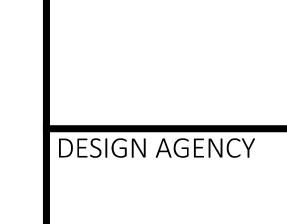

DESIGNER  
BRH

REVIEWER  
CMY 09/05/25

PROJECT ID


95445

SHEET TOTAL

P.29 895

LIC-16/37-14.24/15.47


MODEL: PHASE 4 PAPER SIZE: 34x22 (in) DATE: 1/13/2026 TIME: 3:25:37 PM PLTDRV: OHDOT\_PDF/plcfig PENTBL: OHDOT\_Permit1 USE: Brian.Harlow@dot.ohio.gov WORKSPACE: OHDOTCEw02 WORKSET: 95445 PRODUCT: OpenRoadsDesigner 24.00.00.205  
p:\ohdot\ohdot\pvt\ohdot\pvt-02\Documents\01 Active\Projects\District 05\U\licking\95445\400Engineering\MOTSheets\95445\_MOT001.dgn

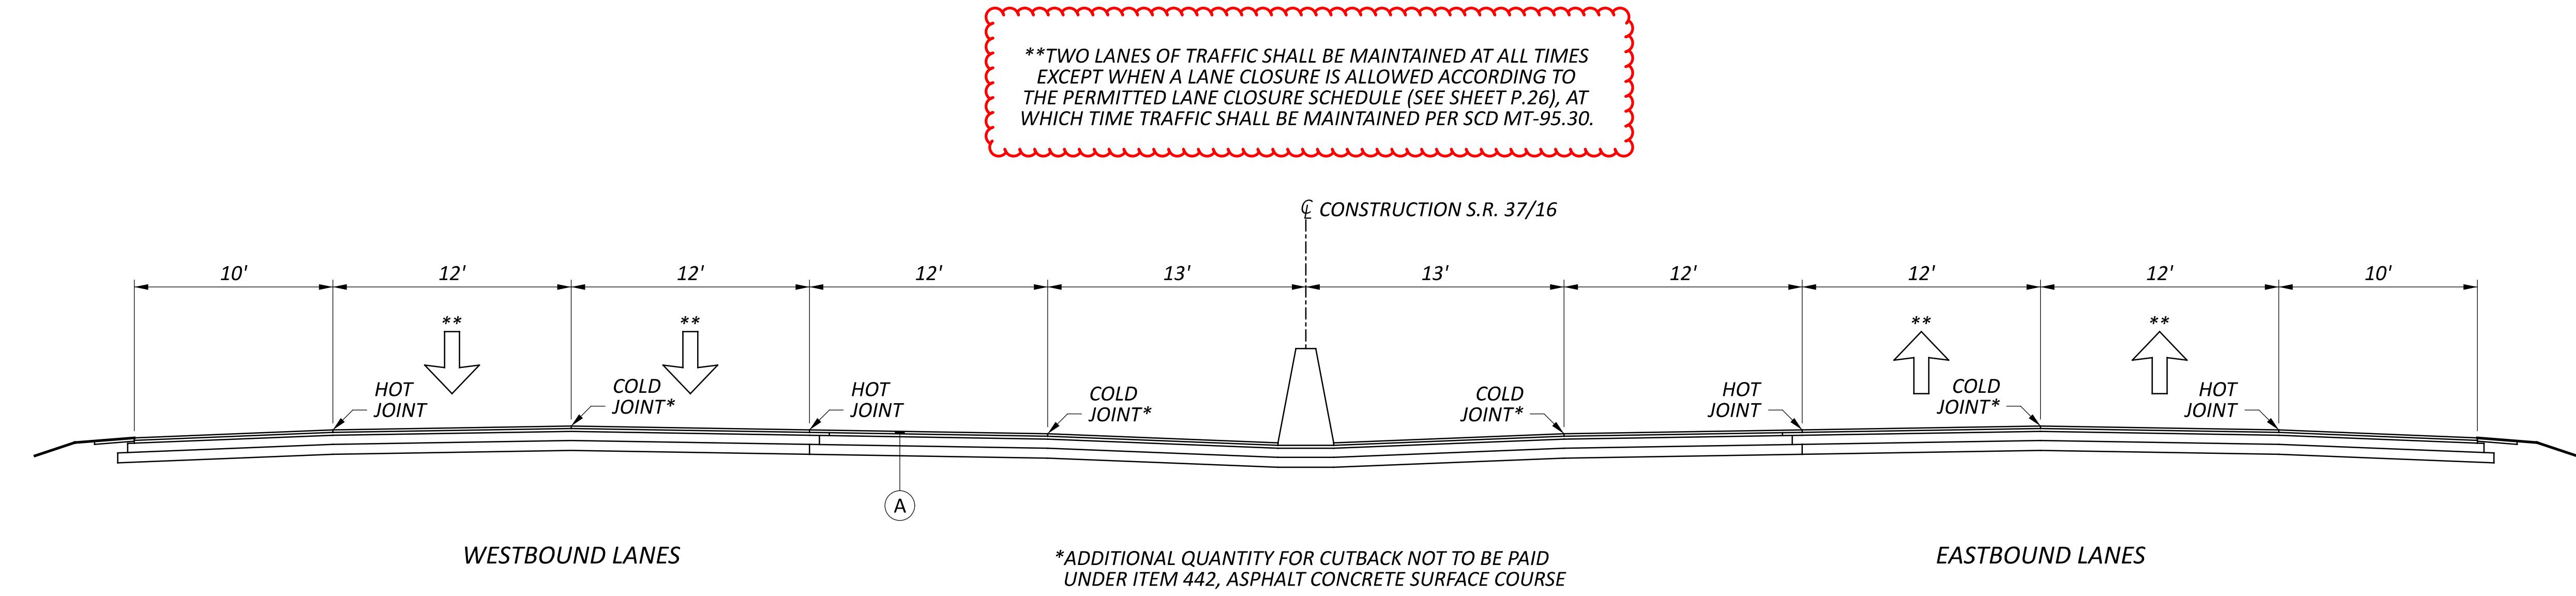

## MOT PHASE 4

FINAL RESURFACING

### LEGEND

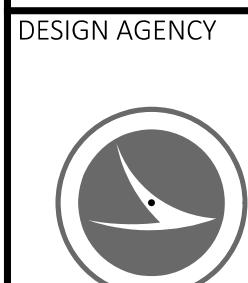


DESIGNER  
BRH  
REVIEWER  
CMY 09/05/25  
PROJECT ID  
95445  
SHEET TOTAL  
P.40 895



SHEET NUMBER							PART.			ITEM	ITEM EXT	GRAND TOTAL	UNIT	DESCRIPTION	SEE SHEET NO.		
22	27	28	29	52	01/NHS	02/NHS	03/NHS										
					60	60		251	01011	60	CY	MAINTENANCE OF TRAFFIC			29		
					132	132		253	02001	132	CY	PARTIAL DEPTH PAVEMENT REPAIR (441), AS PER PLAN			29		
					5,000	5,000		254	01000	5,000	SY	PAVEMENT REPAIR, AS PER PLAN					
					250	250		301	56000	250	CY	PAVEMENT PLANNING, ASPHALT CONCRETE (VARIABLE DEPTH - 3" MAX.)					
					250	250		304	20000	250	CY	ASPHALT CONCRETE BASE, PG64-22, (449)					
					3,600	3,600		407	20000	3,600	GAL	AGGREGATE BASE					
					400	400		408	10000	400	GAL	NON-TRACKING TACK COAT					
					50	50		410	12000	50	CY	PRIME COAT					
					30	30		411	10000	30	CY	TRAFFIC COMPACTED SURFACE, TYPE A OR B					
					200	200		441	70100	200	CY	STABILIZED CRUSHED AGGREGATE					
					50	50		606	15051	50	FT	ASPHALT CONCRETE SURFACE COURSE, TYPE 1, (449), PG70-22M					
					1	1		606	26151	1	EACH	GUARDRAIL, TYPE MGS, AS PER PLAN			29		
					1	1		606	26551	1	EACH	ANCHOR ASSEMBLY, MGS TYPE E, AS PER PLAN (MASH 2016)			29		
					973	973		611	05901	973	FT	ANCHOR ASSEMBLY, MGS TYPE T, AS PER PLAN			29		
					643	643		611	97011	643	FT	15" CONDUIT, TYPE B, AS PER PLAN			29		
					2	2		611	98261	2	EACH	SLOTTED DRAIN, TYPE 2, AS PER PLAN (15")			29		
					3	3		611	98371	3	EACH	CATCH BASIN, NO. 4 WITHOUT APRON, AS PER PLAN			29		
					2	2		611	98635	2	EACH	CATCH BASIN, NO. 6, AS PER PLAN			29		
					1,250	1,250		614	11110	1,250	HOUR	CATCH BASIN RECONSTRUCTED TO GRADE, AS PER PLAN			29		
					1	1		SPECIAL	61411300	1	EACH	LAW ENFORCEMENT OFFICER WITH PATROL CAR FOR ASSISTANCE			28		
					1	1		SPECIAL	61411300	1	EACH	WORK ZONE TRAFFIC SIGNAL (RAMPS A/B)			28		
					4,788	2,208	2,580	614	11630	4,788	FT	WORK ZONE TRAFFIC SIGNAL (RAMPS C/D)			28		
					38	2	36	614	12380	38	EACH	INCREASED BARRIER DELINEATION					
					LS			614	12420	LS		WORK ZONE IMPACT ATTENUATOR, 24" WIDE HAZARDS, (UNIDIRECTIONAL)					
					10			614	12484	10	EACH	DETOUR SIGNING					
					15	15		614	12500	15	EACH	WORK ZONE INCREASED PENALTIES SIGN					
					40	40		614	12600	40	EACH	REPLACEMENT SIGN					
					1	1		614	12756	1	EACH	REPLACEMENT DRUM					
					977	977		614	12800	977	EACH	WORK ZONE CROSSOVER LIGHTING SYSTEM					
					50	50		614	13000	50	CY	WORK ZONE RAISED PAVEMENT MARKER					
					2,941	897	2,044	614	13310	2,941	EACH	ASPHALT CONCRETE FOR MAINTAINING TRAFFIC					
					777	777		614	13310	777	EACH	BARRIER REFLECTOR, TYPE 1 (ONE-WAY)					
					1,638	896	742	614	13350	1,638	EACH	BARRIER REFLECTOR, TYPE 1 (BIDIRECTIONAL)					
					50,000	50,000		614	18000	50,000	EACH	OBJECT MARKER, ONE WAY					
					2	2		614	18000	2	EACH	MAINTAINING TRAFFIC, MISC.: SAFETY REPAIRS			29		
					160	160		614	18601	160	SNMT	MAINTAINING TRAFFIC, MISC.: WORK ZONE CAMERA			29		
					37	19	18	614	20110	37	MILE	PORTABLE CHANGEABLE MESSAGE SIGN, AS PER PLAN					
					144.57	40.85	103.72	614	22110	144.57	MILE	WORK ZONE LANE LINE, CLASS I, 6", 642 PAINT					
					75,582	24,030	51,552	614	23200	75,582	FT	WORK ZONE EDGE LINE, CLASS I, 6", 642 PAINT					
					44,506	15,700	28,806	614	24202	44,506	FT	WORK ZONE CHANNELIZING LINE, CLASS I, 8", 642 PAINT					
					171	171		614	26200	171	FT	WORK ZONE DOTTED LINE, CLASS I, 6", 642 PAINT					
					7	4	3	614	30200	7	EACH	WORK ZONE STOP LINE, CLASS I, 642 PAINT					
					6,350	6,350		615	10000	LS		WORK ZONE ARROW, CLASS I, 642 PAINT					
					99	63	36	615	20000	6,350	SY	ROADS FOR MAINTAINING TRAFFIC					
					50	50		616	10000	99	MGAL	PAVEMENT FOR MAINTAINING TRAFFIC, CLASS A					
					1,758	1,102	656	621	00100	50	CY	WATER					
					1,758	1,102	656	621	54000	1,758	EACH	COMPACTED AGGREGATE					
					103,020	43,408	59,612	622	41100	103,020	FT	RAISED PAVEMENT MARKER REMOVED					
					42,500		42,500	622	80000	42,500	FT	PORTABLE BARRIER, UNANCHORED					
					4	4		626	00110	4	EACH	GLARE SCREEN					
					300	300		808	18700	300	SNMT	BARRIER REFLECTOR, TYPE 2 (ONE-WAY)					
					LS	LS	LS	614	11000	LS		DIGITAL SPEED LIMIT (DSL) SIGN ASSEMBLY					
					LS	LS	LS	623	10001	LS		INCIDENTALS					
					LS	LS	LS	623	11000	LS		MAINTAINING TRAFFIC					
					LS	LS	LS	624	10000	LS		CONSTRUCTION LAYOUT STAKES AND SURVEYING, AS PER PLAN					
					LS												

SHEET NO.	REFERENCE NO.	DESCRIPTION (TYPE OF BARRIER)	LOCATION (STA. TO STA.)	LENGTH (FT)	626	626	626	626	ADDITIONAL DETAILS
					BARRIER REFLECTOR, TYPE 1 (ONE-WAY) (WHITE)	BARRIER REFLECTOR, TYPE 1 (TWO-WAY) (YELLOW/RED)	BARRIER REFLECTOR, TYPE 2 (ONE-WAY) (WHITE)	BARRIER REFLECTOR, TYPE 6 (TWO-WAY) (YELLOW/YELLOW)	
					EACH	EACH	EACH	EACH	
PLAN SPLIT 01/NHS									
P.787-788	BR-1	MEDIAN CABLE RAIL	624+00	639+30	1530			17	100' SPACING
P.787	BR-2	MEDIAN CABLE RAIL ANCHOR ASSEMBLY	624+50	625+00	50			1	DELINATE PR. END ANCHOR
P.788-797	BR-3	MEDIAN CONCRETE BARRIER (EASTBOUND)	639+35	747+93	10,858	110			100' SPACING
P.788-797	BR-4	MEDIAN CONCRETE BARRIER (WESTBOUND)	639+65	747+93	10,828	110			100' SPACING
P.797-803	BR-5	MEDIAN CONCRETE BARRIER (EASTBOUND)	750+57	831+70	8113	83			100' SPACING
P.797-803	BR-6	MEDIAN CONCRETE BARRIER (WESTBOUND)	750+57	831+70	8113	83			100' SPACING
SUB-TOTALS (PLAN SPLIT 01/NHS)					386		18		
PLAN SPLIT 02/NHS									
P.789-790	BR-7	EASTBOUND GUARDRAIL	653+50	660+73	723		9		100' SPACING
P.789-790	BR-8	WESTBOUND GUARDRAIL	654+00	662+46	846		10		100' SPACING
P.791	BR-9	EASTBOUND GUARDRAIL	669+69	671+06	137		3		100' SPACING
P.791	BR-10	EASTBOUND TYPE D CONCRETE BARRIER	671+06	671+63	57	2			DELINATE ENDS OF BARRIER
P.791	BR-11	WESTBOUND TYPE D CONCRETE BARRIER	671+61	672+19	58	2			DELINATE ENDS OF BARRIER
P.791	BR-12	WESTBOUND GUARDRAIL	672+19	673+94	175		3		100' SPACING
P.792	BR-13	WESTBOUND GUARDRAIL	682+00	687+88	588		7		100' SPACING
P.792-793	BR-14	EASTBOUND GUARDRAIL	693+63	697+13	350		5		100' SPACING
P.793	BR-15	WESTBOUND GUARDRAIL	694+88	698+38	350		5		100' SPACING
P.794	BR-16	WESTBOUND GUARDRAIL	707+00	708+88	188		3		100' SPACING
P.795-797	BR-17	WESTBOUND GUARDRAIL	728+88	747+50	1862		20		100' SPACING
P.795-797	BR-18	EASTBOUND GUARDRAIL	729+38	747+13	1775		19		100' SPACING
P.797-800	BR-19	EASTBOUND GUARDRAIL	750+88	793+38	4250		44		100' SPACING
P.797-801	BR-20	WESTBOUND GUARDRAIL	751+50	799+25	4775		49		100' SPACING
P.801	BR-21	EASTBOUND GUARDRAIL	798+25	800+88	263		4		100' SPACING
SUB-TOTALS (PLAN SPLIT 02/NHS)					4		181		
SUB-TOTALS (PLAN SPLIT 01/NHS)									
SUB-TOTALS (PLAN SPLIT 02/NHS)					4		181		
TOTALS CARRIED TO GENERAL SUMMARY									
4 386 181 18 0 0									
SHEET TOTAL 895									

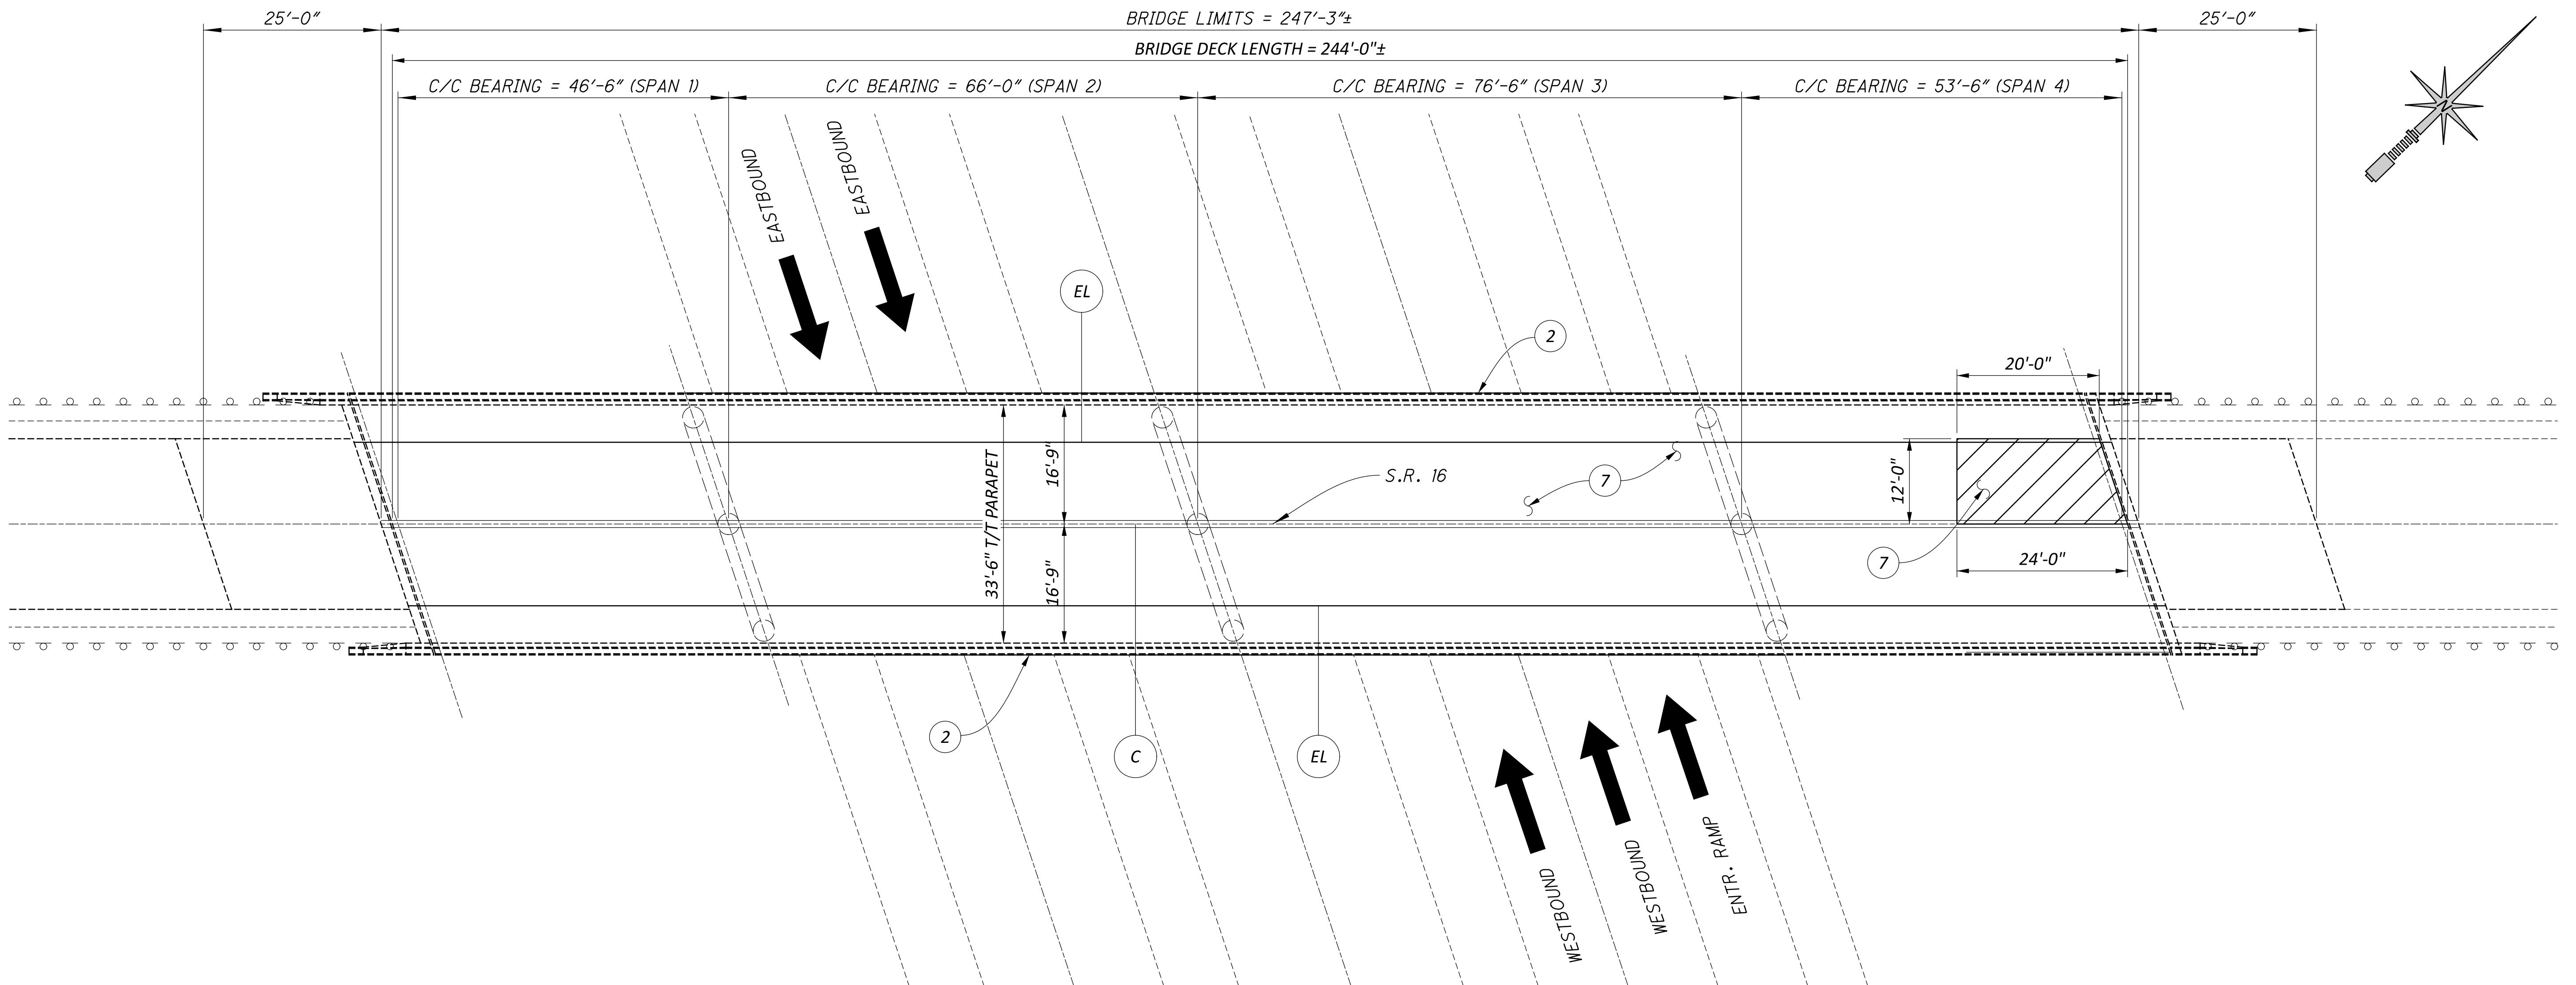

PLAN

## MOT

**LIC-16-14.151:** MAINTAINING TRAFFIC PER MT-97.10. NO IMPACT TO TRAFFIC ALLOWED BETWEEN 6AM AND 6PM MONDAY-FRIDAY. WORK SHALL BE COMPLETED BEFORE PHASE 1 MOT MAY BEGIN.

## WORK TYPE LEGEND

- 1 — ITEM 202 - PORTIONS OF STRUCTURE REMOVED, AS PER PLAN, SUBSTRUCTURE
- 2 — ITEM 202 - REMOVAL MISC.: DETERIORATED DECK EDGES
- 3 — ITEM 511 - CONCRETE, MISC.: CLASS QC2 WITH ACCELERATING ADMIXTURE, APPROACH SLAB AND BACKWALL REPAIR
- 4 — ITEM 512 - SEALING CONCRETE BRIDGE DECKS WITH HMWM RESIN, AS PER PLAN
- 5 — ITEM 516 - 2" DEEP JOINT SEALER, AS PER PLAN (A)
- 6 — ITEM 516 - STRUCTURAL JOINT OR JOINT SEALER, MISC.: 3" BEJS EMSEAL
- 7 — ITEM 519 - PATCHING BRIDGE DECKS, TYPE B


## PAVEMENT MARKING LEGEND

- EL — ITEM 646 - EDGE LINE, 6"
- LL — ITEM 646 - LANE LINE, 6"
- C — ITEM 646 - CENTERLINE, 6"
- CL — ITEM 646 - CHANNELIZING LINE, 8"
- LA — ITEM 646 - LANE ARROW
- WP — ITEM 646 - WORD ON PAVEMENT, 72"

## EXISTING STRUCTURE (SFN: 4501772)

TYPE: CONTINUOUS STEEL BEAM WITH REINFORCED CONCRETE DECK AND SUBSTRUCTURE  
SPANS: 46'-6", 66'-0", 76'-6", 53'-6"  
ROADWAY: 33'-6" T/T PARAPET  
LOAD FREQUENCY: CF-400  
SKEW: 18° 20' 40" RIGHT FORWARD  
WEARING SURFACE: 1" MONOLITHIC CONCRETE  
APPROACH SLABS: 25 FEET LONG (AS-1-81)  
ALIGNMENT: TANGENT  
CROWN: 0.0156 FT/FT

DESIGNER	CHECKER
TAG	JKS
REVIEWER	
TAG	09/15/25
PROJECT ID	95445
SUBSET	TOTAL
0	0
SHEET	TOTAL
P.846	895

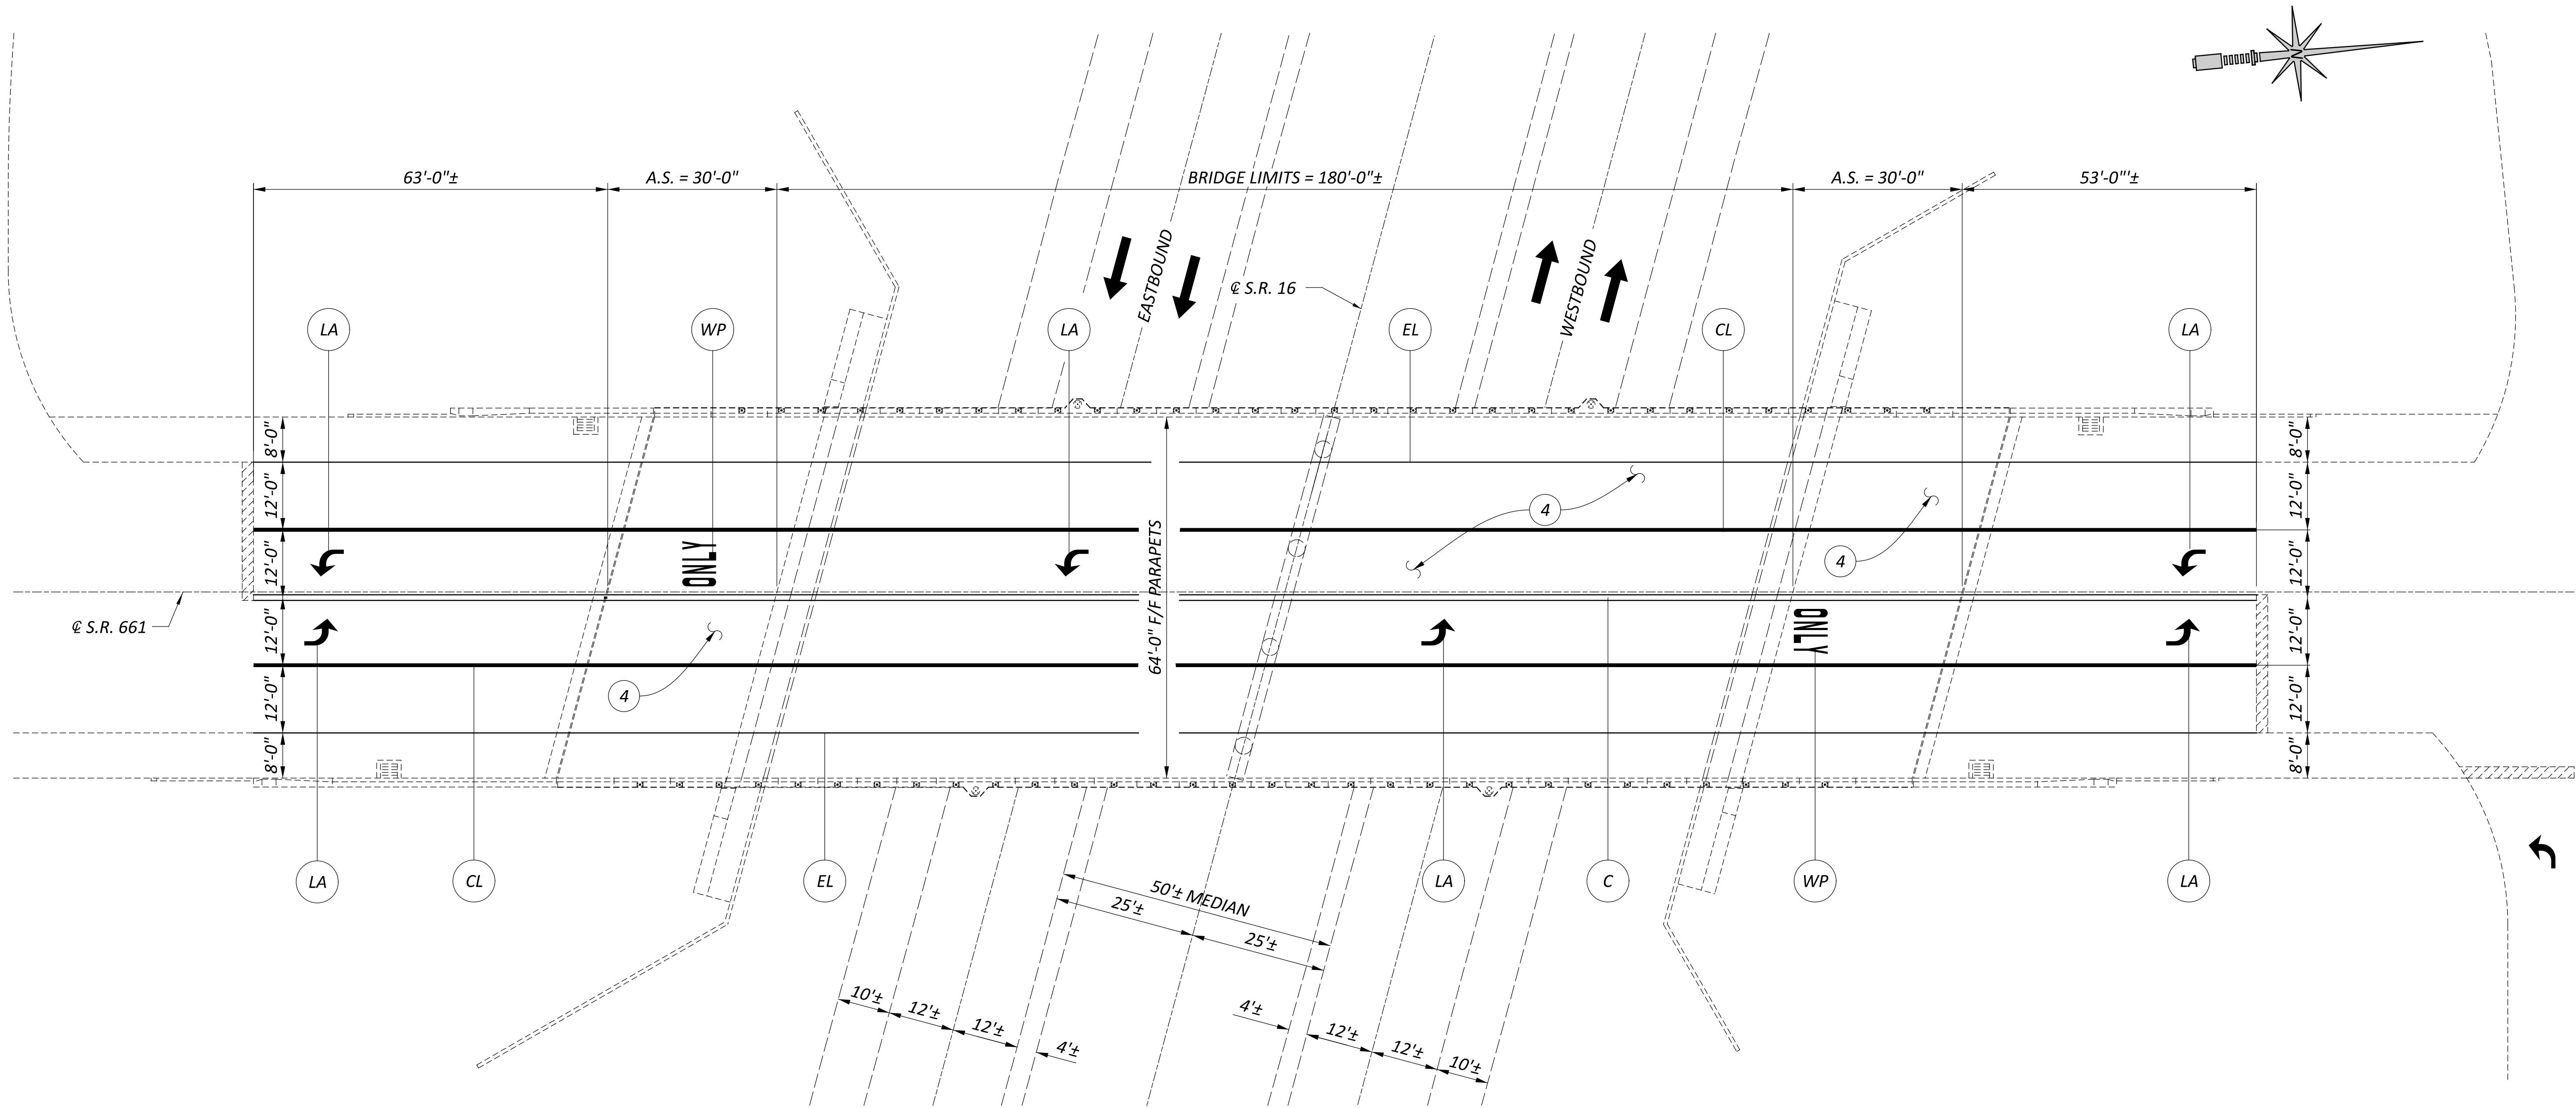

## **WORK TYPE LEGEND**

- 1 — *ITEM 202 - PORTIONS OF STRUCTURE REMOVED, AS PER PLAN, SUBSTRUCTURE*
  - 2 — *ITEM 202 - REMOVAL MISC.: DETERIORATED DECK EDGES*
  - 3 — *ITEM 511 - CONCRETE, MISC.: CLASS QC2 WITH ACCELERATING ADMIXTURE, APPROACH SLAB AND BACKWALL REPAIR*
  - 4 — *ITEM 512 - SEALING CONCRETE BRIDGE DECKS WITH HMWM RESIN, AS PER PLAN***
  - 5 — *ITEM 516 - 2" DEEP JOINT SEALER, AS PER PLAN (A)*
  - 6 — *ITEM 516 - STRUCTURAL JOINT OR JOINT SEALER, MISC.: 3" BEJS EMSEAL*
  - 7 — *ITEM 519 - PATCHING BRIDGE DECKS TYPE B*

## **PAVEMENT MARKING LEGEND**

- EL** — **ITEM 646 - EDGE LINE, 6"**
  - LL** — **ITEM 646 - LANE LINE, 6"**
  - C** — **ITEM 646 - CENTERLINE, 6"**
  - CL** — **ITEM 646 - CHANNELIZING LINE, 8"**
  - LA** — **ITEM 646 - LANE ARROW**
  - WP** — **ITEM 646 - WORD ON PAVEMENT, 72"**

## **EXISTING STRUCTURE (SFN: 4506333)**

TYPE: CONTINUOUS STEEL BEAM WITH REINFORCED CONCRETE DECK, SEMI-INTERGRAL ABUTMENTS AND CAP AND COLUMN PIER.

SPANS: 91'-7", 86'-3"

ROADWAY: 80'-0" T/T PARAPET

LOAD FREQUENCY: HL-93

SKEW:  $4\frac{33}{64}$ '-00"-00" LEFT FORWARD


WEARING SURFACE: 1" MONOLITHIC CONCRETE

APPROACH SLABS: 30 FEET LONG (AS-1-81)

ALIGNMENT: TANGENT

CROWN: 0.0156 FT/FT

SFN <b>4506333</b>	
DESIGN AGENCY	
	
DESIGNER <b>TAG</b>	CHECKER <b>JKS</b>
REVIEWER	
TAG	<b>09/15/25</b>
PROJECT ID	
<b>95445</b>	
SUBSET	TOTAL
<b>0</b>	<b>0</b>
SHEET	TOTAL
<b>P.848</b>	<b>895</b>

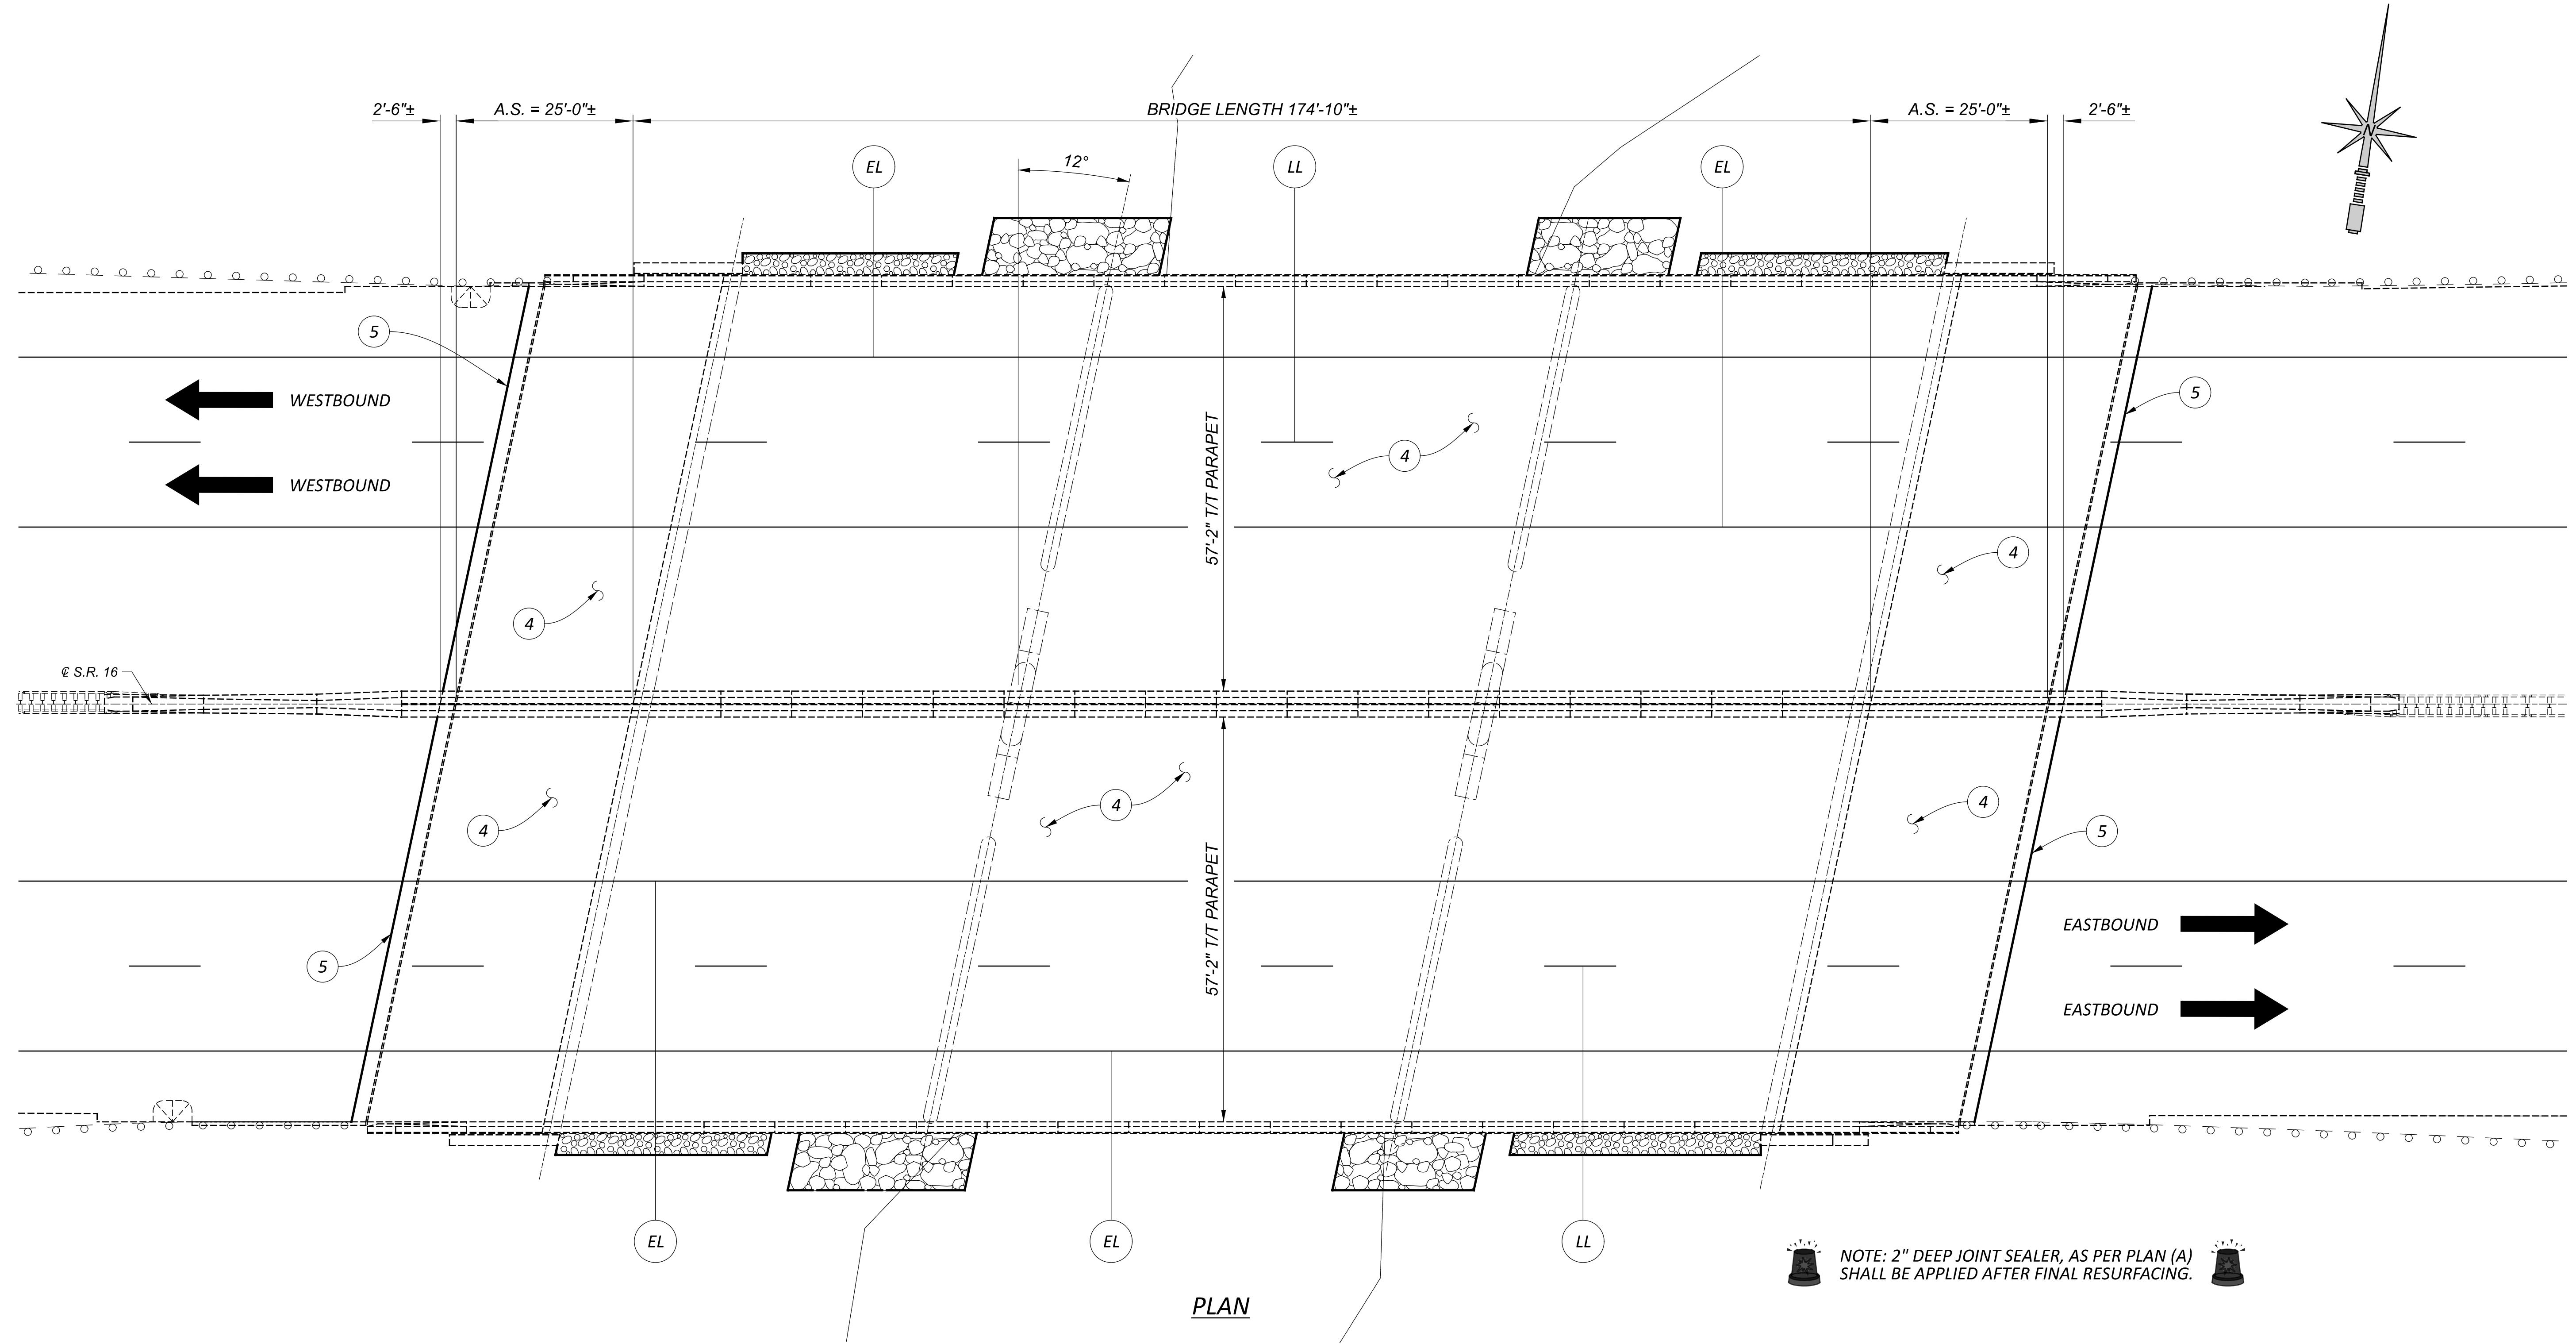

## WORK TYPE LEGEND

- ITEM 202 - PORTIONS OF STRUCTURE REMOVED, AS PER PLAN, SUBSTRUCTURE
- ITEM 202 - REMOVAL MISC.: DETERIORATED DECK EDGES
- ITEM 511 - CONCRETE, MISC.: CLASS QC2 WITH ACCELERATING ADMIXTURE, APPROACH SLAB AND BACKWALL REPAIR
- ITEM 512 - SEALING CONCRETE BRIDGE DECKS WITH HMWM RESIN, AS PER PLAN**
- ITEM 516 - 2" DEEP JOINT SEALER, AS PER PLAN (A)**
- ITEM 516 - STRUCTURAL JOINT OR JOINT SEALER, MISC.: 3" BEJS EMSEAL
- ITEM 519 - PATCHING BRIDGE DECKS, TYPE B

## PAVEMENT MARKING LEGEND

- EL - ITEM 646 - EDGE LINE, 6"
- LL - ITEM 646 - LANE LINE, 6"
- C - ITEM 646 - CENTERLINE, 6"
- CL - ITEM 646 - CHANNELIZING LINE, 8"
- LA - ITEM 646 - LANE ARROW
- WP - ITEM 646 - WORD ON PAVEMENT, 72"

MOT
LIC-16-15.601: PREFORM HMWM SEALING IN PHASE 4, MAINTAIN TRAFFIC PER PUBLISHED PLCS.

## EXISTING STRUCTURE (SFN: 4500725)


TYPE: CONTINUOUS STEEL BEAM WITH REINFORCED CONCRETE DECK AND SUBSTRUCTURE.  
 SPANS: 53'-4¾", 66'-0", 53'-4¾" C/C BEARINGS  
 ROADWAY: 57'-2" TOE/TOE PARAPET  
 LOAD FREQUENCY: HL-93 AND 60 LBS./FT. FWS  
 SKEW: 12°00'00" LEFT FORWARD  
 WEARING SURFACE: 1" MONOLITHIC CONCRETE  
 APPROACH SLABS: 25 FEET LONG (AS-1-15, AS-2-15)  
 ALIGNMENT: TANGENT  
 CROWN: 0.0156 FT/FT

BRIDGE PLAN  
 BRIDGE NO.: LIC-16-15.601  
 OVER RACCOON CREEK

SFN 4500725  
 DESIGN AGENCY



DESIGNER	CHECKER
TAG	JKS
REVIEWER	
TAG 09/15/25	
PROJECT ID	
95445	
SUBSET	TOTAL
0	0
SHEET TOTAL	
P.850 895	

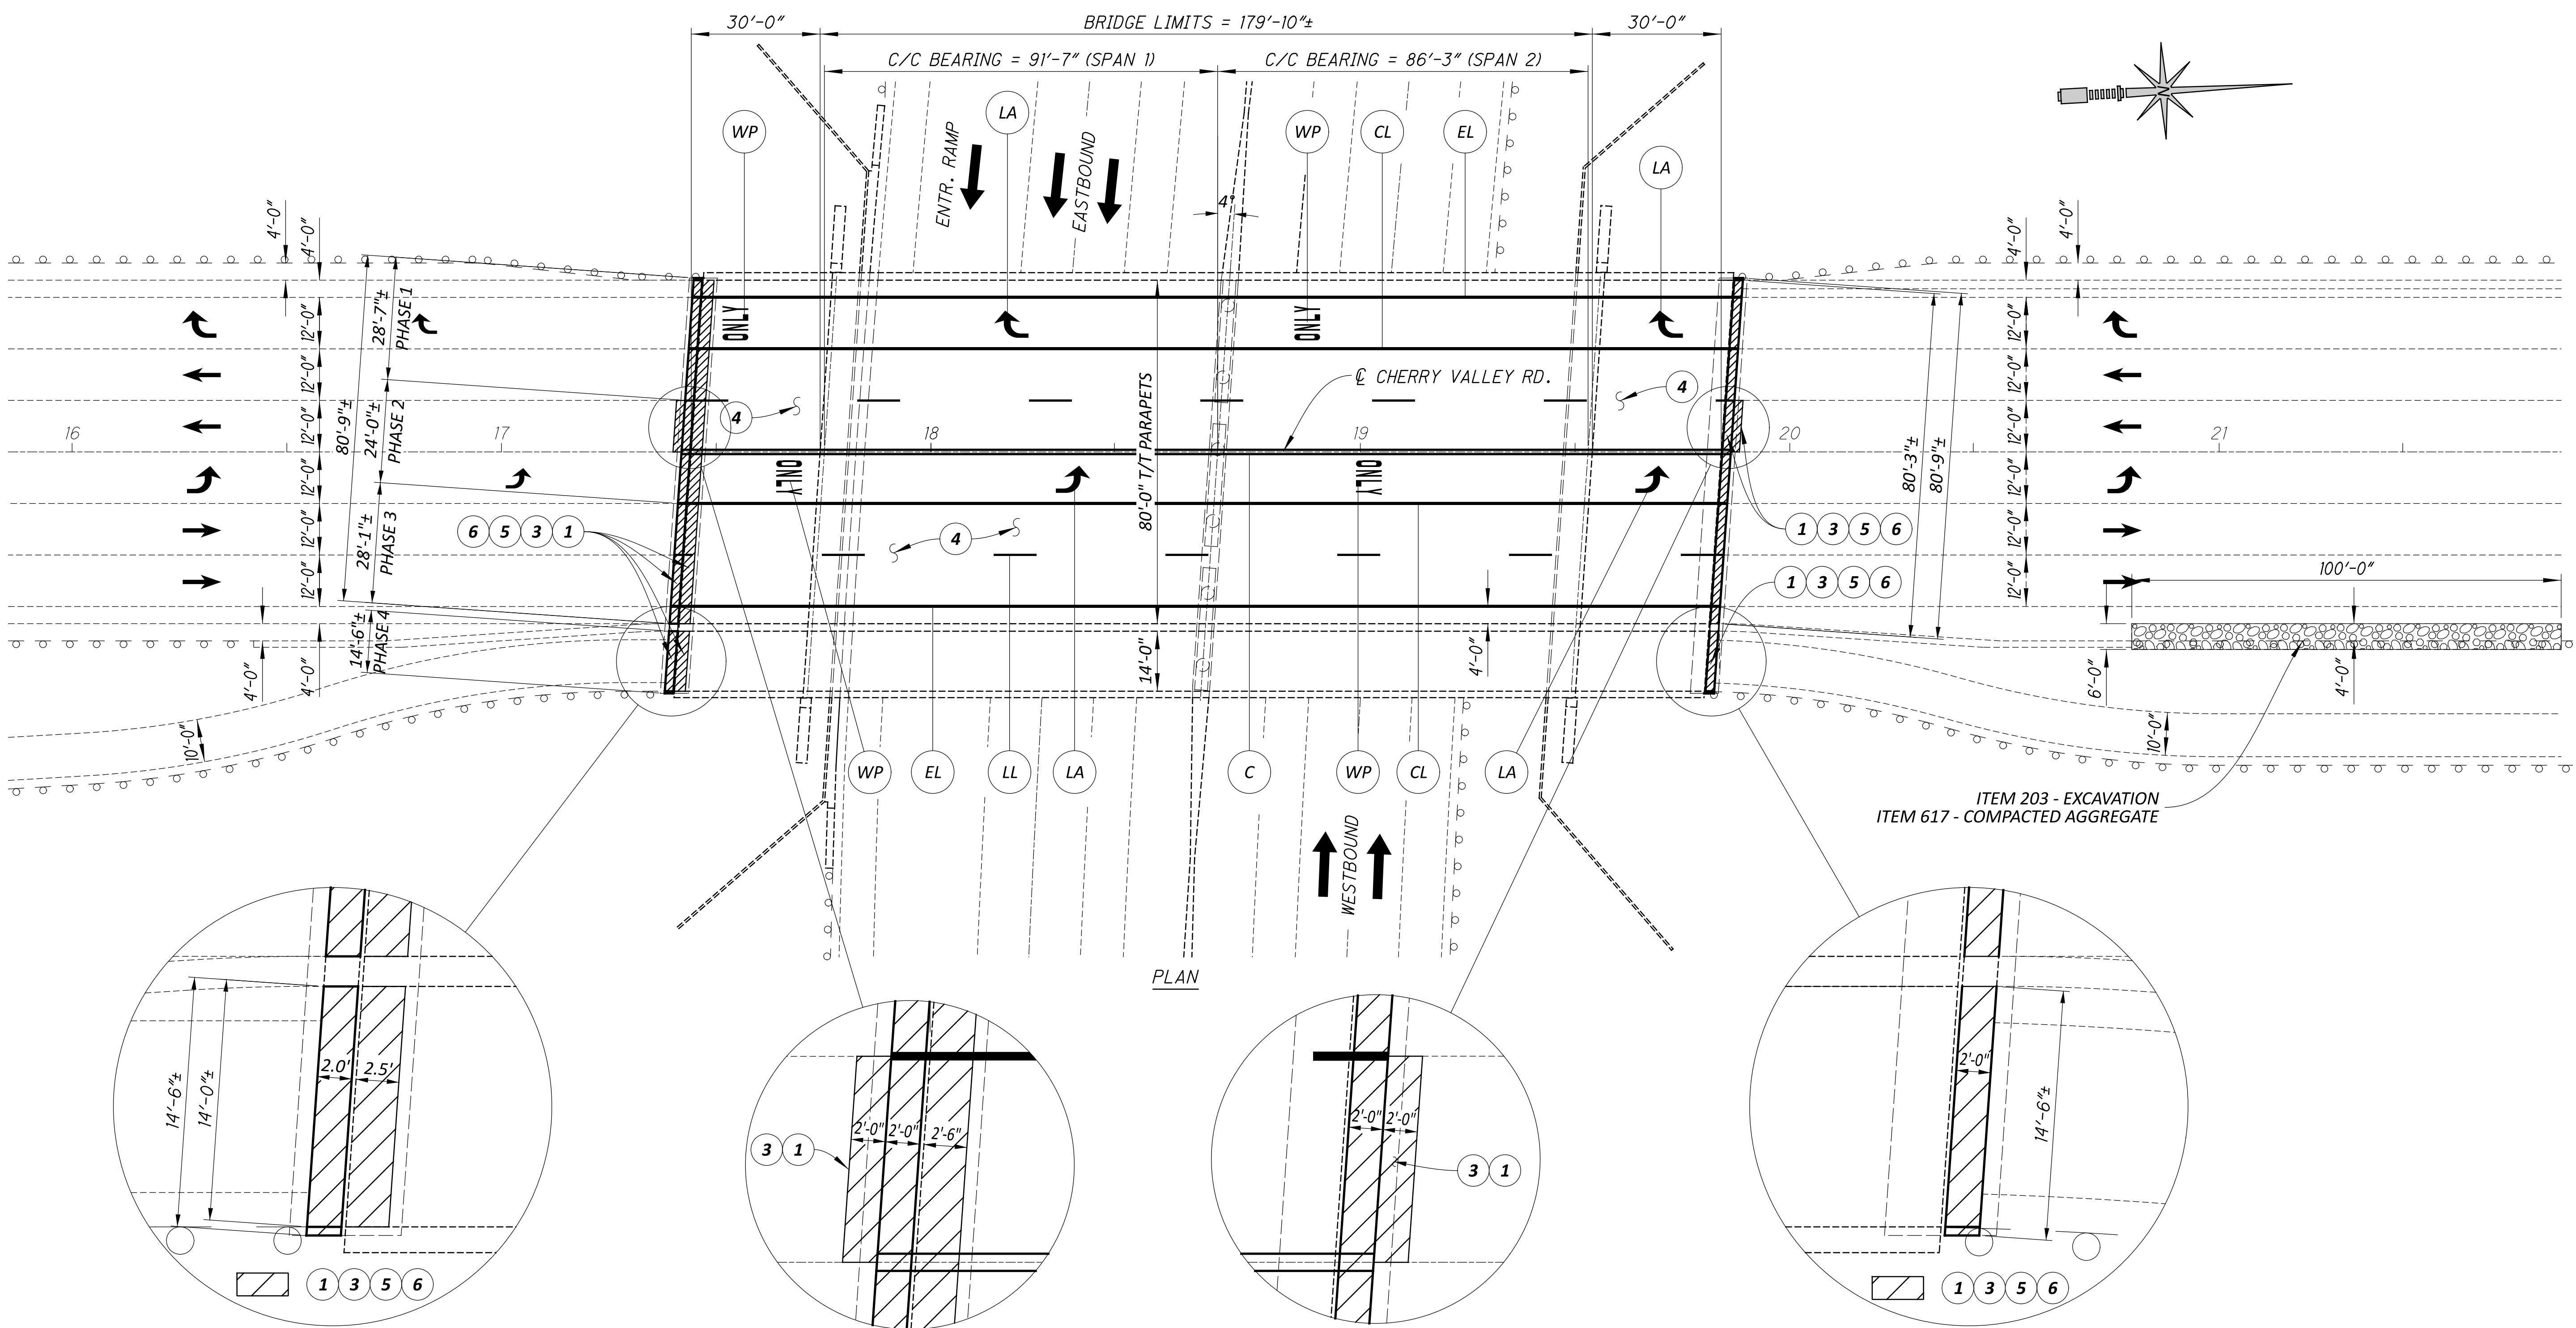

## WORK TYPE LEGEND

- 1 ITEM 202 - PORTIONS OF STRUCTURE REMOVED, AS PER PLAN, SUBSTRUCTURE
- 2 ITEM 202 - REMOVAL MISC.: DETERIORATED DECK EDGES
- 3 ITEM 511 - CONCRETE, MISC.: CLASS QC2 WITH ACCELERATING ADMIXTURE, APPROACH SLAB AND BACKWALL REPAIR
- 4 ITEM 512 - SEALING CONCRETE BRIDGE DECKS WITH HMWM RESIN, AS PER PLAN
- 5 ITEM 516 - 2" DEEP JOINT SEALER, AS PER PLAN (A)
- 6 ITEM 516 - STRUCTURAL JOINT OR JOINT SEALER, MISC.: 3" BEJS EONSEAL
- 7 ITEM 519 - PATCHING BRIDGE DECKS, TYPE B

## PAVEMENT MARKING LEGEND

- EL ITEM 646 - EDGE LINE, 6"
- LL ITEM 646 - LANE LINE, 6"
- C ITEM 646 - CENTERLINE, 6"
- CL ITEM 646 - CHANNELIZING LINE, 8"
- LA ITEM 646 - LANE ARROW
- WP ITEM 646 - WORD ON PAVEMENT, 72"

**MOT**  
LIC-16-17.194: ALWAYS MAINTAIN A MINIMUM OF A SINGLE LANE OF TRAFFIC IN EACH DIRECTION USING MT-95.31 AND MT-95.32. WORK SHALL BE COMPLETED BEFORE PHASE 1 MOT MAY BEGIN.

EXISTING STRUCTURE (SFN: 4500830)	
TYPE: CONTINUOUS STEEL BEAM WITH REINFORCED CONCRETE DECK, SEMI-INTERGRAL ABUTMENTS AND CAP AND COLUMN PIER.	
SPANS: 91'-7", 86'-3"	
ROADWAY: 80'-0" T/T PARAPET	
LOAD FREQUENCY: HL-93	
SKEW: 4°-00'-00" LEFT FORWARD	
WEARING SURFACE: 1" MONOLITHIC CONCRETE	
APPROACH SLABS: 30 FEET LONG (AS-1-81)	
ALIGNMENT: TANGENT	
CROWN: 0.0156 FT/FT	