

AS BUILT PLANS BAUMHART ROAD


COUNTY ROAD NO. 51

INDEX OF SHEETS

- TITLE SHEET
- TYPICAL SECTION
- PLAN AND PROFILE
- CROSS SECTIONS
- LINE SURVEY
- RIGHT OF WAY
- INTERSECTIONS

CONVENTIONAL SIGNS

COUNTY LINE	-----
TOWNSHIP LINE	-----
CORPORATION LINE	=====
ORIGINAL LOT LINE	-----
RIGHT OF WAY	-----
CENTERLINE	-----
PAVEMENT EDGE	-----
BERM	-----
DITCH	=====
CONDUIT	-----
POLES	⊘ ⊘ ⊘ ⊘ ⊘ ⊘ ⊘ ⊘ ⊘
RAILROAD	-----
FENCE	XXXXXXXXXXXXXXXXXXXX
TREES	⊗ ⊗ ⊗ ⊗ ⊗ ⊗ ⊗ ⊗

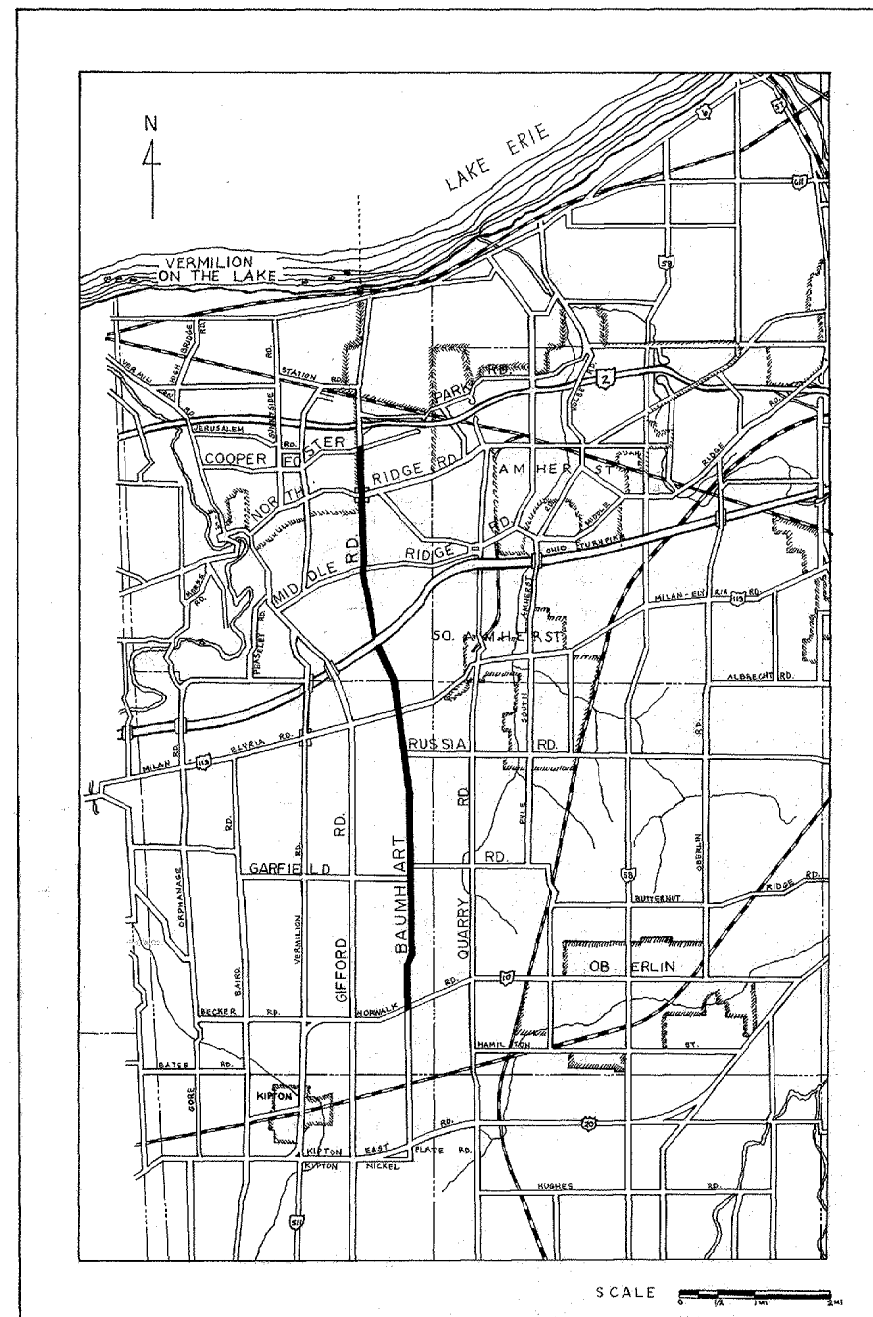





LOCATION MAP

INDEX TO FIELD BOOKS

THESE PLANS WERE PREPARED
BY THE OFFICE OF THE LORAIN
COUNTY ENGINEER

LAWRENCE V. McGLINCHY
LORAIN COUNTY ENGINEER





DRAWN BY: EAD; RJL; JMM
DATE COMPLETED: JULY, 1981
CHECKED BY:

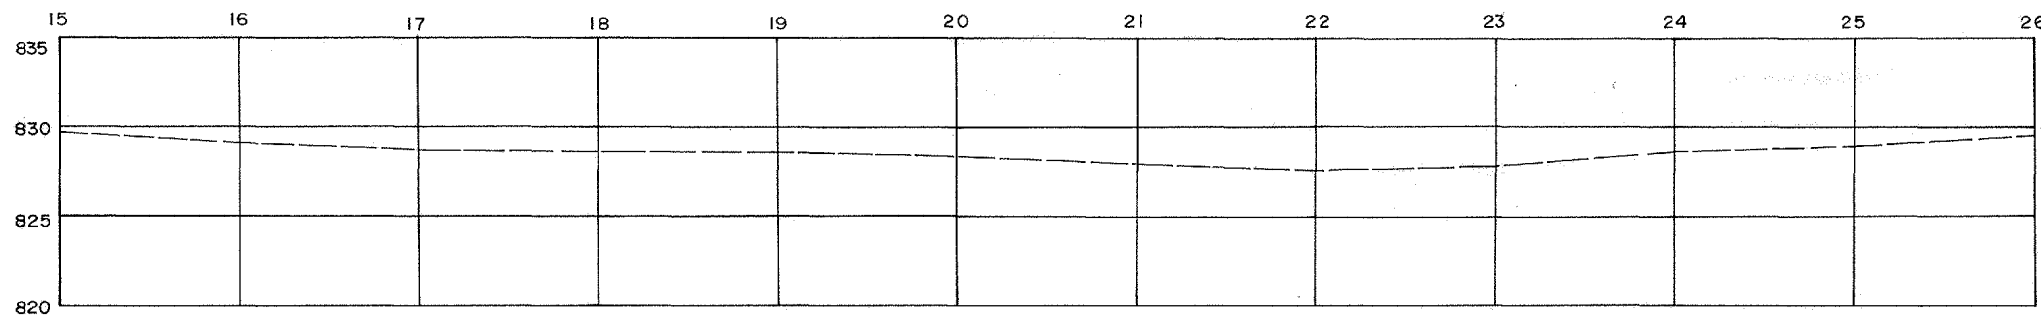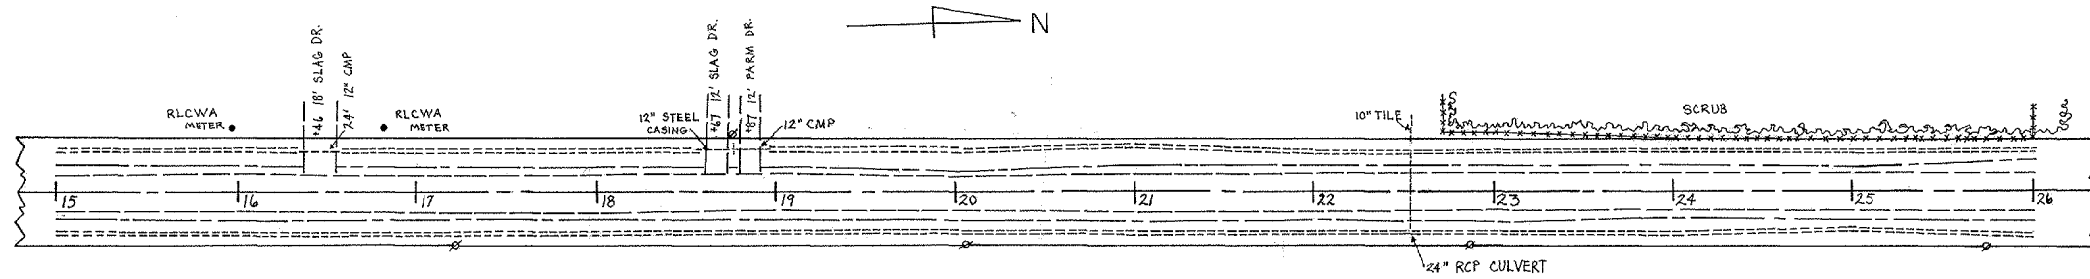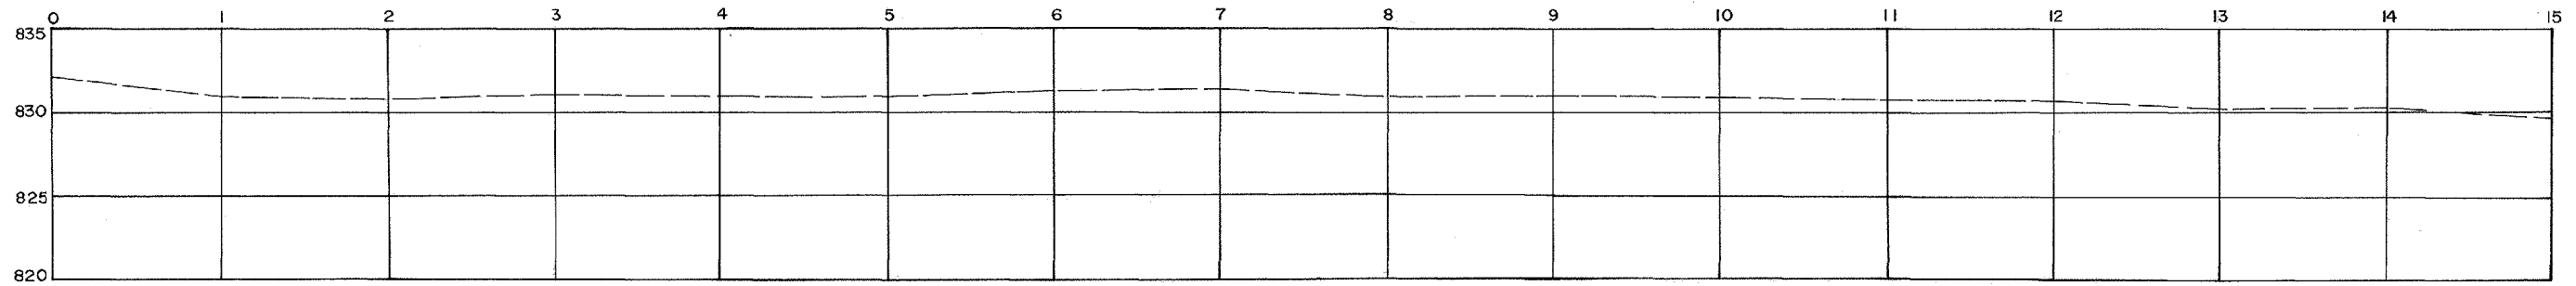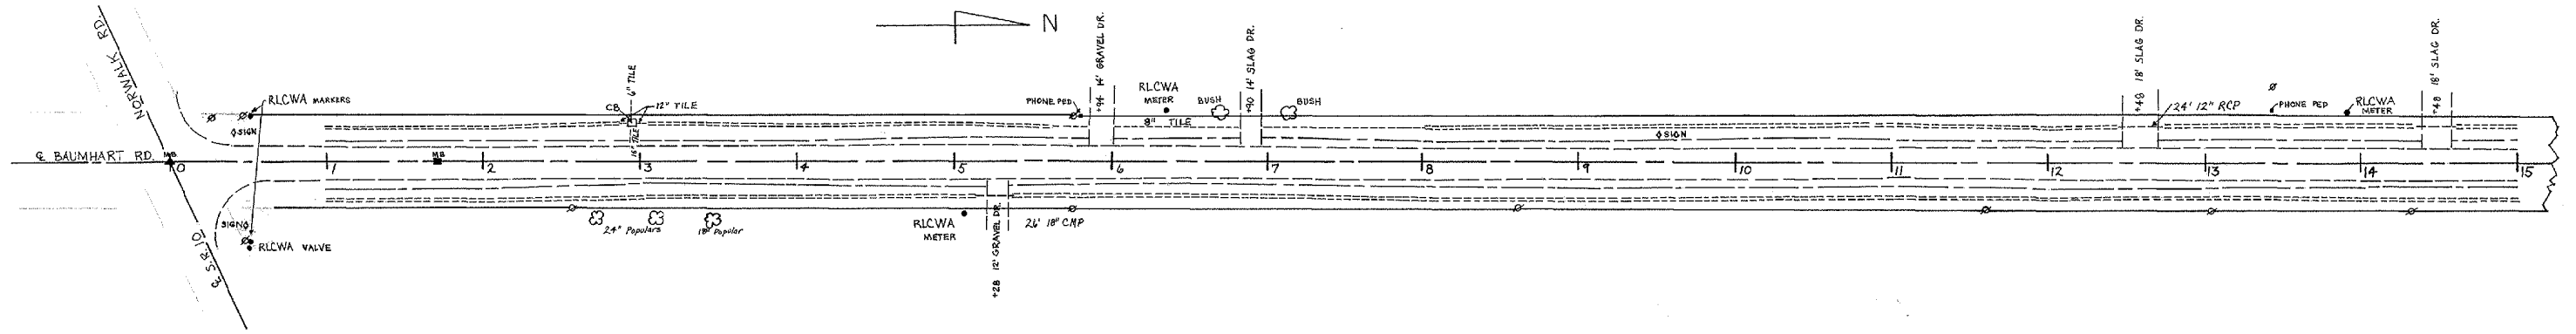

DATE	REVISION	BY

BAUMHART RD.
 HENRIETTA TOWNSHIP
 LIMITS: STA. 0 to 26
 DATE: JULY, 1981
 BY: JMM





SCALE
 HORIZONTAL PLAN 1" = 50'
 VERTICAL PLAN 1" = 5'
 HORIZONTAL 1" = 50'
 VERTICAL 1" = 5'

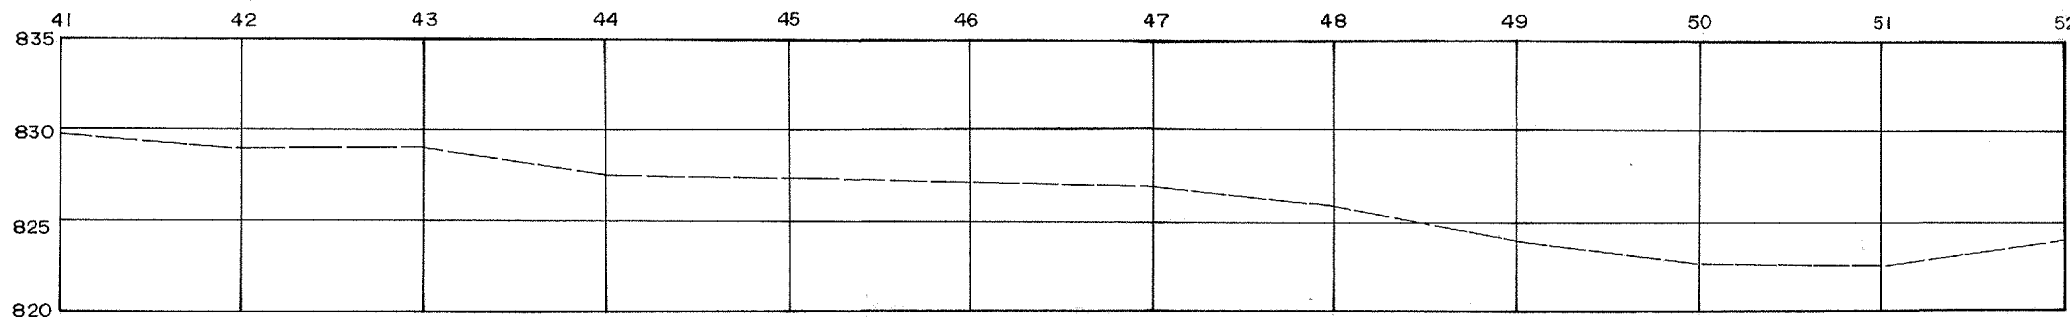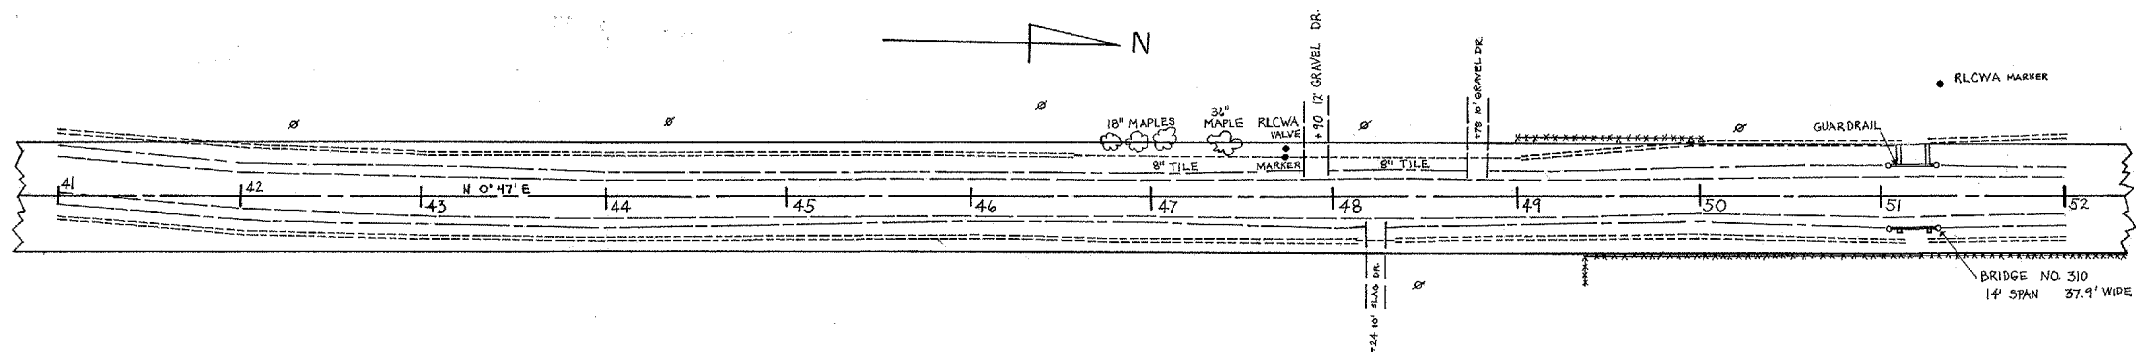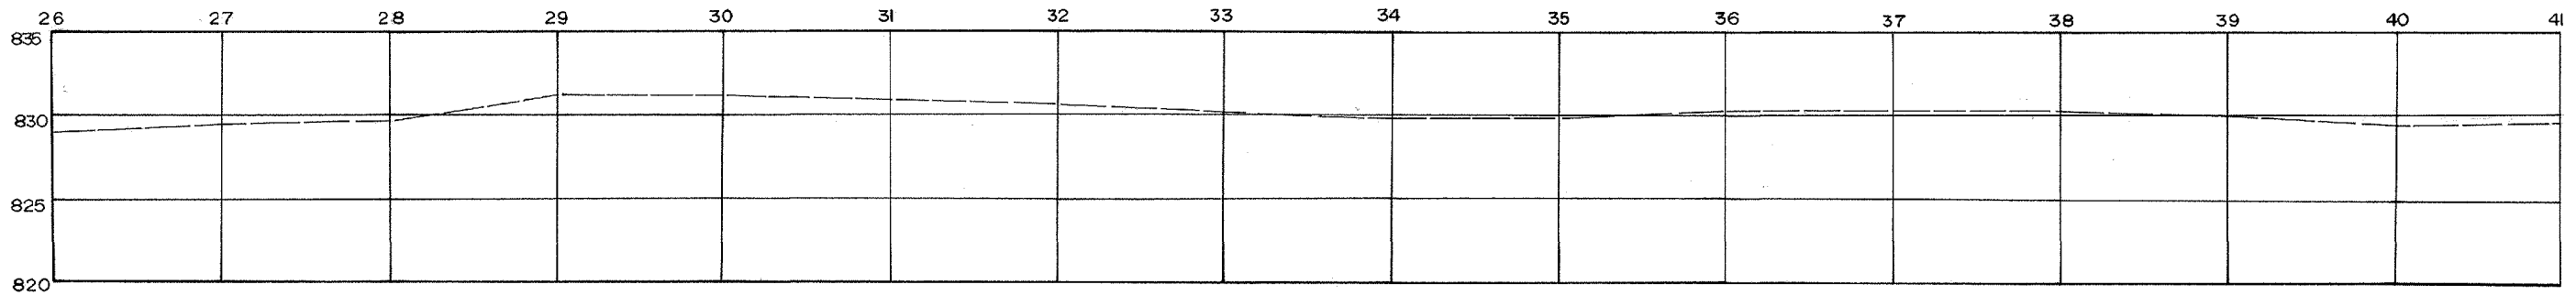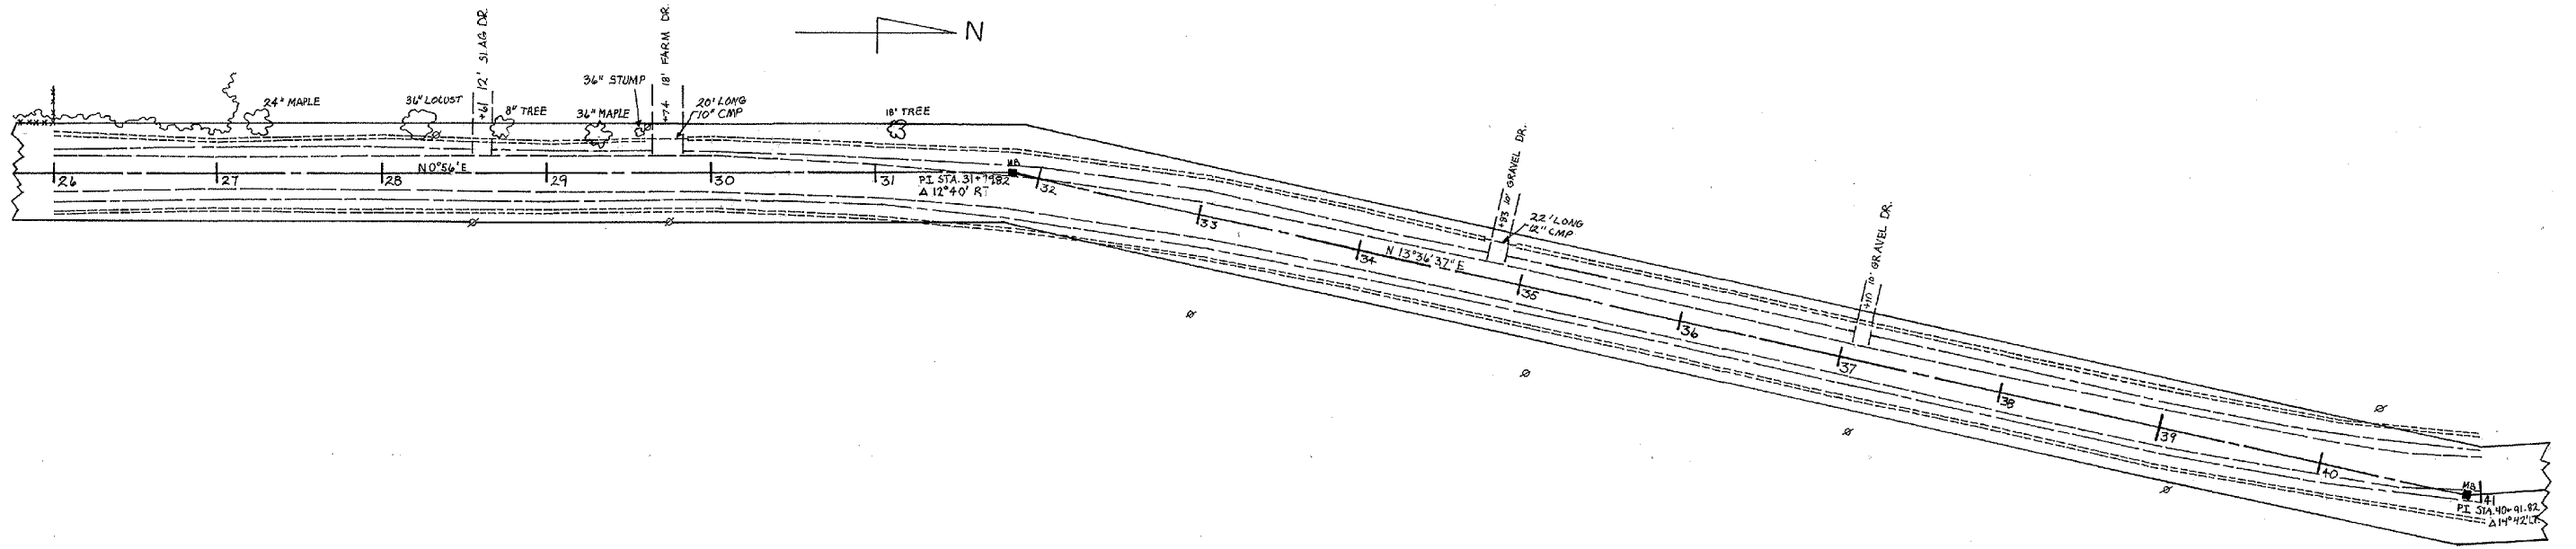

DATE	REVISION	BY

BAUMHART RD.
 HENRIETTA TOWNSHIP
 LIMITS: STA. 26 TO 52
 DATE: JULY, 1981
 BY: JMM





SCALE
 HORIZONTAL PLAN 1" = 50'
 VERTICAL PLAN 1" = 5'
 HORIZONTAL 1" = 50'
 VERTICAL 1" = 5'

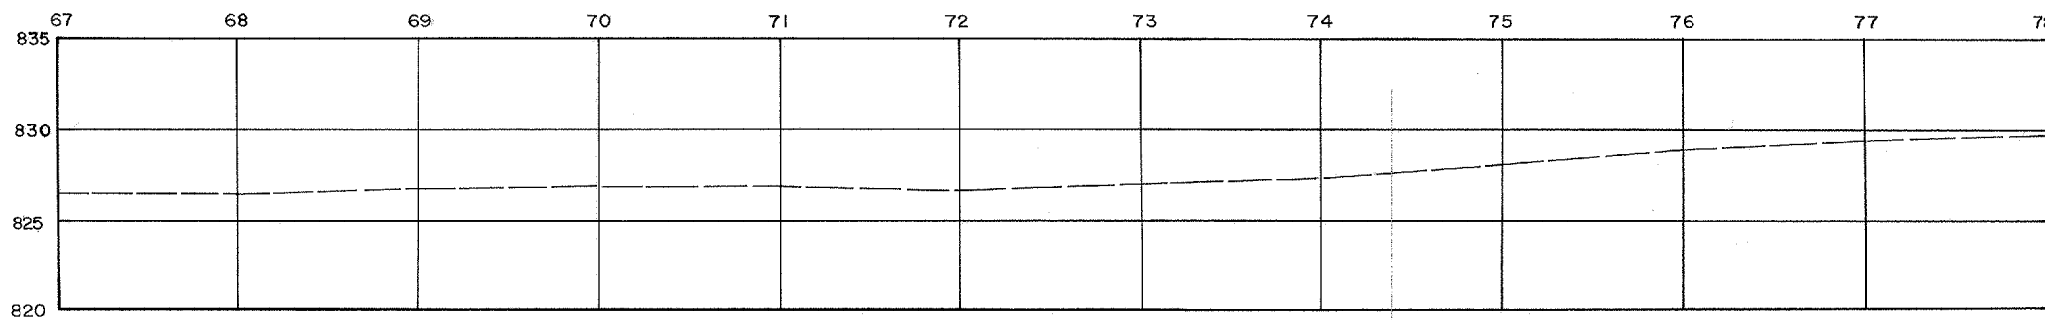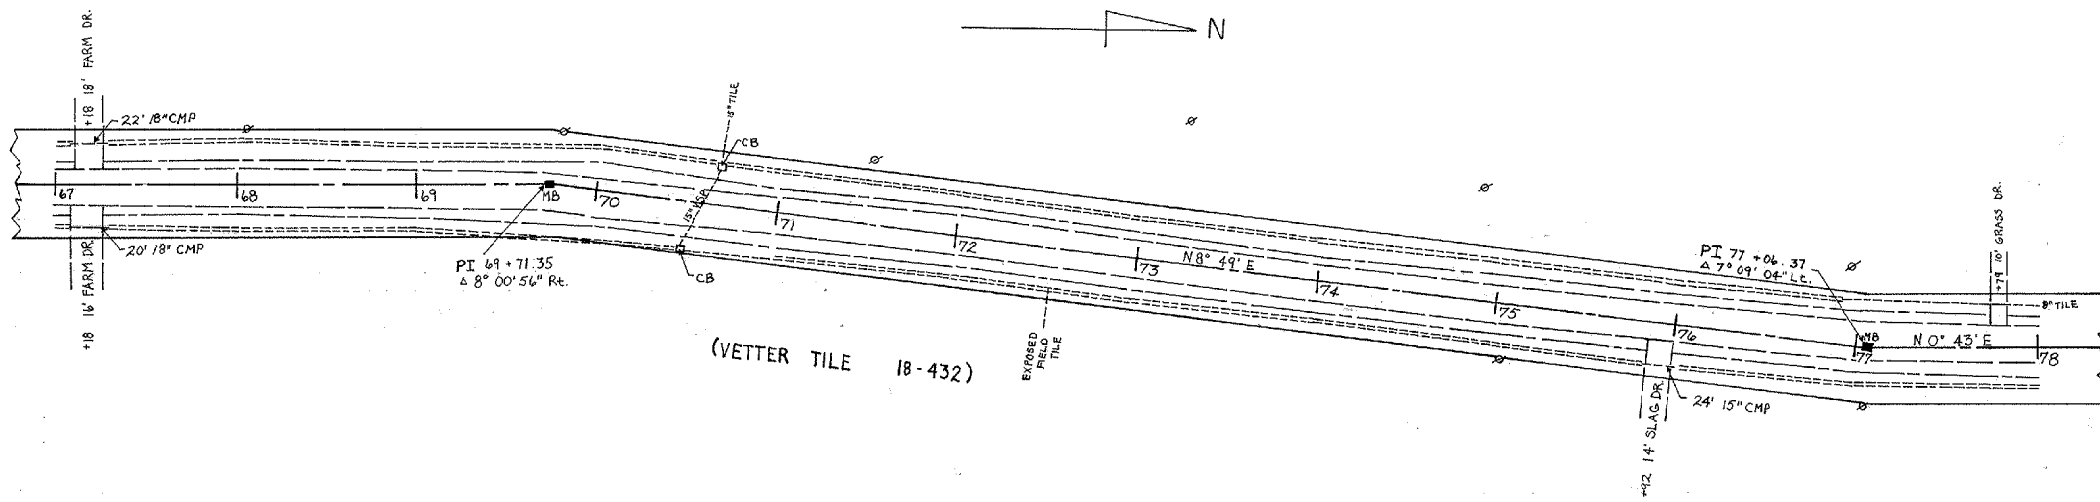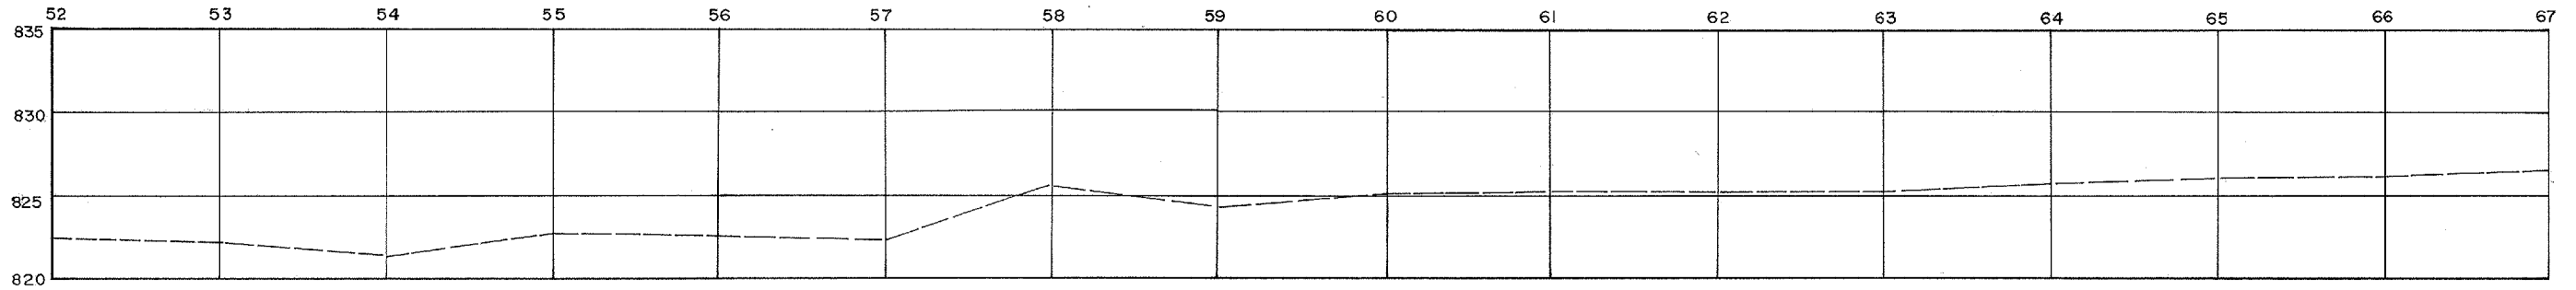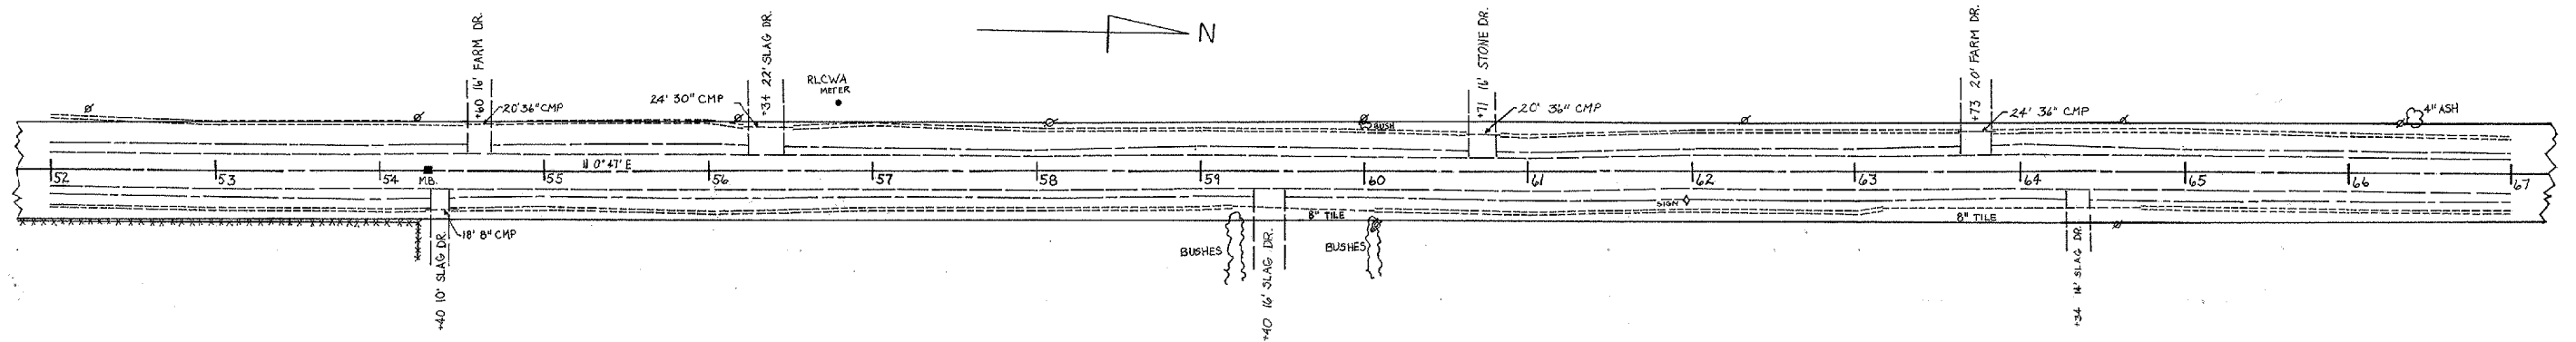

DATE	REVISION	BY

BAUMHART RD.
 HENRIETTA TOWNSHIP
 LIMITS: STA. 52 TO 78
 DATE: JULY, 1981
 BY: JMM





SCALE
 HORIZONTAL PLAN 1"=50'
 VERTICAL PLAN 1"=50'
 HORIZONTAL 1"=50'
 VERTICAL 1"=5'

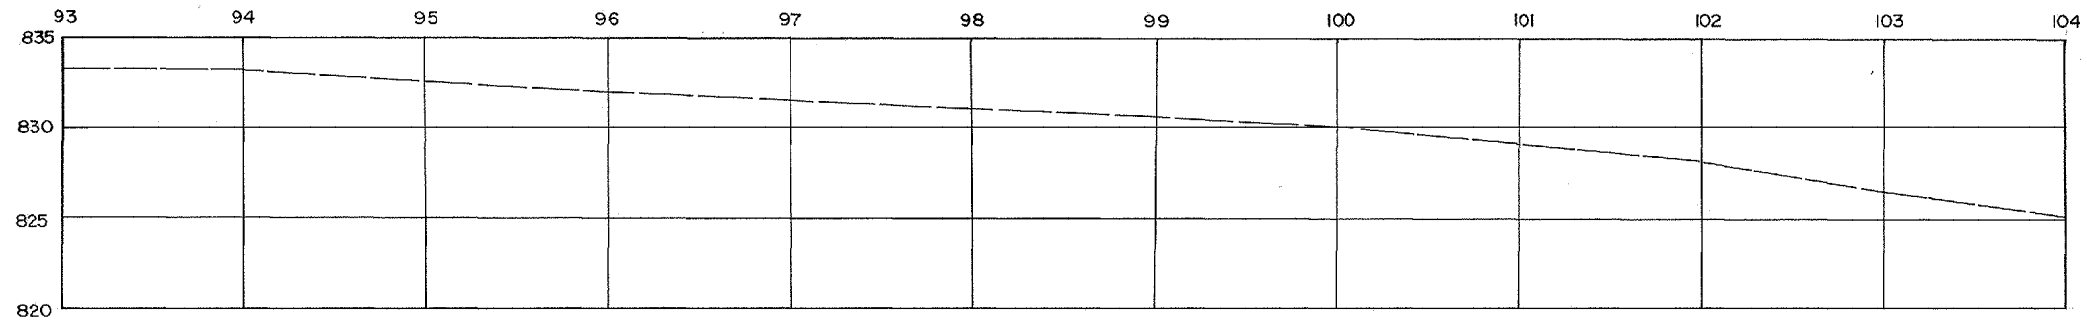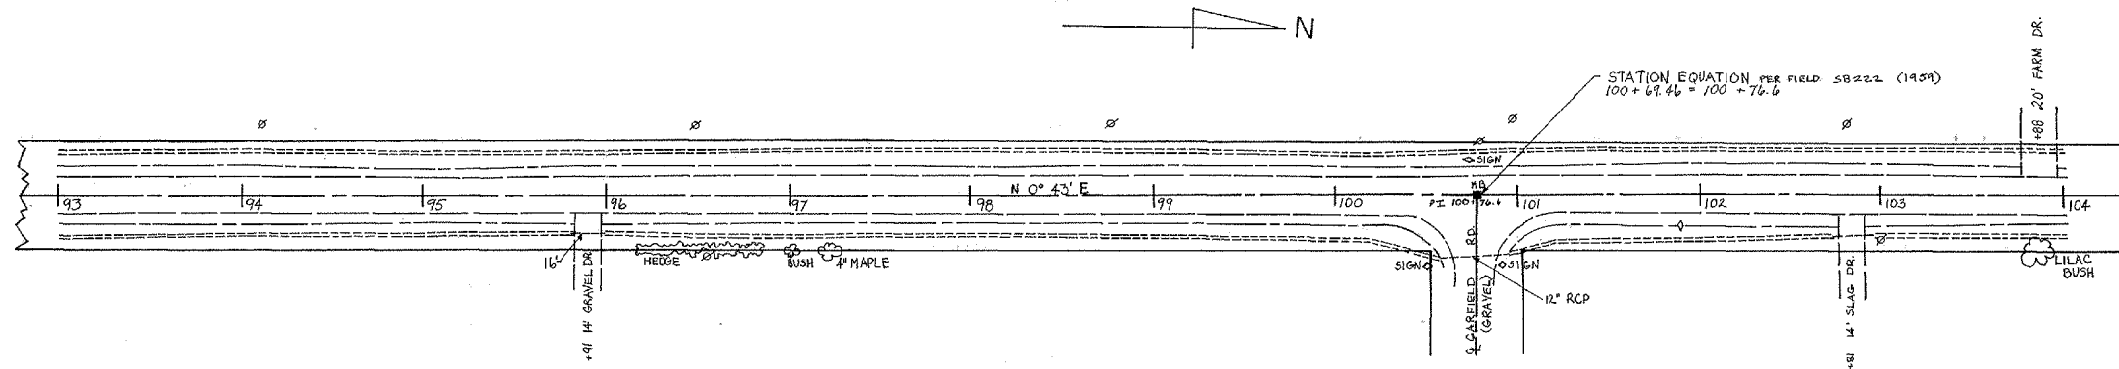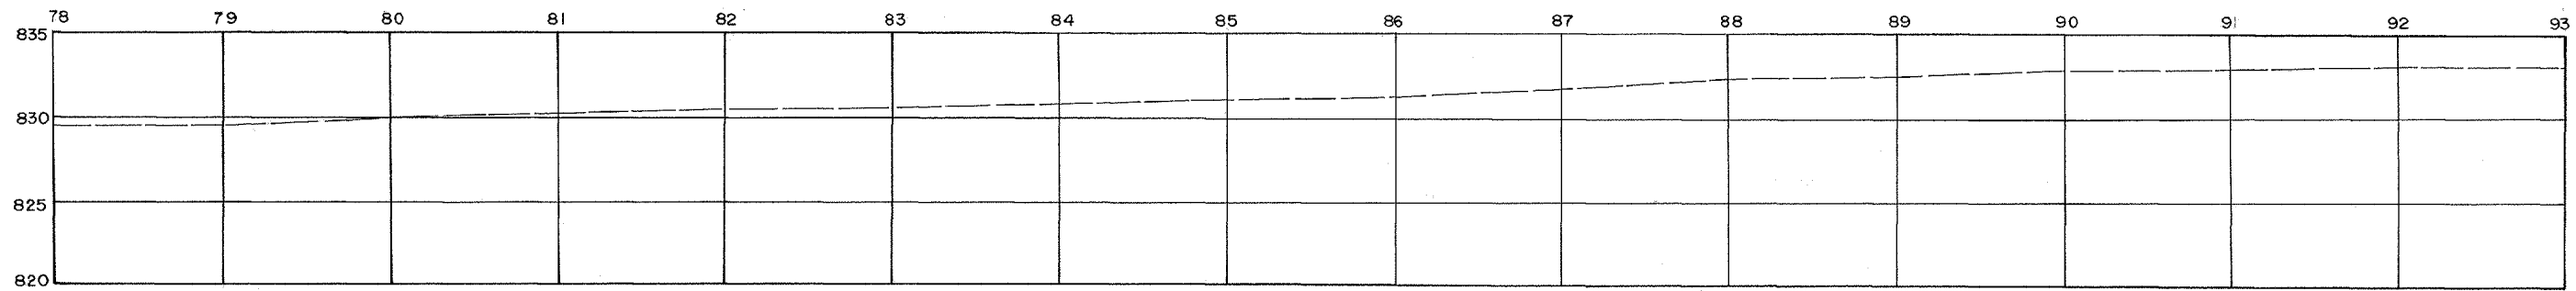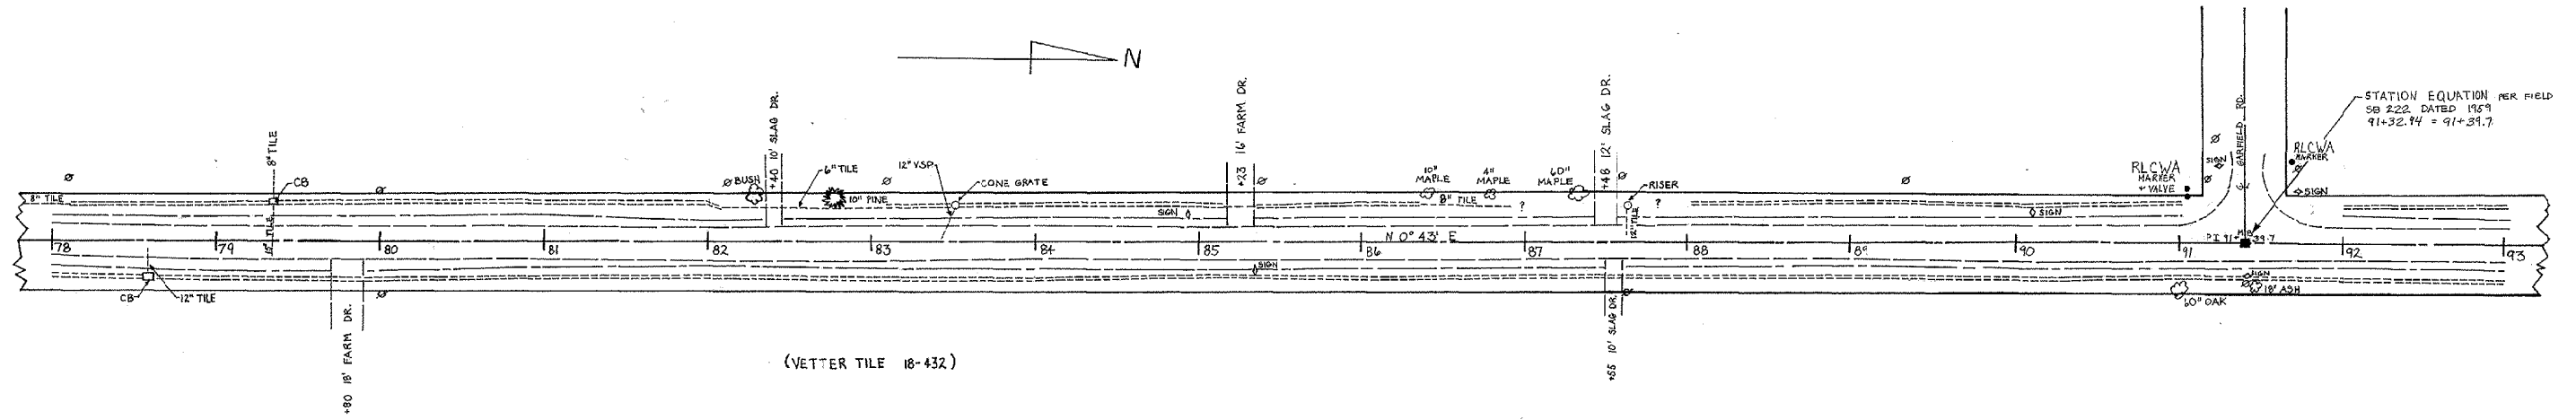

DATE	REVISION	BY

BAUMHART RD.
HENRIETTA TOWNSHIP
LIMITS: STA. 78 to 104
DATE: JULY, 1981
BY: JMM





SCALE
HORIZONTAL PLAN 1"=50'
VERTICAL PLAN
HORIZONTAL 1"=50'
VERTICAL 1"=5'

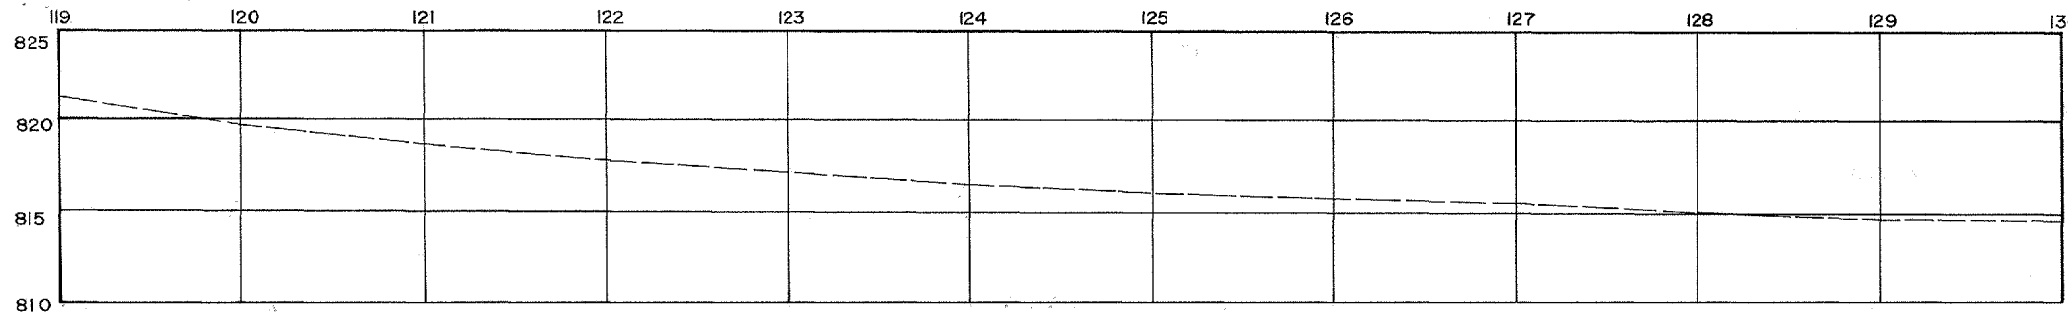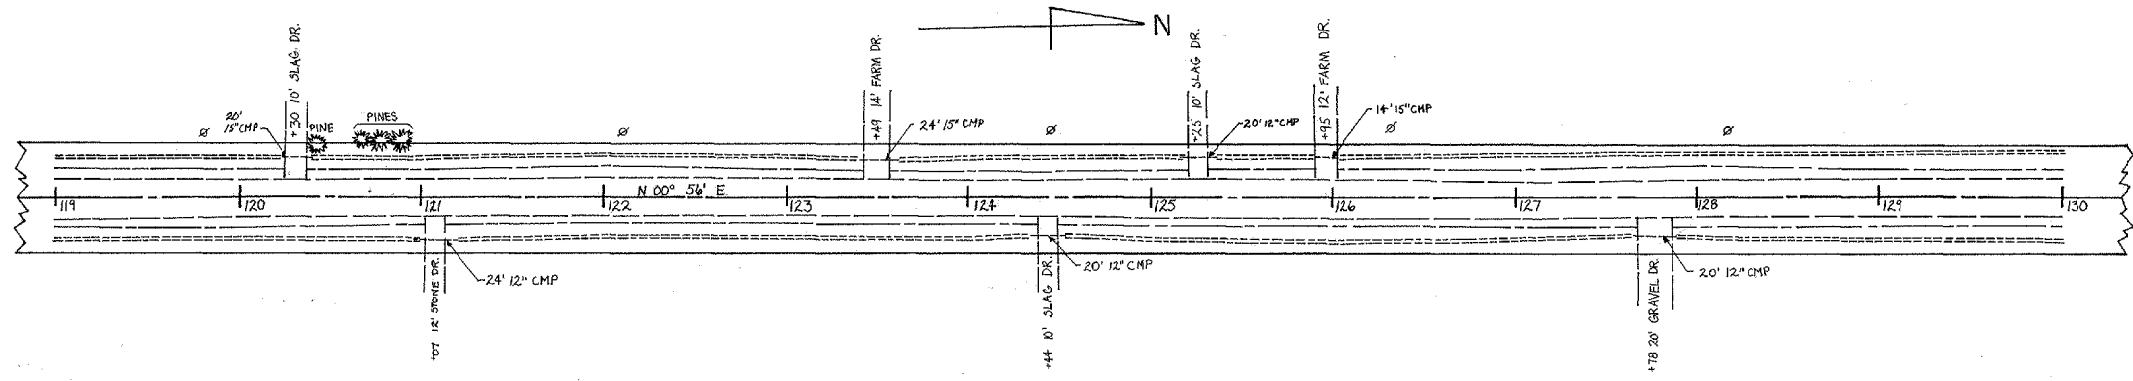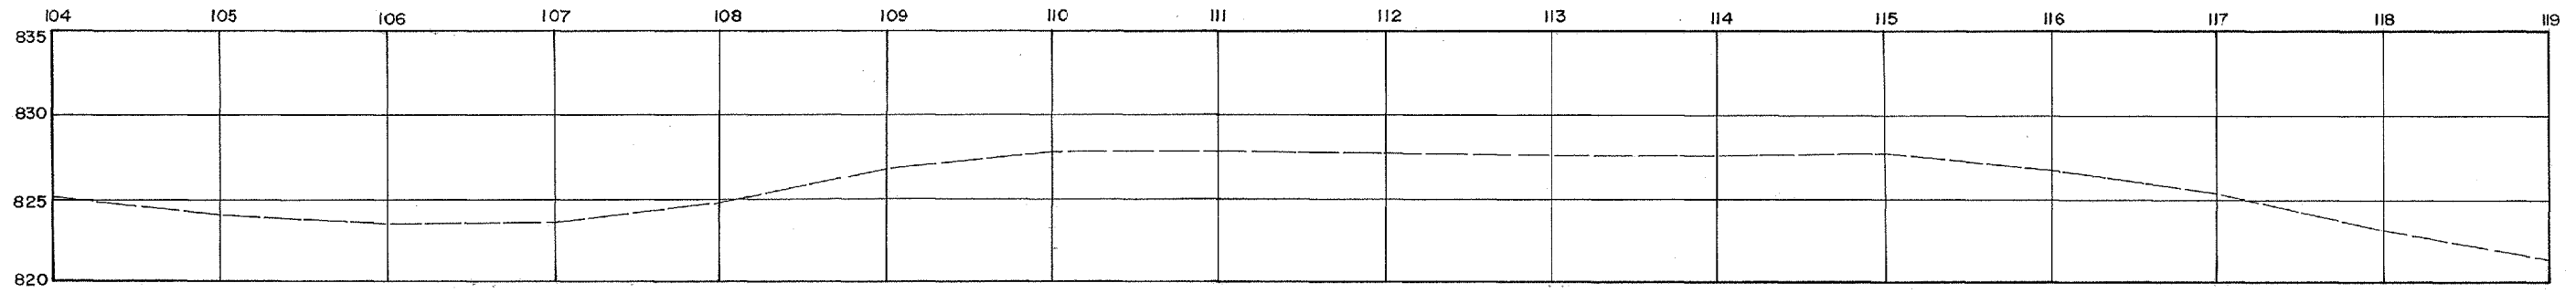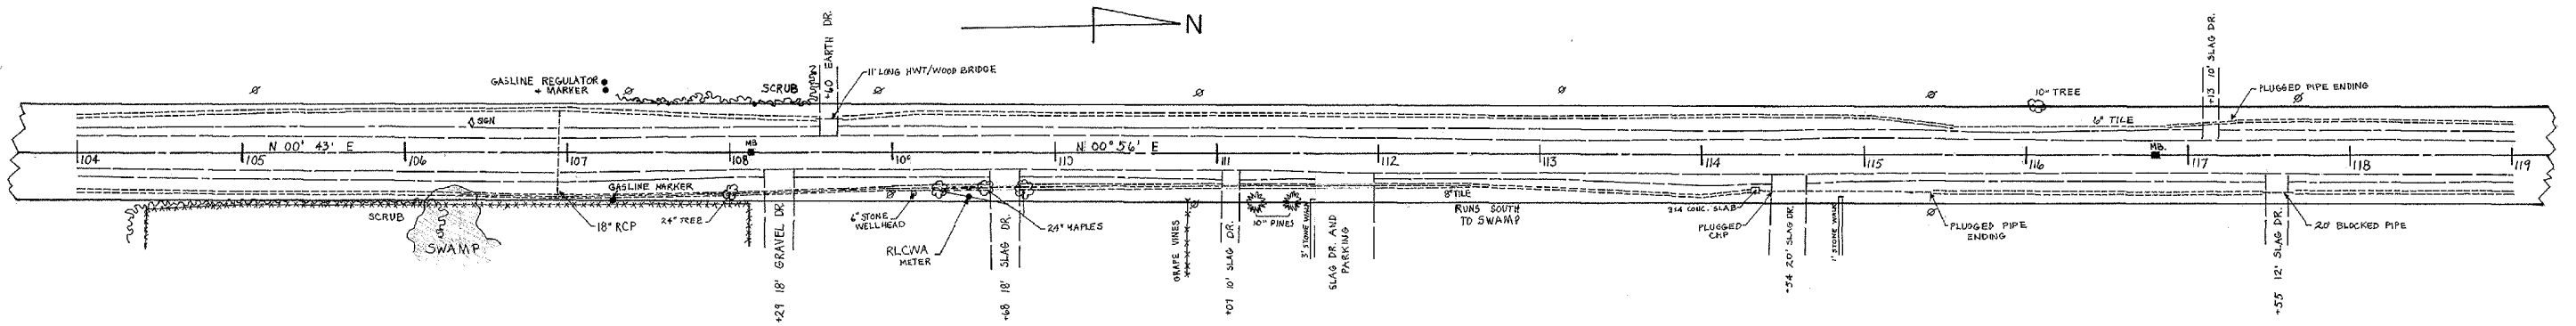

DATE	REVISION	BY

BAUMHART RD.
 HENRIETTA TOWNSHIP
 LIMITS: STA. 104 to 130
 DATE: JULY, 1981
 BY: JMM





SCALE
 HORIZONTAL PLAN 1" = 50'
 VERTICAL PLAN 1" = 5'
 HORIZONTAL 1" = 50'
 VERTICAL 1" = 5'

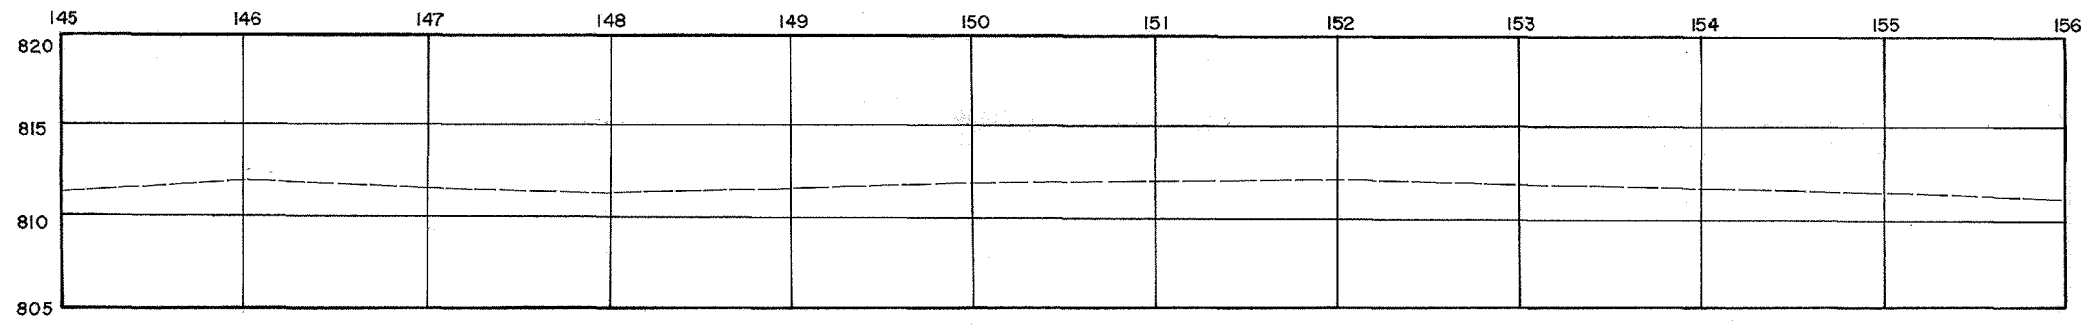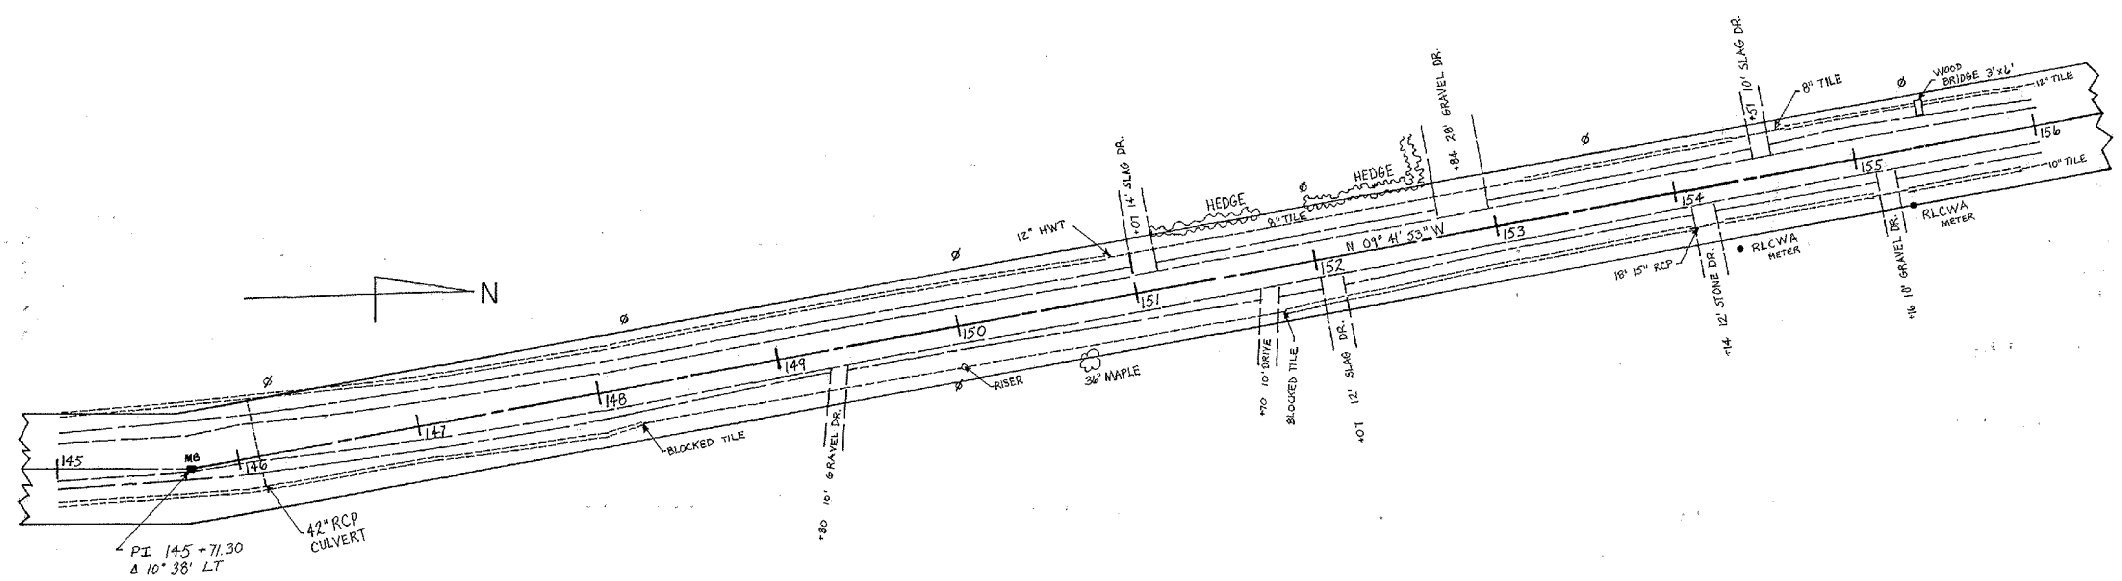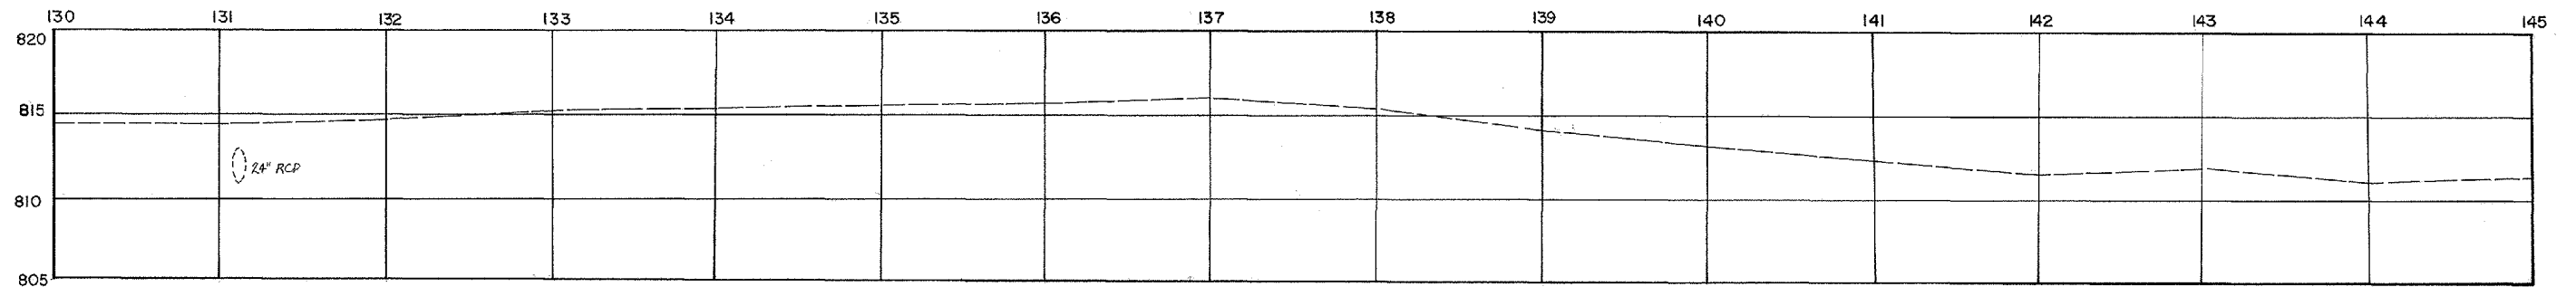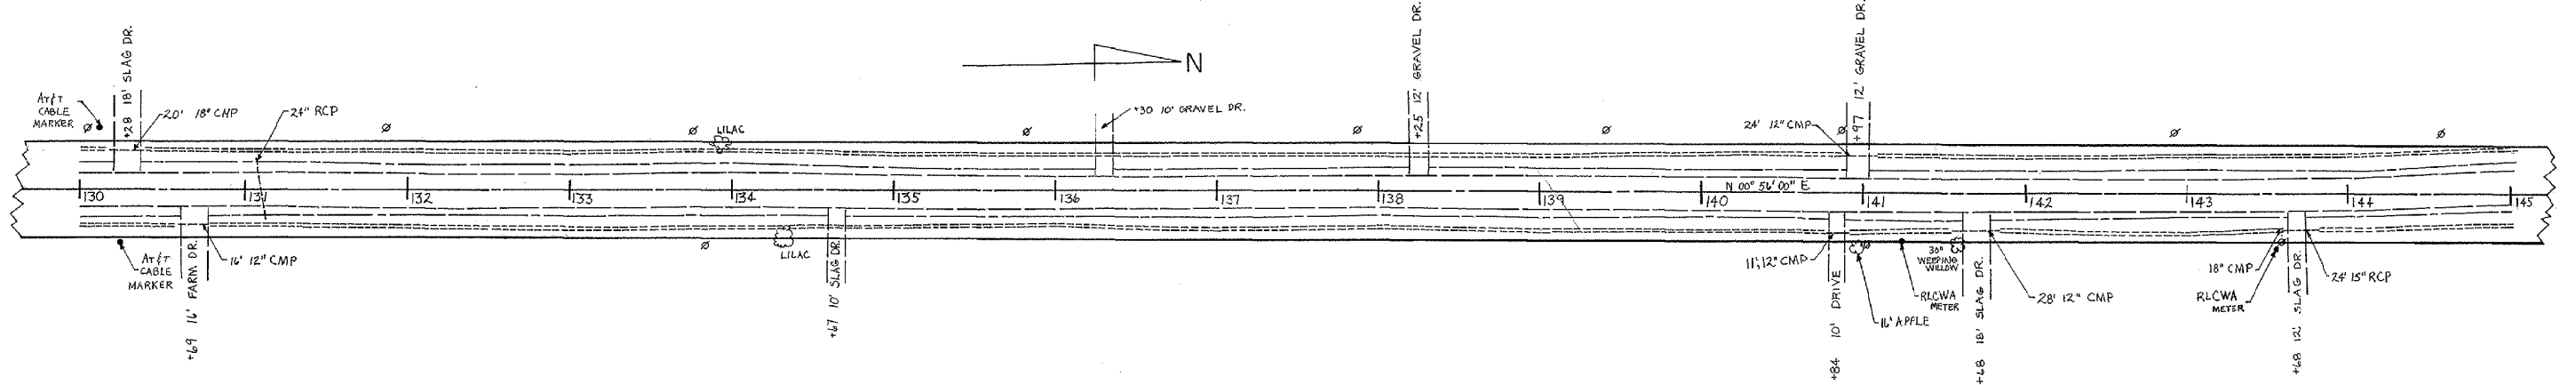

DATE	REVISION	BY

BAUMHART RD.
 HENRIETTA TOWNSHIP
 LIMITS: STA. 130 TO 156
 DATE: AUG, 1981
 BY: JMM

SCALE
 HORIZONTAL PLAN 1"=50'
 VERTICAL PLAN 1"=5'
 HORIZONTAL 1"=50'
 VERTICAL 1"=5'

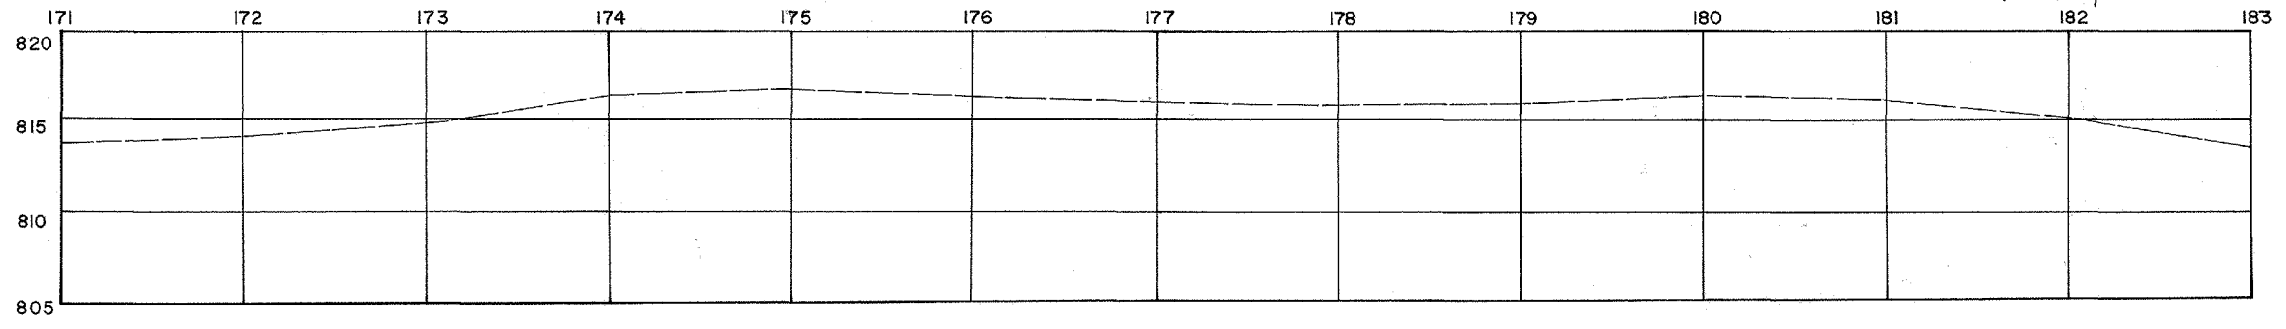
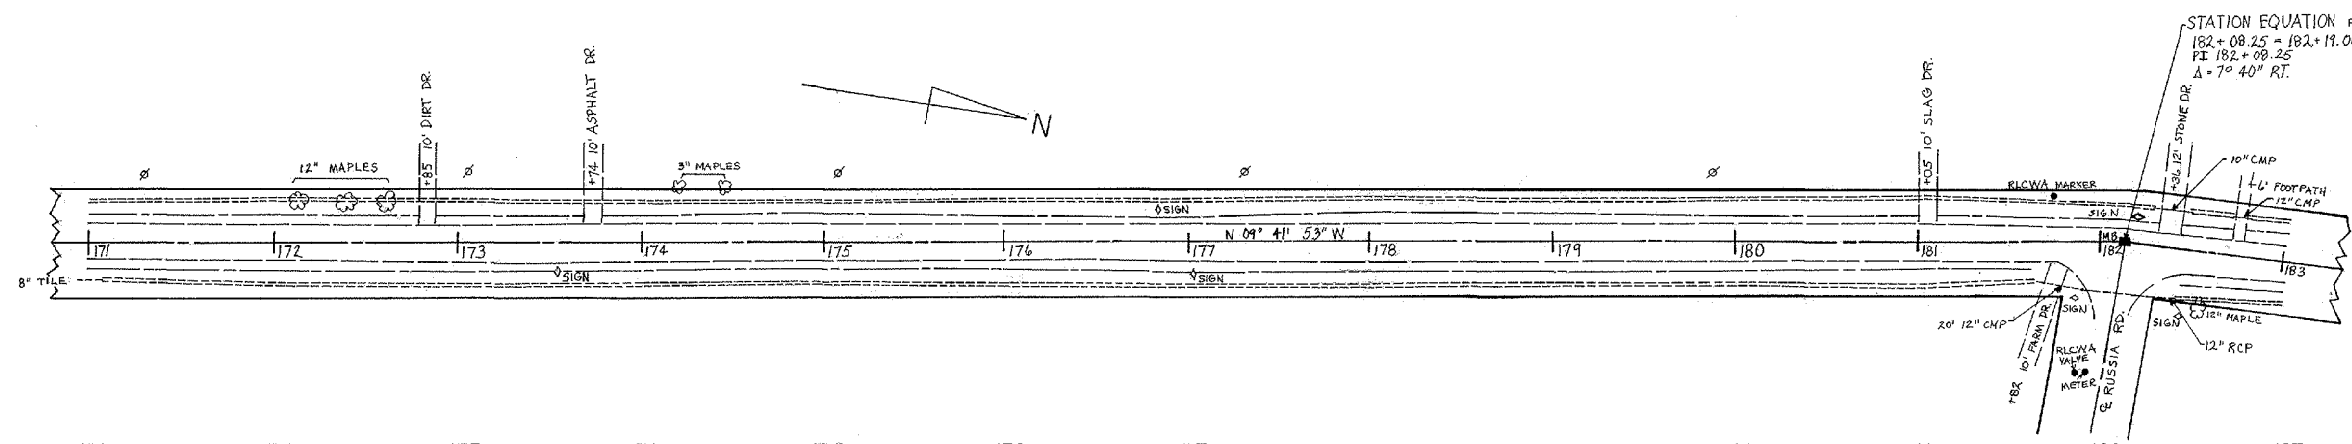
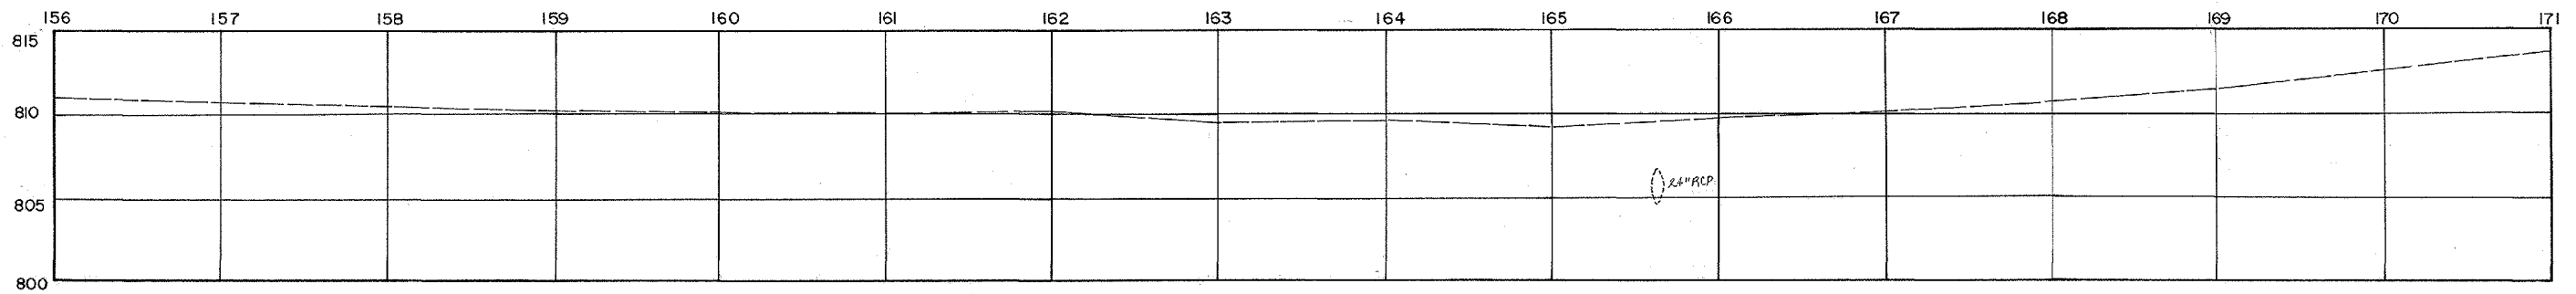
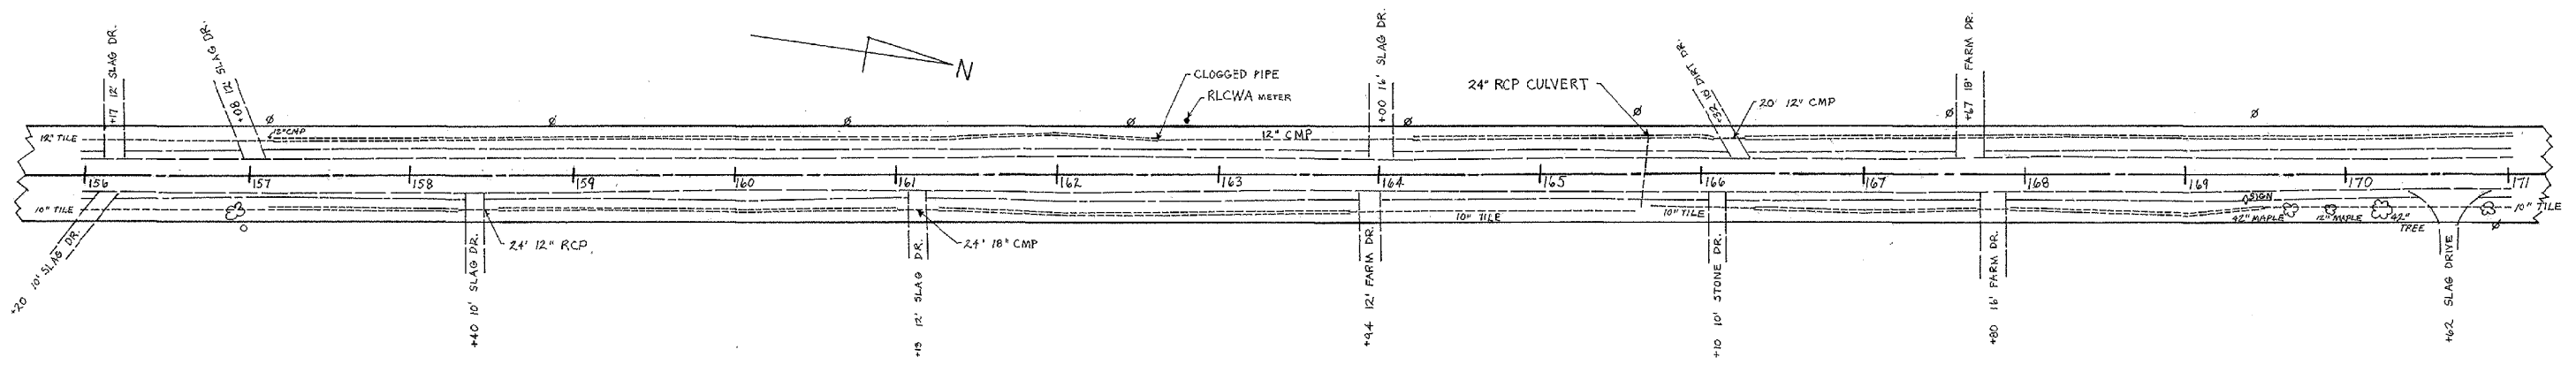


STATION EQUATION PER FIELD SB222 (DATED 1959)
 $182 + 08.25 = 182 + 11.00$
 $PI 182 + 09.25$
 $\Delta = 70.40^\circ RT.$

DATE	REVISION	BY

BAUMHART RD.
 HENRIETTA TOWNSHIP
 LIMITS: STA. 156 TO 183
 DATE: AUG., 1981
 BY: JMM





SCALE
 HORIZONTAL PLAN 1" = 50'
 VERTICAL PLAN
 HORIZONTAL 1" = 50'
 VERTICAL 1" = 5'

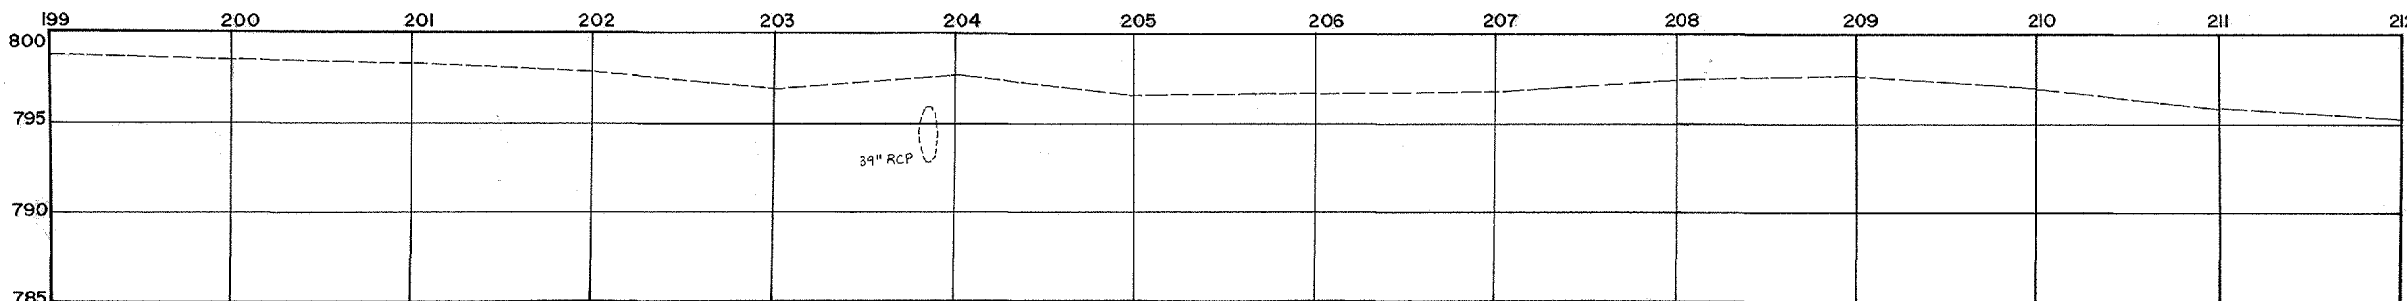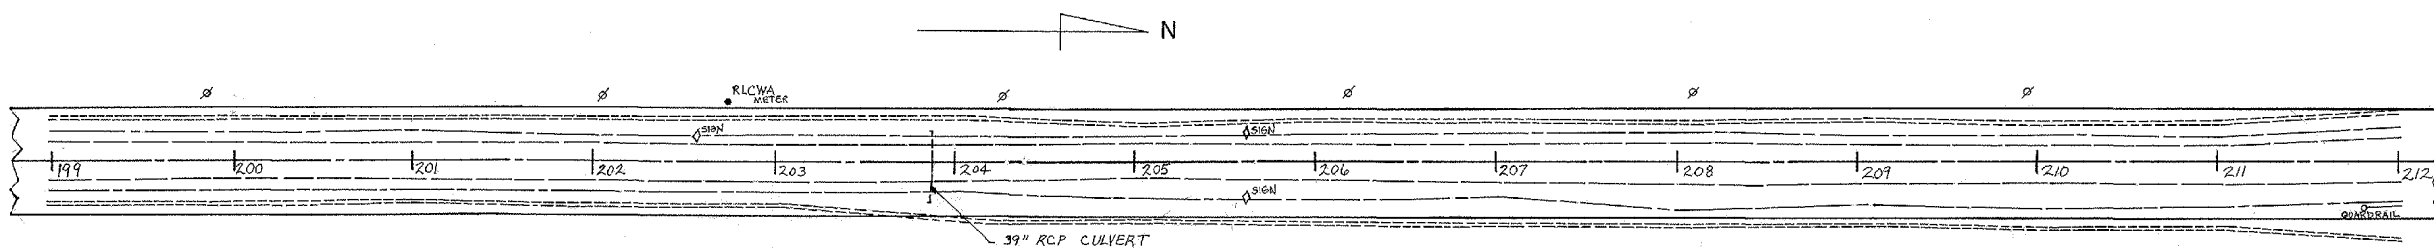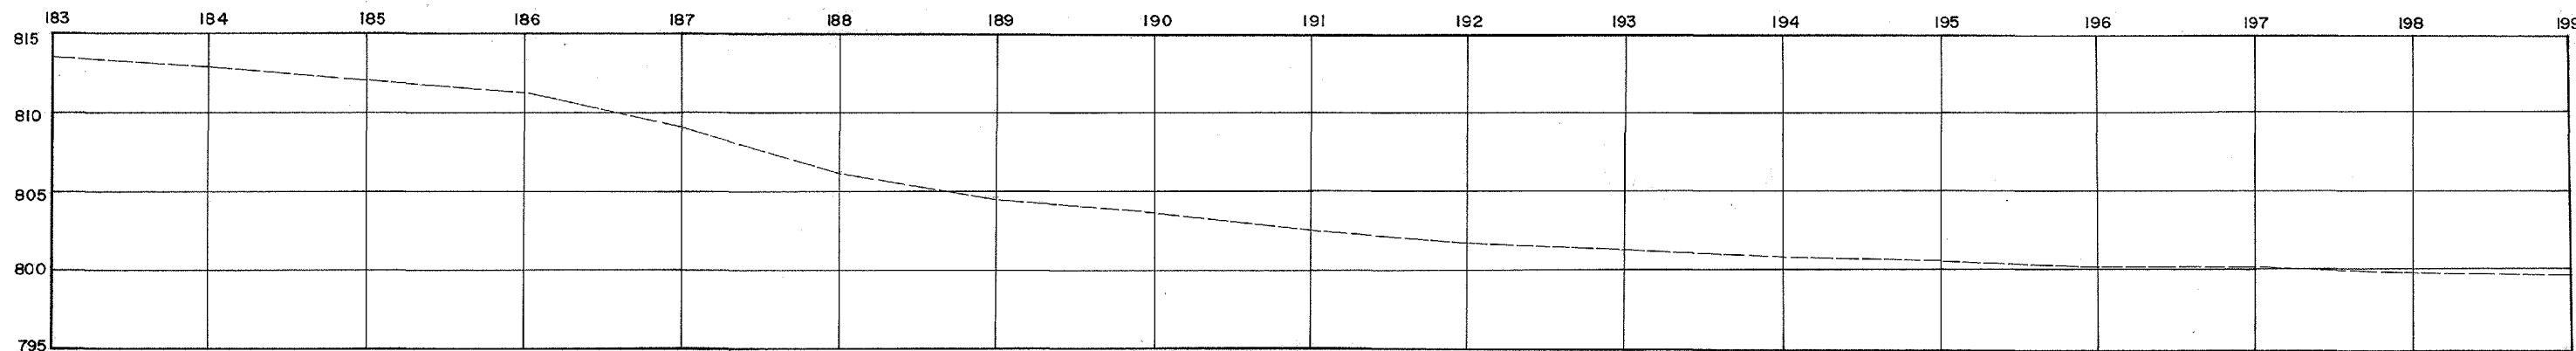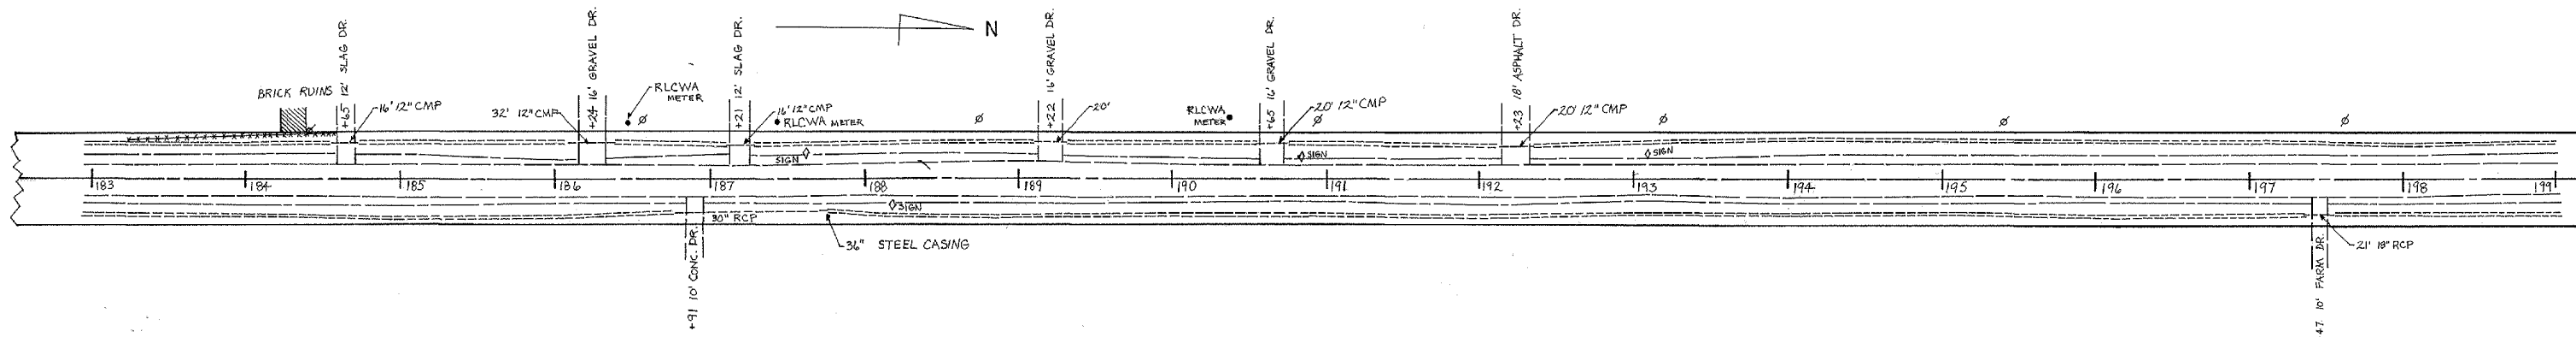

DATE	REVISION	BY





BAUMHART RD.
 HENRIETTA TOWNSHIP
 LIMITS: STA. 183 to 212
 DATE: AUG., 1981
 BY: JMM

SCALE
 HORIZONTAL PLAN 1" = 50'
 VERTICAL PLAN
 HORIZONTAL 1" = 50'
 VERTICAL 1" = 5'

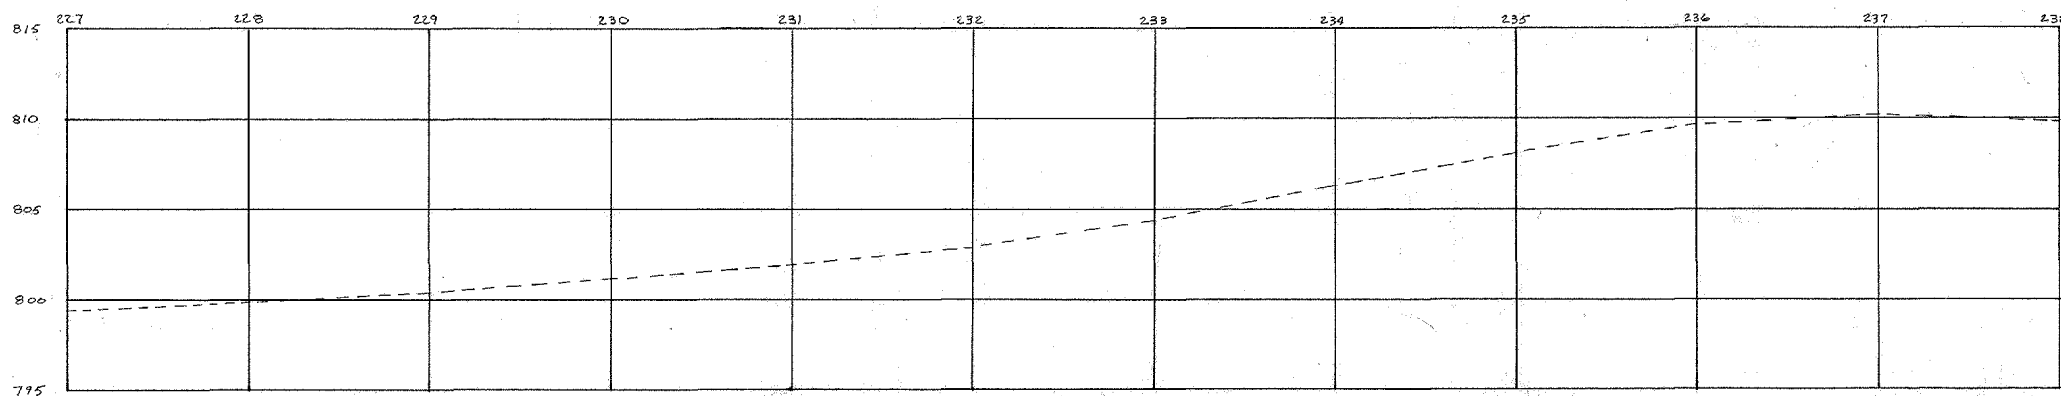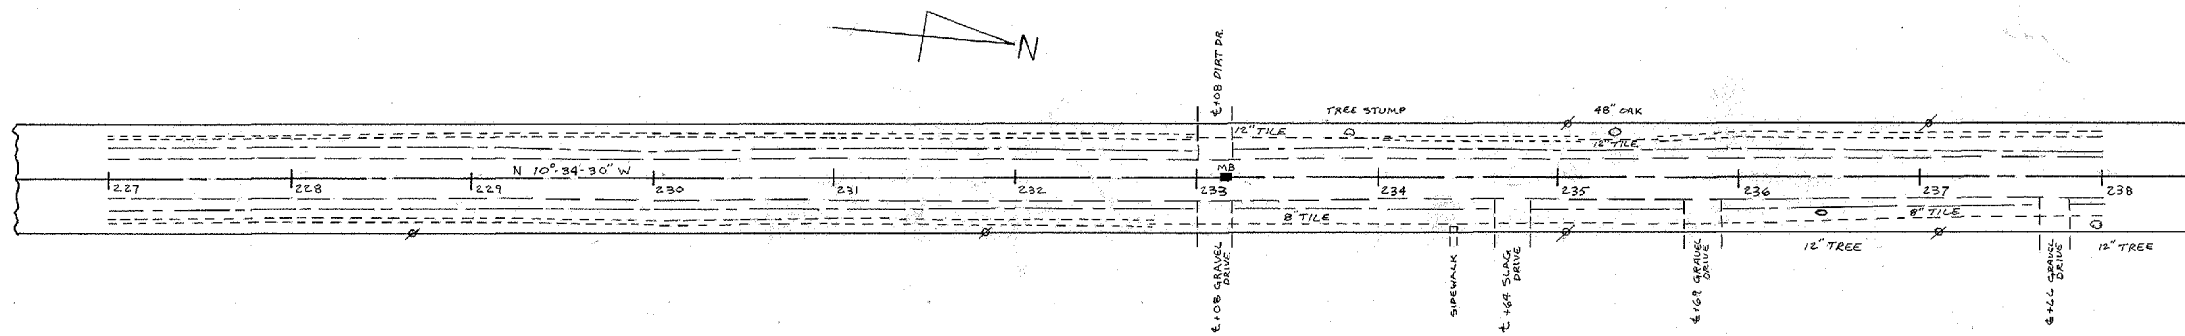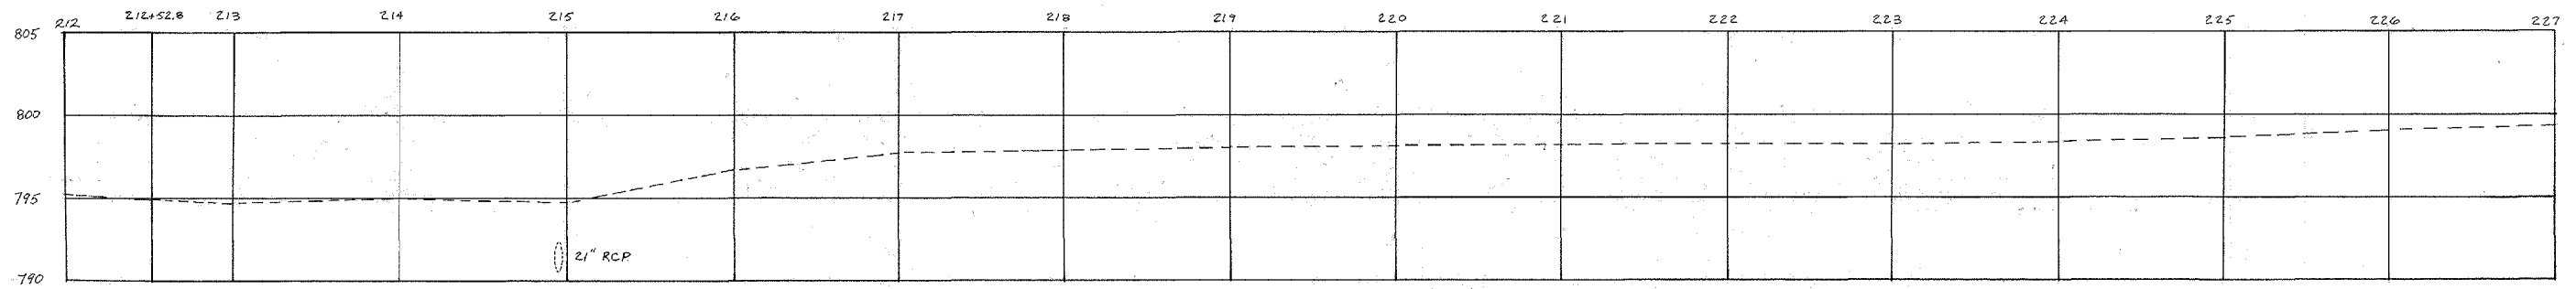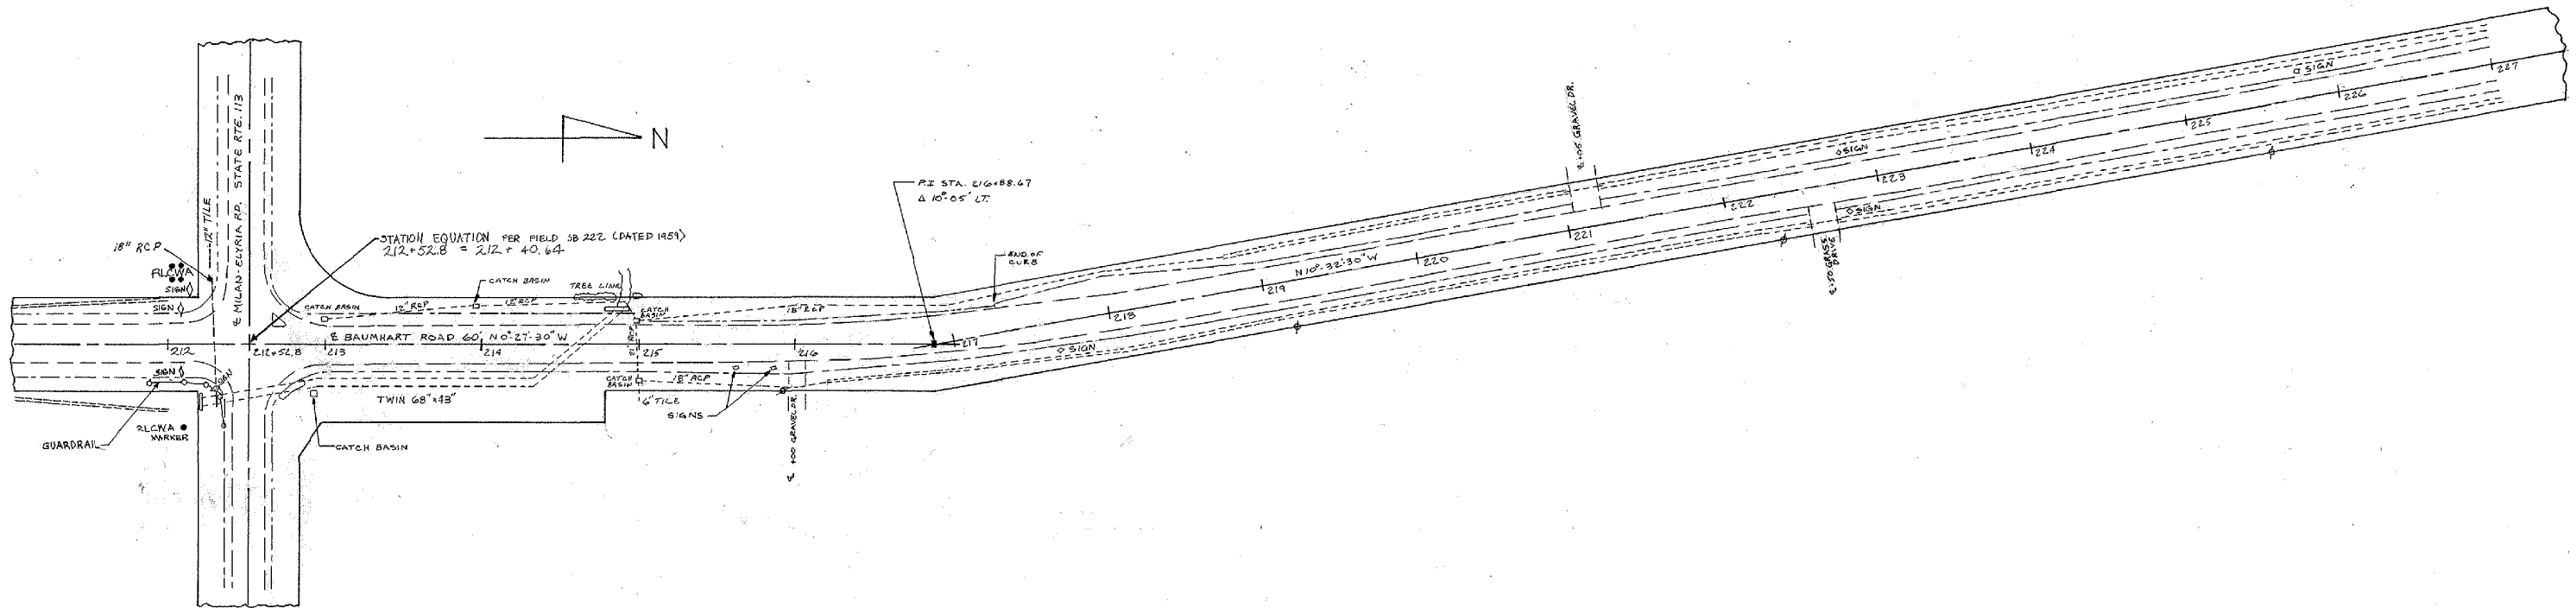

DATE	REVISION	BY





BAUMHART ROAD
HENRIETTA & BROWNHELM
TOWNSHIPS
LIMITS: STA. 212 TO STA. 238
 SCALE
 HORIZONTAL PLAN 1" = 50'
 VERTICAL PLAN 1" = 50'
 HORIZONTAL 1" = 50'
 VERTICAL 1" = 5'

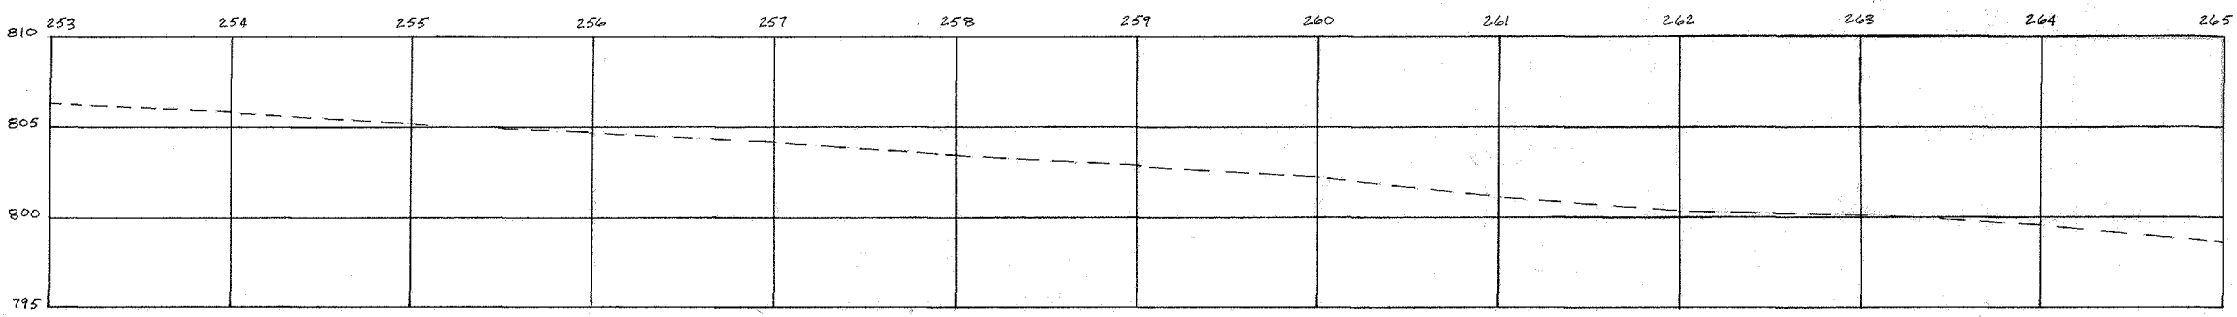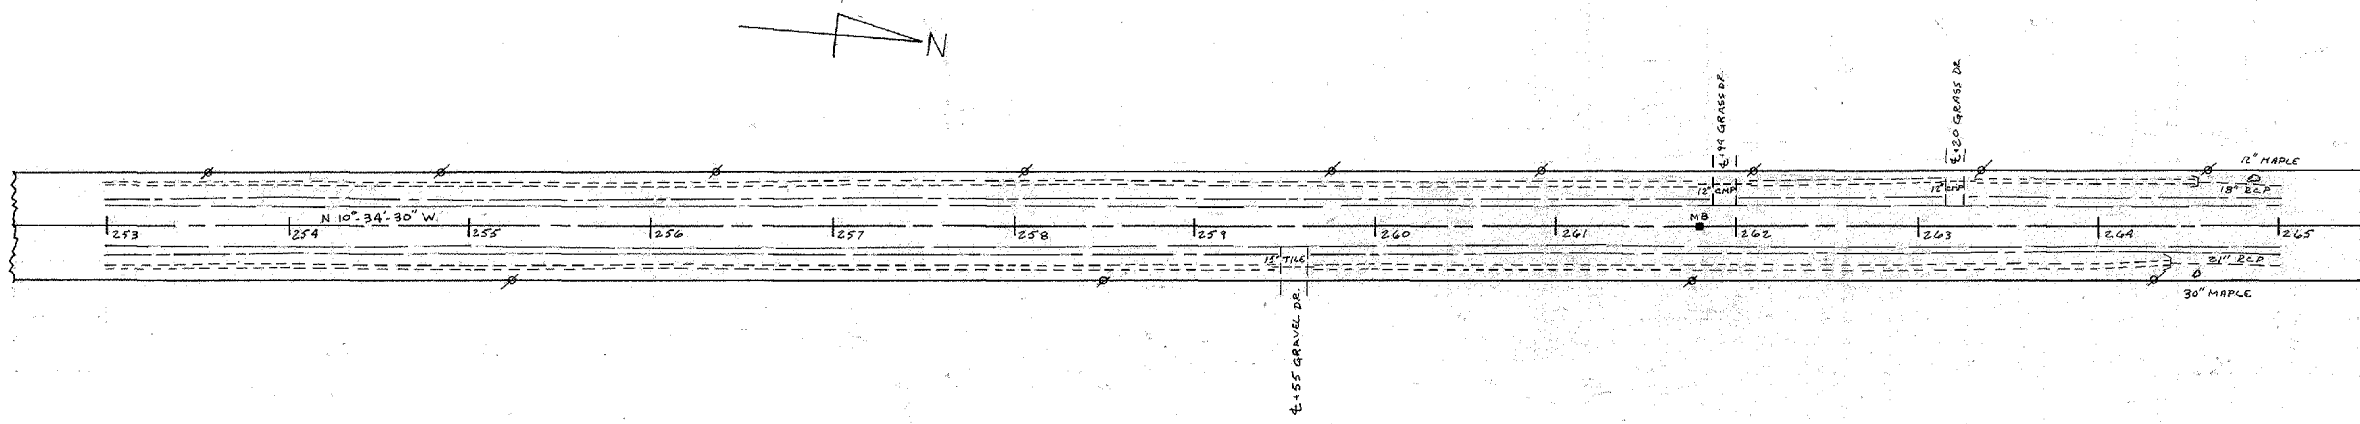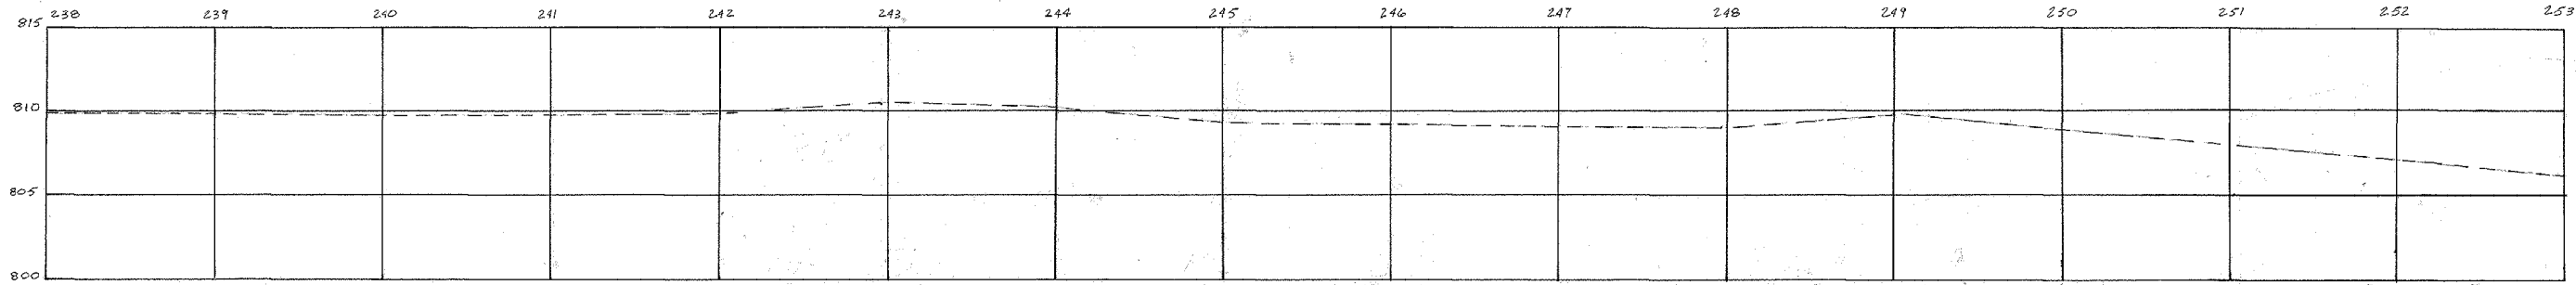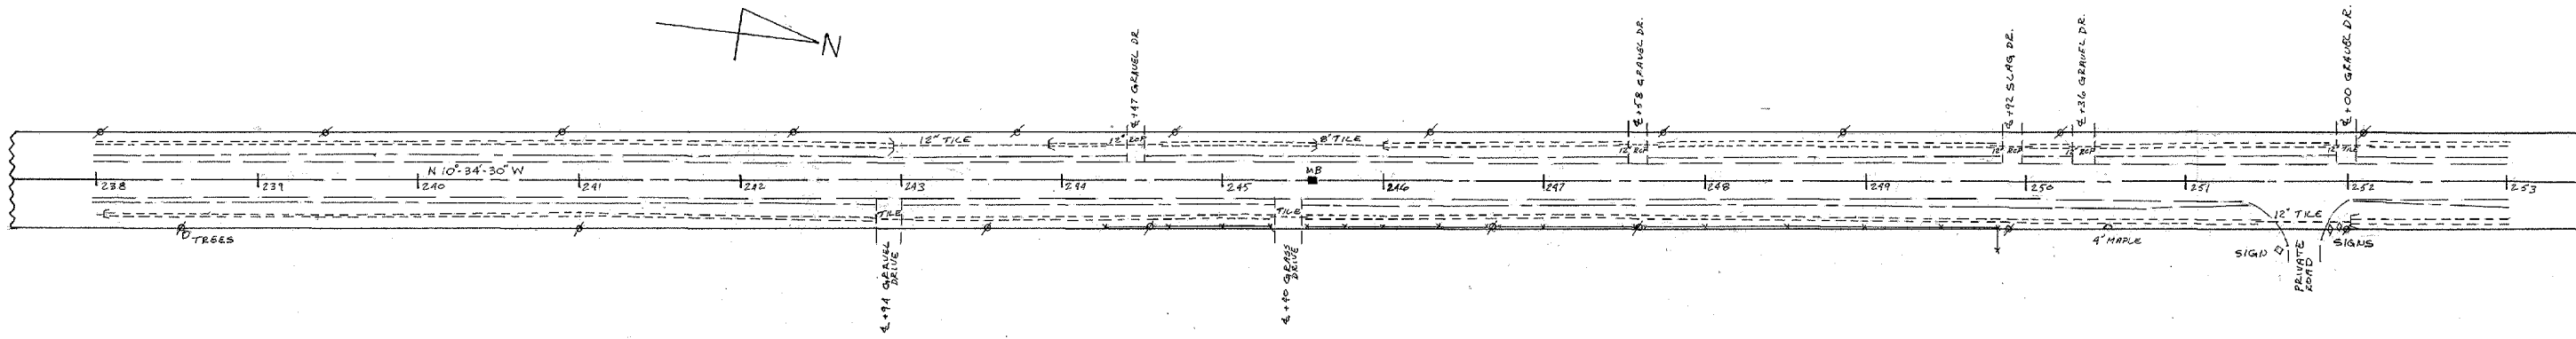

DATE	REVISION	BY

BAUMHART ROAD
 HENRIETTA & BROWNHELM
 TOWNSHIPS
 LIMITS: STA. 238 TO STA. 265
 BY: R.J.L. DATE: FEB, 1981



SCALE	
HORIZONTAL PLAN	1" = 50'
VERTICAL PLAN	1" = 5'

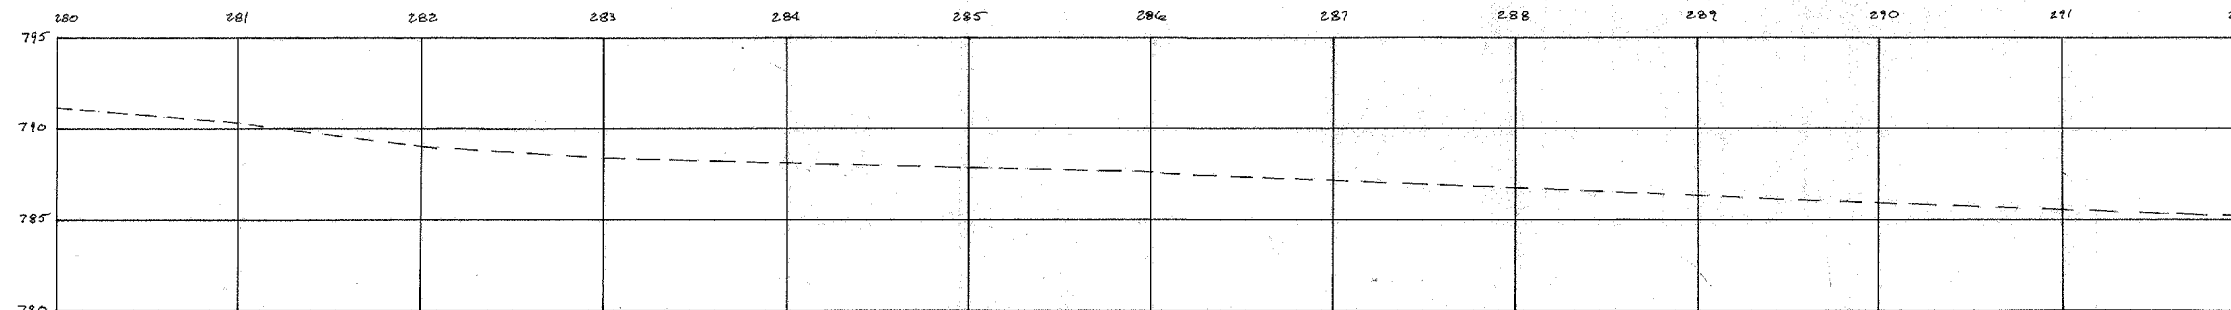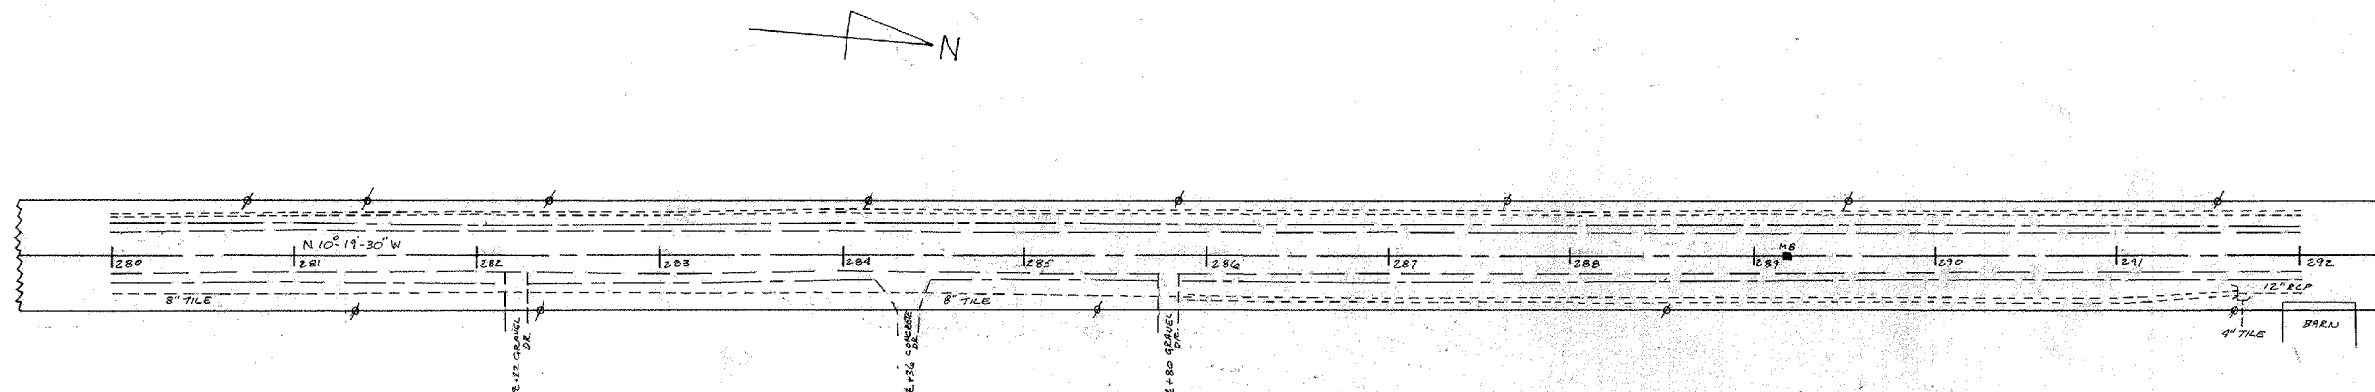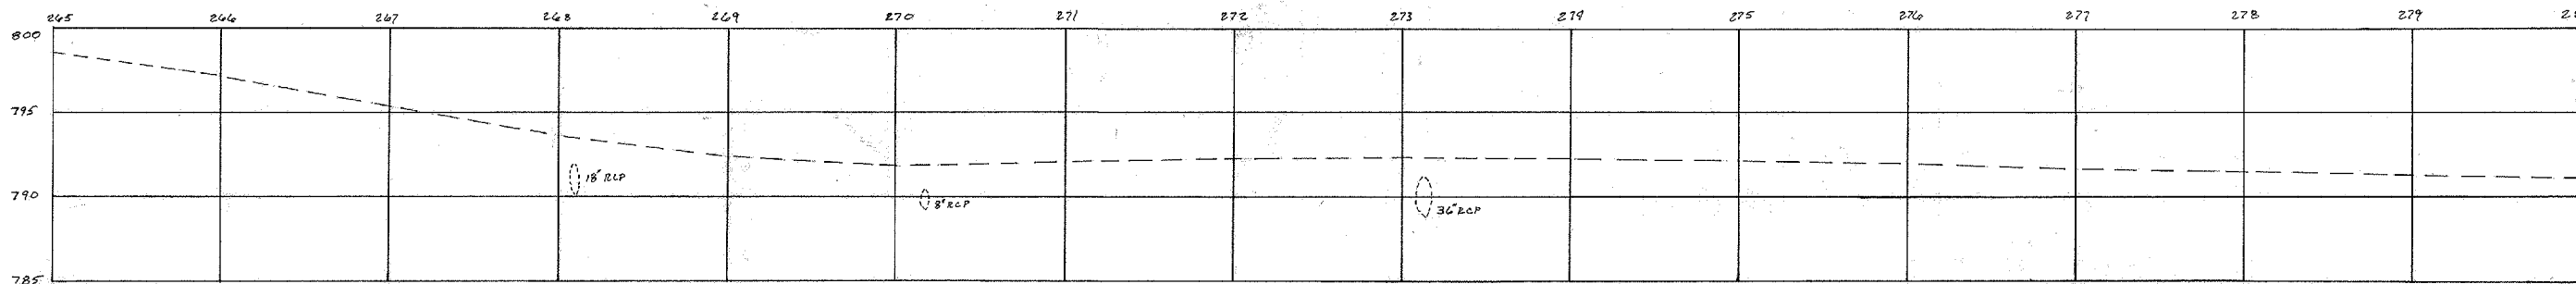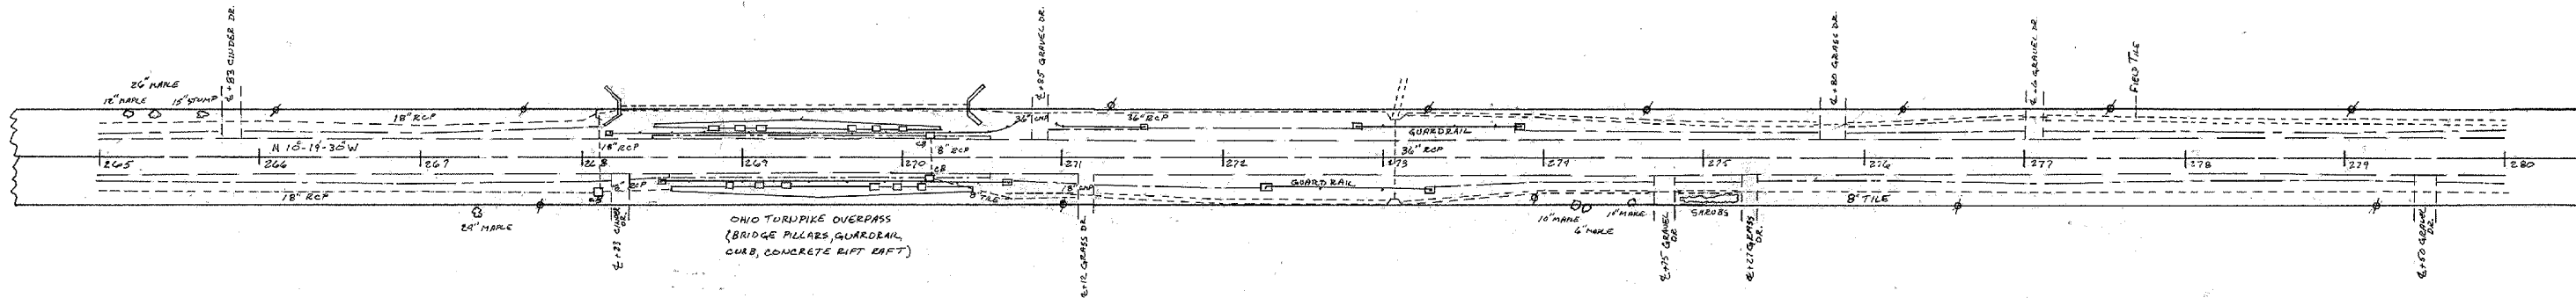


DATE	REVISION	BY

BAUMHART ROAD
 HENRIETTA & BROWNHELM
 TOWNSHIPS
 LIMITS: STA. 265 TO STA. 292
 DATE: FEB, 1981 BY: R.J.L.

SCALE
 HORIZONTAL PLAN 1" = 50'
 VERTICAL PLAN 1" = 5'
 HORIZONTAL 1" = 50'
 VERTICAL 1" = 5'

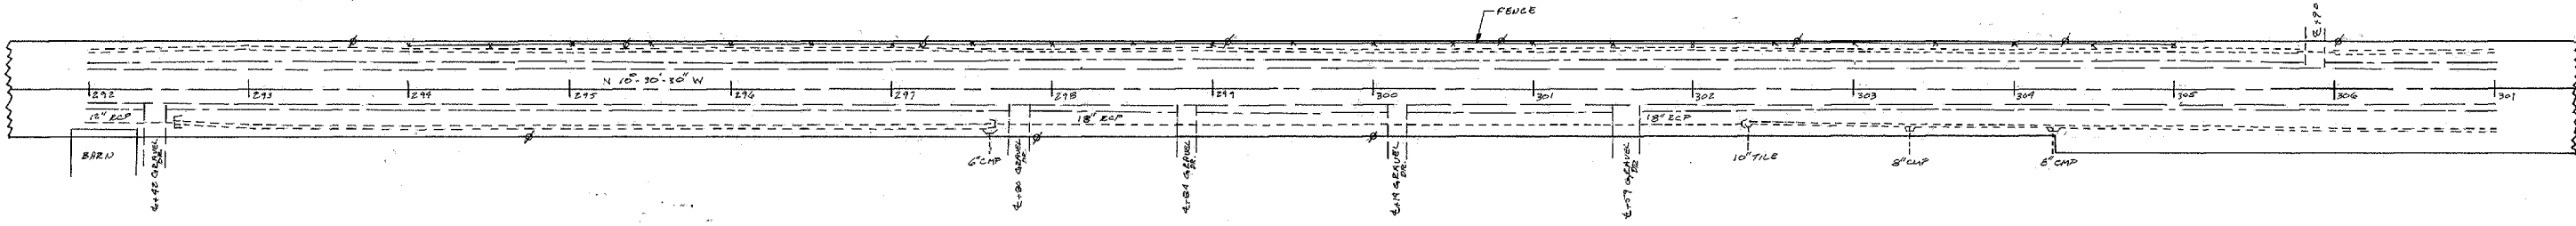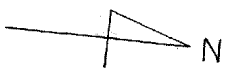

	292	293	294	295	296	297	298	299	300	301	302	303	304	305	306	307
790																
785																
780																
775																




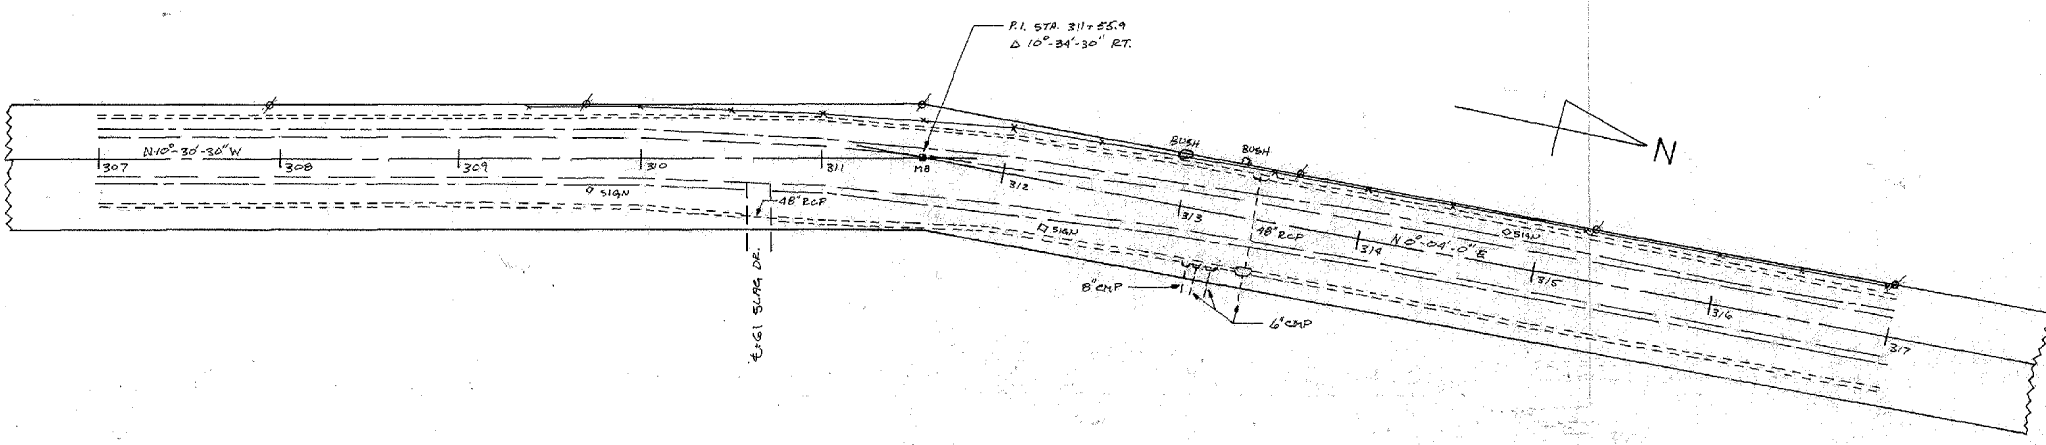


	307	308	309	310	311	312	313	314	315	316	317
790											
785											
780											
775											

DATE	REVISION	BY

BAUMHART ROAD
 HENRIETTA & BROWNHELM
 TOWNSHIPS
 LIMITS: STA. 292 TO STA. 317
 DATE: FEB, 1981 BY: R.J.L.





SCALE
 HORIZONTAL PLAN 1" = 50'
 VERTICAL PLAN
 HORIZONTAL 1" = 50'
 VERTICAL 1" = 5'

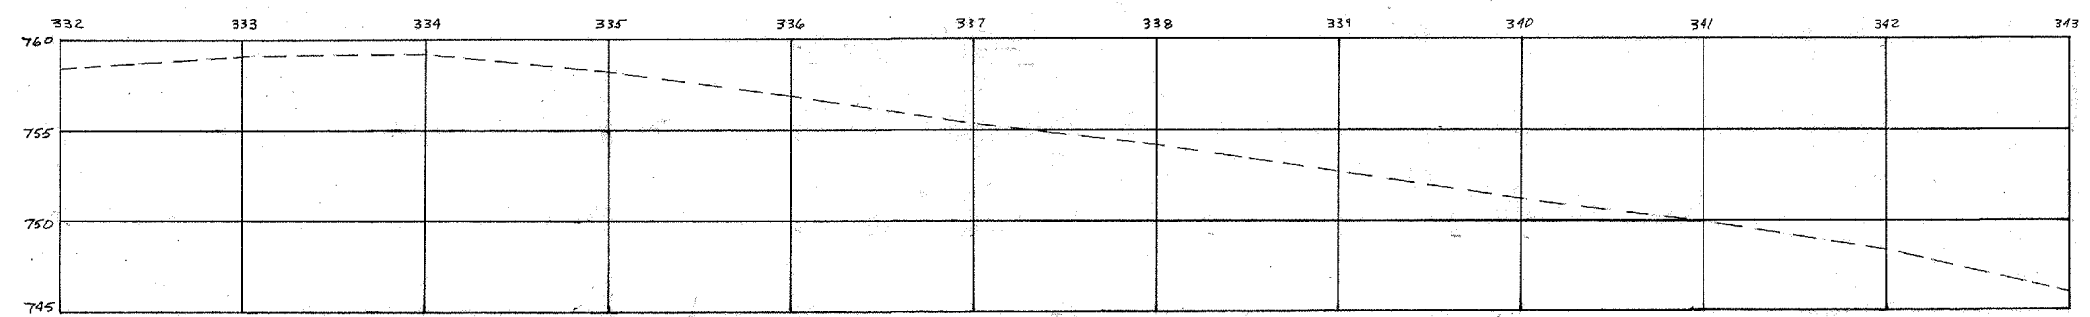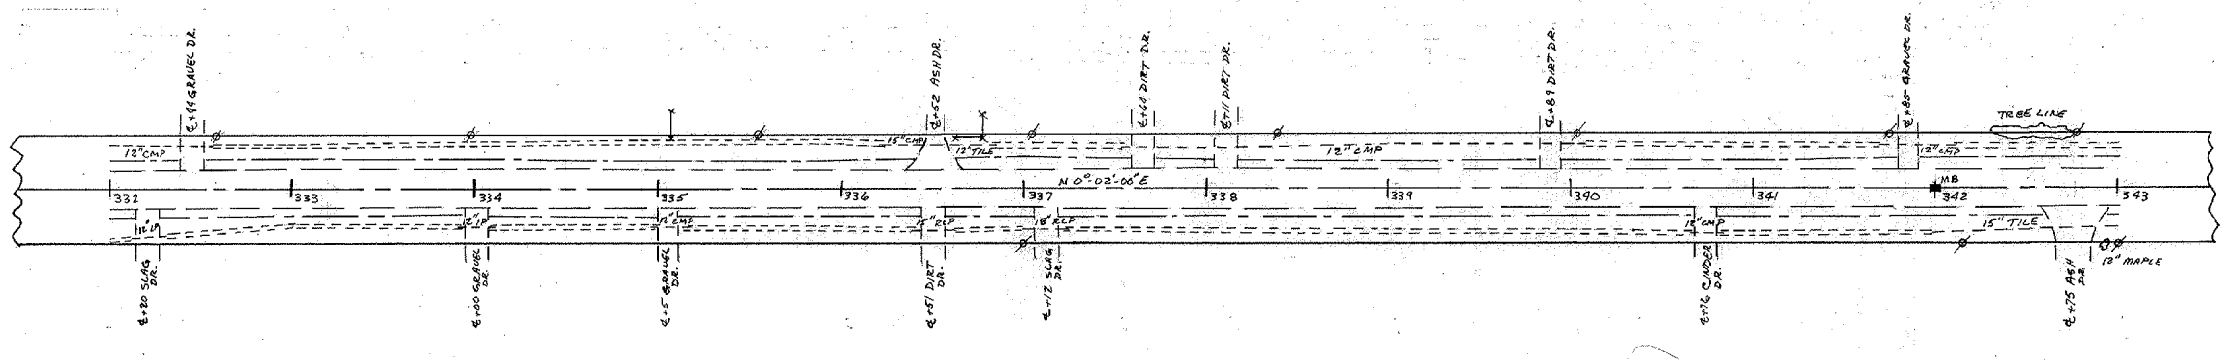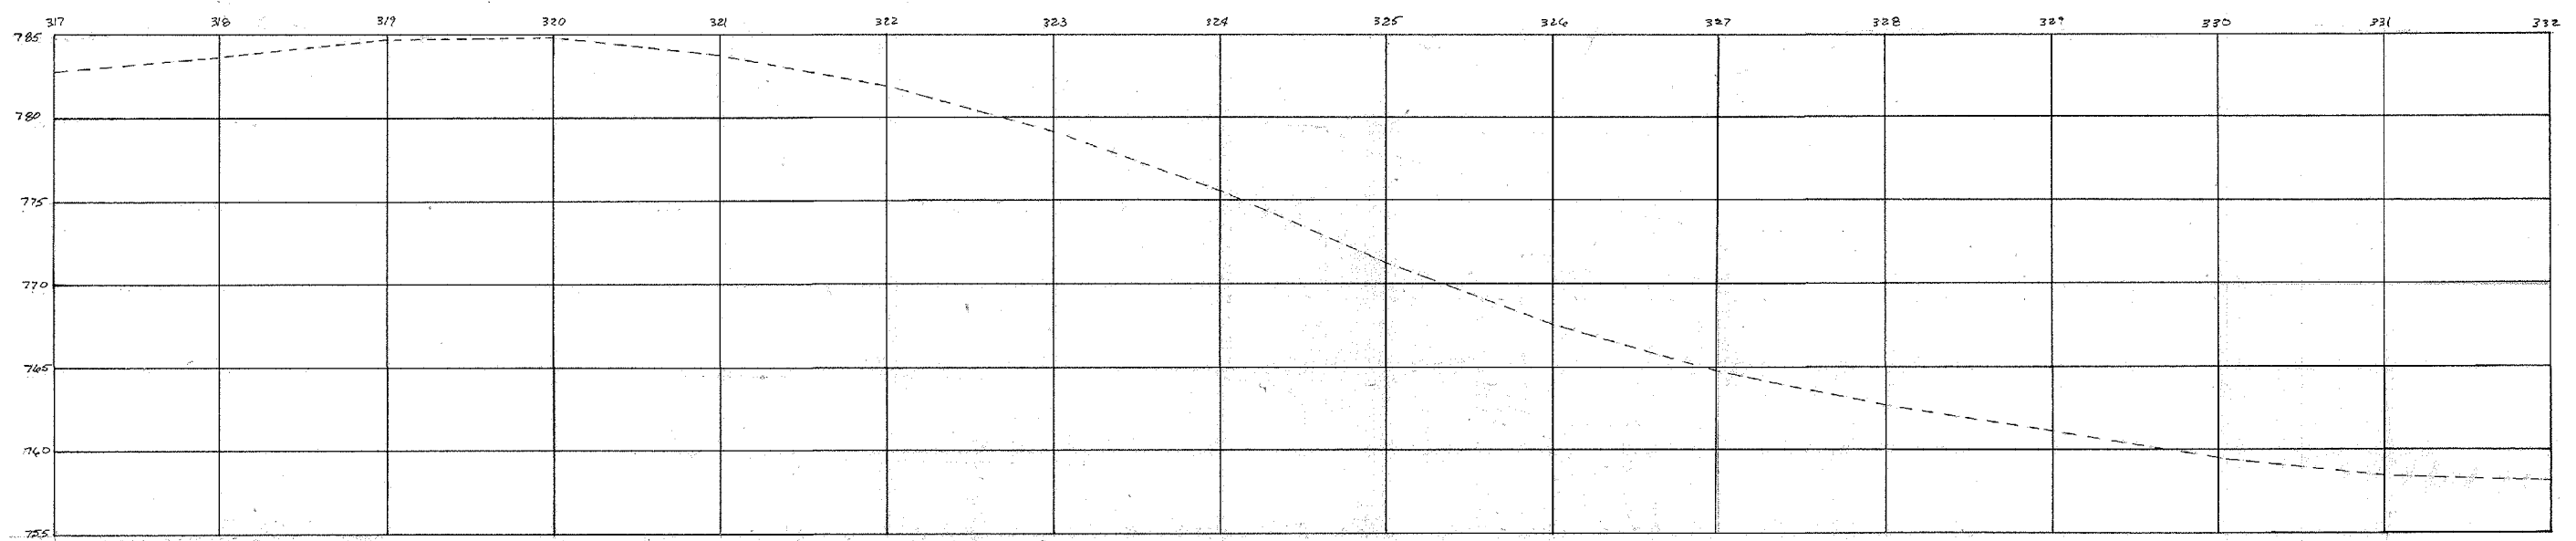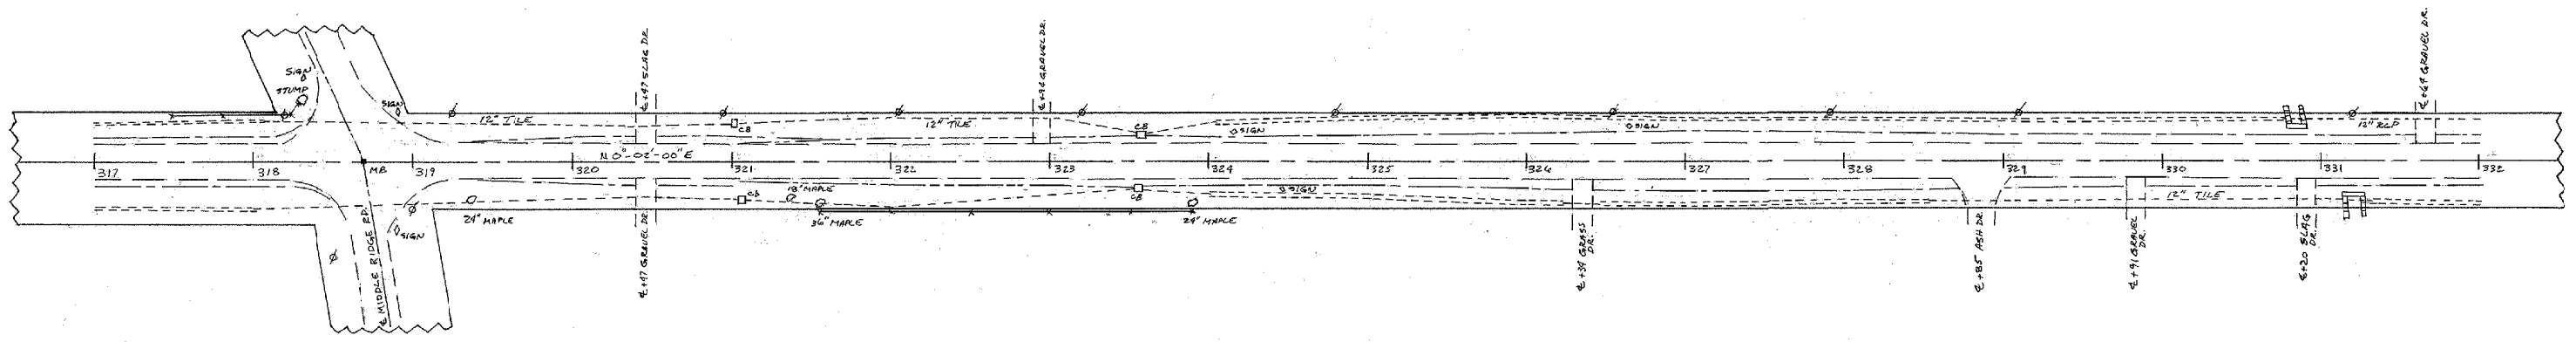

DATE	REVISION	BY

BAUMHART ROAD
 HENRIETTA & BROWNHELM
 TOWNSHIPS
 LIMITS: STA.317 TO STA.343
 DATE: FEB, 1981 BY: R.J.L.





SCALE
 HORIZONTAL PLAN 1"=50'
 VERTICAL PLAN 1"=5'
 HORIZONTAL 1"=50'
 VERTICAL 1"=5'

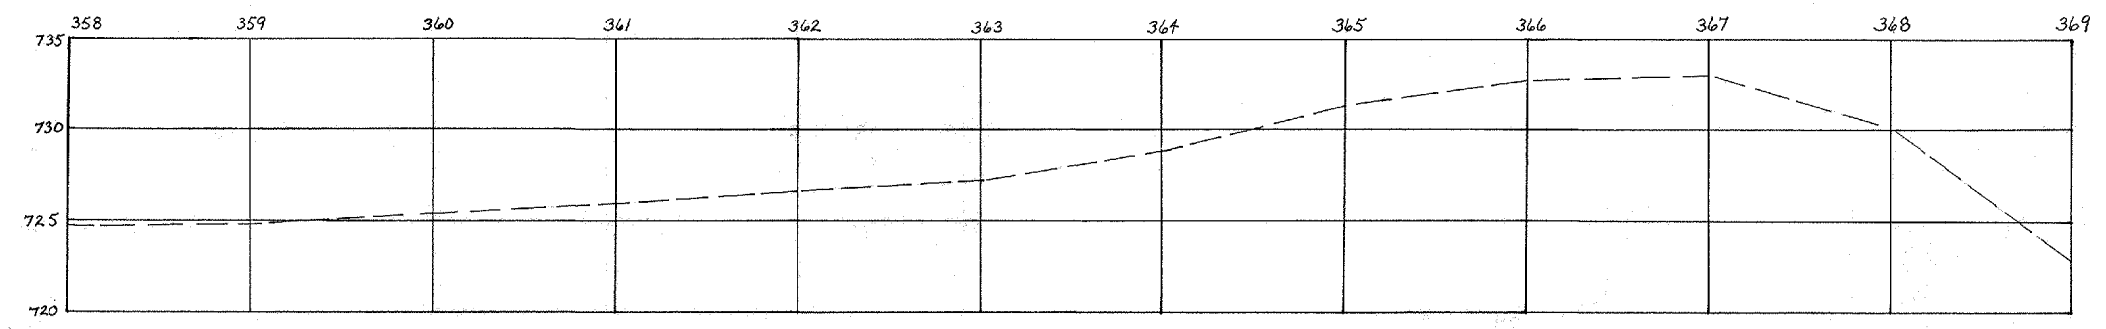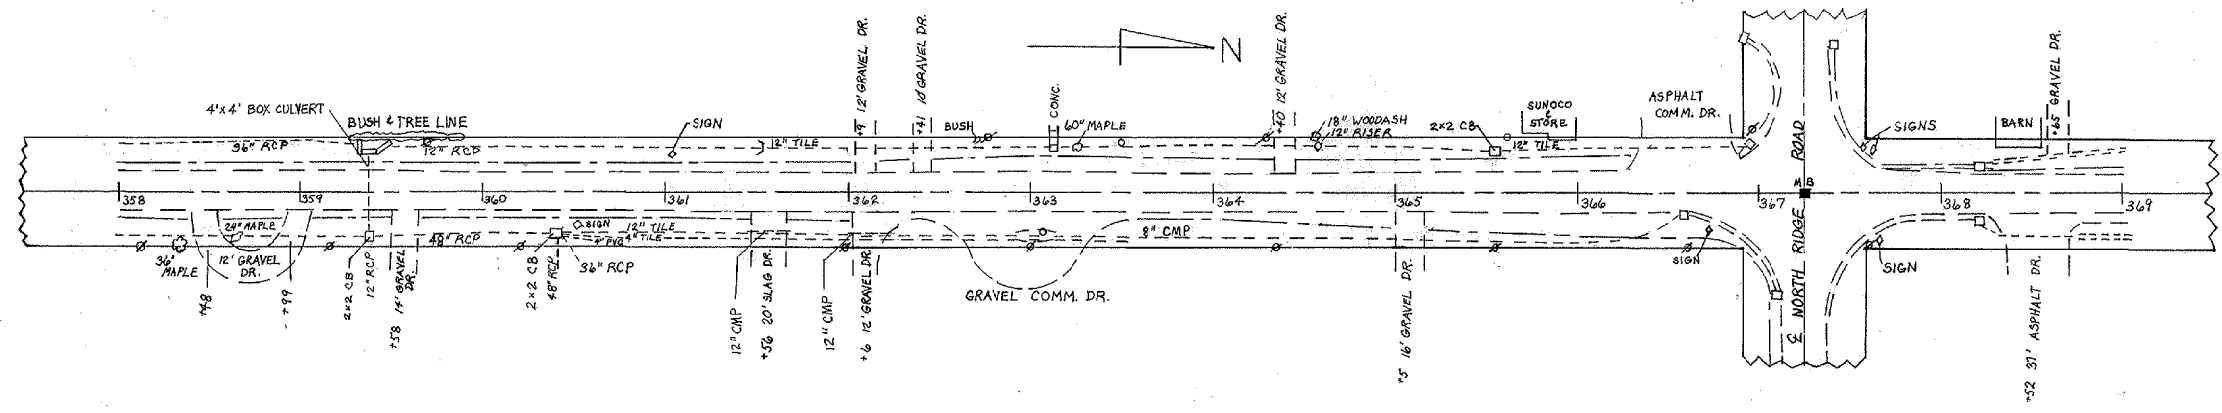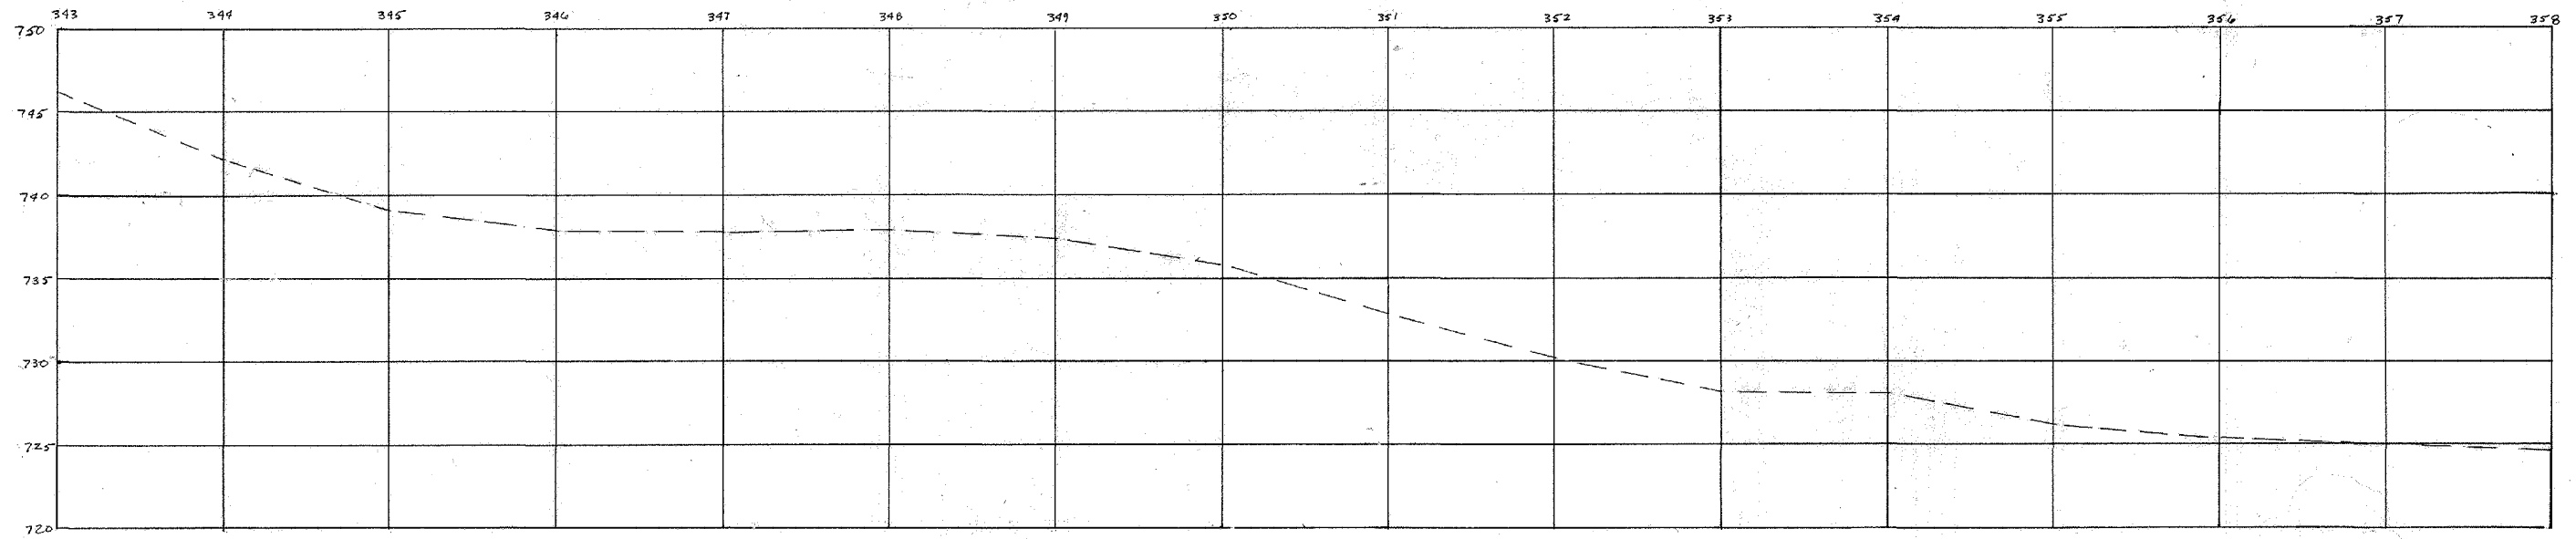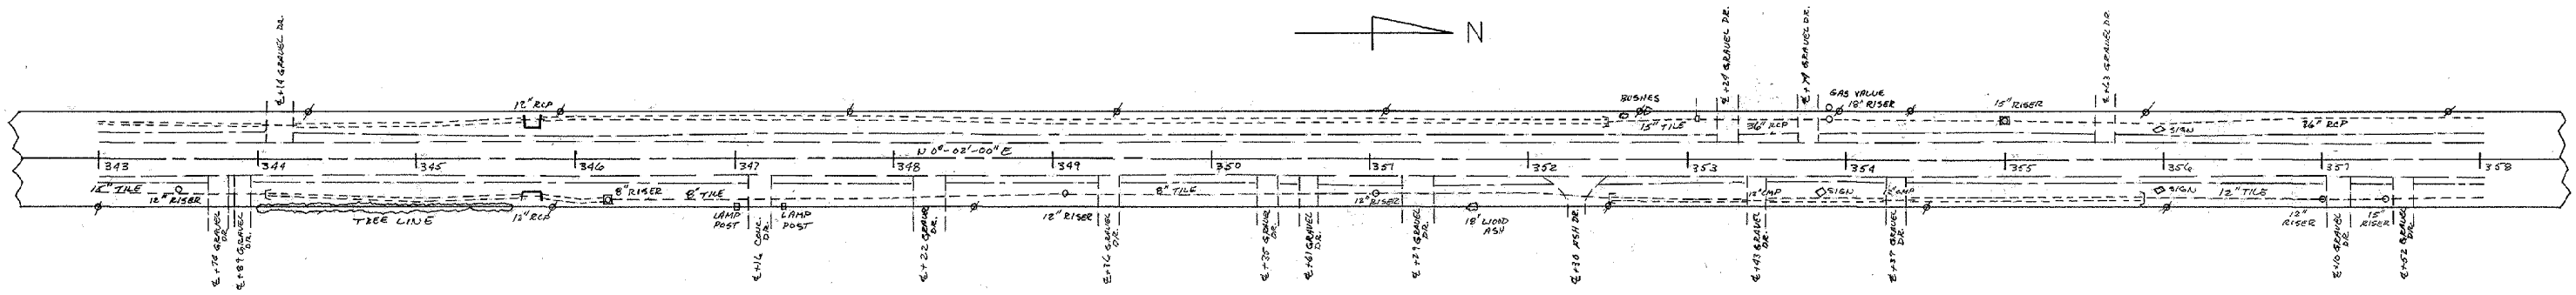

DATE	REVISION	BY

BAUMHART ROAD
 HENRIETTA & BROWNHELM
 TOWNSHIPS
 LIMITS: STA. 343 TO 369
 DATE: JULY, 1981 BY: JMM



SCALE
 HORIZONTAL PLAN 1" = 50'
 VERTICAL PLAN 1" = 5'
 HORIZONTAL 1" = 50'
 VERTICAL 1" = 5'

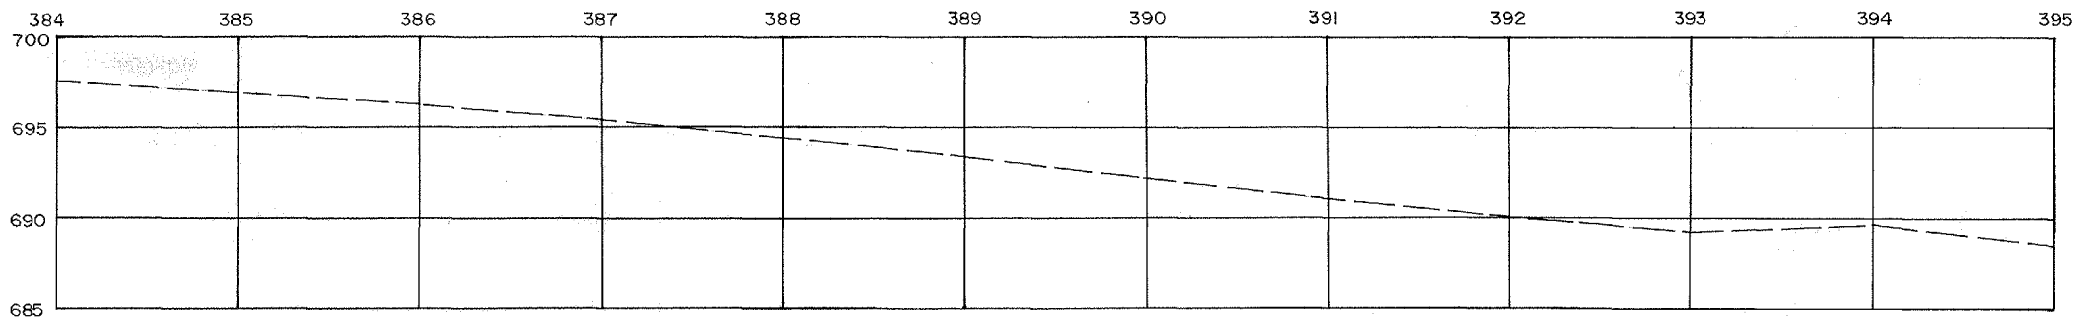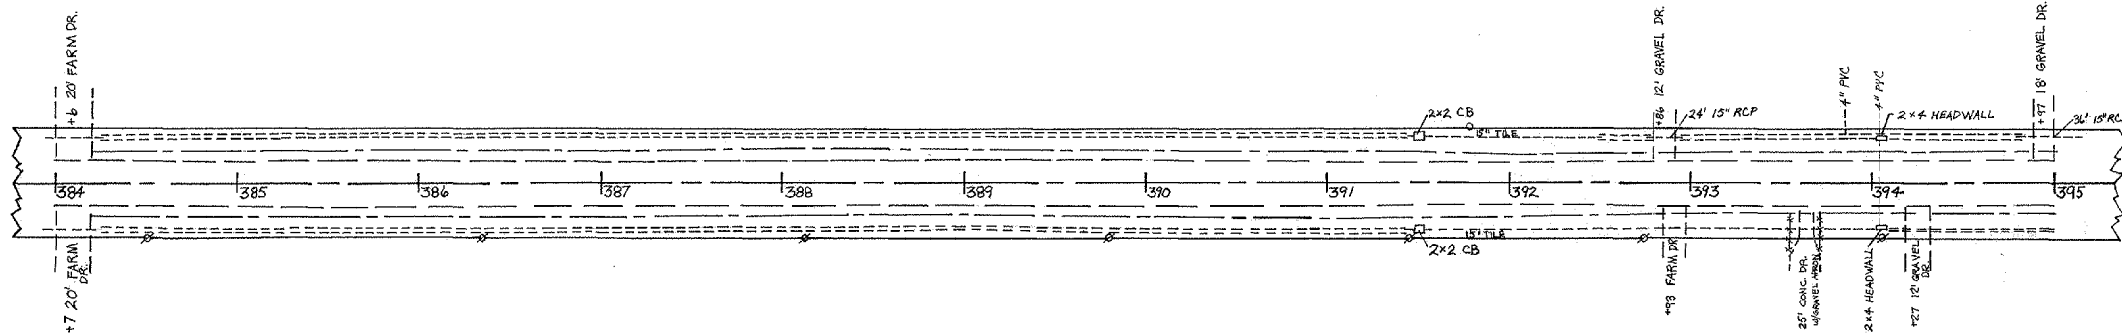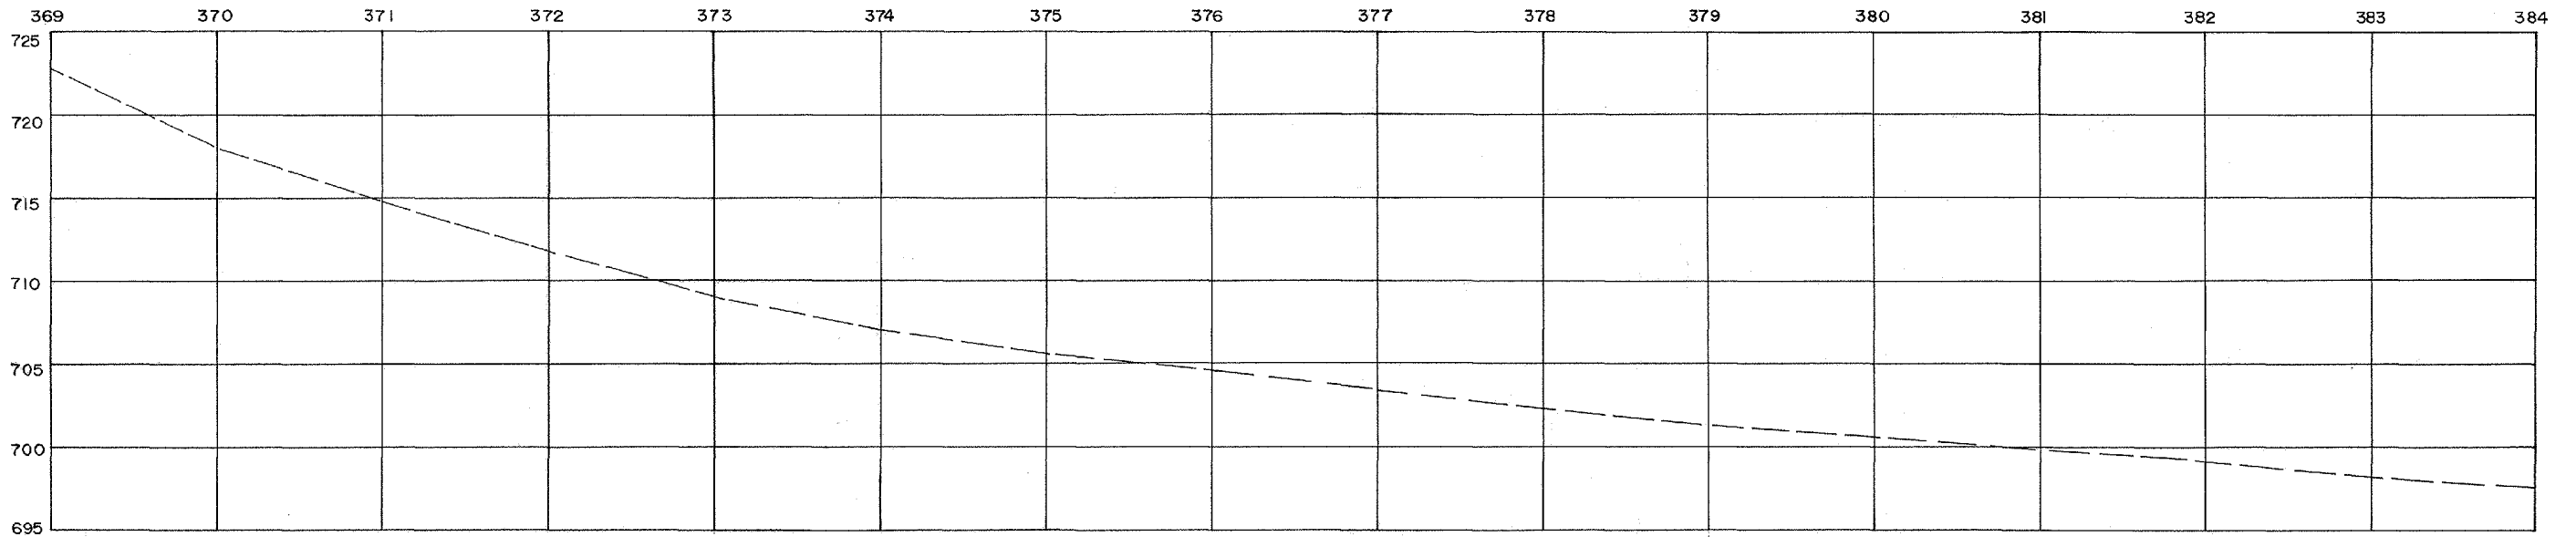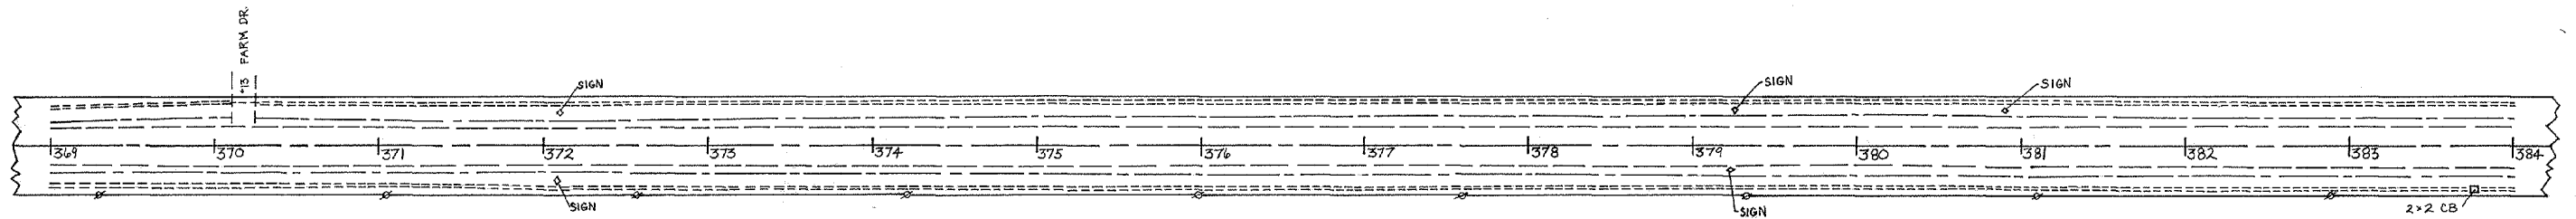

DATE	REVISION	BY

BAUMHART RD.
 HENRIETTA & BROWNHelm
 TOWNSHIPS
 LIMITS: STA. 369 to 395
 DATE: JULY, 1981 BY: JMM

SCALE
 HORIZONTAL PLAN 1"=50'
 VERTICAL PLAN
 HORIZONTAL 1"=50'
 VERTICAL 1"=5'

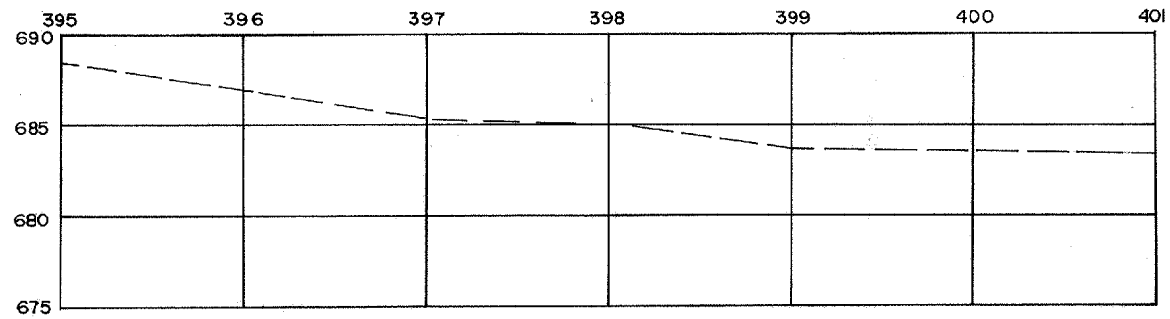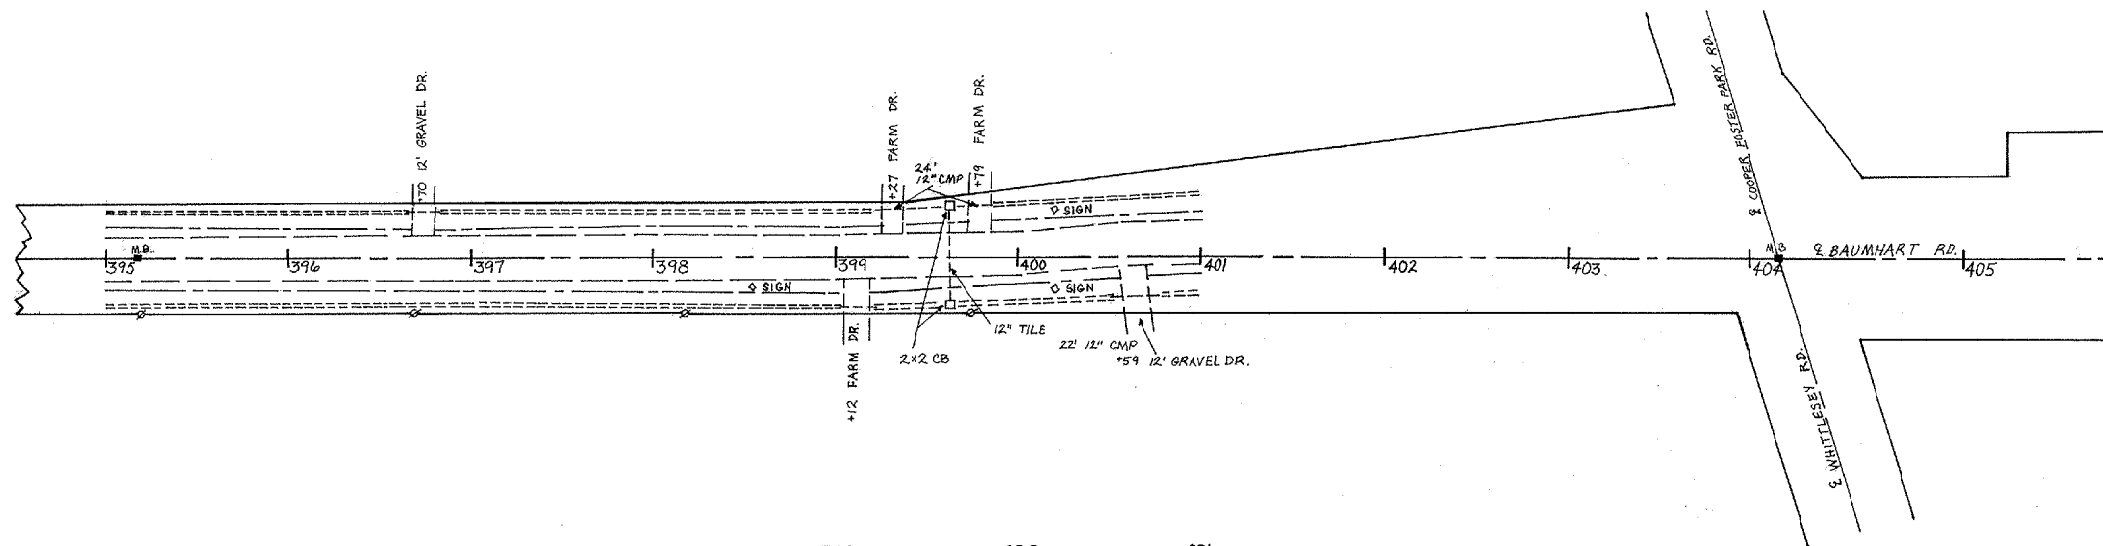

DATE	REVISION	BY

BAUMHART RD.
 HENRIETTA & BROWNHELM
 TOWNSHIPS
 LIMITS: STA. 395 to END
 DATE: JULY, 1981 BY: JMM

SCALE	
HORIZONTAL PLAN	1"=50'
VERTICAL PLAN	
HORIZONTAL	1"=50'
VERTICAL	1"=5'