


LOR-6-15.87

MODEL: Design PAPER SIZE: 17x11 (in.) DATE: 10/24/2022 TIME: 12:43:24 PM USER: RStonecker
W:\Projects\Projects-AE\A250002\107477\400-Engineering\Roadway\Sheets\107477_GS01.dgn

LOCATION		INFORMATION		202			608		659				630			REMARKS	
REF. NO.	INTERSECTION STREET NAME	CURB RAMP POSITION	CURB RAMP TYPE	WALK REMOVED	CURB REMOVED	CURB AND GUTTER REMOVED	4" CONCRETE WALK	CURB RAMP	SEEDING AND MULCHING	TOPSOIL	COMMERCIAL FERTILIZER	WATER	REMOVAL OF GROUND MOUNTED POST SUPPORT AND DISPOSAL	REMOVAL OF GROUND MOUNTED SIGN AND REERECTION	GROUND MOUNTED SUPPORT, NO. 3 POST		
				SF	FT	FT	SF	SF	SY	CY	TON	MGAL	EACH	EACH	FT		
CR 1	MILLER RD	A	C2	78.5				81.1									
CR 2		F	NO WORK													OUTSIDE RW	
CR 3		G	A2	36.9					52.2								
CR 4		I	A2	62.2					41.2	0.5	0.06	0.0001	0.001				
CR 5		J	NO WORK													OUTSIDE RW	
CR 6		L	NO WORK													OUTSIDE RW	
CR 7	BEACPARK TOWER	A	A2	56.1			14.6	42.5									
CR 8		L	A2	30.2				42.2									
CR 9	BEACPARK TOWER	A	NO WORK												OUTSIDE RW		
CR 10		L	A2	37.7				42.5									
CR 10A	SHIELDS RD	I	NO WORK												OUTSIDE RW		
CR 10B		J	NO WORK												OUTSIDE RW		
CR 11	AVONDALE AVE	A	C2	78.0				86.2									
CR 12		G	NO WORK												OUTSIDE RW		
CR 13		K	A2	33.7					33.7								
CR 14		L	A2	47.6					39.6								
CR 15	WESTSHORE RD	B	NO WORK												OUTSIDE RW		
CR 16		E	NO WORK												OUTSIDE RW		
CR 17	AVALON DR	B	A2					112.0									
CR 18		E	A2	75.5	10.2			96.5									
CR 19	MOORE RD	A	A2	40.5	8.1		67.3	44.4									
CR 20		C	A2	206.8			60.1	70.7					1	3	15.5	STOP SIGN	
CR 21		E	NO WORK													OUTSIDE RW	
CR X1		G	NO WORK													EXISTING	
CR X2		I	NO WORK													EXISTING	
CR 22	K	NO WORK													OUTSIDE RW		
CR 23	PARKLAND DR	C	A2					93.9									
CR 24		D	A2					92.2									
CR 25	ROSEWOOD DR	C	NO WORK												OUTSIDE RW		
CR 26		D	A2					59.2									
CR 27	BELMAR BLVD	J	NO WORK												OUTSIDE RW		
CR 28	EDGEWOOD DR	I	A2	86.8			28.9	46.1	1.3	0.14	0.0002	0.004					
CR 29		B	B2	74.4				74.4									
CR 30		E	B1	53.3					50.3								
CR 31	CURTIS DR	J	B1	8.7			28.7	39.5									
CR 32		I	B1	40.6				15.7	44.5								
CR 33	MOOREWOOD AVE	J	A2			9.8		99.9									
CR 34		I	A2			10.3		105.8									
CR 35		J	B1	49.8		10.1		30.1	91.1								
CR 36	PARKWOOD AVE	I	B1	48.2		8.2		83.7									
CR X3	INWOOD BLVD	J	NO WORK												EXISTING		
CR X4		I	NO WORK												EXISTING		
CR X5	BROOKFIELD RD	J	NO WORK												EXISTING		
CR X6		I	NO WORK												EXISTING		
CR 37		A	NO WORK												OUTSIDE RW		
CR 38		I	NO WORK												OUTSIDE RW		
CR 39		J	NO WORK												OUTSIDE RW		
CR 40	SR 83	L	NO WORK												OUTSIDE RW		
CR 41		M	NO WORK												OUTSIDE RW		
CR 42		M	NO WORK												OUTSIDE RW		
CR 43	BEACHDALE DR	C	A2	109.4			46.9	36.2	2.9	0.32	0.0004	0.008					
CR 44		D	A2	47.2			17.4	30.3									
CR 45		I	A2					49.8						1	3	15.5	STOP SIGN
CR 46		J	NO WORK													OUTSIDE RW	
SUBTOTALS TO SHEET 13				1302	18	38	310	1782	5	1	0.001	0.01	2	6	31.0		

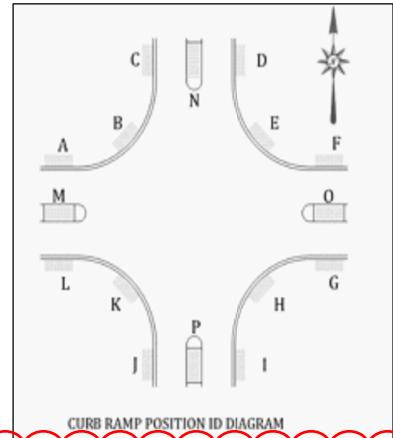

PRECONSTRUCTION PEDESTRIAN FACILITY LAYOUT INSPECTION

THE PROPOSED LAYOUT OF THE PEDESTRIAN FACILITIES INCLUDED IN THESE PLANS IS TO BE FIELD REVIEWED AND VERIFIED FOR COMPLIANCE WITH THE PLANS AND APPROPRIATE STANDARDS PRIOR TO PERFORMING ANY ASSOCIATED REMOVAL OR CONSTRUCTION. THIS MEETING IS INTENDED TO REVIEW PROPOSED WORK AS LAID OUT BY THE CONTRACTOR PRIOR TO THE MEETING; THIS MEETING IS NOT INTENDED TO LAYOUT ALL LOCATIONS IN CONJUNCTION WITH THE CONTRACTOR. THE CONTRACTOR SHOULD ADHERE TO THE PROJECT PLANS ON INITIAL LAYOUT PRIOR TO THIS MEETING, DETERMINE IF THERE ARE QUESTIONS, CONCERNS, OR CONTRACTOR-PROPOSED MODIFICATIONS TO THE DESIGN AT EACH LOCATION, AND BE PREPARED TO DISCUSS ANY SUCH LOCATIONS.

THE MEETING PARTICIPANTS WILL REVIEW EACH LOCATION AS REQUESTED BY THE CONTRACTOR, ADHERING TO THE ABOVE DETAILS. ADDITIONAL LOCATIONS WILL BE VERIFIED BY DISTRICT PERSONNEL FOR ADHERENCE TO THE PLANS AND SPECIFICATIONS.

COORDINATE WITH THE PROJECT ENGINEER TO SCHEDULE THE MEETING WITH ALL APPROPRIATE STAKEHOLDERS IN ORDER TO PROVIDE A MINIMUM OF 14 CALENDAR DAY NOTICE TO ALL MEETING ATTENDEES. THE REQUIRED STAKEHOLDERS ARE THE DISTRICT ADA ENGINEER, DISTRICT ADA COORDINATOR, MUNICIPAL REPRESENTATIVE, PROJECT ENGINEER, AND CONTRACTOR REPRESENTATIVE. THE ENGINEER OF RECORD, ODOT PROJECT MANAGER, ODOT DESIGNERS, AND CONSTRUCTION AREA ENGINEER SHOULD BE INVITED AS OPTIONAL ATTENDEES.

ALL MATERIAL, EQUIPMENT, LABOR, AND INCIDENTALS NEEDED TO COMPLETE THIS MEETING ARE TO BE INCLUDED IN THE CONTRACT BID PRICE FOR THE APPROPRIATE PEDESTRIAN FACILITY ASSOCIATED WITH THIS WORK.

ADA DESIGN WAIVERS

LOCATION DESCRIPTION		ADA FEATURE	APPROVAL DATE	SEE SHEET	LOCATION DESCRIPTION		ADA FEATURE	APPROVAL DATE	SEE SHEET	LOCATION DESCRIPTION		ADA FEATURE	APPROVAL DATE	SEE SHEET
REF. NO.	INTERSECTION STREET NAME	(ID NUMBER) CURB RAMP (RMP#####)	YYYY/MM/DD	P.###	REF. NO.	INTERSECTION STREET NAME	(ID NUMBER) CURB RAMP (RMP#####)	YYYY/MM/DD	P.###	REF. NO.	INTERSECTION STREET NAME	(ID NUMBER) CURB RAMP (RMP#####)	YYYY/MM/DD	P.###
CR 2	MILLER RD	F RMP0008718	2022/06/23	14	CR 10B	SHIELDS RD	J RMP0008723	2022/06/27	16	CR 22	MOORE RD	K RMP0008728	2022/06/27	20
CR 5	MILLER RD	J RMP0008719	2022/06/27	14	CR 12	AVONDALE AVE	G RMP0008724	2022/06/27	17	CR 27	BELMAR BLVD	J RMP0008729	2022/06/27	22
CR 6	MILLER RD	L RMP0008720	2022/06/27	14	CR 15	WESTSHORE RD	B RMP0008725	2022/06/27	18	CR 46	BEACHDALE DR	J RMP0008730	2022/06/27	30
CR 9	BEACPARK TOWER	A RMP0008721	2022/06/27	16	CR 16	WESTSHORE RD	E RMP0008726	2022/06/27	18	CR 73	COVELAND DR	C RMP0008731	2022/06/23	44
CR 10A	SHIELDS RD	I RMP0008722	2022/06/27	16	CR 21	MOORE RD	E RMP0008727	2022/06/27	20					

CURB RAMP SUB-SUMMARY

DESIGN AGENCY



DESIGNER
RLS

REVIEWER
ALT 04-29-22

PROJECT ID
107477

SHEET TOTAL
12 60