


STATE OF OHIO  
DEPARTMENT OF TRANSPORTATION


LOR - 90 - 10.76

CITY OF AMHERST VILLAGE OF SHEFFIELD  
CITY OF AVON AMHERST TOWNSHIP  
CITY ELYRIA ELYRIA TOWNSHIP

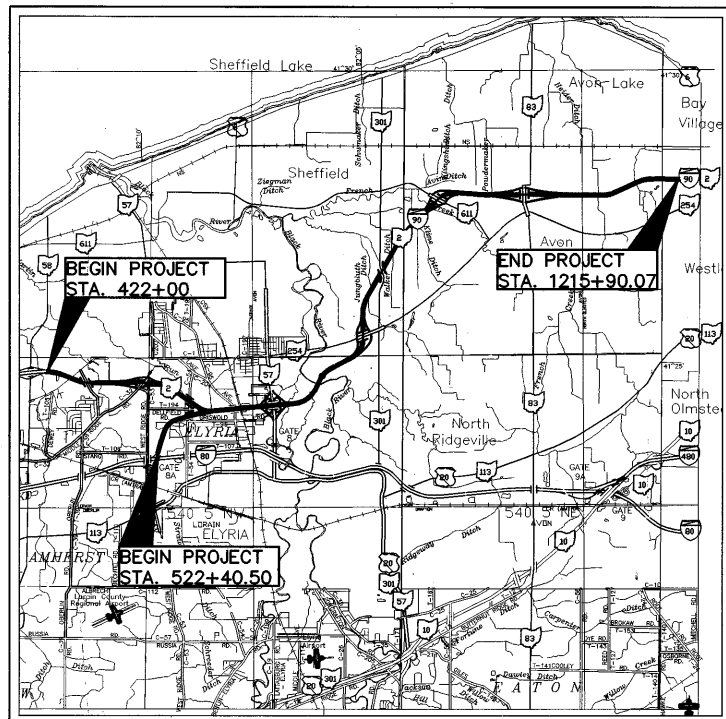

LOCATION MAP

SCALE IN MILES

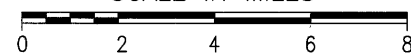

PORTION TO BE IMPROVED   
STATE & FEDERAL ROUTES   
OTHER ROADS


PROJECT LOCATION  
LATITUDE 41°27'50" LONGITUDE 82°00'00"

DESIGN EXCEPTIONS  
NONE REQUIRED

DESIGN DESIGNATION  
SEE SCHEMATIC PLAN

**UNDERGROUND UTILITIES**  
TWO WORKING DAYS  
**BEFORE YOU DIG**  
CALL 1-800-362-2764 (TOLL FREE)  
OHIO UTILITIES PROTECTION SERVICE  
NON-MEMBERS  
MUST BE CALLED DIRECTLY

ENGINEERS SEAL:

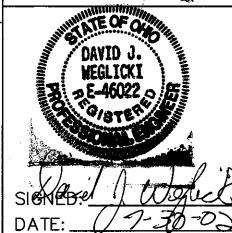

PLAN PREPARED BY:

**REW R.E. WARNER & ASSOCIATES, INC.**  
CONSULTING ENGINEERS  
THREE KING JAMES PARK · SUITE 300  
24600 CENTER RIDGE ROAD  
WESTLAKE, OHIO 44145  
TELEPHONE (440) 835-9400

INDEX OF SHEETS:

TITLE SHEET	1
SCHEMATIC PLAN	2-5
PART A	
EXISTING TYPICAL SECTIONS	6-9
PROPOSED TYPICAL SECTIONS	10-17
GENERAL NOTES	18-19
MAINTENANCE OF TRAFFIC	20
STORM WATER PREVENTION POLLUTION PLAN	21-60
PLAN	61-88
PLAN, INTERCHANGE AND RAMP	89-102
MISCELLANEOUS PAVEMENT DETAILS	103-107
BRIDGE WATERPROOFING DETAIL	108
PROPOSED PROFILE WEST OF BLACK RIVER	109
PAVEMENT MARKING	110-126
PART B	
BRIDGE PLANS	127-150
PART C	
EXISTING TYPICAL SECTIONS	151-153
PROPOSED TYPICAL SECTIONS	154-160
MAINTENANCE OF TRAFFIC	161-188
STORM WATER PREVENTION POLLUTION PLAN	189-190
PLAN AND PROFILE	191-196
PLAN, INTERCHANGE AND RAMP	197-201
CROSS SECTIONS	202-228
SUPERELEVATION TABLES	229-230
MISCELLANEOUS PROFILE TABLE	231
DRAINAGE DETAIL	232
PAVEMENT ELEVATION DETAILS	233-236
TRAFFIC CONTROL	237-247
LIGHTING AND ELECTRIC	248-259
FENCE PLAN	260-274

SPECIAL PROVISIONS

WATERWAY PERMIT NWP #3 & #14

DATE: 2/14/00

STANDARD CONSTRUCTION DRAWINGS										SUPPLEMENTAL SPECIFICATIONS		SUPPLEMENTAL SPECIFICATIONS	
BP-2.2	07-28-00	FLT-M	04-16-98	GR-4.3M	10-21-97	TC-12.30	01-19-01	MT-95.30M	04-25-94	SS 816	04-21-97	SS 265M	06-20-97
BP-2.3	07-28-00			GR-4.4M	11-30-94	TC-21.20	01-19-01	MT-95.40M	04-25-94	SS 842	01-06-99	SS 425M	06-21-97
BP-2.4	07-28-00	F-2.1	04-08-97	GR-5.1M	04-21-95	TC-31.21	04-20-01	MT-98.12M	06-24-93	SS 863	10-12-99		
BP-3.1	07-28-00	F-3.1	04-21-95	GR-5.2M	11-30-94	TC-41.10	01-19-01	MT-98.13M	06-24-93	SS 865	02-22-00	SS 806	09-09-97
BP-5.1	07-28-00	F-3.2	04-08-97	GR-5.3M	11-30-94	TC-42.20	04-20-01	MT-98.14M	06-24-93	SS 904	05-05-98	SS 814	06-02-98
BP-9.1	07-28-00	F-3.3	04-21-95	GR-6.1M	01-03-96	TC-61.10	01-19-01	MT-98.15M	06-24-93	SS 904	05-05-98	SS 830	10-21-98
		F-3.4	04-08-97	GR-6.2M	01-03-96			MT-98.16M	06-24-93	SS 910	07-28-98	SS 855	06-30-98
CB-2.2M	07-12-95					TBR-91M	12-19-94	MT-98.17M	04-25-94	SS 911	07-10-97	SS 870	08-10-99
CB-3.1M	07-12-95	GR-1.1M	10-21-97	HW-2.1M	07-12-95			MT-98.18M	04-25-94			SS 877	04-13-99
		GR-1.2M	01-03-96			SBR-1-99	01-12-99	MT-99.10M	01-30-95			SS 880	11-07-00
DM-1.1M	10-21-97	GR-1.3M	11-30-94	RM-1.1	04-29-99			MT-99.20M	01-30-95			SS 899	10-21-98
DM-4.1M	06-30-95	GR-2.1M	04-14-98					MT-102.10M	01-30-95			SS 905	04-01-98
DM-4.2M	06-30-95	GR-3.1M	10-21-97	SKT-4M	12-11-97			MT-105.10M	04-25-94			SS 906	05-05-98
DM-4.3	04-29-99	GR-3.2M	10-21-97					MT-105.11M	04-25-94			SS 907	10-21-98
DM-4.4	04-29-99	GR-3.3M	10-21-97	AS 8A-2	08-15-77							SS 908	11-07-00
		GR-4.2M	10-21-97									SS 932	10-02-96

PROJECT DESCRIPTION

PART A

RESURFACING AND GUARDRAIL REPLACEMENT OF S.R. 2 AND I-90 INCLUDING INTERCHANGE RAMPS AT S.R. 2 AND MIDDLE RIDGE RD., I-90 AND S.R. 57, AND I-90 AND S.R. 254.

PART B

WIDENING AND RECONSTRUCTION OF FRENCH CREEK BRIDGE.

PART C

WIDENING AND RECONSTRUCTION OF I-90 FROM FRENCH CREEK TO STA. 1018+00, INCLUDING PAVEMENT RESURFACING OF ALL INTERCHANGE RAMPS, RECONSTRUCTING THE EXISTING PAVEMENT AND EXISTING SHOULDER IN THE ADJACENT WIDENING PROJECT TO THE EAST, AND THE REMOVAL AND REPLACEMENT OF ALL R/W FENCING FROM FRENCH CREEK TO THE CUYAHOGA COUNTY LINE.

LIMITED ACCESS

THIS IMPROVEMENT IS ESPECIALLY DESIGNED FOR THROUGH TRAFFIC AND HAS BEEN DECLARED A LIMITED ACCESS HIGHWAY OR FREEWAY BY ACTION OF THE DIRECTOR IN ACCORDANCE WITH THE PROVISIONS OF SECTION 5511.02 OF THE REVISED CODE OF OHIO.

1997 SPECIFICATIONS

THE STANDARD SPECIFICATIONS OF THE STATE OF OHIO, DEPARTMENT OF TRANSPORTATION, INCLUDING CHANGES AND SUPPLEMENTAL SPECIFICATIONS LISTED IN THE PROPOSAL SHALL GOVERN THIS IMPROVEMENT.

MAINTENANCE OF TRAFFIC ENDORSEMENT

I HEREBY APPROVE THESE PLANS AND DECLARE THAT THE MAKING OF THIS IMPROVEMENT WILL NOT REQUIRE THE CLOSING TO TRAFFIC OF THE HIGHWAY AND THAT PROVISIONS FOR THE MAINTENANCE AND SAFETY OF TRAFFIC WILL BE AS SET FORTH ON THE PLANS AND ESTIMATES.

APPROVED \_\_\_\_\_  
DATE \_\_\_\_\_ DISTRICT DEPUTY DIRECTOR

APPROVED \_\_\_\_\_  
DATE \_\_\_\_\_ DIRECTOR, DEPARTMENT OF TRANSPORTATION


FEDERAL PROJECT NO.  
TE21G000(112)

PID NO.  
17891

CONSTRUCTION PROJECT NO.  
3015 - 00


RAILROAD INVOLVEMENT  
NONE

LOR - 190 - 10.76

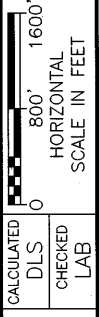

SCHEMATIC PLAN  
I-90 STA. 522+50 TO STA. 635+00 S.R. 2 STA. 422+00 TO STA. 635+00

LOR - 190 - 10.76  
2  
274

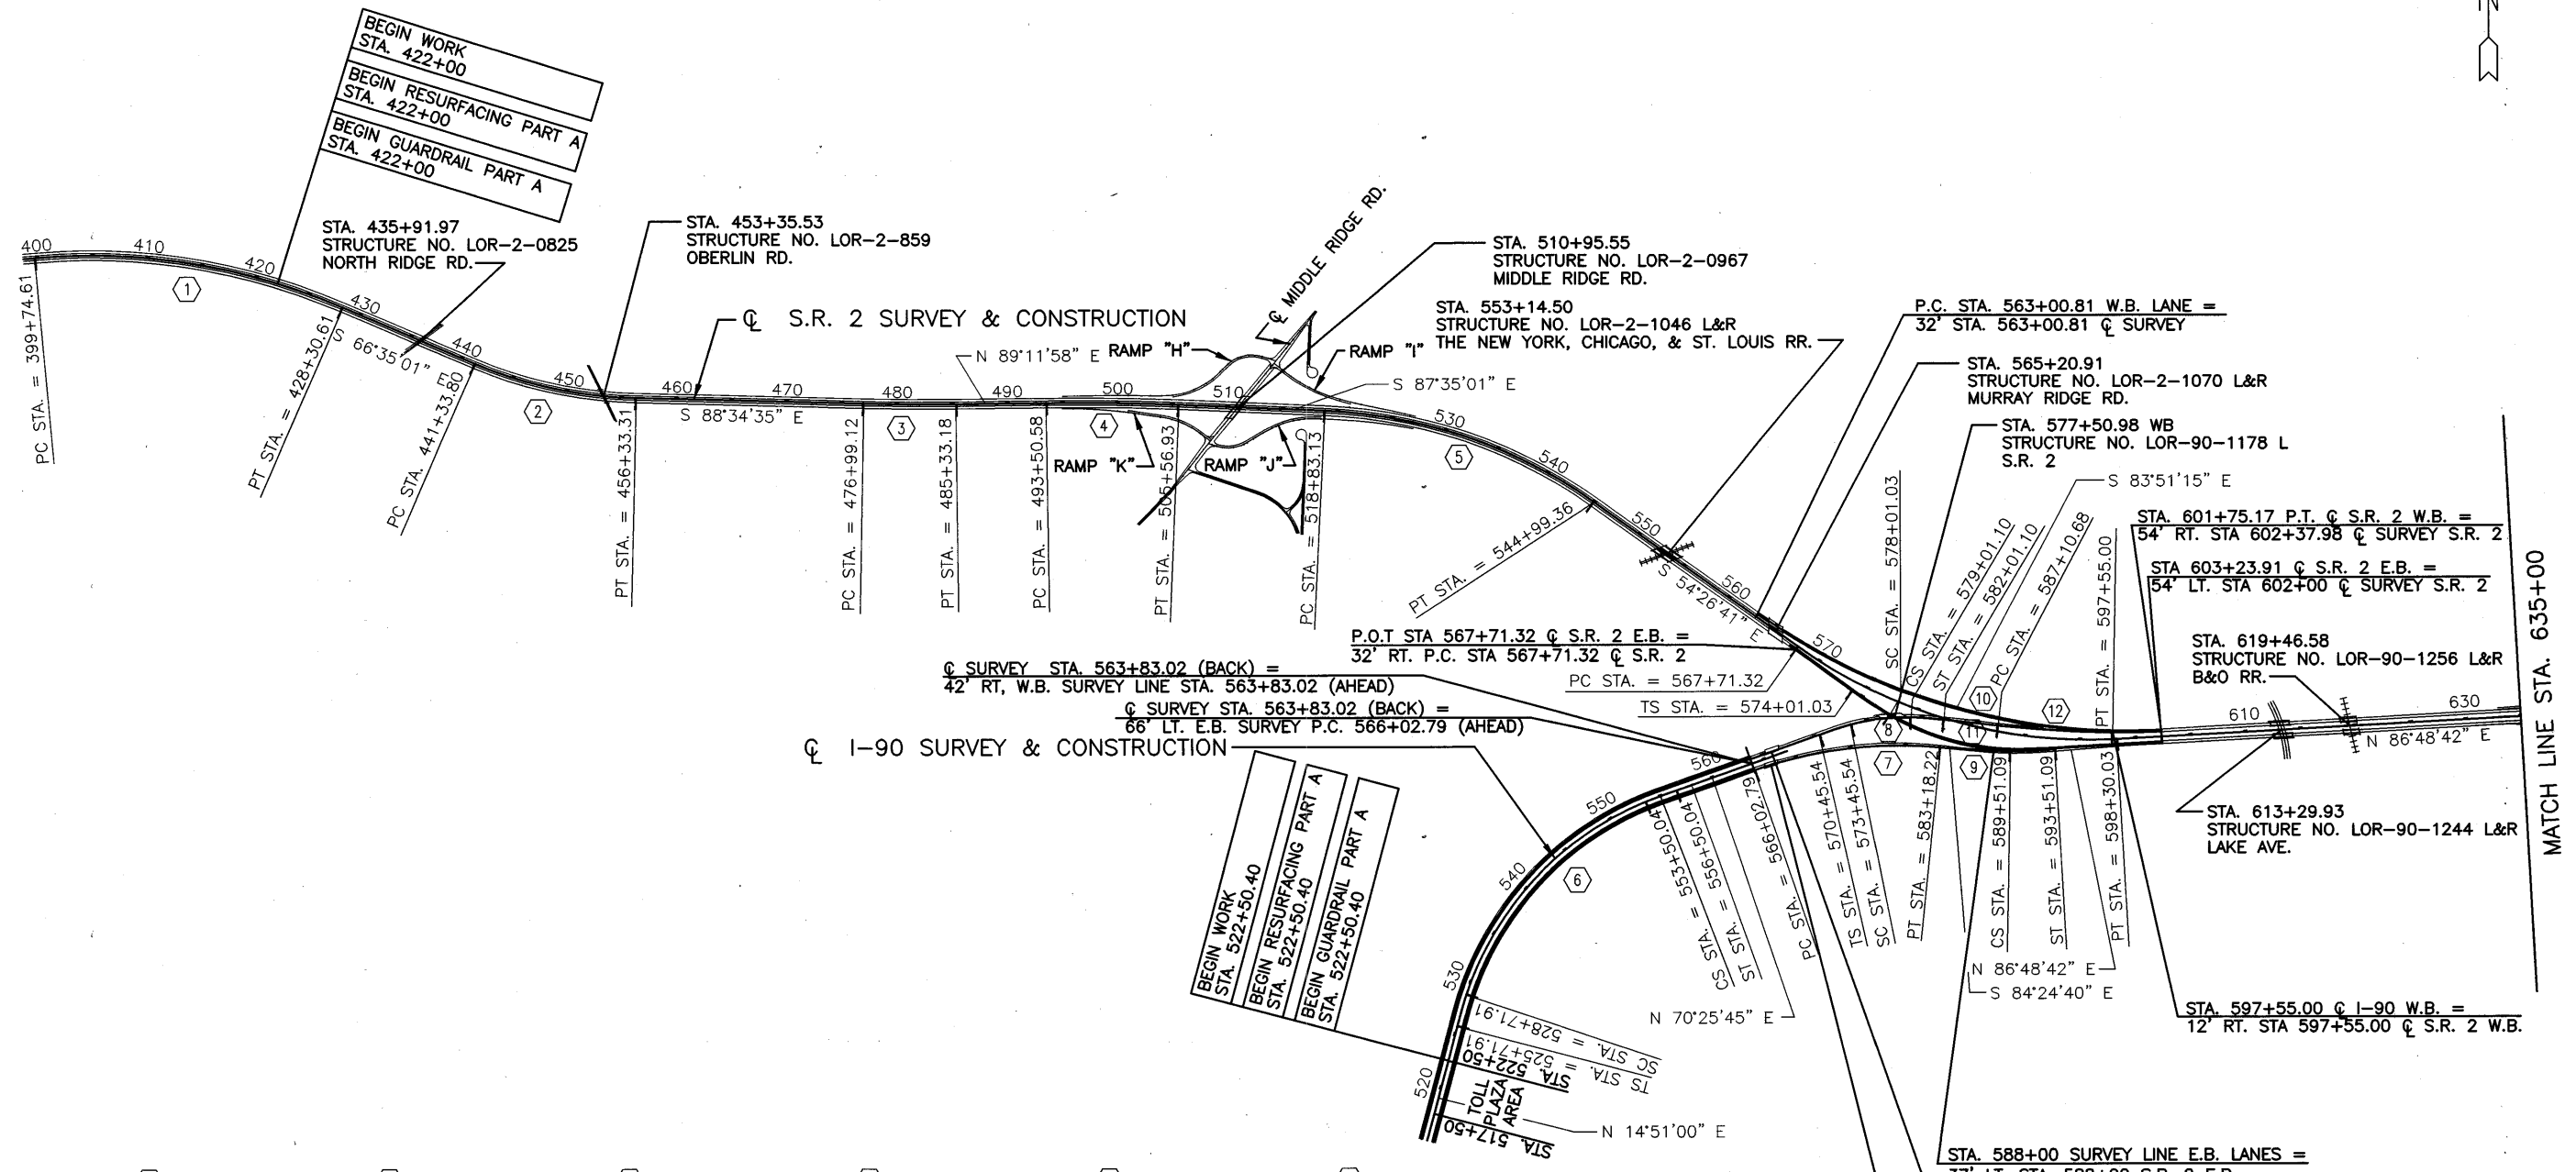


<p><b>CURVE DATA ①</b> P.I. STA. 414+32.93 Δ = 28°33'36" RT. D = 1'00'00" R = 5729.58' T = 1458.32' L = 2856.00' E = 182.68' e<sub>max</sub> = 0.036</p>	<p><b>CURVE DATA ②</b> P.I. STA. 499+53.92 Δ = 21°59'34" LT. D = 1'28'00" R = 3906.53' T = 759.10' L = 1499.51' E = 73.07' e<sub>max</sub> = 0.051</p>	<p><b>CURVE DATA ③</b> P.I. STA. 481+16.20 Δ = 2°13'27" LT. D = 0'16'00" R = 21,485.92' T = 417.08' L = 834.06' E = 4.04' e<sub>max</sub> = 0.001</p>	<p><b>CURVE DATA ④</b> P.I. STA. 499+53.92 Δ = 3°13'01" RT. D = 0'16'00" R = 21,485.92' T = 603.34' L = 1206.35' E = 8.47' e<sub>max</sub> = 0.001</p>	<p><b>CURVE DATA ⑤</b> P.I. STA. 532+28.96 Δ = 33°08'20" RT. D = 1'16'00" R = 4523.35' T = 1345.84' L = 2616.23' E = 195.97' e<sub>max</sub> = 0.045</p>	<p><b>CURVE DATA ⑥</b> P.I. STA. 542+31.82 Δ = 55°33'45" RT. Dc = 49°33'45" Dc = 2'00'00" R = 2864.79' T = 1659.91' L = 300.00' Lc = 2478.13' E = 374.72' Es = 3'00'00" e<sub>max</sub> = 0.066</p>	<p><b>CURVE DATA ⑦</b> P.I. STA. 574+74.56 Δ = 25°09'35" RT. Dc = 1'28'00" R = 3906.53' T = 871.77' L = 1715.43' E = 96.09' e<sub>max</sub> = 0.051</p>	<p><b>CURVE DATA ⑧</b> P.I. STA. 576+31.04 Δ = 25°40'00" RT. Dc = 16°40'00" Dc = 3'00'00" R = 1909.86' Ts = 585.495' Ls = 300.00' Lc = 555.56' Es = 50.94' Es = 3'00'00" e<sub>max</sub> = 0.083</p>	<p><b>CURVE DATA ⑨</b> P.I. STA. 584+08.14 Δ = 38°44'37" LT. Dc = 2'30'00" R = 2291.83' T = 1006.79' Ls = 400.00' Es = 140.59' e<sub>max</sub> = 0.077</p>	<p><b>CURVE DATA ⑩</b> P.I. STA. 583+15.34 Δ = 38°44'37" LT. Dc = 1'00'00" R = 5729.58' T = 2014.53' Lc = 3874.36' E = 343.84' e<sub>max</sub> = 0.036</p>	<p><b>CURVE DATA ⑪</b> P.I. STA. 583+61.74 Δ = 38°44'37" LT. D = 1'16'00" R = 4523.35' T = 1590.42' L = 3058.71' E = 271.45' e<sub>max</sub> = 0.045</p>	<p><b>CURVE DATA ⑫</b> P.I. STA. 592+31.18 Δ = 5°12'05" LT. Dc = 0'30'00" R = 11,459.16' T = 520.50' L = 1040.28' E = 11.82' e<sub>max</sub> = 0.019</p>
------------------------------------------------------------------------------------------------------------------------------------------------------------------------------------------	----------------------------------------------------------------------------------------------------------------------------------------------------------------------------------------	---------------------------------------------------------------------------------------------------------------------------------------------------------------------------------------	----------------------------------------------------------------------------------------------------------------------------------------------------------------------------------------	------------------------------------------------------------------------------------------------------------------------------------------------------------------------------------------	-------------------------------------------------------------------------------------------------------------------------------------------------------------------------------------------------------------------------------------------------	-----------------------------------------------------------------------------------------------------------------------------------------------------------------------------------------	--------------------------------------------------------------------------------------------------------------------------------------------------------------------------------------------------------------------------------------------------	--------------------------------------------------------------------------------------------------------------------------------------------------------------------------------------------	--------------------------------------------------------------------------------------------------------------------------------------------------------------------------------------------	------------------------------------------------------------------------------------------------------------------------------------------------------------------------------------------	------------------------------------------------------------------------------------------------------------------------------------------------------------------------------------------

CURVE DATA <sup>13</sup>  
 P.I. STA. 719+72.20  
 $\Delta = 59^{\circ}48'25''$   
 $D_c = 2^{\circ}00'00''$   
 $R_c = 2864.79'$   
 $T_s = 1798.30'$   
 $L_c = 2690.35'$   
 $L_s = 300.00'$   
 $E_s = 441.47'$   
 $\theta_s = 3^{\circ}00'00''$   
 $L.T. = 200.03'$   
 $S.T. = 100.03'$   
 $e_{max} = 0.066$

CURVE DATA <sup>14</sup>  
 P.I. STA. 750+87.60  
 $\Delta = 36^{\circ}12'32''$   
 $D_c = 2^{\circ}30'00''$   
 $R_c = 2291.83'$   
 $T_s = 950.18'$   
 $L_c = 1048.36'$   
 $L_s = 400.00'$   
 $E_s = 122.44'$   
 $\theta_s = 5^{\circ}00'00''$   
 $L.T. = 266.77'$   
 $S.T. = 133.43'$   
 $e_{max} = 0.077$

CURVE DATA <sup>15</sup>  
 P.I. STA. 796+98.20  
 $\Delta = 62^{\circ}20'45''$   
 $D_c = 2^{\circ}30'00''$   
 $R_c = 2291.83'$   
 $T_s = 1588.21'$   
 $L_c = 2093.83'$   
 $L_s = 400.00'$   
 $E_s = 390.16'$   
 $\theta_s = 5^{\circ}00'00''$   
 $L.T. = 266.77'$   
 $S.T. = 133.43'$   
 $e_{max} = 0.077$

CURVE DATA <sup>16</sup>  
 P.I. STA. 842+77.91  
 $\Delta = 30^{\circ}13'50''$   
 $D = 1^{\circ}28'00''$   
 $R = 3906.53'$   
 $T = 1055.18'$   
 $L = 2061.17'$   
 $E = 140.00'$   
 $e_{max} = 0.051$

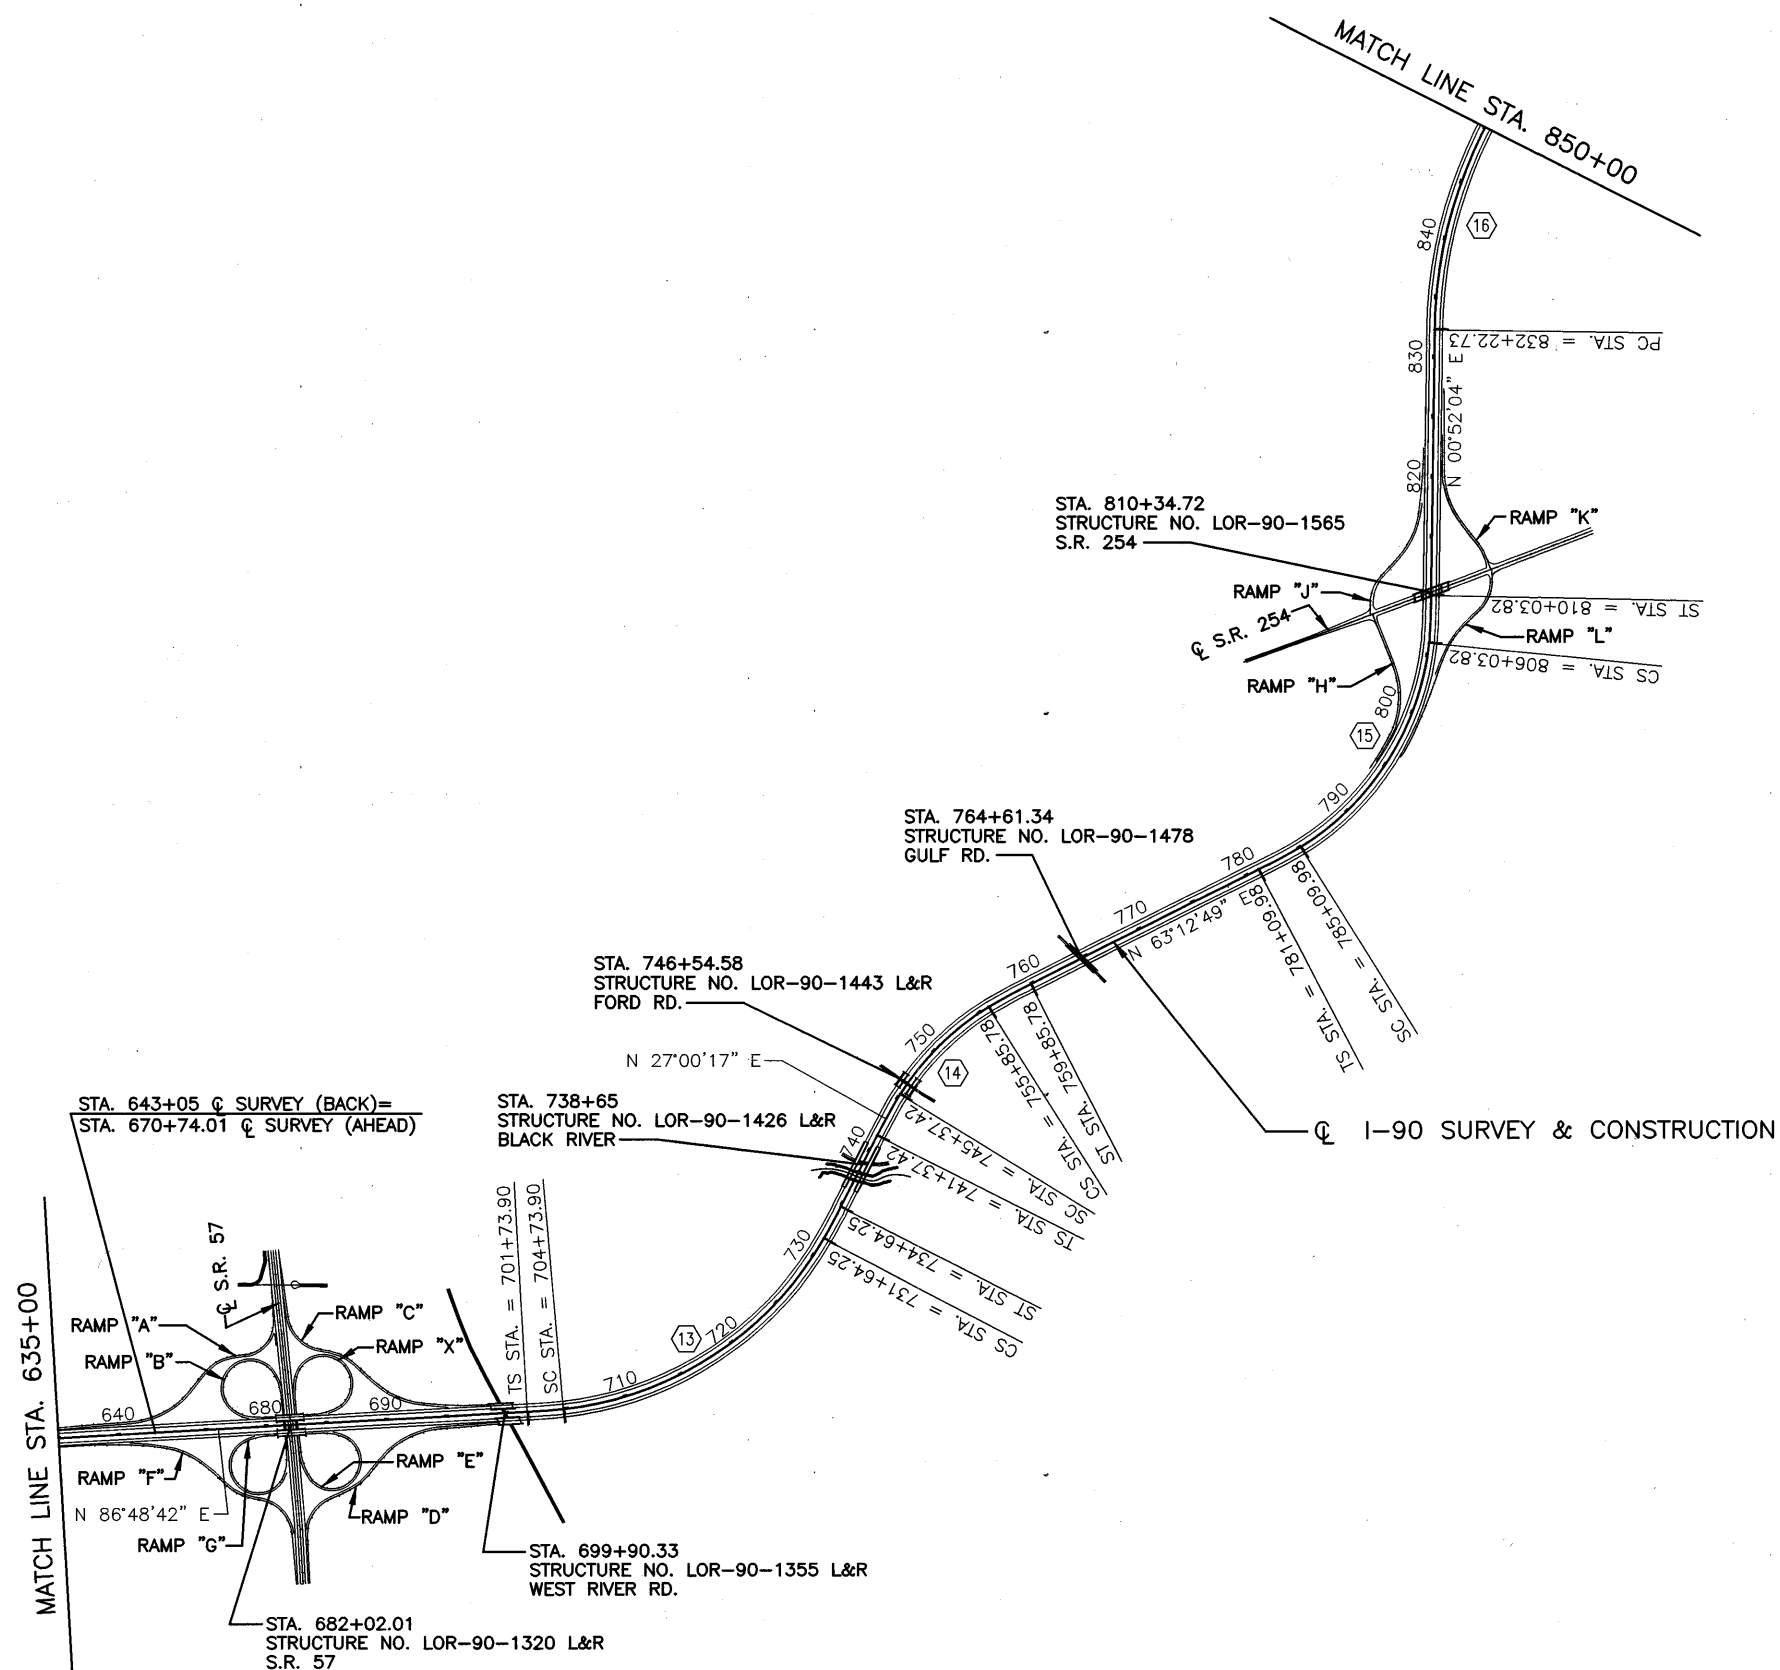

CALCULATED  
 DLS  
 CHECKED  
 LAB

0 800' 1600'  
 HORIZONTAL  
 SCALE IN FEET

**SCHEMATIC PLAN**  
**STA. 635+00 TO STA. 850+00**

LOR - 190 - 10.76

3  
 274




C:\93600\DWG\93600P\L\9-02.DWG J.M.W  
 02-16-2002 7:39AM

CURVE DATA (17)  
 P.I. STA. 924+29.83  
 $\Delta = 14'41'36''$   
 $D_c = 1'00'00''$   
 $R = 5729.58'$   
 $T = 738.72'$   
 $L = 1469.33'$   
 $E = 47.43'$   
 $e_{max} = 0.036$

CURVE DATA (18)  
 P.I. STA. 975+45.59  
 $\Delta = 3'00'00''$   
 $D_c = 1'30'00''$   
 $R = 3819.72'$   
 $T = 100.03'$   
 $L = 200.00'$   
 $E = 1.31'$   
 $e_{max} = 0.052$

CURVE DATA (19)  
 P.I. STA. 988+39.94  
 $\Delta = 45'15'51''$   
 $D_c = 2'00'00''$   
 $R = 2864.79'$   
 $T = 1194.38'$   
 $L = 2263.21'$   
 $E = 239.01'$   
 $e_{max} = 0.066$

CURVE DATA (20)  
 P.I. STA. 1000+08.80  
 $\Delta = 3'00'00''$   
 $D_c = 1'30'00''$   
 $R = 3819.72'$   
 $T = 100.023'$   
 $L = 200.00'$   
 $E = 1.31'$   
 $e_{max} = 0.052$

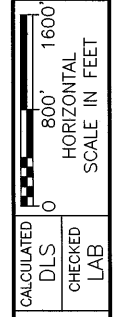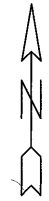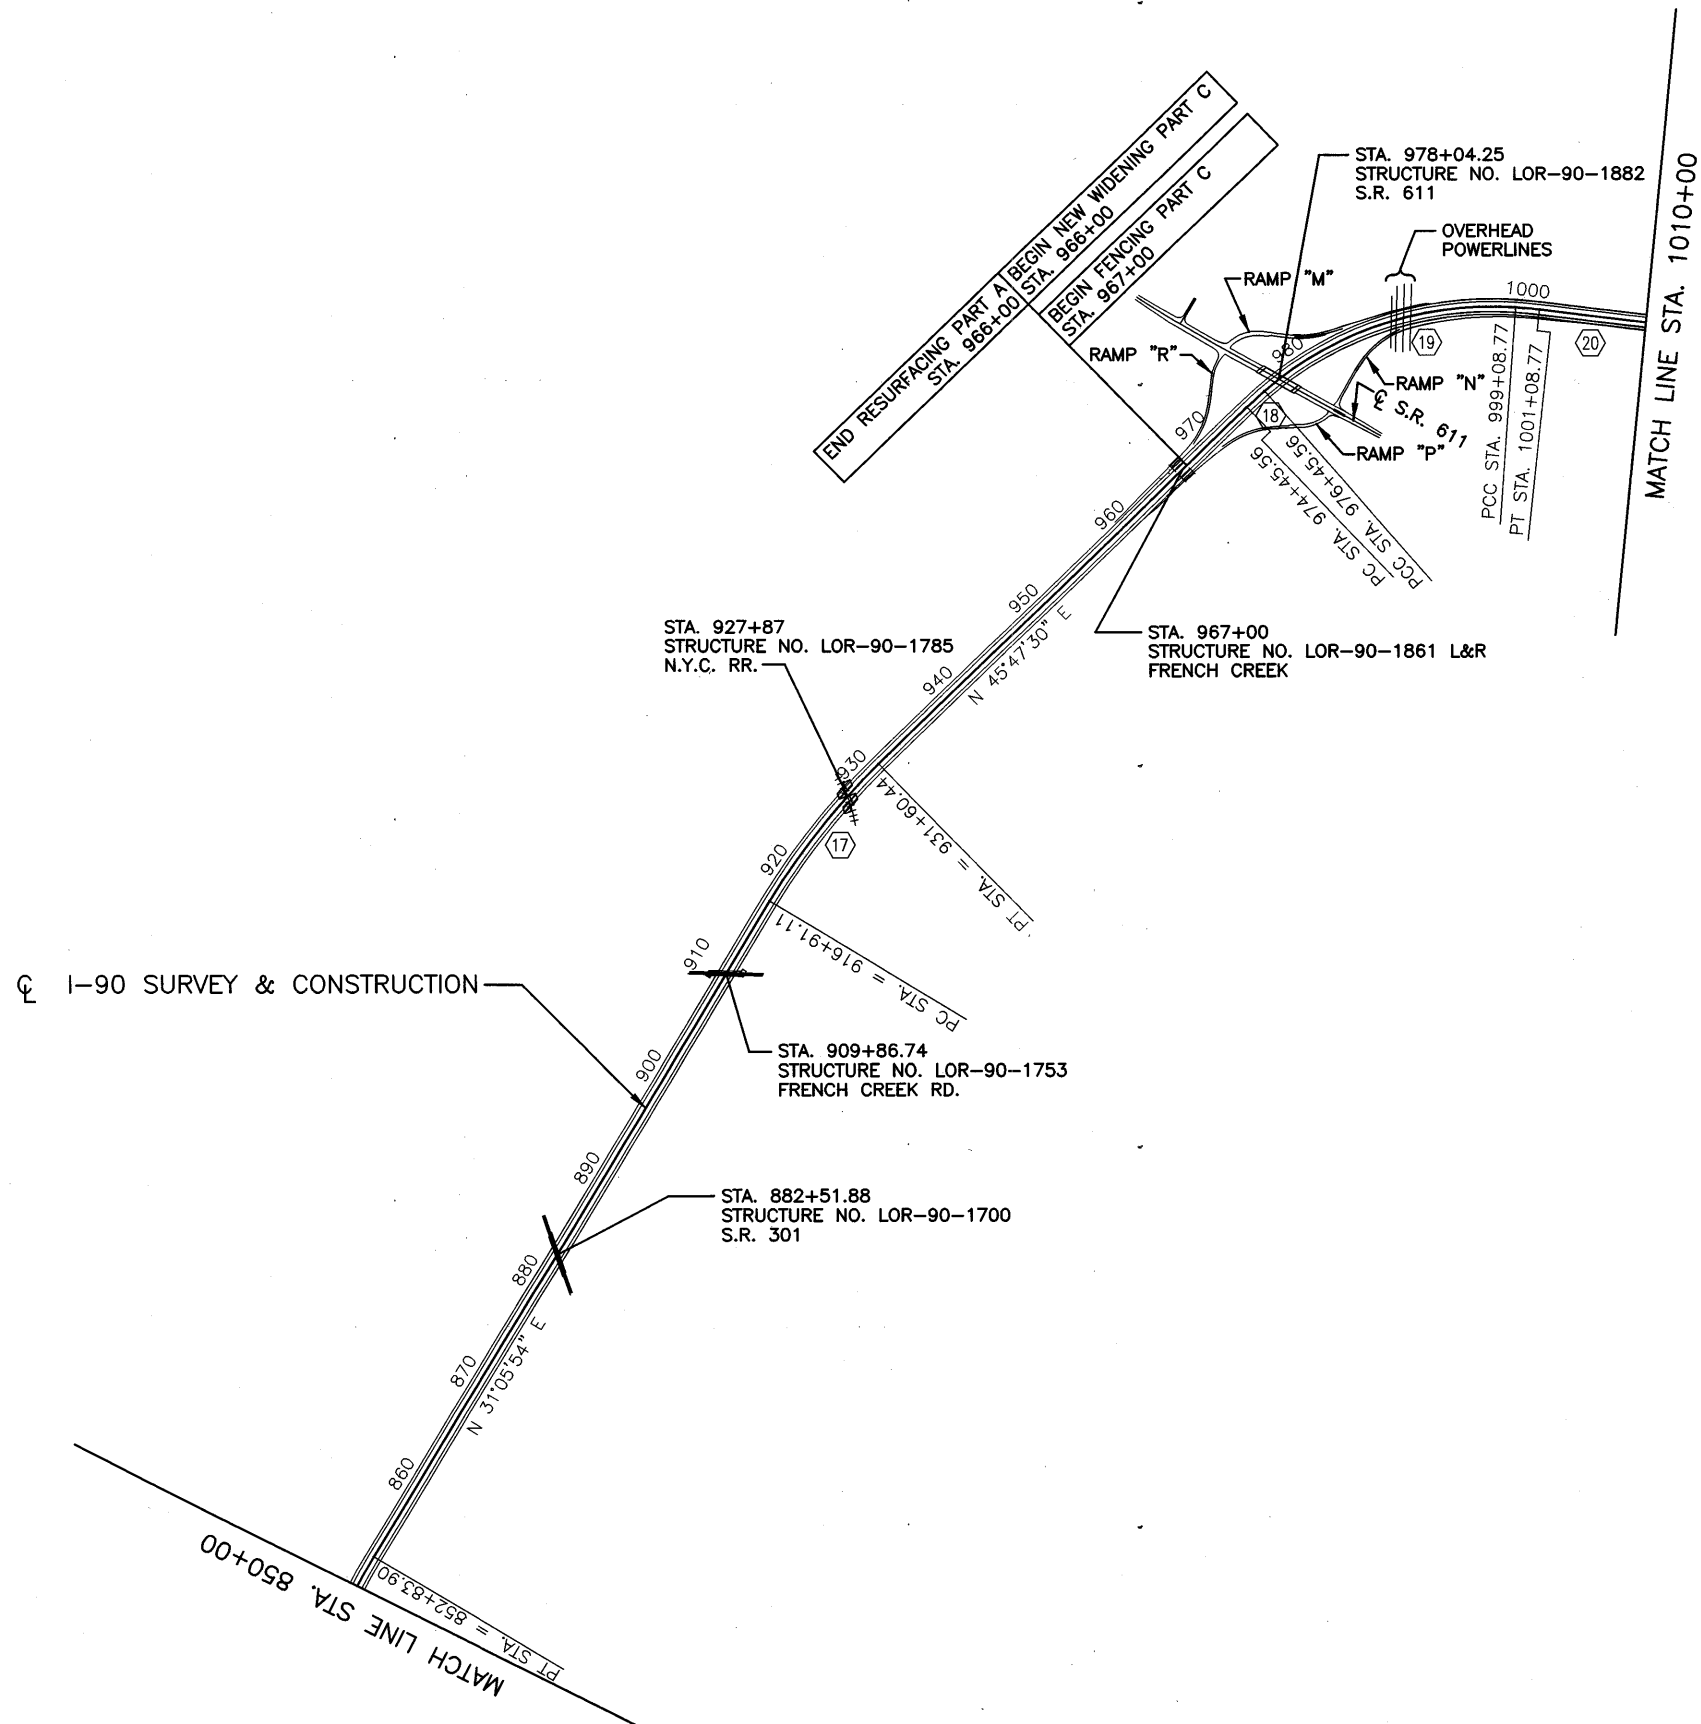

SCHEMATIC PLAN  
 STA. 850+00 TO STA. 1010+00

LOR - 190 - 10.76

**DESIGN DESIGNATION**

CURRENT ADT (2001)	50210
DESIGN YEAR ADT (2021)	72640
K	0.10
D	0.60
T24	0.175
TC	0.105
DESIGN SPEED	70 MPH

C:\318600\DWG\318600\PLANS-03.DWG J MW  
 5-18-2002 7:40AM

CURVE DATA (21)  
 P.I. STA. 1022+54.08  
 $\Delta = 5^{\circ}40'38''$   
 $D_c = 0^{\circ}28'00''$   
 $R = 12,277.67'$   
 $T = 608.77'$   
 $L = 1216.55'$   
 $E = 15.08'$   
 $e_{max} = 0.016$

END NEW WIDENING PART C  
 STA. 1017+70.18 EB  
 STA. 1018+00 WB

BEGIN RECONSTRUCTION OF PREVIOUSLY WIDENED SECTION PART C  
 STA. 1017+70.18 EB  
 STA. 1018+00 WB

END RECONSTRUCTION OF PREVIOUSLY WIDENED SECTION PART C  
 STA. 1035+00

END PROJECT  
 STA. 1215+90.07

END FENCING PART C  
 STA. 1215+90.07

MATCH LINE STA. 1010+00

PC STA. = 1016+45.31

PT STA. = 1028+61.85

PC STA. = 1086+23.77

PT STA. = 1092+68.98

PC STA. = 1147+68.98

PT STA. = 1164+58.23



PT STA. = 1205+15.43

STA. 1068+91.63  
 STRUCTURE NO. LOR-83-183 L&R  
 S.R. 83

STA. 1129+40.29  
 STRUCTURE NO. LOR-90-2169  
 JAYCOX RD.

STA. 1159+52.62  
 STRUCTURE NO. LOR-90-2226  
 LEAR-NAGLE RD.

I-90 SURVEY & CONSTRUCTION

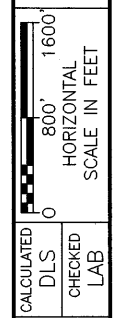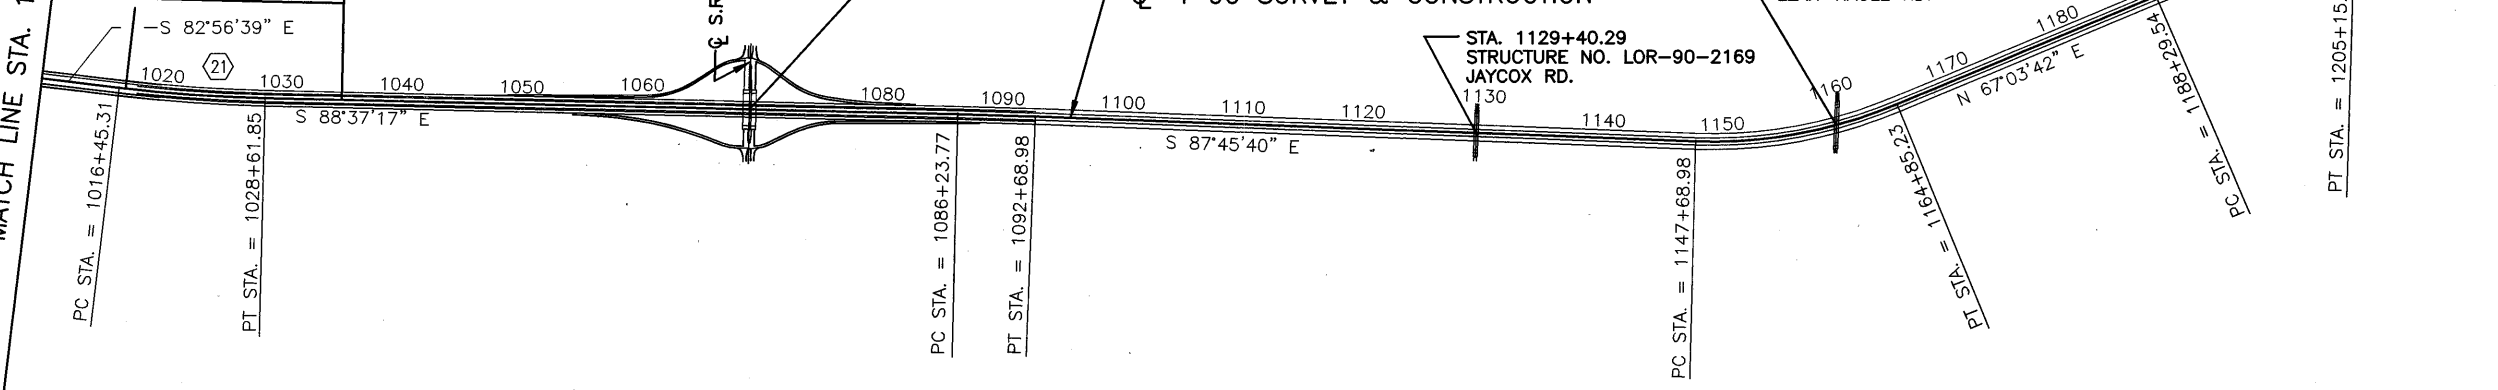

**SCHEMATIC PLAN**  
 STA. 1010+00 TO STA. 1215+90.07


LOR - 190 - 10.76

EXISTING NORMAL TYPICAL SECTIONS - I.R. 90 & S.R. 2 - E.B. & W.B.  
(WITH EXISTING OVERLAY)

CALCULATED  
DLS  
CHECKED  
LAB

EXISTING, E.B. & W.B., NORMAL TYPICAL SECTIONS - I.R. 90

LOR - 190 - 10.76

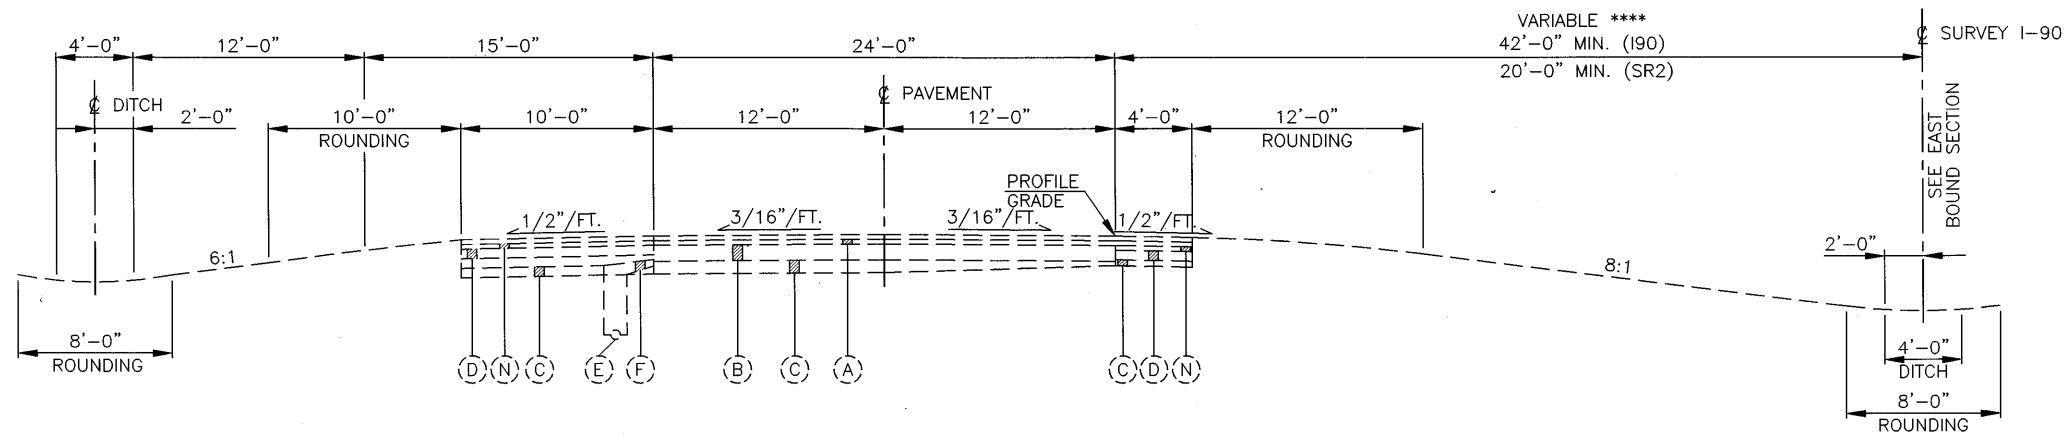

EXISTING NORMAL SECTION (WESTBOUND)


- STA. 429+75 (SR2) TO STA. 439+50 (SR2) (20'-0" MEDIAN)
- STA. 458+25 (SR2) TO STA. 517+25 (SR2) (20'-0" MEDIAN)
- STA. 546+75 (SR2) TO STA. 561+50 (SR2) (20'-0" MEDIAN)
- STA. 522+50.40 (I90) TO STA. 570+01.54 (I90)
- STA. 582+45.10 (I90) TO STA. 585+58.69 (I90)
- STA. 603+87.81 TO STA. 643+05 BACK (EQUATION) = STA. 670+74.01 AHEAD

LEGEND

- (A) 3 1/4" ASPHALT CONCRETE OVERLAY
- (B) 10" REINFORCED CONCRETE PAVEMENT
- (C) VARIABLE THICKNESS SUBBASE
- (D) 6" AGGREGATE BASE
- (E) 6" PIPE UNDERDRAIN
- (F) SPECIAL DRAINAGE CONNECTION
- (G) GUARDRAIL, TYPE 5
- (N) 3" ASPHALT CONCRETE BASE

NOTES:

- \* 8'-0" STA. 422+00 (SR2) TO STA. 579+00 (SR2)
- 8'-0" TO 10'-0" STA. 579+00 (SR2) TO STA. 580+00 (SR2)
- \*\* 10'-0" STA. 422+00 (SR2) TO STA. 579+00 (SR2)
- 10'-0" TO STA. 12'-0" STA. 579+00 (SR2) TO STA. 580+00 (SR2)
- \*\*\* 12'-0" STA. 422+00 (SR2) TO STA. 579+00 (SR2)
- 12'-0" TO 15'-0" STA. 579+00 (SR2) TO STA. 580+00 (SR2)
- \*\*\*\* 20'-0" STA. 422+00 (SR2) TO 579+00 (SR2)
- 42'-0" STA. 602+37.98 (SR2) TO STA. 960+00 (SR2)

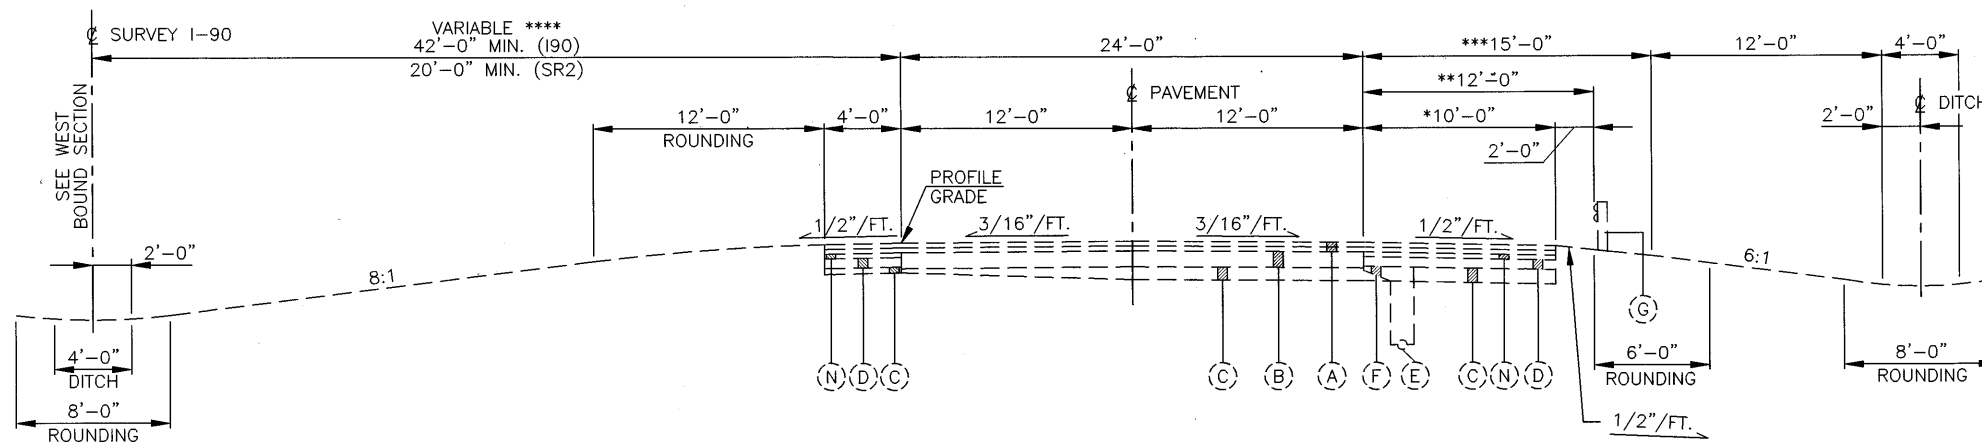


EXISTING NORMAL SECTION (EASTBOUND)

- STA. 429+75 (SR2) TO STA. 439+50 (SR2) (20'-0" MEDIAN)
- STA. 458+25 (SR2) TO STA. 517+25 (SR2) (20'-0" MEDIAN)
- STA. 546+75 (SR2) TO STA. 573+75 (SR2) (20'-0" MEDIAN)
- STA. 593+75 (SR2) TO STA. 603+26.91 BACK (EQUATION) =
- STA. 602+37.98 AHEAD ON SURVEY TO STA. 603+87.81 AHEAD ON SURVEY
- STA. 603+87.81 TO STA. 643+05 BACK (EQUATION) = STA. 670+74.01 AHEAD
- STA. 522+50.40 (I90) TO STA. 560+50 (I90)
- STA. 584+30.22 (I90) TO STA. 586+08 (I90)
- STA. 593+00 (I90) TO STA. 600+00 (I90)

EXISTING SUPERELEVATED TYPICAL SECTIONS - I.R. 90 & S.R. 2 - E.B. & W.B.  
(WITH EXISTING OVERLAY)

CALCULATED  
DLS  
CHECKED  
LAB

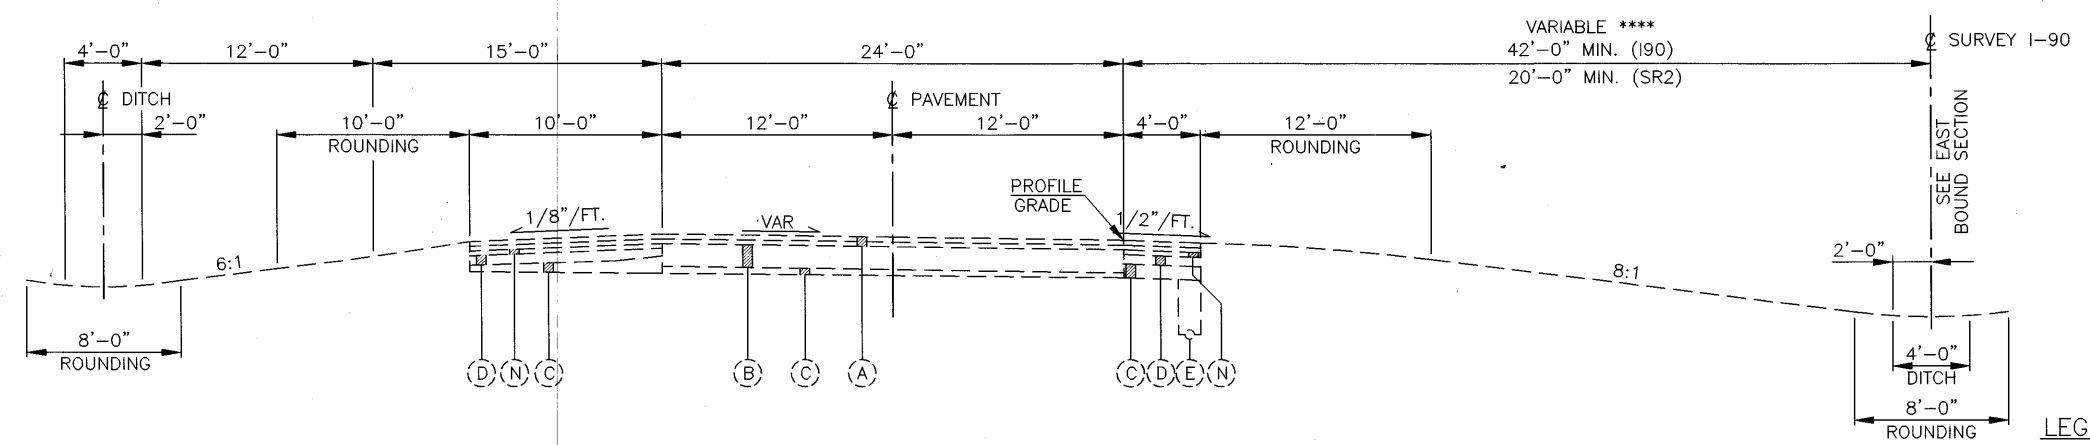

EXISTING SUPERELEVATED SECTION (WESTBOUND)


STA. 422+00 (SR2) TO STA. 429+75 (SR2) (20'-0" MEDIAN)  
 STA. 439+50 (SR2) TO STA. 458+25 (SR2) (20'-0" MEDIAN)  
 STA. 517+25 (SR2) TO STA. 546+75 (SR2) (20'-0" MEDIAN)  
 STA. 561+50 (SR2) TO STA. 601+75.17 BACK (EQUATION) =  
 STA. 602+37.98 AHEAD ON  $\phi$  SURVEY TO STA. 603+87.81 ON  $\phi$  SURVEY  
 STA. 570+01.54 (I90) TO STA. 582+45.10 (I90)  
 STA. 585+58.68 (I90) TO STA. 597+55 (I90)

LEGEND

- (A) 3 1/4" ASPHALT CONCRETE OVERLAY
- (B) 10" REINFORCED CONCRETE PAVEMENT
- (C) VARIABLE THICKNESS SUBBASE
- (D) 6" AGGREGATE BASE
- (E) 6" PIPE UNDERDRAIN
- (F) SPECIAL DRAINAGE CONNECTION
- (G) GUARDRAIL, TYPE 5
- (N) 3" ASPHALT CONCRETE BASE

NOTES:

- \* 8'-0" STA. 422+00 (SR2) TO STA. 579+00 (SR2)
- 8'-0" TO 10'-0" STA. 579+00 (SR2) TO STA. 580+00 (SR2)
- \*\* 10'-0" STA. 422+00 (SR2) TO STA. 579+00 (SR2)
- 10'-0" TO STA. 12'-0" STA. 579+00 (SR2) TO STA. 580+00 (SR2)
- \*\*\* 12'-0" STA. 422+00 (SR2) TO STA. 579+00 (SR2)
- 12'-0" TO 15'-0" STA. 579+00 (SR2) TO STA. 580+00 (SR2)
- \*\*\*\* 20'-0" STA. 422+00 (SR2) TO STA. 579+00 (SR2)
- 42'-0" STA. 602+37.98 (SR2) TO STA. 960+00 (SR2)

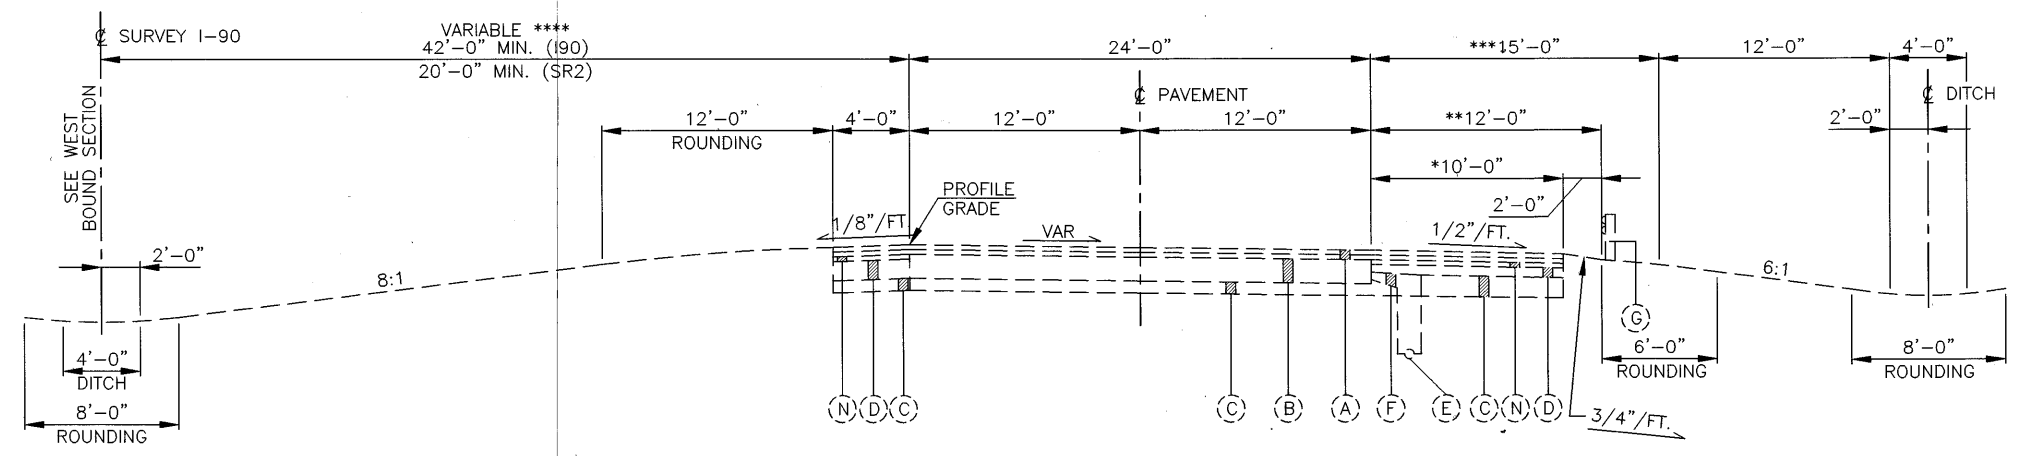

EXISTING SUPERELEVATED SECTION (EASTBOUND)

STA. 422+00 (SR2) TO STA. 429+75 (SR2) (20'-0" MEDIAN)  
 STA. 439+50 (SR2) TO STA. 458+25 (SR2) (20'-0" MEDIAN)  
 STA. 517+25 (SR2) TO STA. 546+75 (SR2) (20'-0" MEDIAN)  
 STA. 573+75 (SR2) TO STA. 593+75 (SR2)  
 STA. 560+50 (I90) TO STA. 584+30.22 (I90)  
 STA. 586+08 (I90) TO STA. 593+00 (I90)

EXISTING, E.B. & W.B., SUPERELEVATED TYPICAL SECTIONS - I.R. 90

LOR - 190 - 10.76


[ 0:\93600\DWGS\93600\FNL\T-02.DWG ] 02  
02-18-2002 9:50AM

EXISTING NORMAL TYPICAL SECTIONS - I.R. 90 & - E.B. & W.B.  
(WITHOUT EXISTING OVERLAY)

CALCULATED  
DLS  
CHECKED  
LAB

EXISTING, E.B. & W.B., NORMAL TYPICAL SECTIONS - I.R. 90

LOR - 190 - 10.76

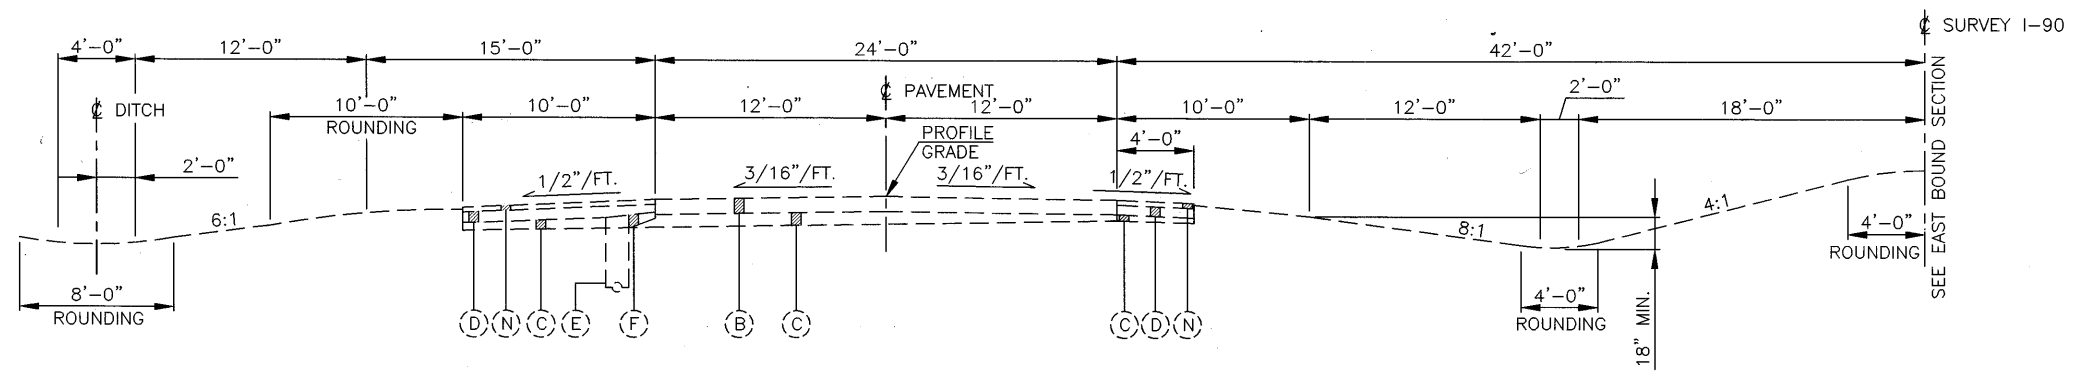


EXISTING NORMAL SECTION (WESTBOUND)

STA. 670+74.01 TO STA. 701+40.00  
 STA. 735+39.29 TO STA. 740+62.42  
 STA. 760+60.78 TO STA. 780+34.99  
 STA. 810+78.82 TO STA. 830+51.48  
 STA. 854+55.15 TO STA. 915+57.86  
 STA. 932+93.69 TO STA. 966+00.00 (MATCH RECONSTRUCTED SECTION)

EXISTING LEGEND

- (B) 10" REINFORCED CONCRETE PAVEMENT
- (C) VARIABLE THICKNESS SUBBASE
- (D) 6" AGGREGATE BASE
- (E) 6" PIPE UNDERDRAIN
- (F) SPECIAL DRAINAGE CONNECTION
- (G) GUARDRAIL, TYPE 5
- (N) 3" ASPHALT BASE

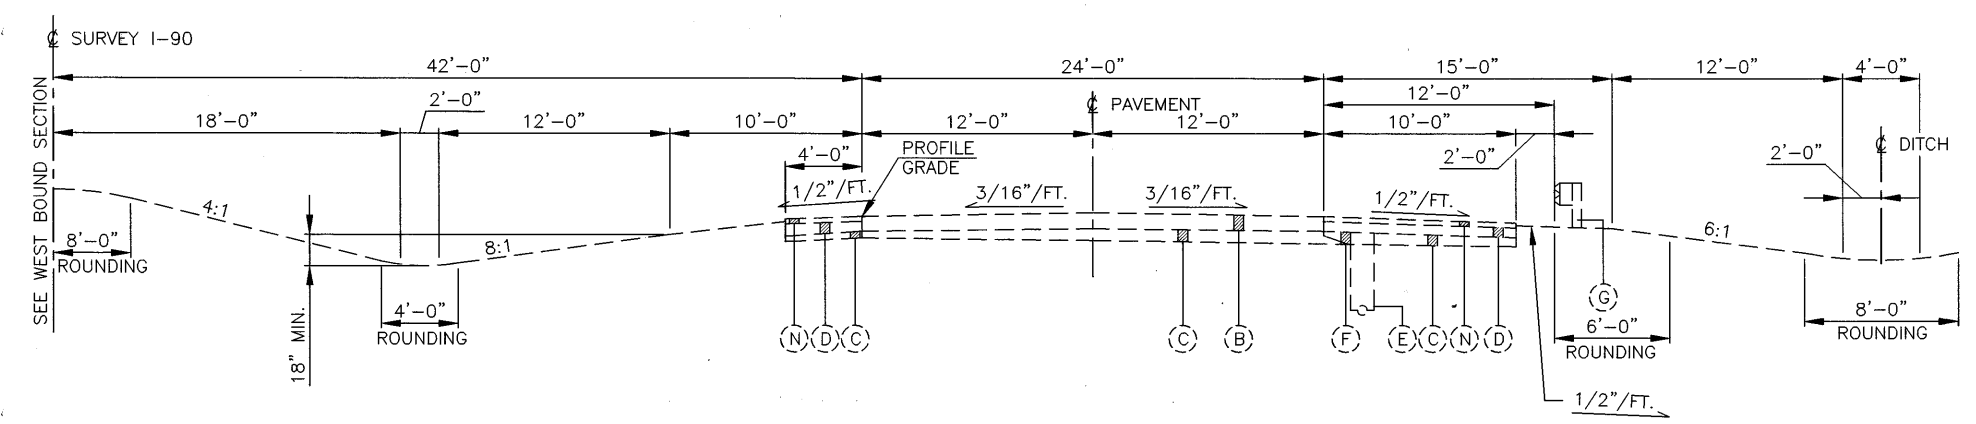


EXISTING NORMAL SECTION (EASTBOUND)

STA. 670+74.01 TO STA. 701+40.00  
 STA. 735+39.29 TO STA. 740+62.42  
 STA. 760+60.78 TO STA. 780+34.99  
 STA. 810+78.82 TO STA. 830+51.48  
 STA. 854+55.15 TO STA. 915+57.86  
 STA. 932+93.69 TO STA. 966+00.00 (MATCH RECONSTRUCTED SECTION)

C:\B3600\DWG\3600P\17-03.DWG J CZ  
 12-18-2002 8:06AM



EXISTING SUPERELEVATED TYPICAL SECTIONS - I.R. 90 - E.B. & W.B.  
(WITHOUT EXISTING OVERLAY)

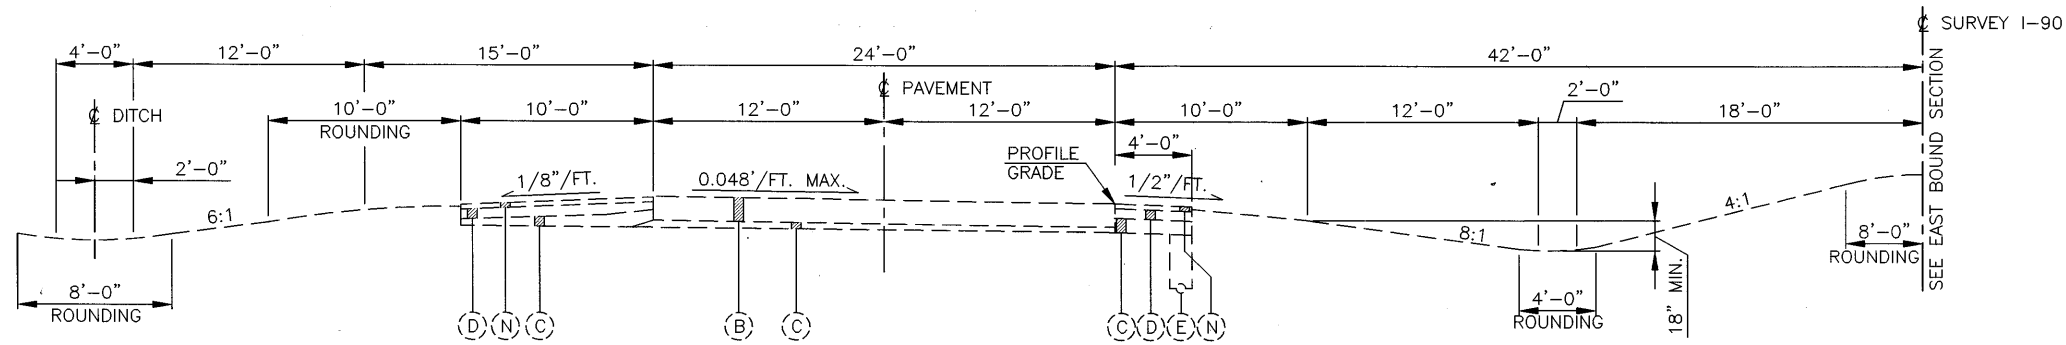


EXISTING SUPERELEVATED SECTION (WESTBOUND)

STA. 701+40.00 TO STA. 735+39.25  
 STA. 740+62.42 TO STA. 760+60.78  
 STA. 780+34.99 TO STA. 810+78.82  
 STA. 830+51.48 TO STA. 854+55.15  
 STA. 915+57.86 TO STA. 932+93.69

EXISTING LEGEND

- (B) 10" REINFORCED CONCRETE PAVEMENT
- (C) VARIABLE THICKNESS SUBBASE
- (D) 6" AGGREGATE BASE
- (E) 6" PIPE UNDERDRAIN
- (F) SPECIAL DRAINAGE CONNECTION
- (G) GUARDRAIL, TYPE 5
- (N) 3" ASPHALT BASE

\*\* OR RATE OF SUPER IF GREATER

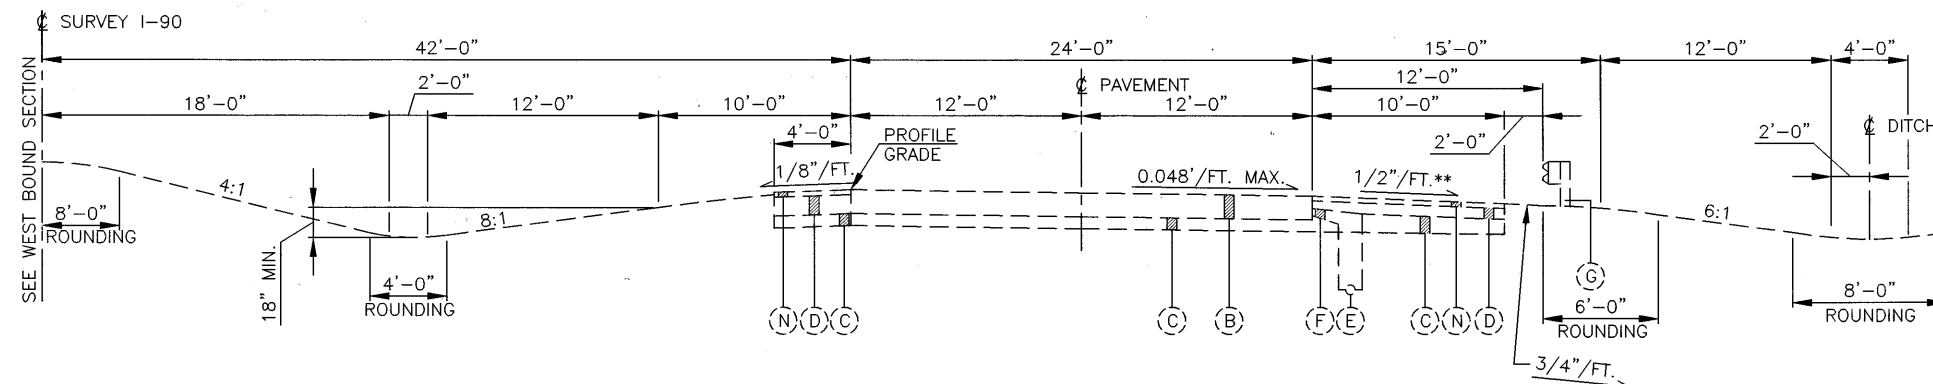


EXISTING SUPERELEVATED SECTION (EASTBOUND)

STA. 701+40.00 TO STA. 735+39.25  
 STA. 740+62.42 TO STA. 760+60.78  
 STA. 780+34.99 TO STA. 810+78.82  
 STA. 830+51.48 TO STA. 854+55.15  
 STA. 915+57.86 TO STA. 932+93.69

# PROPOSED NORMAL TYPICAL SECTIONS - I.R. 90 & S.R. 2 - E.B. & W.B.

(WITH EXISTING OVERLAY)

CALCULATED  
DLS  
CHECKED  
LAB

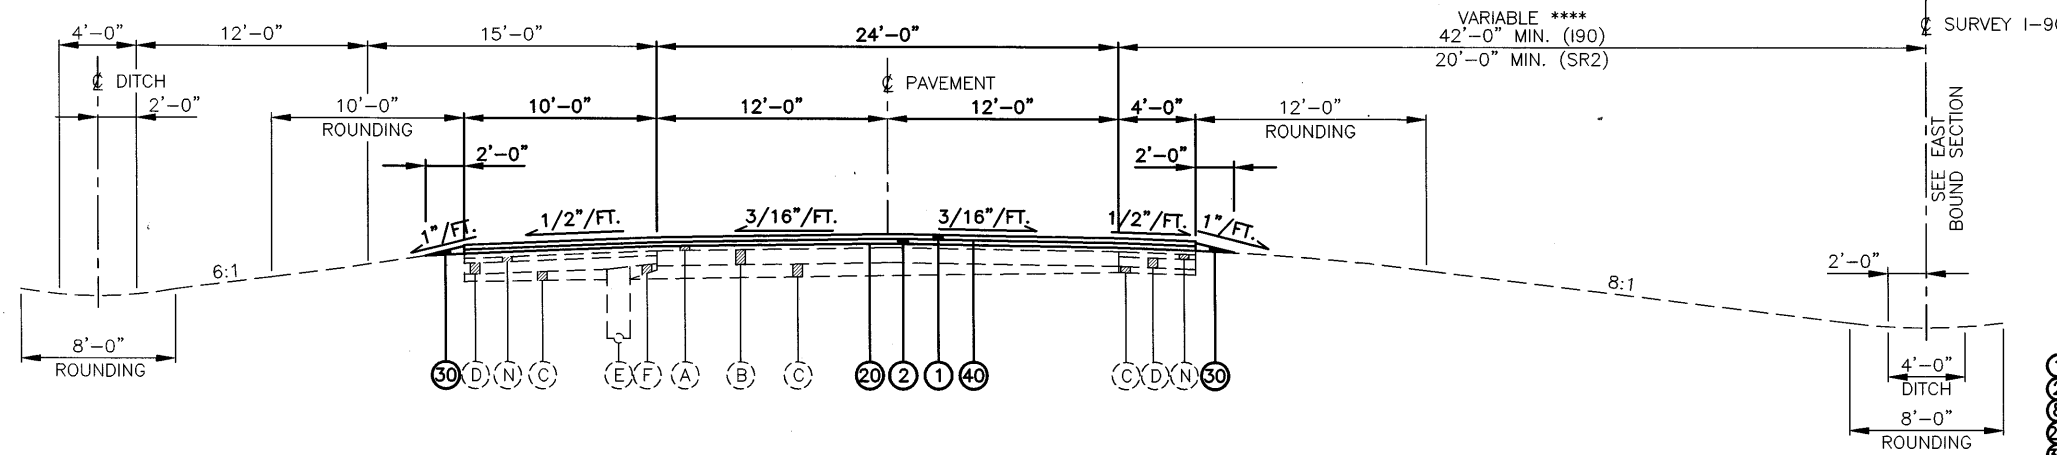

## NORMAL SECTION (WESTBOUND) - I.R. 90 & S.R. 2


STA. 429+75 (SR2) TO STA. 439+50 (SR2) (20'-0" MEDIAN)  
 STA. 458+25 (SR2) TO STA. 517+25 (SR2) (20'-0" MEDIAN)  
 STA. 546+75 (SR2) TO STA. 561+50 (SR2) (20'-0" MEDIAN)  
 STA. 522+50.40 (I90) TO STA. 570+01.54 (I90)  
 STA. 582+45.10 (I90) TO STA. 585+58.69 (I90)  
 STA. 603+87.81 TO STA. 643+05 BACK (EQUATION) = STA. 670+74.01 AHEAD

### LEGEND

- ① ITEM 446 - 1 1/2" ASPHALT CONCRETE SURFACE COURSE TYPE 1H, PG 70-22
- ② ITEM 446 - 1 3/4" ASPHALT CONCRETE INTERMEDIATE COURSE TYPE 2, PG 64-28
- ③ ITEM 606 - GUARDRAIL TYPE 5
- ④ ITEM 407 - TACK COAT (SEE GENERAL NOTE)
- ⑤ ITEM 617 - SHOULDER RECONDITIONING, MISC., COMPACTED AGGREGATE W/ ITEM 408 BITUMINOUS PRIME COAT OR ITEM 617 COMPACTED AGGREGATE, TYPE A
- ⑥ ITEM 407 - TACK COAT (REDUCED RATE PER PLAN NOTE)
- Ⓐ 3 1/4" ASPHALT CONCRETE OVERLAY
- Ⓑ 10" REINFORCED CONCRETE PAVEMENT
- OR-① 15" CONCRETE APPROACH SLAB
- Ⓒ VARIABLE THICKNESS SUBBASE
- Ⓓ 6" AGGREGATE BASE
- Ⓔ 6" PIPE UNDERDRAIN
- Ⓕ SPECIAL DRAINAGE CONNECTION
- Ⓖ GUARDRAIL, TYPE 5
- Ⓗ 3" ASPHALT BASE

### NOTES:

- \* 8'-0" STA. 422+00 (SR2) TO STA. 579+00 (SR2)
- 8'-0" TO 10'-0" STA. 579+00 (SR2) TO STA. 580+00 (SR2)
- \*\* 10'-0" STA. 422+00 (SR2) TO STA. 579+00 (SR2)
- 10'-0" TO STA. 12'-0" STA. 579+00 (SR2) TO STA. 580+00 (SR2)
- \*\*\* 12'-0" STA. 422+00 (SR2) TO STA. 579+00 (SR2)
- 12'-0" TO 15'-0" STA. 579+00 (SR2) TO STA. 580+00 (SR2)
- \*\*\*\* 20'-0" STA. 422+00 (SR2) TO STA. 579+00 (SR2)
- 42'-0" STA. 602+37.98 (SR2) TO STA. 960+00 (SR2)

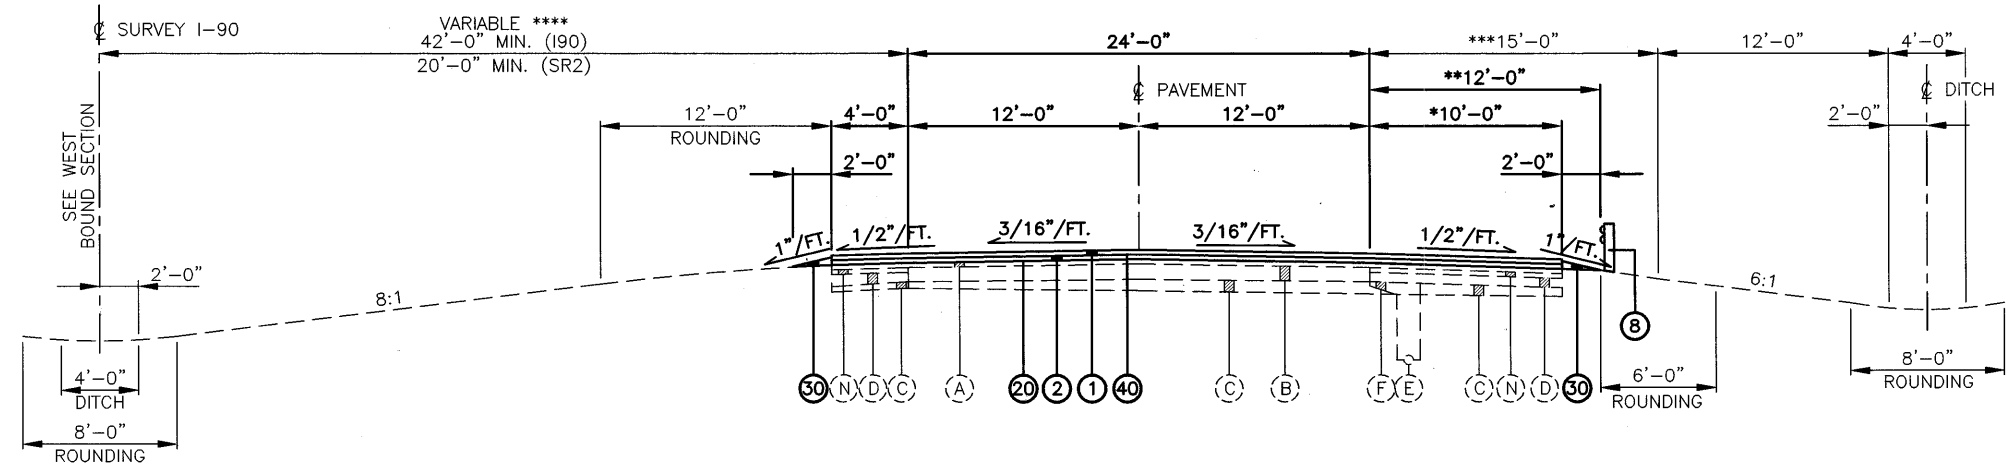

## NORMAL SECTION (EASTBOUND) - I.R.90 & S.R. 2


STA. 429+75 (SR2) TO STA. 439+50 (SR2) (20'-0" MEDIAN)  
 STA. 458+25 (SR2) TO STA. 517+25 (SR2) (20'-0" MEDIAN)  
 STA. 546+75 (SR2) TO STA. 573+75 (SR2) (20'-0" MEDIAN)  
 STA. 593+75 (SR2) TO STA. 603+26.91 BACK (EQUATION) =  
 STA. 602+37.98 AHEAD ON @ SURVEY TO STA. 603+87.81 AHEAD ON @ SURVEY  
 STA. 603+87.81 TO STA. 643+05 BACK (EQUATION) = STA. 670+74.01 AHEAD  
 STA. 522+50.40 (I90) TO STA. 560+50 (I90)  
 STA. 584+30.22 (I90) TO STA. 586+08 (I90)  
 STA. 593+00 (I90) TO STA. 600+00 (I90)

PROPOSED, E.B. & W.B., NORMAL TYPICAL SECTIONS- I.R. 90 - OVERLAY

LOR - I90 - 10.76

PROPOSED SUPERELEVATED TYPICAL SECTIONS - I.R. 90 & S.R. 2 - E.B. & W.B.  
(WITH EXISTING OVERLAY)

CALCULATED  
DLS  
CHECKED  
LAB

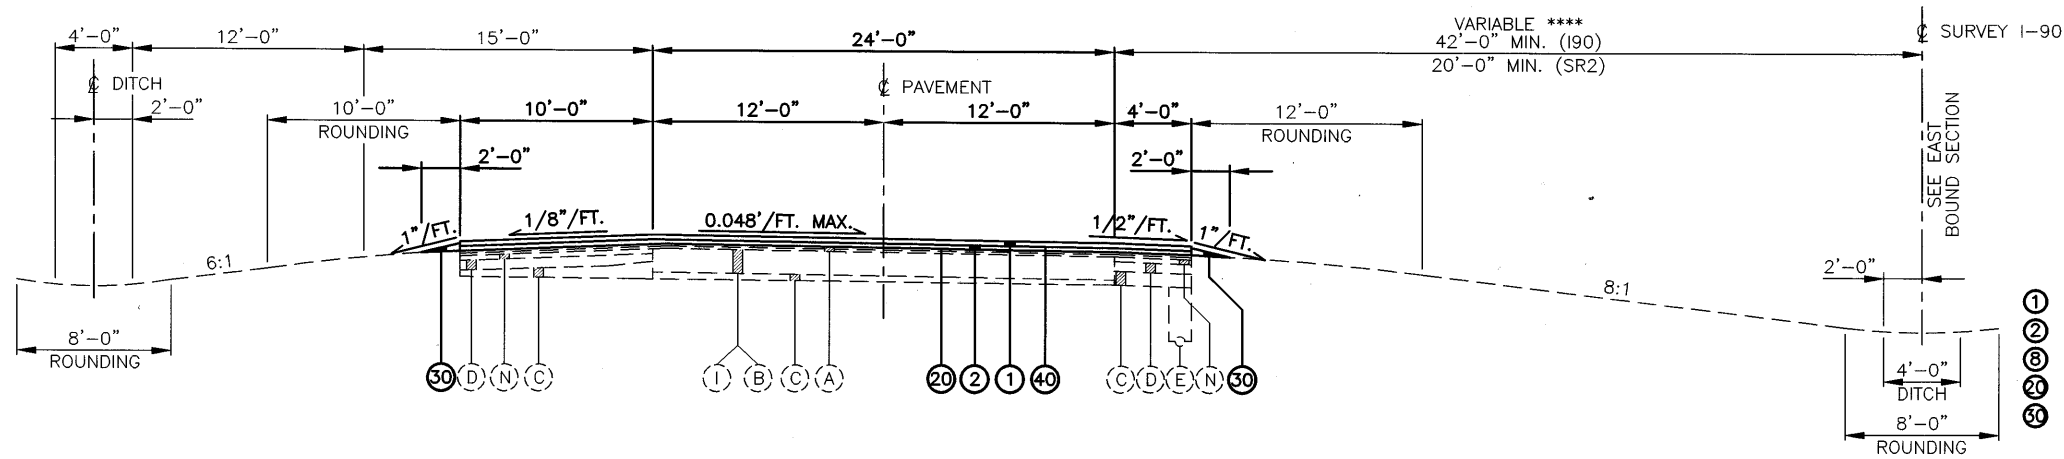

SUPERELEVATED SECTION (WESTBOUND) - I.R.90 & S.R. 2


STA. 422+00 (SR2) TO STA. 429+75 (SR2) (20'-0" MEDIAN)  
 STA. 439+50 (SR2) TO STA. 458+25 (SR2) (20'-0" MEDIAN)  
 STA. 517+25 (SR2) TO STA. 546+75 (SR2) (20'-0" MEDIAN)  
 STA. 561+50 (SR2) TO STA. 601+75.17 BACK (EQUATION) =  
 STA. 602+37.98 AHEAD ON  $\phi$  SURVEY TO STA. 603+87.81 ON  $\phi$  SURVEY  
 STA. 570+01.54 (I90) TO STA. 582+45.10 (I90)  
 STA. 585+58.68 (I90) TO STA. 597+55 (I90)

LEGEND

- ① ITEM 446 - 1 1/2" ASPHALT CONCRETE SURFACE COURSE TYPE 1H, PG 70-22
- ② ITEM 446 - 1 3/4" ASPHALT CONCRETE INTERMEDIATE COURSE TYPE 2, PG 64-28
- ⑧ ITEM 606 - GUARDRAIL TYPE 5
- ④ ITEM 407 - TACK COAT (SEE GENERAL NOTE)
- ⑤ ITEM 617 - SHOULDER RECONDITIONING, MISC., COMPACTED AGGREGATE W/ ITEM 408 BITUMINOUS PRIME COAT OR ITEM 617 COMPACTED AGGREGATE, TYPE A
- ④ ITEM 407 - TACK COAT (REDUCED RATE PER PLAN NOTE)
- (A) 3 1/4" ASPHALT CONCRETE OVERLAY
- (B) 10" REINFORCED CONCRETE PAVEMENT
- OR-(1) 15" CONCRETE APPROACH SLAB
- (C) VARIABLE THICKNESS SUBBASE
- (D) 6" AGGREGATE BASE
- (E) 6" PIPE UNDERDRAIN
- (F) SPECIAL DRAINAGE CONNECTION
- (G) GUARDRAIL, TYPE 5
- (N) 3" ASPHALT CONCRETE

NOTES:

- \* 8'-0" STA. 422+00 (SR2) TO STA. 579+00 (SR2)  
 8'-0" TO 10'-0" STA. 579+00 (SR2) TO STA. 580+00 (SR2)
- \*\* 10'-0" STA. 422+00 (SR2) TO STA. 579+00 (SR2)  
 10'-0" TO STA. 12'-0" STA. 579+00 (SR2) TO STA. 580+00 (SR2)
- \*\*\* 12'-0" STA. 422+00 (SR2) TO STA. 579+00 (SR2)  
 12'-0" TO 15'-0" STA. 579+00 (SR2) TO STA. 580+00 (SR2)
- \*\*\*\* 20'-0" STA. 422+00 (SR2) TO 579+00 (SR2)  
 42'-0" STA. 602+37.98 (SR2) TO STA. 960+00 (SR2)
- \*\*\*\*\* OR RATE OF SUPER IF GREATER

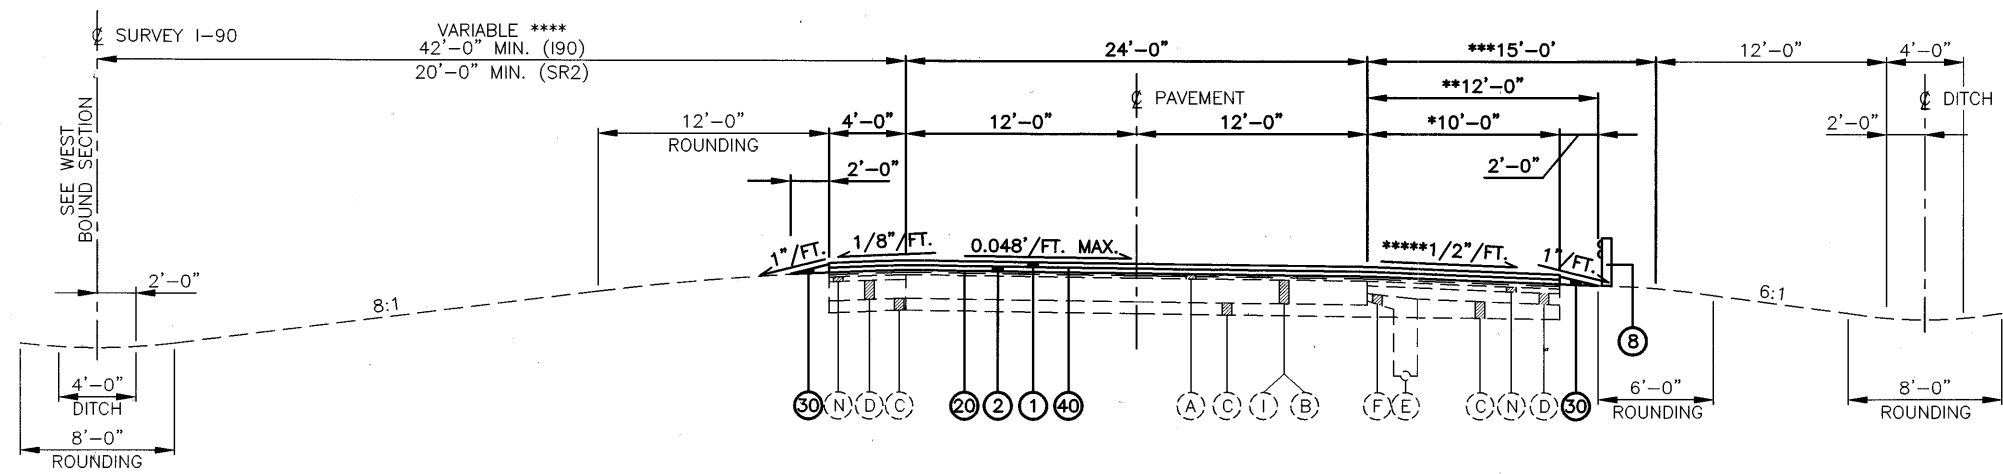

SUPERELEVATED SECTION (EASTBOUND) - I.R.90 & S.R. 2

STA. 422+00 (SR2) TO STA. 429+75 (SR2) (20'-0" MEDIAN)  
 STA. 439+50 (SR2) TO STA. 458+25 (SR2) (20'-0" MEDIAN)  
 STA. 517+25 (SR2) TO STA. 546+75 (SR2) (20'-0" MEDIAN)  
 STA. 573+75 (SR2) TO STA. 593+75 (SR2)  
 STA. 560+50 (I90) TO STA. 584+30.22 (I90)  
 STA. 586+08 (I90) TO STA. 593+00 (I90)


PROPOSED, E.B. & W.B., SUPERELEVATED TYPICAL SECTIONS - I.R. 90 - OVERLAY

LOR - I90 - 10.76

PROPOSED NORMAL TYPICAL SECTIONS - I.R. 90 - E.B. & W.B.  
(WITHOUT EXISTING OVERLAY)


CALCULATED  
DLS  
CHECKED  
LAB

PROPOSED, E.B. & W.B., NORMAL TYPICAL SECTIONS- I.R. 90 - OVERLAY

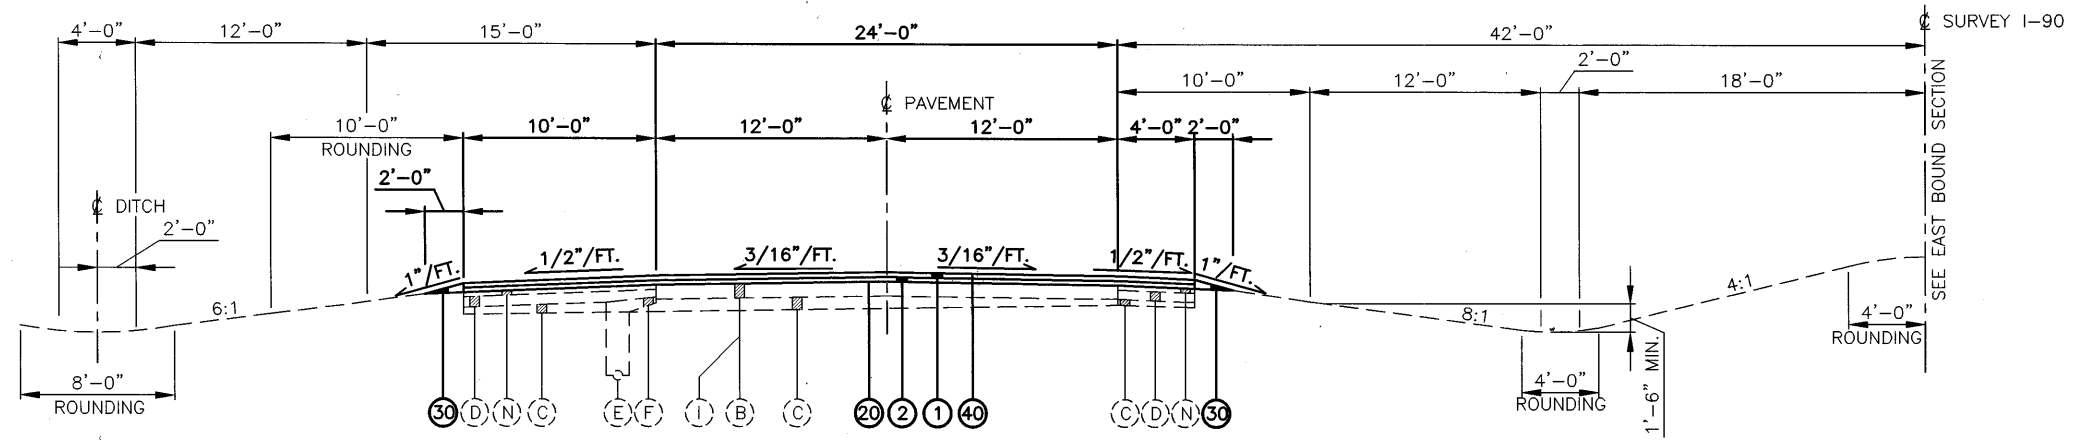

**NORMAL SECTION (WESTBOUND) - I.R. 90 & S.R. 2**  
 STA. 670+74.01 TO STA. 701+40.00  
 STA. 735+39.25 TO STA. 740+62.42  
 STA. 760+60.78 TO STA. 780+34.99  
 STA. 810+78.82 TO STA. 830+51.48  
 STA. 854+55.15 TO STA. 915+57.86  
 STA. 932+93.69 TO STA. 966+00.00 (MATCH RECONSTRUCTED SECTION)

- LEGEND**
- ① ITEM 446 - 1 1/2" ASPHALT CONCRETE SURFACE COURSE TYPE 1H, PG 70-22
  - ② ITEM 446 - 2 1/4" ASPHALT CONCRETE INTERMEDIATE COURSE, TYPE 2, PG 64-28
  - ③ ITEM 606 - GUARDRAIL TYPE 5
  - ④ ITEM 407 - TACK COAT (SEE GENERAL NOTE)
  - ⑤ ITEM 617 - SHOULDER RECONDITIONING, MISC., COMPACTED AGGREGATE W/ ITEM 408 BITUMINOUS PRIME COAT OR ITEM 617 COMPACTED AGGREGATE, TYPE A
  - ⑥ ITEM 407 - TACK COAT (REDUCED RATE PER PLAN NOTE)
  - ⑦ 10" REINFORCED CONCRETE PAVEMENT  
OR ① 15" CONCRETE APPROACH SLAB
  - ⑧ VARIABLE THICKNESS SUBBASE
  - ⑨ 6" AGGREGATE BASE
  - ⑩ 6" PIPE UNDERDRAIN
  - ⑪ SPECIAL DRAINAGE CONNECTION
  - ⑫ GUARDRAIL, TYPE 5
  - ⑬ 3" ASPHALT CONCRETE BASE

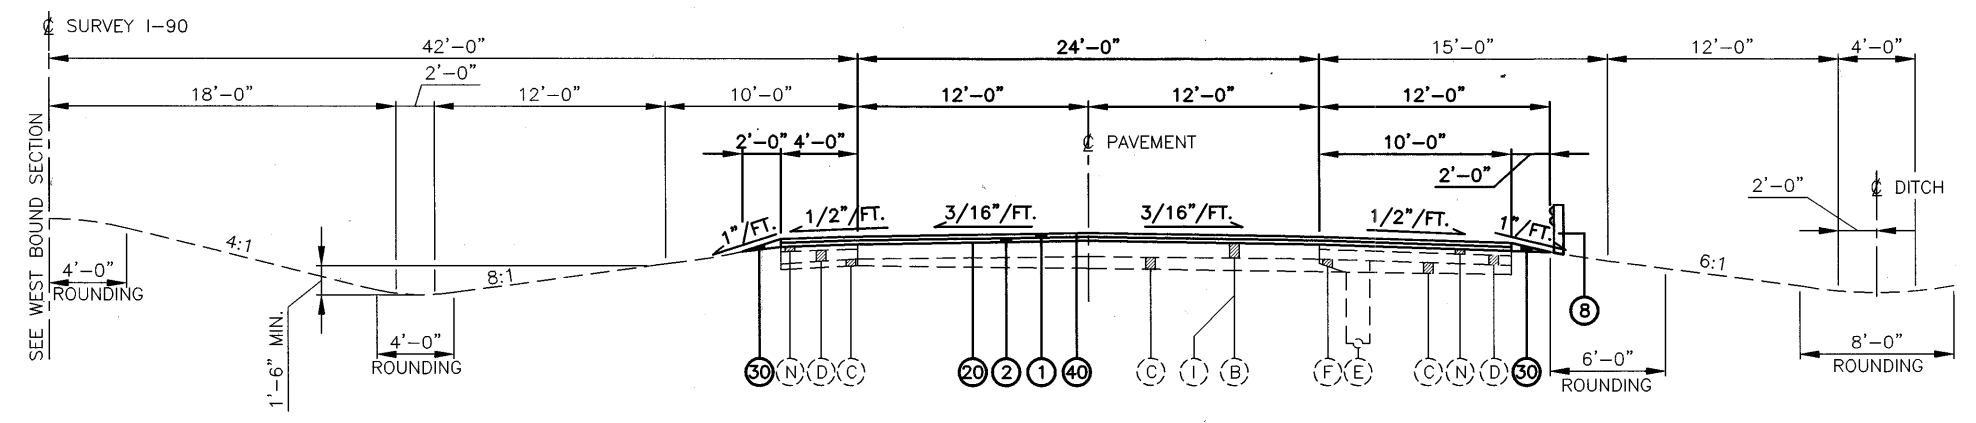


**NORMAL SECTION (EASTBOUND) - I.R.90 & S.R. 2**  
 STA. 670+74.01 TO STA. 701+40.00  
 STA. 735+39.25 TO STA. 740+62.42  
 STA. 760+60.78 TO STA. 780+34.99  
 STA. 810+78.82 TO STA. 830+51.48  
 STA. 854+55.15 TO STA. 915+57.86  
 STA. 932+93.69 TO STA. 966+00.00 (MATCH RECONSTRUCTED SECTION)

LOR - I90 - 10.76

PROPOSED SUPERELEVATED TYPICAL SECTIONS - I.R. 90 - E.B. & W.B.  
(WITHOUT EXISTING OVERLAY)


CALCULATED  
DLS  
CHECKED  
LAB

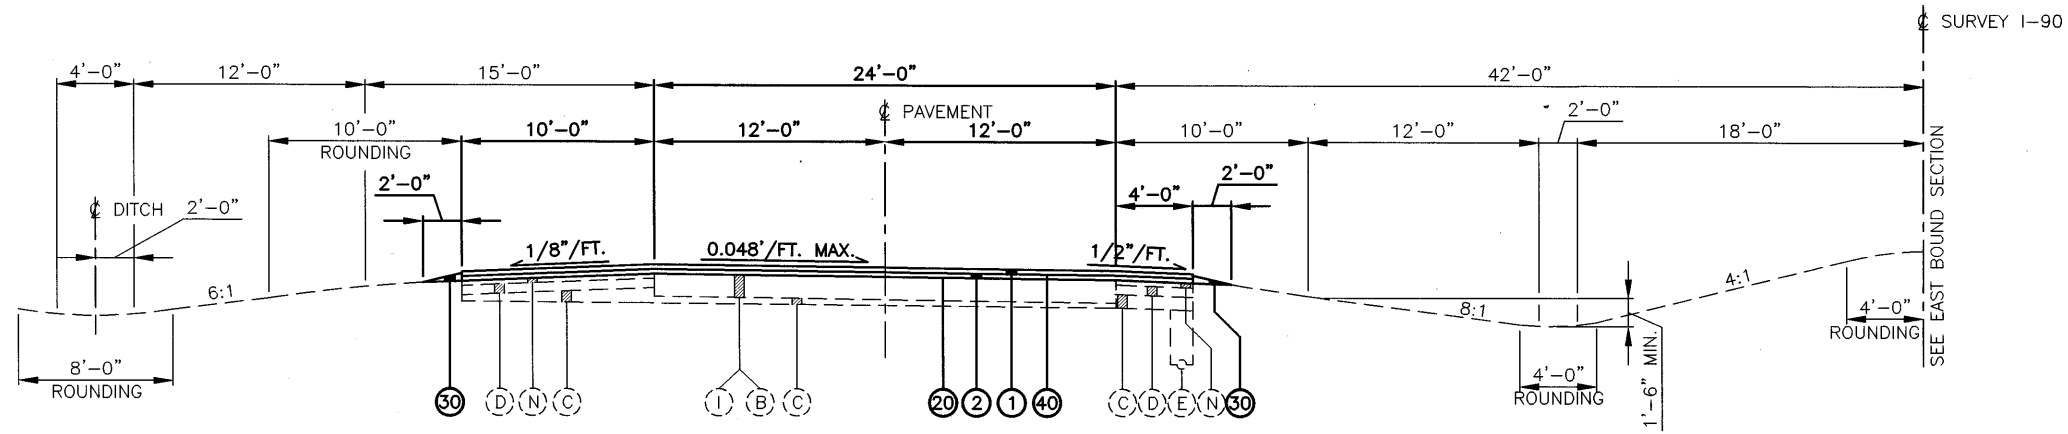

**SUPERELEVATED SECTION (WESTBOUND) - I.R.90 & S.R. 2**  
 STA. 701+40.00 TO STA. 735+39.25  
 STA. 740+62.42 TO STA. 760+60.78  
 STA. 780+34.99 TO STA. 810+78.82  
 STA. 830+51.48 TO STA. 854+55.15  
 STA. 915+57.86 TO STA. 932+93.69

- LEGEND**
- ① ITEM 446 - 1 1/2" ASPHALT CONCRETE SURFACE COURSE TYPE 1H, PG 70-22
  - ② ITEM 446 - 2 1/4" ASPHALT CONCRETE INTERMEDIATE COURSE TYPE 2, PG 64-28
  - ⑧ ITEM 606 - GUARDRAIL TYPE 5
  - ④ ITEM 407 - TACK COAT (SEE GENERAL NOTE)
  - ③① ITEM 617 - SHOULDER RECONDITIONING, MISC., COMPACTED AGGREGATE W/ ITEM 408 BITUMINOUS PRIME COAT OR ITEM 617 COMPACTED AGGREGATE, TYPE A
  - ④① ITEM 407 - TACK COAT (REDUCED RATE PER PLAN NOTE)
  - ⑩ 10" REINFORCED CONCRETE PAVEMENT
  - OR-① 15" CONCRETE APPROACH SLAB
  - ③ VARIABLE THICKNESS SUBBASE
  - ① 6" AGGREGATE BASE
  - ⑤ 6" PIPE UNDERDRAIN
  - ⑤ SPECIAL DRAINAGE CONNECTION
  - ③ GUARDRAIL, TYPE 5
  - ③ 3" ASPHALT BASE

\*\* OR RATE OF SUPER IF GREATER

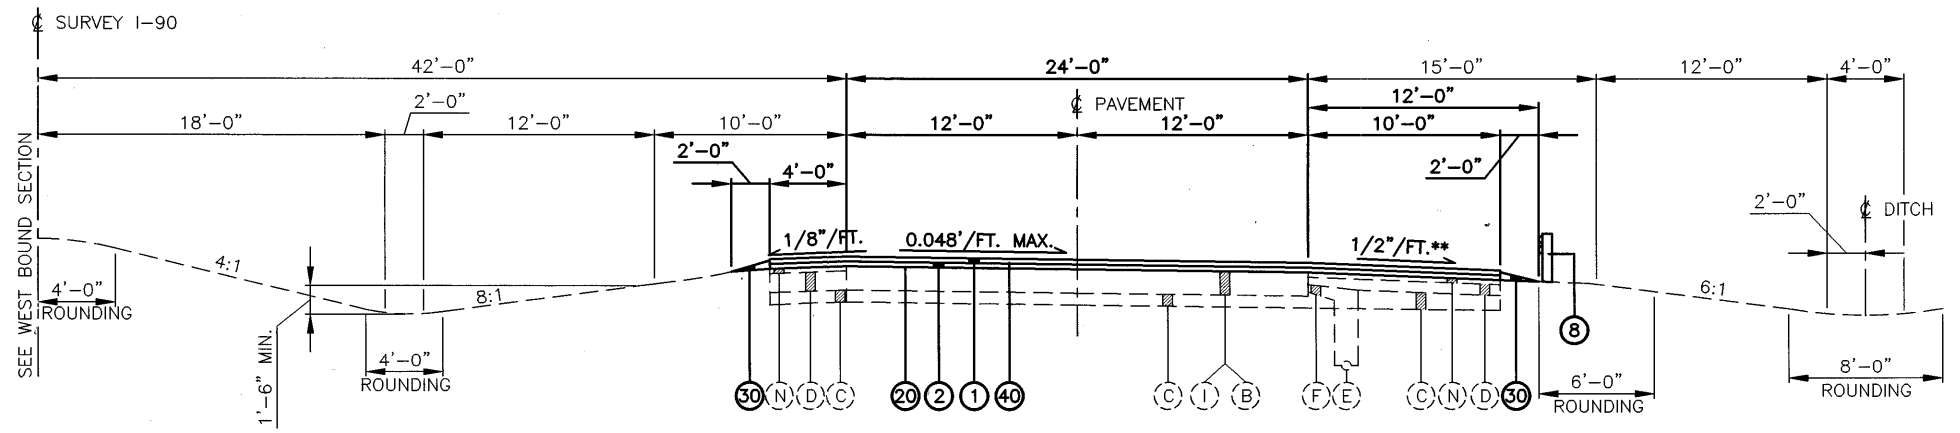

**SUPERELEVATED SECTION (EASTBOUND) - I.R.90 & S.R. 2**  
 STA. 701+40.00 TO STA. 735+39.25  
 STA. 740+62.42 TO STA. 760+60.78  
 STA. 780+34.99 TO STA. 810+78.82  
 STA. 830+51.48 TO STA. 854+55.15  
 STA. 915+57.86 TO STA. 932+93.69

PROPOSED, E.B. & W.B., SUPERELEVATED TYPICAL SECTIONS - I.R. 90 - OVERLAY

LOR - I90 - 10.76


0:\s3600\DWG\S\9360PH\1-08.DWG J GZ  
2-18-2002 3:42PM

# TYPICAL SECTIONS SPEED CHANGE AND RAMP PACING LANES


(WITH EXISTING OVERLAY)

MIDDLE RIDGE ROAD INTERCHANGE RAMPS H,I,J AND K  
STATE ROUTE 57 INTERCHANGE RAMPS A AND F

## EXISTING TYPICALS

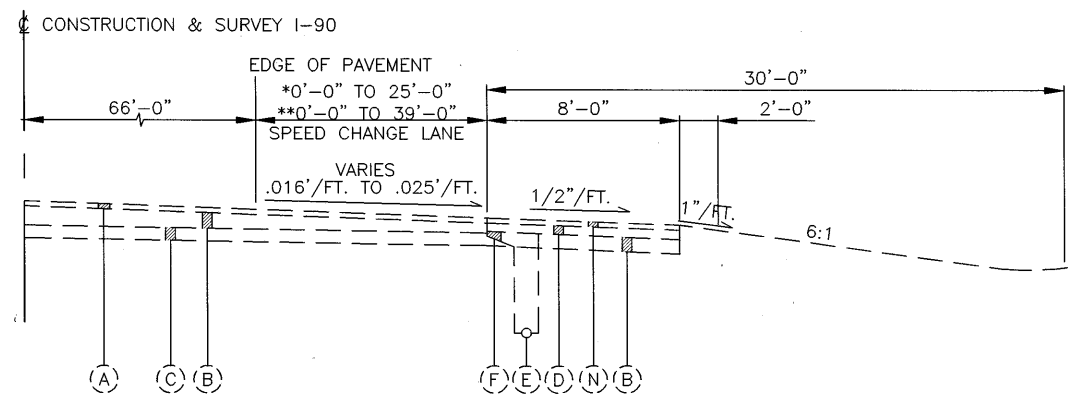

SPEED CHANGE LANE

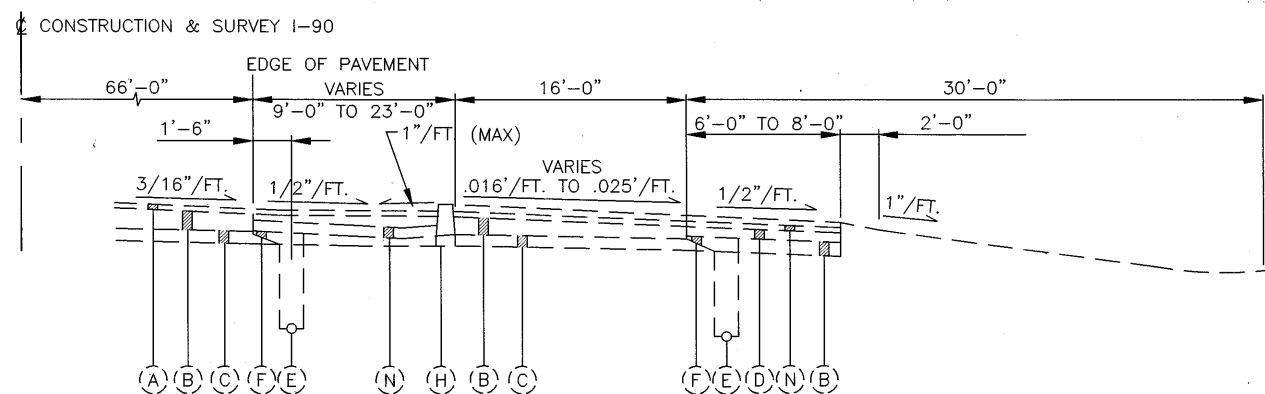


RAMP PACING LANE


### EXISTING LEGEND

- (A) 3 1/4" OVERLAY
- (B) 10" REINFORCED CONCRETE PAVEMENT
- (C) VARIABLE THICKNESS SUBBASE
- (D) 6" AGGREGATE BASE
- (E) 6" PIPE UNDERDRAIN
- (F) SPECIAL DRAINAGE CONNECTION, USING NO.9 AGGREGATE
- (H) CONCRETE CURB, STANDARD TYPE 8
- (N) 3" BITUMINOUS AGGREGATE BASE

## PROPOSED TYPICALS

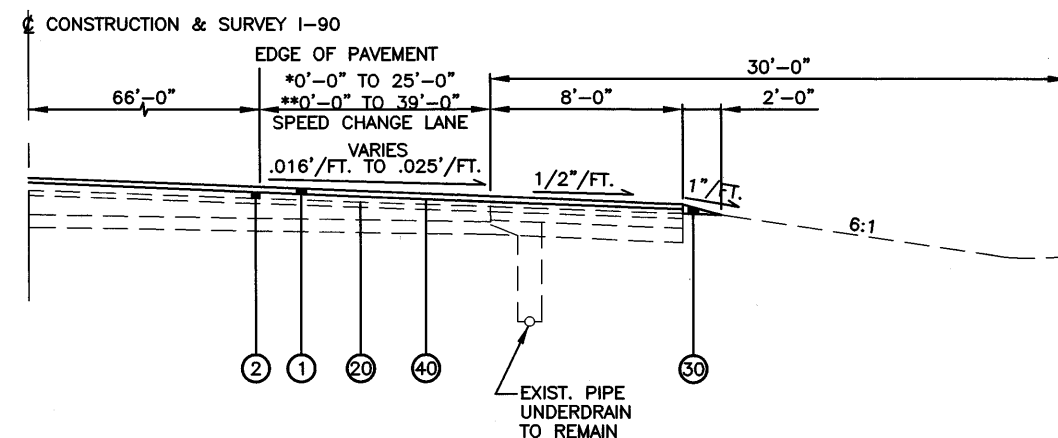

SPEED CHANGE LANE

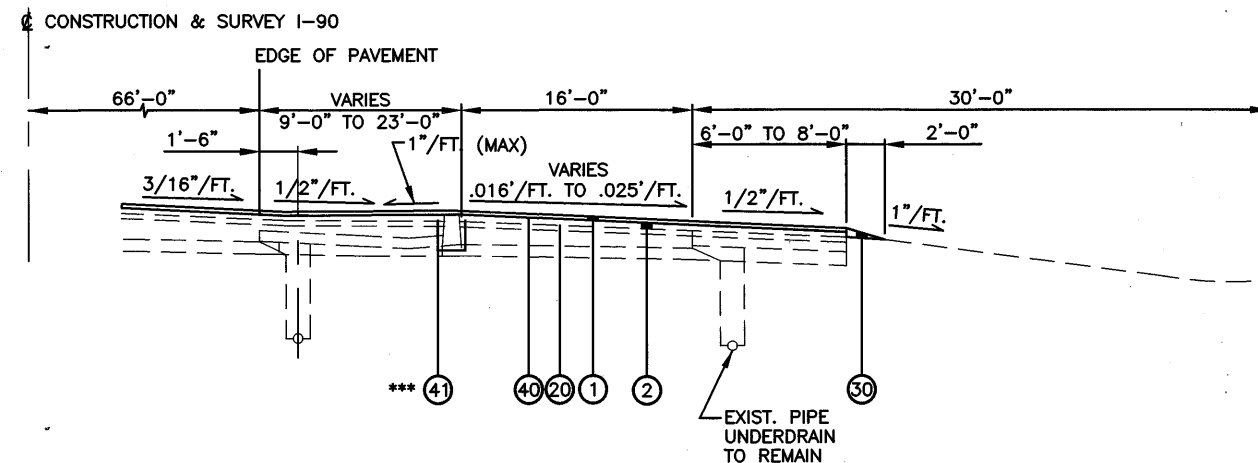

RAMP PACING LANE

### PROPOSED LEGEND

- (1) ITEM 446 - 1 1/4" ASPHALT CONCRETE SURFACE COURSE, TYPE 1H, PG 70-22
- (2) ITEM 446 - 1 3/4" ASPHALT CONCRETE INTERMEDIATE COURSE, TYPE 2, PG 64-28
- (20) ITEM 407 - TACK COAT (SEE GENERAL NOTE)
- (30) ITEM 617 - SHOULDER RECONDITIONING, MISC., COMPACTED AGGREGATE W/ ITEM 408 BITUMINOUS PRIME COAT OR ITEM 617 COMPACTED AGGREGATE, TYPE A
- (40) ITEM 407 - TACK COAT (REDUCED RATE PER PLAN NOTE)
- (41) ITEM 446 - ASPHALT CONCRETE TO FILL IN TRENCH

### NOTES

- \* FOR ENTRANCE TERMINAL
- \*\* FOR EXIT TERMINAL
- \*\*\* ACCELERATION RAMPS ONLY

CALCULATED  
DLS  
CHECKED  
LAB

SPEED CHANGE AND PACING LANES (WITH EXISTING OVERLAY)


LOR - 190 - 10.76

# TYPICAL SECTIONS SPEED CHANGE AND RAMP PACING LANES

(WITHOUT EXISTING OVERLAY)


STATE ROUTE 57 INTERCHANGE RAMPS B,C,D, AND E  
STATE ROUTE 254 INTERCHANGE RAMPS H,J,K AND L

## EXISTING TYPICALS

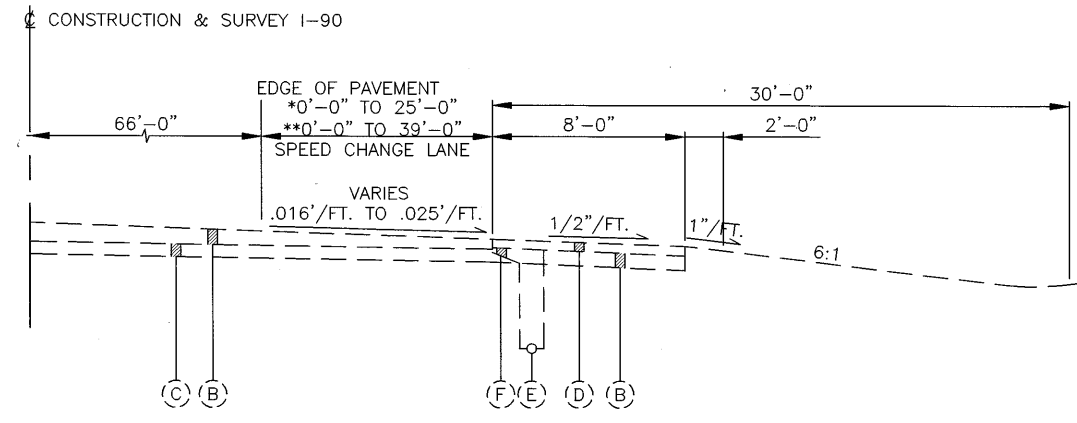


SPEED CHANGE LANE


## PROPOSED TYPICALS

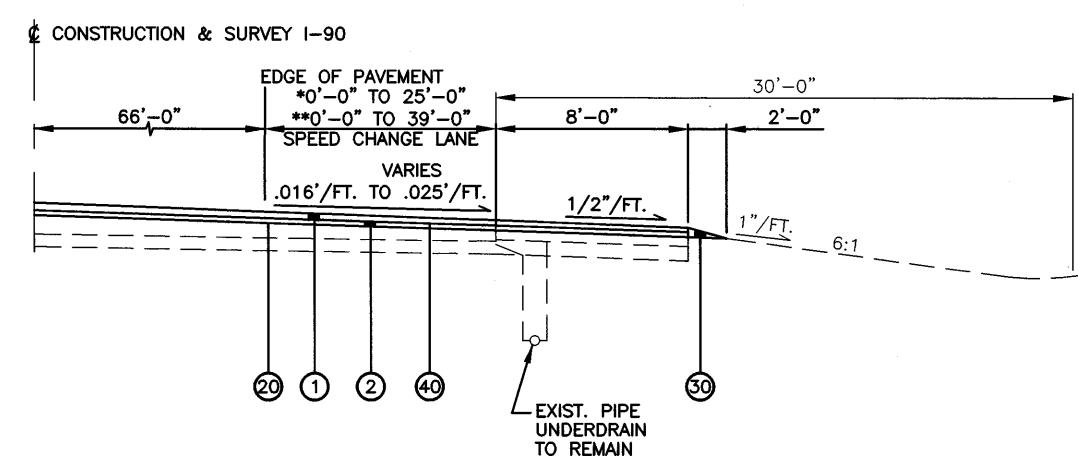

SPEED CHANGE LANE

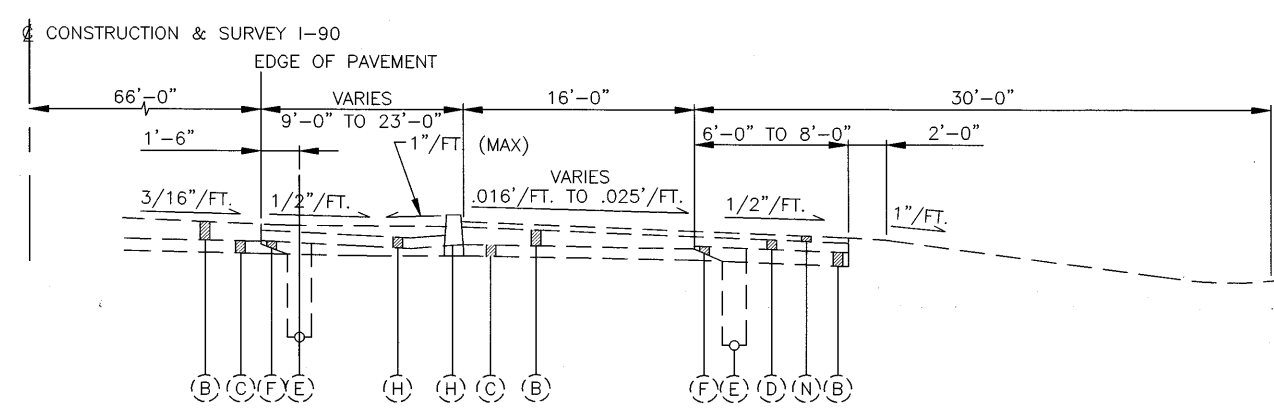

RAMP PACING LANE

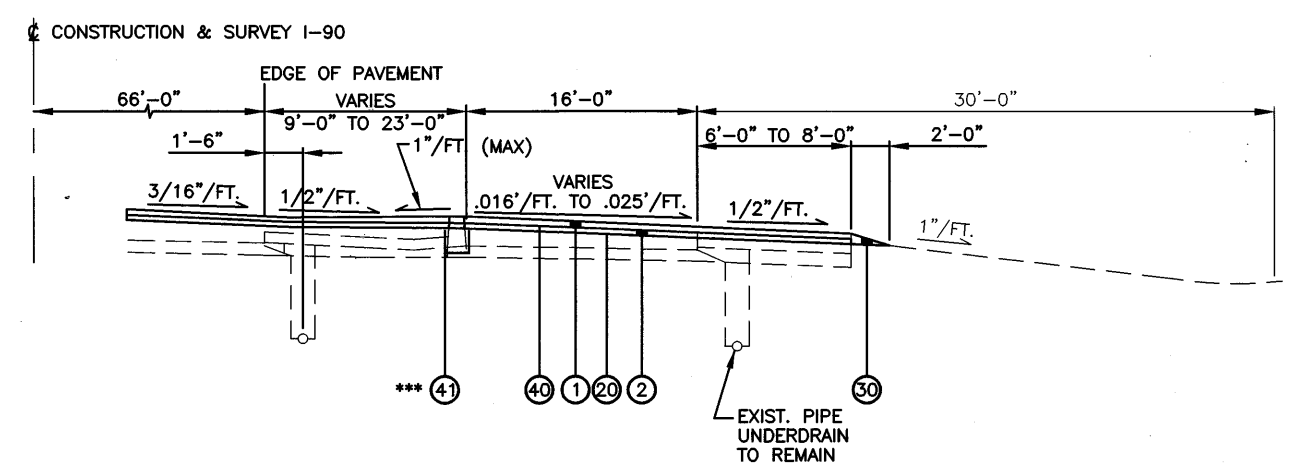

RAMP PACING LANE

### EXISTING LEGEND

- (B) 10" REINFORCED CONCRETE PAVEMENT
- (C) VARIABLE THICKNESS SUBBASE
- (D) 6" AGGREGATE BASE
- (E) 6" PIPE UNDERDRAIN
- (F) SPECIAL DRAINAGE CONNECTION, USING NO.9 AGGREGATE
- (H) CONCRETE CURB, STANDARD TYPE B
- (N) 3" BITUMINOUS AGGREGATE BASE

### PROPOSED LEGEND




- (1) ITEM 446 - 1 1/4" ASPHALT CONCRETE SURFACE COURSE, TYPE 1H, PG 70-22
- (2) ITEM 446 - 2 1/4" ASPHALT CONCRETE INTERMEDIATE COURSE, TYPE 2, PG 64-28
- (20) ITEM 407 - TACK COAT (SEE GENERAL NOTE)
- (30) ITEM 617 - SHOULDER RECONDITIONING, MISC., COMPACTED AGGREGATE W/ ITEM 408 BITUMINOUS PRIME COAT OR ITEM 617 COMPACTED AGGREGATE, TYPE A
- (40) ITEM 407 - TACK COAT (REDUCED RATE PER PLAN NOTE)
- (41) ITEM 446 - ASPHALT CONCRETE TO FILL IN TRENCH

### NOTES

- \* FOR ENTRANCE TERMINAL
- \*\* FOR EXIT TERMINAL
- \*\*\* ACCELERATION RAMPS ONLY




# MIDDLE RIDGE ROAD & SR 57 INTERCHANGE RAMPS A AND F (WITH EXISTING OVERLAY)

EXISTING TYPICAL RAMP SECTIONS  
FILL

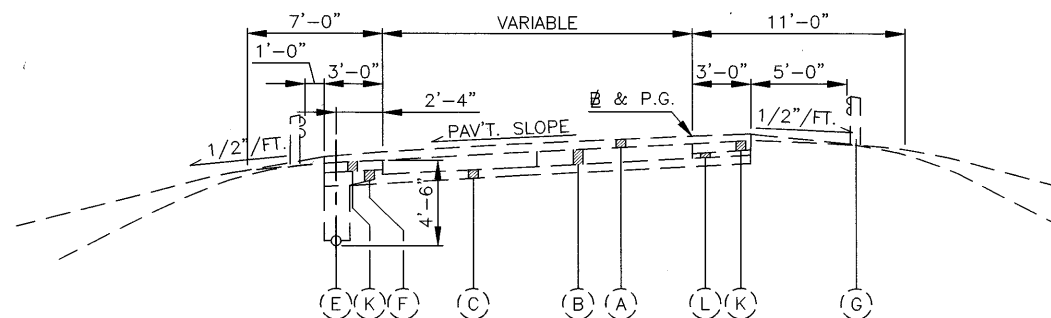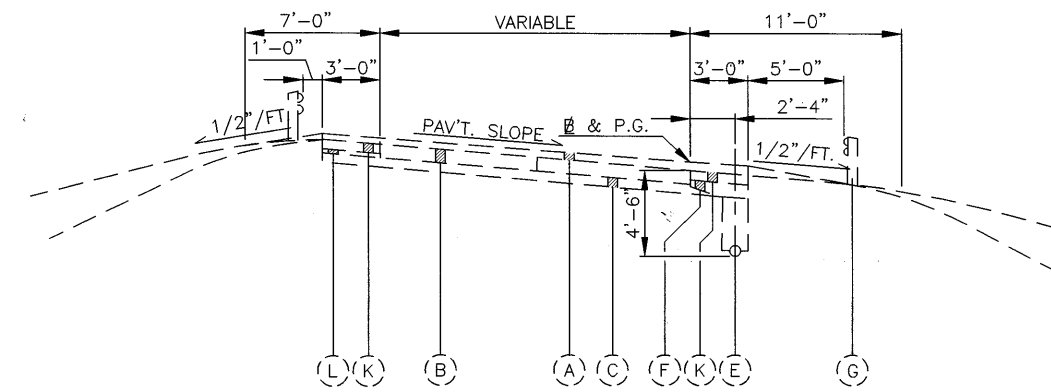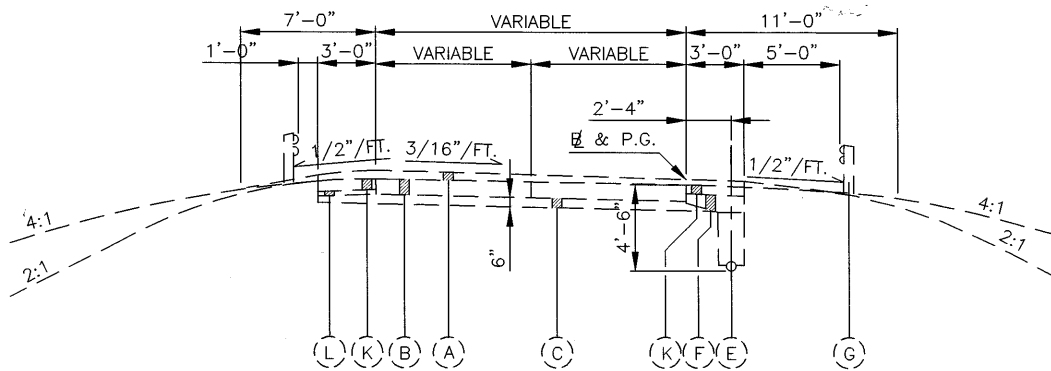

- (A) 3 1/4" ASPHALT CONCRETE OVERLAY
- (B) 10" REINFORCED PORTLAND CEMENT CONCRETE PAVEMENT
- (C) VARIABLE THICKNESS SUBBASE
- (E) 6" PIPE UNDERDRAIN
- (F) SPECIAL DRAINAGE CONNECTION
- (G) GUARDRAIL TYPE 5
- (K) 6" BITUMINOUS AGGREGATE BASE
- (L) 3" AGGREGATE BASE

PROPOSED TYPICAL RAMP SECTIONS  
FILL

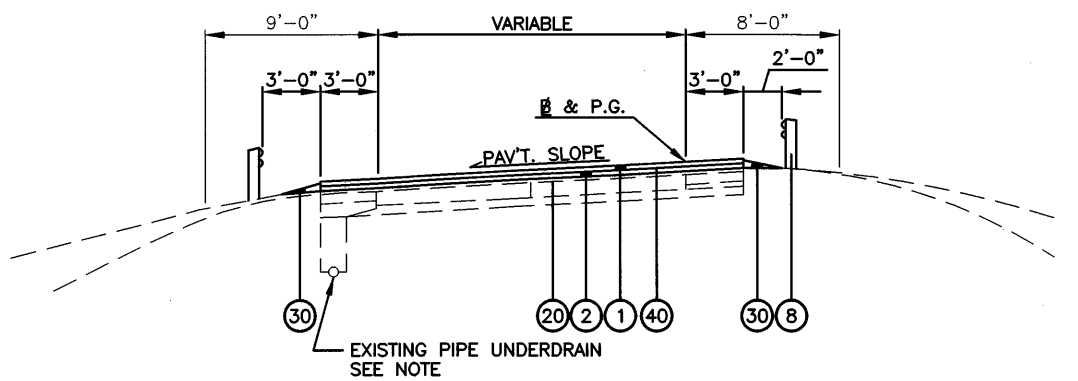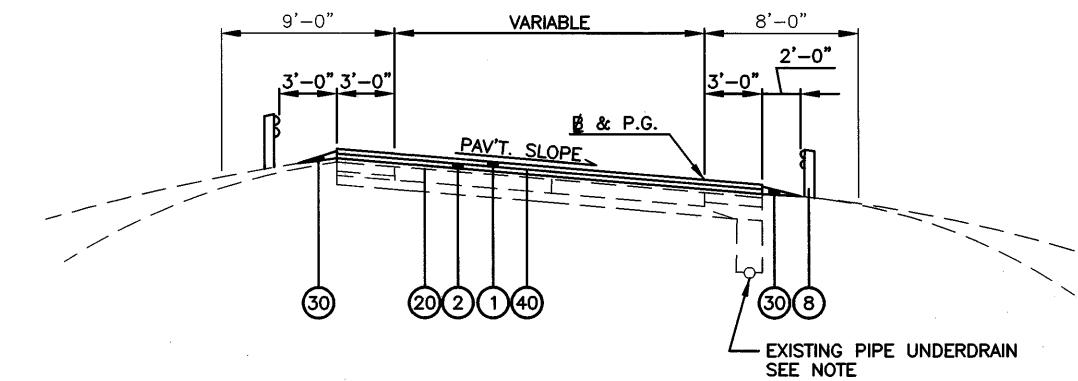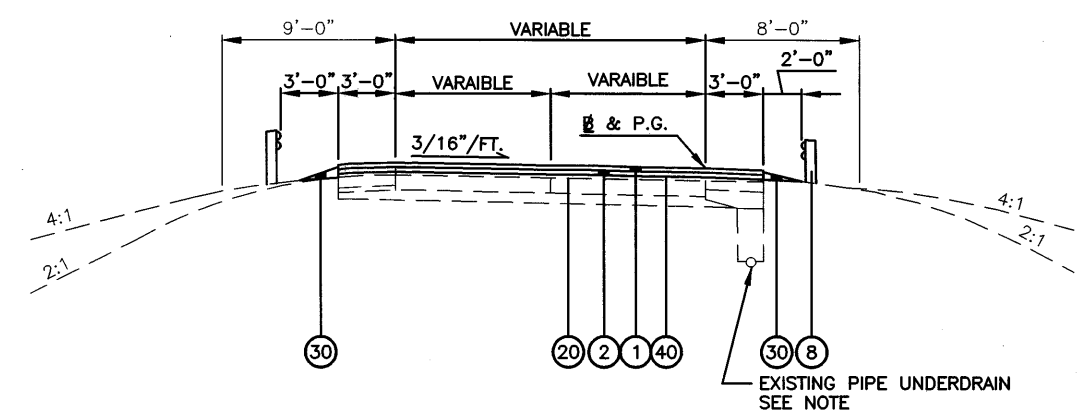

- (1) ITEM 446 - 1 1/2" ASPHALT CONCRETE SURFACE COURSE, TYPE 1H, PG 70-22
- (2) ITEM 446 - 1 3/4" ASPHALT CONCRETE INTERMEDIATE COURSE, TYPE 2, PG 64-28
- (8) ITEM 606 - GUARDRAIL TYPE 5
- (20) ITEM 407 - TACK COAT (SEE GENERAL NOTE)
- (30) ITEM 617 - SHOULDER RECONDITIONING, MISC., COMPACTED AGGREGATE W/ ITEM 408 BITUMINOUS PRIME COAT OR ITEM 617 COMPACTED AGGREGATE, TYPE A
- (40) ITEM 407 - TACK COAT (REDUCED RATE PER PLAN NOTE)

**NOTE:**  
EXISTING UNDERDRAIN TO REMAIN AS LONG AS POSITIVE OUTLET FLOW IS MAINTAINED

RAMP TYPICAL SECTIONS (WITH EXISTING OVERLAY)

LOR - I90 - 10.76




C:\93600\DWG\93600PH11-11.DWG J GZ  
2-18-2002 4:18PM

CALCULATED  
DLS  
CHECKED  
LAB






# RAMP TYPICAL SECTIONS – SR 57 RAMPS B,C,D AND E (WITHOUT EXISTING OVERLAY)

CALCULATED  
DLS  
CHECKED  
LAB

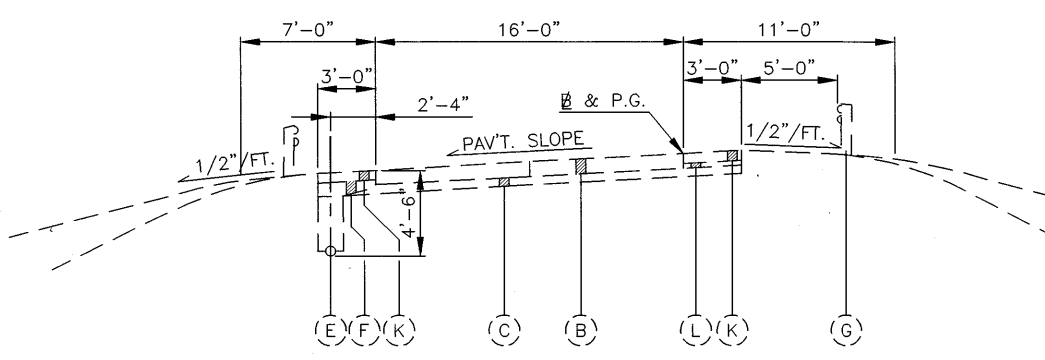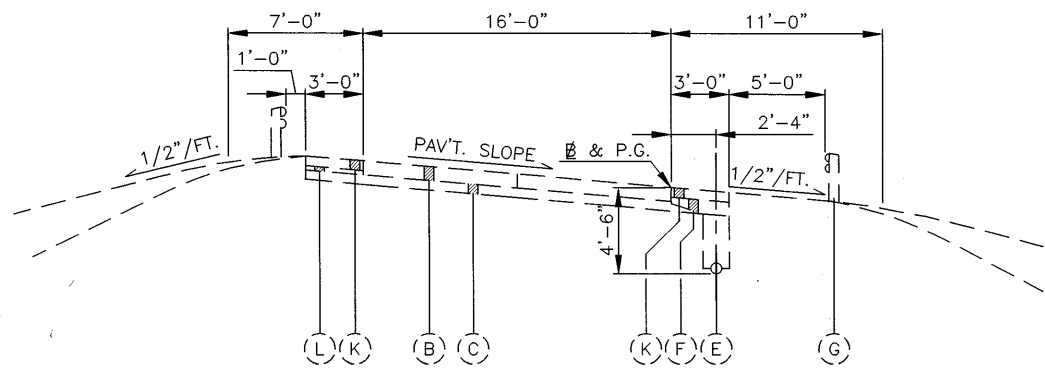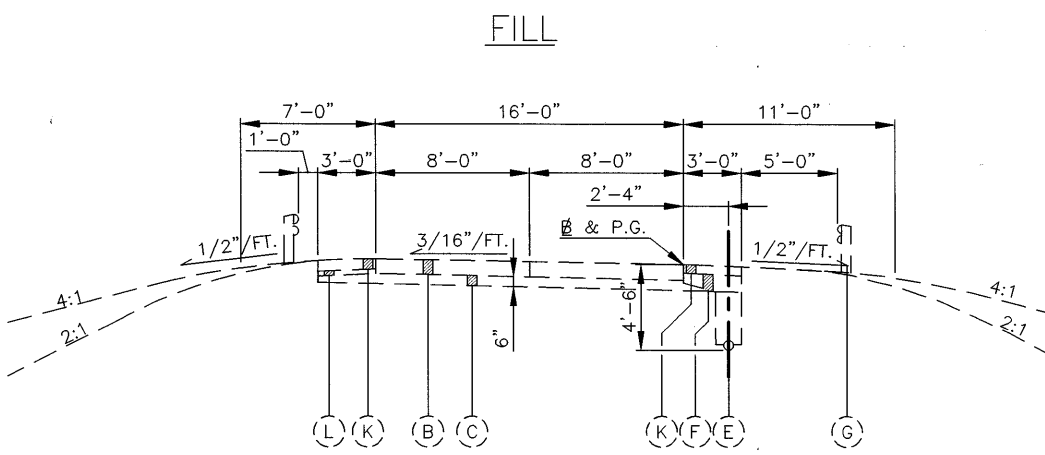

- (B) 10" REINFORCED CONCRETE PAVEMENT
- (C) VARIABLE THICKNESS SUBBASE
- (E) 6" PIPE UNDERDRAIN
- (F) SPECIAL DRAINAGE CONNECTION
- (G) GARDRAIL TYPE 5
- (K) 6" BITUMINOUS AGGREGATE BASE
- (L) 3" AGGREGATE BASE

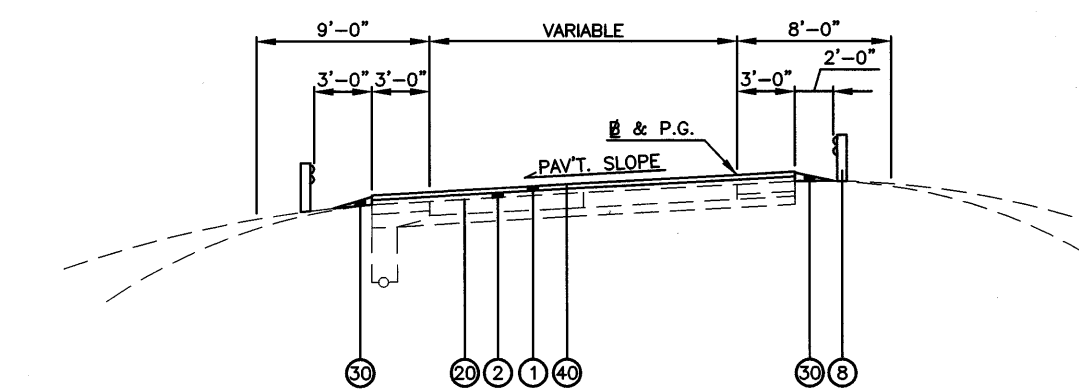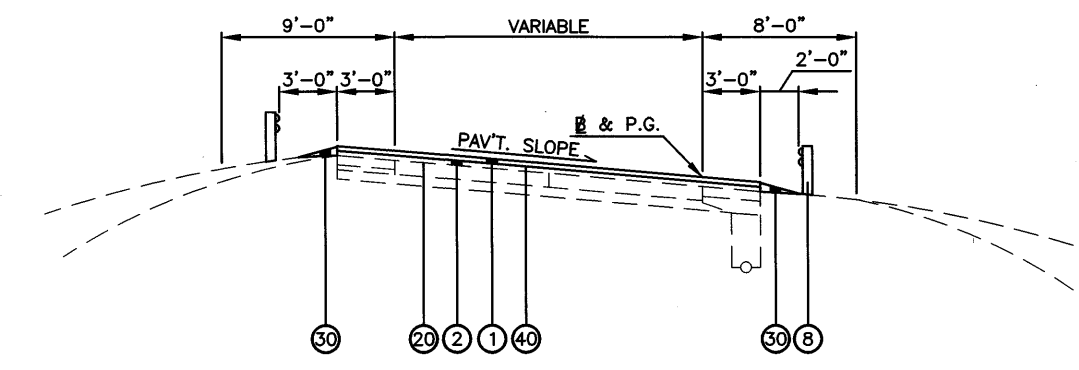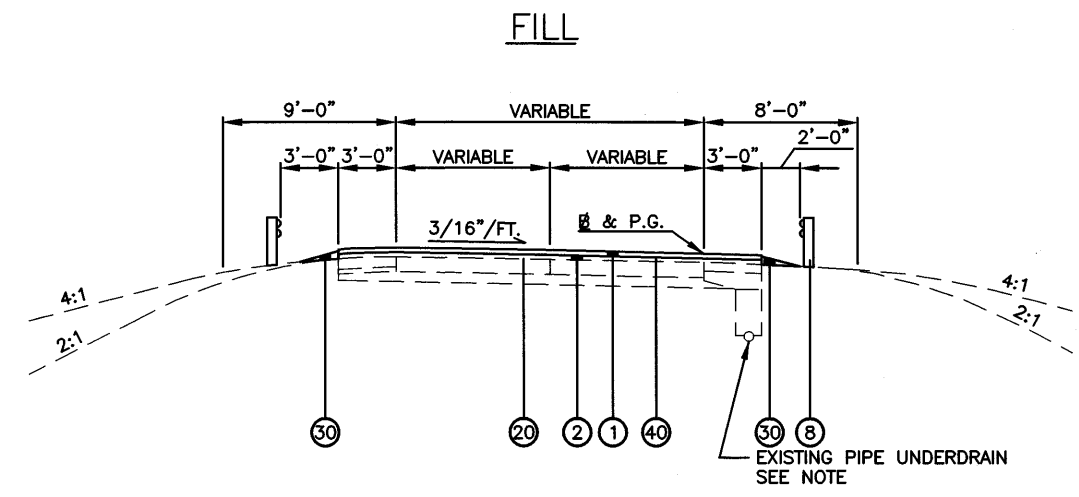

- (1) ITEM 446 – 1 1/2" ASPHALT CONCRETE SURFACE COURSE TYPE 1H, PG 70-22
- (2) ITEM 446 – 2 1/4" ASPHALT CONCRETE INTERMEDIATE COURSE, TYPE 2, PG 64-28
- (8) ITEM 606 – GUARDRAIL TYPE 5
- (20) ITEM 407 – TACK COAT (SEE GENERAL NOTE)
- (30) ITEM 617 – SHOULDER RECONDITIONING, MISC., COMPACTED AGGREGATE W/ ITEM 408 BITUMINOUS PRIME COAT OR ITEM 617 COMPACTED AGGREGATE, TYPE A
- (40) ITEM 407 – TACK COAT (REDUCED RATE PER PLAN NOTE)

**NOTE**  
EXISTING UNDERDRAIN TO REMAIN AS LONG AS POSITIVE OUTLET FLOW IS MAINTAINED

RAMP TYPICAL SECTIONS (WITHOUT EXISTING OVERLAY)

LOR - 190 - 10.76

C:\31600\DWG\31600\PLAN\12.DWG 1 02 22-18-2002 9:24AM

GENERAL NOTES

ROUNDING

THE ROUNDING AT SLOPE BREAKPOINTS SHOWN ON THE TYPICAL SECTIONS APPLY TO ALL CROSS SECTIONS EVEN THOUGH OTHERWISE SHOWN.

UTILITIES

LISTED BELOW ARE ALL UTILITIES LOCATED WITHIN THE PROJECT CONSTRUCTION LIMITS TOGETHER WITH THEIR RESPECTIVE OWNERS:

THE ILLUMINATING COMPANY 6896 MILLER ROAD BRECKSVILLE, OHIO 44141 (440) 546-8748	OHIO EDISON 6326 LAKE AVE. ELYRIA, OHIO, 44035 (440) 324-0231
-------------------------------------------------------------------------------------------	------------------------------------------------------------------------

THE CITY OF AVON 35030 DETROIT ROAD AVON, OHIO 44011 (440) 937-5740	O.D.O.T. (DISTRICT 3) 906 NORTH CLARK STREET ASHLAND, OHIO 44805 (800) 276-4188
------------------------------------------------------------------------------	------------------------------------------------------------------------------------------

THE LOCATION OF THE UNDERGROUND UTILITIES SHOWN ON THE PLANS ARE AS OBTAINED FROM THE OWNERS AS REQUIRED BY SECTION 153.64 O.R.C.

MONUMENTS

MONUMENTS SHALL BE CONSTRUCTED IN ACCORDANCE WITH DETAILS AS SHOWN ON STANDARD CONSTRUCTION DRAWING RM-1.1.

CONTINGENCY QUANTITIES

THE CONTRACTOR SHALL NOT ORDER MATERIALS OR PERFORM WORK FOR ITEMS DESIGNATED BY PLAN NOTE TO BE USED "AS DIRECTED BY THE ENGINEER" UNLESS AUTHORIZED BY THE ENGINEER. THE ACTUAL WORK LOCATIONS AND QUANTITIES USED FOR SUCH ITEMS SHALL BE INCORPORATED INTO THE FINAL CHANGE ORDER GOVERNING COMPLETION OF THIS PROJECT.

ELEVATION DATUM

ALL ELEVATIONS ARE BASED ON U.S.G.S. DATUM.

WORK LIMITS

THE WORK LIMITS SHOWN ON THESE PLANS ARE FOR PHYSICAL CONSTRUCTION ONLY. THE INSTALLATION AND OPERATION OF ALL TEMPORARY TRAFFIC CONTROL AND TEMPORARY TRAFFIC CONTROL DEVICES REQUIRED BY THESE PLANS SHALL BE PROVIDED BY THE CONTRACTOR WHETHER INSIDE OR OUTSIDE THESE WORK LIMITS.

CONVERSION OF STANDARD CONSTRUCTION DRAWINGS

THE METRIC STANDARD DRAWINGS REFERENCED IN THIS PLAN SHALL BE CONVERTED TO ENGLISH UNITS USING THE SI (METRIC) TO ENGLISH CONVERSION FACTORS PROVIDED IN SECTION 109.011 OF THE 1997 CONSTRUCTION AND MATERIALS SPECIFICATIONS. THE APPENDIX OF ATSM E 380 SHALL BE UTILIZED FOR ANY ADDITIONAL CONVERSION FACTORS REQUIRED. CONVERSIONS SHALL BE APPROPRIATELY PRECISE AND SHALL REFLECT STANDARD INDUSTRY ENGLISH VALUES WHERE SUITABLE.

ADDITIONAL SOIL INFORMATION

THE SOIL PROFILE AND/OR STRUCTURE FOUNDATION INVESTIGATION SHEETS CONTAIN ALL AVAILABLE SOIL AND BEDROCK INFORMATION WHICH CAN BE CONVENIENTLY SHOWN. ADDITIONAL SUBSURFACE INVESTIGATIONS MAY HAVE BEEN MADE TO STUDY SOME ASPECT OF THE PROJECT. MORE INFORMATION, IF ANY, MAY BE OBTAINED IN DISTRICT 3, THE BUREAU OF BRIDGES AND STRUCTURAL DESIGN AT 25 SOUTH FRONT STREET IN COLUMBUS, OHIO.

STREAM CHANNEL EXCAVATION

THE CONTRACTOR SHALL TAKE ALL PRECAUTIONS NECESSARY TO PREVENT ANY INCIDENTAL DISCHARGES ASSOCIATED WITH THE EXCAVATION AND HAULING OF MATERIAL FROM THE STREAM CHANNEL. THIS PERTAINS TO ANY EXCAVATION OPERATIONS SUCH AS, FOUNDATION PIER OR ABUTMENT EXCAVATION, CHANNEL CLEANOUT, EXCAVATION FOR ROCK CHANNEL PROTECTION AND REMOVAL OF ANY TEMPORARY FILL ASSOCIATED WITH CONSTRUCTION OPERATIONS.

ROADWAY

ITEM 202 - PAVEMENT REMOVED

PAYMENT FOR SAW CUTTING REQUIRED TO REMOVE EXISTING CONCRETE PAVEMENT AS NOTED IN THE PLANS SHALL BE INCLUDED IN ITEM 202 - PAVEMENT REMOVED.

ITEM 203 - EXCAVATION NOT INCLUDING EMBANKMENT CONSTRUCTION

PAYMENT FOR SAW CUTTING REQUIRED TO REMOVE EXISTING ASPHALT PAVEMENT AS NOTED IN THE PLANS SHALL BE INCLUDED IN ITEM 203 - EXCAVATION NOT INCLUDING EMBANKMENT CONSTRUCTION.

ITEM 203 - PROOF ROLLING

THE AMOUNT OF PROOF ROLLING REQUIRED WILL BE DETERMINED BY THE CONTRACTOR.

FENCE LENGTHS

THE LENGTHS OF FENCE SHOWN IN THE PLANS ARE HORIZONTAL DIMENSIONS. MEASUREMENTS OF THE FINAL QUANTITIES SHALL BE MADE IN ACCORDANCE WITH ITEM 607.

ITEM 407 - TACK COAT

THE RATE OF APPLICATION OF THE 407 TACK COAT SHALL BE SUBJECT TO ADJUSTMENT AS DIRECTED BY THE ENGINEER. AREAS OF TACK COAT STRIPPED BY CONSTRUCTION EQUIPMENT SHALL BE RECOATED PRIOR TO PLACING ASPHALT CONCRETE. PLAN AREAS INDICATE AN AVERAGE APPLICATION RATE OF 0.10 GALLONS PER SQUARE YARD OF TACK COAT FOR ESTIMATING PURPOSES ONLY. SEE THE FOLLOWING PARAGRAPH FOR AN ADDITIONAL APPLICATION REQUIREMENT.

PRIOR TO PLACING THE SURFACE COURSE ON THE NEW INTERMEDIATE COURSE, AN ADDITIONAL APPLICATION OF TACK COAT IS REQUIRED AT AN AVERAGE RATE OF APPLICATION OF 0.05 GALLONS PER SQUARE YARD FOR ESTIMATING PURPOSES ONLY.

GUARDRAIL

ITEM 606 - ANCHOR ASSEMBLY, TYPE B-98

THIS ITEM SHALL CONSIST OF FURNISHING AND INSTALLING EITHER A SRT-350 GUARDRAIL END TERMINAL AS MANUFACTURED BY SYRO INC., 1170 N. STATE STREET, GIRARD, OHIO 44420 (TELEPHONE: 330-545-4373) OR A FLEAT-350 GUARDRAIL END TERMINAL AS MANUFACTURED BY ROAD SYSTEMS, INC., 7631 NEW CASTLE DRIVE, FRANKFORT, IL 60423 (TELEPHONE: 815-464-5917).

THE LENGTH OF EITHER TERMINAL IS CONSIDERED TO BE 37.5', INCLUSIVE OF THE THREE 12.5' LONG RAIL ELEMENTS. INSTALLATION SHALL BE IN ACCORDANCE WITH THE MANUFACTURER'S SPECIFICATIONS AND AT THE LOCATIONS SHOWN IN THE PLANS.

PAYMENT FOR THE ABOVE WORK SHALL BE MADE AT THE UNIT PRICE BID FOR ITEM 606, ANCHOR ASSEMBLY, TYPE B-98, EACH AND SHALL INCLUDE ALL LABOR, TOOLS, EQUIPMENT AND MATERIALS NECESSARY TO CONSTRUCT A COMPLETE AND FUNCTIONAL ANCHOR ASSEMBLY SYSTEM, INCLUDING REFLECTIVE SHEETING AND ALL RELATED HARDWARE AND GRADING, NOT SEPARATELY SPECIFIED AS REQUIRED BY THE MANUFACTURER.

WHERE A TYPE B-98 TERMINAL IS INSTALLED THERE SHALL BE A MINIMUM OF 10:1 SLOPE GRADED TO THE GUARDRAIL.

CONNECTION BETWEEN EXISTING AND PROPOSED GUARDRAIL

WHEN IT IS NECESSARY TO SPLICE PROPOSED GUARDRAIL TO EXISTING GUARDRAIL, ONLY THE EXISTING GUARDRAIL SHALL BE CUT OR PUNCHED. THE CONNECTION SHALL BE CUT OR PUNCHED. THE CONNECTION SHALL BE MADE USING A "W-BEAM RAIL SPLICE" PER THE GUARDRAIL DETAILS SHOWN ON STANDARD CONSTRUCTION DRAWINGS GR-1.1M AND GR-1.2M. PAYMENT SHALL BE INCLUDED IN THE CONTRACT PRICE BID FOR THE RESPECTIVE GUARDRAIL ITEMS.

ITEM 606 - ANCHOR ASSEMBLY, TYPE E-98

THIS ITEM SHALL CONSIST OF FURNISHING AND INSTALLING EITHER A ET-2000 (1997) GUARDRAIL END TERMINAL AS MANUFACTURED BY SYRO, INC., 1170 N. STATE STREET, GIRARD, OHIO 44420 (TELEPHONE: 330-545-4373) OR A SKT-350 GUARDRAIL END TERMINAL AS MANUFACTURED BY ROAD SYSTEMS, INC., 7631 NEW CASTLE DRIVE, FRANKFORT, IL 60423 (TELEPHONE: 815-464-5917).

THE LENGTH OF THE ET-2000 (1997) SYSTEM IS CONSIDERED TO BE 50', INCLUSIVE OF TWO 25' LONG RAIL ELEMENTS. THE LENGTH OF THE SKT-350 SYSTEM IS CONSIDERED TO BE 50' INCLUSIVE OF FOUR 12.5' LONG RAIL ELEMENTS. INSTALLATION SHALL BE AT THE LOCATIONS SPECIFIED IN THE PLANS, IN ACCORDANCE WITH THE MANUFACTURER'S SPECIFICATIONS AND AT THE LOCATIONS SHOWN IN THE PLANS.

PAYMENT FOR THE ABOVE WORK SHALL BE MADE AT THE UNIT PRICE BID FOR ITEM 606, ANCHOR ASSEMBLY, TYPE E-98, EACH, AND SHALL INCLUDE ALL LABOR, TOOLS, EQUIPMENT AND MATERIALS NECESSARY TO CONSTRUCT A COMPLETE AND FUNCTIONAL ANCHOR ASSEMBLY SYSTEM, INCLUDING ALL RELATED TRANSITIONS, REFLECTIVE SHEETING, HARDWARE AND GRADING, NOT SEPARATELY SPECIFIED AS REQUIRED BY THE MANUFACTURER.

PAVEMENT

PART-WIDTH CONSTRUCTION

BECAUSE OF THE NECESSITY TO BUILD THIS PROJECT UNDER TRAFFIC AND TO CONSTRUCT THE FULL PAVEMENT WIDTH IN STAGES, EXTREME CARE SHALL BE TAKEN TO PREVENT THE CONSTRUCTION OF A BUTT JOINT IN THE BASE COURSES. LONGITUDINAL JOINTS SHALL BE LAPPED AS SHOWN ON STANDARD CONSTRUCTION DRAWING BP-3.1.

ITEM 203 - DITCH CLEANOUT

THIS WORK SHALL CONSIST OF RE-ESTABLISHING THE CROSS-SECTION OF AN EXISTING DITCH. SURPLUS OR UNSUITABLE MATERIAL, AS DETERMINED BY THE ENGINEER, SHALL BE DISPOSED OF AS PER 203.05. EMBANKMENT REQUIRED FOR ERODED CONDITIONS SHALL MEET THE REQUIREMENTS OF 203.07 EXCEPT THAT THE COMPACTION REQUIREMENTS ARE WAIVED.

MEASUREMENT OF THE DITCH CLEANOUT SHALL BE THE ACTUAL LINEAR FEET MEASURED ALONG THE CENTERLINE OF THE DITCH.

PAYMENT FOR ALL THE ABOVE SHALL BE INCLUDED IN THE UNIT PRICE BID FOR ITEM 203, DITCH CLEANOUT.

GUARDRAIL REPLACEMENT

NO HAZARD SHALL BE LEFT UNPROTECTED EXCEPT FOR THE ACTUAL TIME NECESSARY TO REMOVE GUARDRAIL, INSTALL EMBANKMENT, GRADE AND REINSTALL GUARDRAIL IN A CONTINUOUS OPERATION. THE REMOVAL OF ALL GUARDRAIL SHALL AT ALL TIMES BE AS DIRECTED BY THE ENGINEER. NO GUARDRAIL SHALL BE REMOVED UNTIL THE REPLACEMENT MATERIAL IS ON SITE, READY FOR INSTALLATION. FAILURE TO COMPLY WITH THIS REQUIREMENT SHALL BE DEEMED SUFFICIENT CAUSE TO ORDER WORK SUSPENDED ON THIS PROJECT UNTIL SUCH TIME THAT THE ENGINEER IS ASSURED OF SAID COMPLIANCE.

EROSION CONTROL

STORMWATER POLLUTION PREVENTION PLAN

THE CONDITIONS OF THE NPDES CONSTRUCTION STORM WATER GENERAL PERMIT (SEE PROPOSAL) SHALL BE MET DURING ALL STAGES OF CONSTRUCTION. THE LOCATION AND TIMING OF ALL EROSION AND SEDIMENT CONTROL ITEMS SHALL BE FIELD ADJUSTED TO PREVENT SIGNIFICANT IMPACTS ON RECEIVING WATERS. IMPLEMENTATION OF THIS STORM WATER POLLUTION PREVENTION PLAN SHALL CONTINUE THROUGHOUT THE DURATION OF THE PROJECT OR UNTIL SUCH TIME THAT THE UPSLOPE DISTURBED AREAS ARE STABILIZED.

INSTALLATION OF SEDIMENT BASINS/DAMS, PERIMETER FILTER FABRIC FENCE, AND DITCH CHECKS SHALL BE CONCURRENT WITH CLEARING AND GRUBBING AND/OR GRADING OPERATIONS.

ALL REASONABLE ATTEMPTS SHOULD BE MADE TO MINIMIZE THE TOTAL AREA OF THE DISTURBED LAND.

AREAS TO REMAIN DORMANT FOR MORE THAN 45 DAYS SHOULD BE IMMEDIATELY STABILIZED WITH TEMPORARY SEEDING AND MULCHING, EROSION CONTROL MATTING OR OTHER APPROPRIATE EROSION CONTROL MEASURES.

ADDITIONAL QUANTITIES OF TEMPORARY SOIL EROSION AND SEDIMENT CONTROL ITEMS ARE GIVEN IN THE GENERAL NOTES.

ITEM 870 - SEEDING AND MULCHING

SEEDING AND MULCHING SHALL BE APPLIED TO ALL AREAS OF PROPOSED GRADING BETWEEN THE LIMITED ACCESS. QUANTITY CALCULATIONS FOR ITEM 870 - SEEDING AND MULCHING ARE BASED ON THESE LIMITS.

EROSION CONTROL

ITEMS 601 AND 670 ARE PROVIDED IN THE PLANS FOR EROSION CONTROL. ROCK OF A STABLE NATURE SHALL NOT BE REMOVED IN ORDER TO PLACE ANY OF THESE ITEMS AND TURF OF A STABLE NATURE SHALL NOT BE REMOVED IN ORDER TO PLACE 670. THE ENGINEER SHALL CHECK AND NON-PERFORM QUANTITIES OR ADJUST LOCATIONS AND QUANTITIES OF THESE ITEMS WHERE INDICATED BY FIELD CONDITIONS DURING CONSTRUCTION. IN ADDITION, THESE ITEMS SHALL MEET THE REQUIREMENT OF 108.04.

WATERING PERMANENT SEEDED AREAS

THE FOLLOWING ITEM IS TO BE USED AS DIRECTED BY THE ENGINEER TO PROMOTE GROWTH AND TO CARE FOR PERMANENT SEEDED AREAS PER SS 870.18:

670, WATER

TEMPORARY SOIL EROSION AND SEDIMENT CONTROL

THE FOLLOWING ITEMS ARE TO BE USED AS DIRECTED BY THE ENGINEER FOR TEMPORARY EROSION AND SEDIMENT CONTROL MEASURES:

877, TEMPORARY SEEDING AND MULCHING

877, TEMPORARY FILTER FABRIC FENCE

870, COMMERCIAL FERTILIZER

870, REPAIR SEEDING AND MULCHING

870, WATER

870, SOIL ANALYSIS TEST

870, AGRICULTURAL LIME

870, PLACING TOPSOIL

CALCULATED  
DLS  
CHECKED  
LAB

GENERAL NOTES

LOR - 190 - 10.76

18-2002 [ 0:03:00 ] DWGS \93600P\L\01-01.DWG ] 02  
4:31PM

DRAINAGE

CROSSINGS AND CONNECTIONS TO EXISTING PIPES AND UTILITIES

WHERE PLANS PROVIDE FOR A PROPOSED CONDUIT TO BE CONNECTED TO, OR CROSS OVER OR UNDER AN EXISTING SEWER OR UNDERGROUND UTILITY, THE CONTRACTOR SHALL LOCATE THE EXISTING PIPES OR UTILITIES BOTH AS TO LINE AND GRADE BEFORE STARTING TO LAY THE PROPOSED CONDUIT.

IF IT IS DETERMINED THAT THE ELEVATION OF THE EXISTING CONDUIT, OR EXISTING APPURTENANCE TO BE CONNECTED, DIFFERS FROM THE PLAN ELEVATION OR RESULTS IN A CHANGE IN THE PLAN CONDUIT SLOPE, THE ENGINEER SHALL BE NOTIFIED BEFORE STARTING CONSTRUCTION OF ANY PORTION OF THE PROPOSED CONDUIT WHICH WOULD BE AFFECTED BY THE VARIANCE IN THE EXISTING ELEVATIONS.

IF IT IS DETERMINED THAT THE PROPOSED CONDUIT WILL INTERSECT AN EXISTING SEWER OR UNDERGROUND UTILITY IF CONSTRUCTED AS SHOWN ON THE PLAN, THE ENGINEER SHALL BE NOTIFIED BEFORE STARTING CONSTRUCTION OF ANY PORTION OF THE PROPOSED CONDUIT WHICH WOULD BE AFFECTED BY THE INTERFERENCE WITH AN EXISTING FACILITY.

PAYMENT FOR ALL THE OPERATIONS DESCRIBED ABOVE SHALL BE INCLUDED IN THE CONTRACT PRICE FOR THE PERTINENT 603 CONDUIT ITEM.

REVIEW OF DRAINAGE FACILITIES

BEFORE ANY WORK IS STARTED ON THE PROJECT AND AGAIN BEFORE FINAL ACCEPTANCE BY THE STATE, REPRESENTATIVES OF THE STATE AND THE CONTRACTOR, ALONG WITH LOCAL REPRESENTATIVES, SHALL MAKE AN INSPECTION OF ALL EXISTING SEWERS WHICH ARE TO REMAIN IN SERVICE AND WHICH MAY BE AFFECTED BY THE WORK. THE CONDITION OF THE EXISTING CONDUITS AND THEIR APPURTENANCE SHALL BE DETERMINED FROM FIELD OBSERVATIONS. RECORDS OF THE INSPECTION SHALL BE KEPT IN WRITING BY THE STATE.

ALL NEW CONDUITS, INLETS, CATCH BASINS, AND MANHOLES CONSTRUCTED AS A PART OF THE PROJECT SHALL BE FREE OF ALL FOREIGN MATTER AND IN A CLEAN CONDITION BEFORE THE PROJECT WILL BE ACCEPTED BY THE STATE.

ALL EXISTING SEWERS INSPECTED INITIALLY BY THE ABOVE MENTIONED PARTIES SHALL BE MAINTAINED AND LEFT IN A CONDITION REASONABLY COMPARABLE TO THAT DETERMINED BY THE ORIGINAL INSPECTION. ANY CHANGE IN THE CONDITION RESULTING FROM THE CONTRACTOR'S OPERATIONS SHALL BE CORRECTED BY THE CONTRACTOR TO THE SATISFACTION OF THE ENGINEER.

PAYMENT FOR ALL THE OPERATIONS DESCRIBED ABOVE SHALL BE INCLUDED IN THE CONTRACT PRICE FOR THE PERTINENT 603 CONDUIT ITEMS.

ITEM 605 - 4" & 6" PIPE UNDERDRAIN W/FABRIC WRAP. 707.31

THE 4" & 6" PIPE UNDERDRAINS SHALL BE CONSTRUCTED IN ACCORDANCE WITH THE PROVISIONS OF ITEM 605 EXCEPT AS FOLLOWS: THEY SHALL HAVE FABRIC FILTER WRAP.

PAYMENT FOR THE ABOVE SHALL BE INCLUDED IN THE CONTRACT PRICE FOR THE PERTINENT 605 ITEM.

ITEM SPECIAL - FILL AND PLUG EXISTING CONDUIT

THIS ITEM SHALL CONSIST OF THE CONSTRUCTION OF BULKHEADS IN AN EXISTING CONDUIT AND FILLING THE AREA THUS SEALED OFF WITH LEAN GROUT, ITEM 613, SAND OR OTHER MATERIAL APPROVED BY THE ENGINEER.

BULKHEADS SHALL BE LOCATED AT THE LIMITS OF THE AREA TO BE FILLED AS INDICATED ON THE PLANS. THE BULKHEADS SHALL CONSIST OF BRICK OR CONCRETE MASONRY WITH A MINIMUM THICKNESS OF 12 INCHES [300 MILLIMETERS].

THE FILL MATERIAL SHALL BE PUMPED INTO PLACE, OR PLACED BY OTHER MEANS APPROVED BY THE ENGINEER, SO THAT, AFTER SETTLEMENT, AT LEAST 90 PERCENT OF THE CROSS-SECTIONAL AREA OF THE CONDUIT, FOR ITS ENTIRE LENGTH, SHALL BE FILLED. THE LENGTH OF FILLED AND PLUGGED CONDUIT TO BE PAID FOR SHALL BE THE ACTUAL NUMBER OF LINEAR FEET [METERS] (MEASURED ALONG THE CENTERLINE OF EACH CONDUIT FROM OUTERFACE TO OUTERFACE OF BULKHEADS) FILLED AND PLUGGED AS DESCRIBED ABOVE.

IN LIEU OF FILLING AND PLUGGING THE EXISTING CONDUIT, THE PIPE MAY BE CRUSHED AND BACKFILLED IN ACCORDANCE WITH THE PROVISIONS OF 203, OR IT MAY BE REMOVED.

THE LENGTH, MEASURED AS PROVIDED ABOVE, SHALL BE PAID FOR AT THE CONTRACT PRICE PER LINEAR FOOT [METER] FOR, ITEM SPECIAL, FILL AND PLUG EXISTING CONDUIT.

ITEM 603 - CONDUIT BORED AND JACKED

WHERE IT IS SPECIFIED THAT A CONDUIT BE INSTALLED BY THE METHOD OF BORING AND JACKING, NO TRENCH EXCAVATION SHALL BE CLOSER THAN 3 FEET TO THE EDGE OF PAVEMENT. TRENCHES SHALL BE ADEQUATELY SUPPORTED AND THE SPECIFICATION REQUIREMENTS FOR CLASS B BEDDING SHALL BE DISREGARDED. IF A CASING PIPE IS USED IN THE BORING AND JACKING OPERATION, THE VOID BETWEEN IT AND THE INTERIOR CARRIER PIPE SHALL BE COMPLETELY FILLED WITH ITEM 613, SAND, GROUT OR OTHER MATERIAL APPROVED BY THE ENGINEER.

ITEM 870-PLACING TOPSOIL AS PER PLAN

IN ADDITION TO ITEM 870 THIS ITEM SHALL CONSIST OF PLACING SUITABLE TOPSOIL, PER 870.13 AS OBTAINED FROM THE PROJECT CONSTRUCTION ACTIVITIES OR FROM OUTSIDE RESOURCES, IF NECESSARY MATERIAL INCLUDE, BUT NOT BE LIMITED TO THAT GATHERED FROM SCALPING OPERATIONS DUEING CLEARING AND GRUBBING, AND TOPSOIL ORGINATING FROM NORMAL EXCAVATION OPERATIONS.

# RESURFACING SECTION

## ITEM 614 - MAINTAINING TRAFFIC

A MINIMUM OF ONE LANE OF TRAFFIC IN EACH DIRECTION SHALL BE MAINTAINED AT ALL TIMES BY USE OF THE EXISTING PAVEMENT.

LENGTH AND DURATION OF LANE CLOSURES AND RESTRICTIONS SHALL BE AT THE APPROVAL OF THE ENGINEER. IT IS THE INTENT TO MINIMIZE THE IMPACT TO THE TRAVELING PUBLIC. LANE CLOSURES OR RESTRICTIONS OVER SEGMENTS OF THE PROJECT IN WHICH NO WORK IS ANTICIPATED WITHIN A REASONABLE TIME FRAME, AS DETERMINED BY THE ENGINEER, SHALL NOT BE PERMITTED. THE LEVEL OF UTILIZATION OF MAINTENANCE OF TRAFFIC DEVICES SHALL BE COMMENSURATE WITH THE WORK IN PROGRESS. THE CONTRACTOR SHALL PROVIDE, ERECT AND MAINTAIN SIGNS AND SIGN SUPPORTS, AS DETAILED IN THE OHIO MANUAL OF UNIFORM TRAFFIC CONTROL DEVICES.

ALL WORK AND TRAFFIC CONTROL DEVICES SHALL BE IN ACCORDANCE WITH 614 AND OTHER APPLICABLE PORTIONS OF THE SPECIFICATIONS, AS WELL AS THE OHIO MANUAL OF UNIFORM TRAFFIC CONTROL DEVICES. PAYMENT FOR ALL LABOR, EQUIPMENT AND MATERIALS SHALL BE INCLUDED IN THE LUMP SUM CONTRACT PRICE FOR 614, MAINTAINING TRAFFIC, UNLESS SEPERATELY ITEMIZED IN THE PLAN.

### WORK TO BE PERFORMED

THE FOLLOWING ITEMS ARE INCLUDED IN THIS SECTION OF THE PROJECT:

- 1.) RESURFACING THE MAINLINE AND RAMPS, WHICH SHALL BE PERFORMED AS A NIGHTTIME OPERATION. SINGLE LANE CLOSURE SHALL BE UTILIZED ON THE MAINLINE, AND PARTIAL LANE CLOSURE ON THE RAMPS. LANE CLOSURE SHALL BE PERMITTED BETWEEN THE HOURS OF 8:00 PM AND 6:00 AM ONLY.
- 2.) GUARDRAIL UPGRADES TO BE PERFORMED DURING THE DAYTIME, AS NOTED UNDER NOTES FOR GUARDRAIL REPLACEMENT.
- 3.) PROFILE ADJUSTMENTS ARE TO BE MADE AS NOTED IN THE PLANS. THIS SHALL BE PERFORMED IN THE SAME MANNER AS RESURFACING.
- 4.) RECONSTRUCTION OF BRIDGE PARAPETS AS NOTED IN THE PLANS SHALL BE PERFORMED AT NIGHT, WHEN THE CONTRACTOR MAY CLOSE THE ADJACENT LANE. ANY GAP IN THE GUARDRAIL WHILE THE PARAPETS CURE SHALL BE PROTECTED WITH PORTABLE CONCRETE BARRIER. THE BARRIER SHALL TAPER BEHIND EXISTING GUARDRAIL IN A MANNER WHICH DOES NOT LEAVE ANY ENDS EXPOSED TO ONCOMING TRAFFIC.
- 5.) REMOVAL OF PACER CURB SHALL BE PERFORMED DURING NIGHTTIME OPERATIONS IN ACCORDANCE WITH APPLICABLE STANDARD CONSTRUCTION DRAWINGS MT-98.13M THROUGH 98.18M.

### TEMPORARY PAVEMENT MARKINGS

IT MAY BE NECESSARY FOR THE CONTRACTOR TO PLACE TEMPORARY LANE LINE MARKINGS ON THE INTERMEDIATE AND/OR FINAL COURSES IF HE/SHE IS UNABLE TO EXPEDITE THE PROJECT. THE PLACEMENT OF THE TEMPORARY PAVEMENT MARKINGS SHALL BE SHOWN ON THE FINAL TRAFFIC CONTROL SHEET XXX. THESE TEMPORARY PAVEMENT MARKINGS SHALL BE APPLIED TO EACH ASPHALT PAVEMENT COURSE OPEN TO TRAFFIC.

## GUARDRAIL REPLACEMENT

NO HAZARD SHALL BE LEFT UNPROTECTED EXCEPT FOR THE ACTUAL TIME NECESSARY TO REMOVE THE EXISTING GUARDRAIL, PREPARE THE SITE, AND INSTALL NEW GUARDRAIL IN A CONTINUOUS OPERATION. THE REMOVAL OF ALL GUARDRAIL SHALL AT ALL TIMES BE AS DIRECTED BY THE ENGINEER. NO GUARDRAIL SHALL BE REMOVED UNTIL THE REPLACEMENT MATERIAL IS ON THE SITE, READY FOR INSTALLATION. FAILURE TO COMPLY WITH THIS REQUIREMENT SHALL BE DEEMED SUFFICIENT CAUSE TO ORDER WORK SUSPENDED UNTIL SUCH TIME AS THE ENGINEER IS ASSURED OF COMPLIANCE.

## FLOODLIGHTING

FLOODLIGHTING OF THE WORK SITE FOR OPERATIONS CONDUCTED DURING NIGHT TIME PERIODS SHALL BE ACCOMPLISHED SO THAT THE LIGHTS DO NOT CAUSE GLARE TO THE DRIVERS ON THE ROADWAY. TO ENSURE THE ADEQUACY OF THE FLOODLIGHT PLACEMENT, THE CONTRACTOR AND THE ENGINEER SHALL DRIVE THROUGH THE WORK SITE EACH NIGHT WHEN THE LIGHTING IS IN PLACE AND PLACEMENT AND SHIELDING SHALL BE ADJUSTED TO THE SATISFACTION OF THE ENGINEER BEFORE WORK PROCEEDS.

PAYMENT FOR ALL LABOR, EQUIPMENT AND MATERIALS SHALL BE INCLUDED IN THE LUMP SUM CONTRACT PRICE FOR MAINTAINING TRAFFIC.

## HOLIDAY WORK RESTRICTIONS

NO WORK SHALL BE PERFORMED AND ALL EXISTING LANES SHALL BE OPEN TO TRAFFIC DURING THE FOLLOWING DESIGNATED HOLIDAYS:

CHRISTMAS	NEW YEARS
MEMORIAL DAY	THE FORTH OF JULY
LABOR DAY	THANKSGIVING

THE PERIOD OF TIME THAT THE "NO WORK" APPLIES DEPENDS ON THE DAY OF THE WEEK ON WHICH THE HOLIDAY FALLS. THE FOLLOWING SCHEDULE SHALL BE USED TO DETERMINE THE PERIOD:

DAY OF THE WEEK	TIME ALL LANES MUST BE OPEN TO TRAFFIC
MONDAY	12 NOON FRIDAY THROUGH 12 NOON TUESDAY
TUESDAY	12 NOON MONDAY THROUGH 12 NOON WEDNESDAY
WEDNESDAY	12 NOON TUESDAY THROUGH 12 NOON THURSDAY
THURSDAY	12 NOON WEDNESDAY THROUGH 12 NOON FRIDAY
FRIDAY	12 NOON THURSDAY THROUGH 12 NOON MONDAY
SATURDAY	12 NOON FRIDAY THROUGH 12 NOON MONDAY
SUNDAY	12 NOON FRIDAY THROUGH 12 NOON MONDAY

NO EXTENSIONS OF TIME SHALL BE GRANTED FOR DELAYS IN MATERIAL DELIVERIES, UNLESS SUCH DELAYS ARE INDUSTRY WIDE, OR FOR LABOR STRIKES, UNLESS SUCH STRIKES ARE INDUSTRY WIDE.

SHOULD THE CONTRACTOR FAIL TO MEET ANY OF THESE REQUIREMENTS, THE CONTRACTOR SHALL BE ASSESSED LIQUIDATED DAMAGES IN ACCORDANCE WITH SECTION 108.07 OF THE CONSTRUCTION AND MATERIALS SPECIFICATIONS.

## WORK-SITE TRAFFIC SUPERVISOR

THE CONTRACTOR SHALL EMPLOY A WORKSITE TRAFFIC SUPERVISOR (WTS), OTHER THAN THE SUPERINTENDENT, FOR THE PURPOSE OF MONITORING THE MAINTENANCE OF TRAFFIC PLAN (MOTP). THE WTS SHALL HAVE EXPERIENCE OR TRAINING IN PROJECT SUPERVISION AND TRAFFIC CONTROL COMMENSURATE WITH THE RESPONSIBILITIES OF MANAGING THE PROJECT MAINTENANCE OF TRAFFIC PLAN AND COORDINATING WITH ANY MOTORIST INFORMATION SYSTEM OUTSIDE THE PROJECT. THE GOALS OF THE WTS POSITION ARE TO MINIMIZE TRAFFIC CONGESTION AND MAXIMIZE PROJECT SAFETY AND EFFICIENCY. THE CONTRACTOR SHALL SUBMIT TO THE ENGINEER FOR APPROVAL A RESUME OF THE EXPERIENCE, TRAINING AND EDUCATION OF THE PERSON PROPOSED FOR WTS. PROJECT WORK SHALL NOT BEGIN WITHOUT AN APPROVED WTS. THE WTS SHALL BE PRESENT WHEN THE CONTRACTOR INSTALLS A TRAFFIC RESTRICTION, LANE CLOSURE, ECT. THE WTS SHALL REVIEW THE TRAFFIC CONTROL PATTERN UPON COMPLETION OF THE INSTALLATION BOTH DURING THE DAY AND THE NIGHT FOR ASSURANCE OF CONTRACT COMPLIANCE. THW WTS SHALL MAKE RECOMMENDATIONS TO MODIFY THE MOTP FOR BETTER/SAFER TRAFFIC FLOW. THESE RECOMMENDATIONS SHALL BE MADE IN WRITING TO THE ENGINEER. NO CHANGES TO THE TRAFFIC CONTROL PLAN SHALL BE MADE UNTIL APPROVAL IS OBTAINED FROM THE ENGINEER IN WRITING.

DAILY, THE WTS SHALL REVIEW THE PROJECT'S TRAFFIC CONTROL WITH A MINIMUM OF TWO REVIEWS EACH WEEK BEING PERFORMED AT NIGHT. THE WTS SHALL BE AT THE PROJECT SITE EVERY DAY OF THE YEAR WHILE TEMPORARY TRAFFIC CONTROL DEVICES ARE IN PLACE. THE FOLLOWING ITEMS SHALL BE INCLUDED IN EACH REVIEW: TRAFFIC CONTROL DEVICE CONDITION, PLACEMENT, AND VISIBILITY; TRAFFIC FLOW CONDITIONS, INCIDENTS, CONGESTIONPOINTS, DELAYS, AND ADEQUACY OF ADVANCED INFORMATIONAL SIGNS BEYOND THE PROJECT LIMITS; INTERACTION OF WORK VEHICLES AND TRAFFIC; EVIDENCE OF ACCIDENTS; PROPER STORAGE OF MATERIALS AND EQUIPMENT; CONFORMANCE WITH MOTP; CONFLICTING OR NON-PERFORMING PAVEMENT MARKINGS. THE WTS SHALL NOTE ANY TRAFFIC CONTROL DEFICIENCIES. DEFICIENT OR IMPROPERLY PLACED TRAFFIC CONTROL DEVICES SHALL BE CORRECTED. THE WTS SHALL HAVE NECESSARY AUTHORITY TO IMMEDIATELY PERFORM THIS CORRECTIVE WORK. DAILY, A RECORD OF REVIEW SHALL BE GIVEN TO THE PROJECT ENGINEER IN WRITING AND SHALL INCLUDE A RECORD OR DEFICIENCIES AND RESOLUTION OF THE DEFICIENCIES.

FAILURE OF THE CONTRACTOR TO COMPLY WITH ANY OF THE ABOVE SHALL CONSTITUTE CAUSE FOR THE PROJECT ENGINEER TO SUSPEND ALL WORK UNTIL ALL CORRECTIONS ARE MADE.

THE WTS OR ANOTHER DESIGNATED SUPERVISOR SHALL BE ON CALL 24 HOURS A DAY, SEVEN DAYS A WEEK. FOR THE DURATION OF THE PROJECT TO PROVIDE NECESSARY MAINTENANCE OPERATIONS ON THE PROJECT. THIS MAY INVOLVE REPAIR OR REPLACEMENT OF SIGNS, DRUMS, PAVEMENT MARKINGS, CONCRETE BARRIERS, GUARDRAIL, PAVEMENT SURFACES, ECT. THIS INDIVIDUAL SHALL BE ABLE TO RESPOND AND BE ON THE PROJECT WITHIN FOUR (4) HOURS AFTER A CALL AND HAVE SUFFICIENT INVENTORY ON HAND TO REPAIR OR REPLACE DAMAGED OR MISSING TRAFFIC DEVICES. THE CONTRACTOR SHALL FURNISH THE PHONE NUMBER(S) OF THE SUPERVISOR ON CALL TO THE LOCAL-STATE POLICE AND STATE HIGHWAY PATROL OFFICES. PAYMENT FOR FURNISHING THE WTS AND ASSOCIATED WORK AND MATERIAL SHALL BE INCLUDED IN THE LUMP SUM PRICE BID FOR THE ITEM 614 MAINTAINING TRAFFIC.

## STANDARD CONSTRUCTION DRAWINGS

THE FOLLOWING MAINTENANCE OF TRAFFIC STANDARD CONSTRUCTION DRAWINGS HAVE BEEN SPECIFIED WITHIN THE MAINTENANCE OF TRAFFIC PLANS:

MT-95.30M	4/25/94	MT-98.13M	6/24/93
MT-98.14M	6/24/93	MT-98.15M	6/24/93
MT-98.16M	6/24/93	MT-98.17M	4/25/94
MT-98.18M	4/25/94	MT-99.10M	1/30/95
MT-99.20M	1/30/95	MT-105.10M	4/25/94
MT-105.11M	4/25/94		

THE METRIC STANDARD DRAWINGS REFERENCED IN THIS PLAN SHALL BE CONVERTED TO ENGLISH UNITS USING THE SI (METRIC) TO ENGLISH CONVERSION FACTORS PROVIDED IN SECTION 109.011 OF THE CMS. THE APPENDIX OF ASTM E 380 SHALL BE UTILIZED FOR ANY ADDITIONAL CONVERSION FACTORS REQUIRED. CONVERSIONS SHALL BE APPROXIMATELY PRECISE AND SHALL REFLECT STANDARD INDUSTRY VALUES WHERE SUITABLE.

CALCULATED  
DLS  
CHECKED  
LAB

MAINTENANCE OF TRAFFIC  
GENERAL NOTES

LOR - 190 - 10.76



M.O.T.

20  
274

PROJECT DATA	
TOTAL AREA (RIGHT-OF-WAY) -----	353.2 AC.± <sup>Δ</sup>
AREA DISTURBED FOR DRAINAGE IMPROVEMENTS	30.7 AC.±
RUNOFF COEFFICIENT FOR PRE-CONSTRUCTION SITE -----	0.55±
RUNOFF COEFFICIENT FOR POST CONSTRUCTION SITE -----	0.55±
SOIL DATA -----	SEE SOIL PROFILE
EVENTUAL RECEIVING WATERS -----	VARIES

USGS QUADRANT NO. N4122.5-W8200/7.5  
 AVON, OHIO  
 LONGITUDE W 82°00'00"\*  
 LATITUDE N 41°27'50"\*

\* LONGITUDE AND LATITUDE TO APPROX. CENTER OF PROJECT

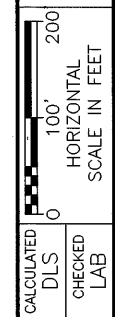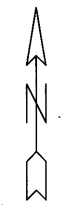

**STORM WATER POLLUTION PREVENTION PLAN**

DUE TO THE THE DESIGN/BUILD NATURE OF THIS PROJECT, THE LIMITS OF GRADING OPERATIONS HAVE YET TO BE FULLY DETERMINED. DUE TO THIS FACT THE SWPPP HAS BEEN LAID OUT FOR THE MOST CONSERVATIVE CASE OF THE WORK THAT IS REQUIRED. IT WILL BE UP TO THE JUDGEMENT OF THE CONTRACTOR'S FIELD PERSONNEL FOR TYPE AND EXTENT OF TREATMENT REQUIRED FOR ACTUAL FIELD CONDITIONS GIVEN THE AMOUNT OF AREA DISTURBED. SEDIMENT BASINS HAVE BEEN SIZED TO PROVIDE A STORAGE VOLUME OF 67 CUBIC YARDS PER ACRE OF CONTRIBUTING DISTURBED DRAINAGE AREA FOR DRAINAGE DRAINAGE AREAS BETWEEN 1 AND 5 ACRES. DITCH CHECKS ARE PROPOSED WHERE THE CONTRIBUTING DISTURBED DRAINAGE AREAS ARE LESS THAN 1 ACRE.

THE CONDITIONS OF THE NPDES CONSTRUCTION STORM WATER GENERAL PERMIT (SEE THE PROPOSAL) SHALL BE MET DURING ALL STAGES OF CONSTRUCTION. THE LOCATION AND TIMING OF ALL EROSION AND SEDIMENT CONTROL ITEMS SHALL BE FIELD ADJUSTED TO PREVENT SIGNIFICANT IMPACTS ON RECIEVING WATERS. IMPLEMENTATION OF THIS STORM WATER POLLUTION PREVENTION PLAN SHALL CONTINUE THROUGHOUT THE DURATION OF THE PROJECT OR UNTIL SUCH TIMES THAT THE UPSLOPE DISTURBED AREAS ARE STABILIZED.

THE CONTRACTOR MAY INSTALL OTHER MEANS OF EROSION AND SEDIMENT CONTROL AT THE LOCATIONS IDENTIFIED HEREIN AND AT OTHER LOCATIONS HE DETERMINES WITHIN THE PROJECT TO ACCOMPLISH THE INTENT OF THIS PLAN. OTHER MEANS OF EROSION CONTROL MAY INCLUDE PLACEMENT OF COARSE STONE OR RIP RAP, AND PLACEMENT OF STRAW OR HAY BALES, TO BE UTILIZED IN CONJUNCTION WITH FILTER FABRIC FENCE. THE CONTRACTOR SHALL PLACE, MAINTAIN AND SUBSEQUENTLY REMOVE SAID EROSION CONTROL FEATURES.

INSTALLATION OF SEDIMENT BASINS/DAMS, PERIMETER FILTER FABRIC FENCE, AND DITCH CHECKS SHALL BE CONCURRENT WITH CLEARING GRUBBING AND/OR GRADING OPERATIONS.

ALL REASONABLE ATTEMPTS SHOULD BE MADE TO MINIMIZE THE TOTAL AREA OF DISTURBED LAND. WHERE POSSIBLE AND WHEN SUFFICIENT QUANTITIES OF WORK ARE READY, PERMANENT EROSION CONTROL FEATURES SHALL BE UTILIZED SUCH AS RESTORING AND THEN SEEDING AND MULCHING DISTURBED AREAS.

AREAS TO REMAIN DORMANT FOR MORE THAN 45 DAYS SHALL BE IMMEDIATE STABILIZED WITH TEMPORARY SEEDING AND MULCHING, EROSION CONTROL MATTING OR OTHER APPROPRIATE EROSION CONTROL MEASURES. THIS WILL OCCUR ON THE OUTSIDES OF THE DITCHES WHERE THE OUTLET CULVERTS AND UNDERDRAIN DISCHARGE, BUT NOT EXCLUSIVE. ANY AREAS WITHIN 50 FT. OF ANY WATER BODY, THEN IT SHALL BE VEGETATED WITHIN 2 DAYS FOLLOWING THE CLEANING AND GRUBBING OPERATIONS.

ALL TEMPORARY EROSION AND SEDIMENT CONTROL MEASURES SHALL BE AS DETAILED ON STANDARD DRAWING DM-4.3 AND DM-4.4 AND SS877.

**PROJECT DESCRIPTION**

THIS PART OF THE PROJECT CONSISTS OF THE OVERLAYING OF SR2 STA 422+00 TO I-90 AND I-90 FROM STA 522+50.40 TO STA 966+00 IN ADDITION ODOT HAS SELECTED AREAS FOR FULL JOINT REPAIR AND DRAINAGE IMPROVEMENTS. THERE WILL BE CATCH BASIN REPLACEMENTS, DITCH AND PIPER CLEAN OUTS, AND DUMP ROCK CHANNEL PROTECTION PLACED.

STORM WATER POLLUTION PREVENTION PLAN.

**LEGEND**


- ⊙ TEMPORARY INLET PROTECT, FILTER FABRIC FENCE (AT ALL EXISTINGAND PROPOSED INLETS)
- ◆ TEMPORARY DITCH CHECK, FILTER FENCE
- FF— FILTER FABRIC FENCE
- ~> DIRECTION OF FLOW DITCH
- ▭ SEDIMENT BASIN

**STORM WATER POLLUTION PREVENTION PLAN (I-90) DETAIL SHEET**


**LOR - I90 - 10.76**

I:\31600 DWG\PROJECTS\SP-01.DWG ] JOR 10-2002 8:11AM

CURVE DATA ①  
 P.I. STA. 414+32.93  
 $\Delta = 28^{\circ}33'36''$  RT.  
 D = 1'00'00"  
 R = 5729.58'  
 T = 1458.32'  
 L = 2856.00'  
 E = 182.68'

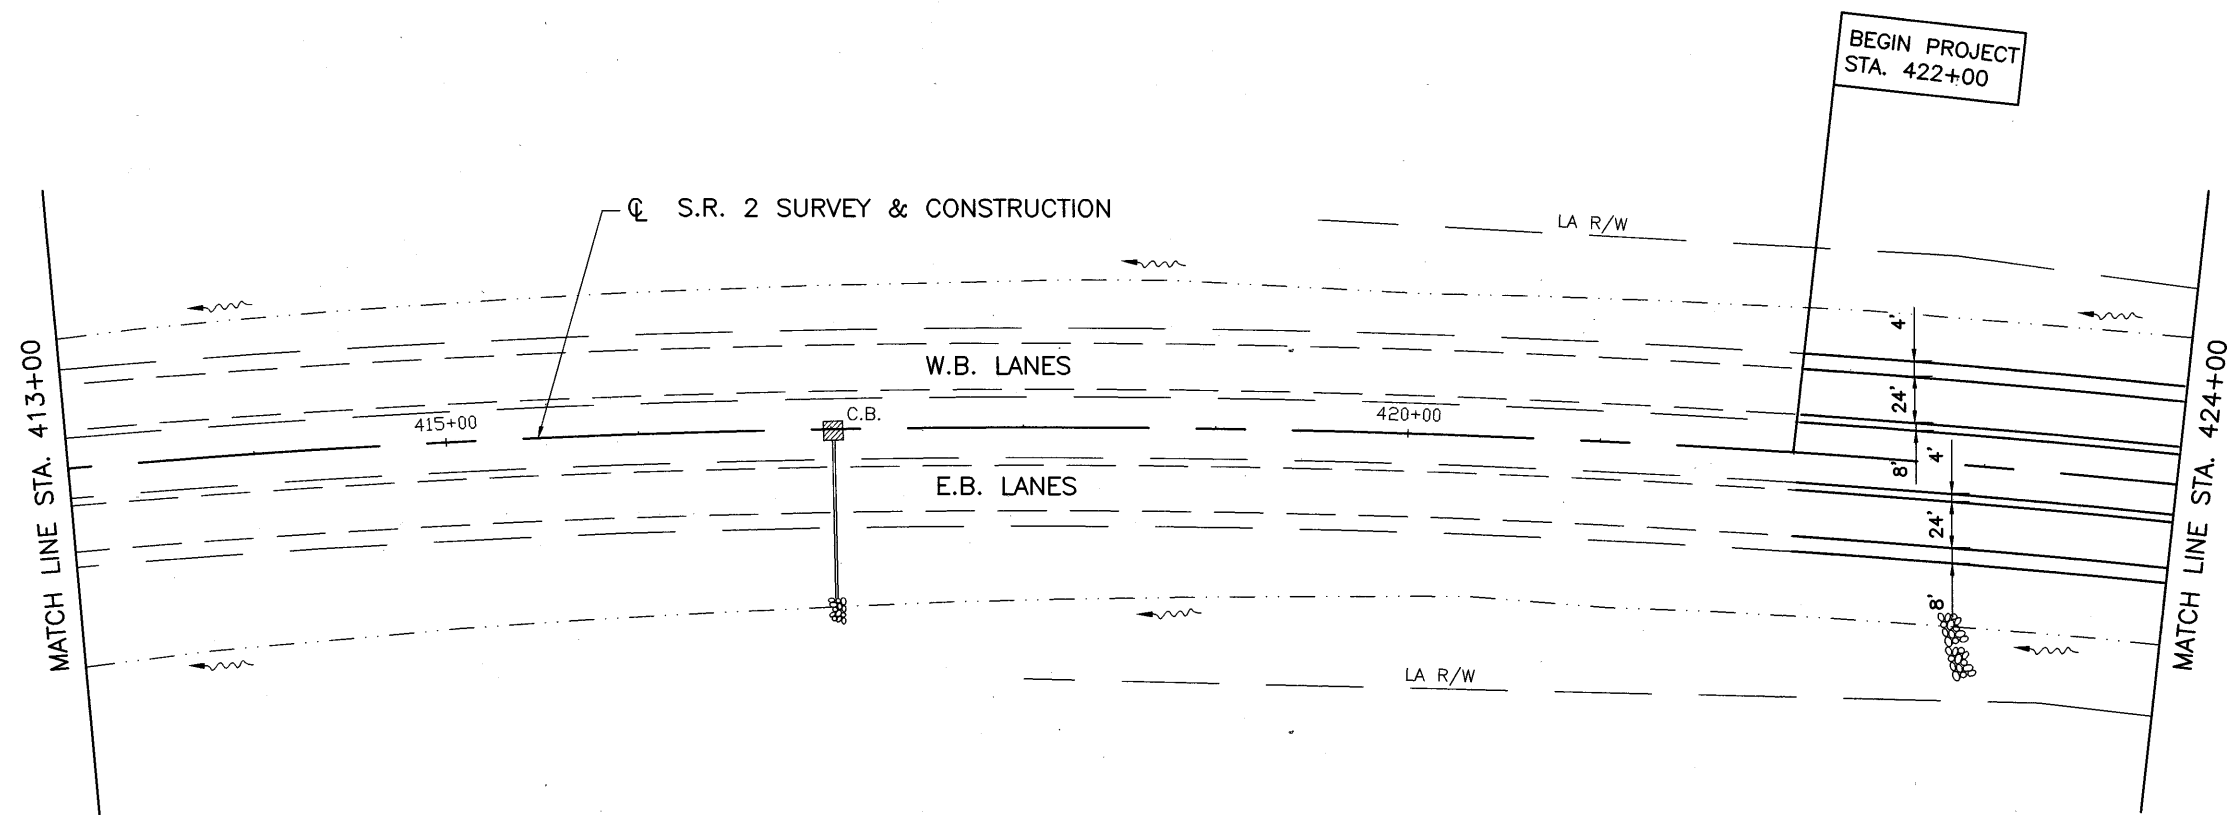

CALCULATED DLS CHECKED LAB  
**STORM WATER POLLUTION PREVENTION PLAN**  
**STA. 413+00 TO STA. 435+00**

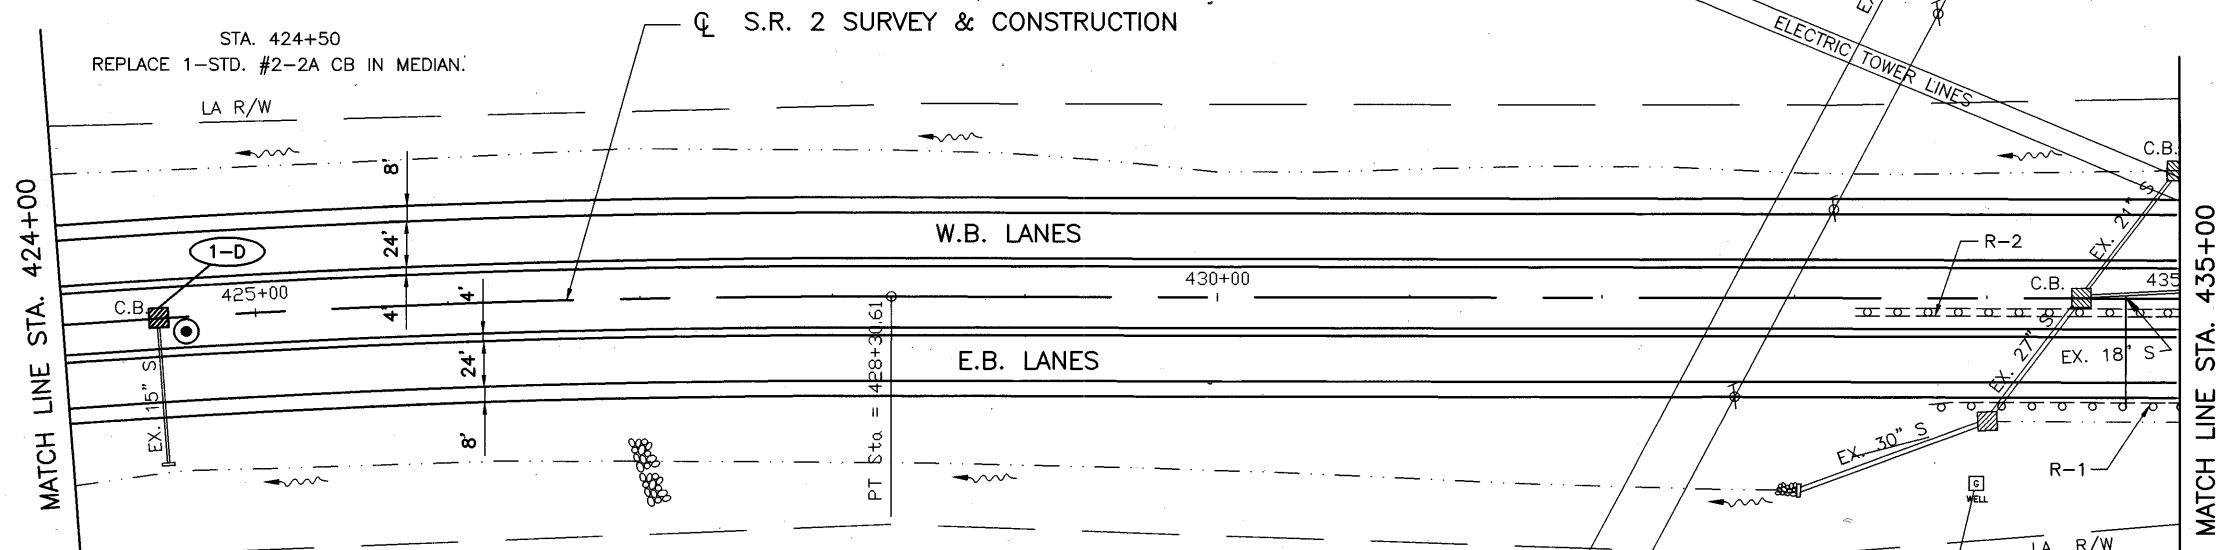


**LEGEND**


- ⊙ TEMPORARY INLET PROTECT, FILTER FABRIC FENCE (AT ALL EXISTING AND PROPOSED INLETS)
- ◆ TEMPORARY DITCH CHECK, FILTER FENCE
- F — FILTER FABRIC FENCE
- ~ DIRECTION OF FLOW DITCH
- ▣ SEDIMENT BASIN

LOR - 190 - 10.76

C:\B\5000\UNRES\EROSION\SP-02.DWG 1 JGR  
 16-2002 4:28PM

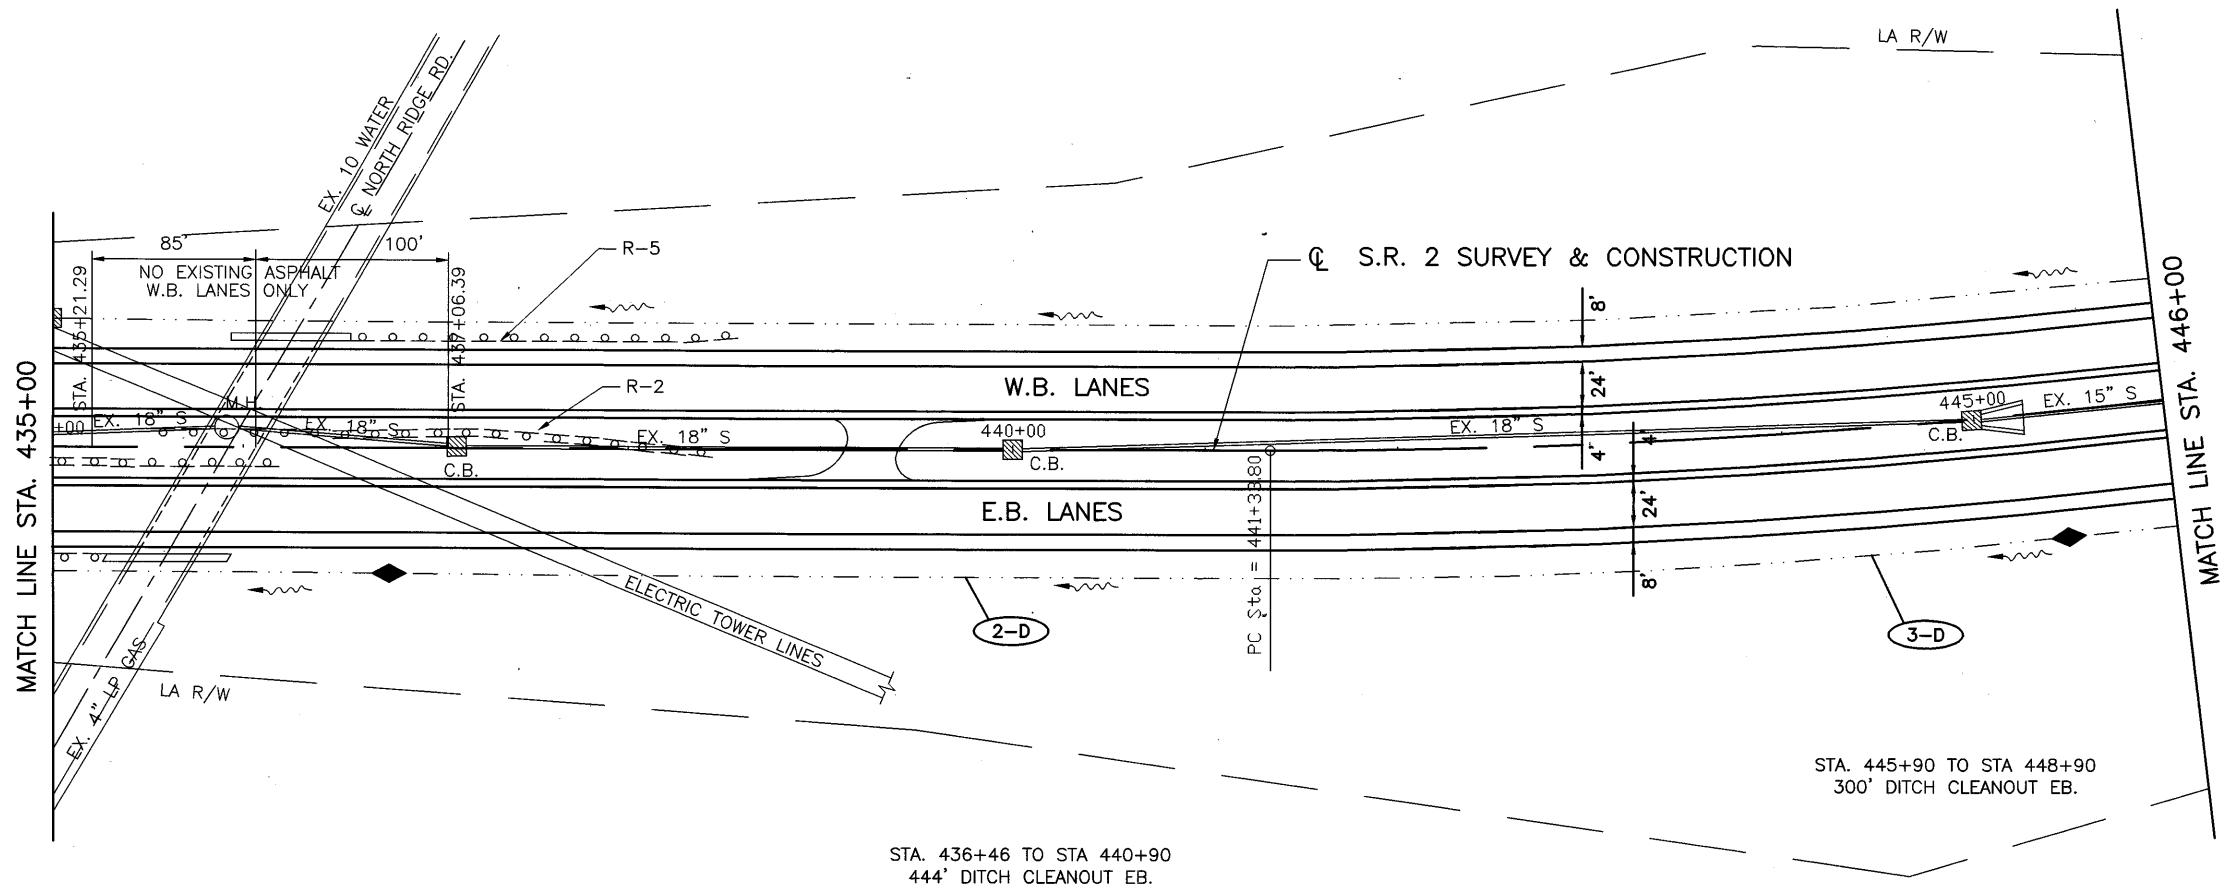

**CURVE DATA** ②  
 P.I. STA. 448+92.90  
 $\Delta = 21^{\circ}59'34''$  LT.  
 D = 1'28'00"  
 R = 3906.53'  
 T = 759.10'  
 L = 1499.51'  
 E = 73.07'

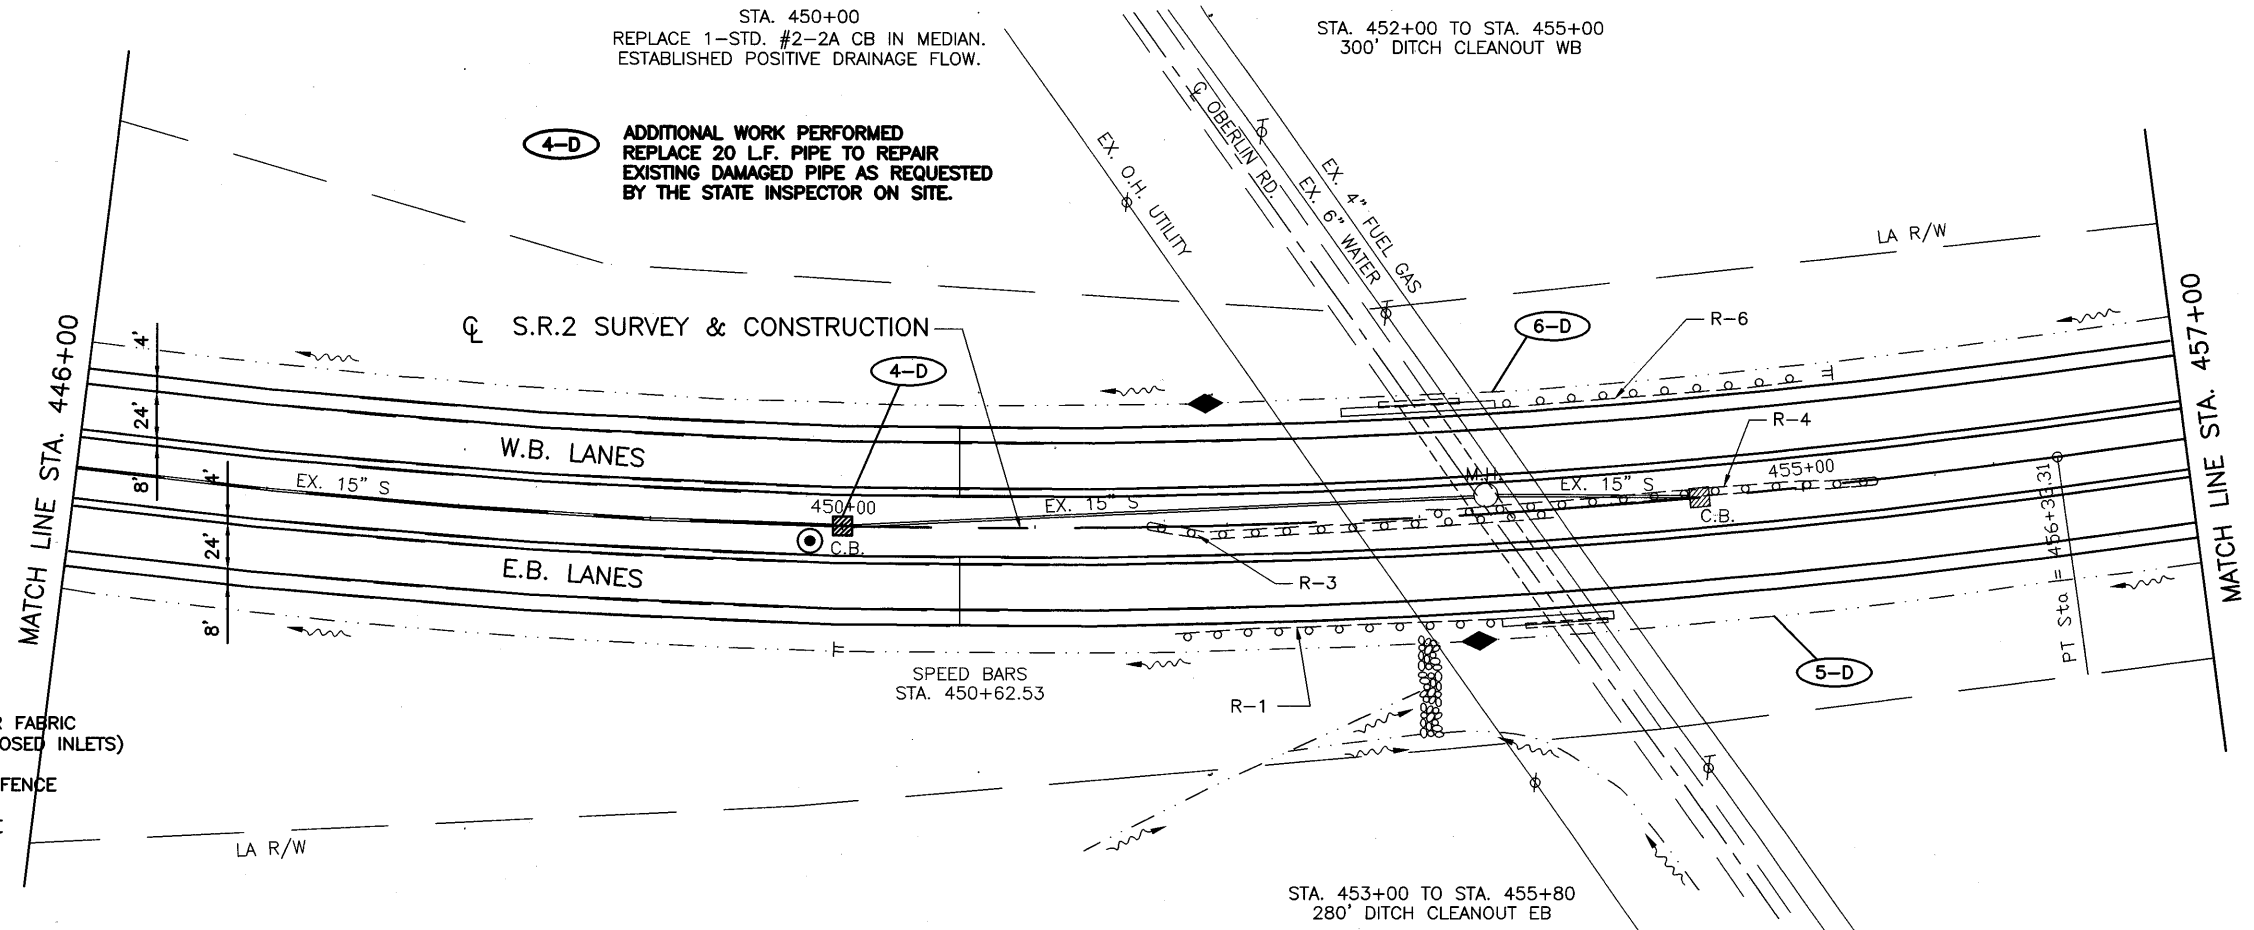


- LEGEND**
- ⊙ TEMPORARY INLET PROTECT, FILTER FABRIC FENCE (AT ALL EXISTING AND PROPOSED INLETS)
  - ◆ TEMPORARY DITCH CHECK, FILTER FENCE
  - FF — FILTER FABRIC FENCE
  - DIRECTION OF FLOW DITCH
  - ▣ SEDIMENT BASIN

CALCULATED	0
DLS	0
CHECKED	LAB

**STORM WATER POLLUTION PREVENTION PLAN**  
**STA. 435+00 TO STA. 457+00**

**LOR - 190 - 10.76**

STA. 462+80 TO STA. 466+50  
370' DITCH CLEANOUT WB

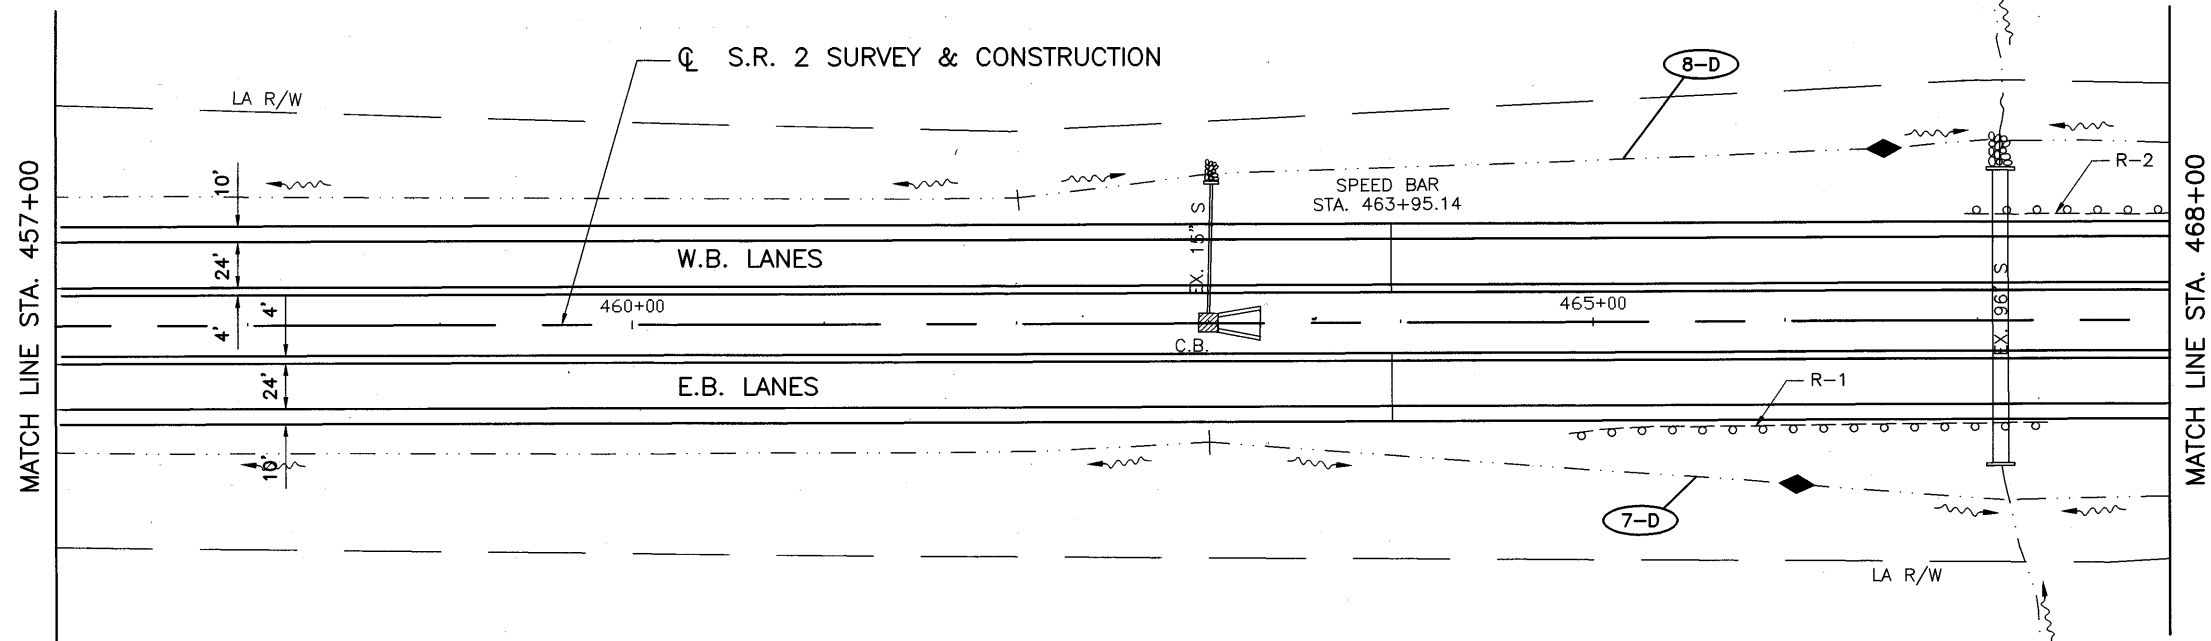


STA. 463+00 TO STA. 466+00  
300' DITCH CLEANOUT EB

CALCULATED	DLS	CHECKED	LAB

**STORM WATER POLLUTION PREVENTION PLAN**  
STA. 457+00 TO STA. 479+00

LOR - 190 - 10.76

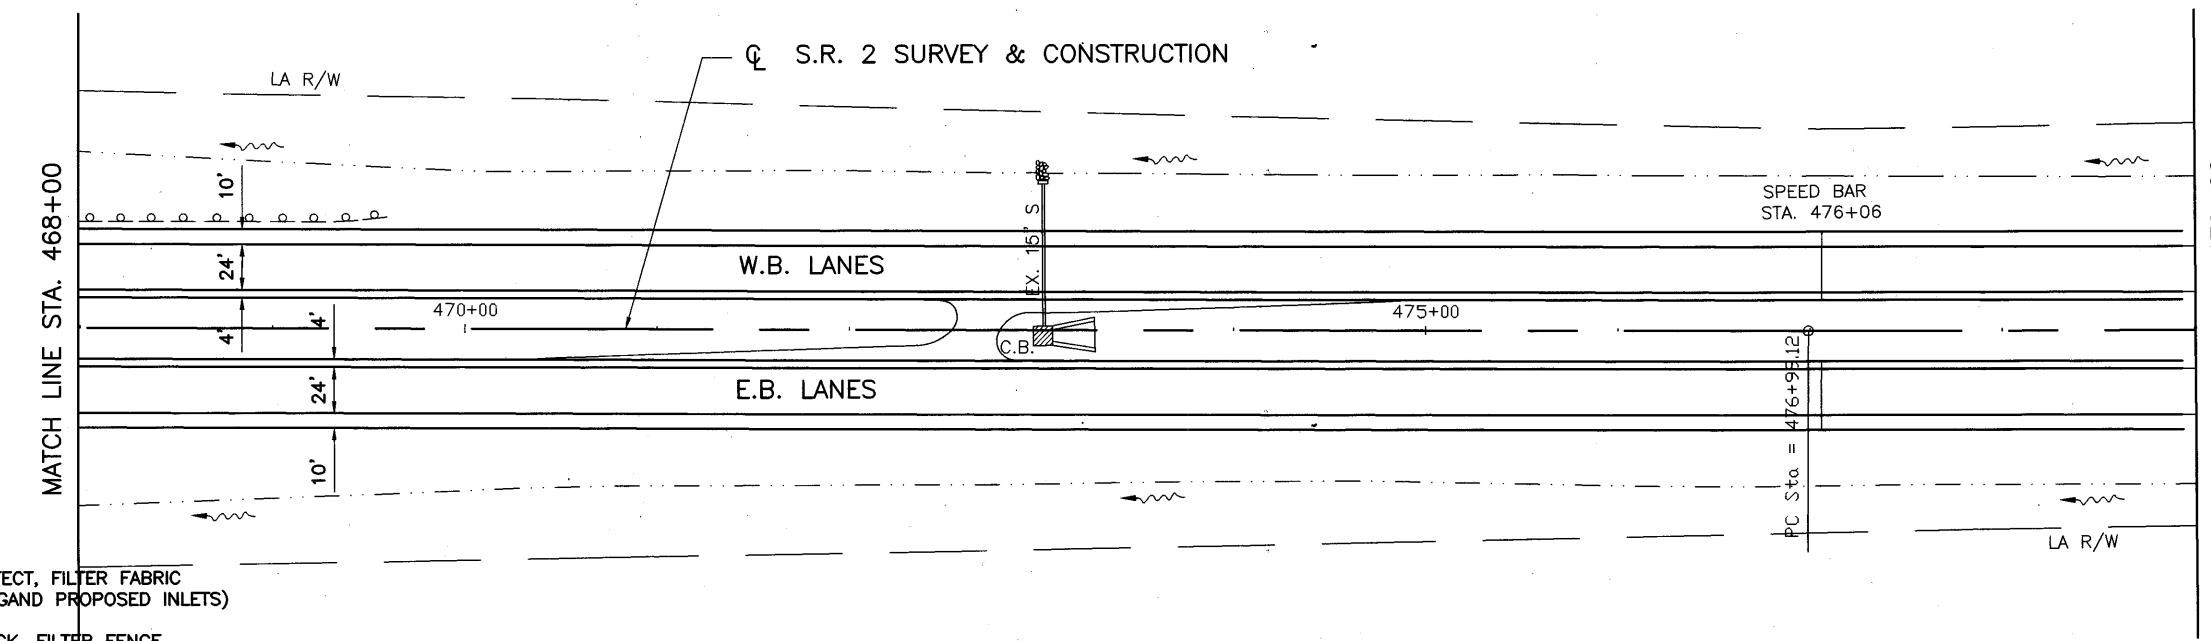


**LEGEND**

- ⊙ TEMPORARY INLET PROTECT, FILTER FABRIC FENCE (AT ALL EXISTING AND PROPOSED INLETS)
- ◆ TEMPORARY DITCH CHECK, FILTER FENCE
- FF — FILTER FABRIC FENCE
- ~> DIRECTION OF FLOW DITCH
- ▣ SEDIMENT BASIN

I:\32600\DWG\VERSION\SP-04.DWG J OR  
 18-2002 8:41AM




CURVE DATA (3)  
 P.I. STA. 481+16.20  
 $\Delta = 2'13'27''$  LT.  
 $D = 0'16'00''$   
 $R = 21,485.92'$   
 $T = 417.08'$   
 $L = 834.06'$   
 $E = 4.04'$

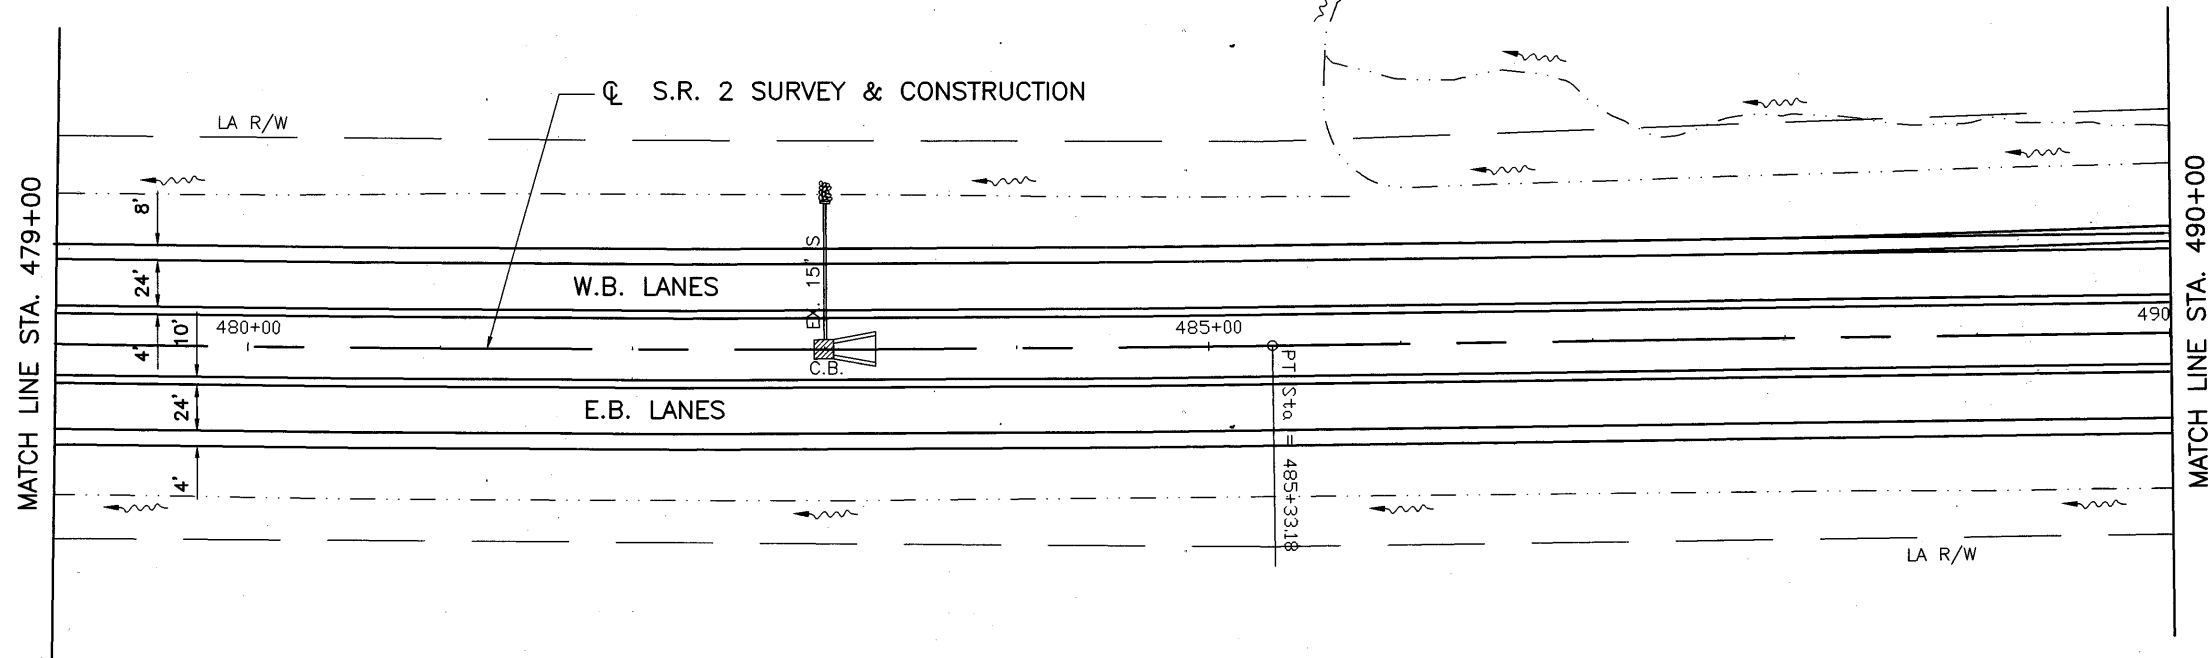

CURVE DATA (4)  
 P.I. STA. 499+53.92  
 $\Delta = 3'13'01''$  RT.  
 $D = 0'16'00''$   
 $R = 21,485.92'$   
 $T = 603.34'$   
 $L = 1206.35'$   
 $E = 8.47'$

STA. 493+00  
 REPLACE LAST 2' OF 85'-15" CLASS J-1.  
 PIPE BROKEN FROM RECENT DITCH WORK  
 FROM ODOT FORCES.

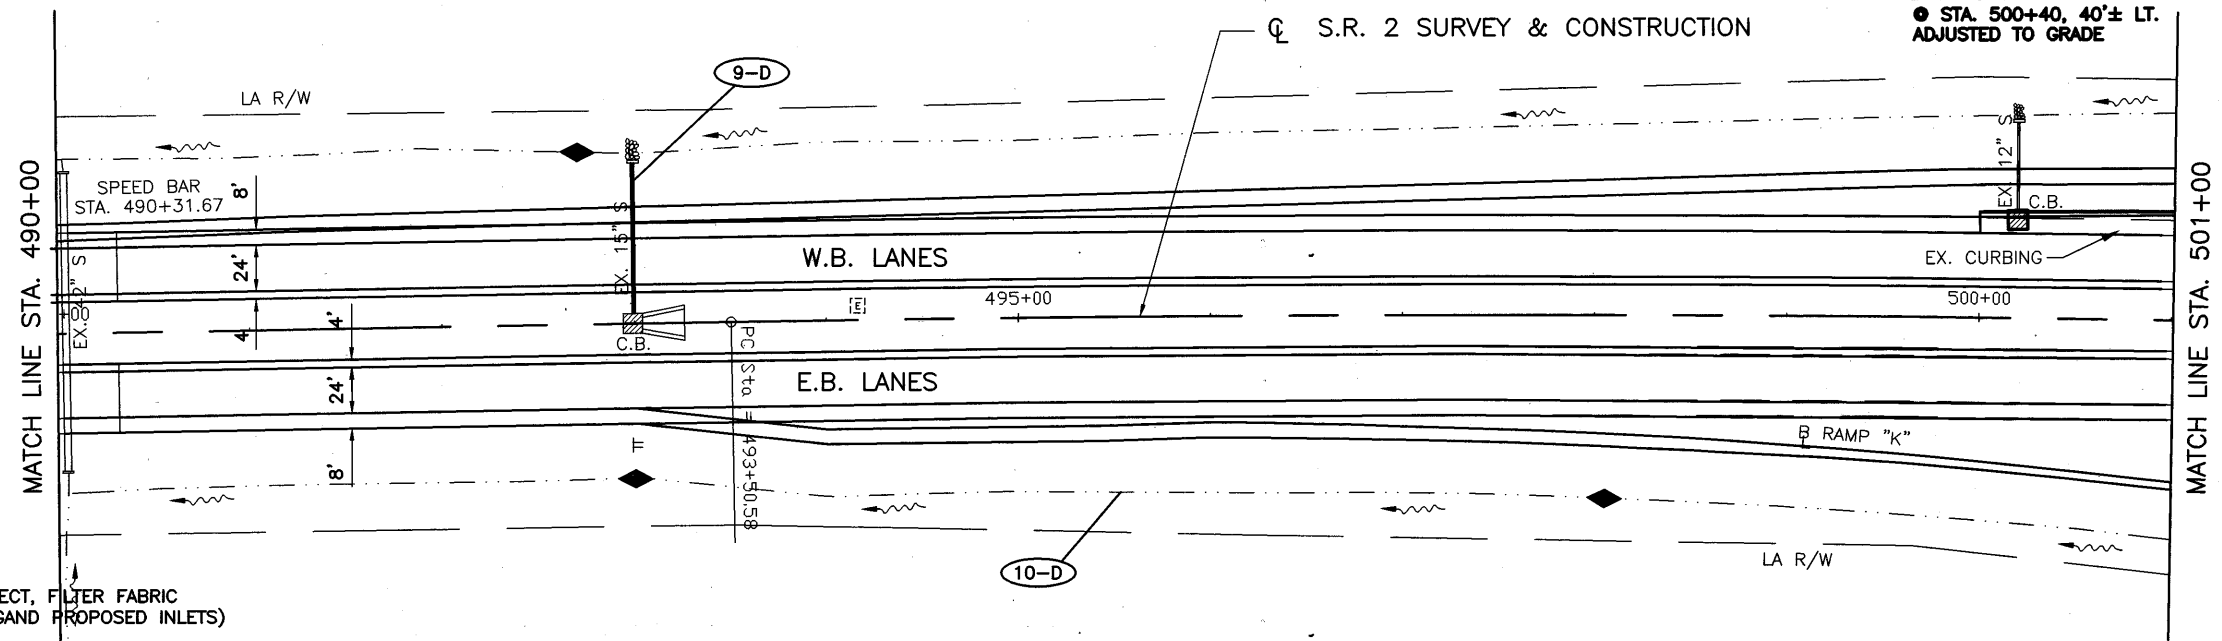

**LEGEND**

- ⊙ TEMPORARY INLET PROTECT, FILTER FABRIC FENCE (AT ALL EXISTING AND PROPOSED INLETS)
- ◆ TEMPORARY DITCH CHECK, FILTER FENCE
- FF— FILTER FABRIC FENCE
- ~> DIRECTION OF FLOW DITCH
- ▣ SEDIMENT BASIN

ESTABLISH POSITIVE DRAINAGE FLOW.  
 STA. 493+00 TO STA. 501+00 EB.  
 800' DITCH CLEANOUT EB


CALCULATED	DLS	CHECKED	LAB

STORM WATER POLLUTION PREVENTION PLAN  
 STA. 479+00 TO STA. 501+00

LOR - 190 - 10.76  
 25  
 274

STA. 503+50  
REPLACE 1-STD #2-2A CB IN MEDIAN.


STA. 505+60 TO STA. 512+20  
660' DITCH CLEANOUT WB

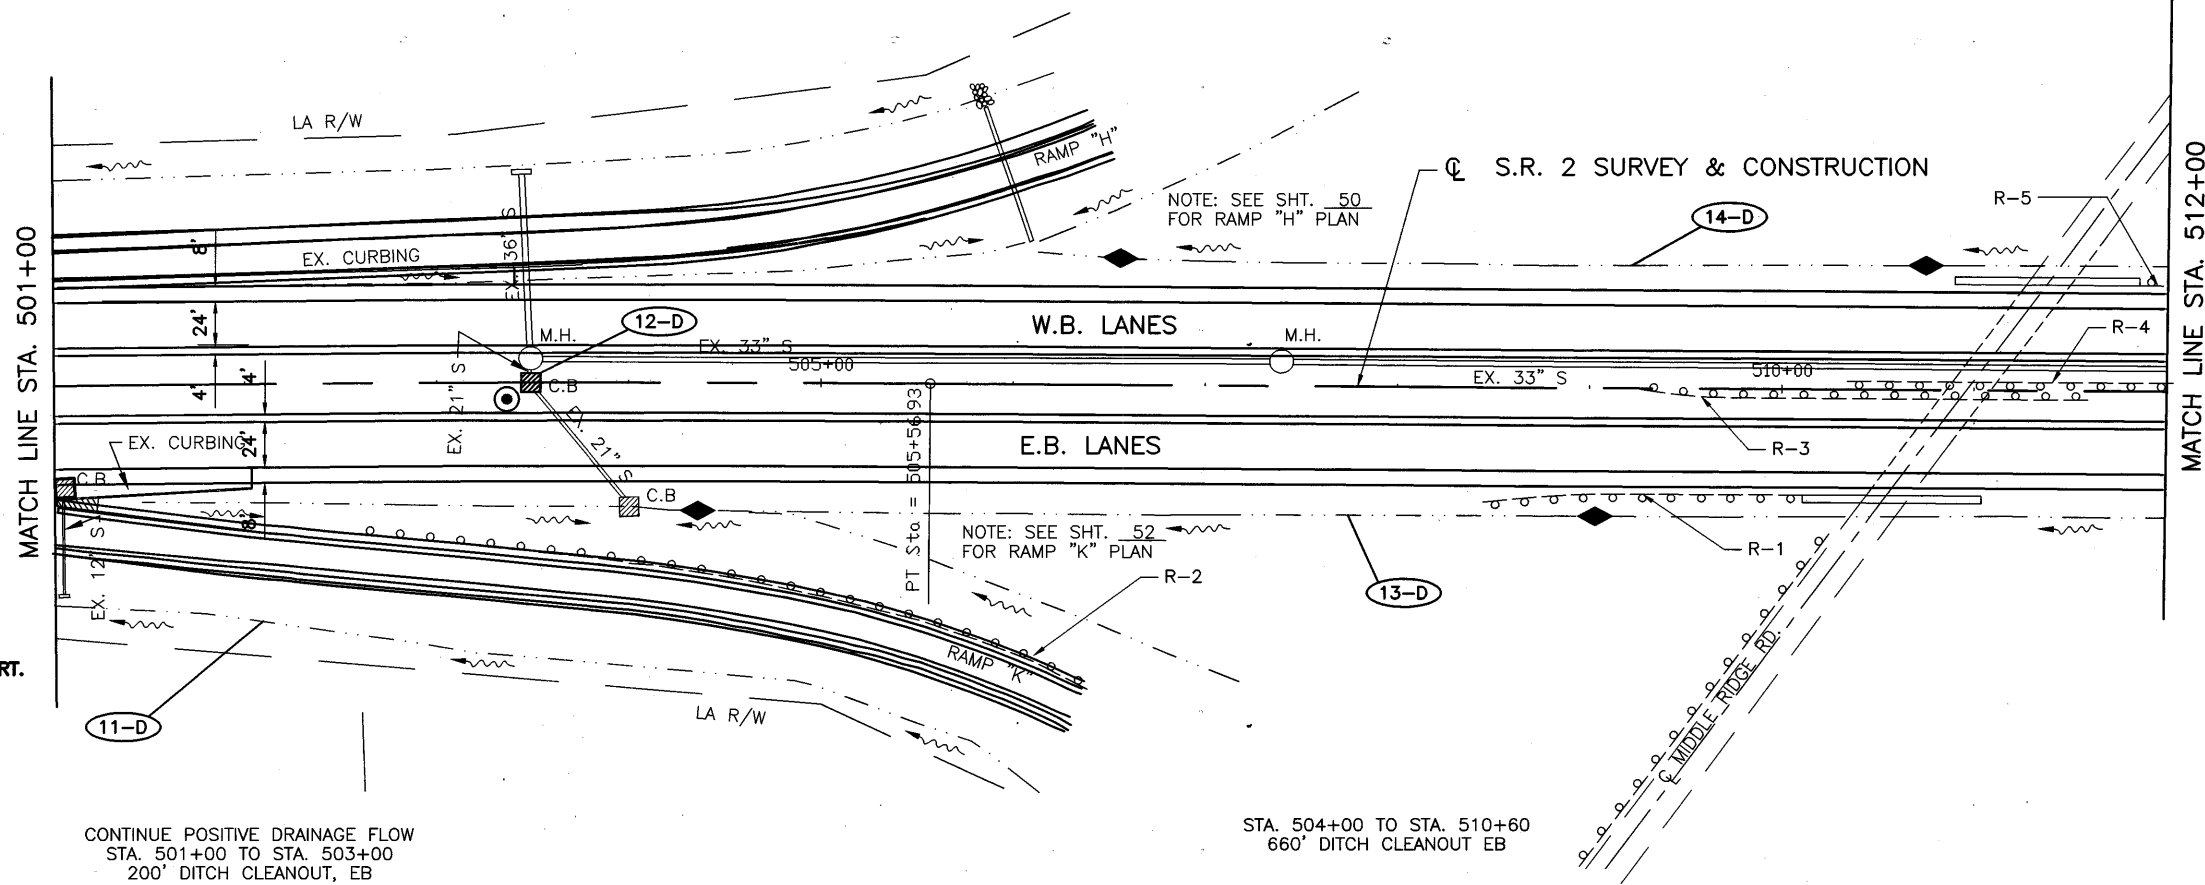

\* EXISTING CATCH BASIN  
● STA. 501+00, 52'± RT.  
ADJUSTED TO GRADE

CONTINUE POSITIVE DRAINAGE FLOW  
STA. 501+00 TO STA. 503+00  
200' DITCH CLEANOUT, EB

STA. 504+00 TO STA. 510+60  
660' DITCH CLEANOUT EB

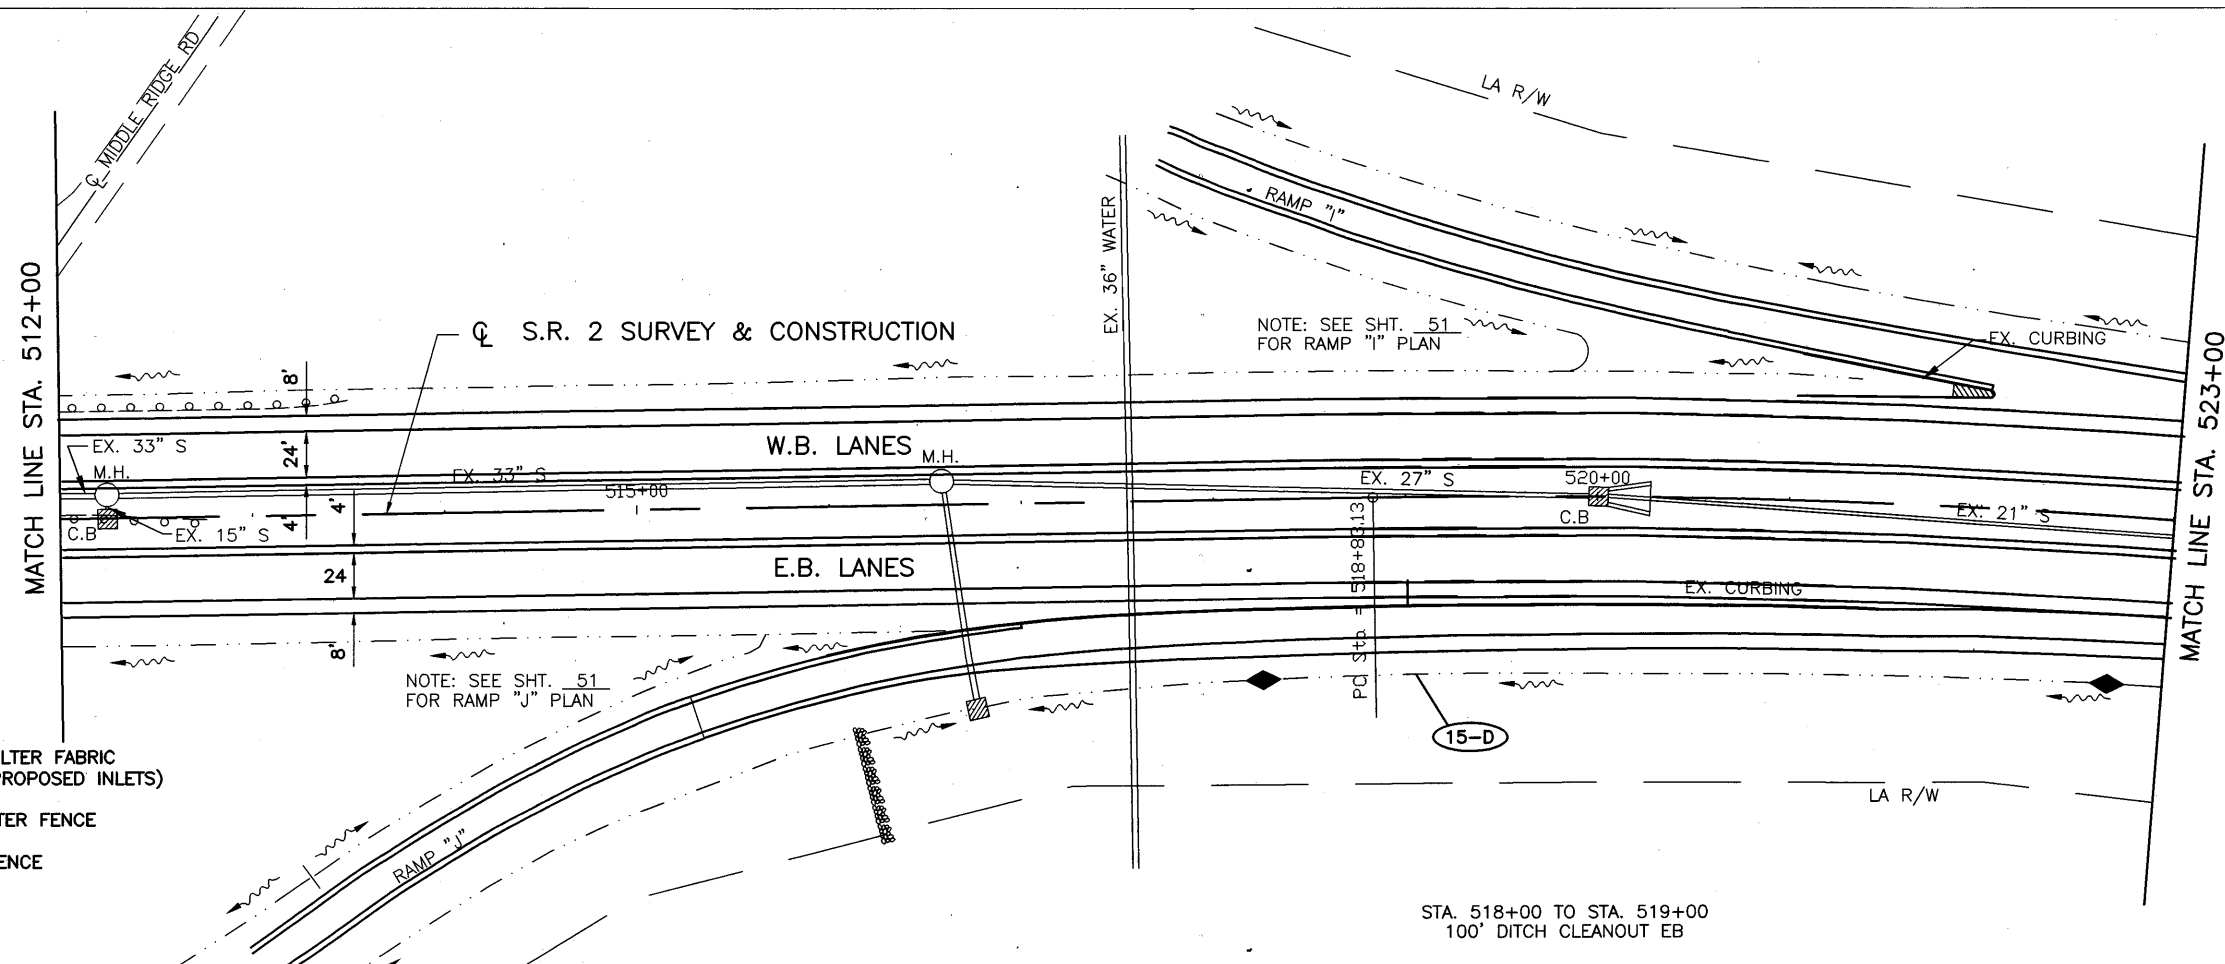

**LEGEND**

- TEMPORARY INLET PROTECT, FILTER FABRIC FENCE (AT ALL EXISTING AND PROPOSED INLETS)
- ◆ TEMPORARY DITCH CHECK, FILTER FENCE
- FF— FILTER FABRIC FENCE
- DIRECTION OF FLOW DITCH
- ▭ SEDIMENT BASIN


STA. 518+00 TO STA. 519+00  
100' DITCH CLEANOUT EB

CALCULATED	DLS	CHECKED	LAB


**STORM WATER POLLUTION PREVENTION PLAN**  
STA. 501+00 TO STA. 523+00

LOR - 190 - 10.76


CURVE DATA 5  
 P.I. STA. 532+28.96  
 $\Delta = 33^{\circ}08'20''$  RT.  
 $D = 1^{\circ}16'00''$   
 $R = 4523.35'$   
 $T = 1345.84'$   
 $L = 2616.23'$   
 $E = 195.97'$

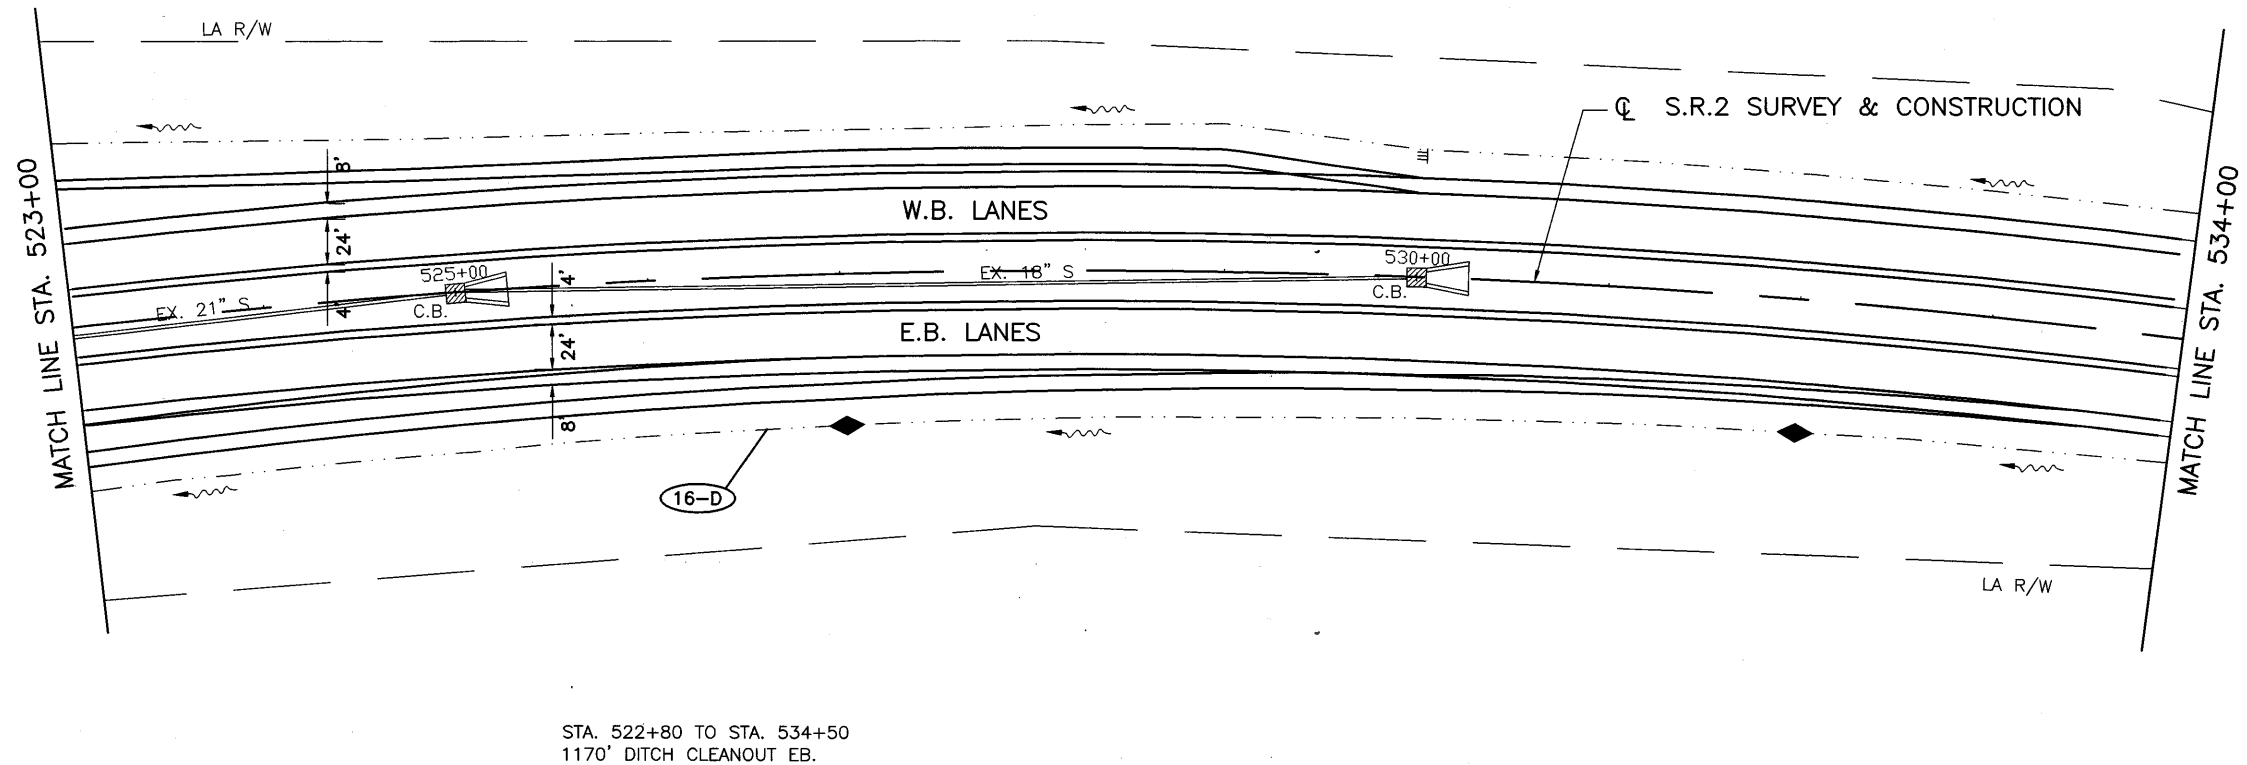

STA. 522+80 TO STA. 534+50  
 1170' DITCH CLEANOUT EB.

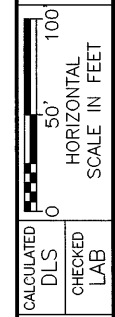

**STORM WATER POLLUTION PREVENTION PLAN**  
**STA. 523+00 TO STA. 545+00**


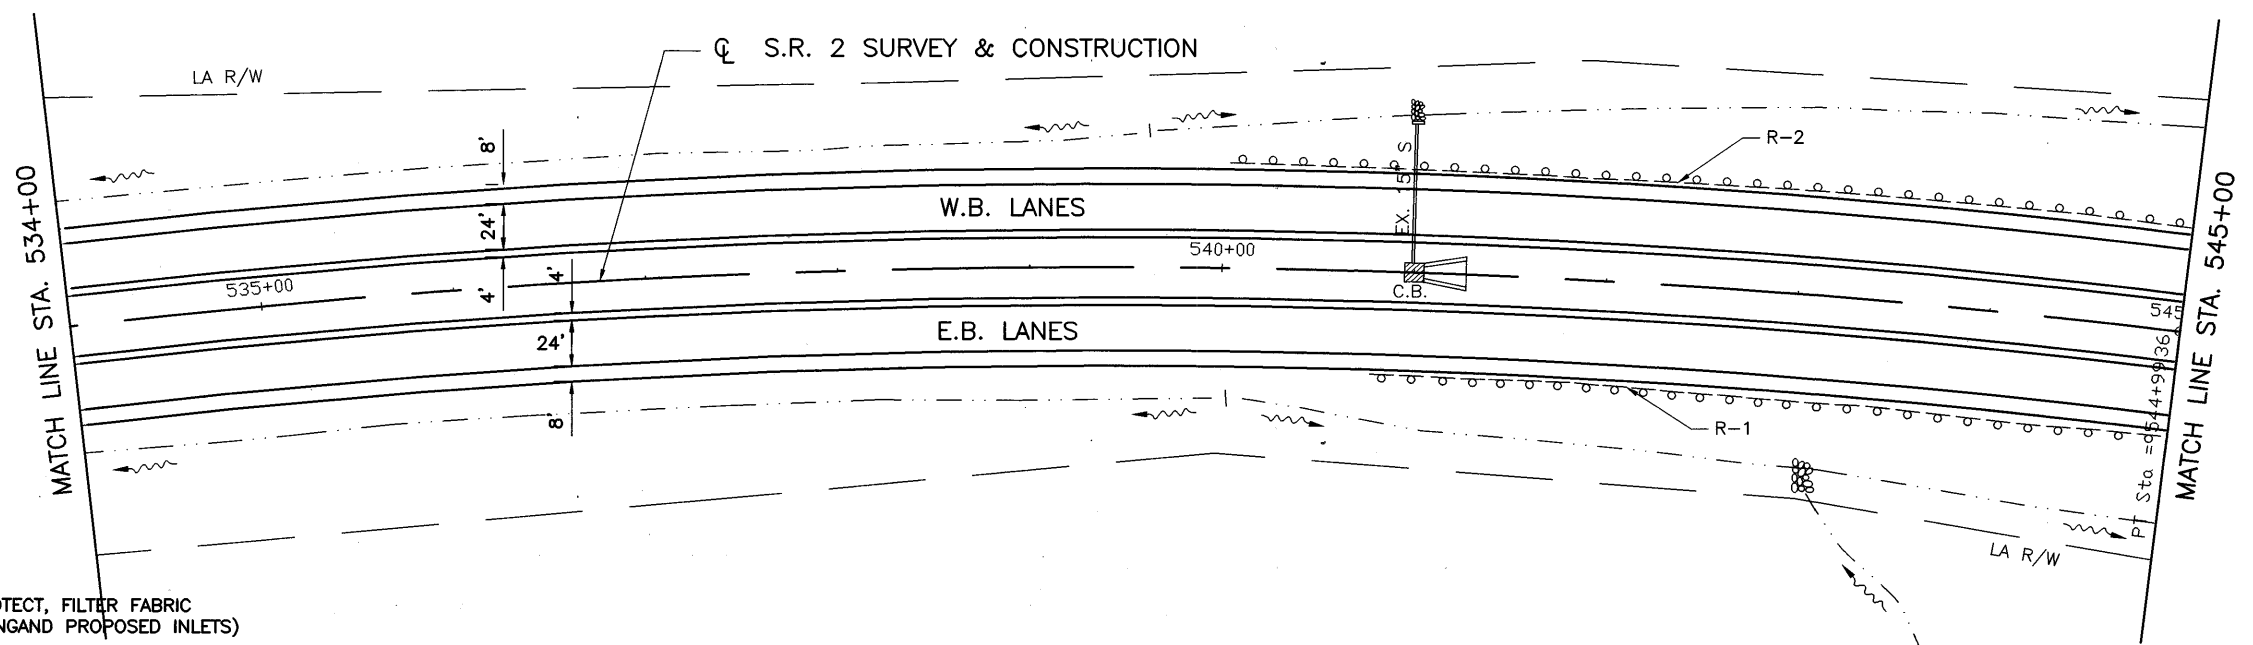


**LEGEND**

- TEMPORARY INLET PROTECT, FILTER FABRIC FENCE (AT ALL EXISTING AND PROPOSED INLETS)
- TEMPORARY DITCH CHECK, FILTER FENCE
- FF FILTER FABRIC FENCE
- DIRECTION OF FLOW DITCH
- SEDIMENT BASIN

**LOR - 190 - 10.76**

O:\316600\WORKS\EROSION\SP-07.DWG [ JGR  
 12-18-2002 9:19AM

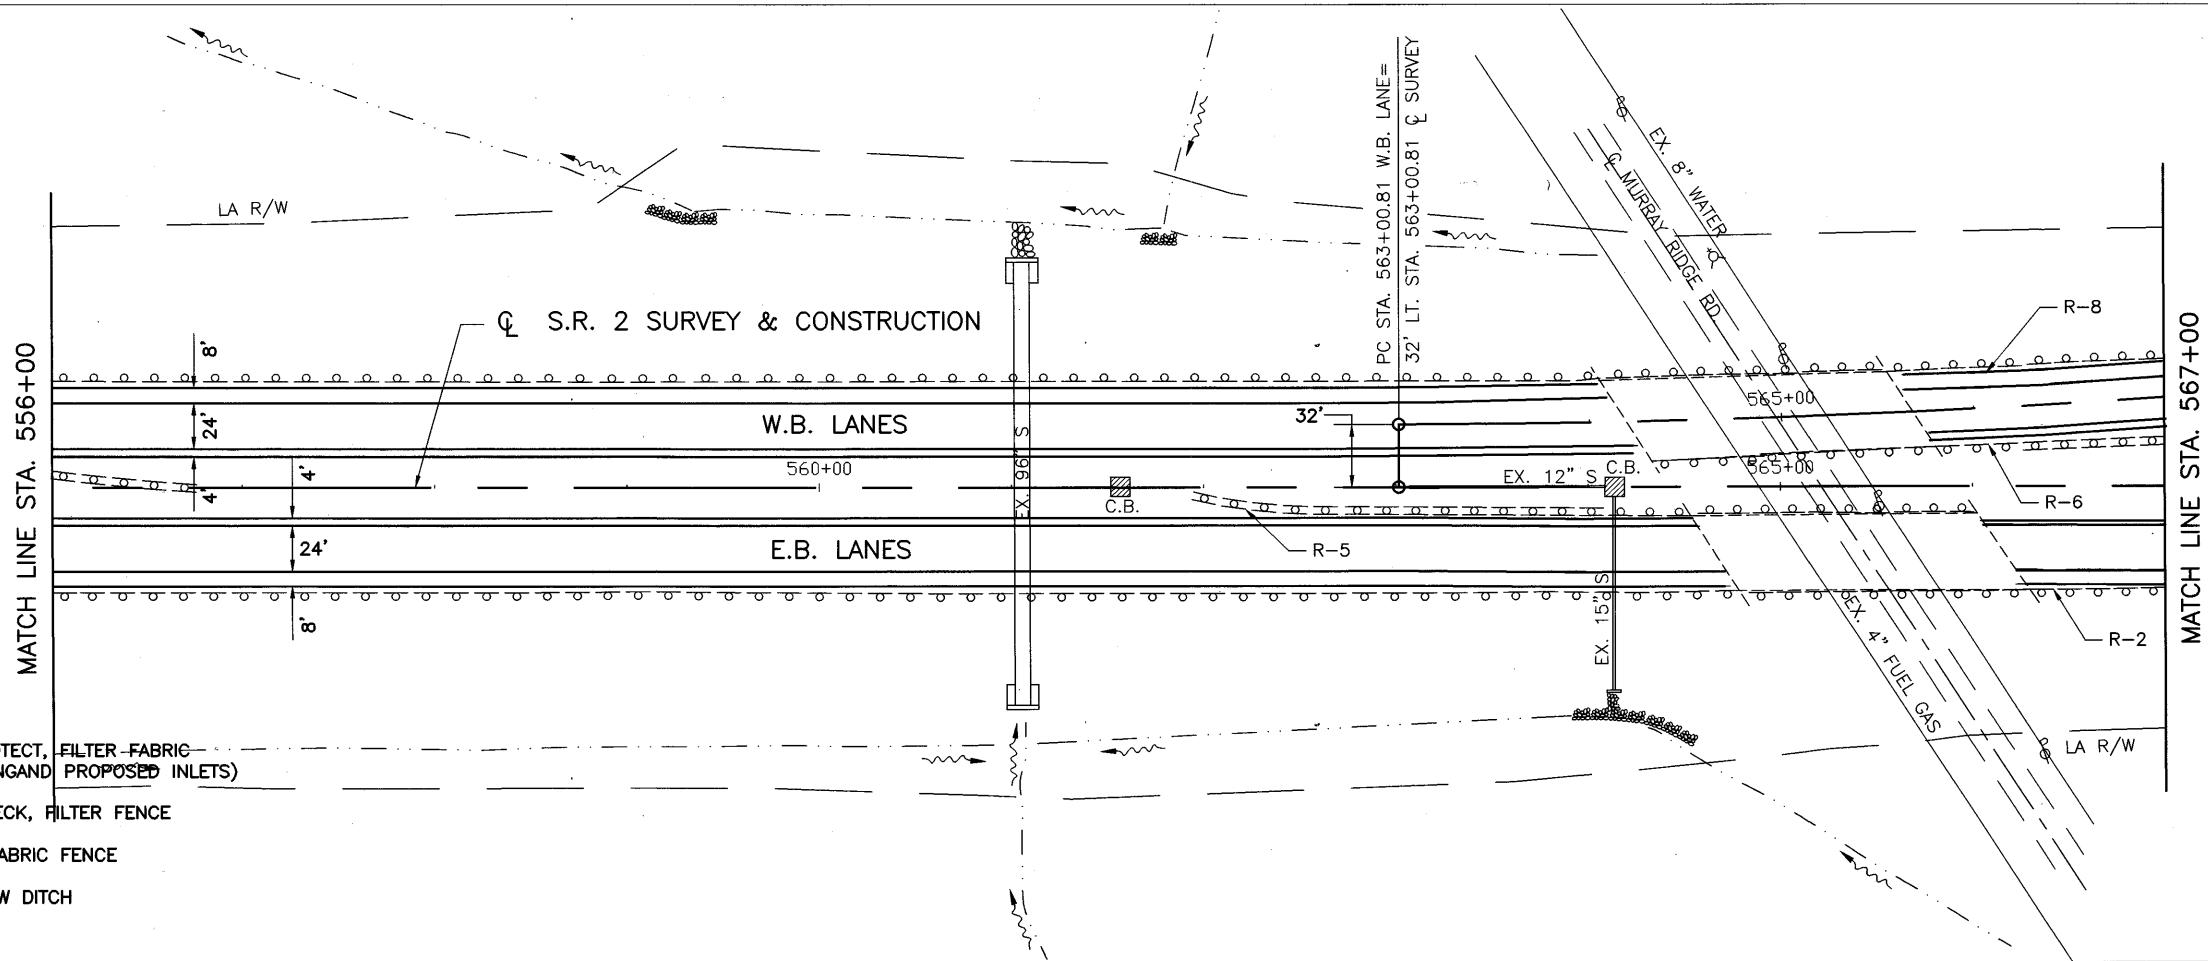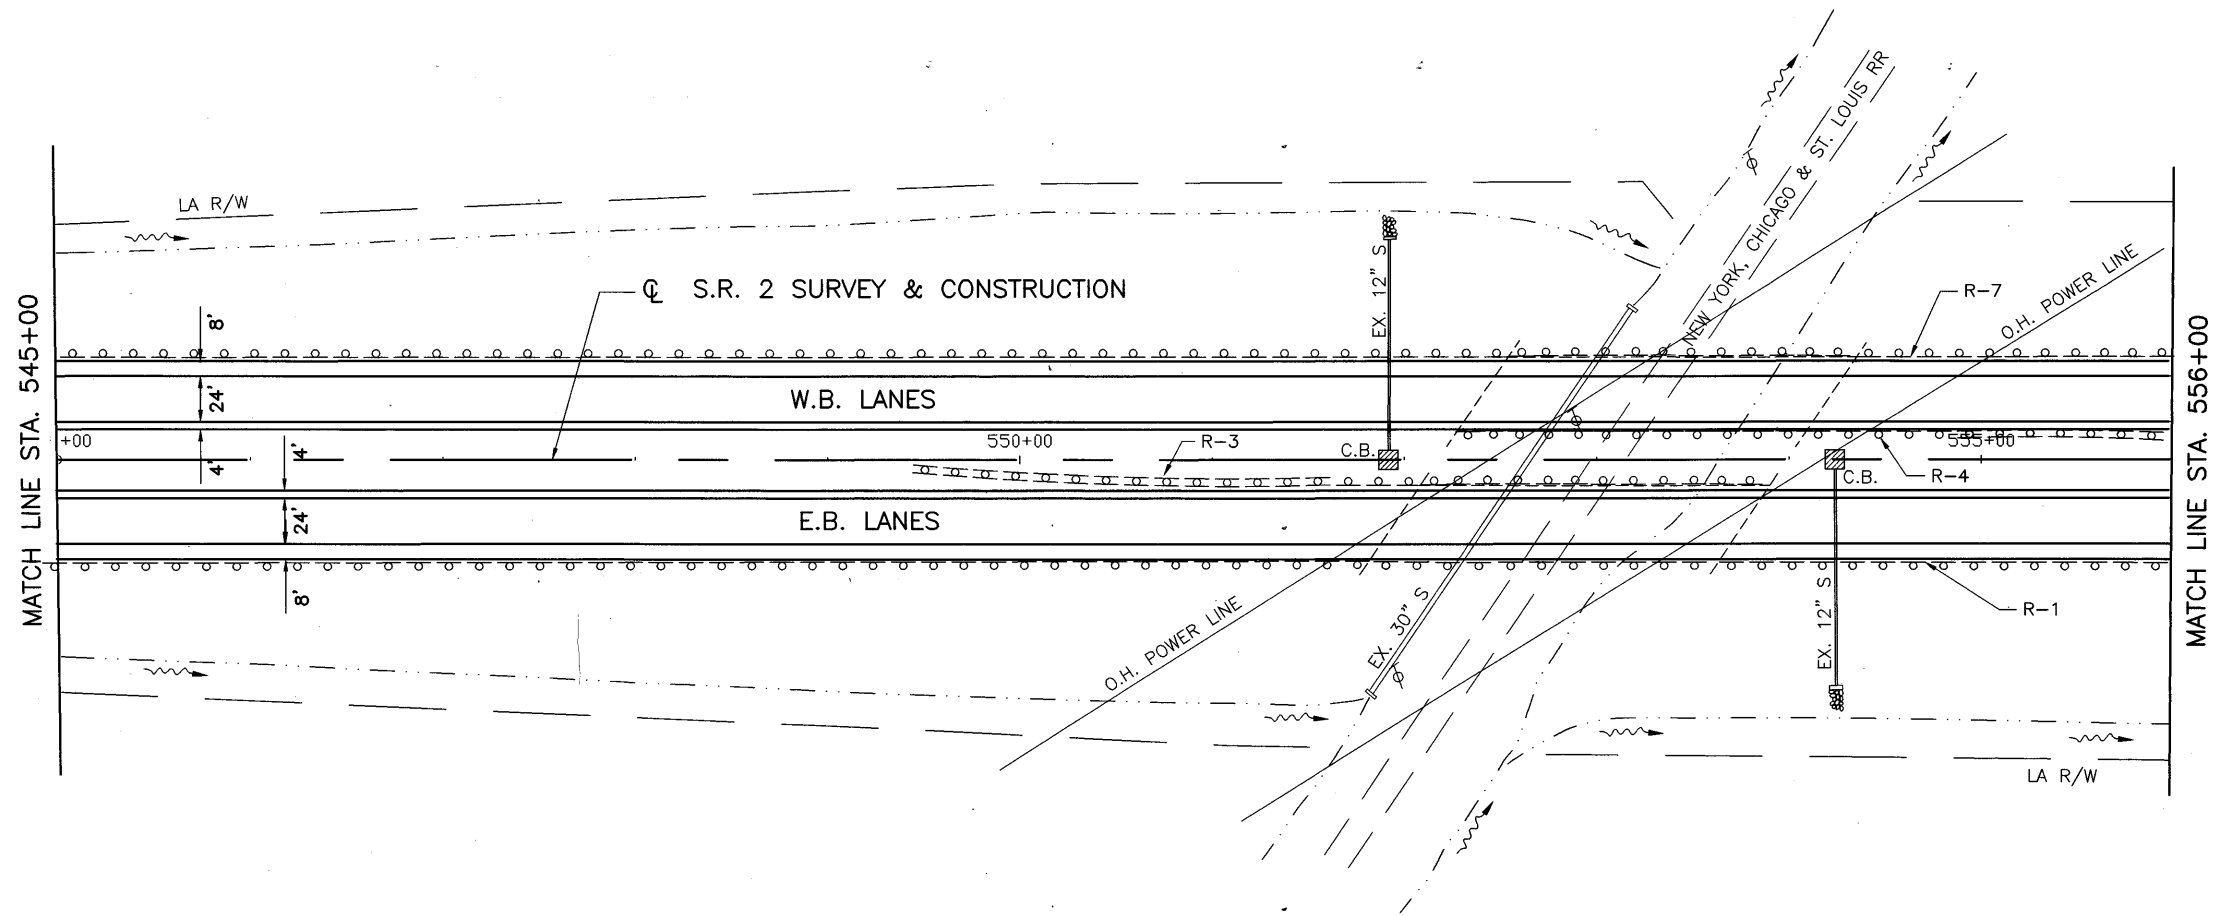

**LEGEND**

- ⊙ TEMPORARY INLET PROTECT, FILTER FABRIC FENCE (AT ALL EXISTING AND PROPOSED INLETS)
- ◆ TEMPORARY DITCH CHECK, FILTER FENCE
- FF— FILTER FABRIC FENCE
- ~ DIRECTION OF FLOW DITCH
- SEDIMENT BASIN


CALCULATED	DLS	CHECKED	LAB

0 50' 100'  
HORIZONTAL  
SCALE IN FEET

**STORM WATER POLLUTION PREVENTION PLAN  
STA. 545+00 TO STA. 567+00**

**LOR - 190 - 10.76**

D:\33600\LMWS\EROSION\SP-06.DWG ] 4/6  
18-2002 4:44PM

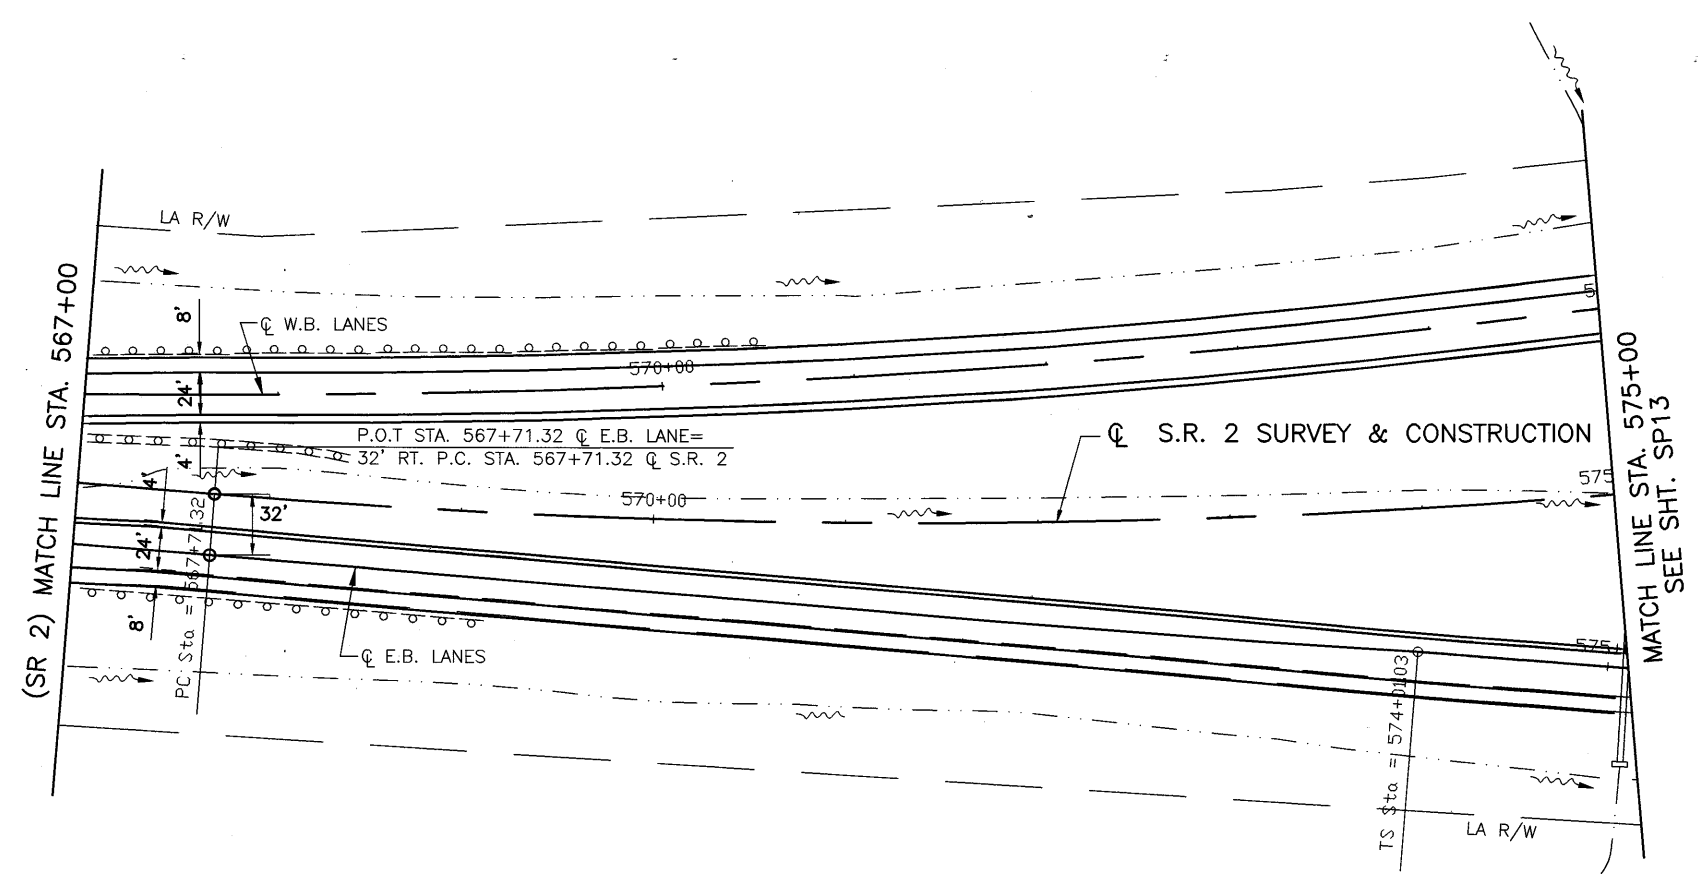

**LEGEND**

- TEMPORARY INLET PROTECT, FILTER FABRIC FENCE (AT ALL EXISTING AND PROPOSED INLETS)
- ◆ TEMPORARY DITCH CHECK, FILTER FABRIC FENCE
- FF — FILTER FABRIC FENCE
- ~> DIRECTION OF FLOW DITCH
- ▭ SEDIMENT BASIN



CALCULATED	0	50	100
DLS			
CHECKED			
LAB			

HORIZONTAL SCALE IN FEET

**STORM WATER POLLUTION PREVENTION PLAN  
STA. 576+ 00 TO STA. 575+00**

**LOR - 190 - 10.76**


D:\33600\DWG\PROJ\SP-09.DWG J.GR  
18-2002 10:49AM

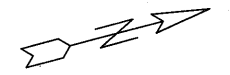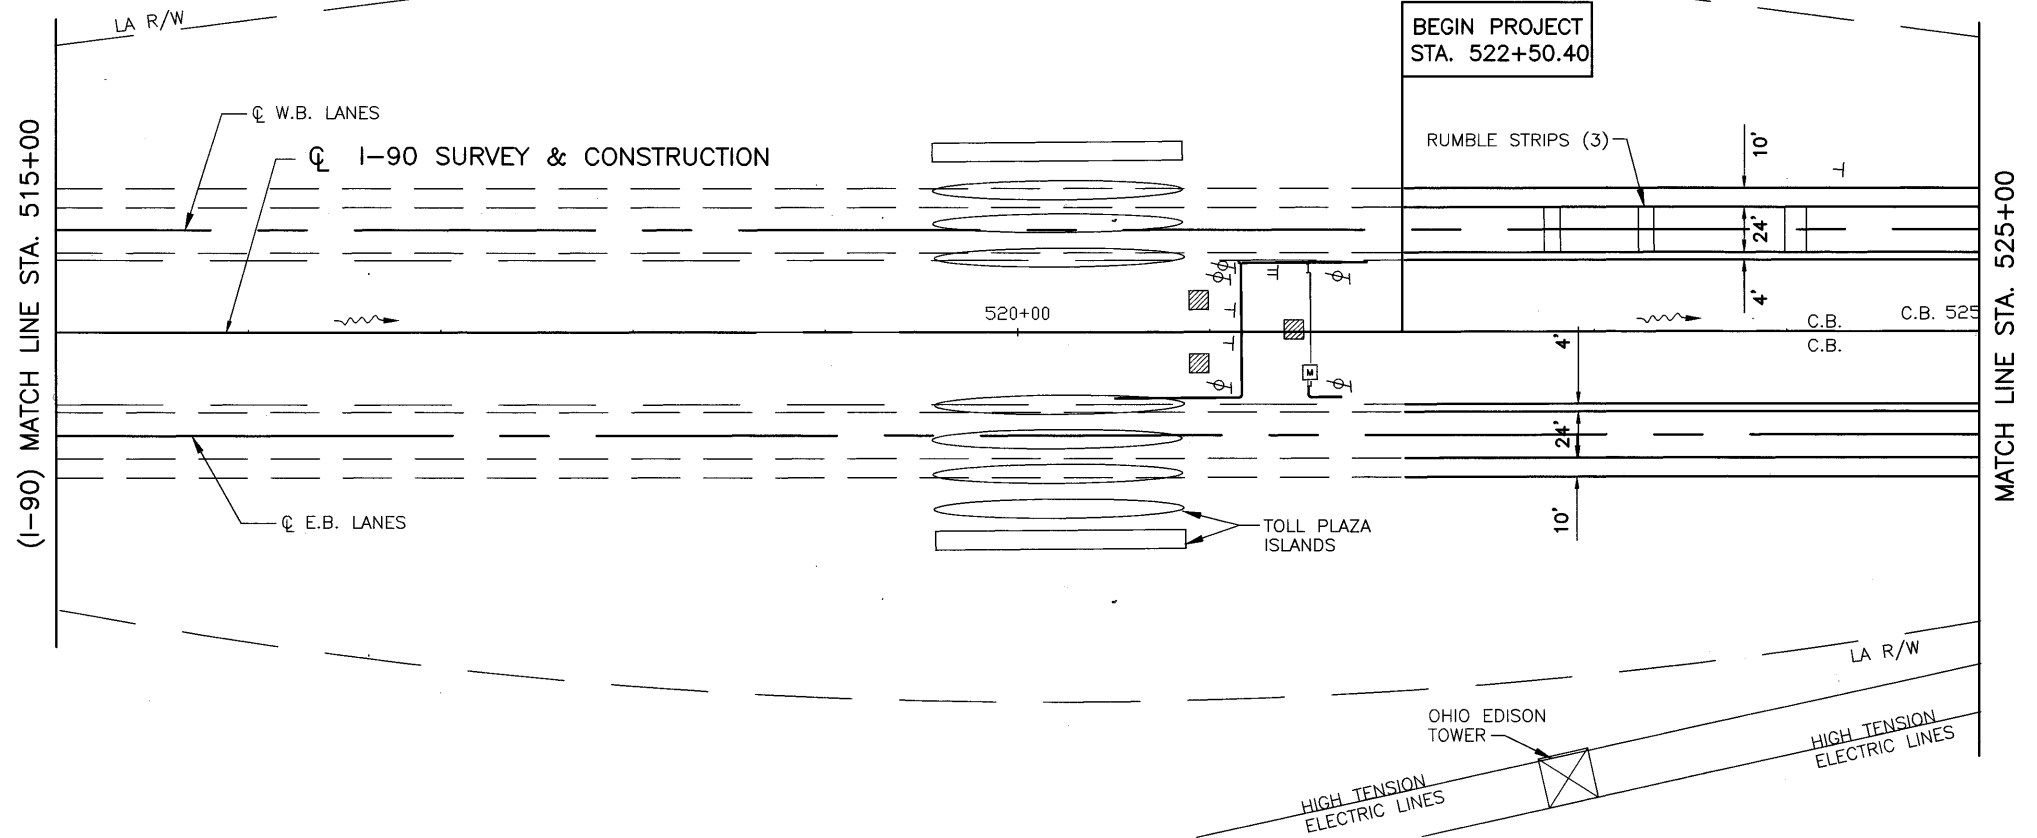

CALCULATED	0
DLS	0
CHECKED	LAB

0 50' 100'  
HORIZONTAL  
SCALE IN FEET

CURVE DATA 6  
 CENTER LINE SURVEY  
 P.I. STA. 542+31.82  
 $\Delta_c = 55^{\circ}33'45''$  RT.  
 $\Delta_c = 49^{\circ}33'45''$   
 $D_c = 2^{\circ}00'00''$   
 $R = 2864.79'$   
 $T = 1659.91'$   
 $L = 300.00'$   
 $L_c = 2478.13'$   
 $E = 374.72''$   
 $\theta_s = 3^{\circ}00'00''$

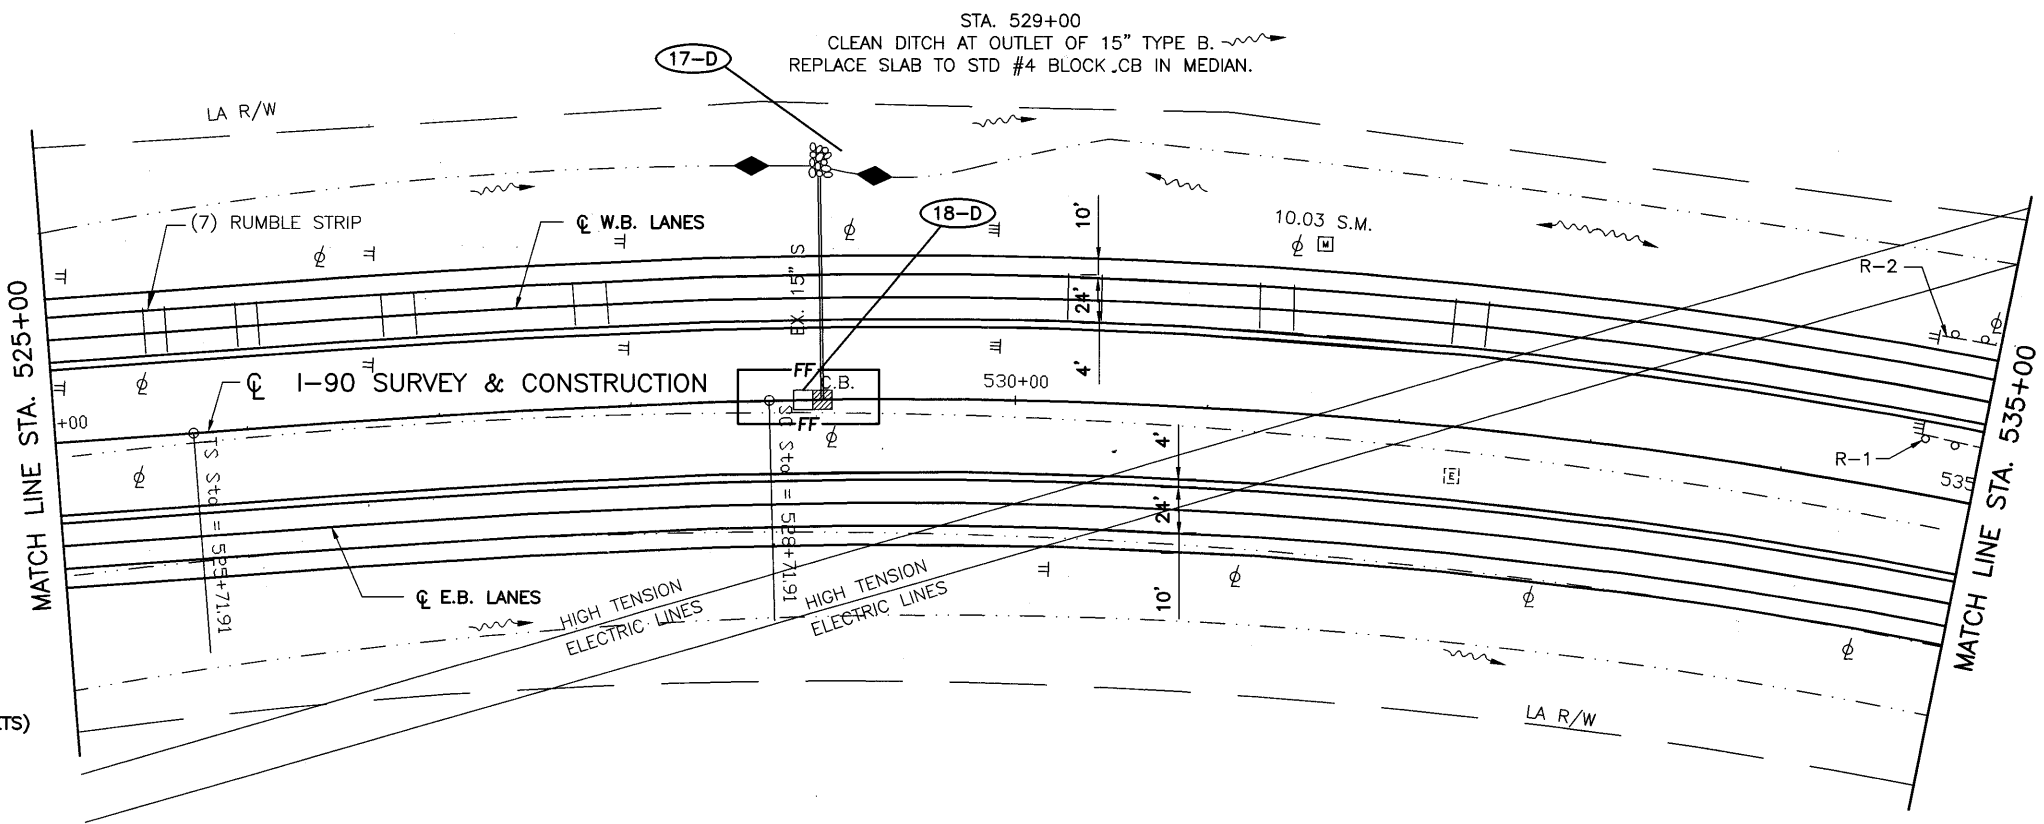


- LEGEND**
- TEMPORARY INLET PROTECT, FILTER FABRIC FENCE (AT ALL EXISTING AND PROPOSED INLETS)
  - TEMPORARY DITCH CHECK, FILTER FABRIC FENCE
  - FF FILTER FABRIC FENCE
  - DIRECTION OF FLOW DITCH
  - SEDIMENT BASIN

**STORM WATER POLLUTION PREVENTION PLAN**  
**STA. 515+00 TO STA. 535+00**



**LOR - 190 - 10.76**

C:\93860\DWG\EROSION\SP-10.DWG JGR 2-18-2002 11:03AM

STA. 541+95  
 CLEAN DITCH 100' BOTH DIRECTIONS AT  
 OUTLET END OF 220' - 60"X38" TYPE A.  
 REPLACE SLAB TO STD # 4 BLOCK CB IN  
 MEDIAN.

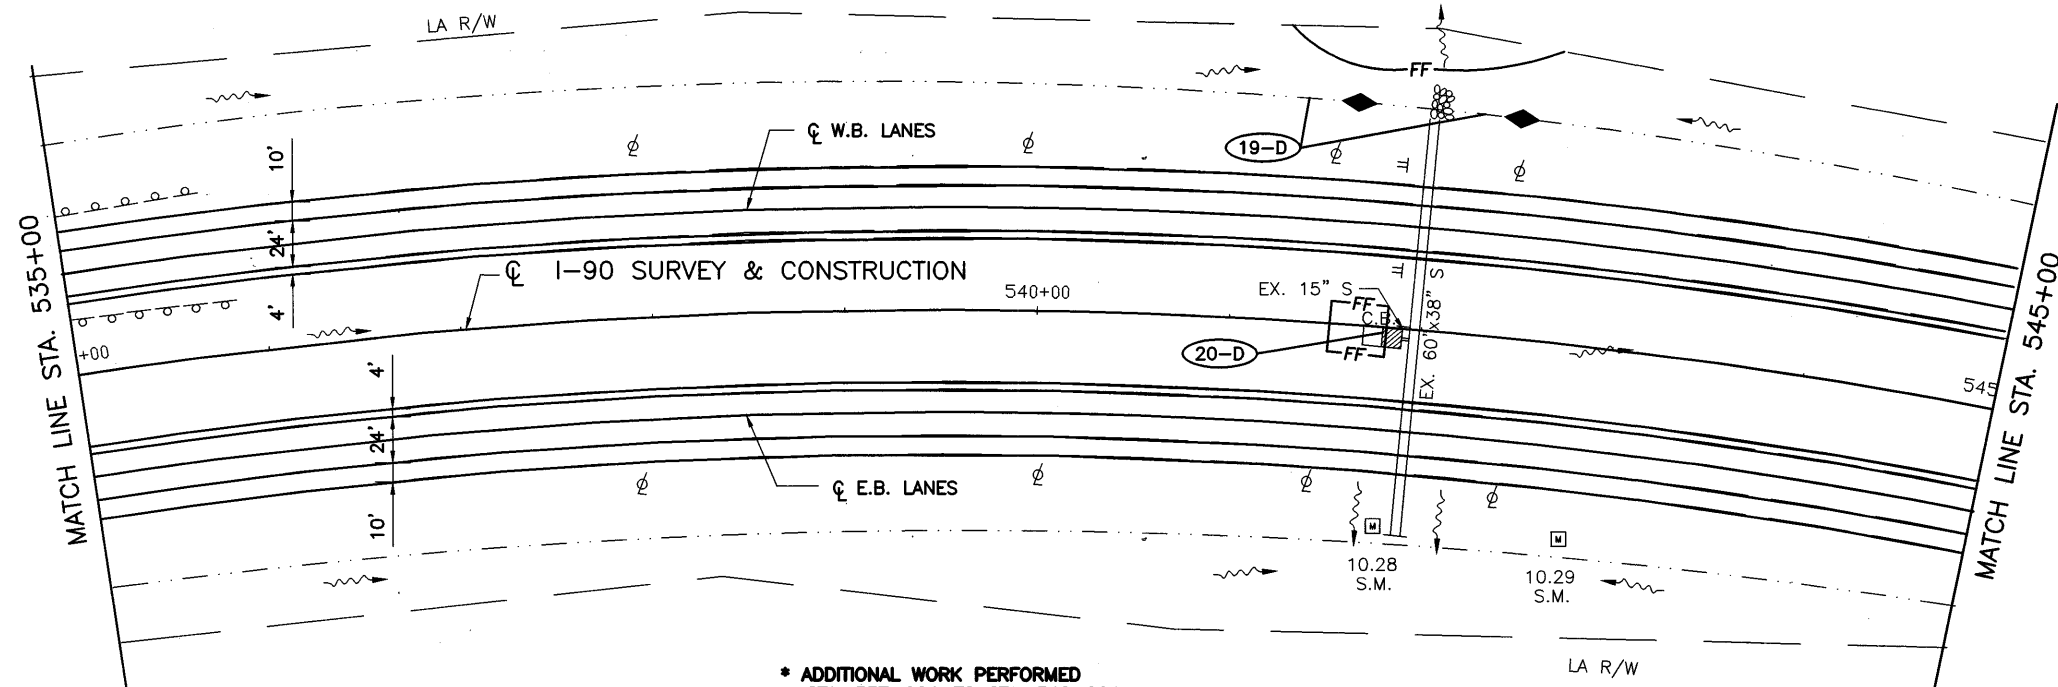

\* ADDITIONAL WORK PERFORMED  
 STA. 537+00± TO STA. 542+00±  
 500' DITCH CLEANOUT EB. AS  
 REQUESTED BY THE STATE INSPECTOR  
 ON SITE.

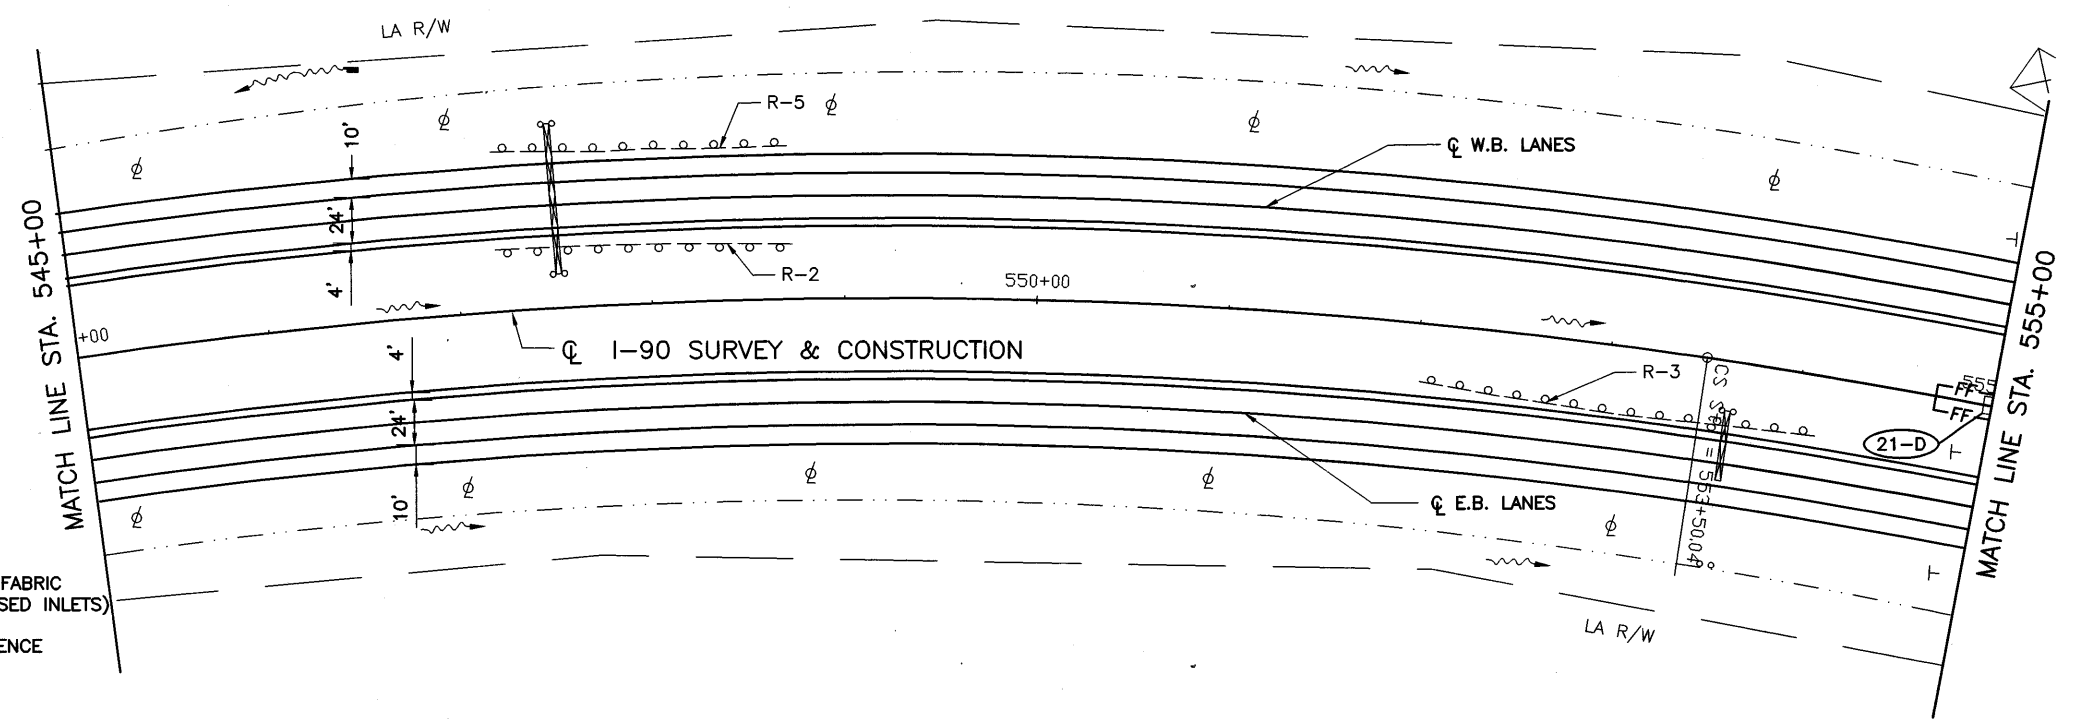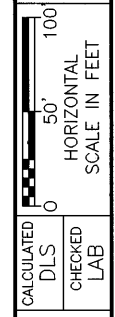


**LEGEND**

- ⊙ TEMPORARY INLET PROTECT, FILTER FABRIC FENCE (AT ALL EXISTING AND PROPOSED INLETS)
- ◆ TEMPORARY DITCH CHECK, FILTER FABRIC FENCE
- FF— FILTER FABRIC FENCE
- ~> DIRECTION OF FLOW DITCH
- ▭ SEDIMENT BASIN


**STORM WATER POLLUTION PREVENTION PLAN**  
 STA. 535+00 TO STA. 555+00

**LOR - I90 - 10.76**

C:\B6600\CMS\EROSION\SP-11.DWG J JOR  
 25-18-2002 11:15AM

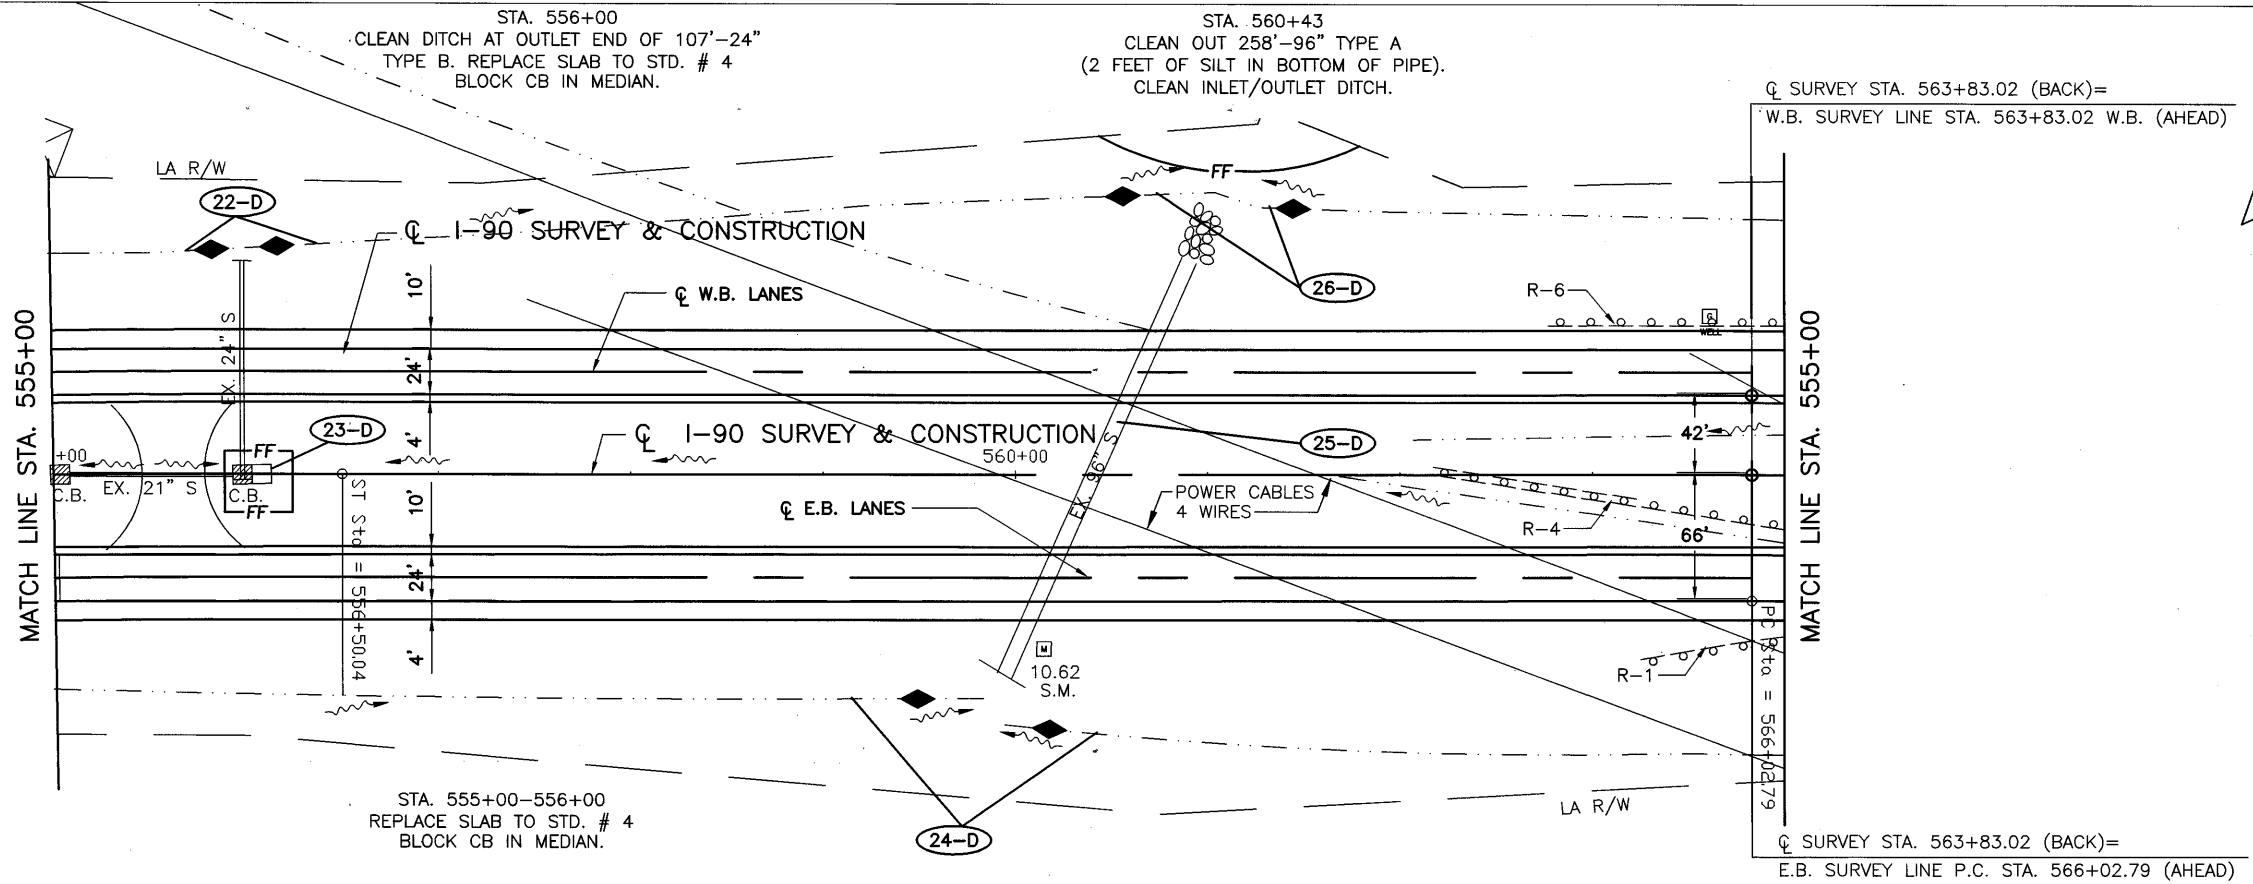

CURVE DATA ⑦  
 SURVEY LINE E.B. LANES  
 P.I. STA. 574+74.56  
 $\Delta = 25^{\circ}09'35''$  RT.  
 $D_c = 1'28'00''$   
 $R = 3906.53'$   
 $T = 871.77'$   
 $L = 1715.43'$   
 $E = 96.09'$

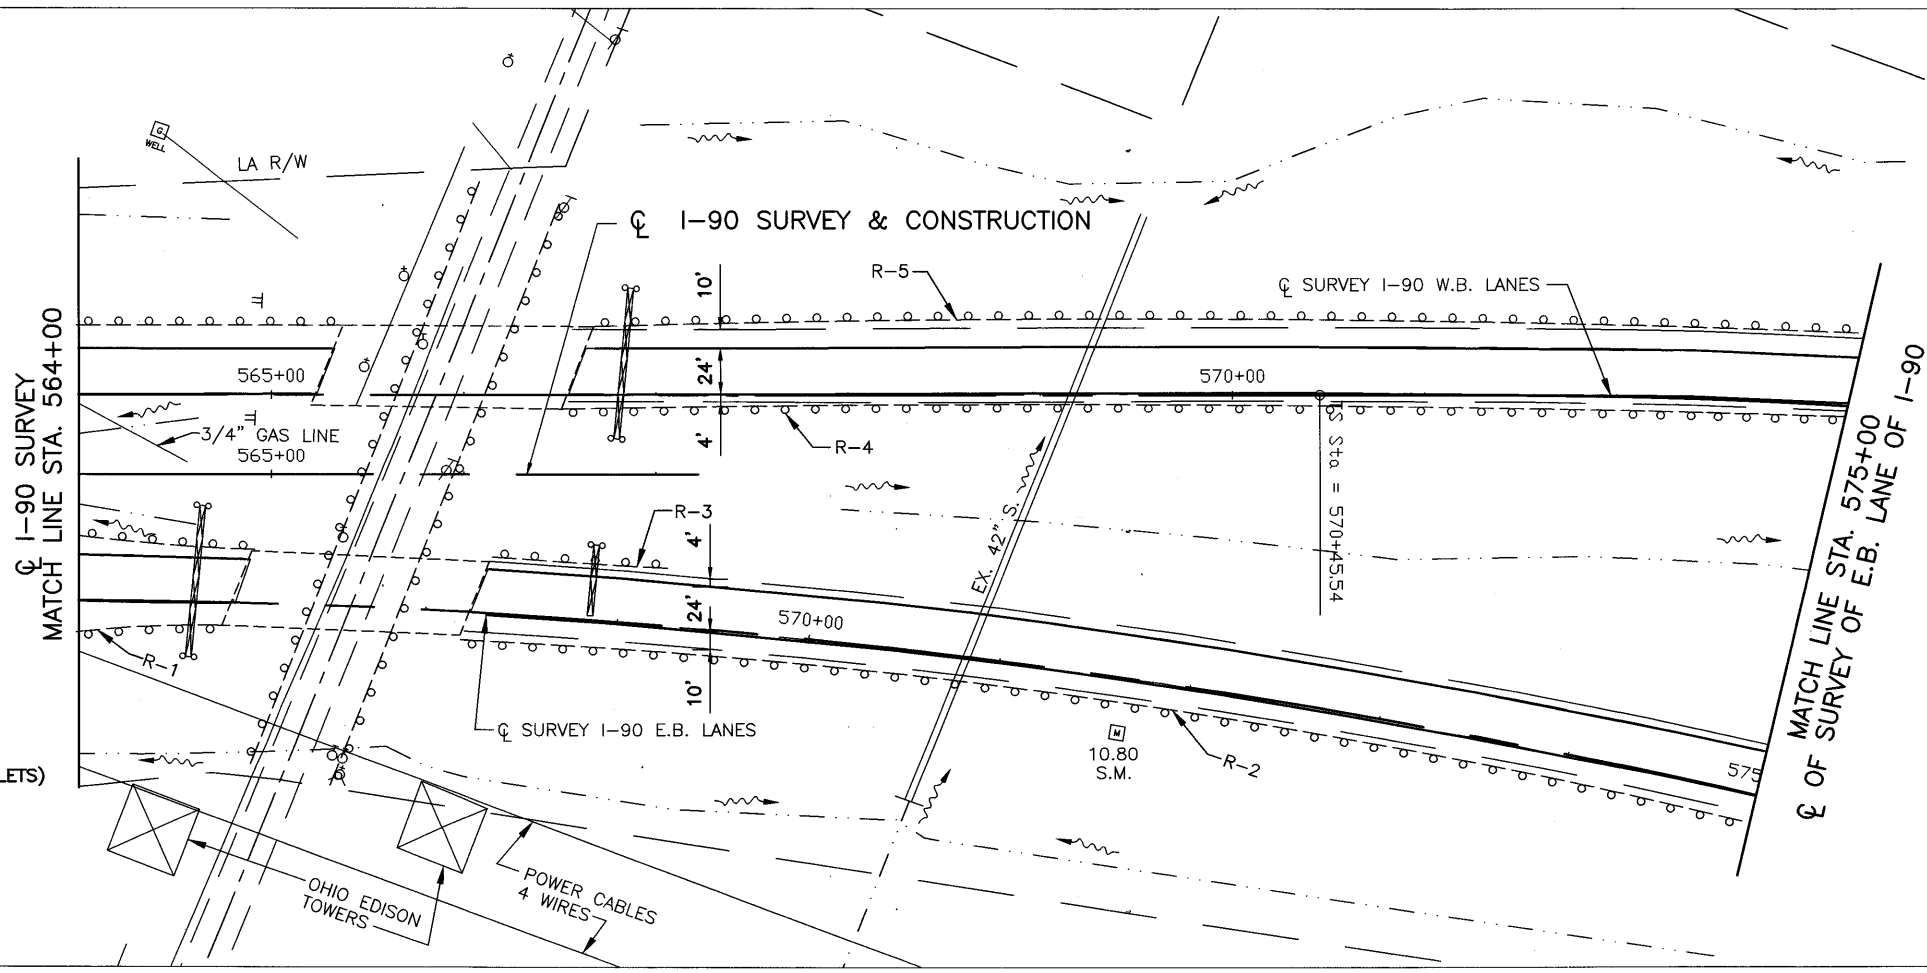

**LEGEND**

- ⊙ TEMPORARY INLET PROTECT, FILTER FABRIC FENCE (AT ALL EXISTING AND PROPOSED INLETS)
- ◆ TEMPORARY DITCH CHECK, FILTER FABRIC FENCE
- FF— FILTER FABRIC FENCE
- DIRECTION OF FLOW DITCH
- ▭ SEDIMENT BASIN



**STORM WATER POLLUTION PREVENTION PLAN  
 STA. 555+00 TO STA. 575+00**


**LOR - 190 - 13.20**



**LEGEND**

- ⊙ TEMPORARY INLET PROTECT, FILTER FABRIC FENCE (AT ALL EXISTING AND PROPOSED INLETS)
- ◆ TEMPORARY DITCH CHECK, FILTER FABRIC FENCE
- FF — FILTER FABRIC FENCE
- DIRECTION OF FLOW DITCH
- ▣ SEDIMENT BASIN

<b>CURVE DATA ⑧</b> SURVEY LINES W.B. LANES P.I. STA. 576+31.04 Δ = 25°40'00" RT. Δc = 16°40'00" Dc = 3'00"00" R = 1909.86' Ts = 585.495' Ls = 300.00' Lc = 555.56' Es = 50.94' θs = 4°30'00"	<b>CURVE DATA ⑨</b> E.B. LANES S.R. 2 P.I. STA. 584+08.14 Δ = 38°44'37" LT. Dc = 2'30"00" R = 2291.83' Ts = 1006.79' Ls = 400.00' Lc = 3874.36' Es = 140.59'	<b>CURVE DATA ⑩</b> W.B. LANES S.R. 2 P.I. STA. 583+15.34 Δ = 38°44'37" LT. Dc = 1'00"00" R = 5729.58' T = 2014.53' Lc = 3874.36' E = 383.84'	<b>CURVE DATA ⑪</b> SURVEY P.I. STA. 583+61.74 Δ = 38°44'37" LT. D = 1'16"00" R = 4523.35' T = 1590.42' L = 3058.71' E = 271.45'
--------------------------------------------------------------------------------------------------------------------------------------------------------------------------------------------------------------------------------	-----------------------------------------------------------------------------------------------------------------------------------------------------------------------------------------	-----------------------------------------------------------------------------------------------------------------------------------------------------------------------	----------------------------------------------------------------------------------------------------------------------------------------------------------

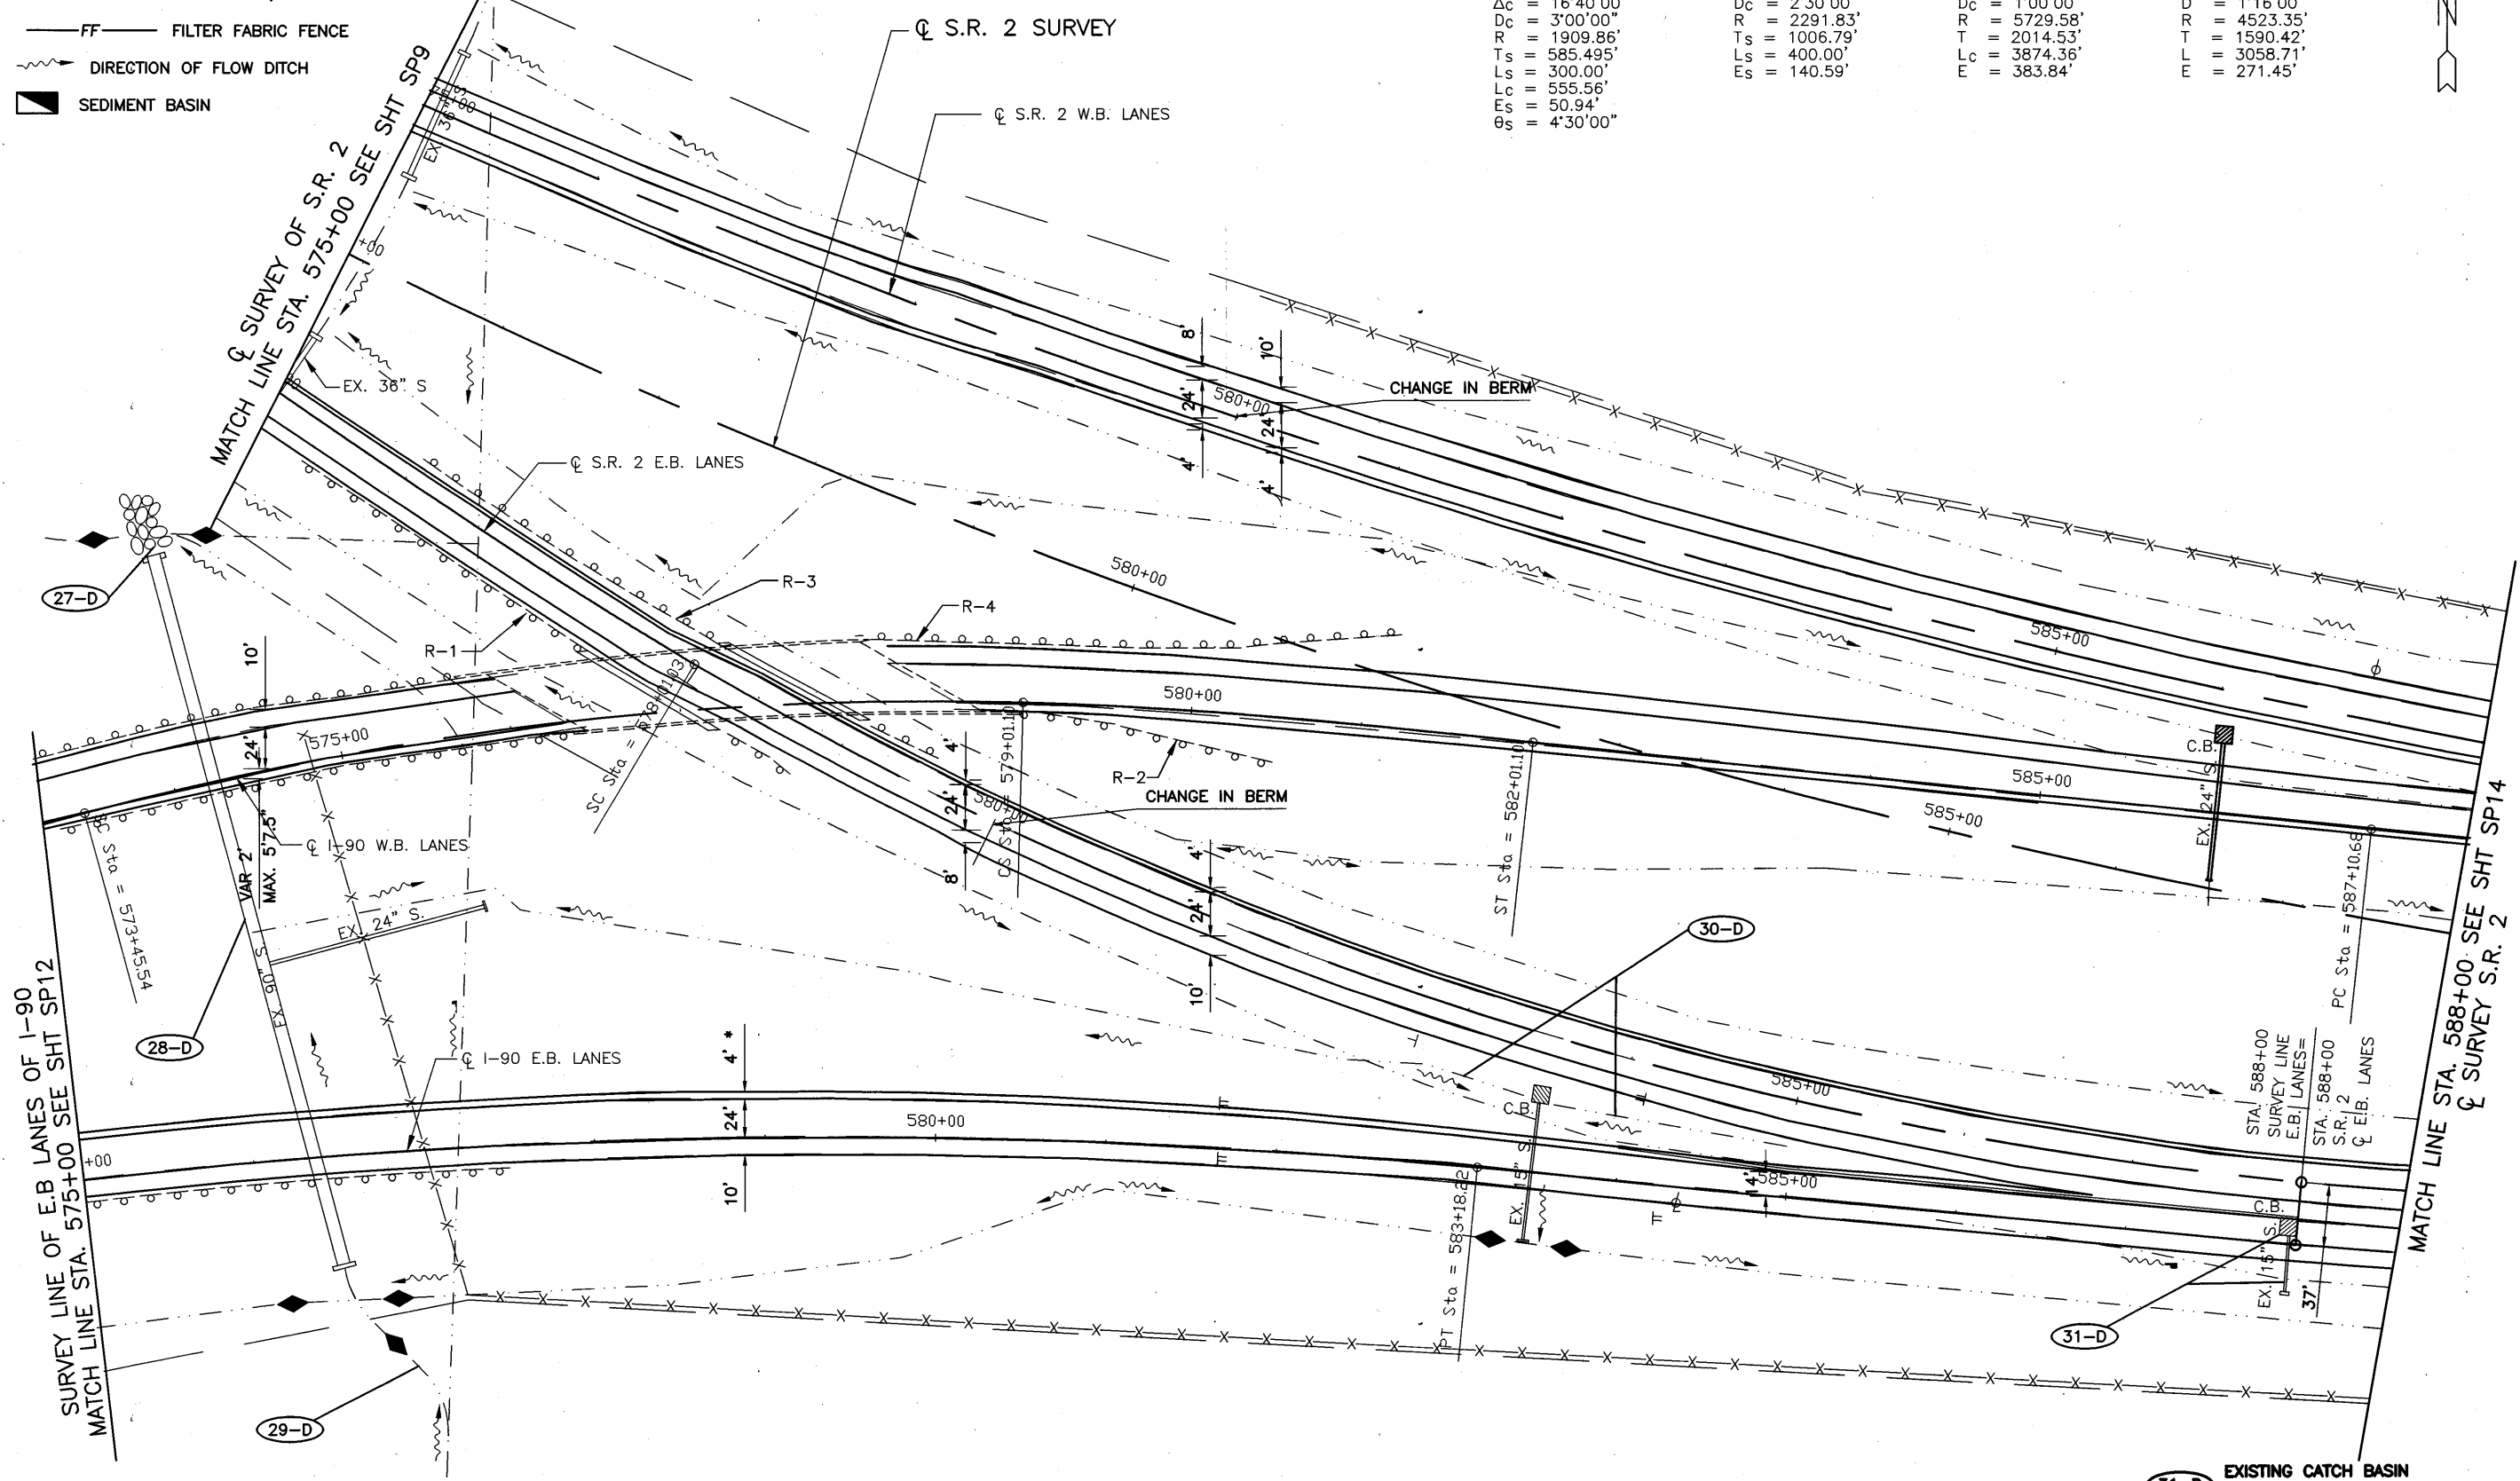


STA. 576+36.5  
CLEAN OUT 430'-90" TYPE A  
CLEAN INLET/OUTLET DITCH.  
(2 FEET OF SILT IN BOTTOM OF PIPE).

STA. 583+50  
CLEAN DITCH 100 FEET BOTH  
DIRECTIONS AT 81°15" TYPE B.

③1-D EXISTING CATCH BASIN  
ADJUSTED TO GRADE AND  
PIPE REMAIN IN PLACE




CALCULATED	DLS	CHECKED	LAB

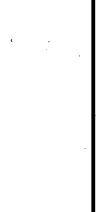

**STORM WATER POLLUTION PREVENTION PLAN  
STA. 575+00 TO STA. 588+00**

**LOR - 190 - 10.76**


CURVE DATA  $\Delta$   
 SURVEY LINE W.B. LANES  
 P.I. STA. 592+31.18  
 $\Delta = 5'12'05''$  LT.  
 $D_c = 0'30'00''$   
 $R = 11,495.16'$   
 $T = 520.50'$   
 $L = 1040.28'$   
 $E = 11.82'$

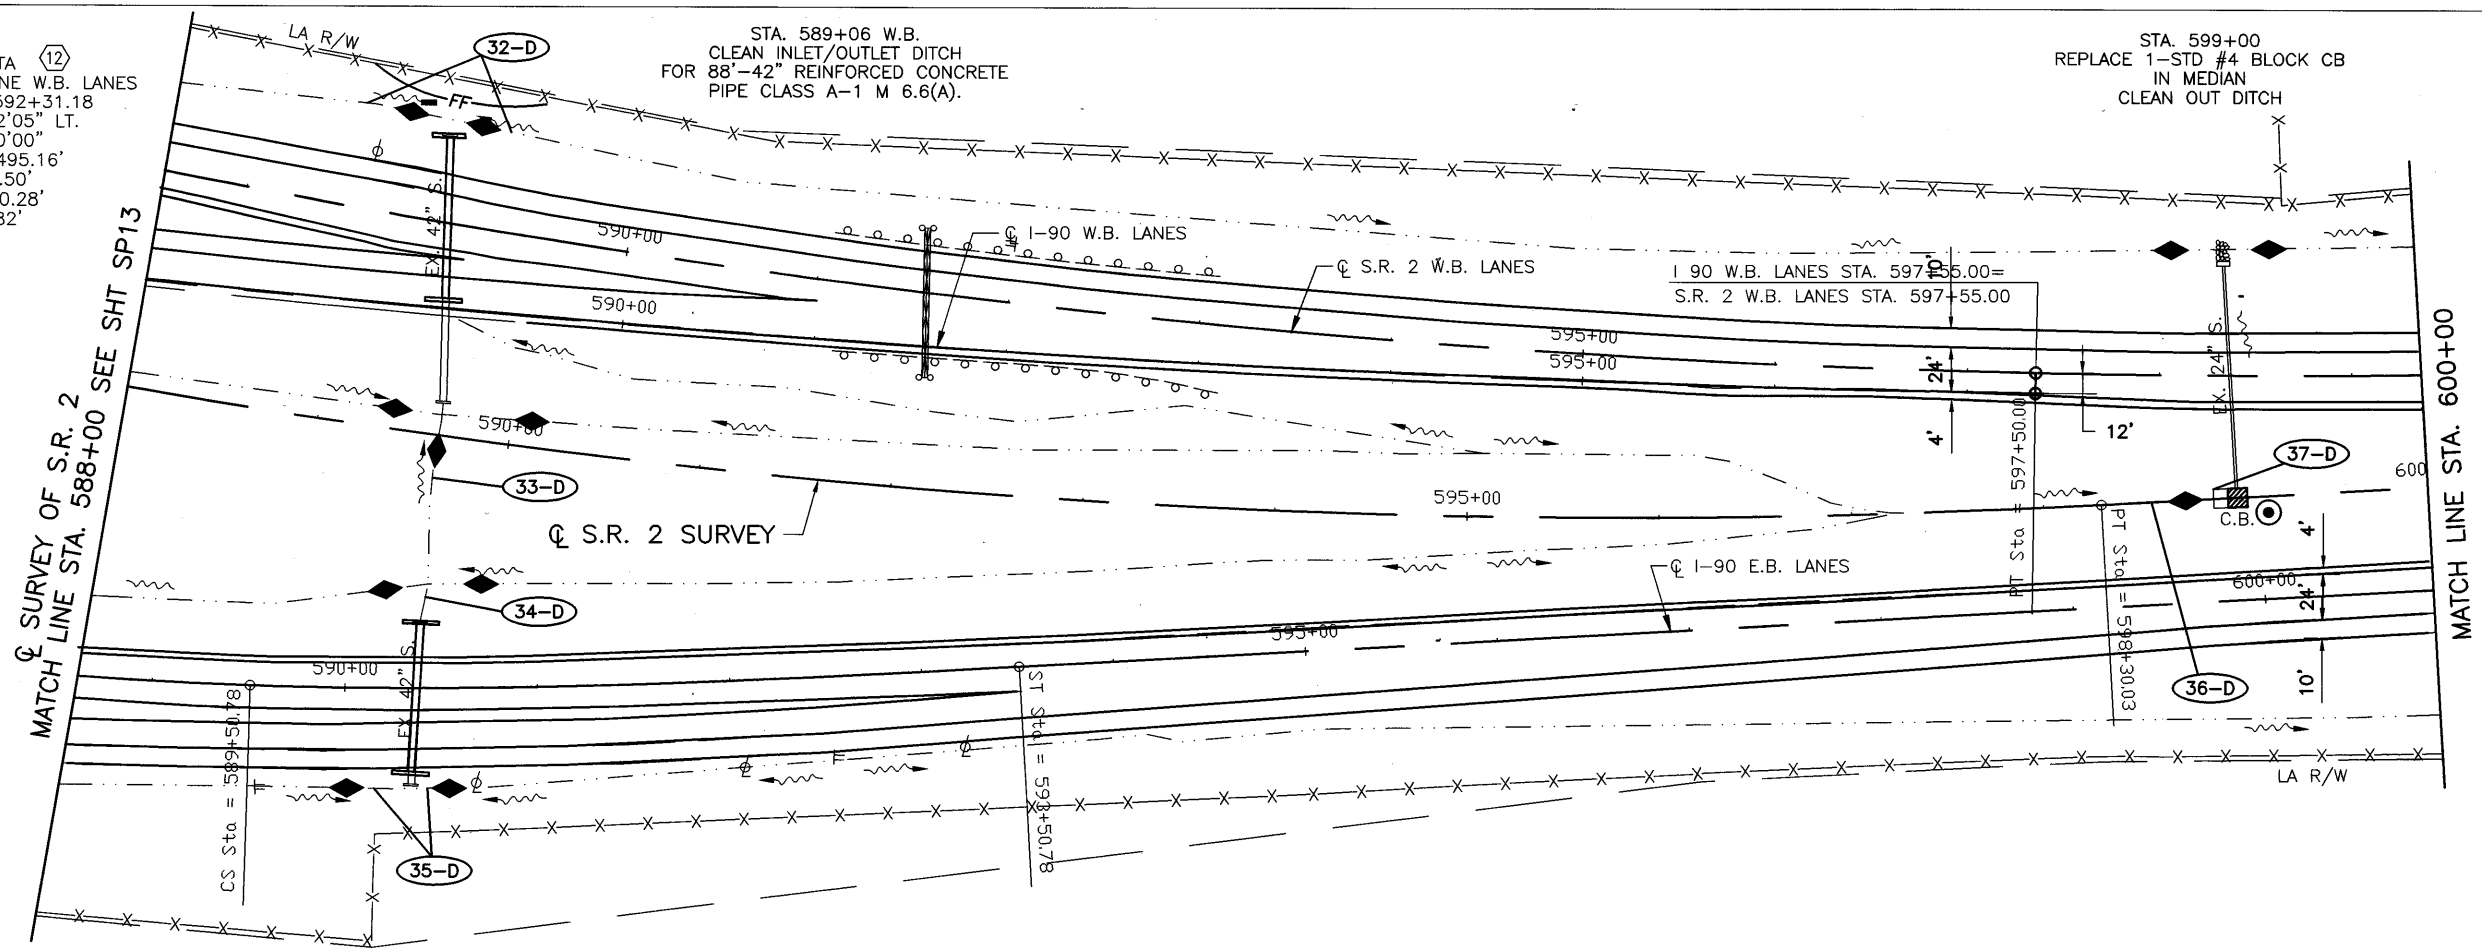

CALCULATED	0
DLS	0
CHECKED	LAB

HORIZONTAL SCALE IN FEET  
 0 50 100

**STORM WATER POLLUTION PREVENTION PLAN**  
**STA. 588+00 TO STA. 611+00**

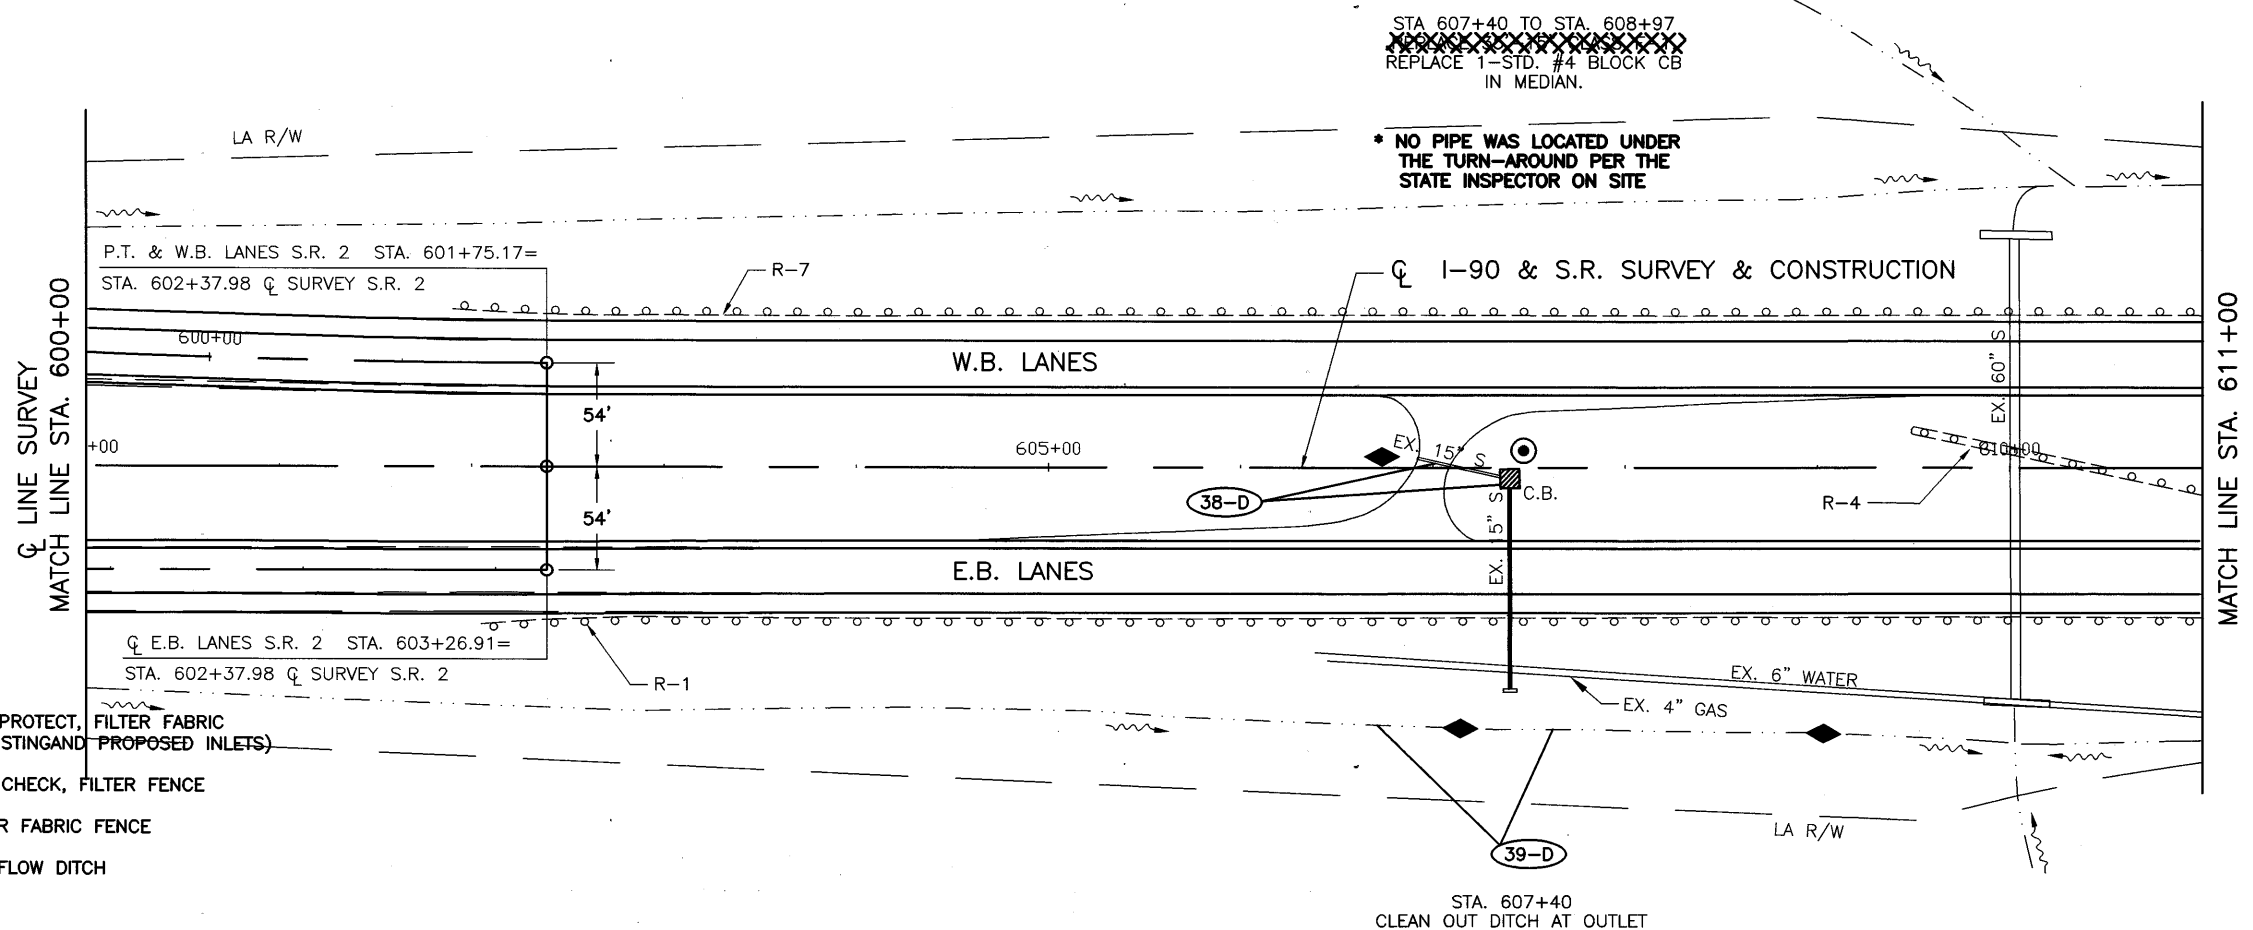


STA. 607+40 TO STA. 608+97  
 REPLACE 1-STD. #4 BLOCK CB  
 IN MEDIAN.

\* NO PIPE WAS LOCATED UNDER  
 THE TURN-AROUND PER THE  
 STATE INSPECTOR ON SITE

**LEGEND**

- TEMPORARY INLET PROTECT, FILTER FABRIC FENCE (AT ALL EXISTING AND PROPOSED INLETS)
- TEMPORARY DITCH CHECK, FILTER FENCE
- FF FILTER FABRIC FENCE
- DIRECTION OF FLOW DITCH
- SEDIMENT BASIN

C:\95600\UNWS\EROSION\SP-14.DWG 1 JGR  
 2-18-2002 2:39PM

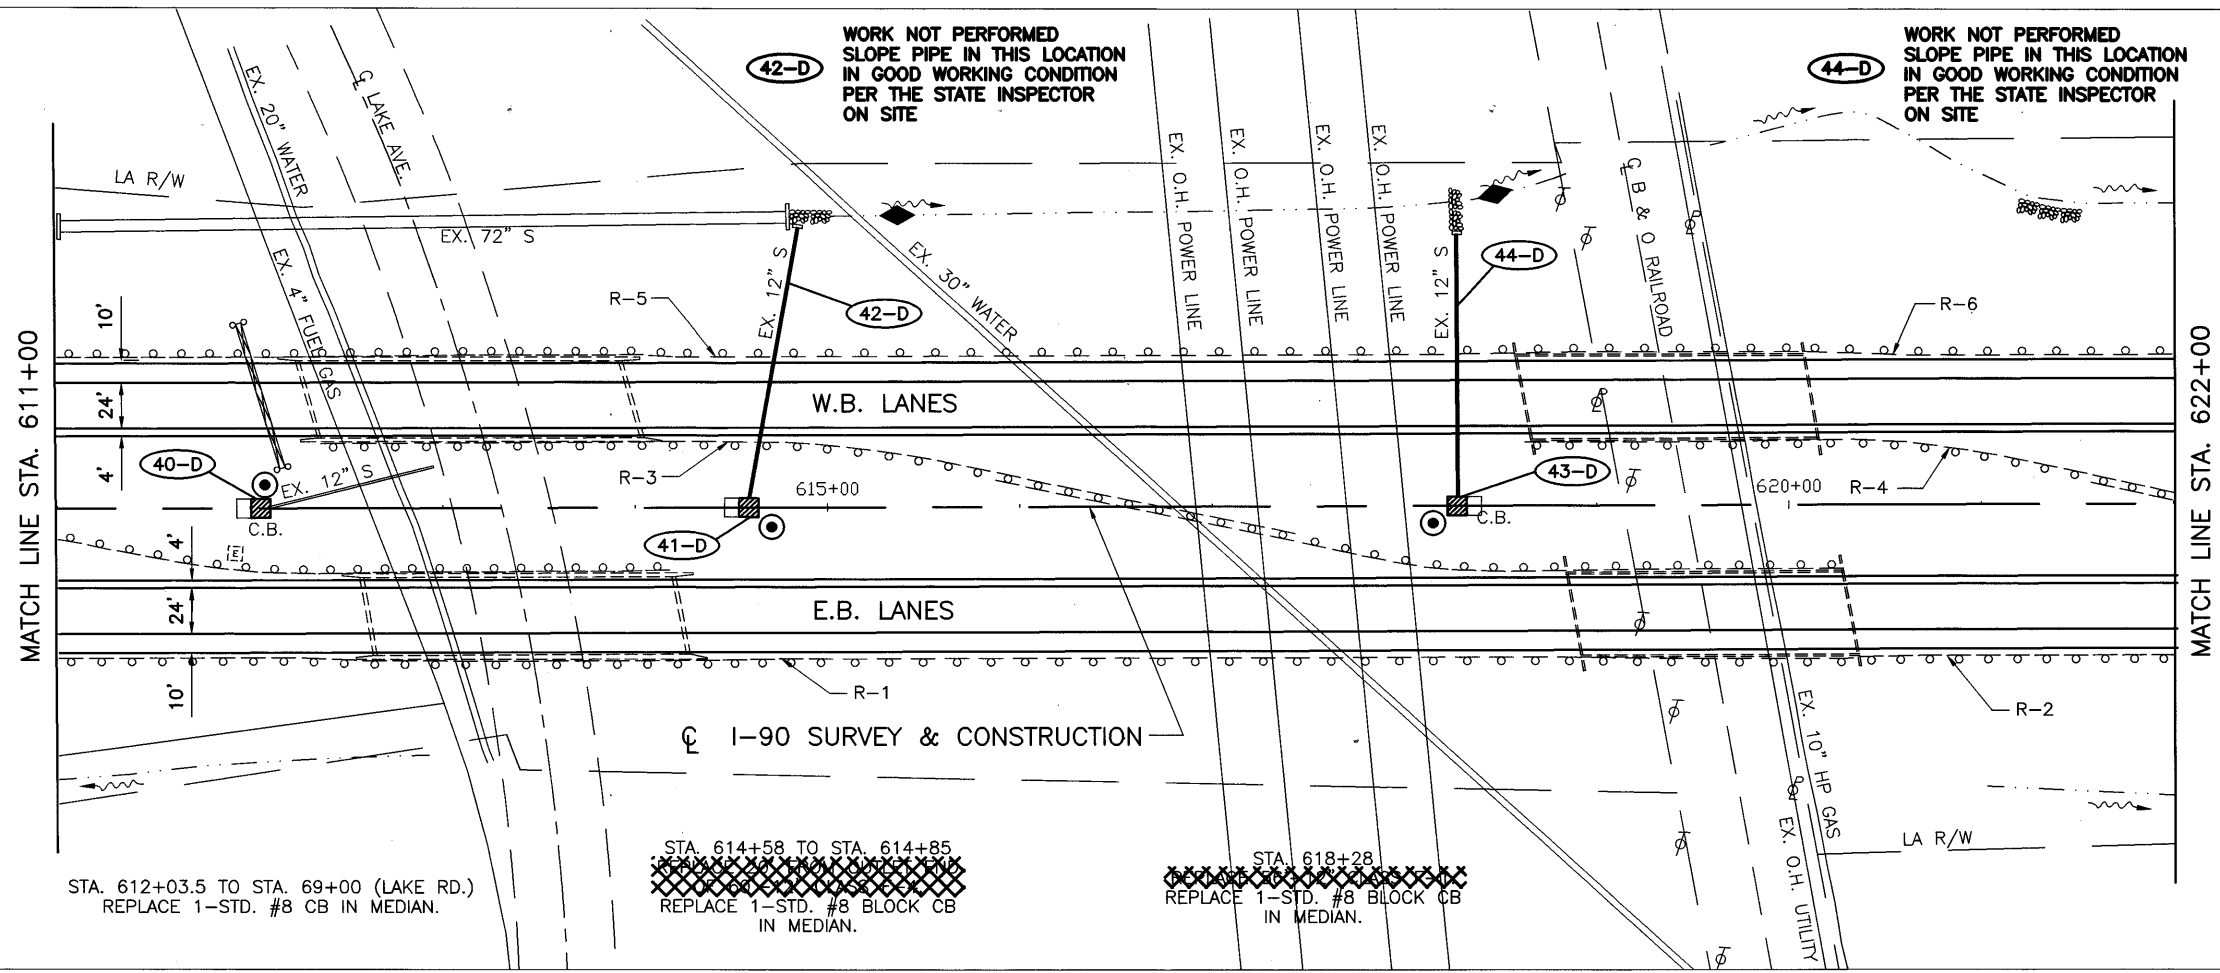

STA. 612+03.5 TO STA. 69+00 (LAKE RD.)  
REPLACE 1-STD. #8 CB IN MEDIAN.

STA. 614+58 TO STA. 614+85  
REPLACE 1-STD. #8 BLOCK CB  
IN MEDIAN.

STA. 618+28  
REPLACE 1-STD. #8 BLOCK CB  
IN MEDIAN.

42-D  
WORK NOT PERFORMED  
SLOPE PIPE IN THIS LOCATION  
IN GOOD WORKING CONDITION  
PER THE STATE INSPECTOR  
ON SITE


44-D  
WORK NOT PERFORMED  
SLOPE PIPE IN THIS LOCATION  
IN GOOD WORKING CONDITION  
PER THE STATE INSPECTOR  
ON SITE



CALCULATED	0
DLS	0
CHECKED	LAB

0 50 100  
HORIZONTAL  
SCALE IN FEET

**STORM WATER POLLUTION PREVENTION PLAN**  
**STA. 611+00 TO STA. 631+00**

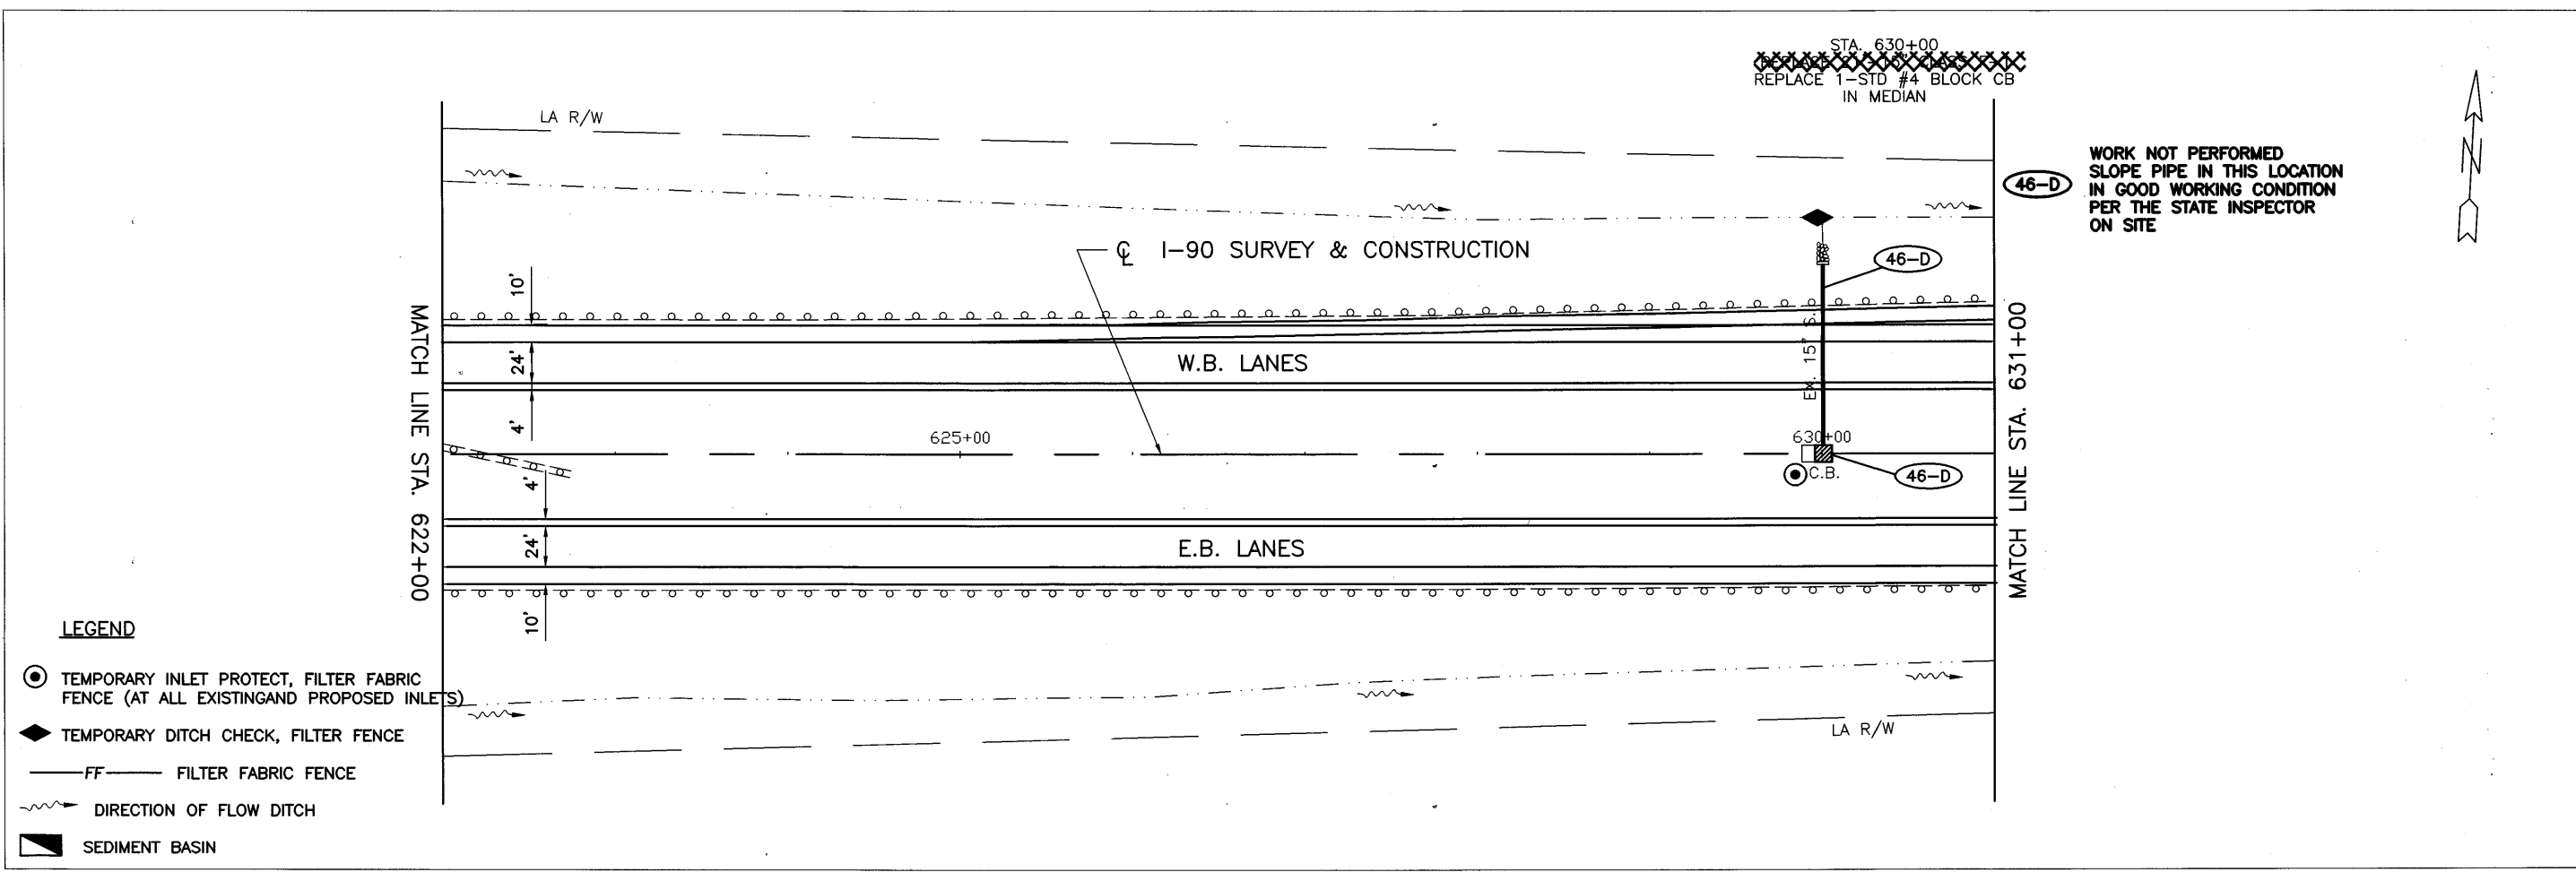

STA. 630+00  
REPLACE 1-STD #4 BLOCK CB  
IN MEDIAN

46-D  
WORK NOT PERFORMED  
SLOPE PIPE IN THIS LOCATION  
IN GOOD WORKING CONDITION  
PER THE STATE INSPECTOR  
ON SITE



**LEGEND**


- TEMPORARY INLET PROTECT, FILTER FABRIC FENCE (AT ALL EXISTING AND PROPOSED INLETS)
- ◆ TEMPORARY DITCH CHECK, FILTER FABRIC
- FF — FILTER FABRIC FENCE
- ~> DIRECTION OF FLOW DITCH
- ▣ SEDIMENT BASIN

C:\93600\DWG\EROSION\SP-15.DWG JGR 2-18-2002 2:52PM

STA. 637+43-639+50  
 REPLACE 1 - STD # 4  
 BLOCK CB IN MEDIAN.

STA. 639+50-640+00  
 CONTRACTOR TO DETERMINE NEED FOR  
 CATCH BASINS DUE TO REMOVAL OF CURB  
 CLEAN OUTLET OF PIPE

(48-D) EXISTING CATCH BASINS  
 ADJUSTED TO GRADE AND  
 PIPES REMAIN IN PLACE  
 (49-D)  
 (50-D)

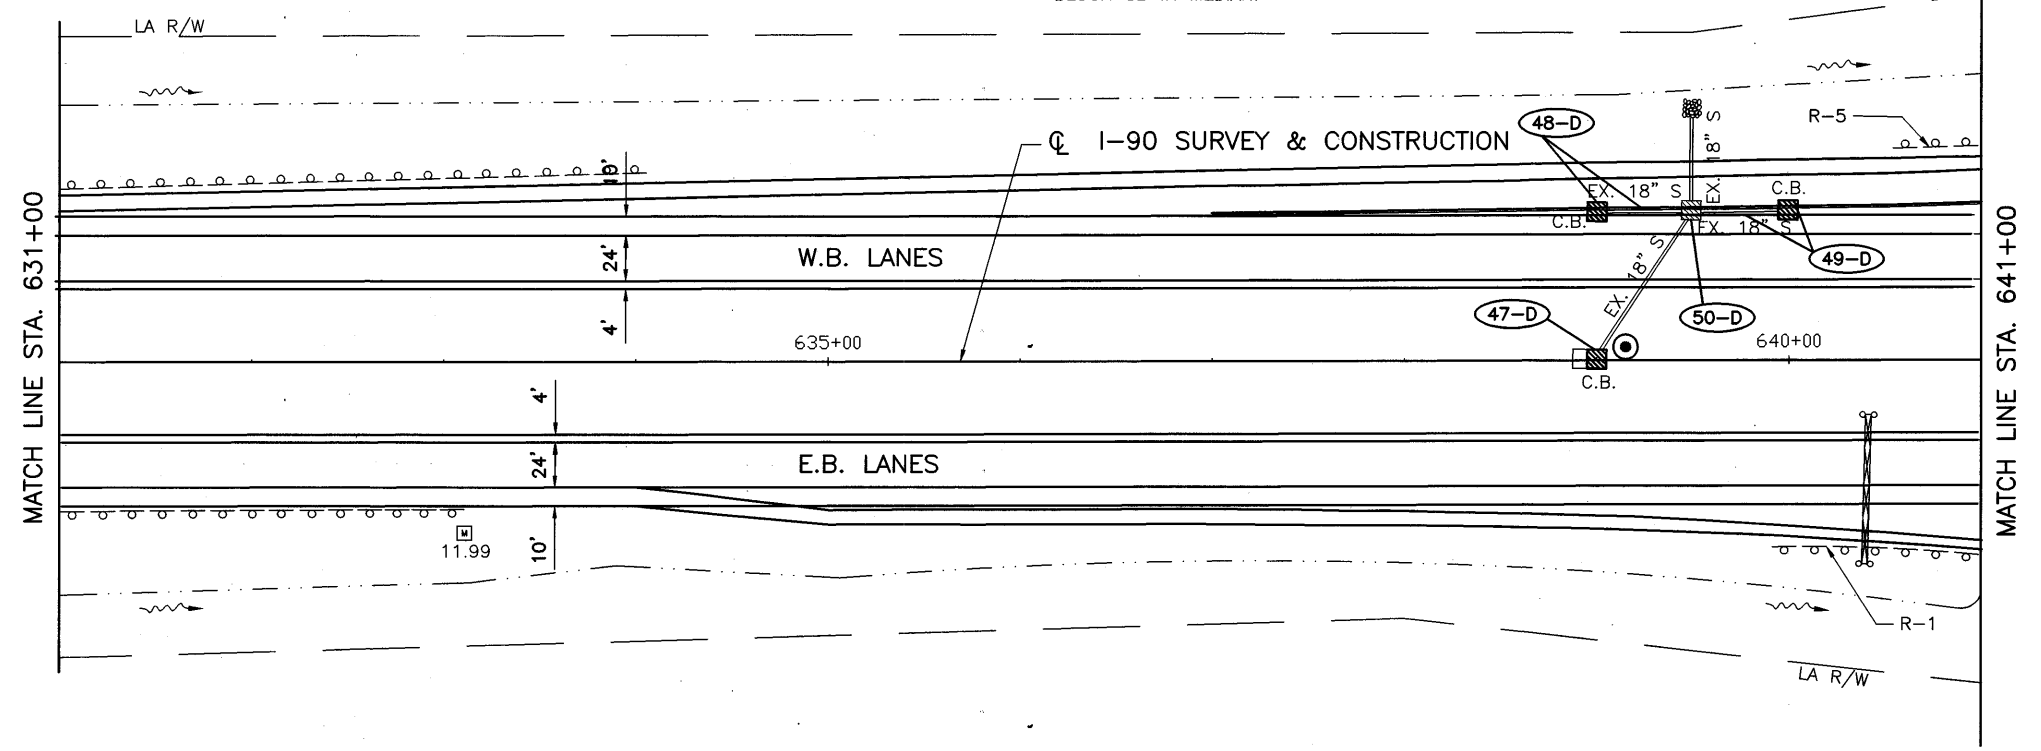


STA. 641+00 - 642+65  
 REPLACE 1 - STD #4 BLOCK  
 C.B. IN MEDIAN.

NOTE: SEE SHT SP35  
 FOR RAMP "A" PLAN

NOTE: SEE SHT SP36  
 FOR RAMP "B" PLAN

STA. 643+05.00  $\phi$  SURVEY BACK=  
 STA. 670+74.01  $\phi$  SURVEY AHEAD

$\phi$  I-90 SURVEY & CONSTRUCTION

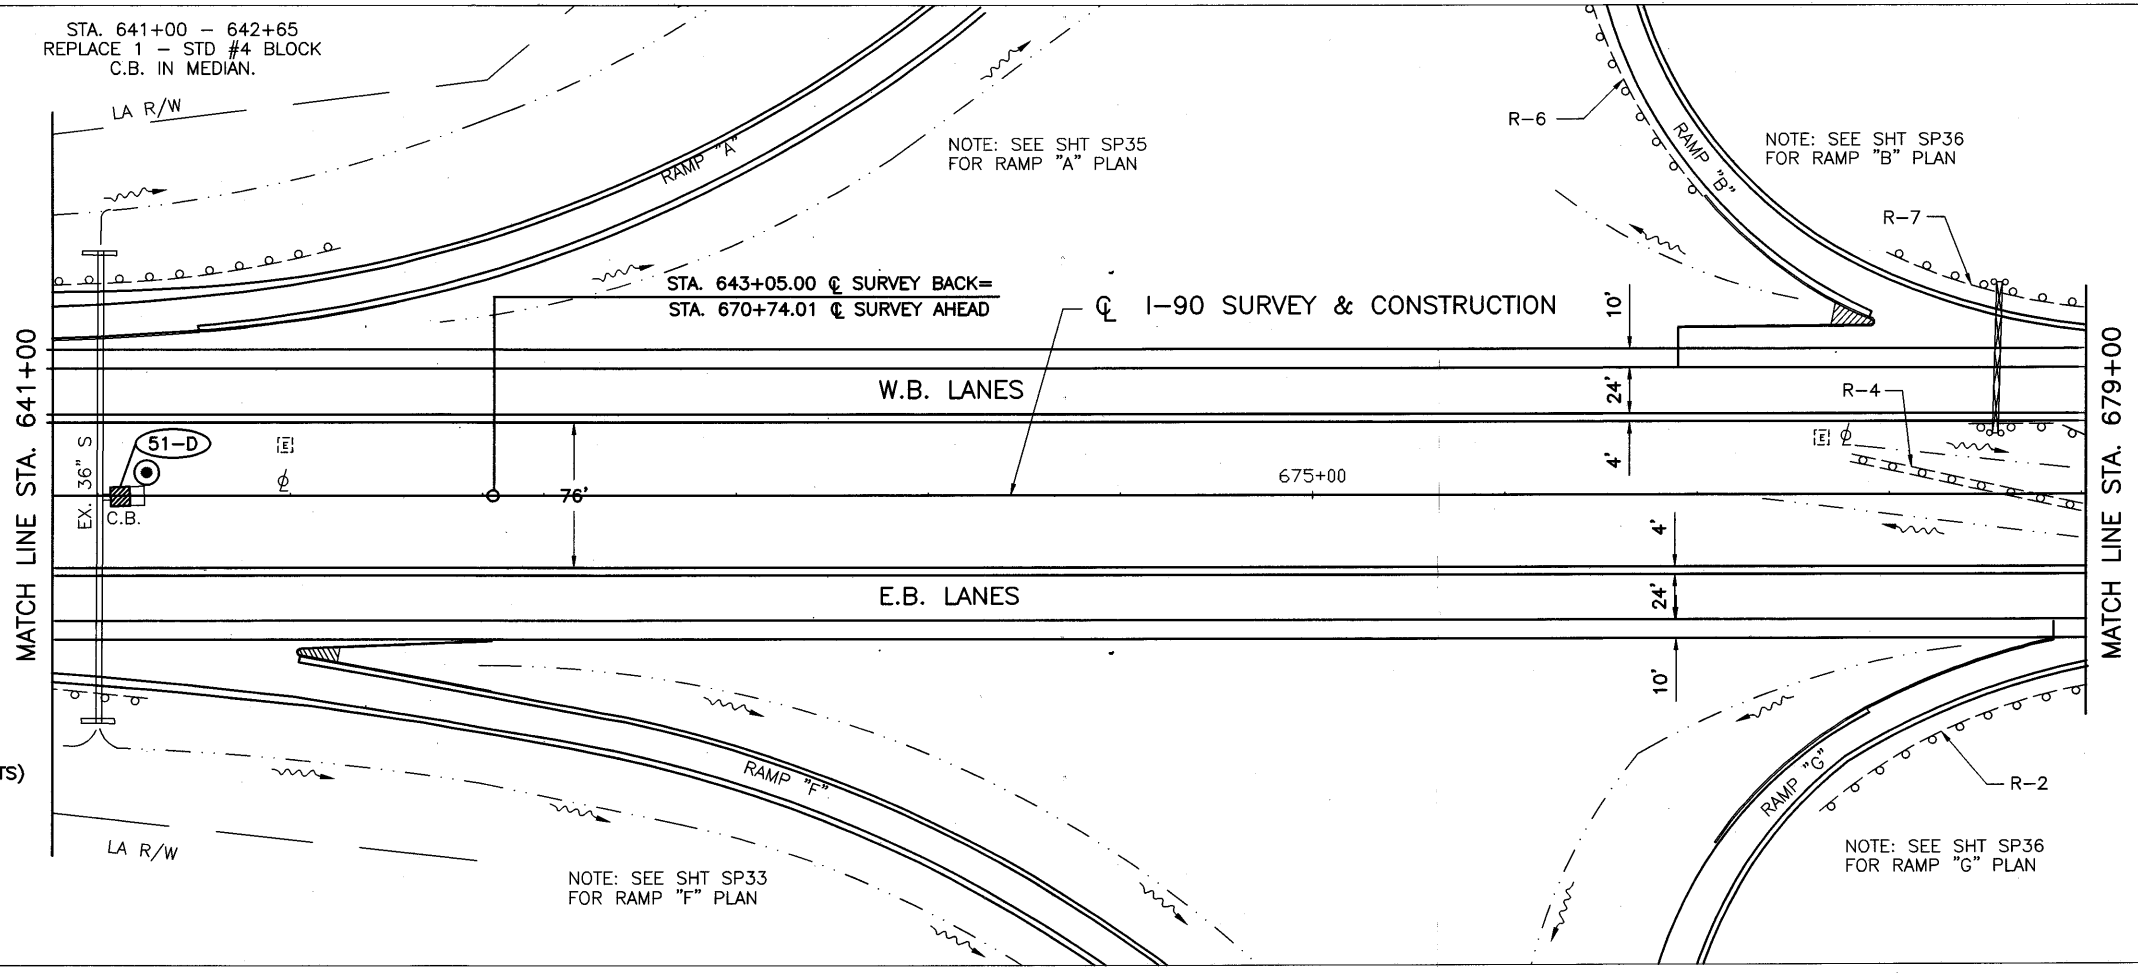

NOTE: SEE SHT SP33  
 FOR RAMP "F" PLAN

NOTE: SEE SHT SP36  
 FOR RAMP "G" PLAN

**LEGEND**



- TEMPORARY INLET PROTECT, FILTER FABRIC FENCE (AT ALL EXISTING AND PROPOSED INLETS)
- TEMPORARY DITCH CHECK, FILTER FABRIC FENCE
- FF FILTER FABRIC FENCE
- DIRECTION OF FLOW DITCH
- SEDIMENT BASIN

CALCULATED	DLS	CHECKED	LAB

STORM WATER POLLUTION PREVENTION PLAN  
 STA. 631+00 TO STA. 679+00

LOR - 190 - 10.76  
 36  
 274

I:\03600\DWG\EROSION\SP-16.DWG JGR  
 02-21-2002 3:28PM

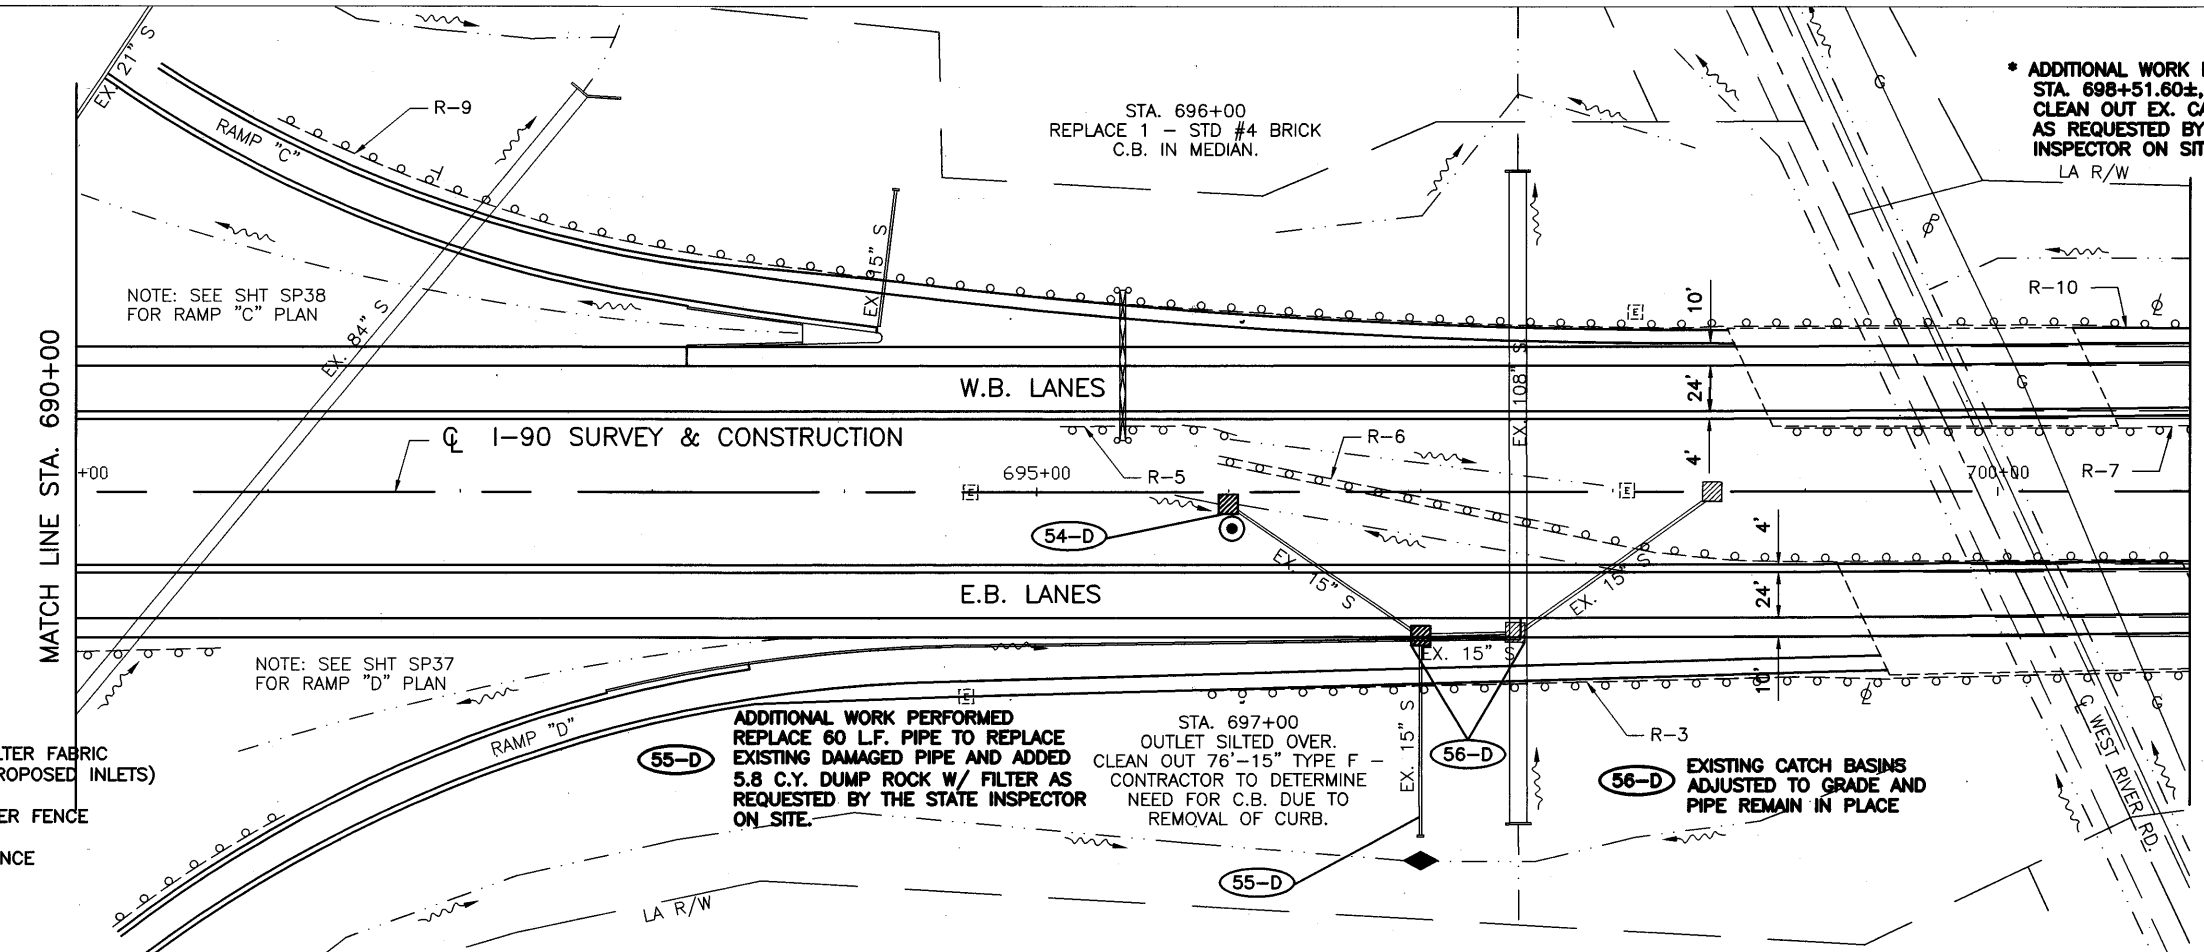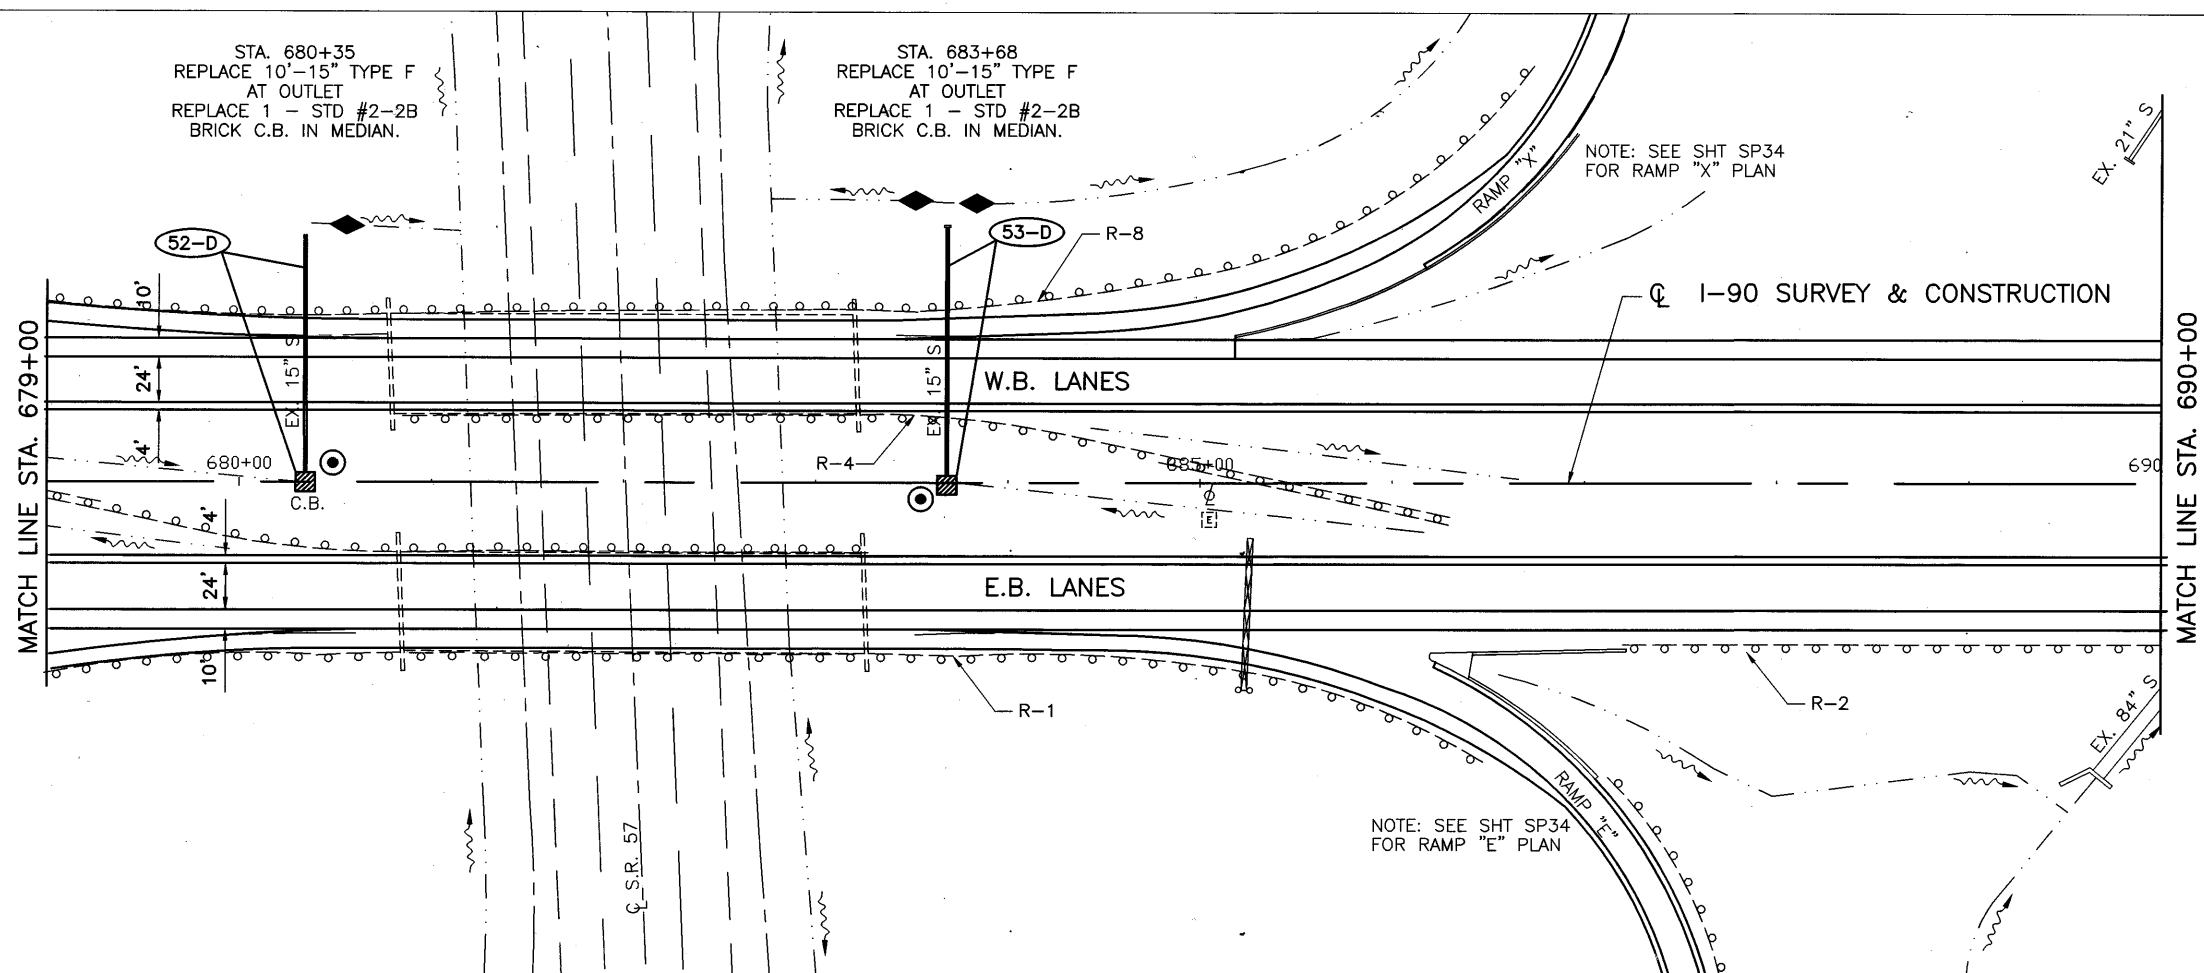

- LEGEND**
- TEMPORARY INLET PROTECT, FILTER FABRIC FENCE (AT ALL EXISTING AND PROPOSED INLETS)
  - TEMPORARY DITCH CHECK, FILTER FENCE
  - FF FILTER FABRIC FENCE
  - DIRECTION OF FLOW DITCH
  - SEDIMENT BASIN




**STORM WATER POLLUTION PREVENTION PLAN**  
**STA. 679+00 TO STA. 701+00**

**LOR - I90 - 10.76**

S:\93600\UNWS\VERSION\SP-17.DWG J.GR 21-2002 3:50PM

CURVE DATA 13  
 P.I. STA. 719  
 $\Delta = 59^{\circ}48'25''$   
 $D_c = 2'00'00''$   
 $R_c = 2864.79$   
 $T_s = 1798.30'$   
 $L_c = 2690.35'$   
 $L_s = 300.00'$   
 $E_s = 441.47'$   
 $\theta_s = 3'00'00''$   
 $L.T. = 200.03'$   
 $S.T. = 100.03'$

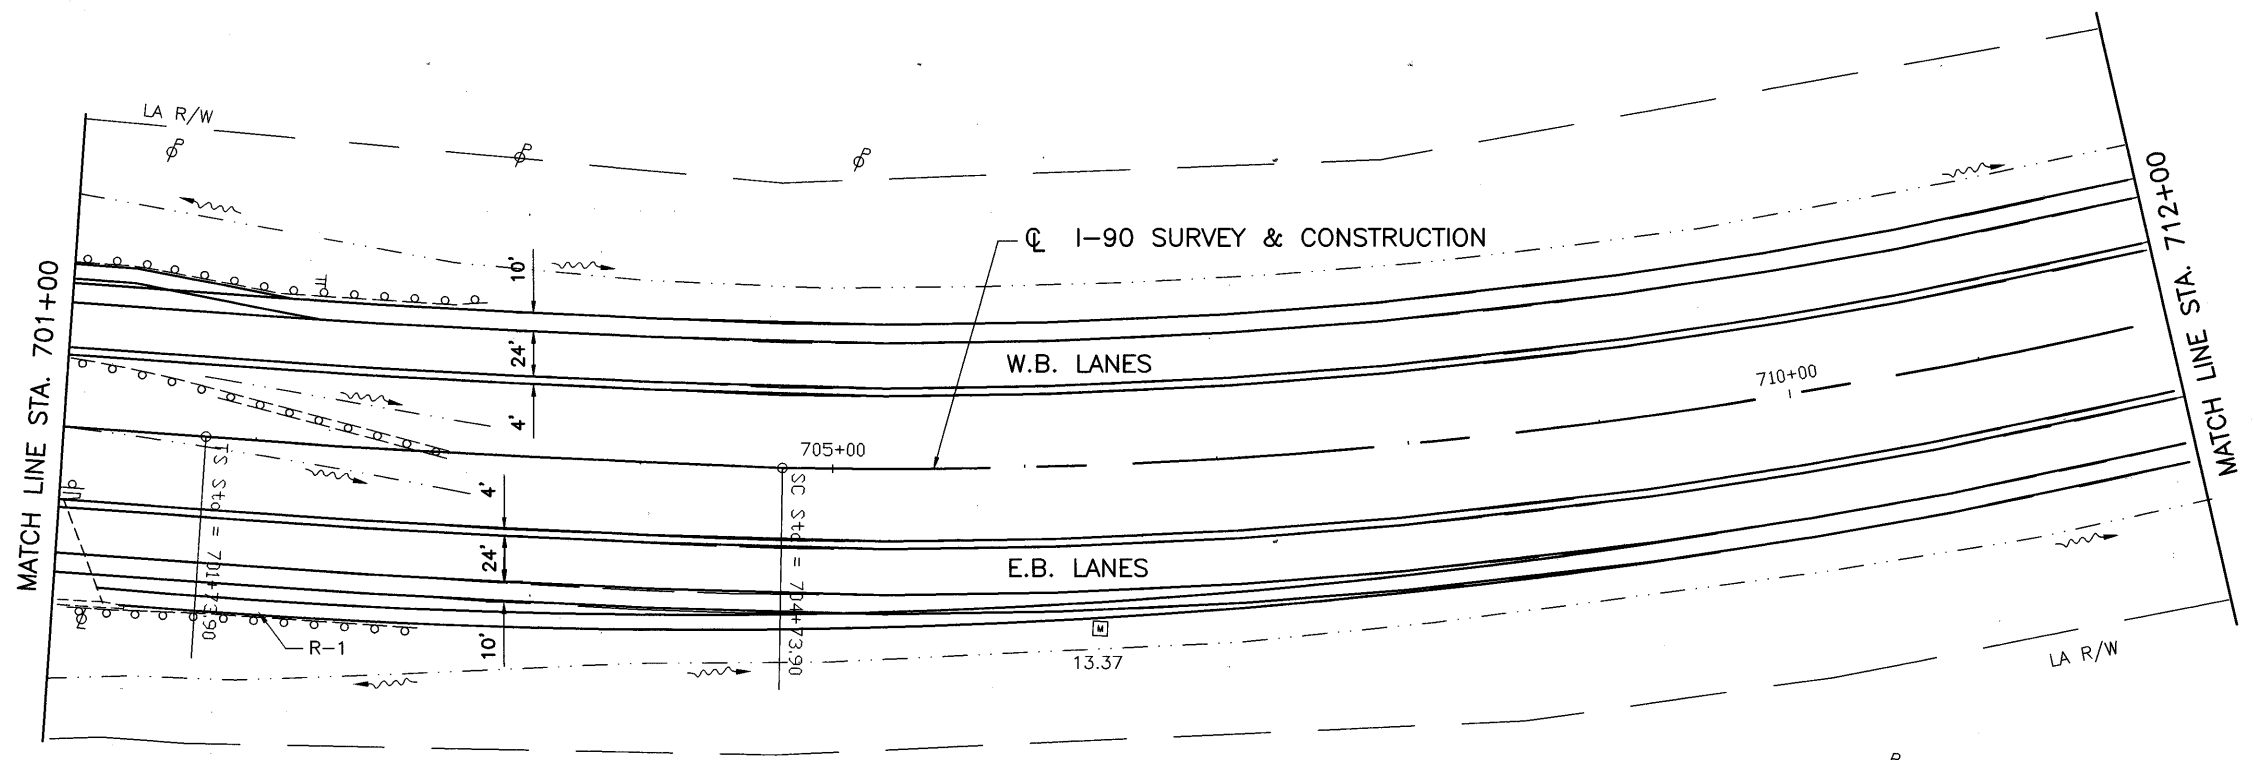

CALCULATED	DLS	CHECKED	LAB


0 50' 100'  
 HORIZONTAL  
 SCALE IN FEET

**STORM WATER POLLUTION PREVENTION PLAN**  
**STA. 701+00 TO STA. 723+00**

STA. 713+00  
 REPLACE 2 - STD #8 BRICK  
 C.B. IN MEDIAN.

STA. 718+00  
 REPLACE 1 - STD #8 BRICK  
 C.B. IN MEDIAN.

STA. 722+50  
 REPLACE 2 - STD #8 BRICK  
 C.B. IN MEDIAN.  
 PLACE DUMP ROCK PROTECTION AT OUTLET  
 (7' X 15' X 18", TYPE C, WITH FILTER)

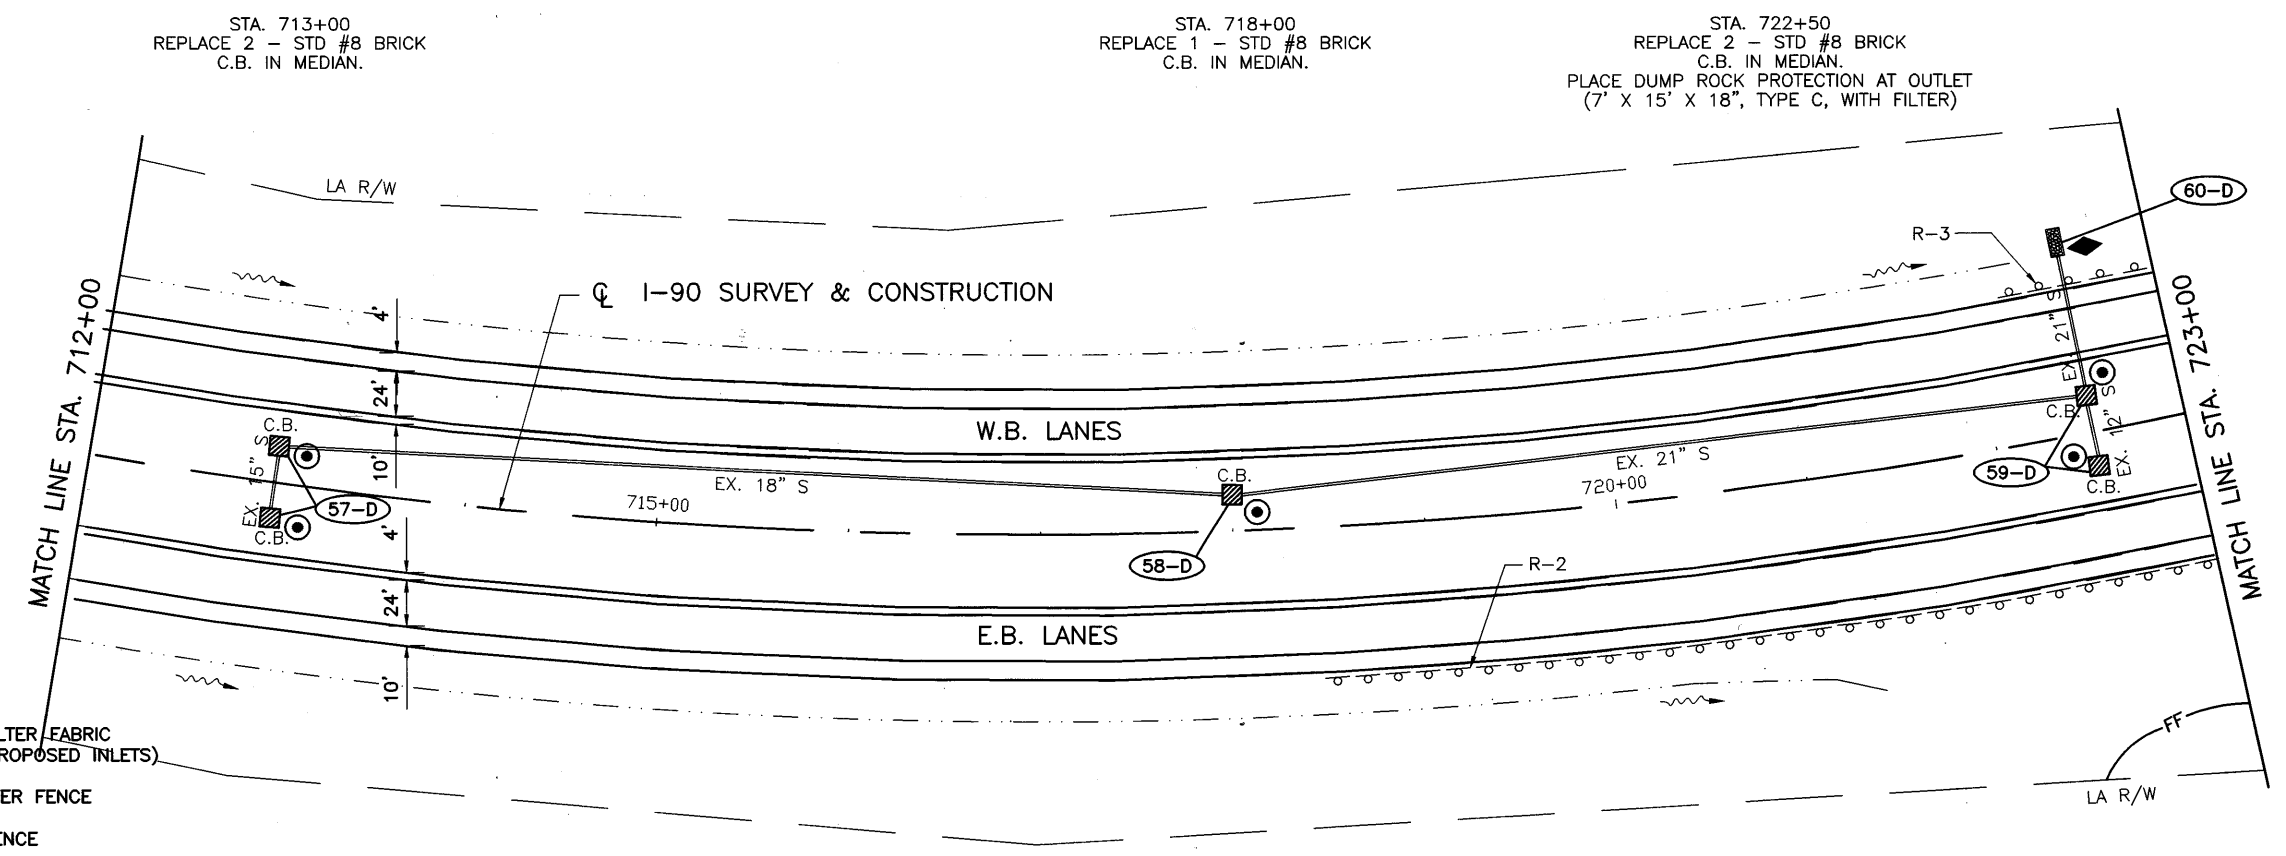

**LEGEND**

- TEMPORARY INLET PROTECT, FILTER FABRIC FENCE (AT ALL EXISTING AND PROPOSED INLETS)
- TEMPORARY DITCH CHECK, FILTER FENCE
- FF - FILTER FABRIC FENCE
- DIRECTION OF FLOW DITCH
- SEDIMENT BASIN

**LOR - 190 - 10.76**

I:\03\600\DWG\EROSION\SP-18.DWG ] JGR  
02-18-2002 3:40PM

STA. 723+45  
PLACE DUMP ROCK  
CHANNEL PROTECTION AT BOTH OUTLET  
AND INLET ENDS OF 108" SCMP.

STA. 730+00  
REPLACE 1-STD #5 BRICK C.B.-EB RIGHTSIDE.  
REPLACE 2-STD. #8 BRICK C.B. WITH APRON  
IN MEDIAN. REPLACE 30' DUMP ROCK CHANNEL  
PROTECTION FROM PIPE OUTLET.

STA. 728+00  
REPLACE 10' OF OUTLET OF 136"-18" TYPE B-B.  
REPLACE 1-STD#5 BRICK CB-EB RIGHTSIDE.  
REPLACE 2-STD#8 BRICK CB IN MEDIAN.



STA. 736+05-736+62  
CLEAN OUTLET DITCH OF 57'-12"  
TYPE C-B-OUTLET SILTED OVER.  
REPLACE 1- STD#2-2B  
BRICK C.B. IN MEDIAN.

STA. 740+80  
REPLACE 20' OF OUTLET OF 104'-15" TYPE F.  
REPLACE 1-STD#2-2B BRICK CB IN MEDIAN.

71-D WORK NOT PERFORMED  
AS REQUESTED BY THE STATE  
INSPECTOR ON SITE

**LEGEND**

- ⊙ TEMPORARY INLET PROTECT, FILTER FABRIC FENCE (AT ALL EXISTING AND PROPOSED INLETS)
- ◆ TEMPORARY DITCH CHECK, FILTER FENCE
- FF— FILTER FABRIC FENCE
- DIRECTION OF FLOW DITCH
- ▣ SEDIMENT BASIN

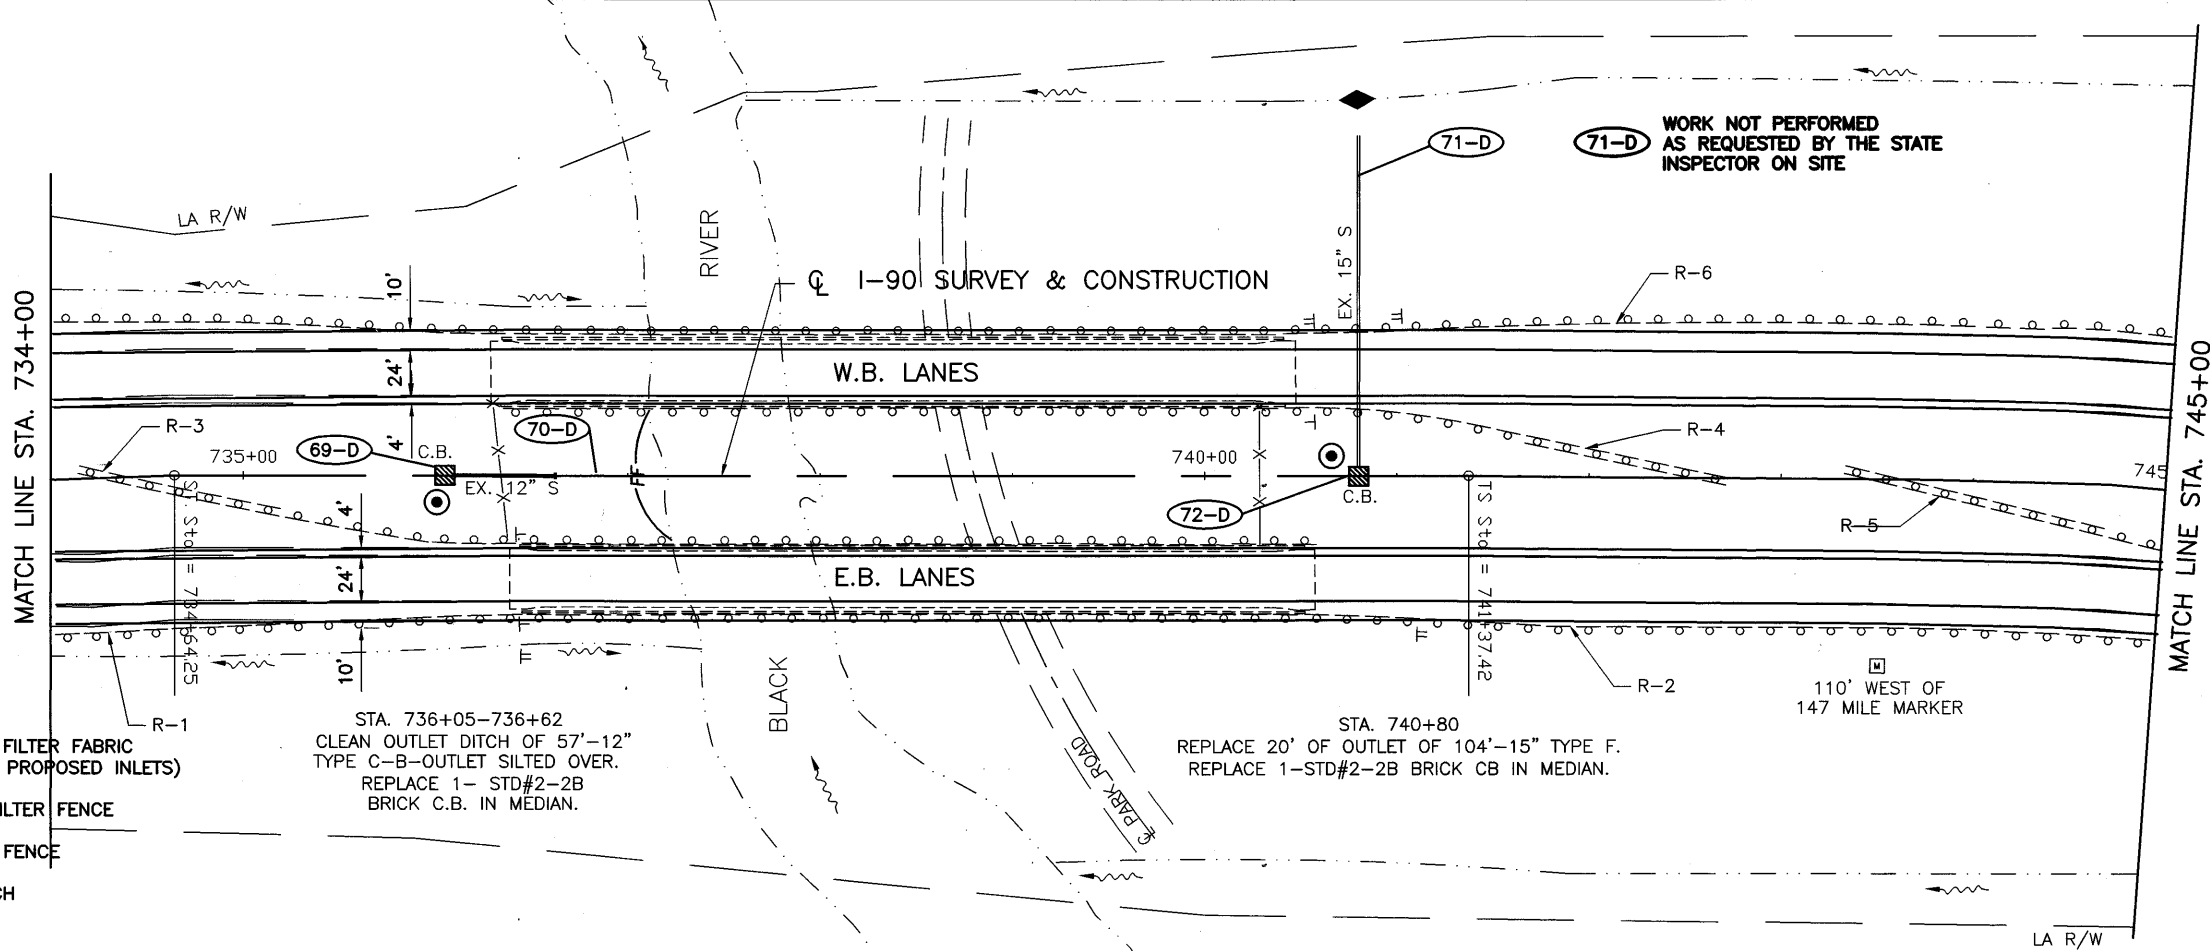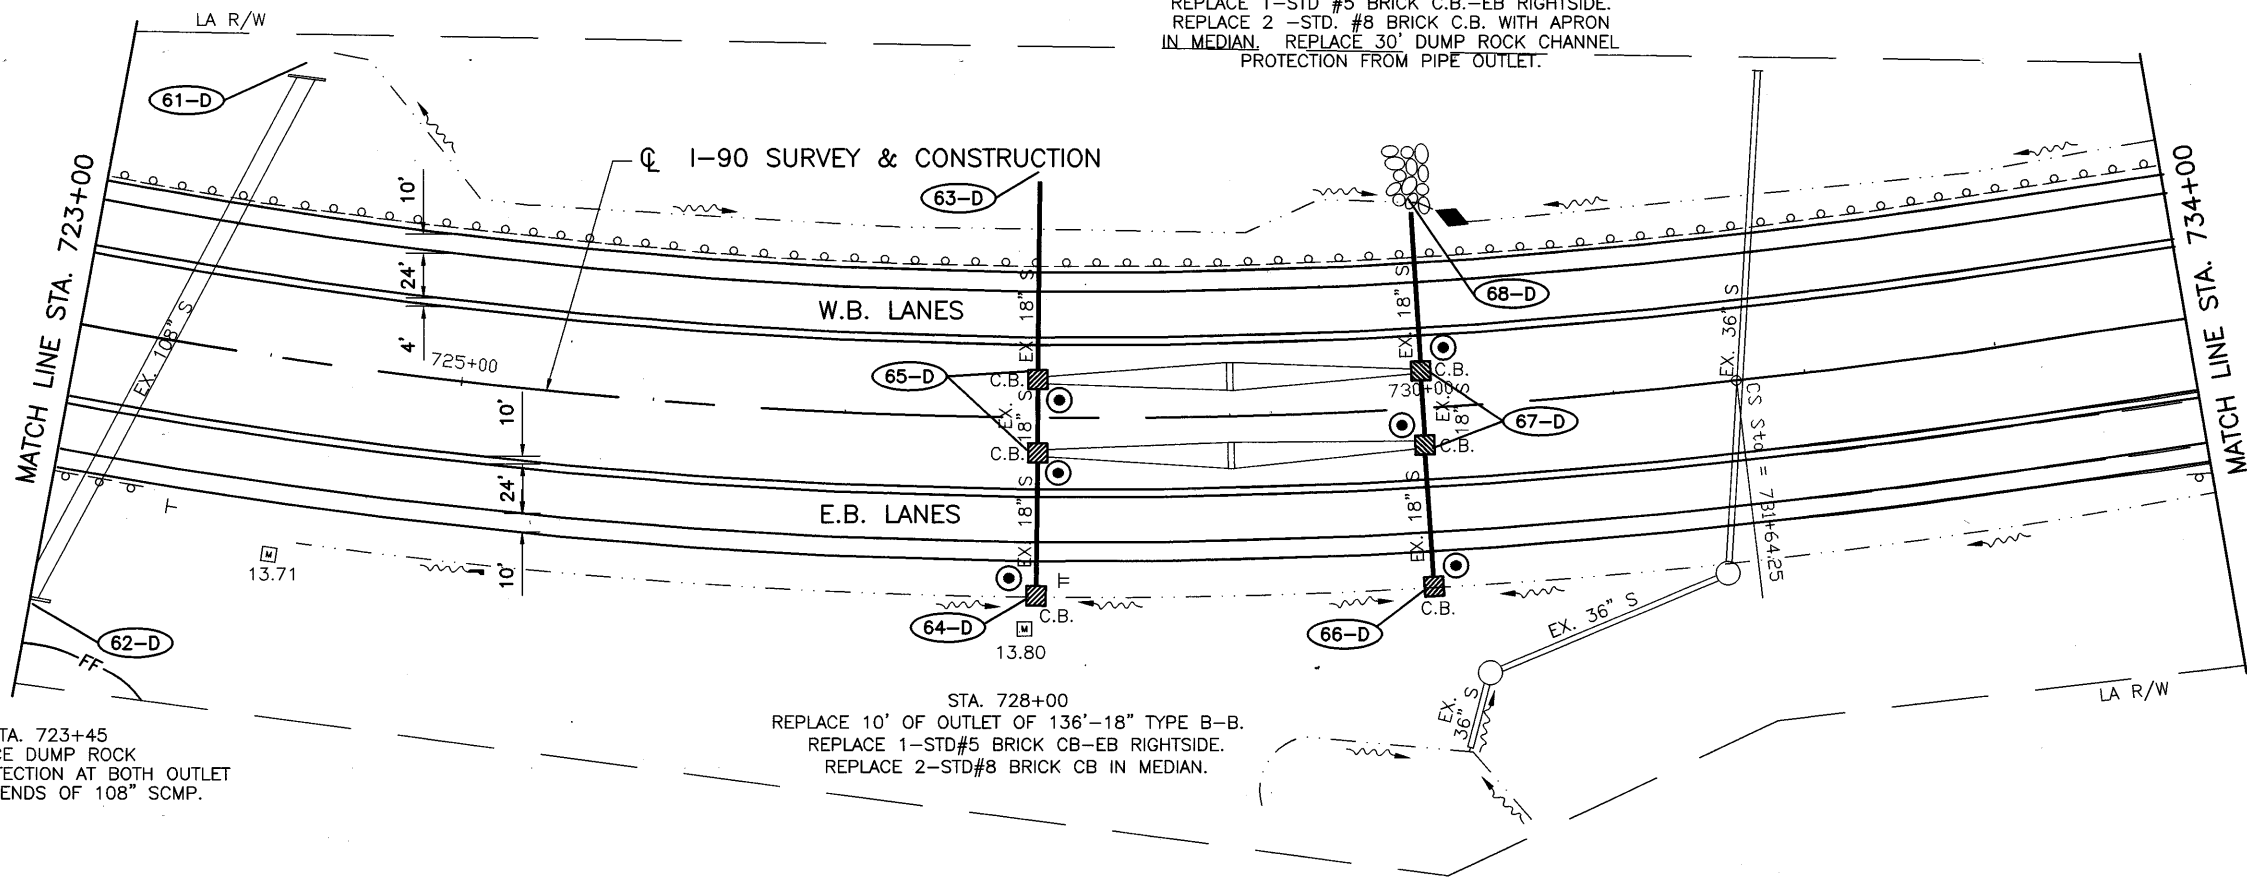


CALCULATED	DLS	CHECKED	LAB

**STORM WATER POLLUTION PREVENTION PLAN**  
STA. 723+00 TO STA. 745+00

LOR - 190 - 10.76

D:\93600\DWG\KOROSON\SP-19.DWG J.GR 18-2002 3:48PM

CURVE DATA 14  
 P.I. STA. 750+87.60  
 $\Delta = 36^{\circ}12'32''$   
 $R_c = 2'30'00''$   
 $T_s = 2291.83'$   
 $L_s = 950.18'$   
 $E_s = 1048.36'$   
 $\theta_s = 400.00'$   
 $L.T. = 122.44'$   
 $S.T. = 5^{\circ}00'00''$   
 $S.T. = 266.77'$   
 $S.T. = 133.43'$

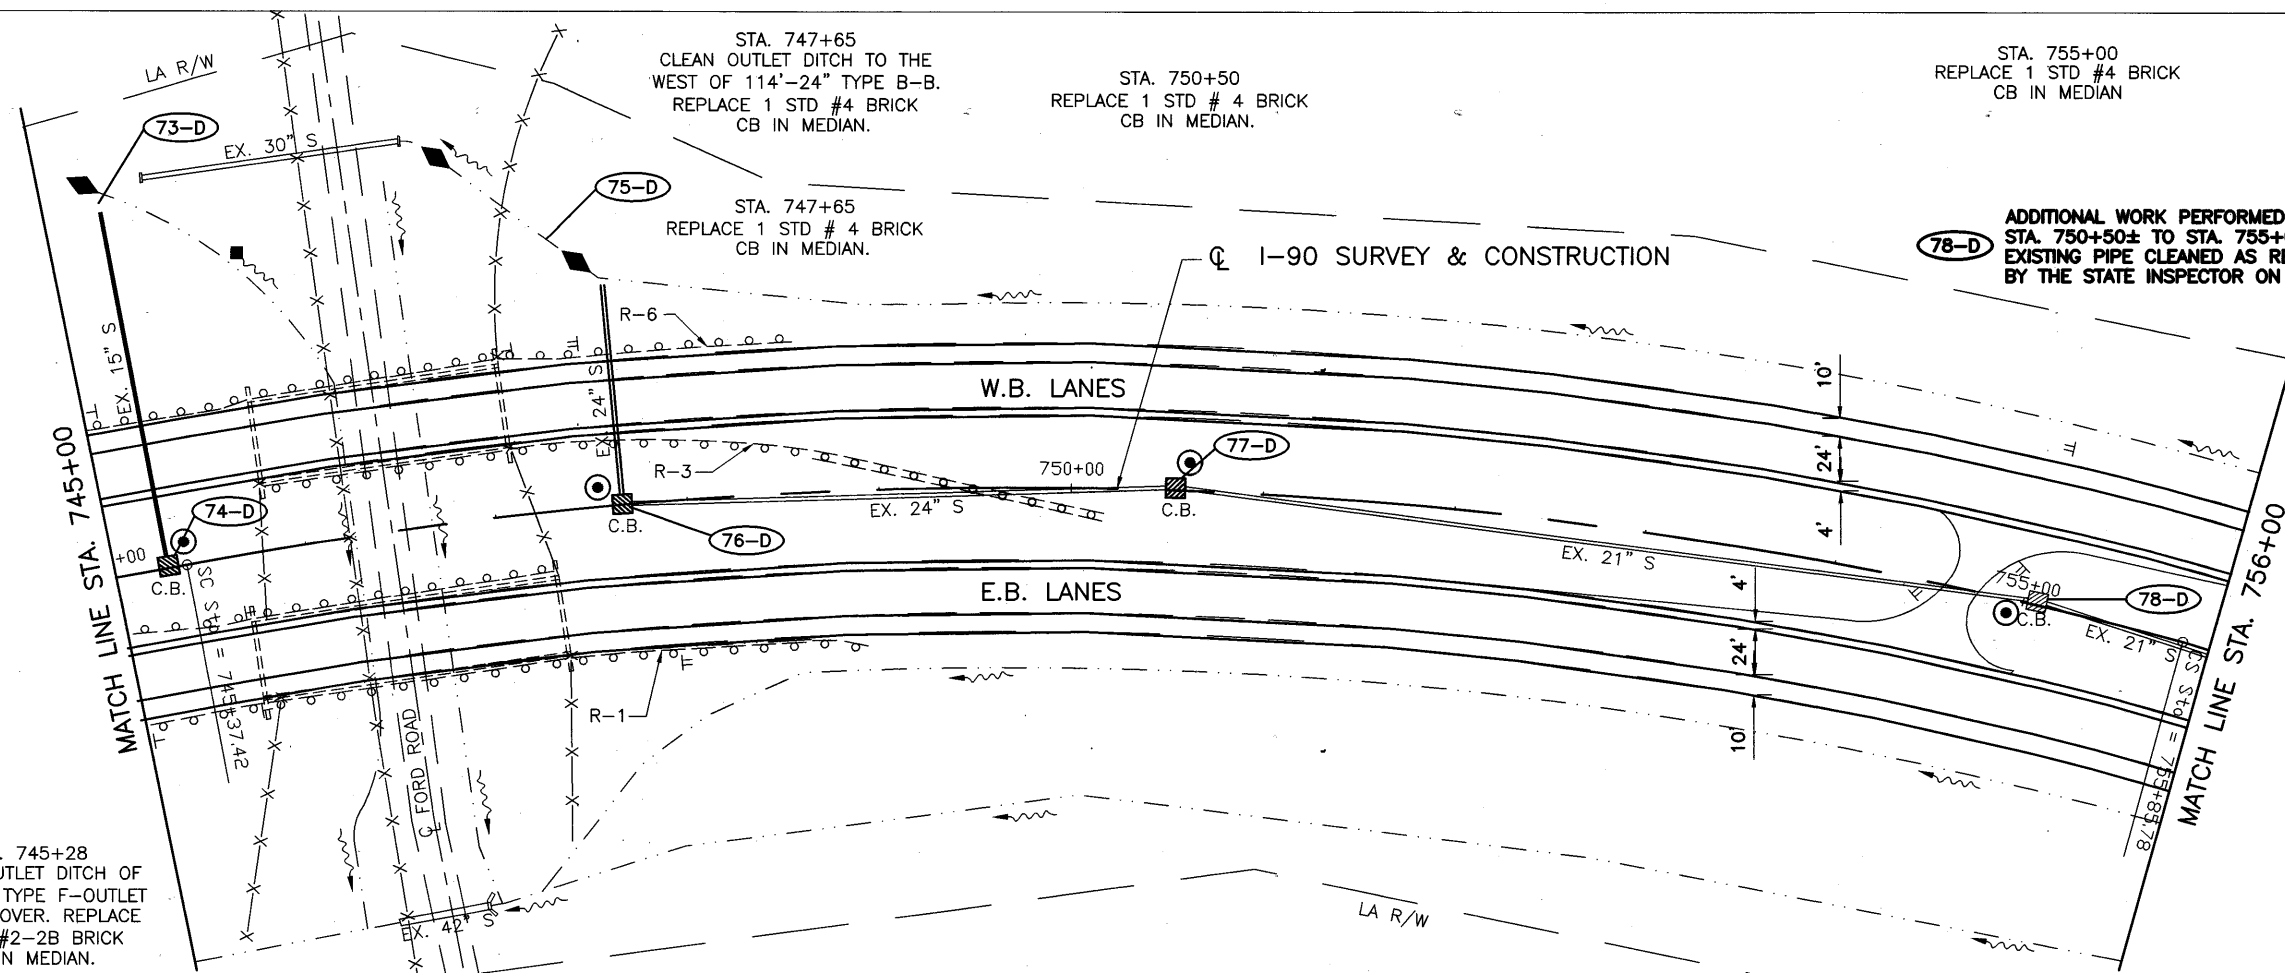

STA. 745+28  
 CLEAN OUTLET DITCH OF  
 106'-15" TYPE F-OUTLET  
 SILTED OVER. REPLACE  
 1 STD #2-2B BRICK  
 CB IN MEDIAN.

STA. 747+65  
 CLEAN OUTLET DITCH TO THE  
 WEST OF 114'-24" TYPE B-B.  
 REPLACE 1 STD #4 BRICK  
 CB IN MEDIAN.

STA. 750+50  
 REPLACE 1 STD # 4 BRICK  
 CB IN MEDIAN.


STA. 755+00  
 REPLACE 1 STD #4 BRICK  
 CB IN MEDIAN

78-D ADDITIONAL WORK PERFORMED  
 STA. 750+50± TO STA. 755+00±  
 EXISTING PIPE CLEANED AS REQUESTED  
 BY THE STATE INSPECTOR ON SITE.

CALCULATED	DLS	CHECKED	LAB

100  
 50'  
 0  
 HORIZONTAL  
 SCALE IN FEET

STORM WATER POLLUTION PREVENTION PLAN  
 STA. 745+00 TO STA. 767+00

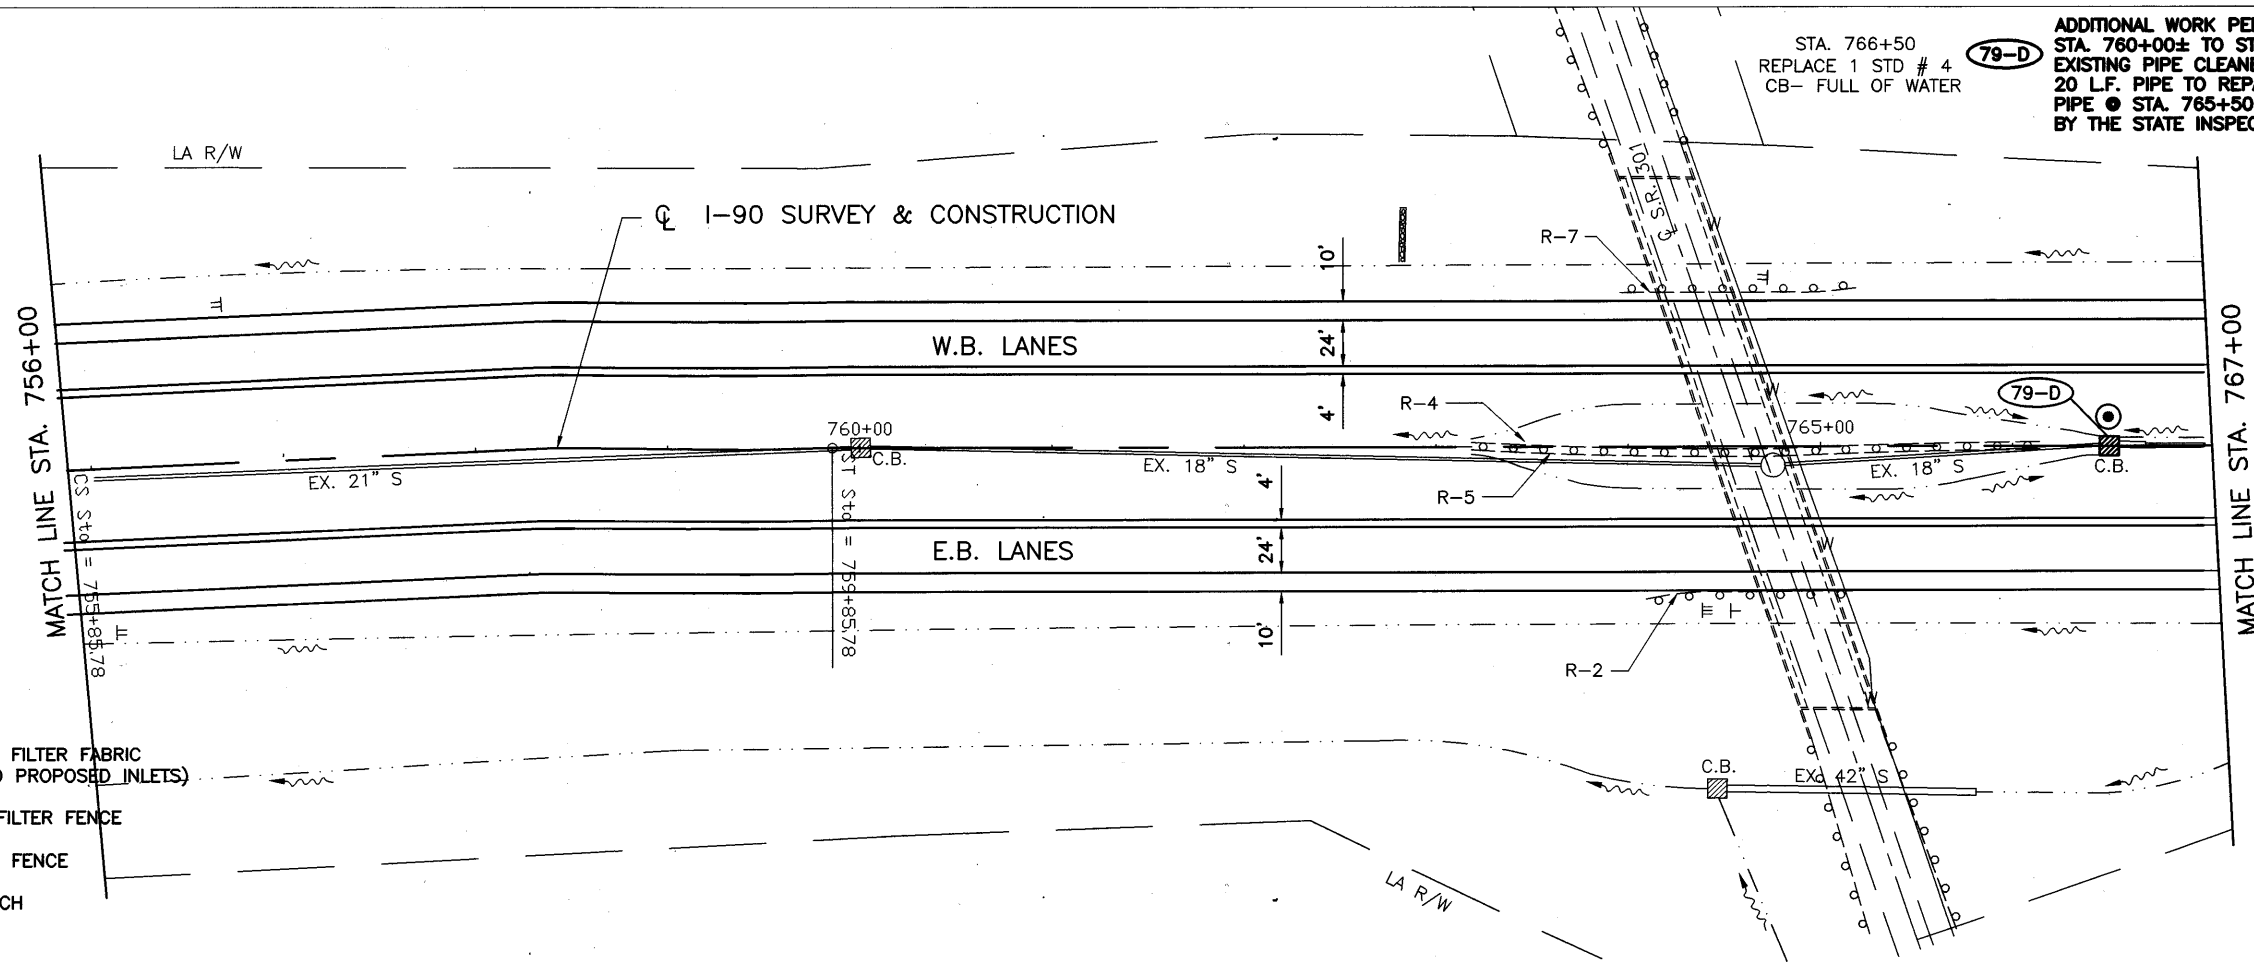

STA. 766+50  
 REPLACE 1 STD # 4  
 CB- FULL OF WATER



79-D ADDITIONAL WORK PERFORMED  
 STA. 760+00± TO STA. 766+50±  
 EXISTING PIPE CLEANED AND REPLACE  
 20 L.F. PIPE TO REPAIR EXISTING DAMAGED  
 PIPE @ STA. 765+50± AS REQUESTED  
 BY THE STATE INSPECTOR ON SITE.

LEGEND

- TEMPORARY INLET PROTECT, FILTER FABRIC FENCE (AT ALL EXISTING AND PROPOSED INLETS)
- TEMPORARY DITCH CHECK, FILTER FABRIC FENCE
- FILTER FABRIC FENCE
- DIRECTION OF FLOW DITCH
- SEDIMENT BASIN

D:\93600\DWG\VERSION\SP-20.DWG J.GR  
 1-19-2002 3:58PM



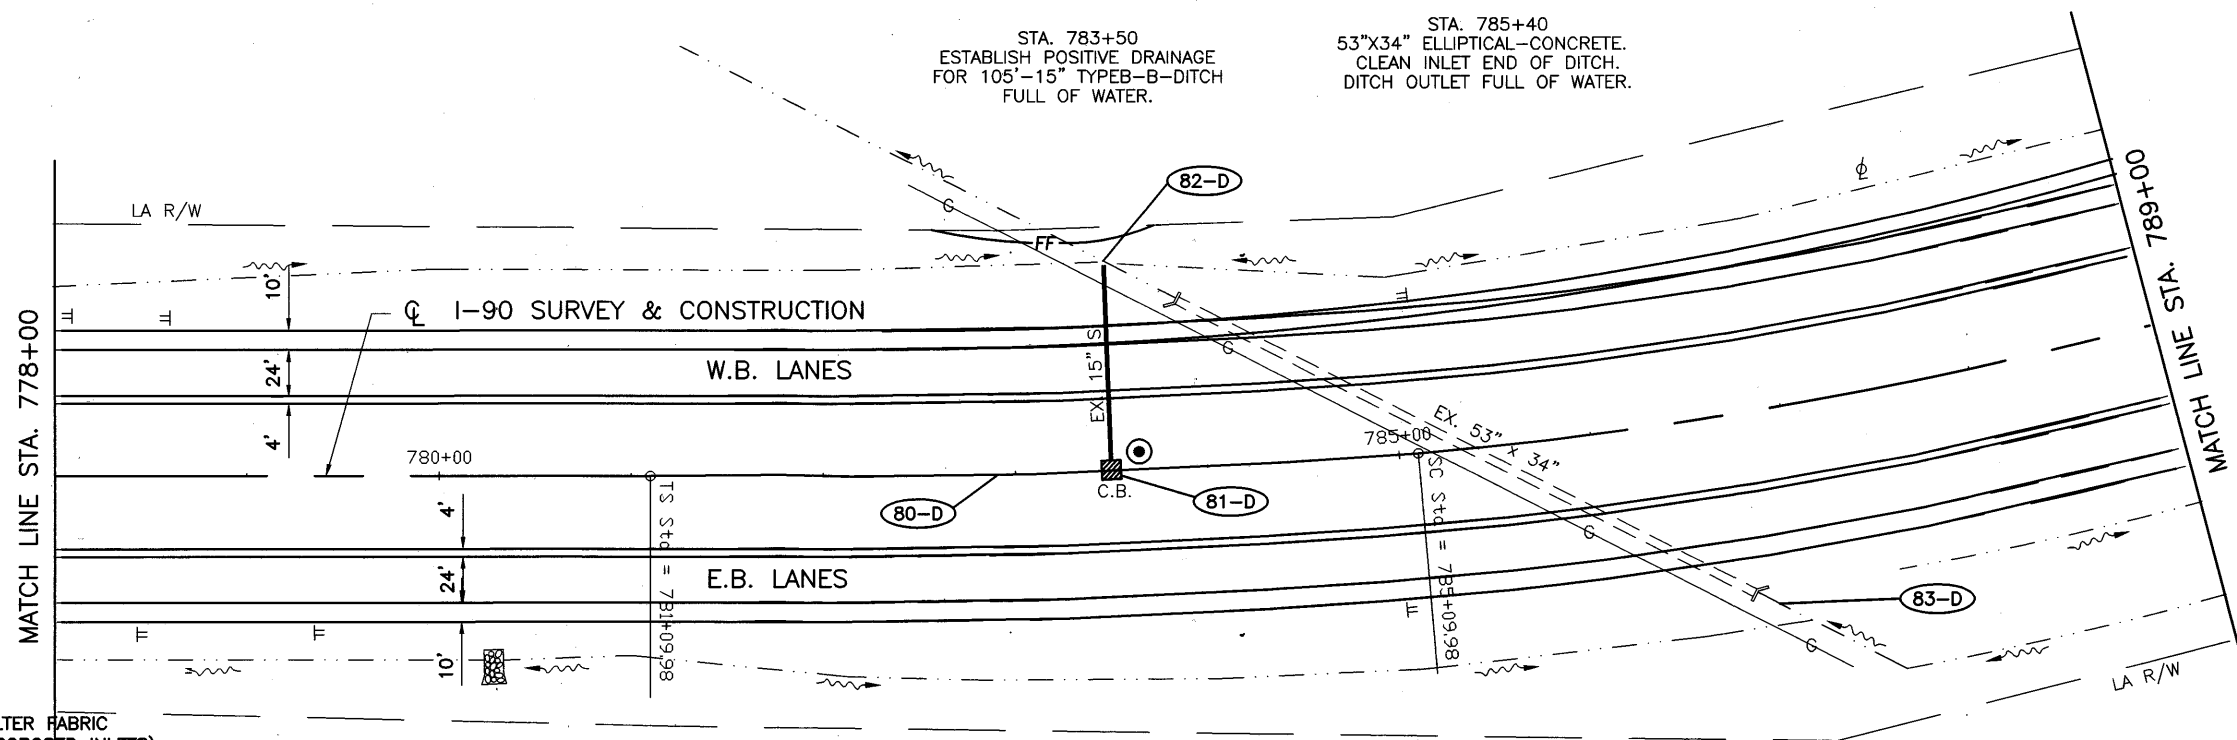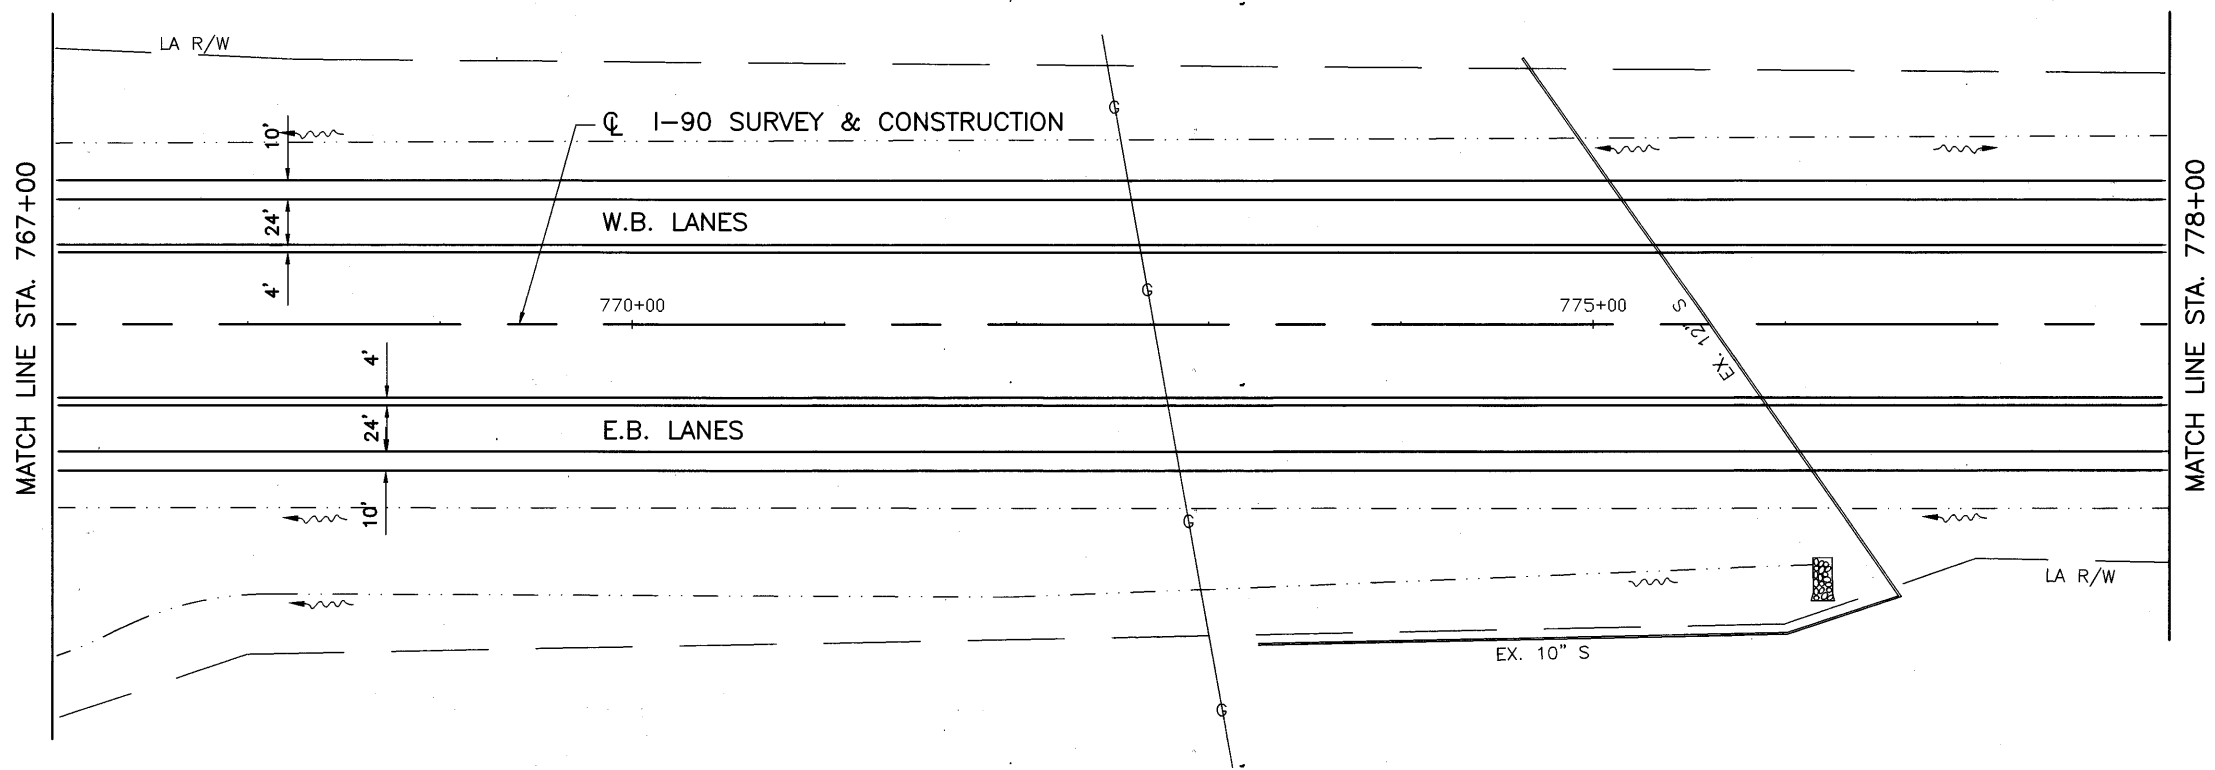

STA. 783+50  
 REPLACE 1 STD #4 BRICK  
 CB IN MEDIAN

**LEGEND**

- ⊙ TEMPORARY INLET PROTECT, FILTER FABRIC FENCE (AT ALL EXISTING AND PROPOSED INLETS)
- ◆ TEMPORARY DITCH CHECK, FILTER FABRIC FENCE
- FF — FILTER FABRIC FENCE
- ~> DIRECTION OF FLOW DITCH
- ▣ SEDIMENT BASIN

CALCULATED	DLS	CHECKED	LAB



0 50' 100'  
 HORIZONTAL  
 SCALE IN FEET

**STORM WATER POLLUTION PREVENTION PLAN**  
**STA. 767+00 TO STA. 789+00**

**LOR - 190 - 10.76**

C:\93600\DWG\VERSION\SP-21.DWG JGR  
 12-19-2002 4:09PM

CURVE DATA <sup>(15)</sup>  
 P.I. STA. 796+98.20  
 $\Delta = 62^{\circ}20'45''$   
 $D_c = 2'30''00''$   
 $R_c = 2291.83'$   
 $T_s = 1588.21'$   
 $L_c = 2093.83'$   
 $L_s = 400.00'$   
 $E_s = 390.16'$   
 $e_s = 5'00''00''$   
 $L.T. = 266.77'$   
 $S.T. = 133.43'$

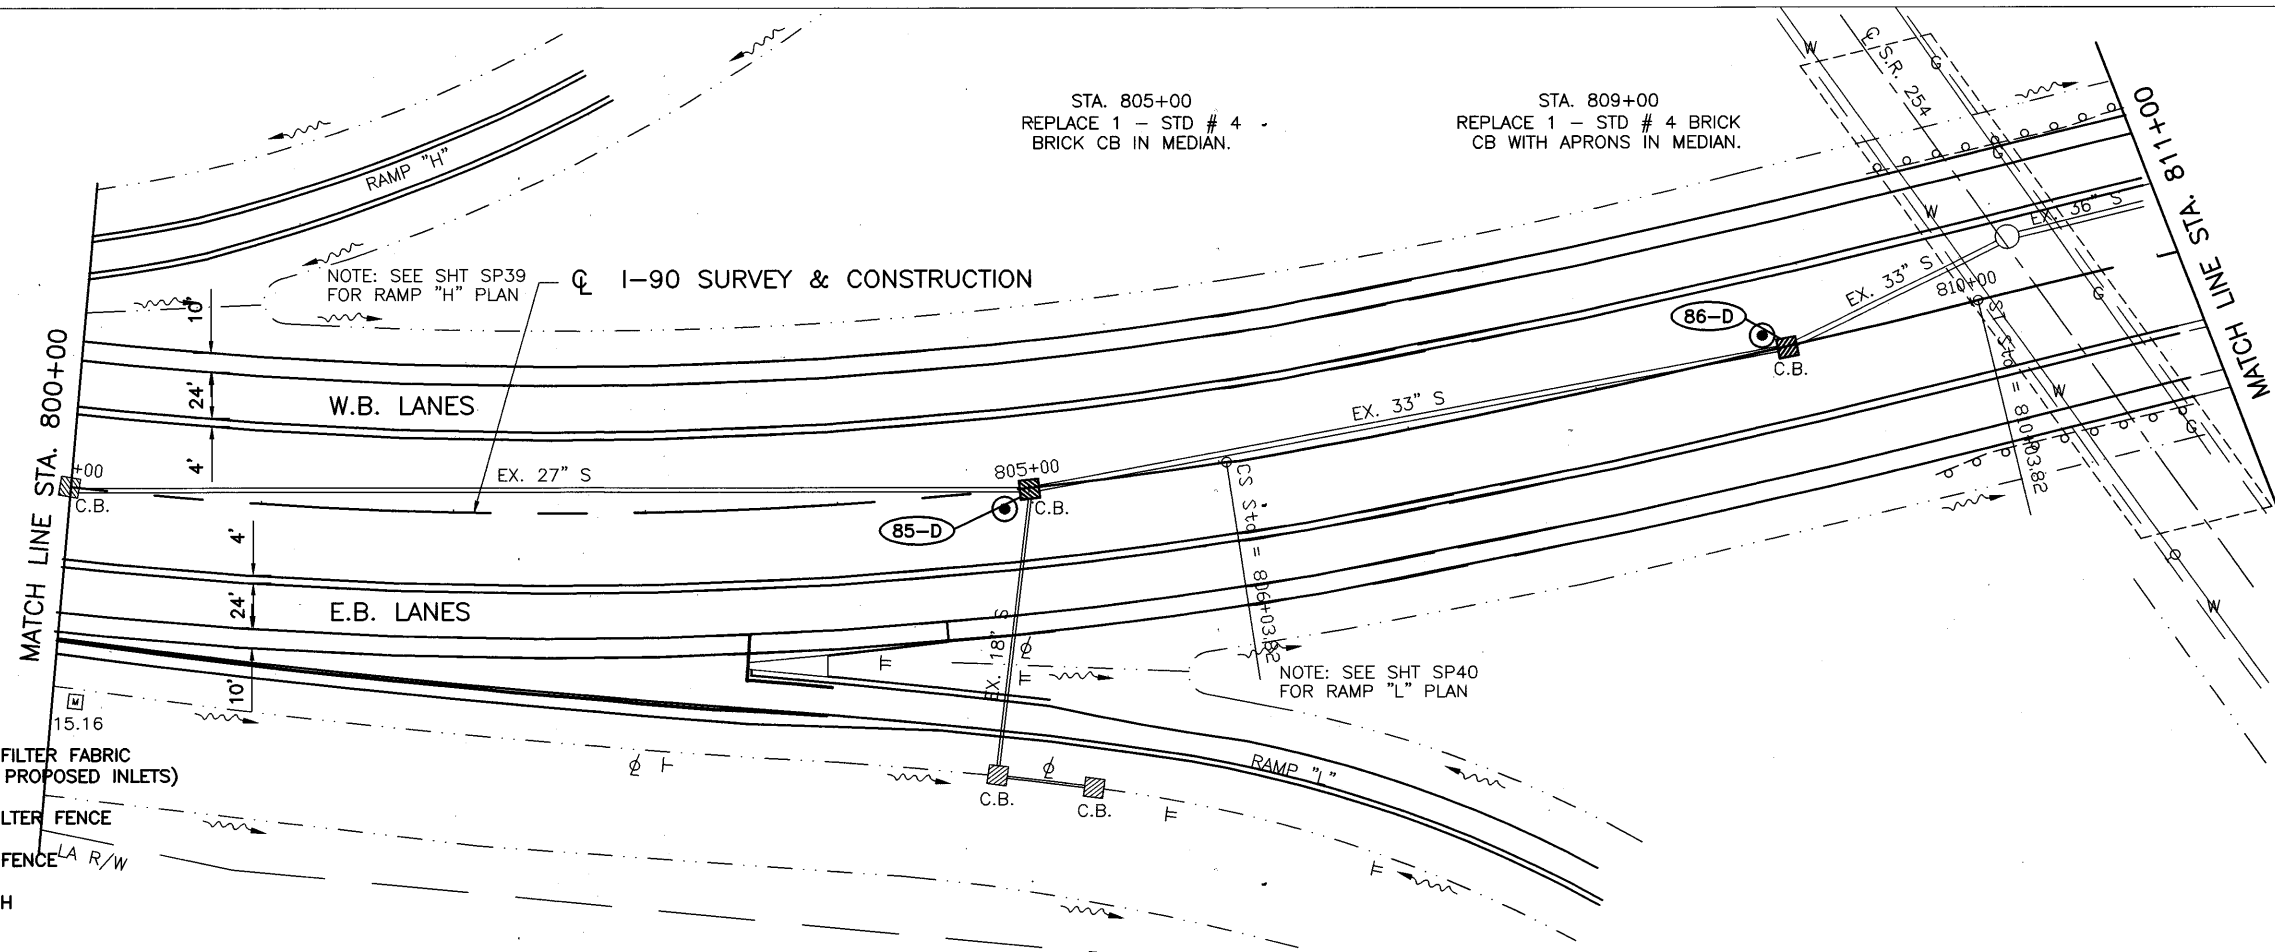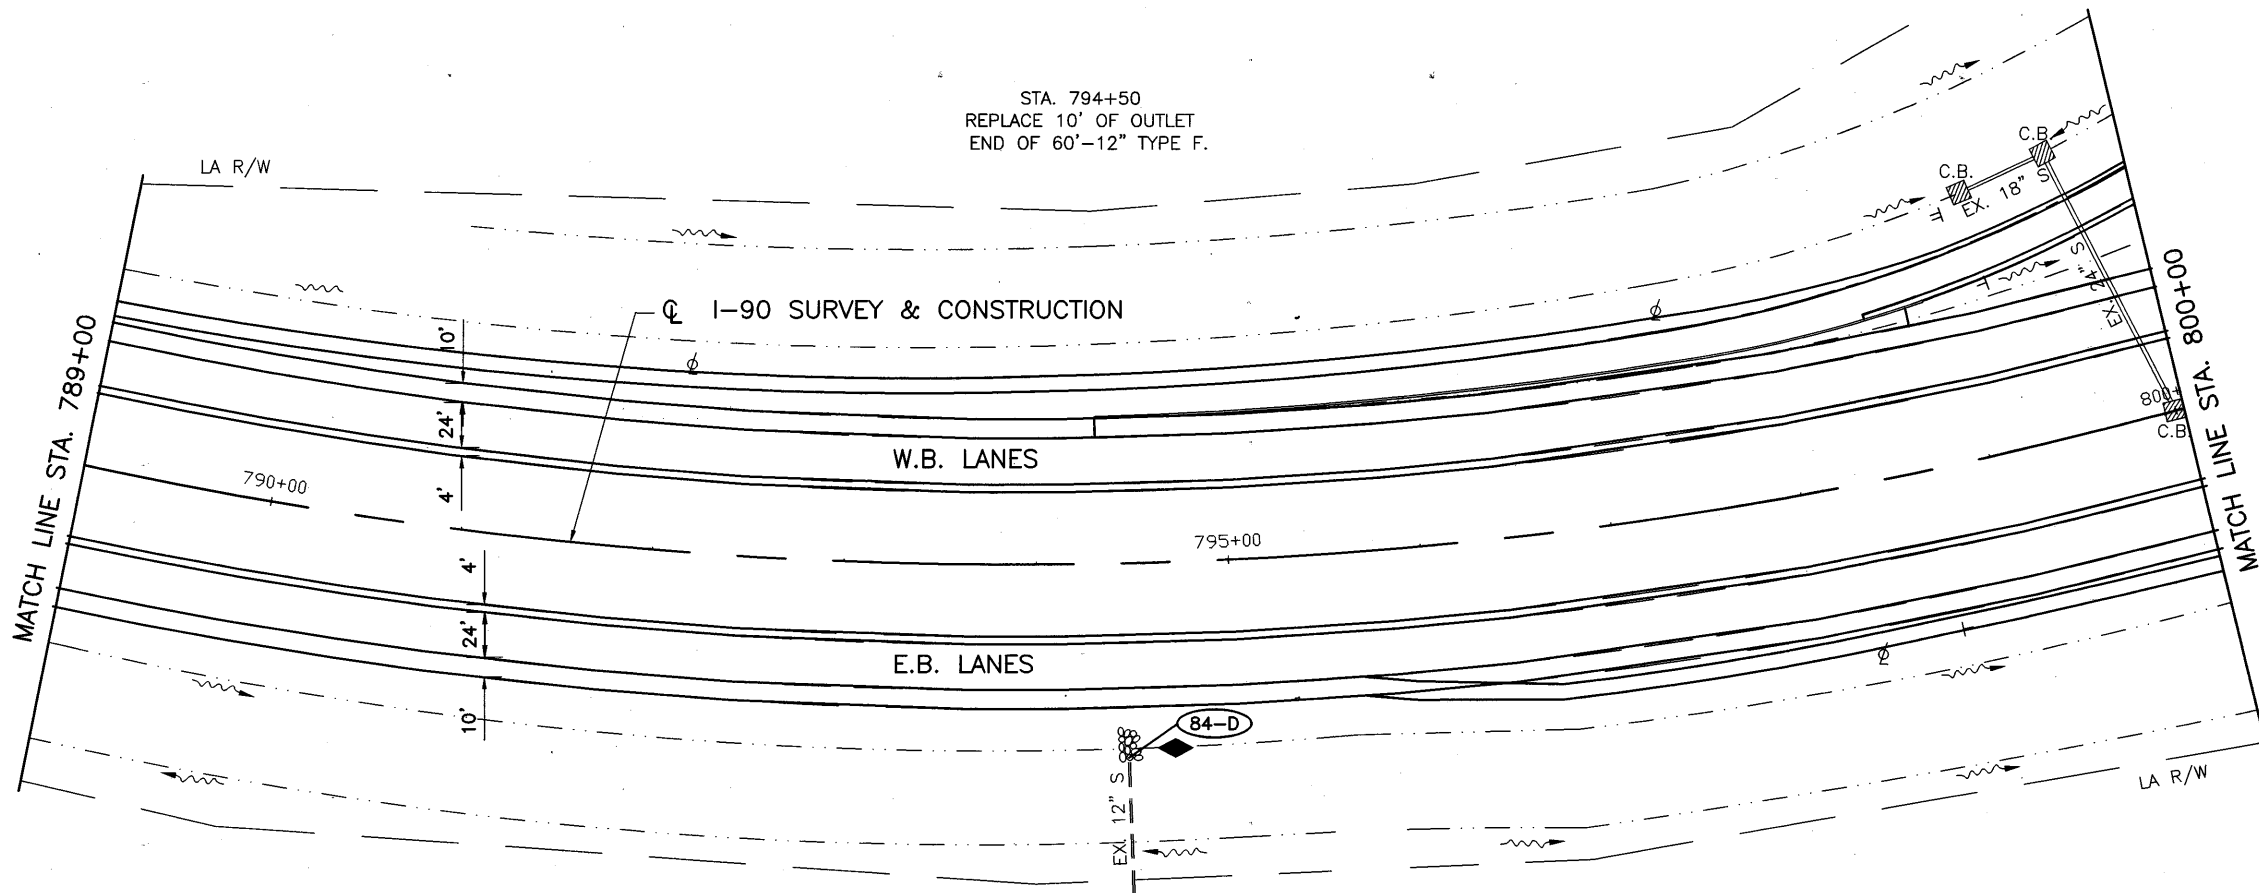

**LEGEND**



- TEMPORARY INLET PROTECT, FILTER FABRIC FENCE (AT ALL EXISTING AND PROPOSED INLETS)
- TEMPORARY DITCH CHECK, FILTER FENCE
- FF FILTER FABRIC FENCE
- DIRECTION OF FLOW DITCH
- SEDIMENT BASIN

CALCULATED	DLS	CHECKED	LAB

**STORM WATER POLLUTION PREVENTION PLAN**  
**STA. 789+00 TO STA. 811+00**

**LOR - 190 - 10.76**

C:\9800\DWG\VERSION\SP-22.DWG J JGR  
 2-19-2002 4:31 PM

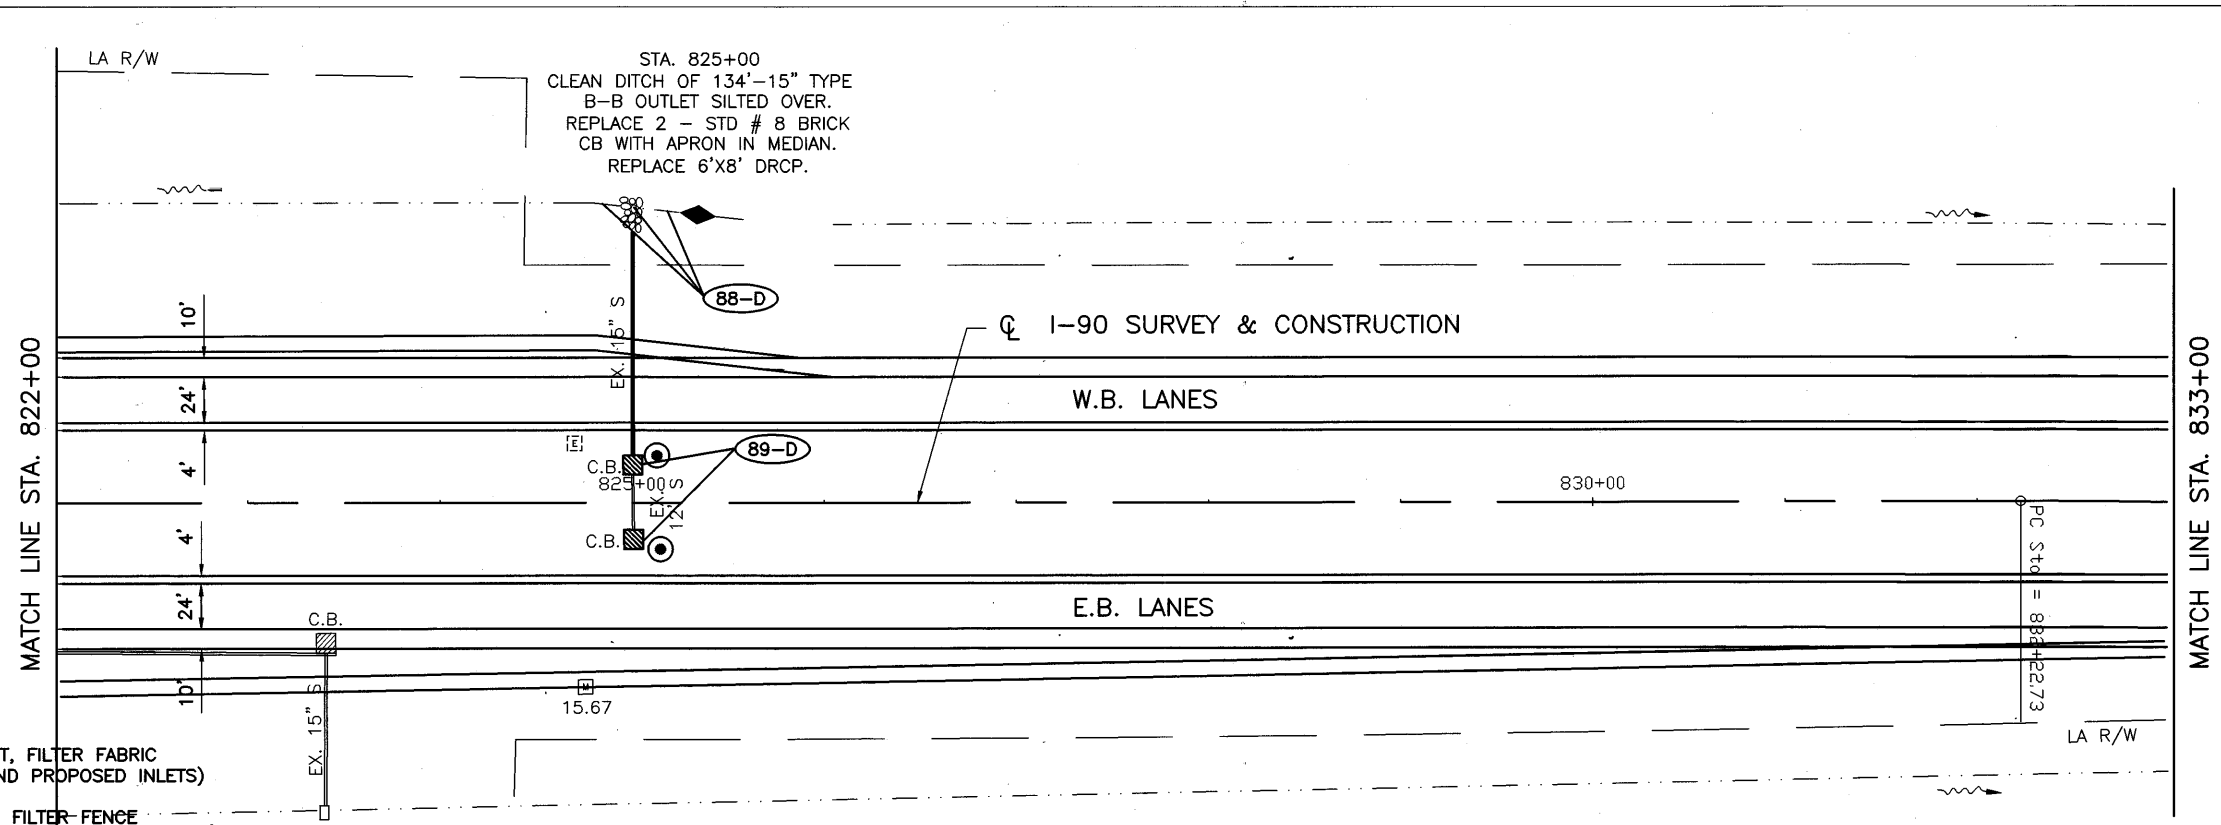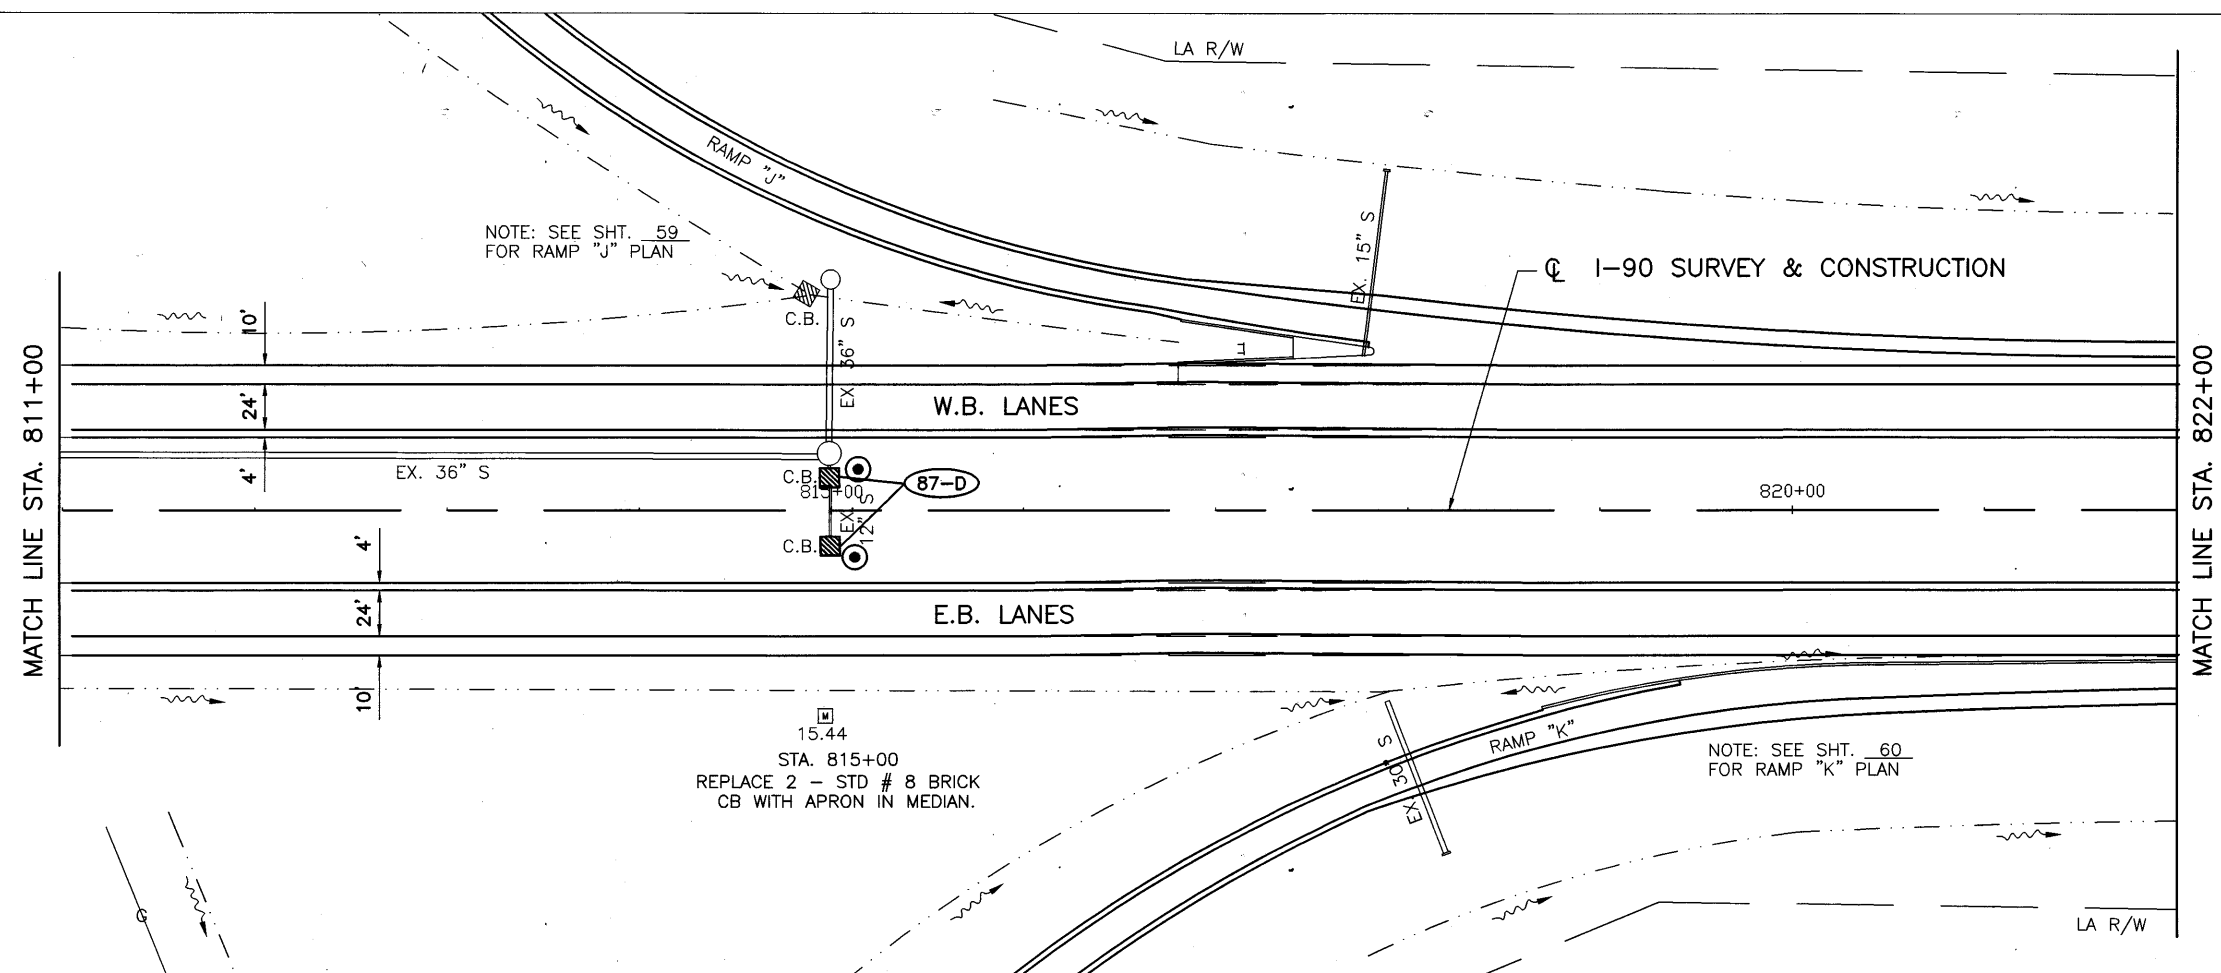

- LEGEND**
- ⊙ TEMPORARY INLET PROTECT, FILTER FABRIC FENCE (AT ALL EXISTING AND PROPOSED INLETS)
  - ◆ TEMPORARY DITCH CHECK, FILTER FENCE
  - FF — FILTER FABRIC FENCE
  - DIRECTION OF FLOW DITCH
  - ▣ SEDIMENT BASIN

CALCULATED	100
DLS	50
CHECKED	0
LAB	

HORIZONTAL SCALE IN FEET



**STORM WATER POLLUTION PREVENTION PLAN**  
**STA. 811+00 TO STA. 833+00**

**LOR - 190 - 10.76**


C:\93600\UNITS\LEGION\SP-23.DWG J.dg  
 12-19-2002 4:51PM

CURVE DATA 16  
 P.I. STA. 842+77.91  
 $\Delta = 30^{\circ}15'50''$   
 $D = 1'28'00''$   
 $R = 3906.53'$   
 $T = 1055.18'$   
 $L = 2061.17'$   
 $E = 140.00'$

STA. 836+00  
 REPLACE 2 STD # 8 BRICK  
 CB IN MEDIAN. REPLACE  
 6'X8' DRCP. CLEAN DITCH  
 OF 124'-15" TYPE B-B,  
 DITCH FULL OF WATER/SILTED.

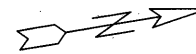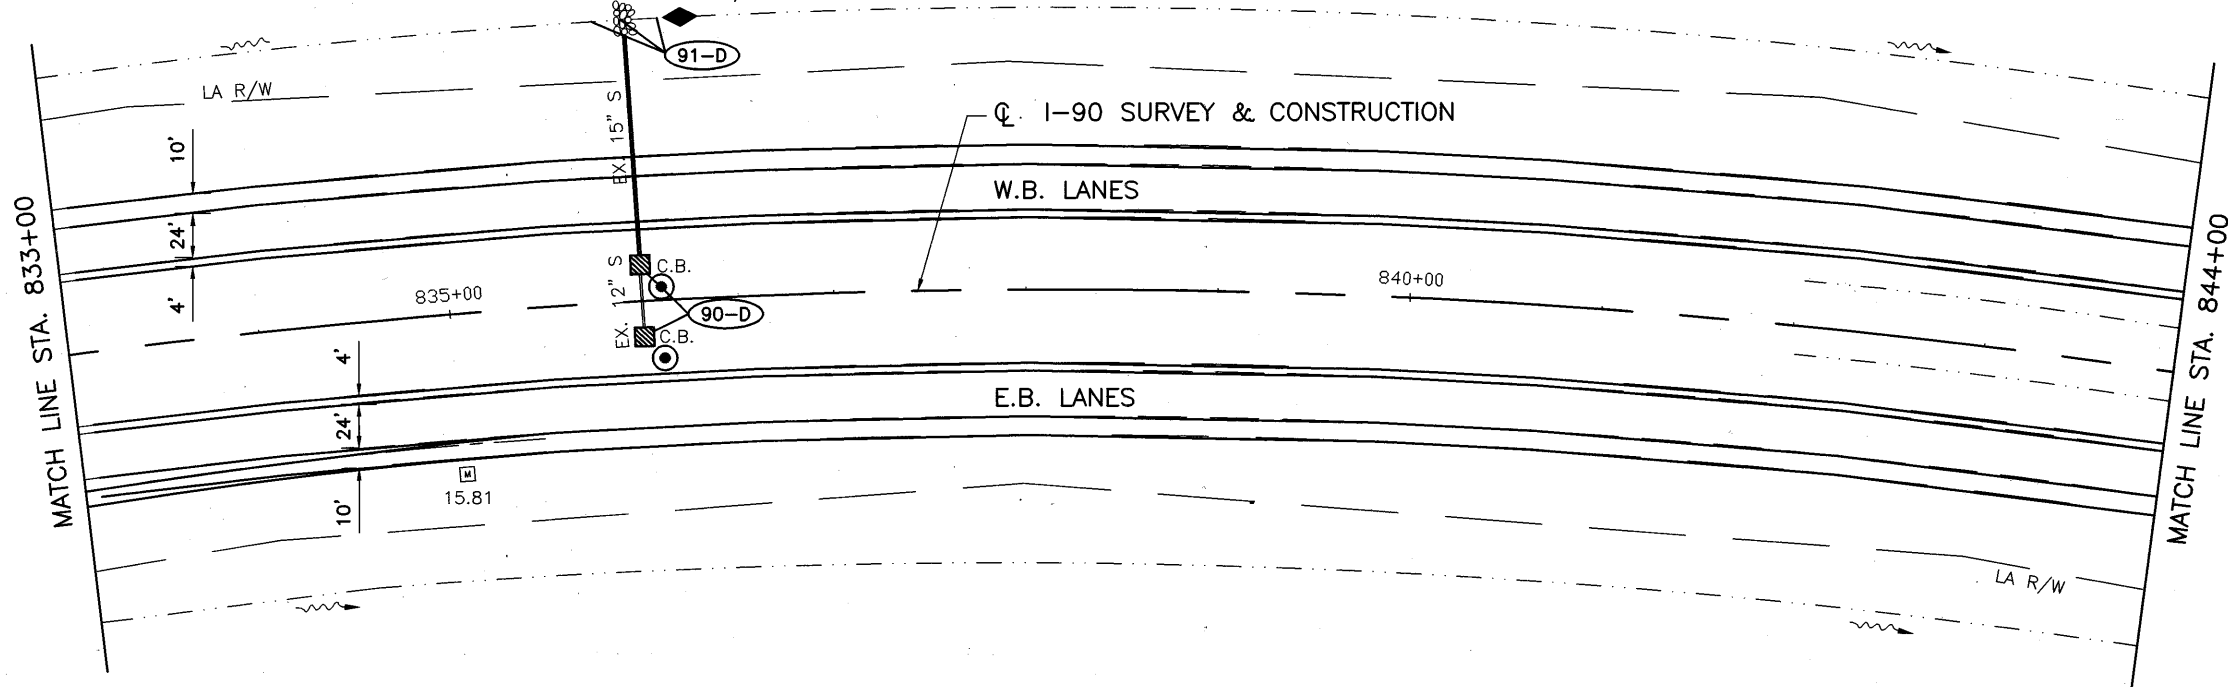

CALCULATED	DLS	CHECKED	LAB

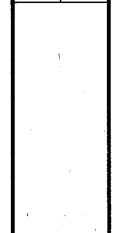



**STORM WATER POLLUTION PREVENTION PLAN**  
**STA. 833+00 TO STA. 855+00**

**LEGEND**

- TEMPORARY INLET PROTECT, FILTER FABRIC FENCE (AT ALL EXISTING AND PROPOSED INLETS)
- TEMPORARY DITCH CHECK, FILTER FENCE
- FILTER FABRIC FENCE
- DIRECTION OF FLOW DITCH
- SEDIMENT BASIN

STA. 845+75-846+25  
 ESTABLISH POSITIVE DRAINAGE  
 FLOW FOR 54'-12"  
 TYPE B-B AND 2 - STD # 4 CB'S.



STA. 845+75  
 CLEAN PIPE OF 143'-15" TYPE B-B.  
 REPLACE 8'X6' DRCP.

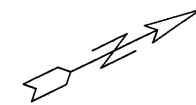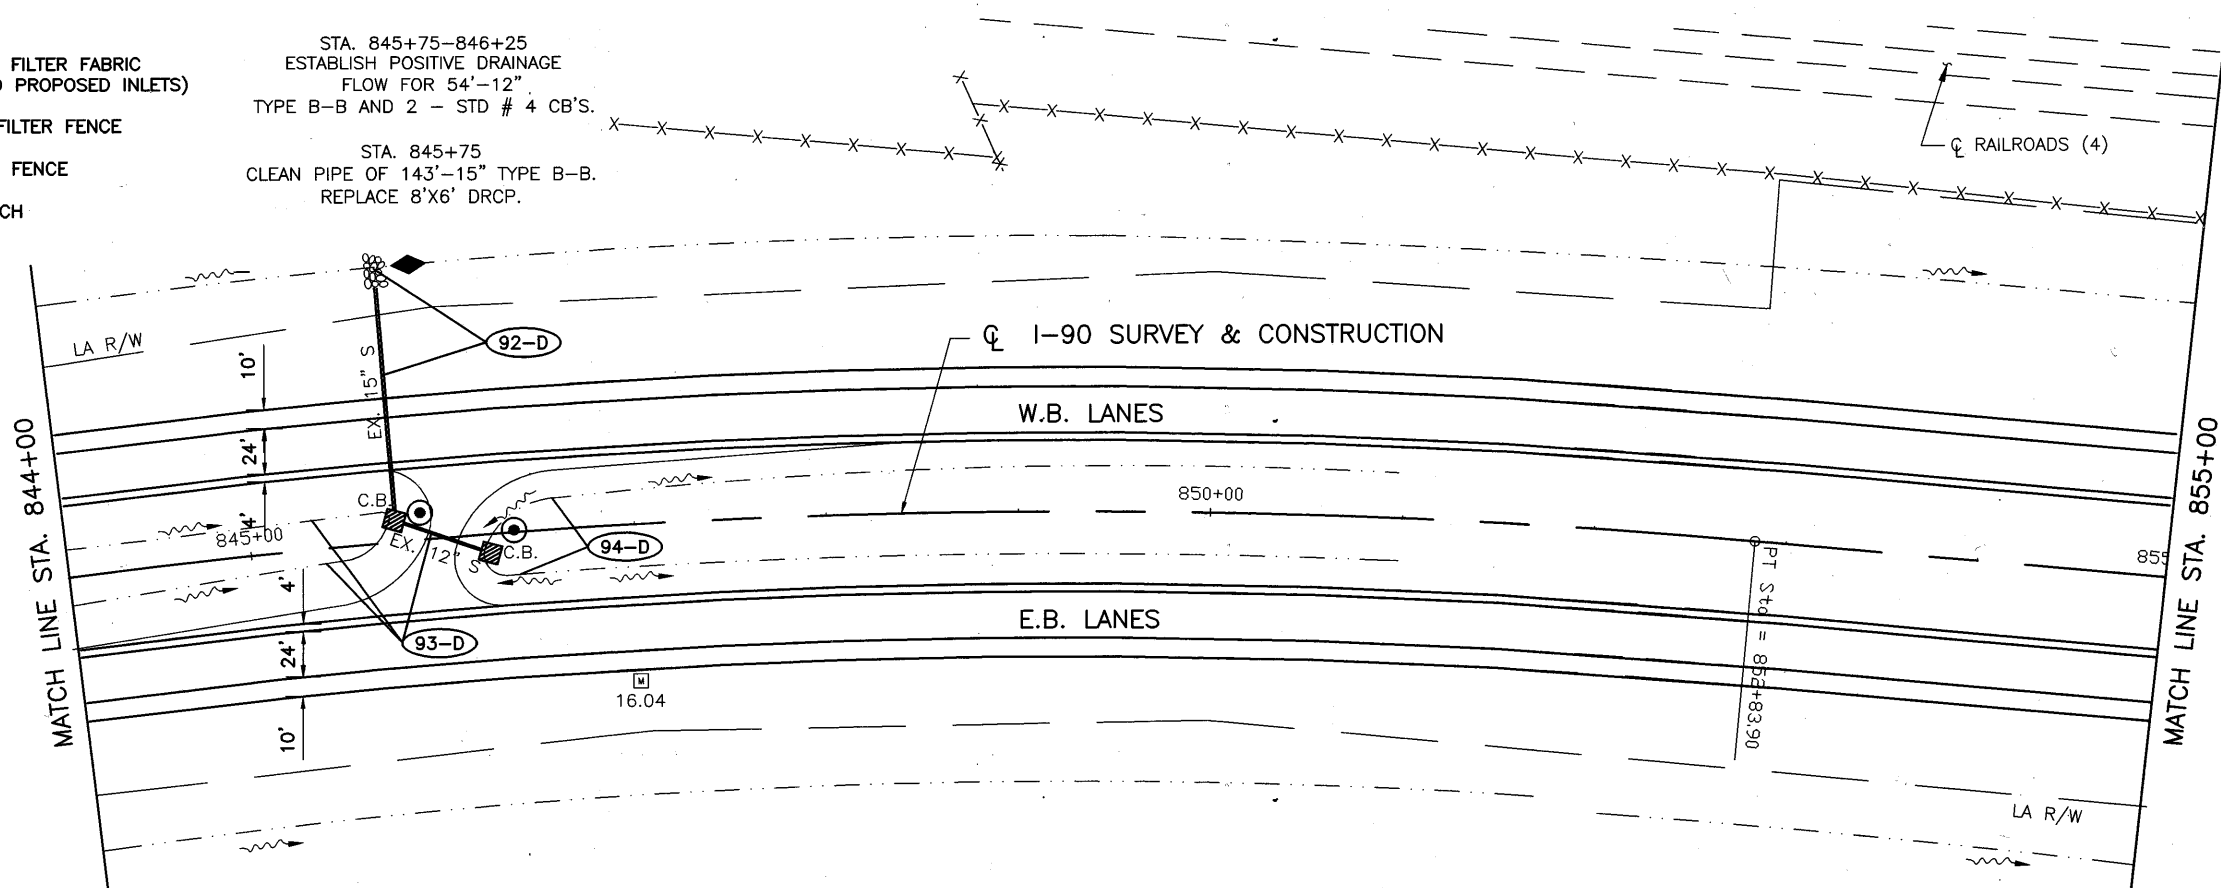

**LOR - 190 - 10.76**

**LEGEND**

- ⊙ TEMPORARY INLET PROTECT, FILTER FABRIC FENCE (AT ALL EXISTING AND PROPOSED INLETS)
- ◆ TEMPORARY DITCH CHECK, FILTER FENCE
- FF FILTER FABRIC FENCE
- DIRECTION OF FLOW DITCH
- ▣ SEDIMENT BASIN

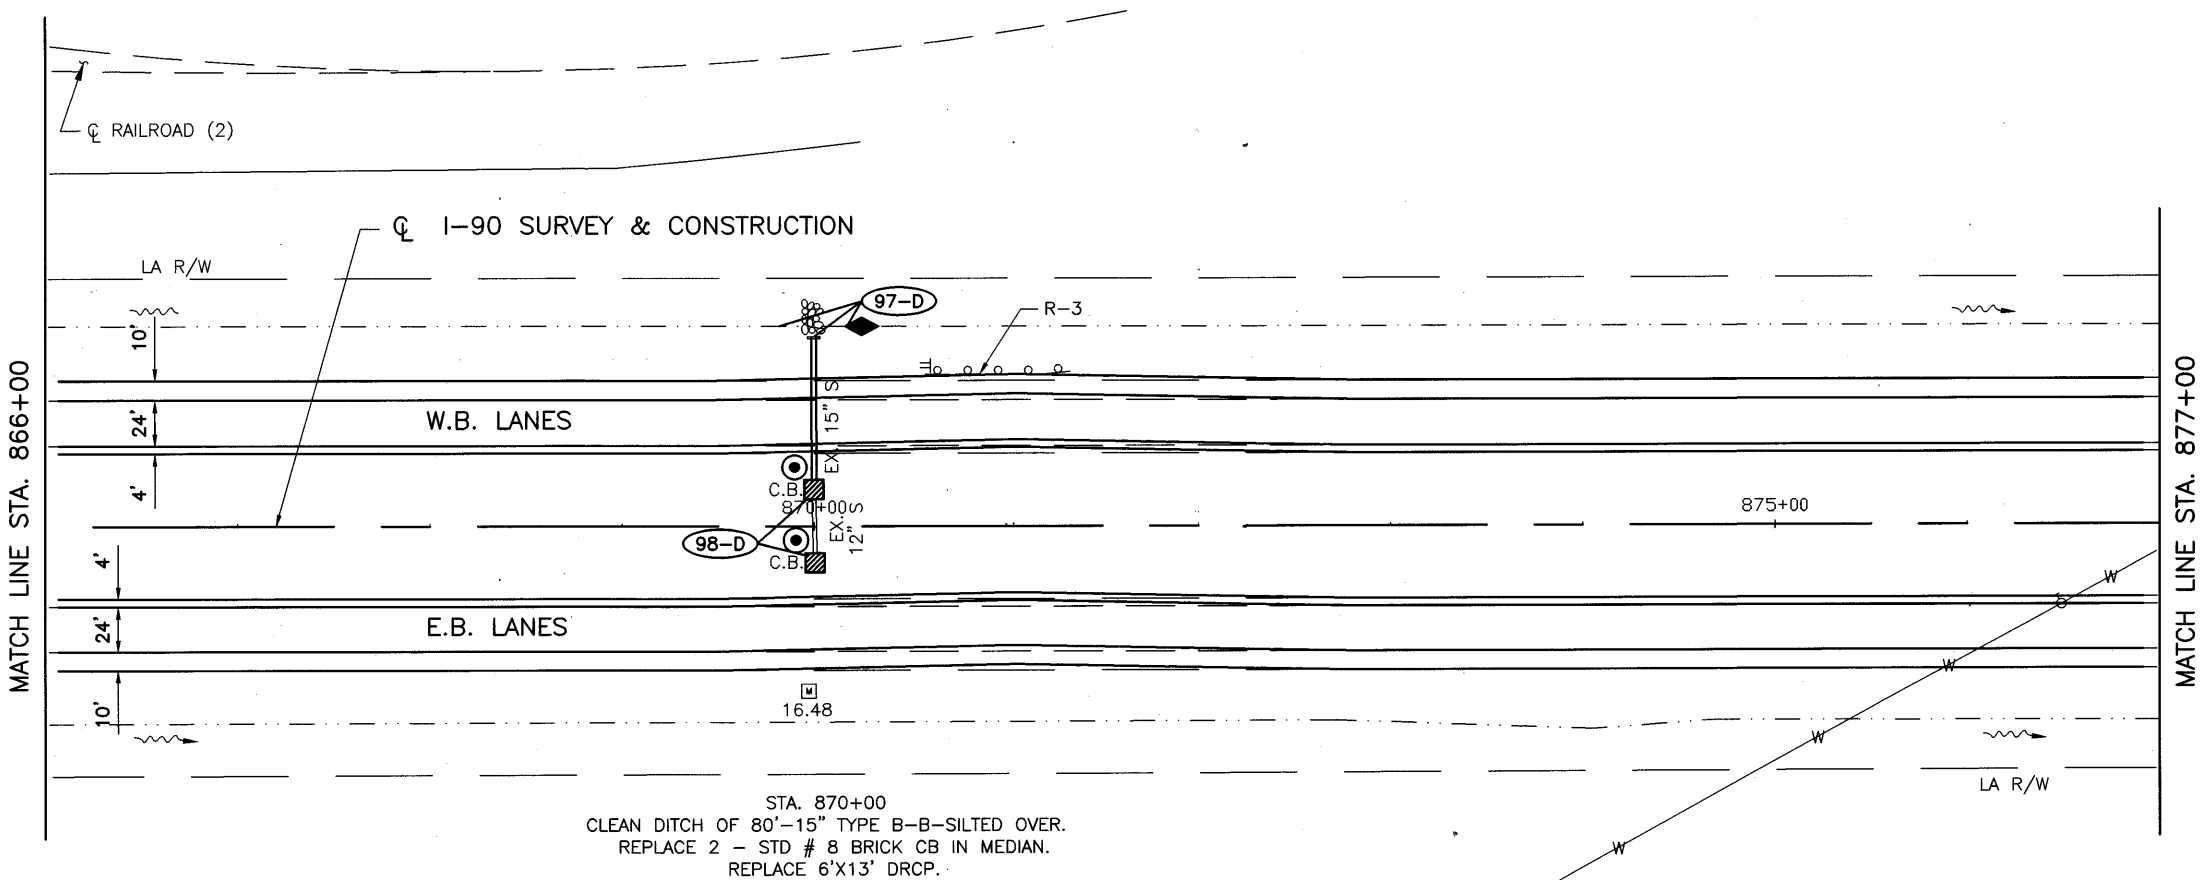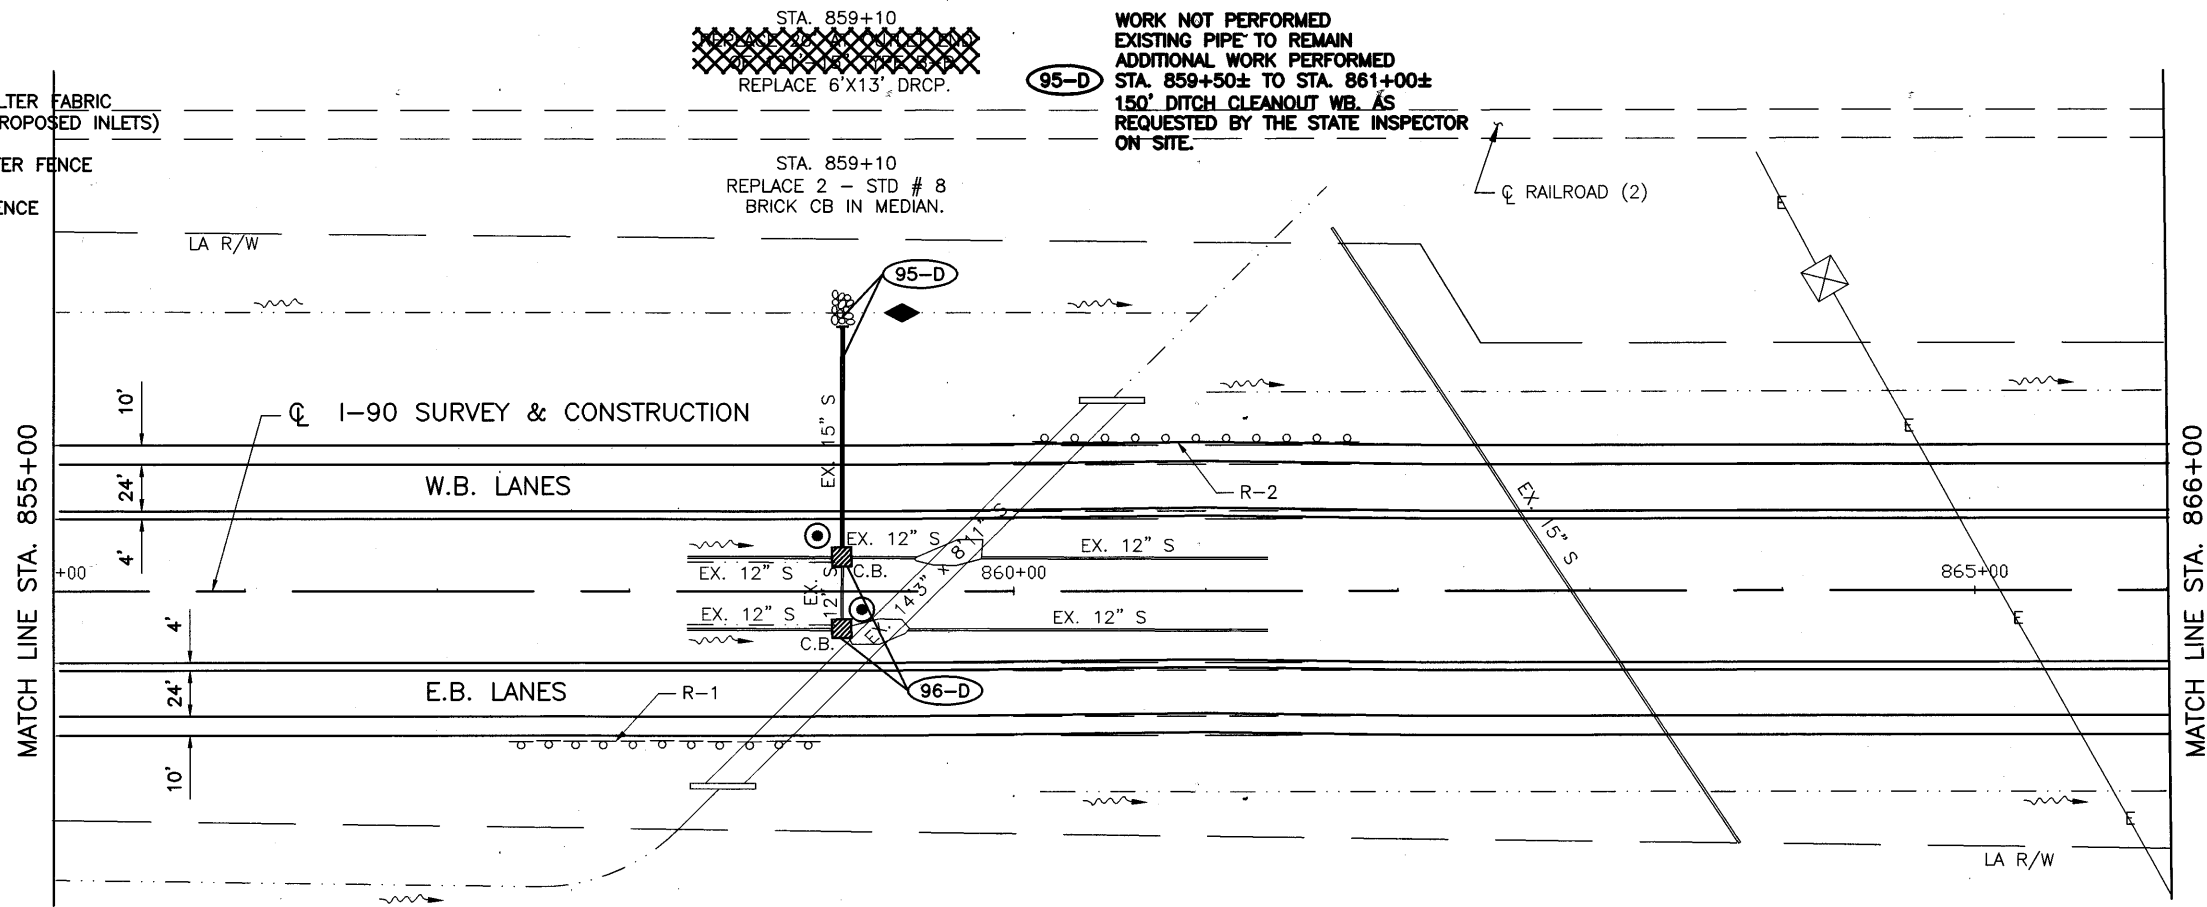



CALCULATED	DLS	CHECKED	LAB

0 50 100  
HORIZONTAL  
SCALE IN FEET

**STORM WATER POLLUTION PREVENTION PLAN  
STA. 855+00 TO STA. 877+00**

**LOR - 190 - 10.76**

0:\936001\DWGS\EROSION\SP-25.DWG JGR  
 2-19-2002 4:43PM

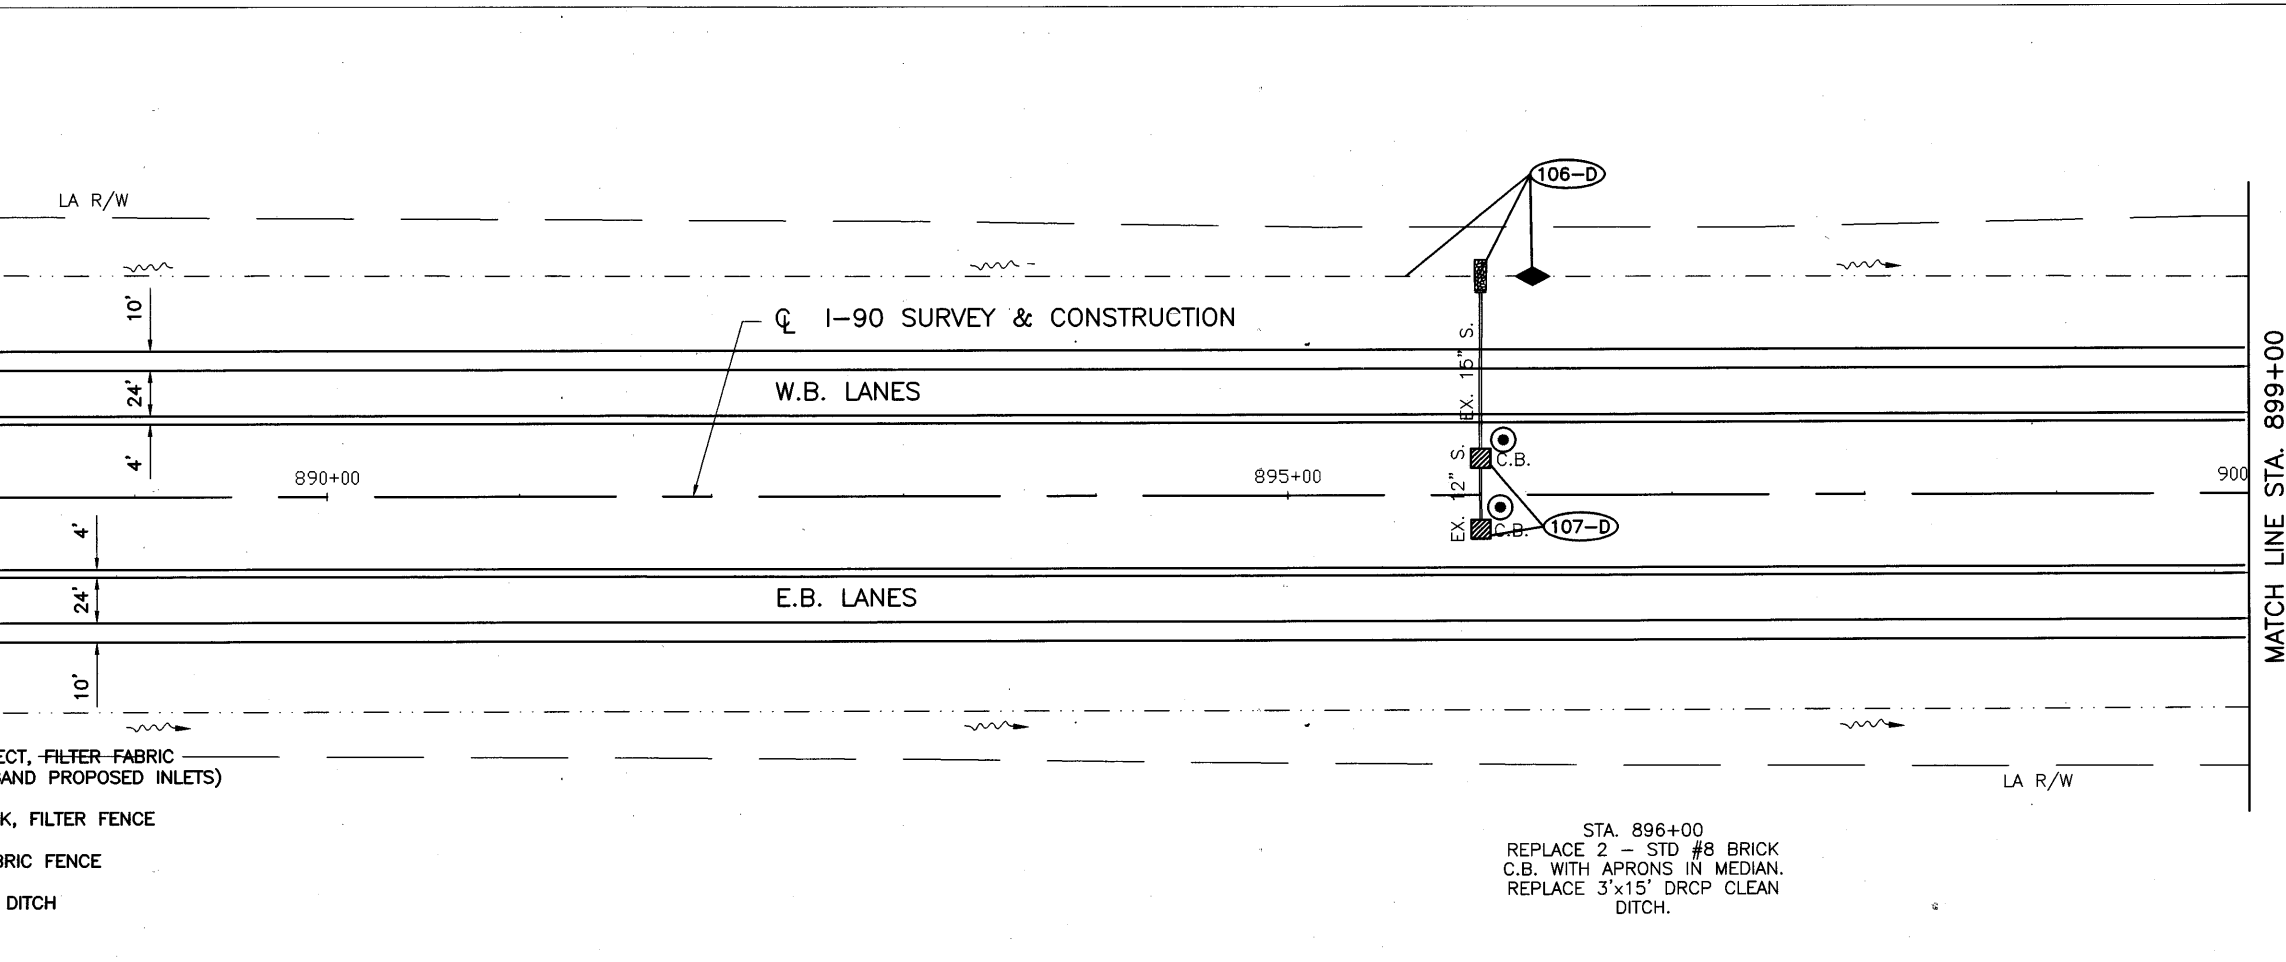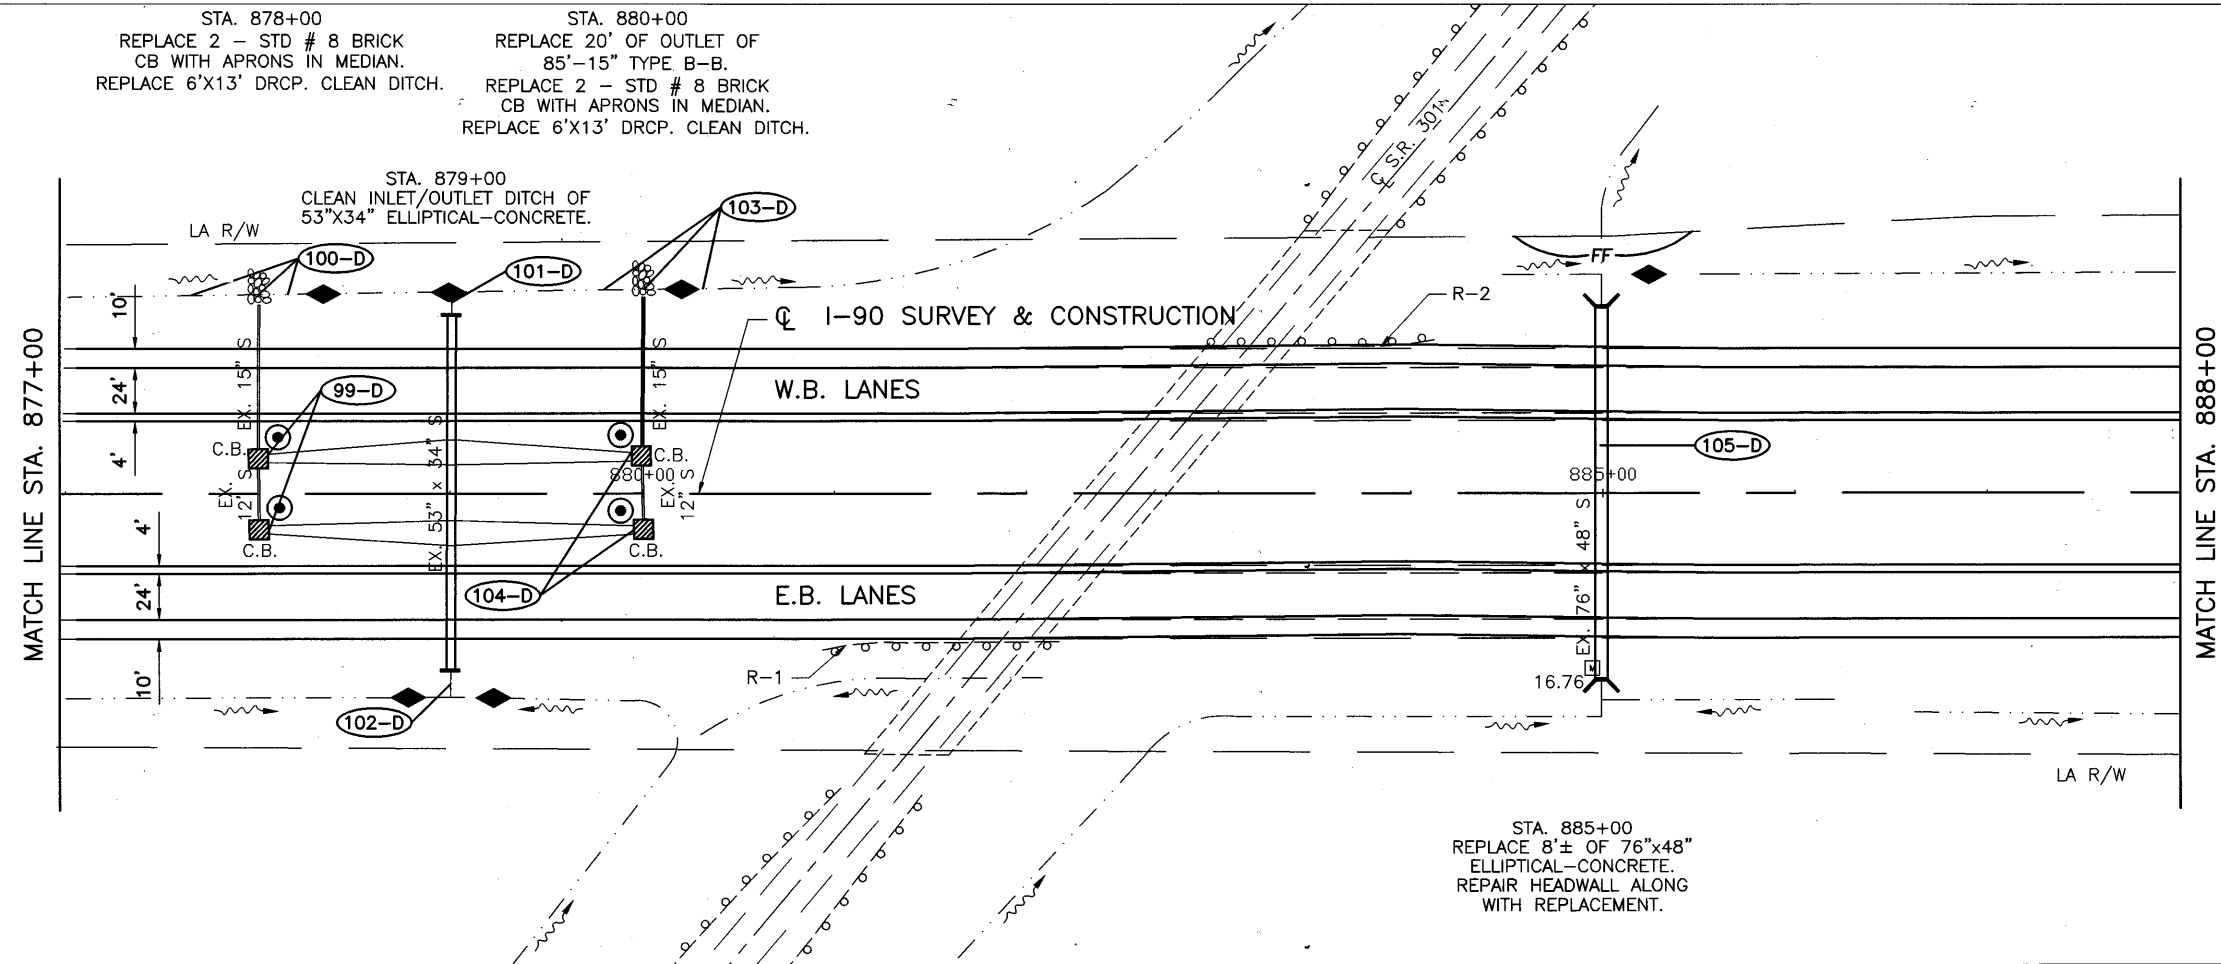

- LEGEND**
- ⊙ TEMPORARY INLET PROTECT, FILTER FABRIC FENCE (AT ALL EXISTING AND PROPOSED INLETS)
  - ◆ TEMPORARY DITCH CHECK, FILTER FENCE
  - FF — FILTER FABRIC FENCE
  - DIRECTION OF FLOW DITCH
  - ▭ SEDIMENT BASIN

CALCULATED	DLS	CHECKED	LAB


STORM WATER POLLUTION PREVENTION PLAN  
STA. 877+00 TO STA. 899+00

LOR - 190 - 10.76

0:\93600\DWG\EROSION\SP-26.DWG JGR 2-19-2002 4:56PM

STA. 902+90  
REPLACE 1 - STD #8 BRICK  
C.B. IN MEDIAN.


STA. 903+28  
REPLACE 1 - STD #8 BRICK  
C.B. IN MEDIAN.

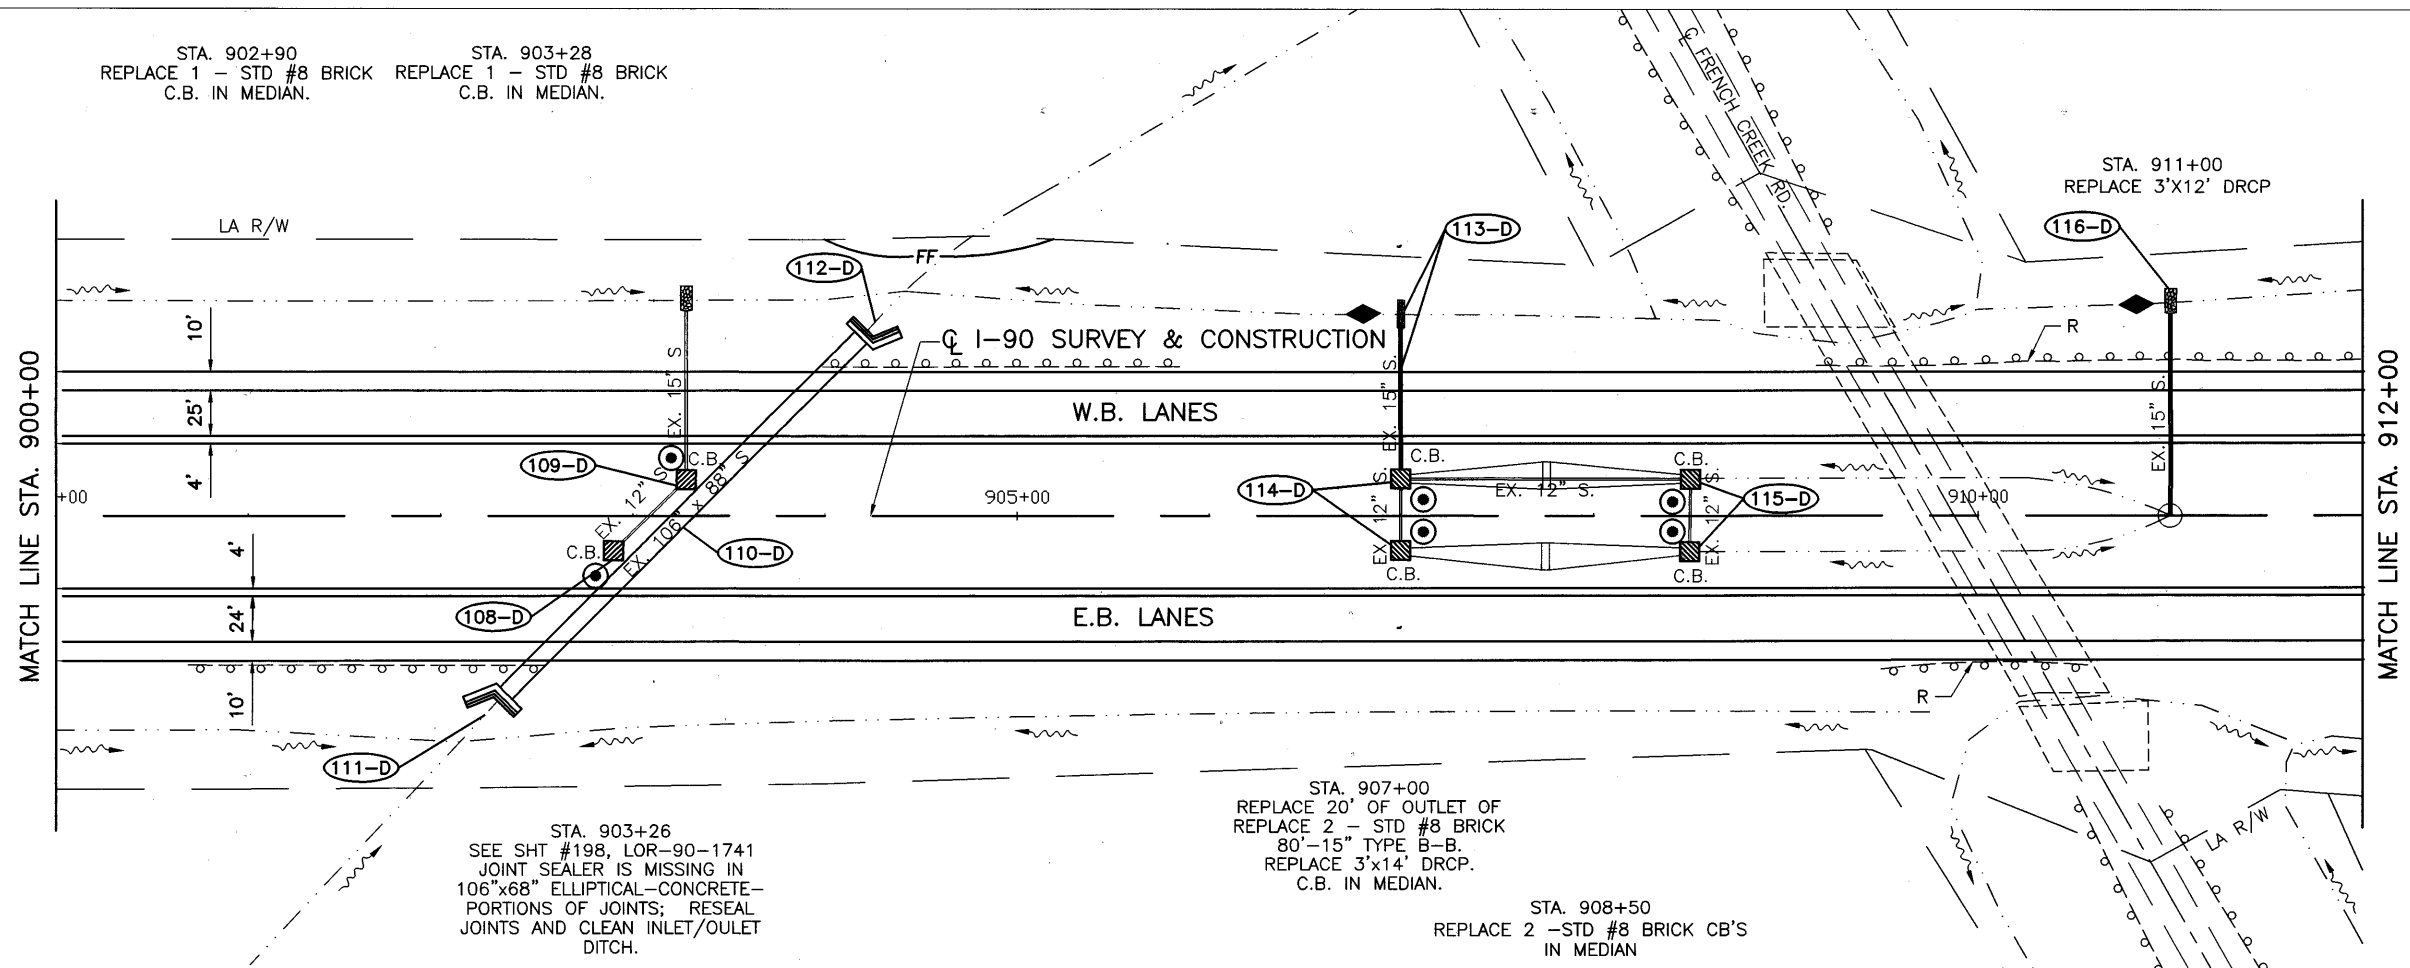

STA. 903+26  
SEE SHT #198, LOR-90-1741  
JOINT SEALER IS MISSING IN  
106"x68" ELLIPTICAL-CONCRETE-  
PORTIONS OF JOINTS; RESEAL  
JOINTS AND CLEAN INLET/OUTLET  
DITCH.

STA. 907+00  
REPLACE 20" OF OUTLET OF  
REPLACE 2 - STD #8 BRICK  
80"-15" TYPE B-B.  
REPLACE 3"x14" DRCP.  
C.B. IN MEDIAN.

STA. 908+50  
REPLACE 2 - STD #8 BRICK CB'S  
IN MEDIAN

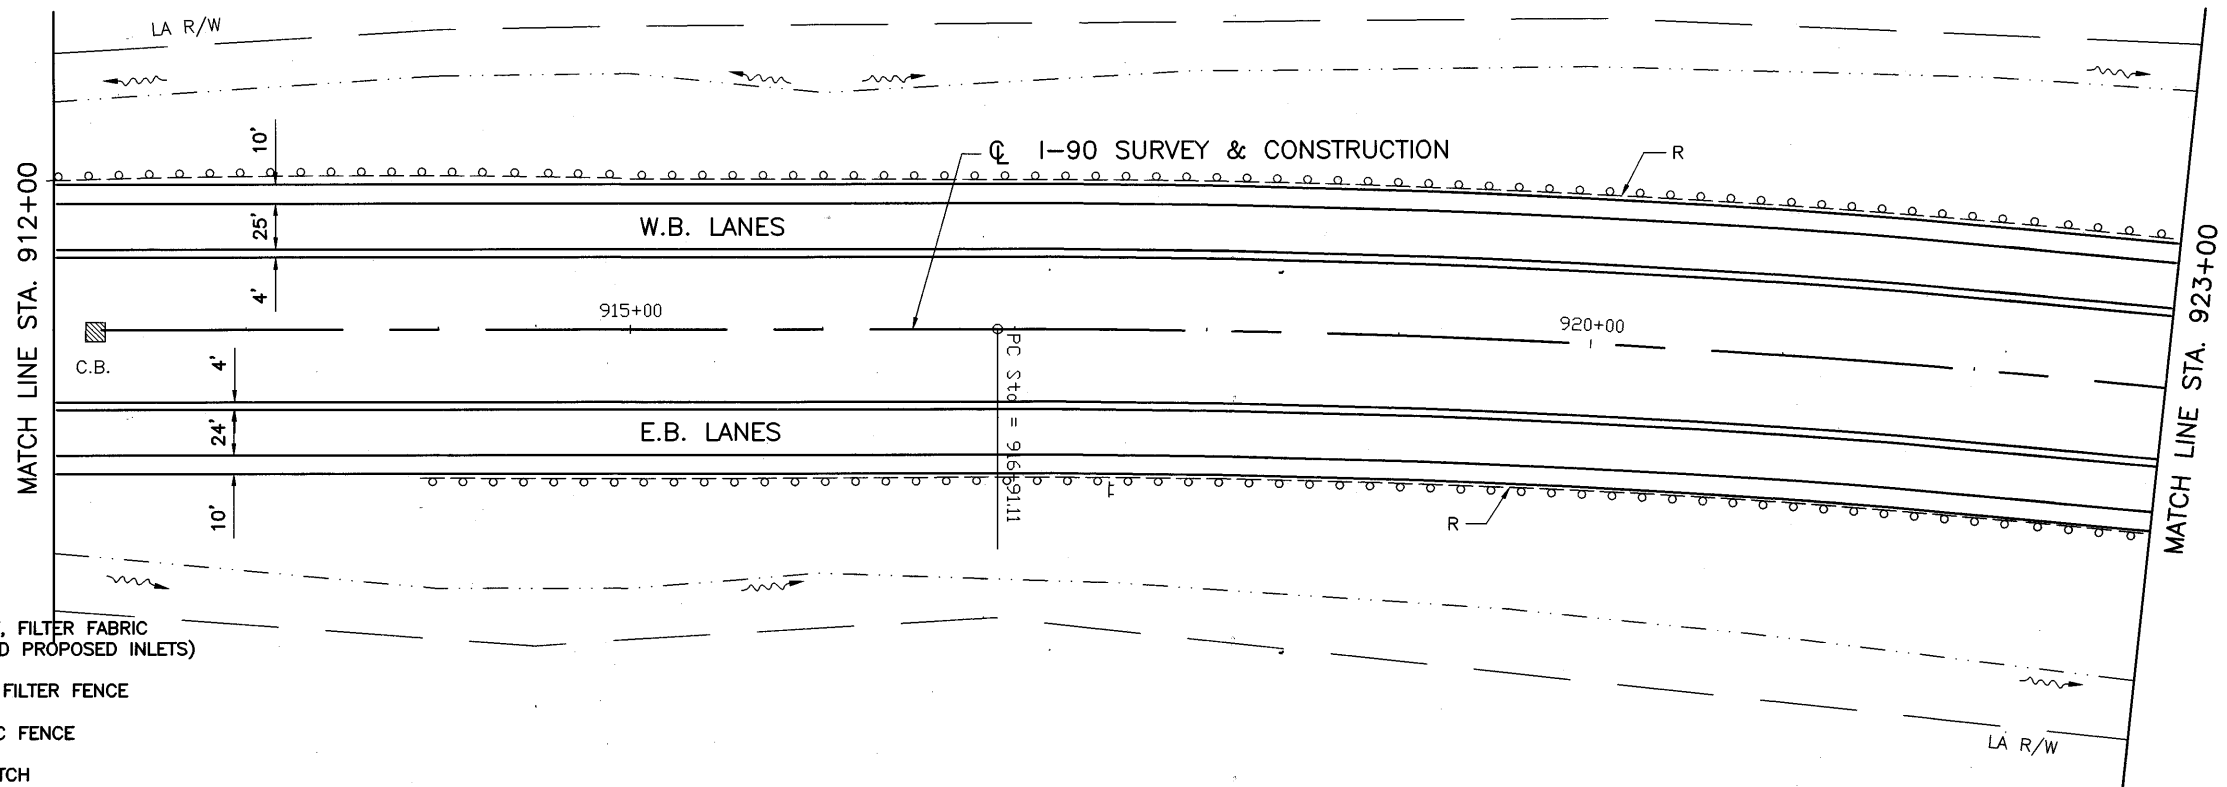

**LEGEND**


- ⊙ TEMPORARY INLET PROTECT, FILTER FABRIC FENCE (AT ALL EXISTING AND PROPOSED INLETS)
- ◆ TEMPORARY DITCH CHECK, FILTER FABRIC
- FF — FILTER FABRIC FENCE
- DIRECTION OF FLOW DITCH
- ▣ SEDIMENT BASIN

CALCULATED	DLS	CHECKED	LAB

**STORM WATER POLLUTION PREVENTION PLAN**  
STA. 885+00 TO STA. 904+00


LOR - 190 - 10.76

C:\05000\DWG\EROSION\SP-27.DWG 1 JGR 02-19-2002 4:58PM

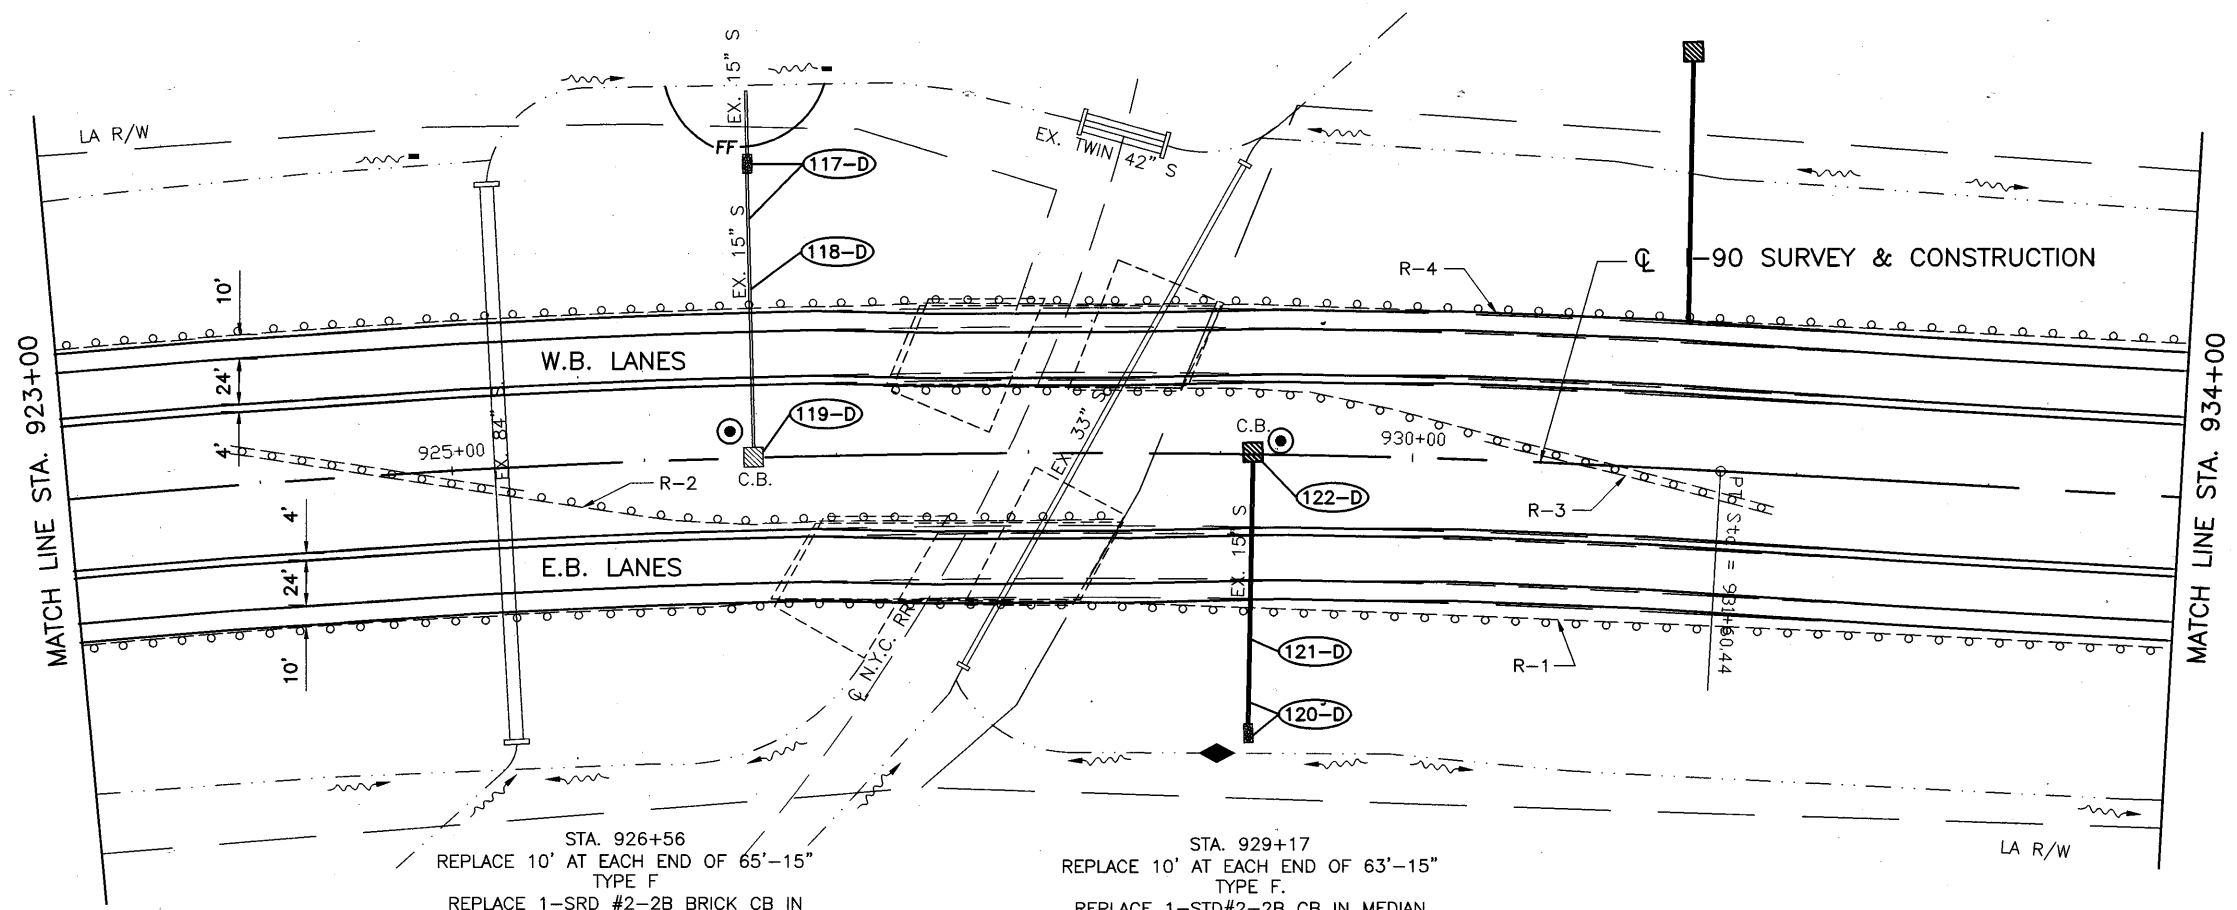

STA. 926+56  
 REPLACE 10' AT EACH END OF 65'-15"  
 TYPE F  
 REPLACE 1-SRD #2-2B BRICK CB IN  
 MEDIAN  
 REPLACE 3'X10' DRCP

STA. 929+17  
 REPLACE 10' AT EACH END OF 63'-15"  
 TYPE F  
 REPLACE 1-STD #2-2B CB IN MEDIAN  
 REPLACE 3'X10' DRCP

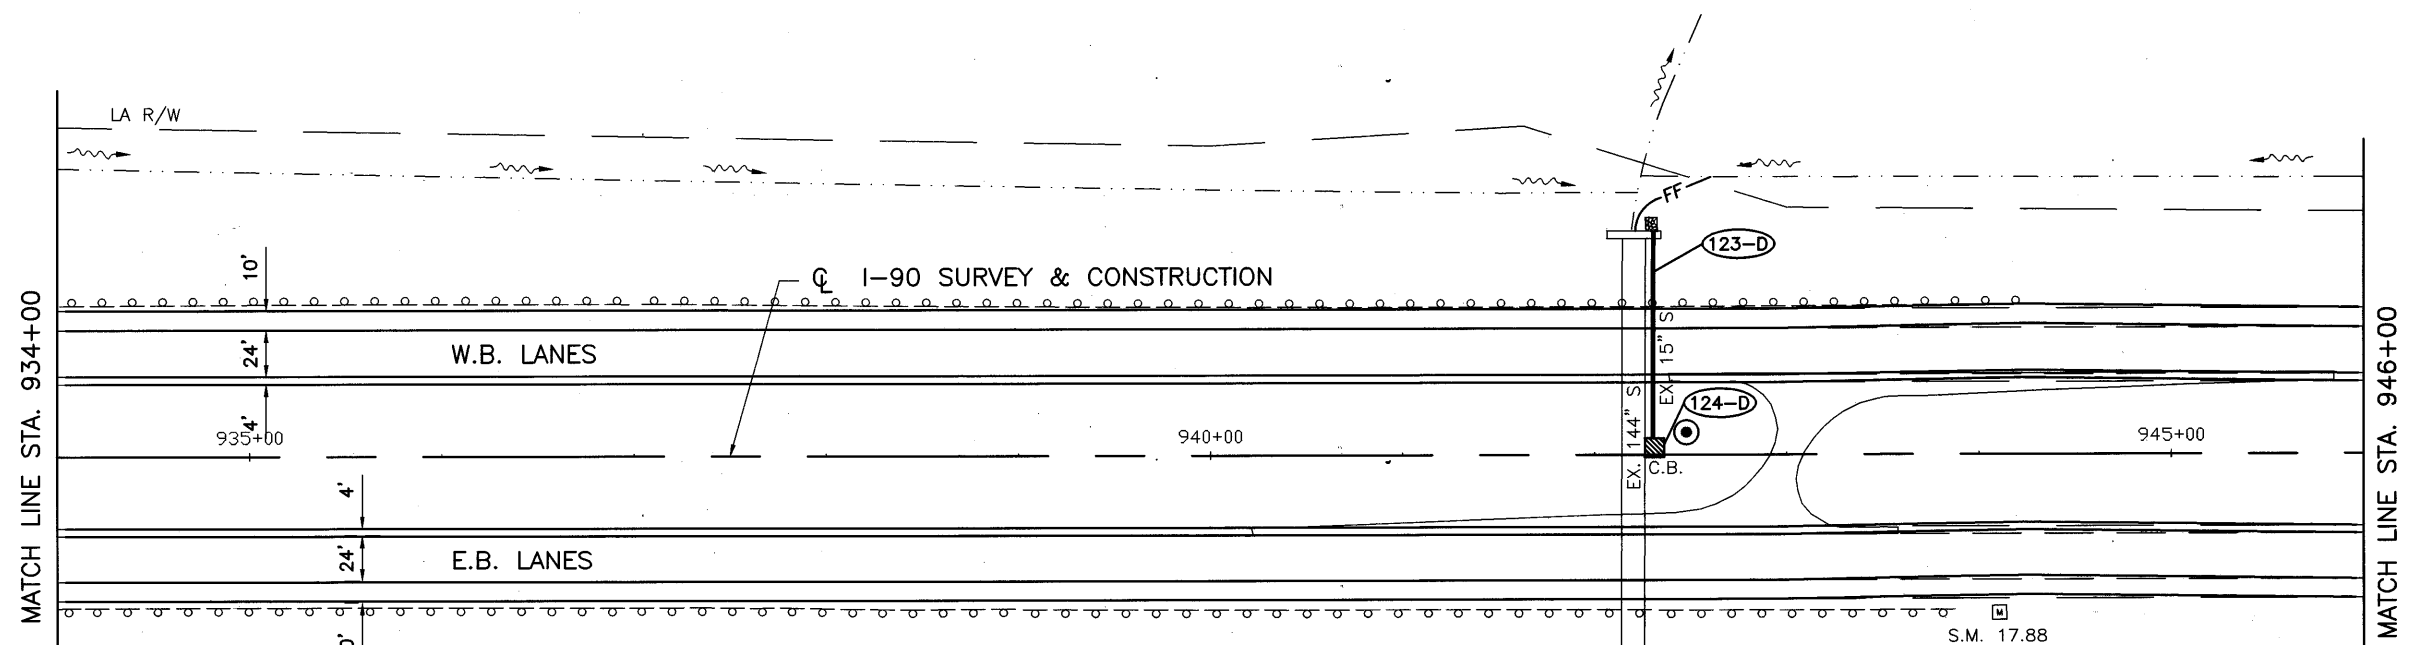

STA. 942+30  
 REPLACE 32'-15" TYPE F  
 REPLACE 1-STD #5 BRICK CB IN MEDIAN

**LEGEND**

- ⊙ TEMPORARY INLET PROTECT, FILTER FABRIC FENCE (AT ALL EXISTING AND PROPOSED INLETS)
- ◆ TEMPORARY DITCH CHECK, FILTER FENCE
- FF — FILTER FABRIC FENCE
- ~ DIRECTION OF FLOW DITCH
- ▣ SEDIMENT BASIN

CALCULATED	DLS	CHECKED	LAB



STORM WATER POLLUTION PREVENTION PLAN  
 STA. 904+00 TO STA. 926+00

LOR - 190 - 10.76

48  
 274

A:\93500\UNITS\EROSION\SP-28.DWG 1 JGR  
 11-19-2002 3:20PM



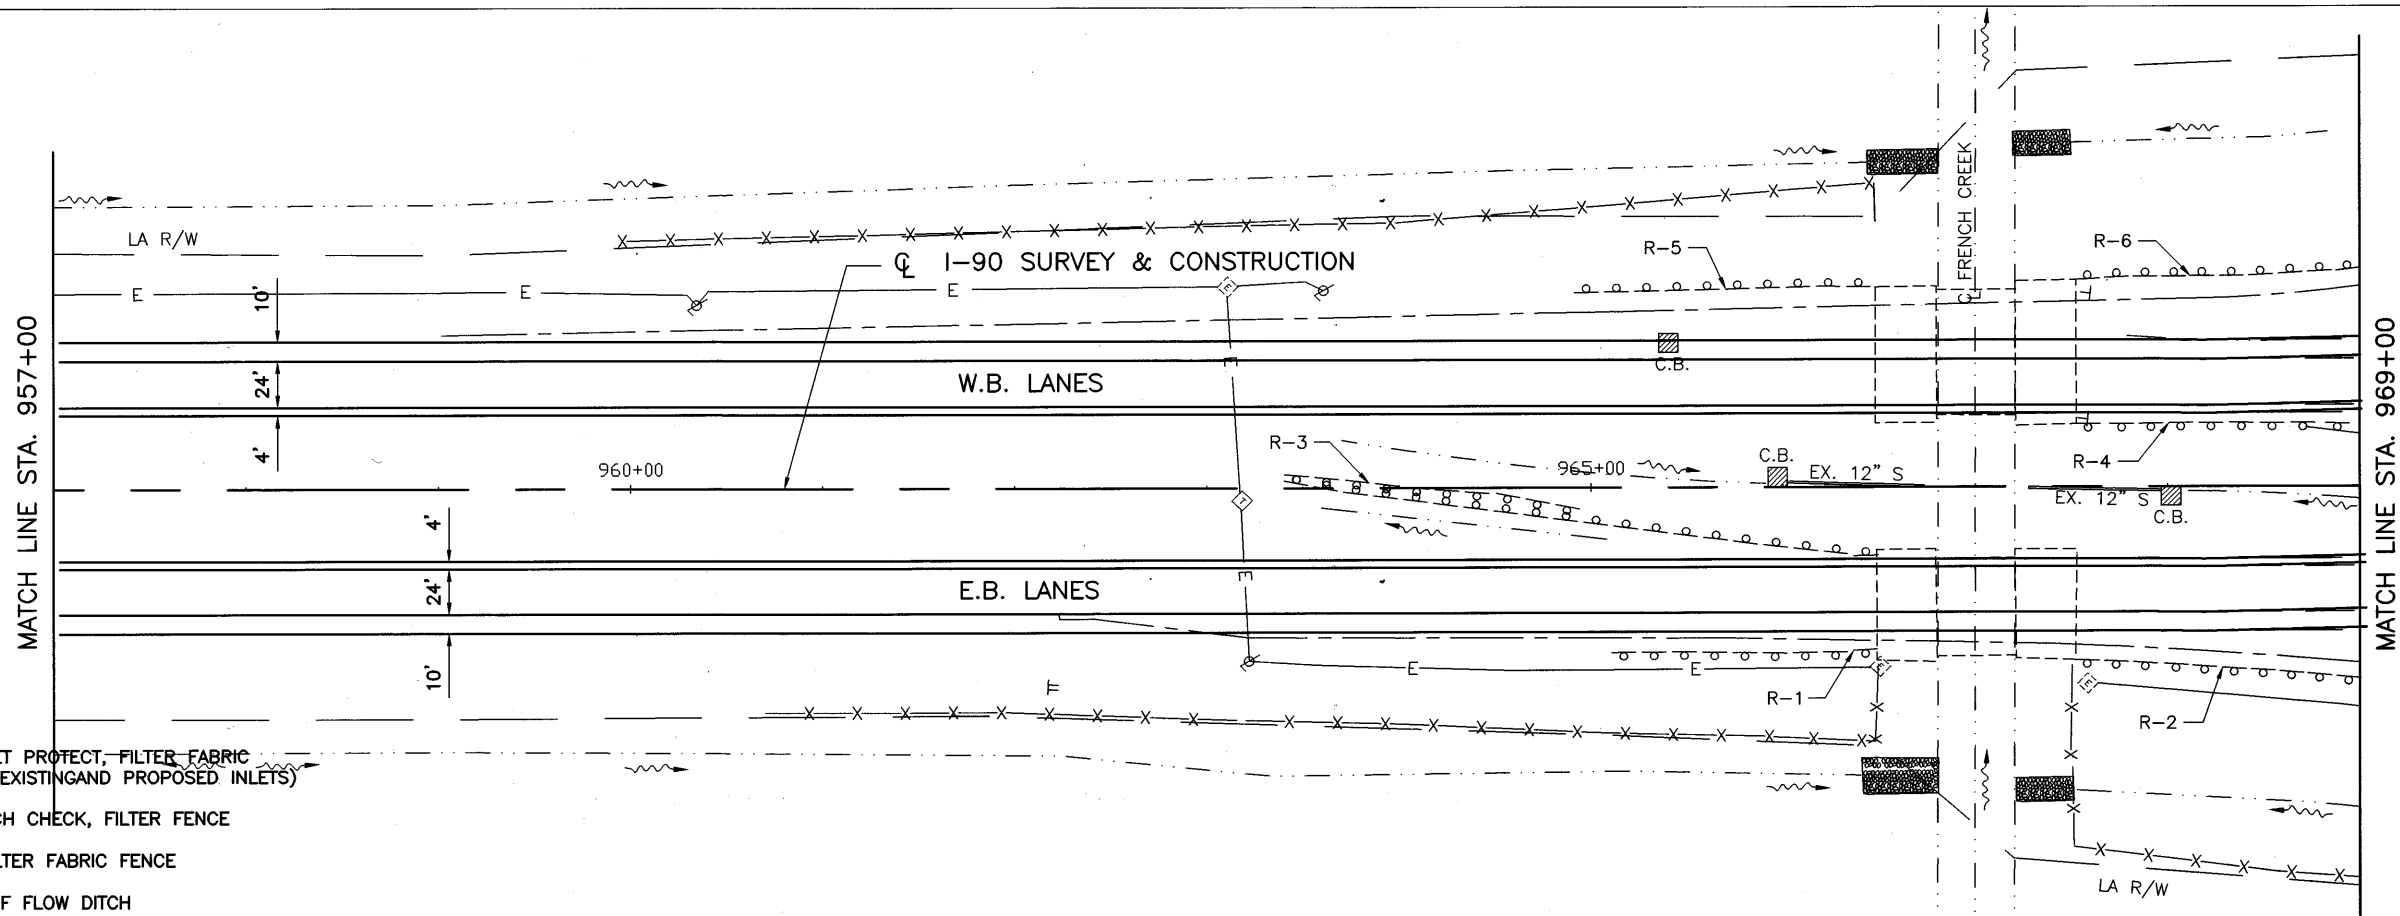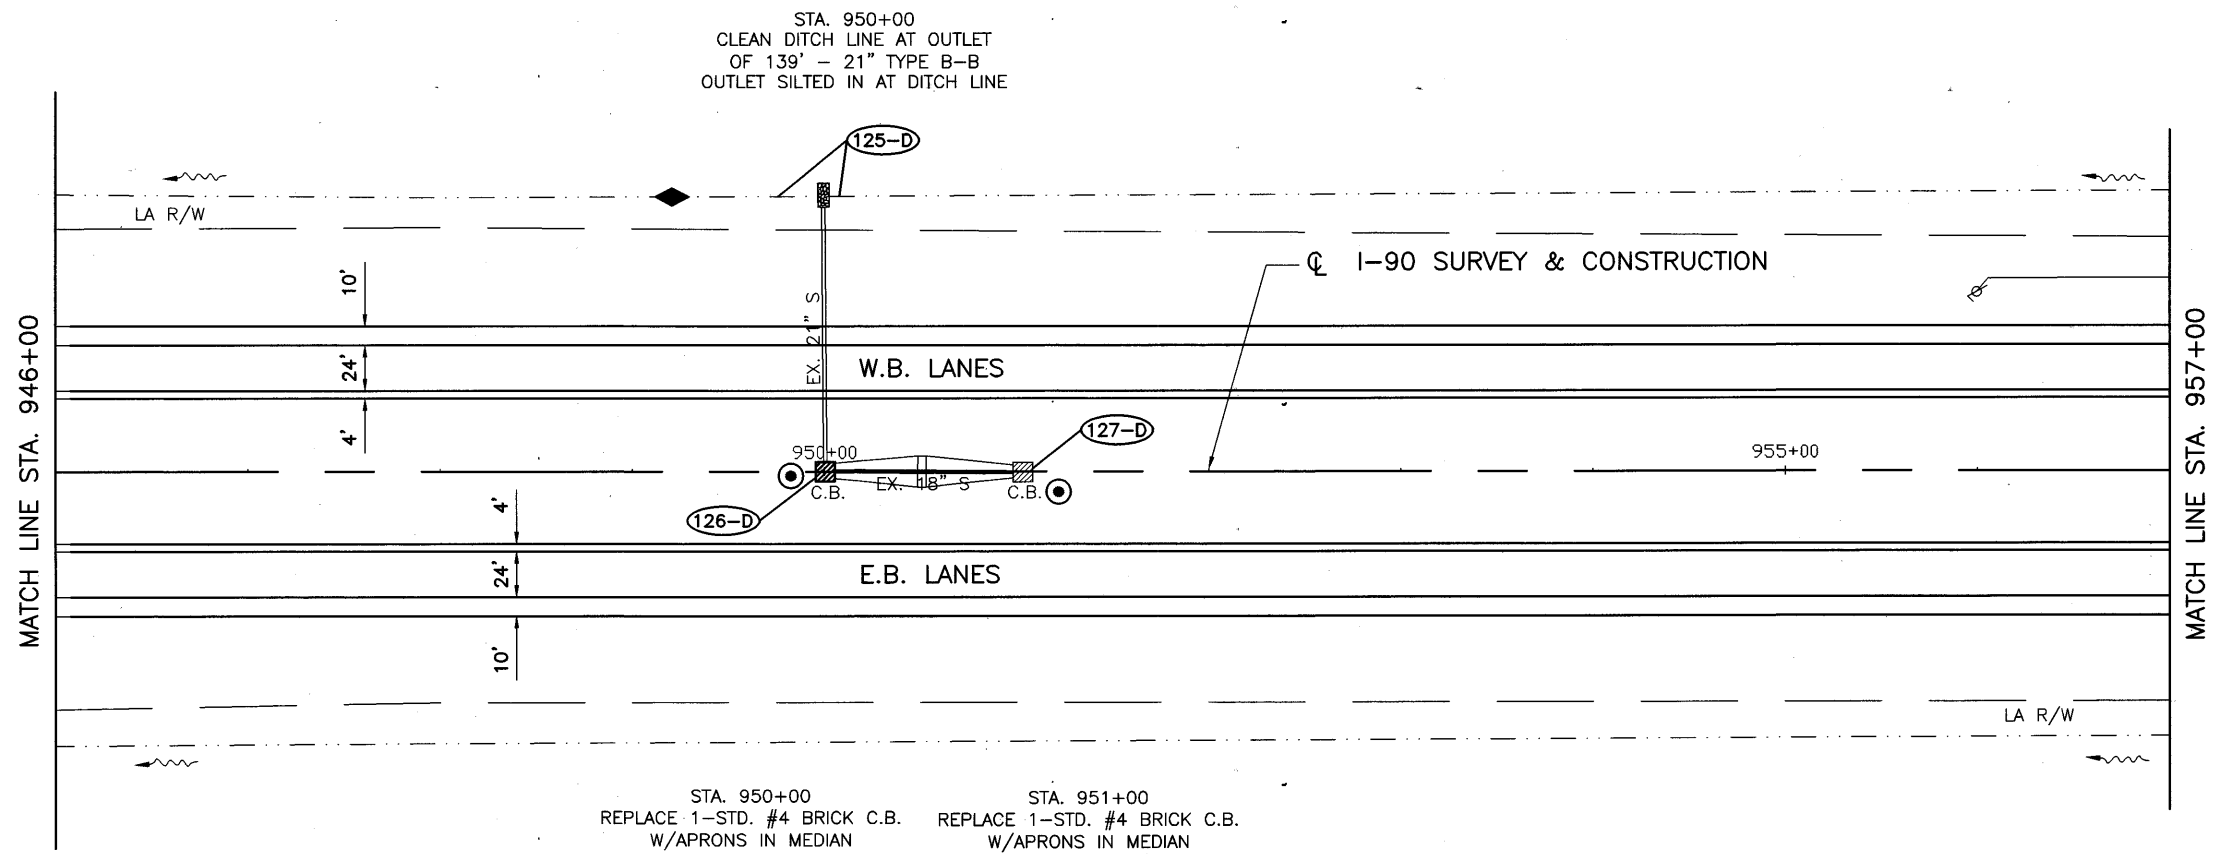

**LEGEND**

- ⊙ TEMPORARY INLET PROTECT, FILTER FABRIC FENCE (AT ALL EXISTING AND PROPOSED INLETS)
- ◆ TEMPORARY DITCH CHECK, FILTER FABRIC FENCE
- FF — FILTER FABRIC FENCE
- ~ DIRECTION OF FLOW DITCH
- ▒ SEDIMENT BASIN

CALCULATED	DLS	CHECKED	LAB



**STORM WATER POLLUTION PREVENTION PLAN  
STA. 946+00 TO STA. 969+00**


**LOR - 190 - 10.76**

O:\94600\DWG\SP-20.DWG J JGR  
 9-19-2002 3:23PM


CALCULATED	DLS	CHECKED	LAB.

**STORM WATER POLLUTION PREVENTION PLAN**  
**STA. H49+99.95 TO STA. H34+45.84**

**LOR-190-10.76**

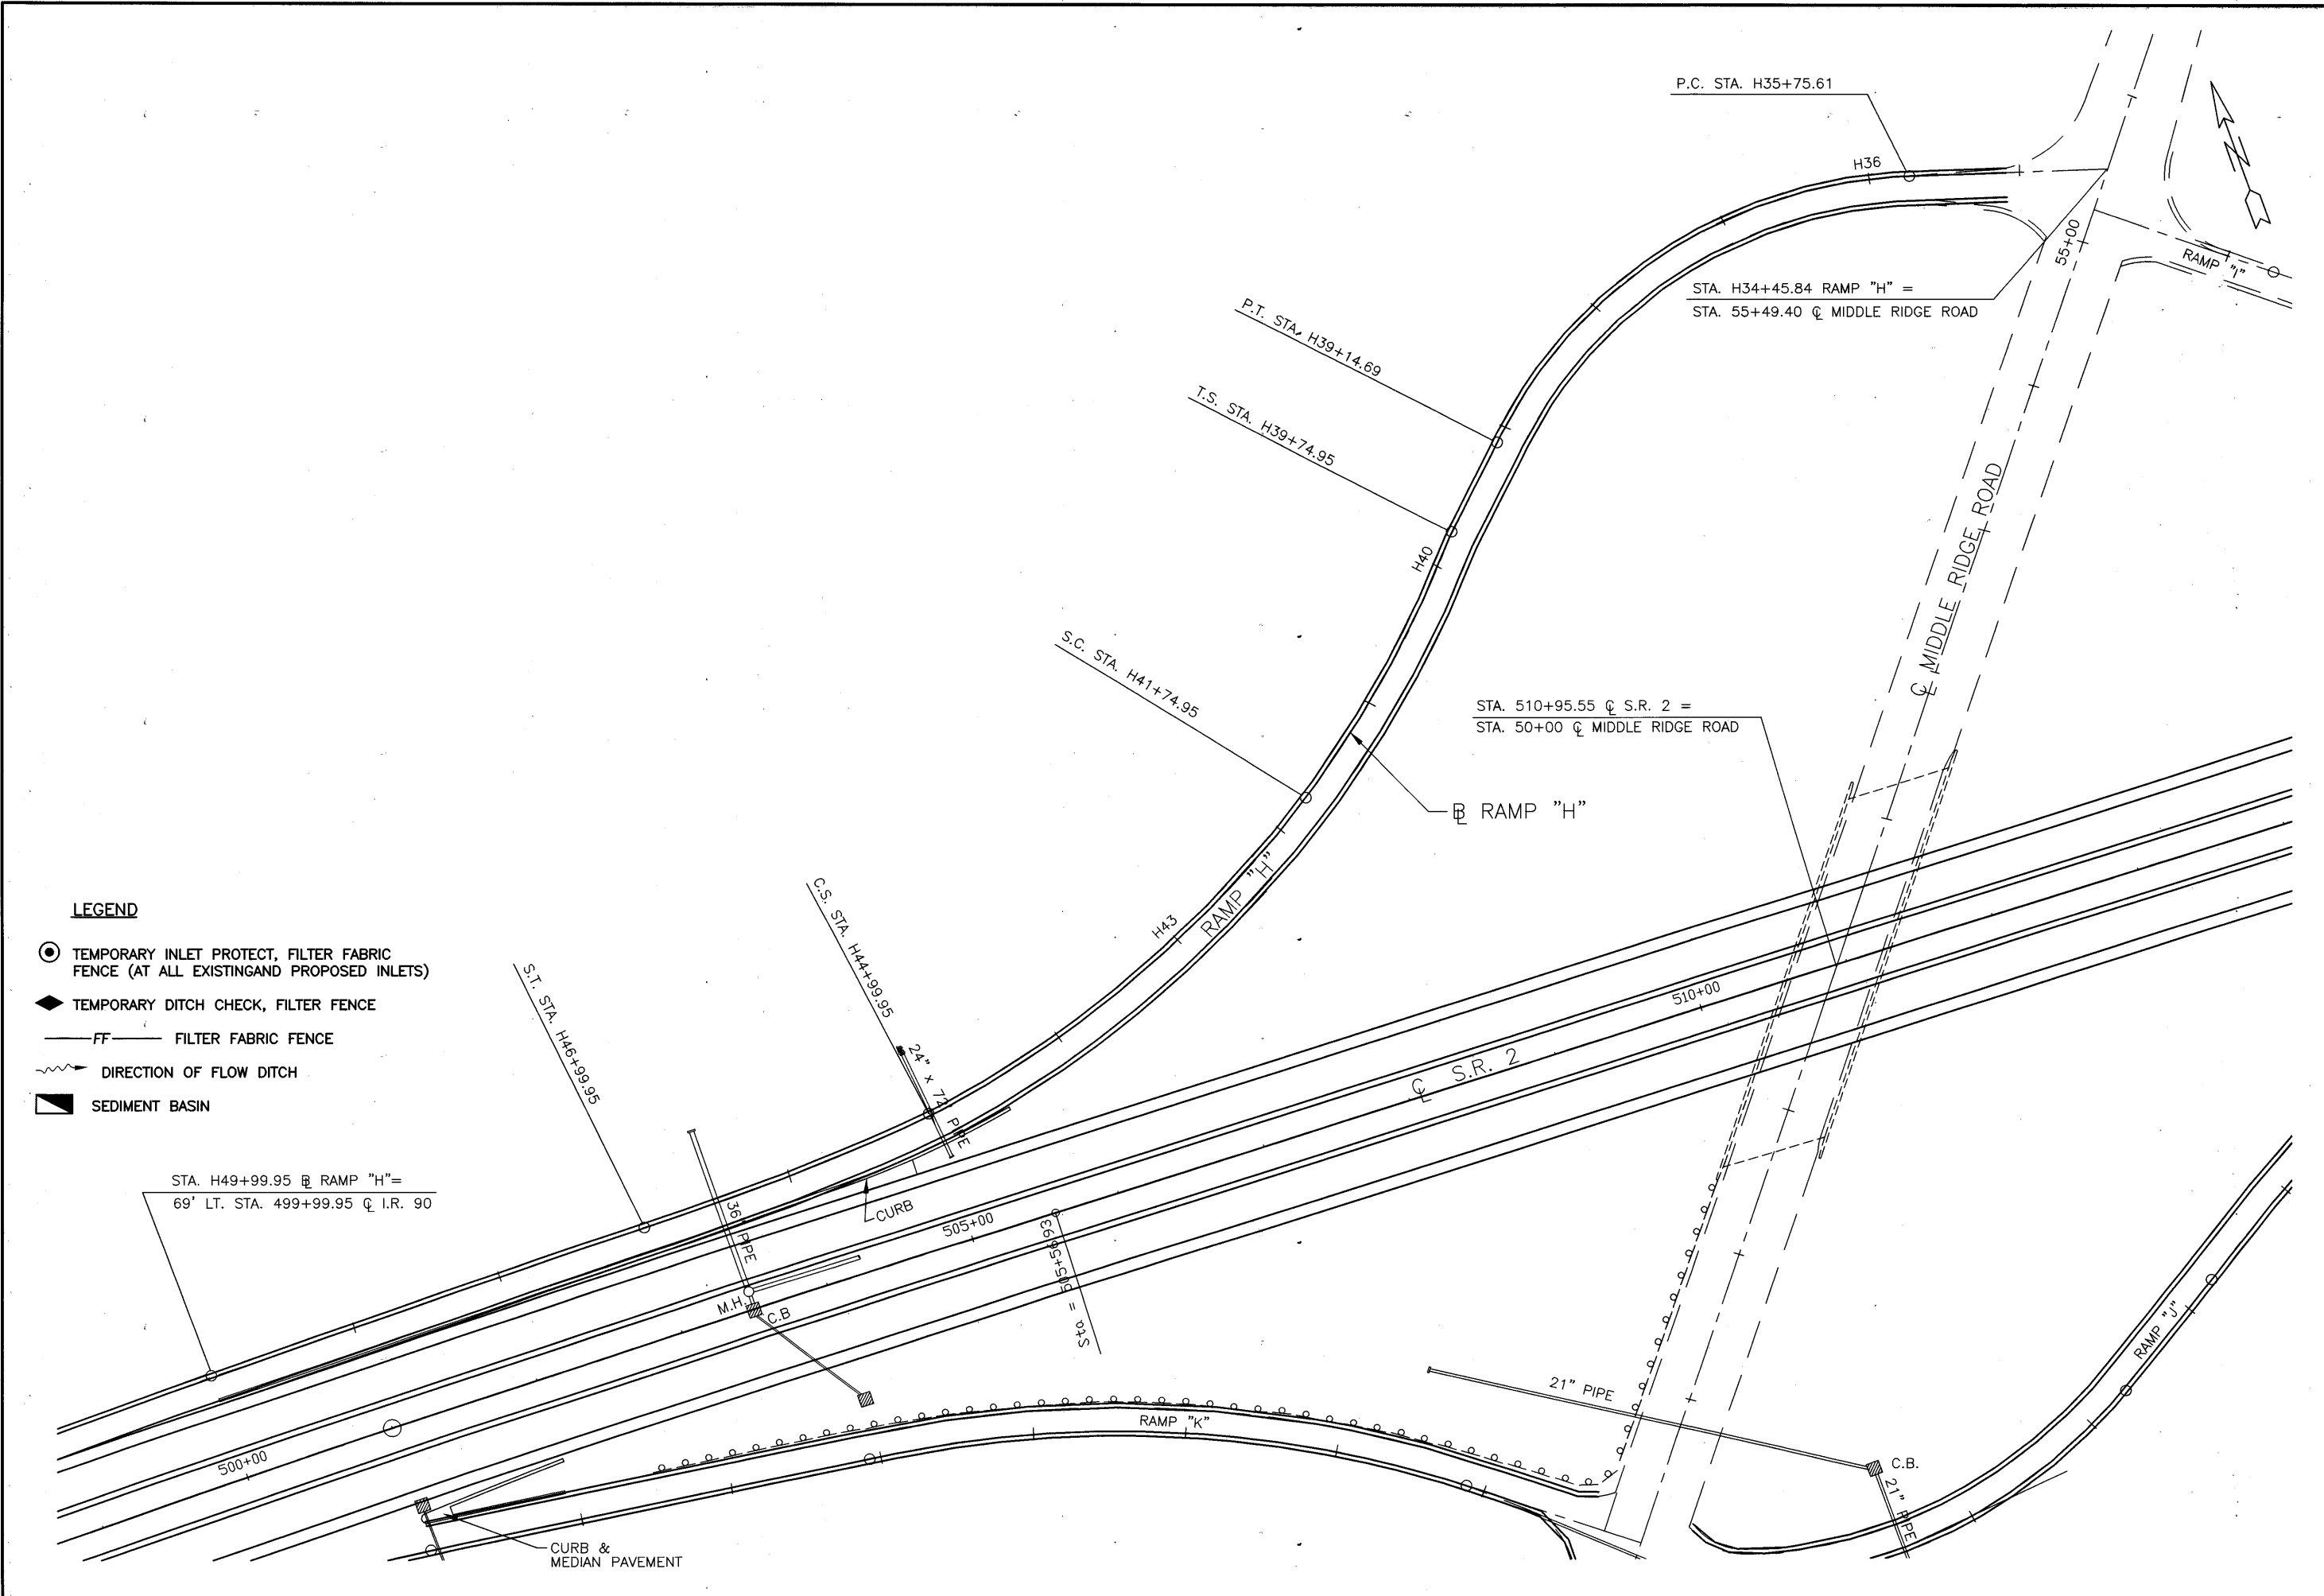


5.1.15 PM 02-15-2002 [ C:\93600\DWG\VERSION\SP-30.DWG ] INW

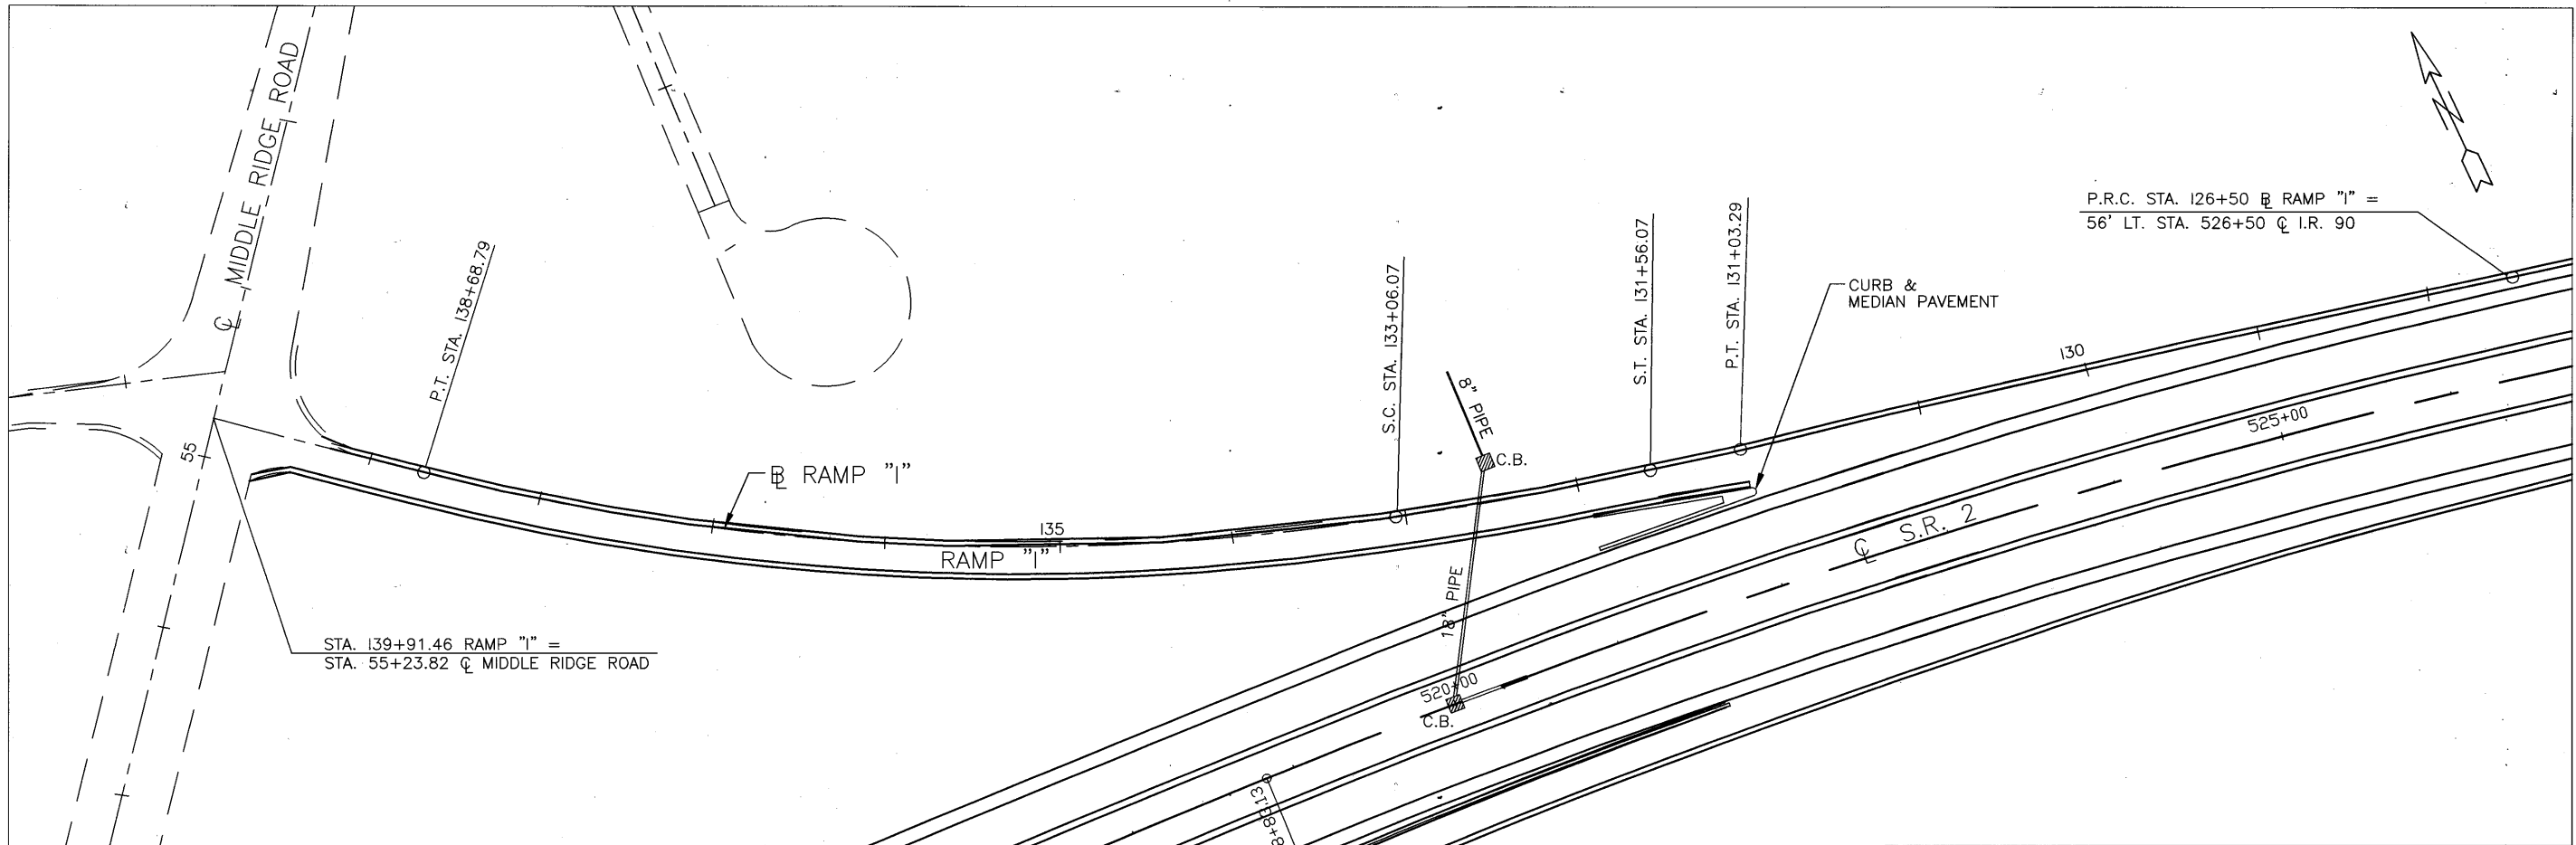

STA. 139+91.46 RAMP "I" =  
STA. 55+23.82  $\phi$  MIDDLE RIDGE ROAD

P.R.C. STA. 126+50  $\phi$  RAMP "I" =  
56' LT. STA. 526+50  $\phi$  I.R. 90

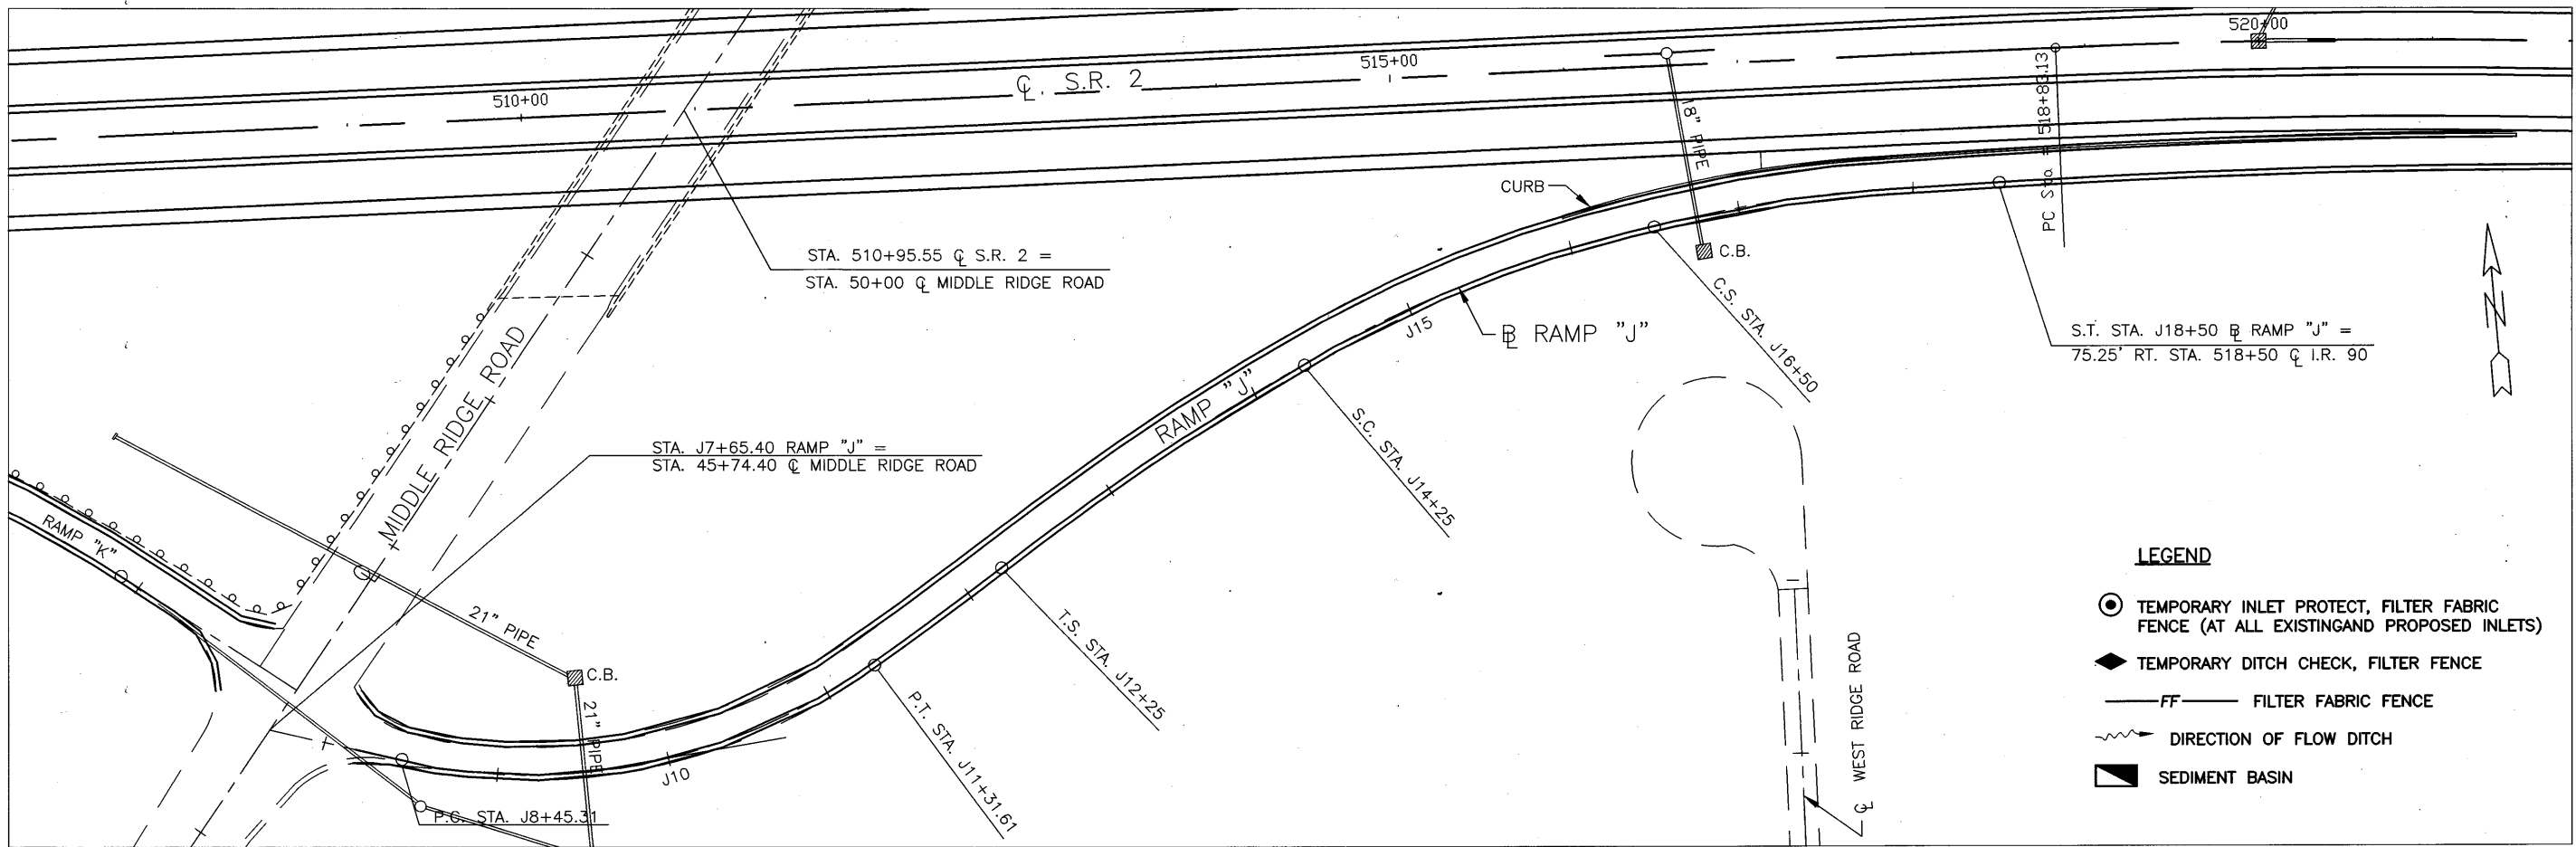

STA. 510+95.55  $\phi$  S.R. 2 =  
STA. 50+00  $\phi$  MIDDLE RIDGE ROAD

S.T. STA. J18+50  $\phi$  RAMP "J" =  
75.25' RT. STA. 518+50  $\phi$  I.R. 90

STA. J7+65.40 RAMP "J" =  
STA. 45+74.40  $\phi$  MIDDLE RIDGE ROAD

**LEGEND**


- TEMPORARY INLET PROTECT, FILTER FABRIC FENCE (AT ALL EXISTING AND PROPOSED INLETS)
- TEMPORARY DITCH CHECK, FILTER FABRIC FENCE
- FF FILTER FABRIC FENCE
- DIRECTION OF FLOW DITCH
- SEDIMENT BASIN



**STORM WATER POLLUTION PREVENTION PLAN**  
**STA. 126+50 TO STA. 139+91.46 & STA. J7+65.40 TO J18+50**

**LOR-190-10.76**

3.17PM 02-19-2002 [ C:\33600\DWG\EROSION.SP-31.DWG ] NJW

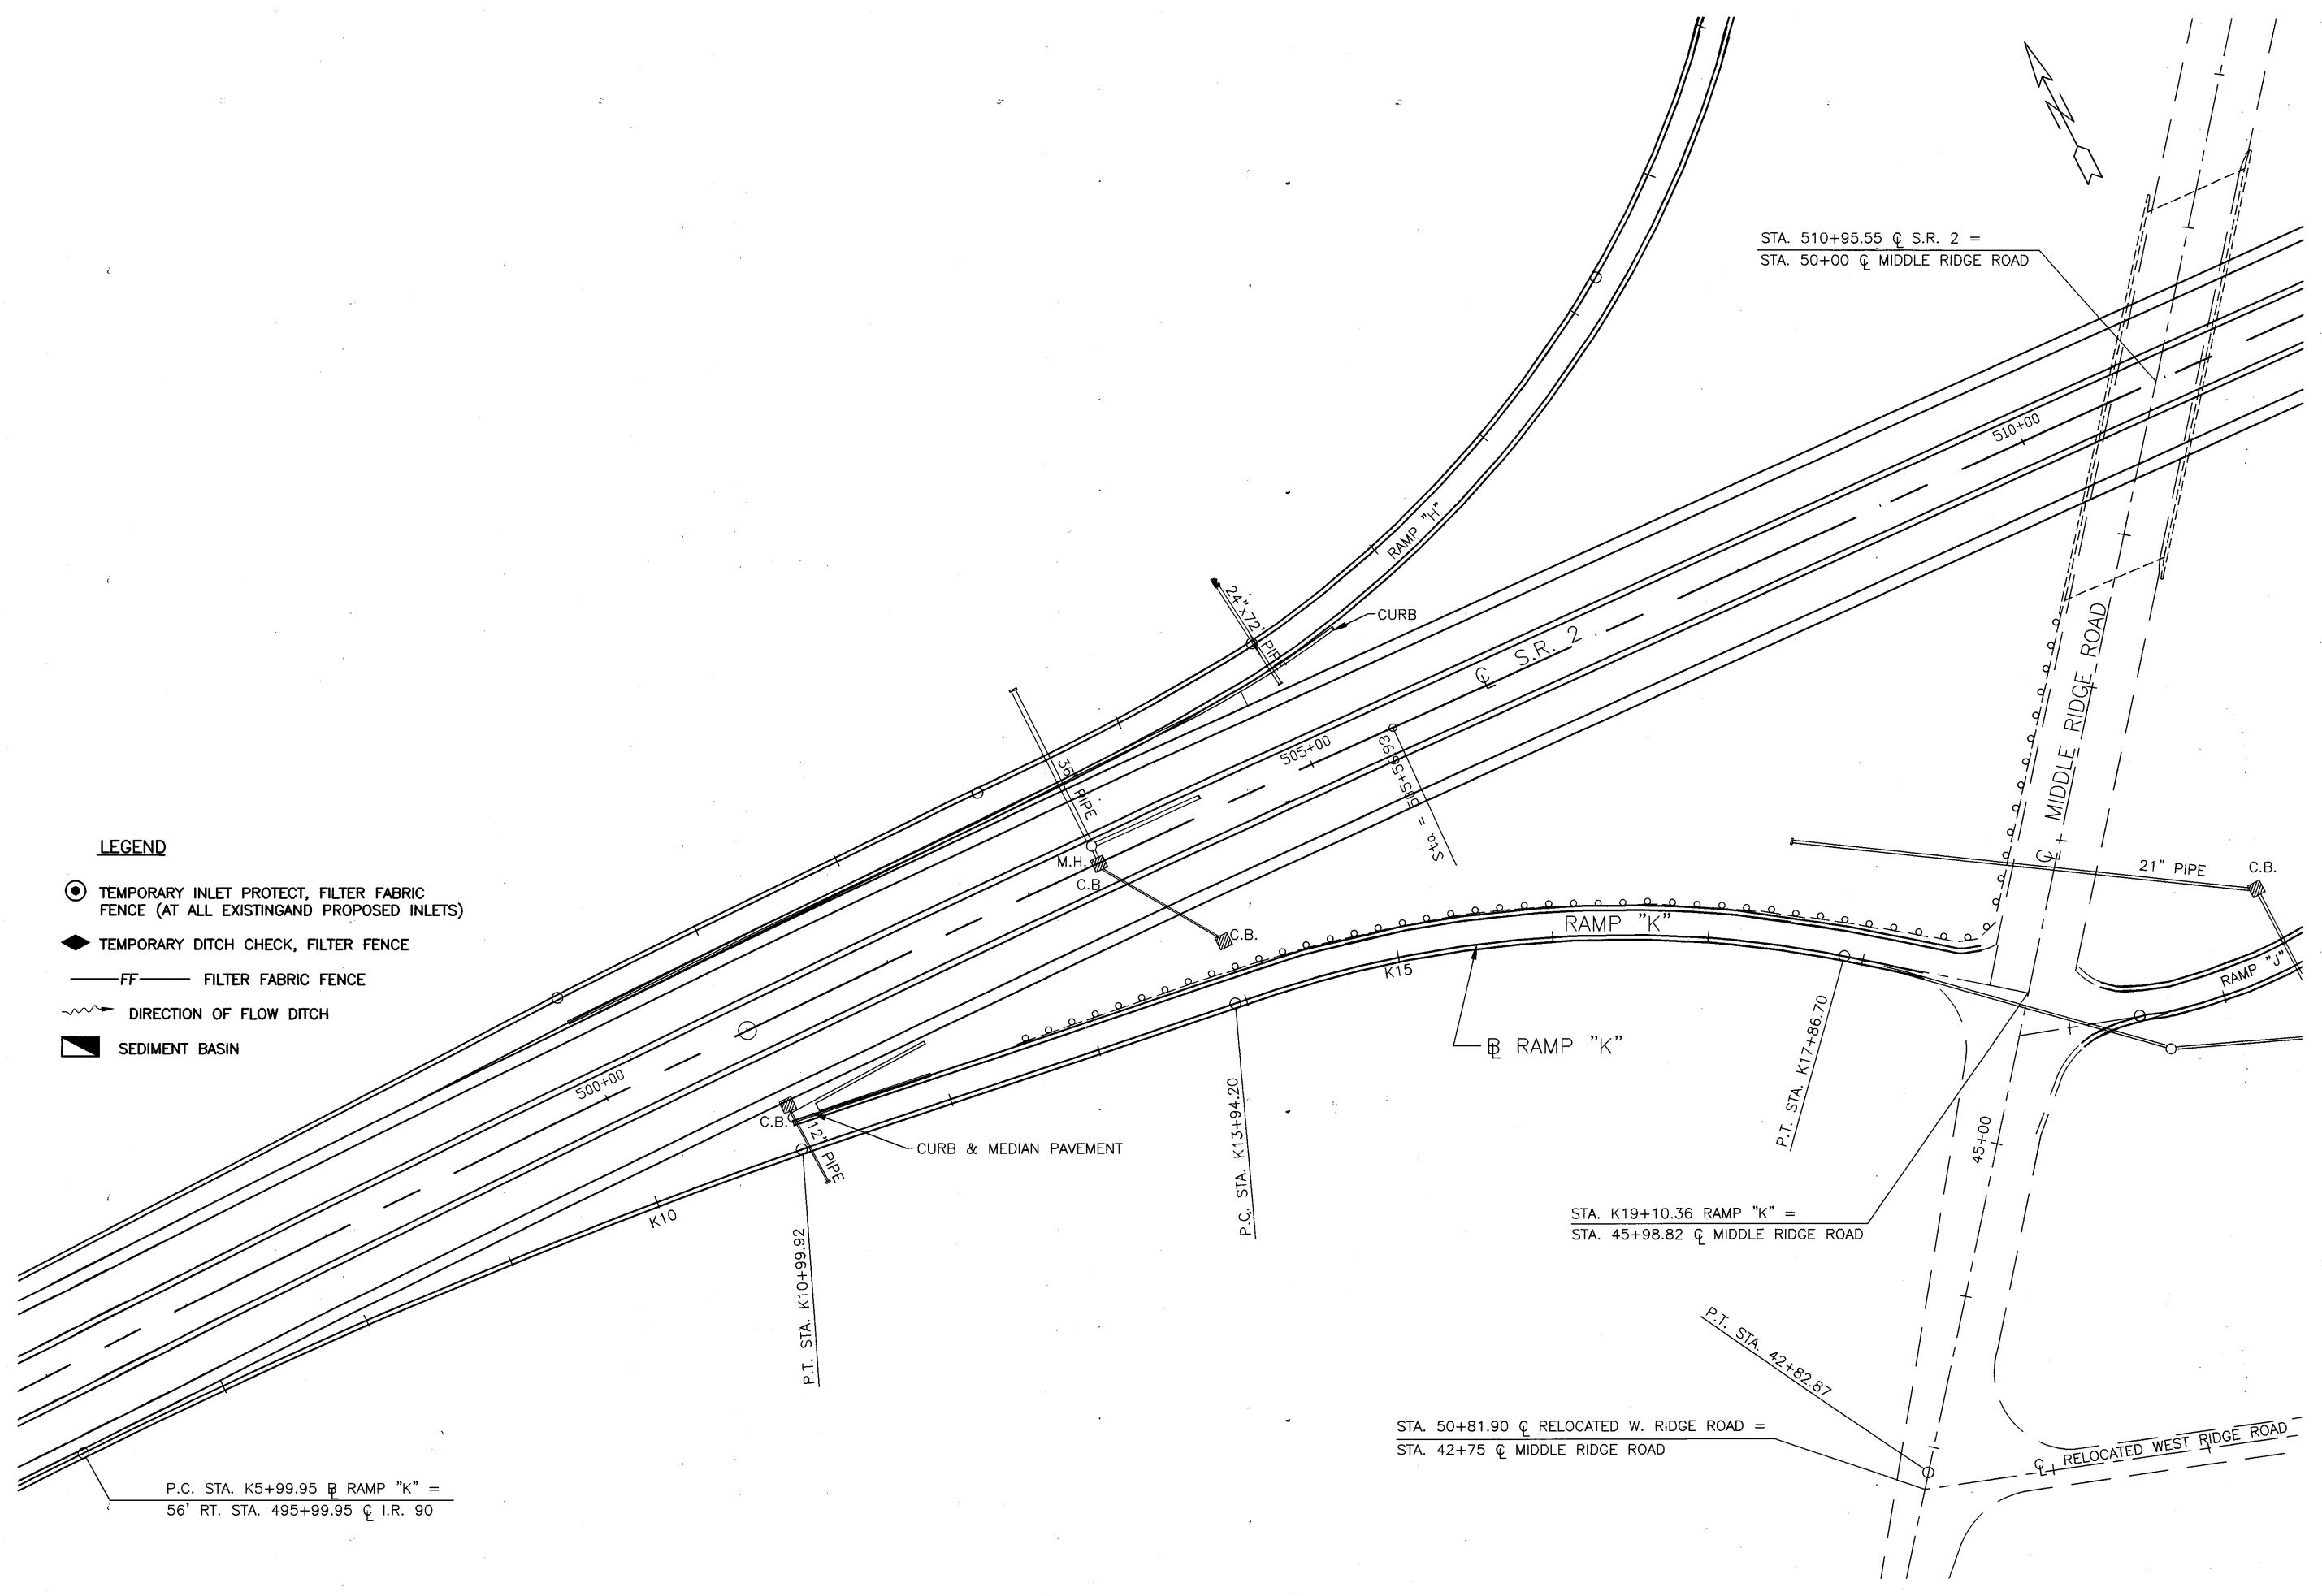

**LEGEND**

- ⊙ TEMPORARY INLET PROTECT, FILTER FABRIC FENCE (AT ALL EXISTING AND PROPOSED INLETS)
- ◆ TEMPORARY DITCH CHECK, FILTER FABRIC FENCE
- FF — FILTER FABRIC FENCE
- DIRECTION OF FLOW DITCH
- ▭ SEDIMENT BASIN

P.C. STA. K5+99.95 @ RAMP "K" =  
56' RT. STA. 495+99.95 @ I.R. 90

STA. K19+10.36 RAMP "K" =  
STA. 45+98.82 @ MIDDLE RIDGE ROAD



STA. 510+95.55 @ S.R. 2 =  
STA. 50+00 @ MIDDLE RIDGE ROAD

STA. 50+81.90 @ RELOCATED W. RIDGE ROAD =  
STA. 42+75 @ MIDDLE RIDGE ROAD

3:21PM 02-19-2002 [ C:\93600\DWG\SPROSKN.SP-32.DWG ] NJW

**LEGEND**

- ⊙ TEMPORARY INLET PROTECT, FILTER FABRIC FENCE (AT ALL EXISTING AND PROPOSED INLETS)
- ◆ TEMPORARY DITCH CHECK, FILTER FENCE
- FF— FILTER FABRIC FENCE
- DIRECTION OF FLOW DITCH
- ▭ SEDIMENT BASIN

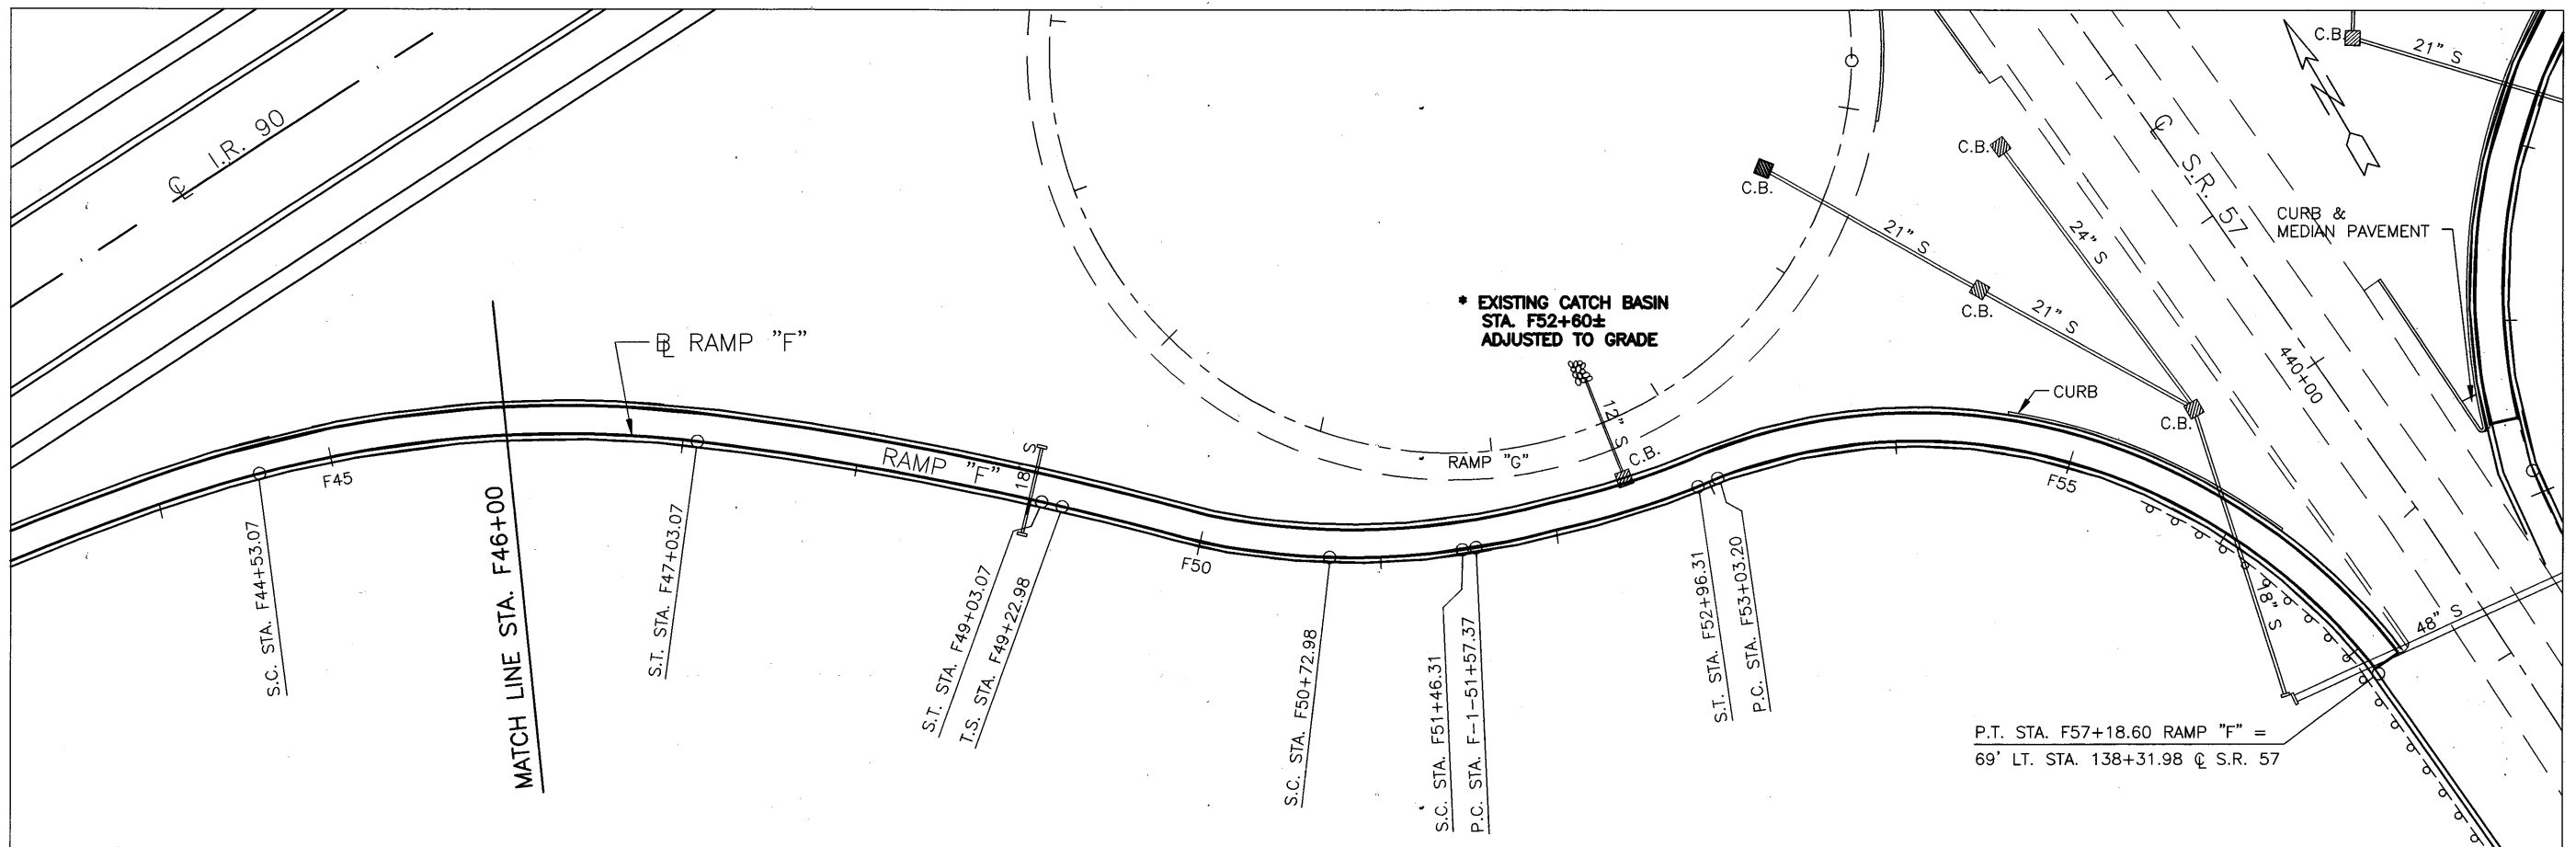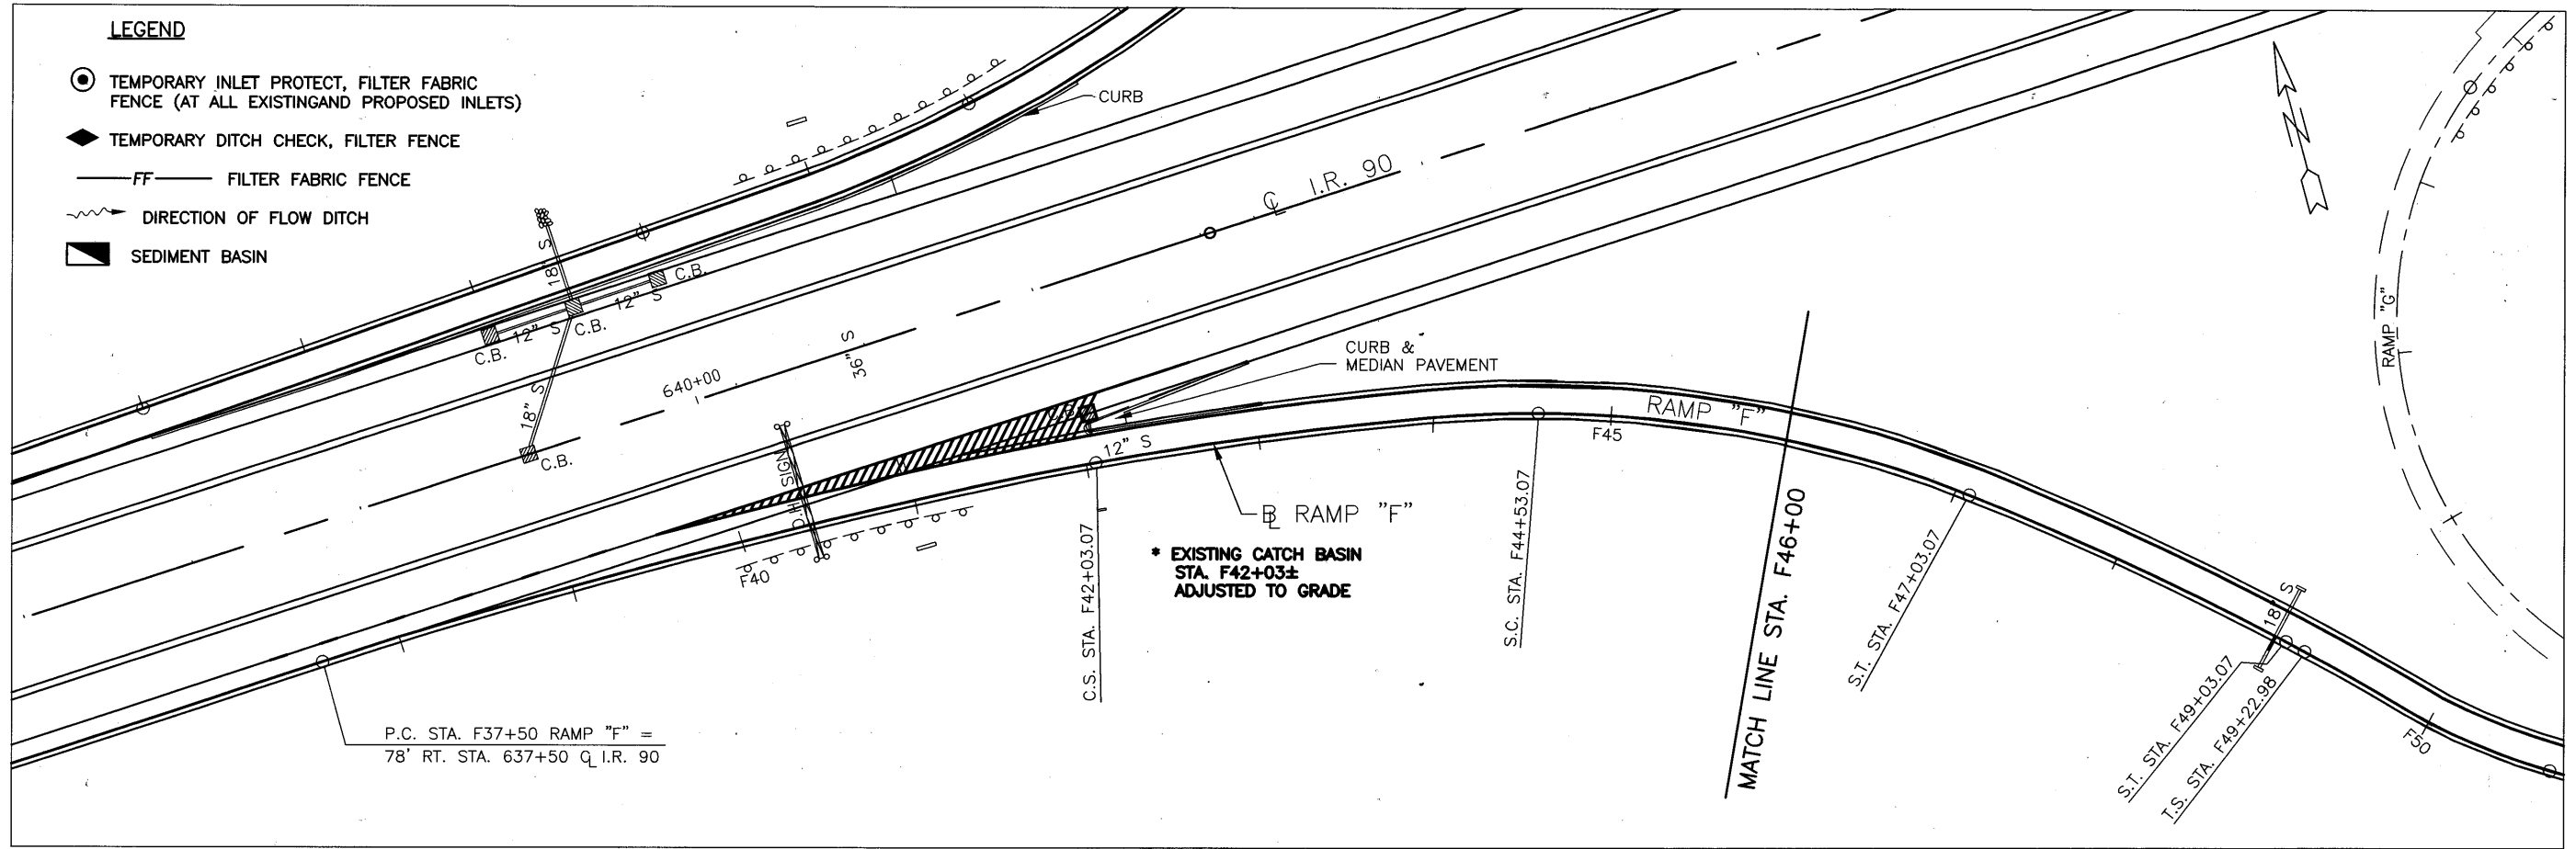


CALCULATED	DLS	CHECKED	LAB



**STORM WATER POLLUTION PREVENTION PLAN  
RAMP "F" - STA. 37+50 TO STA. 57+18.60**

**LOR-190-10.76**

I:\CA\190\190\190\190\SP-33.DWG 1 NEW  
 02-21-2002 3:25PM

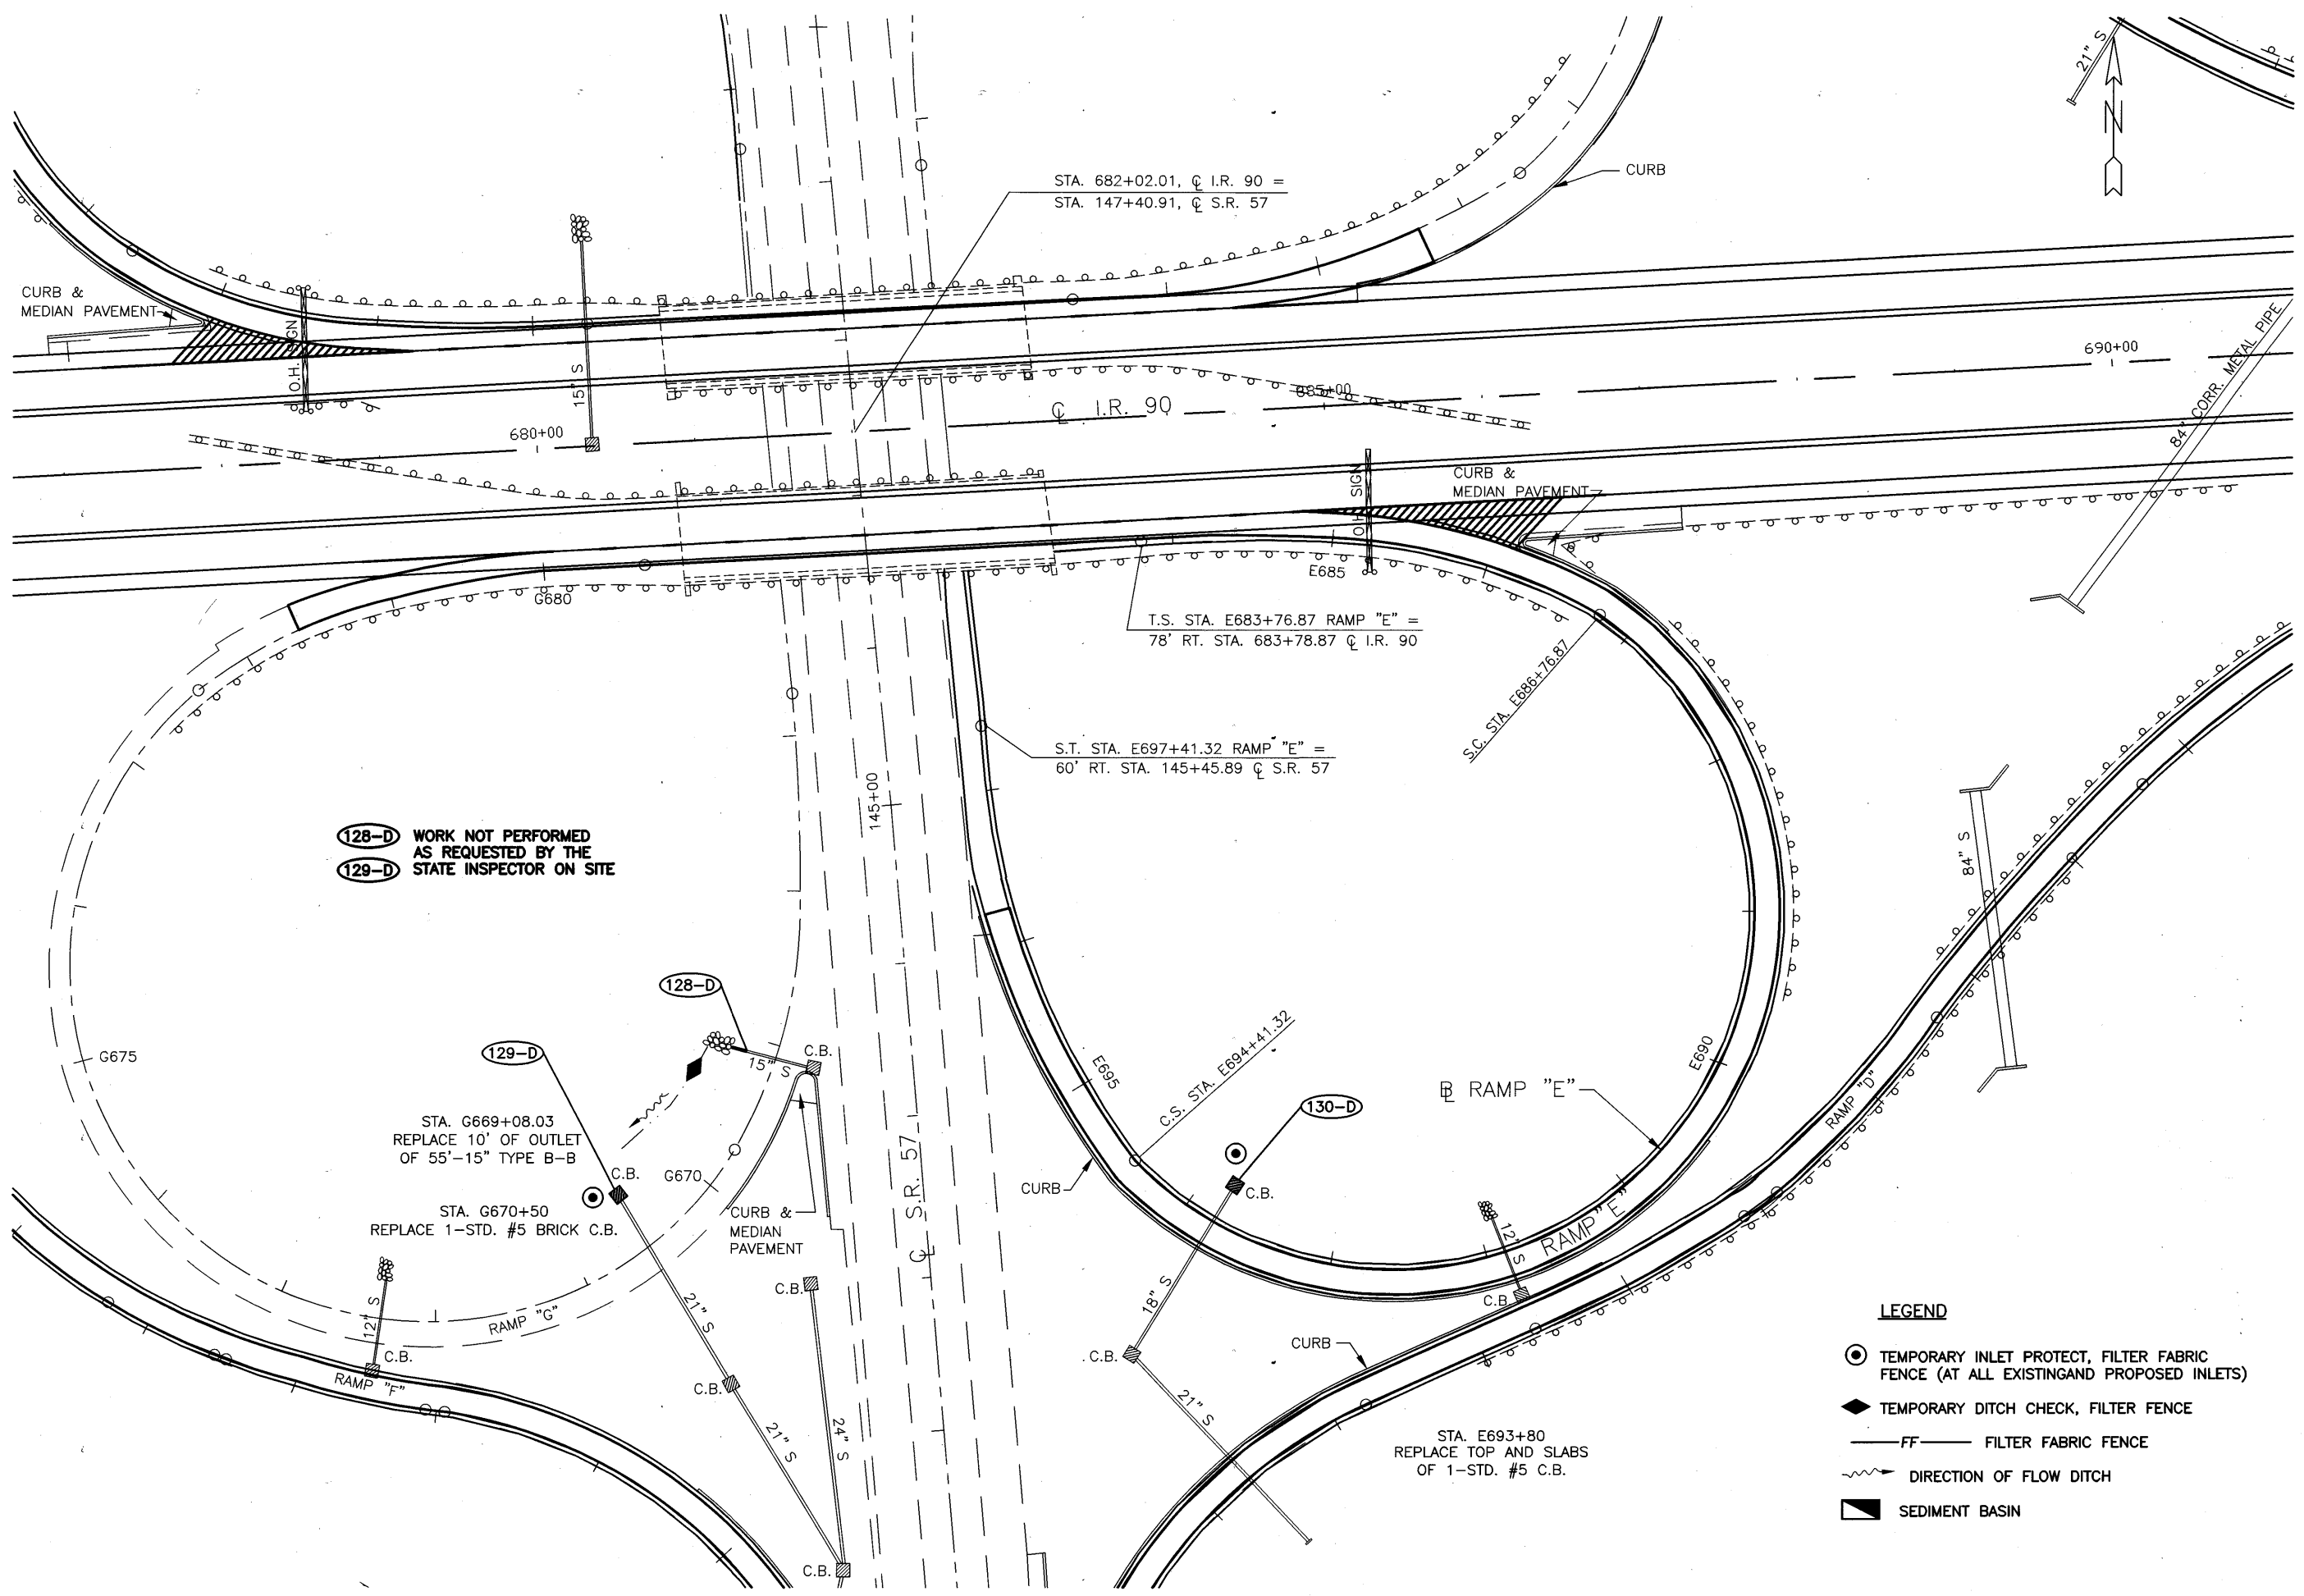

128-D WORK NOT PERFORMED AS REQUESTED BY THE STATE INSPECTOR ON SITE  
 129-D

STA. G669+08.03  
 REPLACE 10' OF OUTLET OF 55'-15" TYPE B-B  
 STA. G670+50  
 REPLACE 1-STD. #5 BRICK C.B.

STA. E693+80  
 REPLACE TOP AND SLABS OF 1-STD. #5 C.B.

**LEGEND**

- ⊙ TEMPORARY INLET PROTECT, FILTER FABRIC FENCE (AT ALL EXISTING AND PROPOSED INLETS)
- ◆ TEMPORARY DITCH CHECK, FILTER FABRIC FENCE
- FF — FILTER FABRIC FENCE
- ~> DIRECTION OF FLOW DITCH
- ▭ SEDIMENT BASIN

CALCULATED	DLS	CHECKED	LAB

0 50' 100'  
 HORIZONTAL SCALE IN FEET



**STORM WATER POLLUTION PREVENTION PLAN  
 RAMP 'E' & 'G'-STA. 683+76.87 TO STA. 697+41.32**

**LOR-190-10.76**

I:\0136001\DWG\EROSION\SP-34.DWG 11/11/02 3:39PM

**LEGEND**

- ⊙ TEMPORARY INLET PROTECT, FILTER FABRIC FENCE (AT ALL EXISTING AND PROPOSED INLETS)
- ◆ TEMPORARY DITCH CHECK, FILTER FENCE
- FF— FILTER FABRIC FENCE
- DIRECTION OF FLOW DITCH
- ▭ SEDIMENT BASIN

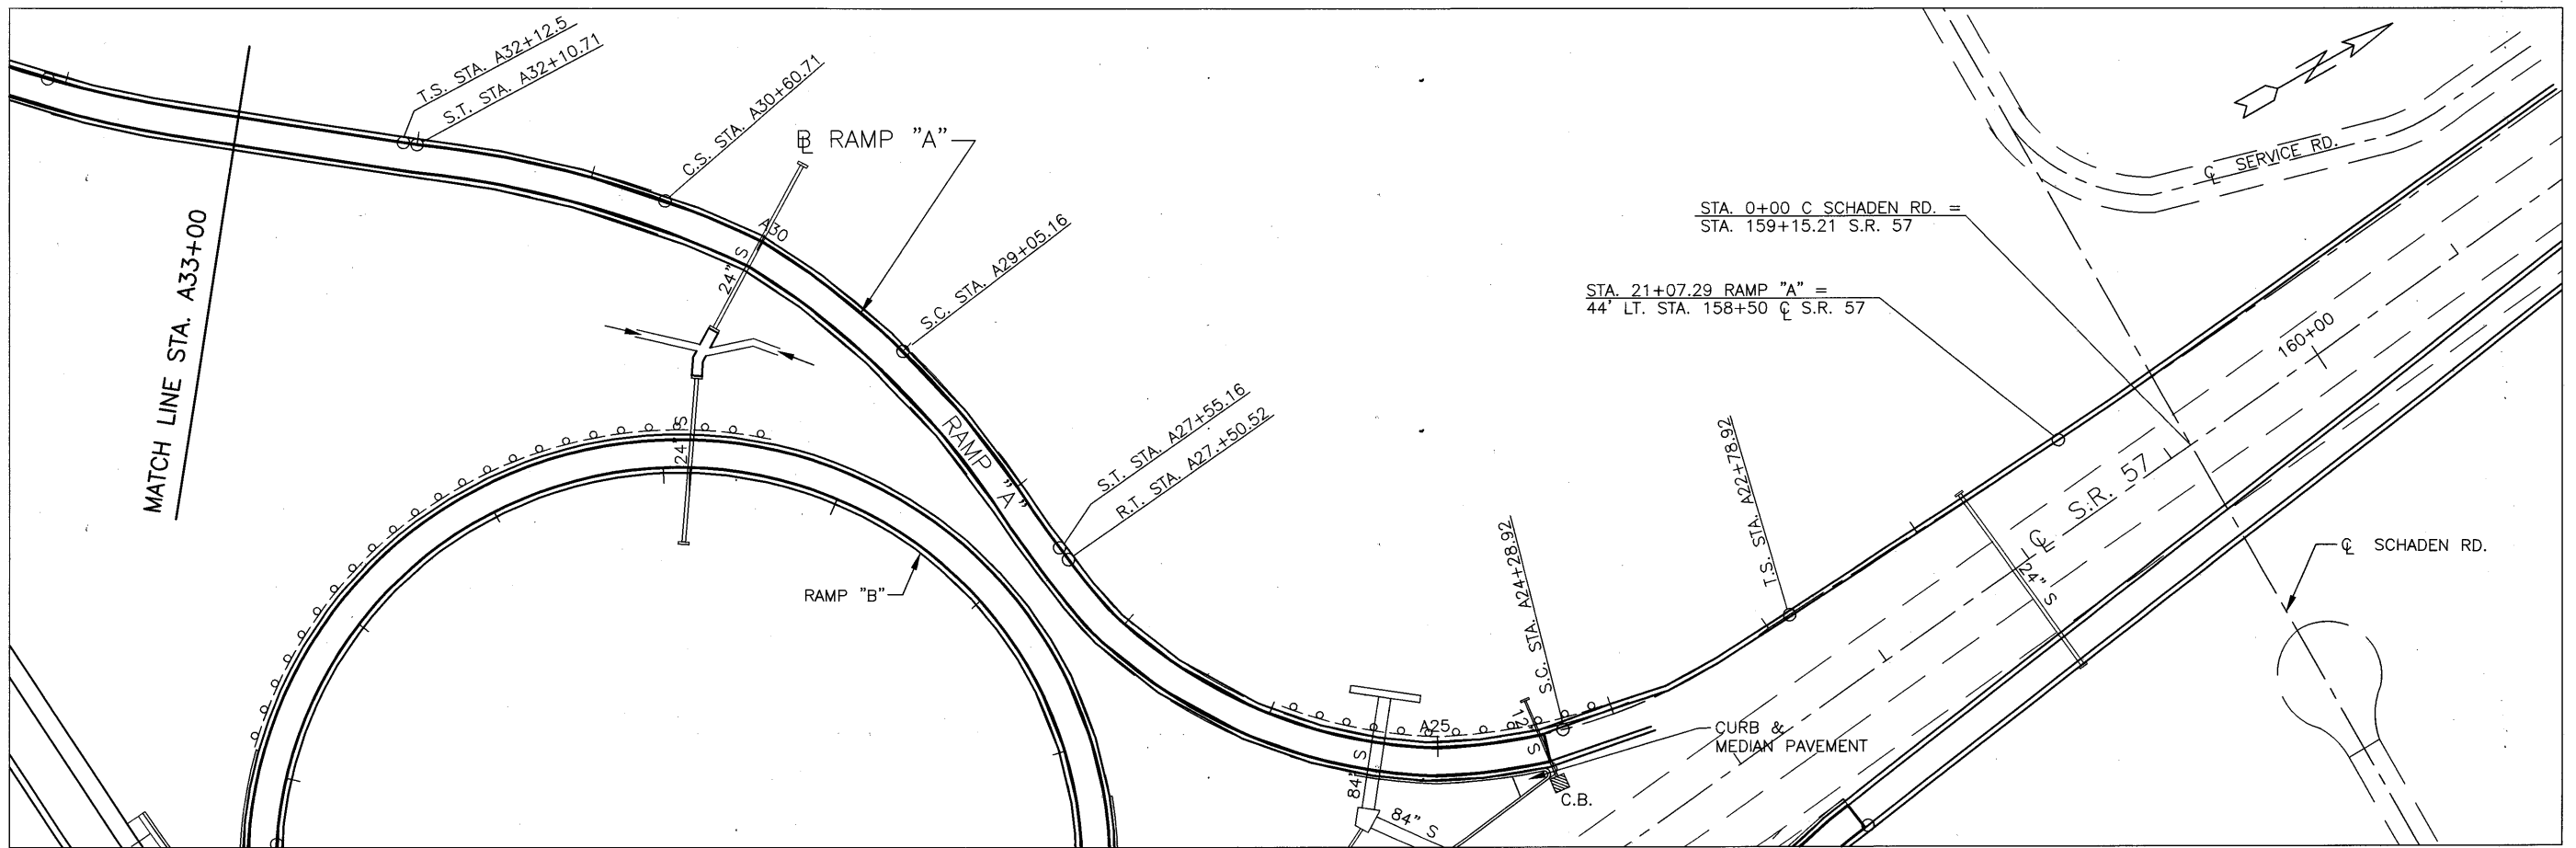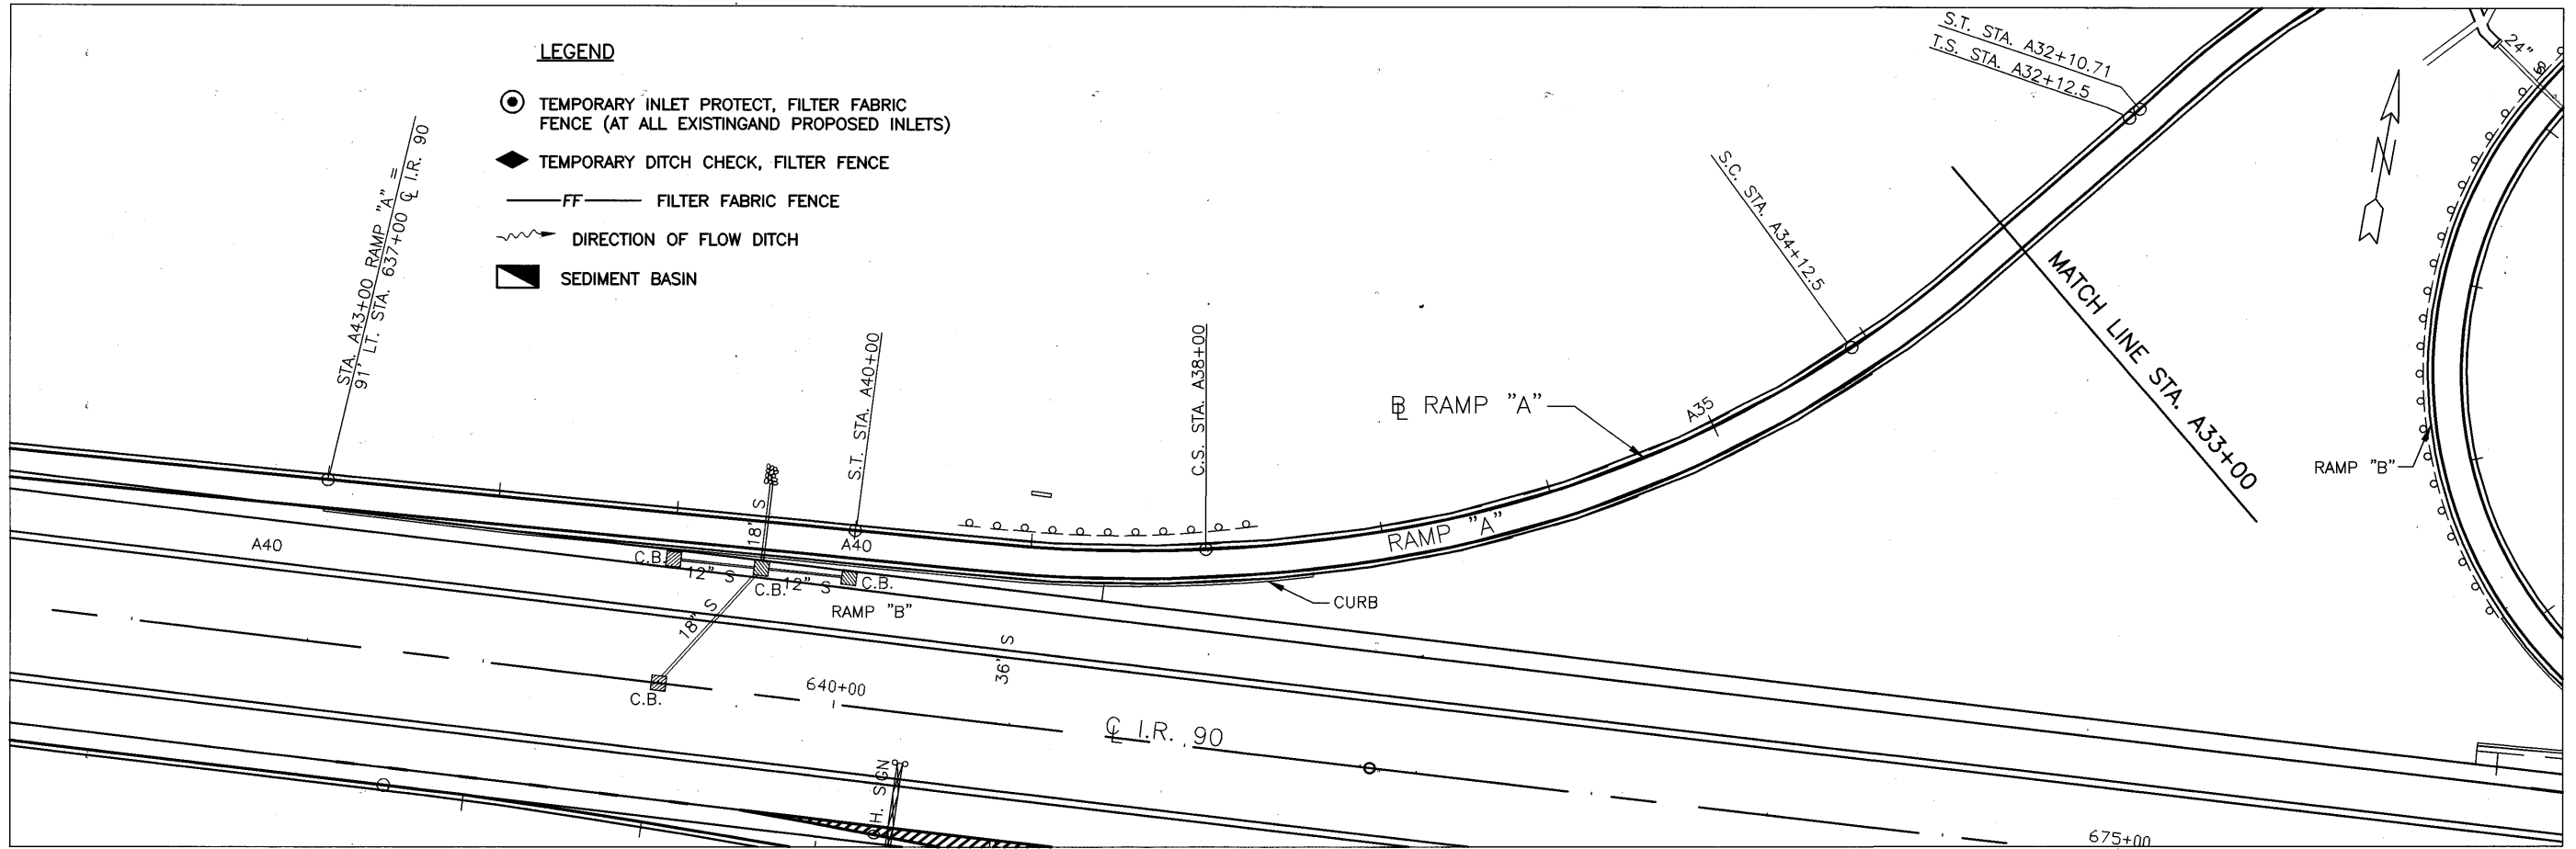

CALCULATED	100
DLS	50
CHECKED	0
LAB	

HORIZONTAL SCALE IN FEET


**STORM WATER POLLUTION PREVENTION PLAN**  
**RAMP "A" - STA. 21+07.29 TO STA. 43+00**

**LOF-190-10.76**

[ 0:\190\DWG\EROSION\SP-35.DWG ] NW  
 02-19-2002 3:42PM

**LEGEND**

- TEMPORARY INLET PROTECT, FILTER FABRIC FENCE (AT ALL EXISTING AND PROPOSED INLETS)
- ◆ TEMPORARY DITCH CHECK, FILTER FABRIC FENCE
- FF— FILTER FABRIC FENCE
- ~ DIRECTION OF FLOW DITCH
- ▭ SEDIMENT BASIN

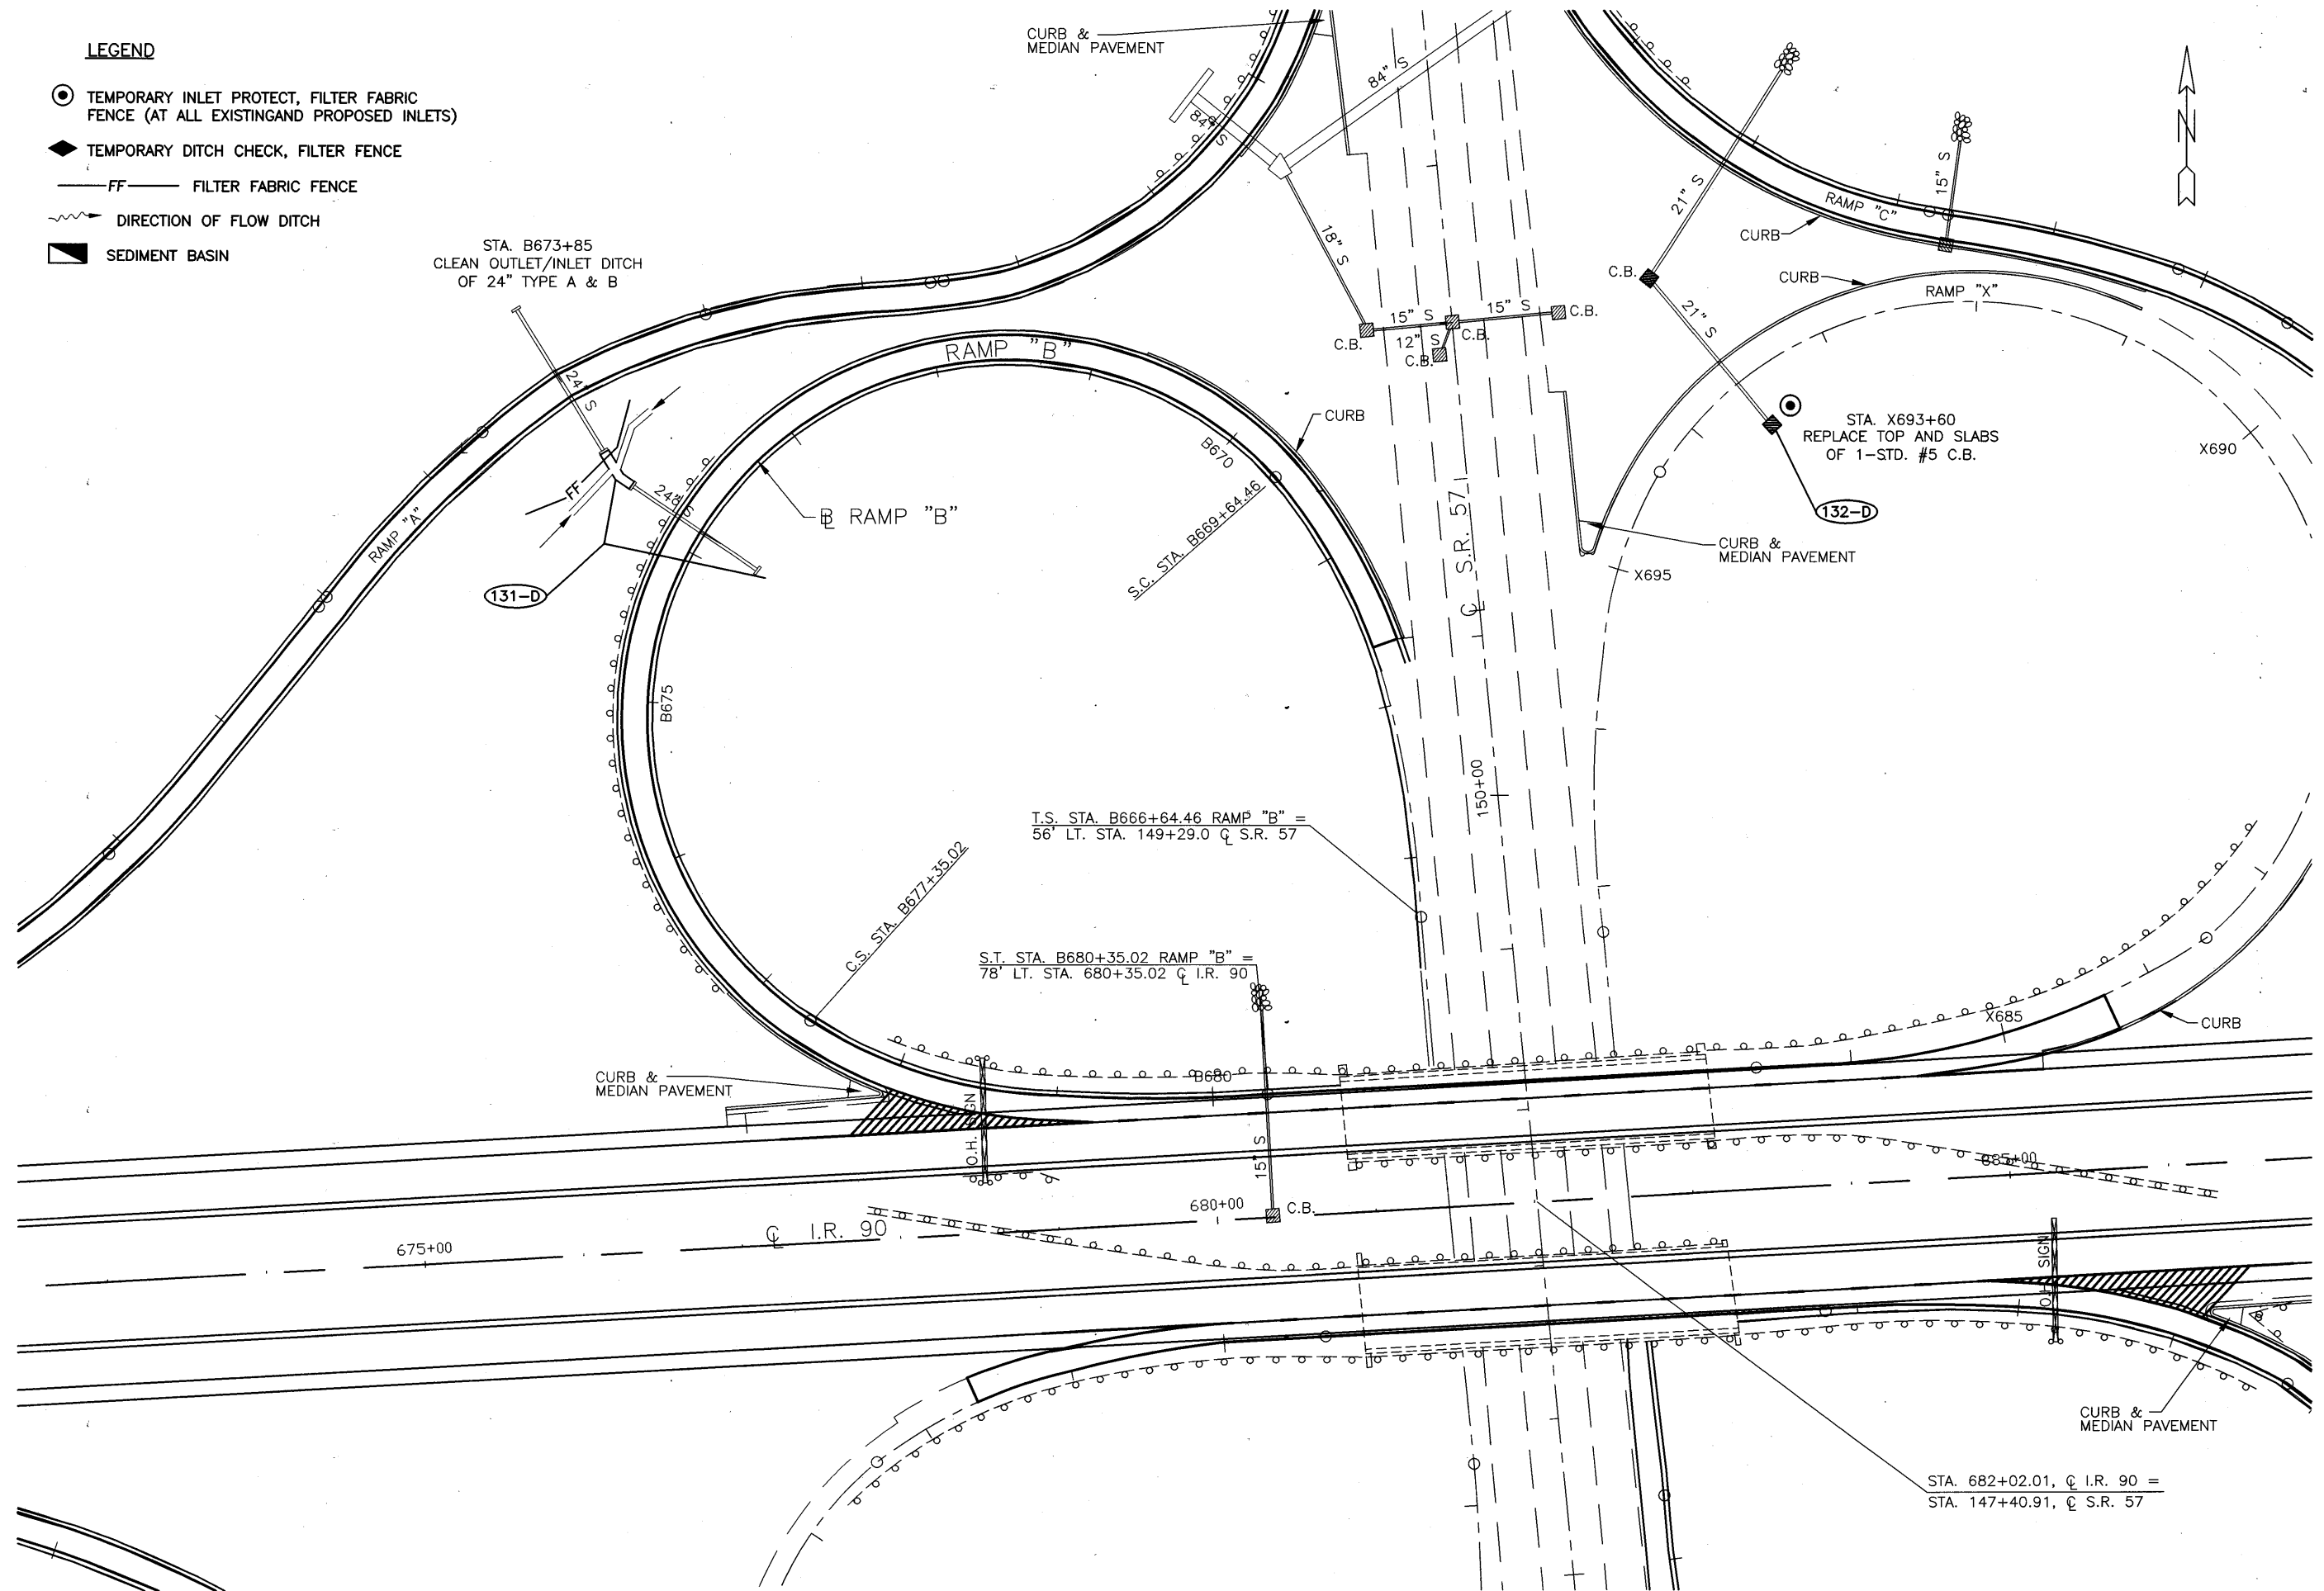

CALCULATED	DLS	CHECKED	LAB



100  
50'  
0  
HORIZONTAL  
SCALE IN FEET

**STORM WATER POLLUTION PREVENTION PLAN  
RAMPS "B" & "X" - STA. 666+64.46 TO STA. 680+35.02**

**LOR-190-10.76**

I:\CA\19000\DWG\EROSION\SP-36.DWG J.N.W 02-19-2002 3:51 PM



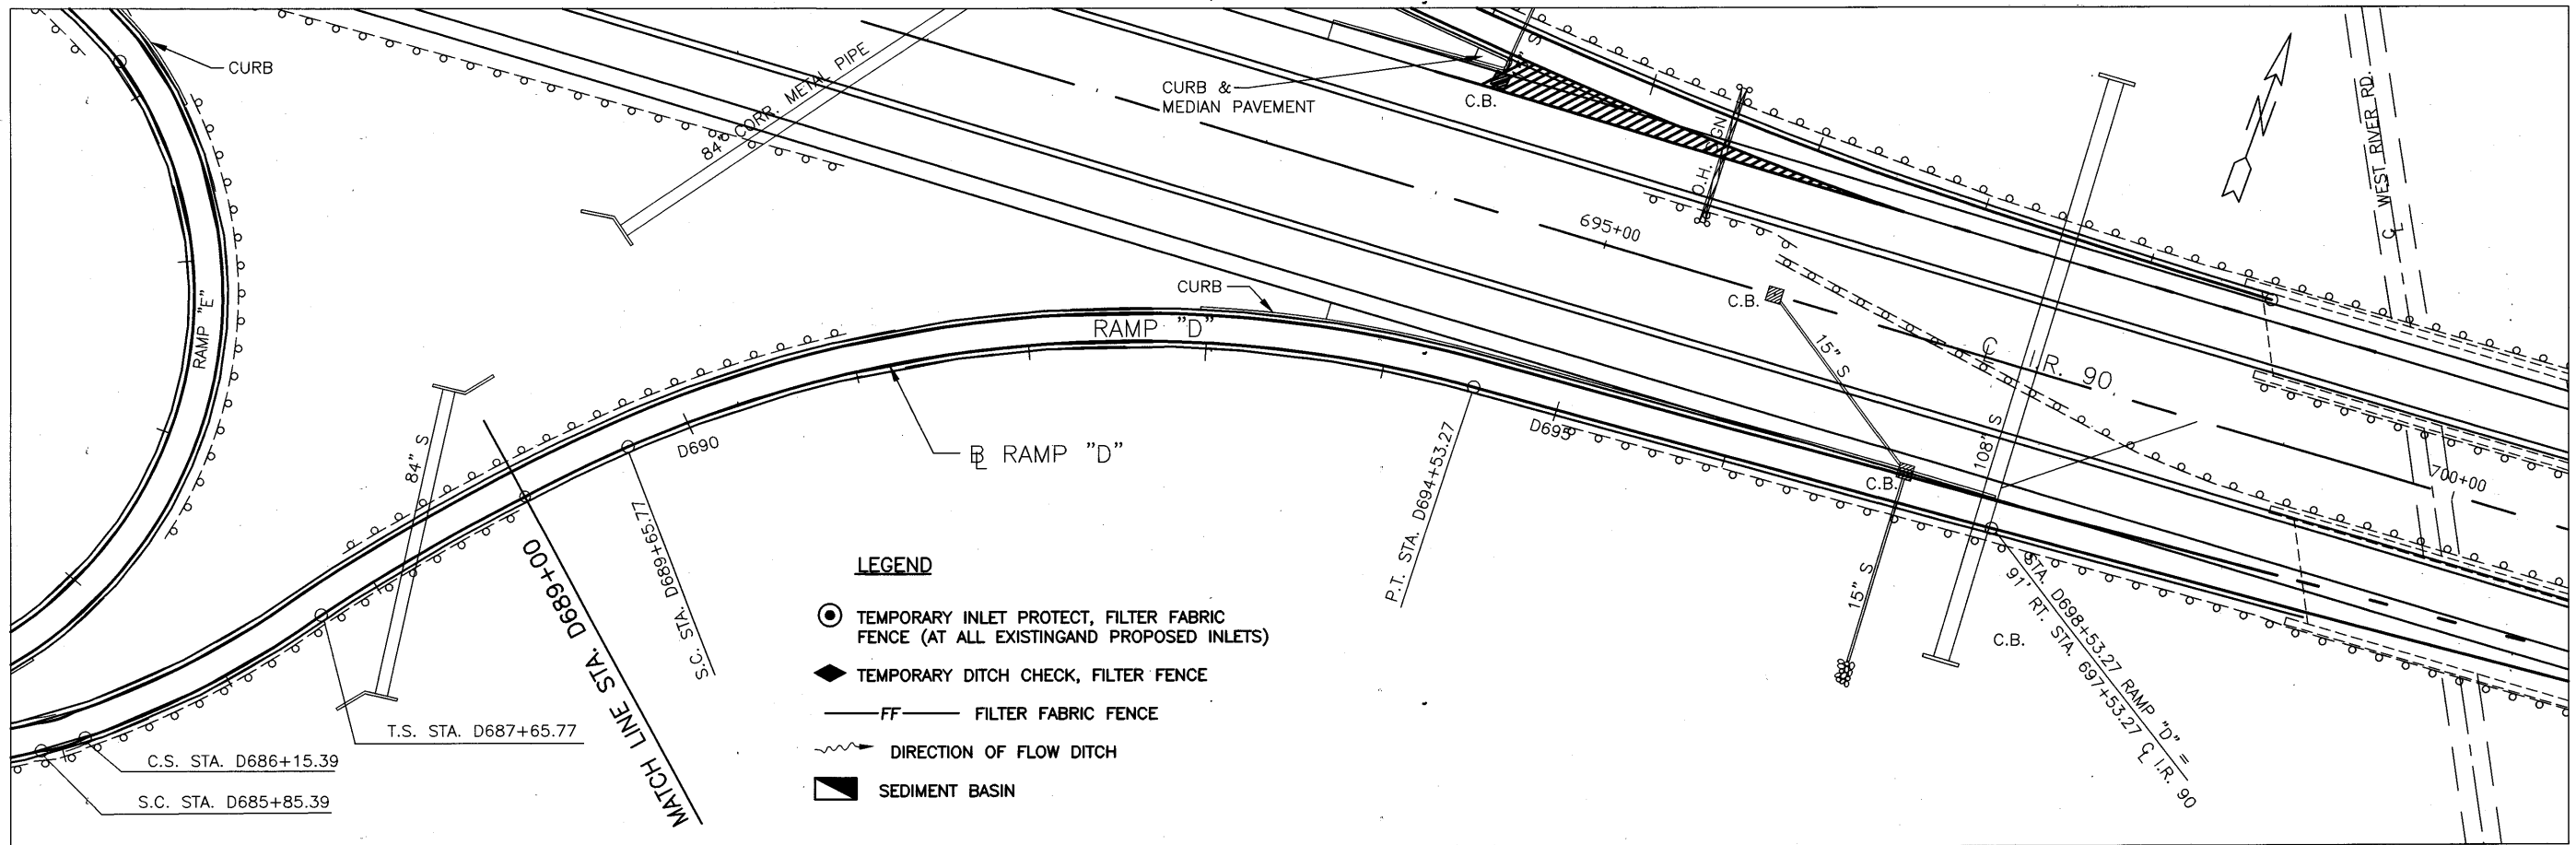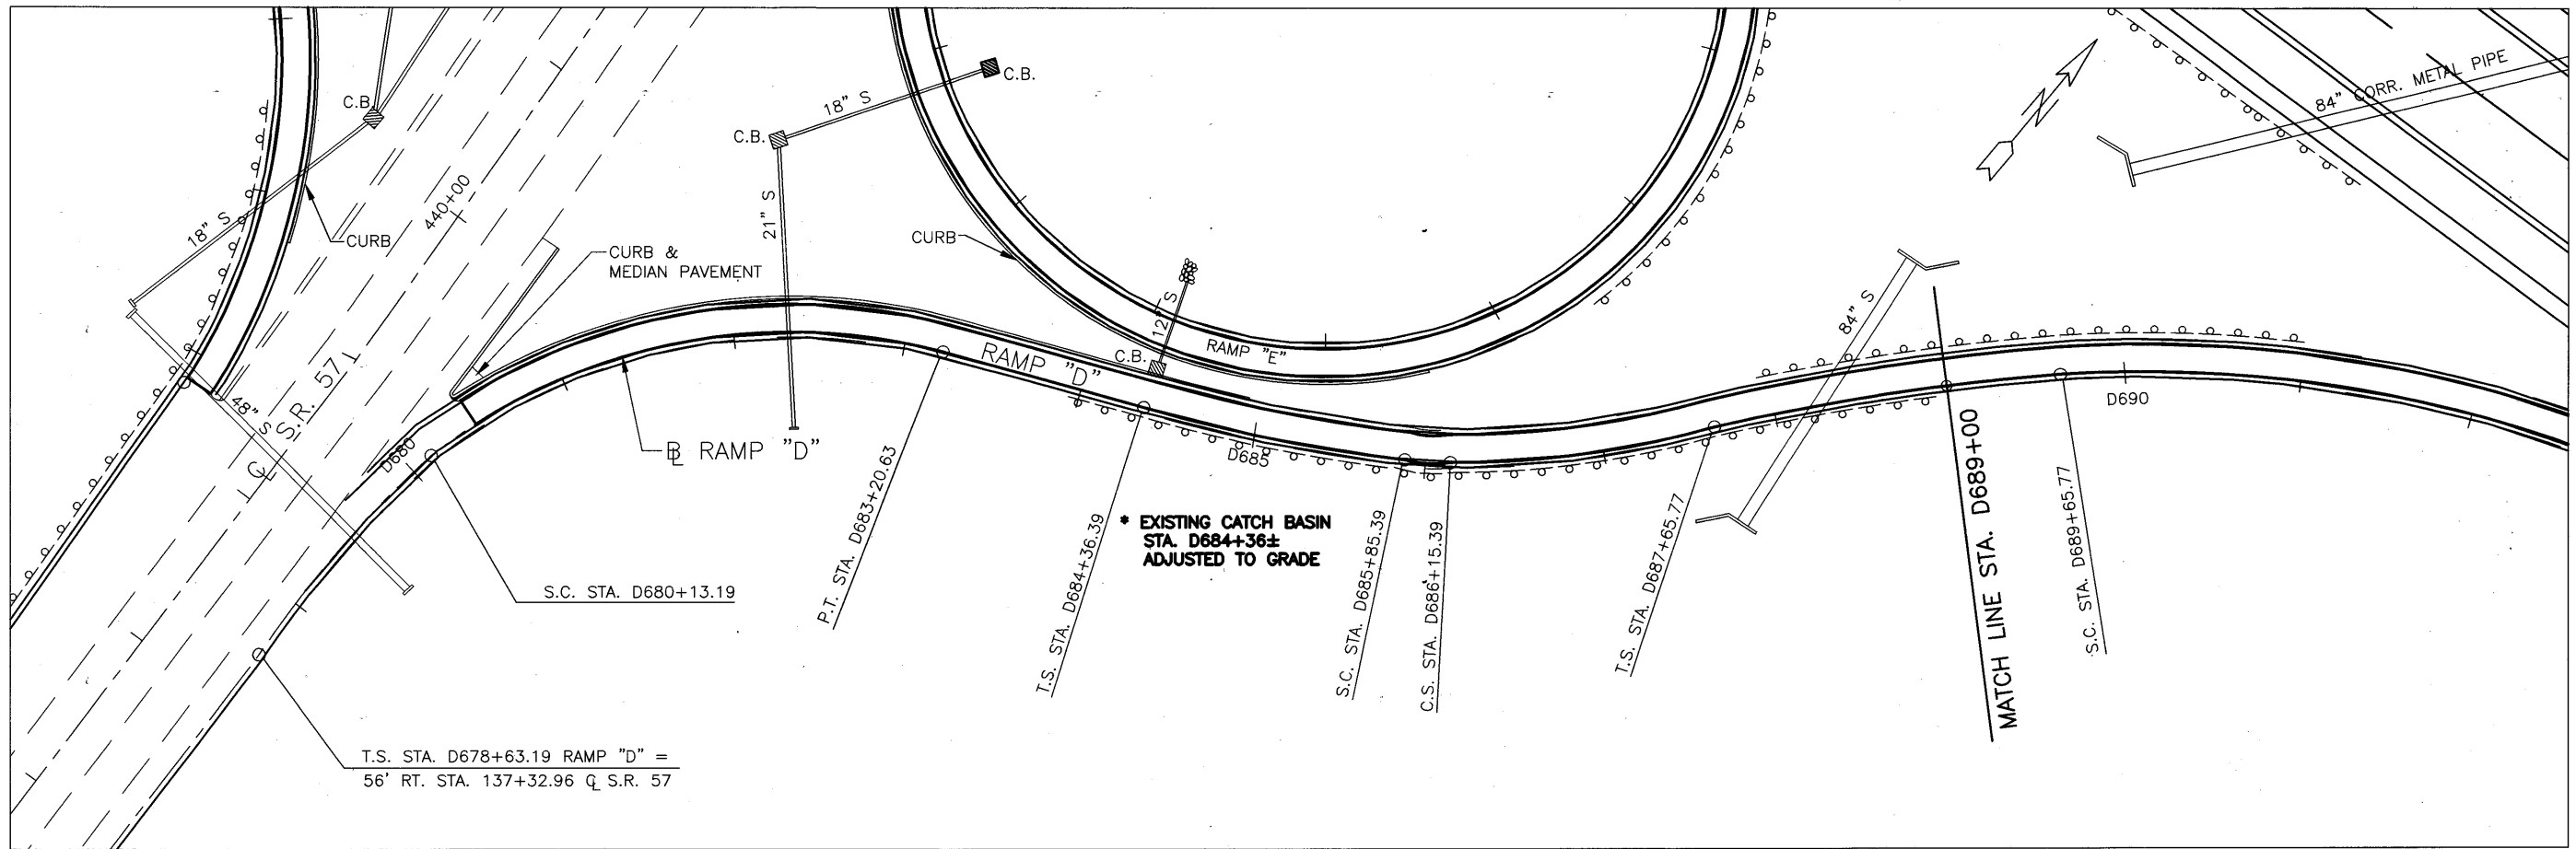

**LEGEND**

- ⊙ TEMPORARY INLET PROTECT, FILTER FABRIC FENCE (AT ALL EXISTING AND PROPOSED INLETS)
- ◆ TEMPORARY DITCH CHECK, FILTER FABRIC FENCE
- FF — FILTER FABRIC FENCE
- DIRECTION OF FLOW DITCH
- ▨ SEDIMENT BASIN



CALCULATED	DLS	CHECKED	LAB

STORM WATER POLLUTION PREVENTION PLAN  
 RAMP "D" - STA. 678+63.19 TO STA. 698+53.27

LOR-190-10.76

57  
274

I:\035000\UNRESERVED\SP-37.DWG 1.NW  
 02-21-2002 3:53PM

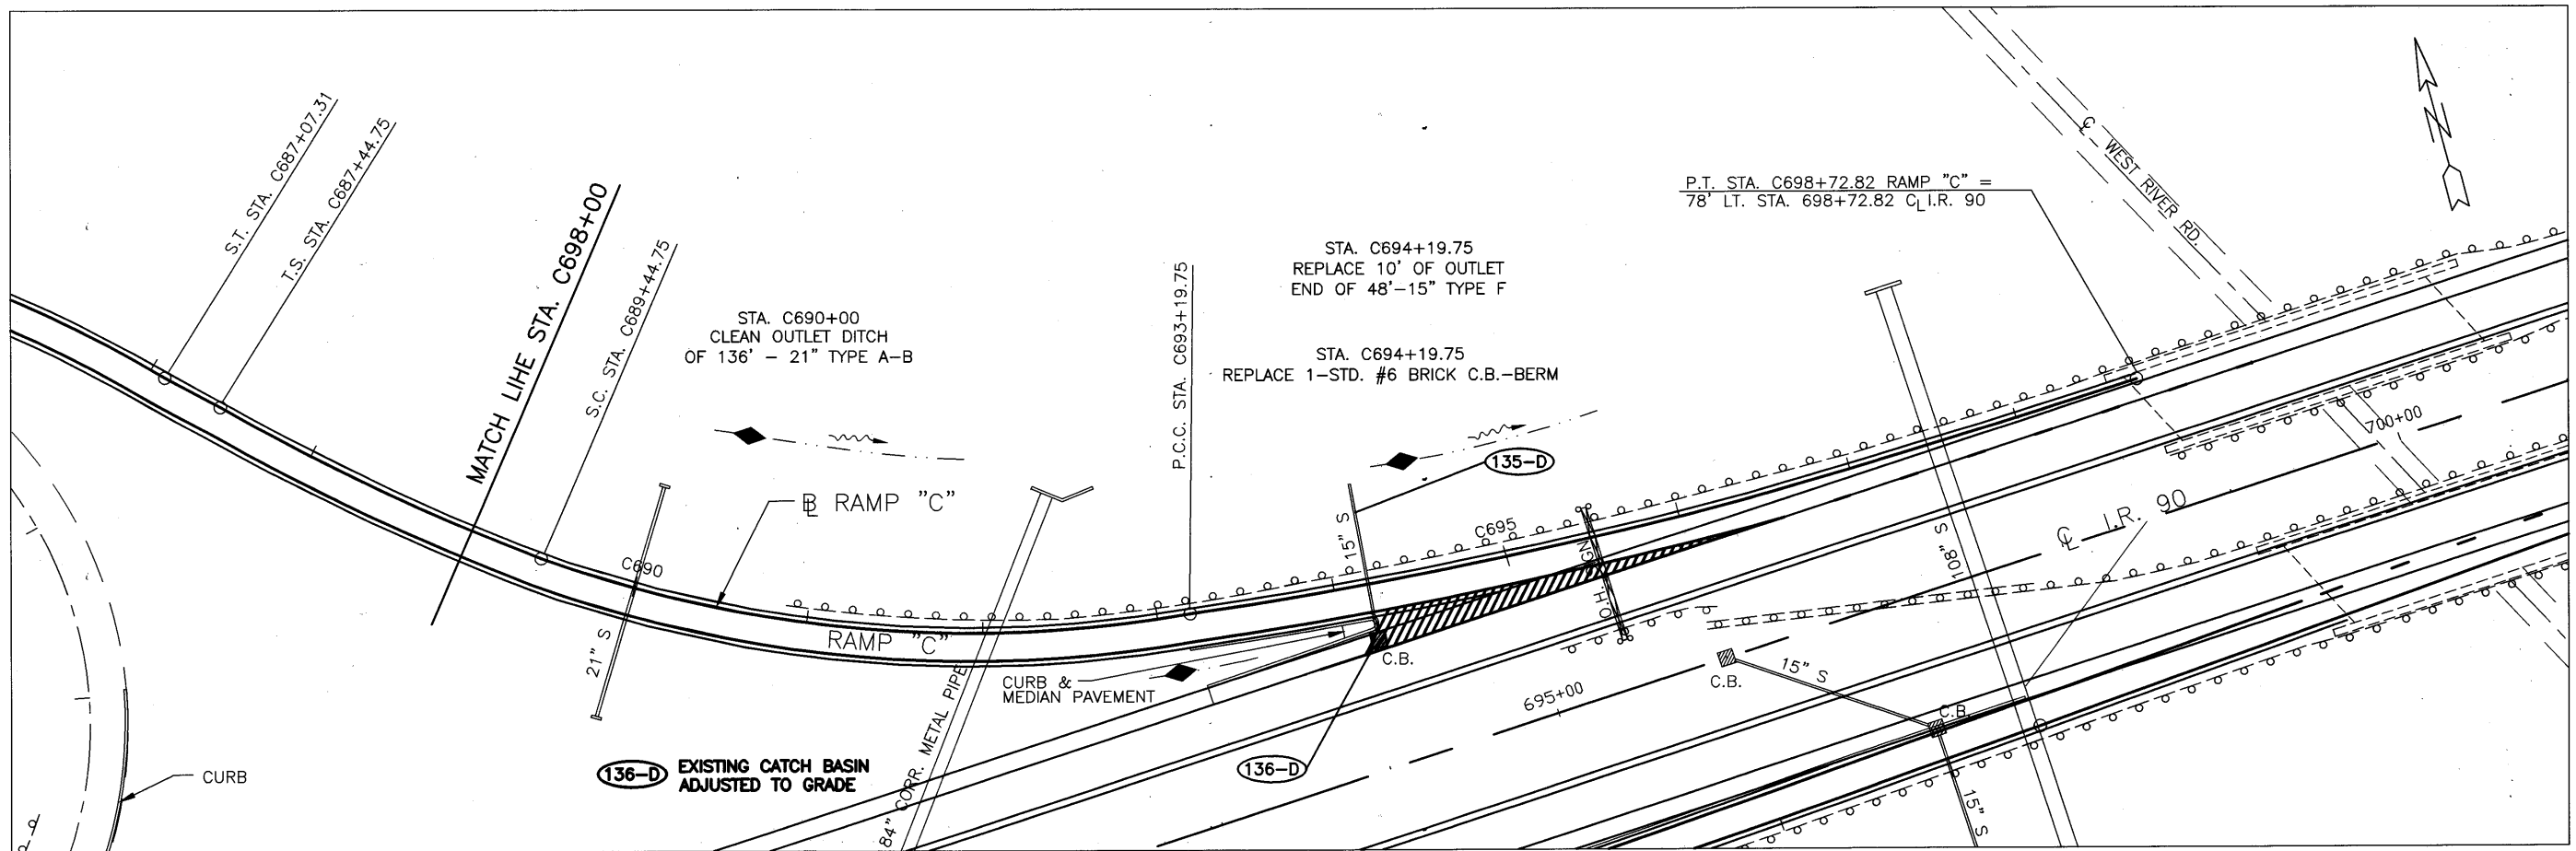
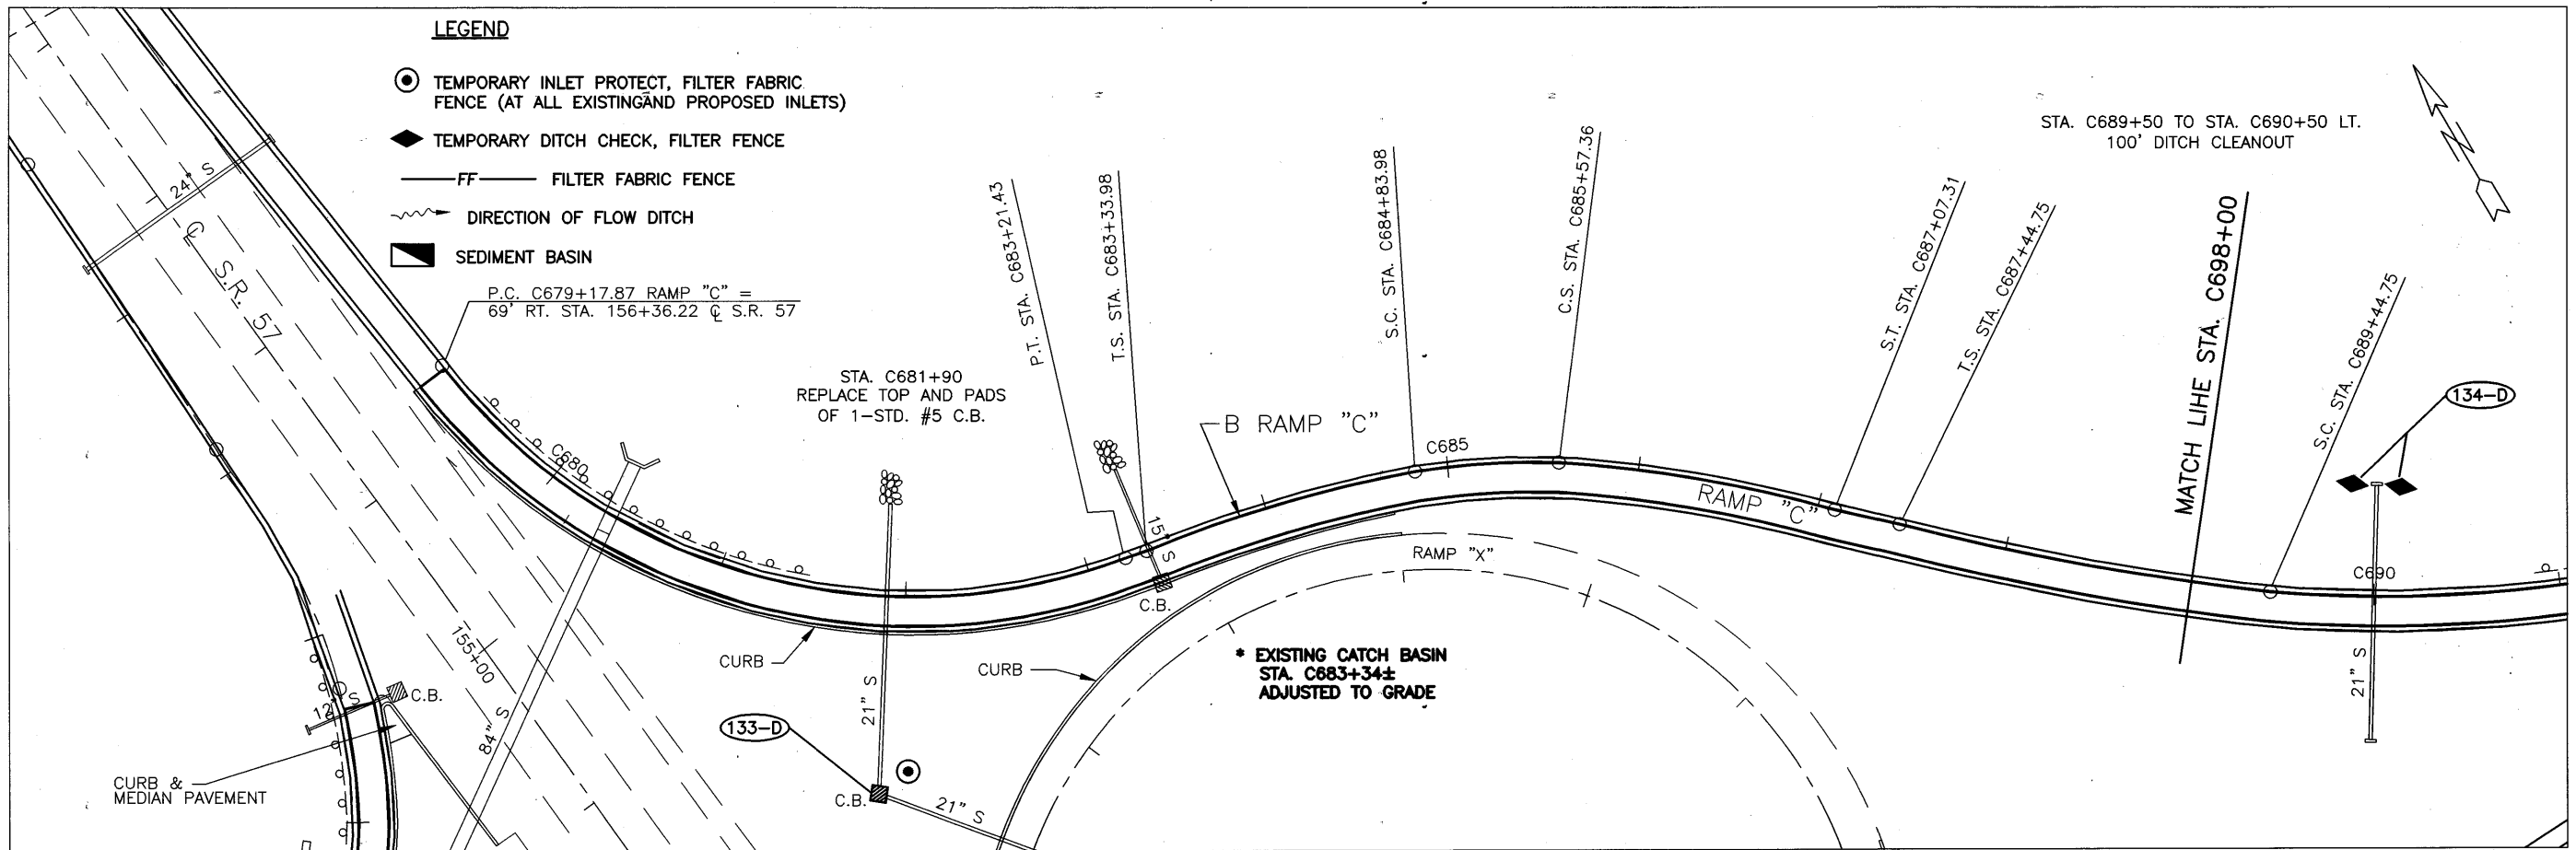


CALCULATED	0
DLS	50
CHECKED	100
LAB	

**STORM WATER POLLUTION PREVENTION PLAN**  
**RAMP "C" - STA. 679+17.87 TO STA. 698+72.82**

**LOR-190-10.76**

C:\035600\UNITS\EROSION\SP-38.DWG 1 NOV 02-21-2002 4:11 PM

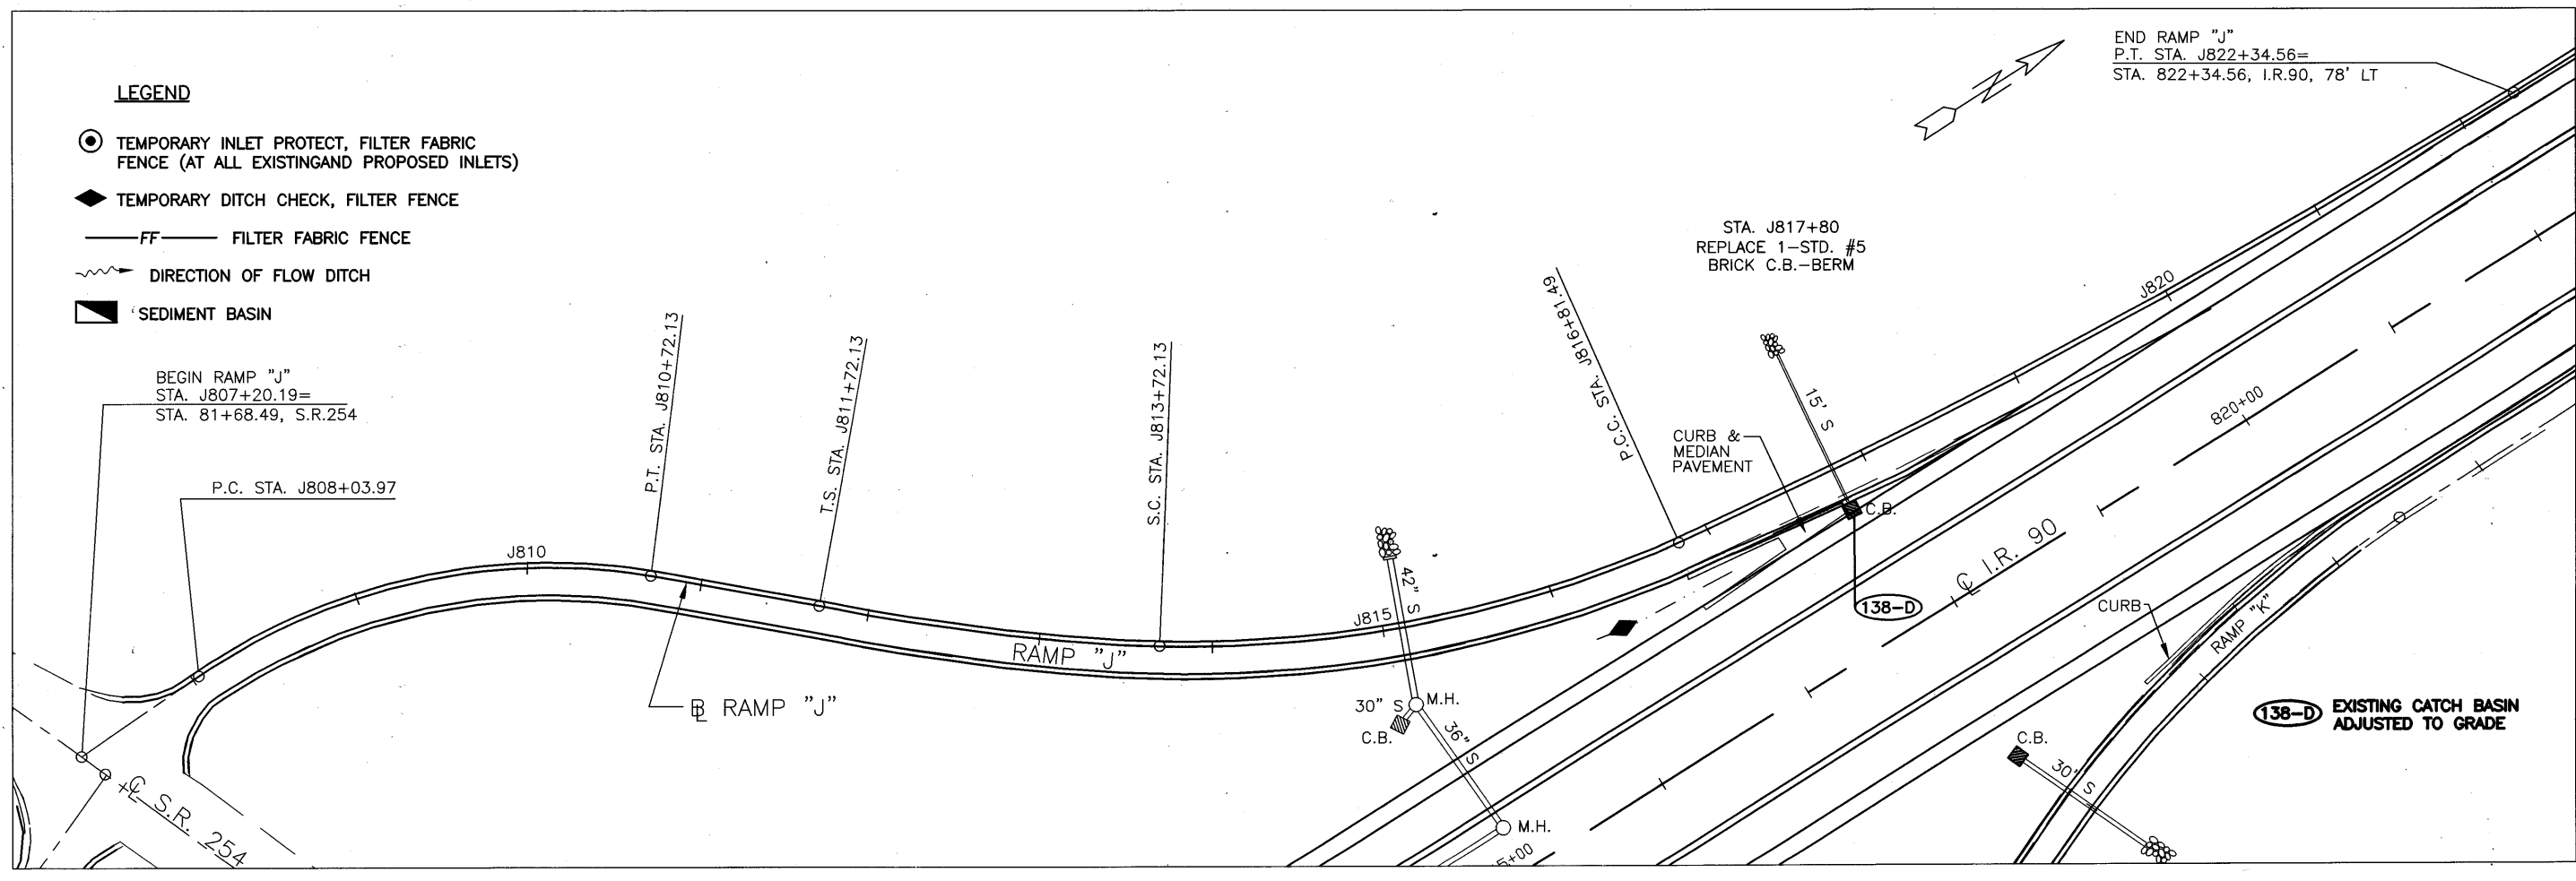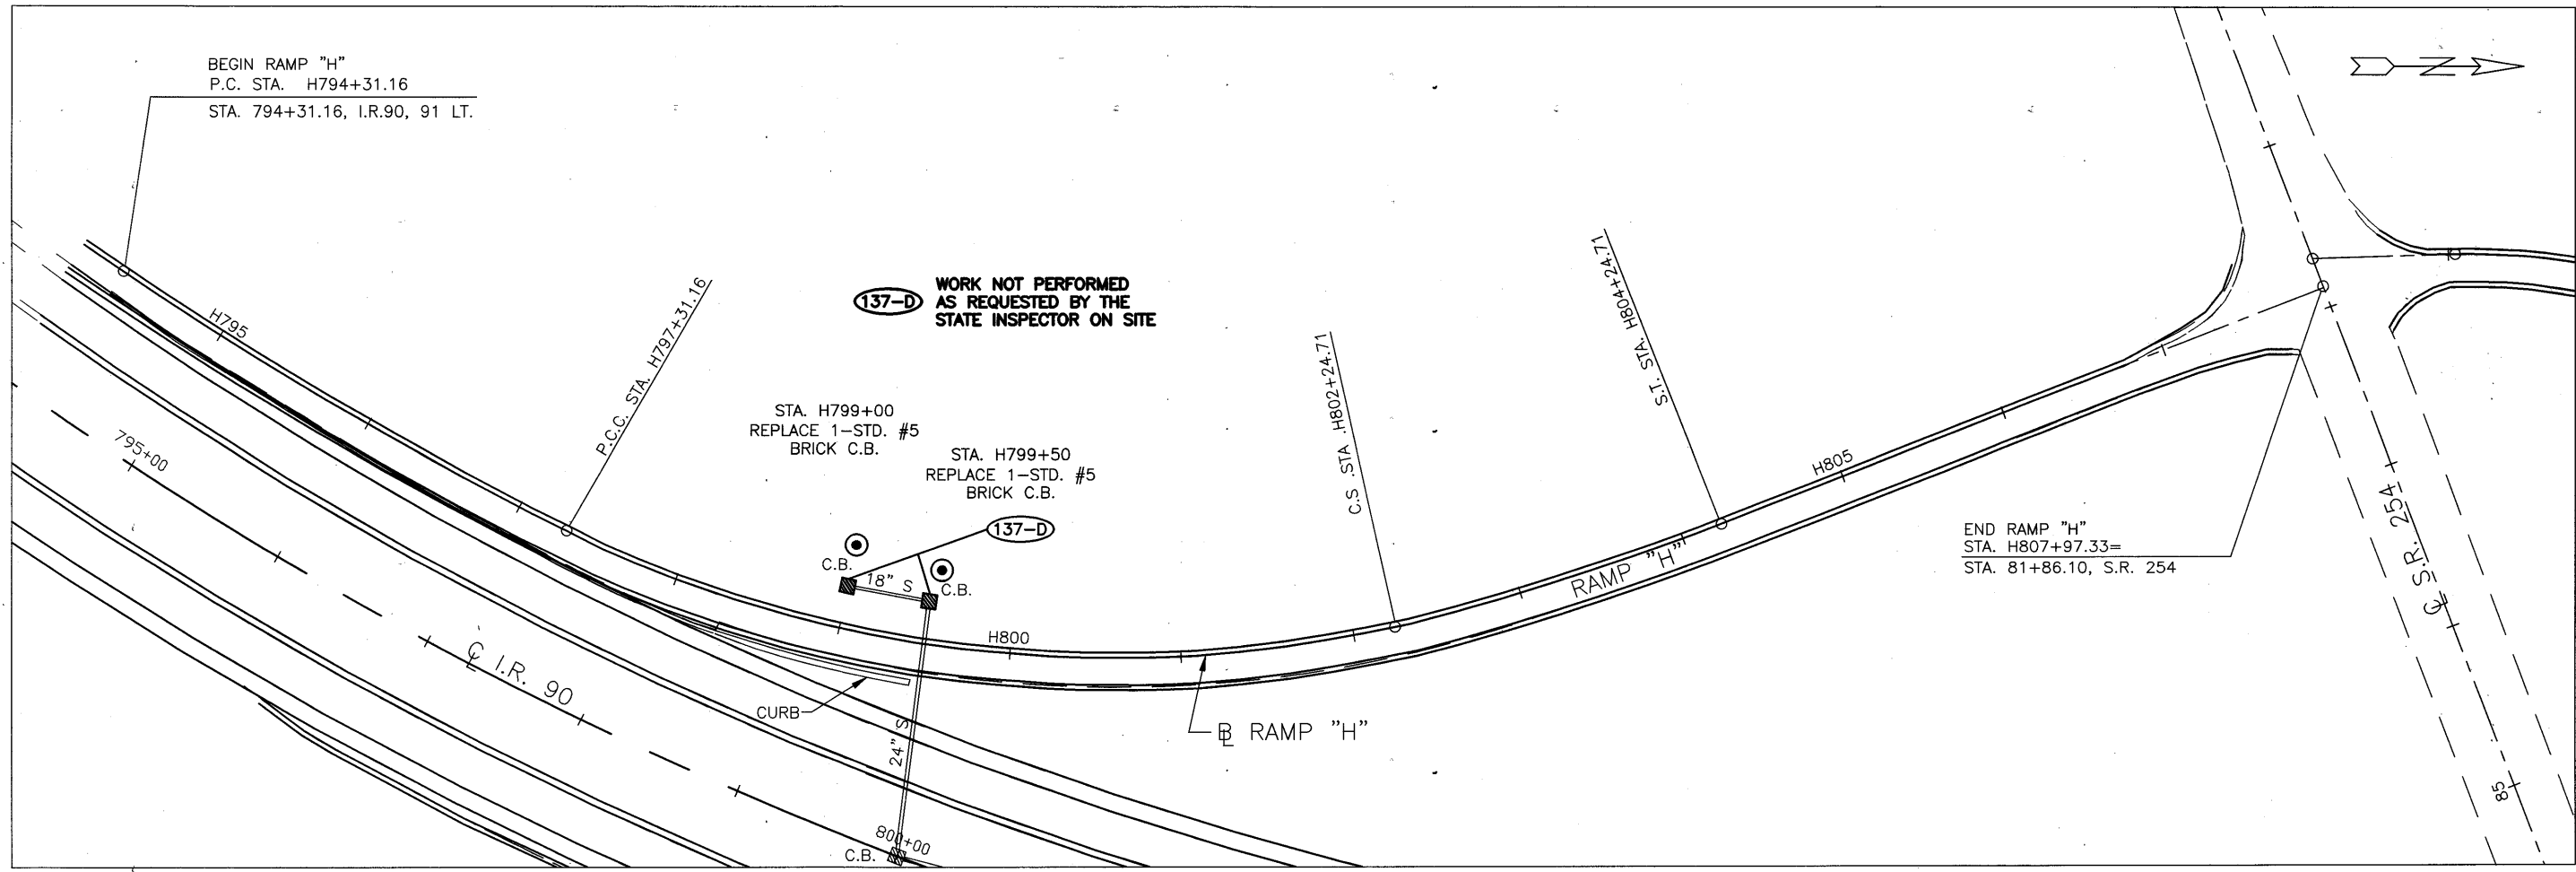

**LEGEND**

- ⊙ TEMPORARY INLET PROTECT, FILTER FABRIC FENCE (AT ALL EXISTING AND PROPOSED INLETS)
- ◆ TEMPORARY DITCH CHECK, FILTER FENCE
- FF— FILTER FABRIC FENCE
- ~ DIRECTION OF FLOW DITCH
- ▭ SEDIMENT BASIN

BEGIN RAMP "J"  
 STA. J807+20.19=  
 STA. 81+68.49, S.R.254

P.C. STA. J808+03.97

END RAMP "J"  
 P.T. STA. J822+34.56=  
 STA. 822+34.56, I.R.90, 78' LT

STA. J817+80  
 REPLACE 1-STD. #5  
 BRICK C.B.-BERM



(138-D) EXISTING CATCH BASIN  
 ADJUSTED TO GRADE

CALCULATED	DLS	CHECKED	LAB

**STORM WATER POLLUTION PREVENTION PLAN**  
**STA. H794+31.16 TO STA. H807+97.33 & STA. J808+03.97 TO STA. J822+34.56**

**LOR-190-10.76**

L:\036601\DWG\VERSION\SP-39.DWG J INW  
 02-21-2002 4:13PM

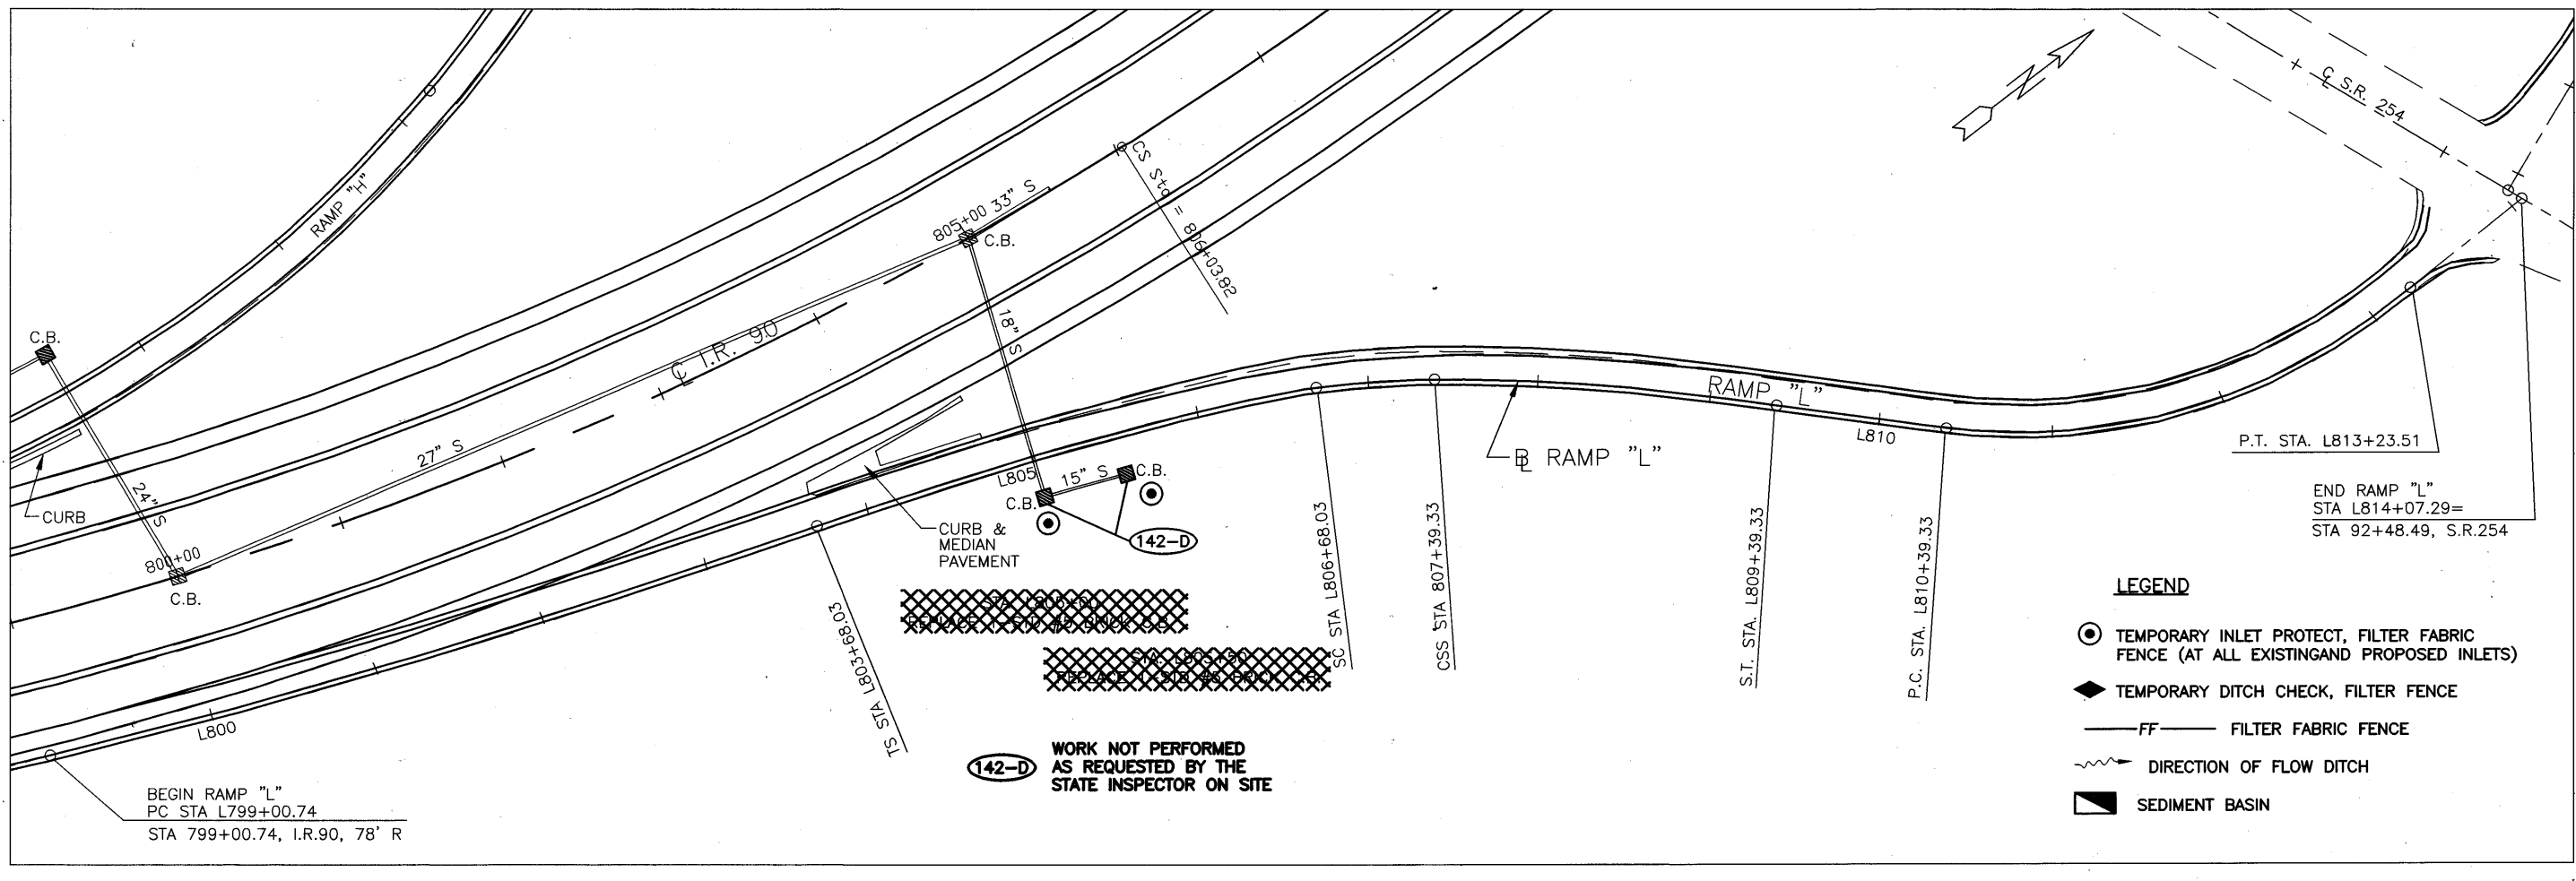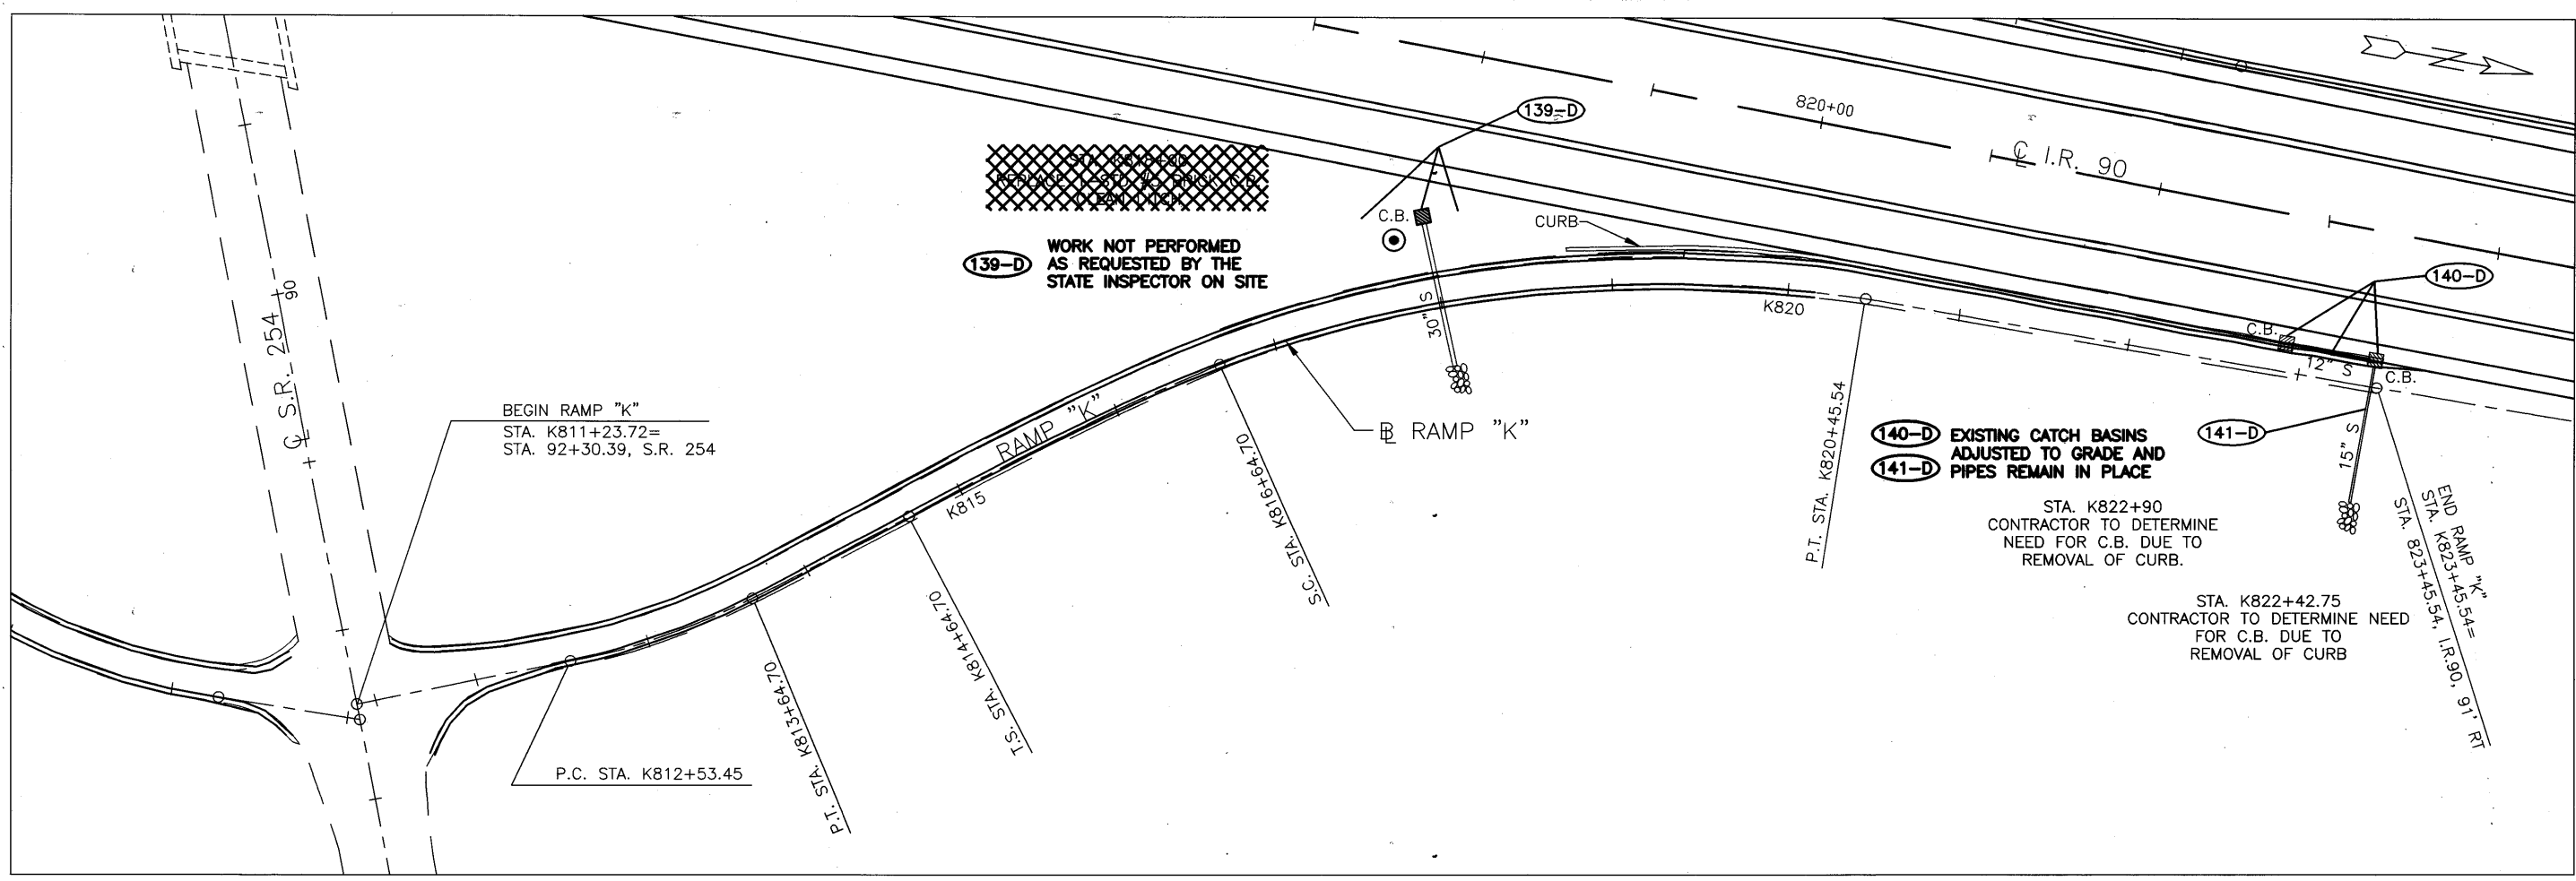


STORM WATER POLLUTION PREVENTION PLAN  
 STA. K811+23.72 TO STA. K823+45.54 & STA. L799+00.74 TO STA. L814+07.29


LOR-190-10.76

L:\0\95600\DWG\SP-40.DWG 11/11/01  
 02-21-2002 4:17PM

CURVE DATA ①  
 P.I. STA. 414+32.93  
 $\Delta = 28^{\circ}33'36''$  RT.  
 D = 1'00'00"  
 R = 5729.58'  
 T = 1458.32'  
 L = 2856.00'  
 E = 182.68'

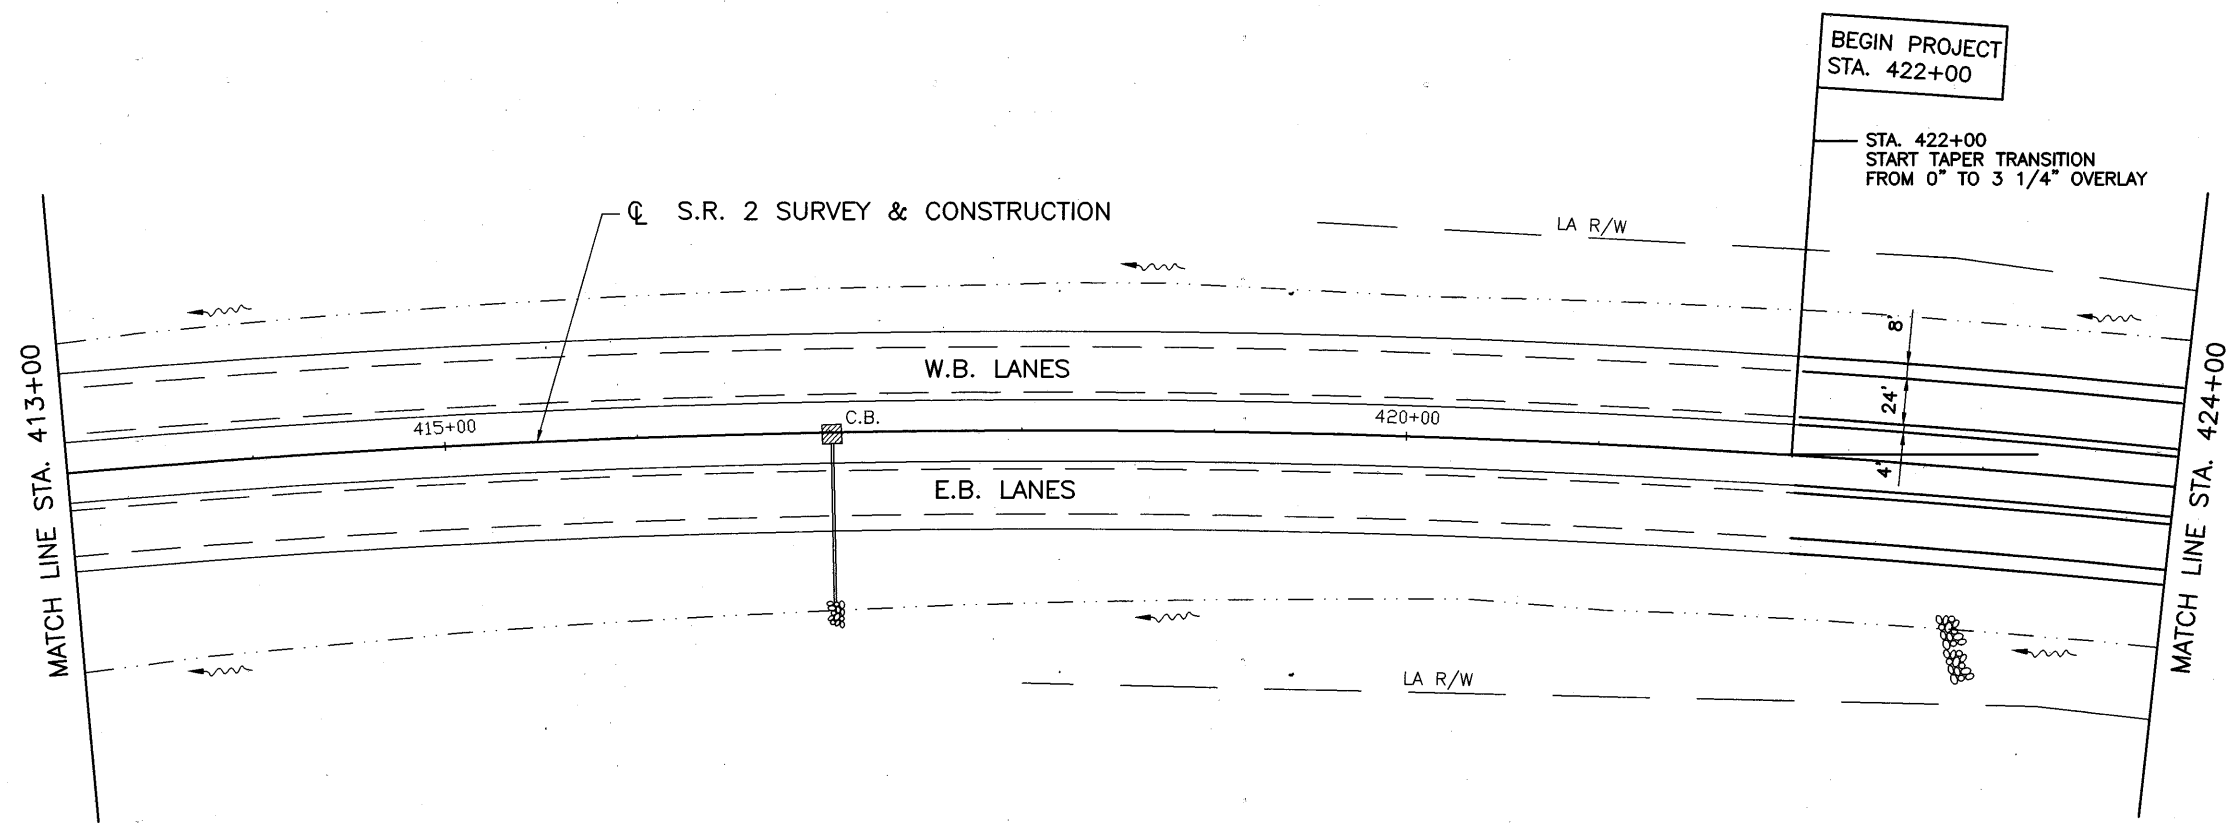


PLAN  
 STA. 413+00 TO STA. 435+00


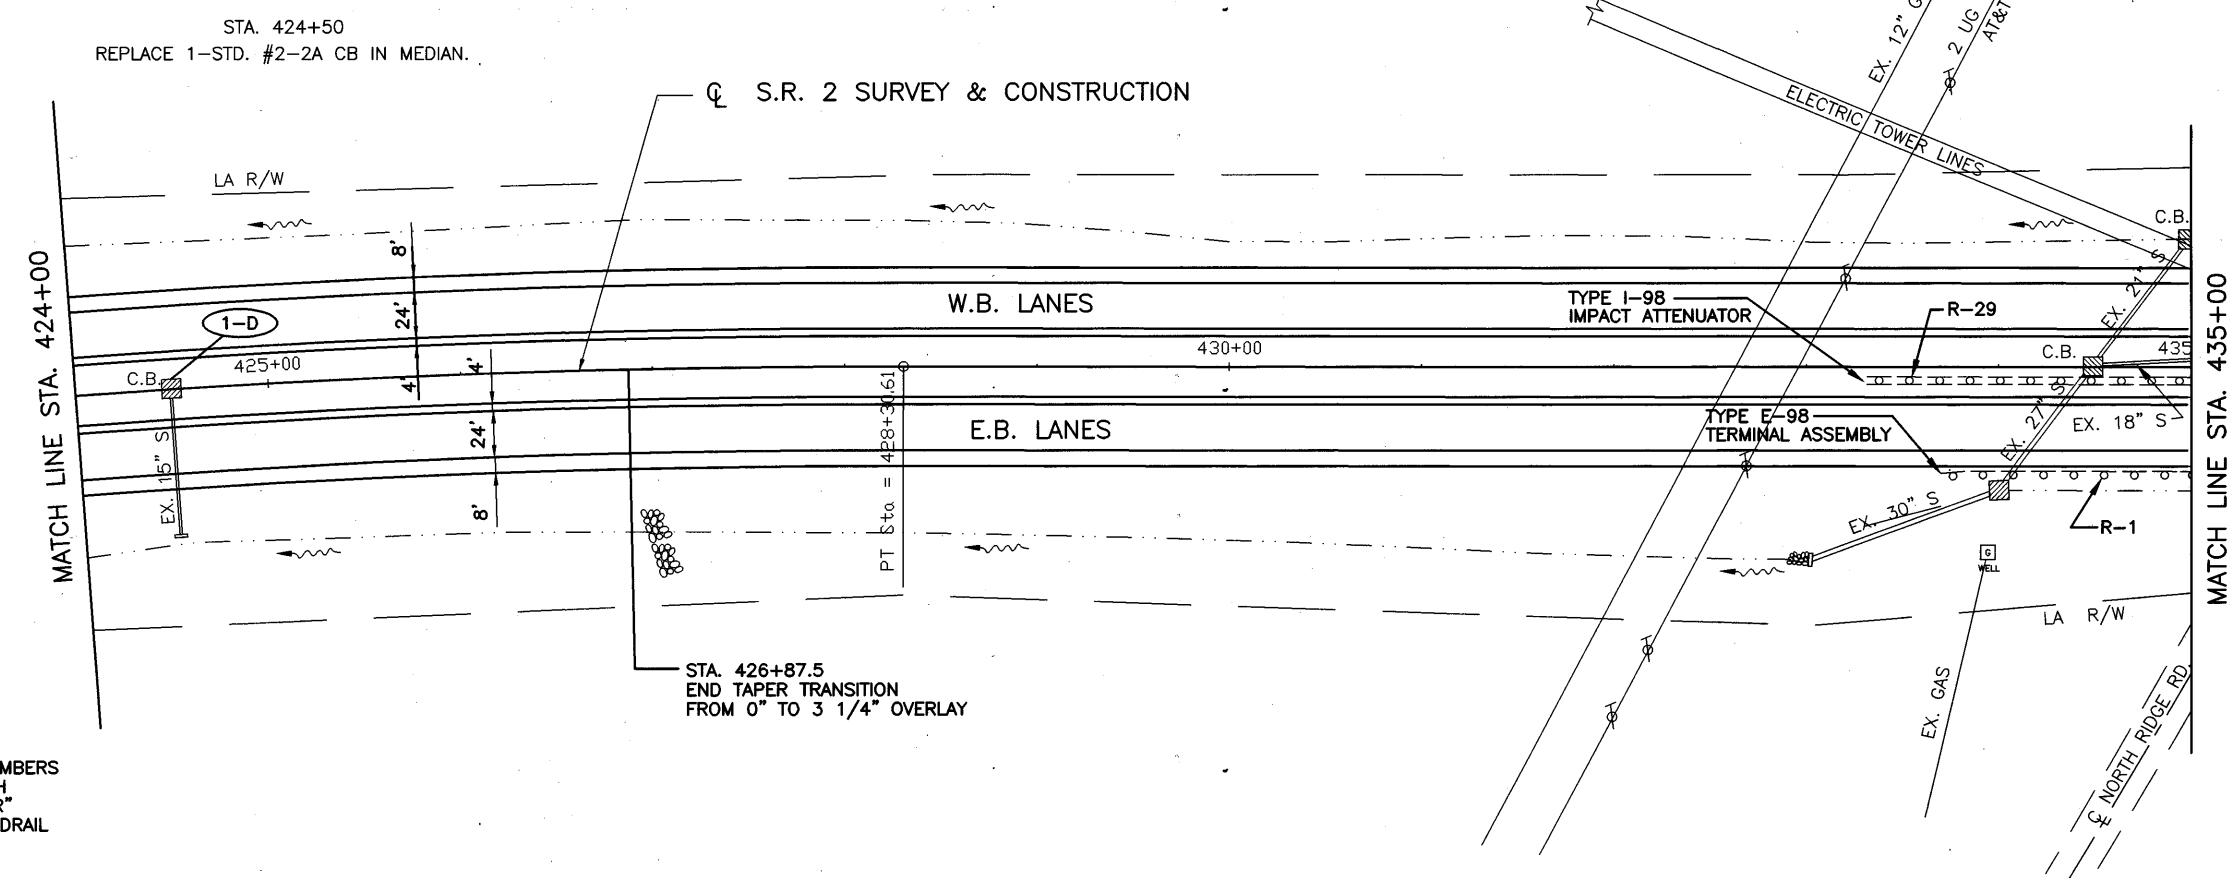


NOTE:  
 THE "R" GUARDRAIL REFERENCE NUMBERS  
 ON ALL THE PLANS REFER TO BOTH  
 THE CORRESPONDING "R" AND "GR"  
 REFERENCE NUMBERS IN THE GUARDRAIL  
 SUB-SUMMARY TABLES.

LOR - 190 - 10.76

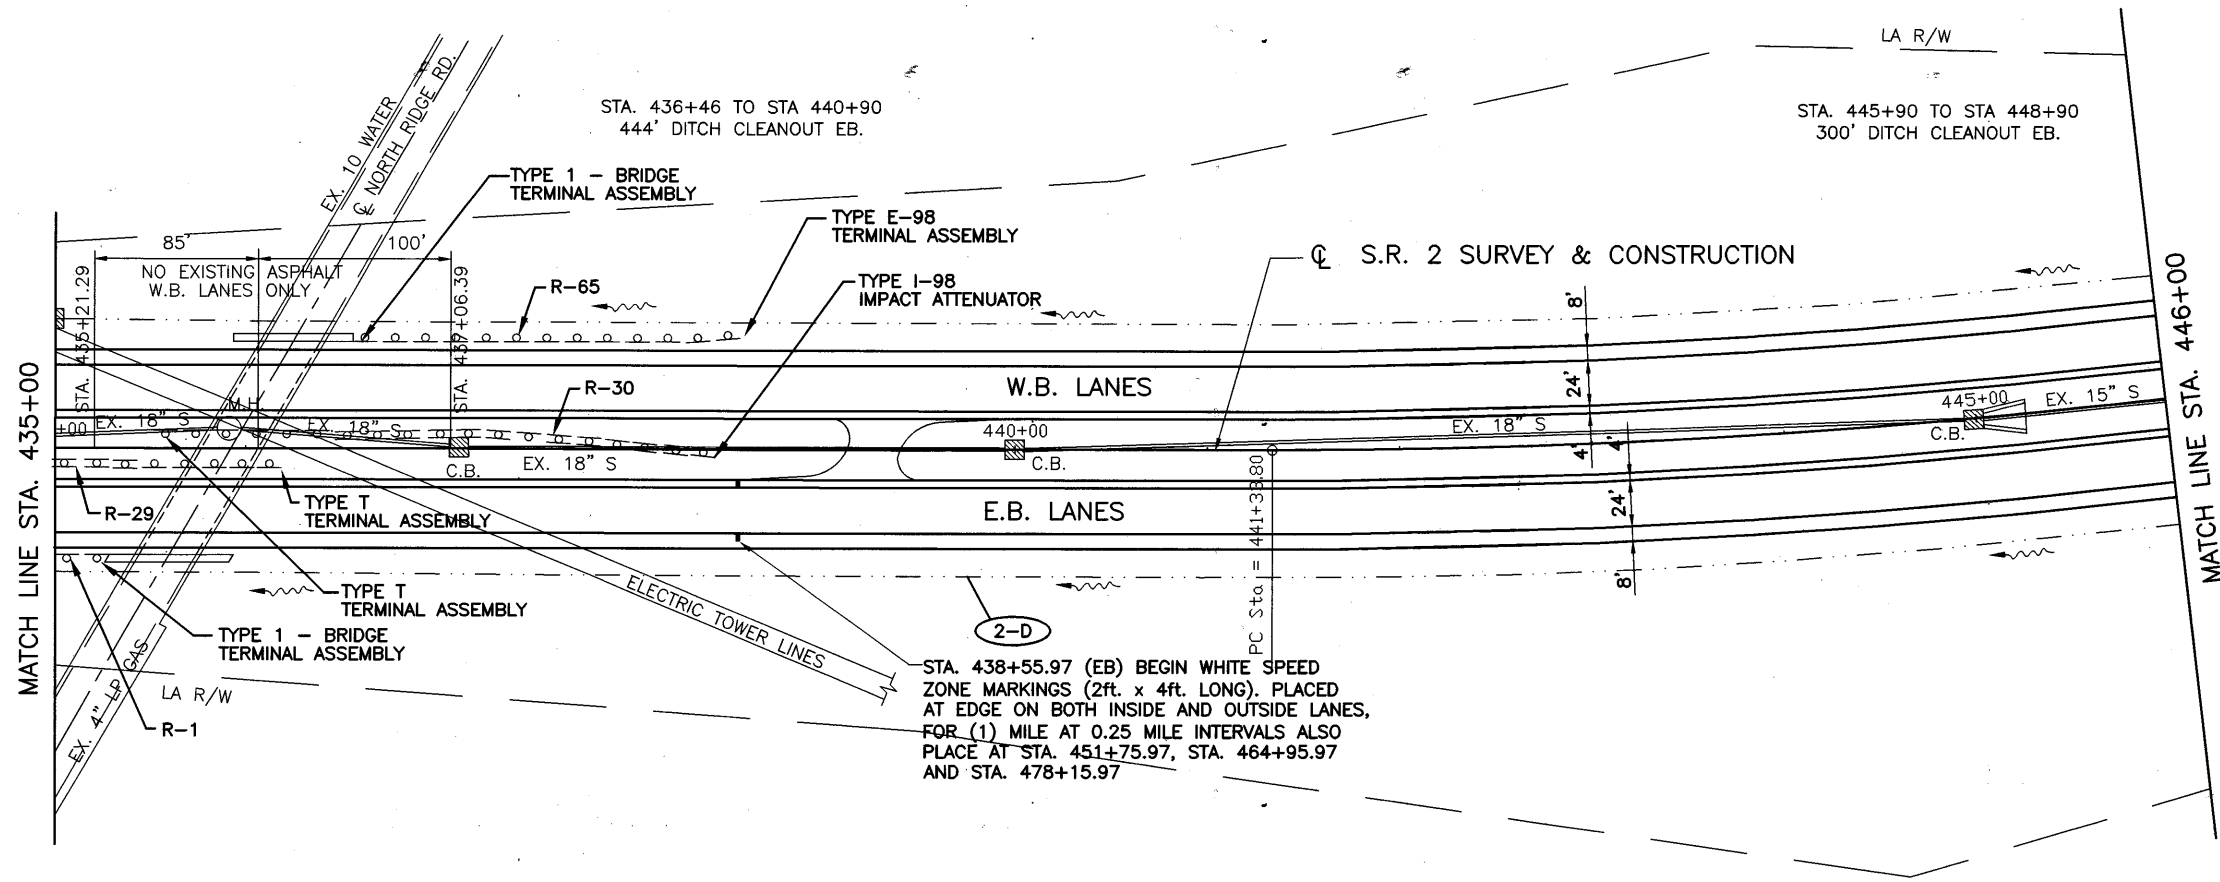



CURVE DATA (2)  
 P.I. STA. 448+92.90  
 $\Delta = 21^{\circ}59'34''$  LT.  
 D = 1'28'00"  
 R = 3906.53'  
 T = 759.10'  
 L = 1499.51'  
 E = 73.07'

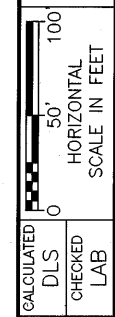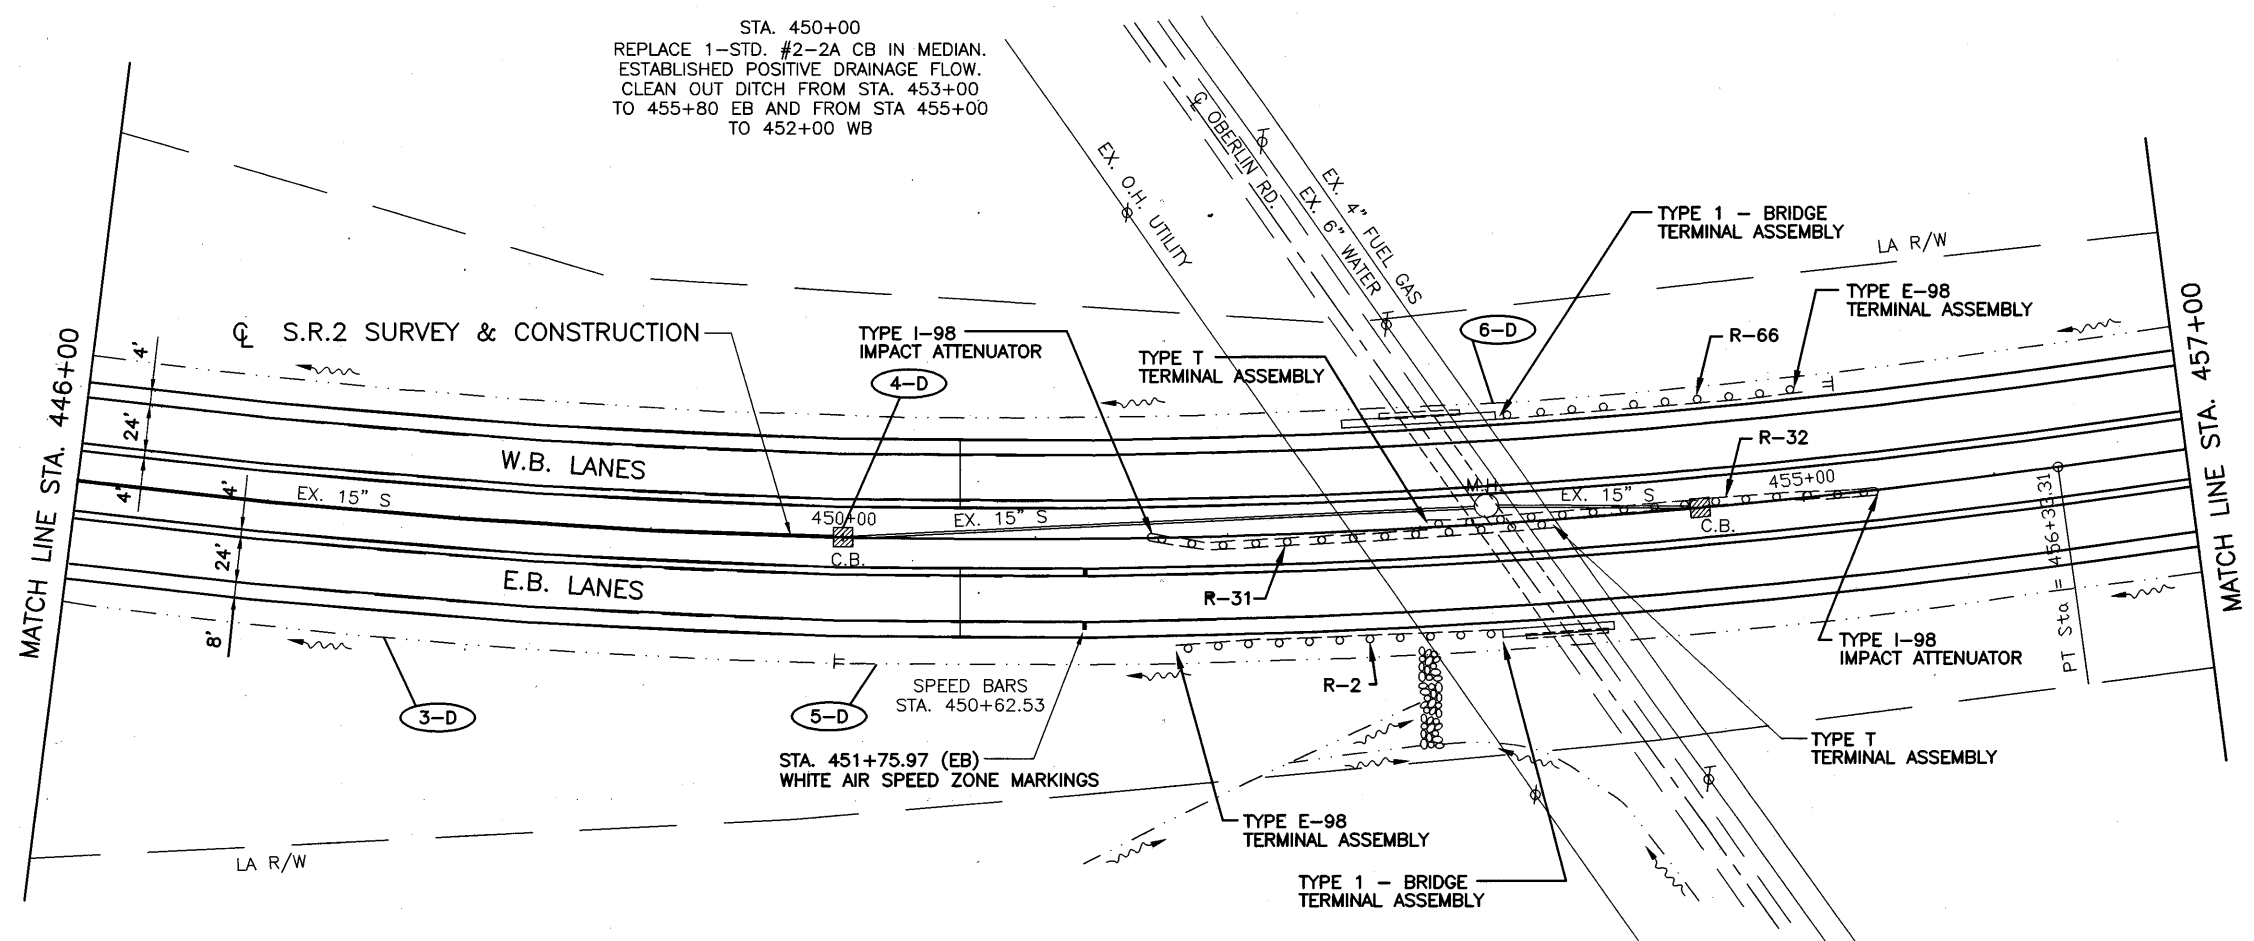


PLAN  
 STA. 435+00 TO STA. 457+00

LOR - 190 - 10.76

62  
 274

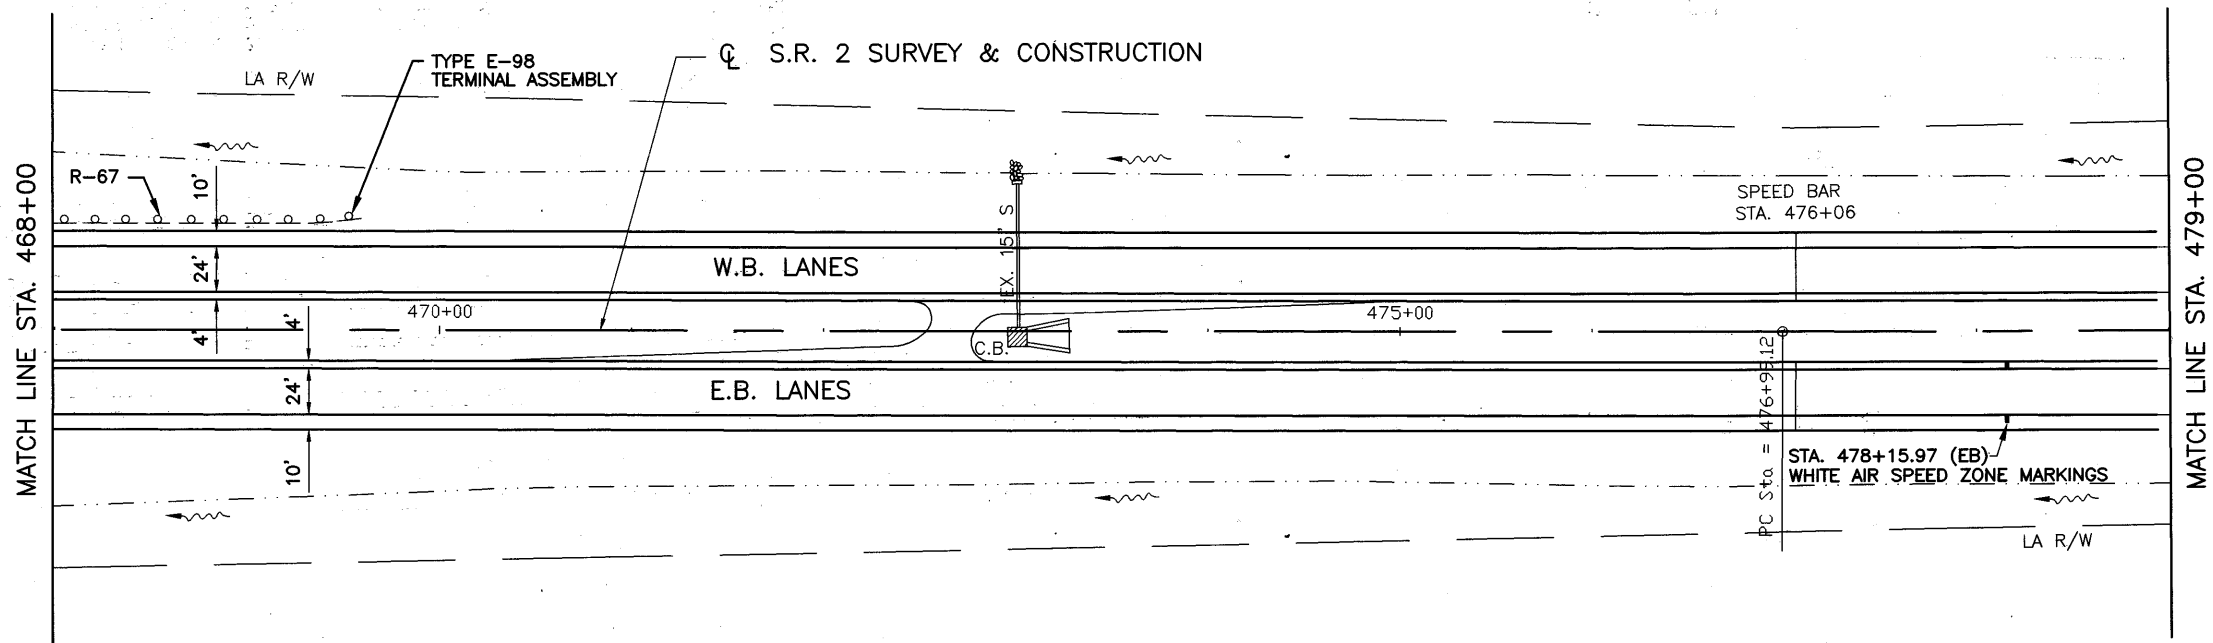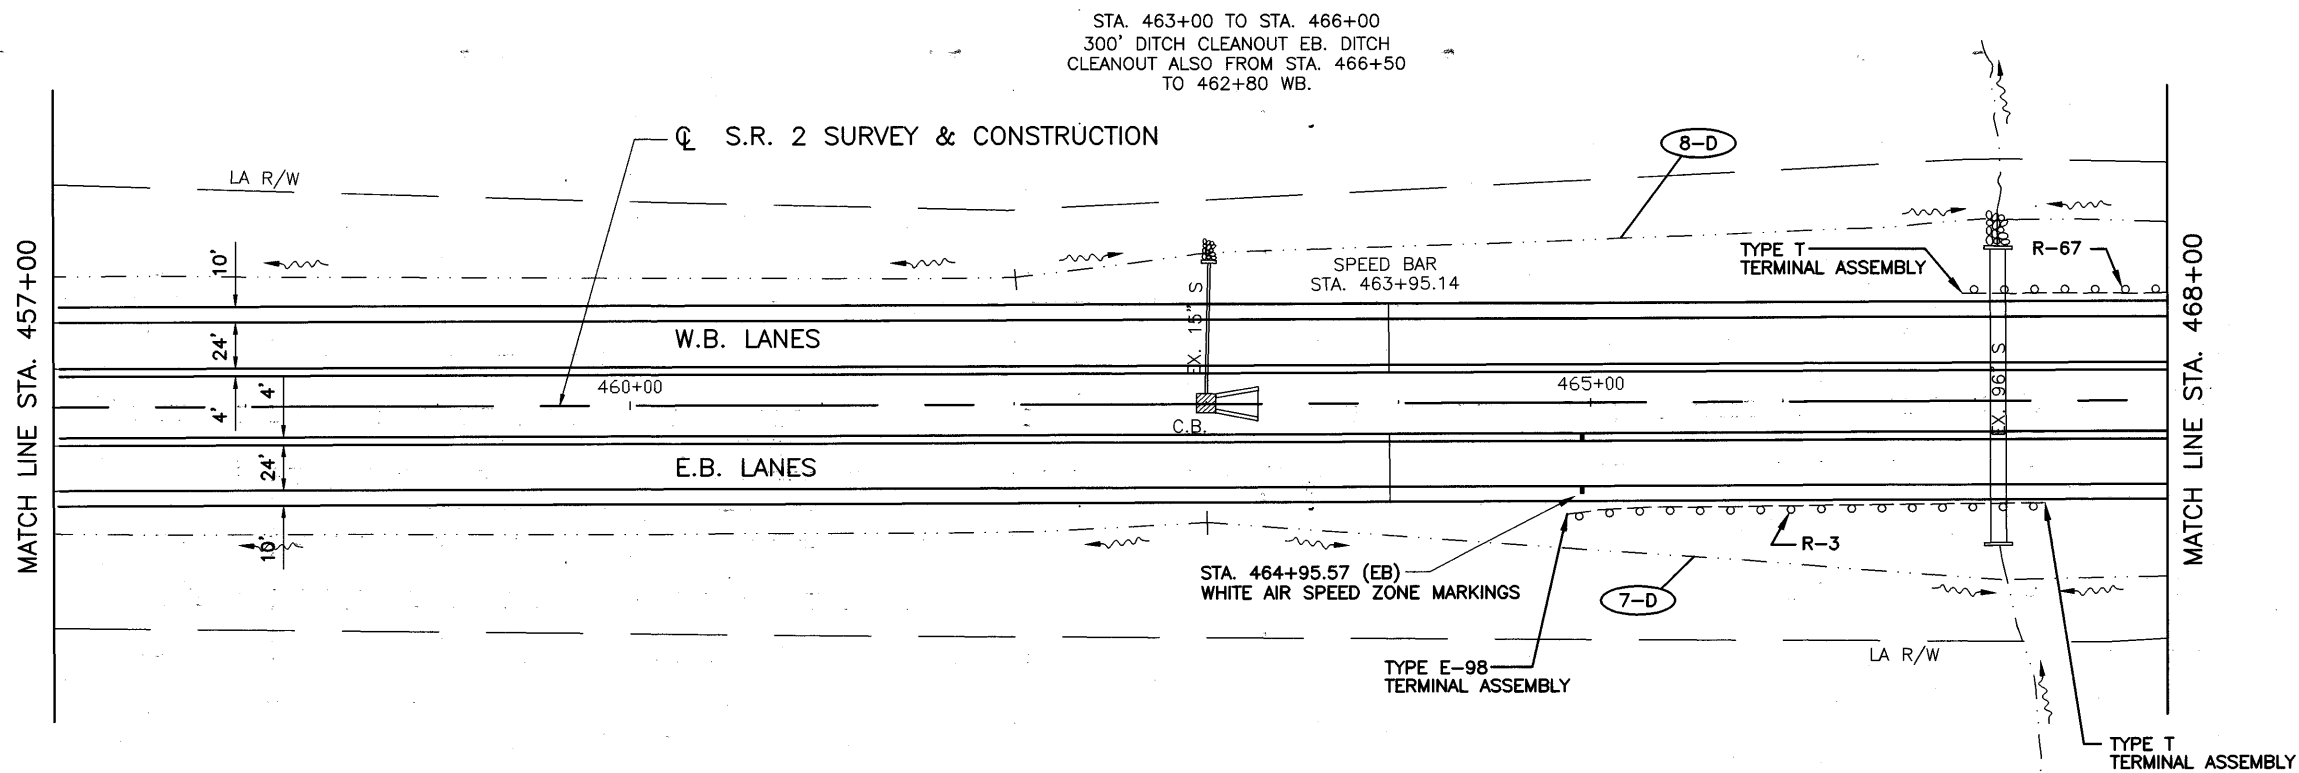

CALCULATED	DLS	CHECKED	LAB

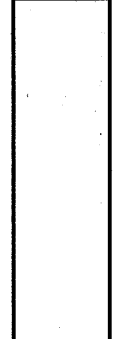


**PLAN**

**STA. 457+00 TO STA. 479+00**

**LOR - 190 - 10.76**


\s0560\pws\0560pnl\p-03.dwg | cz  
 11-2002 7:49AM

CURVE DATA ③  
 P.I. STA. 481+16.20  
 $\Delta = 2'13'27''$  LT.  
 D = 0'16'00"  
 R = 21,485.92'  
 T = 417.08'  
 L = 834.06'  
 E = 4.04'

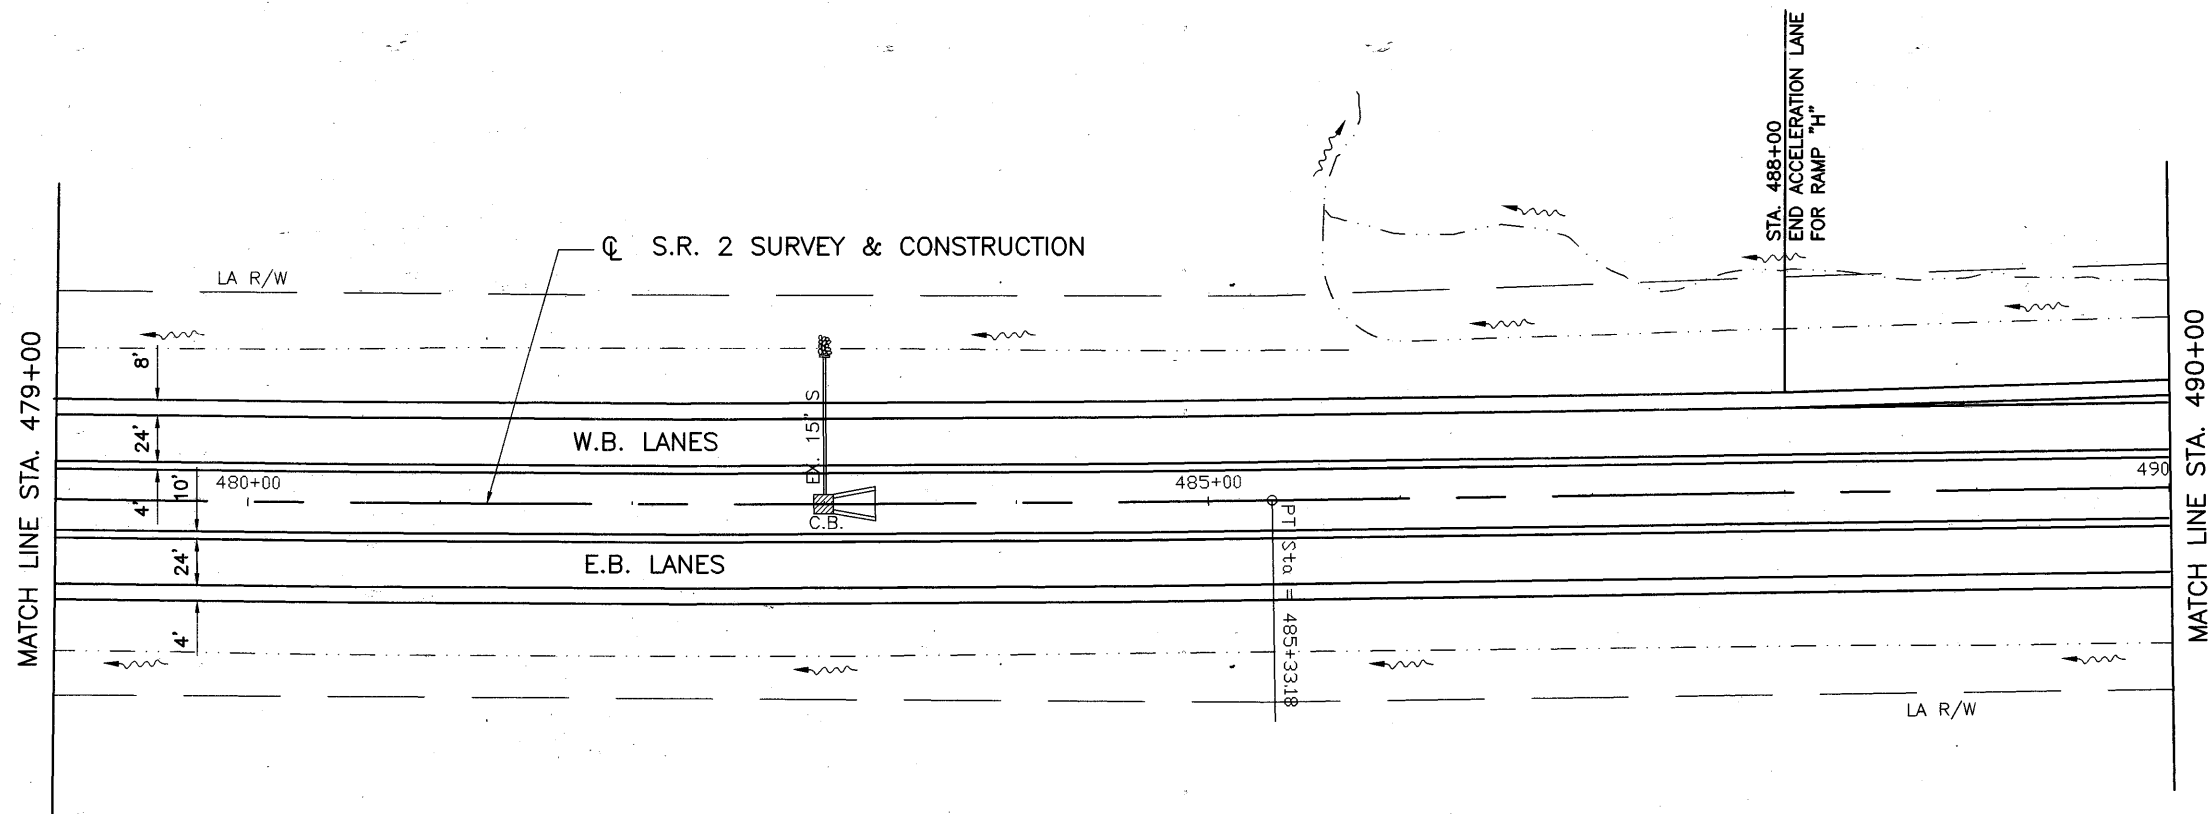


CALCULATED	DLS	CHECKED	LAB

PLAN  
 STA. 479+00 TO STA. 501+00


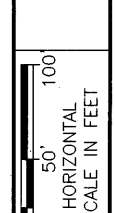


CURVE DATA ④  
 P.I. STA. 499+53.92  
 $\Delta = 3'13'01''$  RT.  
 D = 0'16'00"  
 R = 21,485.92'  
 T = 603.34'  
 L = 1206.35'  
 E = 8.47'

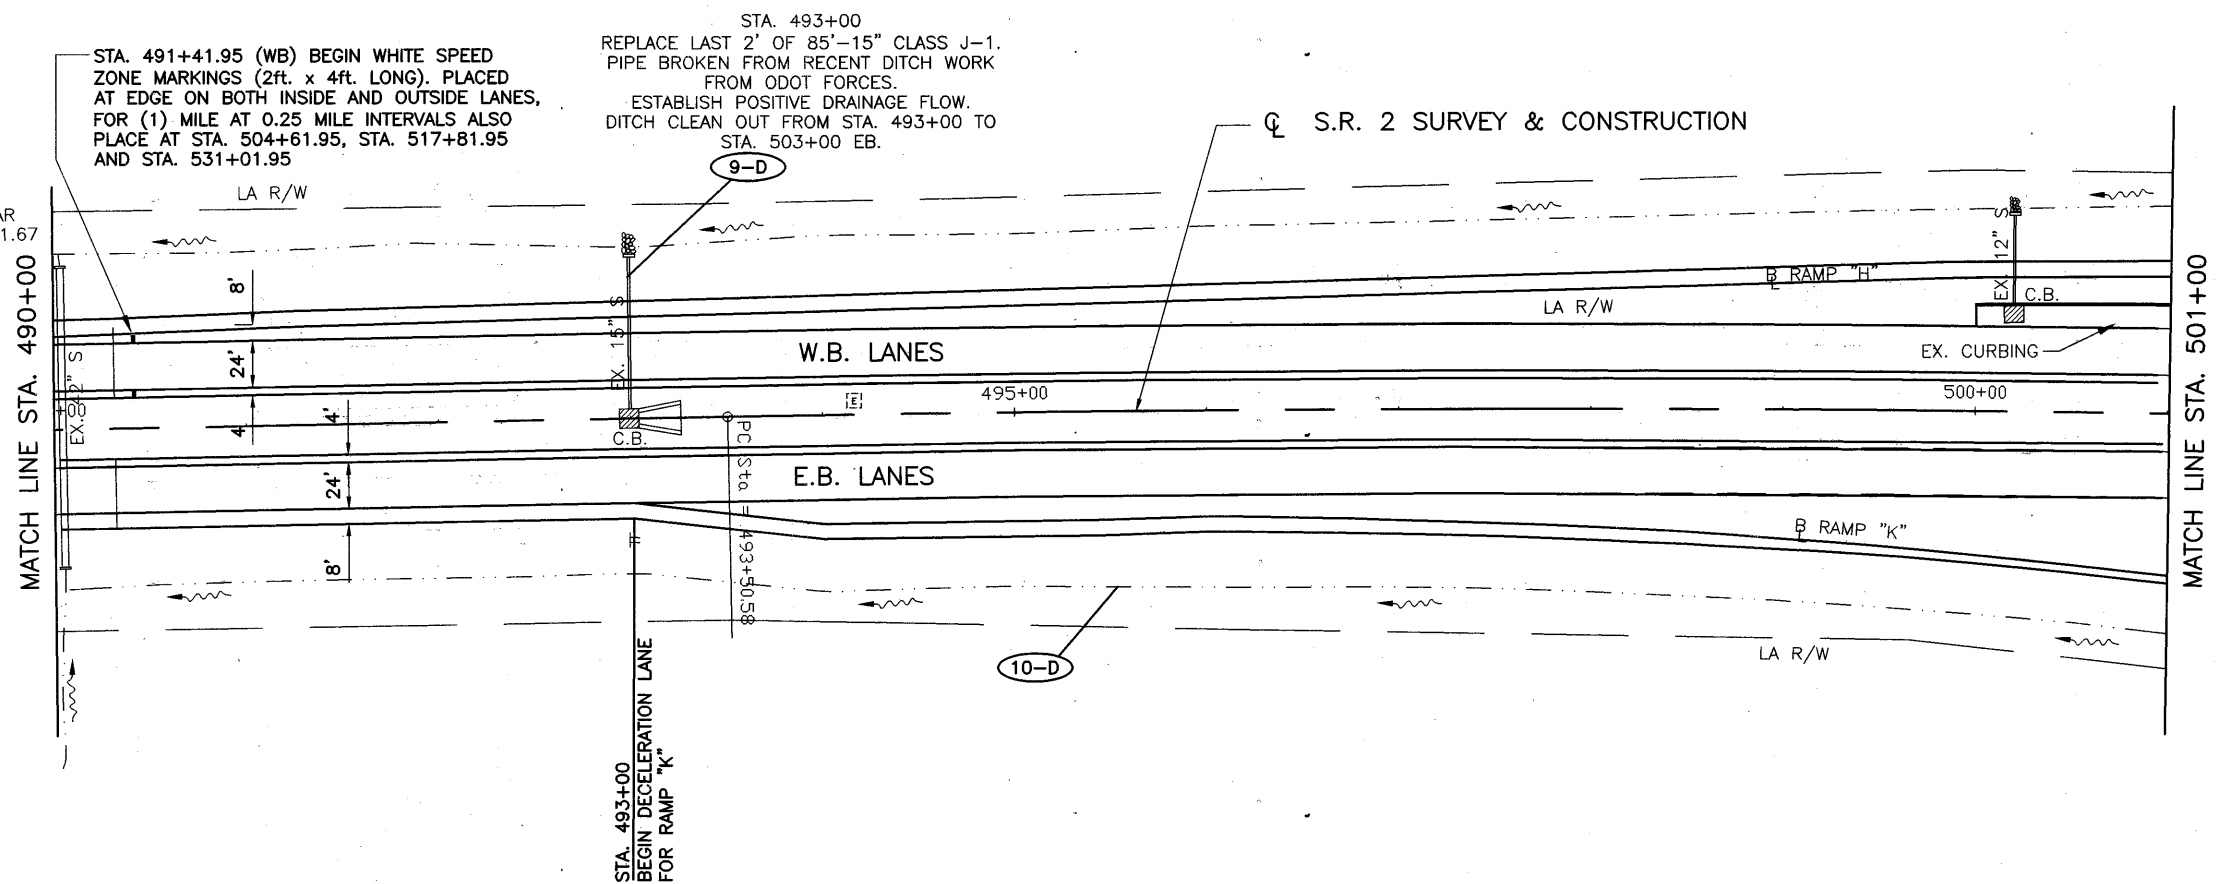

LOR - 190 - 10.76



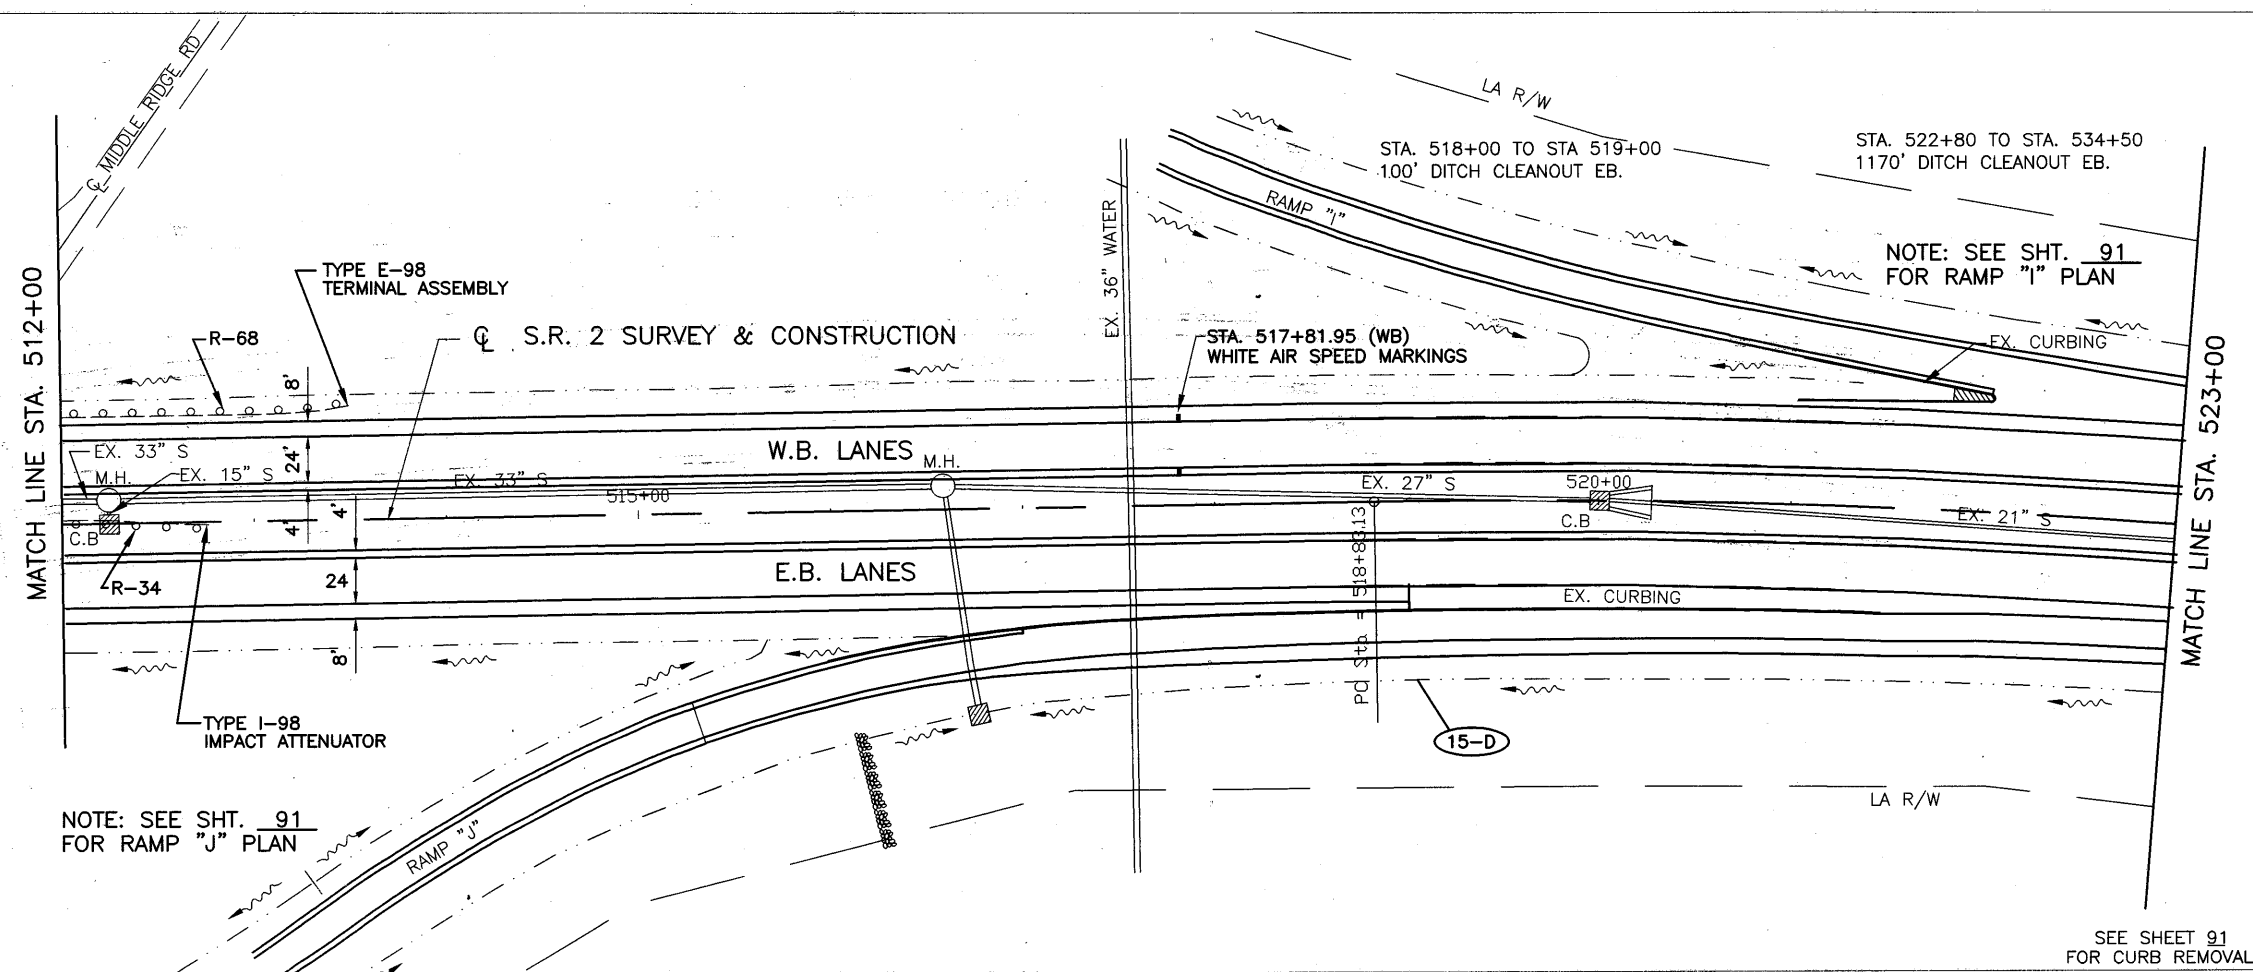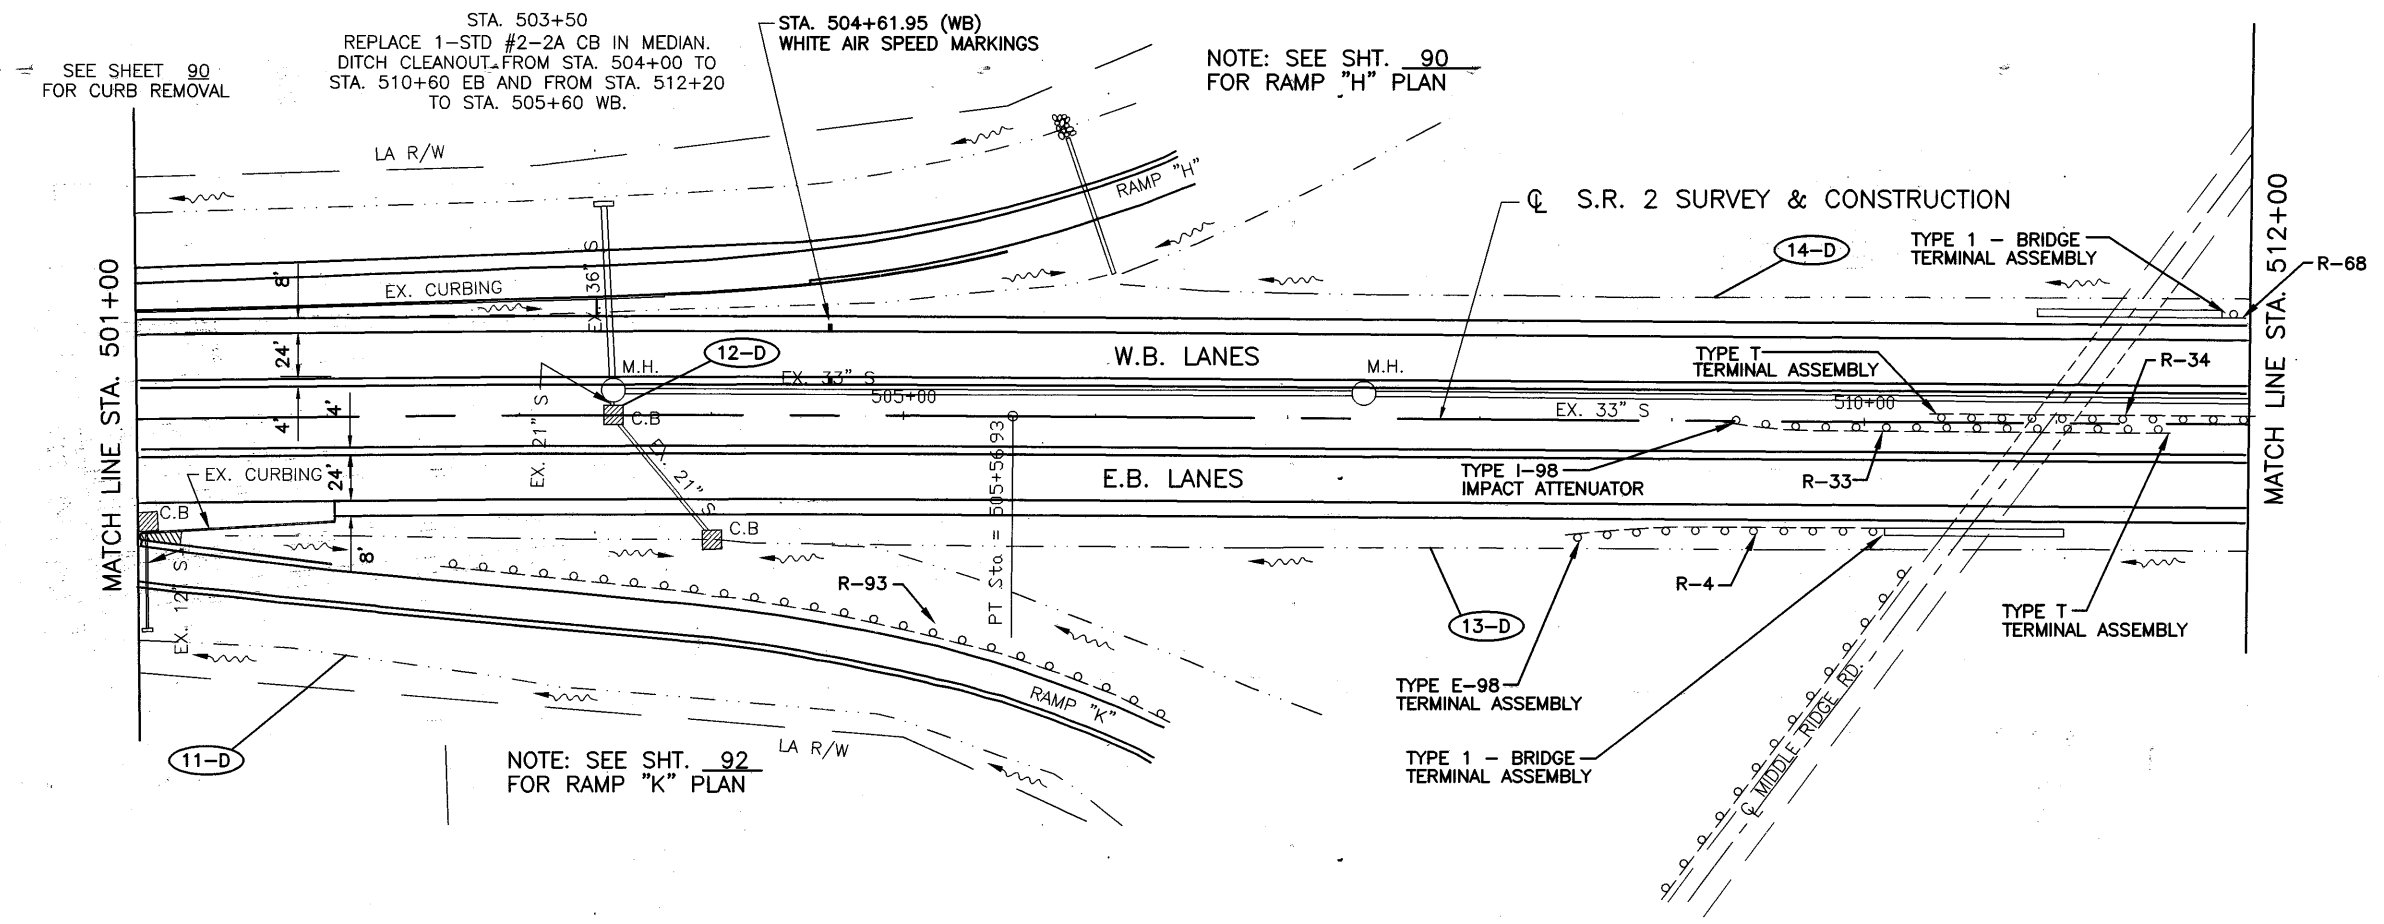

CALCULATED	DLS	CHECKED	LAB

HORIZONTAL  
 SCALE IN FEET


0 50' 100'

PLAN  
 STA. 501+00 TO STA. 523+00


LOR - 190 - 10.76

CURVE DATA (5)  
 P.I. STA. 532+28.96  
 $\Delta = 33^{\circ}08'20''$  RT.  
 D = 1116.00'  
 R = 4523.35'  
 T = 1345.84'  
 L = 2616.23'  
 E = 195.97'


STA. 522+80 TO STA. 534+50  
 1170' DITCH CLEANOUT EB.


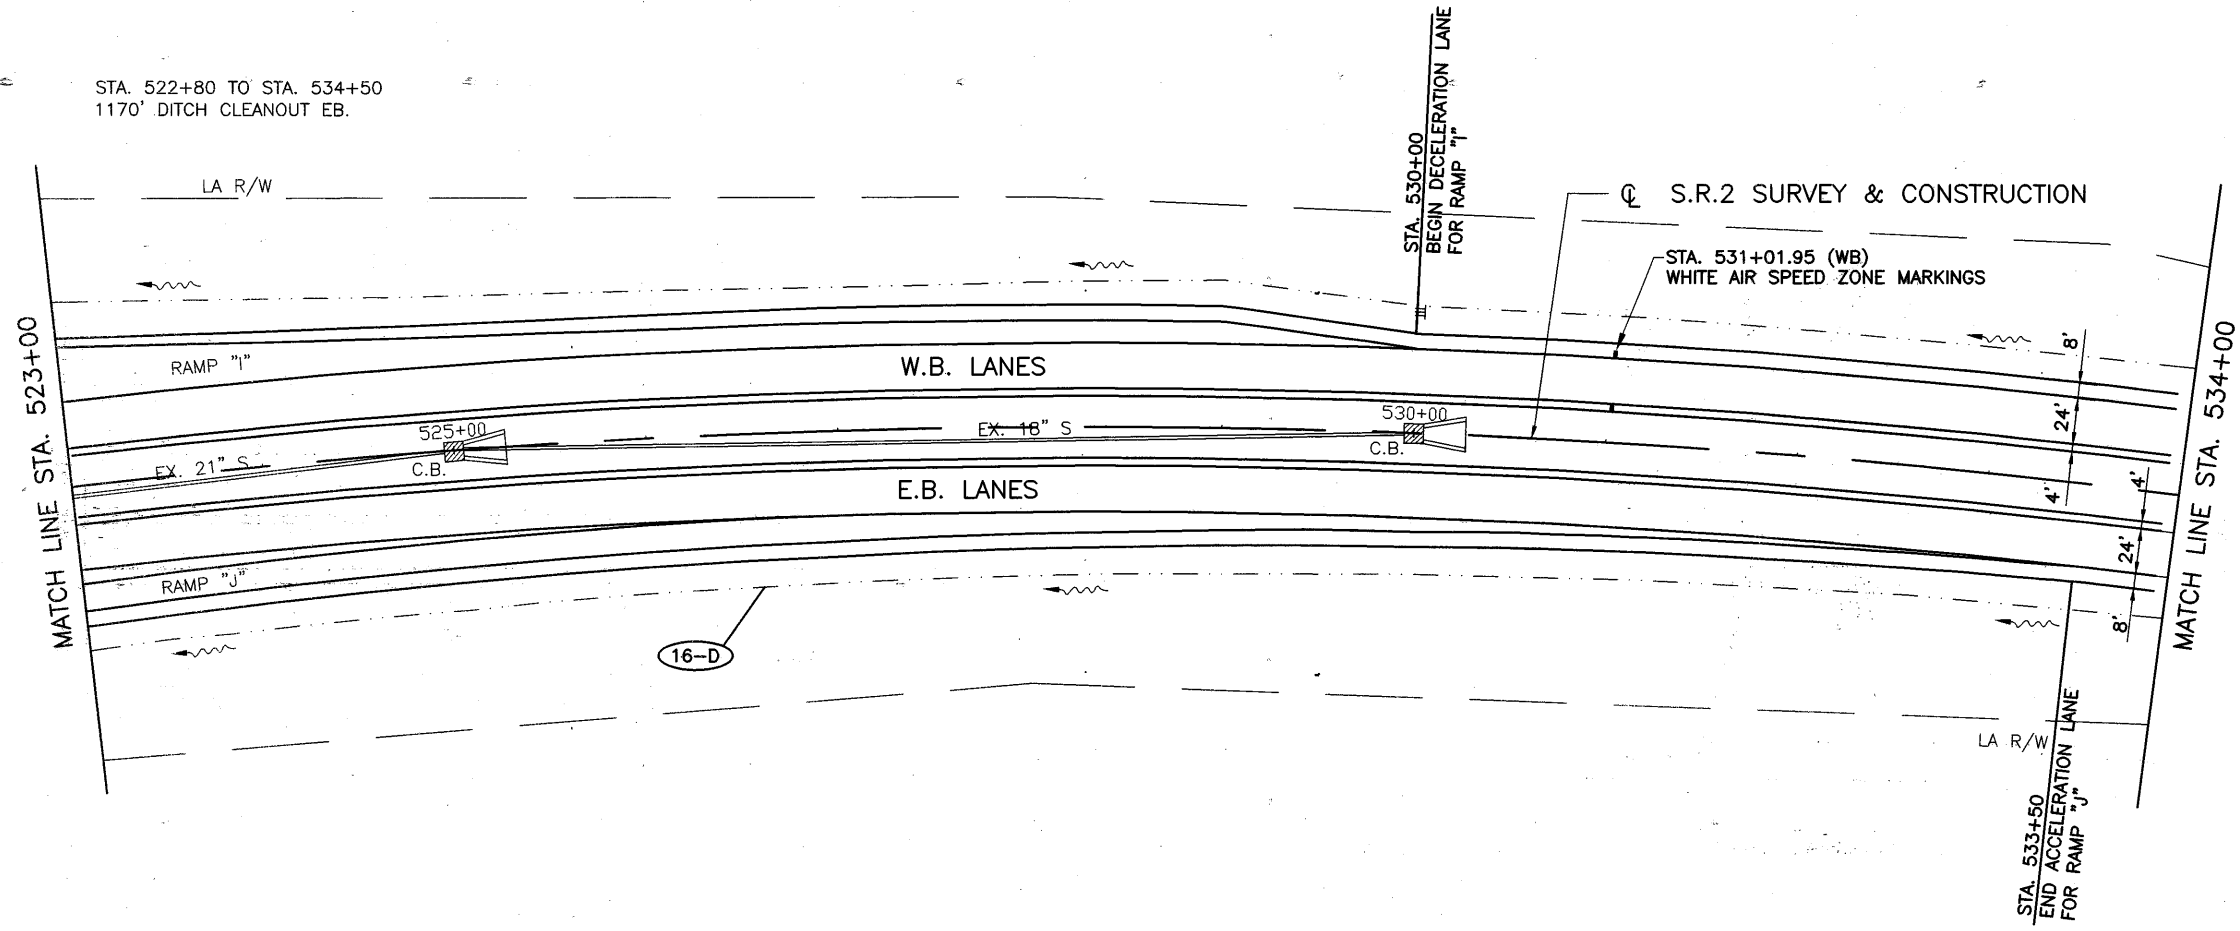


CALCULATED	DLS	CHECKED	LAB

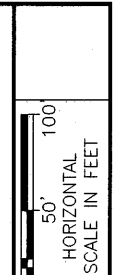

PLAN  
 STA. 523+00 TO STA. 545+00


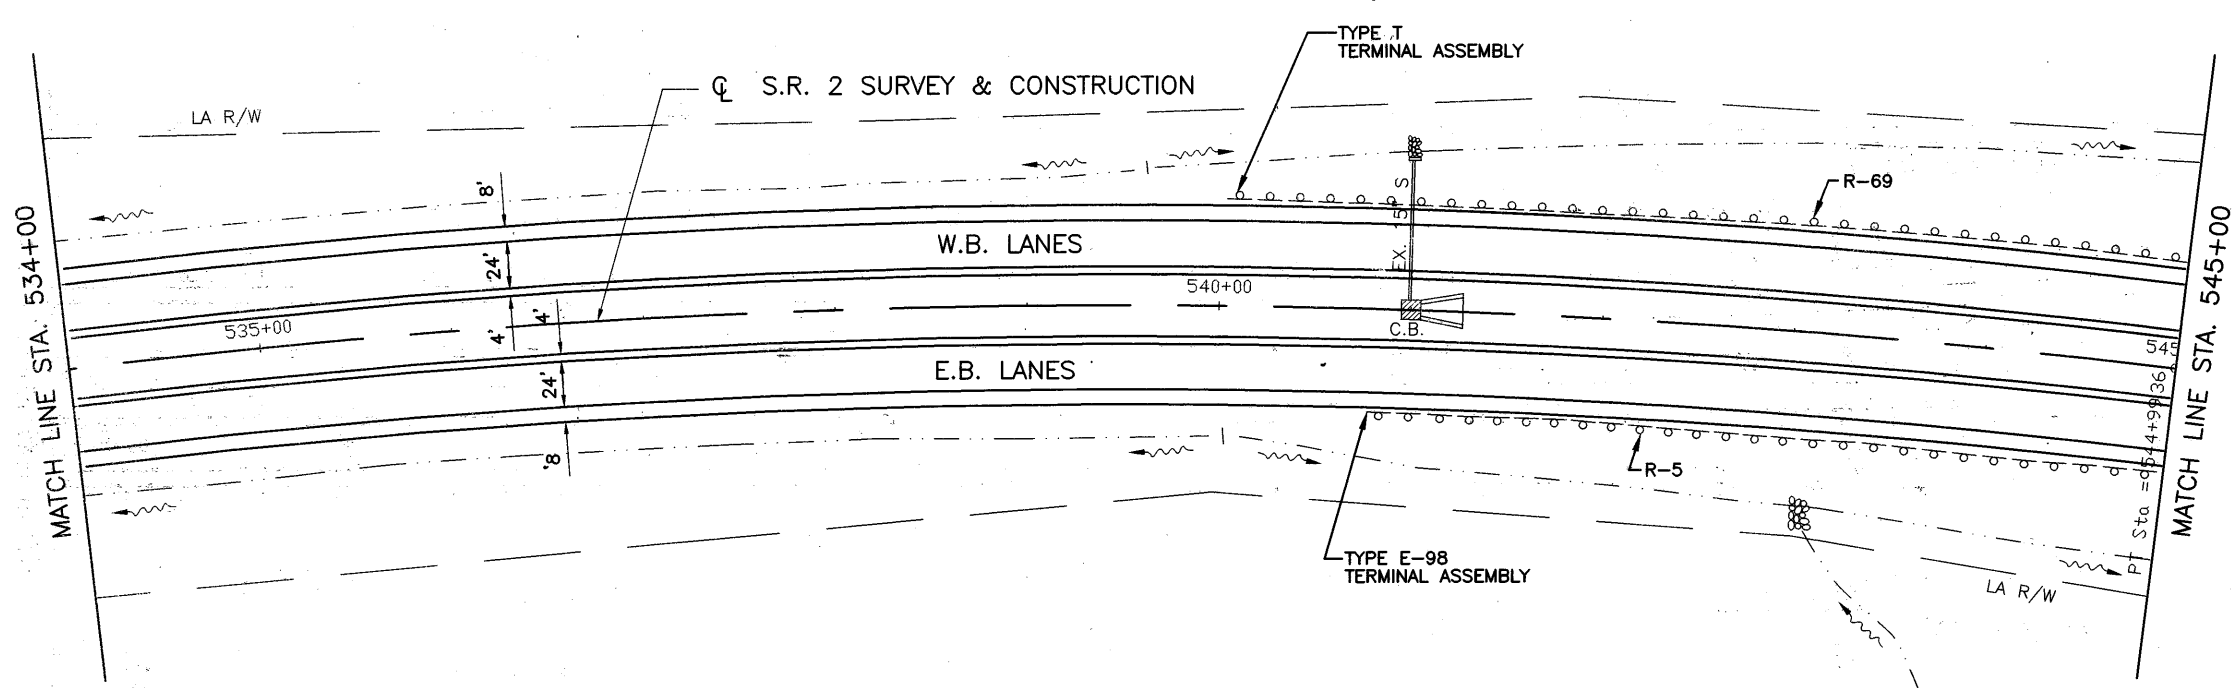


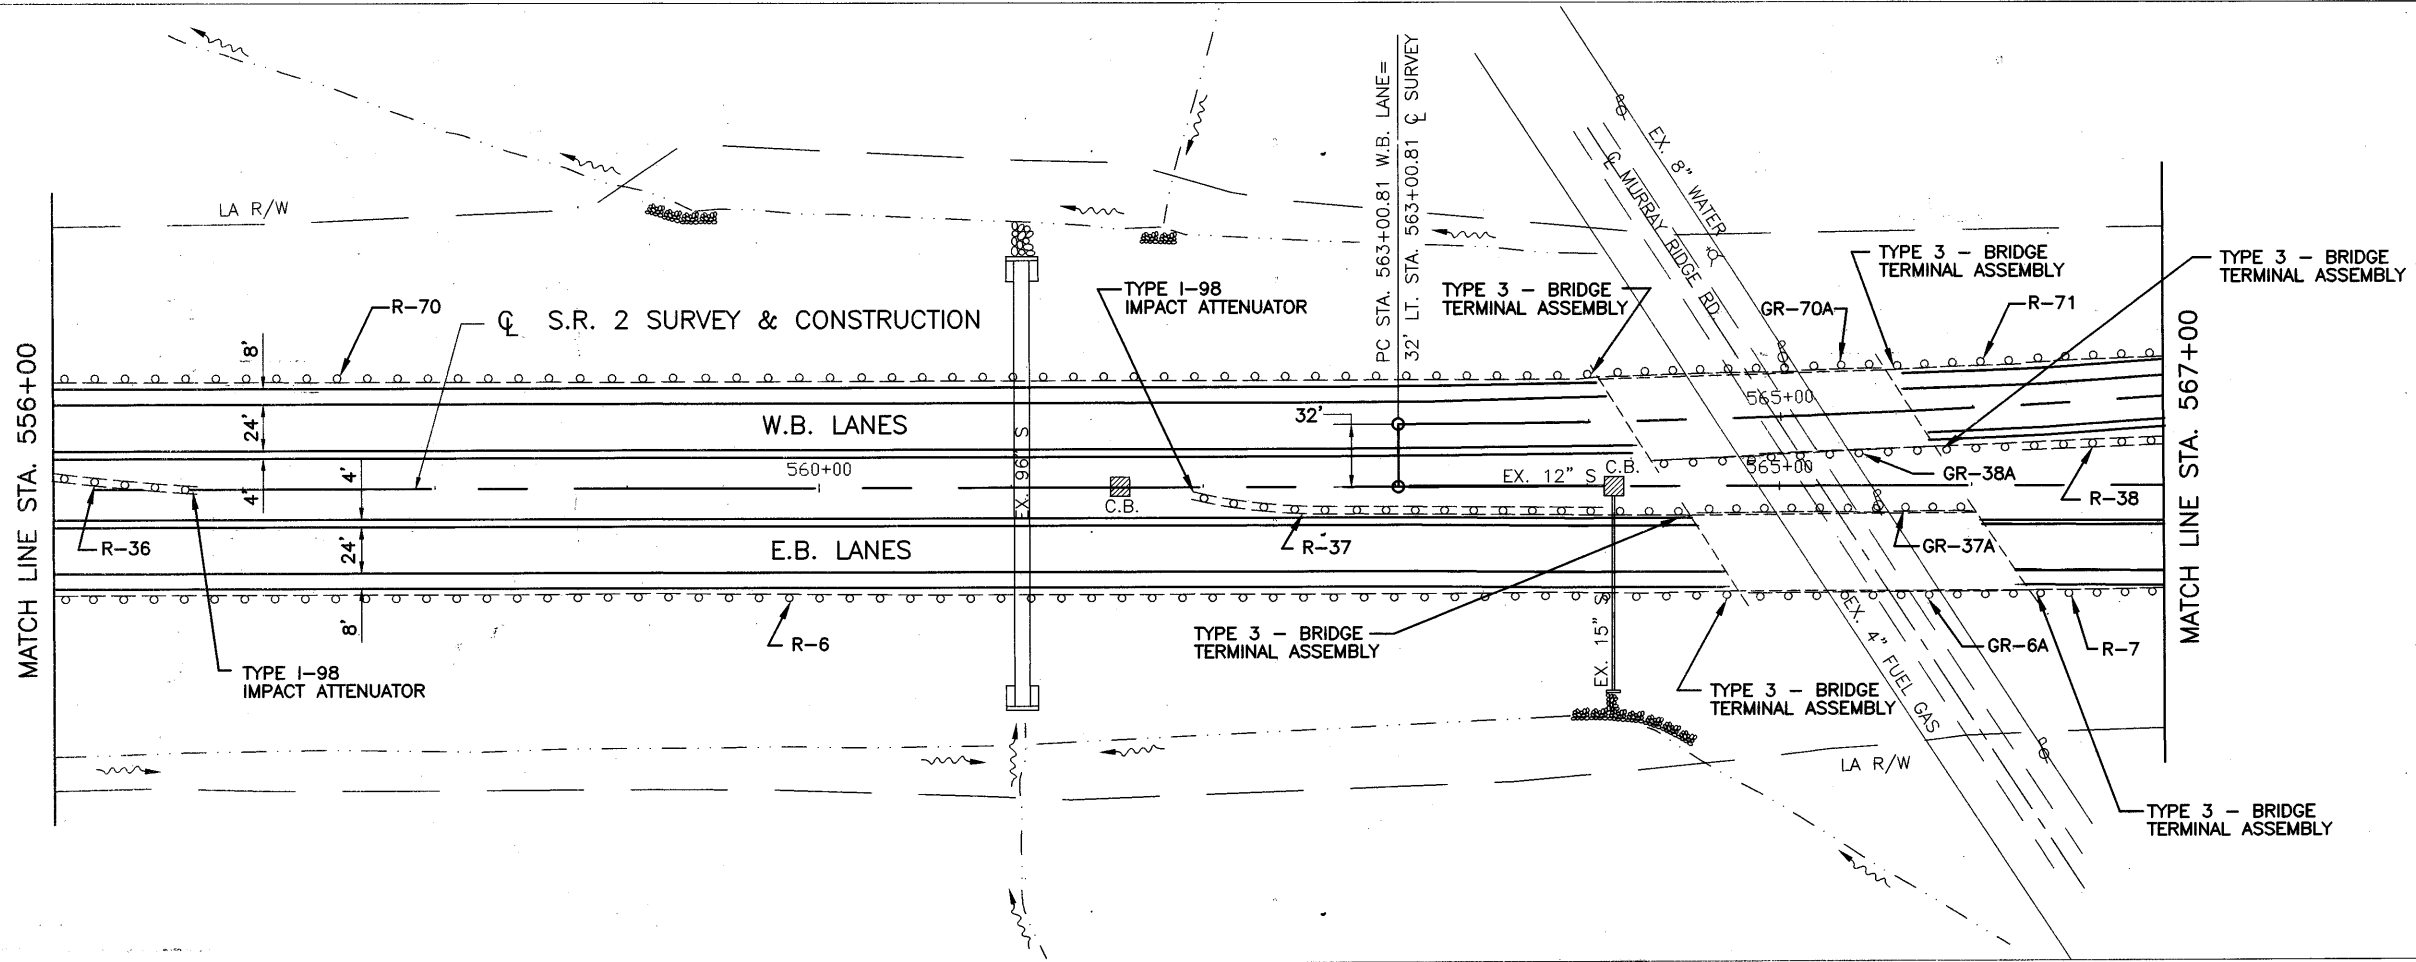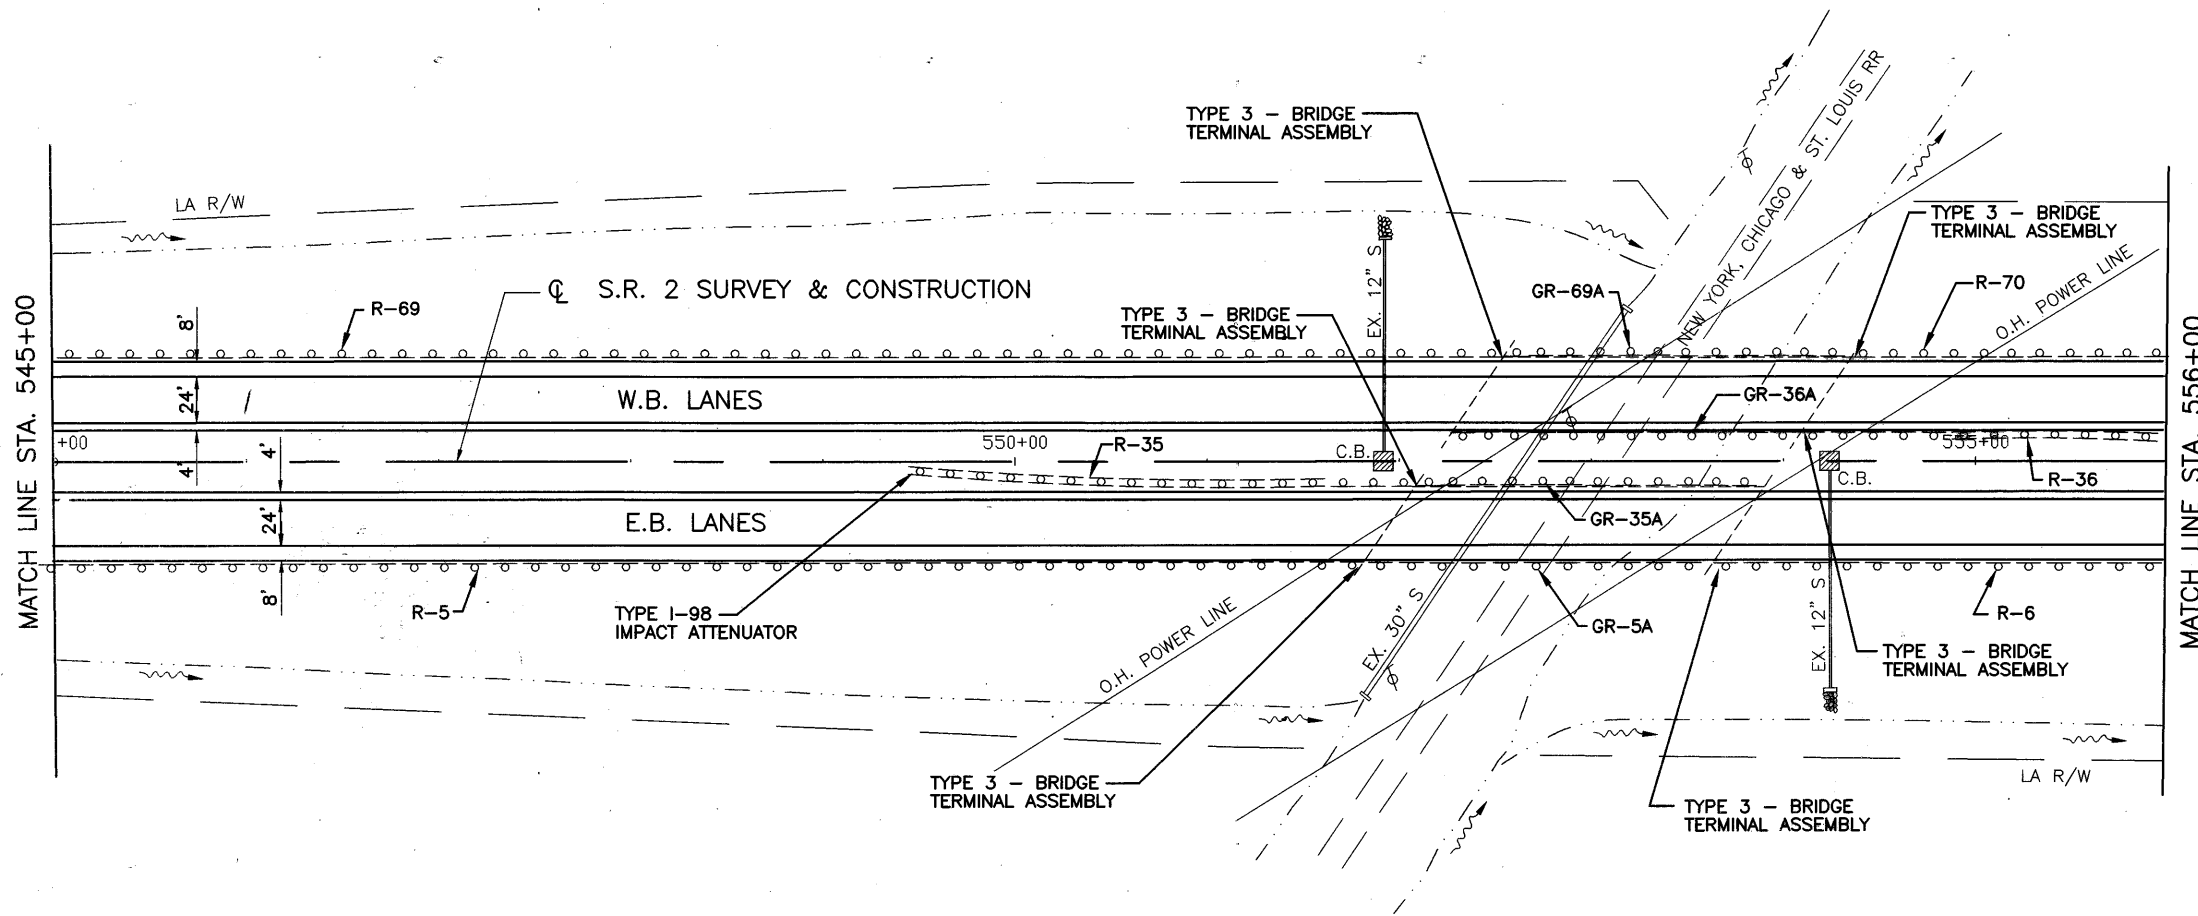

CALCULATED	0	50'	100'
DLS			
CHECKED			
LAB			

PLAN  
STA. 545+00 TO STA. 567+00

LOR - 190 - 10.76

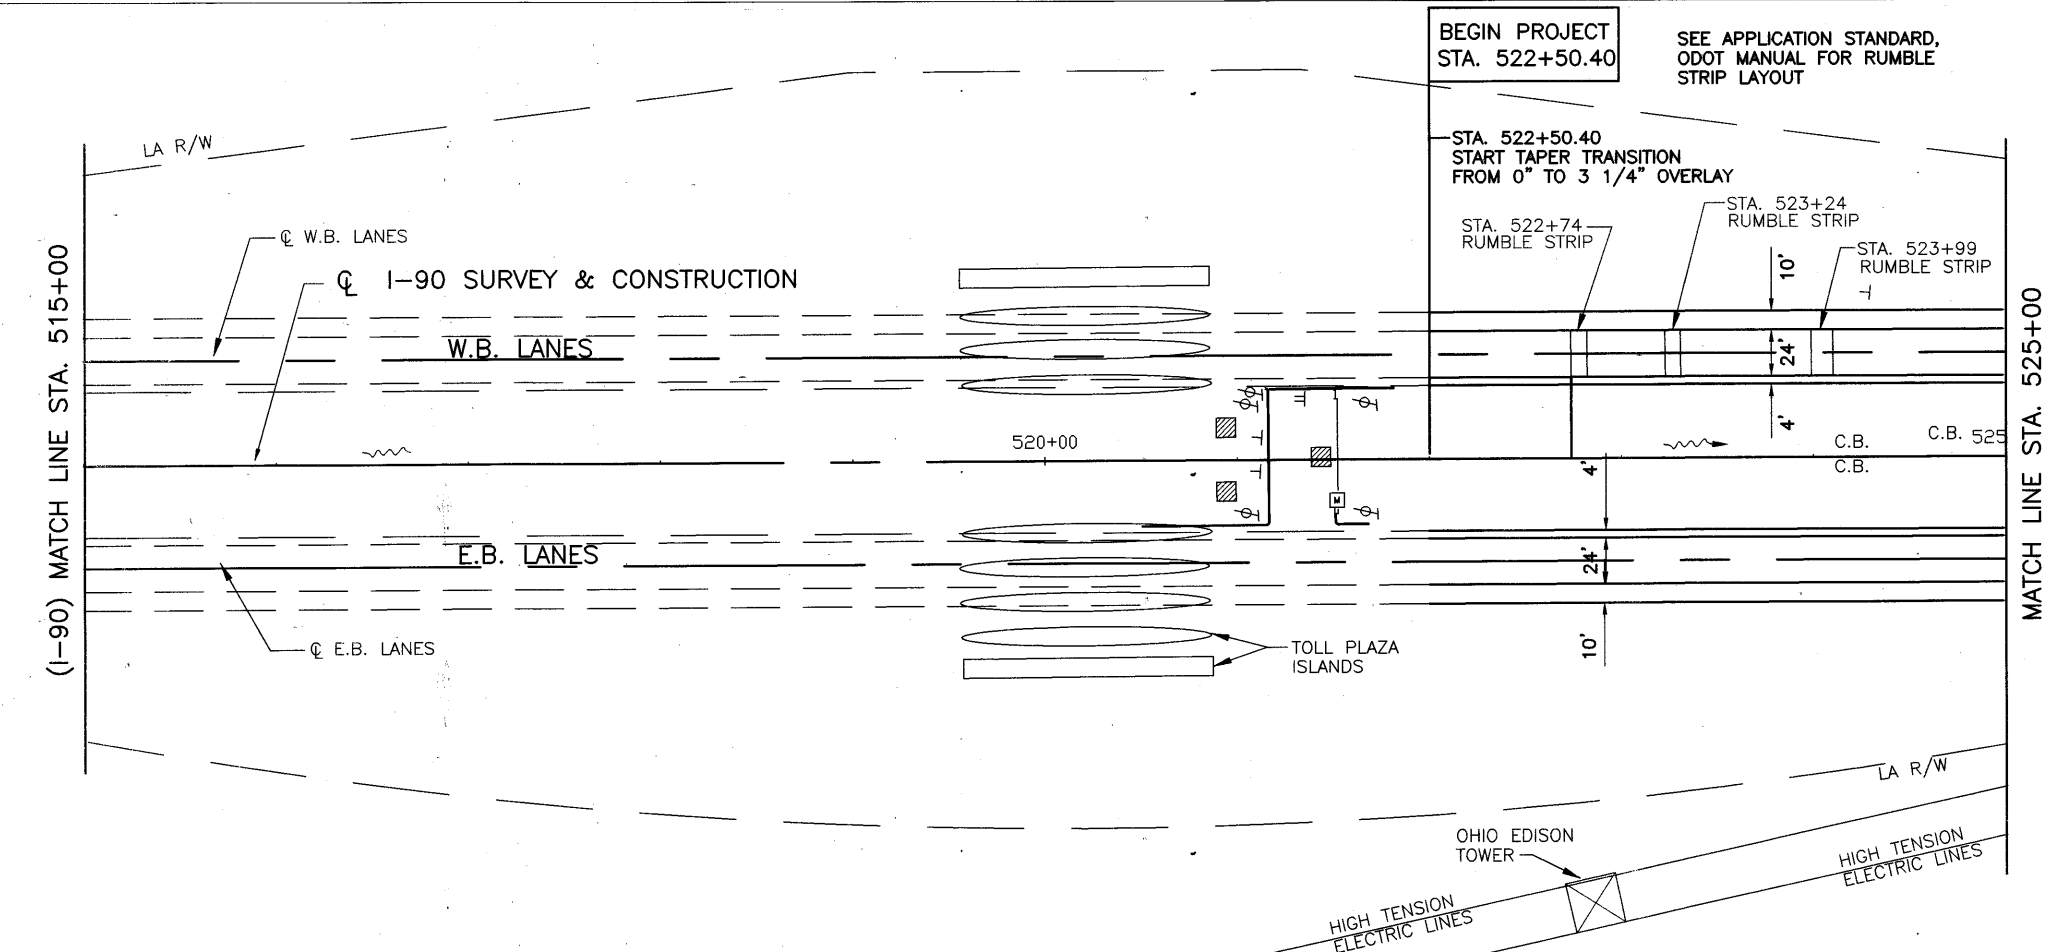
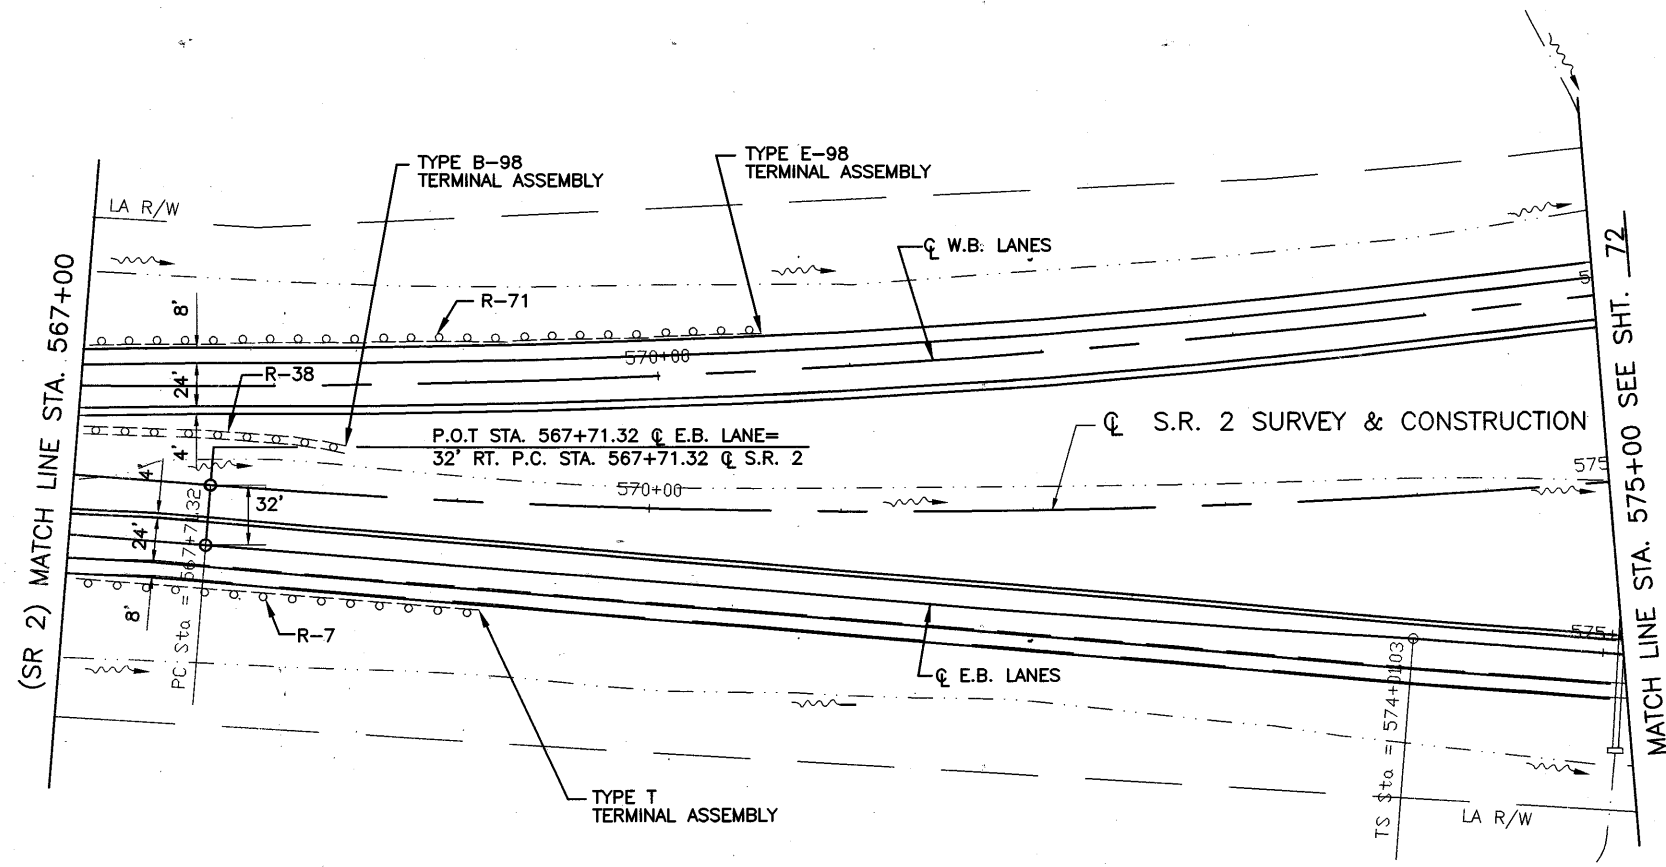


CALCULATED	DLS	CHECKED	LAB

PLAN  
 S.R. 2 STA. 567+00 TO STA. 575+00 & I-90 STA. 515+00 TO STA. 525+00

LOR - 190 - 10.76

CURVE DATA 6  
 CENTER LINE SURVEY  
 P.I. STA. 542+31.82  
 $\Delta = 55^{\circ}33'45''$  RT.  
 $\Delta c = 49^{\circ}33'45''$   
 $Dc = 2^{\circ}00'00''$   
 $R = 2864.79'$   
 $T = 1659.91'$   
 $L = 300.00'$   
 $Lc = 2478.13'$   
 $E = 374.72'$   
 $\theta_s = 3^{\circ}00'00''$

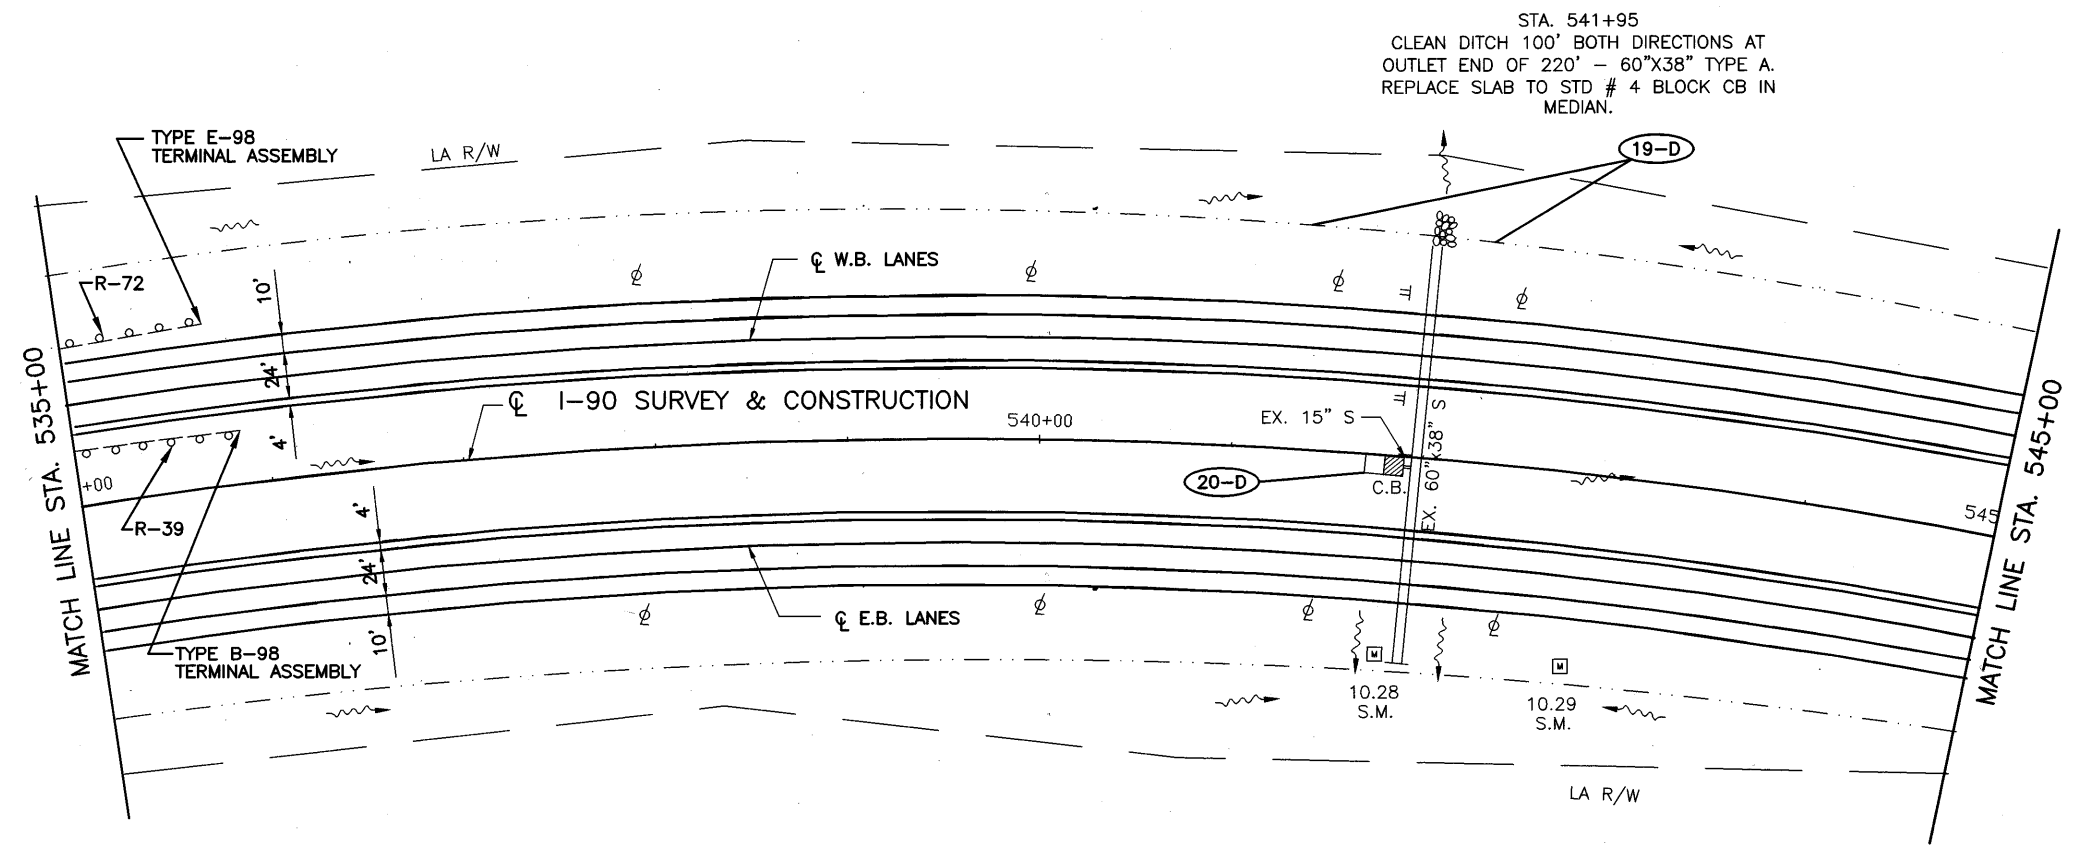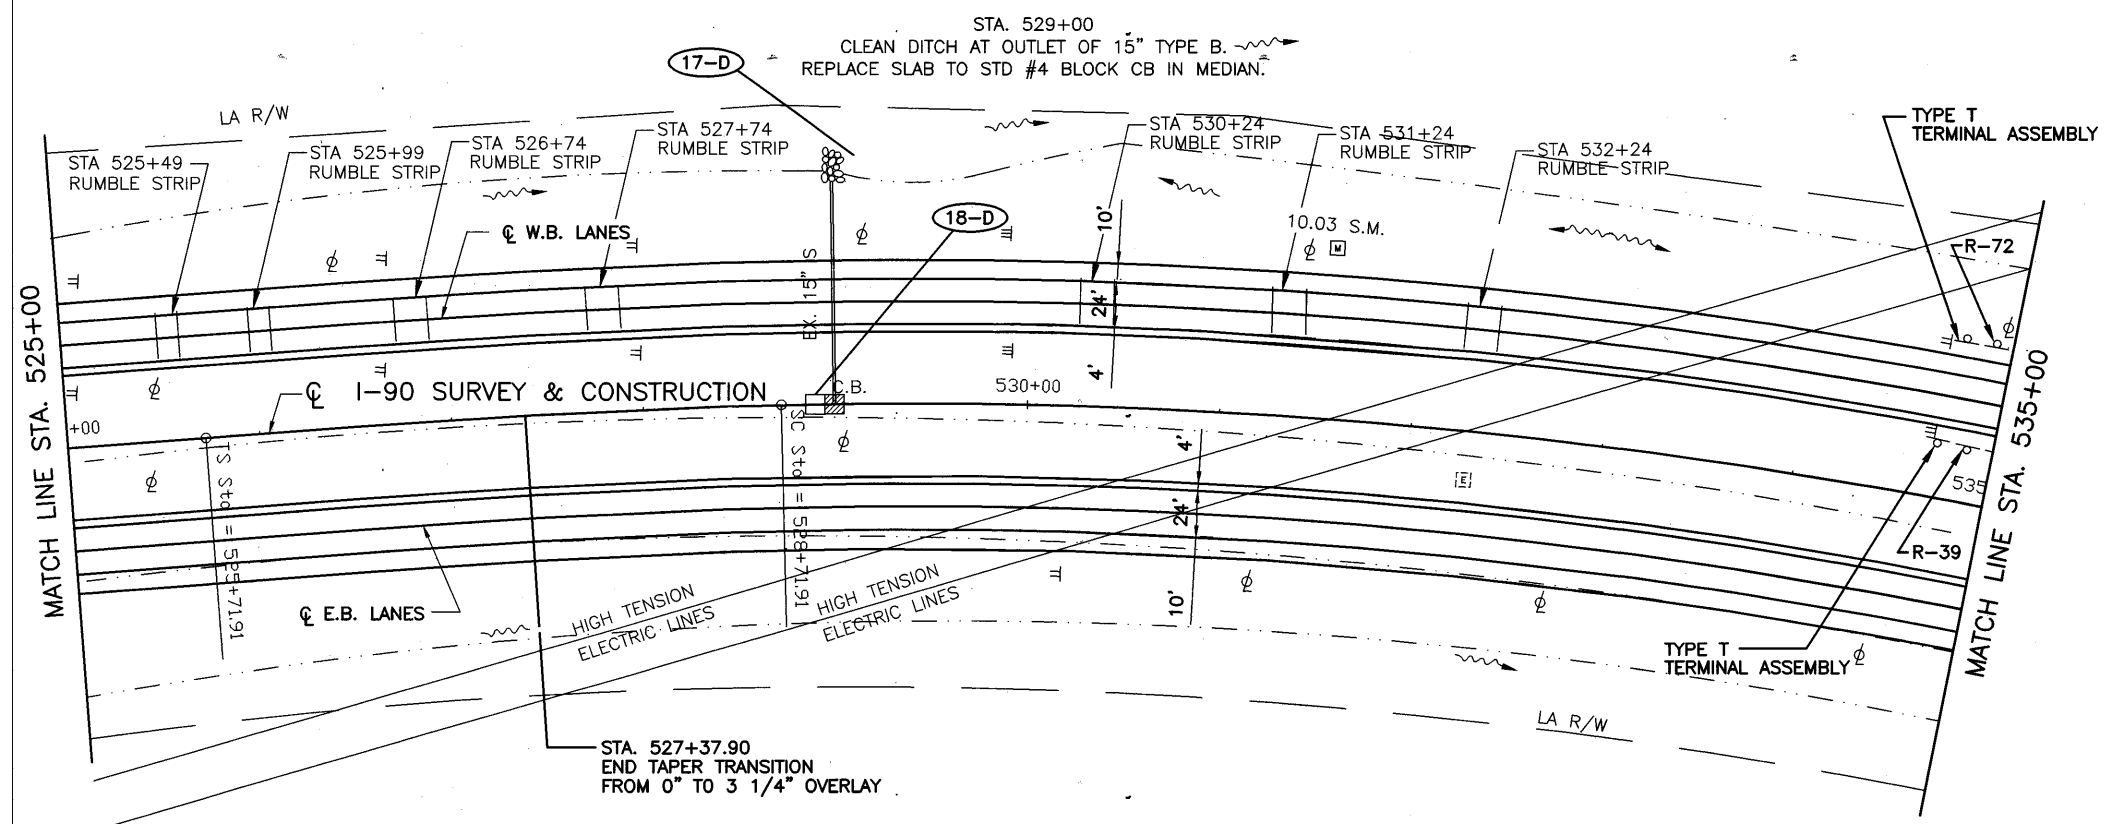

CALCULATED  
 DLS  
 CHECKED  
 LAB



PLAN  
 STA. 525+00 TO STA. 545+00

LOR - 190 - 10.76

69  
 274

100  
 50  
 0  
 HORIZONTAL  
 SCALE IN FEET

I:\93600\DWG5\93600\PLP-09.DWG 1 of 2  
 -12-2002 7:55AM

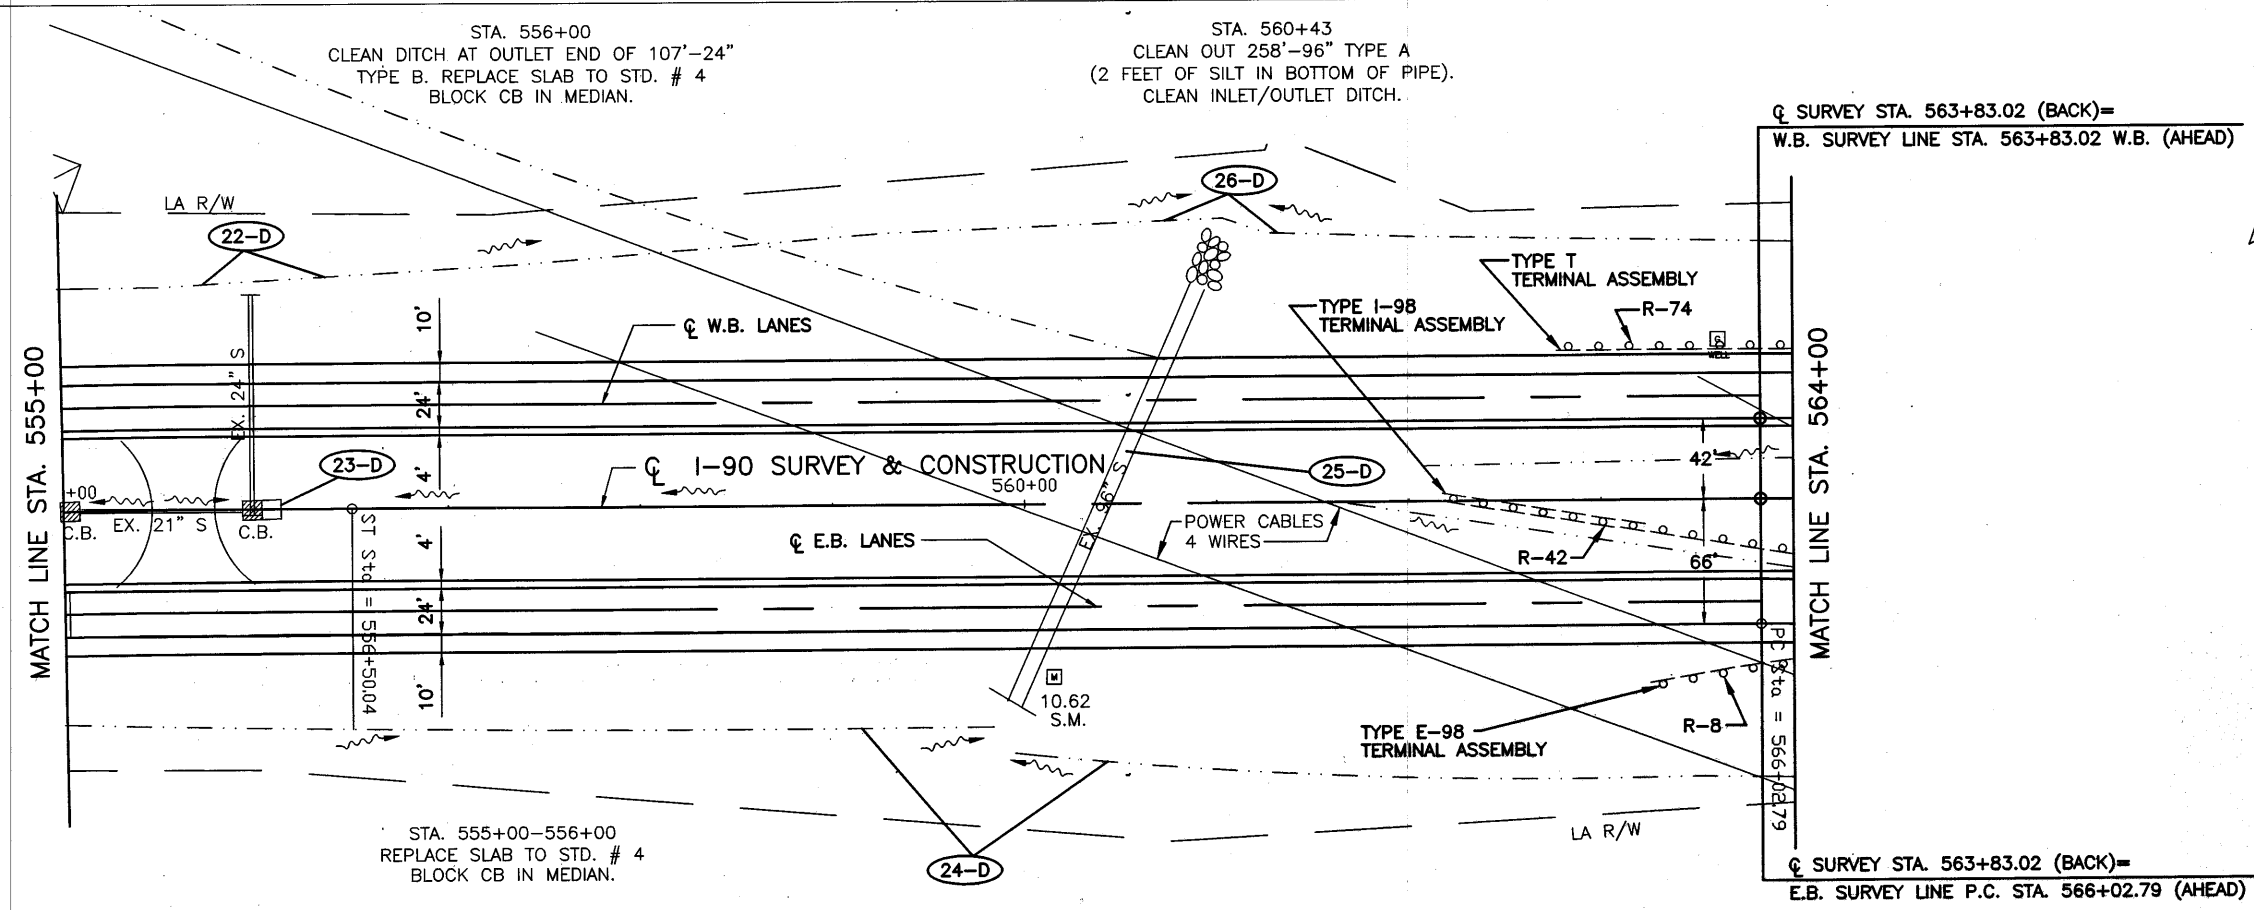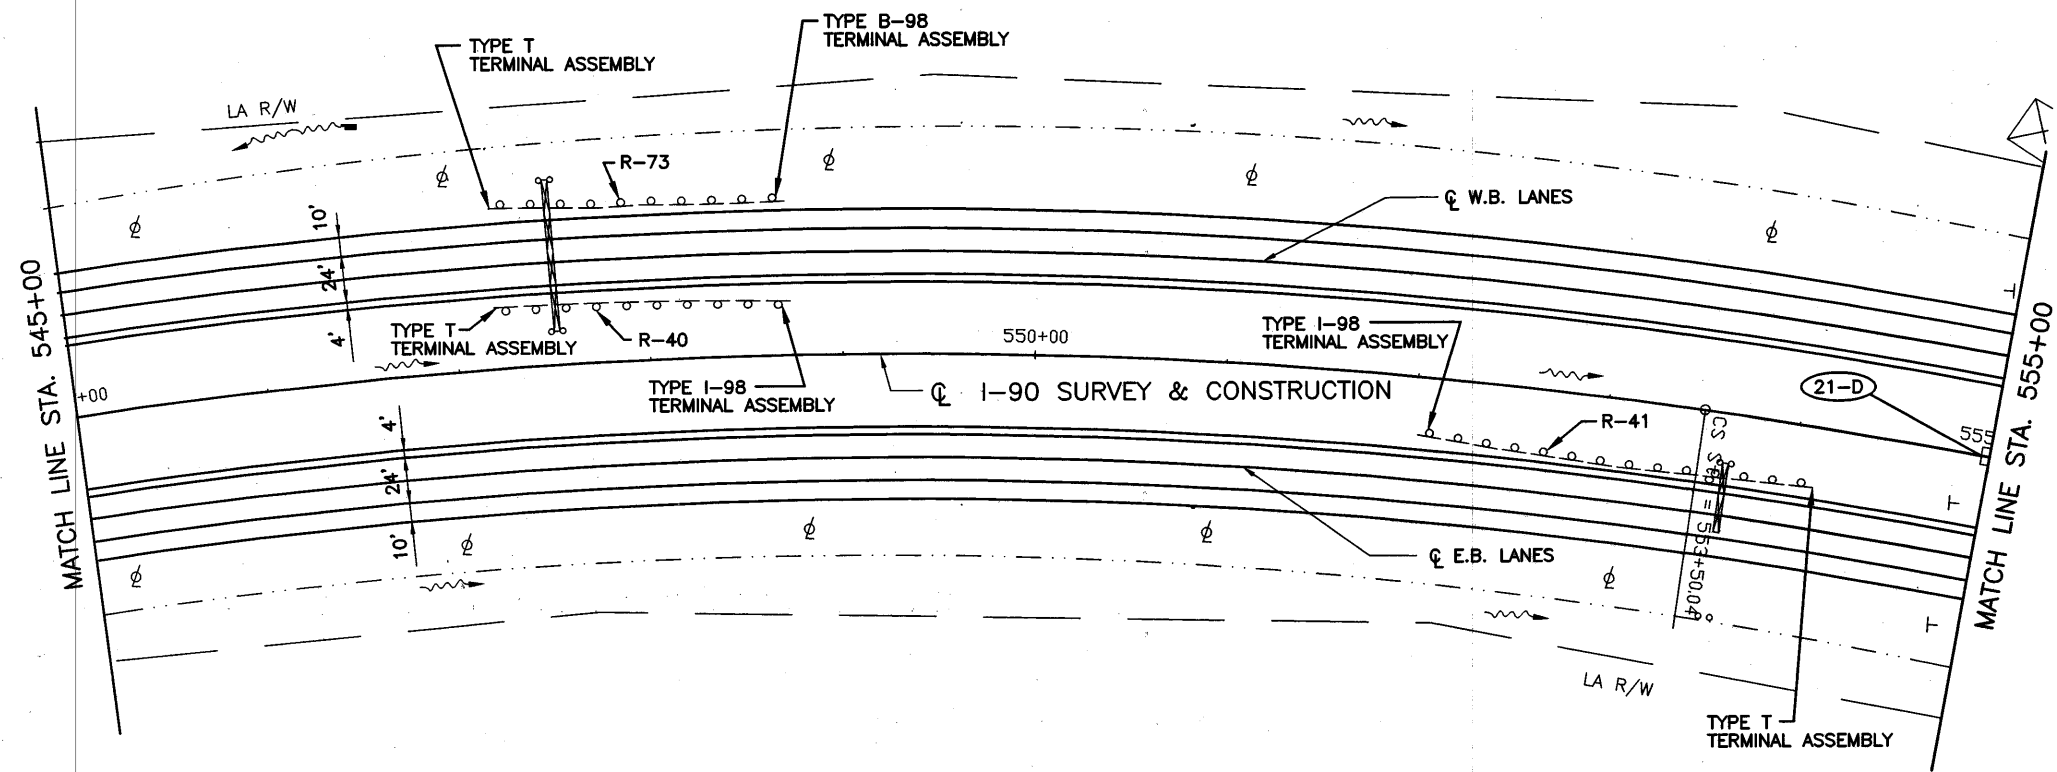


PLAN  
STA. 545+00 TO STA. 564+00


LOR - 190 - 10.76

0:\93600\DWG\33600\FNL\P-10.DWG ] DLS  
 -23-2002 2:45PM

CURVE DATA ⑦  
 SURVEY LINE E.B. LANES  
 P.I. STA. 574+74.56  
 $\Delta = 25^{\circ}09'35''$  RT.  
 $D_c = 1'28''00''$   
 $R = 3906.53'$   
 $T = 871.77'$   
 $L = 1715.43'$   
 $E = .96.09'$

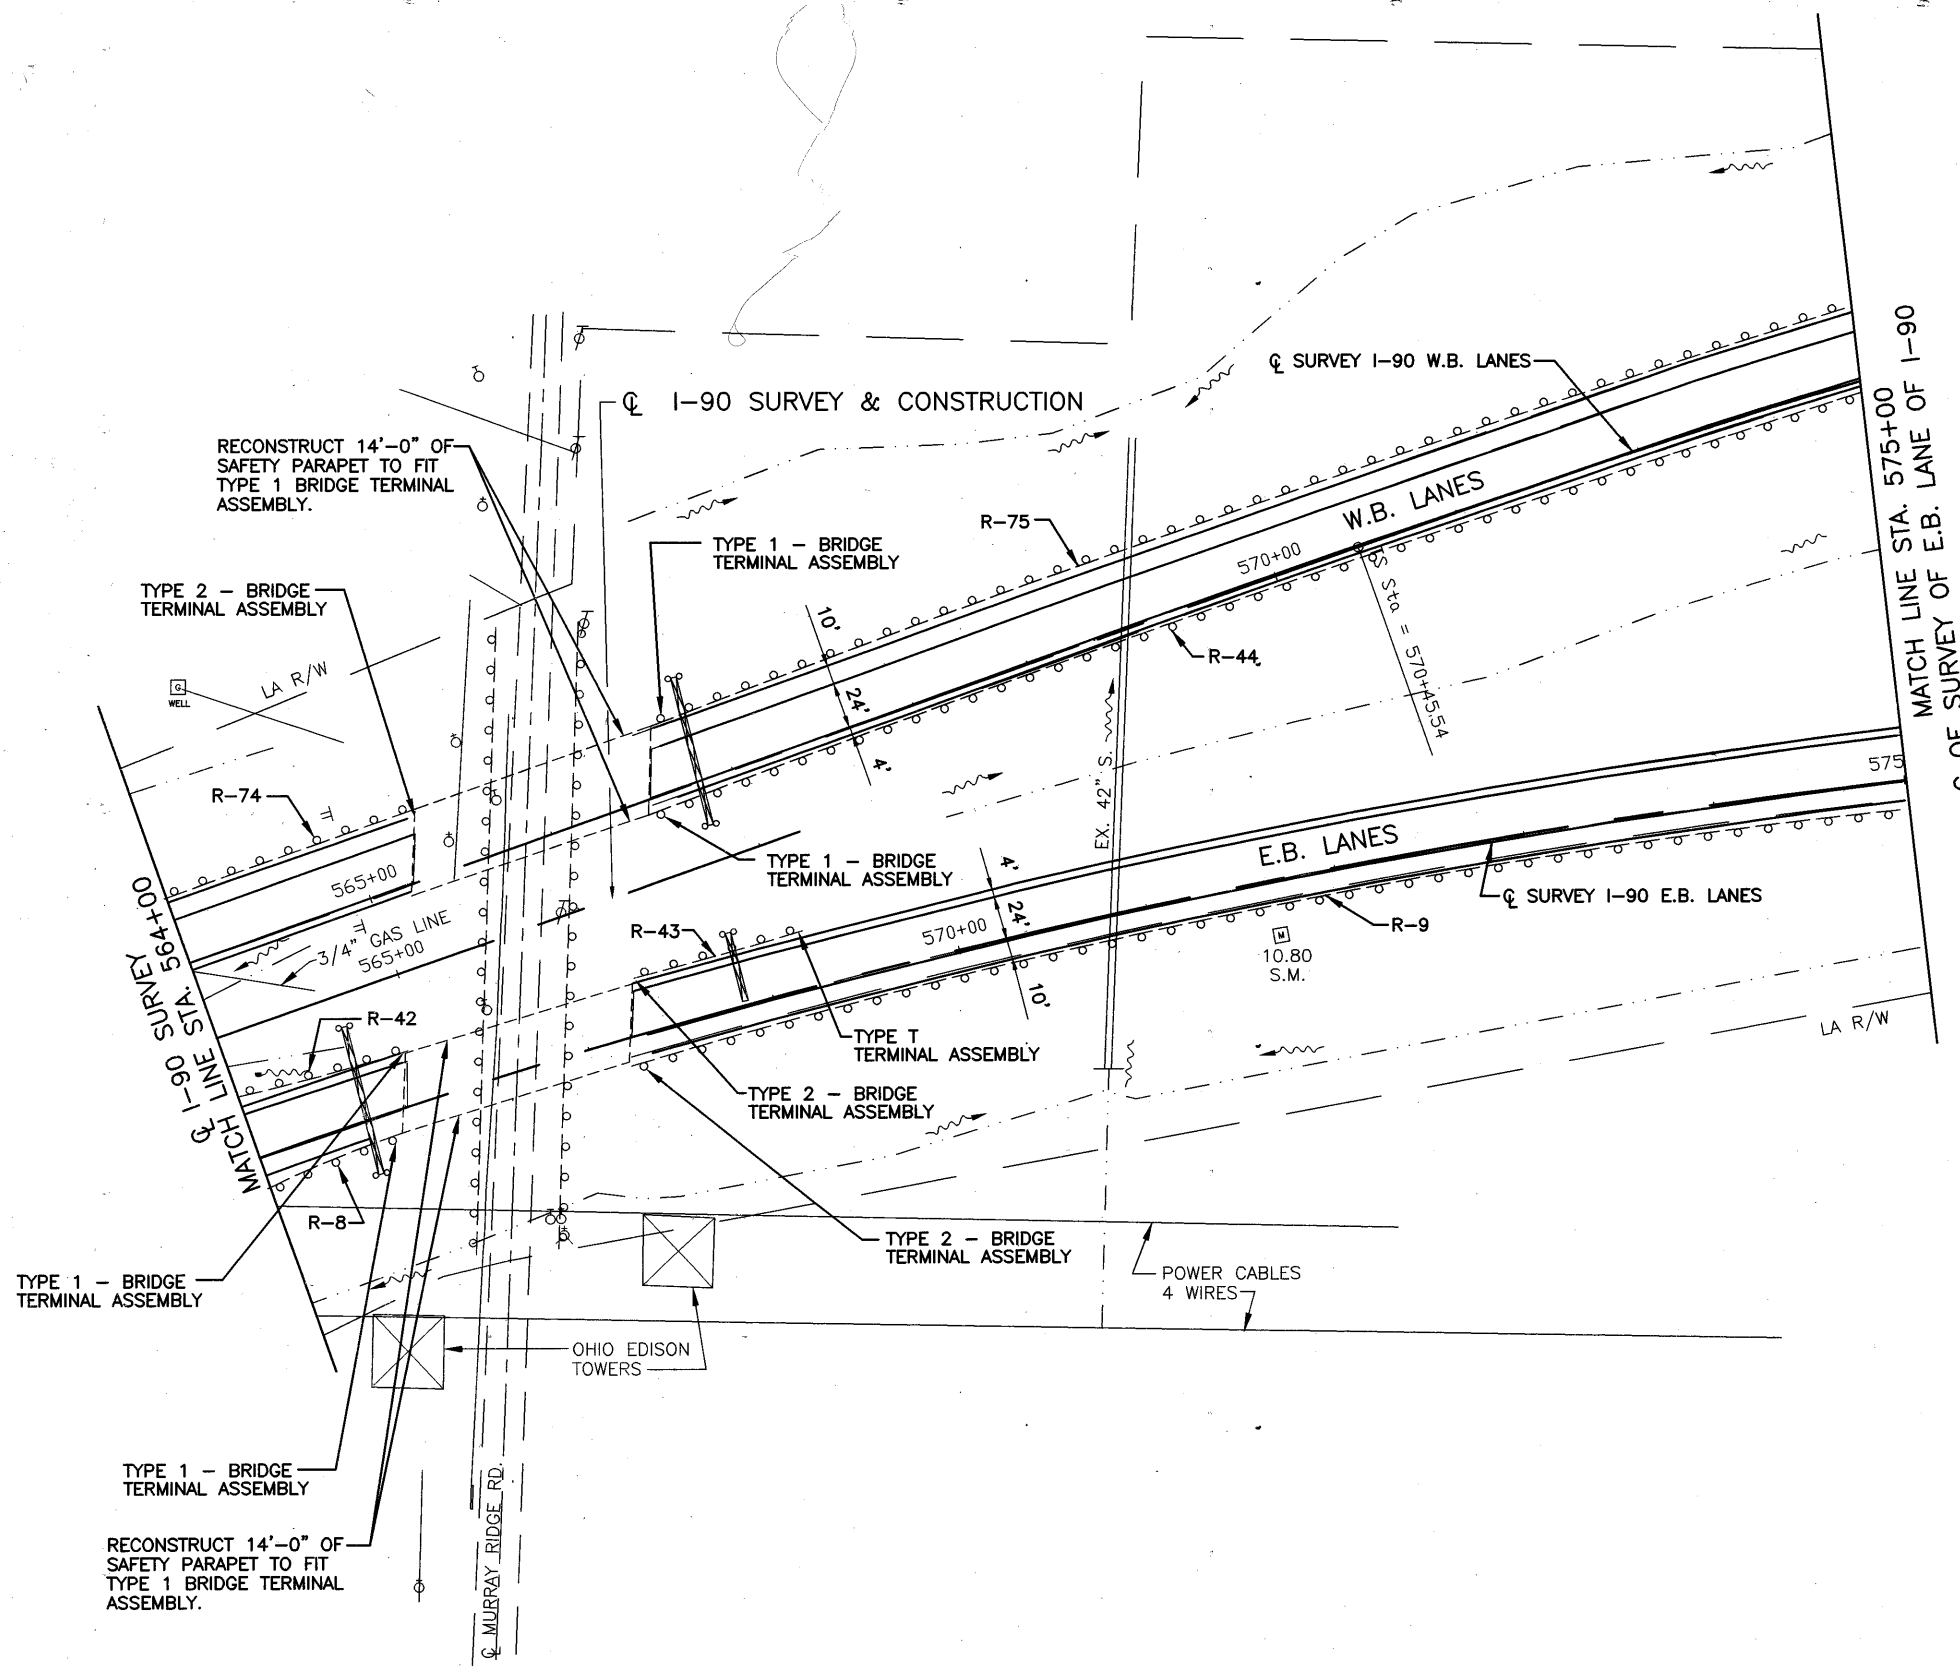

CALCULATED	DLS	CHECKED	LAB

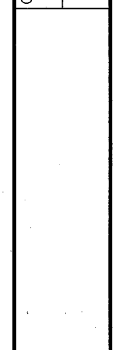


PLAN  
 STA. 562+00 TO STA. 575+00

LOR - I90 - 10.76

**LEGEND**

- ⊙ TEMPORARY INLET PROTECT, FILTER FABRIC FENCE (AT ALL EXISTING AND PROPOSED INLETS)
- ◆ TEMPORARY DITCH CHECK, FILTER FENCE
- FF — FILTER FABRIC FENCE
- DIRECTION OF FLOW DITCH
- ▣ SEDIMENT BASIN

CURVE DATA ⑧	CURVE DATA ⑨	CURVE DATA ⑩	CURVE DATA ⑪
SURVEY LINES W.B. LANES	☉ E.B. LANES S.R. 2	☉ W.B. LANES S.R. 2	☉ SURVEY
P.I. STA. 576+31.04	P.I. STA. 584+08.14	P.I. STA. 583+15.34	P.I. STA. 583+61.74
$\Delta = 25^{\circ}40'00''$ RT.	$\Delta = 38^{\circ}44'37''$ LT.	$\Delta = 38^{\circ}44'37''$ LT.	$\Delta = 38^{\circ}44'37''$ LT.
$\Delta c = 16^{\circ}40'00''$	$D_c = 2^{\circ}30'00''$	$D_c = 1^{\circ}00'00''$	$D = 1^{\circ}16'00''$
$D_c = 3^{\circ}00'00''$	$R = 2291.83'$	$R = 5729.58'$	$R = 4523.35'$
$R = 1909.86'$	$T_s = 1006.79'$	$T = 2014.53'$	$T = 1590.42'$
$T_s = 585.495'$	$L_s = 400.00'$	$L_c = 3874.36'$	$L = 3058.71'$
$L_s = 300.00'$	$E_s = 140.59'$	$E = 383.84'$	$E = 271.45'$
$L_c = 555.56'$			
$E_s = 50.94'$			
$\theta_s = 4^{\circ}30'00''$			

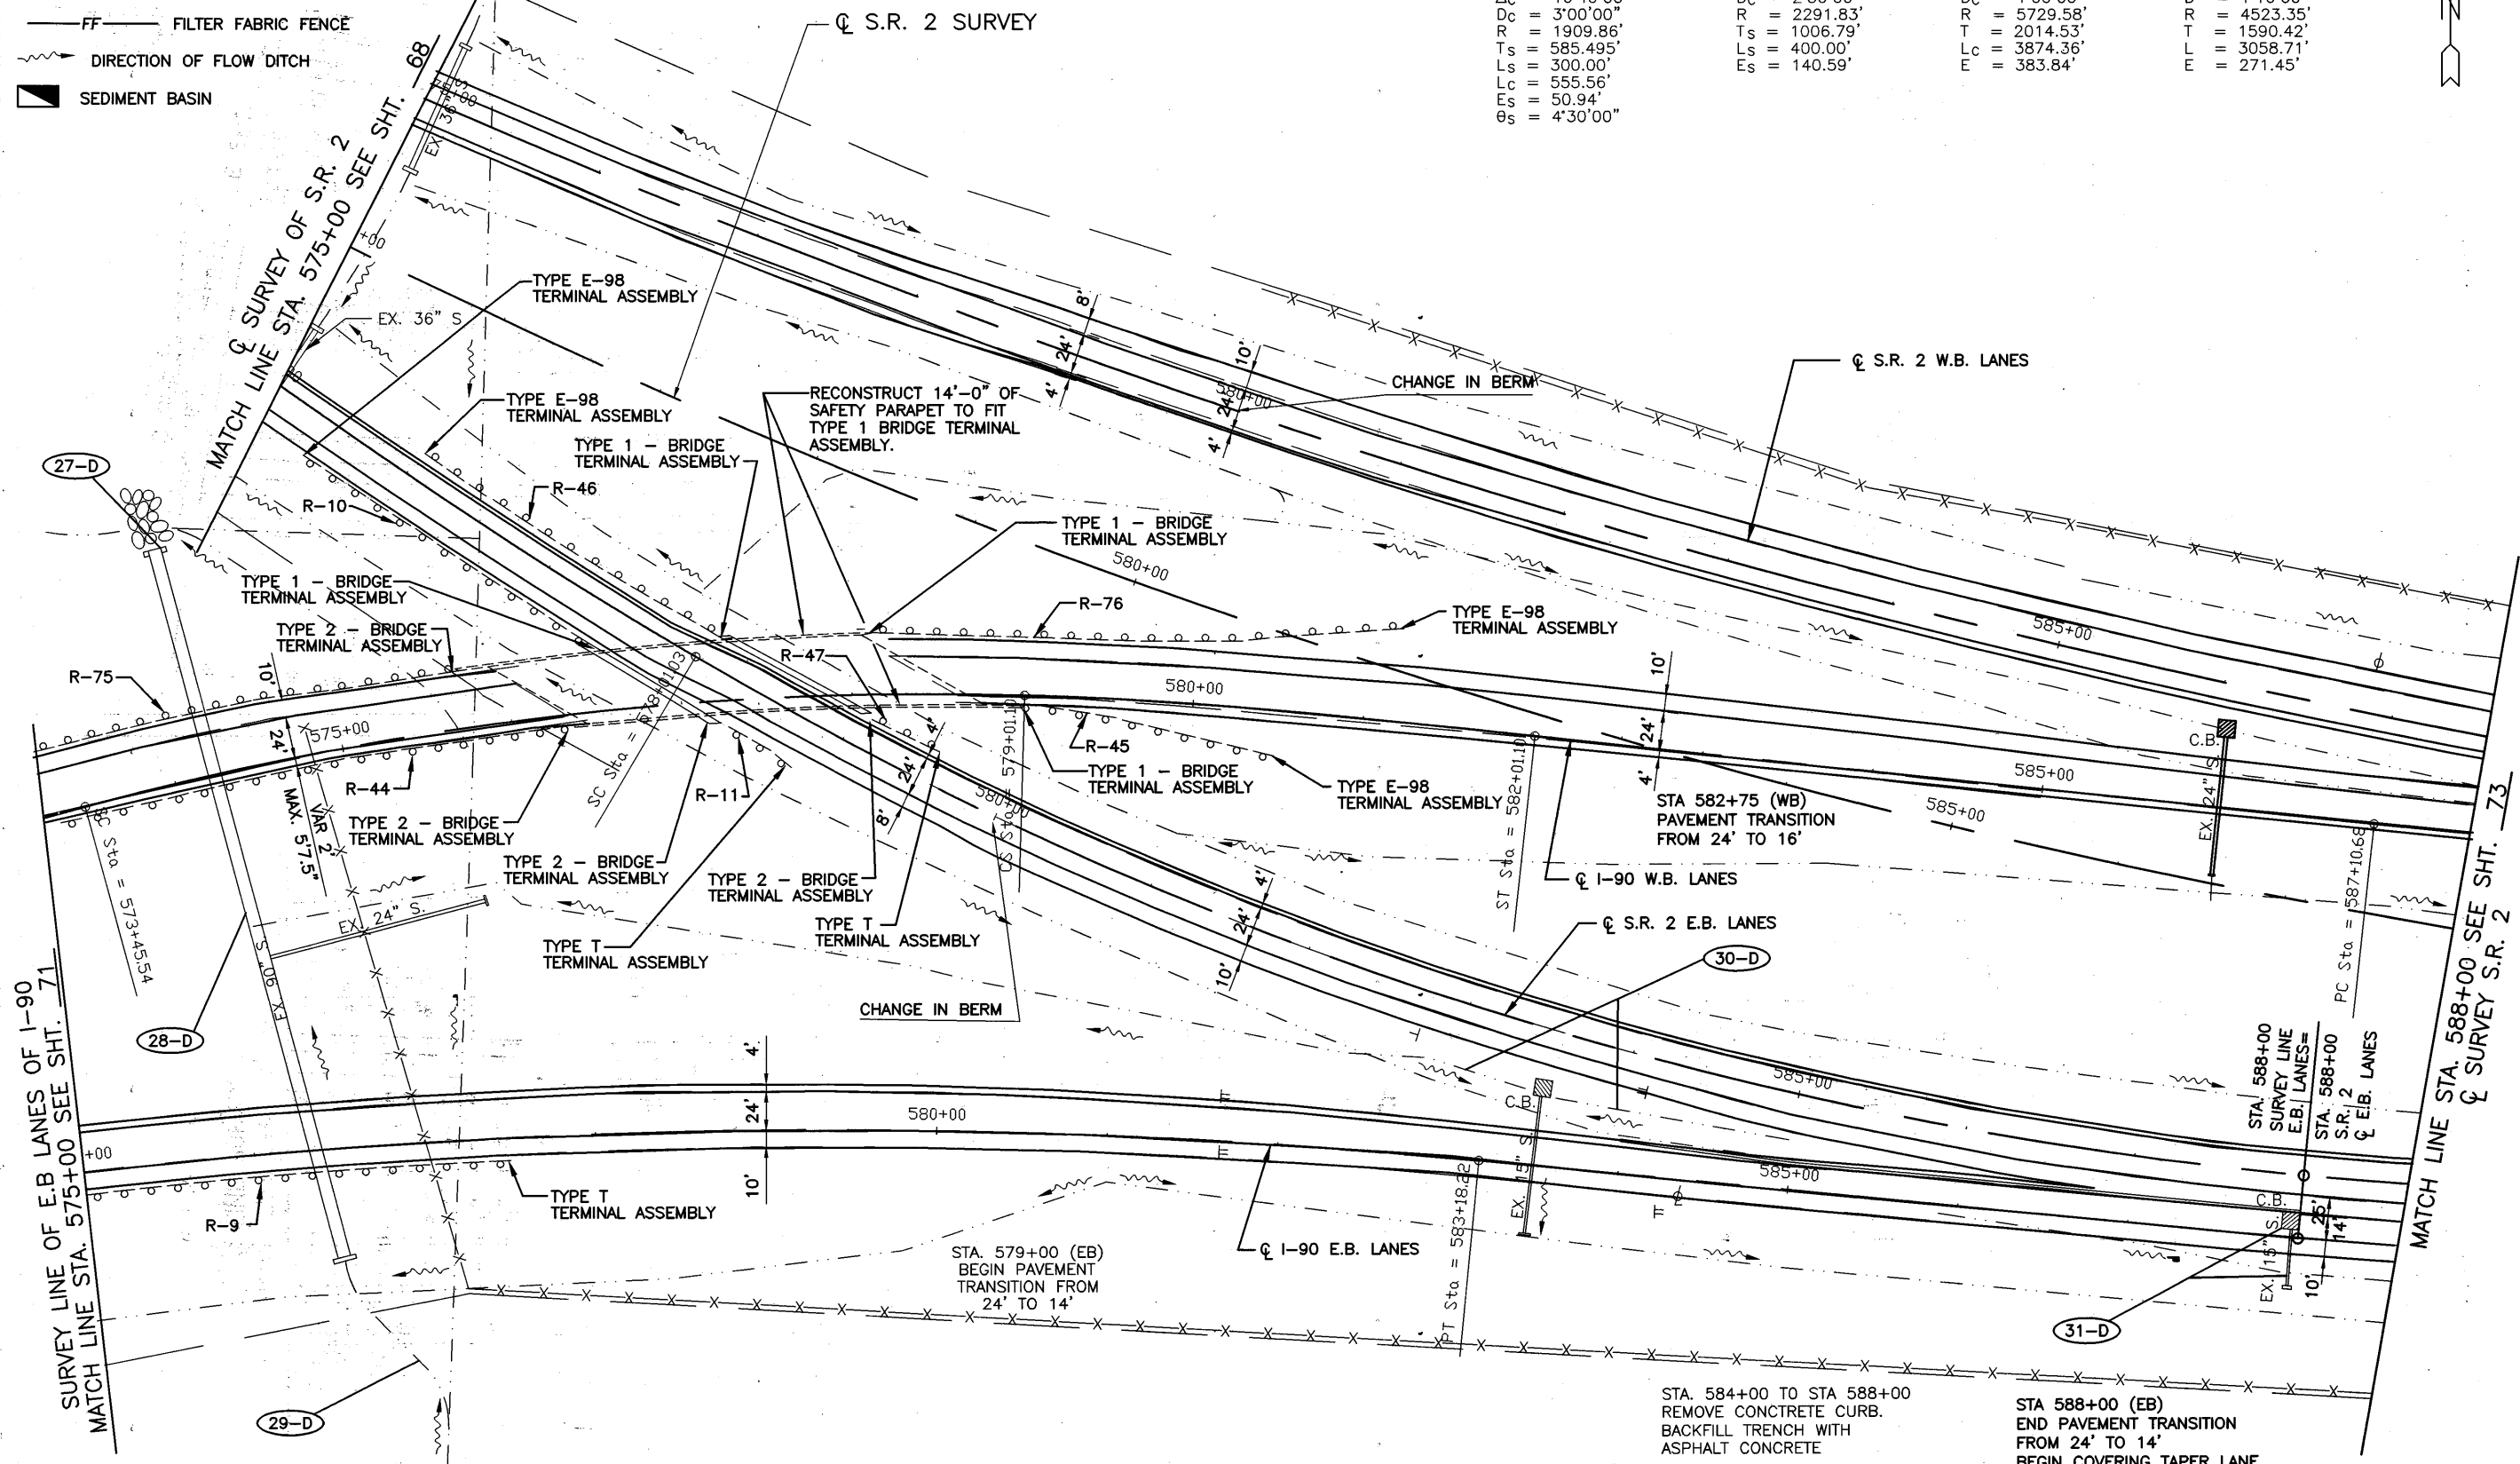

SURVEY LINE OF E.B. LANES OF I-90  
MATCH LINE STA. 575+00 SEE SHT. 71

MATCH LINE STA. 588+00 SEE SHT. 73  
☉ SURVEY S.R. 2

STA. 576+36.5  
CLEAN OUT 430'-90" TYPE A  
CLEAN INLET/OUTLET DITCH.  
(2 FEET OF SILT IN BOTTOM OF PIPE).

STA. 583+50  
CLEAN DITCH 100 FEET BOTH  
DIRECTIONS AT 81'15" TYPE B.

STA. 584+00 TO STA 588+00  
REMOVE CONCRETE CURB.  
BACKFILL TRENCH WITH  
ASPHALT CONCRETE

STA 588+00 (EB)  
END PAVEMENT TRANSITION  
FROM 24' TO 14'  
BEGIN COVERING TAPER LANE

NOTES  
UNLESS OTHERWISE SHOWN ON CROSS SECTIONS

CALCULATED	DLS	CHECKED	LAB





**PLAN**  
STA. 575+00 TO STA. 588+00

**LOR - I90 - 10.76**



CURVE DATA 12  
 SURVEY LINE W.B. LANES  
 P.I. STA. 592+31.18  
 $\Delta = 5'12''05''$  LT.  
 $D_c = 0'30''00''$   
 $R = 11,495.16'$   
 $T = 520.50'$   
 $L = 1040.28'$   
 $E = 11.82'$

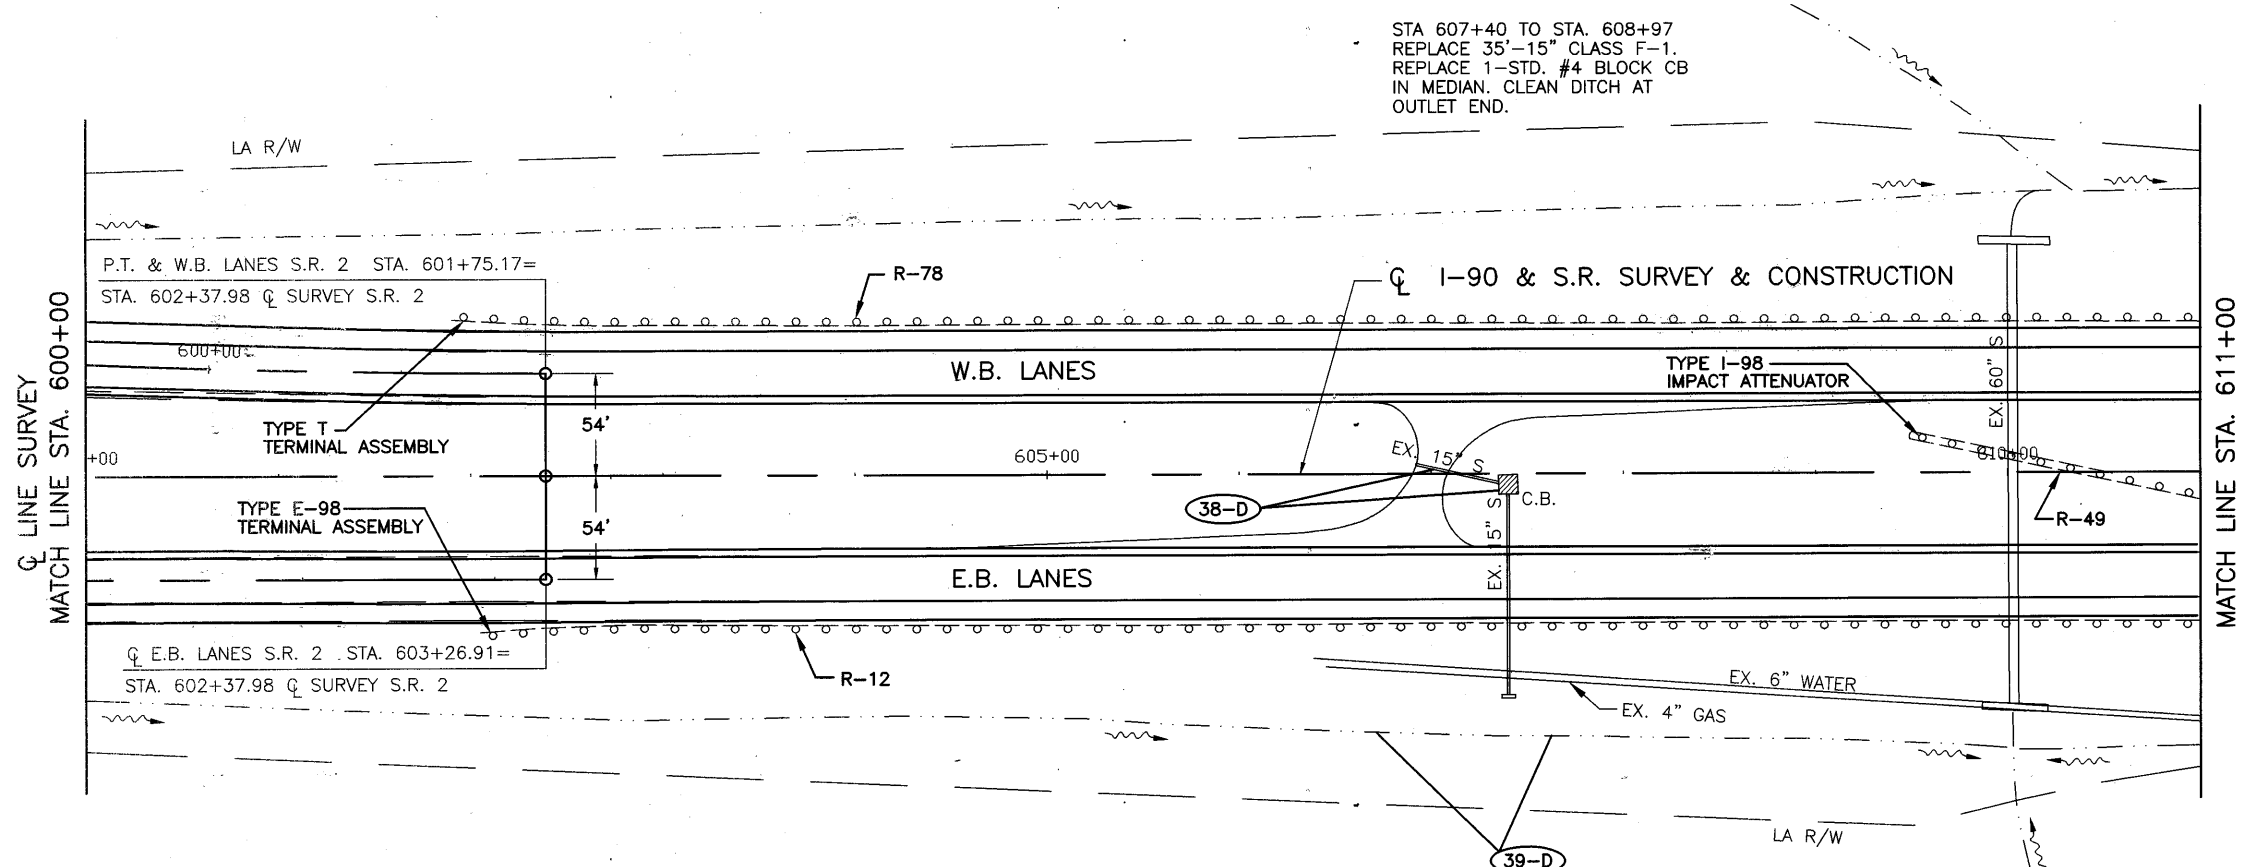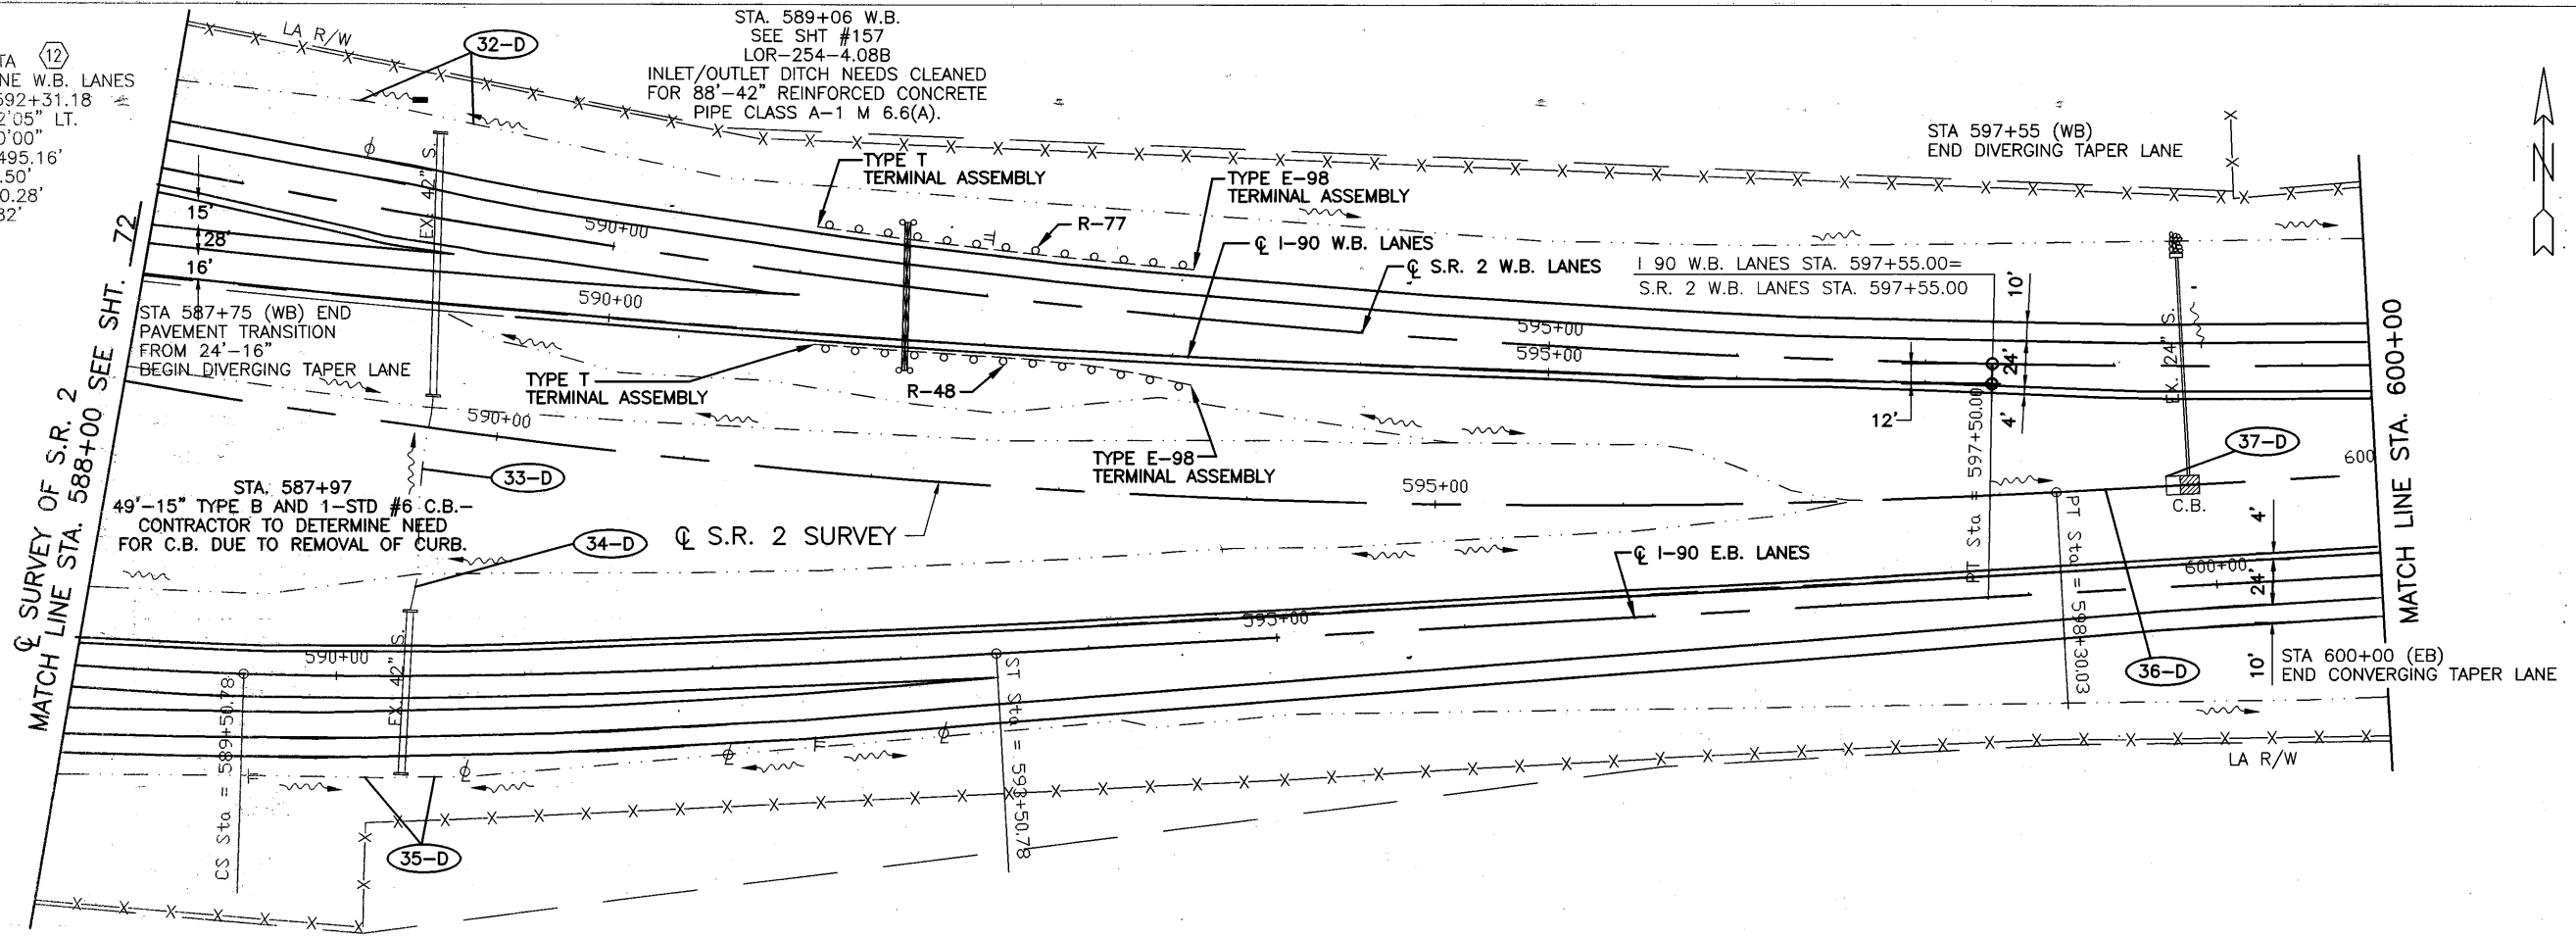


STA 607+40 TO STA. 608+97  
 REPLACE 35'-15" CLASS F-1.  
 REPLACE 1-STD. #4 BLOCK CB  
 IN MEDIAN. CLEAN DITCH AT  
 OUTLET END.

CALCULATED	DLS	CHECKED	LAB

HORIZONTAL SCALE IN FEET  
 0 50 100

PLAN  
 STA. 588+00 TO STA. 611+00

LOR - 190 - 10.76

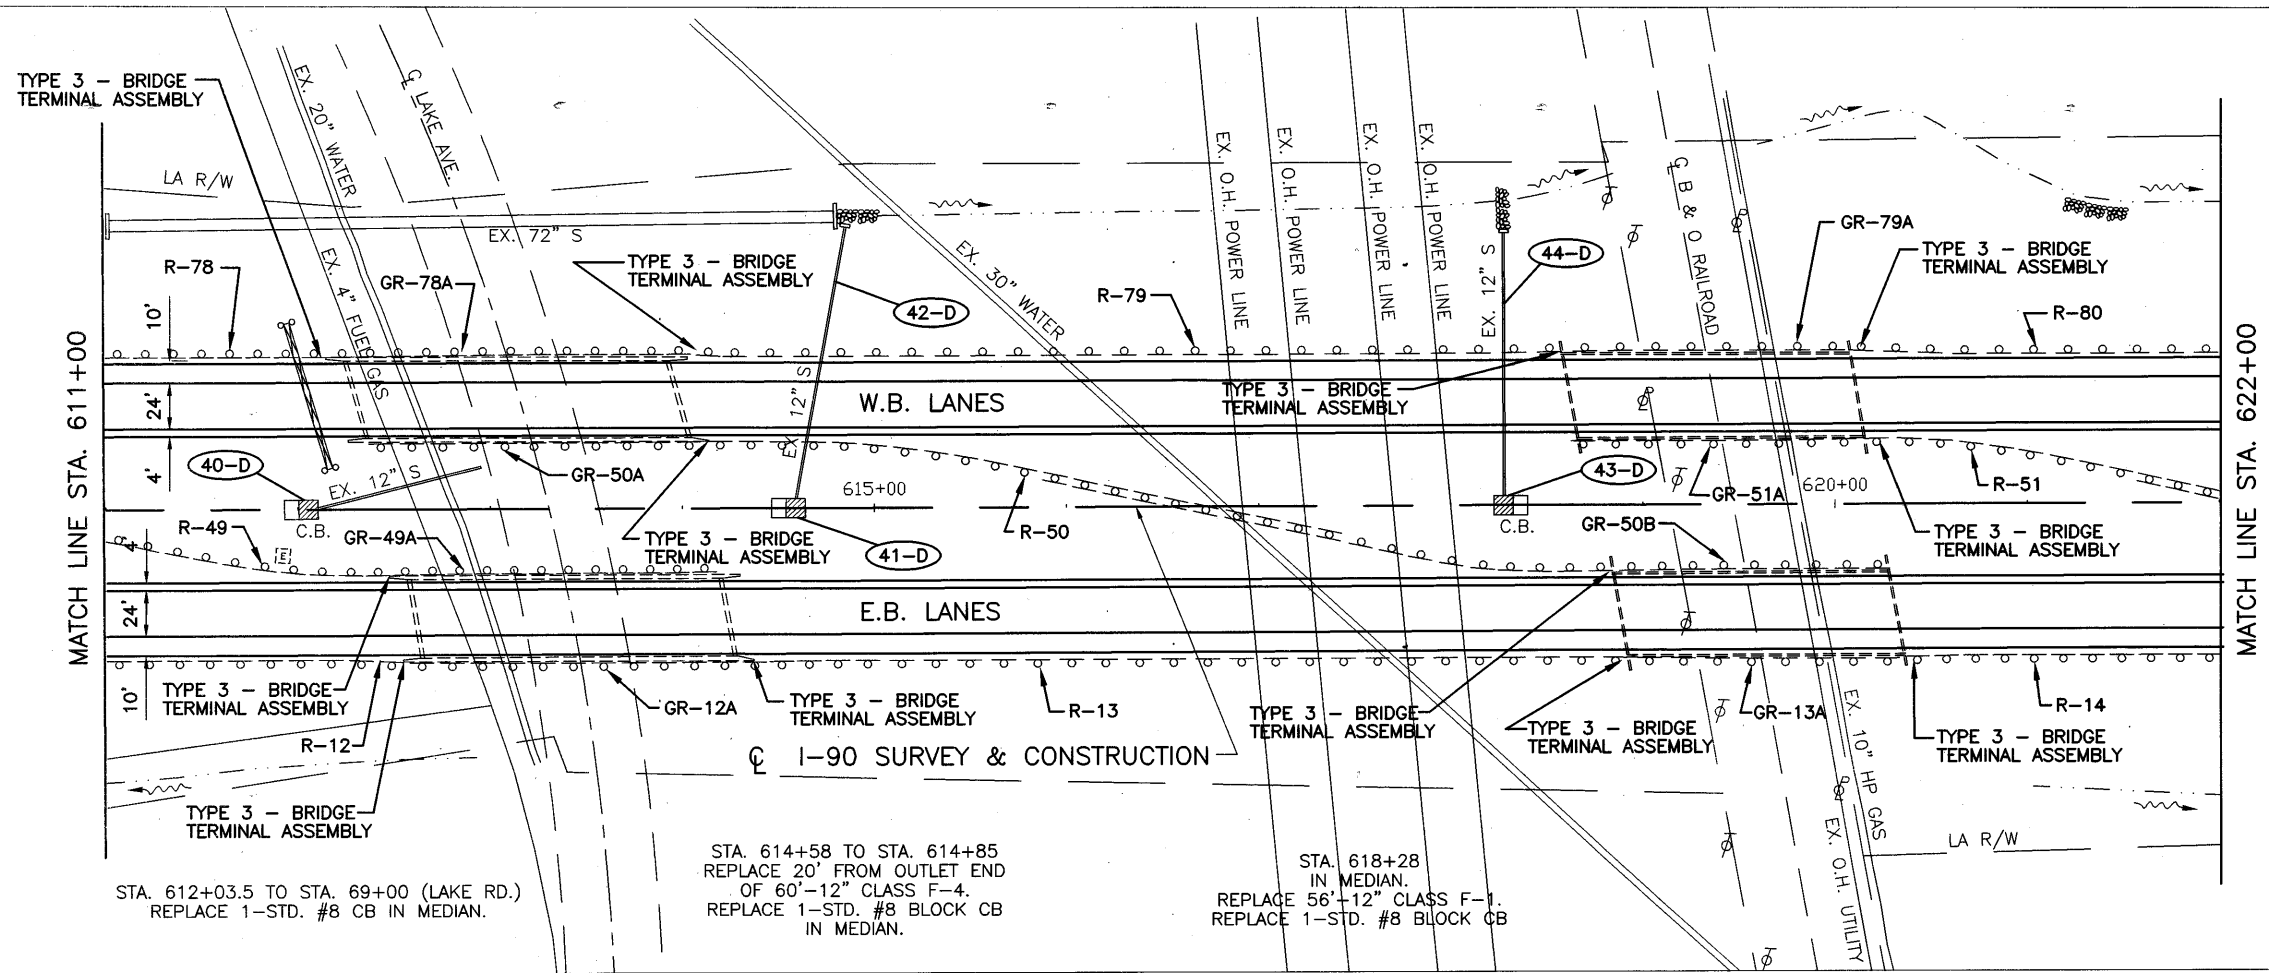

STA. 612+03.5 TO STA. 619+00 (LAKE RD.)  
REPLACE 1-STD. #8 CB IN MEDIAN.


STA. 614+58 TO STA. 614+85  
REPLACE 20' FROM OUTLET END  
OF 60'-12" CLASS F-4.  
REPLACE 1-STD. #8 BLOCK CB  
IN MEDIAN.

STA. 618+28  
IN MEDIAN.  
REPLACE 56'-12" CLASS F-1.  
REPLACE 1-STD. #8 BLOCK CB

CALCULATED	DLS	CHECKED	LAB





**PLAN**  
STA. 611+00 TO STA. 631+00

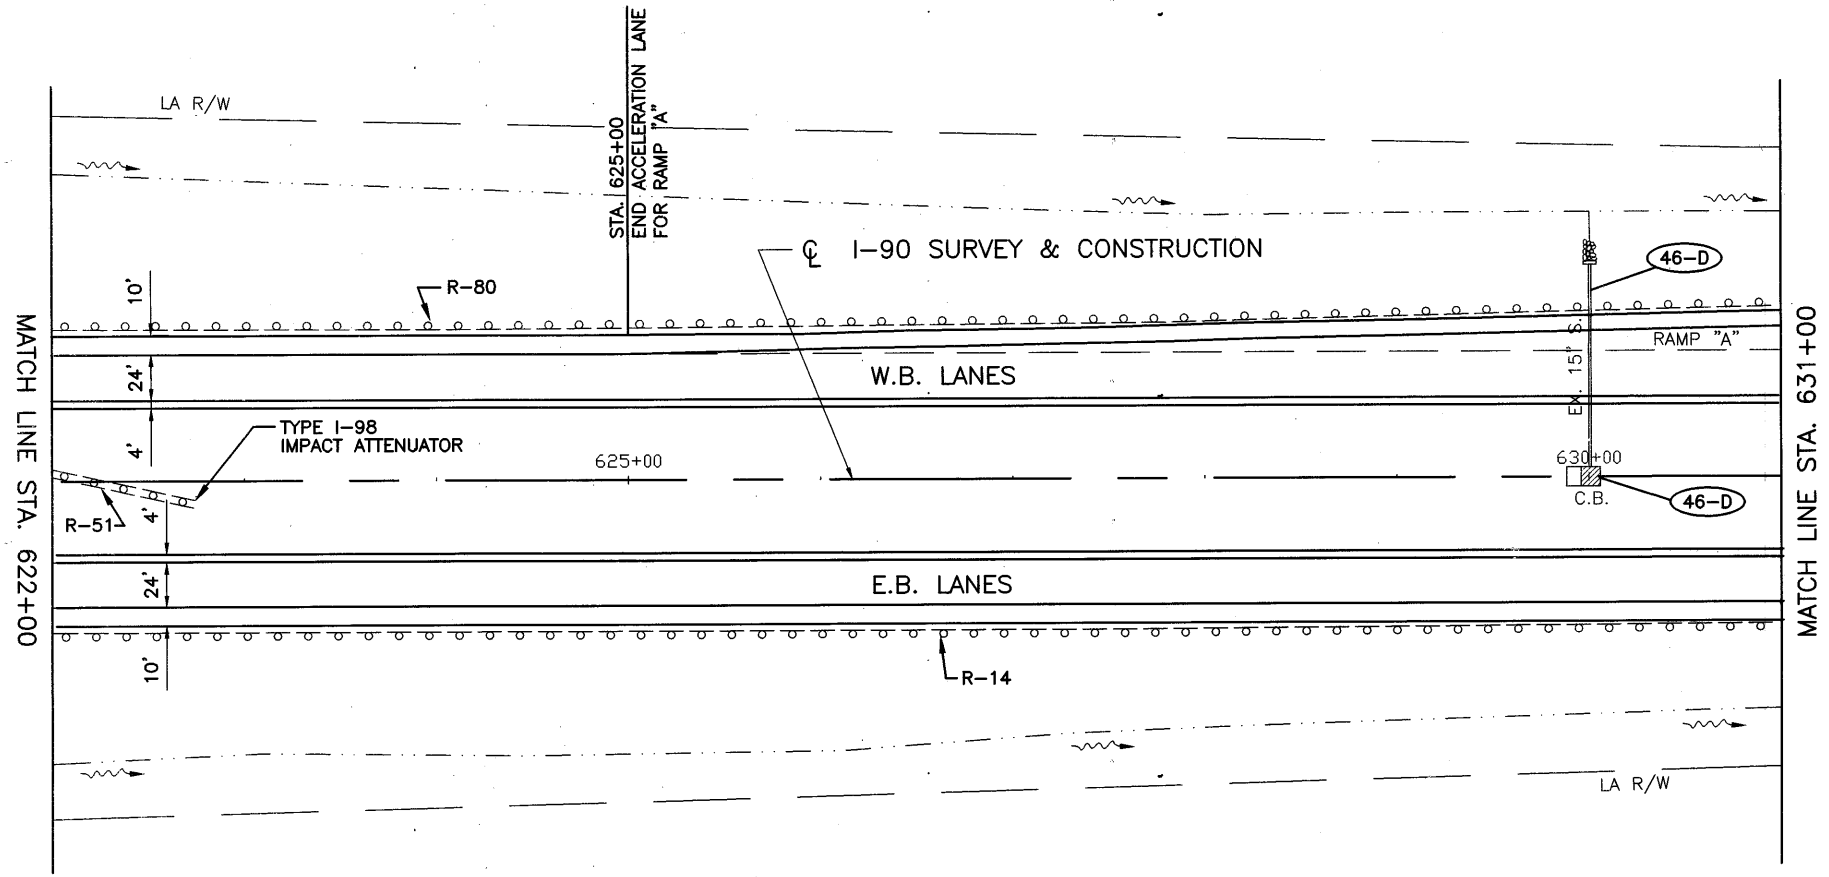

LOR - 190 - 10.76

STA. 637+43-639+50  
 REPLACE 1 - STD # 4  
 BLOCK CB IN MEDIAN.

STA. 639+50-640+00  
 C.B. DUE TO REMOVAL OF CURB.  
 CONTRACTOR TO DETERMINE NEED FOR

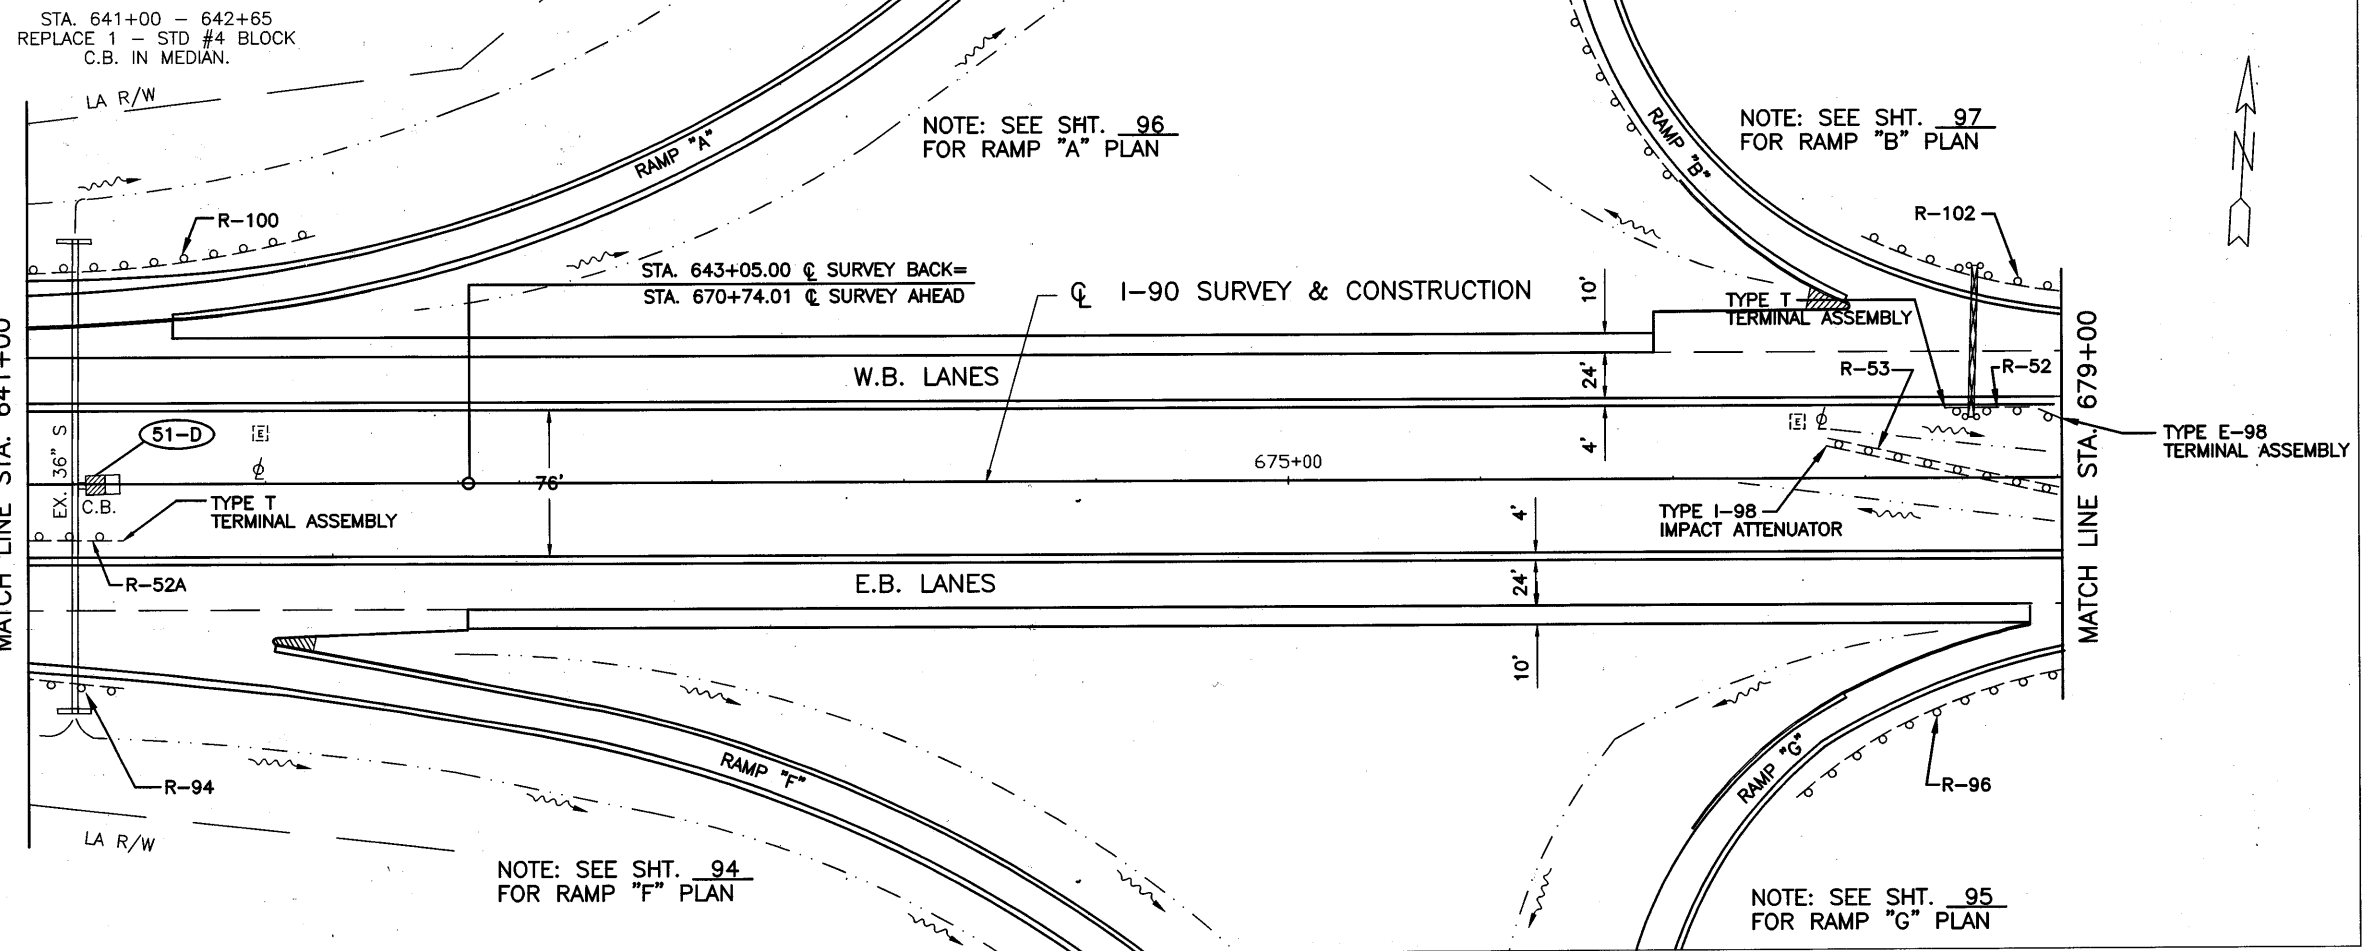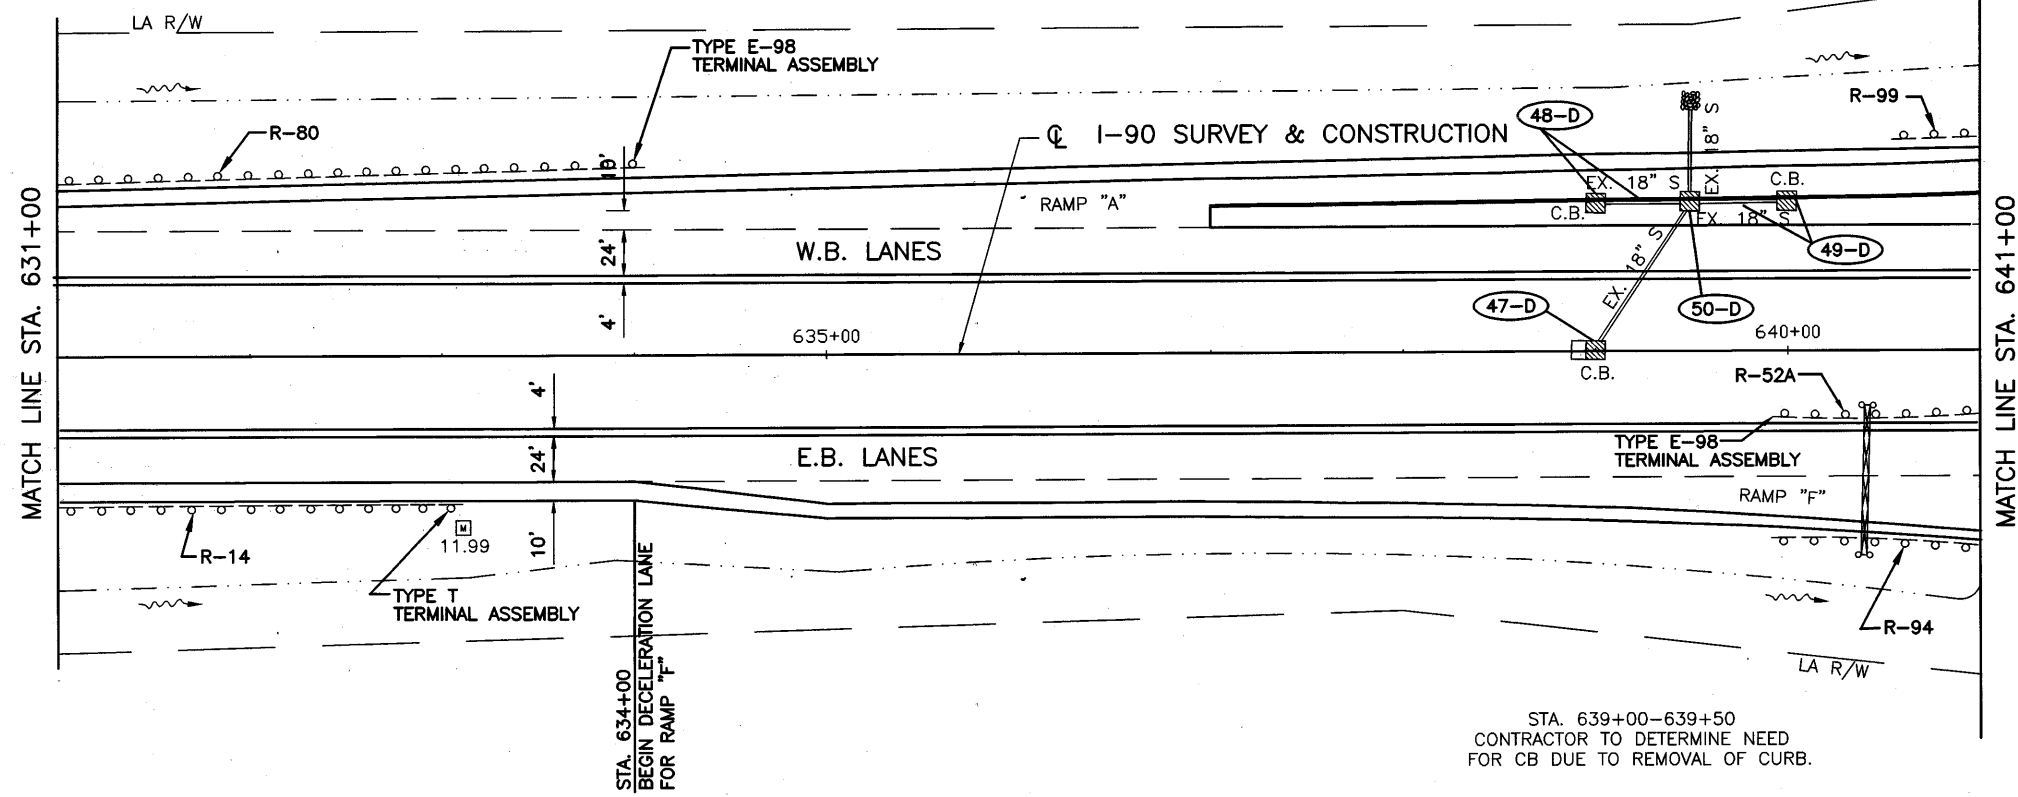

CALCULATED	DLS	CHECKED	LAB

100  
 50'  
 HORIZONTAL  
 SCALE IN FEET

PLAN

STA. 631+00 TO STA. 679+00

LOR - 190 - 10.76



75  
 274

A:\9600\DWG\3\3600\PL\15.DWG J DLS  
 24-2002 3:28PM

STA. 680+35  
35' - 15" TYPE F.  
REPLACE 10' OF OUTLET OF  
REPLACE 1 - STD #2-2B  
BRICK C.B. IN MEDIAN.

STA. 683+68  
40' - 15" TYPE F.  
REPLACE 10' OF OUTLET OF  
REPLACE 1 - STD #2-2B  
BRICK C.B. IN MEDIAN.

NOTE: SEE SHT. 97  
FOR RAMP "X" PLAN

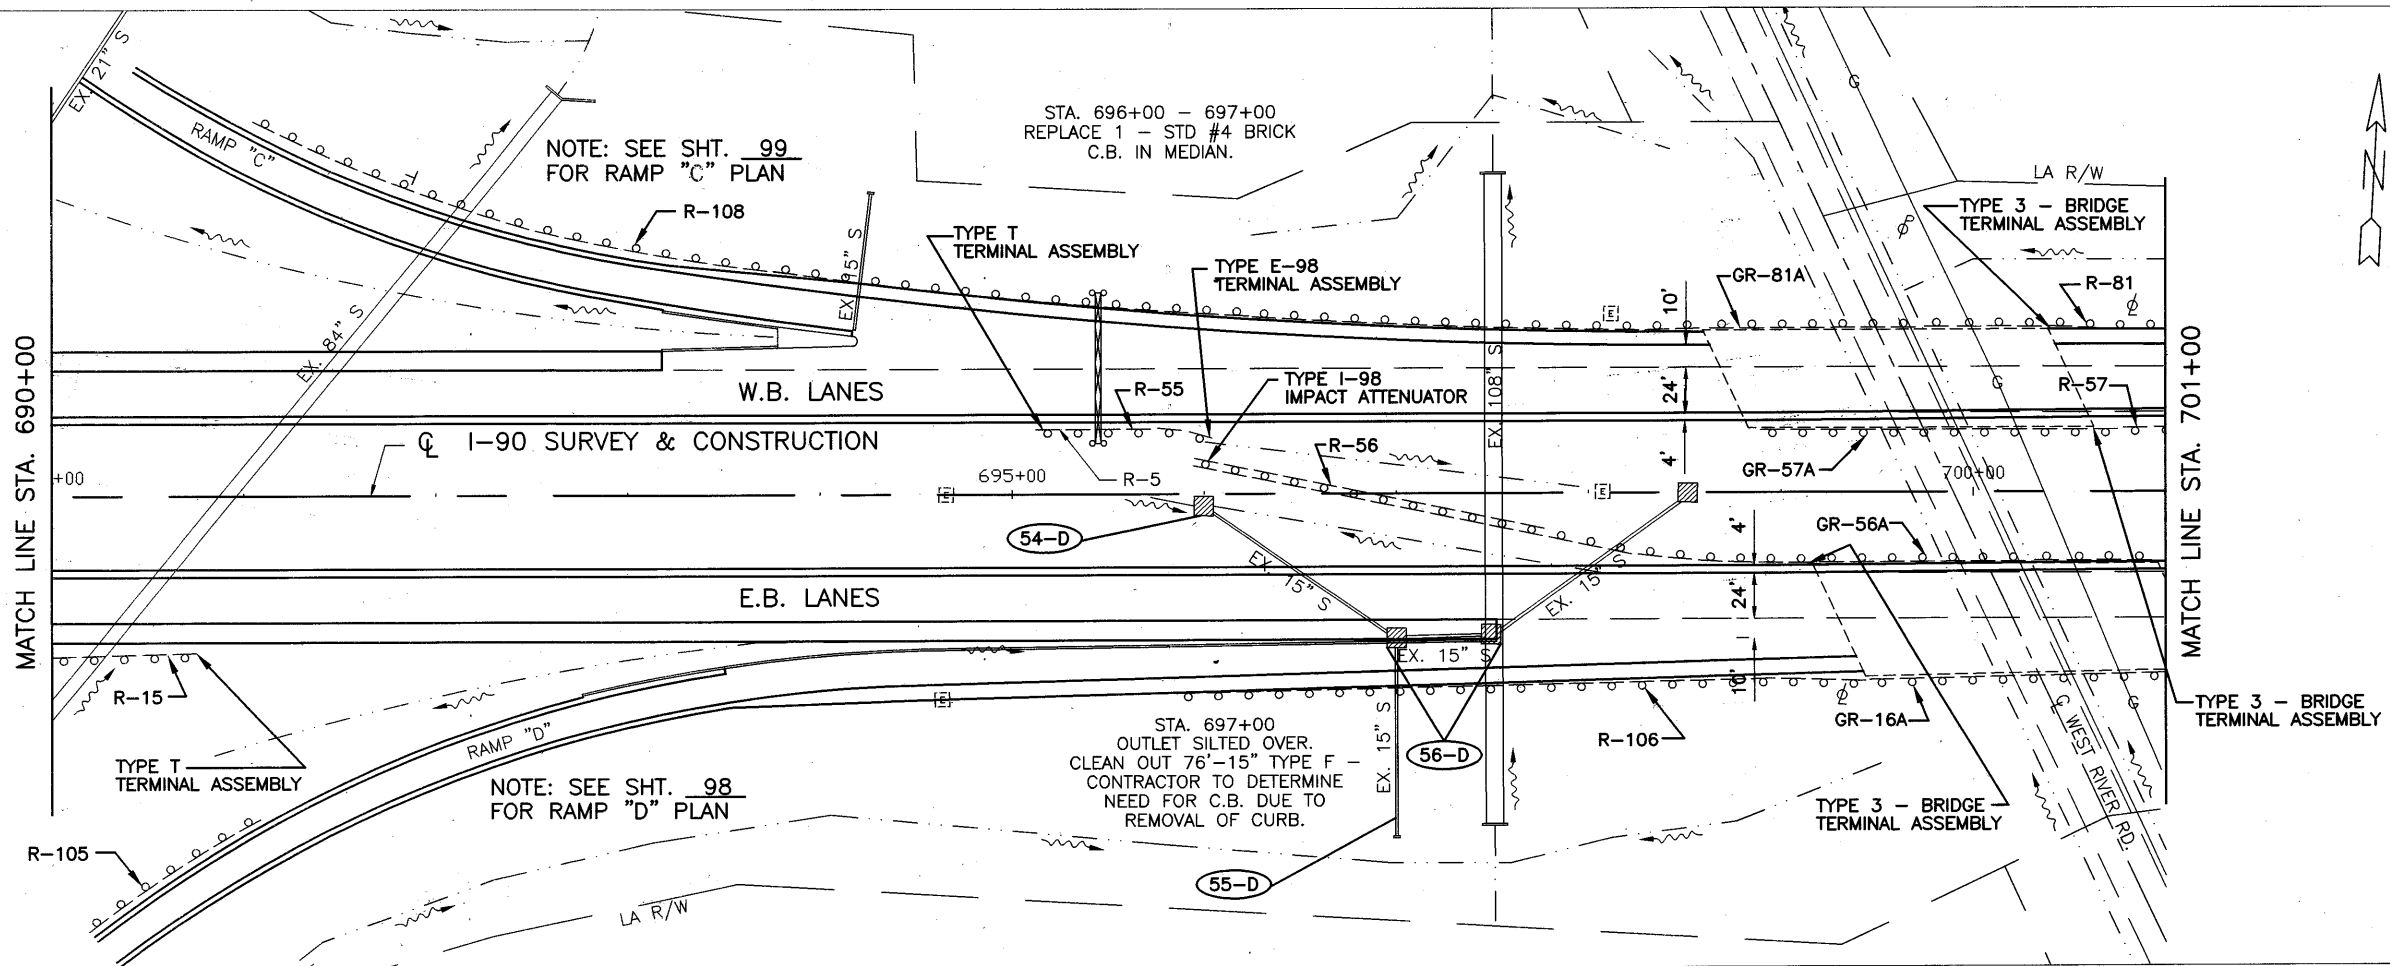
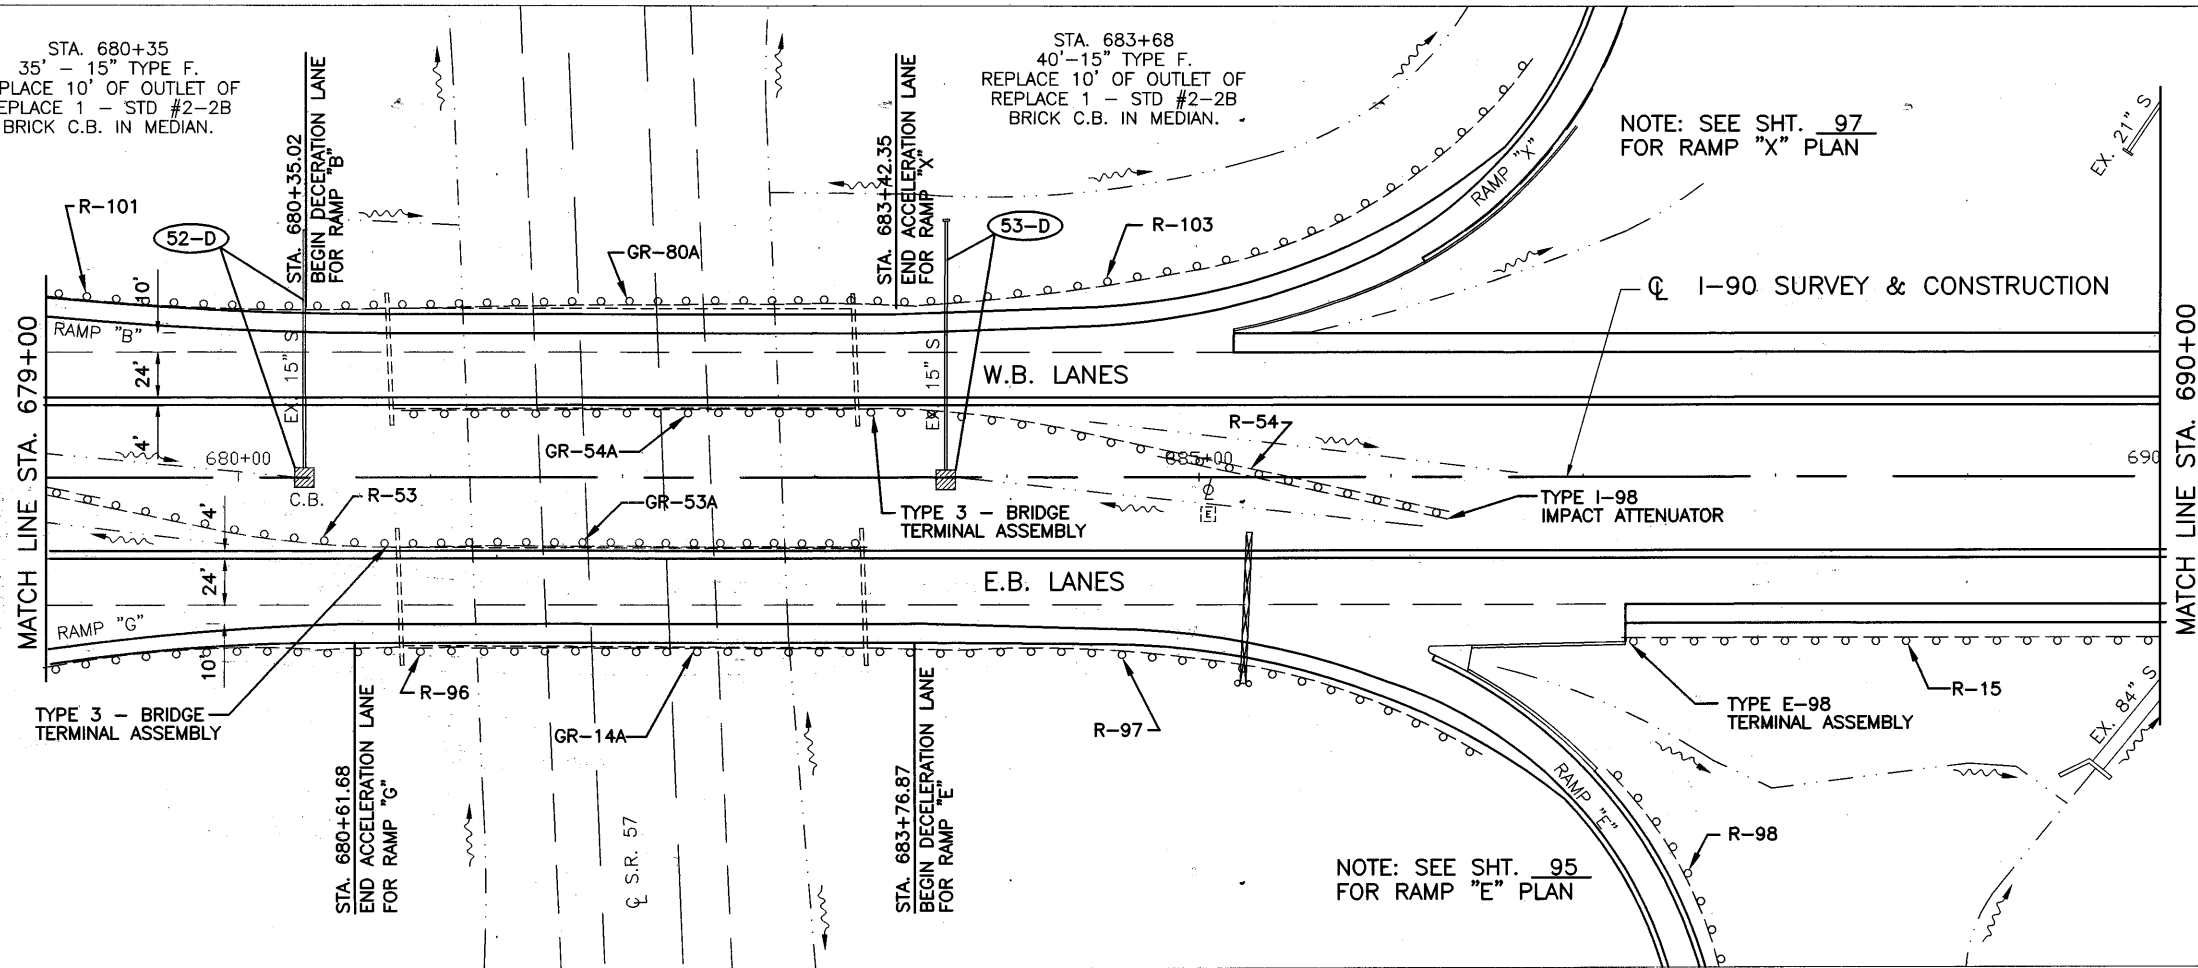


CALCULATED	DLS	CHECKED	LAB

PLAN  
STA. 679+00 TO STA. 701+00

LOR - I90 - 10.76

CURVE DATA 13  
 P.I. STA. 719  
 $\Delta = 59'48'25''$   
 $D_c = 2'00'00''$   
 $R_c = 2864.79$   
 $T_s = 1798.30'$   
 $L_c = 2690.35'$   
 $L_s = 300.00'$   
 $E_s = 441.47'$   
 $\theta_s = 3'00'00''$   
 $L.T. = 200.03'$   
 $S.T. = 100.03'$

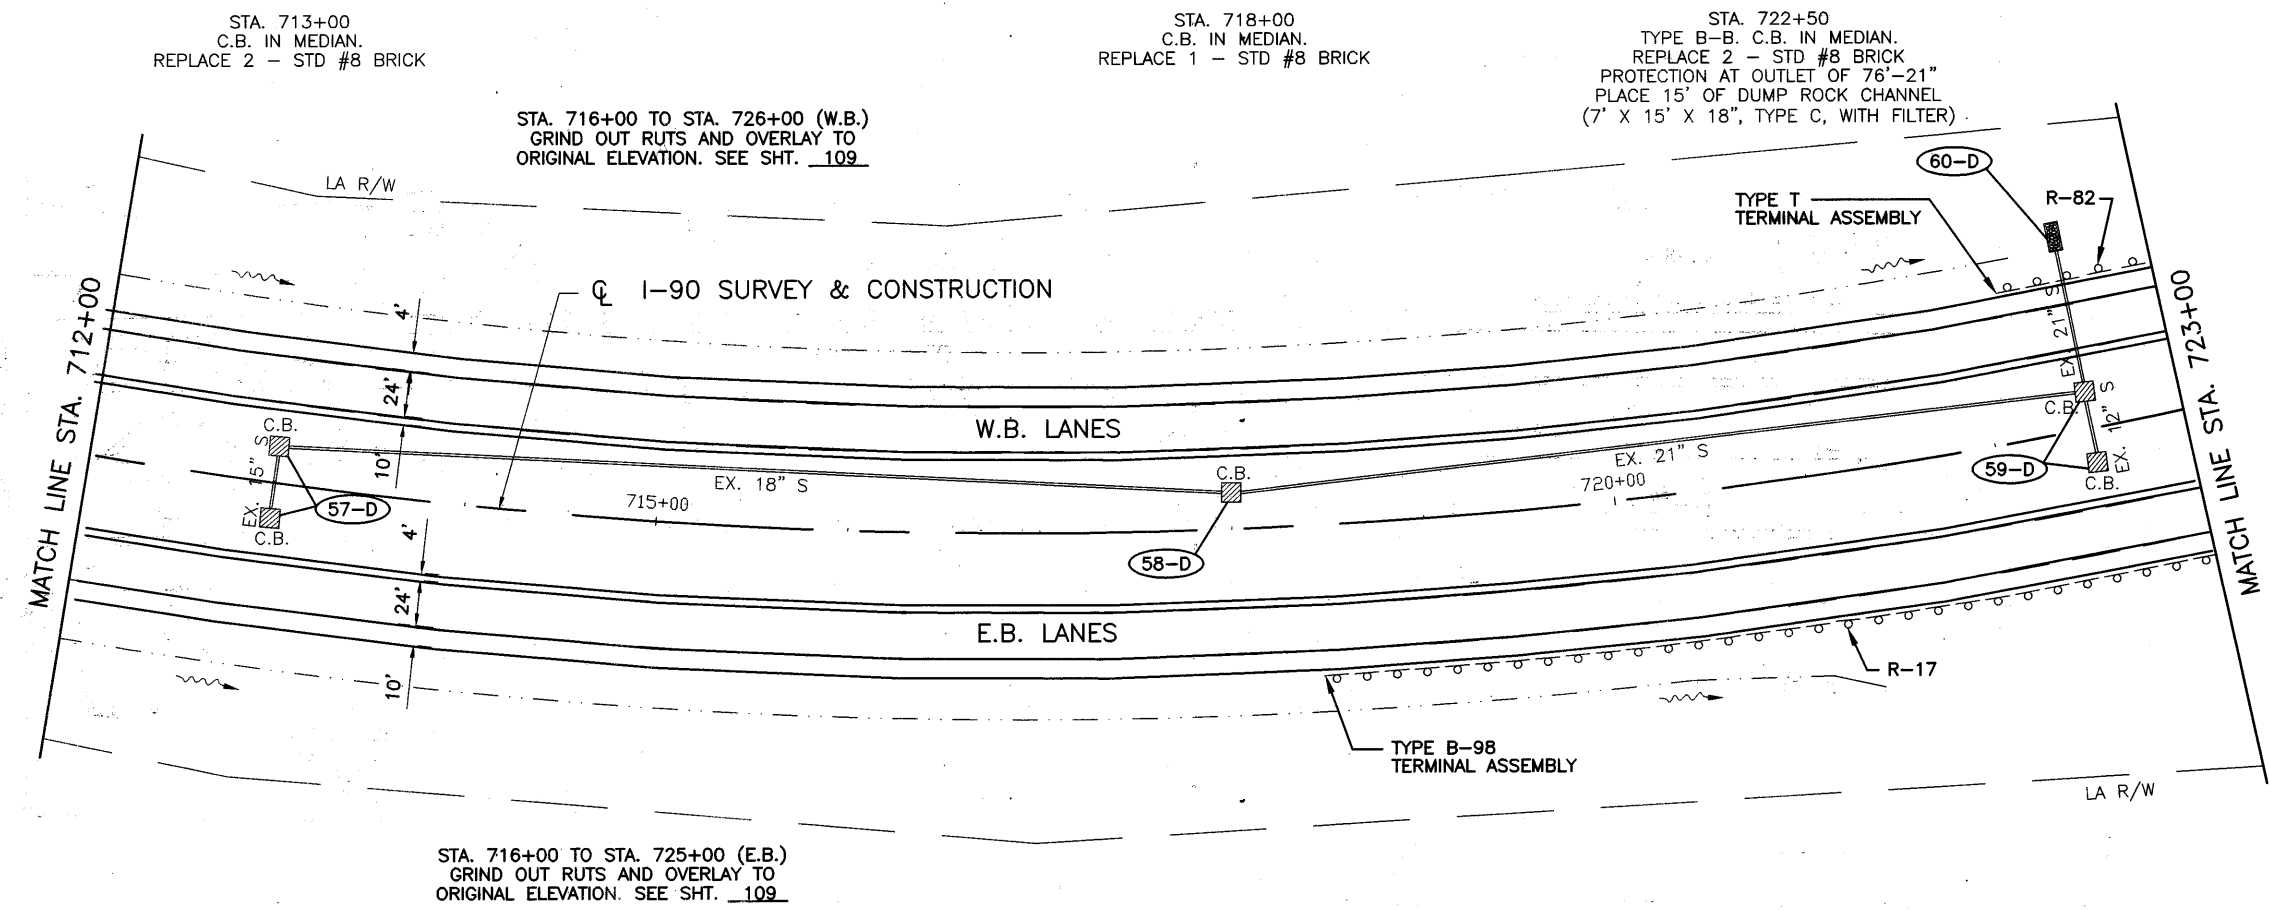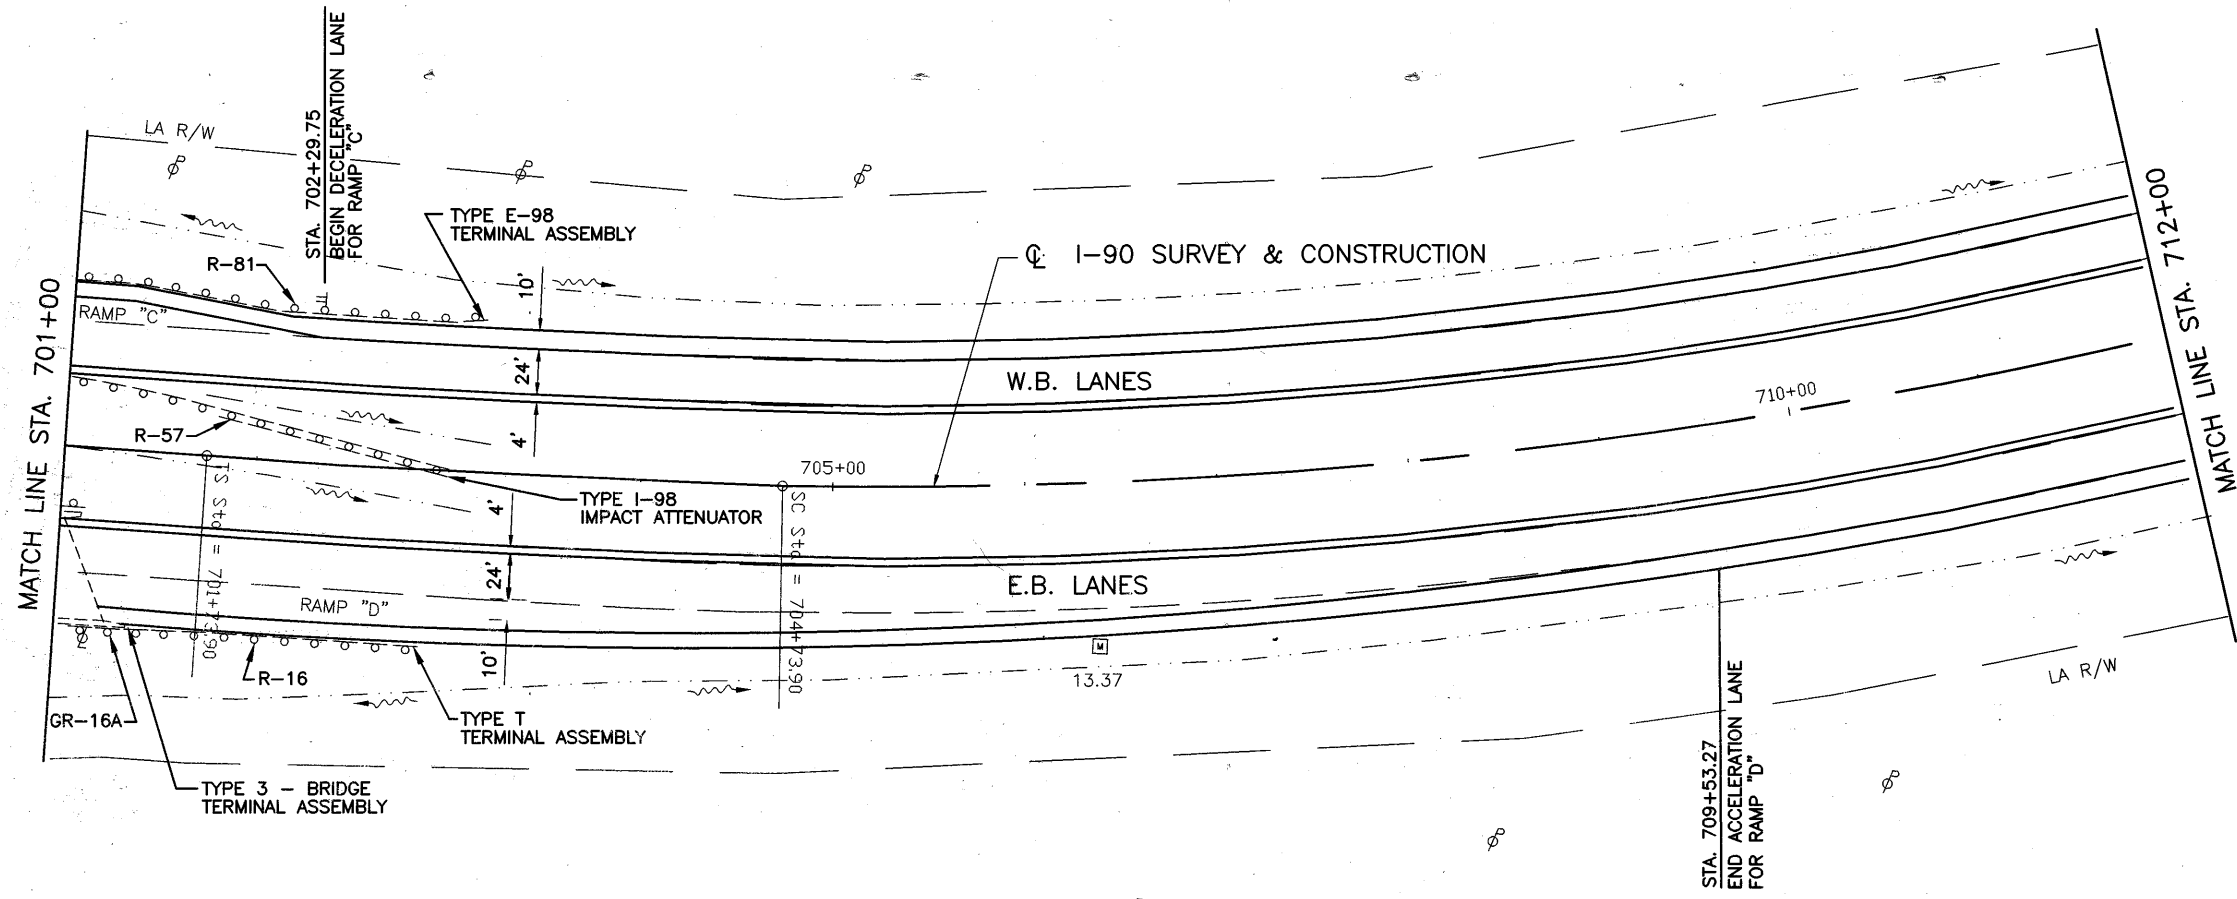

STA. 713+00  
 C.B. IN MEDIAN.  
 REPLACE 2 - STD #8 BRICK


STA. 716+00 TO STA. 726+00 (W.B.)  
 GRIND OUT RUTS AND OVERLAY TO  
 ORIGINAL ELEVATION. SEE SHT. 109

STA. 718+00  
 C.B. IN MEDIAN.  
 REPLACE 1 - STD #8 BRICK

STA. 722+50  
 TYPE B-B. C.B. IN MEDIAN.  
 REPLACE 2 - STD #8 BRICK  
 PROTECTION AT OUTLET OF 76'-21"  
 PLACE 15' OF DUMP ROCK CHANNEL  
 (7' X 15' X 18", TYPE C, WITH FILTER)

STA. 716+00 TO STA. 725+00 (E.B.)  
 GRIND OUT RUTS AND OVERLAY TO  
 ORIGINAL ELEVATION. SEE SHT. 109


CALCULATED	DLS	CHECKED	LAB

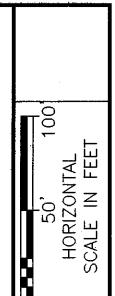

PLAN  
 STA. 701+00 TO STA. 723+00

LOR - I90 - 10.76


CA:\0000\DWG\BAR\00000000\17.DWG 11/27/02 10:07AM

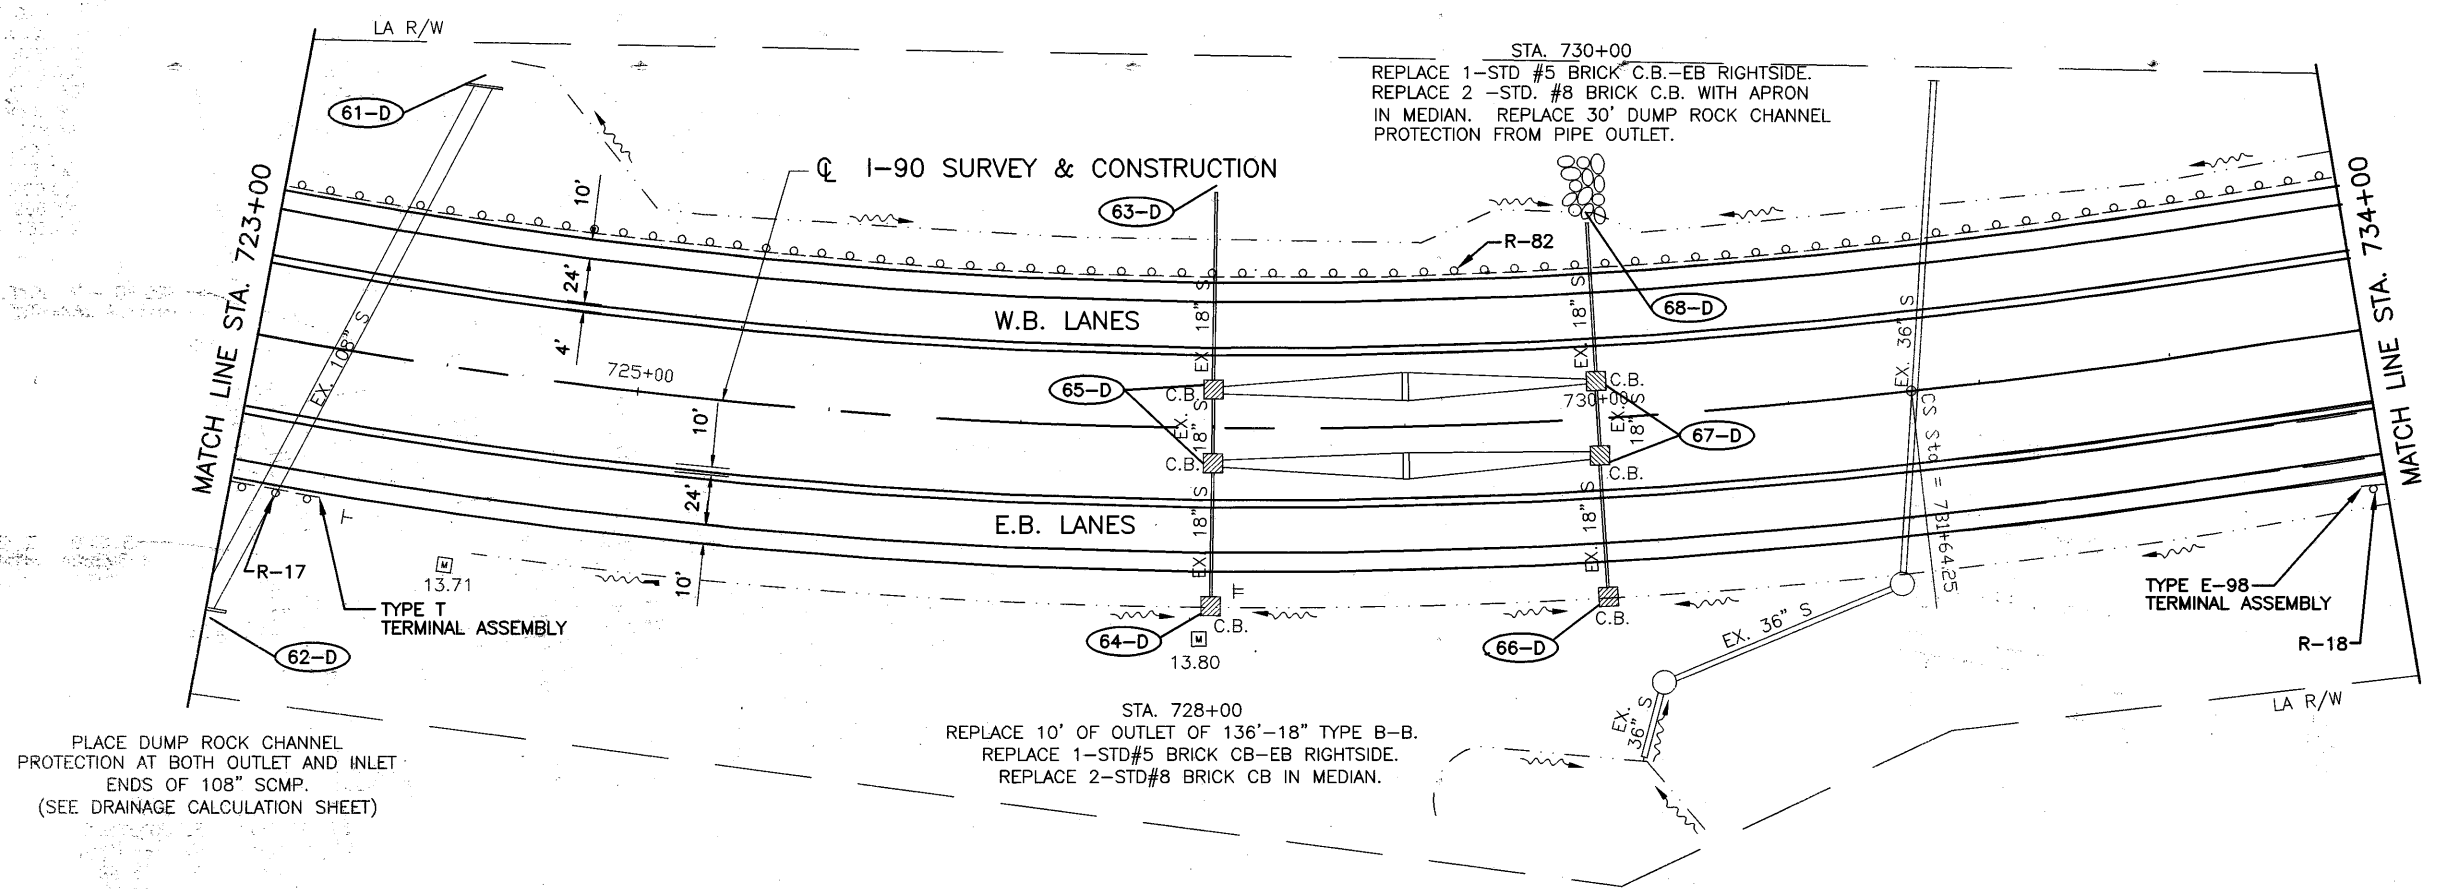

PLACE DUMP ROCK CHANNEL PROTECTION AT BOTH OUTLET AND INLET ENDS OF 108" SCMP. (SEE DRAINAGE CALCULATION SHEET)


STA. 728+00  
 REPLACE 10' OF OUTLET OF 136'-18" TYPE B-B.  
 REPLACE 1-STD#5 BRICK CB-EB RIGHTSIDE.  
 REPLACE 2-STD#8 BRICK CB IN MEDIAN.

STA. 730+00  
 REPLACE 1-STD #5 BRICK C.B.-EB RIGHTSIDE.  
 REPLACE 2 -STD. #8 BRICK C.B. WITH APRON IN MEDIAN. REPLACE 30' DUMP ROCK CHANNEL PROTECTION FROM PIPE OUTLET.

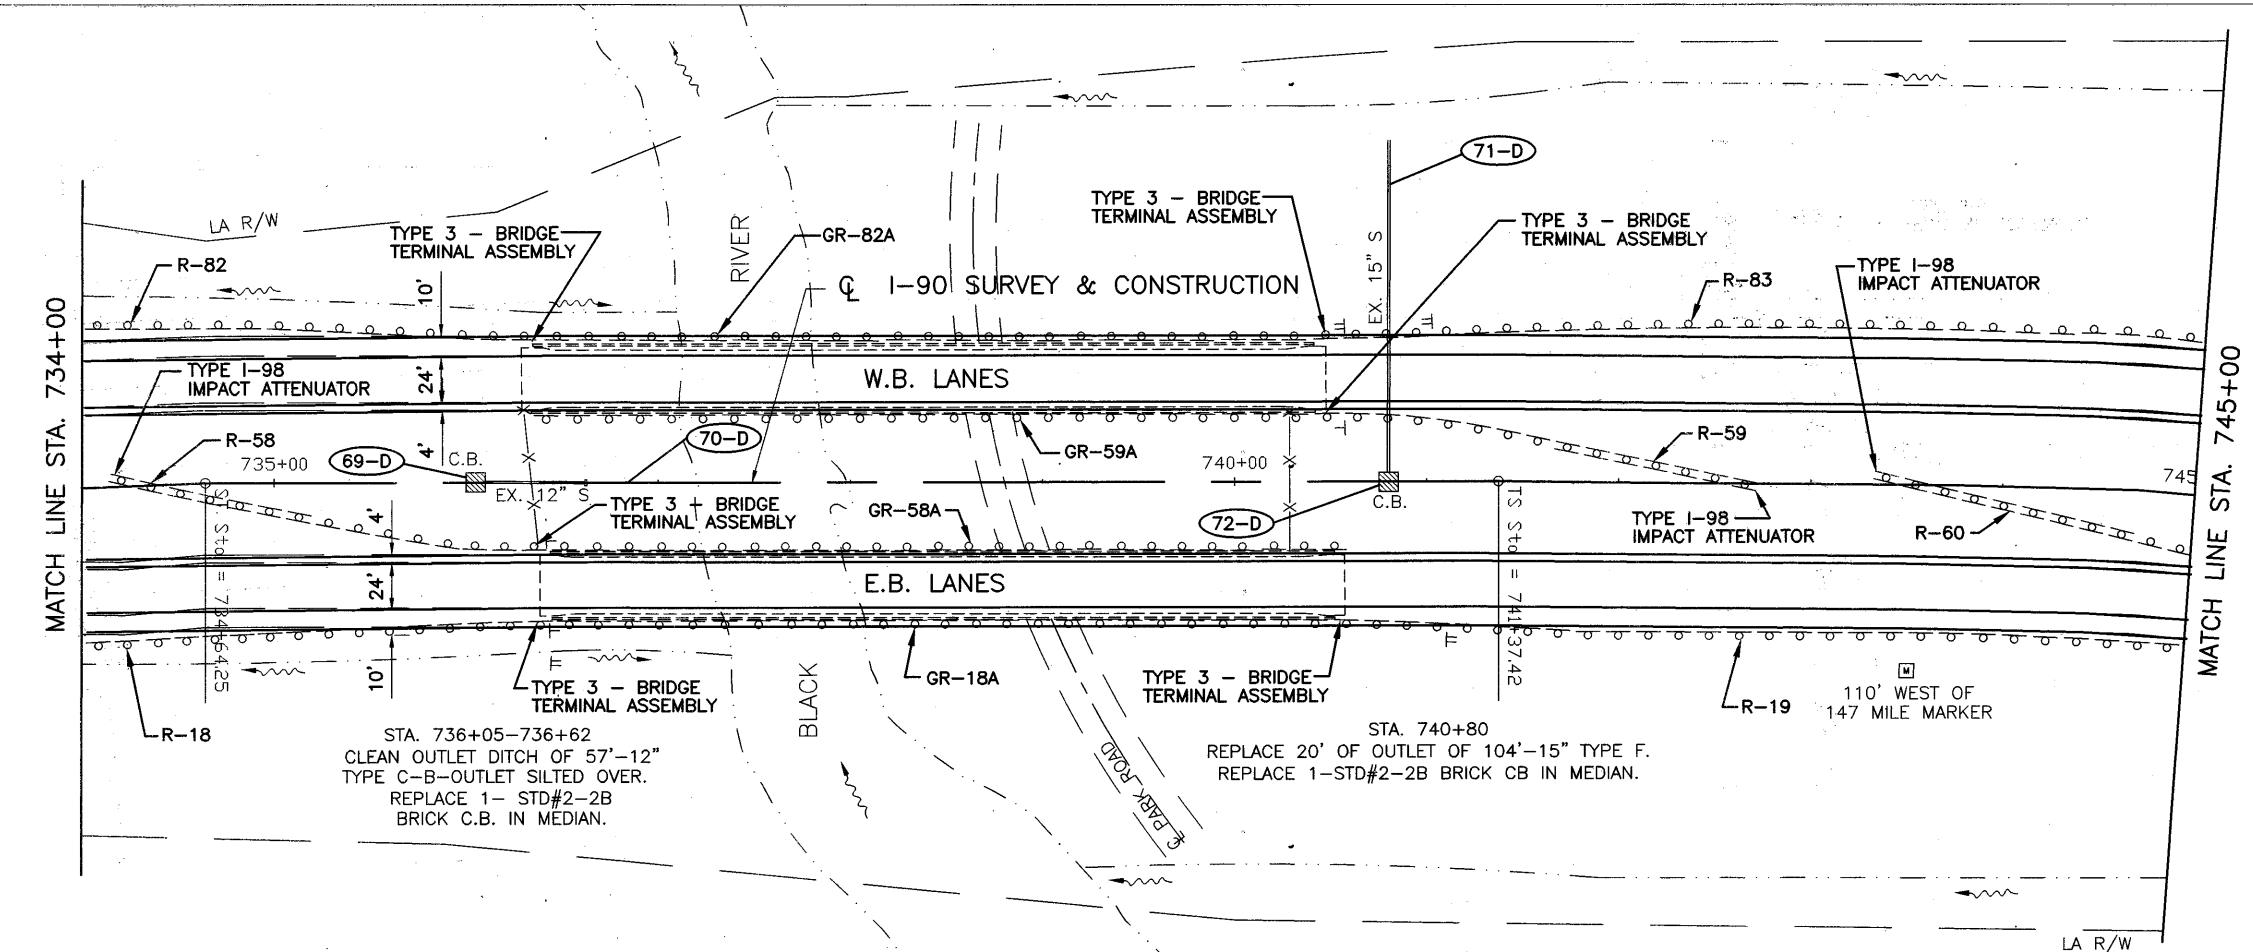

STA. 736+05-736+62  
 CLEAN OUTLET DITCH OF 57'-12" TYPE C-B-OUTLET SILTED OVER.  
 REPLACE 1- STD#2-2B BRICK C.B. IN MEDIAN.



STA. 740+80  
 REPLACE 20' OF OUTLET OF 104'-15" TYPE F.  
 REPLACE 1-STD#2-2B BRICK CB IN MEDIAN.

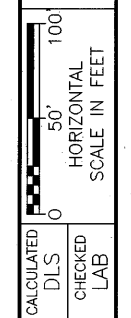

PLAN  
 STA. 723+00 TO STA. 745+00

LOR - 190 - 10.76

CURVE DATA 14  
 P.I. STA. 750+87.60  
 $\Delta = 36^{\circ}12'32''$   
 $D_c = 2^{\circ}30'00''$   
 $R_c = 2291.83'$   
 $T_s = 950.18'$   
 $L_c = 1048.36'$   
 $L_s = 400.00'$   
 $E_s = 122.44'$   
 $\theta_s = 5^{\circ}00'00''$   
 $L.T. = 266.77'$   
 $S.T. = 133.43'$

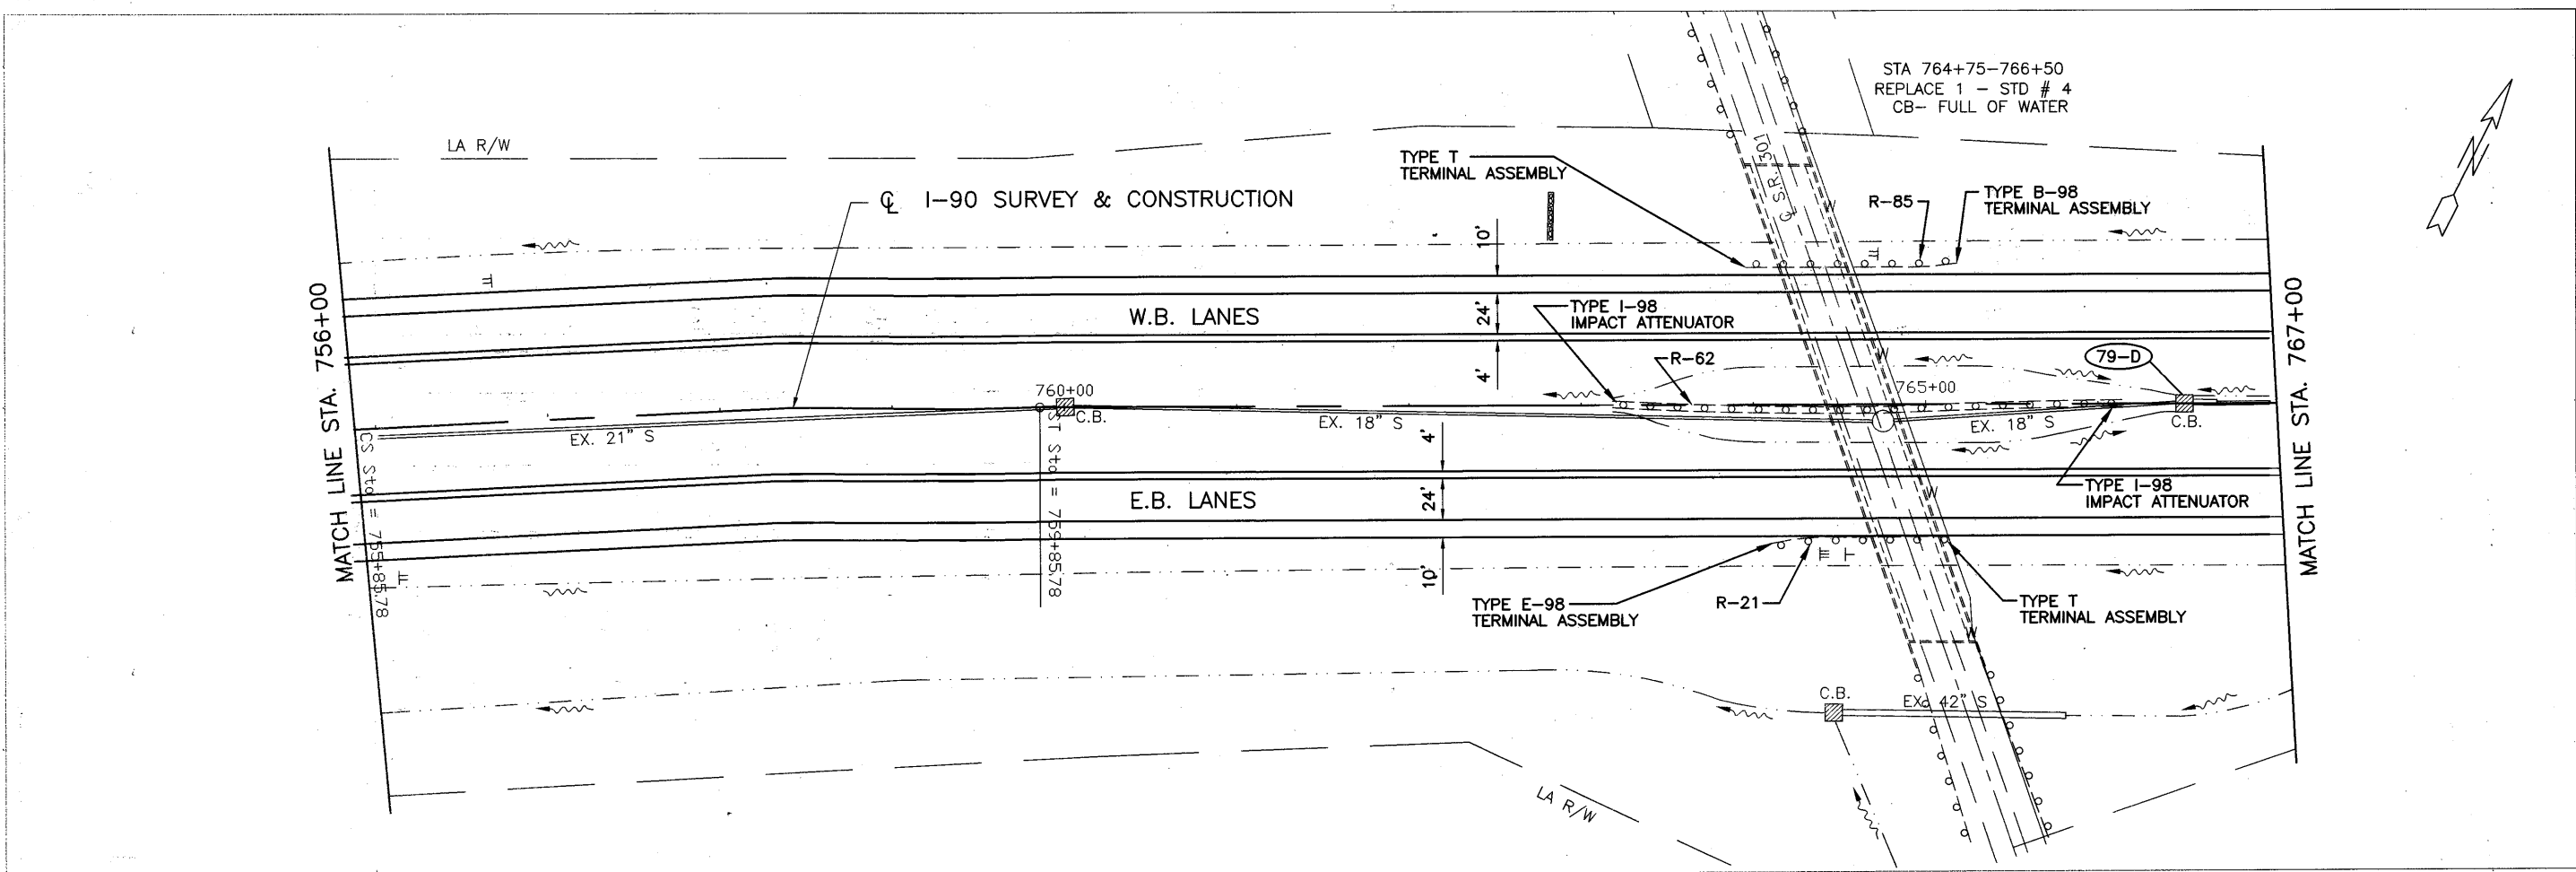
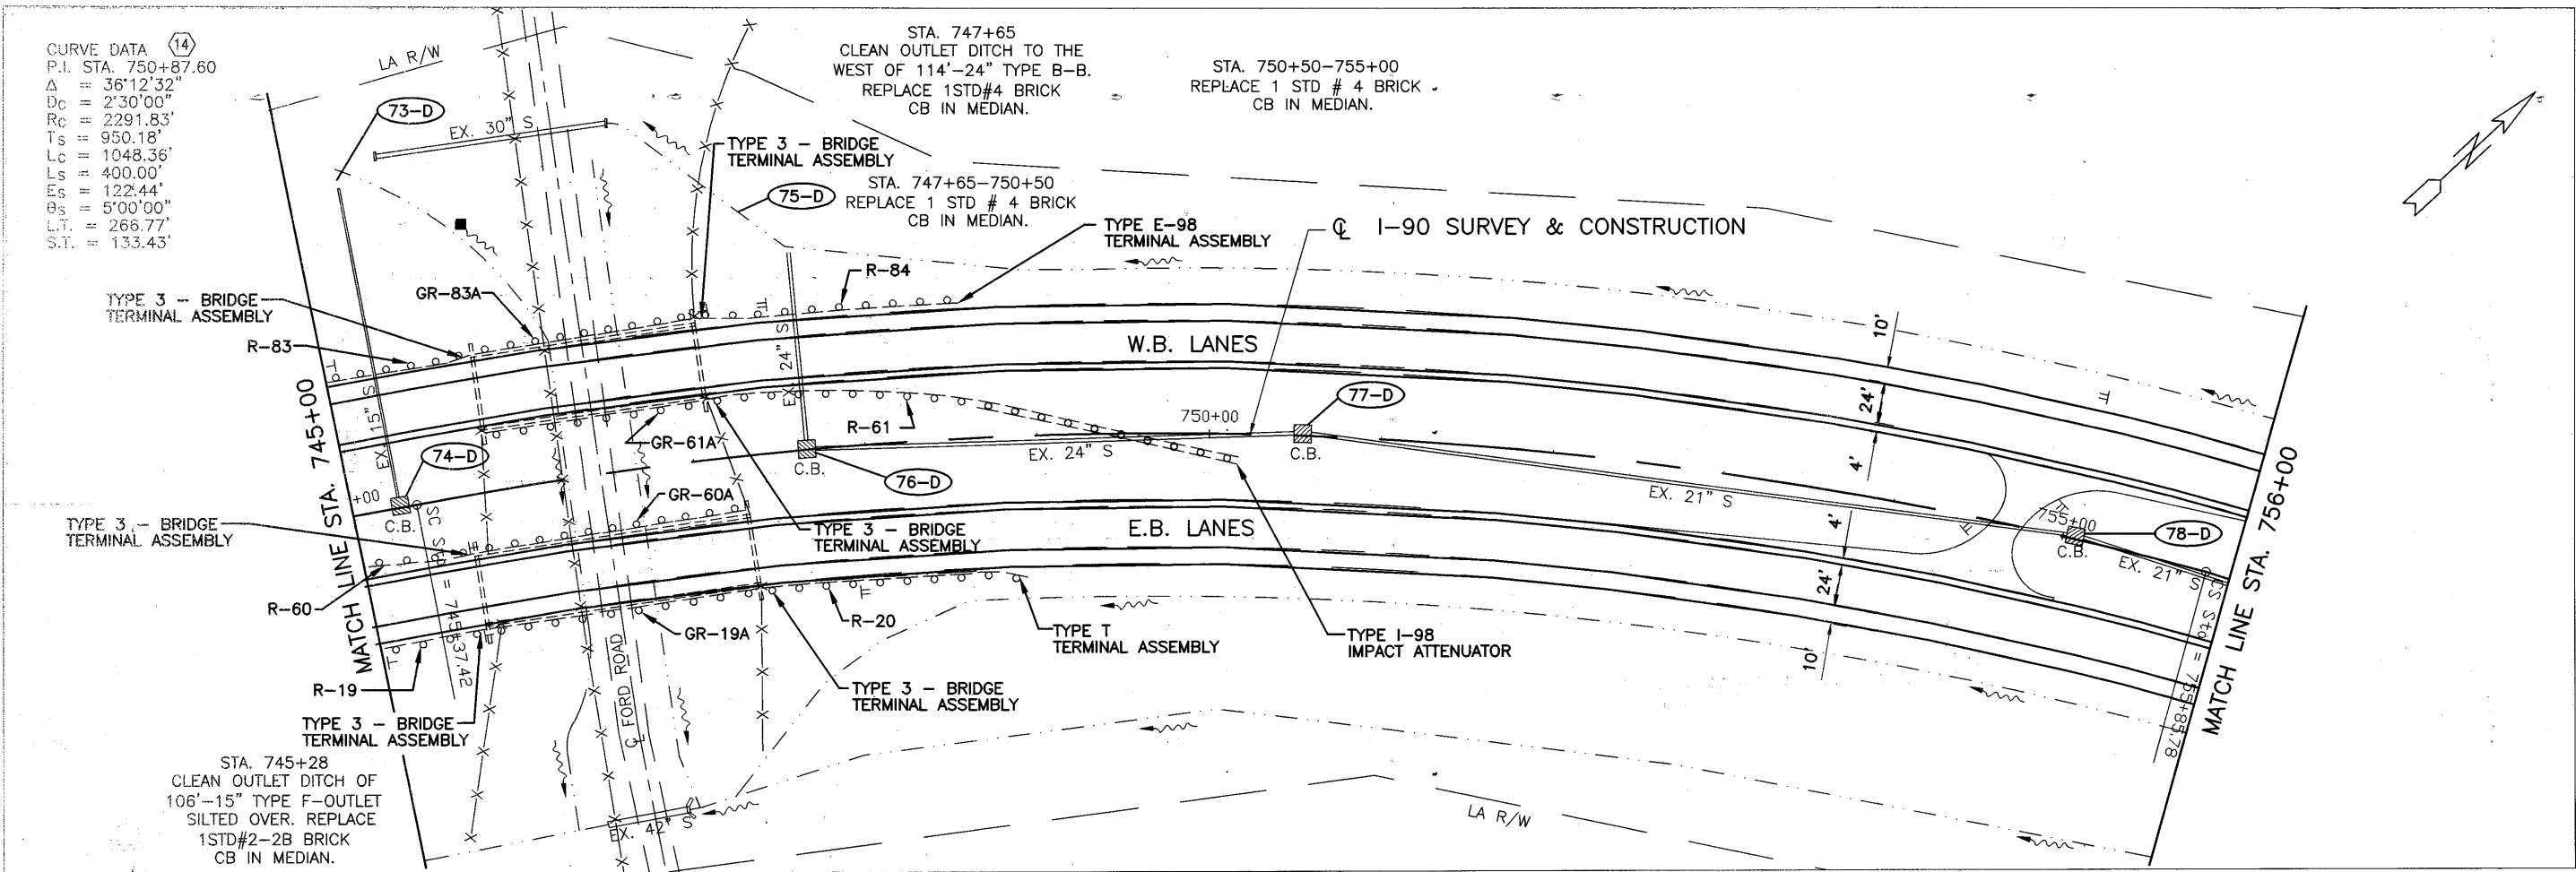


CALCULATED	DLS	CHECKED	LAB

0 50' 100'  
 HORIZONTAL SCALE IN FEET

PLAN  
 STA. 745+00 TO STA. 767+00

LOR - 190 - 10.76

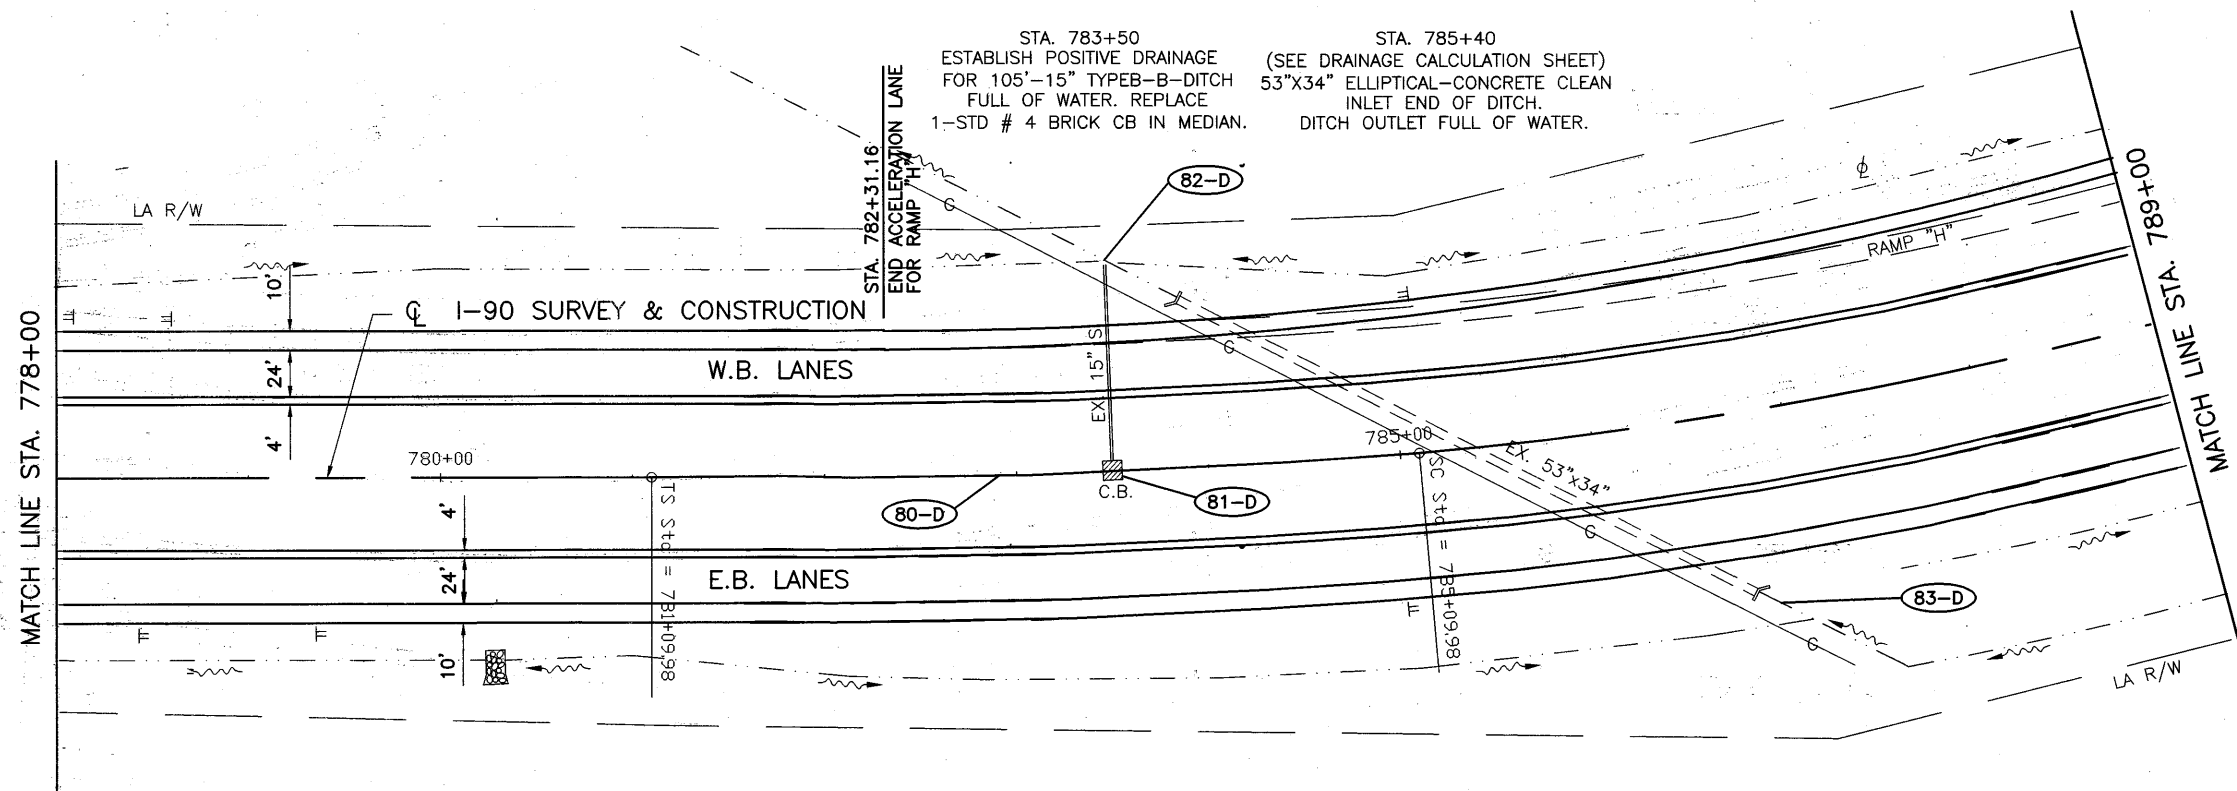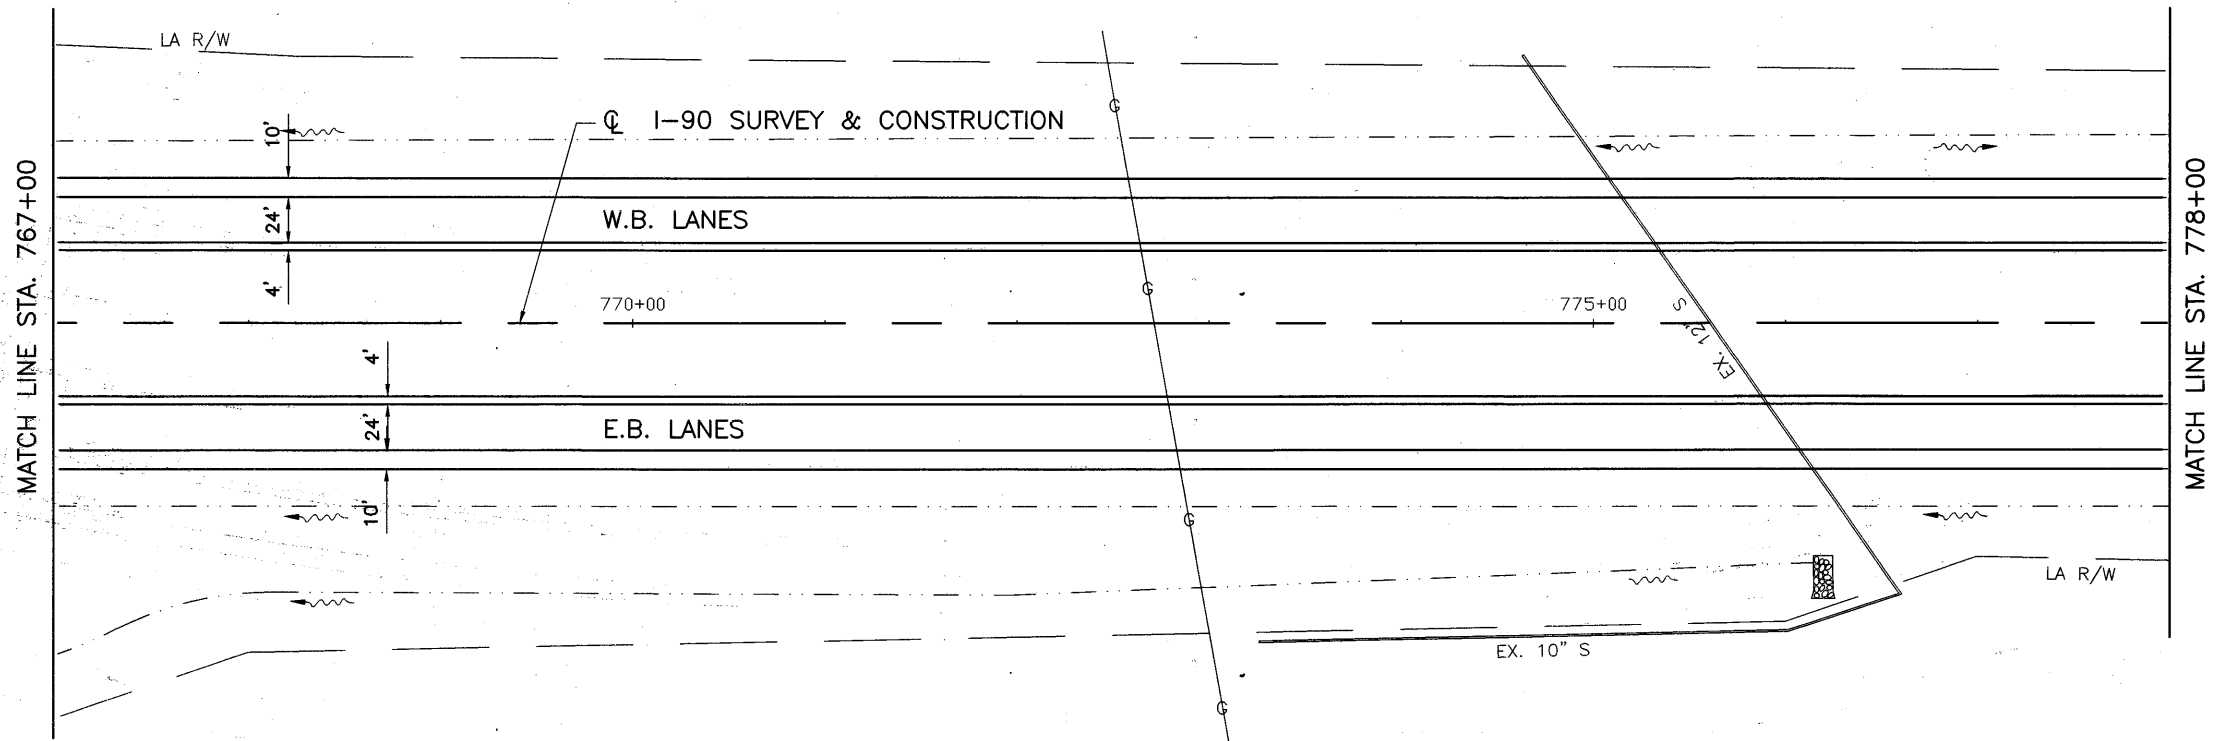

CALCULATED	DLS	CHECKED	LAB





PLAN  
STA. 767+00 TO STA. 789+00

LOR - 190 - 10.76

P:\190\190\DWG\190-10.76\190-10.76.dwg [ 62  
 13-12-2002 8:23AM





CURVE DATA 15  
 P.I. STA. 796+98.20  
 $\Delta = 62^{\circ}20'45''$   
 $D_c = 2^{\circ}30'00''$   
 $R_c = 2291.83'$   
 $T_s = 1588.21'$   
 $L_c = 2093.83'$   
 $L_s = 400.00'$   
 $E_s = 390.16'$   
 $\theta_s = 5^{\circ}00'00''$   
 $L.T. = 266.77'$   
 $S.T. = 133.43'$

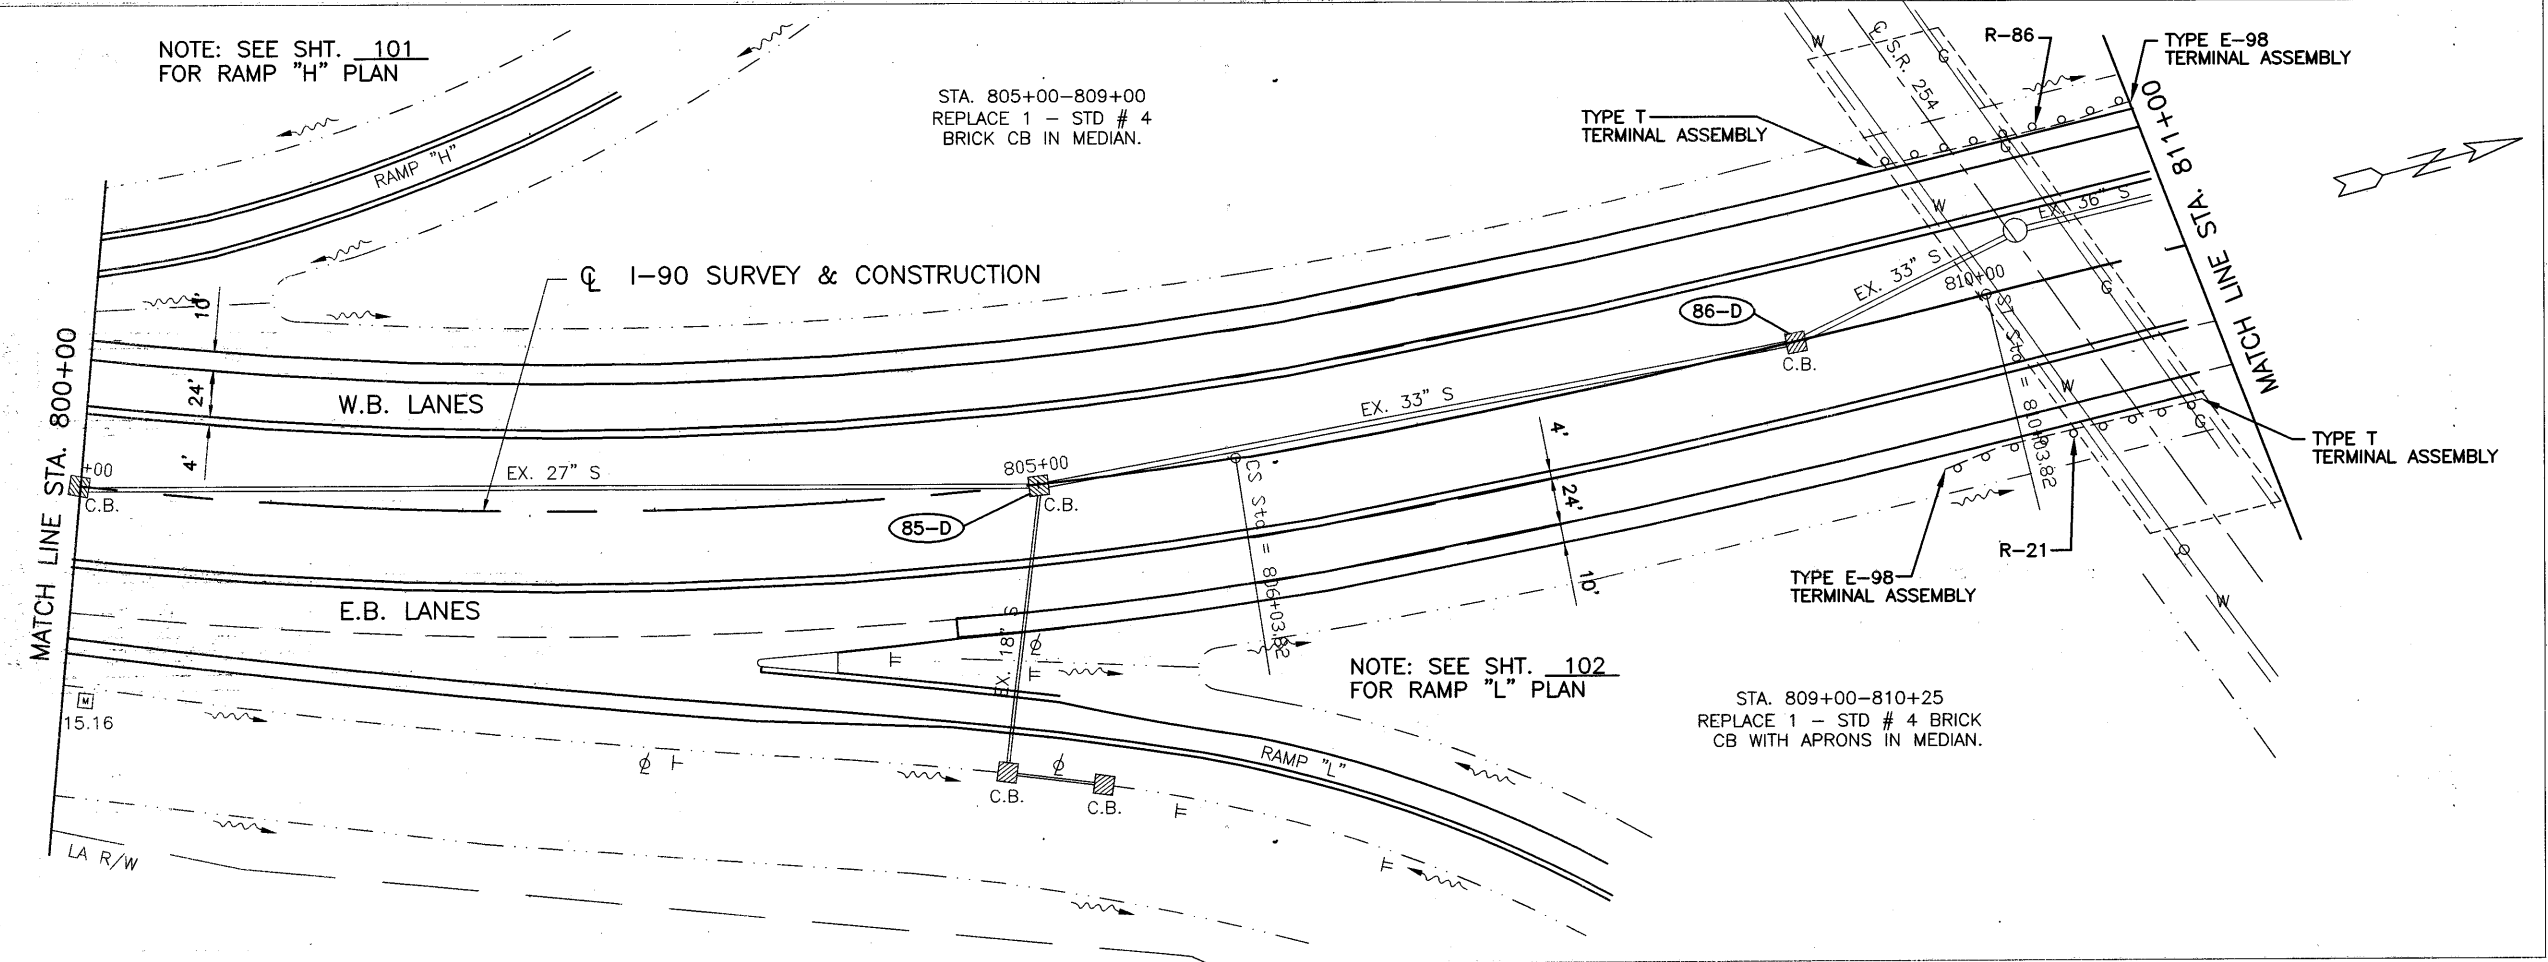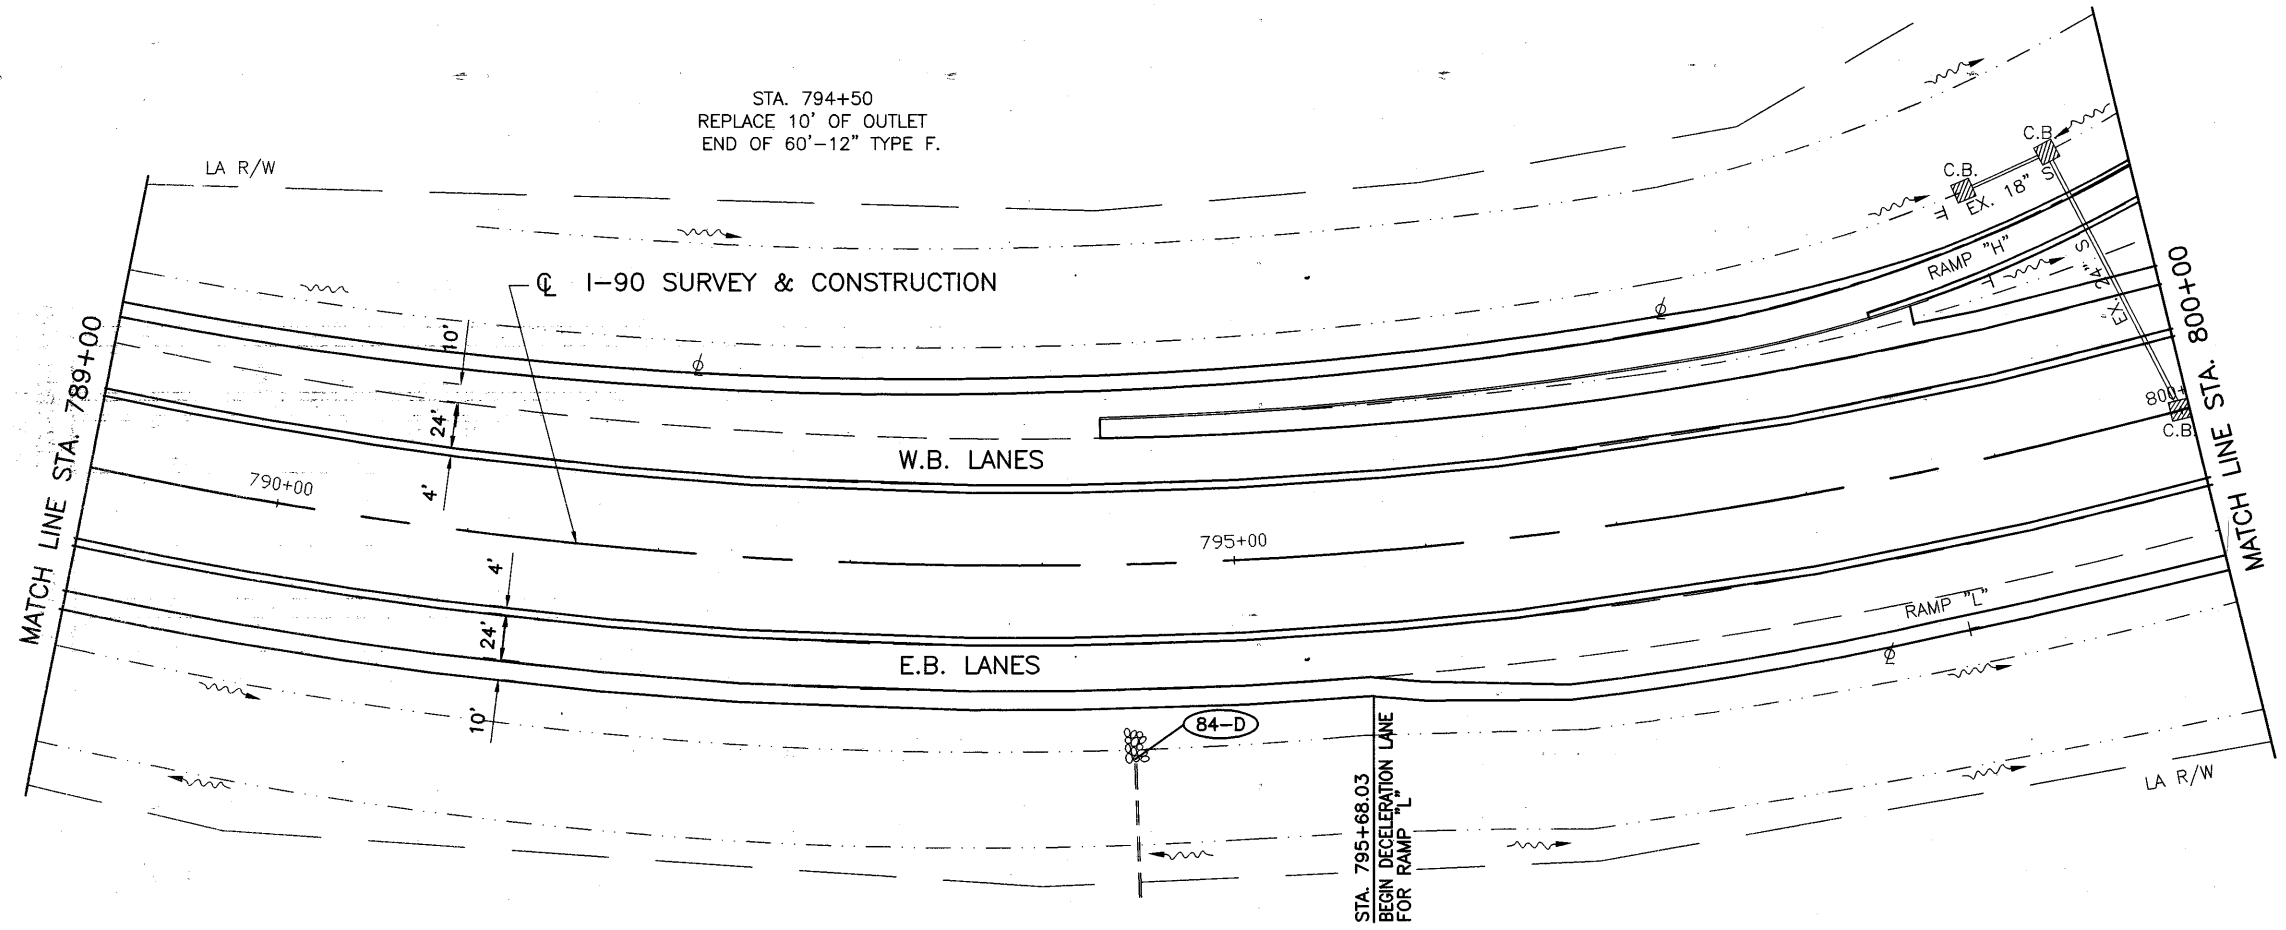

CALCULATED	0
DLS	50'
CHECKED	100
LAB	HORIZONTAL SCALE IN FEET

PLAN  
 STA. 789+00 TO STA. 811+00

LOR - 190 - 10.76

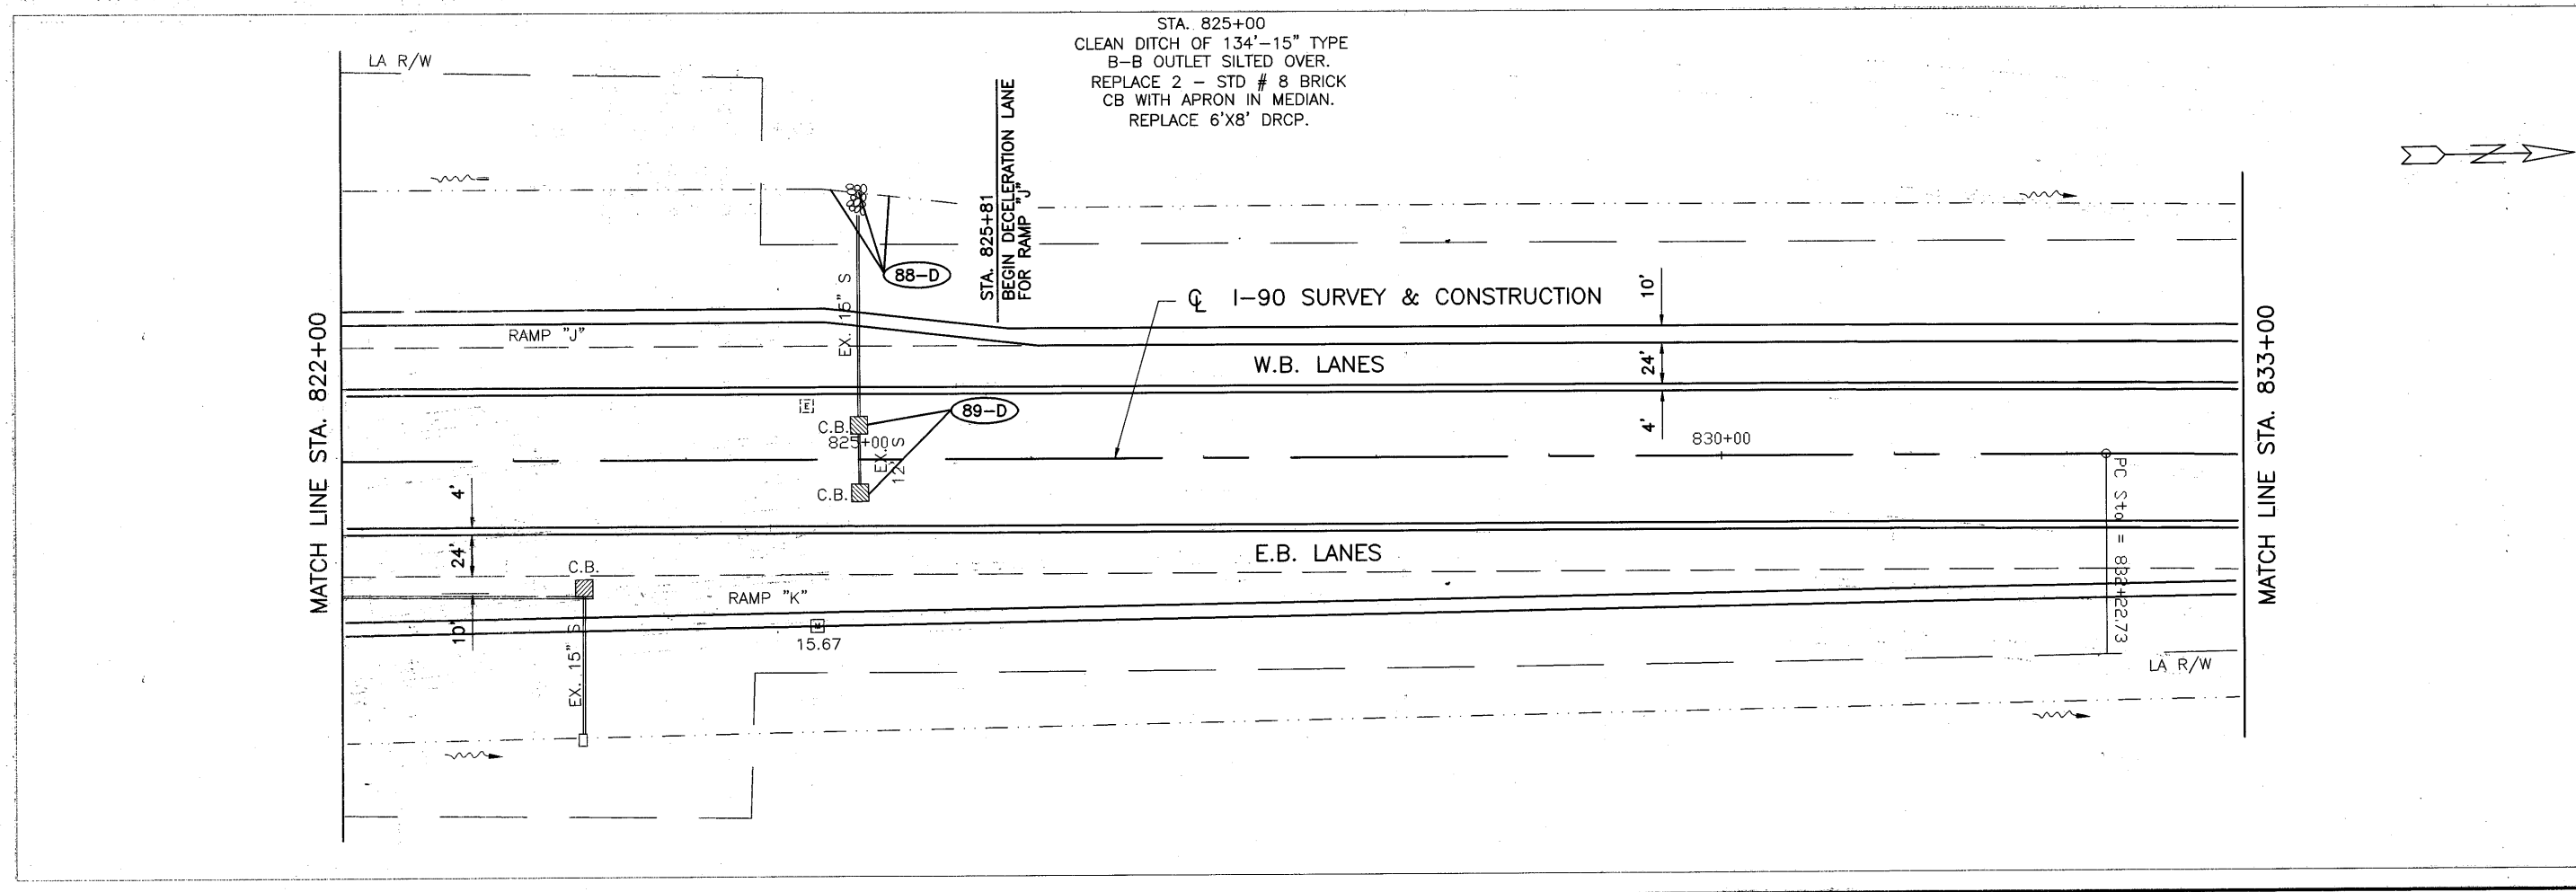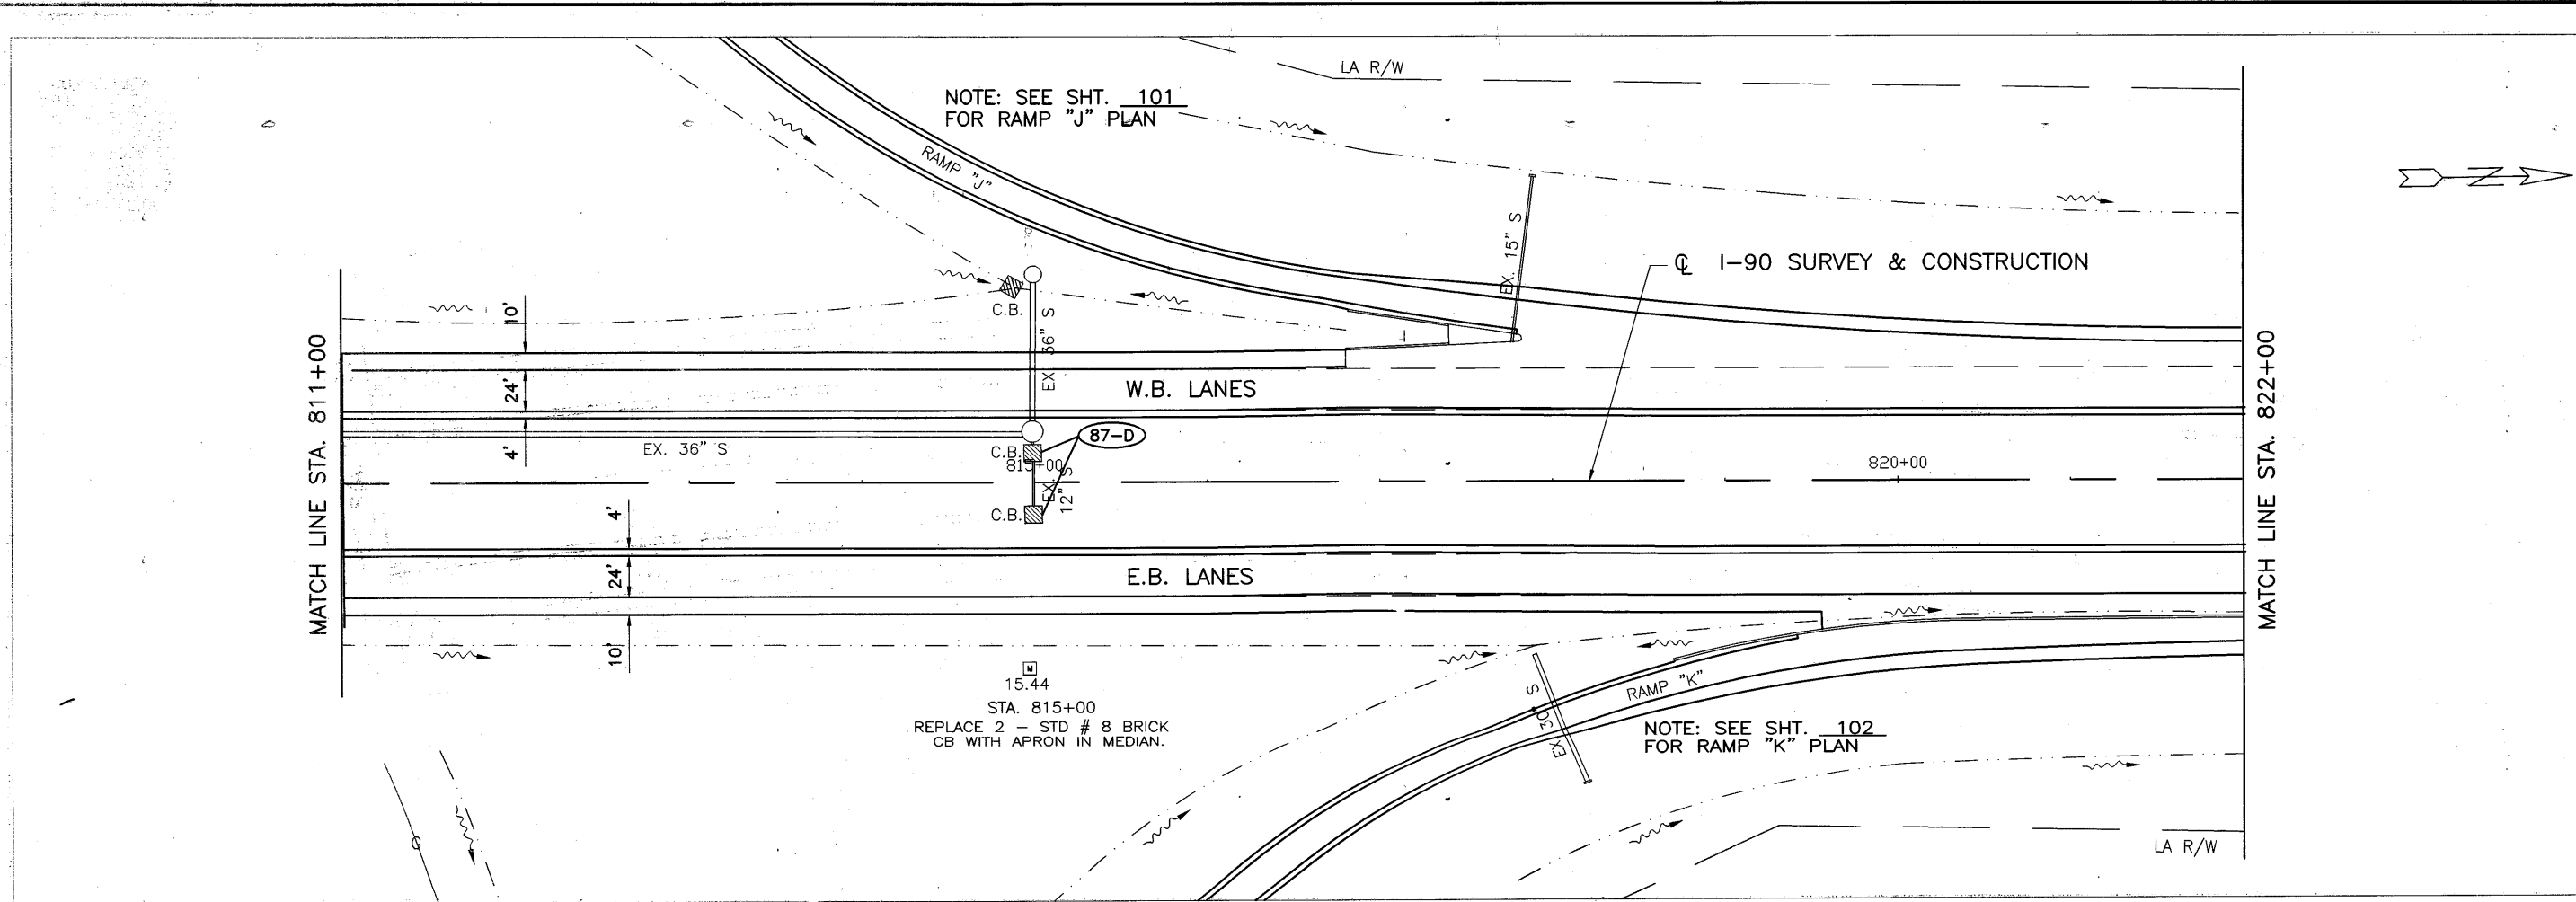

CALCULATED	0	50'	100'
DLS			
CHECKED			
LAB			


HORIZONTAL SCALE IN FEET

PLAN



STA. 811+00 TO STA. 833+00

CURVE DATA 16  
 P.I. STA. 842+77.91  
 $\Delta = 30^{\circ}15'50''$   
 $D = 1'28'00''$   
 $R = 3906.53'$   
 $T = 1055.18'$   
 $L = 2061.17'$   
 $E = 140.00'$

STA. 836+00  
 REPLACE 2 STD # 8 BRICK  
 CB IN MEDIAN. REPLACE  
 6'X8' DRCP. CLEAN DITCH  
 OF 124'-15" TYPE B-B,  
 DITCH FULL OF WATER/SILTED.

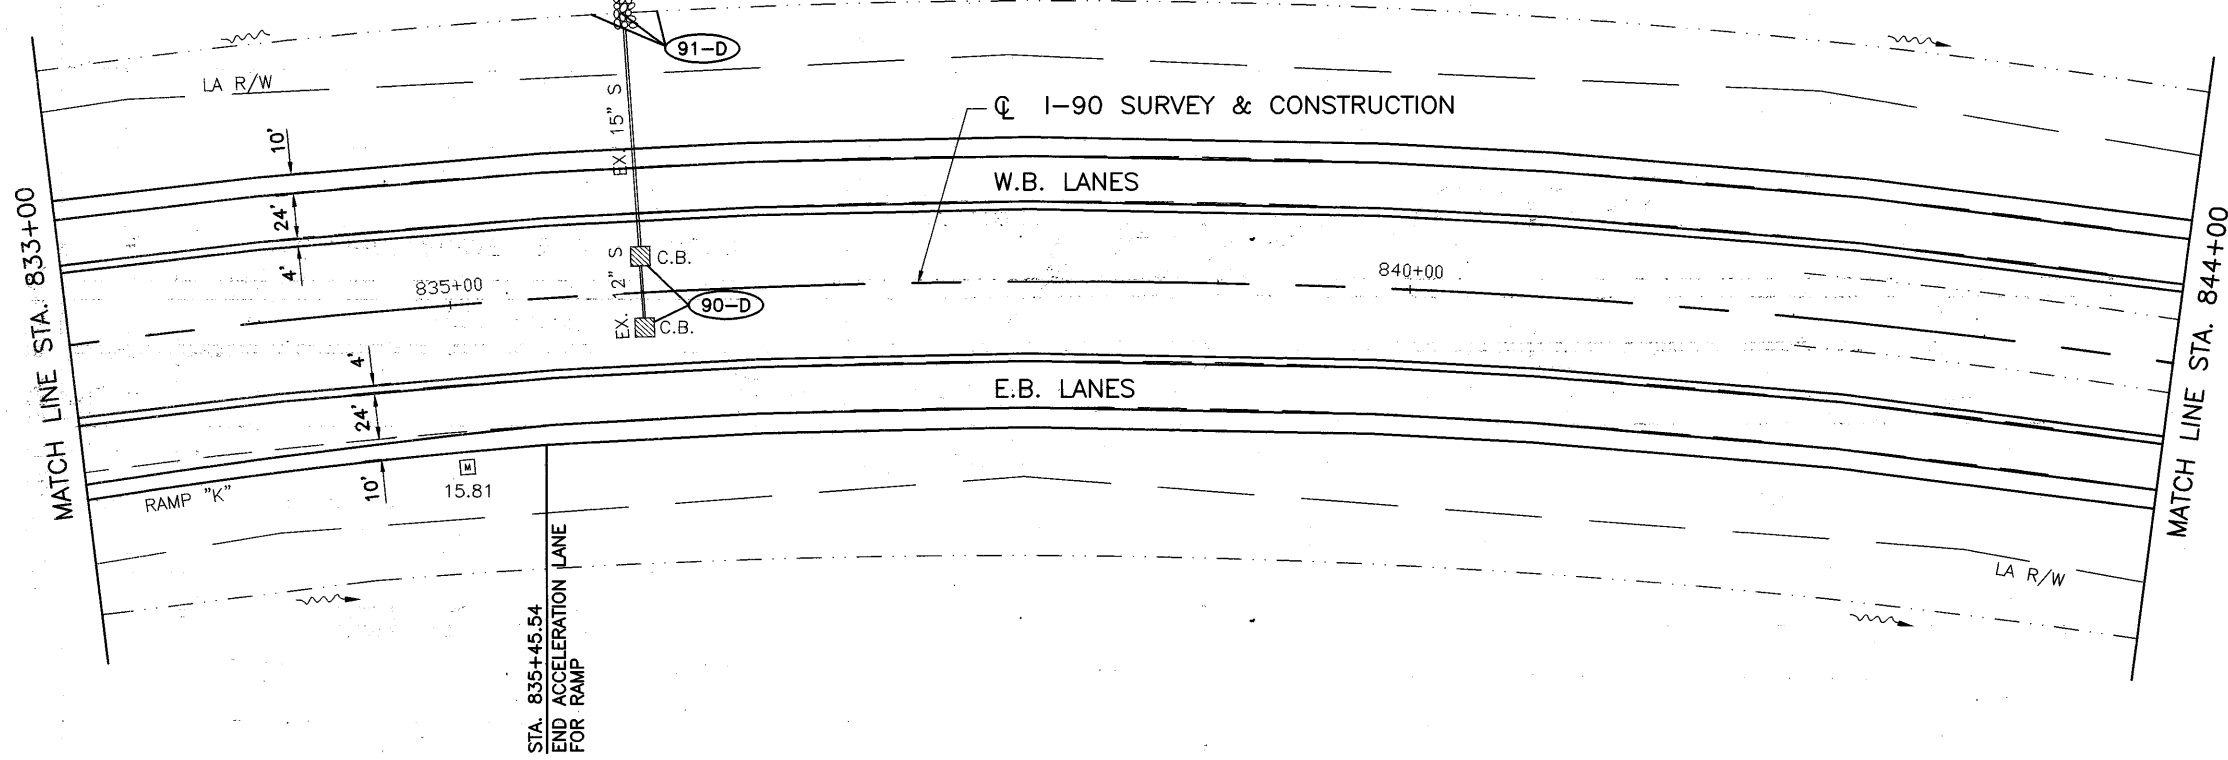

STA. 845+75-846+25  
 ESTABLISH POSITIVE DRAINAGE  
 FLOW FOR 54'-12"  
 TYPE B-B AND 2 - STD # 4 CB'S.  
 STA. 845+75  
 CLEAN PIPE OF 143'-15" TYPE B-B.  
 REPLACE 8'X6' DRCP.

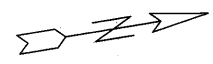
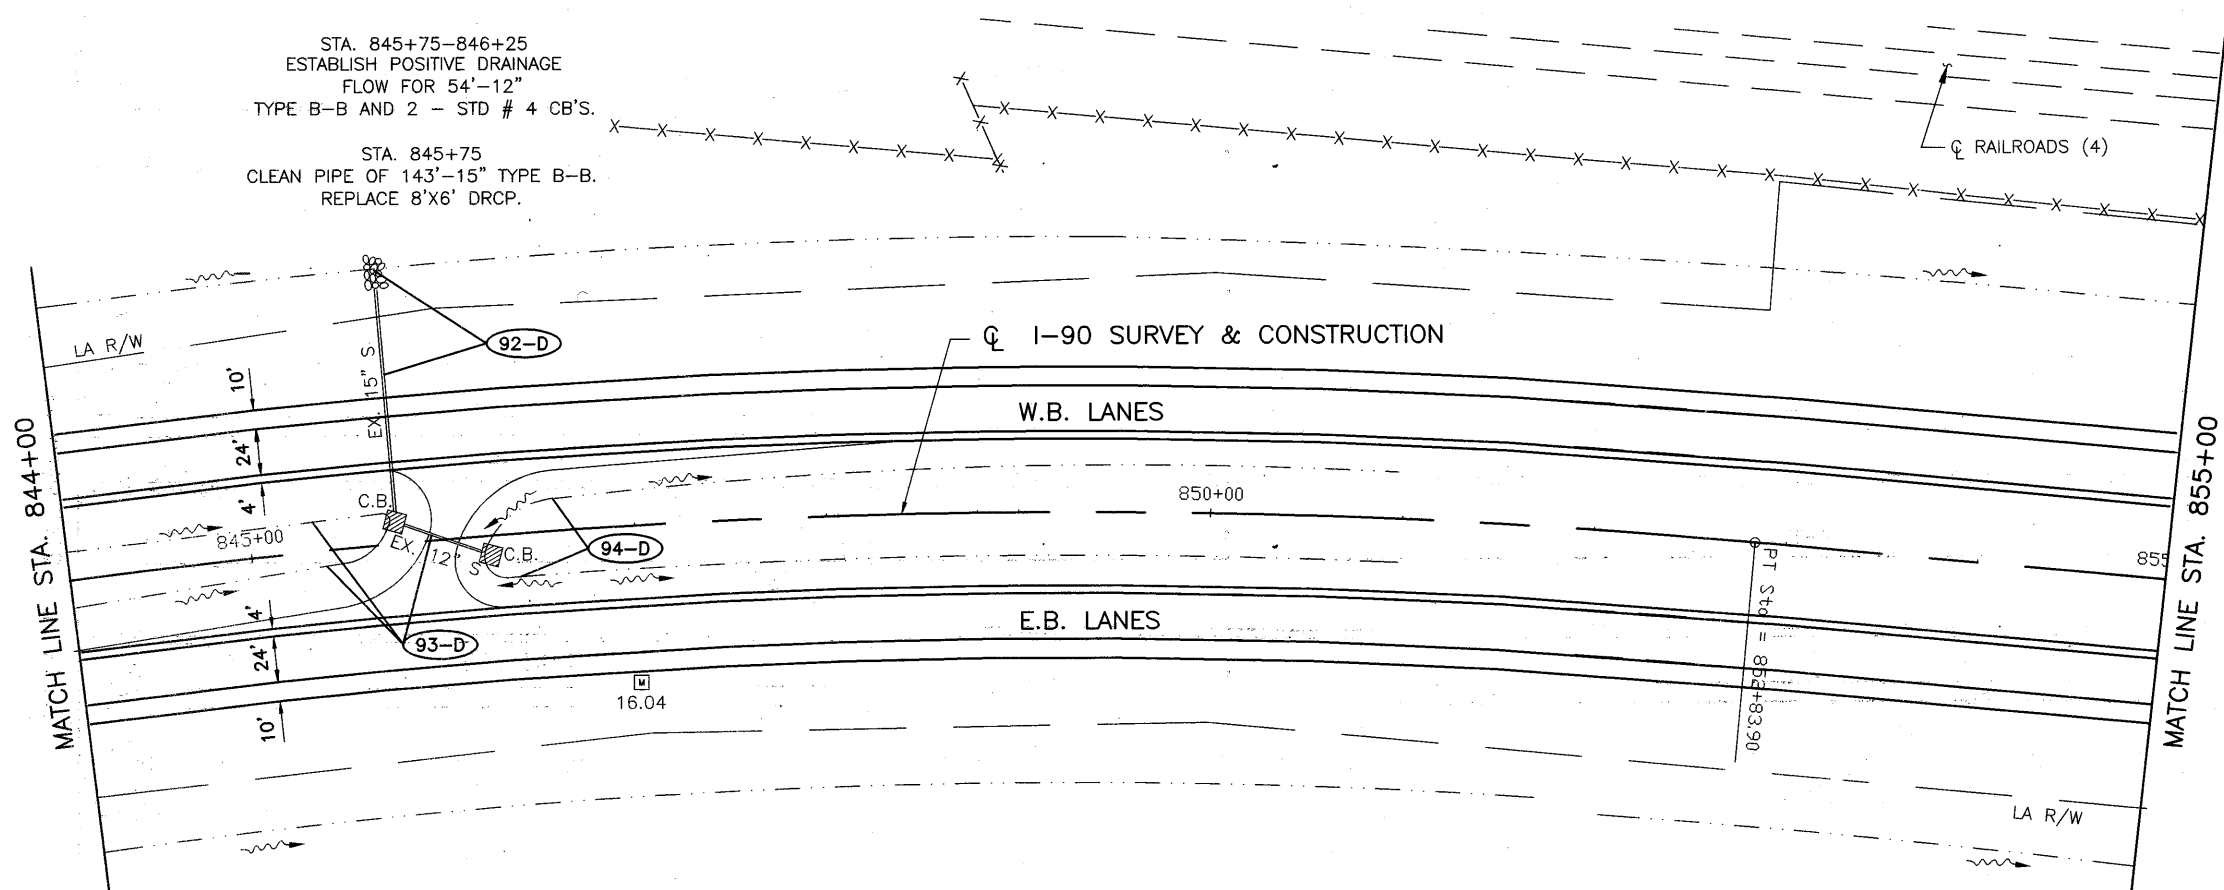


CALCULATED	0
DLS	0
CHECKED	0
LAB	0


0 50' 100'  
 HORIZONTAL  
 SCALE IN FEET

PLAN  
 STA. 833+00 TO STA. 855+00

LOR - I90 - 10.76

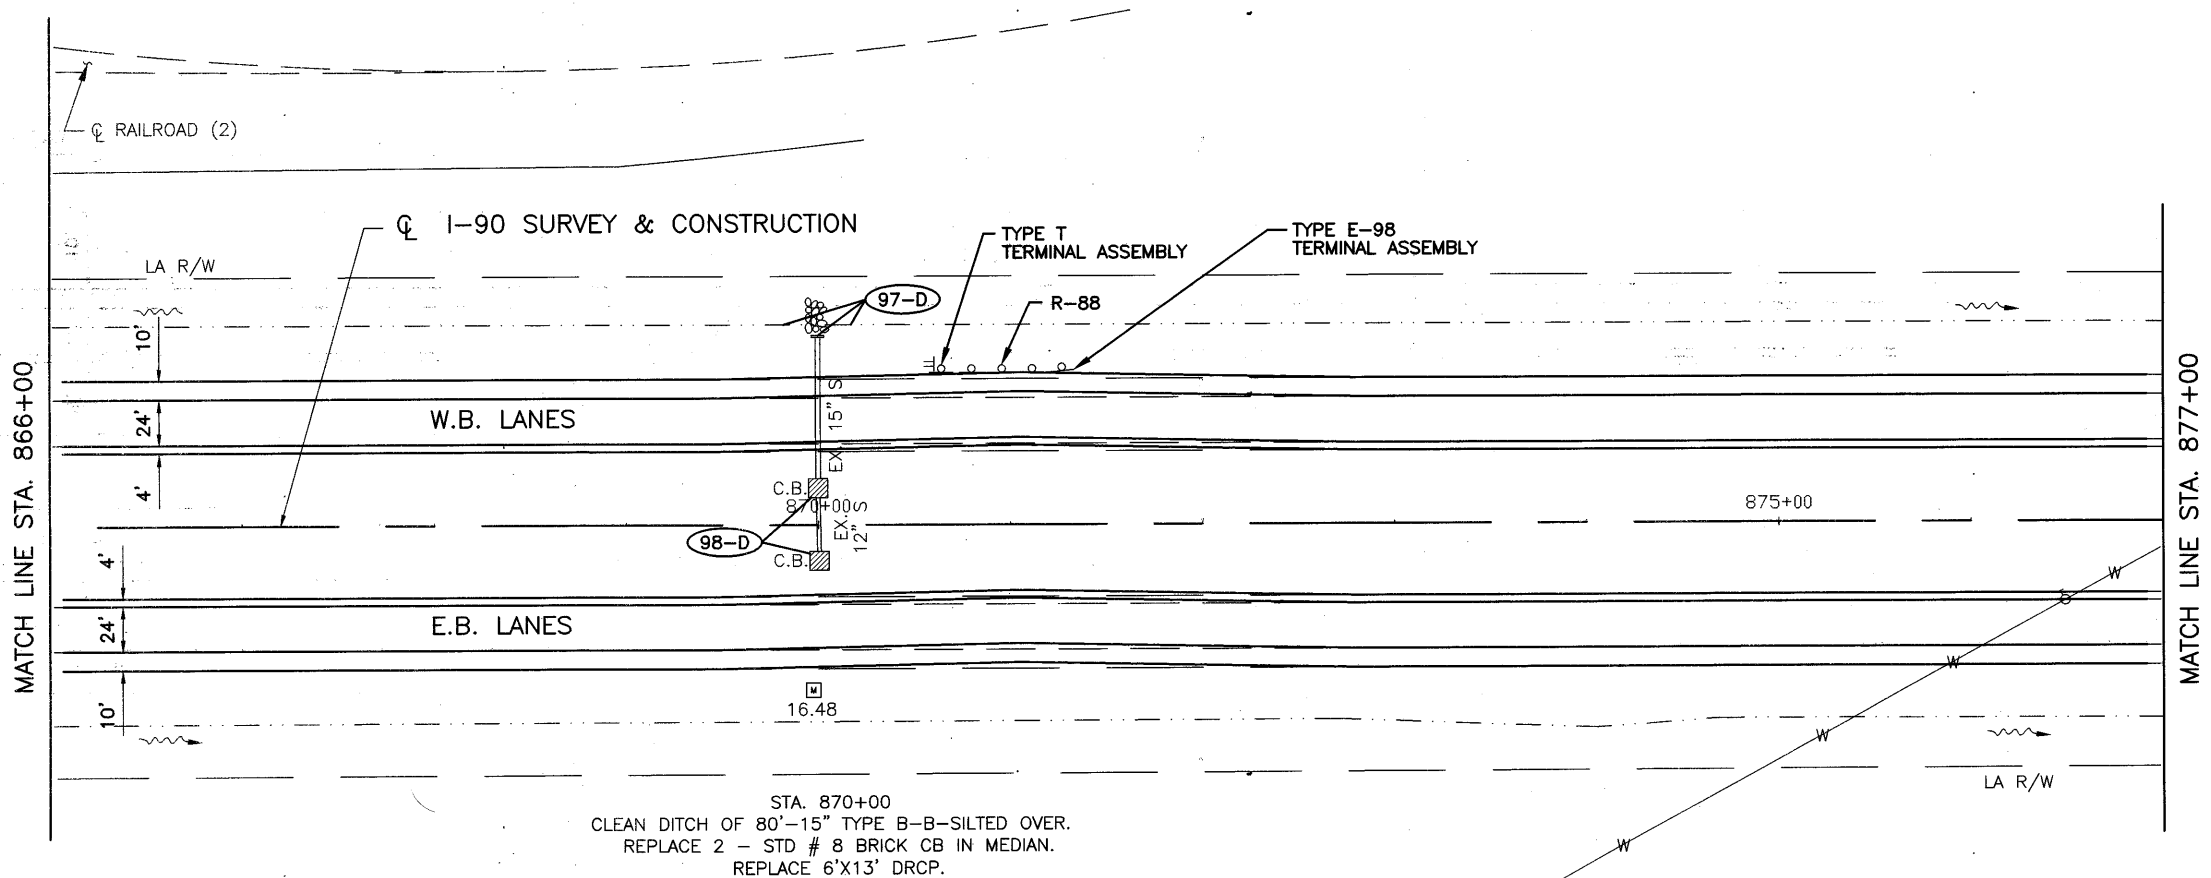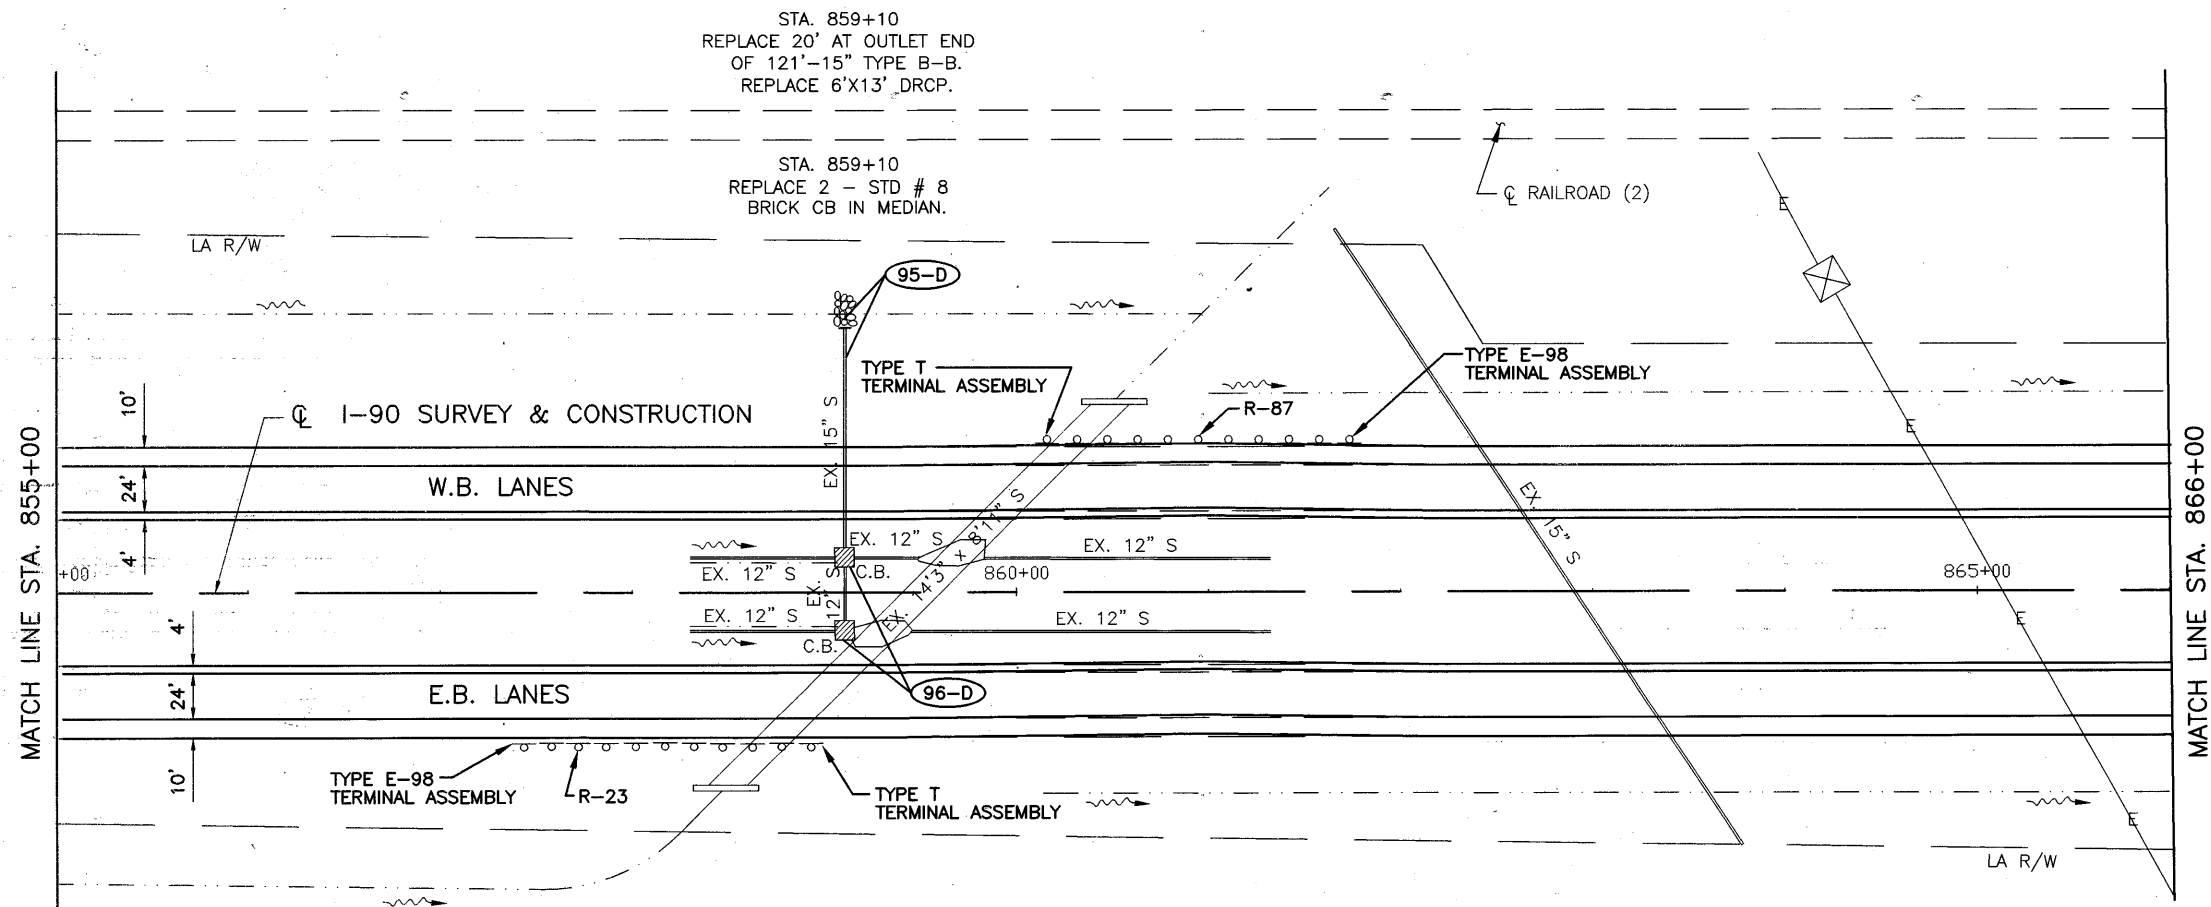



CALCULATED	DLS	CHECKED	LAB

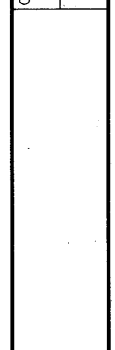


PLAN

STA. 855+00 TO STA. 877+00

LOR - 190 - 10.76

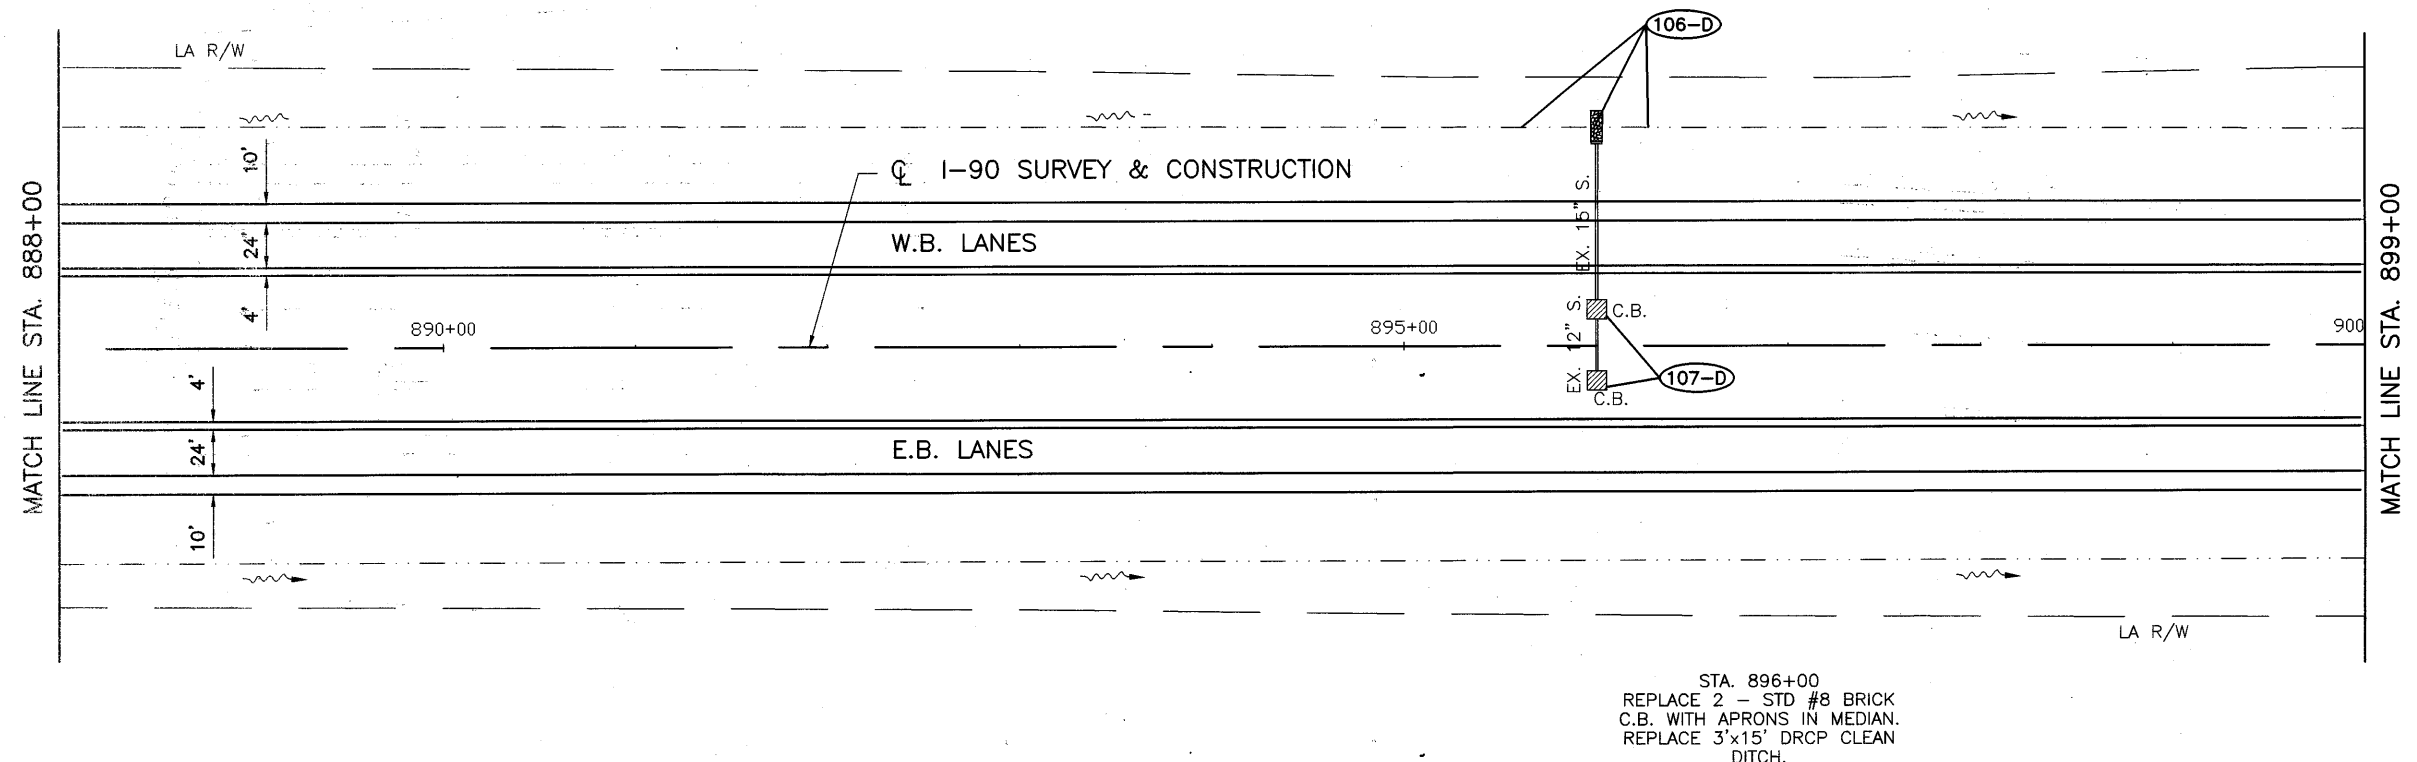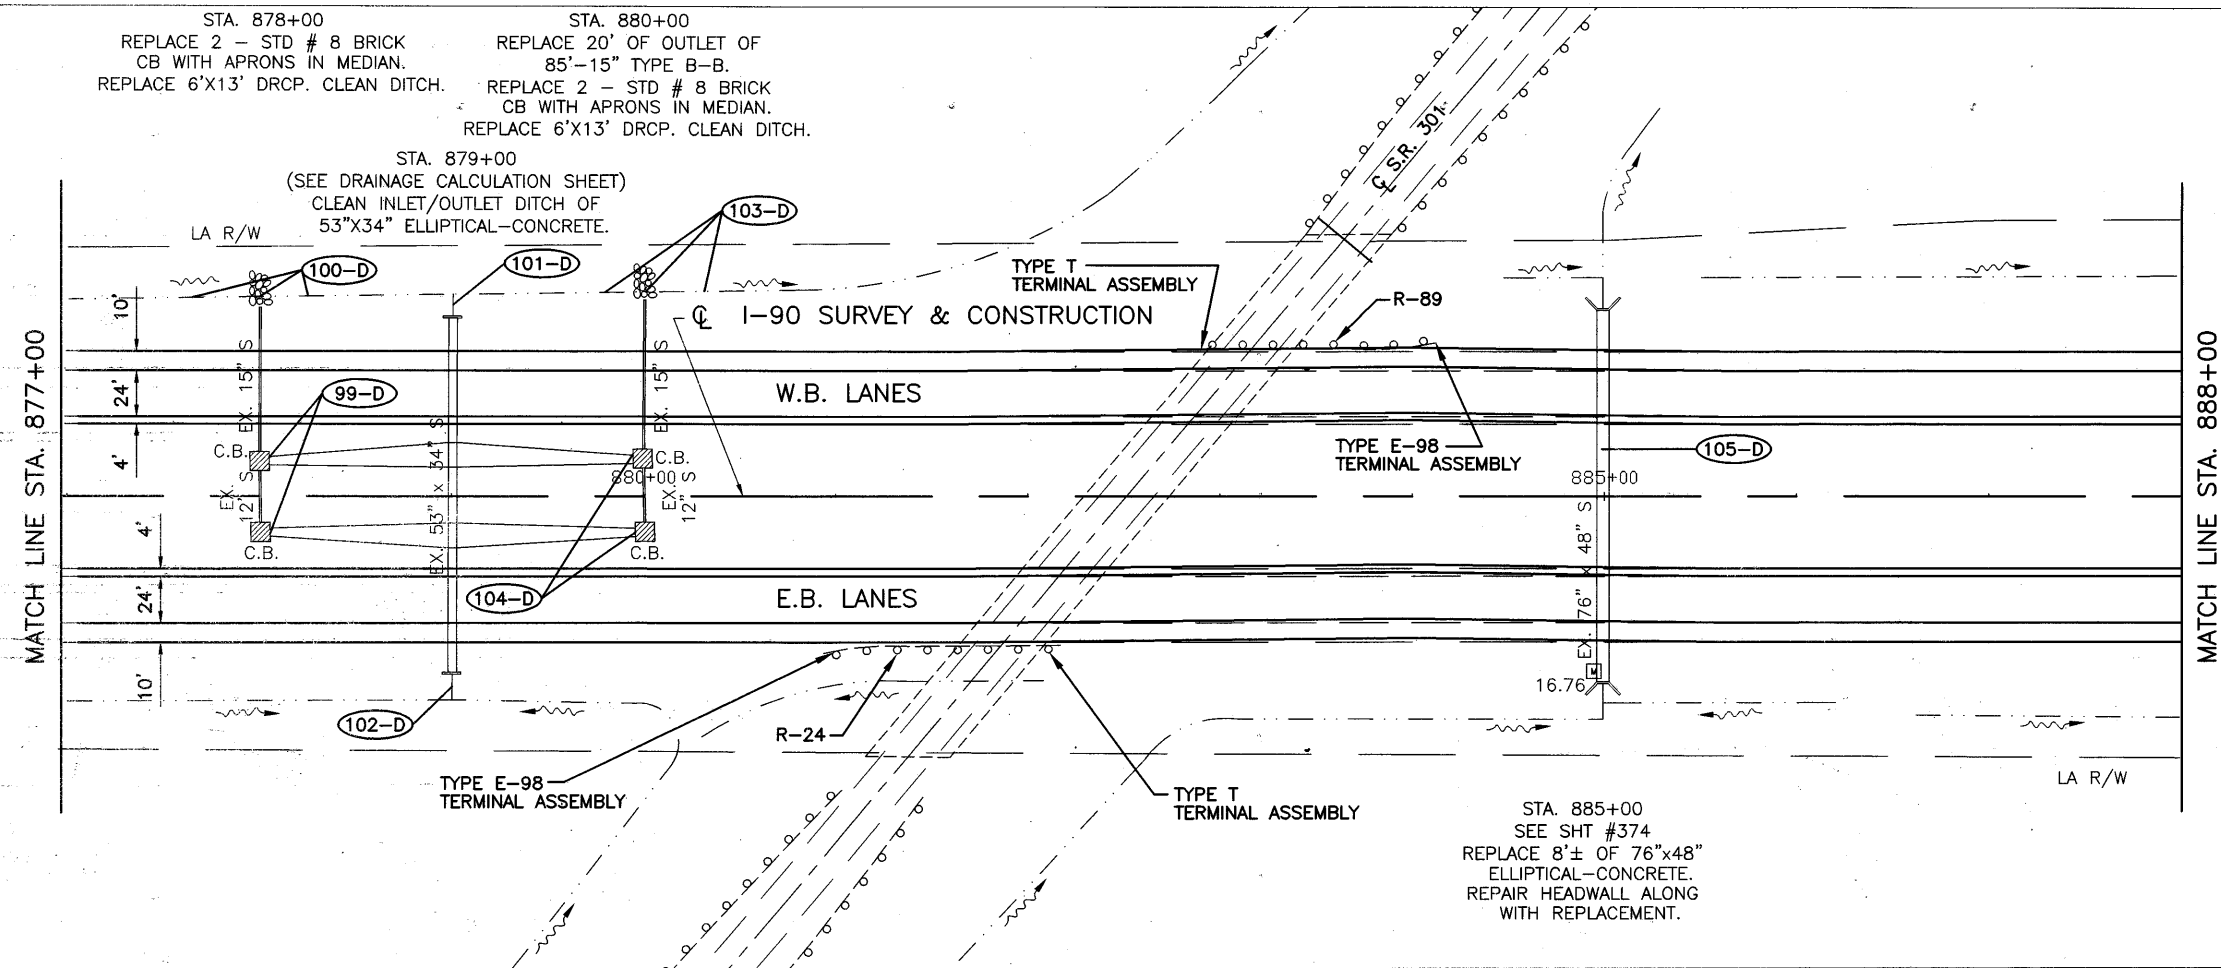

CALCULATED	DLS	CHECKED	LAB

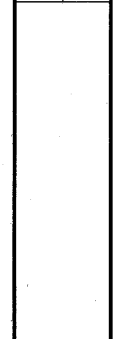



PLAN  
STA. 877+00 TO STA. 899+00

LOR - I90 - 10.76

C:\p1\2005\DWG\1076\1076-10.76.dwg | 02  
 12-12-2005 8:41AM

STA. 902+90 - 903+28  
 REPLACE 1 - STD #8 BRICK  
 C.B. IN MEDIAN.

STA. 903+28  
 REPLACE 1 - STD #8 BRICK  
 C.B. IN MEDIAN.

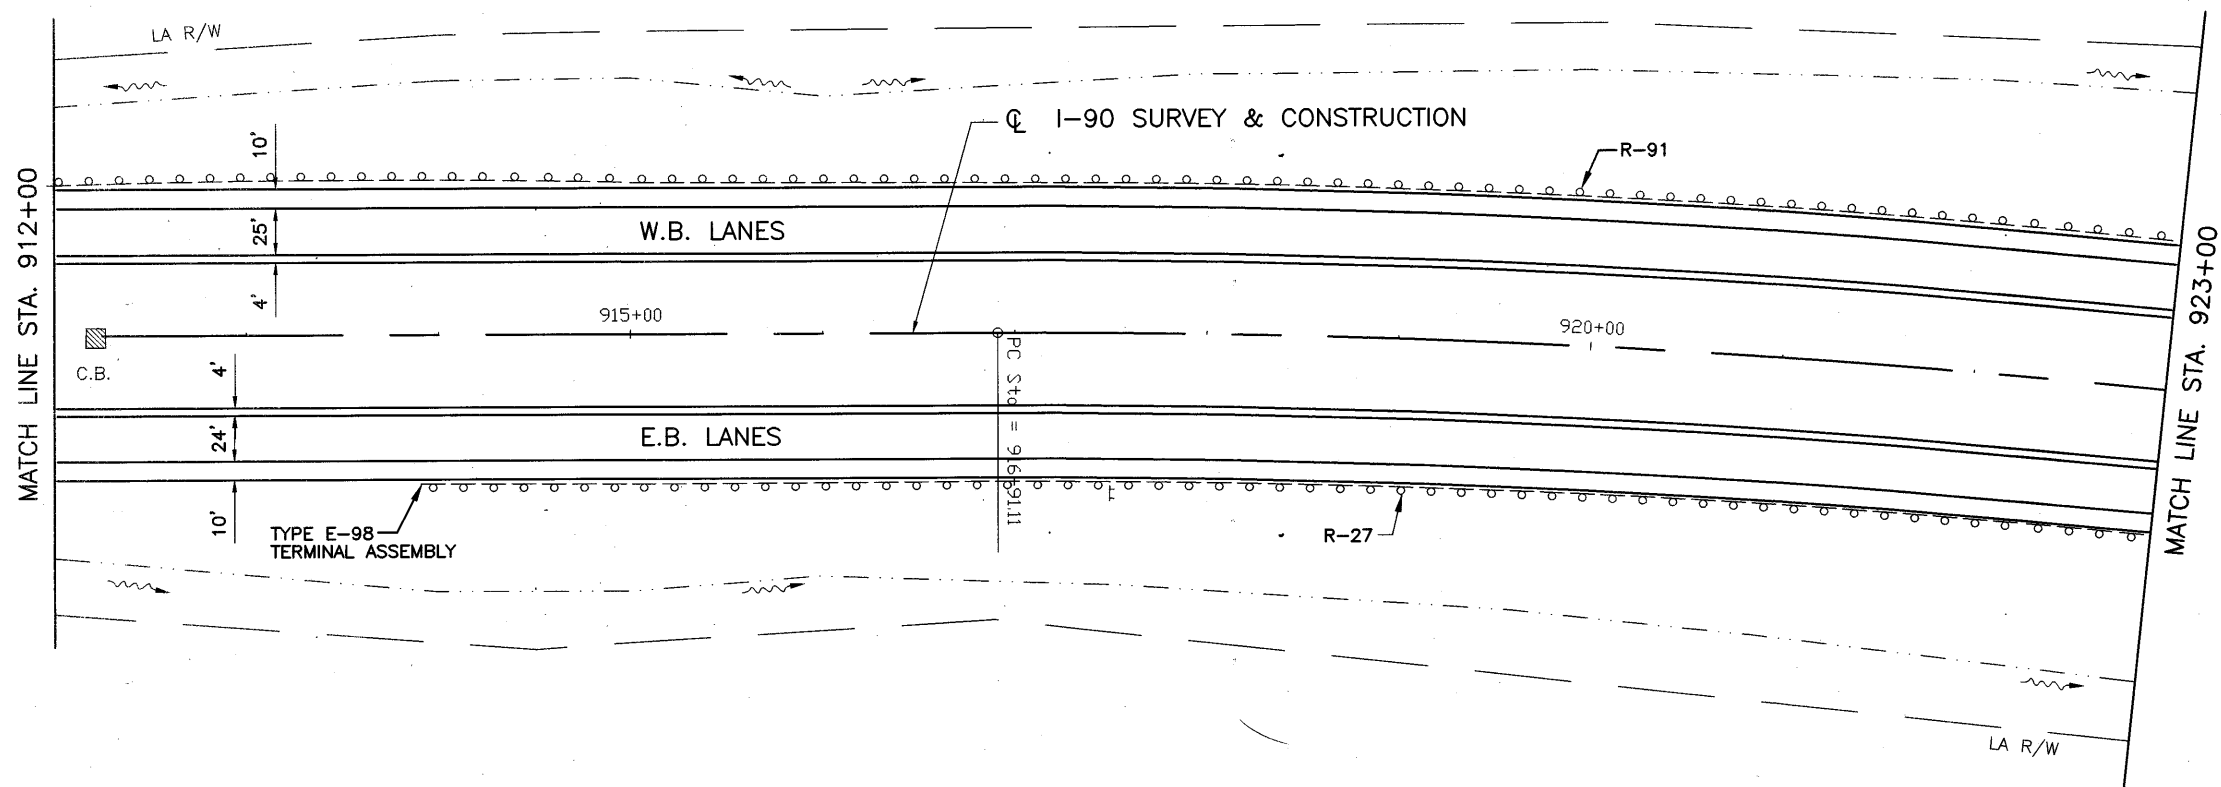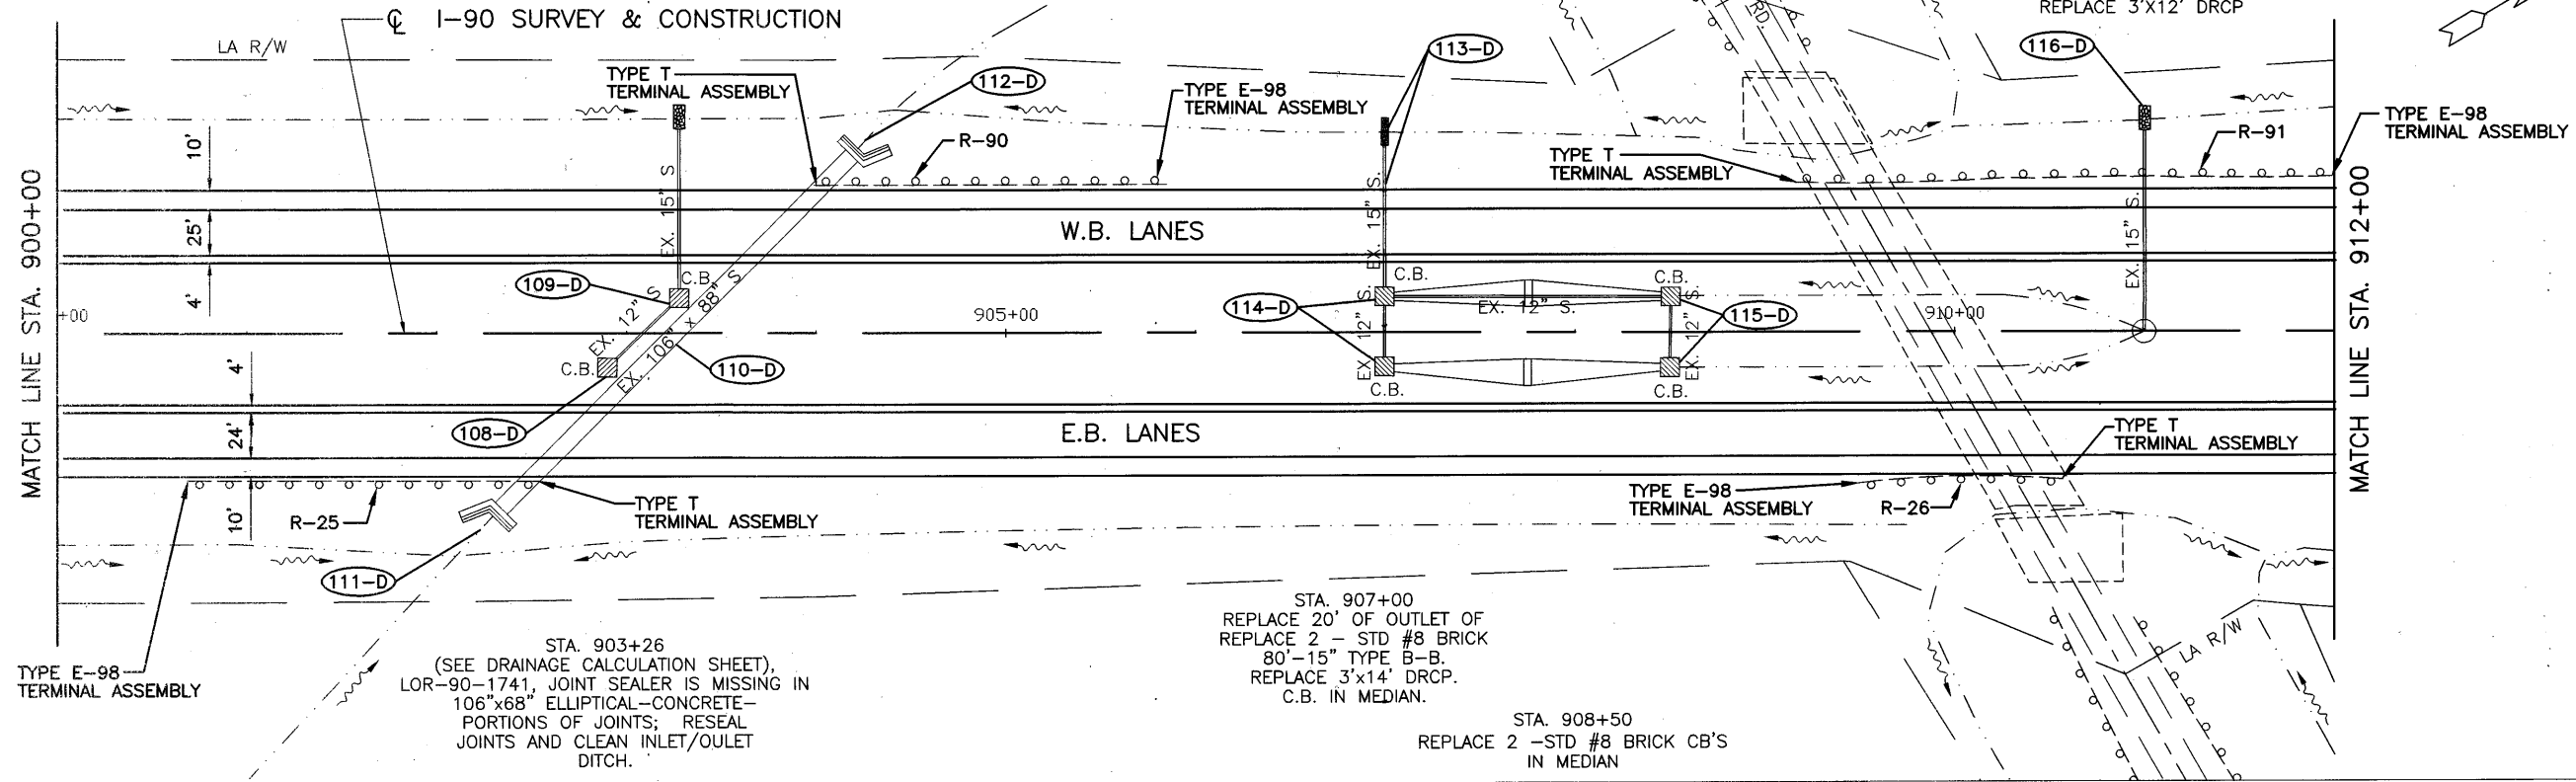


CALCULATED	DLS	CHECKED	LAB

100  
 50  
 0  
 HORIZONTAL  
 SCALE IN FEET


PLAN  
 STA. 885+00 TO STA. 904+00

LOR - 190 - 10.76

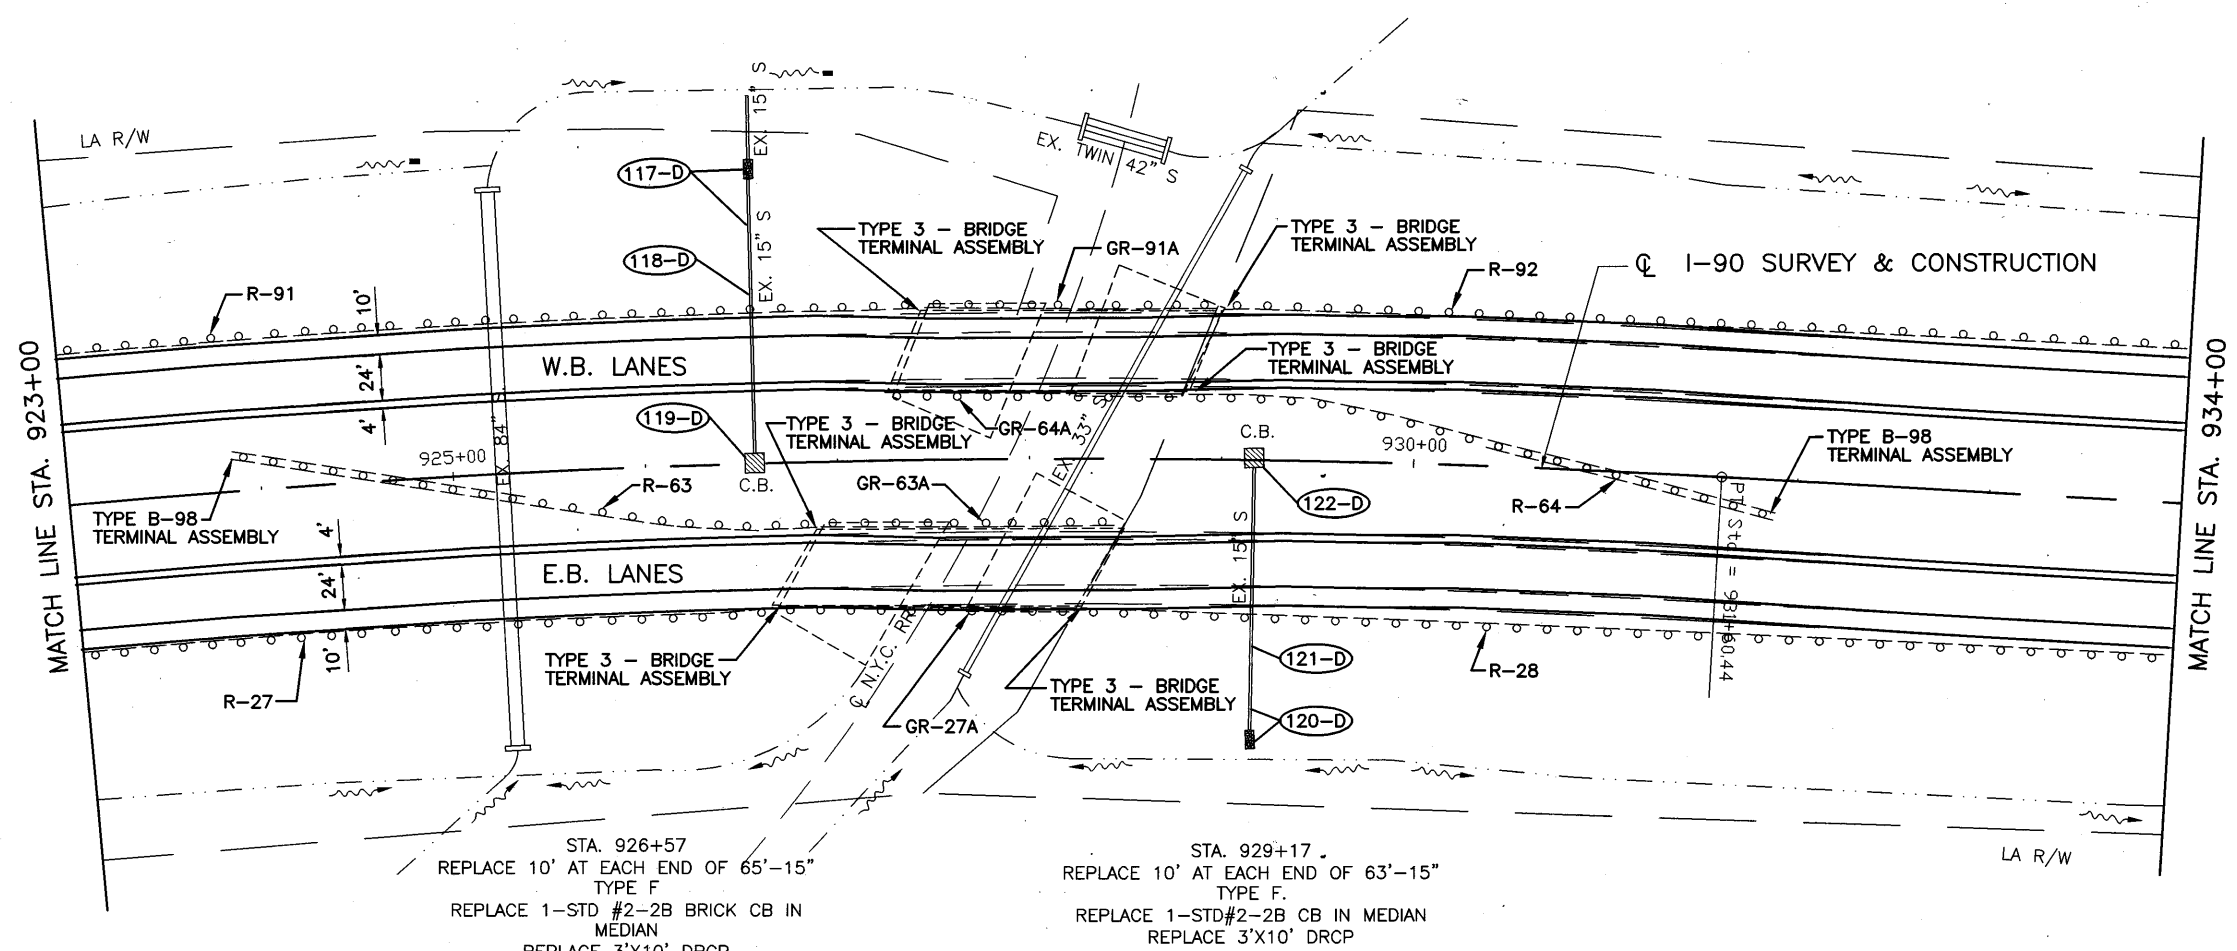

STA. 926+57  
 REPLACE 10' AT EACH END OF 65'-15"  
 TYPE F  
 REPLACE 1-STD #2-2B BRICK CB IN  
 MEDIAN  
 REPLACE 3'X10' DRCP

STA. 929+17  
 REPLACE 10' AT EACH END OF 63'-15"  
 TYPE F  
 REPLACE 1-STD #2-2B CB IN MEDIAN  
 REPLACE 3'X10' DRCP

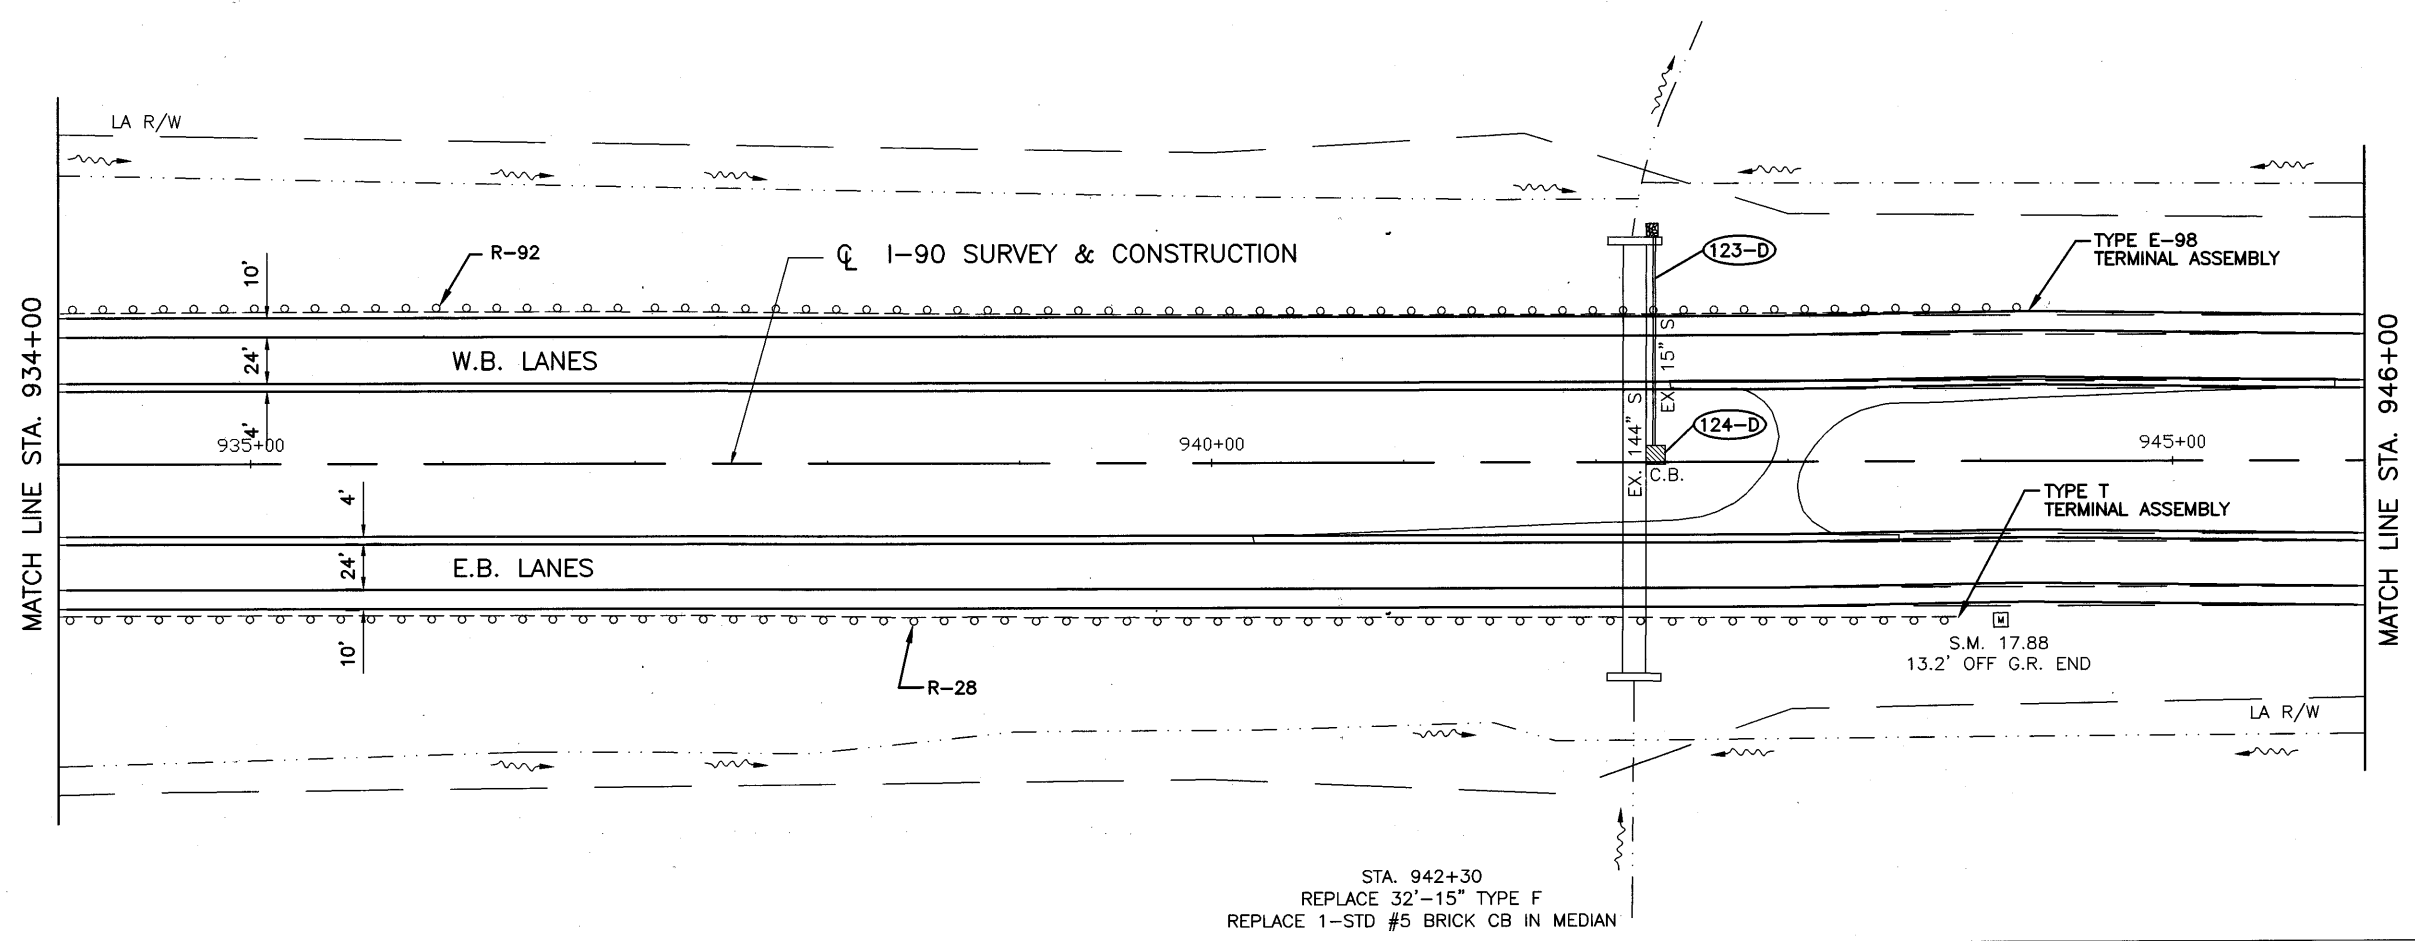

STA. 942+30  
 REPLACE 32'-15" TYPE F  
 REPLACE 1-STD #5 BRICK CB IN MEDIAN

CALCULATED  
 DLS  
 CHECKED  
 LAB



100  
 50  
 0  
 HORIZONTAL  
 SCALE IN FEET

PLAN  
 STA. 904+00 TO STA. 926+00


LOR - I90 - 10.76

87  
 274

D:\95800\DWG\33500\PLN\I-90-10.76.dwg  
 12-2002  
 8:44AM

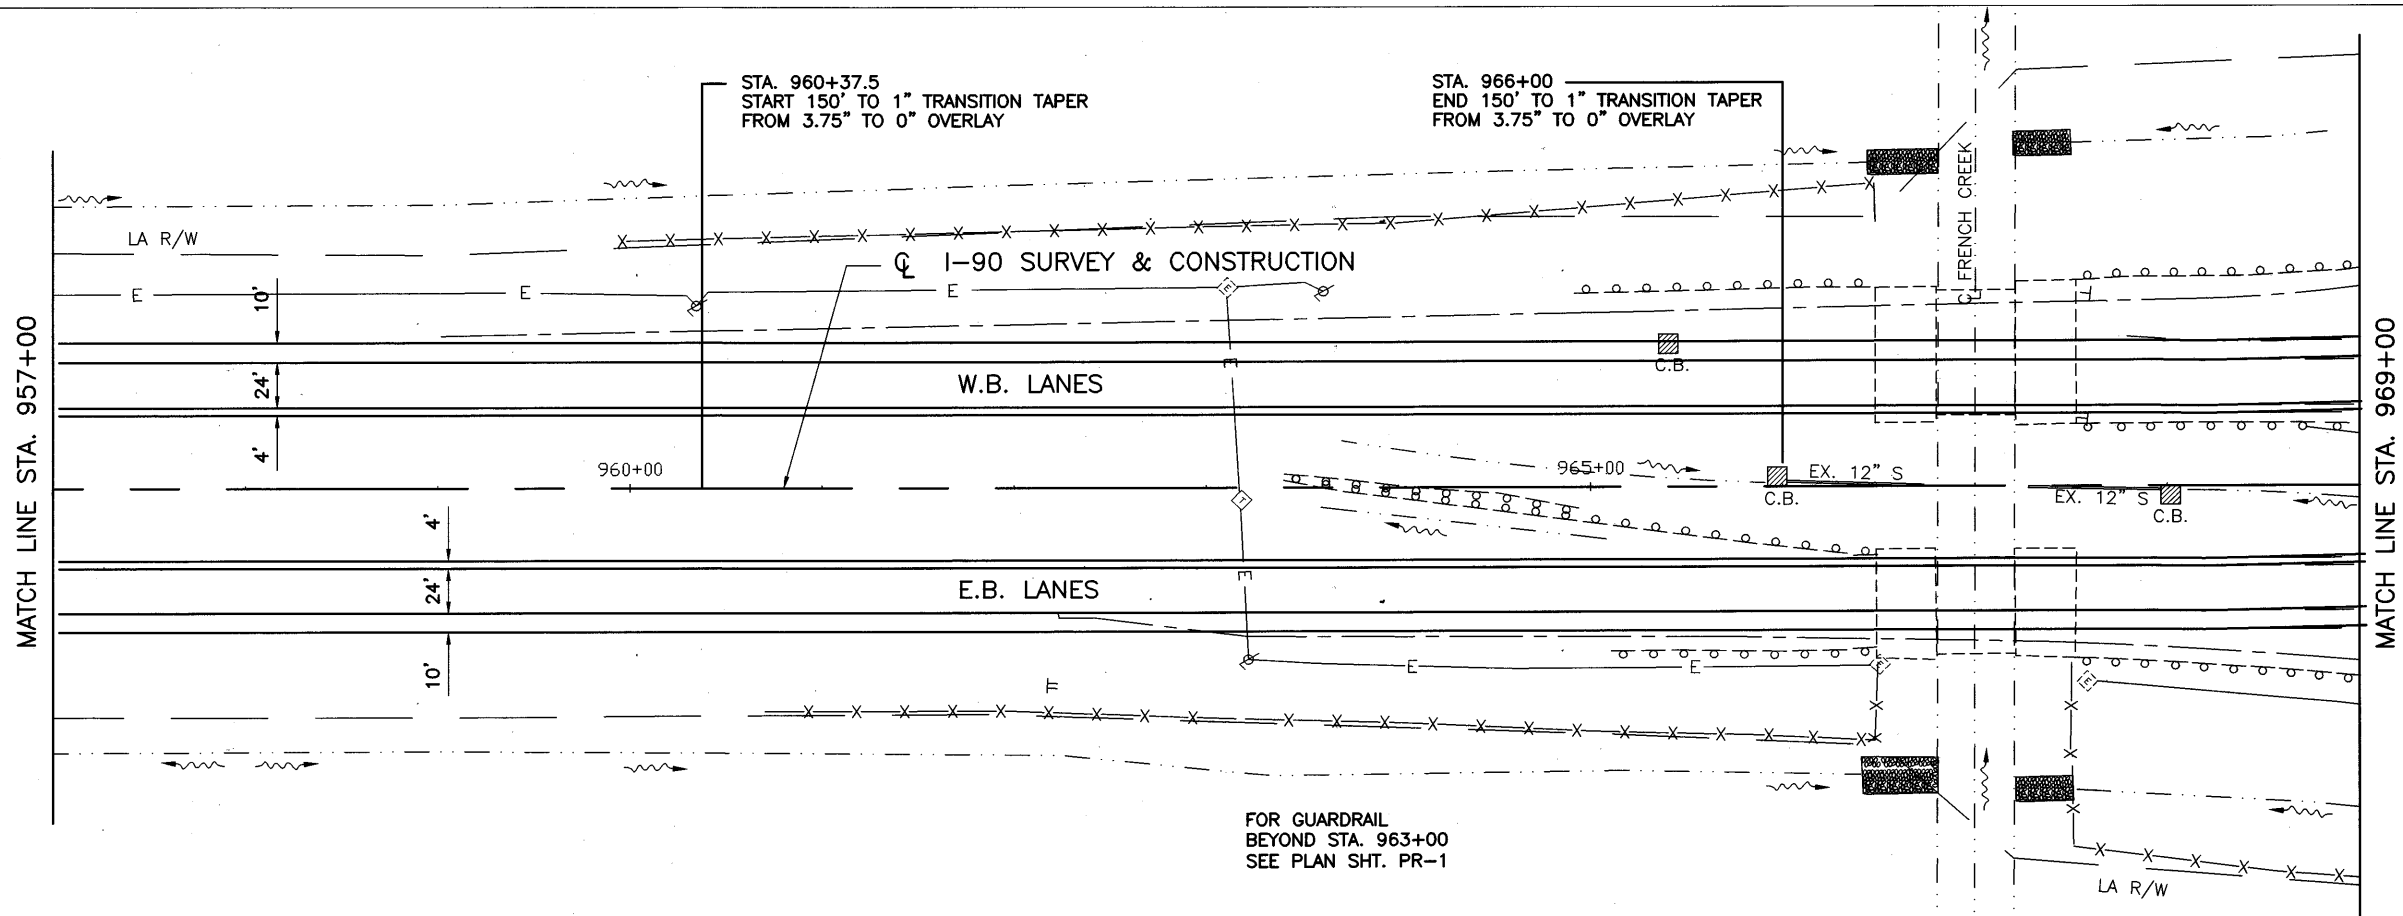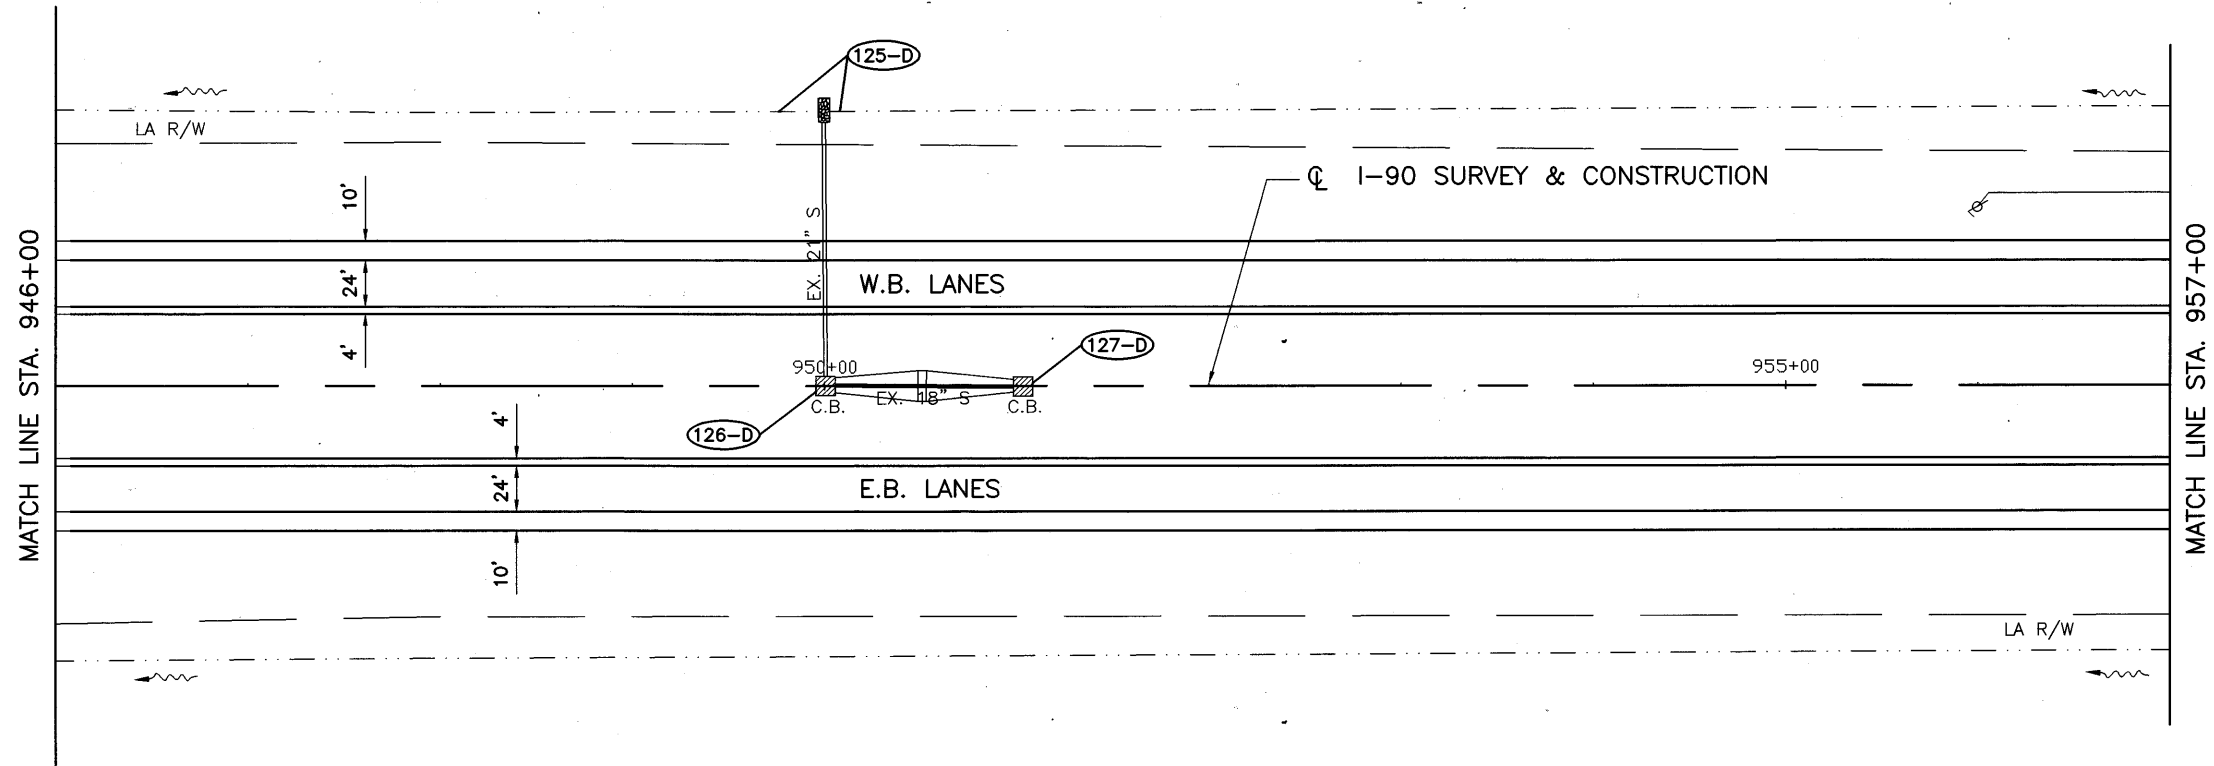

CALCULATED	DLS	CHECKED	LAB

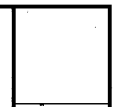

PLAN  
STA. 946+00 TO STA. 969+00

LOR - 190 - 10.76

I:\956001\DWG\956001\956001.P-28.DWG ] 02  
 12-2002 8:56AM




# MIDDLE RIDGE RD. INTERCHANGE

CURVE DATA RAMP "H"  
 P.I. STA. H43+50.70  
 $\Delta = 42^{\circ}00'$   
 $D_c = 8^{\circ}00'$   
 $R = 716.20'$   
 $L_c = 325.0'$   
 $L_s = 200'$   
 $T_s = 375.75'$   
 $E_s = 53.4'$   
 $\theta_s = 8^{\circ}00'$   
 $L.T. = 133.47'$   
 $S.T. = 66.79'$   
 $X = 199.61'$   
 $Y = 9.30'$

CURVE DATA RAMP "H"  
 P.I. STA. H37+63.24  
 $\Delta = 61^{\circ}02'04''$   
 $D = 18^{\circ}00'$   
 $R = 318.31'$   
 $L = 339.08'$   
 $T = 187.63'$   
 $E = 51.18'$

SCALE: 1" = 100'-0"

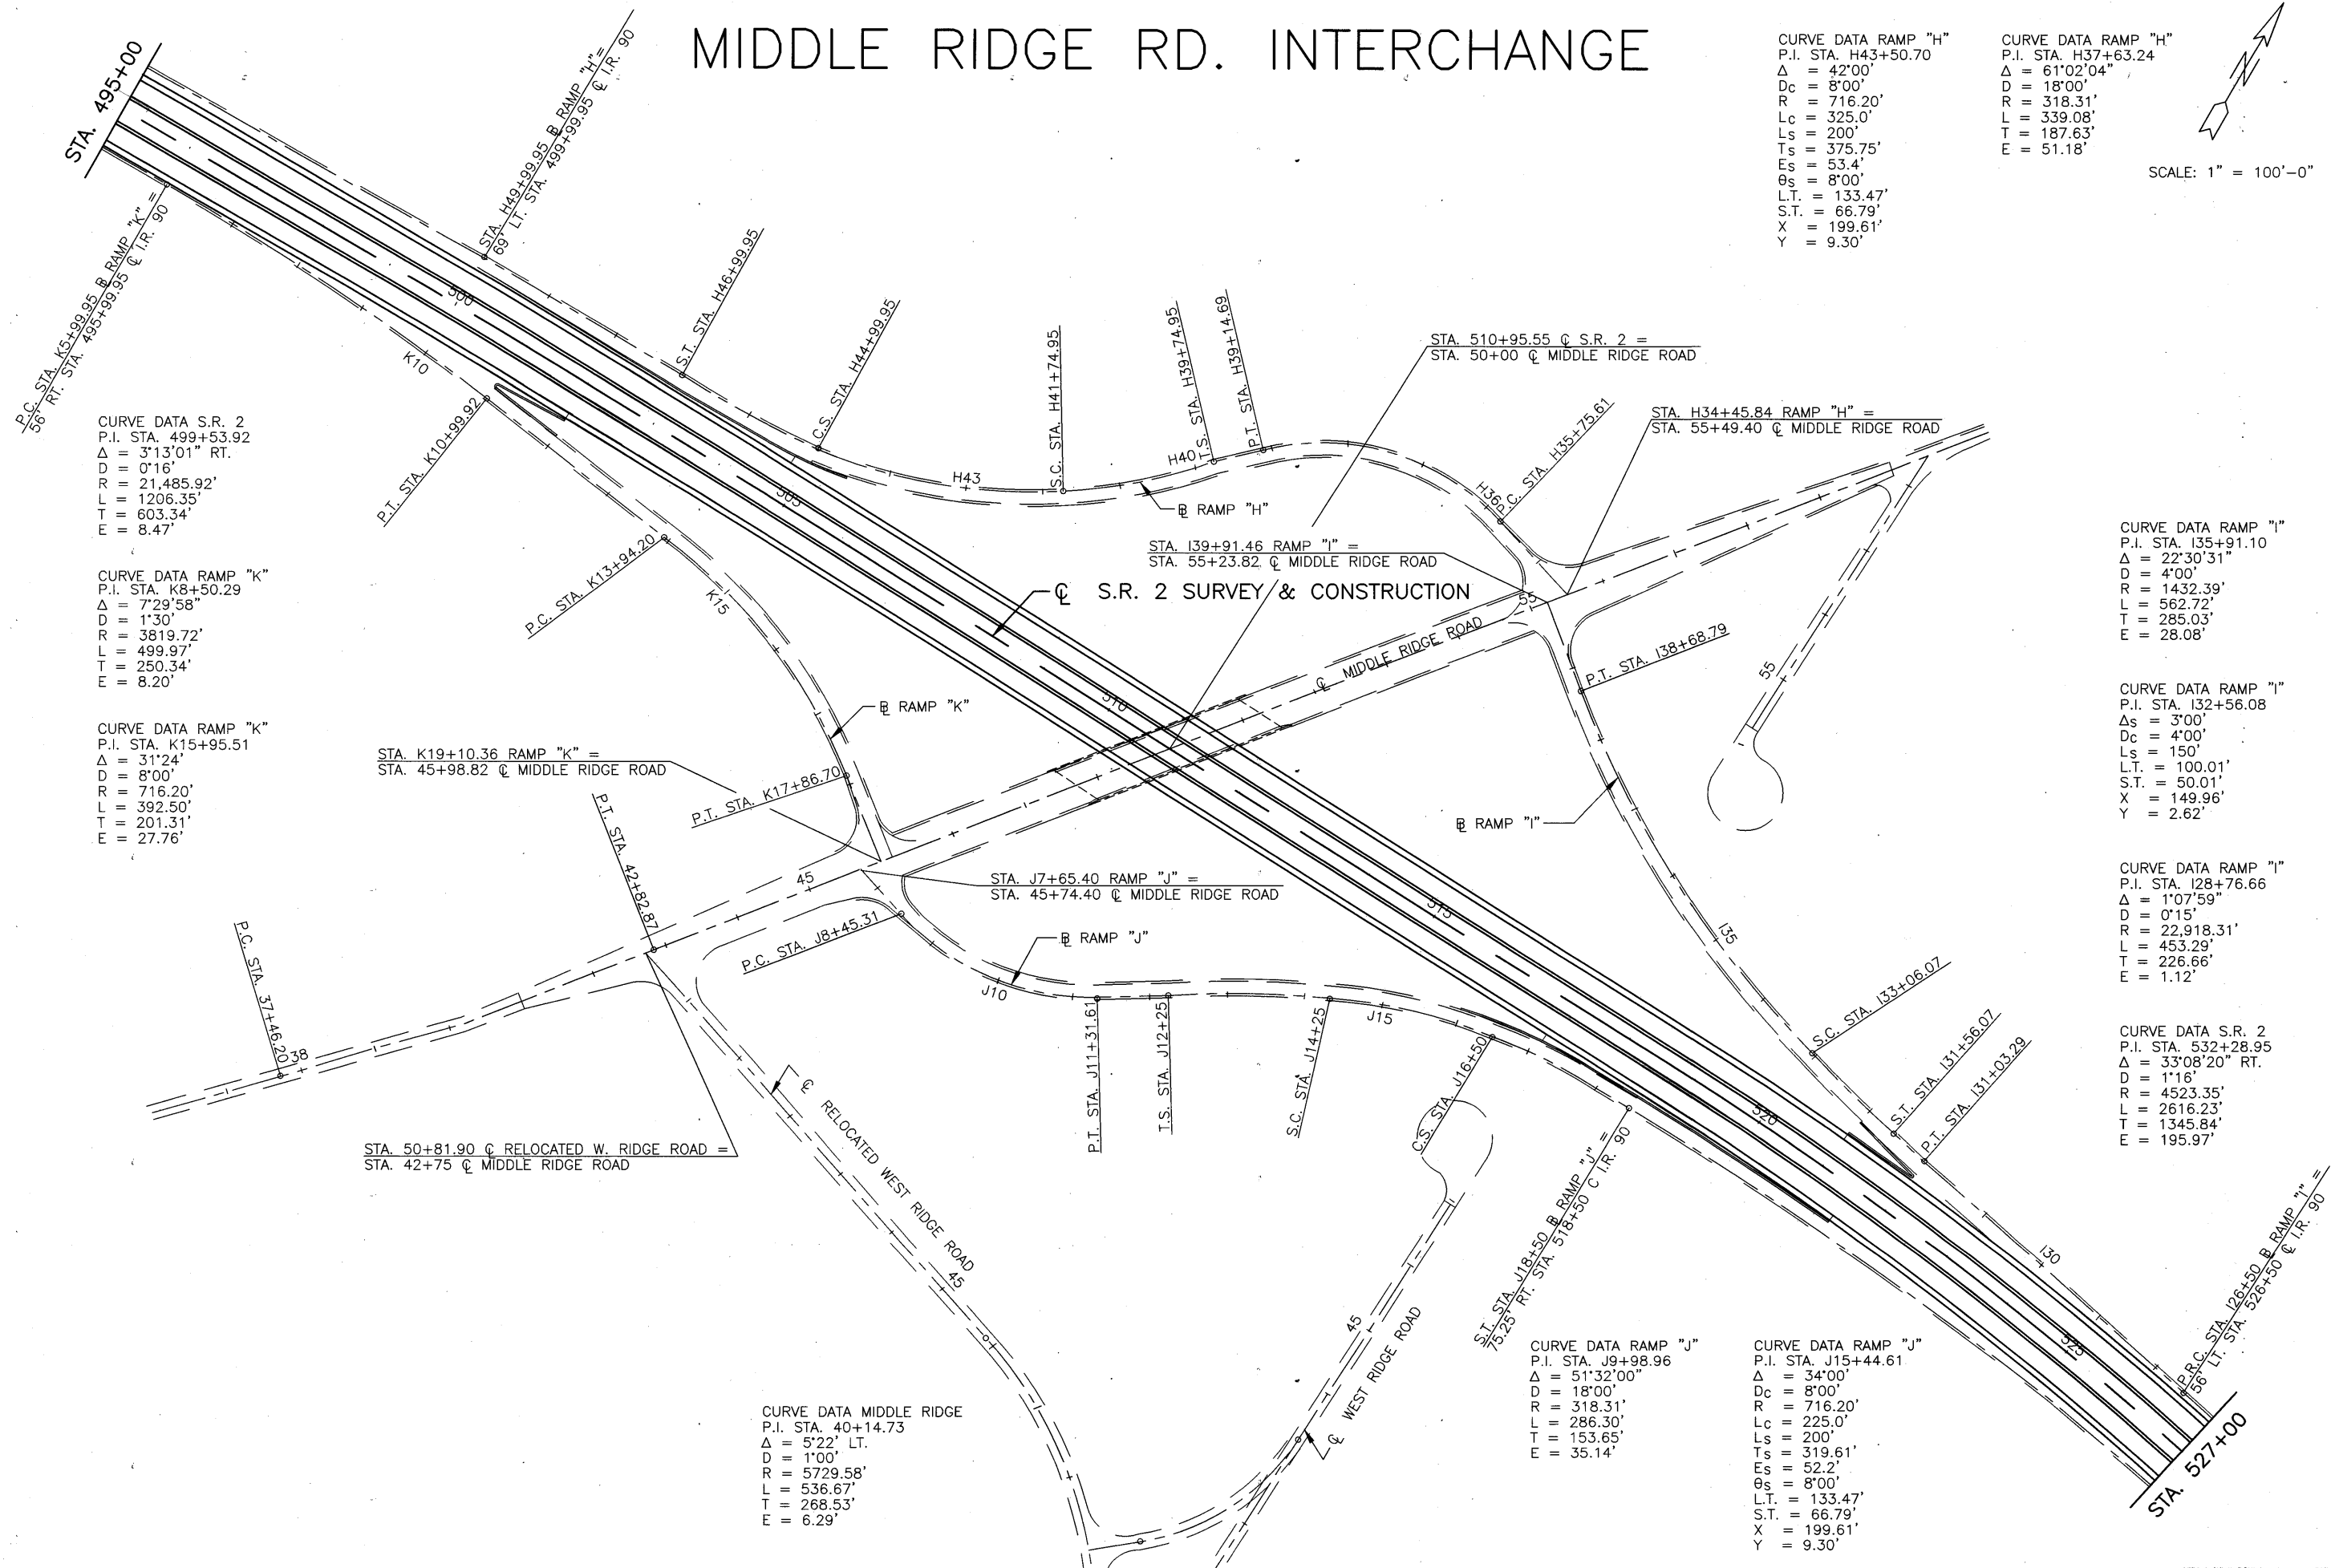

CURVE DATA S.R. 2  
 P.I. STA. 499+53.92  
 $\Delta = 3^{\circ}13'01''$  RT.  
 $D = 0^{\circ}16'$   
 $R = 21,485.92'$   
 $L = 1206.35'$   
 $T = 603.34'$   
 $E = 8.47'$

CURVE DATA RAMP "K"  
 P.I. STA. K8+50.29  
 $\Delta = 7^{\circ}29'58''$   
 $D = 1^{\circ}30'$   
 $R = 3819.72'$   
 $L = 499.97'$   
 $T = 250.34'$   
 $E = 8.20'$

CURVE DATA RAMP "K"  
 P.I. STA. K15+95.51  
 $\Delta = 31^{\circ}24'$   
 $D = 8^{\circ}00'$   
 $R = 716.20'$   
 $L = 392.50'$   
 $T = 201.31'$   
 $E = 27.76'$

CURVE DATA RAMP "I"  
 P.I. STA. I35+91.10  
 $\Delta = 22^{\circ}30'31''$   
 $D = 4^{\circ}00'$   
 $R = 1432.39'$   
 $L = 562.72'$   
 $T = 285.03'$   
 $E = 28.08'$

CURVE DATA RAMP "I"  
 P.I. STA. I32+56.08  
 $\Delta_s = 3^{\circ}00'$   
 $D_c = 4^{\circ}00'$   
 $L_s = 150'$   
 $L.T. = 100.01'$   
 $S.T. = 50.01'$   
 $X = 149.96'$   
 $Y = 2.62'$

CURVE DATA RAMP "I"  
 P.I. STA. I28+76.66  
 $\Delta = 1^{\circ}07'59''$   
 $D = 0^{\circ}15'$   
 $R = 22,918.31'$   
 $L = 453.29'$   
 $T = 226.66'$   
 $E = 1.12'$

CURVE DATA S.R. 2  
 P.I. STA. 532+28.95  
 $\Delta = 33^{\circ}08'20''$  RT.  
 $D = 1^{\circ}16'$   
 $R = 4523.35'$   
 $L = 2616.23'$   
 $T = 1345.84'$   
 $E = 195.97'$

CURVE DATA MIDDLE RIDGE  
 P.I. STA. 40+14.73  
 $\Delta = 5^{\circ}22'$  LT.  
 $D = 1^{\circ}00'$   
 $R = 5729.58'$   
 $L = 536.67'$   
 $T = 268.53'$   
 $E = 6.29'$

CURVE DATA RAMP "J"  
 P.I. STA. J9+98.96  
 $\Delta = 51^{\circ}32'00''$   
 $D = 18^{\circ}00'$   
 $R = 318.31'$   
 $L = 286.30'$   
 $T = 153.65'$   
 $E = 35.14'$


CURVE DATA RAMP "J"  
 P.I. STA. J15+44.61  
 $\Delta = 34^{\circ}00'$   
 $D_c = 8^{\circ}00'$   
 $R = 716.20'$   
 $L_c = 225.0'$   
 $L_s = 200'$   
 $T_s = 319.61'$   
 $E_s = 52.2'$   
 $\theta_s = 8^{\circ}00'$   
 $L.T. = 133.47'$   
 $S.T. = 66.79'$   
 $X = 199.61'$   
 $Y = 9.30'$

GEOMETRIC LAYOUT S.R. 2 & MIDDLE RIDGE RD. INTERCHANGE  
 RAMP SCHEMATIC


ODOT PROJECT 3015-00

8/3/01 02-12-2002 [ 0:\p3600\DWG\3015\ODOT\15-00.DWG ] 62

0.564M 02-12-2002 [ C:\93600\DWG\93800\FIA\9-30.DWG ] 62

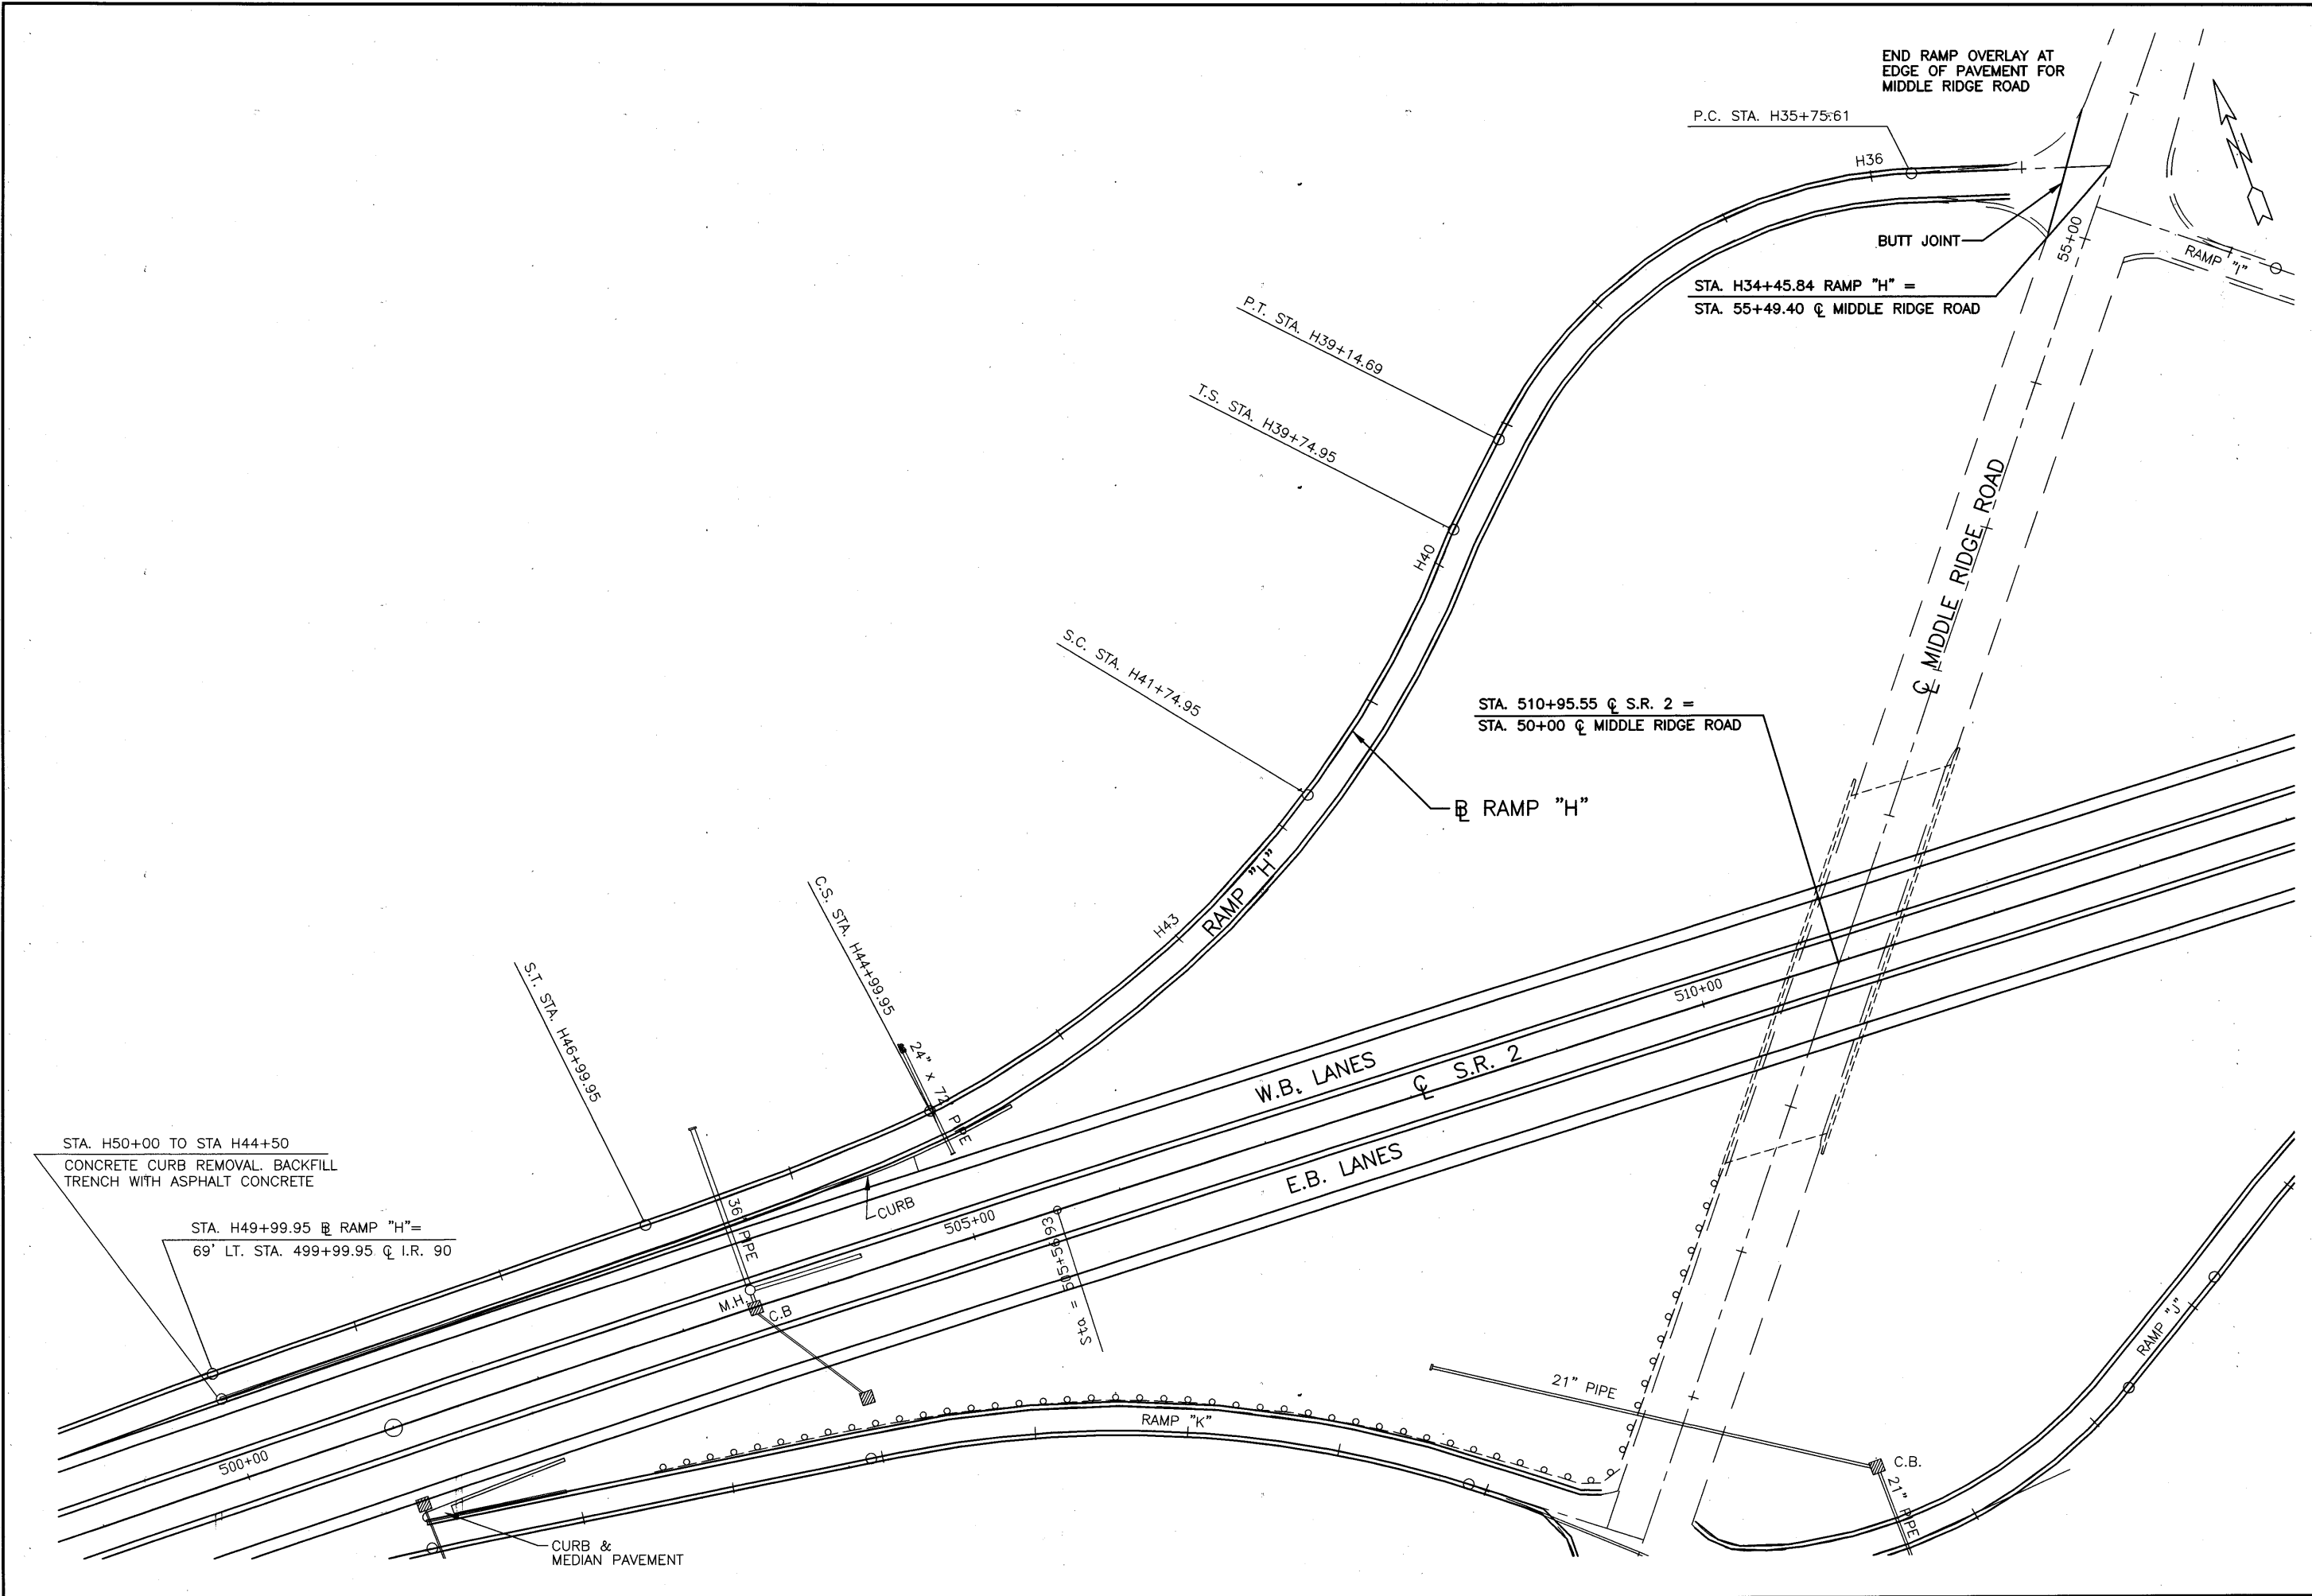


CALCULATED	DLS	CHECKED	LAB

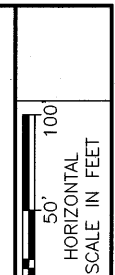

**RAMP 'H' - S.R. 2 & MIDDLE RIDGE ROAD**  
**STA. H49+99.95 TO STA. H34+45.84**

**LOR-190-10.76**

90  
274

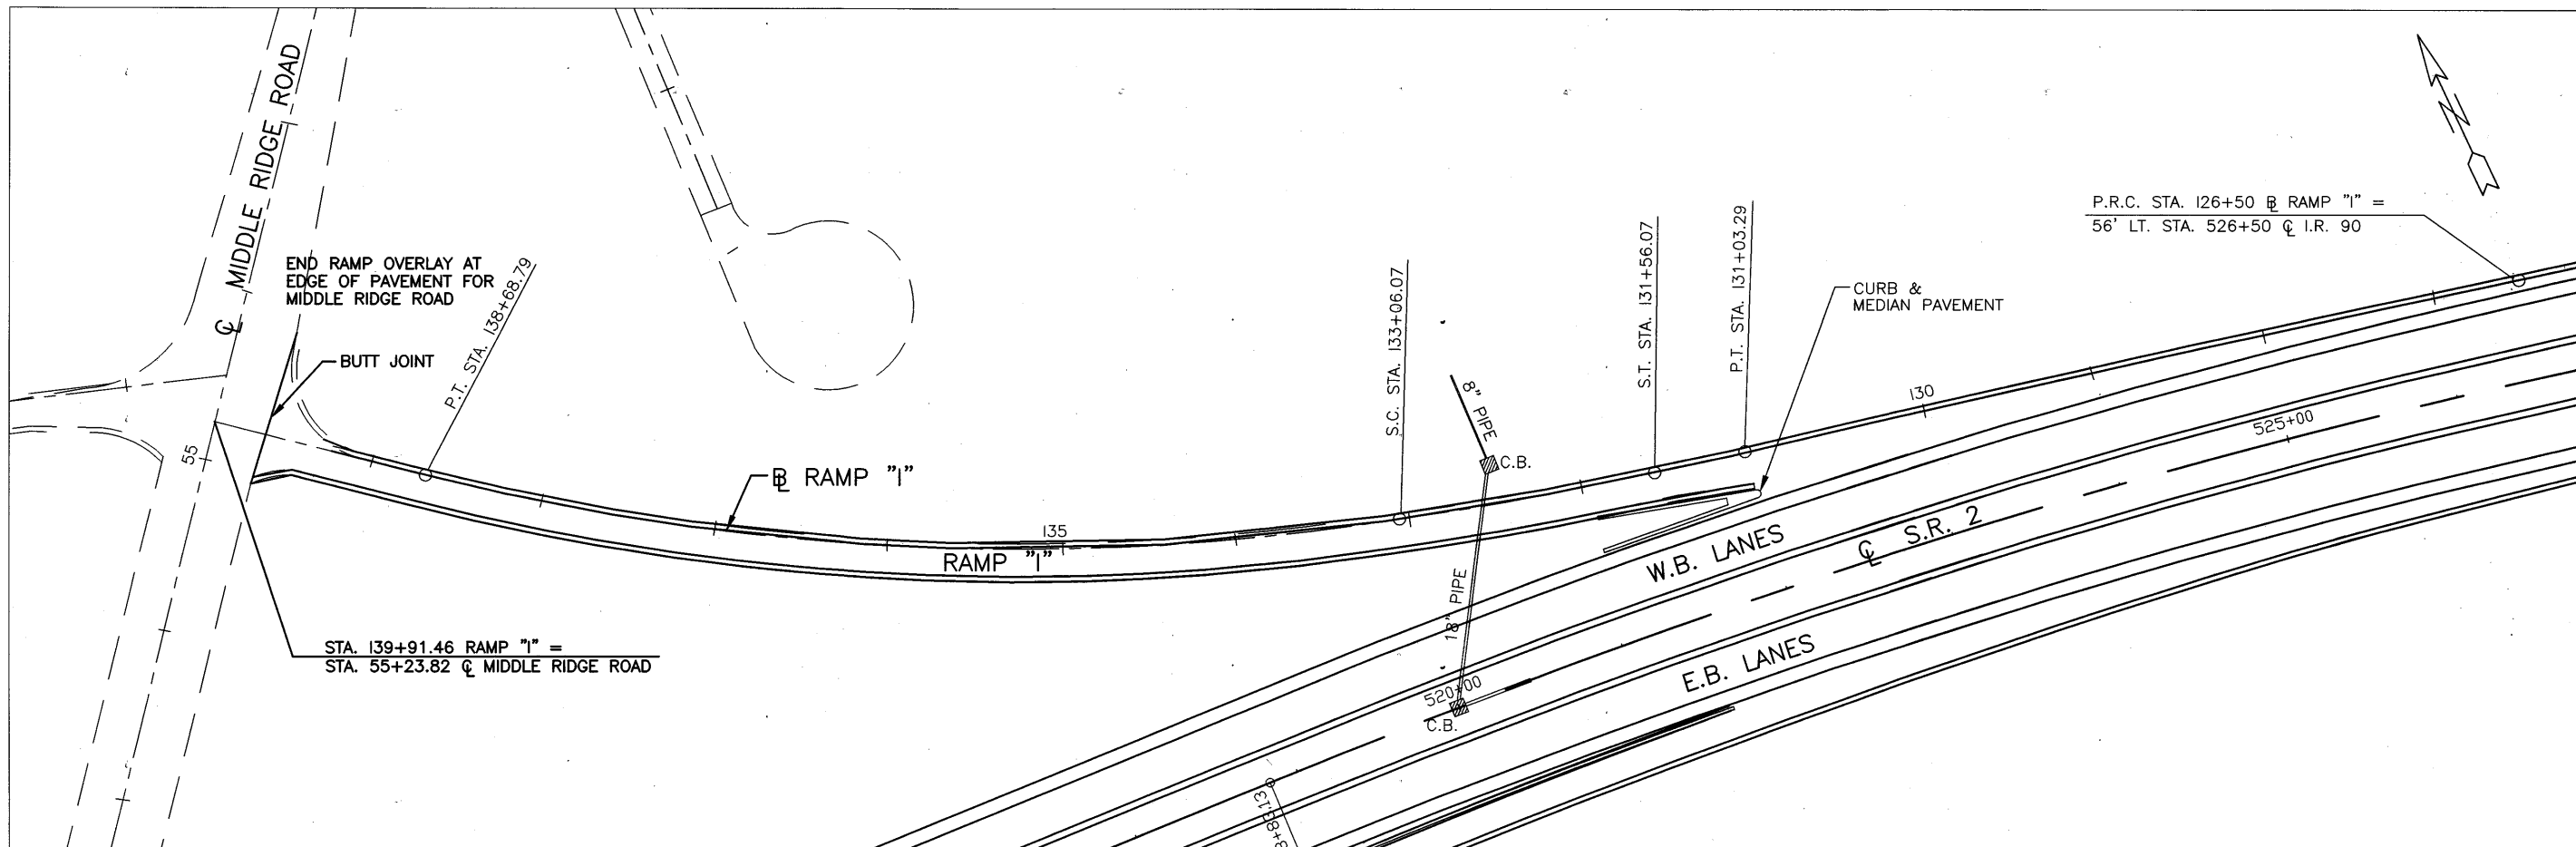

P.R.C. STA. 126+50 @ RAMP "I" =  
56' LT. STA. 526+50 @ I.R. 90

END RAMP OVERLAY AT  
EDGE OF PAVEMENT FOR  
MIDDLE RIDGE ROAD

BUTT JOINT

STA. 139+91.46 RAMP "I" =  
STA. 55+23.82 @ MIDDLE RIDGE ROAD

CURB &  
MEDIAN PAVEMENT



S.C. STA. 133+06.07

S.T. STA. 131+56.07

P.T. STA. 131+03.29

8" PIPE  
C.B.

8" PIPE  
C.B.

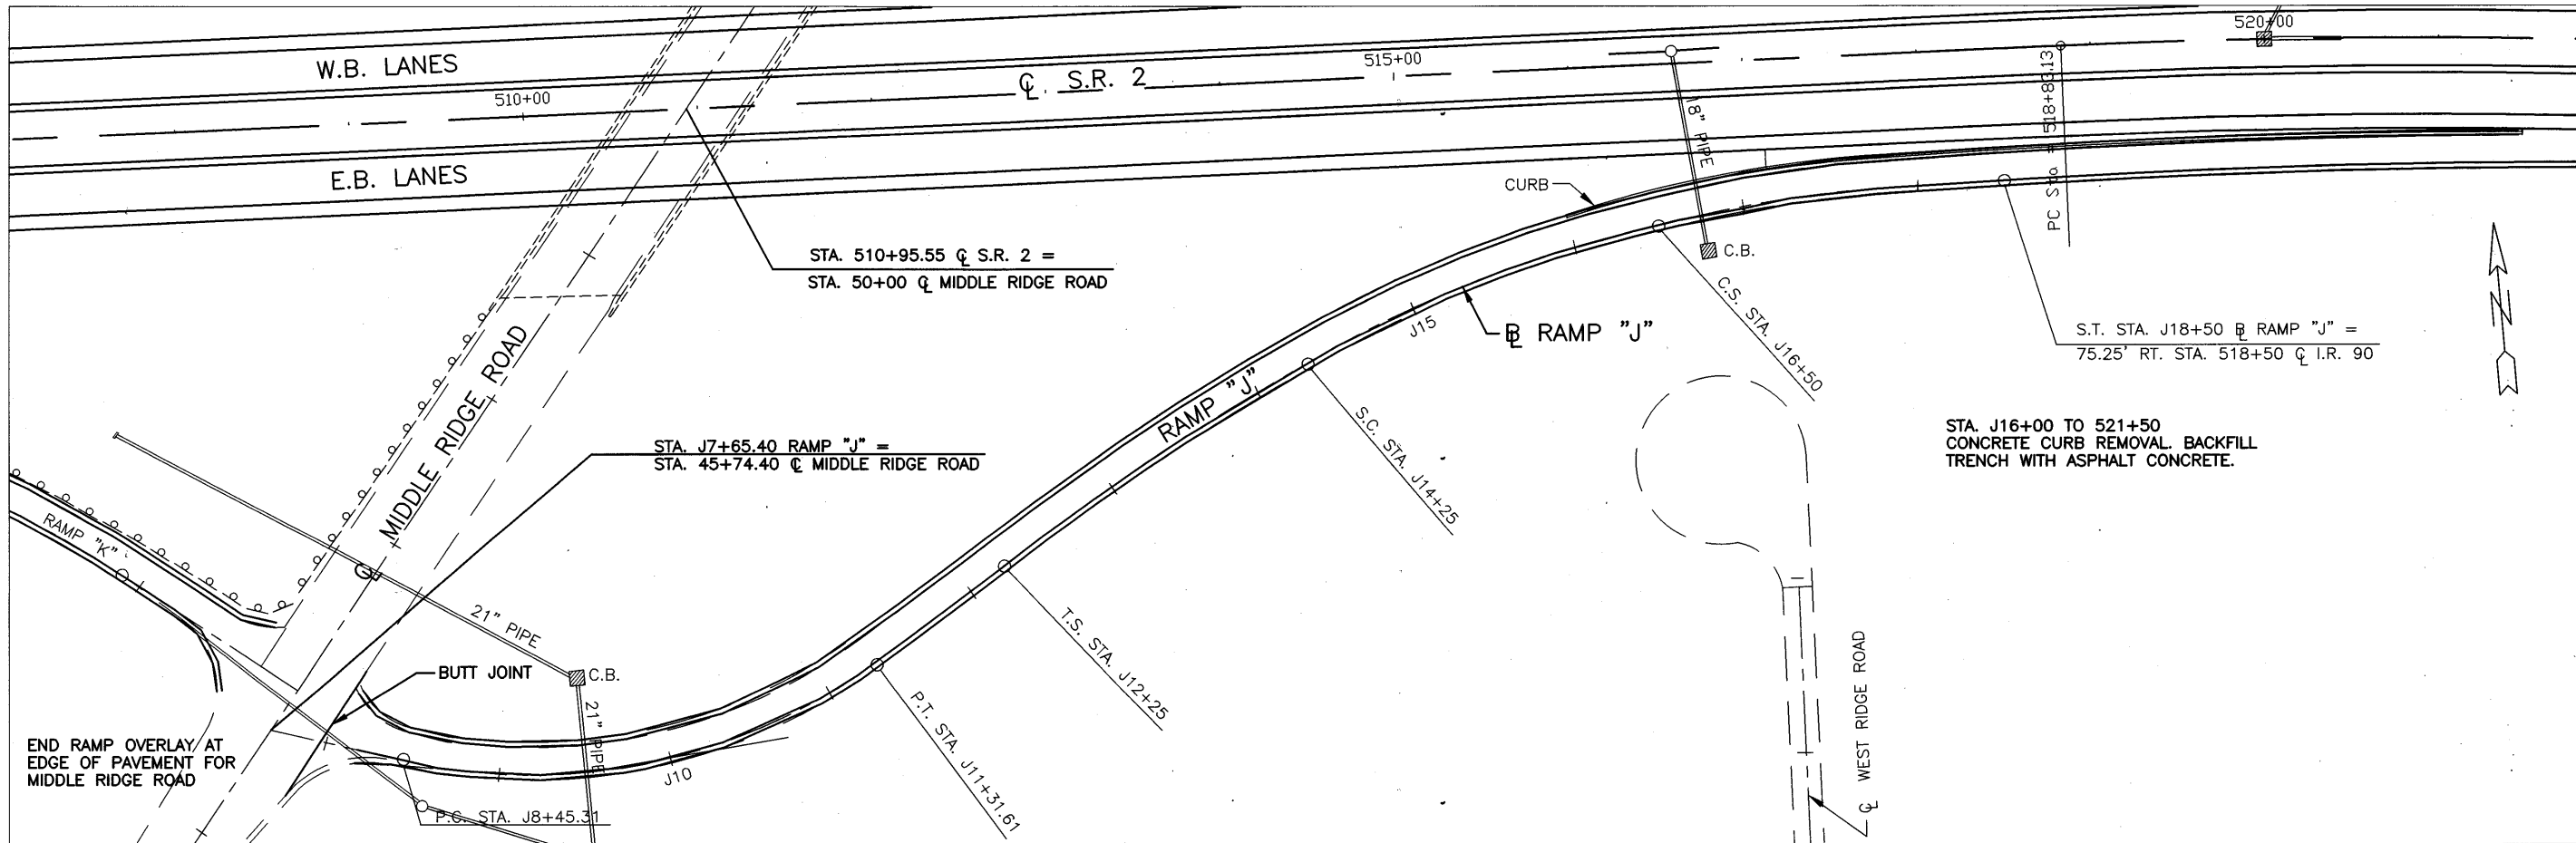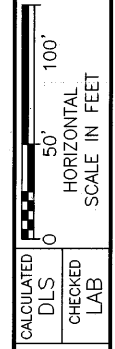

STA. 510+95.55 @ S.R. 2 =  
STA. 50+00 @ MIDDLE RIDGE ROAD

STA. J7+65.40 RAMP "J" =  
STA. 45+74.40 @ MIDDLE RIDGE ROAD

S.T. STA. J18+50 @ RAMP "J" =  
75.25' RT. STA. 518+50 @ I.R. 90

STA. J16+00 TO 521+50  
CONCRETE CURB REMOVAL. BACKFILL  
TRENCH WITH ASPHALT CONCRETE.

END RAMP OVERLAY AT  
EDGE OF PAVEMENT FOR  
MIDDLE RIDGE ROAD

BUTT JOINT

P.C. STA. J8+45.31

P.T. STA. J11+31.61

T.S. STA. J12+25

S.C. STA. J14+25

P.C. STA. = 518+81.13


RAMP "I" & "J" - S.R. 2 & MIDDLE RIDGE ROAD  
STA. 126+50 TO STA. 139+91.46 & STA. J7+65.40 TO J18+50

LOR-190-10.76

91  
274

6/20/04  
 02-12-2002 [ 0:\35600\DWGS\35600\FIN\P-31.DWG ] 62

02-12-2002 [ 0:\93600\DWG\93600\FIN\93600.P-32.DWG ] 62

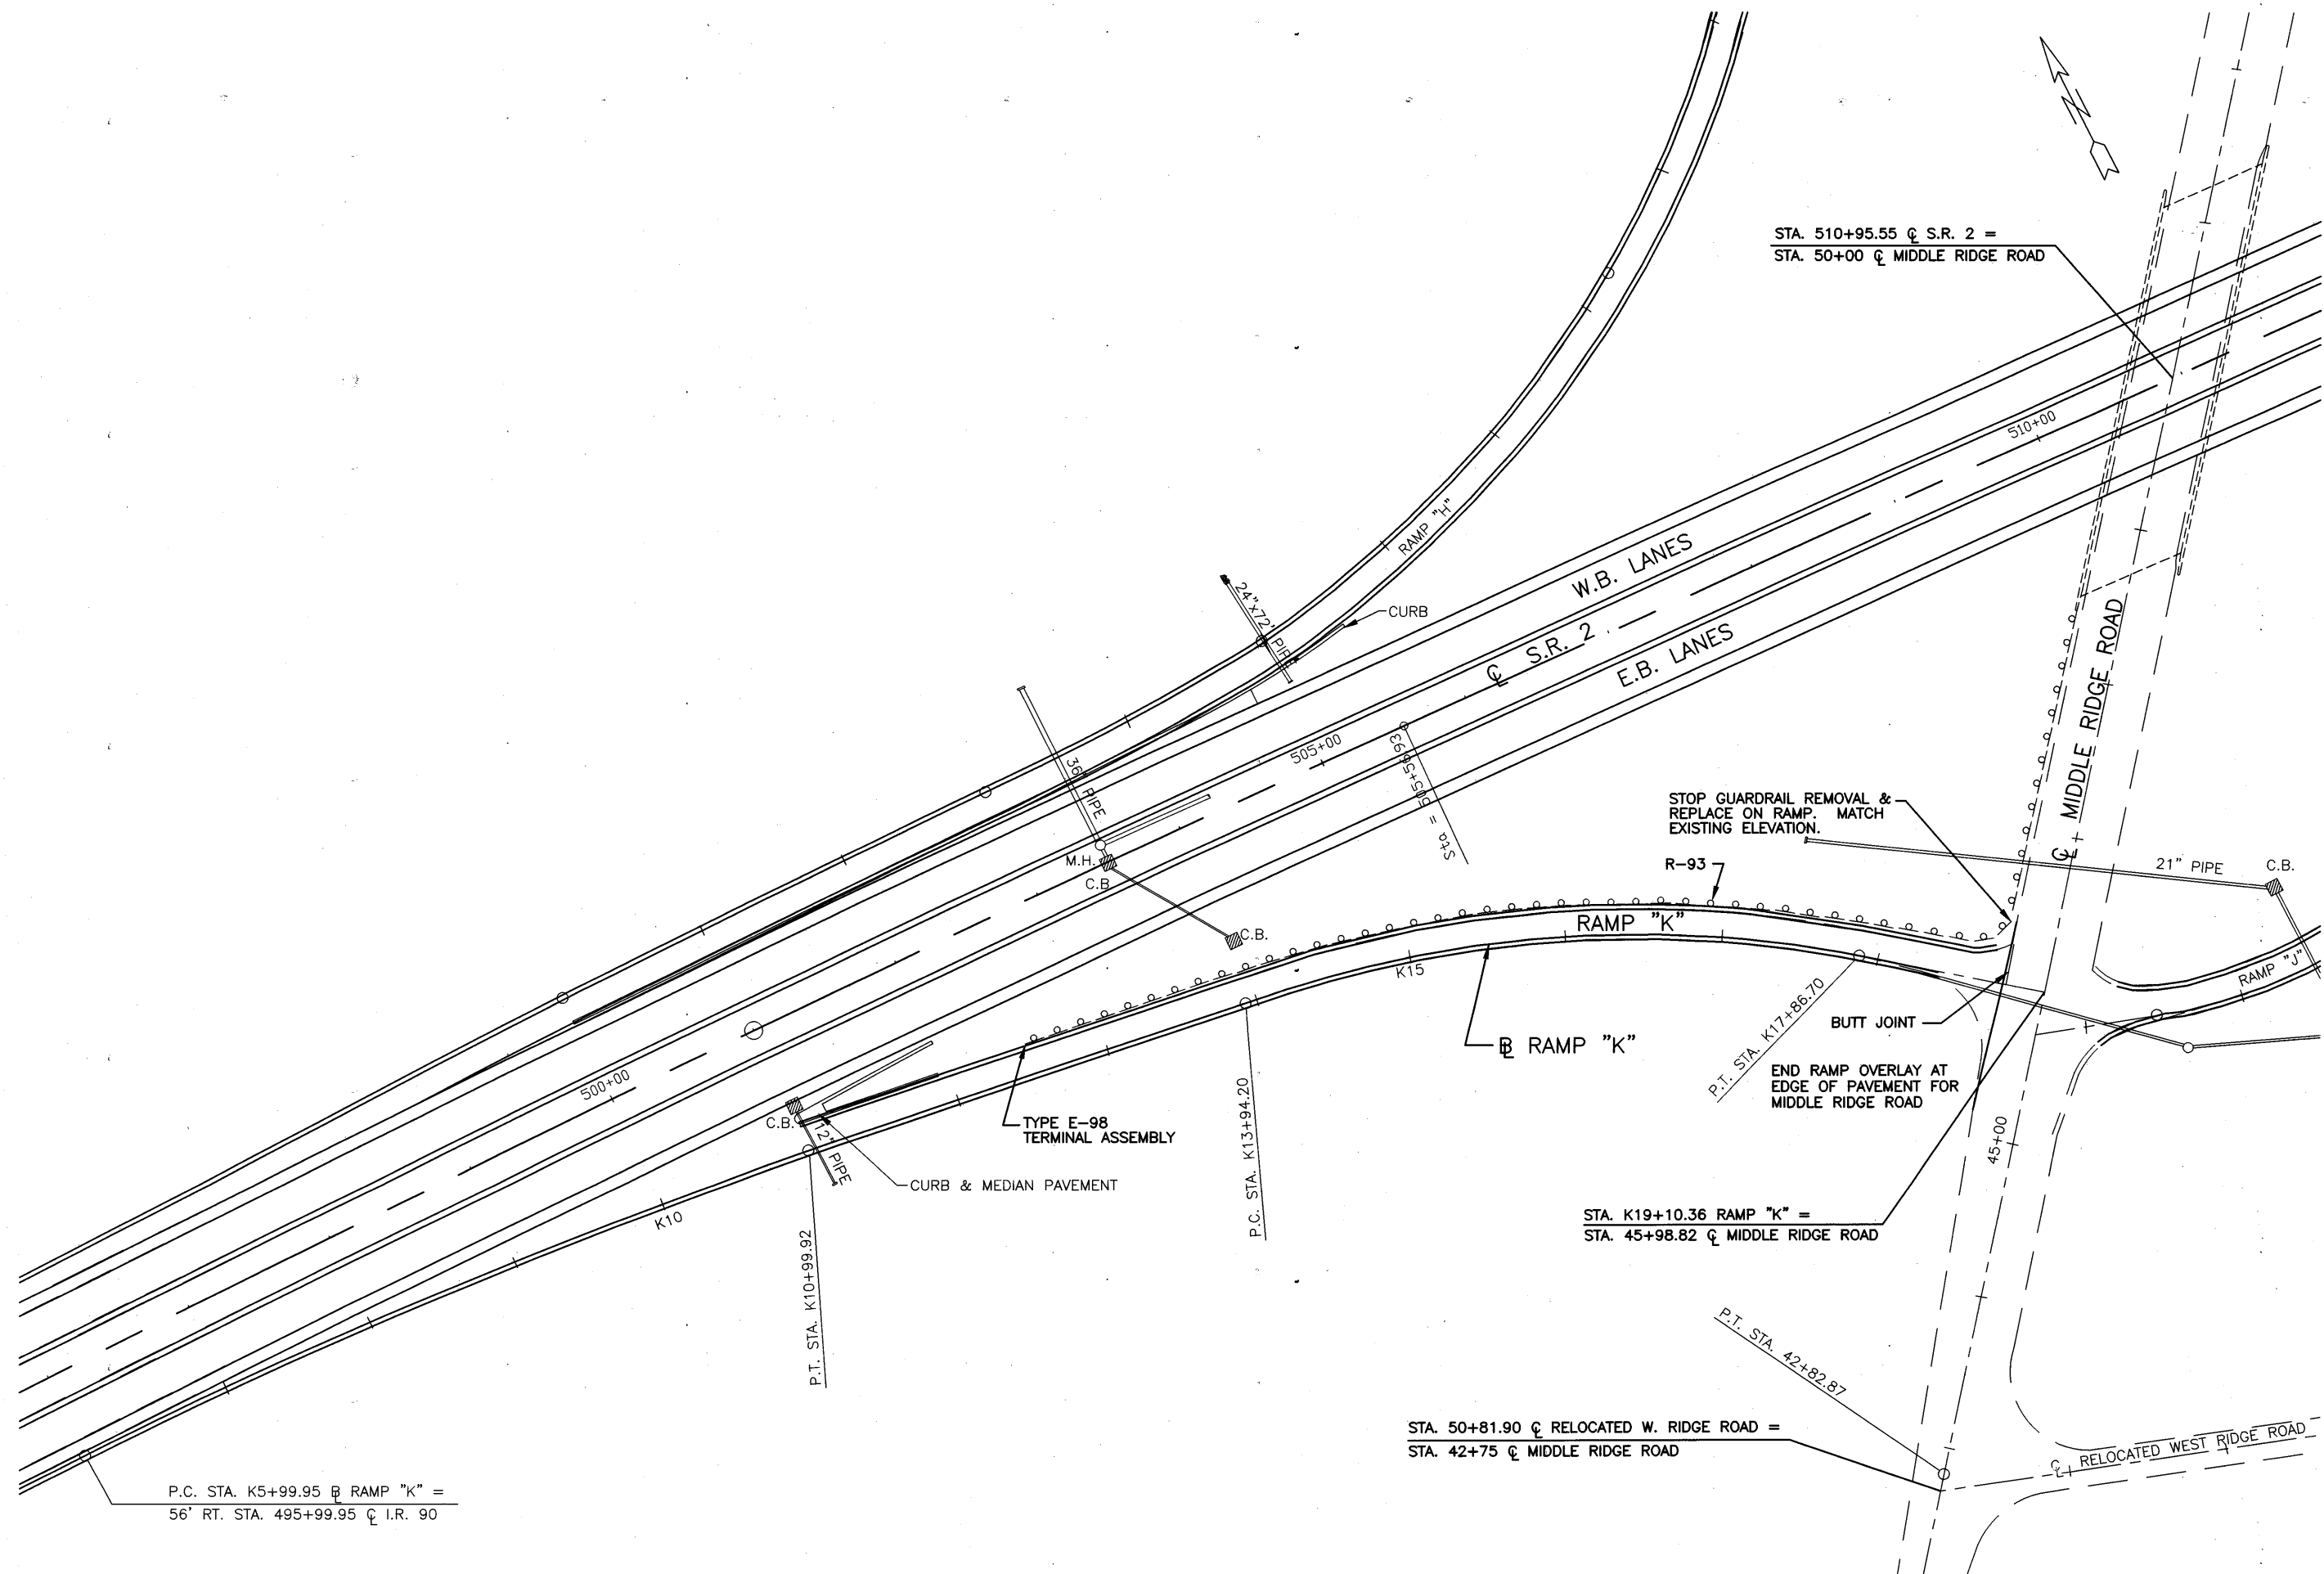

P.C. STA. K5+99.95 @ RAMP "K" =  
56' RT. STA. 495+99.95 @ I.R. 90

STA. 50+81.90 @ RELOCATED W. RIDGE ROAD =  
STA. 42+75 @ MIDDLE RIDGE ROAD

STA. K19+10.36 RAMP "K" =  
STA. 45+98.82 @ MIDDLE RIDGE ROAD

STA. 510+95.55 @ S.R. 2 =  
STA. 50+00 @ MIDDLE RIDGE ROAD

CALCULATED	0
DLS	0
CHECKED	LAB

**RAMP "K" - S.R. 2 & MIDDLE RIDGE ROAD**  
**STA. K5+99.95 TO STA. K19+10.36**

**LOR-190-10.76**

# S.R. 57 INTERCHANGE

**CURVE DATA RAMP "A"**  
 P.I. STA. A23+79.36  
 $\Delta_c = 16'30''$   
 $L_s = 150'$   
 $X_c = 148.76'$   
 $Y_c = 14.31'$   
 $P = 3.59'$   
 $K = 74.79'$   
 $L.T. = 100.44'$   
 $S.T. = 50.40'$

**CURVE DATA RAMP "A"**  
 P.I. STA. 36+24.86  
 $\Delta = 47'00''$   
 $D_c = 8'00''$   
 $R = 716.20'$   
 $L_s = 200'$   
 $T_s = 412.36'$   
 $E_s = 67.3'$   
 $\theta_s = 8'00''$   
 $P = 2.33'$   
 $K = 99.93'$

**CURVE DATA RAMP "A"**  
 P.I. STA. A26+13.84  
 $\Delta = 70'45'07''$   
 $D = 22'00''$   
 $R = 260.44'$   
 $L_s = 321.60'$   
 $T_c = 184.92'$   
 $E = 58.94'$

**CURVE DATA RAMP "B"**  
 $\Delta_c = 197'38'20''$   
 $D_c = 25'$   
 $R_c = 229.18'$   
 $L_c = 770.56'$   
 $L_s = 300'$   
 $\theta_s = 37'30''$   
 $L.T. = 204.68'$   
 $S.T. = 104.27'$

**CURVE DATA RAMP "A"**  
 P.I. STA. 29+92.57  
 $\Delta = 45'49'57''$   
 $D_c = 15'00''$   
 $R = 381.97'$   
 $L_s = 150'$   
 $L_c = 155.55'$   
 $T_s = 237.41'$   
 $L.T. = 100.20'$   
 $S.T. = 50.18'$   
 $X_c = 149.42'$   
 $Y_c = 9.79'$   
 $\theta_s = 11.25'$   
 $P = 2.45'$

**CURVE DATA RAMP "B"**  
 $\Delta_c = 197'38'20''$   
 $D_c = 25'$   
 $R_c = 229.18'$   
 $L_c = 770.56'$   
 $L_s = 300'$   
 $\theta_s = 37'30''$   
 $L.T. = 204.68'$   
 $S.T. = 104.27'$

**CURVE DATA RAMP "X"**  
 $\Delta_c = 197'21'40''$   
 $D_c = 25'$   
 $R_c = 229.18'$   
 $L_c = 789.44'$   
 $L_s = 300'$   
 $\theta_s = 37'30''$   
 $L.T. = 204.68'$   
 $S.T. = 104.27'$


**CURVE DATA RAMP "C"**  
 P.I. STA. C681+51.86  
 $\Delta = 72'38'25''$   
 $D = 18'$   
 $R = 318.31'$   
 $L = 403.56'$   
 $T = 233.99'$   
 $E = 76.75'$

**CURVE DATA RAMP "C"**  
 P.I. STA. C685+24.58  
 $\Delta = 33'30''$   
 $\Delta_c = 11'$   
 $D_c = 15'$   
 $R_c = 381.97'$   
 $L_c = 73.33'$   
 $L_s = 150'$   
 $\theta_s = 11'15''$   
 $L.T. = 100.20'$   
 $S.T. = 50.18'$   
 $T = 190.60'$   
 $E = 19.48'$

**CURVE DATA RAMP "C"**  
 P.I. STA. C688+78.22  
 $\theta_s = 8'$   
 $L_s = 200'$   
 $L.T. = 133.47'$   
 $S.T. = 66.79'$

**CURVE DATA RAMP "C"**  
 P.I. STA. C691+36.66  
 $\Delta = 30'$   
 $D_c = 8'$   
 $R = 716.20'$   
 $L = 375'$   
 $T = 191.91'$   
 $E = 25.27'$

**CURVE DATA RAMP "C"**  
 P.I. STA. C695+96.77  
 $\Delta = 8'17'46''$   
 $D_c = 1'30''$   
 $R = 3819.72'$   
 $L = 553.07'$   
 $T = 277.02'$   
 $E = 10.03'$

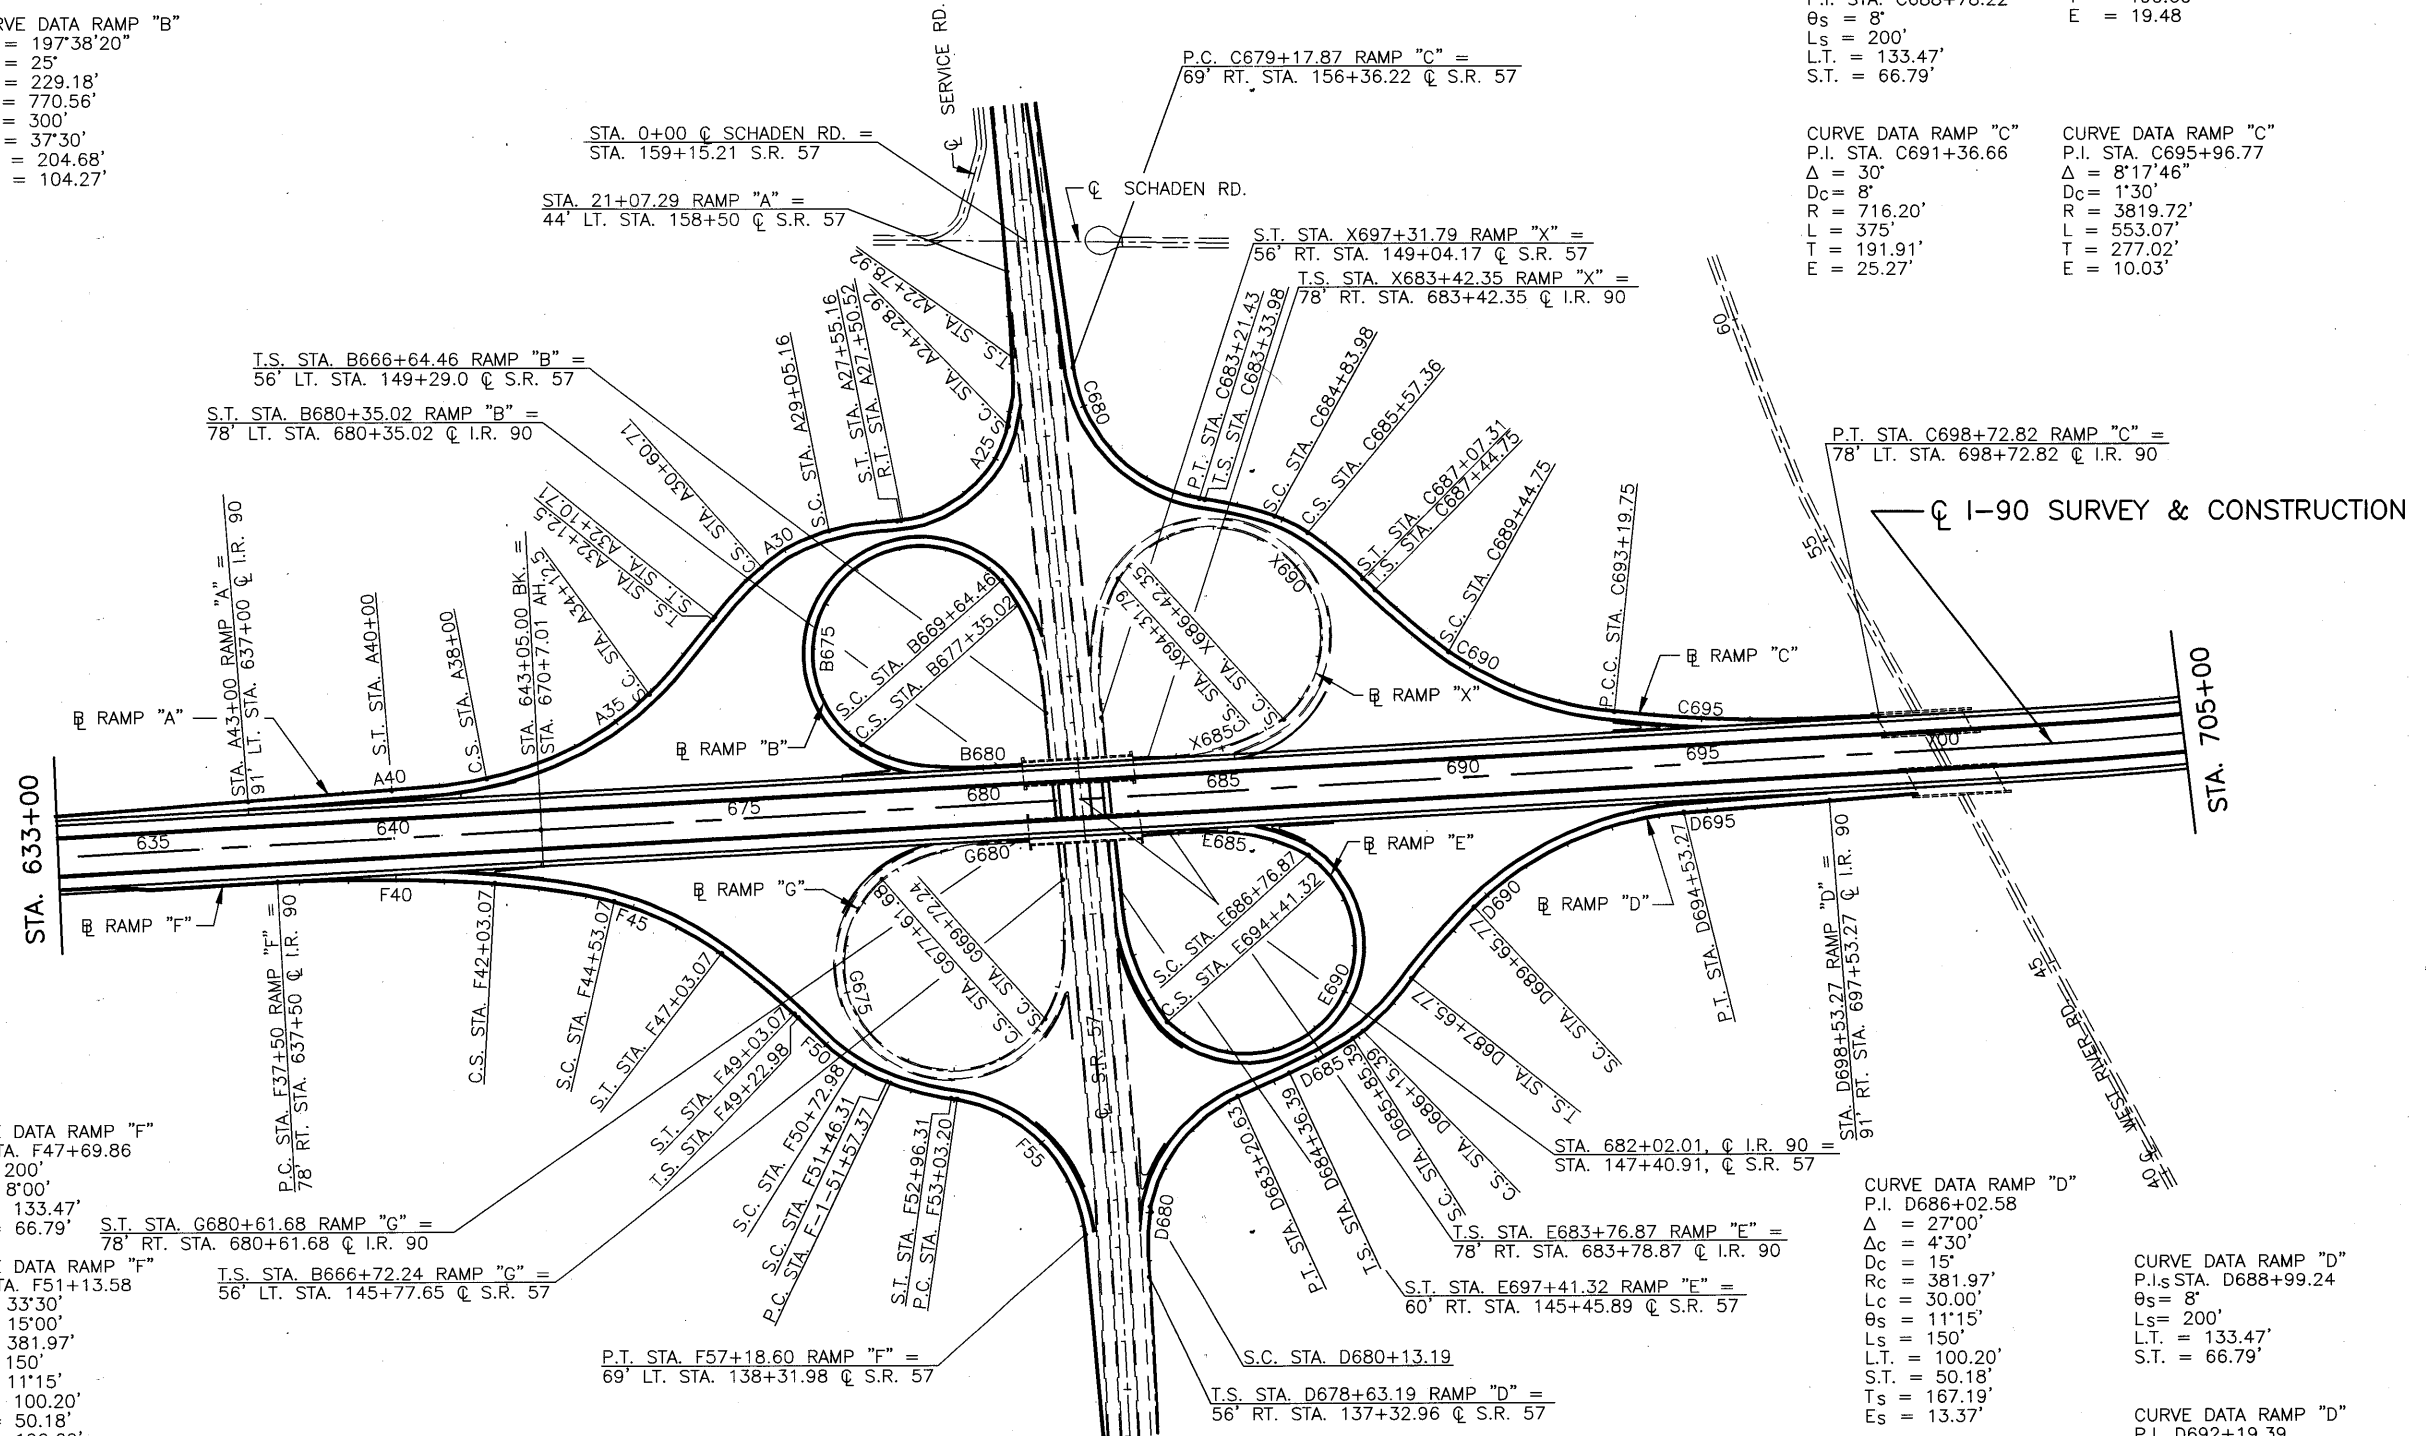

**CURVE DATA RAMP "F"**  
 P.I. STA. F39+76.80  
 $\Delta = 6'47'46''$  RT.  
 $D = 1'30''$   
 $R = 3819.72'$   
 $L = 226.80'$   
 $T = 453.07'$   
 $E = 6.73'$

**CURVE DATA RAMP "F"**  
 P.I. STA. F47+69.86  
 $L_s = 200'$   
 $\theta = 8'00''$   
 $L.T. = 133.47'$   
 $S.T. = 66.79'$

**CURVE DATA RAMP "F"**  
 P.I. STA. F43+57.08  
 $\Delta = 1'53''$   
 $\Delta_2 = 10'00''$   
 $D_1 = 1'30''$   
 $D_2 = 8'00''$   
 $R_1 = 3819.52'$   
 $R_2 = 716.20'$   
 $R_3 = 881.47'$   
 $L_s = 250'$   
 $T_1 = 154.01'$   
 $T_2 = 96.89'$   
 $\theta_A = 8'08''$   
 $P_A = 2.95'$

**CURVE DATA RAMP "F"**  
 P.I. STA. F51+13.58  
 $\Delta = 33'30''$   
 $D = 15'00''$   
 $R = 381.97'$   
 $L_s = 150'$   
 $\theta_s = 11'15''$   
 $L.T. = 100.20'$   
 $S.T. = 50.18'$   
 $T.S. = 190.60'$

**CURVE DATA RAMP "G"**  
 P.I. STA. F51+13.58  
 $\Delta = 33'30''$   
 $D = 15'00''$   
 $R = 381.97'$   
 $L_s = 150'$   
 $\theta_s = 11'15''$   
 $L.T. = 100.20'$   
 $S.T. = 50.18'$   
 $T.S. = 190.60'$

**CURVE DATA RAMP "G"**  
 P.I. STA. F55+46.44  
 $\Delta = 74'46'18''$   
 $D = 18'00''$   
 $R = 318.31'$   
 $L = 415.40'$   
 $T = 243.24'$   
 $E = 82.30'$

**CURVE DATA RAMP "G"**  
 $\Delta = 197'21'40''$   
 $D_c = 25'$   
 $R_c = 229.18'$   
 $L_c = 789.44'$   
 $L_s = 300'$   
 $\theta_s = 37'30''$   
 $L.T. = 204.68'$   
 $S.T. = 104.27'$

**CURVE DATA S.R. 57**  
 P.I. STA. 131+88.74  
 $\Delta = 8'18''$  LT.  
 $D_c = 0'20''$   
 $R = 17188.74'$   
 $L = 2490.00'$   
 $T = 1247.18'$   
 $E = 45.19'$

**CURVE DATA RAMP "E"**  
 $\Delta = 191'06'41''$   
 $D_c = 25'$   
 $R = 229.18'$   
 $L_c = 764.45'$   
 $L_s = 300'$   
 $\theta_s = 37'30''$   
 $L.T. = 204.68'$   
 $S.T. = 104.27'$


**CURVE DATA RAMP "D"**  
 P.I. STA. D679+63.48  
 $L_s = 150'$   
 $\theta_s = 13'30''$   
 $L.T. = 100.20'$   
 $S.T. = 50.27'$

**CURVE DATA RAMP "D"**  
 P.I. STA. D681+80.09  
 $\Delta = 55'20'20''$   
 $D_c = 18'$   
 $R = 318.31'$   
 $L = 307.44'$   
 $T = 166.90'$   
 $E = 41.10'$

**CURVE DATA RAMP "D"**  
 P.I. STA. D688+99.24  
 $\theta_s = 8'$   
 $L_s = 200'$   
 $L.T. = 133.47'$   
 $S.T. = 66.79'$



**CURVE DATA RAMP "D"**  
 P.I. STA. D686+02.58  
 $\Delta = 27'00''$   
 $\Delta_c = 4'30''$   
 $D_c = 15'$   
 $R_c = 381.97'$   
 $L_c = 30.00'$   
 $\theta_s = 11'15''$   
 $L_s = 150'$   
 $L.T. = 100.20'$   
 $S.T. = 50.18'$   
 $T_s = 167.19'$   
 $E_s = 13.37'$

**CURVE DATA RAMP "D"**  
 P.I. STA. D692+19.39  
 $\Delta = 39'00''$   
 $D_c = 8'$   
 $R = 716.20'$   
 $L_c = 487.50'$   
 $T = 253.62'$   
 $E = 43.58'$

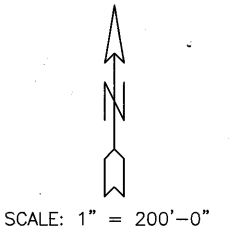

GEOMETRIC LAYOUT I.R.90 & S.R.57 INTERCHANGE RAMP SCHEMATIC

ODOT PROJECT 3015-00

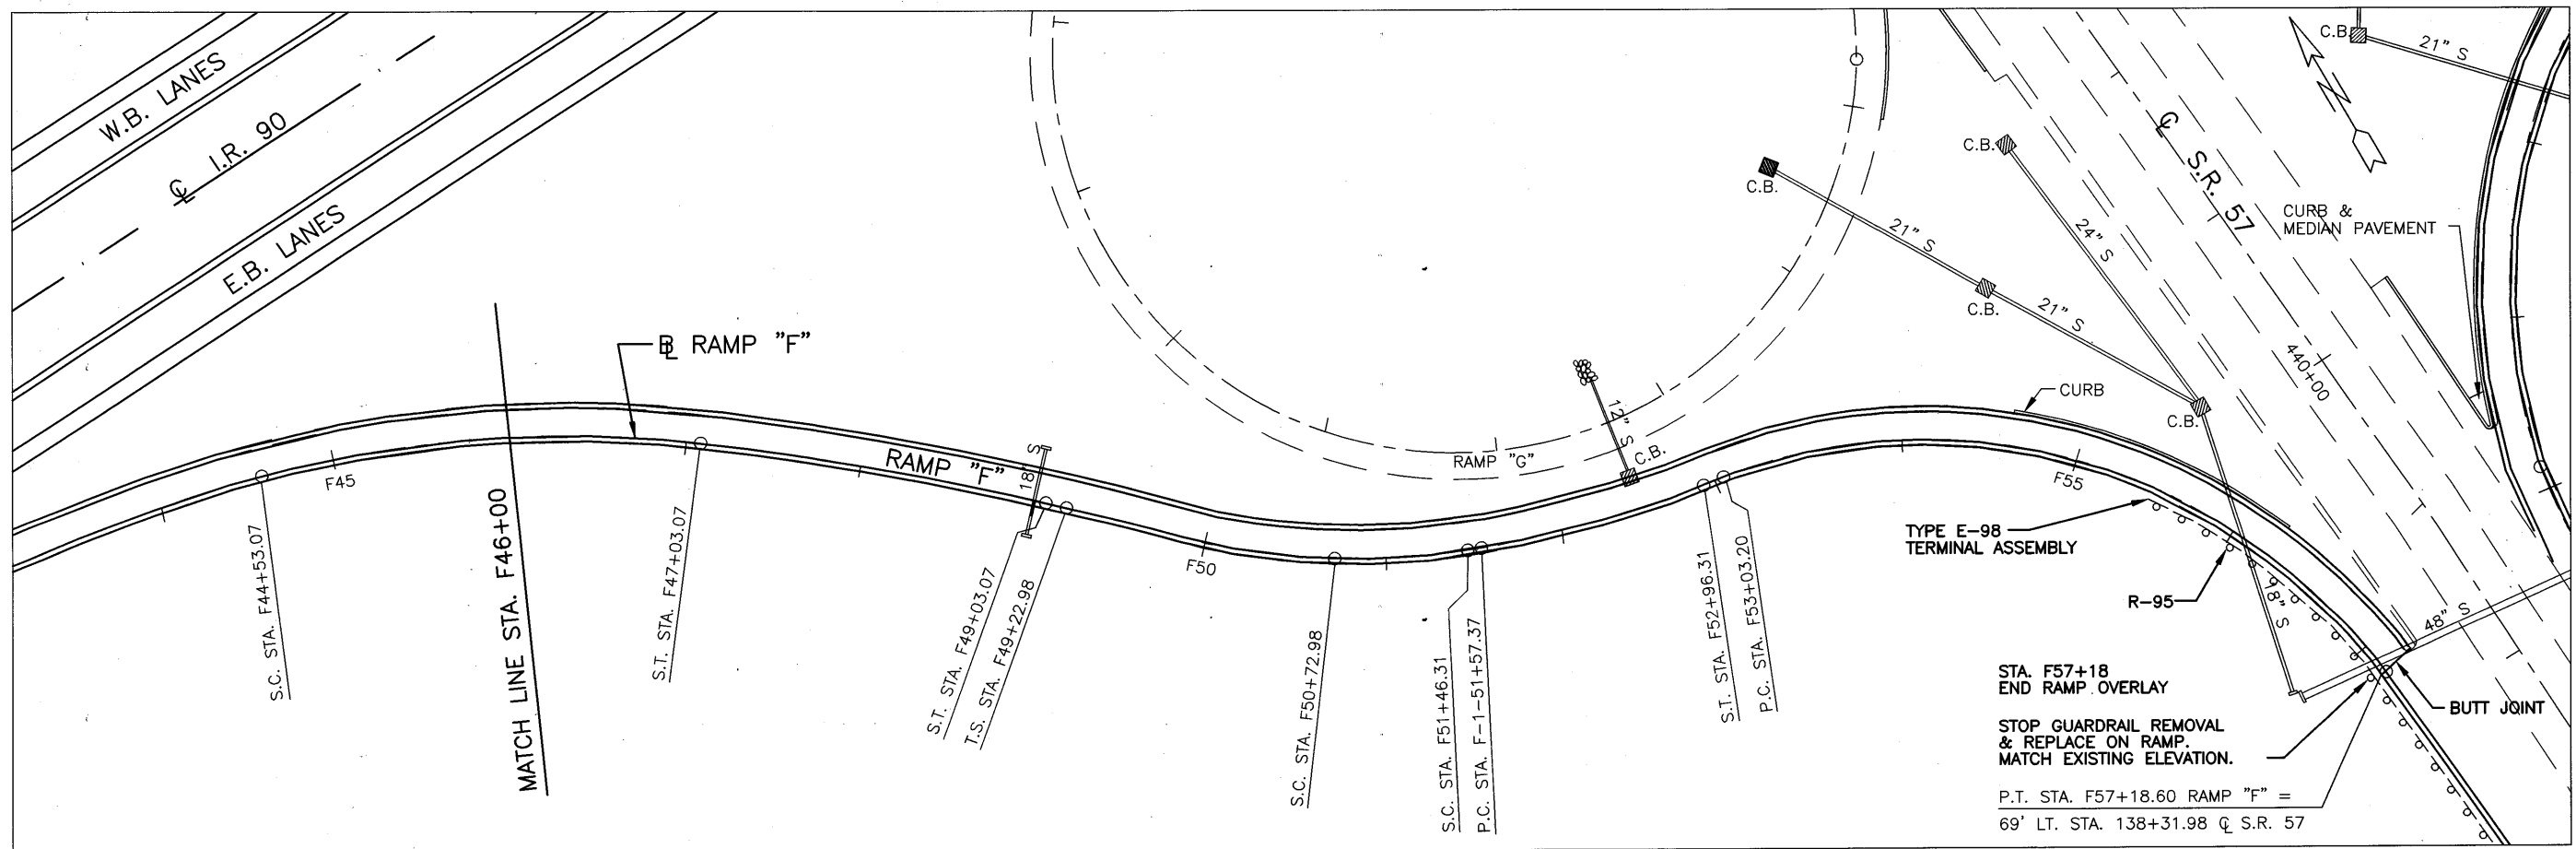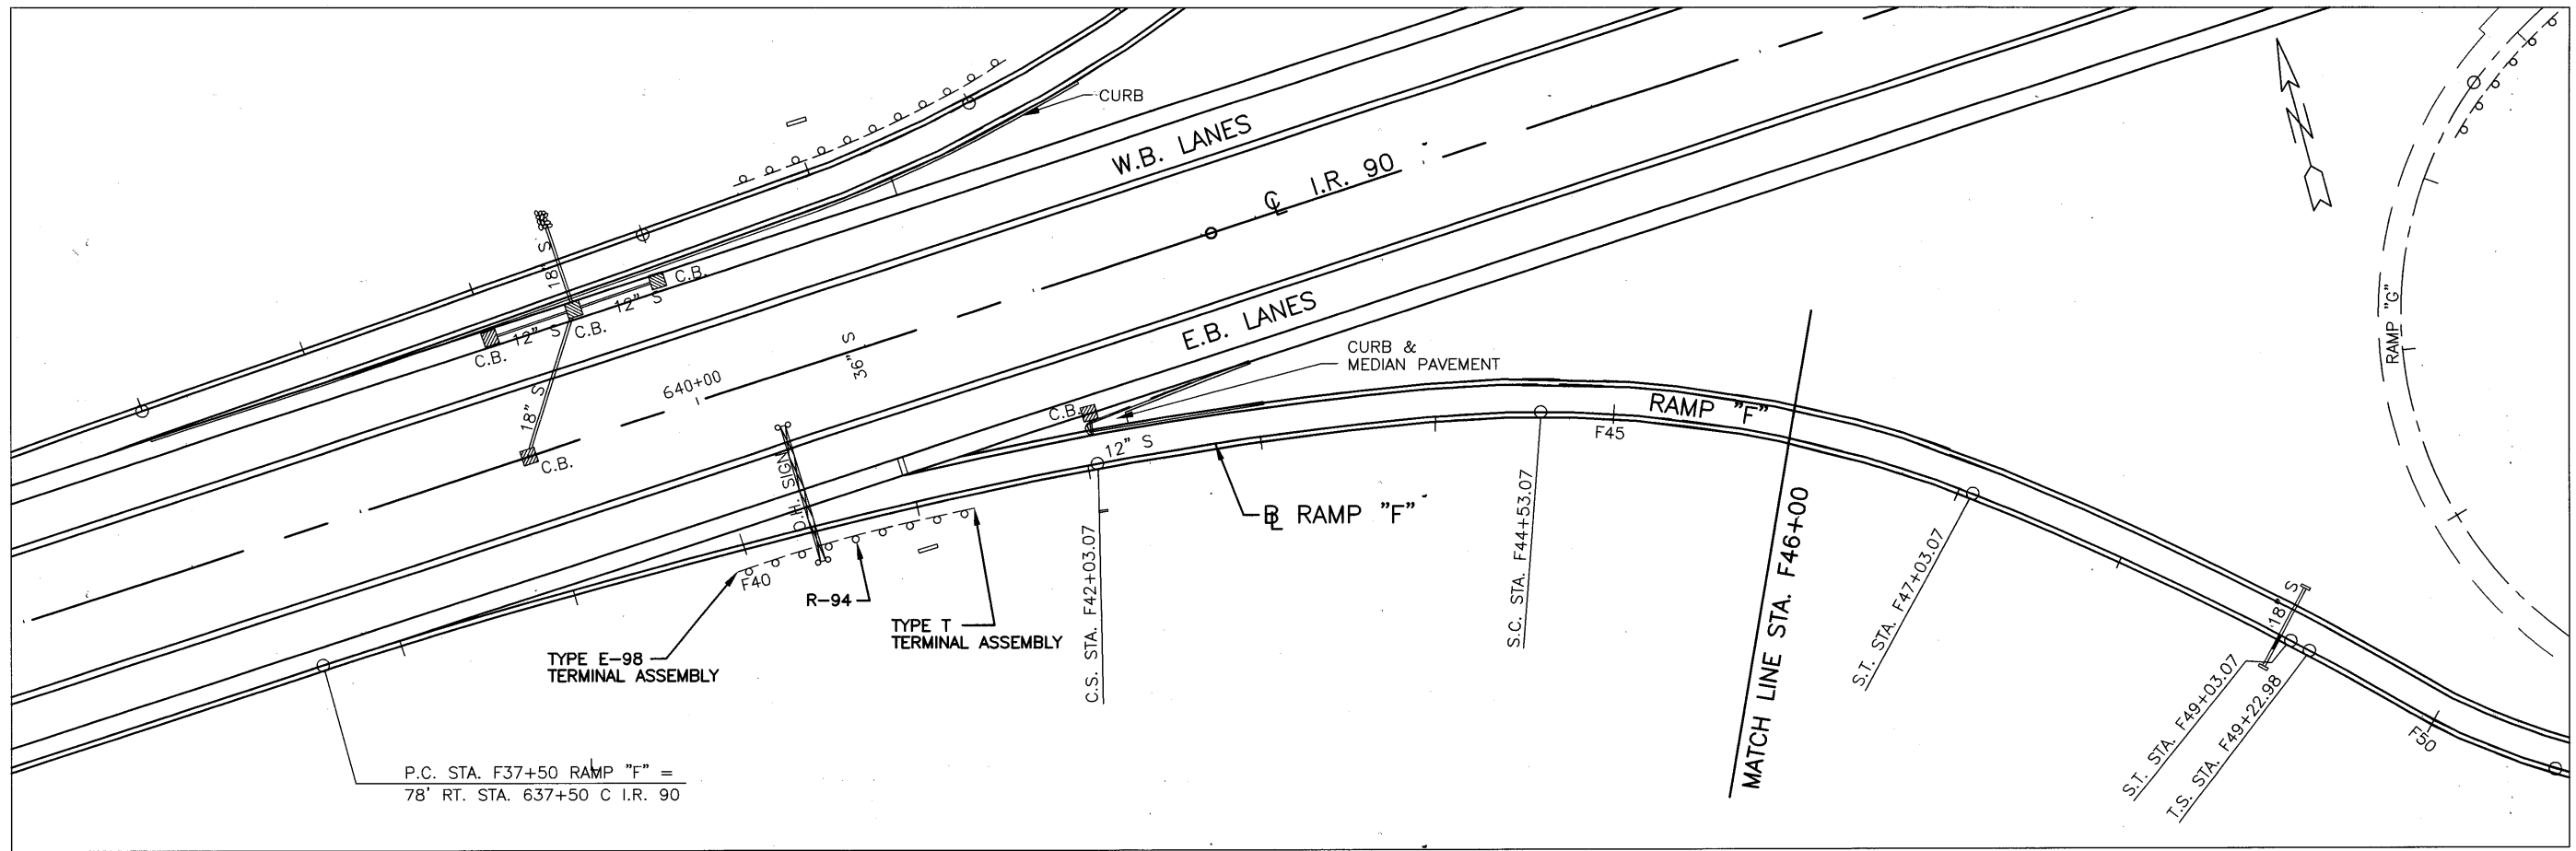


CALCULATED	DLS	CHECKED	LAB



**RAMP "F" - S.R. 57 & I.R. 90**  
**STA. 37+50 TO STA. 57+18.60**

**LOR-190-10.76**

C:\95600\DWG5\95600\FIL\9-34.DWG ] 62  
 02-12-2007 10:12AM

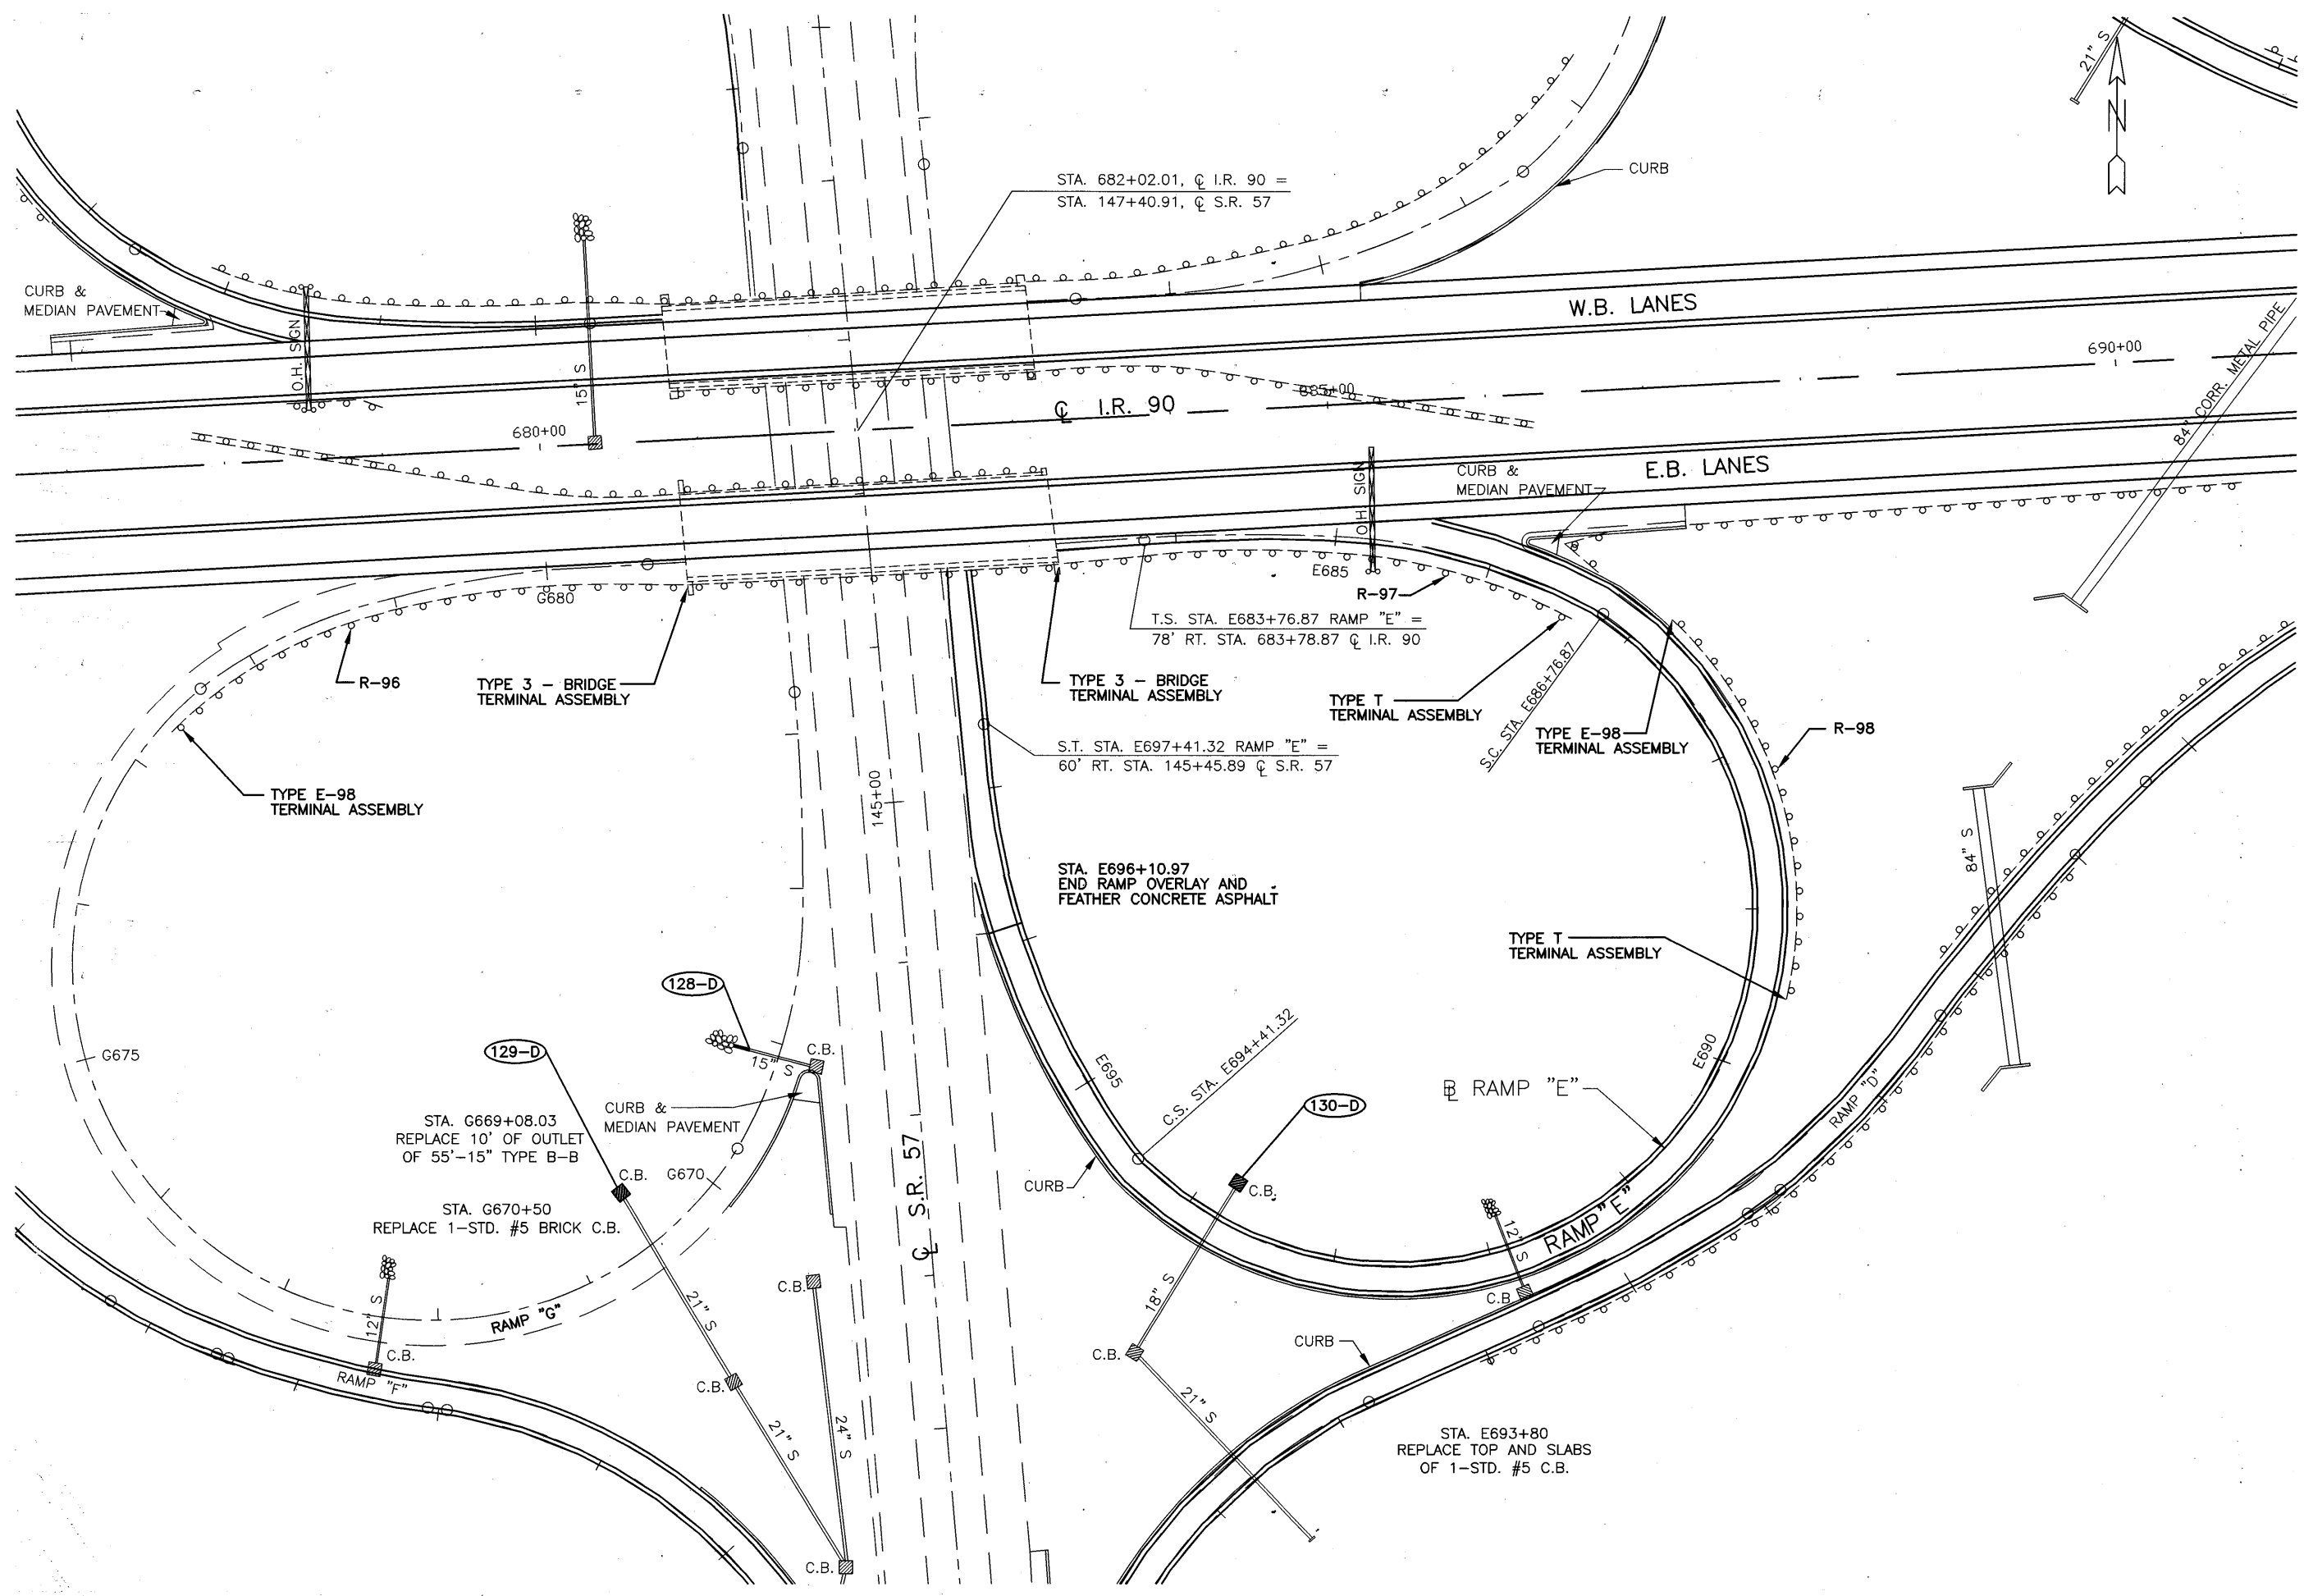

STA. 682+02.01,  $\text{C I.R. 90} =$   
 STA. 147+40.91,  $\text{C S.R. 57}$

W.B. LANES

E.B. LANES

$\text{C I.R. 90}$

145+00

$\text{C S.R. 57}$

T.S. STA. E683+76.87 RAMP "E" =  
 78' RT. STA. 683+78.87  $\text{C I.R. 90}$

TYPE 3 - BRIDGE  
 TERMINAL ASSEMBLY

TYPE T  
 TERMINAL ASSEMBLY

S.T. STA. E697+41.32 RAMP "E" =  
 60' RT. STA. 145+45.89  $\text{C S.R. 57}$

S.C. STA. E686+76.87  
 TYPE E-98  
 TERMINAL ASSEMBLY

STA. E696+10.97  
 END RAMP OVERLAY AND  
 FEATHER CONCRETE ASPHALT

TYPE T  
 TERMINAL ASSEMBLY

TYPE E-98  
 TERMINAL ASSEMBLY

TYPE 3 - BRIDGE  
 TERMINAL ASSEMBLY

STA. G669+08.03  
 REPLACE 10' OF OUTLET  
 OF 55'-15" TYPE B-B

STA. G670+50  
 REPLACE 1-STD. #5 BRICK C.B.

STA. E693+80  
 REPLACE TOP AND SLABS  
 OF 1-STD. #5 C.B.



CALCULATED	DLS	CHECKED	LAB

100  
 50'  
 0  
 HORIZONTAL  
 SCALE IN FEET

**RAMP "E" - S.R. 57 & I.R. 90**  
**STA. 683+76.87 TO STA. 697+41.32**

**LOR-190-10.76**

C:\95000\DWG\95000.P-35.DWG 1 cz  
 02-15-2002 10:23AM

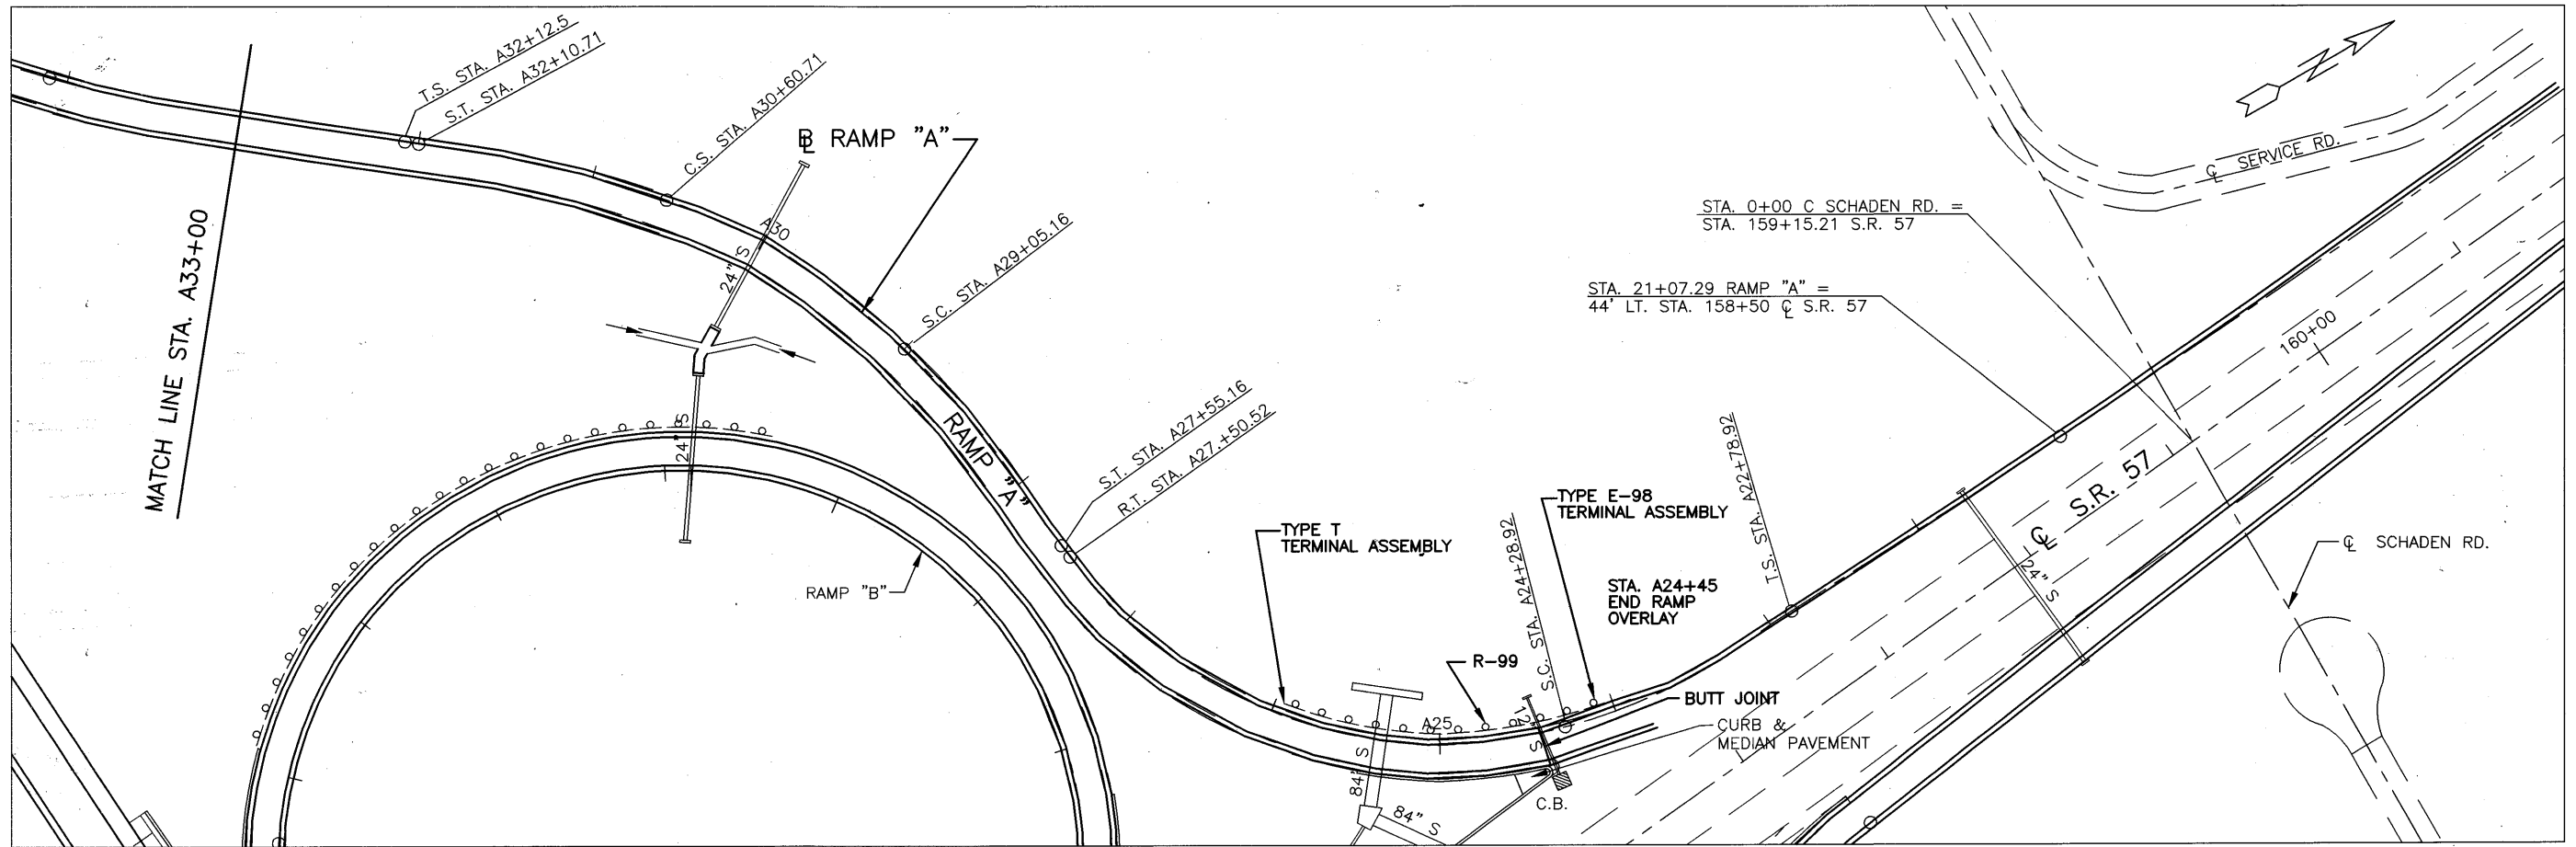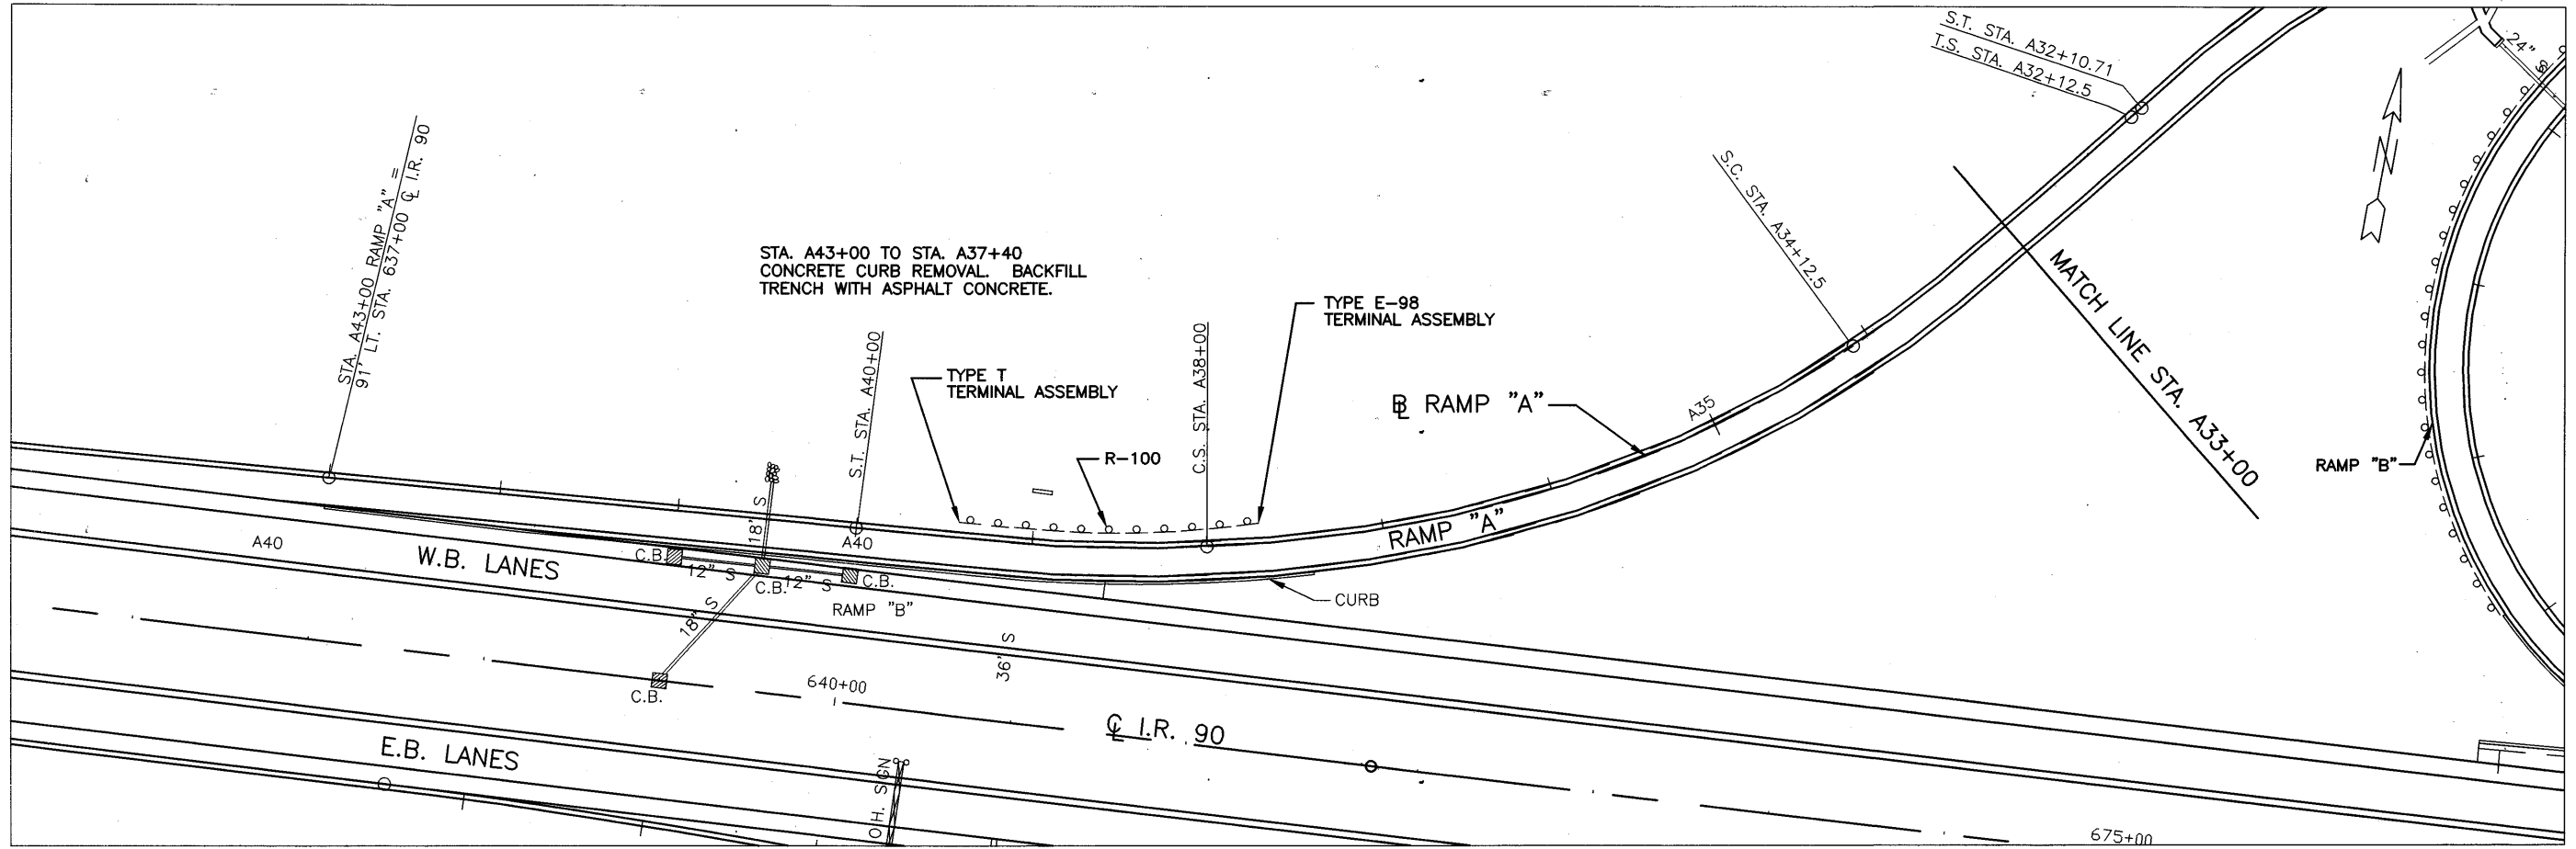

CALCULATED	DLS	CHECKED	LAB


100  
50  
0  
HORIZONTAL  
SCALE IN FEET

RAMP "A" - S.R. 57 & I.R. 90  
STA. 21+07.29 TO STA. 43+00

LOR-190-10.76

E:\C:\B3600\INVIS\B3600\FINAL\LP-36.DWG 1 02  
02-13-2002 8:58AM



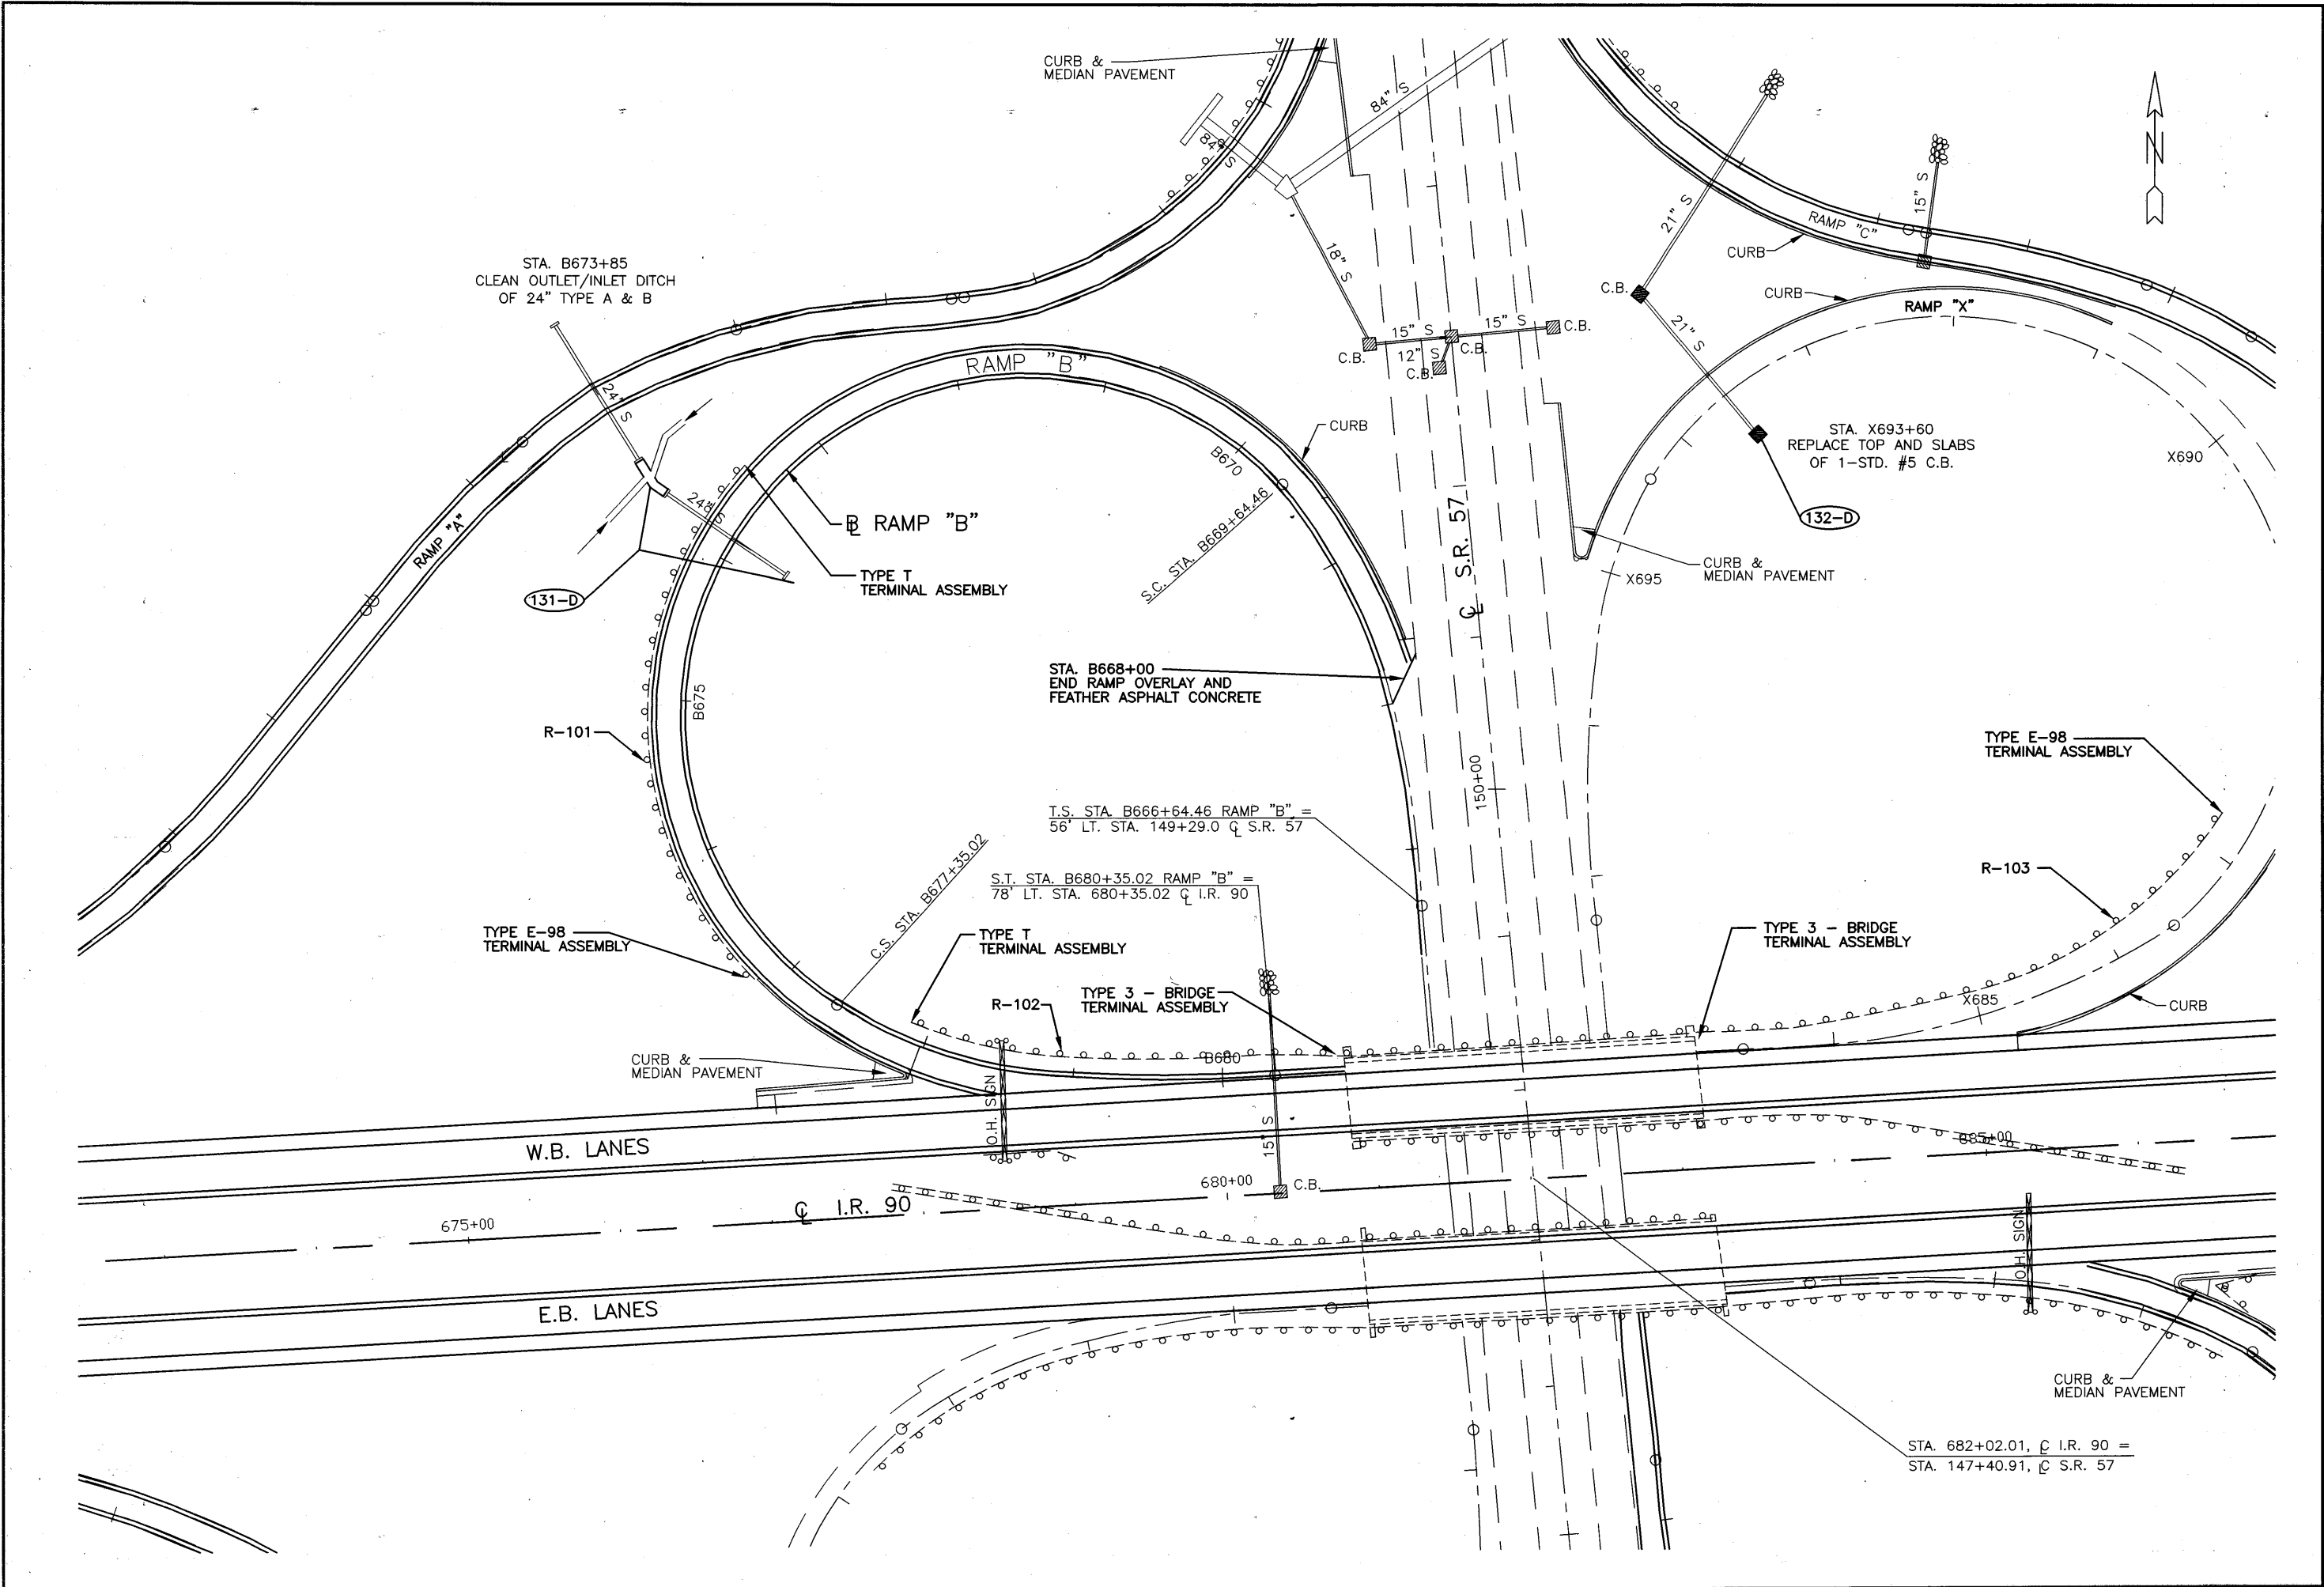

CALCULATED  
DLS  
CHECKED  
LAB




**RAMP "B" - S.R. 57 & I.R. 90**  
**STA. 666+64.46 TO STA. 680+35.02**


**LOR-190-10.76**

97  
274

E:\035600\UNRES\19000\FINAL\19-37.DWG 1 02  
02-19-2002 8:11 AM

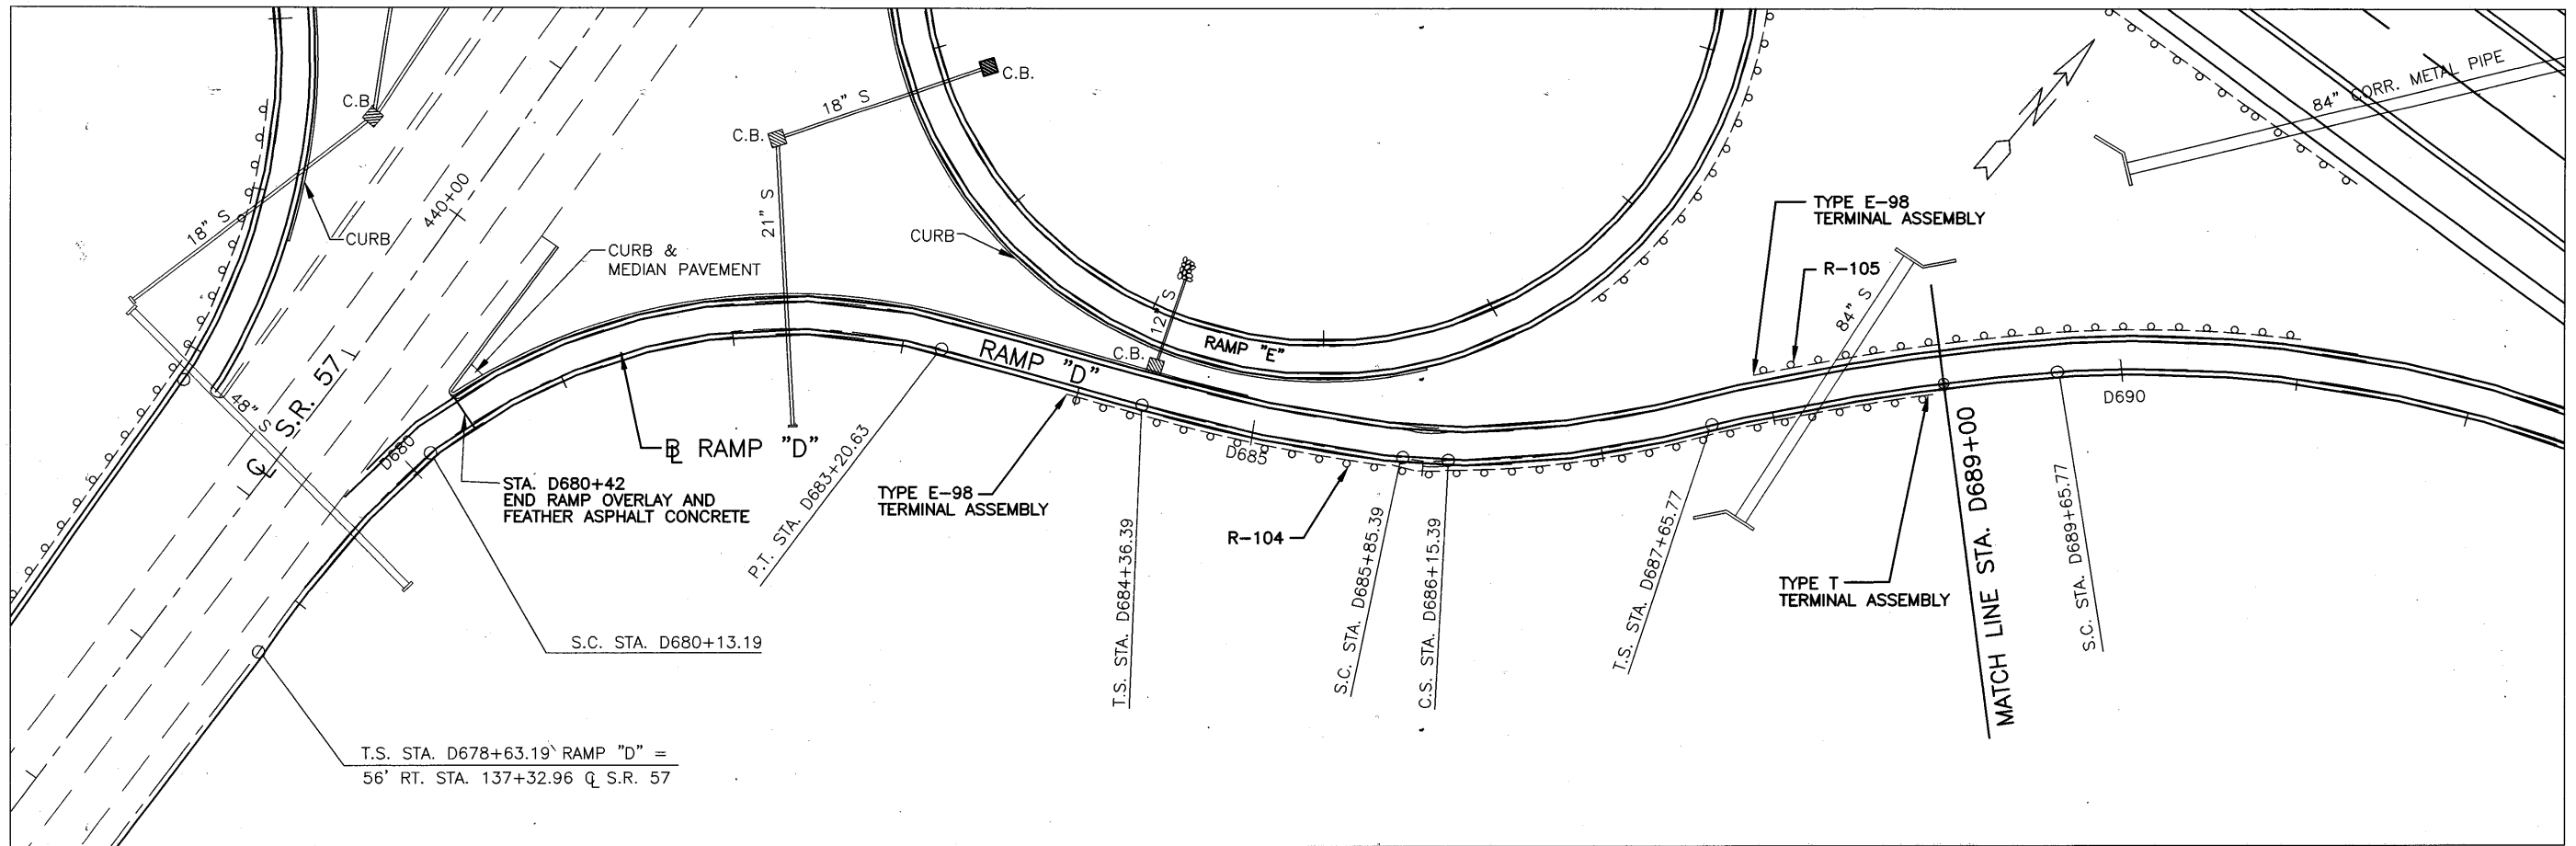

T.S. STA. D678+63.19 RAMP "D" =  
 56' RT. STA. 137+32.96 Q S.R. 57

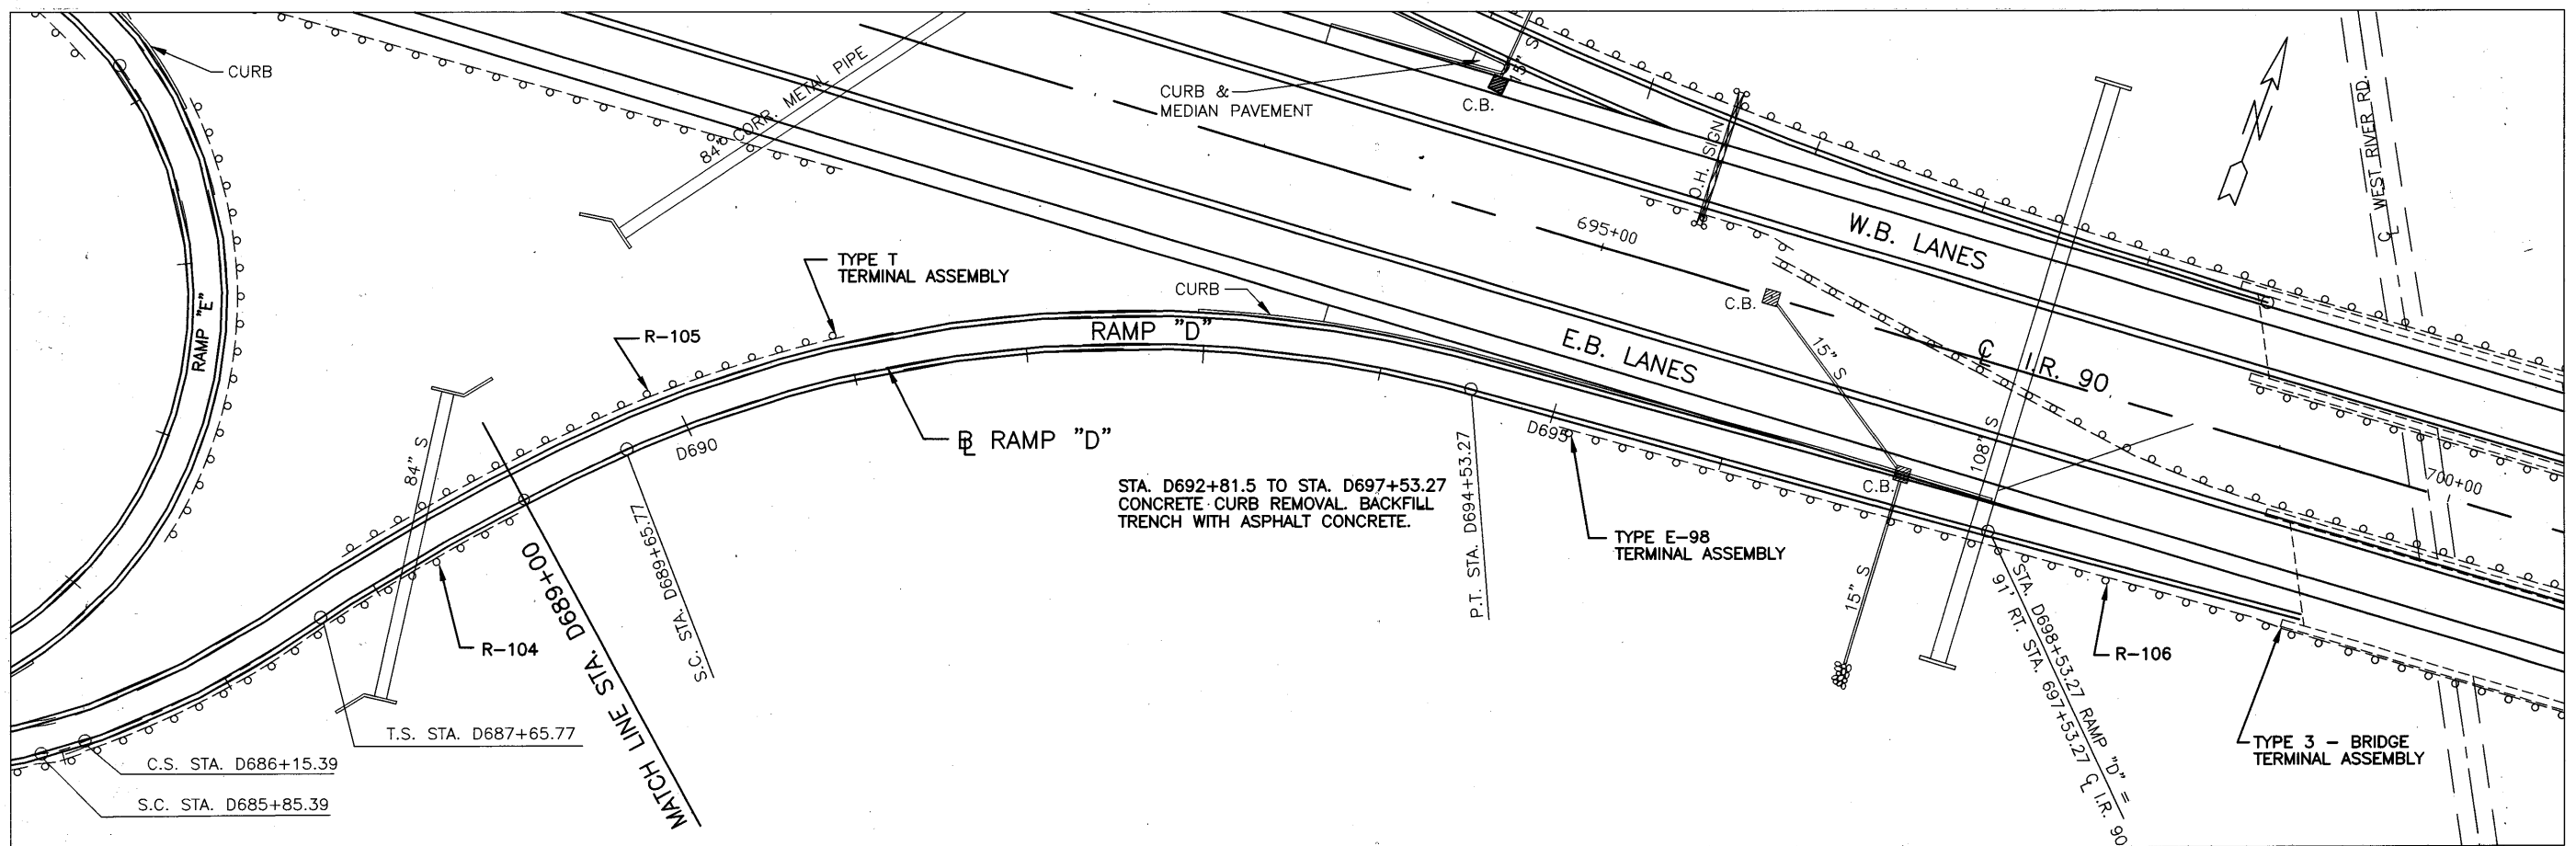

STA. D692+81.5 TO STA. D697+53.27  
 CONCRETE CURB REMOVAL. BACKFILL  
 TRENCH WITH ASPHALT CONCRETE.



CALCULATED	DLS	CHECKED	LAB

HORIZONTAL SCALE IN FEET  
 0 50 100

**RAMP "D" - S.R. 57 & I.R. 90**  
**STA. 678+63.19 TO STA. 698+53.27**

**LOR-190-10.76**

I:\03500\UNSW\3860\FIL\1-38.DWG 11.02  
 02-19-2002 10:39AM

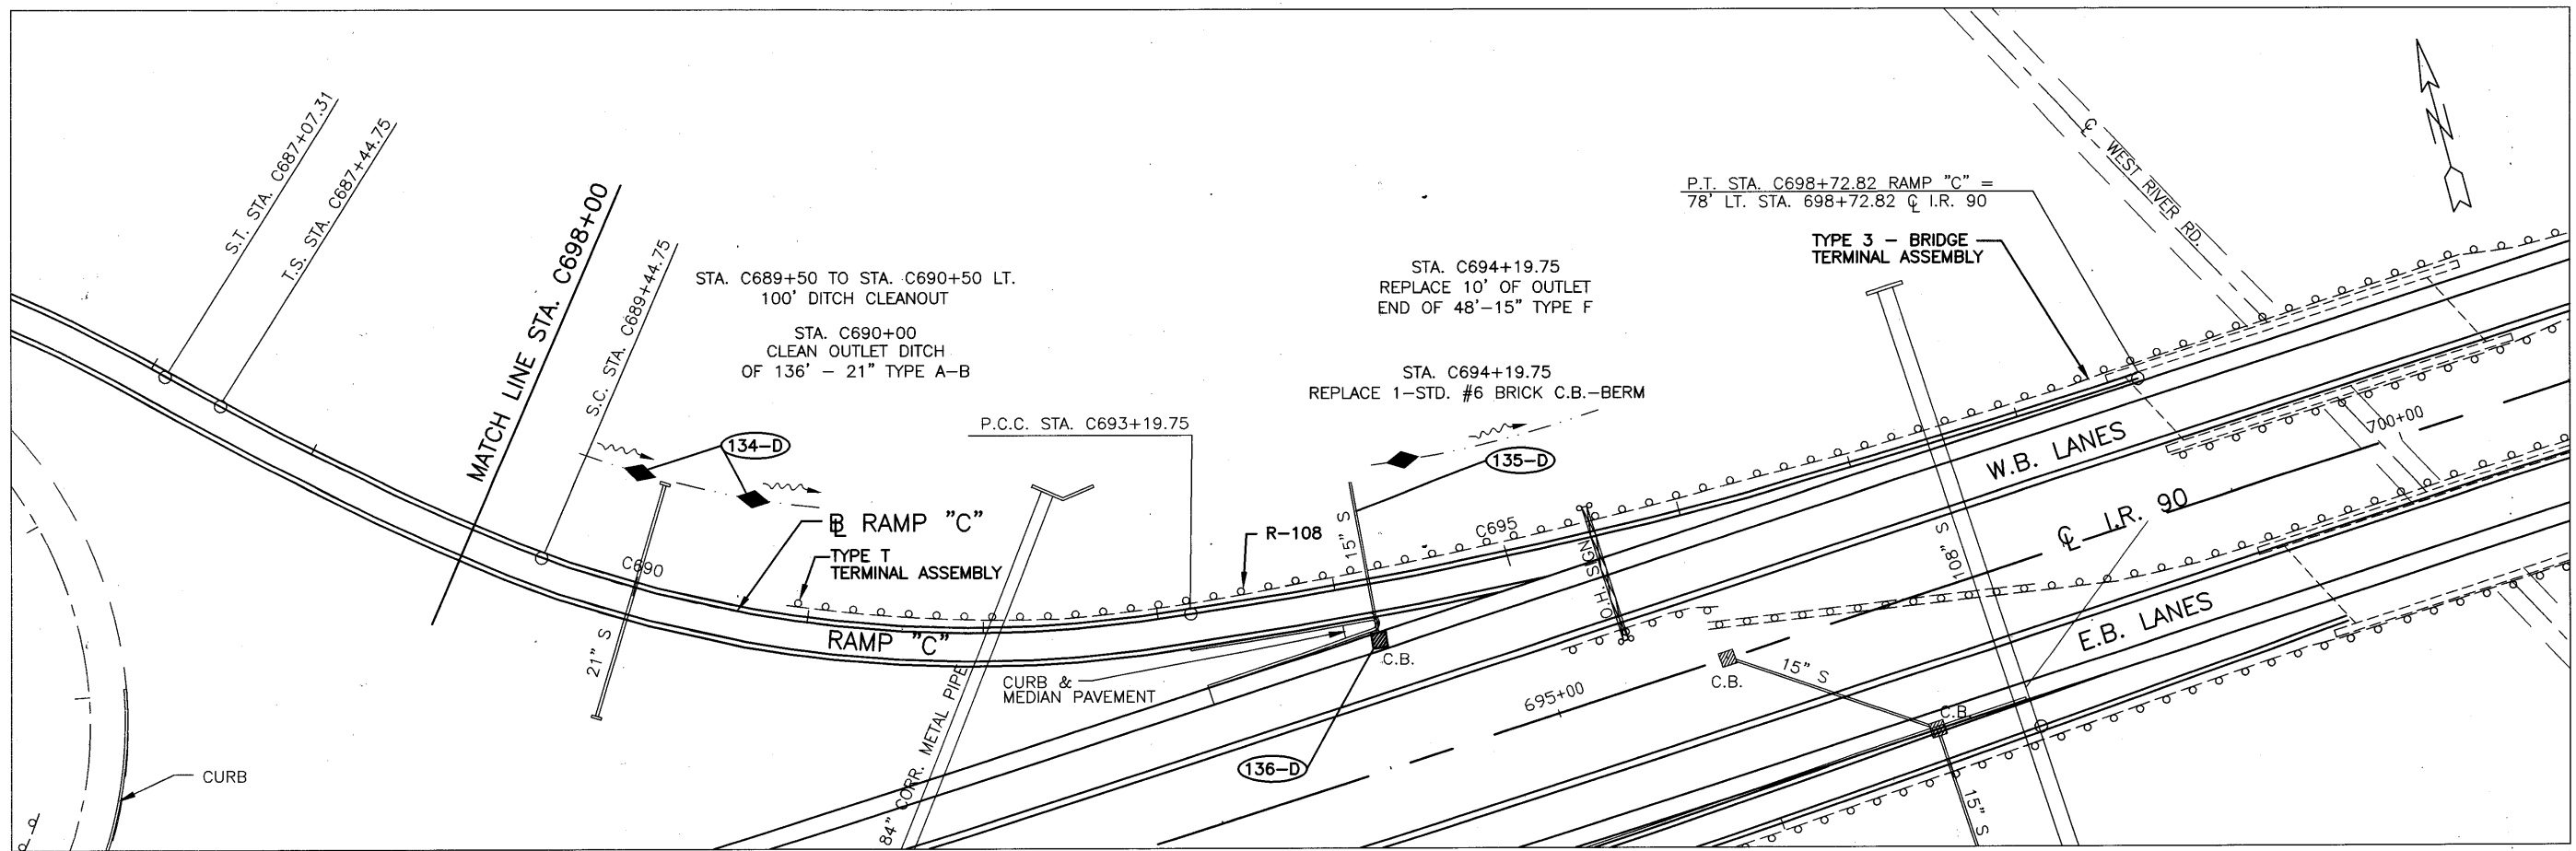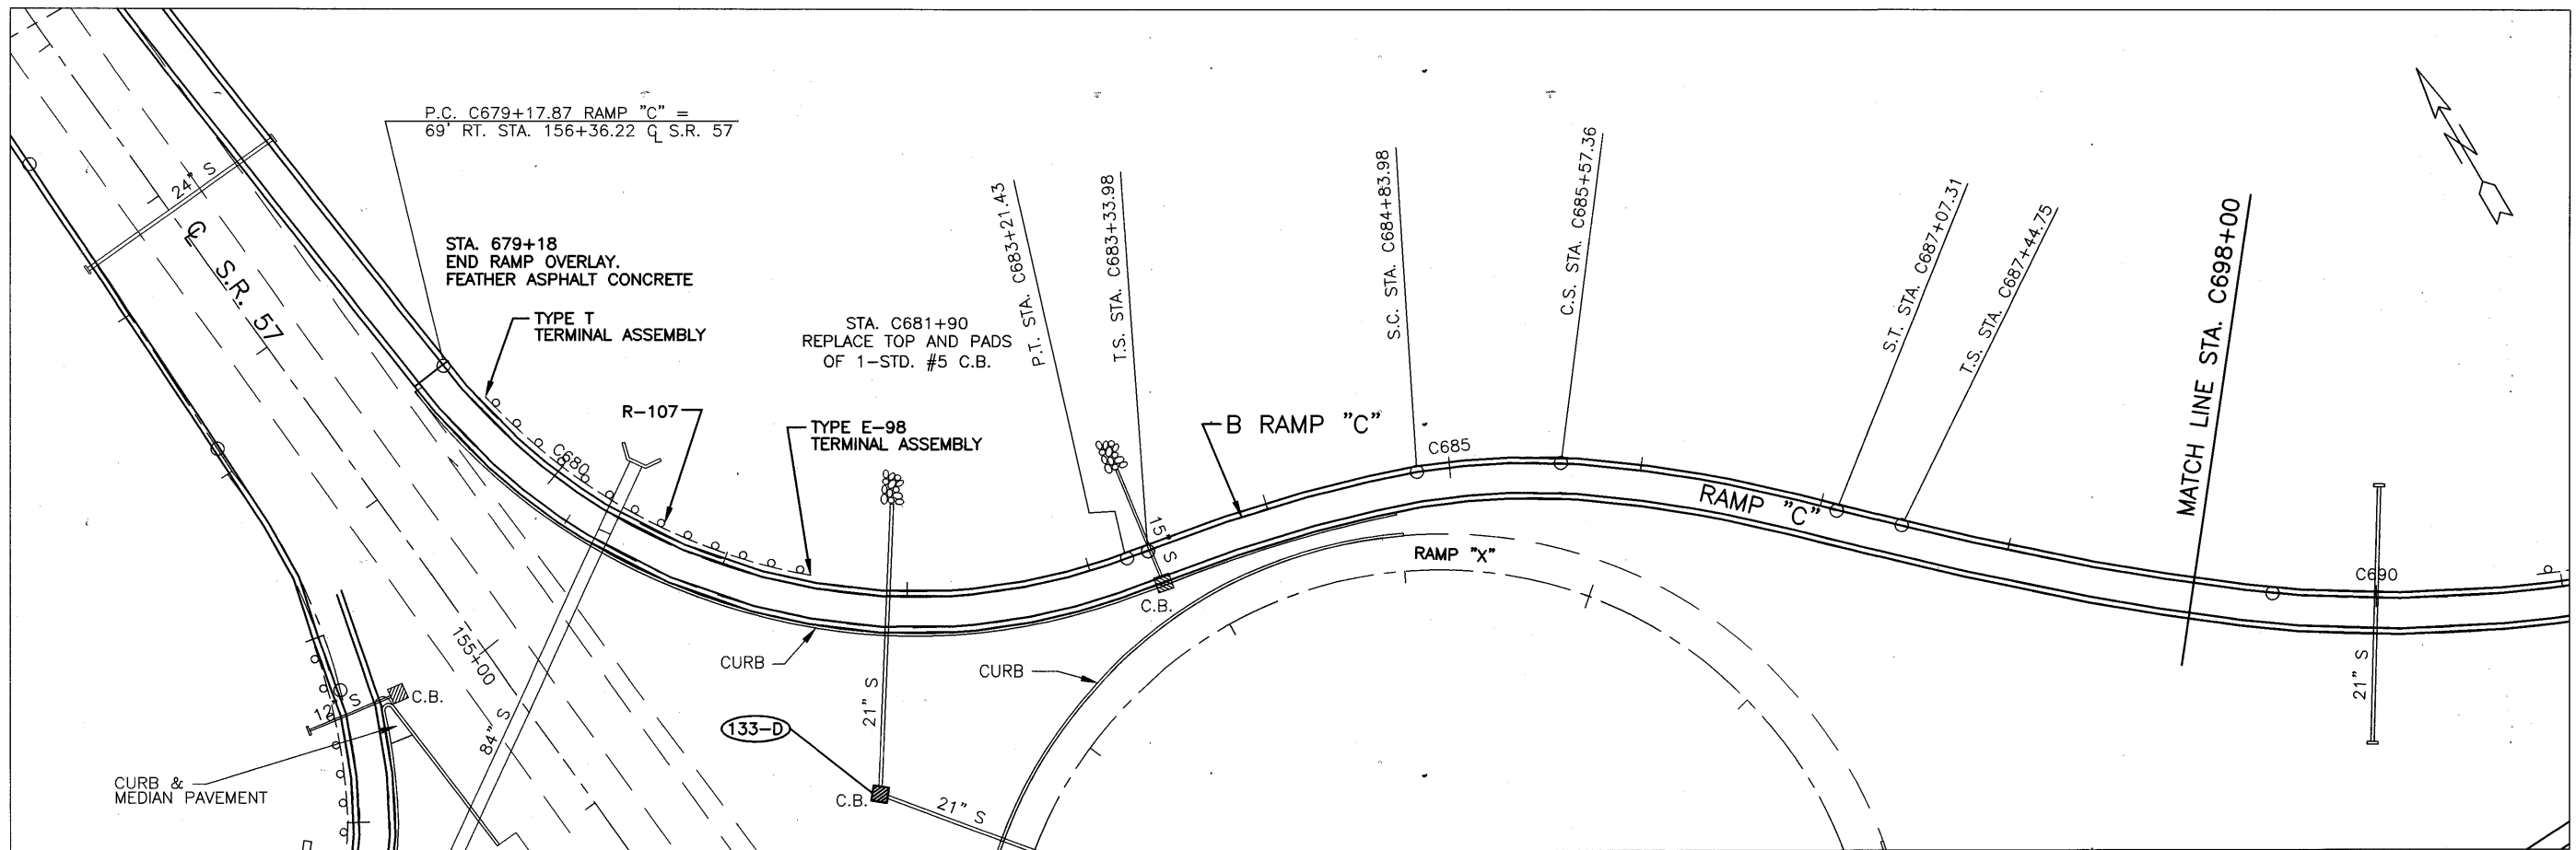


CALCULATED	0
DLS	0
CHECKED	LAB
HORIZONTAL SCALE IN FEET	
0	50
100	

**RAMP "C" - S.R. 57 & I.R. 90**  
**STA. 679+17.87 TO STA. 698+72.82**

**LOR-190-10.76**

F:\01\93500\UNWS\93500\FNL\VP-39.DWG 1 02  
02-13-2002 01:14:44

# S.R. 254 INTERCHANGE

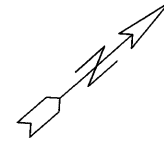

**GEOMETRIC LAYOUT I.R.90 & S.R.254 INTERCHANGE**  
**RAMP SCHEMATIC**

**ODOT PROJECT 3015-00**

**CURVE DATA RAMP "J"**

P.I. STA. J809+44.69 Δ=42°54'22" D=16°00'00" R=358.10' L=268.16' T=140.72' E=26.66'	P.I. STA. J815+29.26 Δ=24°44'57" D=8°00'00" R=716.20' L=309.36' T=157.13' E=17.04'
P.I. STA. J813+05.60 Θs=8°00'00" L.S.=200.00' L.T.=133.47' S.T.=66.79'	P.I. STA. J819+58.51 Δ=8°17'46" D=1°30'00" R=3819.72' L=553.07' T=277.02' E=10.03'

**CURVE DATA RAMP "H"**

P.I. STA. H795+81.37 Δ=7°30'00" D=2°30'00" R=2291.83' L=300.00' T=150.21' E=4.92'	P.I. STA. H799+88.19 Δ=39°29'03" D=8°00'00" R=716.197' L=493.55' T=257.03' E=44.73'
P.I. STA. H802+91.50 Θs=8°00'00" Ls=200.00' L.T.=133.47' S.T.=66.79'	

**CURVE DATA RAMP "K"**

P.I. STA. K818+59.74 Δ=30°28'01" D=8°00'00" R=716.197' L=380.84' T=195.04' E=26.08'	P.I. STA. K815+98.17 Θs=8°00'00" L.S.=200.00' L.T.=133.47' S.T.=66.79'
P.I. STA. K813+09.52 Δ=17°47'58" D=16°00'00" R=358.10' L=111.25' T=56.07' E=4.36'	


**CURVE DATA RAMP "L"**

P.I. STA. L801+34.51 Δ=4°40'22" D=1°00'00" R=5729.58' L=467.29' T=233.77' E=477'	P.I. STA. L808+06.12 Θs=8°00'00" L.S.=200.00' L.T.=133.47' S.T.=66.79'
P.I. STA. L805+68.49 Θs=12°00'00" L.S.=300.00' L.T.=200.46' S.T.=100.42'	P.I. STA. L807+03.71 Δ=5°42'15" D=8°00'00" R=716.20' L=71.30' T=35.68' E=0.89'
	P.I. STA. L811+89.38 Δ=45°28'09" D=16°00'00" R=358.10' L=284.18' T=150.05' E=31.17'



**CURVE DATA I.R. 90**

P.I. STA. 796+98.20 Δ=62°20'45" D=2°30'00" R=2291.83' Lc=2093.83' Ts=1588.21' Es=390.16' Θs=5°00'00" L.S.=400.00' L.T.=266.77' S.T.=133.43'
---------------------------------------------------------------------------------------------------------------------------------------------------------------------------

**BEGIN RAMP "H"**  
P.C. STA. H794+31.16  
STA. 794+31.16, I.R.90, 91-LT.

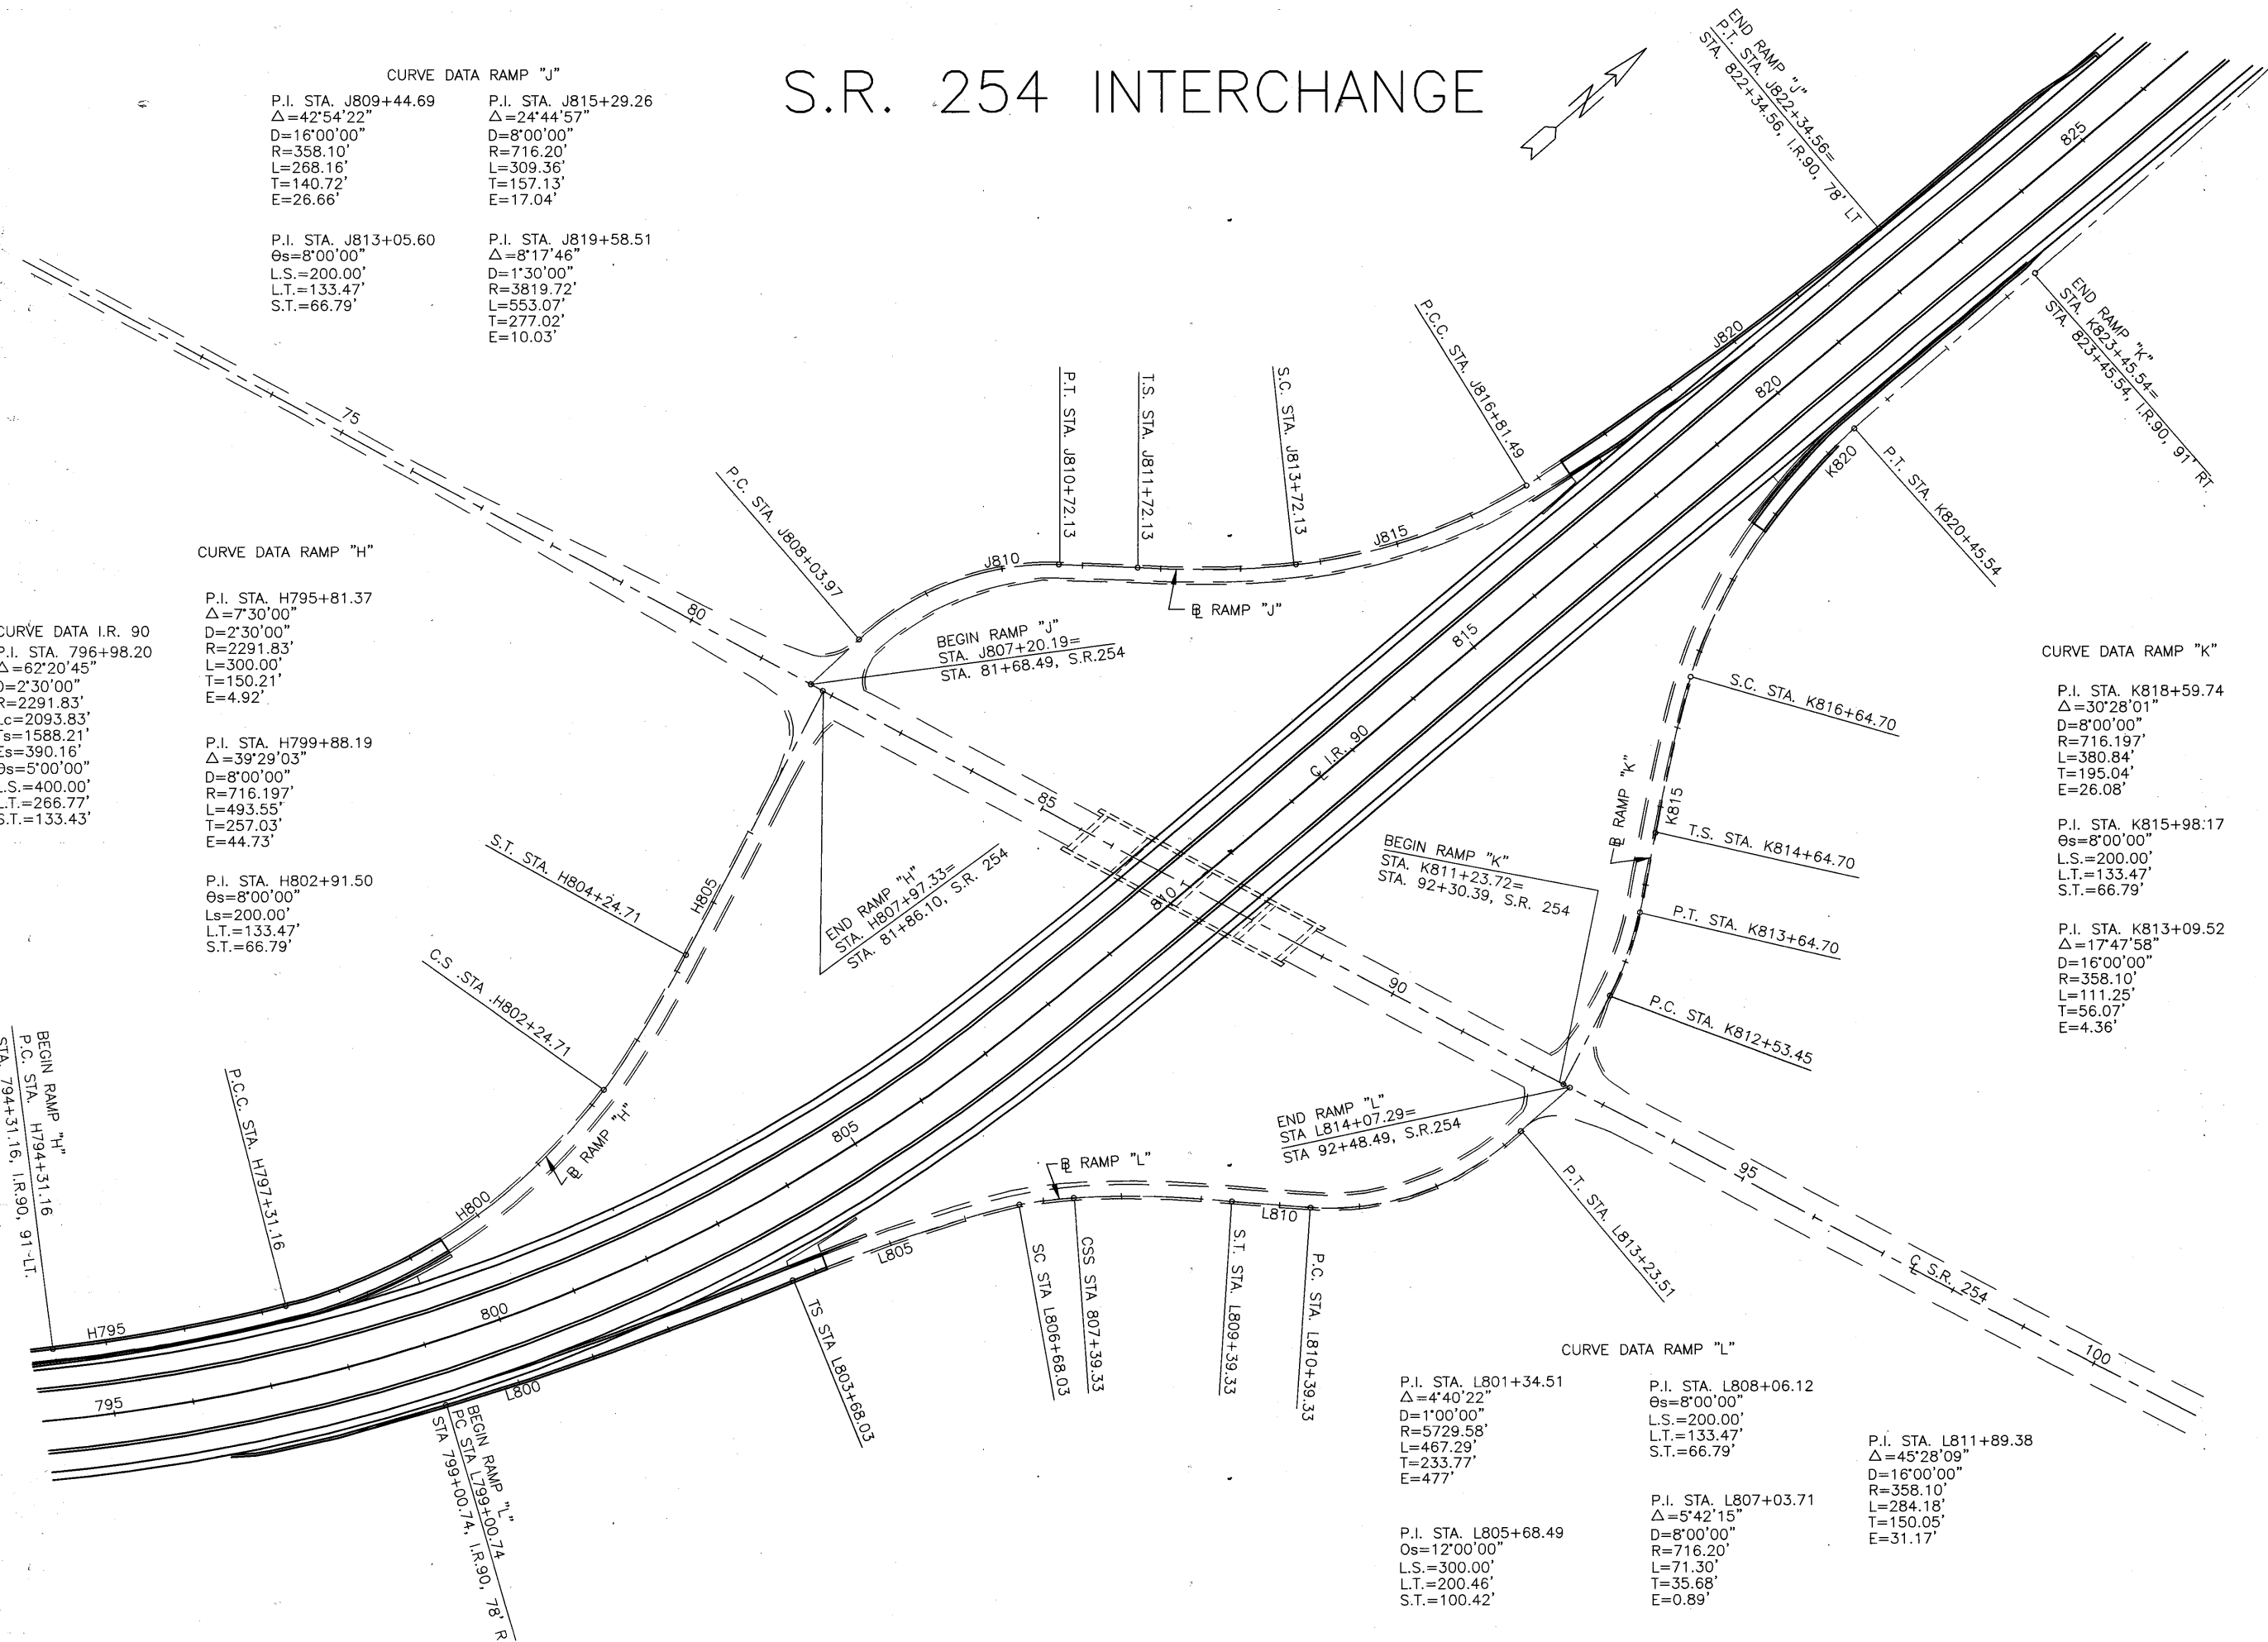

79 [S:\3015\00\3015-00\DWG\3015-00-274.dwg] 274  
 02-13-2007 10:08 AM

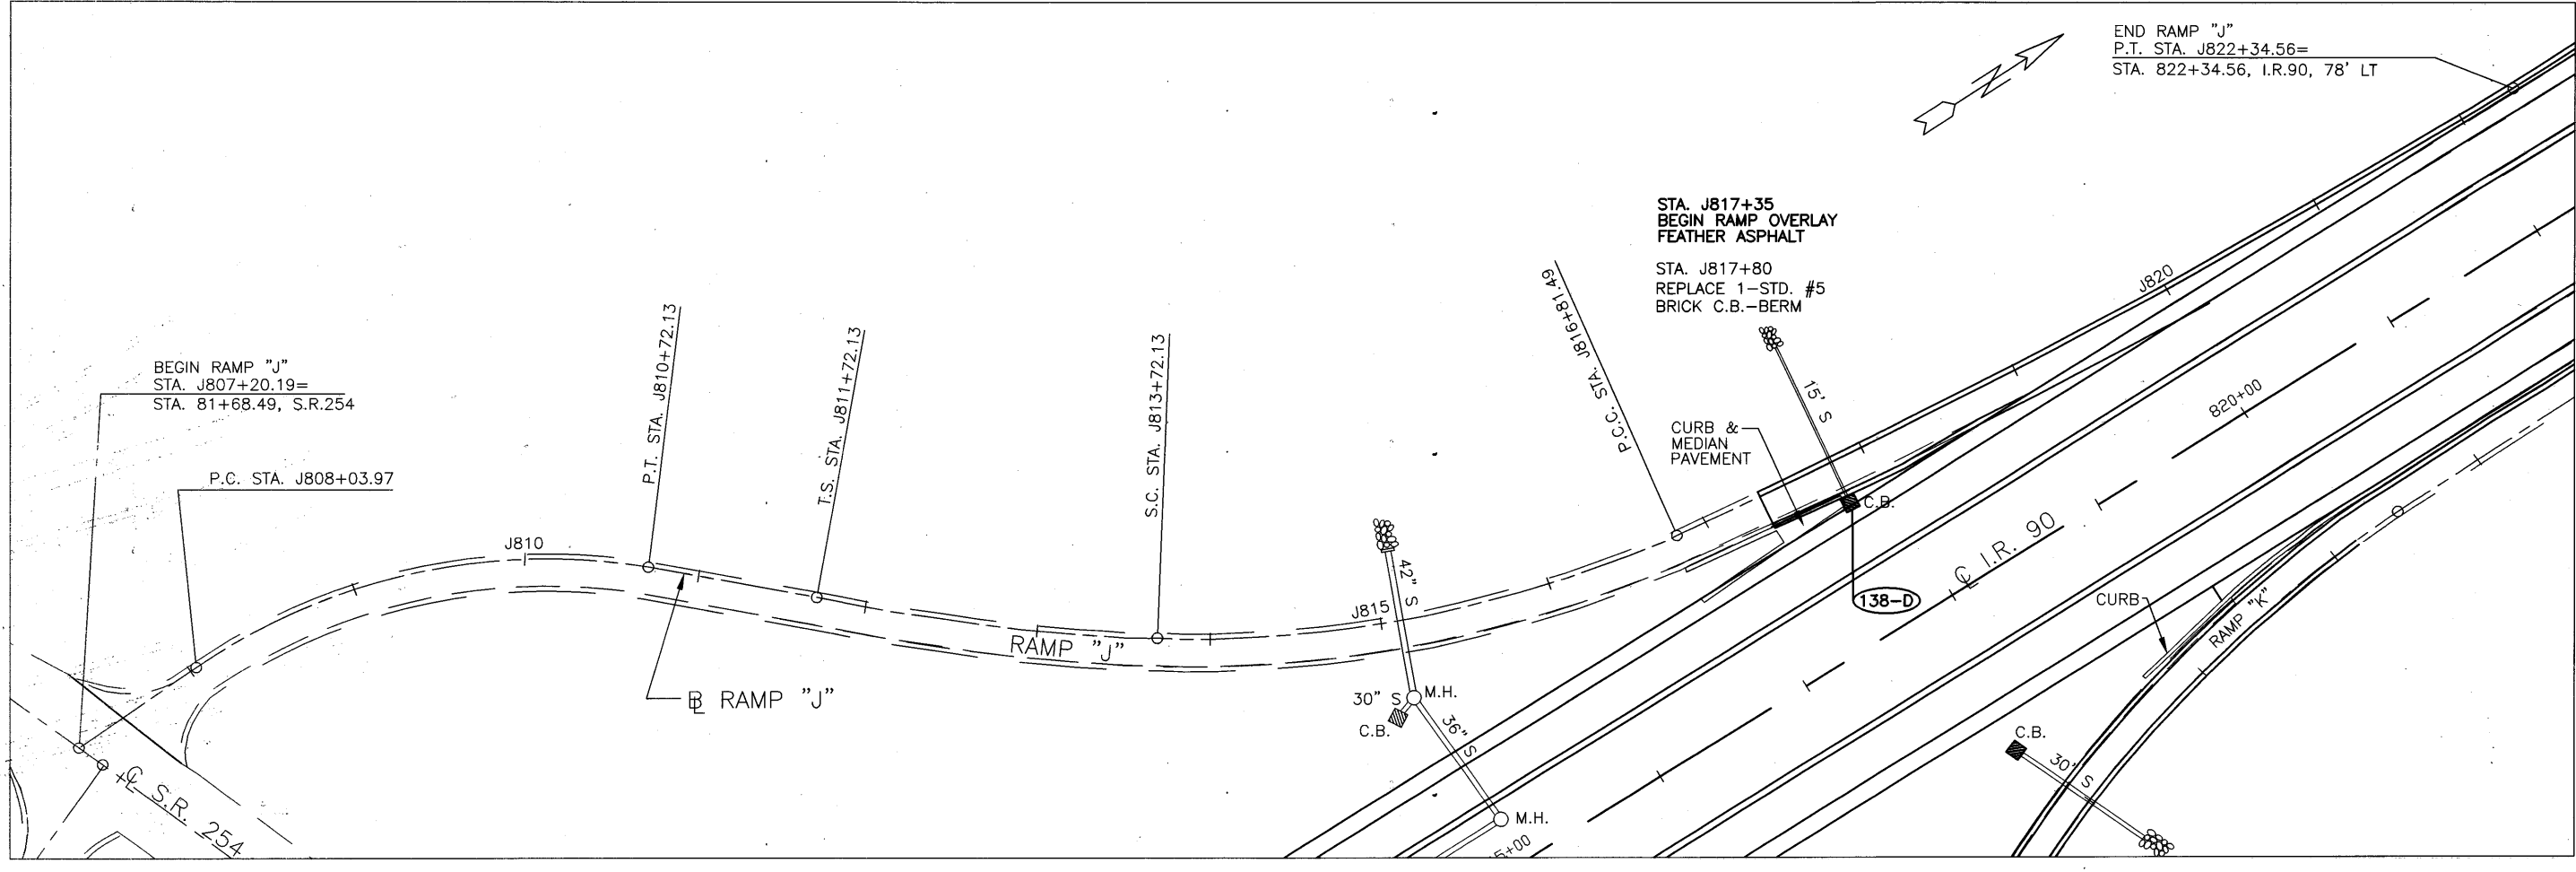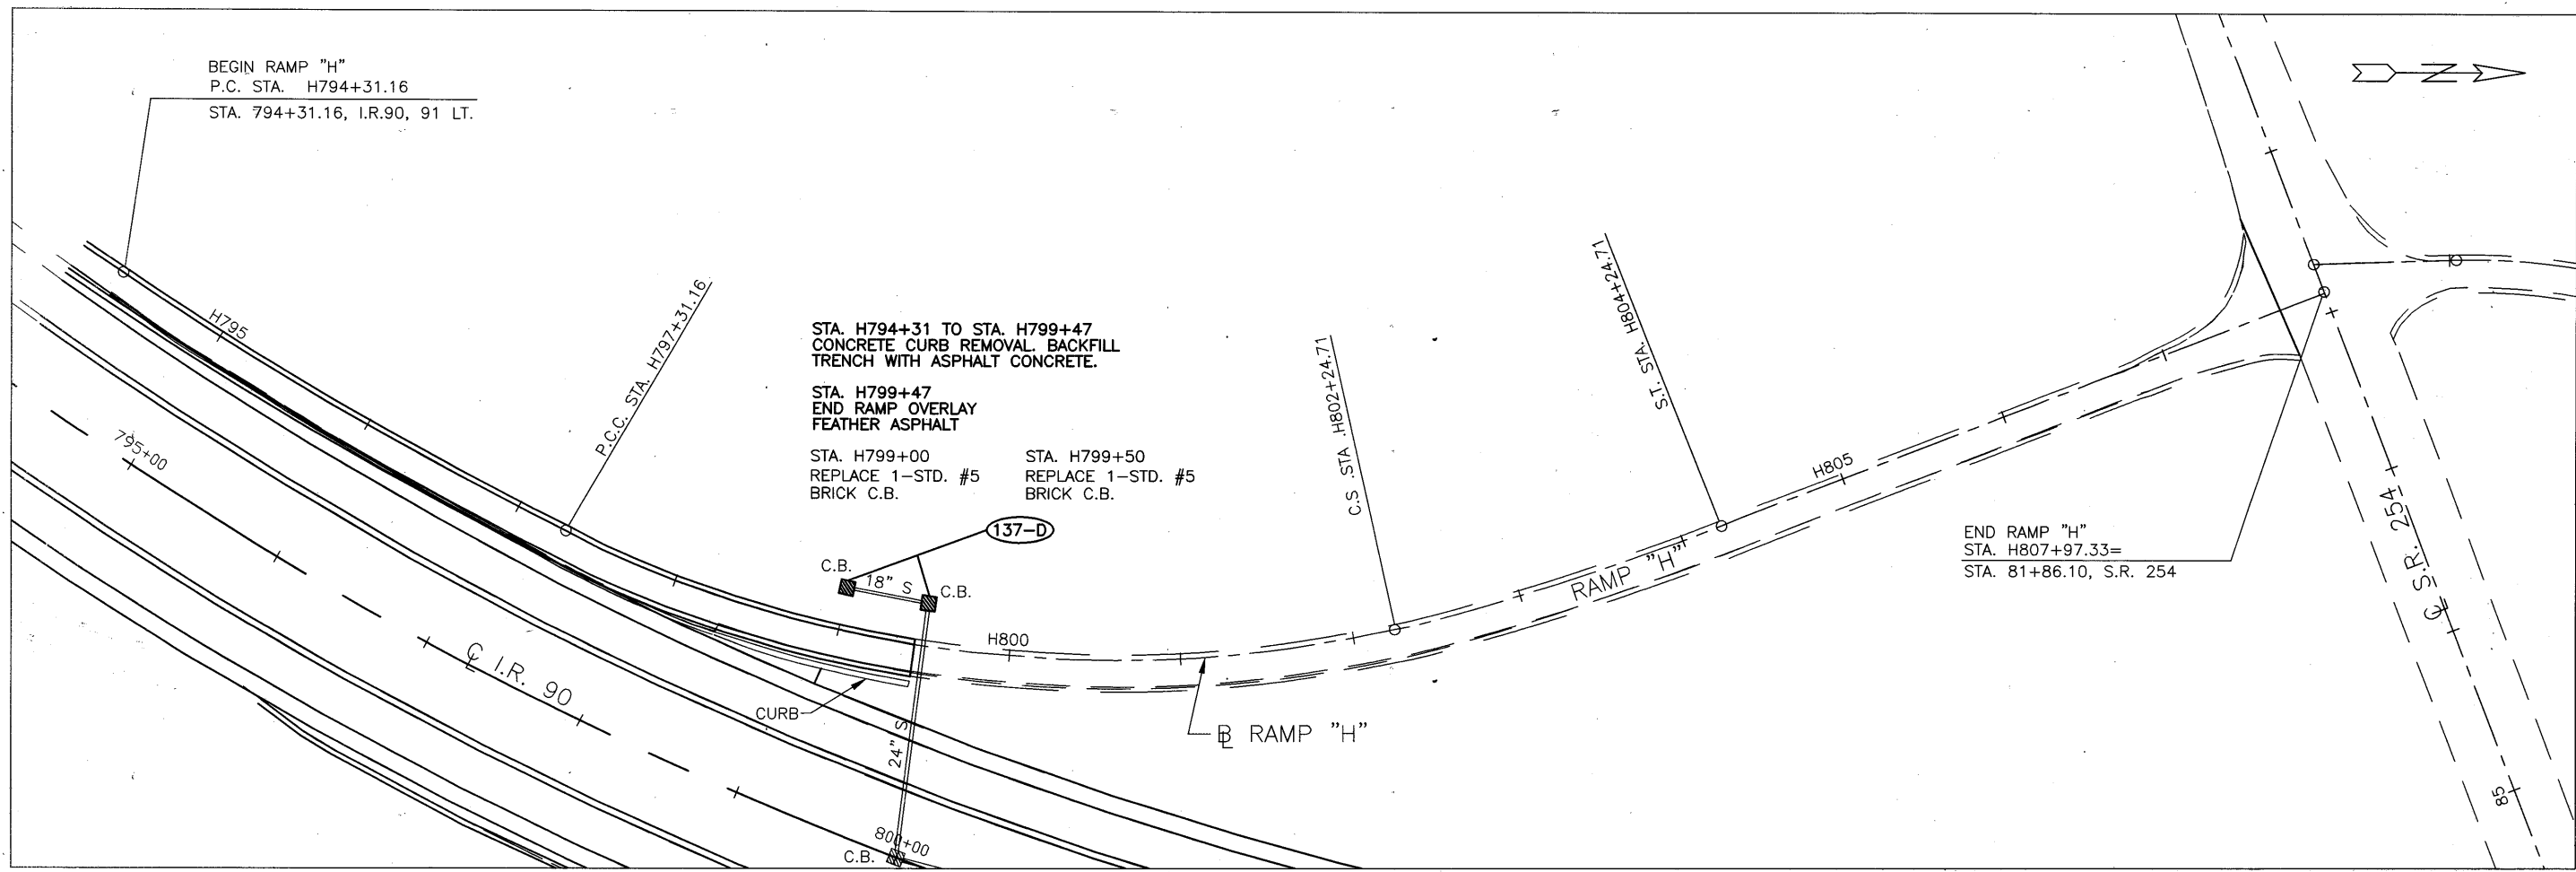



CALCULATED	DLS	CHECKED	LAB

RAMP "H" & RAMP "J" - S.R.254 & I.R. 90  
STA. H794+31.16 TO STA. H807+97.33 & STA. J808+03.97 TO STA. J822+34.56

LOF-190-10.76

101  
274

I:\CA\3630\DWG\DESIGN\LP-41.DWG 11/02  
 02-13-2002 10:17AM

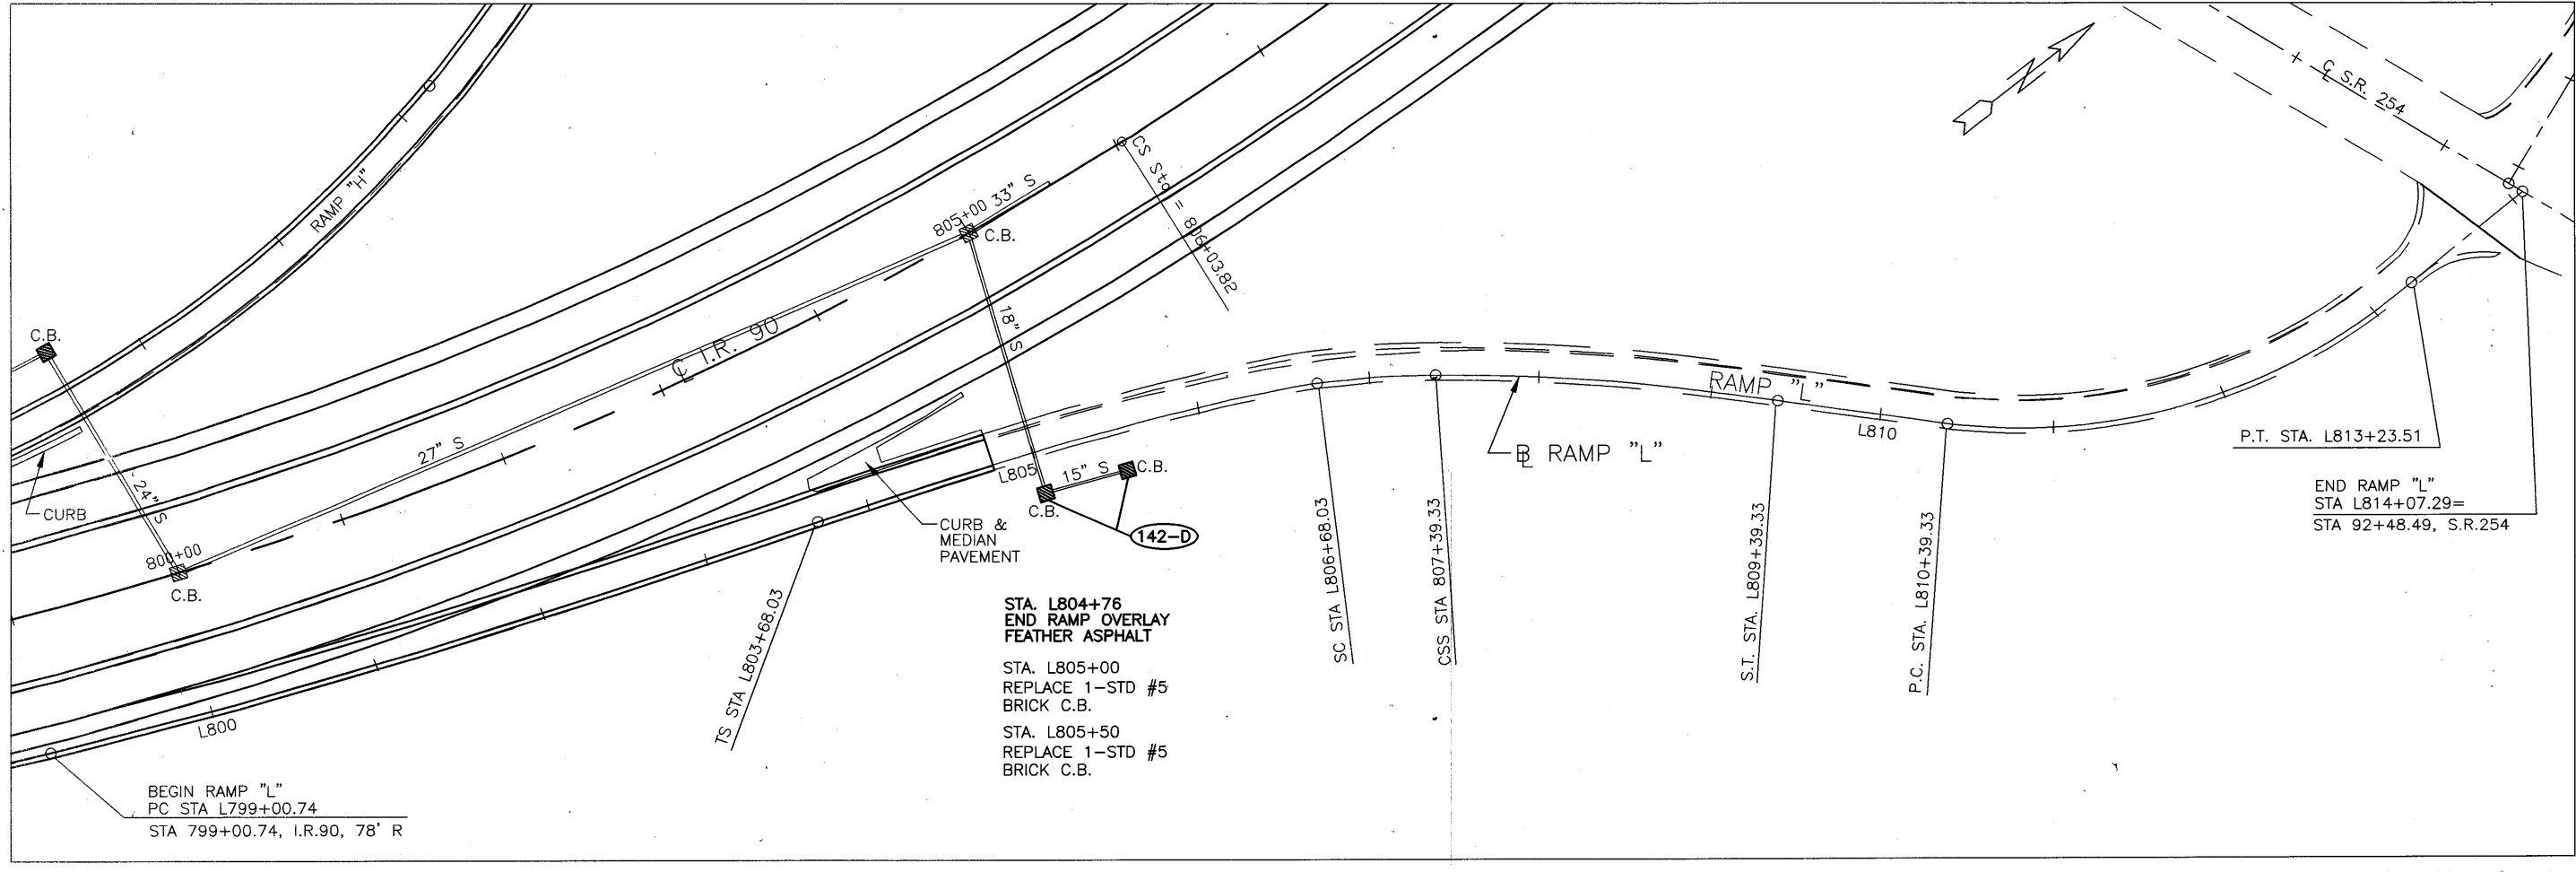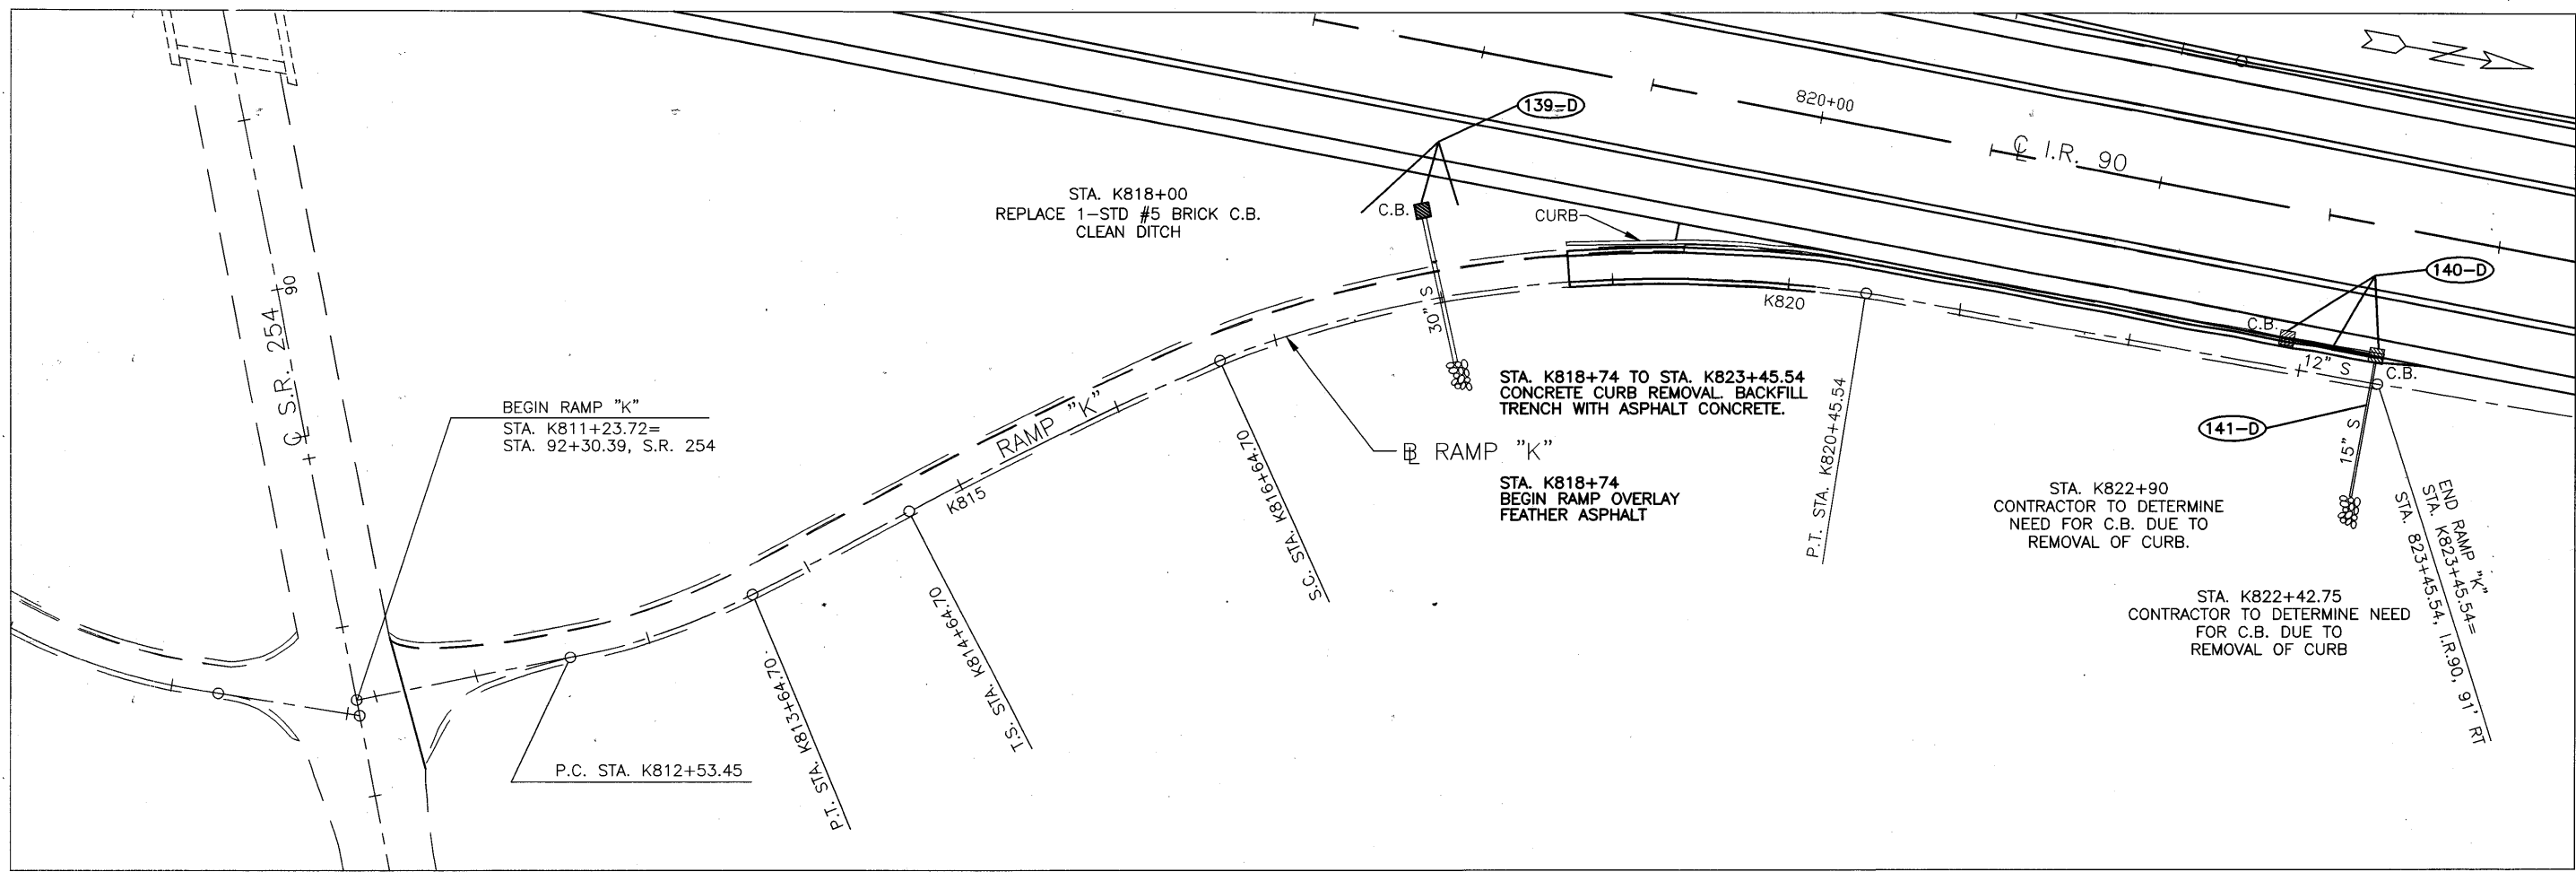


CALCULATED	DLS	CHECKED	LAB

HORIZONTAL SCALE IN FEET  
 0 50 100  
 RAMP "K" & RAMP "L" - S.R. 254 & I.R. 90  
 STA. K811+23.72 TO STA. K823+45.54 & STA. L799+00.74 TO STA. L814+07.29

LOR-190-10.76

PROFILE DETAIL ALONG EXISTING PAVEMENT OVERLAY AT EXPOSED CONCRETE BRIDGE DECKS WITH NO CONCRETE OVERLAY

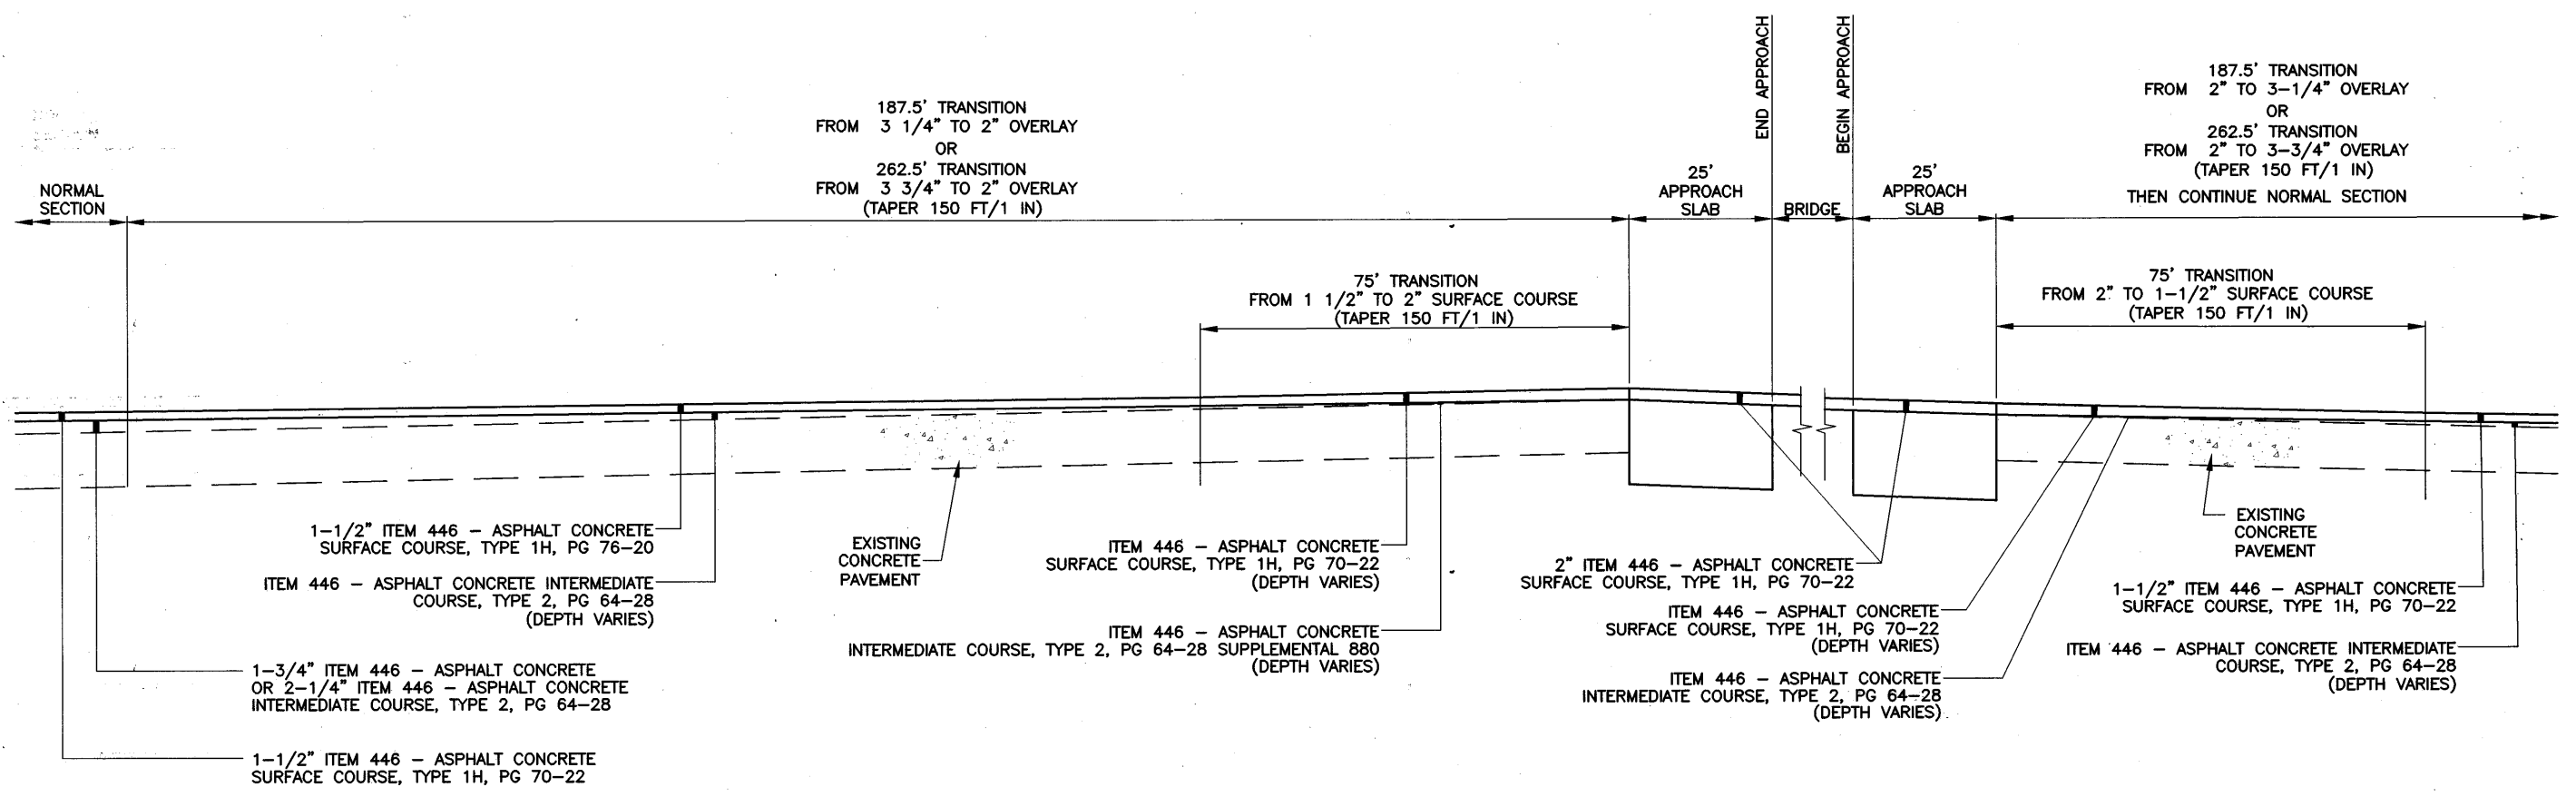


STRUCTURE NO.	END APPROACH SLAB STATIONING	BEGIN APPROACH SLAB STATIONING	TOTAL TRANSITION LENGTH
LOR-2-1046 L&R	STA. 552+18.58 L STA. 552+18.58 R	STA. 554+00.02 L STA. 554+00.02 R	187.5' 187.5'
LOR-90-1355 R	STA. 698+98.85 R	STA. 700+81.81 R	262.5'
LOR-90-1785 L&R	STA. 927+35.89 L STA. 927+77.86 R	STA. 928+89.30 L STA. 928+40.59 R	262.5' 262.5'

MISCELLANEOUS DETAILS

LOR - 190 - 10.76

PROFILE DETAIL ALONG EXISTING PAVEMENT OVERLAY AT BRIDGE DECKS WITH ASPHALT CONCRETE OVERLAY

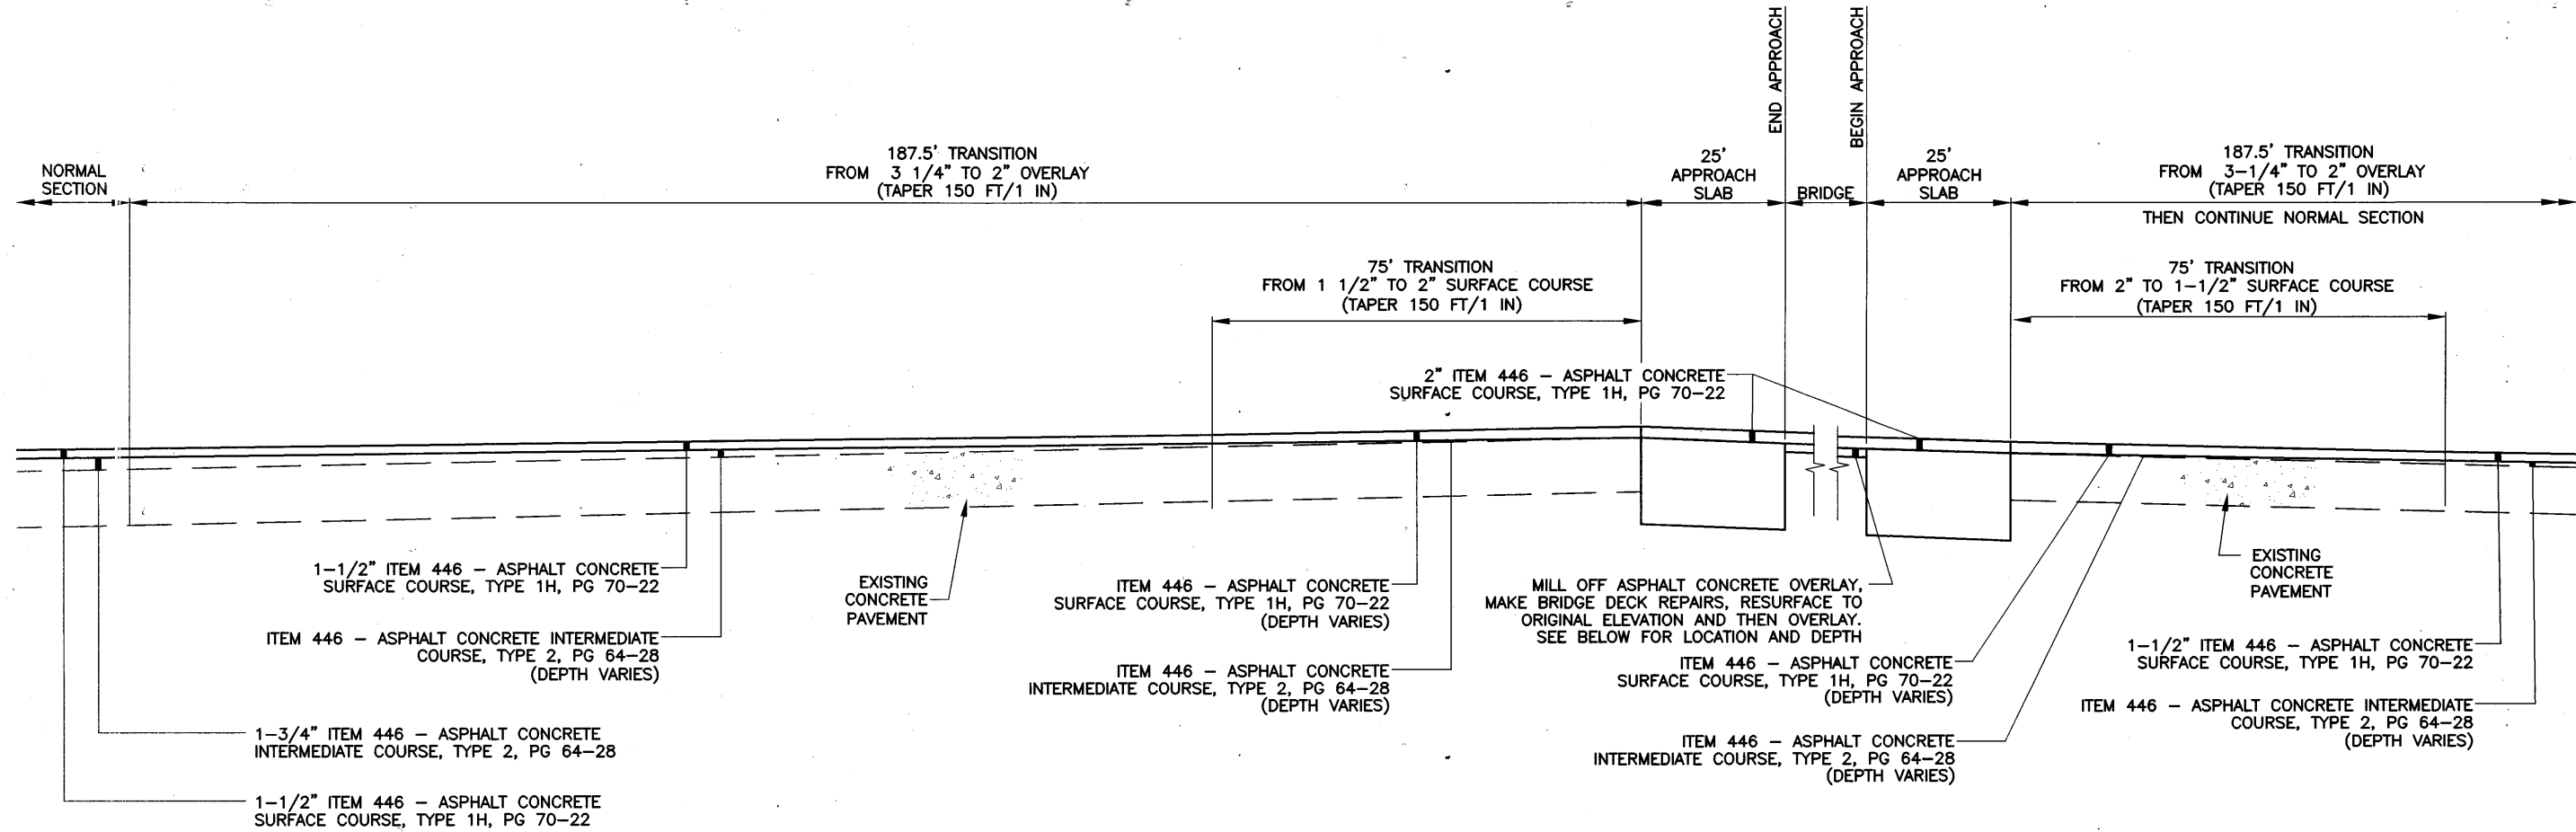




<u>STRUCTURE NO.</u>	<u>END APPROACH SLAB STATIONING</u>	<u>BEGIN APPROACH SLAB STATIONING</u>	<u>TOTAL TRANSITION LENGTH</u>	<u>DEPTH OF EXISTING OVERLAY</u>
LOR-90-1157 L	STA. 565+24.98 L	STA. 566+53.82 L	187.5'	2.5"
LOR-90-1157 R	STA. 567+00.81 R	STA. 568+22.94 R	187.5'	2.5"
LOR-90-1178 L	STA. 576+36.12 L	STA. 578+63.12 L	187.5'	1.5"

CALCULATED  
DLS  
CHECKED  
LAB


MISCELLANEOUS DETAILS

LOR - 190 - 10.76



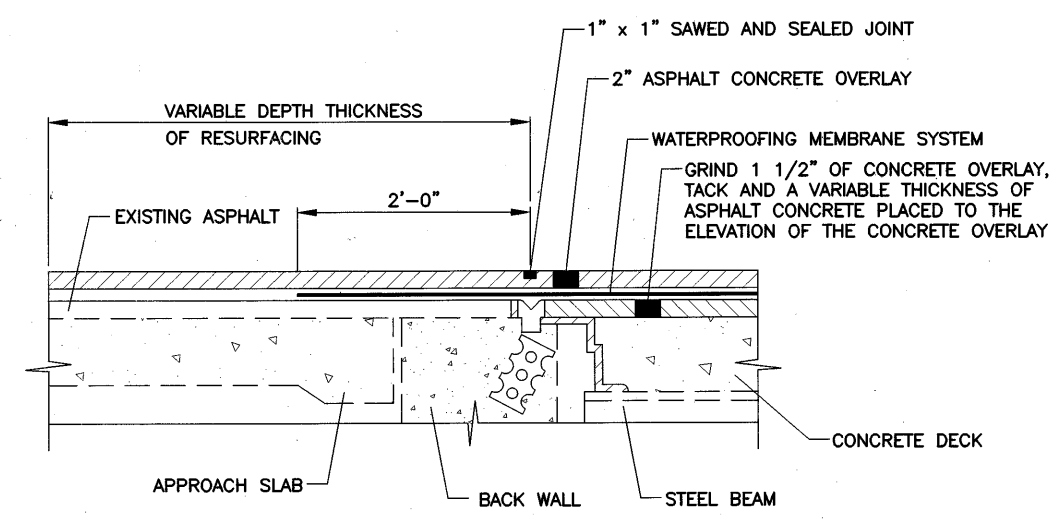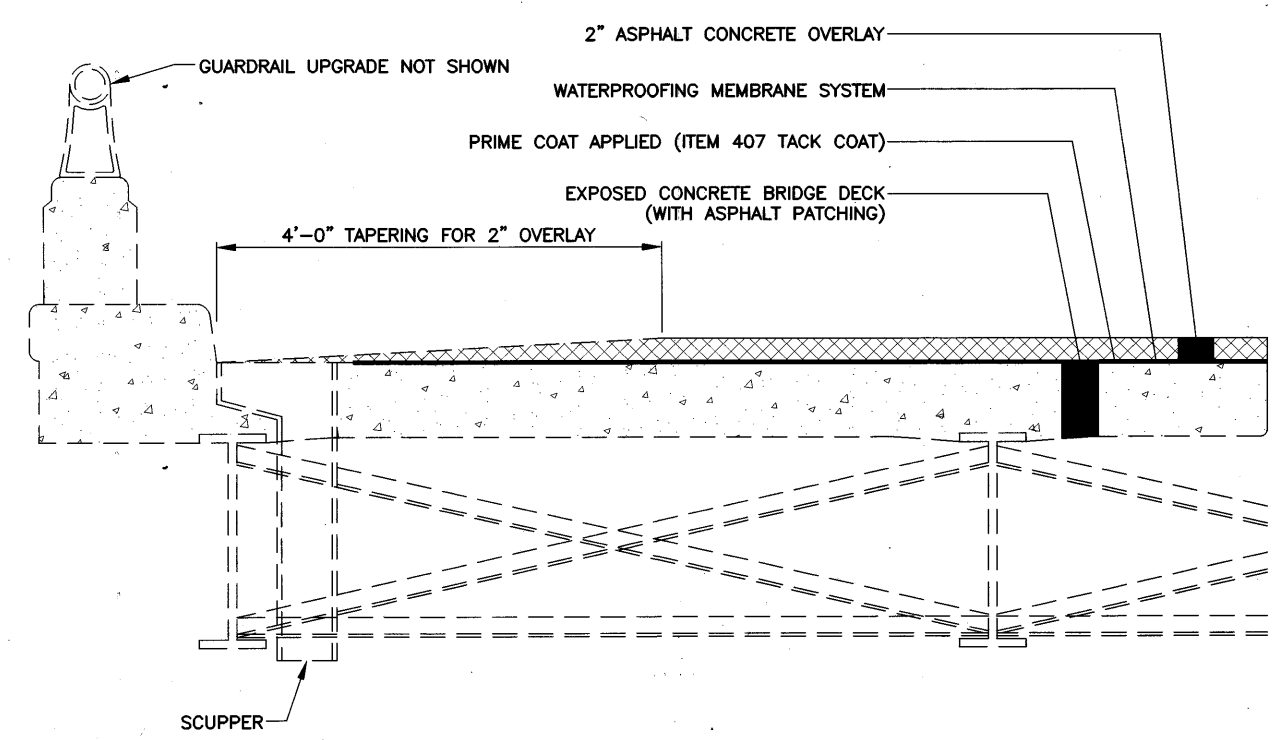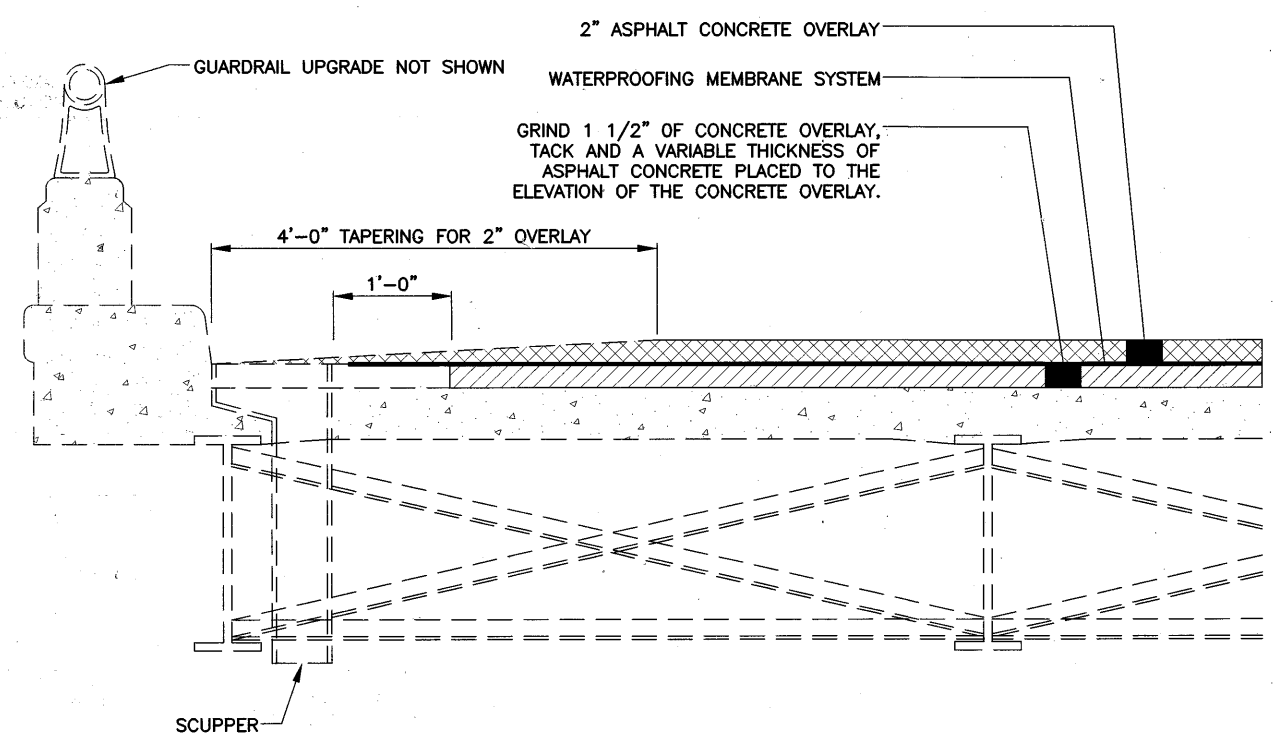


WITH CONCRETE OVERLAY

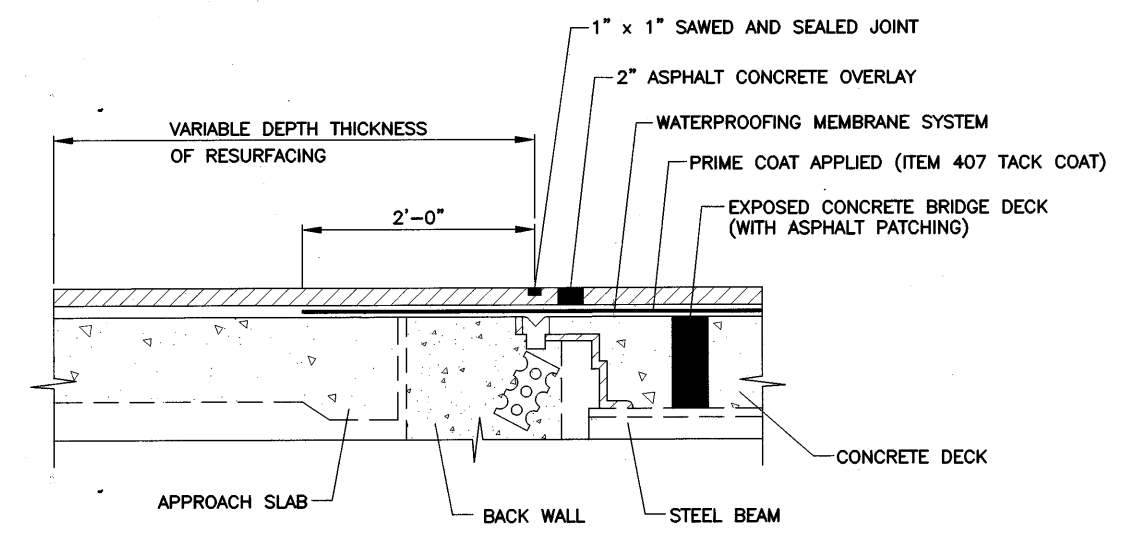

NO EXISTING OVERLAYS

PROFILE DETAIL ALONG EXISTING PAVEMENT OVERLAY AT BRIDGE DECKS WITH EXPOSED CONCRETE OVERLAYS

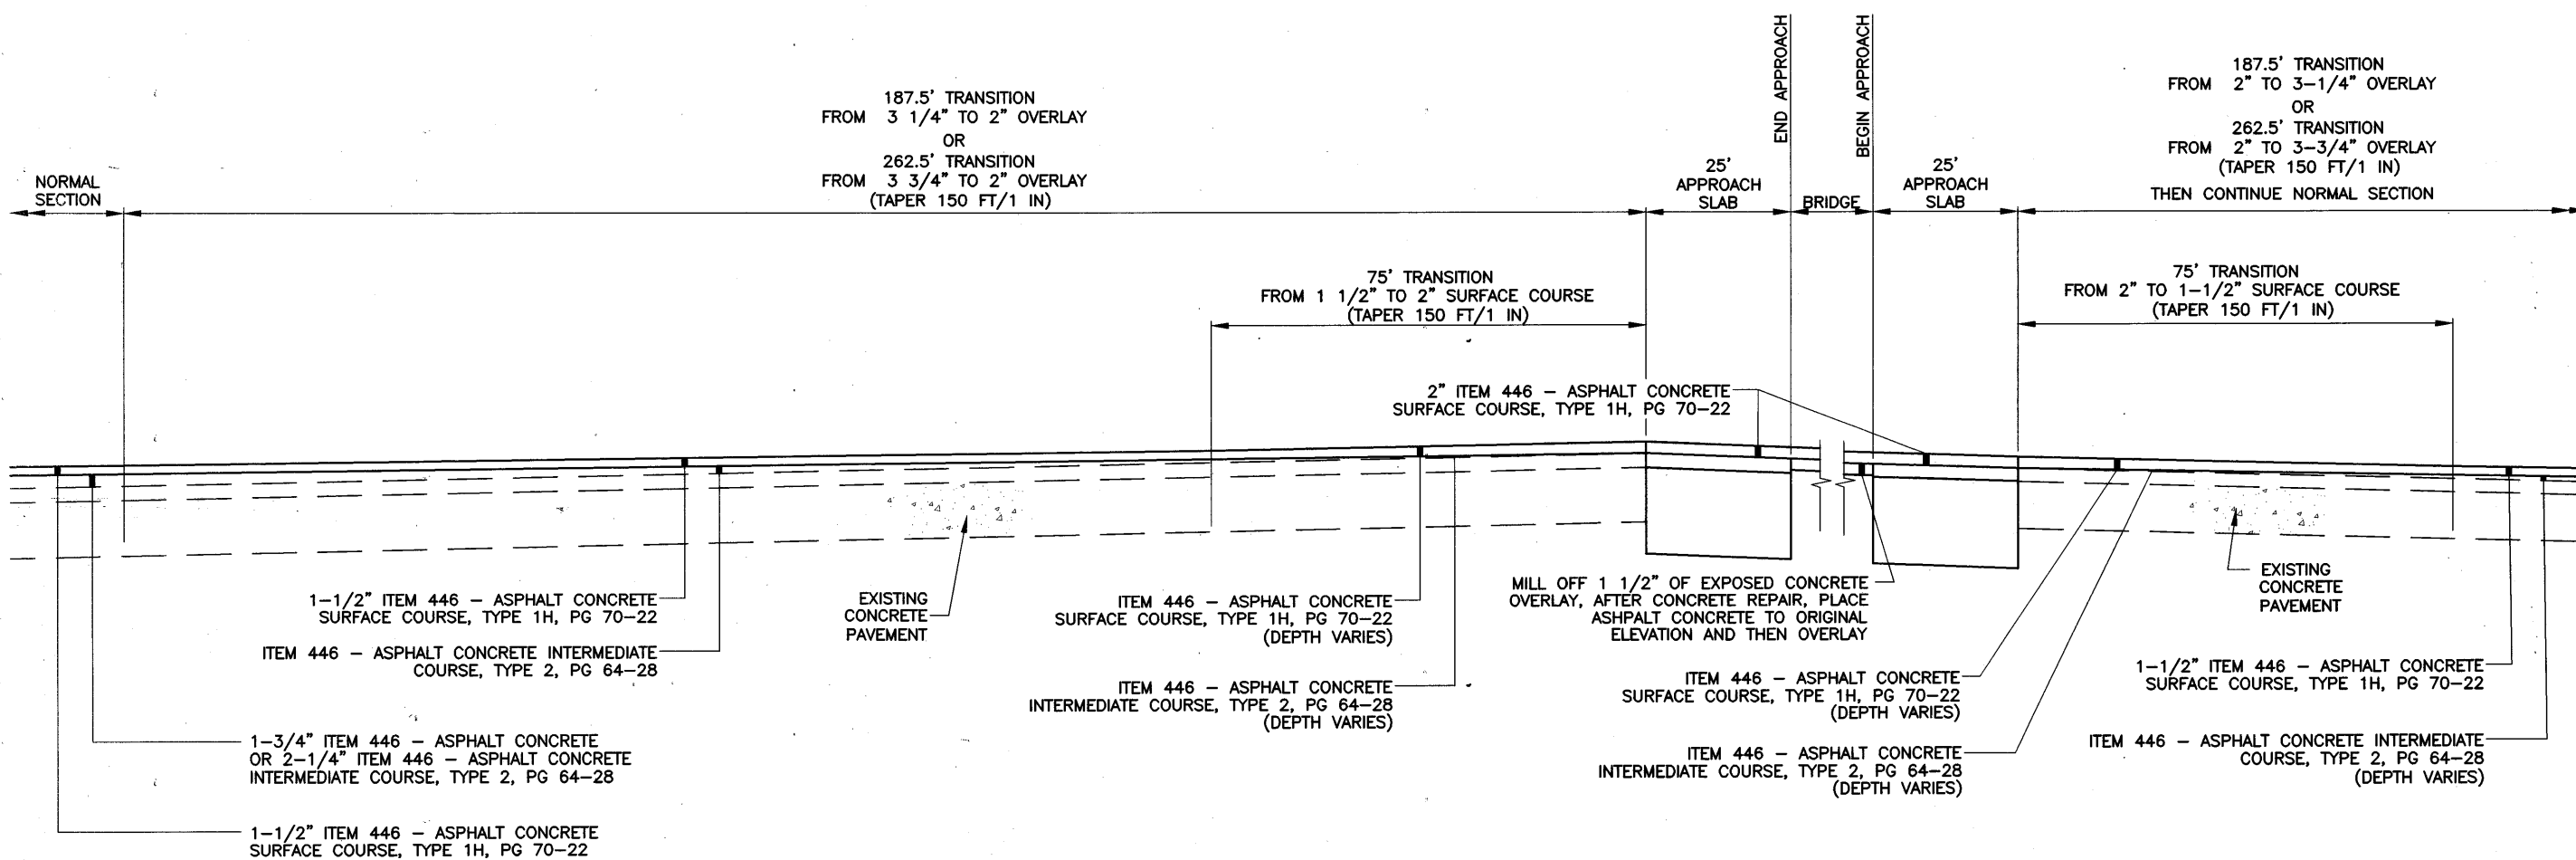


STRUCTURE NO.	END APPROACH SLAB STATIONING	BEGIN APPROACH SLAB STATIONING	TOTAL TRANSITION LENGTH
LOR-2-1070 L&R	STA. 564+20.65 L STA. 564+44.27 R	STA. 565+69.91 L STA. 565+93.66 R	187.5' 187.5'
LOR-90-1244 L&R	STA. 612+31.40 L STA. 612+58.41 R	STA. 614+00.60 L STA. 614+23.99 R	187.5' 187.5'
LOR-90-1256 L&R	STA. 618+72.71 L STA. 618+72.71 R	STA. 620+20.28 L STA. 620+20.28 L	187.5' 187.5'
LOR-90-1320 L&R	STA. 680+81.01 L STA. 680+81.01 R	STA. 683+24.01 L STA. 683+24.01 R	262.5' 262.5'
LOR-90-1355 L	STA. 698+98.85 L	STA. 700+81.81 L	262.5'
LOR-90-1426 L&R	STA. 736+53.75 L STA. 736+63.75 R	STA. 740+22.25 L STA. 740+32.25 R	262.5' 262.5'
LOR-90-1443 L&R	STA. 745+83.18 L STA. 745+65.31 R	STA. 747+09.40 L STA. 747+27.64 R	262.5' 262.5'

MISCELLANEOUS DETAILS

LOR - 190 - 10.76

I:\CA\935001\DWG\935001\935001.DWG 1 02  
 02-10-2002 3:08PM

PROFILE DETAIL AT OVERHEAD STRUCTURES ALONG EXISTING PAVEMENT WITH NO OVERLAY

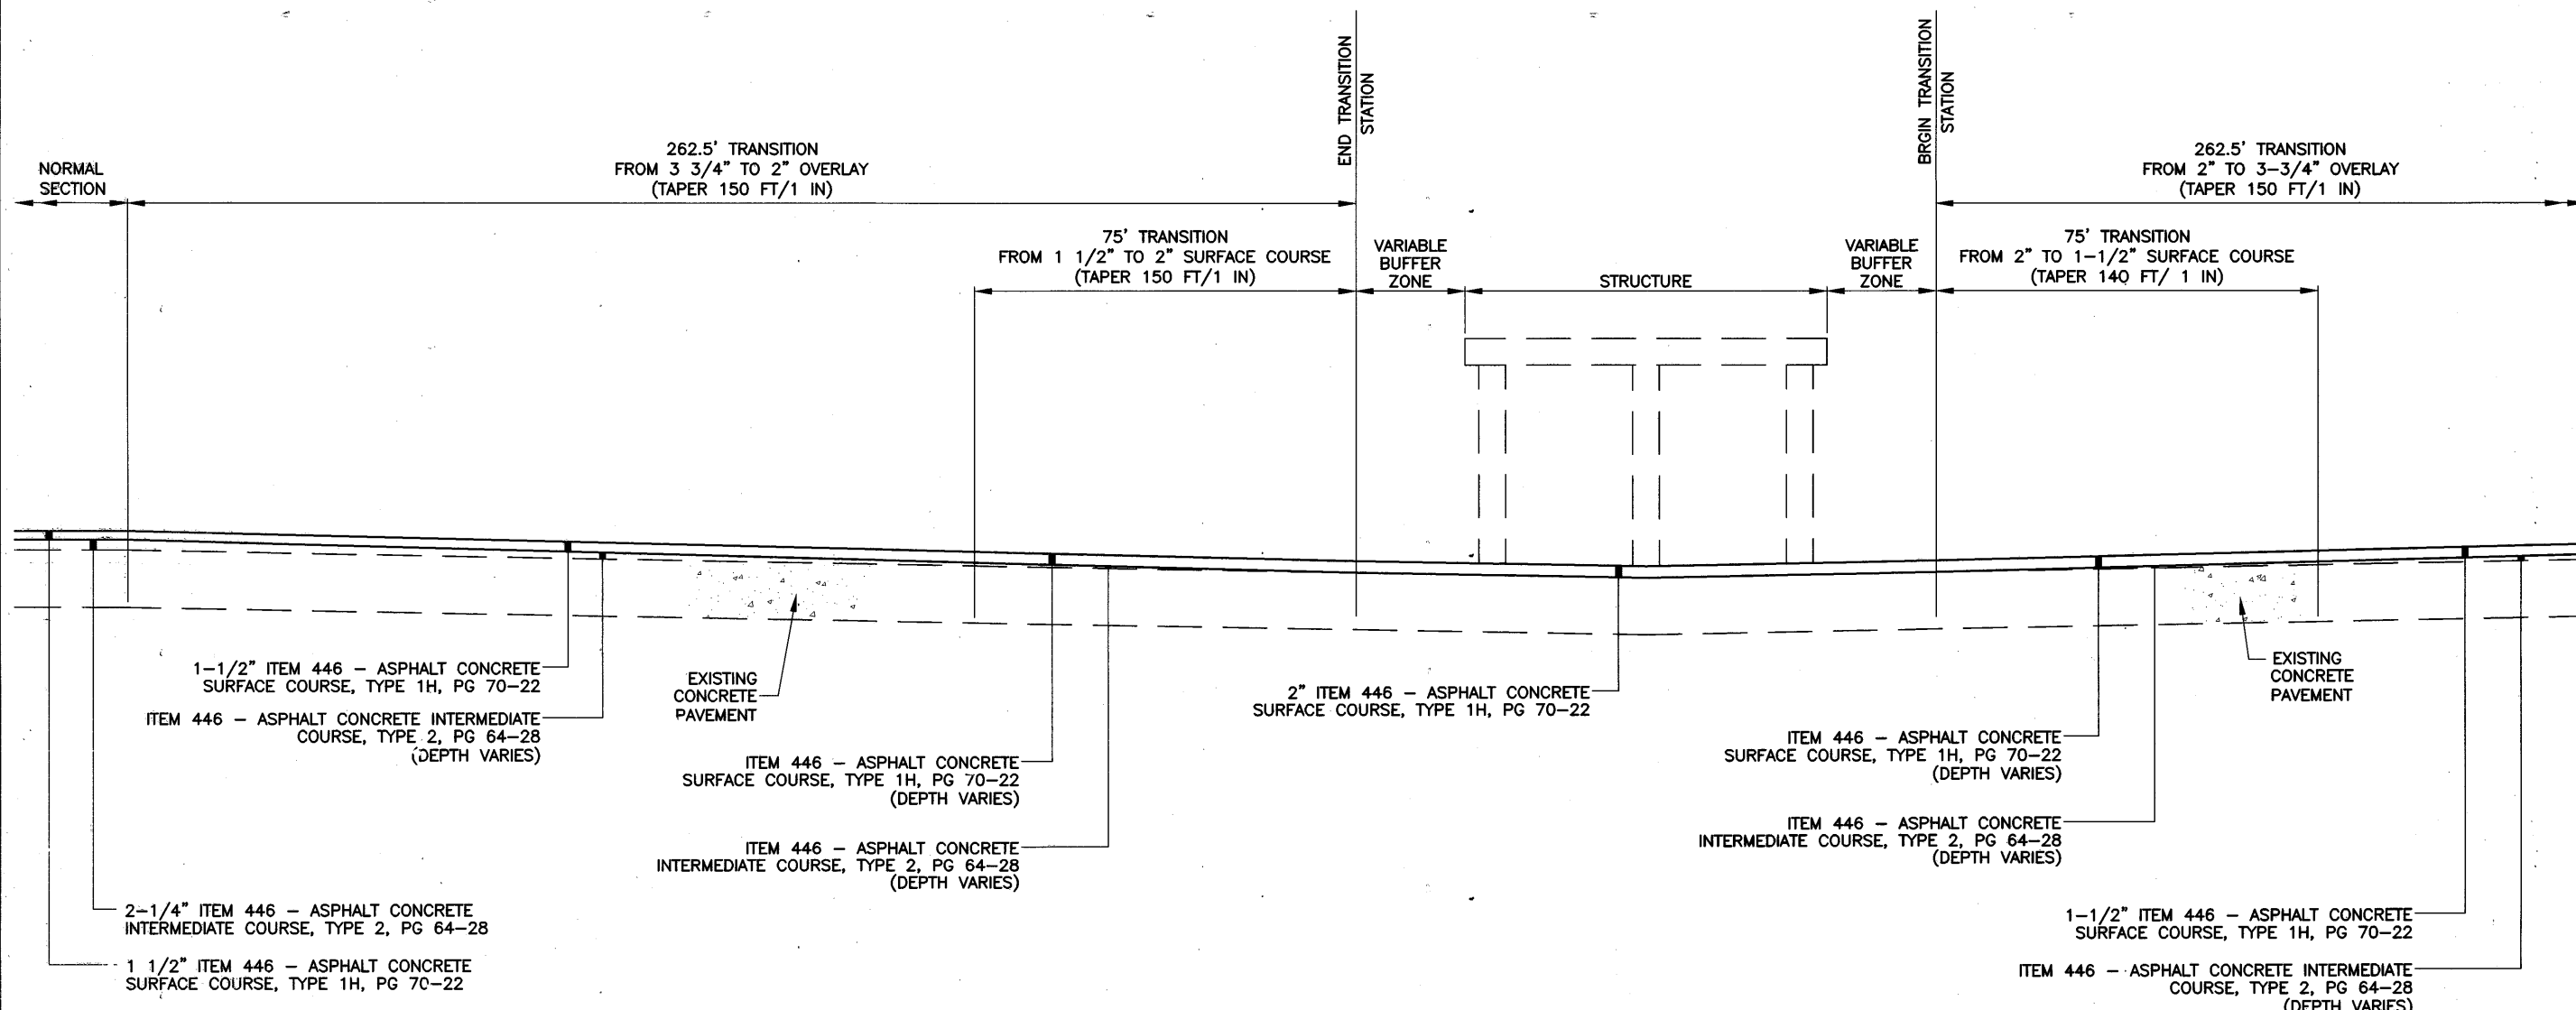

STRUCTURE NO.	END TRANSITION STATIONING	BEGIN TRANSITION STATIONING	TOTAL TRANSITION LENGTH
LOR-90-1478	STA. 762+76.59 L STA. 763+12.38 R	STA. 766+22.92 L STA. 766+57.61 R	262.5' 262.5'
LOR-90-1565	STA. 808+24.07 L STA. 808+65.18 R	STA. 812+03.10 L STA. 812+46.40 R	262.5' 262.5'
LOR-90-1700	STA. 880+78.38 L STA. 880+23.00 R	STA. 884+80.76 L STA. 883+90.14 R	262.5' 262.5'
LOR-90-1753	STA. 907+78.84 L STA. 908+39.77 R	STA. 911+33.71 L STA. 911+94.64 R	262.5' 262.5'


CALCULATED  
DLS  
CHECKED  
LAB

MISCELLANEOUS DETAILS

LOR - 190 - 10.76

I:\GIS\GIS\DWG\190\190-10.76\190-10.76.dwg 2/14/02 2:14 PM

PROFILE DETAIL AT OVERHEAD STRUCTURES ALONG EXISTING PAVEMENT WITH OVERLAY

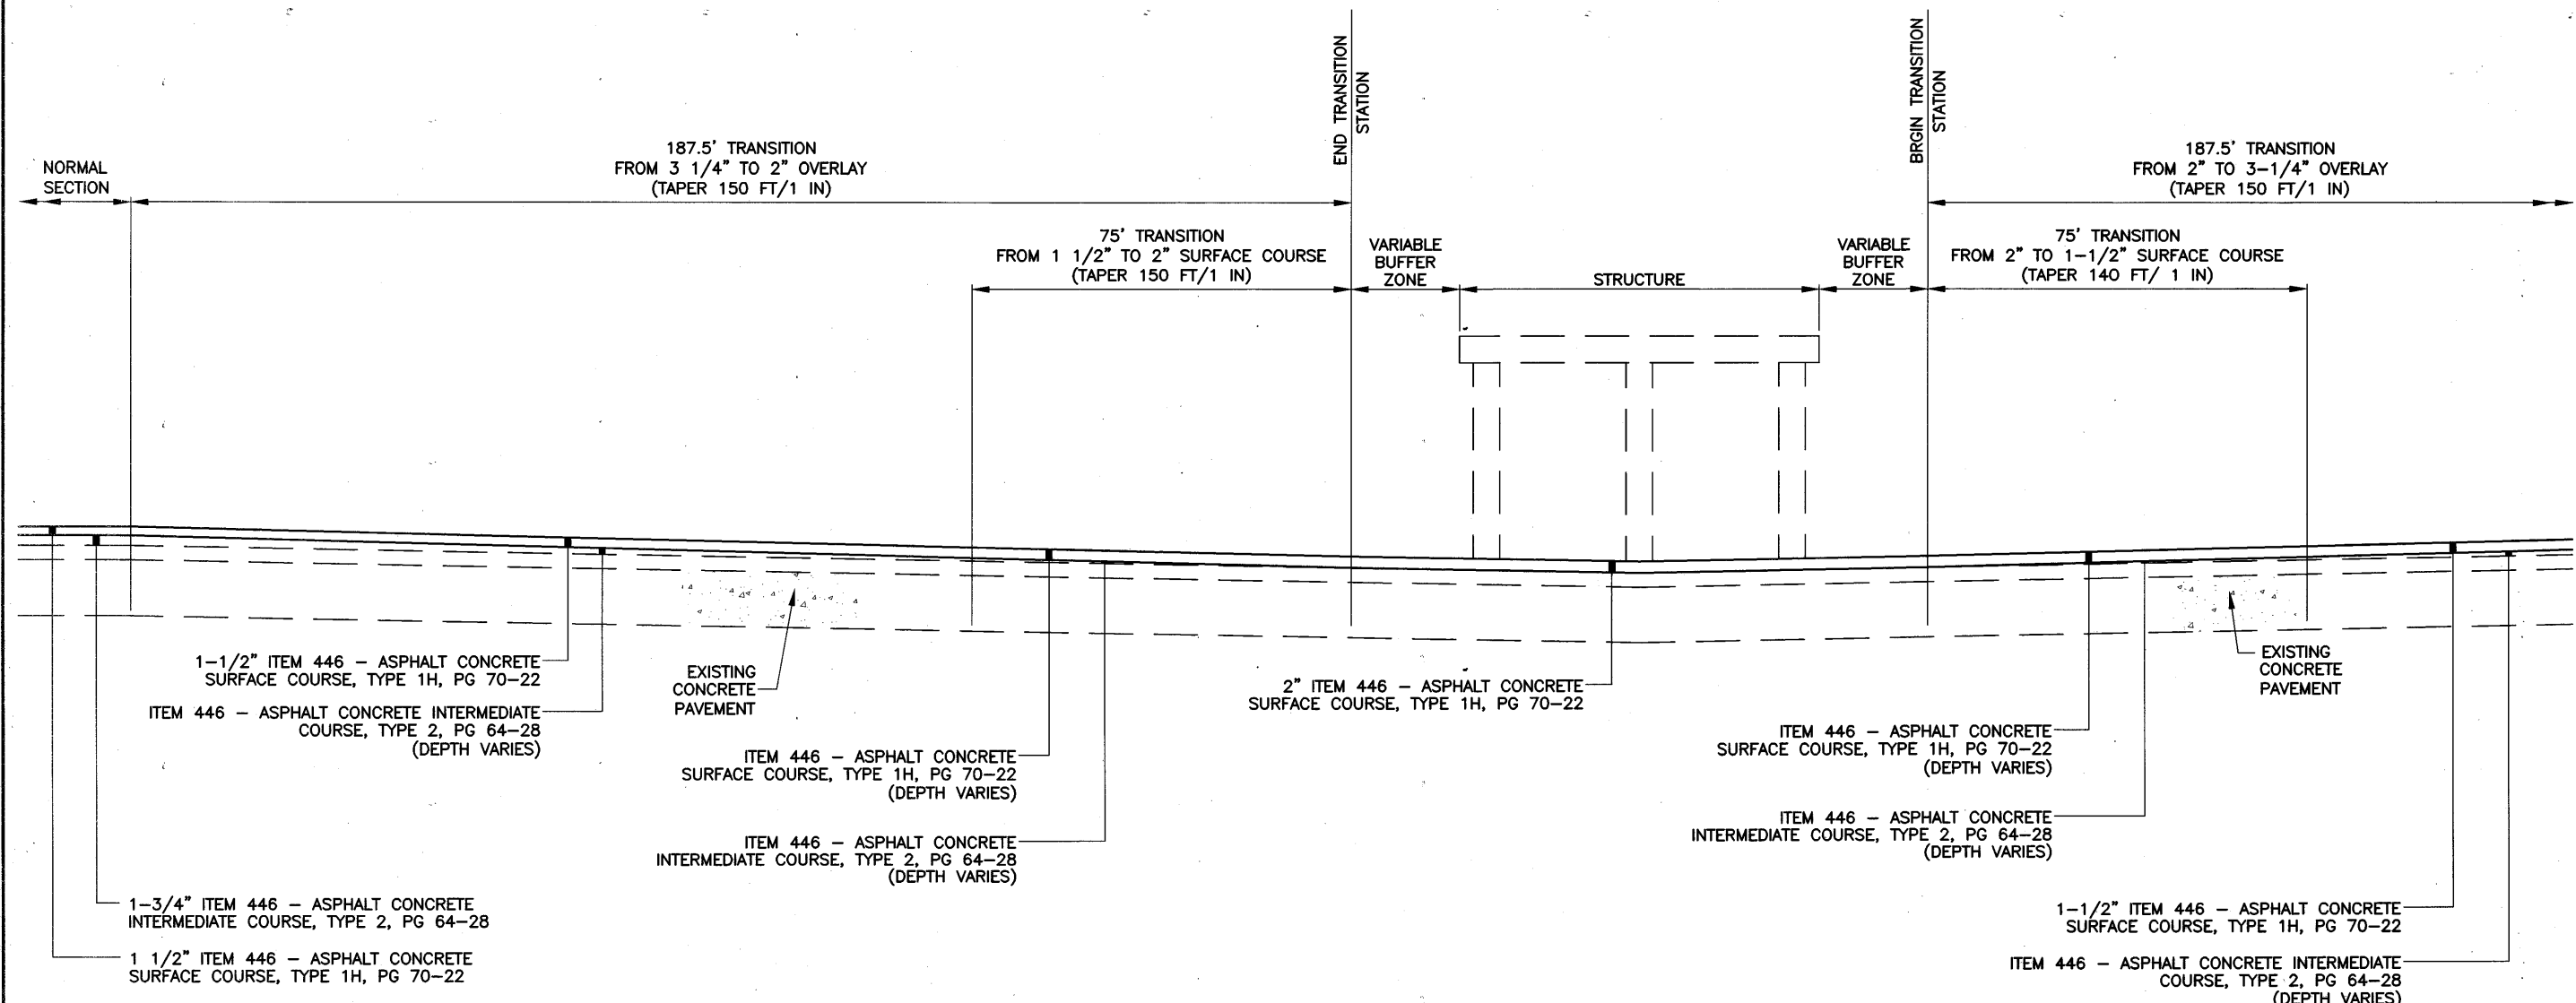


STRUCTURE NO.	END TRANSITION STATIONING	BEGIN TRANSITION STATIONING	TOTAL TRANSITION LENGTH
LOR-2-0825	STA. 434+29.27 L STA. 433+92.32 R	STA. 437+91.63 L STA. 437+54.67 R	187.5' 187.5'
* LOR-2-0859	STA. 451+33.83 L STA. 451+74.23 R	STA. 454+96.62-L STA. 455+35.40 R	187.5' 187.5'
LOR-2-0967	STA. 509+74.37 L STA. 508+76.81 R	STA. 513+22.29 L STA. 512+75.18 R	187.5' 187.5'
LOR-90-1178	STA. 576+15.29 (@ S.R. 2 - E.B. LANES)	STA. 580+34.93 (@ S.R. 2 - E.B. LANES)	187.5'

\* MUST MILL 1" OFF OF EXISTING OVERLAY FROM END TRANSITION STATION TO BEGIN TRANSITION STATION ON LEFT & RIGHT PRIOR TO APPLYING NEW OVERLAY AS INDICATED IN DETAIL ABOVE.


CALCULATED  
DLS  
CHECKED  
LAB

MISCELLANEOUS DETAILS

LOR - 190 - 10.76

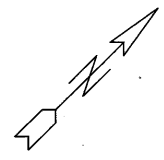


**NOTE:** THE PAVEMENT CROSS SLOPES ARE SLOPED 0.064ft/ft TO THE LEFT. THE PROPOSED PROFILE GRADE ELEVATION IS ALONG THE INSIDE EDGE OF PAVEMENT.

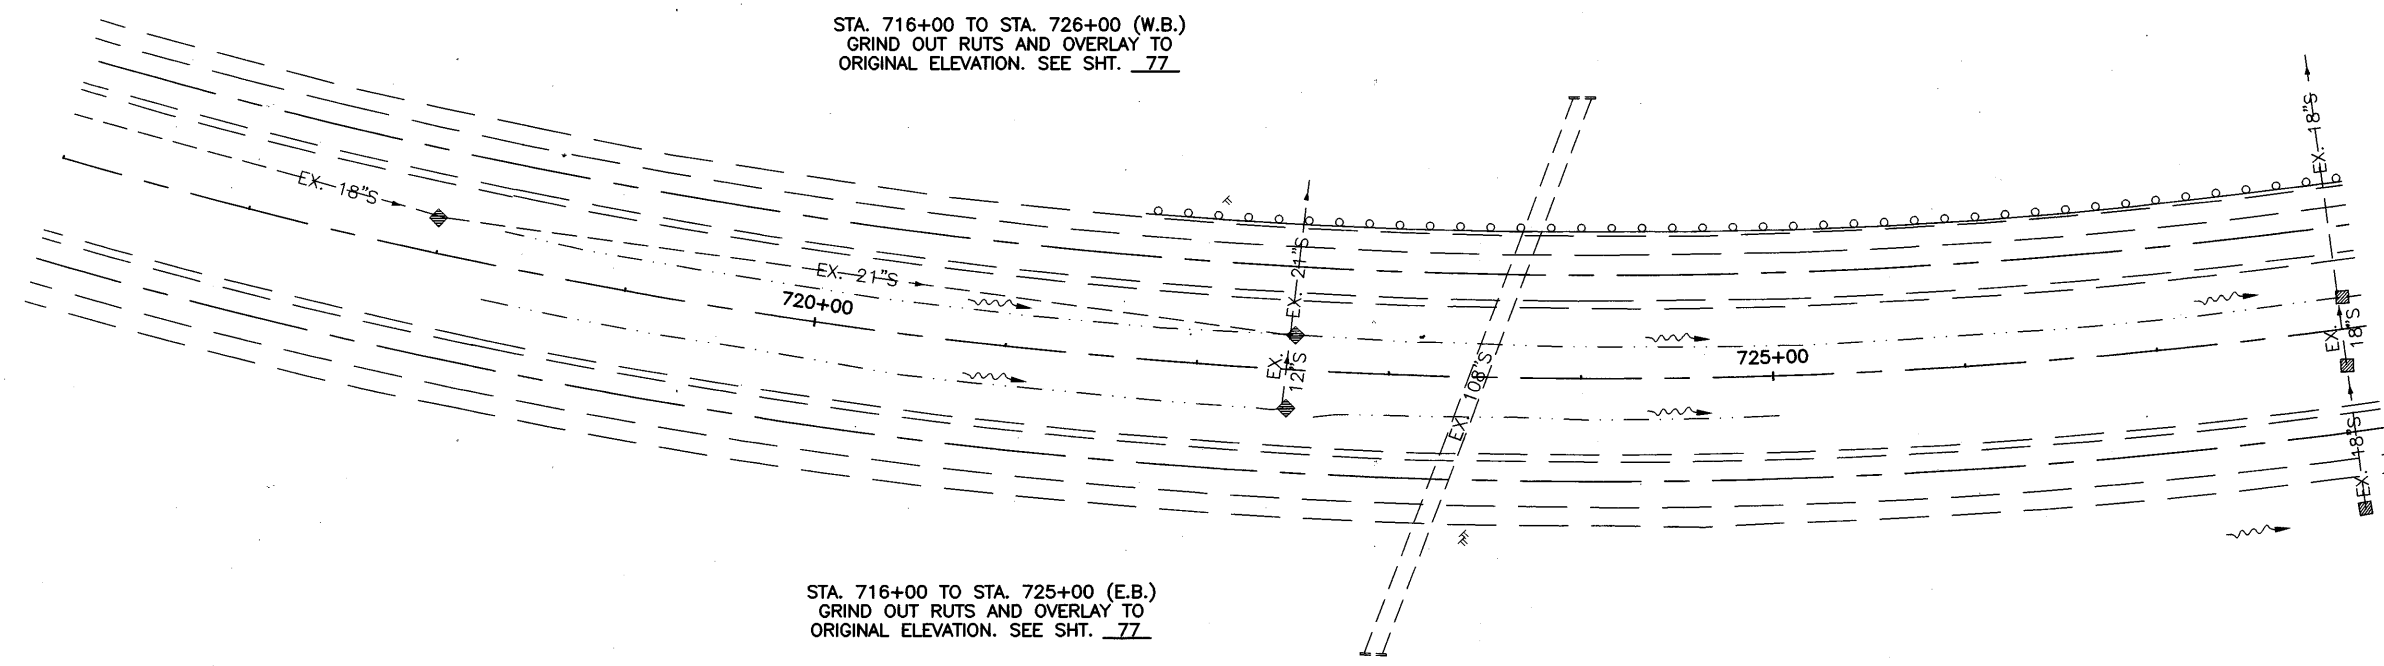

STA. 716+00 TO STA. 726+00 (W.B.)  
GRIND OUT RUTS AND OVERLAY TO ORIGINAL ELEVATION. SEE SHT. 77


STA. 716+00 TO STA. 725+00 (E.B.)  
GRIND OUT RUTS AND OVERLAY TO ORIGINAL ELEVATION. SEE SHT. 77

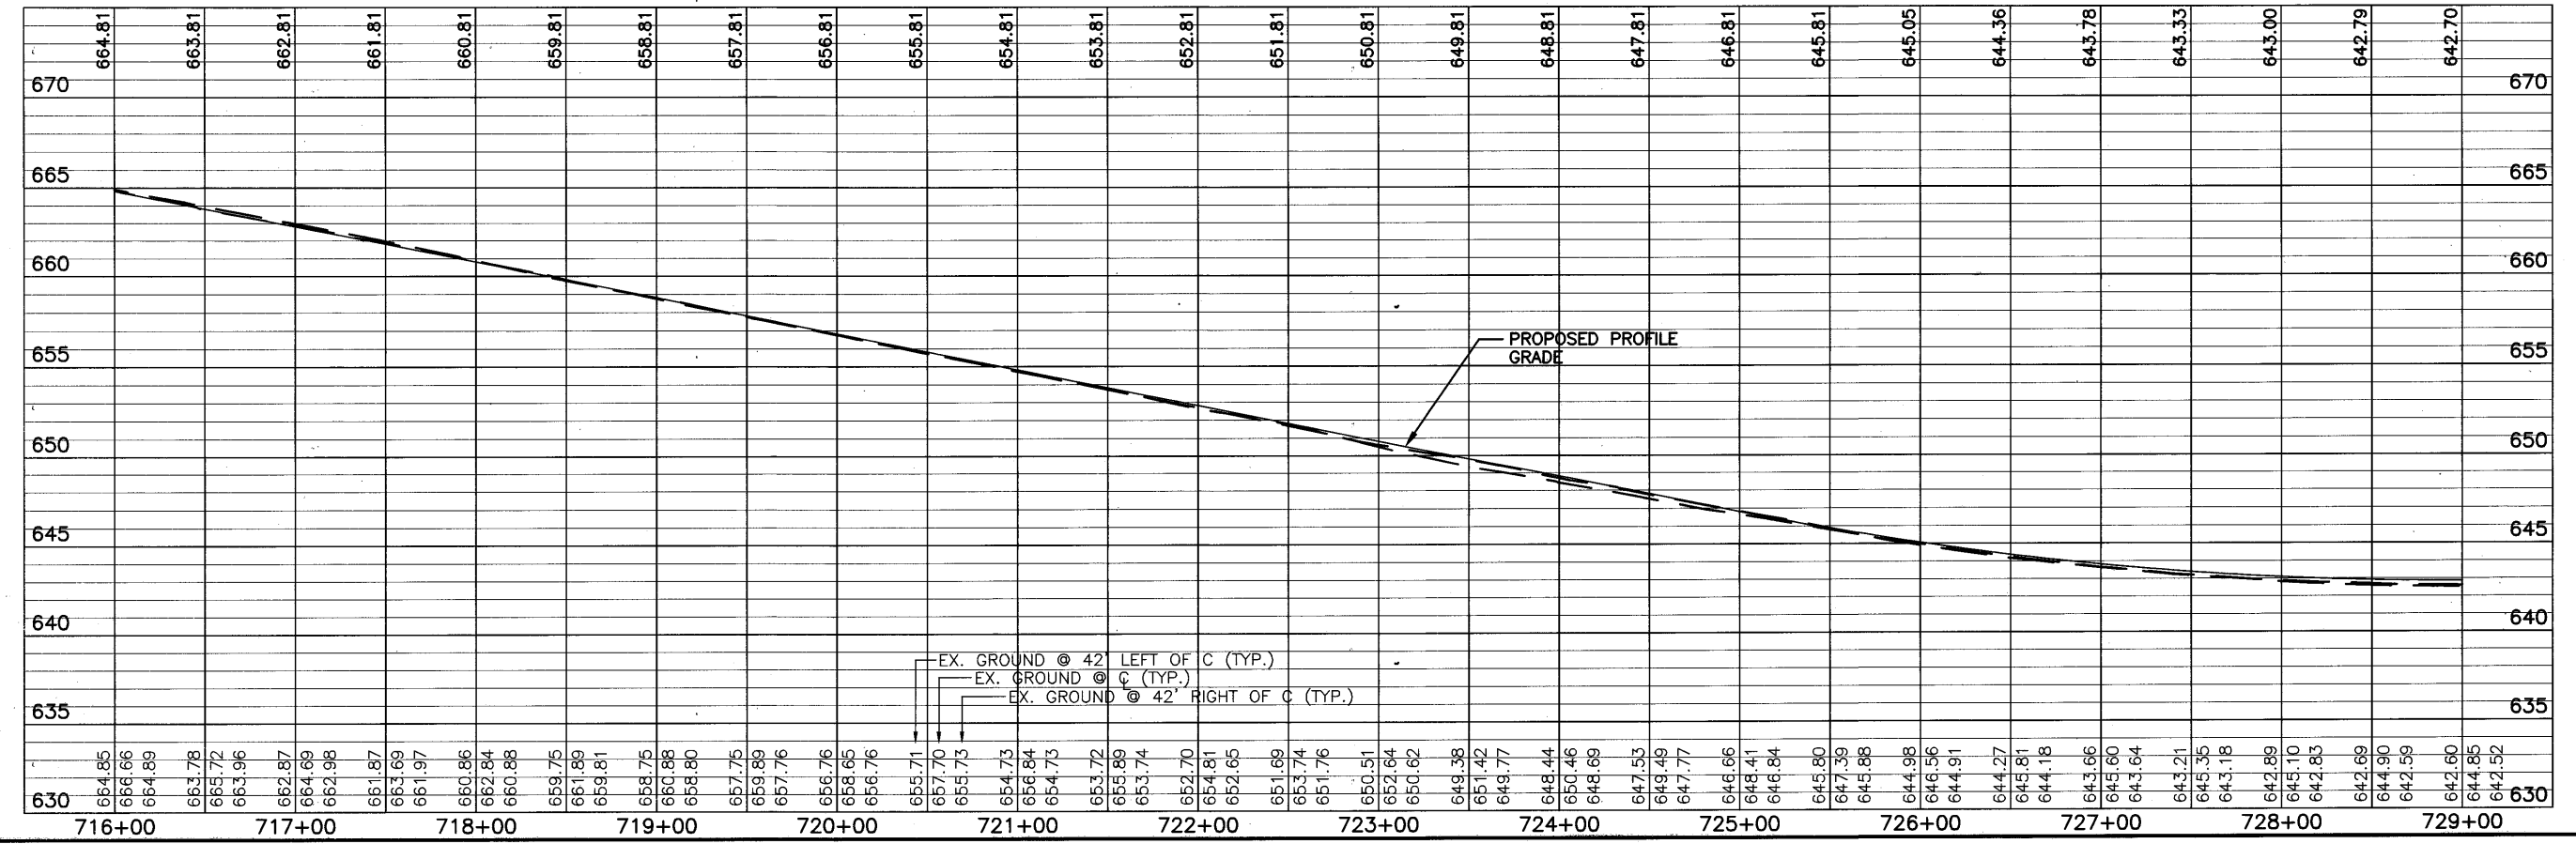


MISCELLANEOUS DETAIL  
PROPOSED PROFILE FOR WEST OF BLACK RIVER

LOR - 190 - 10.76

E:\133500\DWG\133500\FNL\133500.DWG 1:40PM  
02-13-2002

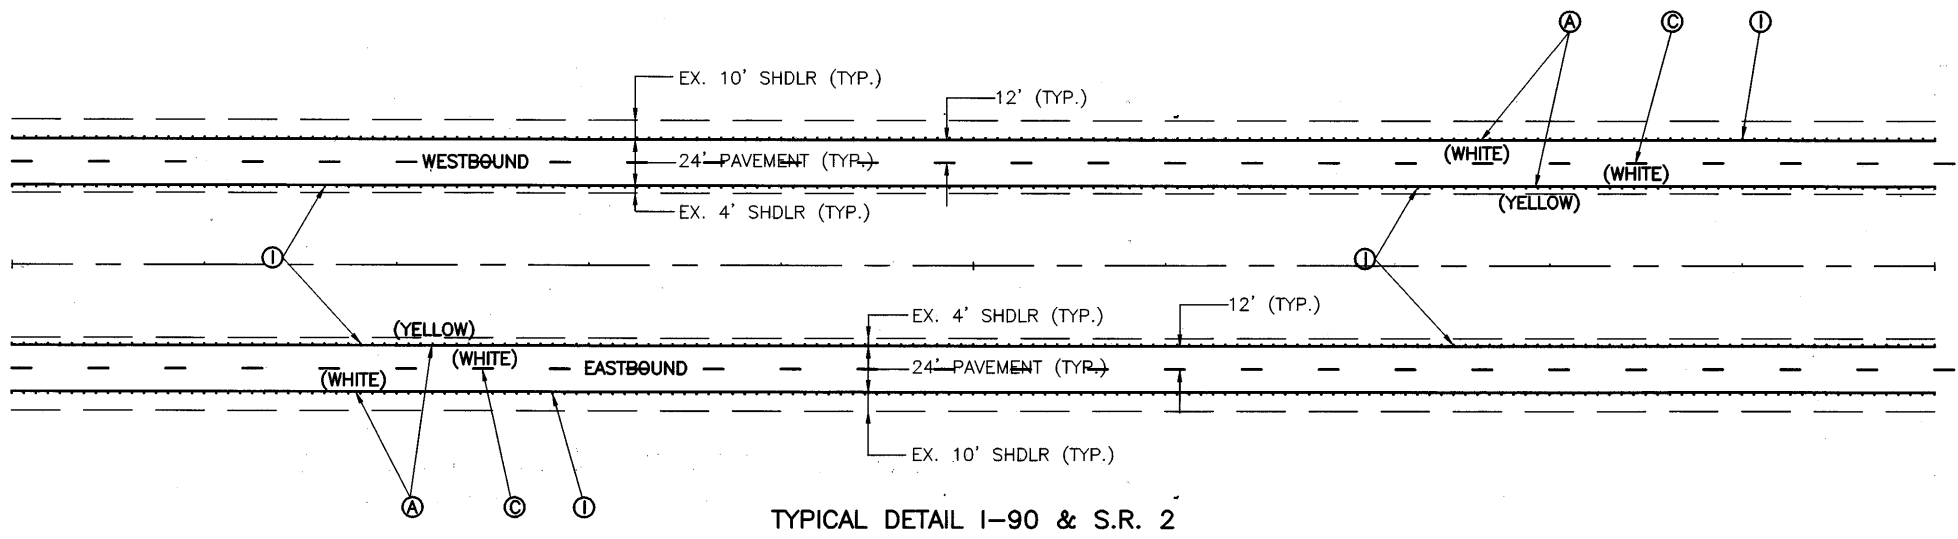

TYPICAL DETAIL I-90 & S.R. 2

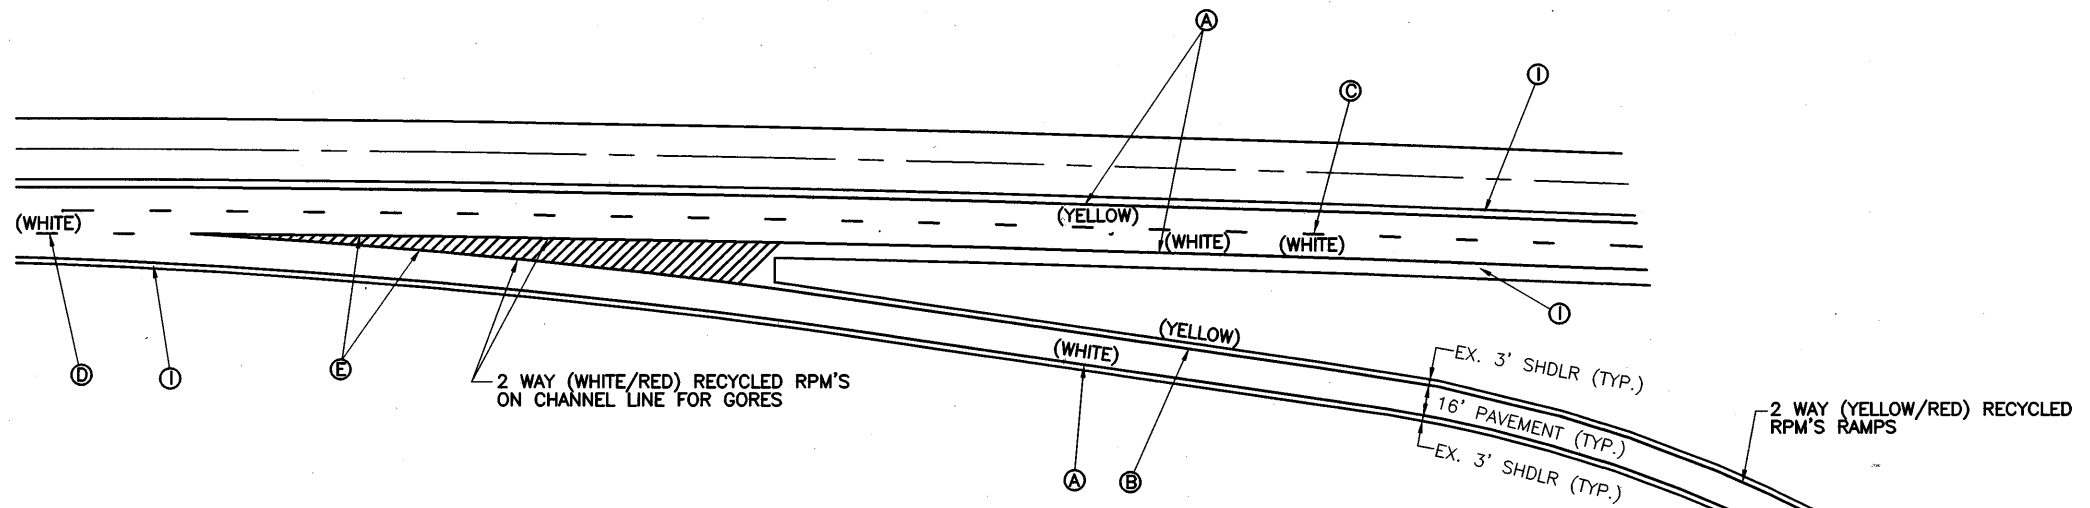


TYPICAL DETAIL FOR RAMPS

**NOTE:**  
SEE STD TC-65.11M FOR PLACING OF RPM'S AT ACCELERATION AND DECELERATION LANES.  
SEE STD TC-72.20 FOR PAVEMENT MARKINGS AT ACCELERATION AND DECELERATION LANES.

- LEGEND**
- (A) ITEM 644 - EDGE LINE
  - (B) ITEM 644 - EDGE LINE, W/ RECYCLED RPM'S
  - (C) ITEM 644 - LANE LINE, W/ 1 WAY WHITE RECYCLED RPM'S
  - (D) ITEM 644 - LANE LINE
  - (E) ITEM 644 - CHANNELIZING LINE, W/ RECYCLED RPM'S
  - (F) ITEM 644 - STOP LINE
  - (G) ITEM 644 - LANE ARROW
  - (H) ITEM 644 - WORD ON PAVEMENT, 96 IN.
  - (I) ITEM 618 - RUMBLE STRIPS, TYPE 2
  - (J) ITEM 620 - DELINEATORS, TYPE D
  - (K) ITEM 620 - DELINEATORS, TYPE C

**NOTE:**  
WHITE AIR SPEED ZONE MARKINGS SHALL START AT STA. 438+55.97 (EB) AND START AT STA. 491+41.85 (WB). THEY SHALL BE 2FT. WIDE AND 4 FT. LONG PLACED AT THE EDGE LINE ON THE INSIDE AND OUTSIDE SHOULDERS OF THE PAVEMENT AT 0.25 MILE INTERVALS OVER A 1 MILE LENGTH OF ROADWAY. THE CONTRACTOR IS RESPONSIBLE FOR HAVING THE MARKINGS LAID OUT BY A REGISTERED SURVEYOR. SEE PLAN SHEETS FOR DETAILED LAYOUT.

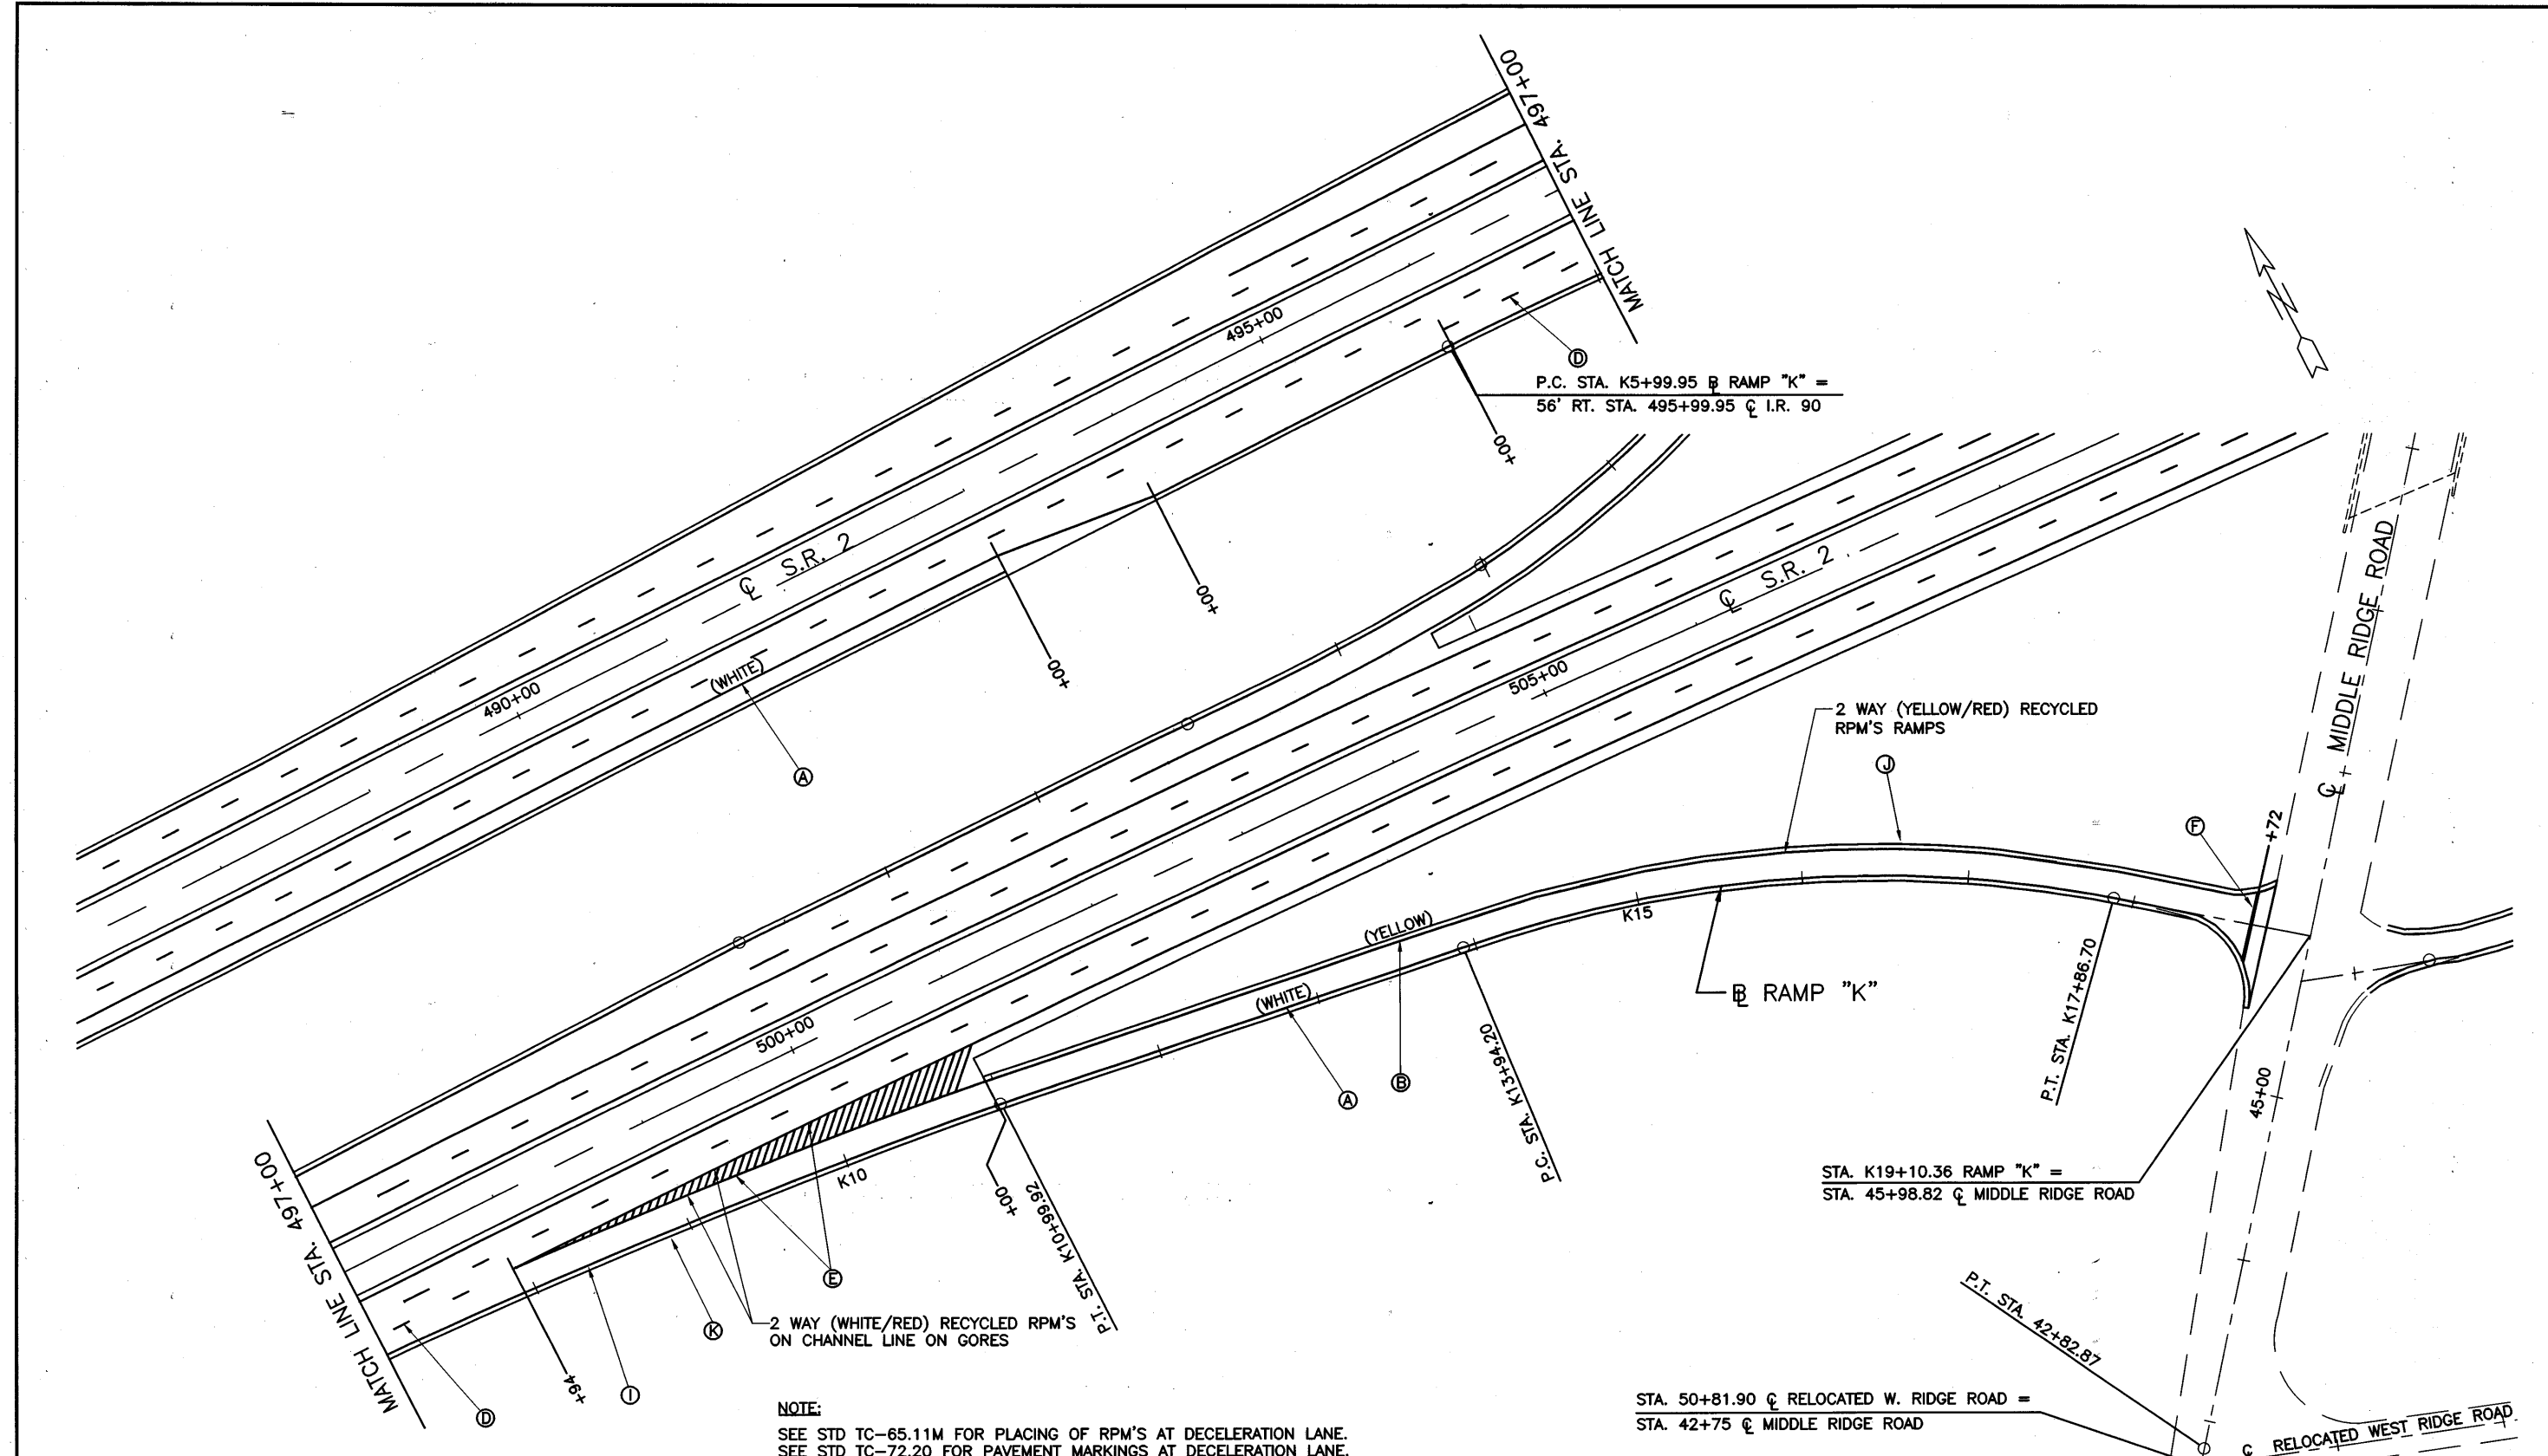

**NOTE:**  
SEE STD TC-65.11M FOR PLACING OF RPM'S AT DECELERATION LANE.  
SEE STD TC-72.20 FOR PAVEMENT MARKINGS AT DECELERATION LANE.

**NOTE:**  
**DIAGONAL STRIPES IN EXIT RAMP MARKINGS SHALL BE 2" WIDE WHITE RAISED STRIPES SET AT A 45° ANGLE TO THE CENTER LINE OF THE THROUGH PAVEMENT AND SLANTED IN THE DIRECTION OF THE FLOW OF TRAFFIC ON SAID PAVEMENT. SPACE BETWEEN THE 2" DIAGONAL STRIPES SHALL BE 12' AS MEASURED PARALLEL TO THE CENTER LINE OF THE THROUGH PAVEMENT. WHITE RAISED PAVEMENT STRIPES PAVEMENT MARKING SHALL BE APPLIED AS PER SPECIFICATIONS ITEM 644. DIAGONAL WHITE STRIPES SHALL BE PLACED BETWEEN THE TWO 8" WHITE CHANNELING LINES AT EXIT RAMP AS SHOWN, TO CONFORM TO ITEM 641.**

- LEGEND**
- (A) ITEM 644 - EDGE LINE
  - (B) ITEM 644 - EDGE LINE, W/ RECYCLED RPM'S
  - (C) ITEM 644 - LANE LINE, W/ 1 WAY WHITE RECYCLED RPM'S
  - (D) ITEM 644 - LANE LINE
  - (E) ITEM 644 - CHANNELIZING LINE, W/ RECYCLED RPM'S
  - (F) ITEM 644 - STOP LINE
  - (G) ITEM 644 - LANE ARROW
  - (H) ITEM 644 - WORD ON PAVEMENT, 96 IN.
  - (I) ITEM 618 - RUMBLE STRIPS, TYPE 2
  - (J) ITEM 620 - DELINEATORS, TYPE D
  - (K) ITEM 620 - DELINEATORS, TYPE C


10.35AM 07-18-2002 [ c:\93600\dms\33600\FNL\93600PML2.DWG ] DLS

**LEGEND**

- (A) ITEM 644 - EDGE LINE
- (B) ITEM 644 - EDGE LINE, W/ RECYCLED RPM'S
- (C) ITEM 644 - LANE LINE, W/ 1 WAY WHITE RECYCLED RPM'S
- (D) ITEM 644 - LANE LINE
- (E) ITEM 644 - CHANNELIZING LINE, W/ RECYCLED RPM'S
- (F) ITEM 644 - STOP LINE
- (G) ITEM 644 - LANE ARROW
- (H) ITEM 644 - WORD ON PAVEMENT, 96 IN.
- (I) ITEM 618 - RUMBLE STRIPS, TYPE 2
- (J) ITEM 620 - DELINEATORS, TYPE D
- (K) ITEM 620 - DELINEATORS, TYPE C

**NOTE:**

SEE STD TC-65.11M FOR PLACING OF RPM'S AT ACCELERATION LANE.  
SEE STD TC-72.20 FOR PAVEMENT MARKINGS AT ACCELERATION LANE.

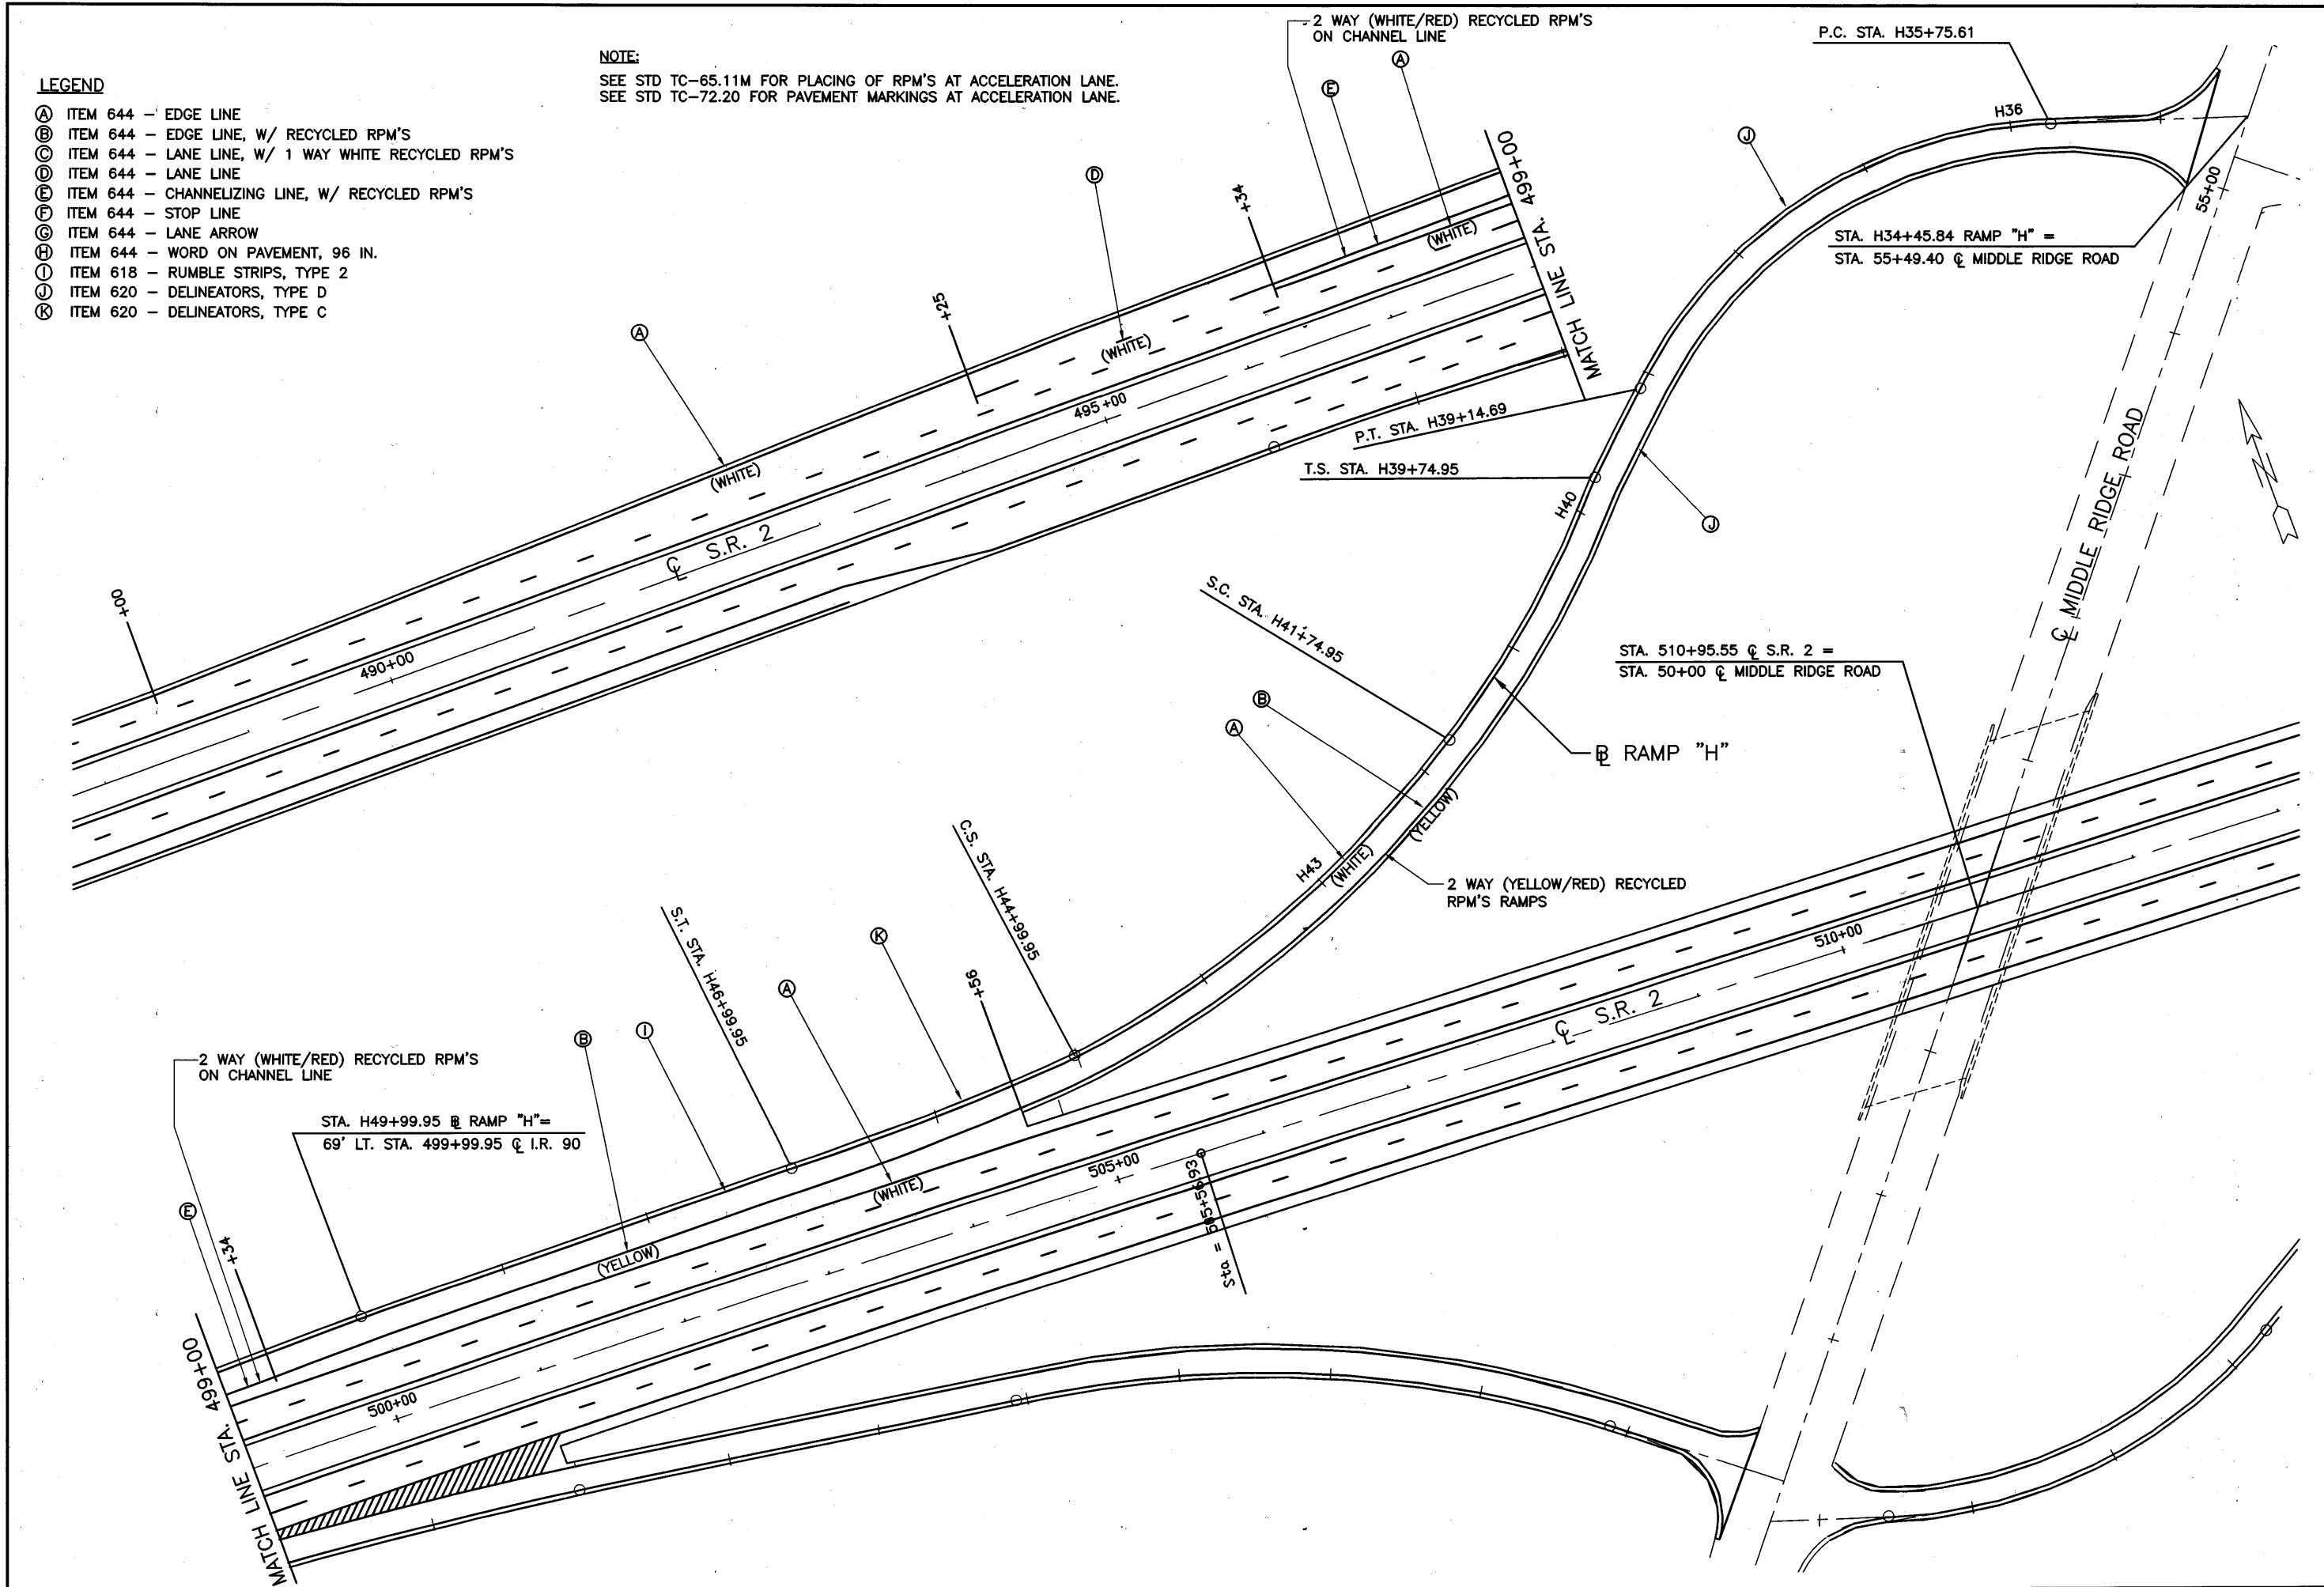

CALCULATED	DLS	CHECKED	LAB




**PLAN RAMP "H" - S.R.2 & MIDDLE RIDGE RD.**  
STA. H49+99.95 TO STA. H34+45.84

LOR-190-10.76

10:42AM 07-18-2002 [ 0:19:00\DWG\93600PL\93600PM3.DWG ] DLS



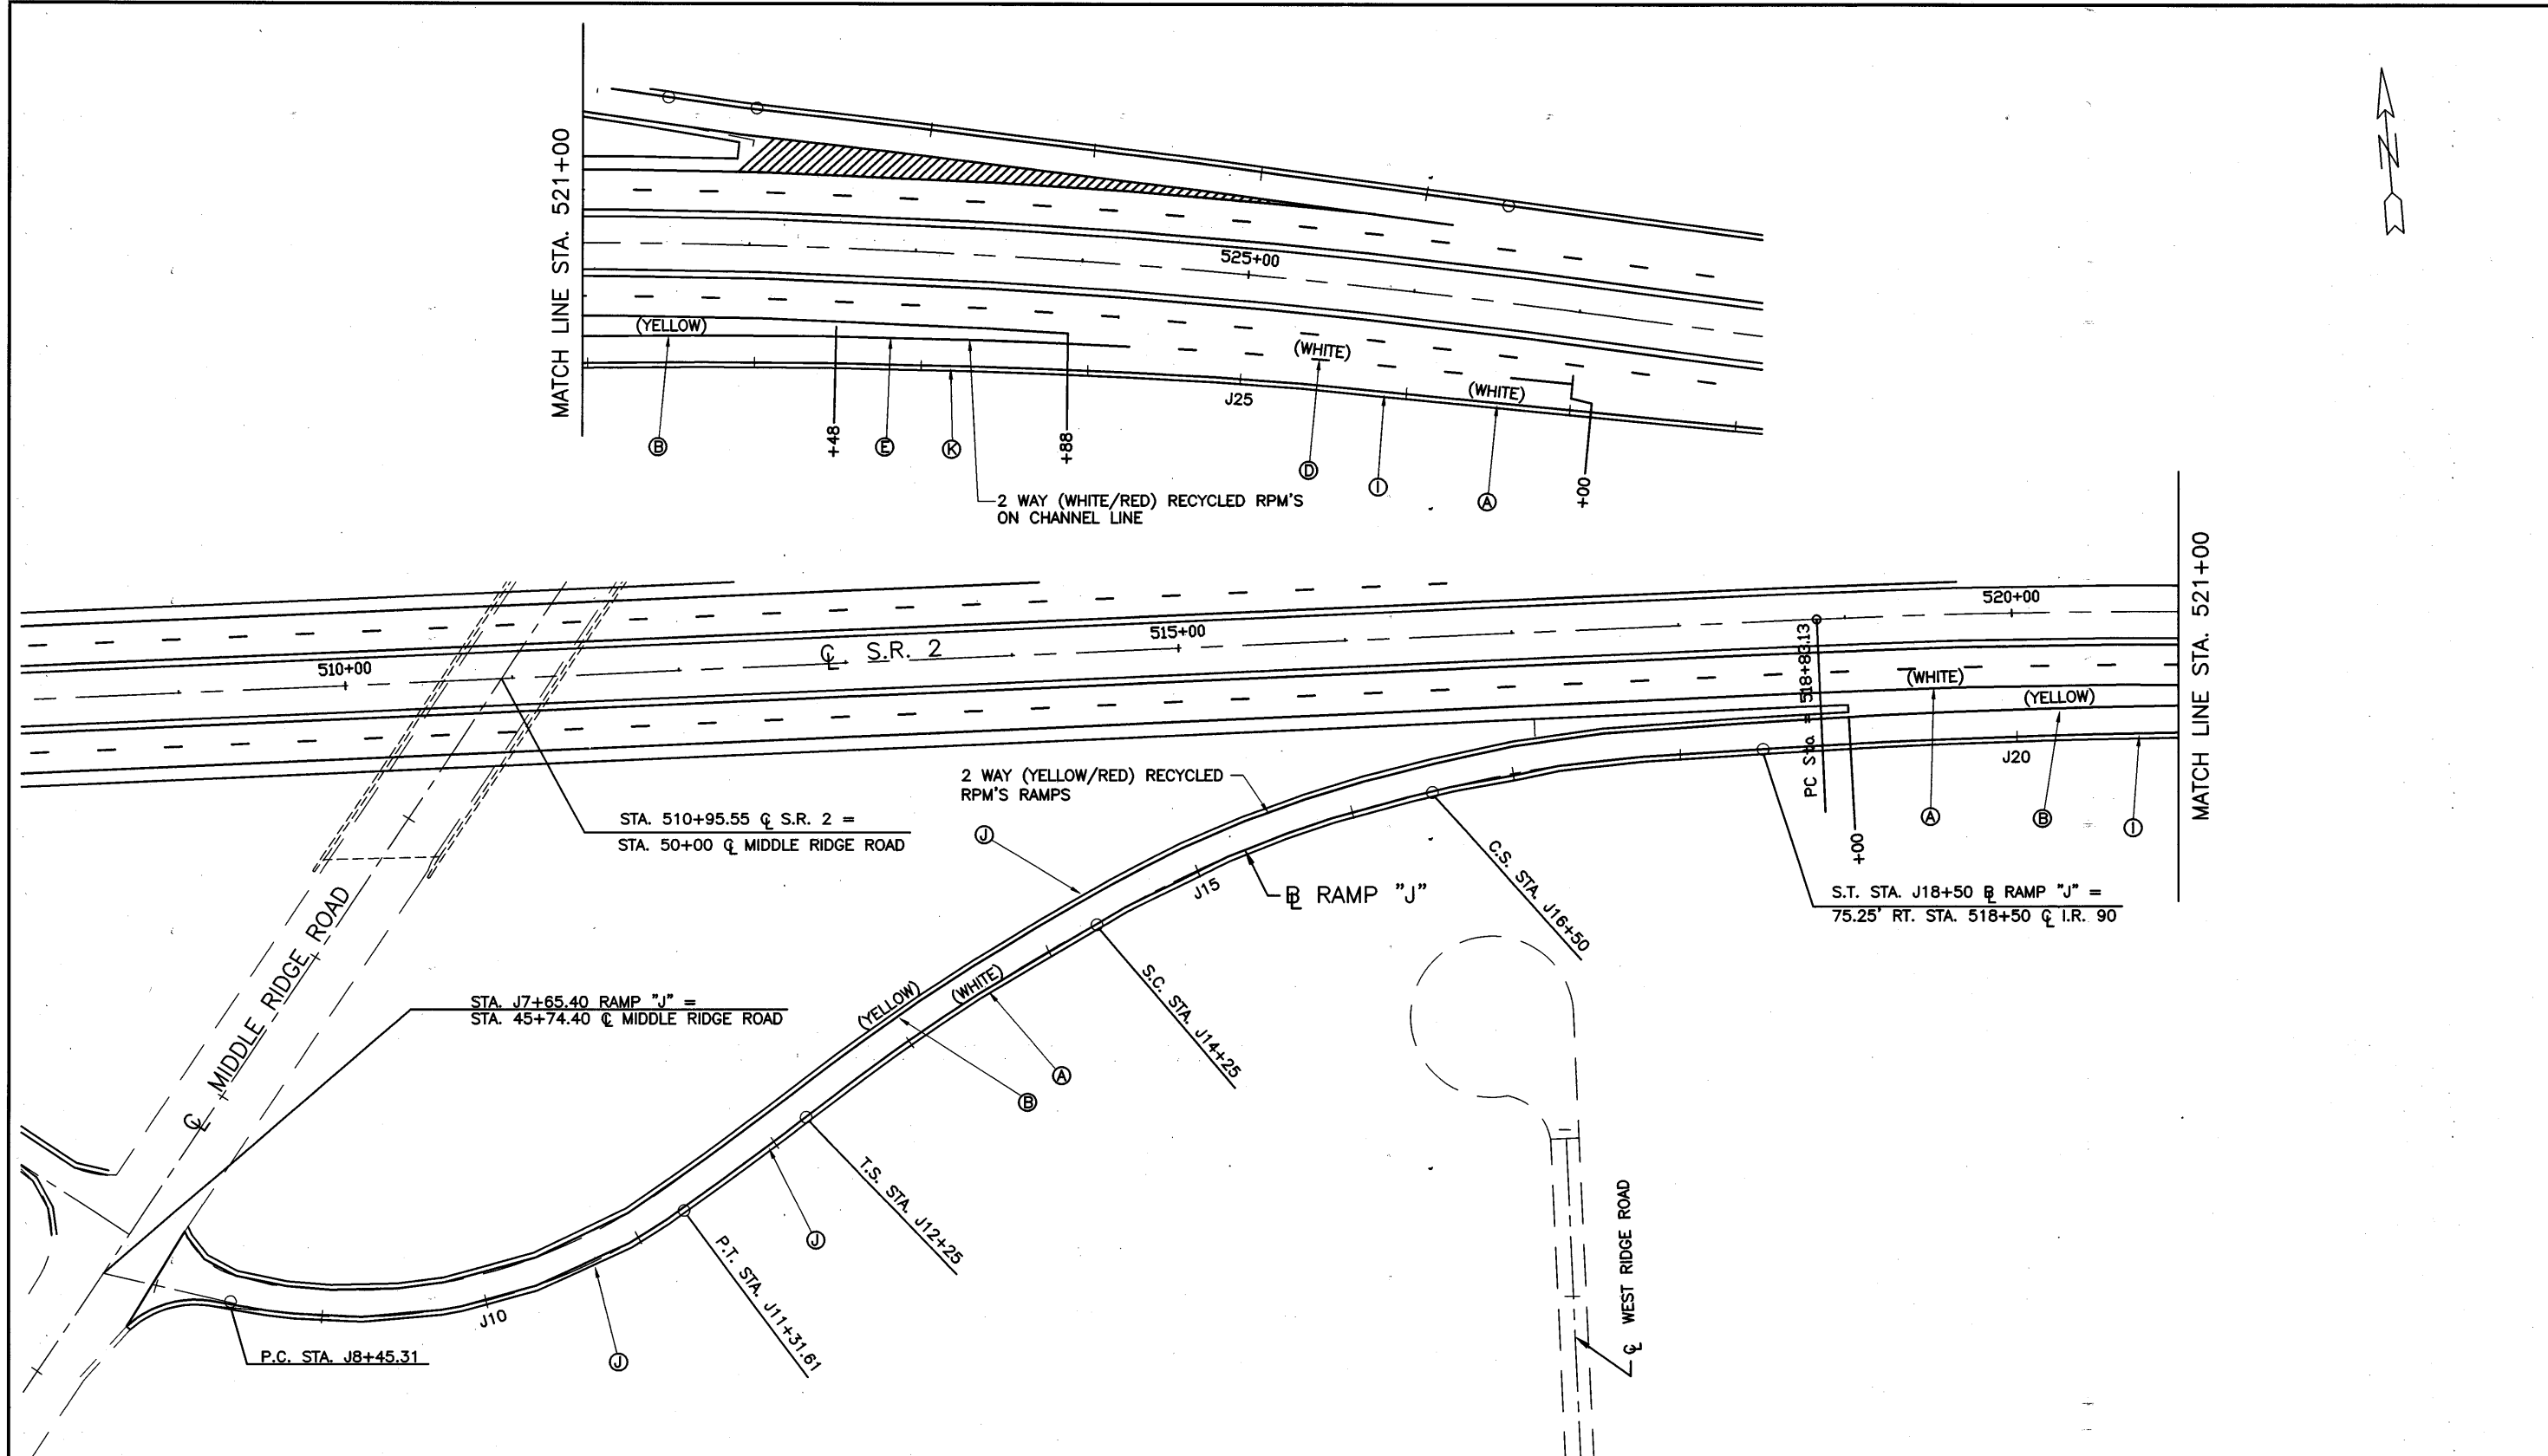


PLAN RAMP "J" - S.R.2 & MIDDLE RIDGE RD.  
 STA. J7+65.40 TO J18+50

LOR-190-10.76

113  
274

- LEGEND**
- (A) ITEM 644 - EDGE LINE
  - (B) ITEM 644 - EDGE LINE, W/ RECYCLED RPM'S
  - (C) ITEM 644 - LANE LINE, W/ 1 WAY WHITE RECYCLED RPM'S
  - (D) ITEM 644 - LANE LINE
  - (E) ITEM 644 - CHANNELIZING LINE, W/ RECYCLED RPM'S
  - (F) ITEM 644 - STOP LINE
  - (G) ITEM 644 - LANE ARROW
  - (H) ITEM 644 - WORD ON PAVEMENT, 96 IN.
  - (I) ITEM 618 - RUMBLE STRIPS, TYPE 2
  - (J) ITEM 620 - DELINEATORS, TYPE D
  - (K) ITEM 620 - DELINEATORS, TYPE C

**NOTE:**  
 SEE STD TC-65.11M FOR PLACING OF RPM'S AT ACCELERATION LANE.  
 SEE STD TC-72.20 FOR PAVEMENT MARKINGS AT ACCELERATION LANE.

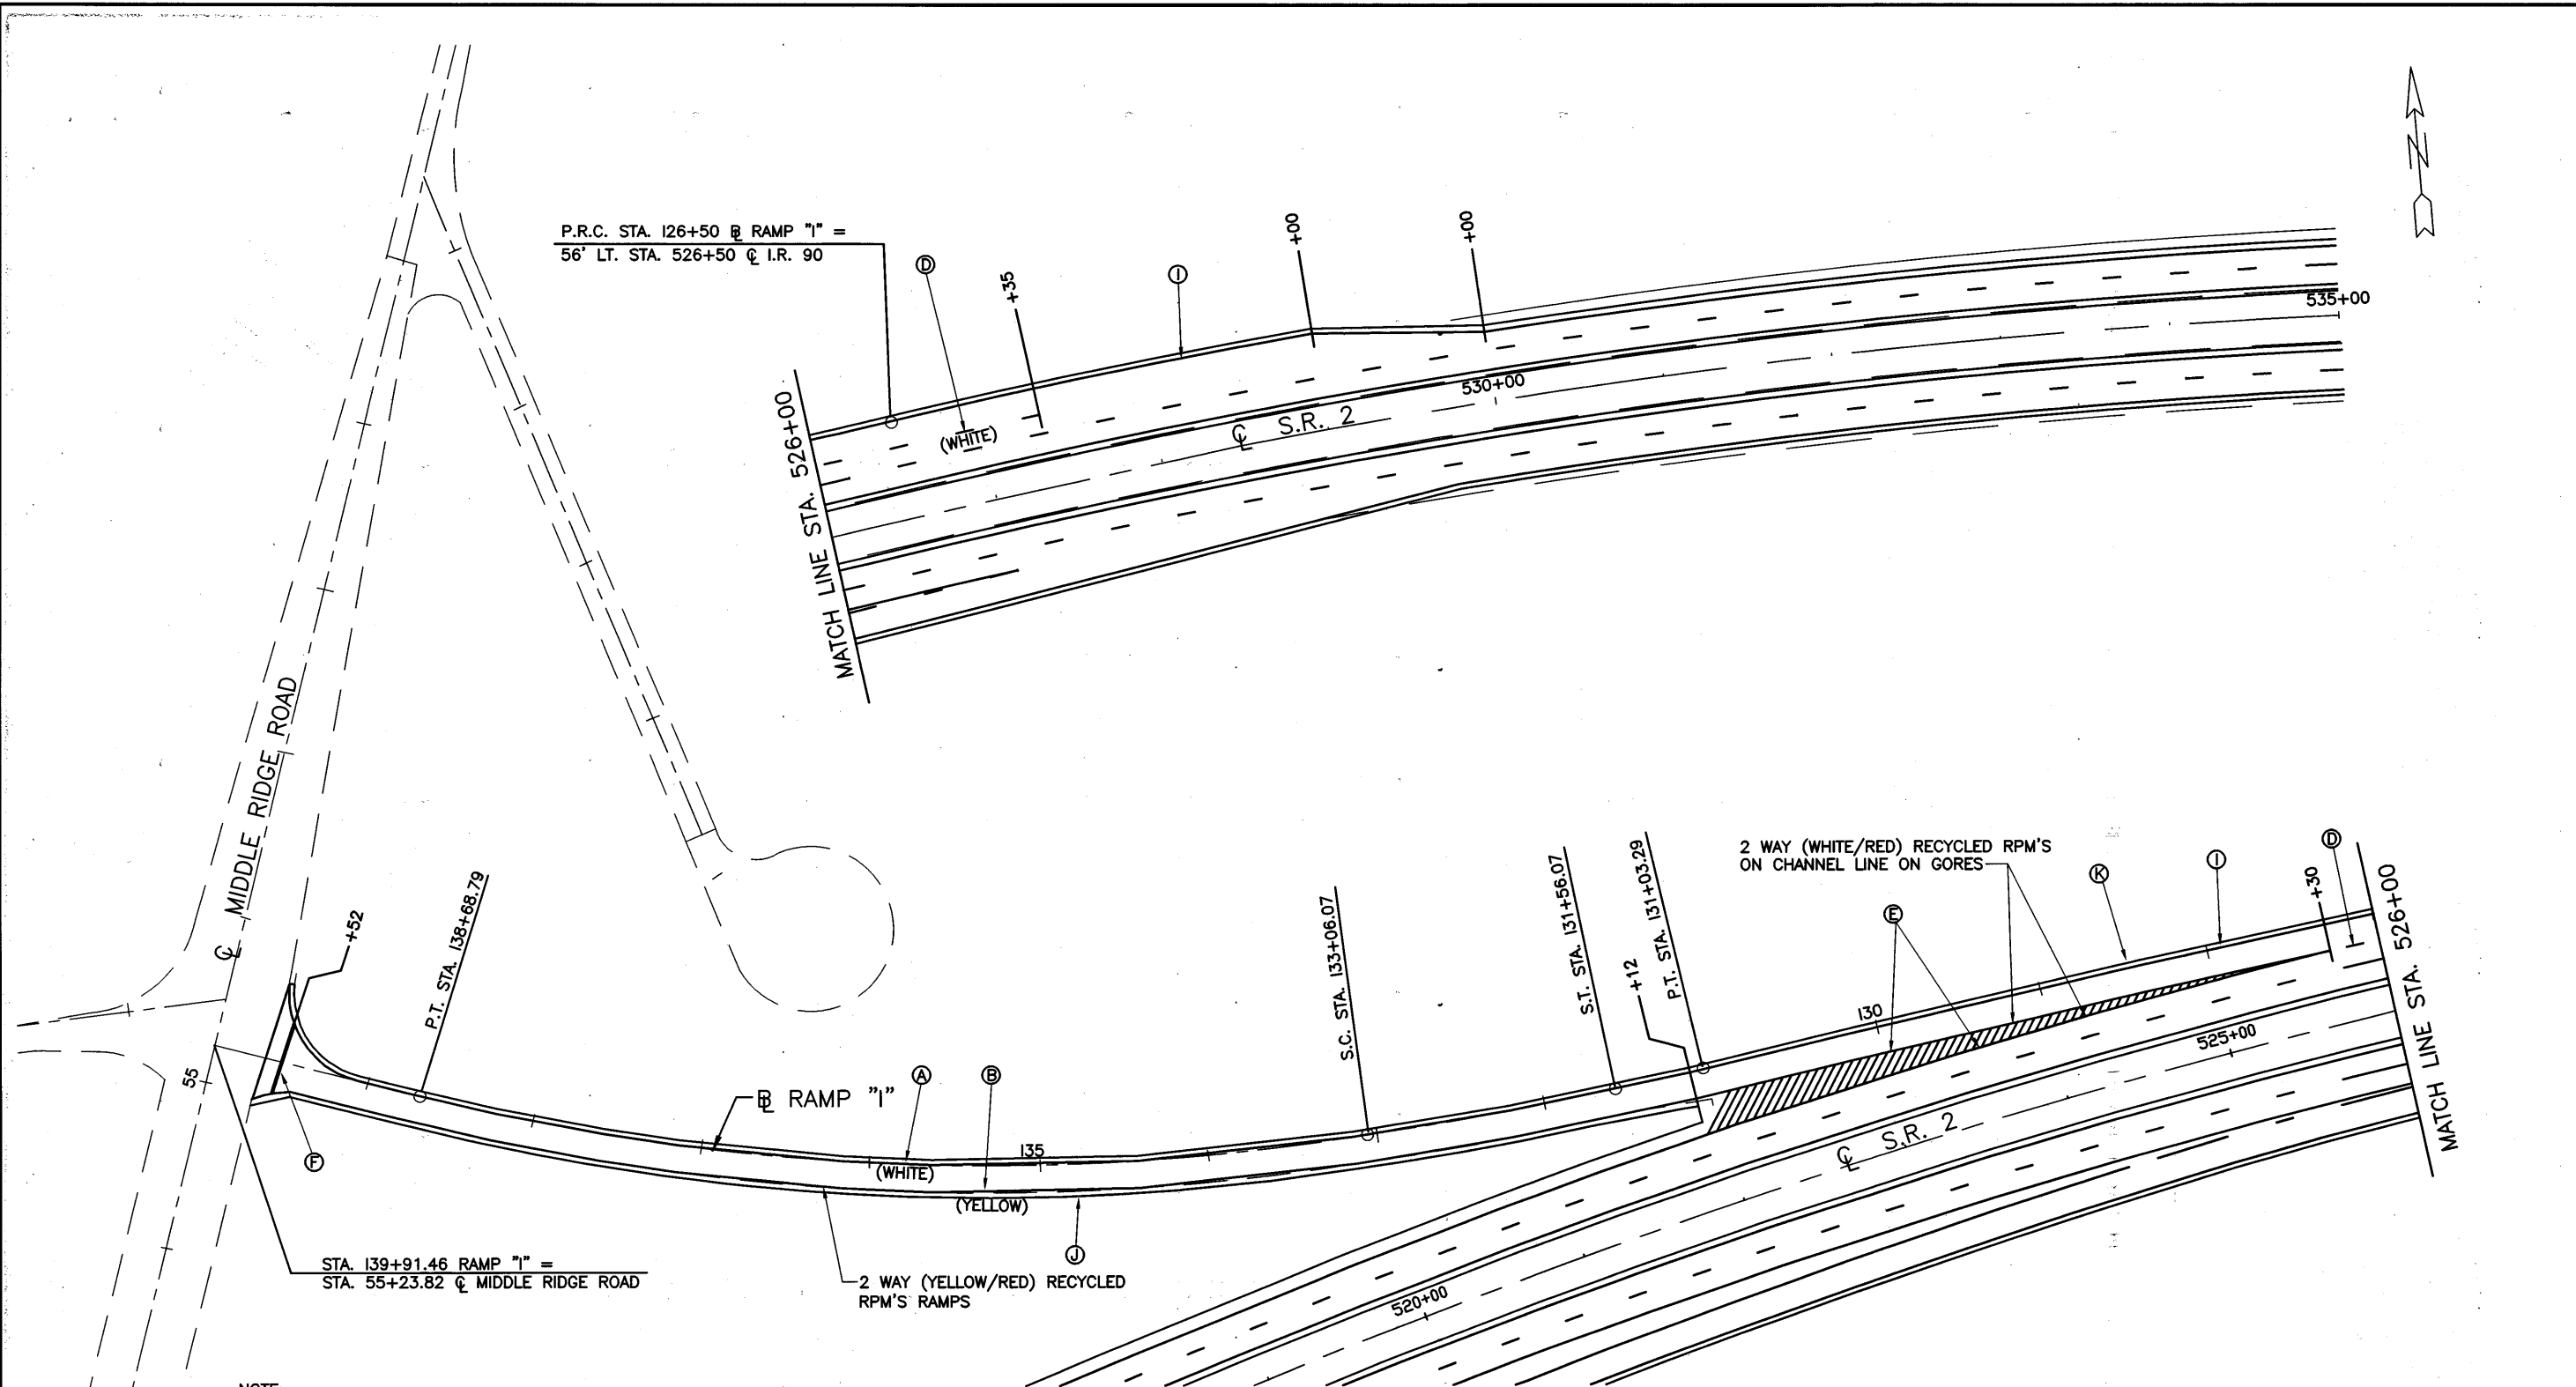


P.R.C. STA. 126+50 @ RAMP "1" =  
56° LT. STA. 526+50 @ I.R. 90

STA. 139+91.46 RAMP "1" =  
STA. 55+23.82 @ MIDDLE RIDGE ROAD

**NOTE:**  
SEE STD TC-65.11M FOR PLACING OF RPM'S AT DECELERATION LANE.  
SEE STD TC-72.20 FOR PAVEMENT MARKINGS AT DECELERATION LANE.

**NOTE:**  
**DIAGONAL STRIPES IN EXIT RAMP MARKINGS SHALL**  
BE 2' WIDE WHITE RAISED STRIPES SET AT A 45°  
ANGLE TO THE CENTER LINE OF THE THROUGH PAVEMENT  
AND SLANTED IN THE DIRECTION OF THE FLOW OF  
TRAFFIC ON SAID PAVEMENT. SPACE BETWEEN THE 2'  
DIAGONAL STRIPES SHALL BE 12' AS MEASURED PARALLEL  
TO THE CENTER LINE OF THE THROUGH PAVEMENT.  
WHITE RAISED PAVEMENT STRIPES PAVEMENT MARKING SHALL  
BE APPLIED AS PER SPECIFICATIONS ITEM 644. DIAGONAL  
WHITE STRIPES SHALL BE PLACED BETWEEN THE TWO 8" WHITE  
CHANNELING LINES AT EXIT RAMPS AS SHOWN, TO COMFORM  
TO ITEM 641.

- LEGEND**
- (A) ITEM 644 - EDGE LINE
  - (B) ITEM 644 - EDGE LINE, W/ RECYCLED RPM'S
  - (C) ITEM 644 - LANE LINE, W/ 1 WAY WHITE RECYCLED RPM'S
  - (D) ITEM 644 - LANE LINE
  - (E) ITEM 644 - CHANNELIZING LINE, W/ RECYCLED RPM'S
  - (F) ITEM 644 - STOP LINE
  - (G) ITEM 644 - LANE ARROW
  - (H) ITEM 644 - WORD ON PAVEMENT, 96 IN.
  - (I) ITEM 618 - RUMBLE STRIPS, TYPE 2
  - (J) ITEM 620 - DELINEATORS, TYPE D
  - (K) ITEM 620 - DELINEATORS, TYPE C

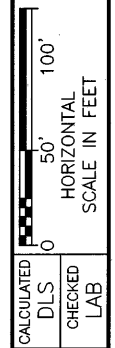


**PLAN RAMP "1" - S.R.2 & MIDDLE RIDGE RD.**  
**STA. 126+50 TO STA. 139+91.46**

**LOR-190-10.76**

114  
274

10:57AM 07-18-2002 [ O:\93600\DWG\93600\FNL\93600PME.DWG ] DLS

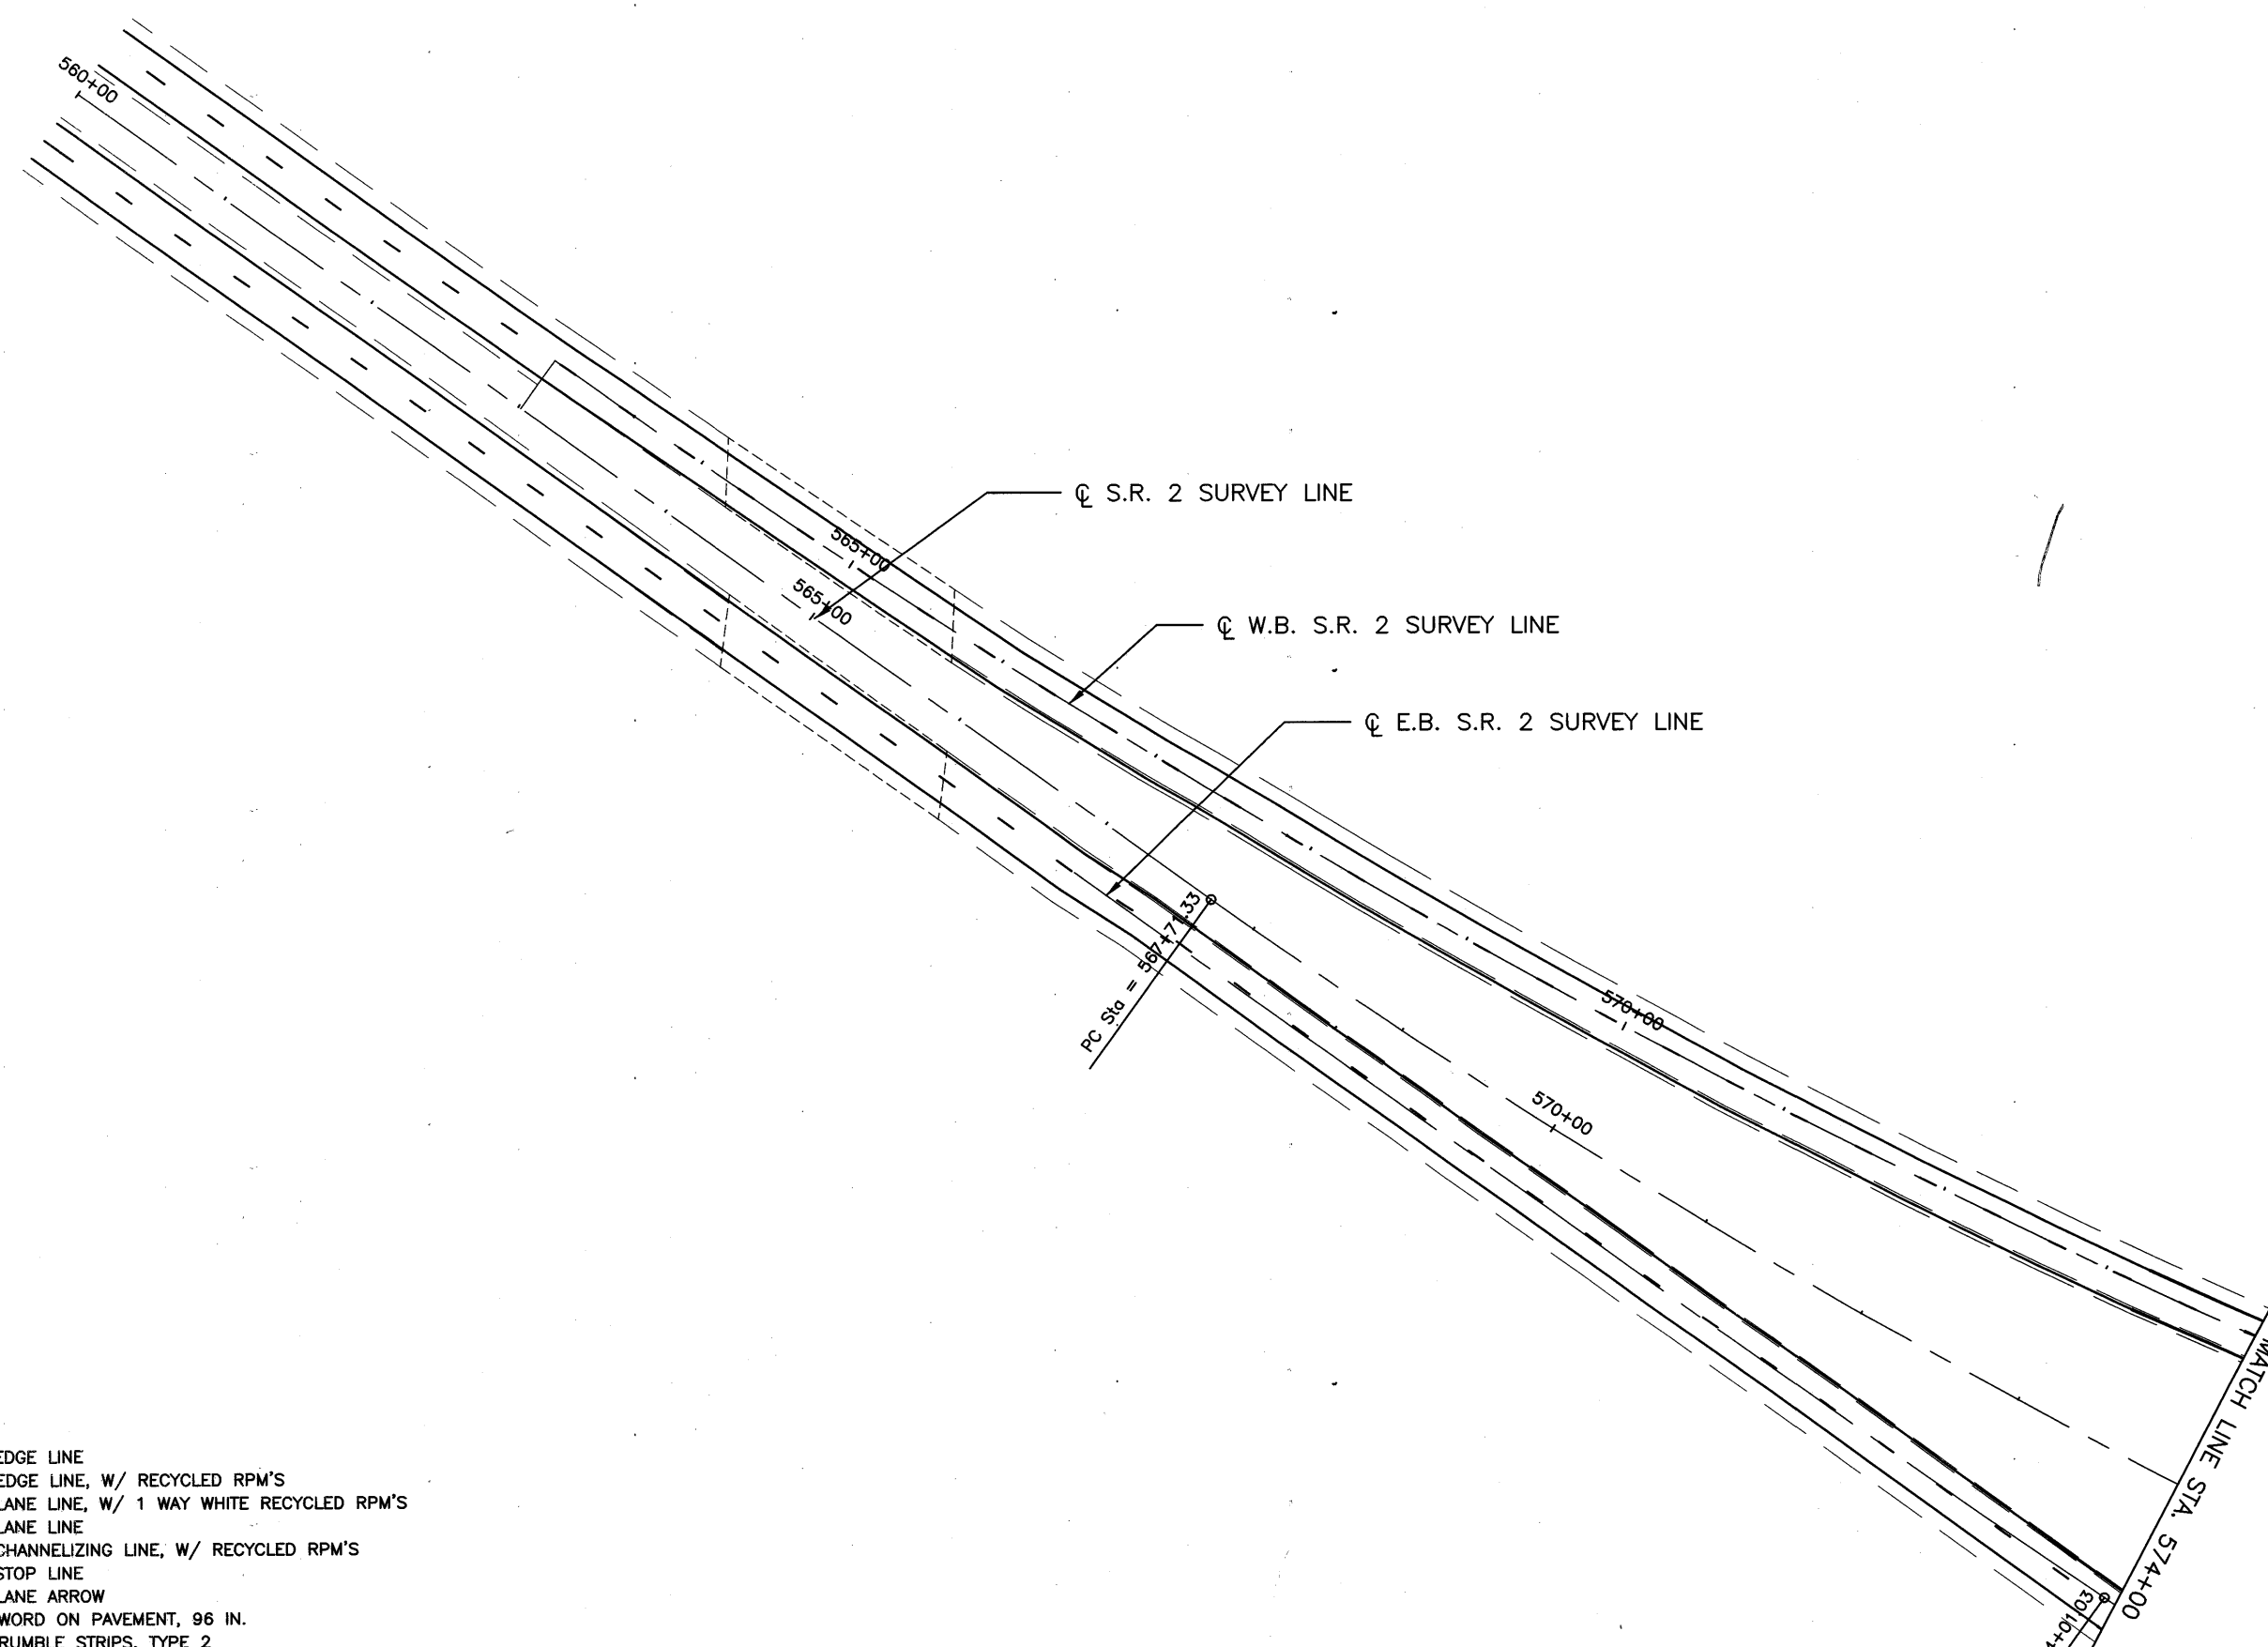

**LEGEND**



- (A) ITEM 644 - EDGE LINE
- (B) ITEM 644 - EDGE LINE, W/ RECYCLED RPM'S
- (C) ITEM 644 - LANE LINE, W/ 1 WAY WHITE RECYCLED RPM'S
- (D) ITEM 644 - LANE LINE
- (E) ITEM 644 - CHANNELIZING LINE, W/ RECYCLED RPM'S
- (F) ITEM 644 - STOP LINE
- (G) ITEM 644 - LANE ARROW
- (H) ITEM 644 - WORD ON PAVEMENT, 96 IN.
- (I) ITEM 618 - RUMBLE STRIPS, TYPE 2
- (J) ITEM 620 - DELINEATORS, TYPE D
- (K) ITEM 620 - DELINEATORS, TYPE C

**PAVEMENT MARKING  
STA. 560+00 TO STA. 574+00**

**LOR - I90 - 10.76**

115  
274

7:35AM 02-13-2002 C:\Users\james\Documents\130202\130202.dwg 1 LUS

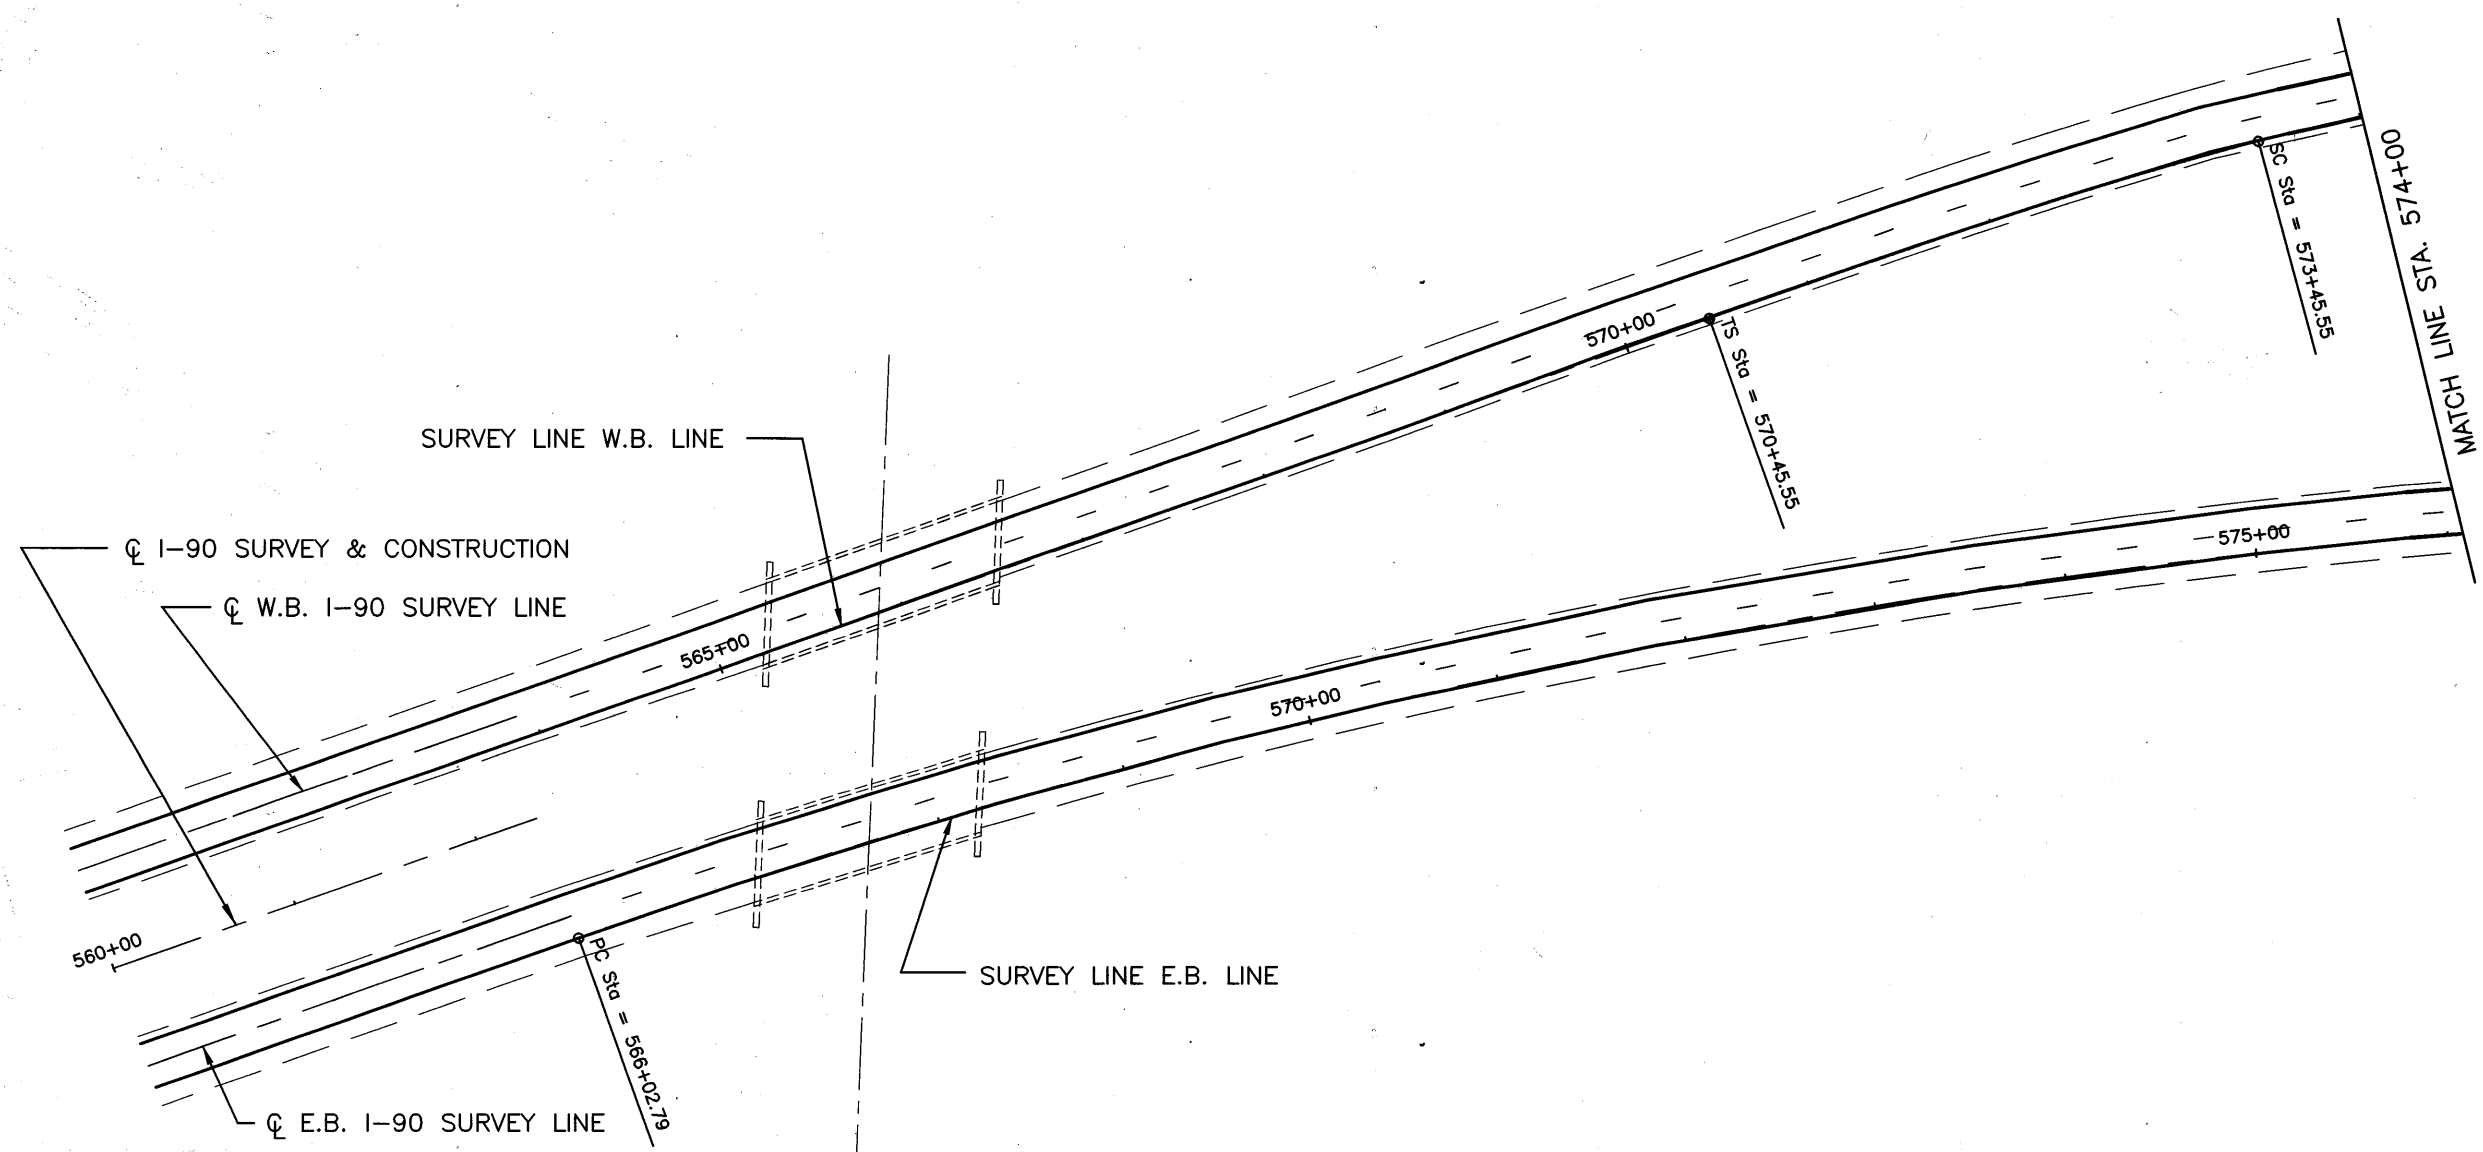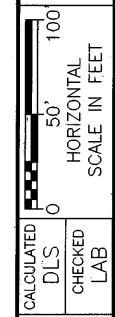


- LEGEND**
- (A) ITEM 644 - EDGE LINE
  - (B) ITEM 644 - EDGE LINE, W/ RECYCLED RPM'S
  - (C) ITEM 644 - LANE LINE, W/ 1 WAY WHITE RECYCLED RPM'S
  - (D) ITEM 644 - LANE LINE
  - (E) ITEM 644 - CHANNELIZING LINE, W/ RECYCLED RPM'S
  - (F) ITEM 644 - STOP LINE
  - (G) ITEM 644 - LANE ARROW
  - (H) ITEM 644 - WORD ON PAVEMENT, 96 IN.
  - (I) ITEM 618 - RUMBLE STRIPS, TYPE 2
  - (J) ITEM 620 - DELINEATORS, TYPE D
  - (K) ITEM 620 - DELINEATORS, TYPE C

**PAVEMENT MARKING**  
**STA. 560+00 TO STA. 574+00**

**LOR - I90 - 10.76**

2:35AM 02-13-2002 [ C:\93860\DWG\93860\PL\9360PM7.DWG ] LAB


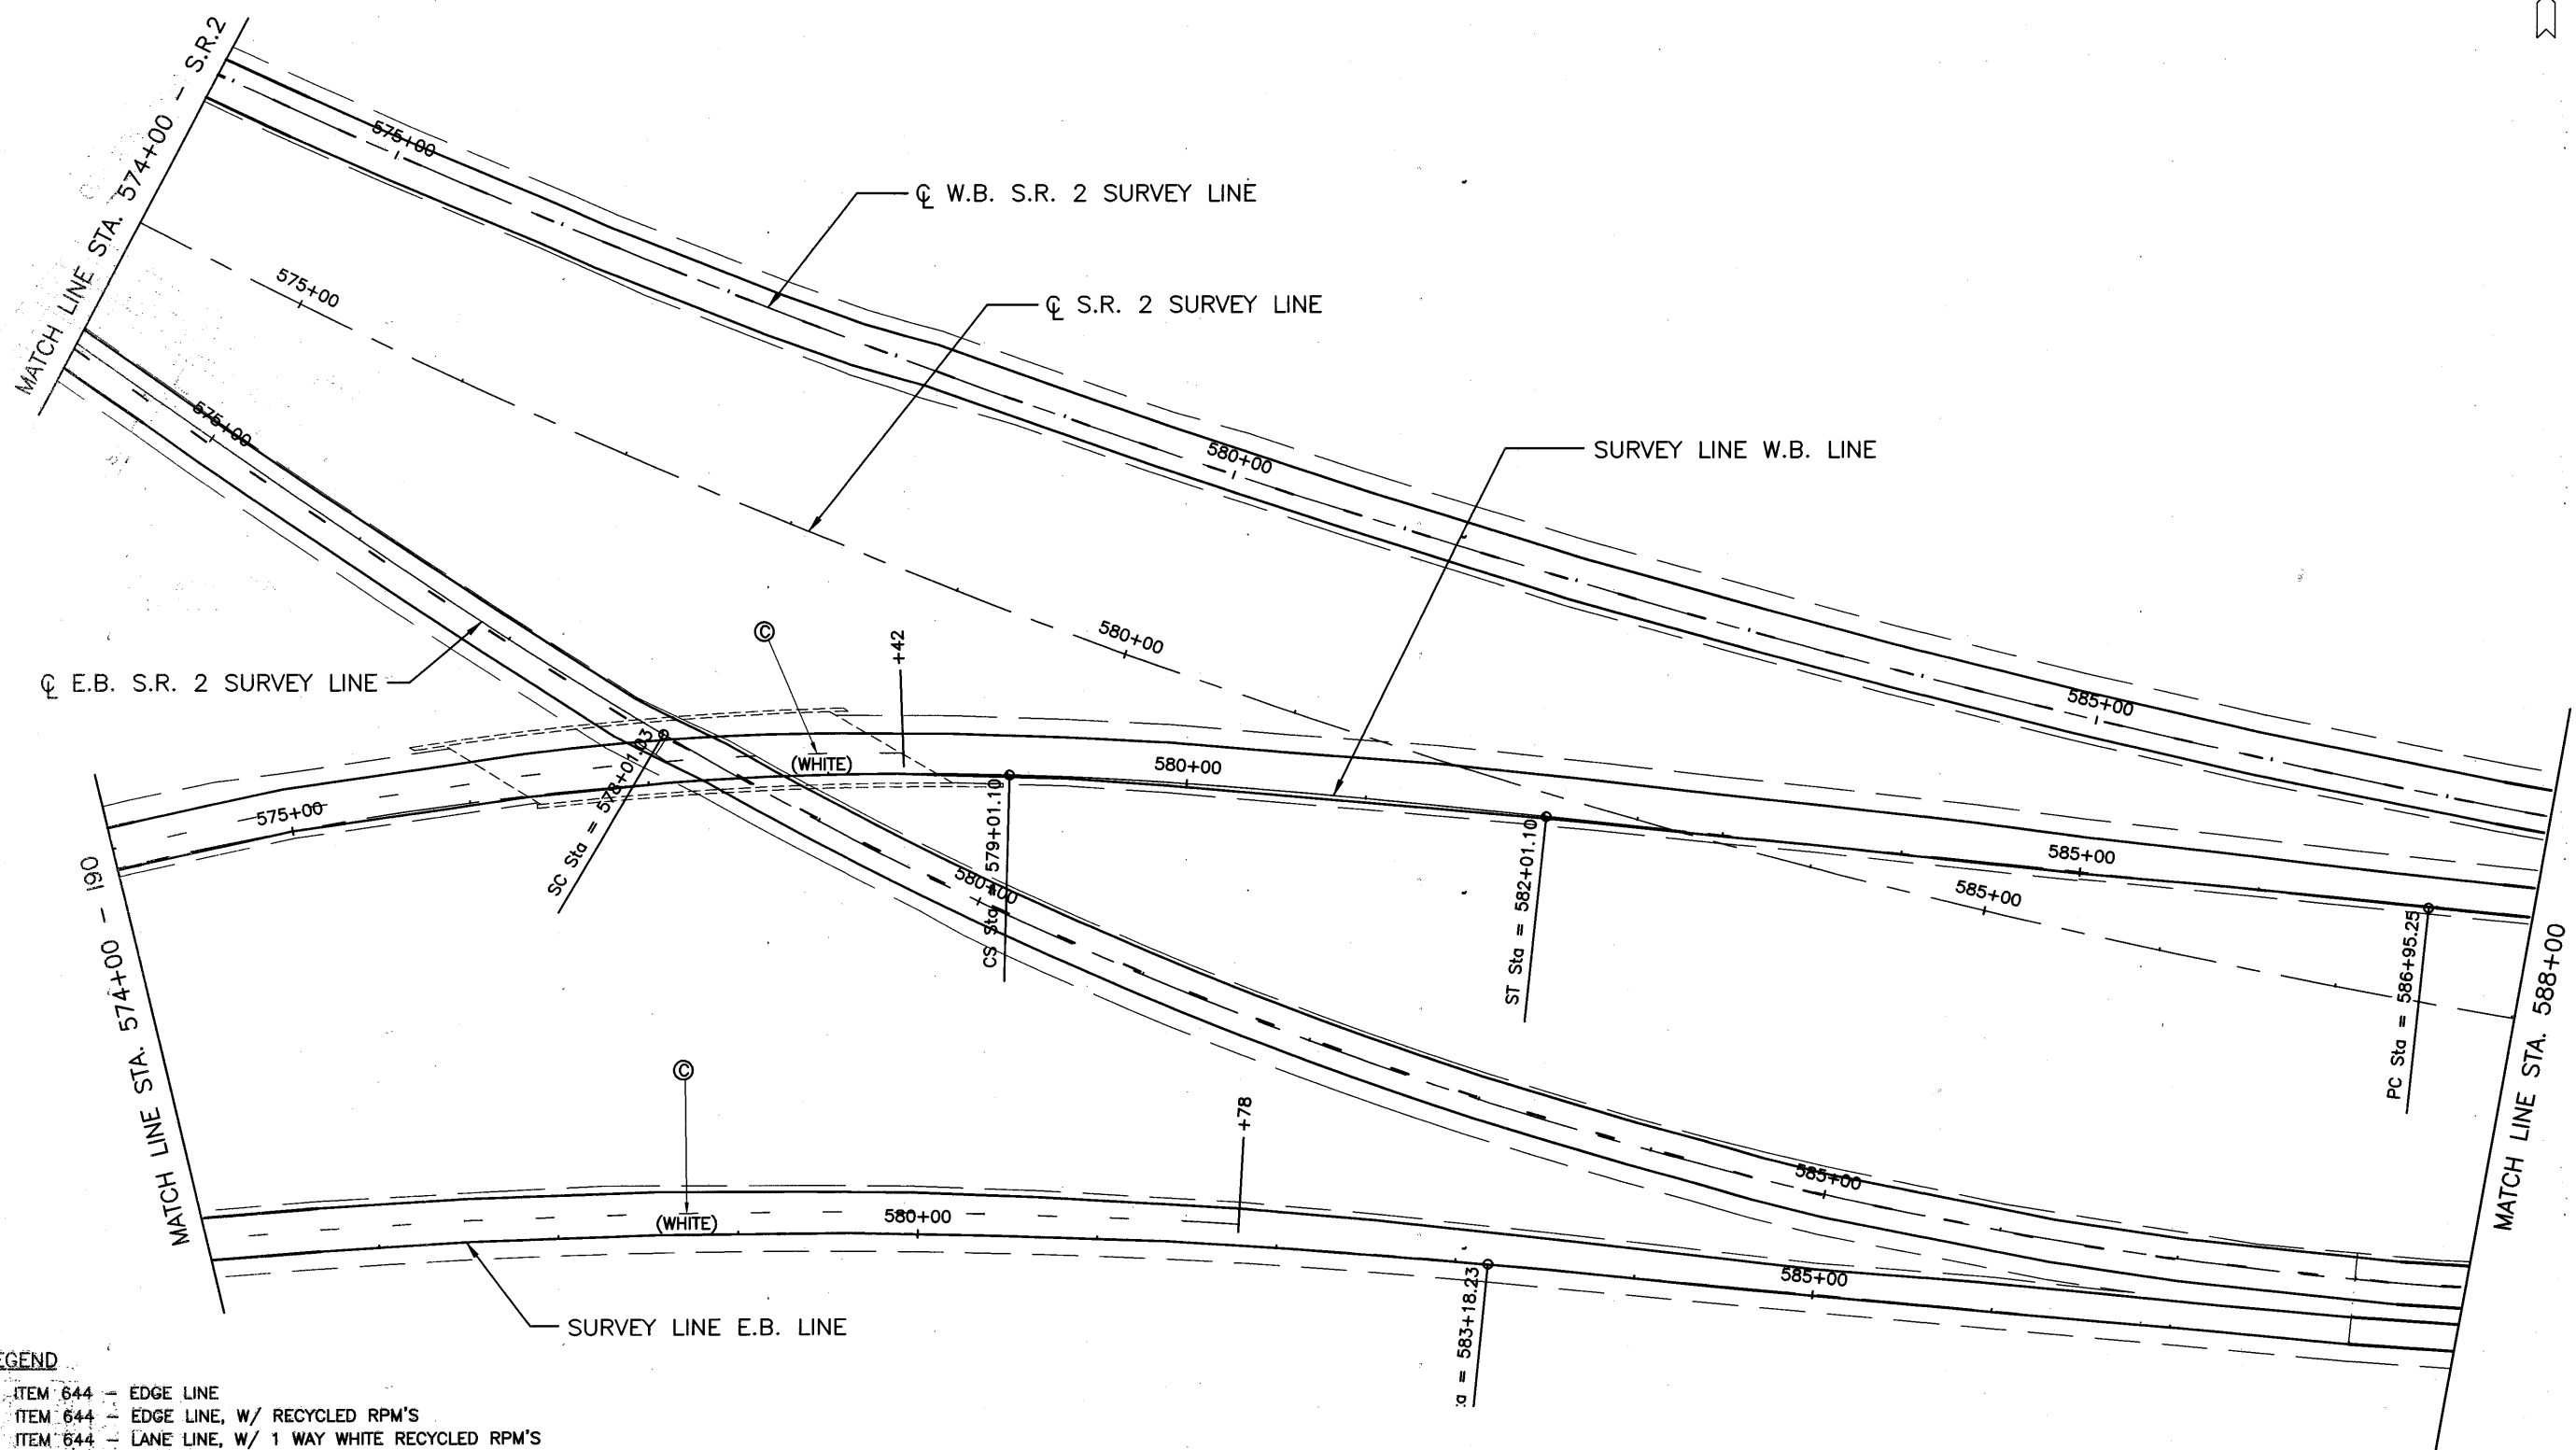


- LEGEND**
- (A) ITEM 644 - EDGE LINE
  - (B) ITEM 644 - EDGE LINE, W/ RECYCLED RPM'S
  - (C) ITEM 644 - LANE LINE, W/ 1 WAY WHITE RECYCLED RPM'S
  - (D) ITEM 644 - LANE LINE
  - (E) ITEM 644 - CHANNELIZING LINE, W/ RECYCLED RPM'S
  - (F) ITEM 644 - STOP LINE
  - (G) ITEM 644 - LANE ARROW
  - (H) ITEM 644 - WORD ON PAVEMENT, 96 IN.
  - (I) ITEM 618 - RUMBLE STRIPS, TYPE 2
  - (J) ITEM 620 - DELINEATORS, TYPE D
  - (K) ITEM 620 - DELINEATORS, TYPE C

I:\05544 [ 01\05544\UNISA\05544\05544\05544.DWG ] DLS  
 02-13-2002

**NOTE:**


DIAGONAL STRIPES IN EXIT RAMP MARKINGS SHALL BE 2' WIDE WHITE RAISED STRIPES SET AT A 45° ANGLE TO THE CENTER LINE OF THE THROUGH PAVEMENT AND SLANTED IN THE DIRECTION OF THE FLOW OF TRAFFIC ON SAID PAVEMENT. SPACE BETWEEN THE 2' DIAGONAL STRIPES SHALL BE 12' AS MEASURED PARALLEL TO THE CENTER LINE OF THE THROUGH PAVEMENT. WHITE RAISED PAVEMENT STRIPES PAVEMENT MARKING SHALL BE APPLIED AS PER SPECIFICATIONS ITEM 644. DIAGONAL WHITE STRIPES SHALL BE PLACED BETWEEN THE TWO 8" WHITE CHANNELING LINES AT EXIT RAMP AS SHOWN, TO CONFORM TO ITEM 641.

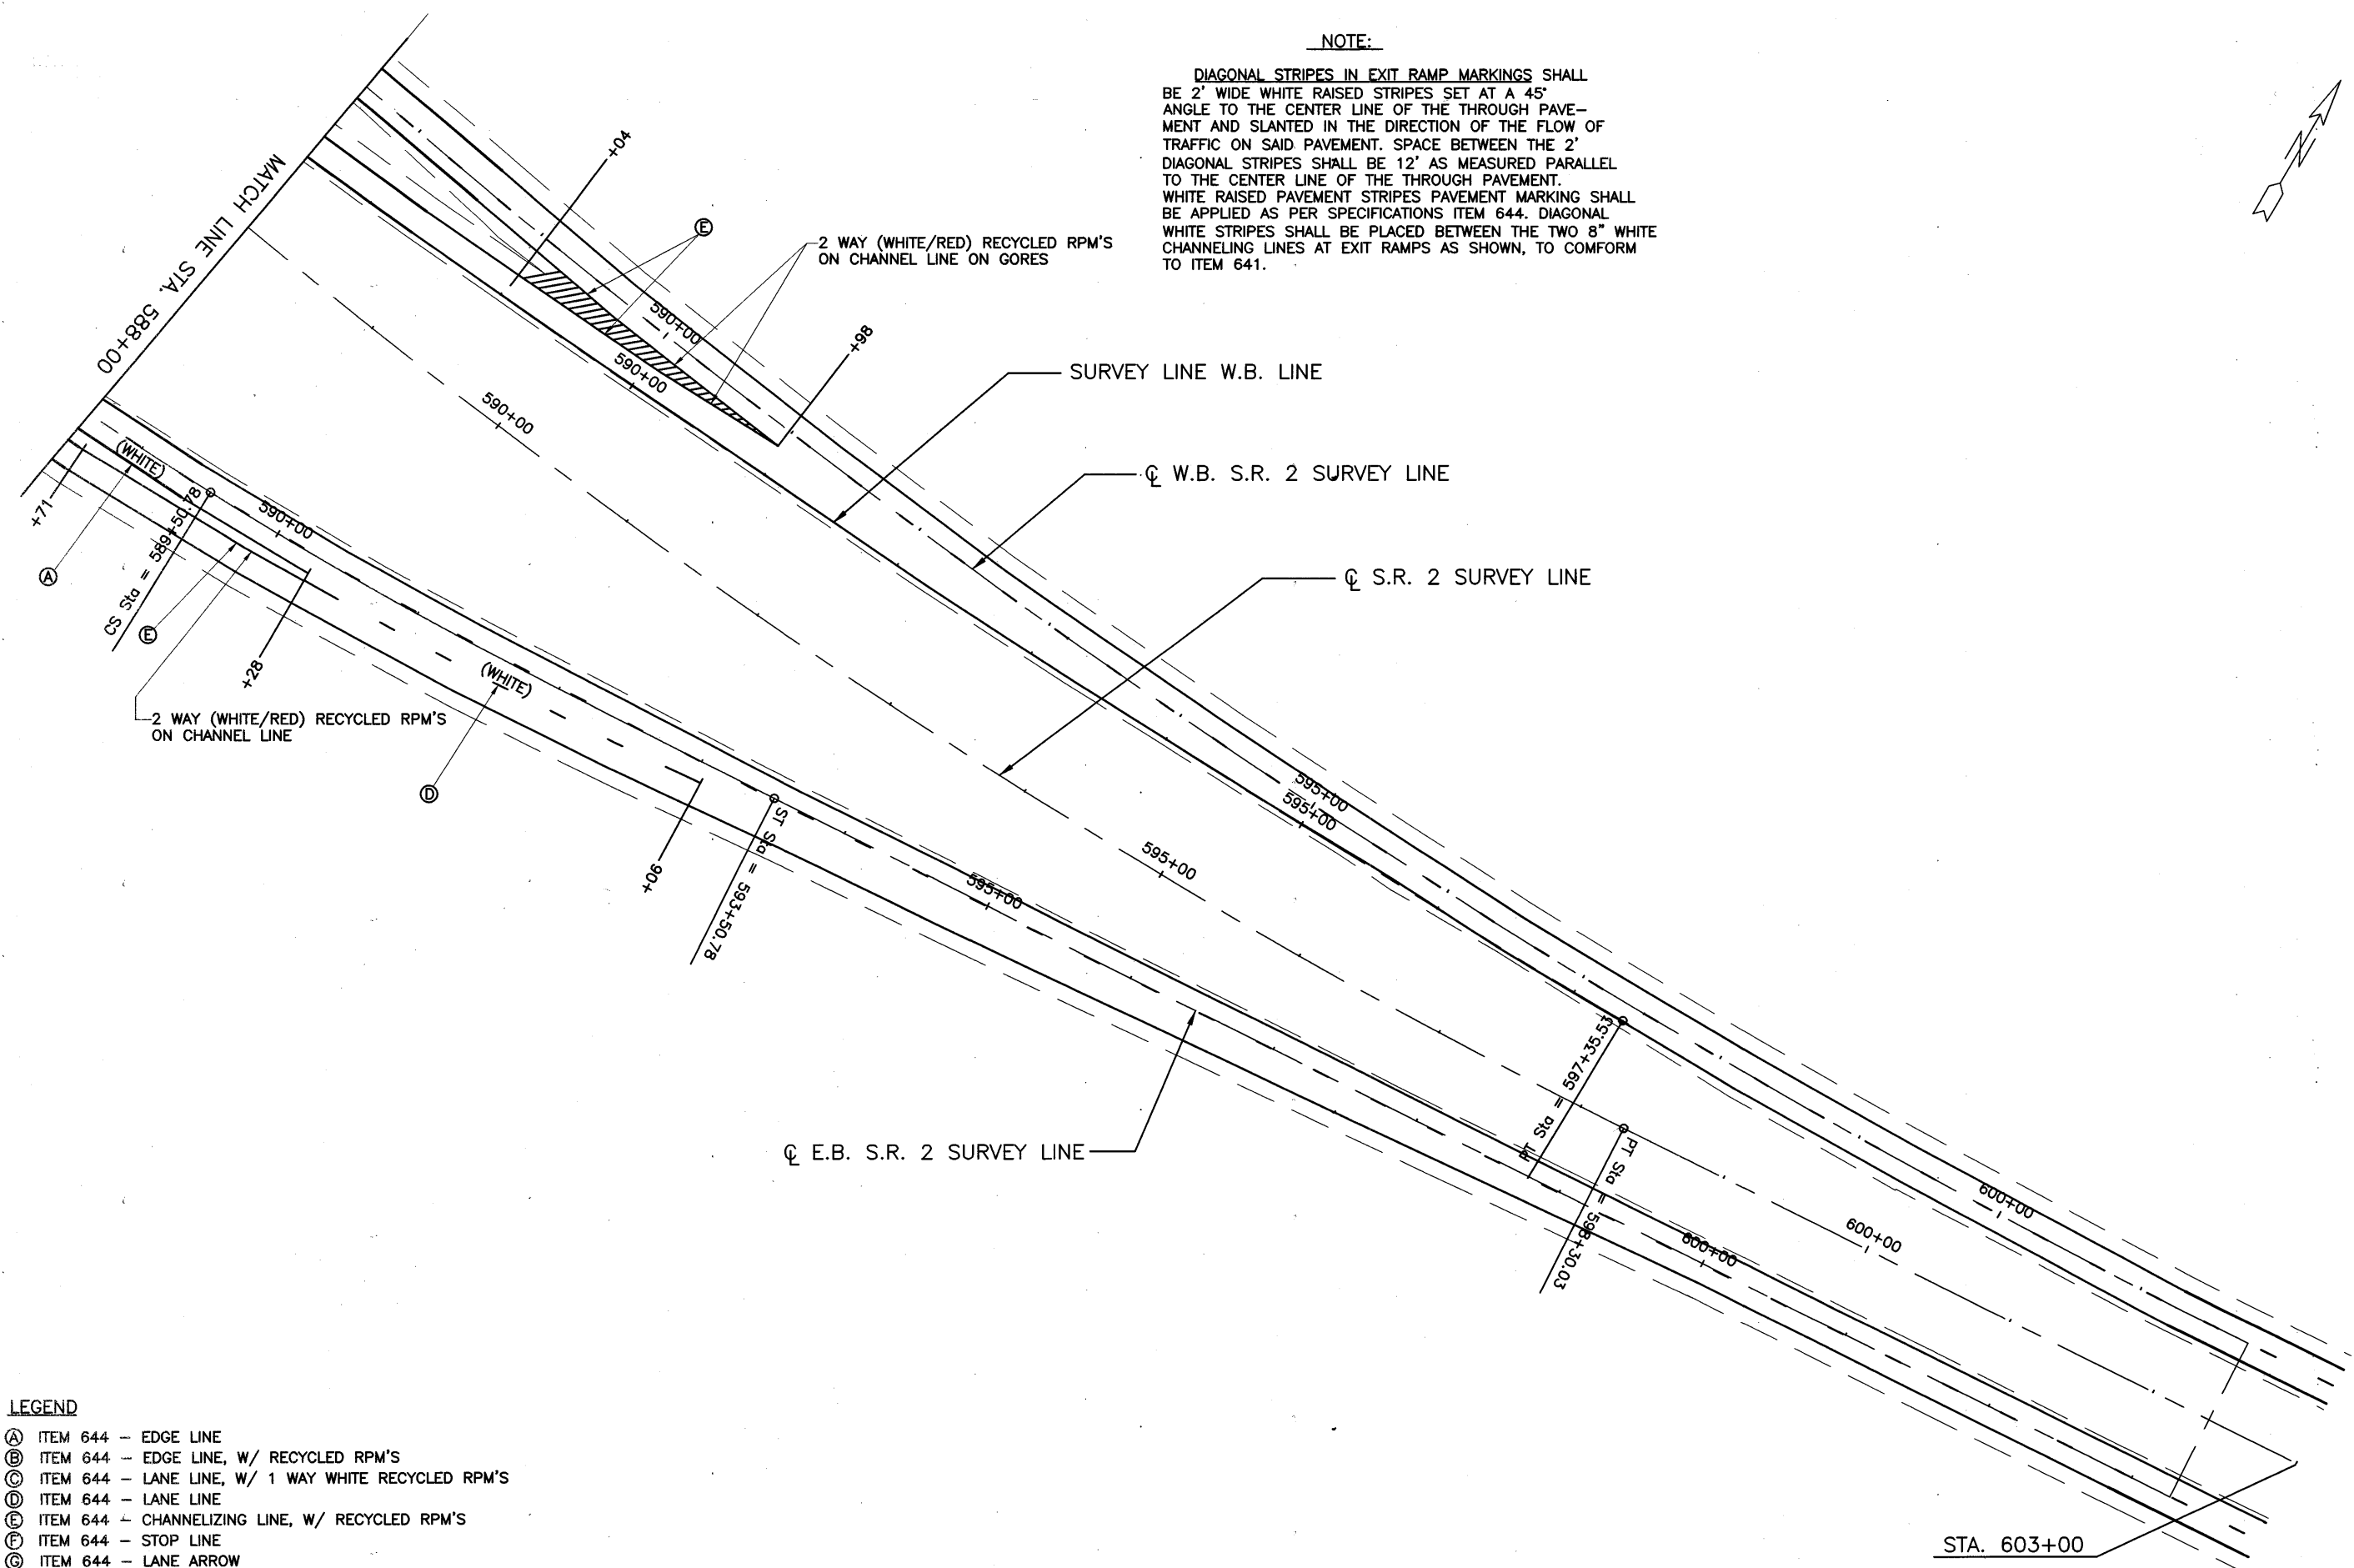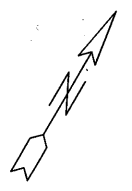

**LEGEND**

- (A) ITEM 644 - EDGE LINE
- (B) ITEM 644 - EDGE LINE, W/ RECYCLED RPM'S
- (C) ITEM 644 - LANE LINE, W/ 1 WAY WHITE RECYCLED RPM'S
- (D) ITEM 644 - LANE LINE
- (E) ITEM 644 - CHANNELIZING LINE, W/ RECYCLED RPM'S
- (F) ITEM 644 - STOP LINE
- (G) ITEM 644 - LANE ARROW
- (H) ITEM 644 - WORD ON PAVEMENT, 96 IN.
- (I) ITEM 618 - RUMBLE STRIPS, TYPE 2
- (J) ITEM 620 - DELINEATORS, TYPE D
- (K) ITEM 620 - DELINEATORS, TYPE C

CALCULATED	DLS	CHECKED	LAB

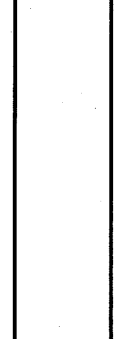

**PAVEMENT MARKING**  
STA. 588+00 TO STA. 603+00



**LOR - 190 - 10.76**

**LEGEND**

- (A) ITEM 644 - EDGE LINE
- (B) ITEM 644 - EDGE LINE, W/ RECYCLED RPM'S
- (C) ITEM 644 - LANE LINE, W/ 1 WAY WHITE RECYCLED RPM'S
- (D) ITEM 644 - LANE LINE
- (E) ITEM 644 - CHANNELIZING LINE, W/ RECYCLED RPM'S
- (F) ITEM 644 - STOP LINE
- (G) ITEM 644 - LANE ARROW
- (H) ITEM 644 - WORD ON PAVEMENT, 96 IN.
- (I) ITEM 618 - RUMBLE STRIPS, TYPE 2
- (J) ITEM 620 - DELINEATORS, TYPE D
- (K) ITEM 620 - DELINEATORS, TYPE C

**NOTE:**

SEE STD TC-65.11M FOR PLACING OF RPM'S AT ACCELERATION LANE.  
SEE STD TC-72.20 FOR PAVEMENT MARKINGS AT ACCELERATION LANE.

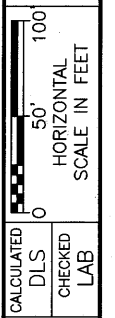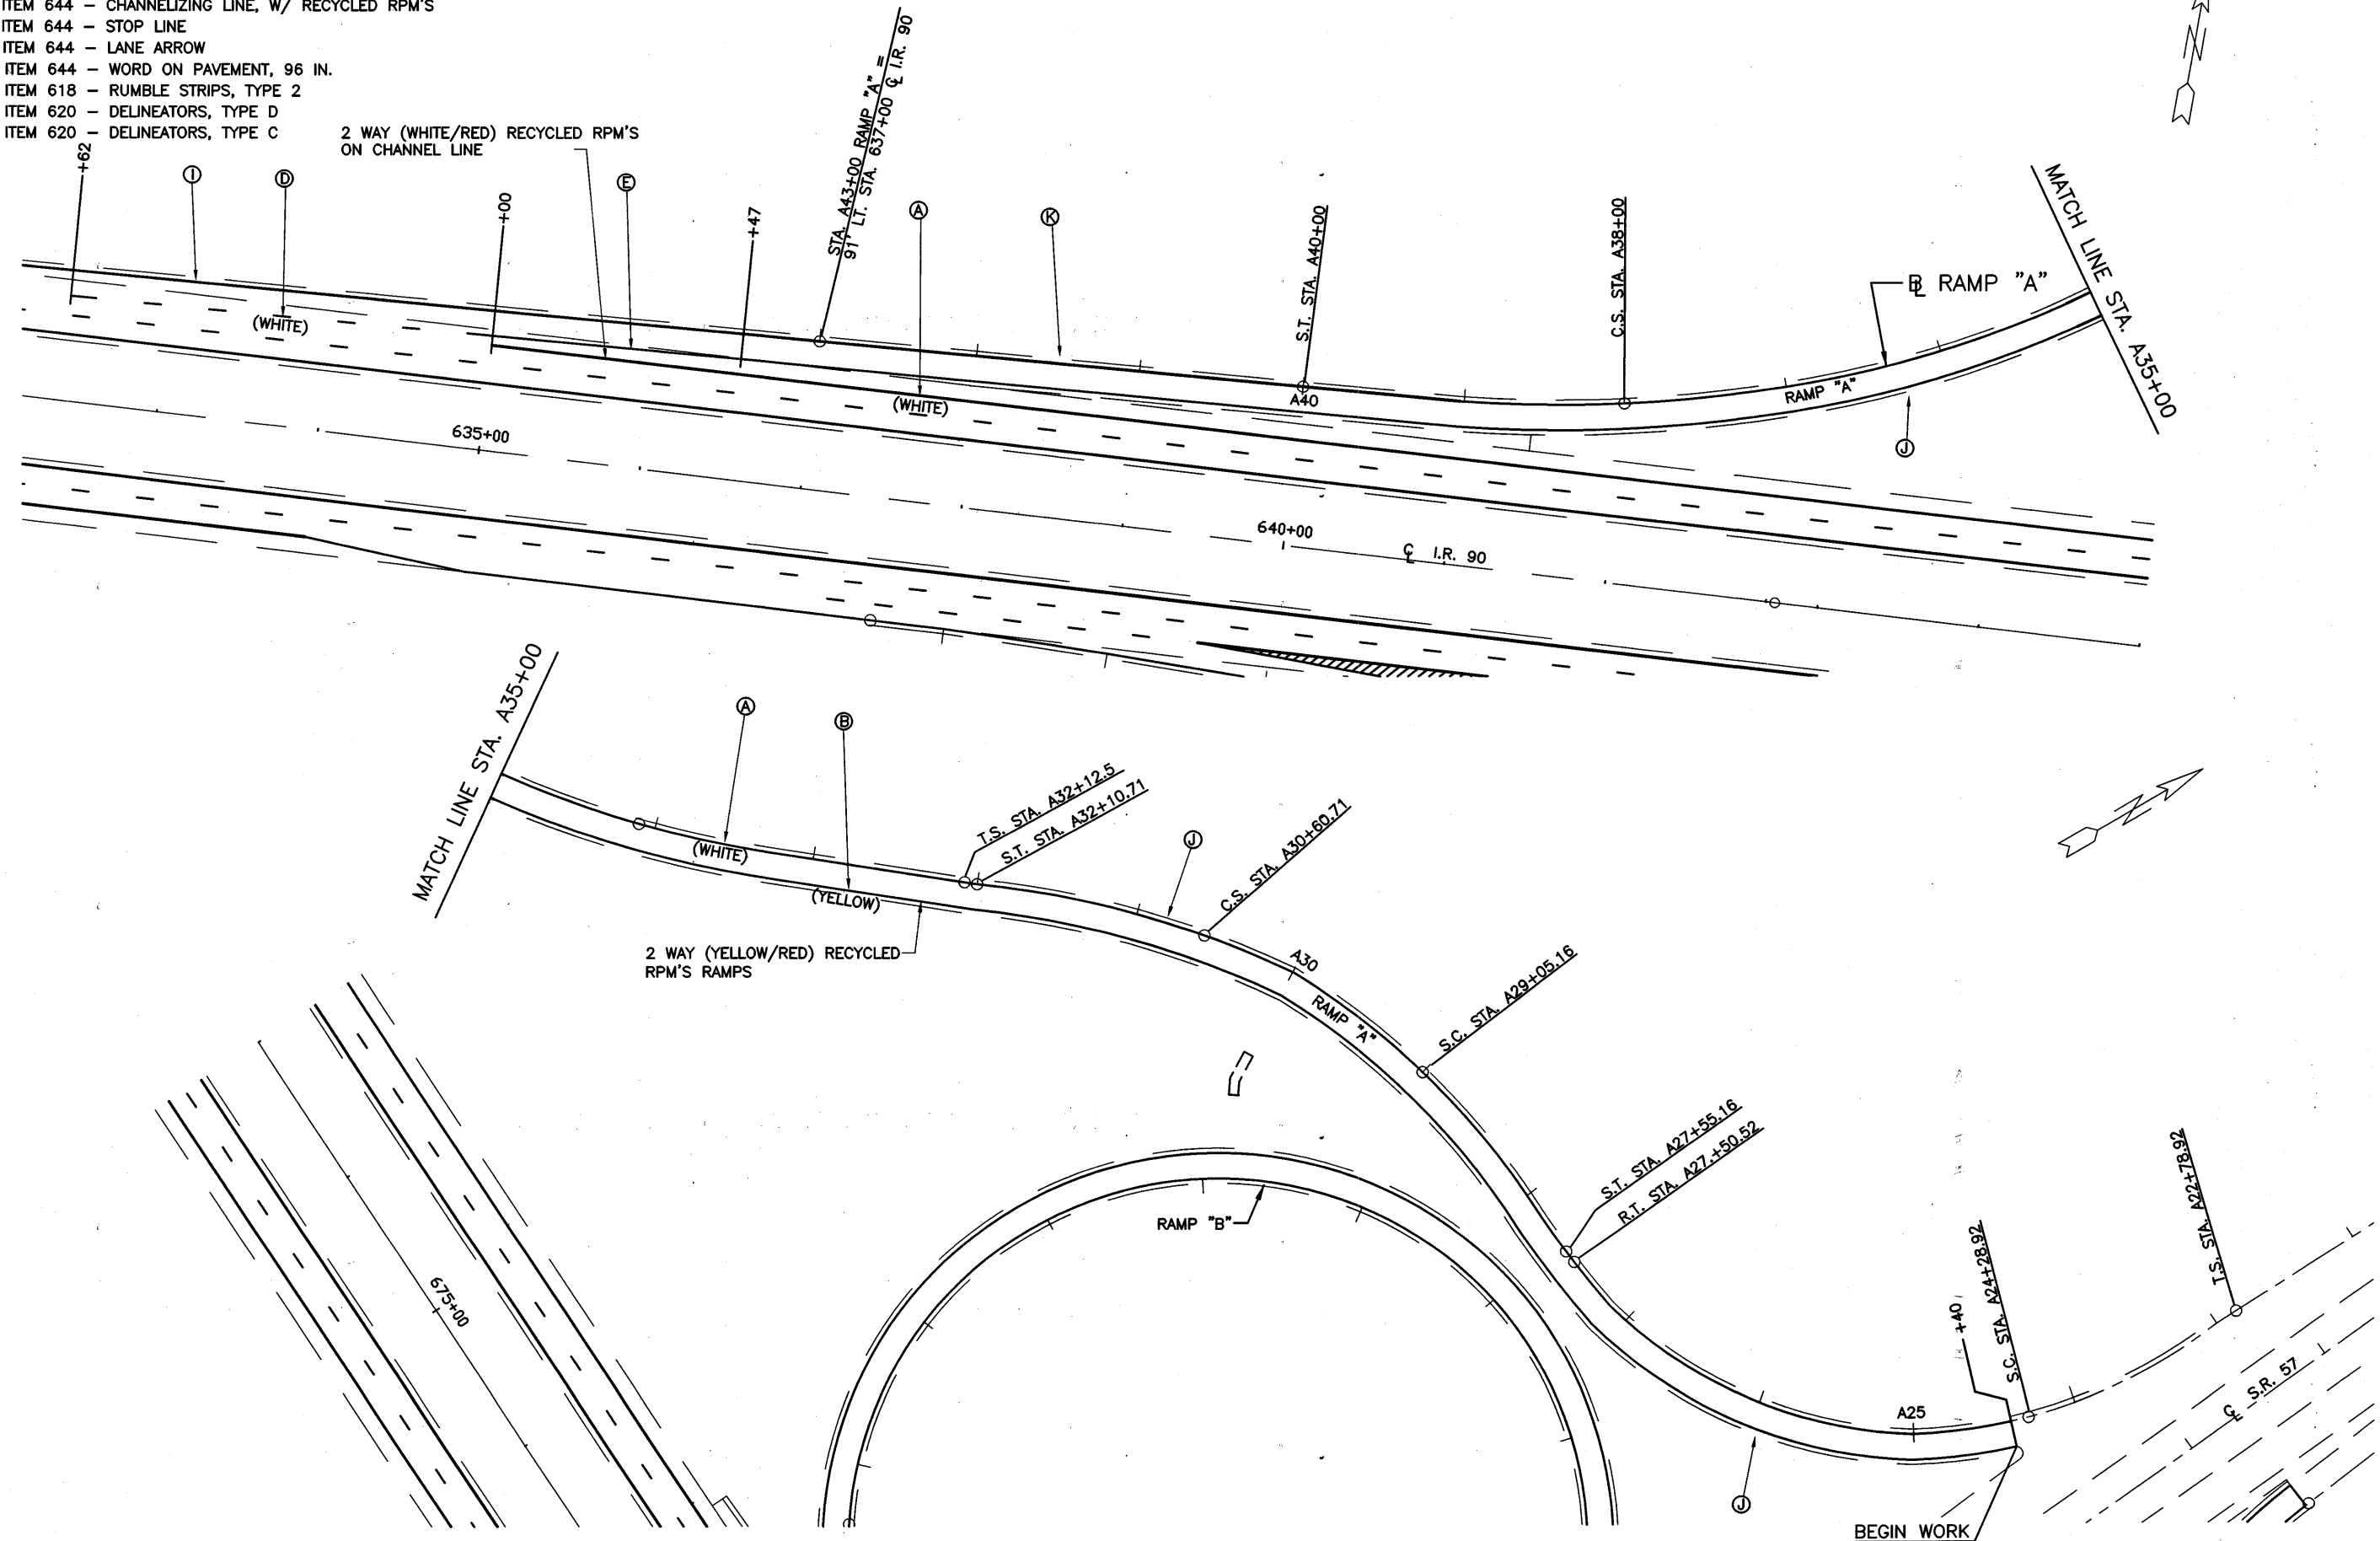


**RAMP "A" - S.R. 57 & I.R. 90  
STA. 21+07.29 TO STA. 43+00**

**LOR - 190 - 10.76**


C:\93500\DWG\9360P\9360P\10.DWG 1 DLS  
 07-18-2002 11:07AM



**NOTE:**  
 DIAGONAL STRIPES IN EXIT RAMP MARKINGS SHALL BE 2' WIDE WHITE RAISED STRIPES SET AT A 45° ANGLE TO THE CENTER LINE OF THE THROUGH PAVEMENT AND SLANTED IN THE DIRECTION OF THE FLOW OF TRAFFIC ON SAID PAVEMENT. SPACE BETWEEN THE 2' DIAGONAL STRIPES SHALL BE 12' AS MEASURED PARALLEL TO THE CENTER LINE OF THE THROUGH PAVEMENT. WHITE RAISED PAVEMENT STRIPES PAVEMENT MARKING SHALL BE APPLIED AS PER SPECIFICATIONS ITEM 644. DIAGONAL WHITE STRIPES SHALL BE PLACED BETWEEN THE TWO 8" WHITE CHANNELING LINES AT EXIT RAMP AS SHOWN, TO COMFORM TO ITEM 641.

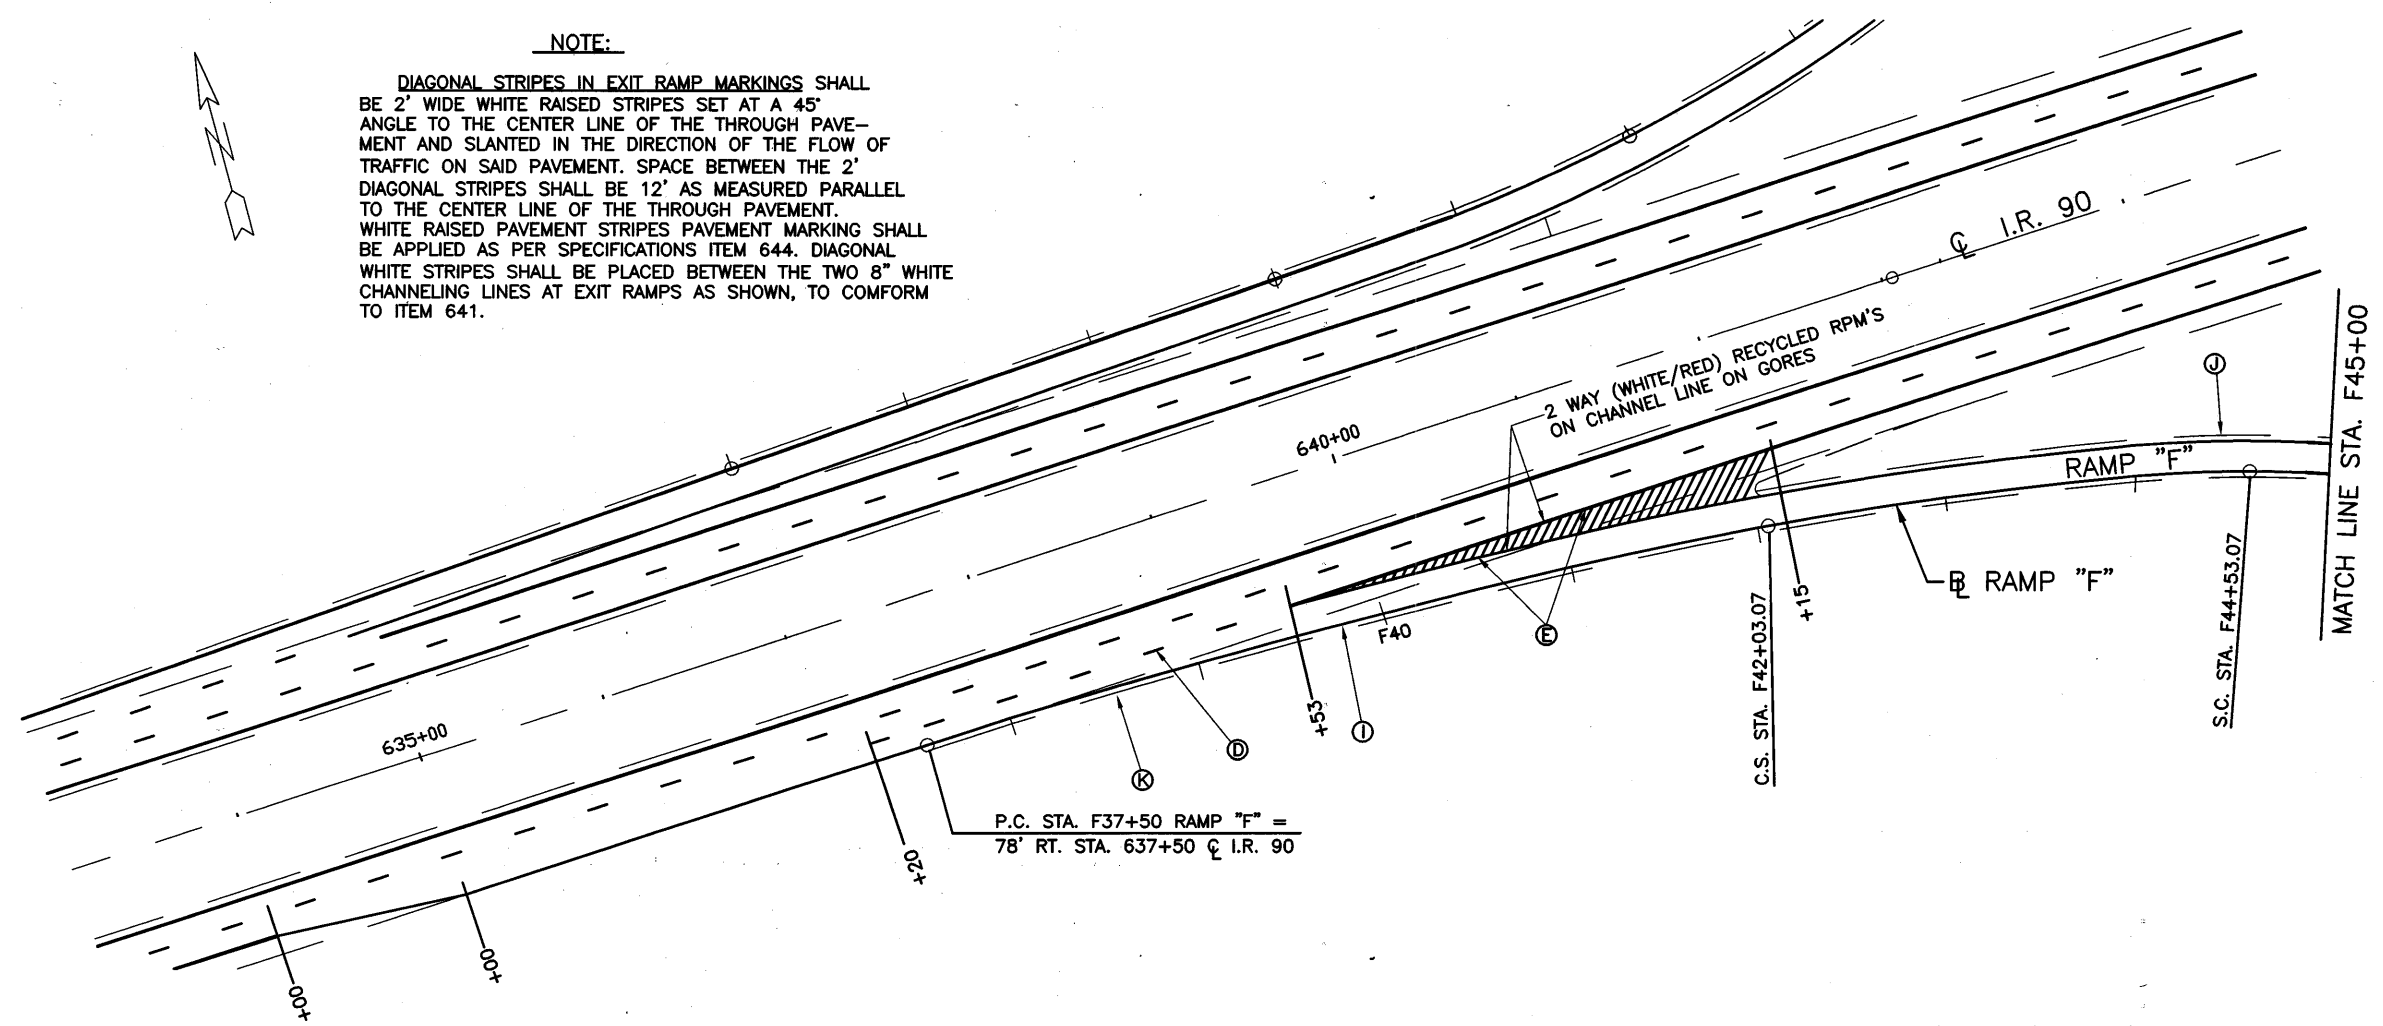

**NOTE:**  
 SEE STD TC-65.11M FOR PLACING OF RPM'S AT ACCELERATION LANE.  
 SEE STD TC-72.20 FOR PAVEMENT MARKINGS AT ACCELERATION LANE.

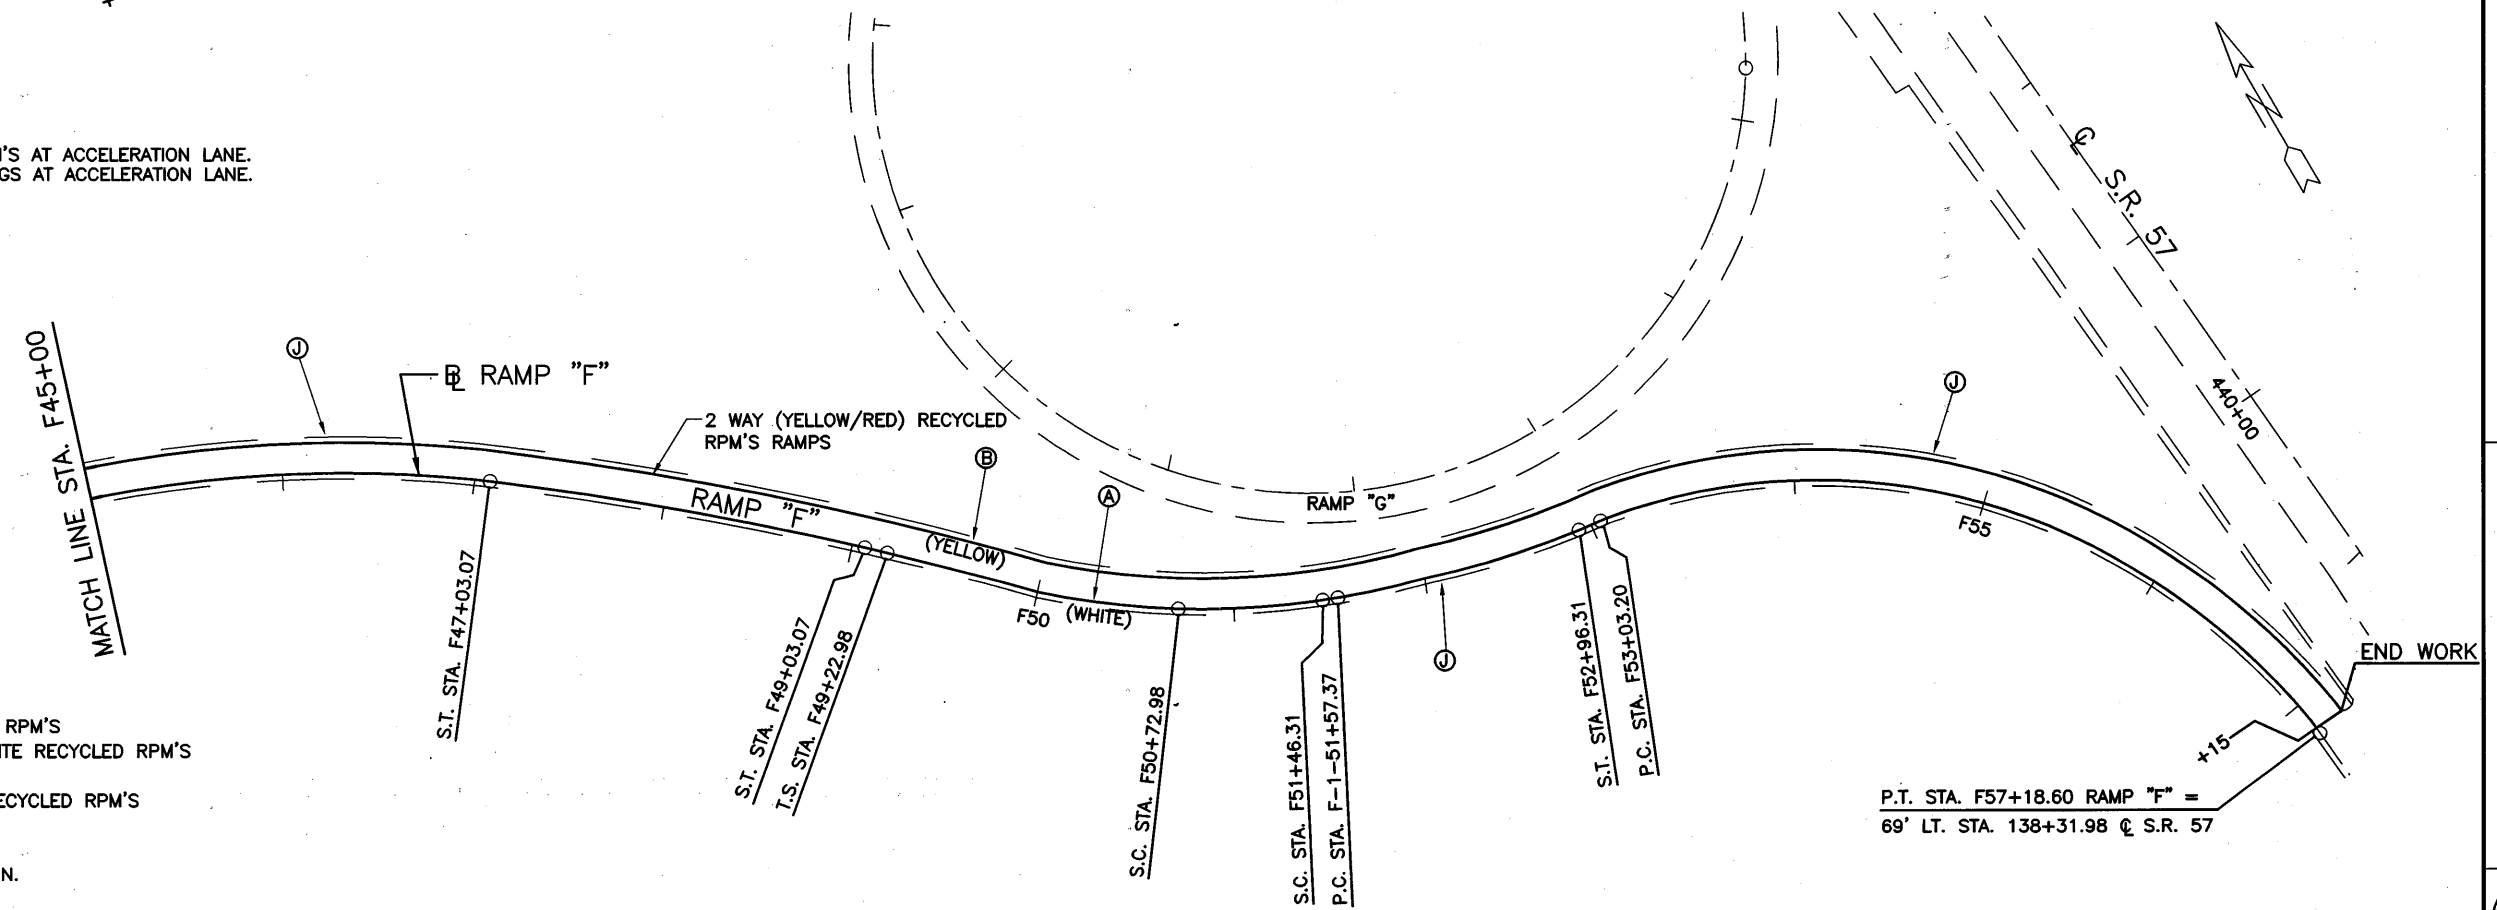

- LEGEND**
- (A) ITEM 644 - EDGE LINE
  - (B) ITEM 644 - EDGE LINE, W/ RECYCLED RPM'S
  - (C) ITEM 644 - LANE LINE, W/ 1 WAY WHITE RECYCLED RPM'S
  - (D) ITEM 644 - LANE LINE
  - (E) ITEM 644 - CHANNELIZING LINE, W/ RECYCLED RPM'S
  - (F) ITEM 644 - STOP LINE
  - (G) ITEM 644 - LANE ARROW
  - (H) ITEM 644 - WORD ON PAVEMENT, 96 IN.
  - (I) ITEM 618 - RUMBLE STRIPS, TYPE 2
  - (J) ITEM 620 - DELINEATORS, TYPE D
  - (K) ITEM 620 - DELINEATORS, TYPE C



**RAMP "F" - S.R. 57 & I.R. 90**  
**STA. 37+50 TO STA. 57+18.60**

**LOR-190-10.76**

120  
274

C:\0195600\DWG\93600P\L\93600P\1.DWG 1 DLS 07-18-2002 11:13AM




**LEGEND**

- (A) ITEM 644 - EDGE LINE
- (B) ITEM 644 - EDGE LINE, W/ RECYCLED RPM'S
- (C) ITEM 644 - LANE LINE, W/ 1 WAY WHITE RECYCLED RPM'S
- (D) ITEM 644 - LANE LINE
- (E) ITEM 644 - CHANNELIZING LINE, W/ RECYCLED RPM'S
- (F) ITEM 644 - STOP LINE
- (G) ITEM 644 - LANE ARROW
- (H) ITEM 644 - WORD ON PAVEMENT, 96 IN.
- (I) ITEM 618 - RUMBLE STRIPS, TYPE 2
- (J) ITEM 620 - DELINEATORS, TYPE D
- (K) ITEM 620 - DELINEATORS, TYPE C

**NOTE:**


SEE STD TC-65.11M FOR PLACING OF RPM'S AT ACCELERATION LANE.  
SEE STD TC-72.20 FOR PAVEMENT MARKINGS AT ACCELERATION LANE.

CALCULATED	DLS	CHECKED	LAB

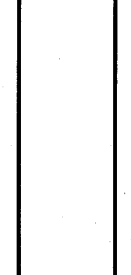

**RAMP "D" - S.R. 57 & I.R. 90**  
**STA. 678+63.19 TO STA. 698+53.27**

**LOR-190-10.76**

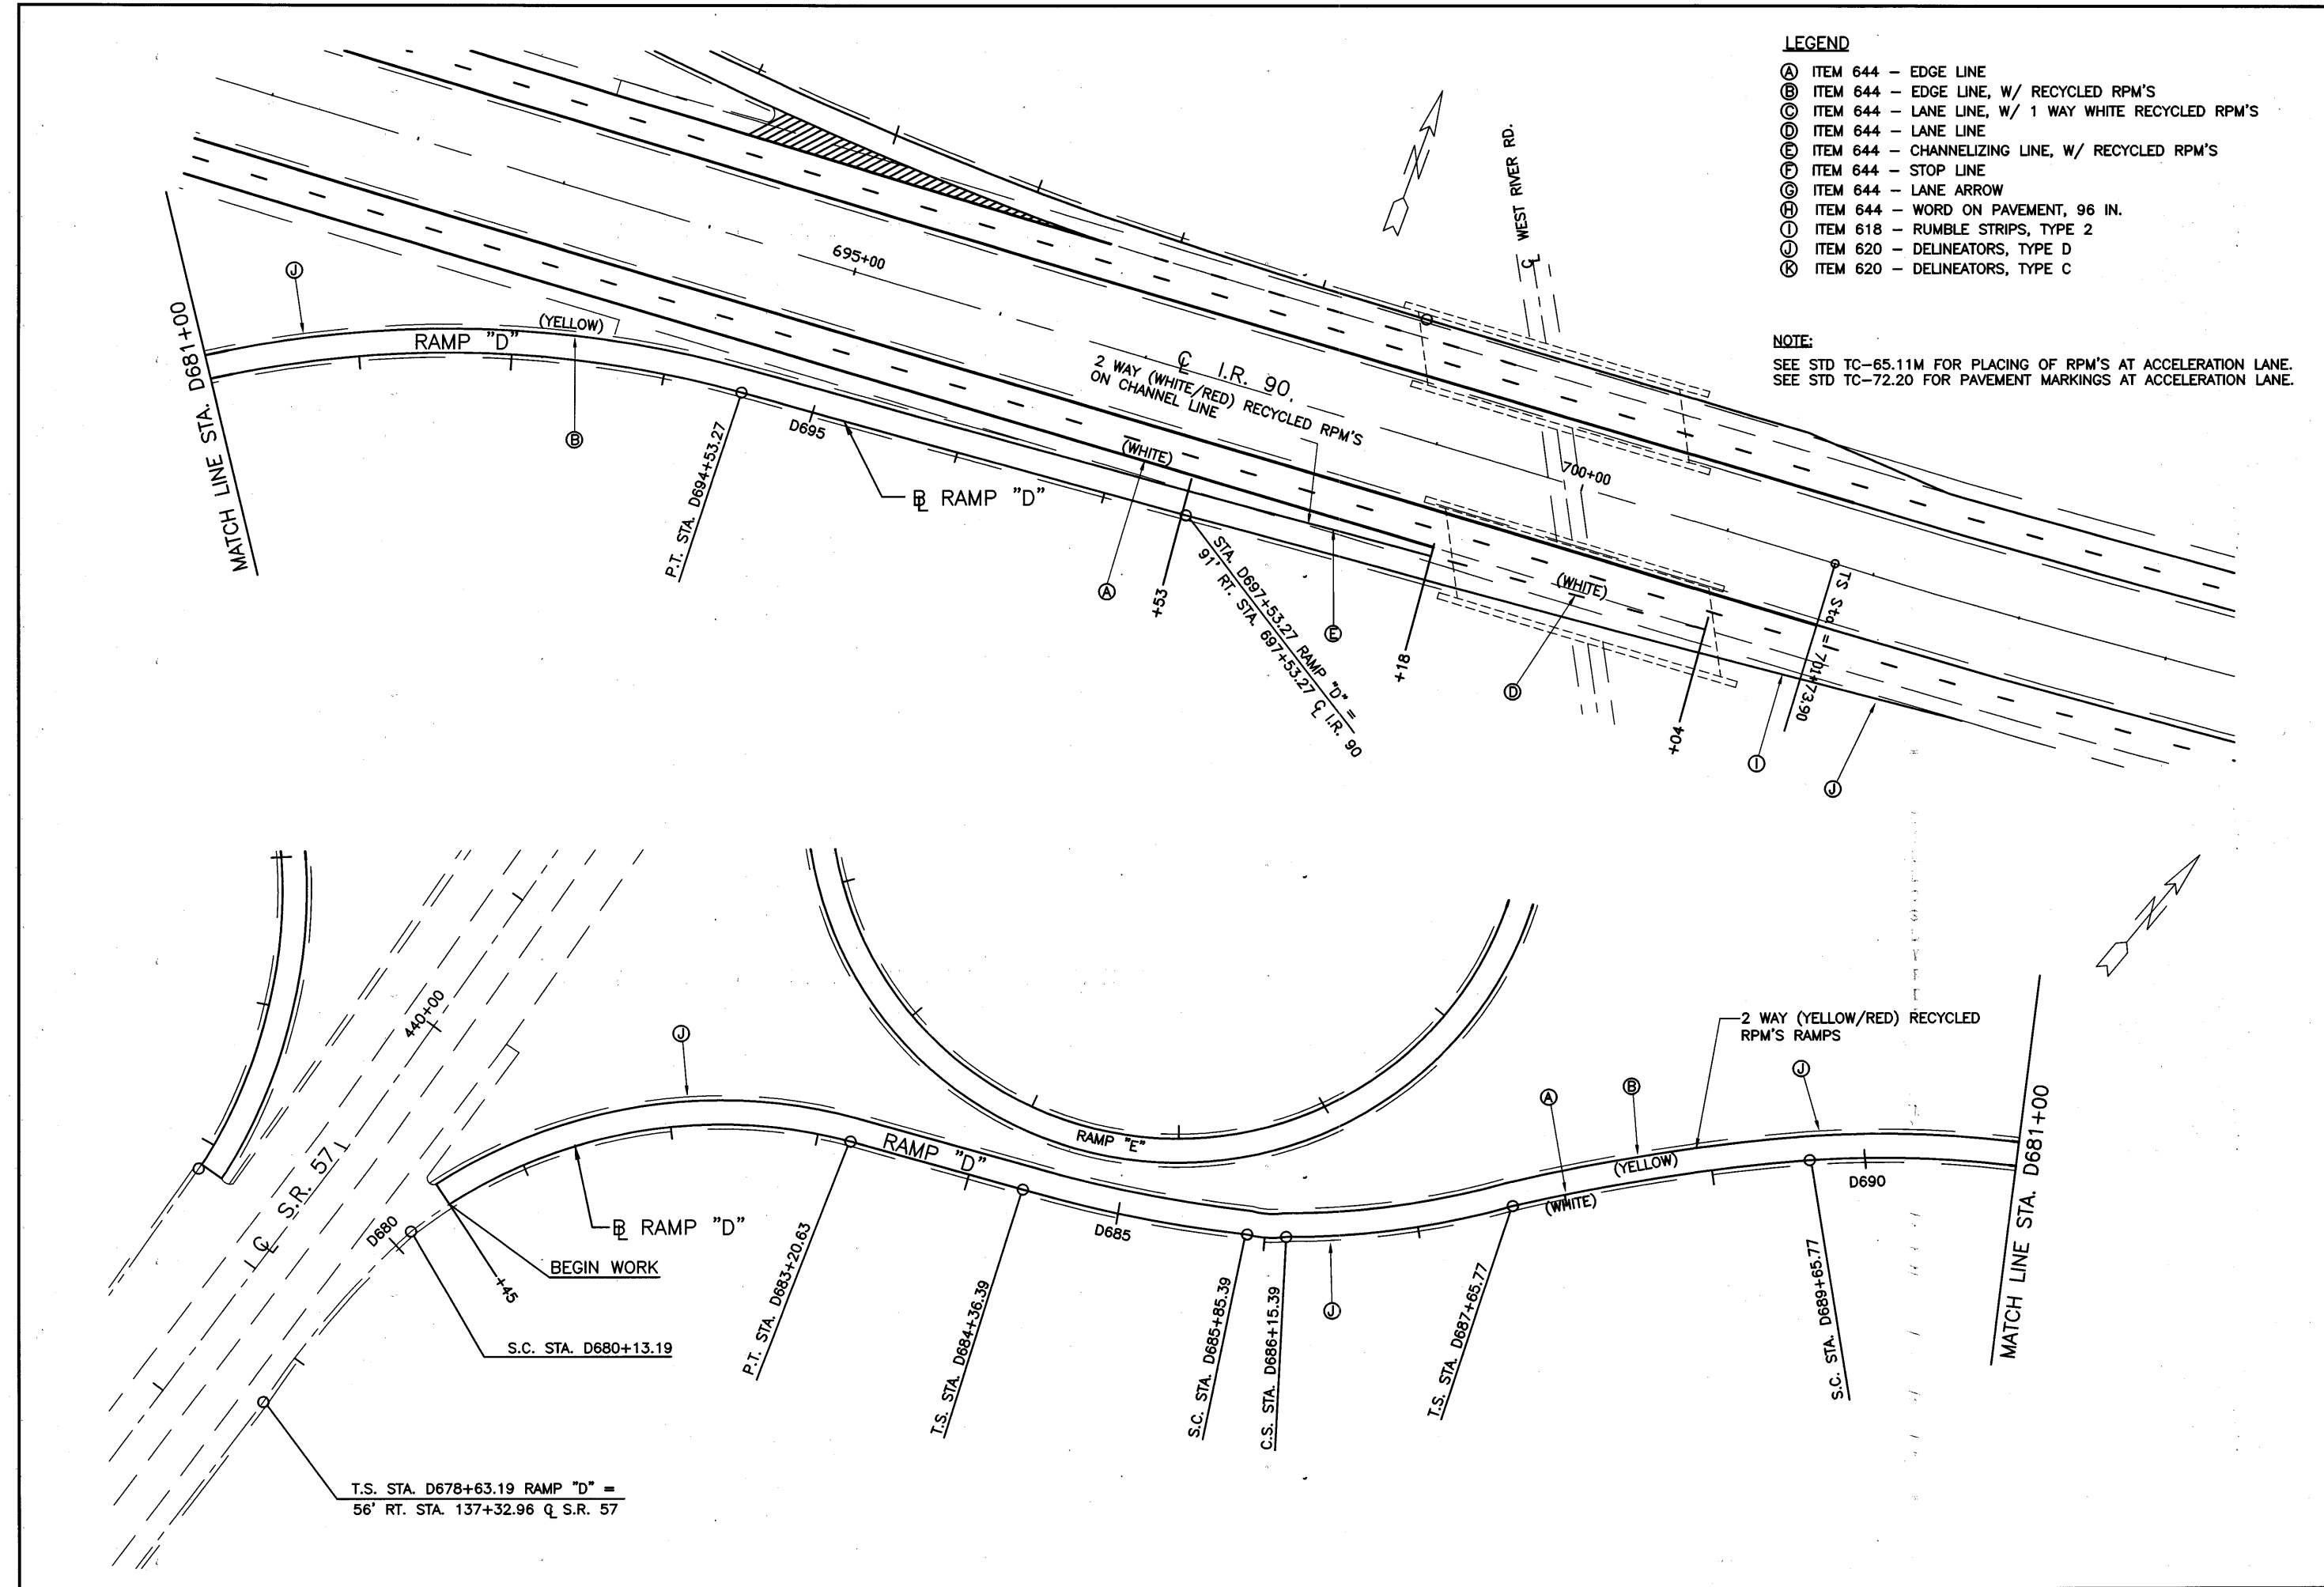


C:\93500\DWG\93500\FNL\93500P12.DWG 1 DLS  
 07-18-2002 1:34PM



RAMP "C" - S.R. 57 & I.R. 90  
 STA. 679+17.87 TO STA. 698+72.82

LOR-190-10.76

122  
 274

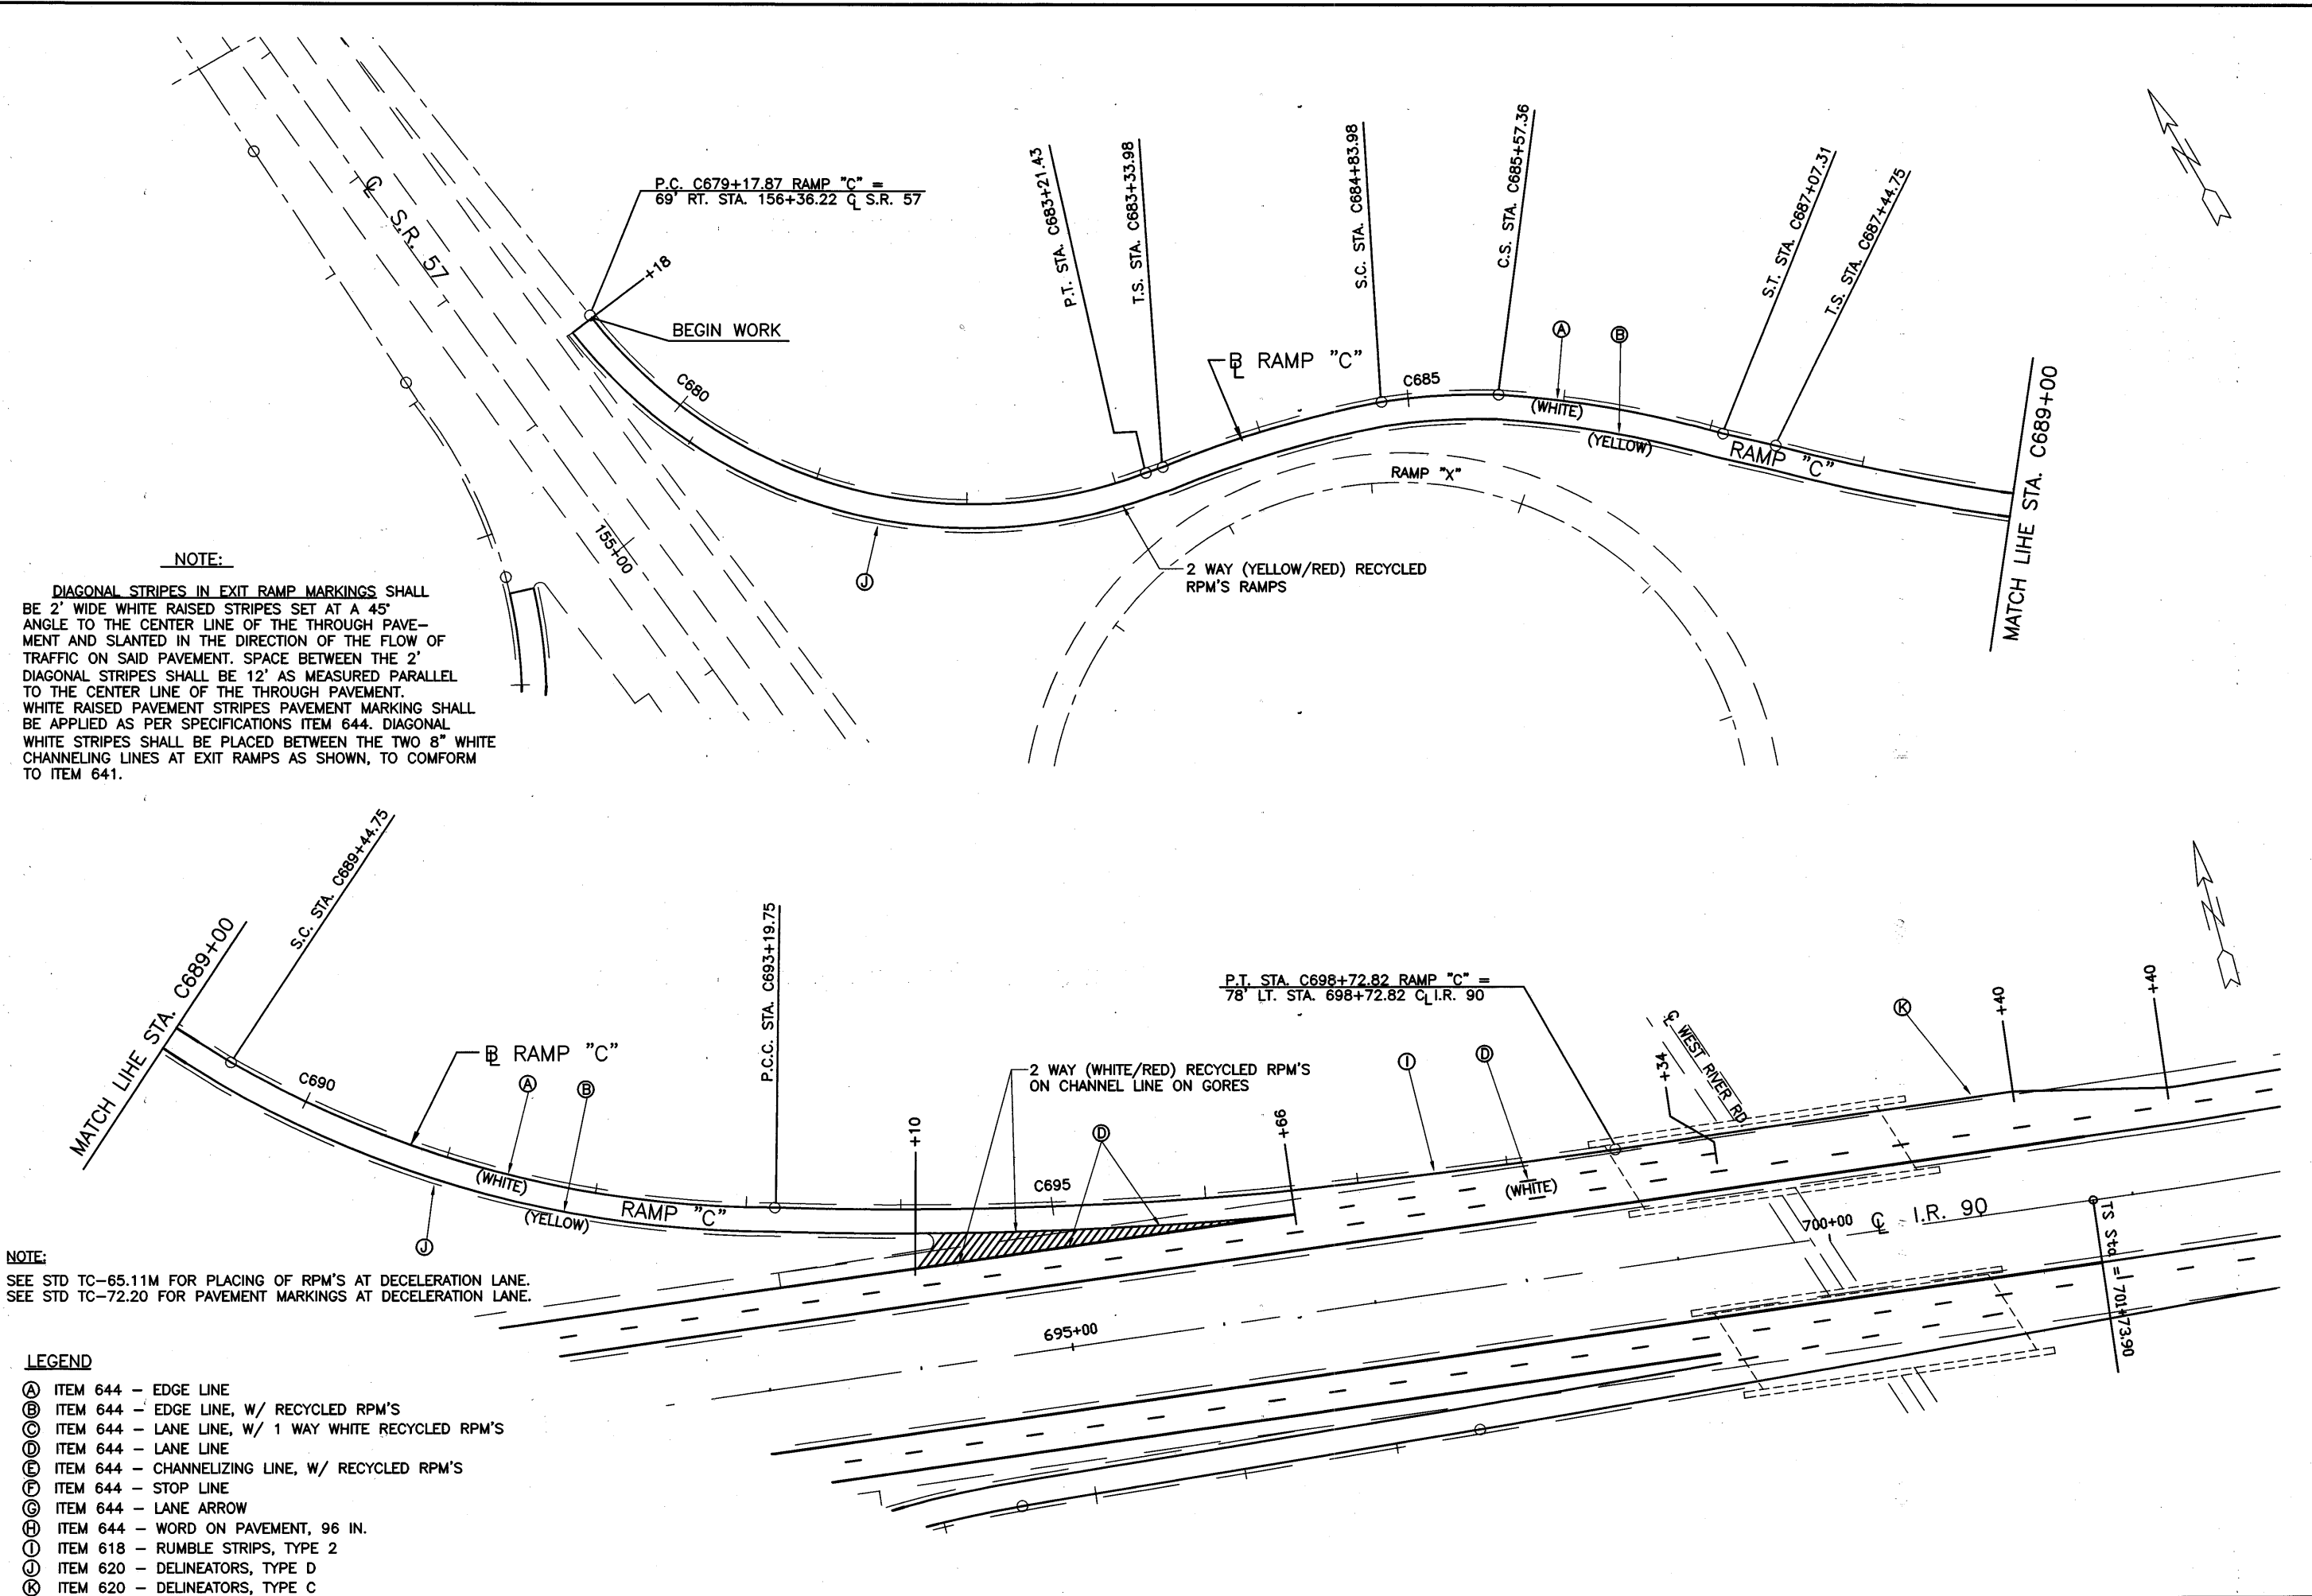

**NOTE:**

DIAGONAL STRIPES IN EXIT RAMP MARKINGS SHALL BE 2' WIDE WHITE RAISED STRIPES SET AT A 45° ANGLE TO THE CENTER LINE OF THE THROUGH PAVEMENT AND SLANTED IN THE DIRECTION OF THE FLOW OF TRAFFIC ON SAID PAVEMENT. SPACE BETWEEN THE 2' DIAGONAL STRIPES SHALL BE 12' AS MEASURED PARALLEL TO THE CENTER LINE OF THE THROUGH PAVEMENT. WHITE RAISED PAVEMENT STRIPES PAVEMENT MARKING SHALL BE APPLIED AS PER SPECIFICATIONS ITEM 644. DIAGONAL WHITE STRIPES SHALL BE PLACED BETWEEN THE TWO 8" WHITE CHANNELING LINES AT EXIT RAMPS AS SHOWN, TO CONFORM TO ITEM 641.

**NOTE:**

SEE STD TC-65.11M FOR PLACING OF RPM'S AT DECELERATION LANE.  
 SEE STD TC-72.20 FOR PAVEMENT MARKINGS AT DECELERATION LANE.

**LEGEND**

- (A) ITEM 644 - EDGE LINE
- (B) ITEM 644 - EDGE LINE, W/ RECYCLED RPM'S
- (C) ITEM 644 - LANE LINE, W/ 1 WAY WHITE RECYCLED RPM'S
- (D) ITEM 644 - LANE LINE
- (E) ITEM 644 - CHANNELIZING LINE, W/ RECYCLED RPM'S
- (F) ITEM 644 - STOP LINE
- (G) ITEM 644 - LANE ARROW
- (H) ITEM 644 - WORD ON PAVEMENT, 96 IN.
- (I) ITEM 618 - RUMBLE STRIPS, TYPE 2
- (J) ITEM 620 - DELINEATORS, TYPE D
- (K) ITEM 620 - DELINEATORS, TYPE C

I:\03600\UNMS\93600PML\93600PM13.DWG 1 DLS  
 07-18-2002 1:44PM





CALCULATED  
DLS  
CHECKED  
LAB

RAMP "E" - S.R. 57 & I.R. 90  
STA. 683+76.87 TO STA. 697+41.32

LOR-190-10.76

123  
274

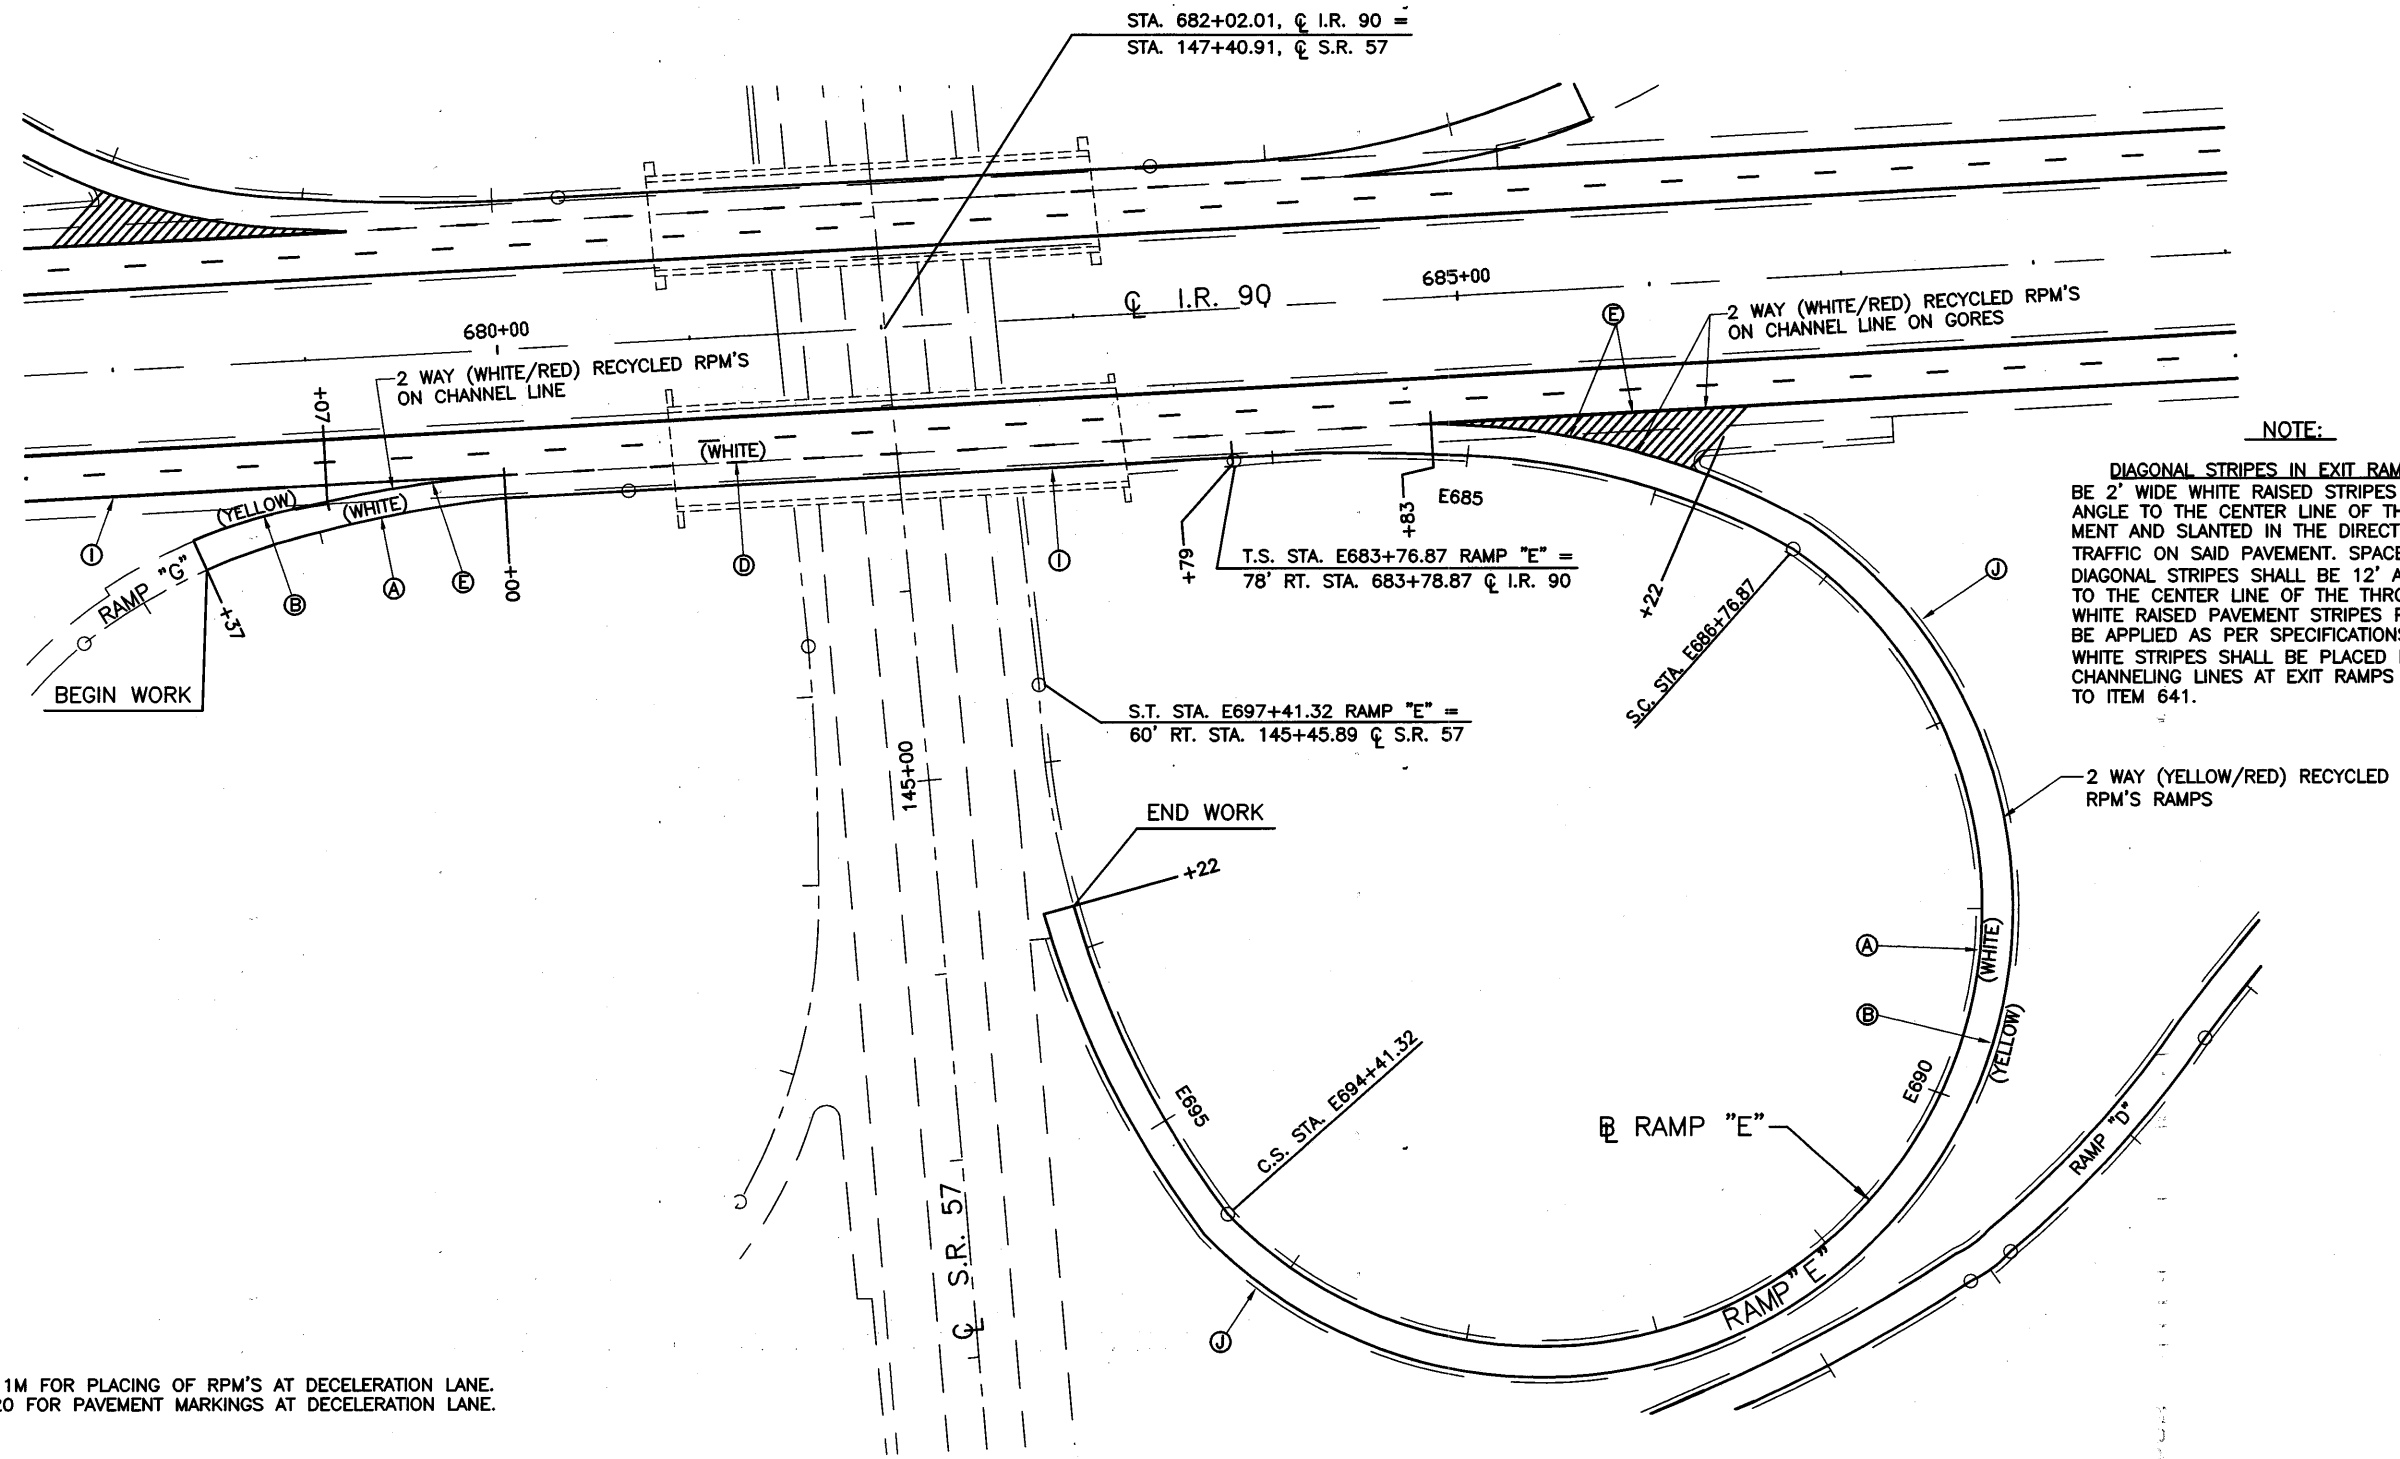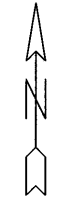


**NOTE:**  
DIAGONAL STRIPES IN EXIT RAMP MARKINGS SHALL BE 2" WIDE WHITE RAISED STRIPES SET AT A 45° ANGLE TO THE CENTER LINE OF THE THROUGH PAVEMENT AND SLANTED IN THE DIRECTION OF THE FLOW OF TRAFFIC ON SAID PAVEMENT. SPACE BETWEEN THE 2' DIAGONAL STRIPES SHALL BE 12" AS MEASURED PARALLEL TO THE CENTER LINE OF THE THROUGH PAVEMENT. WHITE RAISED PAVEMENT STRIPES PAVEMENT MARKING SHALL BE APPLIED AS PER SPECIFICATIONS ITEM 644. DIAGONAL WHITE STRIPES SHALL BE PLACED BETWEEN THE TWO 8" WHITE CHANNELING LINES AT EXIT RAMPS AS SHOWN, TO CONFORM TO ITEM 641.

**NOTE:**  
SEE STD TC-65.11M FOR PLACING OF RPM'S AT DECELERATION LANE.  
SEE STD TC-72.20 FOR PAVEMENT MARKINGS AT DECELERATION LANE.

- LEGEND**
- (A) ITEM 644 - EDGE LINE
  - (B) ITEM 644 - EDGE LINE, W/ RECYCLED RPM'S
  - (C) ITEM 644 - LANE LINE, W/ 1 WAY WHITE RECYCLED RPM'S
  - (D) ITEM 644 - LANE LINE
  - (E) ITEM 644 - CHANNELIZING LINE, W/ RECYCLED RPM'S
  - (F) ITEM 644 - STOP LINE
  - (G) ITEM 644 - LANE ARROW
  - (H) ITEM 644 - WORD ON PAVEMENT, 96 IN.
  - (I) ITEM 618 - RUMBLE STRIPS, TYPE 2
  - (J) ITEM 620 - DELINEATORS, TYPE D
  - (K) ITEM 620 - DELINEATORS, TYPE C

I:\036600\DWG\036600\FNL\036600PM14.DWG ] DLS  
 07-18-2002 1:52PM

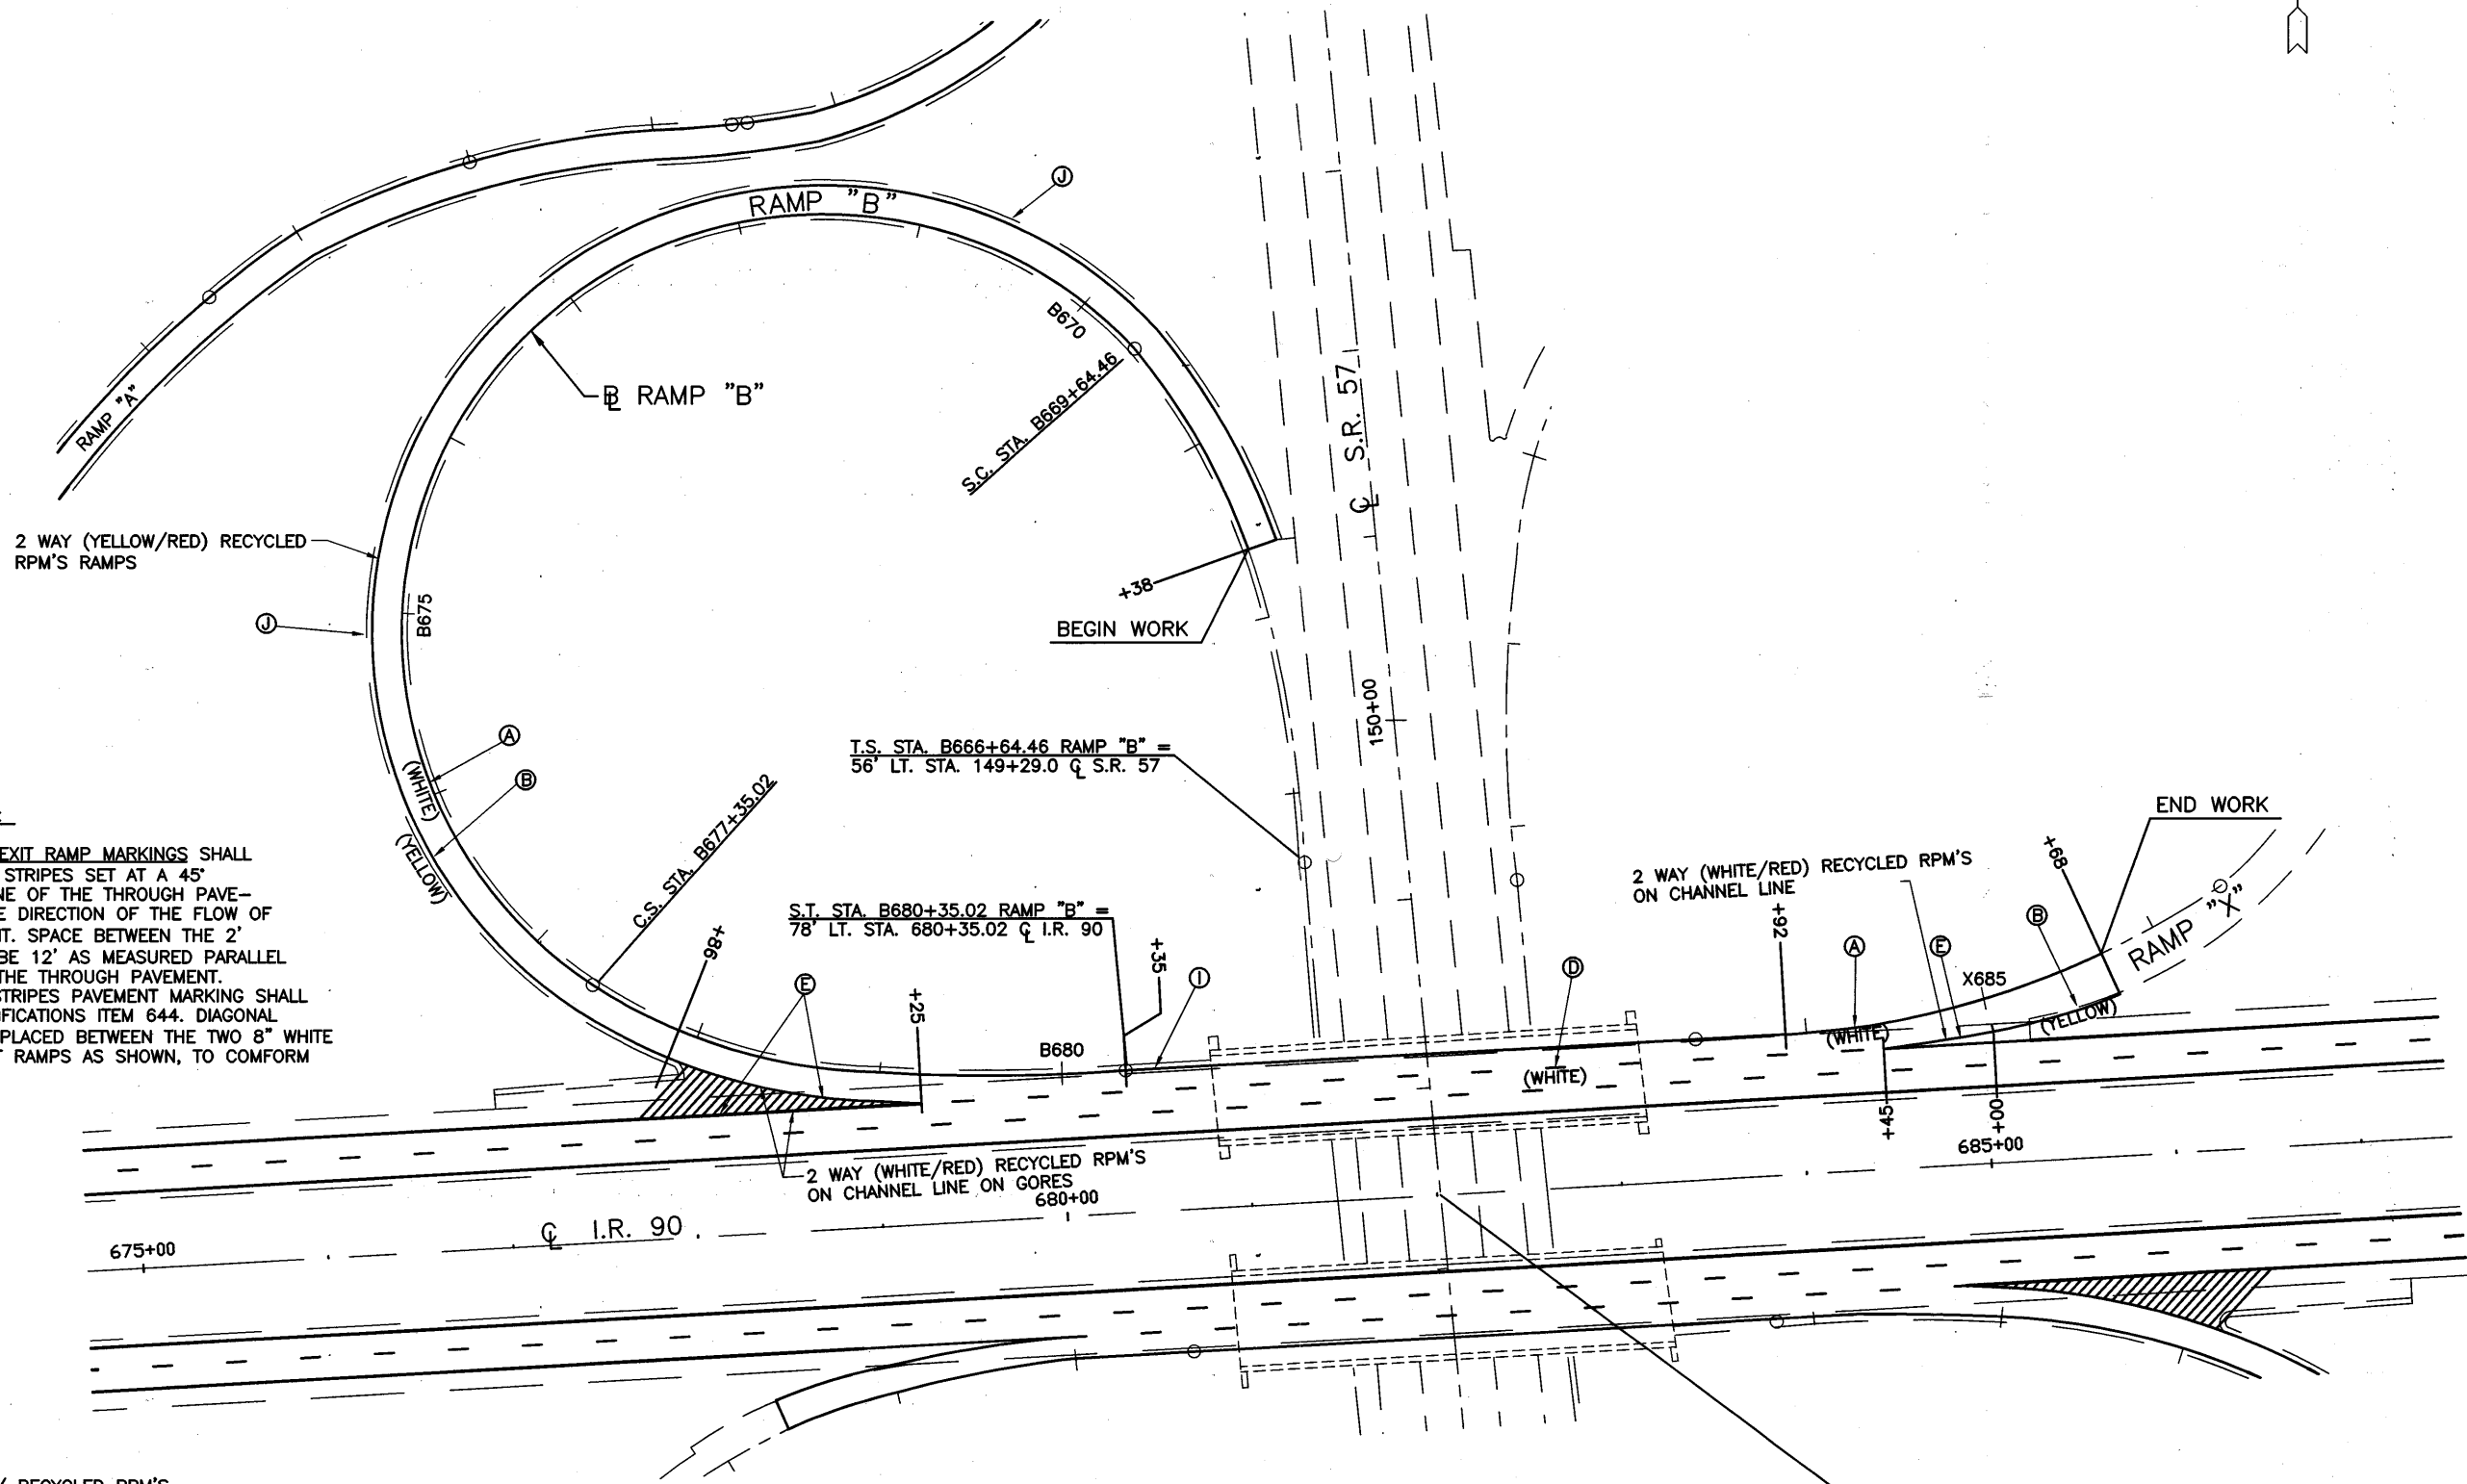

**NOTE:**

DIAGONAL STRIPES IN EXIT RAMP MARKINGS SHALL BE 2' WIDE WHITE RAISED STRIPES SET AT A 45° ANGLE TO THE CENTER LINE OF THE THROUGH PAVEMENT AND SLANTED IN THE DIRECTION OF THE FLOW OF TRAFFIC ON SAID PAVEMENT. SPACE BETWEEN THE 2' DIAGONAL STRIPES SHALL BE 12' AS MEASURED PARALLEL TO THE CENTER LINE OF THE THROUGH PAVEMENT. WHITE RAISED PAVEMENT STRIPES PAVEMENT MARKING SHALL BE APPLIED AS PER SPECIFICATIONS ITEM 644. DIAGONAL WHITE STRIPES SHALL BE PLACED BETWEEN THE TWO 8" WHITE CHANNELING LINES AT EXIT RAMP'S AS SHOWN, TO COMFORM TO ITEM 641.

**LEGEND**

- (A) ITEM 644 - EDGE LINE
- (B) ITEM 644 - EDGE LINE, W/ RECYCLED RPM'S
- (C) ITEM 644 - LANE LINE, W/ 1 WAY WHITE RECYCLED RPM'S
- (D) ITEM 644 - LANE LINE
- (E) ITEM 644 - CHANNELIZING LINE, W/ RECYCLED RPM'S
- (F) ITEM 644 - STOP LINE
- (G) ITEM 644 - LANE ARROW
- (H) ITEM 644 - WORD ON PAVEMENT, 96 IN.
- (I) ITEM 618 - RUMBLE STRIPS, TYPE 2
- (J) ITEM 620 - DELINEATORS, TYPE D
- (K) ITEM 620 - DELINEATORS, TYPE C


**NOTE:**

SEE STD TC-65.11M FOR PLACING OF RPM'S AT ACCELERATION LANE.  
SEE STD TC-72.20 FOR PAVEMENT MARKINGS AT ACCELERATION LANE.




**RAMP "B" - S.R. 57 & I.R. 90  
STA. 666+64.46 TO STA. 680+35.02**

**LOR-190-10.76**

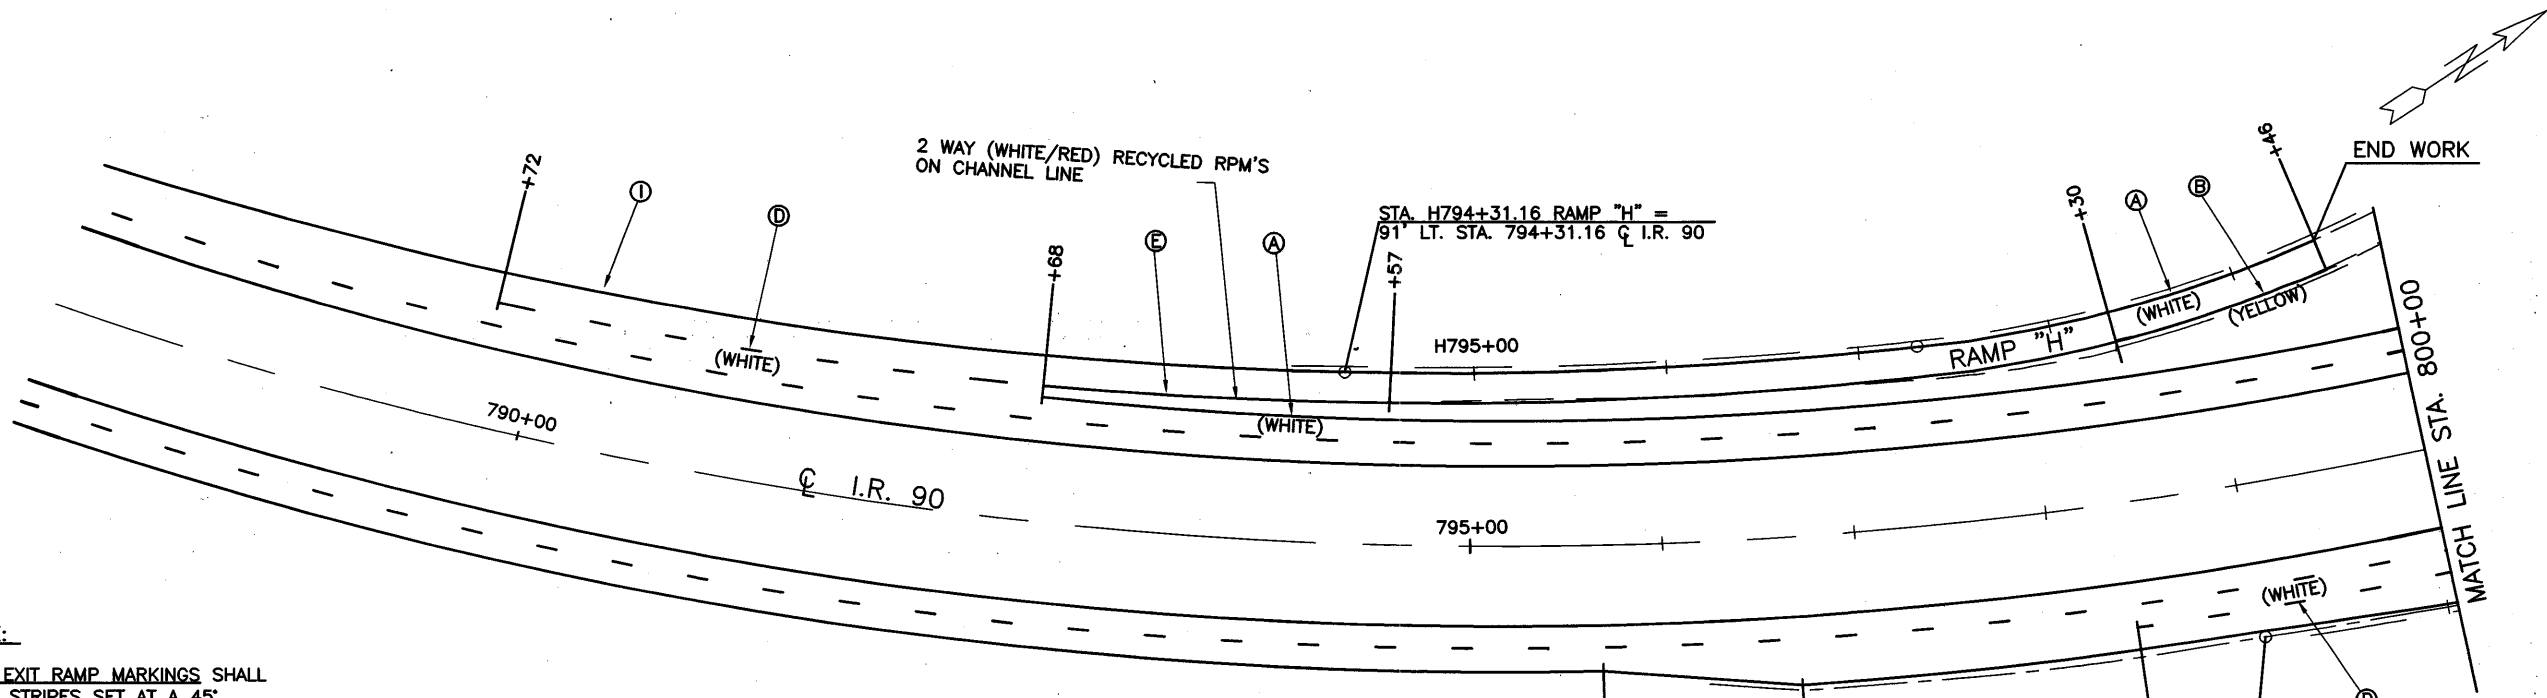

**NOTE:**

DIAGONAL STRIPES IN EXIT RAMP MARKINGS SHALL BE 2' WIDE WHITE RAISED STRIPES SET AT A 45° ANGLE TO THE CENTER LINE OF THE THROUGH PAVEMENT AND SLANTED IN THE DIRECTION OF THE FLOW OF TRAFFIC ON SAID PAVEMENT. SPACE BETWEEN THE 2' DIAGONAL STRIPES SHALL BE 12' AS MEASURED PARALLEL TO THE CENTER LINE OF THE THROUGH PAVEMENT. WHITE RAISED PAVEMENT STRIPES PAVEMENT MARKING SHALL BE APPLIED AS PER SPECIFICATIONS ITEM 644. DIAGONAL WHITE STRIPES SHALL BE PLACED BETWEEN THE TWO 8" WHITE CHANNELING LINES AT EXIT RAMP AS SHOWN, TO COMFORM TO ITEM 641.

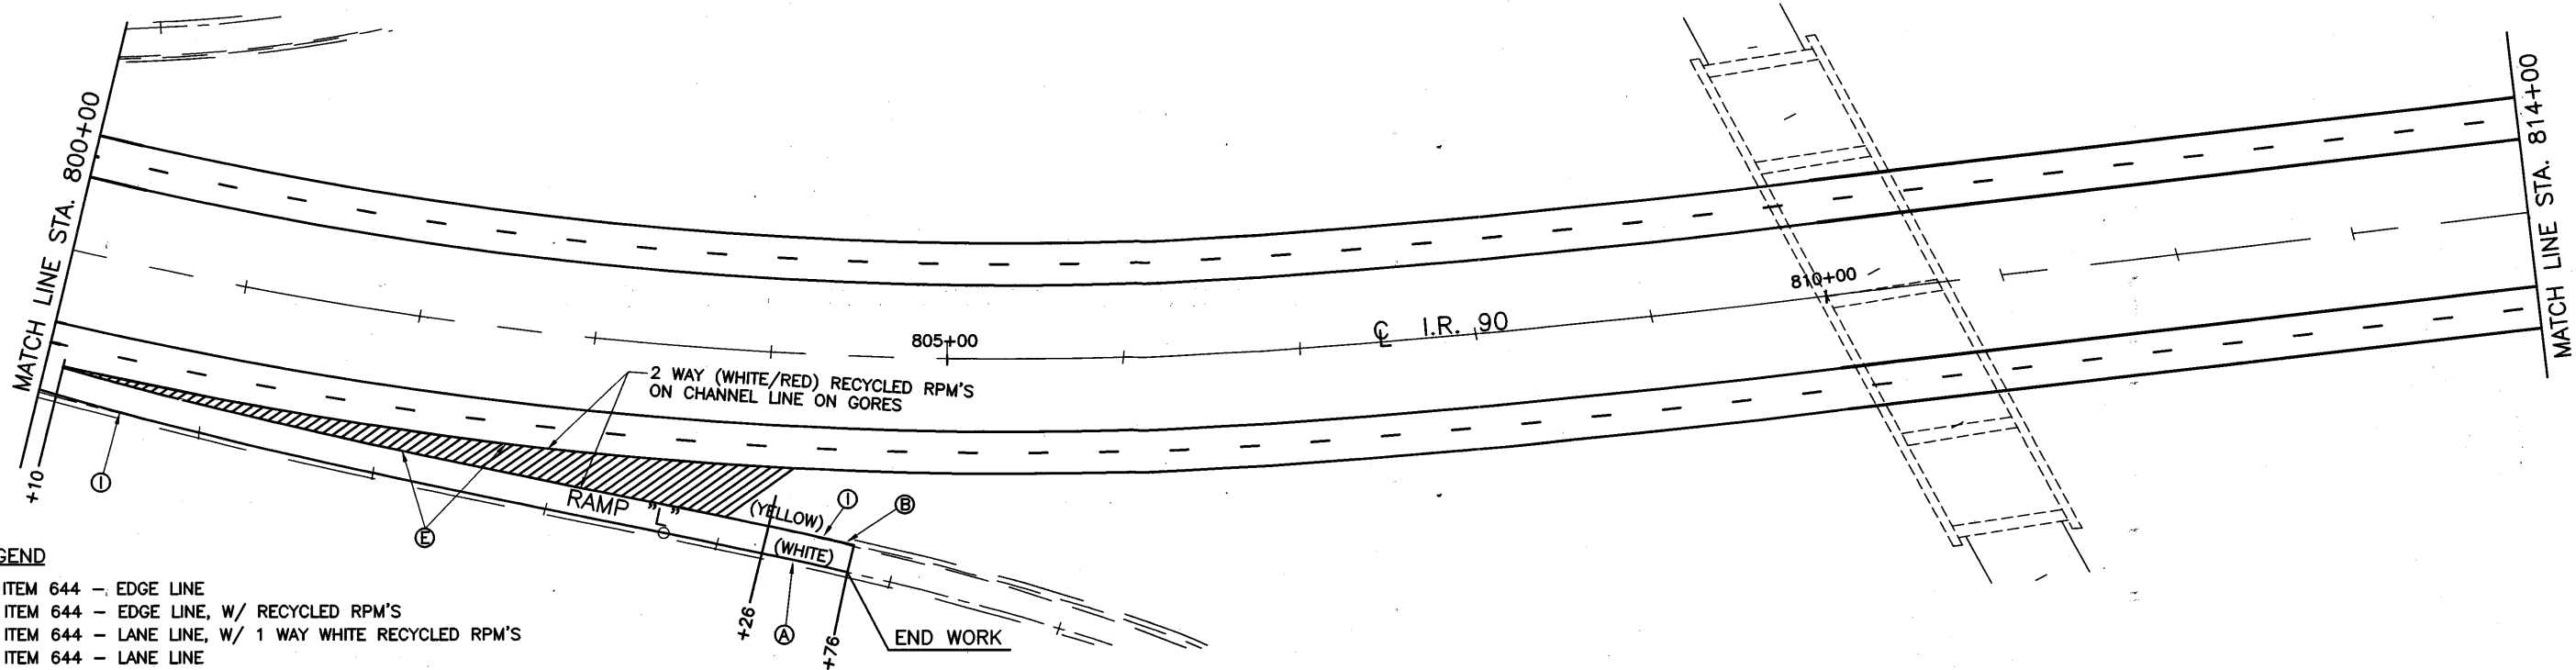


**LEGEND**

- (A) ITEM 644 - EDGE LINE
- (B) ITEM 644 - EDGE LINE, W/ RECYCLED RPM'S
- (C) ITEM 644 - LANE LINE, W/ 1 WAY WHITE RECYCLED RPM'S
- (D) ITEM 644 - LANE LINE
- (E) ITEM 644 - CHANNELIZING LINE, W/ RECYCLED RPM'S
- (F) ITEM 644 - STOP LINE
- (G) ITEM 644 - LANE ARROW
- (H) ITEM 644 - WORD ON PAVEMENT, 96 IN.
- (I) ITEM 618 - RUMBLE STRIPS, TYPE 2
- (J) ITEM 620 - DELINEATORS, TYPE D
- (K) ITEM 620 - DELINEATORS, TYPE C

**NOTE:**


SEE STD TC-65.11M FOR PLACING OF RPM'S AT ACCELERATION AND DECELERATION LANES.  
SEE STD TC-72.20 FOR PAVEMENT MARKINGS AT ACCELERATION AND DECELERATION LANES.

I:\03\3660\DWG\93600PML\93600PML16.DWG ] LAB  
 07-18-2002 7:51 AM

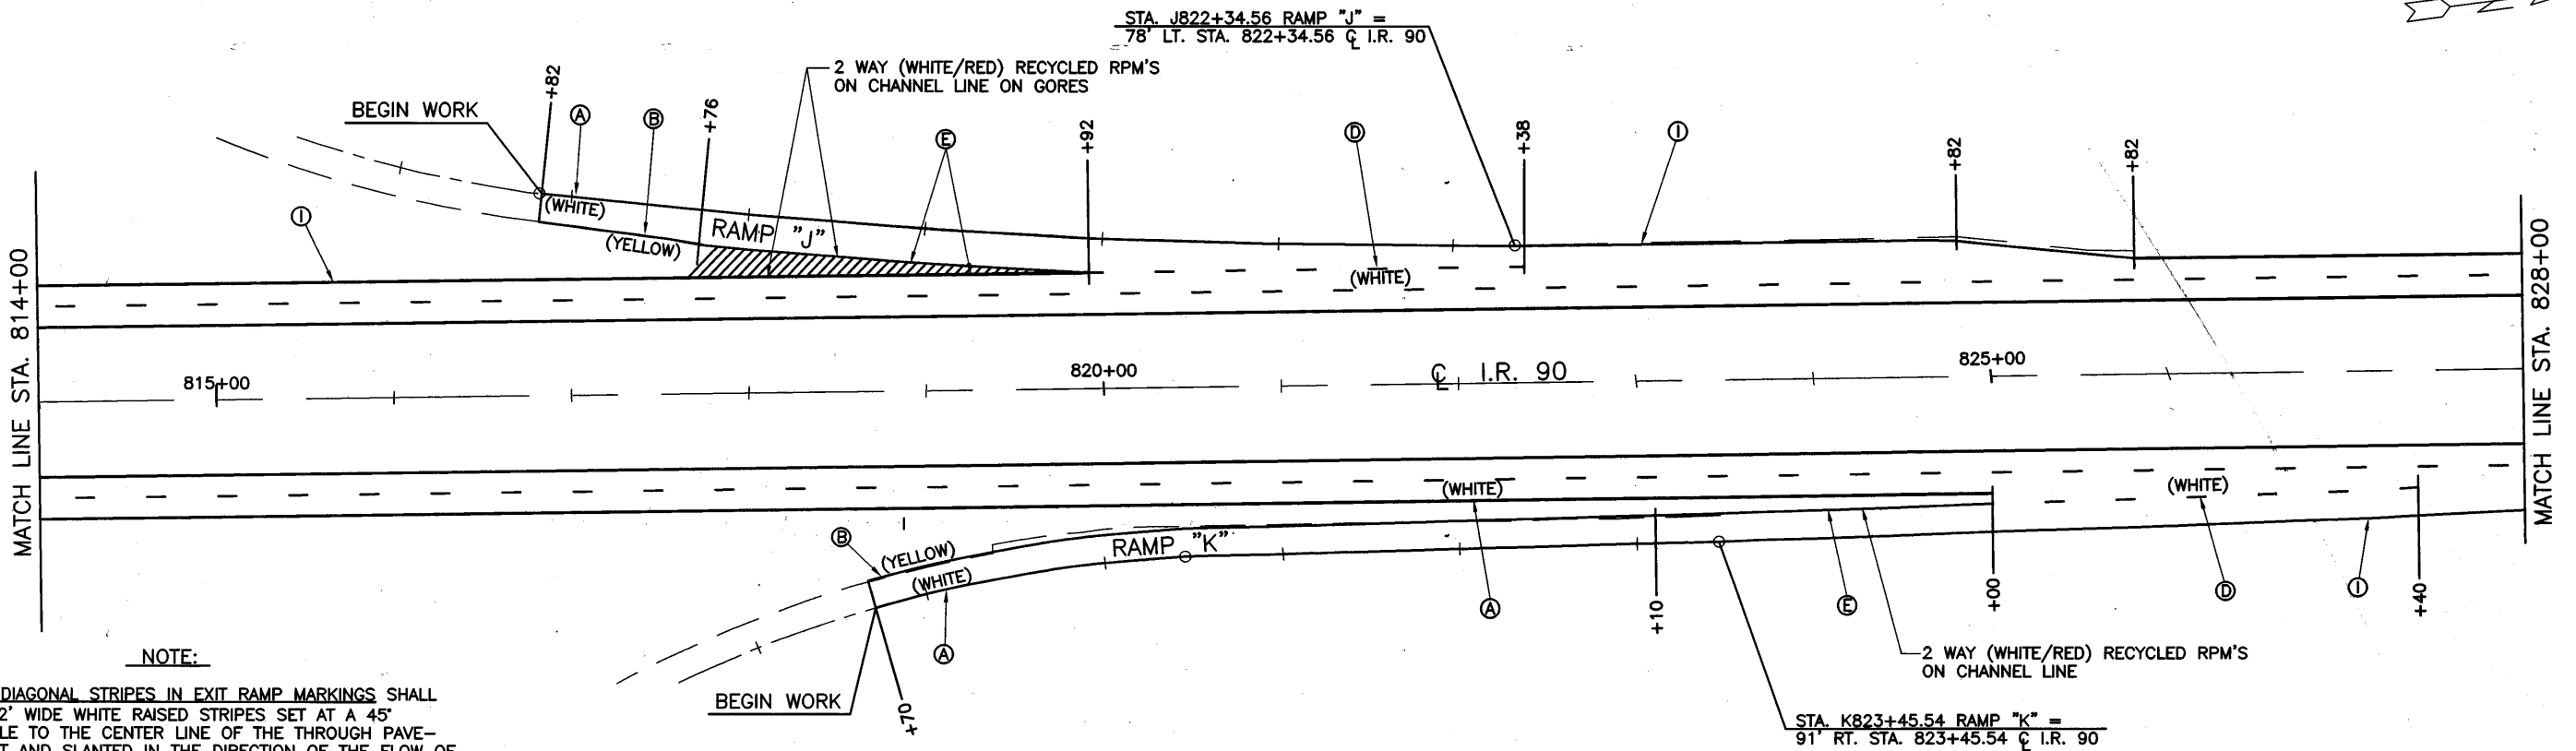

**NOTE:**

DIAGONAL STRIPES IN EXIT RAMP MARKINGS SHALL BE 2" WIDE WHITE RAISED STRIPES SET AT A 45° ANGLE TO THE CENTER LINE OF THE THROUGH PAVEMENT AND SLANTED IN THE DIRECTION OF THE FLOW OF TRAFFIC ON SAID PAVEMENT. SPACE BETWEEN THE 2' DIAGONAL STRIPES SHALL BE 12' AS MEASURED PARALLEL TO THE CENTER LINE OF THE THROUGH PAVEMENT. WHITE RAISED PAVEMENT STRIPES PAVEMENT MARKING SHALL BE APPLIED AS PER SPECIFICATIONS ITEM 644. DIAGONAL WHITE STRIPES SHALL BE PLACED BETWEEN THE TWO 8" WHITE CHANNELING LINES AT EXIT RAMP AS SHOWN, TO CONFORM TO ITEM 641.

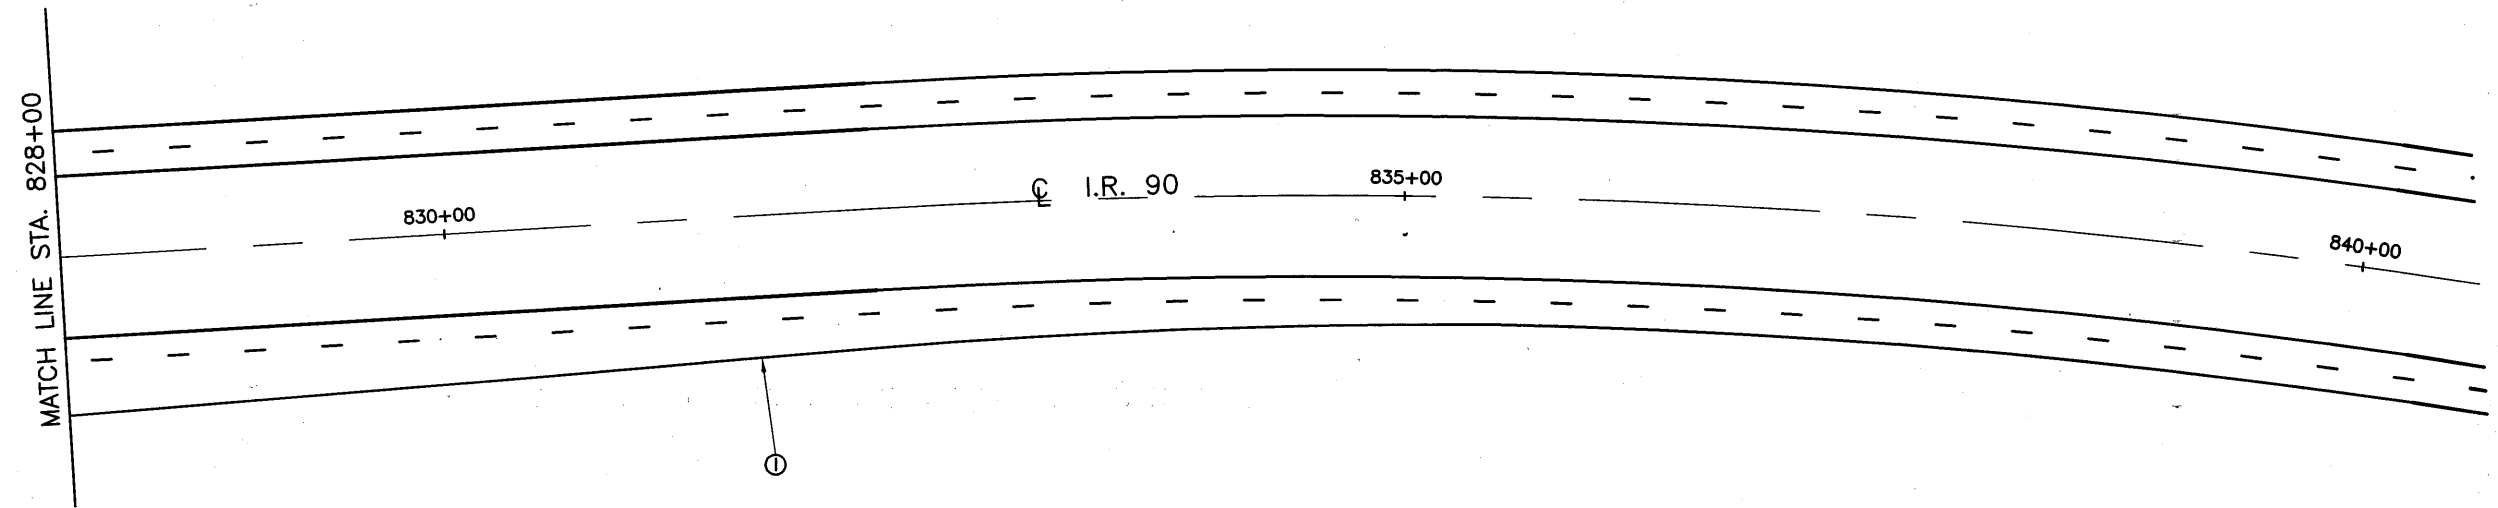

**LEGEND**

- (A) ITEM 644 - EDGE LINE
- (B) ITEM 644 - EDGE LINE, W/ RECYCLED RPM'S
- (C) ITEM 644 - LANE LINE, W/ 1 WAY WHITE RECYCLED RPM'S
- (D) ITEM 644 - LANE LINE
- (E) ITEM 644 - CHANNELIZING LINE, W/ RECYCLED RPM'S
- (F) ITEM 644 - STOP LINE
- (G) ITEM 644 - LANE ARROW
- (H) ITEM 644 - WORD ON PAVEMENT, 96 IN.
- (I) ITEM 618 - RUMBLE STRIPS, TYPE 2
- (J) ITEM 620 - DELINEATORS, TYPE D
- (K) ITEM 620 - DELINEATORS, TYPE C

**NOTE:**

SEE STD TC-65.11M FOR PLACING OF RPM'S AT ACCELERATION AND DECELERATION LANES.  
SEE STD TC-72.20 FOR PAVEMENT MARKINGS AT ACCELERATION AND DECELERATION LANES.


CALCULATED	DLS	CHECKED	LAB



PLAN RAMP'S "J" & "K" - I90 & S.R.254  
STA. 814+00 TO STA. 840+00

LOF-190-10.76

I:\01\93600\UNWS\93600\FNL\93600PM16.DWG | LAB 07-18-2002 7:51AM

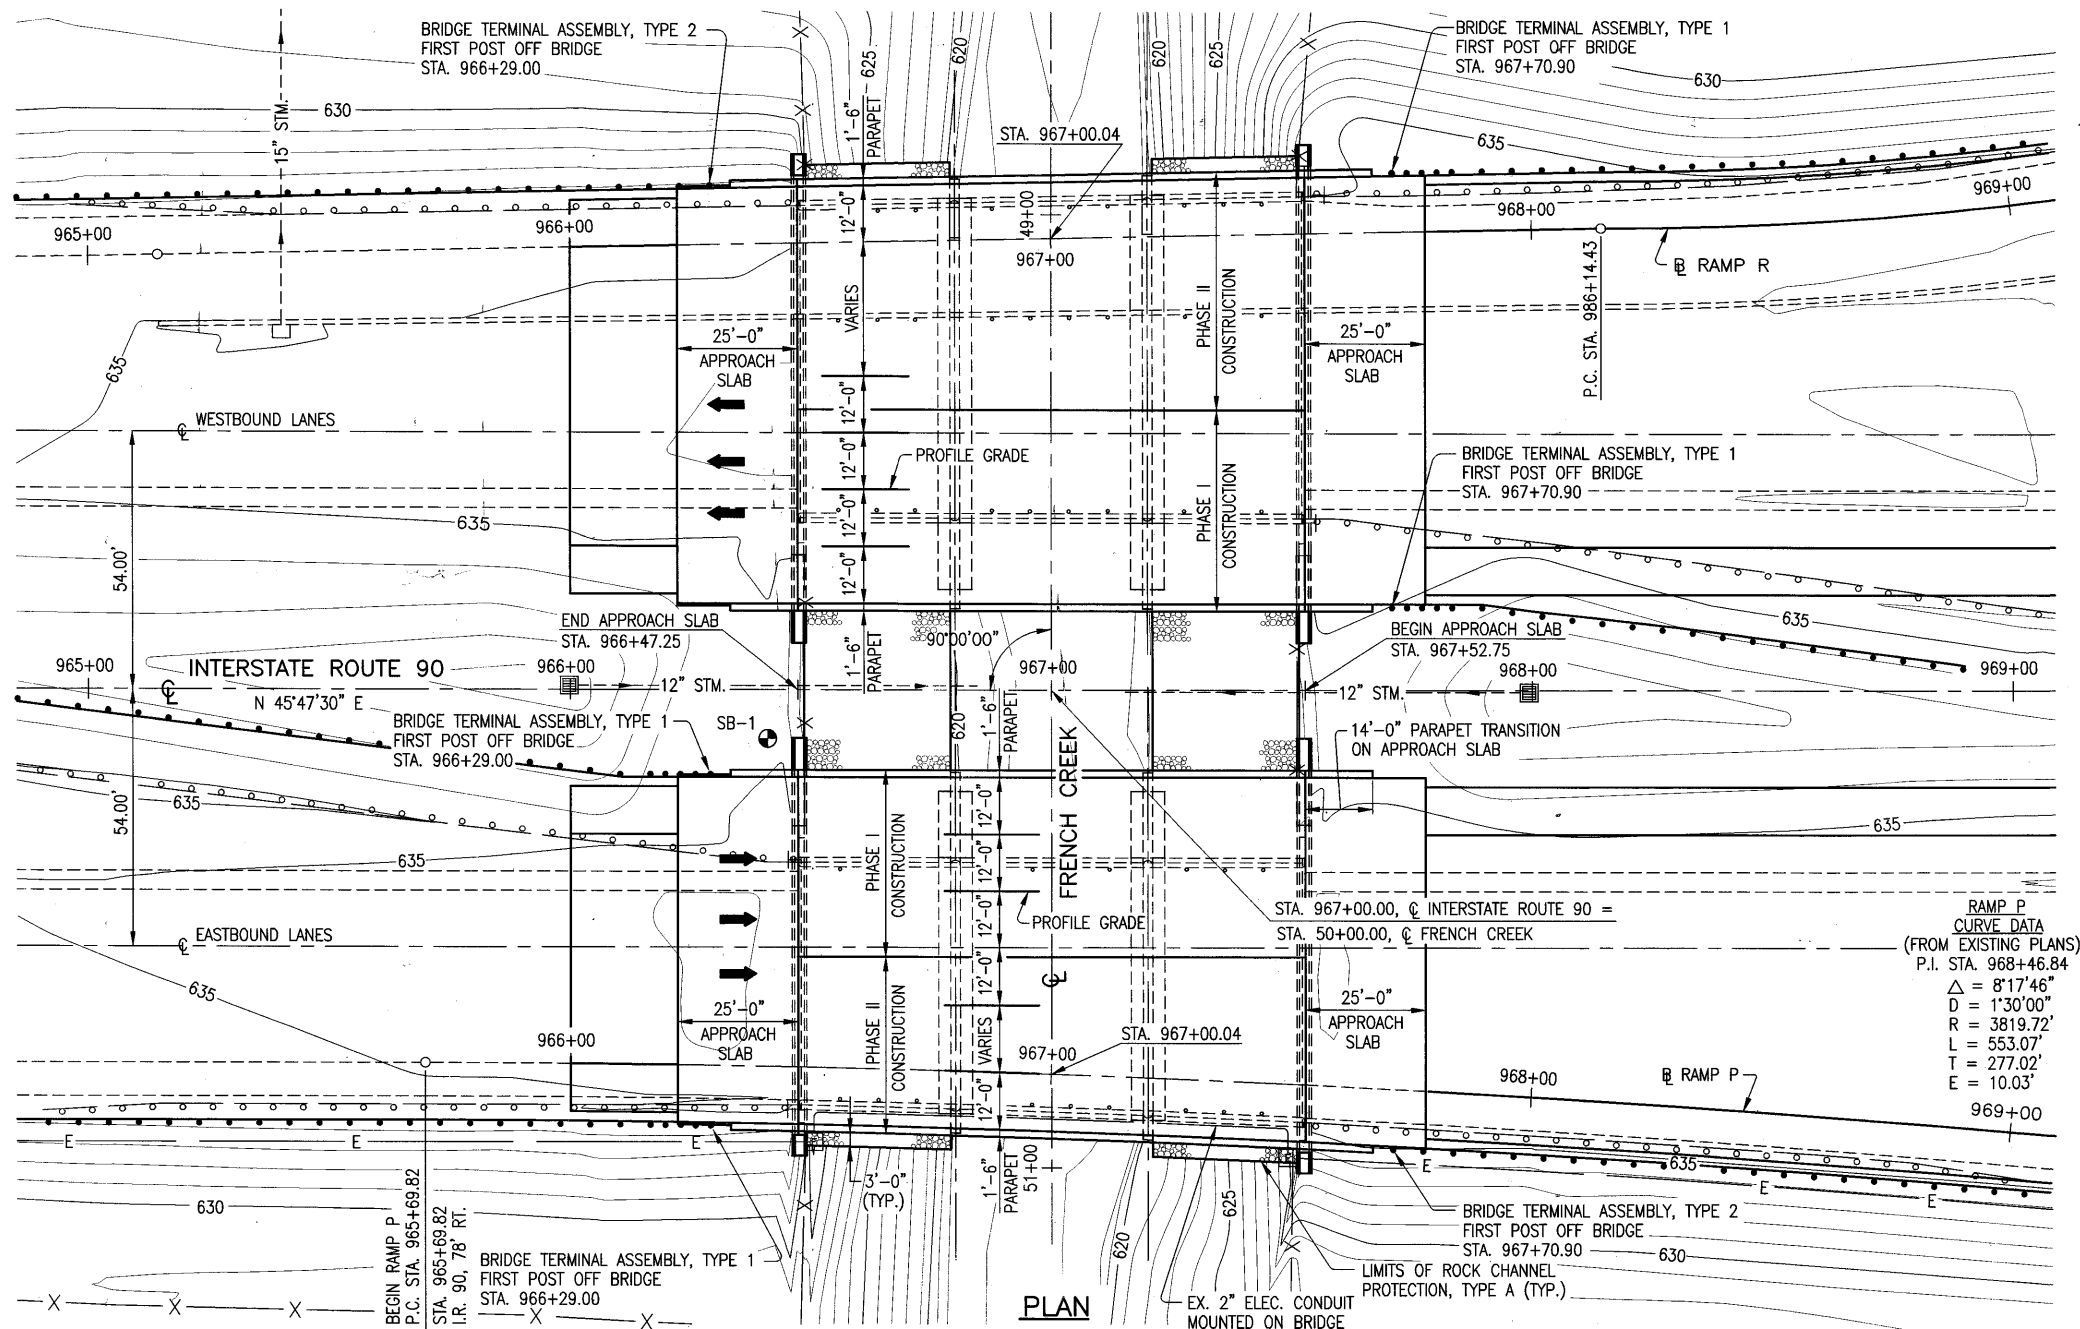

**BENCHMARK No. 1**  
 LOR190 18.44 1997 - DISC IN CONCRETE MONUMENT  
 STA. 974+00, LEFT ELEV. = 635.103

**BENCHMARK No. 2**  
 LOR190 18.68 1996 - STA. 974+70, 150' RIGHT - HEADWALL  
 ELEV. = 625.005

**TRAFFIC DATA**  
 INTERSTATE ROUTE 90  
 CURRENT YEAR A.D.T. (2001) = 50,210  
 DESIGN YEAR A.D.T. (2021) = 72,640  
 CURRENT YEAR A.D.T. (2001) = 8,787  
 DESIGN YEAR A.D.T. (2021) = 12,712


**HYDRAULIC DATA**  
 EXISTING WATERWAY OPENING: 1142 SQ. FT.  
 PROPOSED WATERWAY OPENING: 1142 SQ. FT.  
 Q 50 = 5187 CFS Q 100 = 5642 CFS  
 V 50 = 10.48 FPS V 100 = 10.75 FPS  
 HW 50 = 628.88 HW 100 = 629.47

**EXISTING STRUCTURE**  
 TYPE: 3-SPAN CONTINUOUS REINFORCED CONCRETE SLAB ON REINFORCED CONCRETE SUBSTRUCTURE  
 SPANS: 32'-0"±, 40'-0"±, 32'-0"± c/c SLAB BEARINGS  
 ROADWAY: VARIES LEFT BRIDGE - 65.80'± TO 68.00'± FACE TO FACE PARAPETS, RIGHT BRIDGE - 50.80'± TO 54.40'± FACE TO FACE PARAPETS  
 LOADING: CF2000 (57)  
 SKEW: NONE  
 WEARING SURFACE: 1" MONOLITHIC CONCRETE  
 APPROACH SLABS: AS-1-54 (25'-0" LONG)  
 ALIGNMENT: TANGENT  
 YEAR BUILT: 1970  
 STRUCTURE FILE NO. 4704959(L), 4704983 (R)

**PROPOSED STRUCTURE**  
 PROPOSED WORK: REPLACE AND WIDEN NEW DECK ON WIDENED MODIFIED SUBSTRUCTURE  
 TYPE: 3-SPAN CONTINUOUS REINFORCED CONCRETE SLAB ON REINFORCED CONCRETE SUBSTRUCTURE  
 SPANS: 32'-0"±, 40'-0"±, 32'-0"± c/c SLAB BEARINGS  
 ROADWAY: VARIES LEFT BRIDGE - 87.65' TO 89.90' FACE TO FACE PARAPETS, RIGHT BRIDGE - 72.58' TO 76.21' FACE TO FACE PARAPETS  
 LOADING: HS25 OR THE ALTERNATE MILITARY LOADING  
 SKEW: NONE  
 WEARING SURFACE: 1" MONOLITHIC CONCRETE  
 ALIGNMENT: TANGENT  
 CROWN: 3/16"/FT.  
 LONGITUDE: 82° 03.44'  
 LATITUDE: 41° 27.68'

**FOUNDATION DATA:**  
 PILE DESIGN LOADS (ULTIMATE BEARING VALUE): THE ULTIMATE BEARING VALUE IS 57 TONS PER PILE FOR THE ABUTMENT PILES.  
 ABUTMENT PILES:  
 8 PILES 16 FEET LONG, REAR ABUTMENT, ESTIMATED LENGTH  
 8 PILES 16 FEET LONG, FORWARD ABUTMENT, ESTIMATED LENGTH  
 16 PILES OF ORDER LENGTH 16 FEET LONG  
 0 SPLICES  
 FOUNDATION BEARING PRESSURE: PIER FOOTINGS, AS DESIGNED, PRODUCE A MAXIMUM BEARING PRESSURE OF 2.0 TONS PER SQUARE FOOT.

**NOTES:**  
 1.) THE PROPOSED PROFILE GRADE IS ONLY WITHIN BRIDGE LIMITS. SEE ROADWAY PLANS FOR PAVEMENT ELEVATIONS BEYOND BRIDGE LIMITS.  
 2.) EARTHWORK LIMITS ARE APPROXIMATE. ACTUAL SLOPES SHALL CONFORM TO PLAN CROSS-SECTIONS.

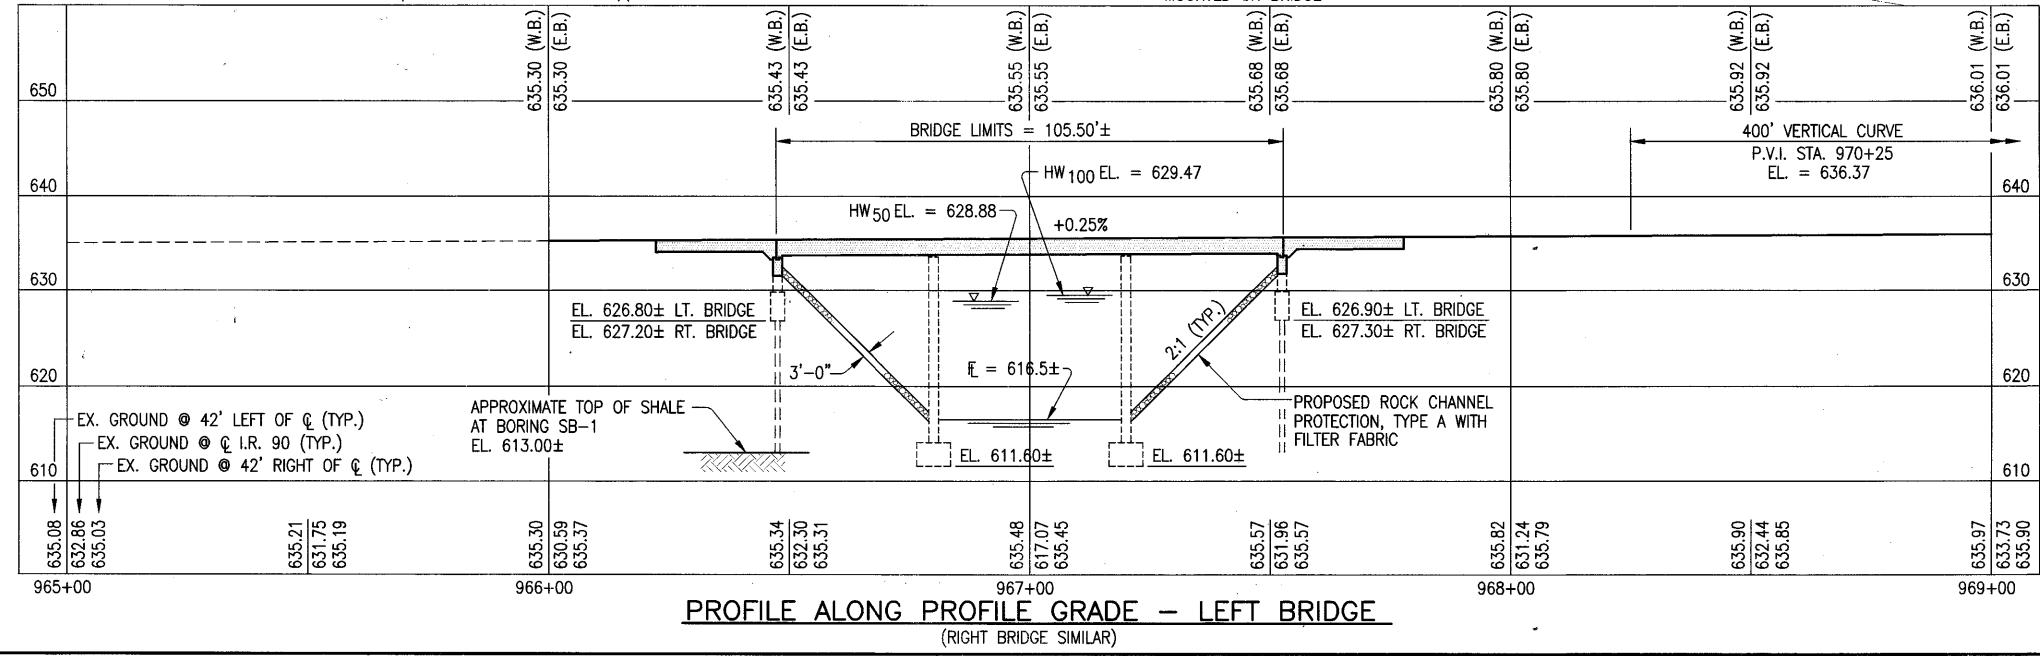

**PROFILE ALONG PROFILE GRADE - LEFT BRIDGE**  
 (RIGHT BRIDGE SIMILAR)

DESIGN AGENCY: JAMES RANK, SURE 300  
 2400 CENTER ROAD  
 WESTLAKE, OHIO 44140  
 TELEPHONE (440) 535-4400  
 FAX (440) 535-4400

DATE: 4/30/01  
 FILE NUMBER: 4704959(L), 4704983 (R)

REVIEWED: RAK  
 STRUCTURE FILE NUMBER: 4704959(L), 4704983 (R)

DRAWN: CAG  
 REVISIONS: RAK

DESIGNED: NFF  
 CHECKED: RAK

LORAIN COUNTY  
 STA. 966+47.25  
 STA. 967+52.75

**SITE PLAN**  
 BRIDGE No. LOR-90-1861 L AND R  
 INTERSTATE ROUTE 90 OVER FRENCH CREEK

LOR-90-10.76

1 / 24

127  
 274

O:\93600\BRIDGE\DWGS\LO90SP1.DWG

**GENERAL NOTES – STRUCTURES**

**STANDARD DRAWINGS AND SUPPLEMENTAL SPECIFICATIONS:**

REFERENCE SHALL BE MADE TO STANDARD DRAWINGS:

- AS-1-91 DATED 4/20/01
- CPA-5-94 DATED 4/20/01
- CPP-2-94 DATED 4/20/01
- CS-1-93 DATED 6/30/95
- IRJ-8-95 DATED 7/6/95
- PCB-91 DATED 7/6/99
- SBR-1-99 DATED 1/12/99

AND TO SUPPLEMENTAL SPECIFICATIONS:

- SS-842 DATED 1/6/99
- SS-843 DATED 5/5/98
- SS-844 DATED 1/6/99
- SS-864 DATED 7/11/00
- SS-899 DATED 10/21/98

**DESIGN SPECIFICATIONS:**

THE EXISTING PORTIONS OF THIS STRUCTURE CONFORM TO THE REQUIREMENTS OF "DESIGN SPECIFICATIONS FOR HIGHWAY STRUCTURES" OF THE OHIO DEPARTMENT OF HIGHWAYS, DATED 9/1/57.

THE NEW WIDENED PORTIONS OF THE STRUCTURE CONFORM TO "STANDARD SPECIFICATIONS FOR HIGHWAY BRIDGES" ADOPTED BY THE AMERICAN ASSOCIATION OF STATE HIGHWAY AND TRANSPORTATION OFFICIALS" (AASHTO), 1996, INCLUDING THE 1997, 1998 AND 1999 INTERIM SPECIFICATION AND THE ODOT BRIDGE DESIGN MANUAL.

**DESIGN LOADING:**

EXISTING SUBSTRUCTURE: CF2000 (57)  
PROPOSED SUBSTRUCTURE AND SUPERSTRUCTURE: HS25 OR THE ALTERNATE MILITARY LOADING

**DESIGN DATA:**

CONCRETE CLASS S – COMPRESSIVE STRENGTH 4500 PSI (SUPERSTRUCTURE)  
CONCRETE CLASS C – COMPRESSIVE STRENGTH 4000 PSI (SUBSTRUCTURE)  
REINFORCING STEEL – ASTM A615, A616 OR A617, GRADE 60 MINIMUM YIELD STRENGTH 60,000 PSI

**DECK PROTECTION METHOD:**

EPOXY COATED REINFORCING STEEL, 2 1/2" CONCRETE COVER AND SEALING OF CONCRETE SURFACES.

**MONOLITHIC WEARING SURFACE:**

MONOLITHIC WEARING SURFACE IS ASSUMED, FOR DESIGN PURPOSES, TO BE 1 INCH THICK.

**PORTIONS OF STRUCTURES REMOVED, AS PER PLAN:**

THIS WORK SHALL INCLUDE THE ELEMENTS INDICATED IN THE PLAN AND GENERAL NOTES AND ARE NOT SEPARATELY LISTED FOR PAYMENT. ITEMS TO BE REMOVED INCLUDE ALL EXISTING MATERIALS BEING REPLACED BY NEW CONSTRUCTION AND MISCELLANEOUS ITEMS THAT ARE NOT SHOWN TO BE INCORPORATED INTO THE FINAL CONSTRUCTION AND ARE DIRECTED TO BE REMOVED BY THE ENGINEER. HYDRAULIC HOE-RAM TYPE HAMMERS MAY BE USED FOR REMOVAL OF THE DECK SLAB, PROVIDED THAT SUBSTRUCTURE ELEMENTS ARE SAW CUT FULL WIDTH PRIOR TO DECK REMOVAL, AND THE HAMMERS ARE NOT PLACED IN DIRECT CONTACT WITH ANY SUBSTRUCTURE ELEMENTS THAT ARE TO BE RETAINED IN THE PROPOSED STRUCTURE.

**CUT LINE CONSTRUCTION JOINT PREPARATION:**

SAW CUT BOUNDARIES OF PROPOSED CONCRETE REMOVAL 1" DEEP. REMOVE CONCRETE TO A ROUGH SURFACE. WHERE PRACTICABLE, THE EXISTING REINFORCING STEEL WHERE REQUIRED IN THE PLANS SHALL BE LEFT IN PLACE. INSTALL DOWEL BARS IF SPECIFIED. PRIOR TO CONCRETE PLACEMENT ABRASIVELY CLEAN JOINT SURFACE AND EXPOSED REINFORCEMENT TO REMOVE LOOSE AND DISINTEGRATED CONCRETE AND LOOSE RUST. THE JOINT SURFACE AND EXPOSED REINFORCEMENT SHALL BE THOROUGHLY CLEANED OF ALL DIRT, DUST AND FOREIGN MATERIAL BY THE USE OF WATER, AIR UNDER PRESSURE, OR OTHER METHODS THAT PRODUCE SATISFACTORY RESULTS. CONCRETE BONDING SURFACES SHALL BE WET WITHOUT FREE WATER AS CONCRETE IS PLACED.

**SUBSTRUCTURE CONCRETE REMOVAL:**

ANY TYPE OF CONCRETE REMOVAL AFFECTING THE SUBSTRUCTURE ELEMENTS SHALL BE BY MEANS OF APPROVED PNEUMATIC HAMMERS EMPLOYING POINTED AND BLUNT CHISEL TOOLS. HYDRAULIC HOE-RAM TYPE HAMMERS WILL NOT BE PERMITTED. THE WEIGHT OF THE HAMMER SHALL NOT BE MORE THAN 35 POUNDS FOR REMOVAL WITHIN 18 INCHES OF PORTIONS TO BE PRESERVED. OUTSIDE THE 18 INCH LIMIT, A HAMMER HEAVIER THAN 35 POUNDS, BUT NOT TO EXCEED 90 POUNDS, MAY BE USED AT THE APPROVAL OF THE ENGINEER. PNEUMATIC HAMMERS SHALL NOT BE PLACED IN DIRECT CONTACT WITH REINFORCING STEEL THAT IS TO BE RETAINED IN THE REBUILT STRUCTURE.

**PILE DRIVING CONSTRAINTS:**

PRIOR TO DRIVING PILES, THE SPILL THROUGH SLOPES AND THE BRIDGE APPROACH EMBANKMENT BEHIND THE ABUTMENTS SHALL BE CONSTRUCTED UP TO THE LEVEL OF THE SUBGRADE ELEVATION FOR A MINIMUM DISTANCE OF 200 FEET BEHIND EACH ABUTMENT. THE EXCAVATION FOR THE ABUTMENT FOOTINGS AND THE INSTALLATION OF THE ABUTMENT PILES SHALL NOT BEGIN UNTIL AFTER THE ABOVE REQUIRED EMBANKMENT HAS BEEN CONSTRUCTED.

**ITEM 503, UNCLASSIFIED EXCAVATION, AS PER PLAN:**

UNCLASSIFIED EXCAVATION SHALL BE IN ACCORDANCE WITH 503 EXCEPT THAT THE BACKFILL MATERIAL BEHIND THE ABUTMENTS SHALL BE 203 MATERIAL PLACED IN 6 INCH LIFTS.

**PILES TO BEDROCK:**

PILES SHALL BE DRIVEN TO REFUSAL ON BEDROCK. REFUSAL SHALL BE CONSIDERED AS OBTAINED BY PENETRATING SOFT BEDROCK FOR SEVERAL INCHES WITH A MINIMUM RESISTANCE OF 20 BLOWS PER INCH OR REFUSAL SHALL BE CONSIDERED AS OBTAINED AFTER THE PILE HAS CONTACTED HARD BEDROCK AND THE PILE HAS THEN RECEIVED AT LEAST 20 BLOWS. THE CONTRACTOR IS RESPONSIBLE FOR SELECTING THE HAMMER SIZE TO ACHIEVE THE REQUIRED DEPTH TO BEDROCK AND REFUSAL.

THE ULTIMATE BEARING VALUE IS 57 TONS PER PILE FOR THE ABUTMENT PILES.

**ABUTMENT PILES:**

- 8 PILES 16 FEET LONG, REAR ABUTMENT, ESTIMATED LENGTH
- 8 PILES 16 FEET LONG, FORWARD ABUTMENT, ESTIMATED LENGTH
- 16 PILES OF ORDER LENGTH 16 FEET LONG
- 0 SPLICES

**ITEM 507, STEEL POINTS, AS PER PLAN:**

STEEL PILE POINTS SHALL BE USED TO PROTECT THE TIPS OF THE PROPOSED STEEL "H" PILING. THE STEEL POINTS SHALL BE FURNISHED BY ASSOCIATED PILE AND FITTING CORPORATION, 262 RUTHERFORD BLVD., CLIFTON, NEW JERSEY 07014; INTERNATIONAL CONSTRUCTION EQUIPMENT, INC., 301 WAREHOUSE DRIVE, MATTHEWS, NORTH CAROLINA 28015; DOUGHERTY FOUNDATION PRODUCTS, INC., P.O. BOX 688, FRANKLIN LAKES, NEW JERSEY 07417; VERA STEEL INC., 3601 NW YEON AVE., P.O. BOX 10559, PORTLAND, OREGON 97210; PILING ACCESSORIES, INC., 3467 GRIBBLE ROAD, MATHEWS, NORTH CAROLINA 28105; OR BY A MANUFACTURER THAT CAN FURNISH A STEEL POINT THAT IS ACCEPTABLE TO DIRECTOR. THE MATERIAL USED FOR THE MANUFACTURING OF PILE POINTS SHALL CONFORM TO ASTM A27/A27M 65/35 [450/240] – CLASS 2 – HEAT TREATED OR AASHTO M103/M103M 65/35 [450/240] – HEAT TREATED. WELDING OF THE PILE POINTS TO THE PILE SHALL BE IN ACCORDANCE WITH AWS D1.5 OR THE MANUFACTURER'S WRITTEN WELDING PROCEDURE SUPPLIED THE ENGINEER BEFORE THE WELDING IS PERFORMED. A NOTARIZED COPY OF THE MILL TEST REPORT SHALL BE SUBMITTED TO THE ENGINEER.

**FOUNDATION BEARING PRESSURE:**

PIER FOOTINGS, AS DESIGNED, PRODUCE A MAXIMUM BEARING PRESSURE OF 2 TONS PER SQUARE FOOT.

**EXISTING STRUCTURE VERIFICATION:**

DETAILS AND DIMENSIONS SHOWN ON THESE PLANS PERTAINING TO THE EXISTING STRUCTURE HAVE BEEN OBTAINED FROM PLANS OF THE EXISTING STRUCTURE AND FROM FIELD OBSERVATIONS AND MEASUREMENTS. CONSEQUENTLY, THEY ARE INDICATIVE OF THE EXISTING STRUCTURE AND THE PROPOSED WORK BUT THEY SHALL BE CONSIDERED TENTATIVE AND APPROXIMATE. THE CONTRACTOR IS REFERRED TO CMS SECTIONS 102.05, 105.02.

CONTRACT BID PRICES SHALL BE BASED UPON A RECOGNITION OF THE UNCERTAINTIES DESCRIBED ABOVE AND UPON A PREBID EXAMINATION OF THE EXISTING STRUCTURE BY THE CONTRACTOR. HOWEVER, ALL PROJECT WORK SHALL BE BASED UPON ACTUAL DETAILS AND DIMENSIONS WHICH HAVE BEEN VERIFIED BY THE CONTRACTOR IN THE FIELD.

**SEALING OF CONCRETE SURFACES:**

ALL EXPOSED CONCRETE SURFACES ON THE SUPERSTRUCTURE, ABUTMENTS AND WINGWALLS SHALL BE SEALED WITH AN EPOXY-URETHANE SEALER MEETING SPECIFICATION 864 TO THE LIMITS SHOWN ON THE PLANS.

**ITEM SPECIAL, DOWEL HOLES:**

THIS ITEM SHALL INCLUDE THE DRILLING OR FORMING OF HOLES INTO CONCRETE OR MASONRY AND THE FURNISHING AND PLACING OF GROUT INTO HOLES. NON-SHRINK EPOXY GROUT SHALL BE USED IN ACCORDANCE WITH CMS 510 AND CMS 705.20. DEPTH OF HOLES SHALL BE AS SHOWN IN PLANS.

**ITEM 518, POROUS BACKFILL WITH FILTER FABRIC:**

THE MATERIAL SHALL BE NO. 57 GRAVEL.

**CONCRETE PARAPETS:**

AS SOON AS A CONCRETE SAW CAN BE OPERATED WITHOUT DAMAGING THE FRESHLY PLACED CONCRETE, 1 1/4" DEEP CONTROL JOINTS SHALL BE SAWED INTO THE PERIMETER OF THE CONCRETE PARAPET. THE SAW CUT SHALL BE MADE IN THE COMPLETE CIRCUMFERENCE OF THE PARAPET, STARTING AND ENDING AT THE ELEVATION OF THE CONCRETE DECK. THE SAWCUTS SHALL BE PLACED AT A MINIMUM OF 6 FEET AND A MAXIMUM OF 10 FEET CENTERS. THE USE OF AN EDGE GUIDE, FENCE, OR JIG IS REQUIRED TO INSURE THAT THE CUT JOINT IS STRAIGHT, TRUE, AND ALIGNED ON ALL FACES OF THE PARAPET. THE JOINT WIDTH SHALL BE THE WIDTH OF THE SAW BLADE, A NOMINAL WIDTH OF 1/4 INCH. THE PERIMETER OF THE DEFLECTION CONTROL JOINT SHALL BE SEALED WITH A CAULKING MATERIAL CONFORMING TO FEDERAL SPECIFICATION, TT-S-00227E TO A MINIMUM DEPTH OF 1 INCH. THE BOTTOM 1/2 INCH OF THE INSIDE AND OUTSIDE FACE SHOULD BE LEFT UNSEALED TO ALLOW WATER TO ESCAPE.

O:\93600\BRIDGE\DWGS\LO090GN1.DWG


DESIGN AGENCY  
R.P. WALKER & ASSOCIATES, INC.  
CONSULTING ENGINEERS  
2460 CENTER RESE ROAD  
COLUMBUS, OHIO 43210  
(614) 466-4400  
JOB NUMBER 93600

DATE	4/30/01
REVIEWED	RAK
STRUCTURE FILE NUMBER	4704959(L) 4704963(R)
DRAWN	KK
DESIGNED	KK
CHECKED	RAK
REVISED	

**GENERAL NOTES**  
BRIDGE No. LOR-90-1861 L AND R  
INTERSTATE ROUTE 90 OVER FRENCH CREEK

LOR-90-10.76  
2 / 24  
128  
274




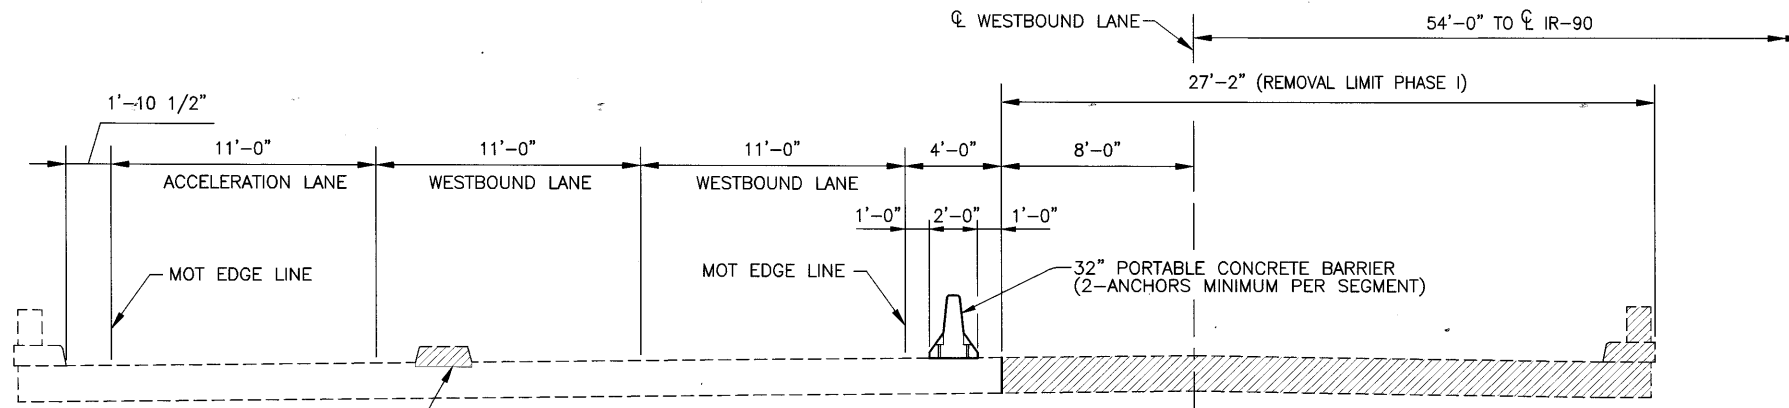

CURB TO BE SAWCUT AND REMOVED PRIOR TO PHASE I REMOVAL (SEE DETAIL A, THIS SHEET)


**MAINTENANCE OF TRAFFIC PHASE I**

**REMOVAL**

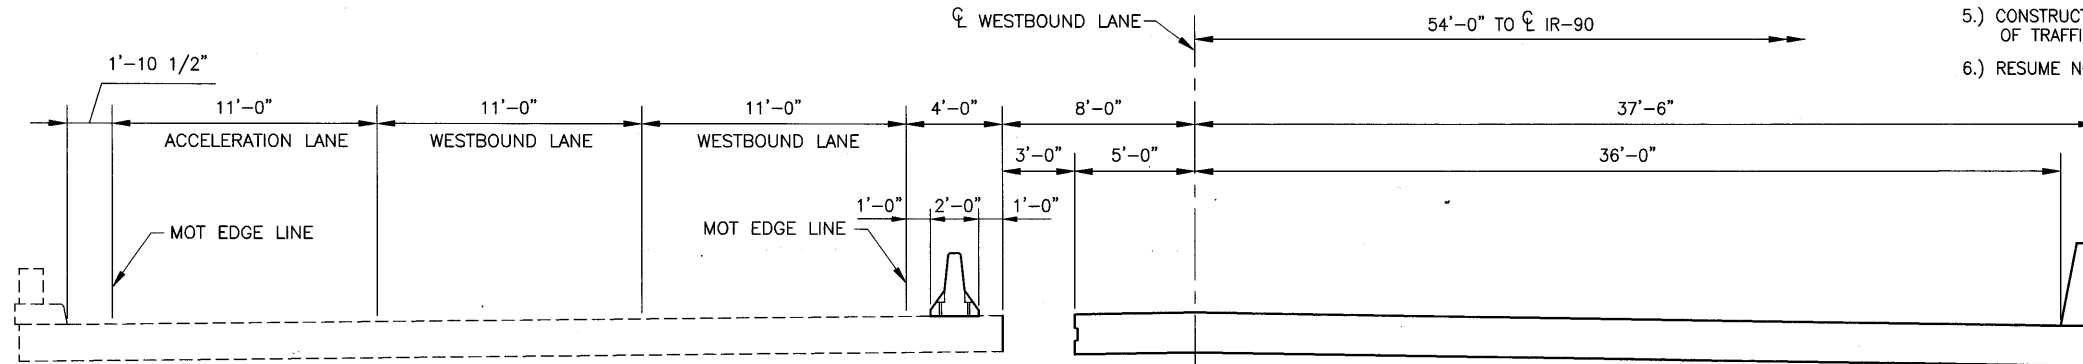


**MAINTENANCE OF TRAFFIC PHASE I**

**CONSTRUCTION**

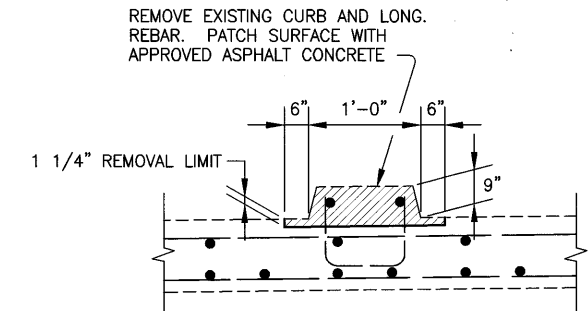


**DETAIL A**

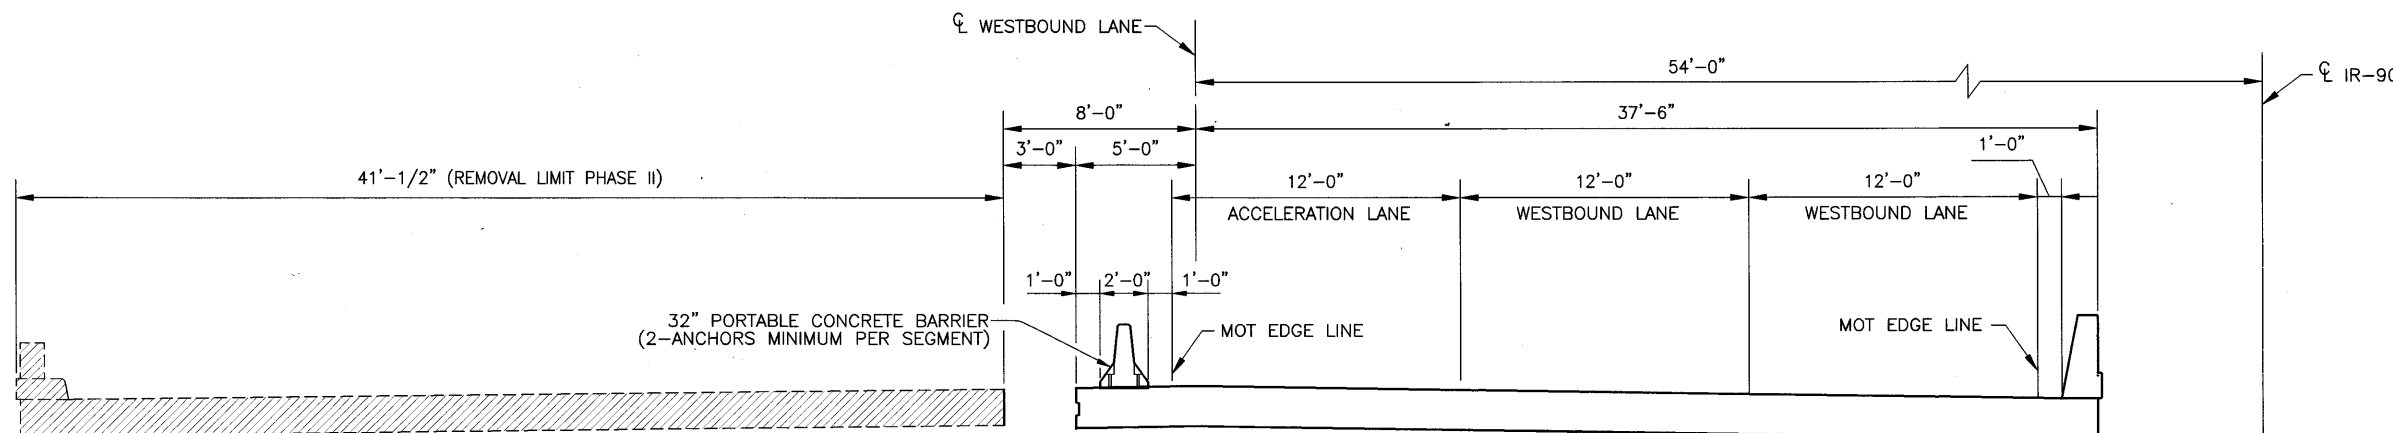

**MAINTENANCE OF TRAFFIC PHASE II**

**REMOVAL**

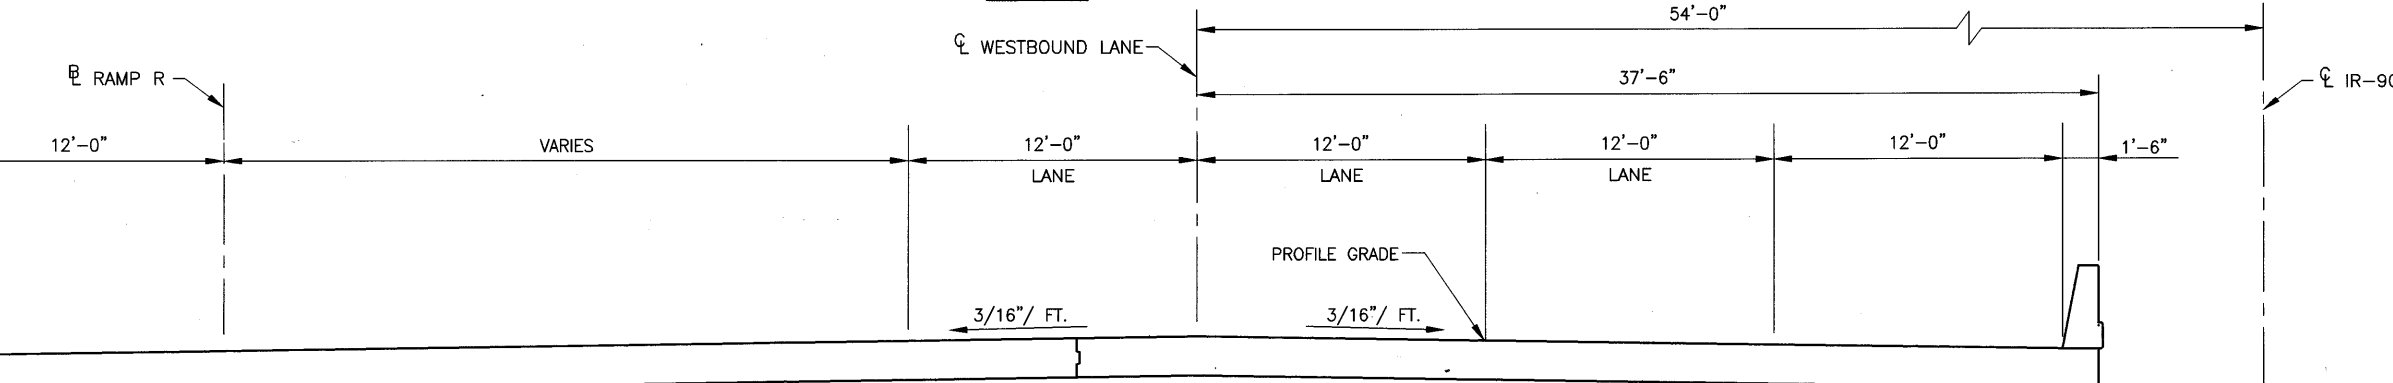

**MAINTENANCE OF TRAFFIC PHASE II**

**CONSTRUCTION**

**SUGGESTED CONSTRUCTION SEQUENCE**

**PHASE I**

- 1.) INSTALL PORTABLE CONCRETE BARRIER AS SHOWN ON PLANS.
- 2.) DIRECT WESTBOUND TRAFFIC TOWARD NORTHERLY PORTION OF THE BRIDGE
- 3.) REMOVE EXISTING DECK TO THE LIMIT SHOWN IN MAINTENANCE OF TRAFFIC PHASE I - REMOVAL.
- 4.) CONSTRUCT NEW PORTION OF ABUTMENT AND PIERS.
- 5.) CONSTRUCT NEW DECK AND PARAPET AS SHOWN ON MAINTENANCE OF TRAFFIC PHASE I - CONSTRUCTION.

**PHASE II**

- 1.) INSTALL PORTABLE CONCRETE BARRIER ON THE NEWLY CONSTRUCTED WORK.
- 2.) DIRECT TRAFFIC TO THE SOUTHERLY PORTION OF THE BRIDGE.
- 3.) REMOVE EXISTING PORTABLE CONCRETE BARRIER AND REMAINING DECK TO THE LIMITS SHOWN IN MAINTENANCE OF TRAFFIC PHASE II - REMOVAL.
- 4.) CONSTRUCT NEW PORTION OF ABUTMENT AND PIERS.
- 5.) CONSTRUCT NEW DECK AND PARAPET AS SHOWN ON MAINTENANCE OF TRAFFIC PHASE II - CONSTRUCTION.
- 6.) RESUME NORMAL TRAFFIC.

O:\93600\BRIDGE\DWGS\LO090PC1.DWG

DESIGN AGENCY: JAMES PARK, SITE 300  
 2400 CENTER ROAD  
 WESTLAKE, OHIO 44146  
 CONSULTING ENGINEERS  
 TELEPHONE (440) 835-4400  
 JOB NUMBER 93600


DATE: 4/30/01  
 REVIEWED: RAK  
 DRAWN: NFF  
 CHECKED: KK  
 STRUCTURE FILE NUMBER: 4704959(C) 4704983(R)  
 JOB NUMBER: 93600

PHASE CONSTRUCTION DETAILS - LEFT BRIDGE  
 BRIDGE No. LOR-90-1861 L AND R  
 INTERSTATE ROUTE 90 OVER FRENCH CREEK


LOR-90-10.76

3/24  
 129  
 274


O:\93600\BRIDGE\DWGS\LO090PC2.DWG

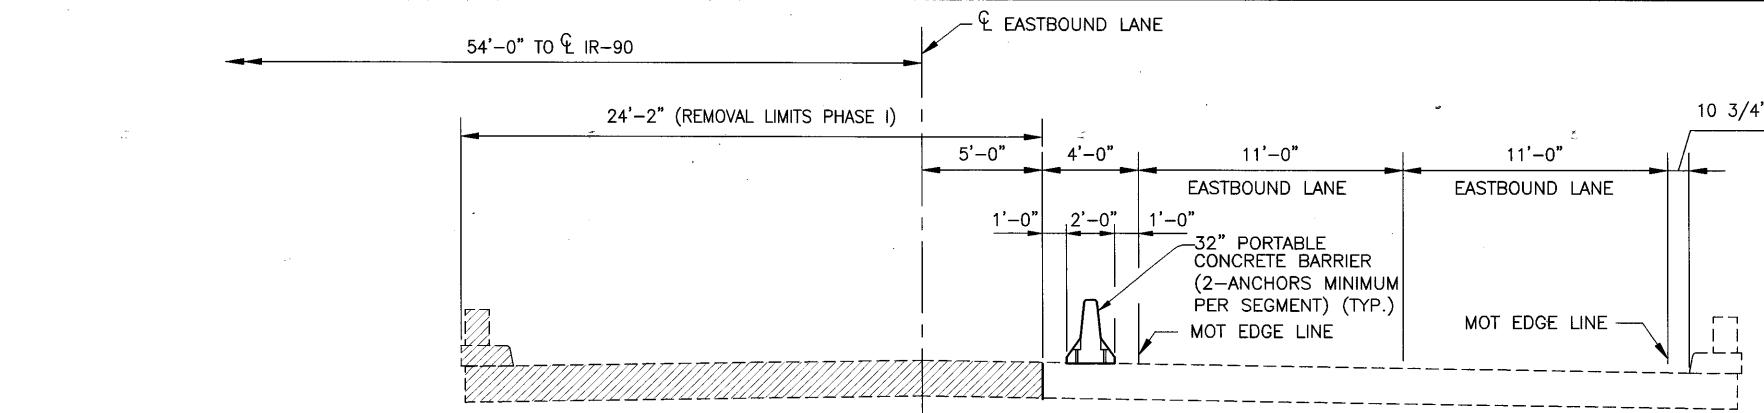


**MAINTENANCE OF TRAFFIC PHASE I  
REMOVAL**

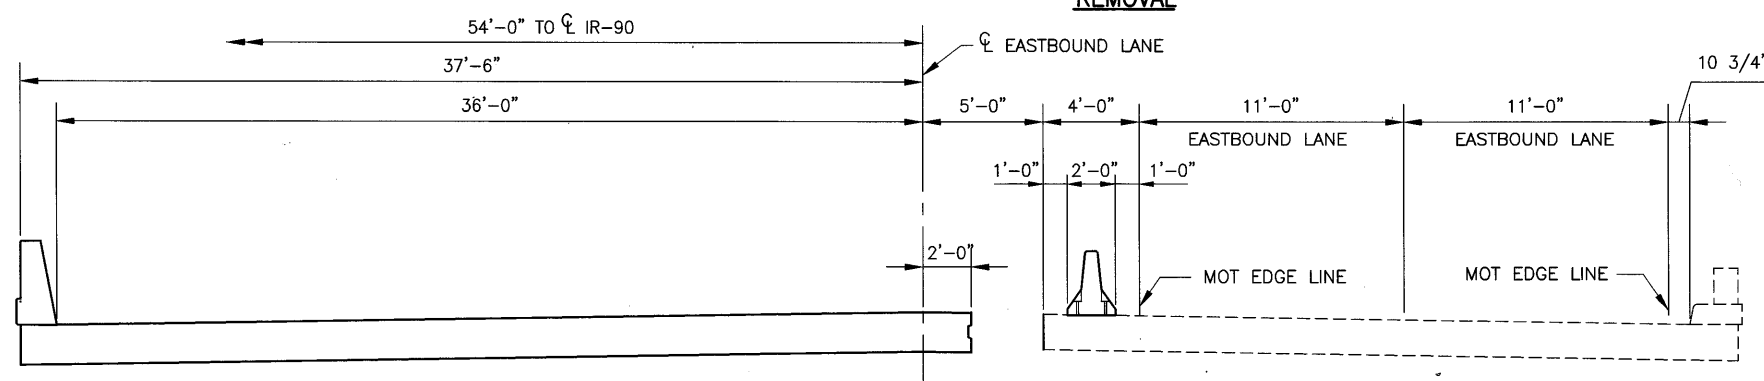

**MAINTENANCE OF TRAFFIC PHASE I  
CONSTRUCTION**

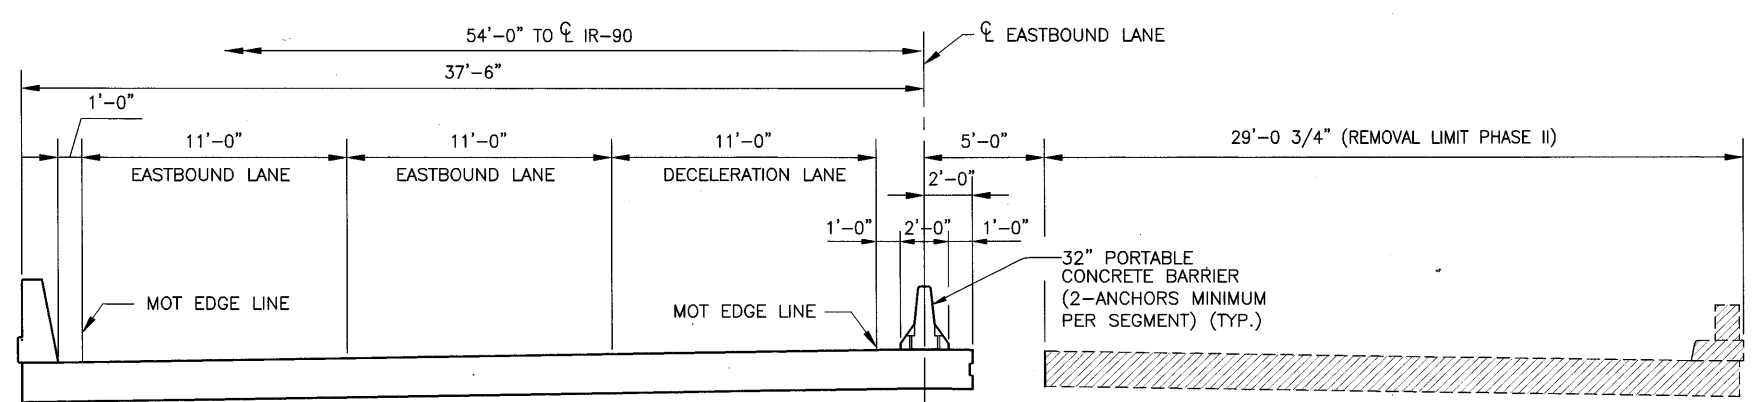

**MAINTENANCE OF TRAFFIC PHASE II  
REMOVAL**

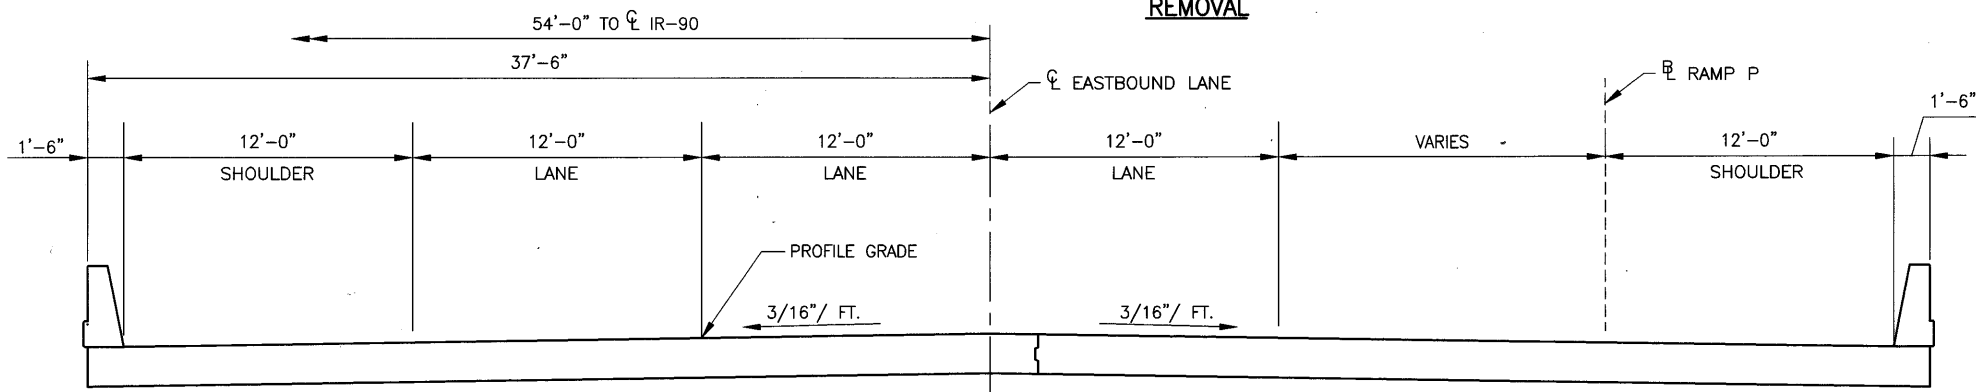

**MAINTENANCE OF TRAFFIC PHASE II  
CONSTRUCTION**

**SUGGESTED CONSTRUCTION SEQUENCE**

**PHASE I**

- 1.) INSTALL PORTABLE CONCRETE BARRIER AS SHOWN ON PLANS.
- 2.) DIRECT EASTBOUND TRAFFIC TOWARD SOUTHERLY PORTION OF THE BRIDGE
- 3.) REMOVE EXISTING DECK TO THE LIMIT SHOWN IN MAINTENANCE OF TRAFFIC PHASE I - REMOVAL.
- 4.) CONSTRUCT NEW PORTION OF ABUTMENT AND PIERS.
- 5.) CONSTRUCT NEW DECK AND PARAPET AS SHOWN ON MAINTENANCE OF TRAFFIC PHASE I - CONSTRUCTION.

**PHASE II**

- 1.) INSTALL PORTABLE CONCRETE BARRIER ON THE NEWLY CONSTRUCTED WORK.
- 2.) DIRECT TRAFFIC TO THE NORTHERLY PORTION OF THE BRIDGE.
- 3.) REMOVE EXISTING PORTABLE CONCRETE BARRIER AND REMAINING DECK TO THE LIMITS SHOWN IN MAINTENANCE OF TRAFFIC PHASE II - REMOVAL.
- 4.) CONSTRUCT NEW PORTION OF ABUTMENT AND PIERS.
- 5.) CONSTRUCT NEW DECK AND PARAPET AS SHOWN ON MAINTENANCE OF TRAFFIC PHASE II - CONSTRUCTION.
- 6.) RESUME NORMAL TRAFFIC.


DESIGN AGENCY  
**REV**  
 THREE WINGS JAMES PARK - SUITE 300  
 2400 CENTER BRIDGE ROAD  
 CONSULTING ENGINEERS  
 TELEPHONE (404) 852-9400  
 FAX NUMBER 93600

DESIGNED	INFF	CHECKED	KK
DRAWN	INFF	REVISED	
REVIEWED	RAK	STRUCTURE FILE NUMBER	4704983(L) 4704983(R)
DATE	4/30/01		


**PHASE CONSTRUCTION DETAILS—RIGHT BRIDGE**  
 BRIDGE No. LOR-90-1861 L AND R  
 INTERSTATE ROUTE 90 OVER FRENCH CREEK

LOR-90-10.76  
 4 / 24  
 130  
 274


O:\93600\BRIDGE\DWGS\LO90MD1.DWG

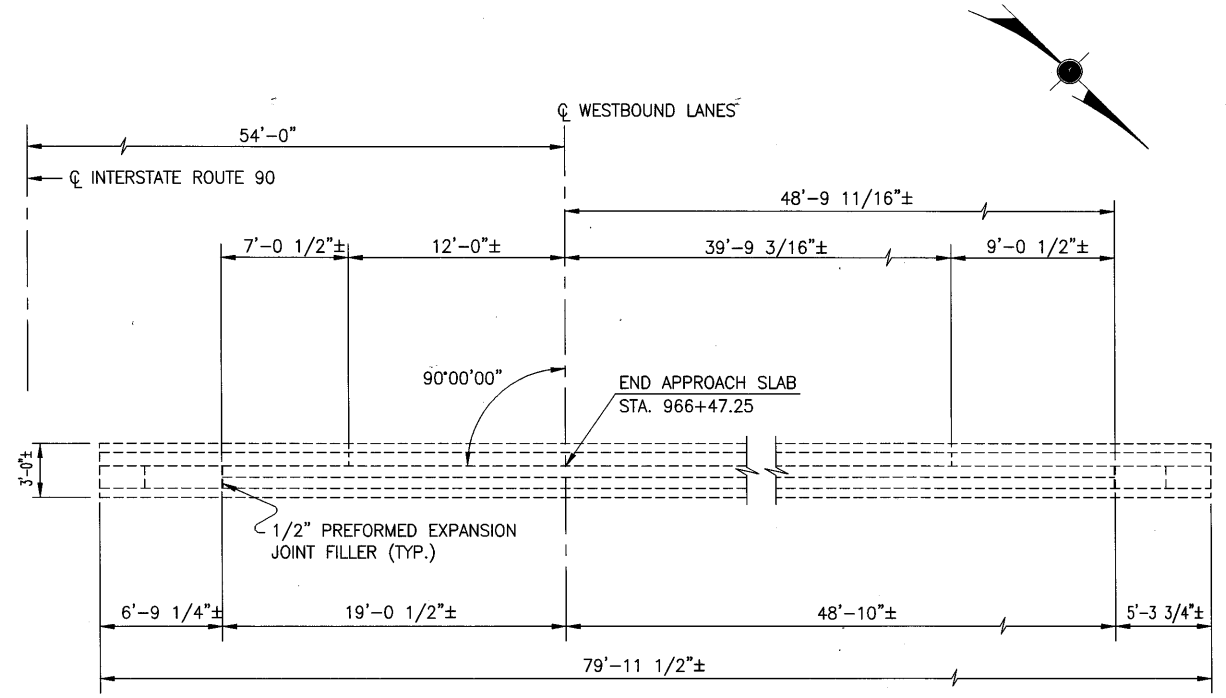


PLAN

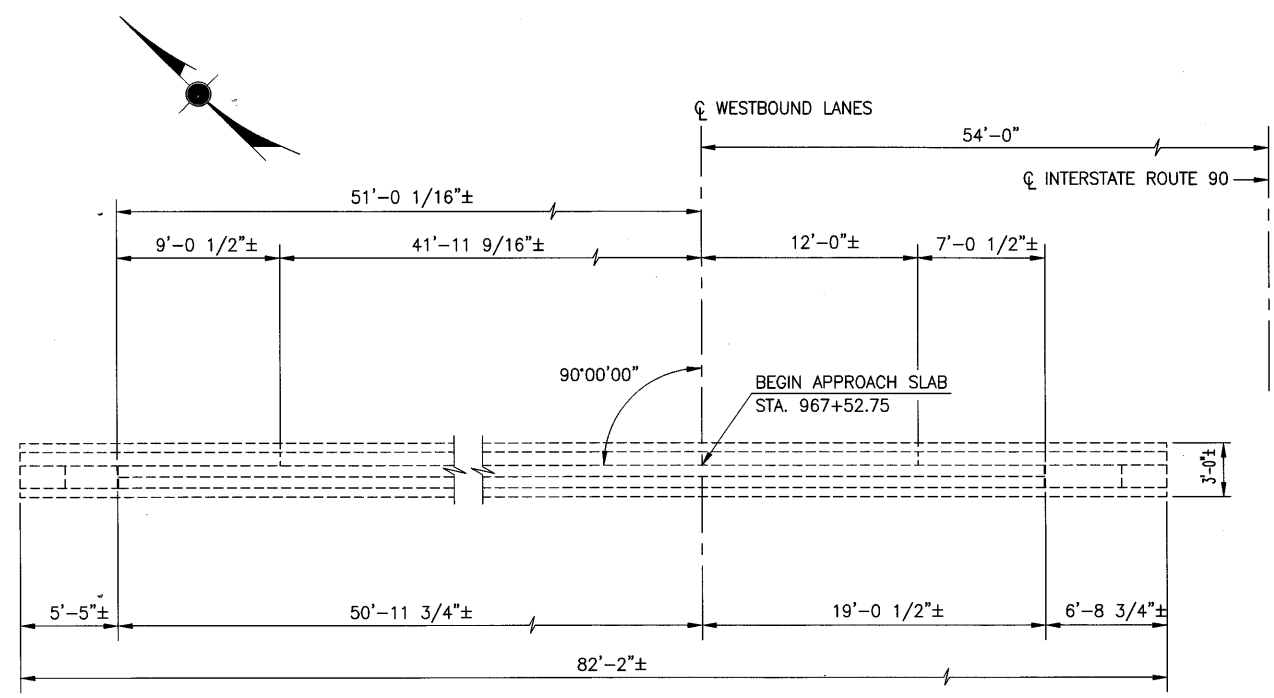


PLAN

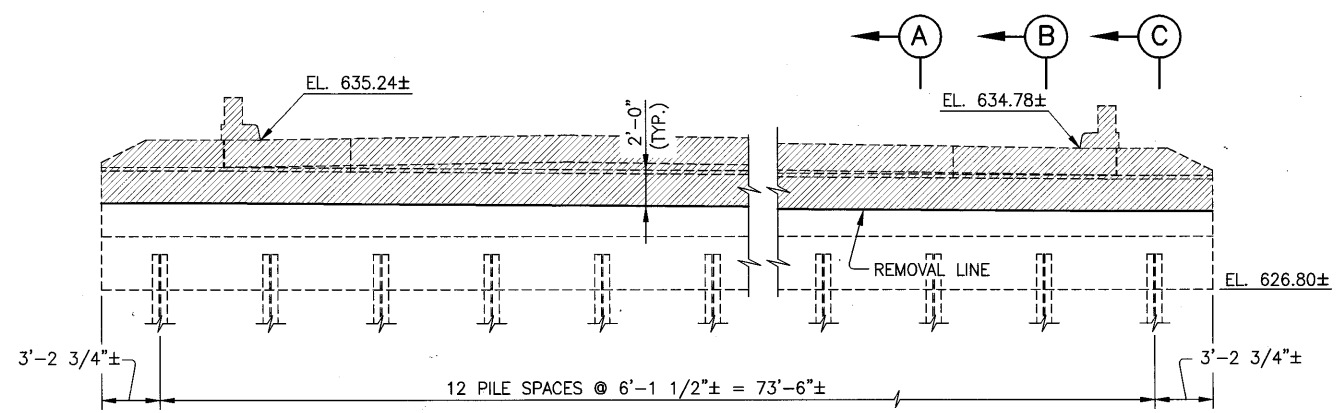


ELEVATION  
REAR ABUTMENT

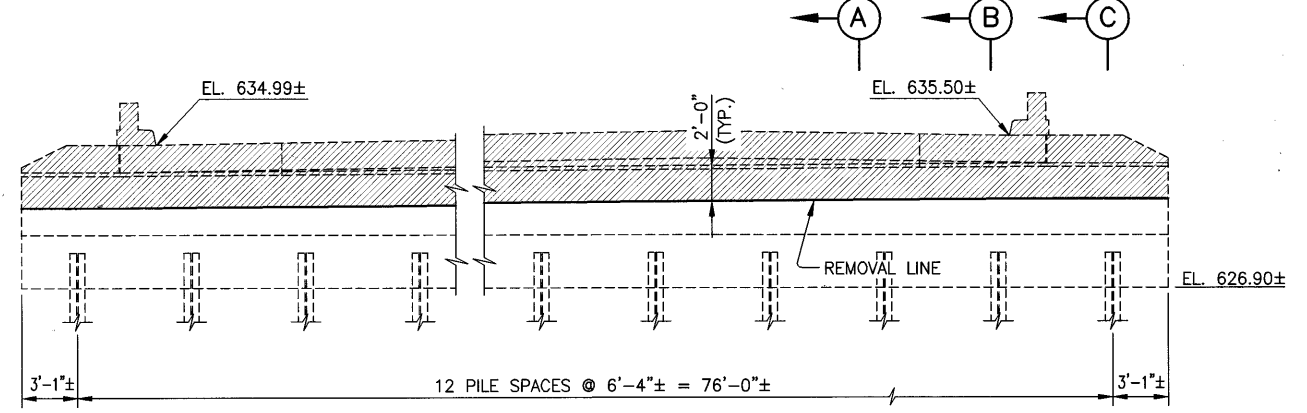


ELEVATION  
FORWARD ABUTMENT

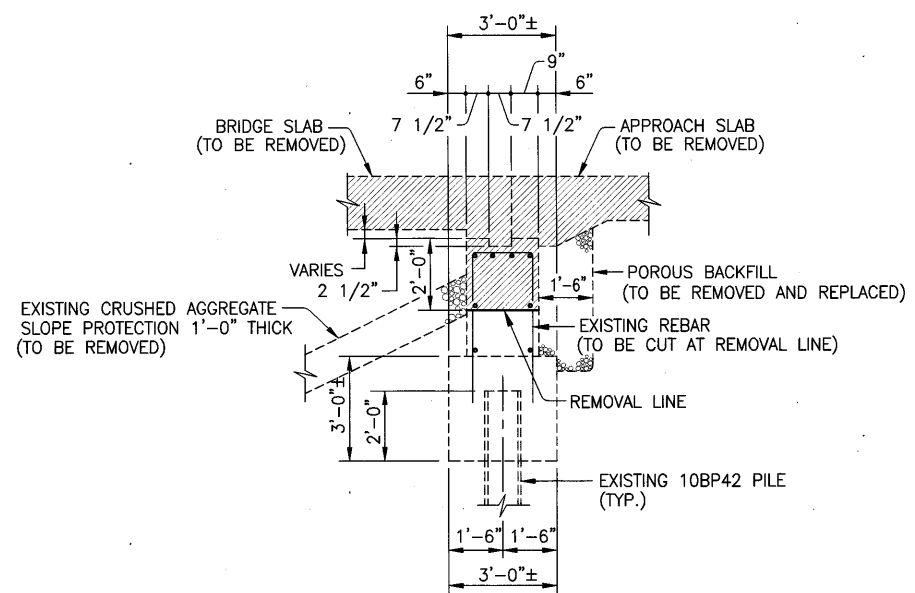

SECTION A-A

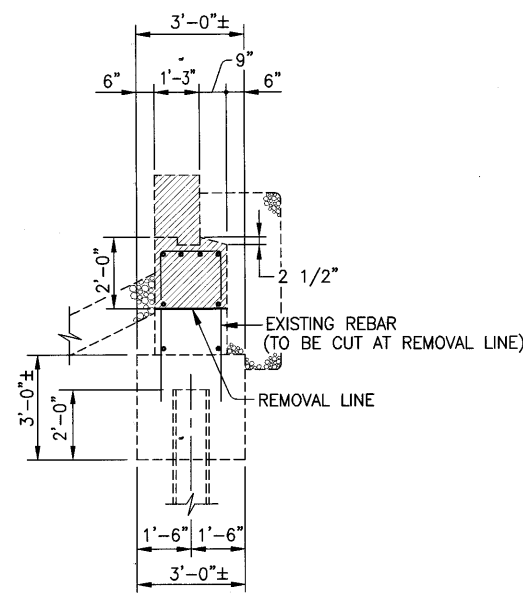

SECTION B-B

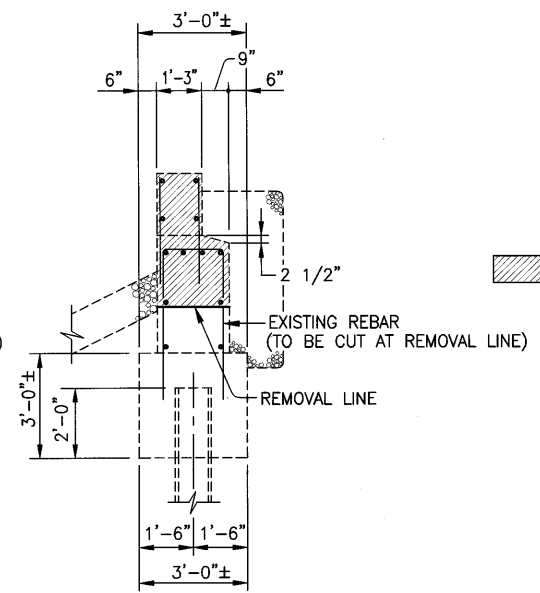

SECTION C-C

▨ - DENOTES REMOVAL LIMITS

DESIGN AGENCY  
R.P. WILSON  
CONSULTING ENGINEERS  
2400 CENTER ROAD  
ANN ARBOR, MI 48106  
TELEPHONE (419) 833-9400  
JOB NUMBER 93300

DATE 4/30/01  
REVIEWED RAK  
DRAWN CAC  
DESIGNED INF  
CHECKED KK  
STRUCTURE FILE NUMBER 4704983(R)  
JOB NUMBER 93300


ABUTMENT REMOVAL DETAILS - LEFT BRIDGE  
BRIDGE No. LOR-90-1861 L AND R  
INTERSTATE ROUTE 90 OVER FRENCH CREEK

LOR-90-10.76


5 / 24

131  
274


O:\93600\BRIDGE\DWGS\LO090MD2.DWG

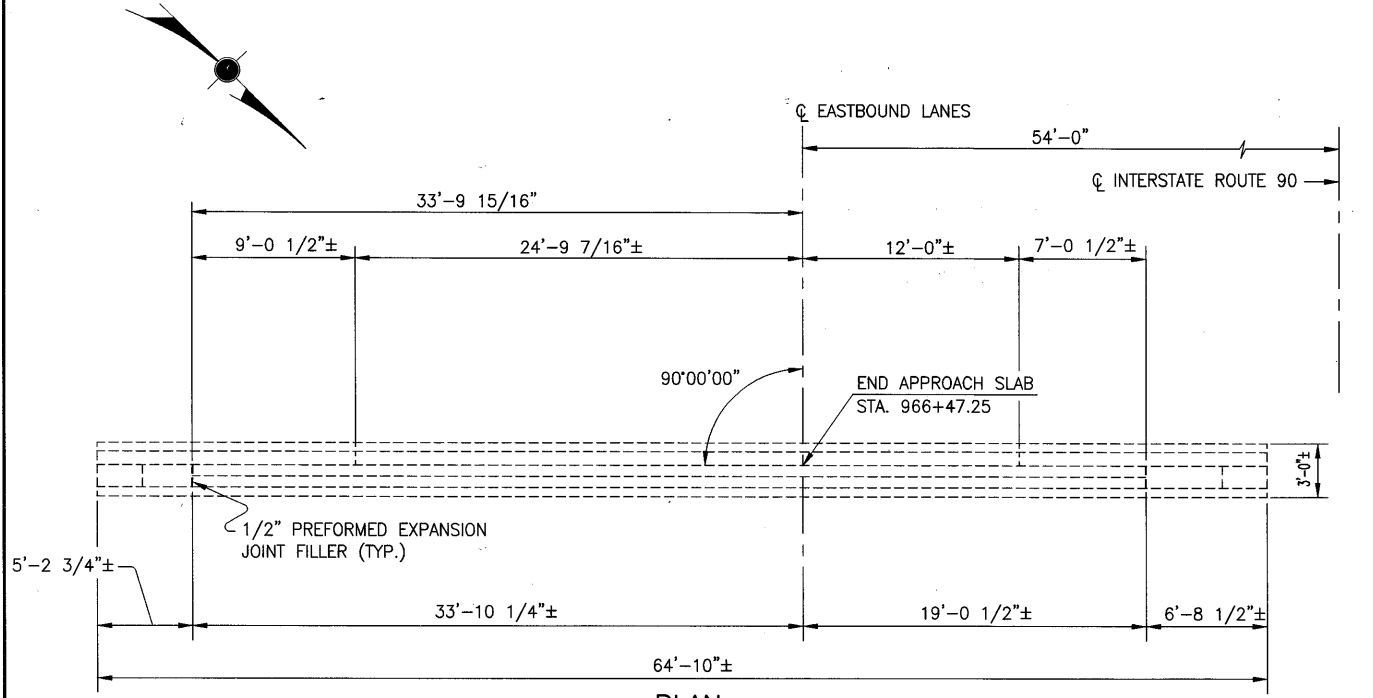


**PLAN**

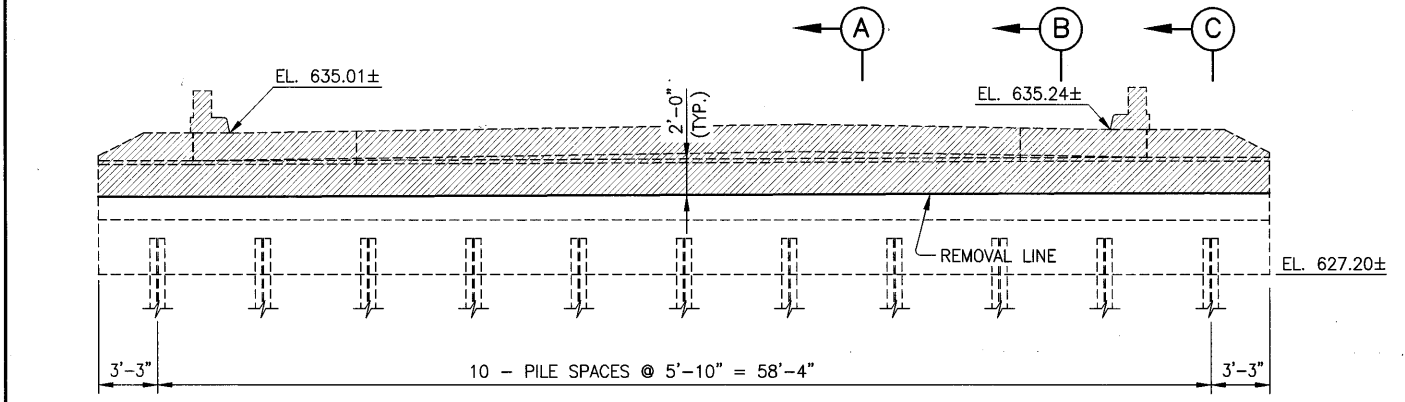


**ELEVATION REAR ABUTMENT**

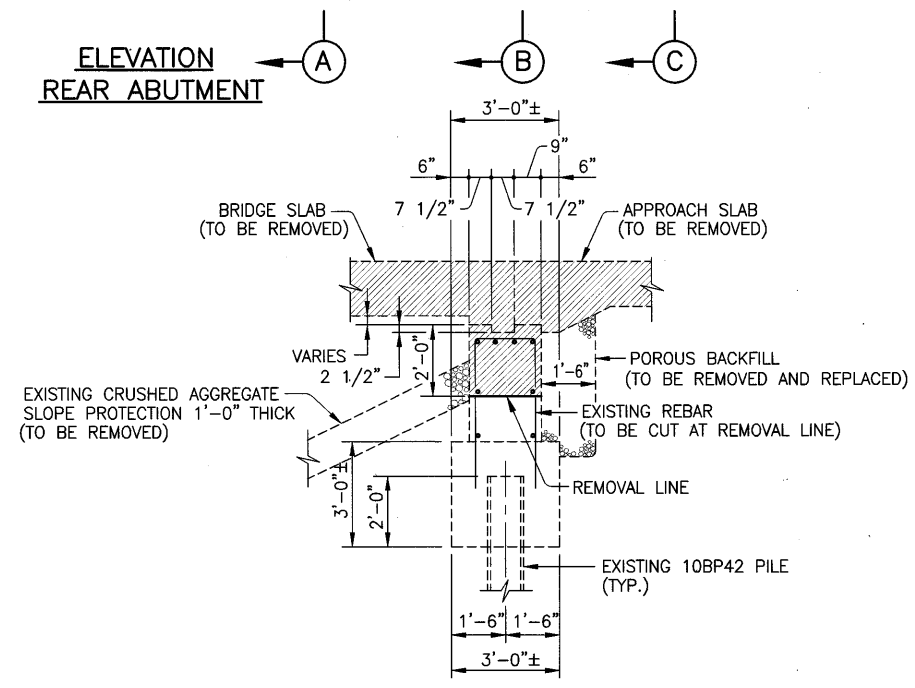


**SECTION A-A**

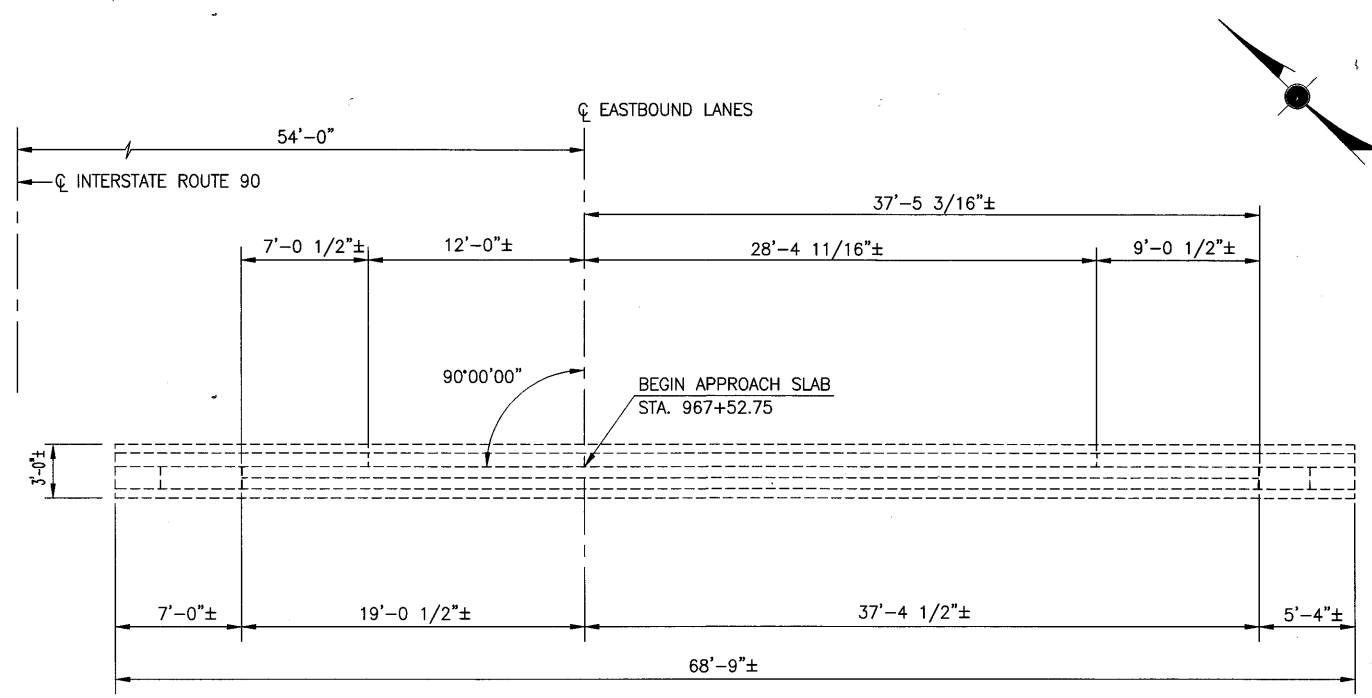

**PLAN**

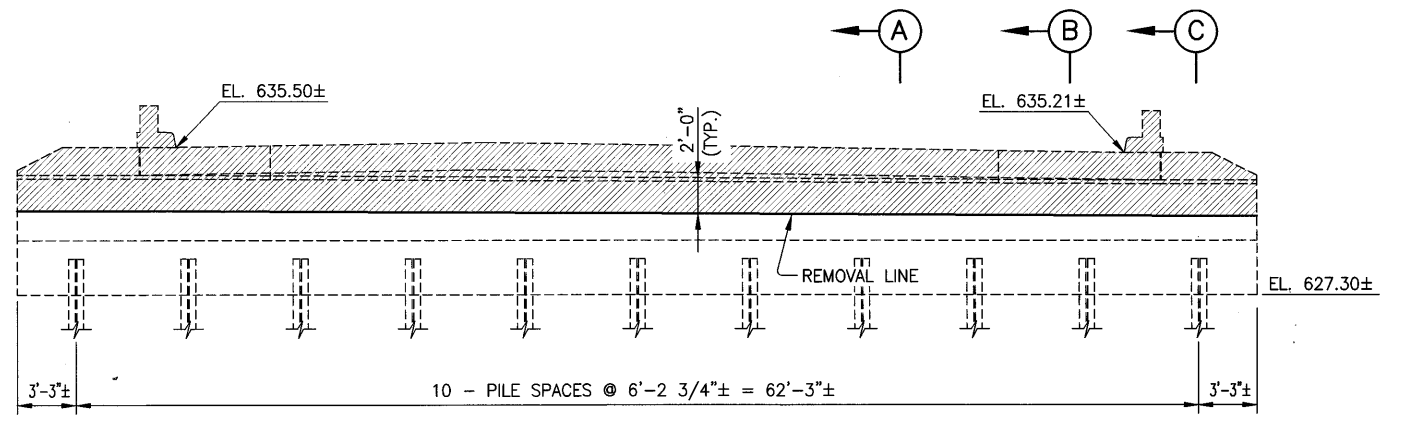

**ELEVATION FORWARD ABUTMENT**

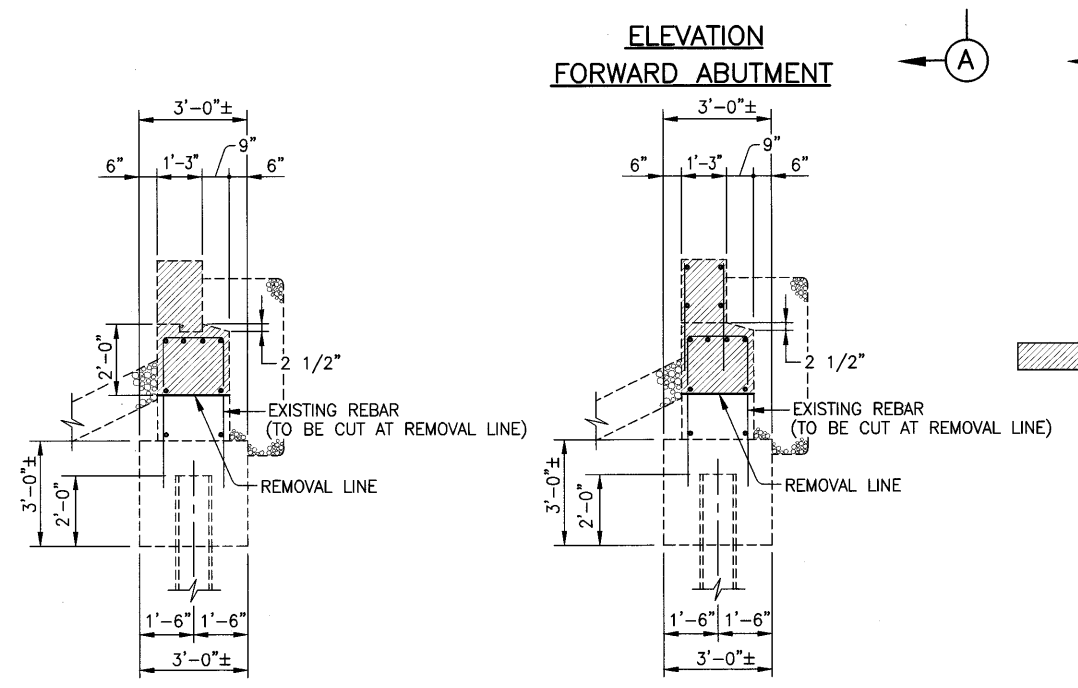


**SECTION B-B**

**SECTION C-C**


— DENOTES REMOVAL LIMITS

DESIGN AGENCY <b>R.W. RAYNER &amp; ASSOCIATES, INC.</b> CONSULTING ENGINEERS 1400 WEST 14TH AVENUE DENVER, CO 80202 TELEPHONE (303) 733-4400 FAX (303) 733-4400	
DATE 4/30/01	
REVIEWED RAK	
DESIGNED NFF	
DRAWN CAG	
CHECKED KK	
STRUCTURE FILE NUMBER 4704959(L) 4704953(R)	
JOB NUMBER 93600	
<b>ABUTMENT REMOVAL DETAILS - RIGHT BRIDGE</b>	
BRIDGE No. LOR-90-1861 L AND R	
INTERSTATE ROUTE 90 OVER FRENCH CREEK	
LOR-90-10.76	
6 / 24	
132 274	


O:\93600\BRIDGE\DWGS\LO090MD3.DWG

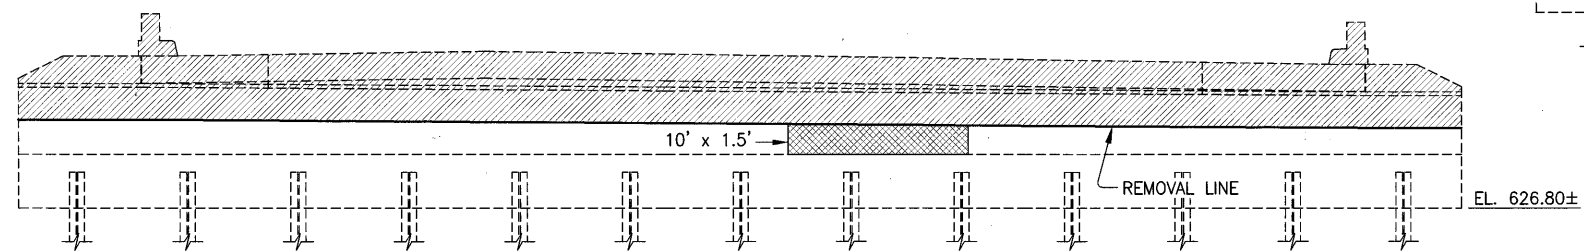


**ELEVATION  
REAR ABUTMENT - LEFT BRIDGE**

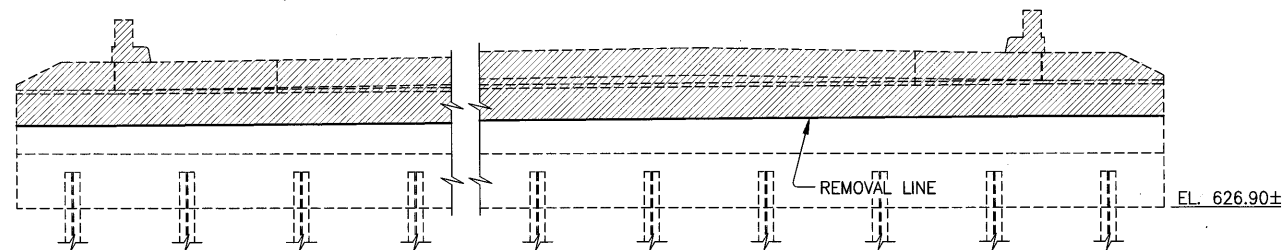

**ELEVATION  
FORWARD ABUTMENT - LEFT BRIDGE**

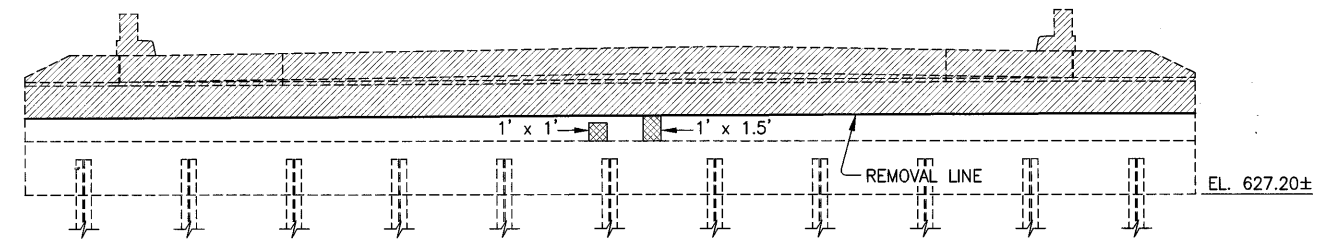

**ELEVATION  
REAR ABUTMENT - RIGHT BRIDGE**

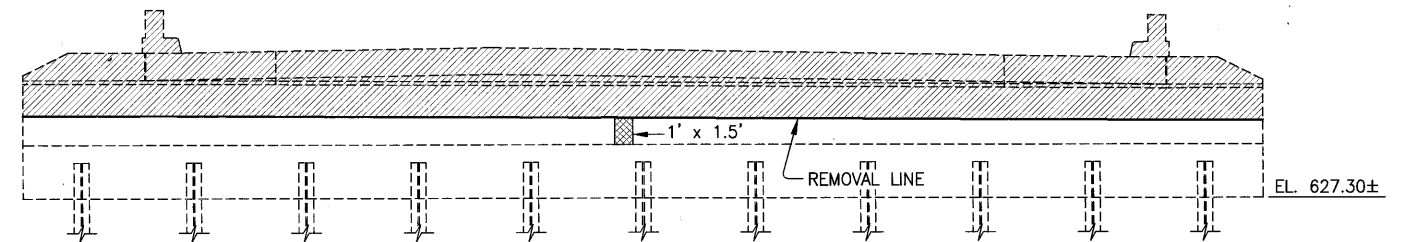

**ELEVATION  
FORWARD ABUTMENT - RIGHT BRIDGE**


- DENOTES REMOVAL LIMITS
- ITEM 843 - PATCHING CONCRETE STRUCTURES WITH TROWELABLE MORTAR

DESIGN AGENCY  
**R.W. HANNA**  
 CONSULTING ENGINEERS  
 2400 CENTER ROAD  
 SUITE 300  
 FRENCH CREEK, ALA 35066  
 TELEPHONE (404) 835-9400  
 FAX (404) 835-9400


DESIGNED	INF	CHECKED	KK
DRAWN	CAG	REVISED	
REVIEWED	RAK	STRUCTURE FILE NUMBER	4704983(R)
DATE	4/30/01		

**ABUTMENT PATCHING DETAILS**  
 BRIDGE No. LOR-90-1861 L AND R  
 INTERSTATE ROUTE 90 OVER FRENCH CREEK

LOR-90-10.76  
 7 / 24  
 133  
 274

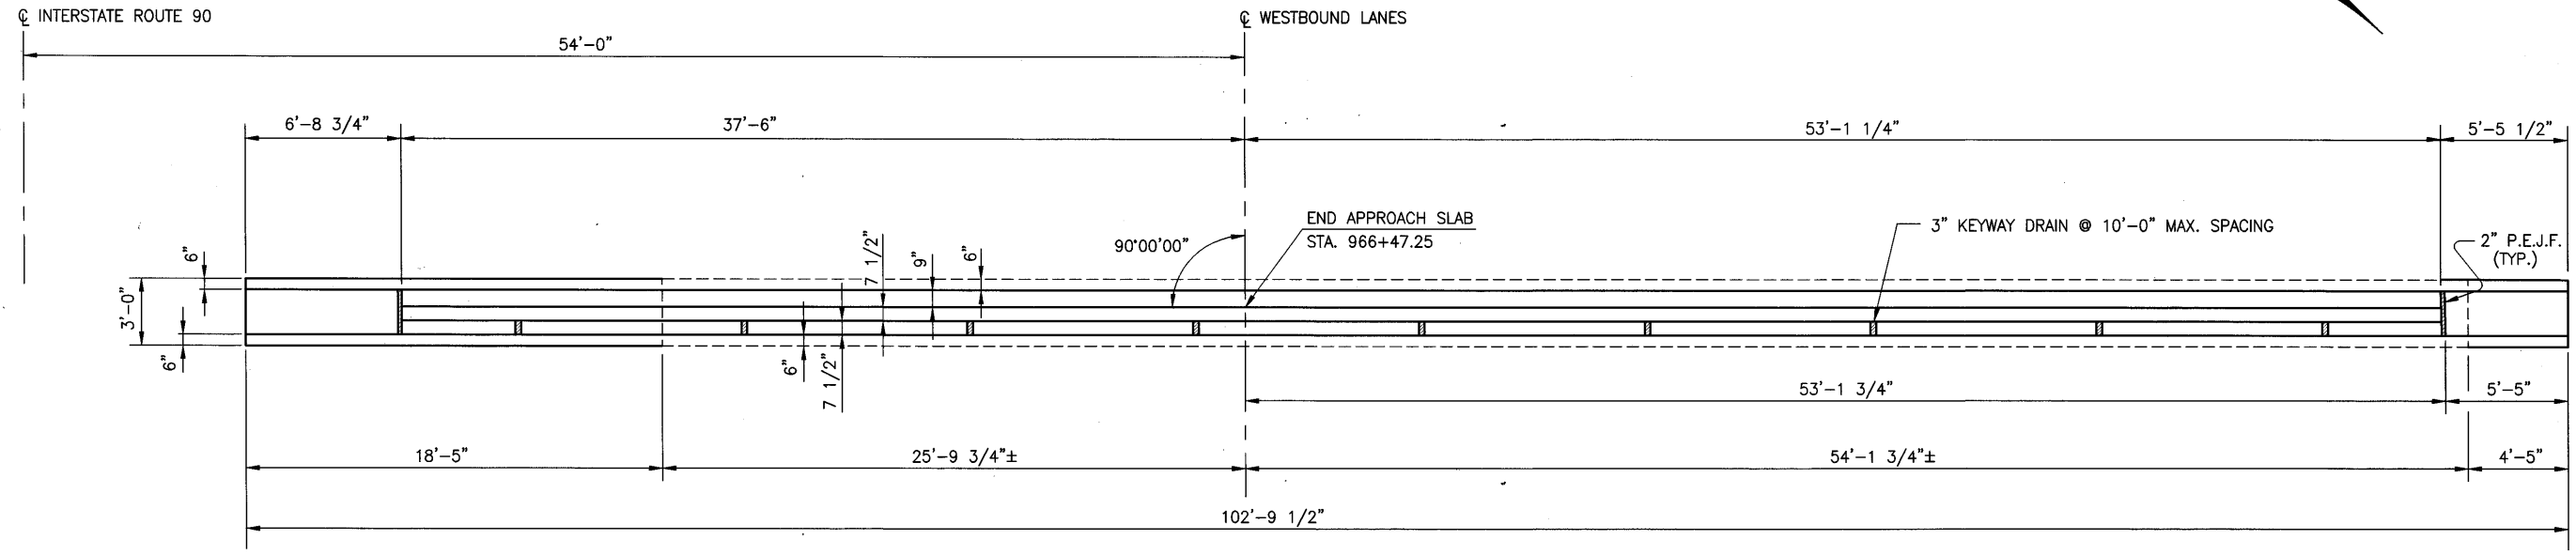

PLAN


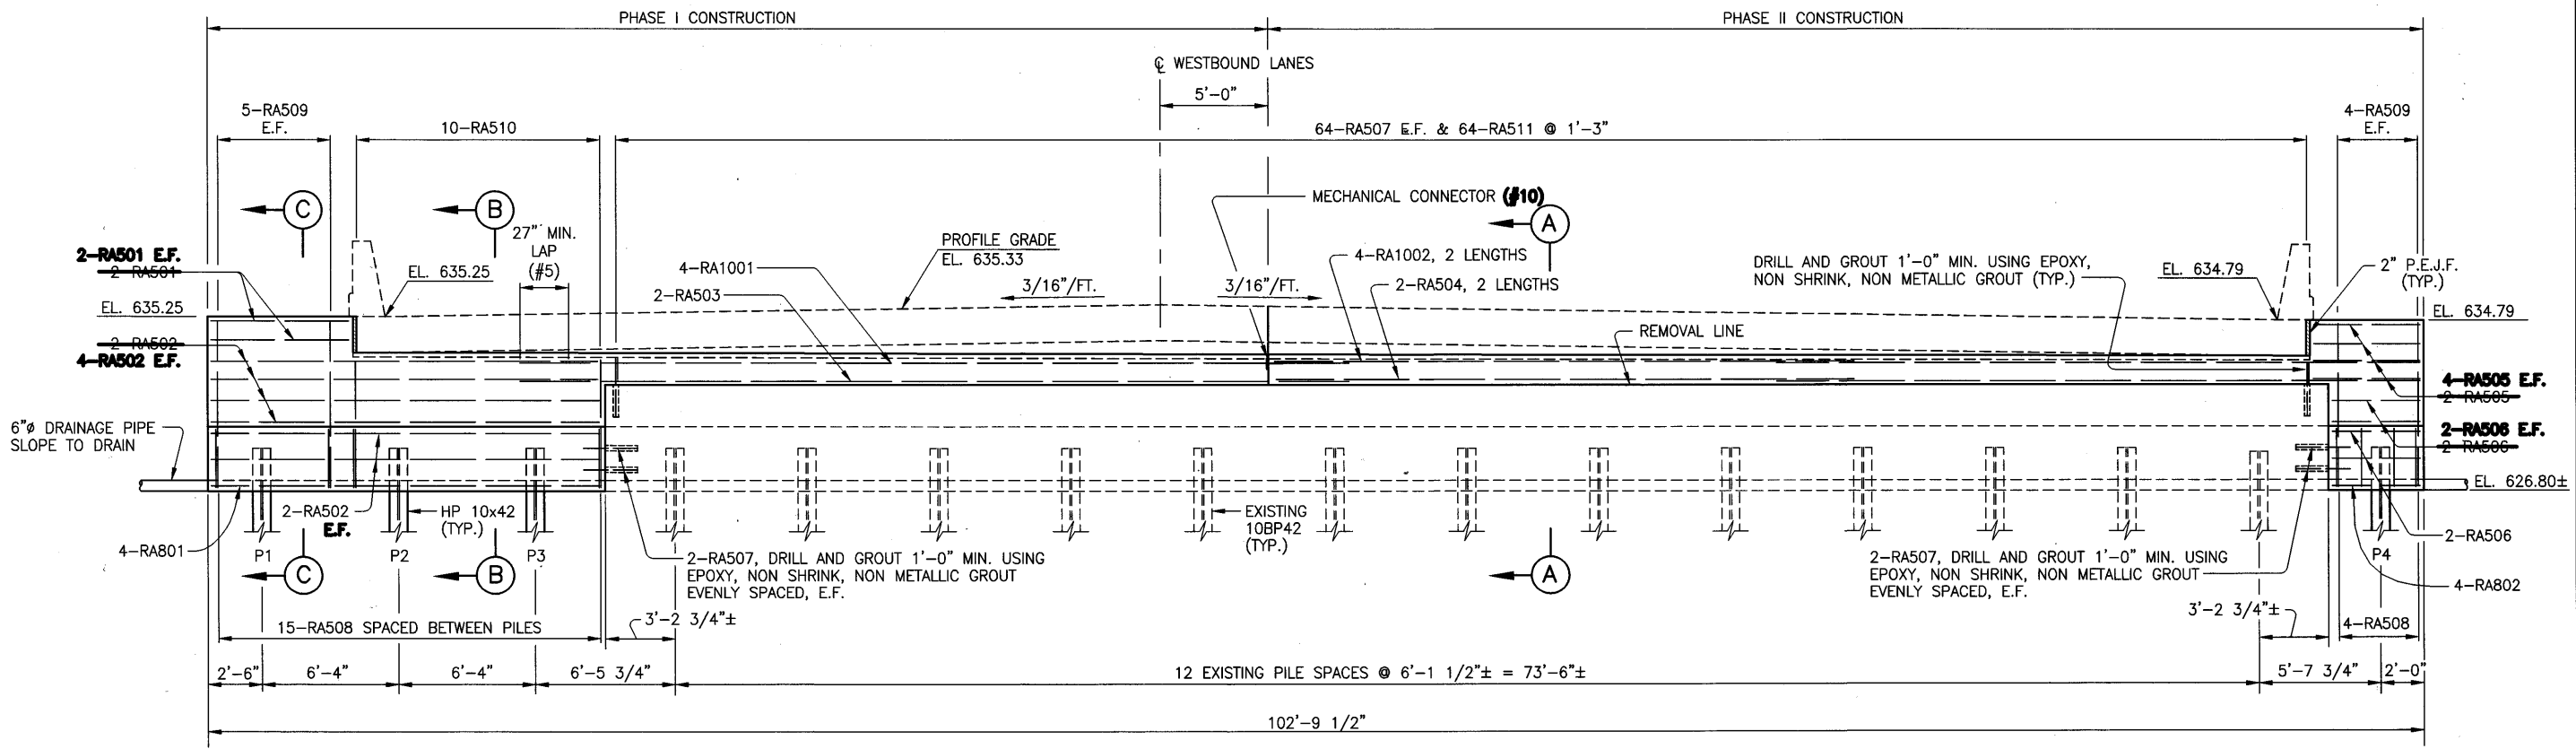


ELEVATION


NOTES:

- FOR SECTIONS A-A, B-B AND C-C, SEE SHEET 12/24

O:\93600\BRIDGE\DWGS\LO09ORA1.DWG

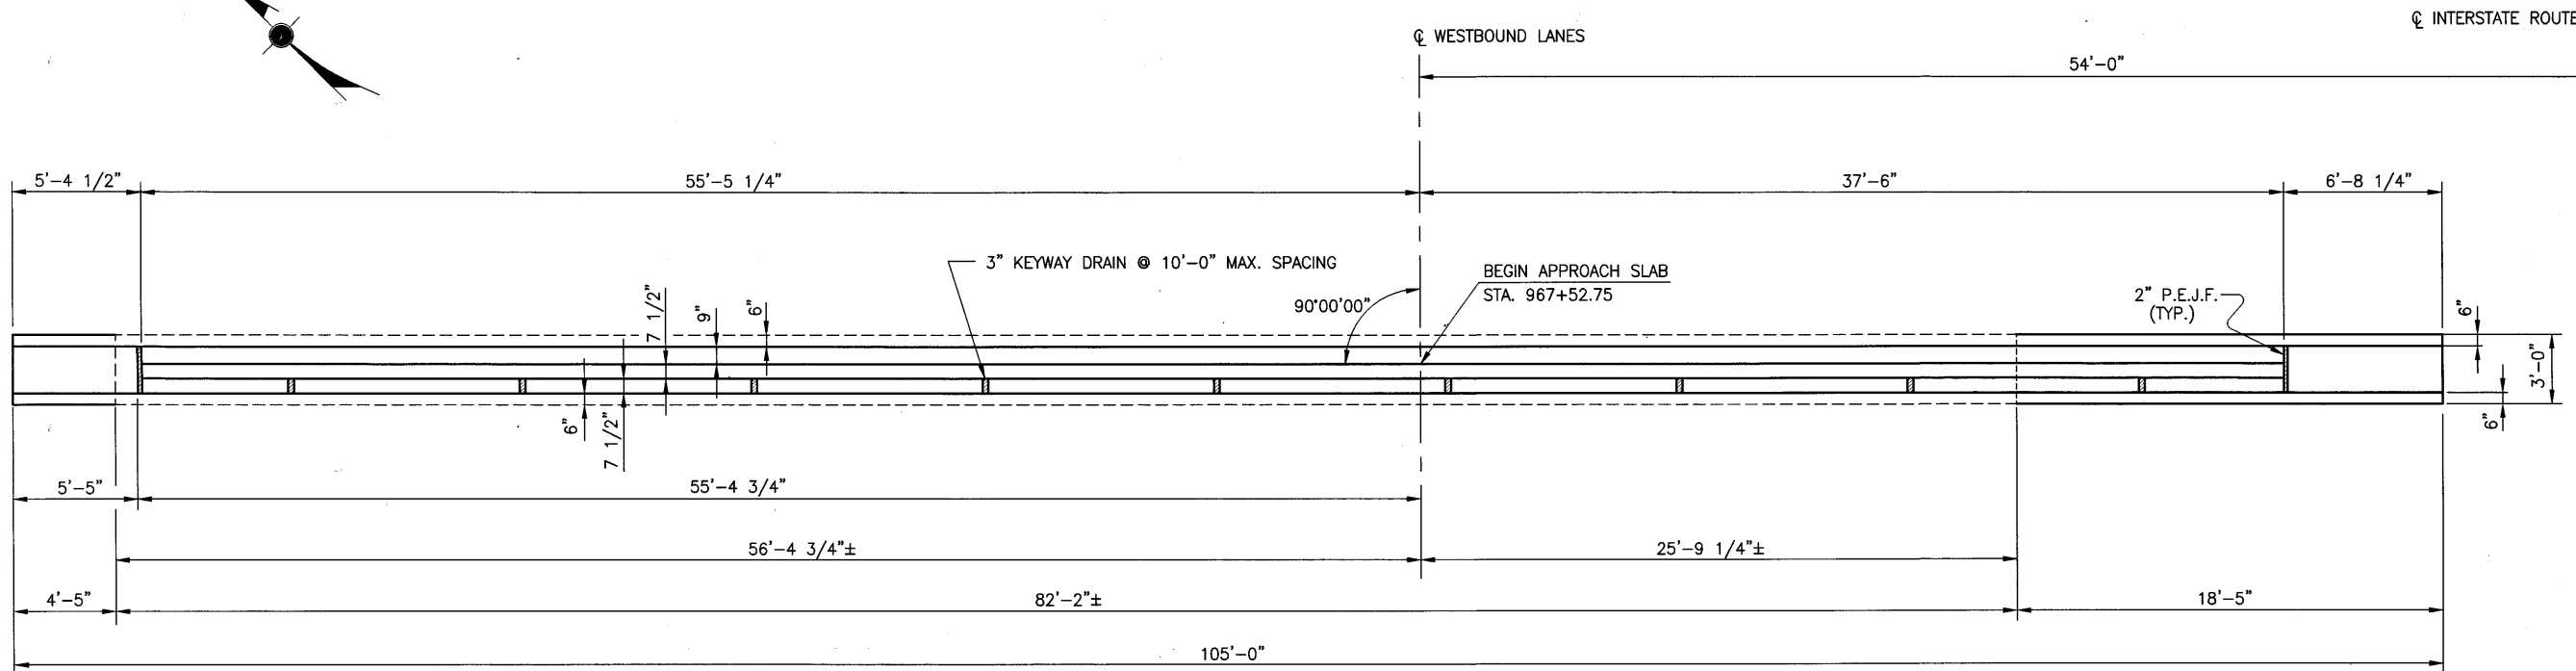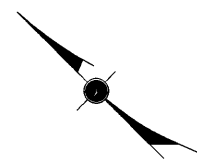

**PLAN**

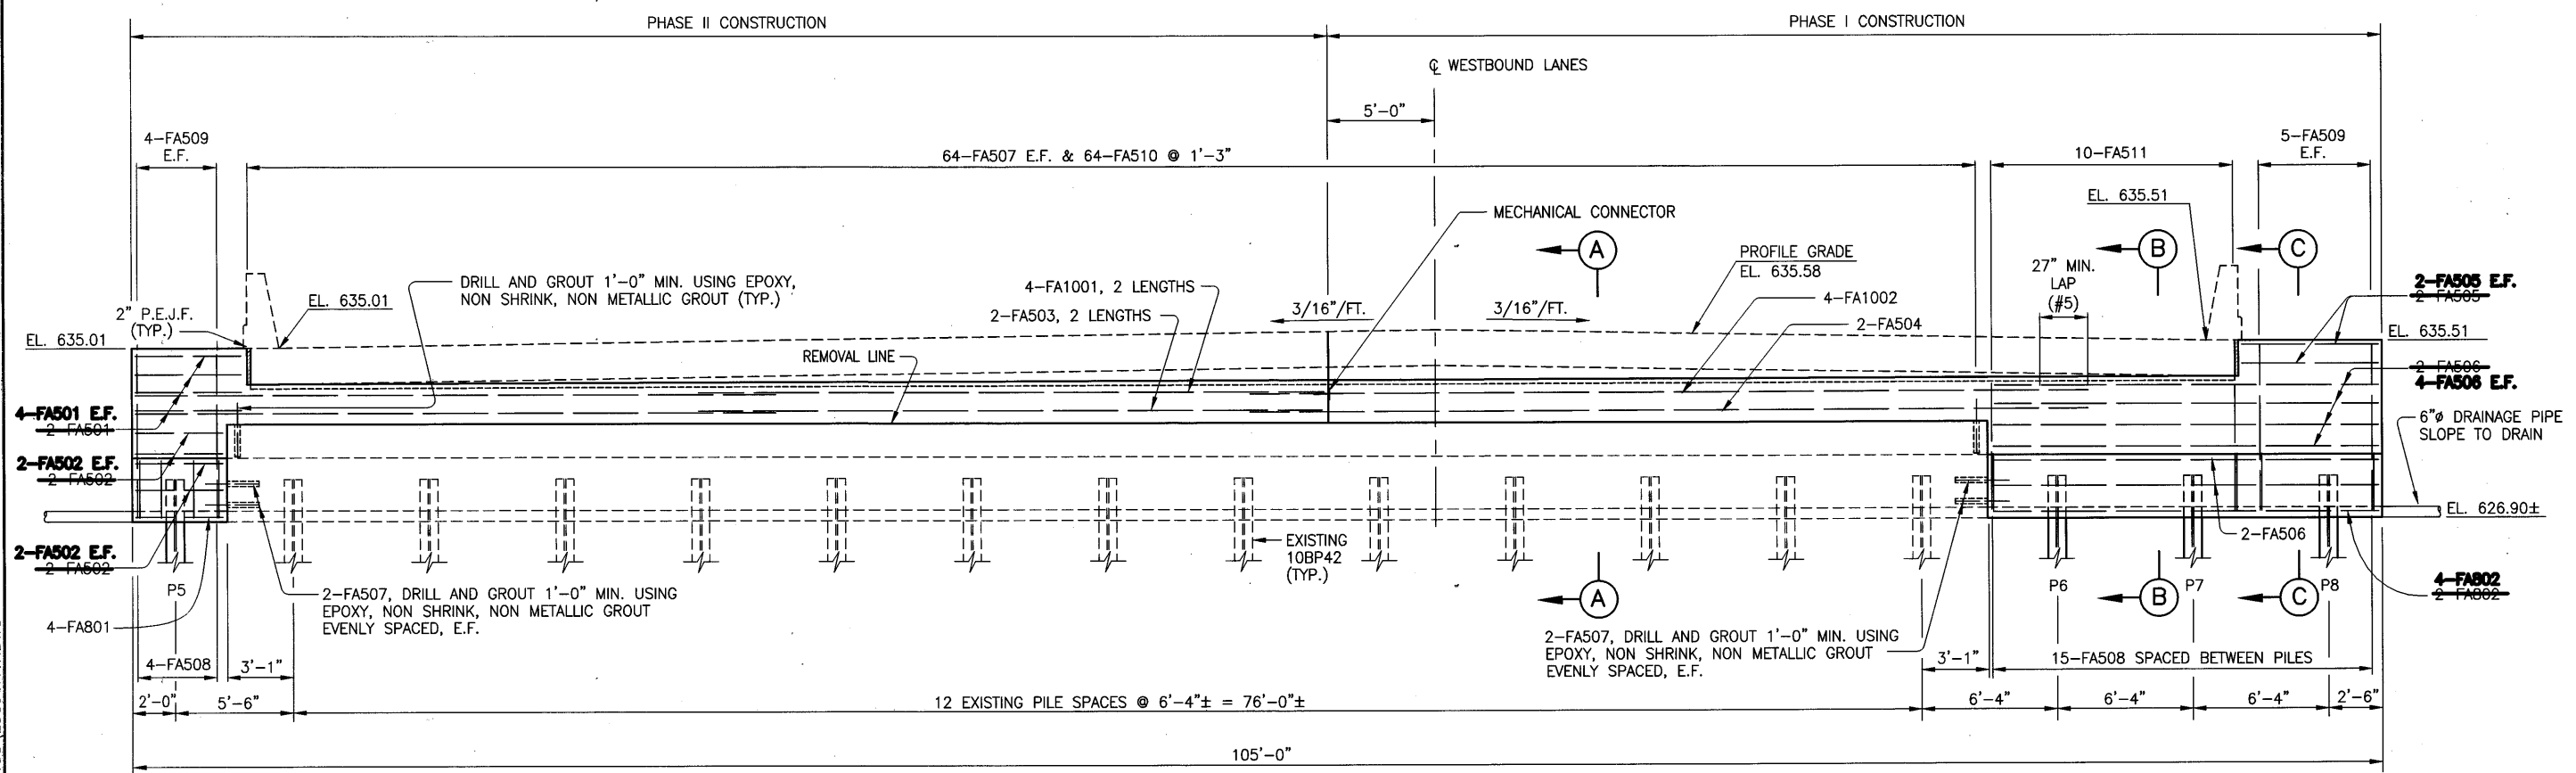

**ELEVATION**

**NOTES:**  
 1.) FOR SECTIONS A-A, B-B AND C-C, SEE SHEET 12/24

O:\93600\BRIDGE\DWGS\LO090FA1.DWG

DESIGN AGENCY  
**R.P. WARD**  
 ENGINEERS  
 CONSULTING ENGINEERS  
 JOB NUMBER 93600



DATE 4/30/01  
 REVIEWED RAK  
 STRUCTURE FILE NUMBER 4704959(L) 4704983(R)  
 DRAWN CAG  
 REVISIONS KK  
 DESIGNED INF  
 CHECKED KK

**FORWARD ABUTMENT - LEFT BRIDGE**  
 BRIDGE No. LOR-90-1861 L AND R  
 INTERSTATE ROUTE 90 OVER FRENCH CREEK


LOR-90-10.76

9 / 24

135  
274

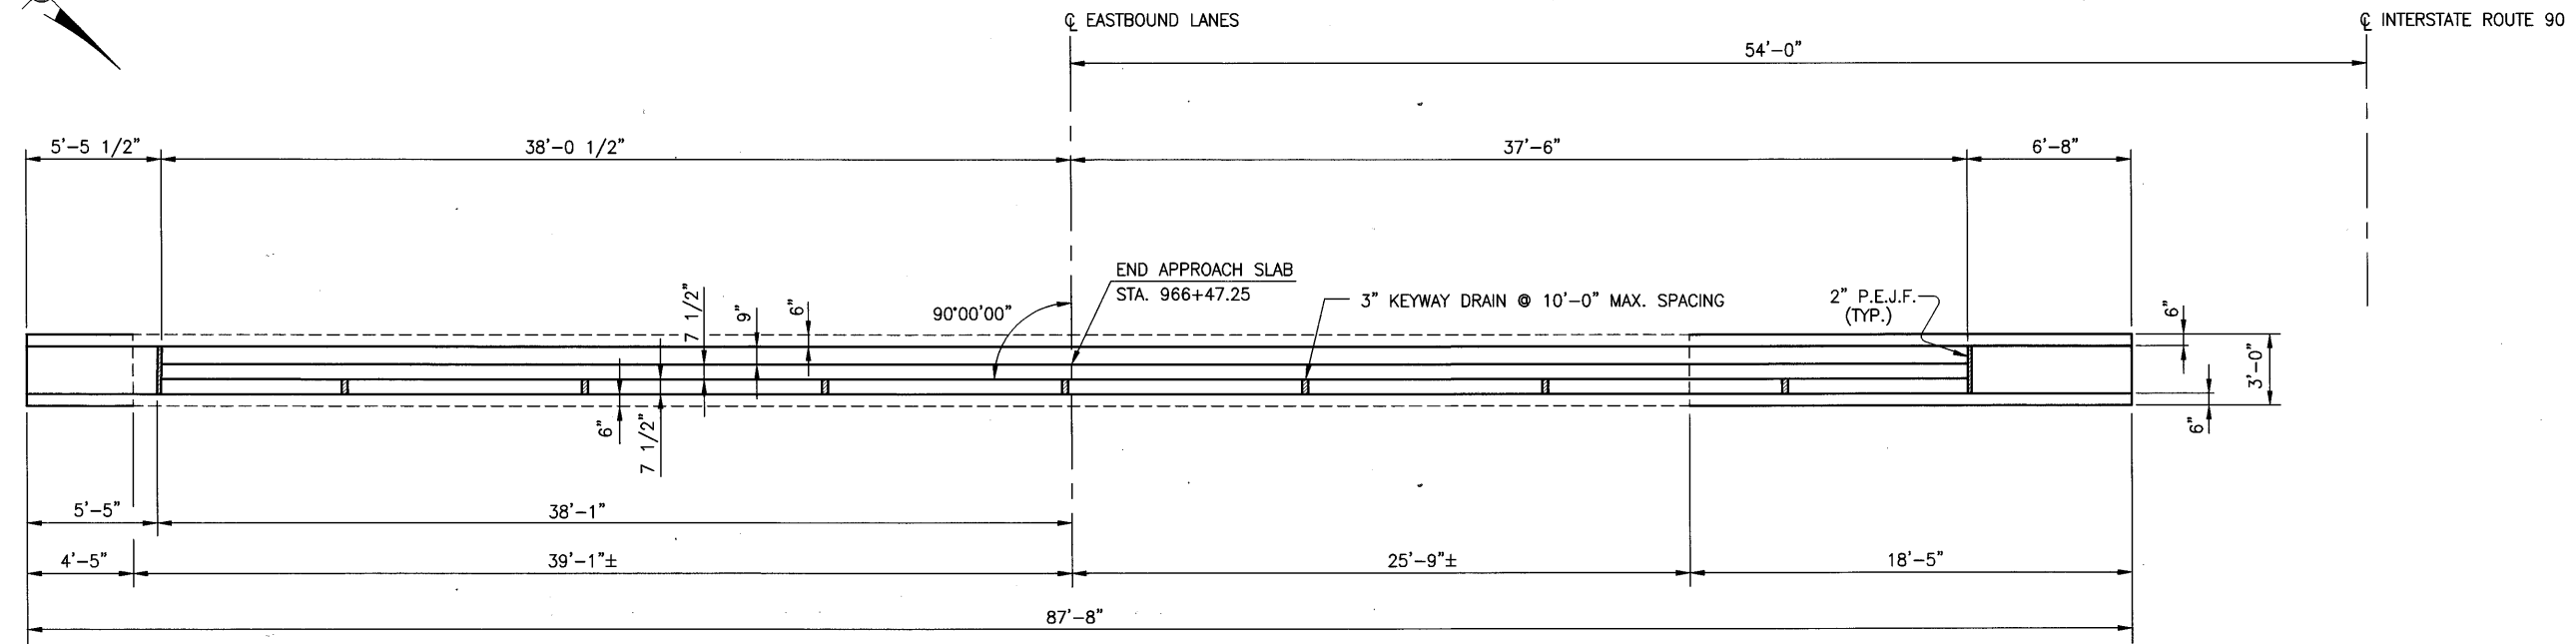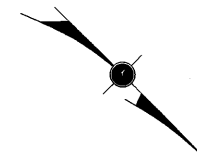

**PLAN**

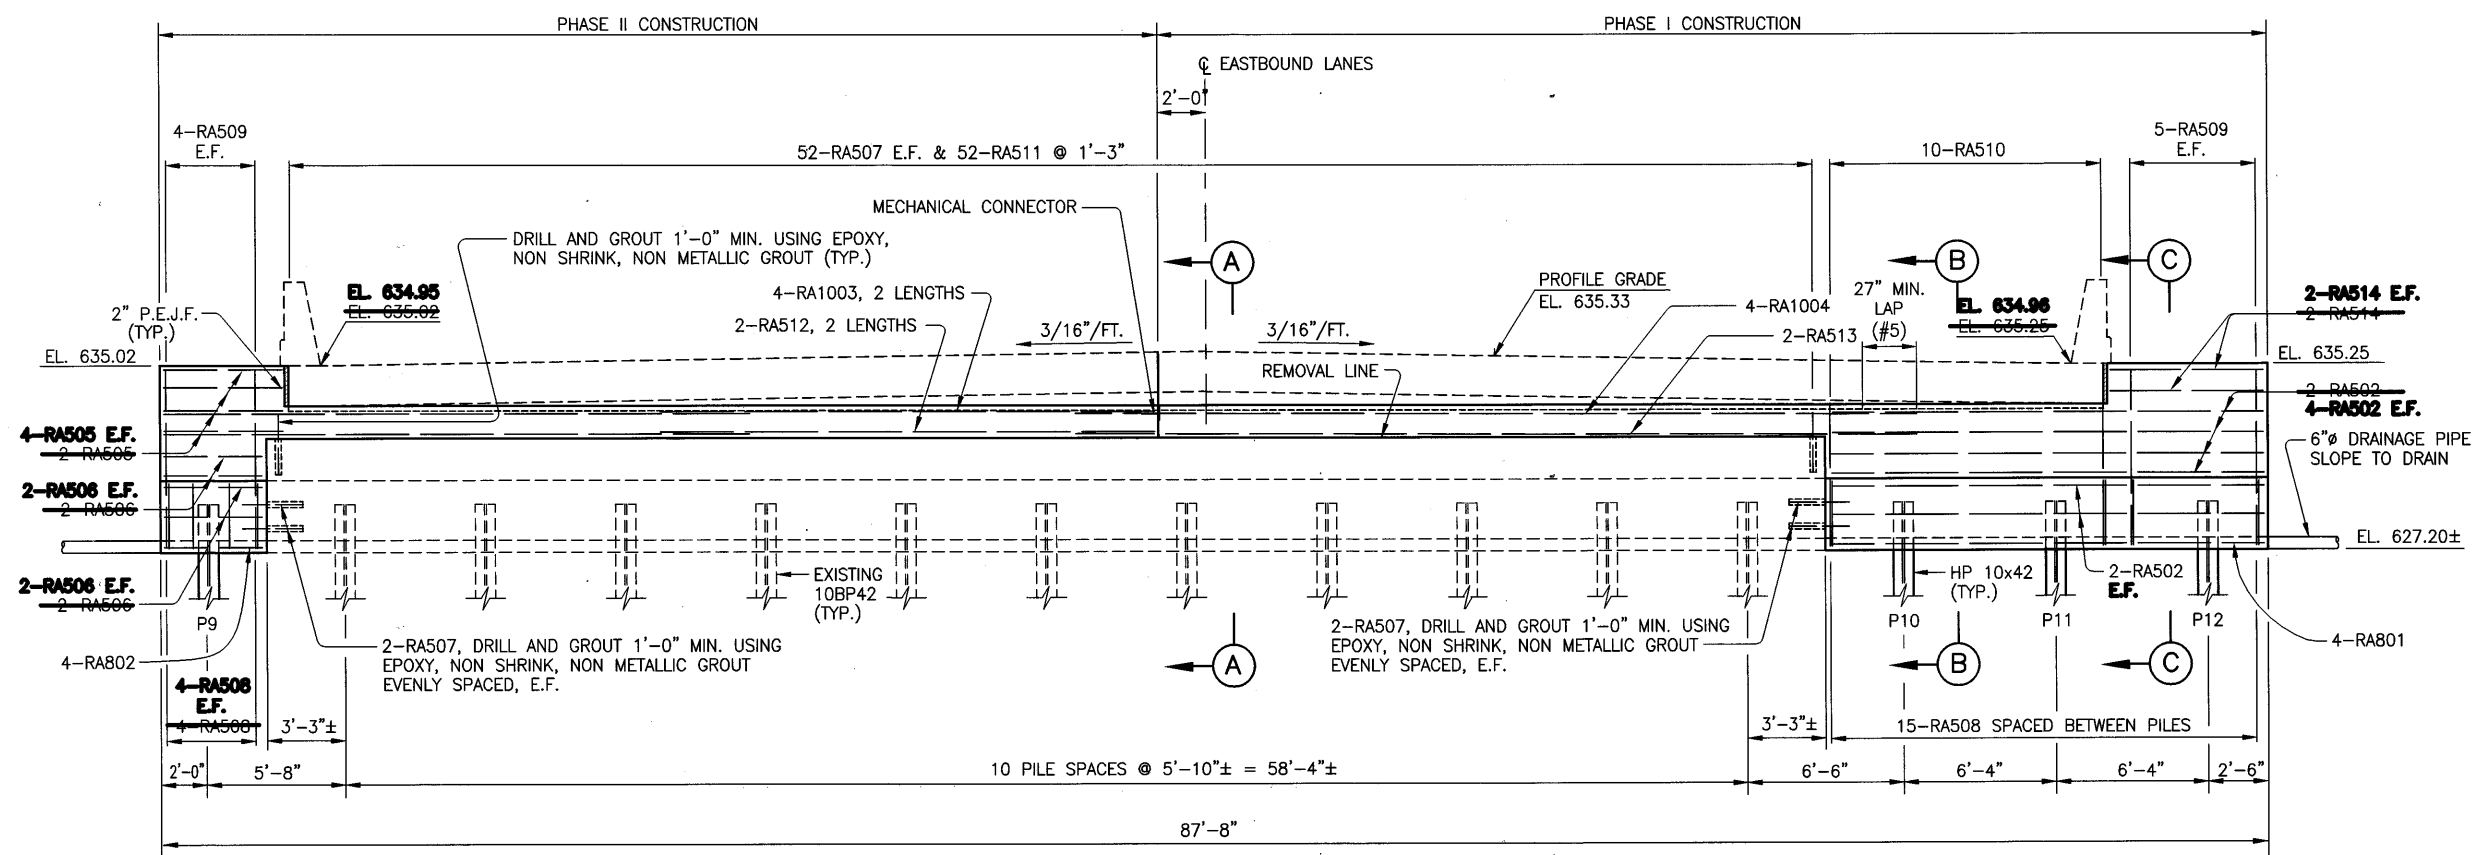

**ELEVATION**

NOTES:  
1.) FOR SECTIONS A-A, B-B AND C-C, SEE SHEET 10/24

O:\93600\BRIDGE\DWGS\LO09ORA2.DWG

DESIGN AGENCY  
**R.R. WARNER**  
A PROFESSIONAL ENGINEERING FIRM  
CONSULTING ENGINEERS  
JOB NUMBER 93600

DATE	4/30/01
REVIEWED	RAK
DRAWN	CAG
DESIGNED	INF
CHECKED	KK
REVISOR	KK
STRUCTURE FILE NUMBER	4794983(R)
REVISED	4794983(R)


**REAR ABUTMENT - RIGHT BRIDGE**  
BRIDGE No. LOR-90-1861 L AND R  
INTERSTATE ROUTE 90 OVER FRENCH CREEK

LOR-90-10.76


10/24

136  
274



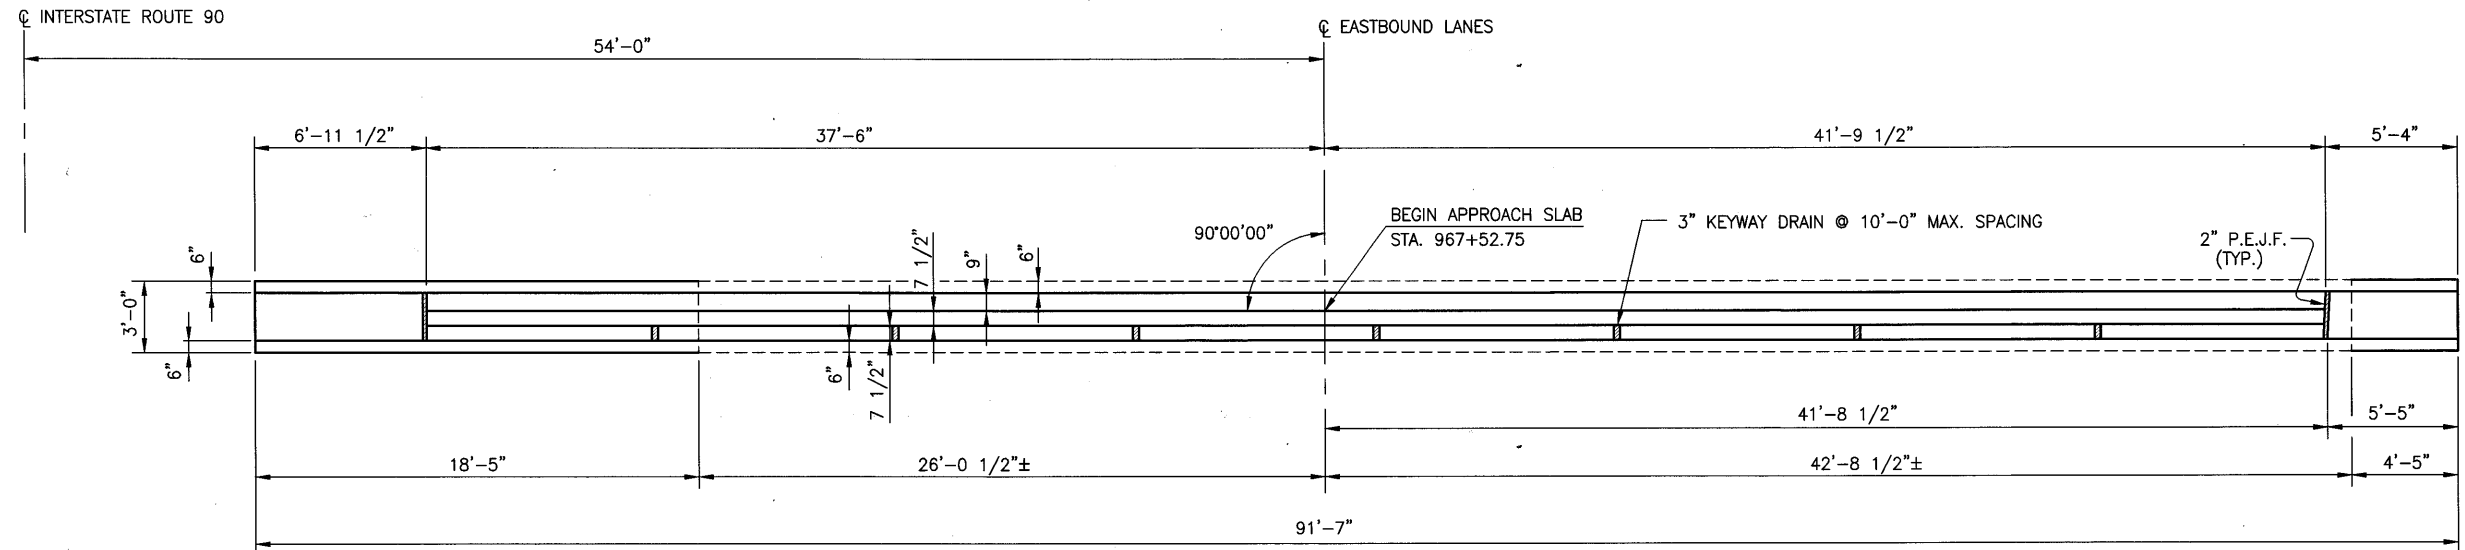


PLAN

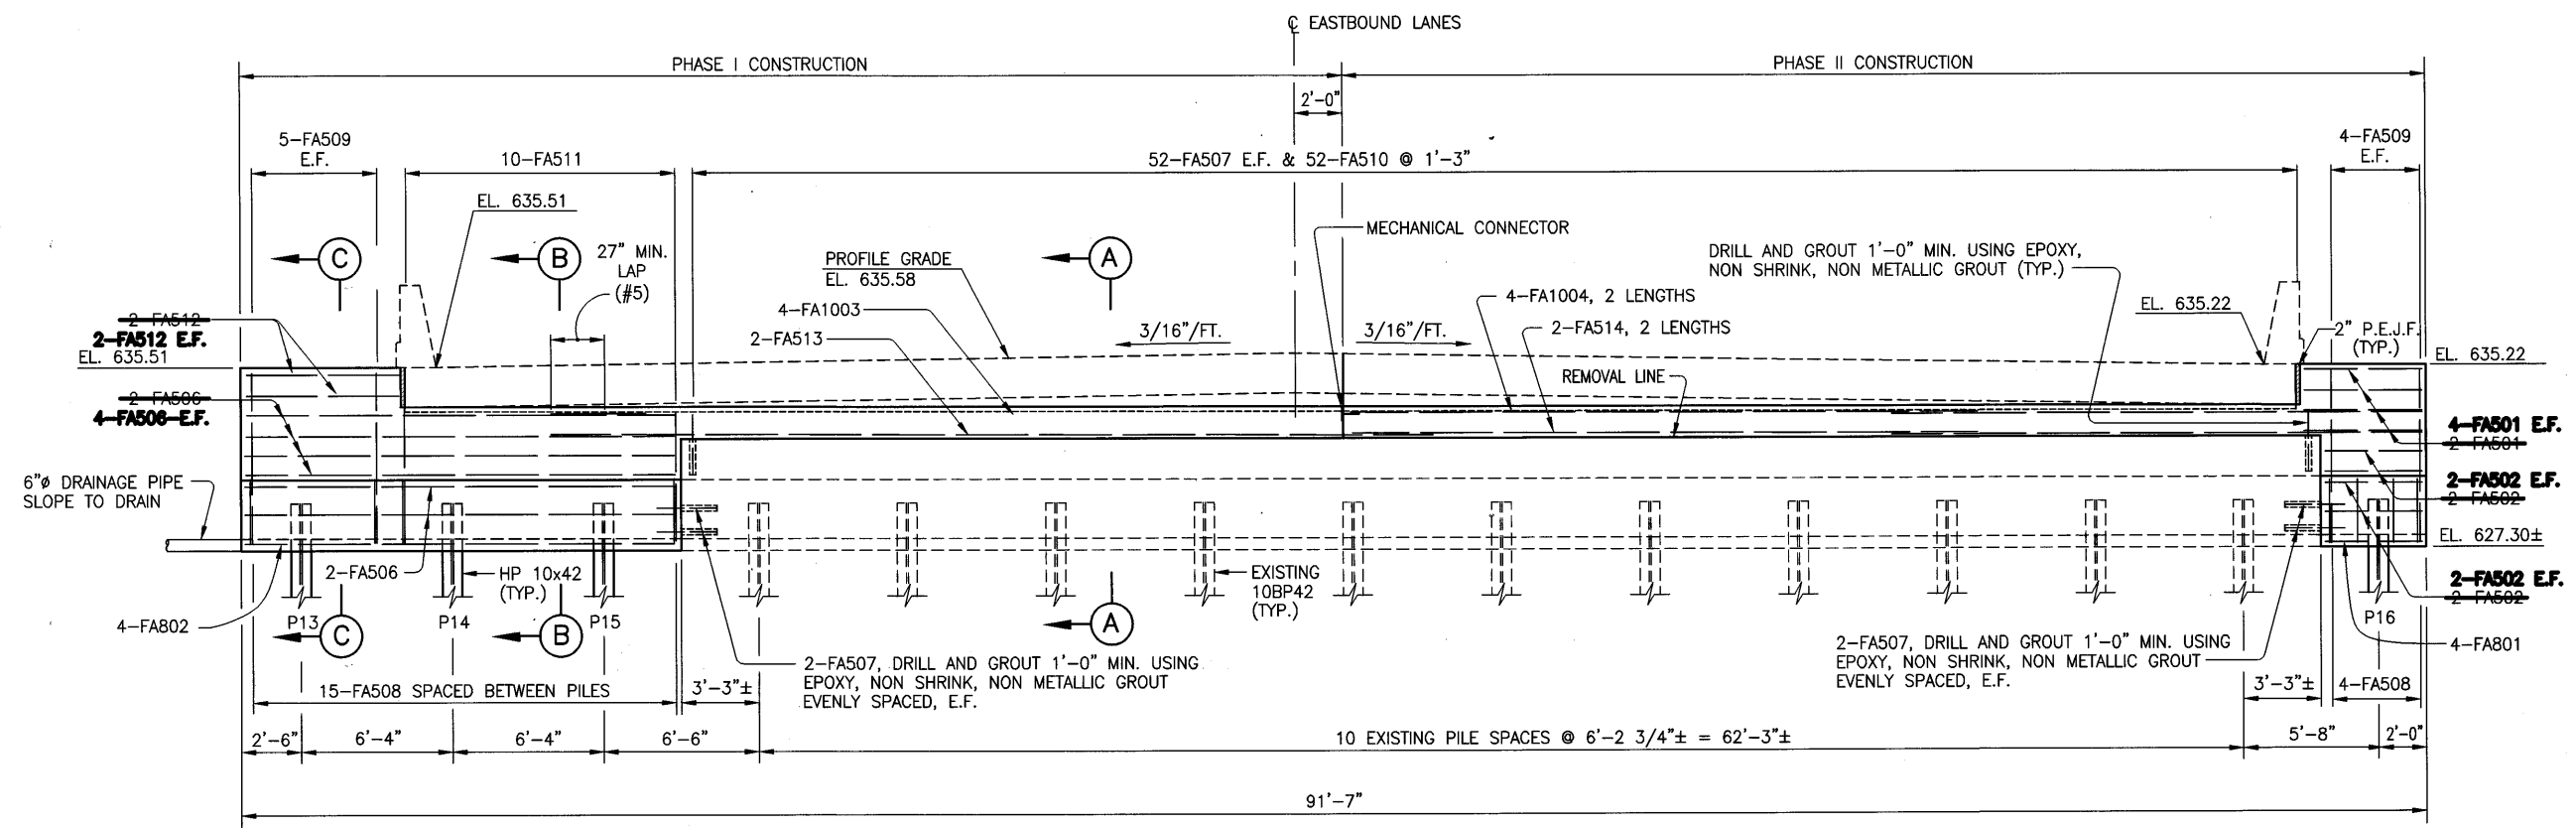


ELEVATION

NOTES:  
 1.) FOR SECTIONS A-A, B-B AND C-C, SEE SHEET 12/24


O:\93600\BRIDGE\DWGS\LO090FA2.DWG

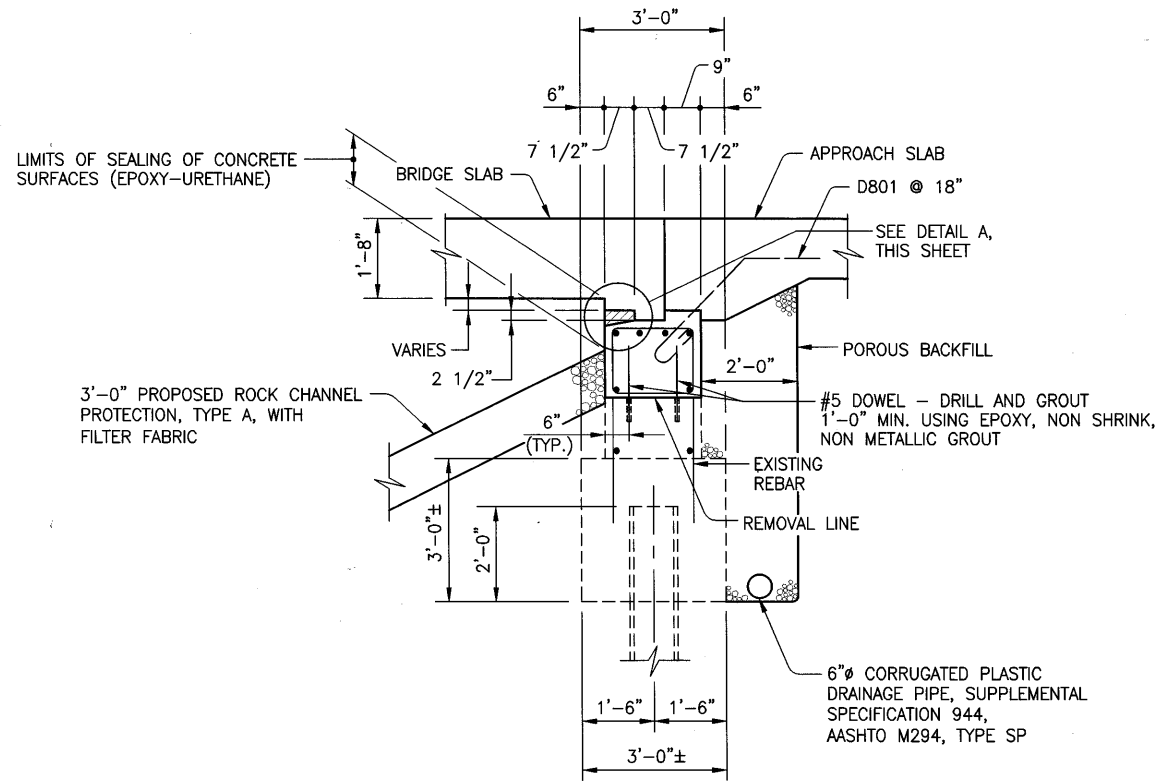


SECTION A-A

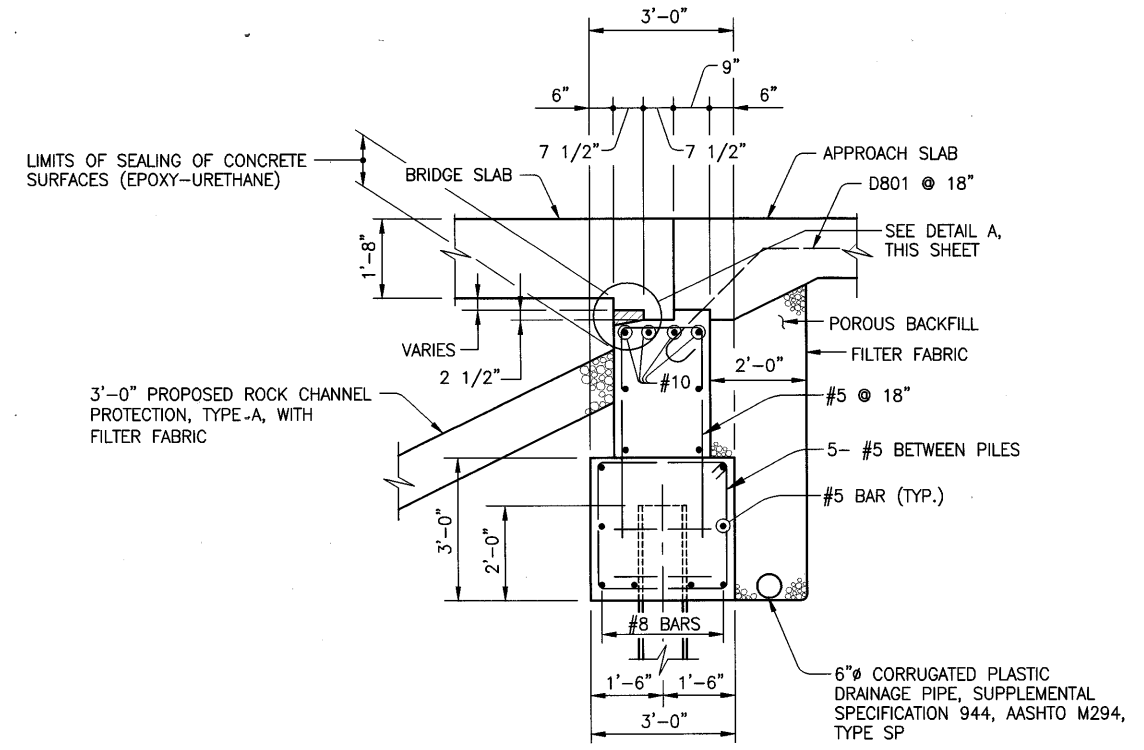

SECTION B-B

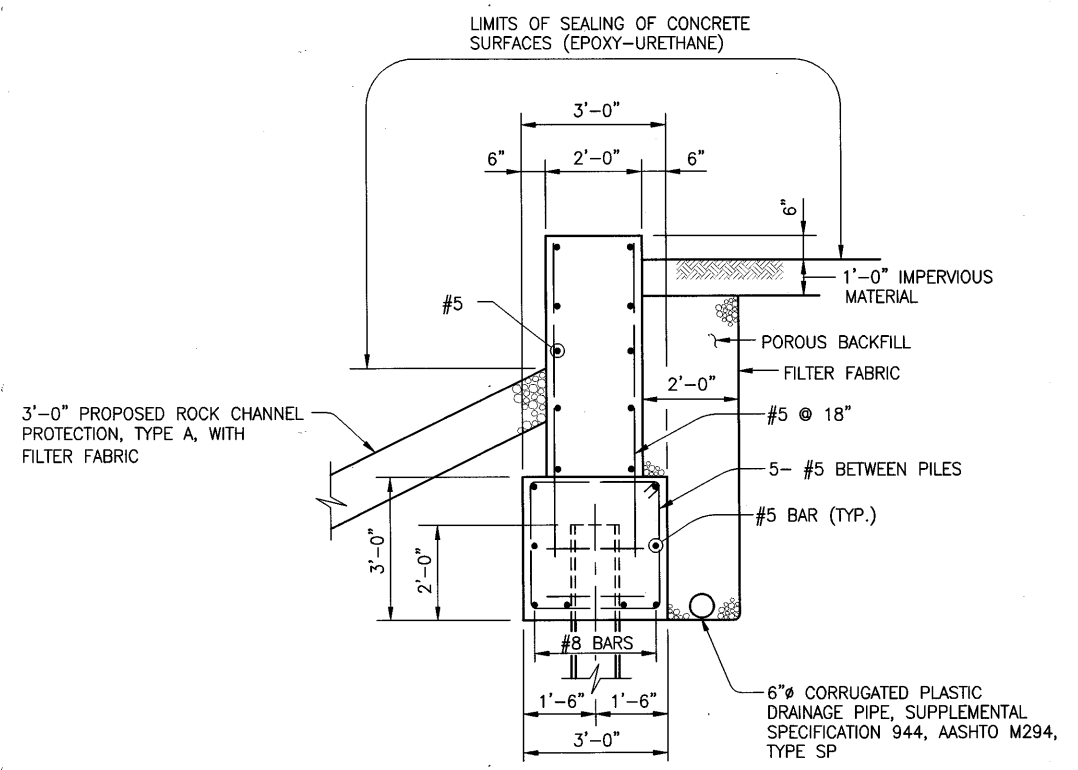

SECTION C-C

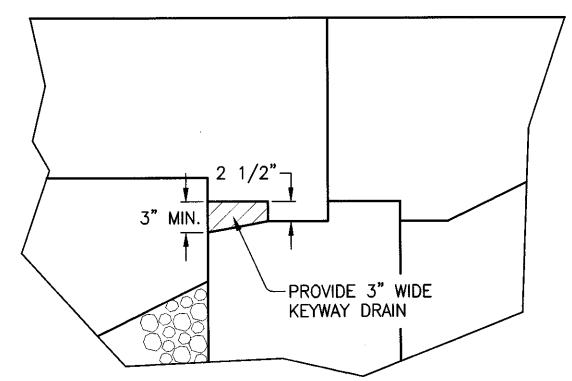

DETAIL A

NOTES:  
1.) SEE GENERAL NOTES, SHEET 2/24 FOR ADDITIONAL INFORMATION.

O:\93600\BRIDGE\LO990MD4.DWG

DESIGN AGENCY  
R.P. WALSH & ASSOCIATES  
CONSULTING ENGINEERS  
JOB NUMBER 93600

DATE 4/30/01  
REVIEWED RAK  
DRAWN CAG  
DESIGNED INF  
CHECKED KK




STRUCTURE FILE NUMBER 4704983(0)

ABUTMENT DETAILS  
BRIDGE No. LOR-90-1861 L AND R  
INTERSTATE ROUTE 90 OVER FRENCH CREEK

LOR-90-10.76

12/24

138  
274

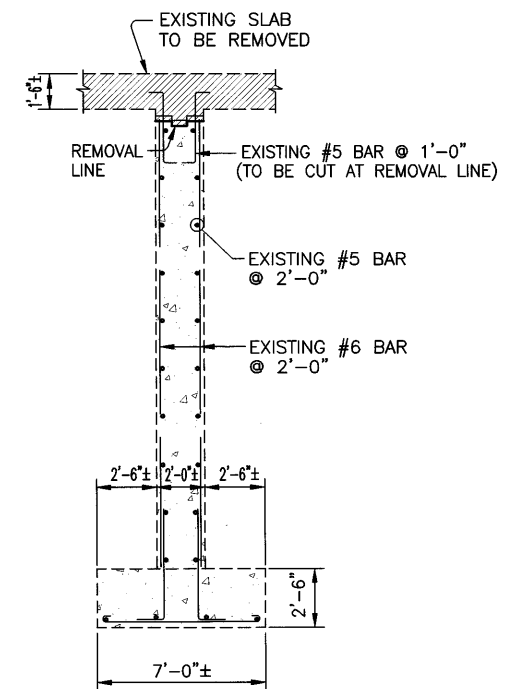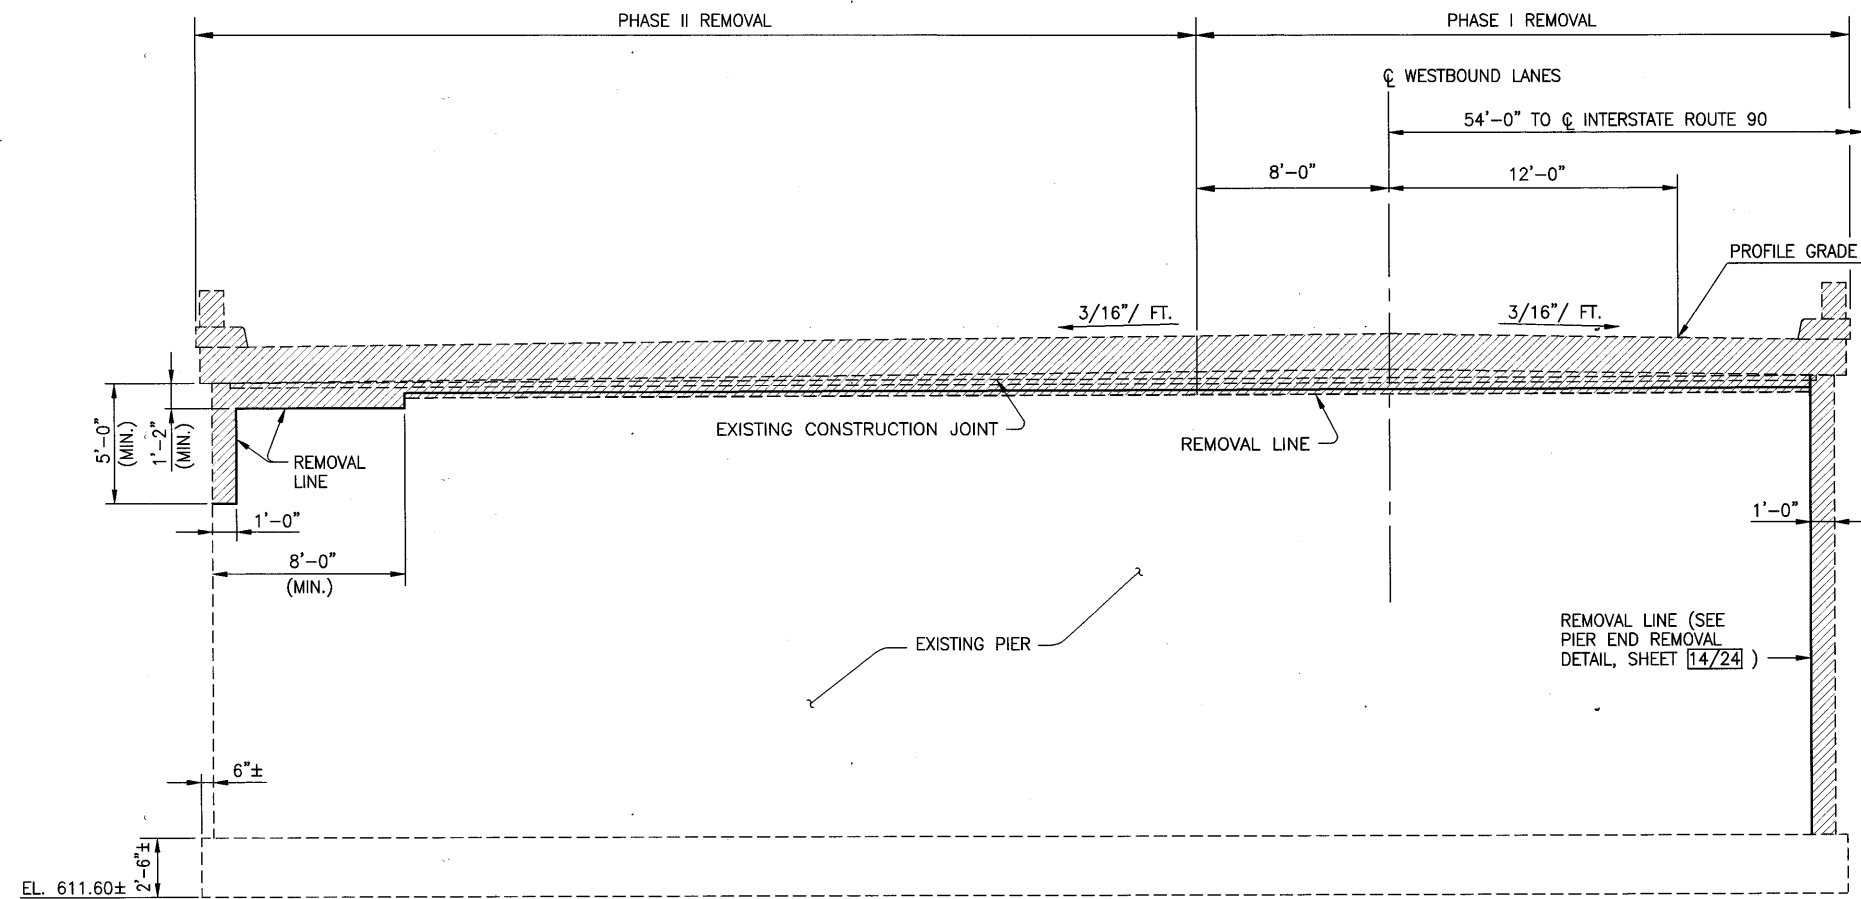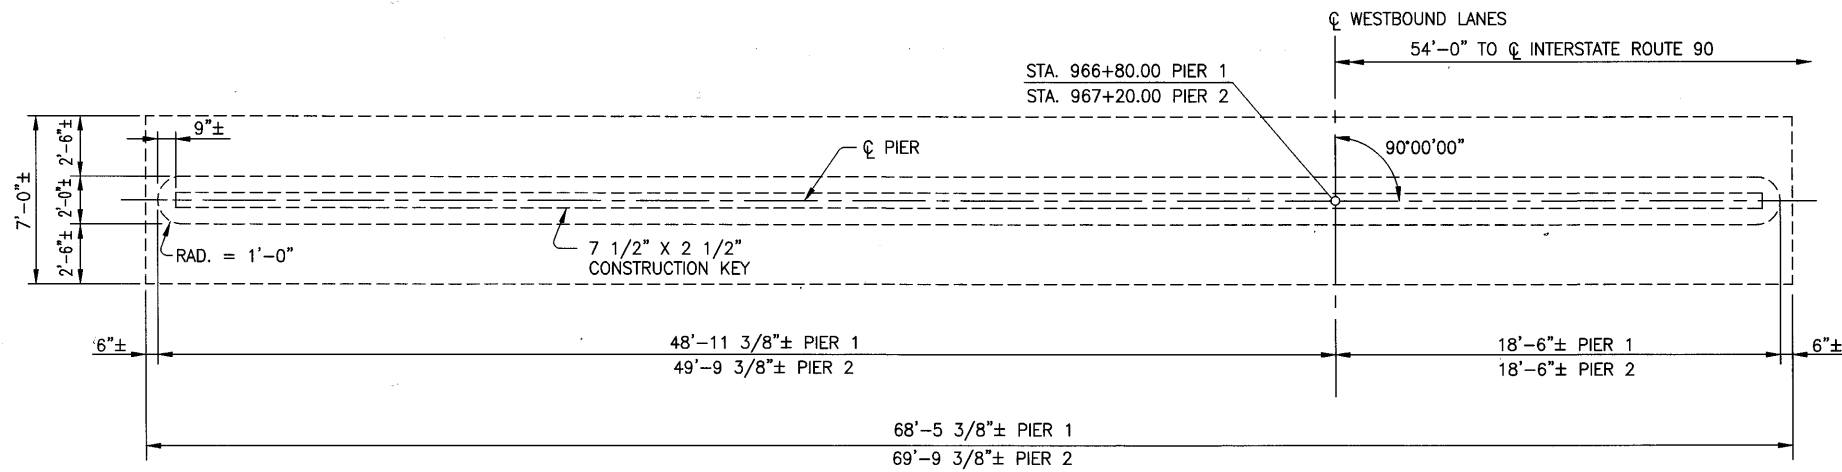

INDICATES REMOVAL

NOTES:  
1.) SEE SHEET 14/24 FOR PIER END REMOVAL DETAIL.

O:\93600\BRIDGE\DWGS\LO090P11.DWG

DESIGN AGENCY  
R.P. WILSON  
CONSULTING ENGINEERS  
JOB NUMBER: 93600


DATE: 4/30/01  
REVIEWED: RAK  
STRUCTURE FILE NUMBER: 4704959(L) 4704983(R)  
DRAWN: CAG  
CHECKED: KK

PIER REMOVAL DETAILS - LEFT BRIDGE  
BRIDGE No. LOR-90-1861 L AND R  
INTERSTATE ROUTE 90 OVER FRENCH CREEK


LOR-90-10.76

13/24



139  
274

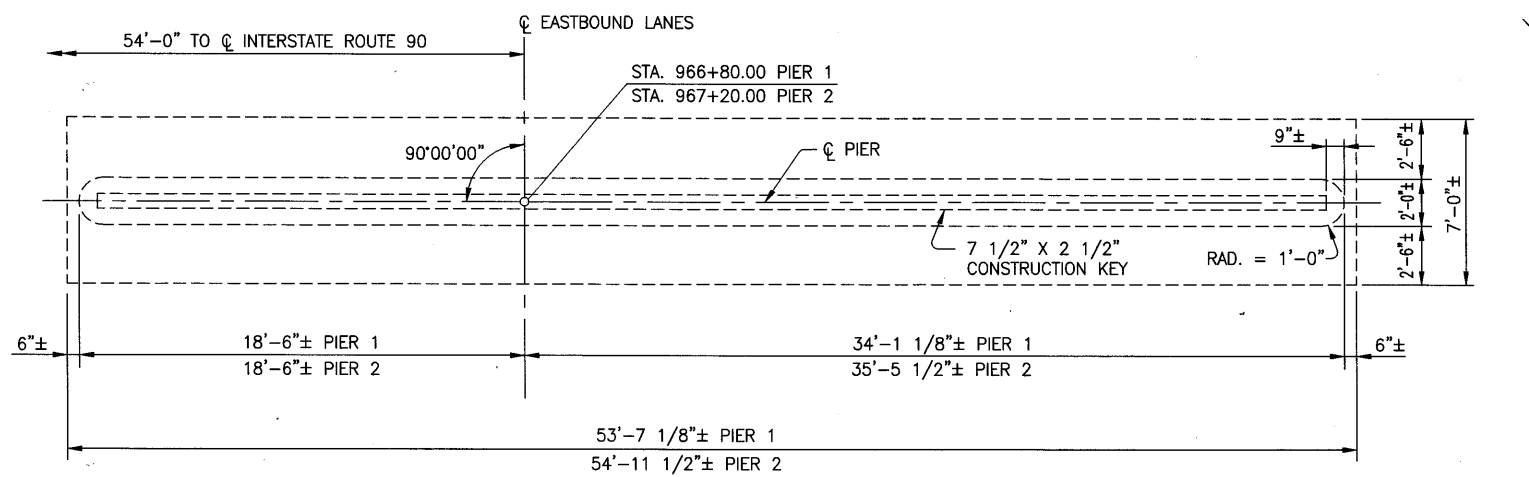


**PLAN**

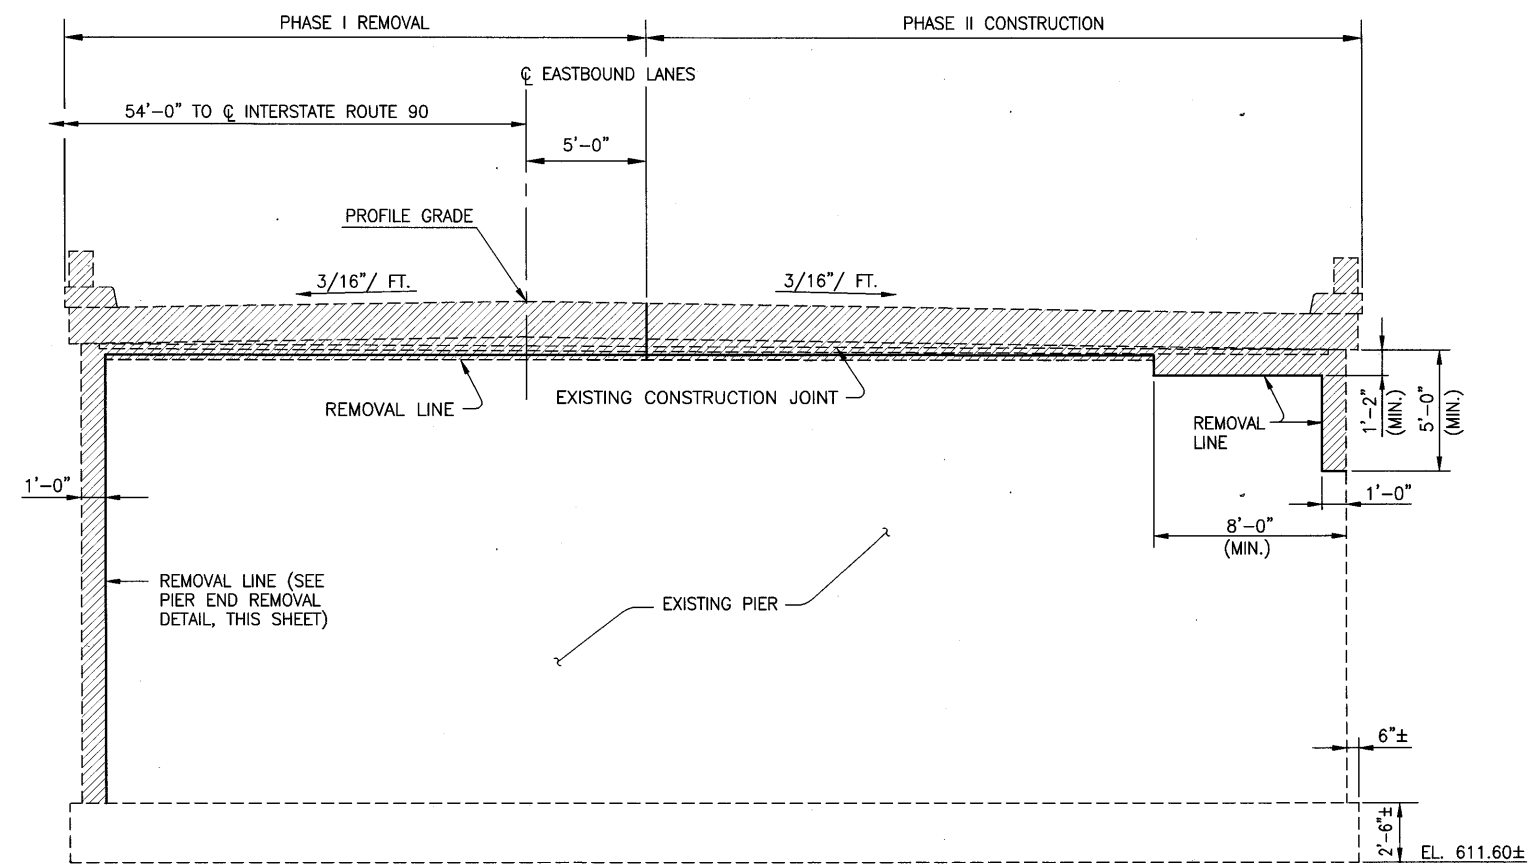

**ELEVATION**

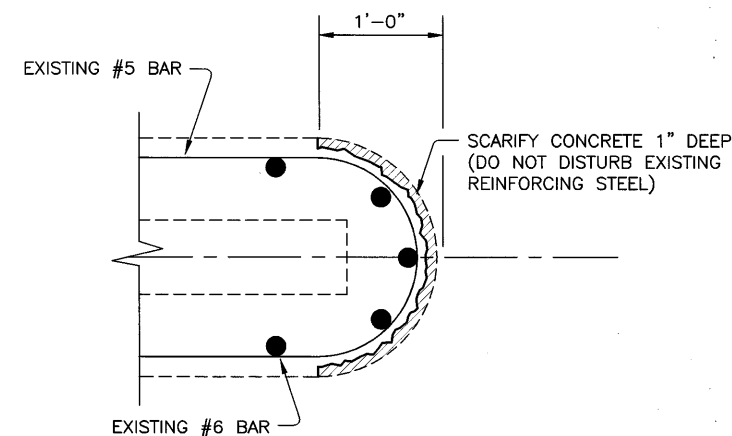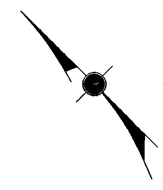

**PIER END REMOVAL DETAIL**

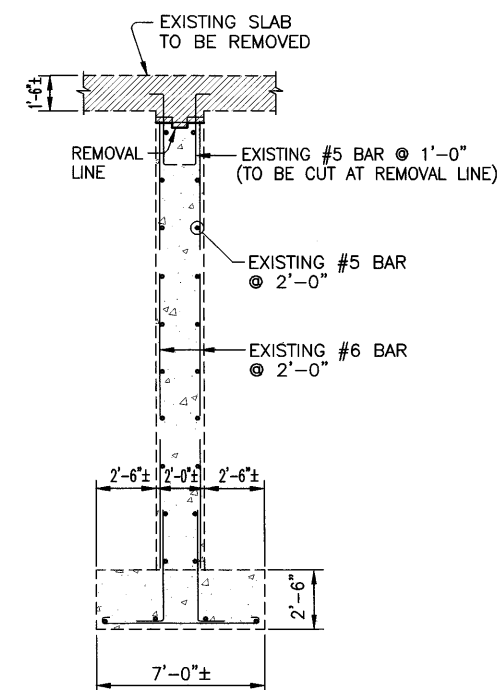


**TYPICAL PIER SECTION**


- INDICATES REMOVAL

O:\93600\BRIDGE\DWGS\LO090P12.DWG

<b>PIER REMOVAL DETAILS - RIGHT BRIDGE</b> BRIDGE No. LOR-90-1861 L AND R INTERSTATE ROUTE 90 OVER FRENCH CREEK	
<b>LOR-90-10.76</b>	DESIGN AGENCY <b>RHW</b> R. H. WILSON CONSULTING ENGINEERS JOB NUMBER 93600
DESIGNED NFF	DATE 4/30/01
CHECKED KK	REVIEWED RAK
DRAWN CAG	STRUCTURE FILE NUMBER 4704983(R)
REVISED	JOB NUMBER 93600

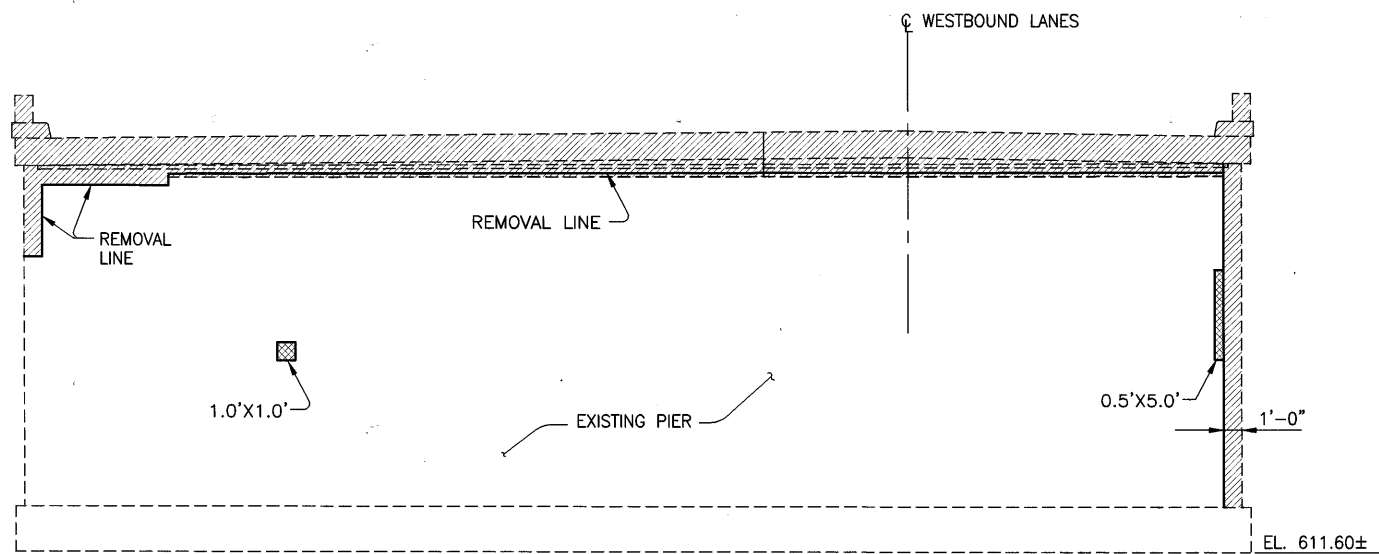


PIER 2-LEFT BRIDGE  
(REAR FACE)

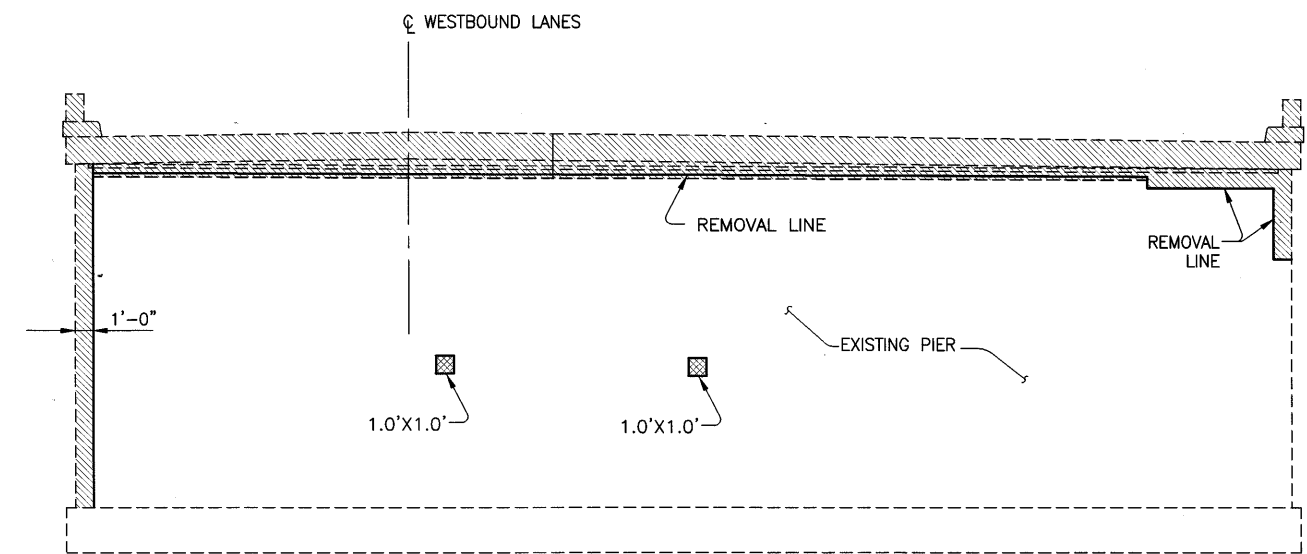


PIER 2-LEFT BRIDGE  
(FORWARD FACE)

SUMMARY OF PIERS REPAIR QUANTITIES - (SQUARE FEET)			
LEFT BRIDGE		RIGHT BRIDGE	
PIER 1	PIER 2	PIER 1	PIER 2
0.0	5.5	5.0	0.0

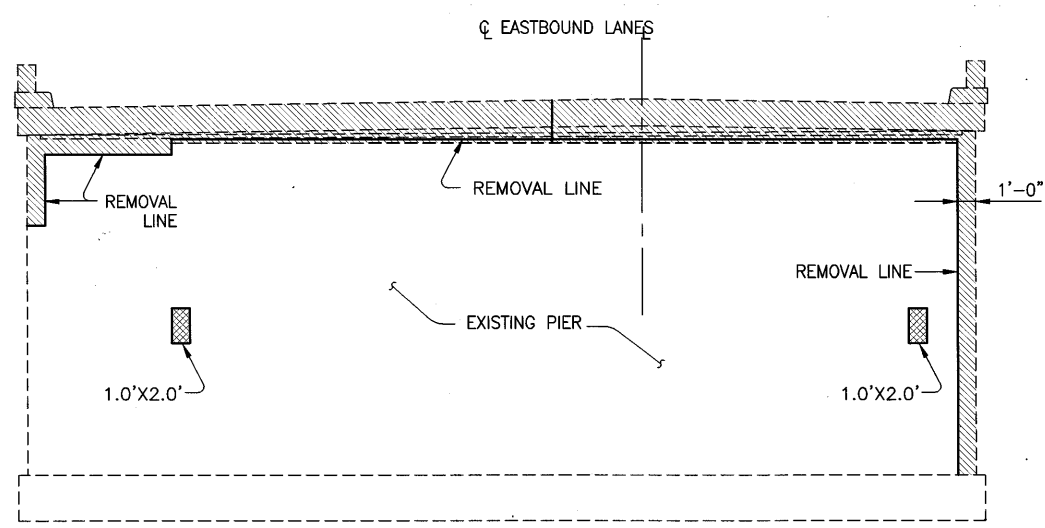

PIER 1-RIGHT BRIDGE  
(REAR FACE)

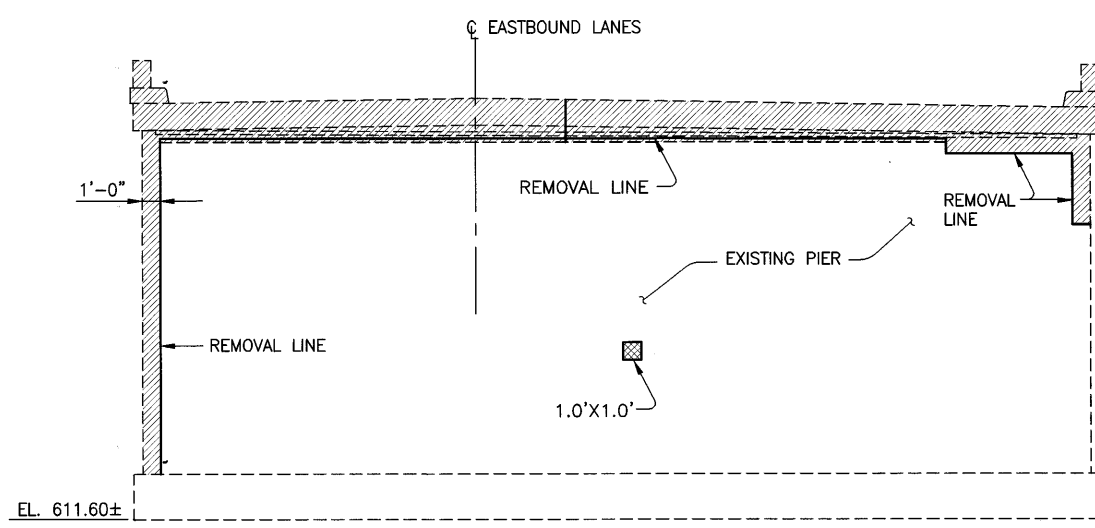

PIER 1-RIGHT BRIDGE  
(FORWARD FACE)

- INDICATES REMOVAL
- ITEM 843- PATCHING CONCRETE STRUCTURES WITH TROWELABLE MORTAR

C:\93600\BRIDGE\DWGS\LO090P13.DWG

DESIGN AGENCY  
R.W. MANIATY  
CONSULTING ENGINEERS  
JOB NUMBER 93600

DATE 4/30/01  
REVIEWED RAK  
DRAWN CAG  
DESIGNED INF  
CHECKED KK


STRUCTURE FILE NUMBER 4704958(L)  
4704983(R)

PIER PATCHING DETAILS  
BRIDGE No. LOR-90-1861 L AND R  
INTERSTATE ROUTE 90 OVER FRENCH CREEK


LOR-90-10.76

15/24  
141/274


O:\93600\BRIDGE\DWGS\LO090P14.DWG

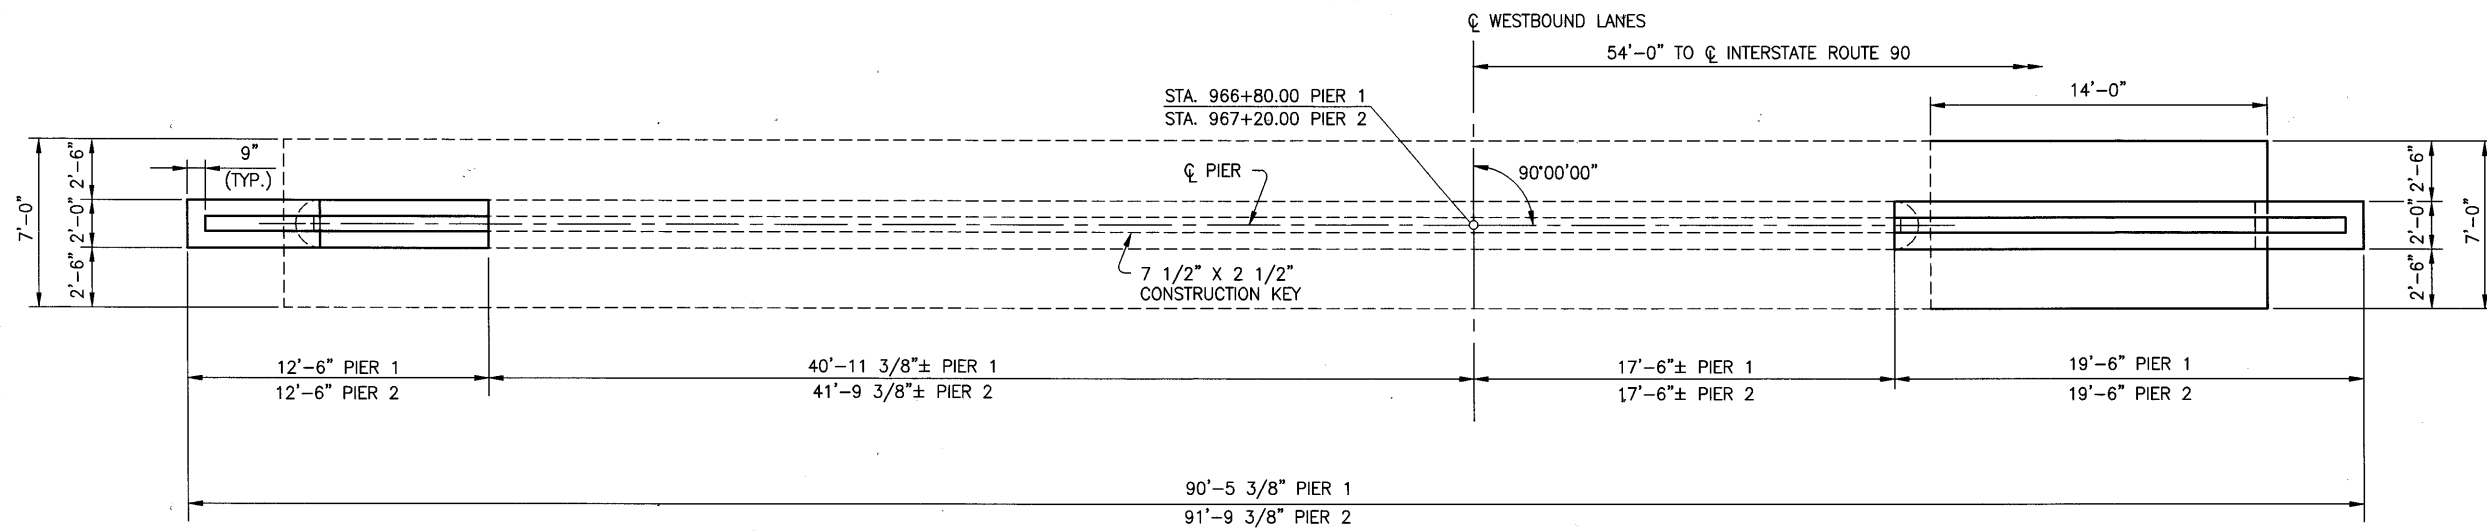

**PLAN**

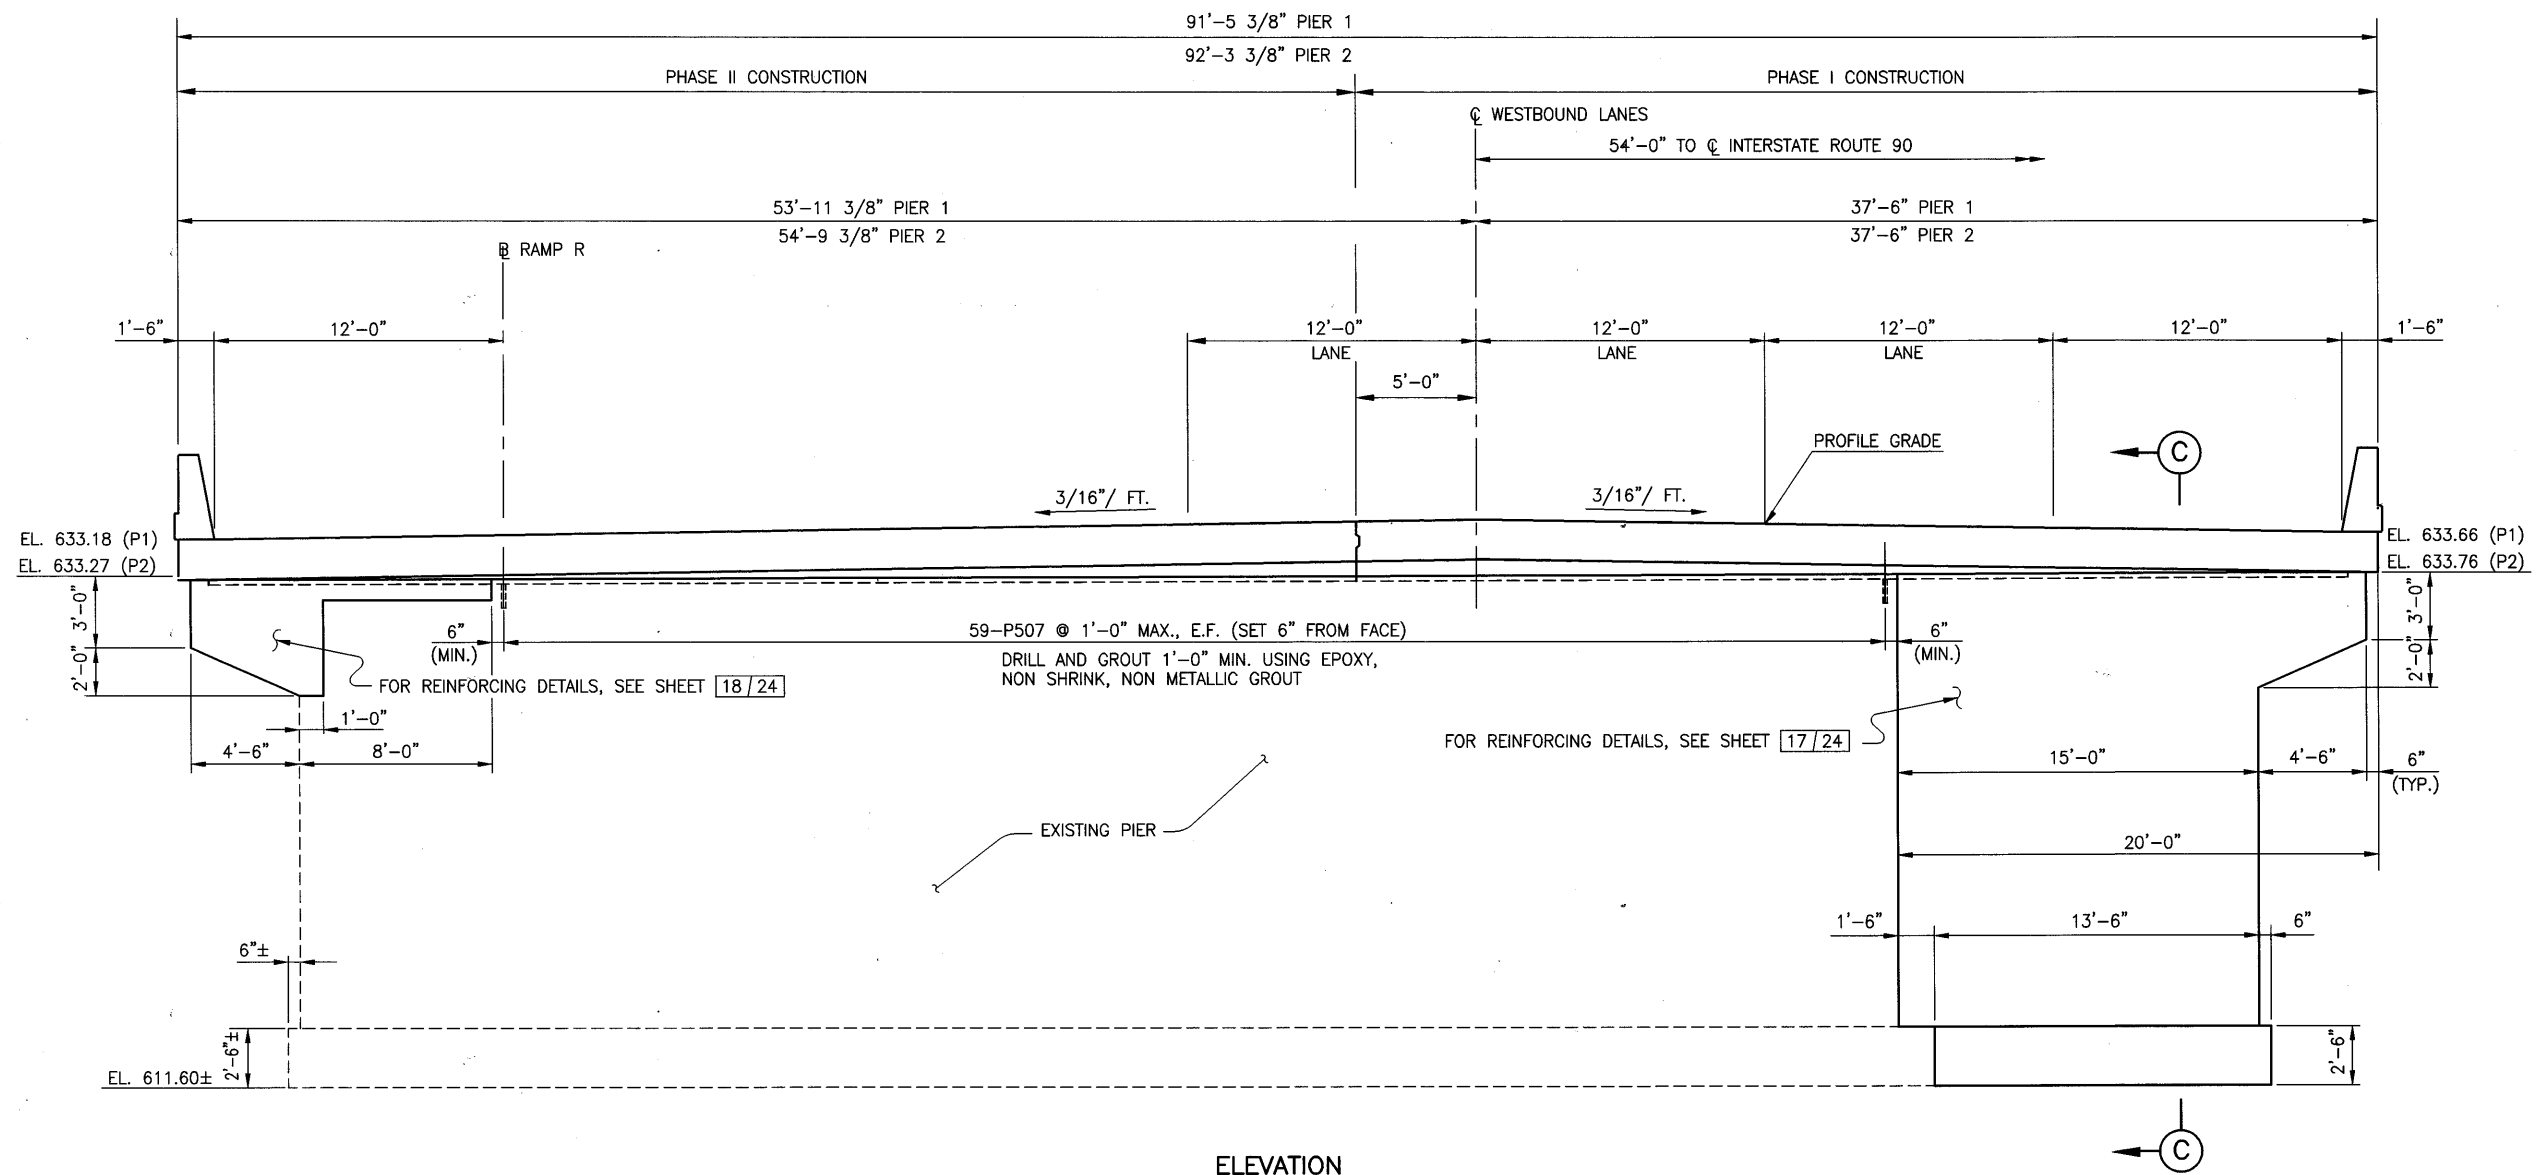

**ELEVATION**

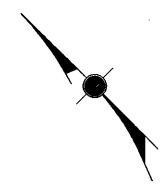

DESIGN AGENCY  
**REIN** R.E. MAINOR & ASSOCIATES, INC.  
 CONSULTING ENGINEERS  
 2000 W. 12TH AVE., SUITE 300  
 WESTLAKE, OHIO 44145  
 TELEPHONE (440) 835-9400  
 FAX (440) 835-9400  
 JOB NUMBER 93600

DESIGNED	DATE
NFF	4/30/01
CHECKED	STRUCTURE FILE NUMBER
KK	4704983 (R)
DRAWN	REVIEWED
CAG	RAK
REVISED	STATION
	4704983(L) 4704983 (R)



**PIER DETAILS - LEFT BRIDGE**  
 BRIDGE No. LOR-90-1861 L AND R  
 INTERSTATE ROUTE 90 OVER FRENCH CREEK

LOR-90-10.76

16 / 24


142  
274

NOTES:  
 1.) FOR SECTION C-C, SEE SHEET 18/24

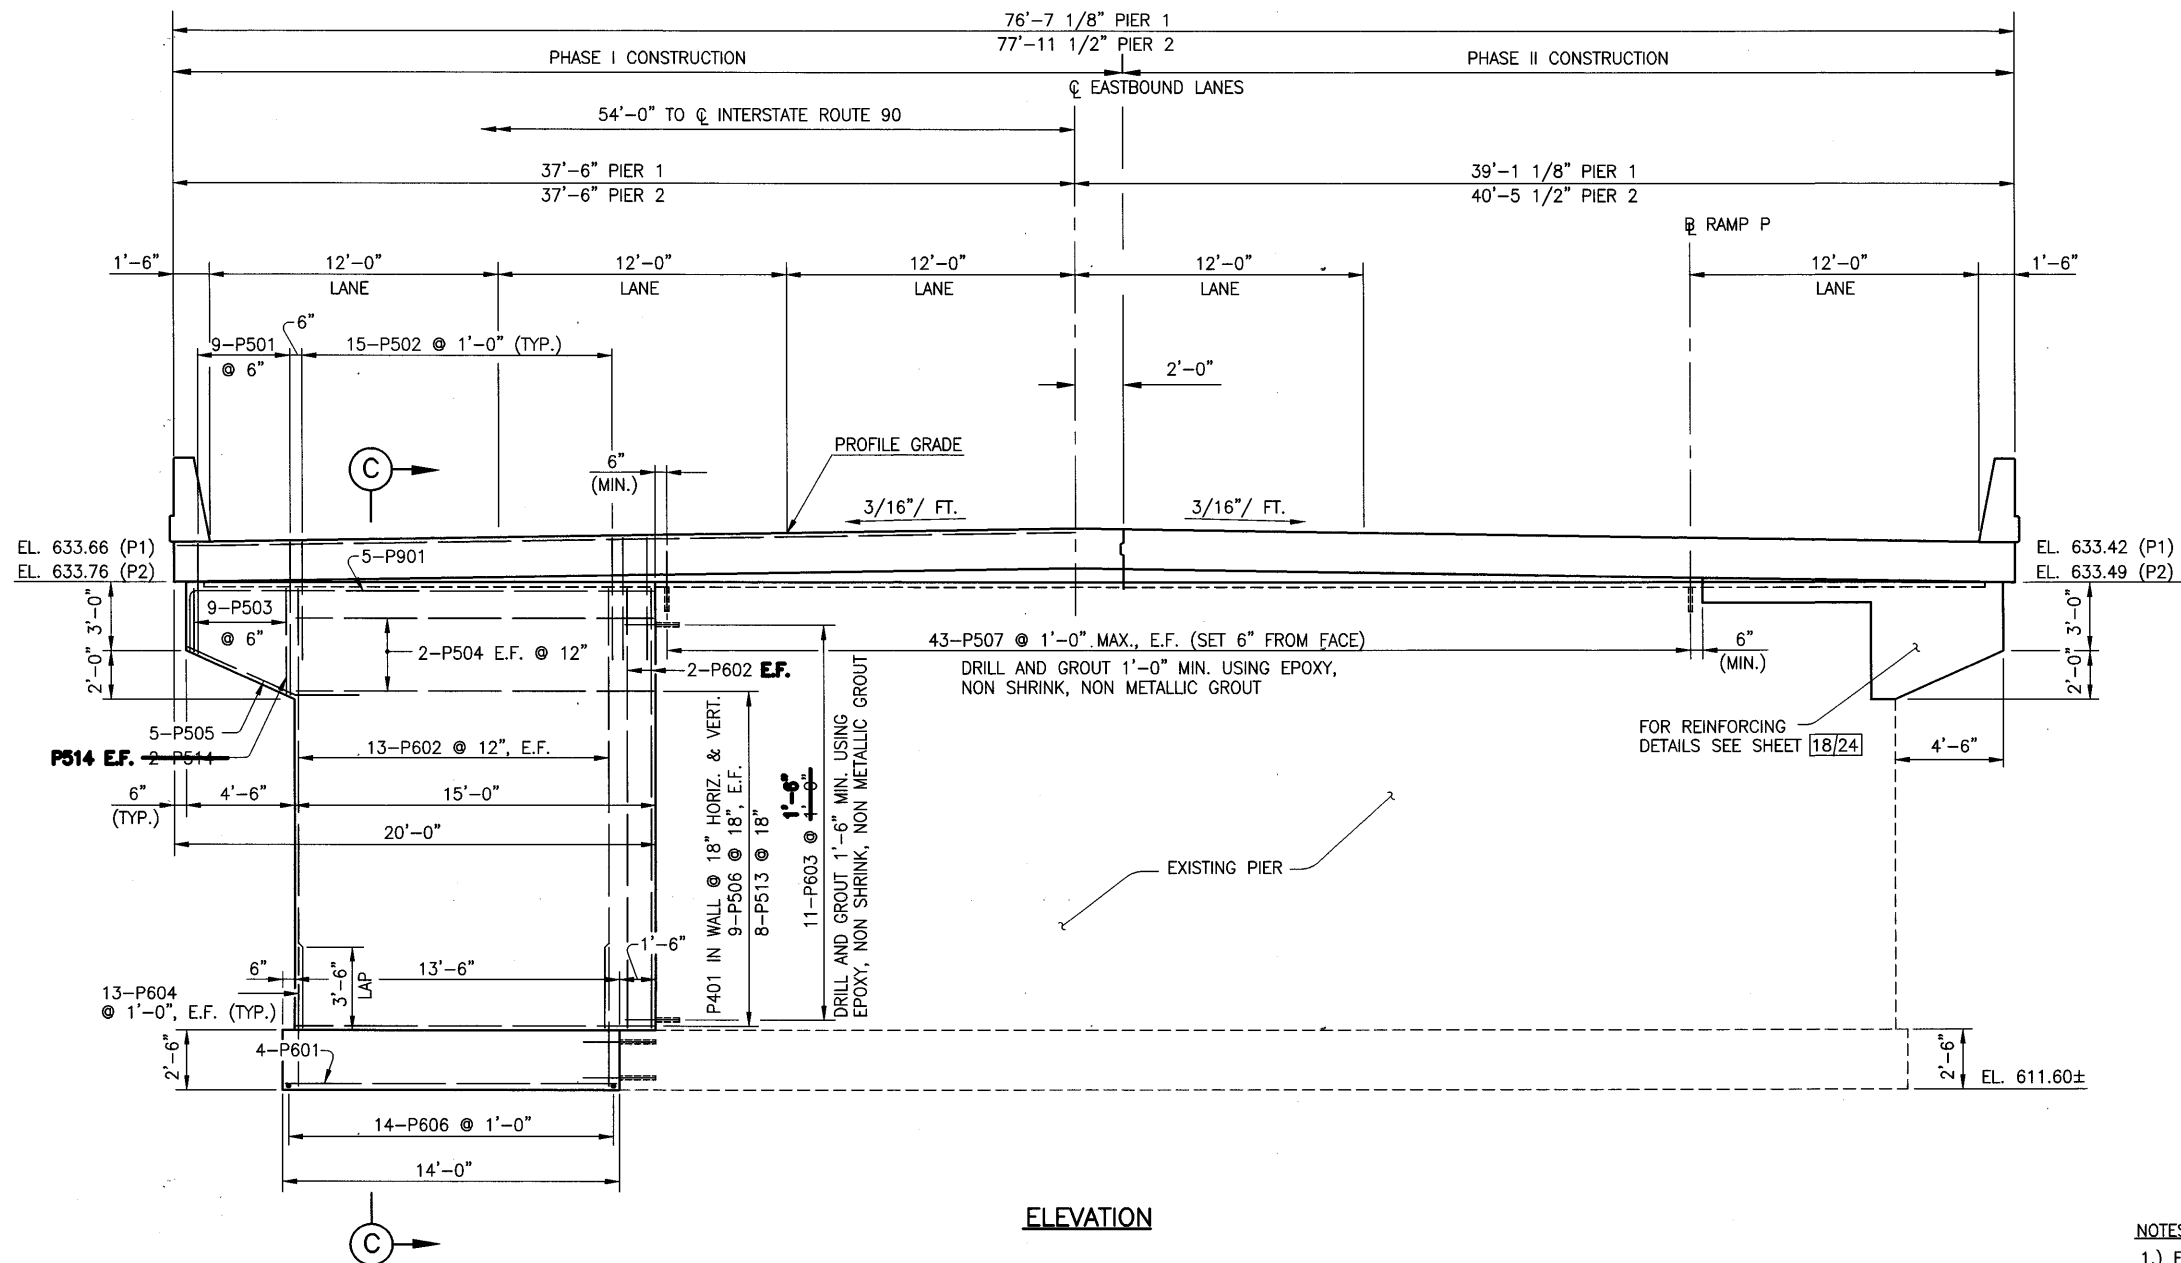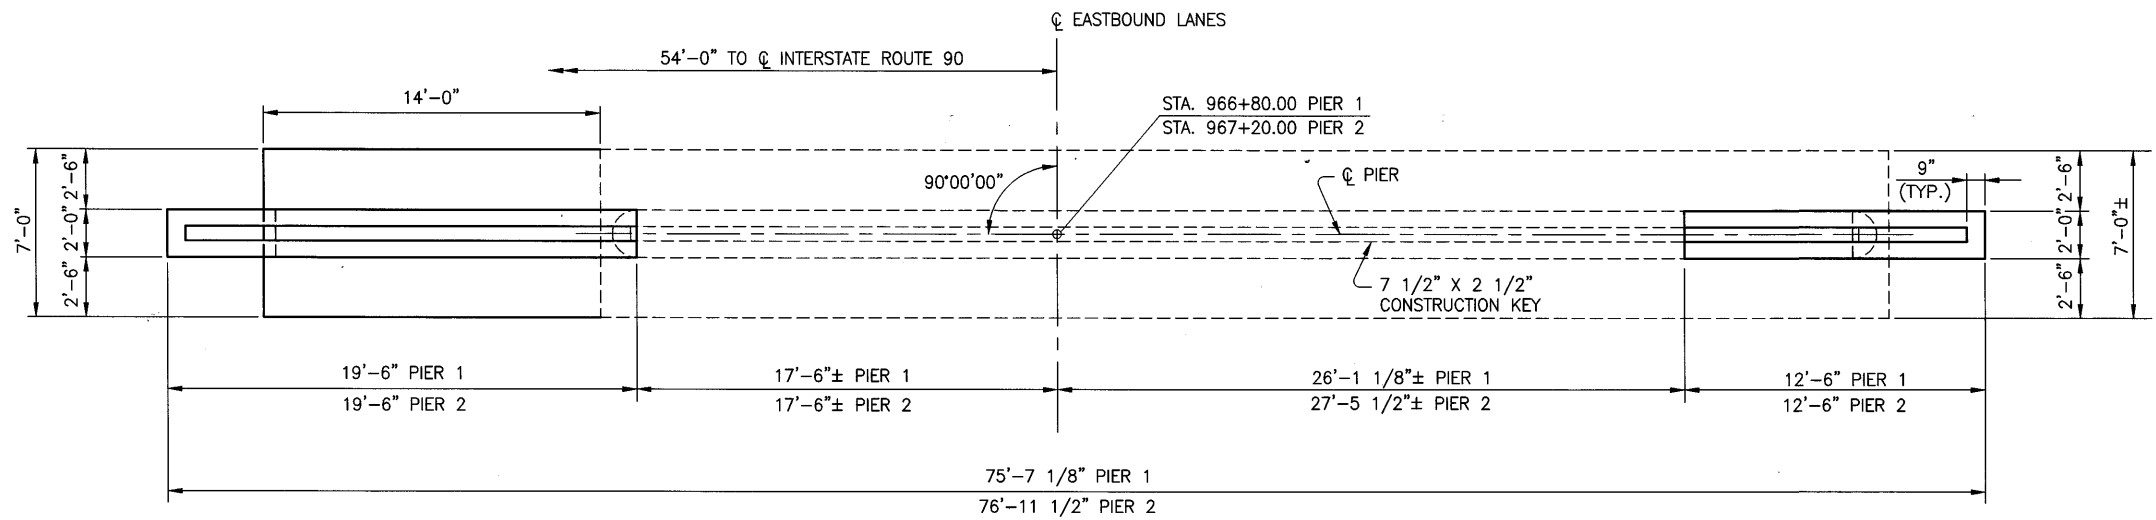


NOTES:  
1.) FOR SECTION C-C, SEE SHEET 18/24


DESIGNED NFF		DATE 4/30/01	DESIGN AGENCY R.P. WARD THREE HING JAMES PARK, SUITE 300 2400 CENTER ROAD CONROE, TEXAS 77447 TELEPHONE (409) 832-2400 JOB NUMBER 93000
CHECKED KK		STRUCTURE FILE NUMBER 4704959(L) 4704953(R)	
DRAWN CAG		REVIEWED RAK	
REVISIONS KK			
<b>PIER DETAILS - RIGHT BRIDGE</b>			
BRIDGE No. LOR-90-1861 L AND R INTERSTATE ROUTE 90 OVER FRENCH CREEK			
LOR-90-10.76		17/24	
		143 274	

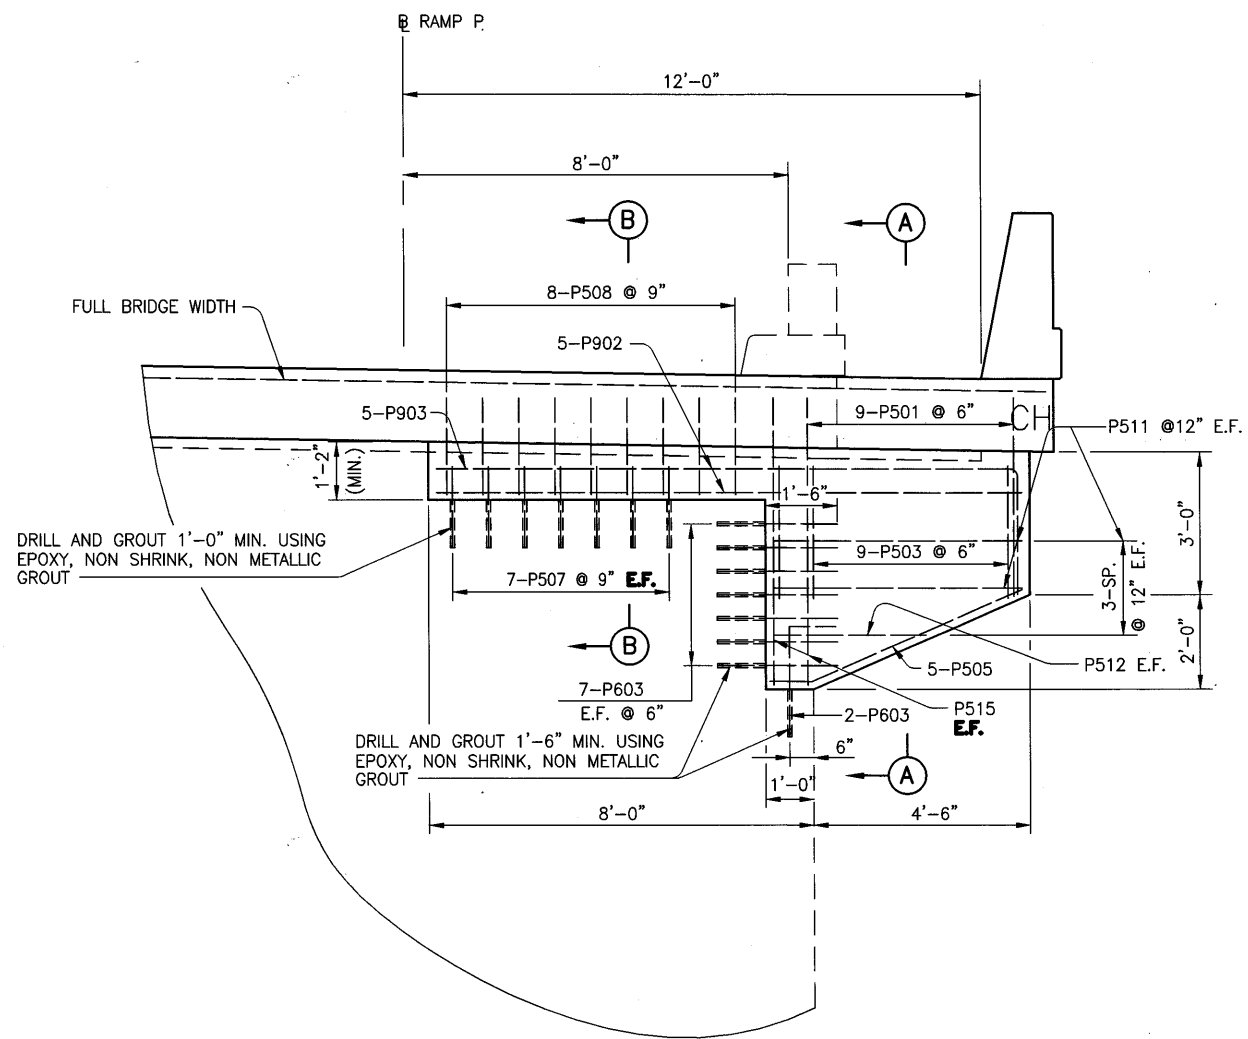


**PART ELEVATION**  
(RIGHT BRIDGE SHOWN, LEFT BRIDGE OPPOSITE HAND)

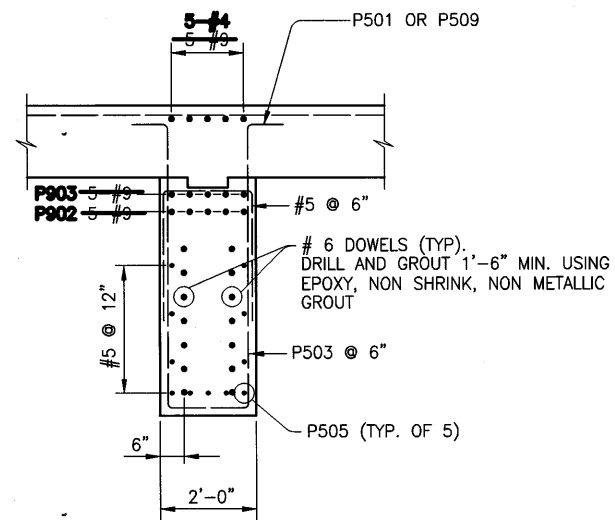

**SECTION A-A**  
(SLAB REINFORCING NOT SHOWN)

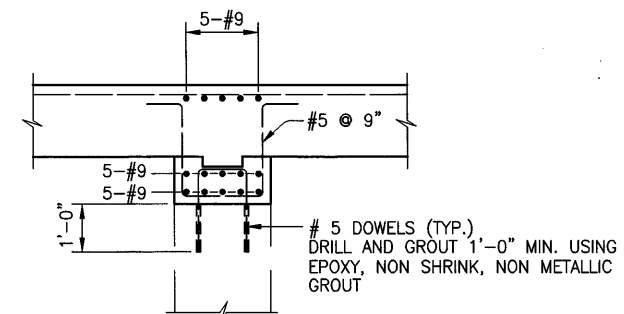

**SECTION B-B**  
(SLAB REINFORCING NOT SHOWN)

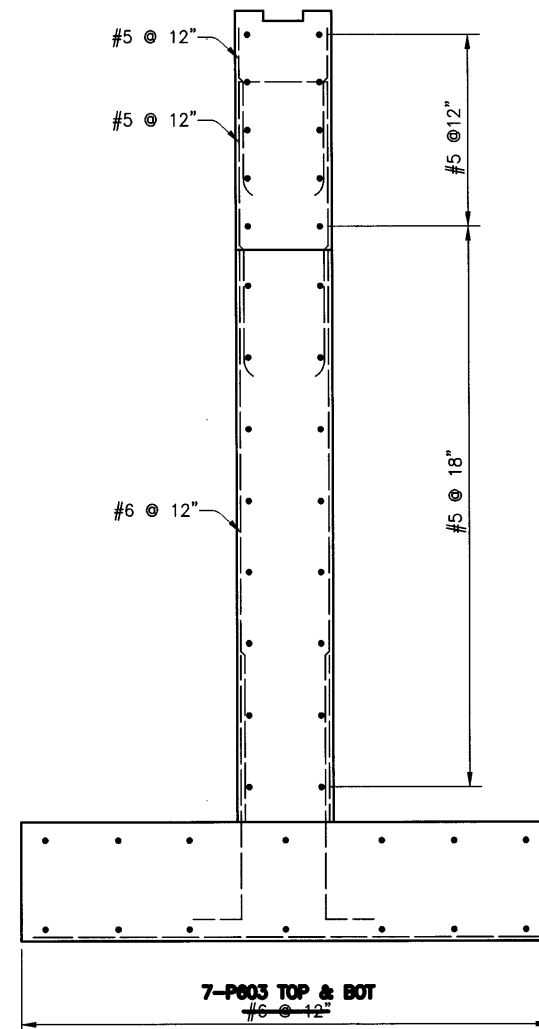


**SECTION C-C**  
(SLAB REINFORCING NOT SHOWN)


DESIGN AGENCY <b>RAW</b> R. W. WARD ASSOCIATES, INC. CONSULTING ENGINEERS JOB NUMBER 93600	DATE 4/30/01	REVIEWED BAK	LORAIN COUNTY STA. 966+47.25 STA. 967+52.75	PIER EXTENSION DETAILS BRIDGE No. LOR-90-1861 L AND R INTERSTATE ROUTE 90 OVER FRENCH CREEK	LOR-90-10.76
	STRUCTURE FILE NUMBER 4704983(R)	DRAWN CAG REVISION KK	CHECKED KK		
144 274					




C:\93600\BRIDGE\DWGS\LO090TS1.DWG

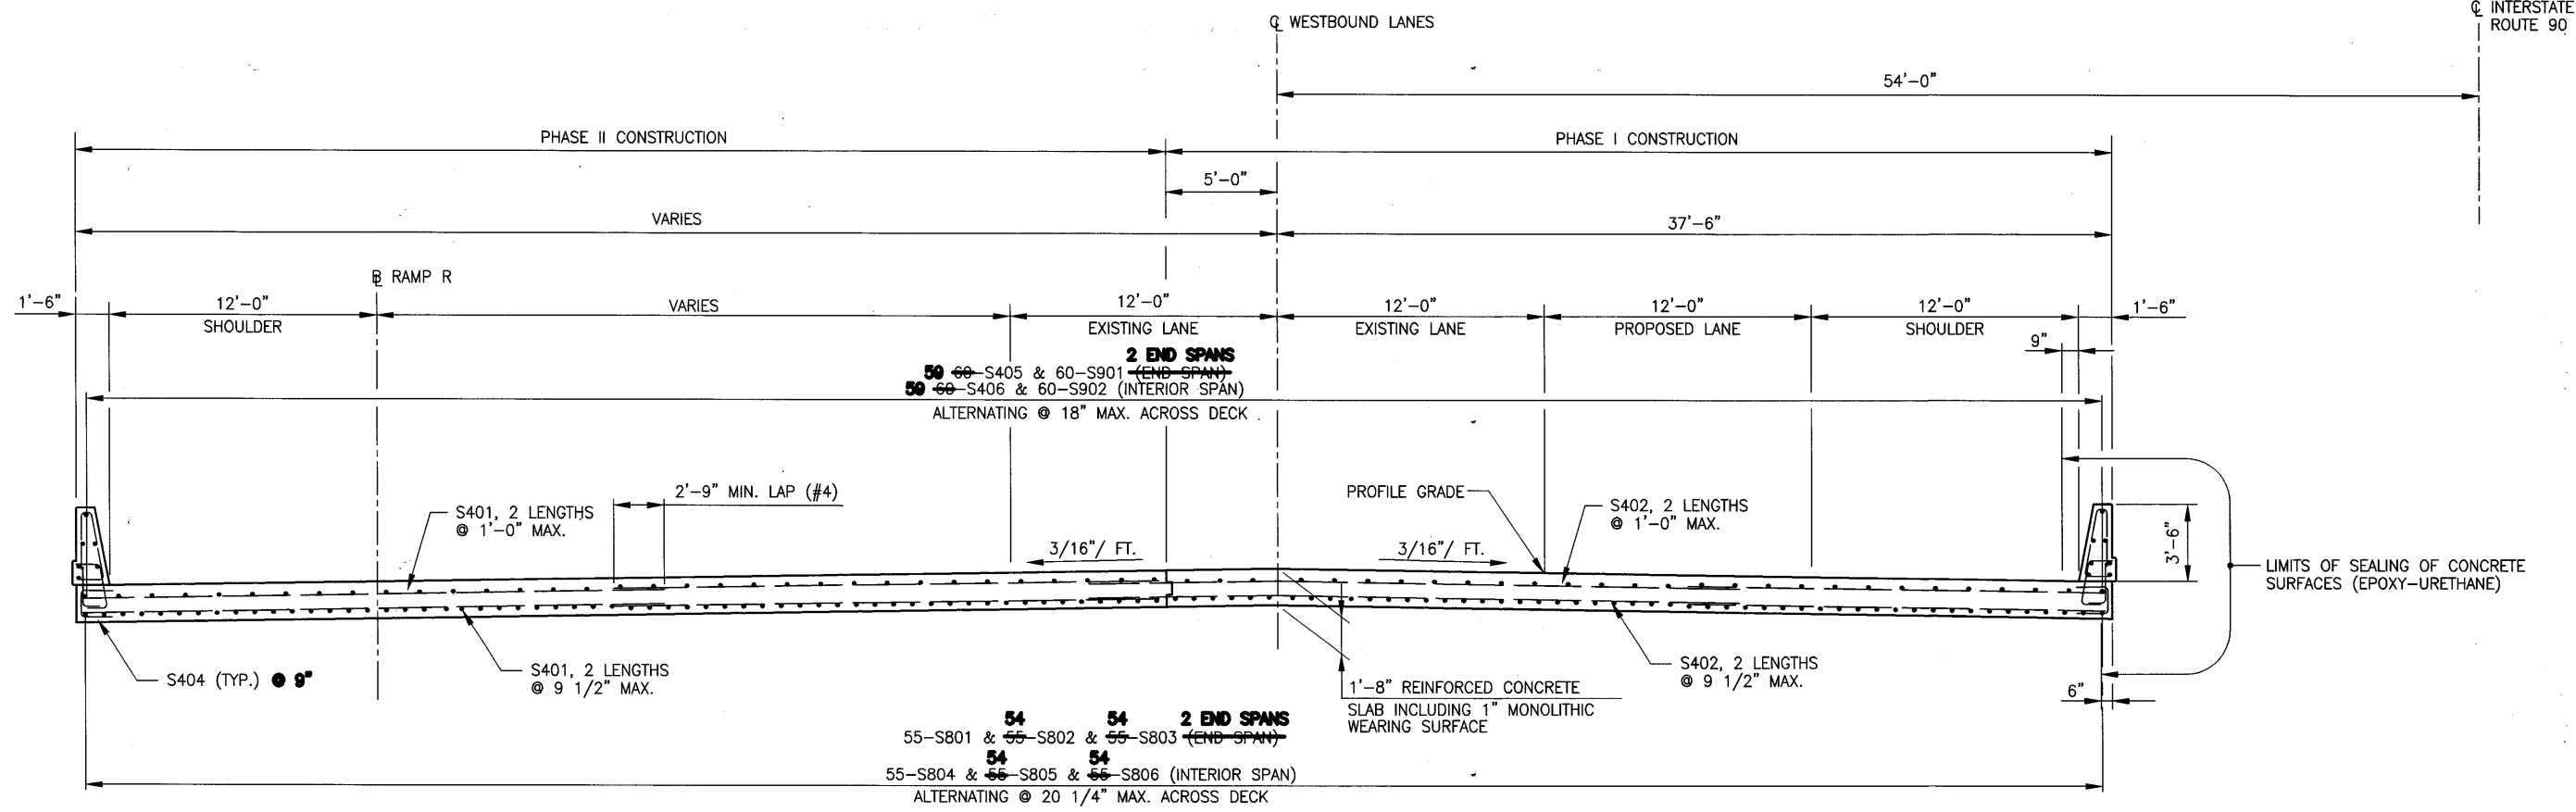

**PROPOSED TRANSVERSE SECTION  
(END AND INTERIOR SPANS)  
(SECTION B-B)**

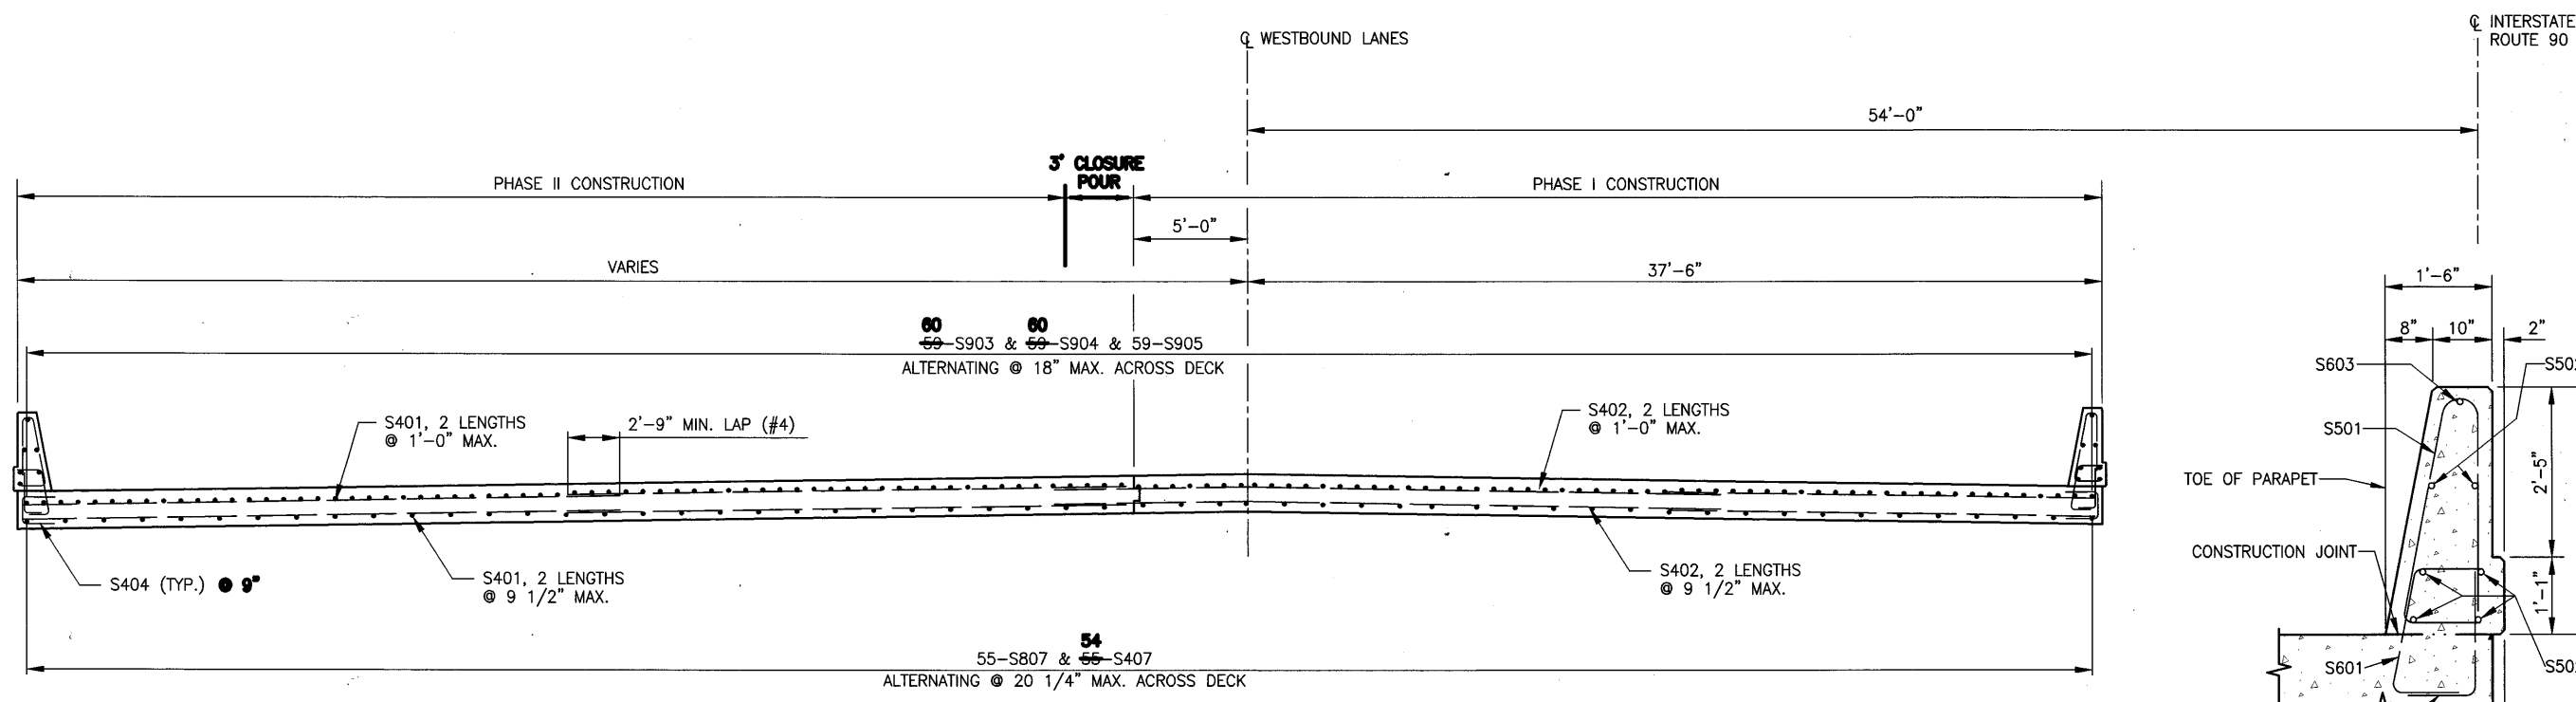


**PROPOSED TRANSVERSE SECTION  
(AT PIERS)  
(SECTION C-C)**

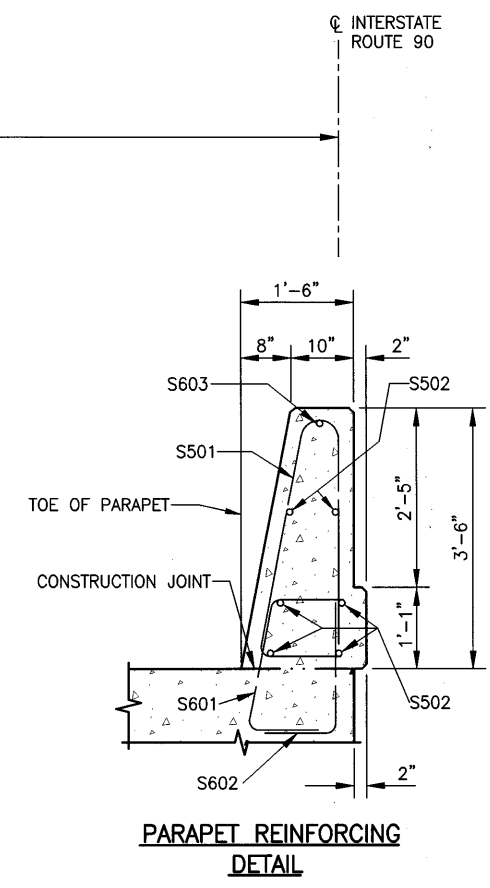


**PARAPET REINFORCING  
DETAIL**

<p>DESIGN AGENCY <b>REV. P. L. WARDEN</b> THREE KING JAMES PARK, SUITE 300 2400 CENTER RESE ROAD MARIETTA, GA 30066 TELEPHONE (404) 835-9400 JOB NUMBER E3500</p>	<p>DATE 4/30/01</p> <p>REVIEWED RAK</p> <p>STRUCTURE FILE NUMBER 4704959(L) 4704959(R)</p>	<p>DESIGNED RAK</p> <p>CHECKED RAK</p>	<p>DRAWN KK</p> <p>REVISED KK</p>	<p><b>TRANSVERSE SECTION - LEFT BRIDGE</b> BRIDGE No. LOR-90-1861 L AND R INTERSTATE ROUTE 90 OVER FRENCH CREEK</p> <p>LOR-90-10.76</p> <p>19/24</p> <p style="text-align: center;">145 274</p>
-------------------------------------------------------------------------------------------------------------------------------------------------------------------------------------------	--------------------------------------------------------------------------------------------------------	------------------------------------------------	-------------------------------------------	-------------------------------------------------------------------------------------------------------------------------------------------------------------------------------------------------------------

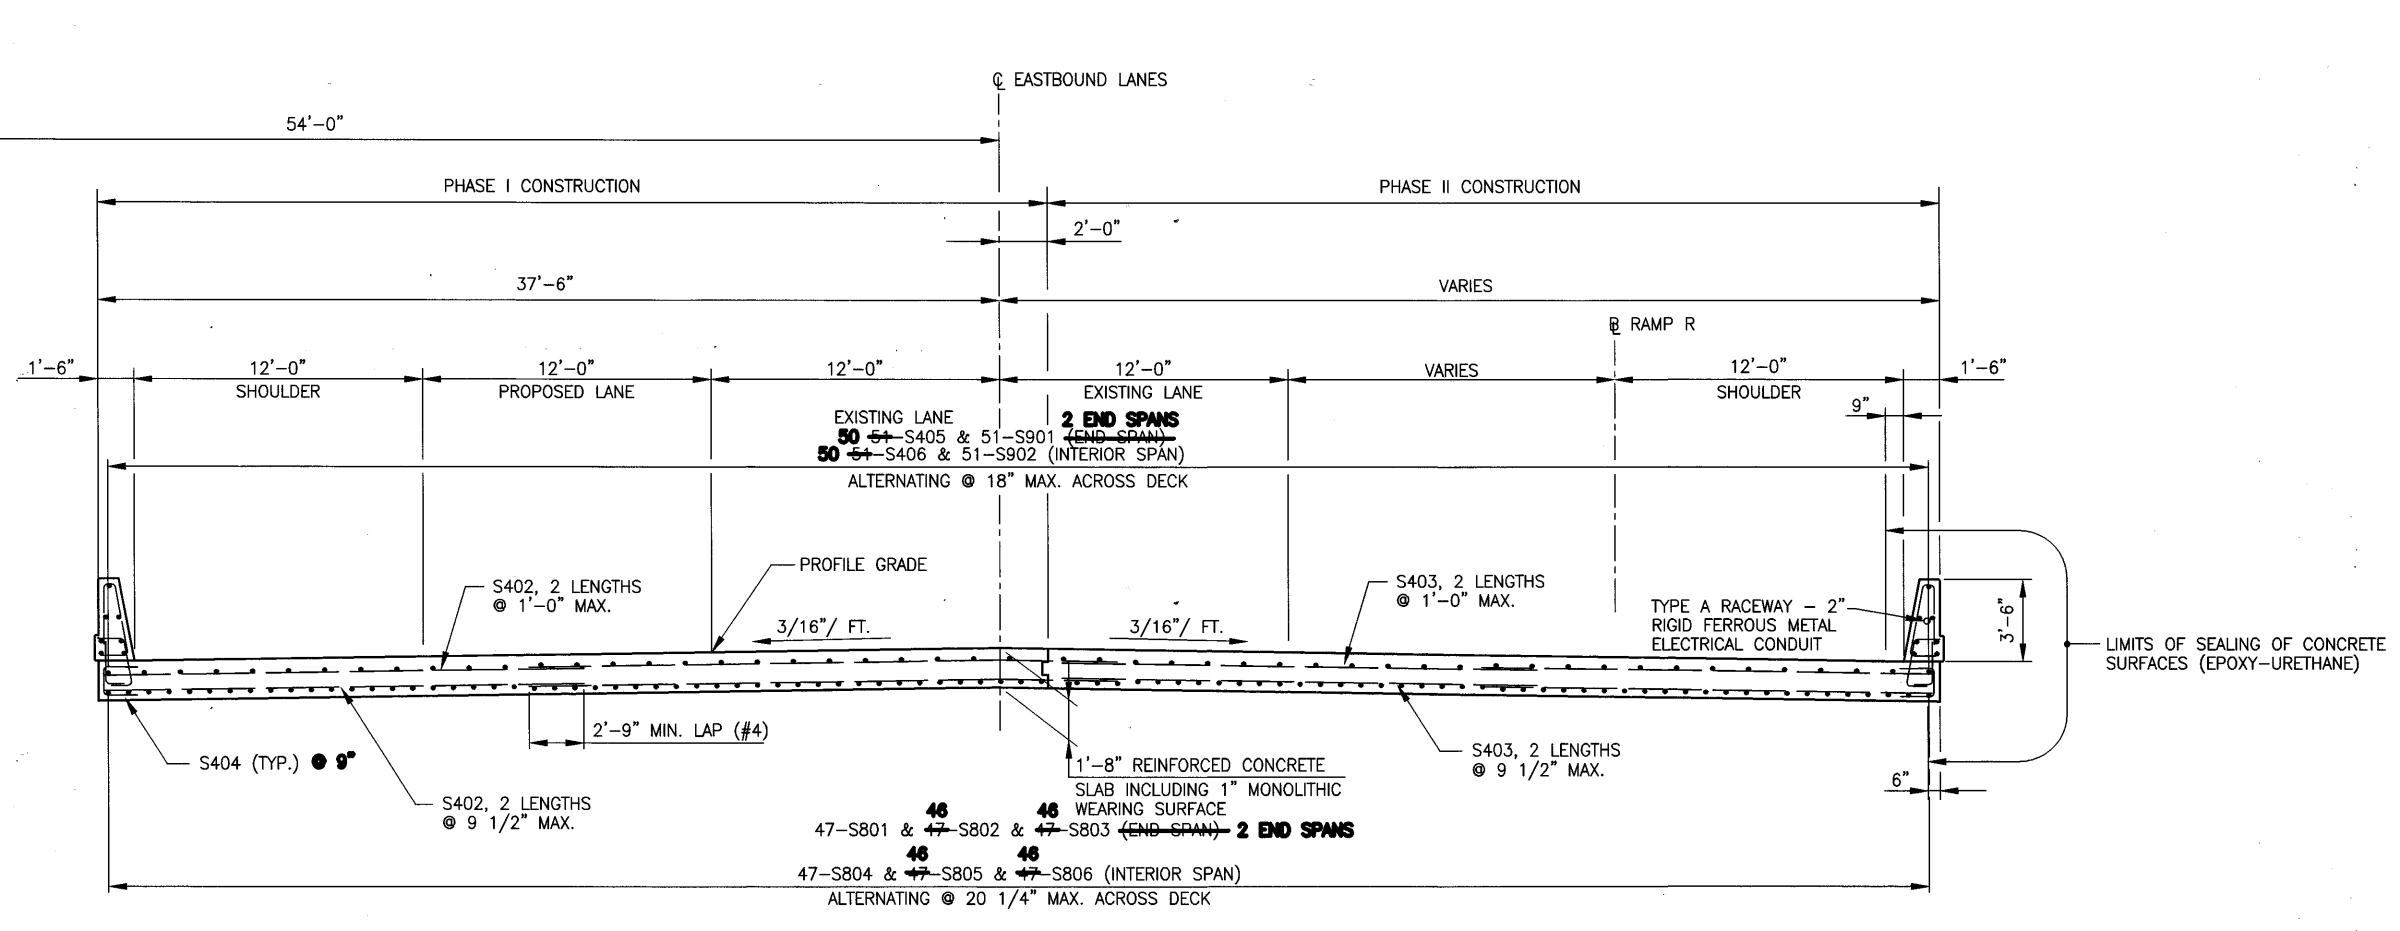

PROPOSED TRANSVERSE SECTION  
 (END AND INTERIOR SPANS)  
 (SECTION B-B)

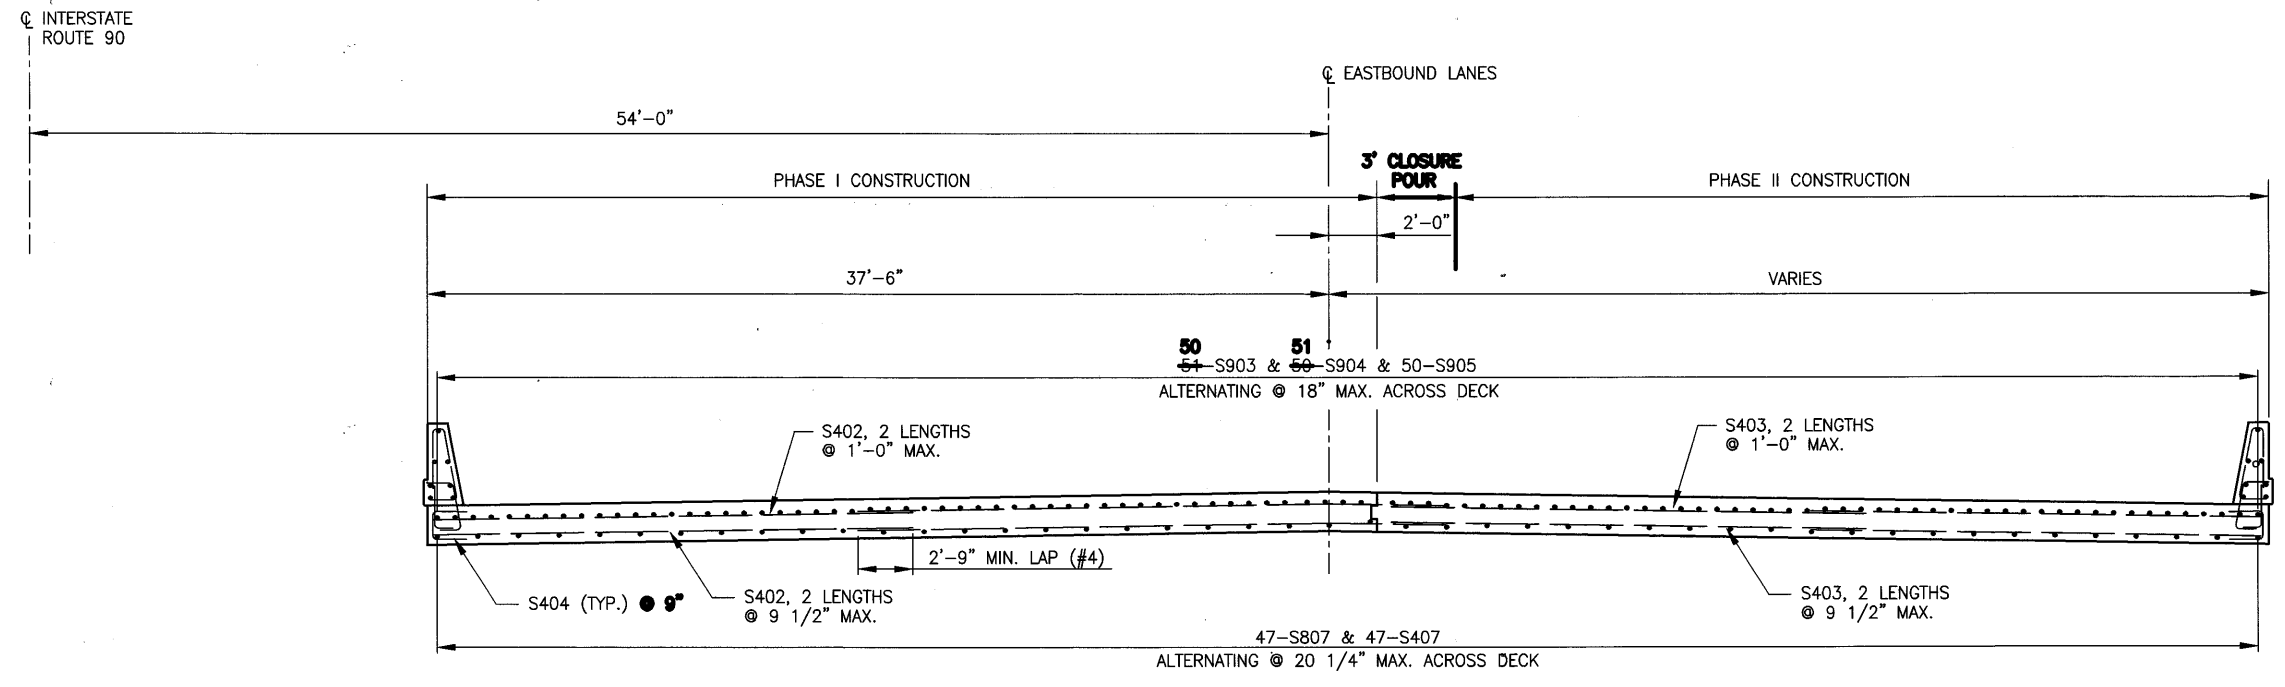


PROPOSED TRANSVERSE SECTION  
 (AT PIERS)  
 (SECTION C-C)


NOTES:  
 1.) SEE SHEET 19/24 FOR PARAPET REINFORCING DETAIL

C:\93600\BRIDGE\DWGS\LO090TS2.DWG


O:\93600\BRIDGE\DWGS\LO090SD1.DWG

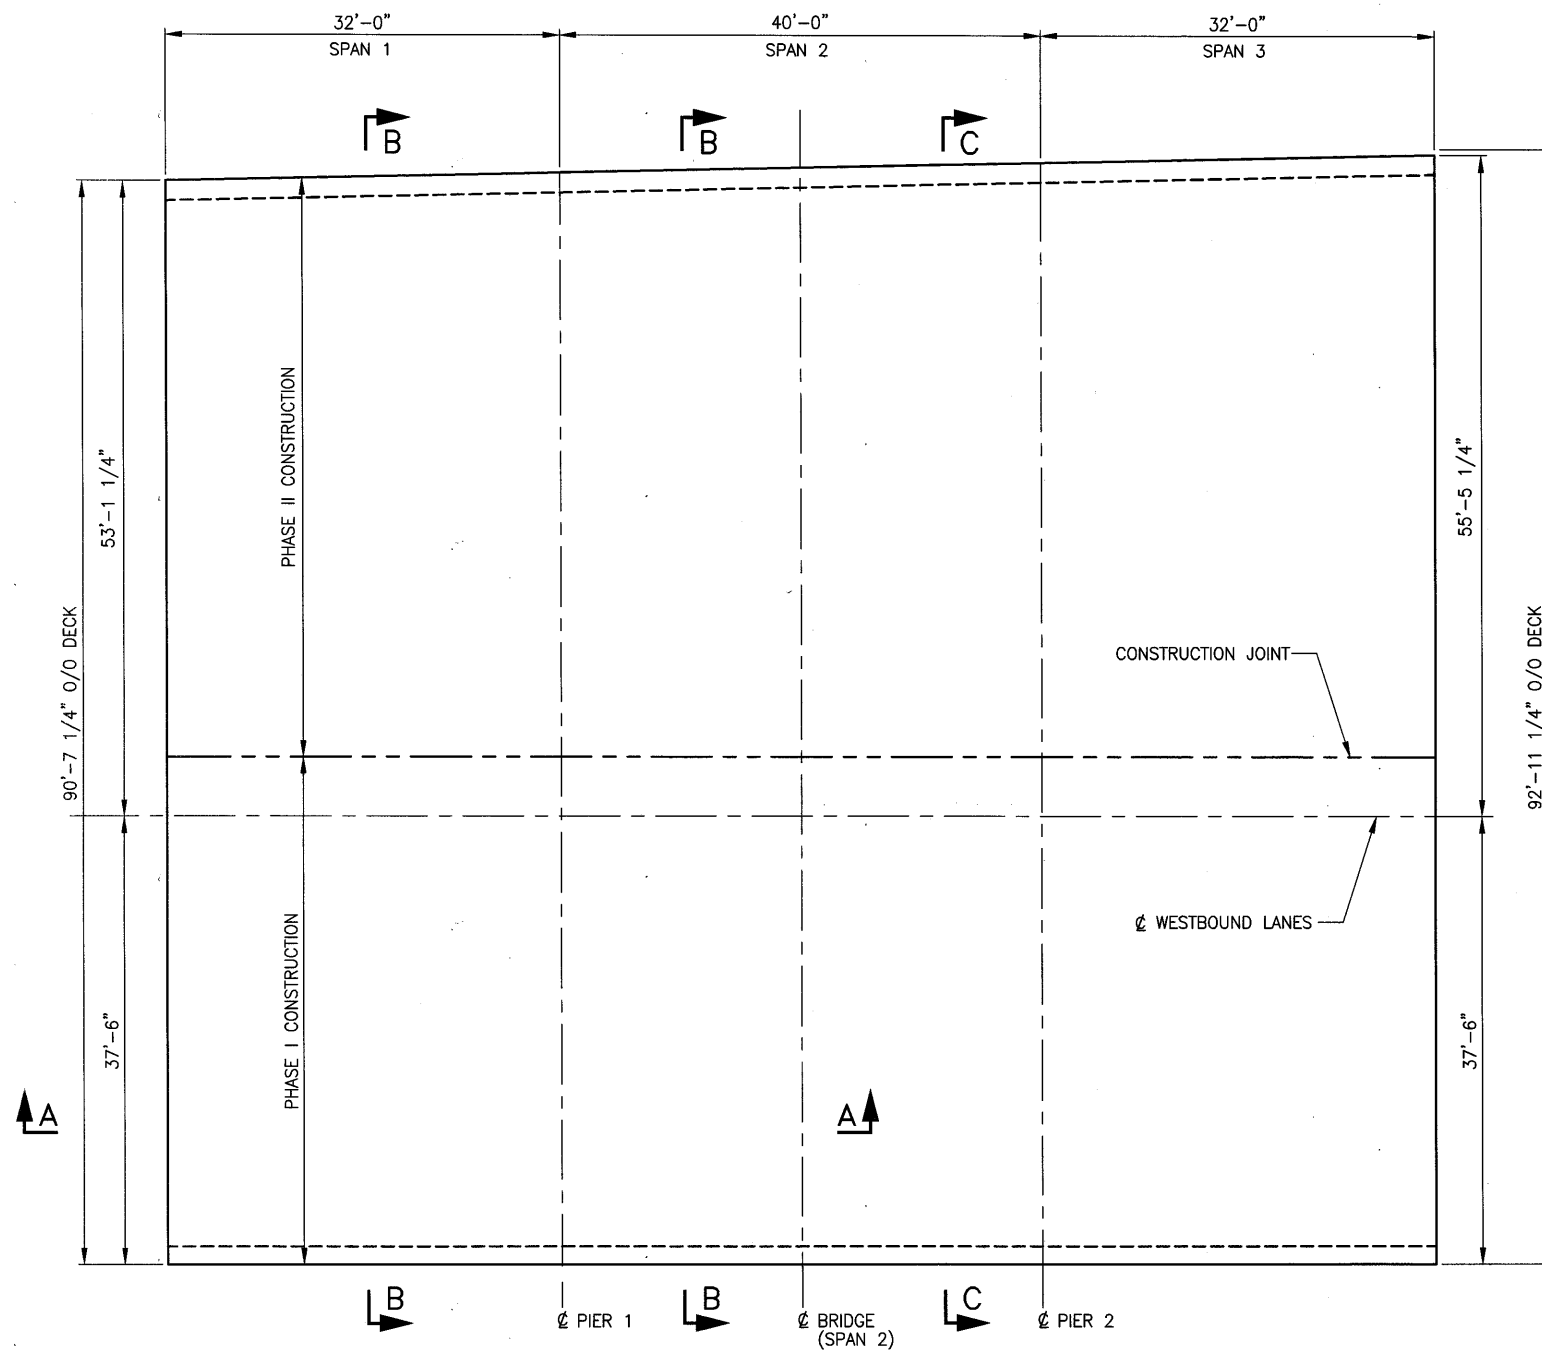


PLAN VIEW

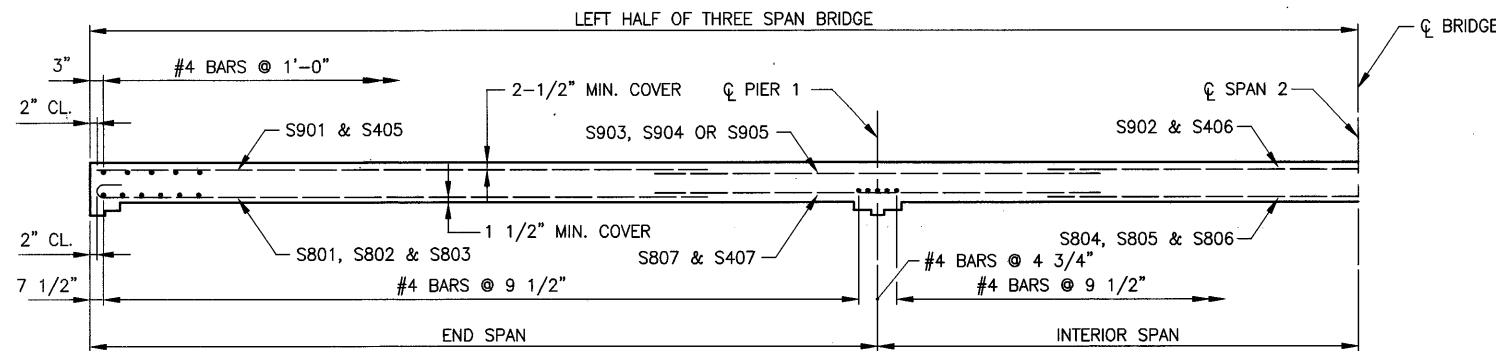

HALF LONGITUDINAL SECTION  
(SECTION A-A)

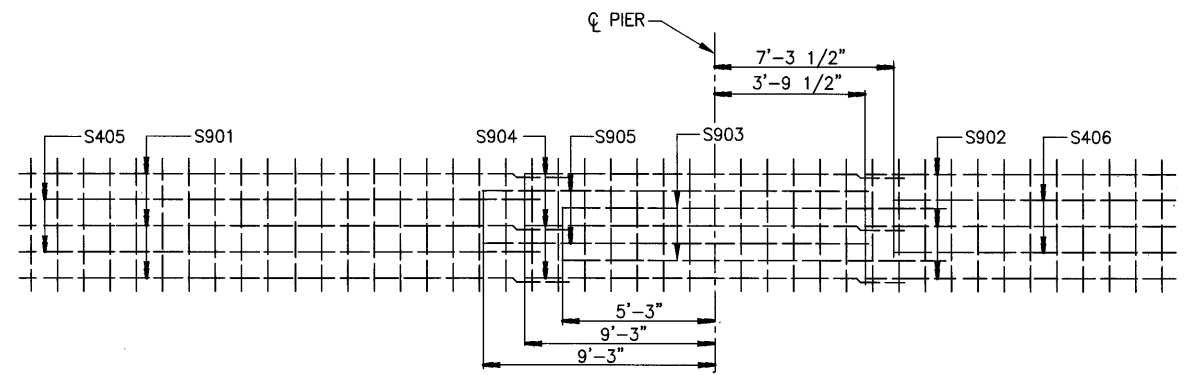

STEEL IN TOP OF SLAB DETAIL

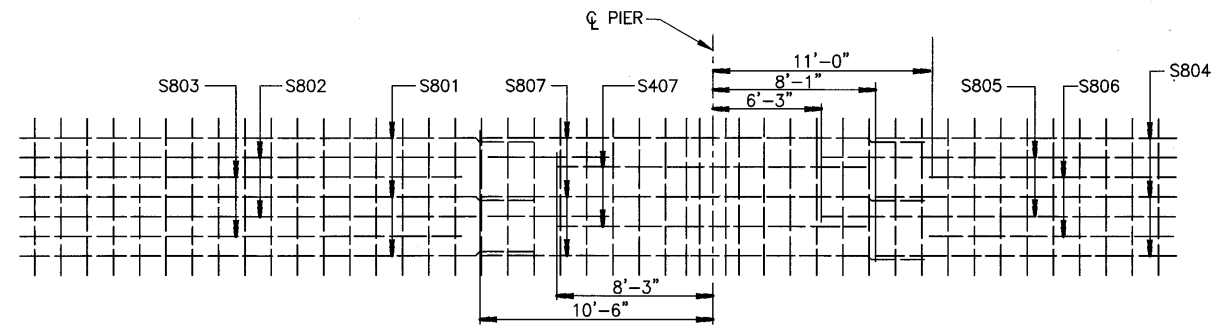

STEEL IN BOTTOM OF SLAB DETAIL

**NOTE:** LONGITUDINAL SLAB REINFORCING IS SYMMETRICAL ABOUT  $\phi$  BRIDGE

**CONSTRUCTION JOINTS:**  
PLACEMENT OF THE CONCRETE DECK SLAB SHALL BE CONTINUOUS. CONSTRUCTION JOINTS SHALL BE PROVIDED ONLY IF A DECK POUR CANNOT BE COMPLETED DUE TO INCLEMENTE CONDITIONS. THE CONSTRUCTION JOINT SHALL CONFORM TO THE REQUIREMENTS OF 511 IN THE CMS.

**CAMBER:**  
CAMBER AS SHOWN IN THE SCREED ELEVATION TABLES SHALL BE PROVIDED TO COMPENSATE DEAD LOAD DEFLECTIONS, IN ADDITION TO ANY CAMBER REQUIRED FOR CONFORMANCE WITH THE PROFILE OF THE HIGHWAY. ALLOWANCE SHALL BE MADE FOR THE DEFLECTION OF ANY FALSE-WORK MEMBERS SUPPORTING THE ACTUAL CONCRETE PLACEMENT.

**NOTES:**

(1) FOR SECTIONS B-B AND C-C, SEE SHEET

19/24

DESIGN AGENCY  
R.R. ENGINEERS  
CONSULTING ENGINEERS  
JOB NUMBER 93600

DATE 4/30/01  
REVIEWED RAK  
DRAWN KK  
DESIGNED KK  
CHECKED RAK

BRIDGE No. LOR-90-1861  
INTERSTATE ROUTE 90 OVER FRENCH CREEK


DECK SLAB PLAN - LEFT BRIDGE

LOR-90-10.76


21/24

147  
274


C:\93600\BRIDGE\DWGS\LO090SD2.DWG

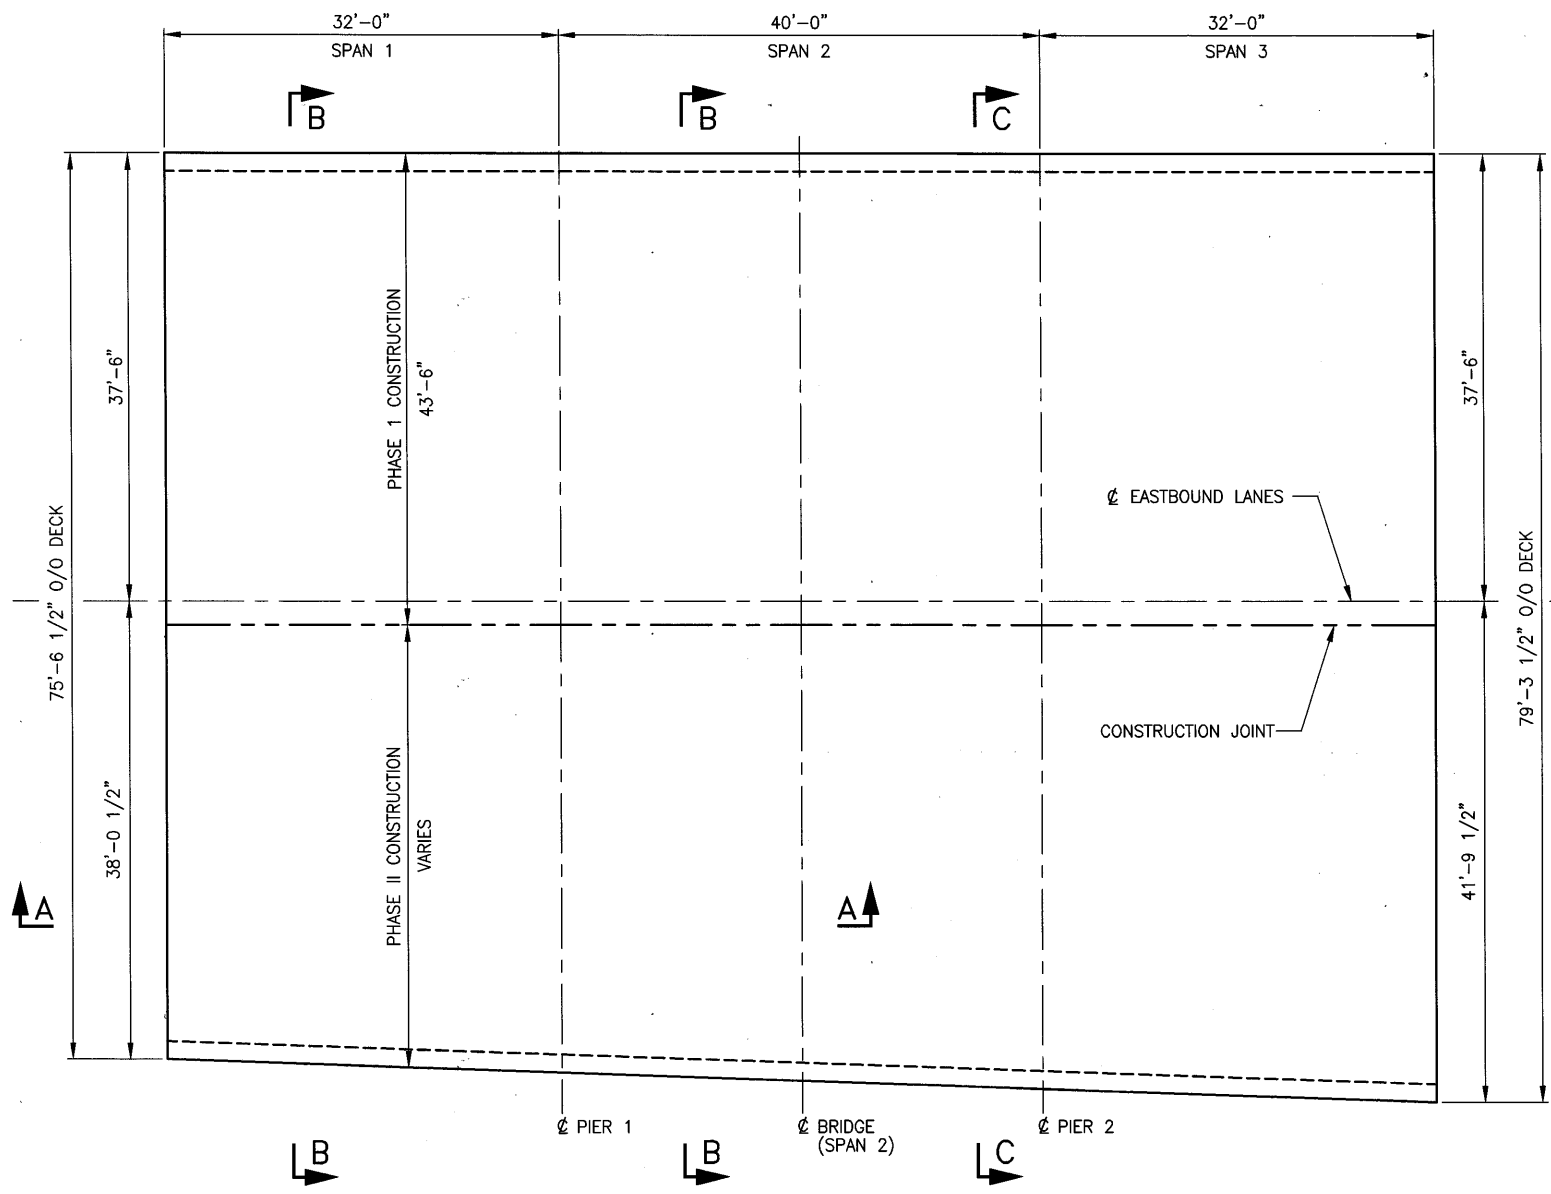


**PLAN VIEW**

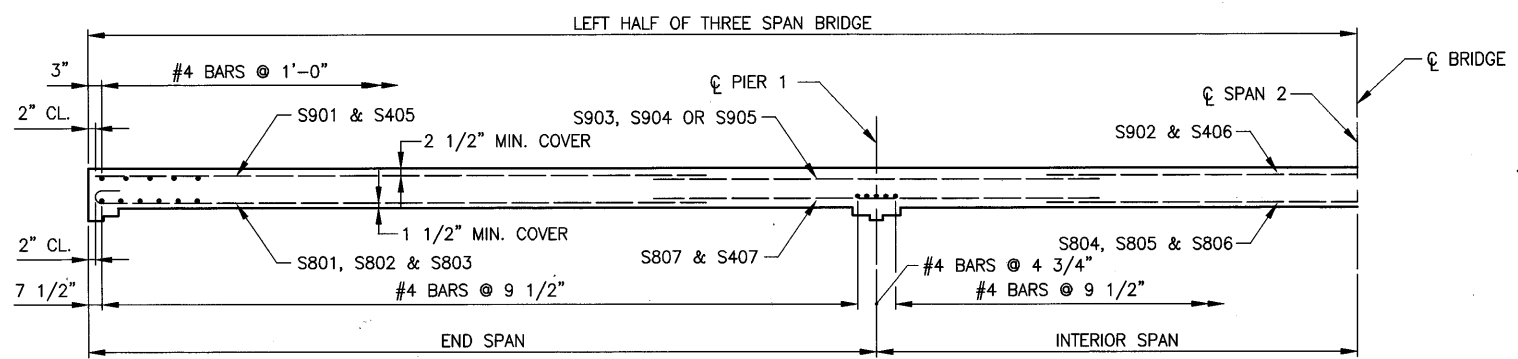


**HALF LONGITUDINAL SECTION (SECTION A-A)**

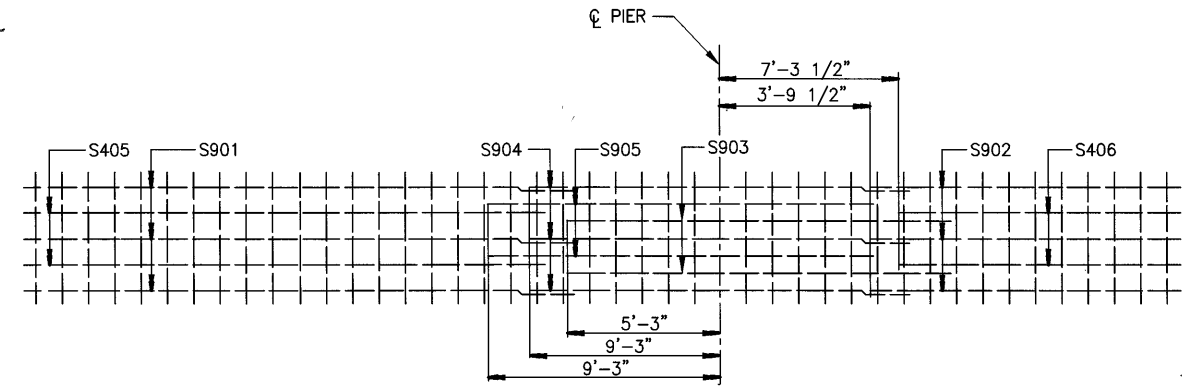

**STEEL IN TOP OF SLAB DETAIL**

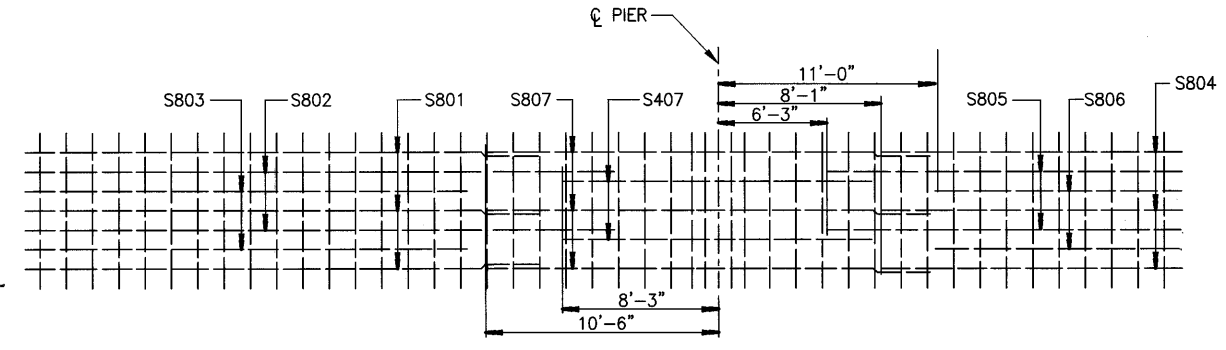


**NOTE:** LONGITUDINAL SLAB REINFORCING IS SYMMETRICAL ABOUT  $\phi$  BRIDGE

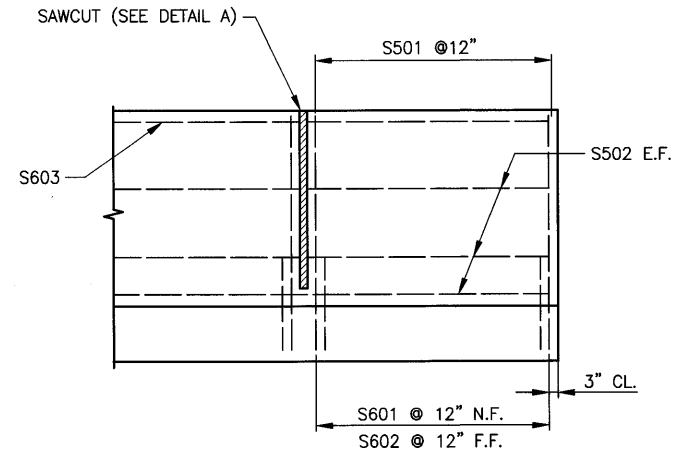

**PARAPET PARTIAL ELEVATION**

**NOTE:** FOR GENERAL NOTES SEE SHEET 2/24 FOR ADDITIONAL INFORMATION.

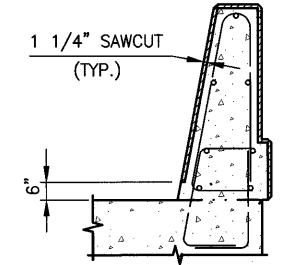


**DETAIL A (SECTION THROUGH SAWCUT) SAWCUT PERIMETER = 7'-6"**

**NOTES:**


- (1) FOR SECTIONS B-B AND C-C, SEE SHEET 20/24

	DATE 4/30/01	REVIEWED RAK	STRUCTURE FILE NUMBER 4704959(L) 4704959(R)	JOB NUMBER 93600
DRAWN KK	REVISIONS	DESIGNED KK	CHECKED RAK	
<b>DECK SLAB PLAN - RIGHT BRIDGE</b> BRIDGE No. LOR-90-1861 INTERSTATE ROUTE 90 OVER FRENCH CREEK				
LOR-90-10.76				
22 / 24				
148 274				

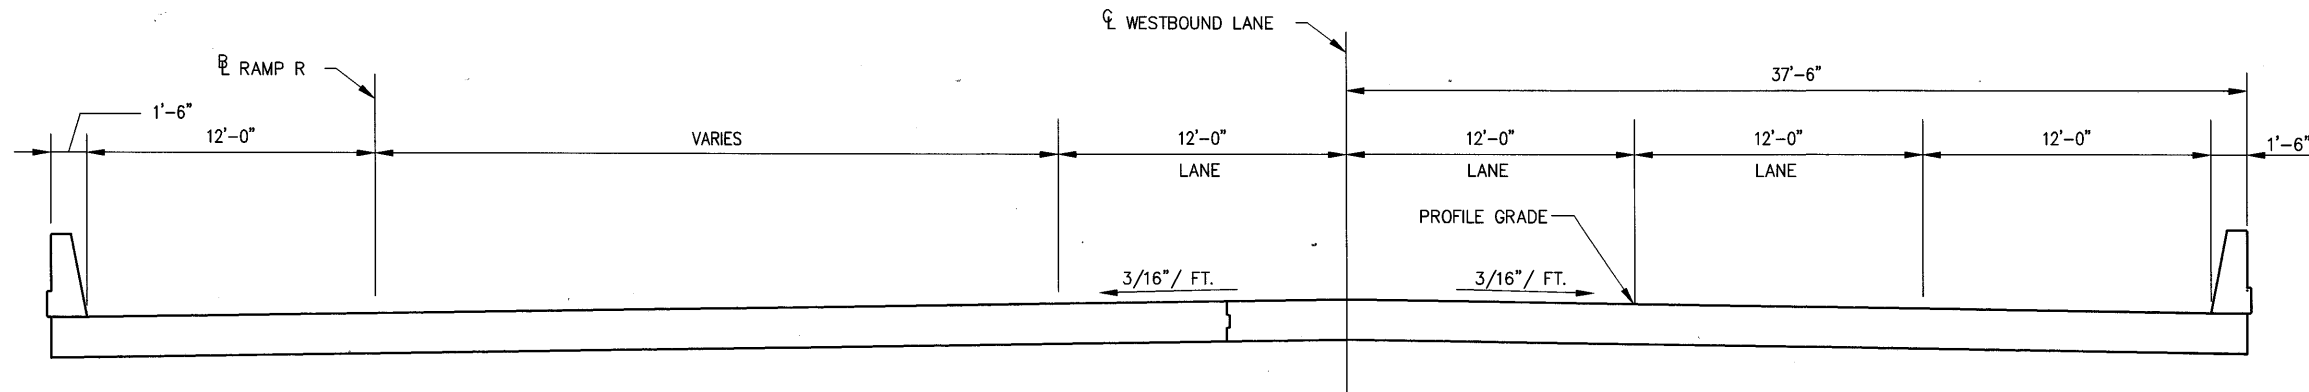

LEFT BRIDGE

	STATION	Q BEARING REAR ABUT.	MIDPOINT SPAN 1	Q BEARING PIER 1	MIDPOINT SPAN 2	Q BEARING PIER 2	MIDPOINT SPAN 3	Q BEARING FORWARD ABUT.
LEFT TOE OF PARAPET	966+48.00	966+64.00	966+80.00	967+00.00	967+20.00	967+36.00	967+52.00	
	635.33	635.37	635.41	635.46	635.50	635.54	635.58	
	634.71	634.75	634.78	634.82	634.86	634.89	634.93	
	0.00	0.04	0.00	0.04	0.00	0.04	0.00	
PHASED CONSTRUCTION JOINT	966+48.00	966+64.00	966+80.00	967+00.00	967+20.00	967+36.00	967+52.00	
	635.33	635.37	635.41	635.46	635.50	635.54	635.58	
	635.44	635.48	635.52	635.57	635.61	635.65	635.69	
	0.00	0.04	0.00	0.04	0.00	0.04	0.00	
CROWN	966+48.00	966+64.00	966+80.00	967+00.00	967+20.00	967+36.00	967+52.00	
	635.33	635.37	635.41	635.46	635.50	635.54	635.58	
	635.52	635.56	635.60	635.65	635.69	635.73	635.77	
	0.00	0.04	0.00	0.04	0.00	0.04	0.00	
RIGHT TOE OF PARAPET	966+48.00	966+64.00	966+80.00	967+00.00	967+20.00	967+36.00	967+52.00	
	635.33	635.37	635.41	635.46	635.50	635.54	635.58	
	634.96	635.00	635.04	635.09	635.13	635.17	635.21	
	0.00	0.04	0.00	0.04	0.00	0.04	0.00	
		634.96	635.04	635.04	635.13	635.13	635.21	635.21

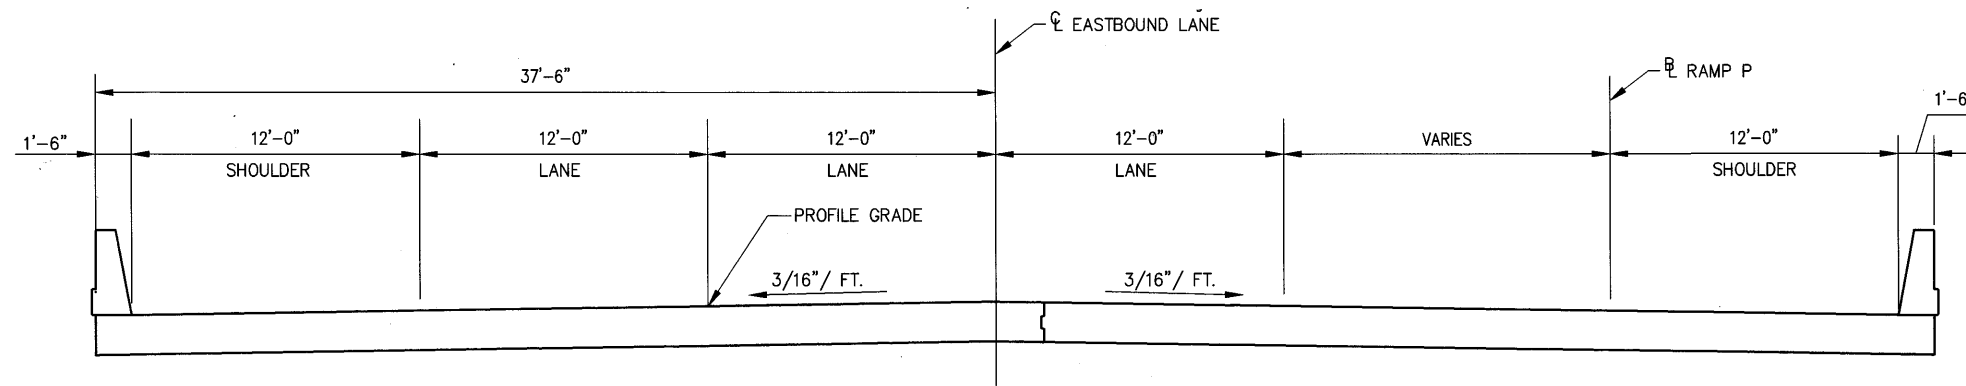

RIGHT BRIDGE

	STATION	Q BEARING REAR ABUT.	MIDPOINT SPAN 1	Q BEARING PIER 1	MIDPOINT SPAN 2	Q BEARING PIER 2	MIDPOINT SPAN 3	Q BEARING FORWARD ABUT.
LEFT TOE OF PARAPET	966+48.00	966+64.00	966+80.00	967+00.00	967+20.00	967+36.00	967+52.00	
	635.33	635.37	635.41	635.46	635.50	635.54	635.58	
	634.96	635.00	635.04	635.09	635.13	635.17	635.21	
	0.00	0.04	0.00	0.04	0.00	0.04	0.00	
CROWN	966+48.00	966+64.00	966+80.00	967+00.00	967+20.00	967+36.00	967+52.00	
	635.33	635.37	635.41	635.46	635.50	635.54	635.58	
	635.52	635.56	635.60	635.65	635.69	635.73	635.77	
	0.00	0.04	0.00	0.04	0.00	0.04	0.00	
PHASED CONSTRUCTION JOINT	966+48.00	966+64.00	966+80.00	967+00.00	967+20.00	967+36.00	967+52.00	
	635.33	635.37	635.41	635.46	635.50	635.54	635.58	
	635.49	635.53	635.57	635.62	635.66	635.70	635.74	
	0.00	0.04	0.00	0.04	0.00	0.04	0.00	
RIGHT TOE OF PARAPET	966+48.00	966+64.00	966+80.00	967+00.00	967+20.00	967+36.00	967+52.00	
	635.33	635.37	635.41	635.46	635.50	635.54	635.58	
	634.95	634.98	635.01	635.05	635.08	635.11	635.14	
	0.00	0.04	0.00	0.04	0.00	0.04	0.00	
		634.95	635.02	635.01	635.09	635.08	635.15	635.14

C:\93600\BRIDGE\DWGS\10090SD3.DWG

DESIGN AGENCY  
**REW**  
 R. P. WARD  
 CONSULTING ENGINEERS  
 2460 CENTER ROAD  
 SUITE 300  
 FRENCH CREEK, ARIZONA 85208  
 TELEPHONE (480) 853-9400  
 FAX (480) 853-9400  
 JOB NUMBER 92157

DATE  
 4/30/01

REVIEWED  
 RAK

STRUCTURE FILE NUMBER  
 4704983(R)

DRAWN  
 KK

CHECKED  
 RAK

**SCREEN ELEVATION TABLES**  
 BRIDGE No. LOR-90-1861 L AND R  
 INTERSTATE ROUTE 90 OVER FRENCH CREEK


LOR-90-10.76

23/24

149  
274

BAR SCHEDULE									
MARK	NUMBER REQ'D	LENGTH	TYPE	DIMENSIONS					WEIGHT (POUNDS)
				A	B	C	D	INC	
<b>REAR ABUTMENTS</b>									
RA501	4	6'-4"	STR						26
RA502	24	18'-1"	STR						452
RA503	2	35'-8"	STR						74
RA504	4	25'-2"	STR						105
RA505	16	5'-1"	STR						84
RA506	16	4'-1"	STR						68
RA507	248	2'-2"	STR						560
RA508	38	10'-9"	2	2'-6"	2'-7"				426
RA509	36	6'-6"	STR						244
RA510	20	11'-9"	1	1'-8"	4'-8"	4'-8"			246
RA511	116	8'-10"	2	2'-8"	1'-5 1/2"				1070
RA512	4	19'-2"	STR						80
RA513	2	30'-0"	STR						63
RA514	4	6'-4"	STR						26
RA801	8	18'-1"	STR						384
RA802	8	4'-1"	STR						88
RA1001	4	44'-9"	STR						770
RA1002	8	30'-1"	STR						1036
RA1003	8	23'-1"	STR						795
RA1004	4	44'-1"	STR						759
TOTAL WEIGHT REAR ABUTMENTS (FOR INFORMATION ONLY)									7356
<b>FORWARD ABUTMENTS</b>									
FA501	16	5'-1"	STR						84
FA502	16	4'-1"	STR						68
FA503	4	27'-6"	STR						115
FA504	2	35'-8"	STR						74
FA505	4	6'-4"	STR						26
FA506	24	18'-0"	STR						450
FA507	248	2'-2"	STR						560
FA508	38	10'-9"	2	2'-6"	2'-7"				426
FA509	36	7'-2"	STR						270
FA510	116	11'-9"	2	2'-8"	1'-5 1/2"				1421
FA511	20	14'-3"	1	1'-8"	6'-5"	6'-5"			298
FA512	4	6'-7"	STR						27
FA513	2	32'-11"	STR						69
FA514	4	22'-2"	STR						46
FA801	8	4'-1"	STR						88
FA802	8	18'-0"	STR						384
FA1001	8	31'-7"	STR						1087
FA1002	4	49'-1"	STR						845
FA1003	4	46'-1"	STR						793
FA1004	8	44'-11"	STR						1546
TOTAL WEIGHT FORWARD ABUTMENTS (FOR INFORMATION ONLY)									8677

BAR SCHEDULE									
MARK	NUMBER REQ'D	LENGTH	TYPE	DIMENSIONS					WEIGHT (POUNDS)
				A	B	C	D	INC	
<b>PIERS</b>									
P401	352	2'-8"	13	1'-8"					627
P501	8	11'-4"	12	1'-8"	4'-2"				3936
	SERIES OF	TO				TO			
P502	60	9'-8"	12	1'-8"	5'-1"				605
P503	72	4'-9"	1	1'-8"	3'-4"	1'-8"			356
P504	32	19'-2"	STR						640
P505	40	5'-8"	4	4'-9"	11"				236
P506	72	14'-8"	STR						1100
P507	464	2'-0"	STR						968
P508	32	7'-10"	12	1'-8"	2'-5"				260
P511	16	5'-2"	STR						88
P512	8	3'-2"	STR						28
P513	32	4'-9"	1	1'-8"	1'-8"	1'-8"			160
P514	8	3'-6"	STR						29
P515	8	15'-6"	12	1'-8"	2'-6"				129
P601	16	13'-8"	STR						328
P602	120	18'-2"	STR						3276
P603	164	2'-8"	STR						658
P604	104	3'-10"	3	5'-0"	10"				912
P606	56	6'-8"	STR						560
P901	20	21'-5"	3	19'-2"	2'-6"				1456
P902	40	14'-5"	3	12'-2"	2'-6"				1960
P903	20	12'-2"	STR						828
TOTAL WEIGHT PIERS (FOR INFORMATION ONLY)									16188
<b>SUPERSTRUCTURE</b>									
S401	482	26'-5"	STR						8505
S402	964	24'-0"	STR						15454
S403	482	21'-3"	STR						6842
S404	556	3'-8"	1	1'-2"	1'-3"	1'-3"			1362
S405	218	25'-1"	STR						3653
S406	109	25'-5"	STR						1851
S407	200	16'-3"	STR						2126
S501	424	7'-5"	10	3'-0"	3'-2"	2.3	1'-1"		3280
S502	120	30'-0"	STR						3754
S601	424	4'-7"	9	2'-7"	1'-1"	1'-1"			3044
S602	424	3'-6"	3	2'-7"	1'-1"				2228
S603	20	30'-0"	STR						902
S801	204	24'-11"	STR						13572
S802	200	26'-0"	STR						13884
S803	200	23'-2"	6	22'-0"					12371
S804	102	23'-10"	STR						6491
S805	100	22'-9"	STR						6074
S806	100	22'-9"	STR						6074
S807	204	21'-6"	STR						11711
S901	222	28'-7"	STR						21575
S902	111	32'-5"	STR						12234
S903	218	20'-3"	STR						15009
S904	222	18'-6"	STR						13964
S905	218	20'-3"	STR						15009
TOTAL WEIGHT SUPERSTRUCTURE (FOR INFORMATION ONLY)									200969

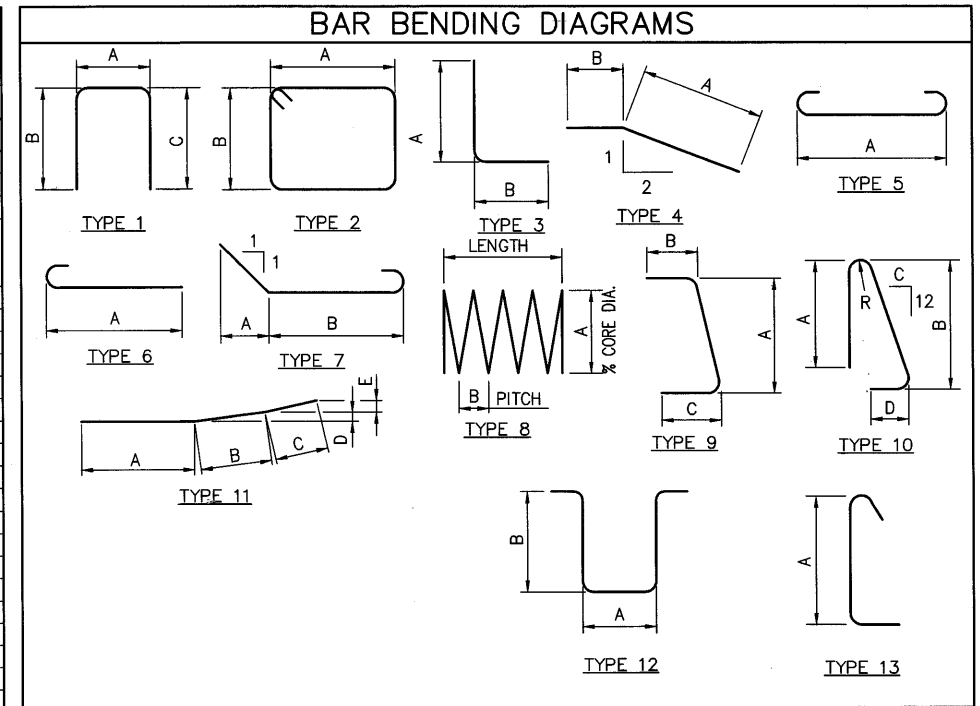

BAR DIMENSIONS SHOWN ARE OUT-TO-OUT UNLESS NOTED. ALL REINFORCING STEEL IS TO BE EPOXY COATED. STRAIGHT BARS ARE INDICATED BY "STR"

**SPACERS:**  
CONCRETE SPACERS OR OTHER APPROVED NONCORROSIVE SPACING DEVICES SHALL BE USED AT SUFFICIENT INTERVALS (NEAR THE BOTTOM AND AT INTERVALS NOT EXCEEDING 10 FEET) TO ENSURE CONCENTRIC SPACING FOR THE ENTIRE CAGE LENGTH. SPACERS SHALL BE CONSTRUCTED OF APPROVED MATERIAL EQUAL IN QUALITY AND DURABILITY TO THE CONCRETE SPECIFIED FOR THE COLUMN. THE SPACERS SHALL HAVE ADEQUATE DIMENSIONS TO ENSURE A MINIMUM 3 INCH CLEARANCE BETWEEN THE OUTSIDE OF THE REINFORCING CAGE AND THE DESIGN DIMENSION OF THE COLUMN.

BAR SIZE IS INDICATED IN THE BAR MARK. THE FIRST LETTER(S) IDENTIFIES THE BAR LOCATION, THE NEXT DIGIT(S) INDICATES THE BAR DESIGNATION. THE REMAINING DIGITS INDICATE THE SEQUENCE NUMBER.

EXAMPLE: A501  
A = LOCATION OF THE BAR IN THE STRUCTURE (ABUTMENT)  
5 = BAR SIZE DESIGNATION (#5, 5/8"Ø)  
01 = SEQUENCE NUMBER

DESIGN AGENCY: R.P. WILNER CONSULTING ENGINEERS  
THREE KING JAMES PARK - SUITE 300  
2400 CENTER REZE ROAD  
WILMINGTON, MASSACHUSETTS 01890  
TELEPHONE (410) 832-9400  
JOB NUMBER 93197

DATE: 4/30/01  
REVIEWED: RAK  
DRAWN: KK  
DESIGNED: KK  
CHECKED: RAK  
STRUCTURE FILE NUMBER: 4704983(L)  
4704989(L)

**REINFORCING SCHEDULE**  
BRIDGE NO. LOR-90-1861 L AND R  
INTERSTATE ROUTE 90 OVER FRENCH CREEK

LOR-90-10.76

24 / 24

150  
274


EXISTING NORMAL TYPICAL SECTIONS - I.R. 90 - E.B. & W.B.  
(WITHOUT EXISTING OVERLAY)

CALCULATED  
DLS  
CHECKED  
LAB

EXISTING, E.B. & W.B., NORMAL TYPICAL SECTIONS - I.R. 90

LOR - 190 - 10.76

151  
274

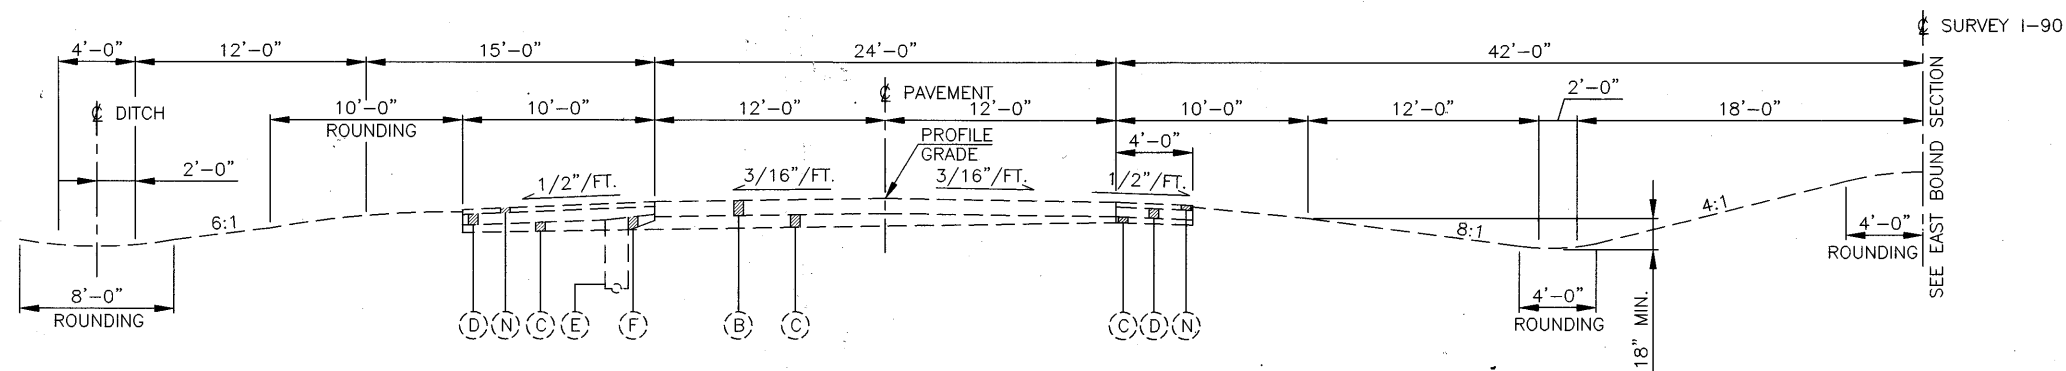


EXISTING NORMAL SECTION (WESTBOUND)

STA. 966+00 TO STA. 971+87.64  
STA. 1003+66.69 TO STA. 1018+00

EXISTING LEGEND

- (B) 10" REINFORCED CONCRETE PAVEMENT
- (C) VARIABLE THICKNESS SUBBASE
- (D) 6" AGGREGATE BASE
- (E) 6" PIPE UNDERDRAIN
- (F) SPECIAL DRAINAGE CONNECTION
- (G) GUARDRAIL, TYPE 5
- (H) 3" ASPHALT BASE


FOR LIMITING STATIONS SEE PROPOSED TYPICAL SECTIONS

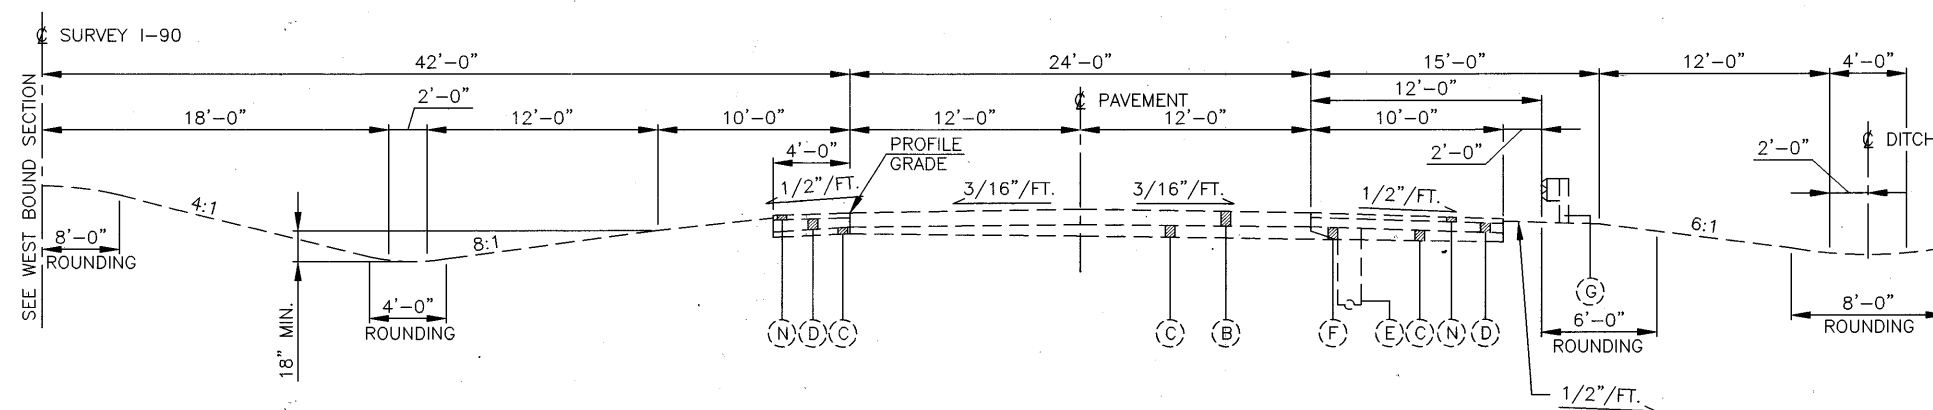

EXISTING NORMAL SECTION (WESTBOUND)

STA. 966+00 TO STA. 971+40.84  
STA. 1004+13.49 TO STA. 1017.18

EXISTING SUPERELEVATED TYPICAL SECTIONS - I.R. 90 - E.B. & W.B.  
(WITHOUT EXISTING OVERLAY)

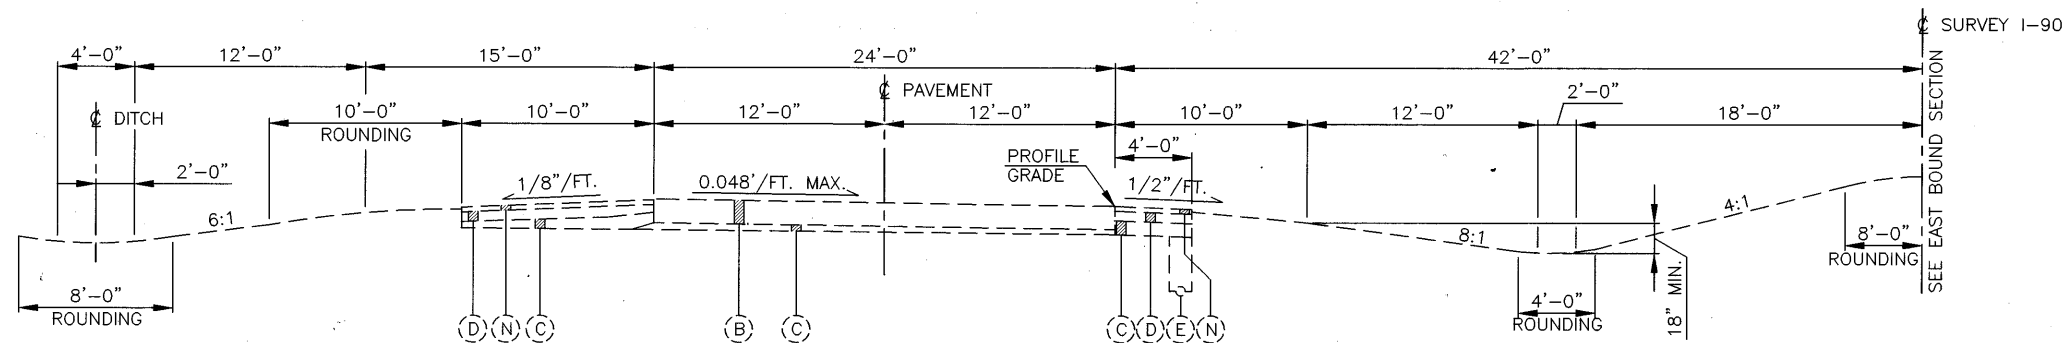


**EXISTING SUPERELEVATED SECTION (WESTBOUND)**

SUPERELEVATION TRANS. STA. 971+87.64 TO STA. 977+81.64  
 FULL SUPERELEVATION STA. 977+81.64 TO STA. 997+72.69  
 SUPERELEVATION TRANS. STA. 997+72.69 TO STA. 1003+66.69

**EXISTING LEGEND**

- (B) 10" REINFORCED CONCRETE PAVEMENT
- (C) VARIABLE THICKNESS SUBBASE
- (D) 6" AGGREGATE BASE
- (E) 6" PIPE UNDERDRAIN
- (F) SPECIAL DRAINAGE CONNECTION
- (G) GUARDRAIL, TYPE 5
- (N) 3" ASPHALT BASE

FOR LIMITING STATIONS SEE PROPOSED TYPICAL SECTIONS.  
 \*\* OR RATE OF SUPER IF GREATER

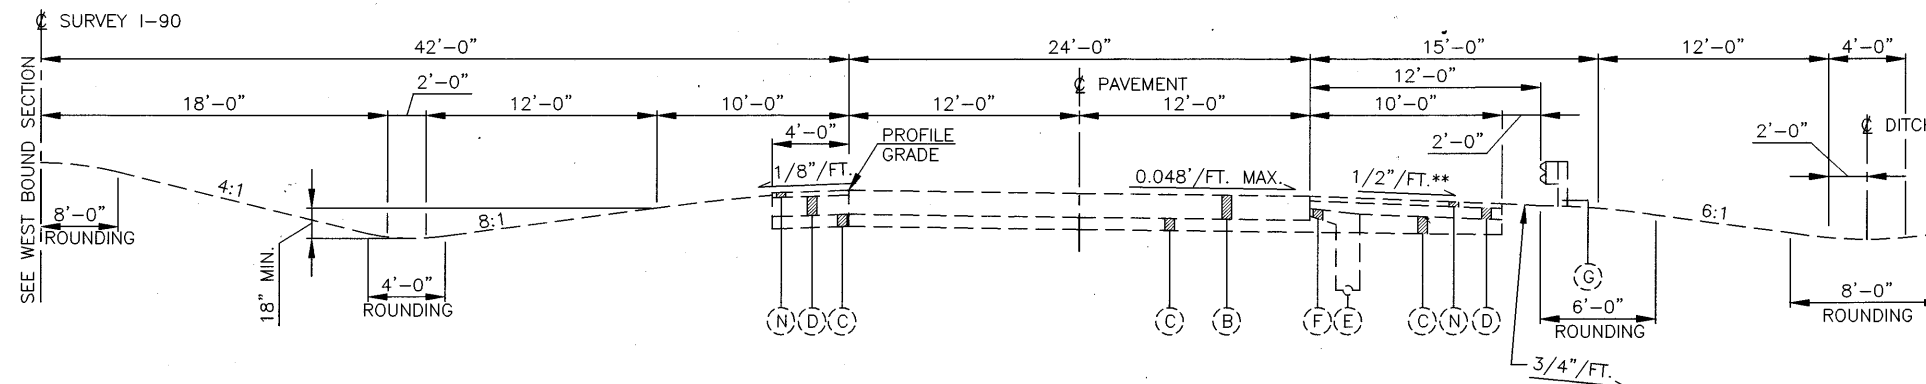


**EXISTING SUPERELEVATED SECTION (WESTBOUND)**

SUPERELEVATION TRANS. STA. 971+40.84 TO STA. 977+81.64  
 FULL SUPERELEVATION STA. 977+81.64 TO STA. 997+72.69  
 SUPERELEVATION TRANS. STA. 997+72.69 TO STA. 1004+13.49



EXISTING TYPICAL SECTIONS - I.R. 90  
 (RECONSTRUCTION OF EXISTING PAVEMENT & PREVIOUSLY WIDENED SECTION)

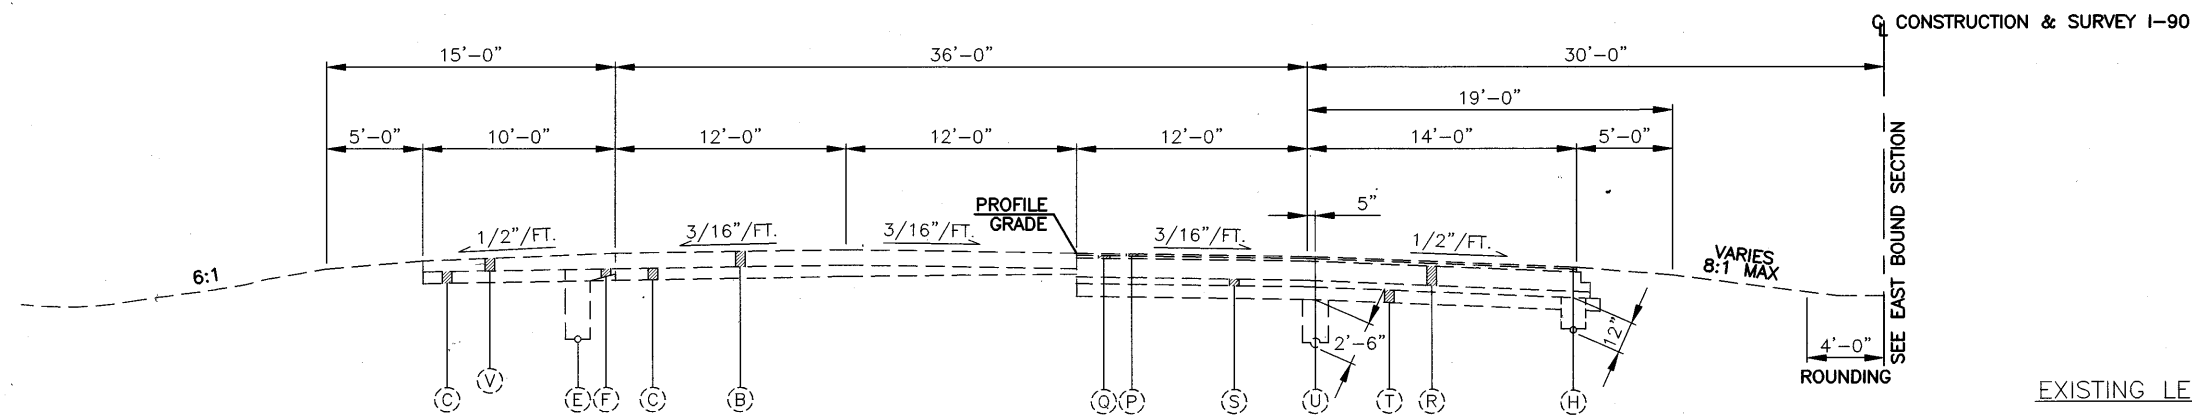


NORMAL SECTION (WESTBOUND)

STA 1018+00 TO STA 1035+00

EXISTING LEGEND

- (B) 10" REINFORCED CONCRETE PAVEMENT
- (C) VARIABLE THICKNESS SUBBASE
- (E) 6" SHALLOW PIPE UNDERDRAIN
- (F) SPECIAL DRAINAGE CONNECTION
- (G) GUARDRAIL, TYPE 5
- (H) 4" SHALLOW PIPE UNDERDRAIN W/FABRIC WRAP, 707.15
- (P) 1 1/4" ASPHALT CONCRETE, SURFACE COURSE, TYPE 1, AC-20
- (Q) 1 3/4" ASPHALT CONCRETE, INTERMEDIATE COURSE, TYPE 2, AC-20
- (R) 12" BITUMINOUS AGGREGATE BASE, AC-20
- (S) 4" ASPHALT TREATED FREE DRAINING BASE
- (T) 8" AGGREGATE BASE
- (U) 6" SHALLOW PIPE UNDERDRAIN W/ FABRIC WRAP, 707.15
- (V) 10" TEMPORARY ASPHALT SHOULDER

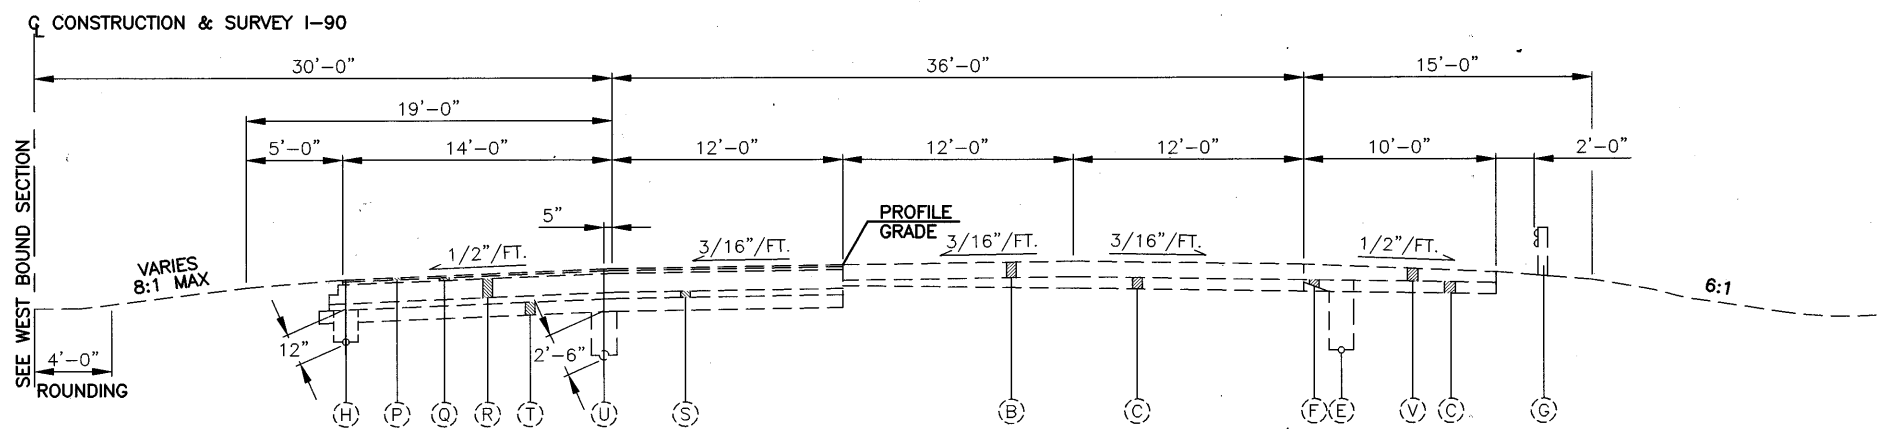

NORMAL SECTION (EASTBOUND)

STA 1017+70.18 TO STA 1035+00


CALCULATED  
 DLS  
 CHECKED  
 LAB

EXISTING TYPICAL SECTIONS - I.R. 90 - (RECONSTRUCTION)


LOR - I90 - 10.76

# PROPOSED TYPICAL SECTIONS - I.R. 90 (WIDENING)


CALCULATED  
DLS  
CHECKED  
LAB

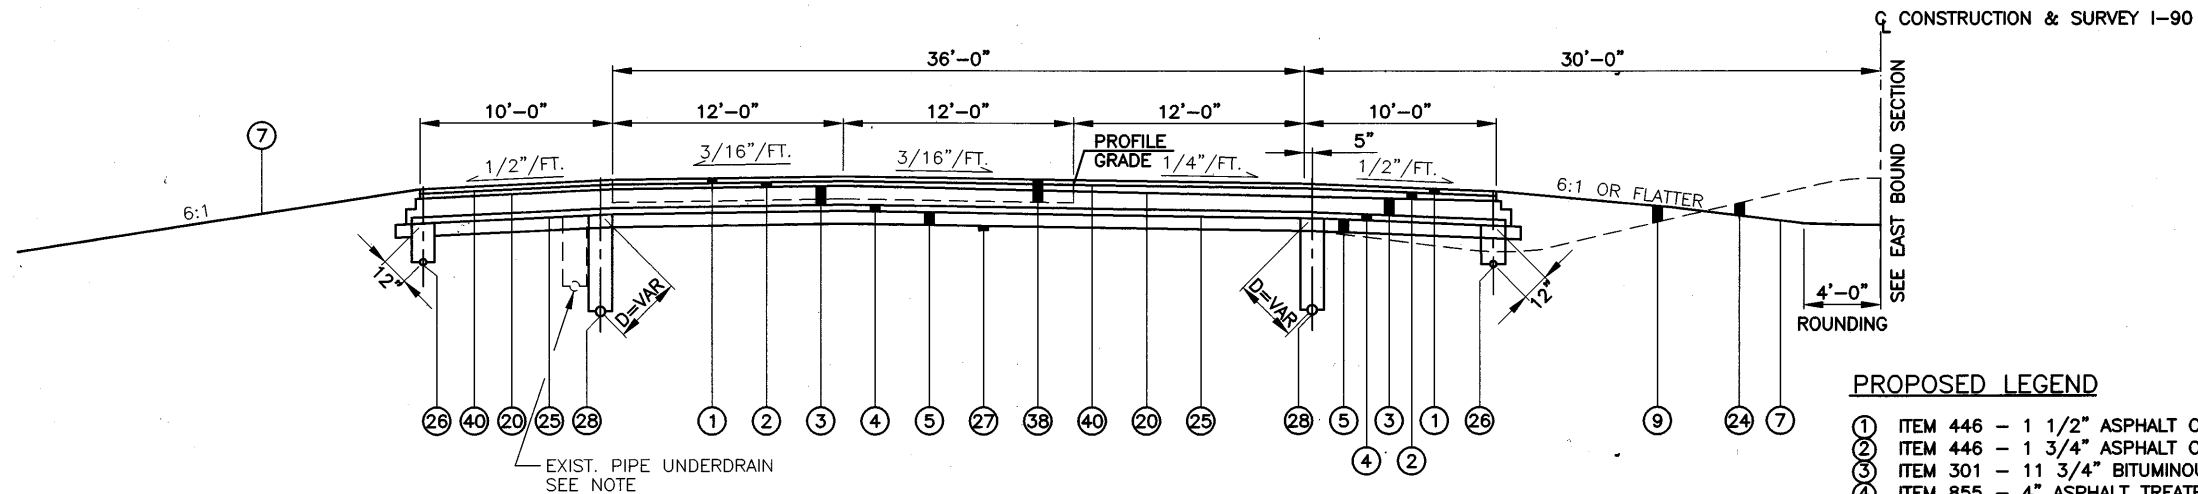

**NORMAL SECTION (WESTBOUND)**  
 STA. 966+00 TO STA. 971+87.64  
 STA. 1003+66.69 TO STA. 1018+00

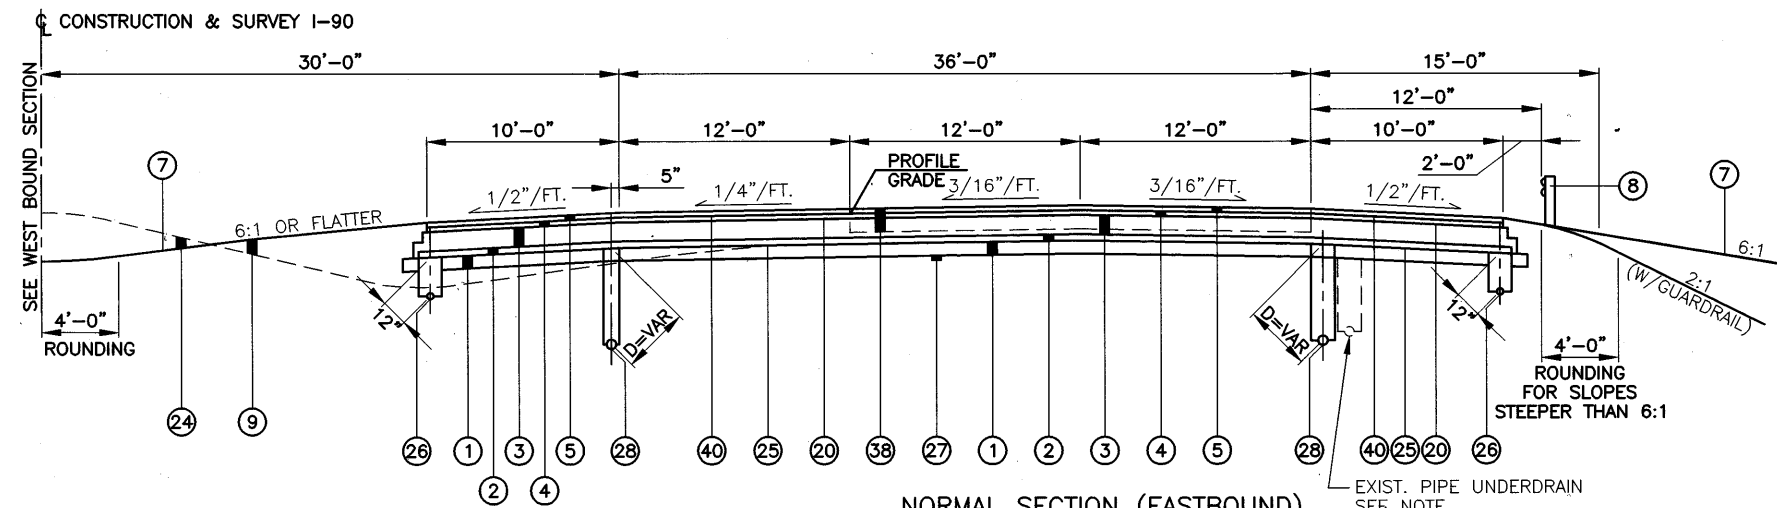

**NORMAL SECTION (EASTBOUND)**  
 STA. 966+00 TO STA. 971+40.84  
 STA. 1004+13.49 TO STA. 1017+70.18

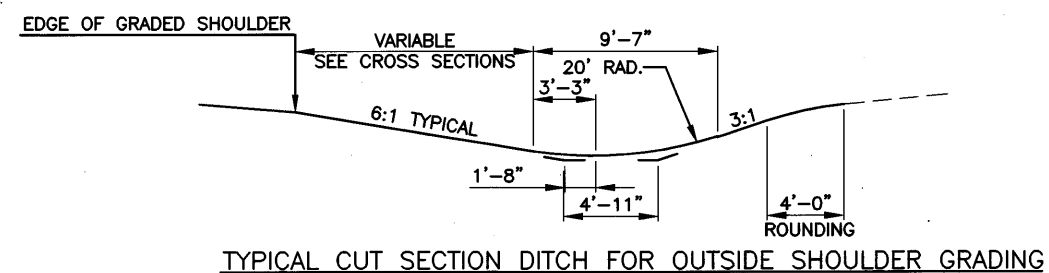


**TYPICAL CUT SECTION DITCH FOR OUTSIDE SHOULDER GRADING**

**PROPOSED LEGEND**

- ① ITEM 446 - 1 1/2" ASPHALT CONCRETE SURFACE COURSE TYPE 1, PG 76-22 MODIFIED
- ② ITEM 446 - 1 3/4" ASPHALT CONCRETE INTERMEDIATE COURSE TYPE 2, PG 70-22 SUPPLEMENTAL 880
- ③ ITEM 301 - 11 3/4" BITUMINOUS AGGREGATE BASE, PG 64-22 SUPPLEMENTAL 880
- ④ ITEM 855 - 4" ASPHALT TREATED FREE DRAINING BASE
- ⑤ ITEM 304 - 8" AGGREGATE BASE
- ⑦ ITEM 870 - SEEDING AND MULCHING (SEE GENERAL NOTE)
- ⑧ ITEM 606 - GUARDRAIL, TYPE 5
- ⑨ ITEM 203 - EMBANKMENT
- ⑩ ITEM 407 - TACK COAT @ 0.10 GALS/SQ. YD.
- ⑪ ITEM 203 - EXCAVATION NOT INCLUDING EMBANKMENT CONSTRUCTION
- ⑫ ITEM 408 - BITUMINOUS PRIME COAT @ 0.40 GALS/SQ. YD.
- ⑬ ITEM 605 - 4" SHALLOW PIPE UNDERDRAIN W/FABRIC WRAP, 707.31, AS PER PLAN
- ⑭ ITEM 203 - SUBGRADE COMPACTION
- ⑮ ITEM 605 - 6" SHALLOW PIPE UNDERDRAIN W/ FABRIC WRAP, 707.31
- ⑯ ITEM 202 - PAVEMENT REMOVED, 10" CONCRETE
- ⑰ ITEM 407 - TACK COAT FOR INTERMEDIATE COURSE @ 0.05 GALS/SQ. YD.

**NOTE**

1. THIS IS A WARRANTY PAVEMENT AND SHALL BE CONSTRUCTED AS PER SUPPLEMENTAL SPECIFICATIONS 880 ASPHALT CONCRETE WITH WARRANTY.
2. THE UNDERDRAIN DEPTHS ARE 18", 30", OR VARIABLE (UNCLASSIFIED). SEE UNDERDRAIN TABLE FOR LOCATIONS.
3. TYPICALS DO NOT SHOW ACCELERATION AND DECELERATION LANES. SEE SHEET T7.
4. EXISTING UNDERDRAIN TO REMAIN AS LONG AS POSITIVE OUTLET FLOW IS MAINTAINED.

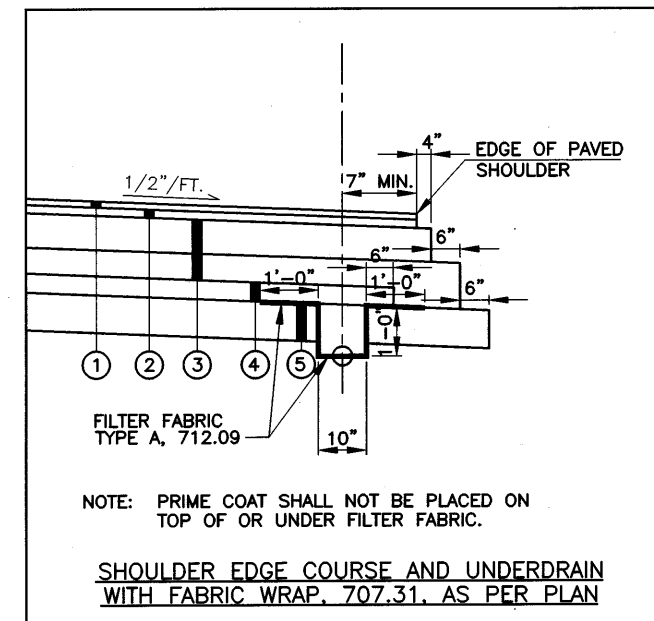


PROPOSED TYPICAL SECTIONS 3 - LANE WIDENING

LOR - 190 - 10.76

# PROPOSED SUPERELEVATED TYPICAL SECTIONS - I.R. 90 (WIDENING)

CALCULATED  
DLS  
CHECKED  
LAB

PROPOSED SUPERELEVATED TYPICAL SECTION 3 - LANE WIDENING

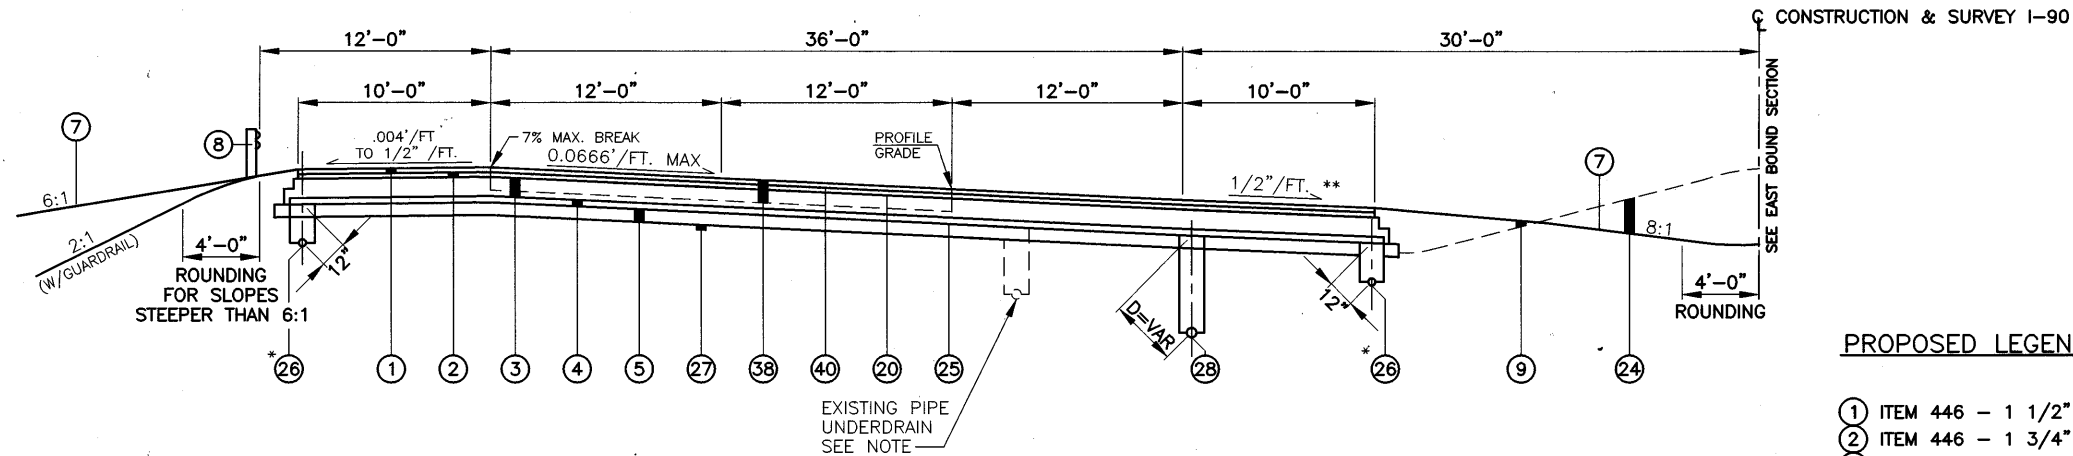

**SUPERELEVATED SECTION (WESTBOUND)**

SUPERELEVATION TRANS. STA. 971+87.64 TO STA. 977+81.64  
 FULL SUPERELEVATION STA. 977+81.64 TO STA. 997+72.69  
 SUPERELEVATION TRANS. STA. 997+72.69 TO STA. 1003+66.69

**PROPOSED LEGEND**


- ① ITEM 446 - 1 1/2" ASPHALT CONCRETE, SURFACE COURSE, TYPE 1, PG 76-22 MODIFIED
- ② ITEM 446 - 1 3/4" ASPHALT CONCRETE, INTERMEDIATE COURSE, TYPE 2, PG 70-22 SUPPLEMENTAL 880
- ③ ITEM 301 - 11 3/4" BITUMINOUS AGGREGATE BASE, PG 64-22 SUPPLEMENTAL 880
- ④ ITEM 855 - 4" ASPHALT TREATED FREE DRAINING BASE
- ⑤ ITEM 304 - 8" AGGREGATE BASE
- ⑦ ITEM 870 - SEEDING AND MULCHING (SEE GENERAL NOTE)
- ⑧ ITEM 606 - GUARDRAIL, TYPE 5
- ⑨ ITEM 203 - EMBANKMENT
- ⑩ ITEM 407 - TACK COAT @ 0.10 GALS/SQ. YD.
- ⑭ ITEM 203 - EXCAVATION NOT INCLUDING EMBANKMENT CONSTRUCTION
- ⑮ ITEM 408 - BITUMINOUS PRIME COAT @ 0.40 GALS/SQ. YD.
- ⑯ ITEM 605 - 4" SHALLOW PIPE UNDERDRAIN W/FABRIC WRAP, 707.31, AS PER PLAN
- ⑰ ITEM 203 - SUBGRADE COMPACTION
- ⑱ ITEM 605 - 6" SHALLOW PIPE UNDERDRAIN W/ FABRIC WRAP, 707.31
- ⑳ ITEM 202 - PAVEMENT REMOVED, 10" CONCRETE
- ㉑ ITEM 407 - TACK COAT FOR INTERMEDIATE COURSE @ 0.05 GALS/SQ. YD.

**NOTES:**

- \* FOR UNDERDRAIN AND EDGE COURSE DETAILS SEE SHEET NO. T4
- \*\* OR RATE OF SUPER IF GREATER

**NOTES:**

1. THIS IS A WARRANTY PAVEMENT AND SHALL BE CONSTRUCTED AS PER SUPPLEMENTAL SPECIFICATIONS 880 ASPHALT CONCRETE WITH WARRANTY.
2. THE UNDERDRAIN DEPTHS ARE 18", 30", OR VARIABLE (UNCLASSIFIED). SEE UNDERDRAIN TABLE FOR LOCATIONS.
3. TYPICALS DO NOT SHOW ACCELERATION AND DECELERATIONS LANES. SEE SHEET T7.
4. EXISTING UNDERDRAIN TO REMAIN AS LONG AS POSITIVE OUTLET FLOW IS MAINTAINED

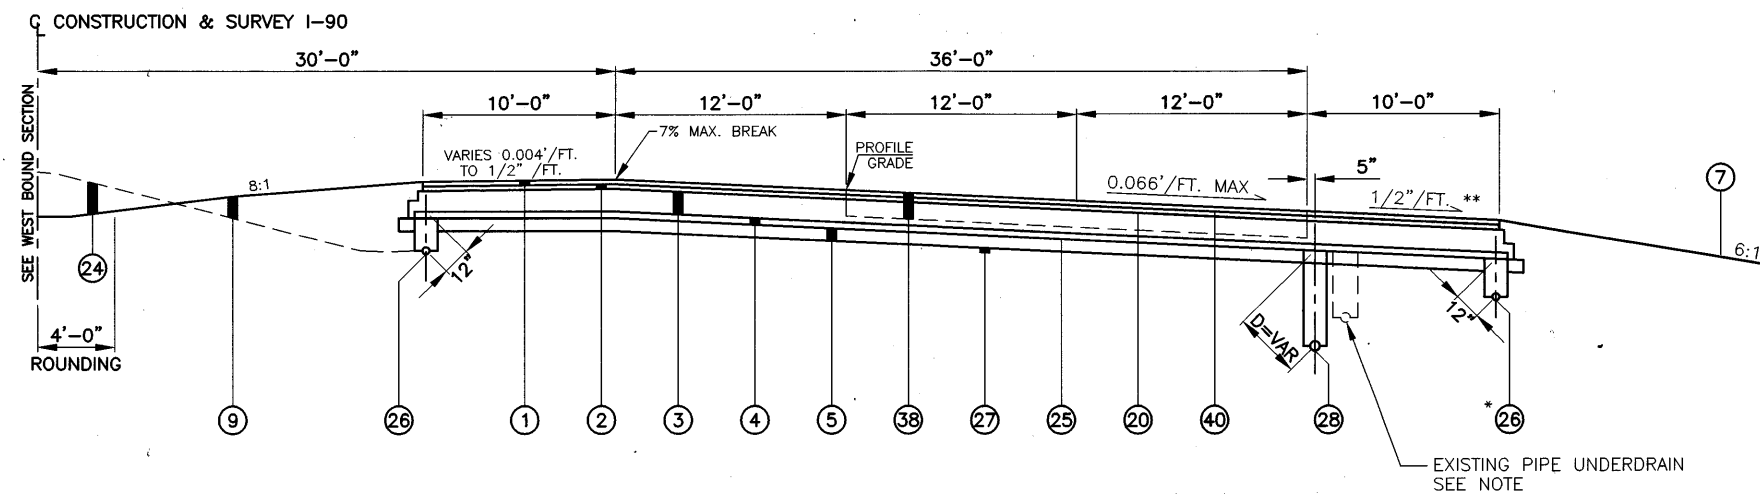

**SUPERELEVATED SECTION (EASTBOUND)**


SUPERELEVATION TRANS. STA. 971+40.84 TO STA. 977+81.64  
 FULL SUPERELEVATION STA. 977+81.64 TO STA. 997+72.69  
 SUPERELEVATION TRANS. STA. 997+72.69 TO STA. 1004+13.49

LOR - 190 - 10.76

I:\93600\WMS\93600\FNL\T-03.DWG 1 LAB  
 -19-2002 12:37PM

# PROPOSED TYPICAL SECTIONS - I.R. 90

(RECONSTRUCTION OF EXISTING PAVEMENT & PREVIOUSLY WIDENED SECTION)

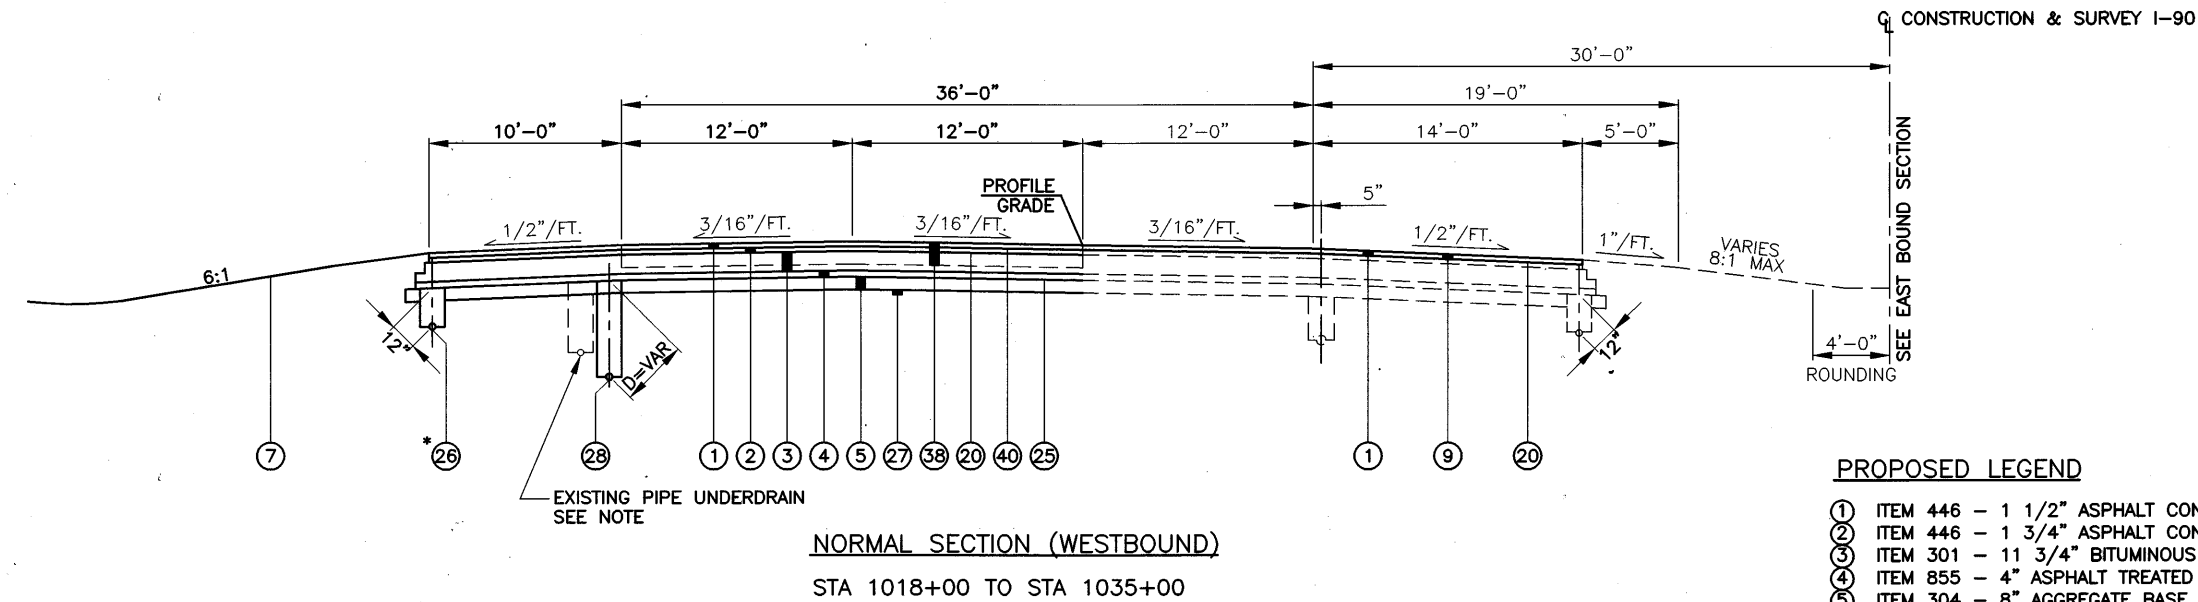


**PROPOSED LEGEND**

- ① ITEM 446 - 1 1/2" ASPHALT CONCRETE, SURFACE COURSE, TYPE 1, PG 76-22 MODIFIED
- ② ITEM 446 - 1 3/4" ASPHALT CONCRETE, INTERMEDIATE COURSE, TYPE 2, PG 70-22 SUPPLEMENTAL 880
- ③ ITEM 301 - 11 3/4" BITUMINOUS AGGREGATE BASE, PG 64-22 SUPPLEMENTAL 880
- ④ ITEM 855 - 4" ASPHALT TREATED FREE DRAINING BASE
- ⑤ ITEM 304 - 8" AGGREGATE BASE
- ⑦ ITEM 870 - SEEDING AND MULCHING (SEE GENERAL NOTE)
- ⑧ ITEM 606 - GUARDRAIL, TYPE 5
- ⑨ ITEM 254 - PAVEMENT PLANNING, BITUMINOUS
- ⑩ ITEM 407 - TACK COAT @ 0.10 GALS/SQ. YD.
- ⑫ ITEM 408 - BITUMINOUS PRIME COAT @ 0.40 GALS/SQ. YD.
- ⑬ ITEM 605 - 4" SHALLOW PIPE UNDERDRAIN W/FABRIC WRAP, 707.31, AS PER PLAN
- ⑭ ITEM 203 - SUBGRADE COMPACTION
- ⑮ ITEM 605 - 6" SHALLOW PIPE UNDERDRAIN W/ FABRIC WRAP, 707.31
- ⑯ ITEM 202 - PAVEMENT REMOVED, 10" CONCRETE
- ⑰ ITEM 407 - TACK COAT FOR INTERMEDIATE COURSE @ 0.05 GALS/SQ. YD.

**NOTES:**

1. THIS IS A WARRANTY PAVEMENT AND SHALL BE CONSTRUCTED AS PER SUPPLEMENTAL SPECIFICATIONS 880 ASPHALT CONCRETE WITH WARRANTY.
  2. THE UNDERDRAIN DEPTHS ARE 18", 30", OR VARIABLE (UNCLASSIFIED). SEE UNDERDRAIN TABLE FOR LOCATIONS.
  3. EXISTING UNDERDRAIN TO REMAIN AS LONG AS POSITIVE OUTLET FLOW IS MAINTAINED
- \* FOR UNDERDRAIN AND EDGE COURSE DETAILS, SEE SHEET T4.

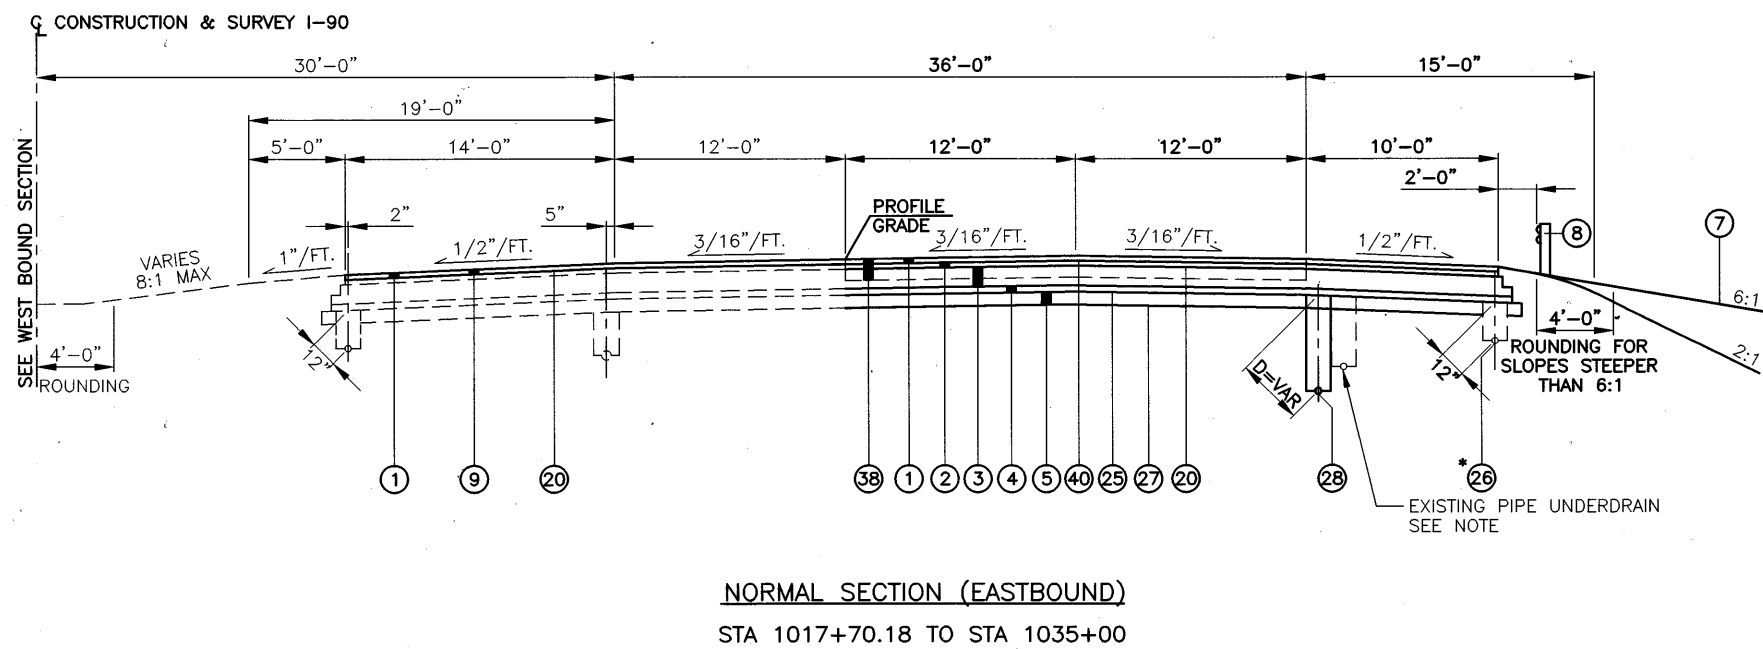


# TYPICAL SECTIONS SPEED CHANGE AND RAMP PACING LANES


## S.R. 611 INTERCHANGE

CALCULATED  
DLS  
CHECKED  
LAB

### EXISTING TYPICALS

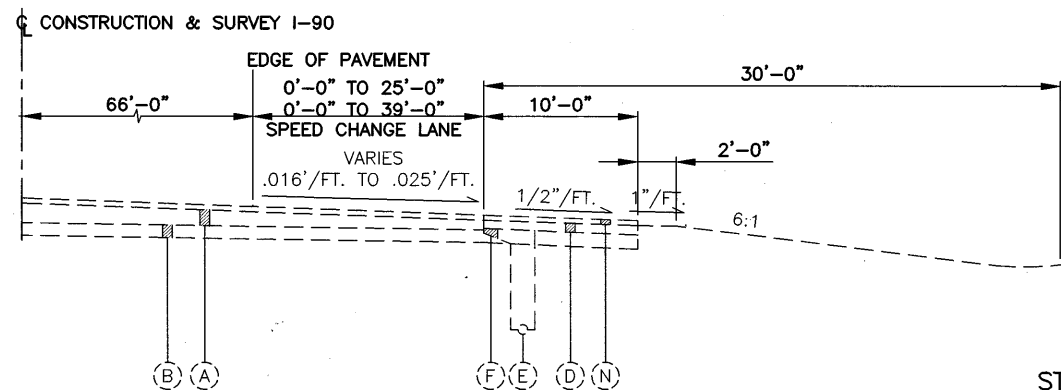

**SPEED CHANGE LANE  
LIMITING STATIONING**

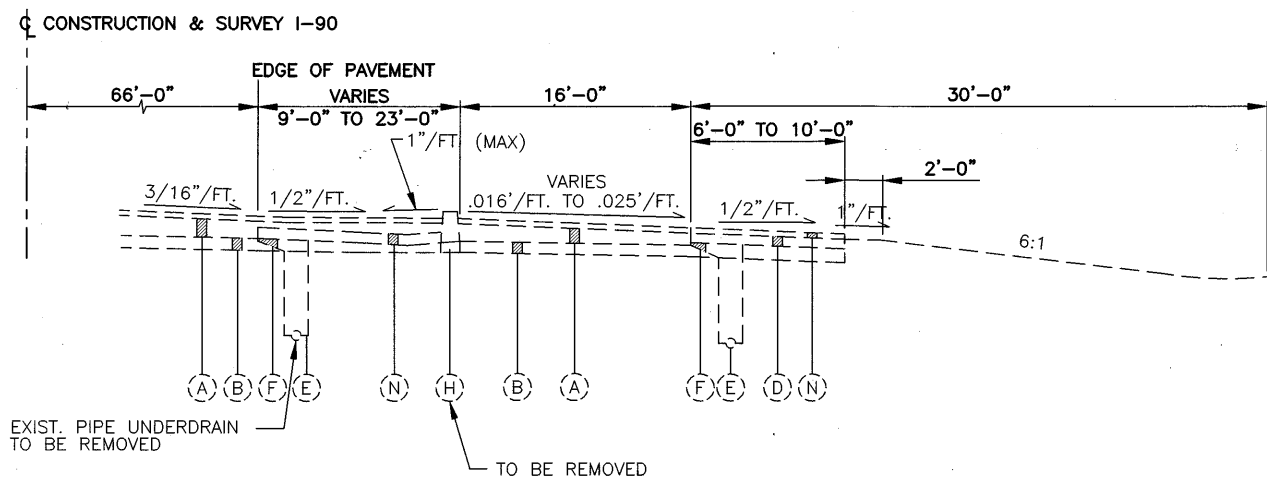


**RAMP PACING LANE  
LIMITING STATIONING**

- EXISTING LEGEND**
- (A) 10" REINFORCED CONCRETE PAVEMENT
  - (B) VARIABLE THICKNESS SUBBASE
  - (D) 6" AGGREGATE BASE
  - (E) 6" PIPE UNDERDRAIN
  - (F) SPECIAL DRAINAGE CONNECTION, USING NO.9 AGGREGATE
  - (G) GUARDRAIL, TYPE 5
  - (H) CONCRETE CURB, STANDARD TYPE 8
  - (N) 3" BITUMINOUS AGGREGATE BASE
  - (H) CURB, TYPE 8


**NOTE**

1. THIS IS A WARRANTY PAVEMENT AND SHALL BE CONSTRUCTED AS PER SUPPLEMENTAL SPECIFICATIONS 880 ASPHALT CONCRETE WITH WARRANTY.
  2. THE UNDERDRAIN DEPTHS ARE 18", 30", OR VARIABLE (UNCLASSIFIED). SEE UNDERDRAIN TABLE FOR LOCATIONS.
  3. EXISTING UNDERDRAIN TO REMAIN AS LONG AS POSITIVE OUTLET FLOW IS MAINTAINED
  4. SEE SHEETS M6 - M9 FOR ACCELERATION AND DECELERATION LAYOUTS
- \* FOR UNDERDRAIN AND EDGE COURSE DETAILS, SEE SHEET T4.

### PROPOSED TYPICALS

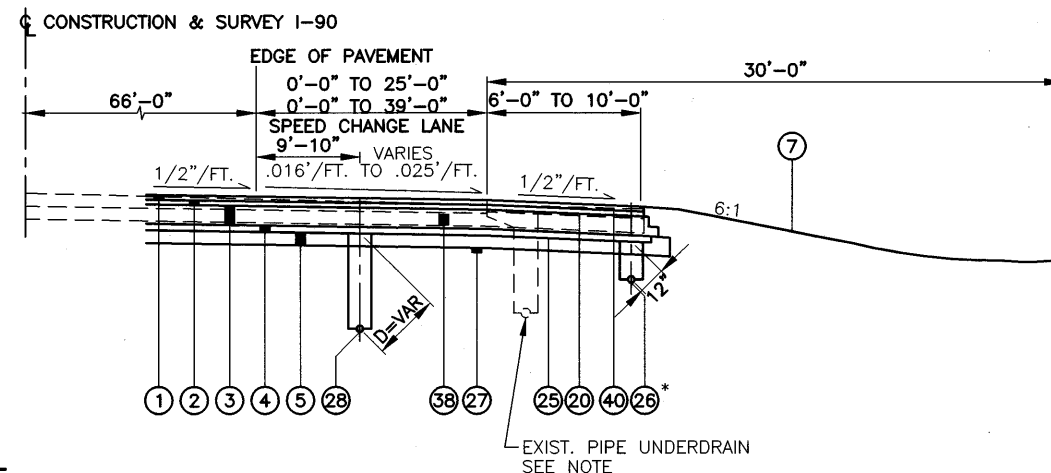

**SPEED CHANGE LANE  
LIMITING STATIONING**

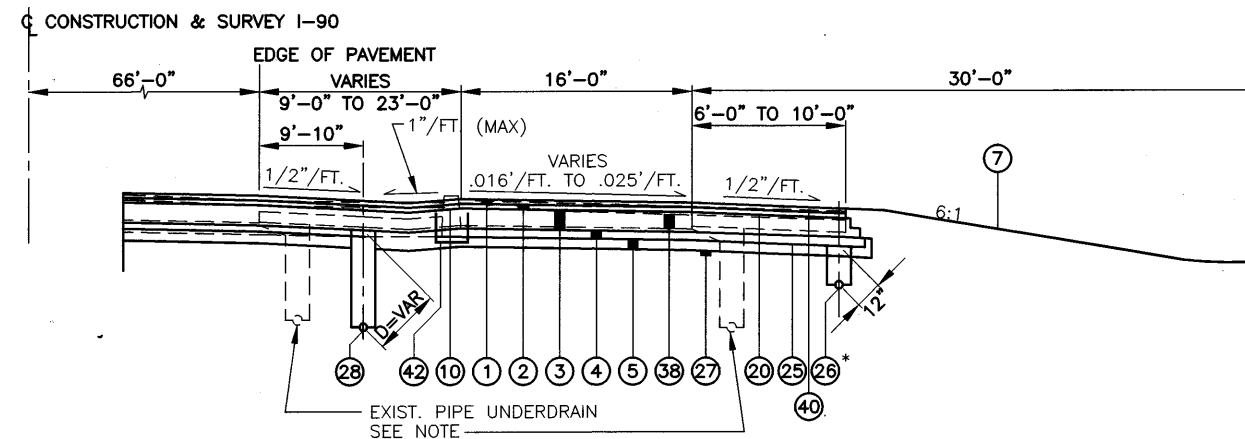

**RAMP PACING LANE  
LIMITING STATIONING**

**PROPOSED LEGEND**

- (1) ITEM 446 - 1 1/2" ASPHALT CONCRETE, SURFACE COURSE, TYPE 1, PG 76-22 MODIFIED
- (2) ITEM 446 - 1 3/4" ASPHALT CONCRETE, INTERMEDIATE COURSE, TYPE 2, 70-22 SUPPLEMENTAL 880
- (3) ITEM 301 - 11 3/4" BITUMINOUS AGGREGATE BASE, PG 64-22 SUPPLEMENTAL 880
- (4) ITEM 855 - 4" ASPHALT TREATED FREE DRAINING BASE
- (5) ITEM 304 - 8" AGGREGATE BASE
- (7) ITEM 870 - SEEDING AND MULCHING (SEE GENERAL NOTE)
- (10) ITEM 202 - CURB REMOVED
- (20) ITEM 407 - TACK COAT @ 0.10 GALS./SQ. YD.
- (25) ITEM 408 - BITUMINOUS PRIME COAT @ 0.40 GALS./SQ. YD.
- (26) ITEM 605 - 4" SHALLOW PIPE U.D. W/FABRIC WRAP, 707.31, AS PER PLAN
- (27) ITEM 203 - SUBGRADE COMPACTION
- (28) ITEM 605 - 6" SHALLOW PIPE UNDERDRAIN W/ FABRIC WRAP, 707.31
- (38) ITEM 202 - PAVEMENT REMOVED, 10" CONCRETE
- (40) ITEM 407 - TACK COAT, @ 0.05 GALS./SQ. YD. (FOR INTERMEDIATE COURSE)
- (42) ITEM 446 - ASPHALT CONCRETE TO FILL IN TRENCH

RAMP "M"  
STA. 990+13.04 TO STA. 992+50.88  
~~RAMP "P"~~  
~~STA. 961+22.89 TO STA. 965+69.82~~  
WORK NOT PERFORMED



RAMP "N"  
STA. 993+21.89 TO STA. 1005+21.89  
~~RAMP "R"~~  
~~STA. 953+14.43 TO STA. 965+14.43~~  
WORK NOT PERFORMED

SPEED CHANGE AND PACING LANES TYPICAL SECTIONS S.R. 611

LOR - 190 - 10.76

# RAMP TYPICAL SECTIONS – SR 611 INTERCHANGE (WITHOUT EXISTING OVERLAY)

CALCULATED  
DLS  
CHECKED  
LAB

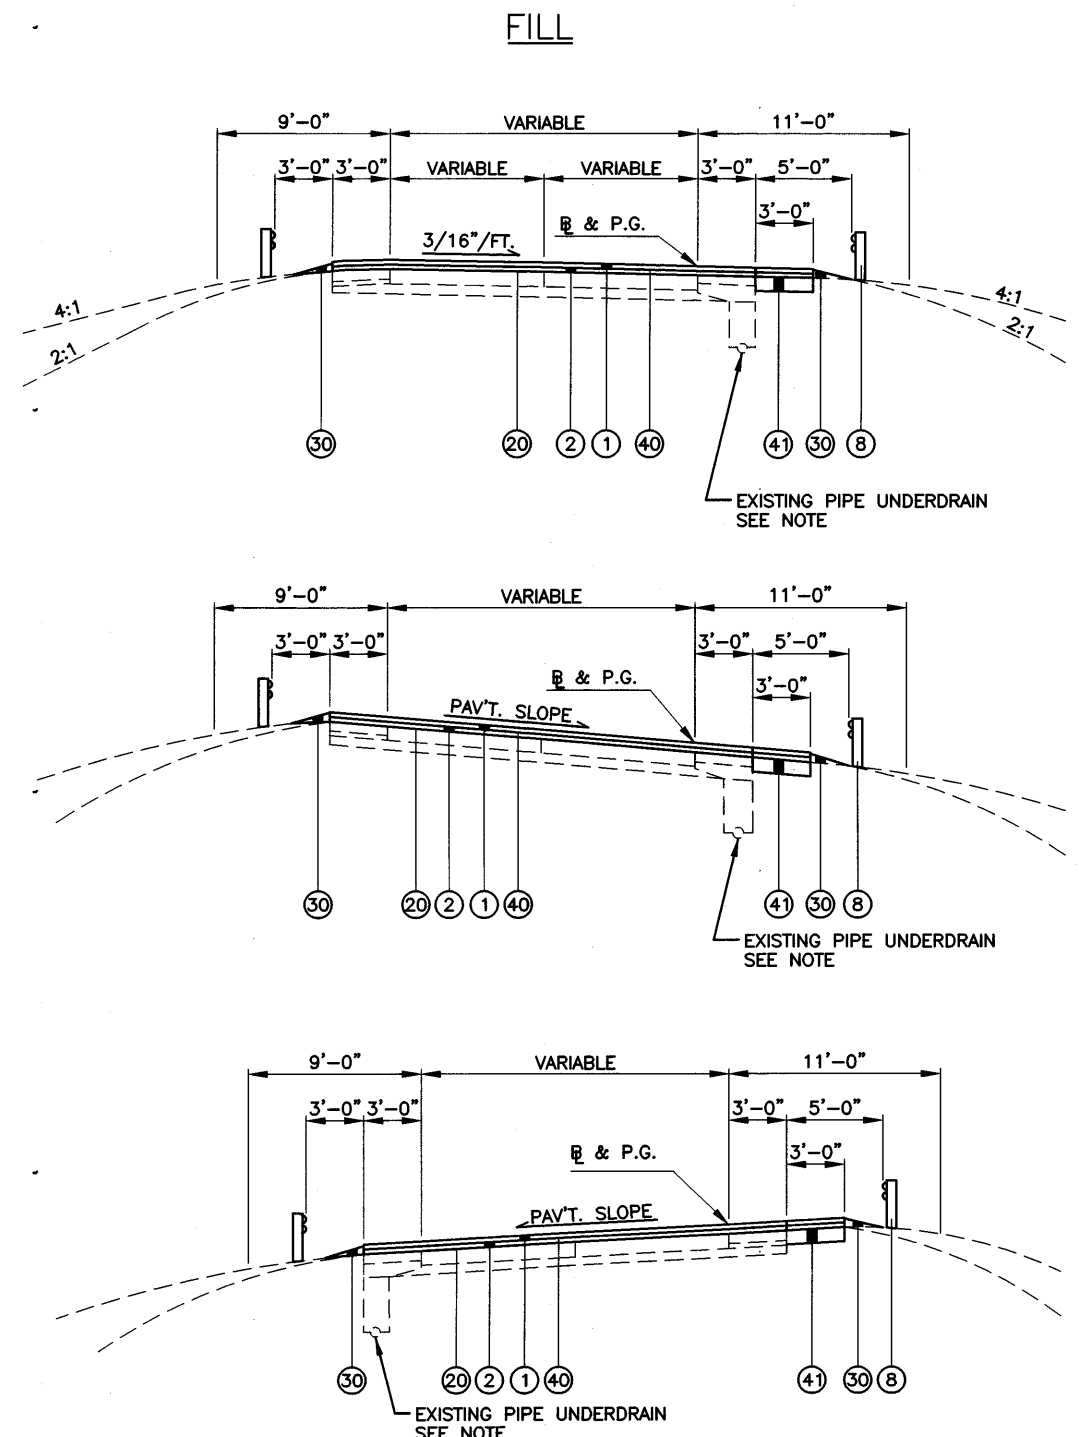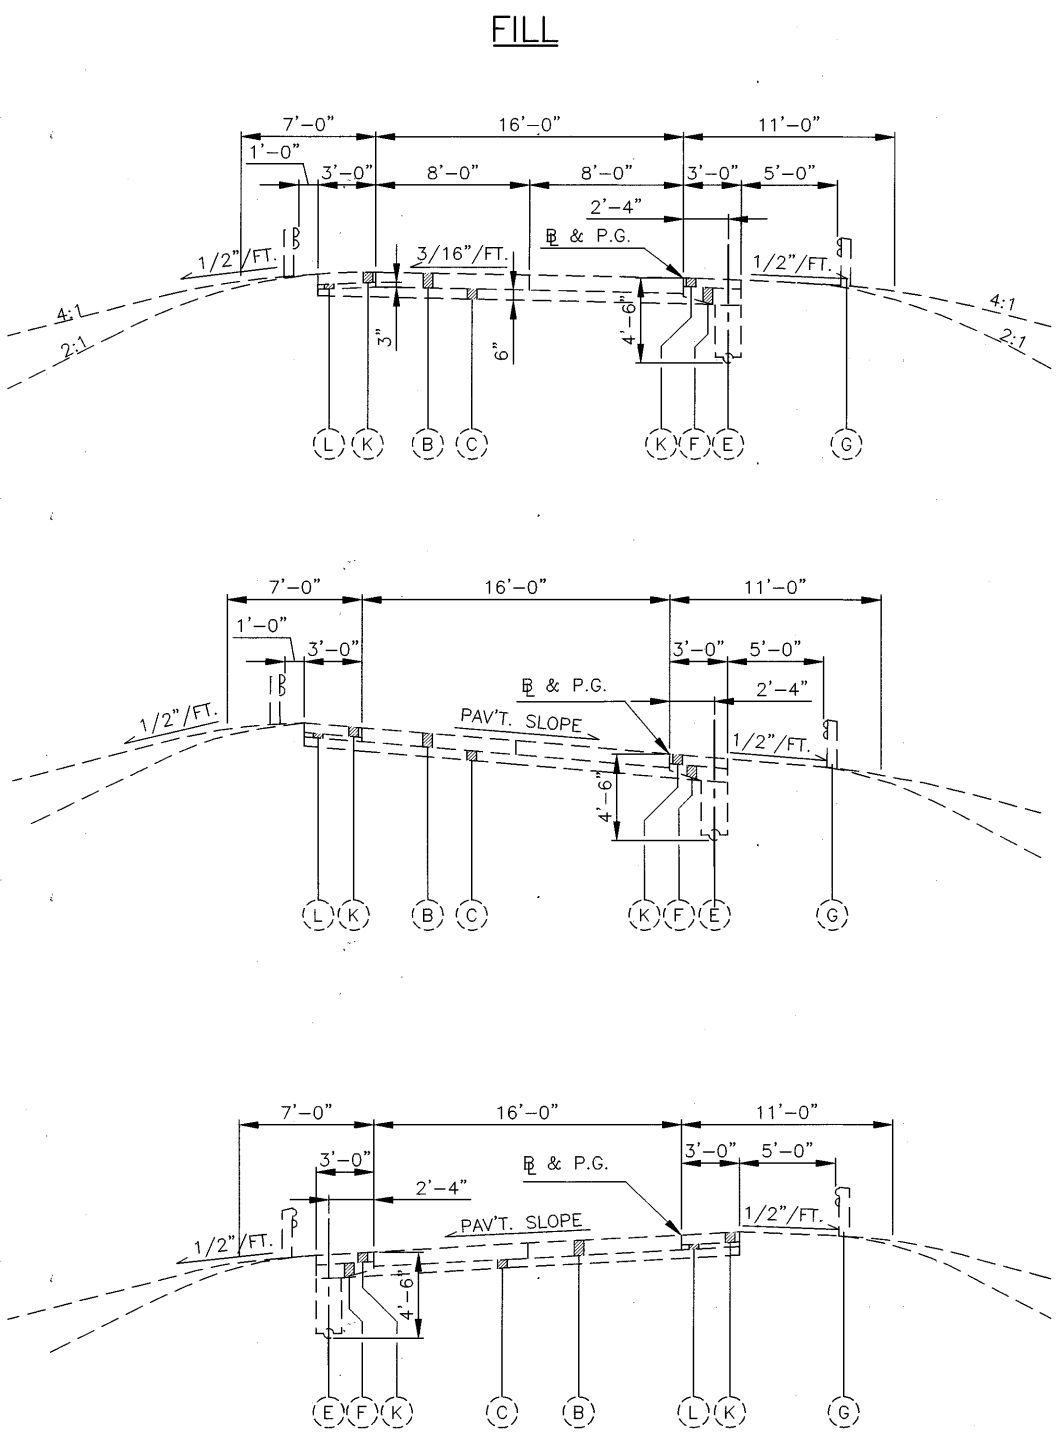

**EXISTING LEGEND**

- (A) 3 1/4" ASPHALT CONCRETE OVERLAY
- (B) 10" REINFORCED CONCRETE PAVEMENT
- (C) VARIABLE THICKNESS SUBBASE
- (E) 6" PIPE UNDERDRAIN
- (F) SPECIAL DRAINAGE CONNECTION
- (G) GARDRAIL, TYPE 5
- (K) 6" BITUMINOUS AGGREGATE BASE
- (L) AGGREGATE BASE

**NOTE:**

EXISTING UNDERDRAIN TO REMAIN AS LONG AS POSITIVE OUTLET FLOW IS MAINTAINED


**PROPOSED LEGEND**

- (1) ITEM 446 – 1 1/2" ASPHALT CONCRETE, SURFACE COURSE, TYPE 1H
- (2) ITEM 446 – 2 1/4" ASPHALT CONCRETE, INTERMEDIATE COURSE, TYPE 2, PG 64-28
- (8) ITEM 606 – GUARDRAIL, TYPE 5
- (20) ITEM 407 – TACK COAT @ 0.10 GALS/SQ. YD.
- (30) ITEM 617 – SHOULDER RECONDITIONING, MISC., COMPACTED AGGREGATE
- (40) ITEM 407 – TACK COAT FOR INTERMEDIATE @ 0.05 GALS/SQ. YD.
- (41) ITEM 301 – 6" BITUMINOUS AGGREGATE BASE, PG 64-22

RAMP TYPICAL SECTIONS (WITHOUT EXISTING OVERLAY)

LOR - 190 - 10.76

A:\956001\DWG\956001\T-X6.DWG J LAB  
19-2002 12:39PM

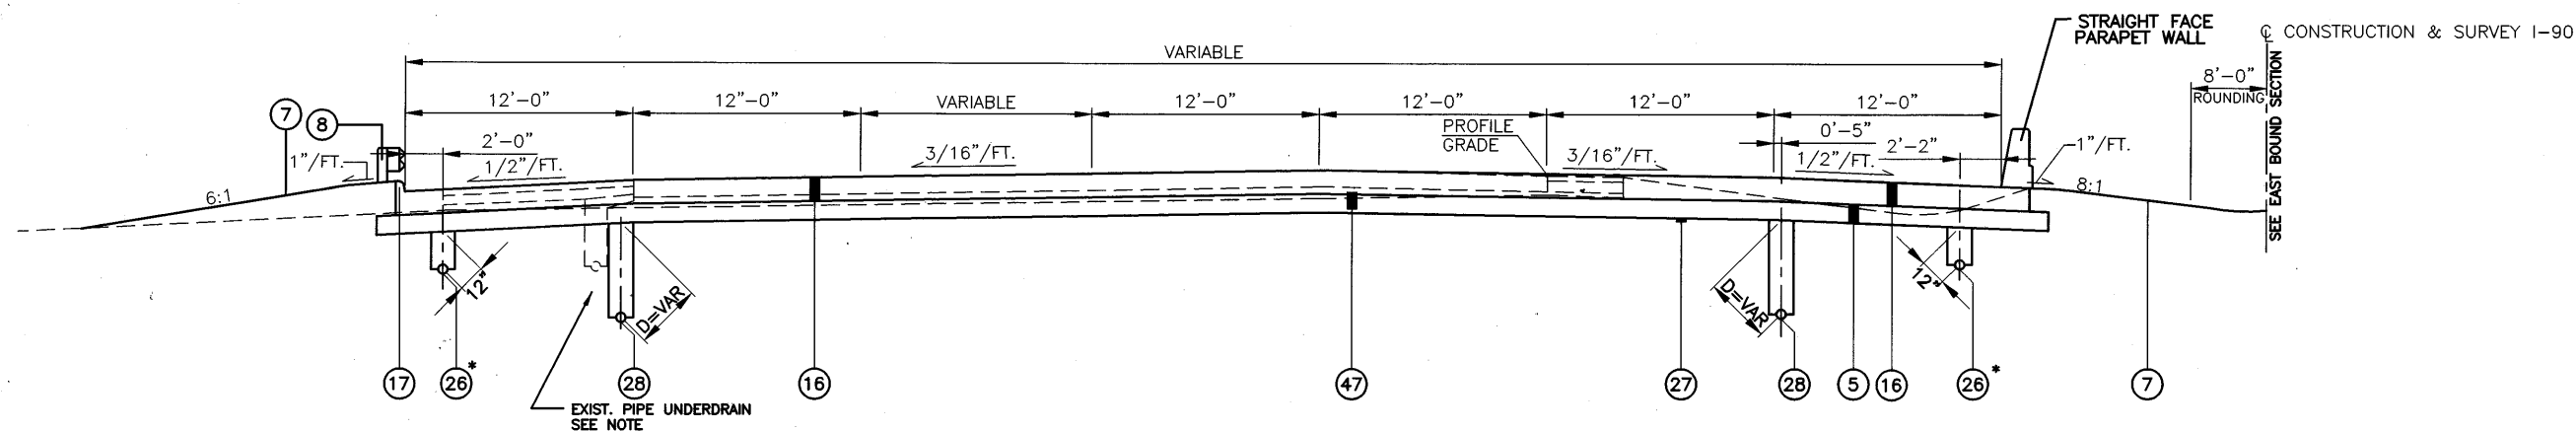

NORMAL APPROACH SLAB SECTION (WESTBOUND)


STA. 966+22.25 TO STA. 966+33.25 (TYPE 2A CURB WILL BE USED ON BOTH SIDES)  
 STA. 966+33.25 TO STA. 966+47.25 (STRAIGHT FACE PARAPET WALL WILL BE USED ON BOTH SIDES)

PROPOSED LEGEND

- 5 ITEM 304 - 8" AGGREGATE BASE
- 7 ITEM 870 - SEEDING AND MULCHING (SEE GENERAL NOTE)
- 8 ITEM 606 - GUARDRAIL, TYPE 5
- 16 ITEM 611 - REINFORCED CONCRETE APPROACH SLAB (T=15"), AS PER PLAN
- 17 ITEM 830 - CURB, TYPE 2A - COST INCLUDED IN ITEM 611
- 26 ITEM 605 - 4" SHALLOW PIPE UNDERDRAIN W/ FABRIC WRAP, 707.31, AS PER PLAN
- 28 ITEM 605 - 6" SHALLOW PIPE UNDERDRAIN W/ FABRIC WRAP, 707.31
- 27 ITEM 203 - SUBGRADE COMPACTION
- 47 ITEM 202 - APPROACH SLAB REMOVED


NOTES


1. THE UNDERDRAIN DEPTHS ARE 18", 30", OR VARIABLE (UNCLASSIFIED). SEE UNDERDRAIN TABLE FOR LOCATIONS.
  2. EXISTING UNDERDRAIN TO REMAIN AS LONG AS POSITIVE OUTLET FLOW IS MAINTAINED
- \* FOR UNDERDRAIN DETAILS SEE DETAIL ON THIS SHEET.

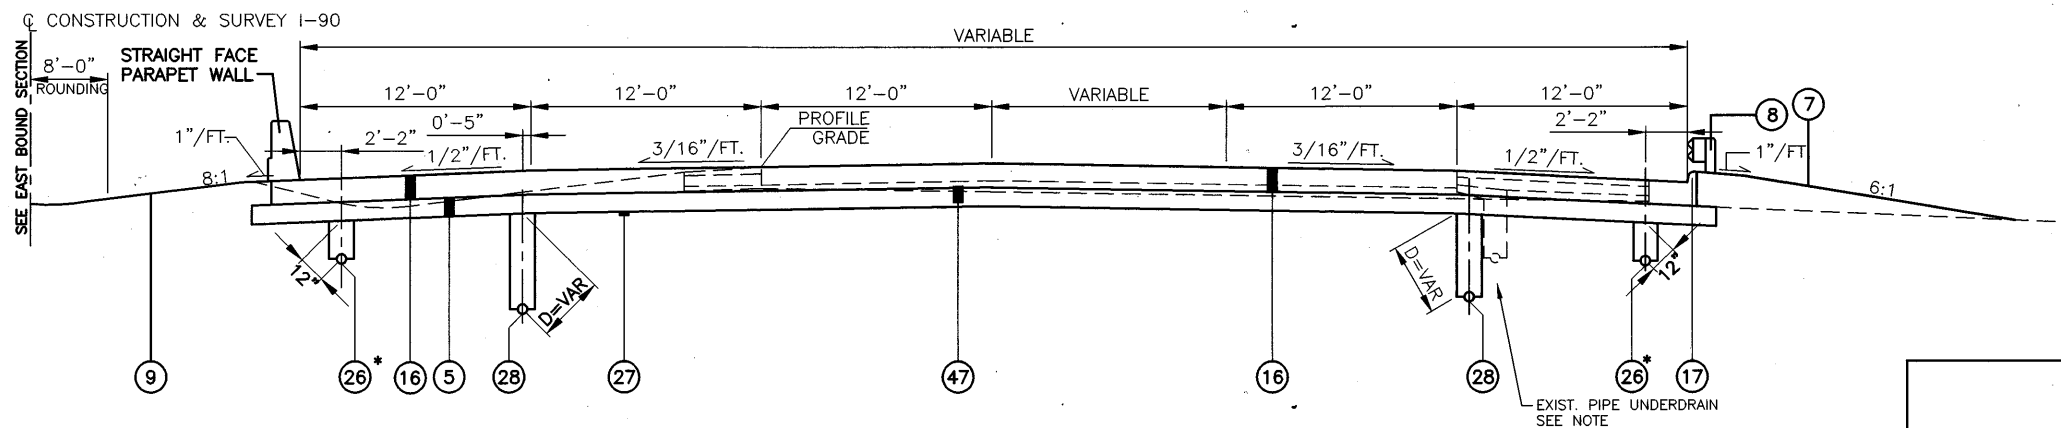

NORMAL APPROACH SLAB SECTION (EASTBOUND)

STA. 966+22.25 TO STA. 966+33.15 (TYPE 2A CURB WILL BE USED ON BOTH SIDES)  
 STA. 966+33.15 TO STA. 966+47.25 (STRAIGHT FACE PARAPET WALL WILL BE USED ON BOTH SIDES)

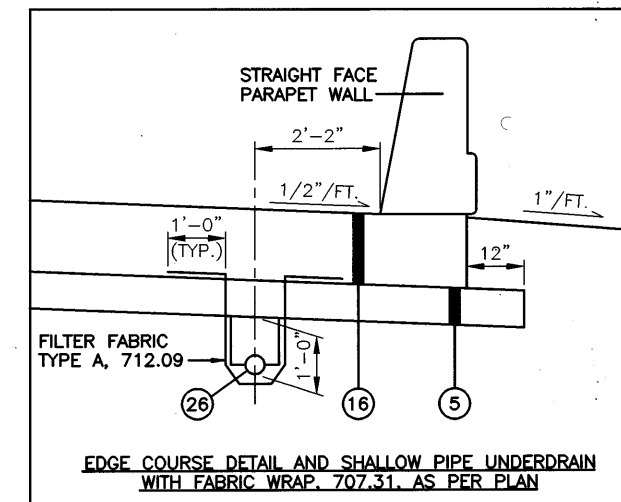

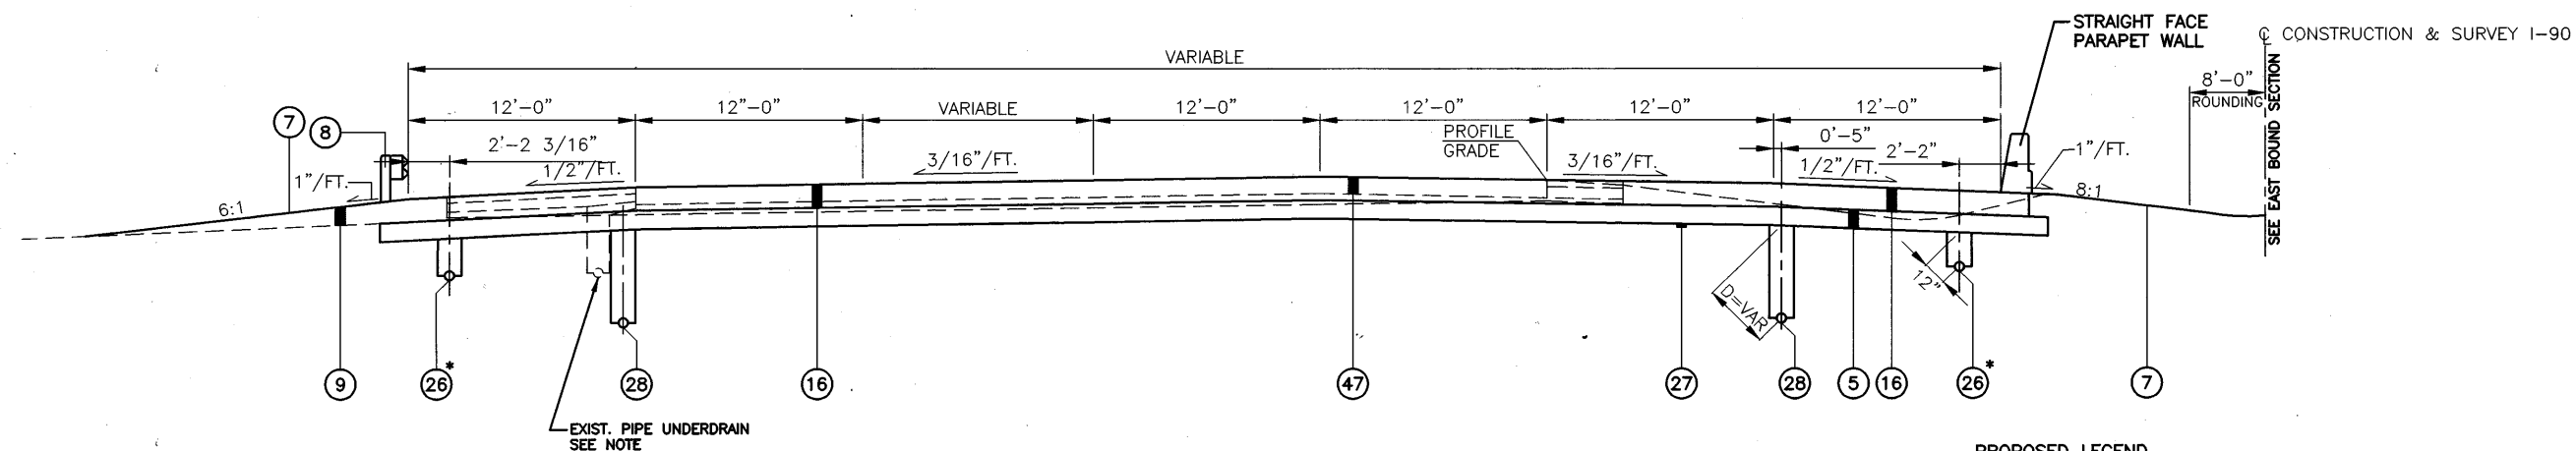

NORMAL APPROACH SLAB SECTION (WESTBOUND)


STA. 967+52.75 TO STA. 967+66.75 (STRAIGHT FACE PARAPET WALL WILL BE USED ON BOTH SIDES)  
STA. 967+66.75 TO STA. 967+77.75

PROPOSED LEGEND

- 5 ITEM 304 - 8" AGGREGATE BASE
- 7 ITEM 870 - SEEDING AND MULCHING (SEE GENERAL NOTE)
- 8 ITEM 606 - GUARDRAIL, TYPE 5
- 16 ITEM 611 - REINFORCED CONCRETE APPROACH SLAB (T=15"), AS PER PLAN
- 26 ITEM 605 - 4" SHALLOW PIPE UNDERDRAIN W/ FABRIC WRAP, 707.31, AS PER PLAN
- 28 ITEM 605 - 6" SHALLOW PIPE UNDERDRAIN W/ FABRIC WRAP, 707.31
- 27 ITEM 203 - SUBGRADE COMPACTION
- 47 ITEM 202 - APPROACH SLAB REMOVED


NOTES

1. THE UNDERDRAIN DEPTHS ARE 18", 30", OR VARIABLE (UNCLASSIFIED). SEE UNDERDRAIN TABLE FOR LOCATIONS.
  2. EXISTING UNDERDRAIN TO REMAIN AS LONG AS POSITIVE OUTLET FLOW IS MAINTAINED.
- \* FOR UNDERDRAIN DETAILS SEE DETAIL ON THIS SHEET.

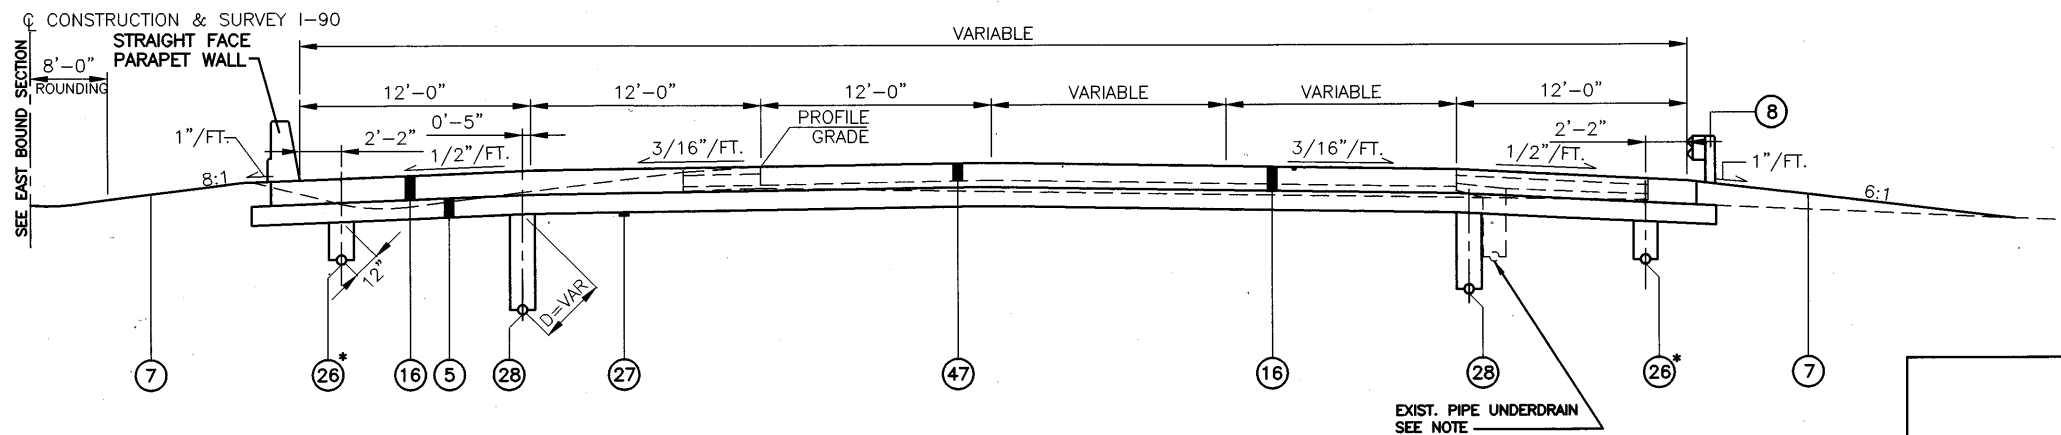

NORMAL APPROACH SLAB SECTION (EASTBOUND)

STA. 967+52.75 TO STA. 967+66.65 (STRAIGHT FACE PARAPET WALL WILL BE USED ON BOTH SIDES)  
STA. 967+66.65 TO STA. 967+77.75

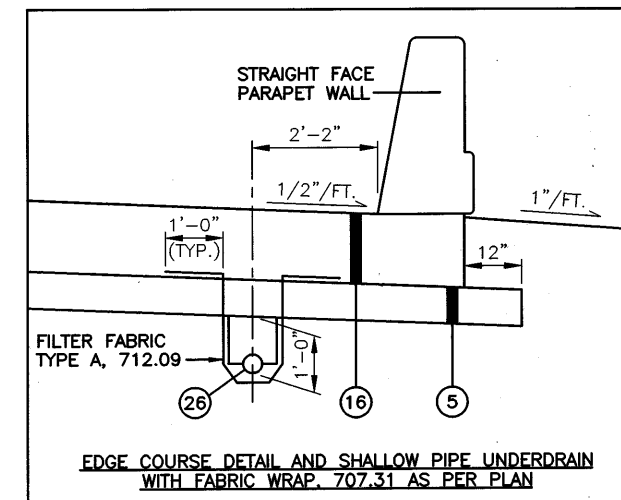



# RECONSTRUCTION SECTION

## ITEM 614 - MAINTAINING TRAFFIC

TWO LANES OF TRAFFIC IN EACH DIRECTION SHALL BE MAINTAINED AT ALL TIMES, WITH THE EXCEPTIONS NOTED IN THE SEQUENCE OF CONSTRUCTION, BY USE OF THE EXISTING PAVEMENT, THE COMPLETED PAVEMENT, AND TEMPORARY SURFACES USING 304, 614 AND 615.

SPECIFIC DIRECTIONS REGARDING LANES CLOSURES FOR EACH SEGMENT OF CONSTRUCTION ARE NOTED IN THE SEQUENCE OF CONSTRUCTION.

THE FOLLOWING ESTIMATED QUANTITIES ARE FOR USE AS DIRECTED BY THE ENGINEER FOR THE MAINTENANCE OF TRAFFIC.

ITEM 614 - BITUMINOUS CONCRETE FOR MAINTAINING TRAFFIC 300 CU. YD.

## GENERAL

ALL WORK AND TRAFFIC CONTROL DEVICES SHALL BE IN ACCORDANCE WITH 614 AND OTHER APPLICABLE PORTIONS OF THE SPECIFICATIONS AND STANDARD CONSTRUCTION DRAWINGS, AS WELL AS THE OHIO MANUAL OF UNIFORM TRAFFIC CONTROL DEVICES. PAYMENT FOR ALL LABOR, EQUIPMENT AND MATERIALS SHALL BE INCLUDED IN THE LUMP SUM CONTRACT PRICE FOR 614, MAINTAINING TRAFFIC, UNLESS SEPERATELY ITEMIZED IN THE PLAN.

THE CONTRACTOR SHALL PROVIDE, ERECT AND MAINTAIN SIGNS AND SIGN SUPPORTS, AS DETAILED IN THE OHIO MANUAL OF UNIFORM TRAFFIC CONTROL DEVICES.

## TRENCH FOR WIDENING

TRENCH EXCAVATION FOR BASE WIDENING SHALL BE ONLY ONE SIDE OF THE PAVEMENT AT A TIME. THE OPEN TRENCH SHALL BE ADQUATELY MAINTAINED AND PROTECTED WITH DRUMS OR BARRICADES AT ALL TIMES. PLACEMENT OF THE PROPOSED BASE MATERIAL SHALL FOLLOW AS CLOSELY AS POSSIBLE BEHIND EXCAVATIONS OPERATIONS. THE LENGTH OF WIDENING TRENCH WHICH IS OPEN AT ANY ONE TIME SHALL BE HELD TO A MINIMUM AND SHALL AT ALL TIMES BE SUBJECT TO THE APPROVAL OF THE ENGINEER.

## OVERNIGHT TRENCH CLOSING

THE BASE WIDENING SHALL BE COMPLETED TO A DEPTH OF NO MORE THAN 1 1/2 INCHES BELOW THE EXISTING PAVEMENT BY THE END OF EACH WORK DAY. NO TRENCH SHALL BE LEFT OPEN OVERNIGHT EXCEPT FOR A SHORT LENGTH (25 FEET OR LESS) OF A WORK SECTION AT THE END OF THE TRENCH. IN CASE WORK MUST BE SUSPENDED BECAUSE OF INCLEMENT WEATHER OR OTHER REASONS, THE TRENCH FOR THE UNCOMPLETED BASE WIDENING SHALL BE BACKFILLED AT THE DIRECTION OF THE ENGINEER.

## GUARDRAIL REPLACEMENT

NO HAZARD SHALL BE LEFT UNPROTECTED EXCEPT FOR THE ACTUAL TIME NECESSARY TO REMOVE THE EXISTING GUARDRAIL, PREPARE THE SITE, AND INSTALL NEW GUARDRAIL IN A CONTINUOUS OPERATION. THE REMOVAL OF ALL GUARDRAIL SHALL AT ALL TIMES BE AS DIRECTED BY THE ENGINEER. NO GUARDRAIL SHALL BE REMOVED UNTIL THE REPLACEMENT MATERIAL IS ON THE SITE, READY FOR INSTALLATION. FAILURE TO COMPLY WITH THIS REQUIREMENT SHALL BE DEEMED SUFFICIENT CAUSE TO ORDER WORK SUSPENDED UNTIL SUCH TIME AS THE ENGINEER IS ASSURED OF COMPLIANCE.

## DUST CONTROL

THE CONTRACTOR SHALL FURNISH AND APPLY WATER AND CALCIUM CHLORIDE FOR DUST CONTROL AS DIRECTED BY THE ENGINEER. THE FOLLOWING CONTINGENCY QUANTITIES HAVE BEEN INCLUDED FOR DUST CONTROL PURPOSES:

ITEM 616 - WATER 200 M. GAL.  
ITEM 616 - CALCIUM CHLORIDE 20 TONS

## ITEM 614 - BARRIER REFLECTOR AND/OR OBJECT MARKERS

BARRIER REFLECTORS AND/OR OBJECT MARKERS SHALL BE INSTALLED ON ALL PORTABLE CONCRETE BARRIER USED FOR TRAFFIC CONTROL. BARRIER REFLECTORS, OBJECT MARKERS AND THEIR INSTALLATION SHALL CONFORM TO THE APPROPRIATE PROPOSAL NOTE AND ITEM 626 EXCEPT THAT THE SPACING SHALL BE 25 FEET.

## TEMPORARY WORK ZONE MARKINGS AND SIGNS

THE FOLLOWING ESTIMATED QUANTITIES ARE FOR USE AS DIRECTED BY THE ENGINEER FOR TEMPORARY WORK ZONE PAVEMENT MARKINGS AND SIGNS PER THE REQUIREMENTS 614.04 AND 614.10.

## ITEM 622 - PORTABLE CONCRETE BARRIER

IT IS ANTICIPATED THAT THE SAME BARRIER WILL BE USED IN VARIOUS PHASES OF CONSTRUCTION. MOVEMENT OF THE CONCRETE BARRIER BETWEEN PHASES SHALL BE ACCOMPLISHED IN ONE WORKING DAY. FLAGGERS SHALL BE UTILIZED FOR PROTECTION OF VEHICULAR TRAFFIC UNTIL MOVEMENT OF THE BARRIER IS COMPLETE.

## FLOODLIGHTING

FLOODLIGHTING OF THE WORK SITE FOR OPERATIONS CONDUCTED DURING NIGHT TIME PERIODS SHALL BE ACCOMPLISHED SO THAT THE LIGHTS DO NOT CAUSE GLARE TO THE DRIVERS ON THE ROADWAY. TO ENSURE THE ADEQUACY OF THE FLOODLIGHT PLACEMENT, THE CONTRACTOR AND THE ENGINEER SHALL DRIVE THROUGH THE WORK SITE EACH NIGHT WHEN THE LIGHTING IS IN PLACE AND PLACEMENT AND SHIELDING SHALL BE ADJUSTED TO THE SATISFACTION OF THE ENGINEER BEFORE WORK PROCEEDS.

PAYMENT FOR ALL LABOR, EQUIPMENT AND MATERIALS SHALL BE INCLUDED IN THE LUMP SUM CONTRACT PRICE FOR MAINTAINING TRAFFIC.

## TEMPORARY PAVEMENT MARKINGS

IT MAY BE NECESSARY FOR THE CONTRACTOR TO PLACE TEMPORARY LANE LINE MARKINGS ON THE INTERMEDIATE AND/OR FINAL COURSES IF HE/SHE IS UNABLE TO EXPEDITE THE PROJECT. THE PLACEMENT OF THE TEMPORARY PAVEMENT MARKINGS SHALL BE SHOWN ON THE FINAL TRAFFIC CONTROL SHEET XXX. THESE TEMPORARY PAVEMENT MARKINGS SHALL BE APPLIED TO EACH ASPHALT PAVEMENT COURSE OPEN TO TRAFFIC.

## ITEM 202 - CURB REMOVED, AS PER PLAN

ITEM 202 - CURB REMOVED AS PER PLAN SHALL BE PERFORMED IN ACCORDANCE WITH ALL APPLICABLE STANDARDS AND SPECIFICATIONS SET FORTH IN THE CONSTRUCTION AND MATERIALS SPECIFICATIONS MANUAL. ADDITIONALLY, THIS ITEM SHALL INCLUDE PATCHING ANY GAP LEFT DUE TO THE REMOVAL. IN ANY AREA WHERE MAINTAINING TRAFFIC IS ANTICIPATED, THE PATCH SHALL MADE USING ASPHALT IN A MANNER TO CREATE A SURFACE SAFE FOR DRIVING AND ABLE TO WITHSTAND ANTICIPATED USE.

## HOLIDAY WORK RESTRICTIONS

NO WORK SHALL BE PERFORMED AND ALL EXISTING LANES SHALL BE OPEN TO TRAFFIC DURING THE FOLLOWING DESIGNATED HOLIDAYS:

CHRISTMAS NEW YEARS  
MEMORIAL DAY THE FORTH OF JULY  
LABOR DAY THANKSGIVING

THE PERIOD OF TIME THAT THE "NO WORK" APPLIES DEPENDS ON THE DAY OF THE WEEK ON WHICH THE HOLIDAY FALLS. THE FOLLOWING SCHEDULE SHALL BE USED TO DETERMINE THE PERIOD:

DAY OF THE WEEK	TIME ALL LANES MUST BE OPEN TO TRAFFIC
MONDAY	12 NOON FRIDAY THROUGH 12 NOON TUESDAY
TUESDAY	12 NOON MONDAY THROUGH 12 NOON WEDNESDAY
WEDNESDAY	12 NOON TUESDAY THROUGH 12 NOON THURSDAY
THURSDAY	12 NOON WEDNESDAY THROUGH 12 NOON FRIDAY
FRIDAY	12 NOON THURSDAY THROUGH 12 NOON MONDAY
SATURDAY	12 NOON FRIDAY THROUGH 12 NOON MONDAY
SUNDAY	12 NOON FRIDAY THROUGH 12 NOON MONDAY

NO EXTENSIONS OF TIME SHALL BE GRANTED FOR DELAYS IN MATERIAL DELIVERIES, UNLESS SUCH DELAYS ARE INDUSTRY WIDE, OR FOR LABOR STRIKES, UNLESS SUCH STRIKES ARE INDUSTRY WIDE.

SHOULD THE CONTRACTOR FAIL TO MEET ANY OF THESE REQUIREMENTS, THE CONTRACTOR SHALL BE ASSESSED LIQUIDATED DAMAGES IN ACCORDANCE WITH SECTION 108.07 OF THE CONSTRUCTION AND MATERIALS SPECIFICATIONS.

## ITEM 614 - WORK ZONE SPEED LIMIT SIGN

THE CONTRACTOR SHALL FURNISH, INSTALL, MAINTAIN, COVER DURING SUSPENSION OF WORK, AND SUBSEQUENTLY REMOVE WORK ZONE SPEED LIMIT SIGNS AND SUPPORTS WITHIN THE WORK ZONE SPEED LIMITS IN ACCORDANCE WITH THE FOLLOWING REQUIREMENTS.

THE CONTRACTOR SHALL COVER OR REMOVE ANY EXISTING SPEDD LIMIT OR MINIMUM SPEED SIGNS WITHIN THE REDUCED SPEED ZONE. THESE SIGNS SHALL BE RESTORED DURING SUSPENSION OR TERMINATION OF THE REDUCED SPEED LIMIT. THE EXPENSE OF COVERING OR REMOVAL AND RESTORATION OF EXISTING SPEED LIMIT OR MINIMUM SPEED SIGNS SHALL BE INCLUDED IN THE PAY ITEM FOR THE WORK ZONE SPEED LIMIT SIGNS.

THE WORK ZONE SPEED LIMIT SIGNS MAY BE ERECTED OR UNCOVERED NO MORE THAN 4 HOURS BEFORE THE ACTUAL START OR WORK. THE SIGNS SHALL BE REMOVED OR COVERED NO LATER THAN 4 HOURS FOLLOWING RESTORATION OF ALL LANES TO TRAFFIC WITH NO RESTRICTIONS, OR SOONER AS DIRECTED BY THE ENGINEER.

THE CONTRACTOR SHALL ERECT A WORK ZONE SPEED LIMIT SIGN IN ADVANCE OF ANY LANE RESTRICTION EXPECTED TO LAST AT LEAST 30 DAYS, OR AS DIRECTED BY THE ENGINEER. THE SIGN SHALL BE MOUNTED ON BOTH SIDES OF DIVIDED HIGHWAYS, 500 FEET IN ADVANCE OF THE LANE REDUCTION TAPER. THE SIGN SHALL BE MOUNTED ON THE RIGHT SIDE, 250 FEET IN ADVANCE OF THE LANE REDUCTION TAPER ON UNDIVIDED HIGHWAYS. THE SIGN SHALL BE REPEATED, ON THE SIDE NEAREST TRAFFIC, EVERY 1 MILE FOR 55 MPH ZONES AND EVERY 1/2 MILE FOR 45 MPH ZONES. THESE SIGNS SHALL ALSO BE ERECTED IMMEDIATELY AFTER EACH OPEN ENTRANCE RAMP WITHIN THE ZONE.

SIGNS TO INDICATE THE RESUMPTION OF THE STATURORY SPEED LIMIT SHALL BE ERECTED AT THE END OF ANY REDUCED SPEED ZONE. R-10 SIGNS SHALL BE USED ON UNDIVIDED ROADWAYS. R-10 AND R-9A SIGNS SHALL BE USED ON DIVIDED ROADWAYS. WHEN USED THE R-10 AND R-9A SIGNS SHALL BE MOUNTED SIDE-BY-SIDE ON SEPERATE SUPPORTS.

THE CONTRACTOR MAY USE SIGN SUPPORTS IN USED BUT GOOD CONDITION PROVIDED THE SIGNS MEET CURRENT ODOT SPECIFICATIONS. SIGN FACES SHALL BE REFLECTORIZED WITH TYPE G SHEET COMPLYING WITH THE REQUIREMENTS OF 730.19 AND U.S. DEPARTMENT OF TRANSPORTATION SUPPLEMENTAL SPECIFICATION FOR TYPE III-C SHEETING, FP-85. WORK ZONE SPEDD LIMIT SIGNS SHALL BE MOUNTED ON TWO (2) ITEM 630 GROUND MOUNTED SUPPORTS, NO. 3 POSTS.

WORK ZONE SPEED LIMIT SIGNS AND SUPPORTS WILL BE MEASURED AS THE NUMBER OF SIGN INSTALLATIONS, INCLUDING THE SIGNS AND NECESSARY SUPPORTS. IF A SIGN AND SUPPORT COMBINATION IS REMOVED AND REERECTED AT ANOTHER LOCATION WITHIN THE THE PROJECT DUE TO CHANGES IN THE SPEED ZONE DIRECTED BY THE ENGINEER, IT SHALL BE CONSIDERED ANOTHER UNIT.

PAYMENT FOR ACCEPTED QUANTITIES, COMPLETE IN PLACE, WILL BE MADE AT THE CONTRACT UNIT PRICE. PAYMENT SHALL BE IN FULL COMPENSATION FOR ALL MATERIALS, LABOR, INCIDENTALS AND EQUIPMENT FOR FURNISHING, ERECTING, MAINTAINING, COVERING DURING SUSPENSION OF WORK, AND REMOVING THE SIGNS AND SUPPORTS.

614, WORK ZONE SPEED LIMITS SIGN 16 EACH

THE SIGNS WILL BE PLACED AT THE FOLLOWING LOCATIONS:

## WORK-SITE TRAFFIC SUPERVISOR

THE CONTRACTOR SHALL EMPLOY A WORKSITE TRAFFIC SUPERVISOR (WTS), OTHER THAN THE SUPERINTENDENT, FOR THE PURPOSE OF MONITORING THE MAINTENANCE OF TRAFFIC PLAN (MOTP). THE WTS SHALL HAVE EXPERIENCE OR TRAINING IN PROJECT SUPERVISION AND TRAFFIC CONTROL COMMENSURATE WITH THE RESPONSIBILITIES OF MANAGING THE PROJECT MAINTENANCE OF TRAFFIC PLAN AND COORDINATING WITH ANY MOTORIST INFORMATION SYSTEM OUTSIDE THE PROJECT. THE GOALS OF THE WTS POSITION ARE TO MINIMIZE TRAFFIC CONGESTION AND MAXIMIZE PROJECT SAFETY AND EFFICIENCY. THE CONTRACTOR SHALL SUBMIT TO THE ENGINEER FOR APPROVAL A RESUME OF THE EXPERIENCE, TRAINING AND EDUCATION OF THE PERSON PROPOSED FOR WTS. PROJECT WORK SHALL NOT BEGIN WITHOUT AN APPROVED WTS. THE WTS SHALL BE PRESENT WHEN THE CONTRACTOR INSTALLS A TRAFFIC RESTRICTION, LANE CLOSURE, ECT. THE WTS SHALL REVIEW THE TRAFFIC CONTROL PATTERN UPON COMPLETION OF THE INSTALLATION BOTH DURING THE DAY AND THE NIGHT FOR ASSURANCE OF CONTRACT COMPLIANCE. THW WTS SHALL MAKE RECOMMENDATIONS TO MODIFY THE MOTP FOR BETTER/SAFER TRAFFIC FLOW. THESE RECOMMENDATIONS SHALL BE MADE IN WRITING TO THE ENGINEER. NO CHANGES TO THE TRAFFIC CONTROL PLAN SHALL BE MADE UNTIL APPROVAL IS OBTAINED FROM THE ENGINEER IN WRITING.

## WORK-SITE TRAFFIC SUPERVISOR

THE CONTRACTOR SHALL EMPLOY A WORKSITE TRAFFIC SUPERVISOR (WTS), OTHER THAN THE SUPERINTENDENT, FOR THE PURPOSE OF MONITORING THE MAINTENANCE OF TRAFFIC PLAN (MOTP). THE WTS SHALL HAVE EXPERIENCE OR TRAINING IN PROJECT SUPERVISION AND TRAFFIC CONTROL COMMENSURATE WITH THE RESPONSIBILITIES OF MANAGING THE PROJECT MAINTENANCE OF TRAFFIC PLAN AND COORDINATING WITH ANY MOTORIST INFORMATION SYSTEM OUTSIDE THE PROJECT. THE GOALS OF THE WTS POSITION ARE TO MINIMIZE TRAFFIC CONGESTION AND MAXIMIZE PROJECT SAFETY AND EFFICIENCY. THE CONTRACTOR SHALL SUBMIT TO THE ENGINEER FOR APPROVAL A RESUME OF THE EXPERIENCE, TRAINING AND EDUCATION OF THE PERSON PROPOSED FOR WTS. PROJECT WORK SHALL NOT BEGIN WITHOUT AN APPROVED WTS. THE WTS SHALL BE PRESENT WHEN THE CONTRACTOR INSTALLS A TRAFFIC RESTRICTION, LANE CLOSURE, ECT. THE WTS SHALL REVIEW THE TRAFFIC CONTROL PATTERN UPON COMPLETION OF THE INSTALLATION BOTH DURING THE DAY AND THE NIGHT FOR ASSURANCE OF CONTRACT COMPLIANCE. THW WTS SHALL MAKE RECOMMENDATIONS TO MODIFY THE MOTP FOR BETTER/SAFER TRAFFIC FLOW. THESE RECOMMENDATIONS SHALL BE MADE IN WRITING TO THE ENGINEER. NO CHANGES TO THE TRAFFIC CONTROL PLAN SHALL BE MADE UNTIL APPROVAL IS OBTAINED FROM THE ENGINEER IN WRITING.

DAILY, THE WTS SHALL REVIEW THE PROJECT'S TRAFFIC CONTROL WITH A MINIMUM OF TWO REVIEWS EACH WEEK BEING PERFORMED AT NIGHT. THE WTS SHALL BE AT THE PROJECT SITE EVERY DAY OF THE YEAR WHILE TEMPORARY TRAFFIC CONTROL DEVICES ARE IN PLACE. THE FOLLOWING ITEMS SHALL BE INCLUDED IN EACH REVIEW: TRAFFIC CONTROL DEVICE CONDITION, PLACEMENT, AND VISIBILITY; TRAFFIC FLOW CONDITIONS, INCIDENTS, CONGESTIONPOINTS, DELAYS, AND ADEQUACY OF ADVANCED INFORMATIONAL SIGNS BEYOND THE PROJECT LIMITS; INTERACTION OF WORK VEHICLES AND TRAFFIC; EVIDENCE OF ACCIDENTS; PROPER STORAGE OF MATERIALS AND EQUIPMENT; CONFORMANCE WITH MOTP; CONFLICTING OR NON-PERFORMING PAVEMENT MARKINGS. THE WTS SHALL NOTE ANY TRAFFIC CONTROL DEFICIENCIES. DEFICIENT OR IMPROPERLY PLACED TRAFFIC CONTROL DEVICES SHALL BE CORRECTED. THE WTS SHALL HAVE NECESSARY AUTHORITY TO IMMEDIATELY PERFORM THIS CORRECTIVE WORK. DAILY, A RECORD OF REVIEW SHALL BE GIVEN TO THE PROJECT ENGINEER IN WRITING AND SHALL INCLUDE A RECORD OR DEFICIENCIES AND RESOLUTION OF THE DEFICIENCIES.

FAILURE OF THE CONTRACTOR TO COMPLY WITH ANY OF THE ABOVE SHALL CONSTITUTE CAUSE FOR THE PROJECT ENGINEER TO SUSPEND ALL WORK UNTIL ALL CORRECTIONS ARE MADE.

THE WTS OR ANOTHER DESIGNATED SUPERVISOR SHALL BE ON CALL 24 HOURS A DAY, SEVEN DAYS A WEEK. FOR THE DURATION OF THE PROJECT TO PROVIDE NECESSARY MAINTENANCE OPERATIONS ON THE PROJECT. THIS MAY INVOLVE REPAIR OR REPLACEMENT OF SIGNS, DRUMS, PAVEMENT MARKINGS, CONCRETE BARRIERS, GUARDRAIL, PAVEMENT SURFACES, ECT. THIS INDIVIDUAL SHALL BE ABLE TO RESPOND AND BE ON THE PROJECT WITHIN FOUR (4) HOURS AFTER A CALL AND HAVE SUFFICIENT INVENTORY ON HAND TO REPAIR OR REPLACE DAMAGED OR MISSING TRAFFIC DEVICES. THE CONTRACTOR SHALL FURNISH THE PHONE NUMBER(S) OF THE SUPERVISOR ON CALL TO THE LOCAL STATE POLICE AND STATE HIGHWAY PATROL OFFICES. PAYMENT FOR FURNISHING THE WTS AND ASSOCIATED WORK AND MATERIAL SHALL BE INCLUDED IN THE LUMP SUM PRICE BID FOR THE ITEM 614 MAINTAINING TRAFFIC.

## STANDARD CONSTRUCTION DRAWINGS

THE FOLLOWING MAINTENANCE OF TRAFFIC STANDARD CONSTRUCTION DRAWINGS HAVE BEEN SPECIFIED WITHIN THE MAINTENANCE OF TRAFFIC PLANS:

MT-95.30M	4/25/94	MT-98.17M	4/25/94
MT-95.40M	4/25/94	MT-98.18M	4/25/94
MT-98.12M	6/24/93	MT-99.10M	1/30/95
MT-98.13M	6/24/93	MT-99.20M	1/30/95
MT-98.14M	6/24/93	MT-102.10M	1/30/95
MT-98.15M	6/24/93	MT-105.10M	4/25/94
MT-98.16M	6/24/93	MT-105.11M	4/25/94

THE METRIC STANDARD DRAWINGS REFERENCED IN THIS PLAN SHALL BE CONVERTED TO ENGLISH UNITS USING THE SI (METRIC) TO ENGLISH CONVERSION FACTORS PROVIDED IN SECTION 109.011 OF THE CMS. THE APPENDIX OF ASTM E 380 SHALL BE UTILIZED FOR ANY ADDITIONAL CONVERSION FACTORS REQUIRED. CONVERSIONS SHALL BE APPROXIMATELY PRECISE AND SHALL REFLECT STANDARD INDUSTRY VALUES WHERE SUITABLE.

CALCULATED  
DLS  
CHECKED  
LAB

MAINTENANCE OF TRAFFIC  
GENERAL NOTES

LOR - 190 - 10.76

M.O.T.

161  
274

# RECONSTRUCTION SECTION

PORTABLE CHANGEABLE MESSAGE SIGN, CLASS II, AS PER PLAN

THE CONTRACTOR SHALL FURNISH, INSTALL, MAINTAIN, AND REMOVE, WHEN NO LONGER NEEDED, PORTABLE CHANGEABLE MESSAGE SIGNS (PCMS) ON SITE, FOR THE DURATION OF CONSTRUCTION OF THE FRENCH CREEK BRIDGE AND THE WIDENED AND REPLACEMENT SECTION. THE SIGN SHALL BE OF TYPE SHOWN ON A LIST OF APPROVED PCMS UNITS MAINTAINED BY THE DIRECTOR. CLASS II UNITS HAVE A MINIMUM LEGIBILITY DISTANCE OF 850 FEET.

EACH SIGN SHALL BE TRAILER MOUNTED AND EQUIPPED WITH A FUNCTIONAL DIMMING MECHANISM TO DIM THE SIGN DURING DARKNESS AND A TAMPER AND VANDAL PROOF ENCLOSURE. EACH SIGN SHALL BE PROVIDED WITH APPROPRIATE TRAINING AND OPERATING INSTRUCTIONS TO ENABLE ON-SITE PERSONNEL TO OPERATE THE UNIT AND TROUBLESHOOT THE UNIT. THE SIGN SHALL ALSO BE CAPABLE OF BEING POWERED BY AN ELECTRICAL SERVICE DROP FROM A LOCAL UTILITY COMPANY.

THE LOCATION, PLACEMENT, OPERATION, MAINTENANCE AND ALL ACTIVATION OF THE SIGNS BY THE CONTRACTOR SHALL BE AS DIRECTED BY THE ENGINEER. THE PCMS SHALL BE LOCATED IN A HIGHLY VISIBLE POSITION YET PROTECTED FROM TRAFFIC. THE CONTRACTOR SHALL, AT THE DIRECTION OF THE ENGINEER, RELOCATE THE PCMS TO IMPROVE VISIBILITY OR ACCOMMODATE CHANGED CONDITIONS. WHEN NOT IN USE, THE PCMS WILL BE OFF, FACING AWAY FROM ALL TRAFFIC AND SHALL DISPLAY ONE OR MORE HIGH INTENSITY YELLOW REFLECTIVE SHEETING SURFACES OF 9 INCH BY 15 INCH MINIMUM SIZE FACING TRAFFIC.

THE ENGINEER SHALL BE PROVIDED ACCESS TO EACH UNIT AND SHALL BE PROVIDED WITH APPROPRIATE TRAINING AND OPERATION INSTRUCTIONS TO ENABLE ODOT PERSONNEL TO OPERATE AND TROUBLESHOOT THE UNIT AND TO REVISE SIGN MESSAGES, IF NECESSARY.

ALL MESSAGES TO BE DISPLAYED ON THE SIGN WILL BE PROVIDED BY THE ENGINEER. THE SIGN SHALL HAVE THE CAPABILITY TO STORE UP TO 99 MESSAGES. MESSAGE MEMORY OR PREPROGRAMMED DISPLAYS SHALL NOT BE LOST AS A RESULT OF POWER FAILURES ON THE BOARD COMPUTER. THE SIGN LEGEND SHALL BE CAPABLE OF BEING CHANGED IN THE FIELD. THREE-LINE PRESENTATION FORMATS WITH UP TO SIX MESSAGE PHASES SHALL BE SUPPORTED, BUT NORMALLY, NOT MORE THAN TWO MESSAGE PHASES SHOULD BE EMPLOYED, ALTHOUGH THREE PHASES MAY BE USED IN UNUSUAL CONDITIONS. PCMS FORMAT SHALL PERMIT THE COMPLETE MESSAGE FOR EACH PHASE TO BE READ AT LEAST ONCE.

THE PCMS UNIT SHALL BE MAINTAINED IN GOOD WORKING ORDER BY THE CONTRACTOR IN ACCORDANCE WITH THE PROVISIONS OF 614.03(C). THE CONTRACTOR SHALL, PRIOR TO ACTIVATING THE UNIT, MAKE ARRANGEMENTS WITH AN AUTHORIZED SERVICE AGENT FOR THE PCMS TO ASSURE PROMPT SERVICE IN THE EVENT OF FAILURE. ANY FAILURE SHALL NOT RESULT IN THE SIGN BEING OUT OF SERVICE FOR MORE THAN 12 HOURS INCLUDING WEEKENDS. FAILURE TO COMPLY MAY RESULT IN AN ORDER TO STOP WORK AND OPEN ALL TRAFFIC LANES AND/OR IN THE DEPARTMENT TAKING APPROPRIATE ACTION TO SAFELY CONTROL TRAFFIC AND THE ENTIRE COST TO CONTROL TRAFFIC ACCRUED BY THE DEPARTMENT WILL BE DEDUCTED FROM MONEYS DUE, OR TO BECOME DUE THE CONTRACTOR IN HIS CONTRACT.

THE CONTRACTOR SHALL BE RESPONSIBLE FOR 24 HOUR PER DAY OPERATION AND MAINTENANCE OF THESE SIGNS ON THE PROJECT FOR THE DURATION OF THE PHASES WHEN THE PLAN REQUIRES THEIR USE.

THE REQUIREMENT TO FURNISH, INSTALL, MAINTAIN AND REMOVE A PCMS UNIT ON THIS PROJECT SHALL NOT IN ANY WAY RELIEVE THE CONTRACTOR OF HIS RESPONSIBILITIES AS OUTLINED IN SECTION 104.04 OF THE CONSTRUCTION AND MATERIALS SPECIFICATIONS.

CALCULATED  
DLS  
CHECKED  
LAB

MAINTENANCE OF TRAFFIC  
GENERAL NOTES

LOR - 190 - 10.76

M.O.T.

162  
274

# RECONSTRUCTION SECTION

## PRE-PHASE I

### TRAFFIC MAINTENANCE

I-90

1. CLOSE OUTSIDE LANE USING DRUMS PER MAINTENANCE OF TRAFFIC STANDARD DRAWING 95.30M (4/25/94)
2. LANE CLOSURE SHALL ONLY BE IN EFFECT BETWEEN THE HOURS OF 8:00 P.M. AND 6:00 A.M. (MONDAY THROUGH THURSDAY) NORMAL TWO LANE OPERATION SHALL BE MAINTAINED AT ALL OTHER TIMES

### RAMPS

1. MAINTAIN ONE 12'-0" LANE USING DRUMS, DURING DAYLIGHT HOURS.
2. MAINTENANCE OF TRAFFIC STANDARD CONSTRUCTION DRAWINGS MT-98.14 THROUGH MT-98.18 SHALL BE USED DURING ANY CONSTRUCTION OCCURRING ALONG THE RAMPS.

### FRENCH CREEK BRIDGE

1. MAINTAIN TRAFFIC AS NEEDED ALONG THE ADJACENT ROADWAY OR RAMPS "P" AND "R".

### WORK PROPOSED

I-90

1. RECONSTRUCT RIGHT SHOULDER.
2. RECONSTRUCTION SHALL BE ONLY DURING OUTSIDE LANE CLOSURE. ALL EXCAVATED AREAS MUST BE FILLED TO ORIGINAL OR PROPOSED GRADE WHEN THE OUTSIDE HAS REOPENED TO TRAFFIC.

### RAMPS

1. RECONSTRUCT SHOULDERS, WITH WORK ON ONLY ONE SIDE AT A TIME.
2. PLACE TEMPORARY PAVEMENT AS NEEDED FOR FUTURE CONSTRUCTION PHASES (AS NOTED IN THE M.O.T. PLANS).
3. ALL AREAS OF CONSTRUCTION CONDUCTED EACH DAY SHALL BE RETURNED TO ORIGINAL OR PROPOSED GRADE BY THE END OF THE DAYS OPERATION, WHICH SHALL BE PERFORMED DURING DAYLIGHT HOURS ONLY.
4. REMOVE CURBING FROM ENTRANCE & EXIT RAMPS, INCLUDING ANY ASSOCIATED CATCH BASIN REMOVAL. RESTORE ANY PAVEMENT DAMAGED AND FILL ANY GAP CAUSED BY THE REMOVAL OF THE CURBING. ENSURE TEMPORARY PAVEMENT & GRADING MAINTAINS POSITIVE PAVEMENT DRAINAGE. CURB REMOVAL SHALL BE PERFORMED USING ITEM 202 - CURB REMOVED AS PER PLAN.

### FRENCH CREEK BRIDGE

1. REMOVE ALL CURBING ALONG THE GORE AREA AND ACCELERATION/DECELERATION LANES.
2. RESTORE ANY PAVEMENT DAMAGED AND FILL ANY GAP CAUSED BY THE REMOVAL OF THE CURBING USING ITEM 202 - CURB REMOVED, AS PER PLAN.

## PHASE I

### TRAFFIC MAINTENANCE

I-90

1. MAINTAIN TWO 12'-0" LANES OF TRAFFIC (EACH DIRECTION) ON OUTSIDE EXISTING PAVEMENT AND RECONSTRUCTED SHOULDER USING PORTABLE CONCRETE BARRIERS PER MAINTENANCE OF TRAFFIC STANDARD CONSTRUCTION DRAWING MT102.10M (1/30/95).

### RAMPS

1. MAINTAIN ACCESS TO RAMPS USING THE APPROPRIATE STANDARD CONSTRUCTION DRAWINGS AS NOTED ON THE MAINTENANCE OF TRAFFIC PHASE I PLANS.

### FRENCH CREEK BRIDGE

1. MAINTAIN TWO 11'-0" LANES OF TRAFFIC USING TEMPORARY PAVEMENT MARKINGS AND PORTABLE CONCRETE BARRIER.
2. THE WESTBOUND STRUCTURE SHALL MAINTAIN A THIRD 11'-0" ACCELERATION LANE ALONG THE TWO MAINLINE LANES FOR RAMP "R".

### WORK PROPOSED

I-90

1. CONSTRUCT INSIDE PORTIONS OF PAVEMENT PER ADJACENT TYPICAL SECTION. CONSTRUCTION SHALL NOT INCLUDE THE FINAL ASPHALT SURFACE COURSE AT THIS TIME.

### RAMPS

1. NO WORK IS ANTICIPATED TO BE PERFORMED ALONG THE RAMPS DURING PHASE I.

### FRENCH CREEK BRIDGE

1. RECONSTRUCT THE PORTIONS OF THE FRENCH CREEK STRUCTURE AS NOTED ON THE BRIDGE PLANS.

## PHASE IIA

### TRAFFIC MAINTENANCE

I-90

1. MAINTAIN TWO LANES OF TRAFFIC (EACH DIRECTION) ON NEW INSIDE PAVEMENT AND SHOULDER CONSTRUCTED DURING PHASE I USING PORTABLE CONCRETE BARRIERS PER MAINTENANCE OF TRAFFIC STANDARD CONSTRUCTION DRAWING MT102.10M (1/30/95).

### RAMPS

1. RAMP "M" - MAINTAIN A MINIMUM 10'-0" LANE ON EXISTING PAVEMENT AND RECONSTRUCTED SHOULDER USING PORTABLE CONCRETE BARRIER ALONG THE LOCATIONS NOTED IN THE PLANS.
2. RAMP "N" - MAINTAIN A MINIMUM 10'-0" LANE ON EXISTING PAVEMENT AND RECONSTRUCTED SHOULDER USING PORTABLE CONCRETE BARRIER ALONG THE LOCATIONS NOTED IN THE PLANS.
3. RAMP "P" - MAINTAIN A MINIMUM 10'-0" LANE ON EXISTING AND TEMPORARY PAVEMENT ALONG THE TEMPORARY BASELINE DETAILED IN THE PLANS. A COMBINATION OF BARRIER AND DRUMS ARE TO BE USED AS SHOWN IN THE PLANS.
4. RAMP "R" - MAINTAIN A MINIMUM 12'-0" LANE ON EXISTING AND TEMPORARY PAVEMENT ALONG THE TEMPORARY BASELINE DETAILED IN THE PLANS. A COMBINATION OF BARRIER AND DRUMS ARE TO BE USED AS SHOWN IN THE PLANS.

### FRENCH CREEK BRIDGE

1. MAINTAIN THREE 11'-0" LANES OF TRAFFIC ON THE STRUCTURES USING TEMPORARY PAVEMENT MARKINGS AND PORTABLE CONCRETE BARRIER.

### WORK PROPOSED

I-90

1. RECONSTRUCT OUTSIDE PORTIONS OF PAVEMENT PER TYPICAL SECTION. CONSTRUCTION SHALL NOT INCLUDE THE FINAL ASPHALT SURFACE COURSE AT THIS TIME.

### RAMPS

1. RECONSTRUCT EXISTING RAMP PAVEMENT AS NOTED IN THE PHASE IIA PLANS.

### FRENCH CREEK BRIDGE

1. RECONSTRUCT THE PORTIONS OF THE FRENCH CREEK STRUCTURE AS NOTED ON THE BRIDGE PLANS.

## PHASE IIB

### TRAFFIC MAINTENANCE

I-90

1. MAINTAIN TWO LANES OF TRAFFIC (EACH DIRECTION) ON NEW INSIDE PAVEMENT AND SHOULDER CONSTRUCTED DURING PHASE I USING PORTABLE CONCRETE BARRIERS PER MAINTENANCE OF TRAFFIC STANDARD CONSTRUCTION DRAWING MT102.10M (1/30/95).

### RAMPS

1. RAMP "M" - MAINTAIN A MINIMUM 10'-0" LANE ON THE RECONSTRUCTED SHOULDER AND PAVEMENT USING PORTABLE CONCRETE BARRIER ALONG THE LOCATIONS NOTED IN THE PLANS.
2. RAMP "N" - MAINTAIN A MINIMUM 10'-0" LANE ON THE RECONSTRUCTED SHOULDER AND PAVEMENT USING PORTABLE CONCRETE BARRIER ALONG THE LOCATIONS NOTED IN THE PLANS.
3. RAMP "P" - MAINTAIN A MINIMUM 10'-0" LANE ON RECONSTRUCTED SHOULDER AND PAVEMENT. A COMBINATION OF BARRIER AND DRUMS ARE TO BE USED AS SHOWN IN THE PLANS.
4. RAMP "R" - MAINTAIN A MINIMUM 12'-0" LANE ON RECONSTRUCTED SHOULDER AND PAVEMENT. A COMBINATION OF BARRIER AND DRUMS ARE TO BE USED AS SHOWN IN THE PLANS.

### FRENCH CREEK BRIDGE

1. BRIDGE CONSTRUCTION HAS BEEN COMPLETED AT THIS POINT. TRAFFIC MAINTENANCE ON THE STRUCTURE CONSISTS ON THE TRANSITIONING REQUIRED TO MAINTAIN TRAFFIC ON THE MAINLINE AND ALONGS RAMPS "P" AND "R" IN A MANNER TO ALLOW FOR CONSTRUCTION OF PHASE II PAVEMENT IMMEDIATELY EAST OF THE APPROACH SLABS. SEE PHASE IIB MAINTENANCE OF TRAFFIC PLANS FOR DETAILS.

### WORK PROPOSED

I-90

1. RECONSTRUCT OUTSIDE PORTIONS OF PAVEMENT PER ADJACENT TYPICAL SECTION. CONSTRUCTION SHALL NOT INCLUDE THE FINAL ASPHALT SURFACE COURSE AT THIS TIME.

### RAMPS

1. RECONSTRUCT EXISTING RAMP PAVEMENT AS NOTED IN THE PHASE IIB PLANS.

### FRENCH CREEK BRIDGE

1. BRIDGE RECONSTRUCTION IS COMPLETE AT THIS TIME.

## PHASE III

### TRAFFIC MAINTENANCE

1. MAINTAIN TRAFFIC THROUGH THE USE OF FLAGGERS AND TEMPORARY NIGHTTIME LANE CLOSURE. A MINIMUM OF ONE 12'-0" LANE SHALL BE OPEN AT ALL TIMES.

### WORK PROPOSED

1. PLACE FINAL SURFACE COURSE OF ASPHALT.
2. PLACE FINAL STRIPING, SIGNAGE, REFLECTIVE PAVEMENT MARKINGS, AND RUMBLE STRIPS.
3. ANY WORK WHICH REQUIRES LANE CLOSURE SHALL BE PERFORMED AT NIGHT.


CALCULATED  
DLS  
CHECKED  
LAB

MAINTENANCE OF TRAFFIC  
SEQUENCE OF CONSTRUCTION

LOR - I90 - 10.76


M.O.T.

163  
274

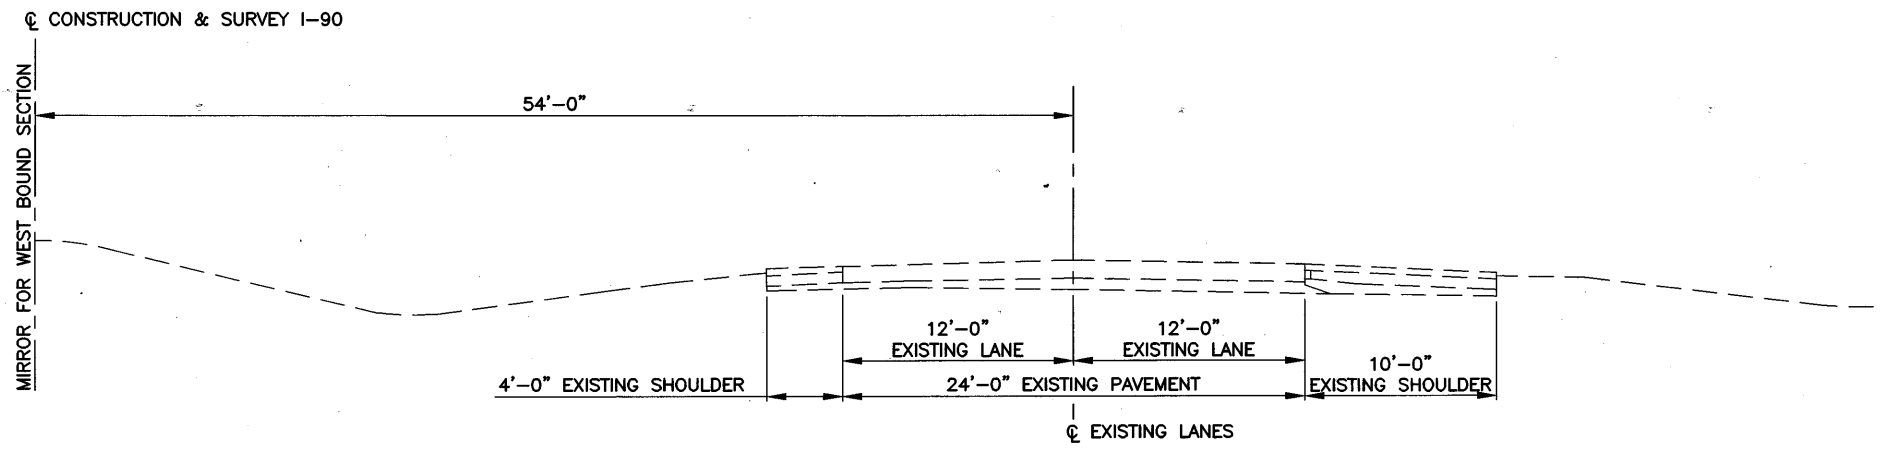


SECTION A-A  
EXISTING CONDITIONS - I-90 FROM FRENCH CREEK STRUCTURE TO STA. 1018+00


- TEMPORARY PAVEMENT MARKING KEY
- (P) TEMPORARY SOLID LANE LINE, WHITE
  - (Q) TEMPORARY EDGE LINE, WHITE
  - (R) TEMPORARY EDGE LINE, YELLOW
  - (S) TEMPORARY LANE LINE, WHITE

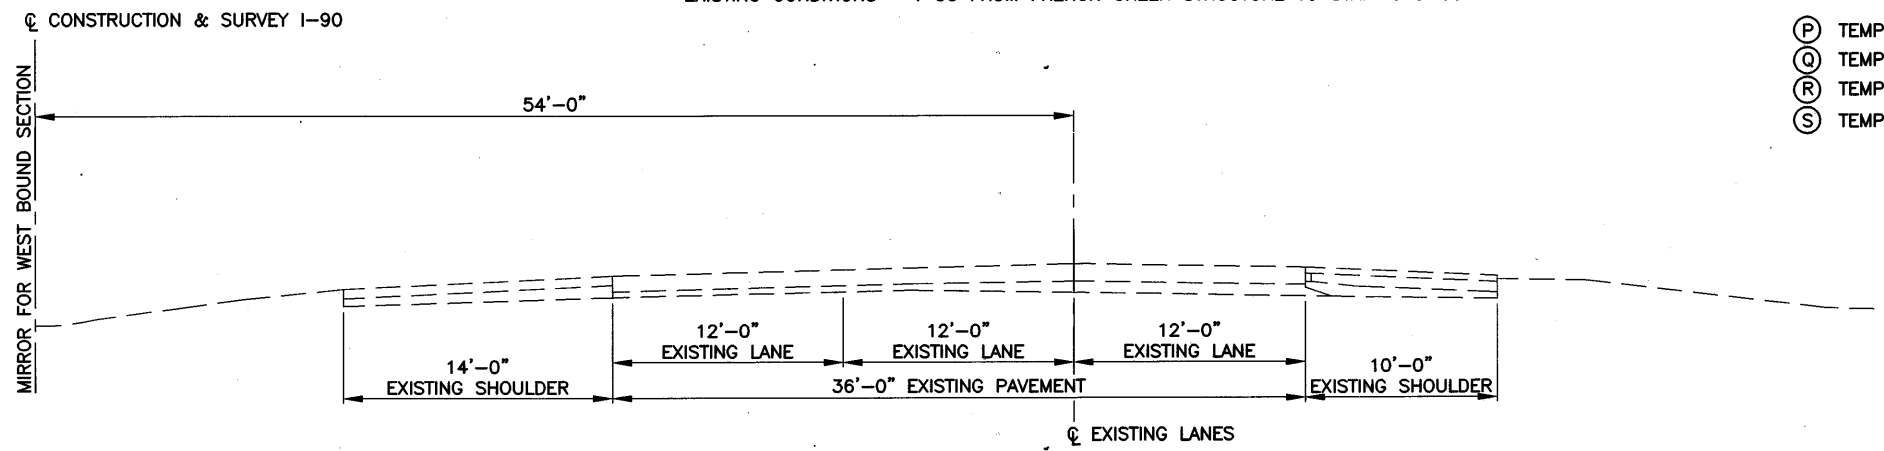

SECTION B-B  
EXISTING CONDITIONS - I-90 FROM STA. 1018+00 TO STA. 1035+00

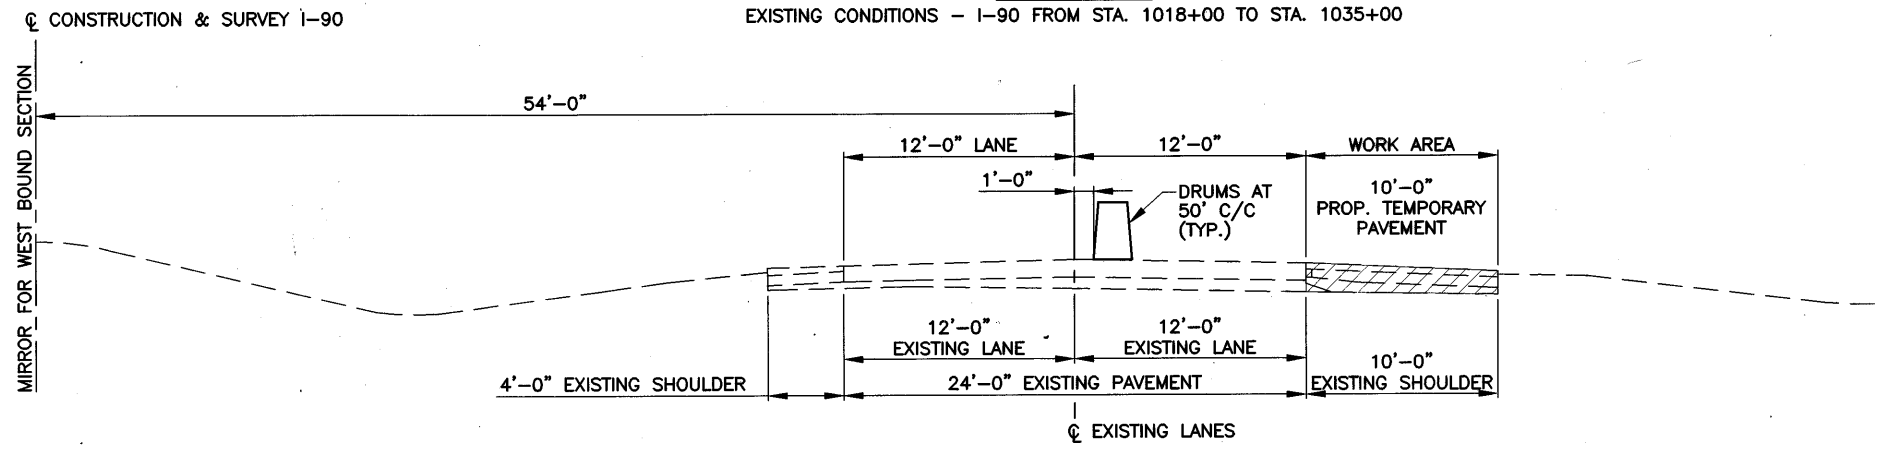

PRE-PHASE I - I-90 FROM FRENCH CREEK STRUCTURE TO STA. 1018+00

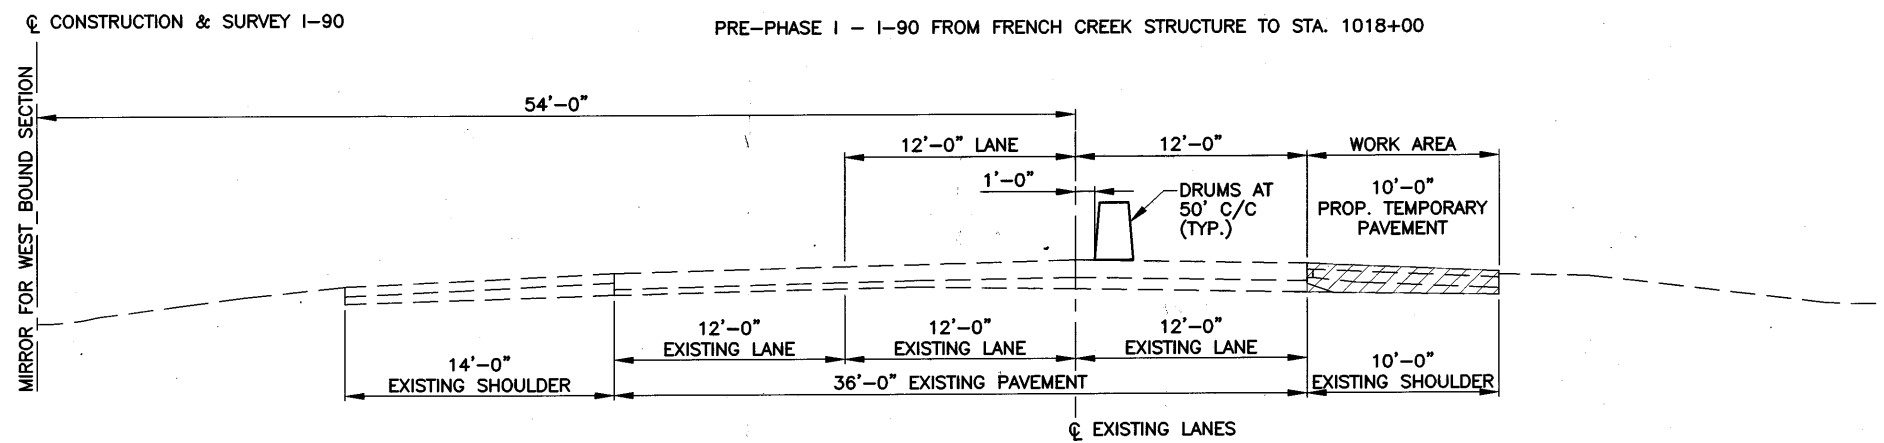

PRE-PHASE I - I-90 FROM STA. 1018+00 TO STA. 1035+00


NOTE: ALL SECTIONS ARE SHOWN FACING IN THE DIRECTION OF TRAVEL

CALCULATED  
DLS  
CHECKED  
LAB

MAINTENANCE OF TRAFFIC  
TYPICAL SECTIONS


LOR - 190 - 10.76

M.O.T.  
164  
274

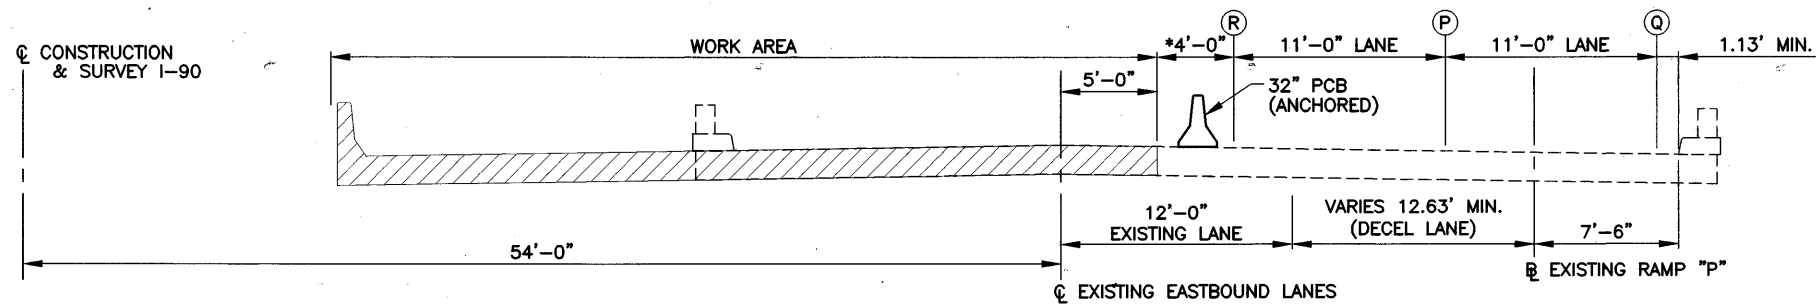


SECTION E-E  
PHASE I - FRENCH CREEK BRIDGE EASTBOUND


- TEMPORARY PAVEMENT MARKING KEY
- (P) TEMPORARY SOLID LANE LINE, WHITE
  - (Q) TEMPORARY EDGE LINE, WHITE
  - (R) TEMPORARY EDGE LINE, YELLOW
  - (S) TEMPORARY LANE LINE, WHITE

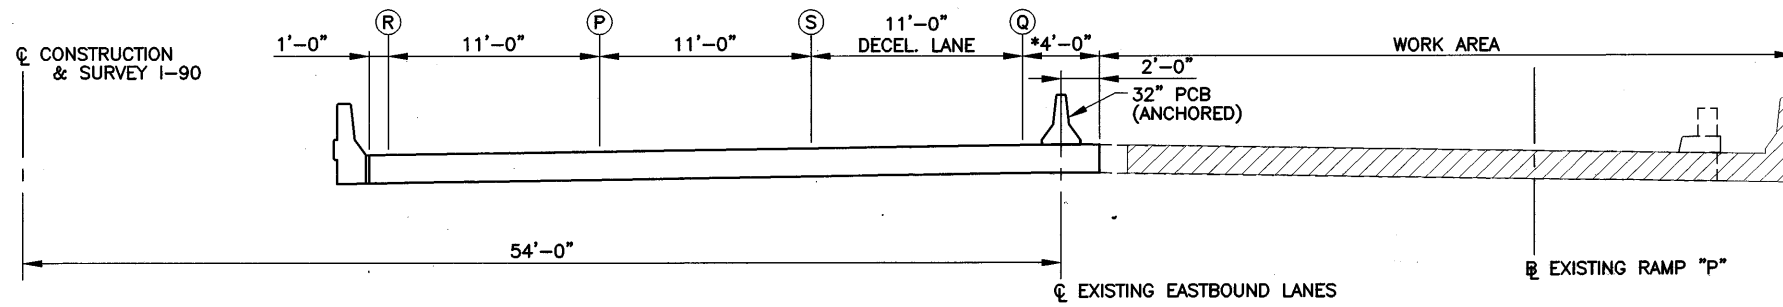

SECTION F-F  
PHASE II - FRENCH CREEK BRIDGE EASTBOUND

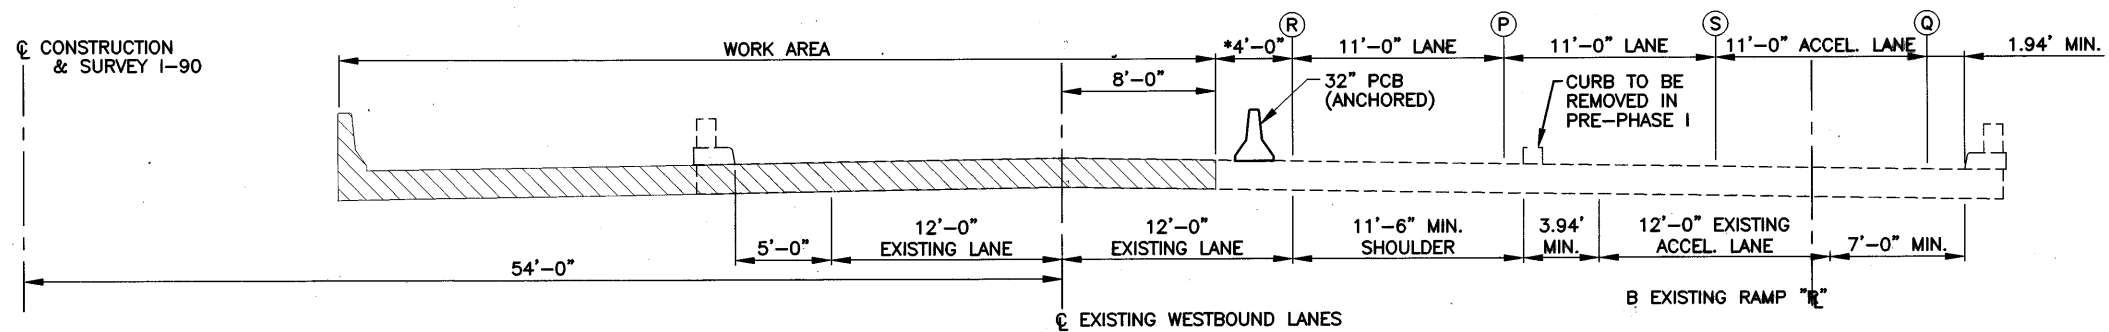

SECTION G-G  
PHASE I - FRENCH CREEK BRIDGE WESTBOUND

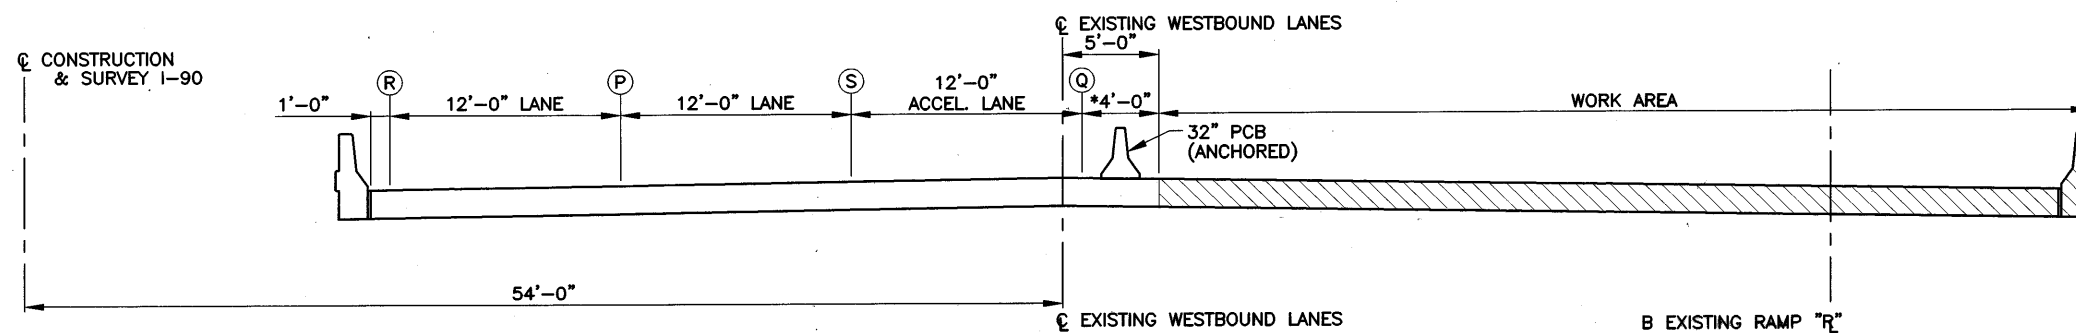

SECTION H-H  
PHASE II - FRENCH CREEK BRIDGE WESTBOUND

- \* 4'-0" INCLUDES
- 1'-0" SHOULDER
- 2'-0" PORTABLE CONCRETE BARRIER
- 1'-0" WORK BUFFER

NOTE: ALL SECTIONS ARE SHOWN FACING IN THE DIRECTION OF TRAVEL

CALCULATED  
DLS  
CHECKED  
LAB

MAINTENANCE OF TRAFFIC  
TYPICAL SECTIONS

LOR - 190 - 10.76


M.O.T.  
165  
274

CALCULATED  
DLS  
CHECKED  
LAB


MAINTENANCE OF TRAFFIC  
TYPICAL SECTIONS

LOR - I90 - 10.76


M.O.T.  
166  
274

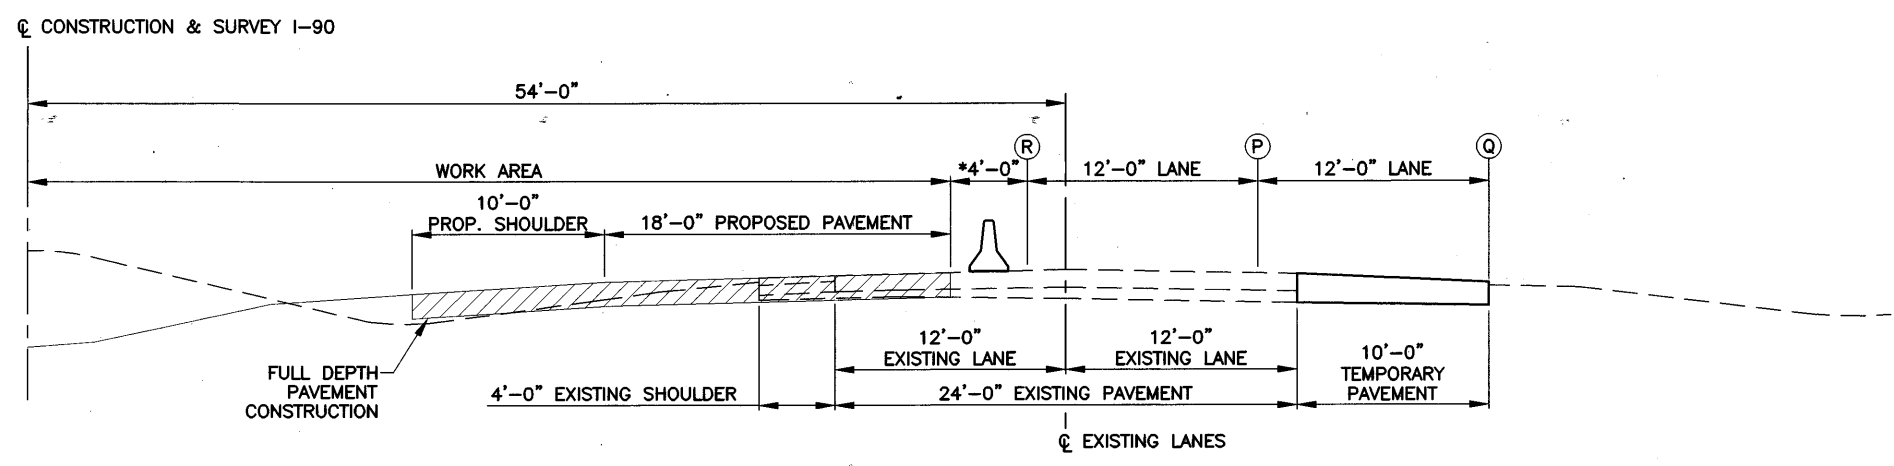


SECTION I-I  
PHASE I - I-90 FROM FRENCH CREEK STRUCTURE TO STA. 1018+00

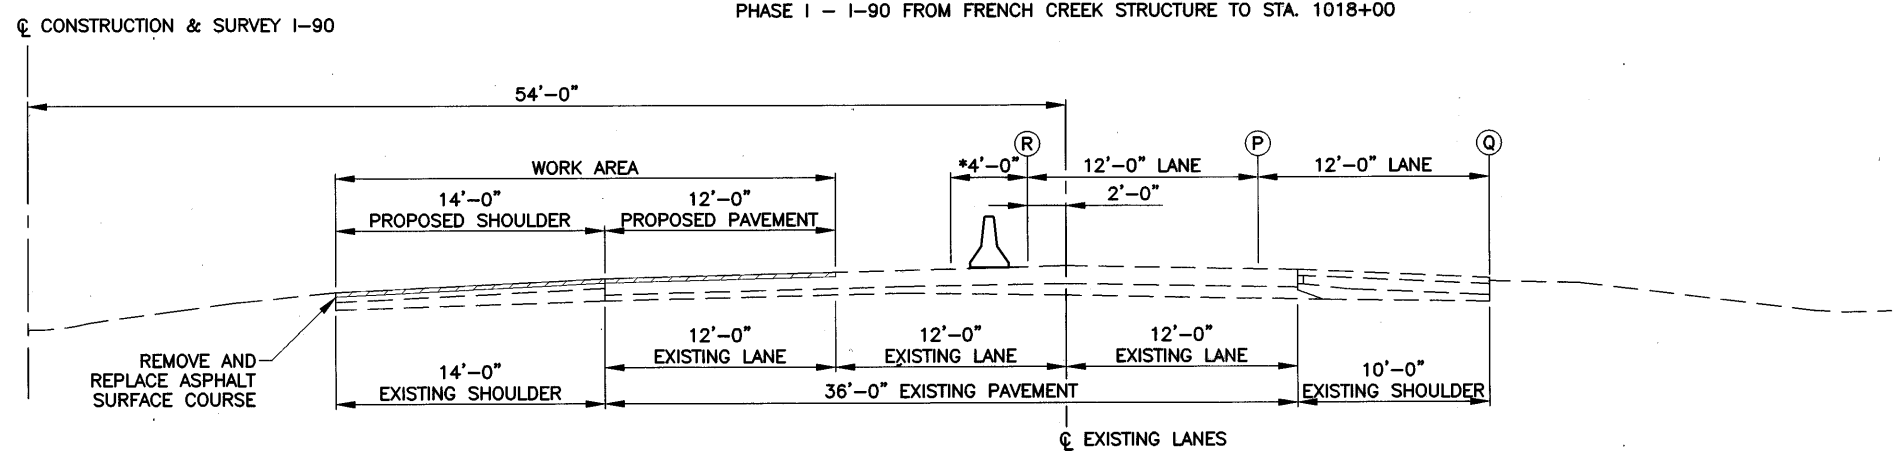

SECTION J-J  
PHASE I - I-90 FROM STA. 1018+00 TO STA. 1035+00

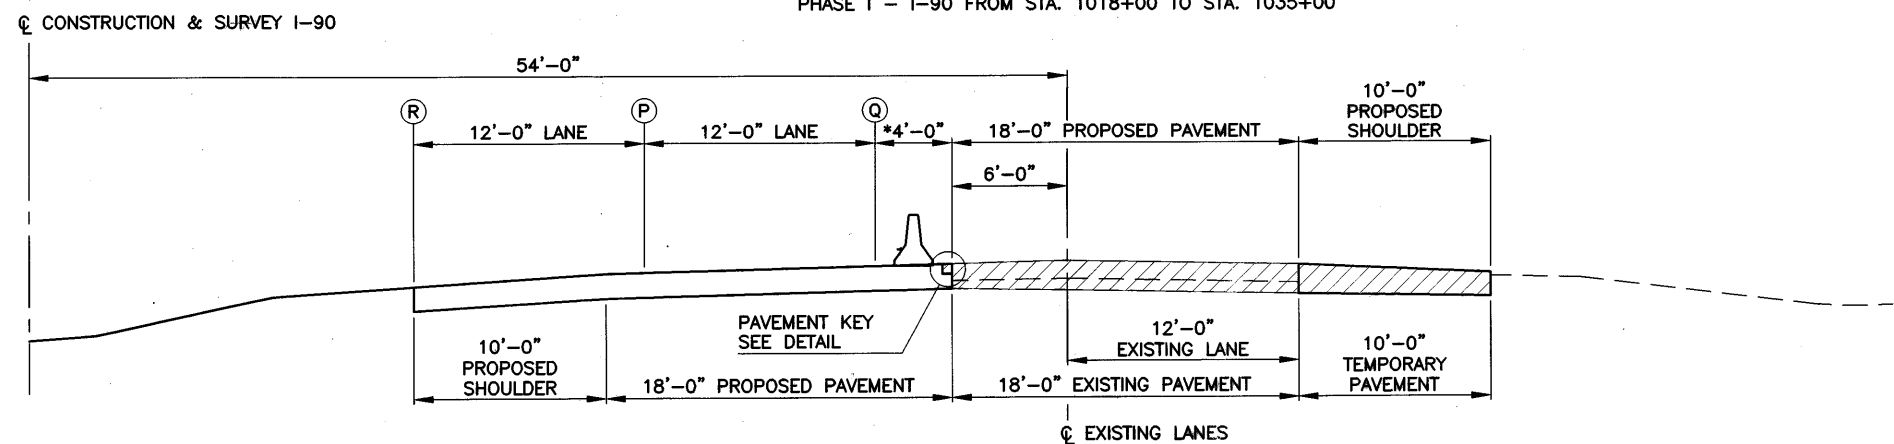


SECTION K-K  
PHASE II - I-90 FROM FRENCH CREEK STRUCTURE TO STA. 1018+00

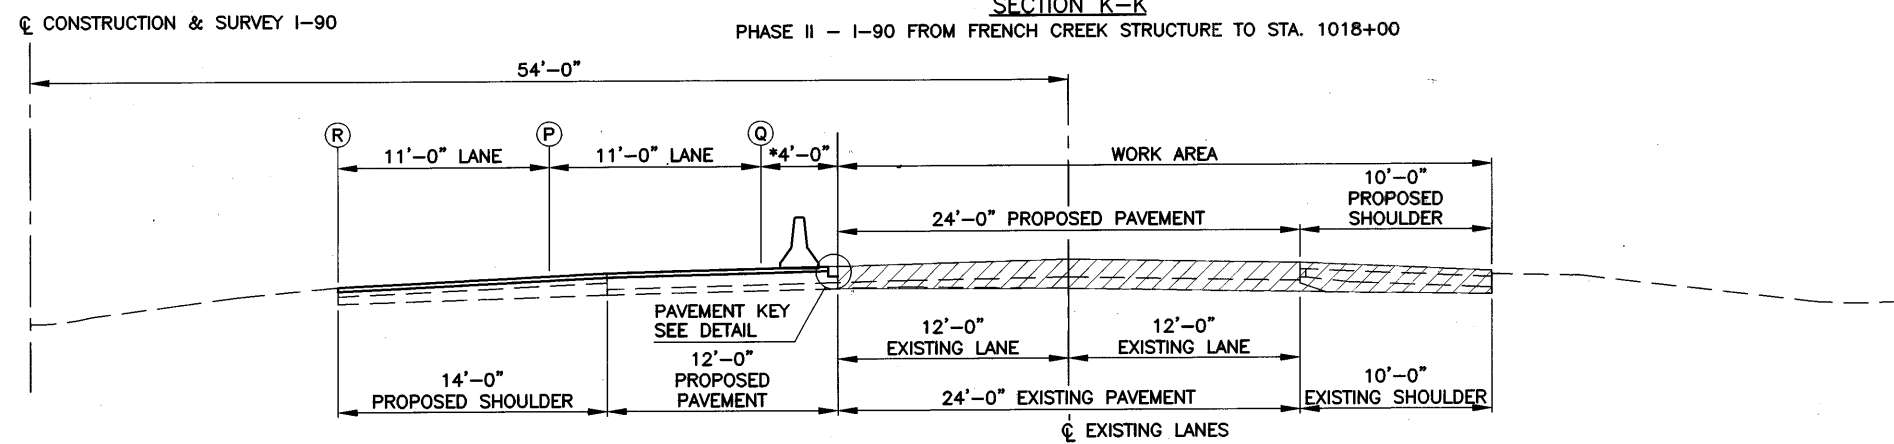


SECTION L-L  
PHASE II - I-90 FROM STA. 1018+00 TO STA. 1035+00

- TEMPORARY PAVEMENT MARKING KEY
- (P) TEMPORARY SOLID LANE LINE, WHITE
  - (Q) TEMPORARY EDGE LINE, WHITE
  - (R) TEMPORARY EDGE LINE, YELLOW
  - (S) TEMPORARY LANE LINE, WHITE

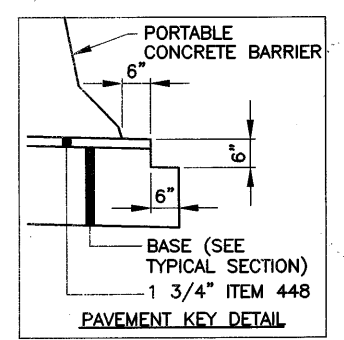


- \* 4'-0" INCLUDES
- 1'-0" SHOULDER
- 2'-0" PORTABLE CONCRETE BARRIER
- 1'-0" WORK BUFFER


NOTE: ALL SECTIONS ARE SHOWN FACING IN THE DIRECTION OF TRAVEL

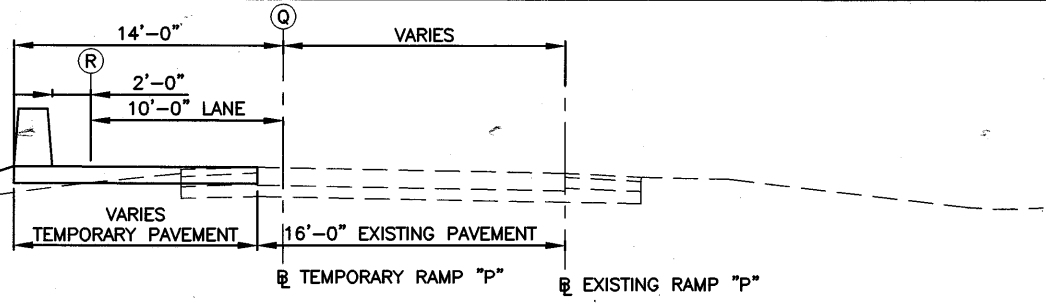


SECTION M-M  
PHASE IIA - RAMP "P"

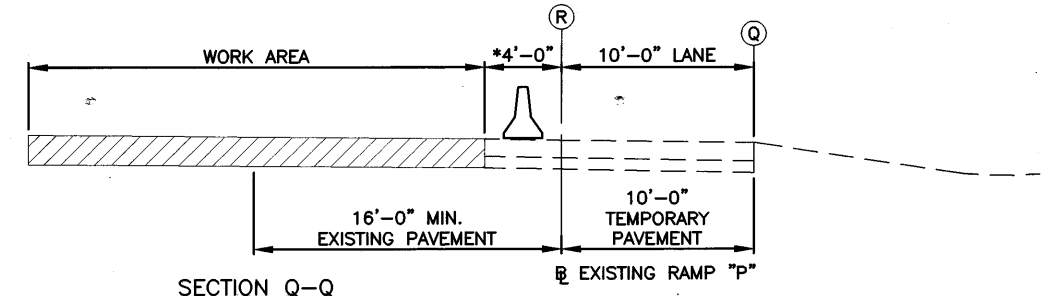


SECTION Q-Q  
PHASE IIA - RAMP "M"

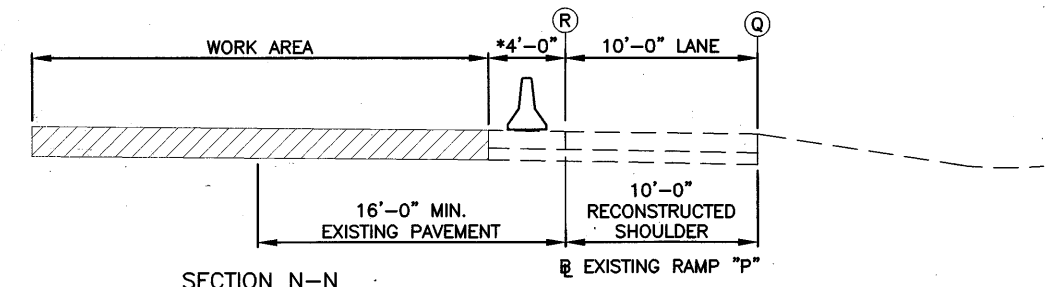


SECTION N-N  
PHASE IIB - RAMP "P"

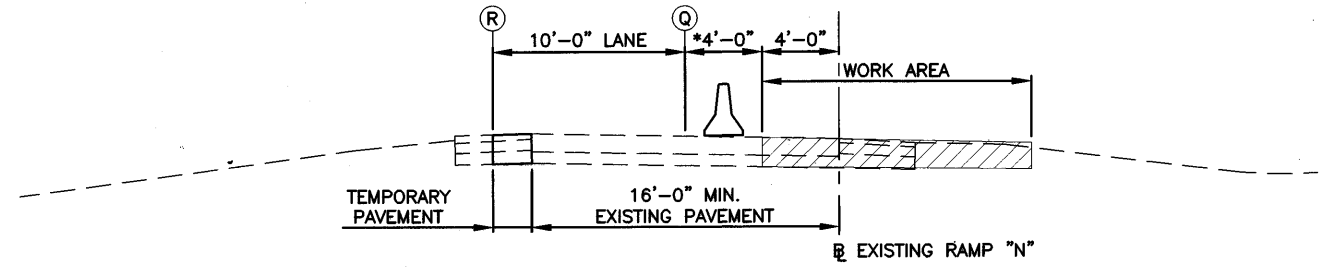


SECTION R-R  
PHASE IIB - RAMP "M"

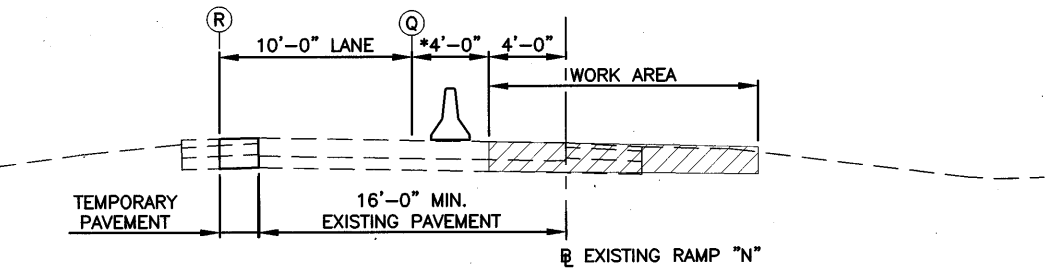


SECTION O-O  
PHASE IIA - RAMP "N"

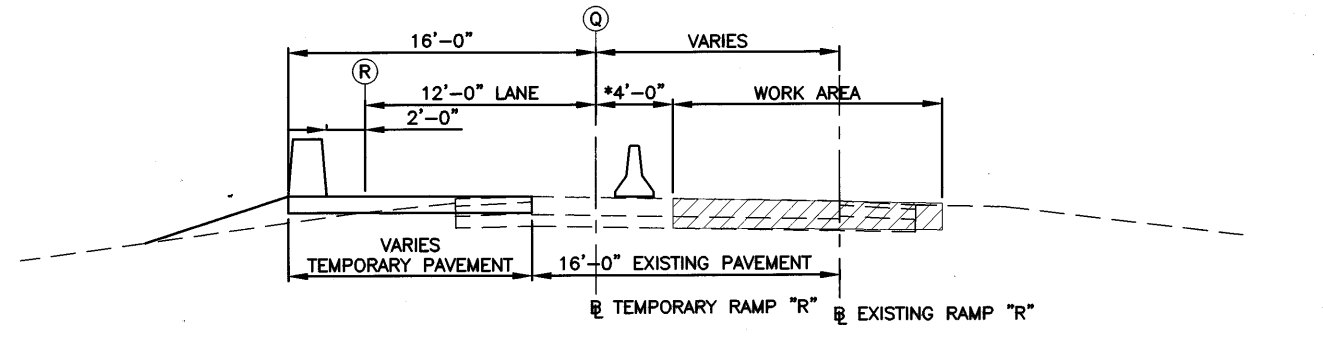

SECTION S-S  
PHASE IIA - RAMP "R"

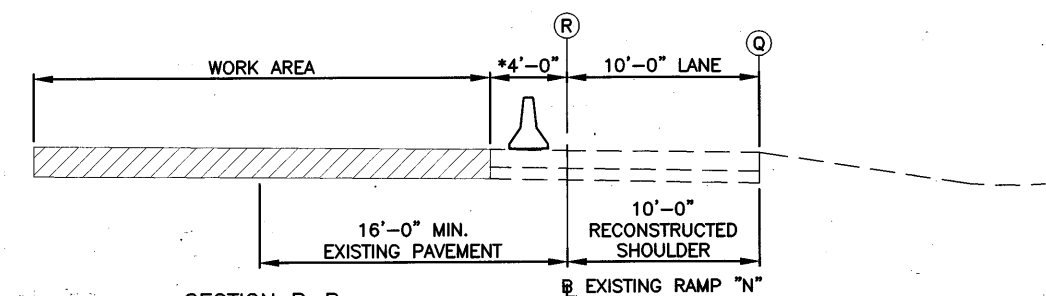

SECTION P-P  
PHASE IIB - RAMP "N"

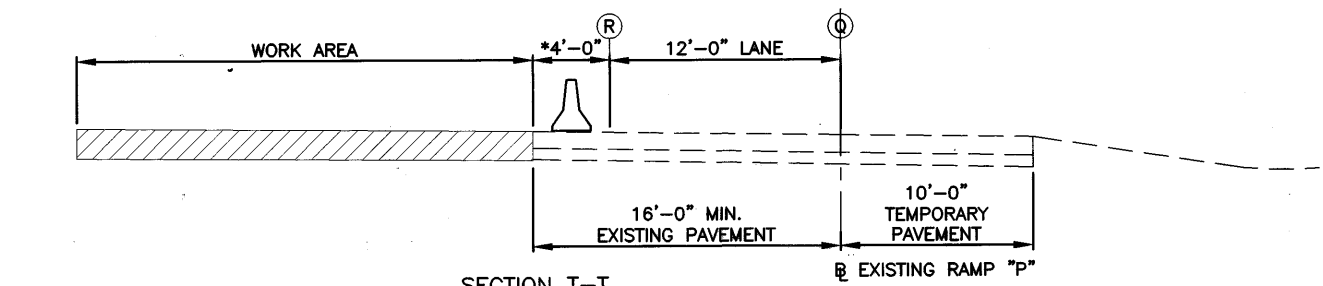

SECTION T-T  
PHASE IIB - RAMP "R"

\* 4'-0" INCLUDES  
1'-0" SHOULDER  
2'-0" PORTABLE CONCRETE BARRIER  
1'-0" WORK BUFFER

NOTE: ALL SECTIONS ARE SHOWN FACING IN THE DIRECTION OF TRAVEL




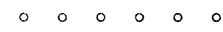

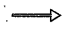
- TEMPORARY PAVEMENT MARKING KEY
- (P) TEMPORARY SOLID LANE LINE, WHITE
  - (Q) TEMPORARY EDGE LINE, WHITE
  - (R) TEMPORARY EDGE LINE, YELLOW
  - (S) TEMPORARY LANE LINE, WHITE

CALCULATED  
DLS  
CHECKED  
LAB

MAINTENANCE OF TRAFFIC  
TYPICAL SECTIONS

LOR - 190 - 10.76




**LEGEND**

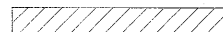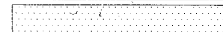-  WORK AREA
-  TEMPORARY PAVEMENT
-  PORTABLE CONCRETE BARRIER
-  TRAFFIC MAINTENANCE DRUMS
-  WESTBOUND TRAFFIC LANE
-  EASTBOUND TRAFFIC LANE

SEE MAINTENANCE OF TRAFFIC DRAWING MT-102.10M FOR ADDITIONAL DETAILS AND SIGNAGE NECESSARY TO TRANSITION W.B. TRAFFIC TO NORMAL OPERATION

SEE MAINTENANCE OF TRAFFIC DRAWING MT-102.10M FOR ADDITIONAL DETAILS AND SIGNAGE NECESSARY TO TRANSITION E.B. TRAFFIC FROM NORMAL OPERATION

SEE MAINTENANCE OF TRAFFIC DRAWING MT-98.16M FOR ADDITIONAL DETAILS AND SIGNAGE NECESSARY FOR RAMP "R" MERGER.

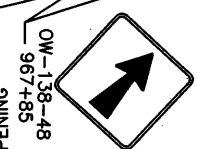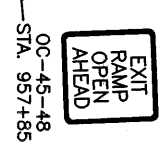
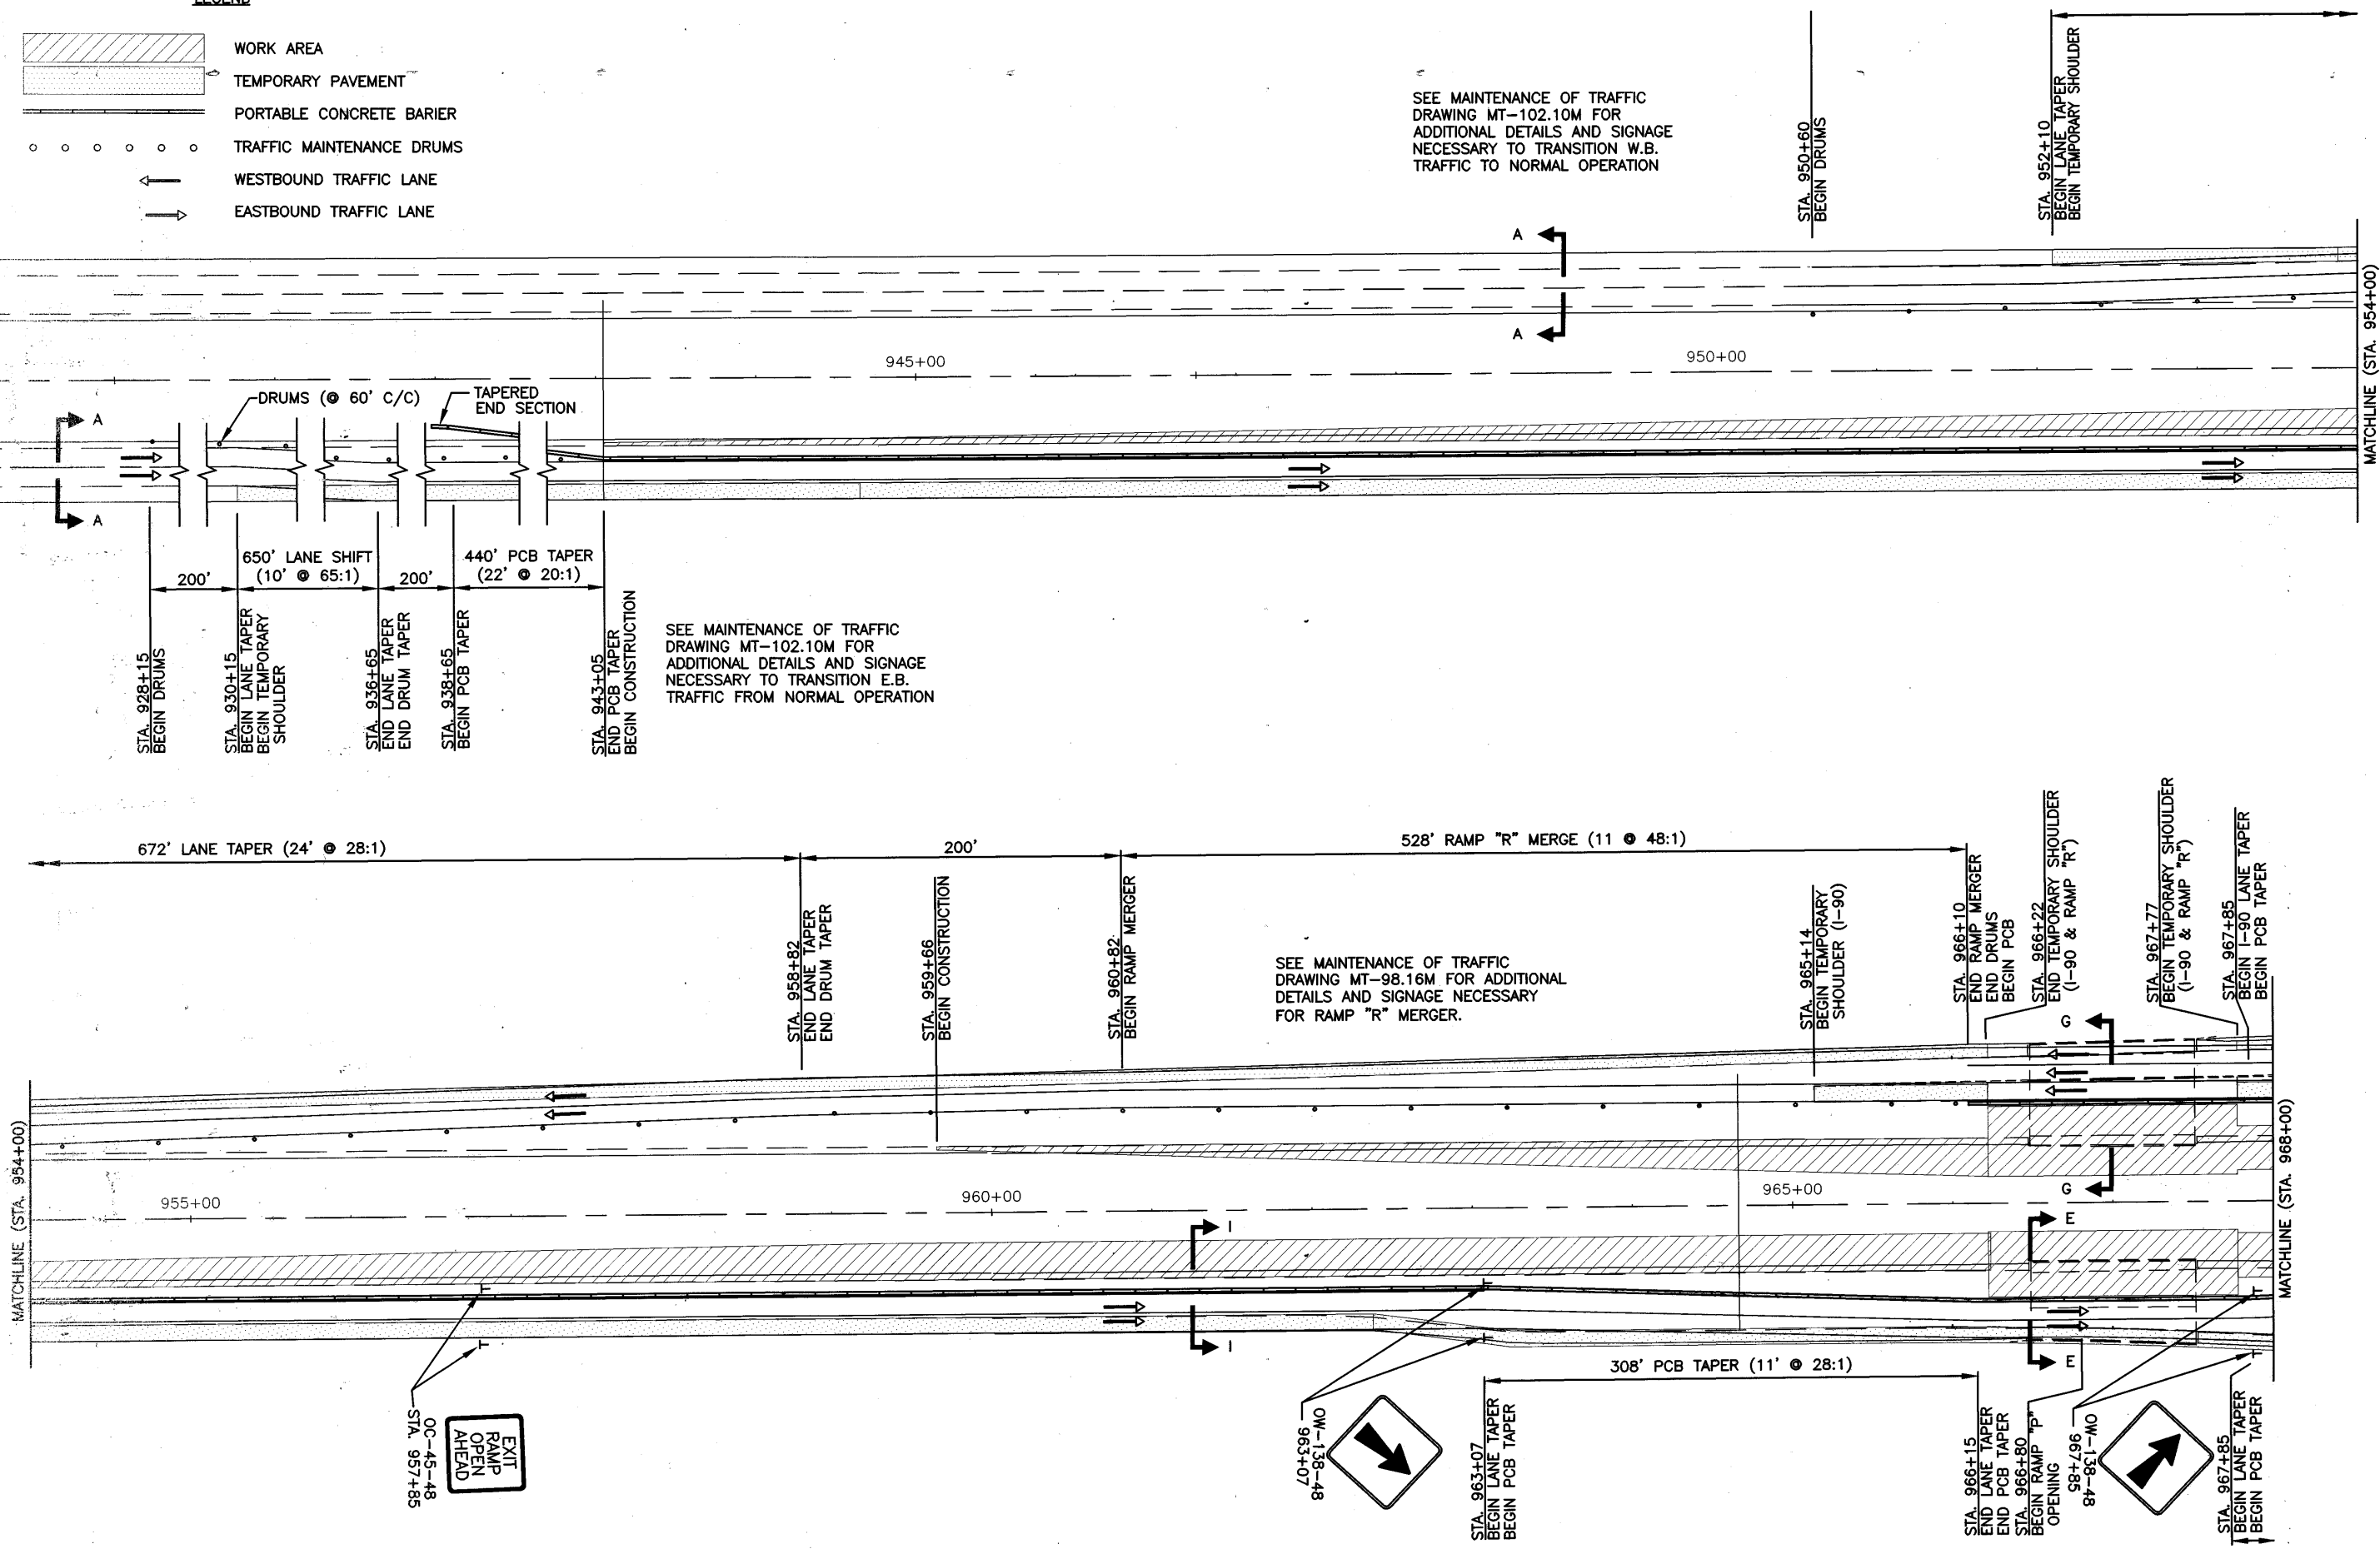


CALCULATED
DLS
CHECKED
LAB

**MAINTENANCE OF TRAFFIC  
PHASE I PLAN**

**LOR - 190 - 10.76**



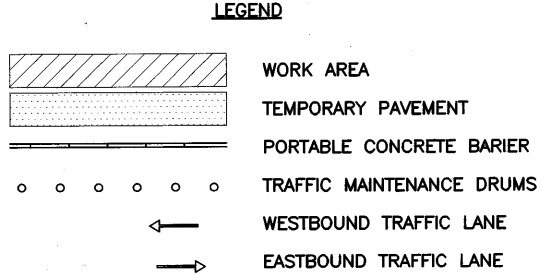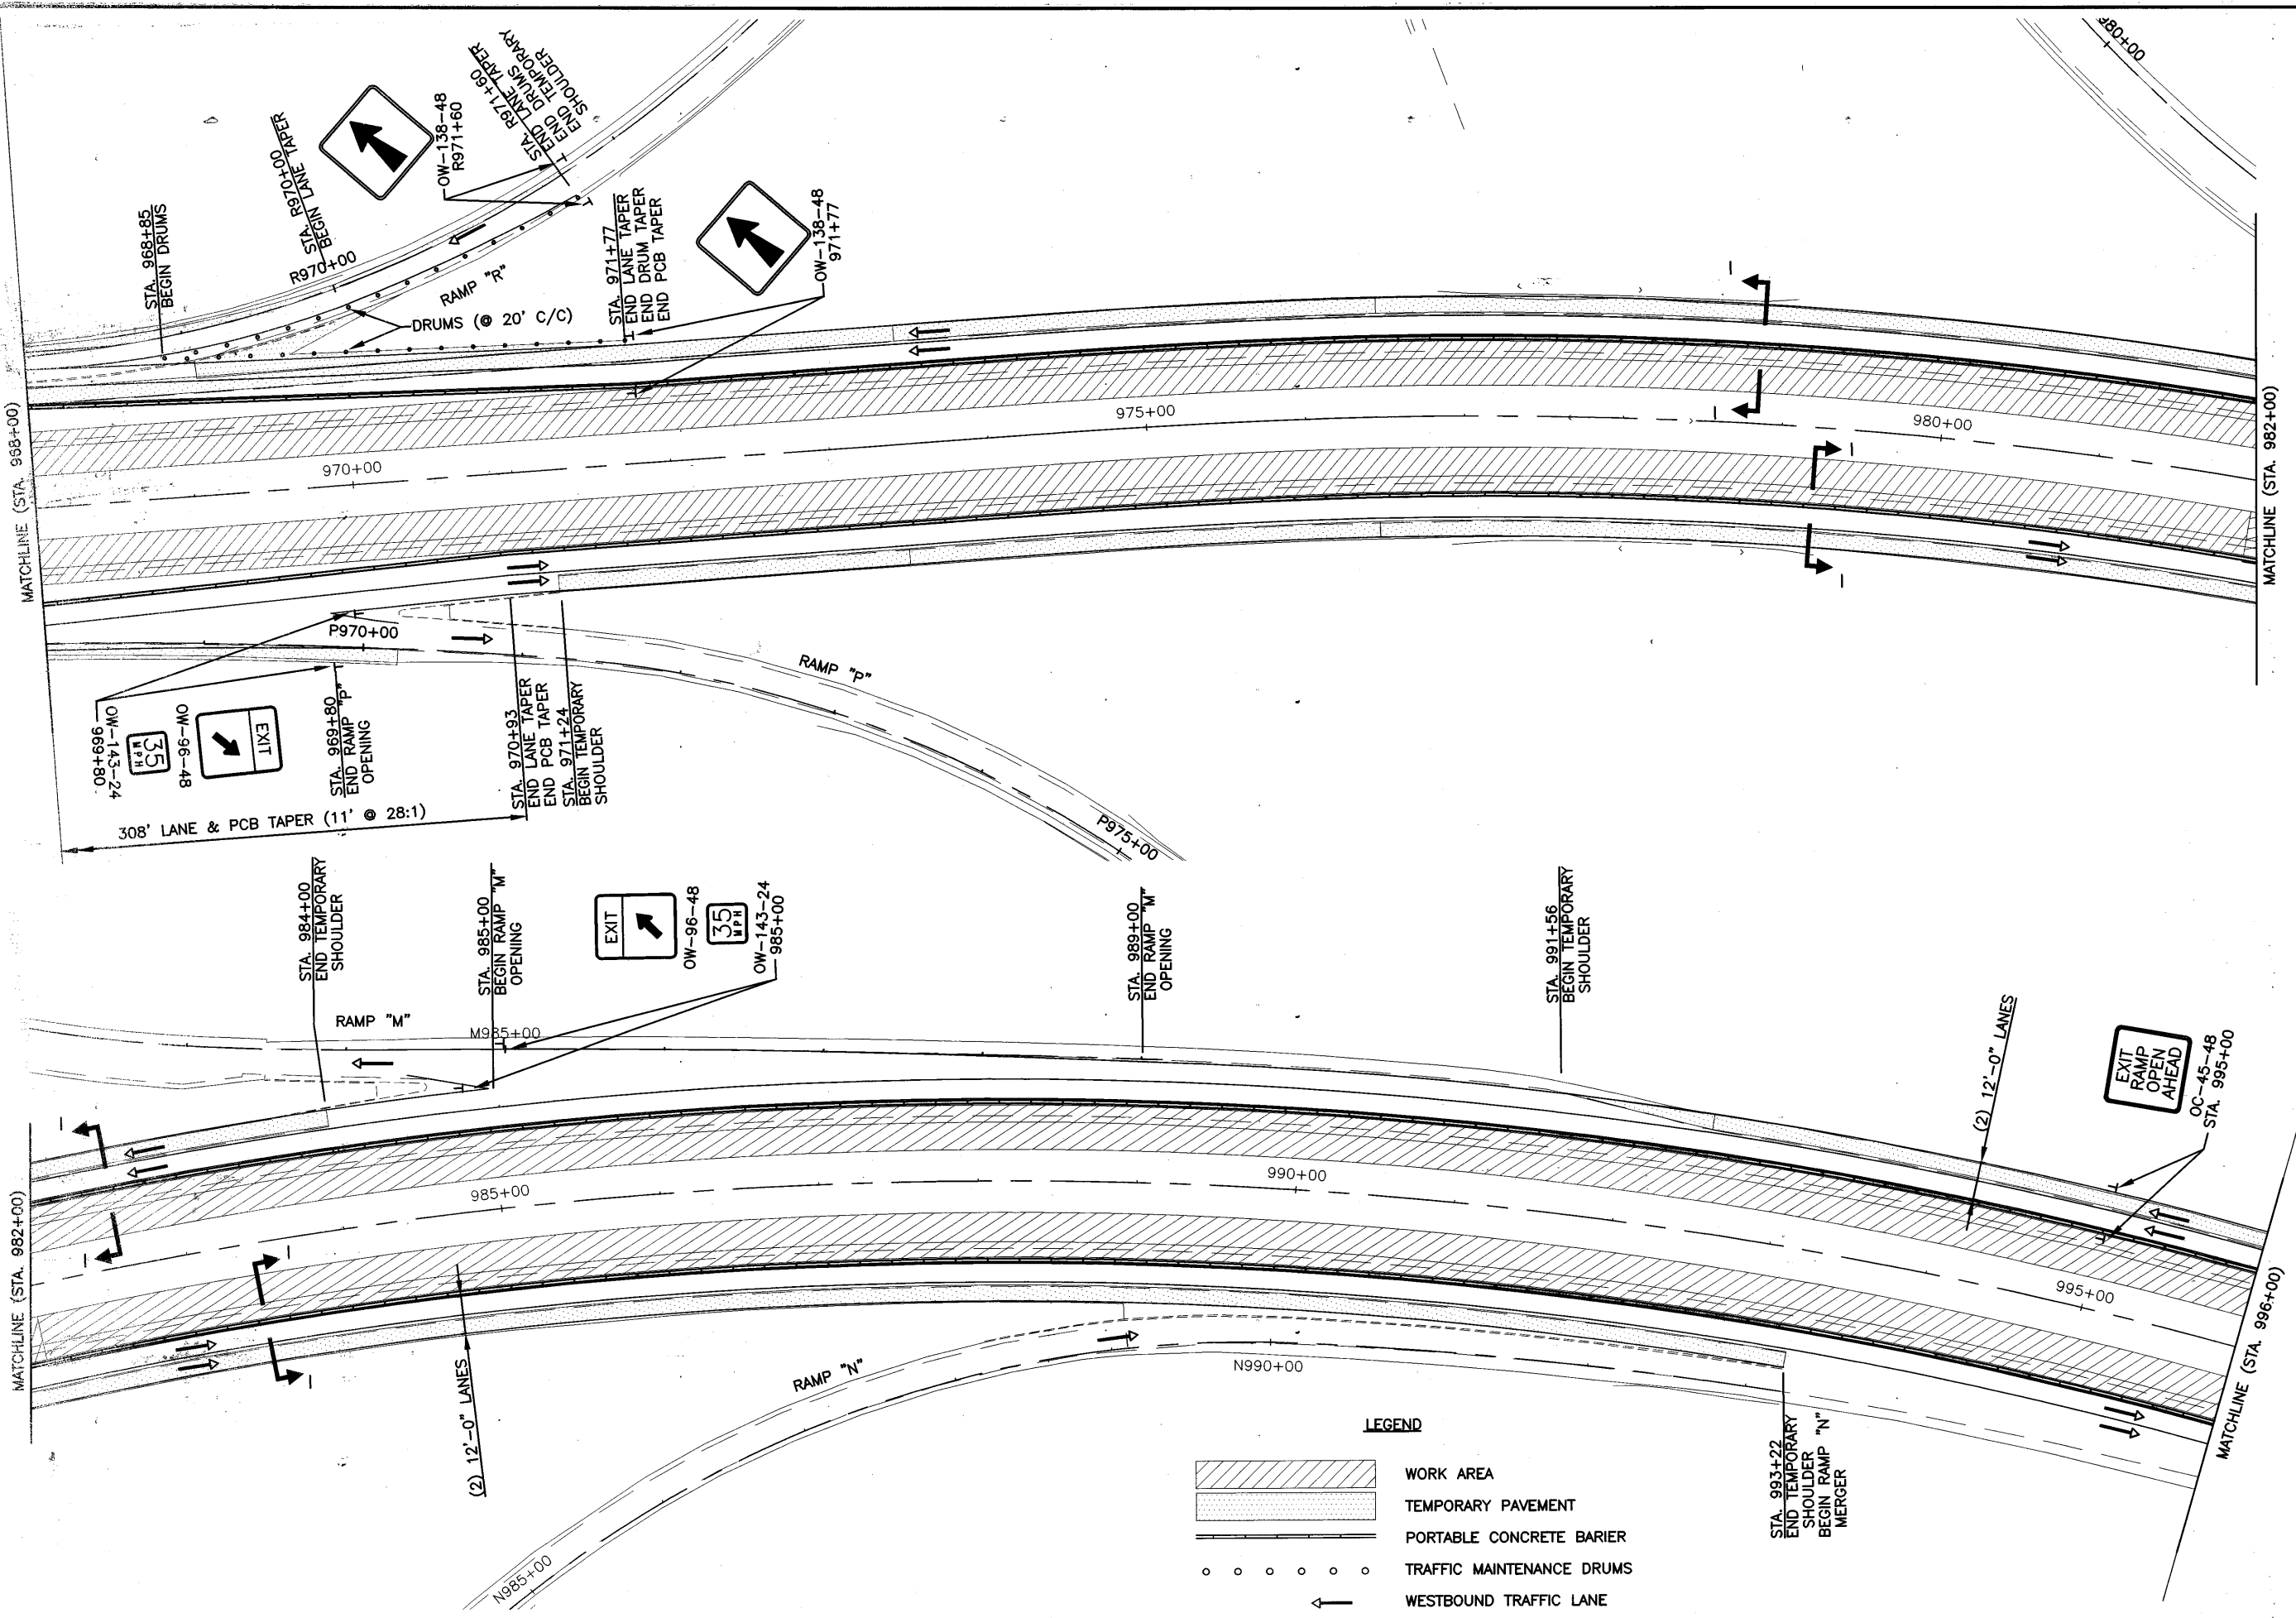


CALCULATED	
DLS	
CHECKED	
LAB	






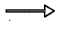
**MAINTENANCE OF TRAFFIC  
PHASE I PLAN**


LOR - 190 - 10.76

M.O.T.


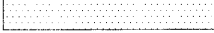
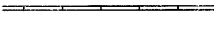
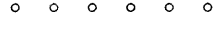
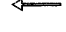

169  
274

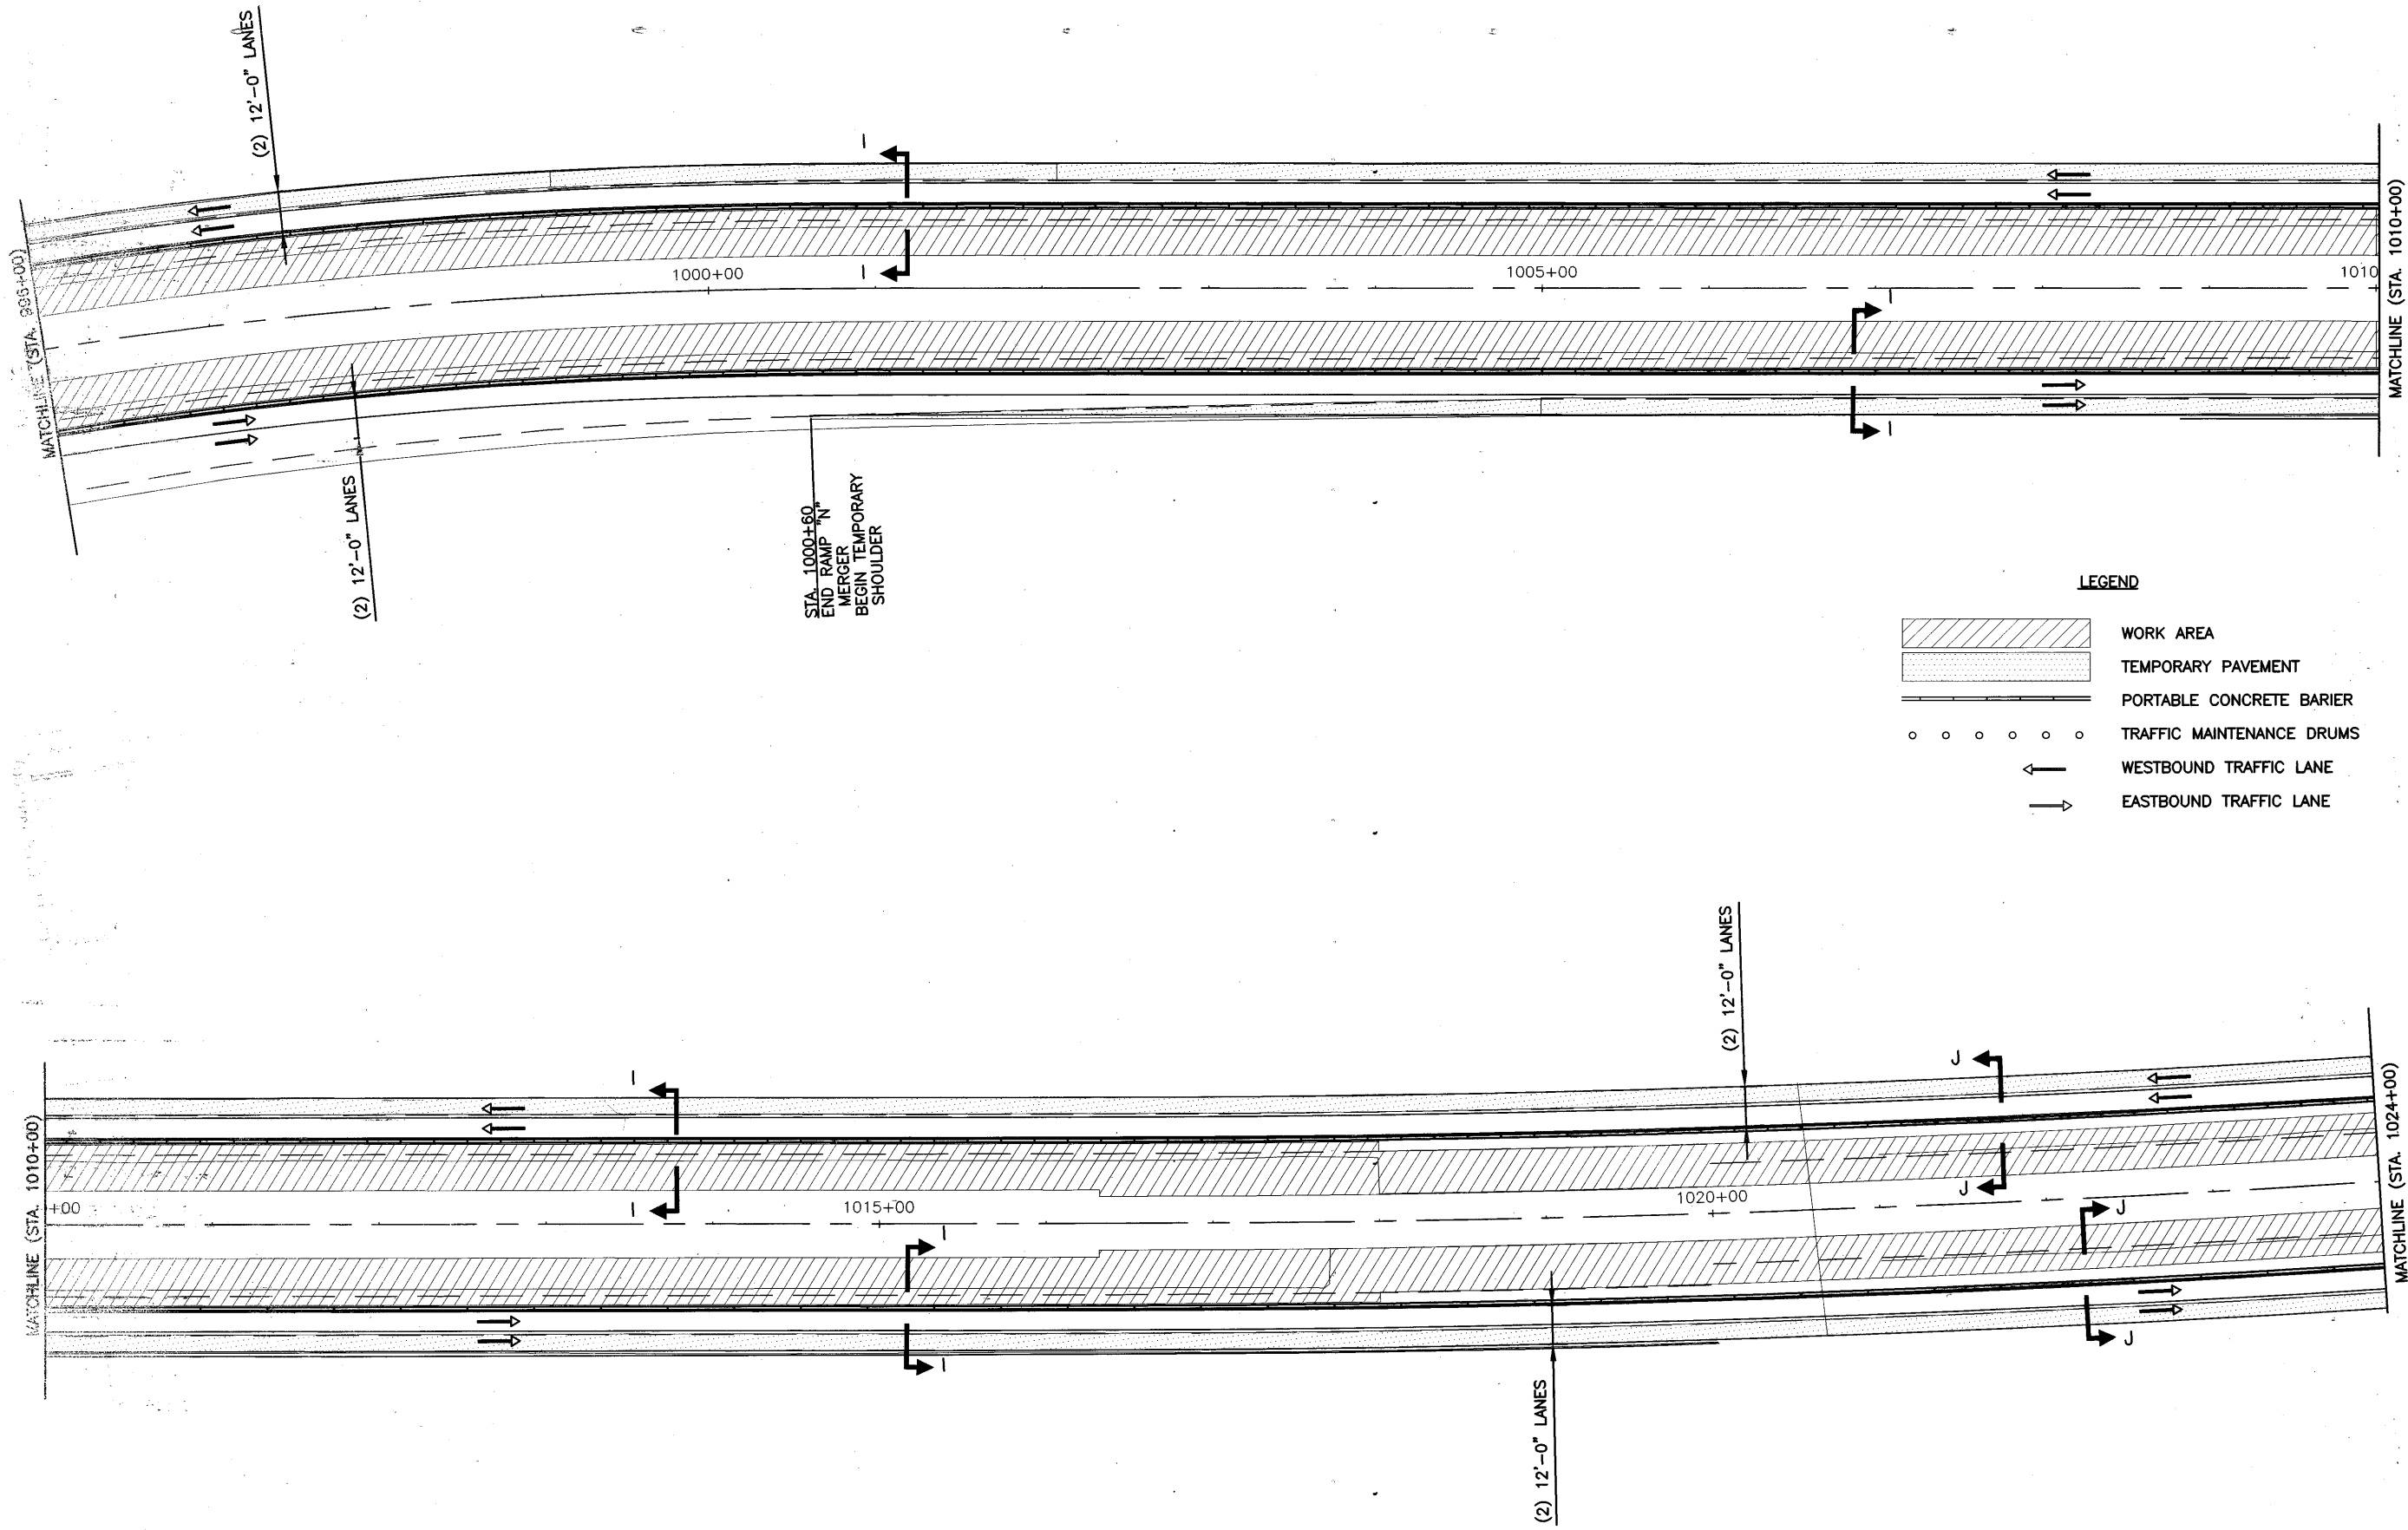

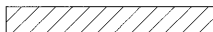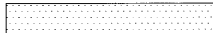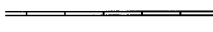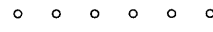- LEGEND**
-  WORK AREA
  -  TEMPORARY PAVEMENT
  -  PORTABLE CONCRETE BARRIER
  -  TRAFFIC MAINTENANCE DRUMS
  -  WESTBOUND TRAFFIC LANE
  -  EASTBOUND TRAFFIC LANE

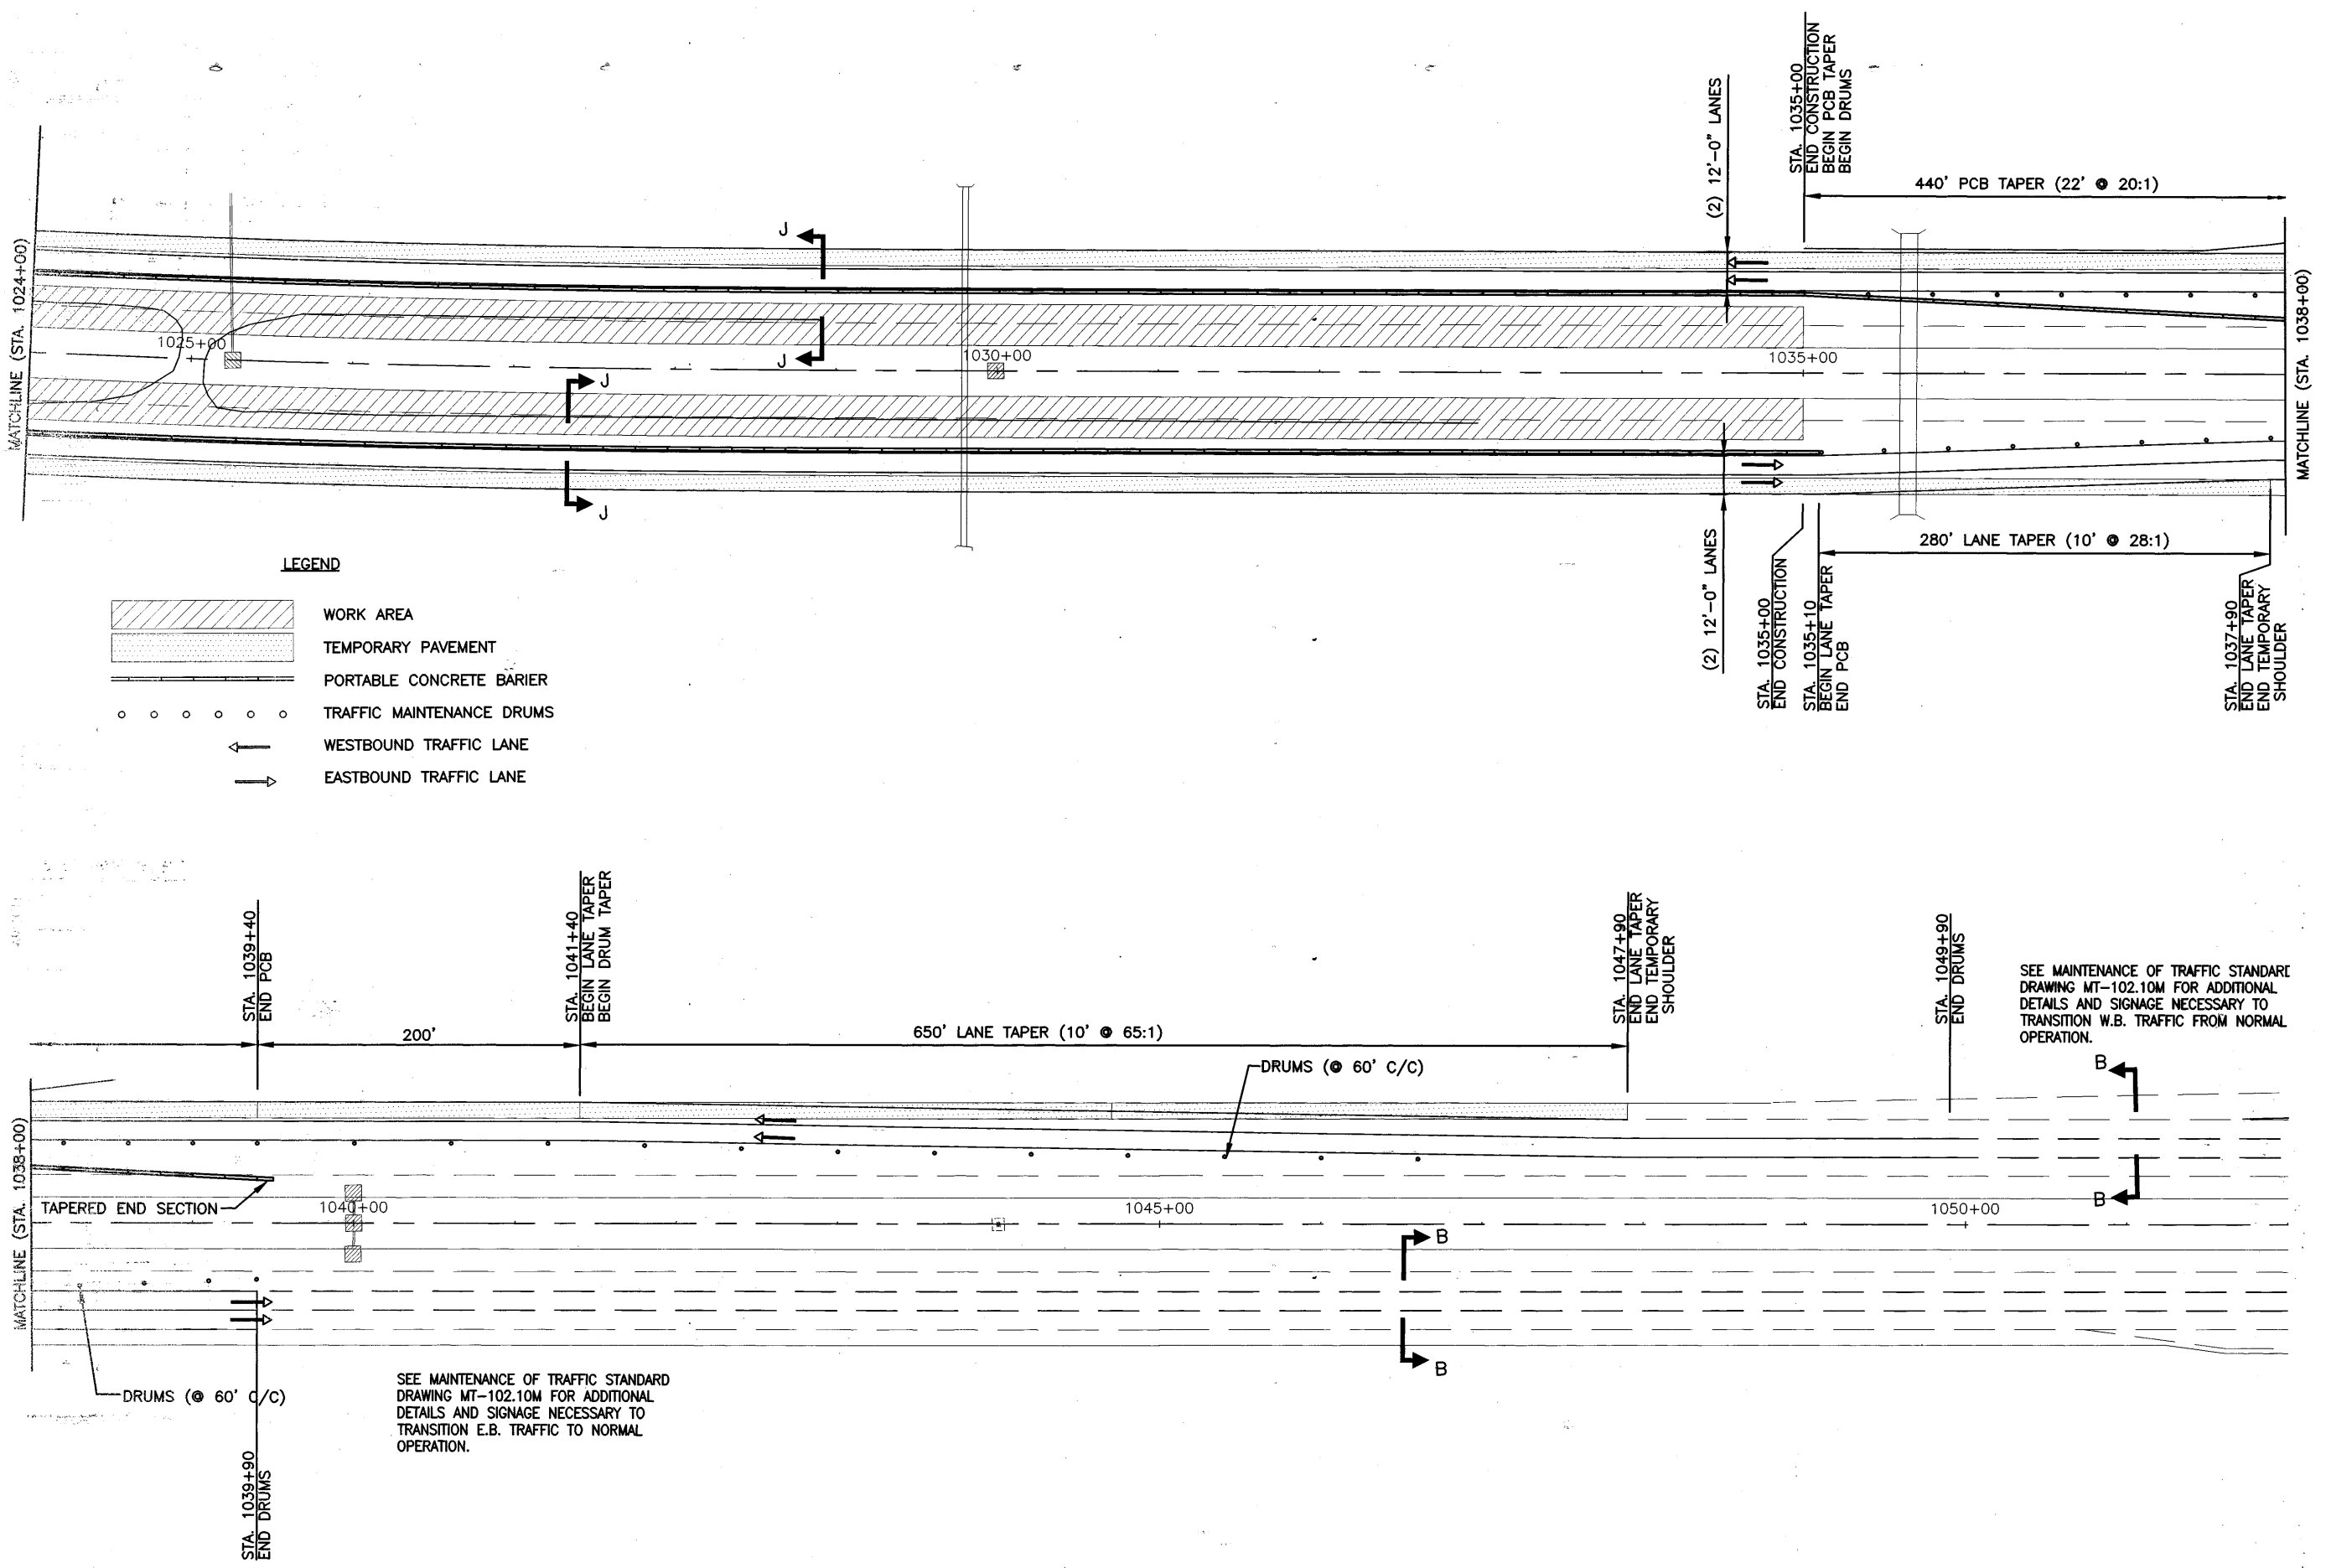

**LEGEND**

-  WORK AREA
-  TEMPORARY PAVEMENT
-  PORTABLE CONCRETE BARRIER
-  TRAFFIC MAINTENANCE DRUMS
-  WESTBOUND TRAFFIC LANE
-  EASTBOUND TRAFFIC LANE

SEE MAINTENANCE OF TRAFFIC STANDARD DRAWING MT-102.10M FOR ADDITIONAL DETAILS AND SIGNAGE NECESSARY TO TRANSITION E.B. TRAFFIC TO NORMAL OPERATION.



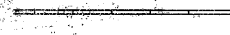
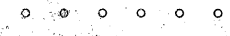


SEE MAINTENANCE OF TRAFFIC STANDARD DRAWING MT-102.10M FOR ADDITIONAL DETAILS AND SIGNAGE NECESSARY TO TRANSITION W.B. TRAFFIC FROM NORMAL OPERATION.


CALCULATED
DLS
CHECKED
LAB

**MAINTENANCE OF TRAFFIC  
PHASE I PLAN**

LOR - 190 - 10.76

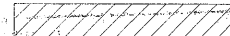**LEGEND**

-  WORK AREA
-  TEMPORARY PAVEMENT
-  PORTABLE CONCRETE BARRIER
-  TRAFFIC MAINTENANCE DRUMS
-  WESTBOUND TRAFFIC LANE
-  EASTBOUND TRAFFIC LANE

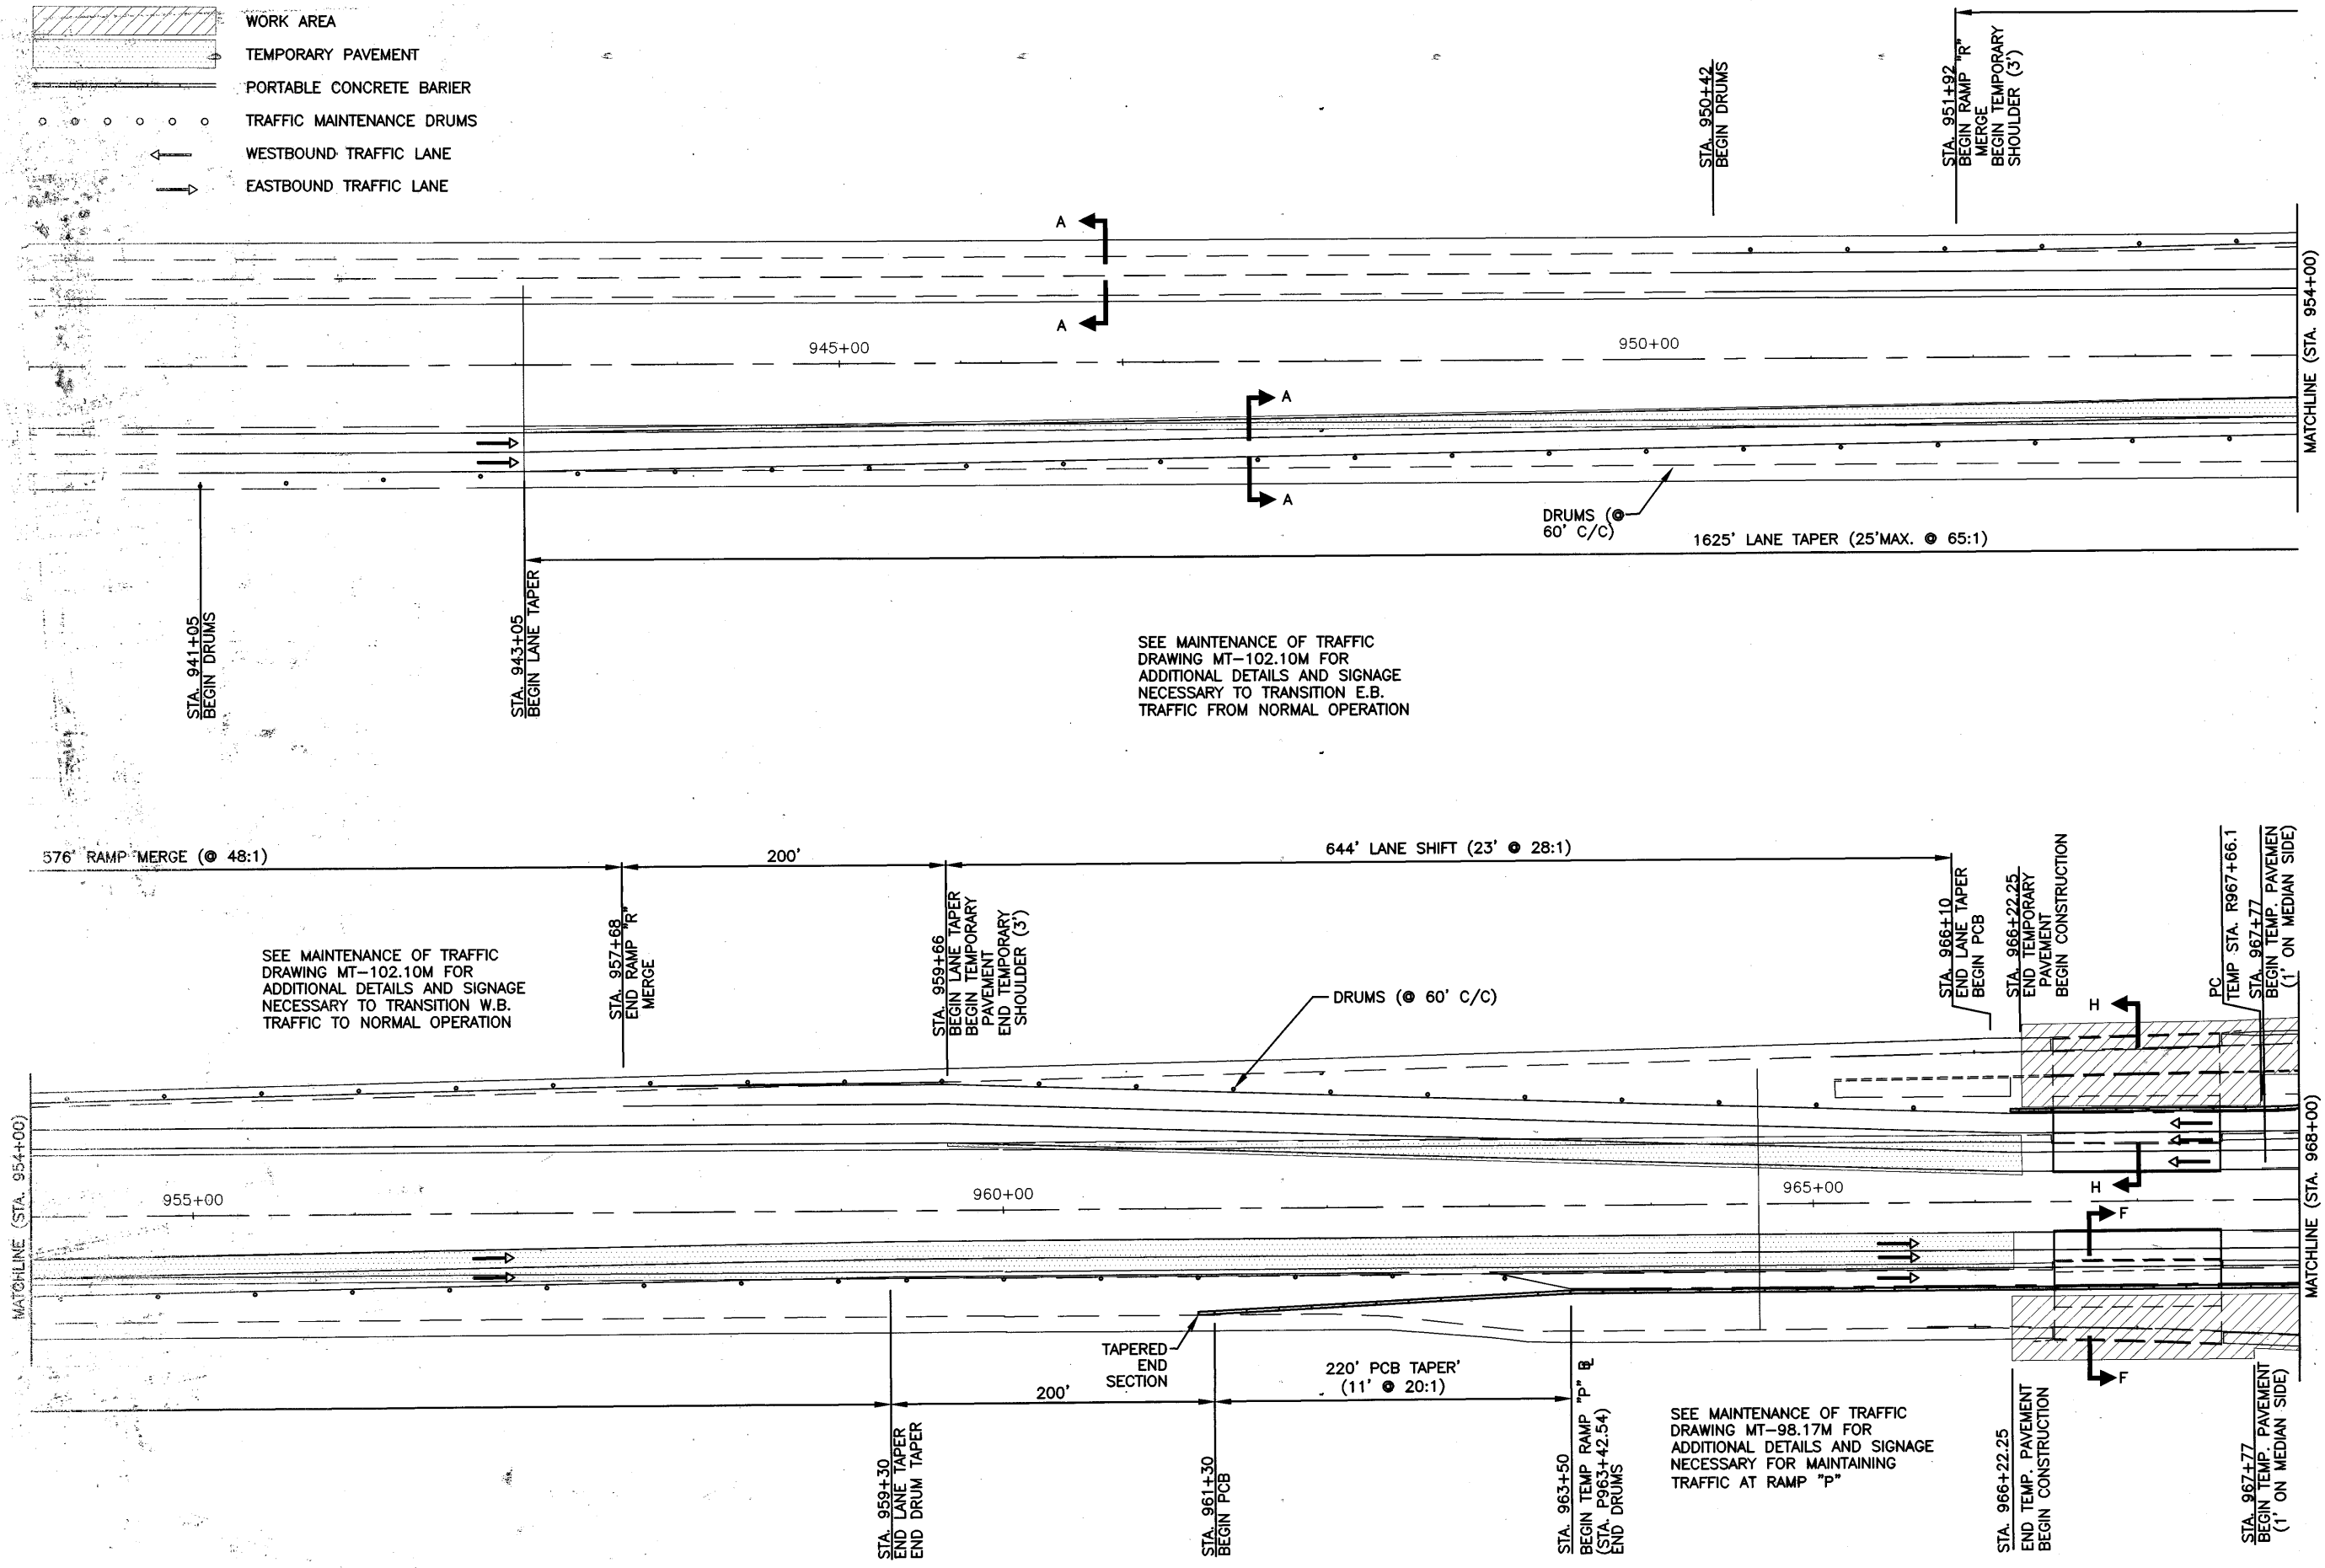


CALCULATED	DLS	CHECKED	LAB
------------	-----	---------	-----

**MAINTENANCE OF TRAFFIC  
PHASE IIA PLAN**

LOR - 190 - 10.76

M.O.T.

172  
274

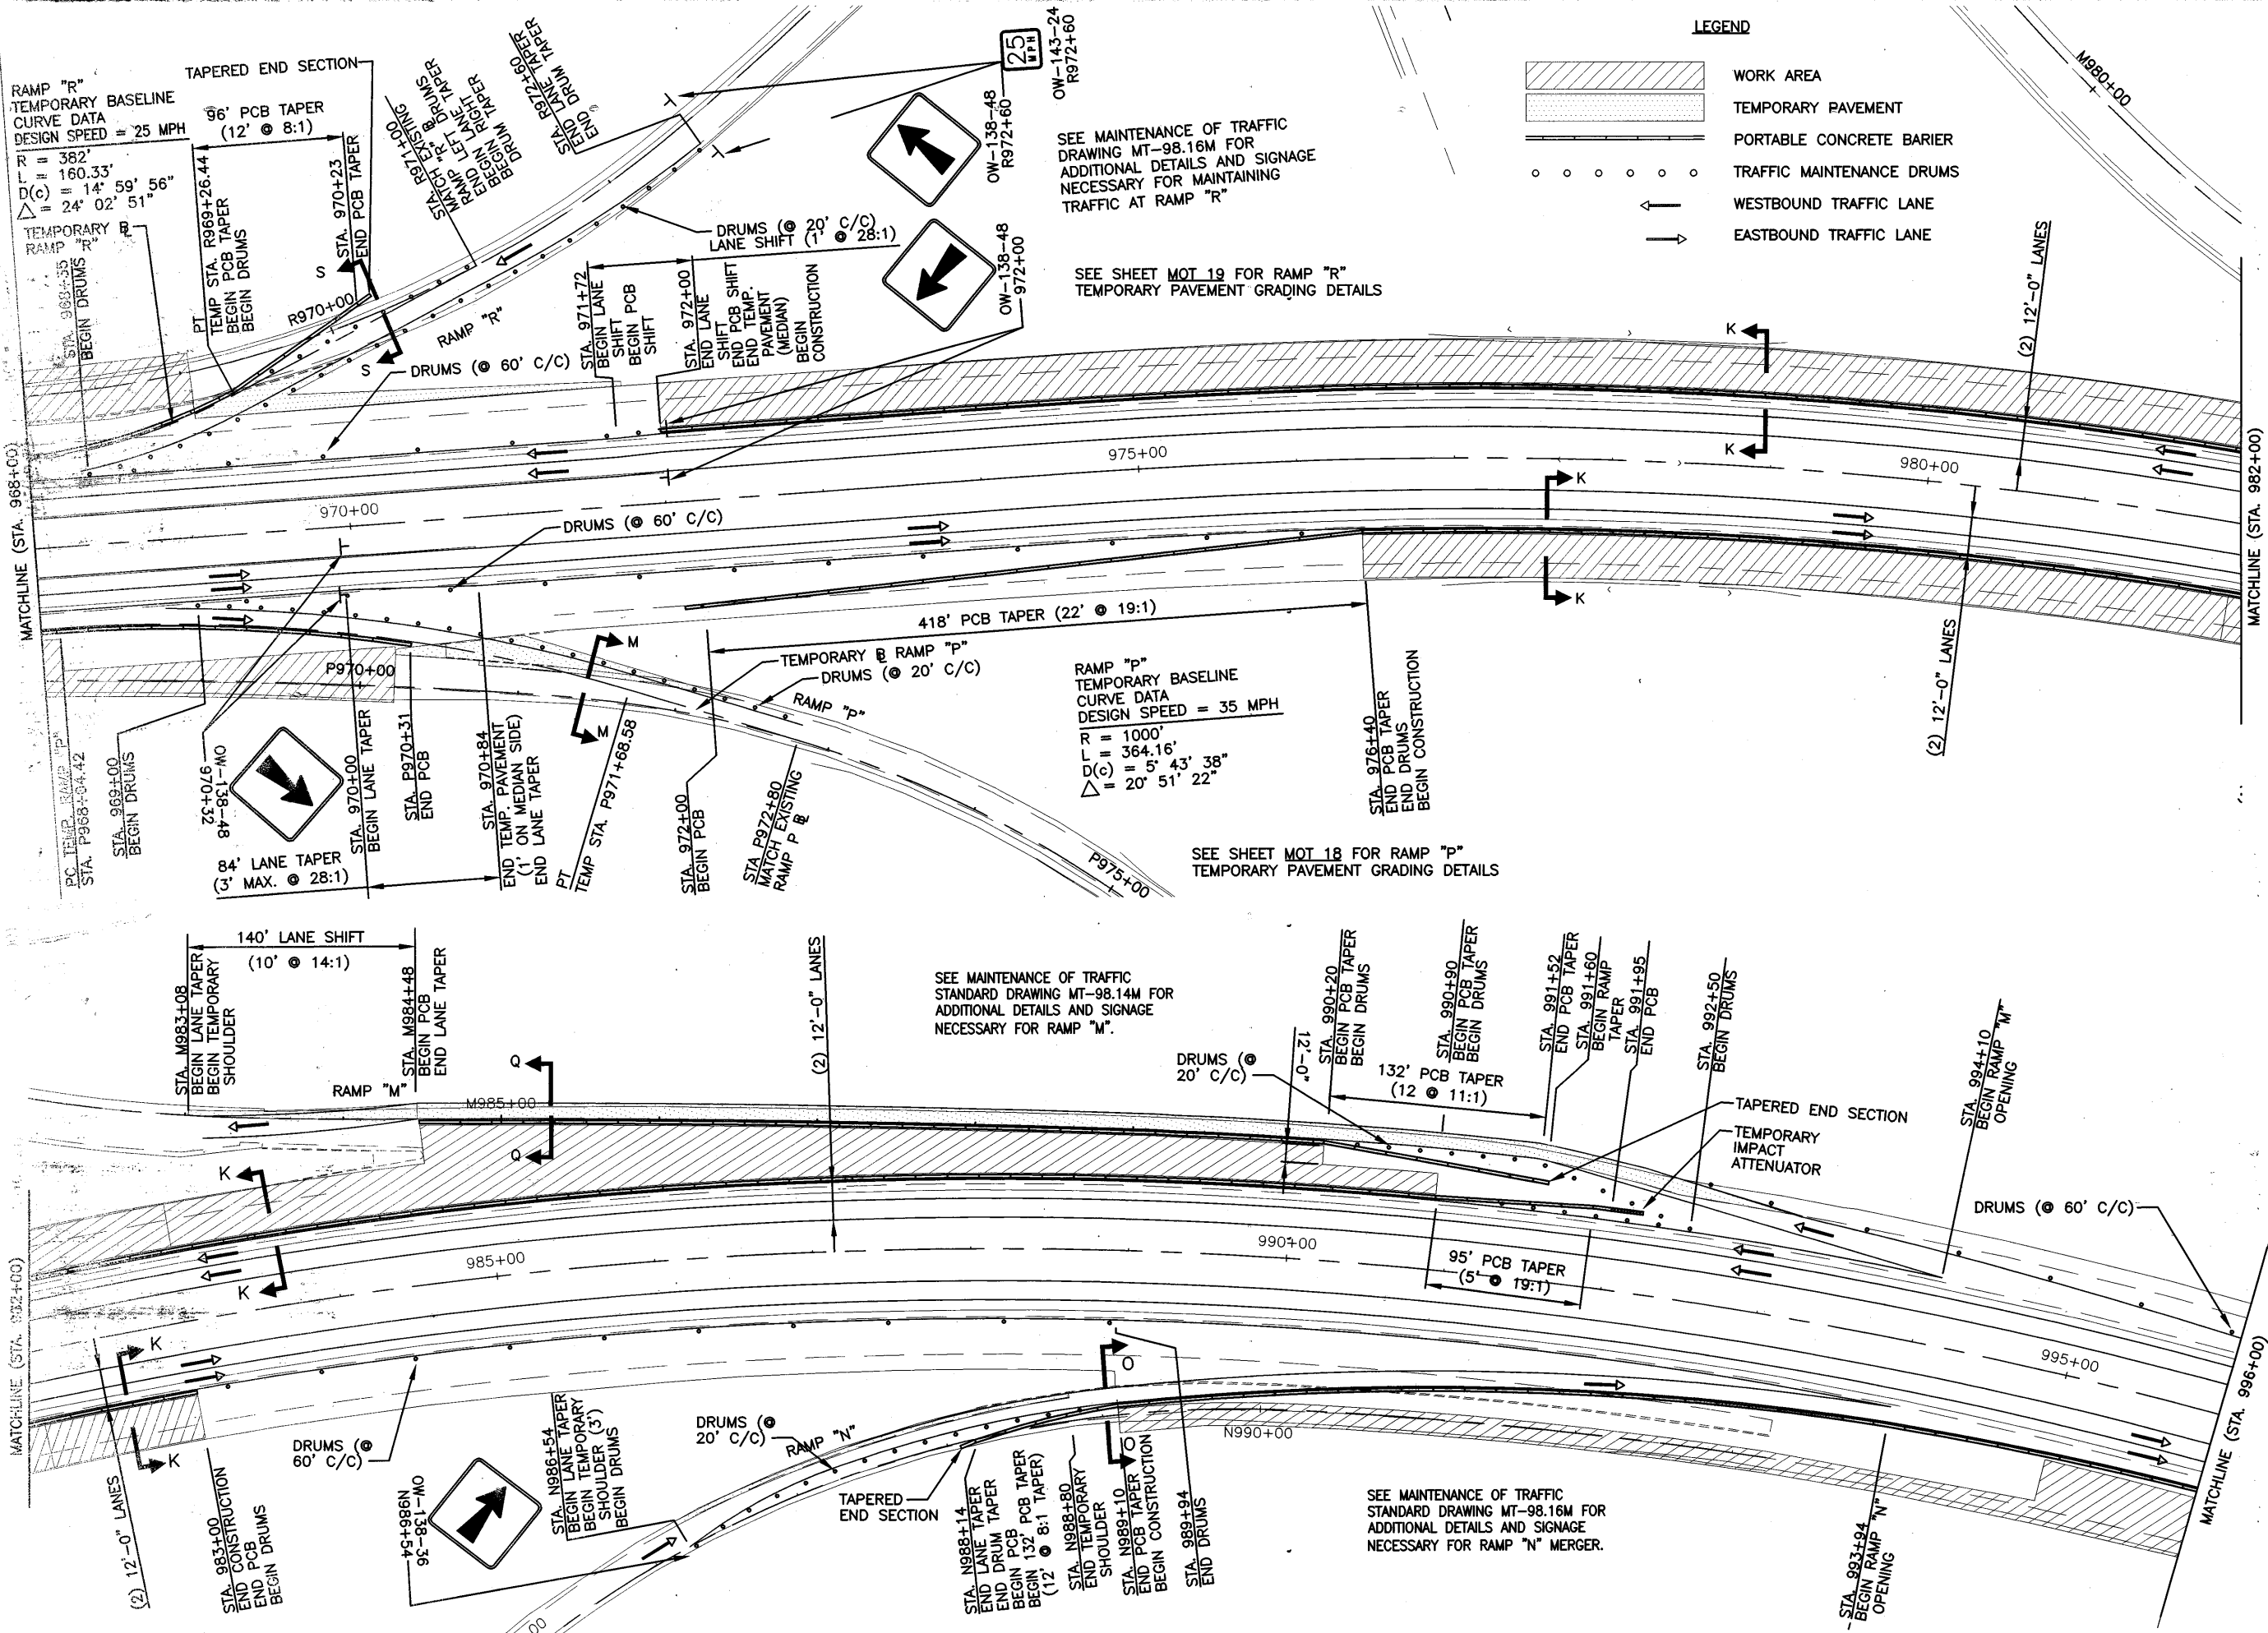

RAMP "R"  
 TEMPORARY BASELINE  
 CURVE DATA  
 DESIGN SPEED = 25 MPH  
 $R = 382'$   
 $L = 160.33'$   
 $D(c) = 14^\circ 59' 56''$   
 $\Delta = 24^\circ 02' 51''$

SEE MAINTENANCE OF TRAFFIC  
 DRAWING MT-98.16M FOR  
 ADDITIONAL DETAILS AND SIGNAGE  
 NECESSARY FOR MAINTAINING  
 TRAFFIC AT RAMP "R"

SEE SHEET M01 19 FOR RAMP "R"  
 TEMPORARY PAVEMENT GRADING DETAILS

RAMP "P"  
 TEMPORARY BASELINE  
 CURVE DATA  
 DESIGN SPEED = 35 MPH  
 $R = 1000'$   
 $L = 364.16'$   
 $D(c) = 5^\circ 43' 38''$   
 $\Delta = 20^\circ 51' 22''$

SEE SHEET M01 18 FOR RAMP "P"  
 TEMPORARY PAVEMENT GRADING DETAILS

SEE MAINTENANCE OF TRAFFIC  
 STANDARD DRAWING MT-98.14M FOR  
 ADDITIONAL DETAILS AND SIGNAGE  
 NECESSARY FOR RAMP "M".

SEE MAINTENANCE OF TRAFFIC  
 STANDARD DRAWING MT-98.16M FOR  
 ADDITIONAL DETAILS AND SIGNAGE  
 NECESSARY FOR RAMP "N" MERGER.

- LEGEND**
- WORK AREA
  - TEMPORARY PAVEMENT
  - PORTABLE CONCRETE BARRIER
  - TRAFFIC MAINTENANCE DRUMS
  - WESTBOUND TRAFFIC LANE
  - EASTBOUND TRAFFIC LANE


CALCULATED	DLS	CHECKED	LAB
------------	-----	---------	-----

**MAINTENANCE OF TRAFFIC  
 PHASE IIA PLAN**

LOR - 190 - 10.76

M.O.T.

173  
 274

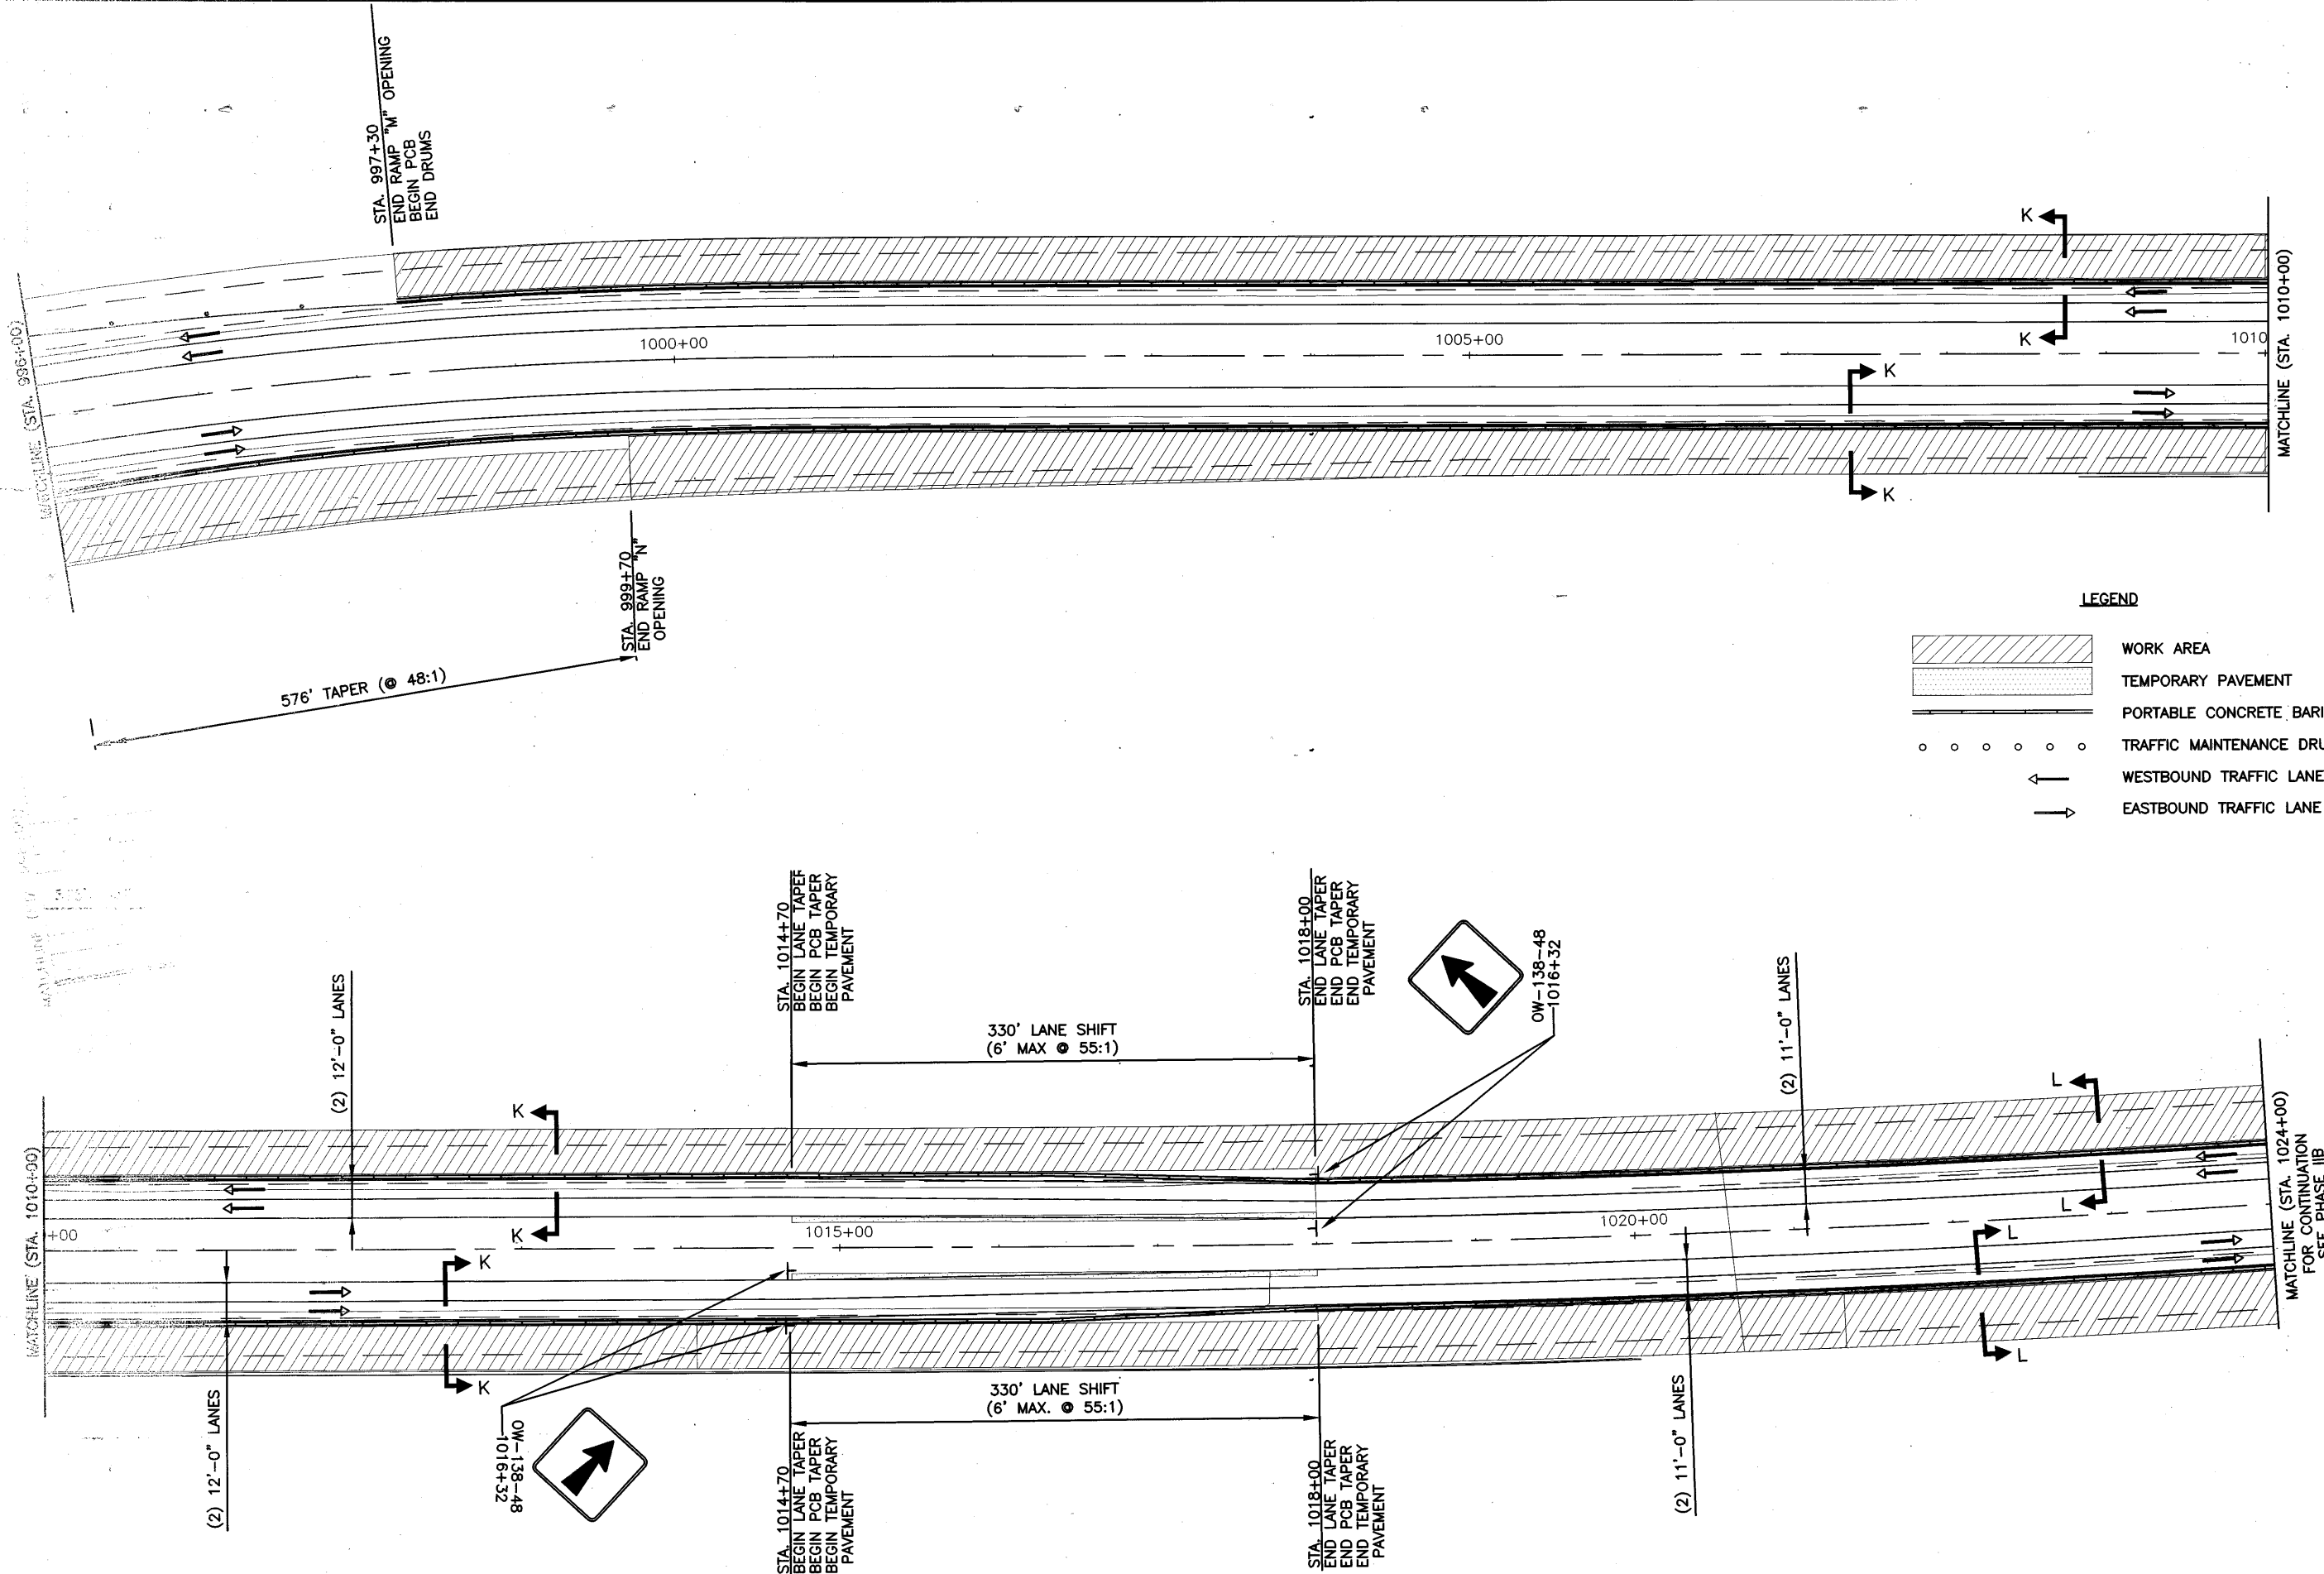

576' TAPER (● 48:1)

STA. 997+30  
END RAMP "M" OPENING  
BEGIN PCB  
END DRUMS

STA. 999+70  
END RAMP "N"  
OPENING

STA. 1014+70  
BEGIN LANE TAPER  
END LANE TAPER  
BEGIN PCB TAPER  
BEGIN TEMPORARY  
PAVEMENT

330' LANE SHIFT  
(6' MAX ● 55:1)

STA. 1018+00  
END LANE TAPER  
END PCB TAPER  
END TEMPORARY  
PAVEMENT

STA. 1014+70  
BEGIN LANE TAPER  
END LANE TAPER  
BEGIN PCB TAPER  
BEGIN TEMPORARY  
PAVEMENT

330' LANE SHIFT  
(6' MAX. ● 55:1)

STA. 1018+00  
END LANE TAPER  
END PCB TAPER  
END TEMPORARY  
PAVEMENT

OW-138-48  
-1016+32

(2) 11'-0" LANES

(2) 11'-0" LANES

(2) 12'-0" LANES



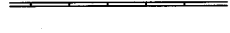



(2) 12'-0" LANES

MATCHLINE (STA. 1010+00)

MATCHLINE (STA. 1010+00)







MATCHLINE (STA. 1024+00)  
FOR CONTINUATION  
SEE PHASE IIB

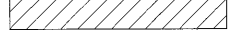
**LEGEND**

 -  WORK AREA
-  TEMPORARY PAVEMENT
-  PORTABLE CONCRETE BARRIER
-  TRAFFIC MAINTENANCE DRUMS
-  WESTBOUND TRAFFIC LANE
-  EASTBOUND TRAFFIC LANE


CALCULATED	
DLS	
CHECKED	
LAB	

**LEGEND**

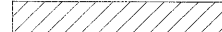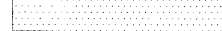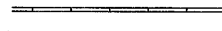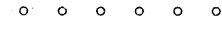-  WORK AREA
-  TEMPORARY PAVEMENT
-  PORTABLE CONCRETE BARRIER
-  TRAFFIC MAINTENANCE DRUMS
-  WESTBOUND TRAFFIC LANE
-  EASTBOUND TRAFFIC LANE

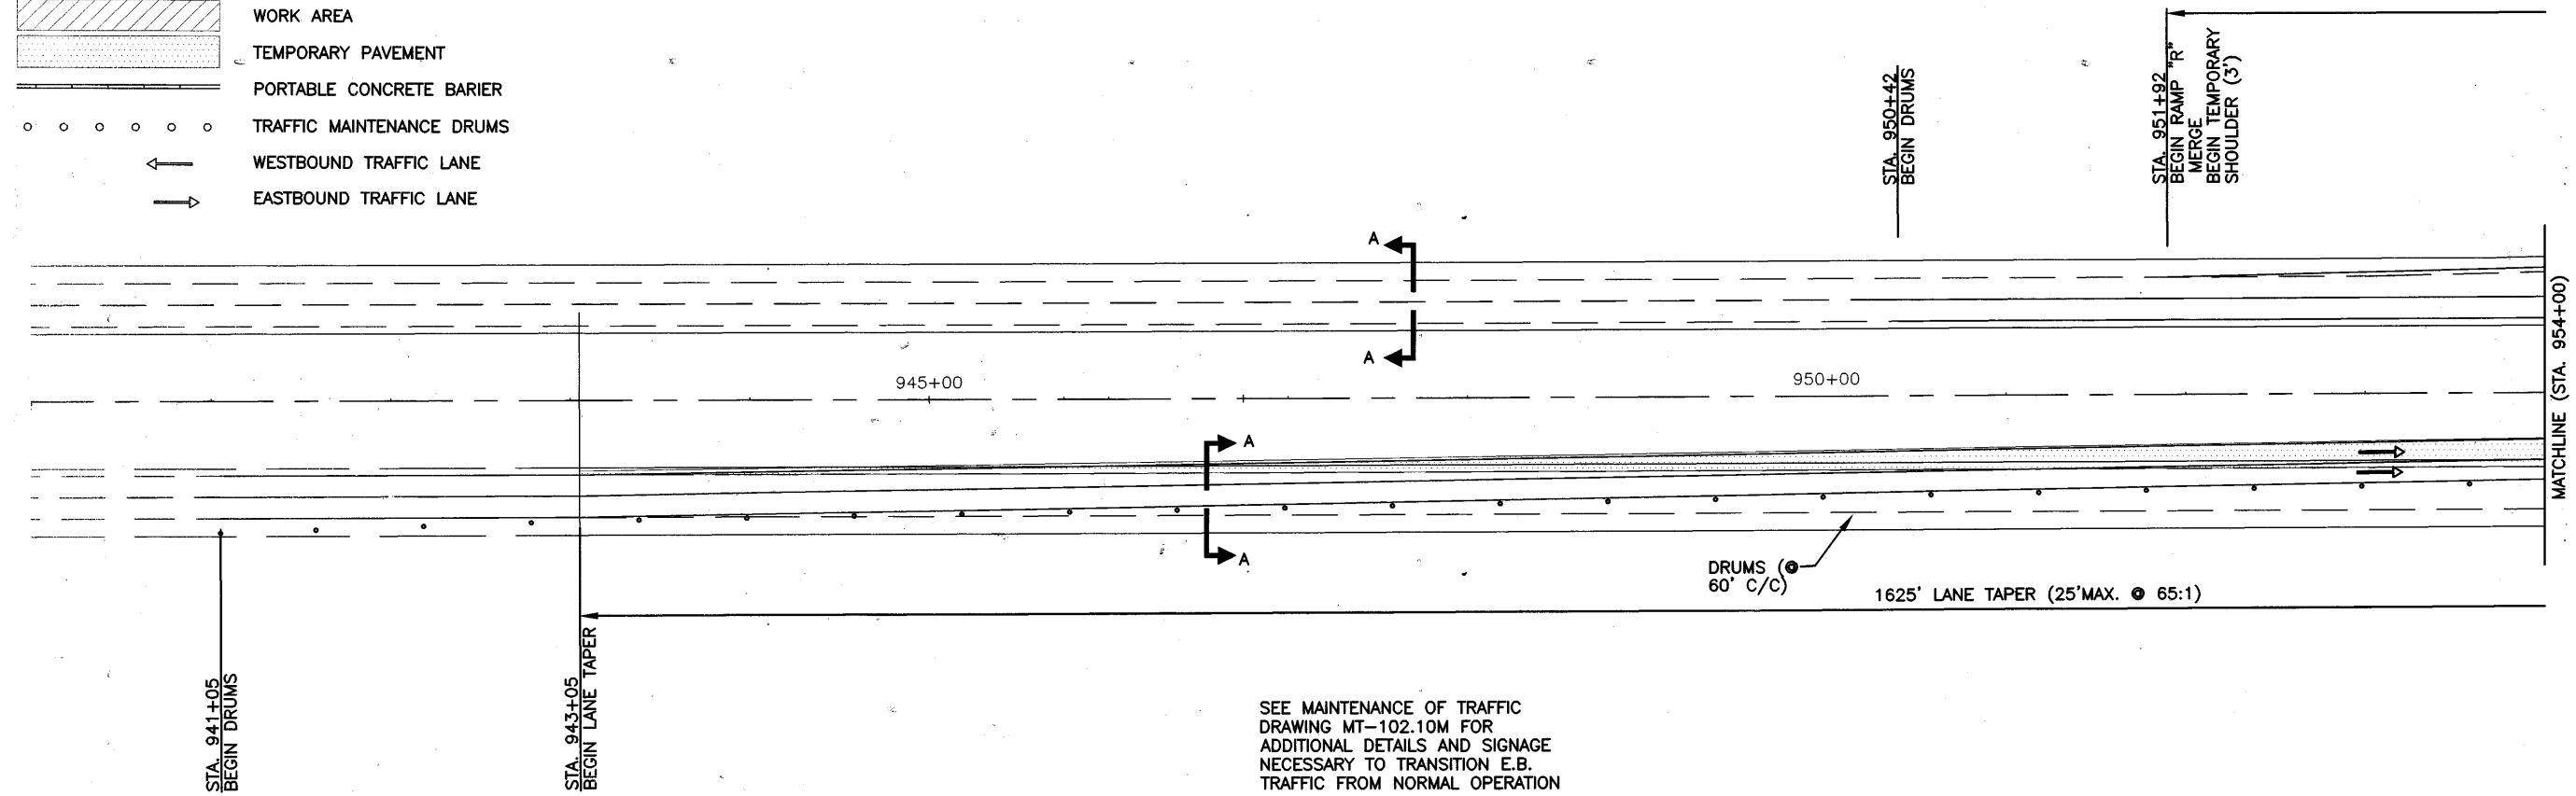

SEE MAINTENANCE OF TRAFFIC DRAWING MT-102.10M FOR ADDITIONAL DETAILS AND SIGNAGE NECESSARY TO TRANSITION E.B. TRAFFIC FROM NORMAL OPERATION

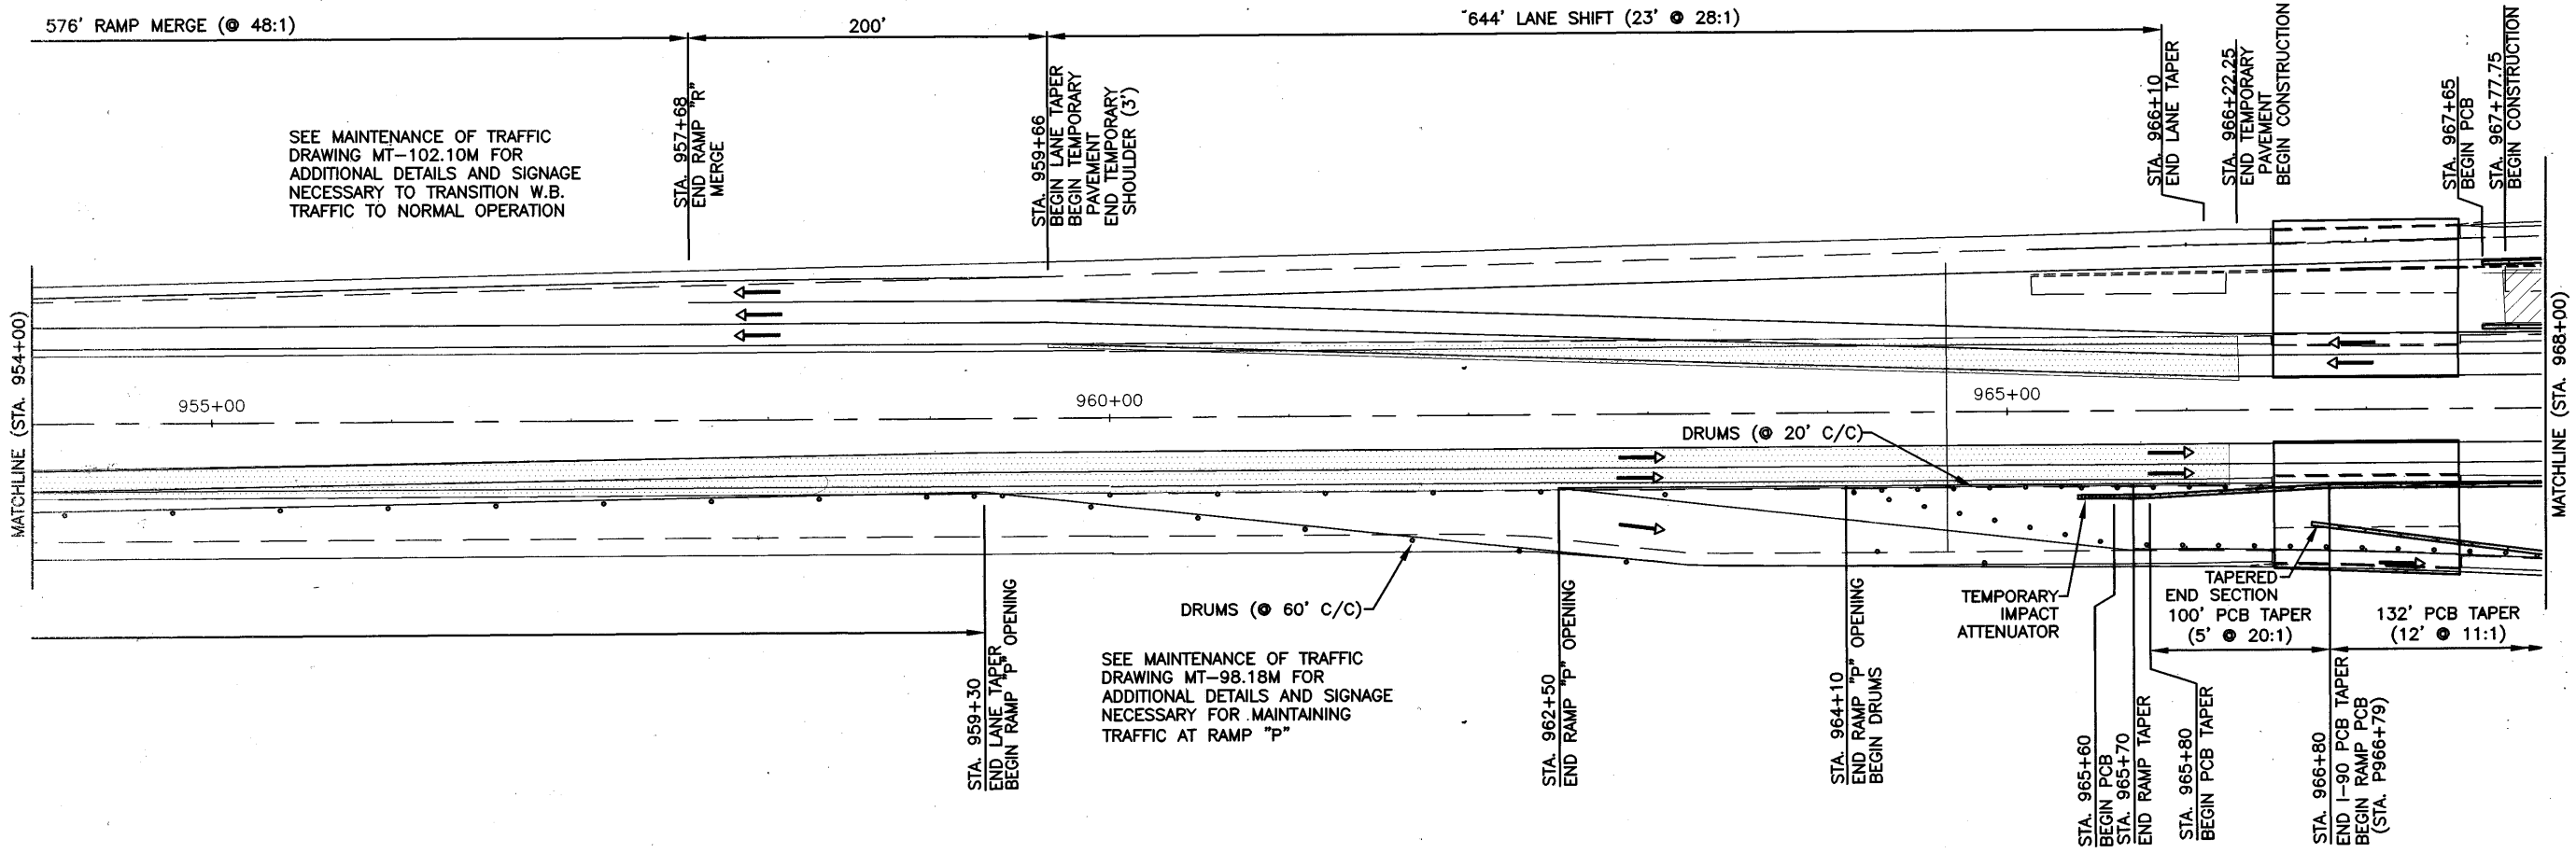

SEE MAINTENANCE OF TRAFFIC DRAWING MT-98.18M FOR ADDITIONAL DETAILS AND SIGNAGE NECESSARY FOR MAINTAINING TRAFFIC AT RAMP "P"

SEE MAINTENANCE OF TRAFFIC DRAWING MT-102.10M FOR ADDITIONAL DETAILS AND SIGNAGE NECESSARY TO TRANSITION W.B. TRAFFIC TO NORMAL OPERATION


CALCULATED  
DLS  
CHECKED  
LAB

**MAINTENANCE OF TRAFFIC  
PHASE IIB PLAN**

**LOR - 190 - 10.76**

M.O.T.

175  
274



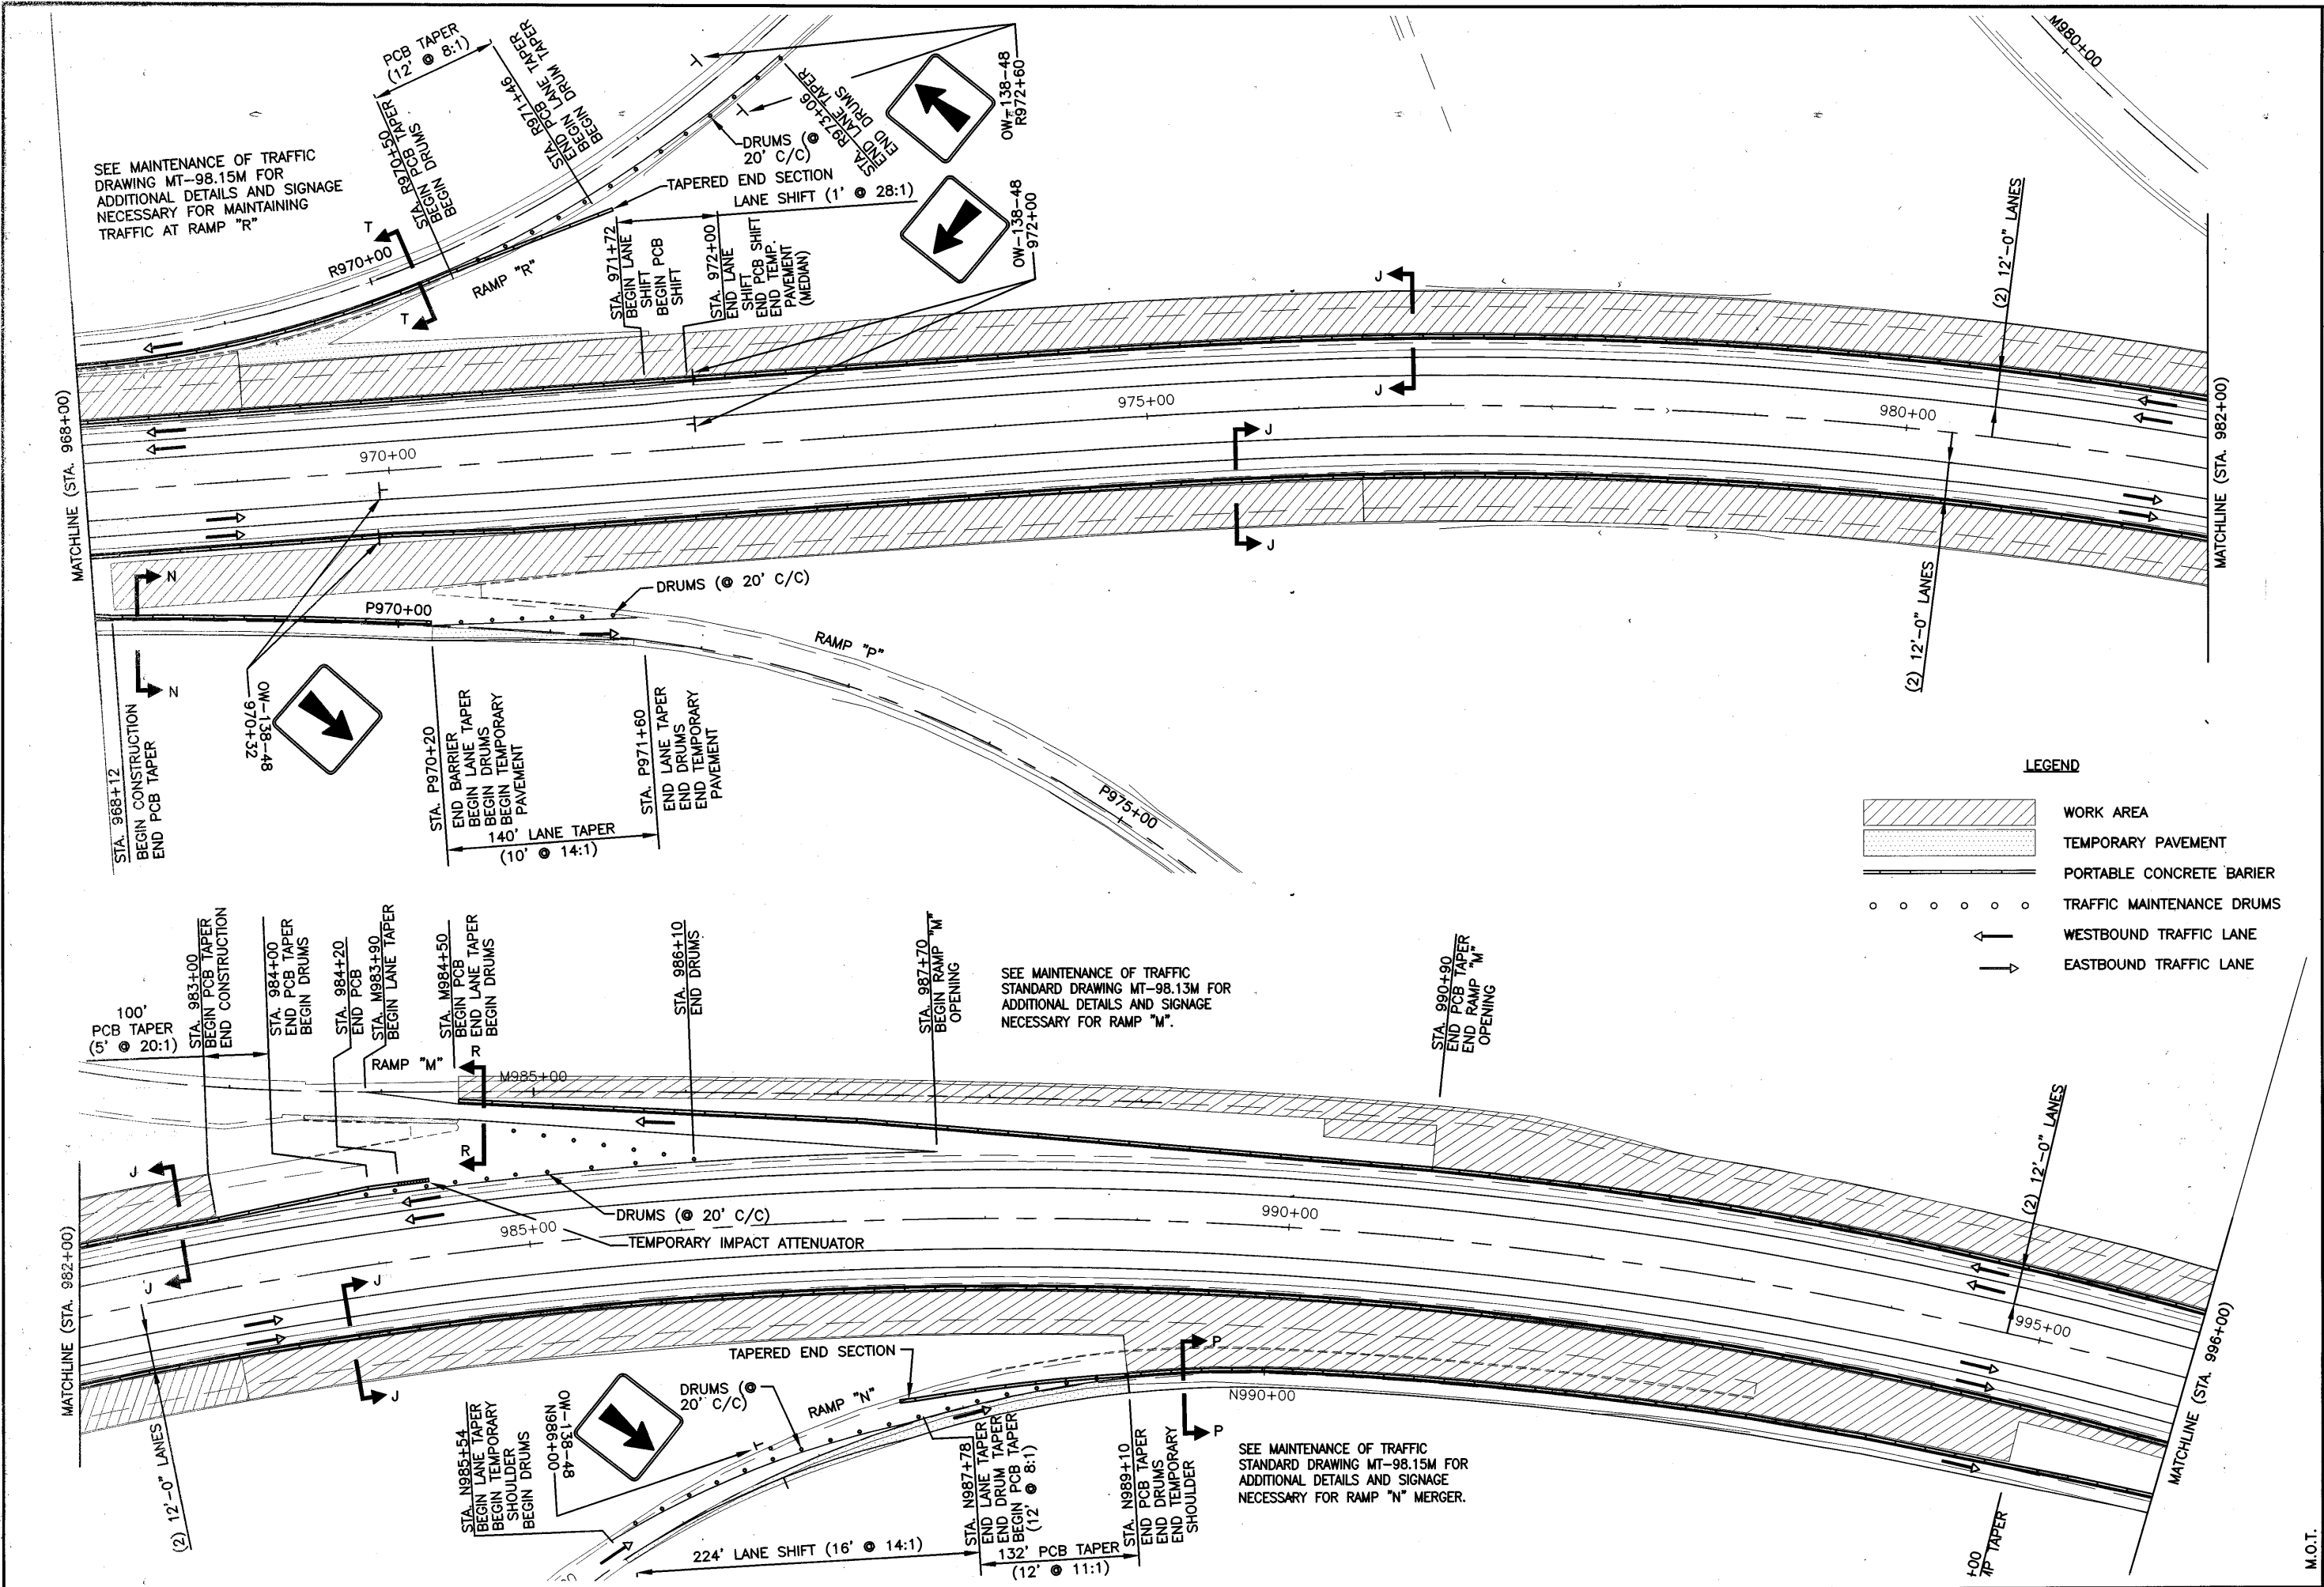





SEE MAINTENANCE OF TRAFFIC DRAWING MT-98.15M FOR ADDITIONAL DETAILS AND SIGNAGE NECESSARY FOR MAINTAINING TRAFFIC AT RAMP "R"

SEE MAINTENANCE OF TRAFFIC STANDARD DRAWING MT-98.13M FOR ADDITIONAL DETAILS AND SIGNAGE NECESSARY FOR RAMP "M".

SEE MAINTENANCE OF TRAFFIC STANDARD DRAWING MT-98.15M FOR ADDITIONAL DETAILS AND SIGNAGE NECESSARY FOR RAMP "N" MERGER.

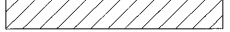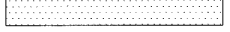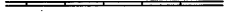**LEGEND**

-  WORK AREA
-  TEMPORARY PAVEMENT
-  PORTABLE CONCRETE BARRIER
-  TRAFFIC MAINTENANCE DRUMS
-  WESTBOUND TRAFFIC LANE
-  EASTBOUND TRAFFIC LANE

CALCULATED	DLS	CHECKED	LAB
------------	-----	---------	-----



**MAINTENANCE OF TRAFFIC  
PHASE IIB PLAN**

LOR - 190 - 10.76


M.O.T.

176  
274



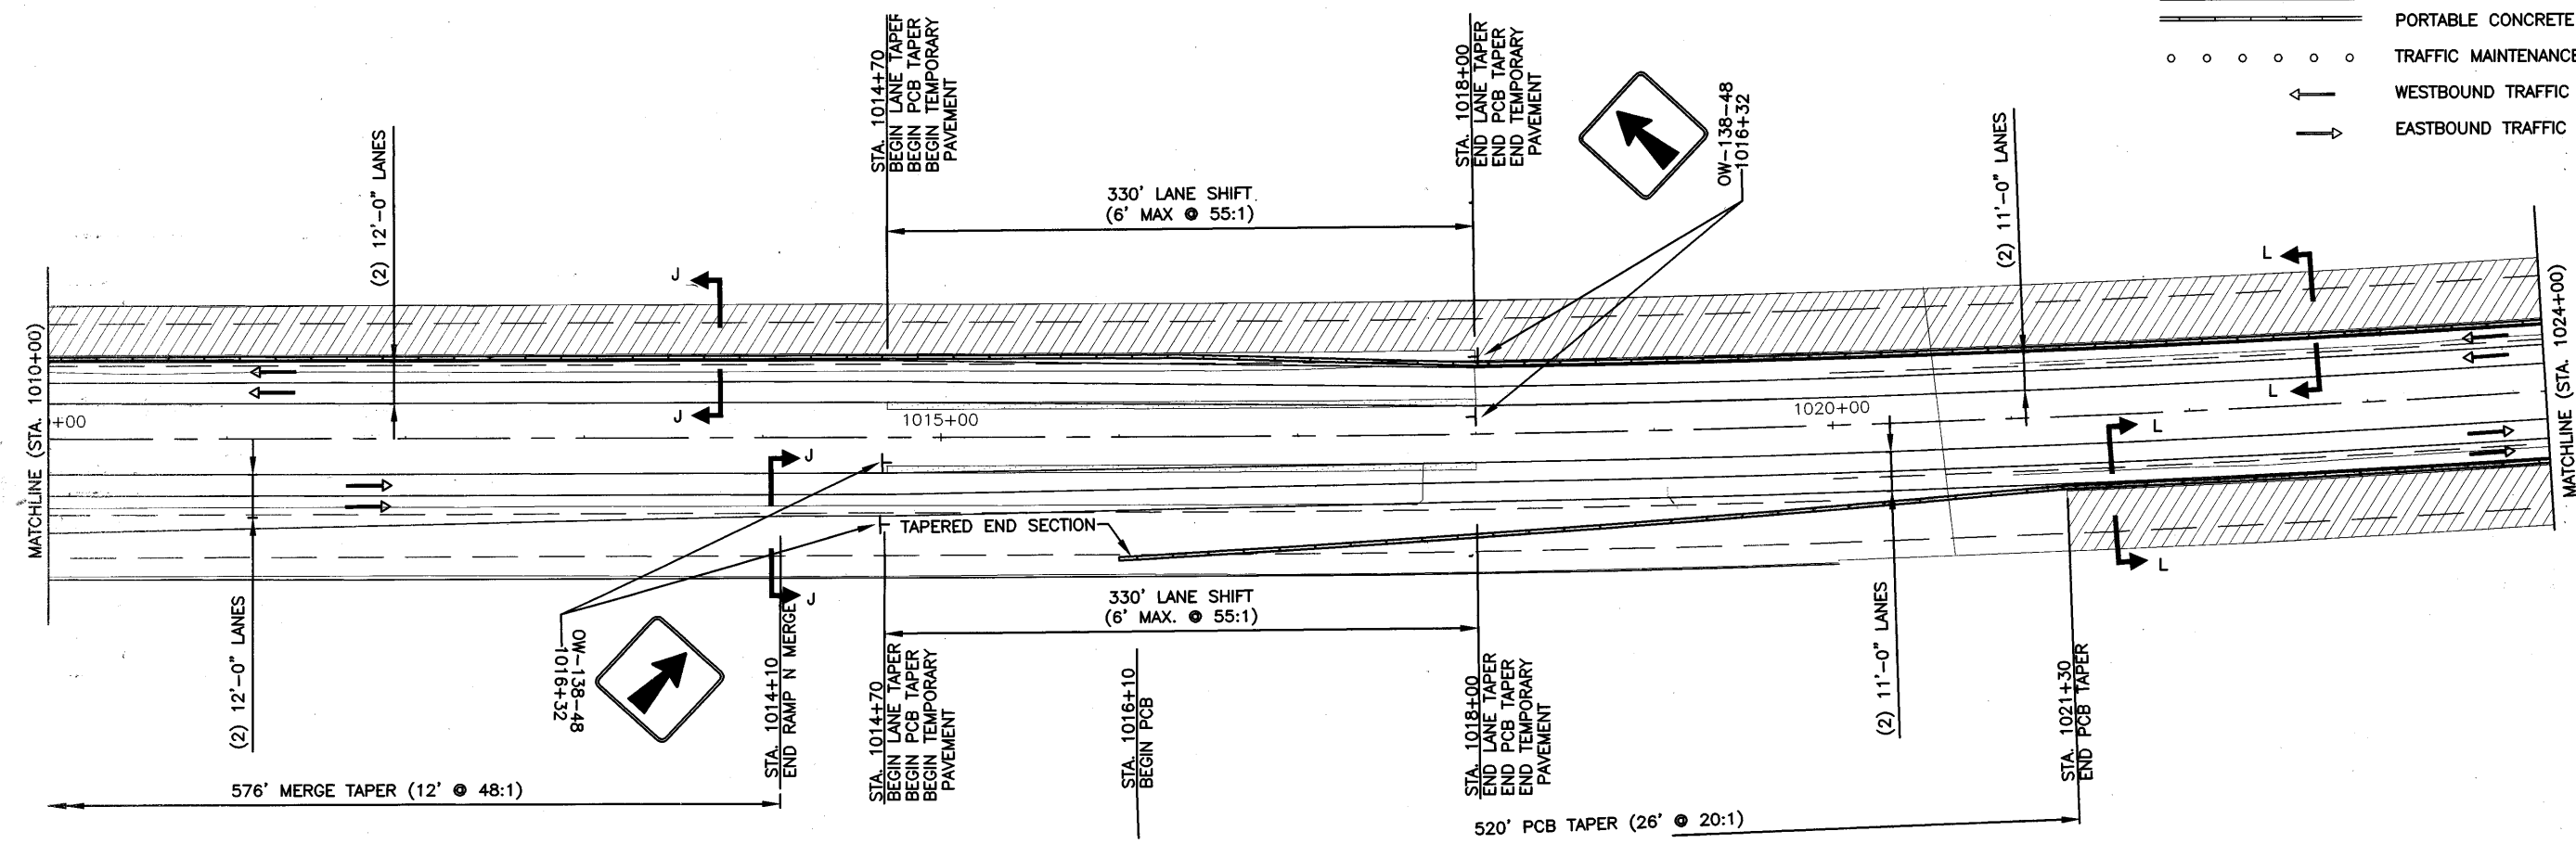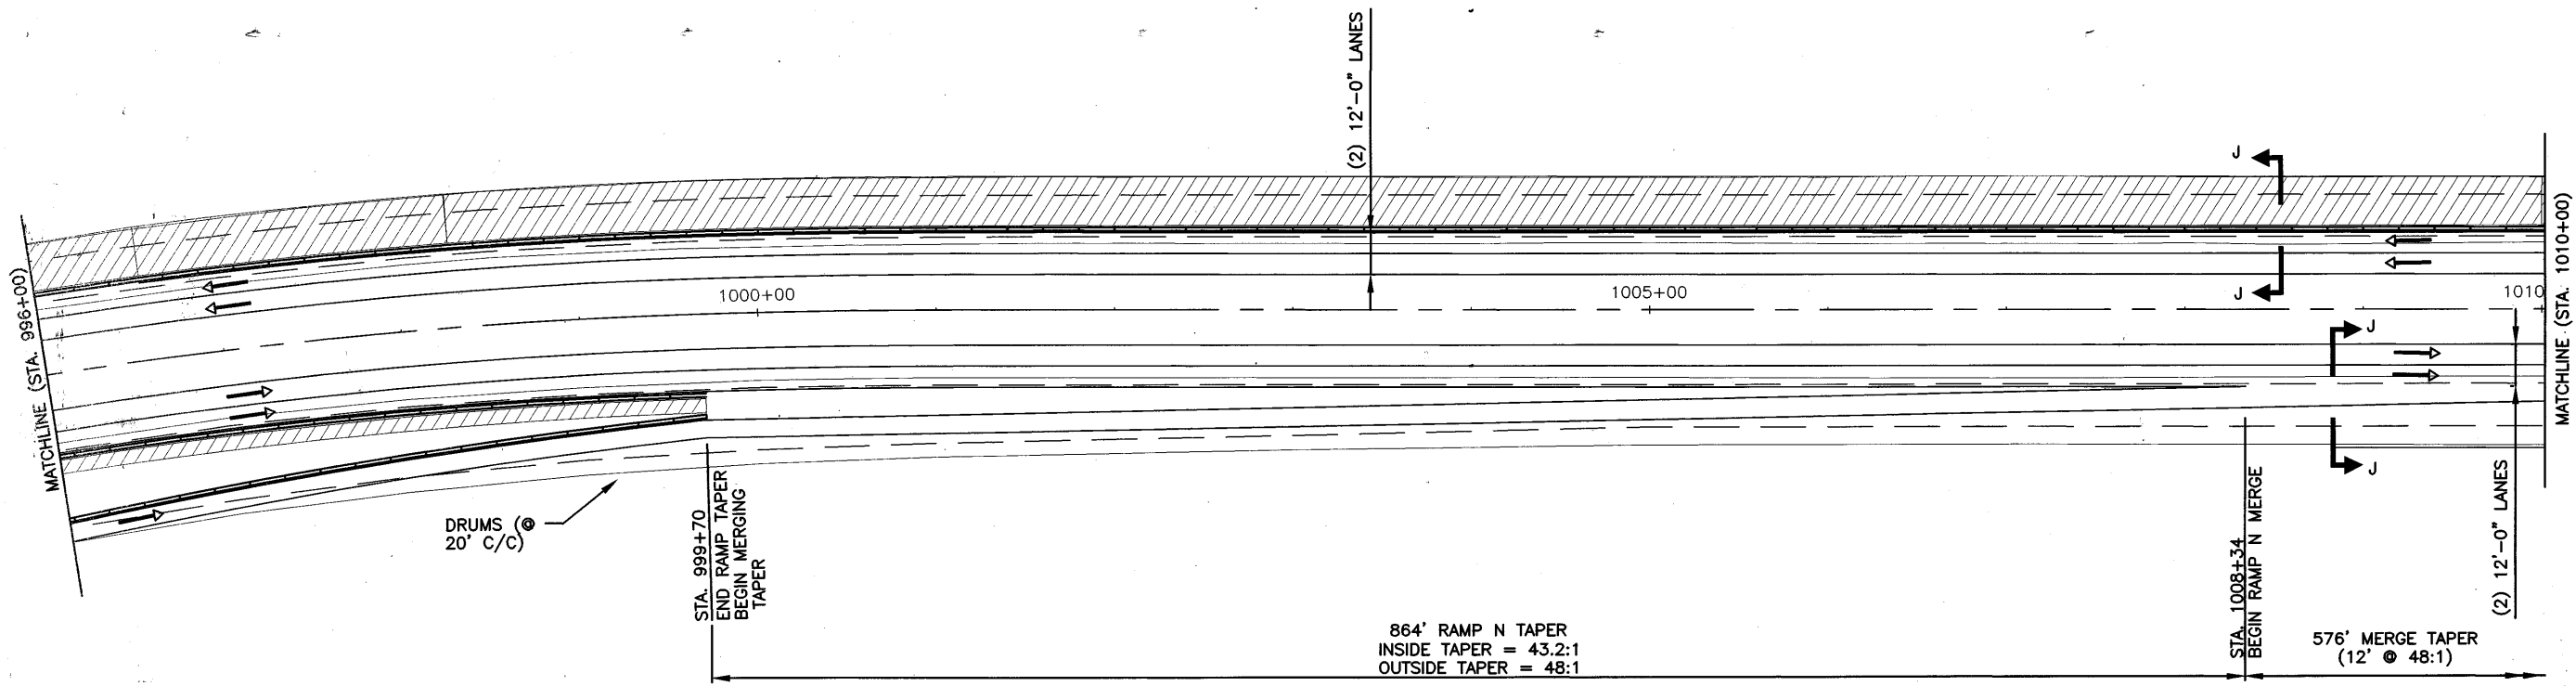

- LEGEND**
- WORK AREA
  - TEMPORARY PAVEMENT
  - PORTABLE CONCRETE BARRIER
  - TRAFFIC MAINTENANCE DRUMS
  - WESTBOUND TRAFFIC LANE
  - EASTBOUND TRAFFIC LANE

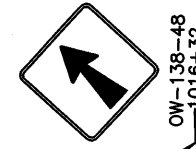


CALCULATED  
DLS  
CHECKED  
LAB

**MAINTENANCE OF TRAFFIC  
PHASE IIB PLAN**


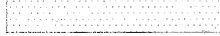
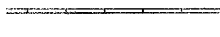
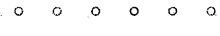



LOR - 190 - 10.76


M.O.T.

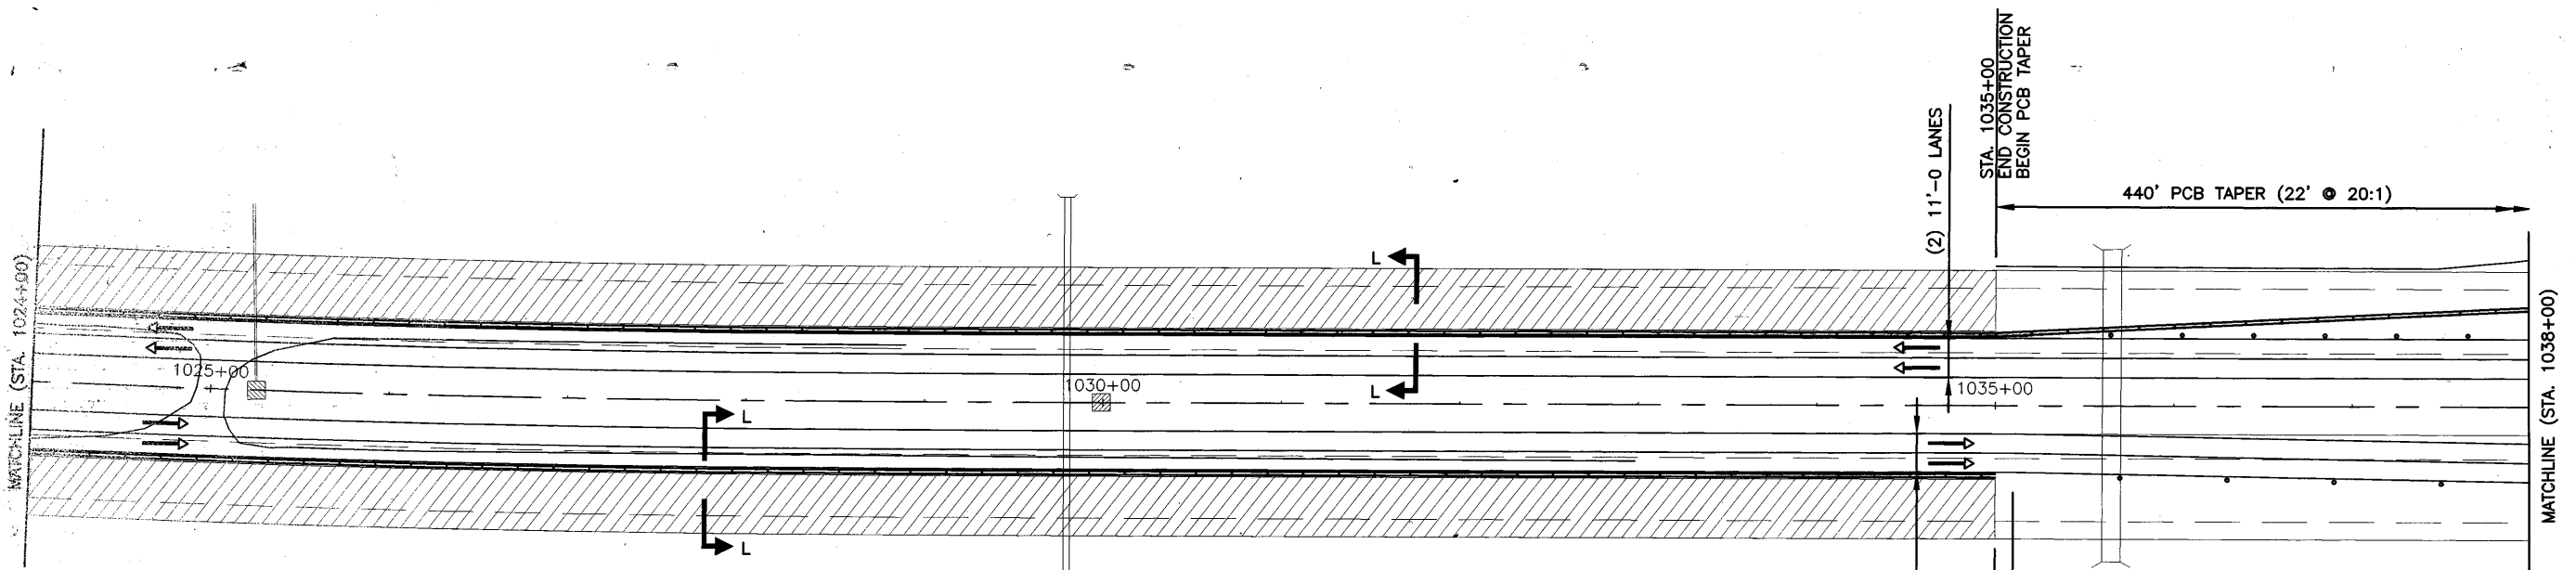177  
274



**LEGEND**

-  WORK AREA
-  TEMPORARY PAVEMENT
-  PORTABLE CONCRETE BARRIER
-  TRAFFIC MAINTENANCE DRUMS
-  WESTBOUND TRAFFIC LANE
-  EASTBOUND TRAFFIC LANE
-  TRAFFIC MAINTENANCE CONES

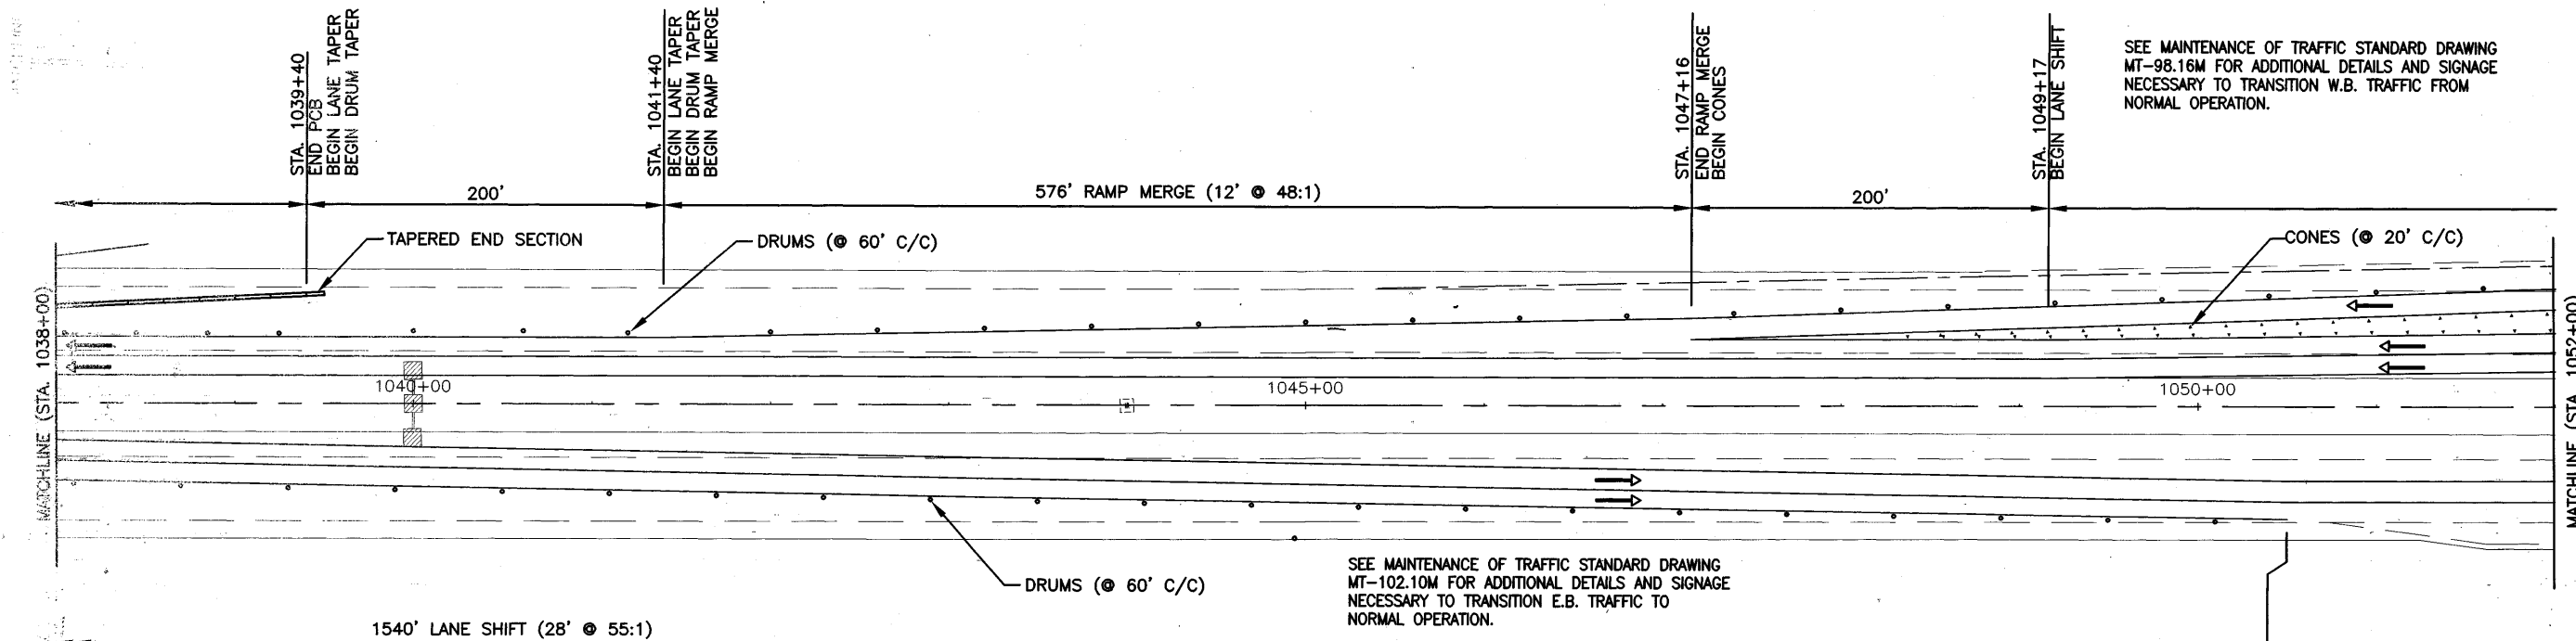


CALCULATED	
DLS	
CHECKED	
LAB	

**MAINTENANCE OF TRAFFIC  
PHASE IIA & IIB PLAN**



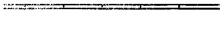
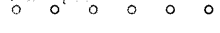

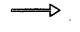

**LOR - 190 - 10.76**

SEE MAINTENANCE OF TRAFFIC STANDARD  
DRAWING MT-102.10M FOR ADDITIONAL  
DETAILS AND SIGNAGE NECESSARY TO  
TRANSITION W.B. TRAFFIC FROM NORMAL  
OPERATION.

1820' LANE SHIFT (28' @ 65:1)

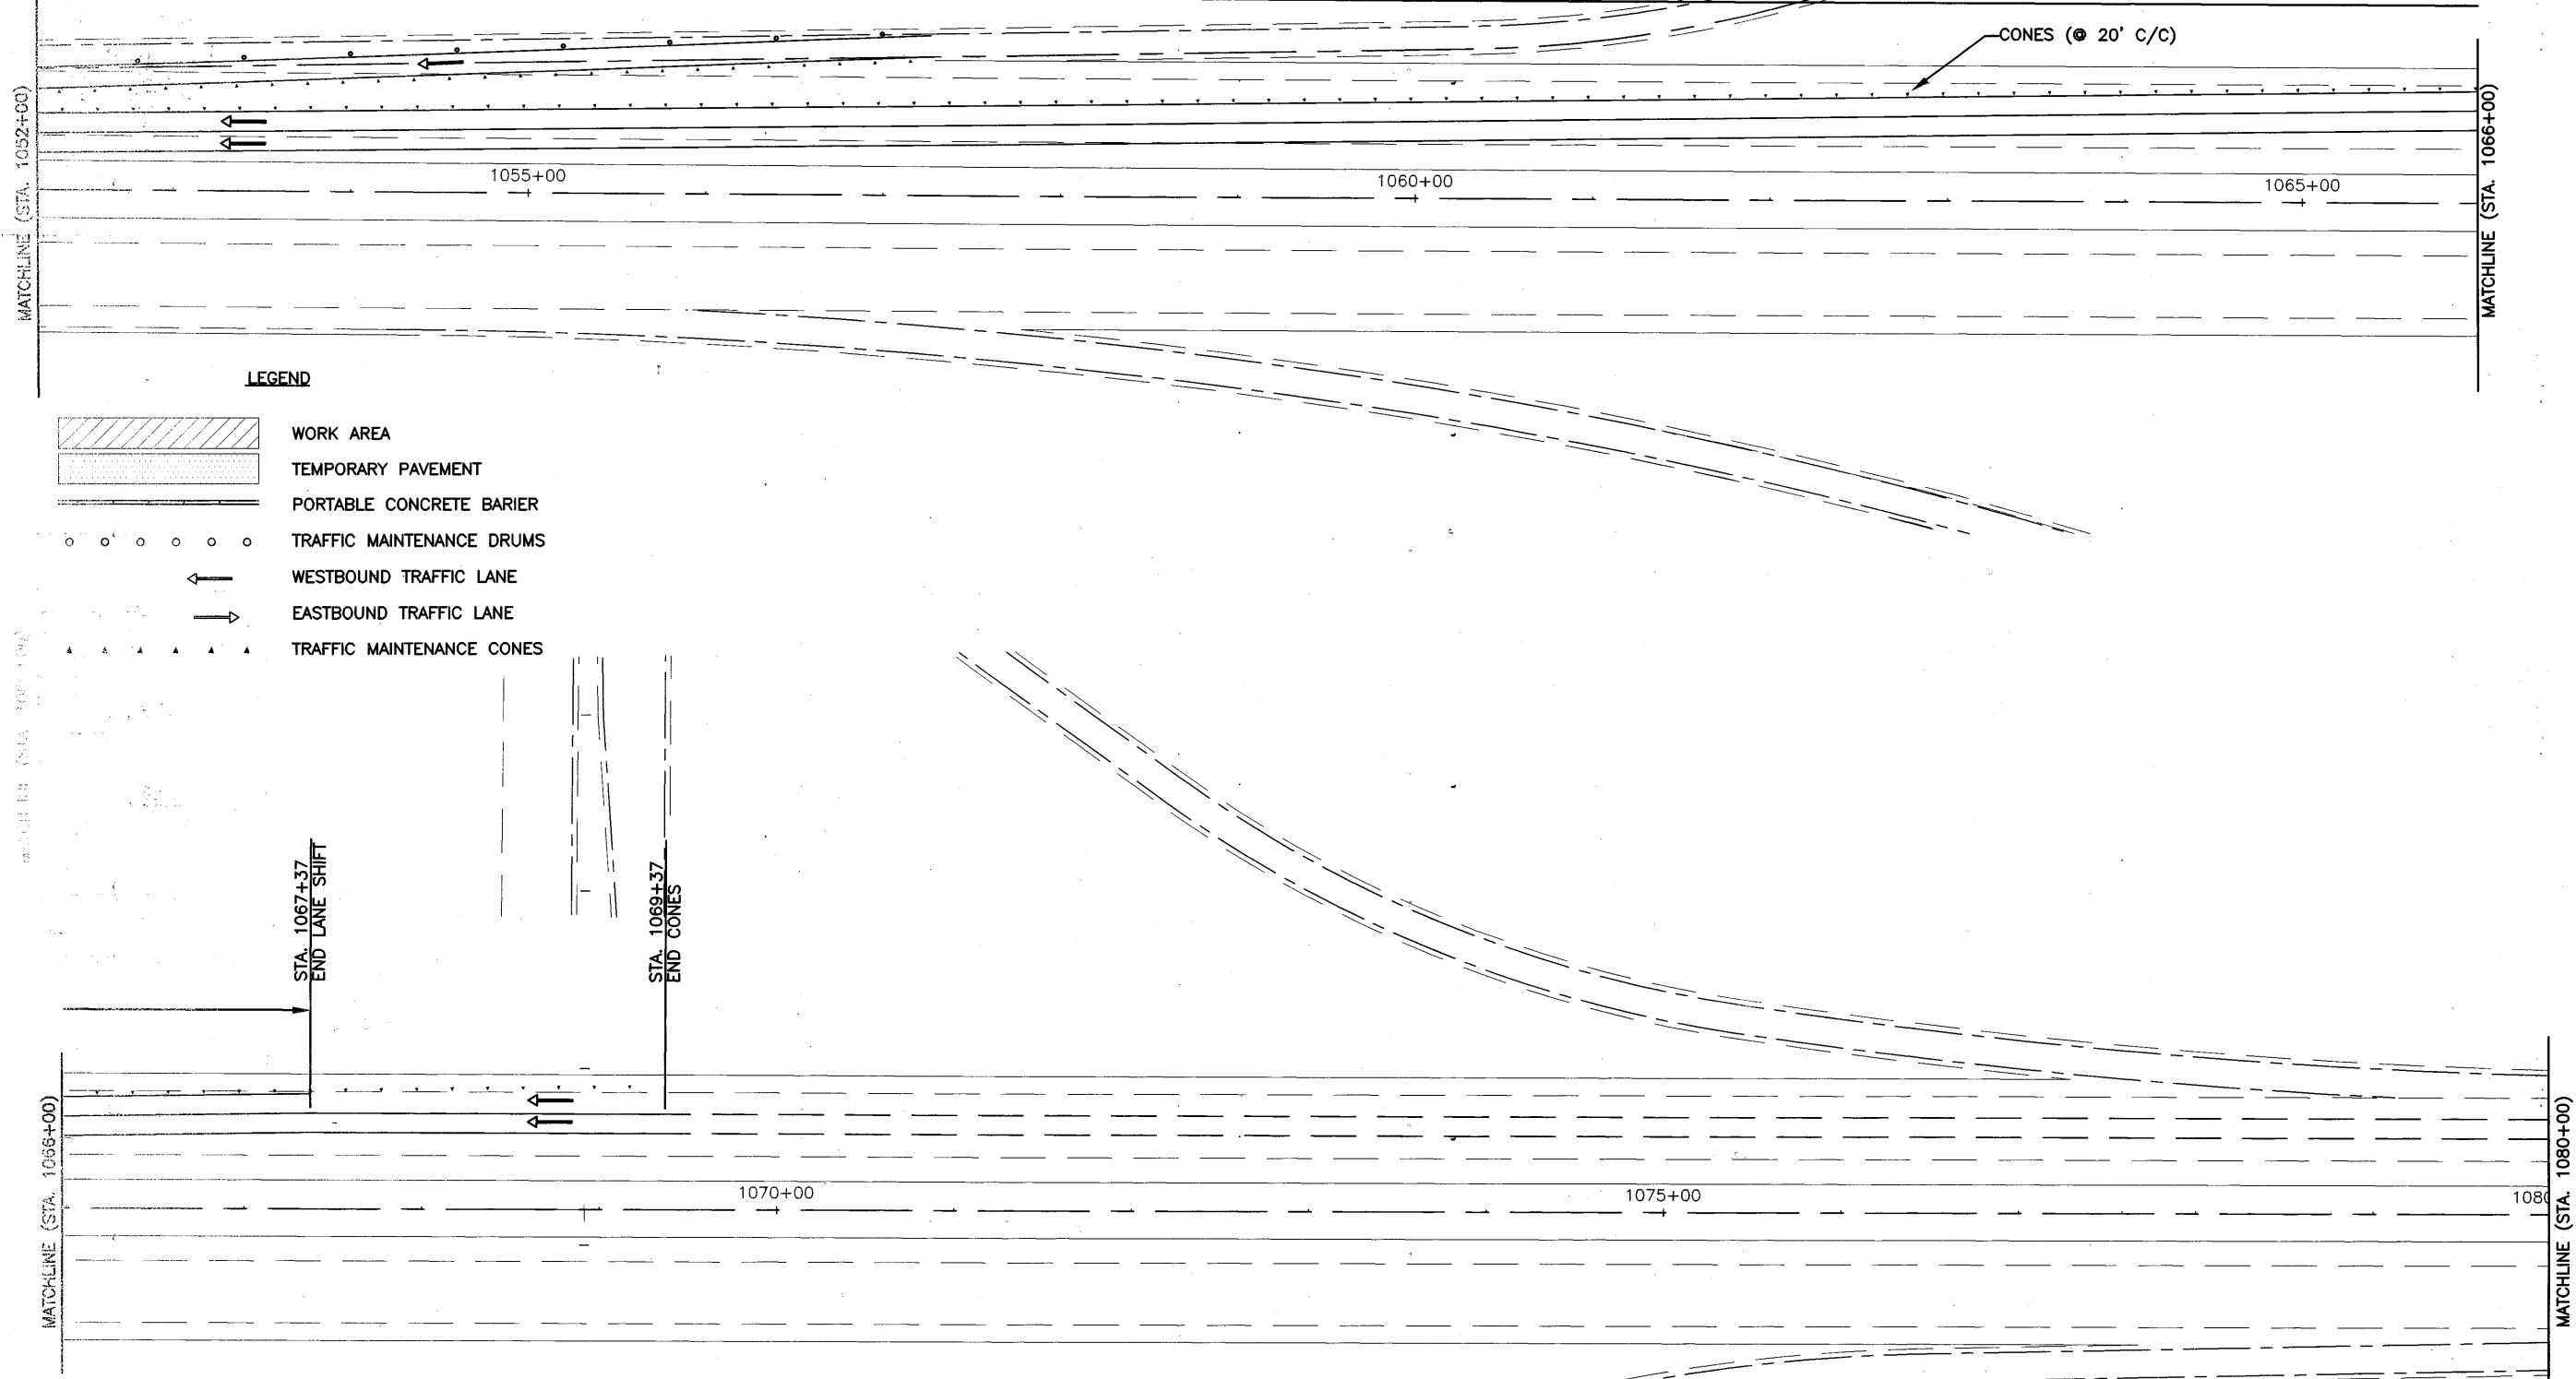


**LEGEND**

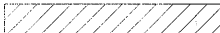-  WORK AREA
-  TEMPORARY PAVEMENT
-  PORTABLE CONCRETE BARRIER
-  TRAFFIC MAINTENANCE DRUMS
-  WESTBOUND TRAFFIC LANE
-  EASTBOUND TRAFFIC LANE
-  TRAFFIC MAINTENANCE CONES


CALCULATED	DLS	CHECKED	LAB
------------	-----	---------	-----

**MAINTENANCE OF TRAFFIC  
PHASE IIA & IIB PLAN**


**LOR - 190 - 10.76**

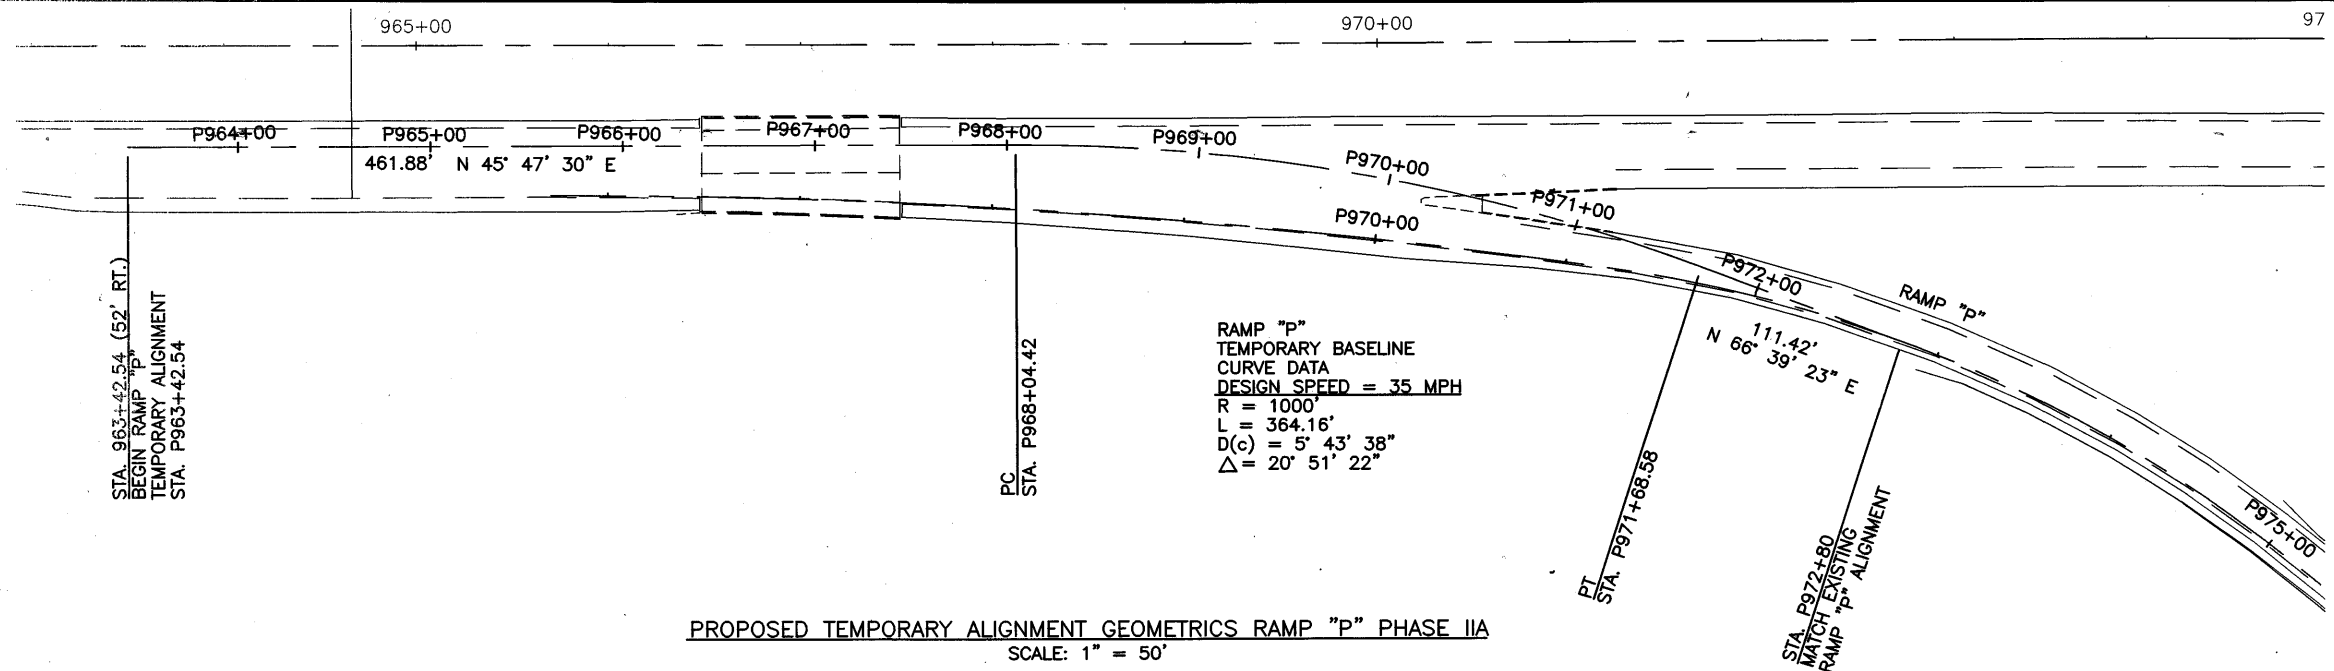

PROPOSED TEMPORARY ALIGNMENT GEOMETRICS RAMP "P" PHASE IIA  
SCALE: 1" = 50'

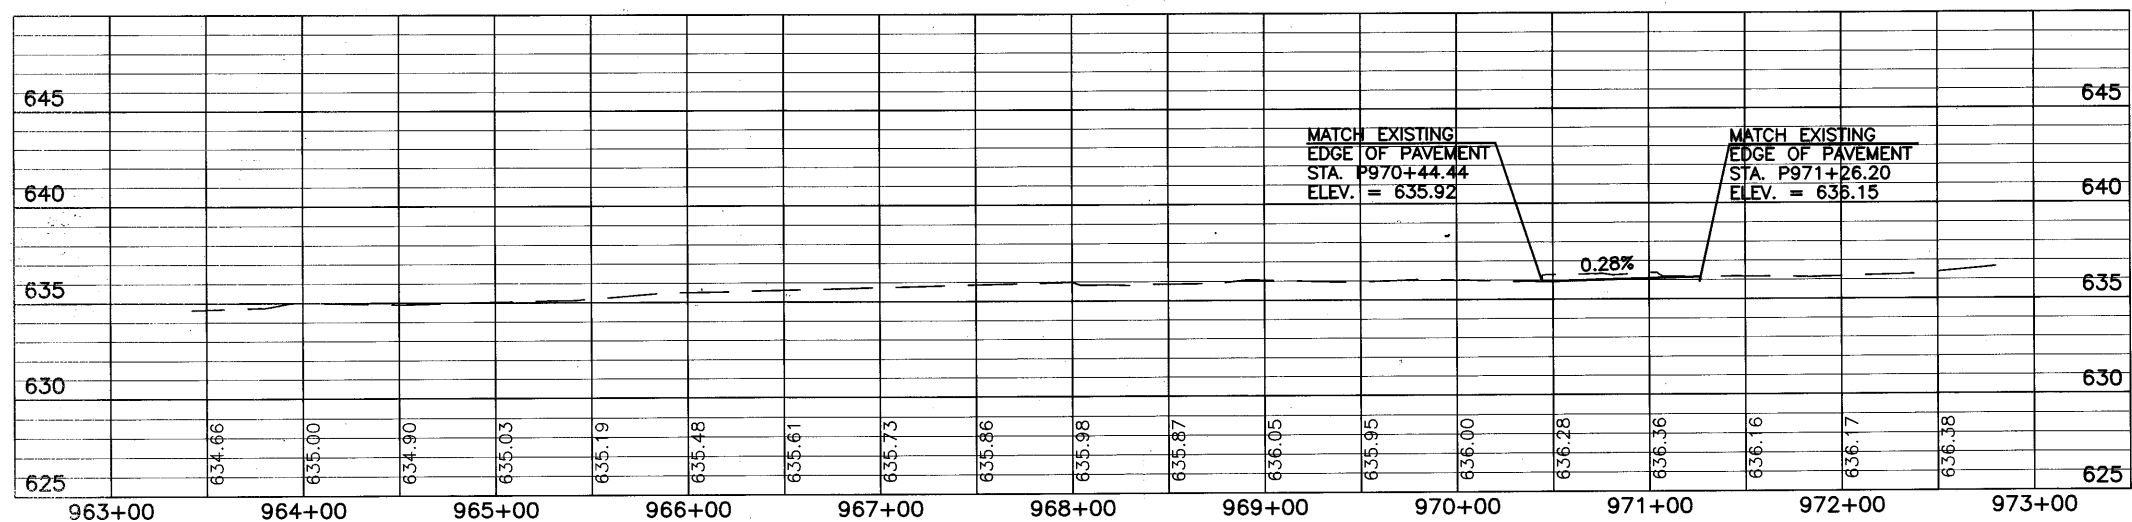

PROPOSED PROFILE FOR TEMPORARY RAMP "P"  
SCALE: 1" = 50'

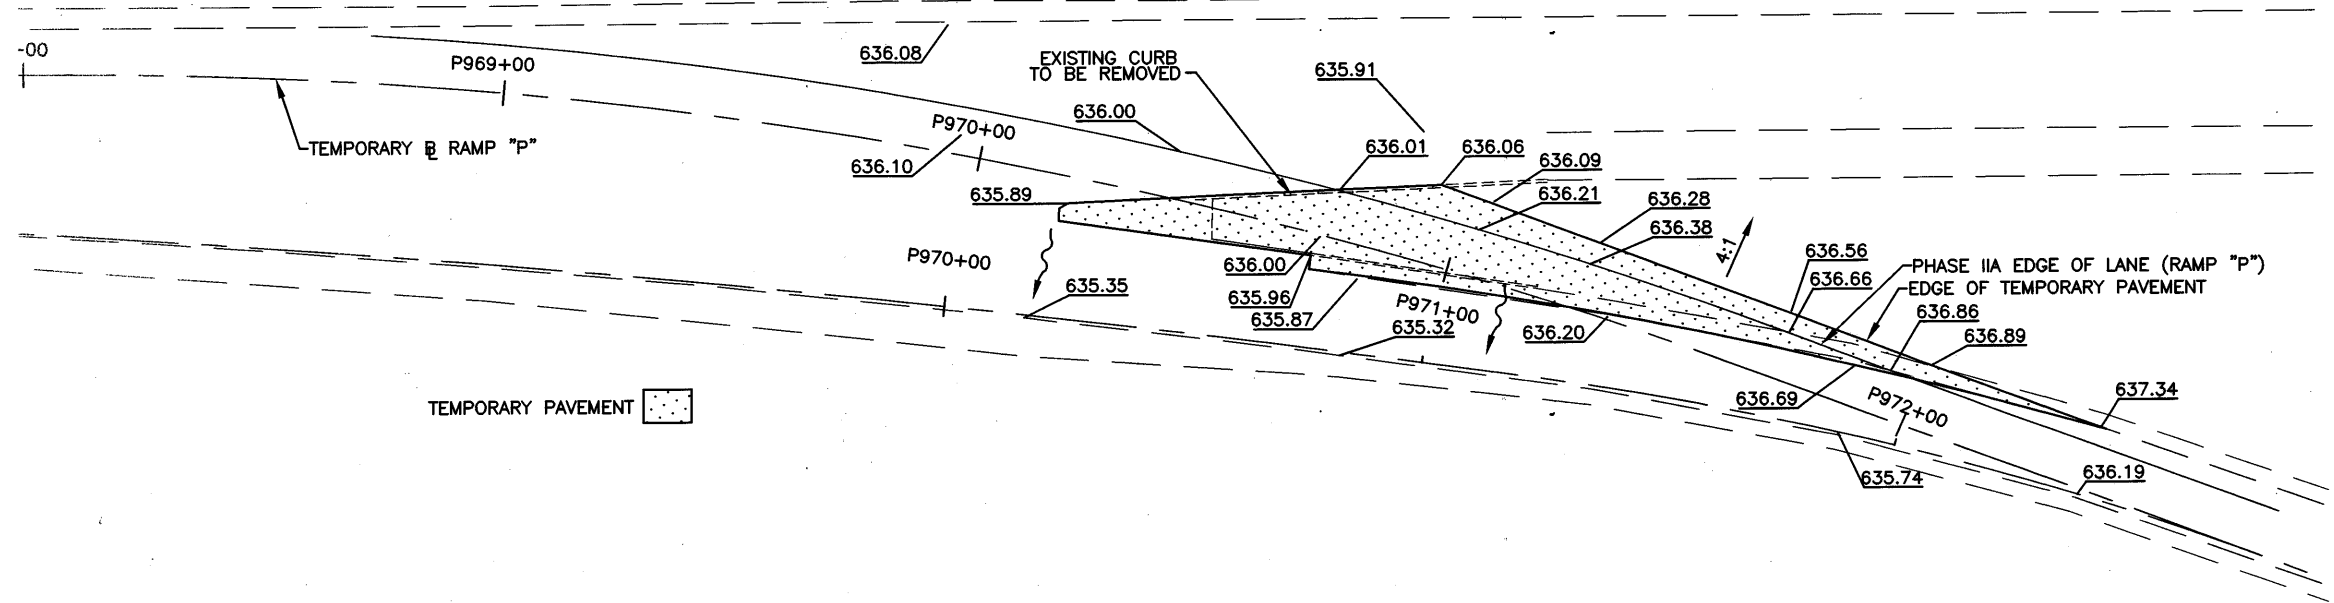


PROPOSED GRADING FOR TEMPORARY RAMP "P" PHASE IIA  
SCALE: 1" = 20'

CALCULATED  
 DLS  
 CHECKED  
 LAB

MAINTENANCE OF TRAFFIC  
 DETAILS


LOR - 190 - 10.76

M.O.T.  
 180  
 274

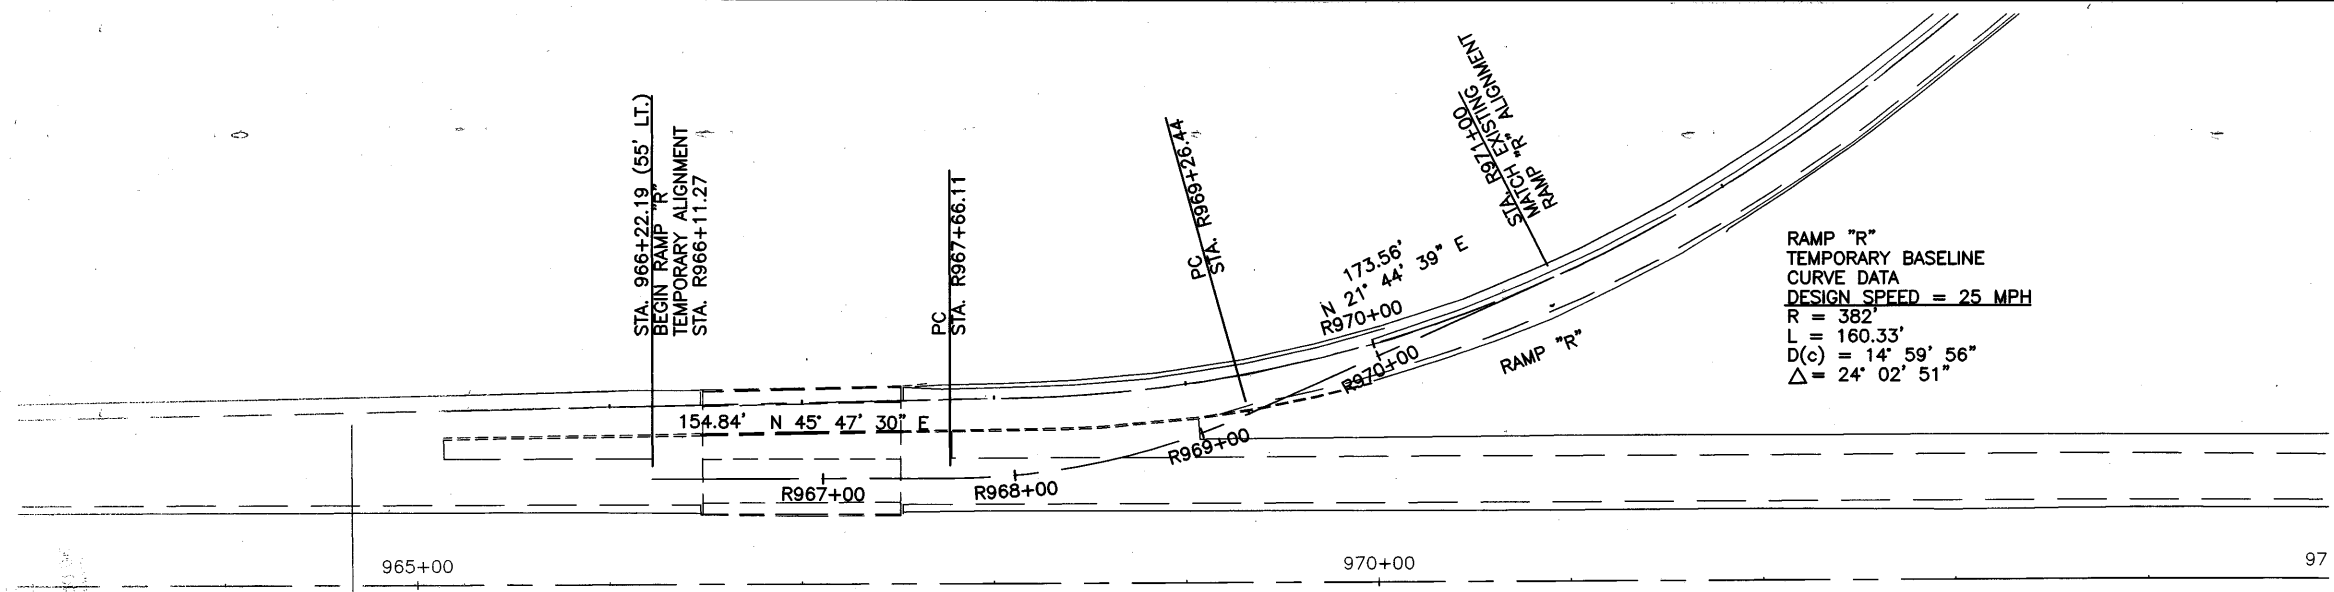


RAMP "R"  
 TEMPORARY BASELINE  
 CURVE DATA  
 DESIGN SPEED = 25 MPH  
 R = 382'  
 L = 160.33'  
 D(c) = 14' 59' 56"  
 Δ = 24' 02' 51"

PROPOSED TEMPORARY ALIGNMENT GEOMETRICS RAMP "R" PHASE IIA  
 SCALE: 1" = 50'

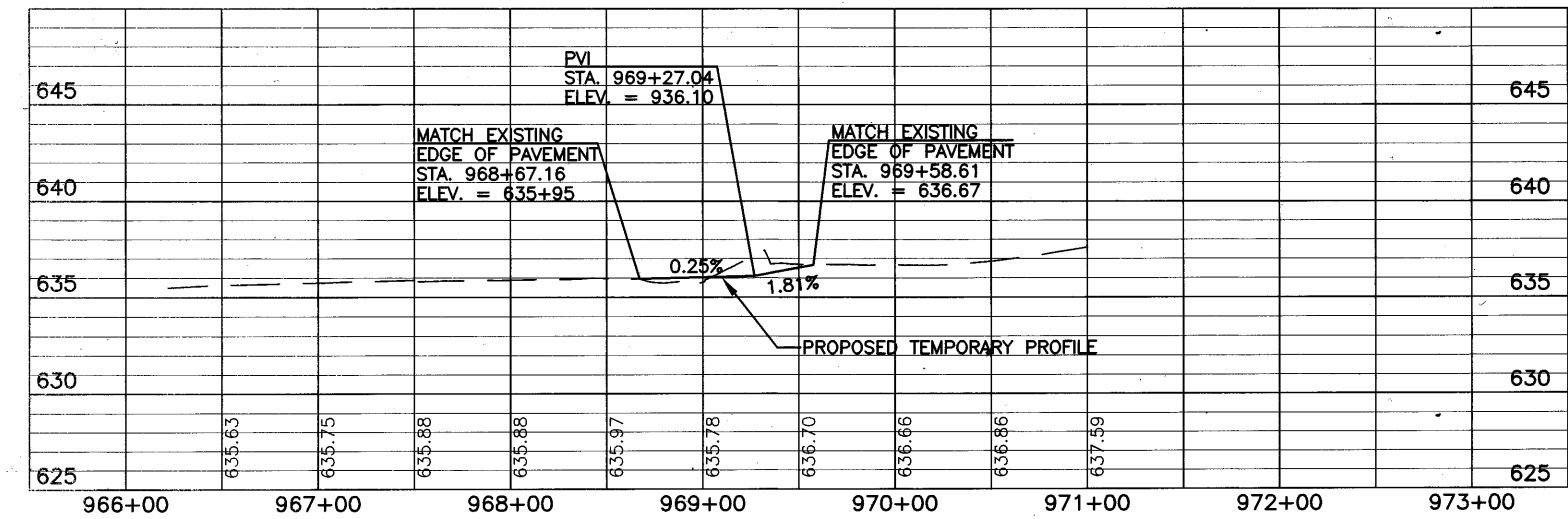

PROPOSED PROFILE FOR TEMPORARY RAMP "R"  
 SCALE: 1" = 50'

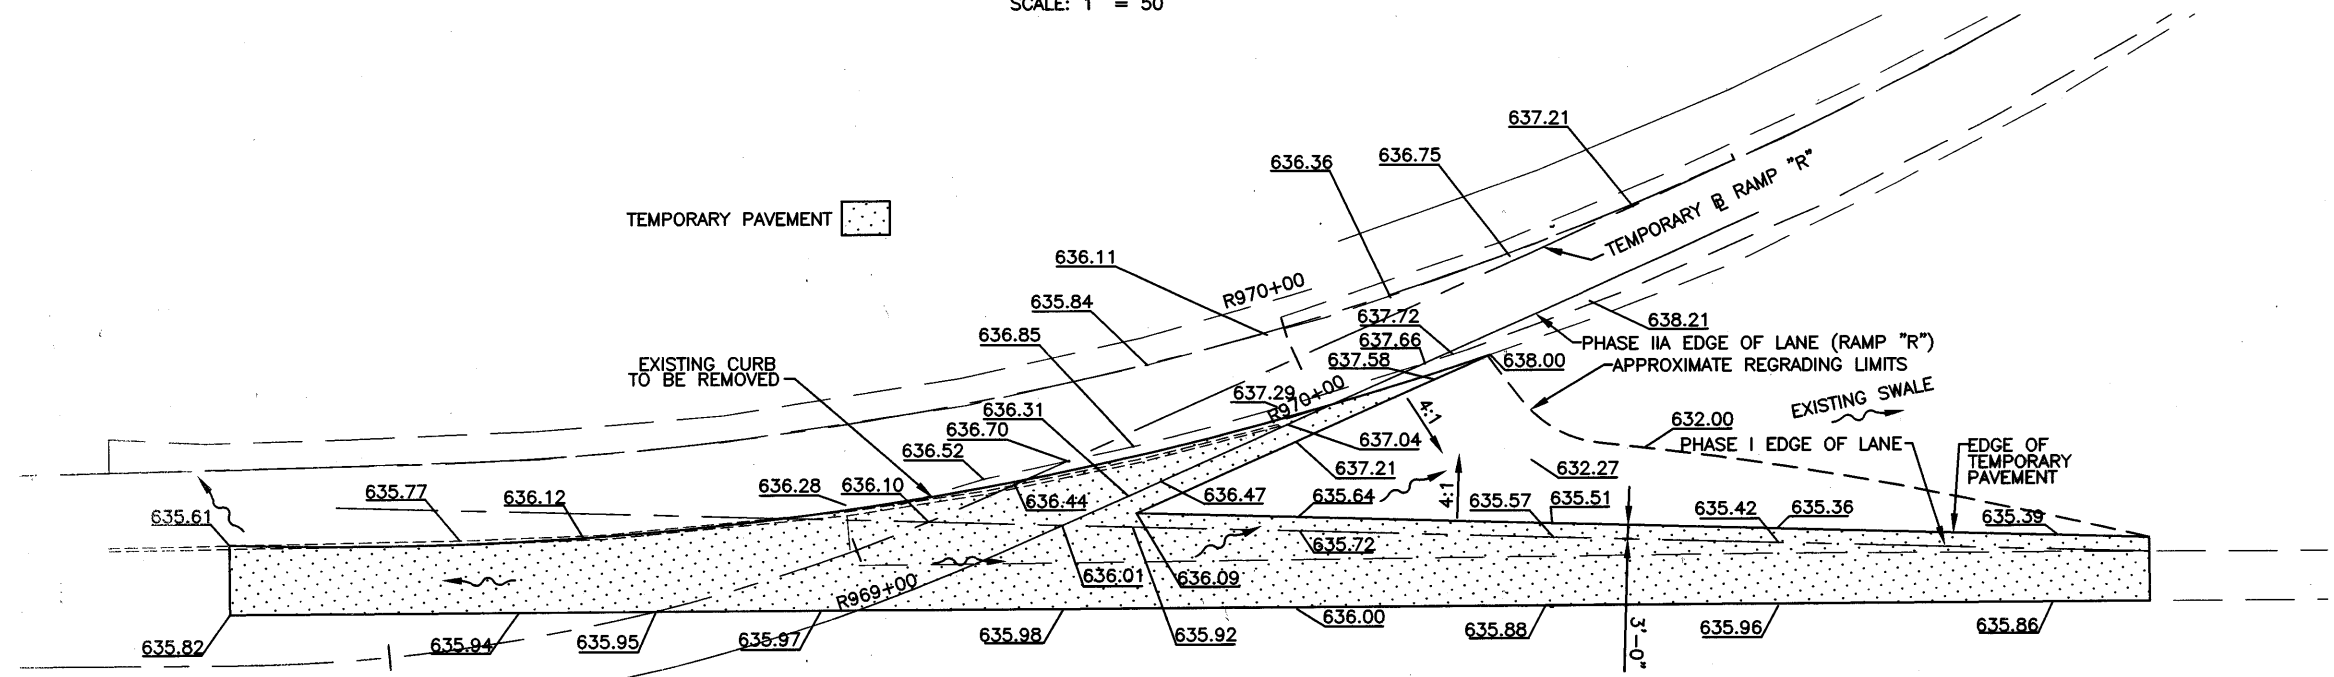




PROPOSED GRADING FOR TEMPORARY RAMP "R" PHASE I & IIA  
 SCALE: 1" = 20'

CALCULATED  
 DLS  
 CHECKED  
 LAB

MAINTENANCE OF TRAFFIC  
 DETAILS

LOR - 190 - 10.76


M.O.T.  
 181  
 274

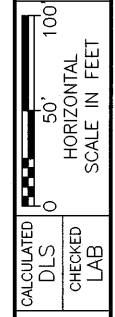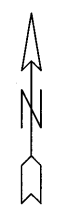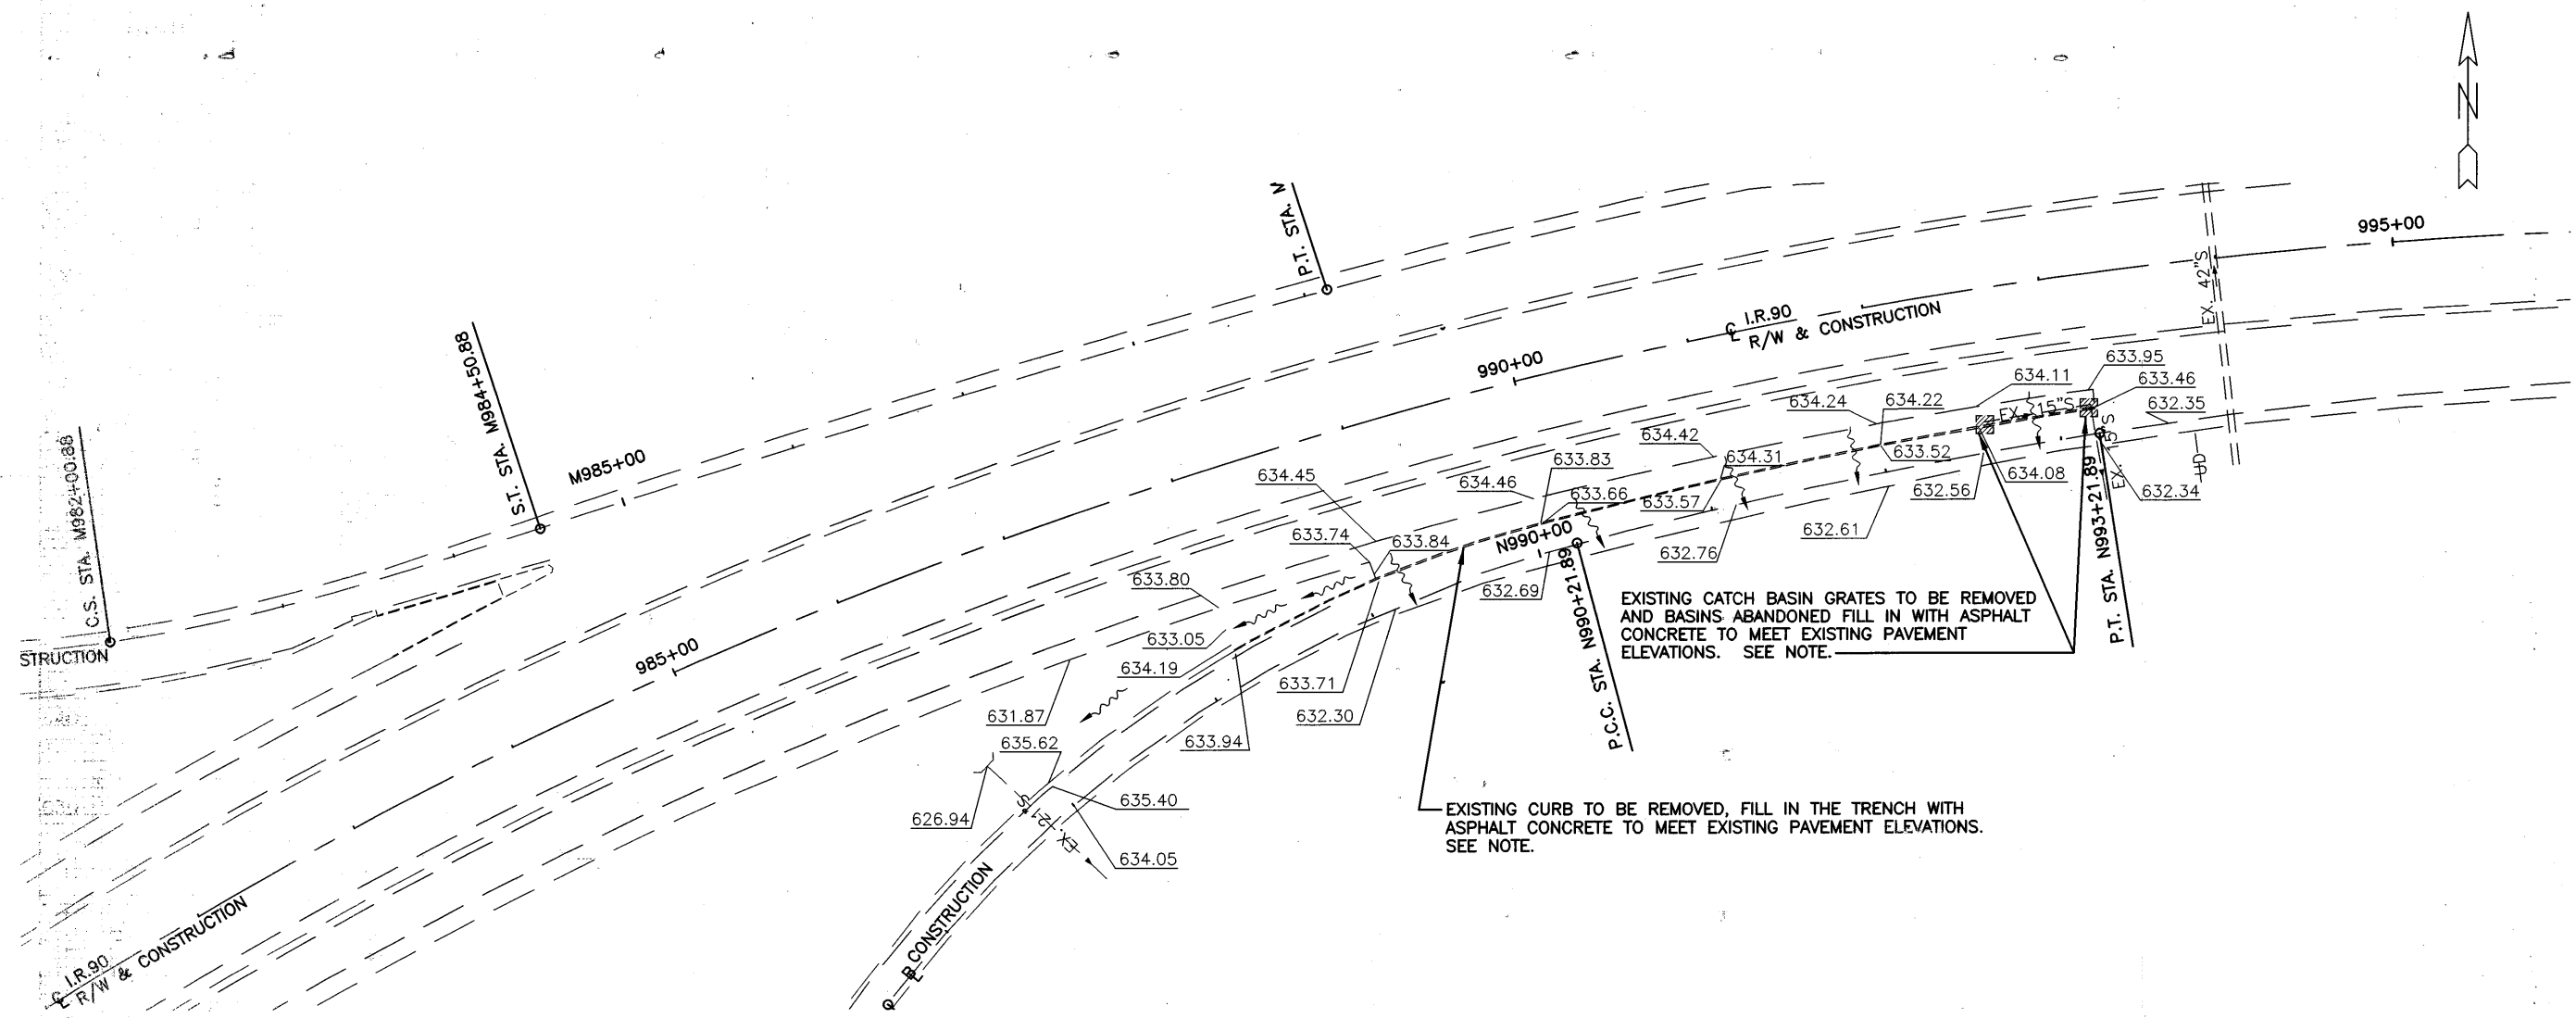

MAINTENANCE OF TRAFFIC  
 DETAILS

LOR - 190 - 10.76

- NOTES:**
1. THE PAVEMENT SHOULD SLOPE TO OUTSIDE OF SHOULDER
  2. THE ELEVATIONS ARE EXISTING

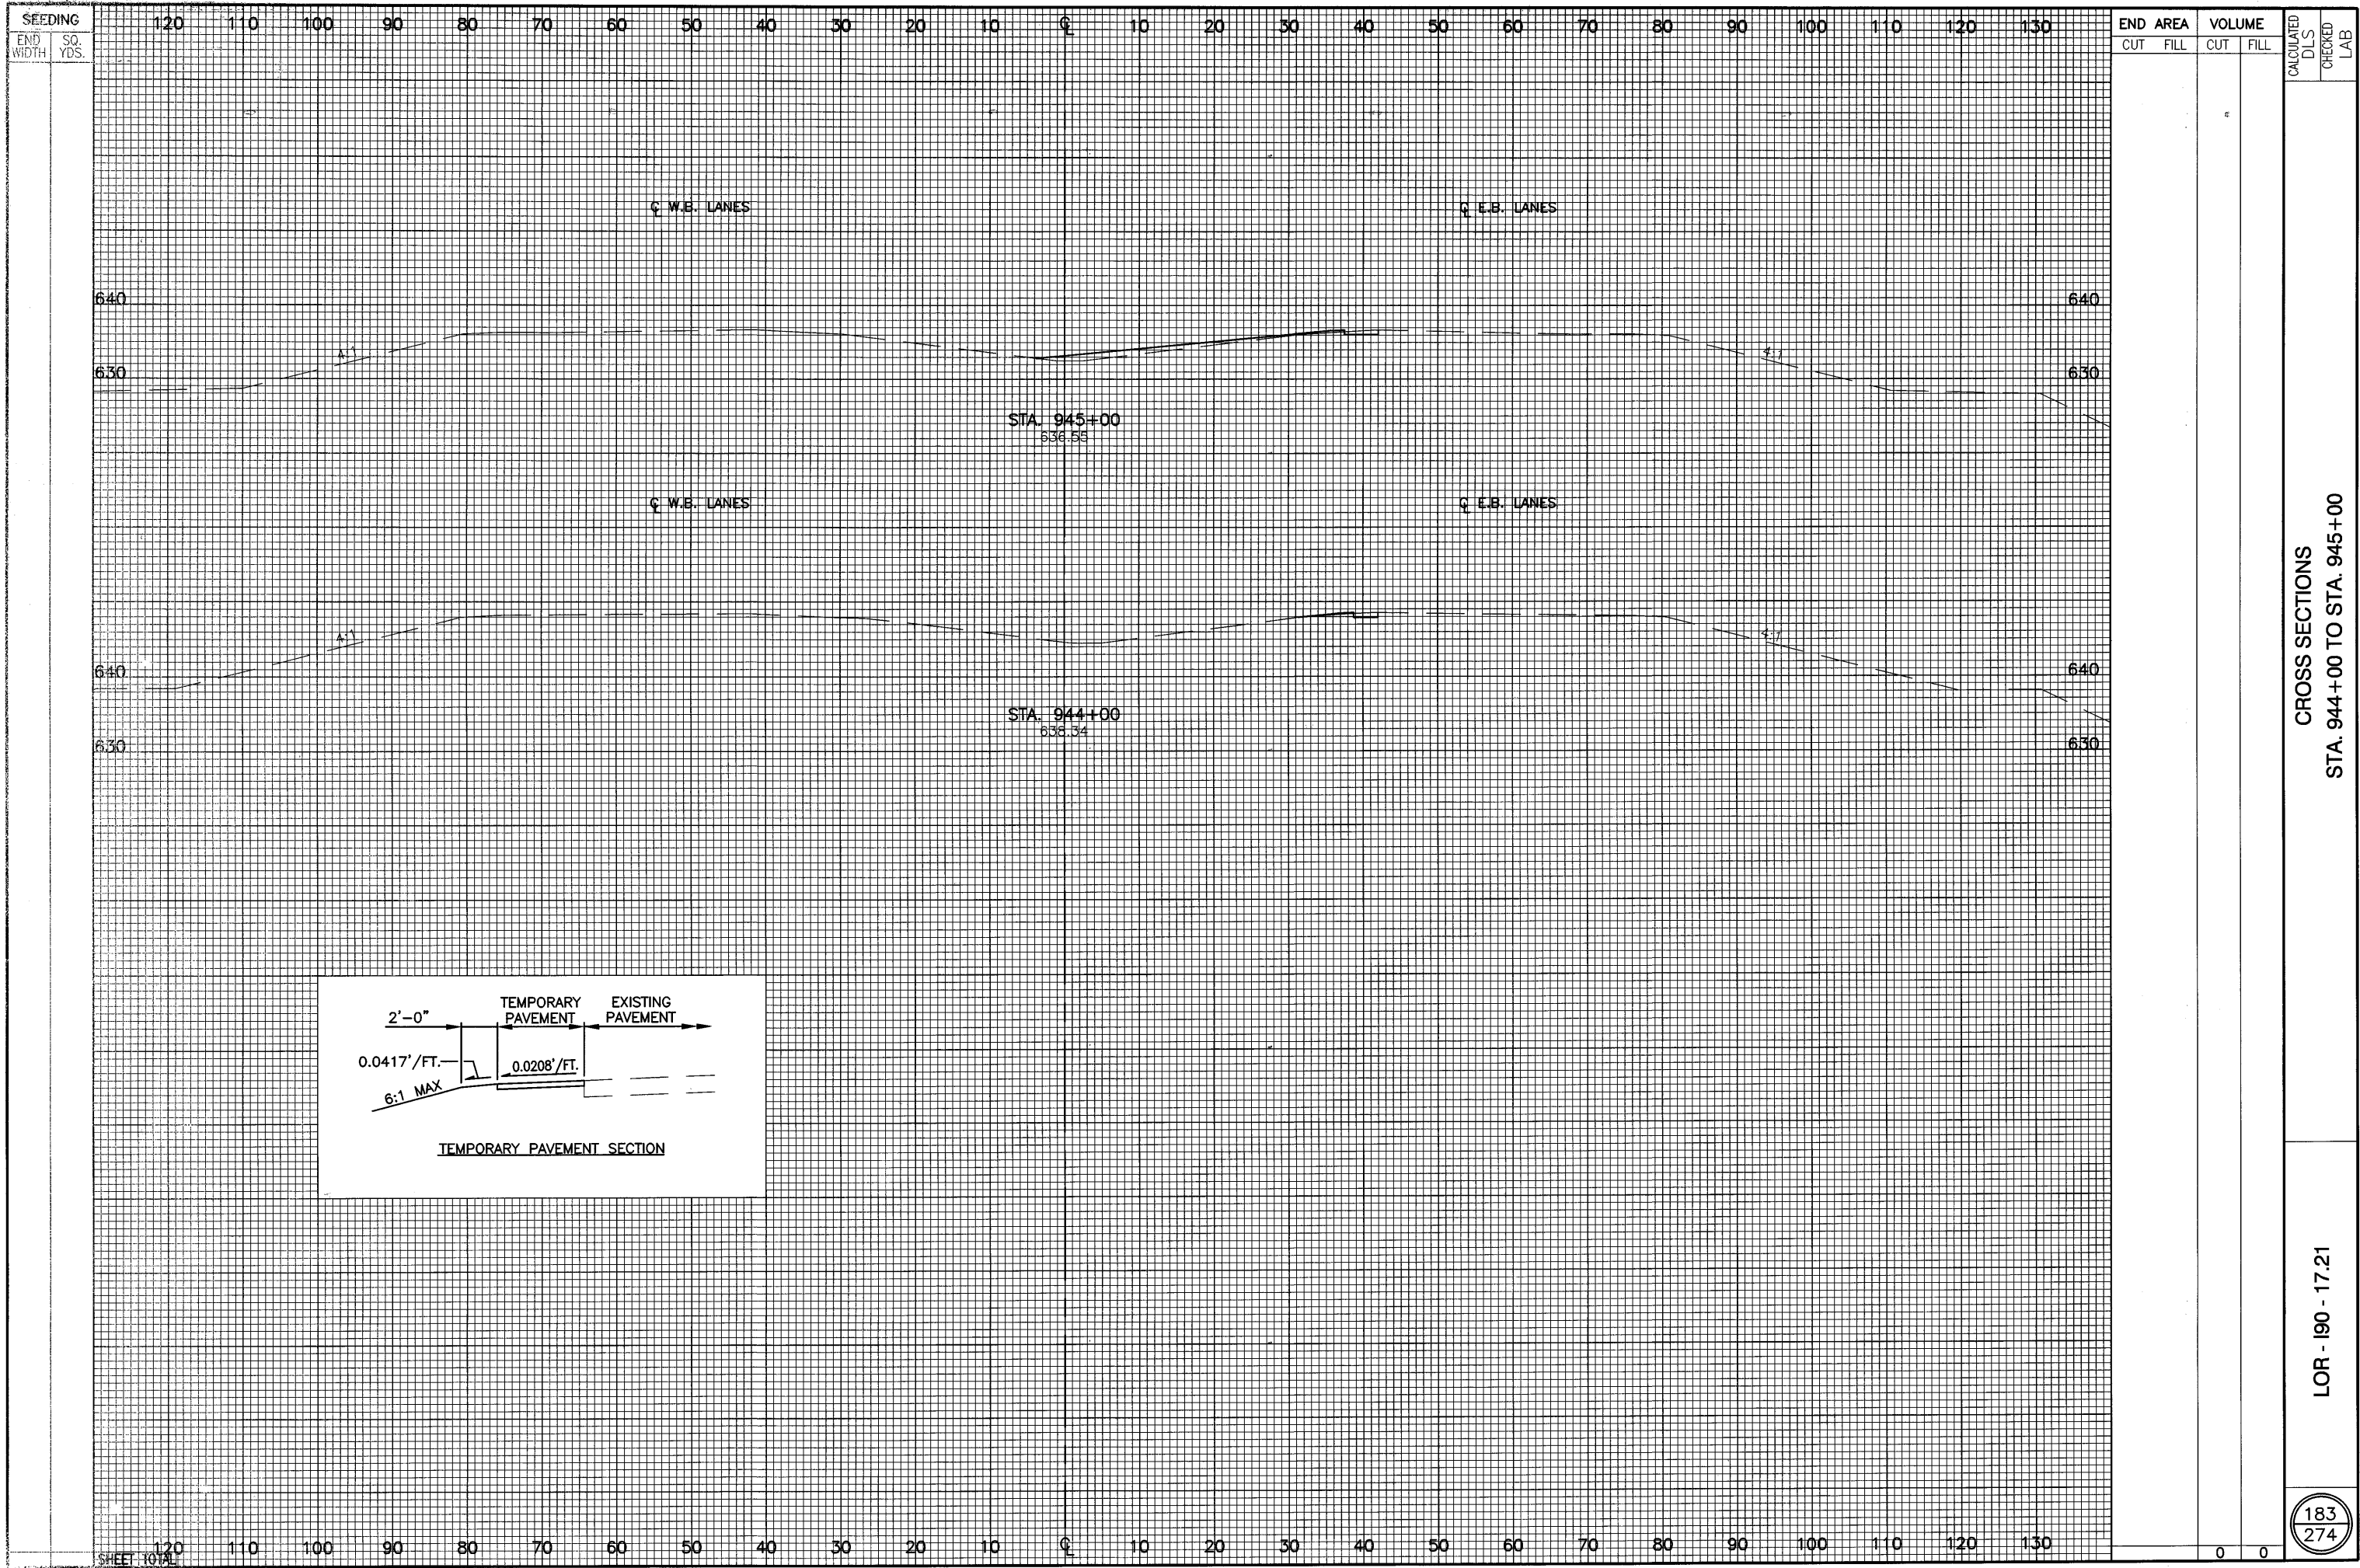

SEEDING		END AREA		VOLUME		CALCULATED DLS	CHECKED LAB
END WIDTH	SQ. YDS.	CUT	FILL	CUT	FILL		
				0	0		

CROSS SECTIONS  
STA. 944+00 TO STA. 945+00


LOR - 190 - 17.21

10-10-10 10:00 AM [D:\PROJECTS\1721\SEC\_242\DWG\_1721.DWG] NUN






5:12PM 02-11-2002 [ C:\ORIG\DWG\Y171\SEC\_185-274.DWG ]

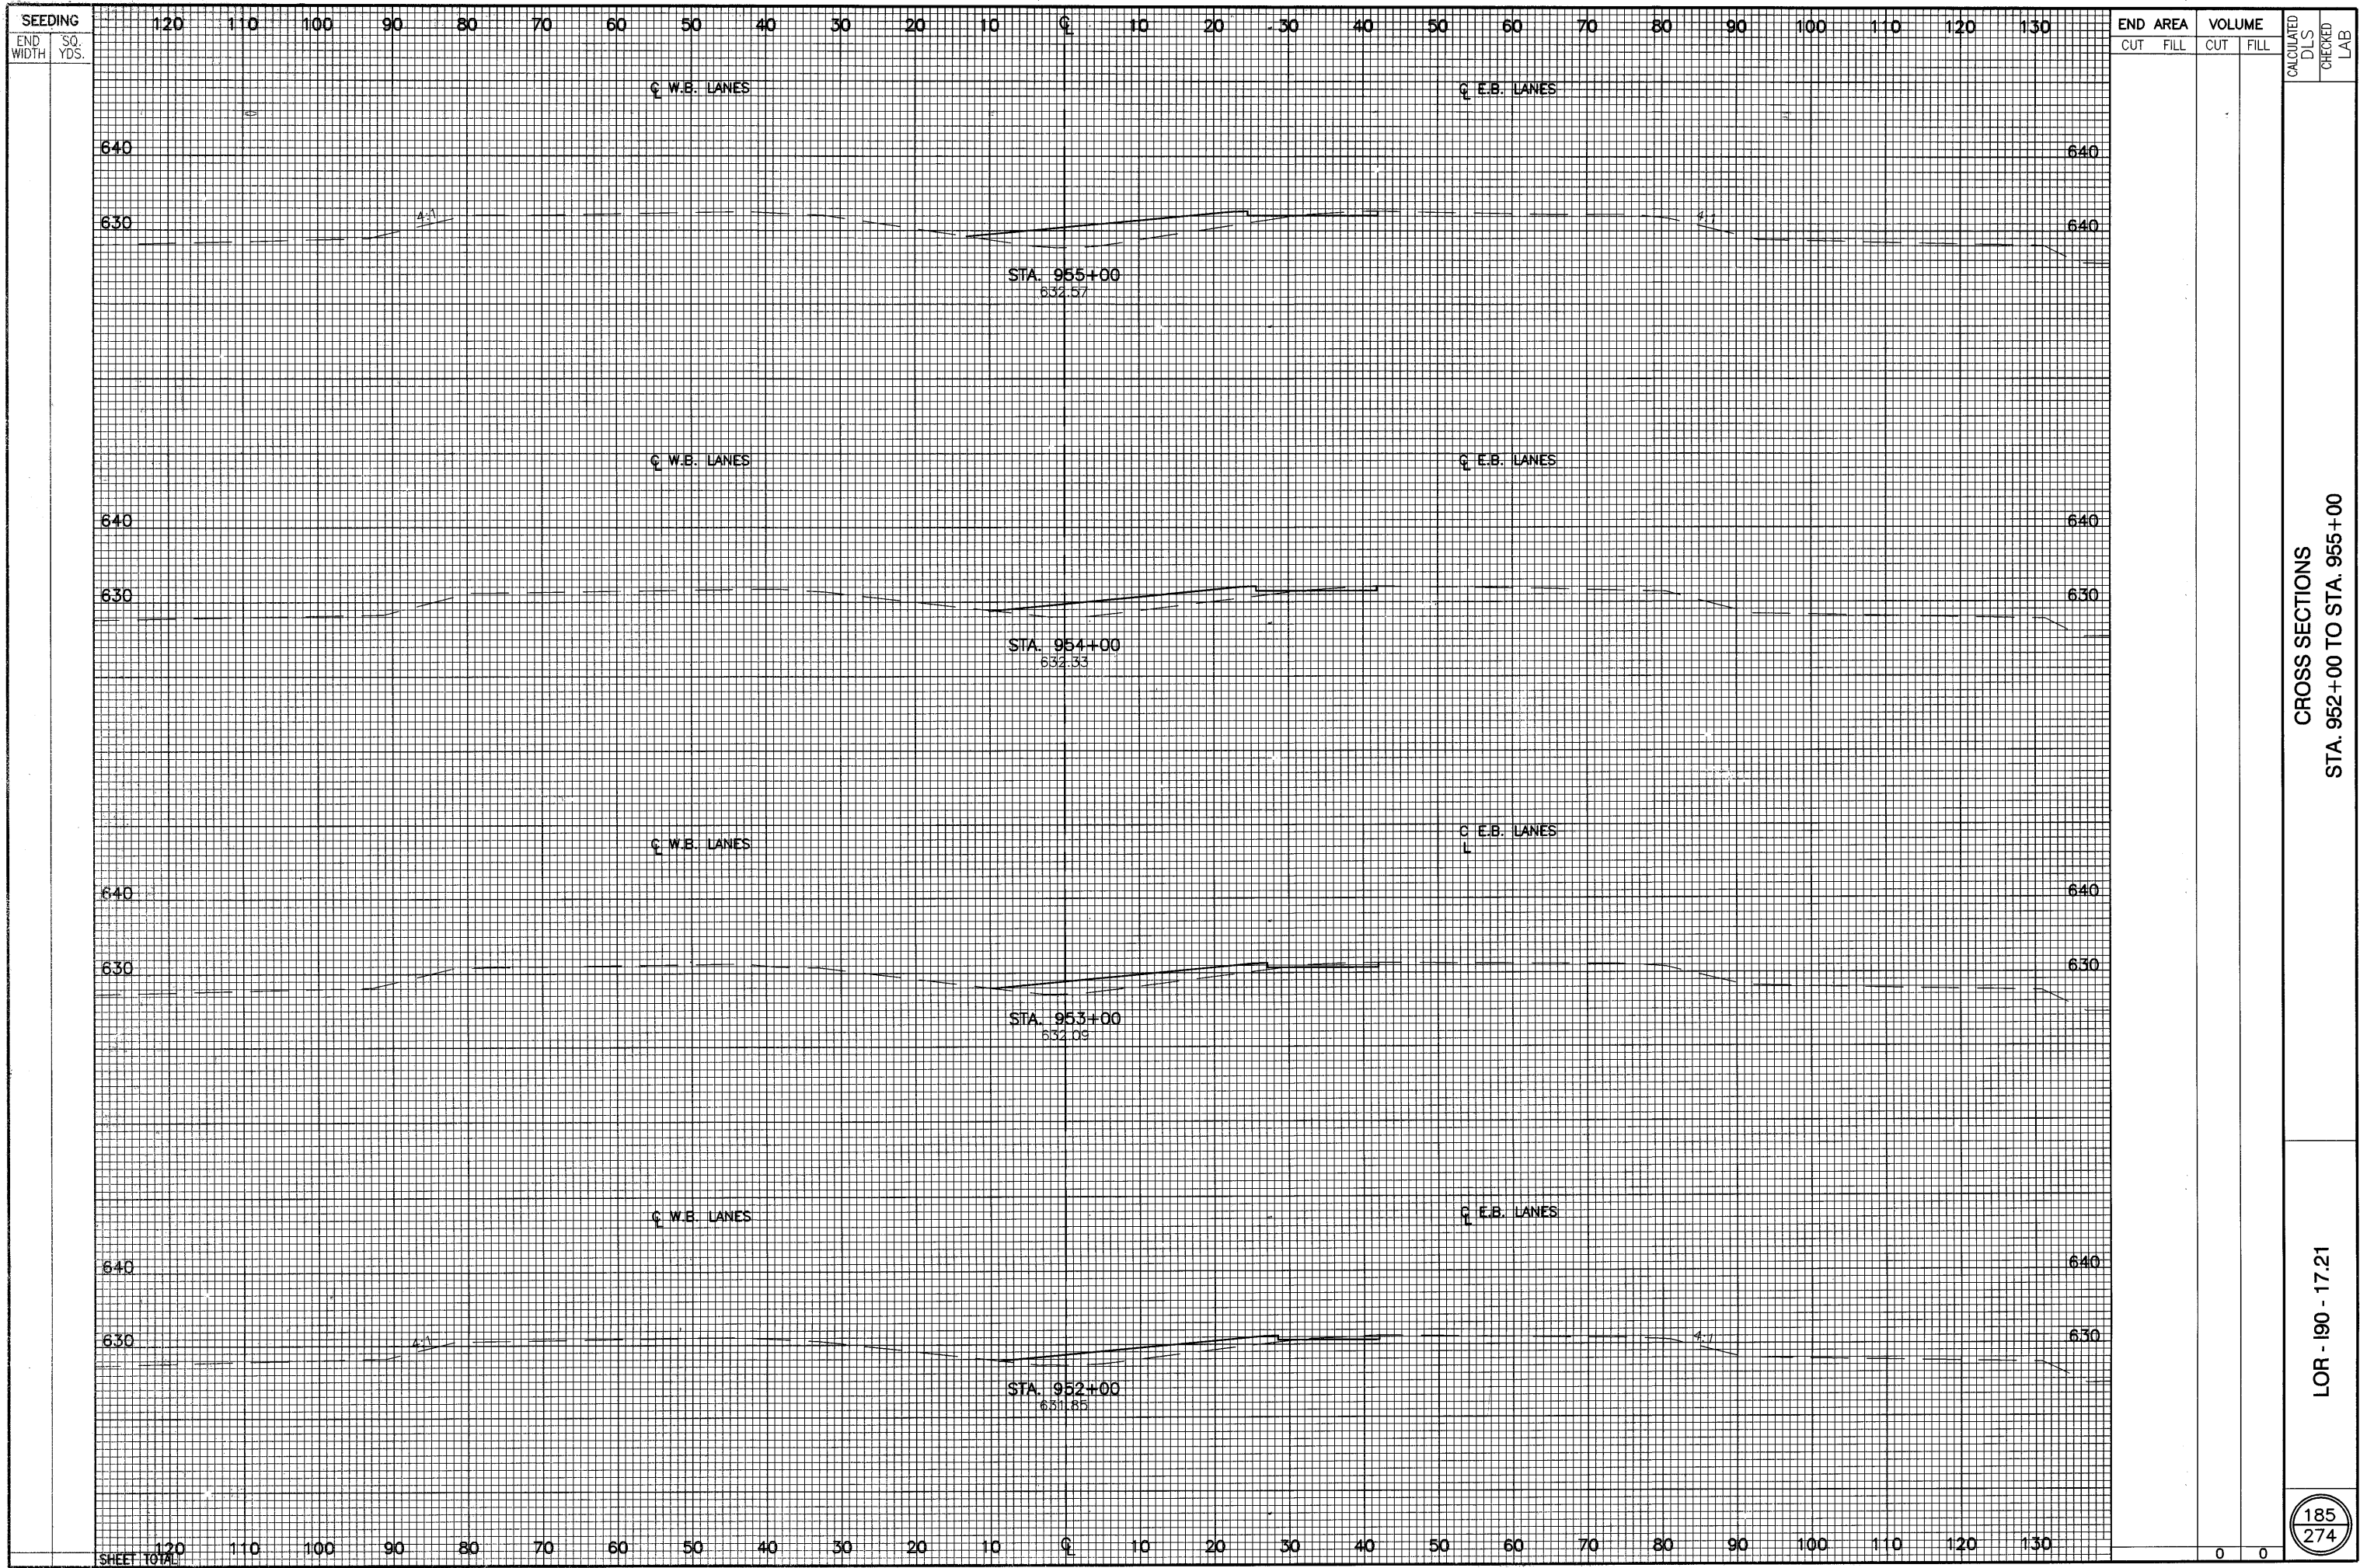

CROSS SECTIONS  
STA. 952+00 TO STA. 955+00

LOR - 190 - 17.21


185  
274

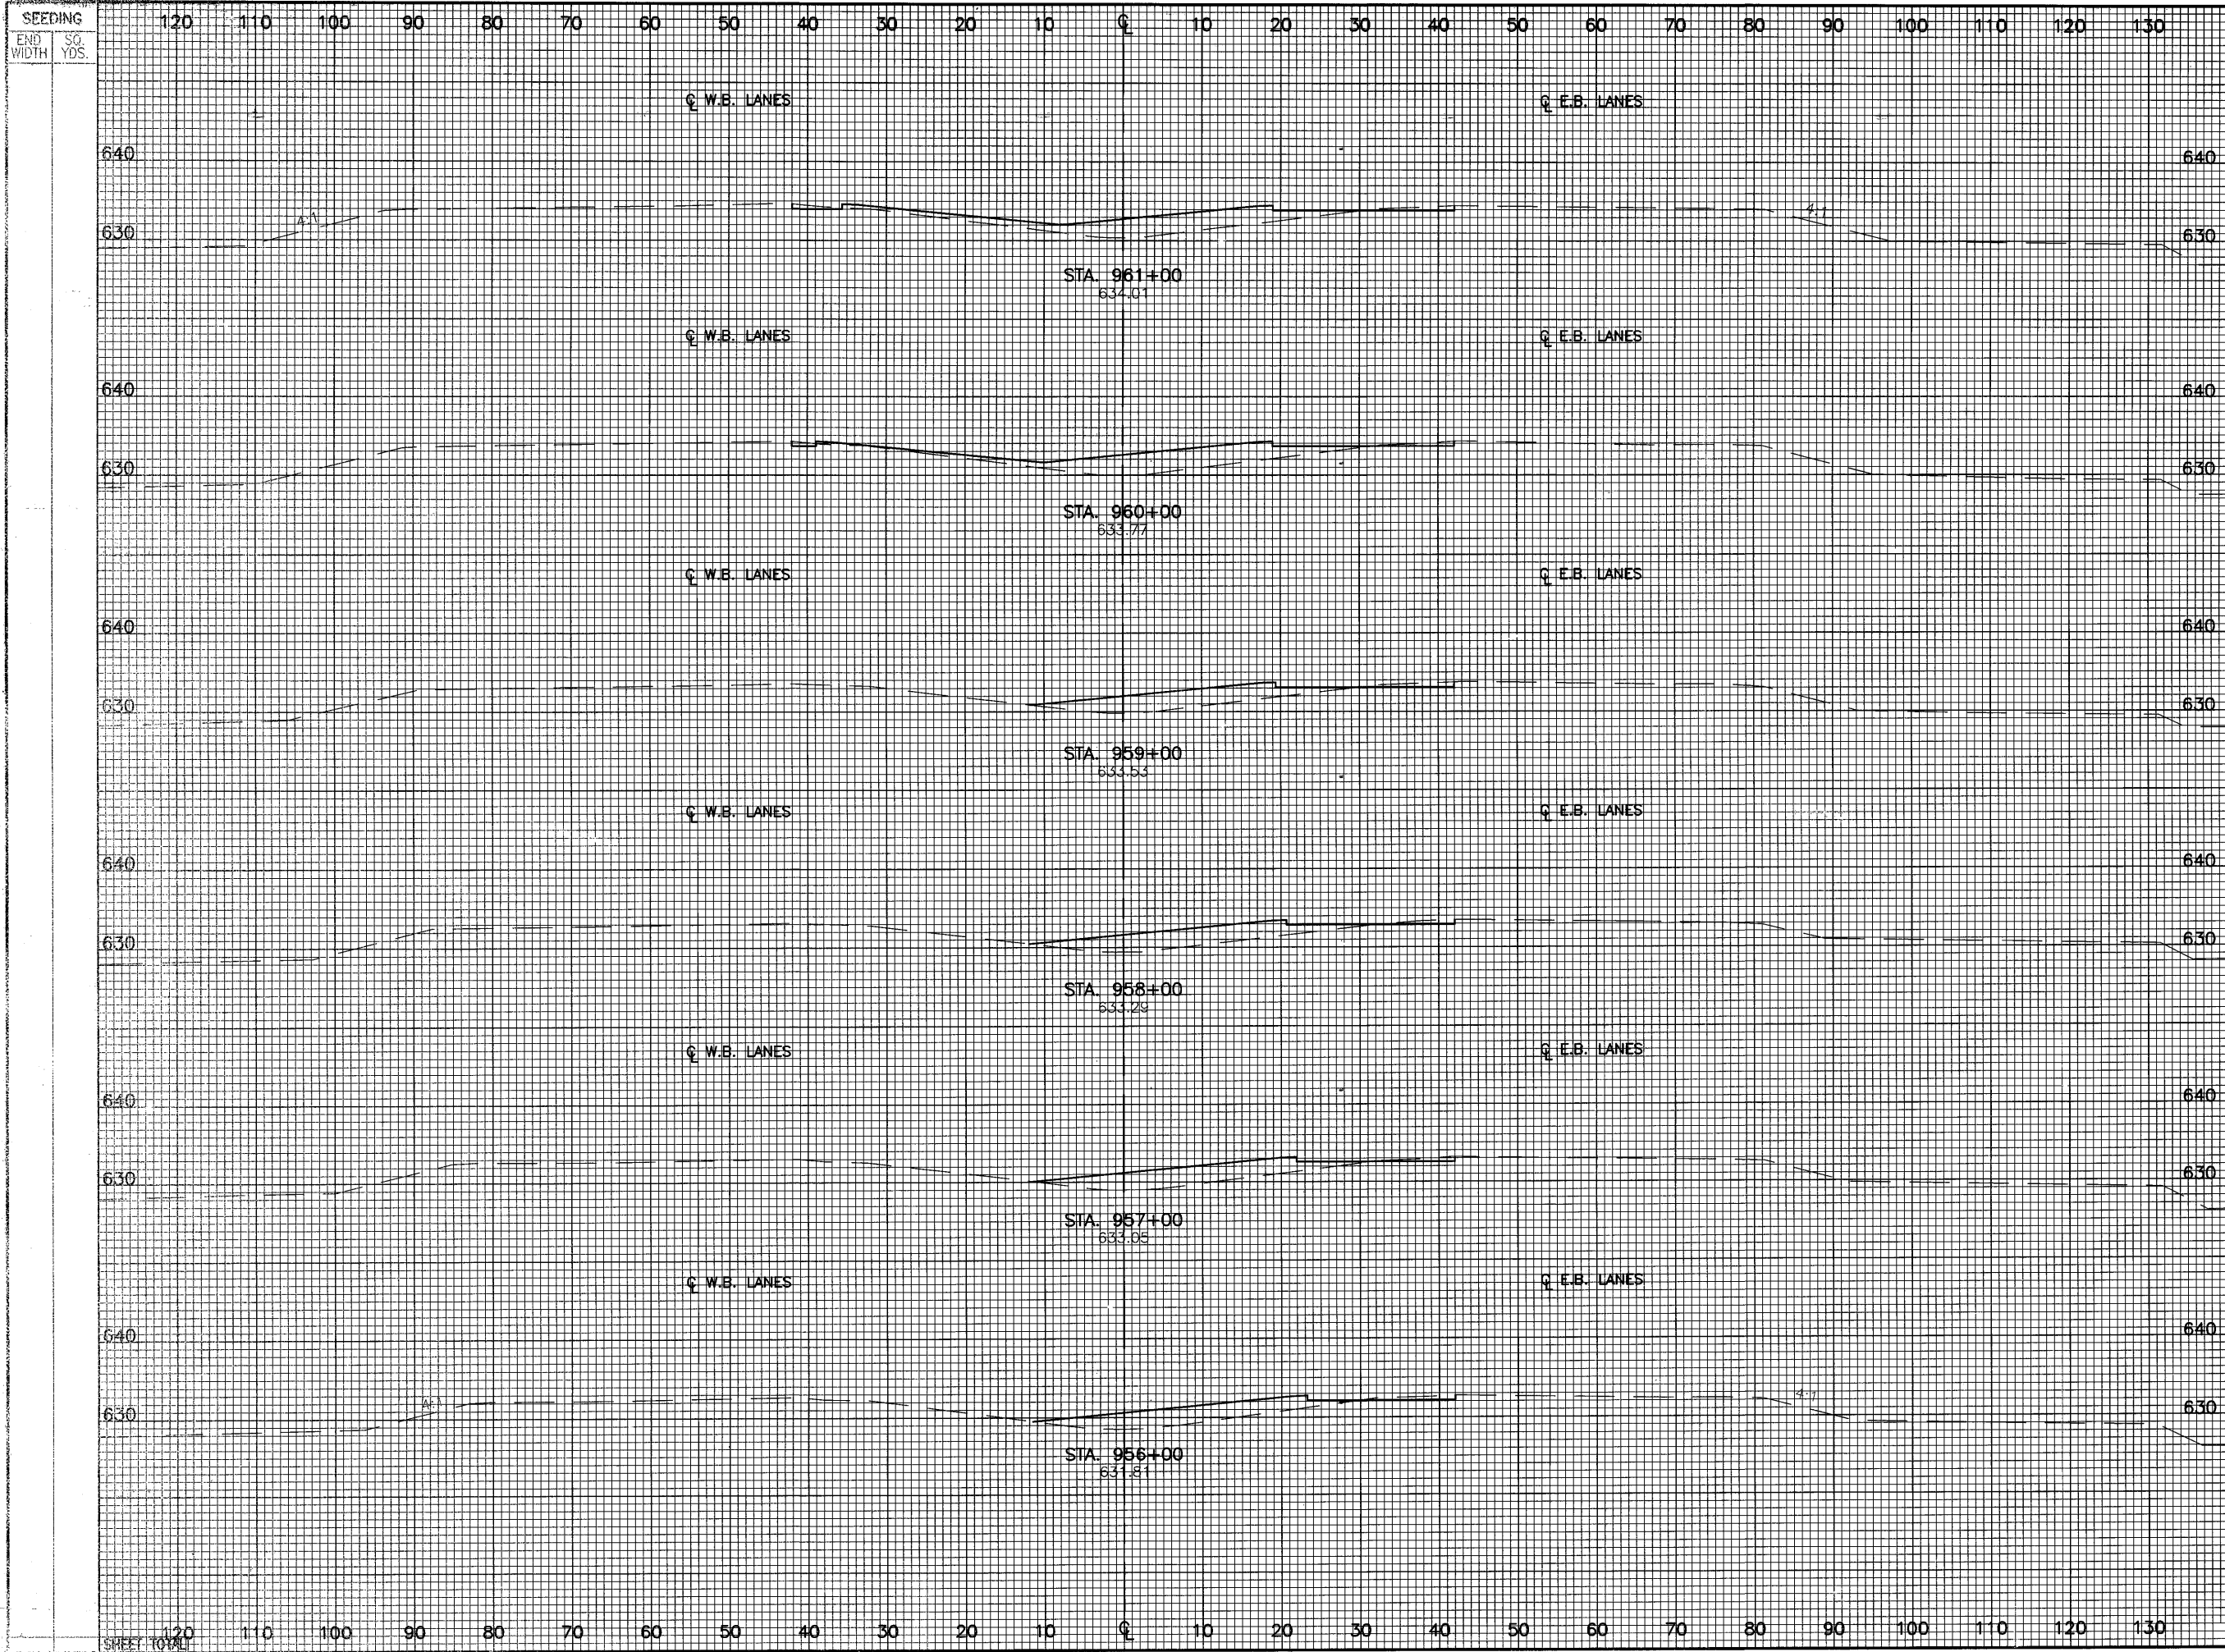

END AREA	VOLUME	CALCULATED	DLS	CHECKED	LAB

CROSS SECTIONS  
 STA. 956+00 TO STA. 961+00  
 LOR - 190 - 17.21  
 186  
 274



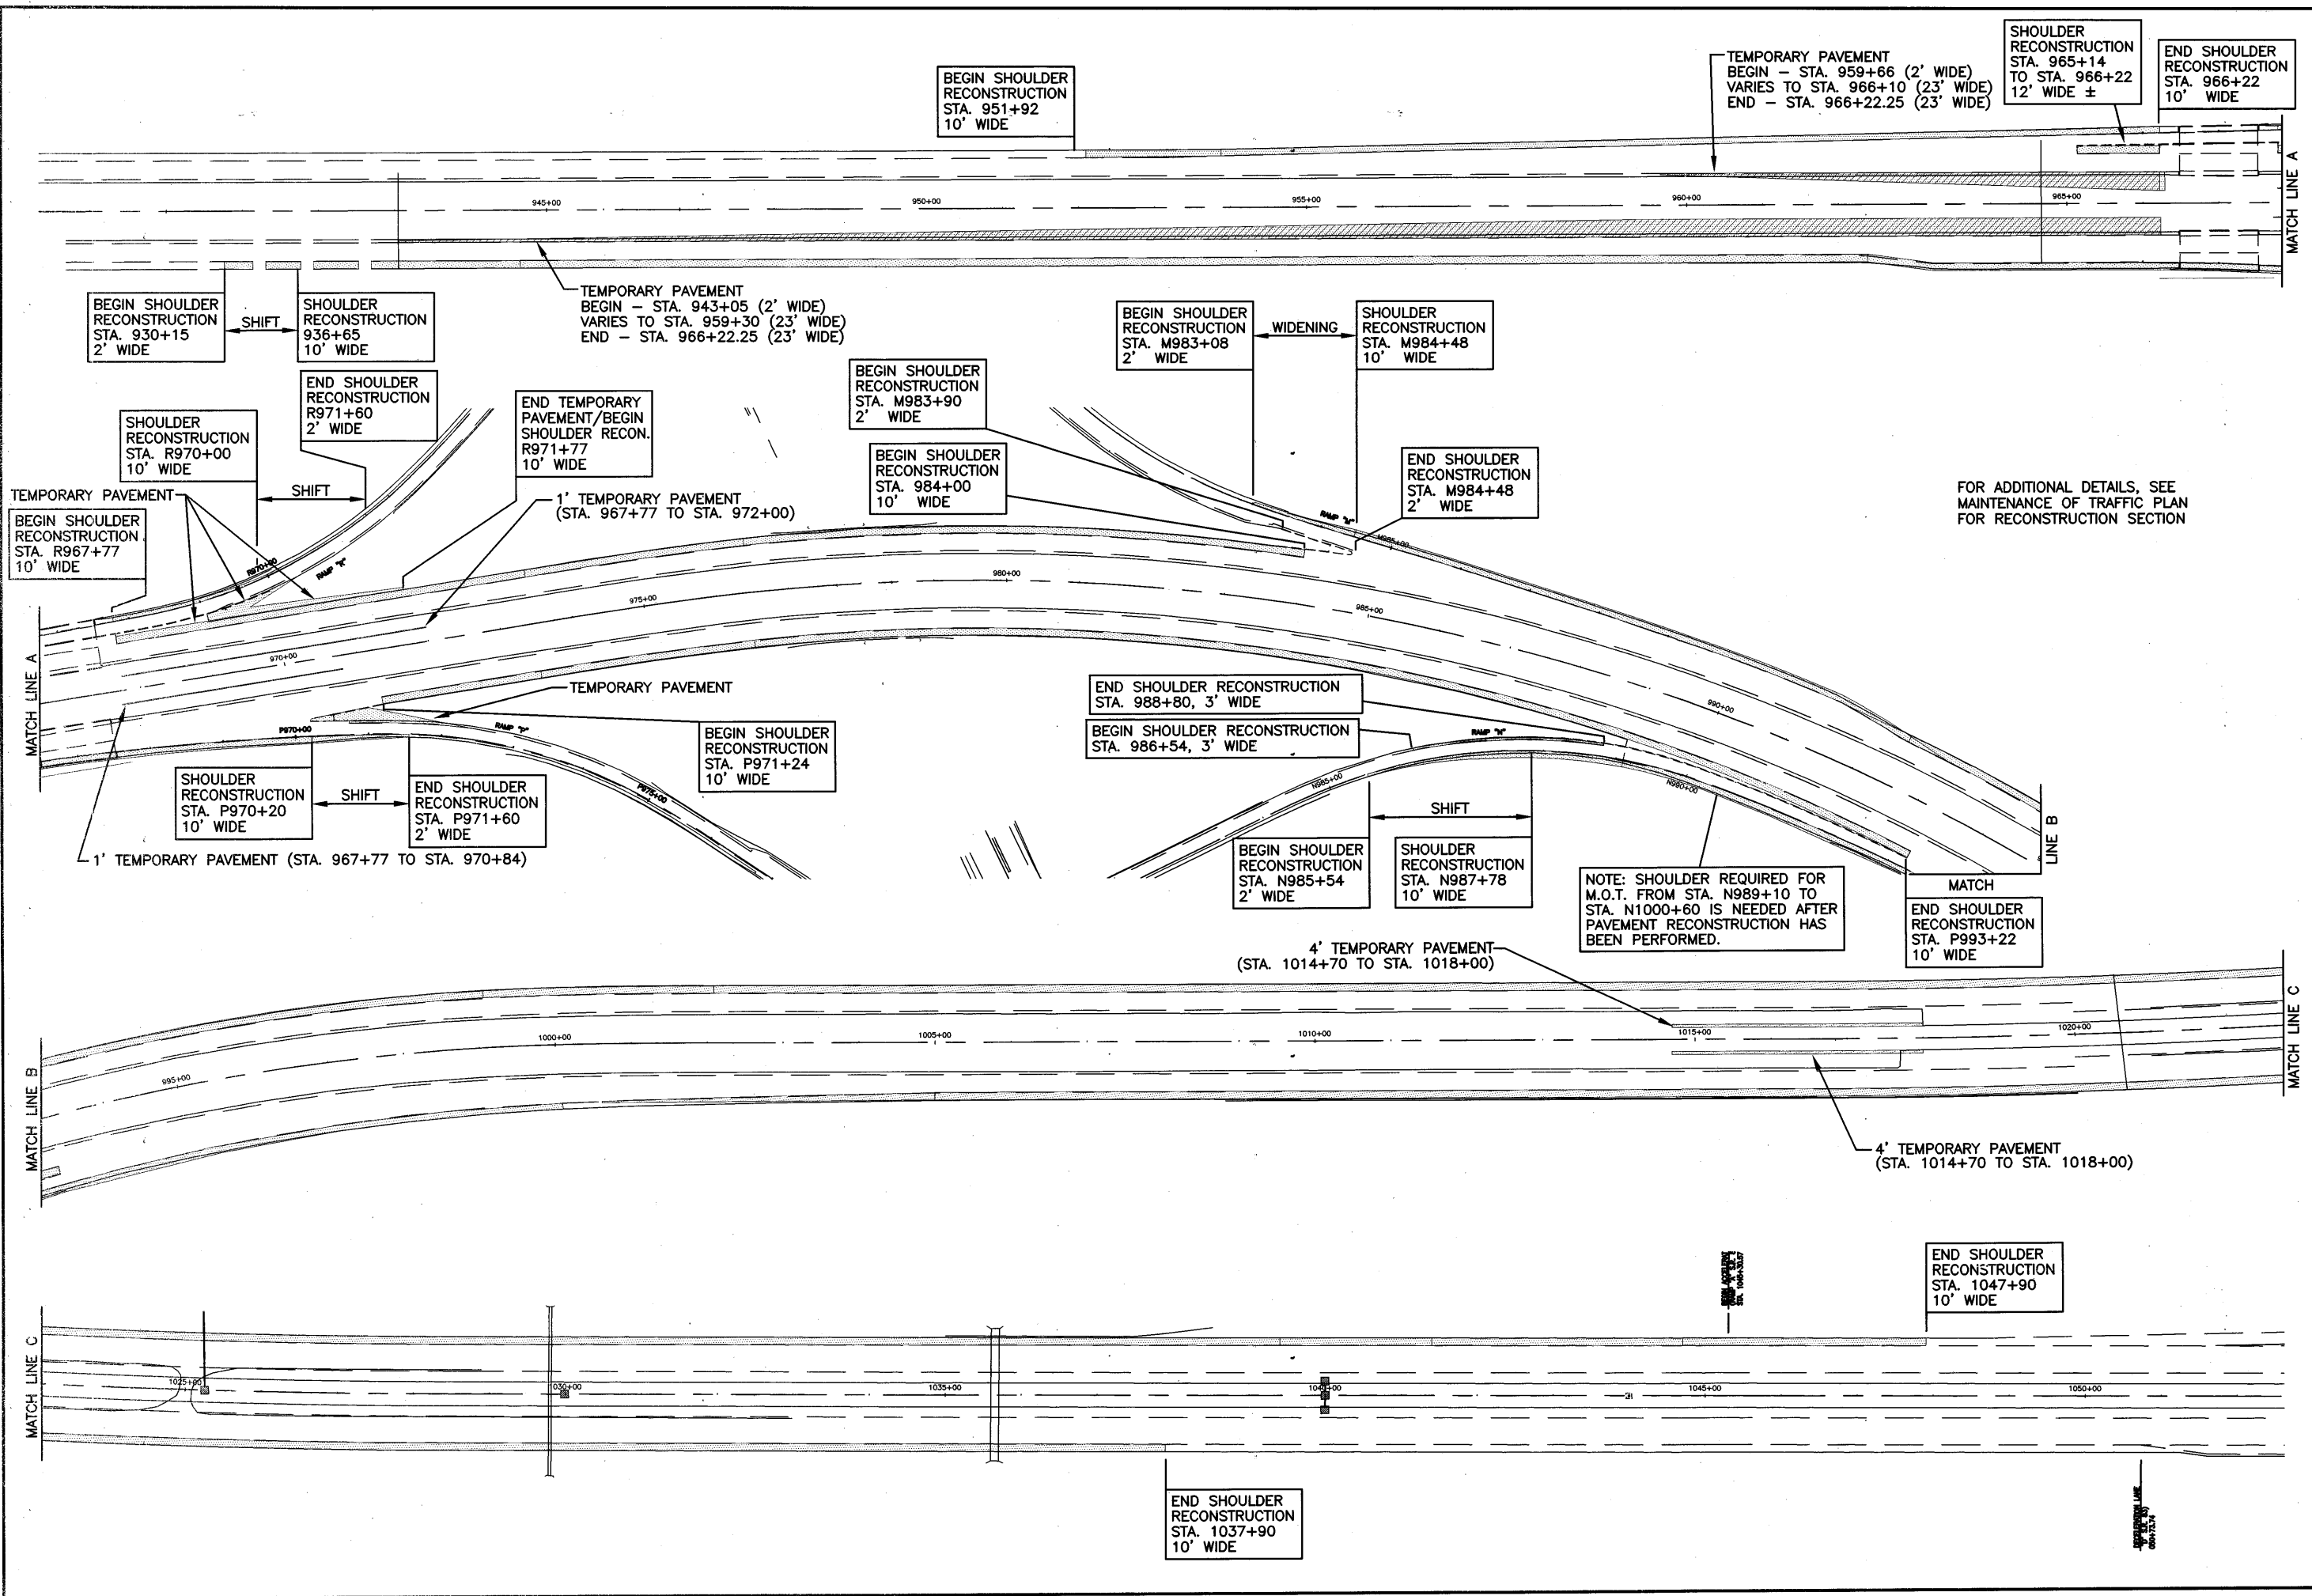

BEGIN SHOULDER RECONSTRUCTION STA. 951+92 10' WIDE

TEMPORARY PAVEMENT BEGIN - STA. 959+66 (2' WIDE) VARIES TO STA. 966+10 (23' WIDE) END - STA. 966+22.25 (23' WIDE)

SHOULDER RECONSTRUCTION STA. 965+14 TO STA. 966+22 12' WIDE ±

END SHOULDER RECONSTRUCTION STA. 966+22 10' WIDE

BEGIN SHOULDER RECONSTRUCTION STA. 930+15 2' WIDE

SHOULDER RECONSTRUCTION STA. 936+65 10' WIDE

TEMPORARY PAVEMENT BEGIN - STA. 943+05 (2' WIDE) VARIES TO STA. 959+30 (23' WIDE) END - STA. 966+22.25 (23' WIDE)

BEGIN SHOULDER RECONSTRUCTION STA. M983+08 2' WIDE

SHOULDER RECONSTRUCTION STA. M984+48 10' WIDE

END SHOULDER RECONSTRUCTION STA. R971+60 2' WIDE

END TEMPORARY PAVEMENT/BEGIN SHOULDER RECON. STA. R971+77 10' WIDE

BEGIN SHOULDER RECONSTRUCTION STA. M983+90 2' WIDE

BEGIN SHOULDER RECONSTRUCTION STA. 984+00 10' WIDE

END SHOULDER RECONSTRUCTION STA. M984+48 2' WIDE

FOR ADDITIONAL DETAILS, SEE MAINTENANCE OF TRAFFIC PLAN FOR RECONSTRUCTION SECTION

BEGIN SHOULDER RECONSTRUCTION STA. R967+77 10' WIDE

SHOULDER RECONSTRUCTION STA. R970+00 10' WIDE

END SHOULDER RECONSTRUCTION STA. P971+60 2' WIDE

1' TEMPORARY PAVEMENT (STA. 967+77 TO STA. 972+00)

END SHOULDER RECONSTRUCTION STA. 988+80, 3' WIDE

BEGIN SHOULDER RECONSTRUCTION STA. 986+54, 3' WIDE

BEGIN SHOULDER RECONSTRUCTION STA. N985+54 2' WIDE

SHOULDER RECONSTRUCTION STA. N987+78 10' WIDE

NOTE: SHOULDER REQUIRED FOR M.O.T. FROM STA. N989+10 TO STA. N1000+60 IS NEEDED AFTER PAVEMENT RECONSTRUCTION HAS BEEN PERFORMED.

END SHOULDER RECONSTRUCTION STA. P993+22 10' WIDE

SHOULDER RECONSTRUCTION STA. P970+20 10' WIDE

END SHOULDER RECONSTRUCTION STA. P971+60 2' WIDE

1' TEMPORARY PAVEMENT (STA. 967+77 TO STA. 970+84)

4' TEMPORARY PAVEMENT (STA. 1014+70 TO STA. 1018+00)

4' TEMPORARY PAVEMENT (STA. 1014+70 TO STA. 1018+00)

END SHOULDER RECONSTRUCTION STA. 1047+90 10' WIDE

END SHOULDER RECONSTRUCTION STA. 1037+90 10' WIDE

CALCULATED  
DLS  
CHECKED  
LAB

MAINTENANCE OF TRAFFIC  
TEMPORARY SHOULDER PLAN


LOR - 190 - 10.76

PROJECT DATA	
TOTAL AREA (RIGHT-OF-WAY) -----	78.5 AC.± Δ
AREA TO UNDERGO EXCAVATION, FILLING OR GRADING -----	23.3 AC.± Δ
RUNOFF COEFFICIENT FOR PRE-CONSTRUCTION SITE -----	0.62±
RUNOFF COEFFICIENT FOR POST CONSTRUCTION SITE -----	0.64±
SOIL DATA -----	SEE SOIL PROFILE
EVENTUAL RECEIVING WATERS -----	FRENCH CREEK, LAKE ERIE

USGS QUADRANT NO. N4122.5-W8200/7.5  
 AVON, OHIO  
 LONGITUDE W 82°03'16"\*  
 LATITUDE N 41°27'48"\*

\* LONGITUDE AND LATITUDE TO APPROX. CENTER OF INTERCHANGE

Δ = STA. 945+00 TO 1035+00

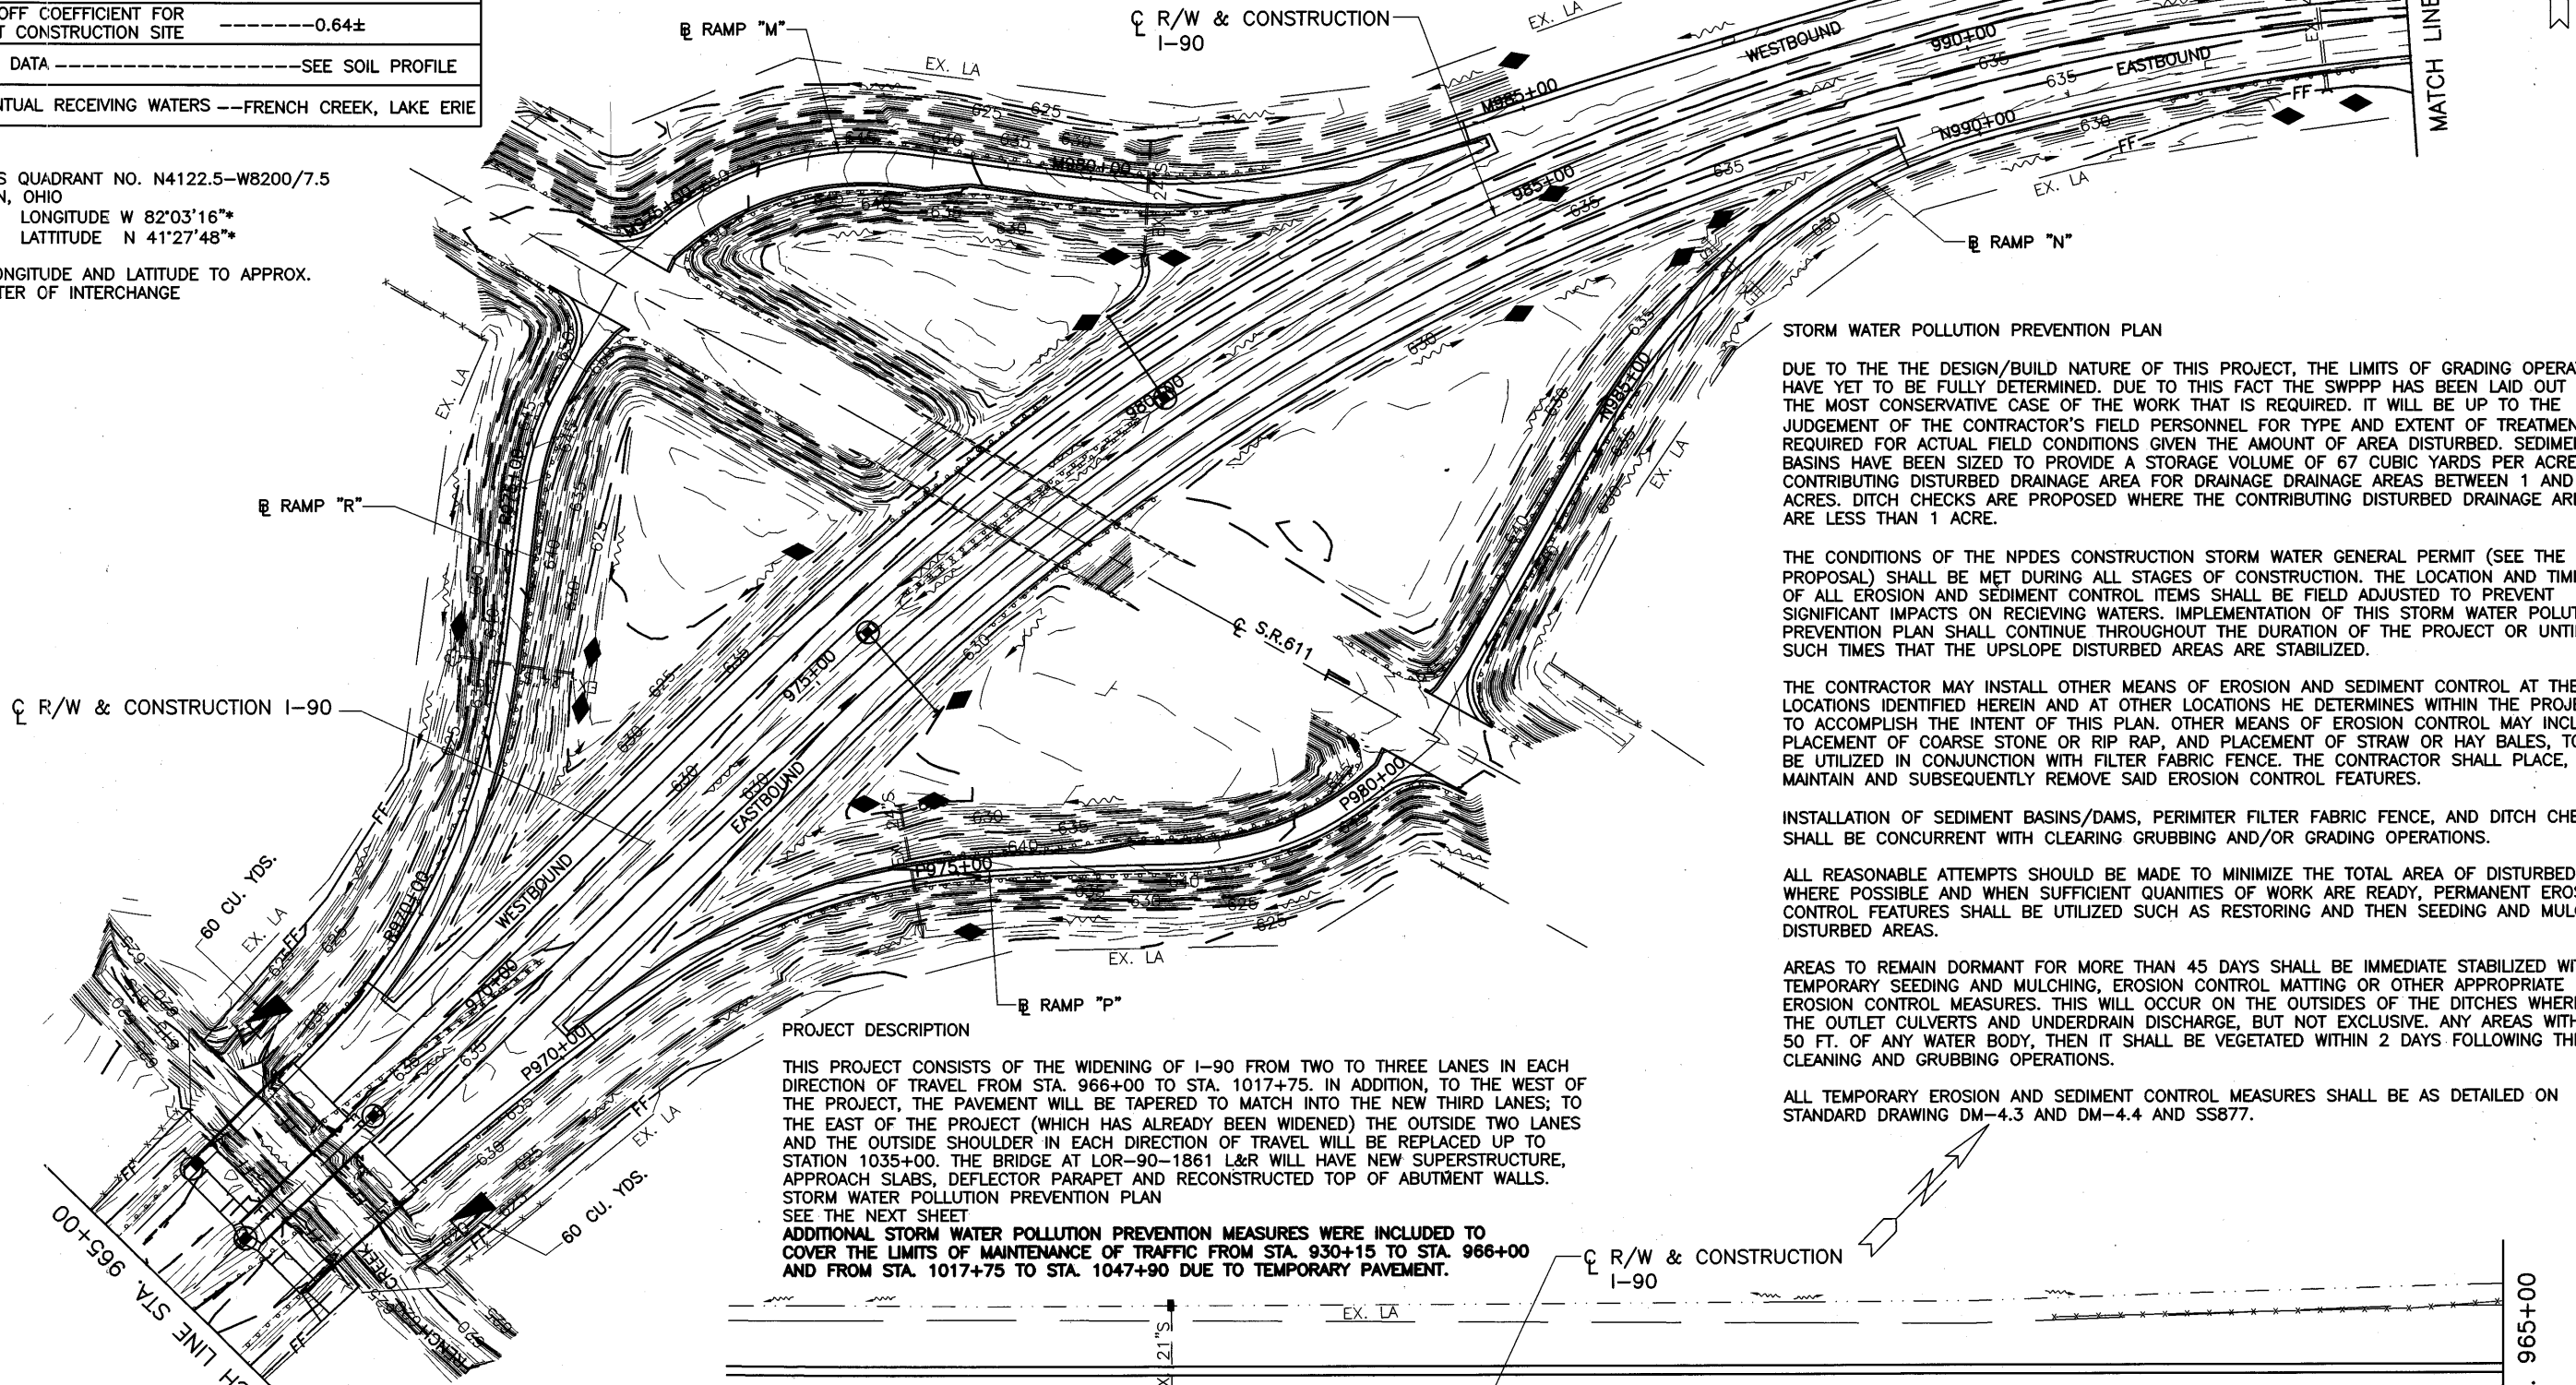

**STORM WATER POLLUTION PREVENTION PLAN**

DUE TO THE THE DESIGN/BUILD NATURE OF THIS PROJECT, THE LIMITS OF GRADING OPERATIONS HAVE YET TO BE FULLY DETERMINED. DUE TO THIS FACT THE SWPPP HAS BEEN LAID OUT FOR THE MOST CONSERVATIVE CASE OF THE WORK THAT IS REQUIRED. IT WILL BE UP TO THE JUDGEMENT OF THE CONTRACTOR'S FIELD PERSONNEL FOR TYPE AND EXTENT OF TREATMENT REQUIRED FOR ACTUAL FIELD CONDITIONS GIVEN THE AMOUNT OF AREA DISTURBED. SEDIMENT BASINS HAVE BEEN SIZED TO PROVIDE A STORAGE VOLUME OF 67 CUBIC YARDS PER ACRE OF CONTRIBUTING DISTURBED DRAINAGE AREA FOR DRAINAGE DRAINAGE AREAS BETWEEN 1 AND 5 ACRES. DITCH CHECKS ARE PROPOSED WHERE THE CONTRIBUTING DISTURBED DRAINAGE AREAS ARE LESS THAN 1 ACRE.

THE CONDITIONS OF THE NPDES CONSTRUCTION STORM WATER GENERAL PERMIT (SEE THE PROPOSAL) SHALL BE MET DURING ALL STAGES OF CONSTRUCTION. THE LOCATION AND TIMING OF ALL EROSION AND SEDIMENT CONTROL ITEMS SHALL BE FIELD ADJUSTED TO PREVENT SIGNIFICANT IMPACTS ON RECEIVING WATERS. IMPLEMENTATION OF THIS STORM WATER POLLUTION PREVENTION PLAN SHALL CONTINUE THROUGHOUT THE DURATION OF THE PROJECT OR UNTIL SUCH TIMES THAT THE UPSLOPE DISTURBED AREAS ARE STABILIZED.

THE CONTRACTOR MAY INSTALL OTHER MEANS OF EROSION AND SEDIMENT CONTROL AT THE LOCATIONS IDENTIFIED HEREIN AND AT OTHER LOCATIONS HE DETERMINES WITHIN THE PROJECT TO ACCOMPLISH THE INTENT OF THIS PLAN. OTHER MEANS OF EROSION CONTROL MAY INCLUDE PLACEMENT OF COARSE STONE OR RIP RAP, AND PLACEMENT OF STRAW OR HAY BALES, TO BE UTILIZED IN CONJUNCTION WITH FILTER FABRIC FENCE. THE CONTRACTOR SHALL PLACE, MAINTAIN AND SUBSEQUENTLY REMOVE SAID EROSION CONTROL FEATURES.

INSTALLATION OF SEDIMENT BASINS/DAMS, PERIMETER FILTER FABRIC FENCE, AND DITCH CHECKS SHALL BE CONCURRENT WITH CLEARING GRUBBING AND/OR GRADING OPERATIONS.

ALL REASONABLE ATTEMPTS SHOULD BE MADE TO MINIMIZE THE TOTAL AREA OF DISTURBED LAND. WHERE POSSIBLE AND WHEN SUFFICIENT QUANTITIES OF WORK ARE READY, PERMANENT EROSION CONTROL FEATURES SHALL BE UTILIZED SUCH AS RESTORING AND THEN SEEDING AND MULCHING DISTURBED AREAS.

AREAS TO REMAIN DORMANT FOR MORE THAN 45 DAYS SHALL BE IMMEDIATE STABILIZED WITH TEMPORARY SEEDING AND MULCHING, EROSION CONTROL MATTING OR OTHER APPROPRIATE EROSION CONTROL MEASURES. THIS WILL OCCUR ON THE OUTSIDES OF THE DITCHES WHERE THE OUTLET CULVERTS AND UNDERDRAIN DISCHARGE, BUT NOT EXCLUSIVE. ANY AREAS WITHIN 50 FT. OF ANY WATER BODY, THEN IT SHALL BE VEGETATED WITHIN 2 DAYS FOLLOWING THE CLEANING AND GRUBBING OPERATIONS.

ALL TEMPORARY EROSION AND SEDIMENT CONTROL MEASURES SHALL BE AS DETAILED ON STANDARD DRAWING DM-4.3 AND DM-4.4 AND SS877.


**PROJECT DESCRIPTION**

THIS PROJECT CONSISTS OF THE WIDENING OF I-90 FROM TWO TO THREE LANES IN EACH DIRECTION OF TRAVEL FROM STA. 966+00 TO STA. 1017+75. IN ADDITION, TO THE WEST OF THE PROJECT, THE PAVEMENT WILL BE TAPERED TO MATCH INTO THE NEW THIRD LANES; TO THE EAST OF THE PROJECT (WHICH HAS ALREADY BEEN WIDENED) THE OUTSIDE TWO LANES AND THE OUTSIDE SHOULDER IN EACH DIRECTION OF TRAVEL WILL BE REPLACED UP TO STATION 1035+00. THE BRIDGE AT LOR-90-1861 L&R WILL HAVE NEW SUPERSTRUCTURE, APPROACH SLABS, DEFLECTOR PARAPET AND RECONSTRUCTED TOP OF ABUTMENT WALLS.

**STORM WATER POLLUTION PREVENTION PLAN**  
 SEE THE NEXT SHEET

**ADDITIONAL STORM WATER POLLUTION PREVENTION MEASURES WERE INCLUDED TO COVER THE LIMITS OF MAINTENANCE OF TRAFFIC FROM STA. 930+15 TO STA. 966+00 AND FROM STA. 1017+75 TO STA. 1047+90 DUE TO TEMPORARY PAVEMENT.**


- LEGEND**
- TEMPORARY INLET PROTECT, FILTER FABRIC FENCE (AT ALL EXISTING AND PROPOSED INLETS)
  - ◆ TEMPORARY DITCH CHECK, FILTER FENCE
  - FF— FILTER FABRIC FENCE
  - ~> DIRECTION OF FLOW DITCH
  - ▣ SEDIMENT BASIN

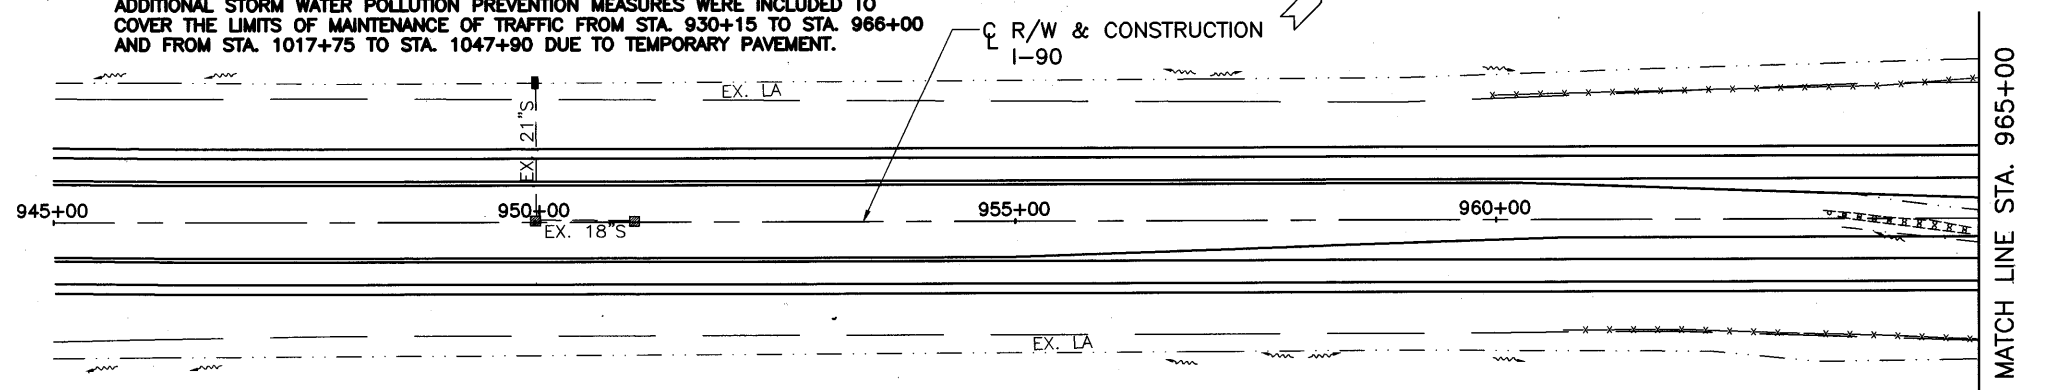

STORM WATER POLLUTION PREVENTION PLAN (I-90)  
 STA. 945+00 TO 1018+00

LOR - 190 - 10.76

7:53AM  
02-21-2002  
[ C:\93600\DWG\VR003\936005.DWG ] DLS

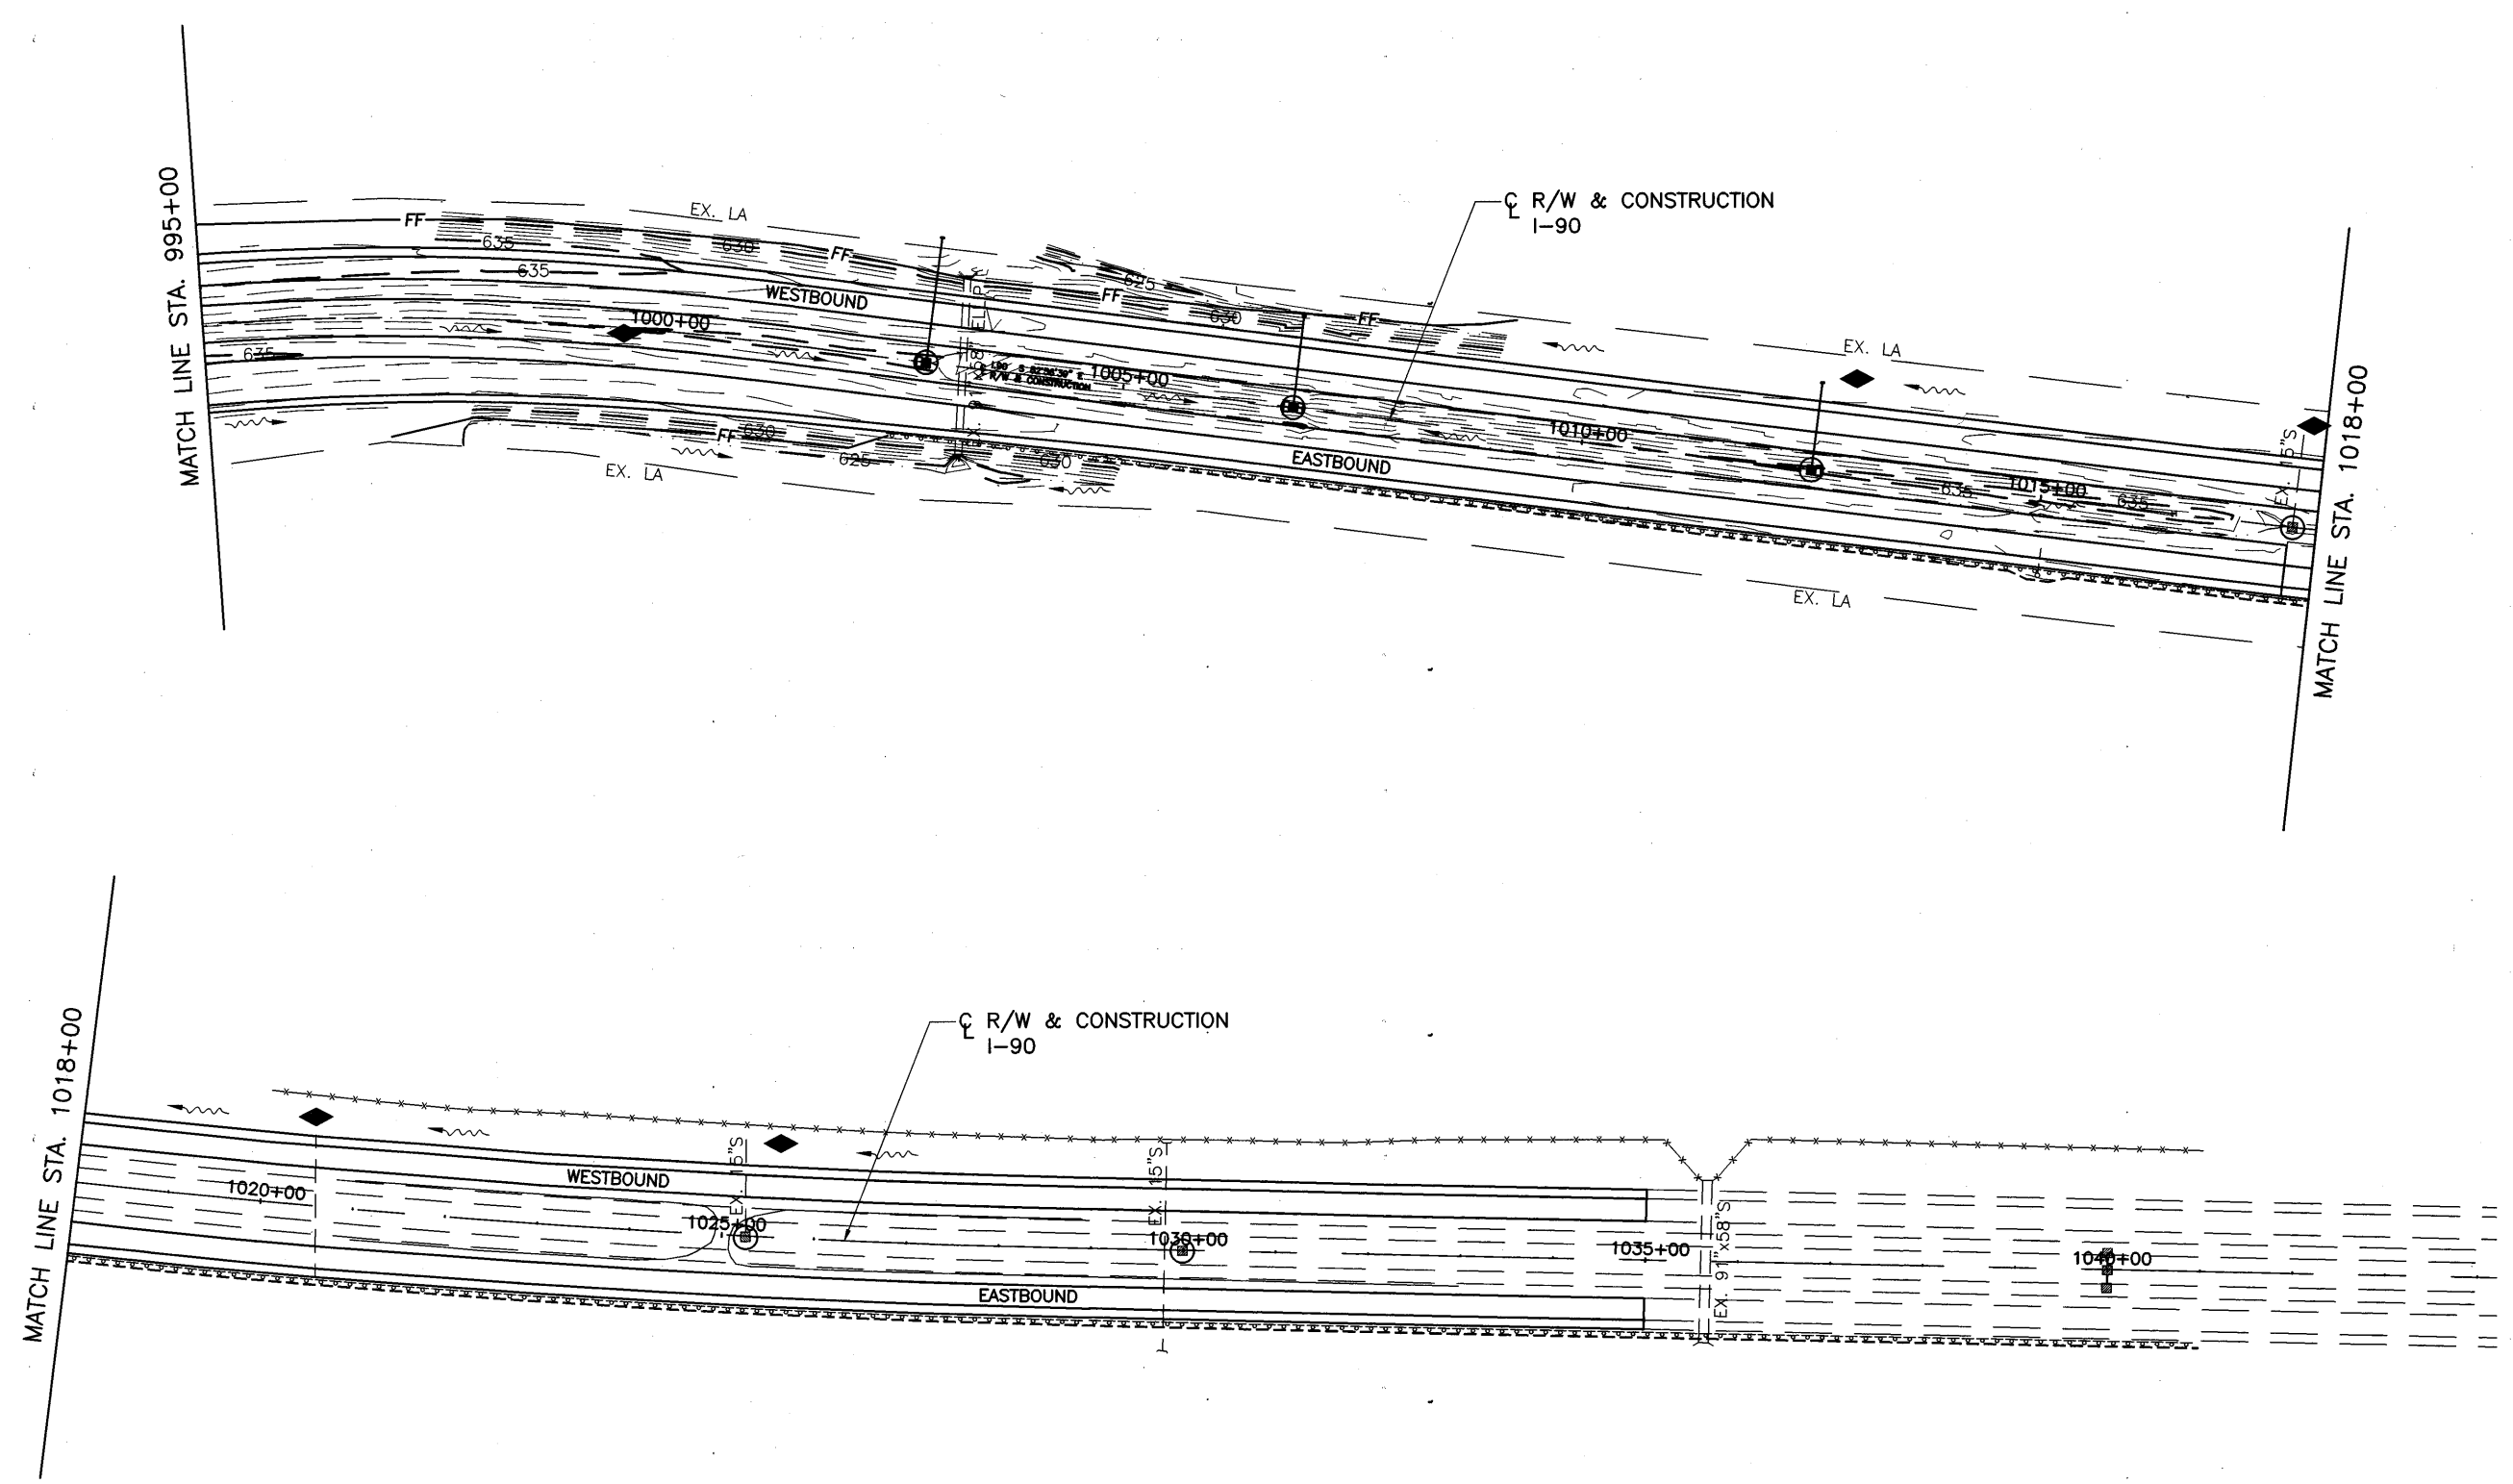


CALCULATED	0	100'	200'
DLS			
CHECKED			
LAB			

HORIZONTAL SCALE IN FEET

**STORM WATER POLLUTION PREVENTION PLAN (I-90)**  
**STA. 1018+00 TO 1035+00**

**LOR - I90 - 10.76**

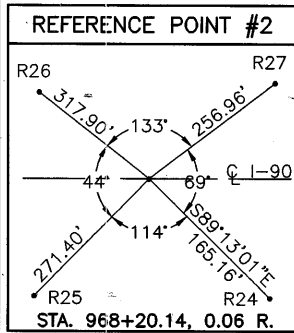


ALL REFERENCE POINTS ARE 5/8" DIA. REBAR WITH A 1 3/4" ORANGE CAP MARKED "DO NOT DISTURB R.E. WARNER CONTROL STATION" SET

BEGIN APPROACH SLAB  
STA. 966+22.25  
END APPROACH SLAB  
STA. 966+47.25

BEGIN APPROACH SLAB  
STA. 967.52.75  
END APPROACH SLAB  
STA. 967+77.75

FOR RAMP "R" CONTINUATION, SEE SHT. 198

FOR RAMP "P" CONTINUATION, SEE SHT. 199

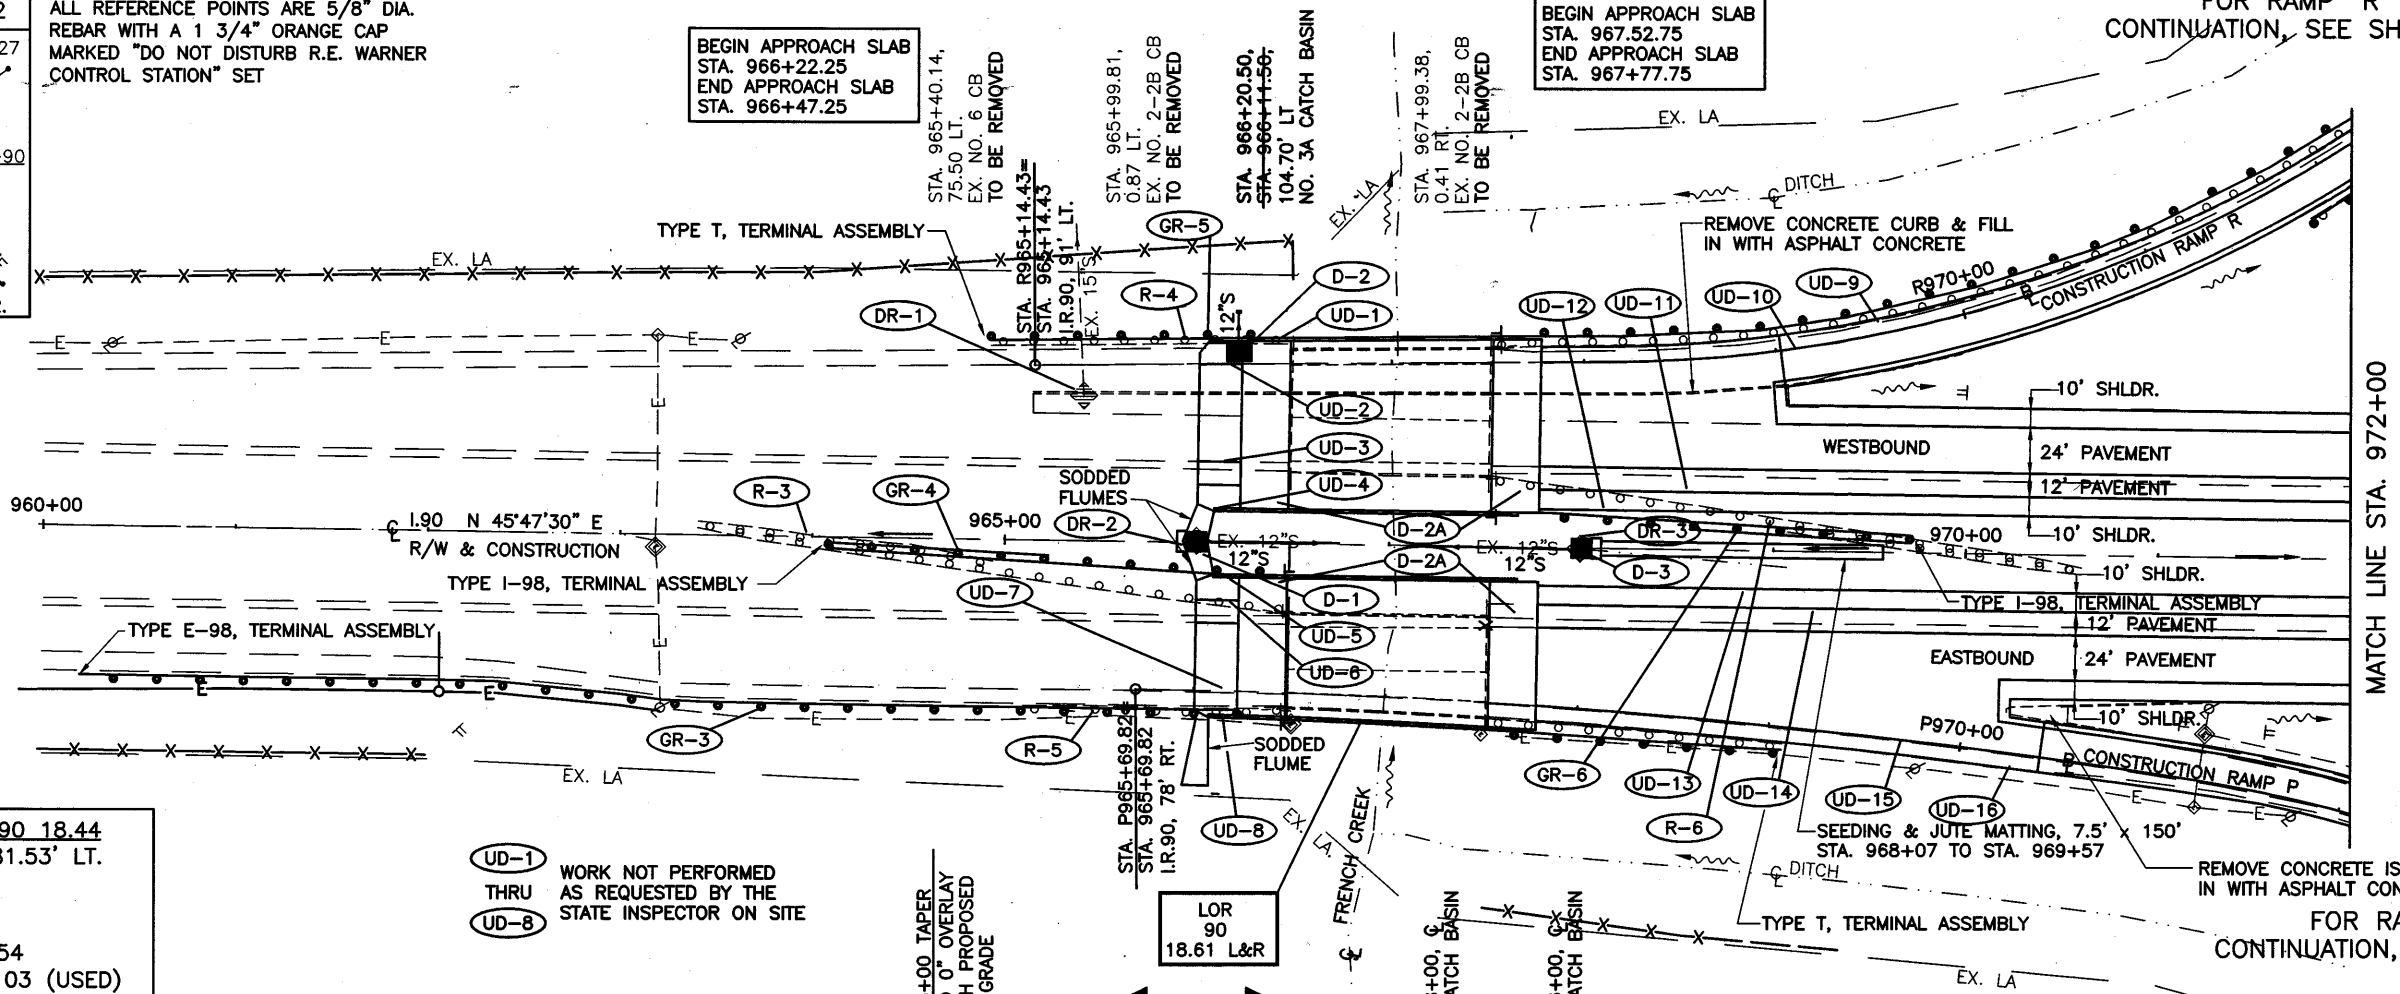


BENCHMARK-LOR 190 18.44  
STA. 973+67.53, 81.53' LT.  
N-10440.2259  
E-10335.7014  
ODOT ELEV.=635.154  
R.E.W. ELEV.=635.103 (USED)

UD-1  
UD-8  
WORK NOT PERFORMED  
THRU  
AS REQUESTED BY THE  
STATE INSPECTOR ON SITE

RESURFACING SECTION  
DOWN TO 0" OVERLAY  
TO MATCH PROPOSED  
PROFILE GRADE

BEGIN THIRD  
LANE WIDENING

LOR 90  
18.61 L&R

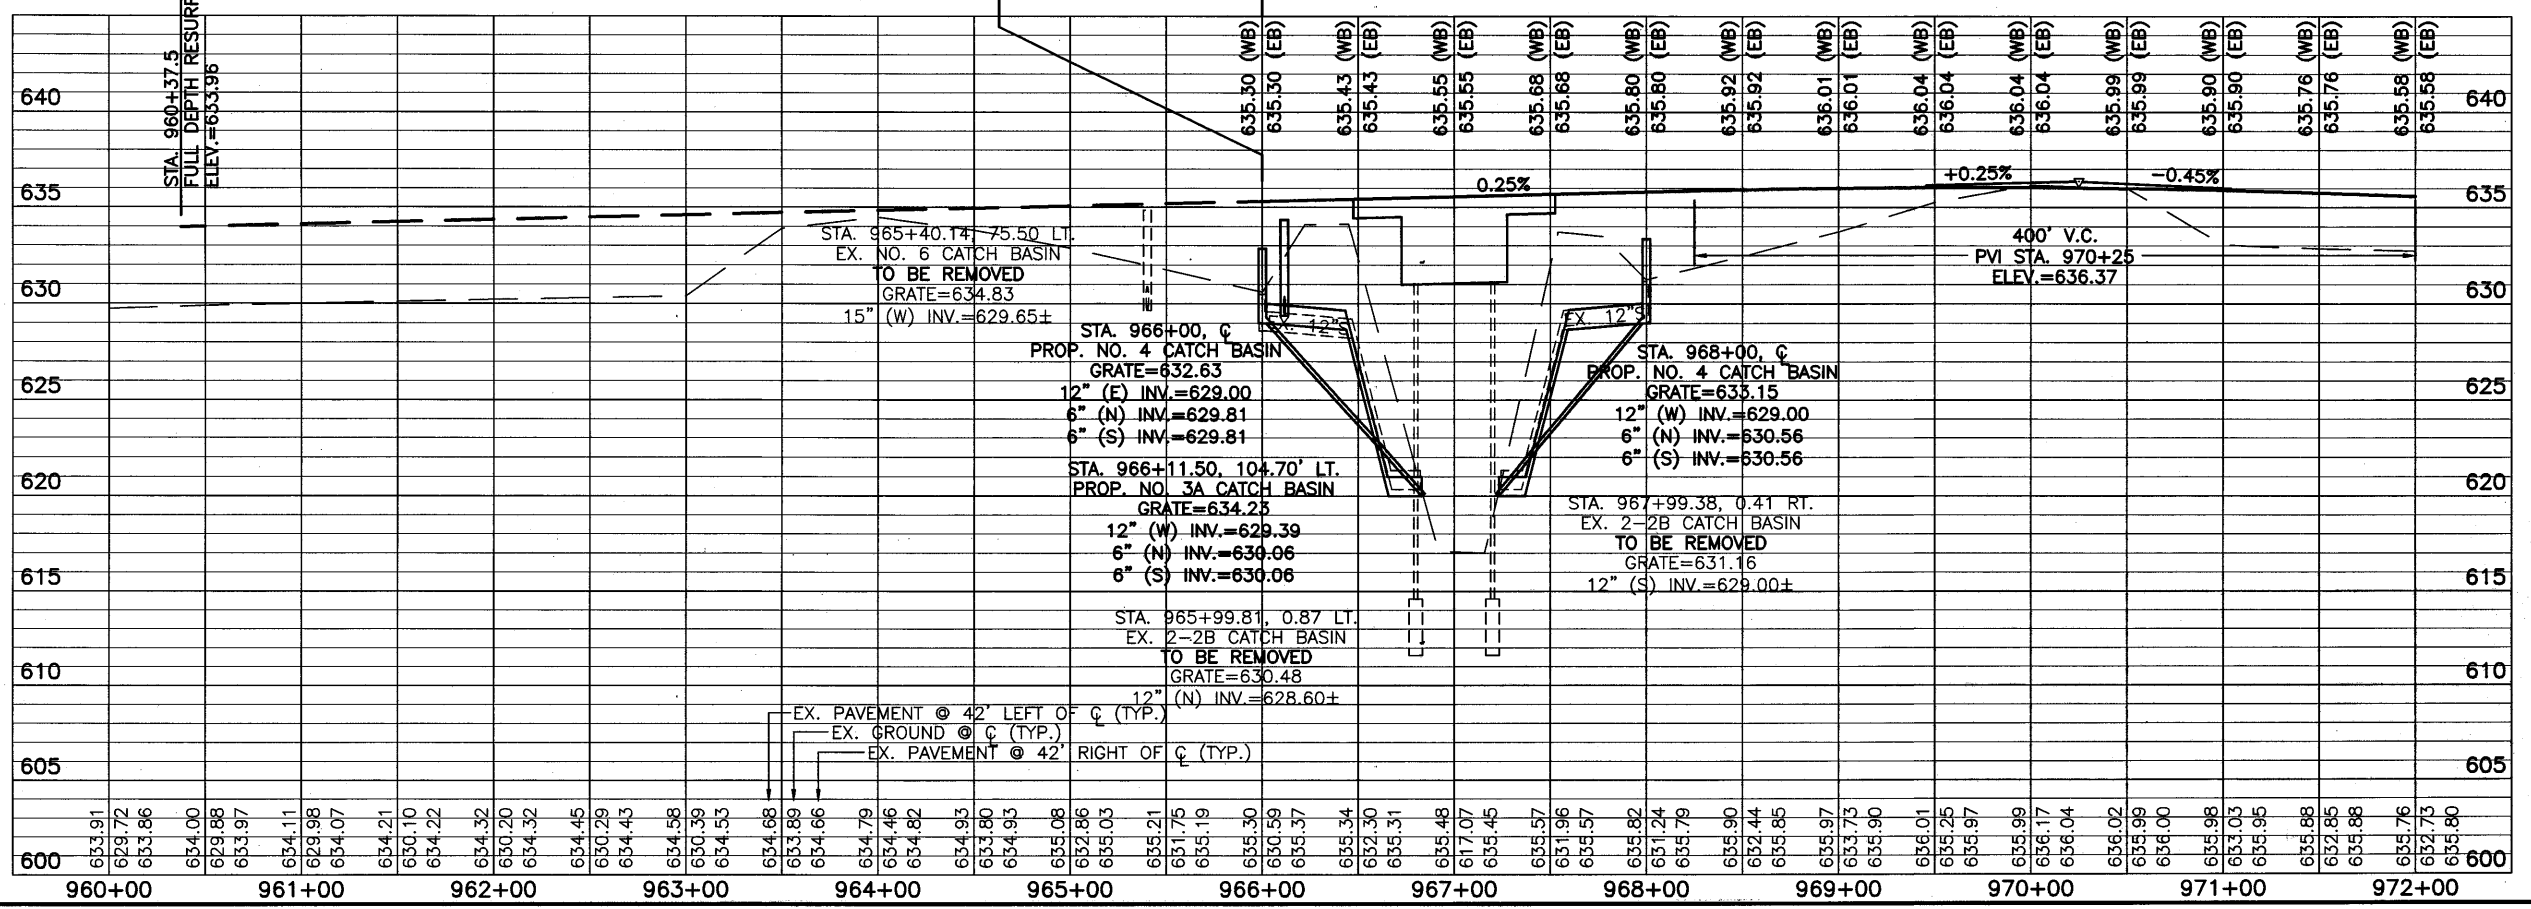


PLAN AND PROFILE  
STA. 960+00 TO STA. 972+00

LOR - 190 - 10.76

191  
274

07-23-2002 2:58PM \\01\pwws\01\1001\1001.dwg I DLS

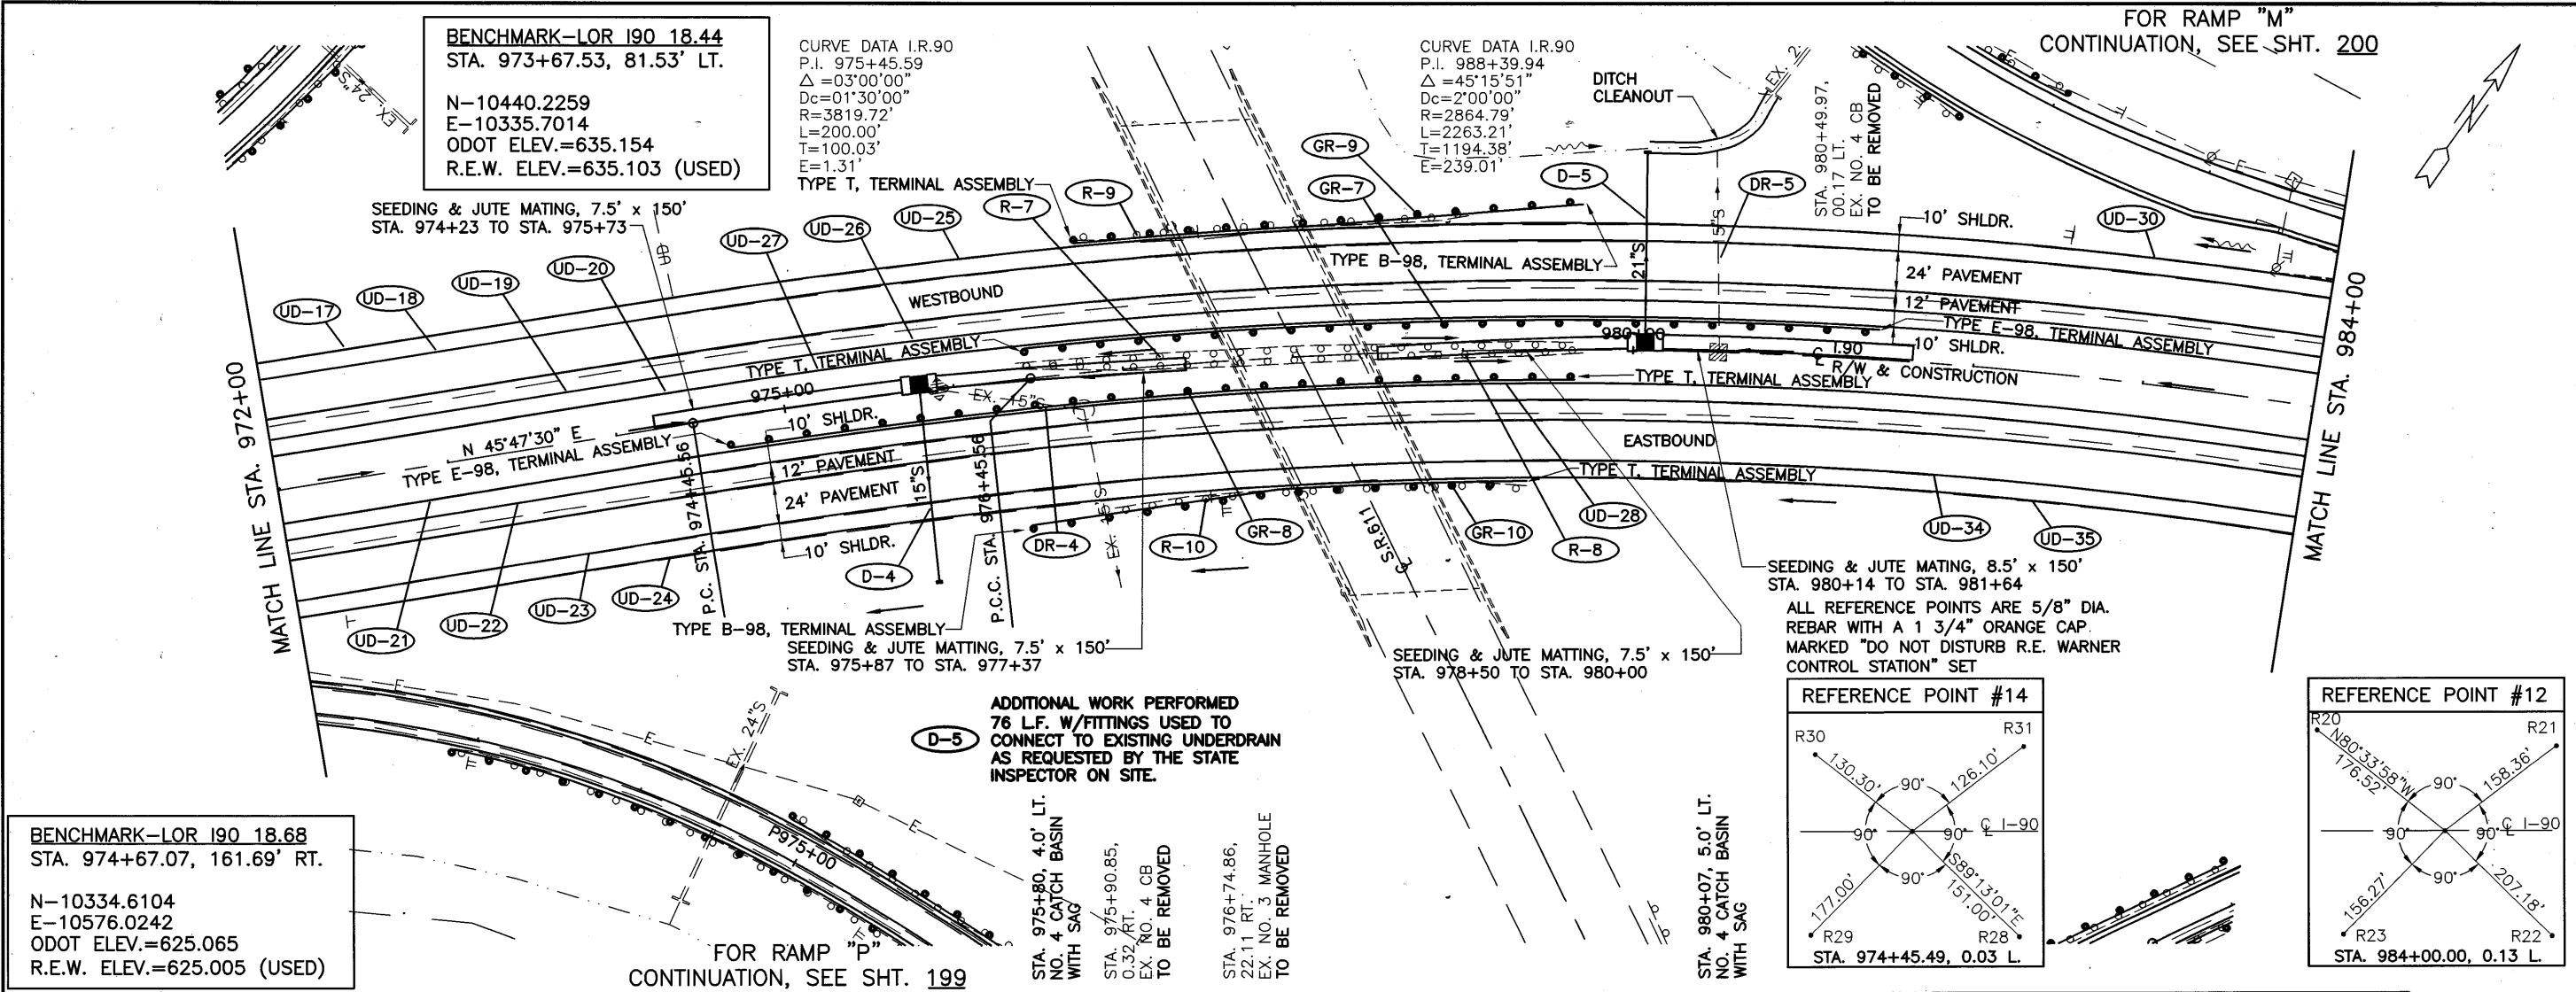

**BENCHMARK-LOR 190 18.44**  
 STA. 973+67.53, 81.53' LT.  
 N=10440.2259  
 E=10335.7014  
 ODOT ELEV.=635.154  
 R.E.W. ELEV.=635.103 (USED)

CURVE DATA I.R.90  
 P.I. 975+45.59  
 Δ=03°00'00"  
 Dc=01'30"00"  
 R=3819.72'  
 L=200.00'  
 T=100.03'  
 E=1.31'  
 TYPE T, TERMINAL ASSEMBLY



CURVE DATA I.R.90  
 P.I. 988+39.94  
 Δ=45°15'51"  
 Dc=2'00"00"  
 R=2864.79'  
 L=2263.21'  
 T=1194.38'  
 E=239.01'  
 TYPE T, TERMINAL ASSEMBLY

FOR RAMP "M"  
 CONTINUATION, SEE SHT. 200

FOR RAMP "P"  
 CONTINUATION, SEE SHT. 199

**BENCHMARK-LOR 190 18.68**  
 STA. 974+67.07, 161.69' RT.  
 N=10334.6104  
 E=10576.0242  
 ODOT ELEV.=625.065  
 R.E.W. ELEV.=625.005 (USED)

ADDITIONAL WORK PERFORMED  
 76 L.F. W/FITTINGS USED TO  
 CONNECT TO EXISTING UNDERDRAIN  
 AS REQUESTED BY THE STATE  
 INSPECTOR ON SITE.

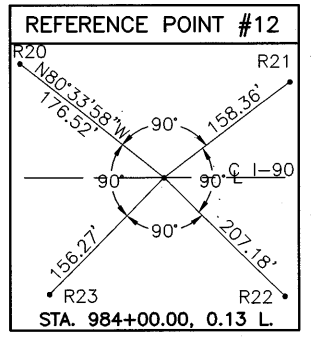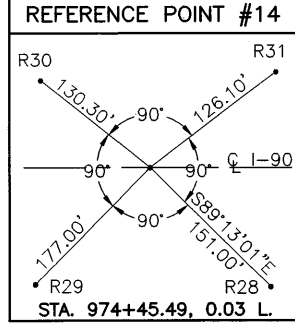

Station	605	610	615	620	625	630	635	640	645
972+00	635.76	635.76	635.76	635.76	635.76	635.76	635.76	635.76	635.76
973+00	635.58	635.58	635.58	635.58	635.58	635.58	635.58	635.58	635.58
974+00	635.36	635.36	635.36	635.36	635.36	635.36	635.36	635.36	635.36
975+00	635.14	635.14	635.14	635.14	635.14	635.14	635.14	635.14	635.14
976+00	634.91	634.91	634.91	634.91	634.91	634.91	634.91	634.91	634.91
977+00	634.69	634.69	634.69	634.69	634.69	634.69	634.69	634.69	634.69
978+00	634.46	634.46	634.46	634.46	634.46	634.46	634.46	634.46	634.46
979+00	634.24	634.24	634.24	634.24	634.24	634.24	634.24	634.24	634.24
980+00	634.01	634.01	634.01	634.01	634.01	634.01	634.01	634.01	634.01
981+00	633.79	633.79	633.79	633.79	633.79	633.79	633.79	633.79	633.79
982+00	633.56	633.56	633.56	633.56	633.56	633.56	633.56	633.56	633.56
983+00	633.35	633.35	633.35	633.35	633.35	633.35	633.35	633.35	633.35
984+00	633.11	633.11	633.11	633.11	633.11	633.11	633.11	633.11	633.11

PLAN AND PROFILE  
 STA. 972+00 TO STA. 984+00


LOR - 190 - 10.76

192  
 274







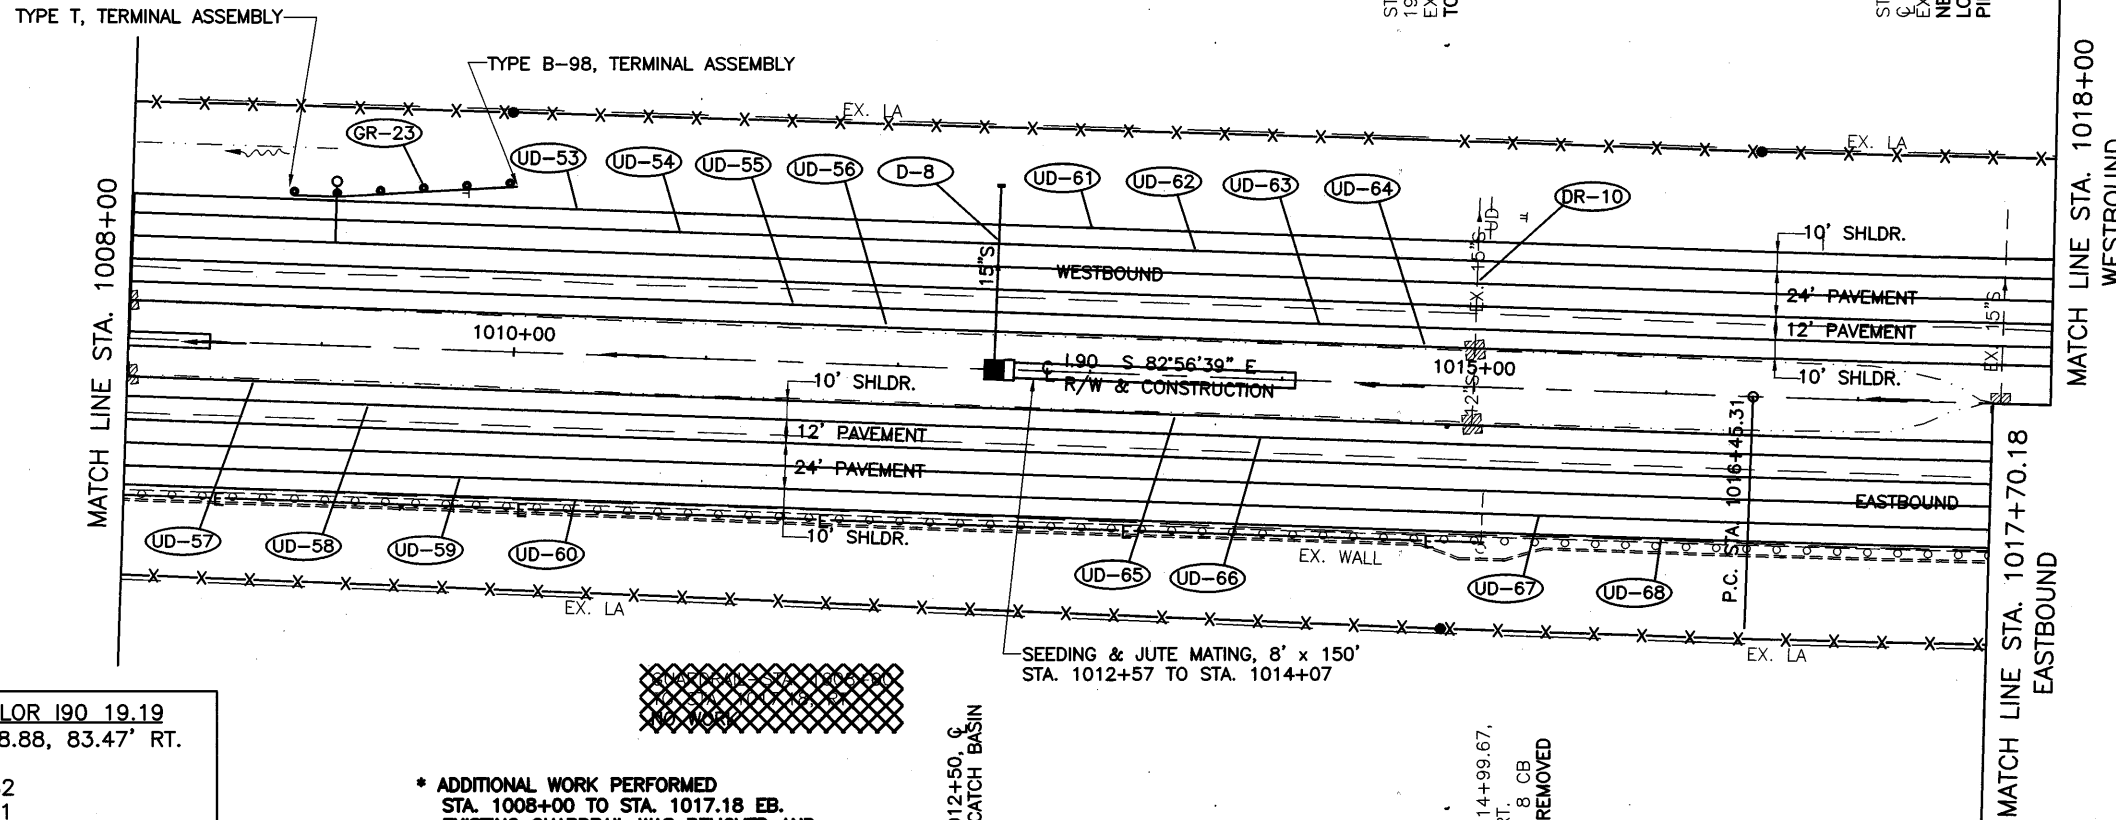


CURVE DATA I.R.90  
 P.I. 1022+54.08  
 $\Delta = 05^{\circ}40'38''$   
 $D_c = 00^{\circ}28'00''$   
 $R = 12277.67'$   
 $L = 1216.55'$   
 $T = 608.77'$   
 $E = 15.08'$

STA. 1014+99.82,  
 19.08 LT.  
 EX. NO. 8 CB  
 TO BE REMOVED

STA. 1017+75.00  
 EX. NO. 4 CB  
 NEW STRUCTURE  
 LOR-90-19.95  
 PID 5984

ALL REFERENCE POINTS ARE 5/8" DIA.  
 REBAR WITH A 1 3/4" ORANGE CAP  
 MARKED "DO NOT DISTURB R.E. WARNER  
 CONTROL STATION" SET

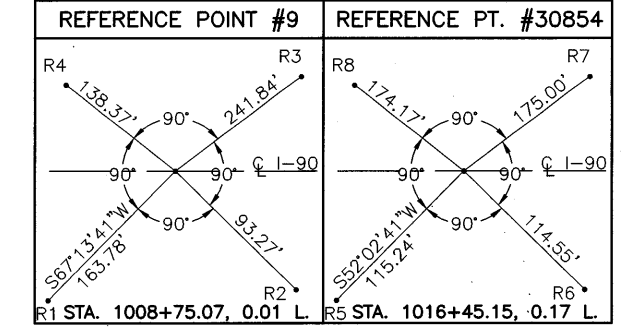

BENCHMARK-LOR 190 19.19  
 STA. 1012+98.88, 83.47' RT.  
  
 N-11025.8182  
 E-14055.2571  
 ODOT ELEV.=632.774  
 R.E.W. ELEV.=632.767 (USED)

\* ADDITIONAL WORK PERFORMED  
 STA. 1008+00 TO STA. 1017.18 EB.  
 EXISTING GUARDRAIL WAS REMOVED AND  
 REPLACED FOR SHOULDER GRADING TO WALL.

STA. 1012+50.0  
 NO. 4 CATCH BASIN

STA. 1014+99.67,  
 19.36 RT.  
 EX. NO. 8 CB  
 TO BE REMOVED

Station	WB Elevation	EB Elevation	Notes
1008+00	632.48	632.16	
1008+10	634.33	632.16	
1008+20	632.57	632.26	
1008+30	632.55	632.26	
1008+40	634.66	632.38	
1008+50	632.60	632.38	
1008+60	632.68	632.50	
1008+70	634.75	632.50	
1008+80	632.69	632.62	
1008+90	632.80	632.62	
1009+00	634.89	632.74	
1009+10	632.84	632.74	
1009+20	632.94	632.86	
1009+30	634.96	632.86	
1009+40	632.96	632.98	
1009+50	633.05	632.98	
1009+60	635.07	633.10	
1009+70	633.10	633.10	
1009+80	633.14	633.22	
1009+90	634.88	633.22	
1010+00	633.18	633.34	
1010+10	633.24	633.34	
1010+20	635.10	633.46	
1010+30	633.31	633.46	
1010+40	633.39	633.58	
1010+50	635.34	633.58	
1010+60	633.40	633.70	
1010+70	633.48	633.82	
1010+80	635.51	633.82	
1010+90	633.50	633.94	
1011+00	633.62	633.94	
1011+10	635.70	634.06	
1011+20	633.67	634.06	
1011+30	633.72	634.23	
1011+40	635.76	634.23	
1011+50	633.75	634.42	
1011+60	633.85	634.42	
1011+70	635.81	634.60	
1011+80	633.90	634.60	
1011+90	634.00	634.77	
1012+00	635.90	634.77	
1012+10	634.02	634.89	
1012+20	634.10	634.97	
1012+30	635.83	635.16	
1012+40	634.14	632.93	
1012+50	634.24	635.10	
1012+60	636.19	635.18	
1012+70	634.27	634.09	
1012+80	634.37	635.18	
1012+90	636.30	634.09	
1013+00	634.37	635.18	
1013+10	634.46		
1013+20	636.44		
1013+30	634.47		
1013+40	634.61		
1013+50	635.91		
1013+60	634.56		
1013+70	634.64		
1013+80	632.89		
1013+90	634.65		
1014+00	634.77		
1014+10	632.58		
1014+20	634.78		
1014+30	634.90		
1014+40	632.74		
1014+50	634.94		
1014+60	635.01		
1014+70	632.84		
1014+80	634.97		
1014+90	635.16		
1015+00	632.93		
1015+10	635.10		
1015+20	635.18		
1015+30	634.09		
1015+40	635.18		

300' V.C.  
 PVI STA. 1007+00  
 ELEV.=631.90

STA. 1012+50.0  
 PROP. NO. 4 CATCH BASIN  
 GRATE=630.05  
 15" (N) INV.=628.13

STA. 1014+99.82, 19.08 LT.  
 EX. NO. 8 CATCH BASIN  
 TO BE REMOVED  
 GRATE=631.79  
 15" (N) INV.=628.81±  
 12" (S) INV.=629.06±

GRADE BREAK  
 STA. 1016+00  
 ELEV.=634.25

STA. 1017+75.00, C  
 EX. NO. 4 CATCH BASIN  
 TO REMAIN  
 GRATE=632.42  
 15" (N) INV.=630.00±

EX. PAVEMENT @ 42' LEFT OF C (TYP.)  
 EX. GROUND @ C (TYP.)  
 EX. PAVEMENT @ 42' RIGHT OF C (TYP.)

STA. 1014+99.67, 19.36 RT.  
 EX. NO. 8 CATCH BASIN  
 TO BE REMOVED  
 GRATE=631.89  
 12" (N) INV.=629.44±




PLAN AND PROFILE  
 STA. 1008+00 TO STA. 1020+00

LOR - 190 - 10.76


BEGIN RECONSTRUCTION PART  
 STA. 1017+70.18 (EB)  
 STA. 1018+00 (WB)

CURVE DATA I.R.90  
 P.I. 1022+54.08  
 $\Delta = 05^{\circ}40'38''$   
 $Dc = 00^{\circ}28'00''$   
 $R = 12277.67'$   
 $L = 1216.55'$   
 $T = 608.77'$   
 $E = 15.08'$

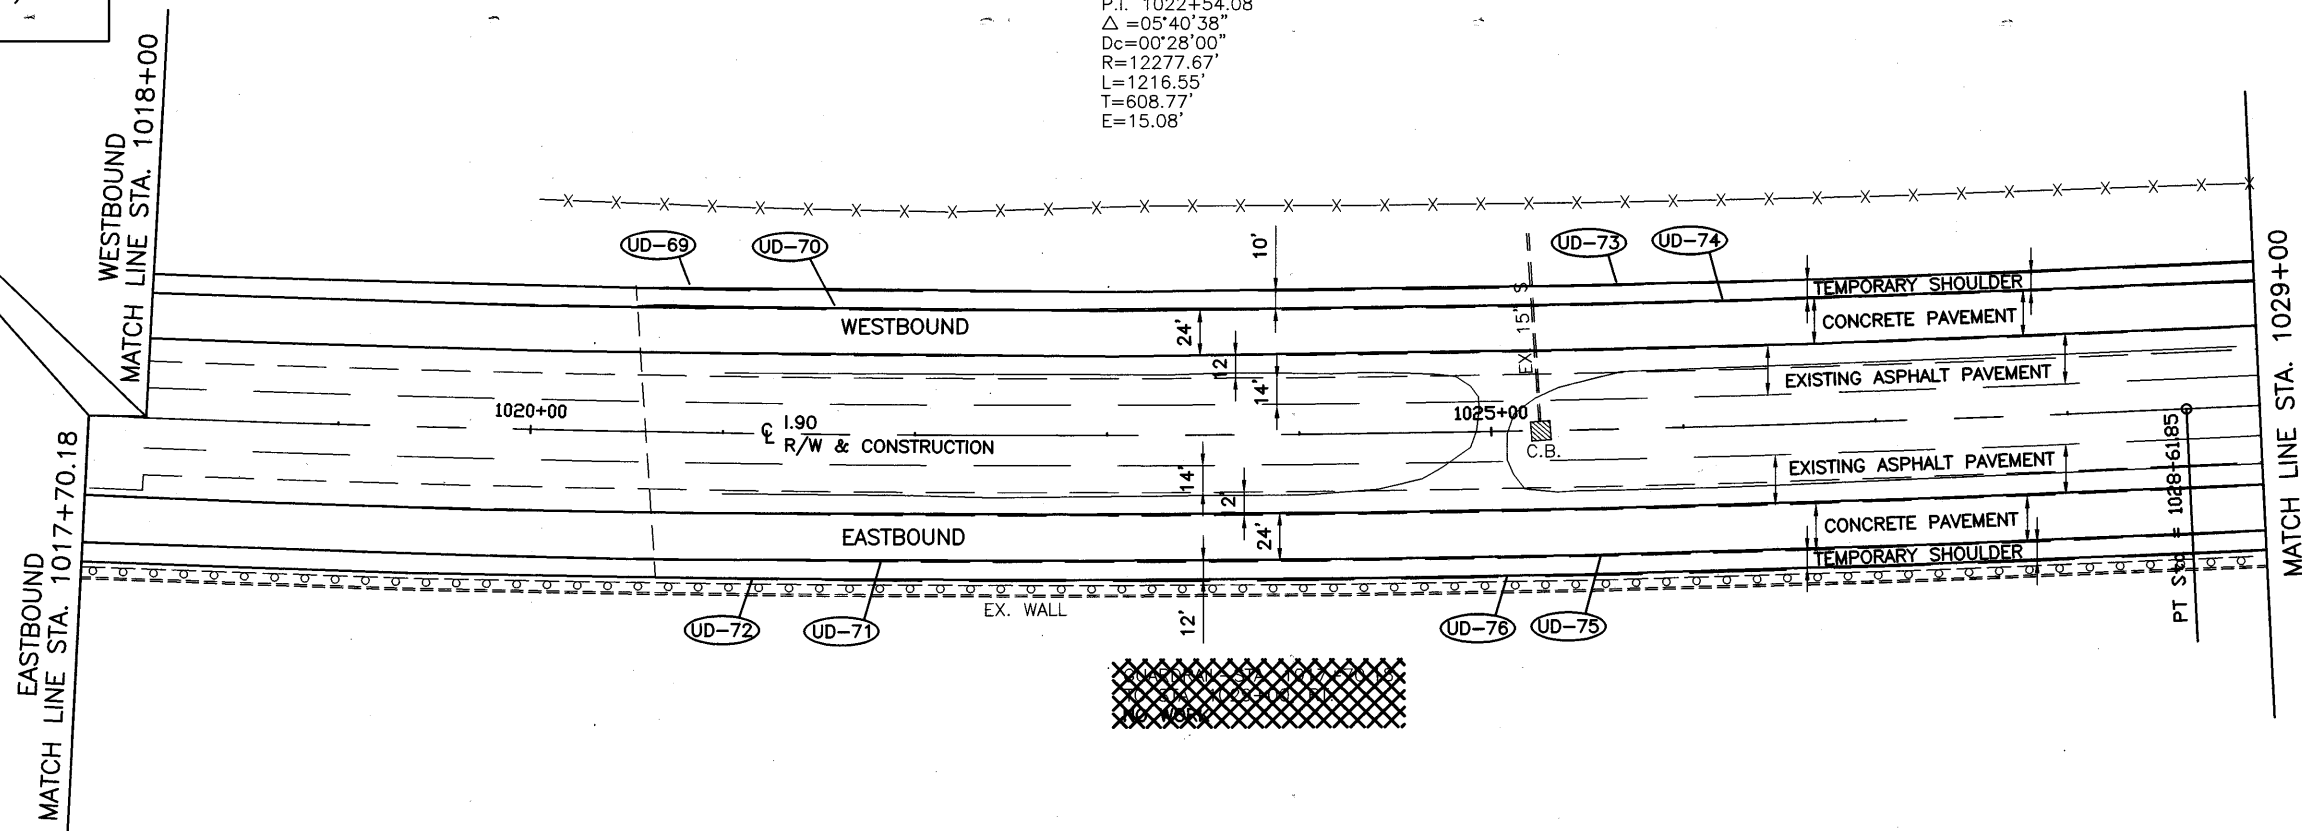

END RECONSTRUCTION PART  
 STA. 1035+00

\* ADDITIONAL WORK PERFORMED  
 STA. 1017.18 TO STA. 1035+00 EB.  
 EXISTING GUARDRAIL WAS REMOVED AND  
 REPLACED FOR SHOULDER GRADING TO WALL.

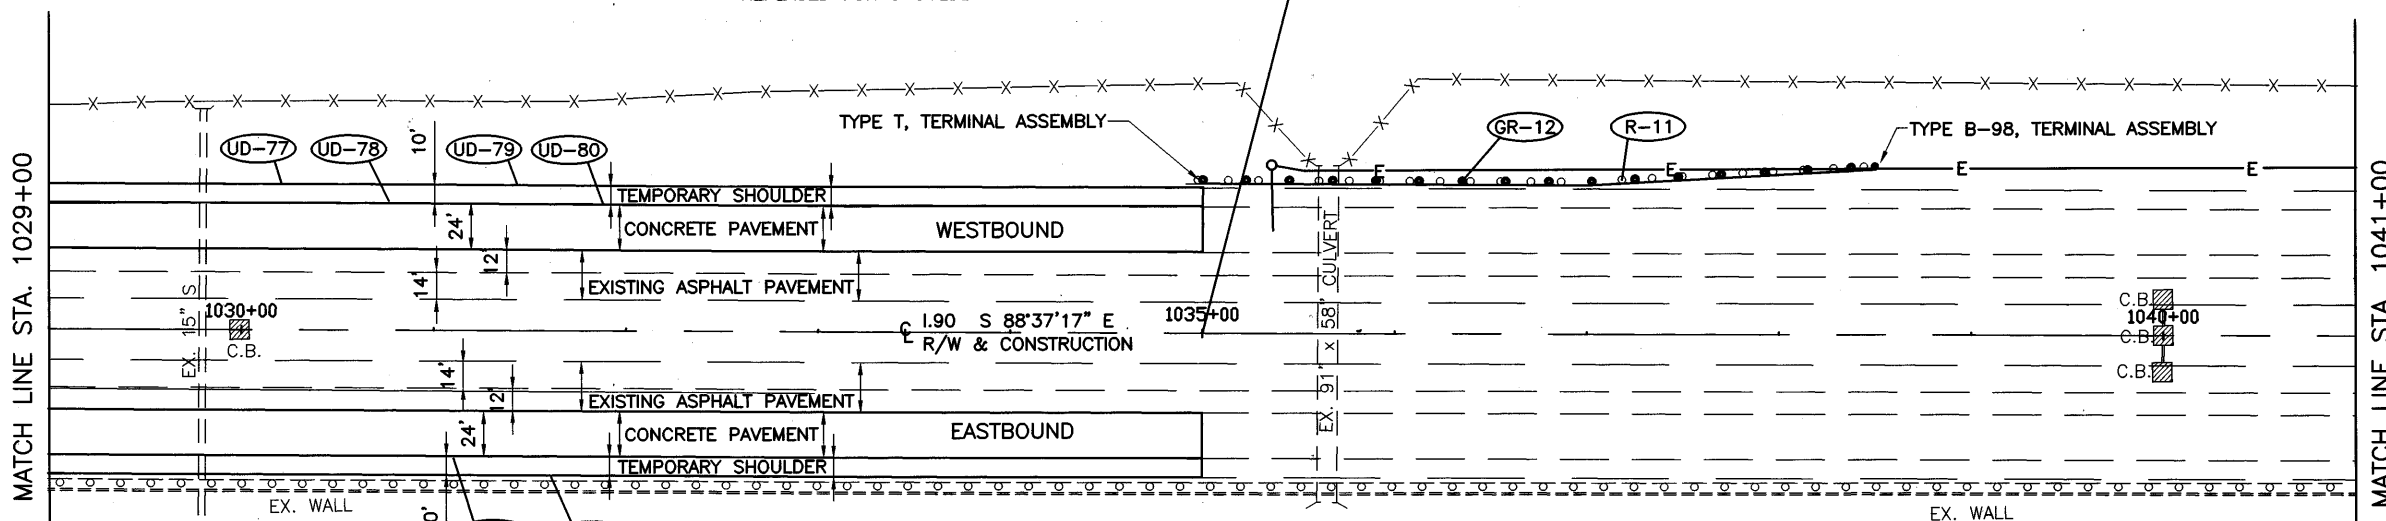

CONNECT 6" UNDERDRAIN, 78' RT FROM  
 EAST INTO EXISTING CROSS CULVERT AT STA  
 1029+84. SEE SPECIAL UNDERDRAIN DETAIL.

NOTE: PROPOSED UNDERDRAIN OUTLETS AT  
 STA. 1029+84± INTO EXISTING CROSS  
 CULVERT INSTEAD OF PROPOSED DESIGN  
 OUTLET AS REQUESTED BY THE INSPECTOR  
 ON SITE.

CALCULATED	DLS	CHECKED	LAB


0 50' 100'  
 HORIZONTAL  
 SCALE IN FEET

PLAN  
 STA. 1017+70.18 TO STA. 1041+00

LOR - 190 - 10.76

196  
 274

2:42PM 02-22-2002 [ C:\93600\DWG\REF003\REF0001.DWG ] DLS

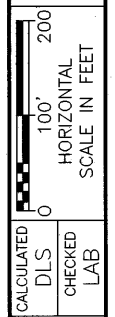

**GEOMETRIC LAYOUT I.R.90 & S.R.611 INTERCHANGE  
RAMP SCHEMATIC**

**LOR - I90 - 10.76**

**CURVE DATA RAMP "M"**  
 P.I. STA. M976+54.03  
 $\Delta = 48^{\circ}59'37''$   
 $D = 16'$   
 $R = 358.10'$   
 $L = 306.21'$   
 $T = 163.17'$   
 $E = 35.42'$

P.I.s STA. M980+30.54  
 $L_s = 200'$   
 $\theta_s = 8'$   
 $L.T. = 133.47'$   
 $S.T. = 66.79'$

P.I. STA. M981+49.07  
 $\Delta = 8^{\circ}18'17''$   
 $D = 8'$   
 $R = 716.20'$   
 $L = 103.81'$   
 $T = 52.00'$   
 $E = 1.89'$

P.I.s STA. M982+84.46  
 $L_s = 250'$   
 $\theta_s = 10'$   
 $L.T. = 166.93'$   
 $S.T. = 83.58'$

P.I. STA. M986+81.99  
 $\Delta = 2^{\circ}18'39''$   
 $D = 0^{\circ}30'$   
 $R = 11,459.16'$   
 $L = 462.16'$   
 $T = 231.11'$   
 $E = 2.33'$

**CURVE DATA RAMP "R"**  
 P.I. STA. R975+57.64  
 $\Delta = 22^{\circ}20'32''$   
 $D_c = 16'$   
 $R = 358.10'$   
 $L = 139.64'$   
 $T = 70.72'$   
 $E = 6.92'$

**BEGIN RAMP "M"**  
 STA. M974+07.52=  
 STA. 217+00.75, S.R.611

P.I.s STA. R972+53.71  
 $L_s = 200'$   
 $\theta_s = 8'$   
 $L.T. = 133.47'$   
 $S.T. = 66.79'$

P.I. STA. R970+04.99  
 $\Delta = 29^{\circ}47'56''$   
 $D_c = 8'$   
 $R = 716.20'$   
 $L = 372.49'$   
 $T = 190.56'$   
 $E = 24.92'$

**END RAMP "R"**  
 STA. R977+56.29=  
 STA. 217+18.36, S.R.611

**CURVE DATA RAMP "N"**  
 P.I. STA. N987+93.59  
 $\Delta = 37^{\circ}58'58''$   
 $D = 8'$   
 $R = 716.20'$   
 $L = 474.79'$   
 $T = 246.49'$   
 $E = 41.23'$

P.I. STA. N991+72.03  
 $\Delta = 6^{\circ}00'00''$   
 $D_c = 2'$   
 $R = 2864.79'$   
 $L = 300.00'$   
 $T = 150.14'$   
 $E = 3.93'$


P.I.s STA. N984+80.57  
 $L_s = 200'$   
 $\theta_s = 8'$   
 $L.T. = 133.47'$   
 $S.T. = 66.79'$

**CURVE DATA RAMP "P"**  
 P.I. STA. P968+46.84  
 $\Delta = 8^{\circ}17'46''$   
 $D_c = 1^{\circ}30'$   
 $R = 3819.72'$   
 $L = 553.07'$   
 $T = 277.02'$   
 $E = 10.03'$

P.I. STA. P972+91.71  
 $\Delta = 26^{\circ}31'39''$   
 $D = 8'$   
 $R = 716.20'$   
 $L = 331.59'$   
 $T = 168.82'$   
 $E = 19.63'$

P.I.s STA. R975+21.27  
 $L_s = 200'$   
 $\theta_s = 8'$   
 $L.T. = 133.47'$   
 $S.T. = 66.79'$

P.I. STA. P978+82.96  
 $\Delta = 39^{\circ}28'24''$   
 $D = 16'$   
 $R = 358.10'$   
 $L = 246.71'$   
 $T = 128.48'$   
 $E = 22.35'$

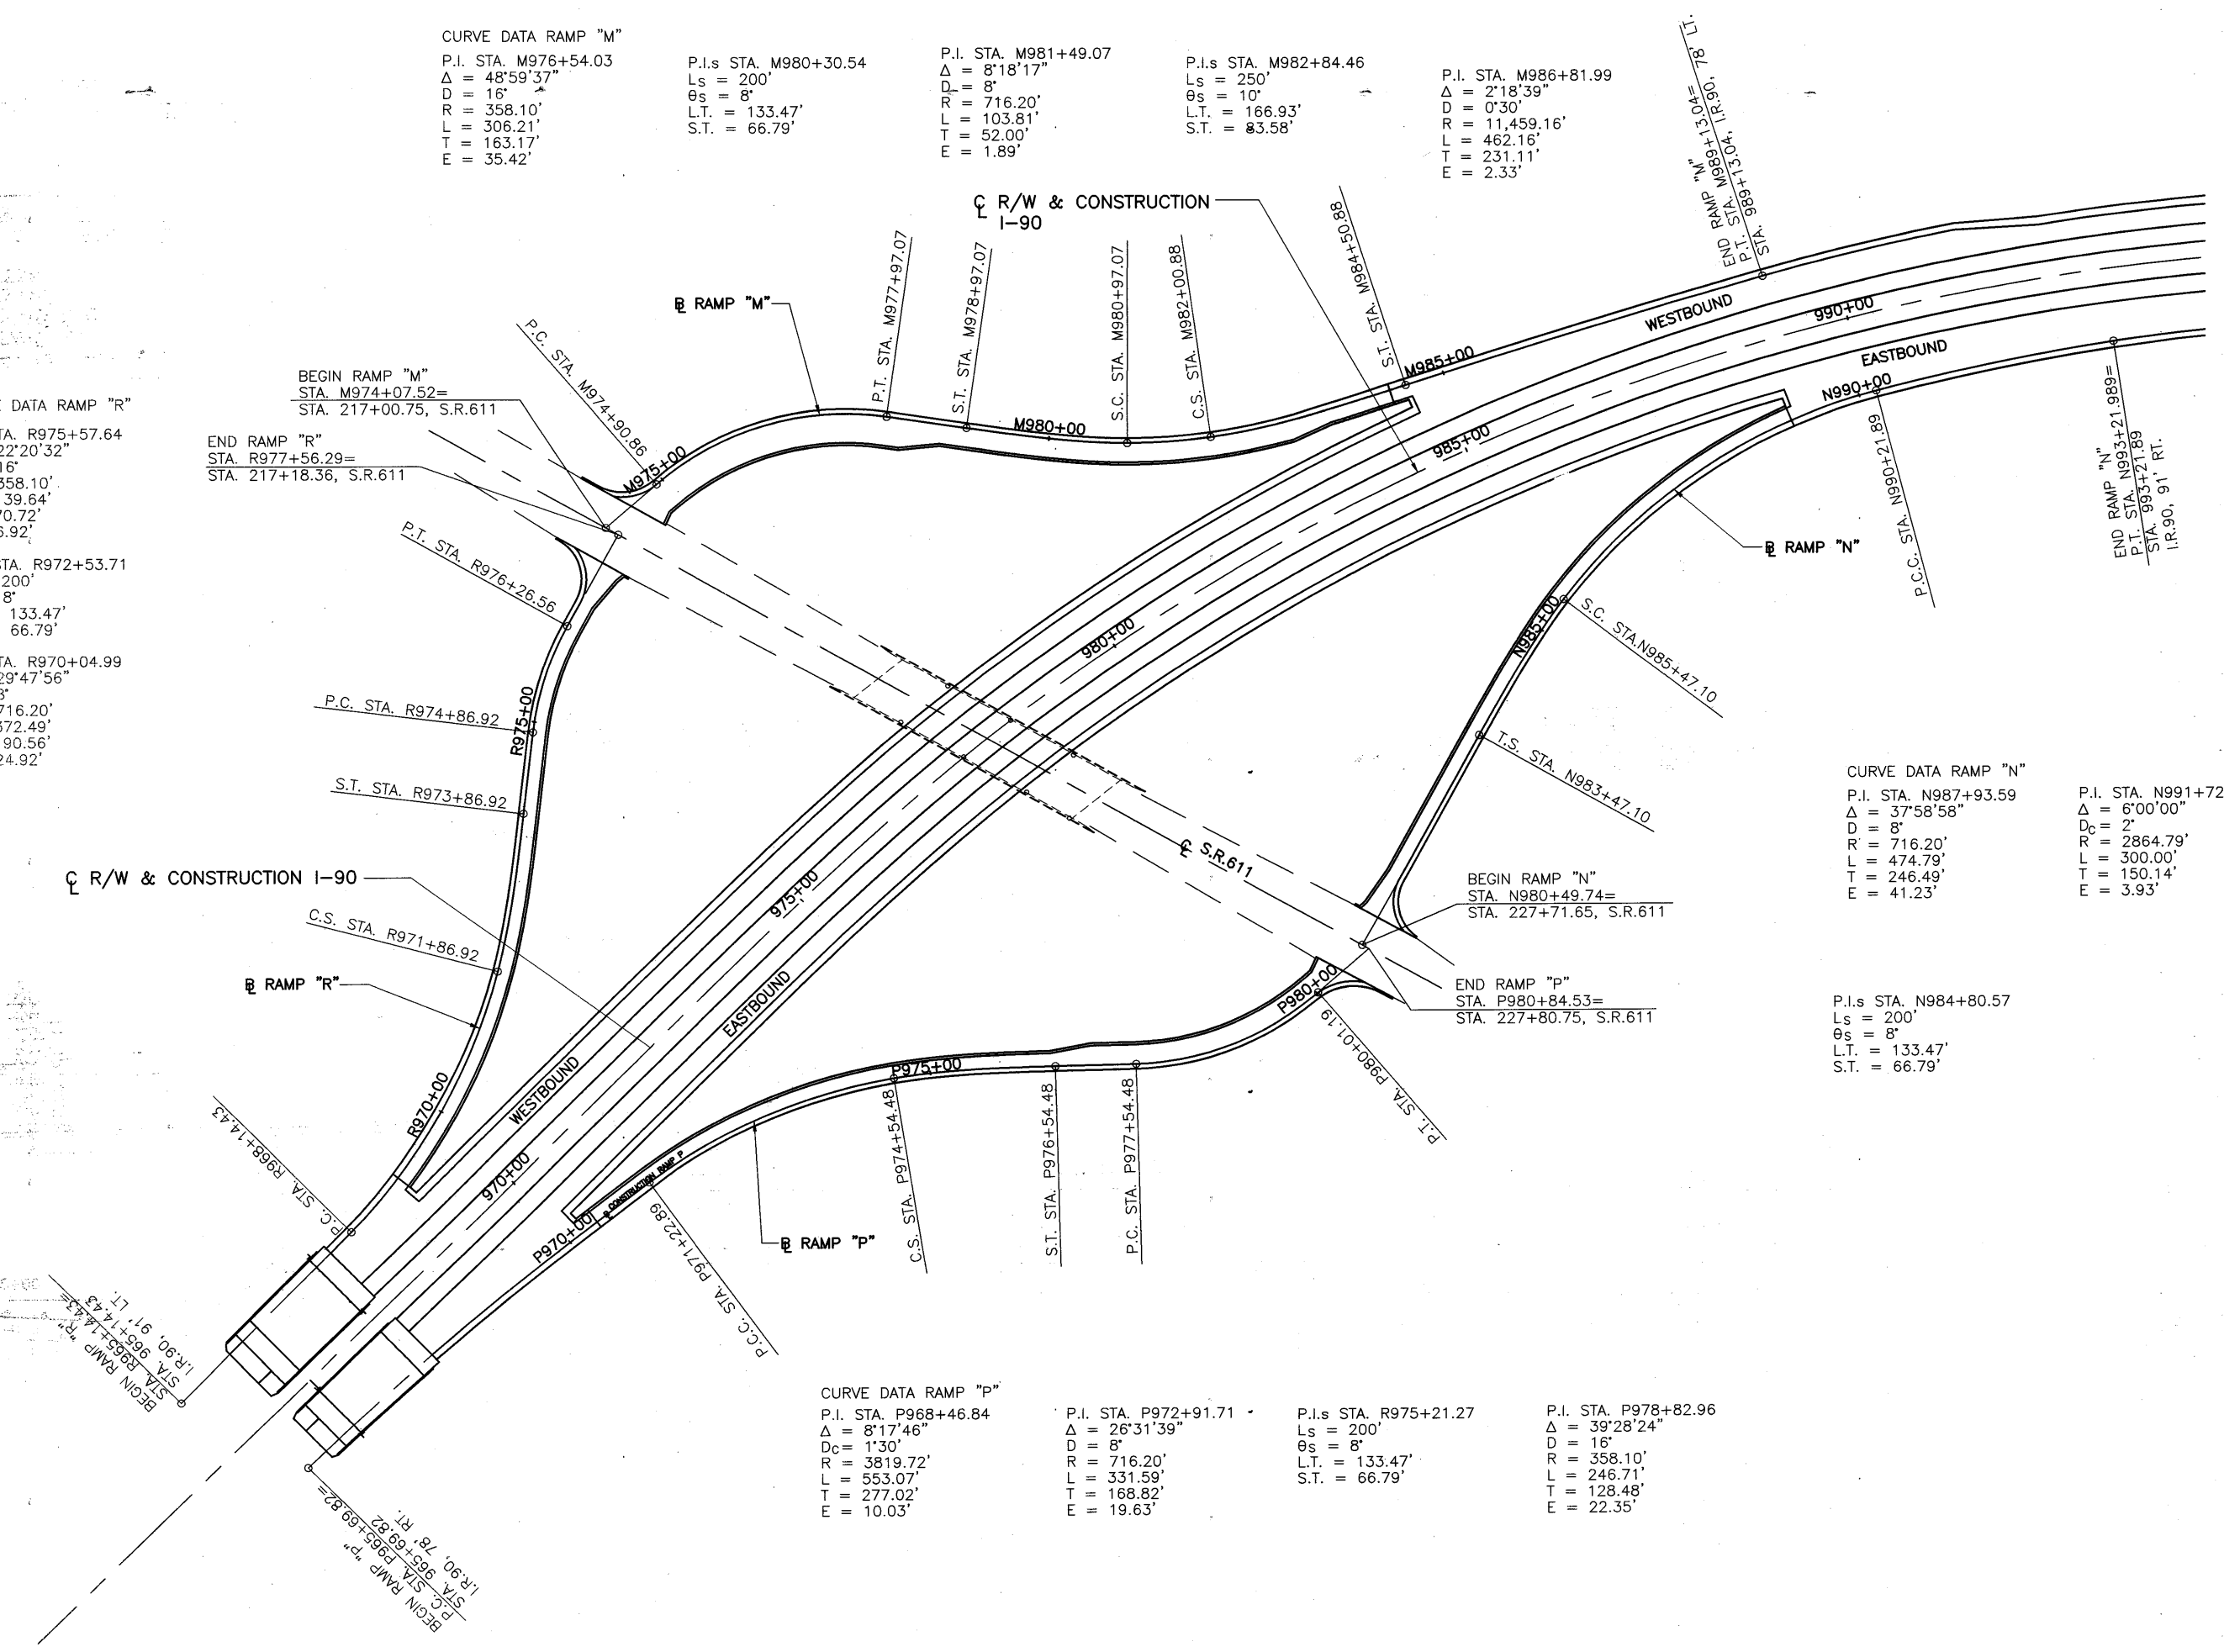


I:\9560\DWG\ASSIGN\PLANS-05.DWG 1 2007  
02-11-2002 7:43AM

FOR RAMP "R"  
CURVE DATA, SEE SHT. 197

BENCHMARK-LOR 190 18.44  
STA. 973+67.53, 81.53' LT.  
N-10440.2259  
E-10335.7014  
ODOT ELEV.=635.154  
R.E.W. ELEV.=635.103 (USED)

NOTE: ON RAMPS, RESURFACE SHOULDER TO THE  
EDGE OF TEMPORARY SHOULDER LIMITS NEEDED  
FOR MAINTENANCE OF TRAFFIC, SEE RAMP  
PLANS FOR STATIONING.

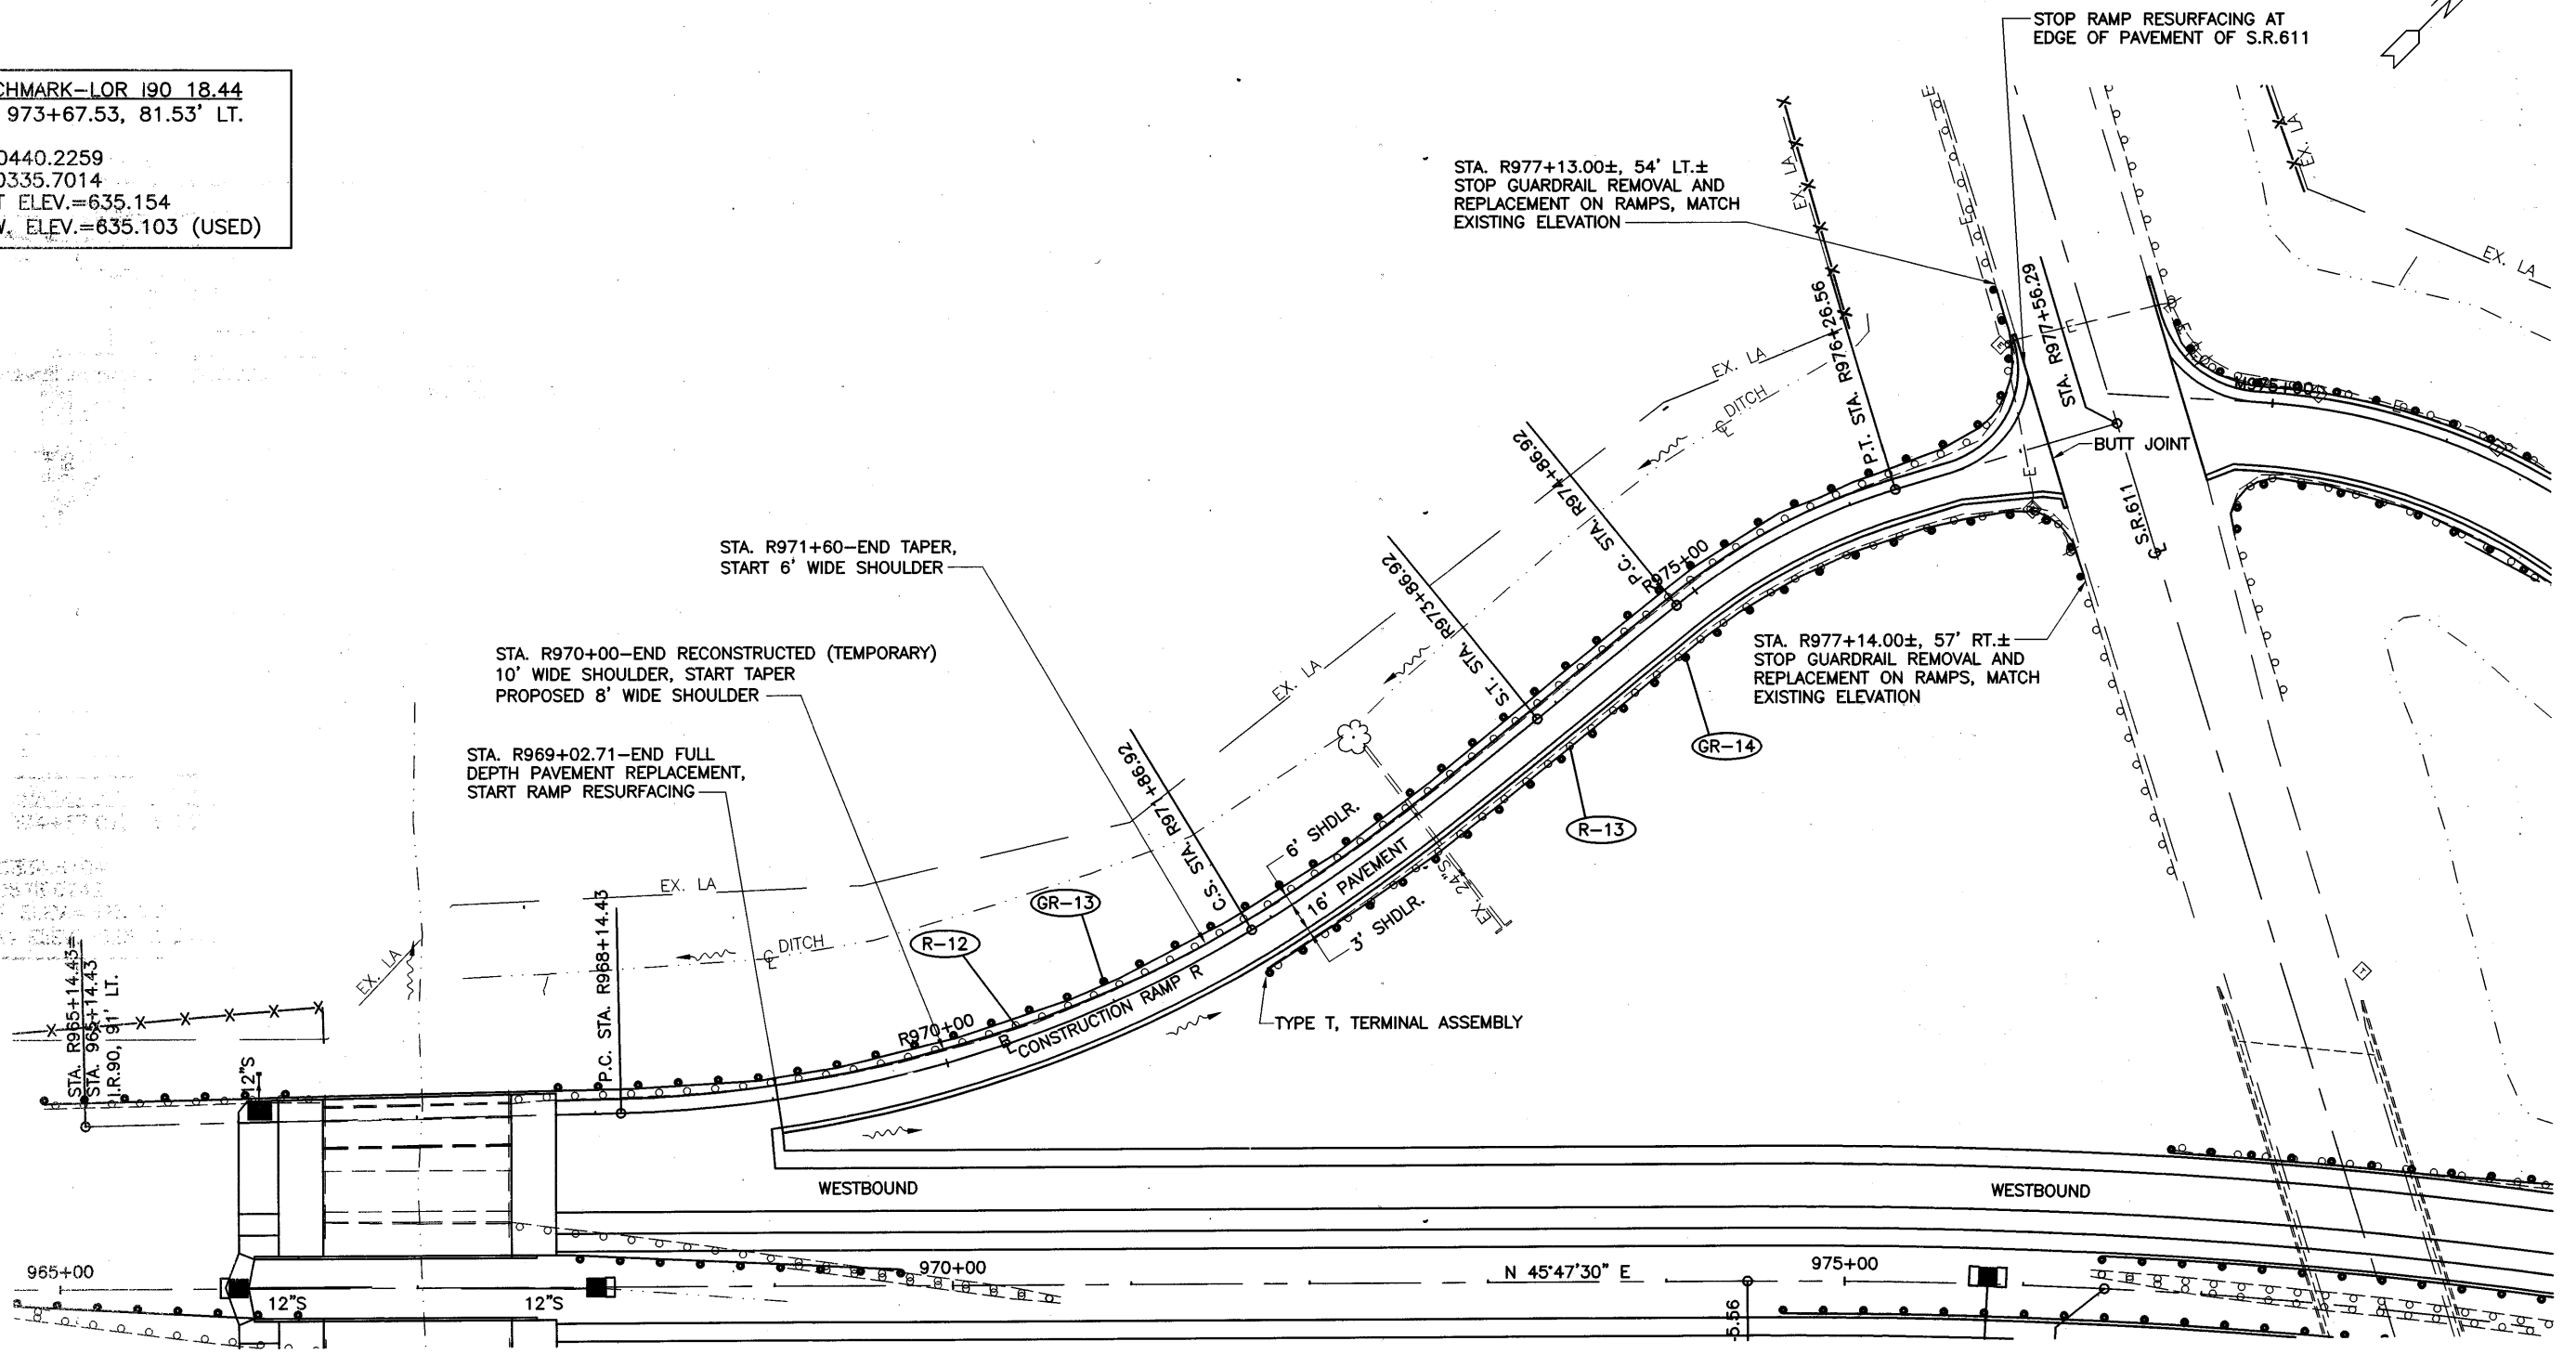

CALCULATED	DLS	CHECKED	LAB


0 50' 100'  
HORIZONTAL  
SCALE IN FEET

PLAN RAMP "R"  
STA. R965+14.43 TO STA. R977+56.29

LOR - 190 - 10.76


FOR RAMP "P"  
CURVE DATA, SEE SHT. 197

NOTE: ON RAMPS, RESURFACE SHOULDER TO THE  
EDGE OF TEMPORARY SHOULDER LIMITS NEEDED  
FOR MAINTENANCE OF TRAFFIC, SEE RAMP  
PLANS FOR STATIONING.

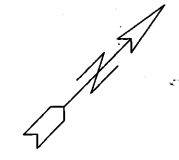

CALCULATED  
DLS  
CHECKED  
LAB

0 50' 100'  
HORIZONTAL  
SCALE IN FEET

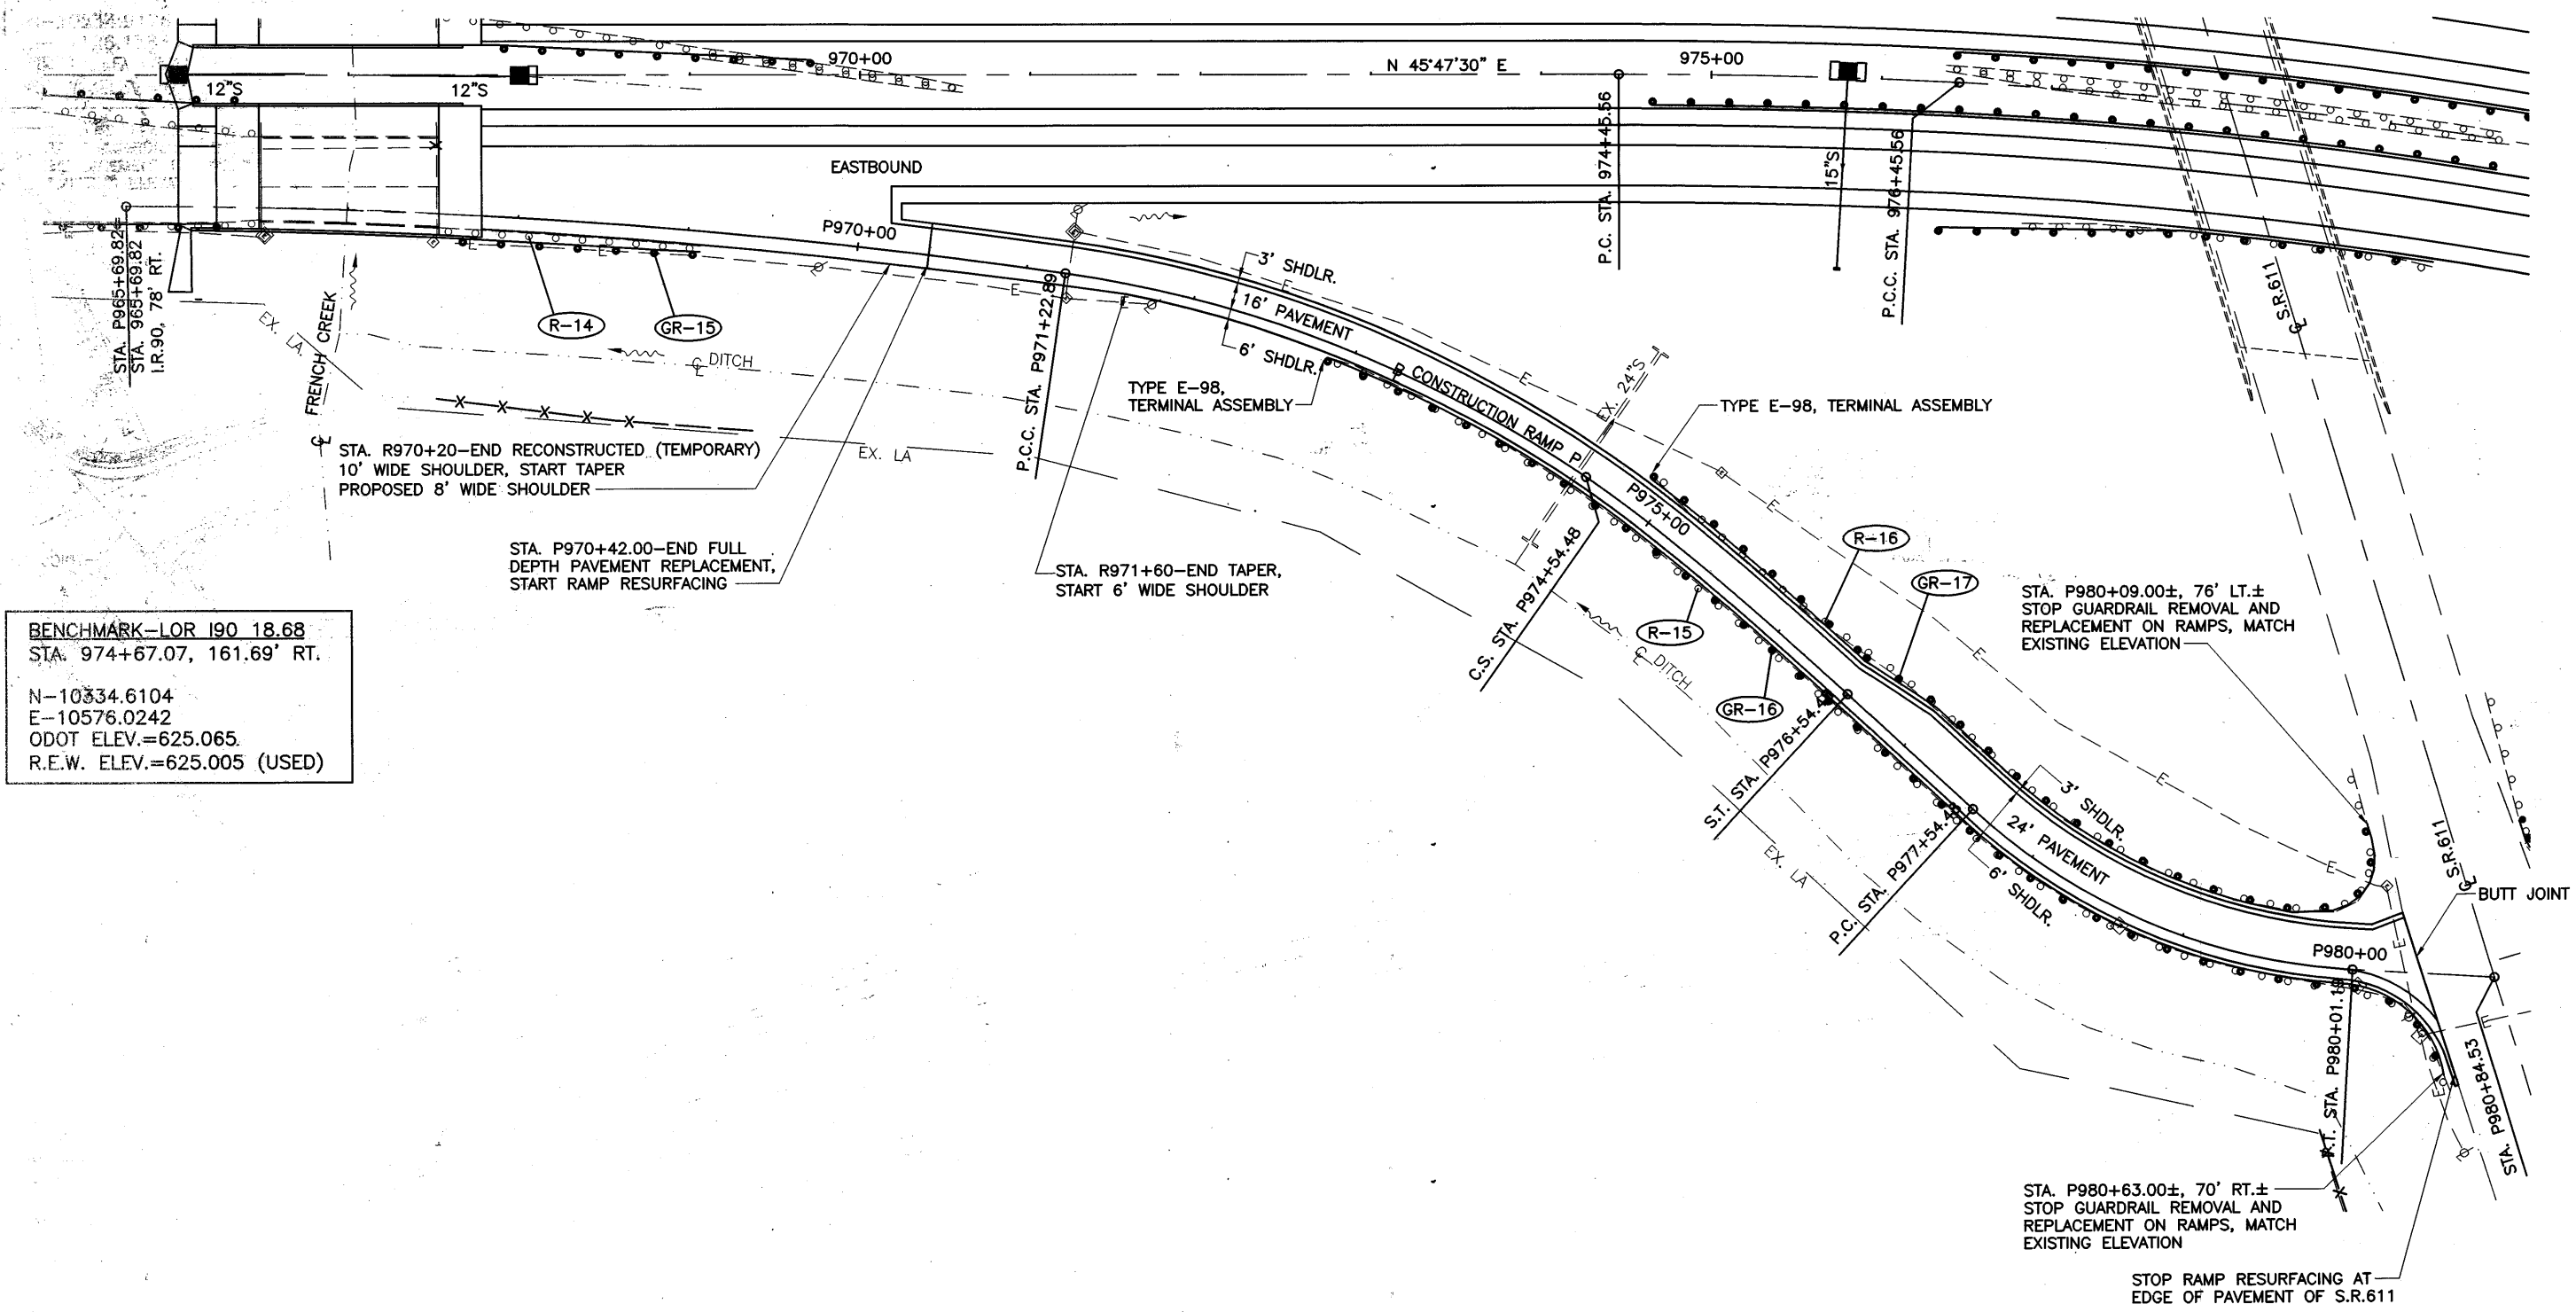

BENCHMARK - LOR 190 18.68  
STA. 974+67.07, 161.69' RT.

N - 10334.6104  
E - 10576.0242  
ODOT ELEV. = 625.065  
R.E.W. ELEV. = 625.005 (USED)


PLAN RAMP "P"  
STA. P965+69.82 TO STA. P980+84.53

LOR - 190 - 10.76

FOR RAMP "M"  
CURVE DATA, SEE SHT. 197.

NOTE: ON RAMPS, RESURFACE SHOULDER TO THE  
EDGE OF TEMPORARY SHOULDER LIMITS NEEDED  
FOR MAINTENANCE OF TRAFFIC, SEE RAMP  
PLANS FOR STATIONING.

BENCHMARK—LOR 190 18.61  
STA. 982+46.49, 83.23' RT.  
N=10844.9176  
E=11126.1783  
ODOT ELEV.=631.580  
R.E.W. ELEV.=631.571 (USED)

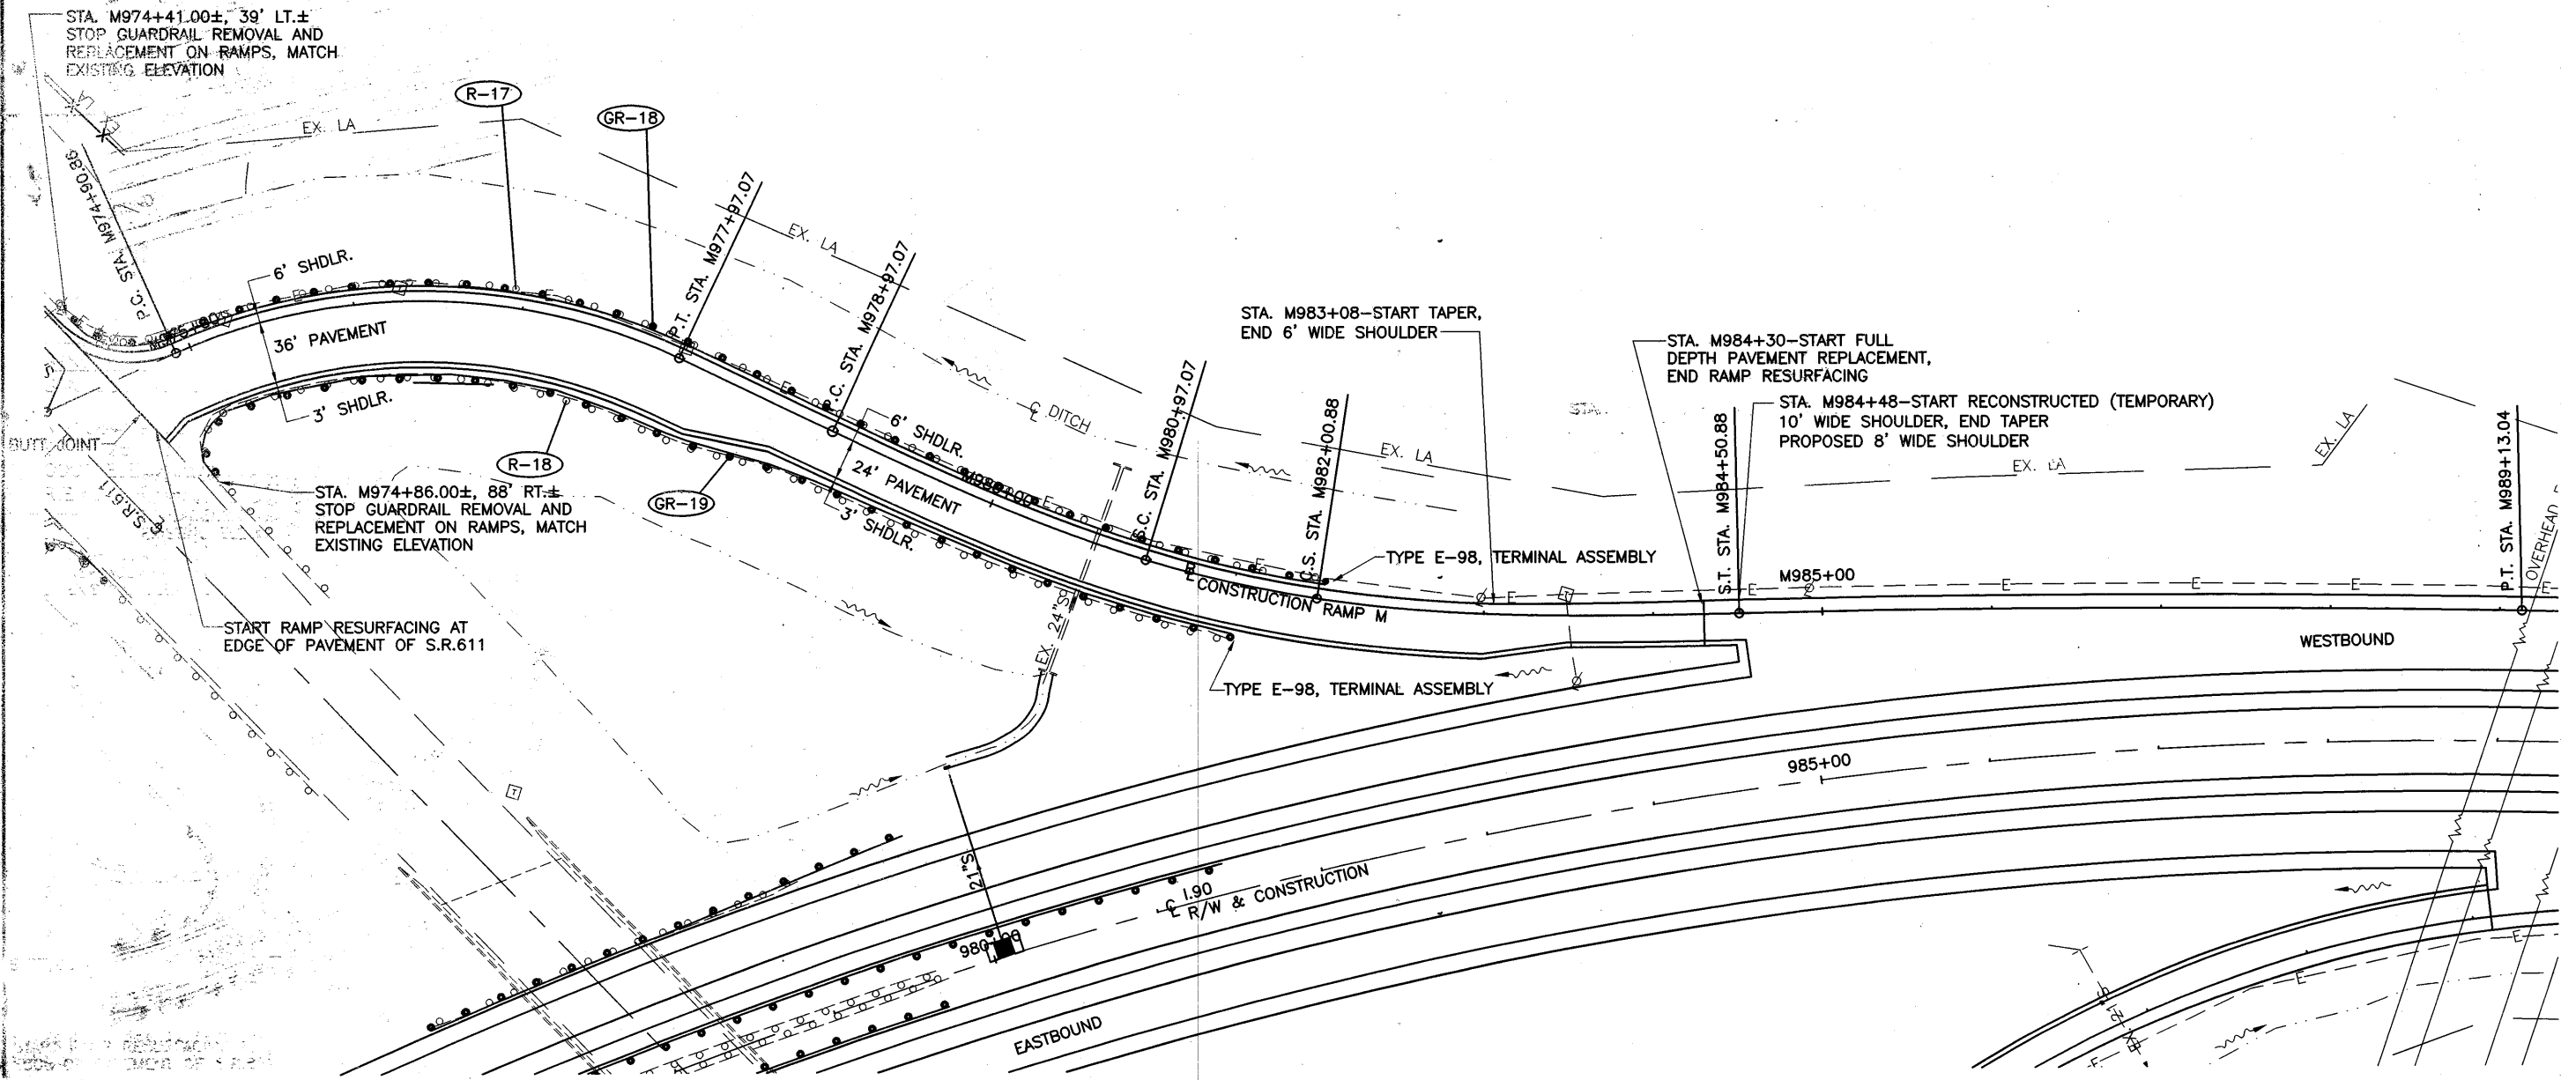

CALCULATED	DLS	CHECKED	LAB

0 50' 100'  
HORIZONTAL  
SCALE IN FEET

PLAN RAMP "M"  
STA. M974+07.52 TO STA. M989+13.04

LOR - 190 - 10.76


200  
274



NOTE: ON RAMP, RESURFACE SHOULDER TO THE  
EDGE OF TEMPORARY SHOULDER LIMITS NEEDED  
FOR MAINTENANCE OF TRAFFIC, SEE RAMP  
PLANS FOR STATIONING.


FOR RAMP "N"  
CURVE DATA, SEE SHT. 197

BENCHMARK—LOR 190 18.61  
STA. 982+46.49, 83.23' RT.  
N=10844.9176  
E=11126.1783  
ODOT ELEV.=631.580  
R.E.W. ELEV.=631.571 (USED)

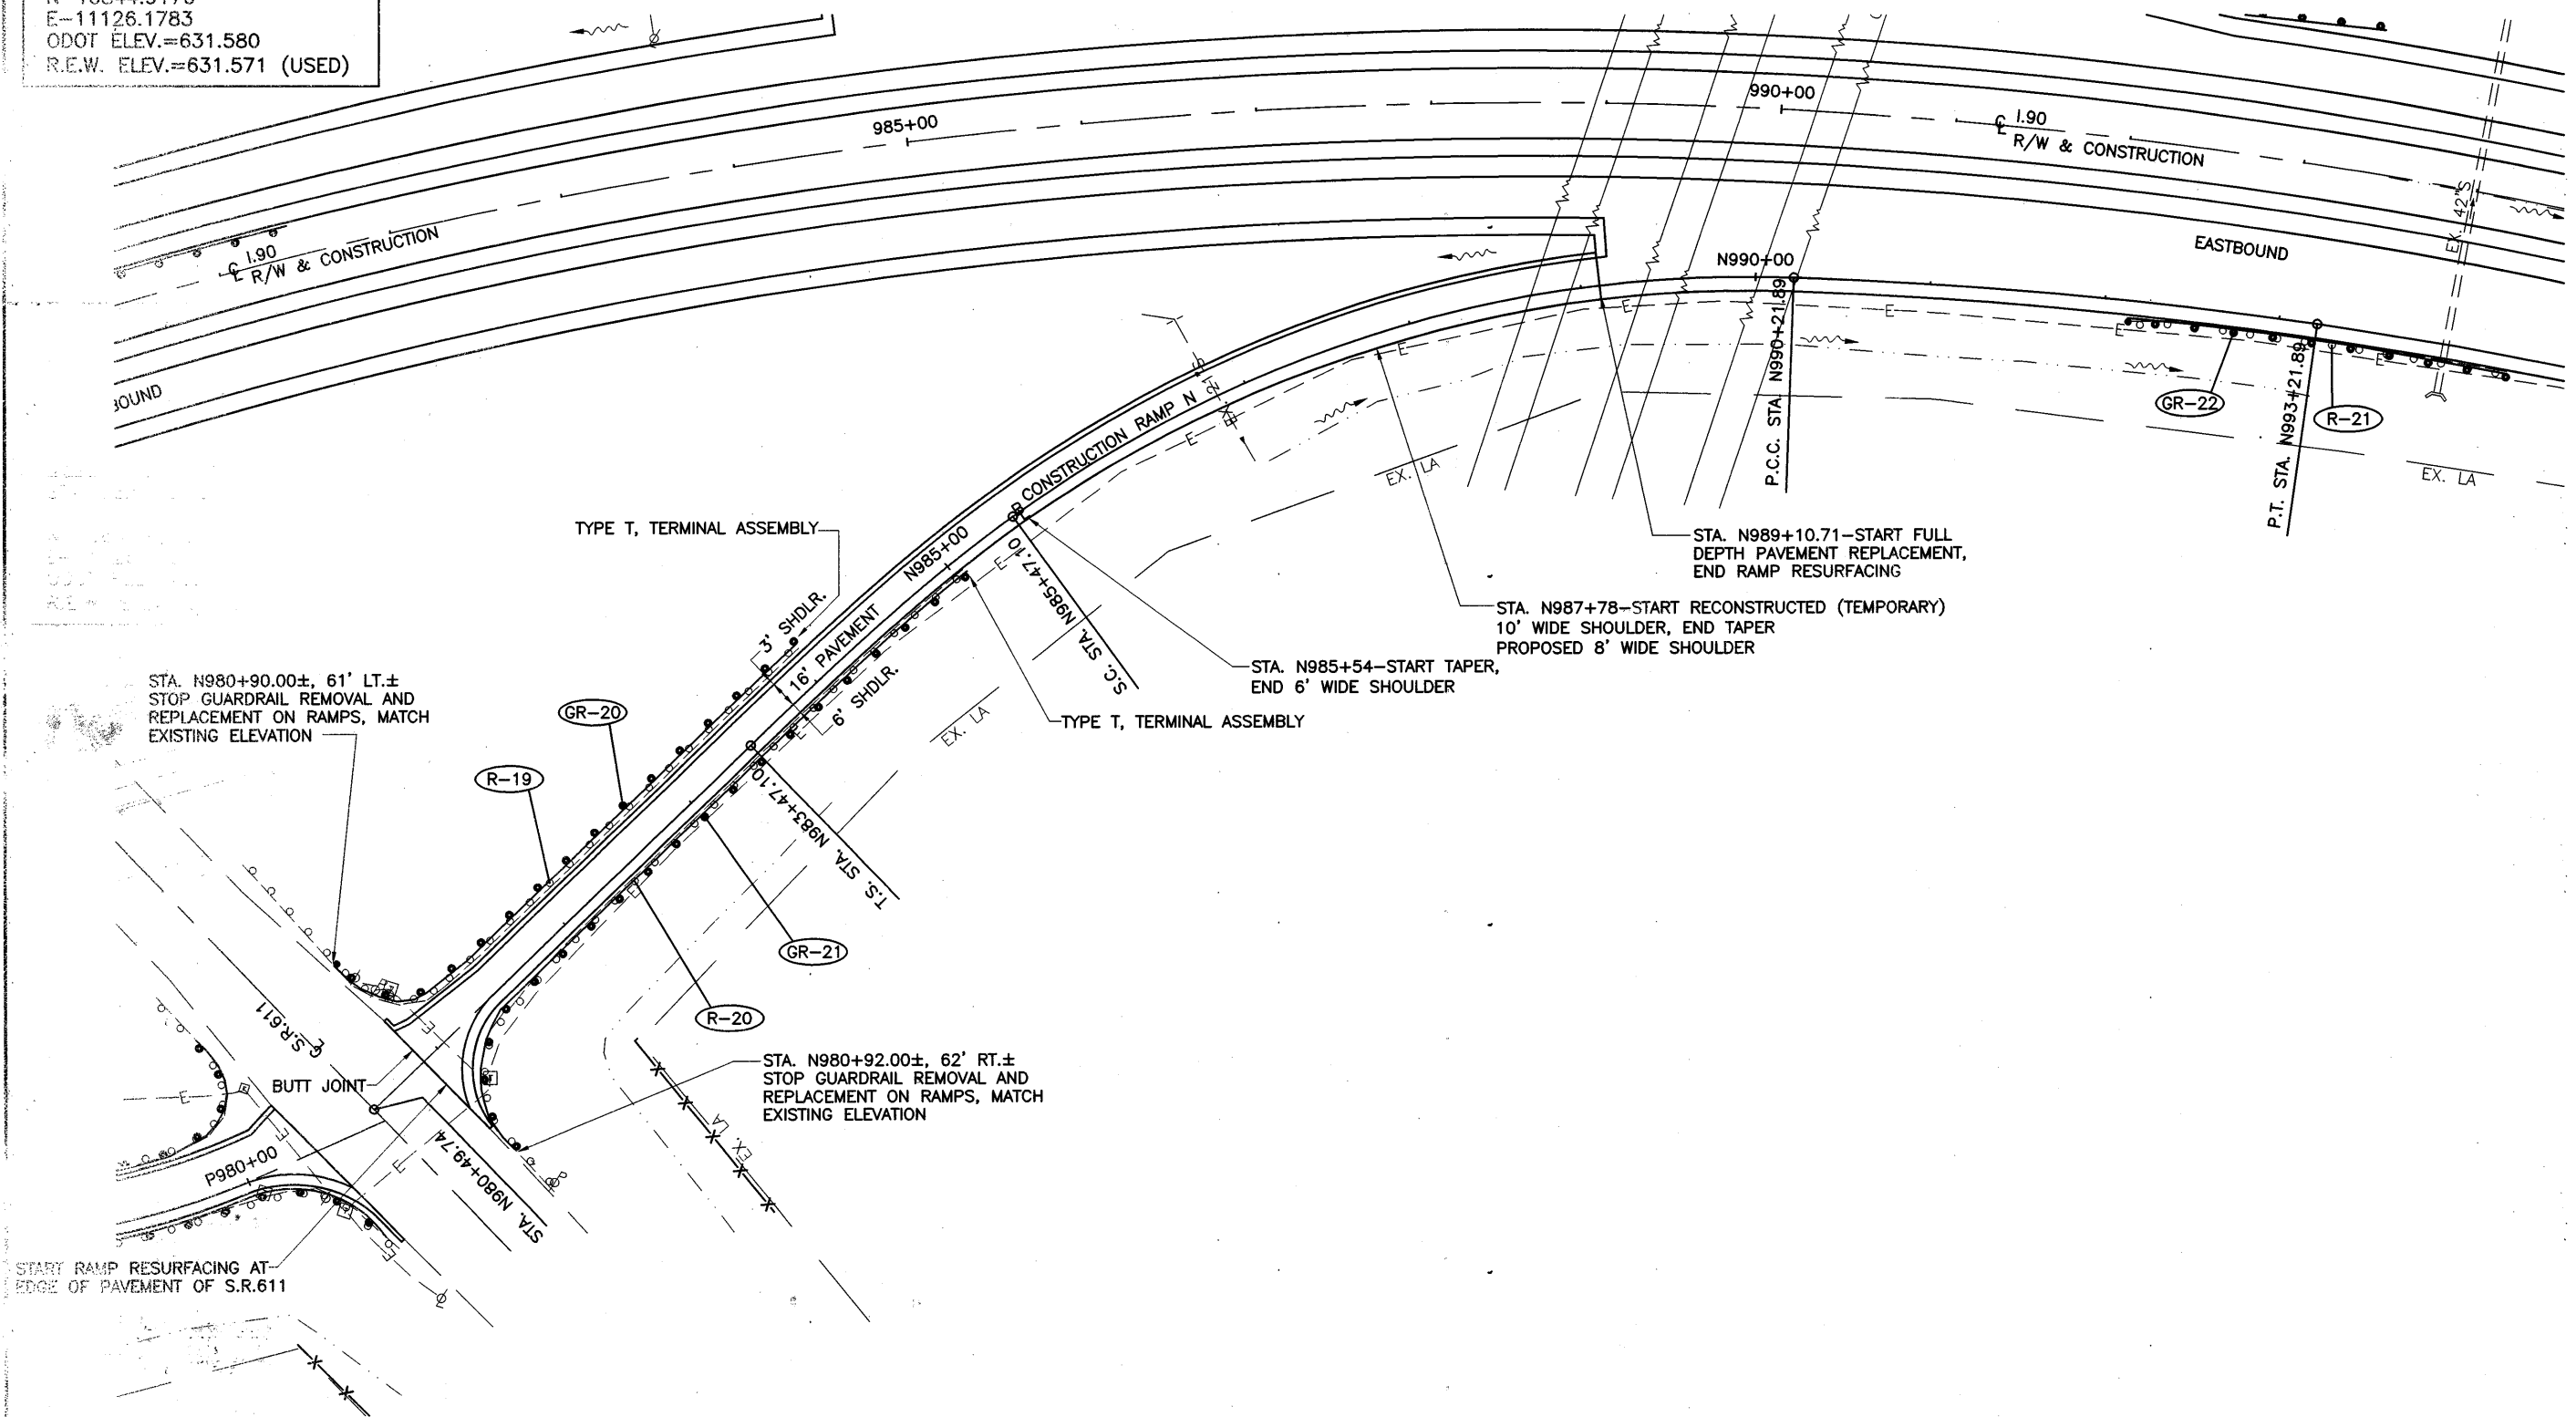

PLAN RAMP "N"  
STA. N980+49.74 TO STA. N993+21.89

LOR - 190 - 10.76

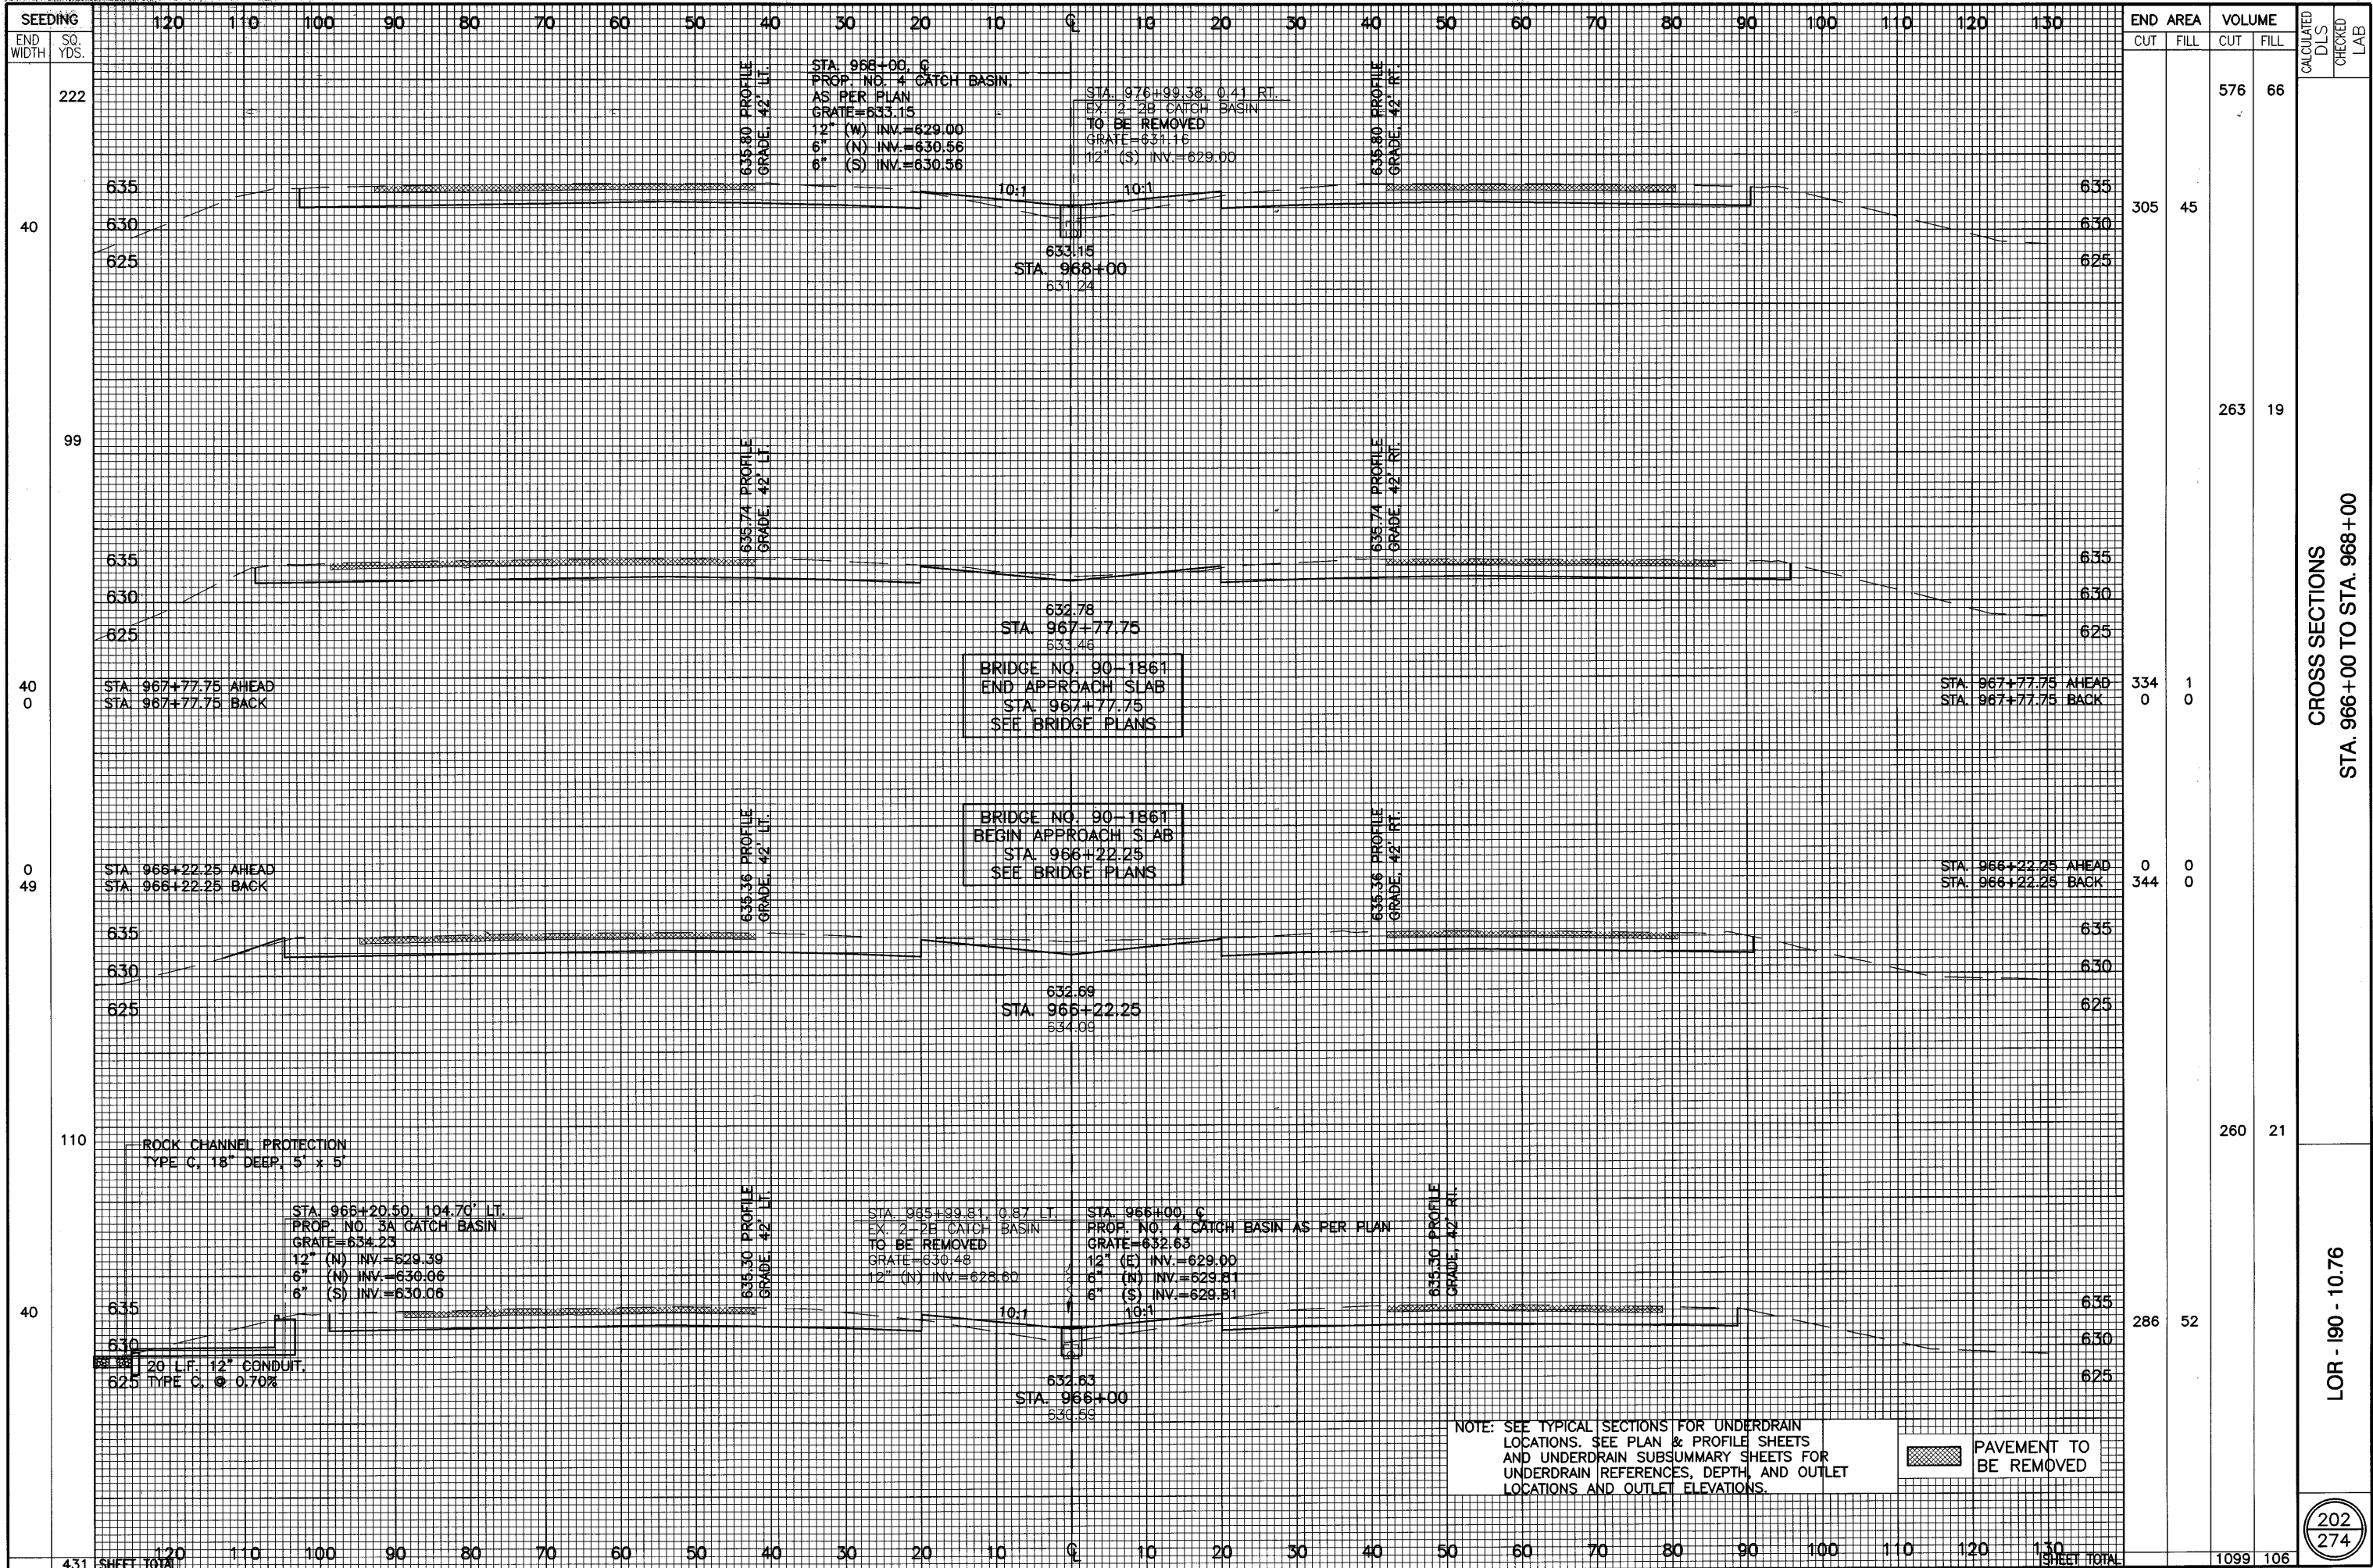


SEEDING END WIDTH SQ. YDS.													END AREA		VOLUME		CALCULATED DLS	CHECKED LAB																		
	120	110	100	90	80	70	60	50	40	30	20	10	0	10	20	30			40	50	60	70	80	90	100	110	120	130	CUT	FILL	CUT	FILL				
222																													576	66						
40																													305	45						
99																													263	19						
40 0																													334 0	1 0						
0 49																													0 344	0 0						
110																													260	21						
40																													286	52						
431																													1099	106						

CROSS SECTIONS  
 STA. 966+00 TO STA. 968+00  
  
 LOR - 190 - 10.76  
 202  
 274

NOTE: SEE TYPICAL SECTIONS FOR UNDERDRAIN LOCATIONS. SEE PLAN & PROFILE SHEETS AND UNDERDRAIN SUBSUMMARY SHEETS FOR UNDERDRAIN REFERENCES, DEPTH, AND OUTLET LOCATIONS AND OUTLET ELEVATIONS.




2/13/04  
2-08-2002

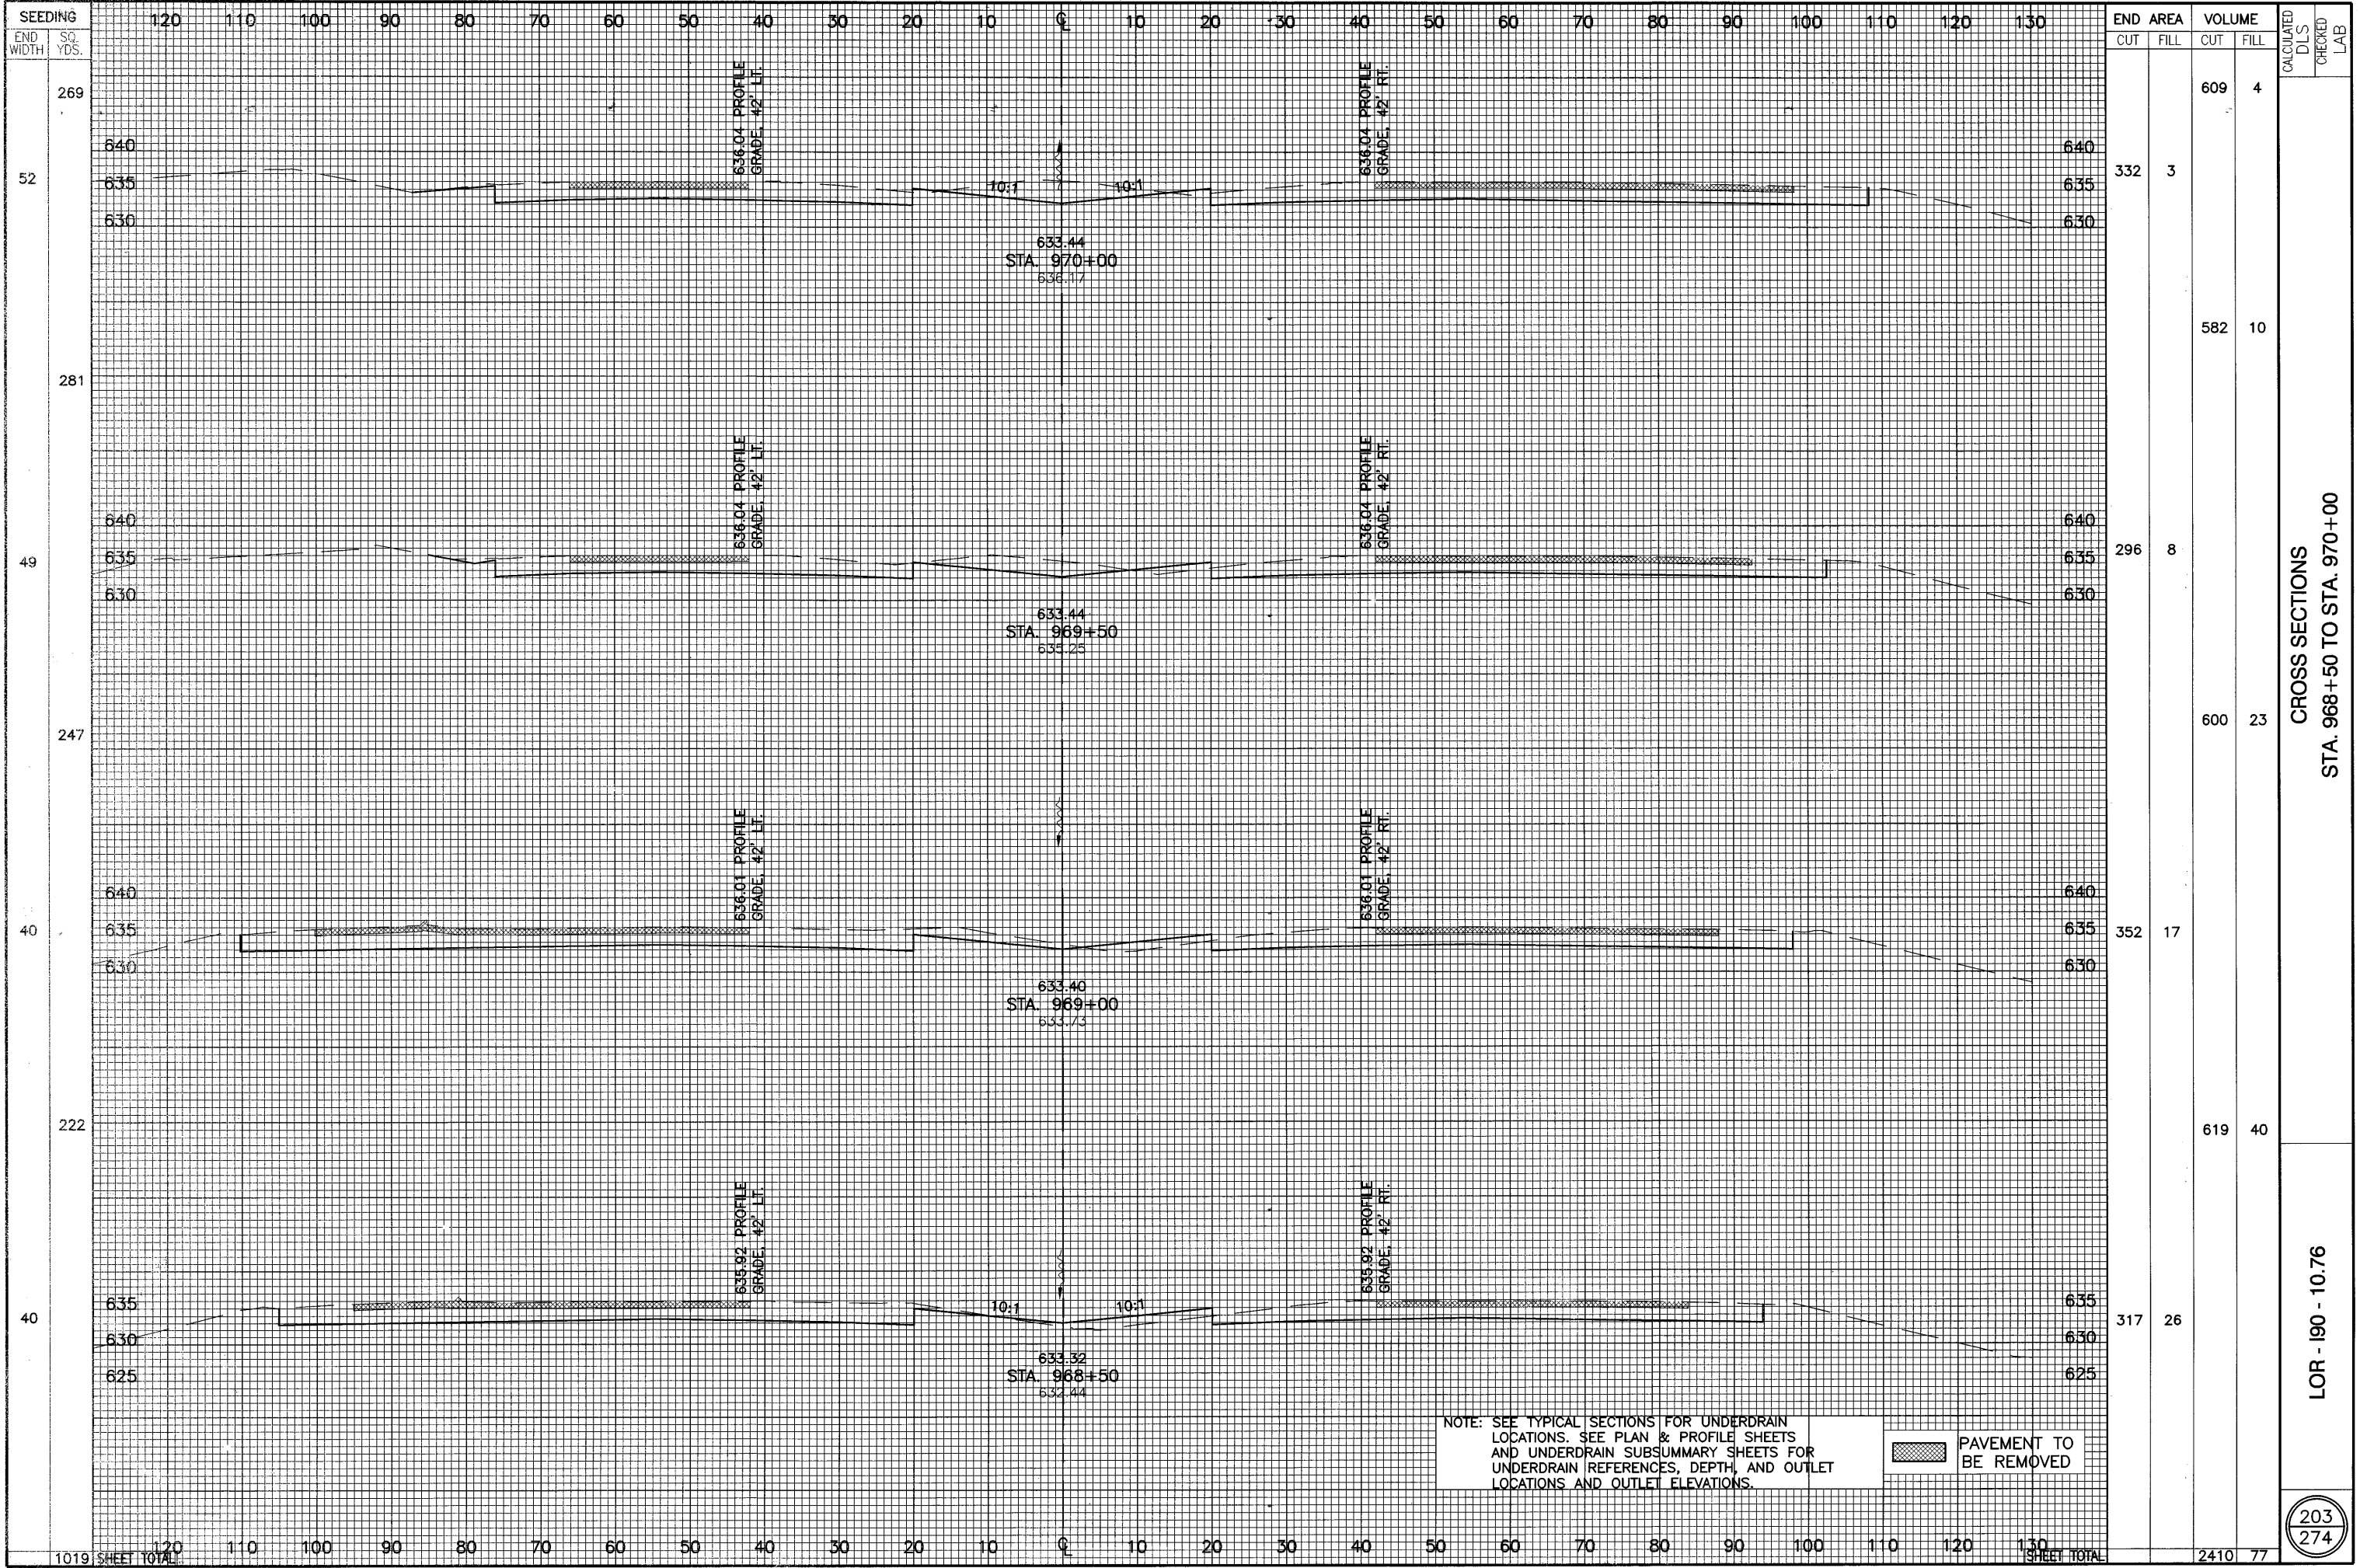

CROSS SECTIONS  
STA. 968+50 TO STA. 970+00

LOR - 190 - 10.76

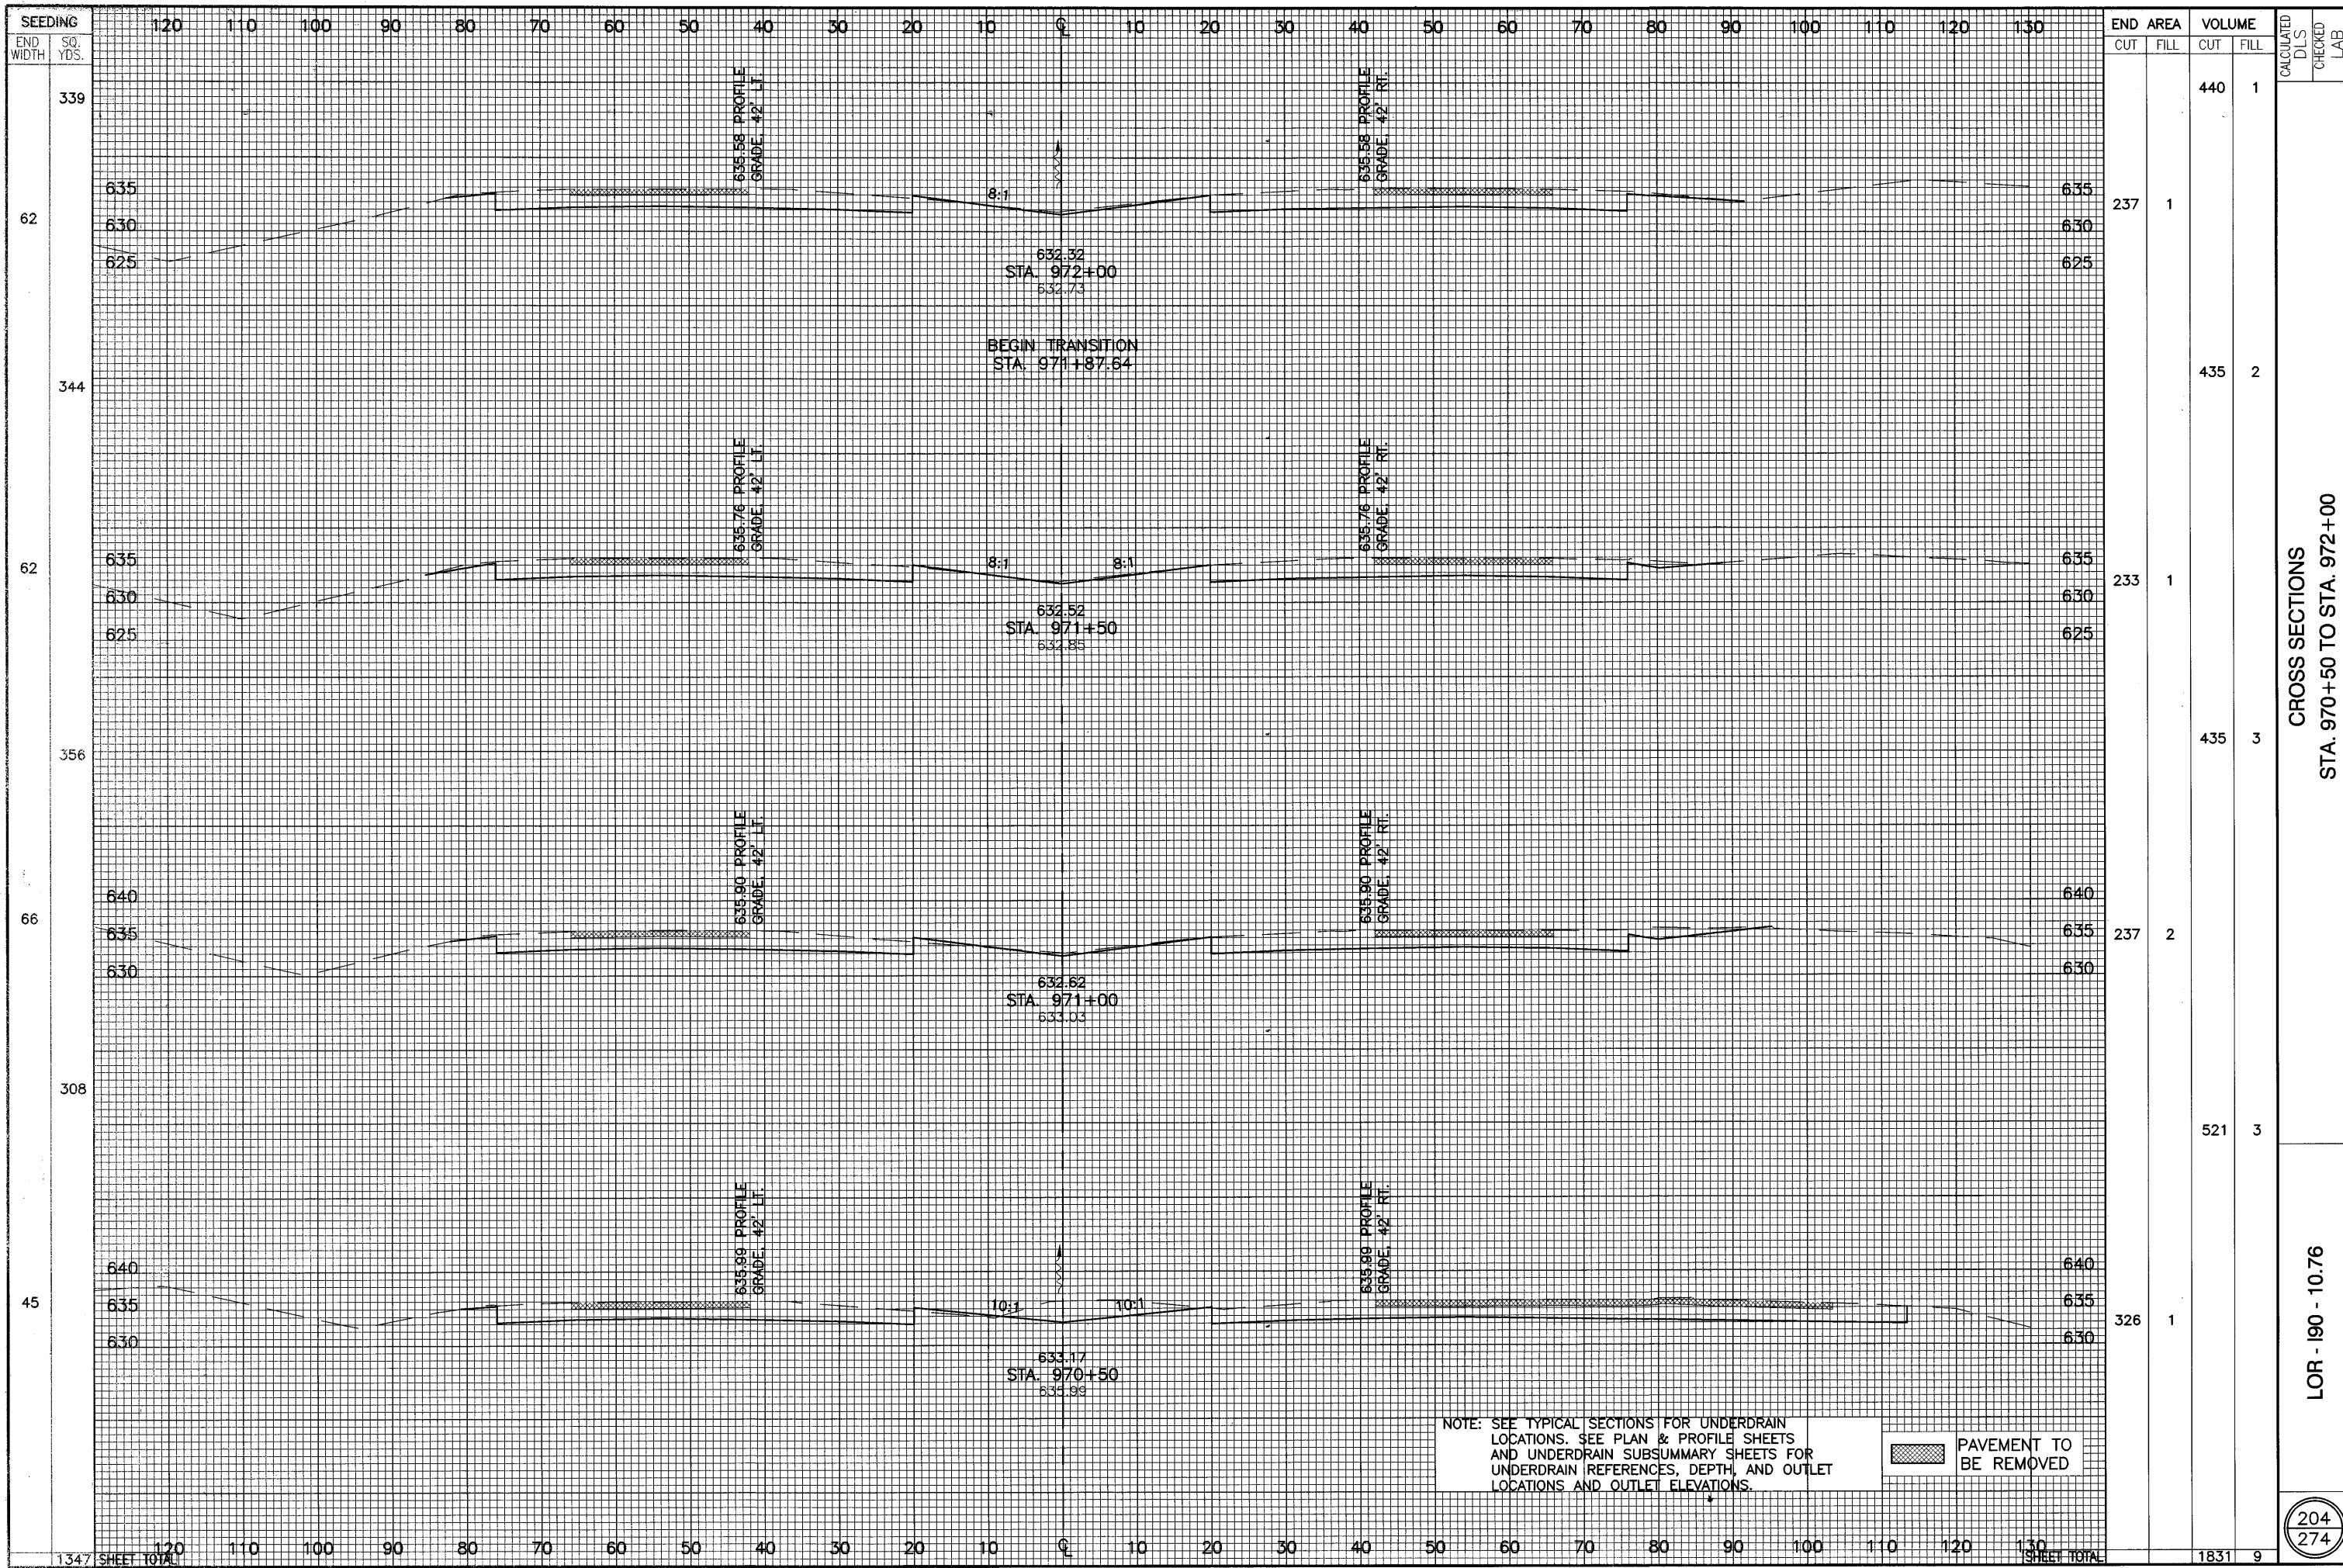

CROSS SECTIONS  
STA. 970+50 TO STA. 972+00


LOR - 190 - 10.76


204  
274


NOTE: SEE TYPICAL SECTIONS FOR UNDERDRAIN LOCATIONS. SEE PLAN & PROFILE SHEETS AND UNDERDRAIN SUBSUMMARY SHEETS FOR UNDERDRAIN REFERENCES, DEPTH, AND OUTLET LOCATIONS AND OUTLET ELEVATIONS.

PAVEMENT TO BE REMOVED

99-0002 [ C:\B2000\DWG\1900A\1900A01.DWG ] BLS

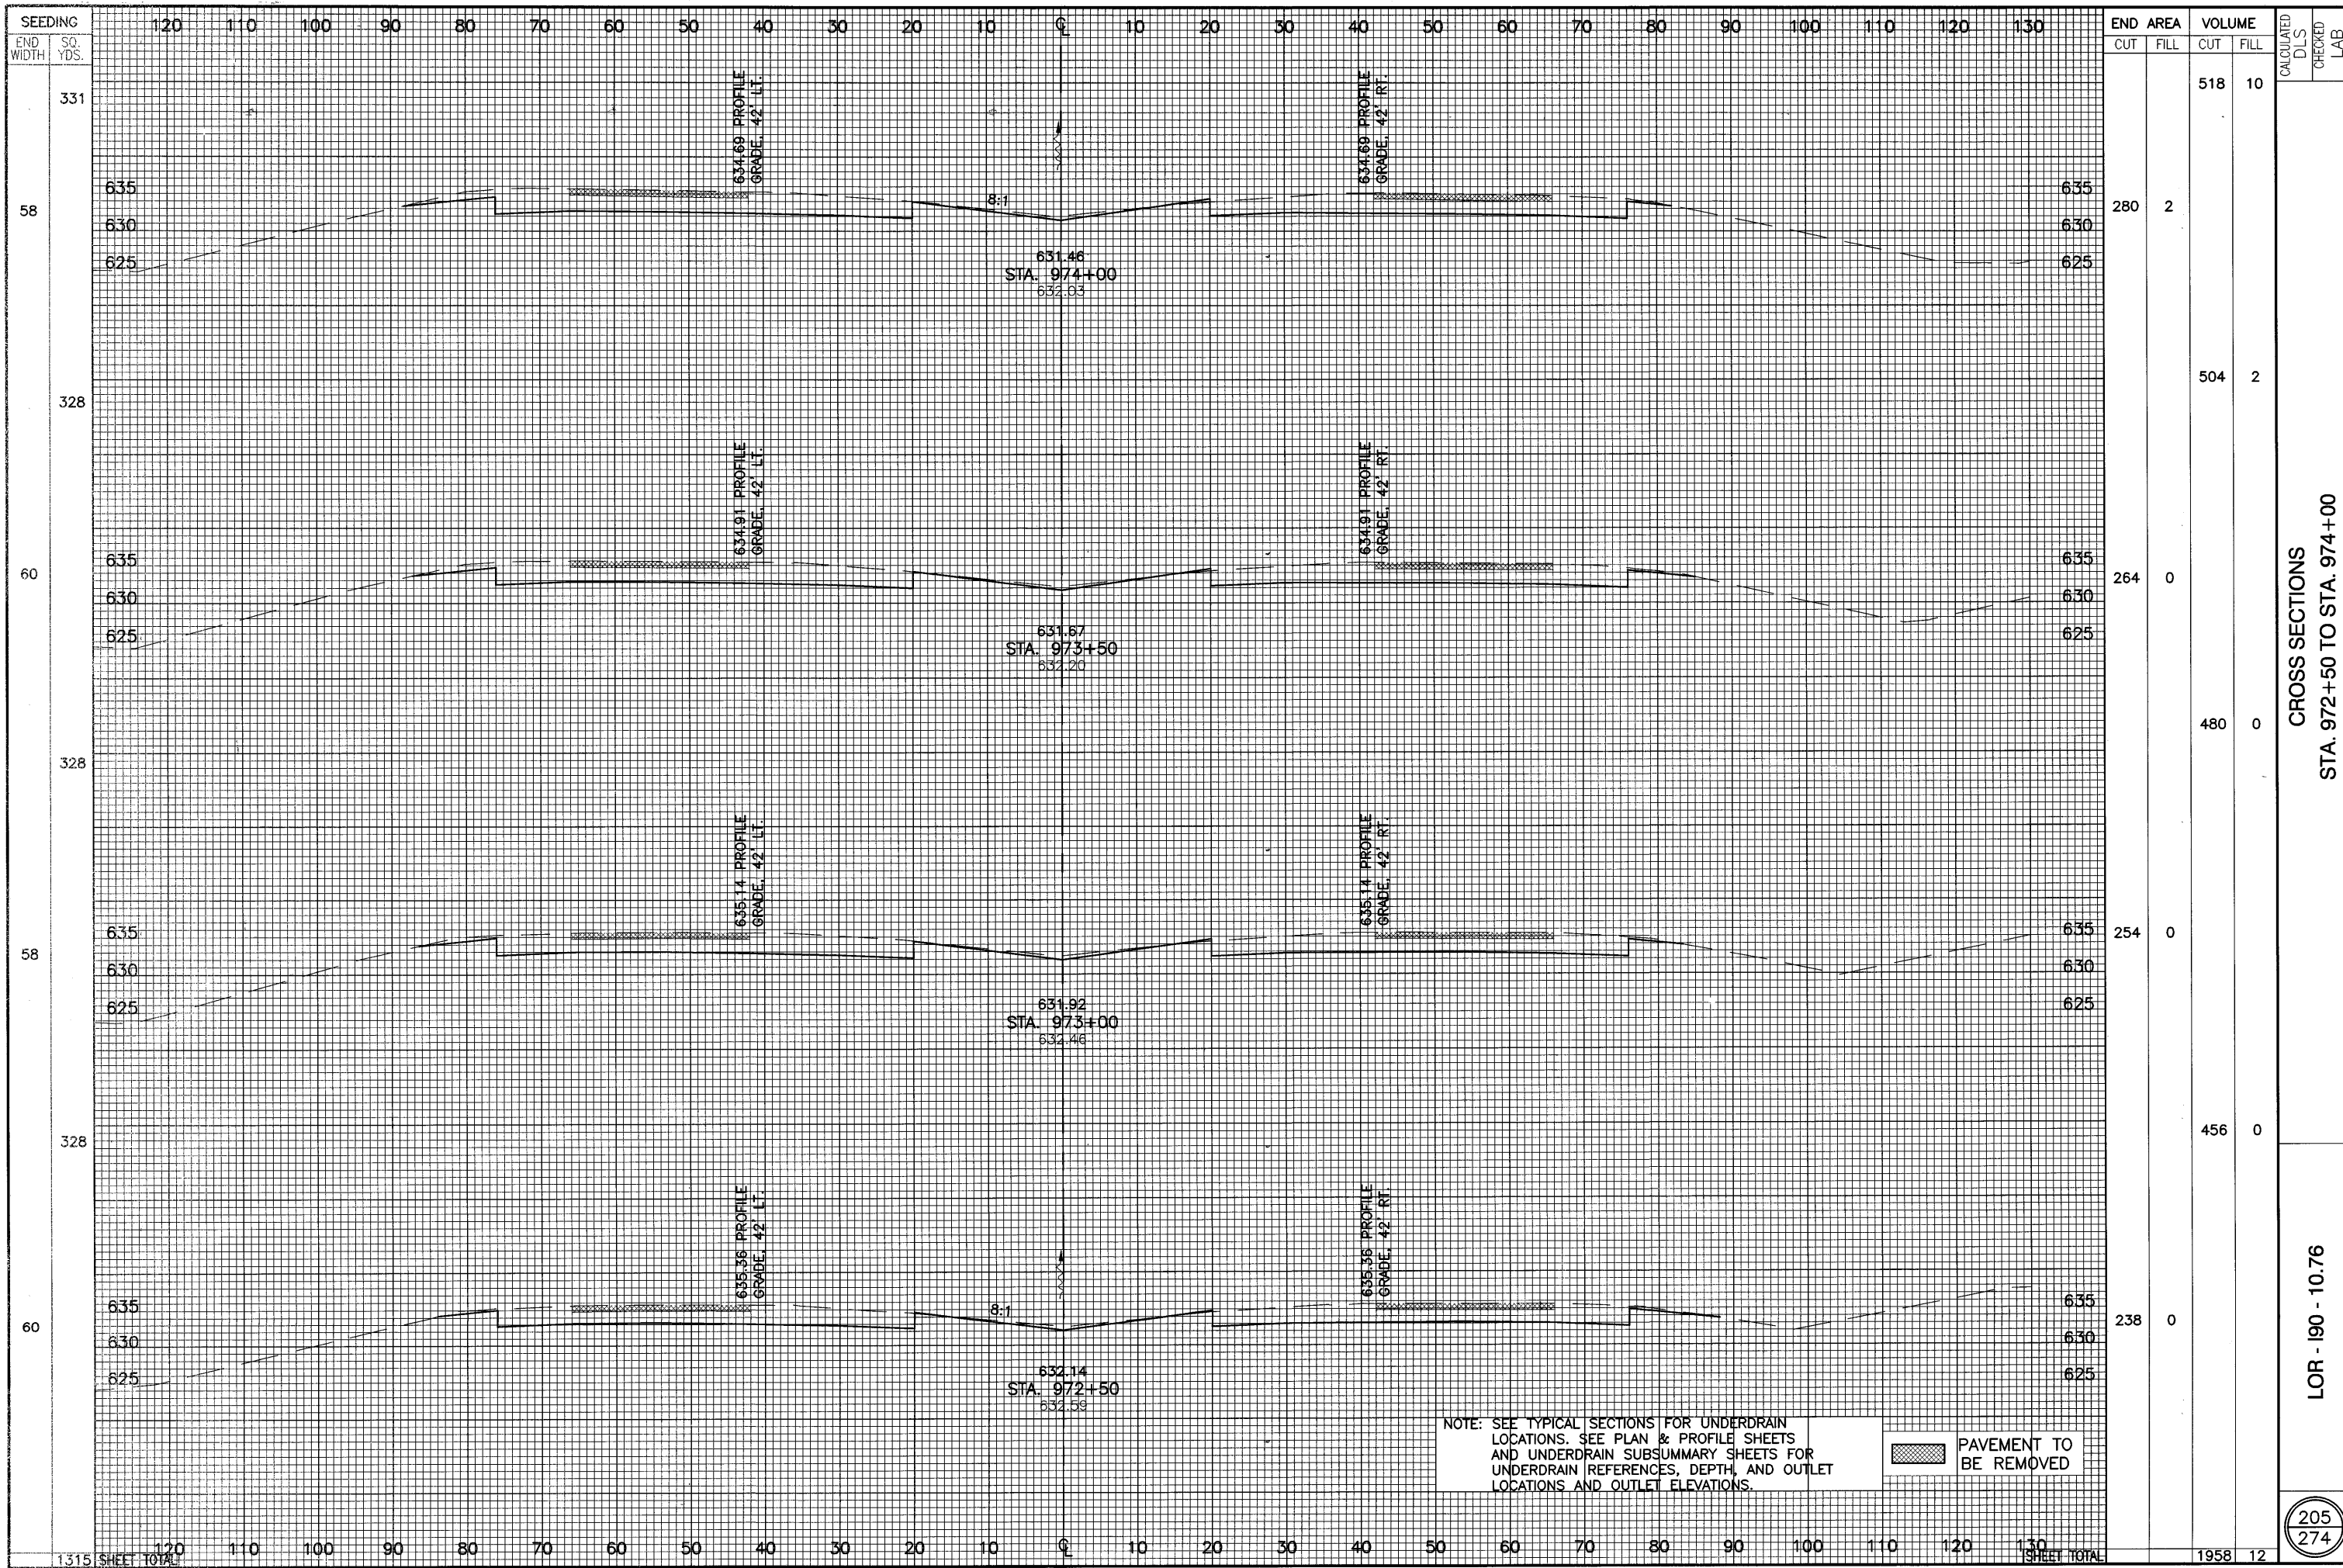

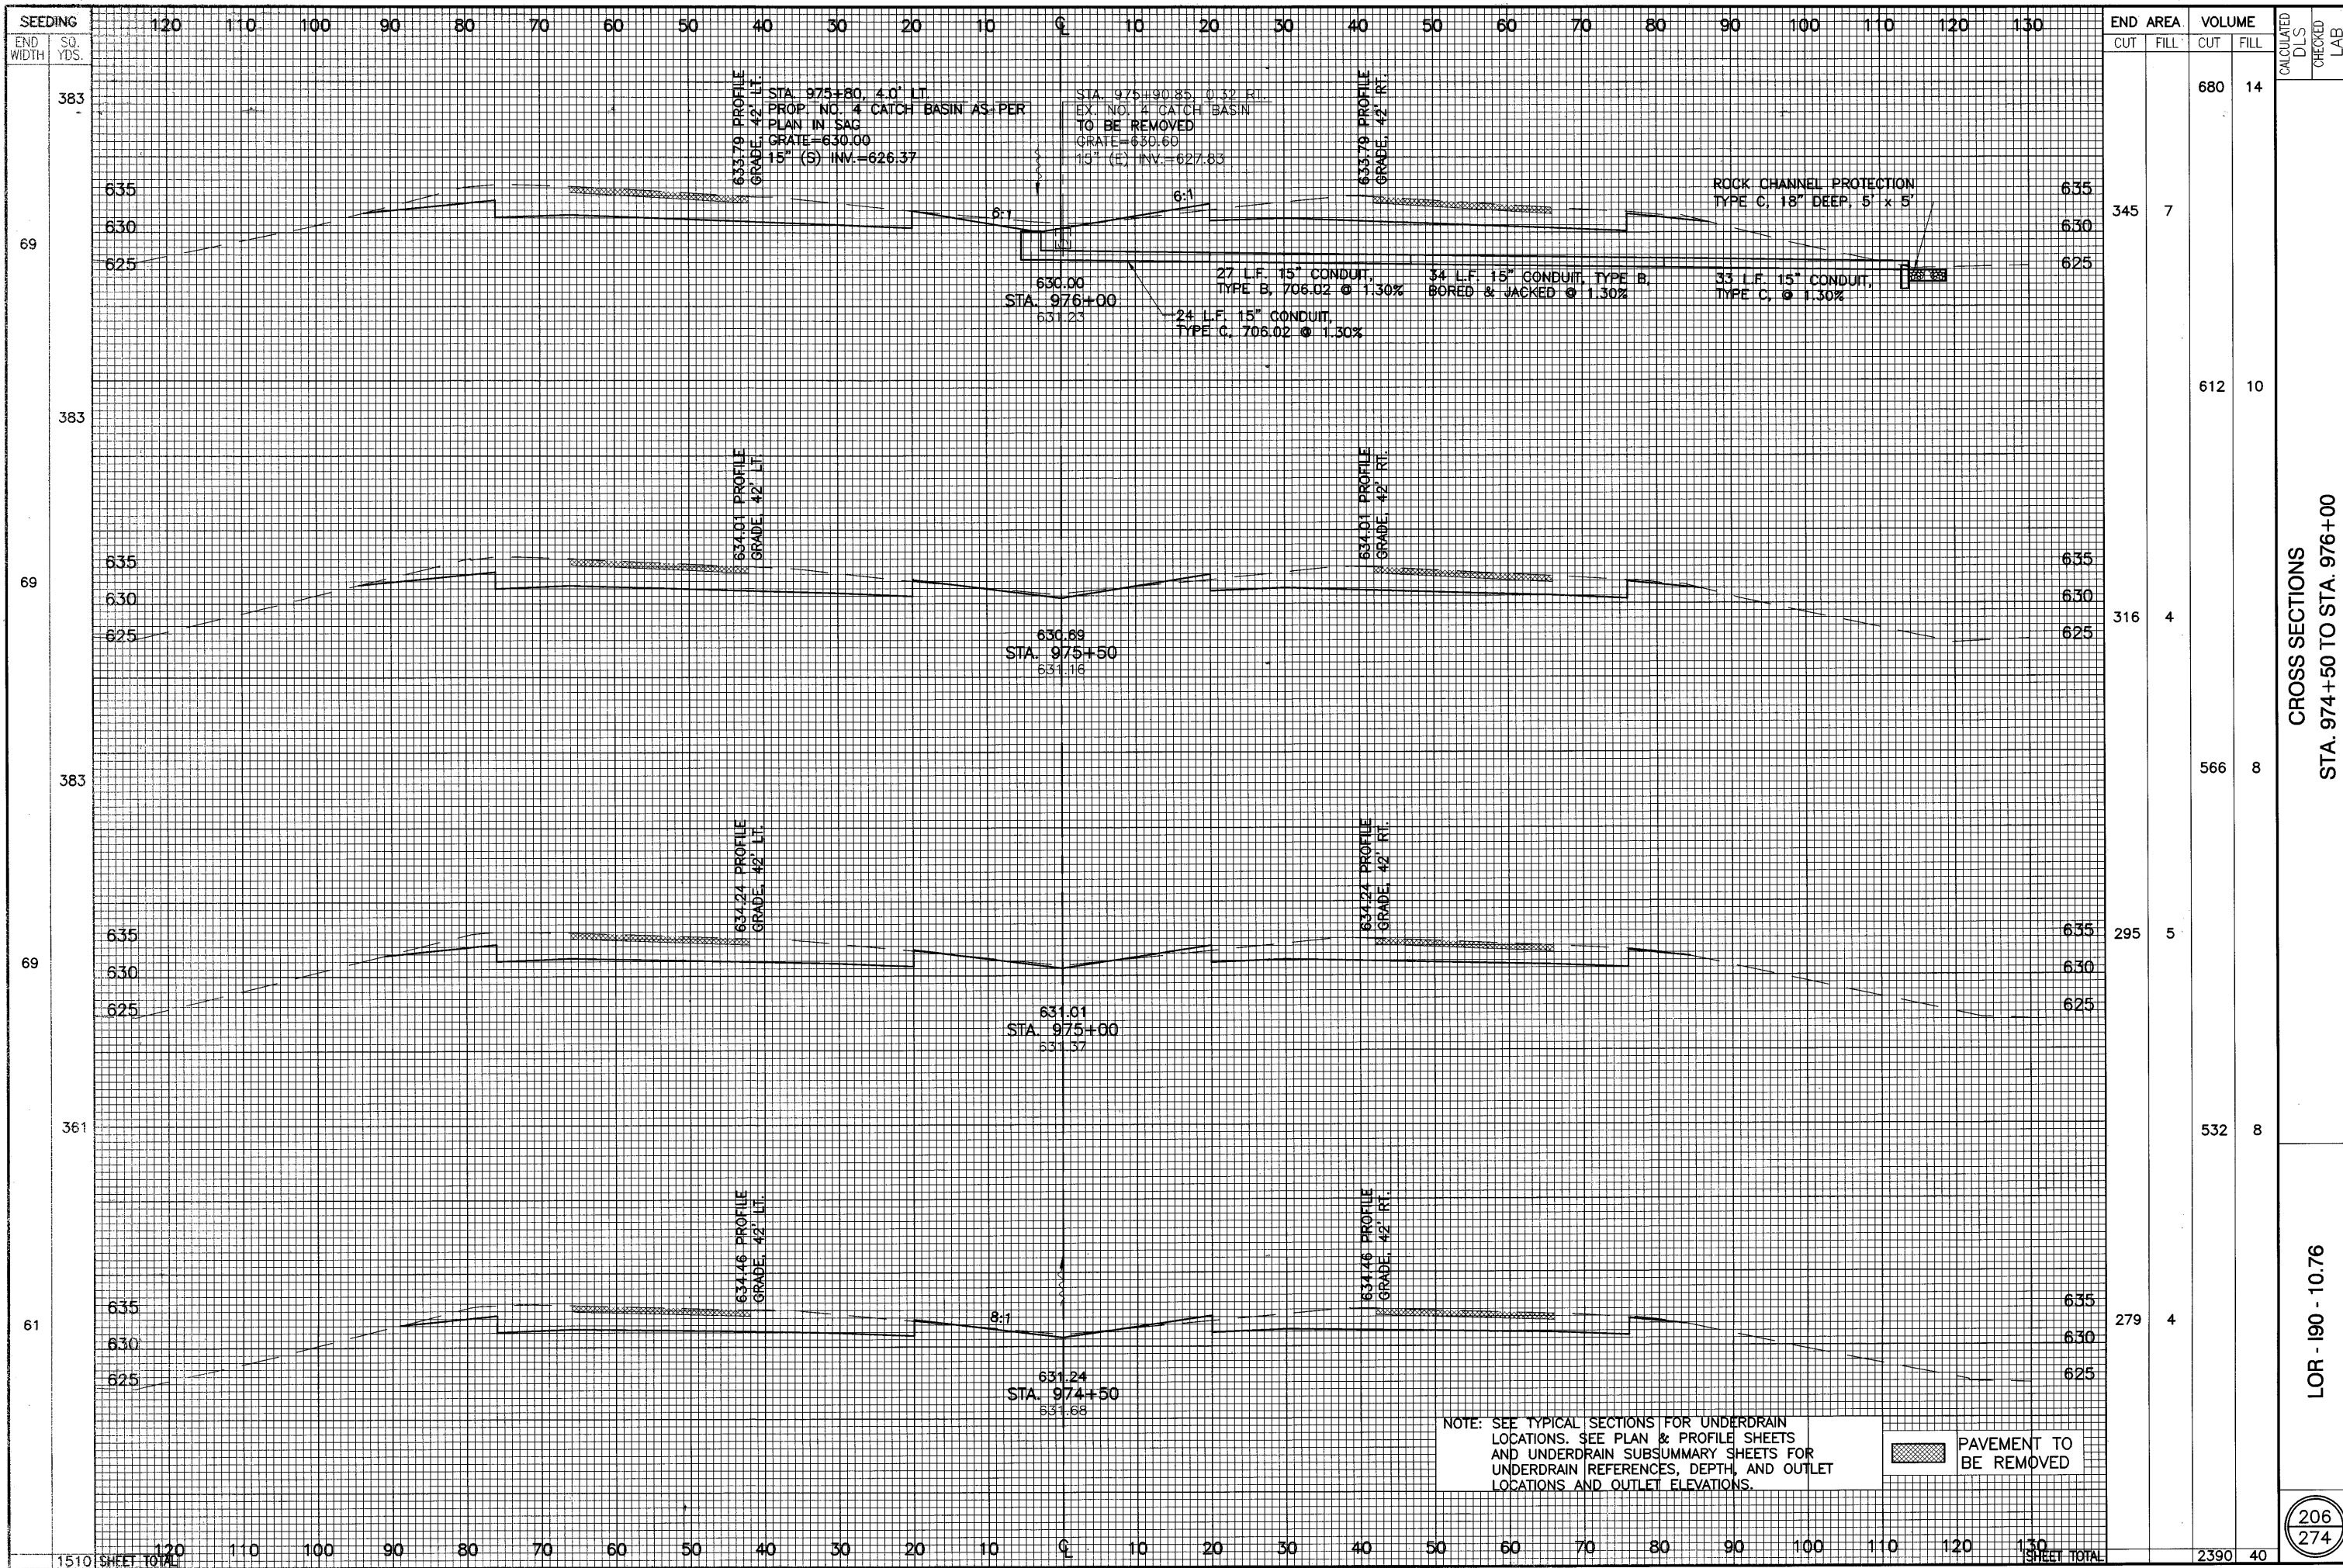


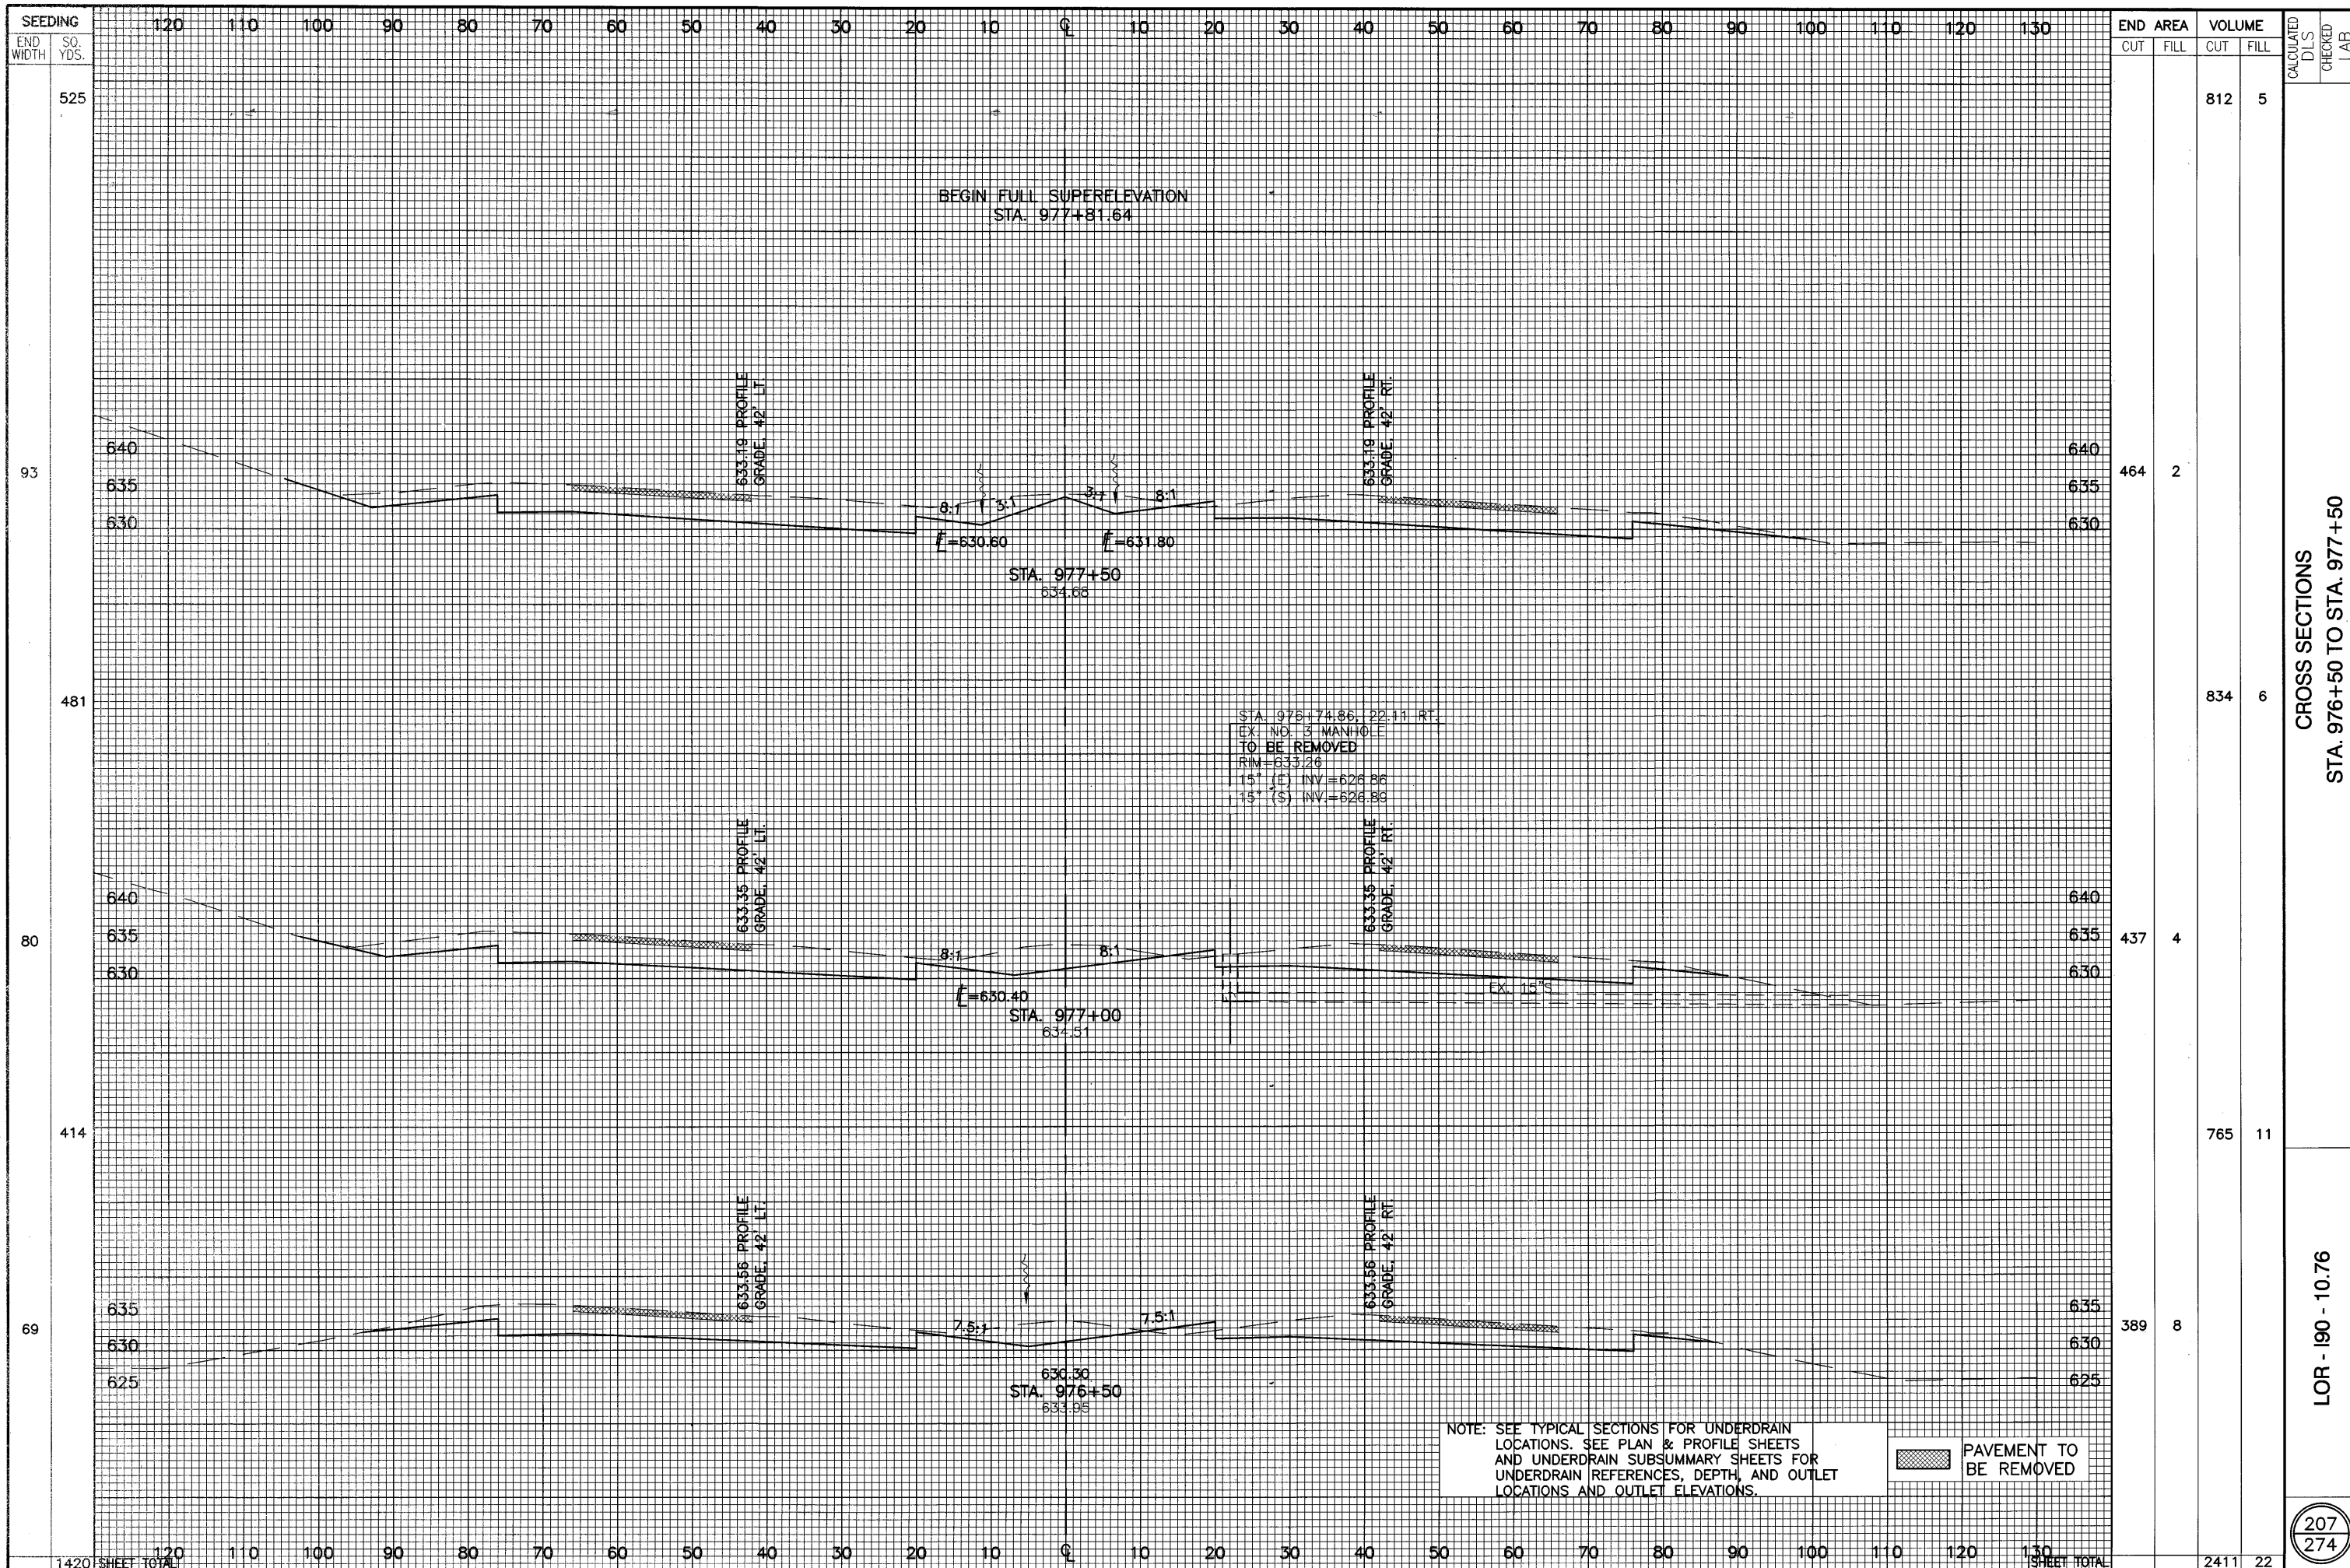

CROSS SECTIONS  
STA. 976+50 TO STA. 977+50

LOR - 190 - 10.76

207  
274

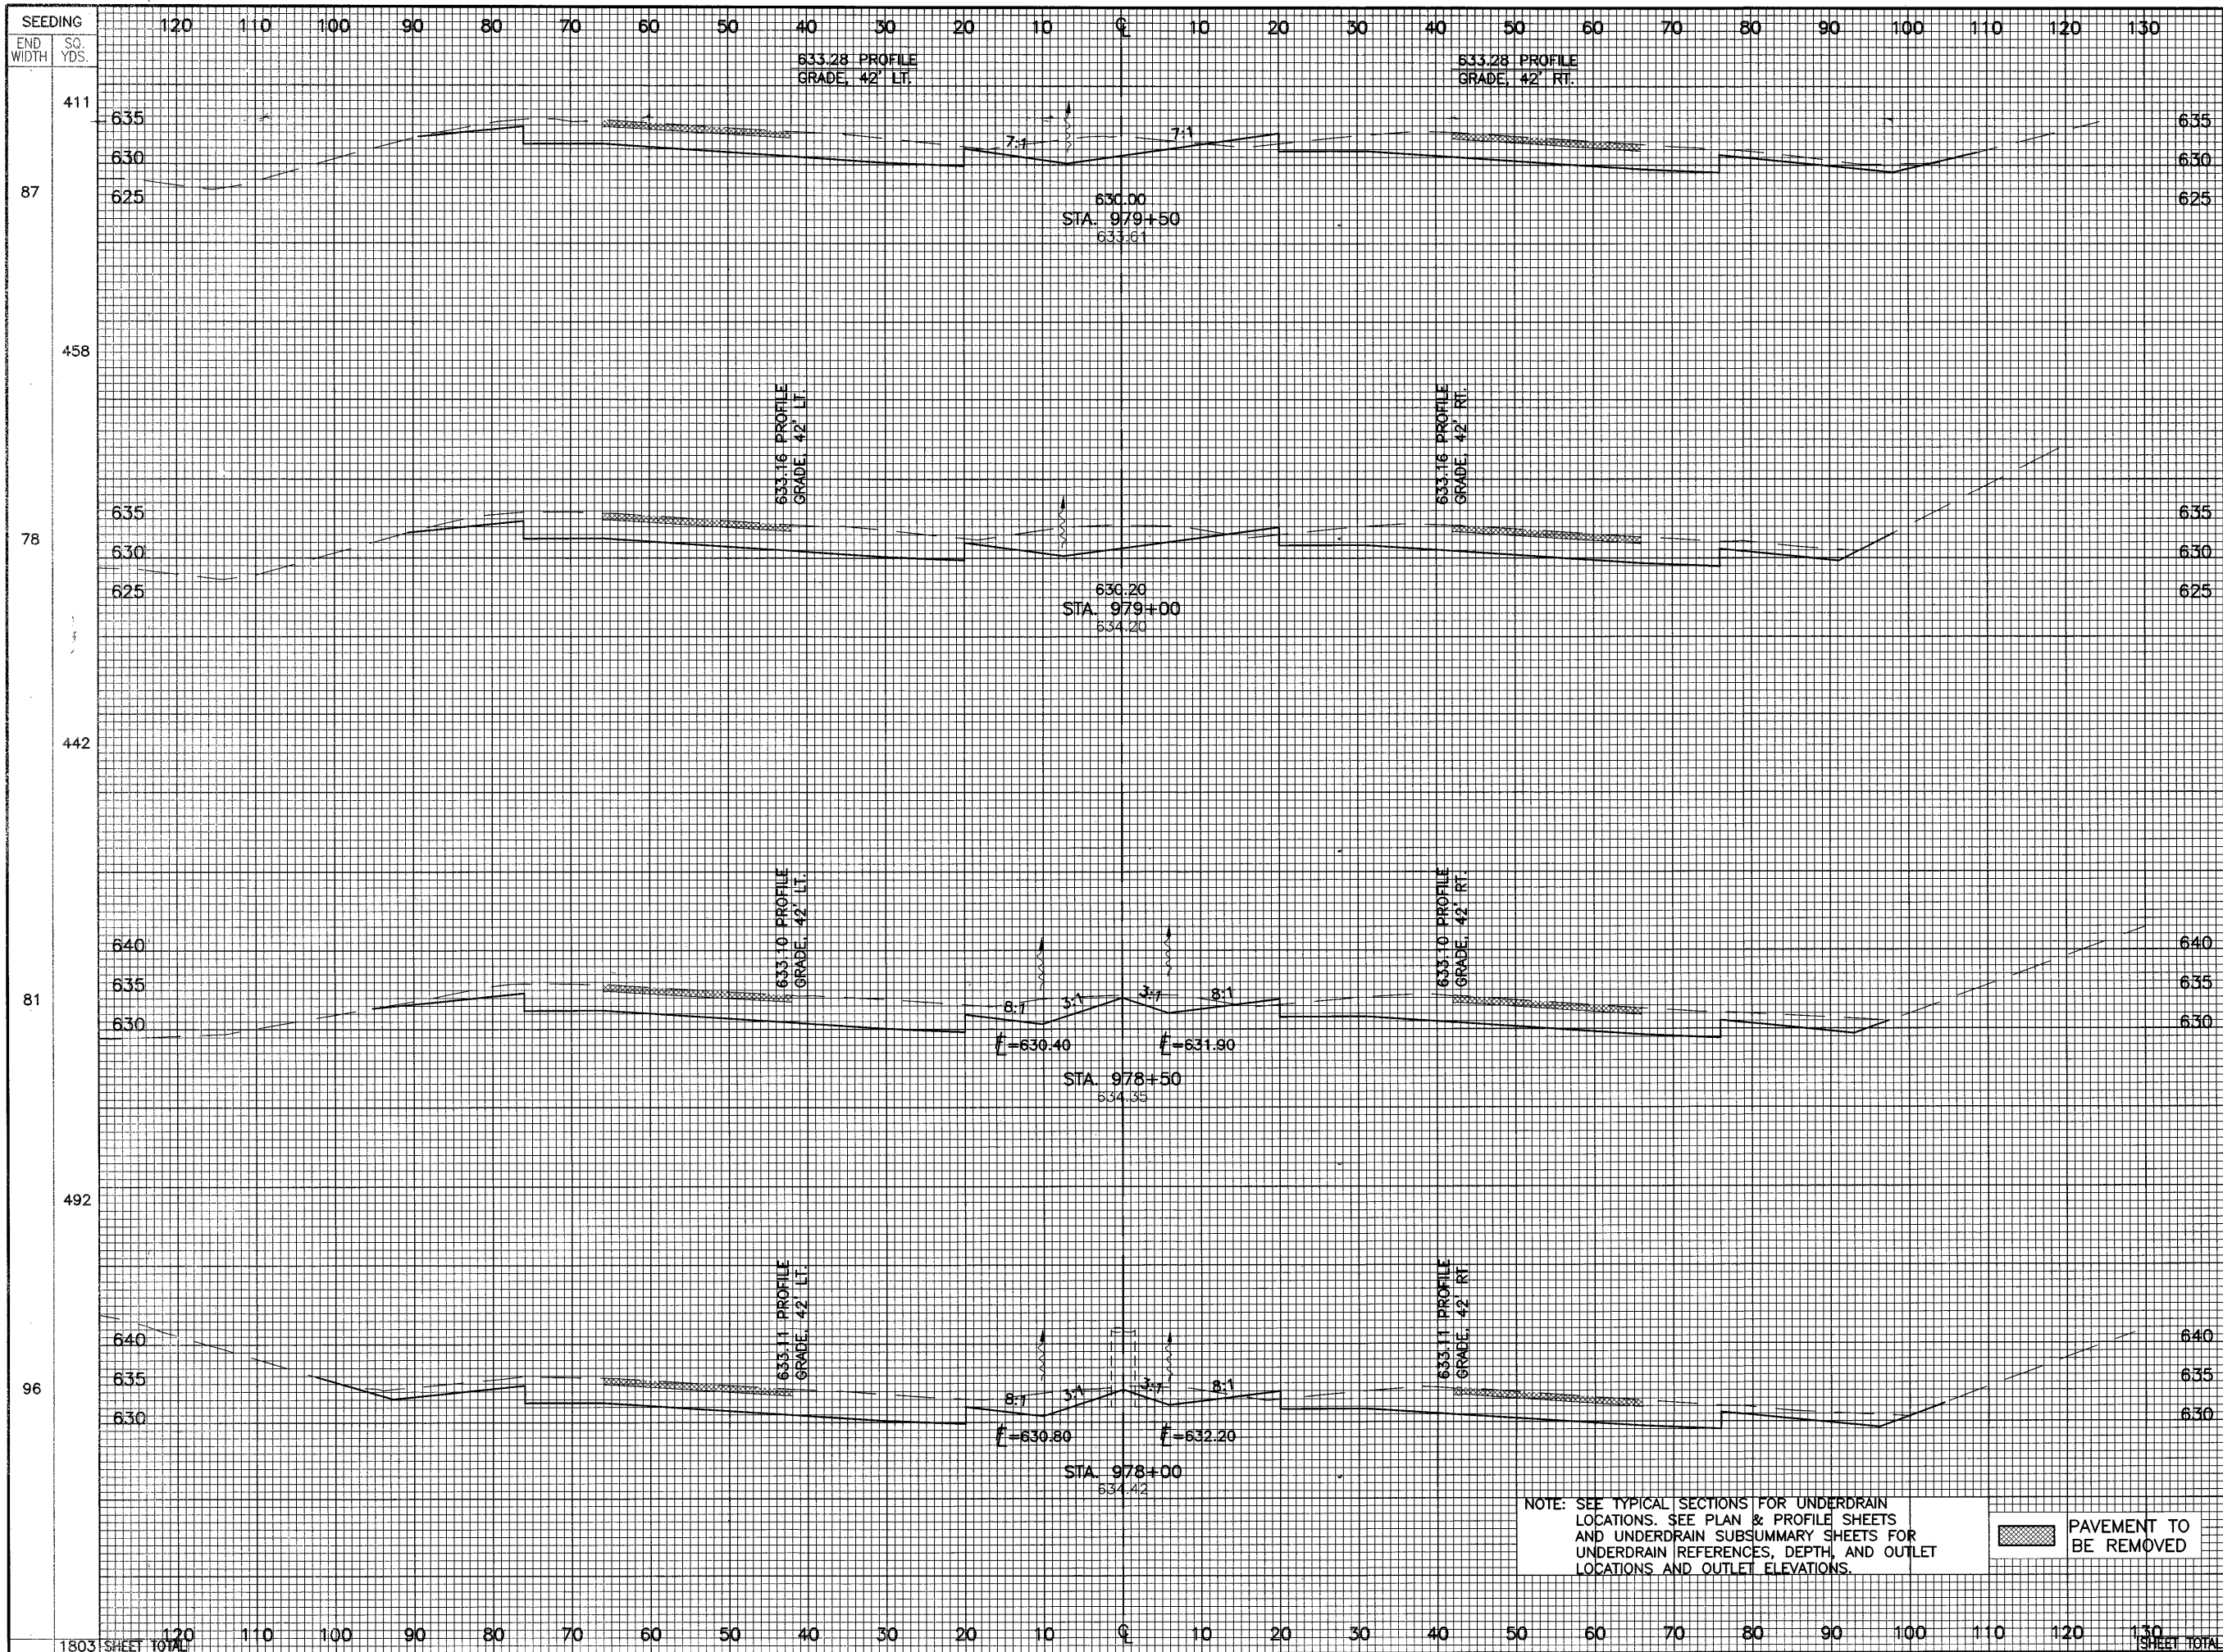

END AREA	VOLUME	CALCULATED		CHECKED	LAB
		CUT	FILL		
363	8	610	19		
		719	11		
414	4				
		778	7		
426	3				
		777	6		
413	3				
		2884	43		

CROSS SECTIONS  
STA. 978+00 TO STA. 979+50


LOR - 190 - 10.76

NOTE: SEE TYPICAL SECTIONS FOR UNDERDRAIN LOCATIONS. SEE PLAN & PROFILE SHEETS AND UNDERDRAIN SUBSUMMARY SHEETS FOR UNDERDRAIN REFERENCES, DEPTH, AND OUTLET LOCATIONS AND OUTLET ELEVATIONS.

PAVEMENT TO BE REMOVED



47M 2-08-2002 [ C:\33600\DWG\19031\F0000001.DWG ] DLS

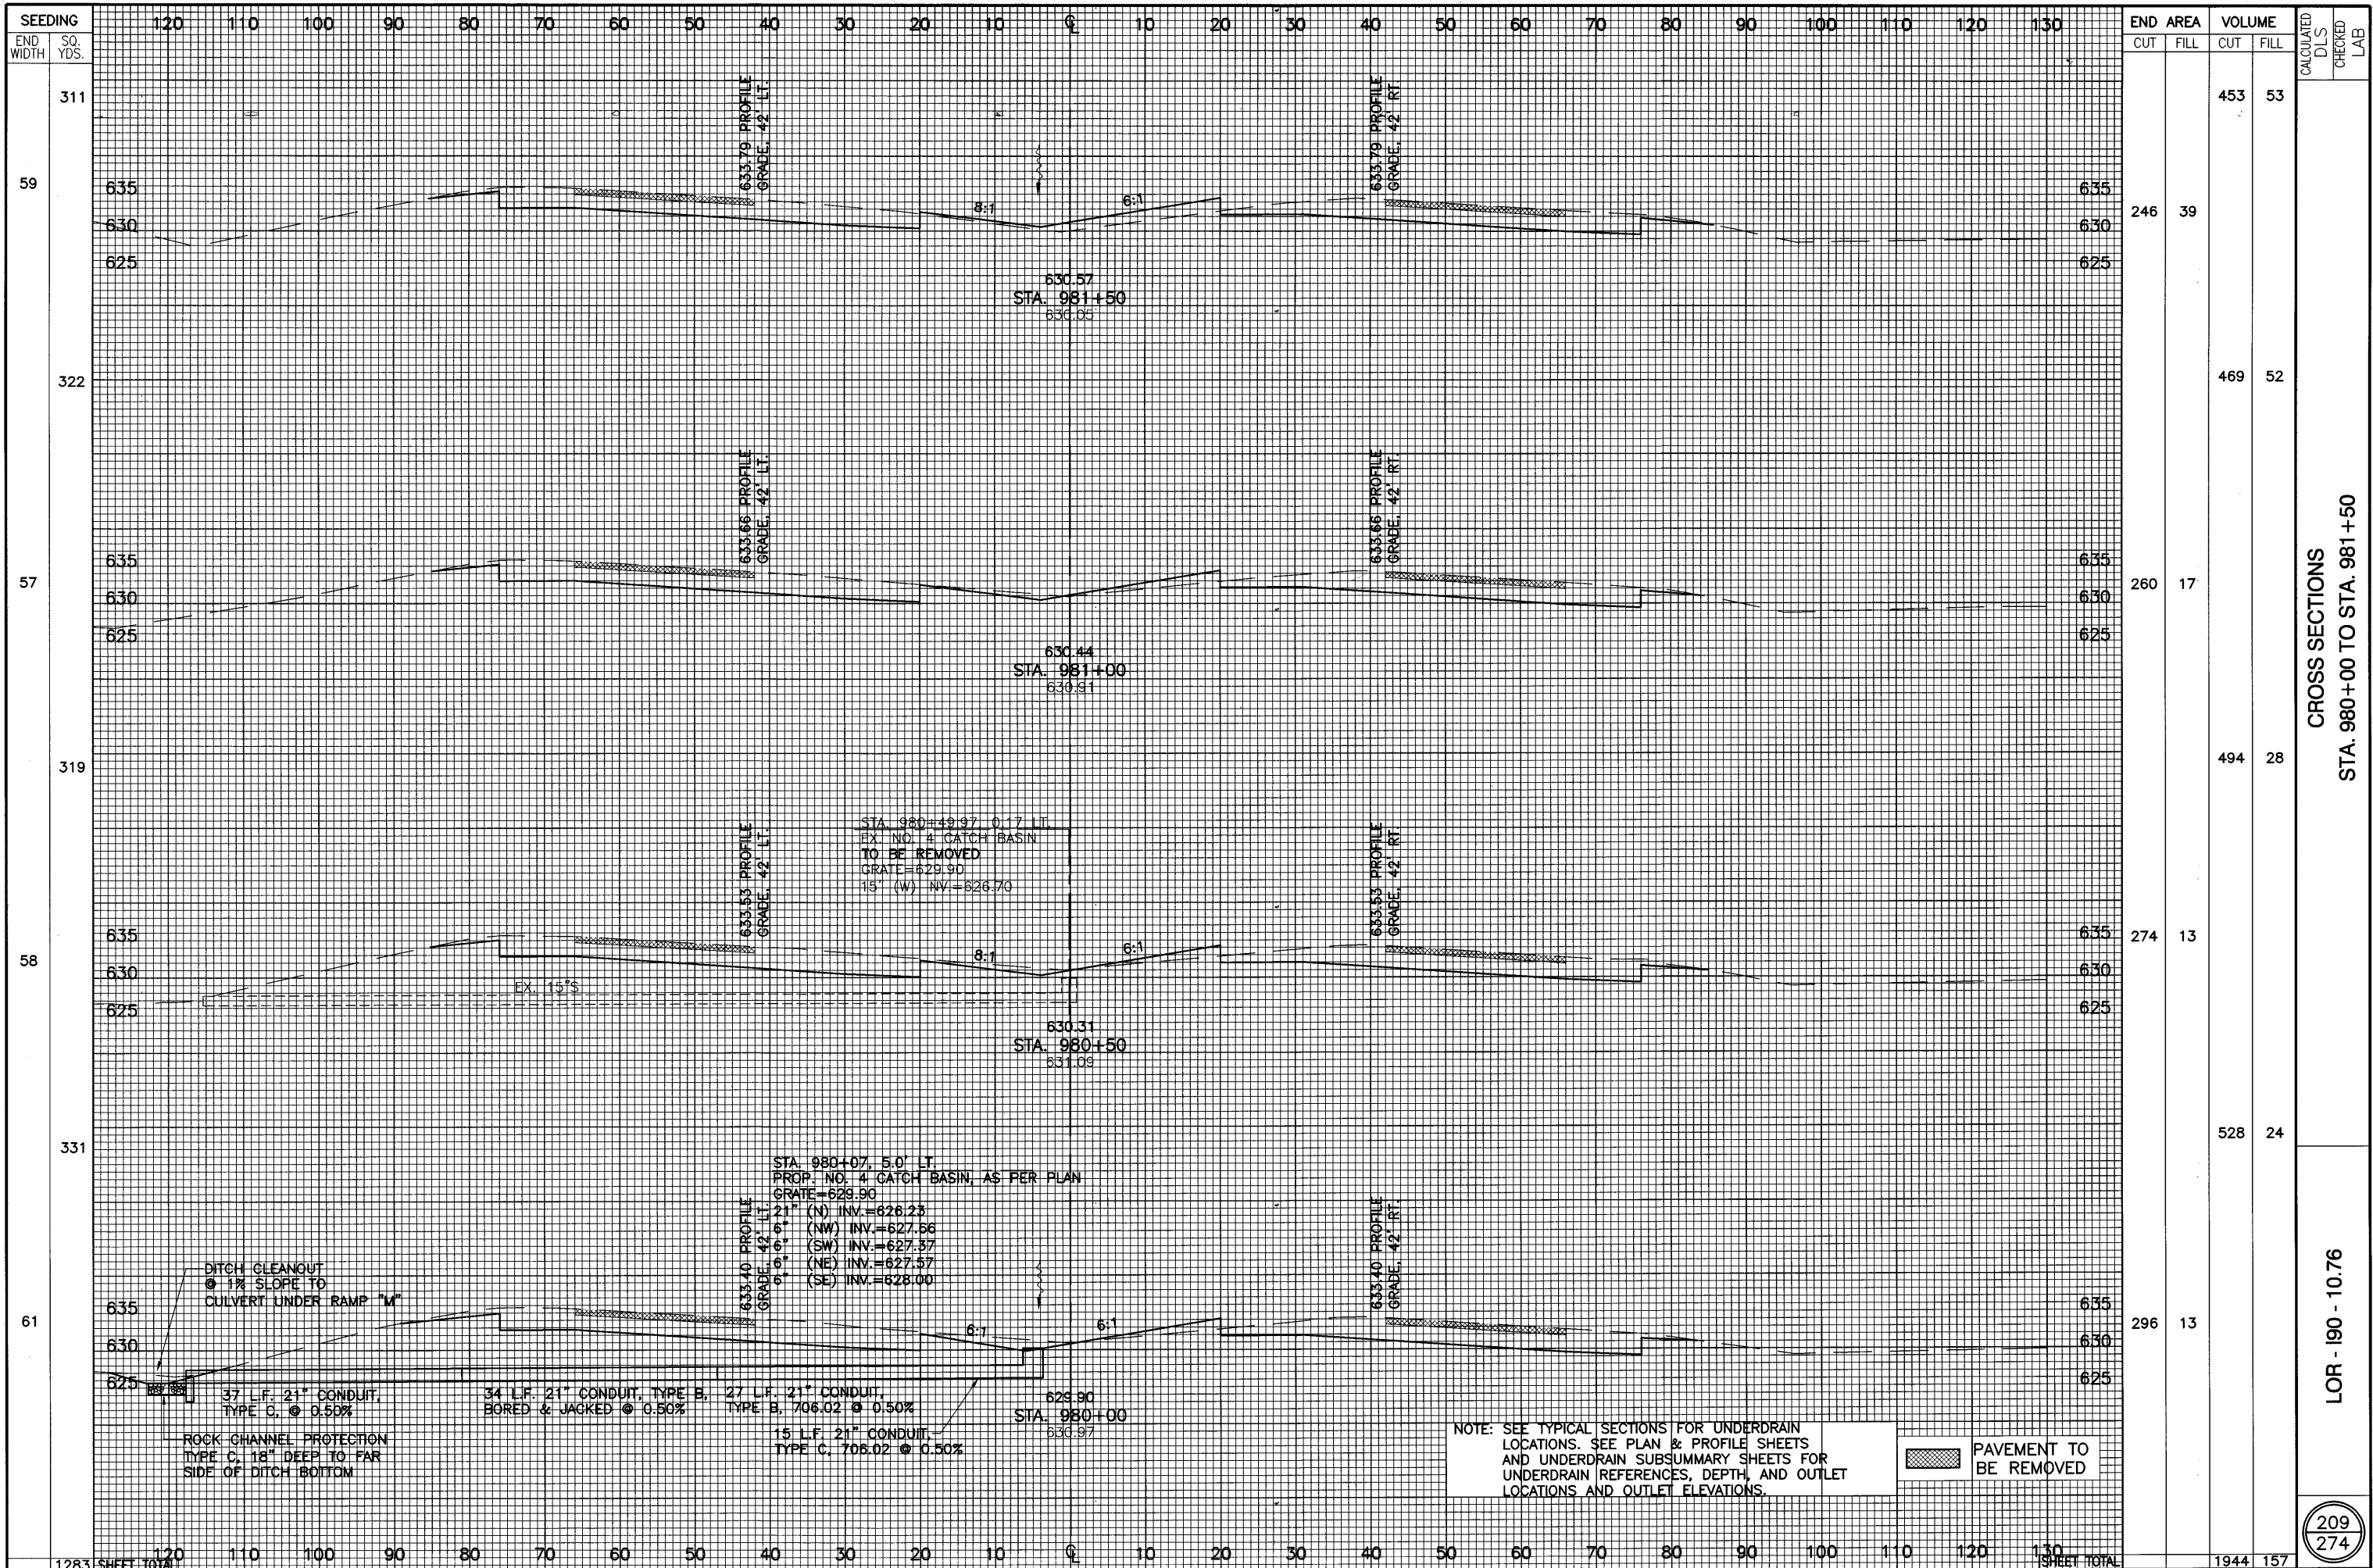

CROSS SECTIONS  
STA. 980+00 TO STA. 981+50

LOR - 190 - 10.76

209  
274

NOTE: SEE TYPICAL SECTIONS FOR UNDERDRAIN LOCATIONS. SEE PLAN & PROFILE SHEETS AND UNDERDRAIN SUBSUMMARY SHEETS FOR UNDERDRAIN REFERENCES, DEPTH, AND OUTLET LOCATIONS AND OUTLET ELEVATIONS.

PAVEMENT TO BE REMOVED

DITCH CLEANOUT  
1% SLOPE TO  
CULVERT UNDER RAMP "M"

ROCK CHANNEL PROTECTION  
TYPE C, 18" DEEP TO FAR  
SIDE OF DITCH BOTTOM

37 L.F. 21" CONDUIT,  
TYPE C, @ 0.50%

34 L.F. 21" CONDUIT, TYPE B,  
BORED & JACKED @ 0.50%

27 L.F. 21" CONDUIT,  
TYPE B, 706.02 @ 0.50%

15 L.F. 21" CONDUIT,  
TYPE C, 706.02 @ 0.50%

STA. 980+07, 5.0' LT.  
PROP. NO. 4 CATCH BASIN, AS PER PLAN  
GRATE=629.90  
21" (N) INV.=626.23  
6" (NW) INV.=627.56  
6" (SW) INV.=627.57  
6" (NE) INV.=627.57  
6" (SE) INV.=628.00

STA. 980+49.97, 0.17 LT.  
EX. NO. 4 CATCH BASIN  
TO BE REMOVED  
GRATE=629.90  
15' (W) INV.=626.70

630.57  
STA. 981+50  
630.05

630.44  
STA. 981+00  
630.91

630.31  
STA. 980+50  
631.09

626.90  
STA. 980+00  
630.97

633.79 PROFILE  
GRADE, 42' LT.

633.79 PROFILE  
GRADE, 42' RT.

633.66 PROFILE  
GRADE, 42' LT.

633.66 PROFILE  
GRADE, 42' RT.


633.53 PROFILE  
GRADE, 42' LT.

633.53 PROFILE  
GRADE, 42' RT.

633.40 PROFILE  
GRADE, 42' LT.

633.40 PROFILE  
GRADE, 42' RT.

16PM 2-08-2002 [ C:\93600\DWG\1903\19030001.DWG ] DLS

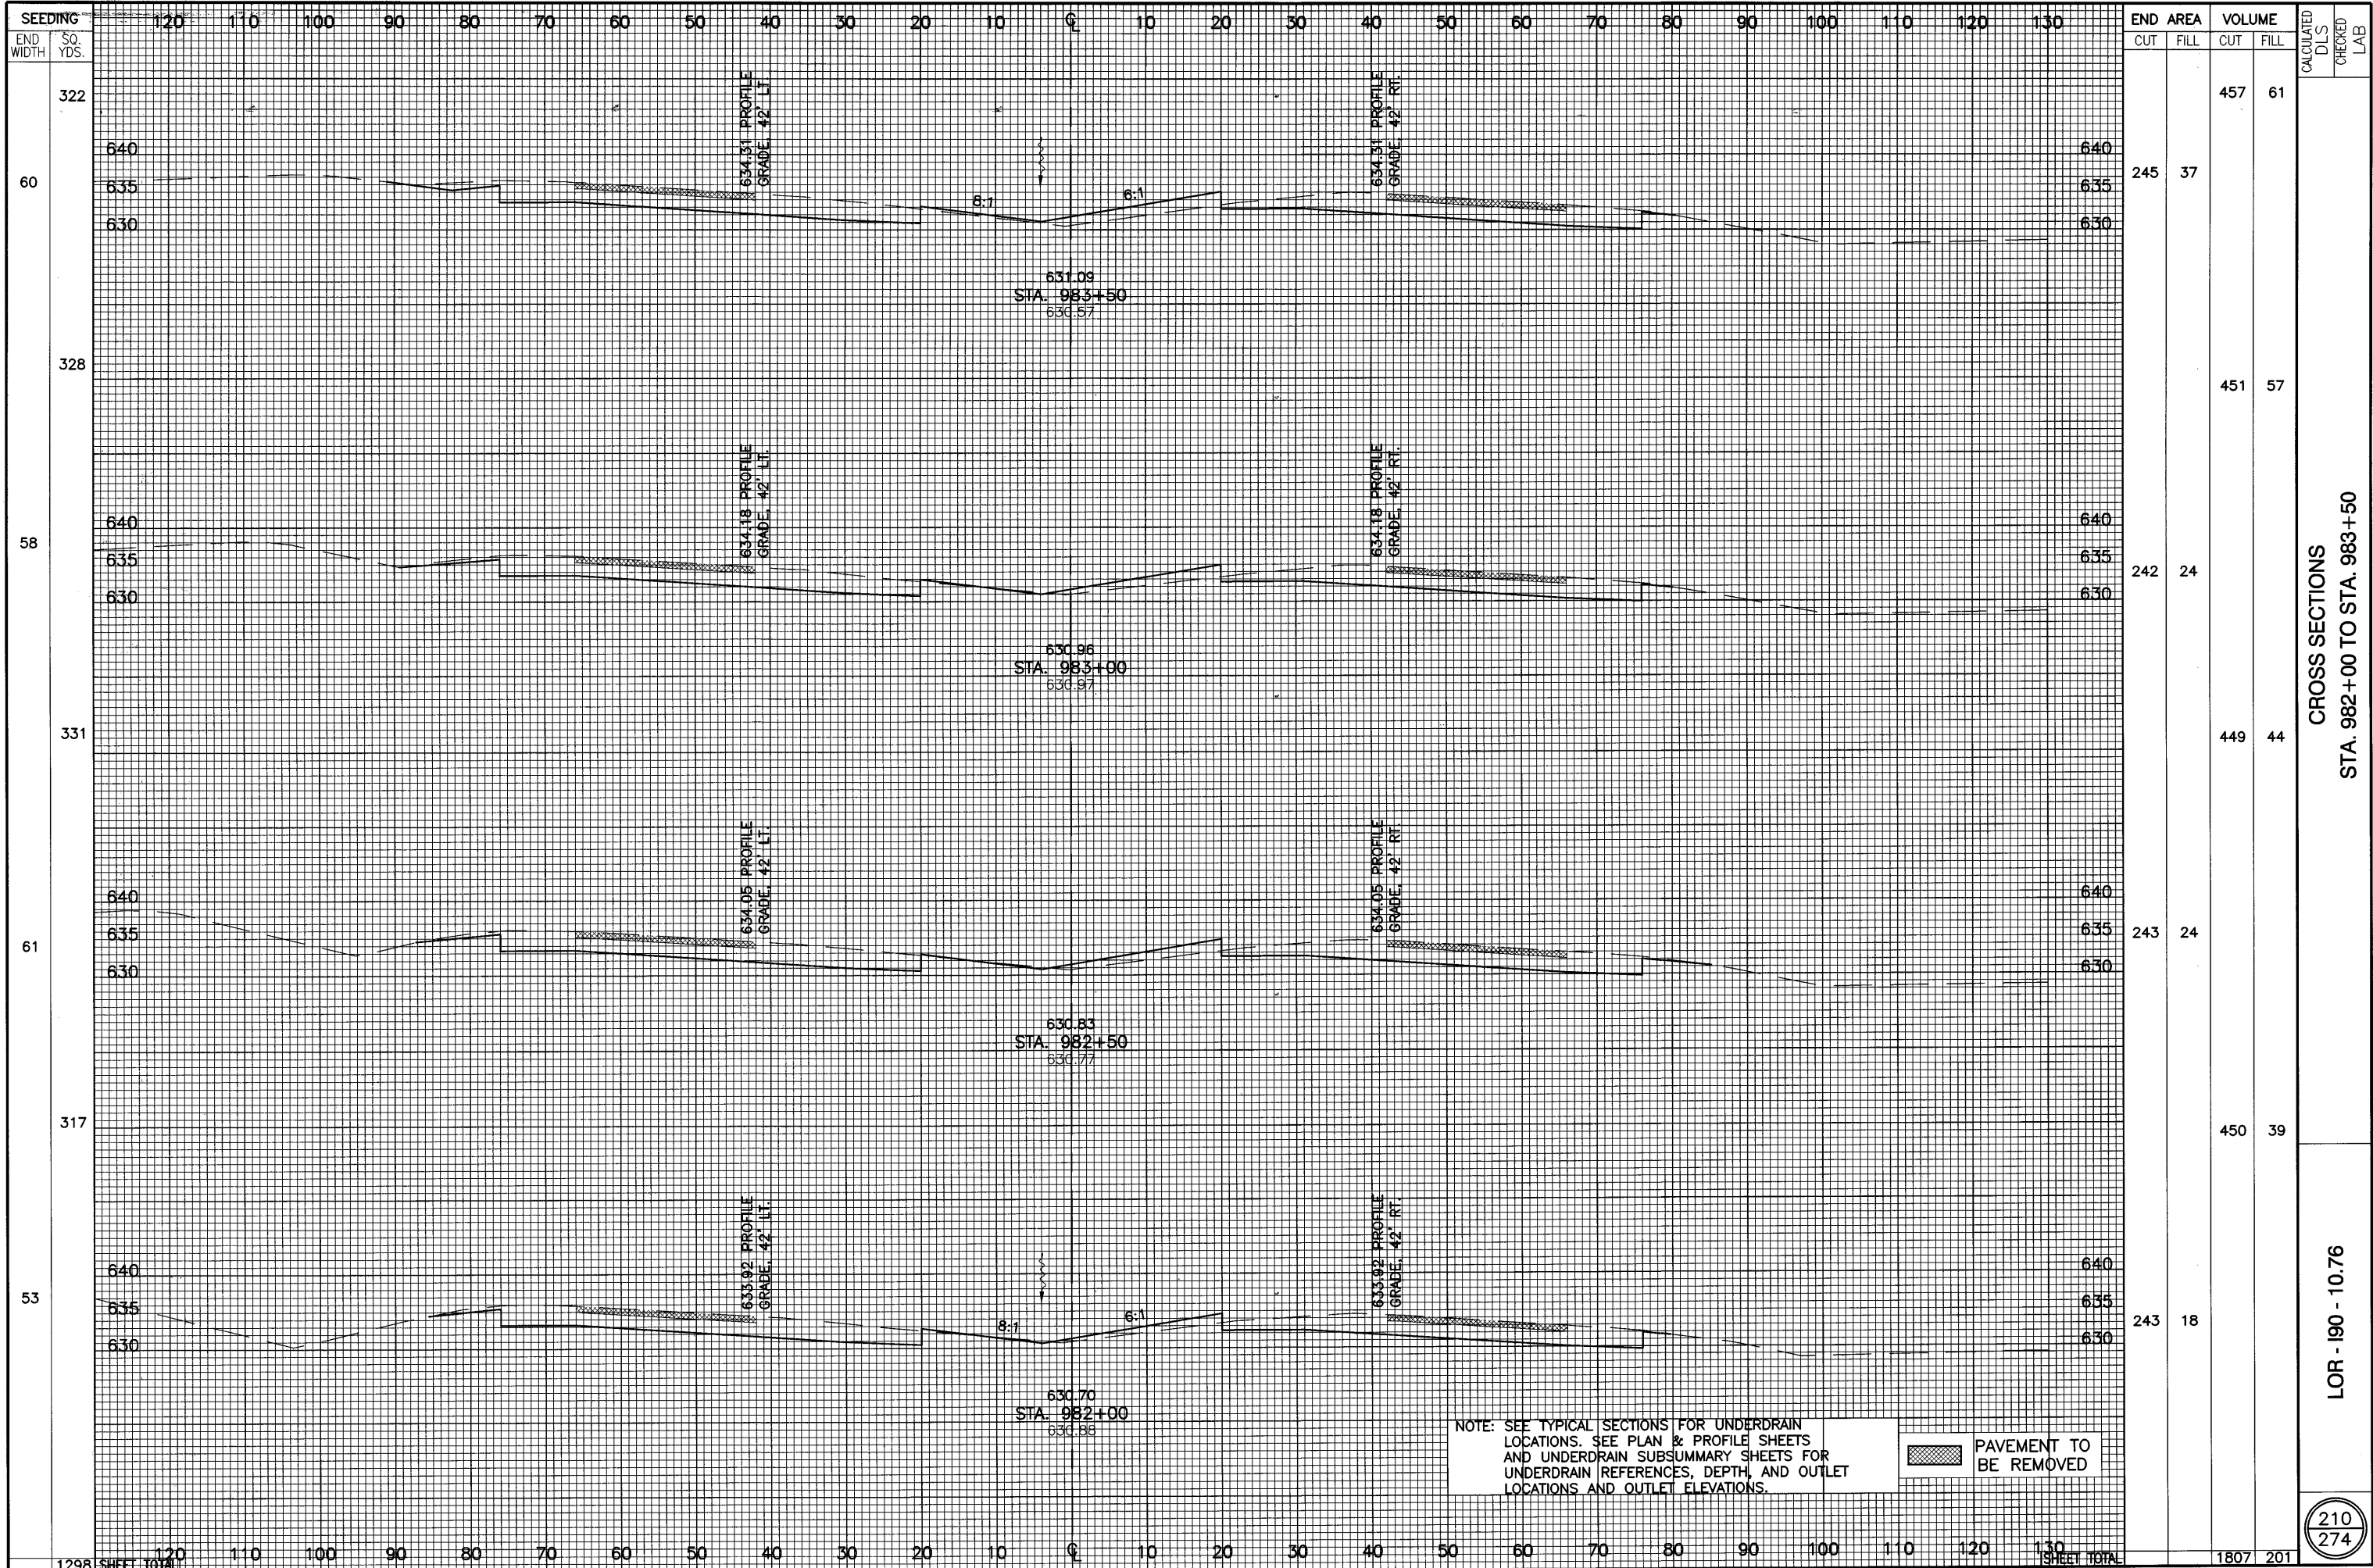

SEEDING END WIDTH	SQ. YDS.	END AREA		VOLUME		CALCULATED DLS	CHECKED LAB
		CUT	FILL	CUT	FILL		
322				457	61		
60		245	37				
328				451	57		
58		242	24				
331				449	44		
61		243	24				
317				450	39		
53		243	18				
1298	SHEET TOTAL	110	90	1807	201		


CROSS SECTIONS  
STA. 982+00 TO STA. 983+50

LOR - 190 - 10.76

210  
274

NOTE: SEE TYPICAL SECTIONS FOR UNDERDRAIN LOCATIONS. SEE PLAN & PROFILE SHEETS FOR UNDERDRAIN REFERENCES, DEPTH, AND OUTLET LOCATIONS AND OUTLET ELEVATIONS.

PAVEMENT TO BE REMOVED

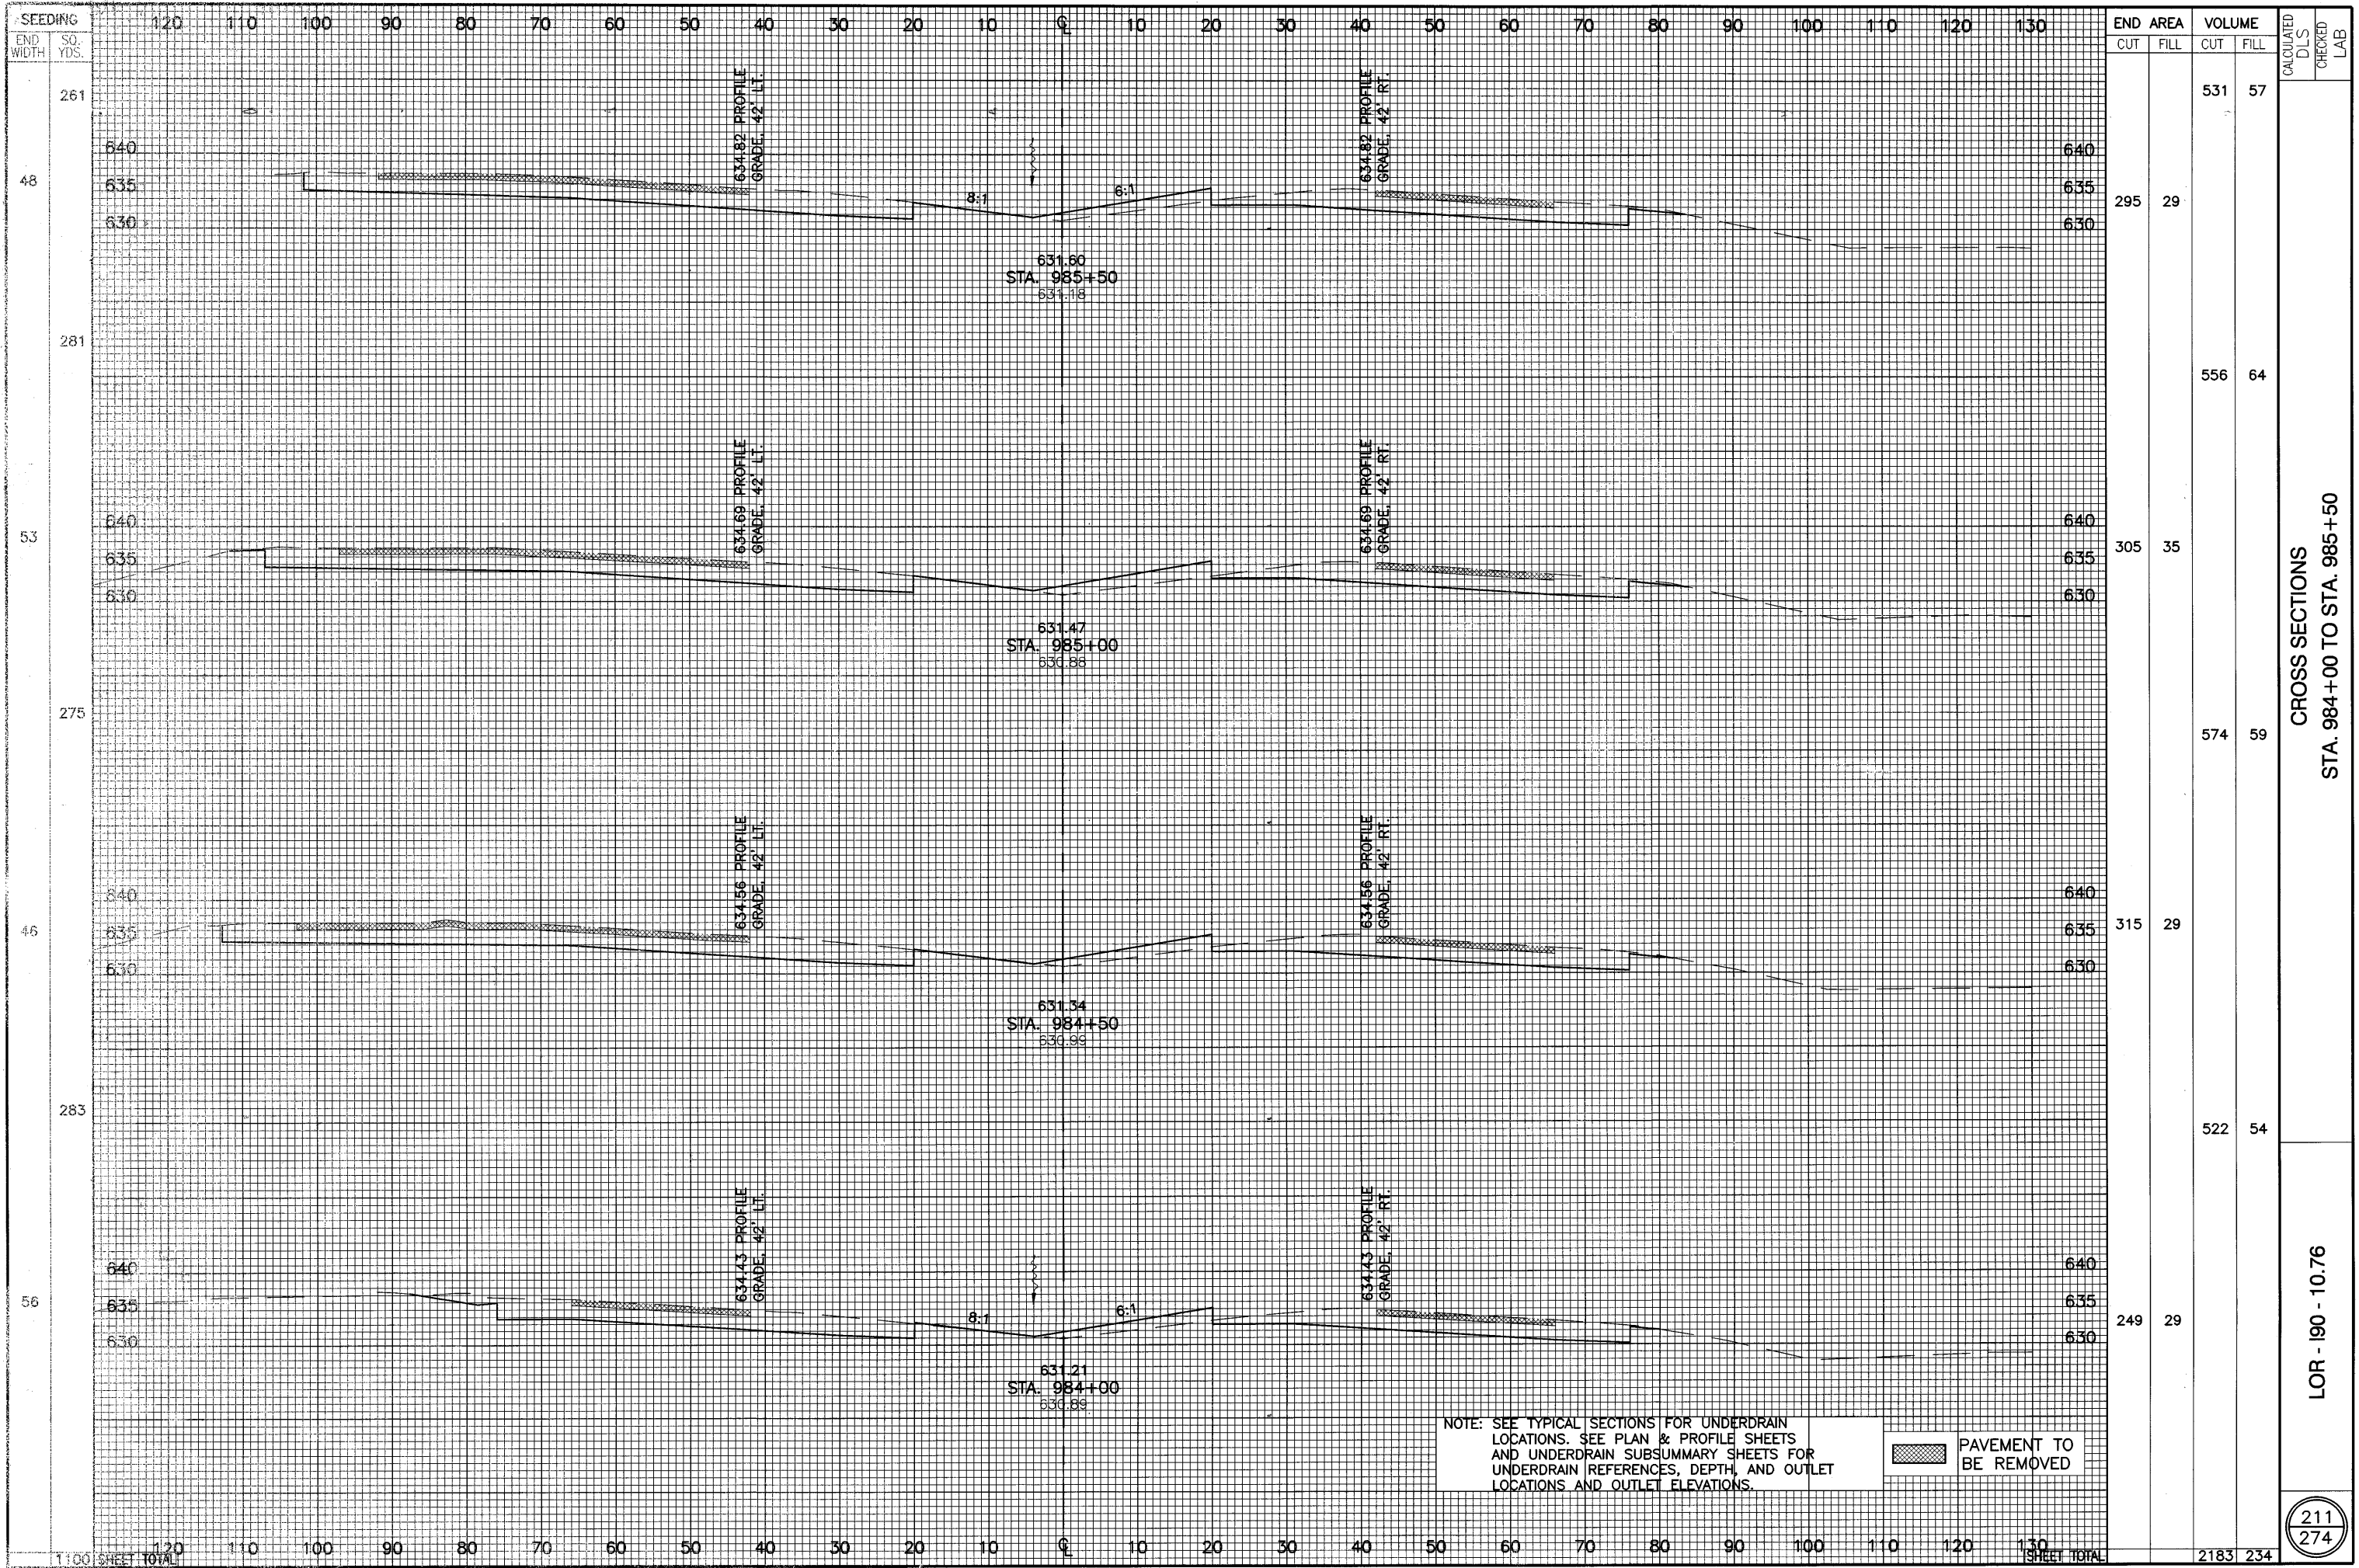

END CUT	AREA FILL	VOLUME		CALCULATED D.I.S.	CHECKED LAB
		CUT	FILL		
295	29	531	57		
		556	64		
305	35				
		574	59		
315	29				
		522	54		
249	29				
<b>1100</b>	<b>SHEET TOTAL</b>	<b>2183</b>	<b>234</b>		


CROSS SECTIONS  
STA. 984+00 TO STA. 985+50


LOR - 190 - 10.76

211  
274

NOTE: SEE TYPICAL SECTIONS FOR UNDERDRAIN LOCATIONS. SEE PLAN & PROFILE SHEETS AND UNDERDRAIN SUBSUMMARY SHEETS FOR UNDERDRAIN REFERENCES, DEPTH, AND OUTLET LOCATIONS AND OUTLET ELEVATIONS.

PAVEMENT TO BE REMOVED

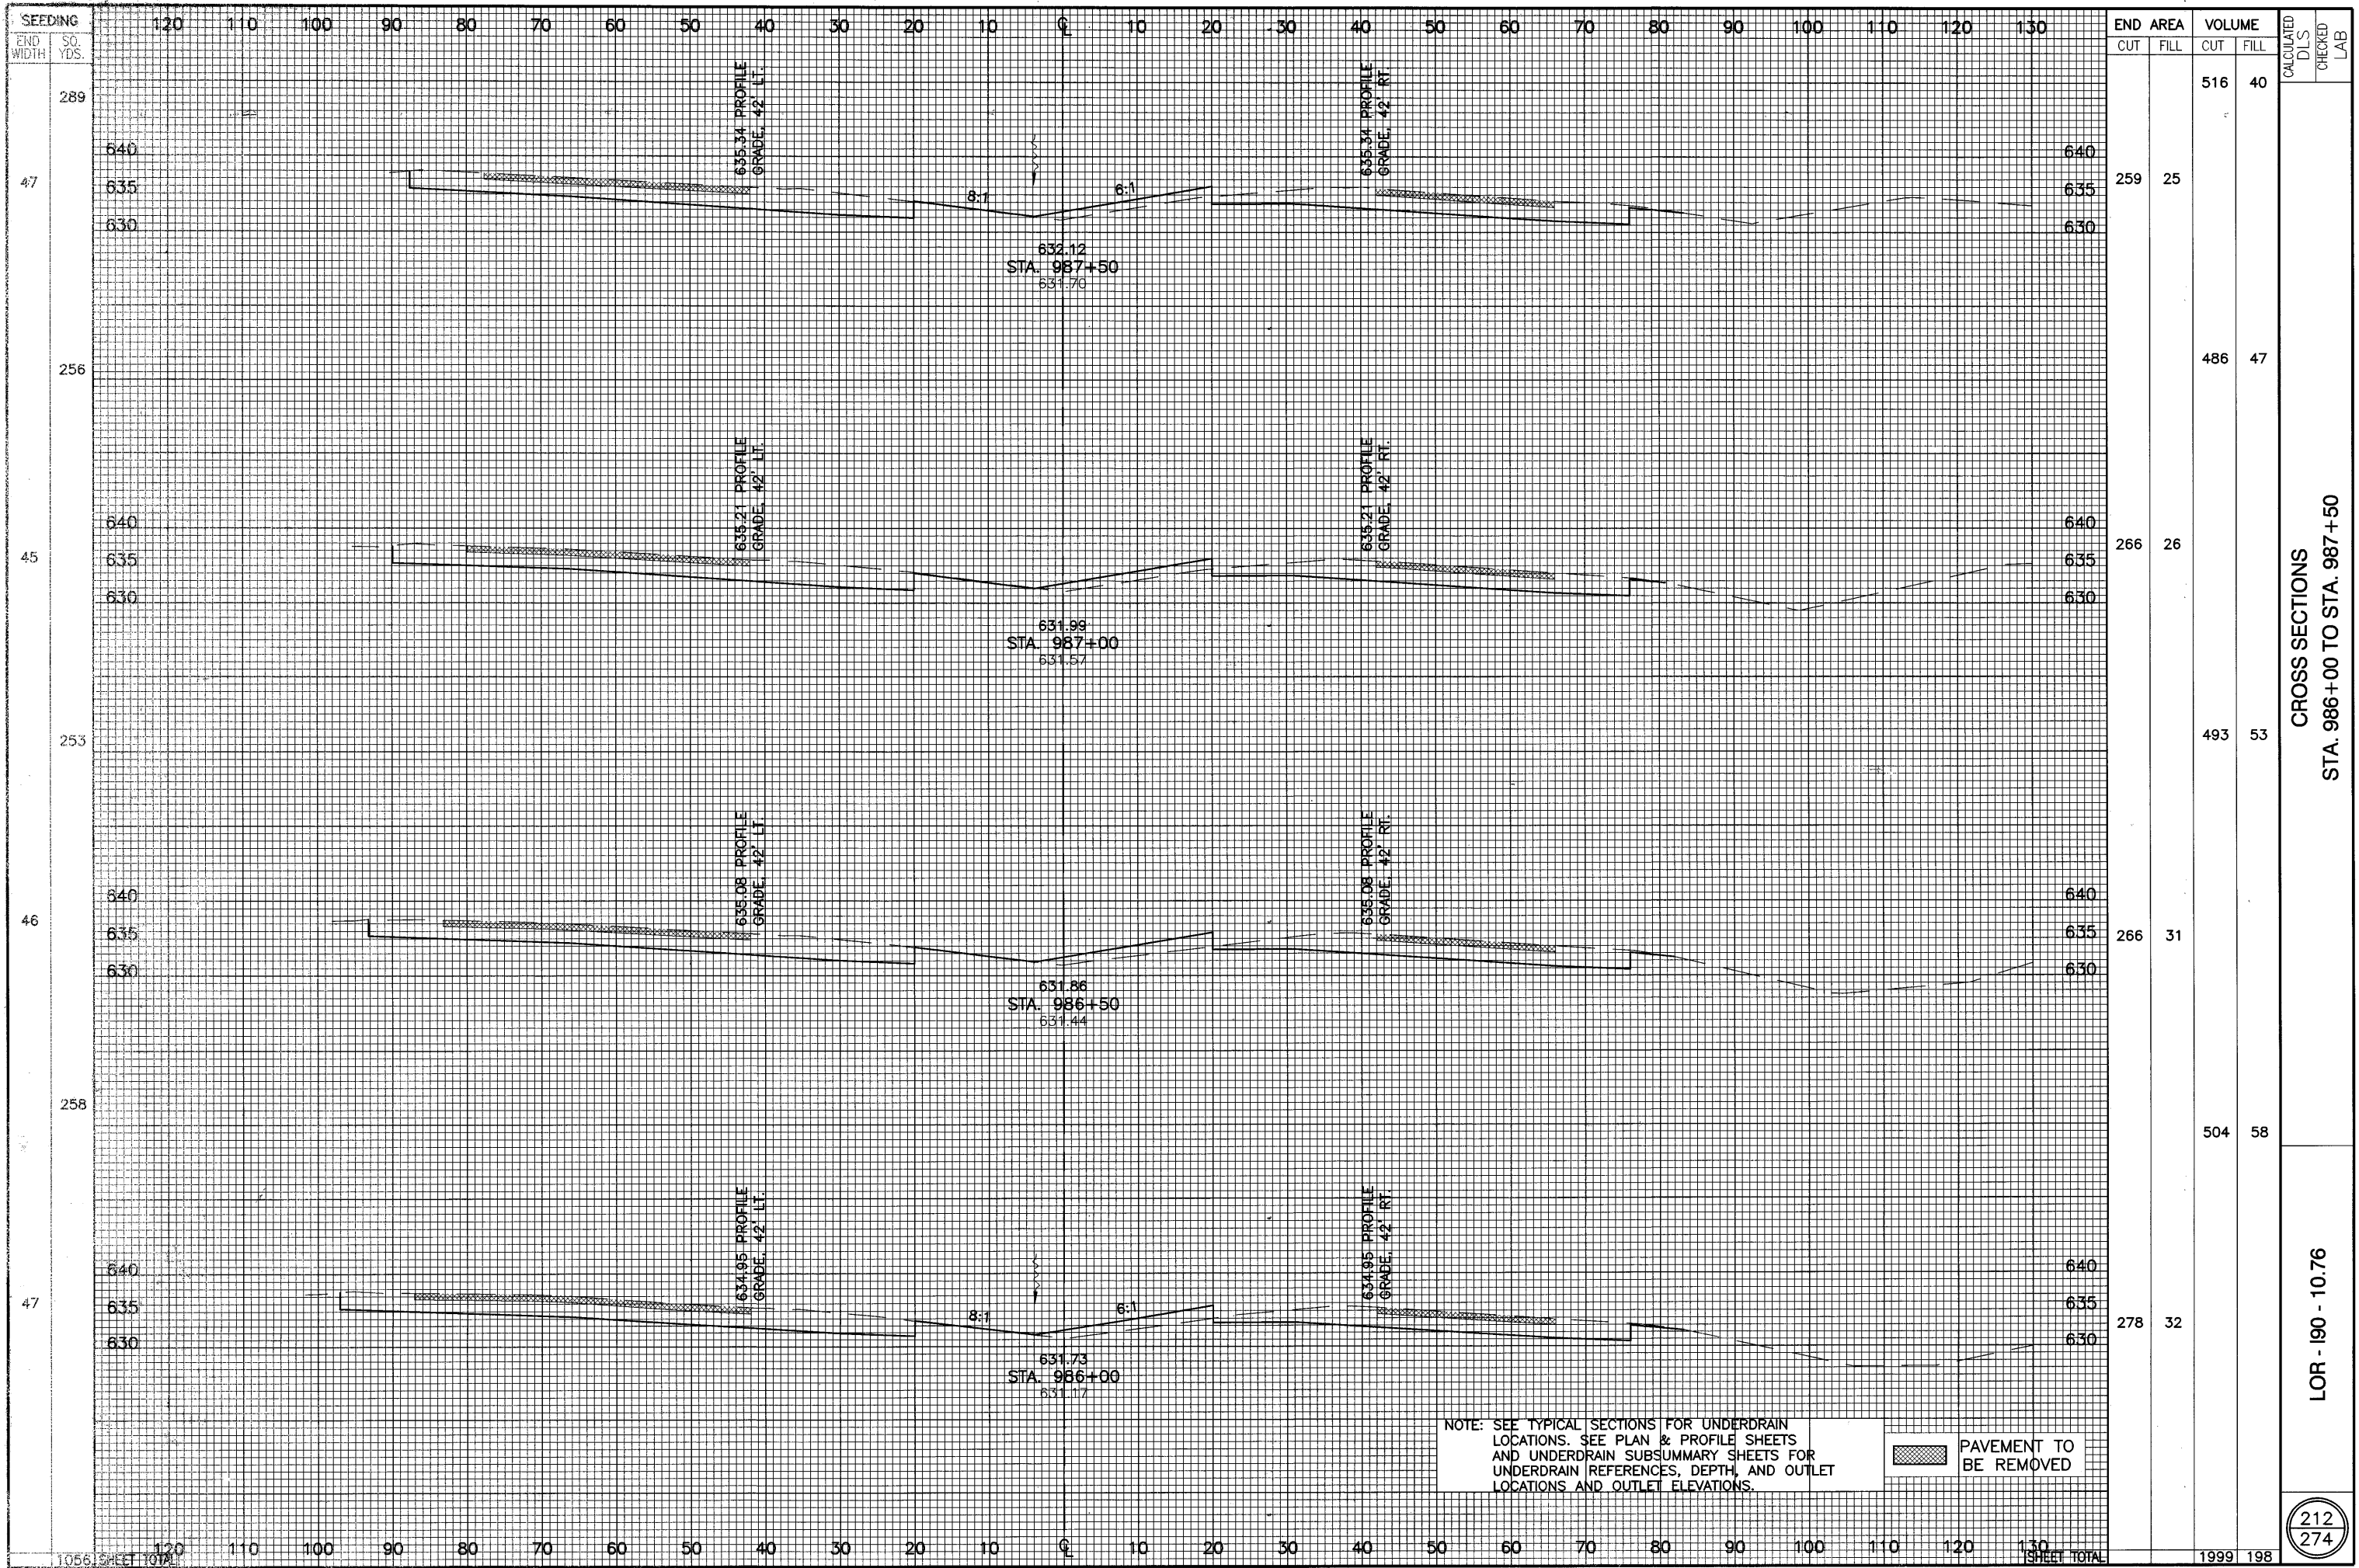

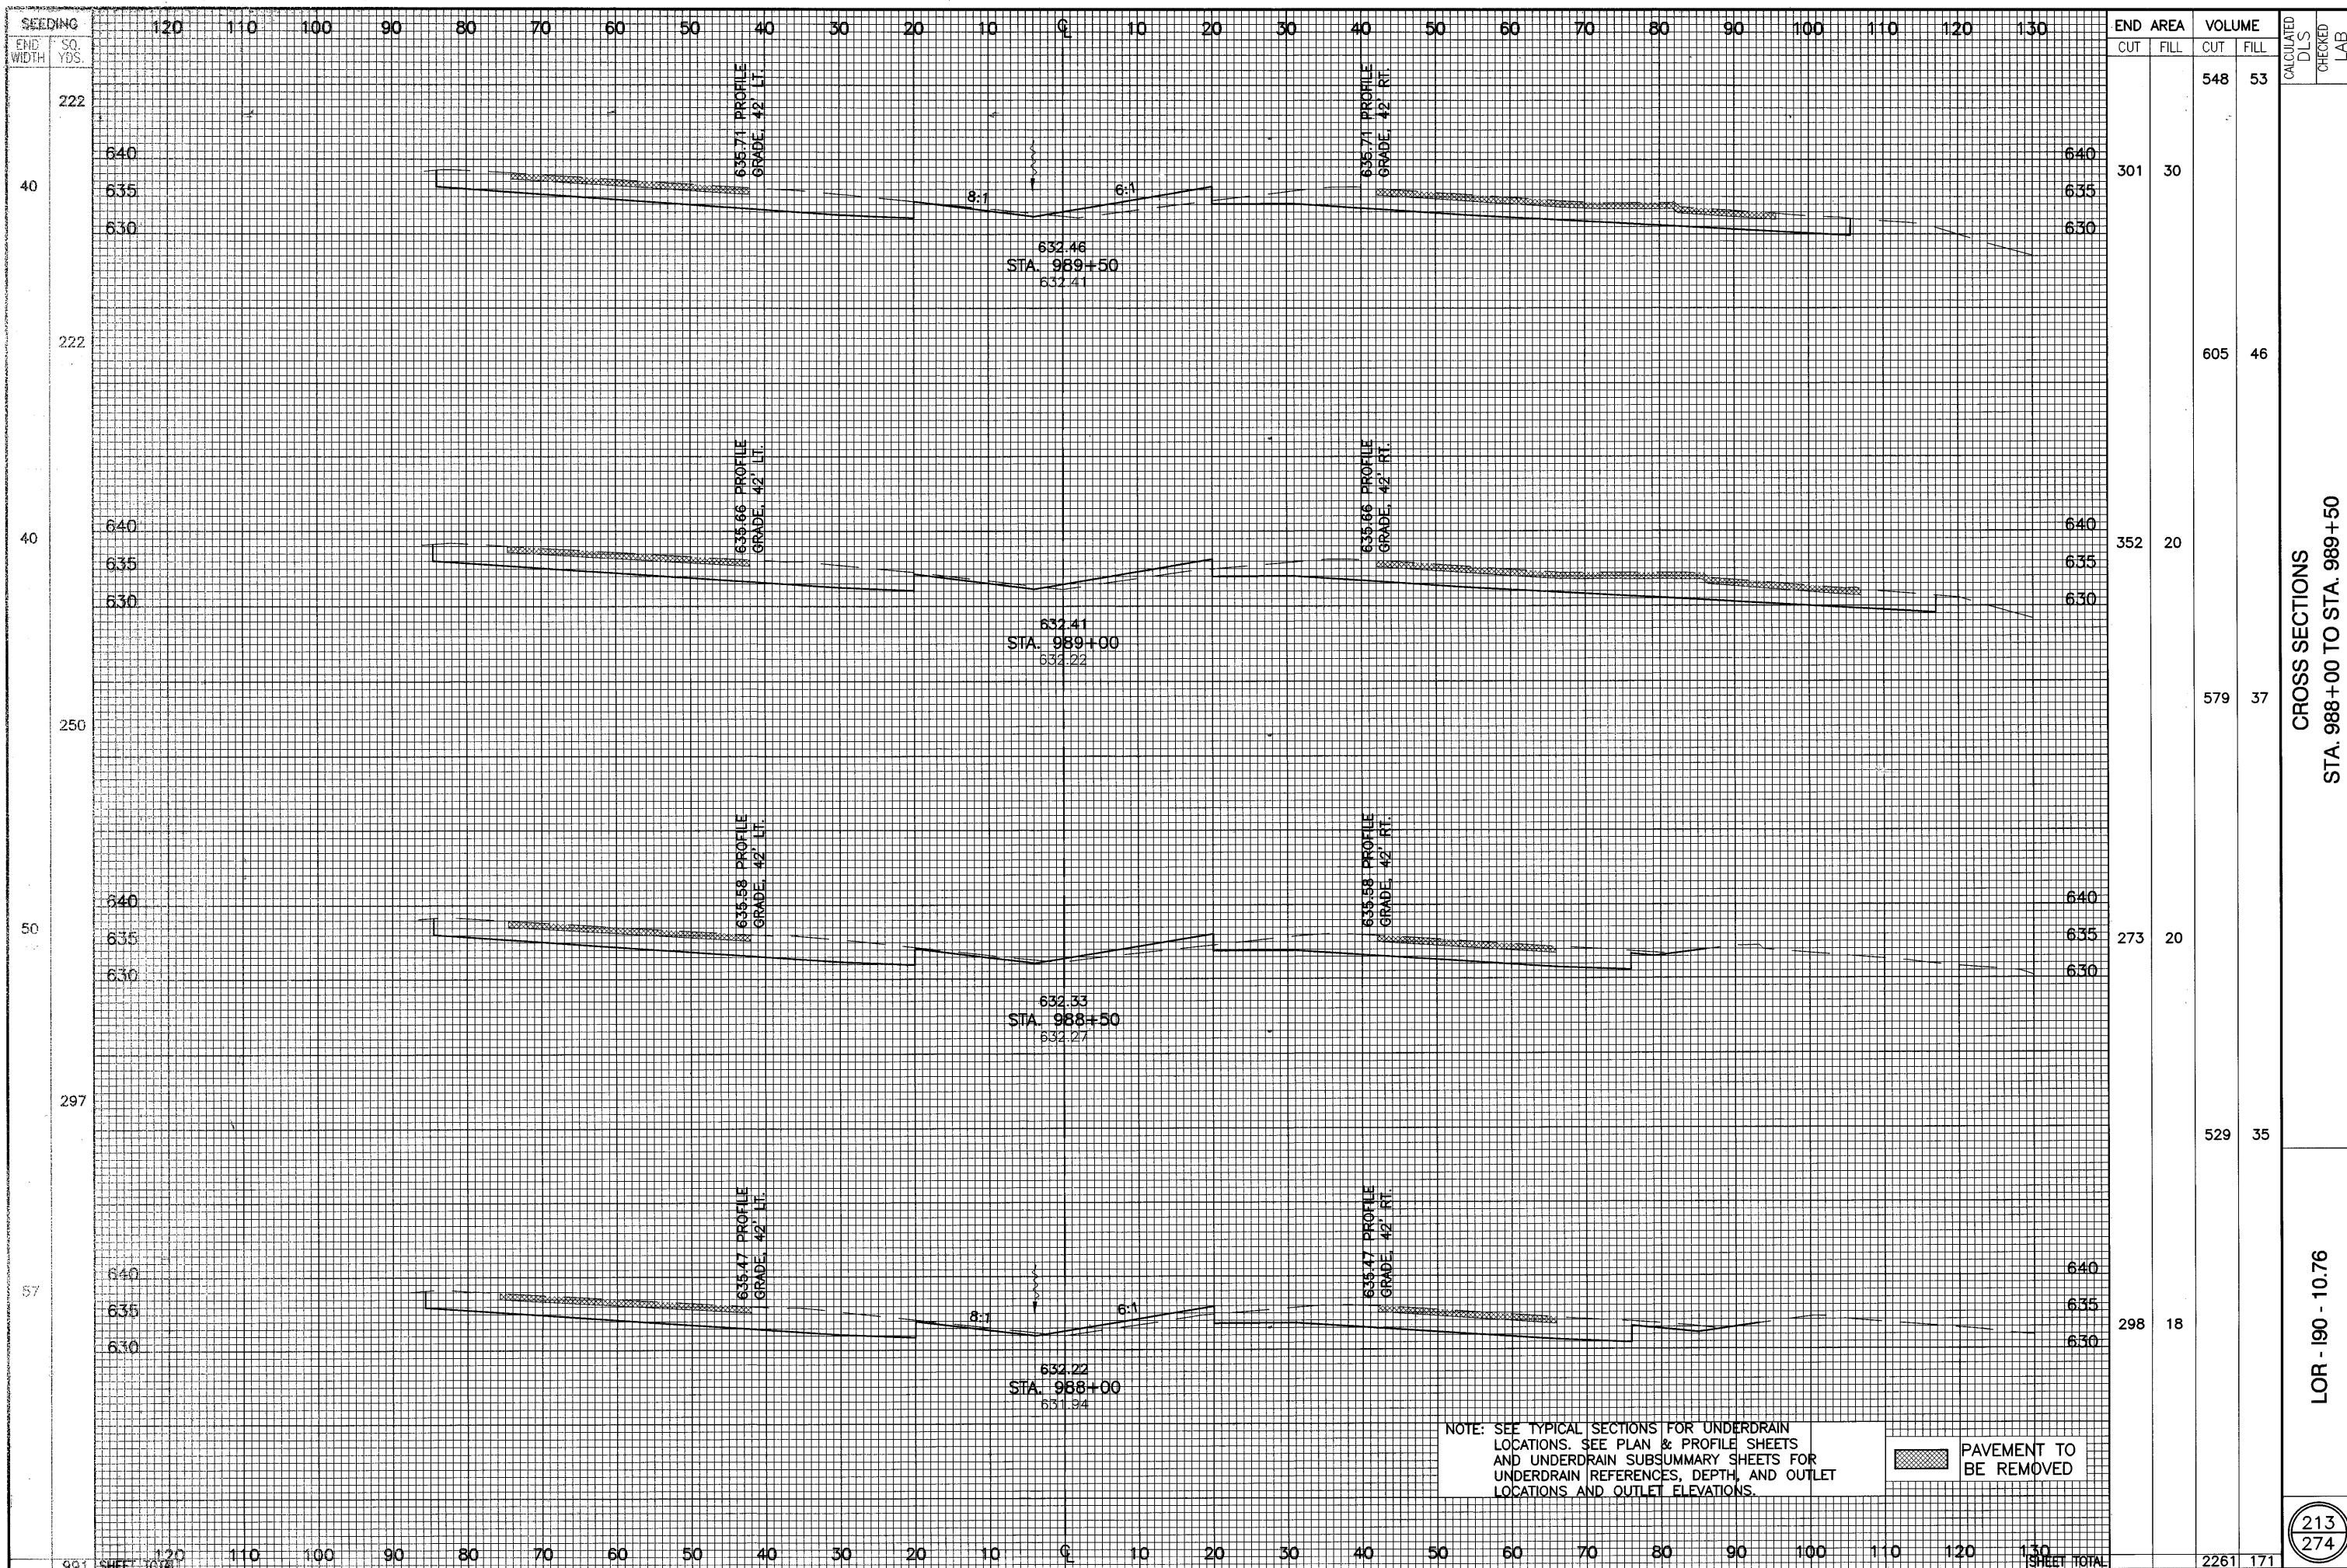

CROSS SECTIONS  
STA. 988+00 TO STA. 989+50

LOR - 190 - 10.76


213  
274

NOTE: SEE TYPICAL SECTIONS FOR UNDERDRAIN LOCATIONS. SEE PLAN & PROFILE SHEETS AND UNDERDRAIN SUBSUMMARY SHEETS FOR UNDERDRAIN REFERENCES, DEPTH, AND OUTLET LOCATIONS AND OUTLET ELEVATIONS.

PAVEMENT TO BE REMOVED

991 SHEET TOTAL

120 110 100 90 80 70 60 50 40 30 20 10 0 10 20 30 40 50 60 70 80 90 100 110 120 130 SHEET TOTAL

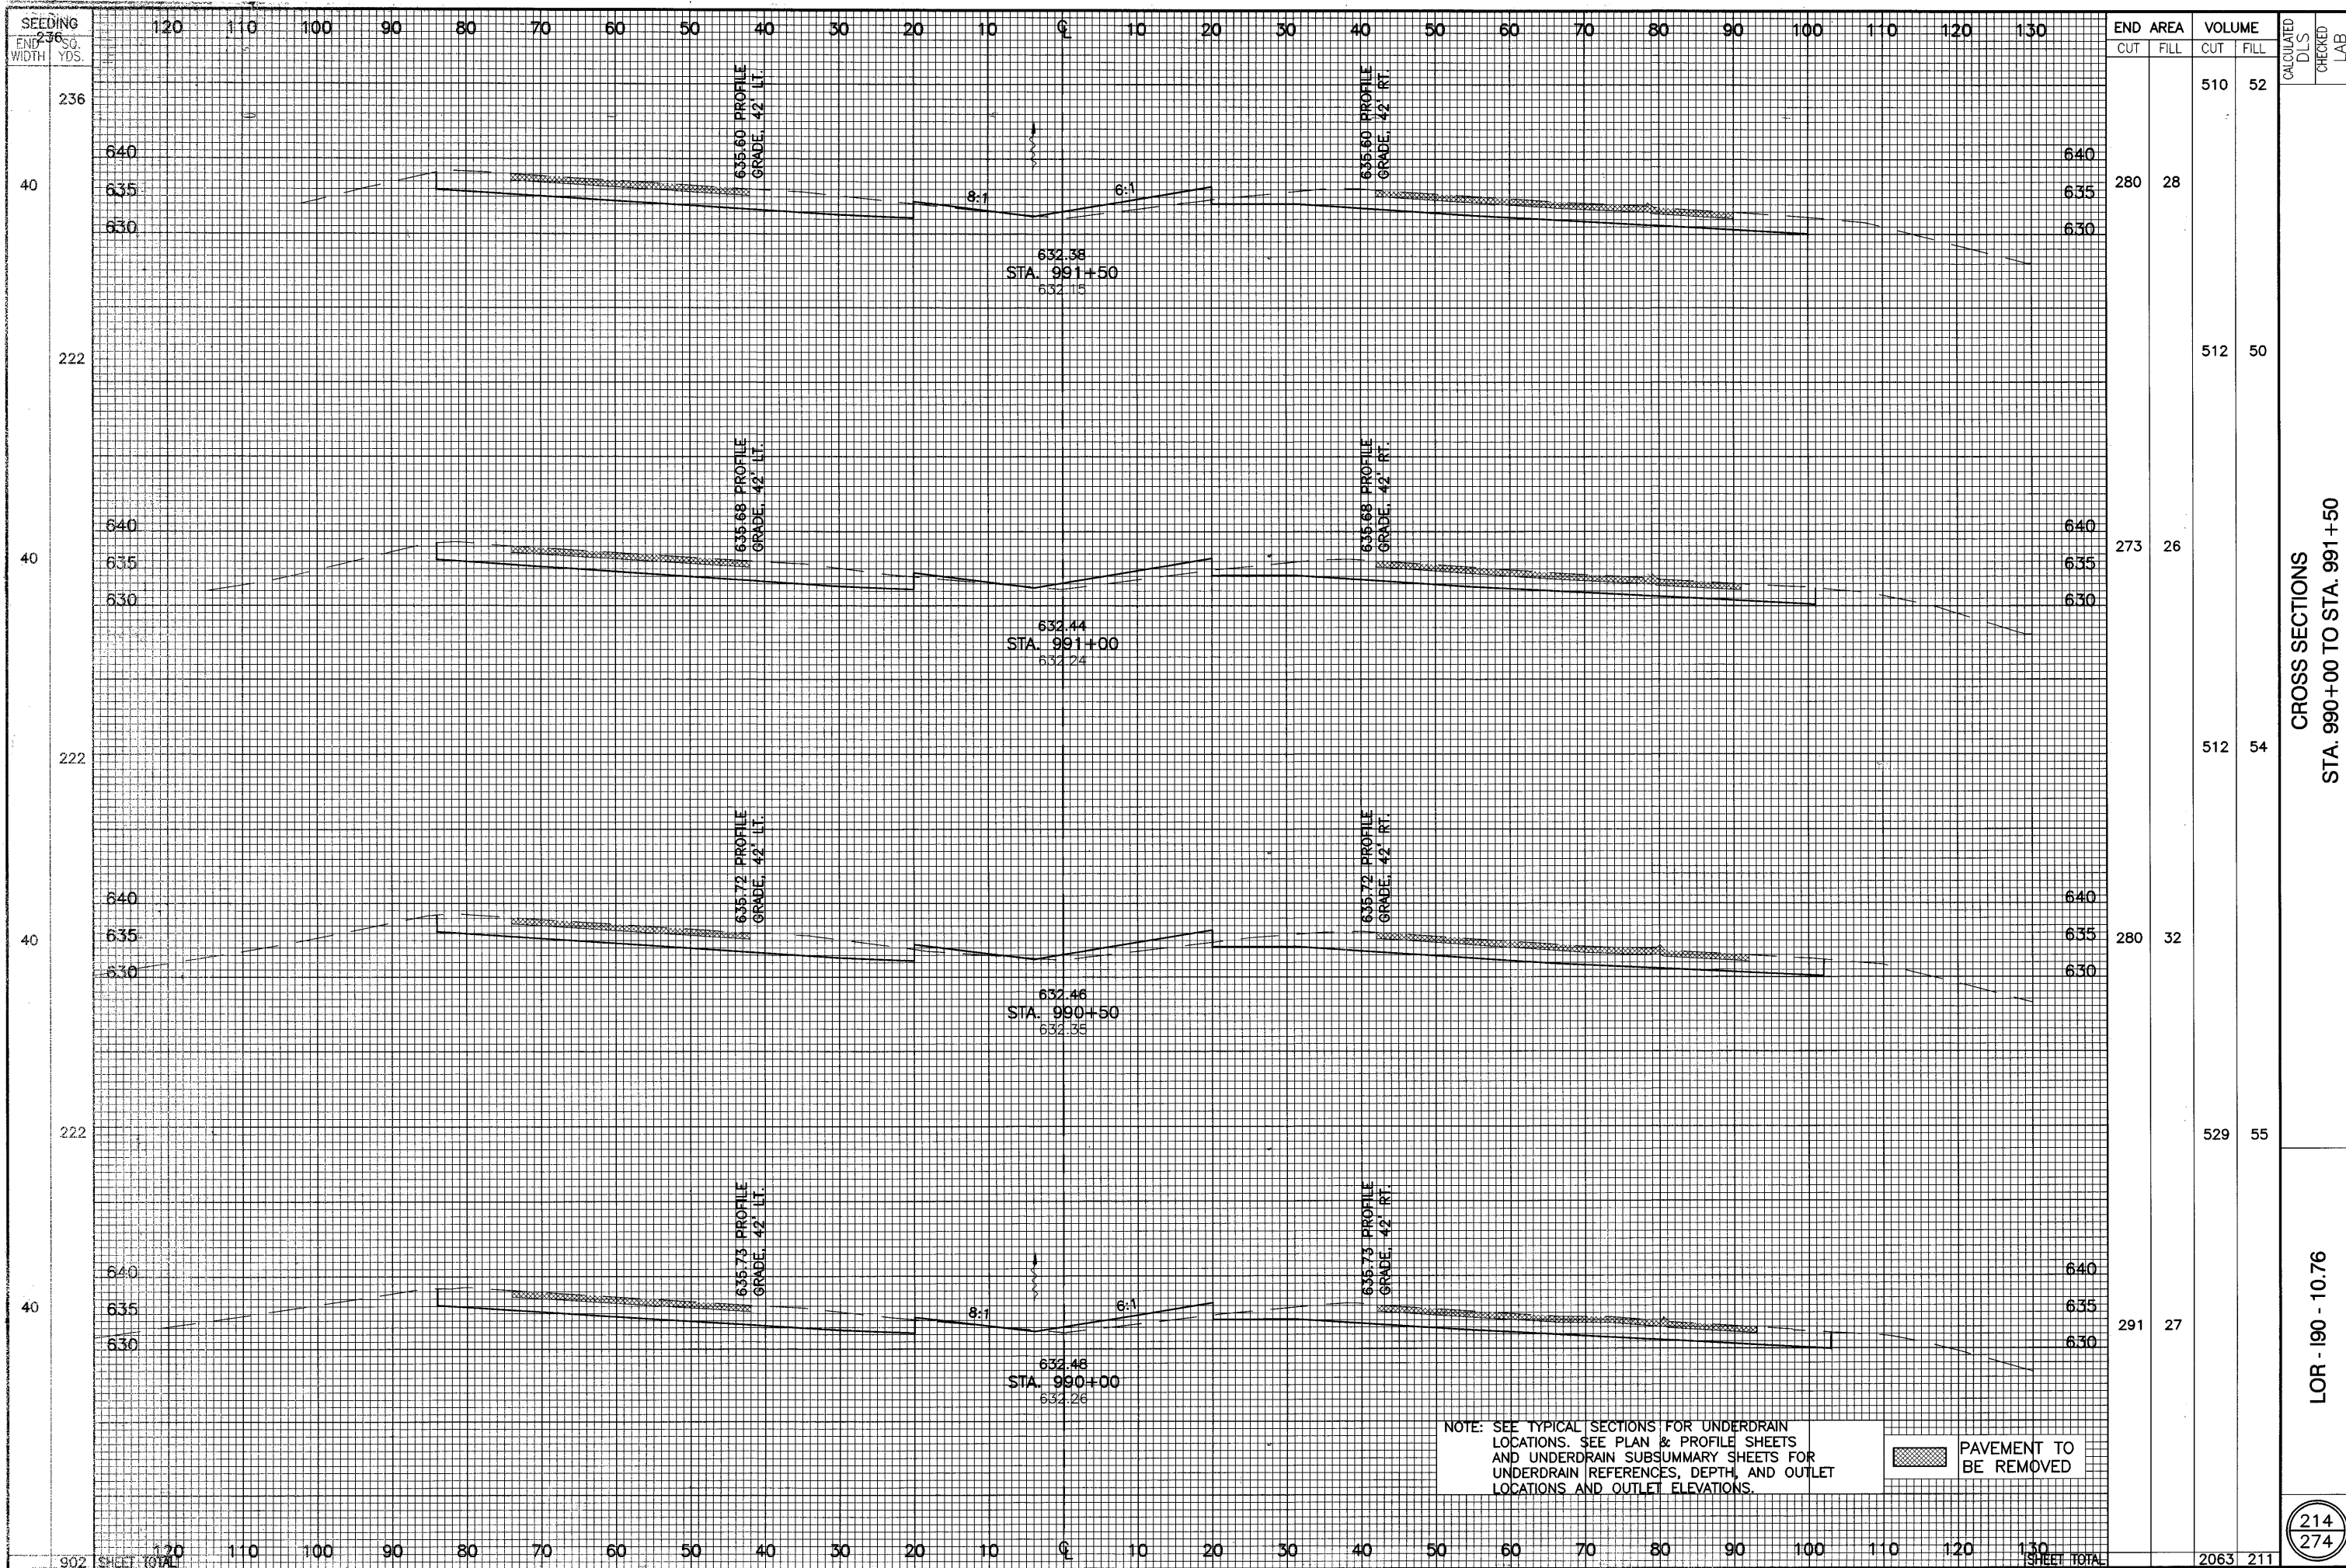

END AREA	VOLUME	CALCULATED	CHECKED		
				CUT	FILL
280	28	510	52		
273	26	512	50		
280	32	512	54		
291	27	529	55		
<b>2063</b>	<b>211</b>				


CROSS SECTIONS  
STA. 990+00 TO STA. 991+50

LOR - 190 - 10.76

NOTE: SEE TYPICAL SECTIONS FOR UNDERDRAIN LOCATIONS. SEE PLAN & PROFILE SHEETS AND UNDERDRAIN SUBSUMMARY SHEETS FOR UNDERDRAIN REFERENCES, DEPTH, AND OUTLET LOCATIONS AND OUTLET ELEVATIONS.

PAVEMENT TO BE REMOVED

SEEDING END WIDTH 236 SQ. YDS. 120 110 100 90 80 70 60 50 40 30 20 10 0 10 20 30 40 50 60 70 80 90 100 110 120 130

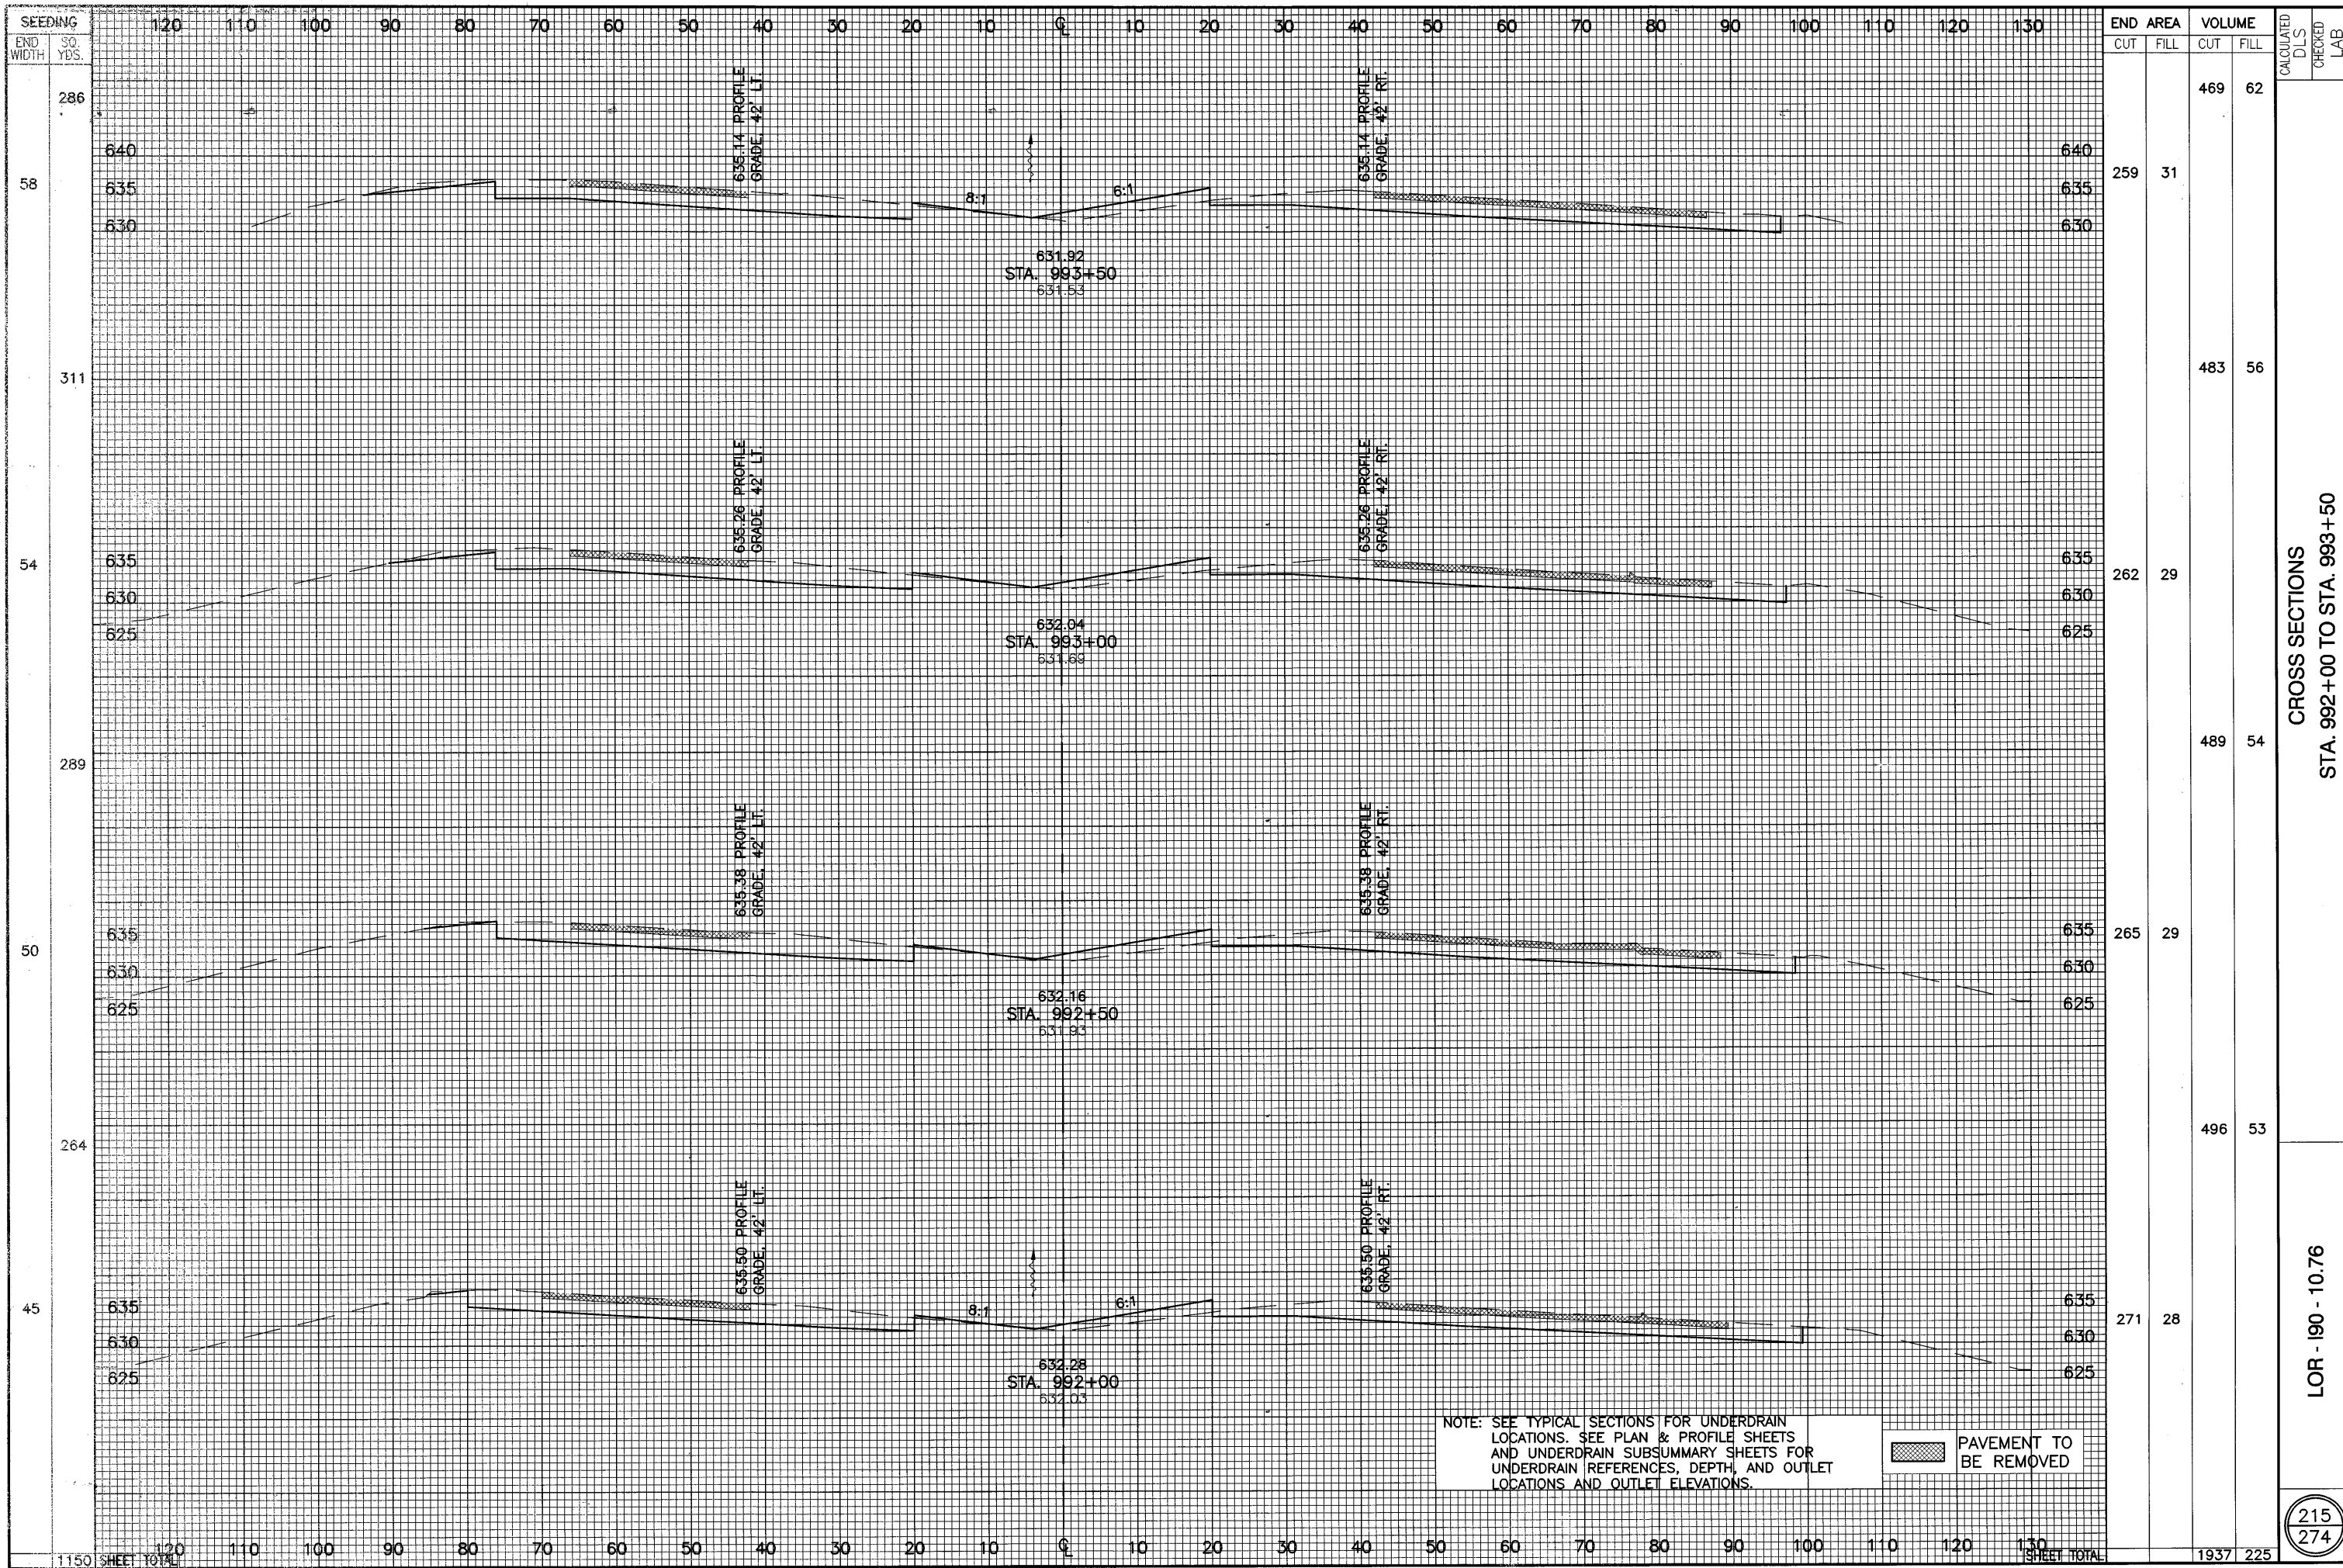


CROSS SECTIONS  
 STA. 992+00 TO STA. 993+50

LOR - 190 - 10.76

NOTE: SEE TYPICAL SECTIONS FOR UNDERDRAIN LOCATIONS. SEE PLAN & PROFILE SHEETS FOR UNDERDRAIN REFERENCES, DEPTH, AND OUTLET LOCATIONS AND OUTLET ELEVATIONS.

PAVEMENT TO BE REMOVED

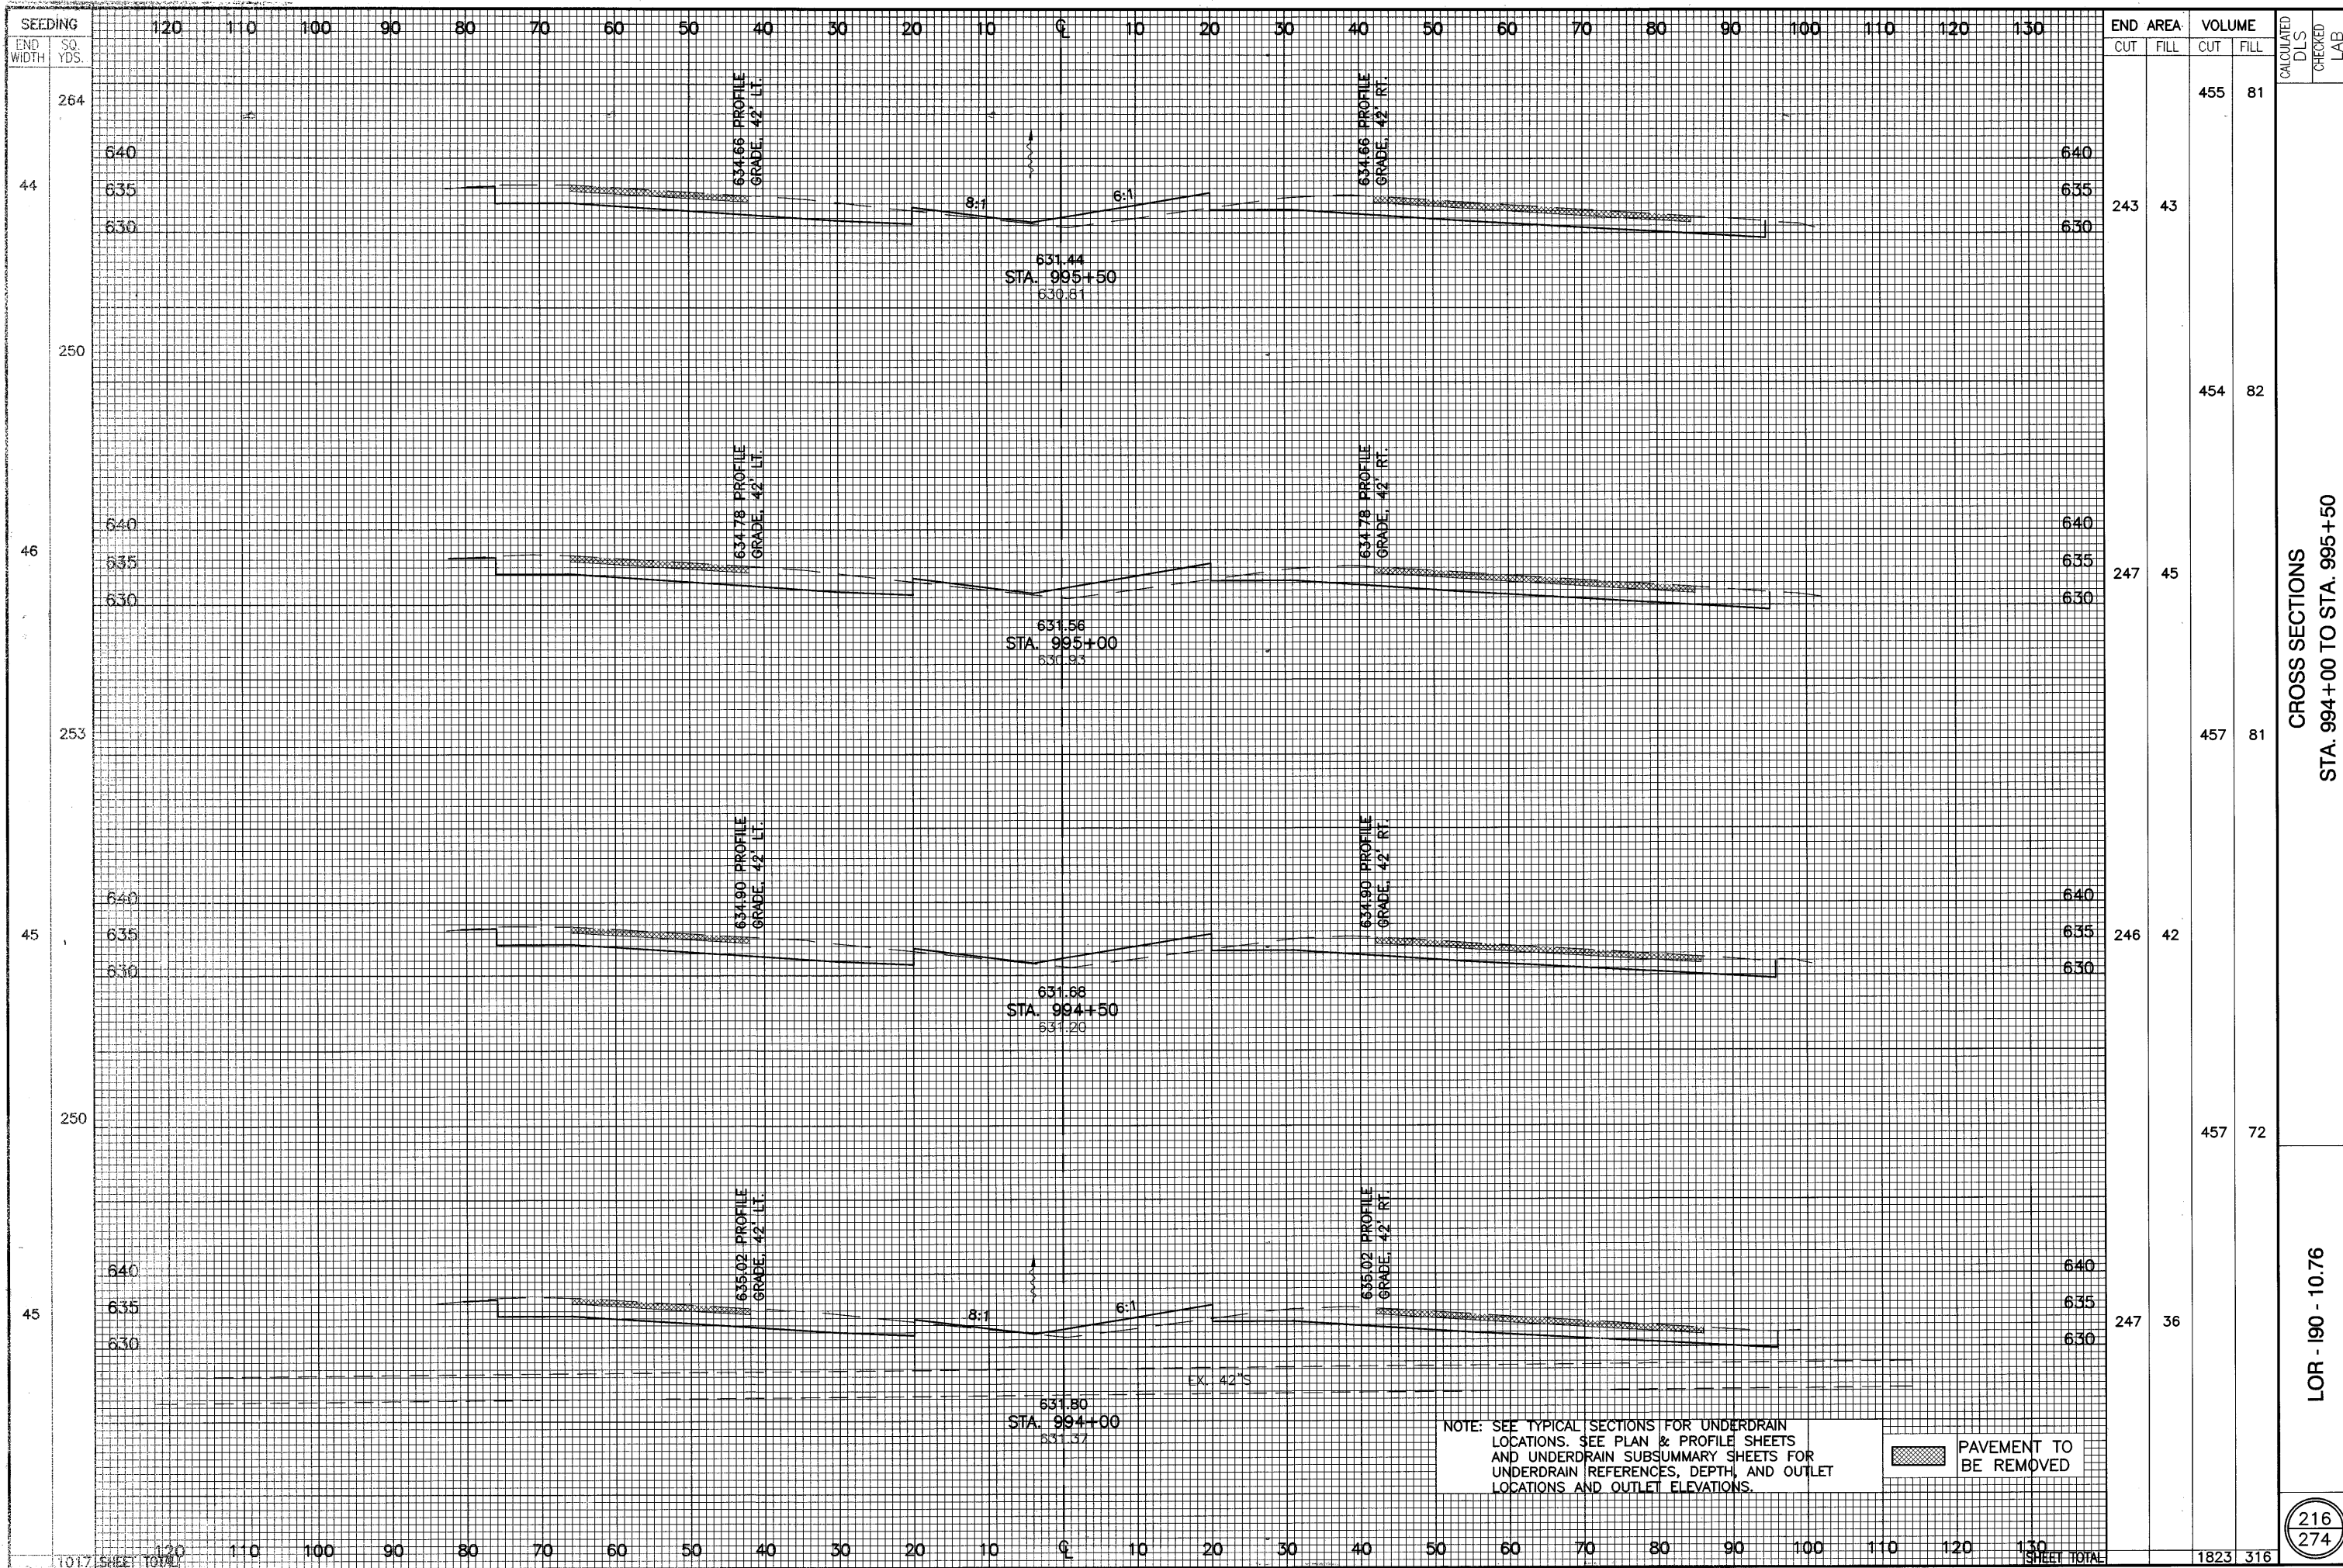

END CUT	AREA FILL	VOLUME		CALCULATED DLS	CHECKED LAB
		CUT	FILL		
243	43	455	81		
247	45	454	82		
246	42	457	81		
247	36	457	72		
<b>1823</b>	<b>316</b>				


CROSS SECTIONS  
STA. 994+00 TO STA. 995+50

LOR - 190 - 10.76

1017 SHEET TOTAL

120 110 100 90 80 70 60 50 40 30 20 10 0 10 20 30 40 50 60 70 80 90 100 110 120 130  
SHEET TOTAL



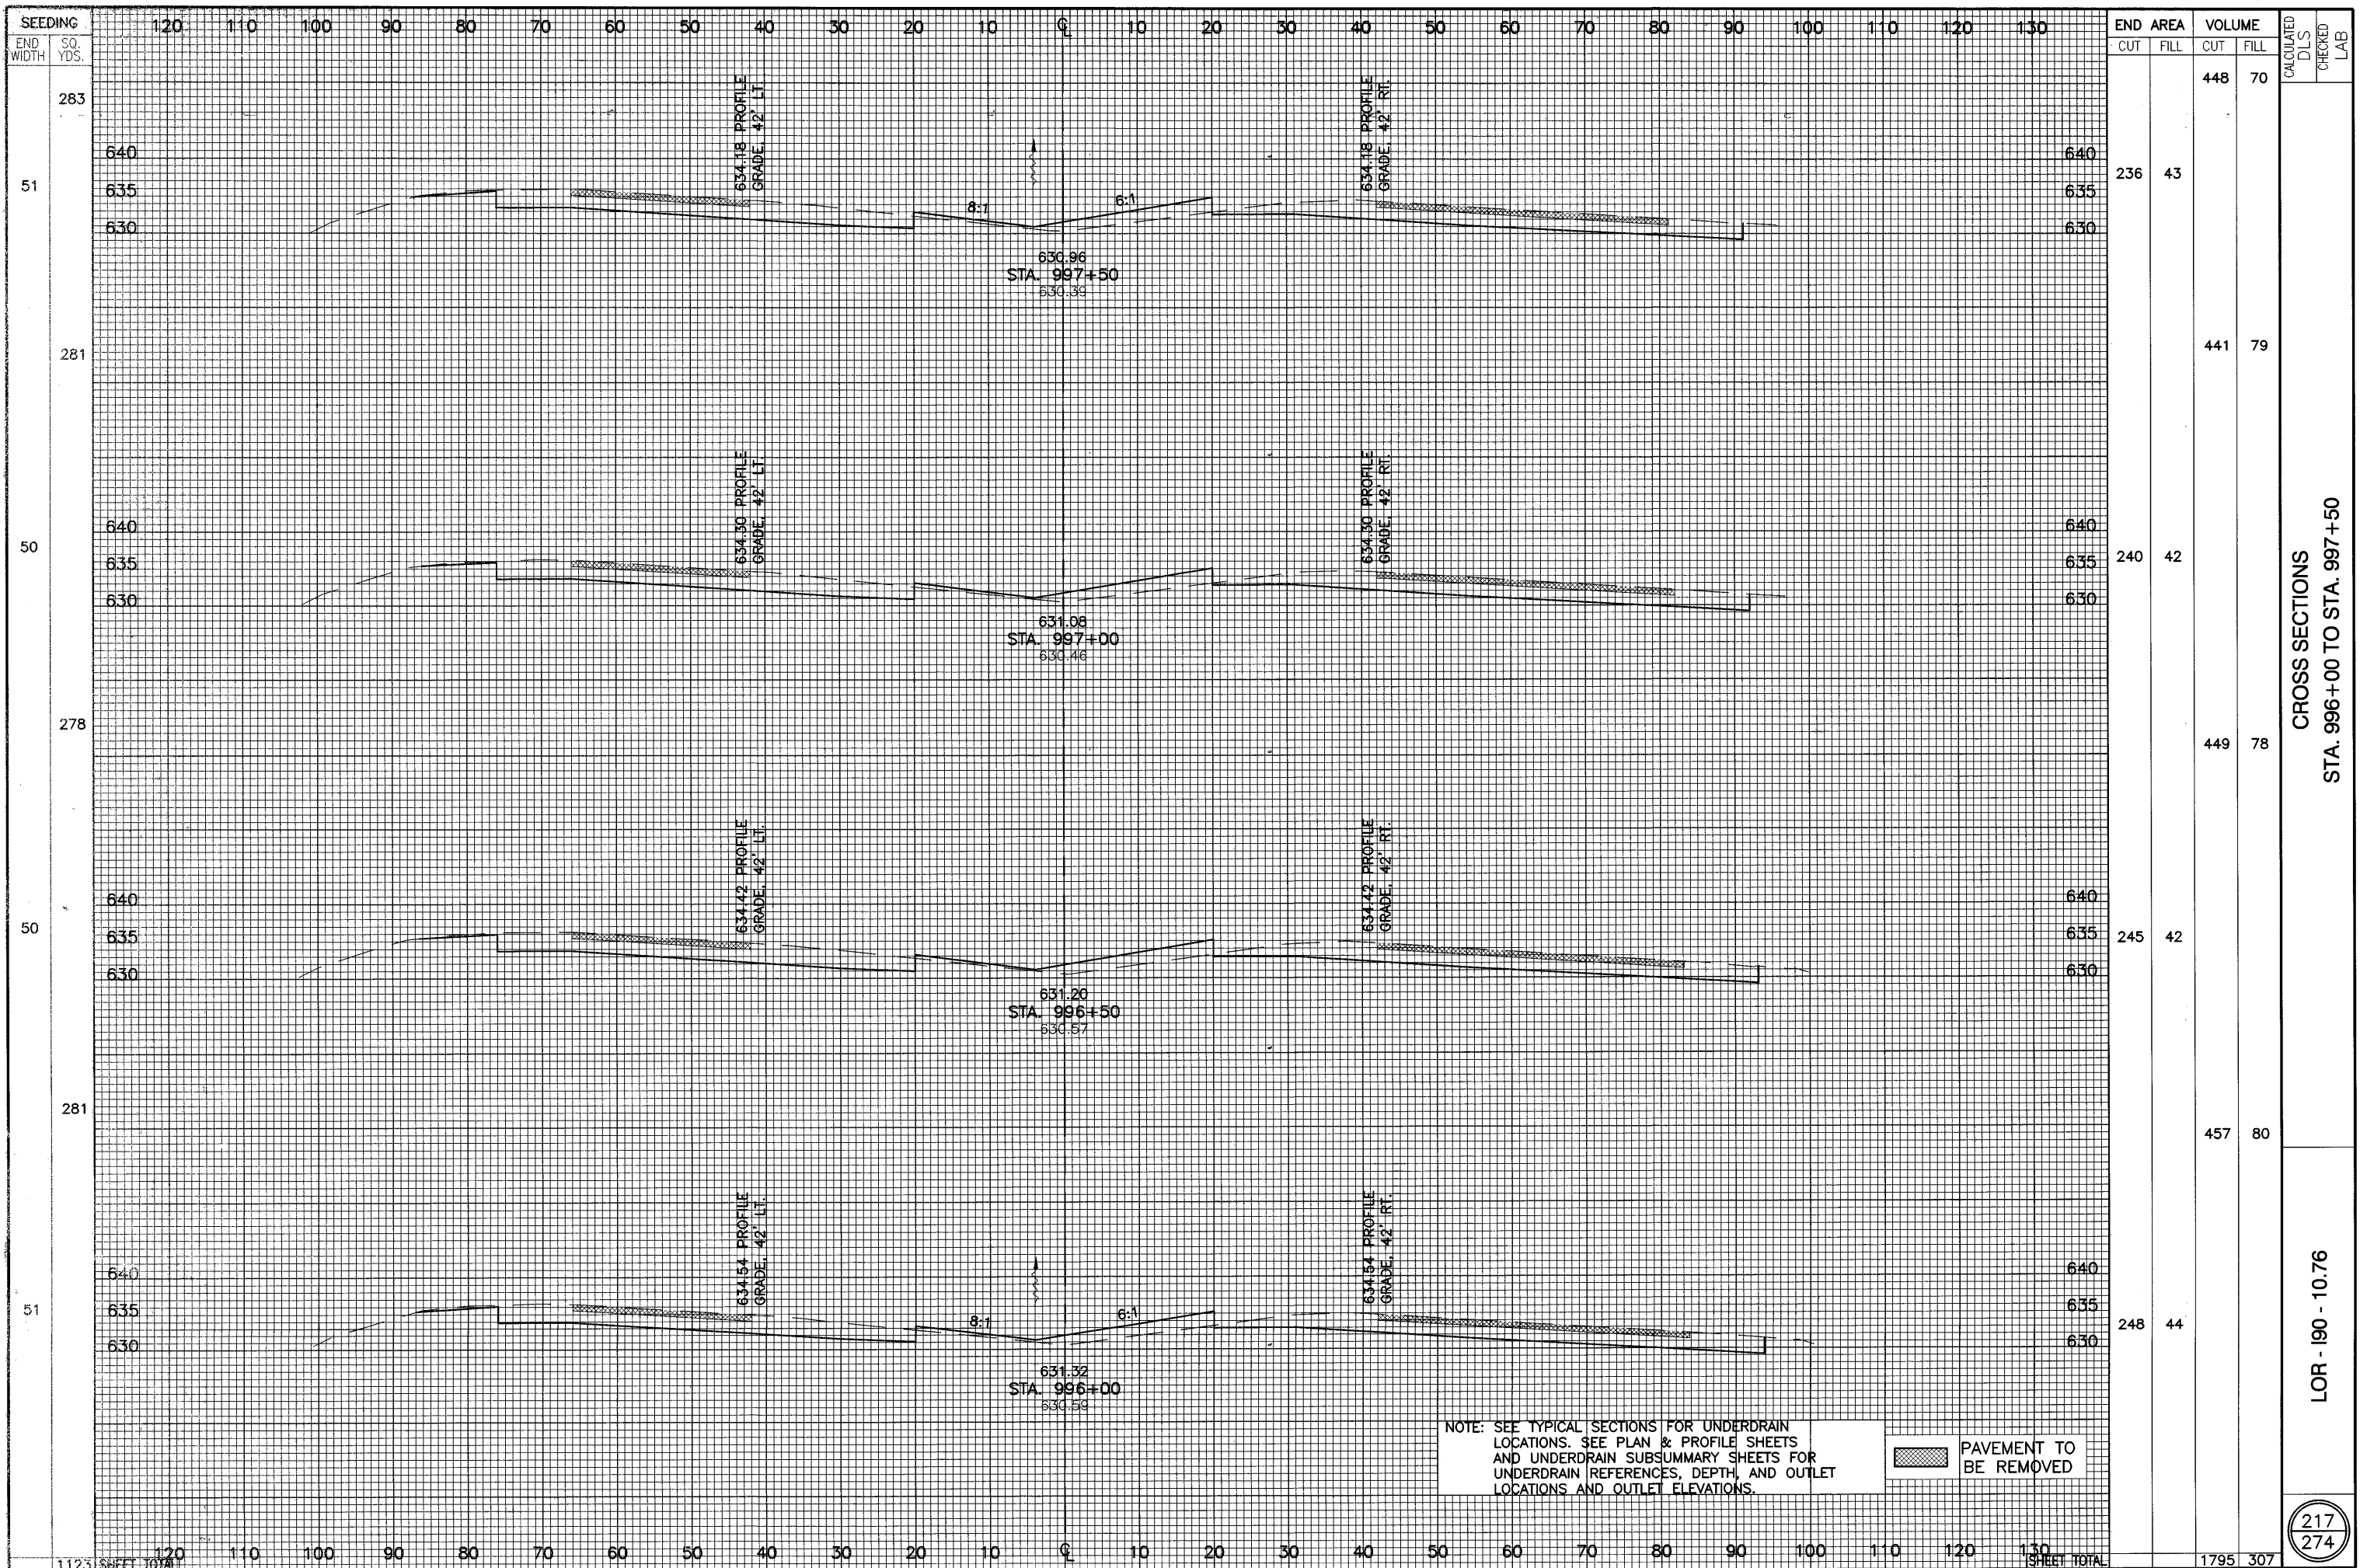

END AREA	VOLUME	CALCULATED	CHECKED	LAB
236	43	448	70	
240	42	441	79	
245	42	449	78	
248	44	457	80	
1795	307			


CROSS SECTIONS  
STA. 996+00 TO STA. 997+50

LOR - 190 - 10.76

217  
274

NOTE: SEE TYPICAL SECTIONS FOR UNDERDRAIN LOCATIONS. SEE PLAN & PROFILE SHEETS FOR UNDERDRAIN REFERENCES, DEPTH, AND OUTLET LOCATIONS AND OUTLET ELEVATIONS.

PAVEMENT TO BE REMOVED

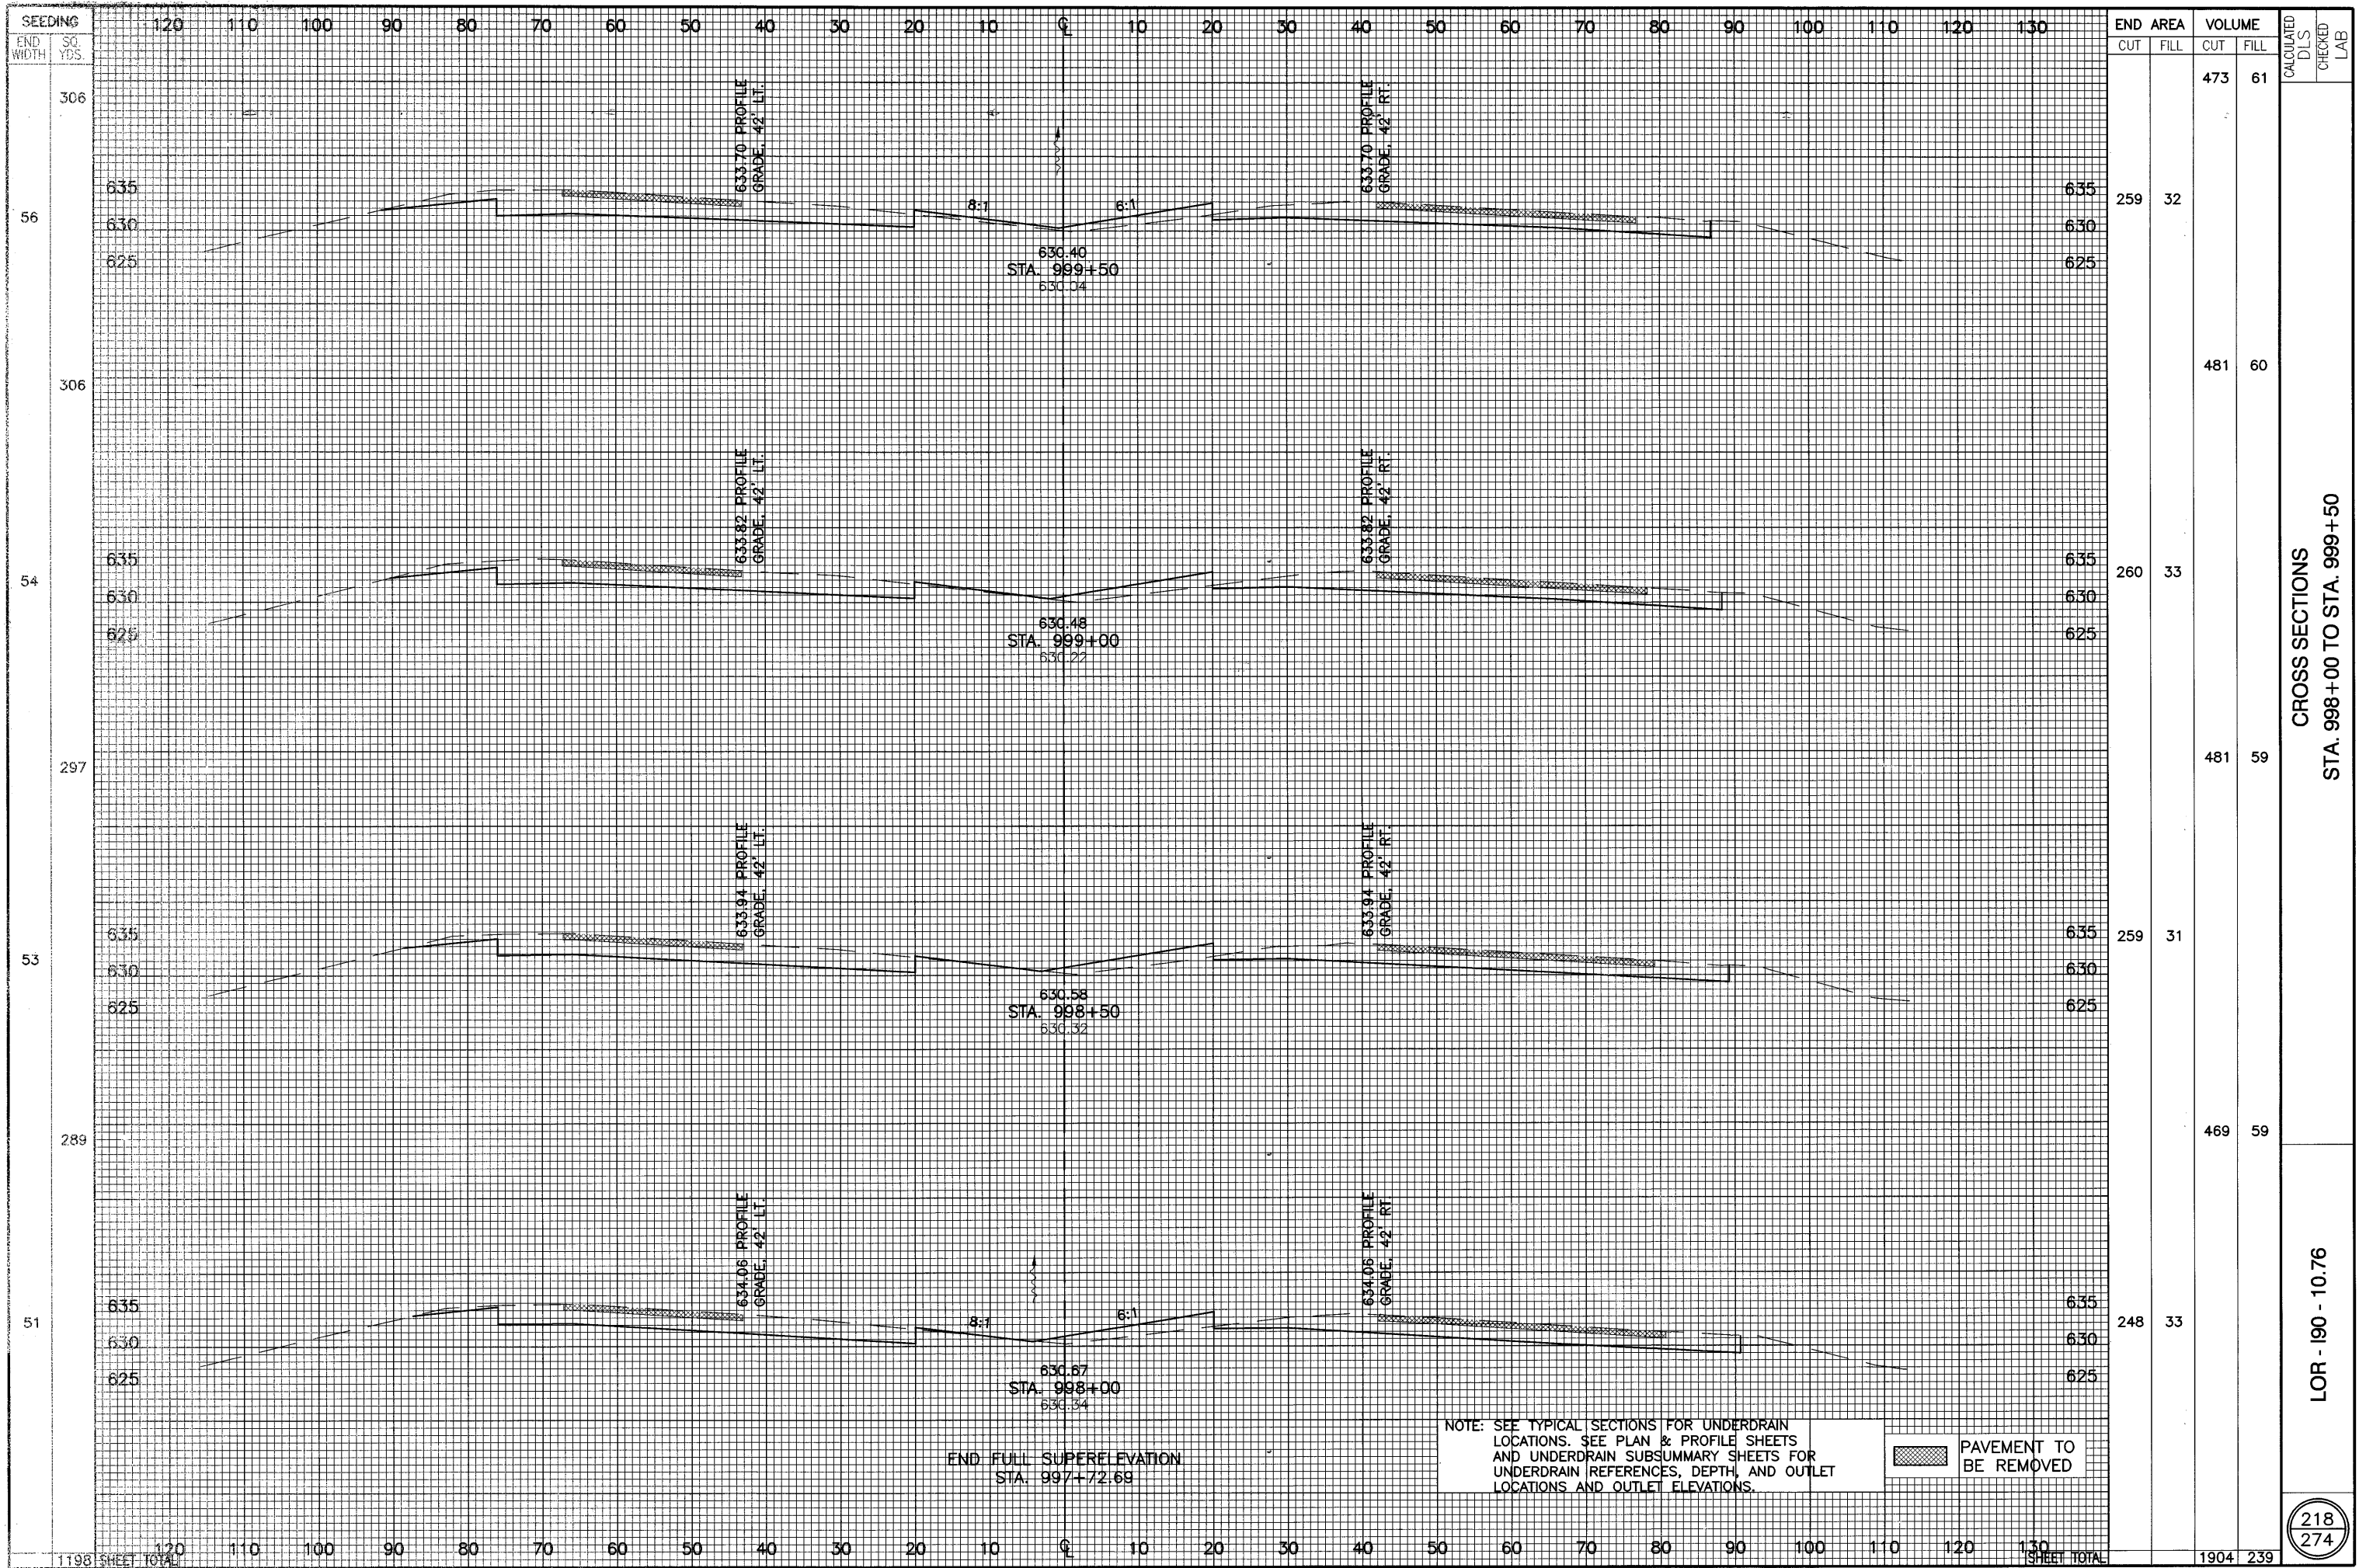


SEEDING END WIDTH SQ YDS.	END AREA		VOLUME		CALCULATED D.S.	CHECKED LAB
	CUT	FILL	CUT	FILL		
306			473	61		
56	635	635	259	32		
	630	630				
	625	625				
306			481	60		
54	635	635	260	33		
	630	630				
	625	625				
297			481	59		
53	635	635	259	31		
	630	630				
	625	625				
289			469	59		
51	635	635	248	33		
	630	630				
	625	625				
1198 SHEET TOTAL			1904	239		

CROSS SECTIONS  
STA. 998+00 TO STA. 999+50

LOR - 190 - 10.76


218  
274

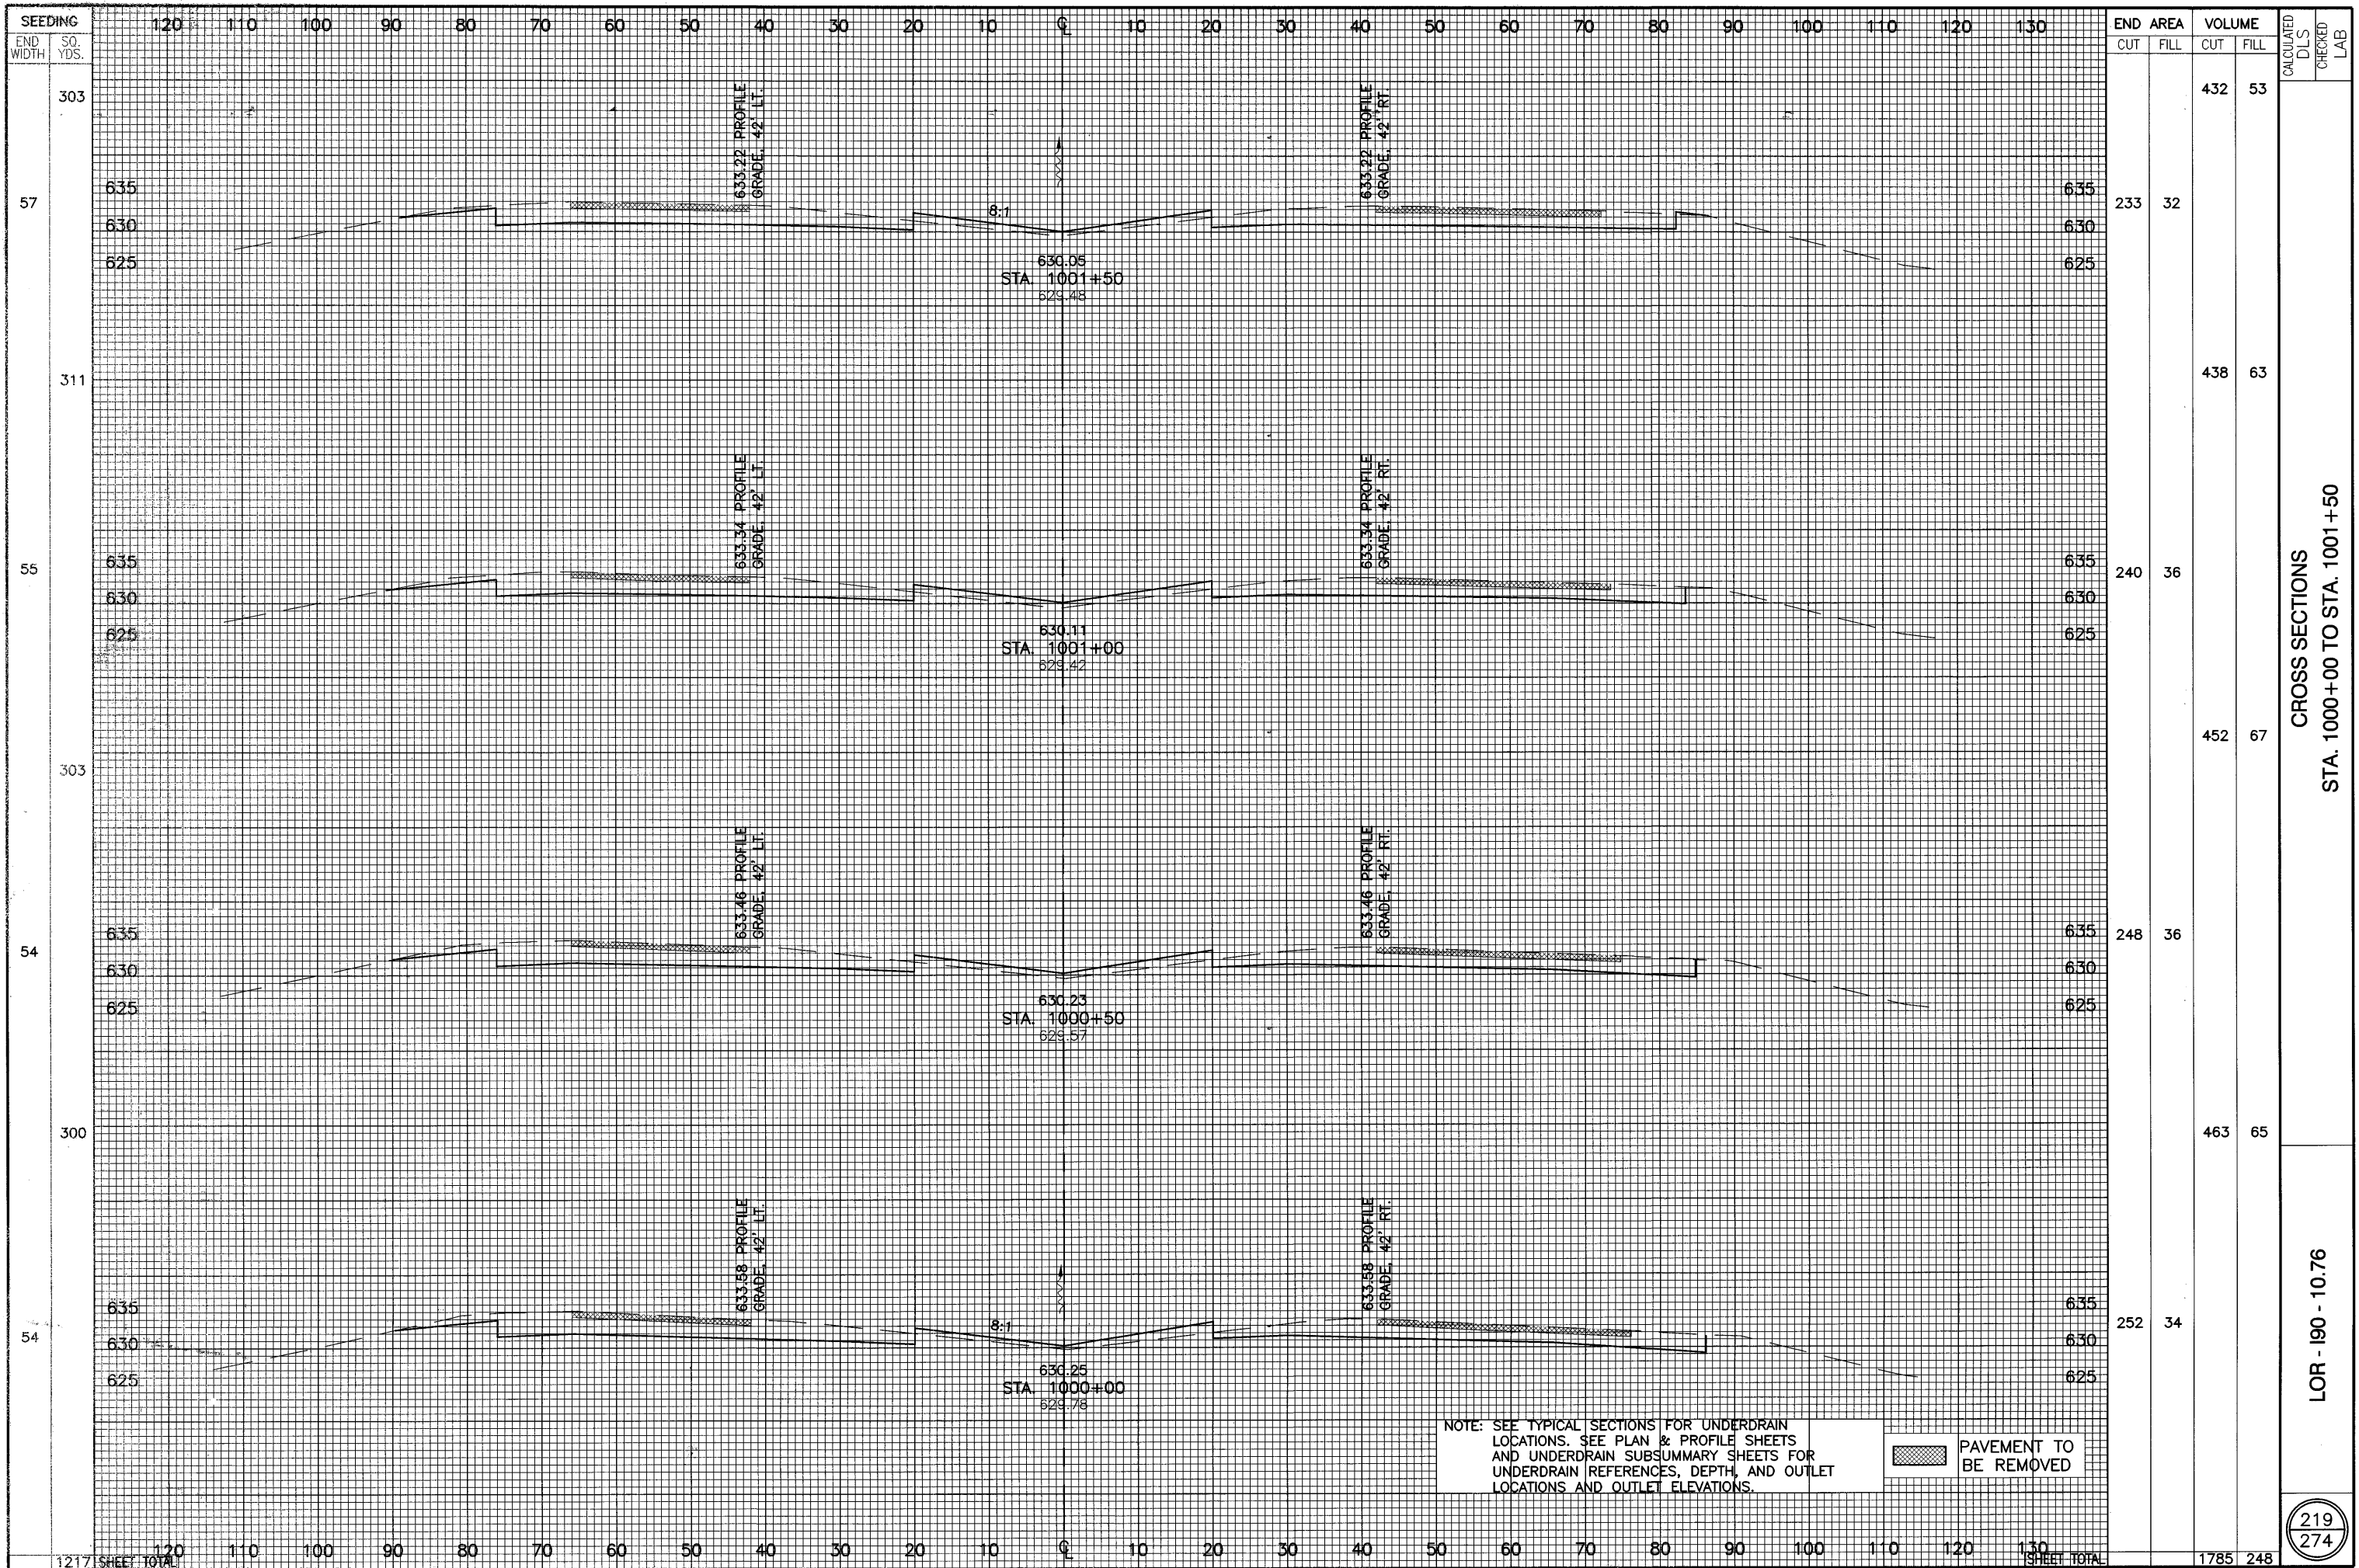

LOR - 190 - 10.76

CROSS SECTIONS  
STA. 1000+00 TO STA. 1001+50

CALCULATED  
D.I.S.  
CHECKED  
LAB

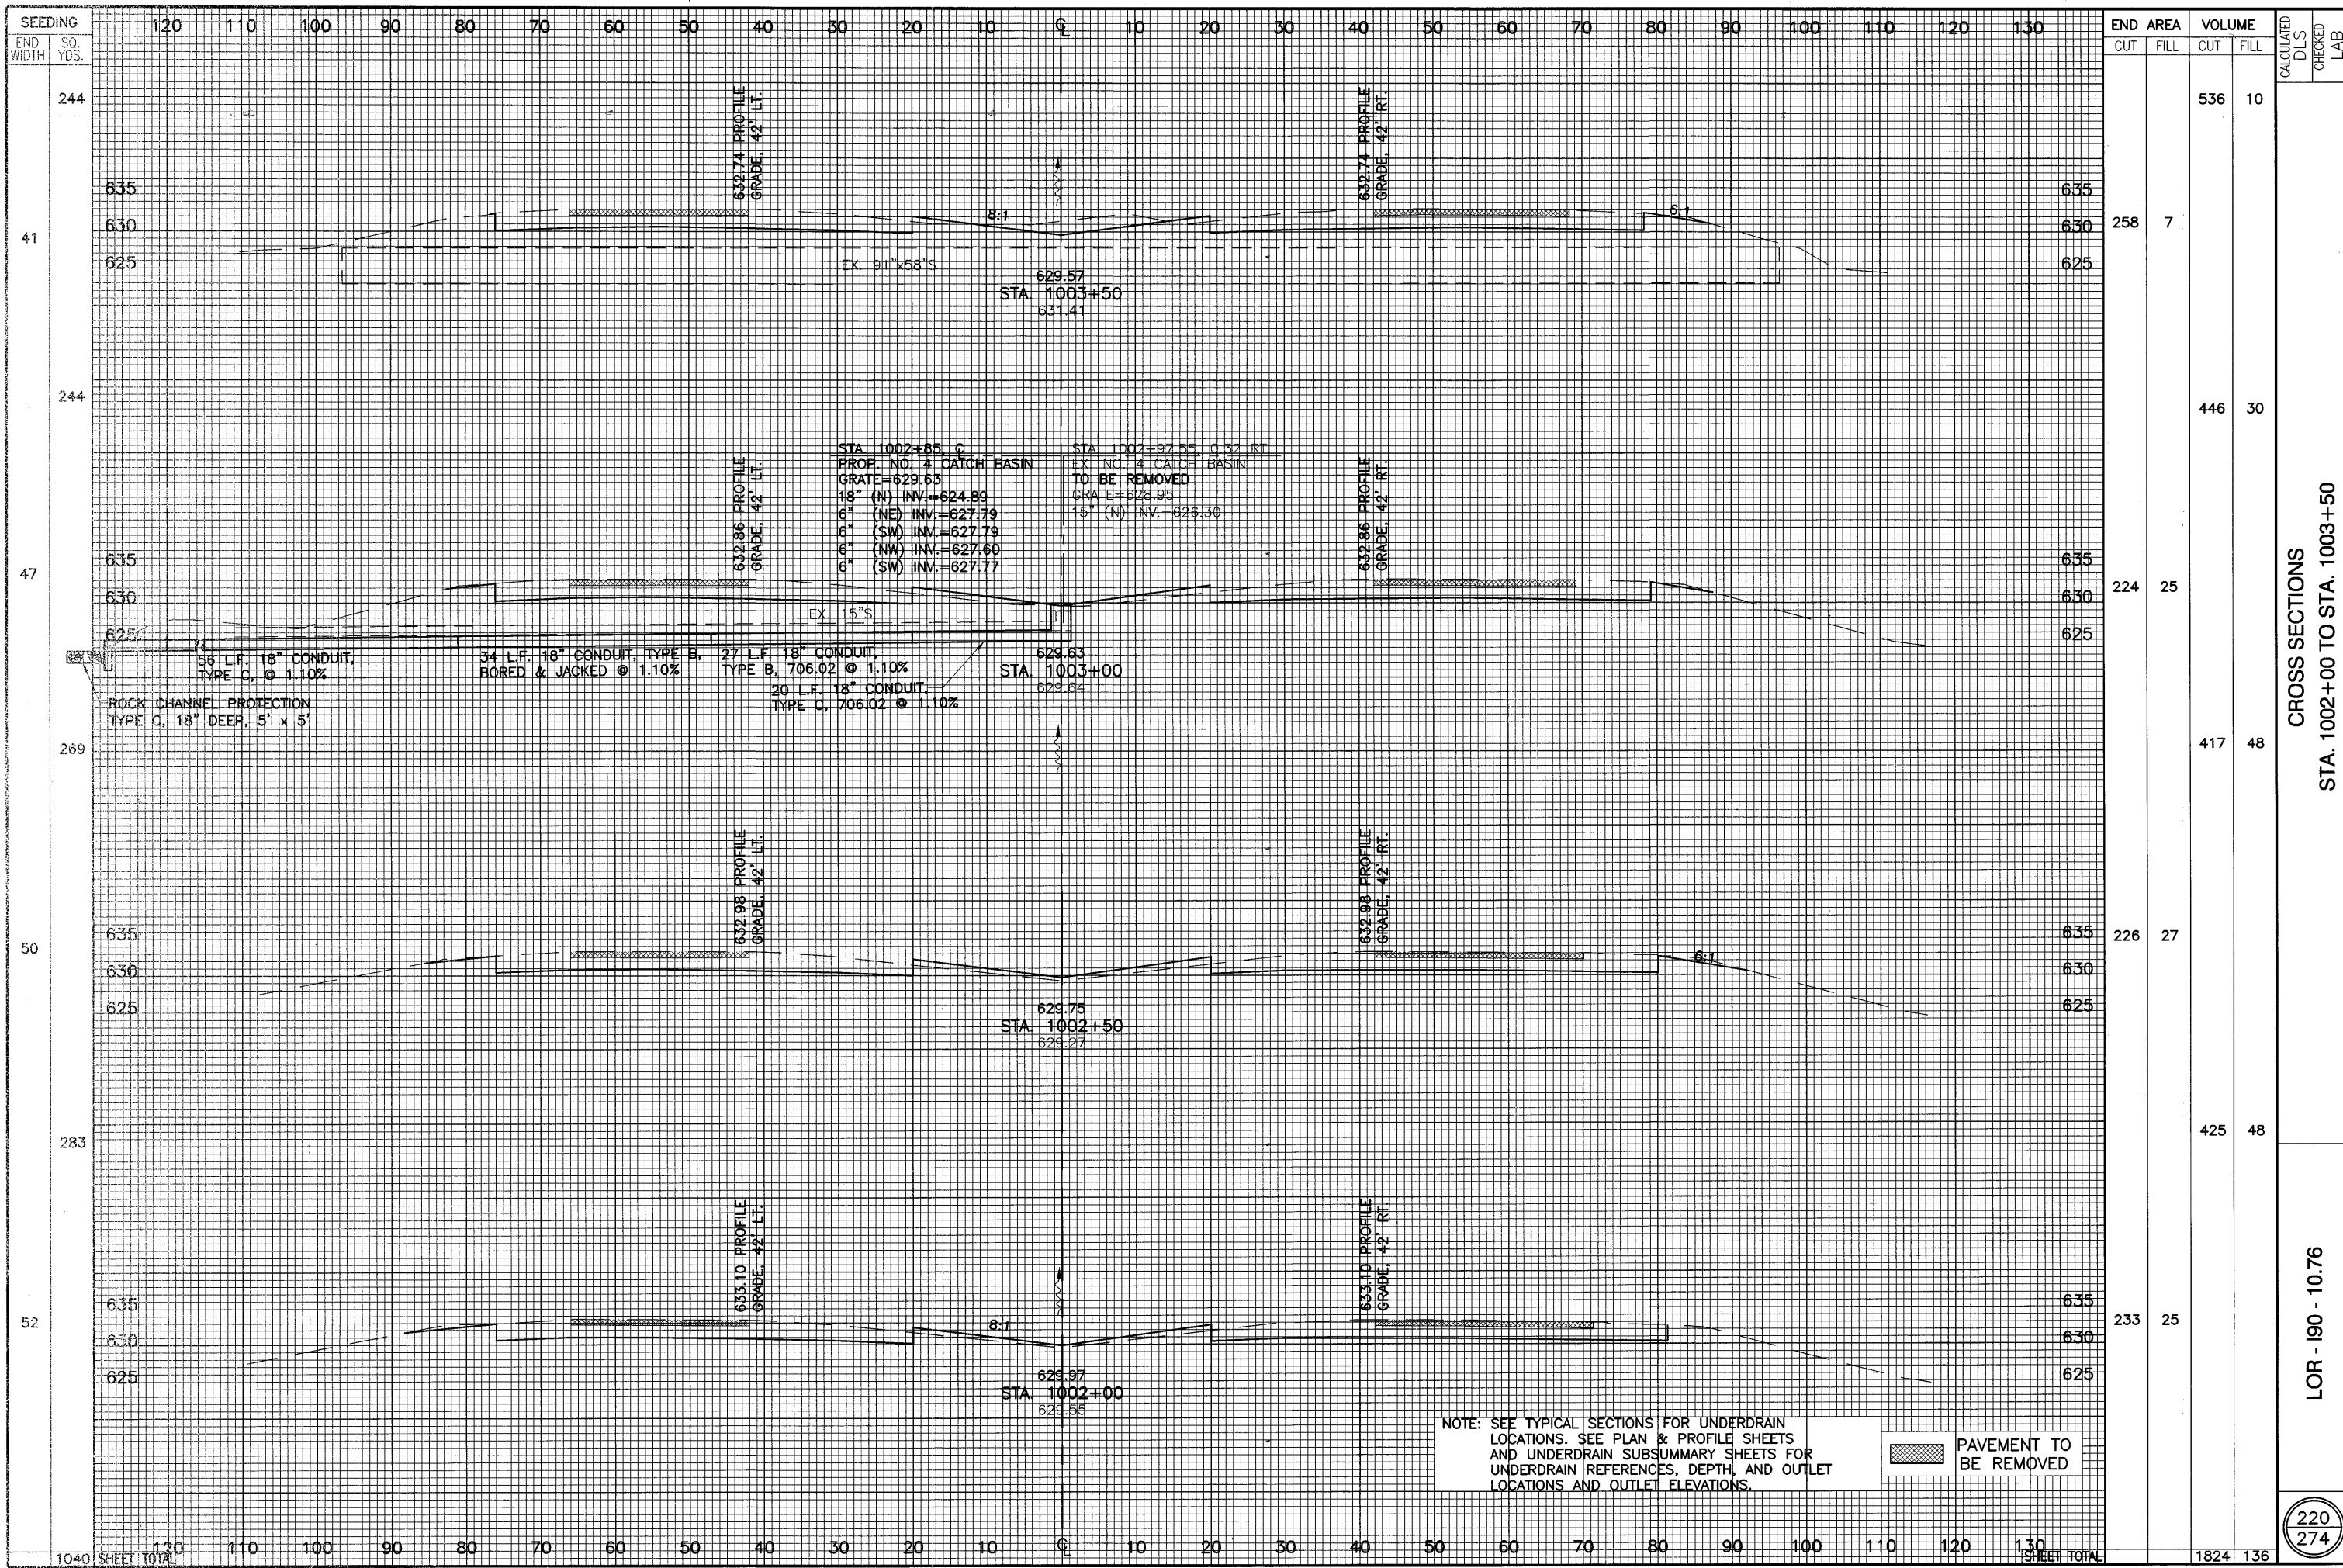

CROSS SECTIONS  
STA. 1002+00 TO STA. 1003+50

LOR - 190 - 10.76

220  
274

NOTE: SEE TYPICAL SECTIONS FOR UNDERDRAIN LOCATIONS. SEE PLAN & PROFILE SHEETS AND UNDERDRAIN SUBSUMMARY SHEETS FOR UNDERDRAIN REFERENCES, DEPTH, AND OUTLET LOCATIONS AND OUTLET ELEVATIONS.

PAVEMENT TO BE REMOVED

STA. 1002+85, C  
PROP. NO. 4 CATCH BASIN  
GRATE=629.63  
18" (N) INV.=624.88  
6" (NE) INV.=627.79  
6" (SW) INV.=627.79  
6" (NW) INV.=627.60  
6" (S) INV.=627.77


STA. 1003+97.55, C.32 RT  
EX. NO. 4 CATCH BASIN  
TO BE REMOVED  
GRATE=628.95  
15" (N) INV.=626.30

56 L.F. 18" CONDUIT, TYPE C, @ 1.10%  
ROCK CHANNEL PROTECTION TYPE C, 18" DEEP, 5' x 5'

34 L.F. 18" CONDUIT, TYPE B, BORED & JACKED @ 1.10%

27 L.F. 18" CONDUIT, TYPE B, 706.02 @ 1.10%


20 L.F. 18" CONDUIT, TYPE C, 706.02 @ 1.10%

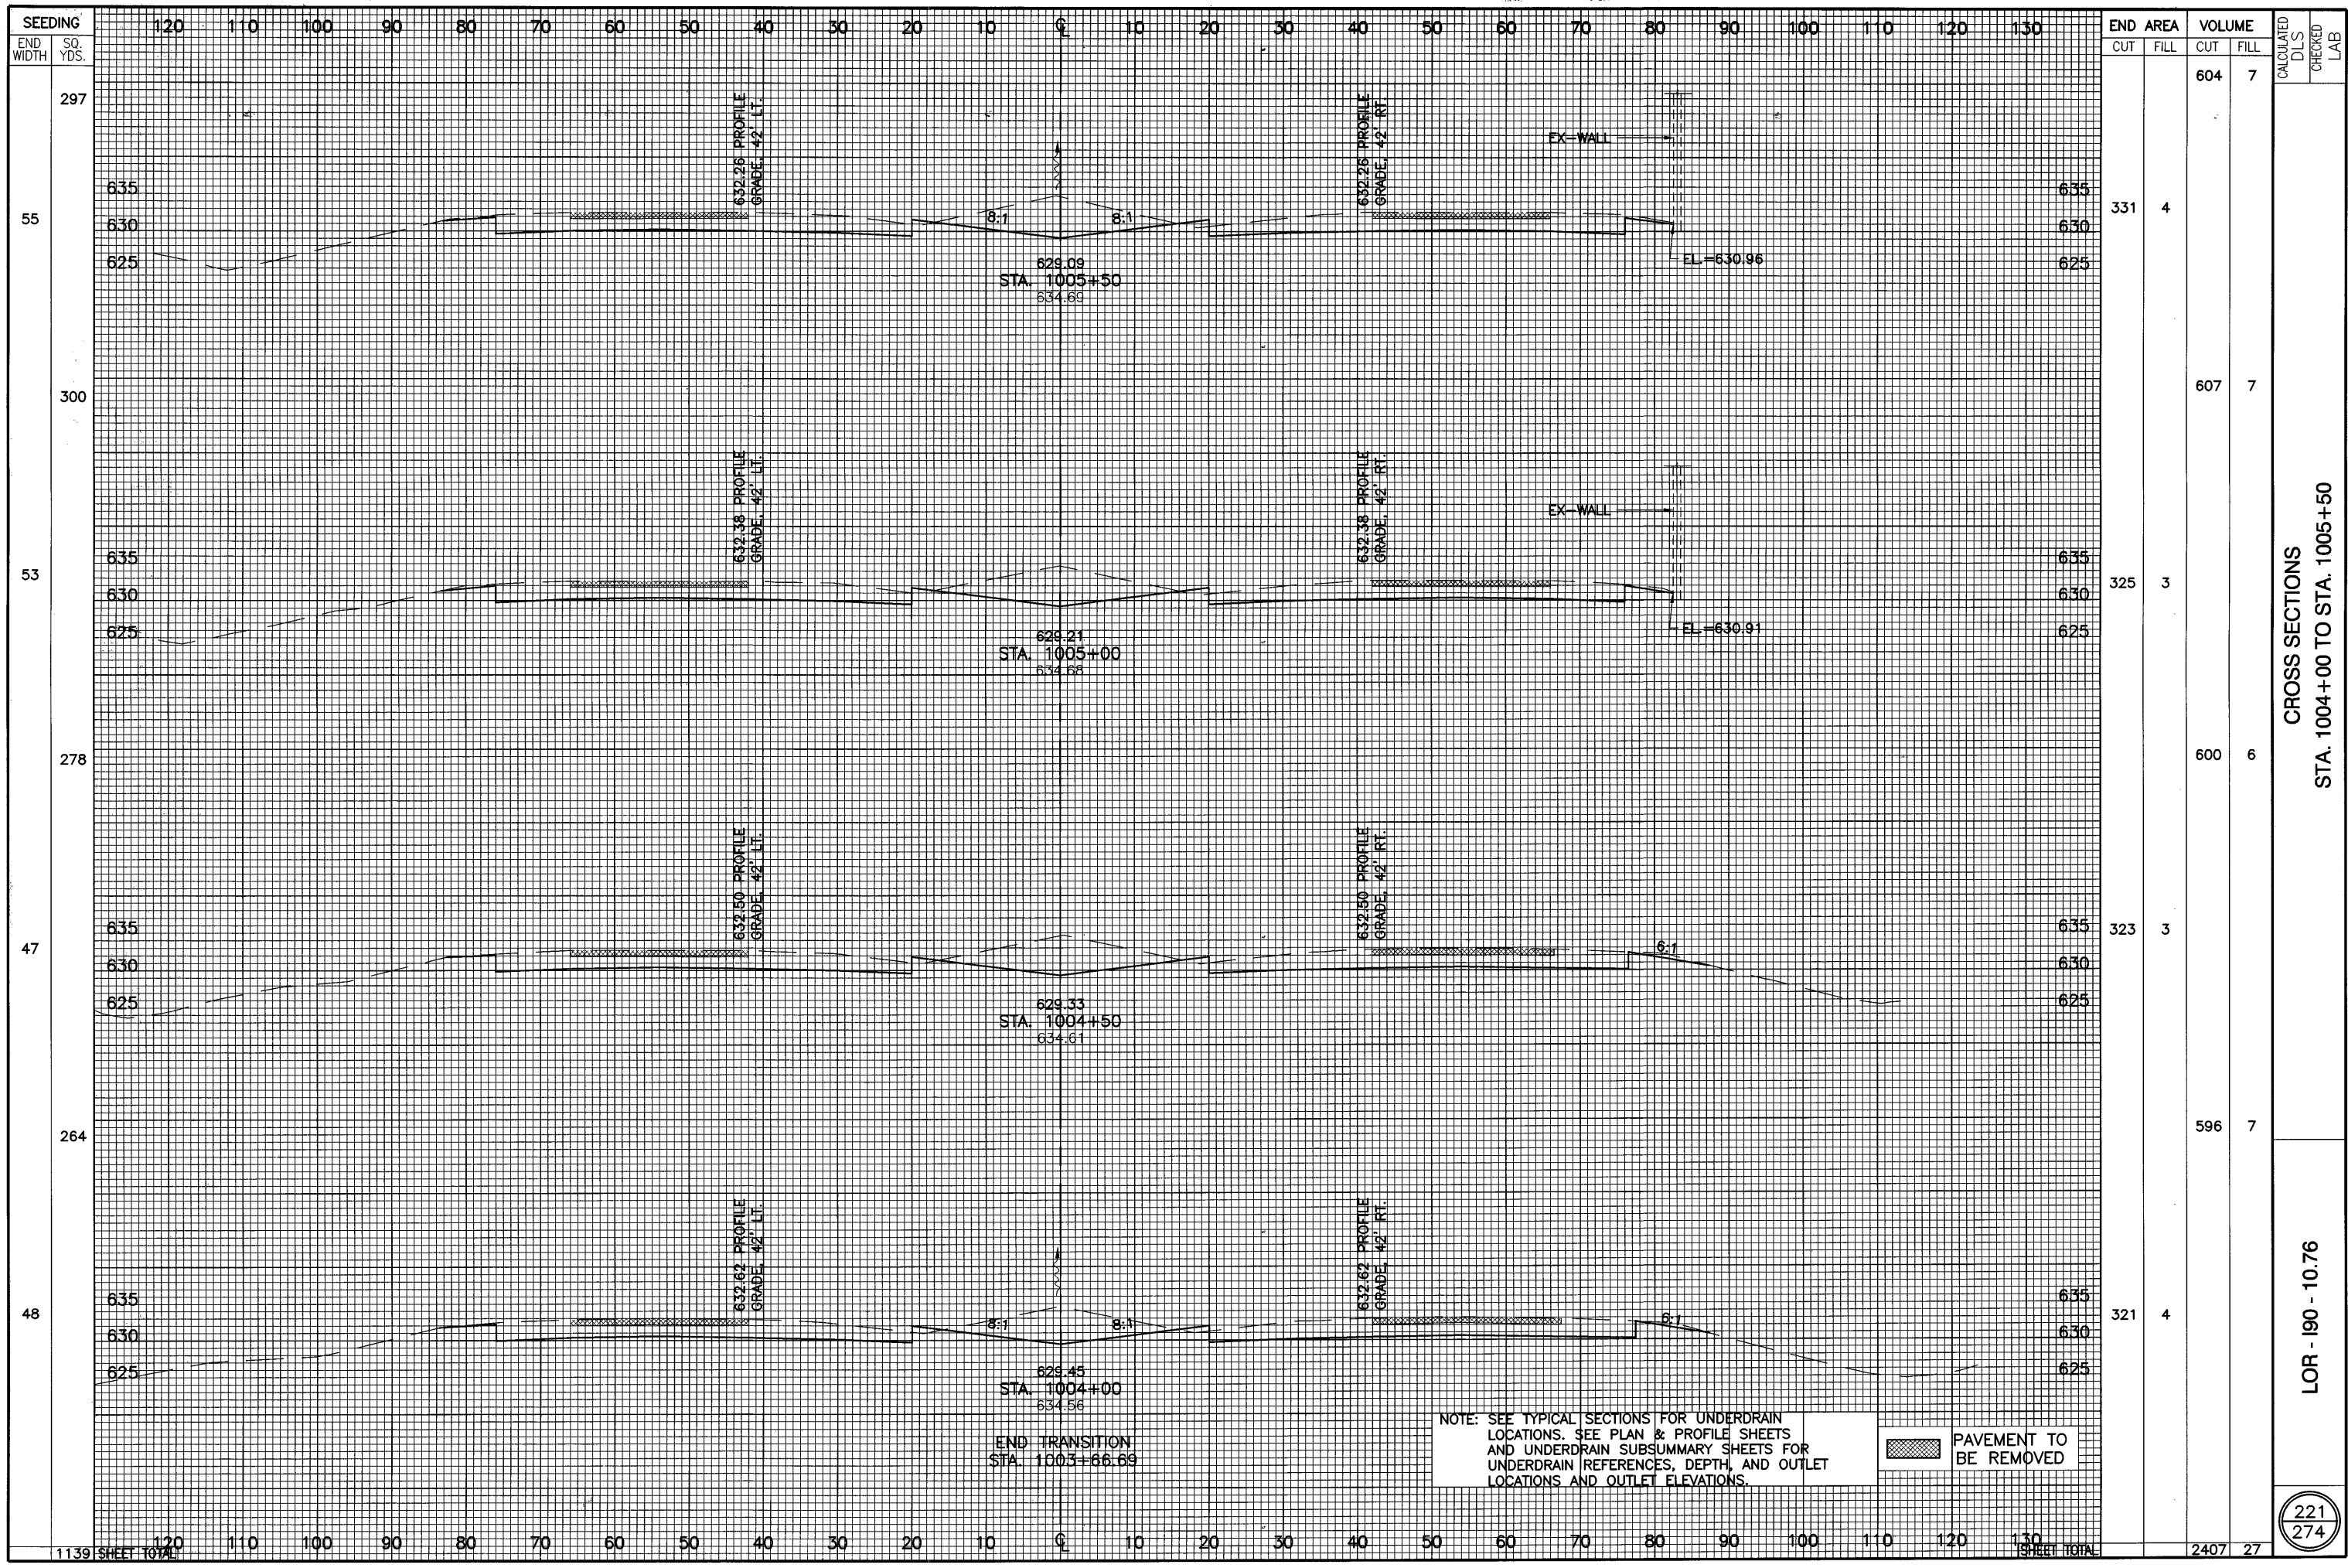

CROSS SECTIONS  
STA. 1004+00 TO STA. 1005+50

LOR - 190 - 10.76

18-2002 [ C:\95600\DWG\19003\19020001.DWG ] DLS

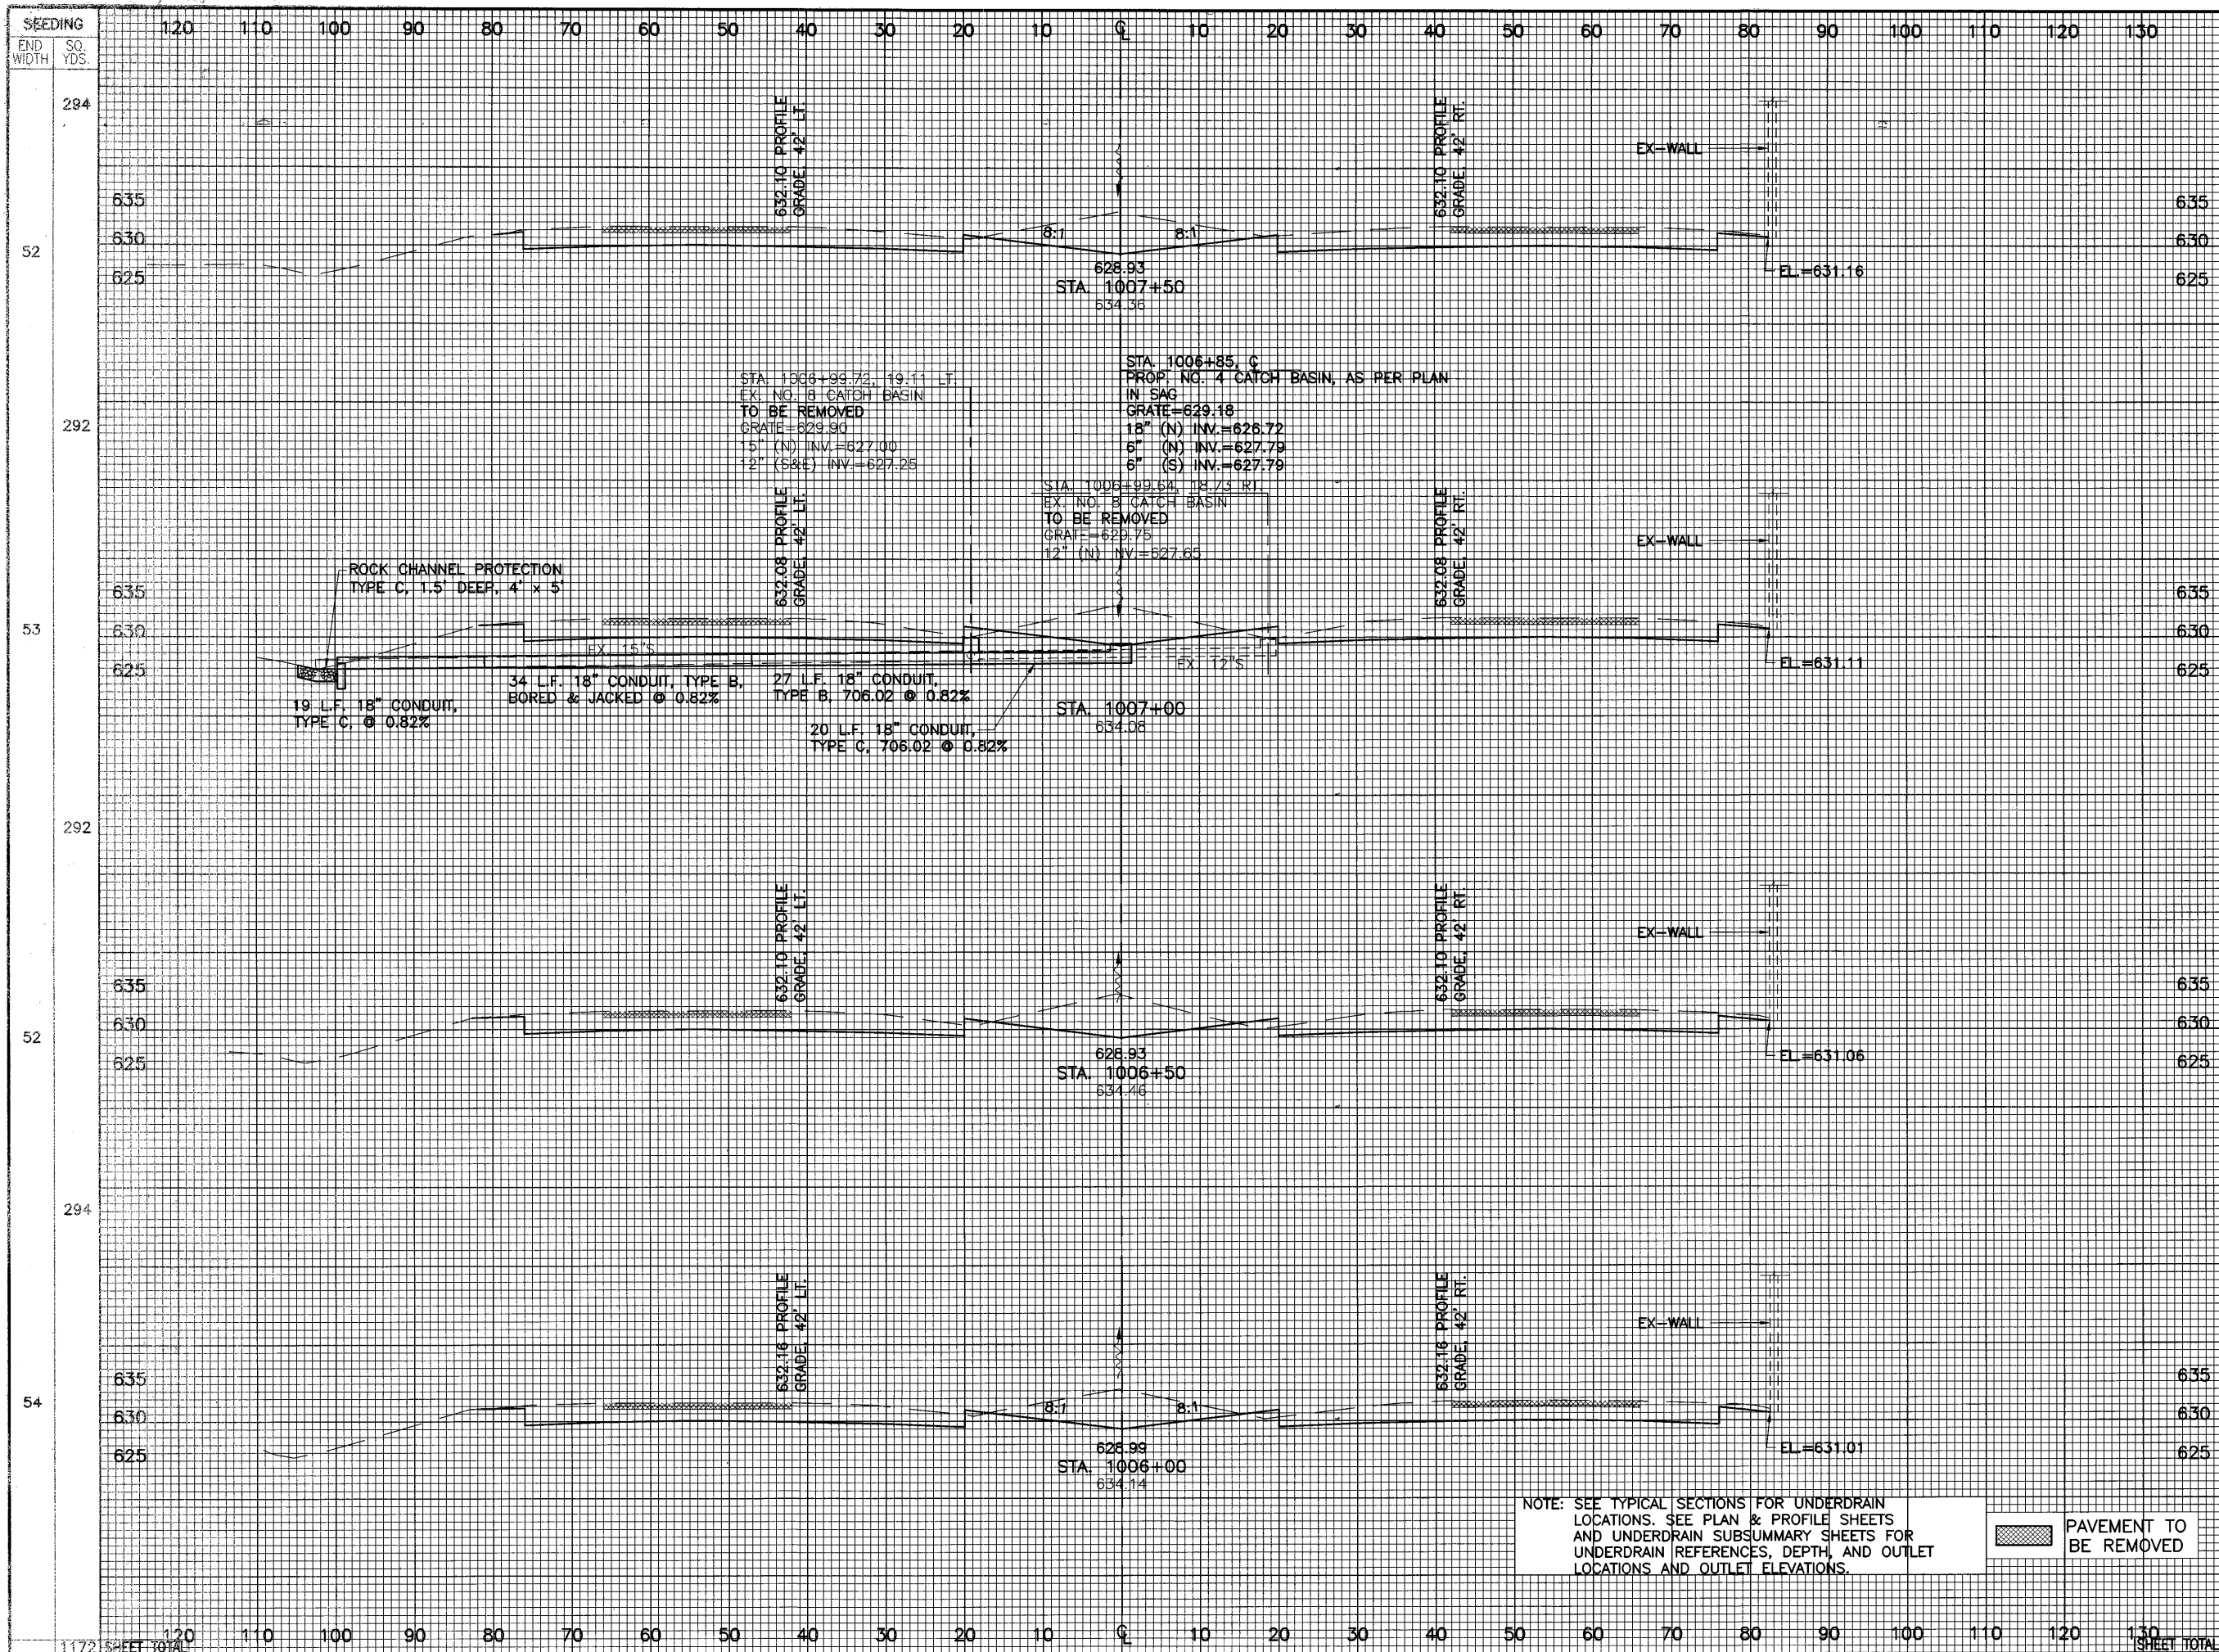


END AREA	VOLUME		CALCULATED DLS	CHECKED LAB
	CUT	FILL		
350	1		619	13
317	8		618	8
600	12		600	12
331	5		331	5
610	8		610	8
328	4		328	4
1172 SHEET TOTAL	1172 SHEET TOTAL		2447	41

NOTE: SEE TYPICAL SECTIONS FOR UNDERDRAIN LOCATIONS. SEE PLAN & PROFILE SHEETS AND UNDERDRAIN SUBSUMMARY SHEETS FOR UNDERDRAIN REFERENCES, DEPTH, AND OUTLET LOCATIONS AND OUTLET ELEVATIONS.

PAVEMENT TO BE REMOVED

CROSS SECTIONS  
STA. 1006+00 TO STA. 1007+50


LOR - 190 - 10.76

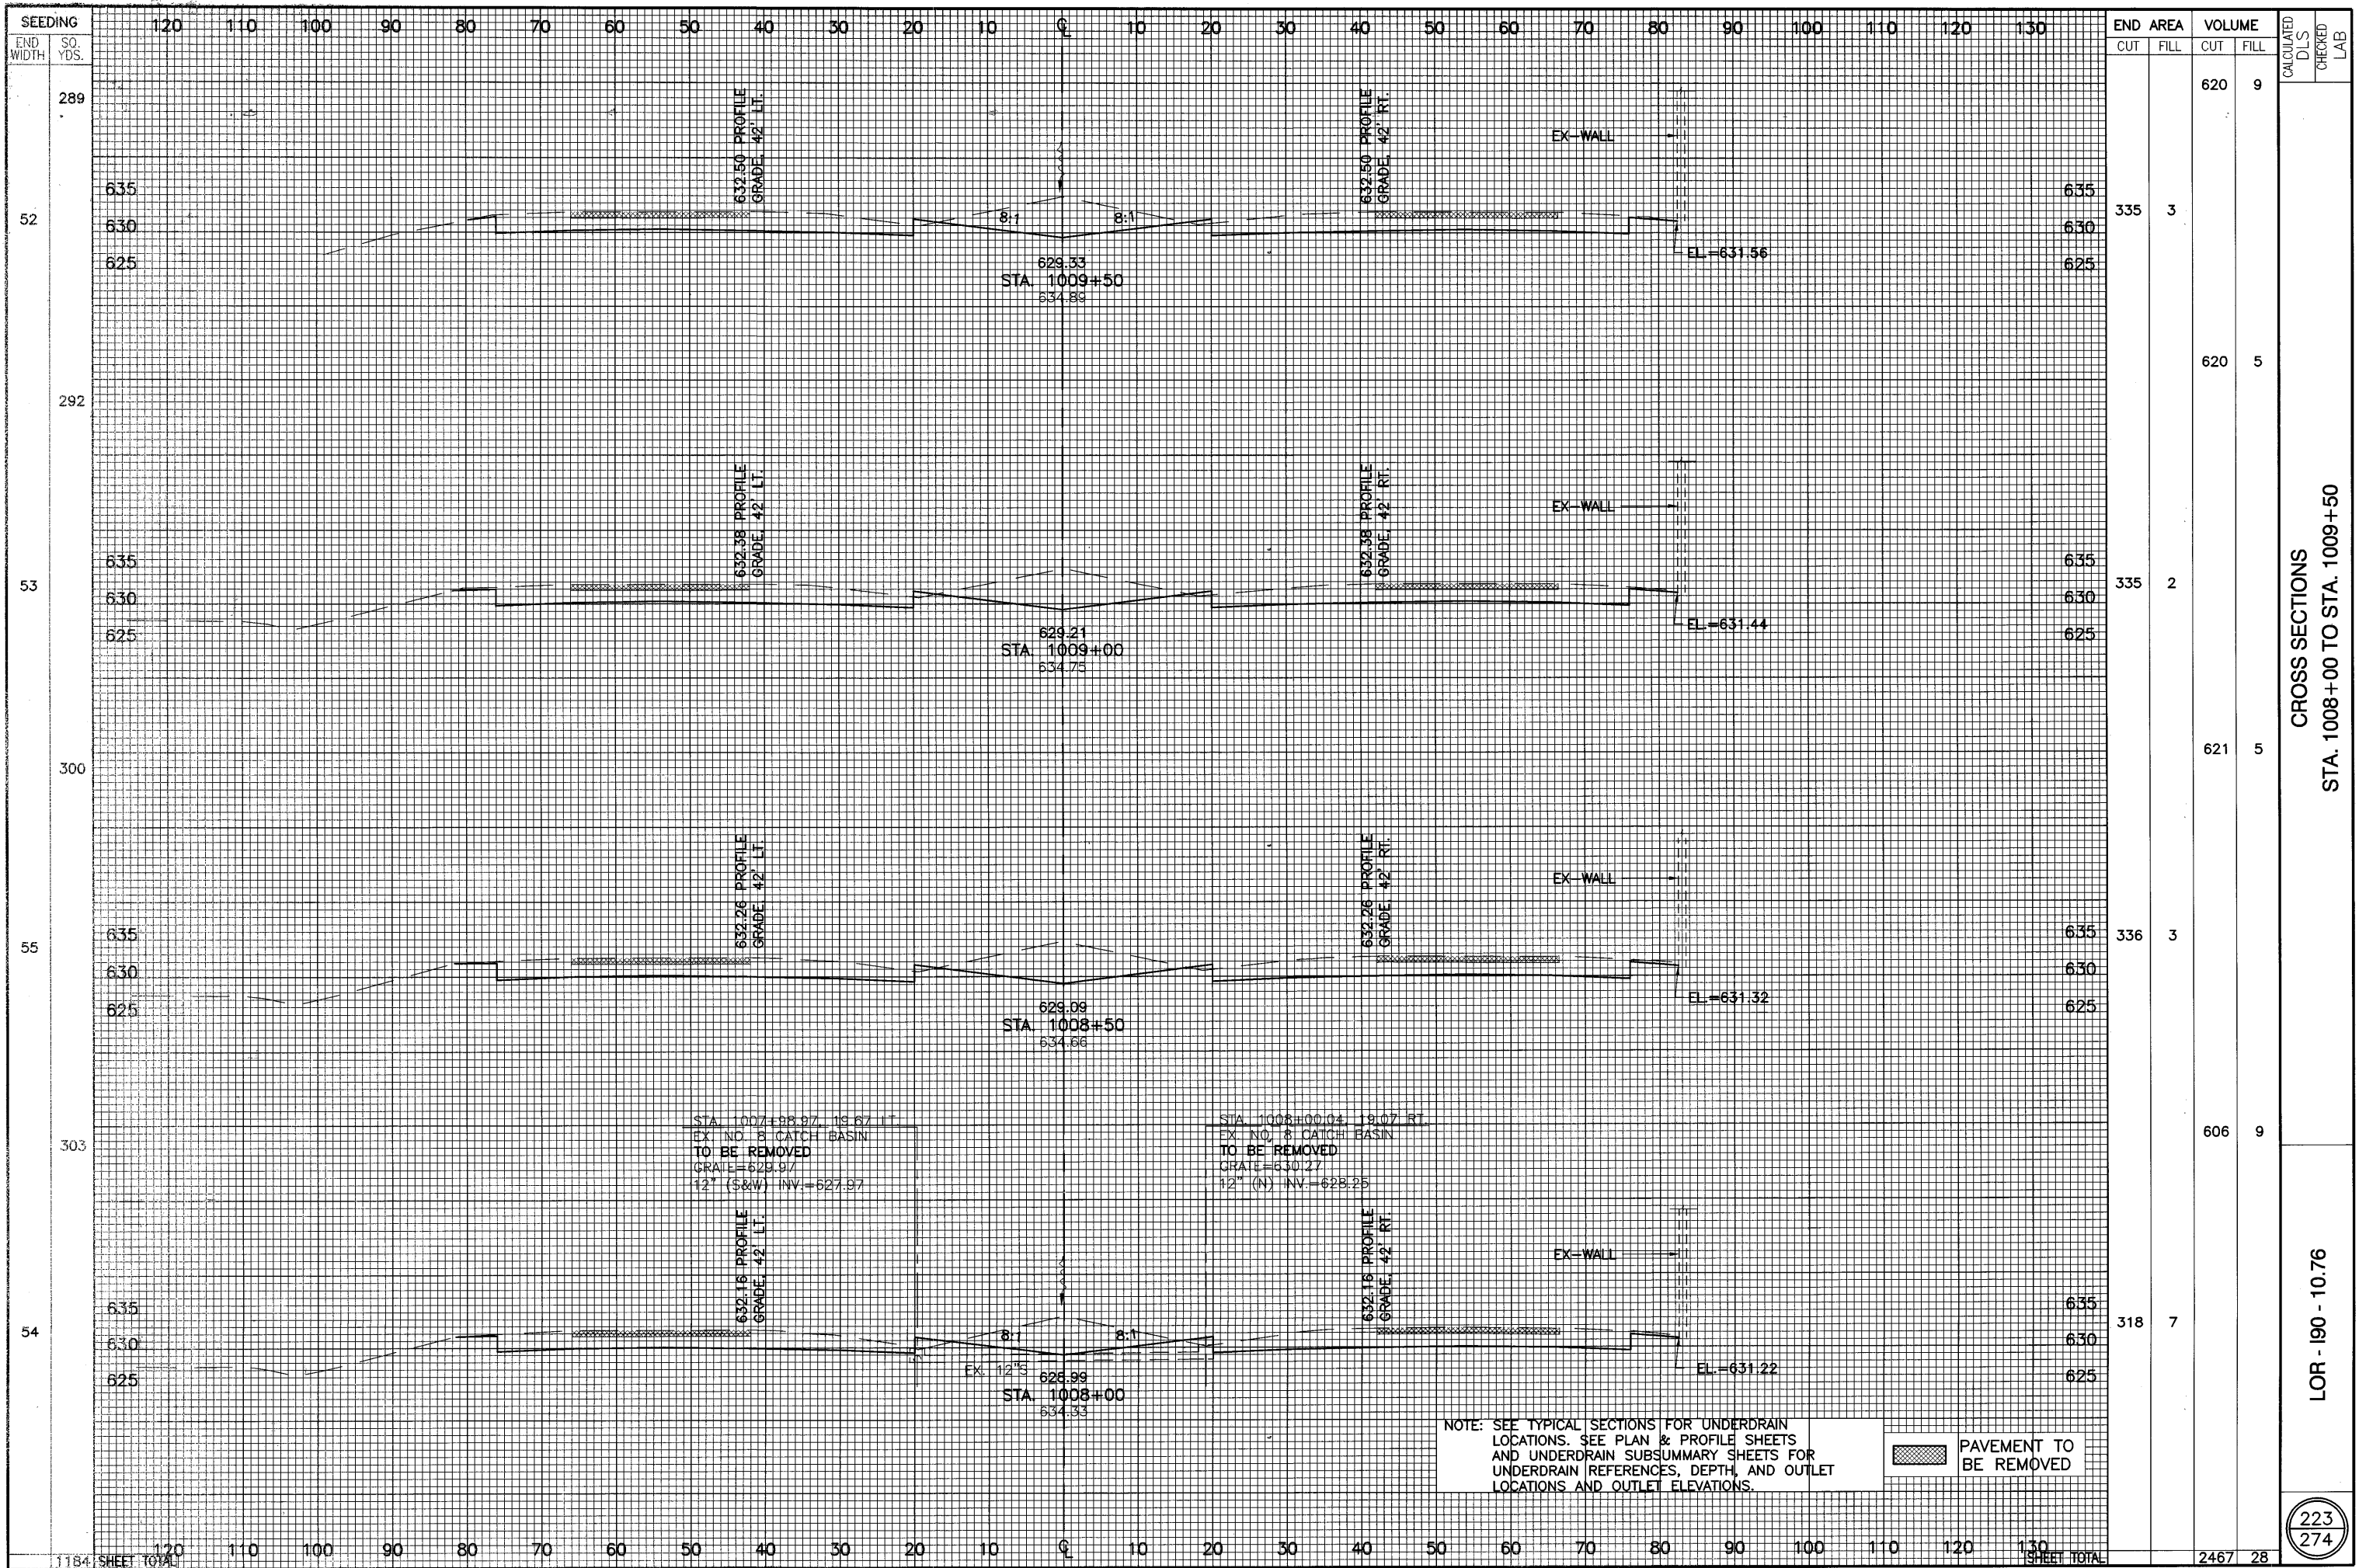

SEEDING END WIDTH SO. YDS.	END AREA		VOLUME		CALCULATED D.I.S.	CHECKED LAB
	CUT	FILL	CUT	FILL		
289			620	9		
52	335	3	620	5		
292			620	5		
53	335	2	621	5		
300			621	5		
55	336	3	606	9		
303			606	9		
54	318	7				
1184 SHEET TOTAL			2467	28		

CROSS SECTIONS  
 STA. 1008+00 TO STA. 1009+50

LOR - 190 - 10.76

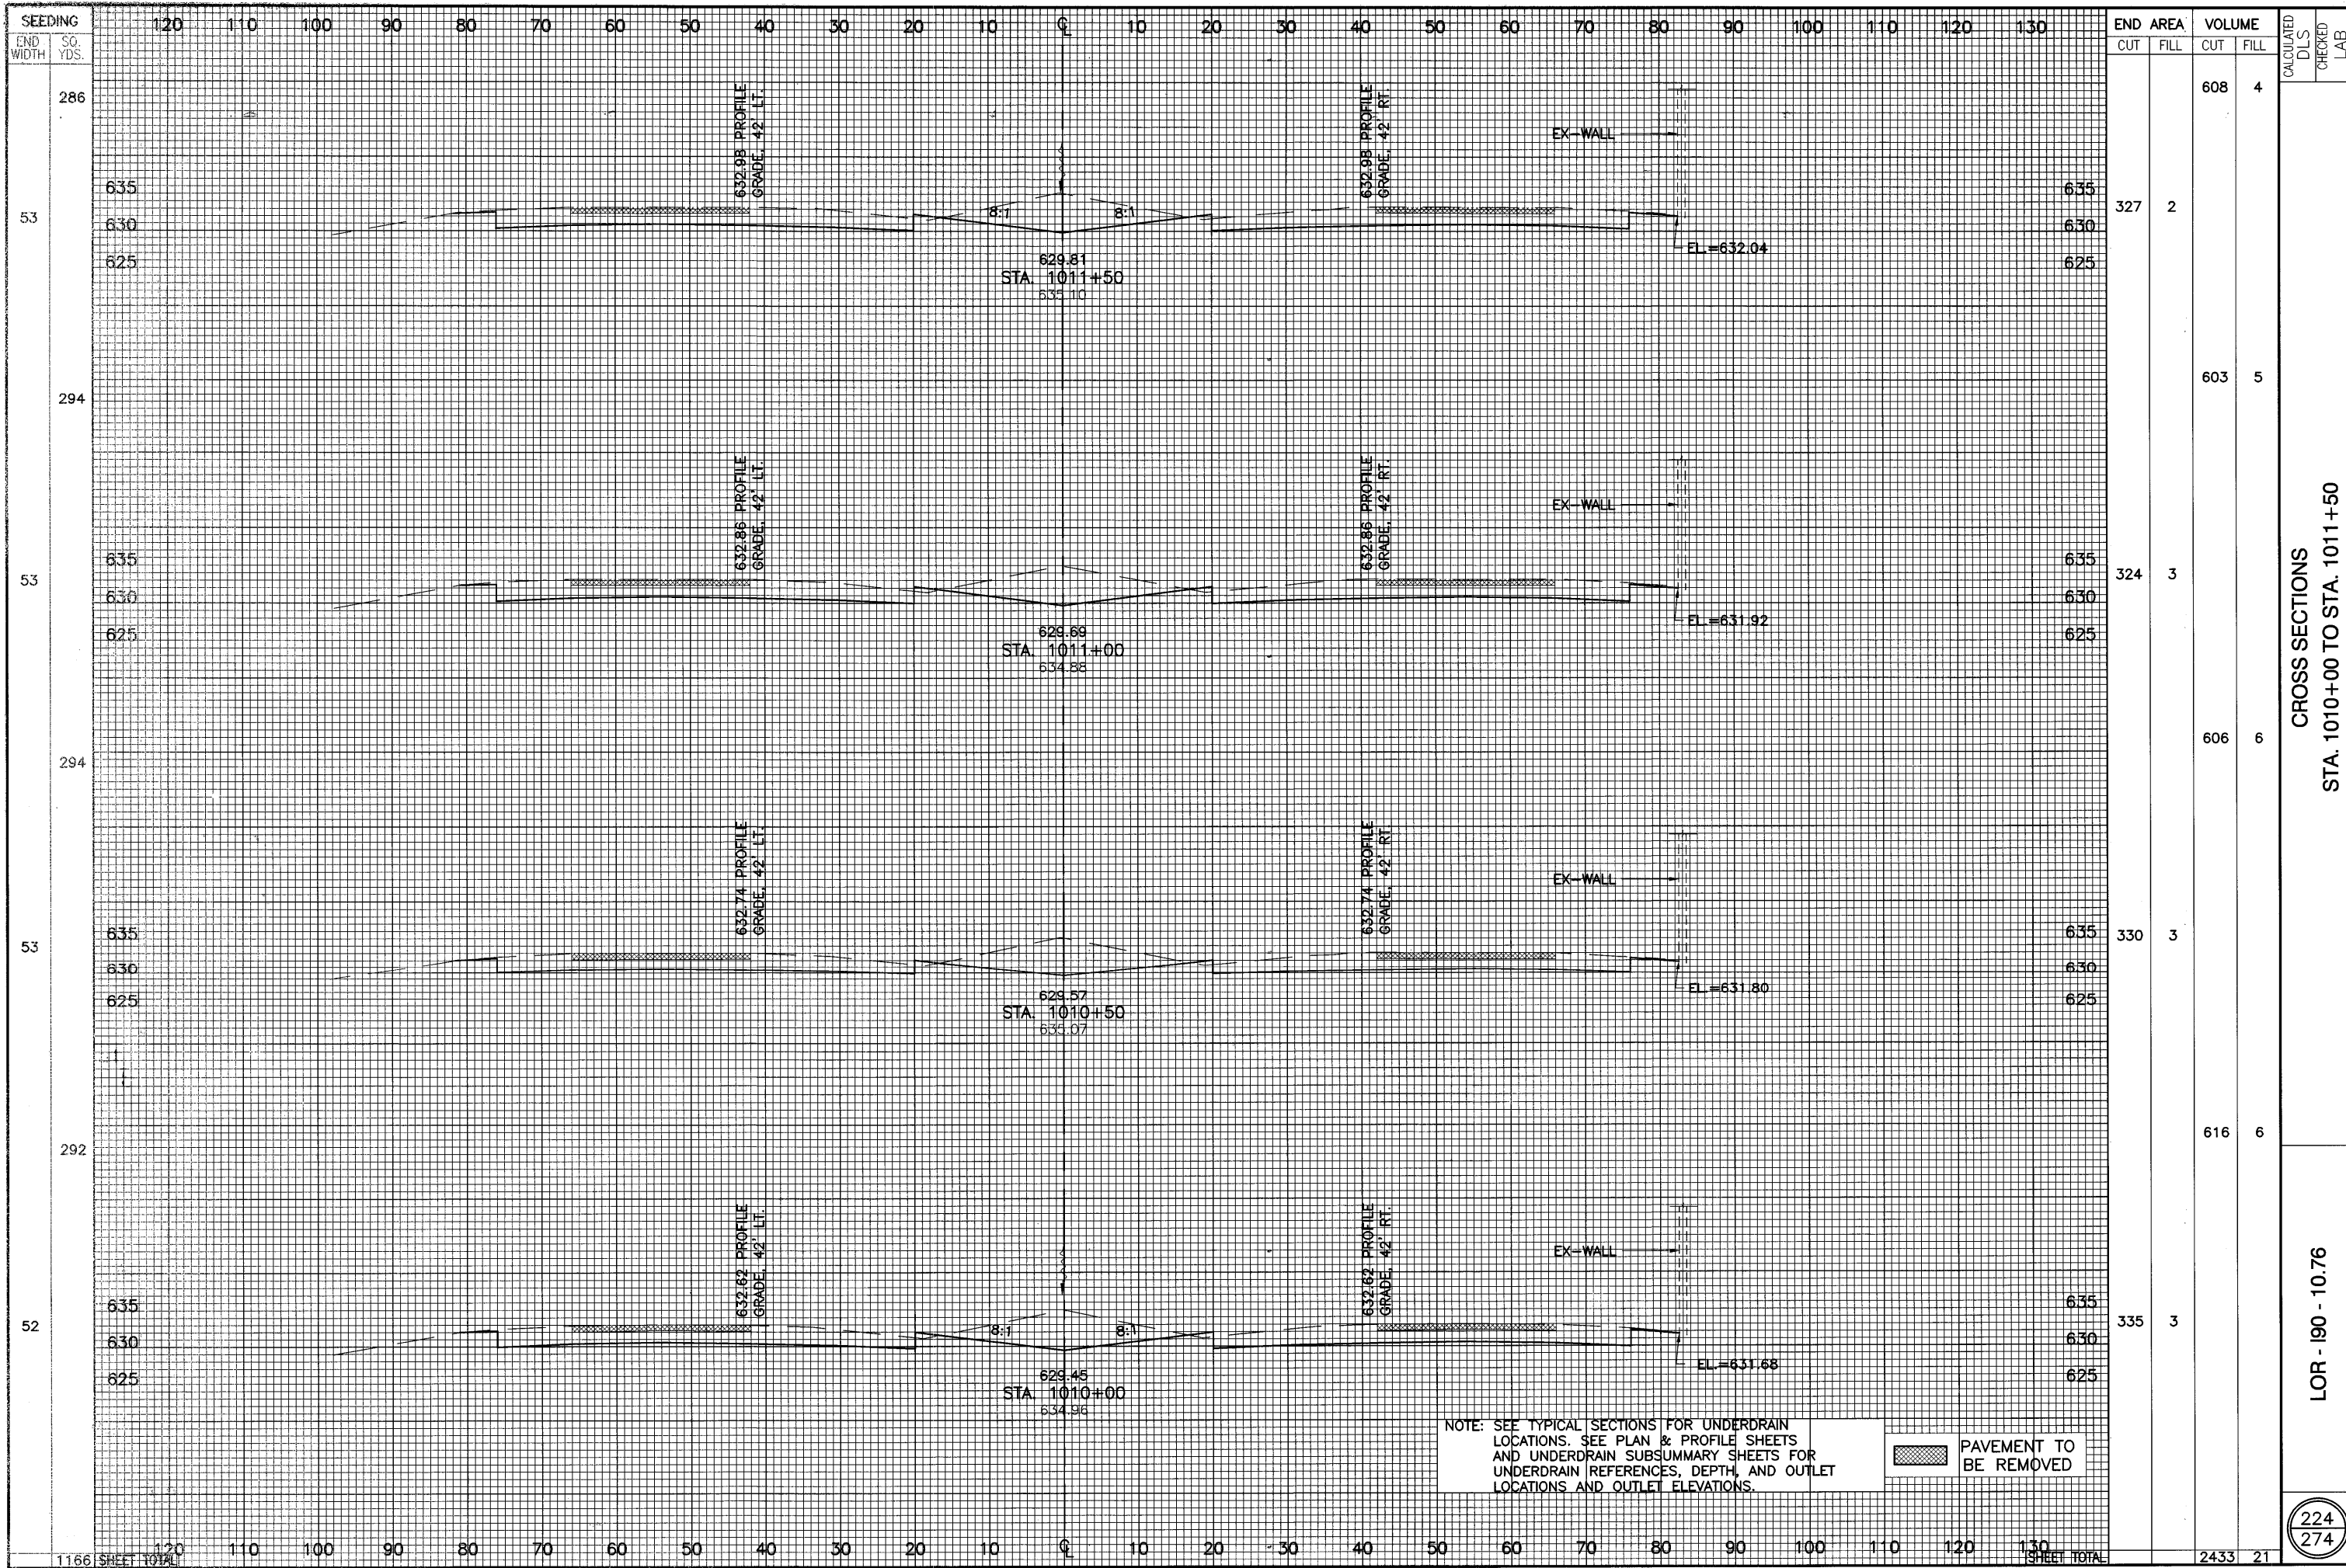


END CUT	AREA FILL	VOLUME		CALCULATED DLS	CHECKED	LAB
		CUT	FILL			
327	2	608	4			
324	3	603	5			
330	3	606	6			
335	3	616	6			
1166	SHEET TOTAL	2433	21			

CROSS SECTIONS  
STA. 1010+00 TO STA. 1011+50


LOR - 190 - 10.76



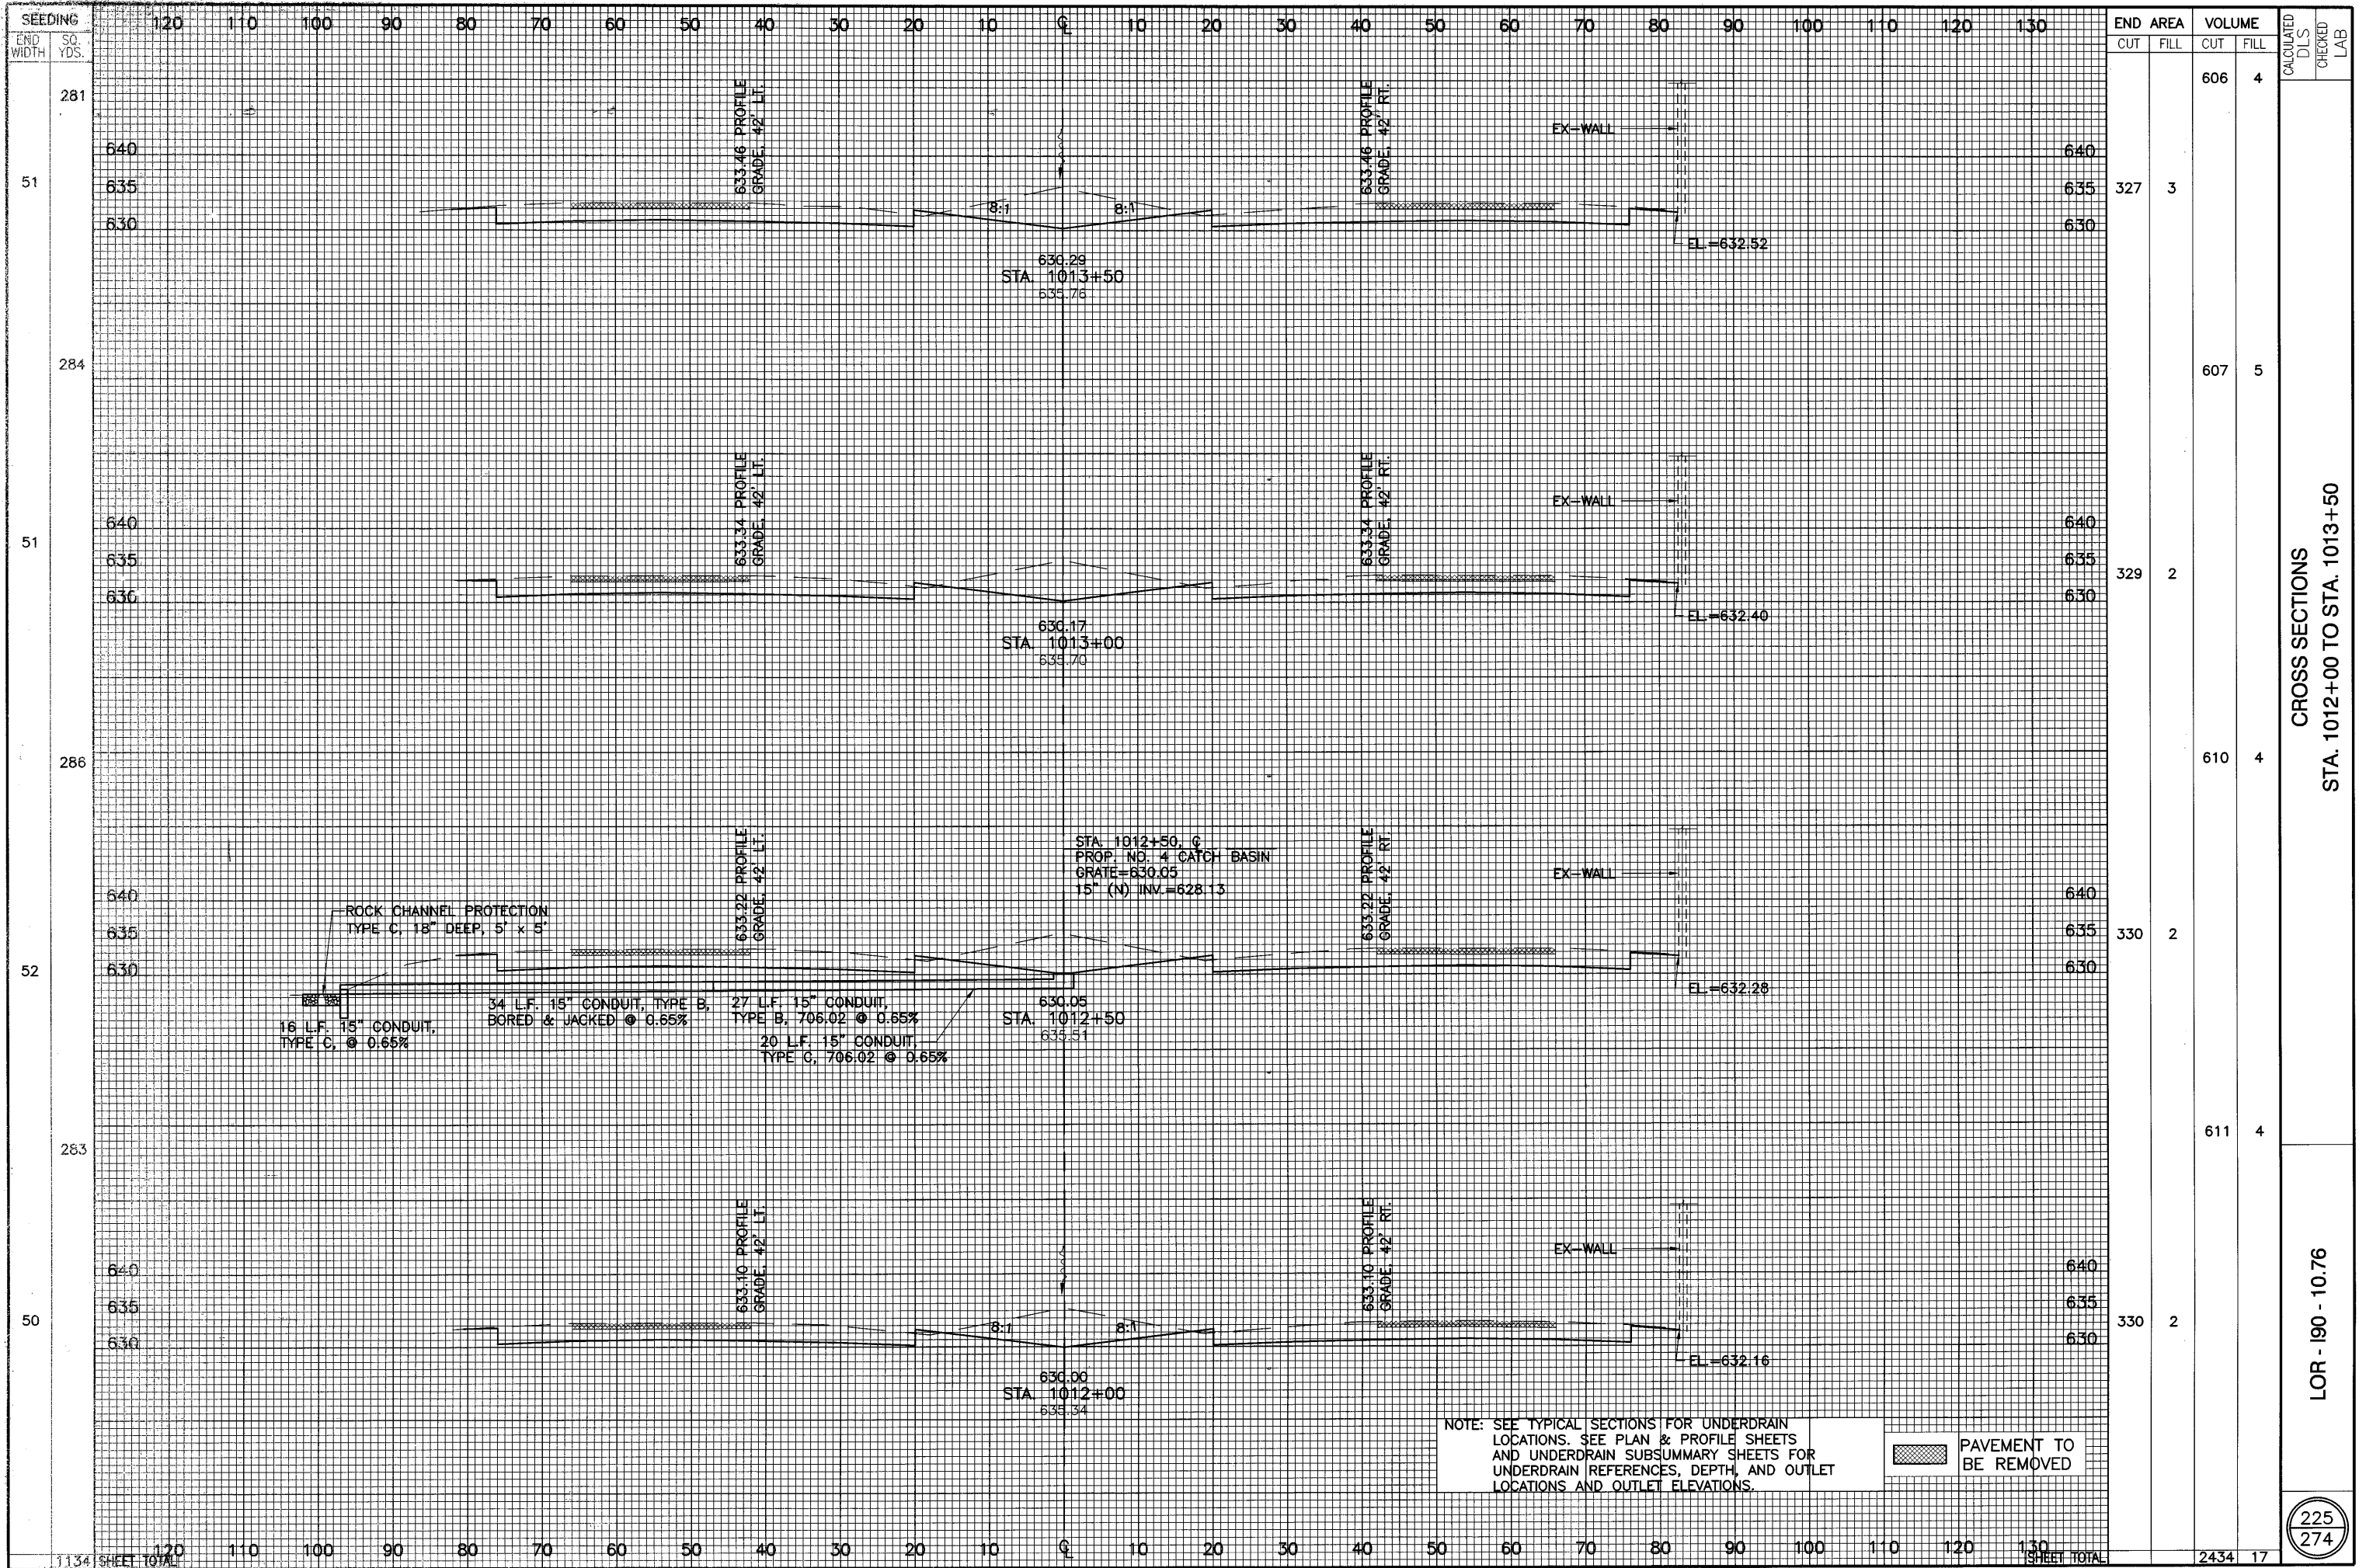

CROSS SECTIONS  
STA. 1012+00 TO STA. 1013+50

LOR - 190 - 10.76

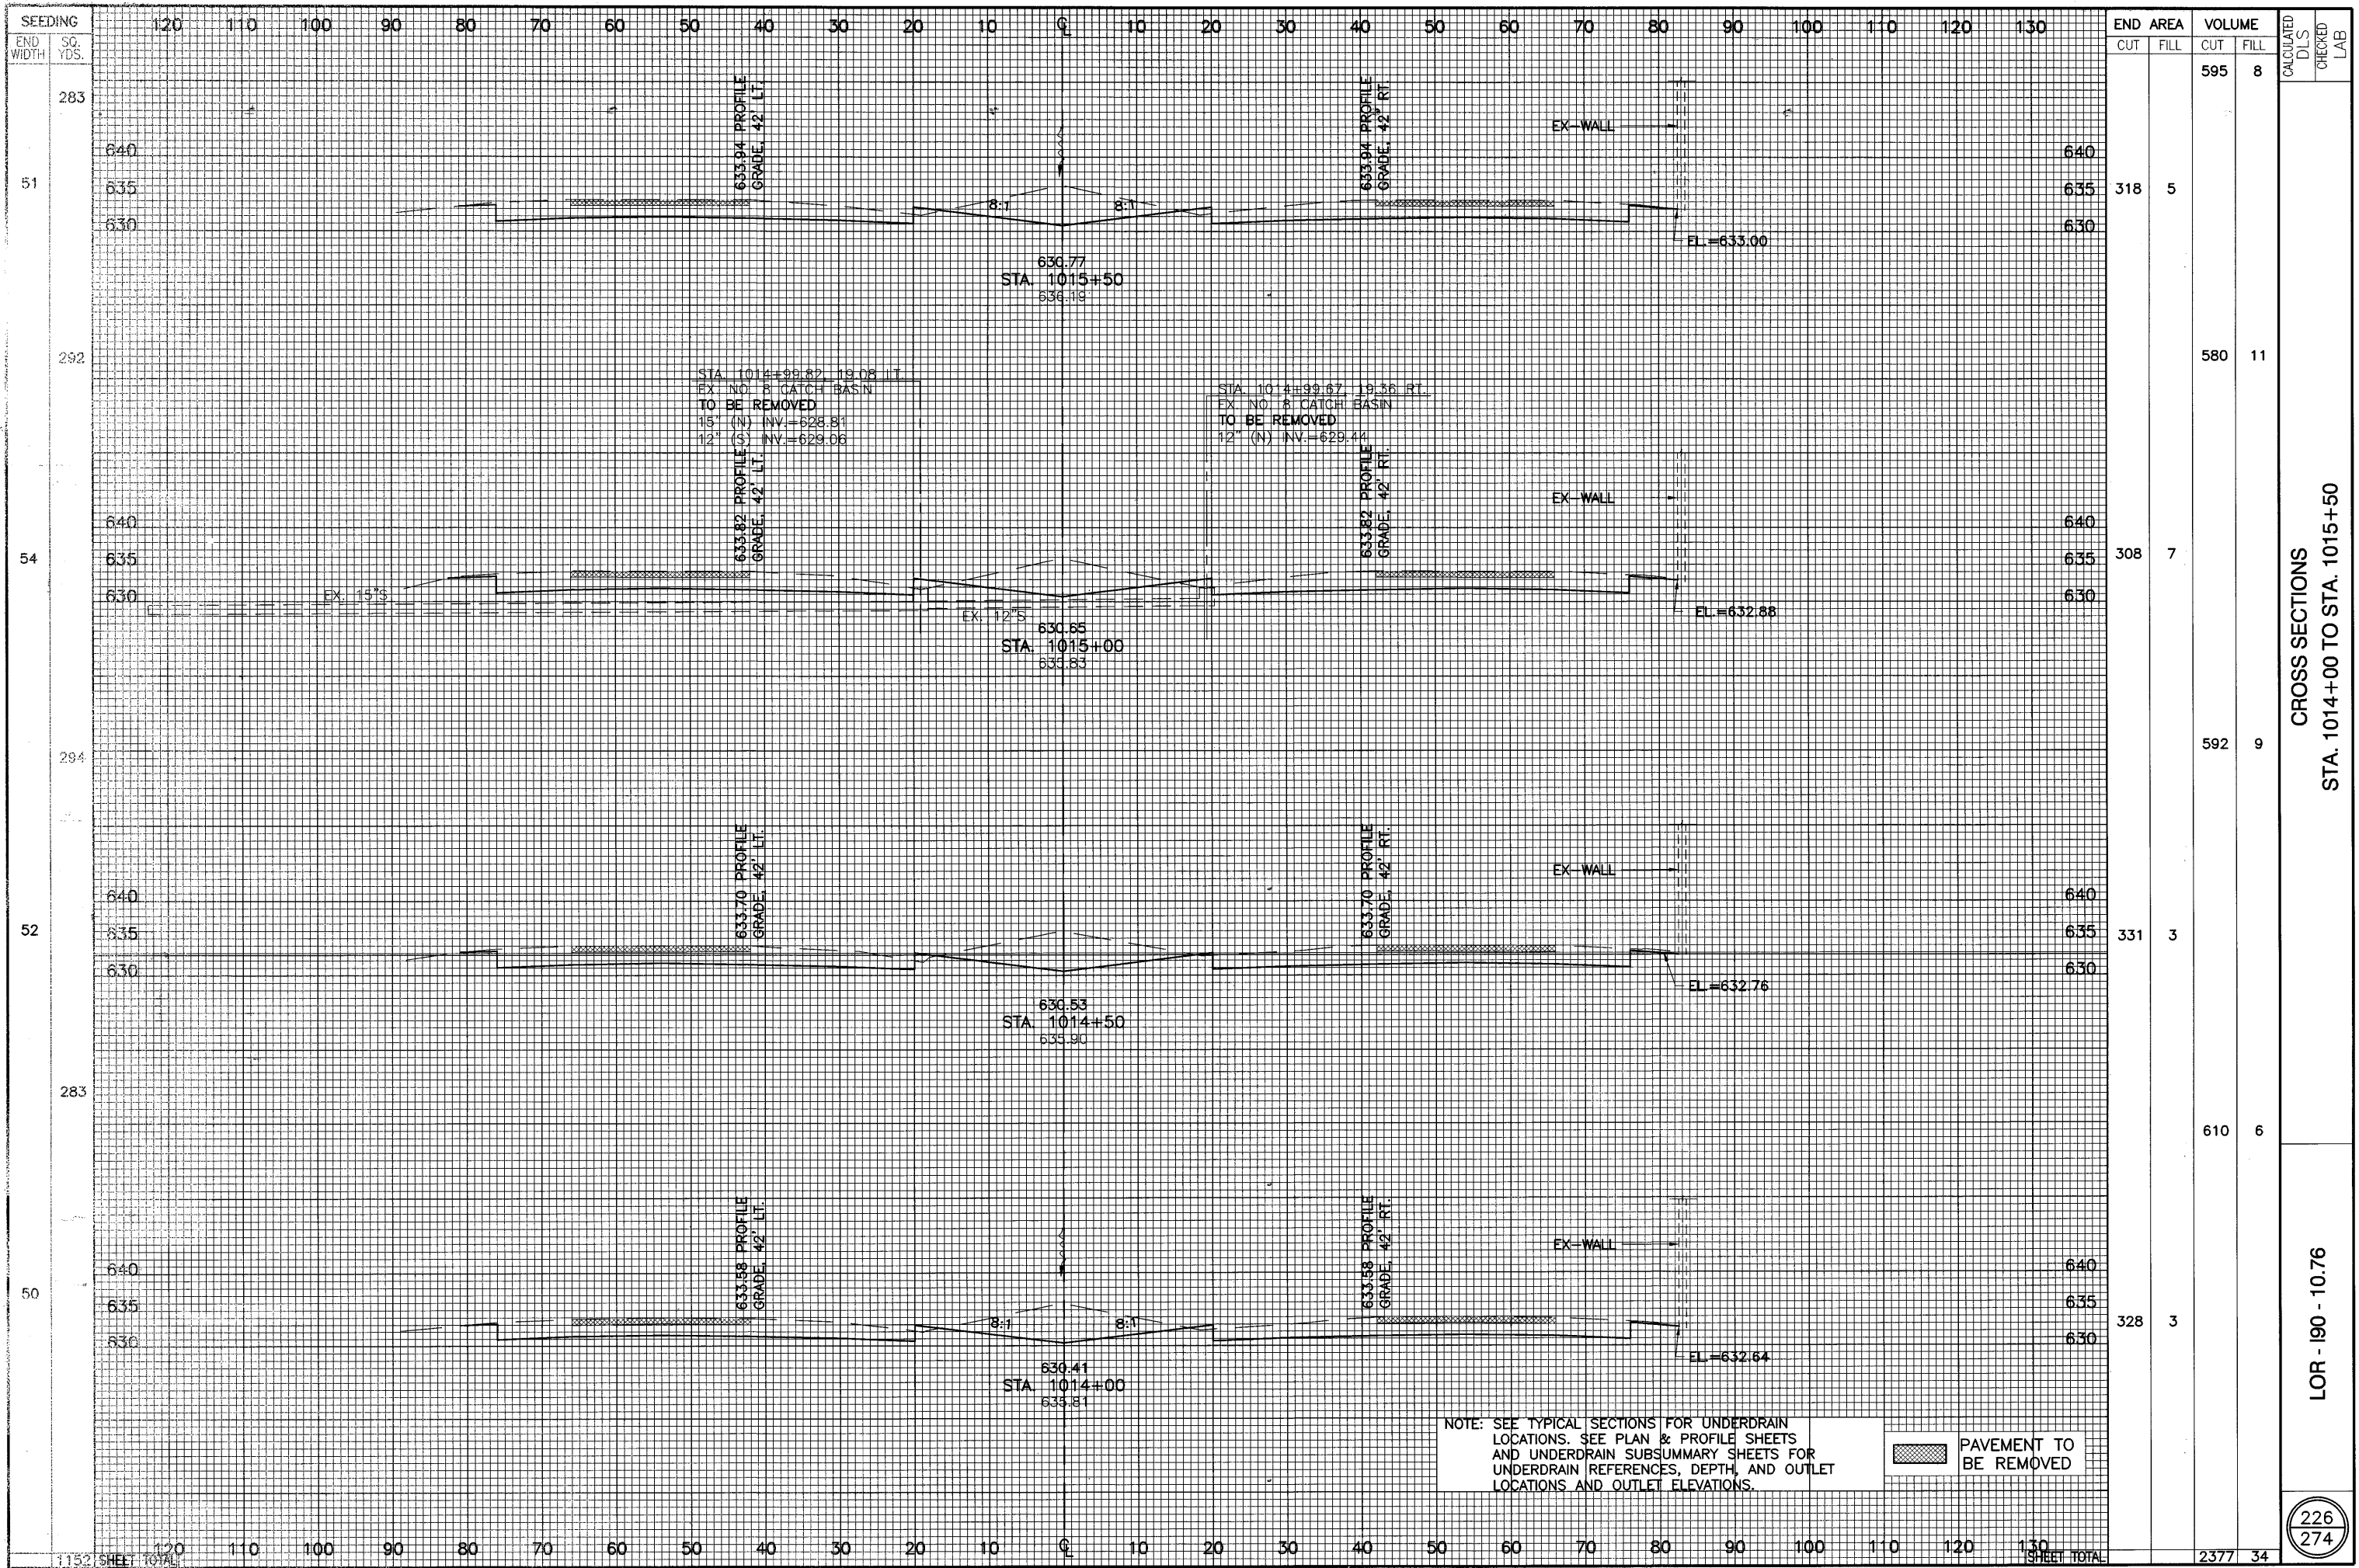


CROSS SECTIONS  
STA. 1014+00 TO STA. 1015+50

LOR - 190 - 10.76

NOTE: SEE TYPICAL SECTIONS FOR UNDERDRAIN LOCATIONS. SEE PLAN & PROFILE SHEETS AND UNDERDRAIN SUBSUMMARY SHEETS FOR UNDERDRAIN REFERENCES, DEPTH, AND OUTLET LOCATIONS AND OUTLET ELEVATIONS.

PAVEMENT TO BE REMOVED

10/24/2002 10:30:00 AM C:\PROJECTS\1016\1016.DWG [DLJ]

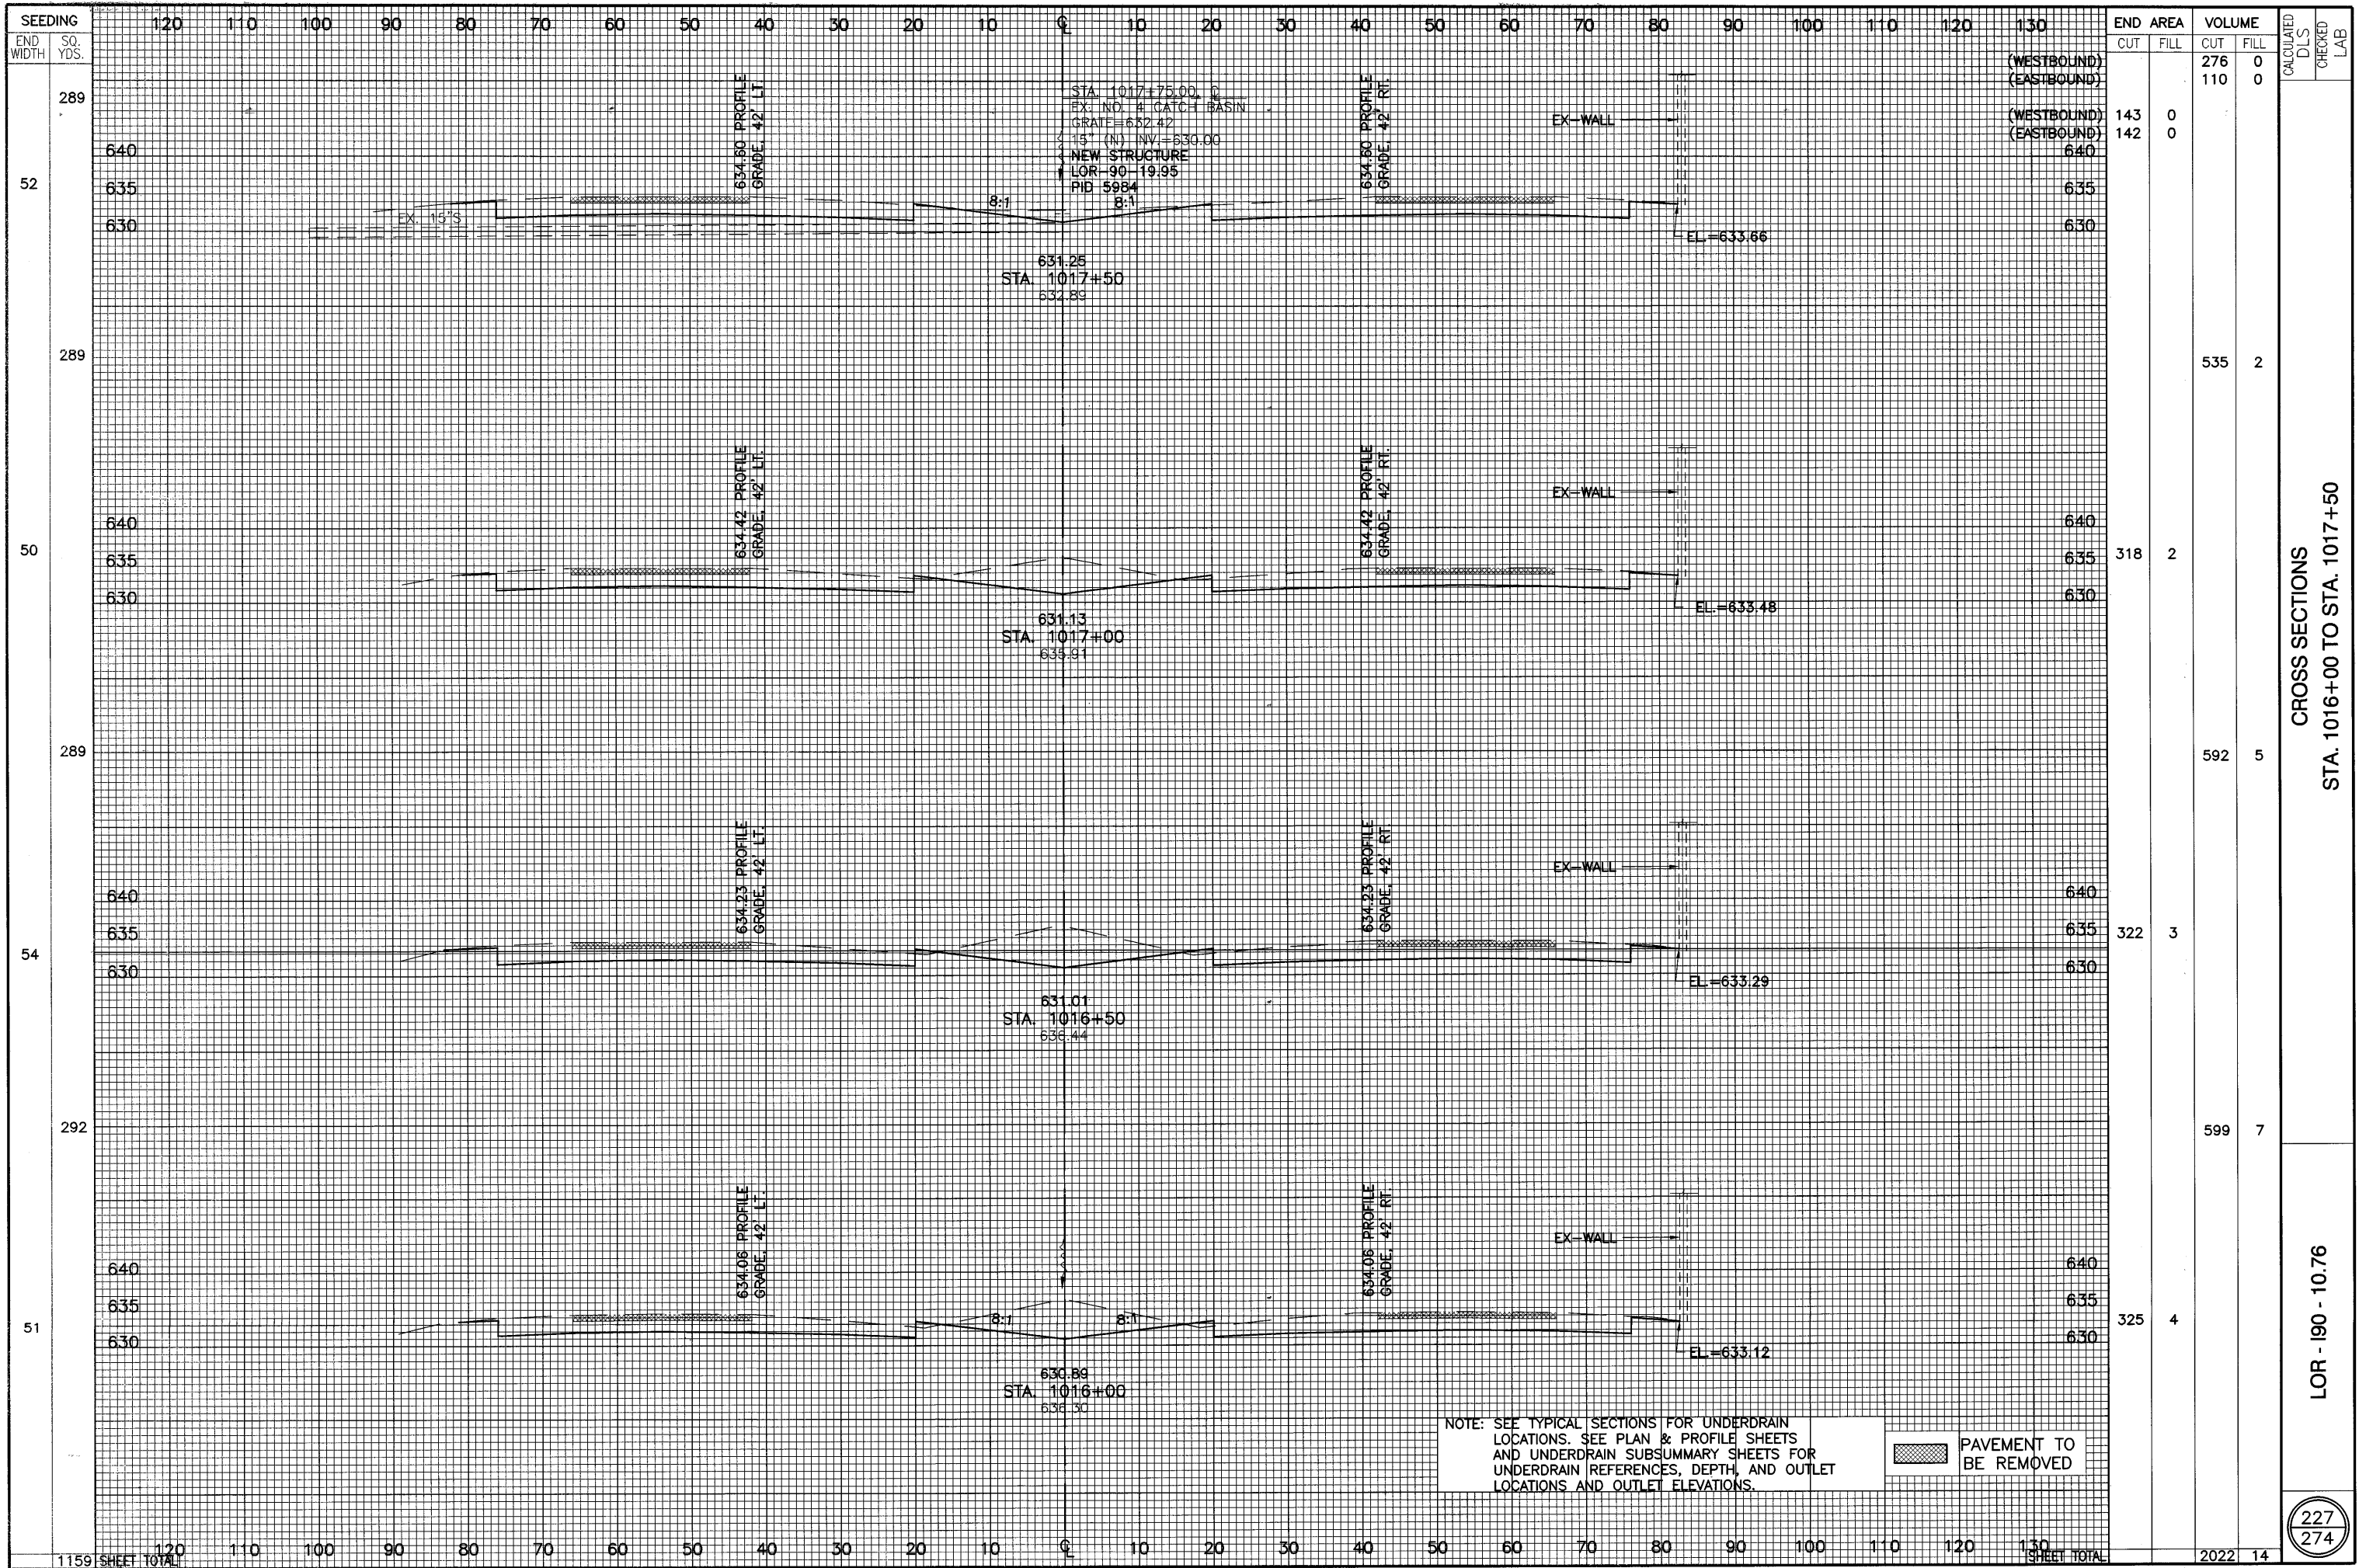

NOTE: SEE TYPICAL SECTIONS FOR UNDERDRAIN LOCATIONS. SEE PLAN & PROFILE SHEETS AND UNDERDRAIN SUBSUMMARY SHEETS FOR UNDERDRAIN REFERENCES, DEPTH, AND OUTLET LOCATIONS AND OUTLET ELEVATIONS.

PAVEMENT TO BE REMOVED

CROSS SECTIONS  
STA. 1016+00 TO STA. 1017+50

LOR - 190 - 10.76


227  
274

1159 SHEET TOTAL

130 SHEET TOTAL

2022 14

4/28/2002 10:00:00 AM \\S:\CAL\10027001.DWG [ DLS

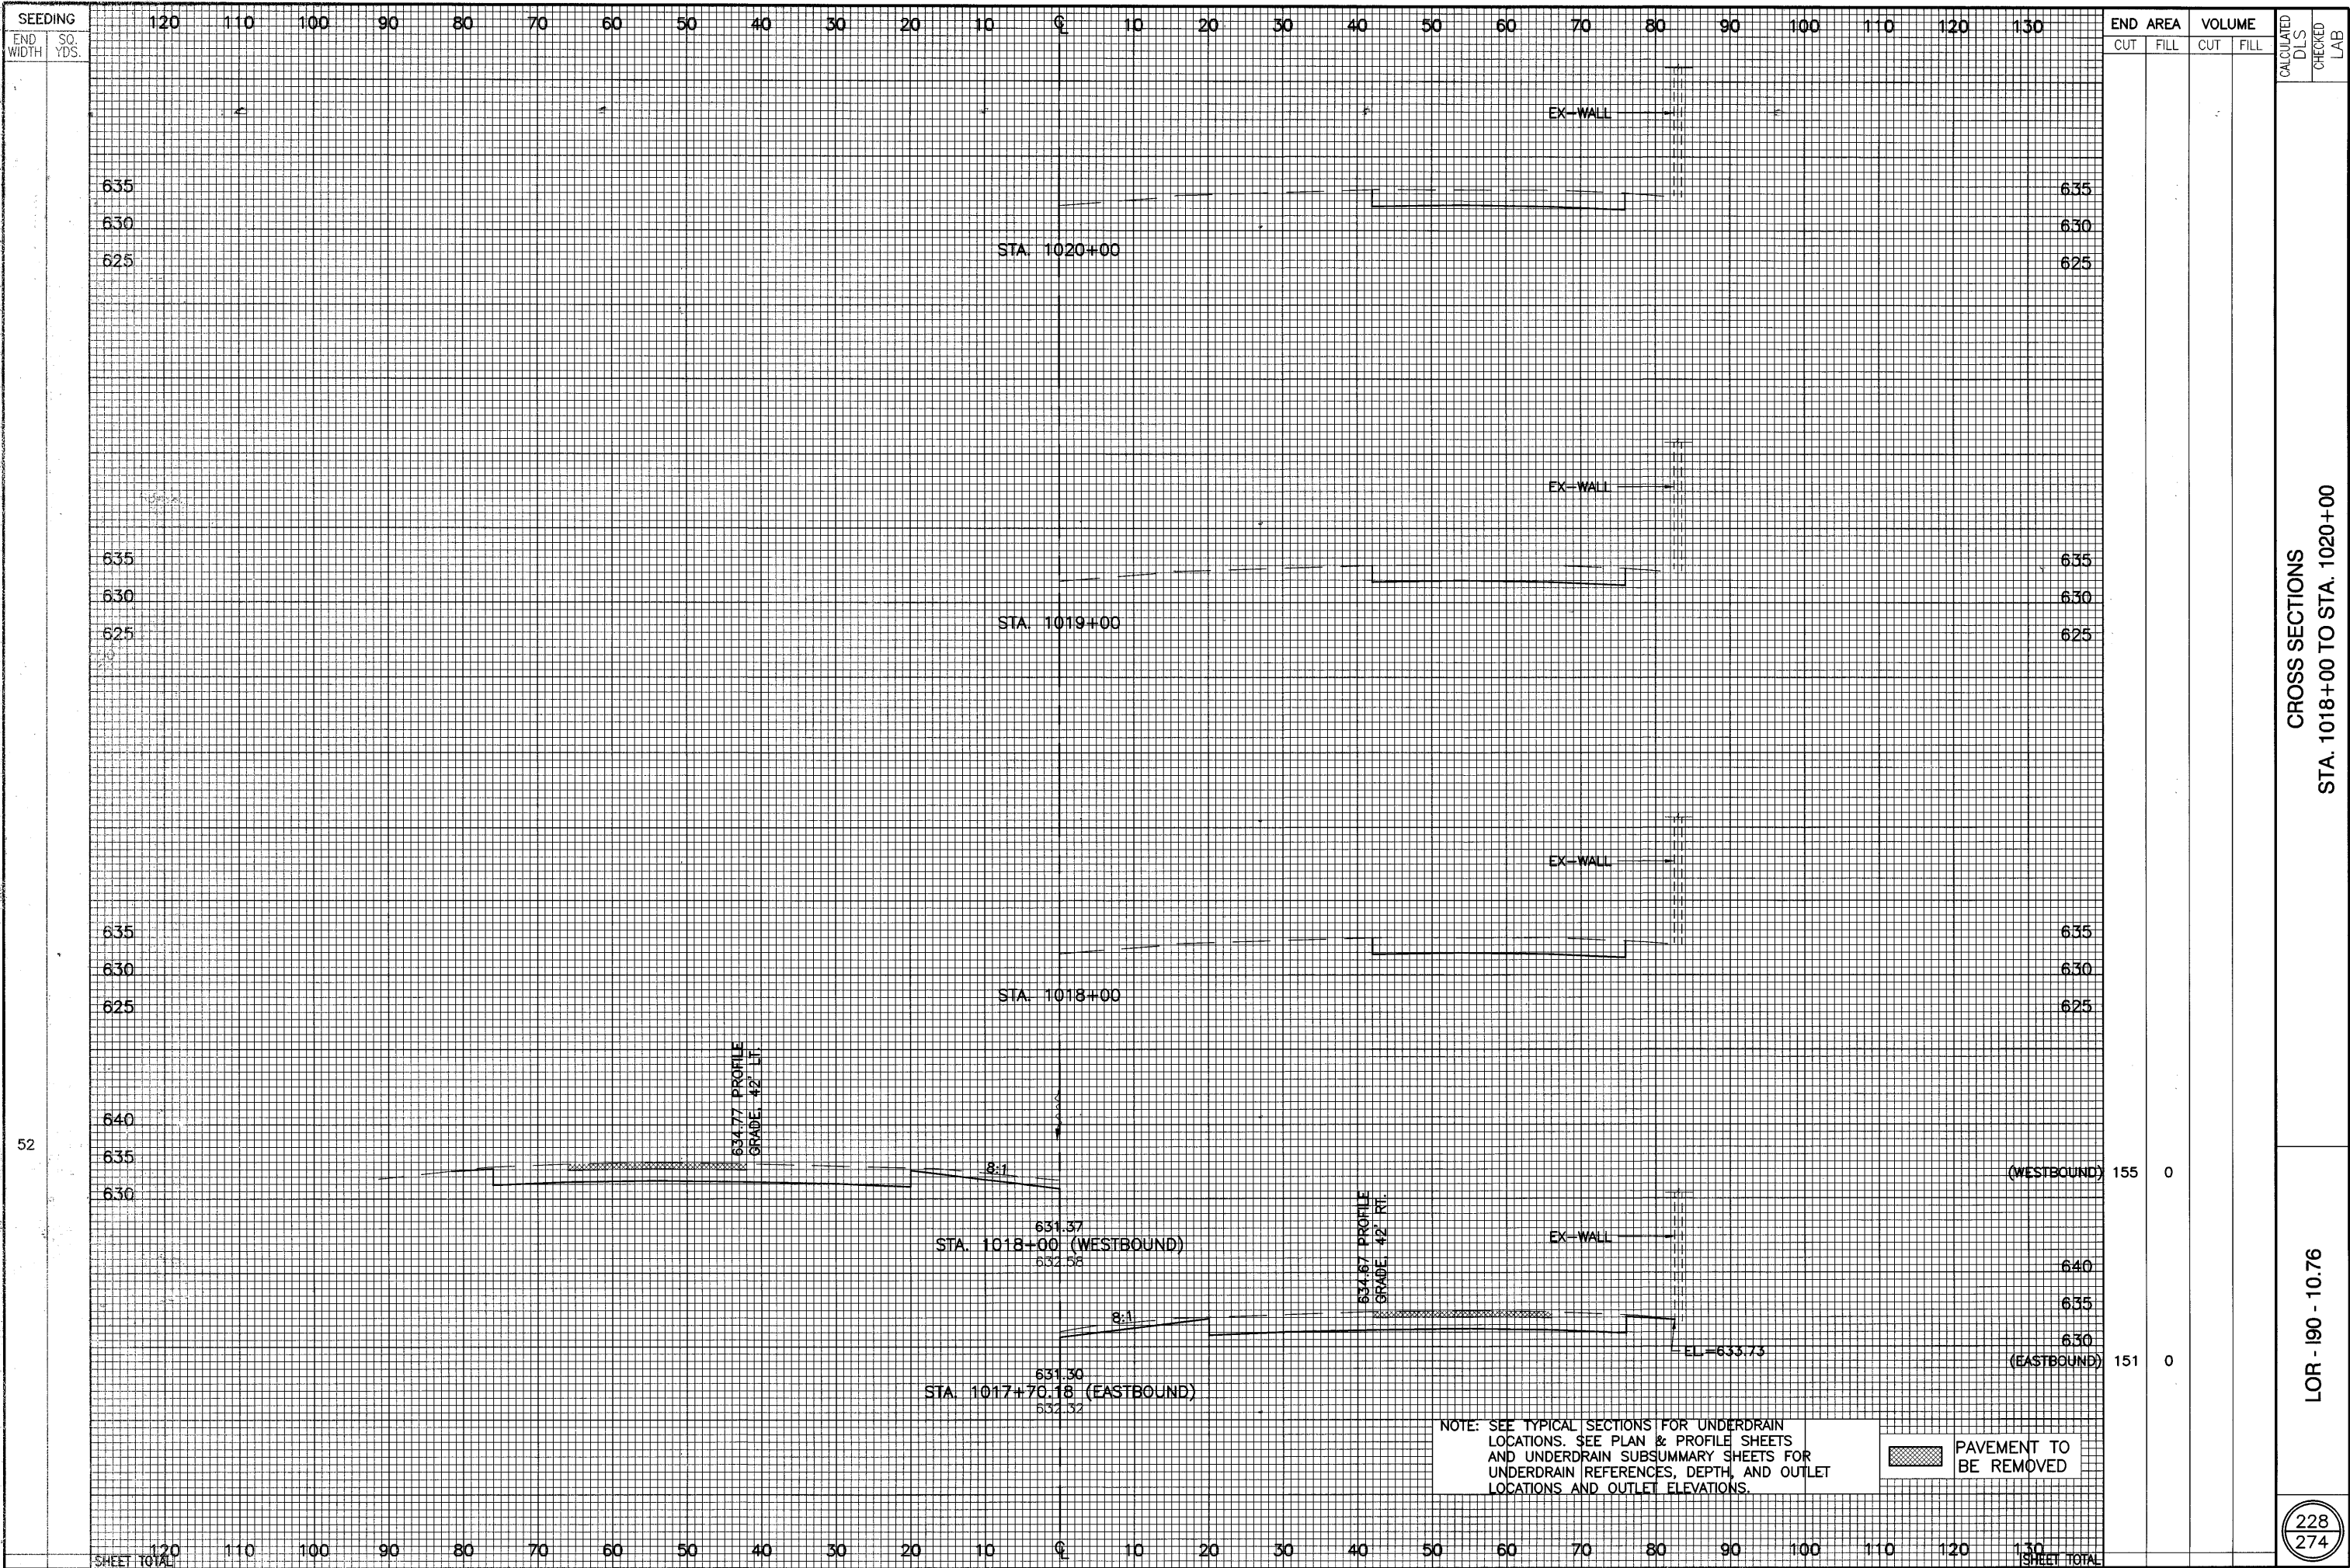

CROSS SECTIONS  
STA. 1018+00 TO STA. 1020+00

LOR - 190 - 10.76

END AREA	VOLUME	CALCULATED DLS	CHECKED	LAB
155	0			
151	0			

52

120 SHEET TOTAL

130 SHEET TOTAL






RECONSTRUCTED 3RD LANE WIDEN PROFILE GRADE ELEVATIONS  
 (EXISTING PROFILE GRADE ELEVATION = PROPOSED PROFILE GRADE ELEVATION)

STATION	WEST BOUND				EAST BOUND			
	ELEVATION PROFILE GRADE ELEVATION	CROWN POINT ELEVATION	OUTSIDE EDGE OF PAVEMENT ELEVATION	OUTSIDE EDGE OF SHOULDER ELEVATION	ELEVATION PROFILE GRADE ELEVATION	CROWN POINT ELEVATION	OUTSIDE EDGE OF PAVEMENT ELEVATION	OUTSIDE EDGE OF SHOULDER ELEVATION
1018+00	634.96	635.15	634.96	634.54	635.00	635.19	635.00	634.58
1019+00	635.00	635.19	635.00	634.58	635.00	635.19	635.00	634.58
1020+00	635.50	635.69	635.50	635.08	635.50	635.69	635.50	635.08
1021+00	635.17	635.36	635.17	634.75	634.99	635.18	634.99	634.57
1022+00	635.61	635.80	635.61	635.19	635.43	635.62	635.43	635.01
1023+00	635.79	635.98	635.79	635.37	635.51	635.70	635.51	635.09
1024+00	635.90	636.09	635.90	635.48	635.71	635.90	635.71	635.29
1025+00	636.03	636.22	636.03	635.61	636.03	636.22	636.03	635.61
1026+00	636.23	636.42	636.23	635.81	636.23	636.42	636.23	635.81
1027+00	636.69	636.88	636.69	636.27	636.51	636.70	636.51	636.09
1028+00	636.94	637.13	636.94	636.52	636.79	636.98	636.79	636.37
1029+00	637.58	637.77	637.58	637.16	637.03	637.22	637.03	636.09
1030+00	637.53	637.72	637.53	637.11	637.26	637.45	637.26	636.61
1031+00	637.73	637.92	637.73	637.31	637.54	637.73	637.54	637.12
1032+00	637.90	638.09	637.90	637.48	637.68	637.87	637.68	637.26
1033+00	638.61	638.80	638.61	638.19	638.63	638.82	638.63	638.21
1034+00	638.89	639.08	638.89	638.47	638.85	639.04	638.85	638.43
1035+00	639.08	639.27	639.08	638.66	639.14	639.33	639.14	638.72




PROFILE GRADE ELEVATIONS  
 (RECONSTRUCTED)


LOR - 190 - 10.76

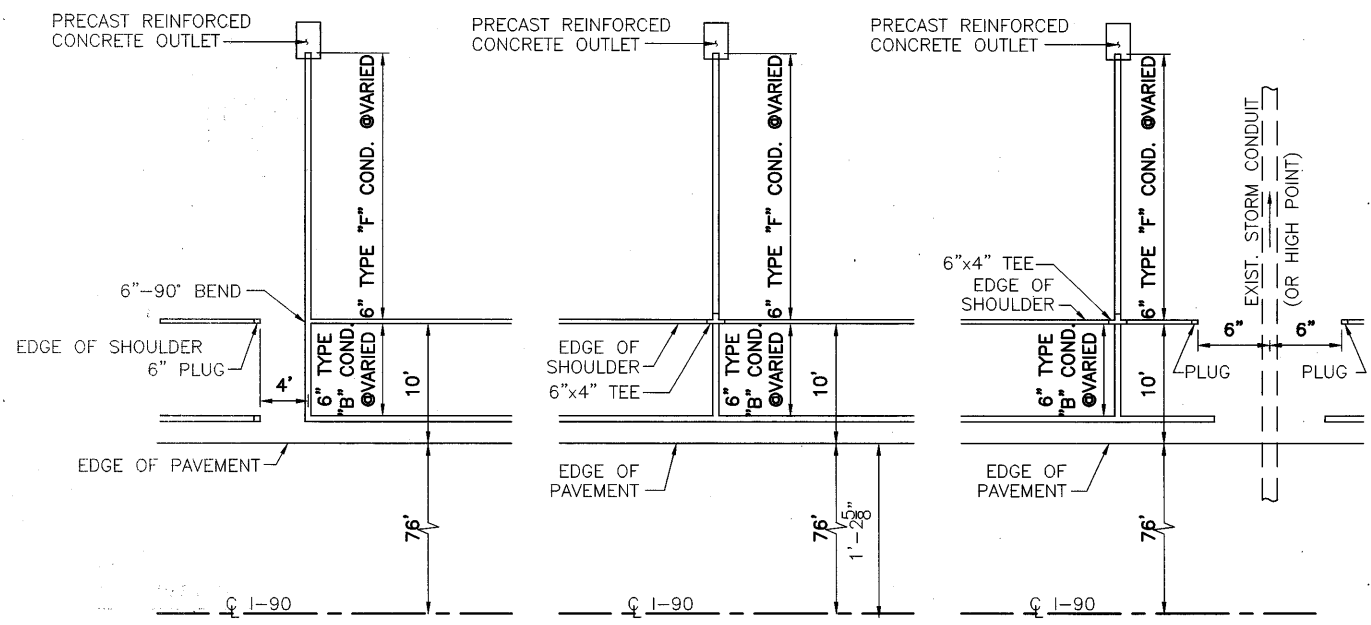

**OUTSIDE EDGE UNDERDRAIN OUTLET DETAILS**  
N.T.S.

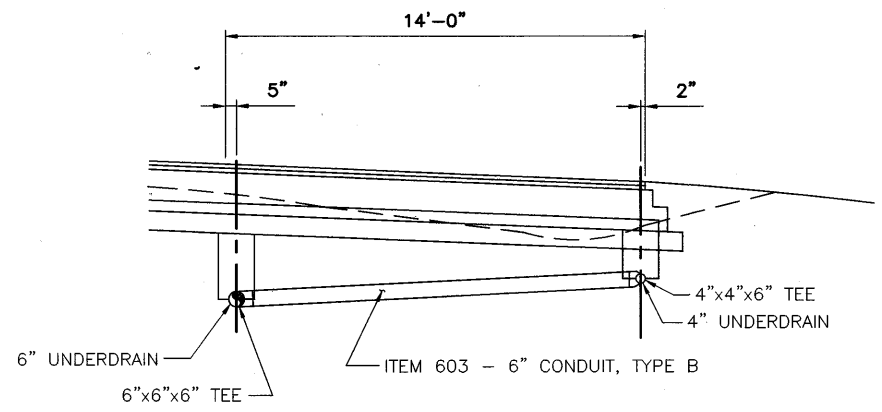


**EDGE OF SHOULDER UNDERDRAIN TIE-INS TO EDGE OF PAVEMENT UNDERDRAINS**  
N.T.S.


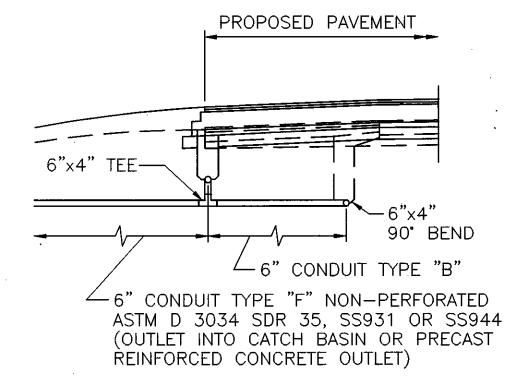


**CONNECTION TO EXISTING UNDERDRAIN DETAILS**  
N.T.S.

ITEM 603 - 6" CONDUIT TYPE F, 707.17, NON PERFORATED, ASTM 3034 SDR 35

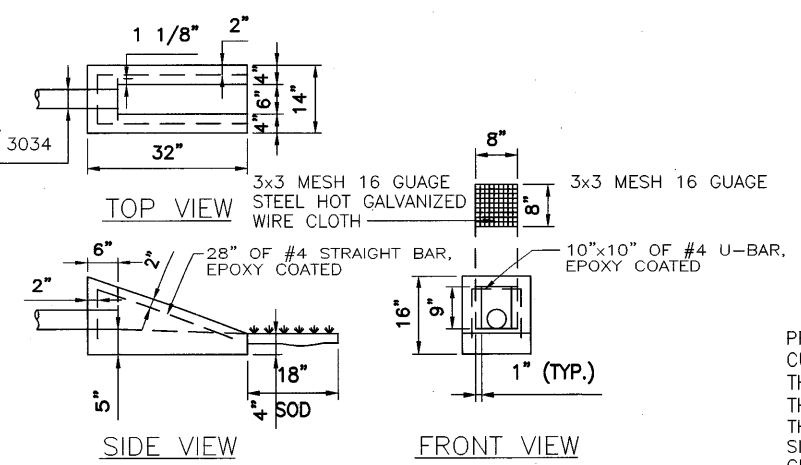

**ITEM SPECIAL - PRECAST REINFORCED CONCRETE OUTLET**  
N.T.S.

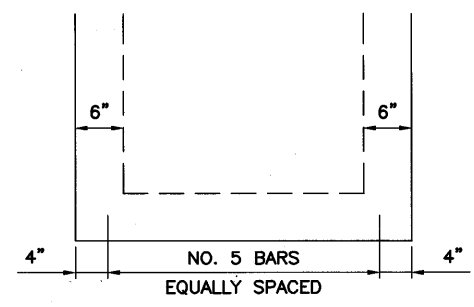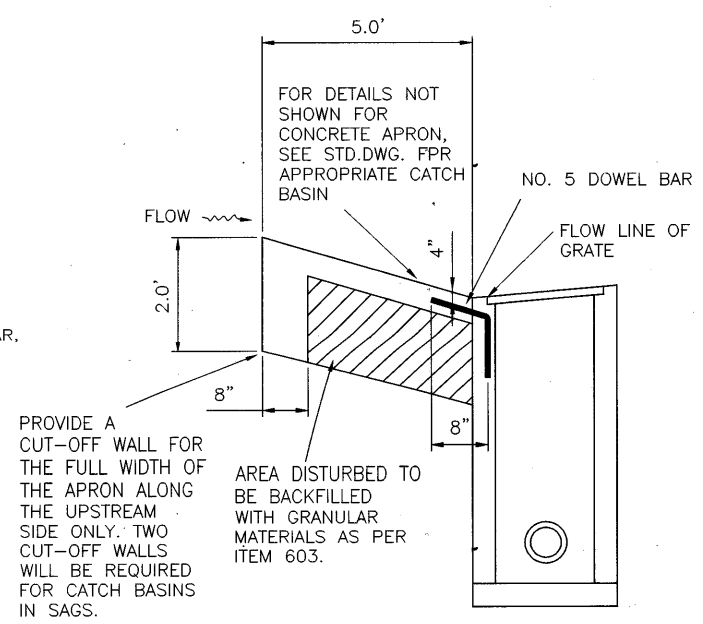


**BAR LOCATION DETAIL**  
N.T.S.

**NOTES:**


1. THE METHOD OF CONSTRUCTION OF THESE CATCH BASINS CAN BE EITHER CAST-IN-PLACE OR PRECAST.
2. FOR DETAILS NOT SHOWN SEE APPROPRIATE STANDARD CONSTRUCTION DRAWINGS OR ORIGINAL CONSTRUCTION PLANS.
3. WHERE APPLICABLE THE REQUIREMENTS OF ITEM 604 SHALL GOVERN THE REPLACEMENT OF THE EXISTING CATCH BASIN. THE CONCRETE APRON SHALL BE REPLACED AND BACKFILL AS SHOWN HERE AND IN THE STANDARD DRAWING FOR THE PERTINENT CATCH BASIN.
4. PAYMENT FOR THE ABOVE WORK SHALL BE INCLUDED IN ITEM SPECIAL - MISC. DRAINAGE AND SHALL CONSTITUTE FULL COMPENSATION FOR FURNISHING ALL MATERIAL, LABOR, TOOLS, AND EQUIPMENT INCIDENTAL TO COMPLETE THIS ITEM OF WORK.
5. THE FURNISHING AND PLACING OF STEEL FOR THE 5/8" x 1/2" DOWEL BARS SHALL BE PER 509 REINFORCING STEEL. THE DOWEL BARS SHALL BE EPOXY COATED PER 509.10. THE DOWEL BARS SHALL BE INSTALLED PER 510 OR CAST INTO THE BASIN. BOLT IN INSERTS MAY BE USED. THE 6" CONCRETE APRON SHALL BE REINFORCED PER 601.04(3).



RAMP "R" ACCELERATION LANE DETAILS

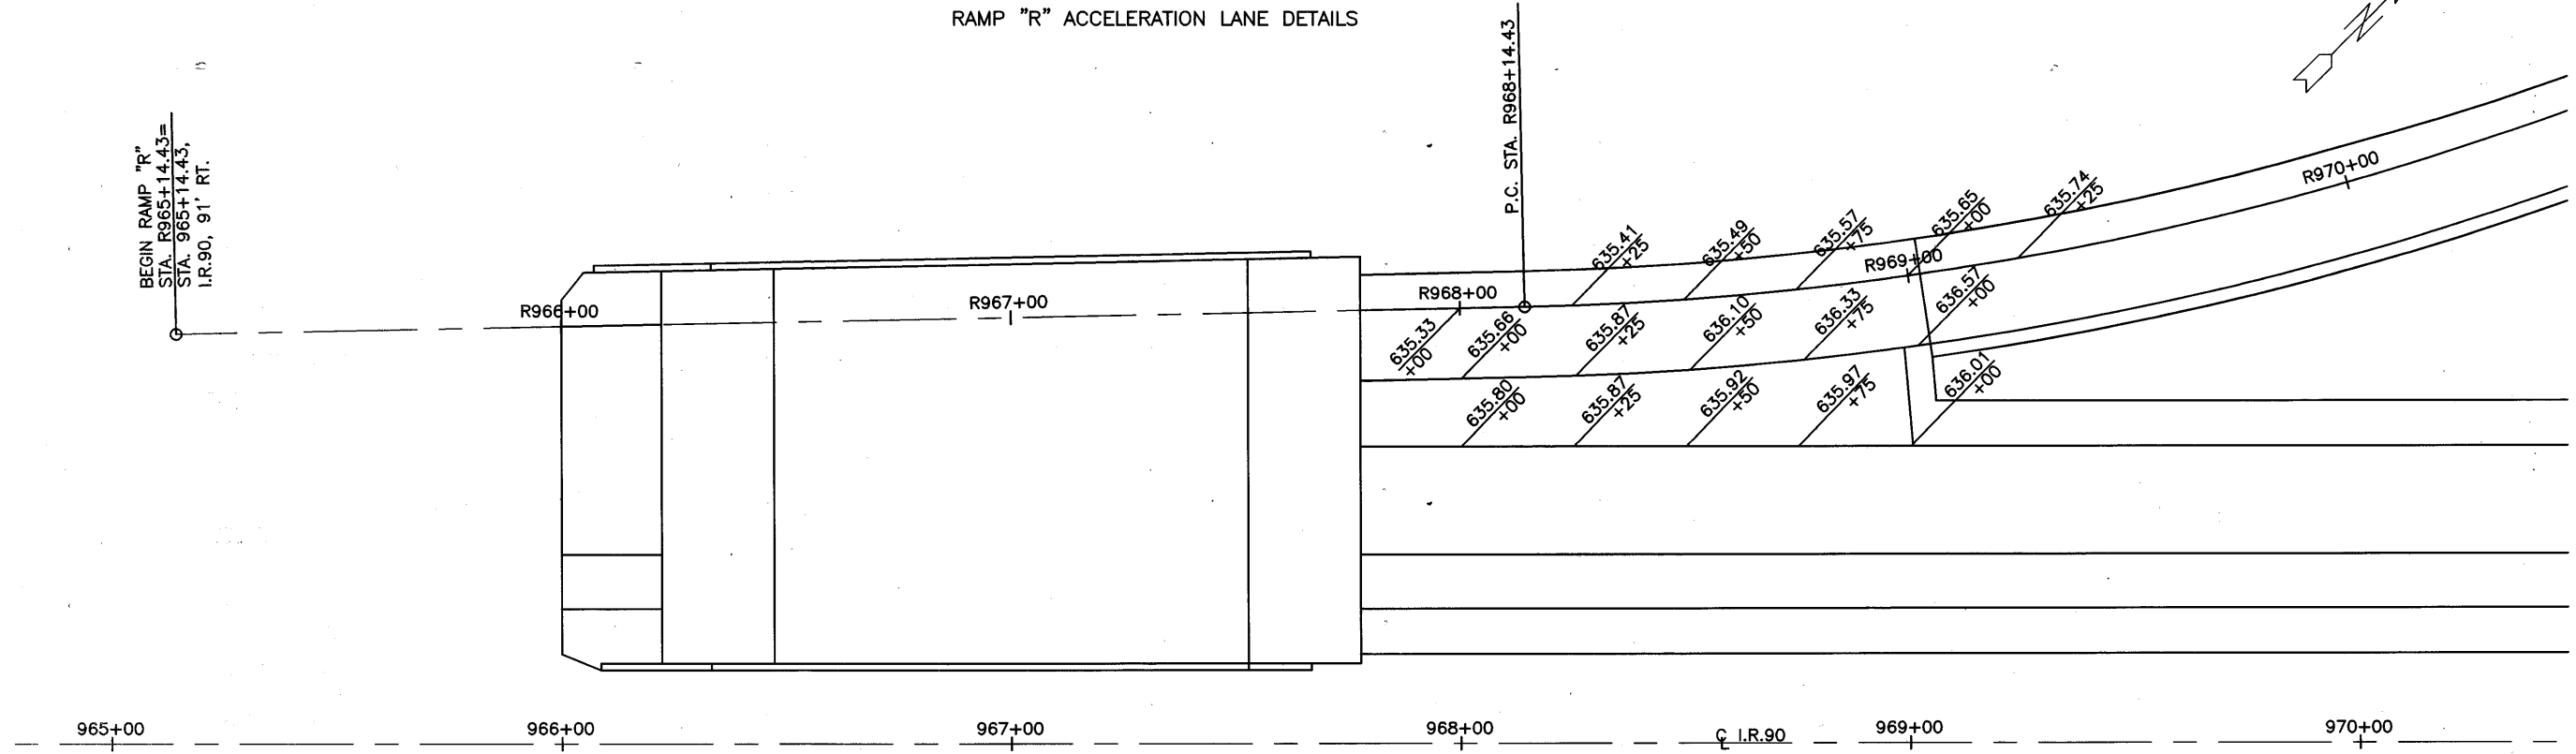

RAMP "P" DECELERATION LANE DETAILS

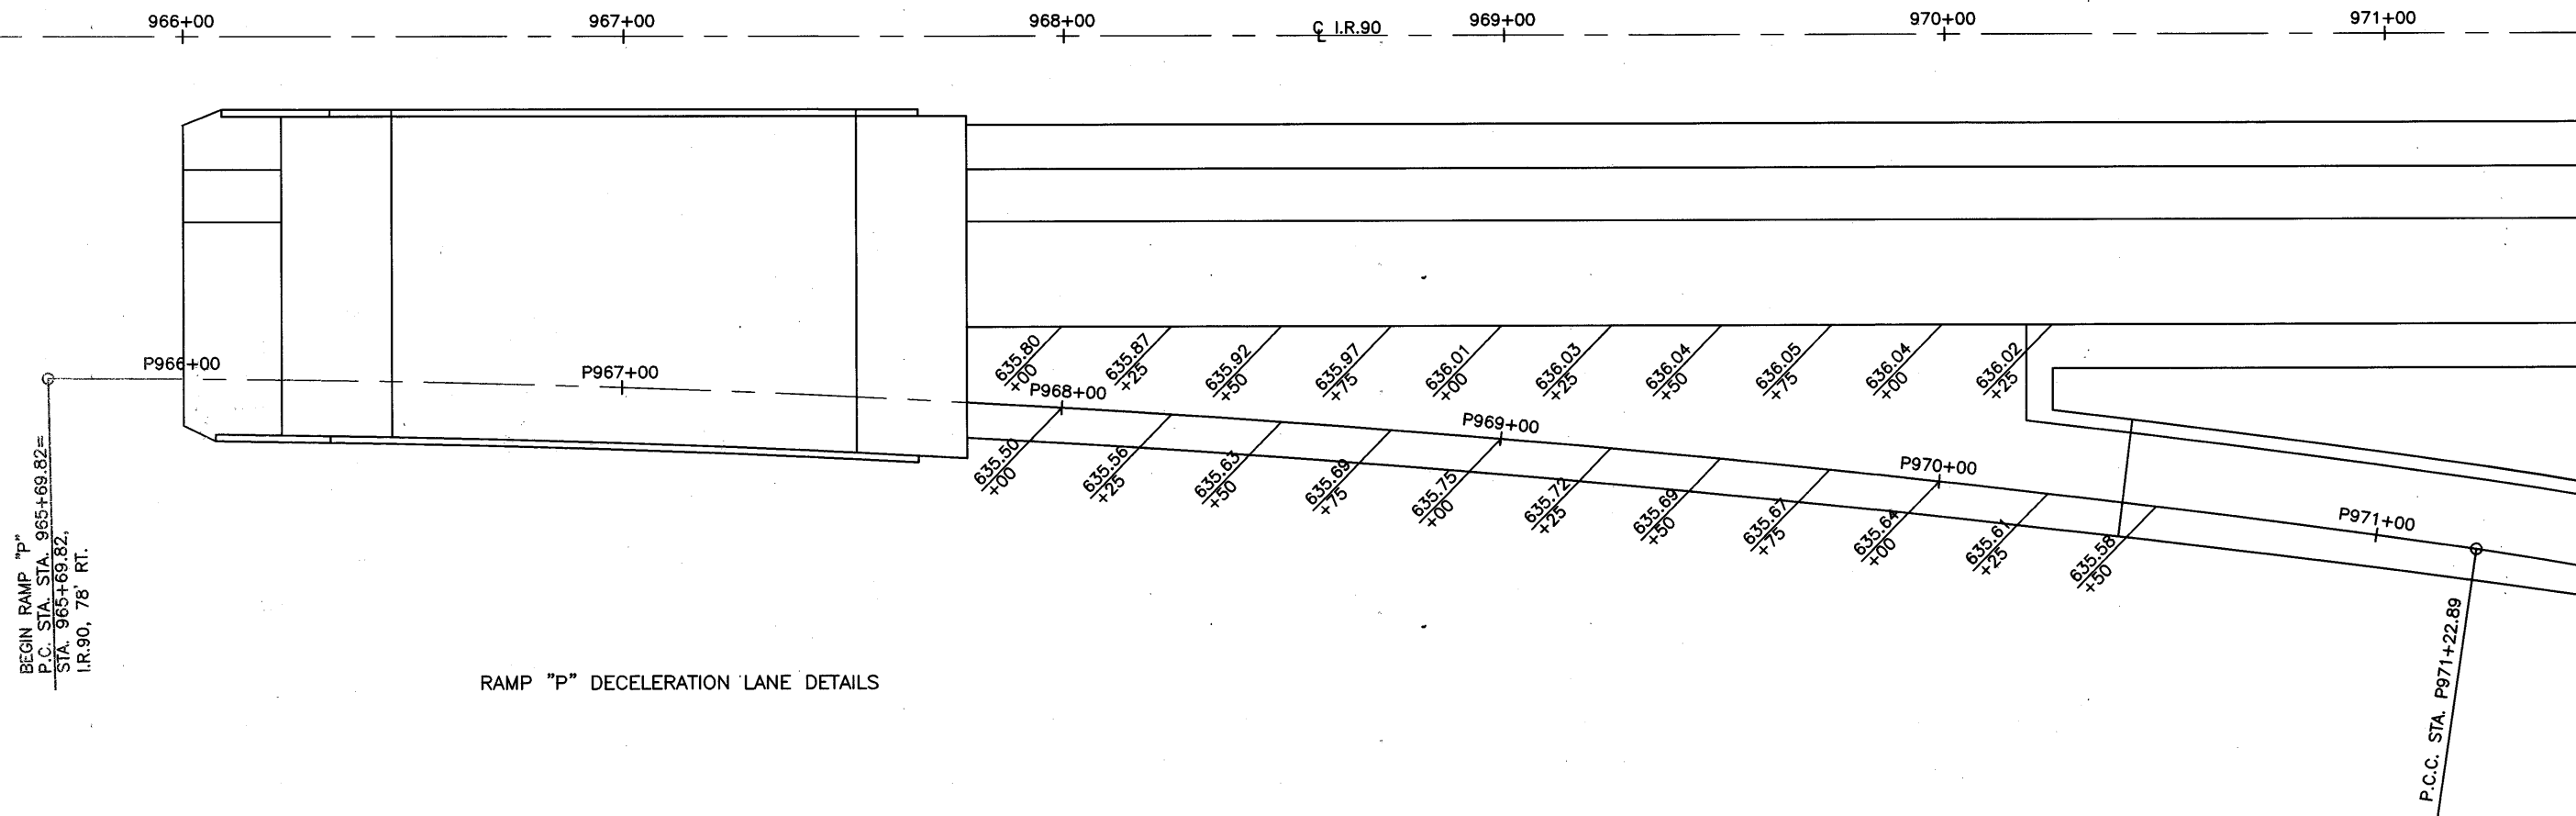

BEGIN RAMP "P"  
P.C. STA. 965+69.82=  
STA. 965+69.82.  
I.R. 90, 78' RT.

BEGIN RAMP "R"  
STA. 965+14.43=  
STA. 965+14.43.  
I.R. 90, 91' RT.

P.C. STA. R968+14.43

P.C.C. STA. P971+22.89


ACCELERATION AND DECELERATION  
LANE ELEVATION DETAILS

LOR - 190 - 10.76


CALCULATED	0	20'	40'
DLS			
CHECKED			
LAB			

HORIZONTAL SCALE IN FEET

RAMP "M" DECELERATION LANE DETAIL

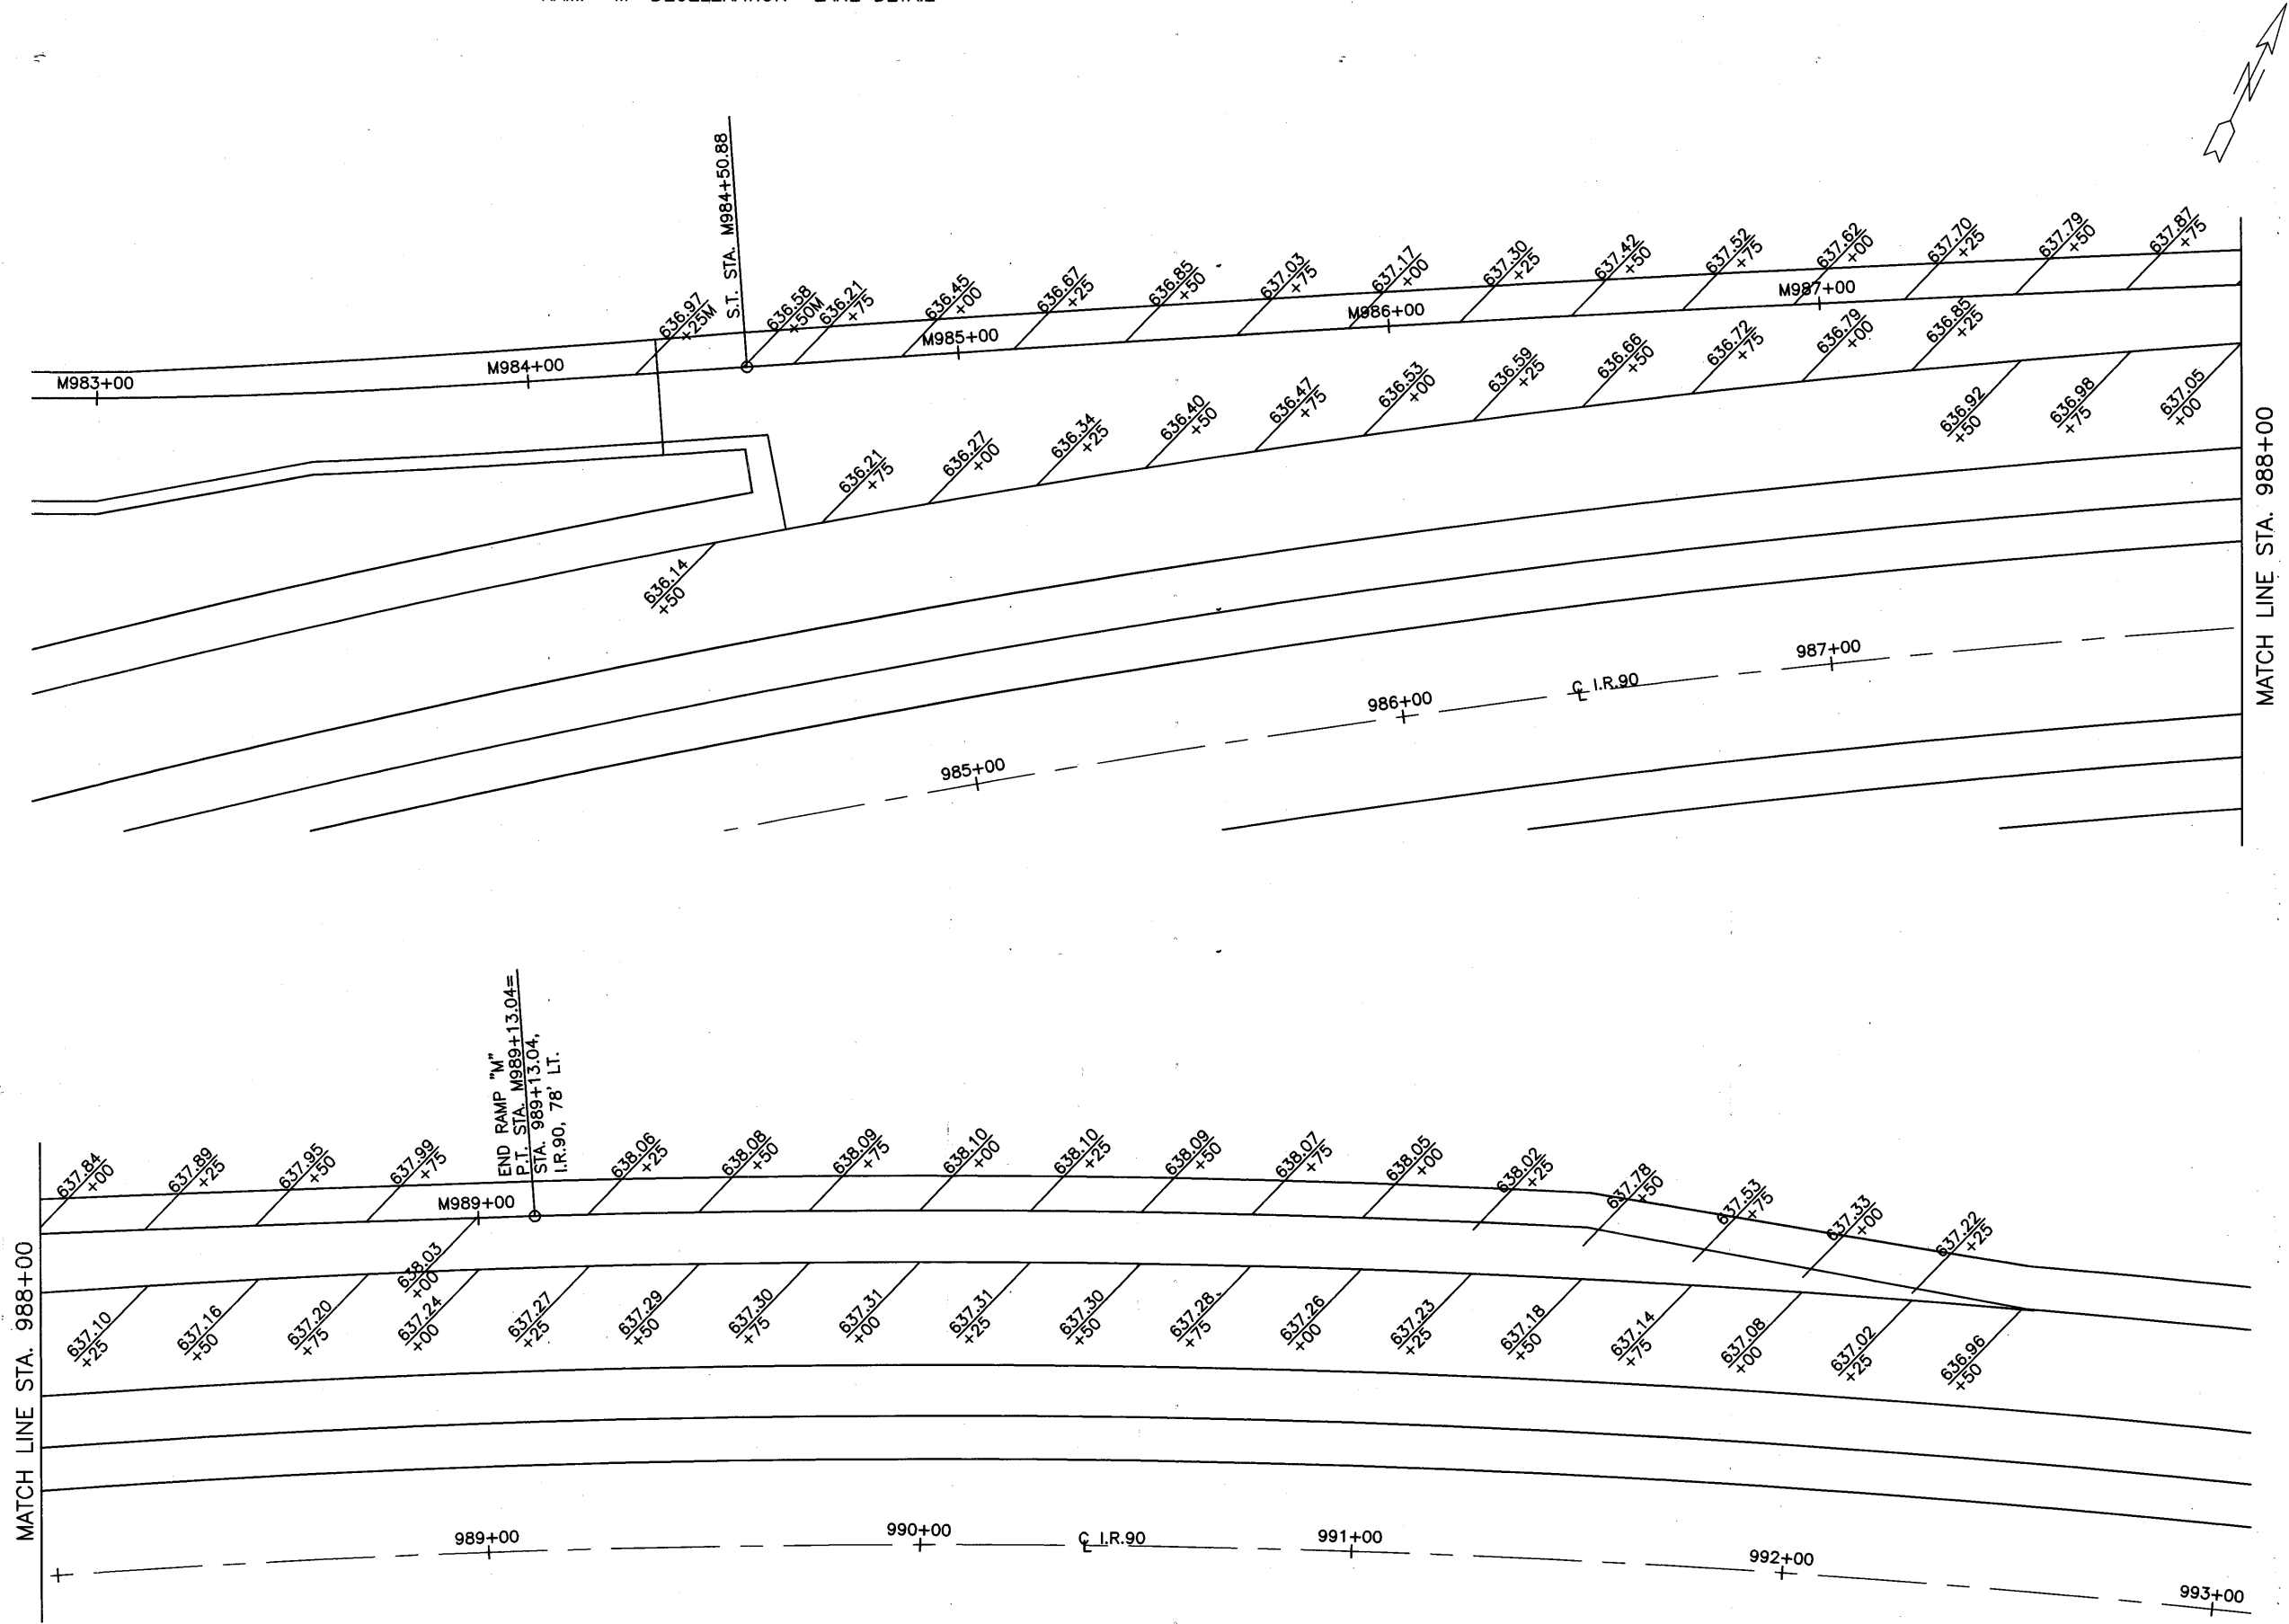

CALCULATED	DLS	CHECKED	LAB

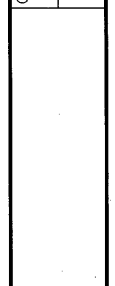


ACCELERATION AND DECELERATION  
LANE ELEVATION DETAILS

LOR - 190 - 10.76

03/21/18 08:55:18 AM 03/21/18 08:55:18 AM 1 107  
03/21/18 08:55:18 AM 03/21/18 08:55:18 AM 1 107

RAMP "N" ACCELERATION LANE DETAIL

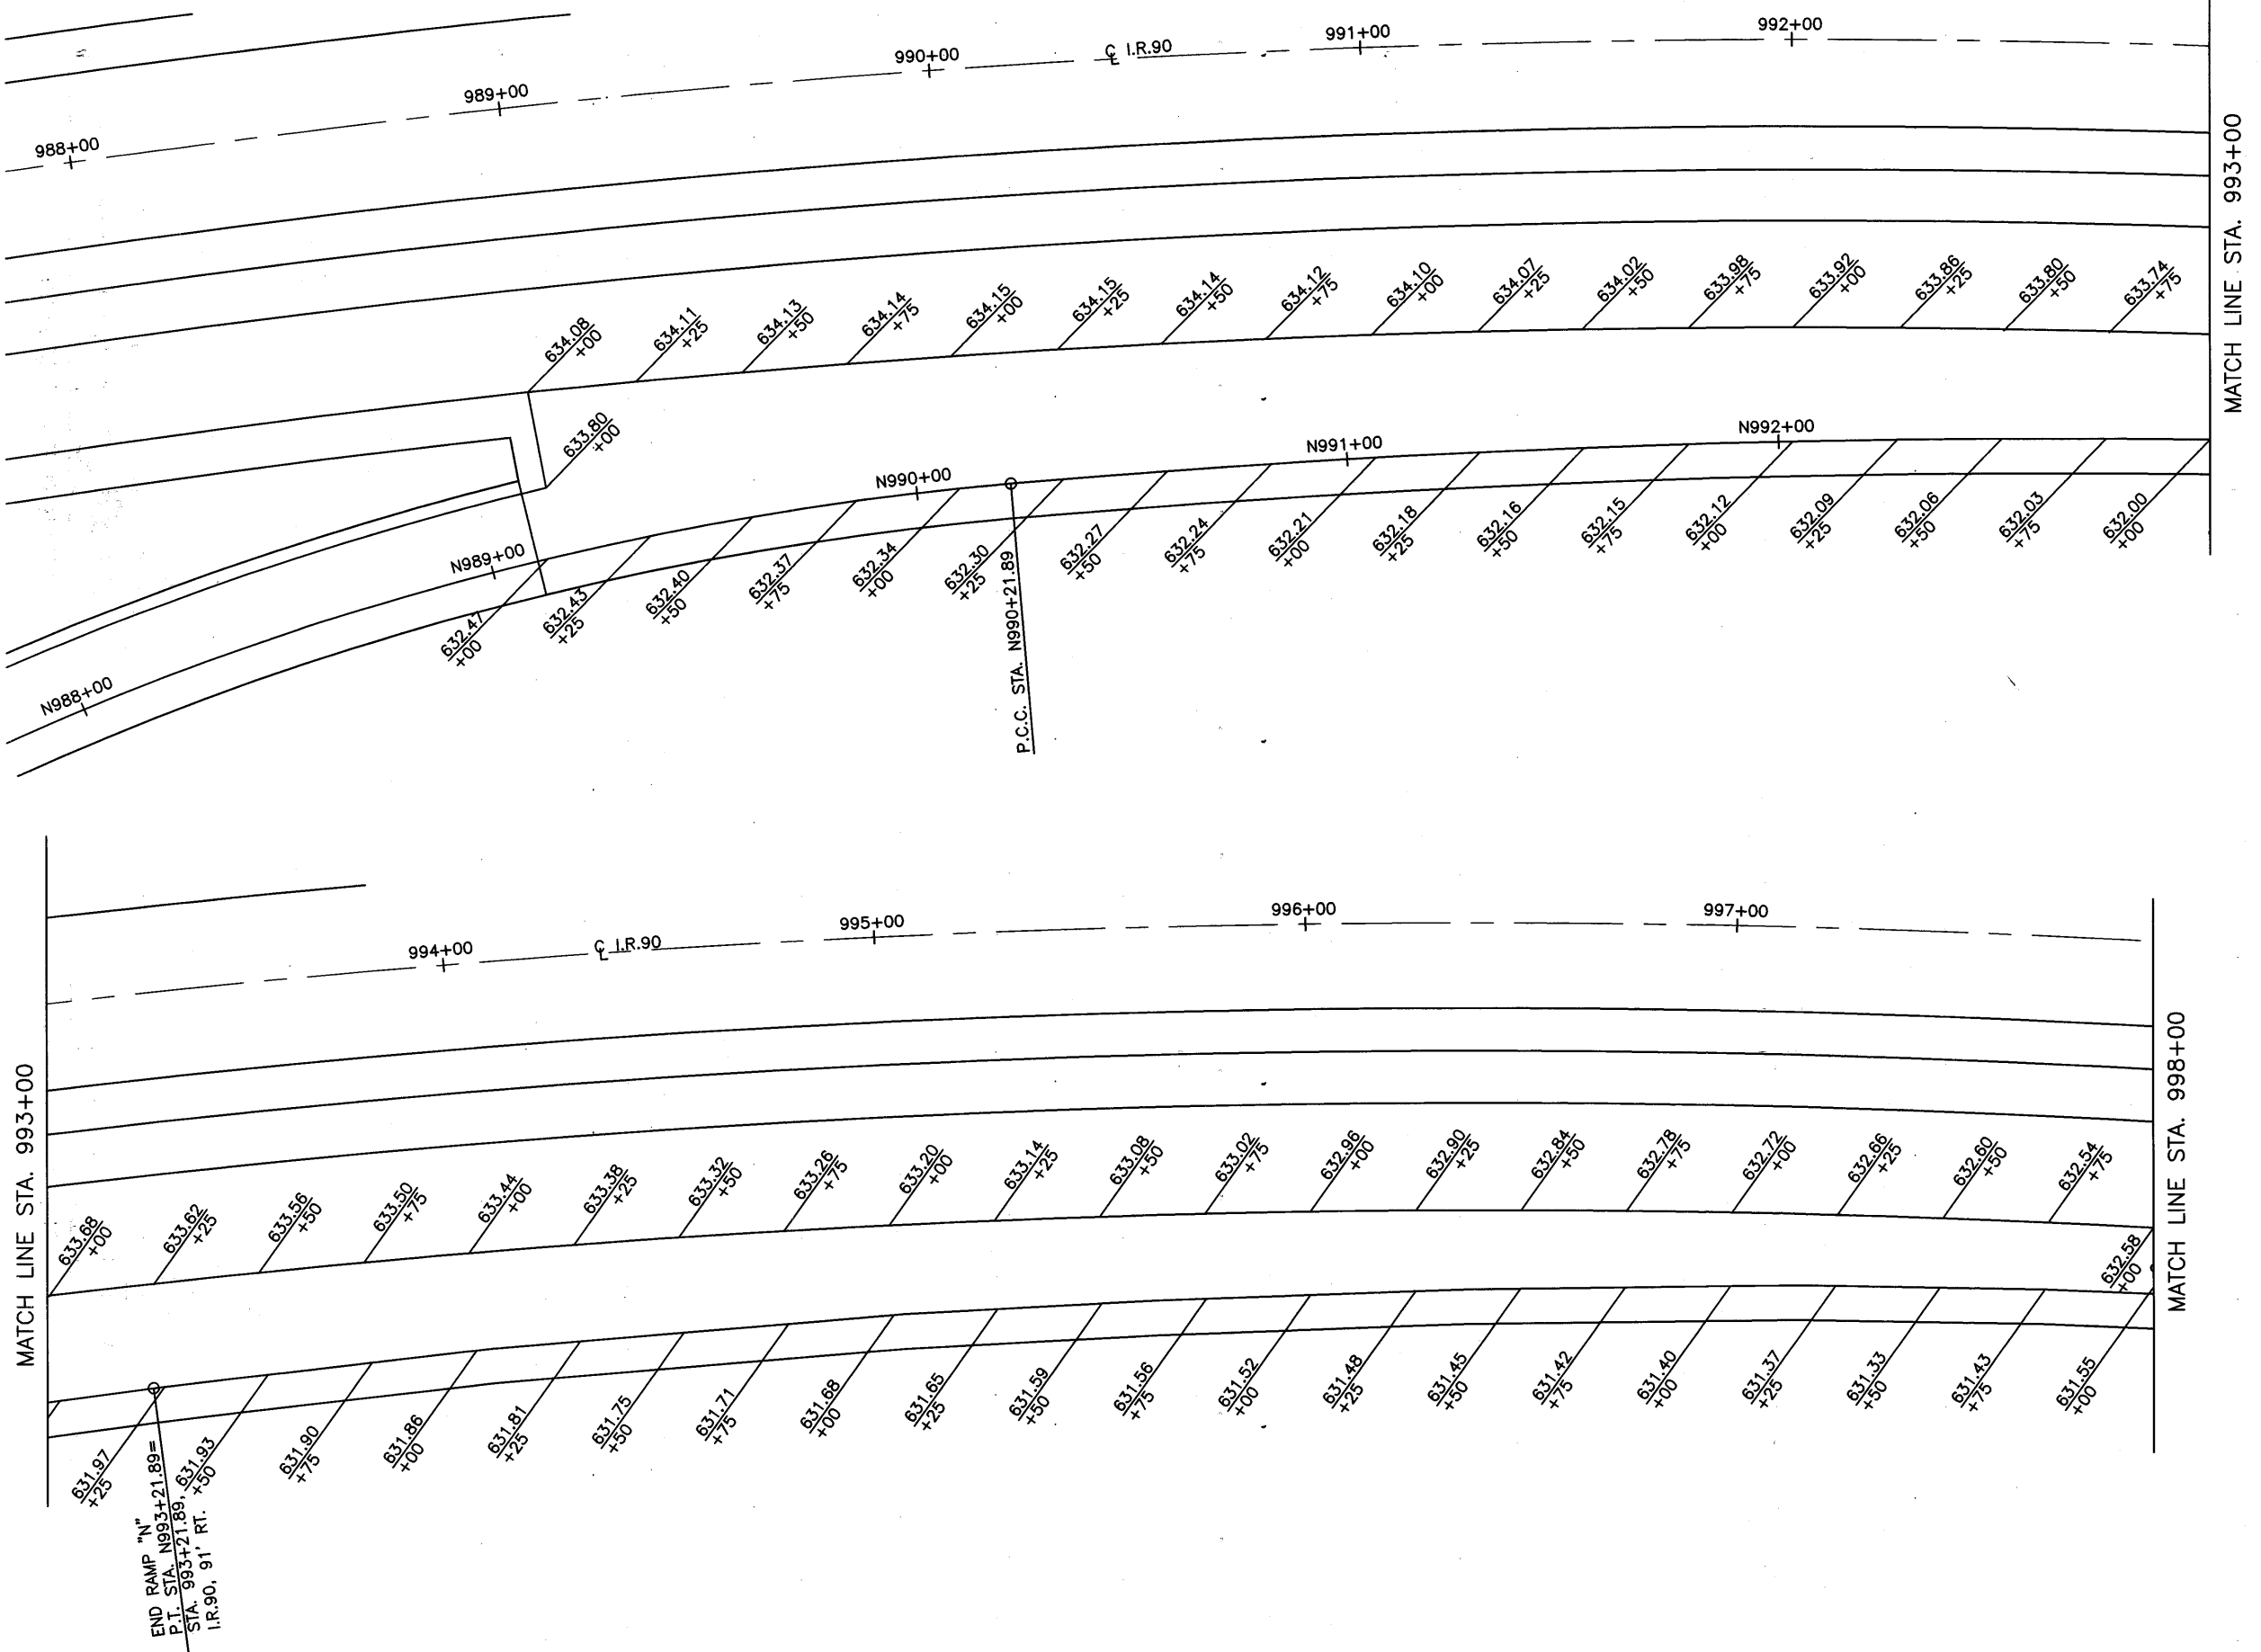


CALCULATED	DLS	CHECKED	LAB

ACCELERATION AND DECELERATION  
LANE ELEVATION DETAILS

LOR - 190 - 10.76

8:53:03 PM 5/13/2002 11:47 AM

RAMP "N" ACCELERATION LANE DETAIL

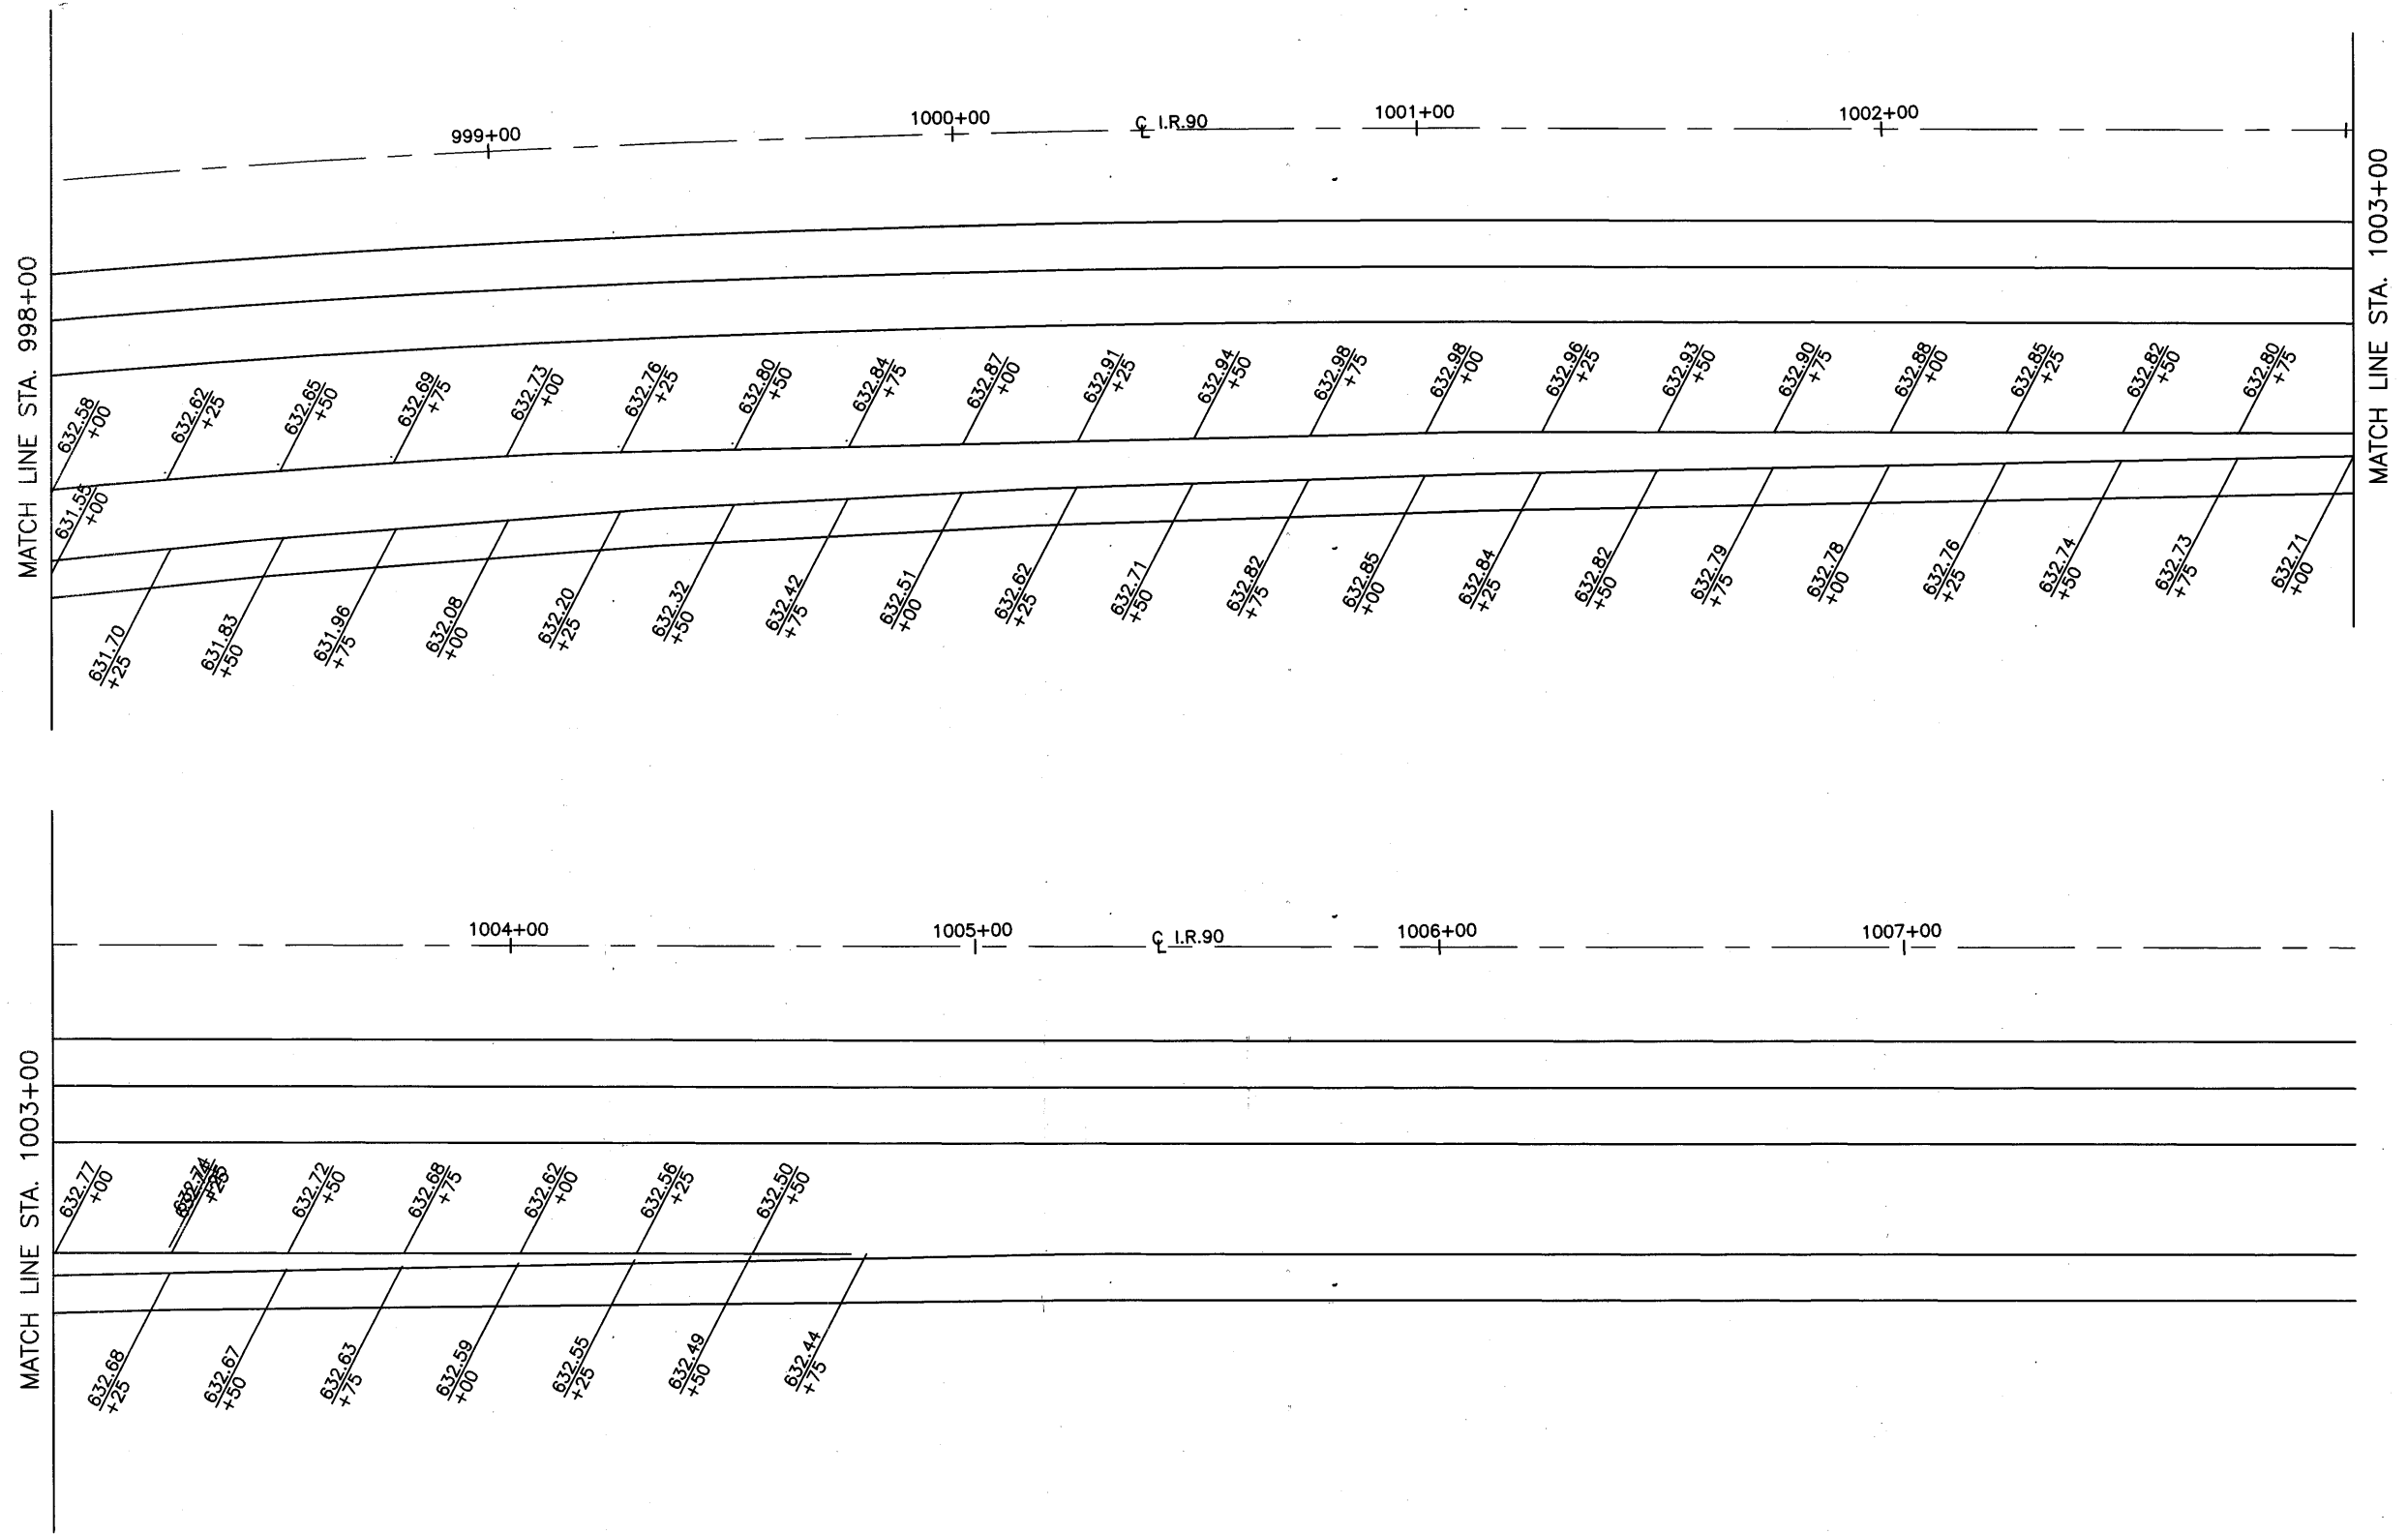


CALCULATED	DLS	CHECKED	LAB

ACCELERATION AND DECELERATION  
LANE ELEVATION DETAILS

LOR - 190 - 10.76

2025 LOR - 190 - 10.76 - 11/14/24

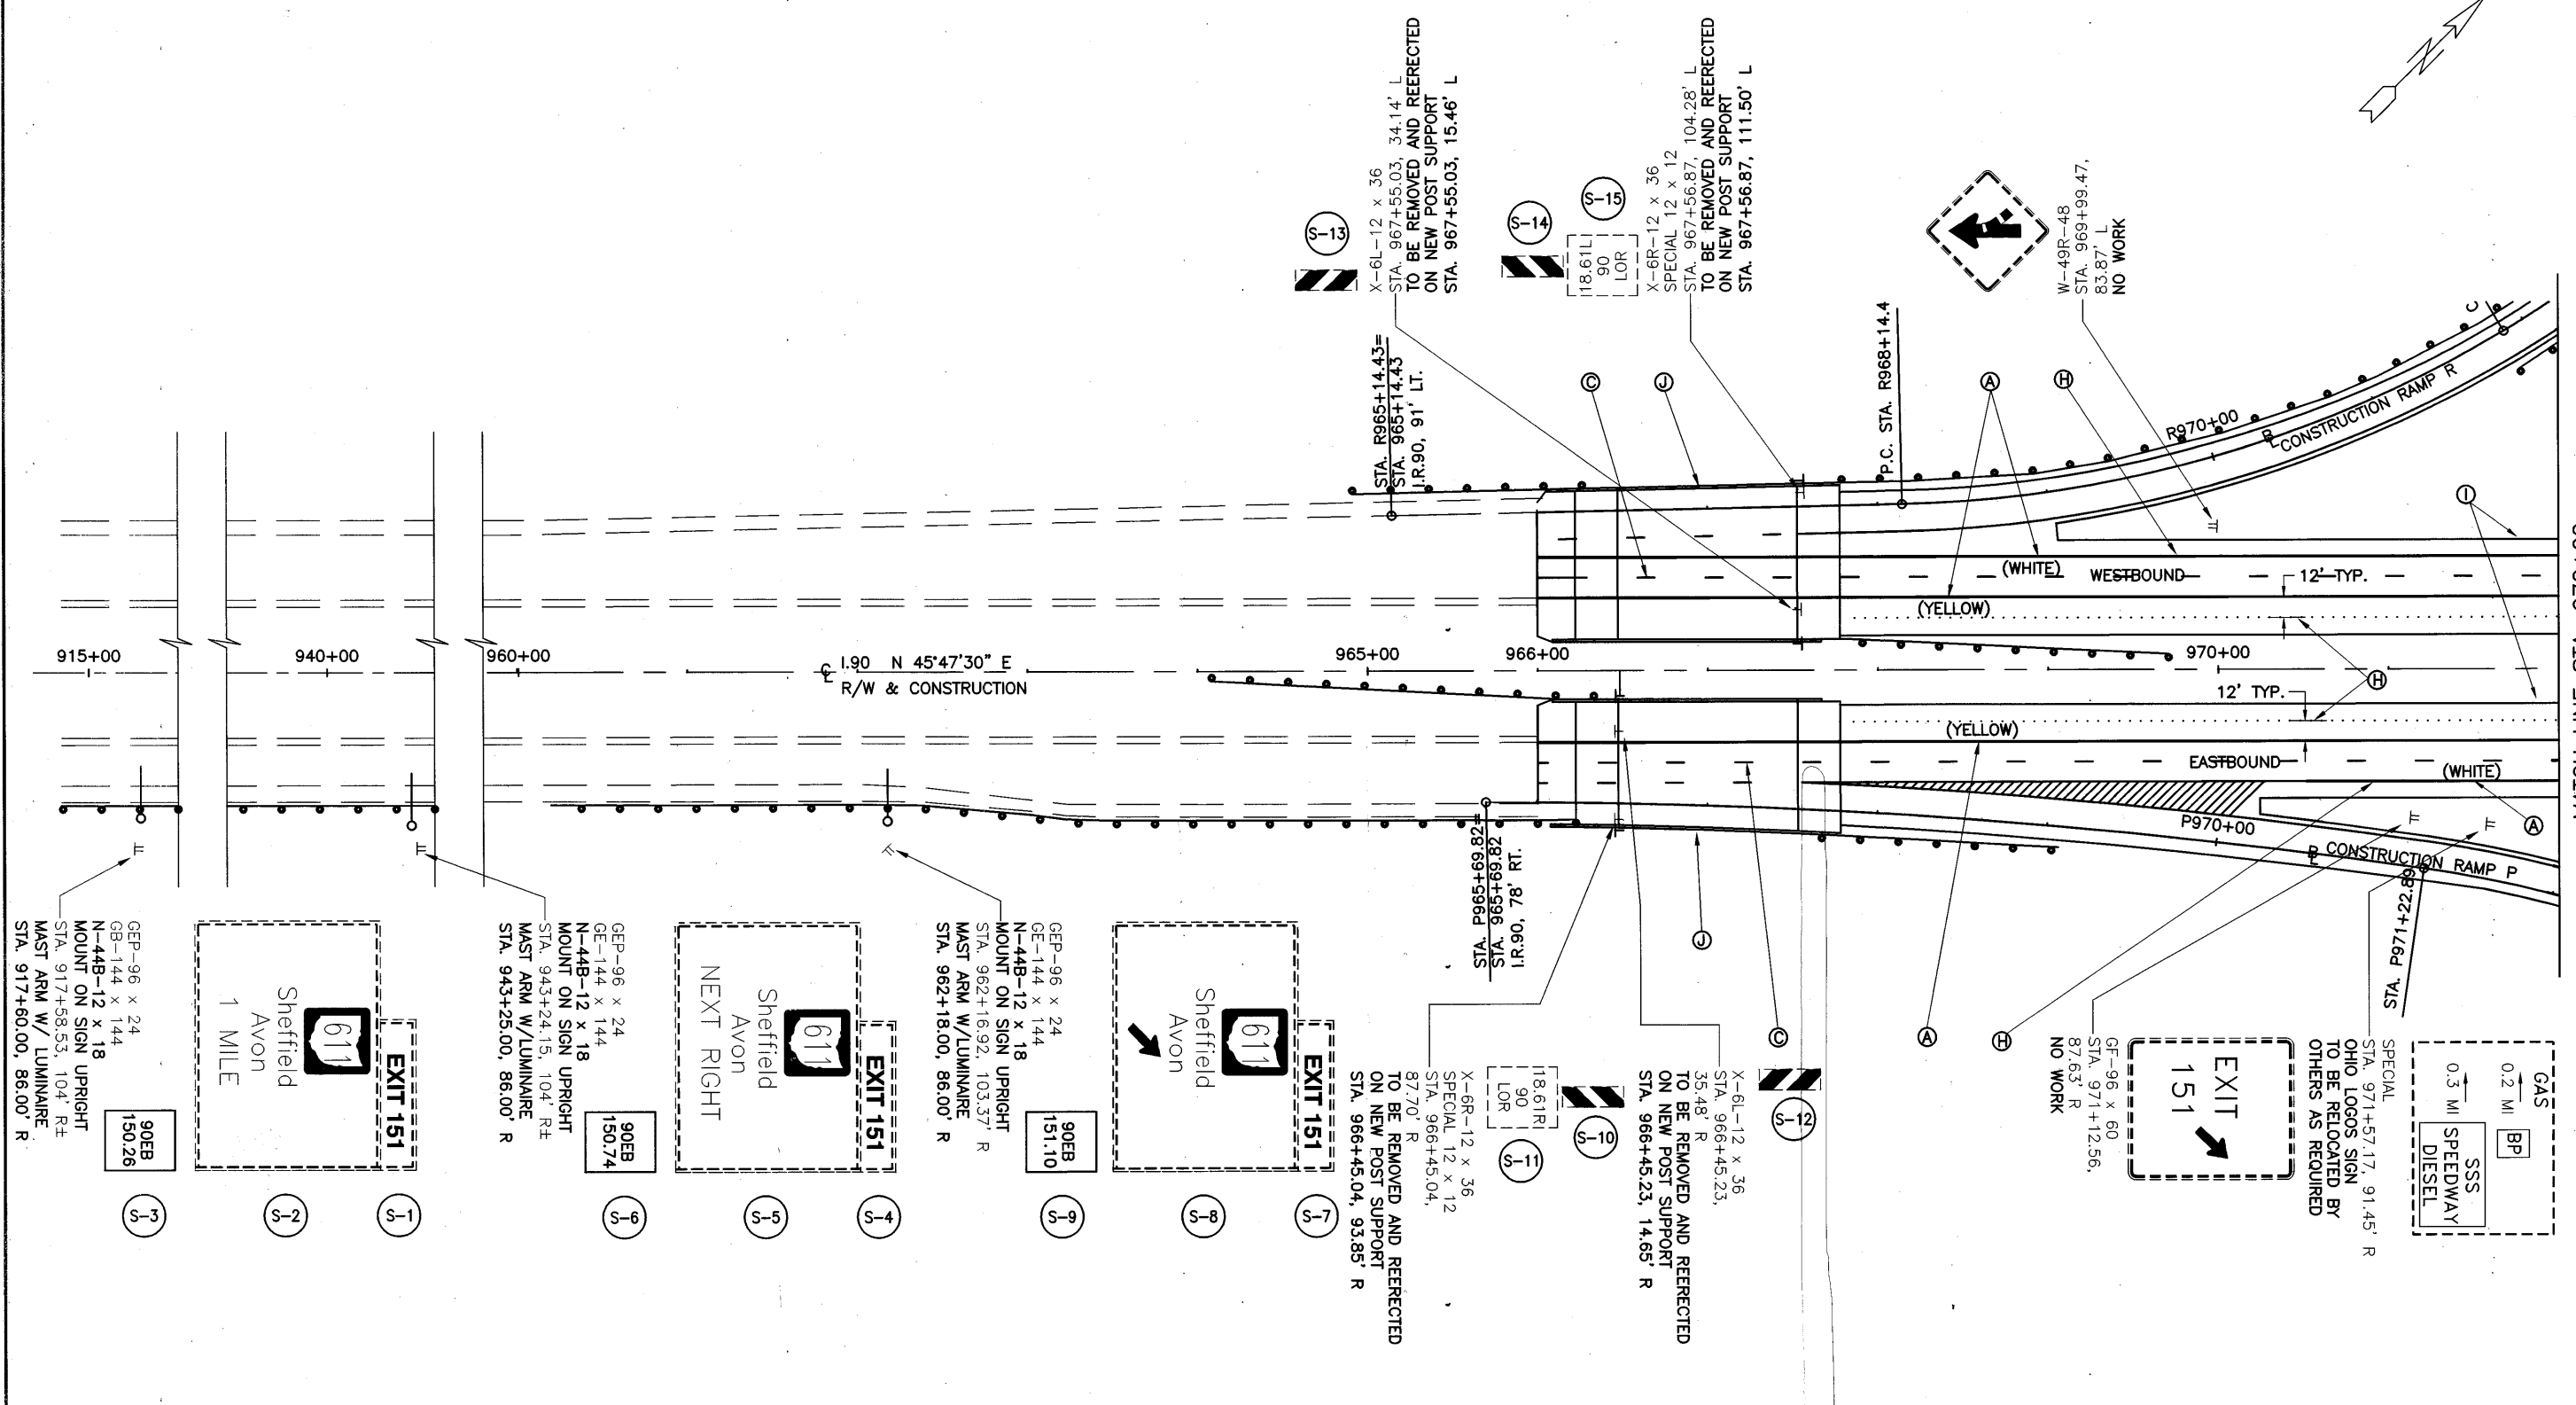

- LEGEND**
- (A) ITEM 644 - EDGE LINE
  - (B) ITEM 644 - EDGE LINE, W/ RAISED PAVEMENT MARKERS (TYP.)
  - (C) ITEM 644 - LANE LINE, W/ RAISED PAVEMENT MARKERS (TYP.)
  - (D) ITEM 644 - CHANNELIZING LINE, W/ RECYCLED RPM'S
  - (E) ITEM 644 - STOP LINE
  - (F) ITEM 644 - LANE ARROW
  - (G) ITEM 644 - WORD ON PAVEMENT, 96 IN.
  - (H) ITEM 618 - RUMBLE STRIPS, TYPE 2
  - (I) ITEM 620 - DELINEATORS, A
  - (J) ITEM 620 - DELINEATORS, B

- LEGEND**
- PROPOSED
  - ▨ EXISTING TO BE REMOVED
  - ▭ EXISTING TO REMAIN

90EB 150.26  
GEP-96 x 24  
GB-144 x 144  
N-44B-12 x 18  
MOUNT ON SIGN UPRIGHT  
STA. 917+58.53, 104' R±  
MAST ARM W/ LUMINAIRE  
STA. 917+60.00, 86.00' R

90EB 150.74  
GEP-96 x 24  
GE-144 x 144  
N-44B-12 x 18  
MOUNT ON SIGN UPRIGHT  
STA. 943+24.15, 104' R±  
MAST ARM W/ LUMINAIRE  
STA. 943+25.00, 86.00' R

90EB 151.10  
GEP-96 x 24  
GE-144 x 144  
N-44B-12 x 18  
MOUNT ON SIGN UPRIGHT  
STA. 962+16.92, 103.37' R  
MAST ARM W/ LUMINAIRE  
STA. 962+18.00, 86.00' R

90EB 151.10  
GEP-96 x 24  
GE-144 x 144  
N-44B-12 x 18  
MOUNT ON SIGN UPRIGHT  
STA. 962+16.92, 103.37' R  
MAST ARM W/ LUMINAIRE  
STA. 962+18.00, 86.00' R

90EB 151.10  
GEP-96 x 24  
GE-144 x 144  
N-44B-12 x 18  
MOUNT ON SIGN UPRIGHT  
STA. 962+16.92, 103.37' R  
MAST ARM W/ LUMINAIRE  
STA. 962+18.00, 86.00' R

90EB 151.10  
GEP-96 x 24  
GE-144 x 144  
N-44B-12 x 18  
MOUNT ON SIGN UPRIGHT  
STA. 962+16.92, 103.37' R  
MAST ARM W/ LUMINAIRE  
STA. 962+18.00, 86.00' R

90EB 151.10  
GEP-96 x 24  
GE-144 x 144  
N-44B-12 x 18  
MOUNT ON SIGN UPRIGHT  
STA. 962+16.92, 103.37' R  
MAST ARM W/ LUMINAIRE  
STA. 962+18.00, 86.00' R

S-13  
X-6L-12 x 36  
STA. 967+55.03, 34.14' L  
TO BE REMOVED AND REERECTED  
ON NEW POST SUPPORT  
STA. 967+55.03, 15.46' L

S-14  
18.61L  
90  
LOR

S-15  
X-6R-12 x 36  
SPECIAL 12 x 12  
STA. 967+56.87, 104.28' L  
TO BE REMOVED AND REERECTED  
ON NEW POST SUPPORT  
STA. 967+56.87, 111.50' L

W-49R-48  
STA. 969+99.47,  
83.87' L  
NO WORK

STA. R965+14.43=  
STA. 965+14.43  
I.R.90, 91' LT.

P.C. STA. R968+14.4

965+00 966+00 970+00

1.90 N 45°47'30" E  
R/W & CONSTRUCTION

12' TYP.

12' TYP.

(WHITE) WESTBOUND

(YELLOW)

(YELLOW)

(WHITE) EASTBOUND

P970+00

P CONSTRUCTION RAMP P

P CONSTRUCTION RAMP R

STA. 971+57.17, 91.45' R  
SPECIAL  
OHIO LOGOS SIGN  
TO BE RELOCATED BY  
OTHERS AS REQUIRED

0.3 MI SPEEDWAY  
DIESEL

0.2 MI  
BP




GAS


STA. 971+12.56,  
87.63' R  
NO WORK

MATCH LINE STA. 972+00

02-08-2002 10:56:00 DWG:V9803A.V9803PHZ.DWG I DLS

- LEGEND**
- (A) ITEM 644 - EDGE LINE
  - (B) ITEM 644 - EDGE LINE, W/ RAISED PAVEMENT MARKERS (TYP.)
  - (C) ITEM 644 - LANE LINE, W/ RAISED PAVEMENT MARKERS (TYP.)
  - (D) ITEM 644 - CHANNELIZING LINE, W/ RECYCLED RPM'S
  - (E) ITEM 644 - STOP LINE
  - (F) ITEM 644 - LANE ARROW
  - (G) ITEM 644 - WORD ON PAVEMENT, 96 IN.
  - (H) ITEM 618 - RUMBLE STRIPS, TYPE 2
  - (I) ITEM 620 - DELINEATORS, A
  - (J) ITEM 620 - DELINEATORS, B

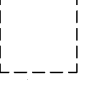- LEGEND**
-  PROPOSED
  -  EXISTING TO BE REMOVED
  -  EXISTING TO REMAIN

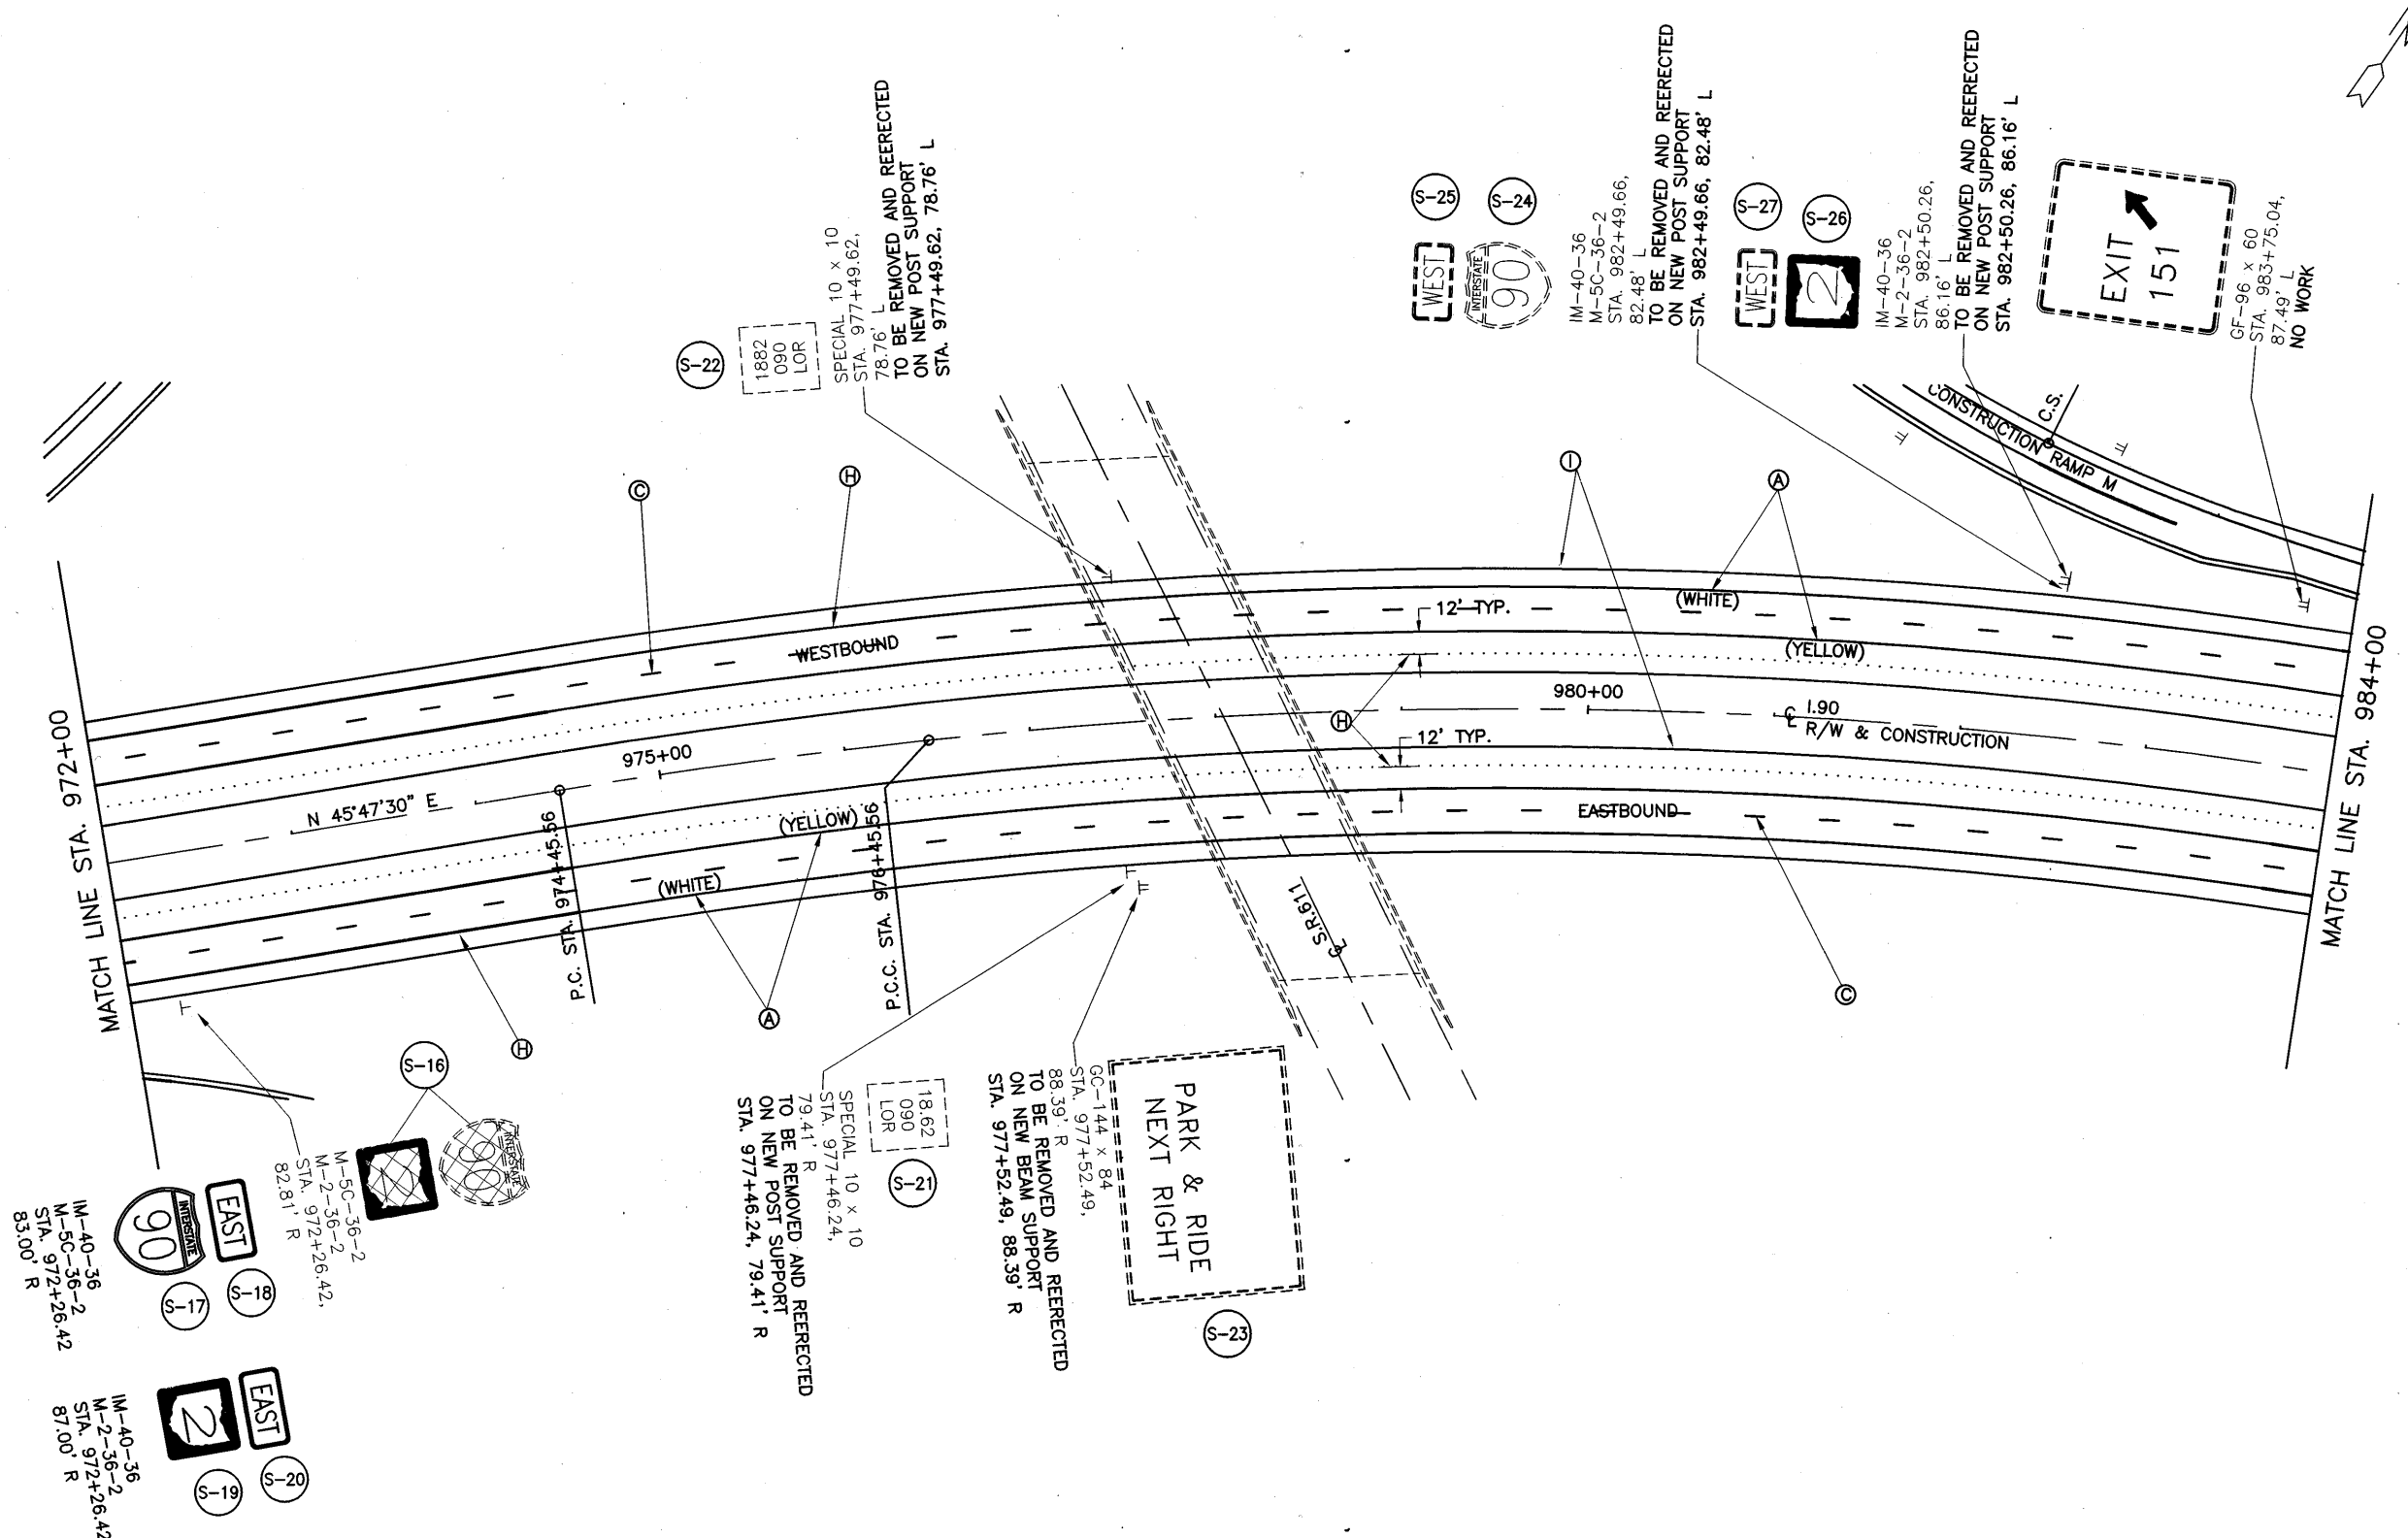


CALCULATED	DLS	CHECKED	LAB

**PAVEMENT MARKING AND SIGNING PLAN**  
**STA. 972+00 TO STA. 984+00**

**LOR - 190 - 10.76**

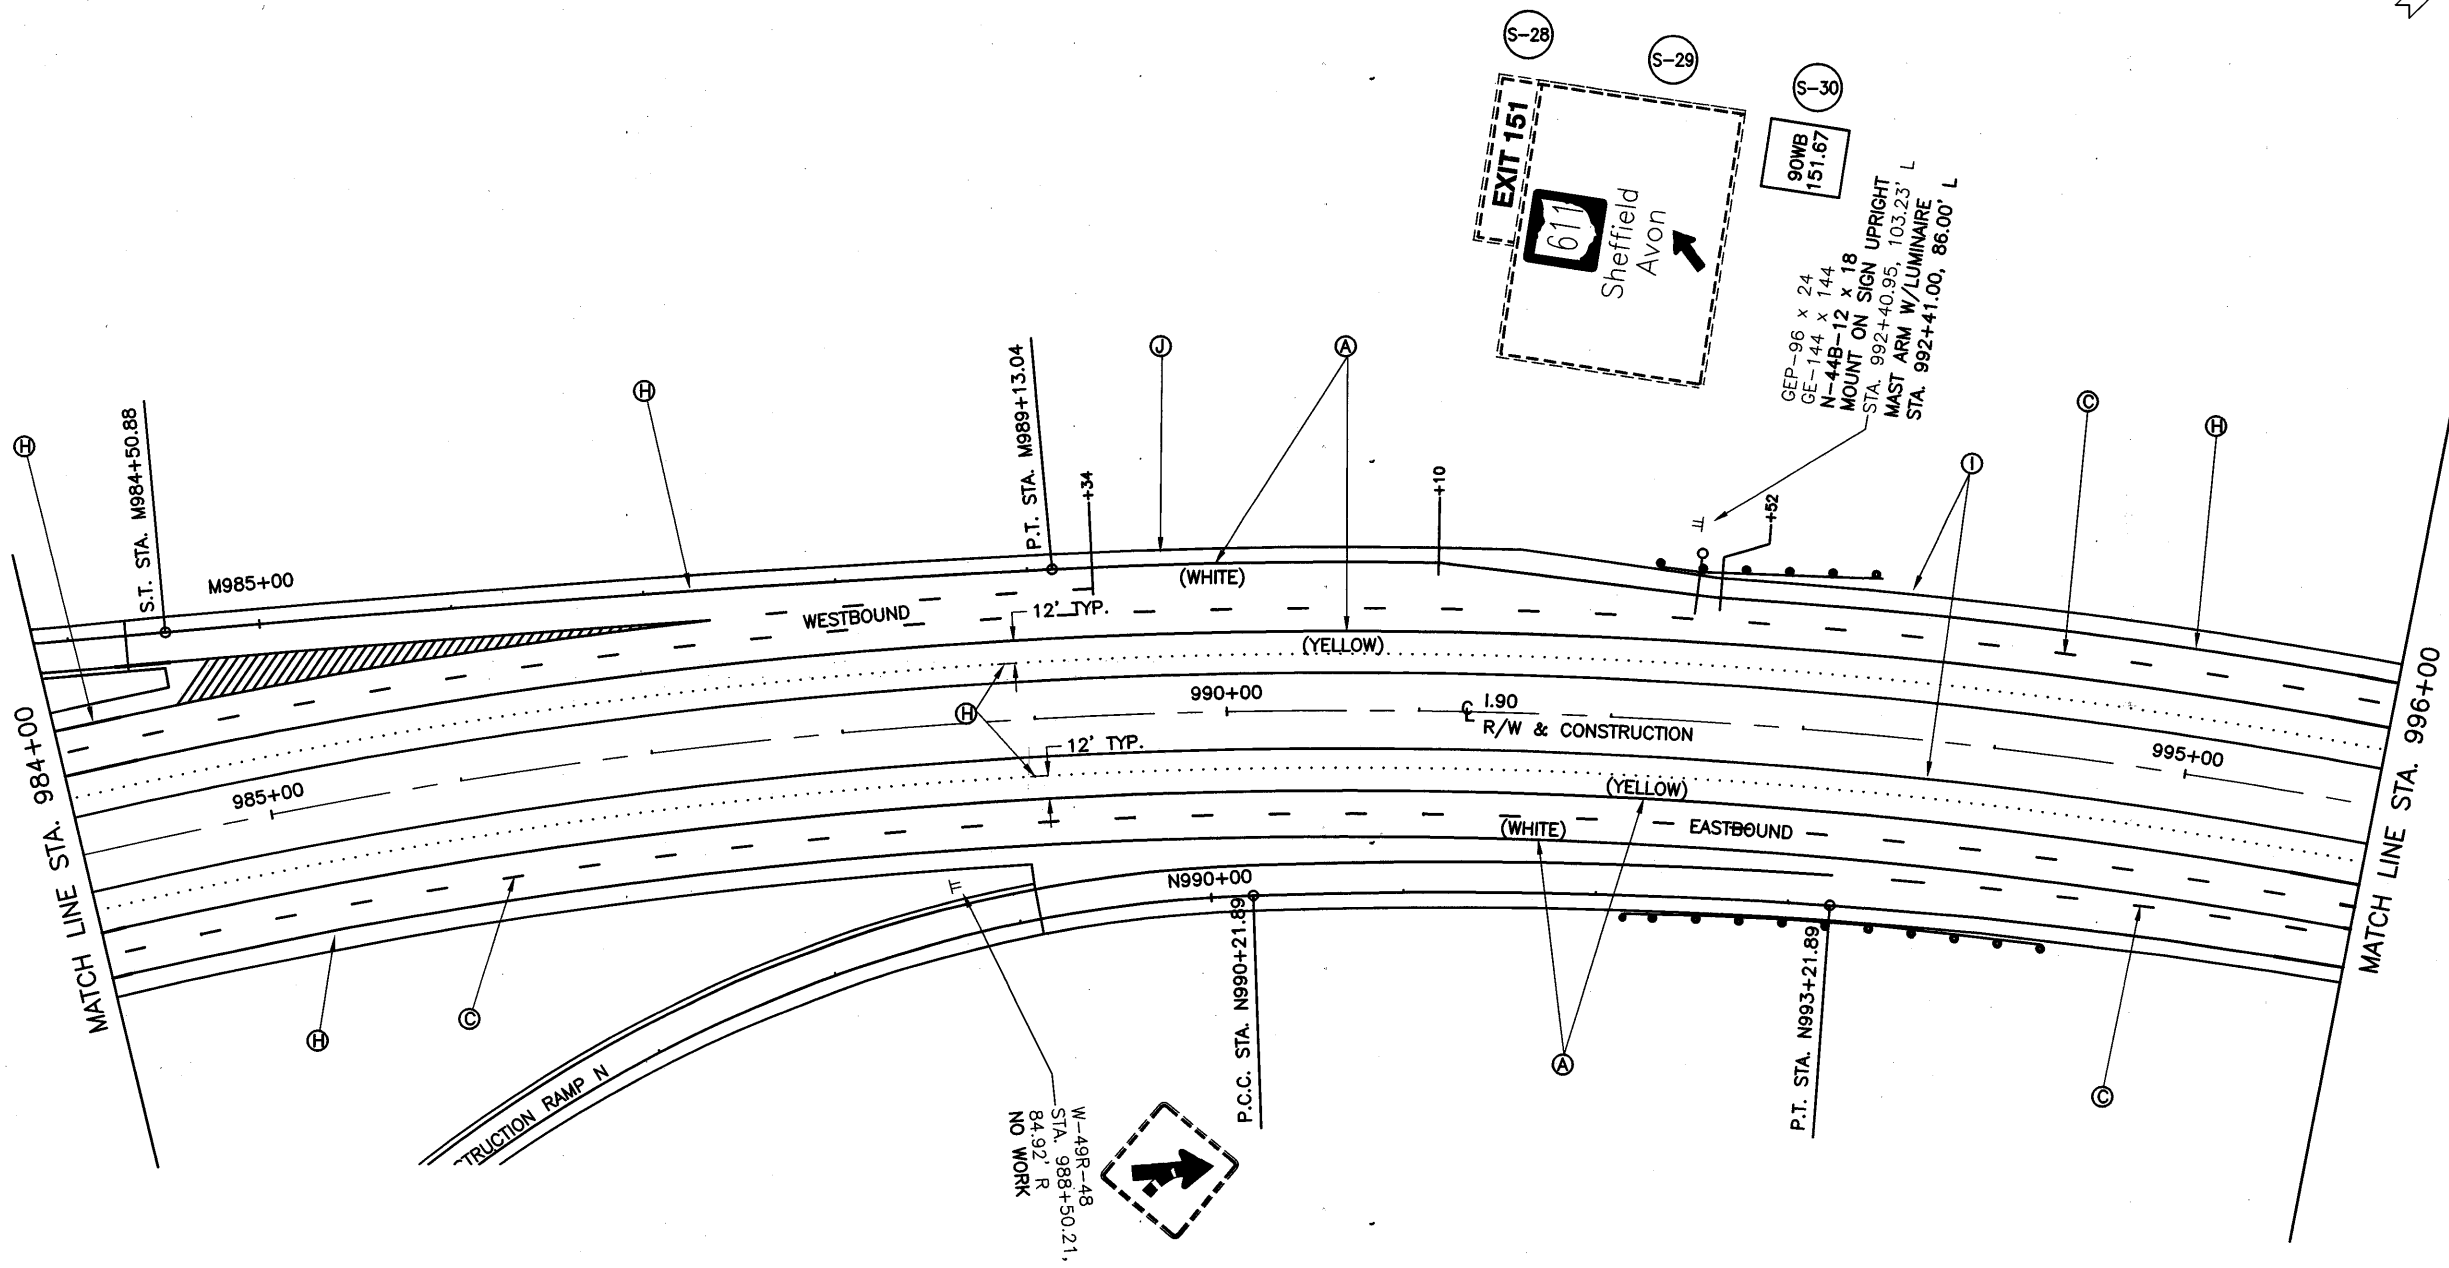

07-19-2002 [ c:\p3600\dwg\1903\1903.dwg ] dls



**LEGEND**

- (A) ITEM 644 - EDGE LINE
- (B) ITEM 644 - EDGE LINE, W/ RAISED PAVEMENT MARKERS (TYP.)
- (C) ITEM 644 - LANE LINE, W/ RAISED PAVEMENT MARKERS (TYP.)
- (D) ITEM 644 - CHANNELIZING LINE, W/ RECYCLED RPM'S
- (E) ITEM 644 - STOP LINE
- (F) ITEM 644 - LANE ARROW
- (G) ITEM 644 - WORD ON PAVEMENT, 96 IN.
- (H) ITEM 618 - RUMBLE STRIPS, TYPE 2
- (I) ITEM 620 - DELINEATORS, A
- (J) ITEM 620 - DELINEATORS, B

**LEGEND**

-  PROPOSED
-  EXISTING TO BE REMOVED
-  EXISTING TO REMAIN

LOR - 190 - 10.76

PAVEMENT MARKING AND SIGNING PLAN  
STA. 984+00 TO STA. 996+00

CALCULATED	DLS	CHECKED	LAB




**LEGEND**

- (A) ITEM 644 - EDGE LINE
- (B) ITEM 644 - EDGE LINE, W/ RAISED PAVEMENT MARKERS (TYP.)
- (C) ITEM 644 - LANE LINE, W/ RAISED PAVEMENT MARKERS (TYP.)
- (D) ITEM 644 - CHANNELIZING LINE, W/ RECYCLED RPM'S
- (E) ITEM 644 - STOP LINE
- (F) ITEM 644 - LANE ARROW
- (G) ITEM 644 - WORD ON PAVEMENT, 96 IN.
- (H) ITEM 618 - RUMBLE STRIPS, TYPE 2
- (I) ITEM 620 - DELINEATORS, A
- (J) ITEM 620 - DELINEATORS, B

**LEGEND**

-   
 PROPOSED
-   
 EXISTING TO BE REMOVED
-   
 EXISTING TO REMAIN

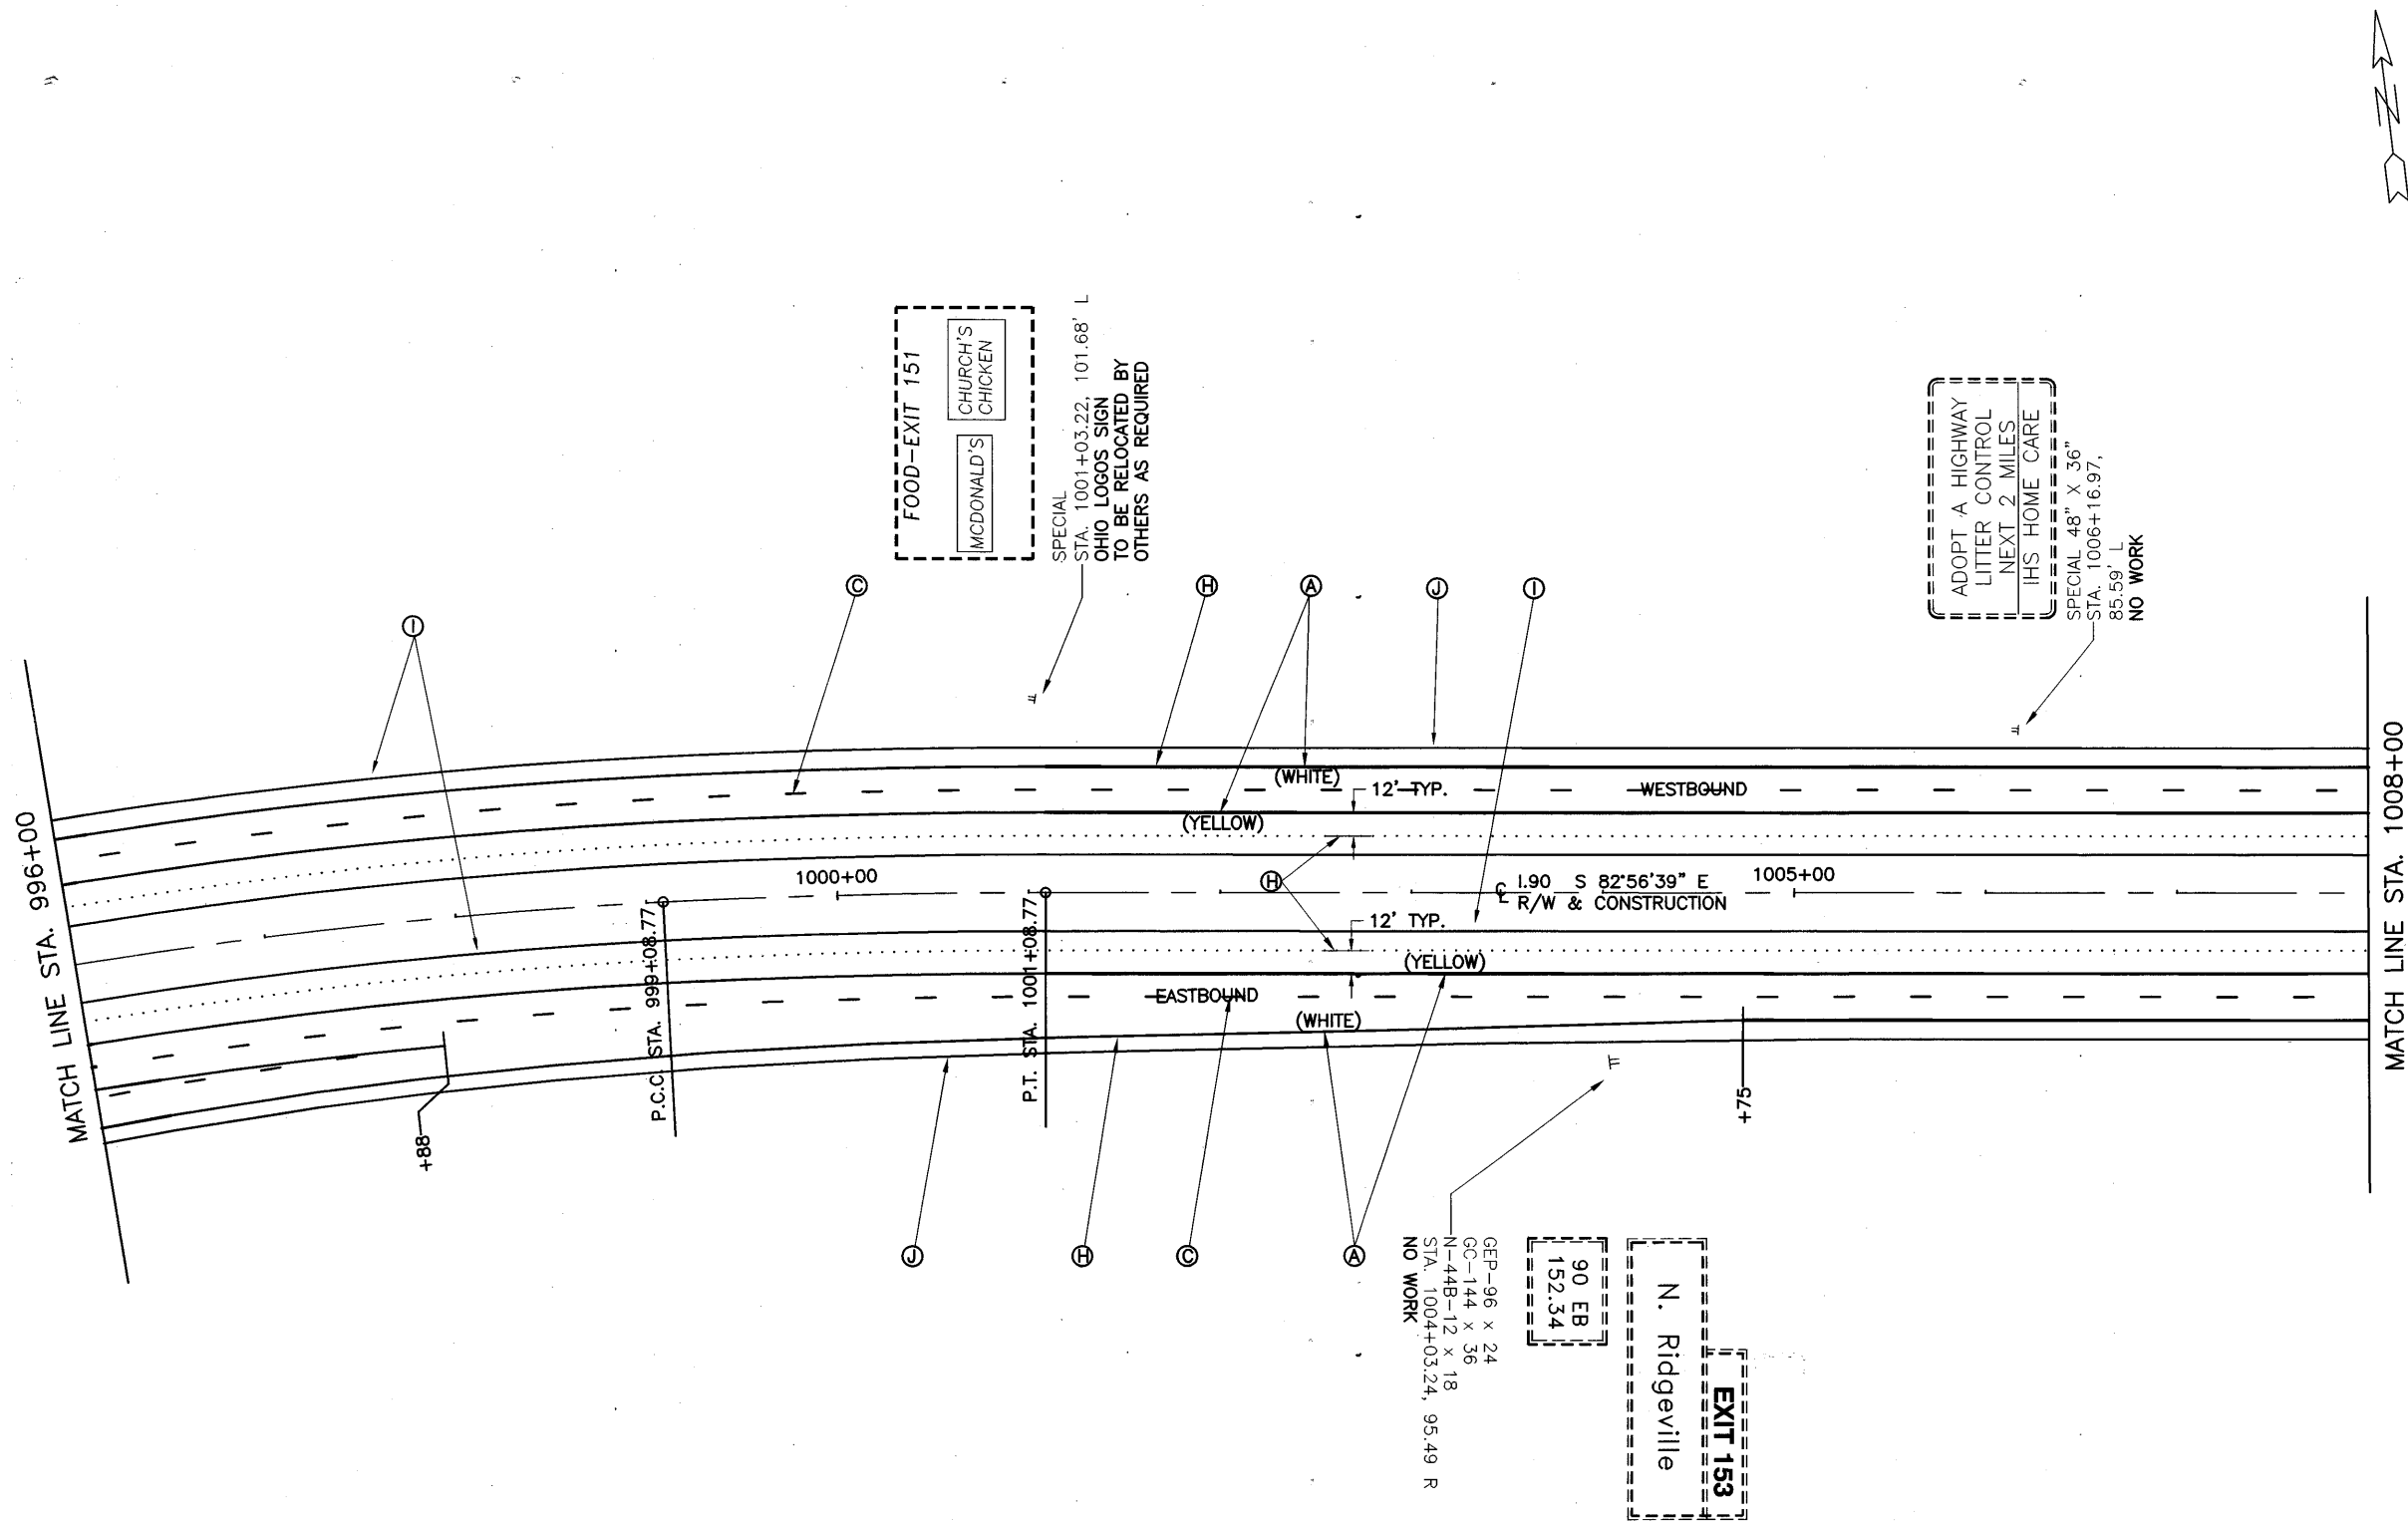


**PAVEMENT MARKING AND SIGNING PLAN**  
 STA. 996+00 TO STA. 1008+00

LOR - 190 - 10.76

240  
274

CALCULATED  
DLS 0  
CHECKED  
LAB  
50'  
100'  
HORIZONTAL  
SCALE IN FEET



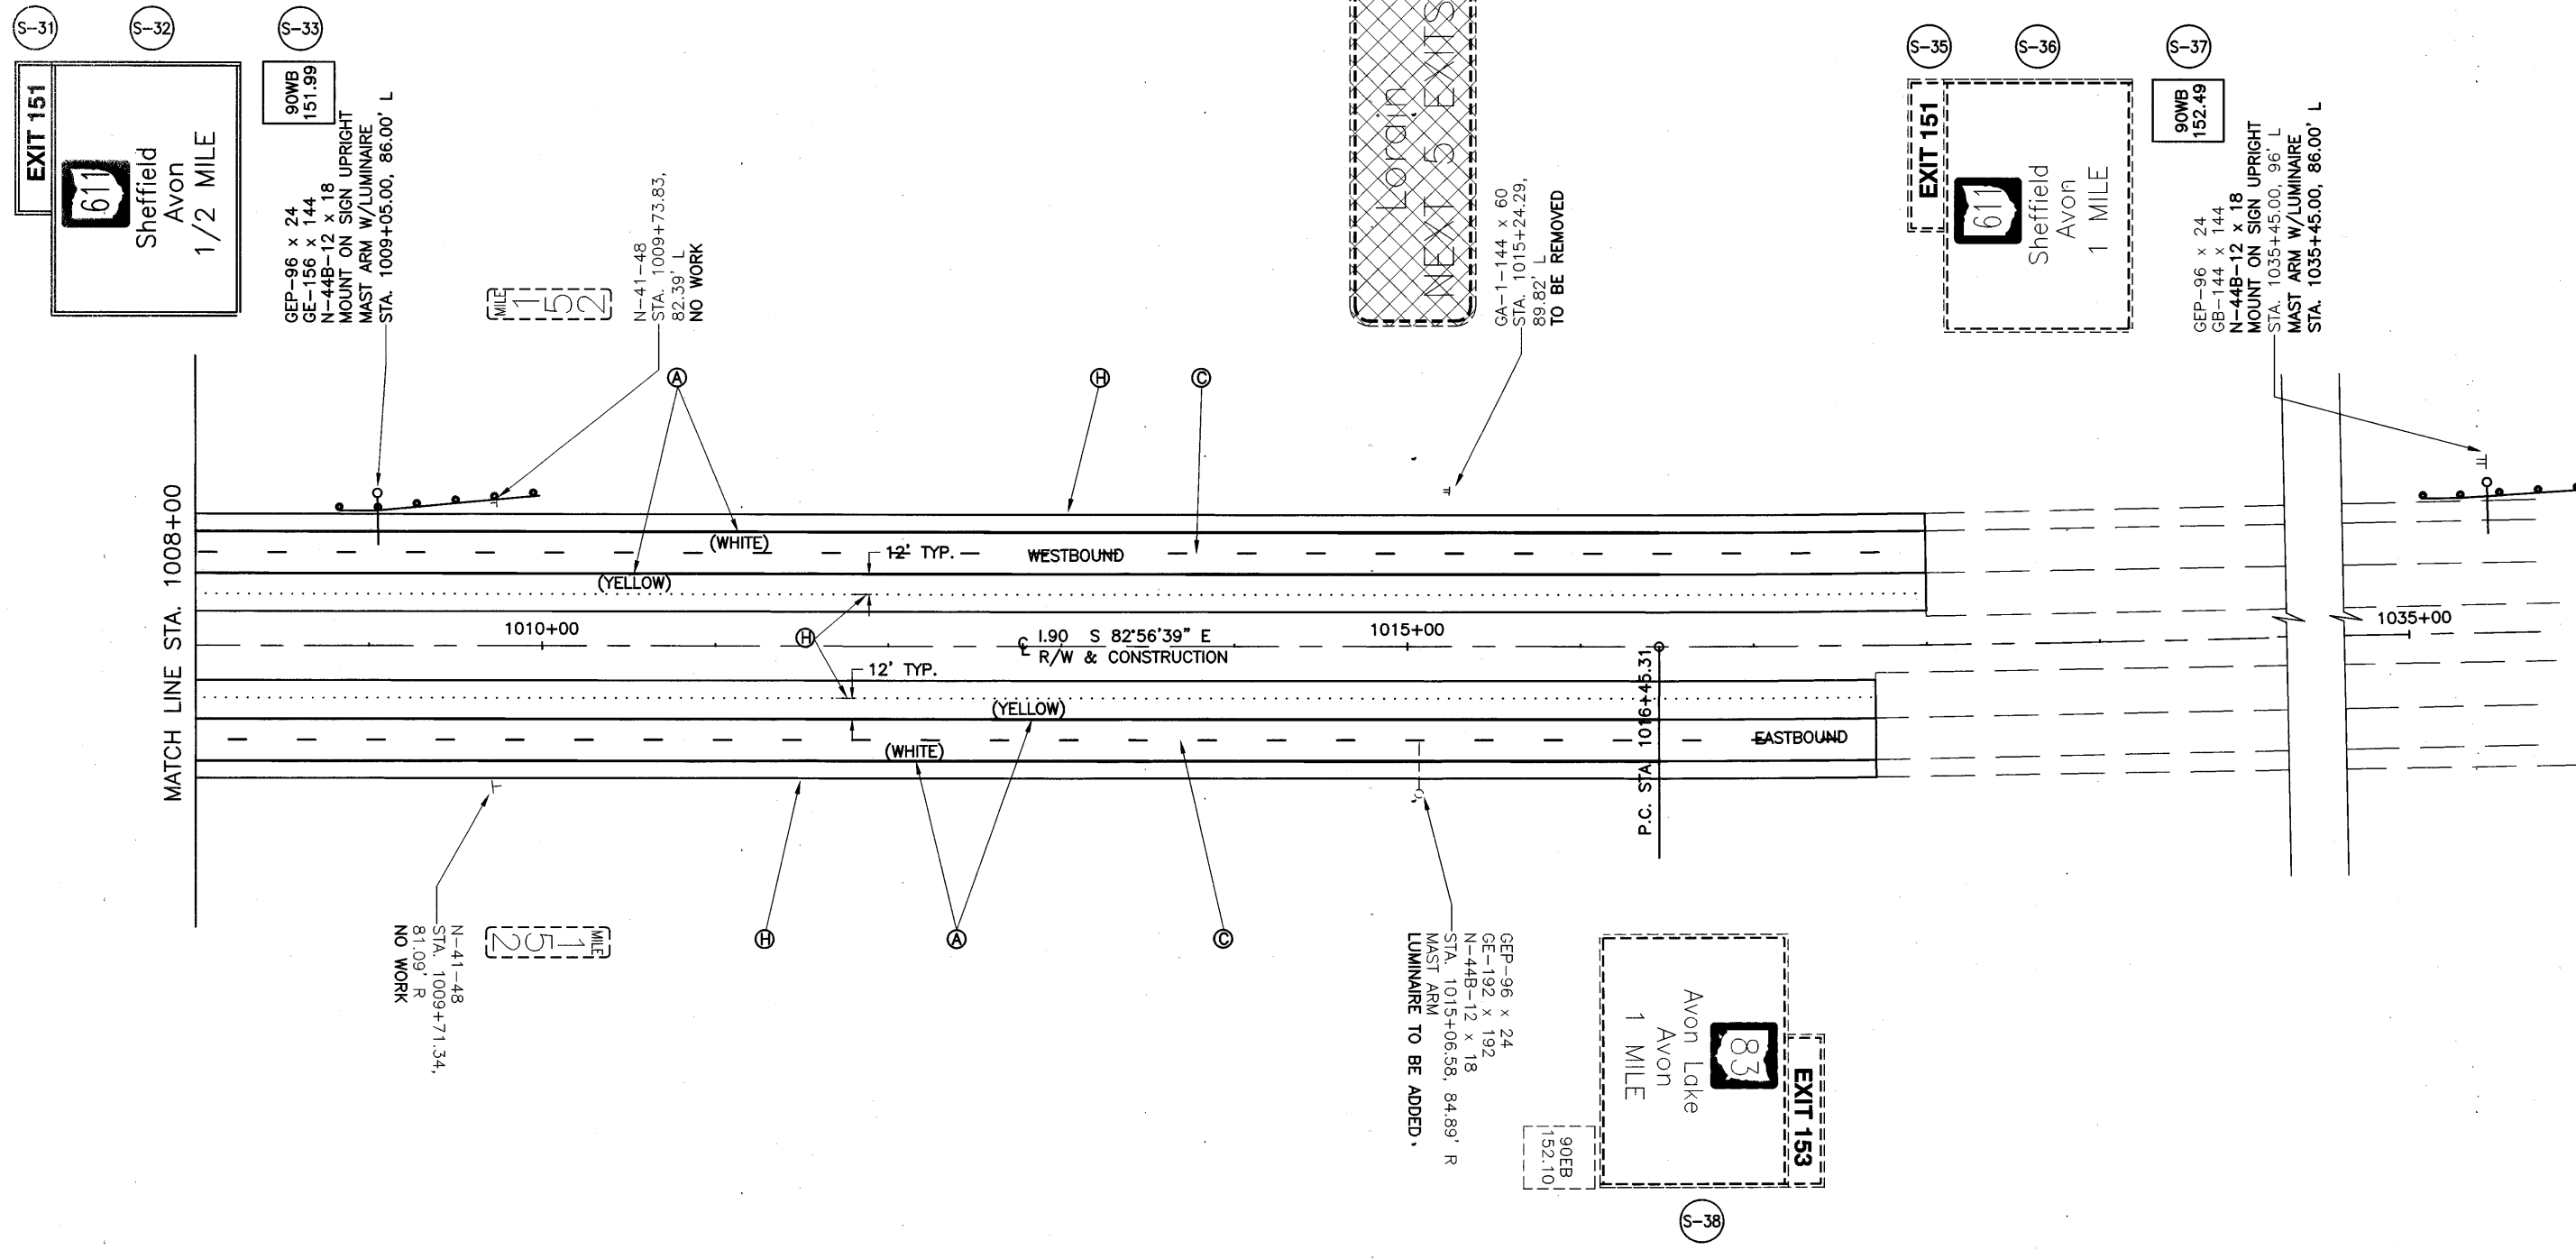

- LEGEND**
- (A) ITEM 644 - EDGE LINE
  - (B) ITEM 644 - EDGE LINE, W/ RAISED PAVEMENT MARKERS (TYP.)
  - (C) ITEM 644 - LANE LINE, W/ RAISED PAVEMENT MARKERS (TYP.)
  - (D) ITEM 644 - CHANNELIZING LINE, W/ RECYCLED RPM'S
  - (E) ITEM 644 - STOP LINE
  - (F) ITEM 644 - LANE ARROW
  - (G) ITEM 644 - WORD ON PAVEMENT, 96 IN.
  - (H) ITEM 618 - RUMBLE STRIPS, TYPE 2
  - (I) ITEM 620 - DELINEATORS, A
  - (J) ITEM 620 - DELINEATORS, B

- LEGEND**
- PROPOSED
  - EXISTING TO BE REMOVED
  - EXISTING TO REMAIN

S-31  
EXIT 151  
Sheffield  
Avon  
1/2 MILE

S-32

S-33  
90WB  
151.99  
GEP-96 x 24  
GE-156 x 144  
N-44B-12 x 18  
MOUNT ON SIGN UPRIGHT  
MAST ARM W/LUMINAIRE  
STA. 1009+05.00, 86.00' L

(MILE) 1 1/2

N-41-48  
STA. 1009+73.83,  
82.39' L  
NO WORK

S-34  
NEXT 5 EXITS

GA-1-144 x 60  
STA. 1015+24.29,  
89.82' L  
TO BE REMOVED

S-35  
EXIT 151  
Sheffield  
Avon  
1 MILE

S-36

S-37  
90WB  
152.49  
GEP-96 x 24  
GB-144 x 144  
N-44B-12 x 18  
MOUNT ON SIGN UPRIGHT  
STA. 1035+45.00, 96' L  
MAST ARM W/LUMINAIRE  
STA. 1035+45.00, 86.00' L

(MILE) 1 1/2

N-41-48  
STA. 1009+71.34,  
81.09' R  
NO WORK

GEP-96 x 24  
GE-192 x 192  
N-44B-12 x 18  
STA. 1015+06.58, 84.89' R  
MAST ARM  
LUMINAIRE TO BE ADDED.

S-38  
EXIT 153  
Avon Lake  
Avon  
1 MILE

90EB  
152.10

P.C. STA 1016+45.31

1.90 S 82°56'39" E  
R/W & CONSTRUCTION

MATCH LINE STA. 1008+00

1035+00

(WHITE)

(YELLOW)

(YELLOW)

(WHITE)

WESTBOUND

EASTBOUND

(MILE) 1 1/2

(MILE) 1 1/2




CALCULATED	0	50	100
DLS			
CHECKED			
LAB			

HORIZONTAL SCALE IN FEET

**PLAN RAMP "M"**  
**STA. M974+07.52 TO STA. M989+13.04**

**LOR - 190 - 10.76**

**242**  
**274**

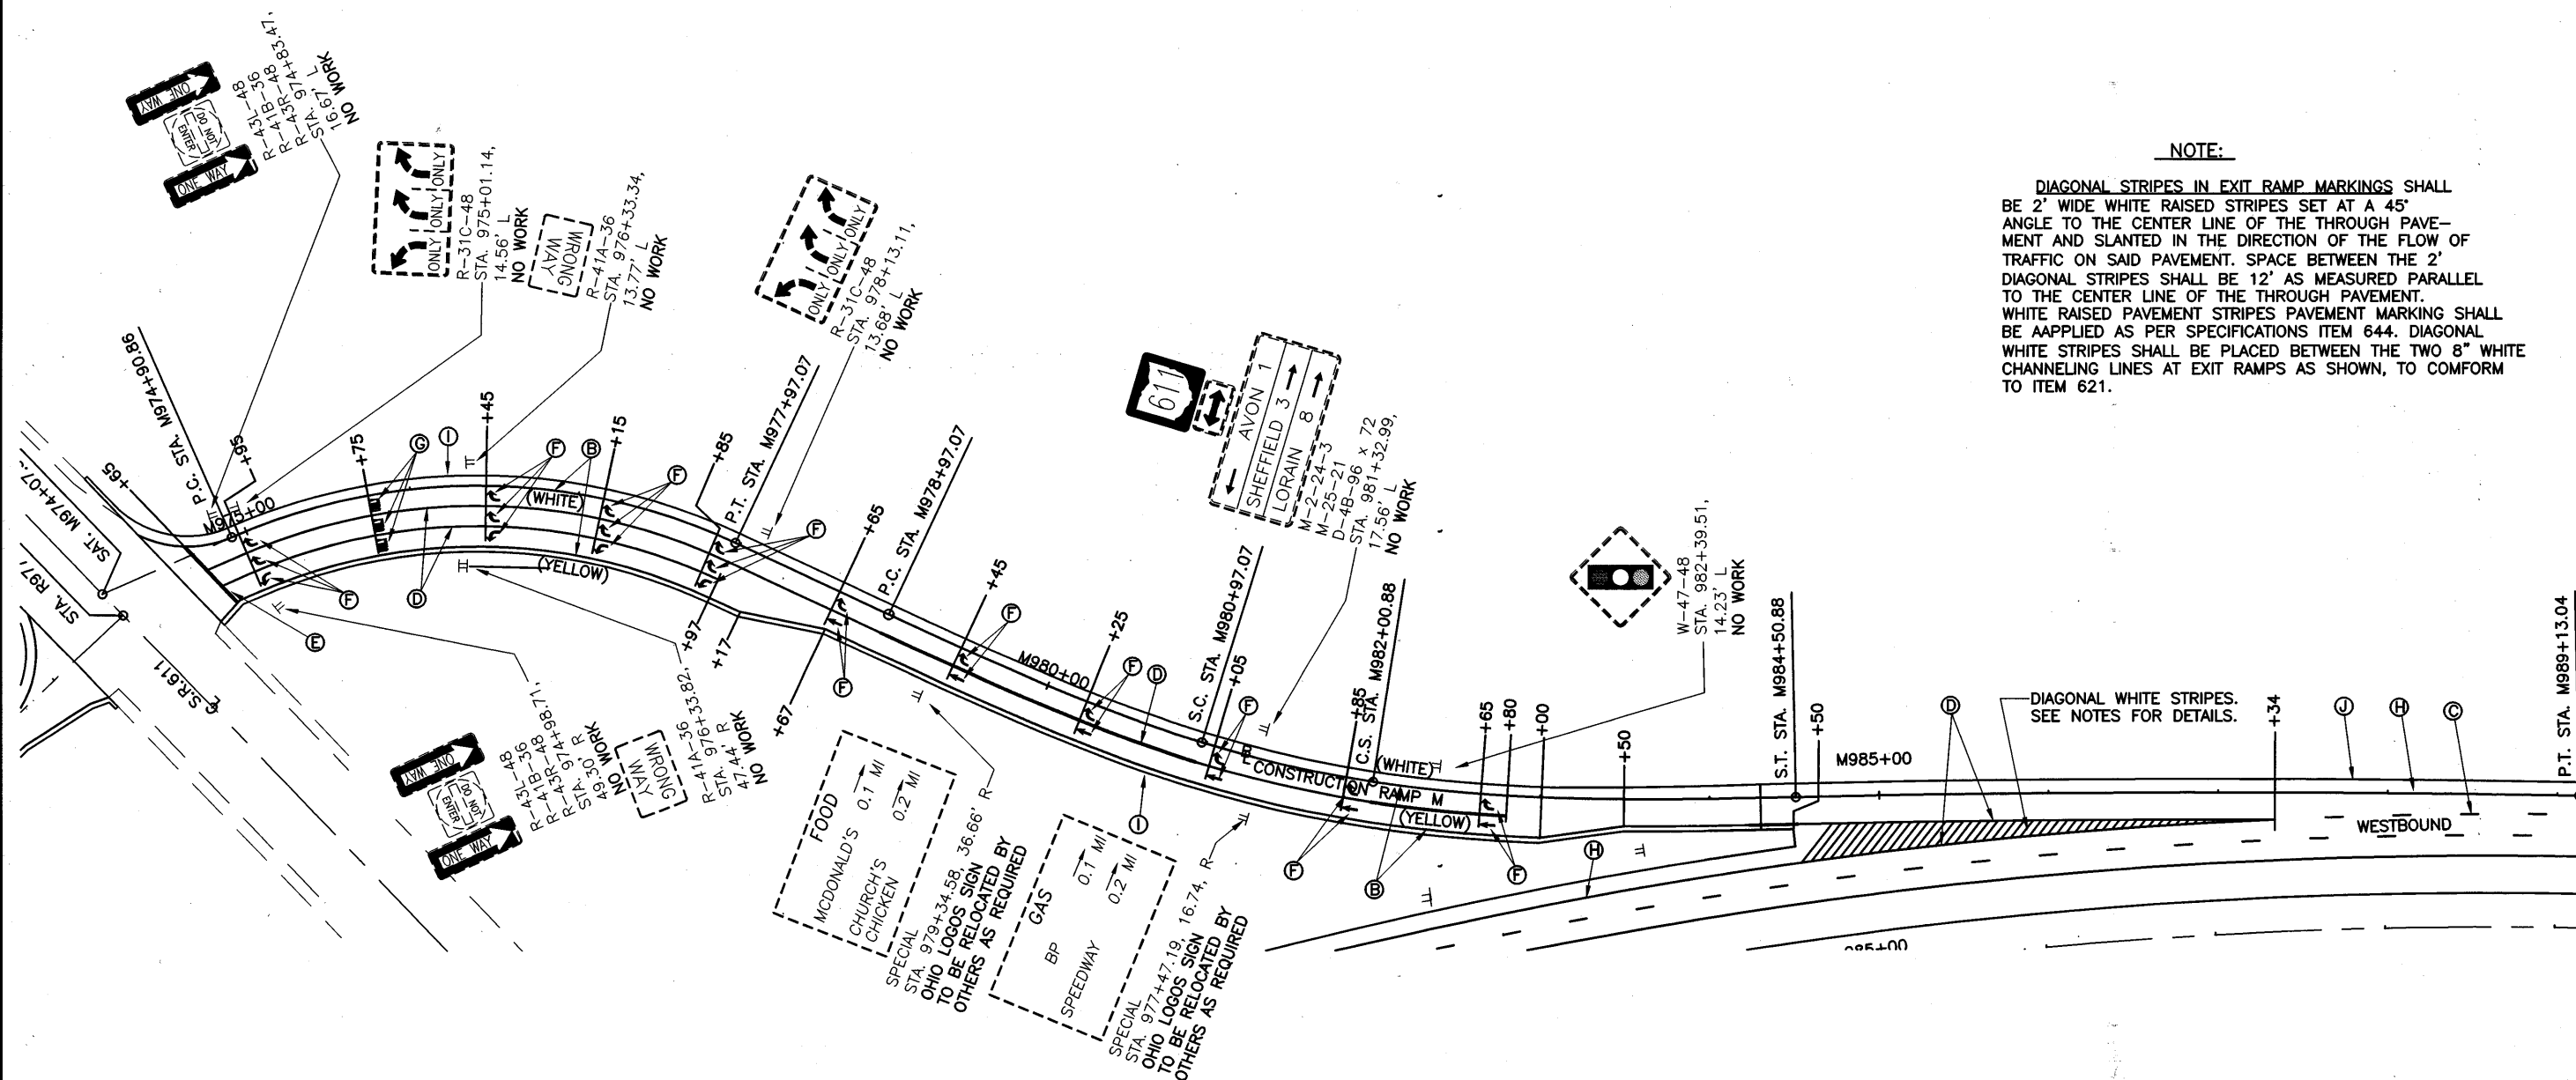


**LEGEND**

- (A) ITEM 644 - EDGE LINE
- (B) ITEM 644 - EDGE LINE, W/ RAISED PAVEMENT MARKERS (TYP.)
- (C) ITEM 644 - LANE LINE, W/ RAISED PAVEMENT MARKERS (TYP.)
- (D) ITEM 644 - CHANNELIZING LINE, W/ RECYCLED RPM'S
- (E) ITEM 644 - STOP LINE
- (F) ITEM 644 - LANE ARROW
- (G) ITEM 644 - WORD ON PAVEMENT, 96 IN.
- (H) ITEM 618 - RUMBLE STRIPS, TYPE 2
- (I) ITEM 620 - DELINEATORS, A
- (J) ITEM 620 - DELINEATORS, B

**LEGEND**






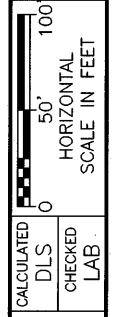

**PLAN RAMP "P"**  
**STA. P965+69.82 TO STA. P980+84.53**

**LOR - 190 - 10.76**

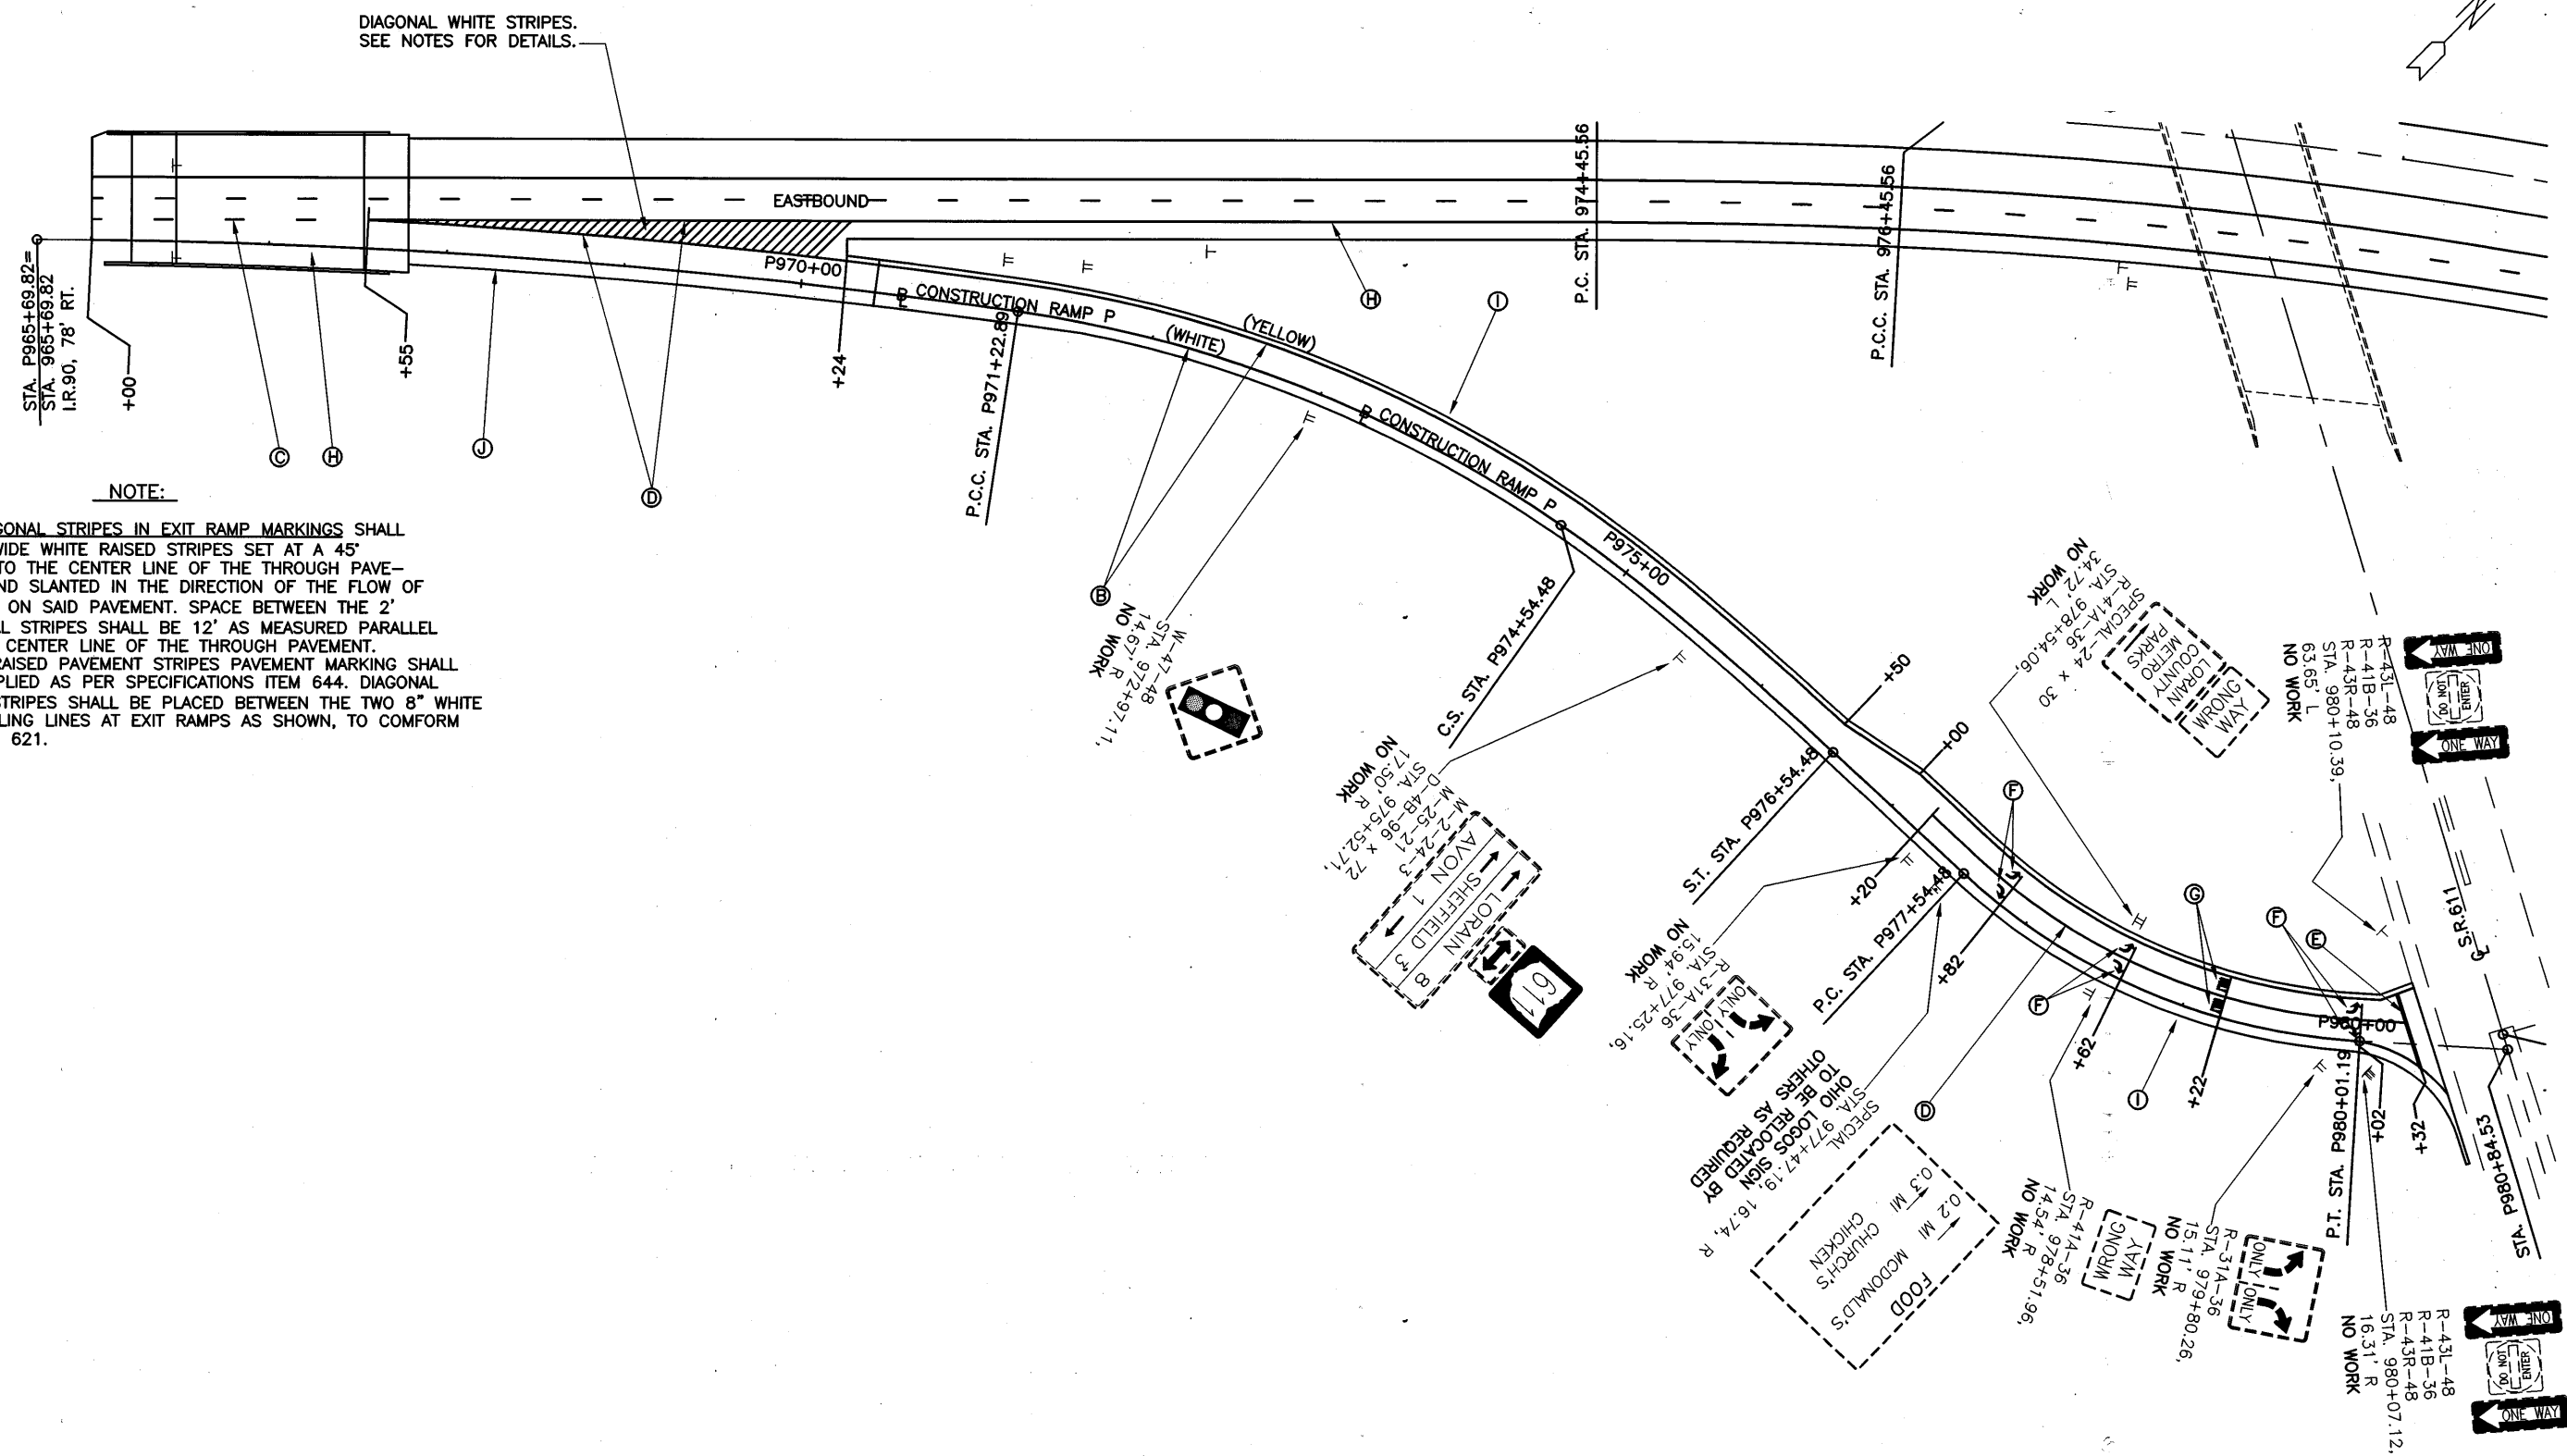

DIAGONAL WHITE STRIPES.  
SEE NOTES FOR DETAILS.


**NOTE:**

DIAGONAL STRIPES IN EXIT RAMP MARKINGS SHALL BE 2' WIDE WHITE RAISED STRIPES SET AT A 45° ANGLE TO THE CENTER LINE OF THE THROUGH PAVEMENT AND SLANTED IN THE DIRECTION OF THE FLOW OF TRAFFIC ON SAID PAVEMENT. SPACE BETWEEN THE 2' DIAGONAL STRIPES SHALL BE 12' AS MEASURED PARALLEL TO THE CENTER LINE OF THE THROUGH PAVEMENT. WHITE RAISED PAVEMENT STRIPES PAVEMENT MARKING SHALL BE APPLIED AS PER SPECIFICATIONS ITEM 644. DIAGONAL WHITE STRIPES SHALL BE PLACED BETWEEN THE TWO 8" WHITE CHANNELING LINES AT EXIT RAMP AS SHOWN, TO CONFORM TO ITEM 621.

- LEGEND**
- (A) ITEM 644 - EDGE LINE
  - (B) ITEM 644 - EDGE LINE, W/ RAISED PAVEMENT MARKERS (TYP.)
  - (C) ITEM 644 - LANE LINE, W/ RAISED PAVEMENT MARKERS (TYP.)
  - (D) ITEM 644 - CHANNELIZING LINE, W/ RECYCLED RPM'S
  - (E) ITEM 644 - STOP LINE
  - (F) ITEM 644 - LANE ARROW
  - (G) ITEM 644 - WORD ON PAVEMENT, 96 IN.
  - (H) ITEM 618 - RUMBLE STRIPS, TYPE 2
  - (I) ITEM 620 - DELINEATORS, A
  - (J) ITEM 620 - DELINEATORS, B

- LEGEND**
- PROPOSED
  - EXISTING TO BE REMOVED
  - EXISTING TO REMAIN

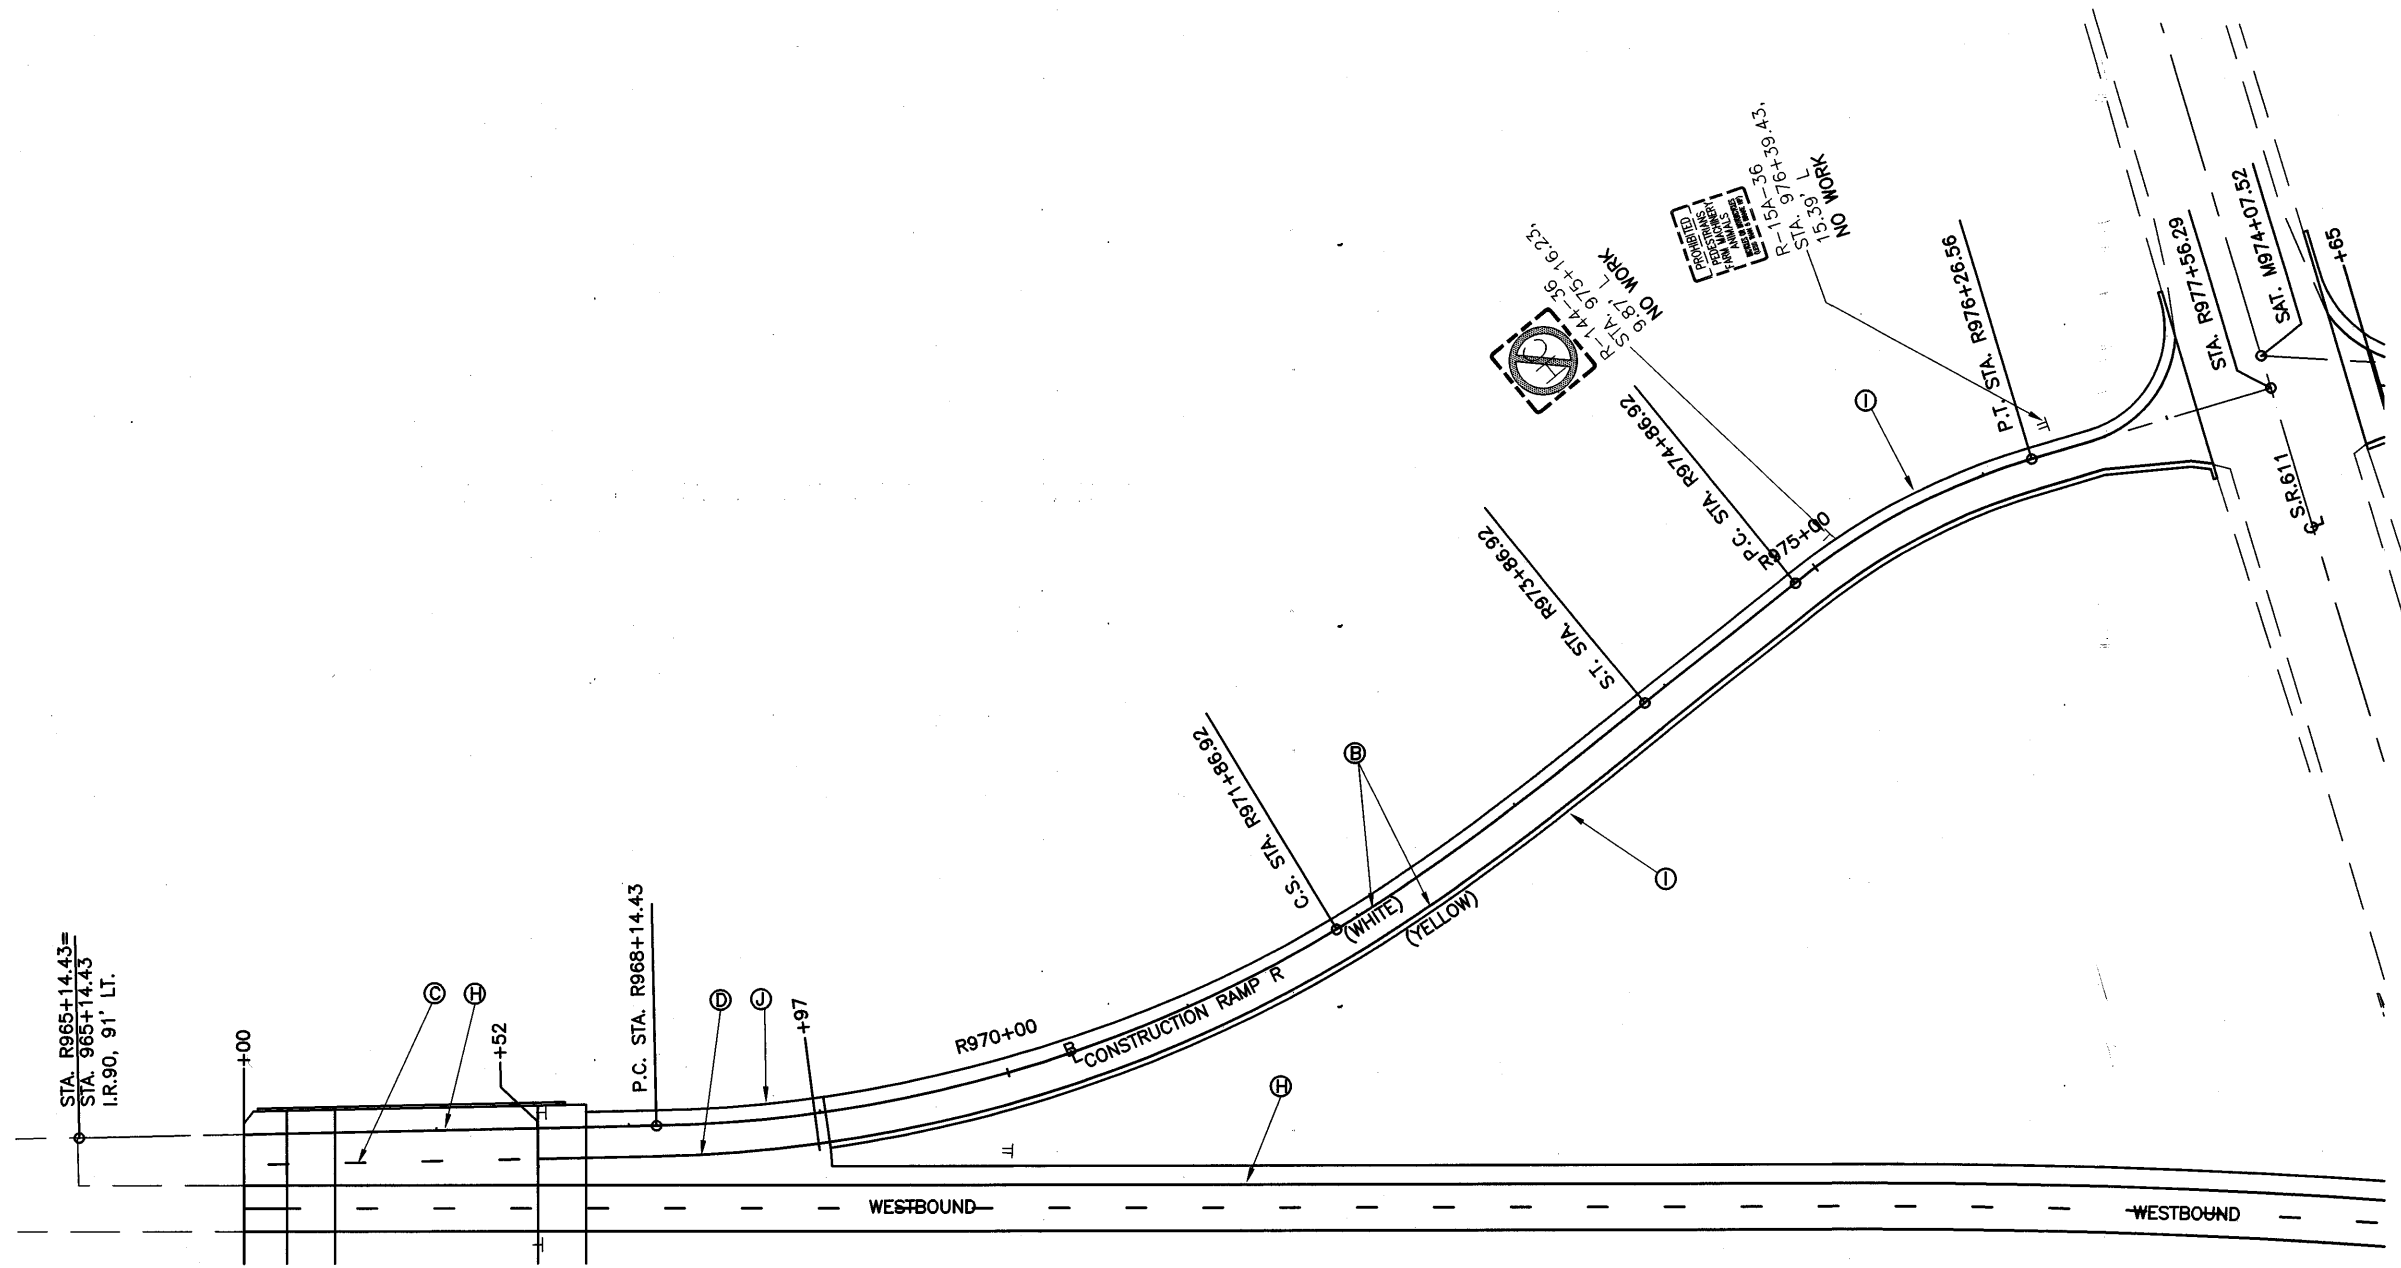


07-19-2002 11:30AM



**LEGEND**

- (A) ITEM 644 - EDGE LINE
- (B) ITEM 644 - EDGE LINE, W/ RAISED PAVEMENT MARKERS (TYP.)
- (C) ITEM 644 - LANE LINE, W/ RAISED PAVEMENT MARKERS (TYP.)
- (D) ITEM 644 - CHANNELIZING LINE, W/ RECYCLED RPM'S
- (E) ITEM 644 - STOP LINE
- (F) ITEM 644 - LANE ARROW
- (G) ITEM 644 - WORD ON PAVEMENT, 96 IN.
- (H) ITEM 618 - RUMBLE STRIPS, TYPE 2
- (I) ITEM 620 - DELINEATORS, A
- (J) ITEM 620 - DELINEATORS, B

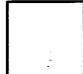**LEGEND**

-   
 PROPOSED
-   
 EXISTING TO BE REMOVED
-   
 EXISTING TO REMAIN

LOR - I90 - 10.76

PLAN RAMP "R"  
 STA. R965 + 14.43 TO STA. R977 + 56.29

CALCULATED	DLS	CHECKED LAB
0	0	0
50'	50'	100'
HORIZONTAL SCALE IN FEET		

245  
274

NOTES

1. THE ALUMINUM CABINET SHALL BE A PEDESTAL MOUNTED SIZE 3 AS SHOWN IN TABLE 7.3-1 OF THE NEMA STANDARD PUBLICATION NO. TS 2-1992. THE NOMINAL DIMENSIONS ARE: 24 INCHES WIDE BY 40 INCHES HIGH BY 15 INCHES DEEP. IT SHALL BE SHEET ALUMINUM AS DETAILED IN SECTION 7.2.2.1 OR CAST ALUMINUM DETAILED IN SECTION 7.2.2.2. IT SHALL ALSO CONFORM TO SECTIONS: 7.4, 7.5 EXCEPT FOR 7.5.7, 7.6 WITH ONE SHELF, 7.7.3, 7.8.3 SIZE 5, 7.8.4. THE CABINET SHALL BE INSTALLED WITH INTERNAL COMPONENTS FOR THE WEIGH-IN-MOTION EQUIPMENT AS NECESSARY TO PROVIDE COMPLETE OPERATION OF THE WIM SYSTEM.
  - A. IT SHALL BE EQUIPPED WITH TWO ADJUSTABLE "C" CHANNELS MOUNTED ON EACH OF THE THREE INTERIOR SIDES FOR THE PURPOSE OF MOUNTING TERMINAL STRIP PANELS AND SHELVING. FURNISH THE CABINETS WITH ONE ADJUSTABLE SHELF WHICH WILL NOT SAG WHEN LOADED WITH THE WIM ELECTRONICS. DESIGN THE SHELVING TO ALLOW FOR THE PASSAGE OF AIR. PLACE NO EQUIPMENT ON THE BOTTOM OF THE CABINET.
  - B. MOUNT A GROUNDING STRIP TO THE TERMINAL STRIP PANEL ON THE CABINET WALL FOR CONNECTION OF ALL COMMON CONDUCTORS WITH THE STRIP GROUNDING TO THE GROUND ROD.
  - C. INSTALL THE HOUSING CABINET AS TO ALLOW ALL EQUIPMENT TO STAND IN AN UPRIGHT POSITION WITH ALL EQUIPMENT AND DEVICES CAPABLE OF BEING REMOVED BY PULLING STRAIGHT OUT AND NOT TURNING SIDEWAYS AND WITHOUT RELOCATING OR DISCONNECTING ONE DEVICE TO REMOVE ANOTHER DEVICE.
  - D. PROVIDE THAT ALL CONNECTIONS ARE MADE ON TERMINAL BLOCKS USING SOLDERED SPADE TYPE CONNECTORS. PROVIDE THAT ALL HOUSING CABINET WIRING AND TERMINALS ARE CLEARLY MARKED AND LABELED AS SHOWN ON THE CABINET WIRING DIAGRAM DETAILS. PROVIDE THAT WIRING IS LACED OR BOUND TOGETHER WITH SELF-LOCKING NYLON TIE-WRAP. MAKE A LOOP NUMBERING DIAGRAM WITH CORRESPONDING TERMINAL NUMBERS FOR EACH SITE AND STORE IN A PLASTIC WEATHER PROOF ENVELOPE IN THE ENCLOSURE. PROVIDE A DUPLICATE DIAGRAM TO THE ODOT PROJECT INSPECTOR.
  - E. INSTALL ALL HOUSING CABINETS SO AS TO WITHSTAND ALL WEATHER CONDITIONS AND PREVENT THE INTRUSION OF REPTILES, RODENTS AND INSECTS.
  - F. THE CABINET SHALL INCLUDE A VENT, BUT NO FAN.
  - G. MOUNTING FACILITIES SHALL INCLUDE ONE BACK PANEL WITH 5 HOLES (ALUMINUM).
  - H. TERMINAL STRIPS MOUNTED HORIZONTALLY ON BACK PANEL 2" FROM TOP AND SIDES EQUIDISTANTLY SPACED FOR 2 LANE APPLICATIONS. SOLAR PANEL AND GROUND BAR TO BE MOUNTED 2" FROM BOTTOM AND LEFT OF BACK PANEL FOR ALL APPLICATIONS. 4-6 LANE APPLICATIONS TO HAVE ONE ROW OF TWO TERMINAL STRIPS MOUNTED HORIZONTALLY 2" FROM TOP AND SIDES OF BACK PLATE AND ONE ROW OF TWO TERMINAL STRIPS MOUNTED 8" FROM TOP AND 2" FROM SIDES OF BACK PLATE EQUIDISTANTLY SPACED. 8 LANE APPLICATIONS TO HAVE TWO ROWS OF THREE TERMINAL BLOCKS W/ 1ST ROW 2" FROM TOP AND SIDES OF BACK PLATE AND SECOND ROW 8" FROM TOP AND 2" FROM SIDES OF BACK PLATE EQUIDISTANTLY SPACED.
  - I. LOCKS KEYED TO STATE MASTER.
2. THE CABINET SHALL BE ORIENTED SO THAT THE DOOR OPENS AWAY FROM THE ROADWAY, SO THAT FIELD TECHNICIAN CAN OBSERVE TRAFFIC WHILE WORKING ON THE SYSTEM.

NOTES



1. ALL LOOPS SHALL BE 6'x8'. LOOPS SHALL BE SPACED 16' FROM LEADING EDGE TO LEADING EDGE. INSTALLATION OF LOOPS SHALL CONFORM TO TC-82.10 AND TC-82.11.
2. THE PIEZOCABLE WIM SENSOR SHALL BE MADE BY MEASUREMENT SPECIALTIES ROAD TRAX BRASS LINGUINI (BL) CLASS I AXLE SENSOR OR EQUIVALENT. THE 11 FOOT SENSOR SHALL BE CENTERED IN THE 12 FOOT LANE.
3. THE ALUMINUM CONTROLLER CABINET SHALL BE A PEDESTAL MOUNTED NEMA SIZE 3 AS SHOWN ON THE NEMA SIZE 3 CABINET DETAILS SHEET. (ATTACHMENT F)
4. CABLE AND WIRE SHALL BE IDENTIFIED IN ACCORDANCE WITH 632.04. IDENTIFICATION SHALL INCLUDE THE DIRECTION OF TRAVEL (I.E., NB, WB) AND THE LOOP NUMBER AS SHOWN. EACH CABLE AND WIRE SHALL HAVE 5' COILED IN THE CONTROLLER CABINET FOR CONNECTION TO THE DATA COLLECTION SYSTEM.
5. ADJACENT LOOPS (TRANSVERSE AND LONGITUDINAL) SHALL BE INSTALLED IN OPPOSITE DIRECTIONS, I.E., LOOP 1 AND LOOP 4, CLOCKWISE AND LOOP 2 AND LOOP 3 COUNTERCLOCKWISE. EACH LOOP SHALL HAVE A SEPARATE LEAD-IN CABLE ROUTED TO THE CONTROLLER CABINET AND TAGGED.
6. REFERENCE IS MADE TO STANDARD DRAWING HL-30.11M FOR DETAILS OF DRAINING PULLBOXES. UNDERDRAINS FOR PULLBOXES SHALL BE USED AS DIRECTED BY THE ENGINEER AND SHALL BE PROVIDED WHERE THE LENGTH REQUIRED FOR A SATISFACTORY OUTLET DOES NOT EXCEED APPROXIMATELY 20'.
7. FIVE (5) WORKING DAYS PRIOR TO THE SCHEDULED INSTALLATION, THE CONTRACTOR SHALL CONTACT OFFICE OF TECH. SERVICES AT 614-466-3727.
8. ALL ITEMS SHALL CONFORM TO C&M SPECIFICATIONS 625, 713, 632, 732, 633 AND 733, UNLESS OTHERWISE SPECIFIED.
9. FOR ASPHALT PAVEMENT, LOOPS AND PIEZOCABLES SHALL BE CUT IN THE ASPHALT SURFACE COURSE. THEY SHALL NOT BE INSTALLED BETWEEN THE INTERMEDIATE AND SURFACE COURSES.
10. PIEZOCABLES SHALL BE INSTALLED WHEN THE TEMP. IS ABOVE 60 DEGREES FAHRENHEIT, OR SPECIAL PROVISION MADE TO ENSURE CURING OF EPOXY TAKES PLACE.
11. THE SOLAR PANEL SHALL BE INSTALLED WITH 2" RIGID CONDUIT MOUNTED IN CONCRETE BASE WITH PANEL BEING AT A MIN. HEIGHT ABOVE GROUND LEVEL OF 15'. SOLAR PANEL OUTPUT CABLE SHALL BE SECURED AND ROUTED TO THE INSIDE OF THE CABINET FOR CONNECTION TO TERMINAL BLOCK. SOLAR PANEL SHALL BE MOUNTED AT A 45° ANGLE FACING SOUTH.
12. SOLAR PANEL SHALL BE A SOLAREX MODEL VLX 32 (32 WATTS) OR AN APPROVED EQUAL WITH MOUNTING HARDWARE AND CABLES.
13. THE CONTRACTOR SHALL BE RESPONSIBLE FOR INSTALLING AND TESTING THE PHONE DROP INSIDE OF THE CONTROLLER CABINET. THE CONTRACTOR SHALL BE RESPONSIBLE FOR ALL CHARGES INCURRED PRIOR TO THE TRANSFER OF THE TELEPHONE ACCOUNT. THE CONTRACTOR SHALL COORDINATE WITH ODOT, TELECOMMUNICATIONS, MR. MIKE WIGGINS (614-466-4452) TO TRANSFER THE TELEPHONE ACCOUNT AND THE BILLING RESPONSIBILITY FROM THE CONTRACTOR TO ODOT.
14. ALL SENSORS ARE TO BE TESTED BY O.D.O.T. PERSONNEL AFTER THE INSTALLATION IS COMPLETE SO AS TO VERIFY THAT THE STATION IS UP AND OPERATING PROPERLY. IF THE ELECTRONIC EQUIPMENT DOES NOT PERFORM PROPERLY BECAUSE OF A POORLY INSTALLED SENSOR, THE CONTRACTOR SHALL BE RESPONSIBLE FOR THE REPLACEMENT OF THE FAULTY SENSOR, AS SOON AS POSSIBLE AT HIS OWN COST.
15. THE PULL BOX COVERS IN THE PAVED SHOULDER SHALL BE A HEAVY DUTY FRAME AND LID (NEENAH R-6686 OR APPROVED EQUAL). THE 18 AND 24 IN. PULL BOX, SHALL CONFORM TO 713.08

CALCULATED  
DLS  
CHECKED  
LAB

AUTOMATIC TRAFFIC RECORDER  
NOTES

LOR - 190 - 10.76

S:\190AM 05-25-2002 [ c:\p3600\dwg\vr003\1356007cd.dwg ] dls

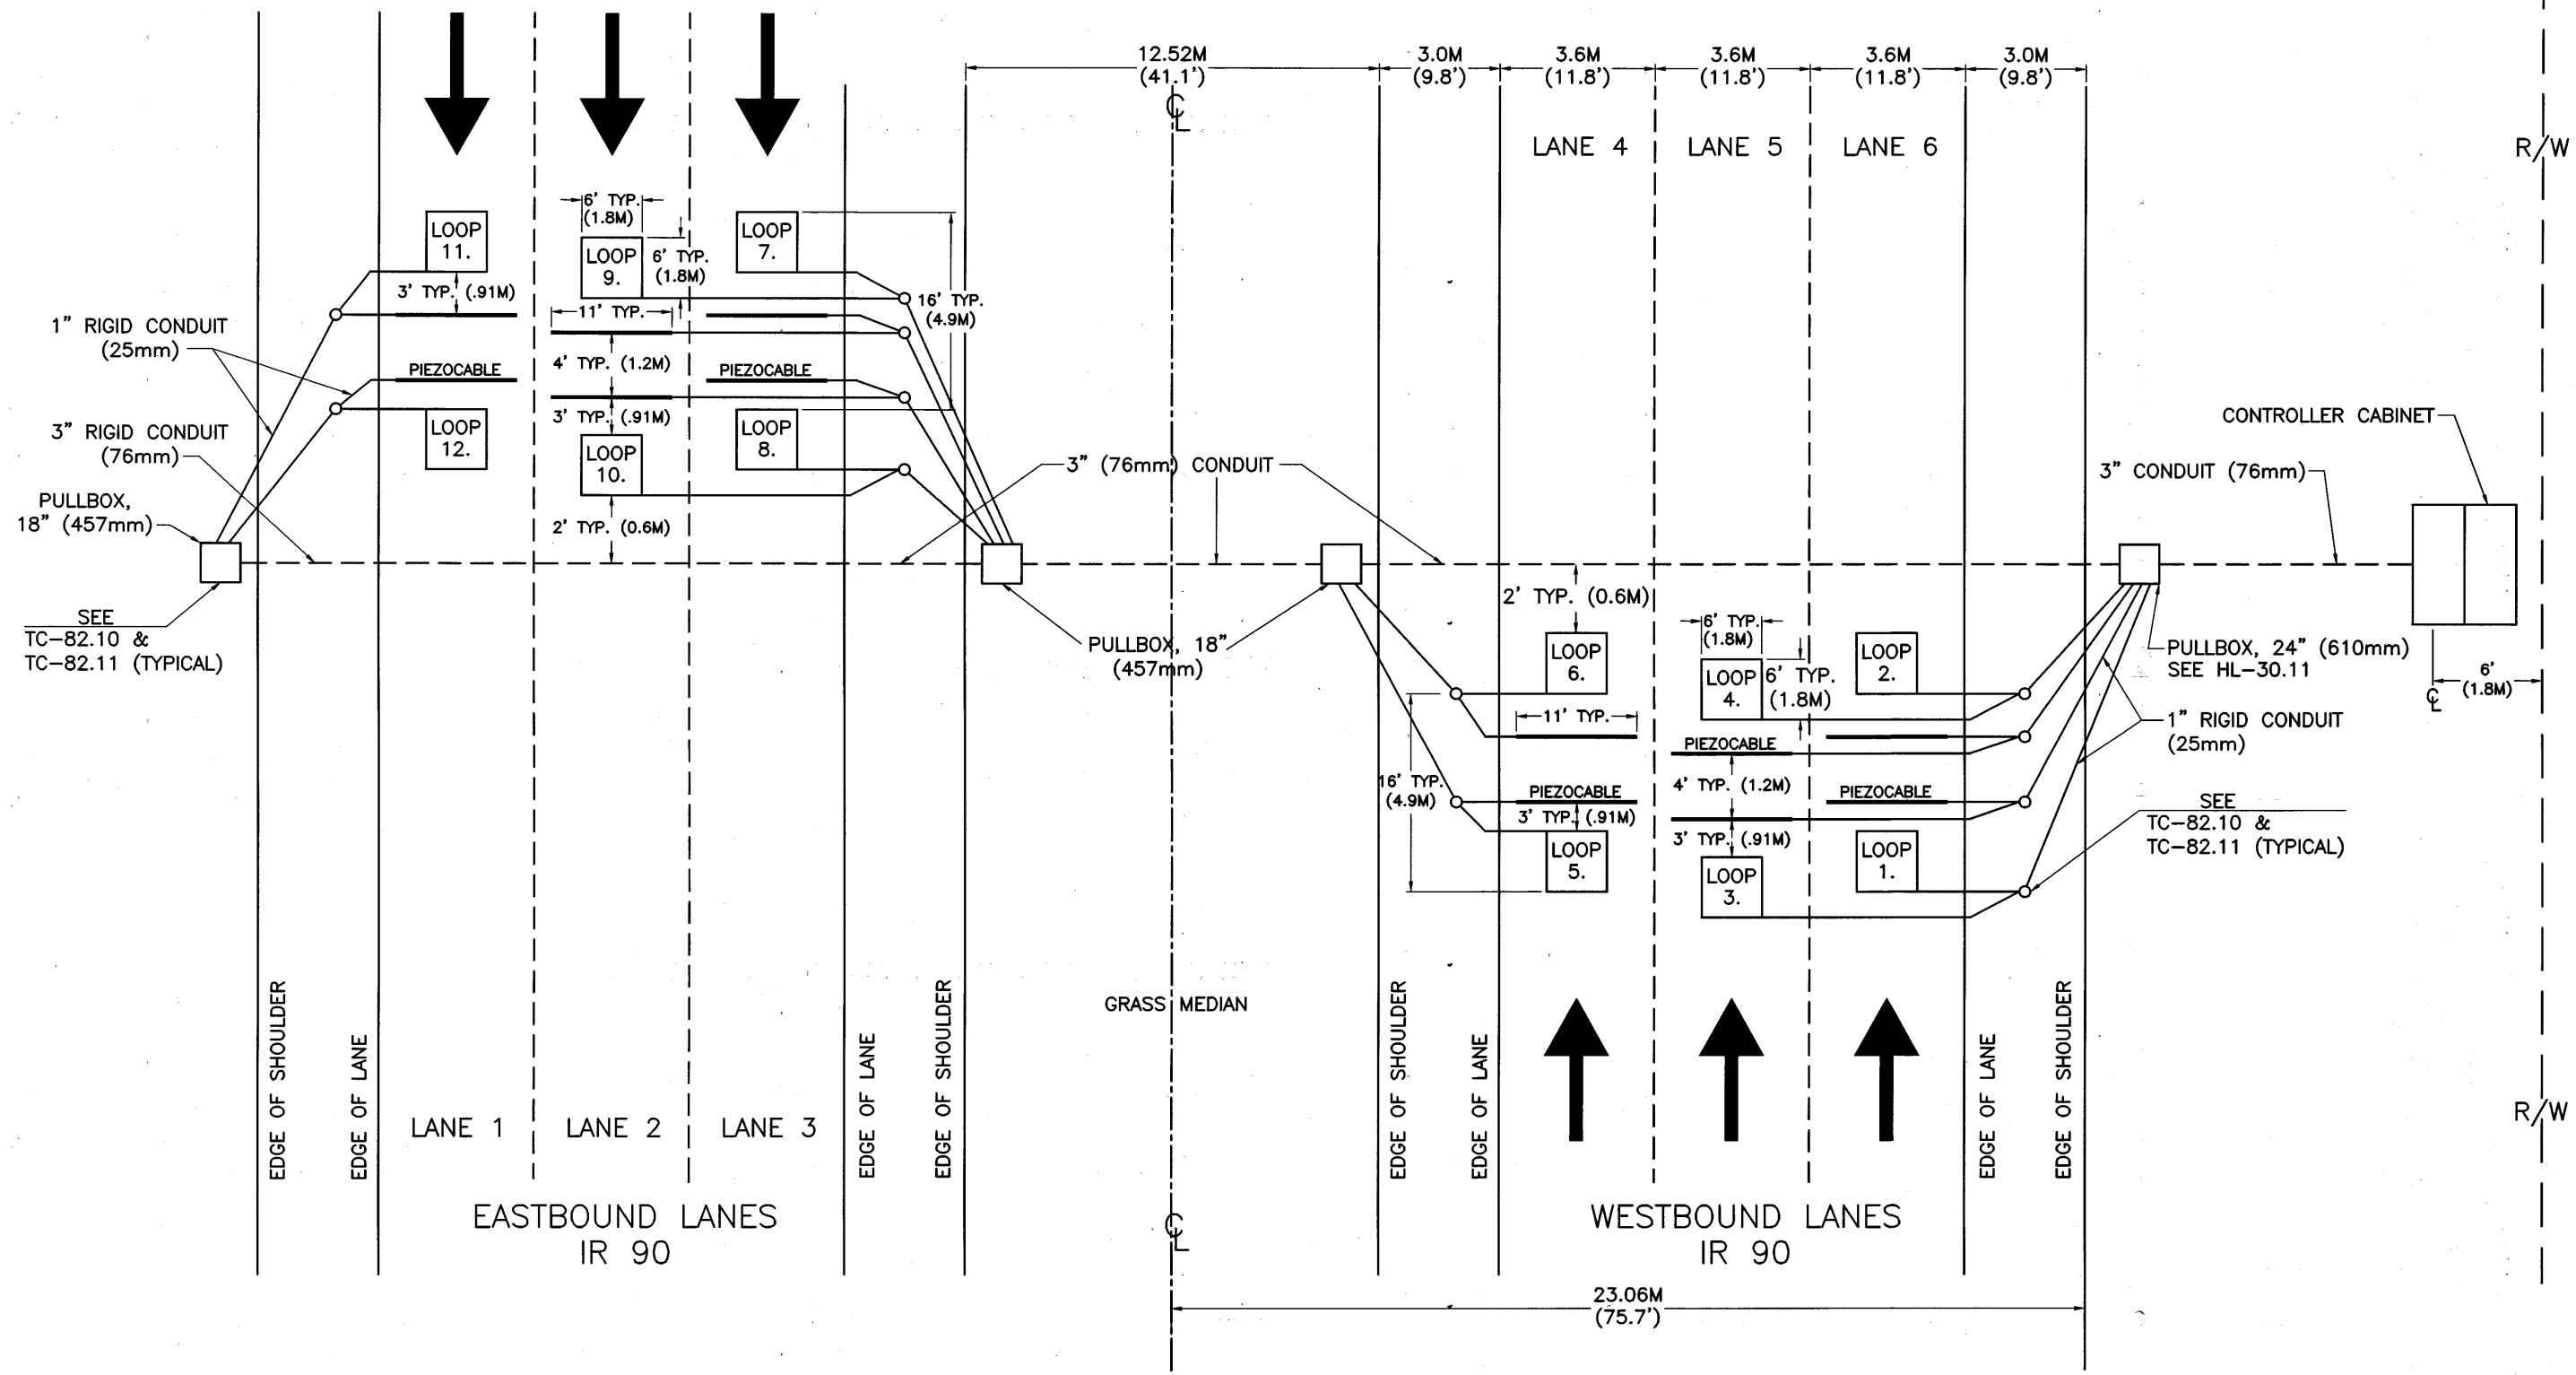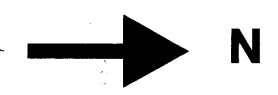


AUTOMATIC TRAFFIC RECORDER INSTALLATION  
6 LANE WEIGH-IN-MOTION STATION  
IR-90, LOG POINT  
DO3 SITE No 47-AA-W#

IR. 90 - 10.76  
PROJECT NUMBER; 003015  
ID #: 17891

AUTOMATIC TRAFFIC RECORDER PLAN SHEET  
FOR WEIGH IN MOTION UNIT

LOR - 190 - 10.76

8:01 AM 05-22-2002 [ c:\p3600\dwg\vr903\190601cd.dwg ] DLS

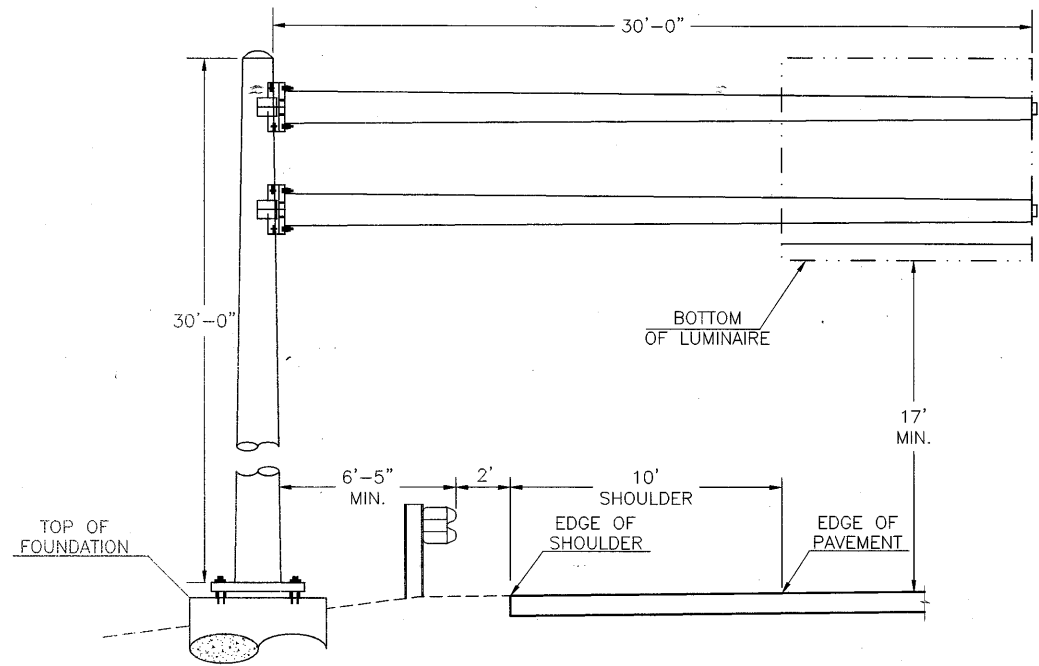

**ELEVATION VIEW**  
NOT TO SCALE

CANTILEVER OVERHEAD SIGN SUPPORT					
LOCATION	TC-12.30, DESIGN 10 OVERHEAD SIGN SUPPORT	ELEV. - TOP OF FOUNDATION	ELEV. - BOTTOM OF SIGN	ELEV. - EDGE OF SHOULDER	ELEV. - EDGE OF PAVEMENT
STA. 917+60.00, 86' RT.	1	645.25	665.85	647.84	648.34
STA. 943+25.00, 86' RT.	1	637.21	657.33	639.39	639.83
STA. 962+18.00, 86' RT.	1	633.05	651.85	633.93	634.35
STA. 992+41.00, 86' LT.	1	636.76	654.49	636.96	636.99
STA. 1009+05.00, 86' LT.	1	631.50	650.14	632.23	632.64
STA. 1035+45.00, 86' LT.	1	637.74	656.71	638.73	639.21



GROUND MOUNDED SUPPORT					
LOCATION	GROUND MOUNDED SUPPORT, W10x12 BEAM	ELEV. - BOTTOM OF SIGN	ELEV. - TOP OF ELEVATION, LT.	ELEV. - TOP OF ELEVATION, RT.	
STA. 977+52.49, 88.39' RT.	2	636.60	630.60	629.85	

CALCULATED  
DLS  
CHECKED  
LAB

MISCELLANEOUS DETAILS

LOR - I90 - 10.76



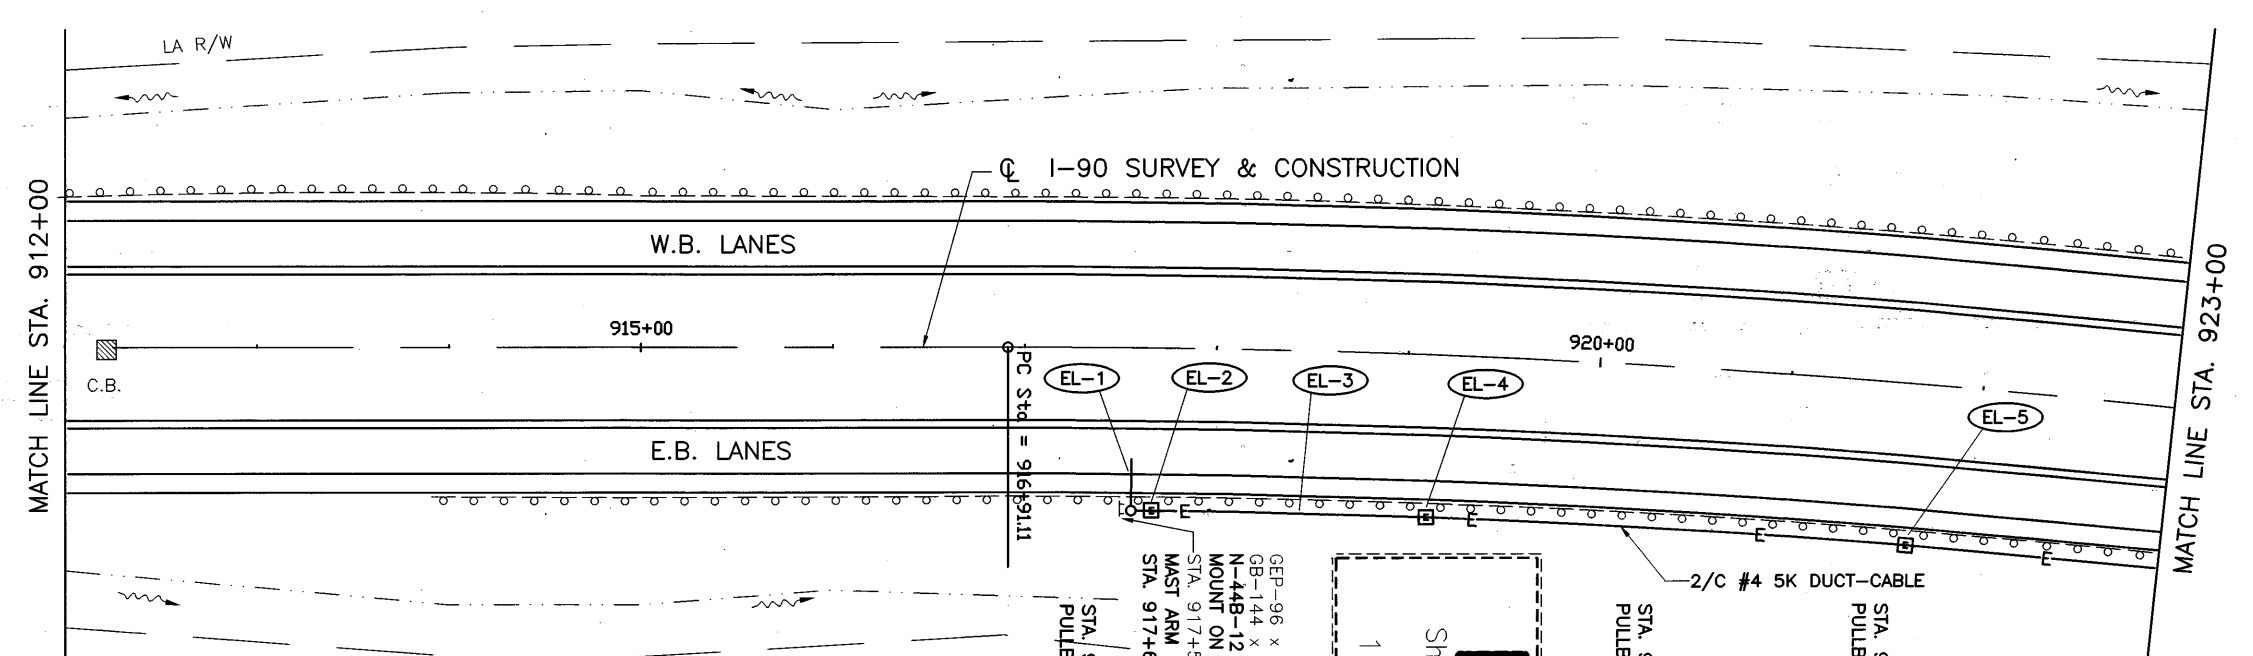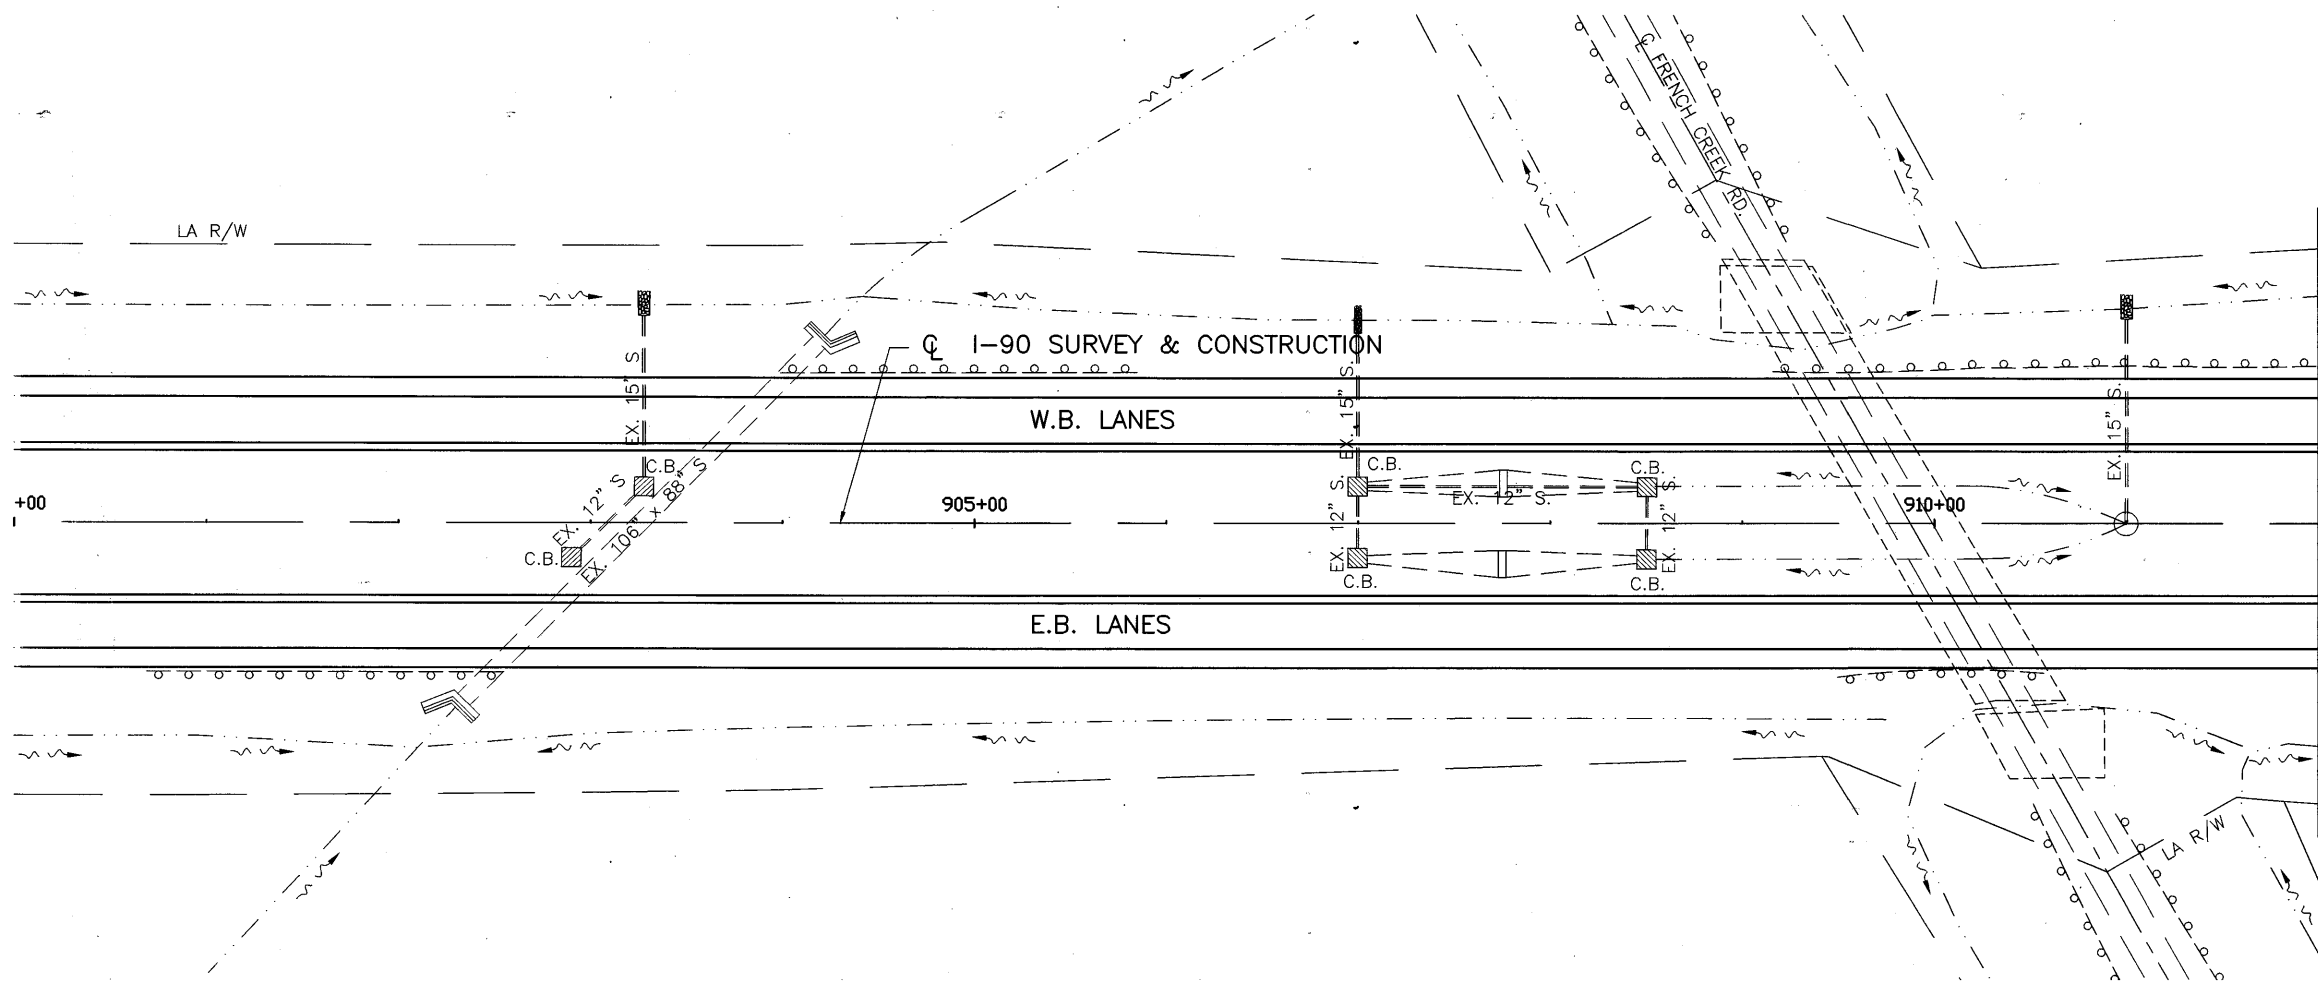

**LEGEND**

- PULLBOX
- CABLE
- SUMMARY REF. NO.

GEP-96 x 24  
 GB-144 x 144  
 N-448-12 x 18  
 MOUNT ON SIGN UPRIGHT  
 STA. 917+58.53, 104' R.H.  
 MAST ARM W/LUMINAIRE  
 STA. 917+60.00, 86.00' R

90EB  
 150.26

611  
 Sheffield  
 Avon  
 1 MILE  
 EXIT 151



STA. 919+15.00, 86.00' R  
 PULLBOX, 18" x 18"

2/C #4 5K DUCT-CABLE

STA. 921+65.00, 86.00' R  
 PULLBOX, 18" x 18"

STA. 917+67.00, 86.00' R  
 PULLBOX, 18" x 18"

PC Sta = 916+91.11

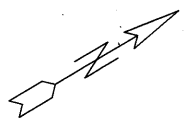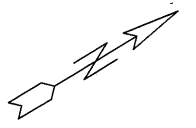

CALCULATED  
 DLS  
 CHECKED  
 LAB

0 50' 100'  
 HORIZONTAL  
 SCALE IN FEET


**LIGHTING PLAN**  
**STA. 885+00 TO STA. 923+00**

**LOR - 190 - 10.76**

248  
 274


250374 02-05-0002 [ C:\46666\WORK\PROJECT\330303\EL.DWG ] DLS



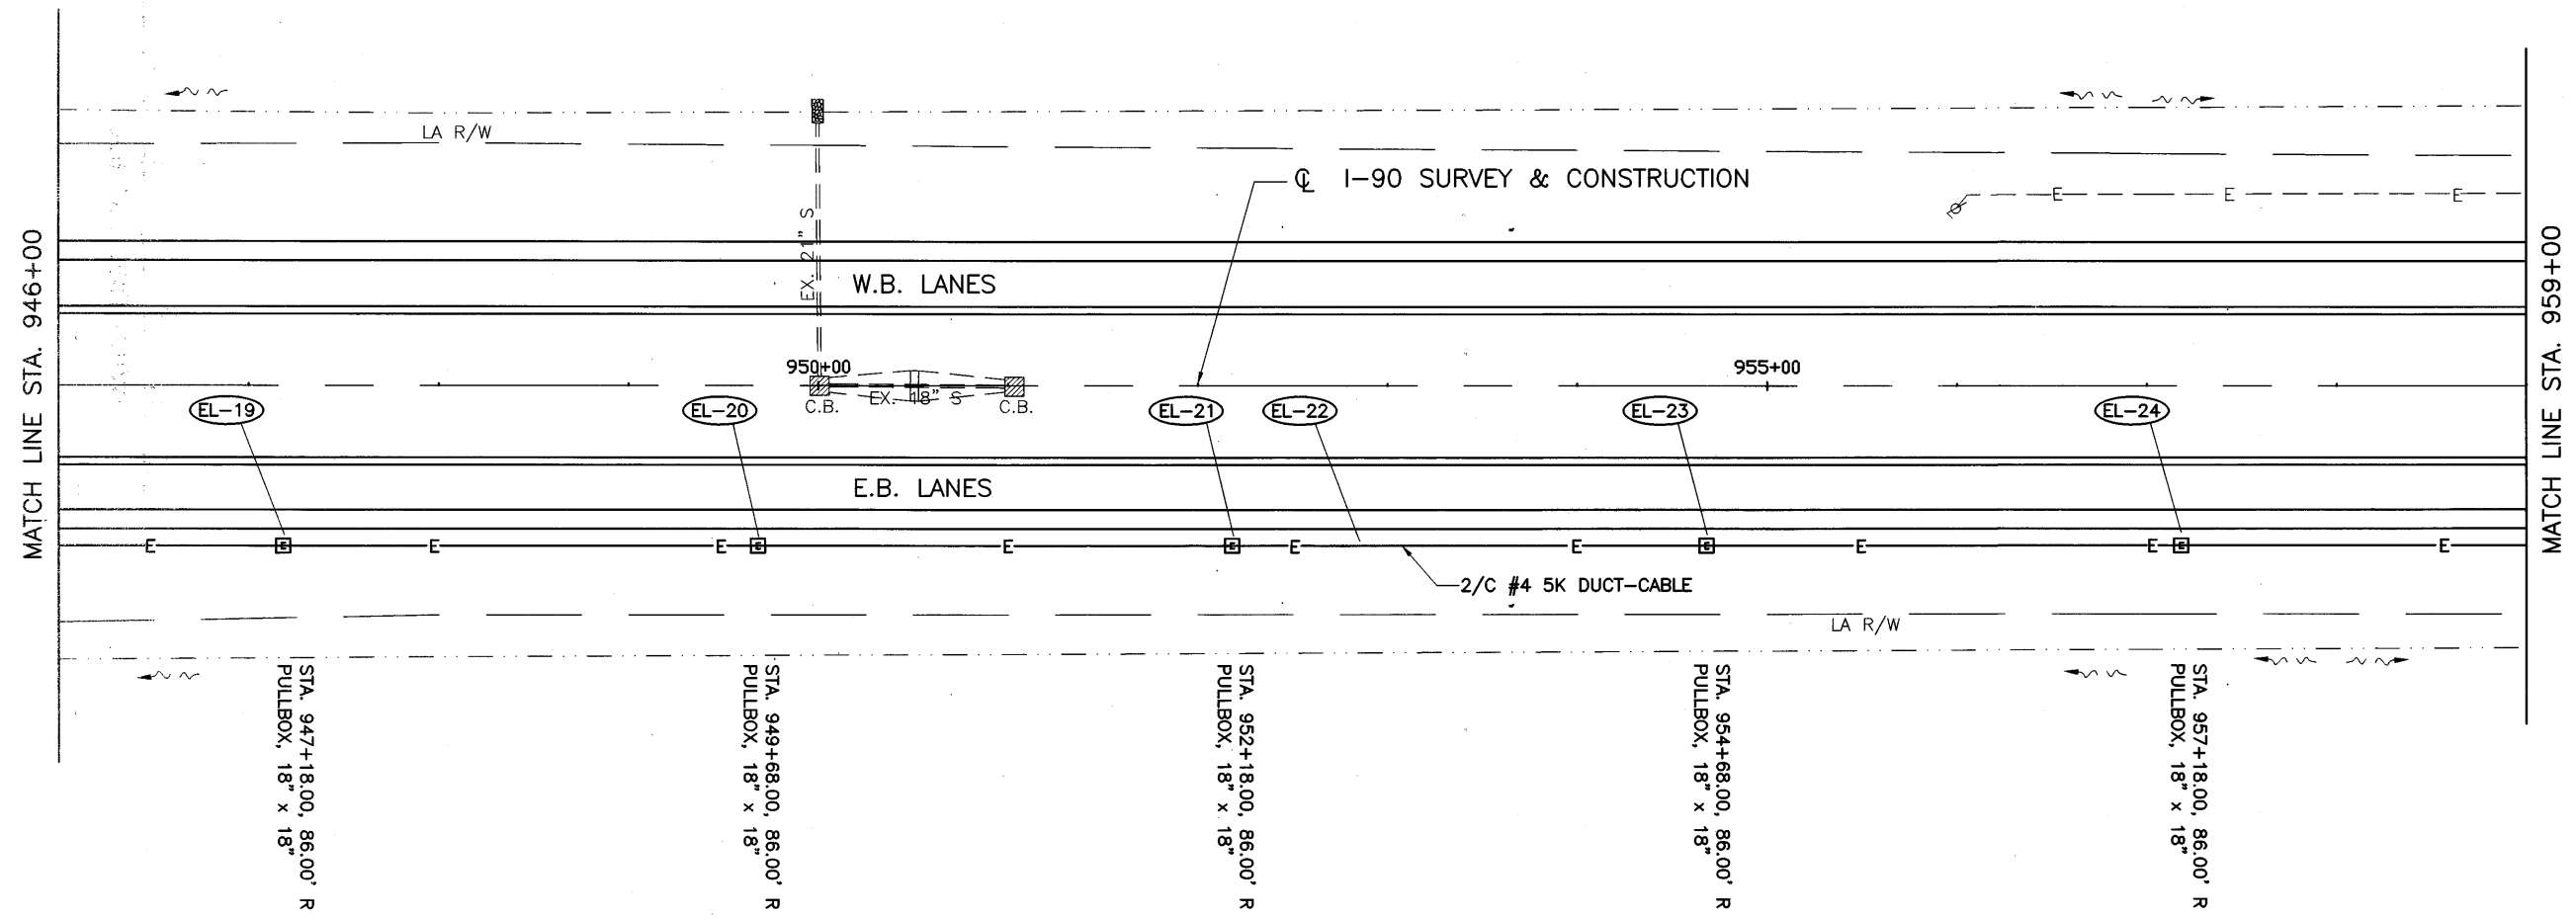

**LEGEND**  
 [E] PULLBOX  
 E CABLE  
 (EL-1) SUMMARY REF. NO.

CALCULATED	DLS	CHECKED	LAB

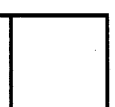


**LIGHTING PLAN**  
**STA. 946+00 TO STA. 959+00**


**LOR - I90 - 10.76**

5:07PM 02-08-2002 C:\P190\DRAWINGS\PROJECTS\I90\10.76\10.76.LSP

**LEGEND**  
 [E] PULLBOX  
 —E— CABLE  
 (EL-1) SUMMARY REF. NO.


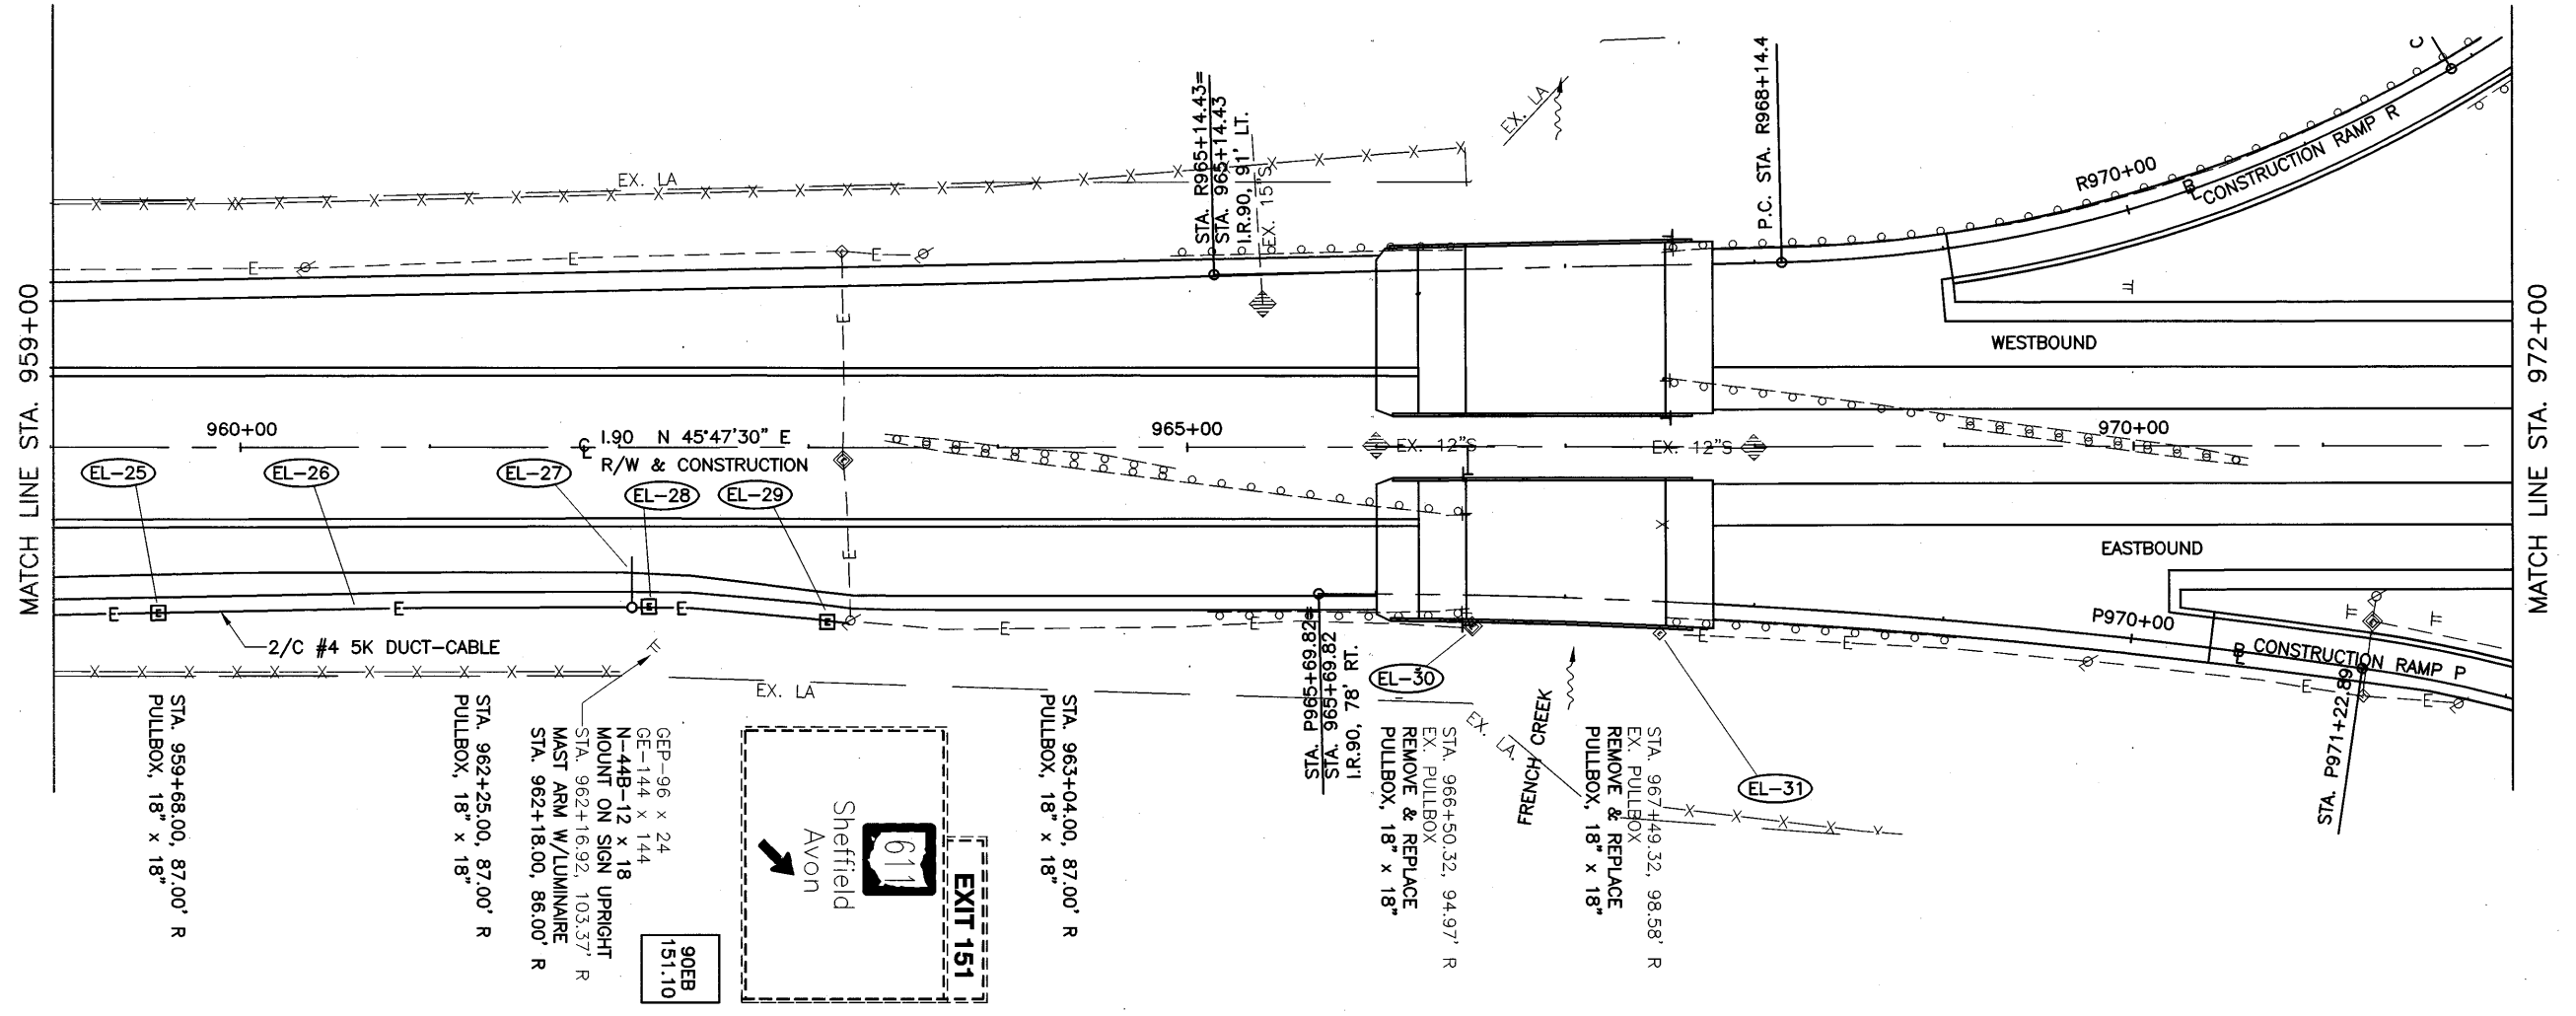


CALCULATED	DLS	CHECKED	LAB

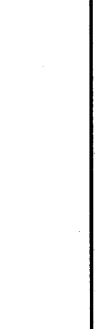
 



**LIGHTING PLAN**  
 STA. 959+00 TO STA. 972+00

LOR - 190 - 10.76

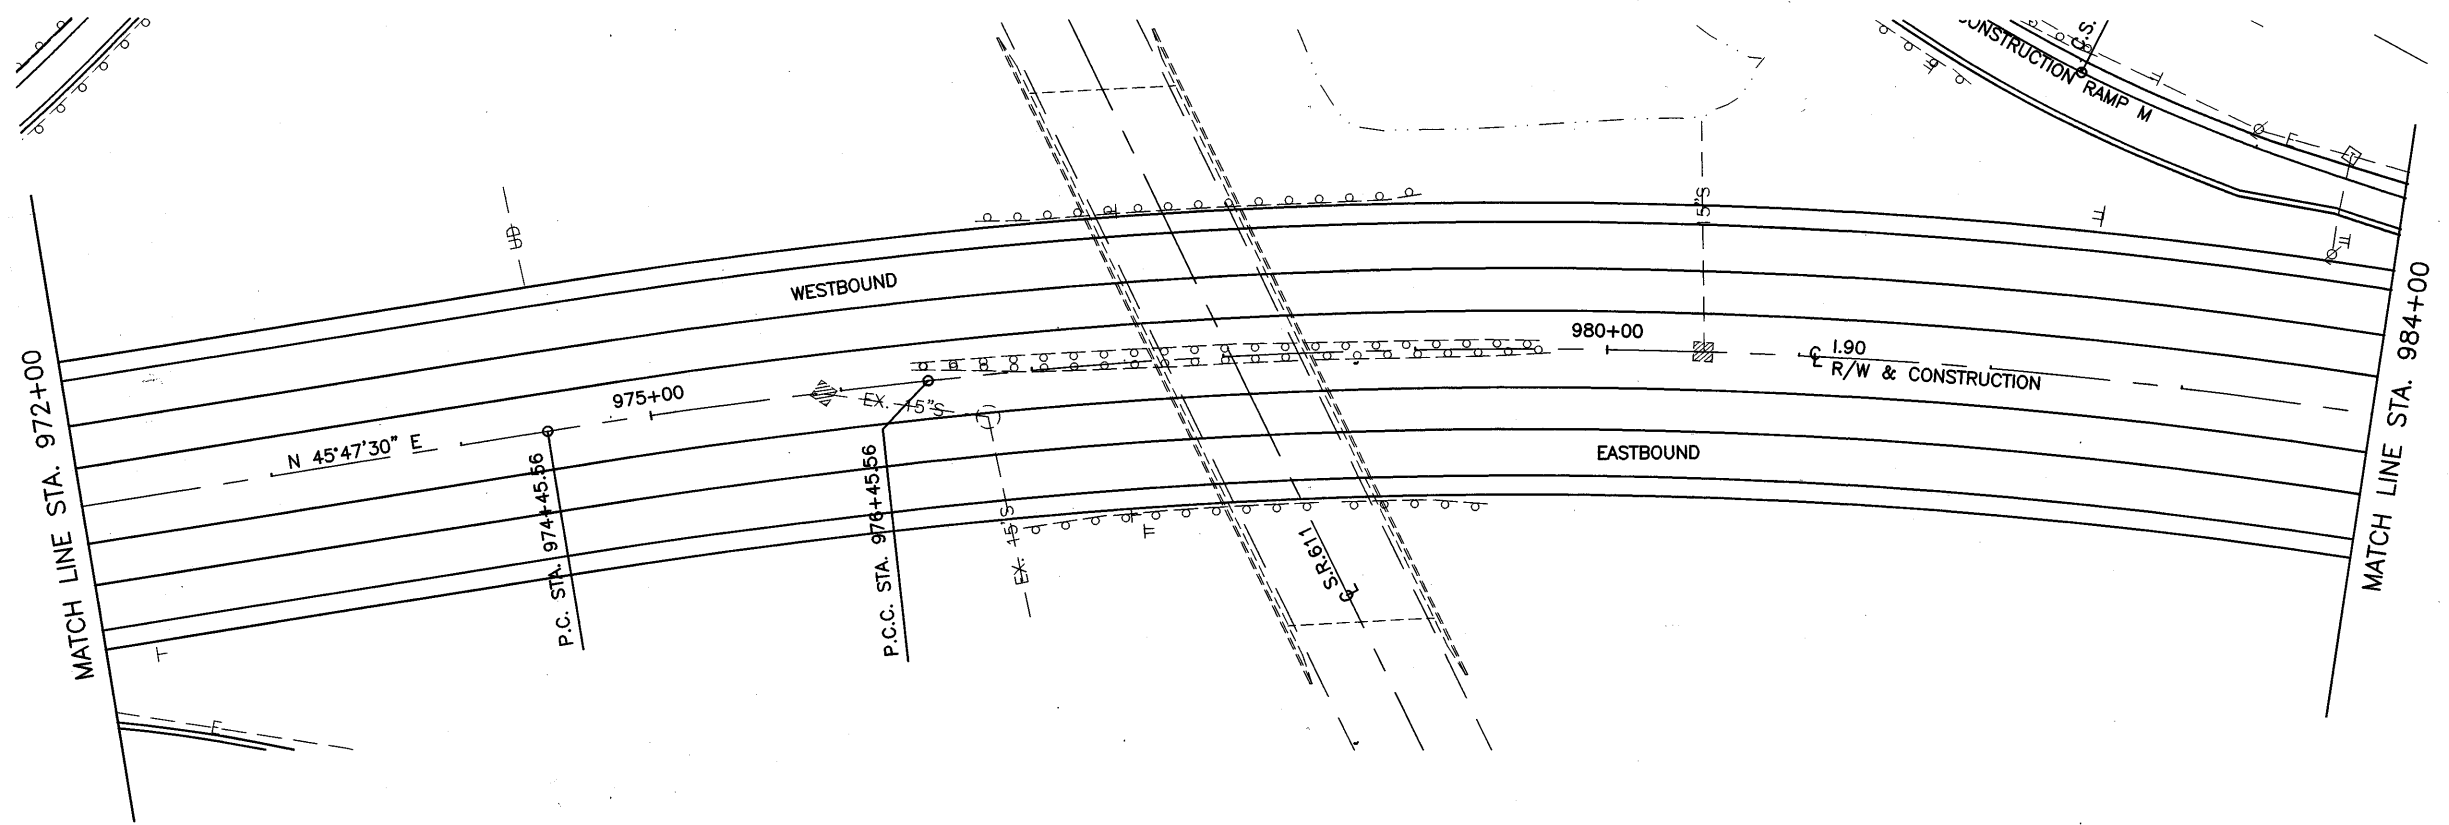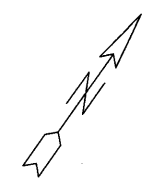

**LEGEND**



-  PULLBOX
-  CABLE
-  SUMMARY REF. NO.

CALCULATED	0	50	100
DLS	HORIZONTAL SCALE IN FEET		
CHECKED			
LAB			

**LIGHTING PLAN  
STA. 972+00 TO STA. 984+00**


**LOR - 190 - 10.76**

3:38PM  
C:\93600\DWG\VRSCA\93600L5.DWG ] OAS

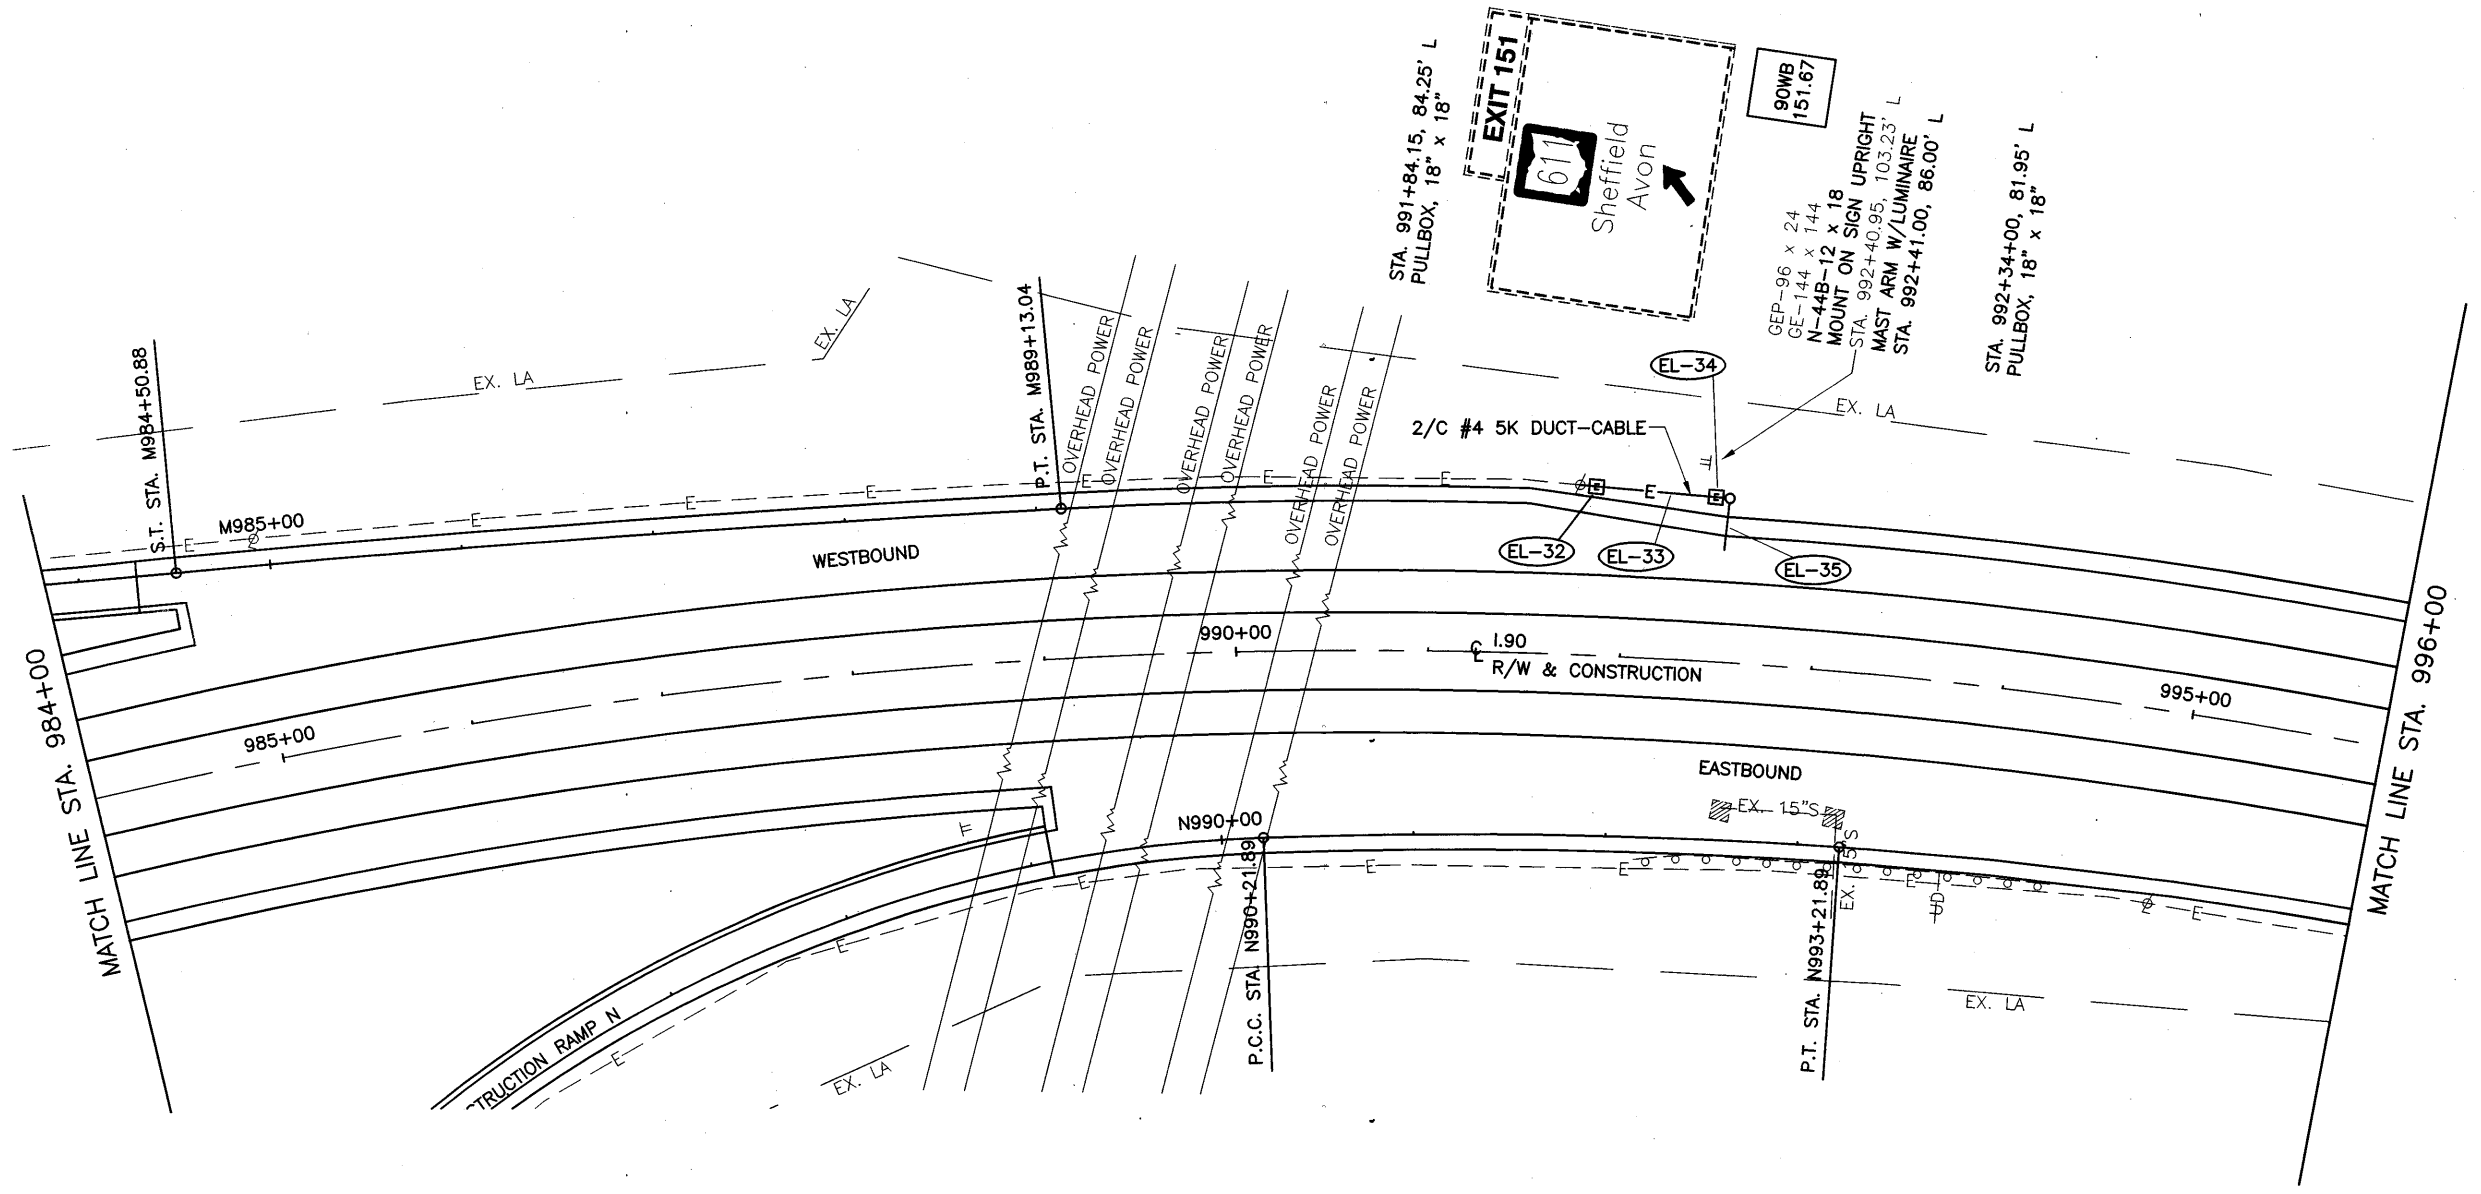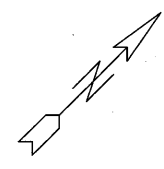

**LEGEND**  
 [E] PULLBOX  
 [E] CABLE  
 (EL-1) SUMMARY REF. NO.

CALCULATED	DLS	CHECKED	LAB

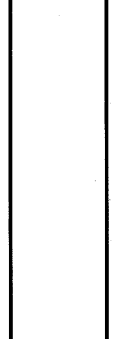


**LIGHTING PLAN**  
 STA. 984+00 TO STA. 996+00

LOR - 190 - 10.76

05-22-2002  
[ O:\93600\DWG\1903\193600EL7.DWG ] DLS

**LEGEND**

- E PULLBOX
- E— CABLE
- EL-1 SUMMARY REF. NO.

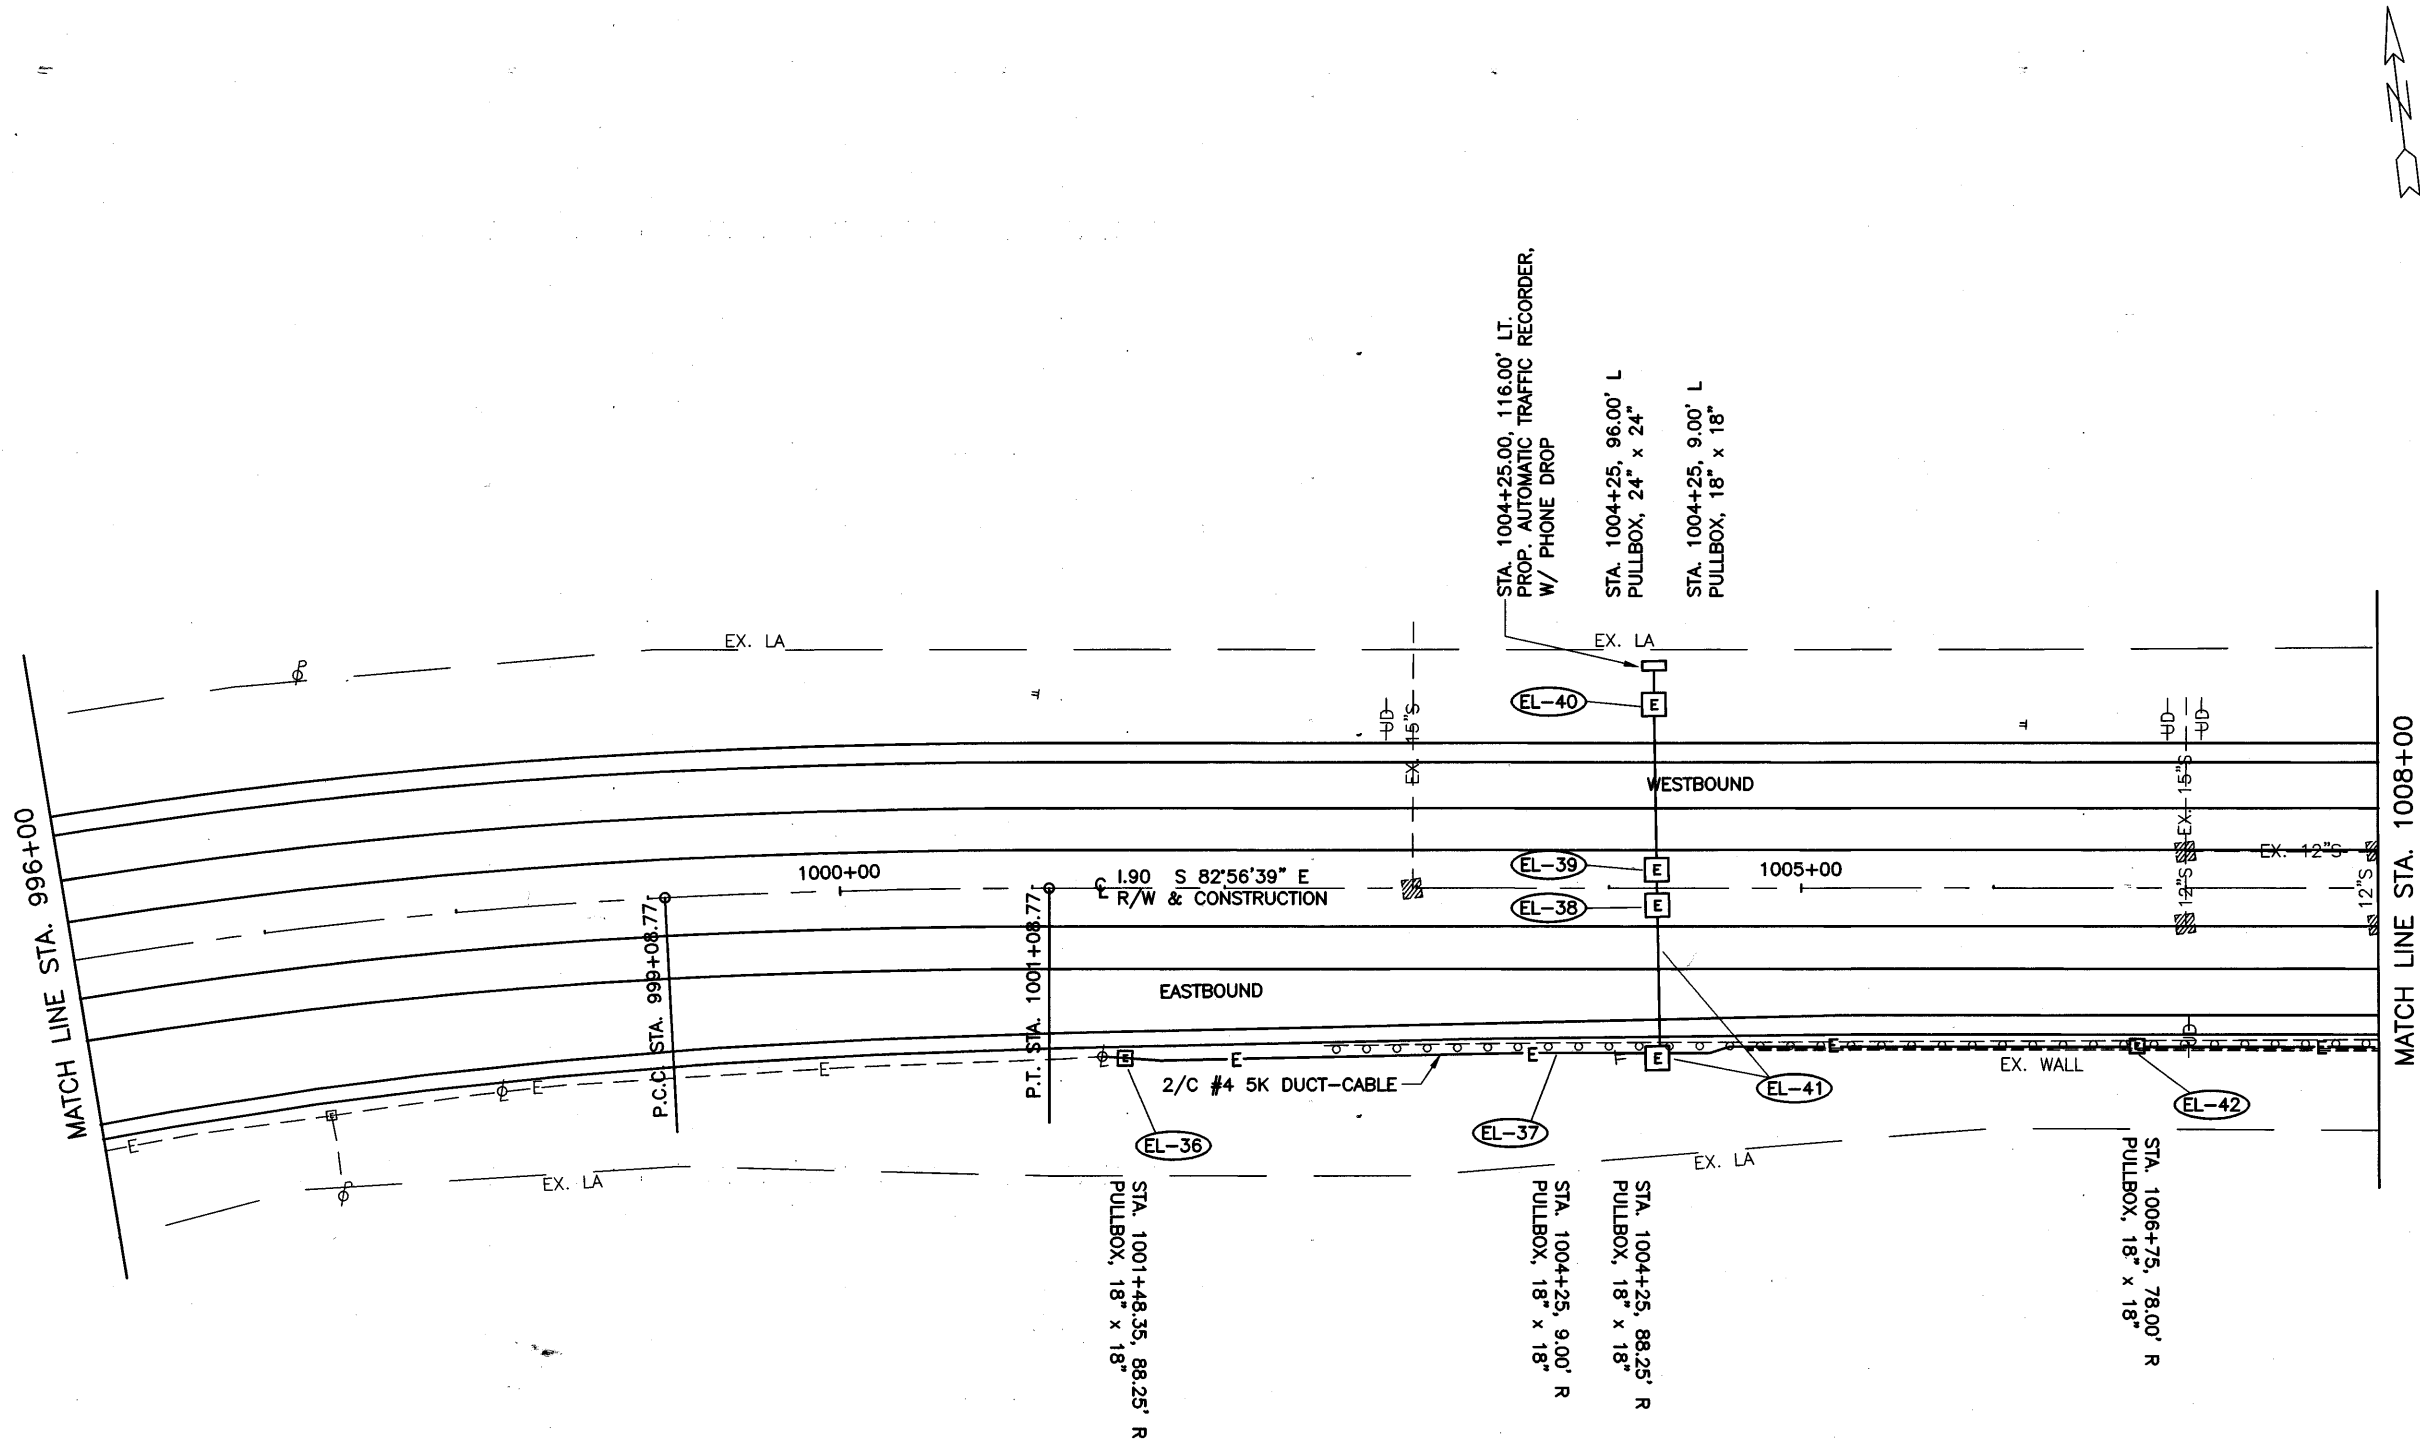

CALCULATED	DLS	CHECKED	LAB



**LIGHTING PLAN**  
**STA. 996+00 TO STA. 1008+00**

LOR - 190 - 10.76



**EXIT 151**


**611**

Sheffield  
Avon  
1/2 MILE

**90WB**  
151.99

GEP-96 x 24  
GE-156 x 144  
N-44B-12 x 18  
MOUNT ON SIGN UPRIGHT  
MAST ARM W/LUMINAIRE  
STA. 1009+05.00, 86.00' L

STA. 1009+12.00, 86.00' L  
PULLBOX, 18" x 18"

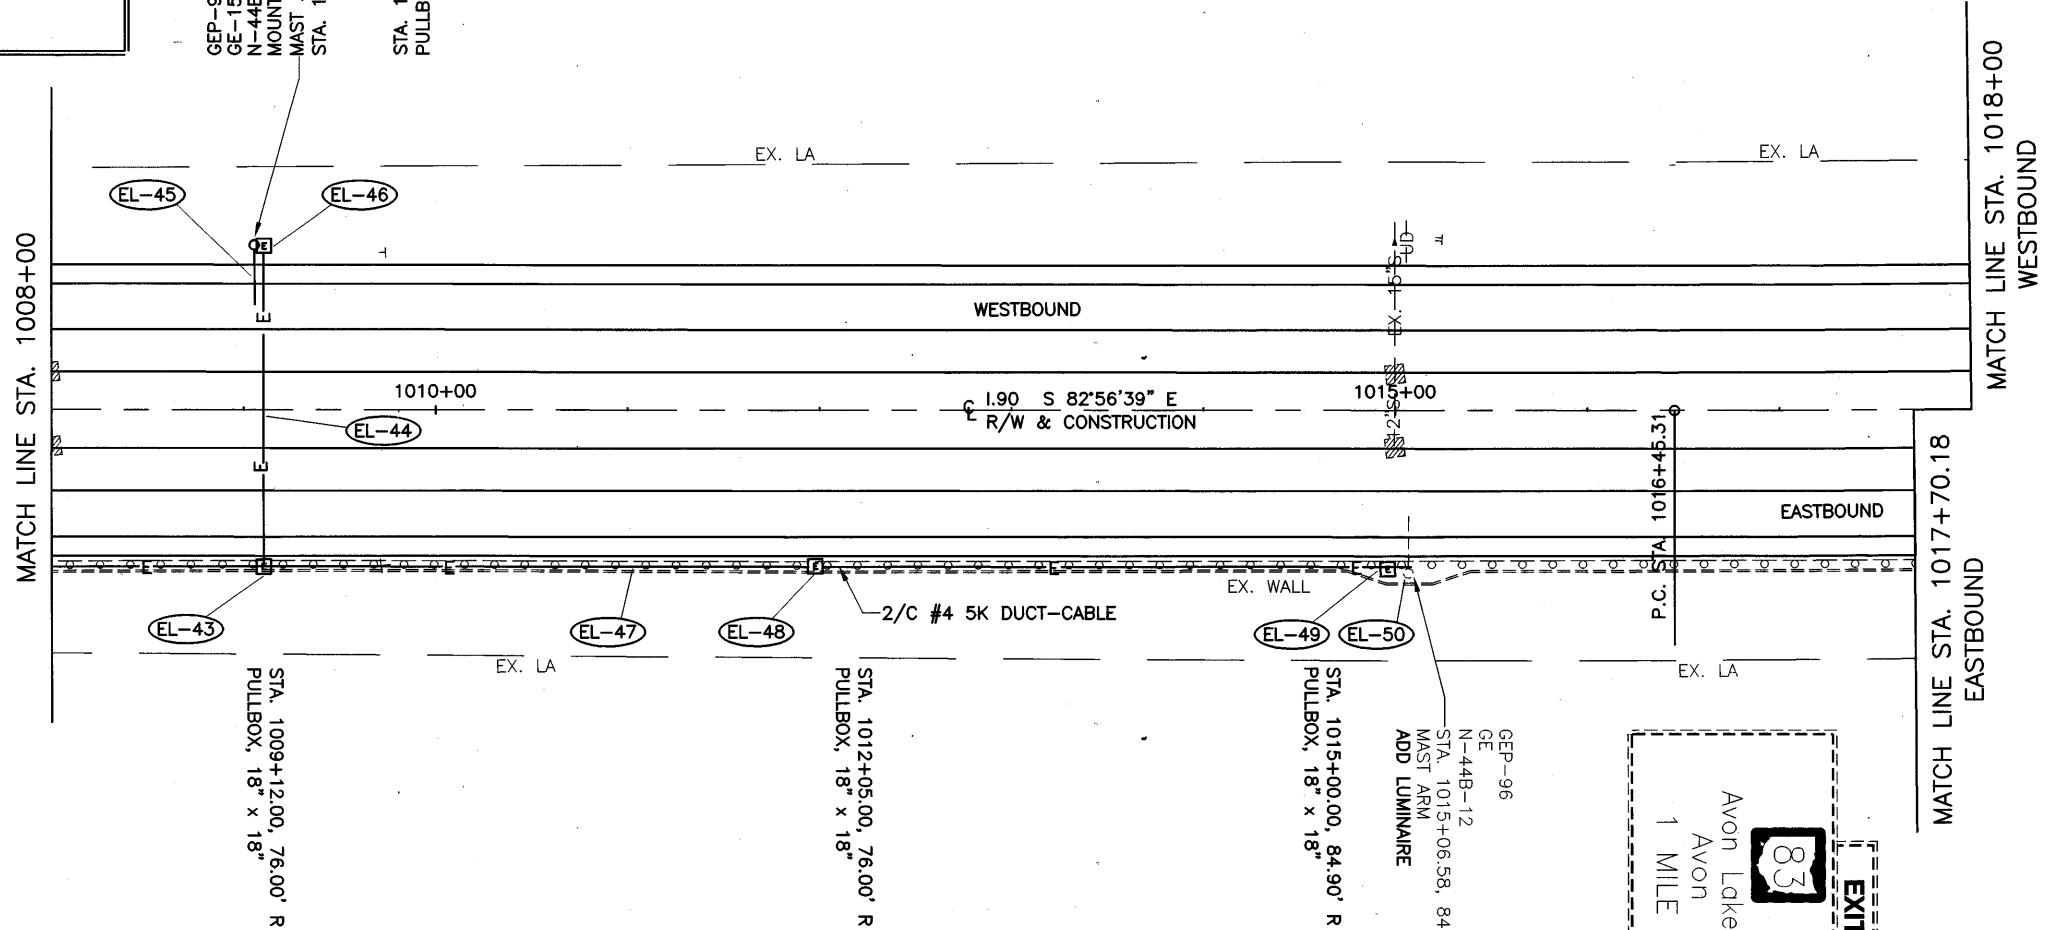

**LEGEND**

PULLBOX

CABLE

SUMMARY REF. NO.


CALCULATED	DLS	CHECKED	LAB

**LIGHTING PLAN**  
**STA. 1008+00 TO STA. 1018+00**

**LOR - 190 - 10.76**




9:14 AM  
02-08-2002  
C:\PROJECTS\I-90\DWG\I-90\I-90.DWG J DLS

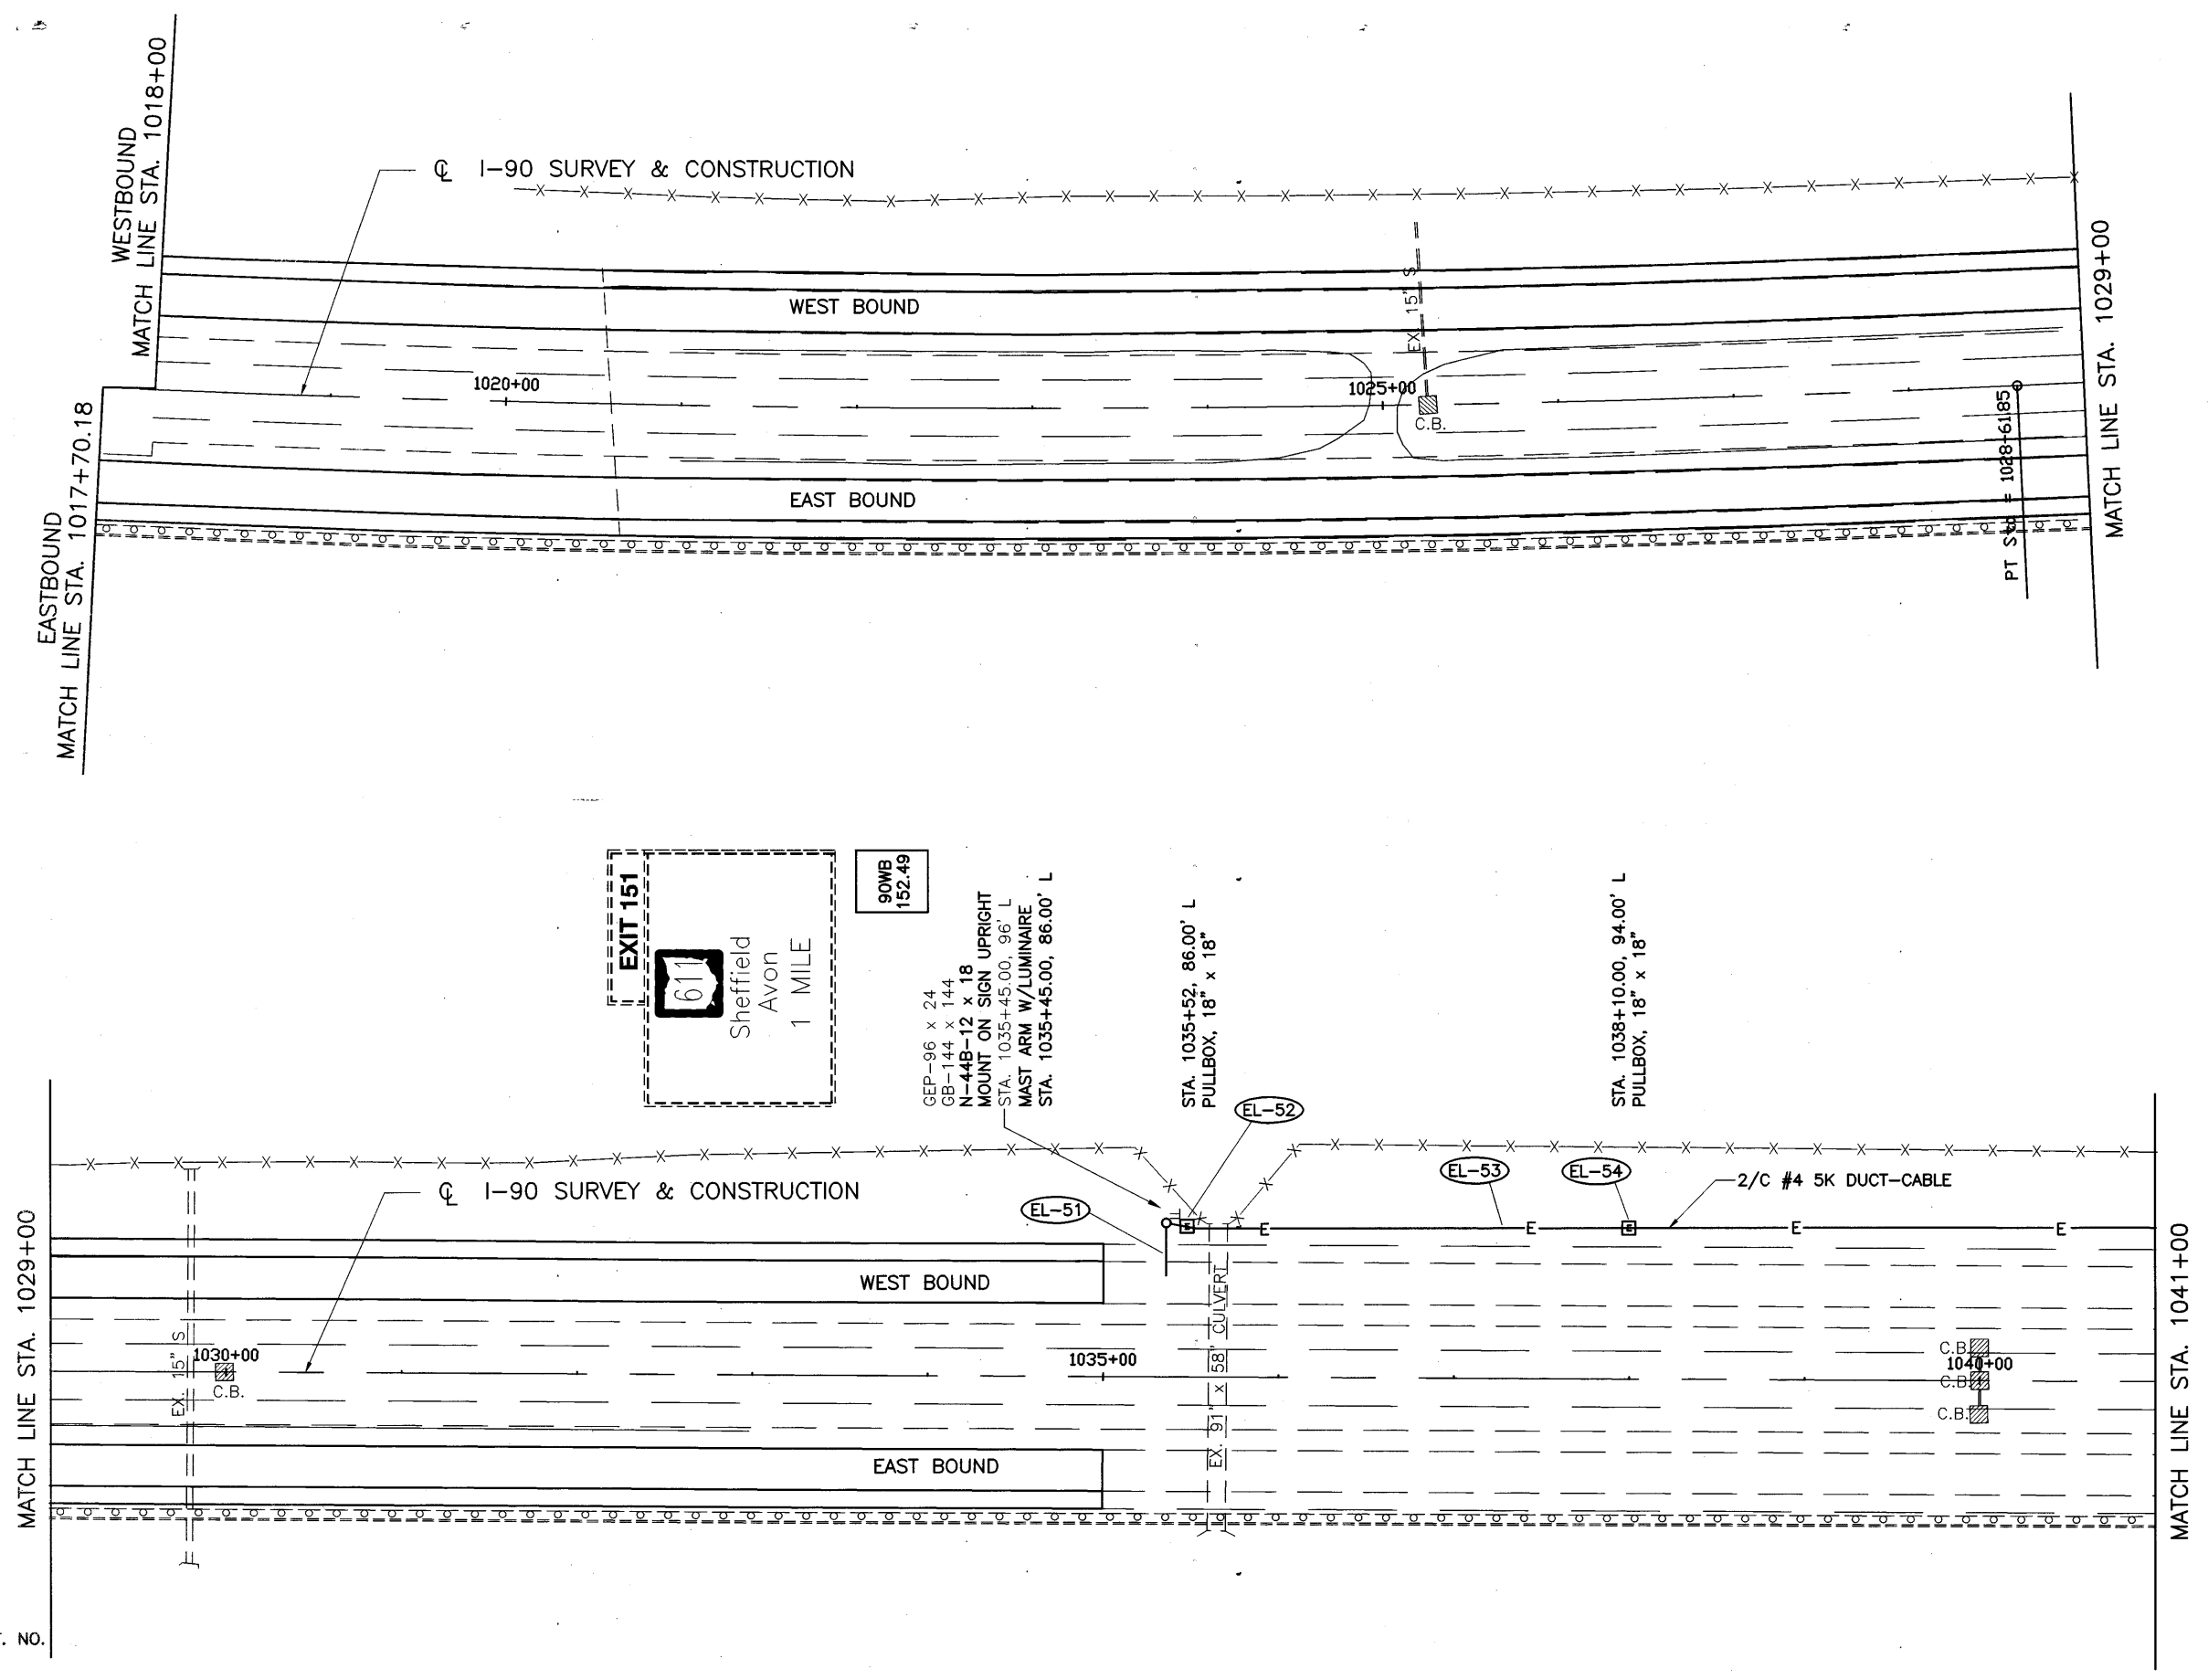

**LEGEND**

- ☐ PULLBOX
- E — CABLE
- EL-1 SUMMARY REF. NO.

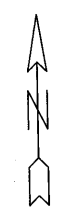


CALCULATED	DLS	CHECKED	LAB

**LIGHTING PLAN**  
STA. 1017+70.18 TO STA. 1041+00

**LOR - 190 - 10.76**

256
274

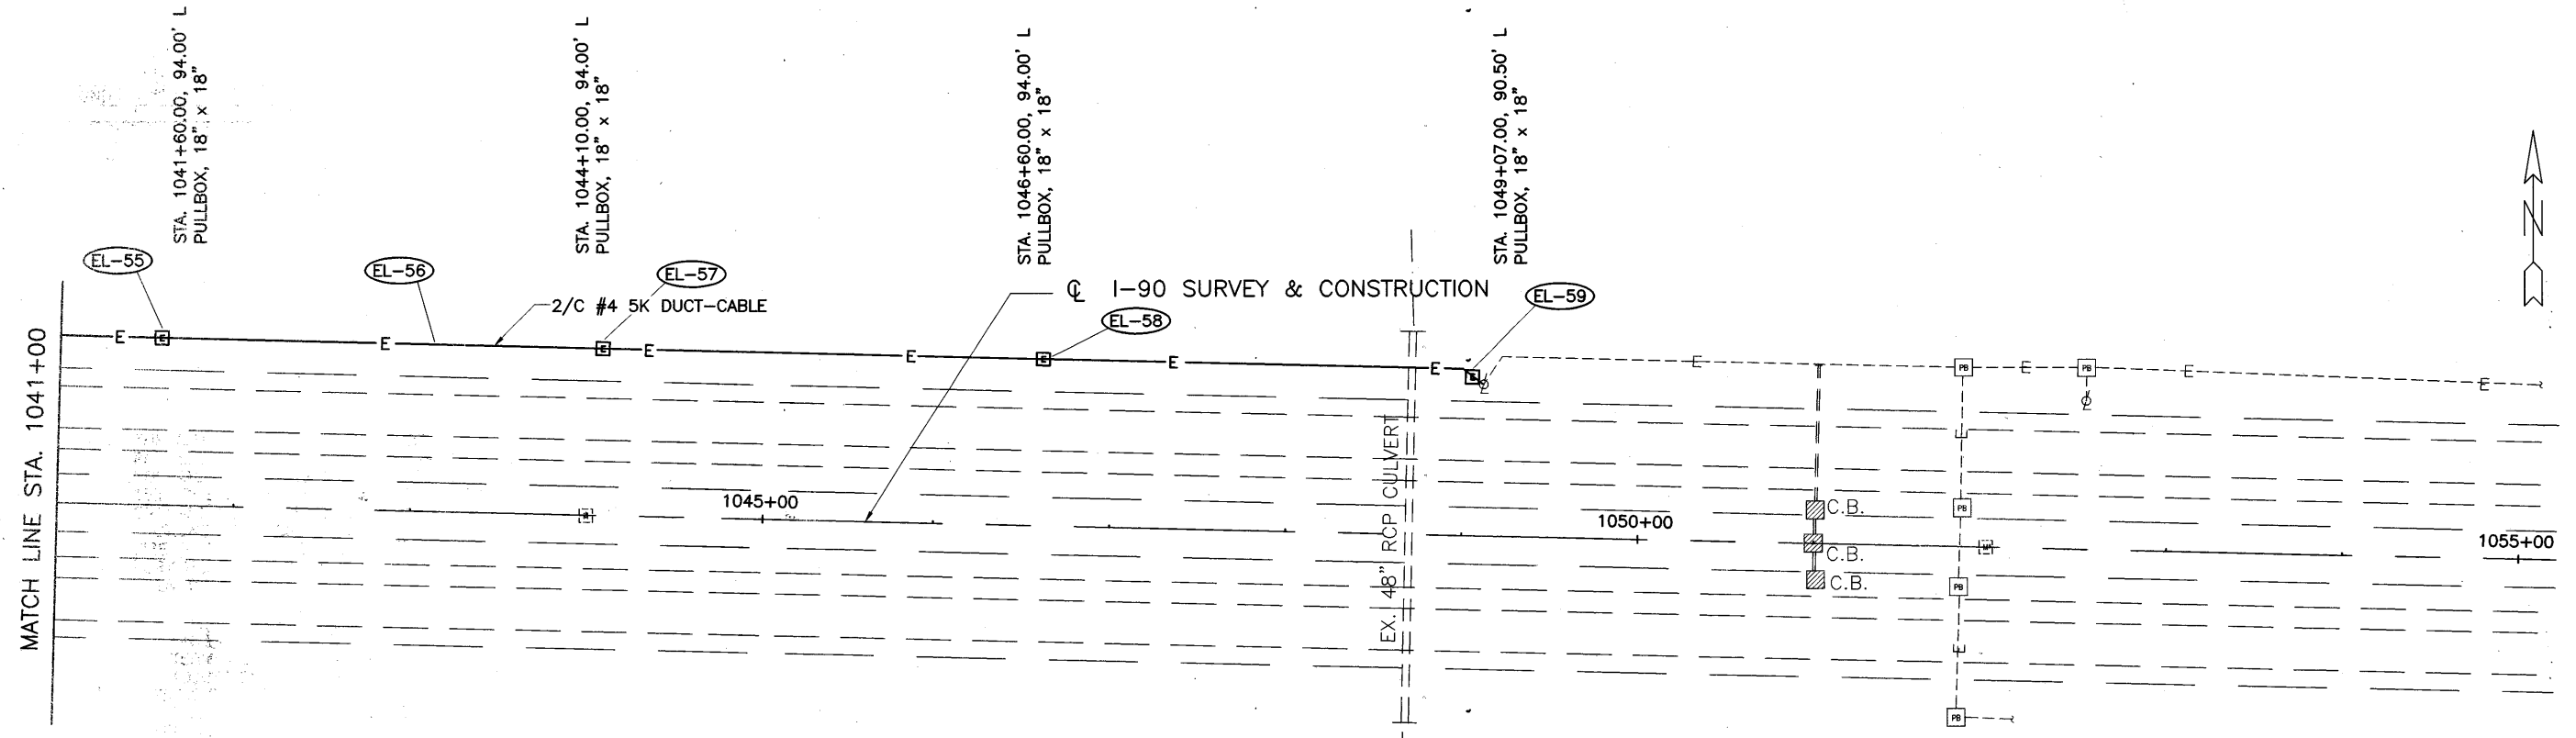


**LEGEND**

[E] PULLBOX

—E— CABLE

(EL-1) SUMMARY-REF. NO.

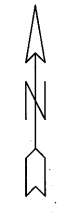


9/20/04  
32-08-2002 [ C:\935601\DWG5\PR6501\_93562501.dwg ] dls

ATTACHMENT F

NEMA SIZE 3 CABINET DETAILS


-NOT TO SCALE-

DETAIL A  
TERMINAL BLOCK

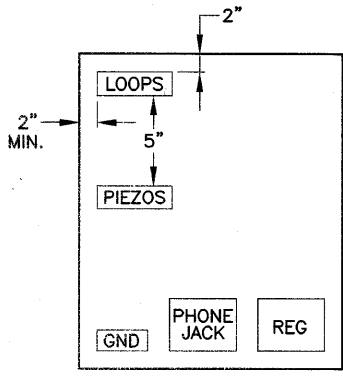

TERMINAL BLOCK DETAILS

- 6 LNS- 12 LOOPS - BEAU TYPE 78024 TERMINAL STRIP OR EQUIVALENT
- 6 LNS- 12 LOOPS & 12 PIEZOS - BEAU TYPE 78024 TERMINAL STRIP OR EQUIVALENT x 2

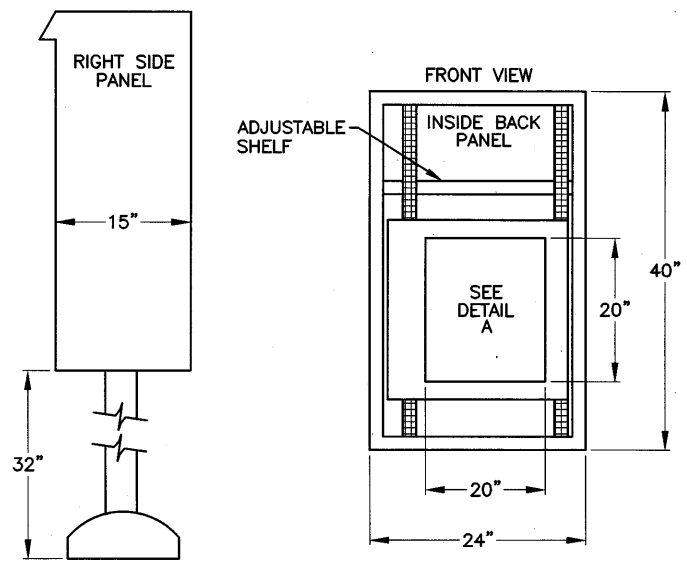


NOTES

- THE ALUMINUM CABINET SHALL BE A PEDESTAL MOUNTED SIZE 3 AS SHOWN IN TABLE 7.3-1 OF THE NEMA STANDARD PUBLICATION NO. TS 2-1992. THE NOMINAL DIMENSIONS ARE: 24 INCHES WIDE BY 40 INCHES HIGH BY 15 INCHES DEEP. IT SHALL BE SHEET ALUMINUM AS DETAILED IN SECTION 7.2.2.1 OR CAST ALUMINUM DETAILED IN SECTION 7.2.2.2. IT SHALL ALSO CONFORM TO SECTIONS: 7.4, 7.5 EXCEPT FOR 7.5.7, 7.6 WITH ONE SHELF, 7.7.3, 7.8.3 SIZE 5, 7.8.4. THE CABINET SHALL BE INSTALLED WITH INTERNAL COMPONENTS FOR THE WEIGH-IN-MOTION EQUIPMENT AS NECESSARY TO PROVIDE COMPLETE OPERATION OF THE WIM SYSTEM.
  - A. IT SHALL BE EQUIPPED WITH TWO ADJUSTABLE "C" CHANNELS MOUNTED ON EACH OF THE THREE INTERIOR SIDES FOR THE PURPOSE OF MOUNTING TERMINAL STRIP PANELS AND SHELVEING. FURNISH THE CABINETS WITH ONE ADJUSTABLE SHELF WHICH WILL NOT SAG WHEN LOADED WITH THE WIM ELECTRONICS. DESIGN THE SHELVEING TO ALLOW FOR THE PASSAGE OF AIR. PLACE NO EQUIPMENT ON THE BOTTOM OF THE CABINET.
  - B. MOUNT A GROUNDING STRIP TO THE TERMINAL STRIP PANEL ON THE CABINET WALL FOR CONNECTION OF ALL COMMON CONDUCTORS WITH THE STRIP GROUNDING TO THE GROUND ROD.
  - C. INSTALL THE HOUSING CABINET AS TO ALLOW ALL EQUIPMENT TO STAND IN AN UPRIGHT POSITION WITH ALL EQUIPMENT AND DEVICES CAPABLE OF BEING REMOVED BY PULLING STRAIGHT OUT AND NOT TURNING SIDEWAYS AND WITHOUT RELOCATING OR DISCONNECTING ONE DEVICE TO REMOVE ANOTHER DEVICE.
  - D. PROVIDE THAT ALL CONNECTIONS ARE MADE ON TERMINAL BLOCKS USING SOLDERED SPADE TYPE CONNECTORS. PROVIDE THAT ALL HOUSING CABINET WIRING AND TERMINALS ARE CLEARLY MARKED AND LABELED AS SHOWN ON THE CABINET WIRING DIAGRAM DETAILS. PROVIDE THAT WIRING IS LACED OR BOUND TOGETHER WITH SELF-LOCKING NYLON TIE-WRAPS. MAKE A LOOP NUMBERING DIAGRAM WITH CORRESPONDING TERMINAL NUMBERS FOR EACH SITE AND STORE IN A PLASTIC WEATHER PROOF ENVELOPE IN THE ENCLOSURE. PROVIDE A DUPLICATE DIAGRAM TO THE ODOT PROJECT INSPECTOR.
  - E. INSTALL ALL HOUSING CABINETS SO AS TO WITHSTAND ALL WEATHER CONDITIONS AND PREVENT THE INTRUSION OF REPTILES, RODENTS AND INSECTS.
  - F. THE CABINET SHALL INCLUDE A VENT, BUT NO FAN.
  - G. MOUNTING FACILITIES SHALL INCLUDE ONE BACK PANEL WITH 5 HOLES (ALUMINUM).
  - H. TERMINAL STRIPS MOUNTED HORIZONTALLY ON BACK PANEL 2" FROM TOP AND SIDES EQUIDISTANTLY SPACED FOR 2 LANE APPLICATIONS. SOLAR PANEL AND GROUND BAR TO BE MOUNTED 2" FROM BOTTOM AND LEFT OF BACK PANEL FOR ALL APPLICATIONS. 4-6 LANE APPLICATIONS TO HAVE ONE ROW OF TWO TERMINAL STRIPS MOUNTED HORIZONTALLY 2" FROM TOP AND SIDES OF BACK PLATE AND ONE ROW OF TWO TERMINAL STRIPS MOUNTED 8" FROM TOP AND 2" FROM SIDES OF BACK PLATE EQUIDISTANTLY SPACED. 8 LANE APPLICATIONS TO HAVE TWO ROWS OF THREE TERMINAL BLOCKS W/ 1ST ROW 2" FROM TOP AND SIDES OF BACK PLATE AND SECOND ROW 8" FROM TOP AND 2" FROM SIDES OF BACK PLATE EQUIDISTANTLY SPACED.
  - I. LOCKS KEYED TO STATE MASTER.
- THE CABINET SHALL BE ORIENTED SO THAT THE DOOR OPENS AWAY FROM THE ROADWAY, SO THAT FIELD TECHNICIAN CAN OBSERVE TRAFFIC WHILE WORKING ON THE SYSTEM.

AUTOMATIC TRAFFIC RECORDER


6 LANE SECTION  
-NOT TO SCALE-

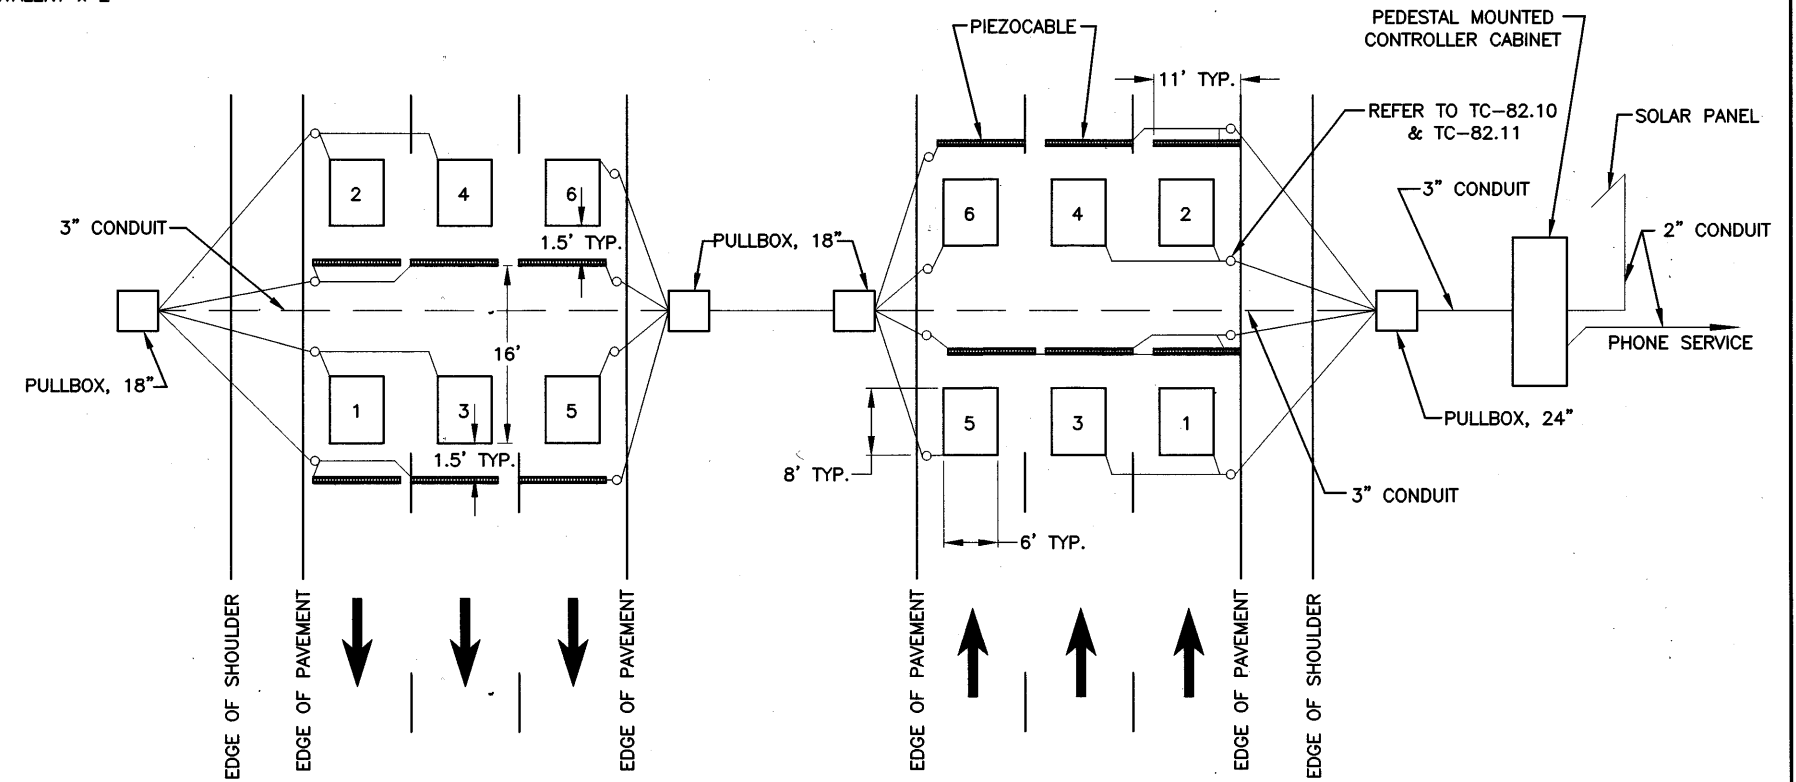

NOTES

- ALL LOOPS SHALL BE 6'x8'. LOOPS SHALL BE SPACED 16' FROM LEADING EDGE TO LEADING EDGE. INSTALLATION OF LOOPS SHALL CONFORM TO TC-82.10 AND TC-82.11.
- THE PIEZOCABLE WIM SENSOR SHALL BE MADE BY MEASUREMENT SPECIALTIES ROAD TRAX BRASS LINGUINI (BL) CLASS I AXLE SENSOR OR EQUIVALENT. THE 11 FOOT SENSOR SHALL BE CENTERED IN THE 12 FOOT LANE.
- THE ALUMINUM CONTROLLER CABINET SHALL BE A PEDESTAL MOUNTED NEMA SIZE 3 AS SHOWN ON THE NEMA SIZE 3 CABINET DETAILS SHEET. (ATTACHMENT F)
- CABLE AND WIRE SHALL BE IDENTIFIED IN ACCORDANCE WITH 632.04. IDENTIFICATION SHALL INCLUDE THE DIRECTION OF TRAVEL (I.E., NB, WB) AND THE LOOP NUMBER AS SHOWN. EACH CABLE AND WIRE SHALL HAVE 5' COILED IN THE CONTROLLER CABINET FOR CONNECTION TO THE DATA COLLECTION SYSTEM.
- ADJACENT LOOPS (TRANSVERSE AND LONGITUDINAL) SHALL BE INSTALLED IN OPPOSITE DIRECTIONS, I.E., LOOP 1 AND LOOP 4, CLOCKWISE AND LOOP 2 AND LOOP 3 COUNTERCLOCKWISE. EACH LOOP SHALL HAVE A SEPARATE LEAD-IN CABLE ROUTED TO THE CONTROLLER CABINET AND TAGGED.
- REFERENCE IS MADE TO STANDARD DRAWING HL-30.11M FOR DETAILS OF DRAINING PULLBOXES. UNDERDRAINS FOR PULLBOXES SHALL BE USED AS DIRECTED BY THE ENGINEER AND SHALL BE PROVIDED WHERE THE LENGTH REQUIRED FOR A SATISFACTORY OUTLET DOES NOT EXCEED APPROXIMATELY 20'.
- FIVE (5) WORKING DAYS PRIOR TO THE SCHEDULED INSTALLATION, THE CONTRACTOR SHALL CONTACT OFFICE OF TECH. SERVICES AT 614-466-3727.
- ALL ITEMS SHALL CONFORM TO C&M SPECIFICATIONS 625, 713, 632, 732, 633 AND 733, UNLESS OTHERWISE SPECIFIED.
- FOR ASPHALT PAVEMENT, LOOPS AND PIEZOCABLES SHALL BE CUT IN THE ASPHALT SURFACE COURSE. THEY SHALL NOT BE INSTALLED BETWEEN THE INTERMEDIATE AND SURFACE COURSES.
- PIEZOCABLES SHALL BE INSTALLED WHEN THE TEMP. IS ABOVE 60 DEGREES FAHRENHEIT, OR SPECIAL PROVISION MADE TO ENSURE CURING OF EPOXY TAKES PLACE.
- THE SOLAR PANEL SHALL BE INSTALLED WITH 2" RIGID CONDUIT MOUNTED IN CONCRETE BASE WITH PANEL BEING AT A MIN. HEIGHT ABOVE GROUND LEVEL OF 15'. SOLAR PANEL OUTPUT CABLE SHALL BE SECURED AND ROUTED TO THE INSIDE OF THE CABINET FOR CONNECTION TO TERMINAL BLOCK. SOLAR PANEL SHALL BE MOUNTED AT A 45° ANGLE FACING SOUTH.
- SOLAR PANEL SHALL BE A SOLAREX MODEL VLX 32 (32 WATTS) OR AN APPROVED EQUAL WITH MOUNTING HARDWARE AND CABLES.
- THE CONTRACTOR SHALL BE RESPONSIBLE FOR INSTALLING AND TESTING THE PHONE DROP INSIDE OF THE CONTROLLER CABINET. THE CONTRACTOR SHALL BE RESPONSIBLE FOR ALL CHARGES INCURRED PRIOR TO THE TRANSFER OF THE TELEPHONE ACCOUNT. THE CONTRACTOR SHALL COORDINATE WITH ODOT, TELECOMMUNICATIONS, MR. MIKE WIGGINS (614-466-4452) TO TRANSFER THE TELEPHONE ACCOUNT AND THE BILLING RESPONSIBILITY FROM THE CONTRACTOR TO ODOT.
- ALL SENSORS ARE TO BE TESTED BY O.D.O.T. PERSONNEL AFTER THE INSTALLATION IS COMPLETE SO AS TO VERIFY THAT THE STATION IS UP AND OPERATING PROPERLY. IF THE ELECTRONIC EQUIPMENT DOES NOT PERFORM PROPERLY BECAUSE OF A POORLY INSTALLED SENSOR, THE CONTRACTOR SHALL BE RESPONSIBLE FOR THE REPLACEMENT OF THE FAULTY SENSOR, AS SOON AS POSSIBLE AT HIS OWN COST.
- THE PULL BOX COVERS IN THE PAVED SHOULDER SHALL BE A HEAVY DUTY FRAME AND LID (NEENAH R-6686 OR APPROVED EQUAL). THE 18 AND 24 IN. PULL BOX, SHALL CONFORM TO 713.08

☉ I-90 SURVEY & CONSTRUCTION

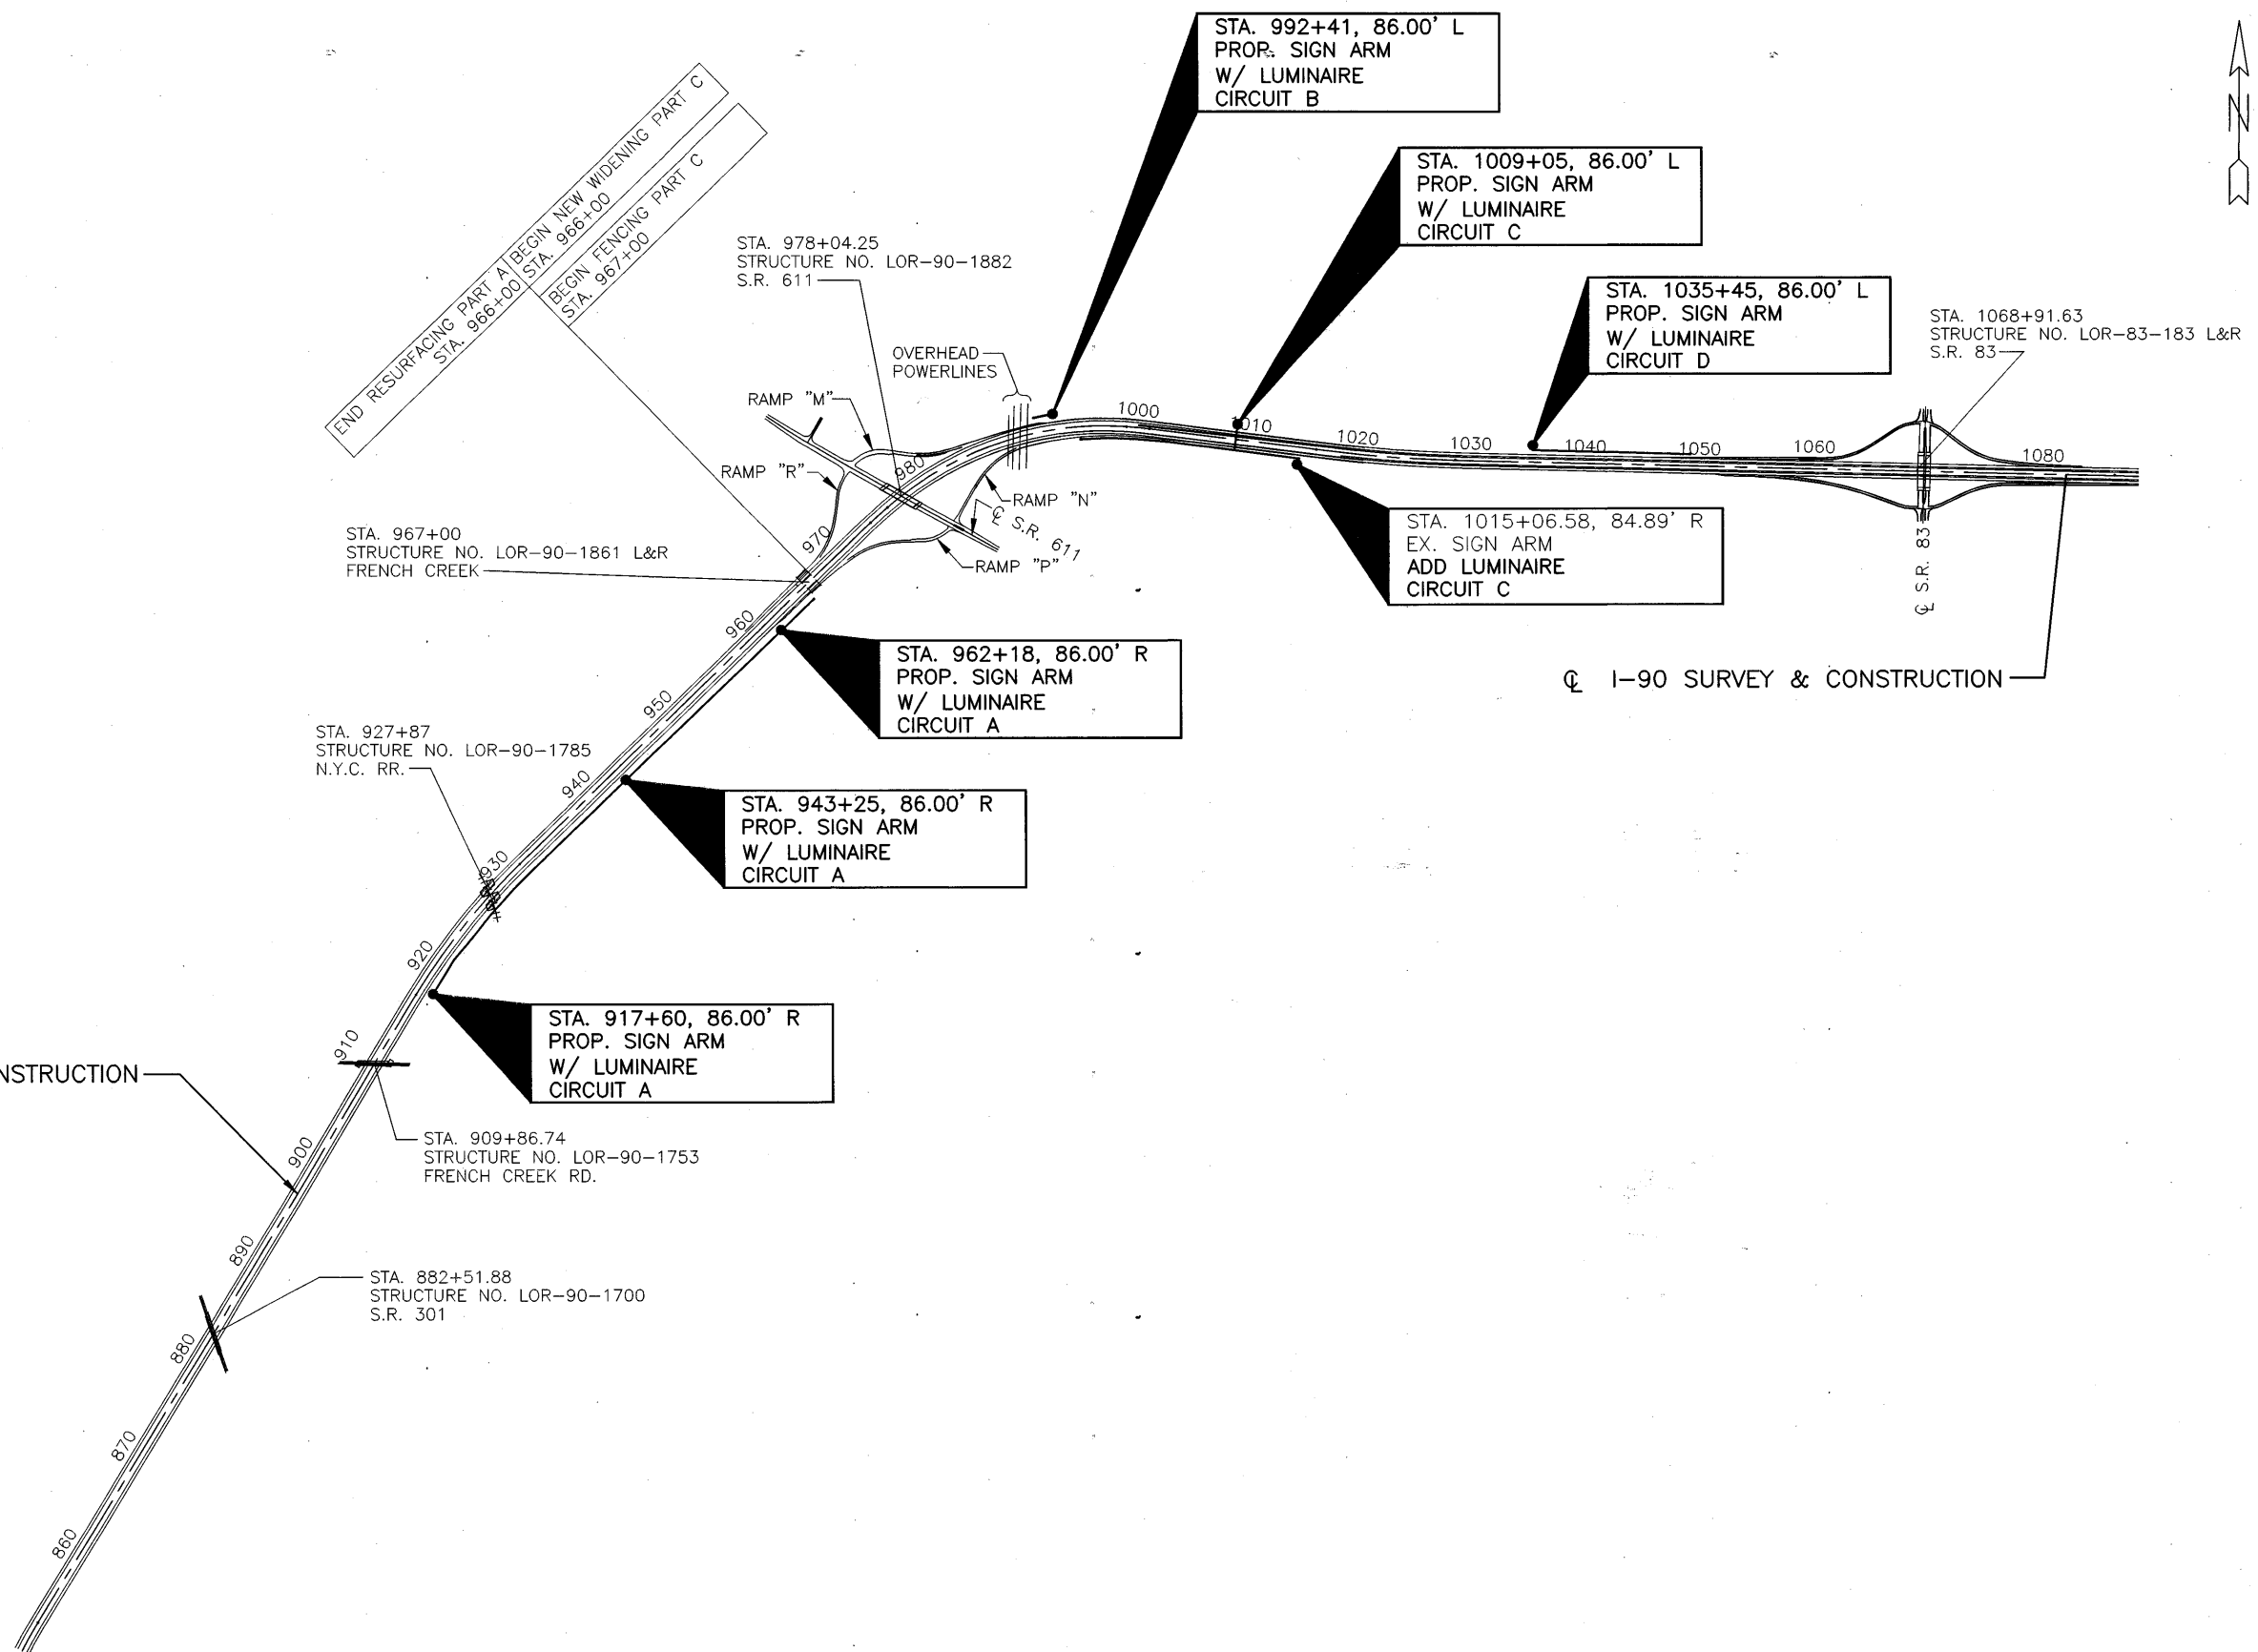

END RESURFACING PART A BEGIN NEW WIDENING PART C  
STA. 966+00

BEGIN FENCING PART C  
STA. 967+00

STA. 992+41, 86.00' L  
PROP. SIGN ARM  
W/ LUMINAIRE  
CIRCUIT B

STA. 1009+05, 86.00' L  
PROP. SIGN ARM  
W/ LUMINAIRE  
CIRCUIT C

STA. 1035+45, 86.00' L  
PROP. SIGN ARM  
W/ LUMINAIRE  
CIRCUIT D

STA. 1068+91.63  
STRUCTURE NO. LOR-83-183 L&R  
S.R. 83

STA. 1015+06.58, 84.89' R  
EX. SIGN ARM  
ADD LUMINAIRE  
CIRCUIT C

STA. 962+18, 86.00' R  
PROP. SIGN ARM  
W/ LUMINAIRE  
CIRCUIT A

STA. 943+25, 86.00' R  
PROP. SIGN ARM  
W/ LUMINAIRE  
CIRCUIT A

STA. 917+60, 86.00' R  
PROP. SIGN ARM  
W/ LUMINAIRE  
CIRCUIT A

STA. 927+87  
STRUCTURE NO. LOR-90-1785  
N.Y.C. RR.


STA. 909+86.74  
STRUCTURE NO. LOR-90-1753  
FRENCH CREEK RD.

STA. 882+51.88  
STRUCTURE NO. LOR-90-1700  
S.R. 301

STA. 978+04.25  
STRUCTURE NO. LOR-90-1882  
S.R. 611

STA. 967+00  
STRUCTURE NO. LOR-90-1861 L&R  
FRENCH CREEK




☉ I-90 SURVEY & CONSTRUCTION

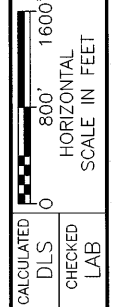

TRAFFIC CONTROL  
LIGHTING LAYOUT

LOR - 190 - 10.76

PROJECT: I-90 SURVEY & CONSTRUCTION  
 DATE: 11/13/03  
 DRAWN BY: J. BROWN  
 CHECKED BY: J. BROWN  
 SCALE: AS SHOWN

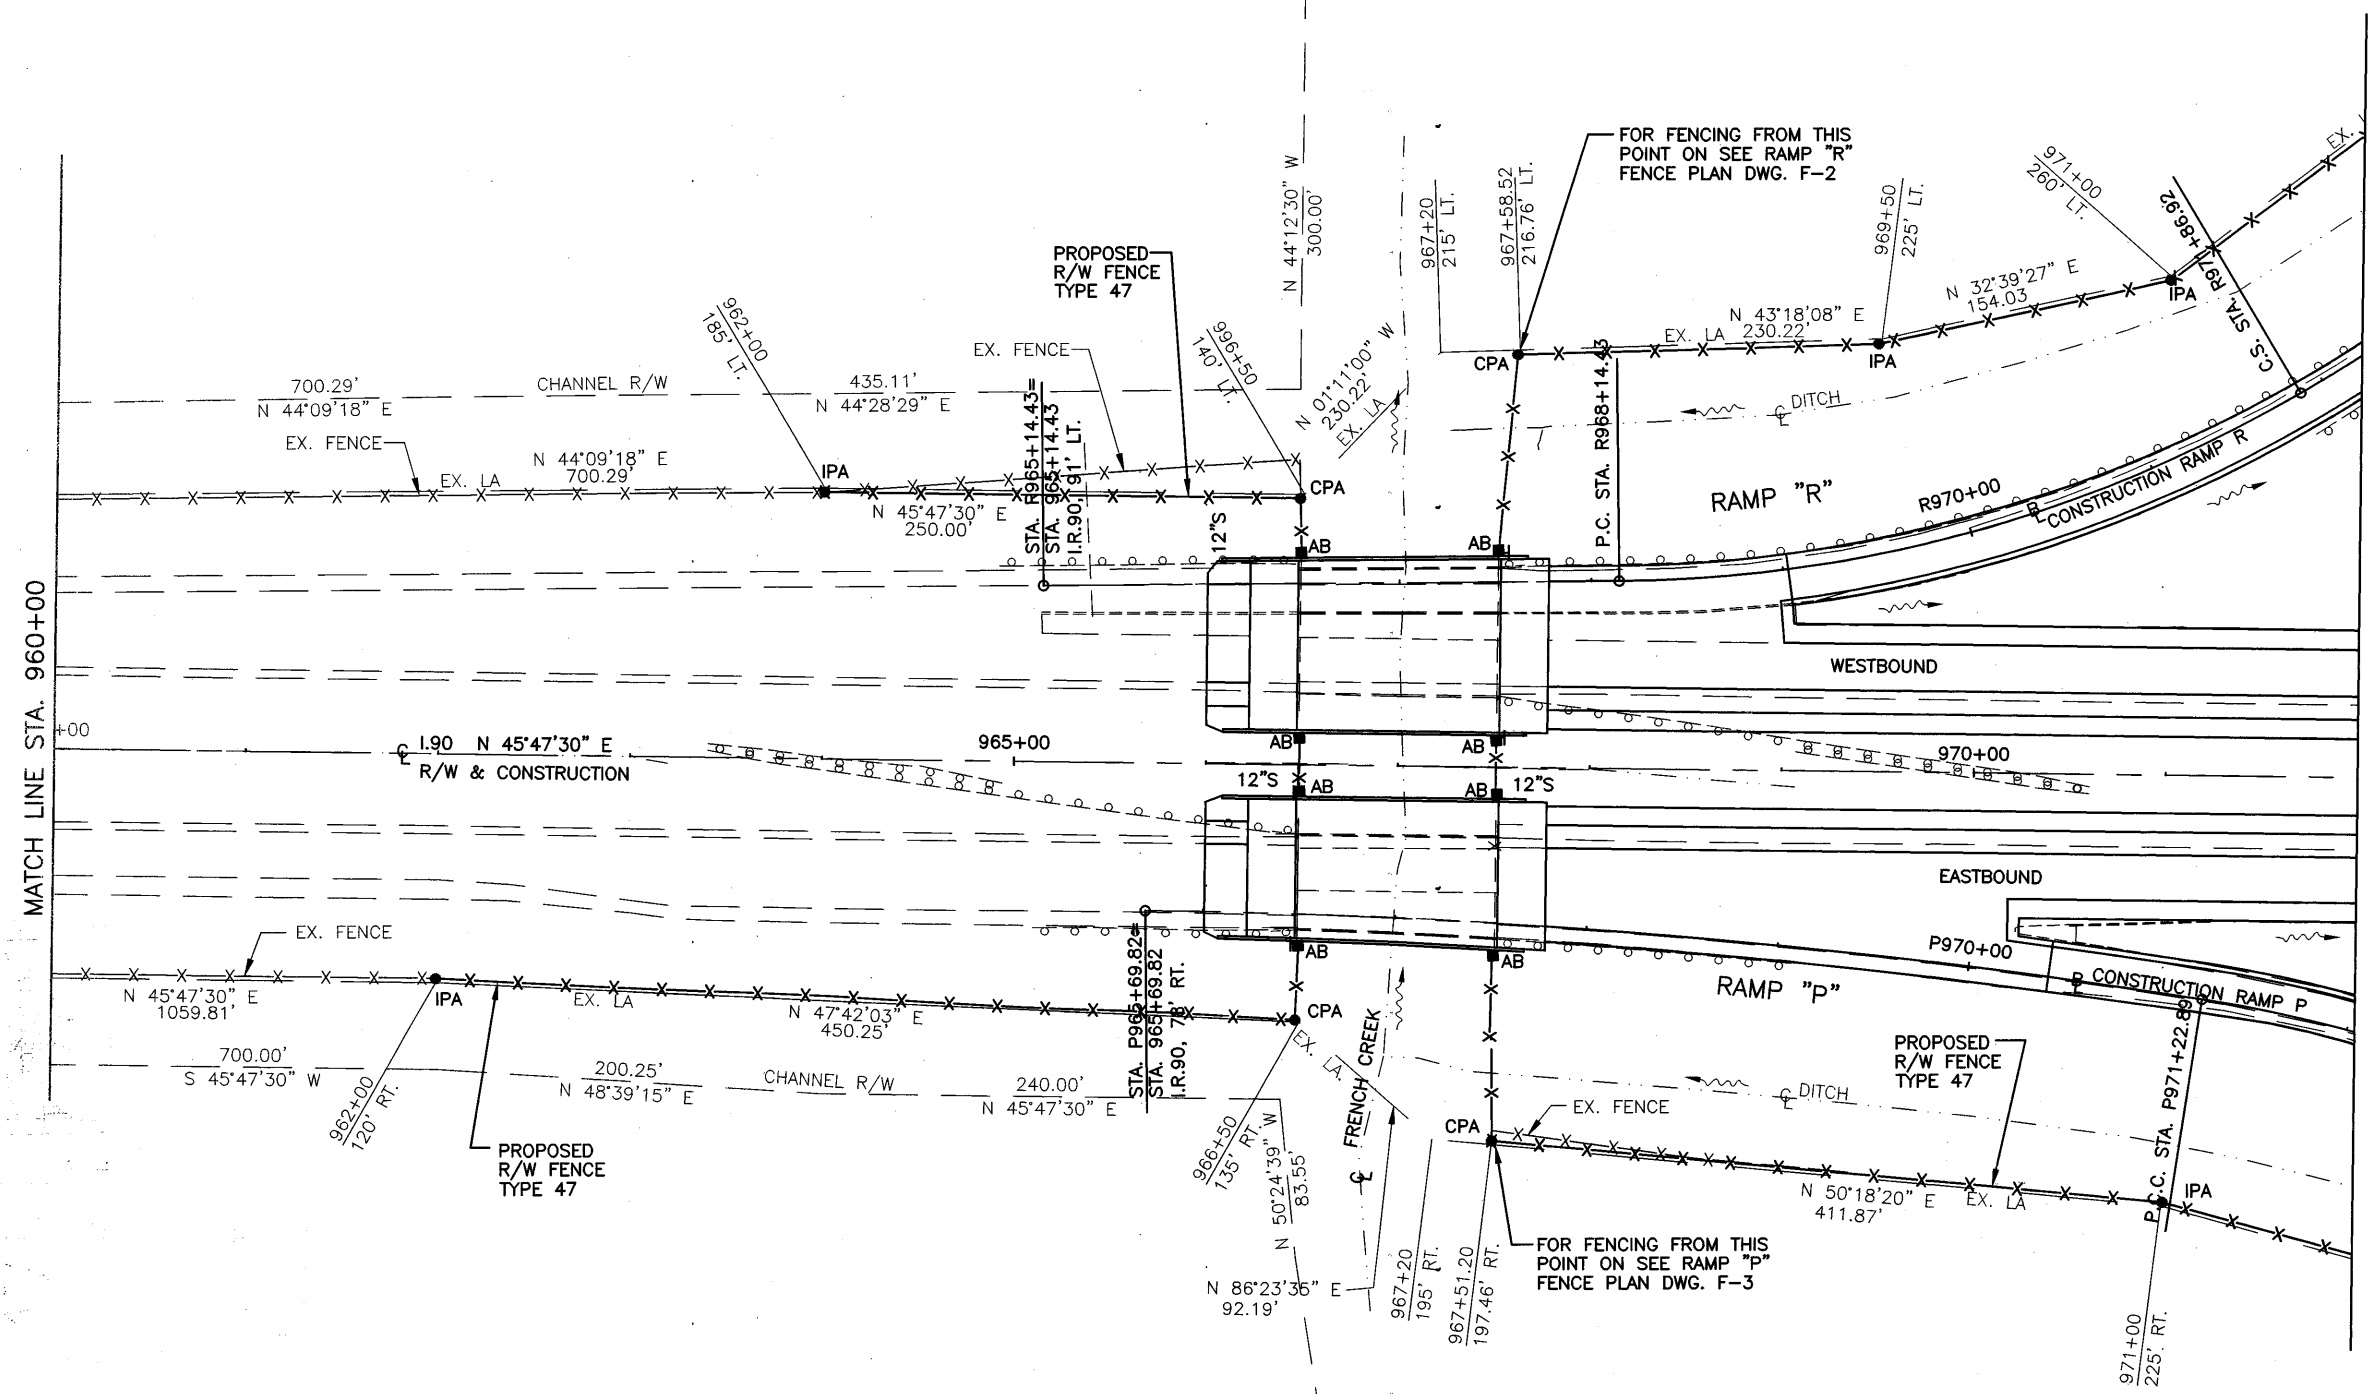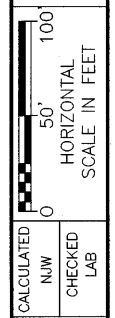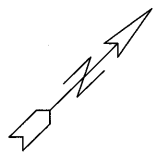

MATCH LINE STA. 960+00

STA. 972+00  
SEE SHEET F6- STA. 987+00  
FOR CONTINUATION OF I.R.90

**LEGEND**

- CPA ● = CORNER POST ASSEMBLY
- IPA ● = INTERMEDIATE POST ASSEMBLY
- WP ● = WOOD POST OR ENCASED STEEL POST
- AB ■ = ABUTMENT CONNECTION



**NOTES:**

- 1.) THE R/W FENCE WILL BE SET 2 FEET INSIDE THE EXISTING LA LINE UNLESS OTHERWISE NOTED ON THE PLANS.
- 2.) THE LENGTH BETWEEN DEFLECTION POINTS IS THE EXISTING LA LENGTH, NOT THE LENGTH OF THE FENCING.

**FENCE PLAN**  
STA. 960+00 TO STA. 972+00

**LOR - 190 - 10.76**


01/25/2001 10:19AM

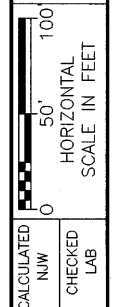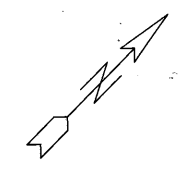

CALCULATED  
N.W.  
CHECKED  
LAB

**FENCE PLAN I.R. 90 & S.R. 611 INTERCHANGE - RAMP "R"  
STA. R965+14.43 TO STA. R977+56.29**

**LOR - 190 - 10.76**

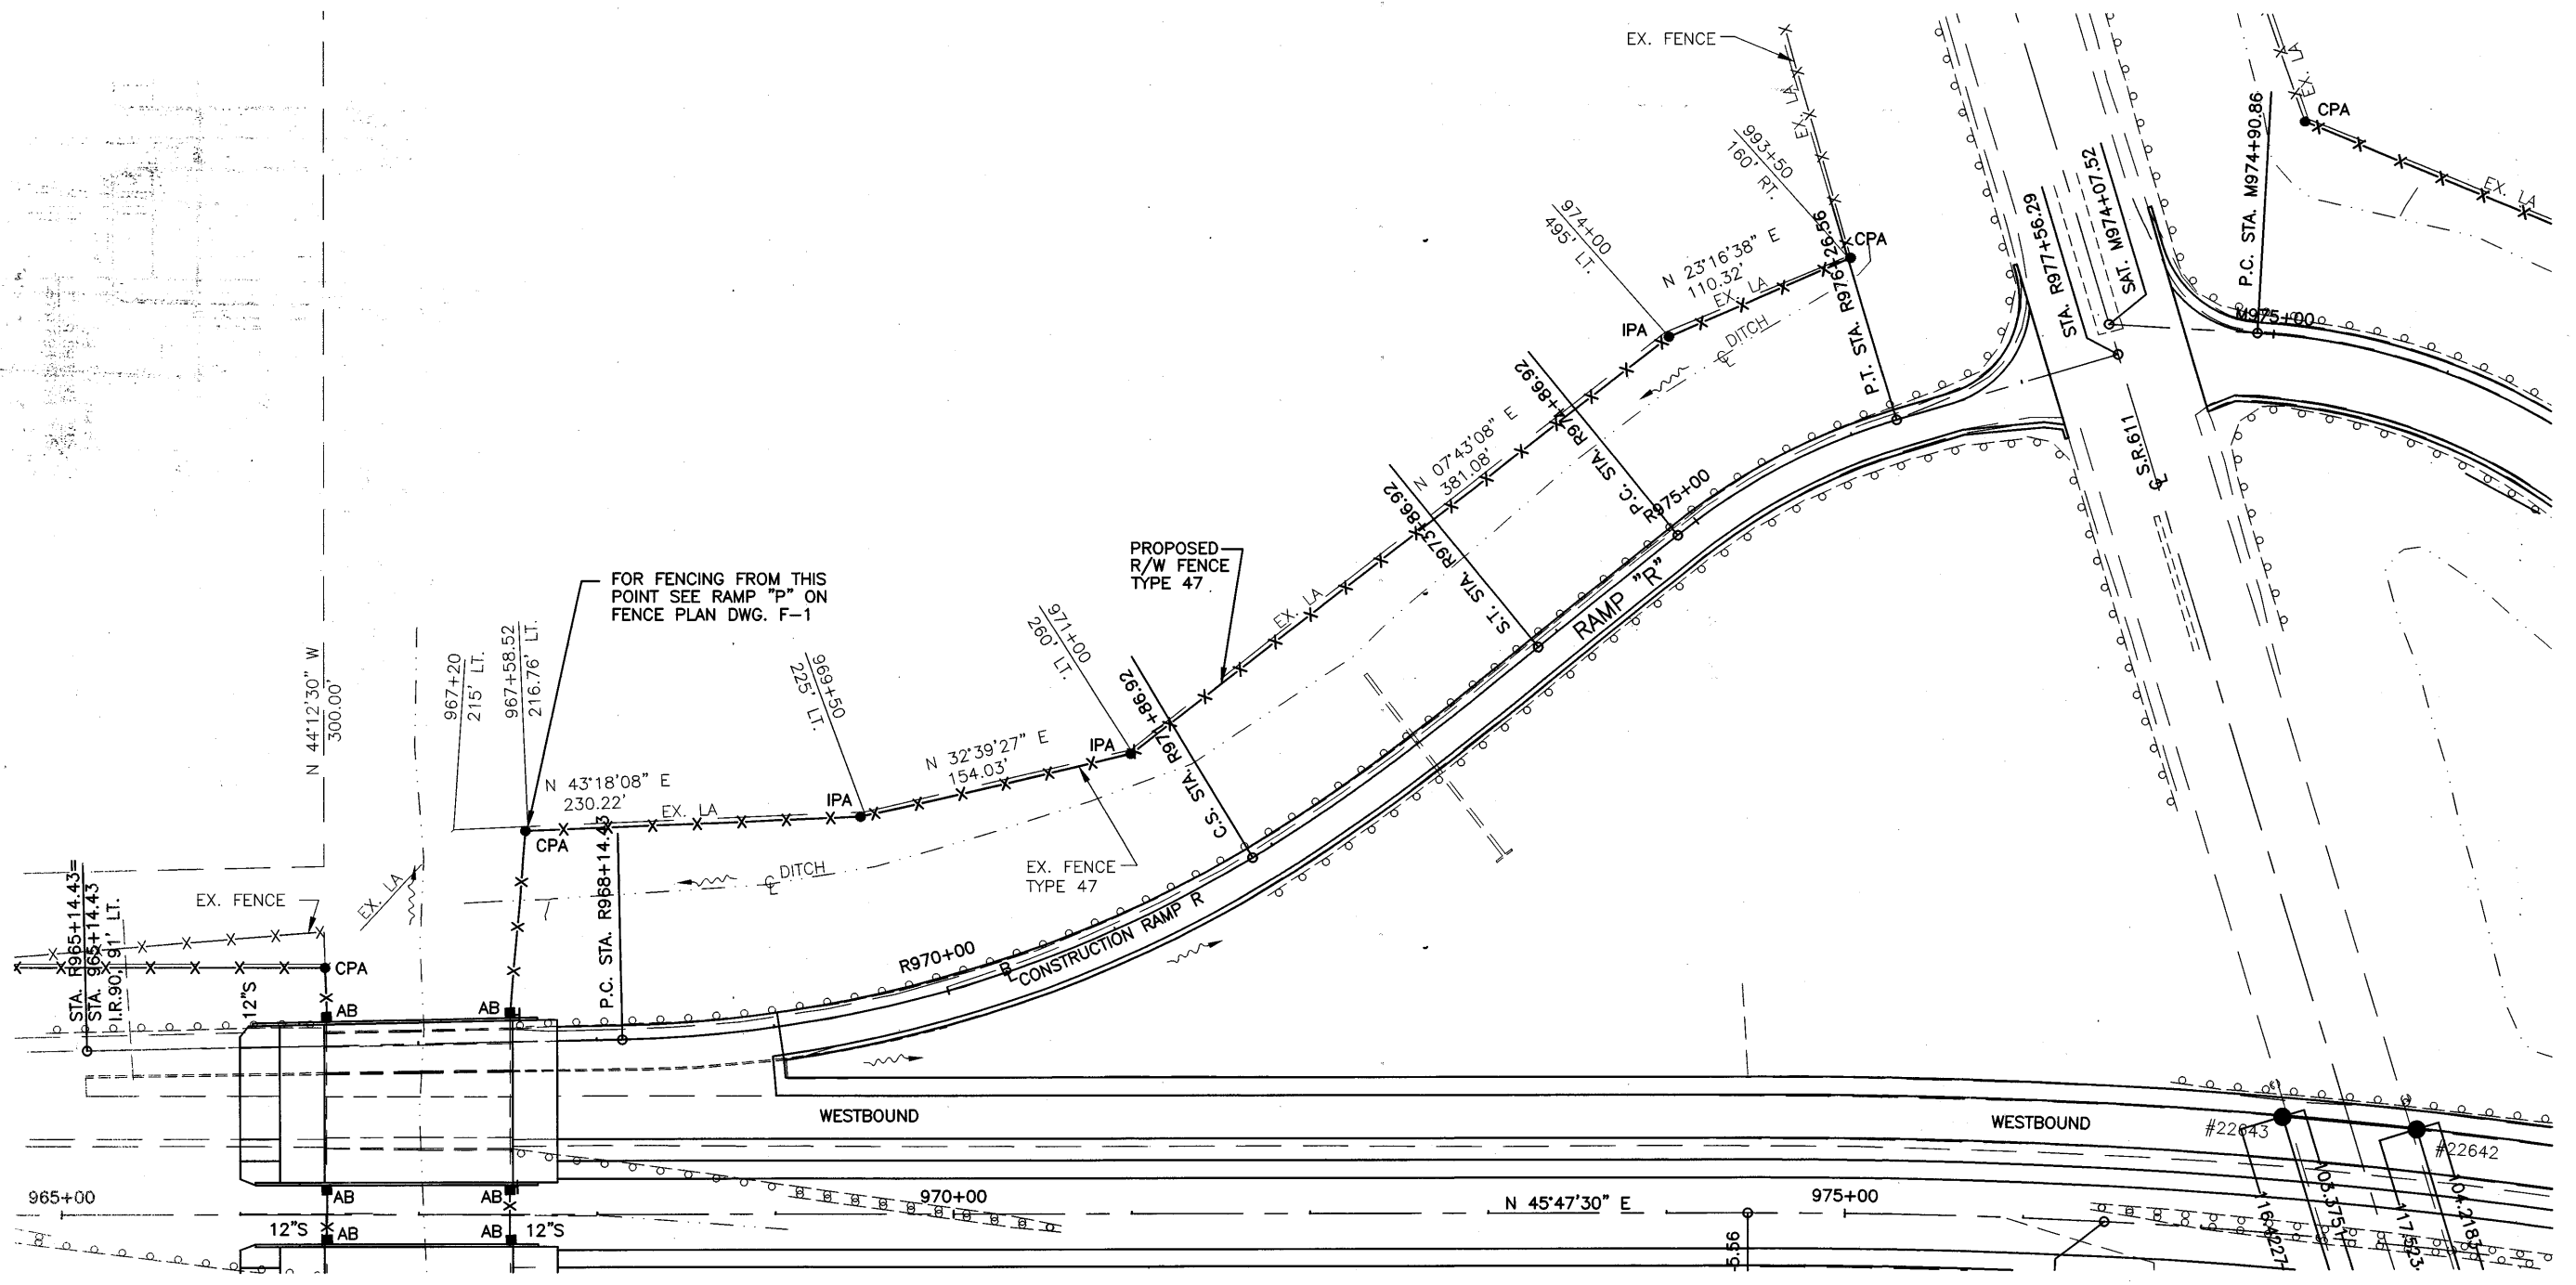




**LEGEND**

- CPA ● = CORNER POST ASSEMBLY
- IPA ● = INTERMEDIATE POST ASSEMBLY
- WP ● = WOOD POST OR ENCASED STEEL POST

**NOTES:**

- 1.) THE R/W FENCE WILL BE SET 2 FEET INSIDE THE EXISTING LA LINE UNLESS OTHERWISE NOTED ON THE PLANS.
- 2.) THE LENGTH BETWEEN DEFLECTION POINTS IS THE EXISTING LA LENGTH, NOT THE LENGTH OF THE FENCING.

T:\QA\3250\DRWGS\FENCE\F-2.DWG 3 MAR 10 2:26PM 10/26/02

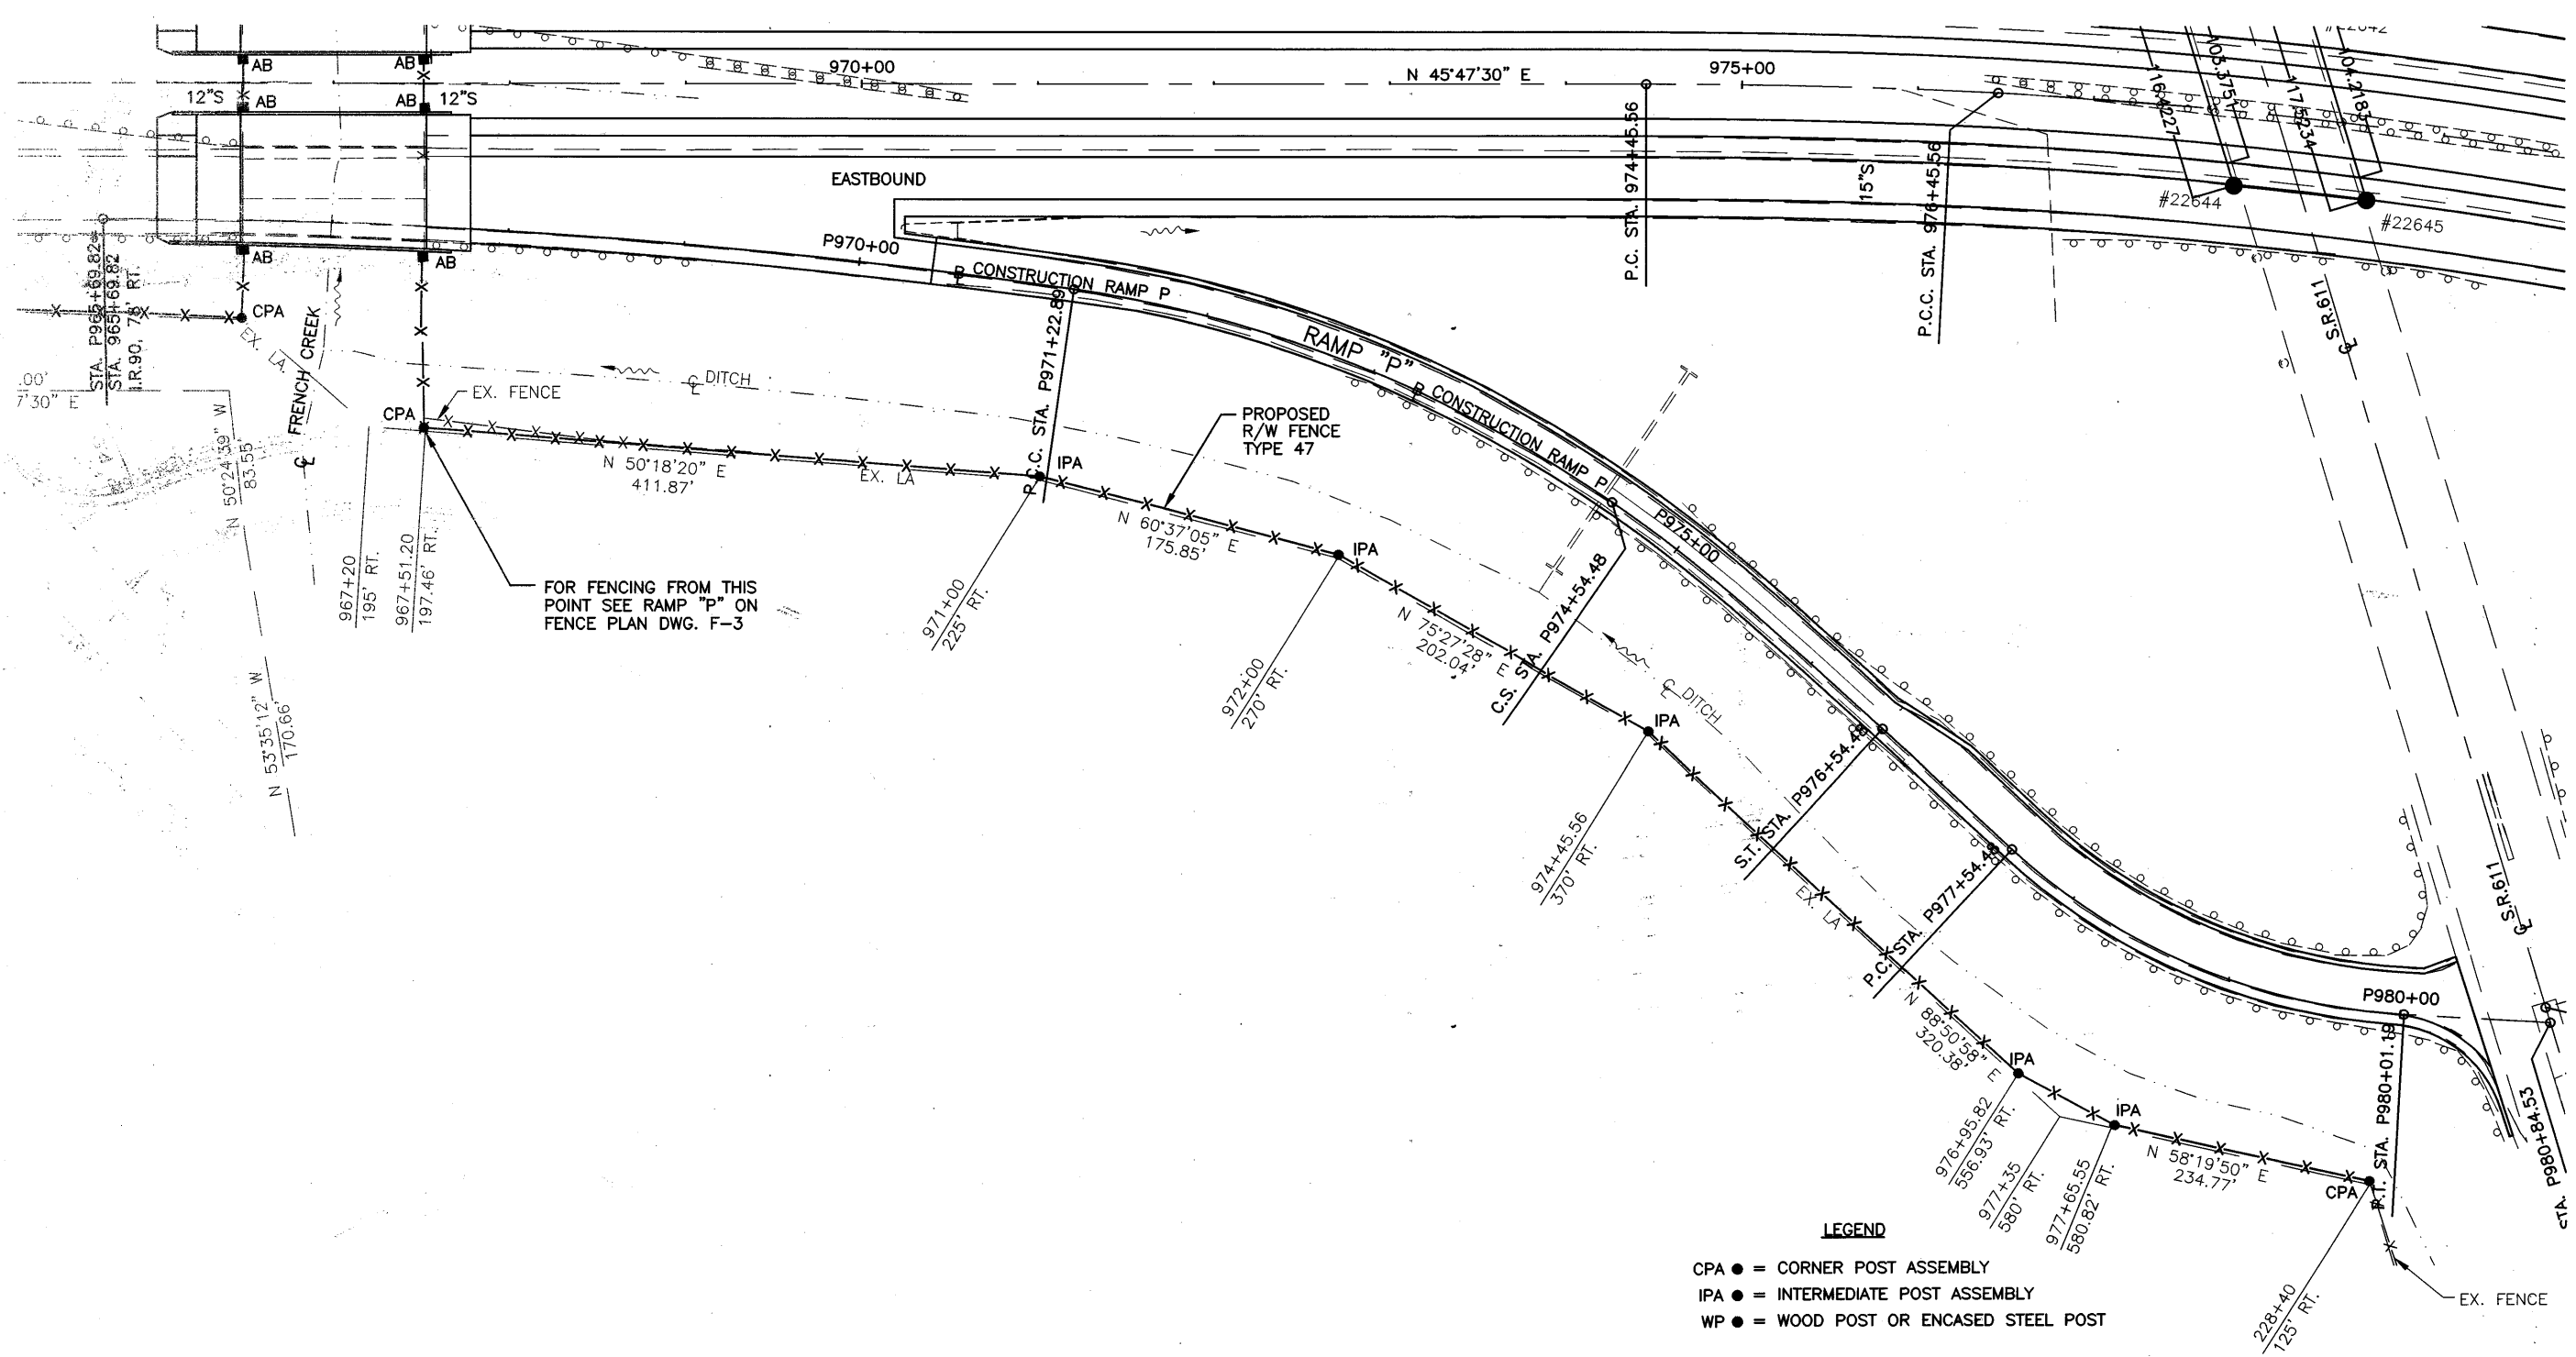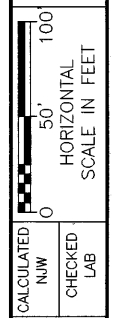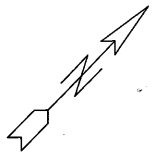

- LEGEND**
- CPA ● = CORNER POST ASSEMBLY
  - IPA ● = INTERMEDIATE POST ASSEMBLY
  - WP ● = WOOD POST OR ENCASED STEEL POST
- NOTES:**
- 1.) THE R/W FENCE WILL BE SET 2 FEET INSIDE THE EXISTING LA LINE UNLESS OTHERWISE NOTED ON THE PLANS.
  - 2.) THE LENGTH BETWEEN DEFLECTION POINTS IS THE EXISTING LA LENGTH, NOT THE LENGTH OF THE FENCING.


**FENCE PLAN I.R. 90 & S.R. 611 INTERCHANGE - RAMP "P"**  
**STA. P965+69.82 TO STA. P980+84.53**

**LOR - I90 - 10.76**



FENCE PLAN I.R. 90 & S.R. 611 INTERCHANGE - RAMP "M"  
STA. M974+07.52 TO STA. M989+13.04

LOR - 190 - 10.76

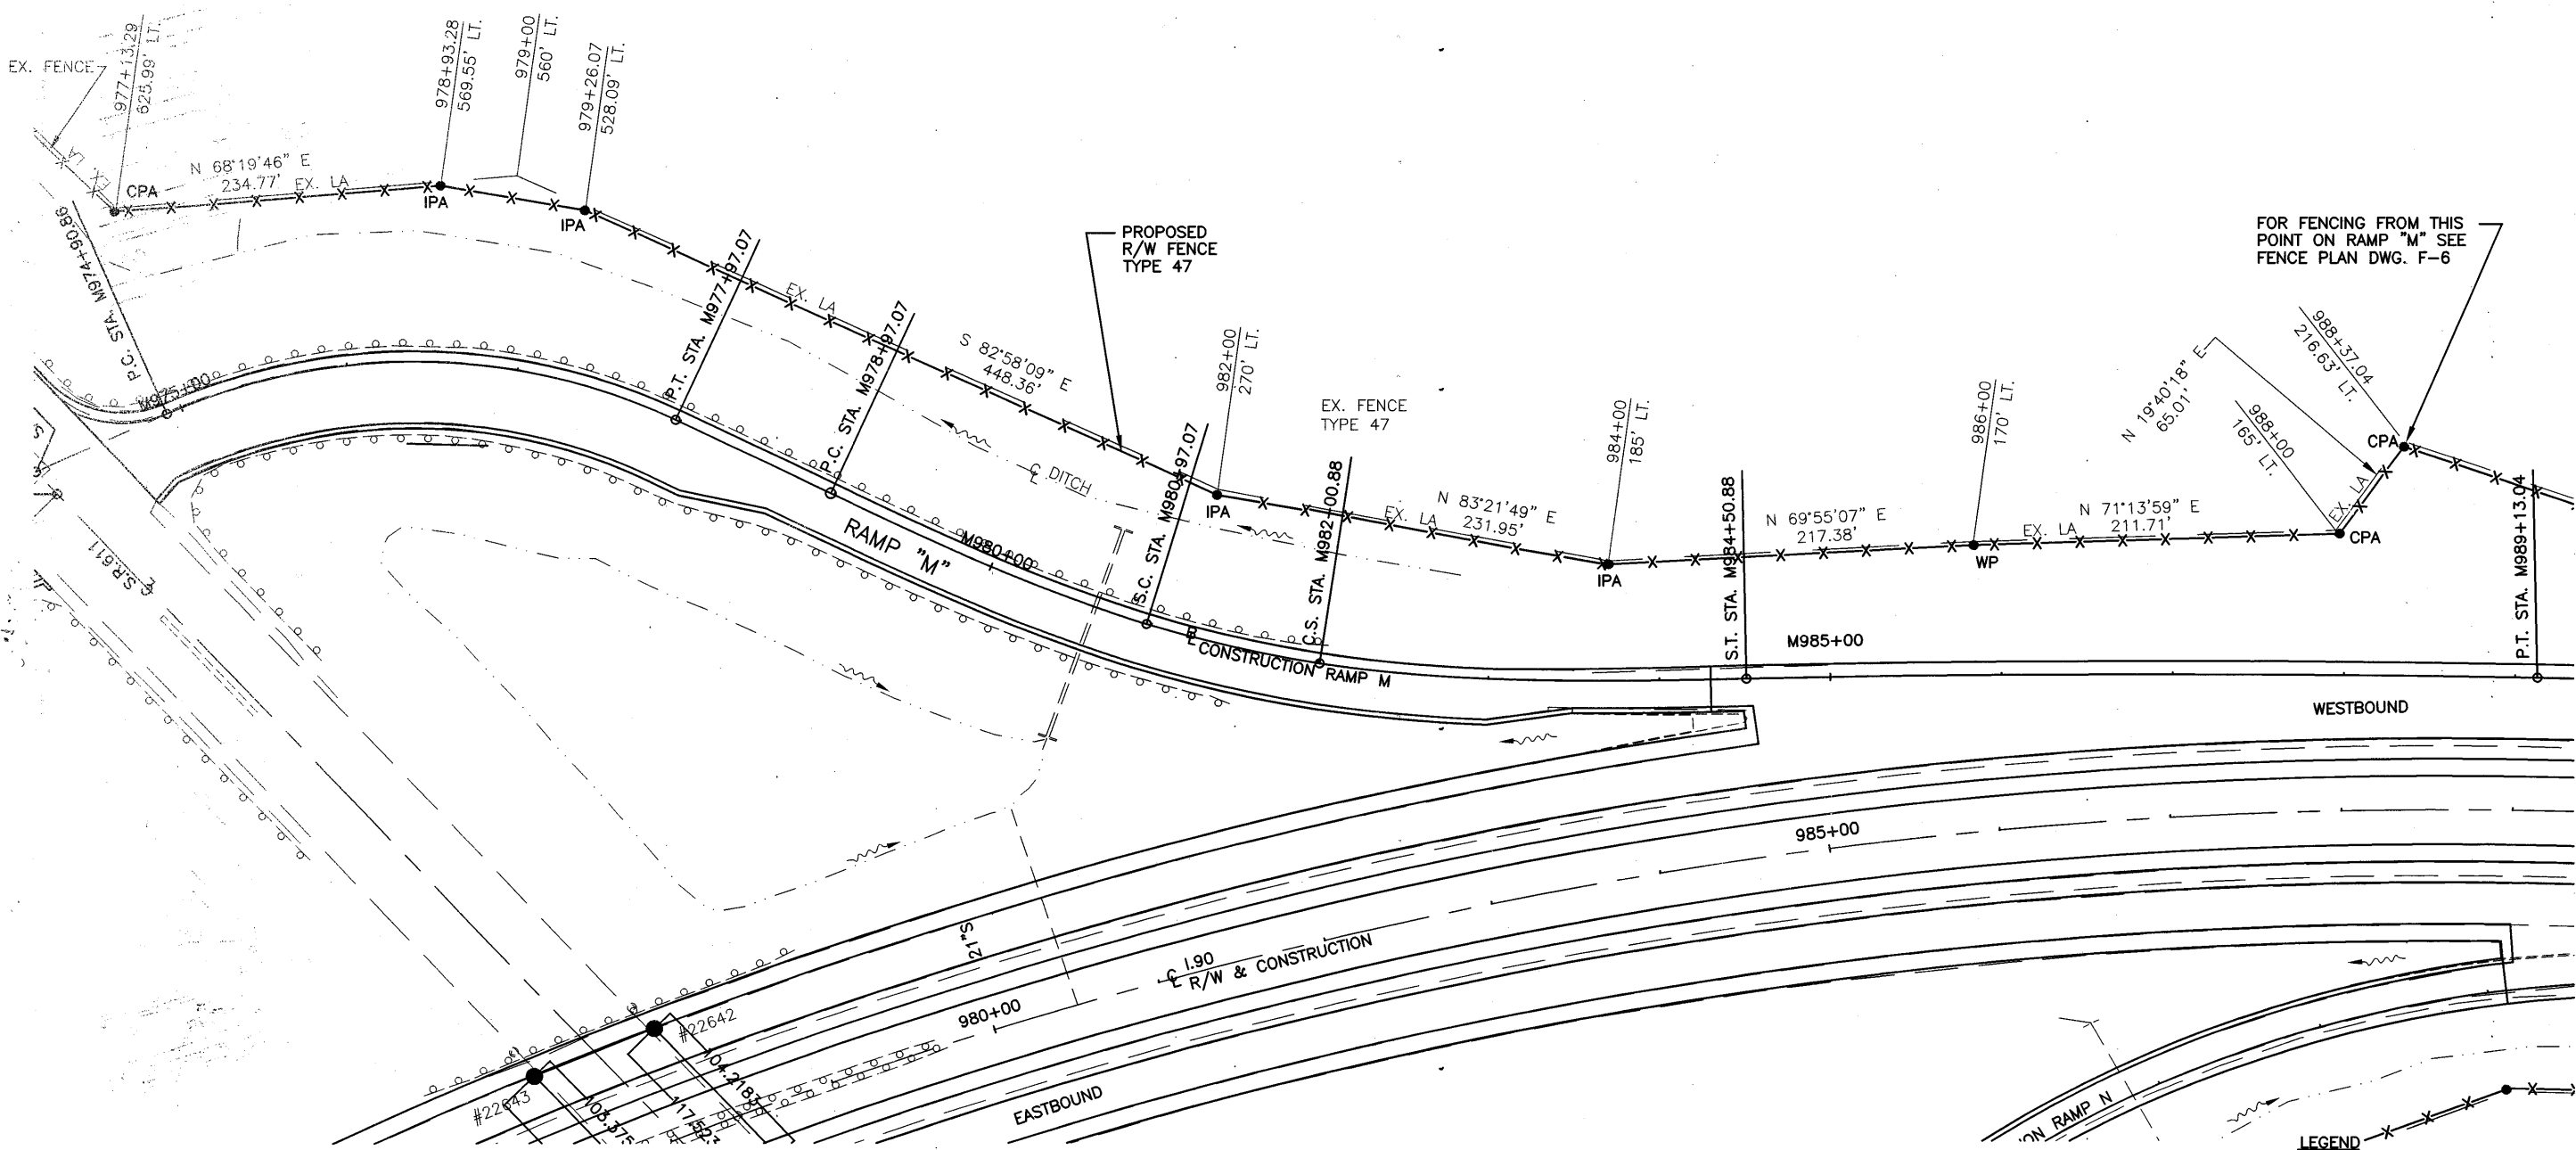

FOR FENCING FROM THIS POINT ON RAMP "M" SEE FENCE PLAN DWG. F-6

- CPA ● = CORNER POST ASSEMBLY  
 IPA ● = INTERMEDIATE POST ASSEMBLY  
 WP ● = WOOD POST OR ENCASED STEEL POST

NOTES:


- 1.) THE R/W FENCE WILL BE SET 2 FEET INSIDE THE EXISTING LA LINE UNLESS OTHERWISE NOTED ON THE PLANS.
- 2.) THE LENGTH BETWEEN DEFLECTION POINTS IS THE EXISTING LA LENGTH, NOT THE LENGTH OF THE FENCING.

LEGEND



02-08-2022 10:22AM I:\PROJECTS\190\190-10.76\190-10.76.dwg



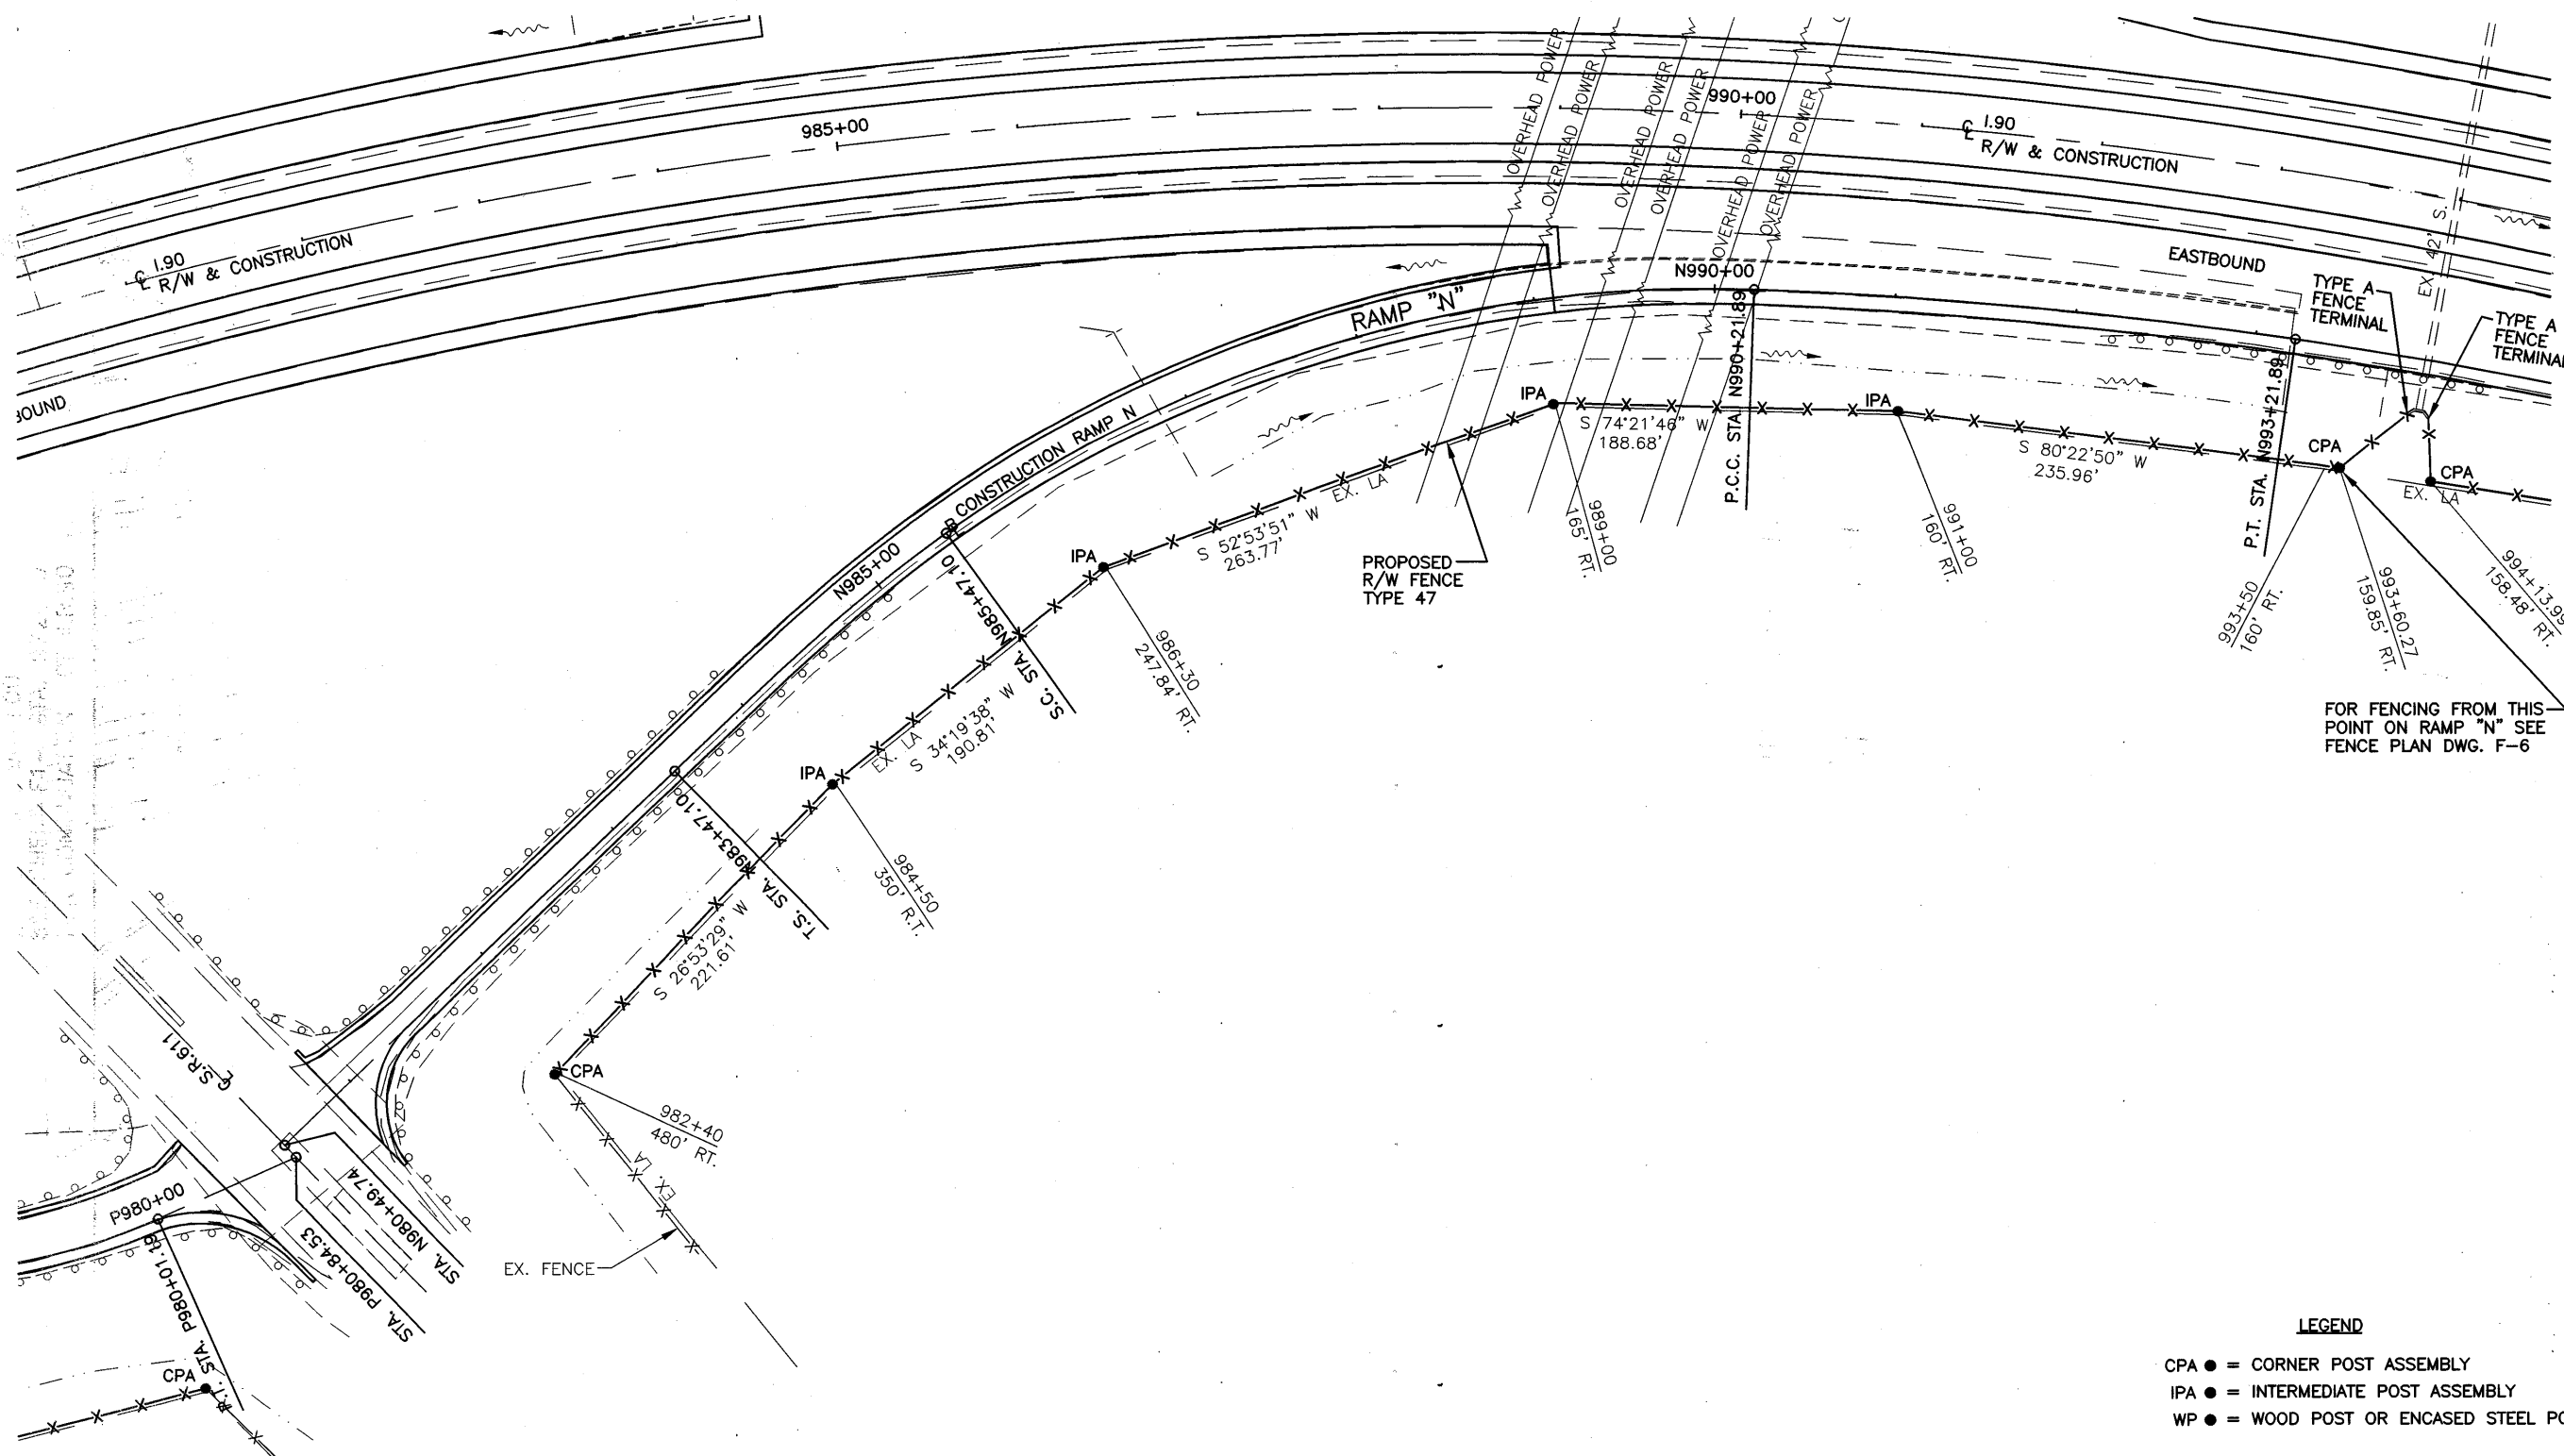

**FENCE PLAN I.R. 90 & S.R. 611 INTERCHANGE - RAMP "N"**  
**STA. N980+49.74 TO STA. N993+21.89**

**LOR - 190 - 10.76**


**LEGEND**

- CPA ● = CORNER POST ASSEMBLY
- IPA ● = INTERMEDIATE POST ASSEMBLY
- WP ● = WOOD POST OR ENCASED STEEL POST

**NOTES:**


- 1.) THE R/W FENCE WILL BE SET 2 FEET INSIDE THE EXISTING LA LENGTH, UNLESS OTHERWISE NOTED ON THE PLANS.
- 2.) THE LENGTH BETWEEN DEFLECTION POINTS IS THE EXISTING LA LENGTH, NOT THE LENGTH OF THE FENCING.

01-08-2022  
 C:\A\3600\DWG\FENCE\F-6.DWG 1:400

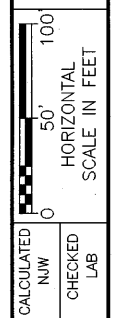

**FENCE PLAN**  
STA. 987+00 TO STA. 1000+00

LOR - 190 - 10.76

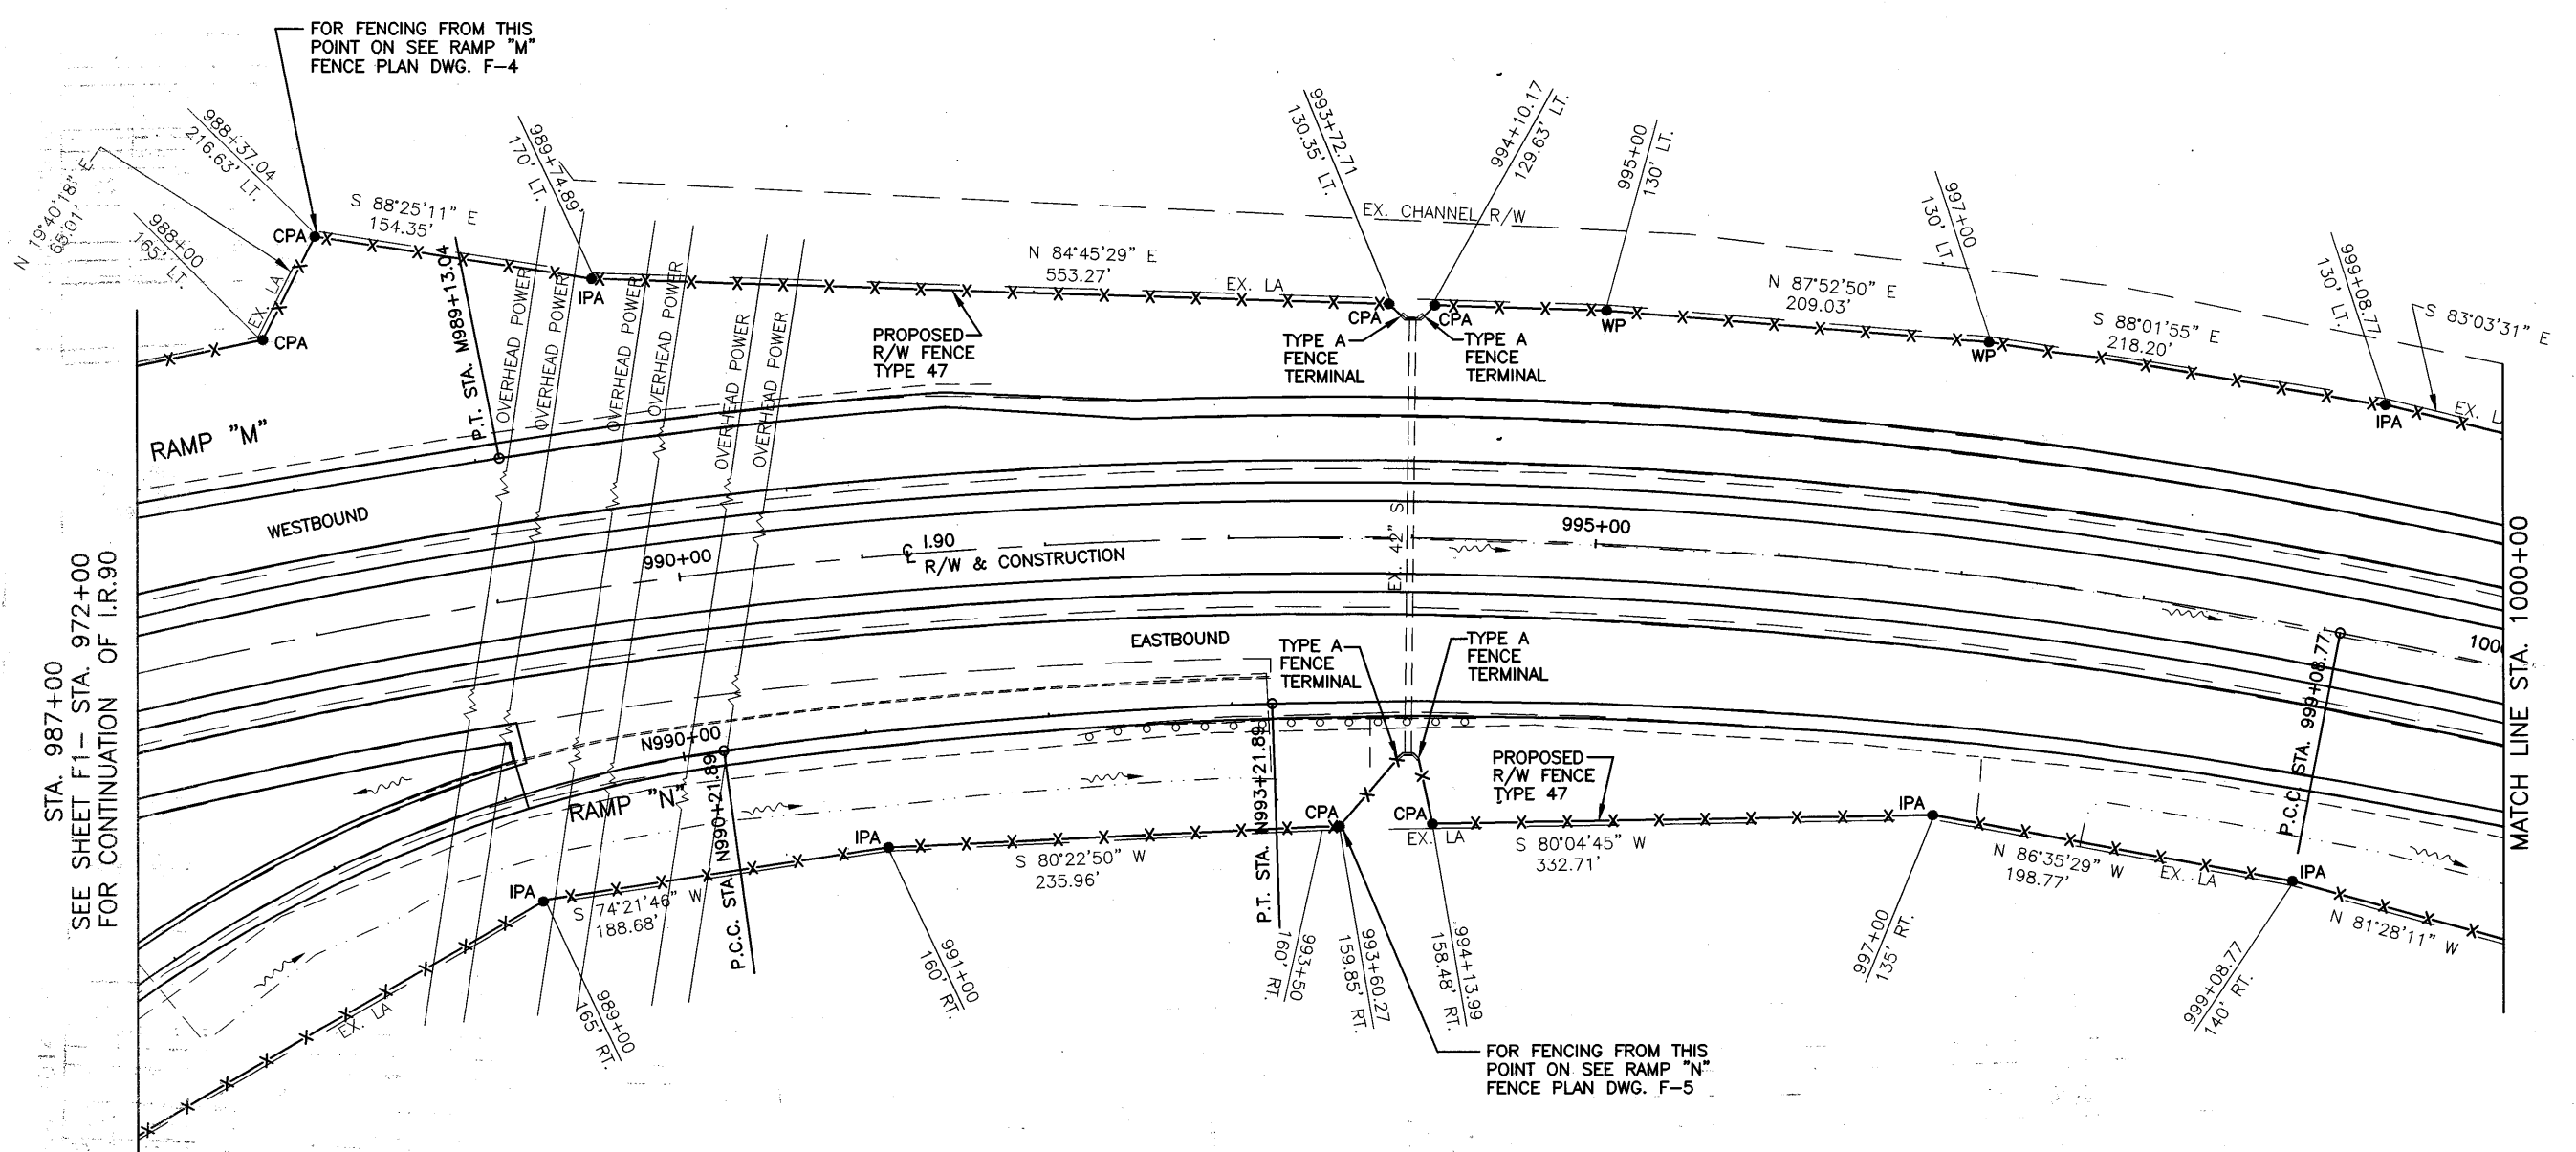



SEE SHEET F1 - STA. 972+00  
FOR CONTINUATION OF I.R.90

MATCH LINE STA. 1000+00

- LEGEND**
- CPA ● = CORNER POST ASSEMBLY
  - IPA ● = INTERMEDIATE POST ASSEMBLY
  - WP ● = WOOD POST OR ENCASED STEEL POST

- NOTES:**
- 1.) THE R/W FENCE WILL BE SET 2 FEET INSIDE THE EXISTING LA LINE UNLESS OTHERWISE NOTED ON THE PLANS.
  - 2.) THE LENGTH BETWEEN DEFLECTION POINTS IS THE EXISTING LA LENGTH, NOT THE LENGTH OF THE FENCING.

D:\39600\39600\FENCE\F-6.DWG 1 NOV 02-08-2002 10:24AM

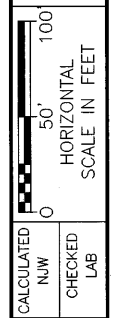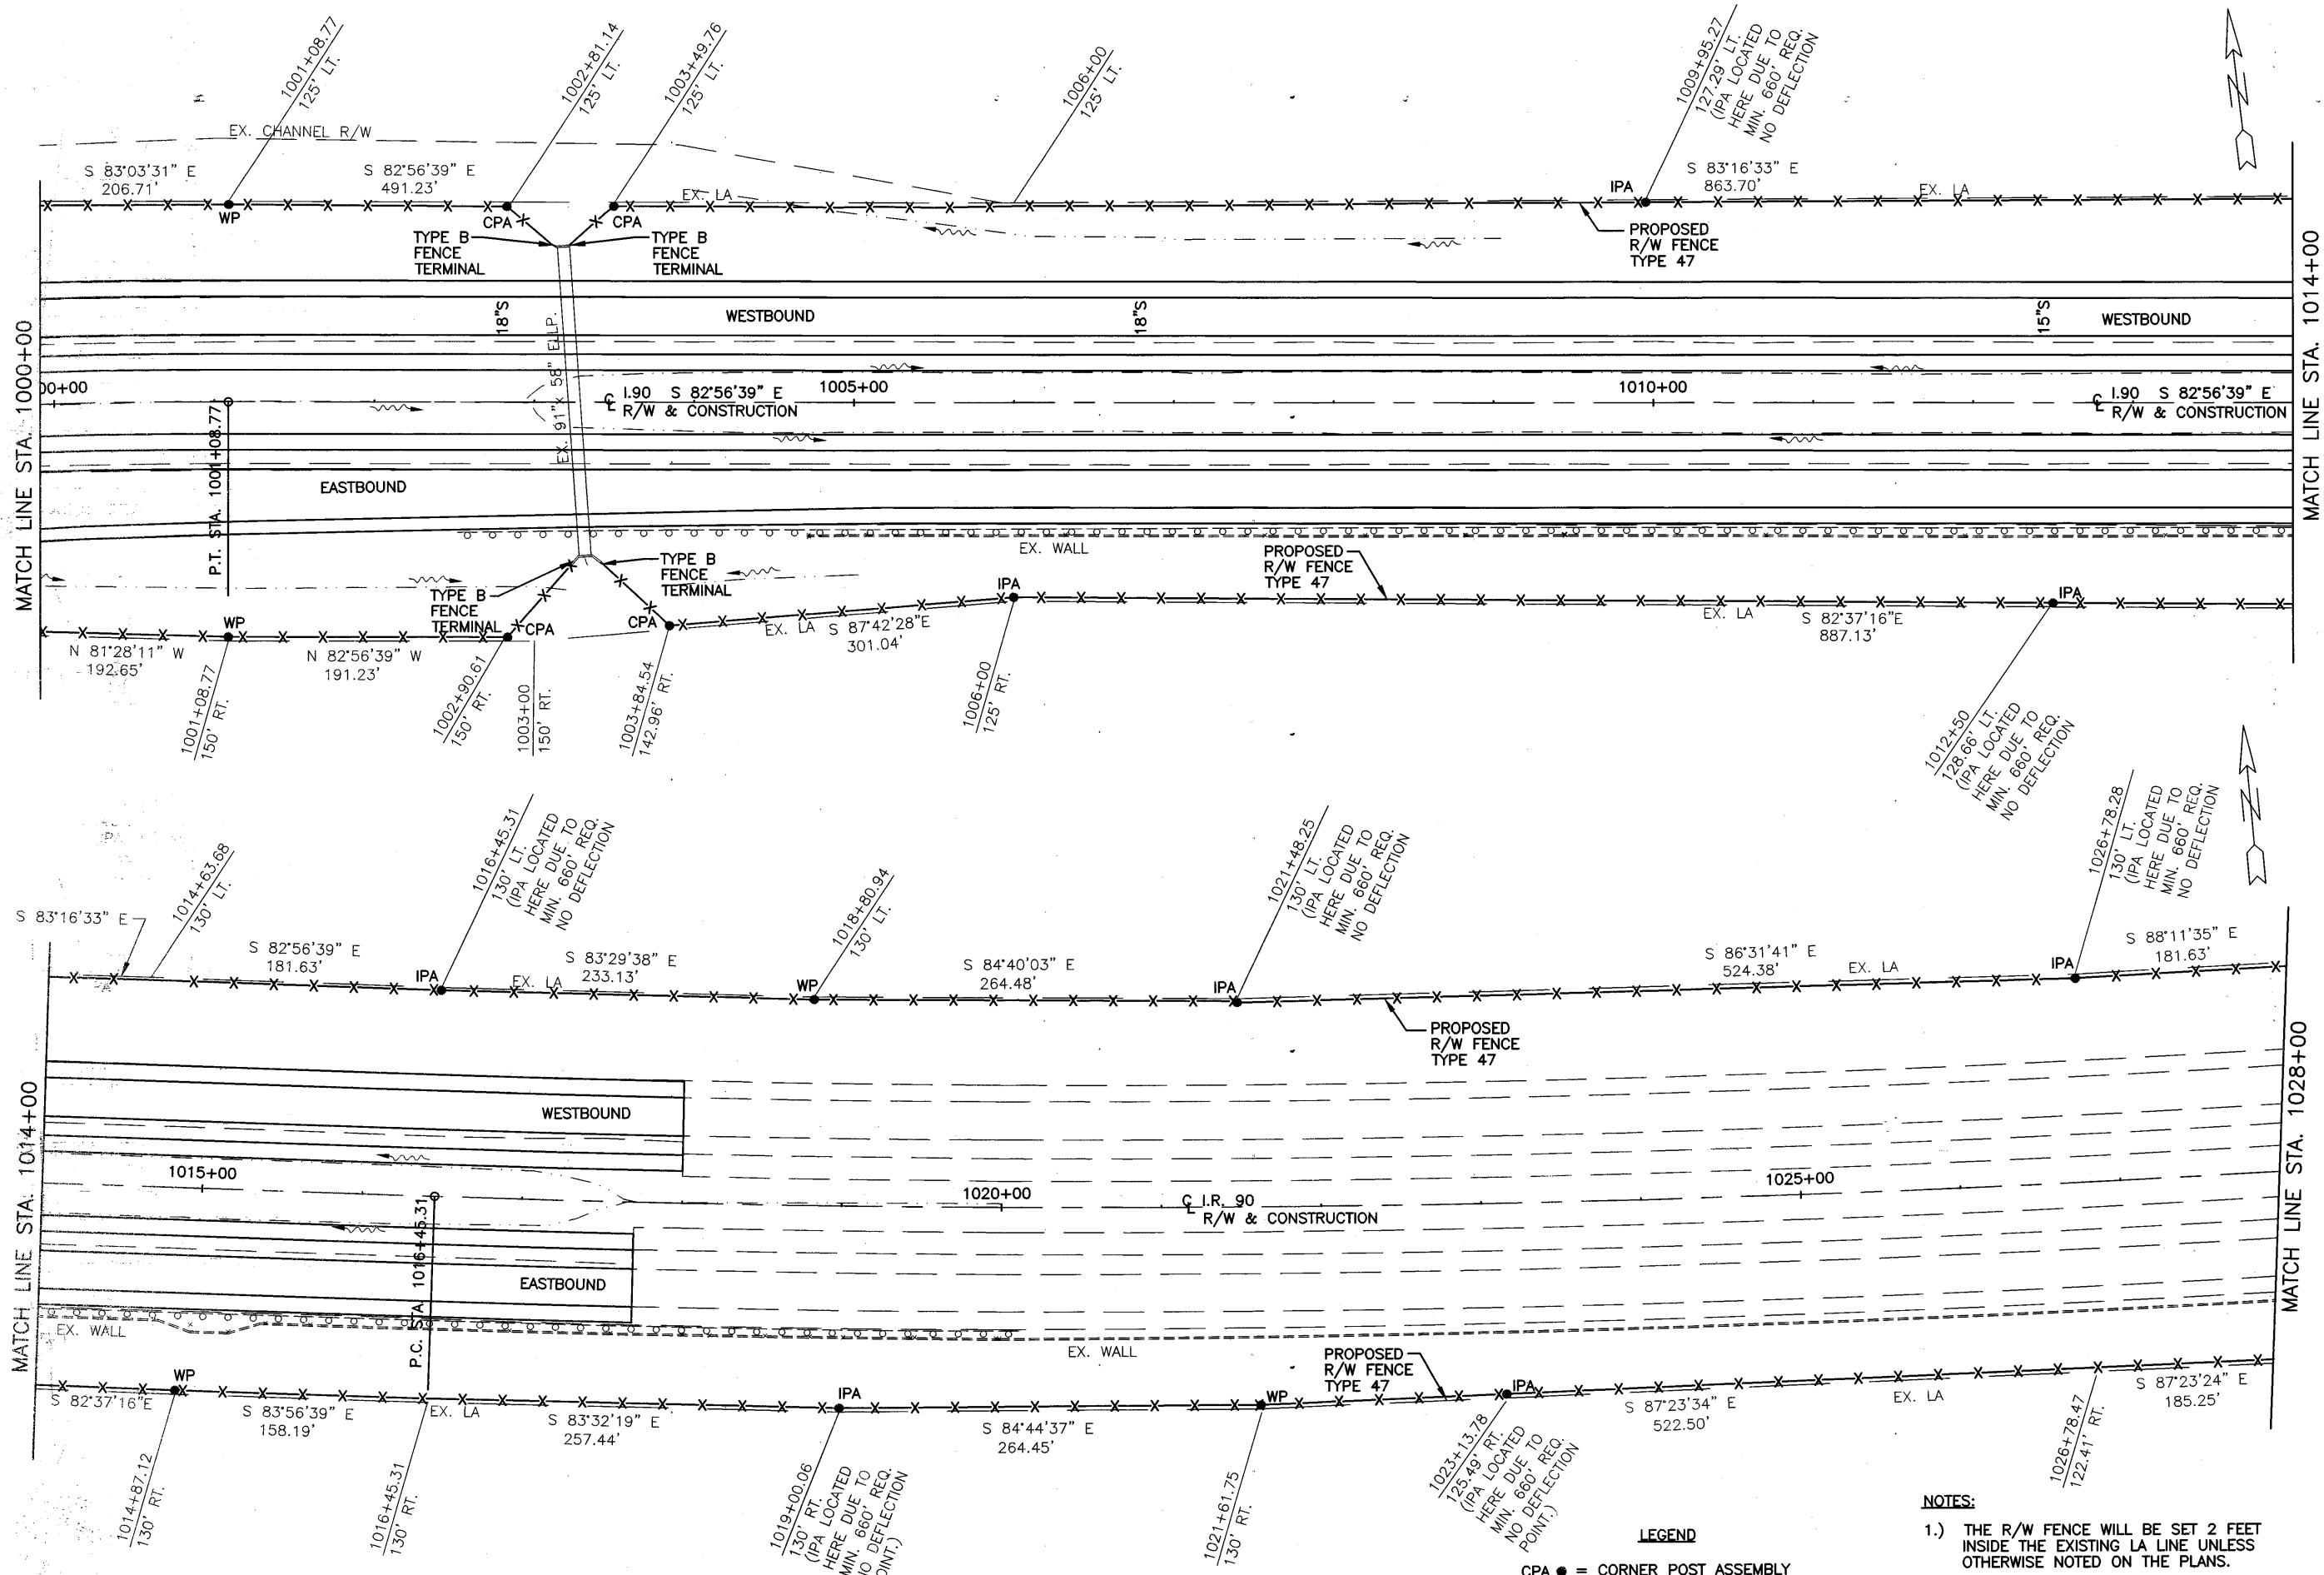


**FENCE PLAN**  
**STA. 1000+00 TO STA. 1028+00**

**LOR - 190 - 10.76**

- LEGEND**
- CPA ● = CORNER POST ASSEMBLY
  - IPA ● = INTERMEDIATE POST ASSEMBLY
  - WP ● = WOOD POST OR ENCASED STEEL POST

- NOTES:**
- 1.) THE R/W FENCE WILL BE SET 2 FEET INSIDE THE EXISTING LA LINE UNLESS OTHERWISE NOTED ON THE PLANS.
  - 2.) THE LENGTH BETWEEN DEFLECTION POINTS IS THE EXISTING LA LENGTH, NOT THE LENGTH OF THE FENCING.

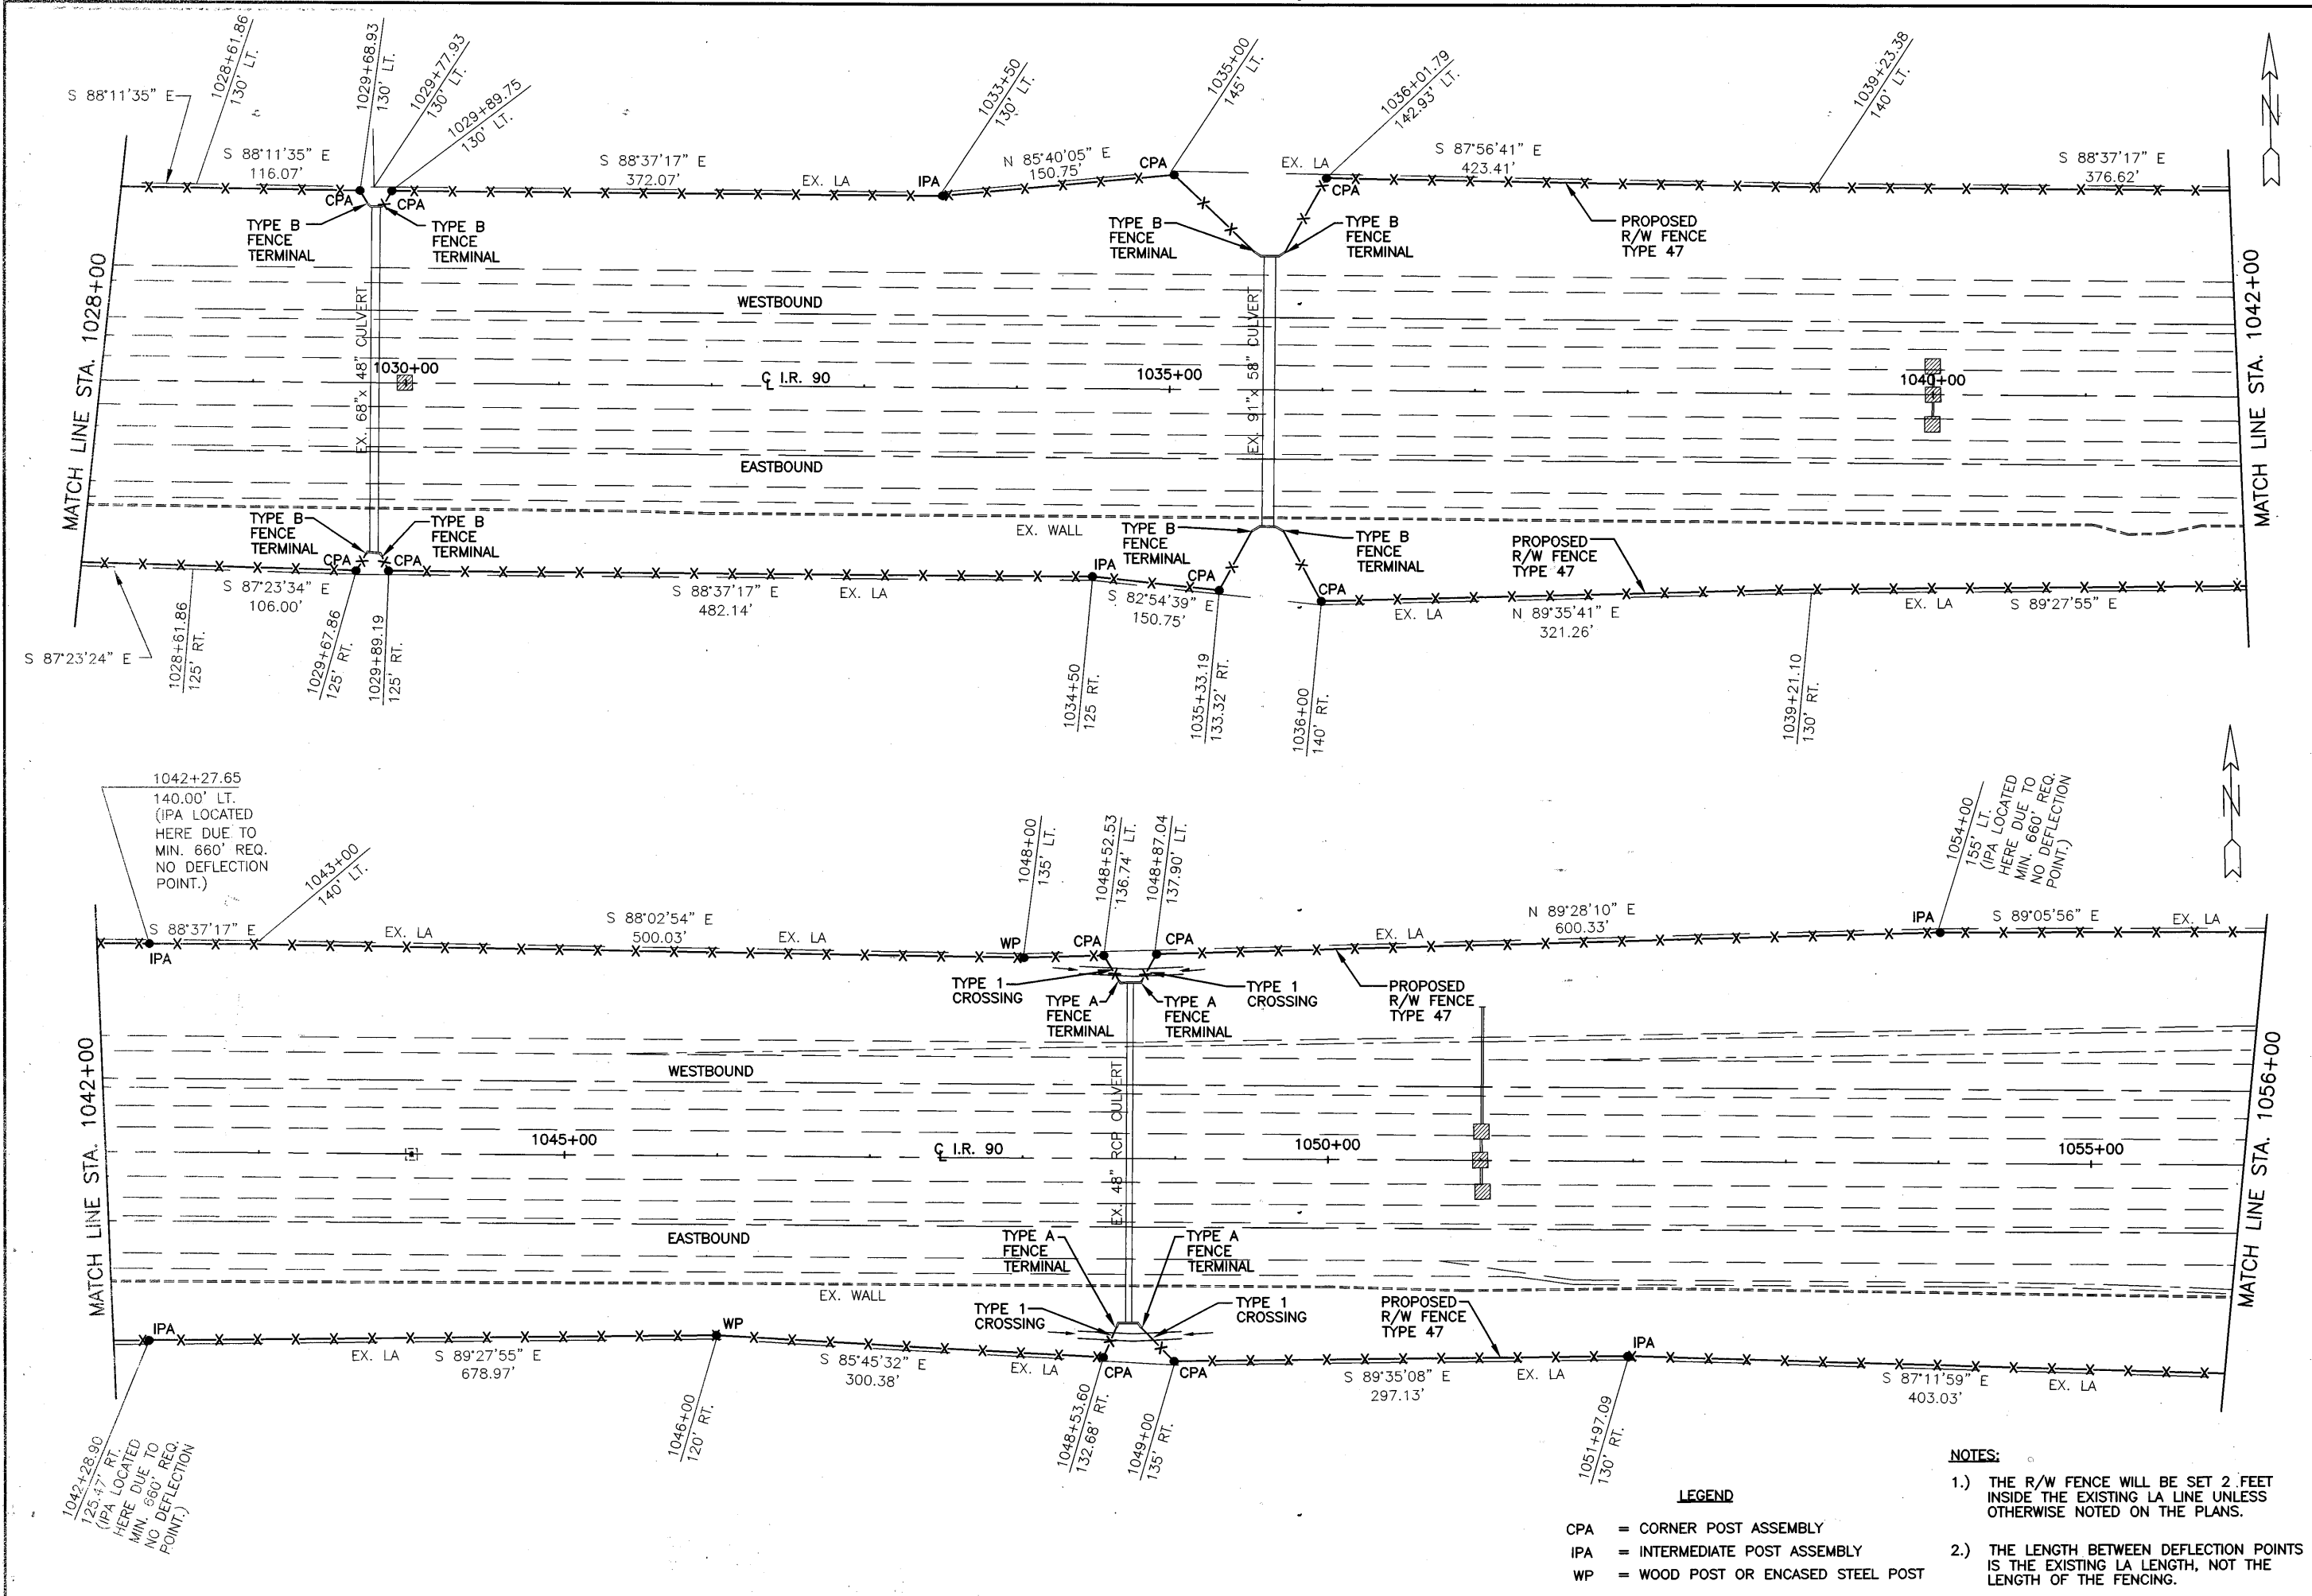

CALCULATED	100
NEW	50
CHECKED	0
LAB	

**FENCE PLAN**  
**STA. 1028+00 TO STA. 1056+00**

**LOR - 190 - 10.76**


**LEGEND**

- CPA = CORNER POST ASSEMBLY
- IPA = INTERMEDIATE POST ASSEMBLY
- WP = WOOD POST OR ENCASED STEEL POST

**NOTES:**

- 1.) THE R/W FENCE WILL BE SET 2 FEET INSIDE THE EXISTING LA LINE UNLESS OTHERWISE NOTED ON THE PLANS.
- 2.) THE LENGTH BETWEEN DEFLECTION POINTS IS THE EXISTING LA LENGTH, NOT THE LENGTH OF THE FENCING.

C:\S2623\WORKS\FENCE\1-BLDG-1.DWG 10/26/04

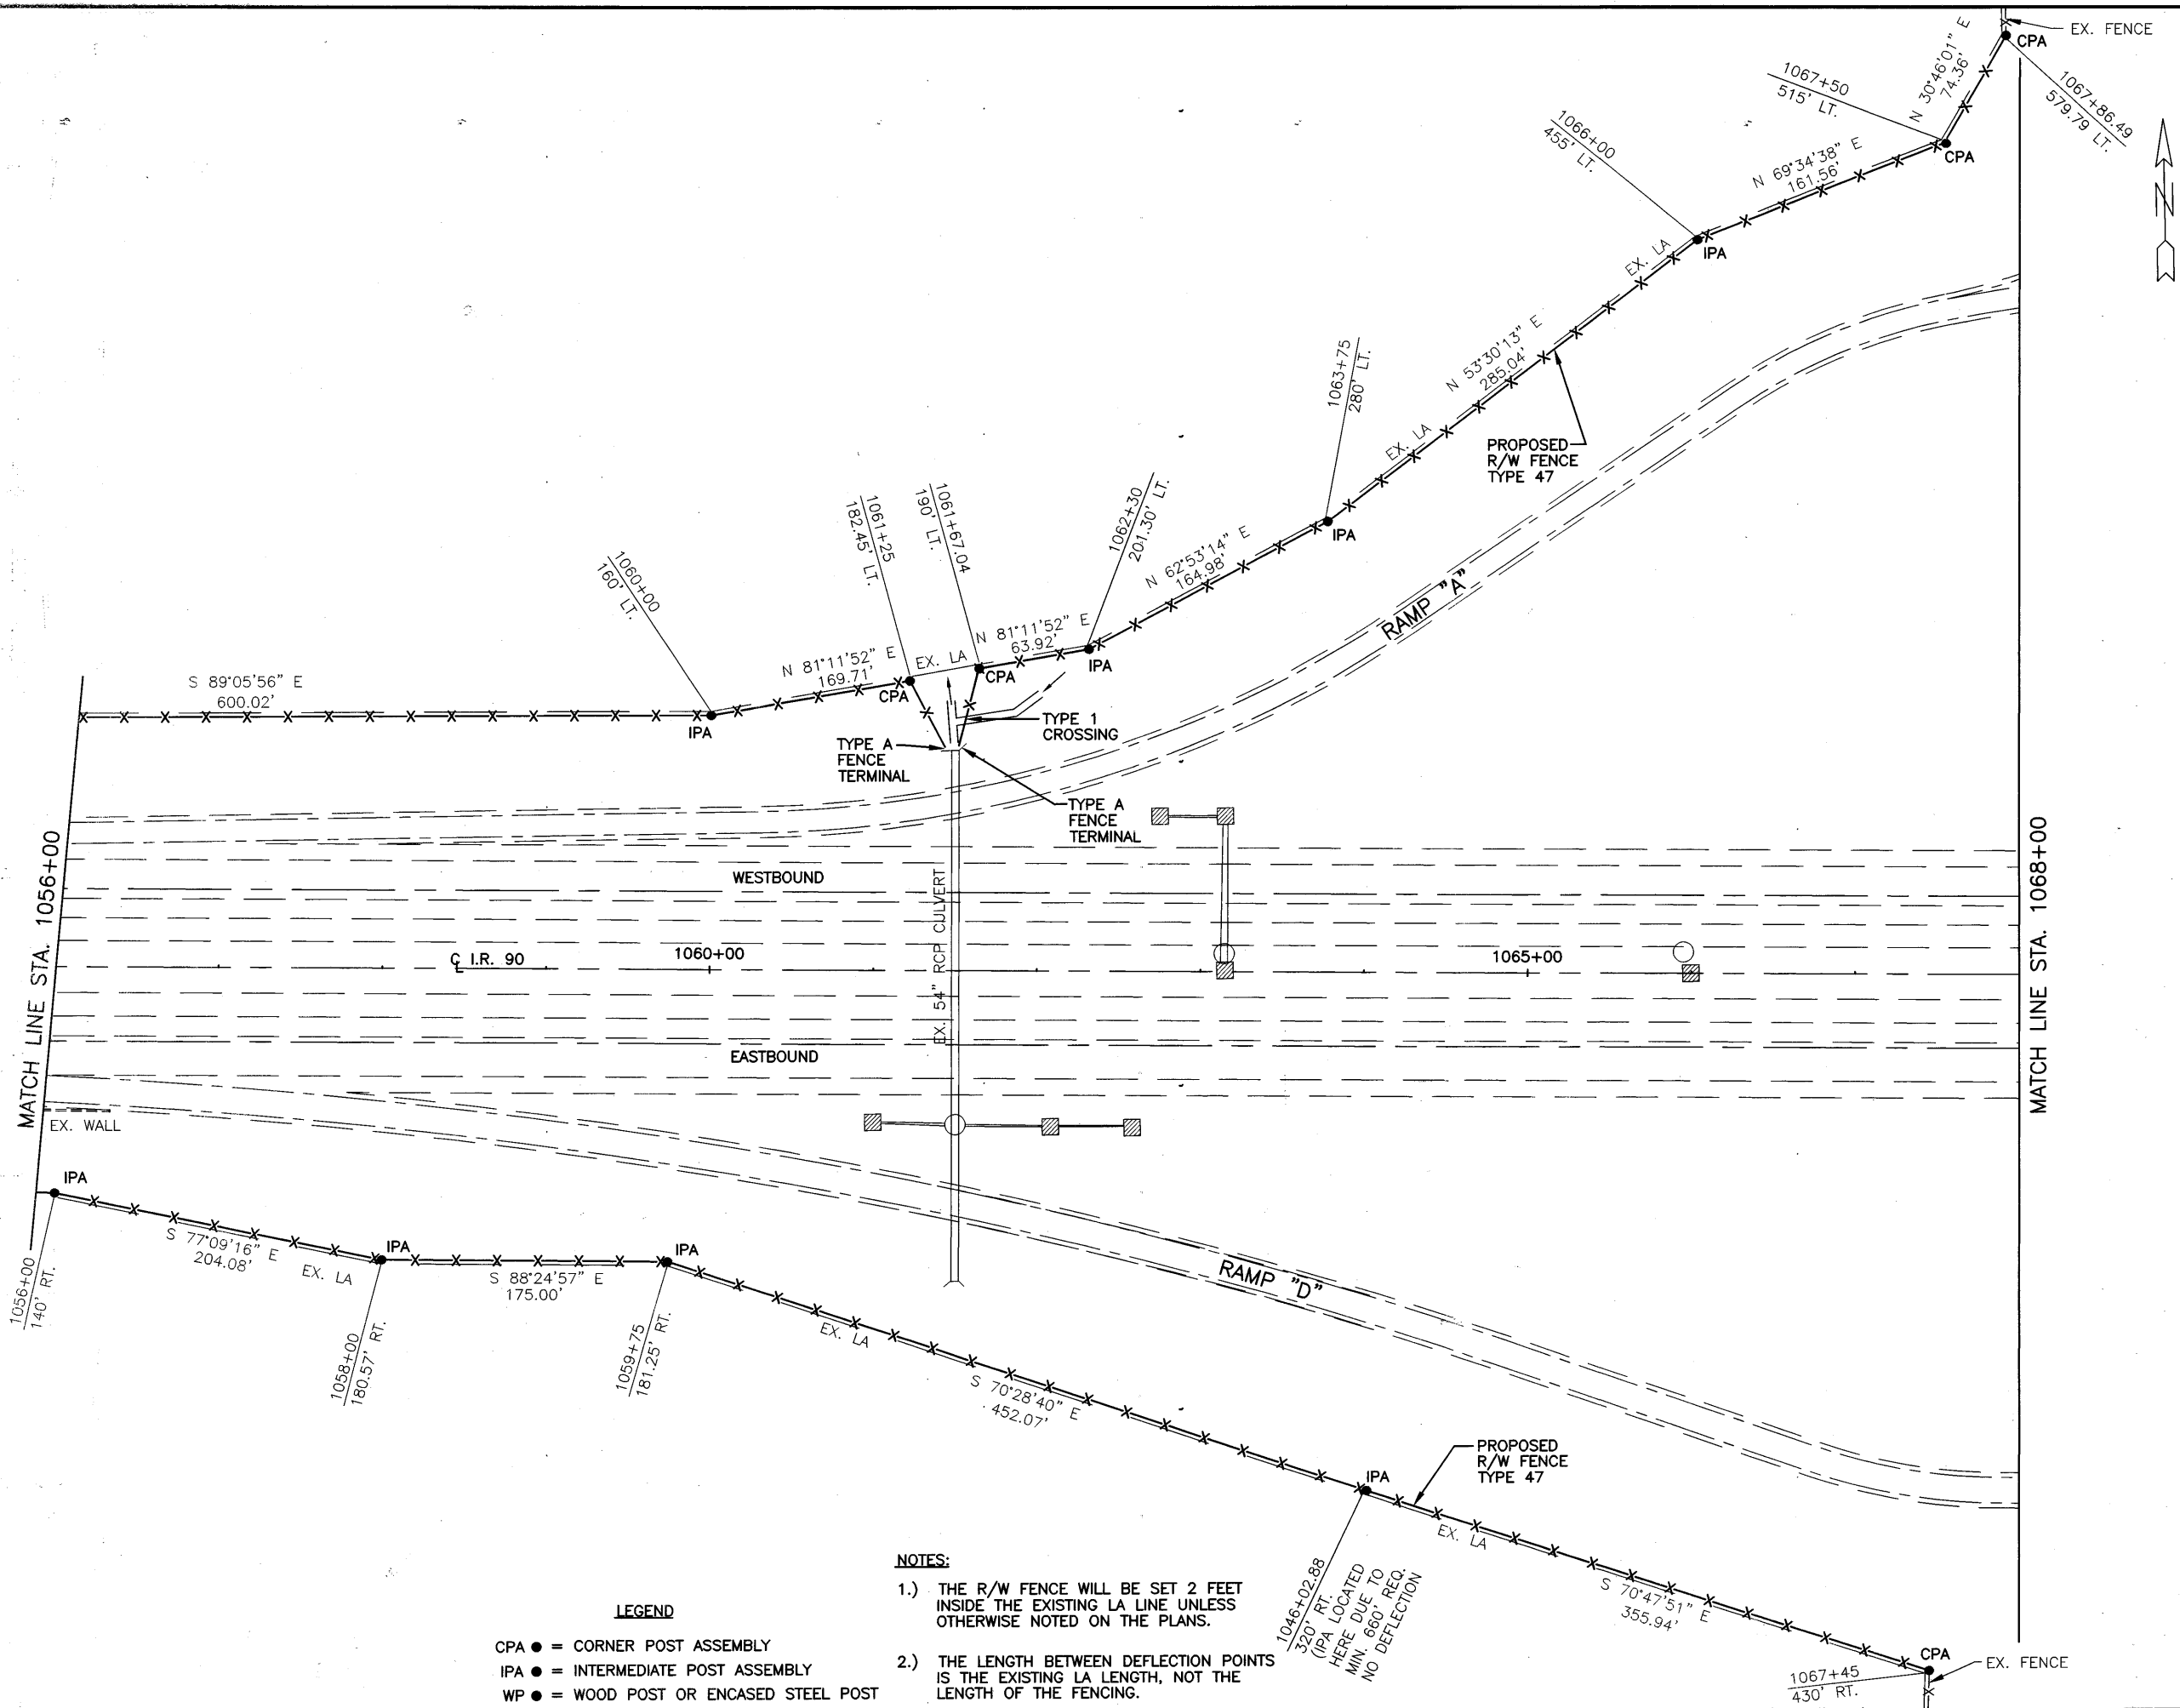

FENCE PLAN  
 STA. 1056+00 TO STA. 1068+00

ODOT PROJECT 3015-00


**NOTES:**

- 1.) THE R/W FENCE WILL BE SET 2 FEET INSIDE THE EXISTING LA LINE UNLESS OTHERWISE NOTED ON THE PLANS.
- 2.) THE LENGTH BETWEEN DEFLECTION POINTS IS THE EXISTING LA LENGTH, NOT THE LENGTH OF THE FENCING.

**LEGEND**


- CPA ● = CORNER POST ASSEMBLY
- IPA ● = INTERMEDIATE POST ASSEMBLY
- WP ● = WOOD POST OR ENCASED STEEL POST

1046+02.88  
 320' RT.  
 (IPA LOCATED  
 HERE DUE TO  
 MIN. 660' REQ.  
 NO DEFLECTION)

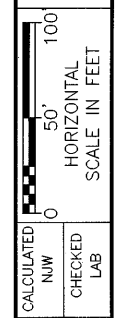

FENCE PLAN  
STA. 1068+00 TO STA. 1082+00


LOR - 190 - 10.76

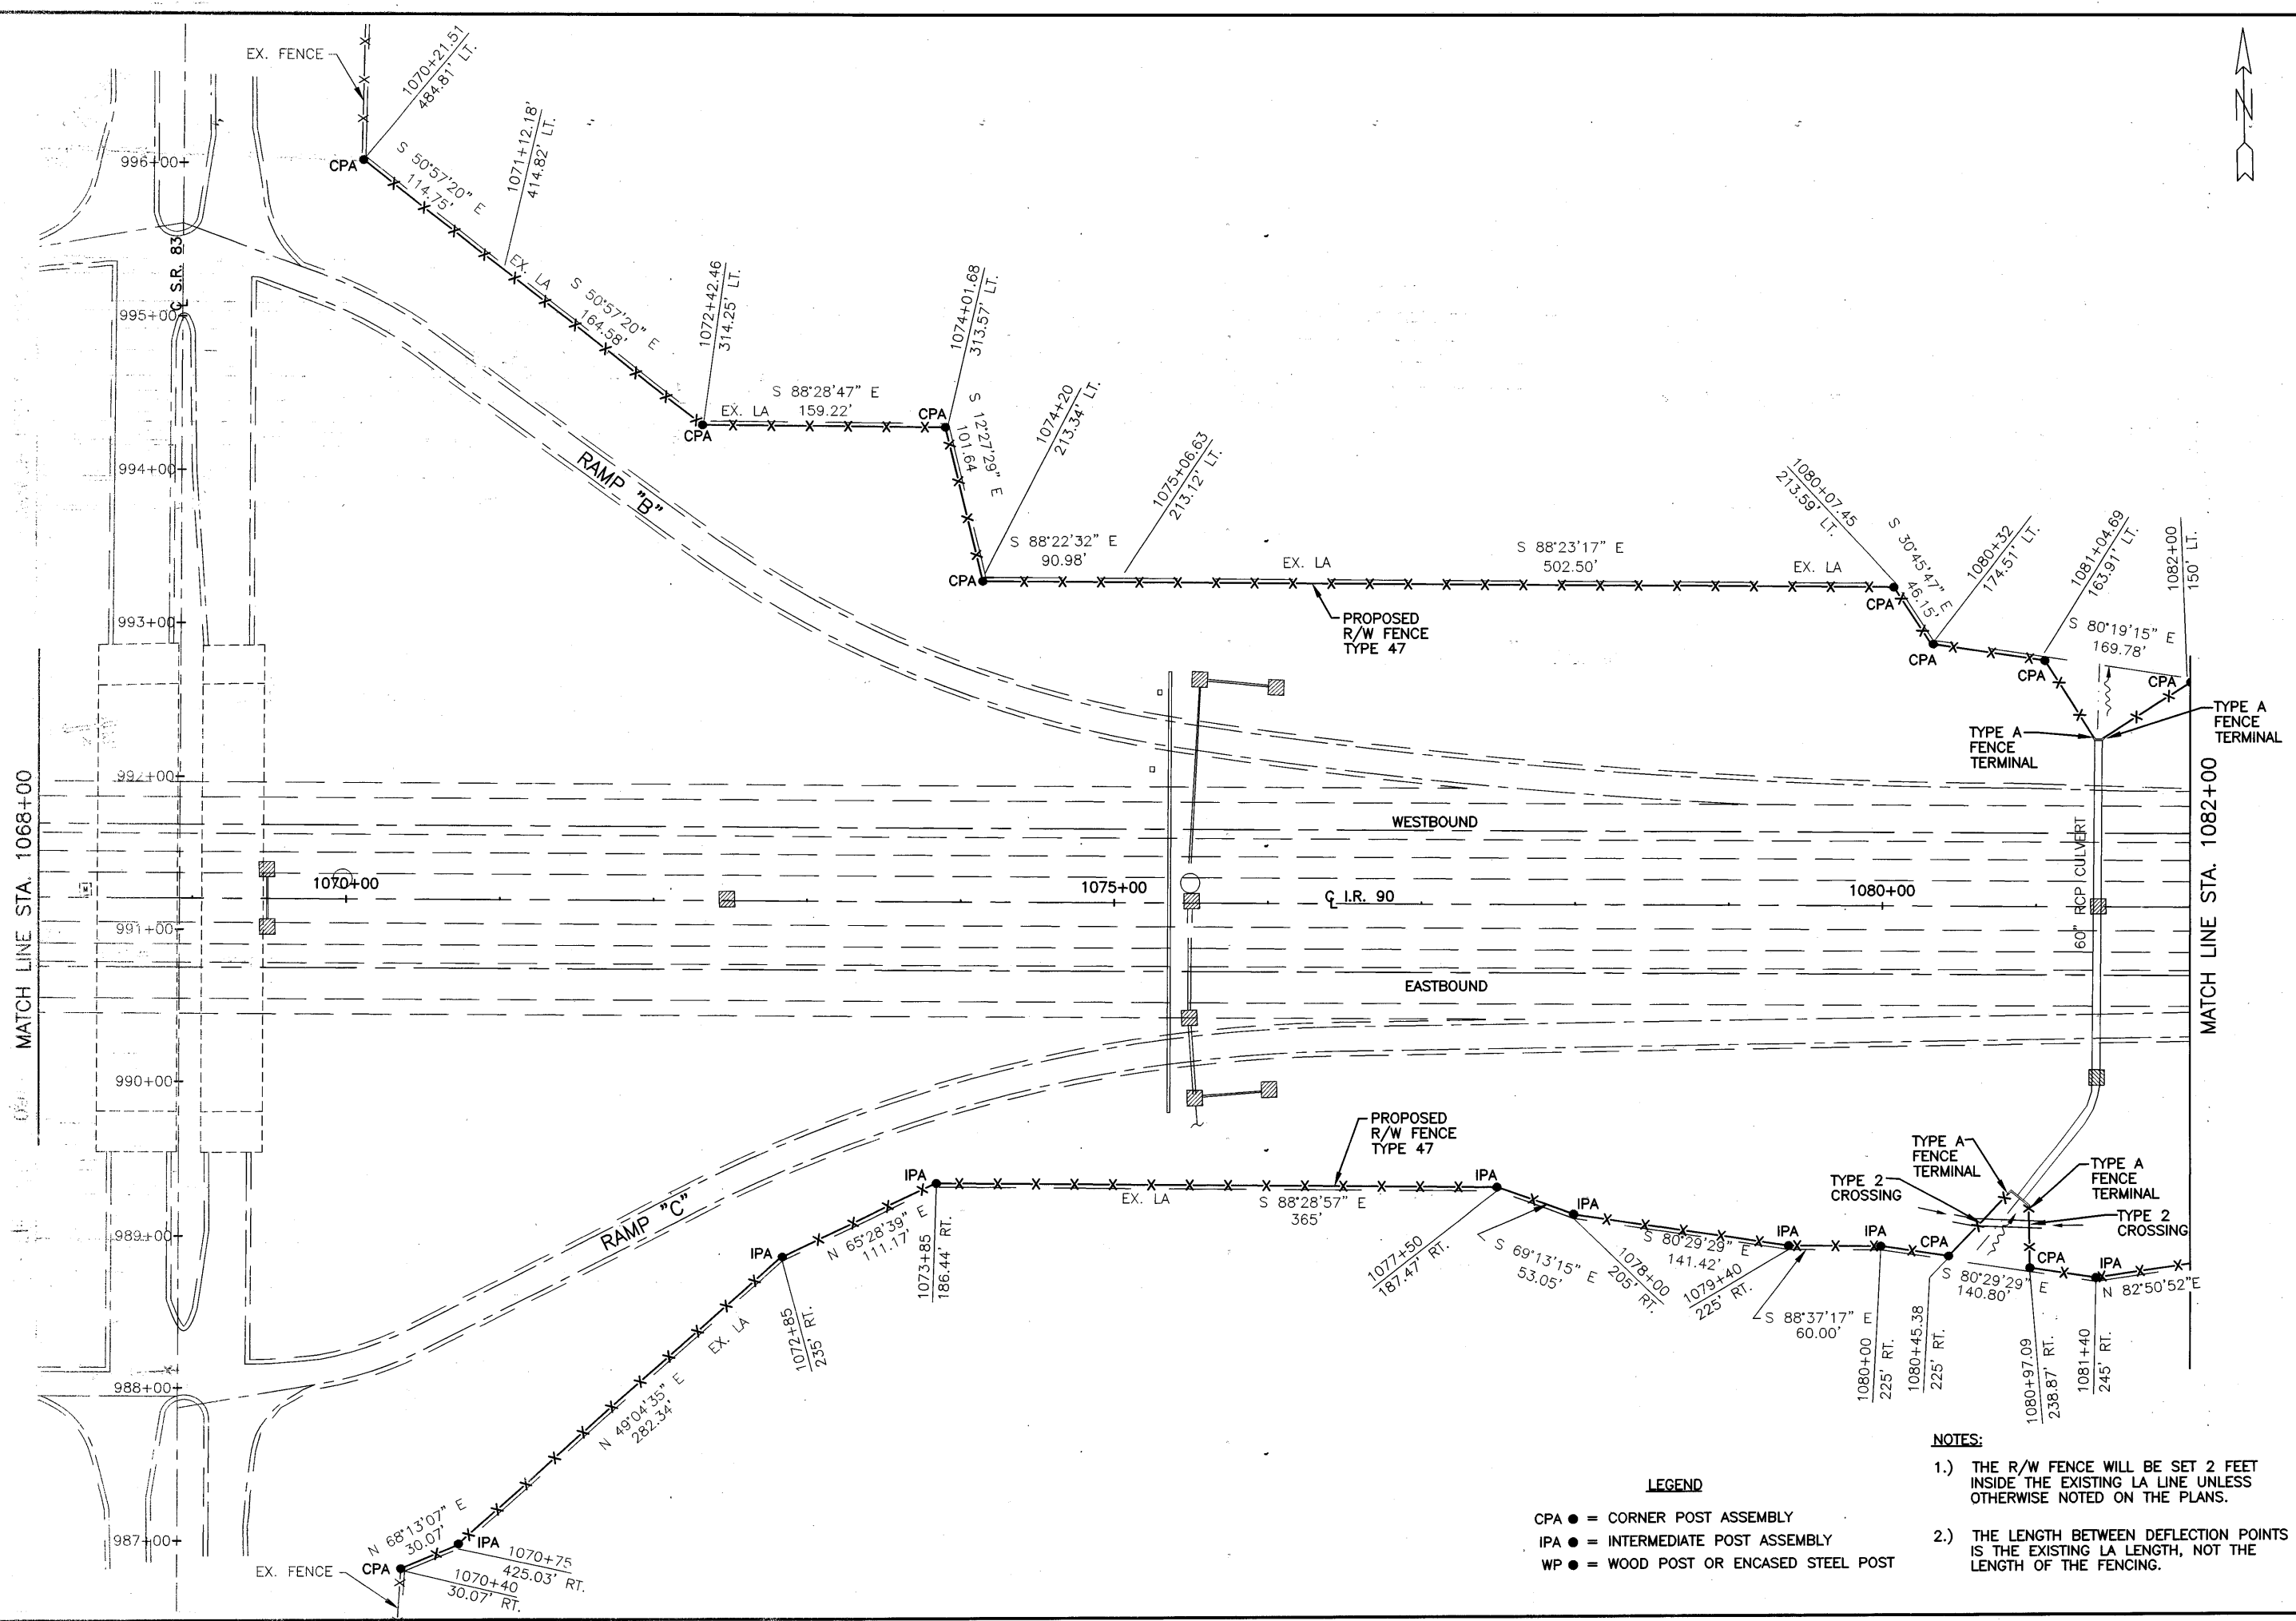

- LEGEND**
- CPA ● = CORNER POST ASSEMBLY
  - IPA ● = INTERMEDIATE POST ASSEMBLY
  - WP ● = WOOD POST OR ENCASED STEEL POST

- NOTES:**
- 1.) THE R/W FENCE WILL BE SET 2 FEET INSIDE THE EXISTING LA LINE UNLESS OTHERWISE NOTED ON THE PLANS.
  - 2.) THE LENGTH BETWEEN DEFLECTION POINTS IS THE EXISTING LA LENGTH, NOT THE LENGTH OF THE FENCING.

I:\A2600\DWG\DWG\FENCE\_V-1.DWG | RW  
 02-08-2002 10:27AM


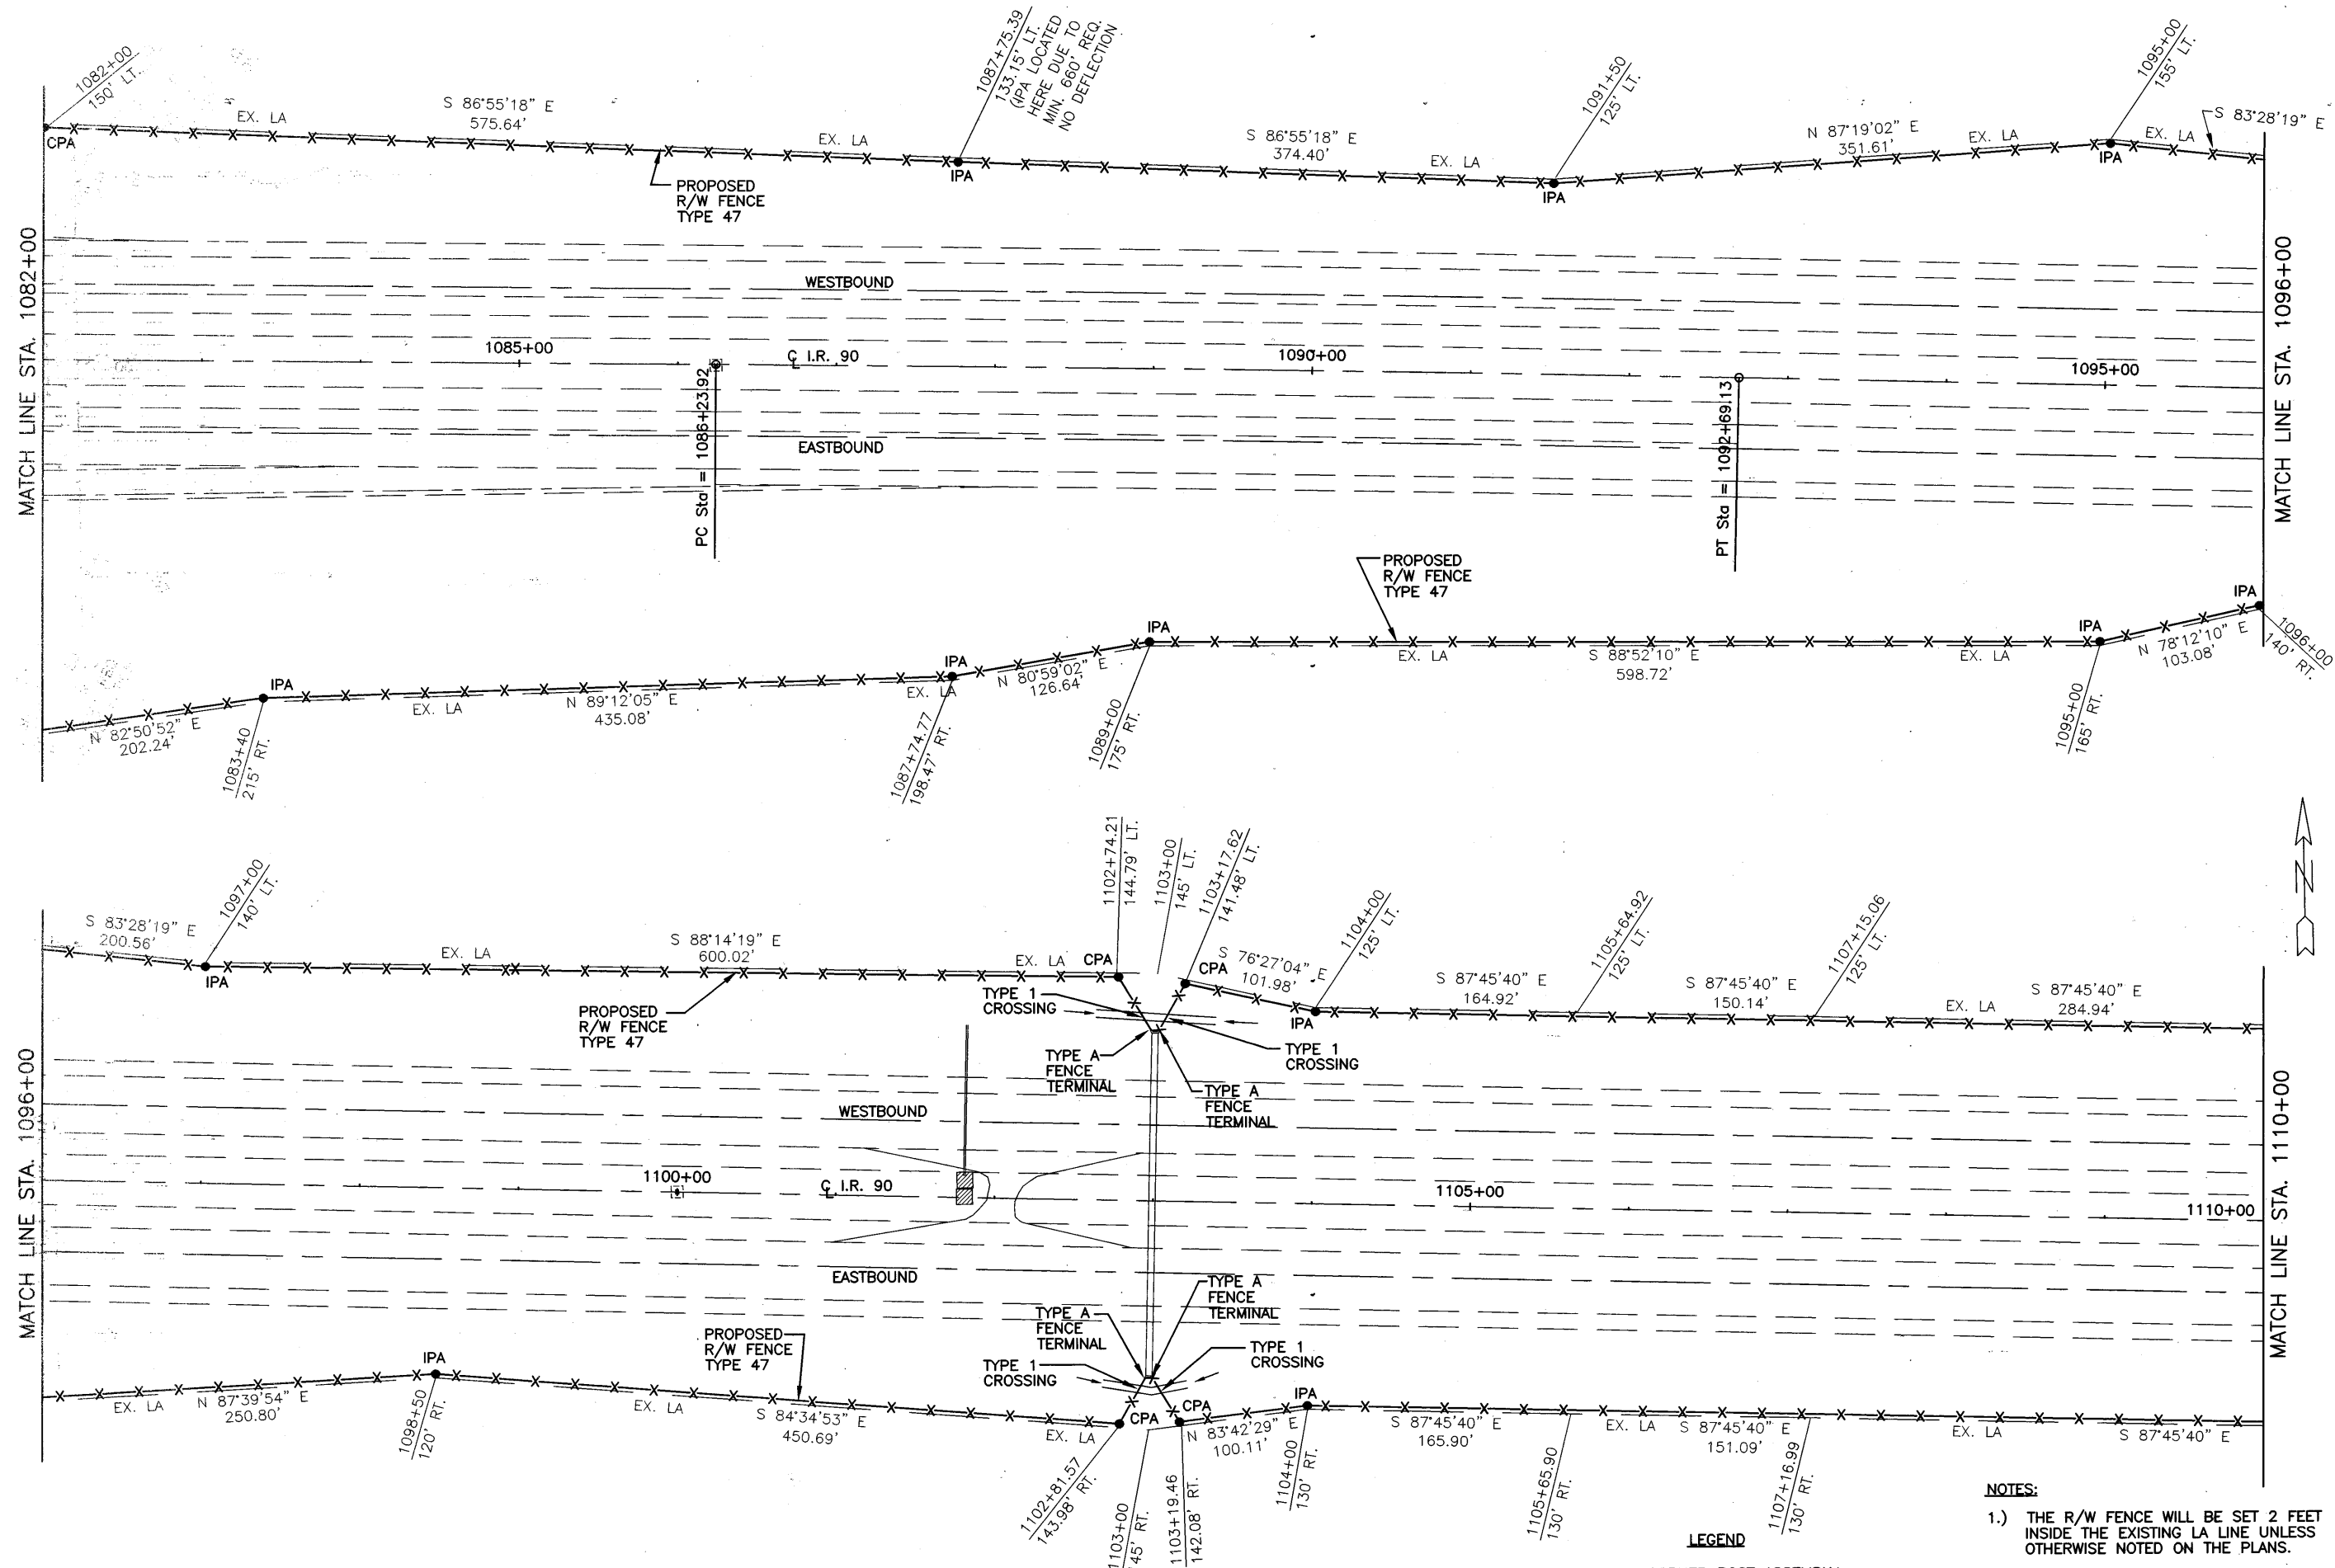


**FENCE PLAN**  
**STA. 1082+00 TO STA. 1110+00**

**LOR - 190-10.76**

- LEGEND**
- CPA ● = CORNER POST ASSEMBLY
  - IPA ● = INTERMEDIATE POST ASSEMBLY
  - WP ● = WOOD POST OR ENCASED STEEL POST

- NOTES:**
- 1.) THE R/W FENCE WILL BE SET 2 FEET INSIDE THE EXISTING LA LINE UNLESS OTHERWISE NOTED ON THE PLANS.
  - 2.) THE LENGTH BETWEEN DEFLECTION POINTS IS THE EXISTING LA LENGTH, NOT THE LENGTH OF THE FENCING.

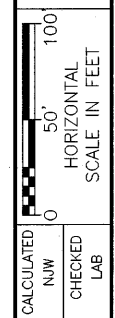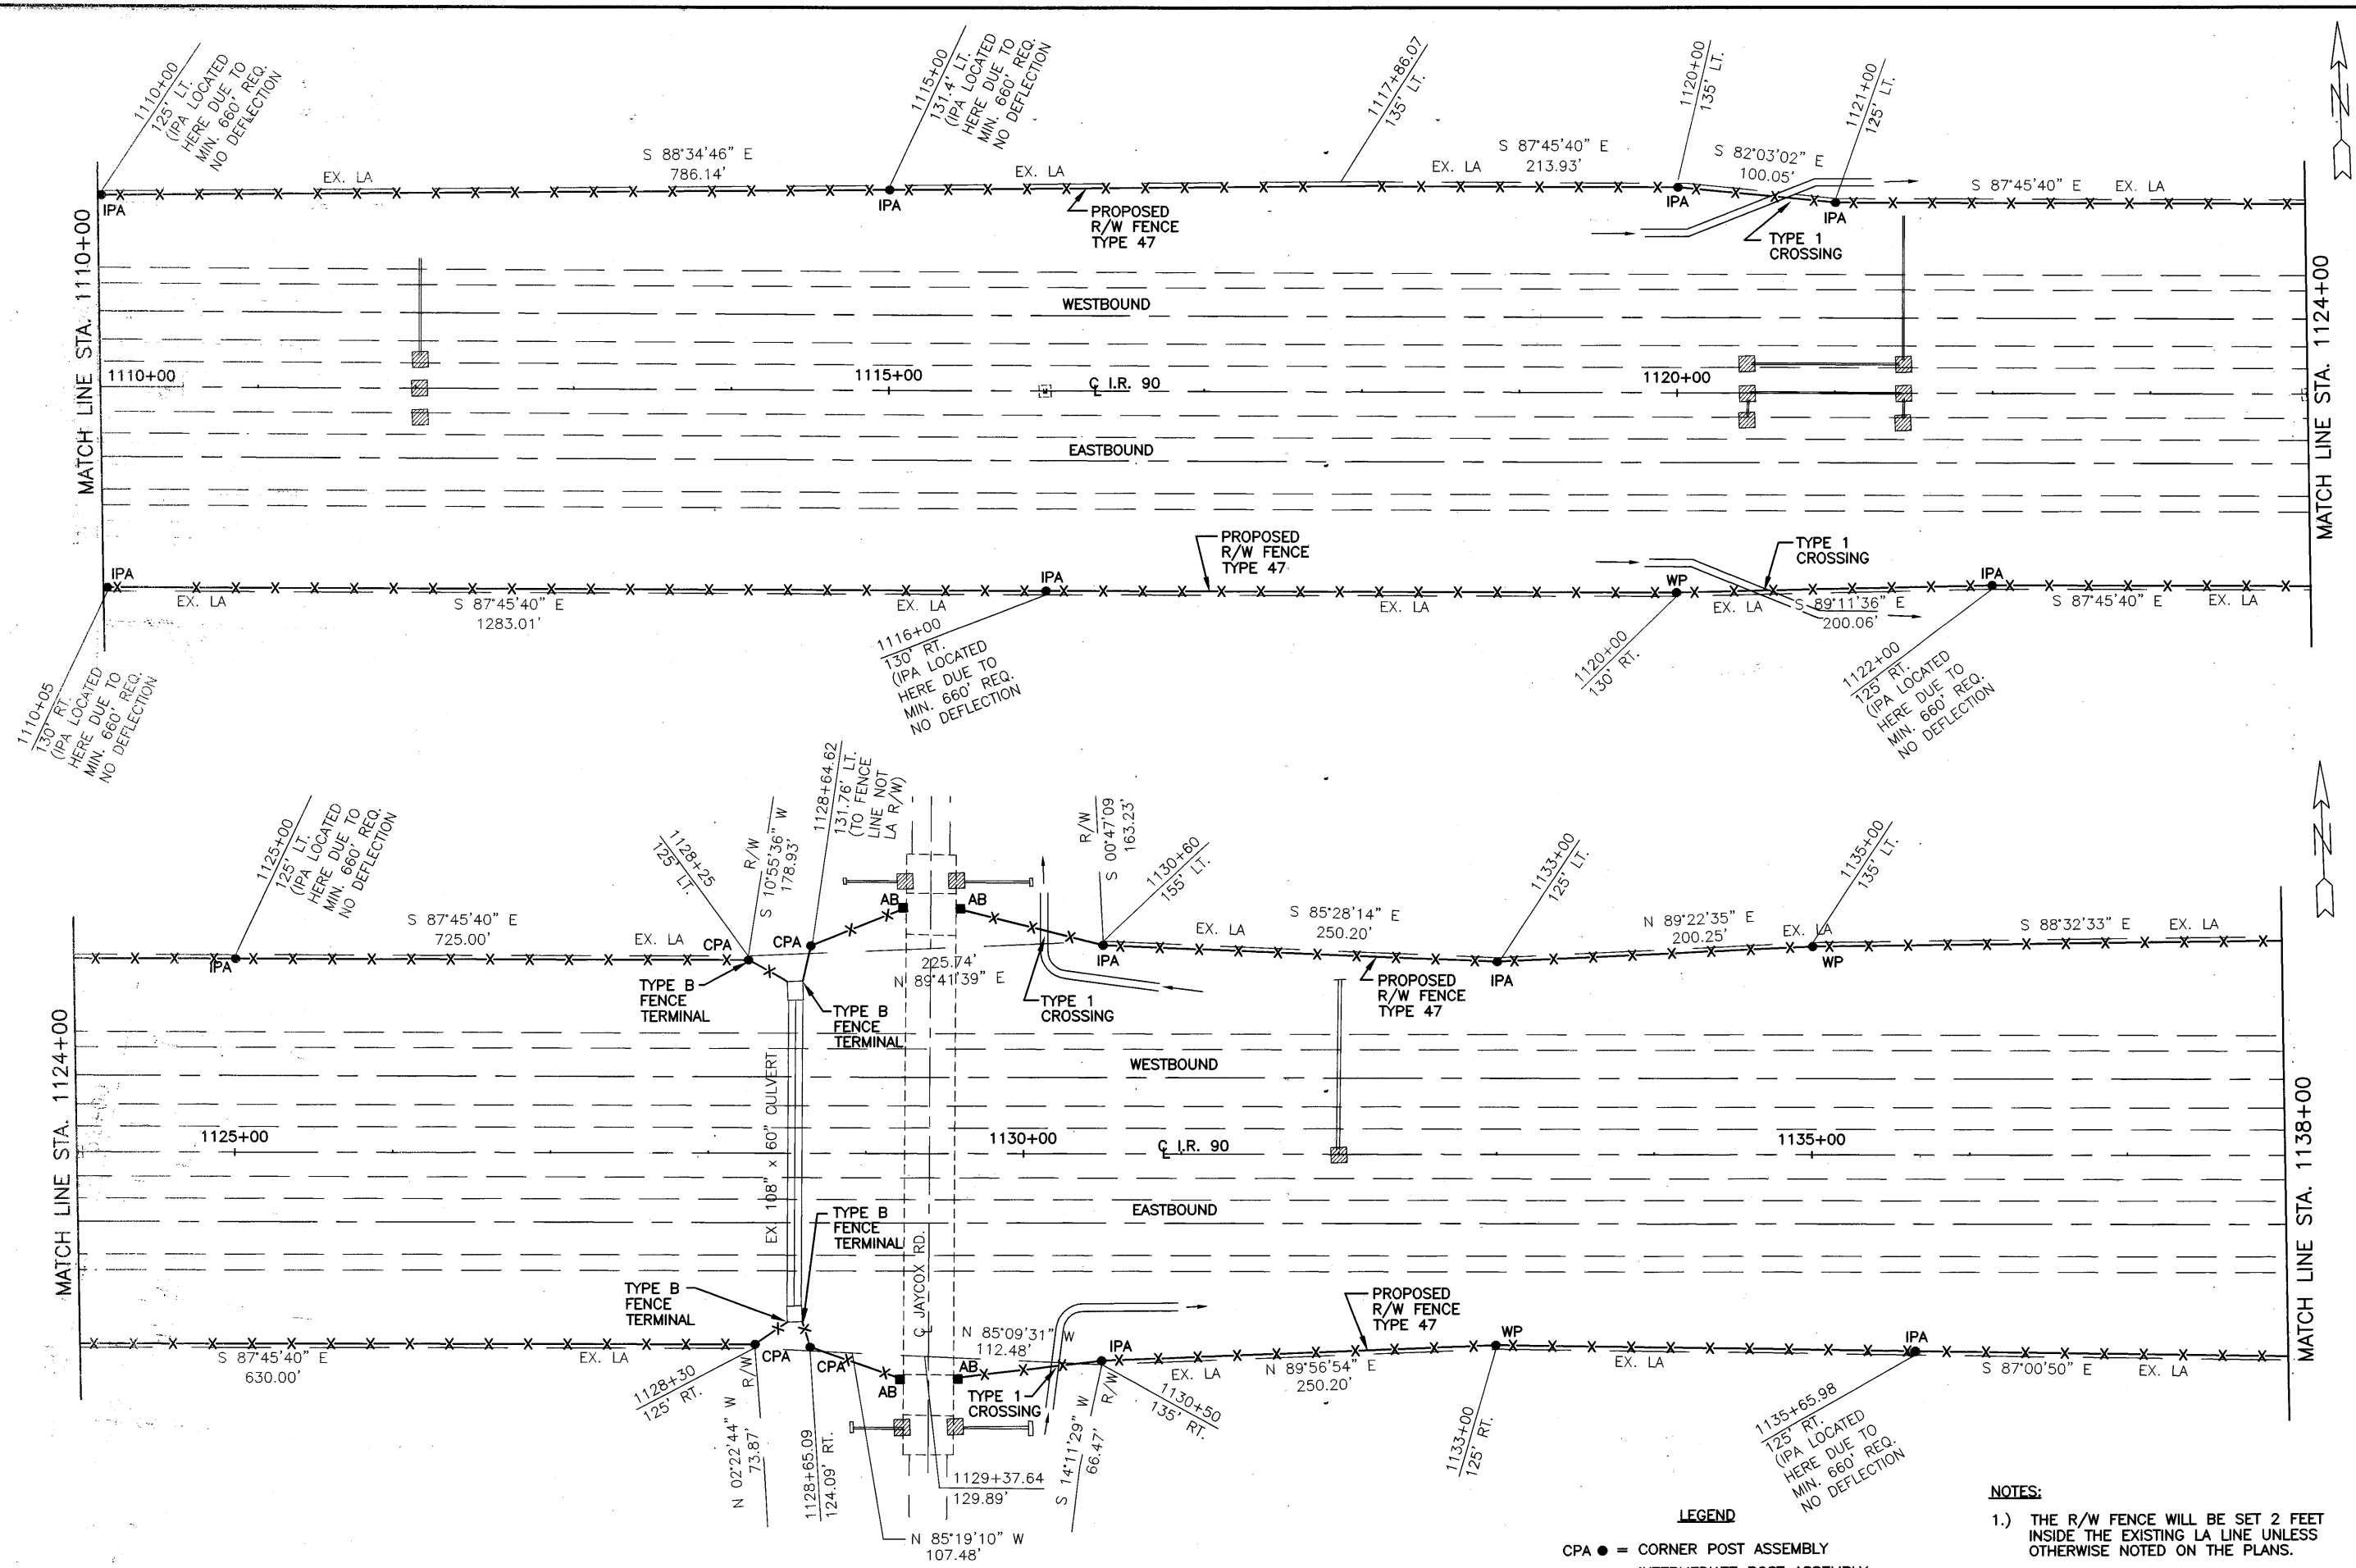

**FENCE PLAN**  
**STA. 1110+00 TO STA. 11138+00**

**LOR 190-10.76**


**LEGEND**

- CPA ● = CORNER POST ASSEMBLY
- IPA ● = INTERMEDIATE POST ASSEMBLY
- WP ● = WOOD POST OR ENCASED STEEL POST
- AB ■ = ABUTMENT CONNECTION

**NOTES:**

- 1.) THE R/W FENCE WILL BE SET 2 FEET INSIDE THE EXISTING LA LINE UNLESS OTHERWISE NOTED ON THE PLANS.
- 2.) THE LENGTH BETWEEN DEFLECTION POINTS IS THE EXISTING LA LENGTH, NOT THE LENGTH OF THE FENCING.



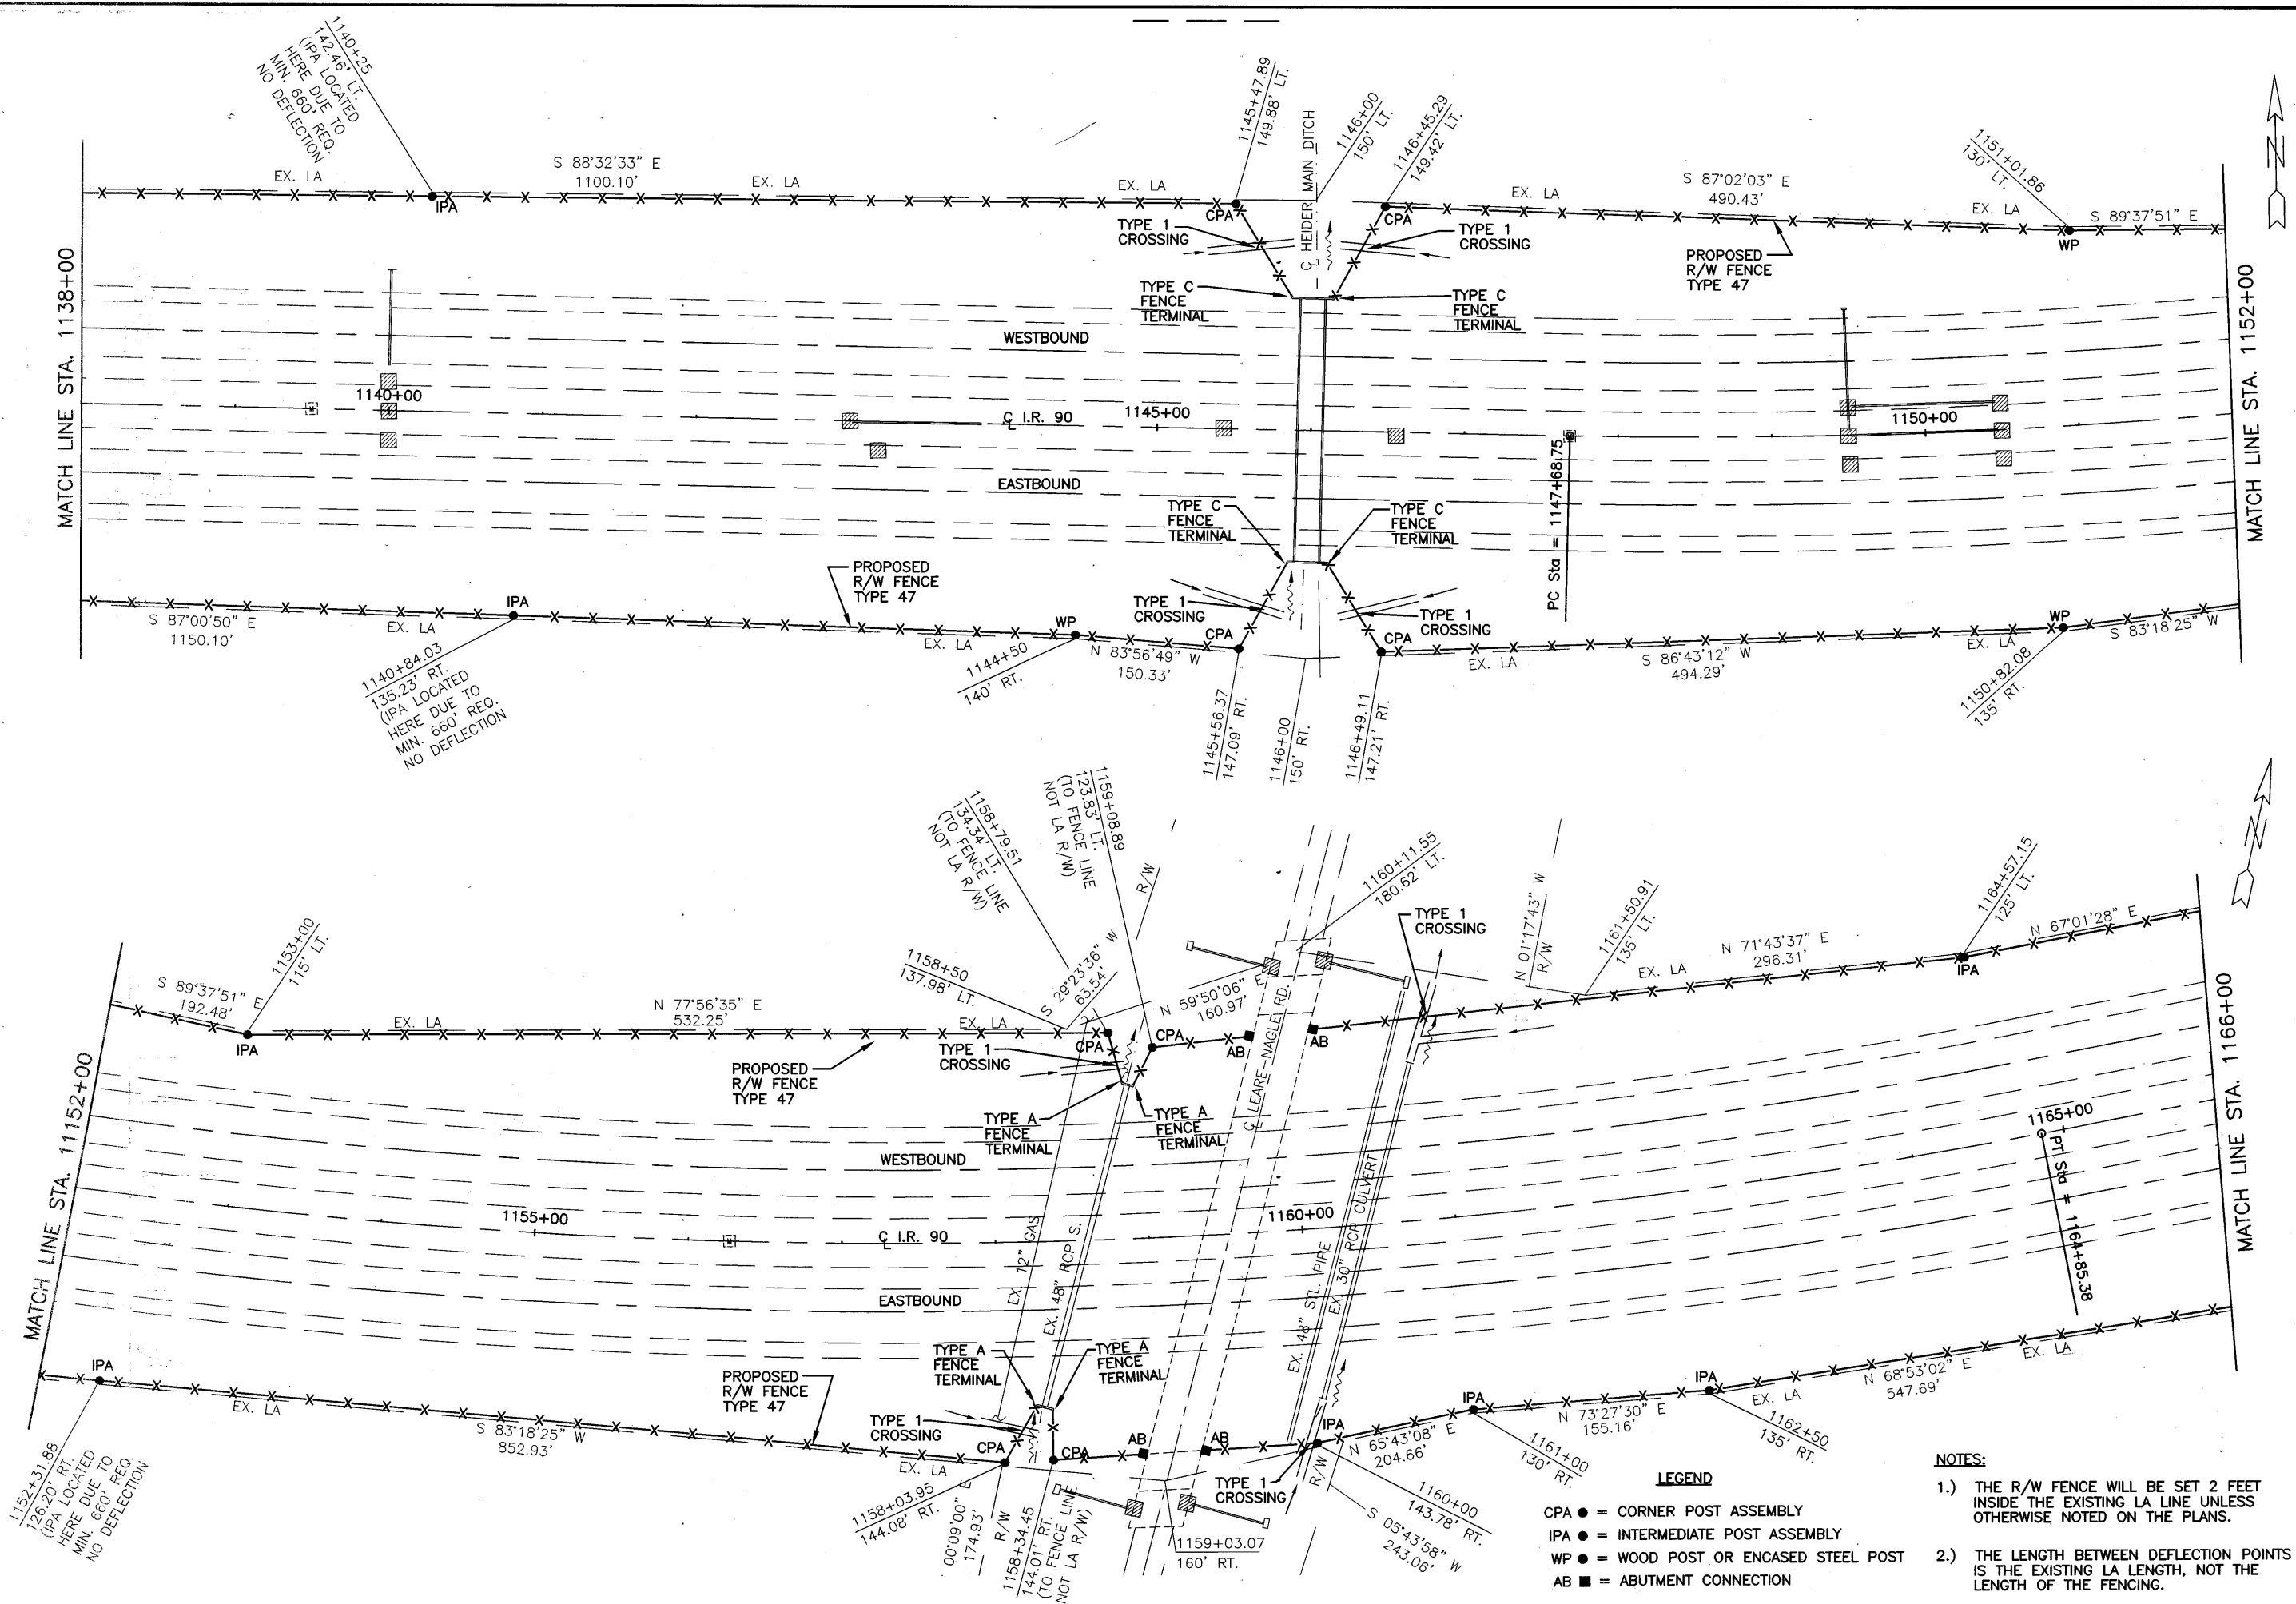

FENCE PLAN  
STA. 1138+00 TO STA. 1166+00


LOR - I90 - 10.76

**LEGEND**

- CPA ● = CORNER POST ASSEMBLY
- IPA ● = INTERMEDIATE POST ASSEMBLY
- WP ● = WOOD POST OR ENCASED STEEL POST
- AB ■ = ABUTMENT CONNECTION

**NOTES:**

- 1.) THE R/W FENCE WILL BE SET 2 FEET INSIDE THE EXISTING LA LINE UNLESS OTHERWISE NOTED ON THE PLANS.
- 2.) THE LENGTH BETWEEN DEFLECTION POINTS IS THE EXISTING LA LENGTH, NOT THE LENGTH OF THE FENCING.

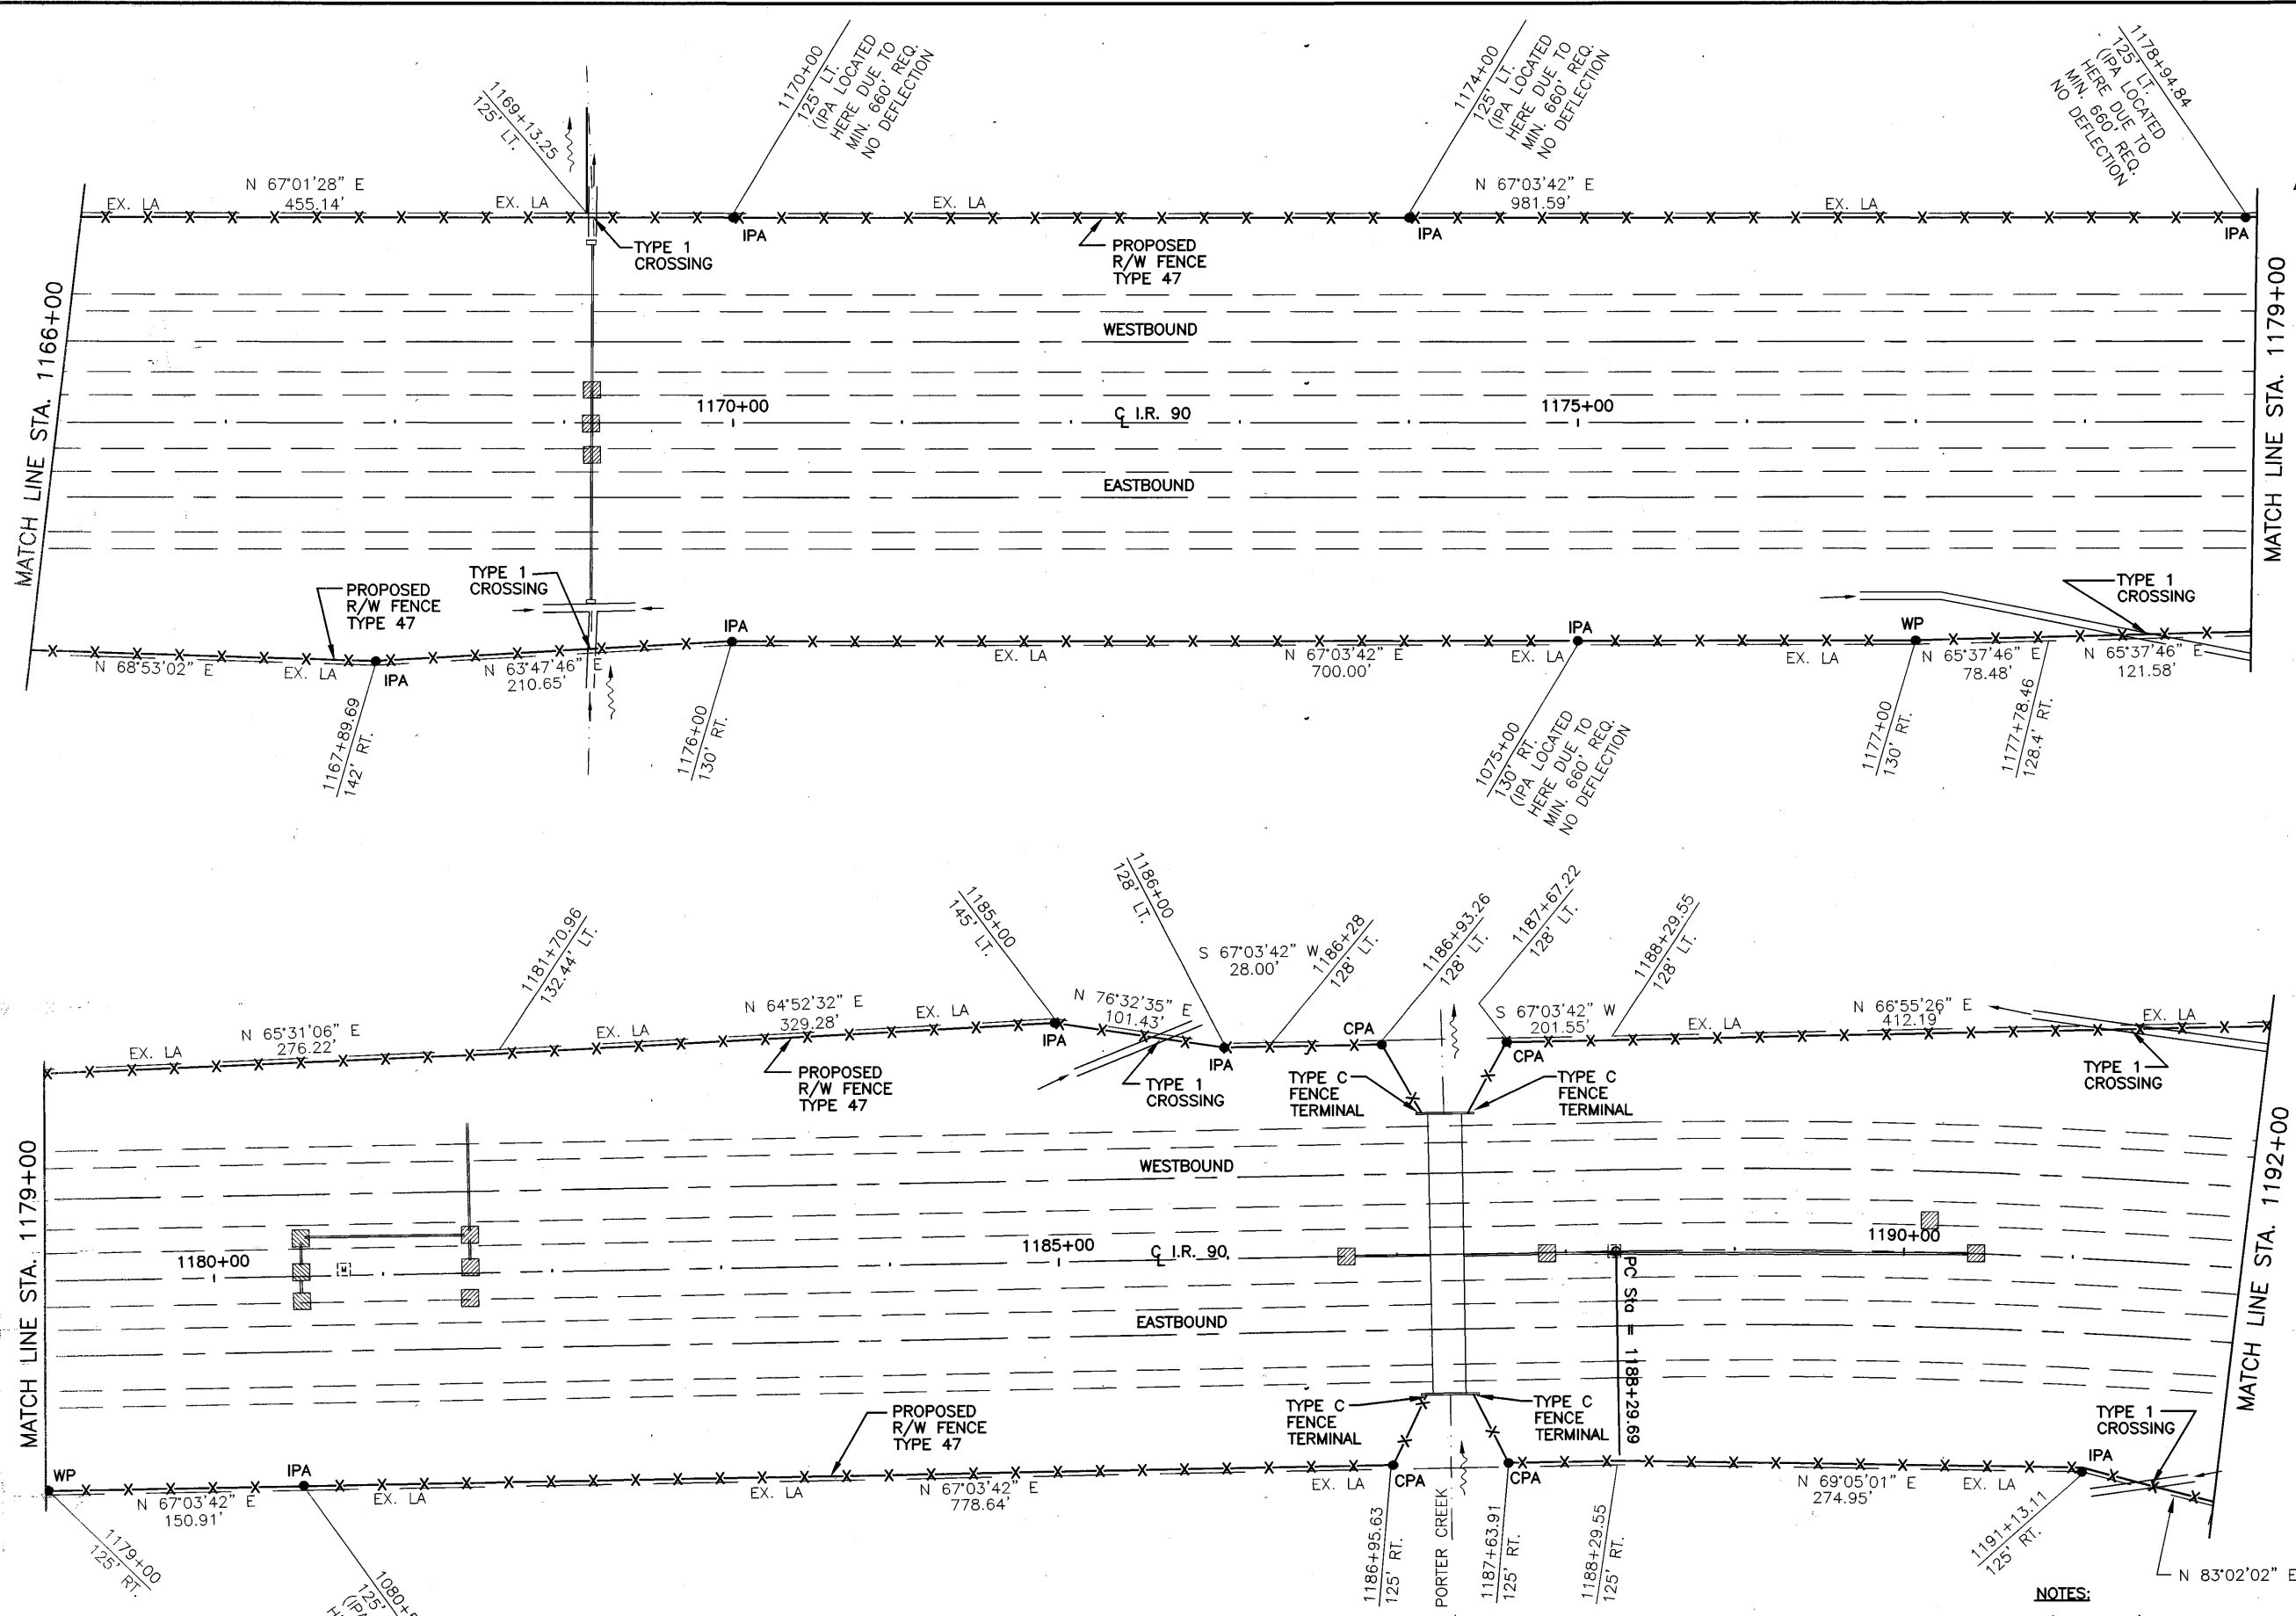

FENCE PLAN  
STA. 1166+00 TO STA. 1192+00

LOR - 190 - 10.76

273  
274

- LEGEND**
- CPA ● = CORNER POST ASSEMBLY
  - IPA ● = INTERMEDIATE POST ASSEMBLY
  - WP ● = WOOD POST OR ENCASED STEEL POST


- NOTES:**
- 1.) THE R/W FENCE WILL BE SET 2 FEET INSIDE THE EXISTING LA LINE UNLESS OTHERWISE NOTED ON THE PLANS.
  - 2.) THE LENGTH BETWEEN DEFLECTION POINTS IS THE EXISTING LA LENGTH, NOT THE LENGTH OF THE FENCING.

E:\3\3680\DWG\PERM\FENCE-14.DWG J NLF  
 05-06-2002 10:30AM

CA

CA

F:\03\9530\CONCRETE\FENCE\F-15.DWG 1 MAR 02-08-2002 10:30AM

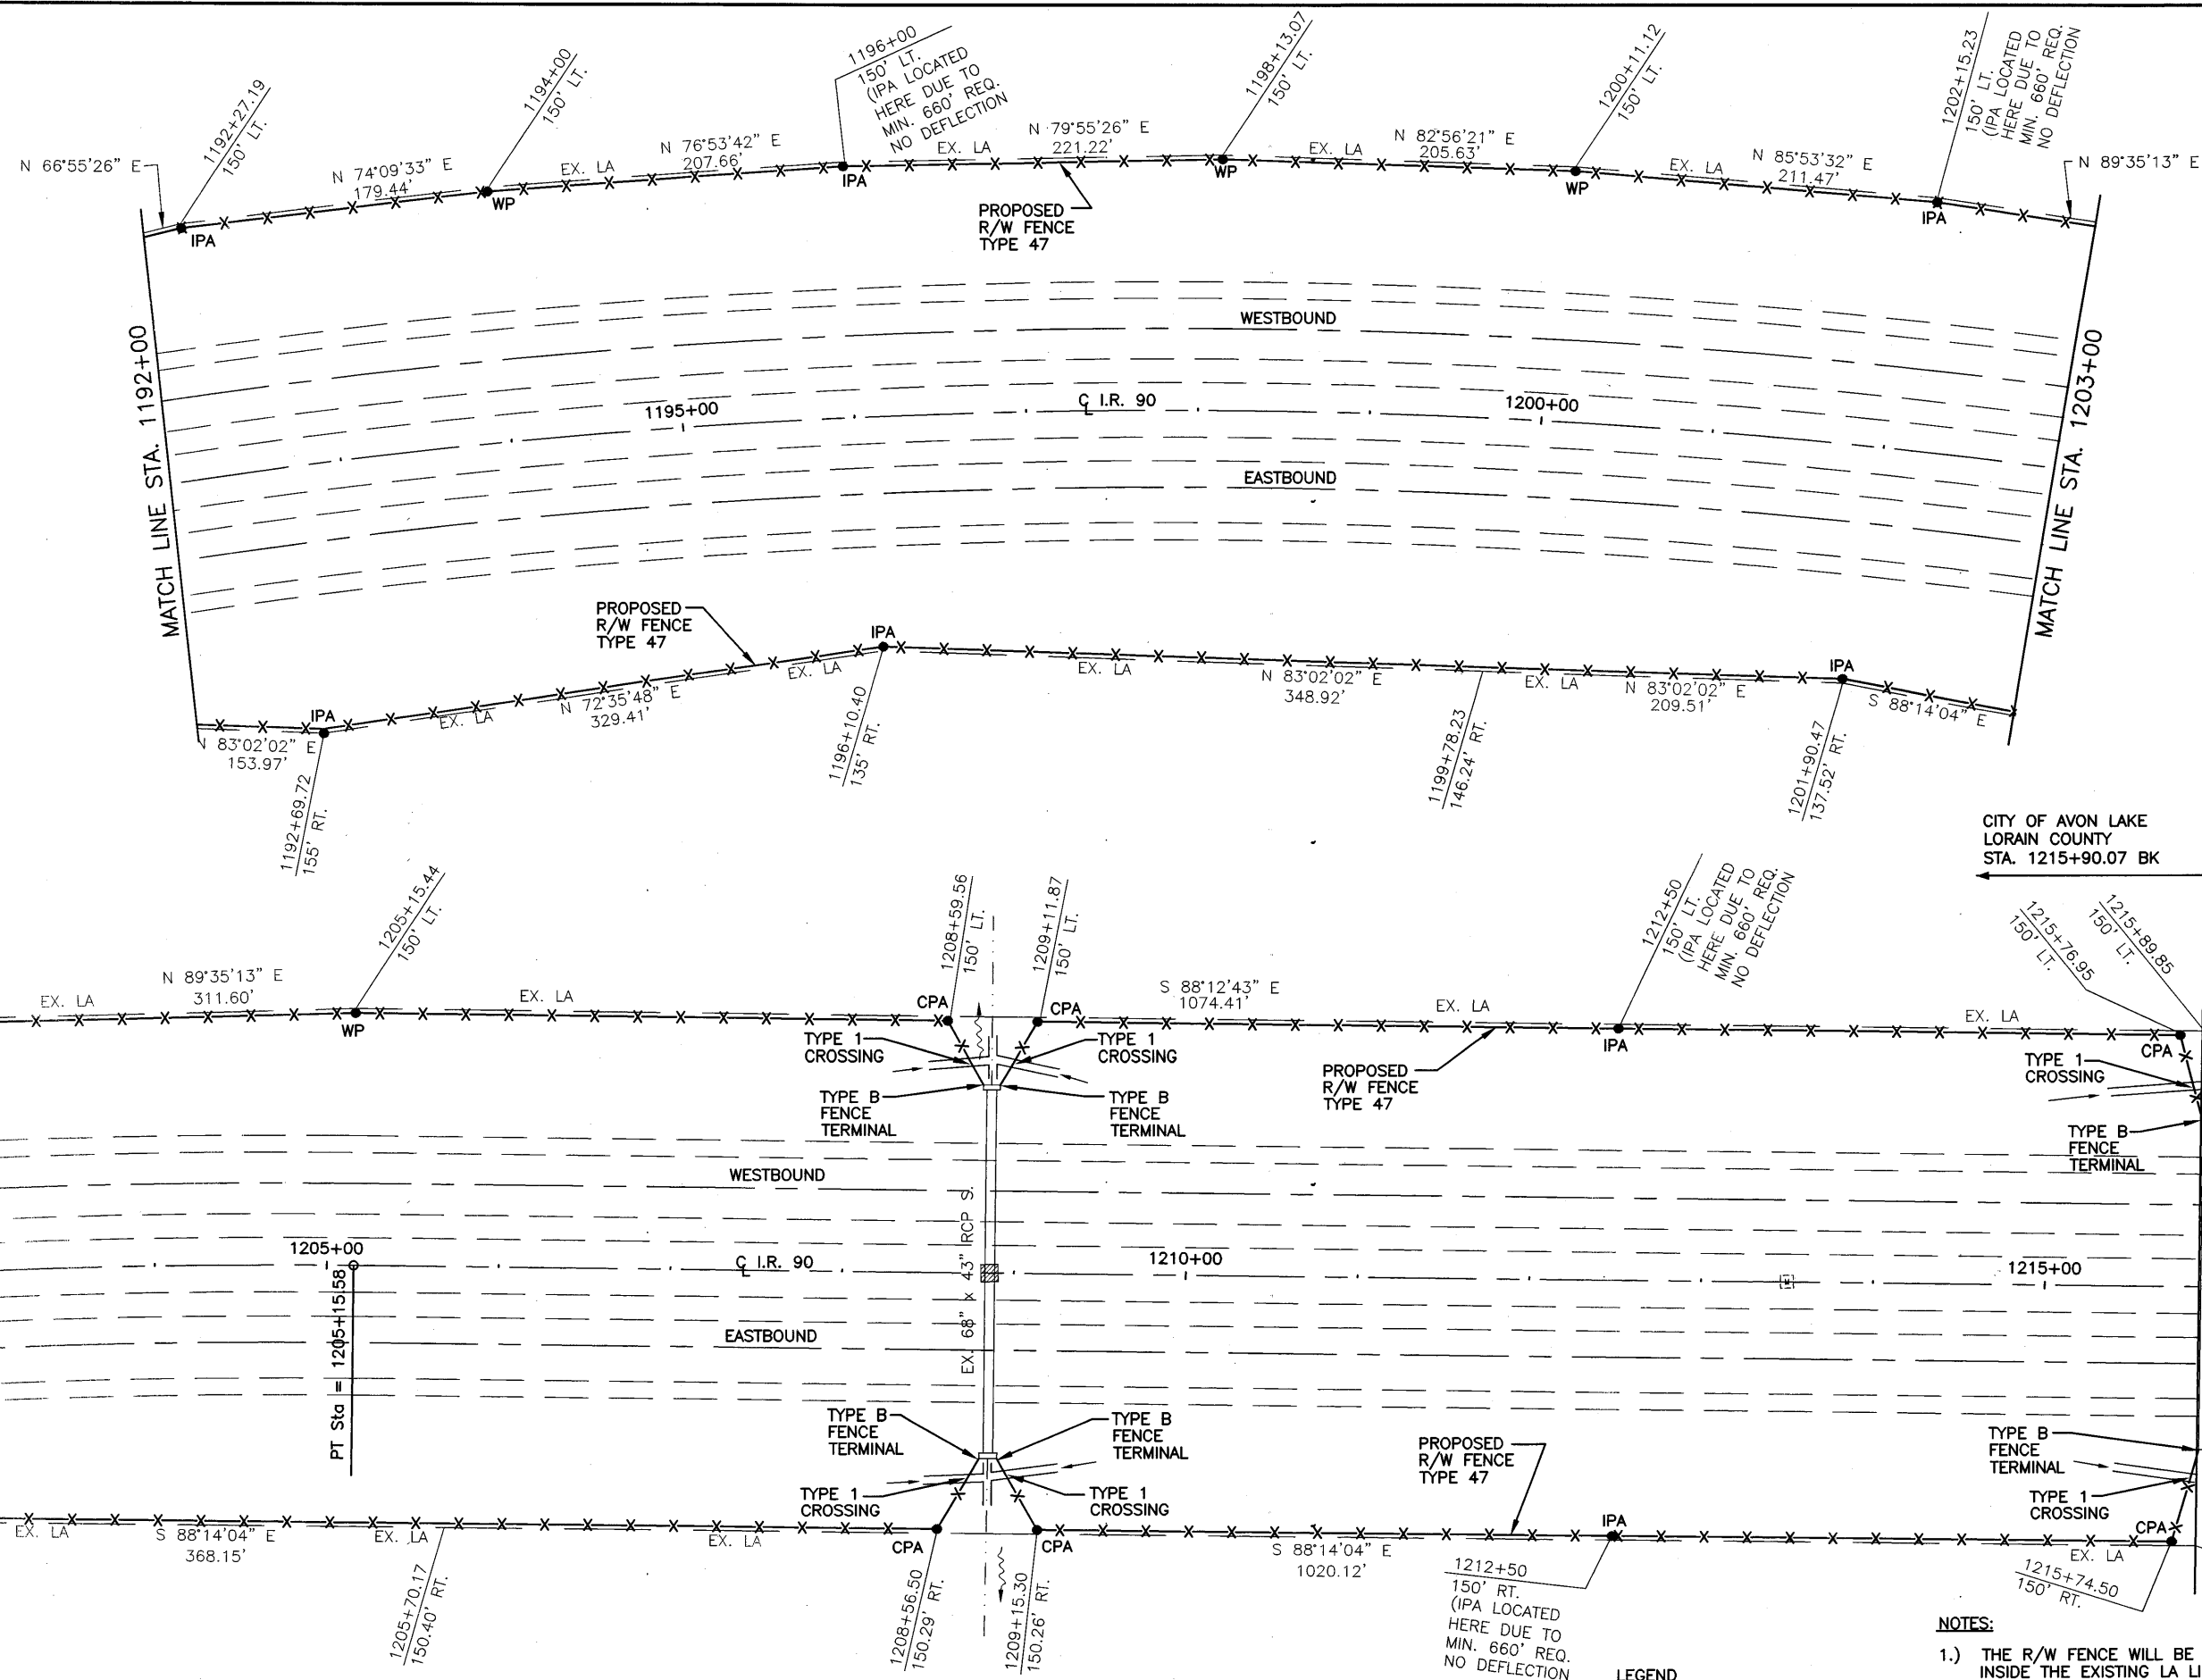

CITY OF AVON LAKE  
LORAIN COUNTY  
STA. 1215+90.07 BK

CITY OF WESTLAKE  
CUYAHOGA COUNTY  
STA. 0000+00 AHD



**FENCE PLAN**  
**STA. 1192+00 TO STA. 1215+90.07**

**LOR - 190 - 10.76**

274  
274

1212+50  
150' RT.  
(IPA LOCATED  
HERE DUE TO  
MIN. 660' REQ.  
NO DEFLECTION

- LEGEND**
- CPA ● = CORNER POST ASSEMBLY
  - IPA ● = INTERMEDIATE POST ASSEMBLY
  - WP ● = WOOD POST OR ENCASED STEEL POST

- NOTES:**
- 1.) THE R/W FENCE WILL BE SET 2 FEET INSIDE THE EXISTING LA LINE UNLESS OTHERWISE NOTED ON THE PLANS.
  - 2.) THE LENGTH BETWEEN DEFLECTION POINTS IS THE EXISTING LA LENGTH, NOT THE LENGTH OF THE FENCING.