SOUTHERN

ORFOLK

 \bigcirc

 \bigcirc

END PROJECT LOR-2-7.97

LOCATION MAP

LATITUDE: 40°55'38"N LONGITUDE: 81°59'14"

		SC	ALE IN MI	LES		
	0	1	2	3	4	h
PORTION	TO BE	IMPROVED	' 			
INTERST#	TE HIGH	WAY				
FEDERAL	ROUTES					_
STATE RO	OUTES					
COUNTY	& TOWNS	HIP ROAL	os			
OTHER R	OADS					

DESIGN DESIGNATION: SEE SHEET 2

DESIGN EXCEPTIONS

NONE REQUIRED

STATE OF OHIO DEPARTMENT OF TRANSPORTATION

LOR-2-3.86

CITY OF AMHERST BROWNHELM TOWNSHIP

LORAIN COUNTY

INDEX OF SHEETS:

TITLE SHEET	1	GUARDRAIL DETAILS	21-29
SCHEMATIC PLAN & DESIGN DESIGNATION	2-4	PAVEMENT MARKING SUB-SUMMARY	30
TYPICAL SECTIONS	5-6	RPM SUB-SUMMARY	31
GENERAL NOTES	7-8	LOOP DETECTOR NOTES & DETAILS	32
GUARDRAIL NOTES	9	STRUCTURE SUB-SUMMARY	33
MAINTENANCE OF TRAFFIC NOTES	10-12	STRUCTURE NOTES	34
GENERAL SUMMARY	<i>13-15</i>	STRUCTURE DETAILS	
PAVEMENT & SHOULDER DATA	16-17	LOR-2-0459 L&R	<i>35</i>
PAVEMENT TRANSITION DETAILS	18	LOR-2-0646 L&R	<i>36</i>
PAVEMENT REPAIR SUB-SUMMARY	19	LOR-2-0742 L&R	37
GUARDRATI SUB-SUMMARY	20		

PROJECT DESCRIPTION

THIS PROJECT WILL INCLUDE PAVEMENT REPAIRS, PLANING AND PAVING WITH ASPHALT CONCRETE, GUARDRAIL REPAIRS, PAVEMENT MARKINGS AND STRUCTURE MAINTENANCE.

EARTH DISTURBED AREAS

PROJECT EARTH DISTURBED AREA:

N/A ACRES

(MAINTENANCE PROJECT)

0407

37

S

(MAINTENANCE PROJECT) ESTIMATED CONTRACTOR EARTH DISTURBED AREA; N/A ACRES

NOTICE OF INTENT EARTH DISTURBED AREA: N/A ACRES

(MAINTENANCE PROJECT)

2019 SPECIFICATIONS


THE STANDARD SPECIFICATIONS OF THE STATE OF OHIO, DEPARTMENT OF TRANSPORTATION, INCLUDING SUPPLEMENTAL SPECIFICATIONS LISTED IN THE PLANS AND CHANGES LISTED IN THE PROPOSAL SHALL GOVERN THIS IMPROVEMENT.

I HEREBY APPROVE THESE PLANS AND DECLARE THAT THE MAKING OF THIS IMPROVEMENT WILL NOT REQUIRE THE CLOSING TO TRAFFIC OF THE HIGHWAY AND THAT PROVISIONS FOR THE MAINTENANCE AND SAFETY OF TRAFFIC WILL BE AS SET FORTH ON THE PLANS AND ESTIMATES.

DATE OS 27/20 TOSTRICT DEPUTY DIRECTOR

TRANSPORTATION



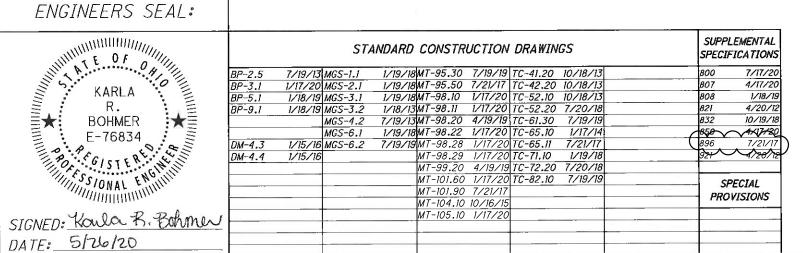

PLANS PREPARED BY: OHIO DEPARTMENT OF **TRANSPORTATION** DISTRICT THREE ENGINEERING

UTILITIES

LISTED BELOW ARE ALL UTILITIES LOCATED WITHIN THE PROJECT CONSTRUCTION LIMITS TOGETHER WITH THEIR RESPECTIVE OWNERS.

THE LOCATION OF THE UNDERGROUND UTILITIES SHOWN ON THE PLANS ARE AS OBTAINED FROM THE OWNERS AS REQUIRED BY SECTION 153.64 O.R.C.

CABLE WIDE OPEN WEST 105 BLAZE INDUSTRIAL PKWY BEREA, OH 44017 866.496.9669

CITY
CITY OF AMHERST
206 SOUTH MAIN
AMHERST, OHIO 44001
440-984-4380

COMMUNICATION CENTURYLINK 175 ASHLAND ROAD, P.O. BOX 3555 MANSFIELD, OH 44907 419.755.7956

COMMUNICATION LEVEL 3 COMMUNICATIONS 106 SOUTH ARLINGTON STREET AKRON, OH 44306 740.275.1133

ELECTRIC OHIO EDISON 1717 ASHLAND ROAD MANSFIELD, OH 44905 419.521.6213

GAS KNOX ENERGY 11872 WORTHINGTON RD PATASKALA, OH 43062 740.927.6731

TRAFFIC ODOT DISTRICT THREE 906 CLARK AVENUE ASHLAND, OH 44805 419.207.7045 CABLE
CHARTER COMMUNICATIONS
5520 WHIPPLE AVENUE NW
NORTH CANTON, OH 44720
330.494.9200

CITY
CITY OF LORAIN
200 W. ERIE AVENUE
LORAIN, OH 44052
440.204.2003

COMMUNICATION EVERSTREAM SOLUTIONS 800 W ST CLAIR, 2ND FLOOR CLEVELAND, OH 44113 216.581.7972

COMMUNICATION VERIZON BUSINESS 120 RAVINE STREET AKRON, OH 44303 330.253.8267

GAS COLUMBIA GAS OF OHIO 1021 N MAIN STREET MANSFIELD, OH 44903 419.528.1137

GAS TC ENERGY 589 N STATE ROAD MEDINA, OH 44256 330.721.4163

WATER NORTHERN OHIO RURAL WATER P.O. BOX 96 COLLINS, OH 44826 419.668.7213

THE AFOREMENTIONED UTILITY COMPANIES AND AGENCIES HAVE VARIOUS FACILITIES IN THE AREA THAT WILL REMAIN IN PLACE DURING CONSTRUCTION.

EXTREME CAUTION SHOULD BE EXERCISED IN AREAS WITH UTILITIES.
SECTIONS 105.07 AND 107.16 OF THE DEPARTMENT OF TRANSPORTATION
CONSTRUCTION AND MATERIALS SPECIFICATIONS REQUIRE, AMONG OTHER
THINGS, THAT THE CONTRACTOR COOPERATE WITH ALL UTILITIES LOCATED
WITHIN THE LIMITS OF THIS CONSTRUCTION PROJECT AND TAKE
RESPONSIBILITY FOR THE PROTECTION OF THE UTILITY PROPERTY AND
SFRVICES.

EXISTING PLANS

EXISTING PLANS ENTITLED LOR-254-0.00 B (LOR-2-3.31-7.97) (1964) MAY BE INSPECTED IN THE ODOT DISTRICT 3 OFFICE IN ASHLAND.

WORK LIMITS

THE WORK LIMITS SHOWN ON THESE PLANS ARE FOR PHYSICAL CONSTRUCTION ONLY. PROVIDE THE INSTALLATION AND OPERATION OF ALL WORK ZONE TRAFFIC CONTROL DEVICES REQUIRED BY THESE PLANS WHETHER INSIDE OR OUTSIDE THESE WORK LIMITS.

ROUTINE MAINTENANCE

BETWEEN THE TIME THAT BIDS ARE TAKEN AND THE START OF CONSTRUCTION, THE MAINTAINING AGENCY MAY ENTER UPON THE PROJECT AND PERFORM ROUTINE MAINTENANCE SUCH AS CRACK SEALING, PATCHING, AND BERM AND SHOULDER REPAIR. THE EFFECTS, IF ANY, OF THE PERFORMANCE OF ROUTINE MAINTENANCE SHALL BE CONSIDERED AS INHERENT IN WORK OF THE CHARACTER PROVIDED FOR IN THE PLAN AND THE RESULTING CONDITIONS SHALL NOT BE CONSIDERED AS DIFFERING MATERIALLY FROM THOSE EXISTING AT THE TIME BIDS WERE TAKEN.

PROFILE AND ALIGNMENT

PLACE THE PROPOSED ASPHALT CONCRETE OVERLAY TO FOLLOW THE ALIGNMENT AND PROFILE OF THE EXISTING PAVEMENT. (PREVIOUS CONSTRUCTION PLANS SHOWING THE ORIGINAL ALIGNMENT AND PROFILE, ARE AVAILABLE FOR INSPECTION AT THE ODOT DISTRICT 3 OFFICE). PLACE THE PROPOSED ASPHALT CONCRETE OVERLAY AS SHOWN ON THE TYPICAL SECTIONS.

ITEM 209 - LINEAR GRADING

THE CONTRACTOR IS REQUIRED TO PERFORM LINEAR GRADING ON THE GRADED SHOULDER. IT IS ANTICIPATED THAT THERE ARE AREAS WHERE THE GRADED SHOULDER IS AT A HIGHER ELEVATION THAN THE ADJACENT PROPOSED PAVEMENT. A 10:1 SLOPE SHALL BE ESTABLISHED, OR AS DIRECTED BY THE ENGINEER, WHEN PERFORMING ITEM 209 LINEAR GRADING. THE INTENT IS TO PROVIDE AN UNOBSTRUCTED AND POSITIVE FLOW OF STORM WATER FROM THE PAVEMENT TO THE DITCH. THE LINEAR GRADING SHALL BE PERFORMED AFTER THE INTERMEDIATE COURSE HAS BEEN COMPLETED AND BEFORE THE SURFACE COURSE IS PLACED. ALL LABOR AND EQUIPMENT NECESSARY TO PERFORM THE ABOVE WORK SHALL BE INCLUDED IN THE UNIT PRICE BID PER MILE FOR ITEM 209 - LINEAR GRADING.

<u>ITEM 251 - PARTIAL DEPTH PAVEMENT REPAIR (ASPHALT CONCRETE BASE)</u> <u>ITEM 253 - PAVEMENT REPAIR</u>

THESE ITEMS OF WORK SHALL CONSIST OF THE REMOVAL OF THE EXISTING ASPHALT CONCRETE PAVEMENT IN AREAS OF EXISTING PAVEMENT FAILURE. CORING HAS BEEN PERFORMED TO HELP DETERMINE THE COMPONENTS THAT MAY BE ENCOUNTERED DURING THIS ITEM OF WORK. THE PAVEMENT CORING INFORMATION IS SHOWN ON THIS SHEET.

PAVEMENT REPAIR SHALL BE PERFORMED BEFORE PAVEMENT PLANING AND PLACEMENT OF THE INTERMEDIATE AND SURFACE COURSES. THE DEPTH OF REMOVAL SHALL BE SUFFICIENT TO REMOVE ALL DETERIORATED PAVEMENT WITH AN AVERAGE DEPTH OF 6" FOR ESTIMATING PURPOSES.

THE CONTRACTOR SHALL BE CAPABLE OF PERFORMING PAVEMENT REPAIRS 4 FEET WIDE FOR TRANSVERSE REPAIRS AND 2 FEET WIDE FOR LONGITUDINAL REPAIRS.

REPLACEMENT MATERIAL SHALL BE ITEM 301 AND SHALL BE PLACED AND COMPACTED TO FINISH FLUSH WITH THE ADJACENT PAVEMENT SURFACE.

PAYMENT SHALL INCLUDE ALL LABOR, EQUIPMENT, AND MATERIALS NECESSARY TO COMPLETE THE PAVEMENT REPAIR. FOR PAYMENT PURPOSES ITEM 251 PARTIAL DEPTH PAVEMENT REPAIR (ASPHALT CONCRETE BASE) IS TO BE A MAXIMUM OF 6" DEEP AND ITEM 253 PAVEMENT REPAIR IS FOR DEPTHS GREATER THAN 6". PAYMENT WILL BE MADE AT THE UNIT BID PRICE PER CUBIC YARD, (BY TICKET WEIGHT CONVERSION), OF ITEM 251 - PARTIAL DEPTH PAVEMENT REPAIR (ASPHALT CONCRETE BASE) OR ITEM 253 - PAVEMENT REPAIR.

ITEM 251 - PARTIAL DEPTH PAVEMENT REPAIR (ASPHALT CONCRETE BASE):
SEE SHEET 19 FOR ESTIMATED QUANTITIES AND LOCATIONS. THE FINAL
LOCATION AND SIZE OF THE REPAIRS ARE TO BE DETERMINED IN THE FIELD
BY THE ENGINEER. IN ADDITION TO THE QUANTITIES PROVIDED ON SHEET
19, THE FOLLOWING ADDITIONAL ESTIMATED QUANTITIES ARE PROVIDED IN
THE GENERAL SUMMARY TO BE USED AS DIRECTED BY THE ENGINEER:
ITEM 251 - PARTIAL DEPTH PAVEMENT REPAIR (ASPHALT CONCRETE BASE)
(LONGITUDINAL): 325 CY
ITEM 251 - PARTIAL DEPTH PAVEMENT REPAIR (ASPHALT CONCRETE BASE)
(TRANSVERSE): 100 CY

ITEM 253 - PAVEMENT REPAIR:
THE FOLLOWING ESTIMATED QUANTITY IS PROVIDED IN THE GENERAL SUMMARY
TO BE USED AS DIRECTED BY THE ENGINEER:
ITEM 253 - PAVEMENT REPAIR: 100 CY

PAVEMENT CORING INFORMATION

COUNTY	ROUTE	SLM	ASPHAL T	CONCRETE	BRICK	LOCATION	DIRECTION	YEAR COREL
LOR	2	4.0	9.0	8.0	0.0	LT. WHEEL PATH	EB	2019
LOR	2	4.0	7.5	9.0	0.0	RT. WHEEL PATH	EB	2019
LOR	2	4.0	13.0	0.0	0.0	SHOULDER	EB	2019
LOR	2	4.6	8.0	8.5	0.0	CENTER OF LANE	EB	2019
LOR	2	4.6	9.0	9.0	0.0	RT. WHEEL PATH	EB	2019
LOR	2	4.6	12.0	0.0	0.0	SHOULDER	EB	2019
LOR	2	5.0	8.0	9.0	0.0	CENTER OF LANE	EB	2019
LOR	2	5.0	10.0	6.0	0.0	RT. WHEEL PATH	EB	2019
LOR	2	5.0	10.0	0.0	0.0	SHOULDER	EB	2019
LOR	2	5.7	7.0	9.0	0.0	CENTER OF LANE	EB	2019
LOR	2	5.7	7.0	9.0	0.0	RT. WHEEL PATH	EB	2019
LOR	2	5.7	13.0	0.0	0.0	SHOULDER	EB	2019
LOR	2	6.0	7.5	8.0	0.0	CENTER OF LANE	EB	2019
LOR	2	6.0	6.0	8.0	0.0	RT. WHEEL PATH	EB	2019
LOR	2	6.0	13.0	0.0	0.0	SHOULDER	EB	2019
LOR	2	6.5	8.0	10.5	0.0	CENTER OF LANE	EB	2019
LOR	2	6.5	8.0	10.0	0.0	RT. WHEEL PATH	EB	2019
LOR	2	6.5	15.0	0.0	0.0	SHOULDER	EB	2019
LOR	2	7.1	7.0	8.5	0.0	CENTER OF LANE	EB	2019
LOR	2	7.1	6.5	9.0	0.0	RT. WHEEL PATH	EB	2019
LOR	2	7.1	9.0	0.0	0.0	SHOULDER	EB	2019
LOR	2	8.0	5.0	8.5	0.0	CENTER OF LANE	EB	2019
LOR	2	8.0	5.0	9.0	0.0	RT. WHEEL PATH	EB	2019
LOR	2	8.0	6.0	2.5	0.0	SHOULDER	EB	2019

<u>ITEM 255 - FULL DEPTH PAVEMENT REMOVAL AND RIGID REPLACEMENT, AS PER PLAN</u>

ITEM 255 - FULL DEPTH PAVEMENT REMOVAL AND RIGID REPLACEMENT, AS PER PLAN IS TO BE USED FOR FULL DEPTH RIGID PAVEMENT REPAIRS. PAVEMENT REPAIRS SHALL BE PERFORMED BEFORE PAVEMENT PLANING AND PLACEMENT OF THE INTERMEDIATE AND SURFACE COURSES. CLASS OC MS (OPTION A) OR CLASS RRCM (OPTION B) WILL BE ALLOWED FOR THE REPAIRS.

CONCRETE SHALL BE PLACED IN THE REPAIR AREA THE SAME DAY THAT THE EXISTING PAVEMENT IS REMOVED FROM THE REPAIR AREA.

SEAL THE PERIMETER SURFACE OF THE REPAIRED AREAS BY APPLYING A 2 TO 4 INCH WIDE STRIP OF APPROVED 705.04 MATERIAL OR 702.01 APPROVED PG BINDER.

PAYMENT FOR ALL OF THE ABOVE SHALL BE AT THE UNIT PRICE BID PER SOUARE YARD FOR THE ABOVE ITEM, AND WILL INCLUDE ALL LABOR, EQUIPMENT, MATERIALS AND INCIDENTALS NECESSARY TO COMPLETE THE ABOVE WORK.

SEE SHEET 19 FOR ESTIMATED QUANTITIES AND LOCATIONS. THE FINAL LOCATION AND SIZE OF THE REPAIRS ARE TO BE DETERMINED IN THE FIELD BY THE ENGINEER. IN ADDITION TO THE QUANTITIES PROVIDED ON SHEET 19, THE FOLLOWING ADDITIONAL ESTIMATED QUANTITIES ARE PROVIDED IN THE GENERAL SUMMARY TO BE USED AS DIRECTED BY THE ENGINEER:

ITEM 255 - FULL DEPTH PAVEMENT REMOVAL AND RIGID REPLACEMENT, CLASS OC MS, AS PER PLAN (OPTION A):
160 SY

ITEM 255 - FULL DEPTH PAVEMENT REMOVAL AND RIGID REPLACEMENT, CLASS RRCM, AS PER PLAN (OPTION B): 160 SY

ITEM 255 - FULL DEPTH PAVEMENT SAWING: 600 SY

Σ

<u> ITEM 614 - WORKSITE TRAFFIC SUPERVISOR</u>

SUBJECT TO APPROVAL OF THE ENGINEER, THE CONTRACTOR SHALL EMPLOY AND IDENTIFY (SOMEONE OTHER THAN THE SUPERINTENDENT) A PREQUALIFIED WORKSITE TRAFFIC SUPERVISOR (WTS) BEFORE STARTING WORK IN THE FIELD. THE WTS SHALL BE TRAINED IN ACCORDANCE WITH CMS 614.03, SHALL HAVE SUCCESSFULLY COMPLETED ODOT ADMINISTERED WTS TESTING (AND RE-TESTING WHEN APPLICABLE) AND BE LISTED ON THE ODOT PREQUALIFIED WTS ROSTER. PREQUALIFICATION EXPIRES EVERY 5 YEARS. RE-TESTING SHALL BE SUCCESSFULLY REPEATED EVERY 5 YEARS TO REMAIN PREQUALIFIED.

THE NAME OF THE PREQUALIFIED WTS AND RELATED 24-HOUR CONTACT INFORMATION SHALL BE PROVIDED TO THE ENGINEER AT THE PRECONSTRUCTION CONFERNCE. IF THE DESIGNATED WTS WILL NOT BE AVAILABLE FULL TIME (24/7), THE CONTRACTOR MAY DESIGNATE AN ALTERNATE (SECONDARY) WTS TO BE AVAILABLE WHEN THE PRIMARY IS OFF DUTY; HOWEVER THE PRIMARY WTS SHALL REMAIN THE POINT OF CONTACT AT ALL TIMES. ANY ALTERNATE (SECONDARY) WTS IS SUBJECT TO THE SAME TRAINING, PREQUALIFICATION AND OTHER REQUIREMENTS OUTLINED WITHIN THIS PLAN NOTE. AT ALL TIMES THE ENGINEER, OR ENGINEER'S REPRESENTATIVES, MUST BE INFORMED OF WHO THE PRIMARY WTS (AND SECONDARY WTS, IF APPLICABLE) IS AT THE CURRENT TIME.

THE WTS POSITION HAS THE PRIMARY RESPONSIBILITY OF IMPLEMENTING THE TRAFFIC MANAGEMENT PLAN (TMP), MONITORING THE SAFETY AND MOBILITY OF THE ENTIRE WORK ZONE, AND CORRECTING TEMPORARY TRAFFIC CONTROL (TTC) DEFICIENCIES FOR THE ENTIRE WORK ZONE. THE WTS, AND ALTERNATE WTS WHEN ON DUTY, SHALL HAVE SUFFICIENT AUTHORITY TO EFFECTIVELY CARRY OUT THE IDENTIFIED WTS RESPONSIBILITIES AND DUTIES. THE DUTIES OF THE WTS ARE AS FOLLOWS:

- 1. BE AVAILABLE ON A 24-HOUR PER DAY BASIS.
- 2. BE ON SITE FOR ALL EMERGENCY TTC NEEDS WITHIN ONE HOUR OF NOTIFICATION BY POLICE OR PROJECT STAFF, AND EFFECT CORRECTIVE MEASURES IMMEDIATELY ON EXISTING WORK ZONE TTC DEVICES.
- 3. ATTEND PRECONSTRUCTION MEETING AND ALL PROJECT MEETINGS WHERE TTC MANAGEMENT IS DISCUSSED.
- 4. BE AVAILABLE ON SITE FOR OTHER MEETINGS OR DISCUSSIONS WITH THE ENGINEER UPON REQUEST.
- 5. BE AWARE OF ALL EXISTING AND PROPOSED TTC OPERATIONS OF THE CONTRACTOR, SUBCONTRACTORS AND SUPPLIERS, AND ENSURE COORDINATION OCCURS BETWEEN THEM TO ELIMINATE CONFLICTING TEMPORARY AND/OR PERMANENT TRAFFIC CONTROL.
- 6. COORDINATE PROJECT ACTIVITIES WITH ALL LAW ENFORCEMENT OFFICERS (LEOS). THE WTS SHALL ALSO BE THE MAIN CONTACT PERSON WITH THE LEOS WHILE LEOS ARE ON THE PROJECT.
- 7. COORDINATE AND FACILITATE MEETINGS WITH ODOT PERSONNEL, LEOS AND OTHER APPLICABLE ENTITIES BEFORE EACH PLAN PHASE SWITCH TO DISCUSS THE WORK ZONE TTC FOR IMPLEMENTING THE PHASE SWITCH. SUBMIT A WRITTEN DETAIL OF MOT OPERATIONS AND SCHEDULE OF EVENTS TO IMPLEMENT THE SWITCH BETWEEN PHASE PLANS TO THE ENGINEER 5 CALENDAR DAYS PRIOR TO THIS MEETING.
- 8. BE PRESENT, ON SITE FOR, AND INVOLVED WITH, EACH TTC SET UP/TAKE DOWN AND EACH PHASE CHANGE IN ACCORDANCE WITH CMS 614.03.
- 9. ON A CONTINUAL BASIS ENSURE THAT THE TTC ZONE AND ALL RELATED DEVICES ARE INSTALLED, MAINTAINED AND REMOVED IN COMPLIANCE WITH THE CONTRACT DOCUMENTS.
- 10. ON A CONTINUAL BASIS FACILITATE CORRECTIVE ACTION(S) NECESSARY TO BRING DEFICIENT TTC ZONES AND ALL RELATED DEVICES INTO COMPLIANCE WITH CONTRACT DOCUMENTS IN THE TIMEFRAME DETERMINED BY THE ENGINEER.
- II. INSPECT, EVALUATE, PROPOSE NECESSARY MODIFICATIONS TO, AND DOCUMENT THE EFFECTIVENESS OF, THE TTC DEVICES AND TRAFFIC OPERATIONS ON A DAILY BASIS (7 DAYS A WEEK). IN ADDITION, PERFORM ONE WEEKLY NIGHT INSPECTION OF THE WORK ZONE SETUP FOR DAYTIME WORK OPERATIONS; AND ONE DAYTIME INSPECTION PER WEEK FOR NIGHTTIME PROJECTS. THIS SHALL INCLUDE (BUT NOT BE LIMITED TO) DOCUMENTATION ON THE FOLLOWING PROJECT EVENTS:
- A. INITIAL TTC SETUP (DAY AND NIGHT REVIEW).
- B. DAILY TTC SETUP AND REMOVAL.
- C. WHEN CONSTRUCTION STAGING CAUSES A CHANGE IN THE TTC SETUP.
 D. CRASH OCCURRENCES WITHIN THE CONSTRUCTION AREA AND WITHIN THE
 INFLUENCE AREA(S) APPROACHING THE WORK ZONE.
- INFLUENCE AREA(S) APPROACHING THE WORK ZONE. E. REMOVAL OF TTC DEVICES AT THE END OF A PHASE OR PROJECT. F. ALL OTHER EMERGENCY TTC NEEDS.

<u>ITEM 614 - WORKSITE TRAFFIC SUPERVISOR (CONTINUED)</u>

12. COMPLETE THE DEPARTMENT APPROVED LONG TERM INSPECTION FORM (CA-D-8) AFTER EACH INSPECTION AS REQUIRED IN # 11 AND SUBMIT IT TO THE ENGINEER THE FOLLOWING WORKDAY. THESE REPORTS SHALL INCLUDE A CHECKLIST OF ALL TTC MAINTENANCE ITEMS TO BE REVIEWED. A COPY OF THE FORM WILL BE PROVIDED AT THE PRE-CONSTRUCTION MEETING. ANY DEFICIENCIES OBSERVED SHALL BE NOTED, ALONG WITH RECOMMENDED OR COMPLETED CORRECTIVE ACTIONS AND THE DATES BY WHICH SUCH CORRECTIONS WERE, OR WILL BE, COMPLETED. A COPY OF THE CONSTRUCTION ADMINISTRATION'S INSPECTION FORMS WEBSITE.

13. HAVE COPIES OF THE ODOT TEMPORARY TRAFFIC CONTROL MANUAL AND CONTRACT DOCUMENTS AVAILABLE AT ALL TIMES ON THE PROJECT.

THE DEPARTMENT WILL DEDUCT:

A. THE PRORATED DAILY AMOUNT OF ITEM 614 MAINTAINING TRAFFIC FOR ANY DAY IN WHICH THE WTS FAILS TO PERFORM THE DUTIES SET FORTH ABOVE. THE PRORATED DAILY AMOUNT WILL BE EQUAL TO THE ORIGINAL BID AMOUNT FOR ITEM 614 MAINTAINING TRAFFIC DIVIDED BY THE DIFFERENCE BETWEEN THE ORIGINAL COMPLETION DATE AND THE FIRST DAY OF WORK, IN CALENDAR DAYS.

B. 1% OF THE ORIGINAL BID AMOUNT FOR ITEM 614 MAINTAINING TRAFFIC FOR ANY DAY THAT A TTC ISSUE IS IDENTIFIED IN THE FIELD AND IS NOT CORRECTED IN THE GIVEN TIMEFRAME PER THE ENGINEER. DEDUCTION B SHALL NOT APPLY TO SITUATIONS COVERED BY DEDUCTION C.

C. 1% OF THE ORIGINAL BID AMOUNT FOR ITEM 614 MAINTAINING TRAFFIC FOR ANY DAY THAT A LANE OR RAMP IS BLOCKED (FULLY OR PARTIALLY) WITHOUT TTC, AS DETERMINED BY THE ENGINEER. THIS DEDUCTION SHALL BE IN ADDITION TO ANY OTHER DISINCENTIVES ESTABLISHED FOR UNAUTHORIZED LANE USE.

FOR DAYS IN WHICH MORE THAN ONE DEDUCTION LISTED ABOVE OCCUR, THE HIGHEST DEDUCTION AMOUNT WILL APPLY.

IF THREE OR MORE TOTAL DAYS RESULT IN TTC ISSUES DESCRIBED IN DEDUCTION B OR C ABOVE, THE PRIMARY WTS SHALL BE IMMEDIATELY REMOVED FROM THE WORK IN ACCORDANCE WITH C&MS 108.05. UPON REMOVAL THE ENGINEER SHALL NOTIFY ODOT CENTRAL OFFICE (WTSPREQUALIFICATION@DOT.OHIO.GOV) TO REGISTER A REMOVAL AGAINST THE STATEWIDE PREOUALIFICATION FOR THE PRIMARY WTS. THREE REMOVALS SHALL CAUSE STATEWIDE DISQUALIFICATION FOR ANY PREVIOUSLY PREQUALIFIED WTS.

PAYMENT FOR THE ABOVE REQUIREMENTS, RESPONSIBILITIES AND DUTIES SHALL BE INCLUDED IN THE LUMP SUM PRICE BID FOR ITEM 614, MAINTAINING TRAFFIC.

<u>INTERIM COMPLETION DATE (FOR FULL DEPTH RIGID REPAIRS EAST OF OAK POINT RD)</u>

THE CONTRACTOR SHALL PERFORM ALL FULL-DEPTH CONCRETE JOINT REPAIRS EAST OF THE OAK POINT/LAKE RD INTERCHANGE PRIOR TO NOVEMBER 23, 2020. THIS DATE SHALL CONSTITUTE AN INTERIM COMPLETION DATE ON THE PROJECT. IF ALL FULL-DEPTH CONCRETE JOINT REPAIRS EAST OF OAK POINT/LAKE RD ARE NOT COMPLETED BY NOVEMBER 23, 2020, A DISINCENTIVE OF \$1,000 PER DAY SHALL BE ASSESSED FOR EACH DAY AFTER NOVEMBER 23, 2020 THAT FULL-DEPTH CONCRETE JOINT REPAIRS ARE NOT COMPLETE. BECAUSE THE CONCRETE JOINT REPAIRS REQUIRE CURE TIME TO ACHIEVE STRENGTH PRIOR TO OPENING THE REPAIRS TO TRAFFIC, THE LANE CLOSURE SCHEDULE BELOW CAN BE USED FOR CONCRETE JOINT REPAIR WORK PERFORMED IN 2020 ONLY.

DIDECTION	ALLOWABLE LANE	CLOSURE TIMES
DIRECTION	WEEKNIGHT	WEEKEND
EACTROUND.	4 DM 7 4M	4 PM FRIDAY -
EASTBOUND	4 PM - 7 AM	7 AM MONDAY
WESTROUND	7 DM - 7 DM	7 PM FRIDAY -
WESTBOUND	7 PW - 3 PW	3 PM MONDAY
EASTROUND	6 014 6 414	6 PM FRIDAY -
EASTBOUND	O FM - O AM	6 AM MONDAY
WESTROUND	7 DM 2 DM	7 PM FRIDAY -
WESTBOUND	I FINI - Z PINI	2 PM MONDAY
	DIRECTION EASTBOUND WESTBOUND WESTBOUND	WEEKNIGHT EASTBOUND 4 PM - 7 AM WESTBOUND 7 PM - 3 PM EASTBOUND 6 PM - 6 AM

HOURLY DISINCENTIVES FOR LANE CLOSURE VIOLATIONS OF \$235 PER MINUTE SHALL BE ASSESSED FOR EACH MINUTE ALL LANES ARE NOT OPEN TO TRAFFIC. THE ABOVE SCHEDULE ALSO APPLIES TO RAMP CLOSURE AND DETOUR TIMES FOR CONCRETE JOINT REPAIR WORK. JOINT REPAIRS MAY BE PERFORMED USING OC MS (OPTION A) OR RRCM (OPTION B) CONCRETE, BUT IN EITHER CASE, ADEQUATE STRENGTH AND/OR CURE TIME SHALL BE ACHIEVED PER THE REQUIREMENTS OF THE CMS PRIOR TO OPENING A CLOSED LANE TO TRAFFIC.

APPROVED MAINTENANCE OF TRAFFIC (MOT) POLICY EXCEPTION

PORTIONS OF THE MOT PLANS AS DESCRIBED BELOW HAVE BEEN APPROVED BY THE MOT EXCEPTION COMMITTEE (MOTEC) PER TRAFFIC MANAGEMENT IN WORK ZONES POLICY (21-008(P)) AND STANDARD PROCEDURE (123-001(SP)).

APPROVED MOT EXCEPTION(S) INCLUDE: ALLOWABLE LANE CLOSURE TIMES AS DETAILED IN THE INTERIM COMPLETION DATE (FOR FULL DEPTH RIGID REPAIRS EAST OF OAK POINT RD) PLAN NOTE ON THIS SHEET.

A MAINTENANCE OF TRAFFIC MEETING SHALL BE HELD A MINIMUM OF T CALENDAR DAYS PRIOR TO IMPLEMENTATION OF EACH APPROVED MOT EXCEPTION. THIS MEETING SHALL INCLUDE THE DISTRICT WORK ZONE TRAFFIC MANAGER AS WELL AS THE CONTRACTOR, WORKSITE TRAFFIC SUPERVISOR (WTS) AND ANY SUBCONTRACTORS INVOLVED WITH TEMPORARY TRAFFIC CONTROL.

IN ADDITION TO ANY NOTIFICATIONS REQUIRED IN OTHER NOTES, THE CONTRACTOR SHALL NOTIFY THE PROJECT ENGINEER AT LEAST 3 BUSINESS DAYS IN ADVANCE OF IMPLEMENTATION OF THE APPROVED MOT EXCEPTION(S) REFERENCED ABOVE SO THAT THE PROJECT ENGINEER CAN SEND EMAIL NOTIFICATION TO THE OFFICE OF ROADWAY ENGINEERING, STATEWIDE TMC, DWZTM AND SPECIAL HAULING PERMITS AT LEAST 2 BUSINESS DAYS IN ADVANCE OF THE IMPLEMENTATION OF THE APPROVED MOT EXCEPTION(S) REFERENCED ABOVE. REFERENCE "EXCEPTION REQUEST APPROVAL DATED 08/27/2020 FOR PID 77537" IN THE NOTIFICATION AND OTHER CORRESPONDENCE.

ANY CHANGES TO THE MOT THAT IMPACT THE PREVIOUSLY APPROVED MOT EXCEPTION(S) LISTED ABOVE SHALL BE APPROVED IN WRITING BY THE APPLICABLE ODOT CENTRAL OFFICE COMMITTEE (MOTEC). IN THE EVENT THAT SUCH CHANGES ARE PROPOSED, THE REQUEST SHALL BE COORDINATED THROUGH THE DISTRICT WORK ZONE TRAFFIC MANAGER (DWZTM) A MINIMUM OF 30 CALENDAR DAYS PRIOR TO THE DESIRED IMPLEMENTATION DATE. IF THE DISTRICT AGREES WITH THE PROPOSED CHANGES THE DWZTM SHALL SEEK APPROVAL FROM THE APPLICABLE ODOT CENTRAL OFFICE COMMITTEE. IN THE EVENT THE PROPOSED CHANGES ARE APPROVED IN WRITING, THE CLOSURES ARE STILL SUBJECT TO NOTIFICATION REQUIREMENTS WITHIN THIS NOTE PRIOR TO IMPLEMENTATION.

WORK ZONE QUEUE DETECTION WARNING SYSTEM

IF THE CONTRACTOR ELECTS TO USE CLASS OC MS (OPTION A) FOR THE FULL DEPTH RIGID REPAIRS WITH A WEEKEND CLOSURE, THE CONTRACTOR SHALL FURNISH, INSTALL, AND MAINTAIN AN APPROVED WORK ZONE QUEUE DETECTION WARNING SYSTEM (WZQDWS) AS PER SUPPLEMENTAL SPECIFICATION 896.

IT IS EXPECTED THAT THE LOCATIONS OF THE WZQDWS DEVICES WILL VARY BASED ON PLANNED OR UNPLANNED PHASE AND TRAFFIC PATTERN CHANGES. PLACEMENT, OPERATION, MAINTENANCE AND ALL ACTIVATION OF THE DEVICES BY THE CONTRACTOR SHALL BE DIRECTED BY THE ENGINEER.

THE FOLLOWING TRAFFIC SENSOR THRESHOLDS AND PORTABLE CHANGEABLE MESSAGE SIGNS (PCMS) MESSAGES SHALL BE USED:

GREATER THAN OR EQUAL TO 50 MPH - USE FOUR CORNER FLASHING CAUTION MODE

BETWEEN 50 MPH AND 25 MPH - TRAFFIC AHEAD XX MPH / SLOW DOWN

BELOW OR EQUAL TO 25 MPH - TRAFFIC AHEAD XX MPH / PREPARE TO STOP

FOUR CORNER FLASHING CAUTION MODE SHALL CONSIST OF THE USE OF ONE ASTERISK IN EACH CORNER OF THE PCMS DISPLAY (4 TOTAL ASTERISKS).

XX SHALL BE ROUNDED UP TO THE NEAREST MULTIPLE OF 5 MPH MINUS 1. OCCUPANCY MAY BE DIRECTED TO BE USED BASED ON CERTAIN TRAFFIC CONDITIONS AND SCENARIOS. ODOT WILL DIRECT THE CONTRACTOR OF THE THRESHOLDS TO BE USED FOR THOSE AREAS WHERE OCCUPANCY IS DIRECTED TO BE USED.

THE FOLLOWING ESTIMATED QUANTITIES HAVE BEEN CARRIED TO THE GENERAL SUMMARY FOR PAVEMENT OPTION A: QC MS FULL DEPTH REPAIRS:

ITEM 896 - PORTABLE NON-INTRUSIVE TRAFFIC SENSOR, CLASS II 10 SIGN MONTHS (ASSUMING 5 SENSORS PER DIRECTION FOR 1 MONTH)

ITEM 896 - PORTABLE CHANGEABLE MESSAGE SIGN 4 SIGN MONTHS (ASSUMING 2 PCMS SIGNS PER DIRECTION FOR 1 MONTH)

					SHEET	NUM.							PART.	ITEM	ITEM	GRAND	UNIT	DESCRIPTION	SE. SHEL	
7	8	10	11	$\left \left\{ \begin{array}{c} 12 \end{array} \right\} \right $	16	17	19	20	30	31	32	01/NHS/P	02/NHS/B 03/SAF/0	1, 1, 1, 1, 1, 1, 1, 1, 1, 1, 1, 1, 1, 1	EXT	TOTAL	OIVII	DESCRIPTION	NO	0.
												 '	Λ ,					ROADWAY		-
								12,556				12,556		202	38000	12,556	FT	GUARDRAIL REMOVED		-
								1,531				1,531		202	38300	1,531	FT	GUARDRAIL REMOVED, BARRIER DESIGN		
								16				16		202	42010	16		ANCHOR ASSEMBLY REMOVED, TYPE E		\neg
								20				20		202	42040	20		ANCHOR ASSEMBLY REMOVED, TYPE T		
								21				21		202	47000	21		BRIDGE TERMINAL ASSEMBLY REMOVED		
								11				11		202	47800	11		IMPACT ATTENUATOR REMOVED		
								220				220		203	20001	220		EMBANKMENT, AS PER PLAN	9	9
								154.95				154.95		209	15001	154.95		RESHAPING UNDER GUARDRAIL, AS PER PLAN	9	9
					9.48	9.39		10.550				18.87		209	60500	18.87	MILE	LINEAR GRADING	_	
								12,556				12,556		606	15050	12,556	FT	GUARDRAIL, TYPE MGS		
				 				1,531				1,531		606	15550	1,531	FT	GUARDRAIL, BARRIER DESIGN, TYPE MGS		
								16				16		606	26150	16		ANCHOR ASSEMBLY, MGS TYPE E (MASH 2016)	+	-
								20				20		606	26550	20		ANCHOR ASSEMBLY, MGS TYPE T		$\overline{}$
								14				14		606	35002	14	EACH	MGS BRIDGE TERMINAL ASSEMBLY, TYPE I		\neg
								7				7		606	35102	7	EACH	MGS BRIDGE TERMINAL ASSEMBLY, TYPE 2		
								10				10		606	60012	10		IMPACT ATTENUATOR, TYPE I (BIDIRECTIONAL)		
								1				1		606	60028	1	EACH	IMPACT ATTENUATOR, TYPE 2 (BIDIRECTIONAL) (65 MPH/24" WIDE)		
														0.70	70000		· · ·	EROSION CONTROL		
												1,000		832	30000	1,000	EACH	EROSION CONTROL		
-				 								+		+		-		DRAINAGE	+	
	18											18		611	98630	18	EACH	CATCH BASIN ADJUSTED TO GRADE		
	1											1		611	99150	1	EACH	INLET ADJUSTED TO GRADE		
	2											2		611	99654	2	EACH	MANHOLE ADJUSTED TO GRADE		
																		PAVEMENT		
25							517					842		251	01042	842	CY	PARTIAL DEPTH PAVEMENT REPAIR (ASPHALT CONCRETE BASE) (LONGITUDINAL)		
20							250					350		251	01042	350	CY	PARTIAL DEPTH PAVEMENT REPAIR (ASPHALT CONCRETE BASE) (TRANSVERSE)		
00												100		253	02000	100	CY	PAVEMENT REPAIR		
						100,353						200,836		254	01000	200,836		PAVEMENT PLANING, ASPHALT CONCRETE (2")		
				2	2 , 997	3,044						6,041		254	01000	6,041	SY	PAVEMENT PLANING, ASPHALT CONCRETE (TAPER 2" TO 3.25")		
					0.570	0.400						4.004		25.4	01000	4.004	CV	PAVEMENT PLANING, ASPHALT CONCRETE (3.25") (ITEM 407 - TACK COAT, 702.13,	+-	
					2,572	2,422						4,994		254 254	01000	4,994	SY		}	
00					530	529	5,640					1,059 6,240		255	01600 20000	1,059 6,240	SY	INTERMEDIATE COURSE. 19 MM.	\	
				1.	3,789	13,759	3,040					27,548		407	20000	27,548		NON-TRACKING TACK COAT TYPE A (448) AND ITHER 255 - FULL DEPTH PAVEMENT	} 	
				I I	4,449	4,410						8,859		408	10001	8,859	GAL	PRIME COAT, AS PER PLAN REMOVAL AND RIGID REPLACEMENT,	$\frac{1}{8}$	8
				 	7,770	7,770						0,000		1 ,00	70007	0,000	OAL	CLASS RRCM	{ ~	
				ϵ	5,630	6,618						13,248		442	00100	13,248	CY	ANTI-SEGREGATION EQUIPMENT	4	
					5,157	5,146						10,303		442	10101	10,303	CY	ASPHALT CONCRETE INTERMEDIATE COURSE, 19 MM, TYPE A (446), AS PER PLAN (PG 64-28)	8	8
					4,416	4,404						8,820		442	10300	8,820	CY	ASPHALT CONCRETE SURFACE COURSE, 12.5 MM, TYPE A (447) (PG 70-22)		
					614	610						1,224		617	10100	1,224	CY	COMPACTED AGGREGATE		
					11,114	11,015						22,129		617	20000	22,129	SY	SHOULDER PREPARATION		
					7.99	7.99						15.98		618	40600	15.98	MILE	RUMBLE STRIPS, SHOULDER (ASPHALT CONCRETE)		
																		PAVEMENT OPTION A: OC MS FULL DEPTH REPAIRS		
20							(1504)					\$1,664		255	10161	1,664	$rac{1}{SY}$	FULL DEPTH PAVEMENT REMOVAL AND RIGID REPLACEMENT, CLASS OC MS, AS PER PLAN	157	7 }
$\widetilde{\sim} +$				570			{1,504}					10		896	00012	10	SNMT }	PORTABLE NON-INTRUSIVE TRAFFIC SENSOR, CLASS II		~
				{ 4 }								1		896	00020	4	SNMT {	PORTABLE CHANGEABLE MESSAGE SIGN		
				\www.												 				
\sim							\sim								~~~~	·····	~~~	PAVEMENT OPTION B: RRCM FULL DEPTH REPAIRS		~
0 X I							\ 1,504 \					1,664		255	10501	1,664	SY 🔾	FULL DEPTH PAVEMENT REMOVAL AND RIGID REPLACEMENT, CLASS RRCM, AS PER PLAN	\ 7	7
ω							~~~					1				~~~~			δ	~
										700		700		201	20100	700	5.00	TRAFFIC CONTROL		
_										709		709		621	00100	709	EACH	RPM		
										16 709		16 709		621 621	00300 54000	16 709	EACH EACH	RPM REFLECTOR RAISED PAVEMENT MARKER REMOVED	_	
				 				201		709		201		626	00110	201	EACH	BARRIER REFLECTOR, TYPE 2 (BIDIRECTIONAL)	+	
								201	240			240		644	00500	240	FT	STOP LINE		
									270			270		1 077	00000	270	' '	OTOL EME		
									683			683		644	00600	683	FT	CROSSWALK LINE		
									1,250			1,250		644	00700	1,250	FT	TRANSVERSE/DIAGONAL LINE THREE TRAFFIC CONTROL		
												21		644	01300	21	EACH	LANE APPOW \$ITEMS HAVE BEEN MOVEL) X	
									21			21		<u> </u>				EARL ARMON	`\$	
									0.56 0.28			21	0.56	807 807	12010	0.56	MILE	WET REFLECTIVE EPOXY PAVEMENT MARKING, EDGE LINE, 6" WET REFLECTIVE EPOXY PAVEMENT MARKING, LANE LINE, 6"		

 \bigcirc

 \bigcirc

 \bigcirc

 \bigcirc

						SHEET NO	UM.						PART.		17514	ITEM	GRAND	/ / A / T T	DESCRIPTION THREE TRAFFIC CONTROL	SEE	LATEE
7	8	10	11	16	17	19	20	30	31	32	33	01/NHS/P	02/NHS/B R	03/SAF/0 T	ITEM	EXT	TOTAL	UNIT	DESCRIPTION SITEMS HAVE BEEN MOVED TO THIS SHEET	SHEET NO.	CALCULAT KRB
								8.37				<u> </u>		8.37	807	14110	8.37	MILE	WET REFLECTIVE THERMOPLASTIC PAVEMENT MARKING, LANE LINE, 6"		-
								3,870						3,870	807	14310	3,870	FT	WET REFLECTIVE THERMOPLASTIC PAVEMENT MARKING, CHANNELIZING LINE, 12"		
								3,450						3,450	807	14410	3,450	FT	WET REFLECTIVE THERMOPLASTIC PAVEMENT MARKING, DOTTED LINE, 6"		4
								28.01						28.01	850	10010	28.01	MILE	GROOVING FOR 6" RECESSED PAVEMENT MARKING, (ASPHALT)		-
								3,450						3,450	850	10110	3,450	FT	GROOVING FOR 6" RECESSED PAVEMENT MARKING, (ASPHALT)		
								3,870						3,870	850	10130	3,870	FT	GROOVING FOR 12" RECESSED PAVEMENT MARKING, (ASPHALT)		
								0.84						0.84	850	20010	0.84	MILE	GROOVING FOR 6" RECESSED PAVEMENT MARKING, (CONCRETE)		_
																			TRAFFIC SIGNALS		-
										7		7			632	26501	7	EACH	DETECTOR LOOP, AS PER PLAN	32	
																			CTDUATURE REPAIR (LOR O AMEA L)		_
											94		94		202	98200	94	FT	STRUCTURE REPAIR (LOR-2-0459 L) REMOVAL MISC.: JOINT SEALER	34	_
											94		94		409	30000	94	FT	SAWING AND SEALING ASPHALT CONCRETE PAVEMENT JOINTS	1 37	\dashv
											414		414		512	10100	414	SY	SEALING OF CONCRETE SURFACES (EPOXY-URETHANE)		
											1,483		1,483		512	73500	1,483	SY	TREATING CONCRETE BRIDGE DECKS WITH GRAVITY FED RESIN		
											414		414		512	74000	414	SY	REMOVAL OF EXISTING COATINGS FROM CONCRETE SURFACES		⊢ >
						1		1			1,062		1,062		512	74500	1,062	FT	REMOVAL OF EXISTING PAVEMENT MARKING	+	<u> </u>
											94		94		516	31000	94	FT	JOINT SEALER		┫
											2		2		SPECIAL	51912510	2	SY	PATCHING CONCRETE BRIDGE DECK, TYPE B OR C	34	2
						1													CTRUCTURE REPAIR (LOR O ALEA D)	1	⊣ ₹
						1		+			94		94		202	98200	94	FT	STRUCTURE REPAIR (LOR-2-0459 R) REMOVAL MISC.: JOINT SEALER	34	
											94		94		409	30000	94	FT	SAWING AND SEALING ASPHALT CONCRETE PAVEMENT JOINTS	1 37	⊣ "
											409		409		512	10100	409	SY	SEALING OF CONCRETE SURFACES (EPOXY-URETHANE)		
											1,465		1,465		512	73500	1,465	SY	TREATING CONCRETE BRIDGE DECKS WITH GRAVITY FED RESIN		
											409		409		512	74000	409	SY	REMOVAL OF EXISTING COATINGS FROM CONCRETE SURFACES		_ <u> </u>
											1,050		1,050		512	74500	1,050	FT	REMOVAL OF EXISTING PAVEMENT MARKING		L
											94		94		516	31000	94	FT	JOINT SEALER		
											1		1		SPECIAL	51912510	1	SY	PATCHING CONCRETE BRIDGE DECK, TYPE B OR C	34	
																			CIDUATURE REPAIR (LOR 2 ACAC L)		_
											80		80		202	98200	80	FT	STRUCTURE REPAIR (LOR-2-0646 L) REMOVAL MISC.: JOINT SEALER	34	_
											76		76		409	30000	76	FT	SAWING AND SEALING ASPHALT CONCRETE PAVEMENT JOINTS	1 37	\dashv
											206		206		512	10100	206	SY	SEALING OF CONCRETE SURFACES (EPOXY-URETHANE)		
											659		659		512	73500	659	SY	TREATING CONCRETE BRIDGE DECKS WITH GRAVITY FED RESIN		
								-			206		206		512	74000	206	SY	REMOVAL OF EXISTING COATINGS FROM CONCRETE SURFACES	+	-
											468		468		512	74500	468	FT	REMOVAL OF EXISTING PAVEMENT MARKING		-
						1					80		80		516	31000	80	FT	JOINT SEALER		
											130		130		519	11100	130	SF	PATCHING CONCRETE STRUCTURE		
											1		1		SPECIAL	51912510	1	SY	PATCHING CONCRETE BRIDGE DECK, TYPE B OR C	34	_
																			STRUCTURE REPAIR (LOR-2-0646 R)		\dashv
											10		10		202	32000	10	FT	CURB REMOVED		
											80		80		202	98200	80	FT	REMOVAL MISC.: JOINT SEALER	34	
											76		76		409	30000	76	FT	SAWING AND SEALING ASPHALT CONCRETE PAVEMENT JOINTS		_
											206 659		206 659		512 512	10100 73500	206 659	SY SY	SEALING OF CONCRETE SURFACES (EPOXY-URETHANE) TREATING CONCRETE BRIDGE DECKS WITH GRAVITY FED RESIN		
					1						033		033		312	73300	033	31	TREATING CONCRETE DRIDGE DECKS WITH GRAVITT FED RESIN	+	_
											206		206		512	74000	206	SY	REMOVAL OF EXISTING COATINGS FROM CONCRETE SURFACES		
											468		468		512	74500	468	FT	REMOVAL OF EXISTING PAVEMENT MARKING]
											80		80		516	31000	80	FT	JOINT SEALER		
											110		110		519 SPECIAL	11100 51912510	110	SF SY	PATCHING CONCRETE STRUCTURE PATCHING CONCRETE BRIDGE DECK, TYPE B OR C	34	
											,				JI LUIAL	31312310	,	37	TATOMNO CONCRETE BRIBDE BEEK, THE B ON C	1 37	⊣ ` i
											10		10		609	14000	10	FT	CURB, TYPE 2-A		_ ເ
																					<u>ا</u> ۾
						1					78		78		202	98200	78	FT	STRUCTURE REPAIR (LOR-2-0742 L) REMOVAL MISC.: JOINT SEALER	34	⊣ ~
											78		78		409	30000	78	FT	SAWING AND SEALING ASPHALT CONCRETE PAVEMENT JOINTS	34	
											342		342		512	10100	342	SY	SEALING OF CONCRETE SURFACES (EPOXY-URETHANE)		
											954		954		512	73500	954	SY	TREATING CONCRETE BRIDGE DECKS WITH GRAVITY FED RESIN		
						1					179		179		512	74000	179	SY	REMOVAL OF EXISTING COATINGS FROM CONCRETE SURFACES	1	_
					-	1		-			684		684		512	74500	684	FT	REMOVAL OF EXISTING PAVEMENT MARKING	+	1/
						1		+			78		78		512	31000	78	FT	JOINT SEALER	+	- (-;
											5		5		SPECIAL	51912510	5		PATCHING CONCRETE BRIDGE DECK, TYPE B OR C	34	3.
				-															,		

KRB	CHECKED	ACM

SUMMAR SUB AIR EP

_	19	\
	3.7	_

									251	251	255	255	255
SL	.М	LANE	WIDTH	LENGTH	INDIVIDUAL REPAIR AREA	TYPE OF REPAIR	ОЕРТН	NUMBER OF REPAIRS	PARTIAL DEPTH PAVEMENT REPAIR (ASPHALT CONCRETE BASE) (LONGITUDINAL)	MENT ICRETE SE)	FULL DEPTH PAVEMENT REMOVAL AND RIGID REPLACEMENT, CLASS OC MS, AS PER PLAN (15"	S. BRCM,	FULL DEPTH PAVEMENT SAWING
BEGIN	END		FT	FT	SY		INCH		CY	CY	SY	SY	FT
3.86	4.00	LT, RT	24	6	16.00	TRANS	15	1) 16	16	60
3.00	4.00	LT, RT	24	4	10.67	TRANS	6	4		7	}	} "	- 00
		LANE LINE	2		22.22		6		7	/	}	1	
		LANE LINE	-	100	۷۷،۷۷	LONG	0	2	1		}	}	
4.00	5.00	LT, RT	24	6	16.00	TRANS	15	6			96	96	360
		LT, RT	24	4	10.67	TRANS	6	13		23	<u> </u>	\ 	
		RT	4	20	8.89	LONG	6	3	4		}	\	
		RT	4	50	22.22	LONG	6	5	19		\	†	
		RT SHOULDER	4	50	22.22	LONG	6	2	7		{	}	
											}	}	
5.00	6.00	LT, RT	24	6	16.00	TRANS	15	15			240	240	900
		LT, RT	24	4	10.67	TRANS	6	21		37	{	}	
		RT	4	50	22.22	LONG	6	8	30	-	}	1	
		RT	12	20	26.67	LONG	6	1	4		}	1	
		L T	4	50	22.22	LONG	6	3	11		>	\	
		RT SHOULDER	4	50	22.22	LONG	6	2	7		}	1	
6.00	7.00	LT, RT	24	6	16.00	TRANS	15	10			160	160	600
		LT, RT	24	4	10.67	TRANS	6	19		34	{	}	
		LANE LINE	2	20	4.44	LONG	6	3	2		}	}	
		RT	4	20	8.89	LONG	6	5	7		{	}	
		RT	12	20	26.67	LONG	6	2	9		<u> </u>	}	
		LT	4	20	8.89	LONG	6	2	3		\$	}	
		LT	12	20	26.67	LONG	6	2	9		,	1	
		RT SHOULDER	4	50	22.22	LONG	6	4	15		}	.	
7.00	7.97	LT, RT	24	6	16.00	TRANS	15	15			240	240	900
		LT, RT	24	4	10.67	TRANS	6	16		28	}	.	
		LANE LINE	2	100	22.22	LONG	6	8	30		}	}	
		RT	4	50	22.22	LONG	6	6	22			}	
		RT LT	12	20	26.67	LONG	6	2	9		{	}	
		RT SHOULDER	12	20 50	26.67 22.22	LONG	6	2	9		{	}	
		NI SHOULDER	+	100	۷۷،۷۷	LONG		4	13		}	}	
AK POL	NT ROAD	RAMP X							10		}	1	
		RAMP Z							10		}	}	
	RAMP D								8	8	}	\	
	RAMP F								12	8	}	\	
											}	1	
	_	FAS	TROUN	ID SLIB	-TOTAL				259	145	752	752	2,820

SI	LM	L ANE	WIDTH	LENGTH	INDIVIDUAL REPAIR AREA	TYPE OF REPAIR	ОЕРТН	NUMBER OF REPAIRS	REPAIR (ASPHALT CONCRETE S BASE) (LONGITUDINAL)	REPAIR (ASPHALT CONCRETE S BASE) (TRANSVERSE)	FULL DEPTH PAVEMENT REMOVAL AND RIGID SEPLACEMENT, CLASS OC SMS, AS PER PLAN (15" CONCRETE, (OPTION A)	FÜLL DEPTH PAVEMENT REMOVAL AND RIGID REPLACEMENT, CLASS, RRCM, 55 AS PER PLAN (15" CONCRETE) (OPTION B)	FULL DEPTH PAVEMENT SAWING
05044	5110				614								
BEGIN	END		FT	FT	SY		INCH		CY	CY	SY :	SY	FT
3.86	4.00	LT, RT	24	4	10.67	TRANS	6	4		7	}	}	
		LANE LINE	2	50	11.11	LONG	6	2	4		{	}	
											}:		
4.00	5.00	LT, RT	24	6	16.00	TRANS	15	9			144	144	540
7.00	3.00	LT, RT	24	4	10.67	TRANS	6	8		14	} '''	177	370
		LANE LINE	2	50	11.11	LONG	6	5	9		} :	}	
		LANE LINE	2	100	22.22	LONG	6	3	11			}	
		RT	4	20	8.89	LONG	6	6	9		{	}	
		RT	12	20	26.67	LONG	6	2	9		{	}	
		LT	12	20	26.67	LONG	6	2	9			}	
5.00	6.00	RT SHOULDER	24	50 6	22.22 16.00	LONG	6 15	5 8	19		128	128	480
3.00	0.00	LT, RT	24	4	10.67	TRANS	6	9		16	120) 120	400
		LANE LINE	2	50	11.11	LONG	6	3	6		{	}	
		RT	4	50	22.22	LONG	6	5	19		{	}	
		RT SHOULDER	4	50	22.22	LONG	6	2			\		
											<u>} </u>	}	
6.00	7.00	LT, RT	24	6	16.00	TRANS	15	14			224	224	840
		LT, RT	24	<i>4</i>	10.67	TRANS	6	11		20	}	}	
		LANE LINE RT	2	50 50	11.11 22.22	L ONG L ONG	6	3	6 15		} :	{	
		RT	12	20	26.67	LONG	6	2	9				
		LT	12	20	26.67	LONG	6	2	9		;		
		RT SHOULDER	4	50	22.22	L ONG	6	4	15		} :		
											}		
7.00	7.97	LT, RT	24	6	16.00	TRANS	15	16			256	256	960
		LT, RT	24	4	10.67	TRANS	6	17 4	7	30	}	}	
		LANE LINE	2	50 100	11.11 22.22	LONG	6 6	6	7 22		} :	}	
		RT	4	50	22.22	LONG	6	5	19		} :	}	
		RT	12	20	26.67	LONG	6	2	9		}	}	
		LT	12	20	26.67	LONG	6	2	9		{	}	
		RT SHOULDER	4	50	22.22	LONG	6	2	7		{	}	
	INT ROAD								10		{	}	
	INT ROAD	KAMP Y							10	0	}	}	
										-	}	}	
,. n. J0	. NAMII E								+ -	10	<u>}</u>	 	
	-	WES	TBOUN	ID SUB	-TOTAL		1	1	258	105	752	752	2820
		TOTALS CAR	RIED	TO GEI	NERAL SUMI	MARY			517	250	1,504	1,504	5,640
	RAMP C RAMP E					MARY			517 ITEM 40 ITEM 442 19 MM, 1 ITEM 255	250 7 - TACK (2 - ASPHAL 1 YPE A (44. 5 - FULL D	1,504 COAT, 702.1. T CONCRET. 8) HAS BEEN EPTH PAVEN	E	1,504 3 HAS BEEN R E INTERMEDIA

 \bigcirc

 \bigcirc

 \bigcirc

 \bigcirc