

UTILITIES

LISTED BELOW ARE ALL UTILITIES LOCATED WITHIN THE PROJECT CONSTRUCTION LIMITS TOGETHER WITH THEIR RESPECTIVE OWNERS:

ANR PIPELINE (TRANSCANADA)  
6357 SR 66 NORTH  
DEFIANCE, OHIO 43512  
419-783-3136  
US\_CROSSINGS@TRANSCANADA.COM

COLUMBIA GAS OF OHIO, INC.  
2901 E. MANHATTAN BLVD.  
TOLEDO, OHIO 43611  
419-539-6209  
CLINTWELLS@NISOURCE.COM

COLUMBIA PIPELINE GROUP  
1600 DUBLIN ROAD  
COLUMBUS, OHIO 43215  
419-722-1888  
JOSEPH.STEWART@TRANSCANADA.COM  
US\_CROSSINGS@TRANSCANADA.COM

DOMINION EAST OHIO  
320 SPRINGSIDE DRIVE, SUITE 230  
AKRON, OHIO 44333  
330-664-2572  
KATHERINE.A.MCCULLOUGH@DOM.COM

PANHANDLE EASTERN PIPELINE  
9371 ZIONSVILLE ROAD  
INDIANAPOLIS, IN 46268  
317-879-3039  
NATHAN.CLOUD@ENERGYTRANSFER.COM

INDEPENDENTS FIBER NETWORK  
13888 S. DIXIE DRIVE  
WAPAKONETA, OHIO 45895  
419-739-3100  
SEMANS@CNTEAM.NET

AT&T - OHIO  
130 NORTH ERIE ST., ROOM 206  
TOLEDO, OHIO 43604  
419-245-5694  
RF1281@ATT.COM

MONCLOVA TOWNSHIP  
4335 ALBON ROAD  
MONCLOVA, OHIO 43542  
419-865-9662  
HGRIM@MONCLOVATWP.ORG

WINDSTREAM OHIO  
6777 ENGLE ROAD, SUITE E  
MIDDLEBURG HEIGHTS, OH 44130  
734-790-6558  
JEFF.WEBB@WINDSTREAM.COM

LEVEL 3 COMMUNICATIONS  
CENTURYLINK  
1025 ELDORADO BLVD.  
BROOMFIELD, COLORADO 80021  
NATIONALRELO@CENTURYLINK.COM

TOLEDO EDISON - LAKEWOOD (FIRST ENERGY)  
6099 ANGOLA ROAD  
HOLLAND, OH 43528  
RRSWOPE@FIRSTENERGYCORP.COM

FIRST ENERGY - TRANSMISSION  
76 SOUTH MAIN ST.  
AKRON, OHIO 44308  
MWALTON@FIRSTENERGYCORP.COM

UTILITIES (CONTINUED)

BUCKEYE BROADBAND  
2700 OREGON ROAD  
NORTHWOOD, OHIO 43619  
419-724-3713  
MSHEAHAN@TELESYSTEM.US

SPECTRUM  
3100 ELIDA ROAD  
LIMA, OHIO 45805  
234-208-4684  
ANDY.FETTERMAN@CHARTER.COM

ODOT DISTRICT 2  
317 EAST POE ROAD  
BOWLING GREEN, OHIO 43202  
419-373-4404

CITY OF MAUMEE WATER  
400 CONANT  
MAUMEE, OHIO 43537  
734-777-0624  
PBURTCH@MAUMEE.ORG

GENERATION PIPELINE  
445 HUTCHINSON AVE., SUITE 830  
COLUMBUS, OHIO 43235  
281-770-3143  
JHARTMAN@SOMERSETGAS.COM

LUCAS COUNTY SANITARY ENGINEER  
1111 S. MCCORD RD.  
HOLLAND, OHIO 43528  
JSHAW@CO.LUCAS.OH.US

LUCAS COUNTY ENGINEER  
1049 S. MCCORD RD.  
HOLLAND, OHIO 43528  
419-213-2860  
MPNIEWSKI@CO.LUCAS.OH.US

THE LOCATION OF THE UNDERGROUND UTILITIES SHOWN ON THE PLANS ARE AS OBTAINED FROM THE OWNERS AS REQUIRED BY SECTION 153.64 O.R.C.

ROUNDING

THE ROUNDING AT SLOPE BREAKPOINTS SHOWN ON THE TYPICAL SECTIONS APPLIES TO ALL CROSS-SECTIONS, EVEN THOUGH OTHERWISE SHOWN.

WORK LIMITS

THE WORK LIMITS SHOWN ON THESE PLANS ARE FOR PHYSICAL CONSTRUCTION ONLY. PROVIDE THE INSTALLATION AND OPERATION OF ALL WORK ZONE TRAFFIC CONTROL AND WORK ZONE TRAFFIC CONTROL DEVICES REQUIRED BY THESE PLANS WHETHER INSIDE OR OUTSIDE THESE WORK LIMITS.

EXISTING PLANS

EXISTING PLANS MAY BE INSPECTED IN THE ODOT DISTRICT 2 OFFICE IN BOWLING GREEN, OHIO.

MONUMENT ASSEMBLIES

CONSTRUCT MONUMENT ASSEMBLIES IN ACCORDANCE WITH THE DETAILS SHOWN ON THE STANDARD CONSTRUCTION DRAWINGS AND AT THE LOCATIONS SHOWN ON THE CENTERLINE PLAT SHEET NO. 3 OF 46 OF THE RIGHT OF WAY PLAN SET.

THE FOLLOWING QUANTITIES ARE CARRIED FORWARD TO THE GENERAL SUMMARY:

ITEM 623, MONUMENT ASSEMBLY	4 EACH
ITEM 623, REFERENCE MONUMENT	20 EACH

SURVEY PARAMETERS

PRIMARY PROJECT CONTROL MONUMENTS GOVERN ALL POSITIONING ON ODOT PROJECTS. SEE SHEET 33. OF THE PLANS FOR A TABLE CONTAINING PROJECT CONTROL INFORMATION. USE THE FOLLOWING PROJECT CONTROL, VERTICAL POSITIONING, AND HORIZONTAL POSITIONING PARAMETERS FOR ALL SURVEYING:

PROJECT CONTROL  
POSITIONING METHOD: STATIC GNSS  
MONUMENT TYPE: TYPE A  
VERTICAL POSITIONING  
ORTHOMETRIC HEIGHT DATUM: NAVD88  
GEOID: GEOID12A

HORIZONTAL POSITIONING  
REFERENCE FRAME: NAD83(2011)  
ELLIPSOID: GRS80  
MAP PROJECTION: LAMBERT CONFORMAL CONIC  
COORDINATE SYSTEM: OHIO STATE PLACE NORTH ZONE  
COMBINED SCALE FACTOR: 1.0000434020 (GRID TO GROUND)  
ORIGIN OF COORDINATE SYSTEM: 0,0,0  
UNITS ARE IN U.S. SURVEY FEET.  
USE THE FOLLOWING CONVERSION FACTOR:  
1 METER = 3.280833333 U.S. SURVEY FEET.

USE THE POSITIONING METHODS AND MONUMENT TYPE USED IN THE ORIGINAL SURVEY TO RESTORE ALL MONUMENTS RELATED TO PRIMARY PROJECT CONTROL THAT ARE DAMAGED OR DESTROYED BY CONSTRUCTION ACTIVITIES. RESTORE THE DAMAGED OR DESTROYED MONUMENTS IN ACCORDANCE WITH CMS 623.

CLEARING AND GRUBBING

ALTHOUGH THERE ARE NO SPECIFIC TREES OR STUMPS SPECIFICALLY MARKED FOR REMOVAL WITHIN THE LIMITS OF THE PROJECT, A LUMP SUM QUANTITY IS INCLUDED IN THE GENERAL SUMMARY FOR ITEM 201, CLEARING AND GRUBBING. PRIOR TO BIDDING, ODOT FORCES FELL ALL THE TREES IDENTIFIED AS INDIANA BAT TREES WITHIN THE PROJECT LIMITS. IT SHALL BE THE CONTRACTOR'S RESPONSIBILITY TO TAKE OWNERSHIP OF FELLED TREES ALONG WITH CLEARING AND GRUBBING DEBRIS AND PROPERLY DISPOSE ACCORDING TO ITEM 201. THIS WORK WILL INCLUDE THE REMOVAL OF STUMPS (APPROXIMATELY 200) AND DEBRIS OF THE CUT DOWN TREES COMPLETED BY ODOT FORCES.

IT SHOULD BE NOTED, ODOT FORCES DID NOT CUT DOWN THE NON-INDIANA BAT TREES. IT SHALL BE THE CONTRACTOR'S RESPONSIBILITY TO REMOVE ANY TREES NECESSARY TO PERFORM THE PROPOSED WORK IN ACCORDANCE WITH ITEM 201. ALL PROVISIONS AS SET FORTH IN THE SPECIFICATION, UNDER THIS ITEM ARE INCLUDED IN THE LUMP SUM PRICE BID FOR ITEM 201, CLEARING AND GRUBBING.

PROTECTION OF RIGHT-OF-WAY LANDSCAPING

PRIOR TO BEGINNING WORK, THE CONTRACTOR, THE PROJECT ENGINEER, AND A REPRESENTATIVE OF THE MAINTAINING AGENCY WILL REVIEW AND RECORD ALL LANDSCAPING ITEMS WITHIN THE RIGHT-OF-WAY (BOTH WITHIN AND OUTSIDE THE CONSTRUCTION LIMITS) A RECORD OF THIS REVIEW WILL BE KEPT IN THE PROJECT ENGINEER'S FILES. PRIOR TO FINAL ACCEPTANCE, A FINAL REVIEW OF LANDSCAPING ITEMS WILL BE MADE.

CONSTRUCT ALL ACTIVITIES, EQUIPMENT STORAGE, AND STAGING TO WITHIN THE CONSTRUCTION LIMITS. UNLESS OTHERWISE IDENTIFIED IN THE PLANS OR PROPOSAL, THE CONSTRUCTION LIMITS ARE IDENTIFIED AS 30 FEET FROM THE EDGE OF PAVEMENT.

SUBMIT A WRITTEN REQUEST TO THE PROJECT ENGINEER TO USE ANY AREA OUTSIDE THESE LIMITS. THE DOCUMENT SUBMITTED MUST CLEARLY IDENTIFY THE AREA AND EXPLAIN THE PROPOSED USE AND RESTORATION OF THE AREA. THE REQUEST MUST BE APPROVED, IN WRITING, BEFORE THE CONTRACTOR HAS PERMISSION TO USE THE AREA.

ANY ITEMS DAMAGED BEYOND THE CONSTRUCTION LIMITS, AS DEFINED ABOVE, WILL BE REPLACED IN KIND OR AS APPROVED BY THE PROJECT ENGINEER.

FENCE LENGTHS

THE LENGTHS OF FENCE SHOWN IN THE PLANS ARE HORIZONTAL DIMENSIONS. MEASUREMENTS OF THE FINAL QUANTITIES WILL BE IN ACCORDANCE WITH ITEM 607.

CONSTRUCTION NOISE

ACTIVITIES AND LAND USE ADJACENT TO THIS PROJECT MAY BE AFFECTED BY CONSTRUCTION NOISE. MEASURES SHOULD BE TAKEN TO MINIMIZE NOISE AS MUCH AS FEASIBLE AT ALL TIMES INCLUDING NOT OPERATING POWER-OPERATED CONSTRUCTION-TYPE DEVICES BETWEEN 9 P.M. AND 7 A.M.

IN ADDITION, DO NOT OPERATE AT ANY TIME ANY DEVICE IN SUCH A MANNER THAT THE NOISE CREATED SUBSTANTIALLY EXCEEDS THE NOISE CUSTOMARILY AND NECESSARILY ATTENDANT TO THE REASONABLE AND EFFICIENT PERFORMANCE OF SUCH EQUIPMENT. CONTRACTORS SHALL ASSUME THE FOLLOWING EQUIPMENT WILL BE PERMITTED TO BE UTILIZED DURING ALL HOURS OF THE PROJECT. THEY MAY ALSO ASSUME THAT EQUIPMENT CREATING NOISE LEVELS EQUAL TO OR LESS THAN THE FOLLOWING EQUIPMENT WILL ALSO BE PERMITTED.

AIR COMPRESSORS	MATERIAL HANDLING
GRINDERS	CONCRETE DECK CUTTING SAWS
BACK UP BEEPERS	GENERATORS
MILLING MACHINES	IMPACT WRENCHES
HEAVY EQUIPMENT IDLING	

THE DEPARTMENT WILL OBTAIN AN OFFICIAL WAIVER FOR THE EQUIPMENT, TIMES AND DURATIONS NEEDED FOR WORK EXCEEDING THE NOISE ORDINANCE FROM THE CITY OF MAUMEE.

SEEDING AND MULCHING

THE FOLLOWING QUANTITIES ARE PROVIDED TO PROMOTE GROWTH AND CARE OF PERMANENT SEEDED AREAS:

659, TOPSOIL	22,637 CU. YD.
659, SOIL ANALYSIS TEST	3 EACH
659, SEEDING AND MULCHING	203,933 SQ. YD.
659, REPAIR SEEDING AND MULCHING	10,197 SQ. YD.
659, INTER-SEEDING	10,197 SQ. YD.
659, COMMERCIAL FERTILIZER	45.88 TON
659, LIME	42.14 ACRES
659, WATER	1,129 M. GAL.
659, MOWING	459 M. SQ.FT.

SEEDING AND MULCHING SHALL BE APPLIED TO ALL AREAS OF EXPOSED SOIL BETWEEN THE RIGHT-OF-WAY LINES, AND WITHIN THE CONSTRUCTION LIMITS FOR AREAS OUTSIDE THE RIGHT-OF-WAY LINES COVERED BY WORK AGREEMENT OR SLOPE EASEMENT. QUANTITY CALCULATIONS FOR SEEDING AND MULCHING ARE BASED ON THESE LIMITS.

ENDANGERED BAT HABITAT REMOVAL

THIS PROJECT IS LOCATED WITHIN THE KNOWN HABITAT RANGES OF THE FEDERALLY LISTED AND PROTECTED INDIANA BAT, AND NORTHERN LONG-EARED BAT. NO TREES SHALL BE REMOVED UNDER THIS PROJECT FROM APRIL 1 THROUGH SEPTEMBER 30. ALL NECESSARY TREE REMOVAL SHALL OCCUR FROM OCTOBER 1 THROUGH MARCH 31. THIS REQUIREMENT IS NECESSARY TO AVOID AND MINIMIZE IMPACTS TO THESE SPECIES AS REQUIRED BY THE ENDANGERED SPECIES ACT (ESA). FOR THE PURPOSES OF THIS NOTE, A TREE IS DEFINED AS: A LIVE, DYING, OR DEAD WOODY PLANT, WITH A TRUNK 3 INCHES OR GREATER IN DIAMETER AT A HEIGHT OF 4.5 FEET ABOVE THE GROUND SURFACE, AND WITH A MINIMUM HEIGHT OF 13 FEET.

ENDANGERED UPLAND SANDPIPER

THE PROJECT IS LOCATED WITHIN THE KNOWN HABITAT OF THE STATE ENDANGERED UPLAND SANDPIPER. THE HABITAT CONSISTS OF DEVELOPED OPEN SPACE, MOWED GRASS, PASTURES, SIMILAR TO GRASSY EXPANSES OF AIRPORTS. THE CONTRACTOR SHALL NOT CONDUCT ANY WORK WITHIN THE HABITAT BETWEEN APRIL 1 AND JULY 31 UNLESS THE FOLLOWING CONDITIONS ARE MET AND MAINTAINED:

ALL GRASSY AREAS AND ESTABLISHED FIELDS WITHIN CONSTRUCTION AREAS THAT ARE ANTICIPATED TO BE DISTURBED BETWEEN APRIL 1 AND JULY 31 MUST BE MOWED SUCH THAT THE GRASS/ VEGETATION IS 3-4 INCHES OR LESS IN HEIGHT PRIOR TO APRIL 1, AND THE AREAS MUST BE MAINTAINED AT THESE HEIGHTS THRU JULY 31.

CONSTRUCTION AREAS THAT ARE ANTICIPATED TO BE DISTURBED OUTSIDE OF THE RESTRICTED DATES LISTED ABOVE WILL NOT REQUIRE THE MOWING CONDITION.

ALL WORK RELATED TO THE PROTECTION OF THE ENDANGERED UPLAND SANDPIPER, MOWING OPERATIONS SHALL BE CONSIDERED INCIDENTAL TO THE LUMP SUM FOR ITEM 201, CLEARING AND GRUBBING.

CALCULATED  
MAL  
CHECKED  
KDK

GENERAL NOTES

LUC-475-01.85

30  
637

C:\PROJECTS\TOHODT10\_PEO1\Drawing\99731\Design\Roadway\Sheets\99731\_GN001.dgn Sheet 4/15/2022 9:05:33 AM mlove





M:\16017 (Ar-cadis - LUC-475-01.85, 20A Interchange)\ProjectData\99731\Design\Drainage\Sheets\99731\_GS300.dgn Sheet 4/26/2022 2:54:26 PM ADC

SHEET	REF. NO.	STATION		SIDE	CENTERLINE ROADWAY REFERENCE	602	611	611	611	611	611	611	611	611	611	611	611	611	611	611	611	611	611	611	611	611	611	611	611	611	611	611	611	611	601							
		CONCRETE MASONRY	24" CONDUIT, TYPE A			27" CONDUIT, TYPE A	30" CONDUIT, TYPE A	36" CONDUIT, TYPE A	48" CONDUIT, TYPE A	54" CONDUIT, TYPE A	12" CONDUIT, TYPE B	15" CONDUIT, TYPE B	18" CONDUIT, TYPE B	21" CONDUIT, TYPE B	24" CONDUIT, TYPE B	30" CONDUIT, TYPE B	12" CONDUIT, TYPE C	15" CONDUIT, TYPE C	18" CONDUIT, TYPE C	24" CONDUIT, TYPE C	36" CONDUIT, TYPE C	54" CONDUIT, TYPE C	12" CONDUIT, TYPE D	15" CONDUIT, TYPE D	18" CONDUIT, TYPE D	24" CONDUIT, TYPE D	CONDUIT, BORED OR JACKED, 15" TYPE B	CONDUIT, BORED OR JACKED, 27" TYPE A	CONDUIT, BORED OR JACKED, 30" TYPE A	MANHOLE ADJUSTED TO GRADE	MANHOLE RECONSTRUCTED TO GRADE	MANHOLE, NO. 3	CATCH BASIN, NO. 3A	CATCH BASIN, NO. 2-2B	WATER QUALITY BASIN, DETENTION	INLET, NO. 3B	INLET, NO. 3C	CATCH BASIN, NO. 6	DUMPED ROCK FILL, TYPE C			
		FROM	TO			CY	FT	FT	FT	FT	FT	FT	FT	FT	FT	FT	FT	FT	FT	FT	FT	FT	FT	FT	FT	FT	FT	FT	FT	FT	FT	FT	FT	FT	FT							
130	D-39	SR 20A - RAMP C1 65+74 65+74		LT/RT	RP C1	1.38				121																									2.7							
133	D-40	SR 20A - RAMP D1 88+03 88+09		LT/RT	RP D1	1.38				192																									2.7							
155	D-41	SALISBURY - RAMP E 142+50 142+56		LT	RP E	1.32					11																								5.7							
137	D-42	US 20A 542+95 543+29		RT	20A	0.25							5																						1.8							
137	D-43	543+30 543+45		LT	20A										5	12																										
137	D-44	543+45 543+45		LT/RT	20A																			67																		
137	D-45	543+45 543+45		RT	20A	0.25																													1.8							
137	D-46	544+50 544+50		LT	20A	0.25										23																			1.8							
137	D-47	544+50 544+50		RT	20A	0.25																													1.8							
138	D-48	545+50 545+50		LT	20A	0.25																													2.4							
138	D-49	545+50 545+50		RT	20A	0.25																													3.1							
138	D-50	546+46 546+46		LT	20A	0.25																													6.2							
138	D-51	546+75 546+75		LT/RT	20A	2.18				205																									3.6							
138	D-52	546+95 547+00		RT	20A	0.25																													7.3							
138	D-53	548+98 548+99		LT/RT	20A																																					
138	D-54	548+95 548+99		LT	20A	0.25																													12.4							
140	D-55	551+60 551+60		LT	20A																																					
140	D-56	550+70 551+60		LT	20A																																					
138 + 140	D-57	550+02 550+70		LT	20A	0.25																													15.6							
142	D-58	557+71 557+71		LT/RT	20A																																					
142	D-59	557+71 559+50		LT/RT	20A																																					
142 + 144	D-60	559+50 560+07		LT	20A	0.25																													9.3							
144	D-61	560+50 560+50		LT/RT	20A																																					
144	D-62	560+50 561+09		LT	20A	0.25																													6.2							
144	D-63	562+27 562+27		LT/RT	20A	0.25																													6.2							
144	D-64	563+20 563+20		LT	20A	0.25																													3.1							
144	D-65	563+20 563+20		RT	20A	0.25																													2.2							
146	D-66	566+25 566+50		RT	20A																																					
146	D-67	566+50 566+50		LT/RT	20A																																					
146	D-68	566+50 566+50		LT	20A																																					
146	D-69	566+50 568+15		LT	20A																																					
146	D-70	568+15 568+36		LT	20A	0.31																																				
146 - 147	D-71	568+71 571+25		RT	20A																																					
146	D-71A	568+59 568+59		RT	20A																																					
147	D-72	571+25 571+25		RT	20A																																					
147	D-73	571+25 571+25		LT/RT	20A																																					
147	D-74	572+00 572+95		LT	20A																																					
147	D-75	572+95 574+00		LT	20A																																					
147	D-76	572+95 572+95		LT/RT	20A																																					
147	D-77	572+95 573+00		RT	20A																																					
147	D-78	572+95 573+05		RT	20A																																					
147	D-79	573+15 573+15		LT	20A																																					
148	D-80	575+98 576+18		RT	20A																																					
SUBTOTAL FROM SHEET 44						10.4	0	0	0	313	205	11	5	891	0	0	0	0	0	205	468	216	8	0	0	15	304	20	10	252	0	0	1	1	12	21	3	0	0	0	2	95.9
SUBTOTAL FROM SHEET 43						15.1	32	284	130	32	0	0	0	1413	869	536	0	119	0	0	0	34	65	36	0	0	0	0	0	221	291	294	0	0	3	0	0	2	10	13	1	60.5
TOTALS CARRIED TO GENERAL SUMMARY						25.5	32	284	130	345	205	11	5	2294	869	536	0	119	205	468	216	42	65	36	15	304	20	10	473	291	294	1	1	15	21	3	2	10	13	3	156	


CALCULATED  
 ADC  
 CHECKED  
 SRC  
**DRAINAGE SUBSUMMARY (2 OF 2)**  
**LUC-475-01.85**  
 44  
 637



TRAFFIC SIGNAL SUBSUMMARY

ITEM	QUANTITY	UNIT	ITEM DESCRIPTION	REFERENCE
625	325	FT	CONDUIT, 2", 725.05	
625	46	FT	CONDUIT, 3", 725.05	
625	470	FT	CONDUIT, JACKED OR DRILLED, 725.04, 3"	
625	371	FT	TRENCH	
625	4	EACH	PULL BOX, 725.06, SIZE 18	
625	1	EACH	PULL BOX, 725.06, SIZE 30	
625	11	EACH	GROUND ROD	
630	6	EACH	SIGN SUPPORT ASSEMBLY, POLE MOUNTED	
630	4.5	SF	SIGN, FLAT SHEET	
632	5	EACH	VEHICULAR SIGNAL HEAD, (LED), 3-SECTION, 12" LENS, 1-WAY, POLYCARBONATE	5
632	7	EACH	VEHICULAR SIGNAL HEAD, (LED), 5-SECTION, 12" LENS, 1-WAY, POLYCARBONATE	
632	6	EACH	PEDESTRIAN SIGNAL HEAD (LED), TYPE D2, AS PER PLAN	480
632	12	EACH	COVERING OF VEHICULAR SIGNAL HEAD	
632	6	EACH	COVERING OF PEDESTRIAN SIGNAL HEAD	
632	6	EACH	PEDESTRIAN PUSHBUTTON	
632	1057	FT	SIGNAL CABLE, 2 CONDUCTOR, NO. 14 AWG	
632	1081	FT	SIGNAL CABLE, 5 CONDUCTOR, NO. 14 AWG	
632	1888	FT	SIGNAL CABLE, 7 CONDUCTOR, NO. 14 AWG	
632	4	EACH	SIGNAL SUPPORT FOUNDATION, AS PER PLAN	479
632	6	EACH	PEDESTAL FOUNDATION	
632	94	FT	POWER CABLE, 3 CONDUCTOR, NO. 6 AWG	
632	333	FT	SERVICE CABLE, 3 CONDUCTOR, NO. 6 AWG	
632	1	EACH	POWER SERVICE, AS PER PLAN	479
632	1	EACH	CONDUIT RISER, 2" DIAMETER	
632	4	EACH	SIGNAL SUPPORT, TYPE TC-81.22, DESIGN 14, AS PER PLAN	479
632	6	EACH	PEDESTAL, 8", TRANSFORMER BASE, AS PER PLAN	479
632	1	EACH	REMOVAL OF TRAFFIC SIGNAL INSTALLATION	
633	1	EACH	CABINET, TYPE TS-2, AS PER PLAN	480
633	1	EACH	CABINET FOUNDATION, AS PER PLAN	479
633	1	EACH	CONTROLLER WORK PAD, AS PER PLAN	479
633	1	EACH	UNINTERRUPTIBLE POWER SUPPLY (UPS), 1000 WATT, AS PER PLAN	480
809	1	EACH	HIGH-SPEED ETHERNET RADIO	
809	4	EACH	ADVANCE RADAR DETECTION, AS PER PLAN	480
809	4	EACH	STOP LINE RADAR DETECTION, AS PER PLAN	482
809	1	EACH	ATC CONTROLLER, AS PER PLAN (PROGRAM AND INSTALL ONLY)	480

WIRING DIAGRAM

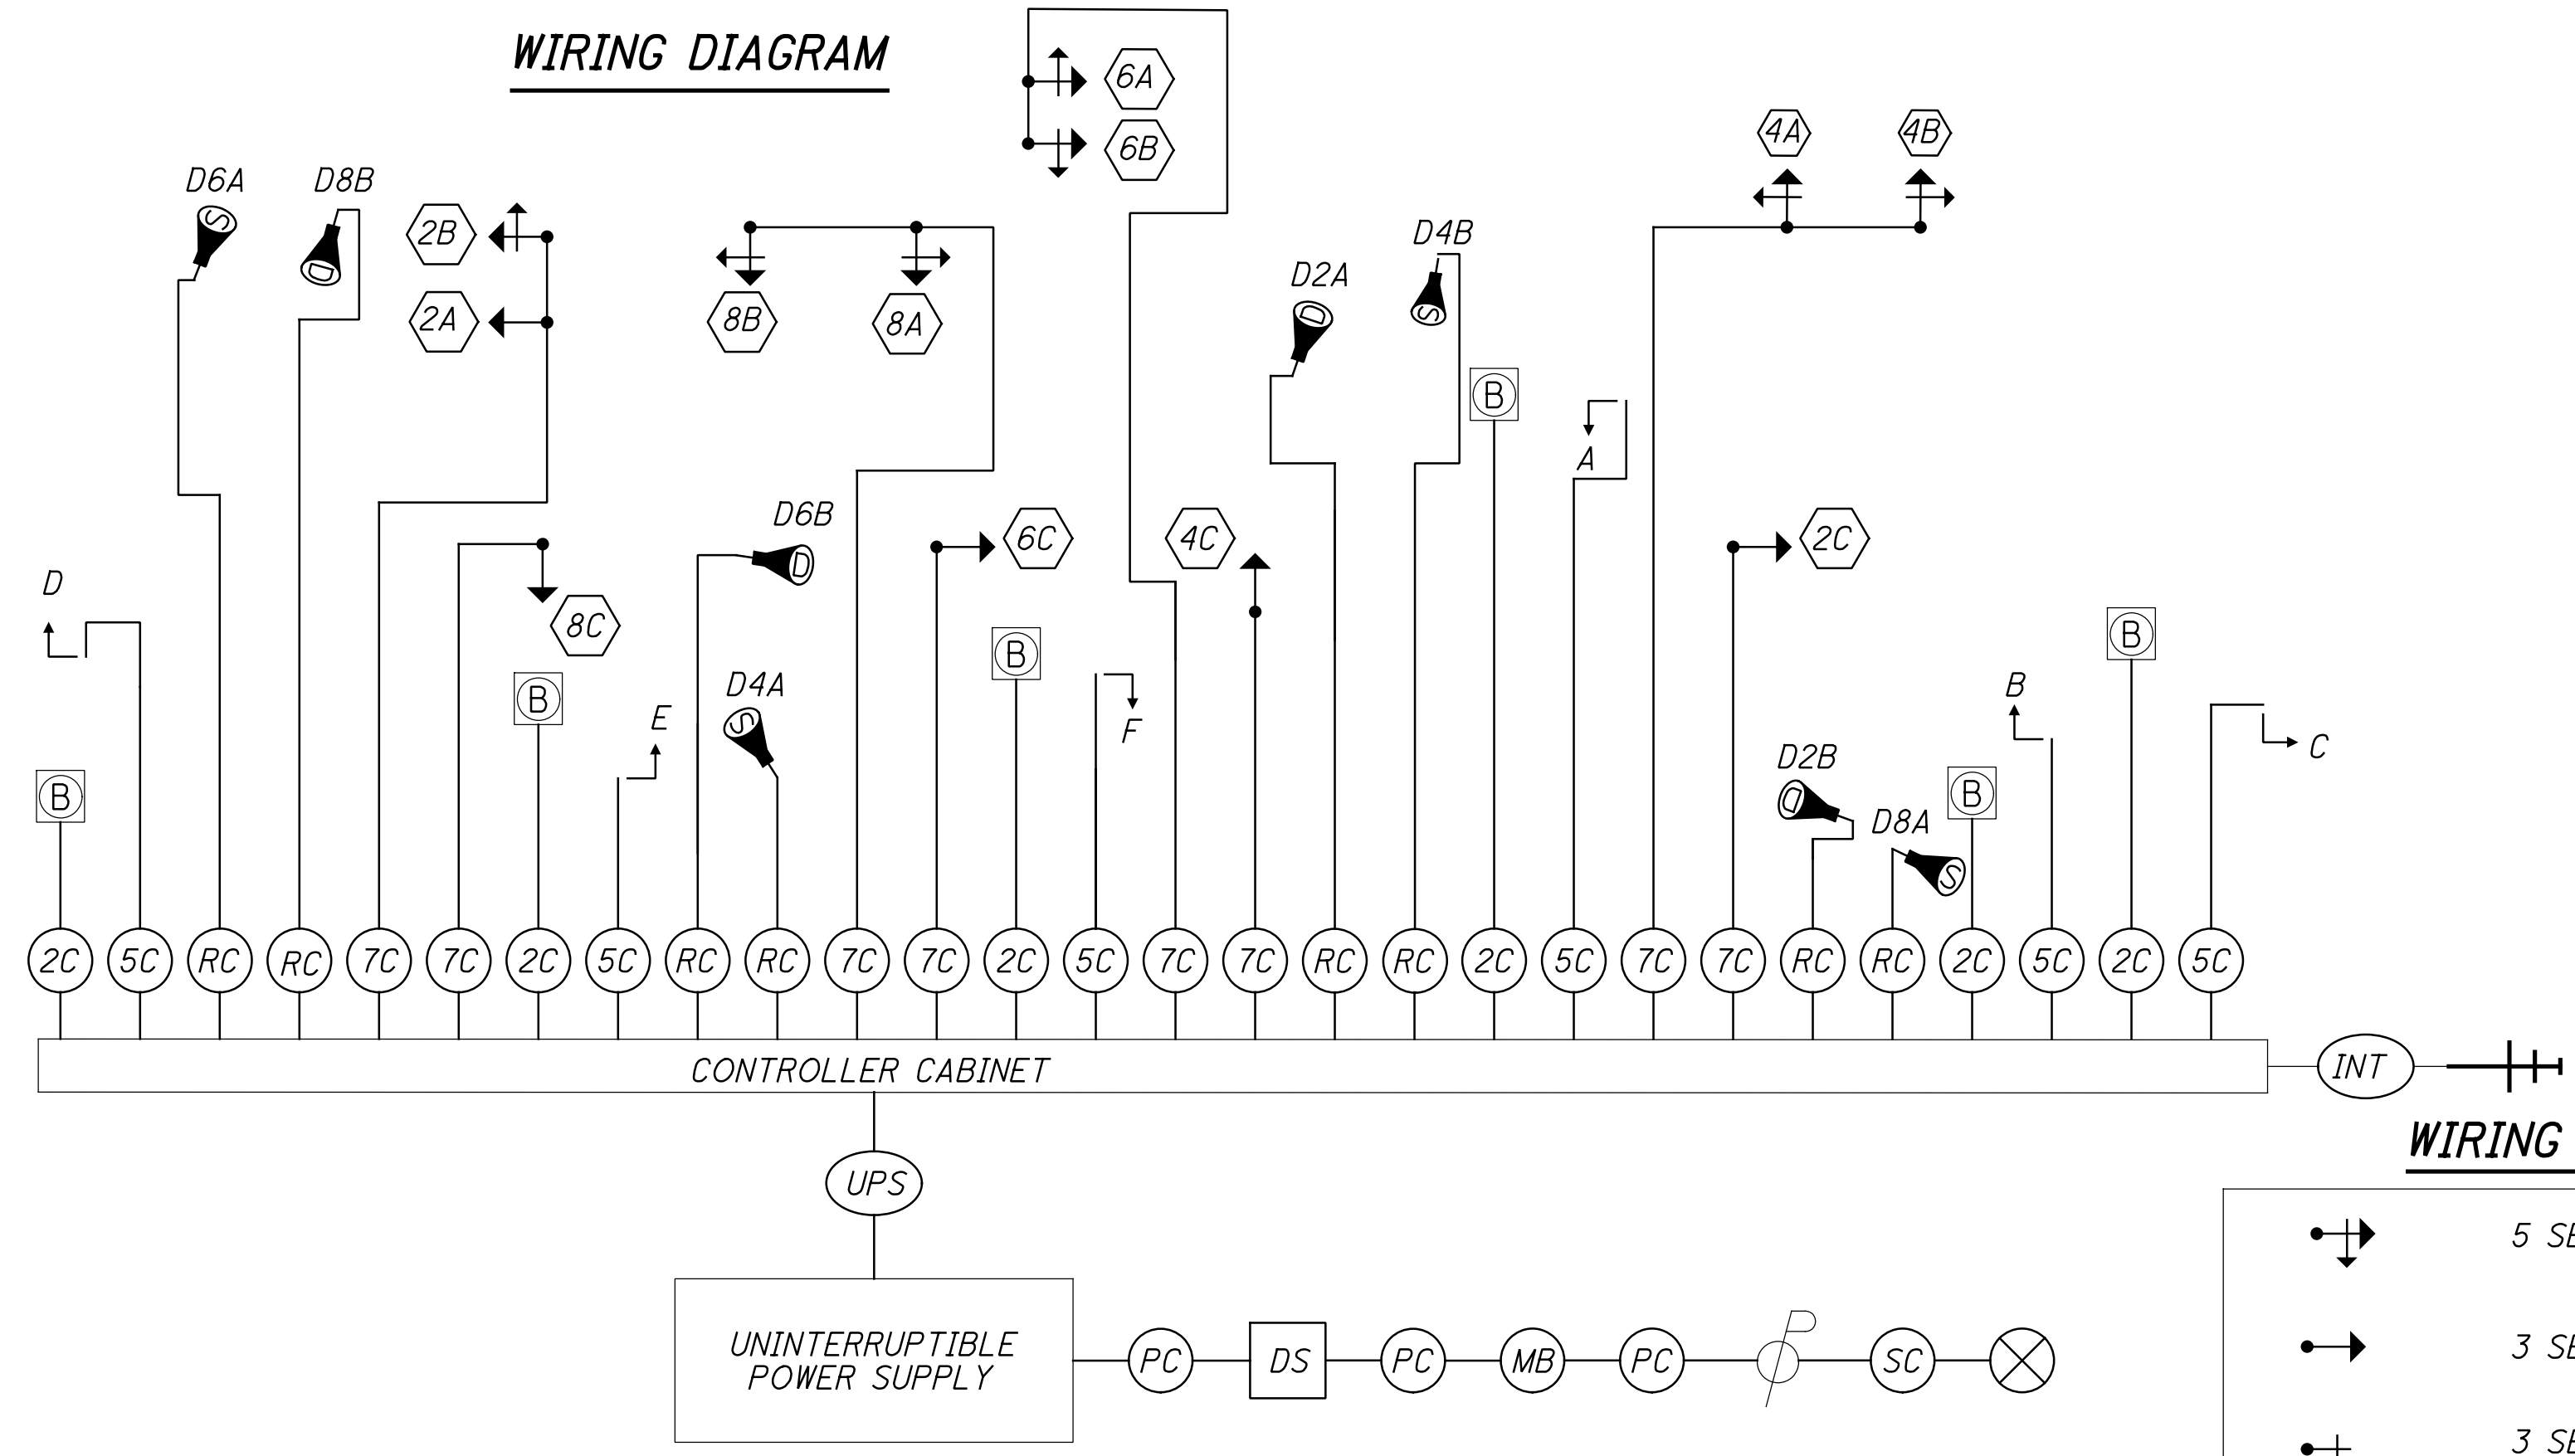

WIRING DIAGRAM LEGEND

- 5 SECTION VEHICULAR SIGNAL HEAD, 1-WAY
- 3 SECTION VEHICULAR SIGNAL HEAD, 1-WAY
- 3 SECTION VEHICULAR SIGNAL HEAD, TURN ARROWS 1-WAY
- PEDESTRIAN SIGNAL HEAD
- PEDESTRIAN PUSH BUTTON
- DILEMMA ZONE RADAR DETECTION UNIT
- STOP BAR RADAR DETECTION UNIT
- HIGH SPEED ETHERNET RADIO ANTENNA
- INTERCONNECT CABLE
- POWER SOURCE
- SIGNAL CABLE, 2 CONDUCTOR, NO. 14 AWG
- SIGNAL CABLE, 5 CONDUCTOR, NO. 14 AWG
- SIGNAL CABLE, 7 CONDUCTOR, NO. 14 AWG
- RADAR DETECTION CABLE
- SERVICE CABLE, 3 CONDUCTOR, NO. 6 AWG
- POWER CABLE, 2 CONDUCTOR, NO. 6 AWG
- SIGNAL SUPPORT POLE NO. ...
- METER BASE
- DISCONNECT SWITCH
- UNINTERRUPTIBLE POWER SUPPLY CABLE

FIELD WIRING HOOK-UP CHART

SIGNAL HEAD	INDICATION	FIELD TERMINAL	FLASH	SIGNAL HEAD	INDICATION	FIELD TERMINAL	FLASH
2A	R	Ø2 R	Y	4A	R	Ø4 R	R
	Y	Ø2 Y			Y	Ø4 Y	
	G	Ø2 G			G	Ø4 G	
-				(SB RT)	---Y-->	5 Y	
					---G-->	5 G	
2B	R	Ø2 R	Y	8B	R	Ø8 R	R
	Y	Ø2 Y			Y	Ø8 Y	
	G	Ø2 G			G	Ø8 G	
(EB LT)	<--Y---	Ø5 Y	Y	(NB LT)	<--Y---	Ø3 Y	R
	<--G---	Ø5 G			<--G---	Ø3 G	
6B	R	Ø6 R	Y	8A	R	8 R	R
	Y	Ø6 Y			Y	8 Y	
	G	Ø6 G			G	8 G	
(WB LT)	<--Y---	Ø1 Y	Y	PEDESTRIAN MOVEMENTS			OUT
	<--G---	Ø1 G		PED	W	Ø4 PED	
				WEST	DW	Ø4 PED	
6A	R	Ø6 R	Y	PED	W	Ø8 PED	OUT
	Y	Ø6 Y		EAST	DW	Ø8 PED	
	G	Ø6 G		PED	W	Ø2 PED	
(WB RT)	---Y-->	Ø7 Y	R	SOUTH	DW	Ø2 PED	OUT
	---G-->	Ø7 G		OVERLAPS			
				OLA	---Y-->	Ø5 Y	
			---G-->	Ø5 G			
4B	R	Ø4 R	R	OLB	---Y-->	Ø7 Y	DARK
	Y	Ø4 Y			---G-->	Ø7 G	
	G	Ø4 G		OLC	---Y-->	Ø1 Y	
(SB LT)	<--Y---	Ø7 Y		---G-->	Ø1 G		
	<--G---	Ø7 G					


LS = LOAD SWITCH

C:\Projects\T0H0D10\PE01\Drawing\99731\Design\Signals\99731\_CPB54.dgn Sheet 4/2/2022 11:22:16 AM mlvse

TRAFFIC SIGNAL SUBSUMMARY

ITEM	QUANTITY	UNIT	ITEM DESCRIPTION	REFERENCE
625	312	FT	CONDUIT, 2", 725.05	
625	179	FT	CONDUIT, 3", 725.04	
625	293	FT	CONDUIT, 3", 725.05	
625	784	FT	TRENCH	
625	1	EACH	PULL BOX, 725.06, SIZE 7	
625	7	EACH	PULL BOX, 725.06, SIZE 30	
625	9	EACH	GROUND ROD	
630	9	EACH	SIGN HANGER ASSEMBLY, MAST ARM	
630	2	EACH	SIGN SUPPORT ASSEMBLY, POLE MOUNTED	
630	76.5	SF	SIGN, FLAT SHEET	
632	12	EACH	VEHICULAR SIGNAL HEAD, (LED), 3-SECTION, 12" LENS, 1-WAY, POLYCARBONATE	5
632	2	EACH	PEDESTRIAN SIGNAL HEAD (LED), TYPE D2, AS PER PLAN	480
632	12	EACH	COVERING OF VEHICULAR SIGNAL HEAD	
632	2	EACH	COVERING OF PEDESTRIAN SIGNAL HEAD	
632	2	EACH	PEDESTRIAN PUSHBUTTON	
632	314	FT	SIGNAL CABLE, 2 CONDUCTOR, NO. 14 AWG	
632	322	FT	SIGNAL CABLE, 5 CONDUCTOR, NO. 14 AWG	
632	1770	FT	SIGNAL CABLE, 7 CONDUCTOR, NO. 14 AWG	
632	4	EACH	SIGNAL SUPPORT FOUNDATION, AS PER PLAN	479
632	4	EACH	PEDESTAL FOUNDATION	
632	148	FT	POWER CABLE, 3 CONDUCTOR, NO. 6 AWG	
632	920	FT	SERVICE CABLE, 3 CONDUCTOR, NO. 6 AWG	
632	1	EACH	POWER SERVICE, AS PER PLAN	479
632	1	EACH	CONDUIT RISER, 2" DIAMETER	
632	1	EACH	SIGNAL SUPPORT, TYPE TC-81.22, DESIGN 2, AS PER PLAN	479
632	1	EACH	SIGNAL SUPPORT, TYPE TC-81.22, DESIGN 4, AS PER PLAN	479
632	2	EACH	SIGNAL SUPPORT, TYPE TC-81.22, DESIGN 12, AS PER PLAN	479
632	4	EACH	PEDESTAL, MISC.: 15', TRANSFORMER BASE	479
633	1	EACH	CABINET, TYPE TS-2, AS PER PLAN	480
633	1	EACH	CABINET FOUNDATION, AS PER PLAN	479
633	1	EACH	CONTROLLER WORK PAD, AS PER PLAN	479
633	1	EACH	UNINTERRUPTIBLE POWER SUPPLY (UPS), 1000 WATT, AS PER PLAN	480
809	1	EACH	HIGH-SPEED ETHERNET RADIO	
809	1	EACH	ADVANCE RADAR DETECTION, AS PER PLAN	480
809	4	EACH	STOP LINE RADAR DETECTION, AS PER PLAN	482
809	1	EACH	ATC CONTROLLER, AS PER PLAN (PROGRAM AND INSTALL ONLY)	480

WIRING DIAGRAM

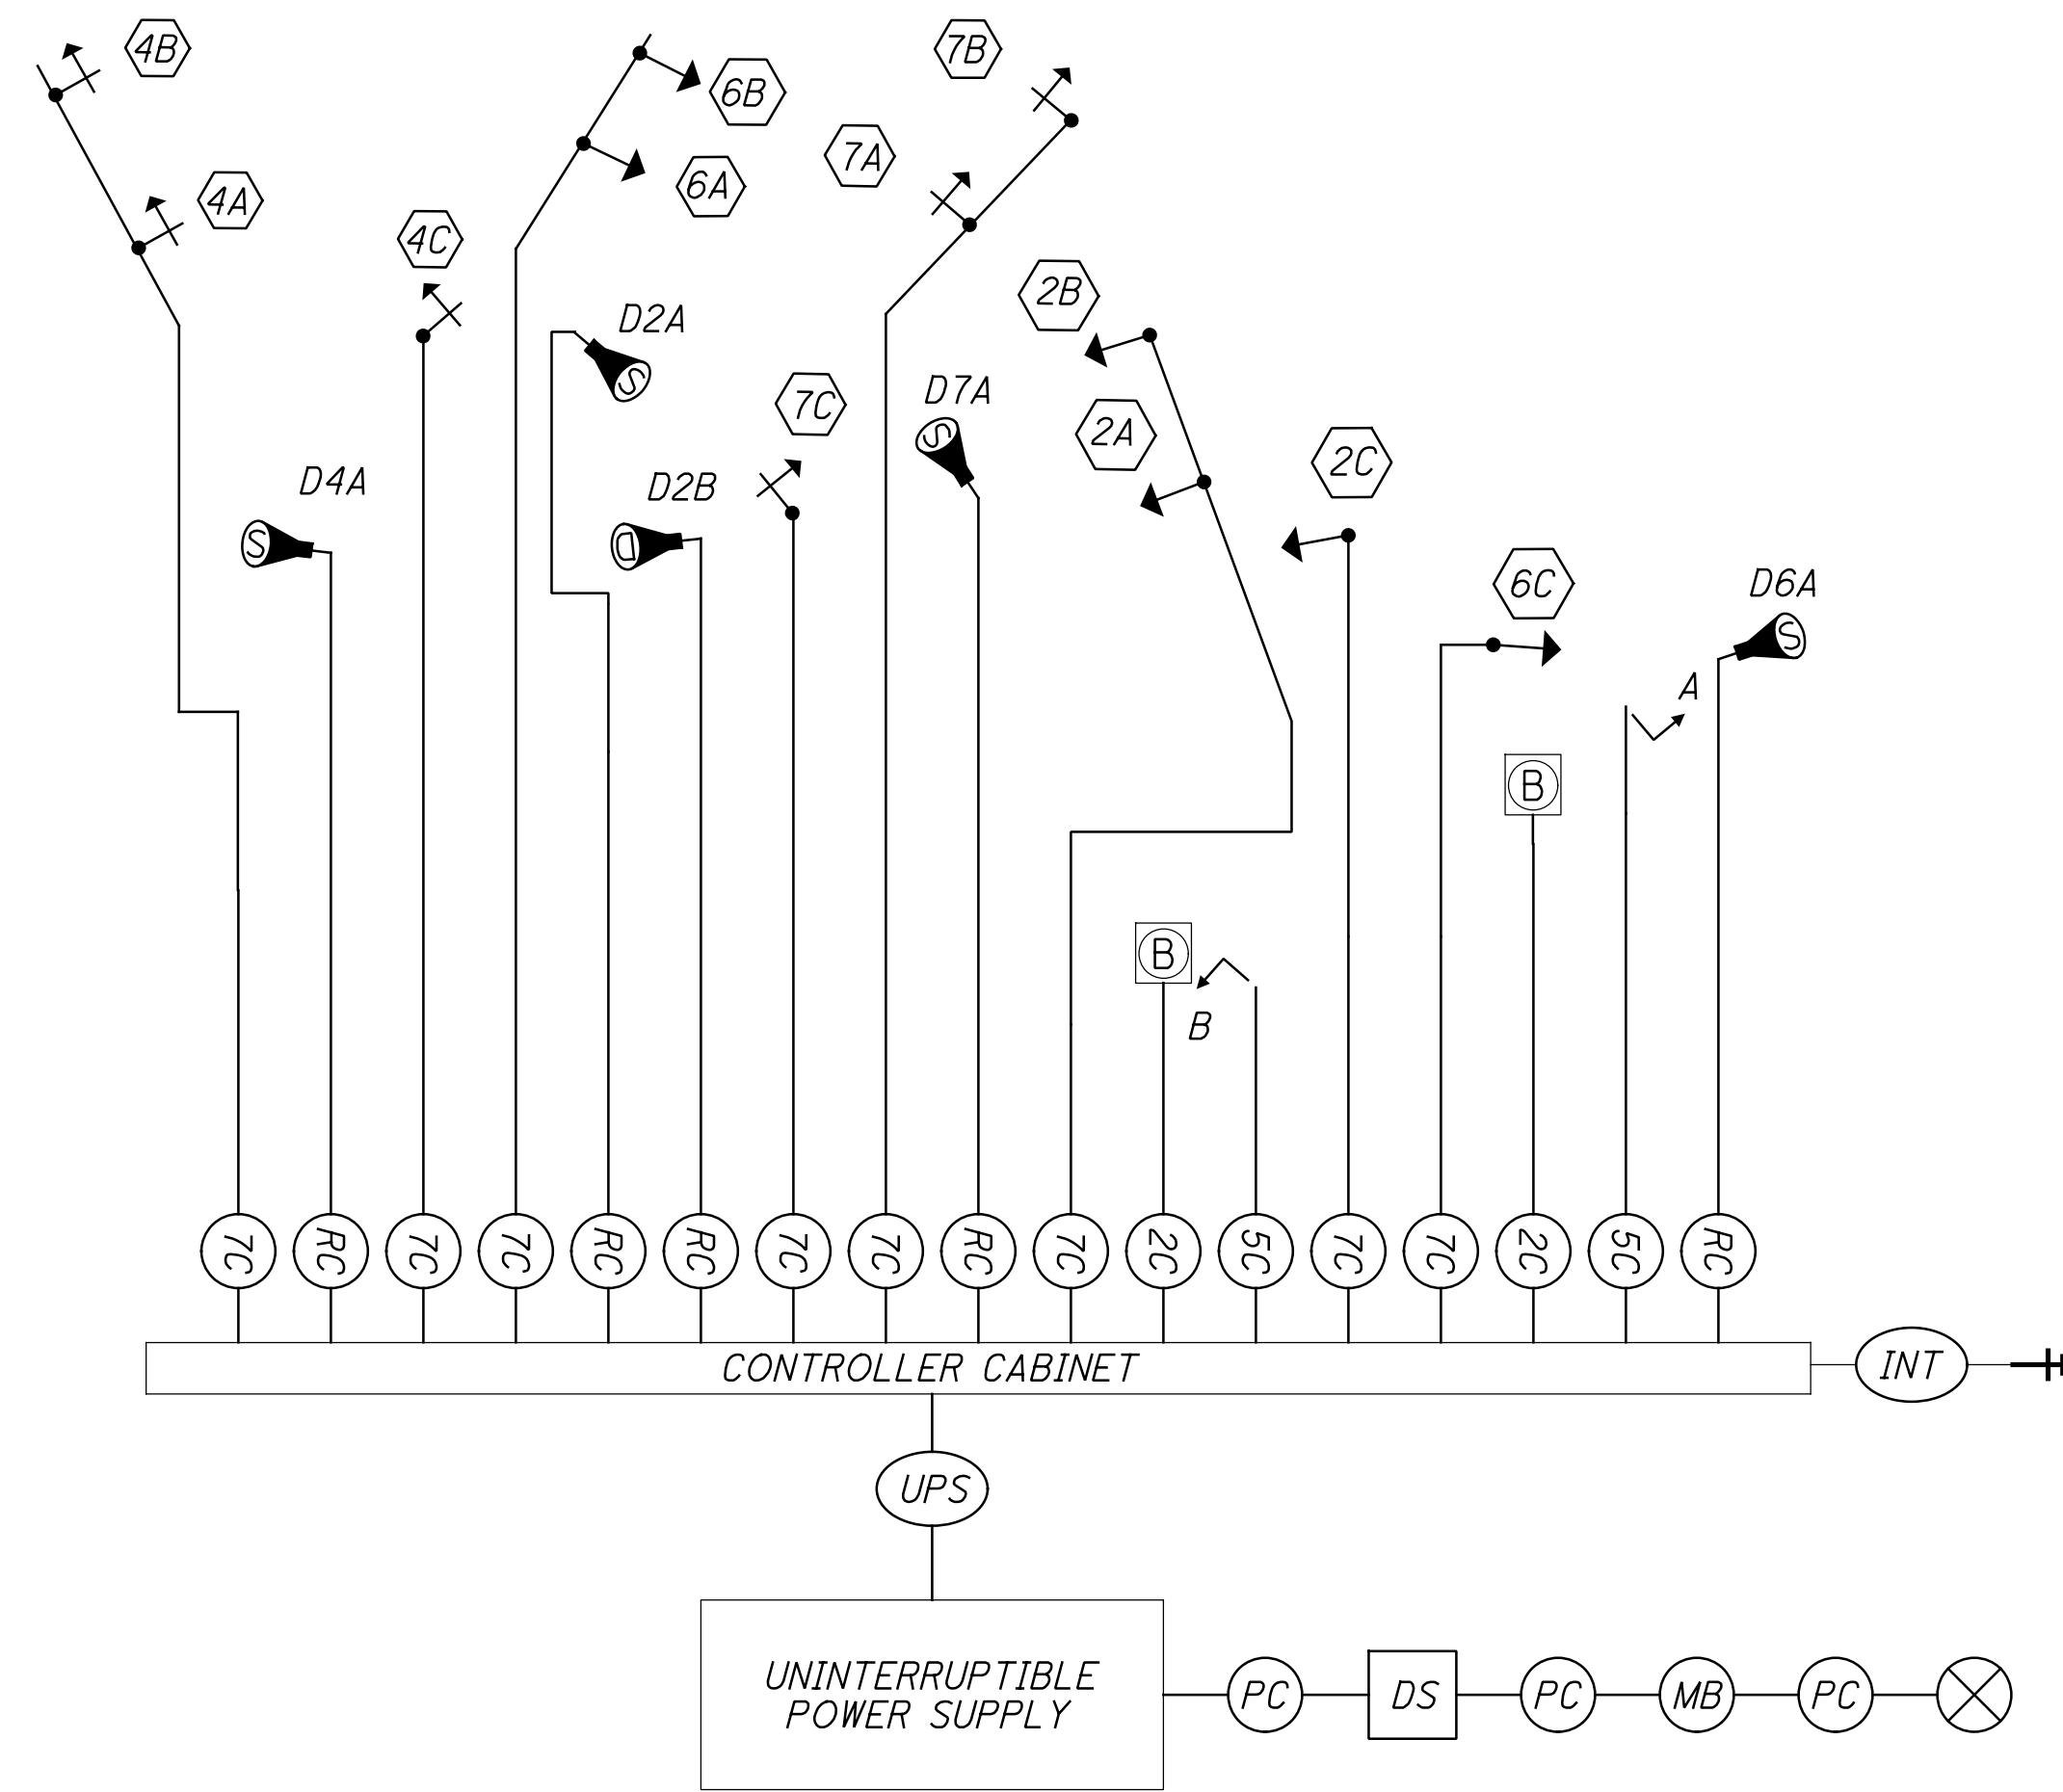

WIRING DIAGRAM LEGEND

- 5 SECTION VEHICULAR SIGNAL HEAD, 1-WAY
- 3 SECTION VEHICULAR SIGNAL HEAD, 1-WAY
- 3 SECTION VEHICULAR SIGNAL HEAD, TURN ARROWS 1-WAY
- PEDESTRIAN SIGNAL HEAD
- PEDESTRIAN PUSH BUTTON
- DILEMMA ZONE RADAR DETECTION UNIT
- STOP BAR RADAR DETECTION UNIT
- HIGH SPEED ETHERNET RADIO
- INTERCONNECT CABLE
- POWER SOURCE
- SIGNAL CABLE, 2 CONDUCTOR, NO. 14 AWG
- SIGNAL CABLE, 5 CONDUCTOR, NO. 14 AWG
- SIGNAL CABLE, 7 CONDUCTOR, NO. 14 AWG
- RADAR DETECTION CABLE
- SERVICE CABLE, 3 CONDUCTOR, NO. 6 AWG
- POWER CABLE, 2 CONDUCTOR, NO. 6 AWG
- SIGNAL SUPPORT POLE NO. --
- METER BASE
- DISCONNECT SWITCH
- UNINTERRUPTIBLE POWER SUPPLY CABLE

FIELD WIRING HOOK-UP CHART

SIGNAL HEAD	INDICATION	FIELD TERMINAL	FLASH	SIGNAL HEAD	INDICATION	FIELD TERMINAL	FLASH
2A, 2B	R	Ø2 R	R				
	Y	Ø2 Y					
	G	Ø2 G					
6A, 6B	R	Ø6 R	R				
	Y	Ø6 Y					
	G	Ø6 G					
4A, 4B	R	Ø4 R	R				
	---Y-->	Ø4 Y					
	---G-->	Ø4 G					
(SB RT)				PEDESTRIAN MOVEMENTS			
				PED NORTH	W DW	Ø2 PED	OUT
7A, 7B	R	Ø7 R	R				
	<--Y---	Ø7 Y					
	<--G---	Ø7 G					
(SB LT)				OVERLAPS			

LS = LOAD SWITCH

CALCULATED  
BRO  
CHECKED  
DRJ

TRAFFIC SIGNAL PLAN DETAILS  
US 20A & SOUTHBOUND I-475 RAMPS

LUC-475-01.85


490  
637

C:\Projects\T0H0D10\_P010\Drawing\99731\Design\Signals\Sheets\99731\_CPI68.dgn\_Sheet 4/21/2022 11:28:50 AM mlove

TRAFFIC SIGNAL SUBSUMMARY

ITEM	QUANTITY	UNIT	ITEM DESCRIPTION	REFERENCE
625	336	FT	CONDUIT, 2", 725.05	
625	317	FT	CONDUIT, 3", 725.04	
625	263	FT	CONDUIT, 3", 725.05	
625	916	FT	TRENCH	
625	4	EACH	PULL BOX, 725.06, SIZE 7	
625	2	EACH	PULL BOX, 725.06, SIZE 18	
625	3	EACH	PULL BOX, 725.06, SIZE 30	
625	11	EACH	GROUND ROD	
630	9	EACH	SIGN HANGER ASSEMBLY, MAST ARM	
630	4	EACH	SIGN SUPPORT ASSEMBLY, POLE MOUNTED	
630	78.0	SF	SIGN, FLAT SHEET	
632	12	EACH	VEHICULAR SIGNAL HEAD, (LED), 3-SECTION, 12" LENS, 1-WAY, POLYCARBONATE	5
632	4	EACH	PEDESTRIAN SIGNAL HEAD (LED), TYPE D2, AS PER PLAN	480
632	12	EACH	COVERING OF VEHICULAR SIGNAL HEAD	
632	4	EACH	COVERING OF PEDESTRIAN SIGNAL HEAD	
632	4	EACH	PEDESTRIAN PUSHBUTTON	
632	920	FT	SIGNAL CABLE, 2 CONDUCTOR, NO. 14 AWG	
632	936	FT	SIGNAL CABLE, 5 CONDUCTOR, NO. 14 AWG	
632	1834	FT	SIGNAL CABLE, 7 CONDUCTOR, NO. 14 AWG	
632	4	EACH	SIGNAL SUPPORT FOUNDATION, AS PER PLAN	479
632	6	EACH	PEDESTAL FOUNDATION	
632	89	FT	POWER CABLE, 3 CONDUCTOR, NO. 6 AWG	
632	1	EACH	POWER SERVICE, AS PER PLAN	479
632	1	EACH	CONDUIT RISER, 2" DIAMETER	
632	2	EACH	SIGNAL SUPPORT, TYPE TC-81.22, DESIGN 2, AS PER PLAN	479
632	2	EACH	SIGNAL SUPPORT, TYPE TC-81.22, DESIGN 4, AS PER PLAN	479
632	3	EACH	PEDESTAL, 8', TRANSFORMER BASE, AS PER PLAN	479
632	3	EACH	PEDESTAL, MISC.:15', TRANSFORMER BASE	479
633	1	EACH	CABINET, TYPE TS-2, AS PER PLAN	480
633	1	EACH	CABINET FOUNDATION, AS PER PLAN	479
633	1	EACH	CONTROLLER WORK PAD, AS PER PLAN	479
633	1	EACH	UNINTERRUPTIBLE POWER SUPPLY (UPS), 1000 WATT, AS PER PLAN	480
809	1	EACH	HIGH-SPEED ETHERNET RADIO	
809	1	EACH	ADVANCE RADAR DETECTION, AS PER PLAN	480
809	4	EACH	STOP LINE RADAR DETECTION, AS PER PLAN	482
809	1	EACH	ATC CONTROLLER, AS PER PLAN (PROGRAM AND INSTALL ONLY)	480

WIRING DIAGRAM

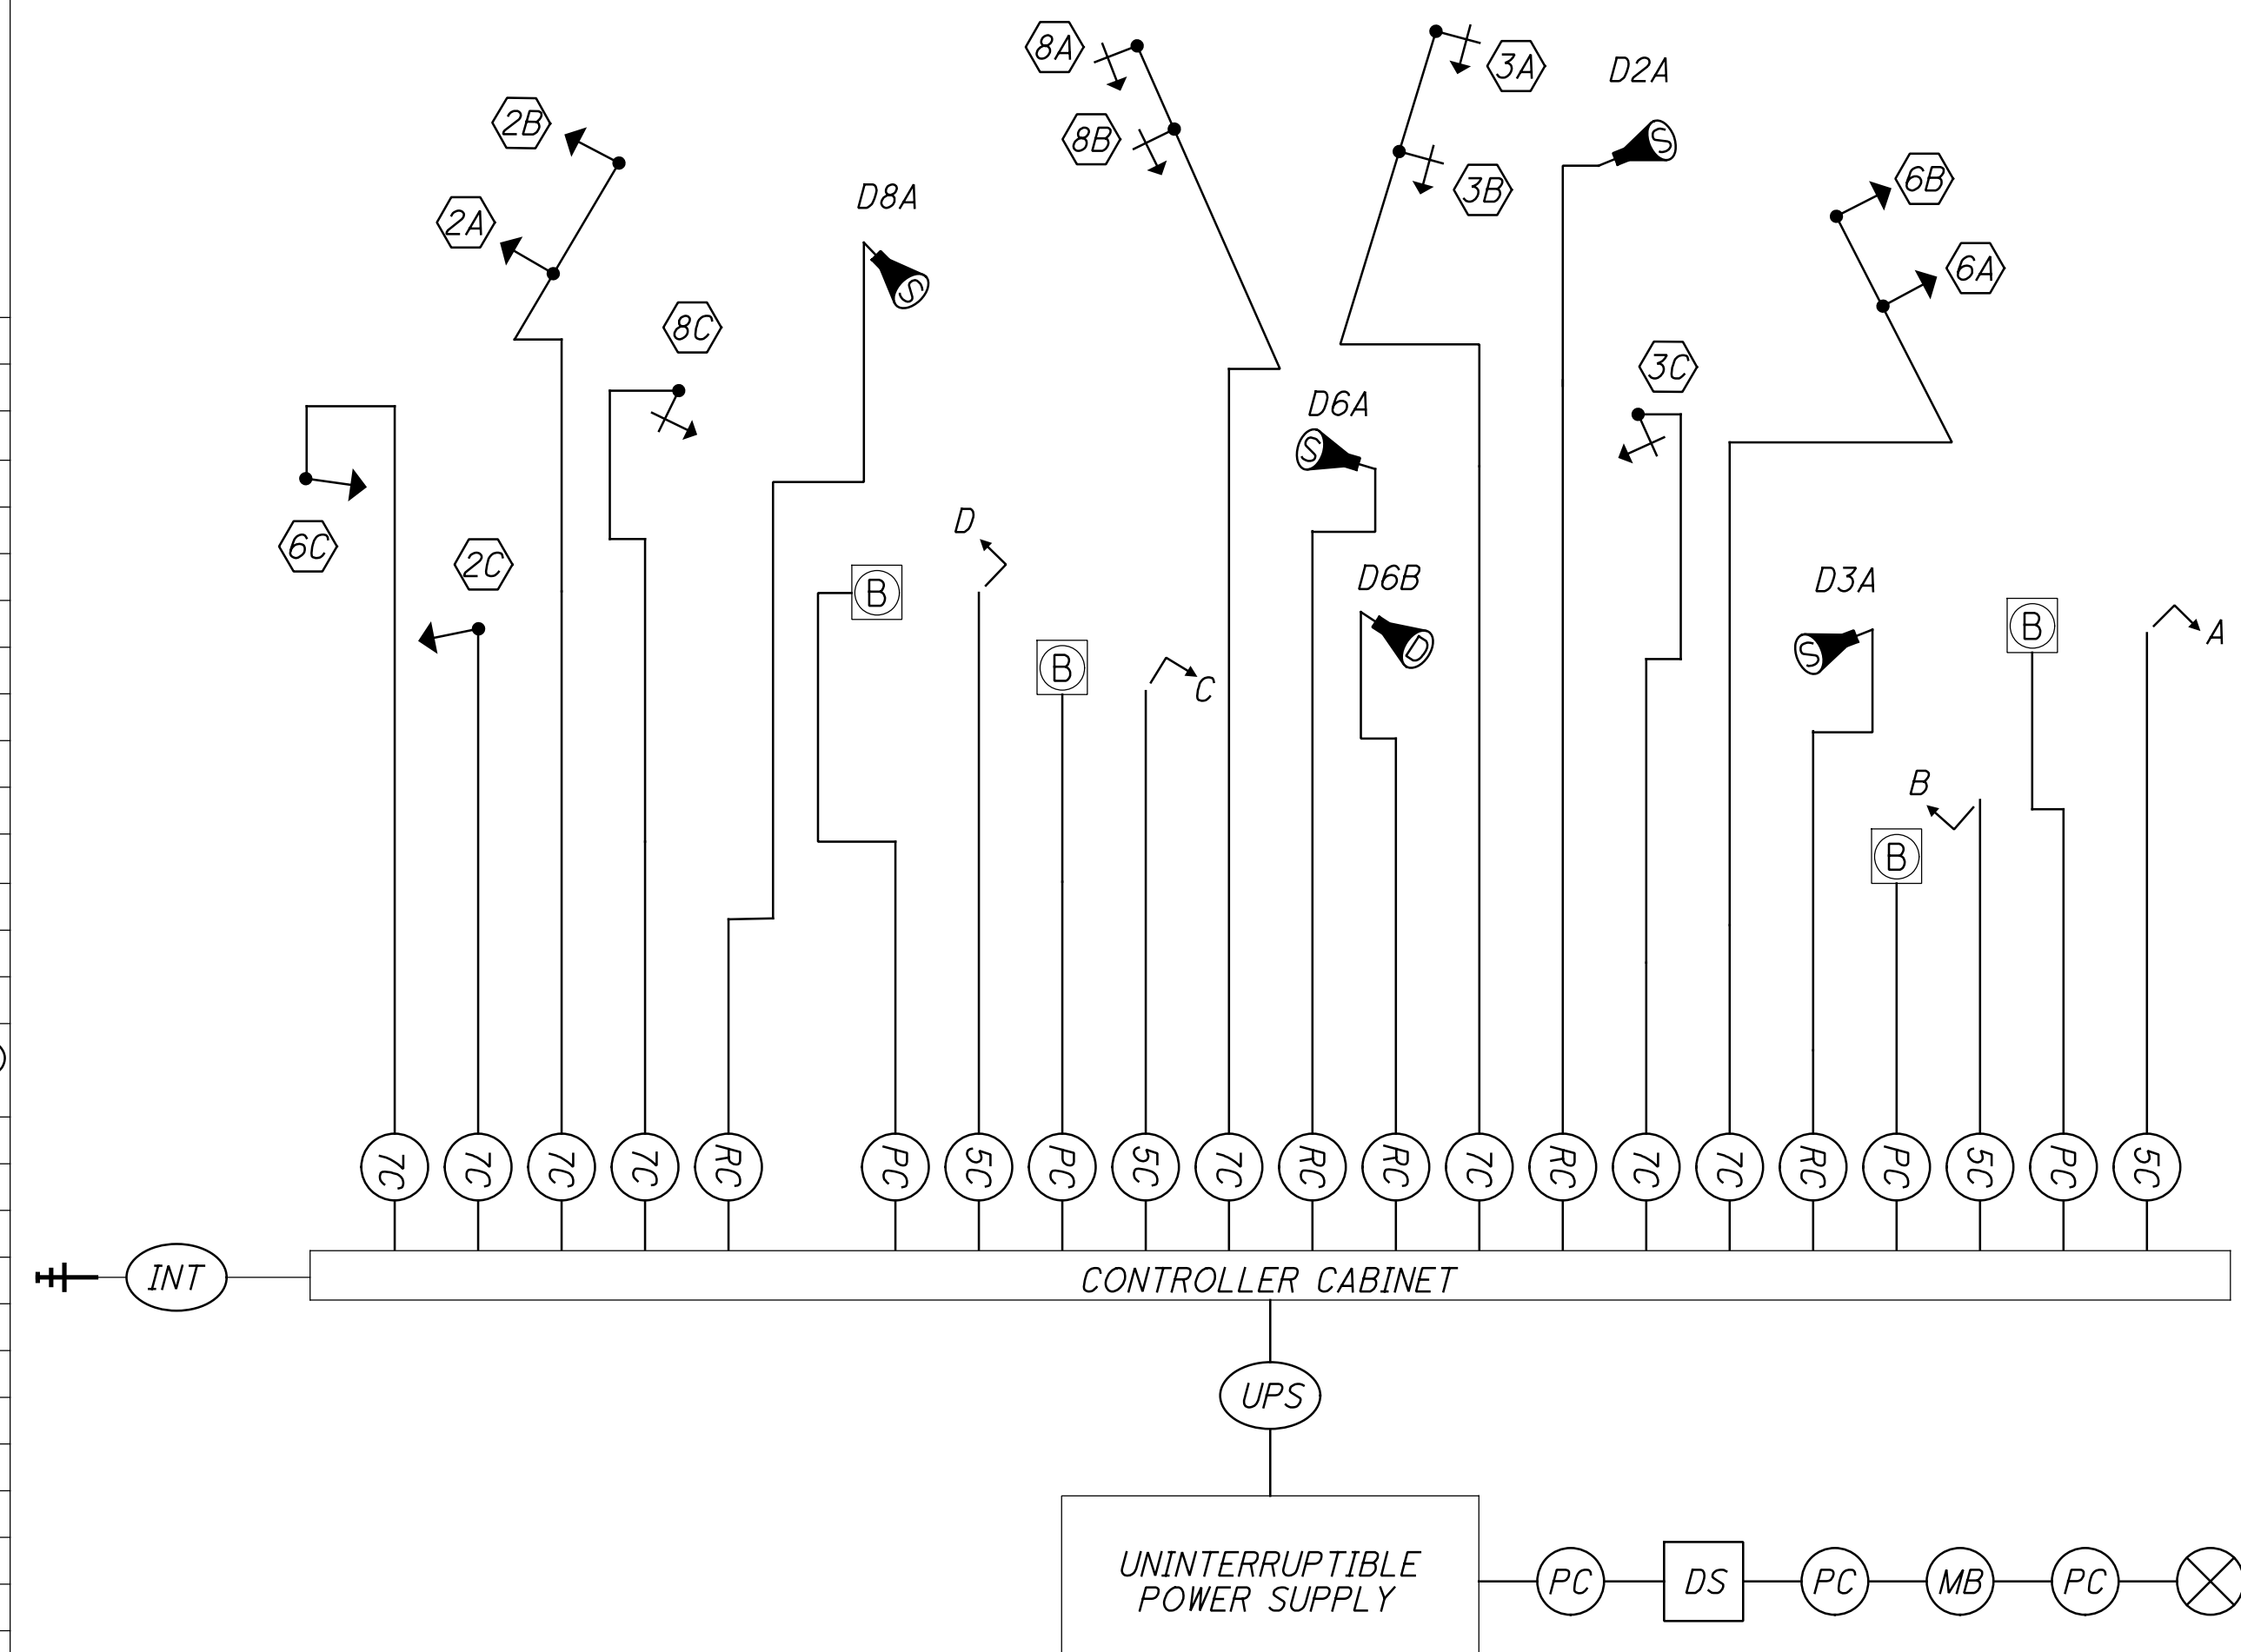

WIRING DIAGRAM LEGEND

- 5 SECTION VEHICULAR SIGNAL HEAD, 1-WAY
- 3 SECTION VEHICULAR SIGNAL HEAD, 1-WAY
- 3 SECTION VEHICULAR SIGNAL HEAD, TURN ARROWS 1-WAY
- PEDESTRIAN SIGNAL HEAD
- PEDESTRIAN PUSH BUTTON
- DILEMMA ZONE RADAR DETECTION UNIT
- STOP BAR RADAR DETECTION UNIT
- HIGH SPEED ETHERNET RADIO
- INTERCONNECT CABLE
- POWER SOURCE
- SIGNAL CABLE, 2 CONDUCTOR, NO. 14 AWG
- SIGNAL CABLE, 5 CONDUCTOR, NO. 14 AWG
- SIGNAL CABLE, 7 CONDUCTOR, NO. 14 AWG
- RADAR DETECTION CABLE
- SERVICE CABLE, 3 CONDUCTOR, NO. 6 AWG
- POWER CABLE, 2 CONDUCTOR, NO. 6 AWG
- SIGNAL SUPPORT POLE NO. 1
- METER BASE
- DISCONNECT SWITCH
- UNINTERRUPTIBLE POWER SUPPLY CABLE

FIELD WIRING HOOK-UP CHART

SIGNAL HEAD	INDICATION	FIELD TERMINAL	FLASH	SIGNAL HEAD	INDICATION	FIELD TERMINAL	FLASH
2A, 2B	R	∅2 R	R				
	Y	∅2 Y					
	G	∅2 G					
6A, 6B	R	∅6 R	R				
	Y	∅6 Y					
	G	∅6 G					
3A, 3B	R	∅3 R	R				
	<--Y-->	∅3 Y					
	<--G-->	∅3 G					
(NB LT)				PEDESTRIAN MOVEMENTS			
				PED	W	∅2 PED	OUT
				NORTH	DW	∅2 PED	
				PED	W	∅2 PED	
			NORTH	DW	∅2 PED		
8A, 8B	R	∅8 R	R				
	<--Y-->	∅8 Y					
	<--G-->	∅8 G					
(NB RT)				OVERLAPS			

LS = LOAD SWITCH


CALCULATED  
BRO  
CHECKED  
DRJ

TRAFFIC SIGNAL PLAN DETAILS  
US 20A & NORTHBOUND I-475 RAMPS



LUC-475-01.85

494  
637


C:\Projects\T0H0D10\PE0\Drawing\99731\Design\Signals\Sheets\99731\_CPI62.dgn Sheet 4/21/2022 11:36:33 AM move

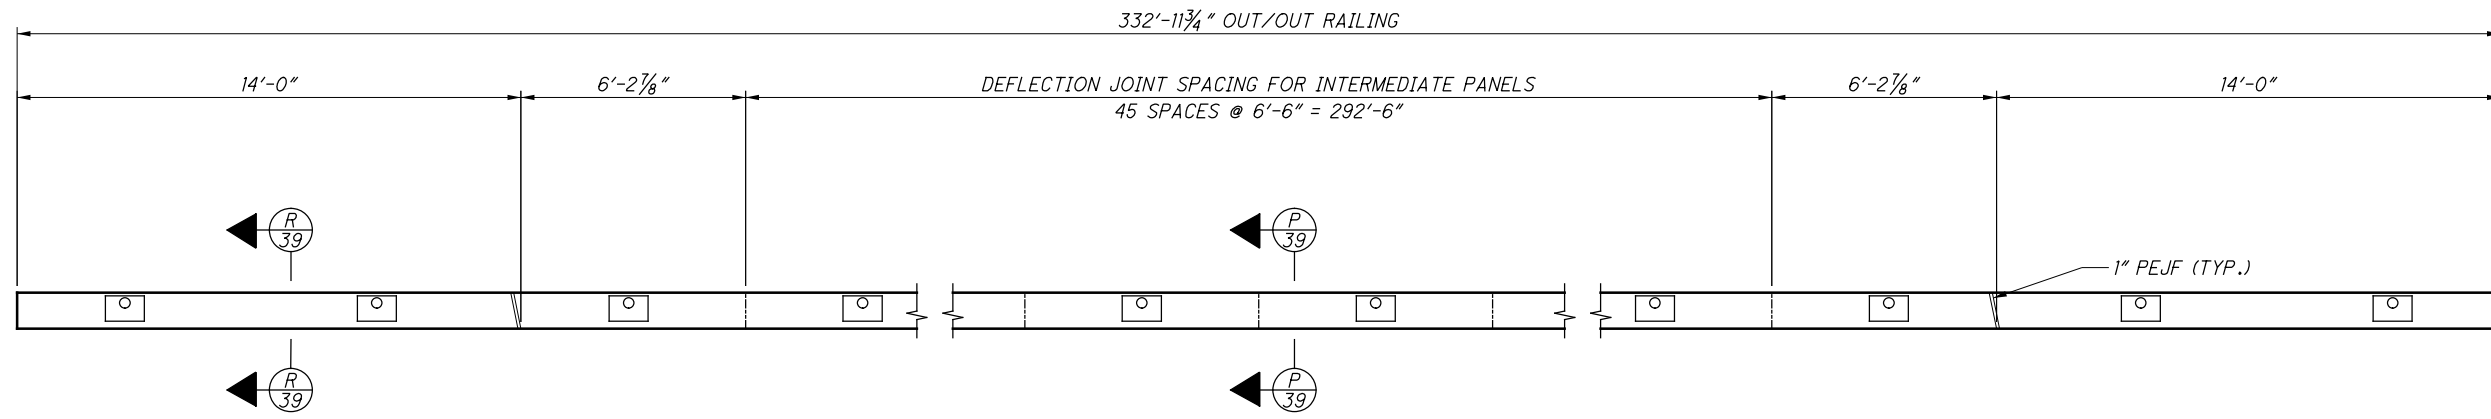

**RAILING PLAN**

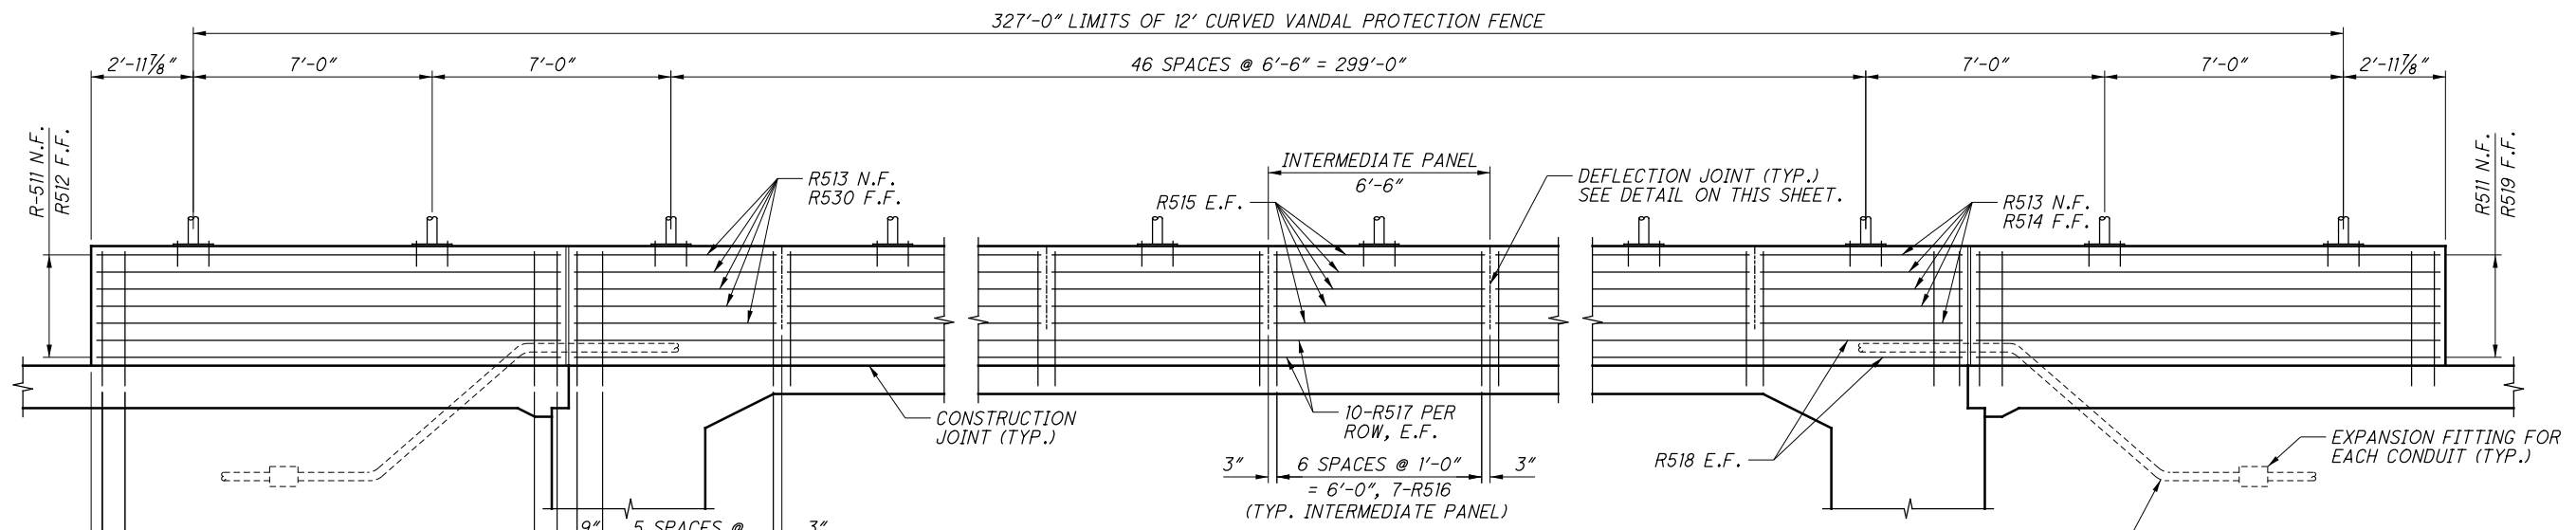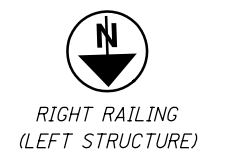


**RAILING ELEVATION**

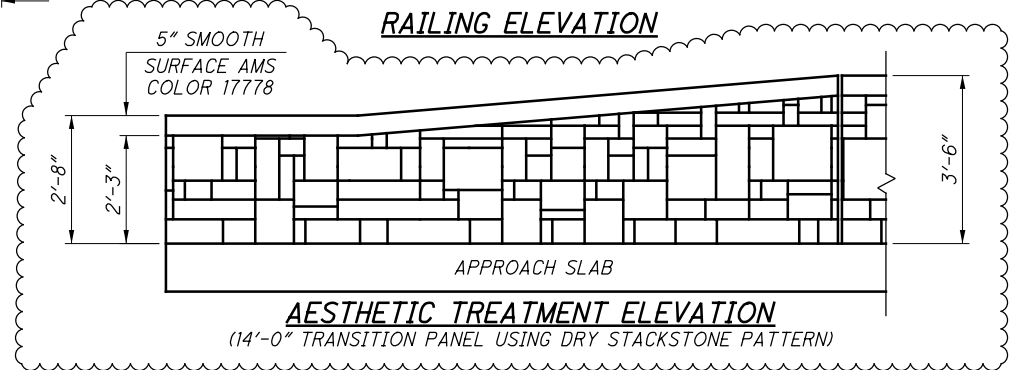


**AESTHETIC TREATMENT ELEVATION**  
(14'-0" TRANSITION PANEL USING DRY STACKSTONE PATTERN)

- NOTES**
- REINFORCING SPLICE LENGTHS SHALL BE AS FOLLOWS UNLESS OTHERWISE NOTED:  
#5 BARS - 2'-5"
  - SEE STD. DWG. BR-2-15 FOR SAWCUT DETAILS
  - SEE STD. DWG. VPF-1-90 FOR DETAILS ON 12' CURVED VANDAL PROTECTION FENCE. USE BP-3 BASE PLATE AND PS-1 POST SECTION.
  - PARAPET AESTHETIC TREATMENT SHALL BE INCLUDED FOR PAYMENT UNDER ITEM 511, CLASS QC2 CONCRETE WITH QC/QA, BRIDGE DECK (PARAPET), AS PER PLAN.

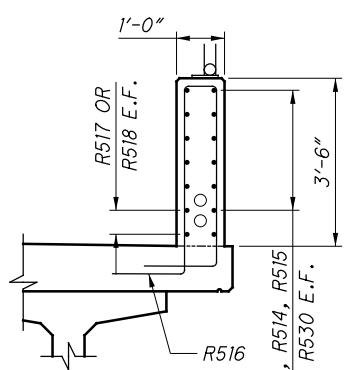


**SECTION P-P**

(DECK REINFORCING NOT SHOWN)

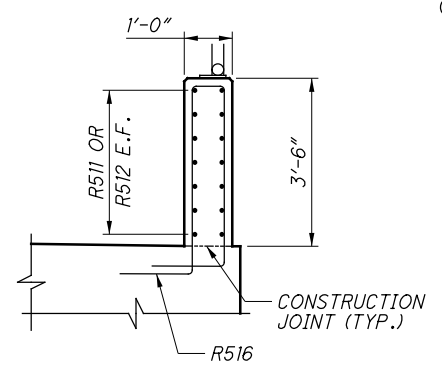


**SECTION R-R**

(APPROACH SLAB REINFORCING NOT SHOWN)

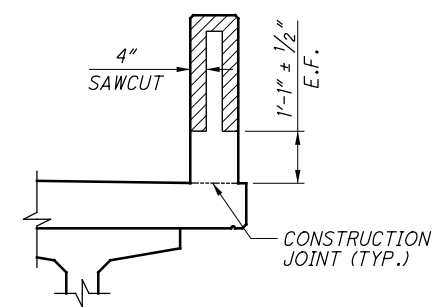

**DEFLECTION JOINT DETAIL**

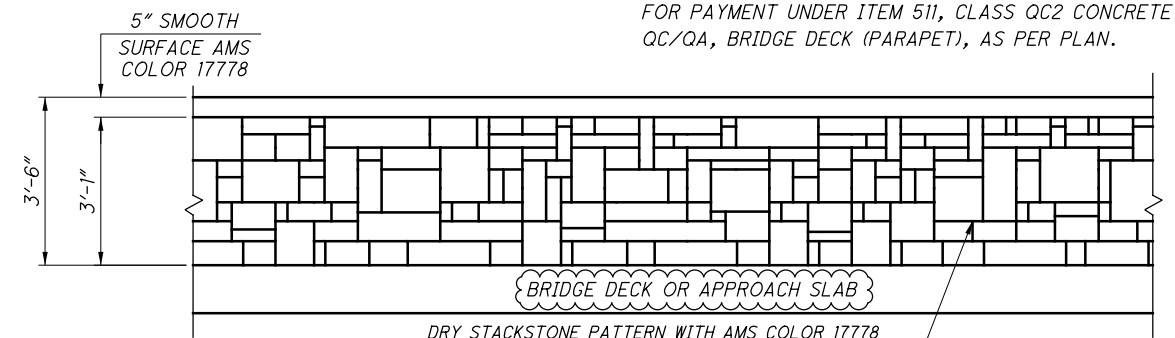

DRY STACKSTONE PATTERN WITH AMS COLOR 17778  
(CREATE 2 DISTINCT FORMS WITH A DIFFERENT RANDOM TEXTURE PATTERN, ALTERNATE USE OF EACH FORM)

**AESTHETIC TREATMENT ELEVATION**  
(FULL LENGTH EXTERIOR PARAPET FASCIA BOTH STRUCTURES - 4 TOTAL FACES)

DESIGN AGENCY: DGL Consulting Engineers, LLC  
3455 Briarfield Blvd., Suite E  
Maumee, Ohio 43537 (419) 535-1015

DATE: 3-9-18  
REVIEWED: LLA  
DRAWN: SAM  
DESIGNED: SAM  
CHECKED: KWL

STRUCTURE FILE NUMBER: 4801025L/4801026R

**SUPERSTRUCTURE DETAILS (19 OF 20)**  
BRIDGE NO.: LUC-20A-1048 (L & R)  
US 20A OVER I-475/US 23

LUC-475-01.85  
PID No. 99731

39/46

582  
637



C:\Users\sgault\OneDrive - ARCADIS\Desk\top\LUC475\T0HODT10\PE01(2)\T0HODT10\PE01\Drawings\99731\Design\M0T\_Sheets\99731\_MN008.dgn Sheet 4/28/2022 5:11:04 PM sgault

**ITEM 625 SPECIAL - MAINTAIN EXISTING LIGHTING**

EXISTING ROADWAYS WHICH ARE TO REMAIN OPEN TO TRAFFIC DURING CONSTRUCTION OF THIS PROJECT AND ARE LIGHTED SHALL HAVE THE LIGHTING MAINTAINED AS DESCRIBED HEREIN. ANY NEW ROADWAYS THAT ARE TO BE LIGHTED SHALL BE LIT WITH NEW OR TEMPORARY LIGHTING PRIOR TO BEING OPENED TO

BEFORE ANY WORK IS STARTED IN THE IMMEDIATE VICINITY OF ANY EXISTING LIGHTING CIRCUITS, REPRESENTATIVES OF THE STATE, THE MAINTAINING AGENCY, AND THE CONTRACTOR SHALL MAKE A VISUAL INSPECTION OF THE OF THE EXISTING ROADWAY LIGHTING CIRCUITS TO BE MAINTAINED. DURING THIS INSPECTION A WRITTEN RECORD OF THE CONDITION OF THE EXISTING LIGHTING SHALL BE MADE BY THE STATE'S REPRESENTATIVE. THIS WRITTEN REPORT SHALL NOTE INDIVIDUAL LUMINAIRES WHICH ARE NOT STANDING, AND INDIVIDUAL CIRCUITS WHICH ARE NOT IN WORKING ORDER. THE COMPLETED REPORT SHALL BE SIGNED BY THE REPRESENTATIVES OF THE STATE, THE MAINTAINING AGENCY, AND THE CONTRACTOR.

IF, AS A RESULT OF THIS INSPECTION, IT IS DETERMINED THAT THE CONDITION OF THE EXISTING SYSTEM IS BELOW THAT REQUIRED FOR THE SAFETY OF THE TRAVELING PUBLIC, THEN THE MAINTAINING AGENCY SHALL MAKE REPAIRS NECESSARY TO RETURN THE SYSTEM TO AN ACCEPTABLE CONDITION. FOLLOWING THESE REPAIRS, THE SYSTEM SHALL AGAIN BE INSPECTED, AND A REPORT MADE AND SIGNED AS OUTLINED HEREIN.

WHEN THE EXISTING SYSTEM IS IN AN ACCEPTABLE CONDITION, IT SHALL BE TURNED OVER TO THE CONTRACTOR WHO SHALL THEN BE REQUIRED TO MAINTAIN THE EXISTING LIGHTING TO THE CONDITION OUTLINED IN THIS REPORT WITH THE EXCEPTION OF KNOCKDOWNS DUE TO TRAFFIC ACCIDENTS.

REPLACEMENT OF KNOCKED DOWN UNITS SHALL BE DONE ONLY WHEN THE ENGINEER HAS DETERMINED THAT THE REPLACEMENT OF THE KNOCKED DOWN UNIT IS NECESSARY AND SHALL BE PAID SEPARATELY ON A PER UNIT BASIS.

BETTERMENTS SHALL BE COVERED IN ITEMS OF WORK PERTAINING TO THE CONSTRUCTION OF PERMANENT IMPROVEMENTS. THE STATE SHALL GIVE THE CONTRACTOR ONE COPY OF THE EXISTING LIGHTING CIRCUITRY LAYOUT.

WHEN THE CONTRACTOR HAS TAKEN OVER THE MAINTENANCE OF THE EXISTING SYSTEM, THE CONTRACTOR SHALL PROVIDE ALL REQUIRED LAYOUT AND LOCATING OF EXISTING LIGHTING CIRCUITS WITHIN THE PROJECT.

PRIOR TO INSTALLING TEMPORARY LIGHTING THE CONTRACTOR SHALL SUBMIT A TEMPORARY LIGHTING PLAN TO THE ENGINEER.

THIS PLAN SHALL SHOW LOCATIONS OF POLES, LENGTHS OF BRACKET ARMS, STYLES OF LUMINAIRES, MOUNTING HEIGHTS, WIRING METHODS AND OTHER PERTINENT INFORMATION. THE TEMPORARY LIGHTING SHALL PROVIDE AN AVERAGE INITIAL INTENSITY OF 1.2 FOOTCANDLES WITH AN AVERAGE TO MINIMUM UNIFORMITY NOT TO EXCEED 3:1. MOUNTING HEIGHT OF TEMPORARY LUMINAIRES SHALL NOT BE LESS THAN 30 FEET, AND THE MINIMUM OVERHEAD CONDUCTOR CLEARANCE SHALL BE 20 FEET. TEMPORARY OVERHEAD CONSTRUCTION SHALL NOT BE LESS THAN GRADE "B" FOR STRENGTH REQUIREMENTS AS DEFINED BY THE NATIONAL ELECTRIC SAFETY CODE. WOOD POLES WITH OVERHEAD WIRING MAY BE USED. HOWEVER, TEMPORARY LIGHTING SHALL MEET FEDERAL AND STATE SAFETY CRITERIA. IF BREAKAWAY POLES ARE USED TO MEET THESE CRITERIA, THEN UNDERGROUND WIRING SHALL BE USED. RECONDITIONED OR USED MATERIALS MAY BE FURNISHED FOR TEMPORARY LIGHTING.

**ITEM 625 SPECIAL - MAINTAIN EXISTING LIGHTING (CONTINUED)**

ALL MATERIALS NECESSARY TO COMPLETE THE TEMPORARY LIGHTING SHALL BE FURNISHED AND INSTALLED BY THE CONTRACTOR. A SEPARATE POWER SERVICE WILL BE PROVIDED BY THE CONTRACTOR FOR THE TEMPORARY LIGHTING SYSTEM. THE TEMPORARY LIGHTING SHALL NOT BE SPLICED INTO EXISTING LIGHTING CIRCUITS. THE CONTRACTOR SHALL PAY ALL HOOK-UP FEES AND ELECTRICAL COSTS FOR THE TEMPORARY SYSTEM. THESE COSTS SHALL BE PAID FOR UNDER THE LUMP SUM ITEM SPECIAL MAINTAIN EXISTING LIGHTING. WHEN NO LONGER NEEDED THE TEMPORARY LIGHTING INSTALLATION SHALL BE REMOVED AND PROPERLY DISPOSED OF BY THE CONTRACTOR.

THE LUMP SUM BID FOR "ITEM SPECIAL - MAINTAIN EXISTING LIGHTING," SHALL INCLUDE PAYMENT FOR ALL LABOR, EQUIPMENT, MATERIALS, INCIDENTALS, AND TEMPORARY POWER SERVICES NECESSARY TO MAINTAIN THE EXISTING LIGHTING AS SPECIFIED HEREIN.

THE UNIT BID PRICE FOR EACH "ITEM SPECIAL - REPLACEMENT OF EXISTING LIGHTING UNIT" SHALL BE FULL PAYMENT FOR THE REPLACEMENT OF AN EXISTING UNIT WHICH HAS BEEN KNOCKED DOWN AFTER THE AFOREMENTIONED INSPECTION AND SHALL INCLUDE ALL LABOR, EQUIPMENT, MATERIALS, AND INCIDENTALS NECESSARY TO PROVIDE A REPLACEMENT FOR SUCH UNIT. THE FOLLOWING QUANTITIES ARE FOR USE AS DIRECTED BY THE DEPARTMENT'S ENGINEER.

ITEM SPECIAL- REPLACEMENT OF EX LIGHTING UNIT - 5 EA  
ITEM SPECIAL- MAINTAIN EXISTING LIGHTING UNIT - LUMP

**LANE VALUE CONTRACT (PN 127)**

THE CONTRACTOR SHALL BE ASSESSED DISINCENTIVES AS DESIGNATED IN THE LANE VALUE CONTRACT TABLES/TIME LIMITATION NOTES FOR EACH UNIT OF TIME THE DESCRIBED CRITICAL LANE/RAMP IS RESTRICTED FROM FULL USE BY THE TRAVELING PUBLIC WITHIN THE RESTRICTED TIME PERIOD. THE LANE VALUE CONTRACT AMOUNT IS LOCATED IN THE TIME LIMITATION AND GENERAL MOT NOTES. THE DISINCENTIVES WILL BE ASSESSED FOR ALL RESTRICTIONS OF THE CRITICAL WORK.

CRITICAL WORK IS SHOWN IN THE LANE VALUE CONTRACT TABLE.

CRITICAL WORK IS DEFINED AS HAVING THE DESIGNATED SECTIONS OPEN TO UNRESTRICTED TRAFFIC AS SHOWN IN THE TABLE, OR THE ENTIRE PROJECT IF NOT OTHERWISE LISTED.

UNRESTRICTED TRAFFIC IS DEFINED AS ALL TRAFFIC LANES BEING AVAILABLE FOR USE WITH SPECIFIED STRIPING AND SAFETY FEATURES IN PLACE.

LANE VALUE CONTRACT TABLE				
ROUTE	RESTRICTION/NUMBER OF LANES TO BE MAINTAINED	RESTRICTED TIME PERIOD	TIME UNIT	DISINCENTIVE \$ PER TIME UNIT
I-475	2 LANES	WEEKDAYS: 6AM-9PM; WEEKENDS: 6AM-7PM	EACH MINUTE	\$215
I-475 (AFTER 3 LANES OPEN IN ONE OR BOTH DIRECTIONS)	3 LANES	WEEKDAYS: 7-9AM AND 2-7PM; WEEKENDS: 3-6PM	EACH MINUTE	\$215
	2 LANES	WEEKDAYS: 6AM-9PM; WEEKENDS: 6AM-7PM	EACH MINUTE	\$215
PART 3: US-24	2 LANES	WEEKDAYS: 7-9AM AND 2-7PM; WEEKENDS: 3-6PM	EACH MINUTE	\$215

**ITEM 614 MAINTAINING TRAFFIC, MISC.: 6"X8" SOLID WOOD POST, AS PER PLAN**

THIS ITEM SHALL CONSIST OF INSTALLING AND REMOVING GROUND MOUNTED 6"X8" SOLID WOOD POSTS. FIGURE 298-26 OF THE TRAFFIC ENGINEERING MANUAL(P. 2-219) SHOULD BE USED AS A GUIDE FOR INSTALLATION OF THE 6"X8" POSTS.

GRADE 2 SOUTHERN YELLOW PINE SHALL BE USED AND SHALL BE PRESSURE TREATED WITH CCA PRESERVATIVE.

PAYMENT WILL BE MADE PER UNIT PRICE BID PER EACH ITEM 614 MAINTAINING TRAFFIC, MISC.: 6"X8" SOLID WOOD POST, AS PER PLAN.

**ITEM 614 MAINTAINING TRAFFIC, MISC.: SIGN (FLAT SHEET), AS PER PLAN**

THIS ITEM CONSISTS OF INSTALLING AND REMOVING A FLAT SHEET SIGN APPROPRIATE FOR OUTDOOR USE. ATTACHMENT AND MOUNTING MATERIALS SHALL BE IN CONFORMANCE WITH NCHRP REPORT 350. SEE SHEETS 70-171 FOR LOCATION AND SIZES OF THE TEMPORARY SIGNAGE. THIS SIGNAGE IS TO BE REMOVED ONCE THE PERMANENT SIGNS HAVE BEEN PLACED ON THE OVERHEAD SIGN SUPPORTS.

PAYMENT WILL BE MADE PER UNIT PRICE BID PER SQUARE FOOT OF ITEM 614 MAINTAINING TRAFFIC, MISC.: SIGN (FLAT SHEET), AS PER PLAN.

CALCULATED  
BRO  
CHECKED  
DRJ

MAINTENANCE OF TRAFFIC GENERAL NOTES

LUC-475-01.85

**SEQUENCE OF CONSTRUCTION**

**PID 95875 (MAINLINE I-475 WIDENING AND REPLACEMENT)**

IT IS ASSUMED ALL DRAINAGE, LIGHTING, AND ANCILLARY ITEMS WILL BE CONSTRUCTED DURING THE PHASE THEY ARE LOCATED WITHIN.

SWITCHING BETWEEN PHASES SHALL BE COMPLETED DURING NIGHT TIME, WEEKEND OR OFF PEAK HOURS AS APPROVED BY THE ENGINEER.

SHOULDERS ON I-475 WILL REQUIRE CLOSING FOR INSTALLATION OF OVERHEAD AND GROUND MOUNTED SIGNS LOCATED OUTSIDE OF THE PROJECT LIMITS. TRAFFIC SHALL BE MAINTAINED PER MT-95.45.

THE CONTRACTOR HAS THE ABILITY TO DO ANY WORK CONCURRENTLY THAT WILL NOT IMPACT I-475 OR RAMP TRAFFIC BEYOND WHAT IS STATED IN THE PLANS AT ANY TIME.

THE PID 95875 PROJECT (WIDENING AND REPLACEMENT OF I-475) WILL BE CONSTRUCTED IN THREE MAIN PHASES:

**PRE-PHASE 1**

COMPLETE EARTHWORK AND TEMPORARY PAVEMENT ON THE SOUTHBOUND SIDE FROM STA. 51+11 TO 64+50. TWO LANES OF TRAFFIC SHALL BE MAINTAINED UTILIZING A SHOULDER CLOSURE PER STANDARD CONSTRUCTION DRAWING 95.45 DURING PERMITTED LANE CLOSURE TIMES.

**PRE-PHASE 1A**

AFTER PRE-PHASE 1, THE TWO SOUTHBOUND LANES SHALL BE SHIFTED TO THEIR PROPOSED PHASE 1 LOCATION TO ACCOMMODATE THE CONSTRUCTION OF TEMPORARY PAVEMENT IN THE MEDIAN, RAMP/MAINLINE Crossovers AND PLACEMENT OF PORTABLE CONCRETE BARRIER WALL. TRAFFIC SHALL BE MAINTAINED PER STANDARD CONSTRUCTION DRAWINGS MT-95.30 AND MT-95.45. SINGLE LANE CLOSURES WILL BE PERMITTED IN ACCORDANCE WITH THE PERMITTED LANE CLOSURE NOTE ON SHEET 33.

**PHASE 1**

TWO LANES OF TRAFFIC ON NB AND SB I-475 SHALL BE MAINTAINED AT ALL TIMES.

TWO NORTHBOUND LANES OF TRAFFIC SHALL BE CROSSED OVER TO THE SOUTHBOUND DIRECTION PER THE PLANS. PHASE 1 WOULD WIDEN AND RECONSTRUCT THE ENTIRE PORTION OF THE NORTHBOUND DIRECTION UP TO AND INCLUDING THE INTERMEDIATE COURSE.

THE NORTHBOUND MONCLOVA BRIDGE WOULD BE CONSTRUCTED DURING THIS PHASE. SEE SEQUENCE OF CONSTRUCTION NOTES ON THIS SHEET FOR PID 96482 PROJECT FOR ADDITIONAL DETAILS FOR THE MONCLOVA BRIDGE CONSTRUCTION.

IN THE VICINITY OF THE US 20A BRIDGE TRAFFIC WOULD BE SHIFTED TO THE OUTSIDE TO ALLOW FOR THE CONSTRUCTION OF THE SUB STRUCTURE. SEE SEQUENCE OF CONSTRUCTION NOTES ON SHEET 45 FOR PID 99731 PROJECT FOR ADDITIONAL DETAILS FOR US 20A CONSTRUCTION.

**SEQUENCE OF CONSTRUCTION (CONT)**

**PHASE 1 (CONTINUED)**

NEAR THE COMPLETION OF PHASE 1, SHORT TERM LANE CLOSURES WOULD BE REQUIRED TO RESURFACE AND WIDEN THE PAVEMENT ADJACENT TO THE MAUMEE RIVER BRIDGE IN ACCORDANCE WITH THE PERMITTED LANE CLOSURE NOTE ON SHEET 33.

ALL RAMPS SHALL BE MAINTAINED DURING PHASE 1 WITH EXCEPTION OF THE I-475 NB ENTRANCE RAMP FROM US 24-WB WHICH SHALL BE CLOSED FOR THE DURATION OF PHASE 1 AND SHORT TERM CLOSURES FOR THE OTHER US 24 RAMPS FOR RESURFACING AND BARRIER REMOVAL AND REPLACEMENT. SEE PLANS FOR DETAILS. SEE DETOUR PLANS FOR THE DETOUR OF THE WESTBOUND US 24 NORTHBOUND ENTRANCE RAMP.

**PHASE 2**

TWO LANES OF TRAFFIC ON NB AND SB I-475 SHALL BE MAINTAINED AT ALL TIMES.

TWO SOUTHBOUND LANES OF TRAFFIC SHALL BE CROSSED OVER TO THE NORTHBOUND DIRECTION PER THE PLANS ON TO THE COMPLETED PHASE 1 PAVEMENT. PHASE 2 WOULD WIDEN AND RECONSTRUCT THE ENTIRE PORTION OF THE SOUTHBOUND DIRECTION UP TO AND INCLUDING THE INTERMEDIATE COURSE.

THE SOUTHBOUND MONCLOVA BRIDGE WOULD BE CONSTRUCTED DURING THIS PHASE. SEE SEQUENCE OF CONSTRUCTION NOTES ON THIS SHEET FOR PID 96482 PROJECT FOR ADDITIONAL DETAILS FOR THE MONCLOVA BRIDGE CONSTRUCTION.

IN THE VICINITY OF THE US 20A BRIDGE SEE SEQUENCE OF CONSTRUCTION NOTES ON SHEET 45 FOR PID 99731 PROJECT FOR ADDITIONAL DETAILS FOR US 20A CONSTRUCTION.

NEAR THE COMPLETION OF PHASE 2, SHORT TERM LANE CLOSURES WOULD BE REQUIRED TO RESURFACE AND WIDEN THE PAVEMENT ADJACENT TO THE MAUMEE RIVER BRIDGE IN ACCORDANCE WITH THE PERMITTED LANE CLOSURE NOTE ON SHEET 33.

ALL RAMPS SHALL BE MAINTAINED DURING PHASE 2 WITH EXCEPTION I-475 SB ENTRANCE RAMPS FROM US-24 EB AND US-24 WB WHICH SHALL BE CLOSED FOR THE DURATION OF PHASE 2 AND SHORT TERM CLOSURES FOR US 24 RAMPS FOR RESURFACING AND BARRIER REMOVAL AND REPLACEMENT. SEE PLANS FOR DETAILS.

**PHASE 3**

PHASE 3 SHALL CONSIST OF THE PLACEMENT OF THE FINAL SURFACE COURSE AND PERMANENT PAVEMENT MARKINGS AS WELL AS ANY BARRIER REPLACEMENT WITHIN THE US 24 INTERCHANGE. A MINIMUM OF 2 LANES OF TRAFFIC IN EACH DIRECTION ON I-475 AND ALL RAMPS SHALL BE MAINTAINED AT ALL TIMES. TRAFFIC SHALL BE MAINTAINED PER MT-95.30, OMTCD FIGURE 6H-37 AND MT-99.20. LANE CLOSURES SHALL BE IN ACCORDANCE WITH THE PERMITTED LANE CLOSURE NOTE ON SHEET 33.

**PID 96482 - MAINTENANCE OF TRAFFIC FOR MONCLOVA ROAD UNDERNEATH IR-475**

NO OTHER TRAFFIC RESTRICTIONS ON MONCLOVA ROAD WILL BE ALLOWED EXCEPT AS DESCRIBED BELOW.

MONCLOVA ROAD SHALL REMAIN COMPLETELY OPEN TO BOTH EASTBOUND AND WESTBOUND TRAFFIC WHEN US20A IS CLOSED FOR CONSTRUCTION. NO FLAGGING OPERATIONS WILL BE ALLOWED ON MONCLOVA ROAD WHEN US20A IS CLOSED FOR CONSTRUCTION.

**WESTBOUND MONCLOVA ROAD - CLOSURES AND FLAGGING OPERATIONS**

WESTBOUND MONCLOVA ROAD CLOSURES AND FLAGGING OPERATIONS WILL NOT BE LIMITED EXCEPT WHEN US20A IS CLOSED AS NOTED ABOVE.

**EASTBOUND MONCLOVA ROAD - CLOSURE**

THE CONTRACTOR MAY CLOSE EASTBOUND MONCLOVA ROAD FOR THE NUMBER OF DAYS SHOWN IN TABLE 1 (THIS IS IN ADDITION TO THE ALLOWABLE FLAGGING DAYS). THE CONTRACTOR WILL BE PAID AN INCENTIVE FOR THE NUMBER OF ALLOWABLE CLOSURE DAYS NOT UTILIZED OR WILL BE ASSESSED A DISINCENTIVE FOR EACH DAY EXCEEDING THE ALLOWABLE CLOSURE DAYS. MULTIPLE CLOSURES ARE ALLOWED. COMPLETE CLOSURES OF MONCLOVA RD SHALL BE SPACED A MINIMUM OF 2 WEEKS APART REGARDLESS OF ANY SPECIFIC COMPLETE CLOSURE DURATION. CLOSURE DURATIONS IN TABLE 1 SHOW THE TOTAL CLOSURE DAYS ALLOWED FOR BOTH THE RIGHT AND LEFT STRUCTURES TOGETHER.

**EASTBOUND MONCLOVA ROAD - FLAGGING OPERATIONS**

THE CONTRACTOR MAY RESTRICT TRAFFIC WITH A FLAGGING OPERATION FOR THE NUMBER OF DAYS SHOWN IN TABLE 1 (THIS IS IN ADDITION TO THE ALLOWABLE CLOSURE DAYS). THE CONTRACTOR WILL BE PAID AN INCENTIVE FOR THE NUMBER OF ALLOWABLE FLAGGING DAYS NOT UTILIZED OR WILL BE ASSESSED A DISINCENTIVE FOR EACH DAY EXCEEDING THE ALLOWABLE FLAGGING DAYS.

FLAGGING DURATIONS IN TABLE 1 SHOW THE TOTAL FLAGGING DAYS ALLOWED FOR BOTH THE RIGHT AND LEFT STRUCTURES TOGETHER. FLAGGING FOR ANY PORTION OF THE DAY WILL COUNT AS A FULL FLAGGING DAY REGARDLESS OF THE ACTUAL FLAGGING DURATION.

STOPPAGE OF TRAFFIC BY FLAGGERS SHALL NOT EXCEED 5 MINUTES AT A TIME. ONCE THE 5-MINUTE INTERVAL IS COMPLETE, TRAFFIC SHALL BE ALLOWED TO FLOW UNTIL ALL QUEUED TRAFFIC HAS PASSED THROUGH THE PROJECT.

IF A FLAGGING OPERATION STOPS TRAFFIC FOR MORE THAN 5 MINUTES, DAMAGES IN THE AMOUNT OF \$25 PER MINUTE WILL BE ASSESSED AND THAT DAY WILL COUNT AS CLOSURE DAY AS WELL AS A FLAGGING DAY.

FLAGGERS SHALL GIVE PRIORITY TO ALL EMERGENCY VEHICLES DURING FLAGGING OPERATIONS. WORK SHALL IMMEDIATELY CEASE WHEN THE TRAFFIC QUEUE CONTAINS AN EMERGENCY VEHICLE WITH EMERGENCY SIGNALS OPERATING. TRAFFIC SHALL BE RELEASED TO ALLOW THE EMERGENCY VEHICLE TO PASS.

DESCRIPTION OF CRITICAL WORK	DURATION	TIME PERIOD	DISINCENTIVE \$ PER TIME PERIOD	INCENTIVE \$ PER TIME PERIOD	MAXIMUM INCENTIVE \$
COMPLETE CLOSURE OF MONCLOVA ROAD	70	CALENDAR DAYS	\$5,000	\$2,000	\$20,000
FLAGGING OPERATIONS ON MONCLOVA ROAD	90	CALENDAR DAYS	\$5,000	\$500	\$10,000

**PID 96482 - MAINTENANCE OF TRAFFIC FOR MONCLOVA ROAD UNDERNEATH IR-475 (CONTINUED)**

**NOTIFICATION**

COMPLETE CLOSURE AND FLAGGING OPERATIONS SHALL BE COMMUNICATED WITH MCLAREN ST. LUKE'S HOSPITAL, PROMEDICA TOLEDO HOSPITAL EMERGENCY AND URGENT CARE, AND LOCAL EMERGENCY/AMBULANCE SERVICES. THE PROJECT ENGINEER WILL COORDINATE THIS COMMUNICATION AND PROVIDE A LIST OF PARTIES TO BE INCLUDED. NOTIFICATION TIME FRAMES SHALL MEET THE REQUIREMENTS DETAILED IN THE NOTICE TO OFFICE OF COMMUNICATION TIME TABLE ON SHEET 33 .

CLOSURE AND FLAGGING COMMUNICATIONS WILL INCLUDE THE TIME OF DAY THAT THE RESTRICTION WILL BEGIN AND END. RESTRICTING THE ROADWAY PRIOR TO THE STATED TIME OF DAY OR EXTENDING A RESTRICTION PAST THE STATED TIME OF DAY WILL RESULT IN A \$25/MINUTE DAMAGE. THE CONTRACTOR SHALL USE PORTABLE MESSAGE BOARDS AT THE FOLLOWING LOCATIONS PRIOR TO AND DURING A CLOSURE/FLAGGING EVENT. THE PROJECT ENGINEER WILL PROVIDE MESSAGES TO BE USED.

MONCLOVA RD. AND N. JEROME ROAD  
BRIARFIELD AND 20A  
RUSSELL RD. AND FALLEN TIMBERS LANE

CALCULATED  
BRO  
CHECKED  
DRJ

MAINTENANCE OF TRAFFIC GENERAL NOTES

LUC-475-01.85

C:\Users\sgault\OneDrive - ARCADIS\Desk\top\LUC475\TOHOD\IO\PE01(2)\TOHOD\IO\PE01\Drawing\_99731\Design\M01\Sheets\99731\_MN004C.dgn Sheet 4/18/2022 10:50:10 AM sgault



I:\Project\DATA\LUC-475-0.09\Design\M0T\Sheets\95875\_M500.dgn Sheet 4/29/2022 9:49:51 AM akasem

REF NO.	SHEET NO.	STATION TO STATION	SIDE	614	614	614	614	614	614	614	614	614	614	614	614	614	614	615	622	622	622				
				WORK ZONE IMPACT ATTENUATOR, 24" WIDE HAZARDS, (UNIDIRECTIONAL)	MAINTAINING TRAFFIC, MISC.:6"x8" SOLID WOOD POST, AS PER PLAN	MAINTAINING TRAFFIC, MISC.:SIGN (FLAT SHEET)	WORK ZONE LANE LINE, CLASS I, 4" (WHITE)	WORK ZONE CENTER LINE, CLASS I(WHITE)	WORK ZONE EDGE LINE, CLASS I, 6" (YELLOW)	WORK ZONE EDGE LINE, CLASS I, 6", 807 PAINT(YELLOW)	WORK ZONE EDGE LINE, CLASS I, 6", 807 PAINT	WORK ZONE CHANNELIZING LINE, CLASS I, 12"(WHITE)	WORK ZONE CHANNELIZING LINE, CLASS I, 12", 807 PAINT(YELLOW)	WORK ZONE DOTTED LINE, CLASS I(WHITE)	WORK ZONE DOTTED LINE, CLASS I	WORK ZONE DOTTED LINE, CLASS I, 6", 807 PAINT	WORK ZONE LANE LINE, CLASS I, 6", 807 PAINT	WORK ZONE STOP LINE, CLASS I	PAVEMENT FOR MAINTAINING TRAFFIC, CLASS A, AS PER PLAN	PORTABLE BARRIER, 50", AS PER PLAN	PORTABLE BARRIER, "Y" CONNECTOR	PORTABLE BARRIER, UNANCHORED			
PID 99731 PHASE 1				EACH	EACH	SF	FT	FT	FT	FT	FT	FT	FT	FT	FT	FT	FT	SY	FT	EACH	FT				
SN-101	70	10+01	RT		1	32																			
WCH-1	70	1+96.00	14+40.00	LT										782	782										
WCH-2	70	3+00.00	17+00.00	LT/RT										1348	1348										
WDW-1	70	5+08.00	9+13.00	RT												405		405							
WDW-2	70	1+95.00	14+40.00	LT												1245		1245							
WEW-1	70	14+40.00	16+40.00	LT					200	200															
WEW-2	70	14+40.00	17+00.00	LT					260	260															
WEW-3	70	3+00.00	5+08.00	RT					208	208															
WEW-4	70	9+13.00	17+00.00	RT					792	792															
WEW-5	70	9+13.00	11+25.00	RT					215	215															
WEY-1	70	5+33.00	17+00.00	LT							1167	1167													
WEY-2	70	3+00.00	17+00.00	LT/RT							1348	1348													
WIA-1	70	9+70.00		RT	1																				
WL-1	70	13+13.00	17+00.00	LT				387																	
PB-1	70	5+08.00	14+45.00	RT/LT																	942				
PB-2	70	9+80.00	17+00.00	RT																	725				
PB-3	70	9+70.00	17+00.00	RT/LT																1	735				
PB-4	70	13+13.00	17+00.00	LT																					
TP-1	70	5+08.00	17+00.00	LT/RT															2957						
SN-102	71	20+01	RT		1	32																			
WCH-1	71	17+00.00	18+03.00	LT										103	103										
WEW-1	71	17+00.00	31+00.00	LT					1400	1400															
WEW-2	71	17+00.00	31+00.00	LT					1400	1400															
WEY-1	71	17+00.00	31+00.00	LT							1400	1400													
WEY-2	71	17+00.00	31+00.00	LT							1400	1400													
WL-1	71	17+00.00	31+00.00	LT				1400													1400				
WL-2	71	18+03.00	31+00.00	LT				1297													1297				
PB-1	71	17+00.00	31+00.00	LT																	1400				
PB-2	71	17+00.00	31+00.00	LT																					
PB-3	71	17+00.00	31+00.00	LT																	1400				
TP-1	71	17+00.00	31+00.00	LT															2929						
SN-103	72	34+79	RT		1	32																			
WDW-1	72	41+97.00	42+50.00	LT										53	53										
WEW-1	72	31+00.00	42+50.00	LT					1150	1150															
WEW-2	72	31+00.00	41+43.00	LT					1043	1043															
WEW-3	72	34+42.00	42+50.00	LT & RT					821	821															
WEY-1	72	31+00.00	42+50.00	LT							1150	1150													
WEY-2	72	31+00.00	42+50.00	LT							1150	1150													
WEY-3	72	32+14.00	40+32.00	LT & RT							832	832													
WIA-1	72	34+97.00		RT	1																				
WL-1	72	31+00.00	42+50.00	LT				1150													1150				
WL-2	72	31+00.00	42+50.00	LT				1150													1150				
PB-1	72	31+00.00	42+50.00	LT																					
PB-2	72	31+00.00	40+32.00	LT																	1150				
PB-3	72	35+07.00	36+30.00	LT & RT																	1				
PB-4	72	34+97.00	42+50.00	LT & RT																					
TP-1	72	31+00.00	42+50.00	LT & RT																	3259				
TP-2	72	34+88.00	38+27.00	RT										170	170						726				
WDW-1	73	45+43.00	50+13.00	LT												470		470							
WDW-2	73	42+50.00	48+50.00	LT												600		600							
WEW-1	73	42+50.00	45+43.00	LT																					
WEW-2	73	48+50.00	55+00.00	LT																					
WEW-3	73	50+13.00	55+00.00	LT					294	294															
WEY-1	73	42+50.00	55+00.00	LT					1250	1250															
WEY-2	73	42+50.00	55+00.00	LT					600	600															
<b>TOTALS CARRIED TO SHEET</b>				<b>69</b>	2	3	96	5384			9633	9633	10947	10947	2456	2456	2720		2720	5384		9871	2937	2	7040

CALCULATED JRB  
 CHECKED XXX  
**MAINTENANCE OF TRAFFIC SUBSUMMARY - MAINLINE**  
**LUC-475-0.09**  
 58  
 855





I:\Project\09-LUC-475-0.09\Design\W01\Sheets\95875\_MS003.dgn Sheet 4/29/2022 9:49:51AM dkaseml

REF NO.	SHEET NO.	STATION TO STATION		SIDE	614	614	614	614	614	614	614	614	614	614	614	614	614	615	622	622	622		
					WORK ZONE IMPACT ATTENUATOR, 24" WIDE HAZARDS, (UNIDIRECTIONAL)	MAINTAINING TRAFFIC, MISC.:6"x8" SOLID WOOD POST, AS PER PLAN	MAINTAINING TRAFFIC, MISC.:SIGN (FLAT SHEET)	WORK ZONE LANE LINE, CLASS I, 4" (WHITE)	WORK ZONE CENTER LINE, CLASS I(WHITE)	WORK ZONE EDGE LINE, CLASS I, 6"(YELLOW)	WORK ZONE EDGE LINE, CLASS I, 6", 807 PAINT(YELLOW)	WORK ZONE EDGE LINE, CLASS I, 6"	WORK ZONE EDGE LINE, CLASS I, 6", 807 PAINT	WORK ZONE CHANNELIZING LINE, CLASS I, 12"(WHITE)	WORK ZONE CHANNELIZING LINE, CLASS I, 12", 807 PAINT(YELLOW)	WORK ZONE DOTTED LINE, CLASS I(WHITE)	WORK ZONE DOTTED LINE, CLASS I	WORK ZONE DOTTED LINE, CLASS I, 6", 807 PAINT	WORK ZONE LANE LINE, CLASS I, 6", 807 PAINT	WORK ZONE STOP LINE, CLASS I	PAVEMENT FOR MAINTAINING TRAFFIC, CLASS A, AS PER PLAN	PORTABLE BARRIER, 50", AS PER PLAN	PORTABLE BARRIER, "Y" CONNECTOR
PID 99731 PHASE 1 CONTINUED					EACH	EACH	SF	FT	FT	FT	FT	FT	FT	FT	FT	FT	FT	FT	FT	FT	FT	FT	
WEW-3	78	154+30.00	162+50.00	LT						820	820												
WEY-1	78	137+50.00	162+50.00	LT								2500	2500										
WEY-2	78	137+50.00	162+50.00	LT								2500	2500										
WL-1	78	137+50.00	162+50.00	LT				2500									2500						
WL-2	78	137+50.00	162+50.00	LT				2500									2500						
TP-1	78	137+50.00	162+50.00	LT														6025					
PB-1	78	137+50.00	162+50.00	LT															2500				
PB-2	78	137+50.00	162+50.00	LT																	2500		
SN-104	79	183+96		RT		2	58																
WEW-1	79	162+50.00	187+50.00	LT						2500	2500												
WEW-2	79	162+50.00	178+03.00	LT						1553	1553												
WEY-1	79	162+50.00	187+50.00	LT								2500	2500										
WEY-2	79	162+50.00	187+50.00	LT								2500	2500										
WL-1	79	162+50.00	187+50.00	LT				2500									2500						
WL-2	79	162+50.00	187+50.00	LT				2500									2500						
PB-1	79	162+50.00	187+50.00	LT															2500				
PB-2	79	162+50.00	166+04.00	LT																		354	
TP-1	79	162+50.00	163+02.00	LT														126					
TP-2	79	177+02.00	187+50.00	LT														2579					
WEW-1	80	187+50.00	201+00.00	LT						1350	1350												
WEW-2	80	196+48.00	201+00.00	LT						452	452												
WEY-1	80	187+50.00	201+00.00	LT								1350	1350										
WEY-2	80	187+50.00	201+00.00	LT								1350	1350										
WL-1	80	187+50.00	201+00.00	LT				1350									1350						
WL-2	80	187+50.00	201+00.00	LT				1350									1350						
PB-1	80	187+50.00	201+00.00	LT															1350				
PB-2	80	196+48.00	201+00.00	LT																		452	
TP-1	80	187+50.00	201+00.00	LT														3308					
SN-105	81	205+50		LT		2	58																
SN-106	81	219+78		RT		2	58																
SN-107	81	225+17		LT		1	32																
WDW-1	81	218+56.00	223+47.00	LT												491		491					
WDW-2	81	221+26.00	226+00.00	LT												474		474					
WEW-1	81	201+00.00	226+00.00	LT						2500	2500												
WEW-2	81	201+00.00	226+00.00	LT/RT						2504	2504												
WEW-3	81	223+47.00	226+00.00	LT						253	253												
WEY-1	81	201+00.00	226+00.00	LT								2500	2500										
WEY-2	81	201+00.00	226+00.00	LT								2500	2500										
WL-1	81	201+00.00	226+00.00	LT				2500									2500						
WL-2	81	201+00.00	226+00.00	LT				2500									2500						
PB-1	81	201+00.00	226+00.00	LT															2500				
PB-2	81	201+00.00	218+56.00	LT																		1756	
PB-3	81	224+67.00	226+00.00	LT																		133	
TP-1	81	201+00.00	226+00.00	LT & RT														5878					
TP-2	81	225+53.00	226+00.00	RT														31					
WDW-1	82	226+00.00	229+90.00	LT												390		390					
WEW-1	82	226+00.00	238+60.00	LT						1275	1275												
WEW-2	82	226+00.00	239+00.00	LT						1300	1300												
WEW-3	82	229+90.00	235+88.00	LT						599	599												
WEW-4	82	229+90.00	239+00.00	LT						910	910												
WEW-5	82	226+00.00	230+82.00	RT						486	486												
WEY-1	82	226+00.00	239+00.00	LT								1300	1300										
WEY-2	82	226+00.00	239+00.00	LT								1300	1300										
WEY-3	82	226+00.00	230+82.00	RT								486	486										
WEY-4	82	235+88.00	238+60.00	LT								293	293										
<b>TOTALS CARRIED TO SHEET</b>					<b>69</b>	<b>7</b>	<b>206</b>	<b>17700</b>		<b>16502</b>	<b>16502</b>	<b>21079</b>	<b>21079</b>			<b>1355</b>		<b>1355</b>	<b>17700</b>		<b>17947</b>	<b>8850</b>	<b>5195</b>

CALCULATED	JI
	CHECKED
DEK	
<b>MAINTENANCE OF TRAFFIC SUBSUMMARY - MAINLINE</b>	
<b>LUC-475-0.09</b>	
60	
855	

I:\ProjectData\LUC\95875\_LUC-475-0.09\_Design\M01\Sheets\95875\_M5004.dgn Sheet 4/29/2022 9:49:52 AM dkaseml

REF NO.	SHEET NO.	STATION TO STATION	SHEET	614	614	614	614	614	614	614	614	614	614	614	614	614	614	614	615	622	622	622		
				WORK ZONE IMPACT ATTENUATOR, 24" WIDE HAZARDS, (UNIDIRECTIONAL)	MAINTAINING TRAFFIC, MISC.:6"x8" SOLID WOOD POST, AS PER PLAN	MAINTAINING TRAFFIC, MISC.:SIGN (FLAT SHEET)	WORK ZONE LANE LINE, CLASS I, 4"	WORK ZONE CENTER LINE, CLASS I	WORK ZONE EDGE LINE, CLASS I, 6" (WHITE)	WORK ZONE EDGE LINE, CLASS I, 6", 807 PAINT(WHITE)	WORK ZONE EDGE LINE, CLASS I, 6"(YELLOW)	WORK ZONE EDGE LINE, CLASS I, 6", 807 PAINT(YELLOW)	WORK ZONE CHANNELIZING LINE, CLASS I, 12"	WORK ZONE CHANNELIZING LINE, CLASS I, 12", 807 PAINT	WORK ZONE DOTTED LINE, CLASS I(WHITE)	WORK ZONE DOTTED LINE, CLASS I(YELLOW)	WORK ZONE DOTTED LINE, CLASS I, 6", 807 PAINT(WHITE)	WORK ZONE LANE LINE, CLASS I, 6", 807 PAINT	WORK ZONE STOP LINE, CLASS I	PAVEMENT FOR MAINTAINING TRAFFIC, CLASS A, AS PER PLAN	PORTABLE BARRIER, 50", AS PER PLAN	PORTABLE BARRIER, "Y" CONNECTOR	PORTABLE BARRIER, UNANCHORED	
				EACH	EACH	SF	FT	FT	FT	FT	FT	FT	FT	FT	FT	FT	FT	FT	SY	FT	EACH	FT		
SUBTOTALS CARRIED FROM SHEET				58	2	3	96	5384		9633	9633	10947	10947	2456	2456	2720		2720	5384		9871	2937	2	7040
SUBTOTALS CARRIED FROM SHEET				59				15001		19017	19017	19000	19000					15001		23548	9500		9238	
SUBTOTALS CARRIED FROM SHEET				60		7	206	17700		16502	16502	21079	21079			1355		1355	17700		17947	8850		5195
SUBTOTALS CARRIED FROM SHEET				61	2			8680	5000	22447	22447	18692	18692	1865	1865	1543		1543	8680		180	5000		7096
SUBTOTALS CARRIED FROM SHEET				62	3	8	238			7275	7275	4389	4389	750	750	420		420			4818	2052		4390
SUBTOTALS CARRIED FROM SHEET				62A		1	32			6634	6634	9014	9014	498	498	353		353			1878			
SUBTOTALS CARRIED FROM SHEET				62B		1	32			6634	6634	9014	9014	498	498	353		353			1878			
SUBTOTALS CARRIED FROM SHEET				62C		7	224	7510		15593	15593	11077	11077	2339	2339	1006		1006	7510		3112	3250		3160
SUBTOTALS CARRIED FROM SHEET				62D	1	4	96	21700		15585	15585	22033	22033						21700			8750		8897
SUBTOTALS CARRIED FROM SHEET				62E		1	32	13776		16362	16362	13987	13987	1046	1046	2004		2004	13776		1964	8750		5619
SUBTOTALS CARRIED FROM SHEET				62F		2	64	11721		17284	17284	19989	19989	5730	5730	1626		1626	11721		2171	6462	1	4078
SUBTOTALS CARRIED FROM SHEET				62G	1	13	325			11703	11703	8086	8086	1368	1368	1513	741	772	1		8245			55
SUBTOTALS CARRIED FROM SHEET				63	2	7	154			10566	10566	8108	8108	3796	3796	2396		2396			3024		1	4020
SUBTOTALS CARRIED FROM SHEET				64	6					11537	11537	9011	9011	1518	1518	2695		2695			4735		1	15277
SUBTOTALS CARRIED FROM SHEET				65	1					15124	15124	11324	11324	2670	2670	4120		4120			2542		1	9583
SUBTOTALS CARRIED FROM SHEET				66	2	7	146			7868	7868	3605	3605	4686	4686	3184		3184			2550		3	6367
SUBTOTALS CARRIED FROM SHEET				67	7				2450	8506	3949	3378	3378	445	350	420		420		47	1503		1	6320
SUBTOTALS CARRIED FROM SHEET				68	1			830	2950	4701				25		500	65		33					675
LINEAR TOTALS				FT				102302	10400	222971	213713	202733	202733	29690	29570	26208	806	24967	101473				55551	
LINEAR TOTALS				MI				19.375	1.970	42.229	40.476	38.396	38.396	5.623	5.600	4.964	0.153	4.729	19.218				10.521	
<b>TOTALS CARRIED TO SHEET 208 / 208A</b>					28	61	1645	19.38	1.97	82.705		76.793		11.223		5.116		23.947		80	89966	55551	10	97010

CALCULATED	JRB
	CHECKED
XXX	
<b>MAINTENANCE OF TRAFFIC SUBSUMMARY - MAINLINE</b>	
<b>LUC-475-0.09</b>	
(61)	
855	

I:\ProjectData\LUC-475-0.09\Design\M01\Sheets\95875\_MS005.dgn Sheet 4/29/2022 9:49:52 AM dkaseml

REF NO.	SHEET NO.	STATION TO STATION	SIDE	614	614	614	614	614	614	614	614	614	614	614	614	614	614	615	622	622	622	CALCULATED JRB CHECKED XXX																				
				WORK ZONE IMPACT ATTENUATOR, 24" WIDE HAZARDS, (UNIDIRECTIONAL) EACH	MAINTAINING TRAFFIC, MISC.:6"x8" SOLID WOOD POST, AS PER PLAN EACH	MAINTAINING TRAFFIC, MISC.:SIGN (FLAT SHEET) SF	WORK ZONE LANE LINE, CLASS I, 4" (WHITE) FT	WORK ZONE CENTER LINE, CLASS I(WHITE) FT	WORK ZONE EDGE LINE, CLASS I, 6"(YELLOW) FT	WORK ZONE EDGE LINE, CLASS I, 6", 807 PAINT(YELLOW) FT	WORK ZONE EDGE LINE, CLASS I, 6" FT	WORK ZONE EDGE LINE, CLASS I, 6", 807 PAINT FT	WORK ZONE CHANNELIZING LINE, CLASS I, 12"(WHITE) FT	WORK ZONE CHANNELIZING LINE, CLASS I, 12", 807 PAINT(YELLOW) FT	WORK ZONE DOTTED LINE, CLASS I(WHITE) FT	WORK ZONE DOTTED LINE, CLASS I FT	WORK ZONE DOTTED LINE, CLASS I, 6", 807 PAINT FT	WORK ZONE LANE LINE, CLASS I, 6", 807 PAINT FT	WORK ZONE STOP LINE, CLASS I FT	PAVEMENT FOR MAINTAINING TRAFFIC, CLASS A, AS PER PLAN SY	PORTABLE BARRIER, 50", AS PER PLAN FT		PORTABLE BARRIER, "Y" CONNECTOR EACH	PORTABLE BARRIER, UNANCHORED FT																		
<b>PID 99731 PHASE 1 CONTINUED</b>																																										
PB-1	85	276+00.00	301+00.00	LT/RT																																						
PB-2	85	279+35.00	288+71.00	LT																																						
PB-3	85	292+00.00	299+76.00	LT/RT																																						
TP-1	85	292+00.00	299+53.00	LT/RT																																						
WCH-1	86	301+00.00	304+75.00	RT																																						
WCH-2	86	301+00.00	304+75.00	RT																																						
WEW-1	86	301+00.00	304+75.00	RT																																						
WEY-1	86	301+00.00	308+67.00	LT																																						
WEY-2	86	301+00.00	304+75.00	RT																																						
WL-1	86	301+00.00	301+50.00	LT																																						
PB-1	86	301+00.00	301+74.00	RT																																						
<b>PID 99731 PHASE 1A</b>																																										
SN-108	87	9+95		RT																																						
WEW-1	87	7+54.00	17+50.00	RT																																						
WEY-1	87	9+13.00	17+50.00	RT																																						
WIA-1	87	7+17.00		RT																																						
PB-1	87	7+17.00	11+45.00	RT																																						
TP-1	87	17+21.00	17+50.00	RT																																						
WEW-1	88	17+50.00	23+64.00	RT																																						
WEW-2	88	25+90.00	31+00.00	RT																																						
WEY-1	88	17+50.00	23+64.00	RT																																						
WEY-2	88	25+90.00	31+00.00	RT																																						
TP-1	88	17+50.00	20+00.00	RT																																						
TP-2	88	20+00.00	22+24.00	RT																																						
TP-3	88	25+90.00	27+08.00	RT																																						
TP-4	88	27+08.00	29+19.00	RT																																						
WEW-1	89	31+00.00	43+10.00	LT/RT																																						
WEY-1	89	31+00.00	35+91.00	LT/RT																																						
TP-1	89	31+73.00	33+56.00	RT																																						
TP-2	89	32+84.00	40+13.00	LT/RT																																						
WEW-1	91	111+00.00	116+79.00	LT																																						
WIA-1	91	100+30.00		LT																																						
PB-1	91	95+00.00	100+30.00	LT																																						
PB-2	91	111+00.00	116+79.00	LT																																						
SN-109	94	188+70		RT																																						
SN-110	95	215+00		LT																																						
WEW-1	95	218+56.00	224+67.00	LT																																						
PB-1	95	218+56.00	224+67.00	LT																																						
SN-111	96	228+30		LT																																						
SN-112	96	234+00		RT																																						
WDW-1	96	228+30.00	232+50.00	LT																																						
WEW-1	96	228+30.00	238+50.00	LT/RT																																						
WEY-1	96	232+50.00	238+50.00	LT/RT																																						
WIA-1	96	233+96.00		LT																																						
TP-1	96	232+50.00	235+73.00	LT/RT																																						
TP-2	96	235+73.00	237+50.00	RT																																						
TP-3	96	237+50.00	238+50.00	RT																																						
WEW-1	97	238+50.00	242+41.00	RT																																						
WEW-2	97	244+06.00	251+00.00	RT																																						
<b>TOTALS CARRIED TO SHEET</b>				<b>69</b>	3	8	238																																			

**MAINTENANCE OF TRAFFIC SUBSUMMARY - MAINLINE**

**LUC-475-0.09**



I:\ProjectData\LUC\95875\_LUC-475-0.09\Design\M0T\Sheets\95875\_MS006.dgn Sheet 4/29/2022 9:49:53 AM dkosemi

REF NO.	SHEET NO.	STATION TO STATION		SIDE	614	614	614	614	614	614	614	614	614	614	614	614	614	615	622	622	622		
					WORK ZONE IMPACT ATTENUATOR, 24" WIDE HAZARDS, (UNIDIRECTIONAL)	MAINTAINING TRAFFIC, MISC.:6"x8" SOLID WOOD POST, AS PER PLAN	MAINTAINING TRAFFIC, MISC.:SIGN (FLAT SHEET)	WORK ZONE LANE LINE, CLASS I, 4" (WHITE)	WORK ZONE CENTER LINE, CLASS I(WHITE)	WORK ZONE EDGE LINE, CLASS I, 6"(YELLOW)	WORK ZONE EDGE LINE, CLASS I, 6", 807 PAINT(YELLOW)	WORK ZONE EDGE LINE, CLASS I, 6"	WORK ZONE EDGE LINE, CLASS I, 6", 807 PAINT	WORK ZONE CHANNELIZING LINE, CLASS I, 12"(WHITE)	WORK ZONE CHANNELIZING LINE, CLASS I, 12", 807 PAINT(YELLOW)	WORK ZONE DOTTED LINE, CLASS I(WHITE)	WORK ZONE DOTTED LINE, CLASS I	WORK ZONE DOTTED LINE, CLASS I, 6", 807 PAINT	WORK ZONE LANE LINE, CLASS I, 6", 807 PAINT	WORK ZONE STOP LINE, CLASS I	PAVEMENT FOR MAINTAINING TRAFFIC, CLASS A, AS PER PLAN	PORTABLE BARRIER, 50", AS PER PLAN	PORTABLE BARRIER, "Y" CONNECTOR
PID 99731 PHASE 1A CONTINUED					EACH	EACH	SF	FT	FT	FT	FT	FT	FT	FT	FT	FT	FT	FT	FT	FT	FT	FT	
WEY-1	97	238+50.00	242+41.00	RT																			
WEY-2	97	244+06.00	251+00.00	RT									463	463									
TP-1	97	238+50.00	242+41.00	RT																		351	
TP-2	97	244+06.00	245+86.00	RT																		232	
TP-3	97	245+86.00	247+60.00	RT																		343	
WEW-1	98	251+00.00	263+82.00	RT						1282	1282												
WEW-2	98	253+42.00	276+00.00	RT						2296	2296												
WEW-3	98	259+82.00	263+82.00	RT									400	400									
WEY-1	98	251+00.00	276+00.00	RT									2500	2500									
WEY-2	98	253+42.00	259+82.00	RT									1046	1046									
TP-1	98	253+42.00	257+33.00	RT																		453	
TP-2	98	257+33.00	259+82.00	RT																		499	
WEW-1	99	276+00.00	299+77.00	RT						2377	2377												
WEY-1	99	276+00.00	304+75.00	RT									2875	2875									
WCW-1	99	299+77.00	304+75.00	RT											498	498							
PID 99731 PHASE 1B																							
SN-113	100	9+92		RT		1	32																
WEW-1	100	16+75.00	20+04.00	RT						359	359												
WEW-2	100	27+69.00	31+00.00	RT						320	320												
WEY-1	100	16+75.00	20+54.00	RT									359	359									
WEY-2	100	27+69.00	31+00.00	RT									320	320									
WDW-1	101	30+89.00	34+42.00	RT												353						353	
WEY-1	101	31+00.00	33+89.00	RT									289	289									
<b>TOTALS CARRIED TO SHEET</b>					<b>69</b>	<b>1</b>	<b>32</b>			<b>6634</b>	<b>6634</b>	<b>9014</b>	<b>9014</b>	<b>498</b>	<b>498</b>	<b>353</b>		<b>353</b>				<b>1878</b>	

<b>MAINTENANCE OF TRAFFIC SUBSUMMARY - MAINLINE</b>	CALCULATED	JRB
	CHECKED	XXX
<b>LUC-475-0.09</b>		
(62A) 855		

I:\ProjectData\LUC-475-0.09\Design\M01\Sheets\95875\_MS007.dgn Sheet 4/29/2022 9:49:53 AM dkaseml

REF NO.	SHEET NO.	STATION TO STATION	SIDE	614	614	614	614	614	614	614	614	614	614	614	614	614	614	615	622	622	622		
				WORK ZONE IMPACT ATTENUATOR, 24" WIDE HAZARDS, (UNIDIRECTIONAL) EACH	MAINTAINING TRAFFIC, MISC.:6"x8" SOLID WOOD POST, AS PER PLAN EACH	MAINTAINING TRAFFIC, MISC.:SIGN (FLAT SHEET) SF	WORK ZONE LANE LINE, CLASS I, 4" (WHITE) FT	WORK ZONE CENTER LINE, CLASS I(WHITE) FT	WORK ZONE EDGE LINE, CLASS I, 6"(YELLOW) FT	WORK ZONE EDGE LINE, CLASS I, 6", 807 PAINT(YELLOW) FT	WORK ZONE EDGE LINE, CLASS I, 6" FT	WORK ZONE EDGE LINE, CLASS I, 6", 807 PAINT FT	WORK ZONE CHANNELIZING LINE, CLASS I, 12"(WHITE) FT	WORK ZONE CHANNELIZING LINE, CLASS I, 12", 807 PAINT(YELLOW) FT	WORK ZONE DOTTED LINE, CLASS I(WHITE) FT	WORK ZONE DOTTED LINE, CLASS I FT	WORK ZONE DOTTED LINE, CLASS I, 6", 807 PAINT FT	WORK ZONE LANE LINE, CLASS I, 6", 807 PAINT FT	WORK ZONE STOP LINE, CLASS I FT	PAVEMENT FOR MAINTAINING TRAFFIC, CLASS A, AS PER PLAN SY	PORTABLE BARRIER, 50", AS PER PLAN FT	PORTABLE BARRIER, "Y" CONNECTOR EACH	PORTABLE BARRIER, UNANCHORED FT
<b>PID 99731 PHASE 2</b>																							
WCH-1	102	6+85	14+73												788	788							
WCH-2	102	6+85	14+73												416	416							
WDW-1	102	5+26	5+85														158		158				
WEW-1	102	4+00	16+50	LT & RT						1261	1261												
WEW-2	102	4+00	14+73	RT						1063	1063												
WEW-3	102	14+73	16+50	RT						177	177												
WEY-1	102	4+00	16+50	LT & RT									1260	1260									
WEY-2	102	4+00	16+50	RT									1250	1250									
WL-1	102	4+00	16+50	LT & RT																1260			
WL-2	102	4+00	16+50	RT						1260											1250		
TP-1	102	6+66	14+80	LT & RT																1364			
PB-1	102	9+01	16+50	RT																	750		
PB-2	102	9+92	16+50	LT & RT																	660		
SN-114	103	25+50		LT		1	32																
WEW-1	103	16+50	29+00	RT						1250	1250												
WEW-2	103	16+50	29+00	RT						1250	1250												
WEW-3	103	25+65	29+00	LT						342	342												
WEY-1	103	16+50	29+00	RT									1250	1250									
WEY-2	103	16+50	29+00	RT									1250	1250									
WEY-3	103	26+52	29+00	LT									250	250									
WL-1	103	16+50	29+00	RT																1250			
WL-2	103	16+50	29+00	RT						1250											1250		
PB-1	103	16+50	29+00	RT																1250			
PB-2	103	16+50	29+00	RT																	1250		
SN-115	104	39+56		LT		1	32																
WDW-1	104	40+23	41+50	LT													132		132				
WEW-1	104	29+00	41+50	RT						1250	1250												
WEW-2	104	29+00	41+50	RT						1250	1250												
WEW-3	104	20+00	25+96	-						597	597												
WEW-4	104	29+00	40+23	LT						1184	1184												
WEW-5	104	26+43	41+50	RT						1505	1505												
WEY-1	104	29+00	41+50	RT									1250	1250									
WEY-2	104	29+00	41+50	RT									1250	1250									
WEY-3	104	20+00	24+65	RT									470	470									
WEY-4	104	29+00	41+50	LT									1317	1317									
WEY-5	104	26+43	41+50	RT									1530	1530									
WL-1	104	29+00	41+50	RT																1250			
WL-2	104	29+00	41+50	RT						1250											1250		
PB-1	104	29+00	41+50	RT																1250			
PB-2	104	29+00	41+50	RT																	1250		
TP-1	104	203+40	203+81	LT & RT																40			
TP-2	104	200+00	203+40	LT & RT																91			
TP-3	104	21+59	24+07	LT & RT																545			
TP-4	104	20+00	21+59	LT & RT																252			
SN-116	105	42+82		RT		1	32																
SN-117	105	47+25		RT		2	64																
SN-118	105	60+50		RT		2	64																
WCH-1	105	48+78	56+18	RT											741	741							
WCH-2	105	52+24	56+18	RT											394	394							
WDW-1	105	44+08	47+91	RT																384	384		
WDW-2	105	56+18	59+50	RT																332	332		
WEW-1	105	41+50	44+08	LT																			
WEW-2	105	47+91	62+50	LT						258	258												
WEW-3	105	41+50	62+50	RT						1459	1459												
WEW-4	105	41+50	47+91	LT						2100	2100												
TOTALS CARRIED TO SHEET					<b>69</b>	7	224	7510		15593	15593	11077	11077	2339	2339	1006		1006	7510		3112	3250	3160

<b>LUC-475-0.09</b>	<b>MAINTENANCE OF TRAFFIC SUBSUMMARY - MAINLINE</b>	CALCULATED DEK CHECKED XXX
62B 855		



I:\Project\DATA\LUC-475-0.09\Design\M01\Sheets\95875.MS009.dgn Sheet 4/29/2022 9:49:54 AM dkaseml

REF NO.	SHEET NO.	STATION TO STATION		SIDE	614	614	614	614	614	614	614	614	614	614	614	614	614	615	622	622	622						
					WORK ZONE IMPACT ATTENUATOR, 24" WIDE HAZARDS, (UNIDIRECTIONAL)	MAINTAINING TRAFFIC, MISC.:6"X8" SOLID WOOD POST, AS PER PLAN	MAINTAINING TRAFFIC, MISC.:SIGN (FLAT SHEET)	WORK ZONE LANE LINE, CLASS I, 4" (WHITE)	WORK ZONE CENTER LINE, CLASS I(WHITE)	WORK ZONE EDGE LINE, CLASS I, 6"(YELLOW)	WORK ZONE EDGE LINE, CLASS I, 6", 807 PAINT(YELLOW)	WORK ZONE EDGE LINE, CLASS I, 6", 807 PAINT	WORK ZONE CHANNELIZING LINE, CLASS I, 12"(WHITE)	WORK ZONE CHANNELIZING LINE, CLASS I, 12", 807 PAINT(YELLOW)	WORK ZONE DOTTED LINE, CLASS I(WHITE)	WORK ZONE DOTTED LINE, CLASS I	WORK ZONE DOTTED LINE, CLASS I, 6", 807 PAINT	WORK ZONE LANE LINE, CLASS I, 6", 807 PAINT	WORK ZONE STOP LINE, CLASS I	PAVEMENT FOR MAINTAINING TRAFFIC, CLASS A, AS PER PLAN	PORTABLE BARRIER, 50", AS PER PLAN	PORTABLE BARRIER, "Y" CONNECTOR	PORTABLE BARRIER, UNANCHORED				
PID 99731 PHASE 2 CONTINUED					EACH	EACH	SF	FT	FT	FT	FT	FT	FT	FT	FT	FT	FT	FT	FT	FT	FT	FT	FT				
PB-2	110	137+50	150+00	RT																		1250					
WEW-1	111	150+00	175+00	RT						1904	1904																
WEW-2	111	164+21	175+00	RT						1079	1079																
WEY-1	111	150+00	175+00	RT								2500	2500														
WEY-2	111	150+00	175+00	RT								2500	2500														
WL-1	111	150+00	175+00	RT				2500														2500					
WL-2	111	150+00	175+00	RT				2500														2500					
PB-1	111	150+00	175+00	RT															2500								
PB-2	111	150+00	175+00	RT																			977				
WEW-1	112	175+00	200+00	RT						2500	2500																
WEW-2	112	175+00	200+00	RT						2500	2500																
WEY-1	112	175+00	200+00	RT								2500	2500														
WEY-2	112	175+00	200+00	RT								2500	2500														
WL-1	112	175+00	200+00	RT				2500														2500					
WL-2	112	175+00	200+00	RT				2500														2500					
PB-1	112	175+00	200+00	RT															2500								
PB-2	112	175+00	200+00	RT																			2500				
WCH-1	113	221+00	222+36	RT										136	136												
WCH-2	113	30+00	31+70	RT										170	170												
WDW-1	113	203+20	210+35	RT												715		715									
WEW-1	113	200+00	225+00	RT						2500	2500																
WEW-2	113	200+00	225+00	LT & RT						2507	2507																
WEW-3	113	222+36	225+00	RT						264	264																
WEY-1	113	200+00	225+00	RT								2500	2500														
WEY-2	113	200+00	225+00	RT								2500	2500														
WEY-3	113	222+70	225+00	LT & RT								237	237														
WL-1	113	200+00	225+00	RT				2500														2500					
WL-2	113	200+00	225+00	RT				2500														2500					
WL-3	113	210+35	221+00	RT				1065														1065					
PB-1	113	200+00	225+00	RT																		2500					
PB-2	113	200+00	225+00	LT & RT																			1071				
TP-1	113	204+43	224+09	LT & RT															1964								
WCH-1	114	233+11	236+85	RT										365	365												
WCH-2	114	233+11	236+85	RT										375	375												
WDW-1	114	226+80	231+00	RT												420		420									
WEW-1	114	225+00	236+85	RT						1185	1185																
WEW-2	114	225+00	237+50	RT						1250	1250																
WEW-3	114	225+00	237+50	LT						1257	1257																
WEW-4	114	236+75	237+50	RT						75	75																
WEY-1	114	225+00	237+50	RT								1250	1250														
WEY-2	114	225+00	237+50	RT								1250	1250														
WEY-3	114	225+00	237+50	RT								1250	1250														
WL-1	114	225+00	237+50	LT																		1250					
WL-2	114	225+00	237+50	RT																		1250					
WL-3	114	231+00	233+11	RT				211														211					
PB-1	114	225+00	237+50	RT																		1250					
PB-2	114	225+00	237+50	RT																			1071				
SN-121	115	245+20		LT			1	32																			
WCH-1	115	245+25	250+00	RT												479		479									
WCH-2	115	246+10	250+00	RT												390		390									
WEW-1	115	237+50	239+38	LT						214	214																
WEW-2	115	237+50	246+10	RT						860	860																
WEW-3	115	243+35	250+00	RT						1250	1250																
<b>TOTALS CARRIED TO SHEET</b>					<b>69</b>		1	32	13776			16362	16362	13987	13987	1046	1046	2004		2004		13776		1964	8750		5619

MAINTENANCE OF TRAFFIC SUBSUMMARY - MAINLINE

LUC-475-0.09

CALCULATED  
DEK  
CHECKED  
XXX

62D  
855









C:\Users\sgault\OneDrive - ARCADIS\Desktop\LUC475\TOD\TOD\PEO1 (2)\TOD\TOD\PEO1\Drawing\_99731\Design\99731\MS002.dgn Sheet 4/20/2022 3:56:49 PM sgault

REF NO.	SHEET NO.	STATION TO STATION		SIDE	614																				615			622		622	
					614	614	614	614	614	614	614	614	614	614	614	614	614	614	614	614	614	614	614	614	615	615	622	622	622		
PID 99731 PHASE 1 CONTINUED					EACH	EACH	SF	MILE	FT	FT	FT	FT	FT	FT	FT	FT	FT	FT	FT	FT	MILE	FT	SY	FT	EACH	FT					
WDW-2	134	150+00.00	154+30.00	LT																430		430									
PB-1	134	150+00.00	175+00.00	RT																						2500					
PB-2	134	172+92.00	175+00.00	RT																						208					
WIA-1	134	172+92.00		RT	1																										
TP-1	135	174+33.00	196+48.00	LT																			2523								
WEW-1	135	175+00.00	196+48.00	LT					2148	2148																					
PB-1	135	175+00.00	196+48.00	RT																						2148					
PB-2	135	175+00.00	175+40.00	RT																						40					
WEY-1	135	175+00.00	176+28.00	LT							128	128																			
WCH-1	135	176+28.00	178+03.00	LT									175	175																	
WCH-2	135	176+28.00	178+03.00	LT									175	175																	
WDW-1	135	178+03.00	196+48.00	LT													1845		1845												
PID 99731 PHASE 1A																															
WEW-1	136	64+00.00	75+00.00	RT						1100	1100																				
WDW-1	136	64+00.00	68+20.00	RT													420		420												
WCH-1	136	68+20.00	69+95.00	RT									175	175																	
WCH-2	136	68+20.00	69+95.00	RT									175	175																	
WIA-1	136	69+74.00		LT	1																										
TP-1	136	64+00.00	72+24.00	RT																		1207									
PB-1	136	64+00.00	74+29.00	RT																						1029					
PB-2	136	69+74.00	75+00.00	RT																			1			526					
WEY-1	136	69+95.00	75+00.00	RT							505	505																			
WEW-1	137	75+00.00	100+00.00	RT						2500	2500															2500					
PB-1	137	75+00.00	100+00.00	RT																											
WEY-1	137	75+00.00	100+00.00	RT							2500	2500																			
WEW-1	138	100+00.00	125+00.00	RT						2500	2500															2500					
PB-1	138	100+00.00	125+00.00	RT																											
WEY-1	138	100+00.00	125+00.00	RT							2500	2500																			
WEW-1	139	125+00.00	126+22.00	RT						122	122																				
WEW-2	139	127+60.00	137+50.00	RT						990	990																				
WEW-3	139	136+64.00	137+50.00	RT						86	86																				
WEY-1	139	125+00.00	126+86.00	RT								186	186																		
WEY-2	139	127+45.00	137+50.00	RT								1005	1005																		
WEY-3	139	136+54.00	137+50.00	RT								96	96																		
PB-1	139	125+00.00	126+14.00	RT																						114					
PB-2	139	127+76.00	137+50.00	RT																						974					
PB-3	139	129+66.00	131+61.00	RT																						195					
WIA-1	139	127+76.00		RT	1																										
WIA-2	139	129+66.00		RT	1																										
TP-1	139	128+92.00	130+09.00	RT																		351									
PB-1	140	137+50.00	145+91.00	RT																						841					
PB-2	140	137+91.00	150+00.00	RT																						1209					
PB-3	140	140+98.00	145+91.00	RT																						493					
WEY-1	140	137+50.00	150+00.00	RT								1250	1250																		
WEY-2	140	137+50.00	145+91.00	RT								841	841																		
WEW-1	140	137+50.00	145+91.00	RT						841	841																				
WEW-2	140	137+50.00	150+00.00	RT						1250	1250																				
WIA-1	140	137+91.00		RT	1																										
WIA-2	140	140+98.00		RT	1																										
TP-1	140	137+50.00	141+84.00	RT																		654									
WCH-1	140	145+91.00	150+00.00	RT									409	409																	
WCH-2	140	145+91.00	150+00.00	RT									409	409																	
<b>TOTALS CARRIED TO SHEET</b>					<b>69</b>	6					11537	11537	9011	9011	1518	1518	2695		2695			4735		1	15277						

CALCULATED TB CHECKED DRJ  
**LUC-475-01.85**  
 64  
 855

**MAINTENANCE OF TRAFFIC SUBSUMMARY**





C:\Users\sgault\OneDrive - ARCADIS\Desk\top\LUC475\TOHOD\TO.PE0\Drawing\_99731\Design\MOT\_Sheets\99731\_MS004.dgn Sheet 4/20/2022 4:00:08 PM sgault

REF NO.	SHEET NO.	STATION TO STATION	SIDE	614		614		614		614		614		614		614		614		615		622		622		
				WORK ZONE IMPACT ATTENUATOR, 24" WIDE HAZARDS, (UNIDIRECTIONAL)	MAINTAINING TRAFFIC, MISC.: 6"X8" SOLID WOOD POST, AS PER PLAN	MAINTAINING TRAFFIC, MISC.:SIGN (FLAT SHEET)	WORK ZONE LANE LINE, CLASS I, 4"	WORK ZONE CENTER LINE, CLASS I	WORK ZONE EDGE LINE, CLASS I, 6" (WHITE)	WORK ZONE EDGE LINE, CLASS I, 6", 807 PAINT(WHITE)	WORK ZONE EDGE LINE, CLASS I, 6"(YELLOW)	WORK ZONE EDGE LINE, CLASS I, 6", 807 PAINT(YELLOW)	WORK ZONE CHANNELIZING LINE, CLASS I, 12"	WORK ZONE CHANNELIZING LINE, CLASS I, 12", 807 PAINT	WORK ZONE DOTTED LINE, CLASS I(WHITE)	WORK ZONE DOTTED LINE, CLASS I, 6", 807 PAINT(WHITE)	WORK ZONE LANE LINE, CLASS I, 6", 807 PAINT	WORK ZONE STOP LINE, CLASS I	PAVEMENT FOR MAINTAINING TRAFFIC, CLASS A, AS PER PLAN	PORTABLE BARRIER, 50", AS PER PLAN	PORTABLE BARRIER, "Y" CONNECTOR	PORTABLE BARRIER, UNANCHORED				
PID 99731 PHASE 2 CONTINUED				EACH	EACH	SF	MILE	FT	FT	FT	FT	FT	FT	FT	FT	FT	FT	MILE	FT	SY	FT	EACH	FT			
WEY-1	147	137+50.00	140+49.00	LT									463	463												
WEY-2	147	137+50.00	139+02.00	RT									152	152												
WEY-3	147	138+73.00	142+13.00	RT									340	340												
WEY-4	147	140+13.00	150+00.00	LT									987	987												
WEW-1	147	137+50.00	140+33.00	LT					463	463																
WEW-2	147	137+50.00	141+12.00	RT					362	362																
WEW-3	147	138+79.00	150+00.00	RT					1121	1121																
WEW-4	147	140+82.00	150+00.00	LT					918	918																
WCH-1	147	139+02.00	150+00.00	RT										1098	1098											
WCH-2	147	139+02.00	150+00.00	RT										1098	1098											
WCH-3	147	142+13.00	147+46.00	RT										533	533											
WCH-4	147	142+13.00	147+46.00	RT										533	533											
WDW-1	147	147+46.00	150+00.00	RT												254		254								
TP-1	147	140+50.00	143+74.00	LT																554						
PB-1	147	137+50.00	139+82.00	LT																				245		
PB-2	147	140+82.00	150+00.00	LT																				918		
PB-3	147	144+80.00	150+00.00	LT																				520		
WIA-1	147	139+82.00		LT	1																					
PB-1	148	150+00.00	151+76.00	LT																		1		176		
PB-2	148	150+00.00	157+74.00	LT																				774		
WDW-1	148	150+00.00	151+86.00	RT												186		186								
SN-8	148	151+00.00		RT		1	28																			
WDW-2	148	151+86.00	164+22.00	RT												1236		1236								
WDW-3	148	153+54.00	157+74.00	RT												420		420								
WIA-1	148	151+76.00		LT	1																					
WCH-1	148	150+00.00	151+86.00	RT											186	186										
WCH-2	148	150+00.00	151+86.00	RT											186	186										
WCH-3	148	151+78.00	153+54.00	RT											176	176										
WCH-4	148	151+78.00	153+54.00	RT											176	176										
WEY-1	148	150+00.00	151+78.00	LT									178	178												
WEW-1	148	150+00.00	157+74.00	LT						774	774															
WEW-2	148	150+00.00	164+22.00	RT						1422	1422															
TP-1	148	150+26.00	157+74.00	LT																966						
SN-9	148	158+00.00		RT			6																			
SN-10	148	158+00.00		RT		2	36																			
SN-11	148	170+00.00		RT			6																			
SN-12	148	170+00.00		RT		2	32																			
SN-13	148	198+00.00		RT			6																			
SN-14	148	198+00.00		RT		2	32																			
PID 99731 PHASE 2A																										
WEW-1	149	91+87.00	99+07.00	RT						720	720															
TP-1	150	107+08.00	114+01.00	LT																						
WDW-1	150	105+33.00	109+61.00	LT																1030						
WDW-2	150	115+44.00	122+04.00	LT												428		428								
WEW-1	150	105+33.00	125+00.00	LT						1967	1967															
WEW-2	150	123+79.00	125+00.00	LT						121	121															
WCH-1	150	109+61.00	111+36.00	RT											175	175										
WCH-2	150	109+61.00	111+36.00	RT											175	175										
WCH-3	150	122+04.00	123+79.00	LT											175	175										
WCH-4	150	122+04.00	123+79.00	LT											175	175										
PB-1	150	104+00.00	125+00.00	LT																				2100		
PB-2	150	111+08.00	125+00.00	LT																		1		1392		
PB-3	150	123+79.00	125+00.00	LT																		1		121		
PB-4	150	123+79.00	125+00.00	LT																				121		
WEY-1	150	111+36.00	125+00.00	LT									1364	1364												
WEY-2	150	123+79.00	125+00.00	LT									121	121												
<b>TOTALS CARRIED TO SHEET</b>				<b>69</b>	<b>2</b>	<b>7</b>	<b>146</b>					<b>7868</b>	<b>7868</b>	<b>3605</b>	<b>3605</b>	<b>4686</b>	<b>4686</b>	<b>3184</b>		<b>3184</b>			<b>2550</b>	<b>3</b>	<b>6367</b>	

CALCULATED  
 MAK  
 CHECKED  
 DRJ  
**MAINTENANCE OF TRAFFIC SUBSUMMARY**  
**LUC-475-01.85**  
 66  
 855









I:\ProjectData\LUC\95875\_LUC-475-0.09\_Design\M01\Sheets\95875\_M502.dgn Sheet 4/29/2022 9:49:56 AM dkasemi

REF NO.	SHEET NO.	STATION TO STATION	SHEET	614	614	614	614	614	614	614	614	614	614	614	614	614	614	614	615	622	622	622		
				WORK ZONE IMPACT ATTENUATOR, 24" WIDE HAZARDS, (UNIDIRECTIONAL)	MAINTAINING TRAFFIC, MISC.:6"x8" SOLID WOOD POST, AS PER PLAN	MAINTAINING TRAFFIC, MISC.:SIGN (FLAT SHEET)	WORK ZONE LANE LINE, CLASS I, 4"	WORK ZONE CENTER LINE, CLASS I	WORK ZONE EDGE LINE, CLASS I, 6" (WHITE)	WORK ZONE EDGE LINE, CLASS I, 6", 807 PAINT(WHITE)	WORK ZONE EDGE LINE, CLASS I, 6"(YELLOW)	WORK ZONE EDGE LINE, CLASS I, 6", 807 PAINT(YELLOW)	WORK ZONE CHANNELIZING LINE, CLASS I, 12"	WORK ZONE CHANNELIZING LINE, CLASS I, 12", 807 PAINT	WORK ZONE DOTTED LINE, CLASS I(WHITE)	WORK ZONE DOTTED LINE, CLASS I(YELLOW)	WORK ZONE DOTTED LINE, CLASS I, 6", 807 PAINT(WHITE)	WORK ZONE LANE LINE, CLASS I, 6", 807 PAINT	WORK ZONE STOP LINE, CLASS I	PAVEMENT FOR MAINTAINING TRAFFIC, CLASS A, AS PER PLAN	PORTABLE BARRIER, 50", AS PER PLAN	PORTABLE BARRIER, "Y" CONNECTOR	PORTABLE BARRIER, UNANCHORED	
				EACH	EACH	SF	FT	FT	FT	FT	FT	FT	FT	FT	FT	FT	FT	FT	SY	FT	EACH	FT		
SUBTOTALS CARRIED FROM SHEET				58	2	3	96	5384		9633	9633	10947	10947	2456	2456	2720		2720	5384		9871	2937	2	7040
SUBTOTALS CARRIED FROM SHEET				59				15001		19017	19017	16500	16500						15001		23548	9500		9238
SUBTOTALS CARRIED FROM SHEET				60		7	206	17700		16502	16502	21079	21079			1355		1355	17700		17947	8850		5195
SUBTOTALS CARRIED FROM SHEET				61	2			8680	5000	22447	22447	18692	18692	1865	1865	1543		1543	8680		180	5000		7096
SUBTOTALS CARRIED FROM SHEET				62	3	8	238			7275	7275	4389	4389	750	750	420		420			4818	2052		4390
SUBTOTALS CARRIED FROM SHEET				62A		1	32			6634	6634	9014	9014	498	498	353		353			1878			
SUBTOTALS CARRIED FROM SHEET				62B		7	224	7510		15593	15593	11077	11077	2339	2339	1006		1006	7510		3112	3250		3160
SUBTOTALS CARRIED FROM SHEET				62C	1	4	96	21700		15585	15585	22033	22033						21700			8750		8897
SUBTOTALS CARRIED FROM SHEET				62D		1	32	13776		16362	16362	13987	13987	1046	1046	2004		2004	13776		1964	8750		5619
SUBTOTALS CARRIED FROM SHEET				62E		2	64	11721		17284	17284	19989	19989	5730	5730	1626		1626	11721		2171	6462	1	4078
SUBTOTALS CARRIED FROM SHEET				62F	1	13	325			11703	11703	8086	8086	1368	1368	1513	741	772	1		8245			55
SUBTOTALS CARRIED FROM SHEET				63	2	7	154			10566	10566	8108	8108	3796	3796	2396		2396			3024		1	4020
SUBTOTALS CARRIED FROM SHEET				64	6					11537	11537	9011	9011	1518	1518	2695		2695			4735		1	15277
SUBTOTALS CARRIED FROM SHEET				65	1					15124	15124	11324	11324	2670	2670	4120		4120			2542		1	9583
SUBTOTALS CARRIED FROM SHEET				66	2	7	146			7868	7868	3605	3605	4686	4686	3184		3184			2550		3	6367
SUBTOTALS CARRIED FROM SHEET				67	7				2450	8506	3949	3378	3378	445	350	420		420			1503		1	6320
SUBTOTALS CARRIED FROM SHEET				68	1			830	2950	4701				25		500	65							675
LINEAR TOTALS				FT				102302	10400	216337	207079	191219	191219	29192	29072	25855	806	24614	101473			55551		
LINEAR TOTALS				MI				19.375	1.970	40.973	39.220	36.216	36.216	5.529	5.506	4.897	0.153	4.662	19.218			10.521		
<b>TOTALS CARRIED TO SHEET 208 / 208A</b>					28	60	1613	19.38	1.97	40.973	39.220	36.216	36.216	29192	29072	26661		24614	19.218	80	88088	55551	10	97010

CALCULATED DEK CHECKED XXX  
**MAINTENANCE OF TRAFFIC SUBSUMMARY - MAINLINE**  
**LUC-475-0.09**  
 69  
 855

I:\ProjectData\LUC\95875\_LUC-475-0.09\_Design\M0T\Sheets\95875\_MP029.dgn\_Sheet 4/25/2022 7:11:38 AM jbidnge

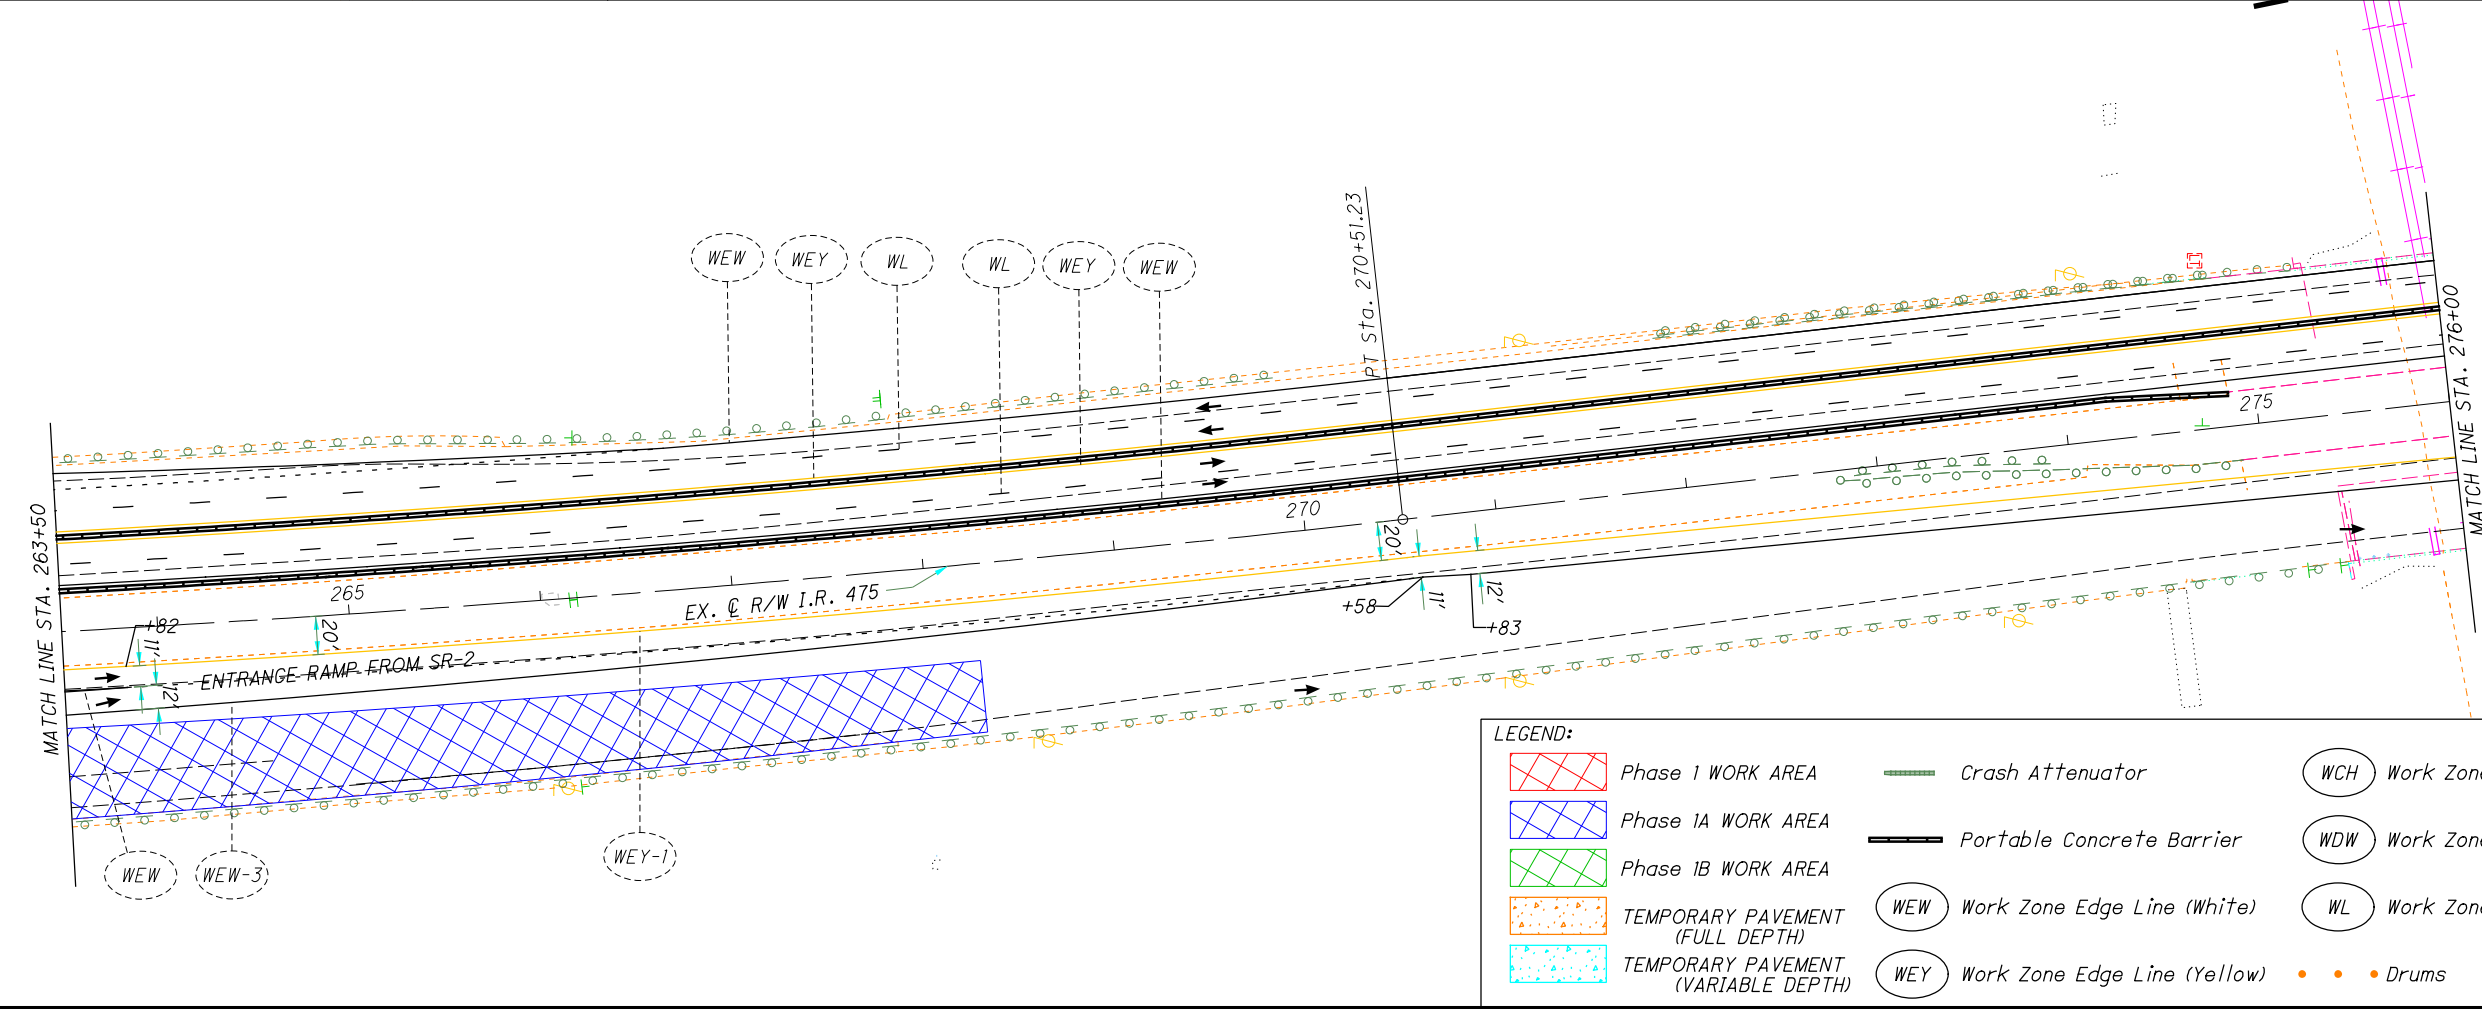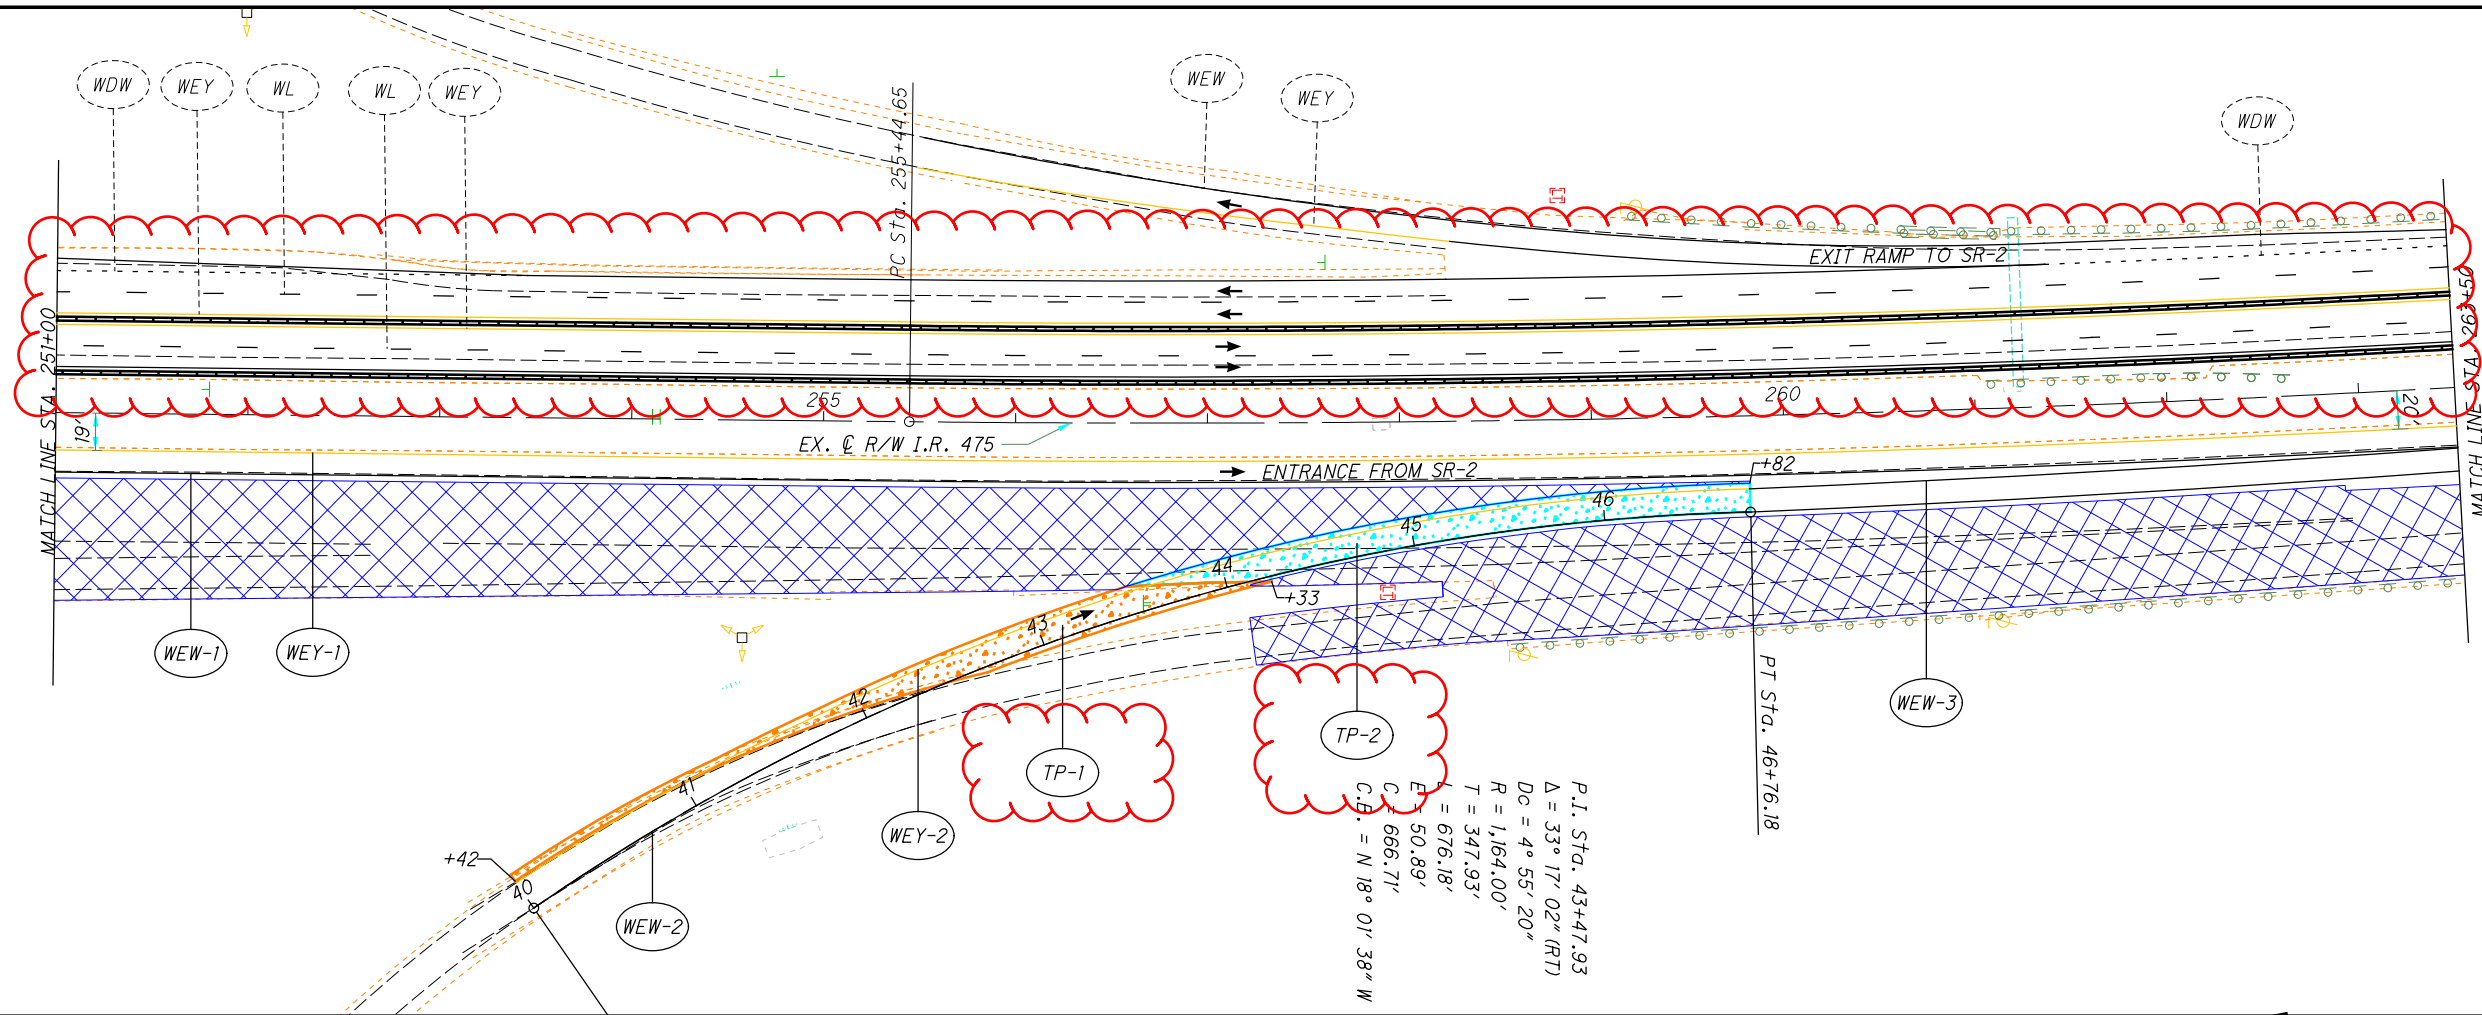

**LEGEND:**


	Phase I WORK AREA		Crash Attenuator		Work Zone Channelizing Line
	Phase IA WORK AREA		Portable Concrete Barrier		Work Zone Dotted Line (White)
	Phase IB WORK AREA		Work Zone Edge Line (White)		Work Zone Lane Line (White)
	TEMPORARY PAVEMENT (FULL DEPTH)		Work Zone Edge Line (Yellow)		Drums
	TEMPORARY PAVEMENT (VARIABLE DEPTH)				





**MAINTENANCE OF TRAFFIC - MAINLINE**  
**PHASE 1A - STA. 251+00 TO STA. 276+00**

**LUC-475-0.09**



C:\Users\sgault\OneDrive - ARCADIS\Desk\top\LUC475\TOHOD10\PE01(2)\TOHOD10\PE01\Drawing\99731\Design\MOT\Sheets\99731\_MPO1.dgn Sheet 4/19/2022 4:25:19 PM sgault

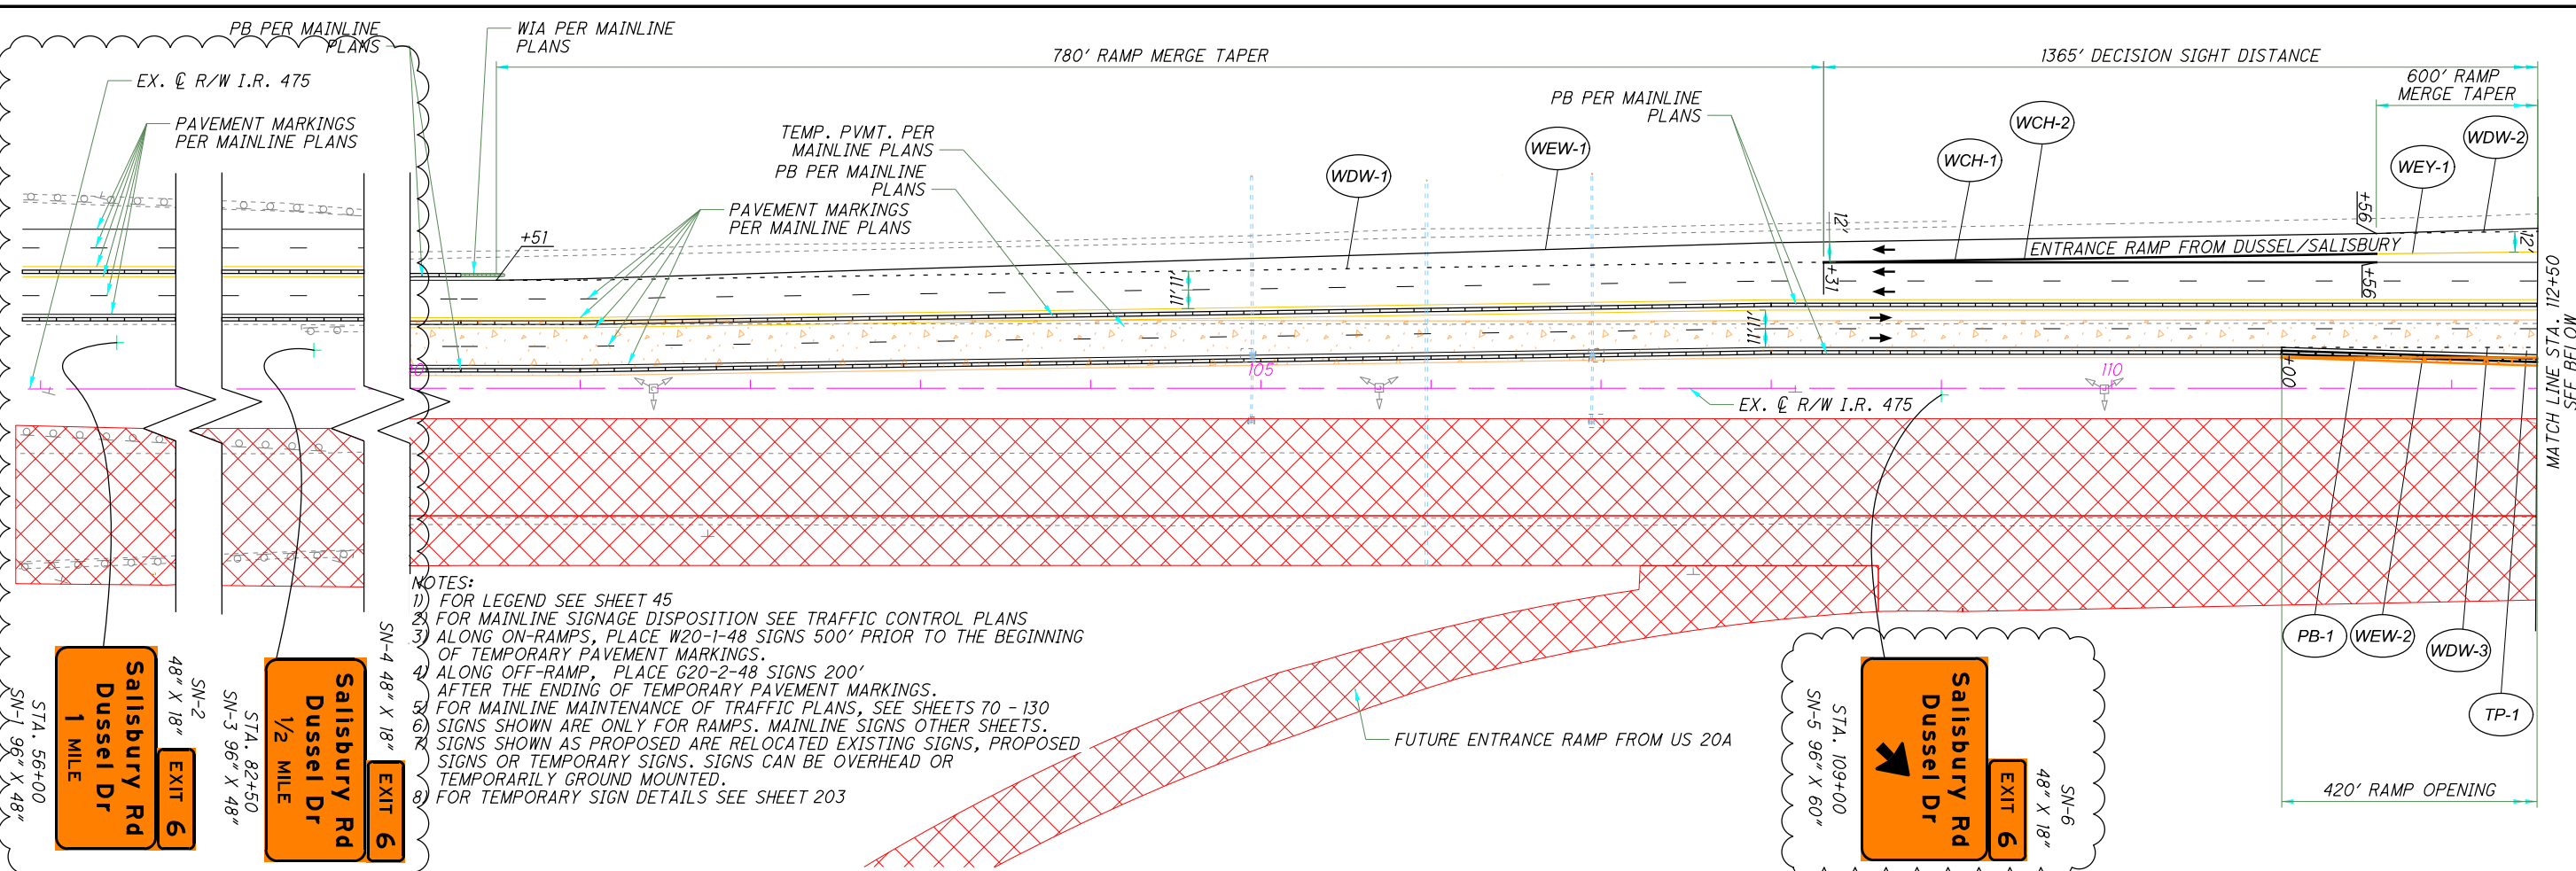

- NOTES:**
- 1) FOR LEGEND SEE SHEET 45
  - 2) FOR MAINLINE SIGNAGE DISPOSITION SEE TRAFFIC CONTROL PLANS
  - 3) ALONG ON-RAMPS, PLACE W20-1-48 SIGNS 500' PRIOR TO THE BEGINNING OF TEMPORARY PAVEMENT MARKINGS.
  - 4) ALONG OFF-RAMP, PLACE G20-2-48 SIGNS 200' AFTER THE ENDING OF TEMPORARY PAVEMENT MARKINGS.
  - 5) FOR MAINLINE MAINTENANCE OF TRAFFIC PLANS, SEE SHEETS 70 - 130
  - 6) SIGNS SHOWN ARE ONLY FOR RAMPS. MAINLINE SIGNS OTHER SHEETS.
  - 7) SIGNS SHOWN AS PROPOSED ARE RELOCATED EXISTING SIGNS, PROPOSED SIGNS OR TEMPORARY SIGNS. SIGNS CAN BE OVERHEAD OR TEMPORARILY GROUND MOUNTED.
  - 8) FOR TEMPORARY SIGN DETAILS SEE SHEET 203

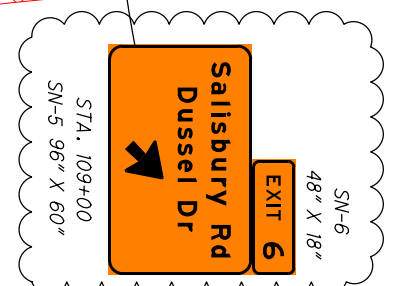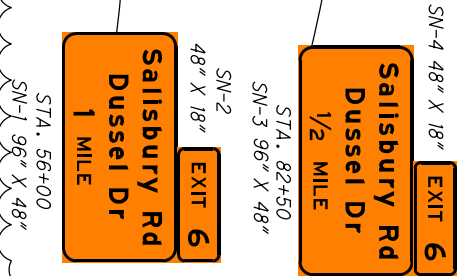

**MAINTENANCE OF TRAFFIC - RAMP DETAILS**  
**I-475 - PHASE 1 - STA. 100+00 TO STA. 125+00**

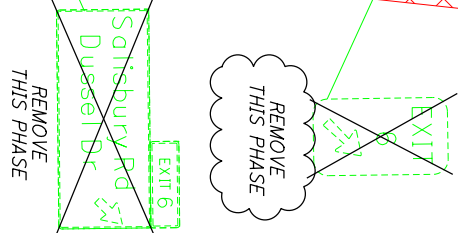
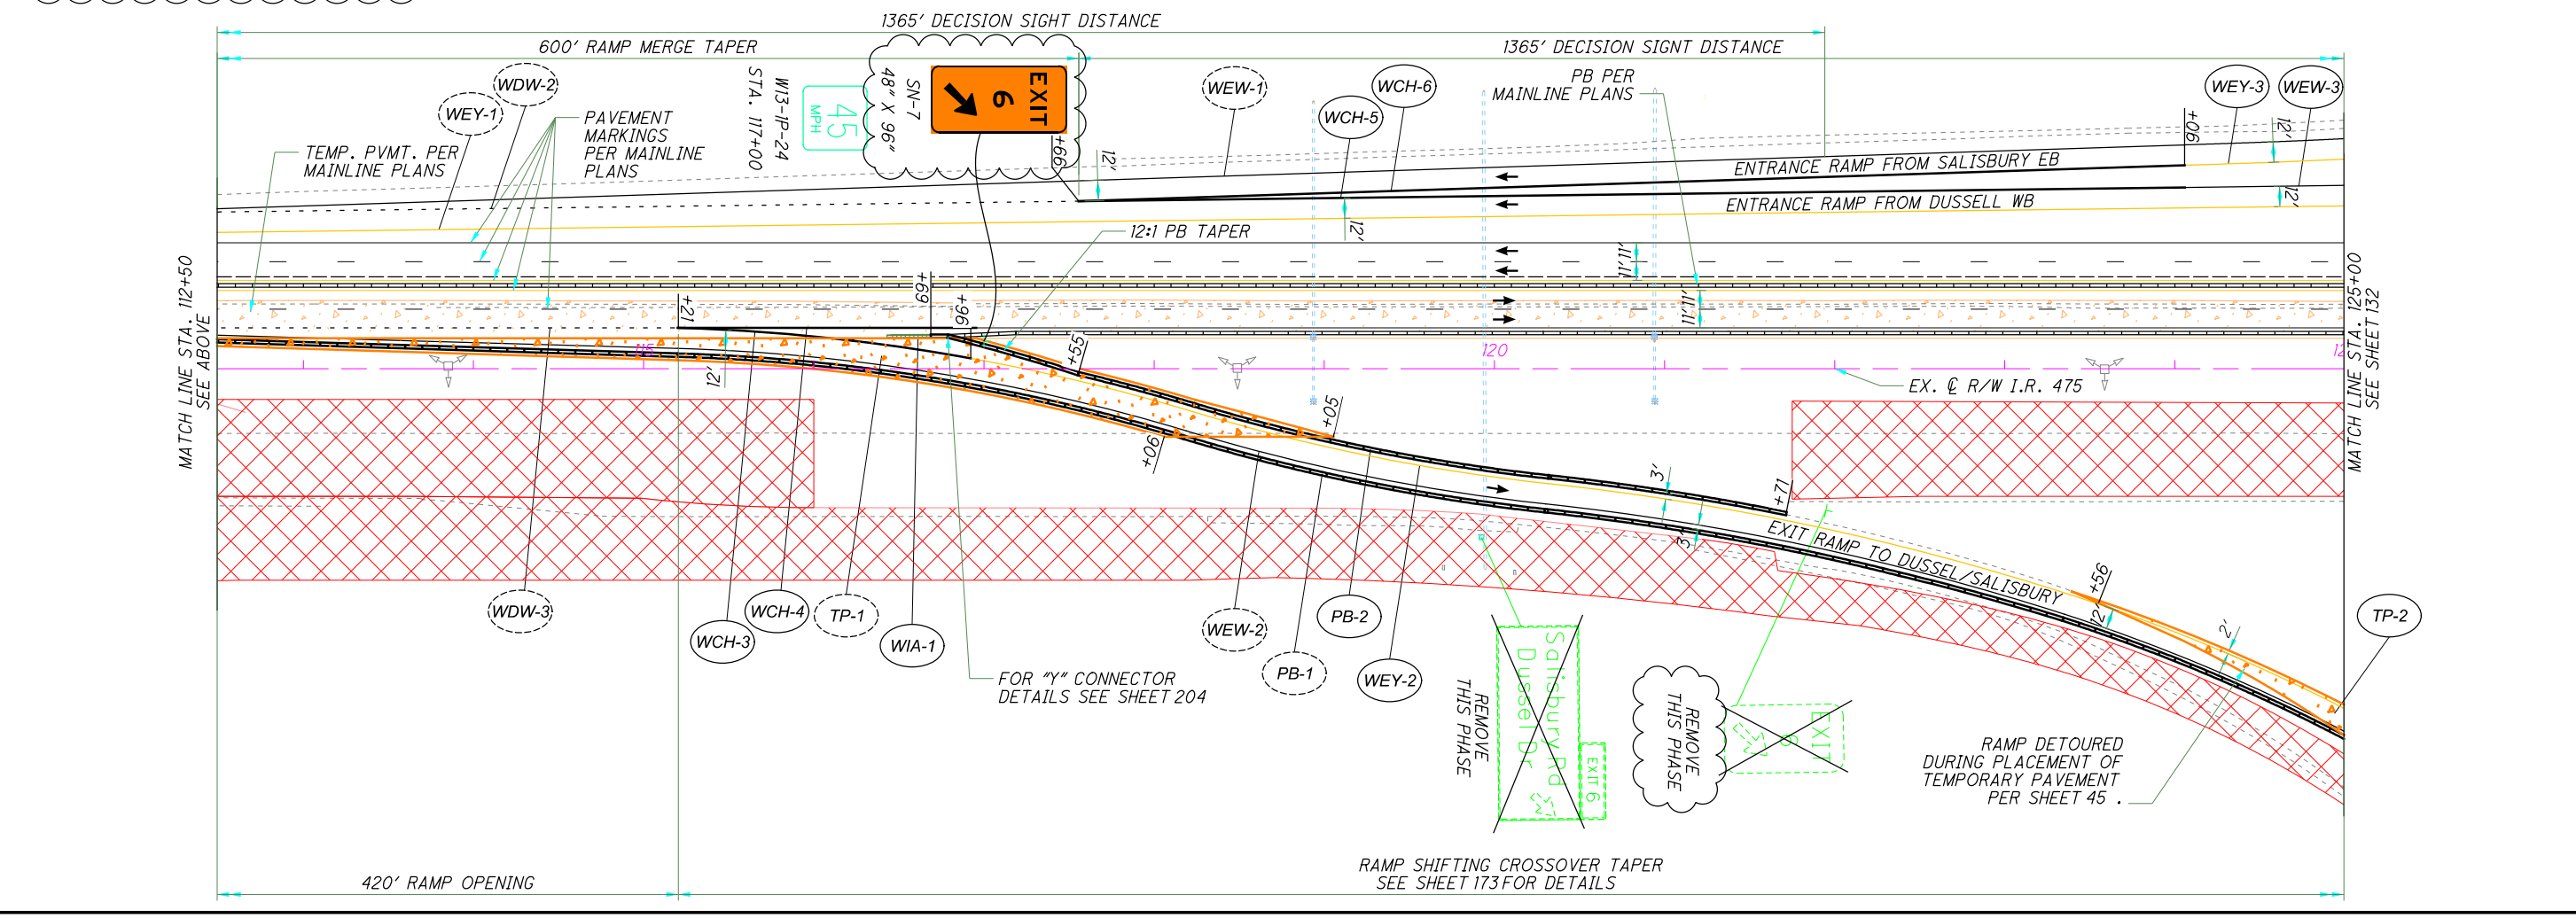


**LUC-475-01.85**





**NOTES:**

- 1) FOR LEGEND SEE SHEET 45
- 2) FOR MAINLINE SIGNAGE DISPOSITION SEE TRAFFIC CONTROL PLANS
- 3) ALONG ON-RAMPS, PLACE W20-1-48 SIGNS 500' PRIOR TO THE BEGINNING OF TEMPORARY PAVEMENT MARKINGS.
- 4) ALONG OFF-RAMP, PLACE G20-2-48 SIGNS 200' AFTER THE ENDING OF TEMPORARY PAVEMENT MARKINGS.
- 5) FOR MAINLINE MAINTENANCE OF TRAFFIC PLANS, SEE SHEETS 70 - 130
- 6) SIGNS SHOWN ARE ONLY FOR RAMPS. MAINLINE SIGNS OTHER SHEETS.
- 7) SIGNS SHOWN AS PROPOSED ARE RELOCATED EXISTING SIGNS, PROPOSED SIGNS OR TEMPORARY SIGNS. SIGNS CAN BE OVERHEAD OR TEMPORARILY GROUND MOUNTED.

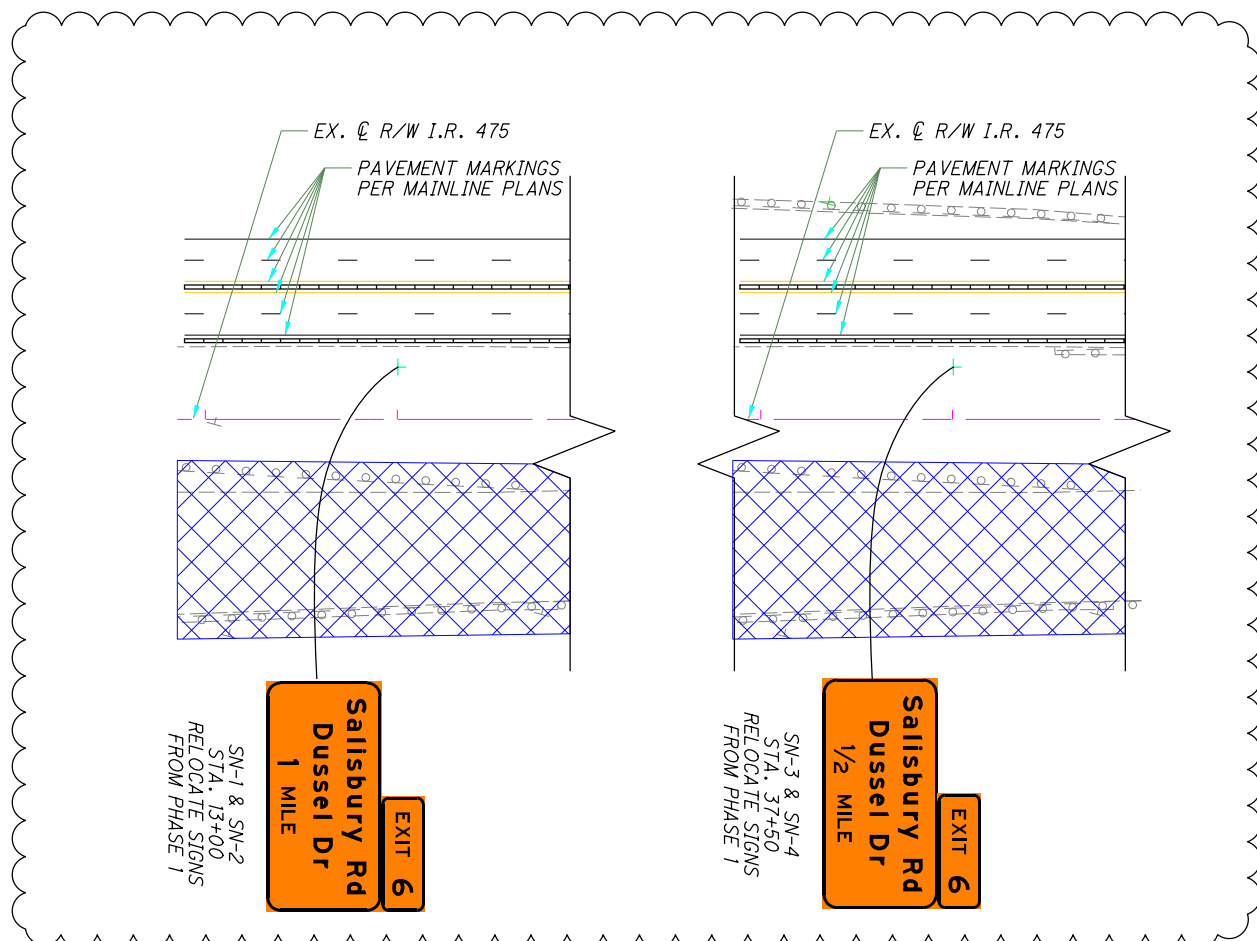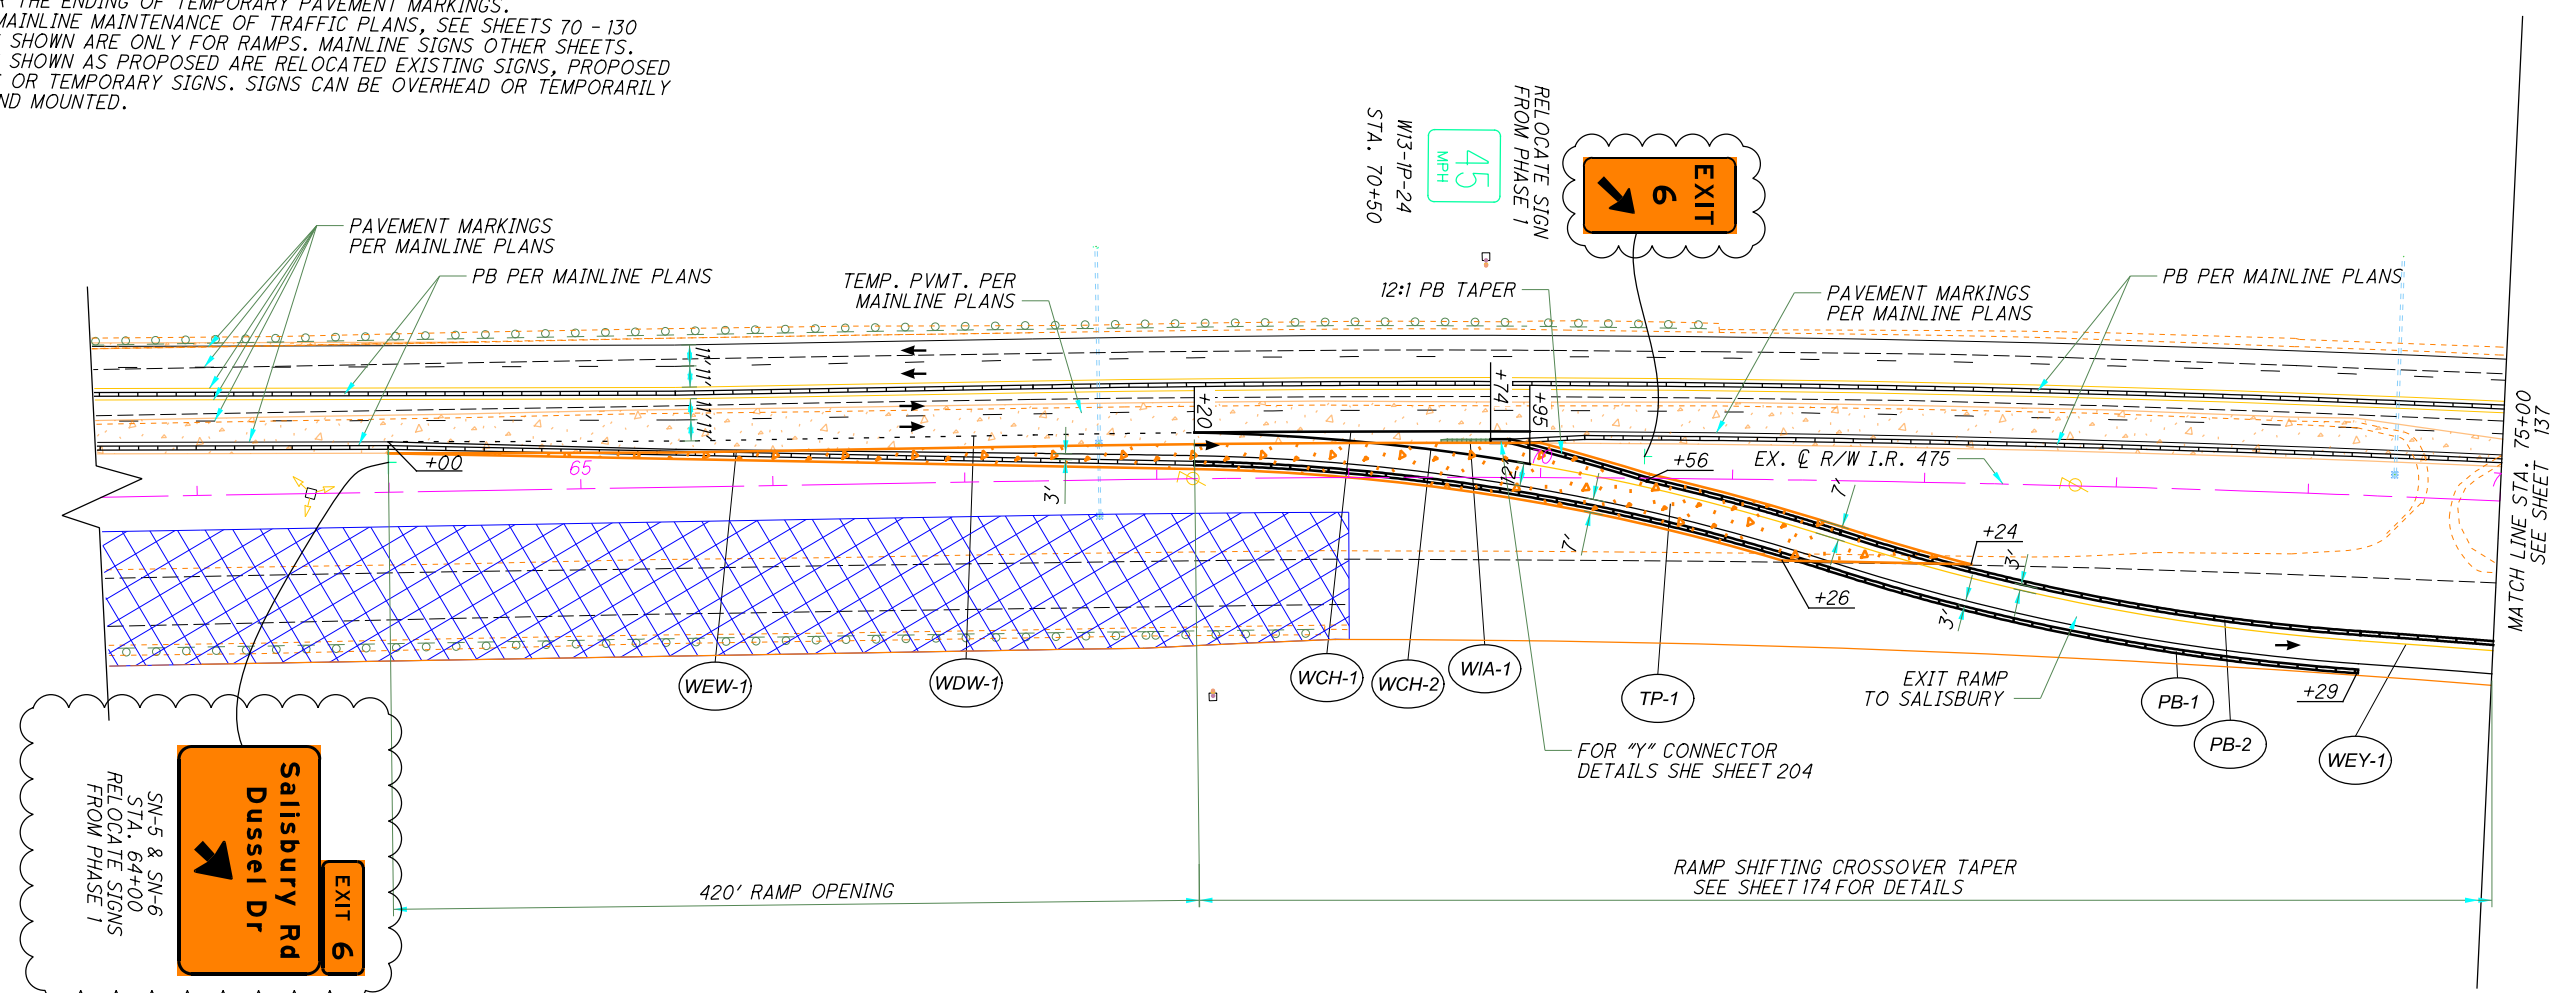

C:\Users\sgault\OneDrive - ARCADIS\Desk\top\LUC475\TOHOD\TOPE01(2)\TOHOD\TOPE01\Drawings\99731\Design\01\Sheets\99731\_MP206.dgn Sheet 4/19/2022 4:48:29 PM sgault

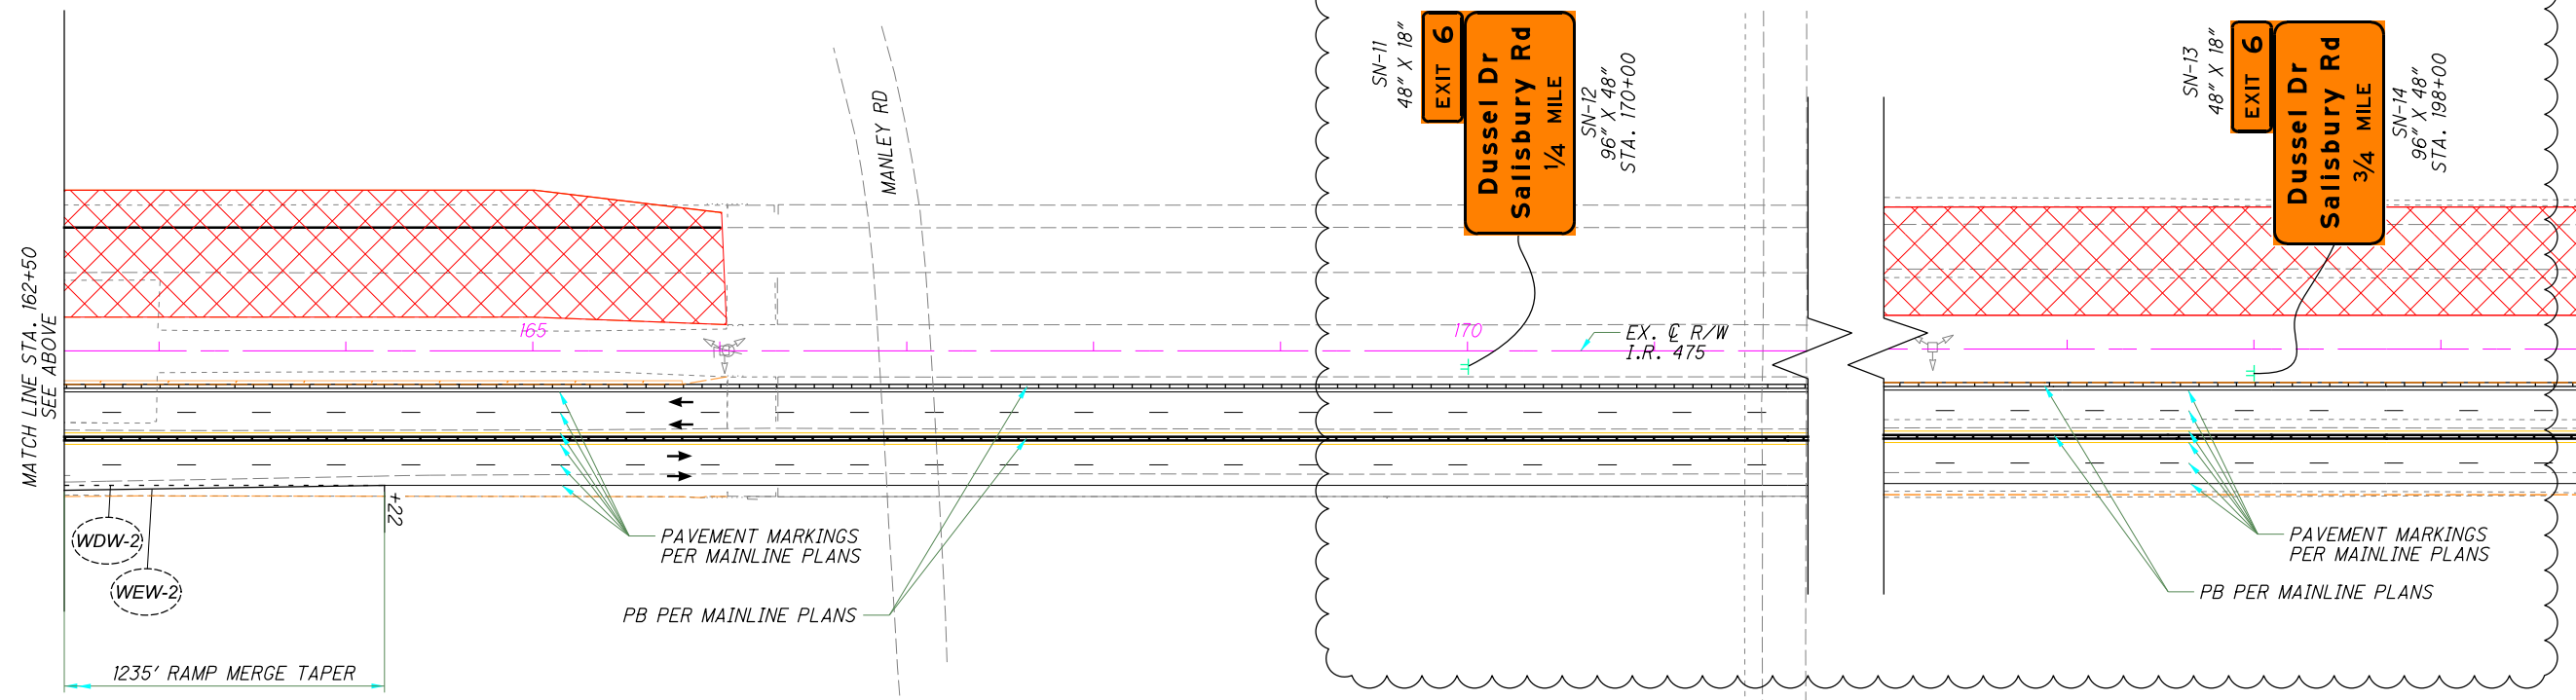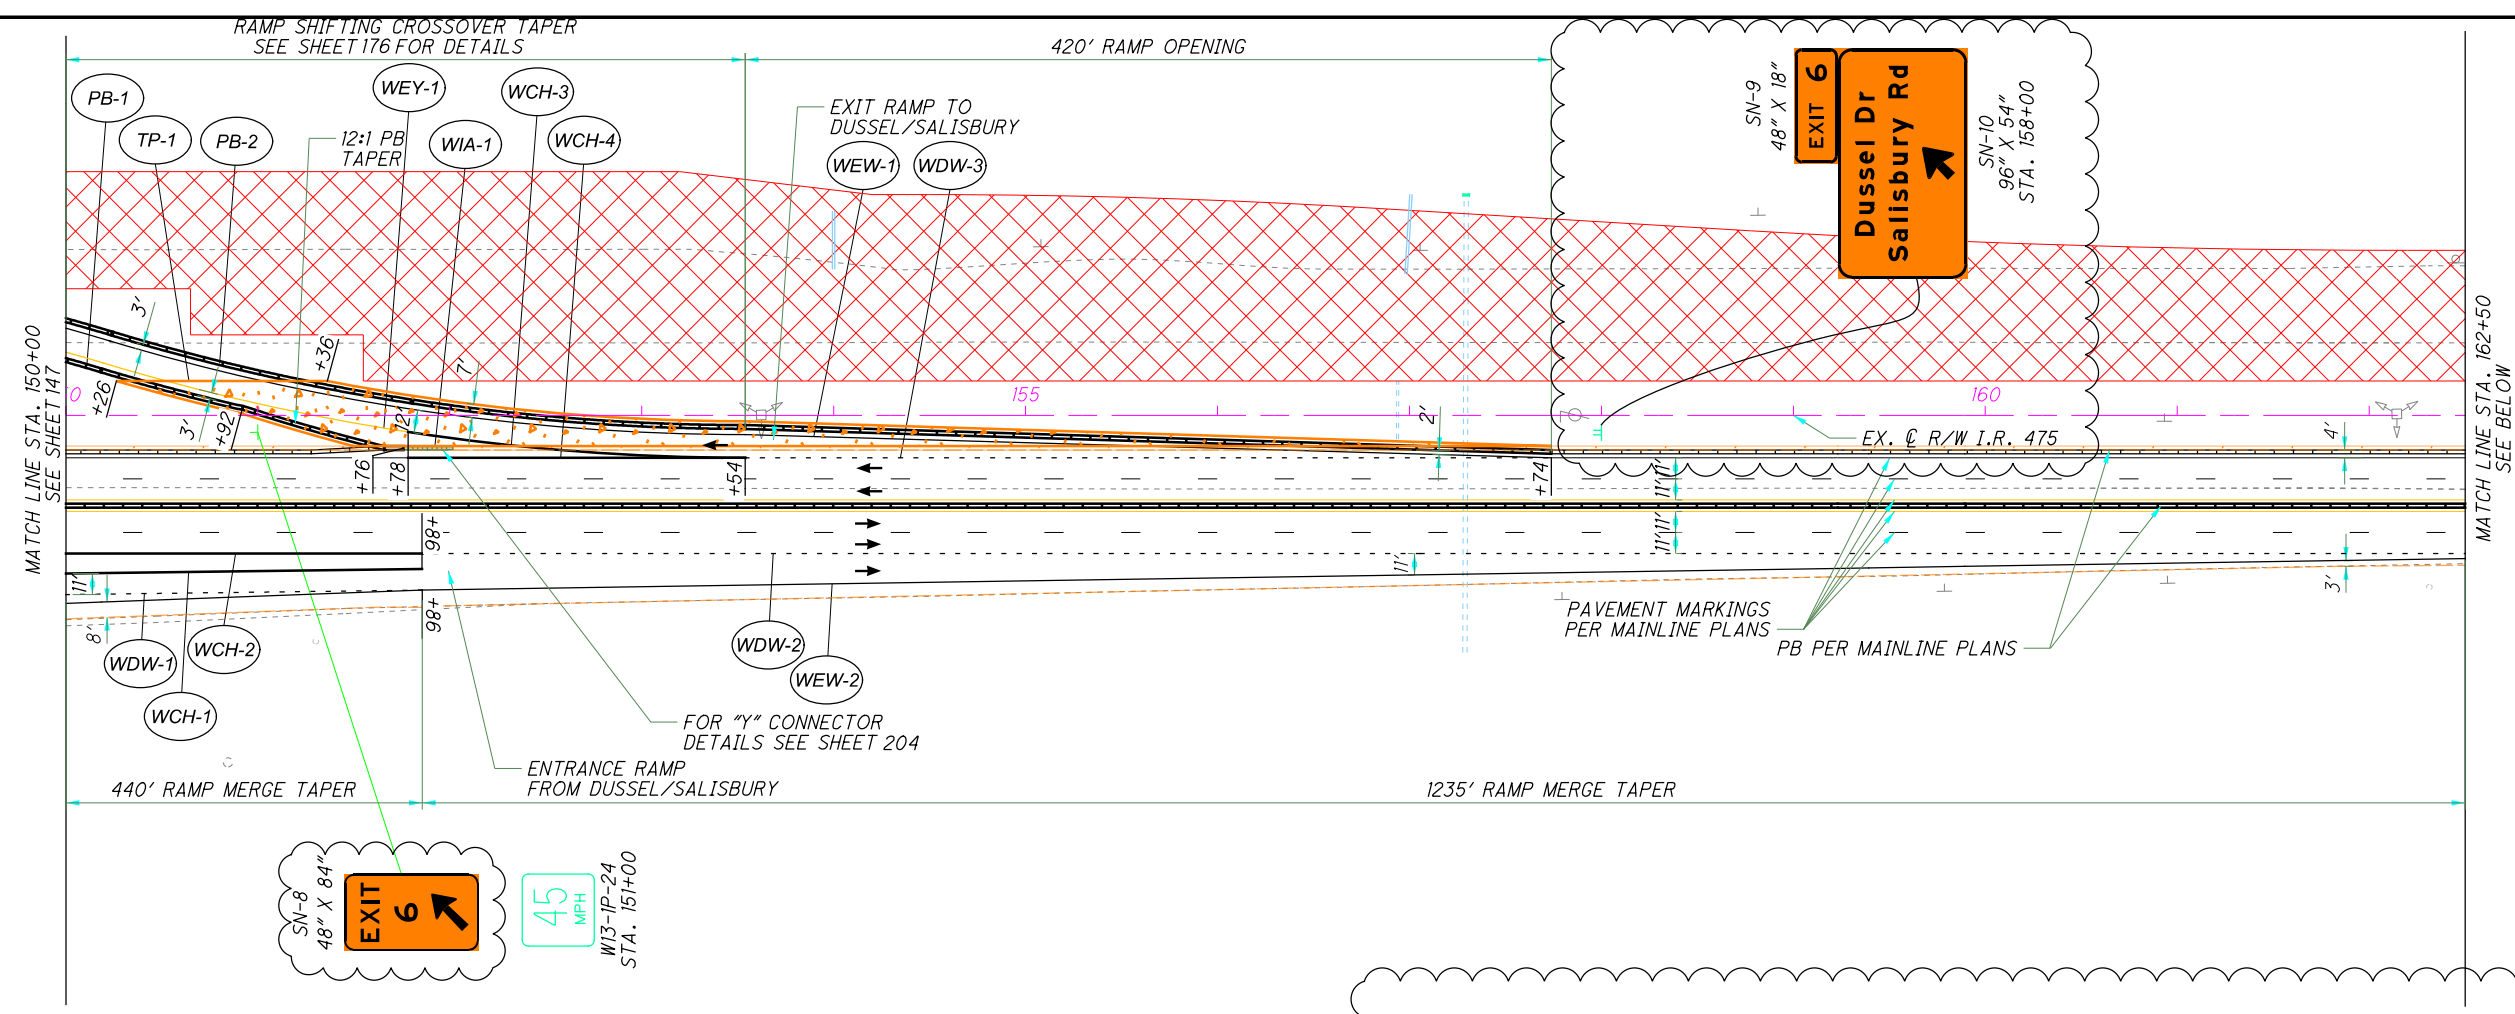

- NOTES:
- 1) FOR LEGEND SEE SHEET 45
  - 2) FOR MAINLINE SIGNAGE DISPOSITION SEE TRAFFIC CONTROL PLANS
  - 3) ALONG ON-RAMPS, PLACE W20-1-48 SIGNS 500' PRIOR TO THE BEGINNING OF TEMPORARY PAVEMENT MARKINGS.
  - 4) ALONG OFF-RAMP, PLACE G20-2-48 SIGNS 200' AFTER THE ENDING OF TEMPORARY PAVEMENT MARKINGS.
  - 5) FOR MAINLINE MAINTENANCE OF TRAFFIC PLANS, SEE SHEETS 70 - 130
  - 6) SIGNS SHOWN ARE ONLY FOR RAMPS. MAINLINE SIGNS OTHER SHEETS.
  - 7) SIGNS SHOWN AS PROPOSED ARE RELOCATED EXISTING SIGNS, PROPOSED SIGNS OR TEMPORARY SIGNS. SIGNS CAN BE OVERHEAD OR TEMPORARILY GROUND MOUNTED.
  - 8) FOR TEMPORARY SIGN DETAIL SEE SHEET 203


CALCULATED TB  
CHECKED BRO

0 50 100  
HORIZONTAL SCALE IN FEET

N


**MAINTENANCE OF TRAFFIC - RAMP DETAILS**  
**I-475 - PHASE 2 - STA. 150+00 TO STA. 175+00**



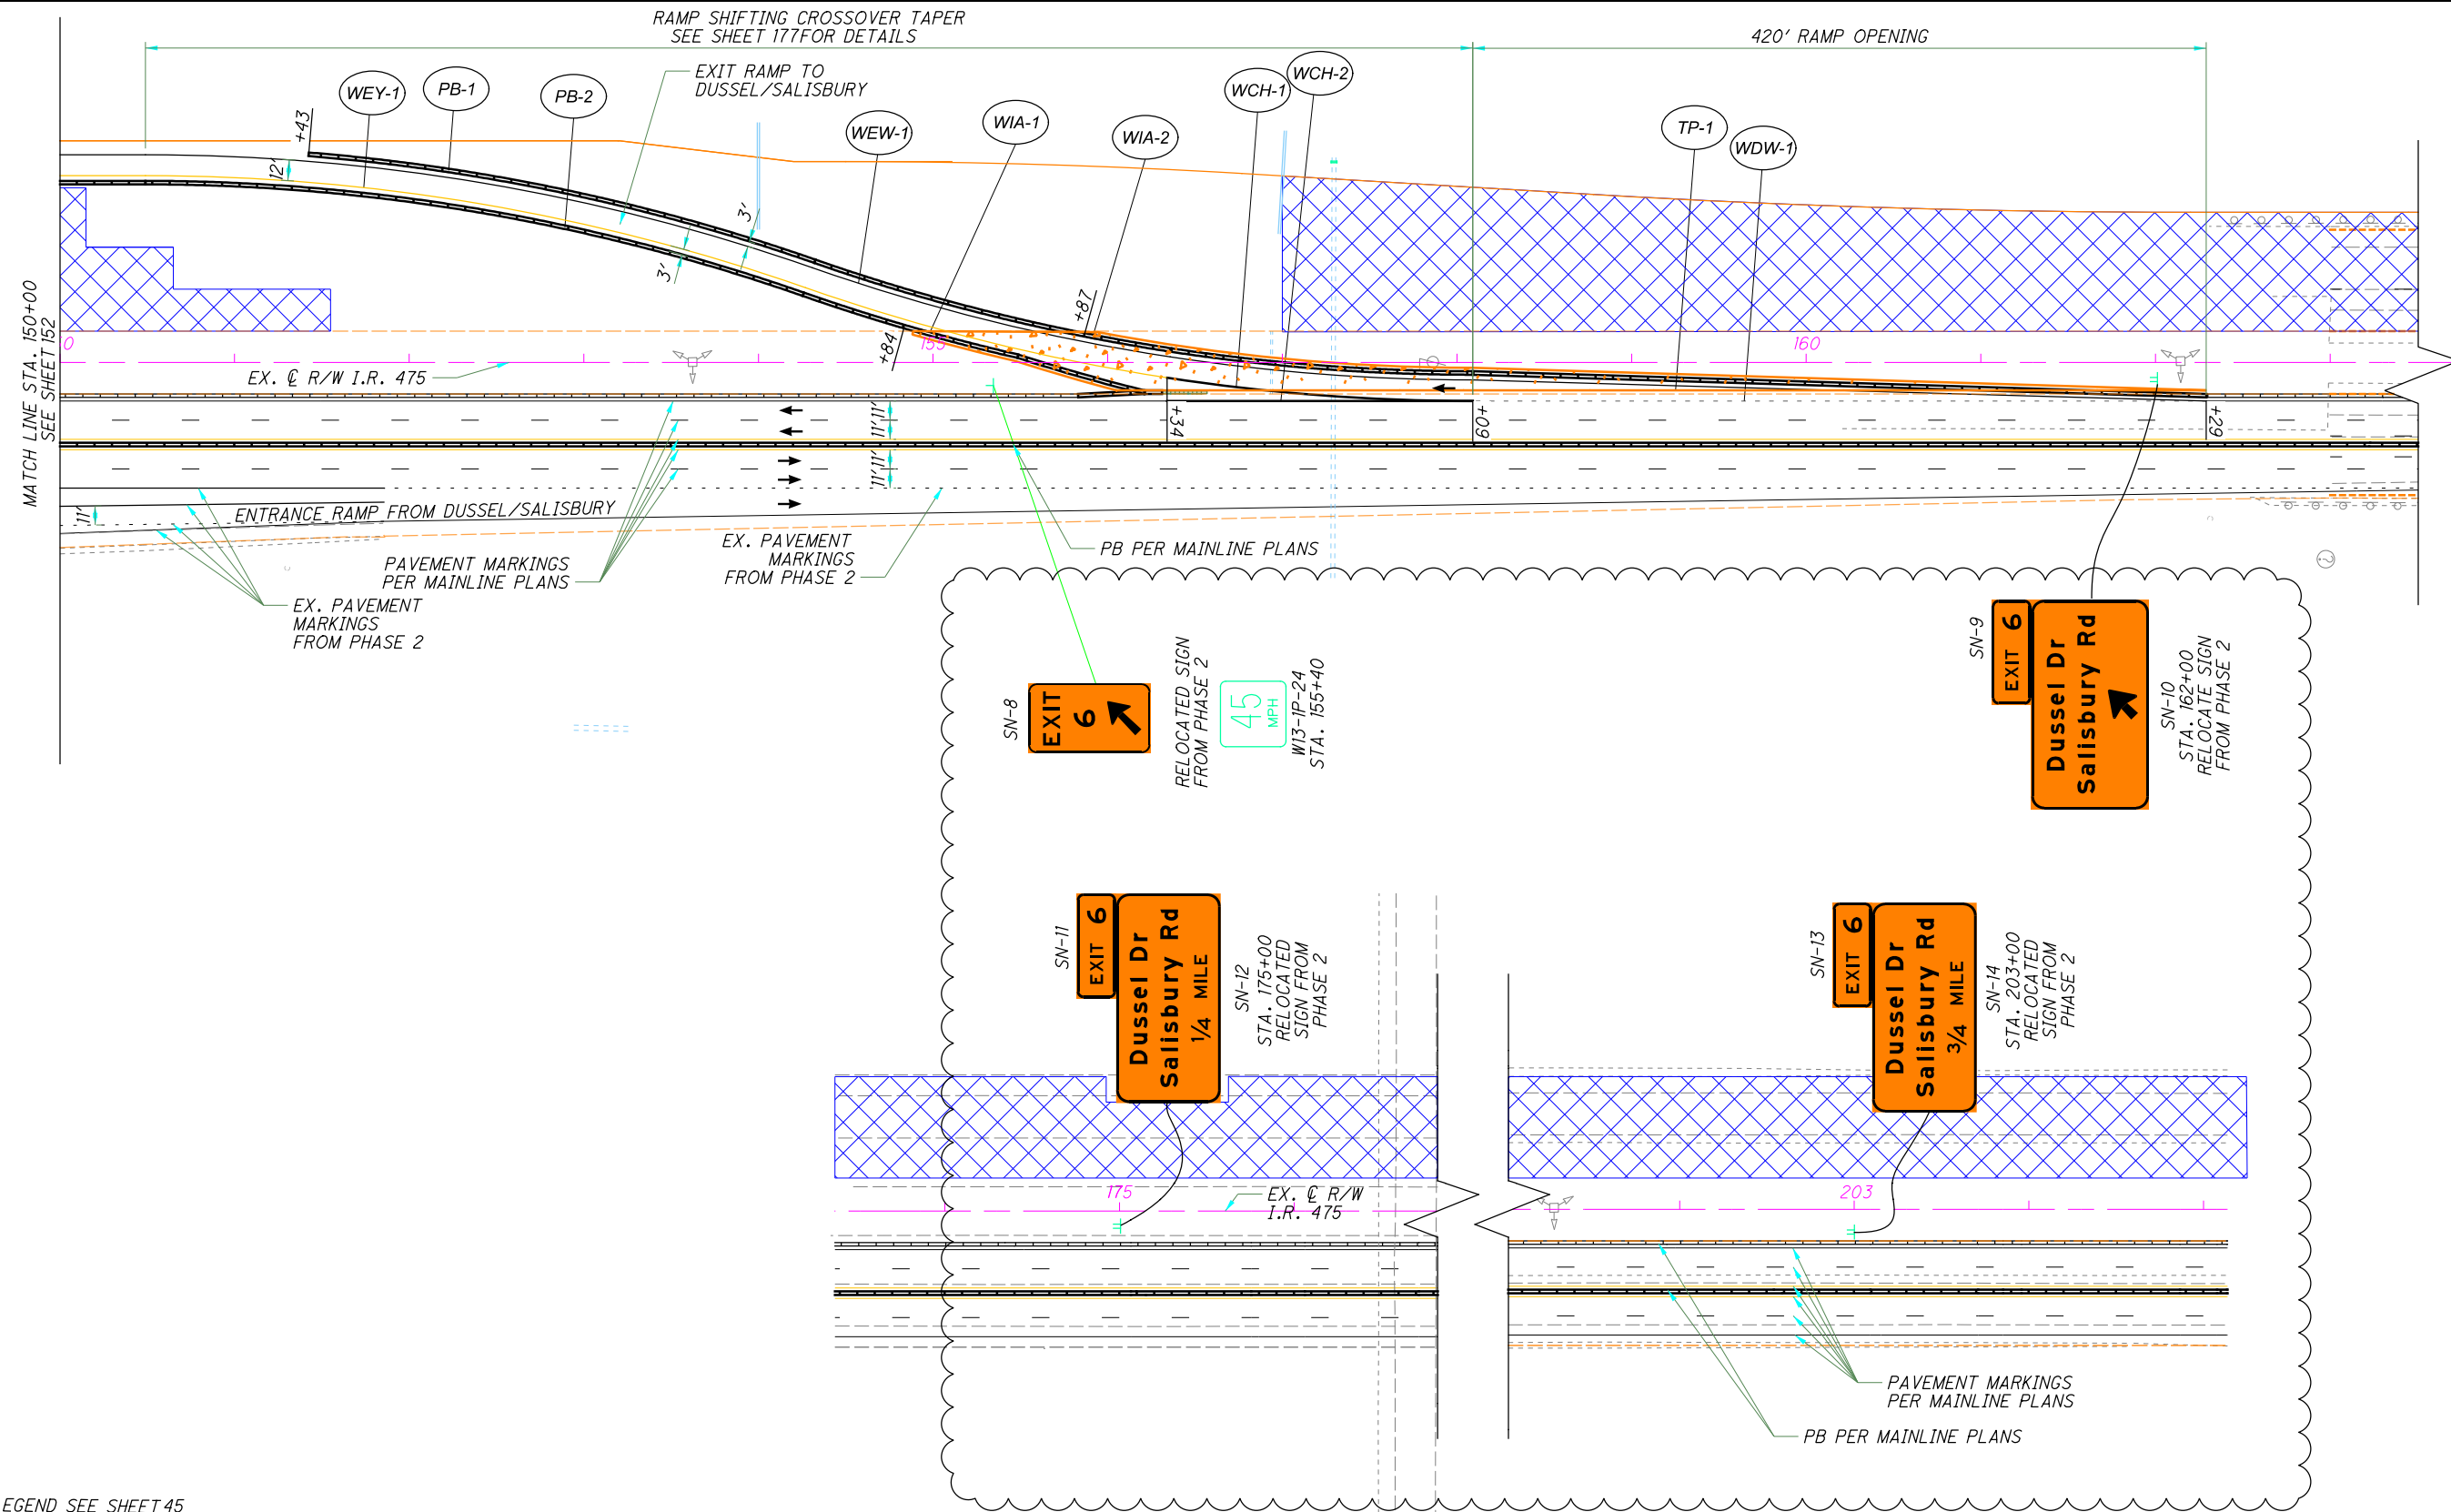


- NOTES:
- 1) FOR LEGEND SEE SHEET 45
  - 2) FOR MAINLINE SIGNAGE DISPOSITION SEE TRAFFIC CONTROL PLANS
  - 3) ALONG ON-RAMPS, PLACE W20-1-48 SIGNS 500' PRIOR TO THE BEGINNING OF TEMPORARY PAVEMENT MARKINGS.
  - 4) ALONG OFF-RAMP, PLACE G20-2-48 SIGNS 200' AFTER THE ENDING OF TEMPORARY PAVEMENT MARKINGS.
  - 5) FOR MAINLINE MAINTENANCE OF TRAFFIC PLANS, SEE SHEETS 70 - 130
  - 6) SIGNS SHOWN ARE ONLY FOR RAMPS. MAINLINE SIGNS OTHER SHEETS.
  - 7) SIGNS SHOWN AS PROPOSED ARE RELOCATED EXISTING SIGNS, PROPOSED SIGNS OR TEMPORARY SIGNS. SIGNS CAN BE OVERHEAD OR TEMPORARILY GROUND MOUNTED.
  - 8) FOR TEMPORARY SIGN DETAILS SEE SHEET 203


C:\Users\sgault\OneDrive - ARCADIS\Desk\top\LUC475\TOHOD\TOPEO1(2)\TOHOD\TOPEO1\Drawing\9973\Design\M01\Sheets\9973\MDI01.dgn Sheet 4/19/2022 5:21:22 PM sgault

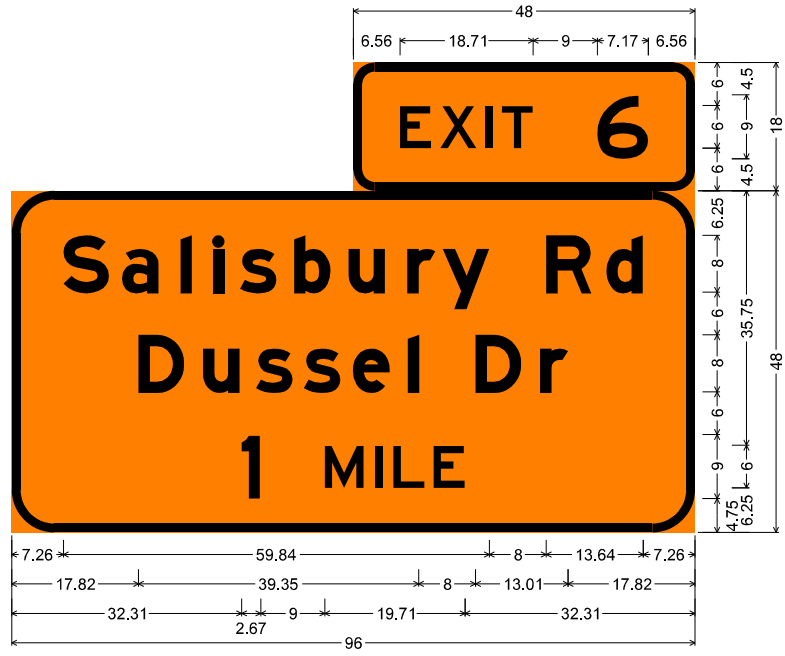


SN-1, SN-2  
3.00" Radius, 1.25" Border, Black on Orange;  
"EXIT 6", E;  
6.00" Radius, 1.25" Border, Black on Orange;  
"Salisbury Rd", E Mod; "Dussel Dr", E Mod; "1 MILE", E;

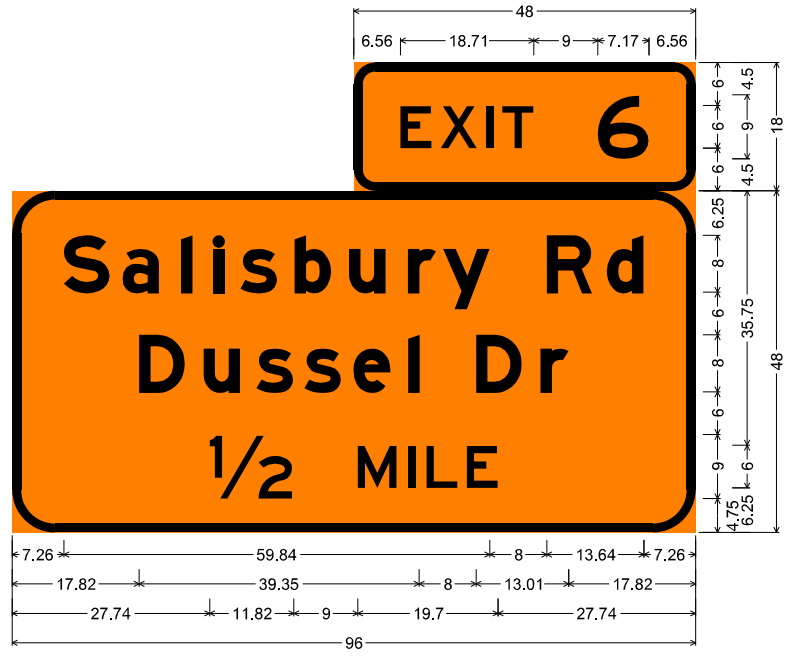


SN-3, SN-4  
3.00" Radius, 1.25" Border, Black on Orange;  
"EXIT 6", E;  
6.00" Radius, 1.25" Border, Black on Orange;  
"Salisbury Rd", E Mod; "Dussel Dr", E Mod; "1/2 MILE", E;

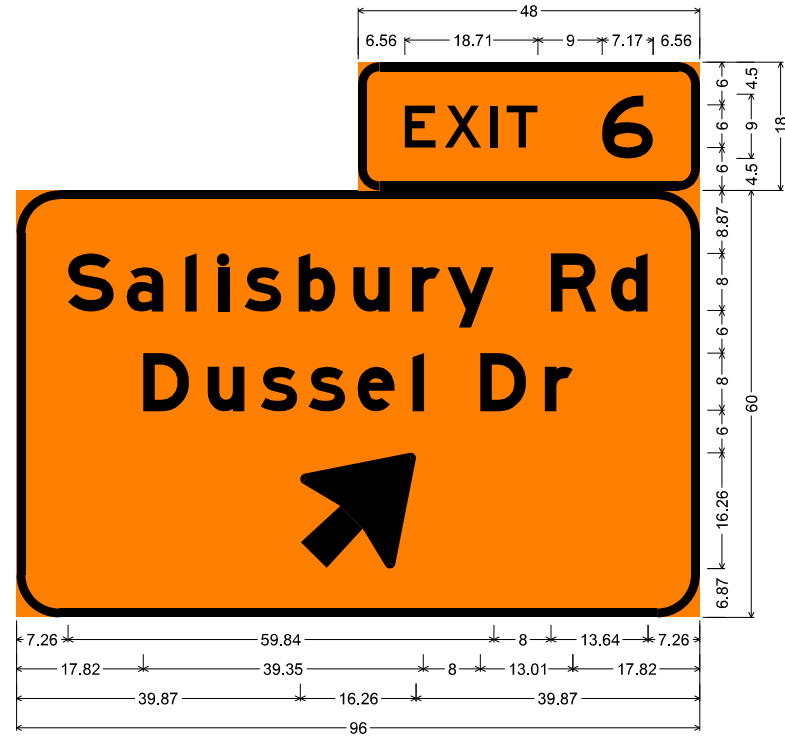


SN-5, SN-6  
3.00" Radius, 1.25" Border, Black on Orange;  
"EXIT 6", E;  
6.00" Radius, 1.25" Border, Black on Orange;  
"Salisbury Rd", E Mod; "Dussel Dr", E Mod; Arrow B-3 - 20.00" 45°;

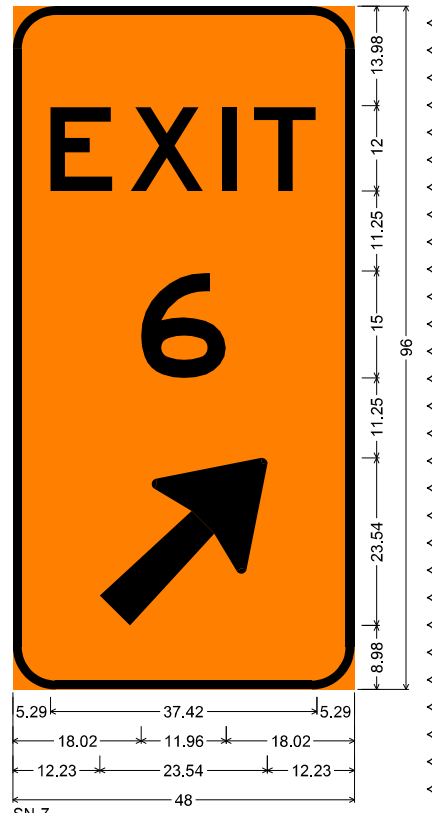


SN-7  
6.00" Radius, 1.25" Border, Black on Orange;  
"EXIT", E; "6", E;  
Arrow A-2 - 30.00" 45°;

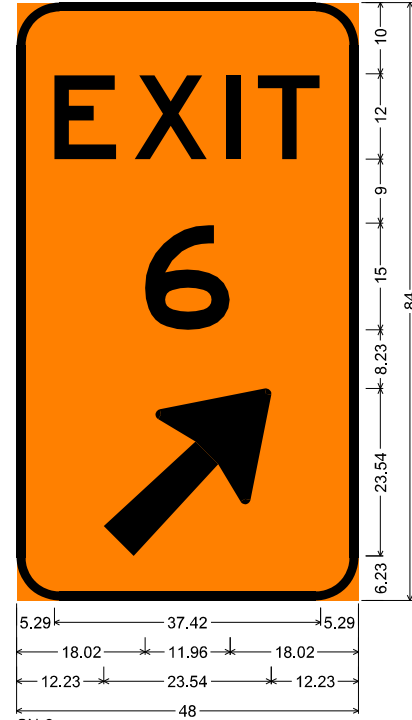


SN-8  
6.00" Radius, 1.25" Border, Black on Orange;  
"EXIT", E; "6", E;  
Arrow A-2 - 30.00" 45°;

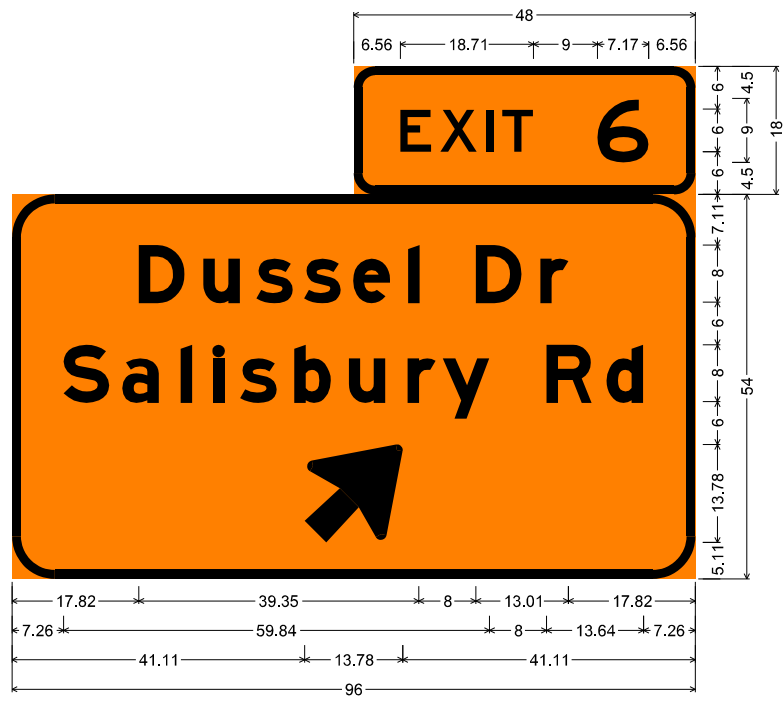

SN-9, SN-10  
3.00" Radius, 1.25" Border, Black on Orange;  
"EXIT 6", E;  
6.00" Radius, 1.25" Border, Black on Orange;  
"Dussel Dr", E Mod; "Salisbury Rd", E Mod; Arrow B-4 - 17.00" 45°;

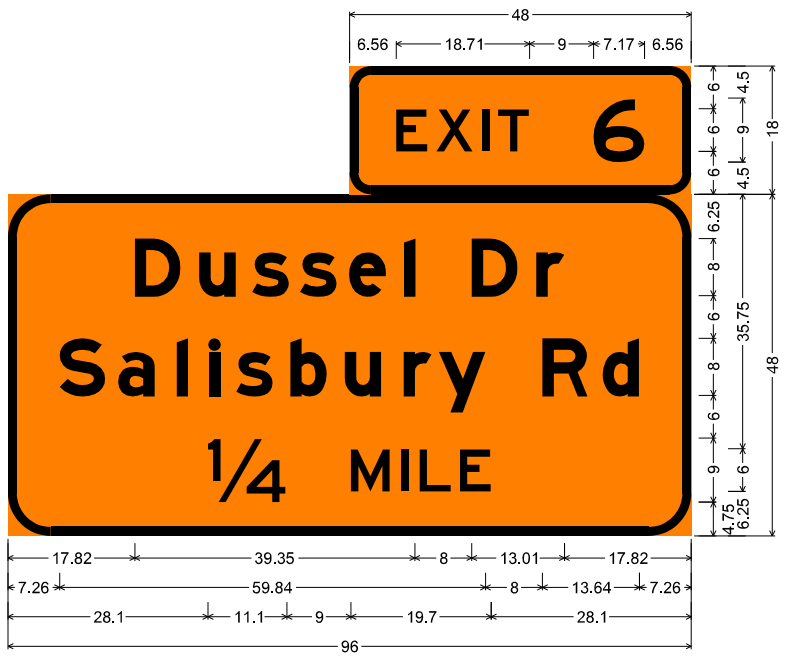

SN-11, SN-12  
3.00" Radius, 1.25" Border, Black on Orange;  
"EXIT 6", E;  
6.00" Radius, 1.25" Border, Black on Orange;  
"Dussel Dr", E Mod; "Salisbury Rd", E Mod; "1/4 MILE", E;

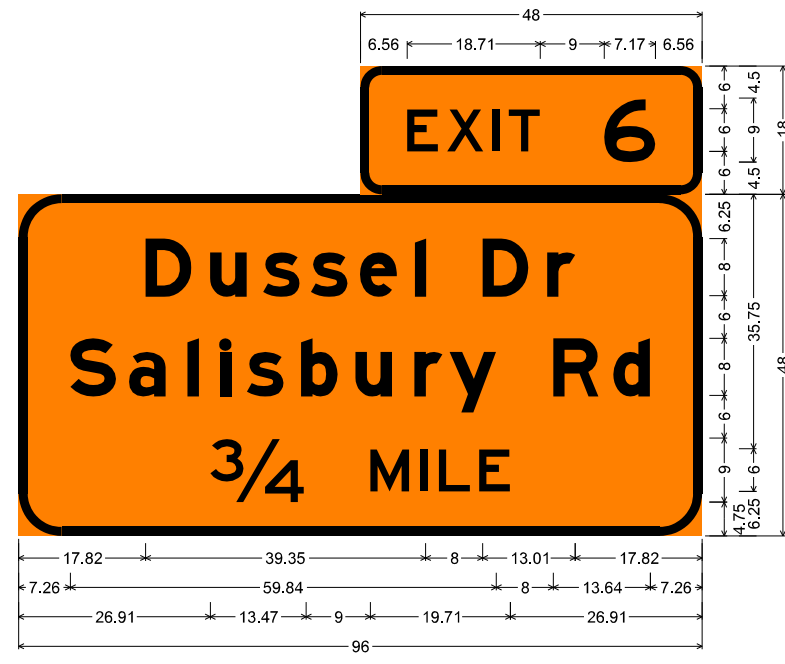

SN-13, SN-14  
3.00" Radius, 1.25" Border, Black on Orange;  
"EXIT 6", E;  
6.00" Radius, 1.25" Border, Black on Orange;  
"Dussel Dr", E Mod; "Salisbury Rd", E Mod; "3/4 MILE", E;

CALCULATED  
CAJ  
CHECKED  
BRO

MAINTENANCE OF TRAFFIC SIGNING DETAILS

LUC-475-01.85

I:\ProjectData\LUC\95875\LUC-475-0.09\Design\Roadway\Sheets\95875\_GS004.dgn Sheet 4/29/2022 9:52:20 AM jbinge

REF NO.	SHEET NO.	STATION TO STATION			203	203	203	203	659	
					EXCAVATION	EMBANKMENT	GRANULAR MATERIAL, TYPE B	GRANULAR MATERIAL, TYPE D	SEEDING AND MULCHING	
				CY	CY	CY	CY	SY		
		IR 475								
	331	12+00.00	TO 13+00.00	827	510			2118		
	332	13+50.00	14+50.00	811	286			1412		
	333	15+00.00	16+00.00	408	93			1040		
	334	16+50.00	17+50.00	570	349			1760		
	335	18+00.00	19+00.00	554	198			1290		
	336	19+50.00	20+50.00	553	185			1001		
	337	21+00.00	22+00.00	516	101			841		
	338	22+50.00	23+50.00	762	41			811		
	339	24+00.00	25+00.00	938	43			734		
	340	25+50.00	26+50.00	649	40			806		
	341	27+00.00	28+00.00	926	122			897		
	342	28+50.00	29+50.00	1118	30			912		
	343	30+00.00	31+00.00	1098	25			654		
	344	31+50.00	32+50.00	1101	29			740		
	345	33+00.00	34+00.00	1012	93			826		
	346	34+50.00	35+50.00	1067	45			824		
	347	36+00.00	37+00.00	1045	22			809		
	348	37+50.00	38+50.00	960	25			718		
	349	39+00.00	40+00.00	699	73			1648		
	350	40+50.00	41+50.00	368	450			2988		
	351	42+00.00	43+00.00	188	1122			2484		
	352	43+50.00	44+50.00	124	1701			2309		
	353	45+00.00	46+00.00	59	2397			2381		
	354	46+50.00	47+50.00	6	2821			2326		
	355	48+00.00	49+00.00	0	2199			1556		
	356	51+00.00	52+00.00	3012	10218	118	343	1718		
	357	52+50.00	53+50.00	6591	18962	222	654	3657		
	358	54+00.00	55+00.00	6502	18333	226	659	3680		
	359	55+50.00	56+50.00	6581	16685	235	688	3727		
	360	57+00.00	58+00.00	6369	13728	220	643	3803		
	361	58+50.00	59+50.00	6175	11049	57	167	3707		
	362	60+00.00	61+00.00	5860	8818			3551		
	363	61+50.00	62+50.00	3500	4563			2229		
	364	63+00.00	64+00.00	1603	1772			1310		
	365	64+50.00	65+50.00	524	79			606		
	366	66+00.00	67+00.00	631	24			606		
	367	67+36.36	68+00.00	453	14			402		
	368	68+50.00	69+50.00	665	41			606		
	369	70+00.00	71+00.00	670	46			606		
	370	71+50.00	72+50.00	728	30			606		
	371	73+00.00	74+00.00	691	44			606		
	372	74+50.00	75+50.00	644	21			606		
	373	76+00.00	77+00.00	746	32			606		
	374	77+50.00	78+50.00	705	29			606		
	375	79+00.00	80+00.00	686	42			606		
	376	80+50.00	81+50.00	777	42			606		
	377	82+00.00	83+00.00	775	39			606		
	378	83+50.00	84+50.00	796	36			606		
	379	85+00.00	86+00.00	780	51			606		
	380	86+50.00	87+50.00	769	49			606		
	381	88+00.00	89+00.00	812	35			606		
	382	89+50.00	90+50.00	815	36			606		
	383	91+00.00	92+00.00	818	37			606		
	384	92+50.00	93+50.00	851	29			606		
<b>TOTALS CARRIED TO SHEET 3 OF 3</b>				76888	117884	1078	3154	73183		

REF NO.	SHEET NO.	STATION TO STATION			203	203	203	203	659	
					EXCAVATION	EMBANKMENT	GRANULAR MATERIAL, TYPE B	GRANULAR MATERIAL, TYPE D	SEEDING AND MULCHING	
				CY	CY	CY	CY	SY		
		IR 475								
	385	94+00.00	TO 95+00.00	887	24			606		
	386	95+50.00	96+50.00	875	25			606		
	387	97+00.00	98+00.00	960	11			606		
	388	98+50.00	99+50.00	933	17			606		
	389	100+00.00	100+50.00	561	16			404		
	390	101+00.00	102+00.00	695	38			606		
	391	102+50.00	103+50.00	609	41			606		
	392	104+00.00	105+00.00	625	30			606		
	393	105+50.00	106+50.00	626	9			606		
	394	107+00.00	108+00.00	619	26			606		
	395	108+50.00	109+50.00	583	39			606		
	396	110+00.00	111+00.00	573	44			606		
	397	111+50.00	112+50.00	560	54			606		
	398	113+00.00	114+00.00	568	47			606		
	399	114+50.00	115+50.00	556	38			606		
	400	116+00.00	117+00.00	549	38			606		
	401	117+50.00	118+50.00	552	31			606		
	402	119+00.00	120+00.00	625	11			606		
	403	120+50.00	121+50.00	616	16			606		
	404	122+00.00	123+00.00	601	20			606		
	405	123+50.00	124+50.00	620	19			606		
	406	125+00.00	126+00.00	612	28			606		
	407	126+50.00	127+50.00	601	41			606		
	408	128+00.00	129+00.00	648	31			606		
	409	129+50.00	130+50.00	675	19			606		
	410	131+00.00	132+00.00	690	14			606		
	411	132+50.00	133+50.00	650	8			606		
	412	134+00.00	135+00.00	609	3			606		
	413	135+50.00	136+50.00	699	7			606		
	414	137+00.00	138+00.00	663	15			606		
	415	138+50.00	139+50.00	622	15			606		
	416	140+00.00	141+00.00	687	9			606		
	417	141+50.00	142+50.00	714	10			703		
	418	143+00.00	144+00.00	665	20			729		
	419	144+50.00	145+50.00	656	24			711		
	420	146+00.00	147+00.00	588	19			688		
	421	147+50.00	148+50.00	605	12			701		
	422	149+00.00	150+00.00	716	4			712		
	423	150+50.00	151+50.00	763	1			674		
	424	152+00.00	153+00.00	701	4			656		
	425	153+50.00	154+50.00	656	8			667		
	426	155+00.00	156+00.00	634	12			669		
	427	156+50.00	157+50.00	610	21			660		
	428	158+00.00	159+00.00	760	7			675		
	429	159+50.00	160+50.00	770	2			692		
	430	161+00.00	162+00.00	799	3			677		
	431	162+50.00	163+50.00	564	3			675		
	432	164+00.00	165+00.00	216	13			702		
	433	165+50.00	173+50.00	152	4			443		
	434	174+00.00	175+00.00	146	16			1483		
	435	175+50.00	176+50.00	221	32			1429		
	436	177+00.00	178+00.00	445	28			1541		
	437	178+50.00	179+50.00	468	79			1335		
	438	180+00.00	181+00.00	519	173			786		
<b>TOTALS CARRIED TO SHEET 3 OF 3</b>				33317	1379			37198		

CALCULATED  
 JRB  
 CHECKED  
 XXX  
**EARTHWORK SUBSUMMARY SHEET 1 OF 3**  
**LUC-475-0.09**  
 212  
 855

I:\ProjectData\LUC\95875\_LUC-475-0.09\_Design\Roadway\Sheets\95875\_GS005.dgn Sheet 4/29/2022 9:52:20 AM jbinge

REF NO.	SHEET NO.	STATION TO STATION		203	203	203	203	659
				EXCAVATION CY	EMBANKMENT CY	GRANULAR MATERIAL, TYPE B CY	GRANULAR MATERIAL, TYPE D CY	SEEDING AND MULCHING SY
IR 475								
439		181+50.00	TO 182+50.00	601	143			713
440		183+00.00	184+00.00	815	20			730
441		184+50.00	185+50.00	923	7			839
442		186+00.00	187+00.00	984	4			799
443		187+50.00	188+50.00	964	2			740
444		189+00.00	190+00.00	873	5			757
445		190+50.00	191+50.00	777	11			763
446		192+00.00	193+00.00	682	28			782
447		193+50.00	194+50.00	618	45			771
448		195+00.00	196+00.00	610	64			799
449		196+50.00	197+50.00	626	45			802
450		198+00.00	199+00.00	647	31			829
451		199+50.00	200+50.00	643	34			848
452		201+00.00	202+00.00	850	5			898
453		202+50.00	203+50.00	855	7			1093
454		204+00.00	205+00.00	835	13			1042
455		205+50.00	206+50.00	781	17			939
456		207+00.00	208+00.00	688	35			1035
457		208+50.00	209+50.00	666	39			1014
458		210+00.00	211+00.00	618	57			1211
459		211+50.00	212+50.00	655	26			1182
460		213+00.00	214+00.00	425	35			1238
461		214+50.00	215+50.00	236	52			1128
462		216+00.00	217+00.00	271	52			1096
463		217+50.00	218+50.00	237	77			1013
464		219+00.00	220+00.00	222	79			1027
465		220+50.00	221+50.00	205	73			952
466		222+00.00	223+00.00	239	49			795
467		223+50.00	224+50.00	226	1			377
468		225+00.00	226+00.00	144	4			675
469		226+50.00	227+50.00	69	13			810
470		228+00.00	229+00.00	76	8			703
471		230+00.00	231+00.00	7	0			132
472		231+50.00	232+50.00	162	4			663
473		233+00.00	234+00.00	187	0			405
474		234+50.00	235+50.00	177	0			389
475		236+00.00	237+00.00	302	8			738
476		237+50.00	238+50.00	191	14			440
477		239+00.00	240+00.00	162	1			289
478		240+50.00	241+50.00	167	1			298
479		242+00.00	243+00.00	169	0			211
480		243+50.00	244+50.00	185	0			276
481		245+00.00	246+00.00	289	33			800
482		246+50.00	247+50.00	282	22			457
483		248+00.00	249+00.00	221	2			313
484		249+50.00	250+50.00	216	5			358
485		251+00.00	252+00.00	233	4			376
486		252+50.00	253+50.00	292	35			876
487		254+00.00	255+00.00	720	6			1066
488		255+44.65	256+00.00	397	6			809
489		256+50.00	257+50.00	327	9			630
490		258+00.00	259+00.00	448	7			550
491		259+50.00	260+50.00	326	0			209
492		261+00.00	262+00.00	285	0			191
<b>TOTALS CARRIED TO SHEET 3 OF 3</b>				23806	1238			38876

REF NO.	SHEET NO.	STATION TO STATION		203	203	203	203	659
				EXCAVATION CY	EMBANKMENT CY	GRANULAR MATERIAL, TYPE B CY	GRANULAR MATERIAL, TYPE D CY	SEEDING AND MULCHING SY
IR 475								
493		262+50.00	TO 263+50.00	272	0			195
494		264+00.00	265+00.00	255	0			177
495		265+50.00	266+50.00	220	2			197
496		267+00.00	268+00.00	195	0			283
US 24 & IR 475 RAMP F								
498		26+43.23	27+50.00	49	35			423
499		28+00.00	29+00.00	208	253			111
500		29+50.00	30+50.00	435	973			1781
501		31+00.00	32+00.00	555	1331			2127
502		32+50.00	34+00.00	448	1909			2721
503		34+50.00	35+54.90	264	667			1364
504		36+00.00	37+50.00	516	1375			1981
505		37+54.90	39+00.00	1008	1582	26	75	1382
506		39+50.00	41+00.00	3564	7654	168	499	3040
507		41+50.00	42+50.00	2729	5957	120	348	1708
508		43+00.00	44+00.59	2948	6051	119	344	1517
509		44+50.00	46+00.00	3994	9849	175	517	2094
510		46+50.00	48+00.00	4421	11549	164	479	1994
511		48+50.00	48+78.16	1802	4735	64	188	783
US 24 & IR 475 RAMP G								
512		39+00.00	40+00.00	12	3			14
513		40+50.00	41+00.00	33	15			60
514		41+50.00	42+50.00	9	147			125
515		42+76.65	43+50.00		212			108
516		44+00.00	45+00.00		379			183
517		45+50.00	46+50.00		363			208
518		47+00.00	48+00.00		329			231
519		48+50.00			102			81
NOISE WALL 1A								
628		1100+00.00	1101+50.00	444	491			270
				750	864			446
629		1102+00.00	1103+58.00	594	659			361
				431	506			315
630		1104+00.00	1106+00.00	461	513			301
				511	531			359
631		1106+50.00	1110+00.00	71	13			116
				88	9			86
632		1110+30.00	1111+40.07	35	4			36
				8	0			20
NOISE WALL 2A								
633		2100+00.00	2102+50.00	507	609			399
				468	529			353
634		2103+00.00	2105+50.00	543	671			403
				812	855			497
635		2106+00.00	2109+50.00	263	246			220
				94	4			68
636		2110+30.00	2111+00.00	56	5			56
				3	0			7
<b>TOTALS CARRIED TO SHEET 3 OF 3</b>				30076	61981	836	2450	29201

EARTHWORK SUBSUMMARY SHEET 2 OF 3

LUC-475-0.09

CALCULATED  
JRB  
CHECKED  
XXX

213  
855



I:\Project+Data\LUC\95875\_LUC-475-0.09\_Design\Roadway\Sheets\95875\_GS006.dgn Sheet 4/29/2022 9:52:21 AM jbidinge



REF NO.	SHEET NO.	STATION TO STATION		203	203	203	203	659
				EXCAVATION	EMBANKMENT	GRANULAR MATERIAL, TYPE B	GRANULAR MATERIAL, TYPE D	SEEDING AND MULCHING
				CY	CY	CY	CY	SY
NOISE WALL 4A								
641	4101+00.00		4103+50.00	7	0			30
				27	0			66
642	4104+00.00		4105+81.00	20	5			43
				24	2			70
643	4106+00.00		4107+25.00	4	1			36
				0	0			0
NOISE WALL 5A								
644	5100+00.00		5103+50.00	25	0			65
				44	0			115
645	5104+00.00		5107+50.00	52	0			219
				57	0			266
646	5108+00.00		5111+50.00	56	0			355
				53	0			288
647	5112+00.00		5115+50.00	46	0			233
				47	0			146
648	5116+00.00		5118+50.00	46	0			128
				0	0			0
NOISE WALL 5B								
649	5200+50.00		5204+00.00	24	9			96
				44	8			75
650	5204+50.00		5208+00.00	39	13			90
				177	144			113
651	5208+50.00		5212+00.00	281	275			258
				896	1133			507
NOISE WALL 5C								
652	5301+00.00		5304+07.00	34	5			139
				24	0			47
653	5304+50.00		5307+91.00	26	0			59
				29	4			108
654	5308+00.00		5310+50.00	7	0			21
				29	0			109
655	5311+00.00		5312+25.00	15	2			62
				0	0			0
NOISE WALL 6A								
656	6101+00.00		6104+50.00	50	0			190
				80	0			303
657	6105+00.00		6108+50.00	34	46			322
				55	15			141
658	6109+00.00		6109+50.00	14	2			38
				0	0			0
NOISE WALL 6B								
659	6201+00.00		6203+84.00	18	7			64
				9	15			99
660	6204+00.00		6206+00.00	28	4			66
				17	0			48
661	6206+50.00		6209+00.00	27	0			40
				4	0			0
<b>TOTALS CARRIED TO SHEET 3 OF 3</b>				2469	1690			5055

REF NO.	SHEET NO.	STATION TO STATION		203	203	203	203	659
				EXCAVATION	EMBANKMENT	GRANULAR MATERIAL, TYPE B	GRANULAR MATERIAL, TYPE D	SEEDING AND MULCHING
				CY	CY	CY	CY	SY
NOISE WALL 6C								
662	6300+00.00	TO	6303+50.00	22	1			10
				75	8			67
663	6304+00.00		6307+15.00	558	641			424
				707	869			515
664	6307+50.00		6308+99.31	273	308			267
				22	23			30
NOISE WALL 6D								
665	6400+00.00		6402+50.00	49	41			38
				63	3			43
666	6403+00.00		6405+00.00	20	7			45
				28	13			78
NOISE WALL 6E								
667	6500+00.00		6503+00.00	31	0			43
				57	0			188
668	6503+50.00		6505+00.00	29	0			204
				0	0			0
<b>EARTHWORK TOTALS THIS SHEET</b>				1934	1914			1952
<b>EARTHWORK TOTALS FROM 1 OF 3</b>				76888	117884	1078	3154	73183
<b>EARTHWORK TOTALS FROM 2 OF 3</b>				33317	1379			37198
<b>EARTHWORK TOTALS FROM 3 OF 3</b>				23806	1238			38876
<b>EARTHWORK TOTALS FROM 2 OF 3</b>				30076	61981	836	2450	29201
<b>EARTHWORK TOTALS FROM 3 OF 3</b>				2469	1690			5055
<b>TOTALS CARRIED TO GENERAL SUMMARY</b>				168490	186086	1914	5604	185465

CALCULATED JRB  
 CHECKED XXX  
**EARTHWORK SUBSUMMARY SHEET 3 OF 3**  
**LUC-475-0.09**  
 214  
 855



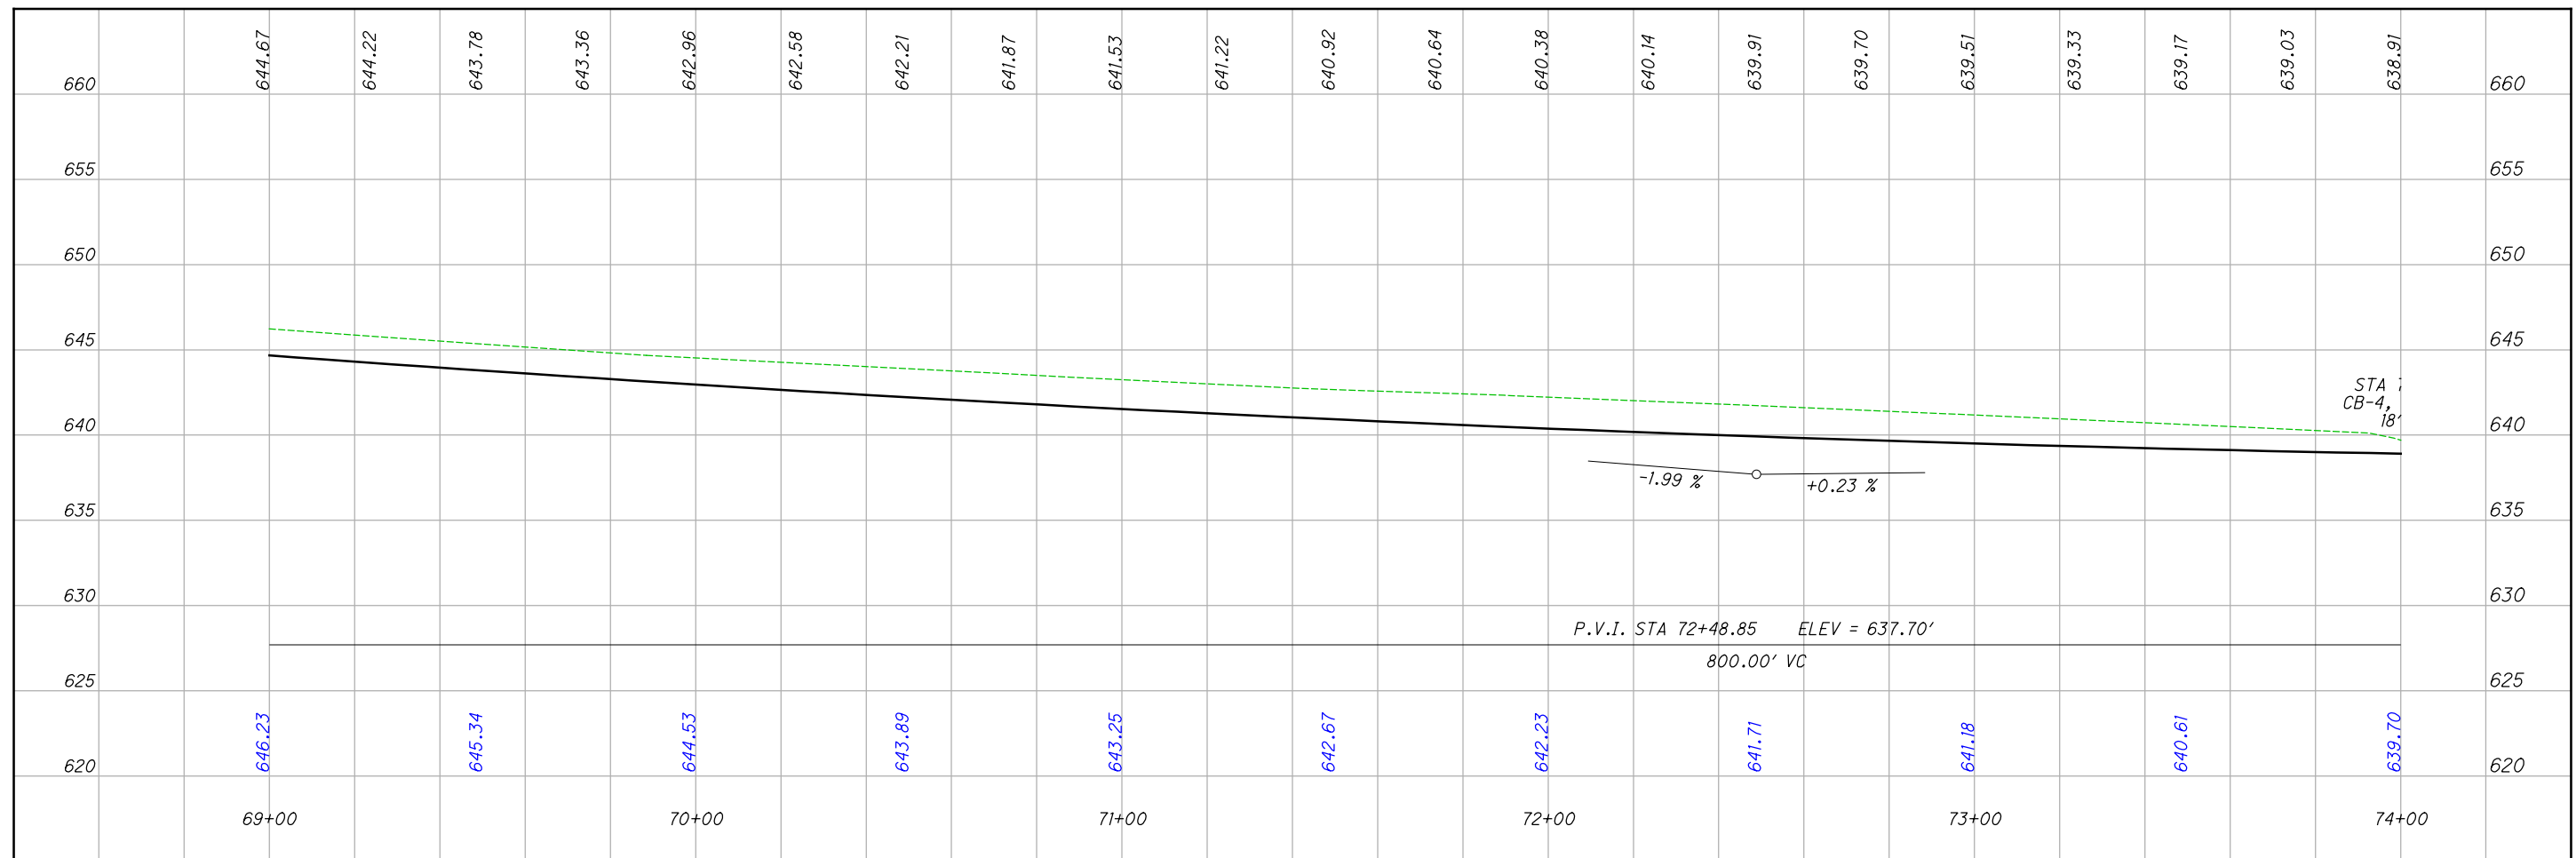
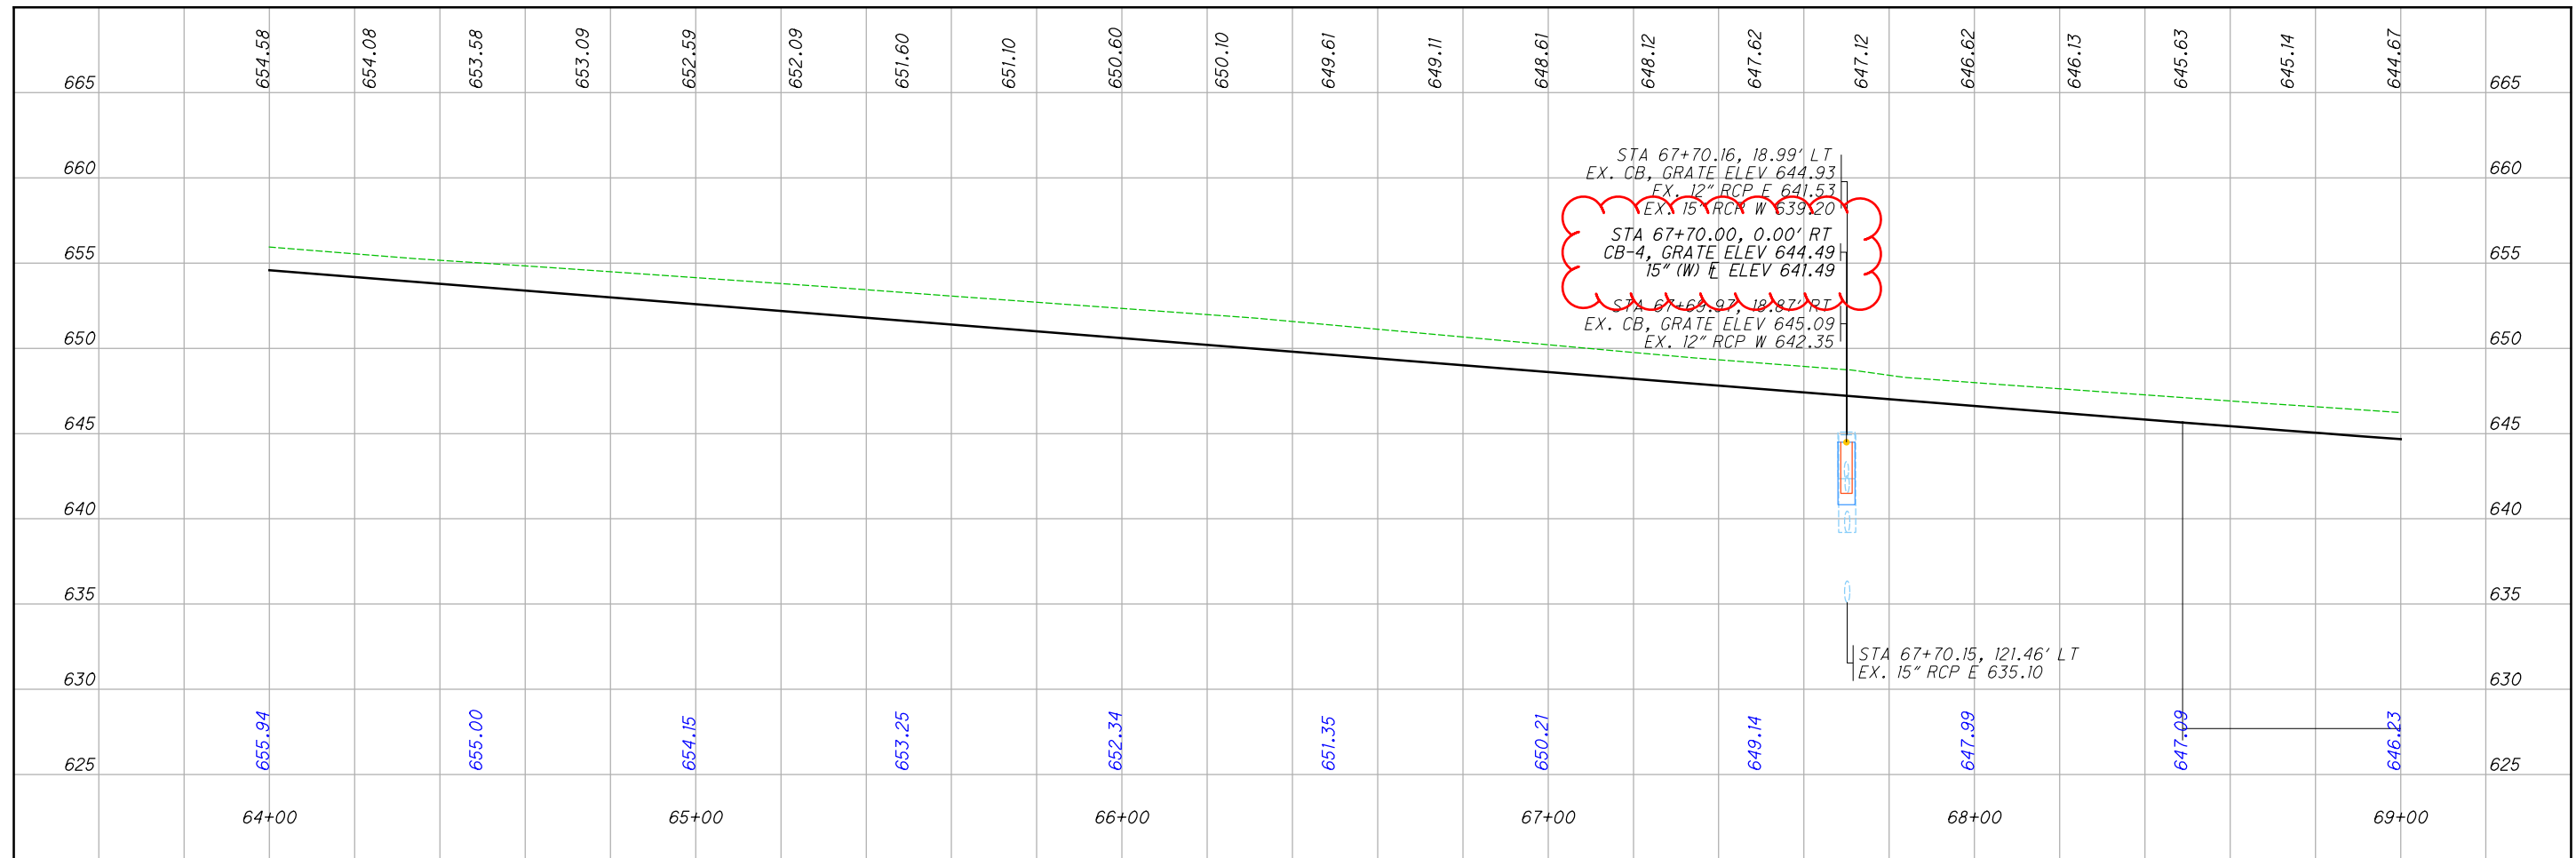


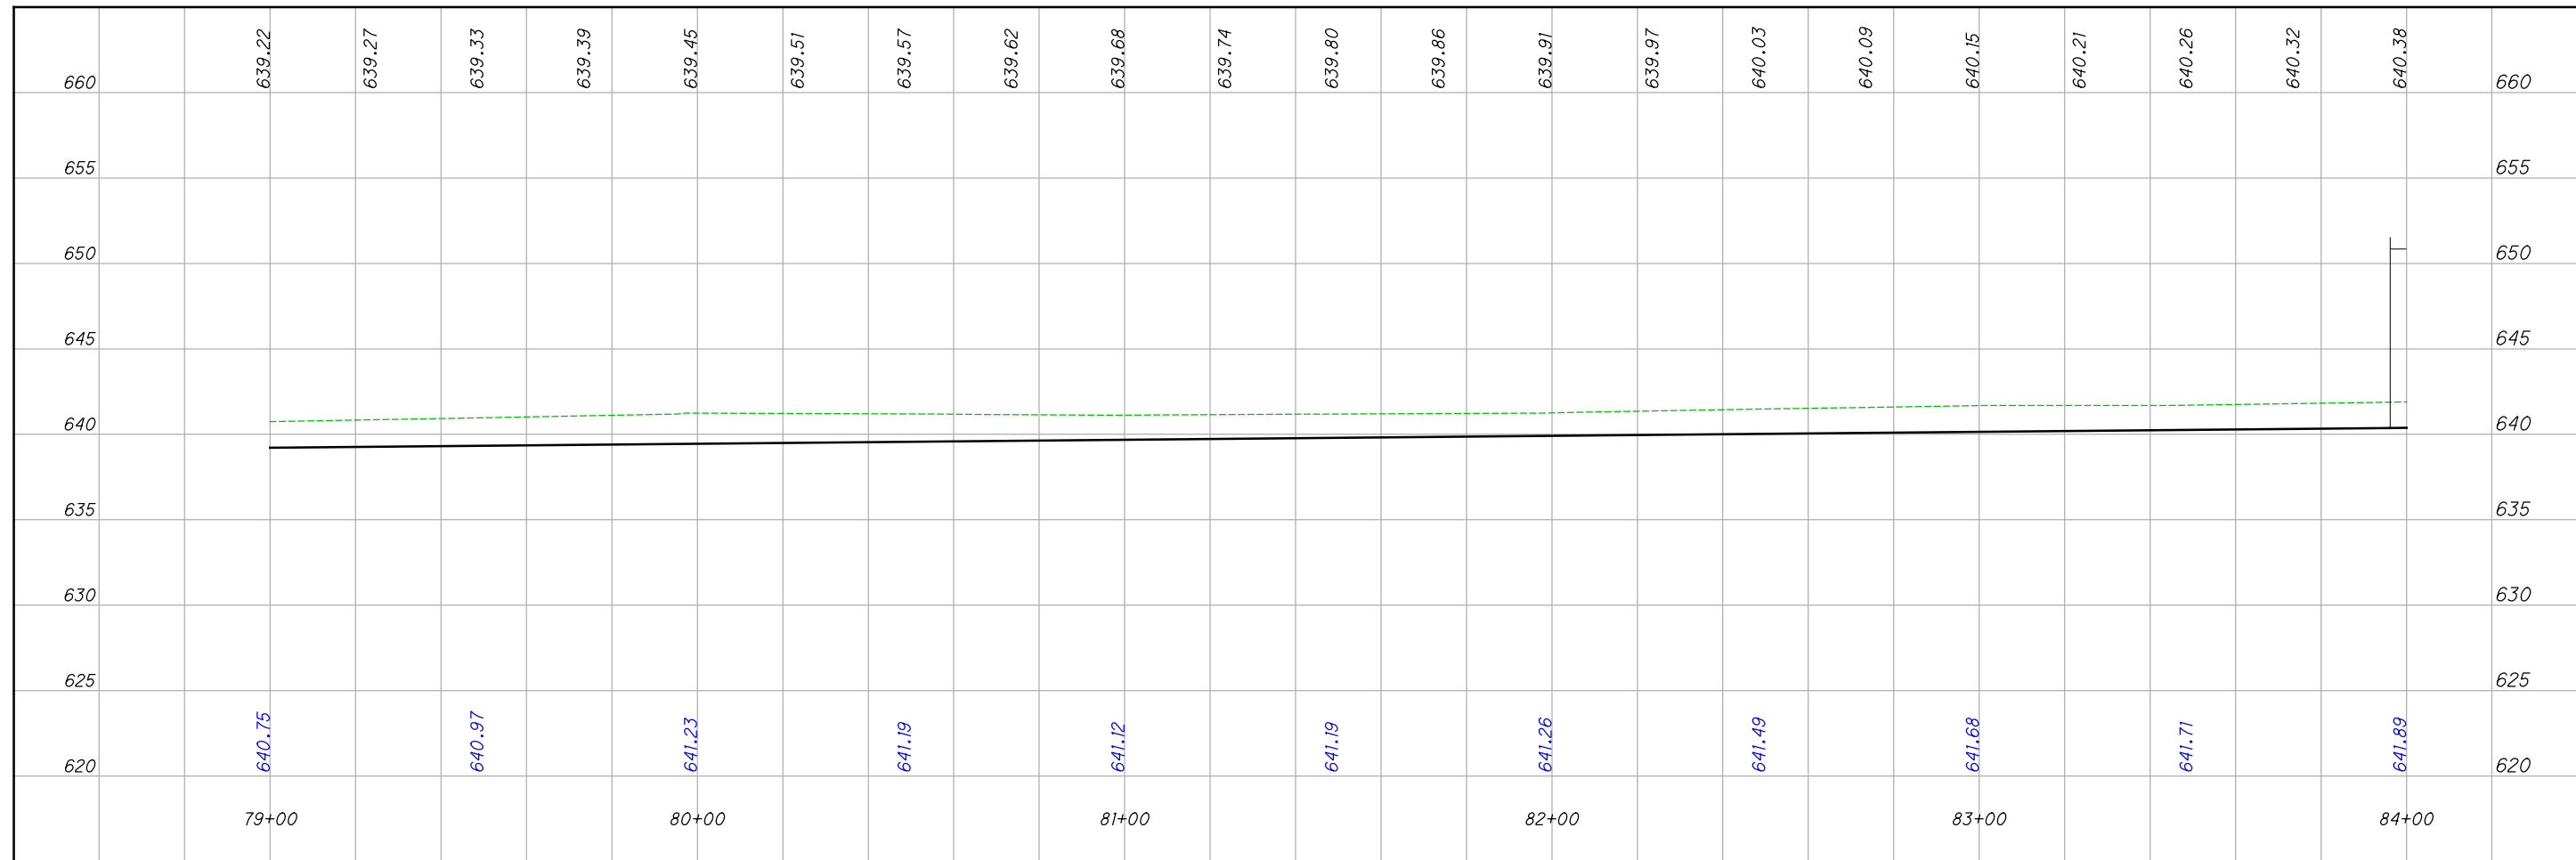
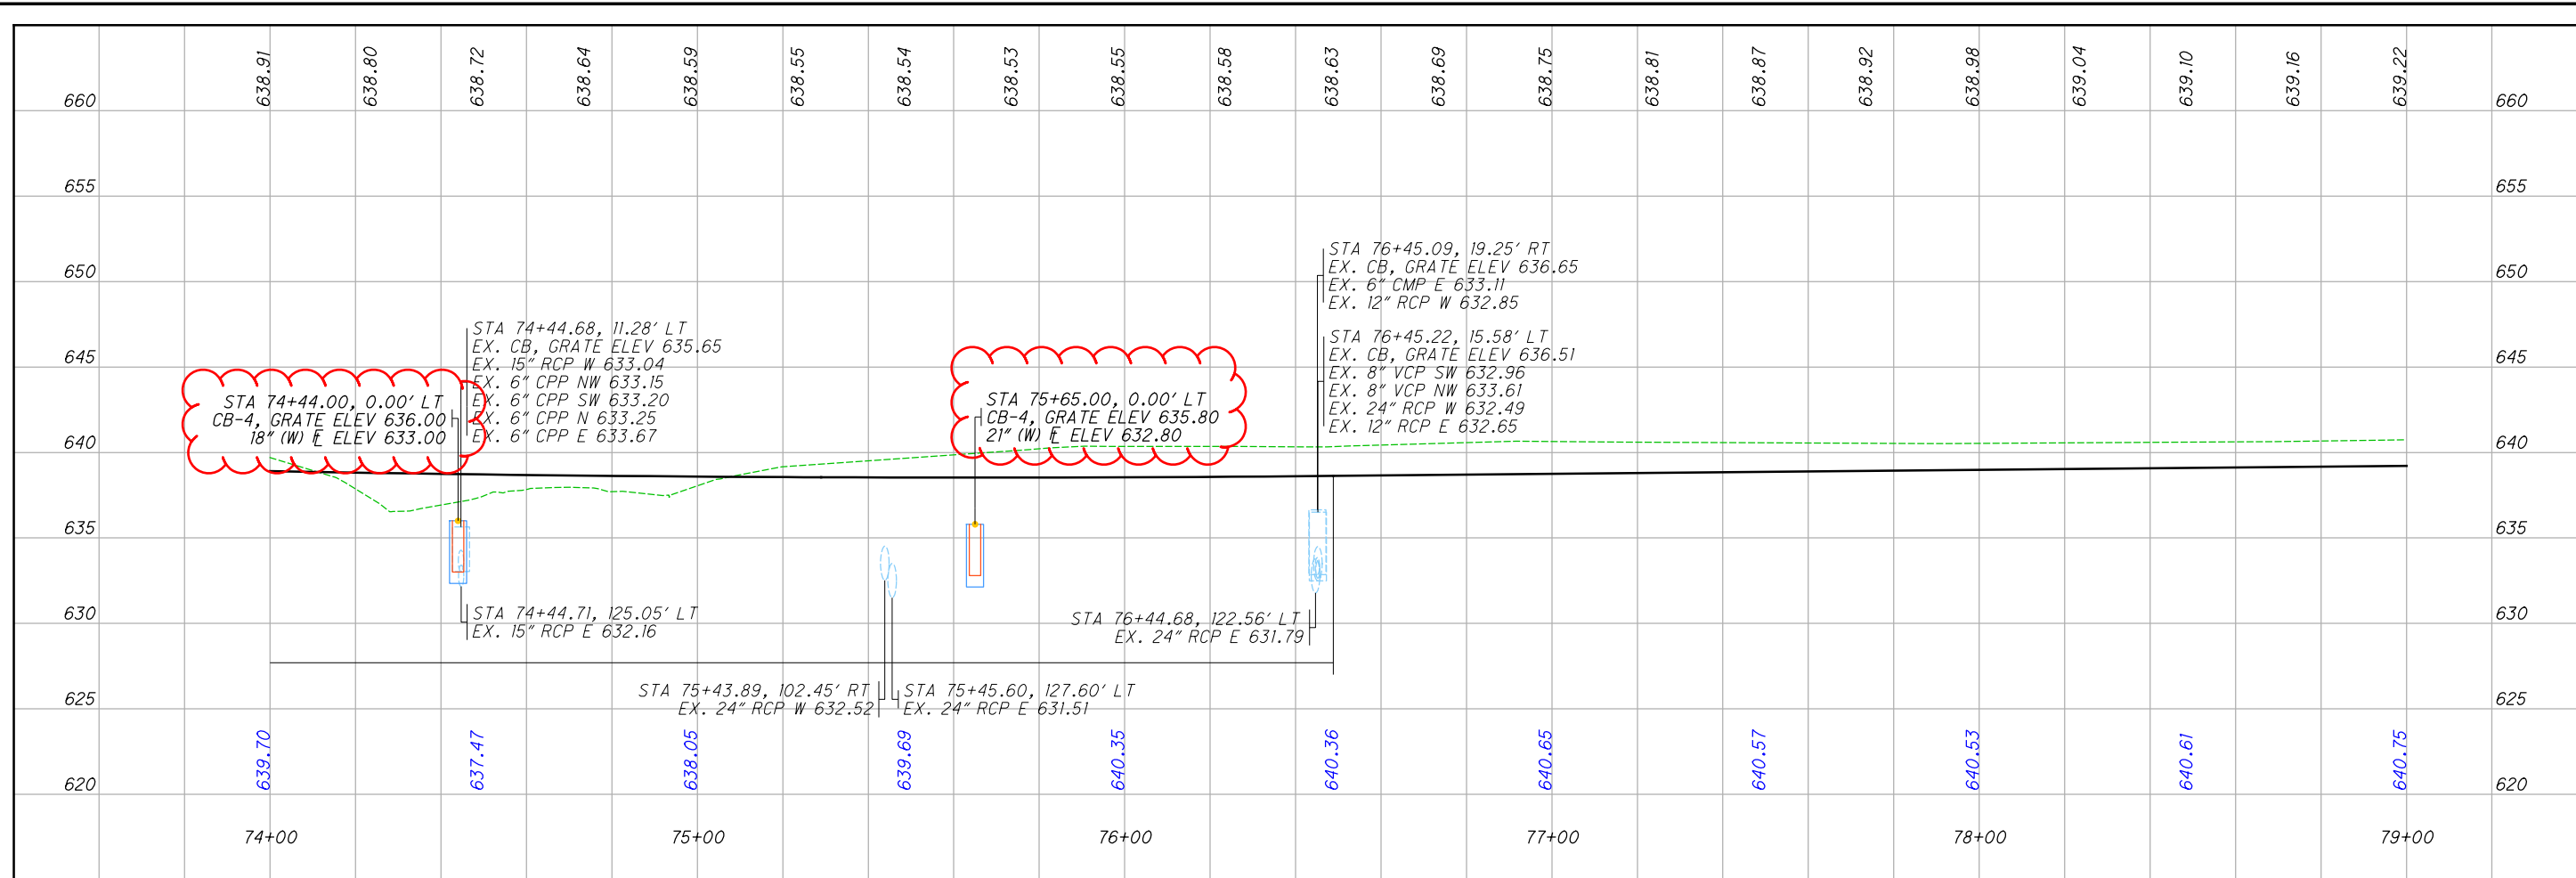


CALCULATED  
JRB  
CHECKED  
XXX

PROFILE IR 475 - STA. 74+00 TO STA. 84+00

LUC-475-0.09

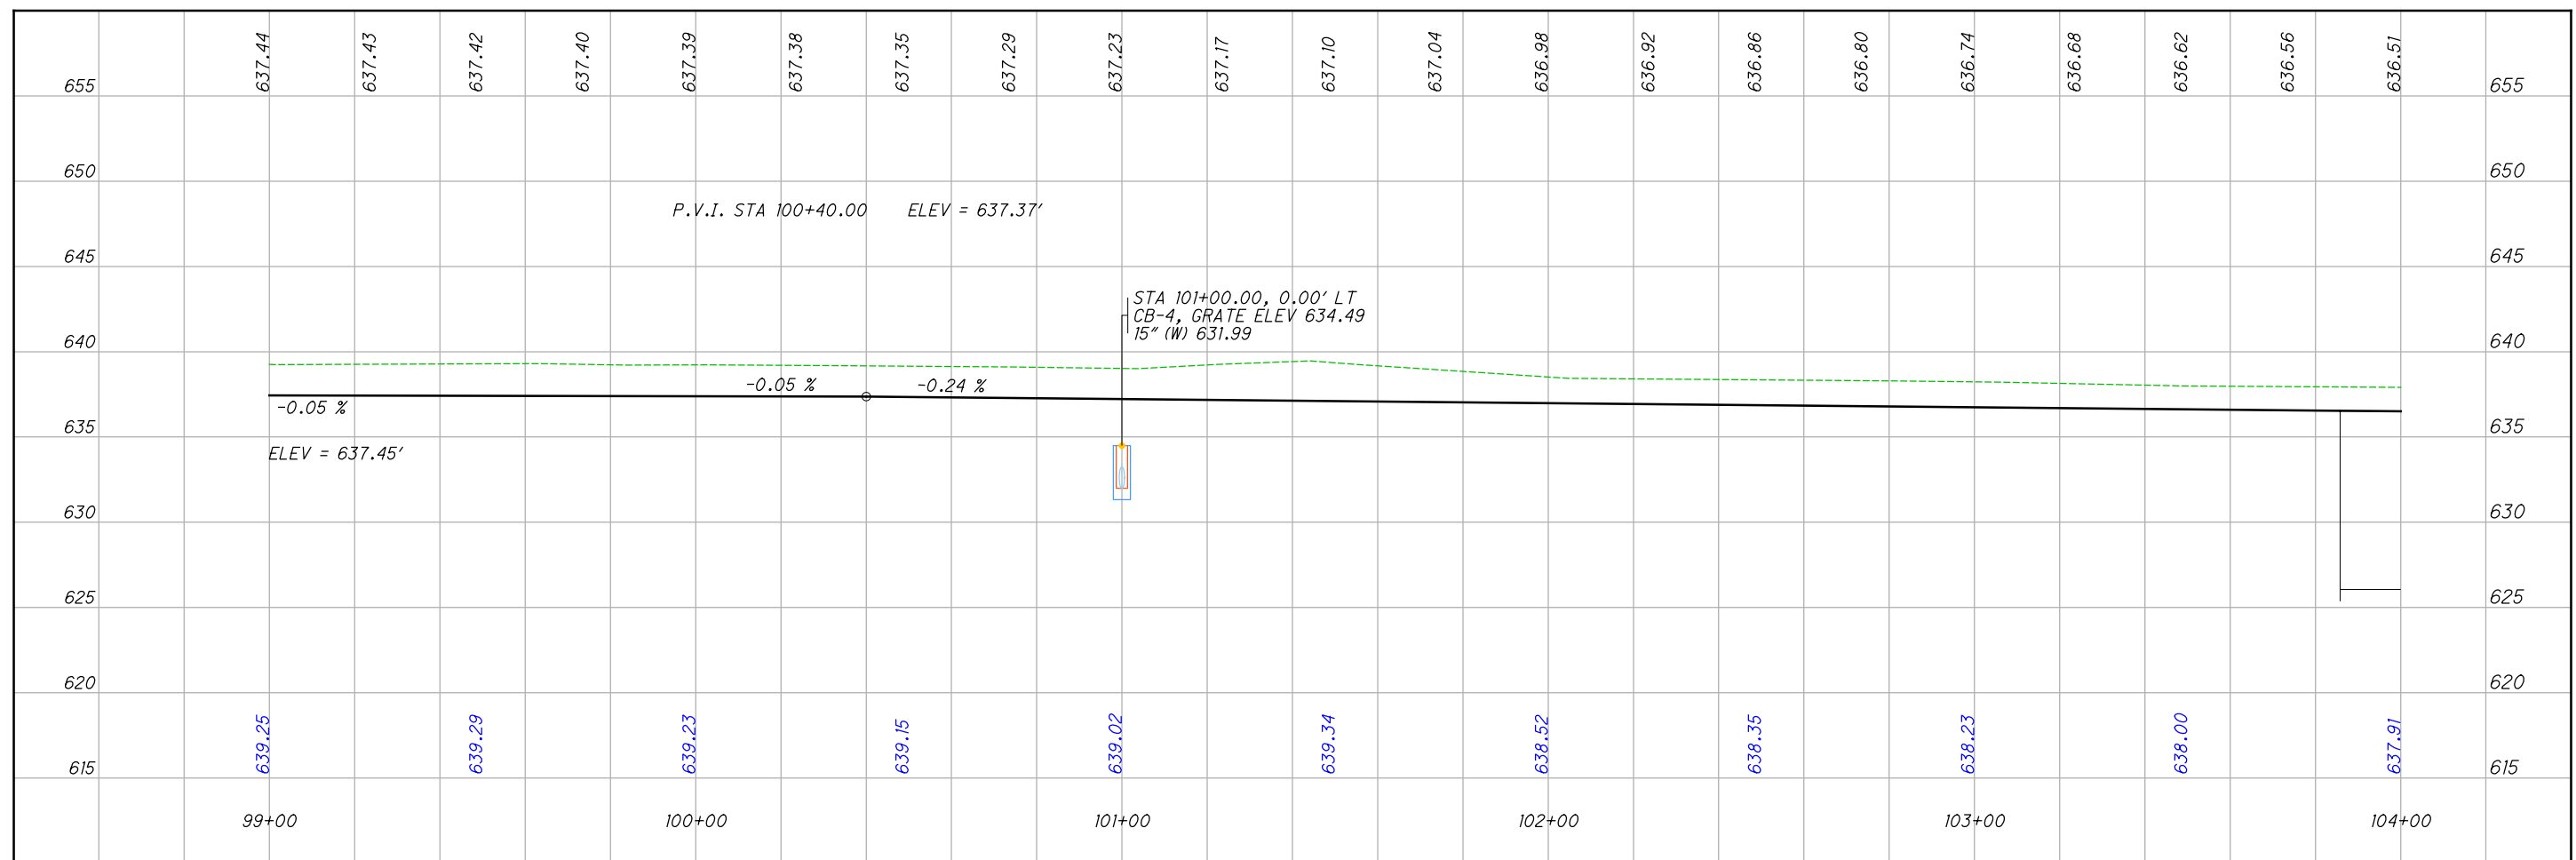
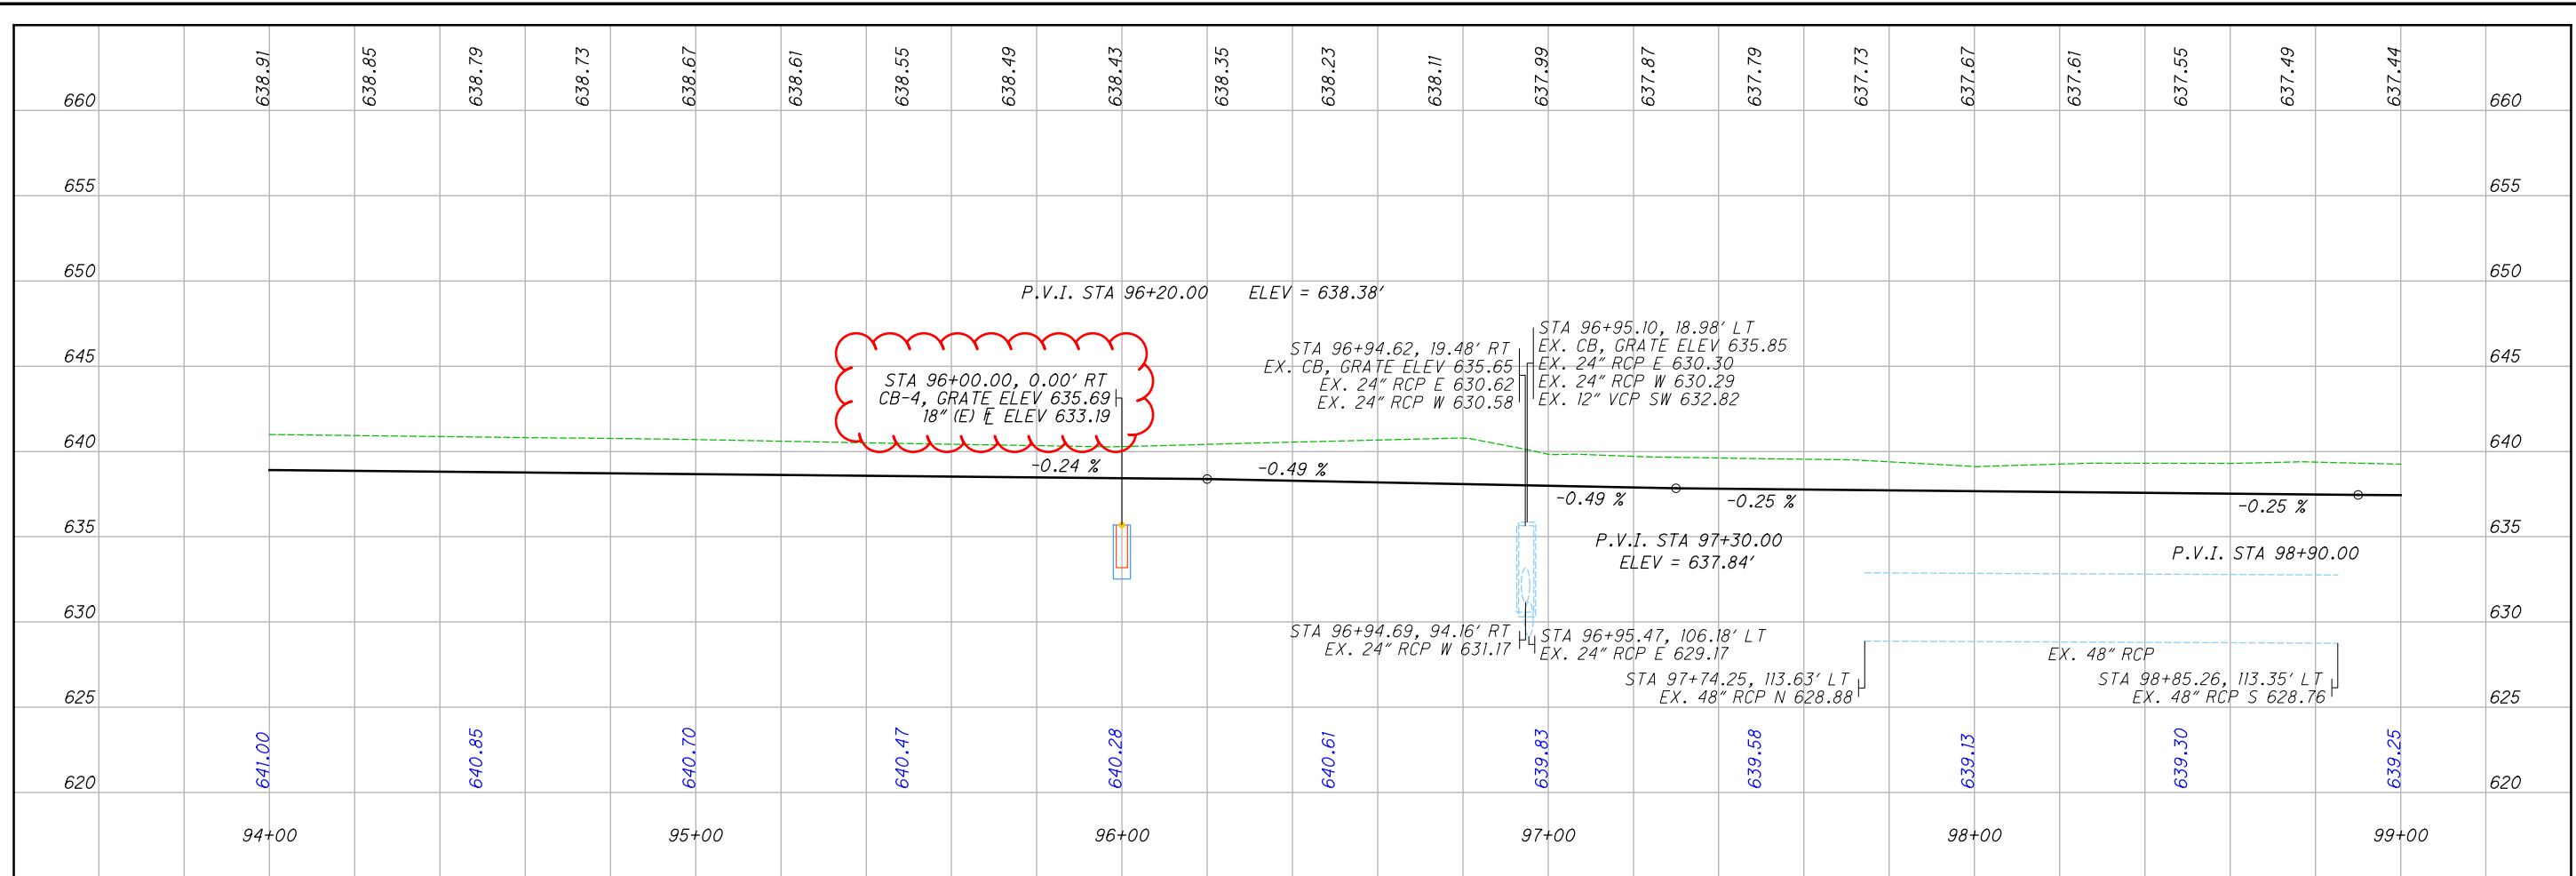


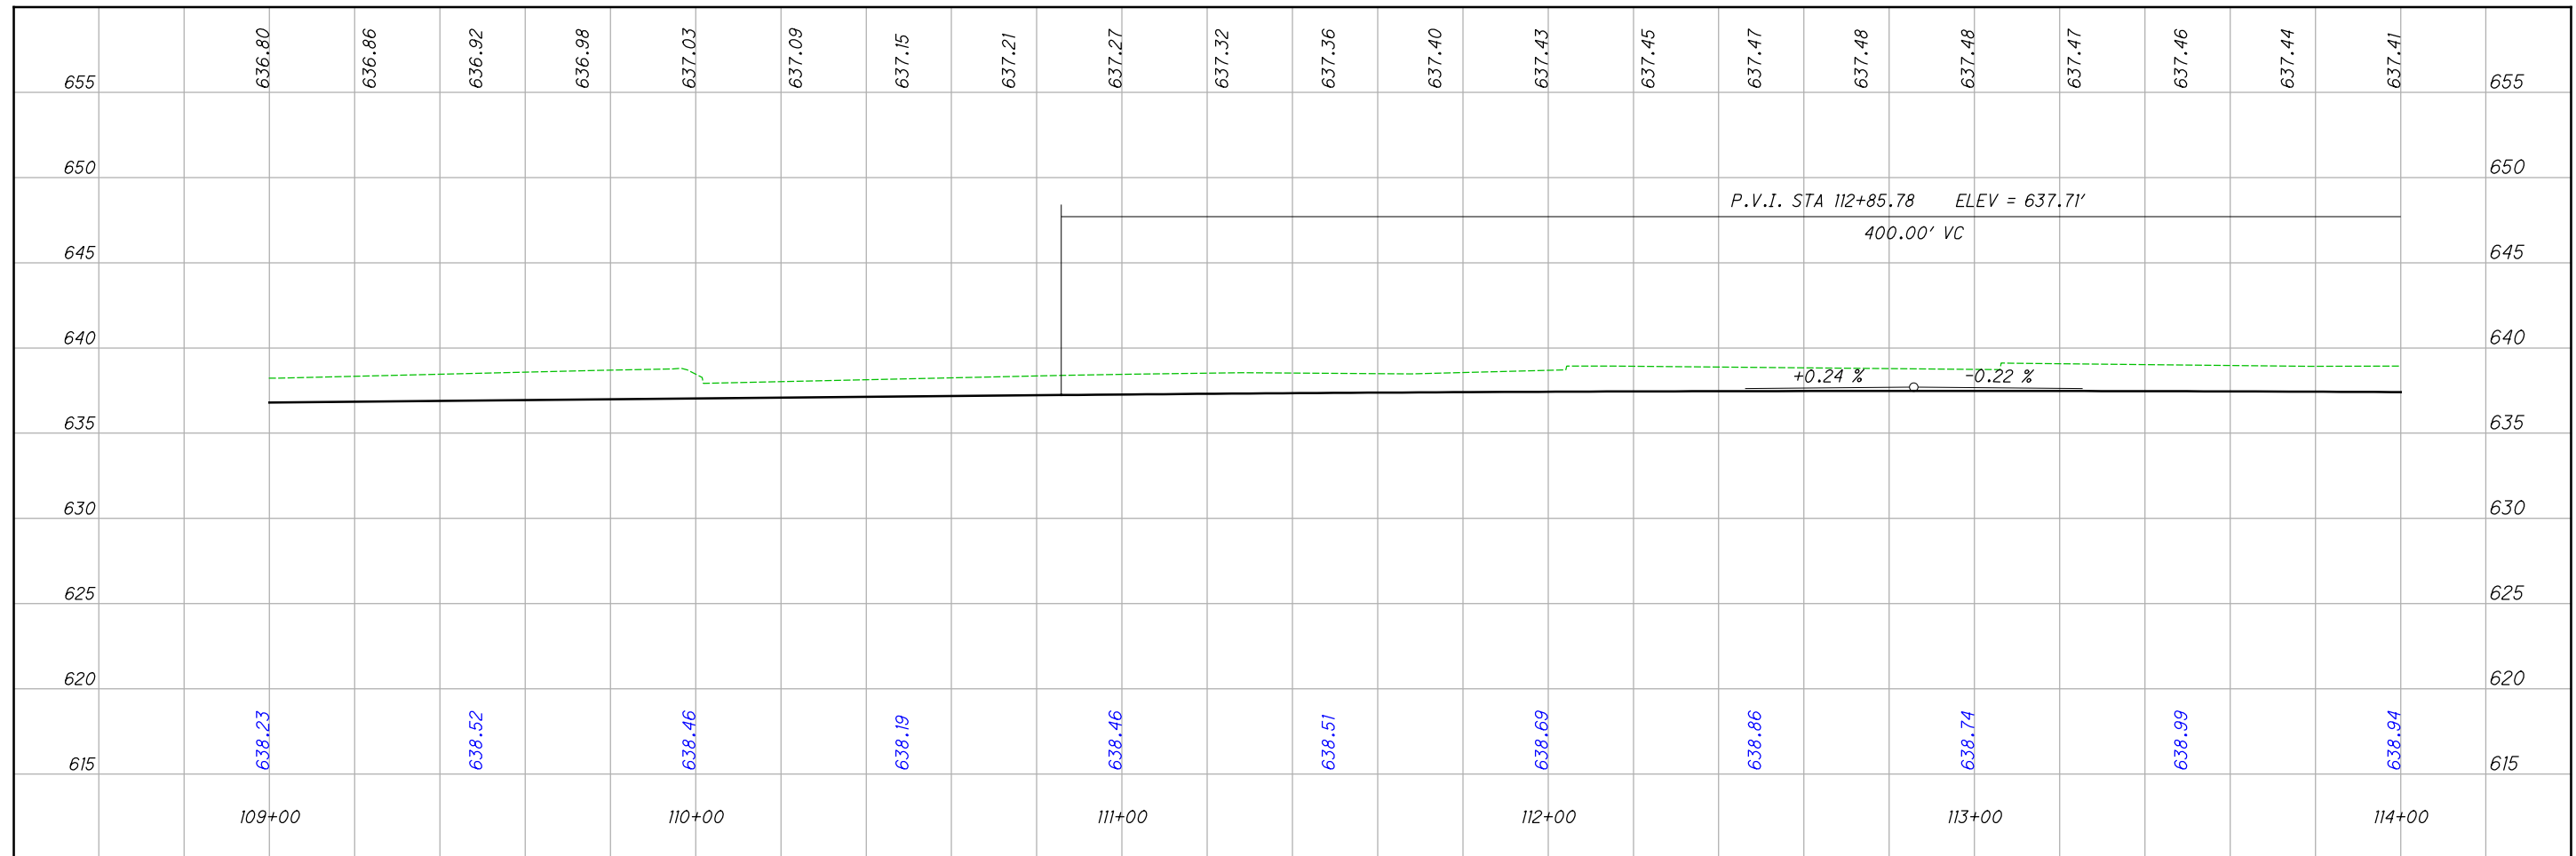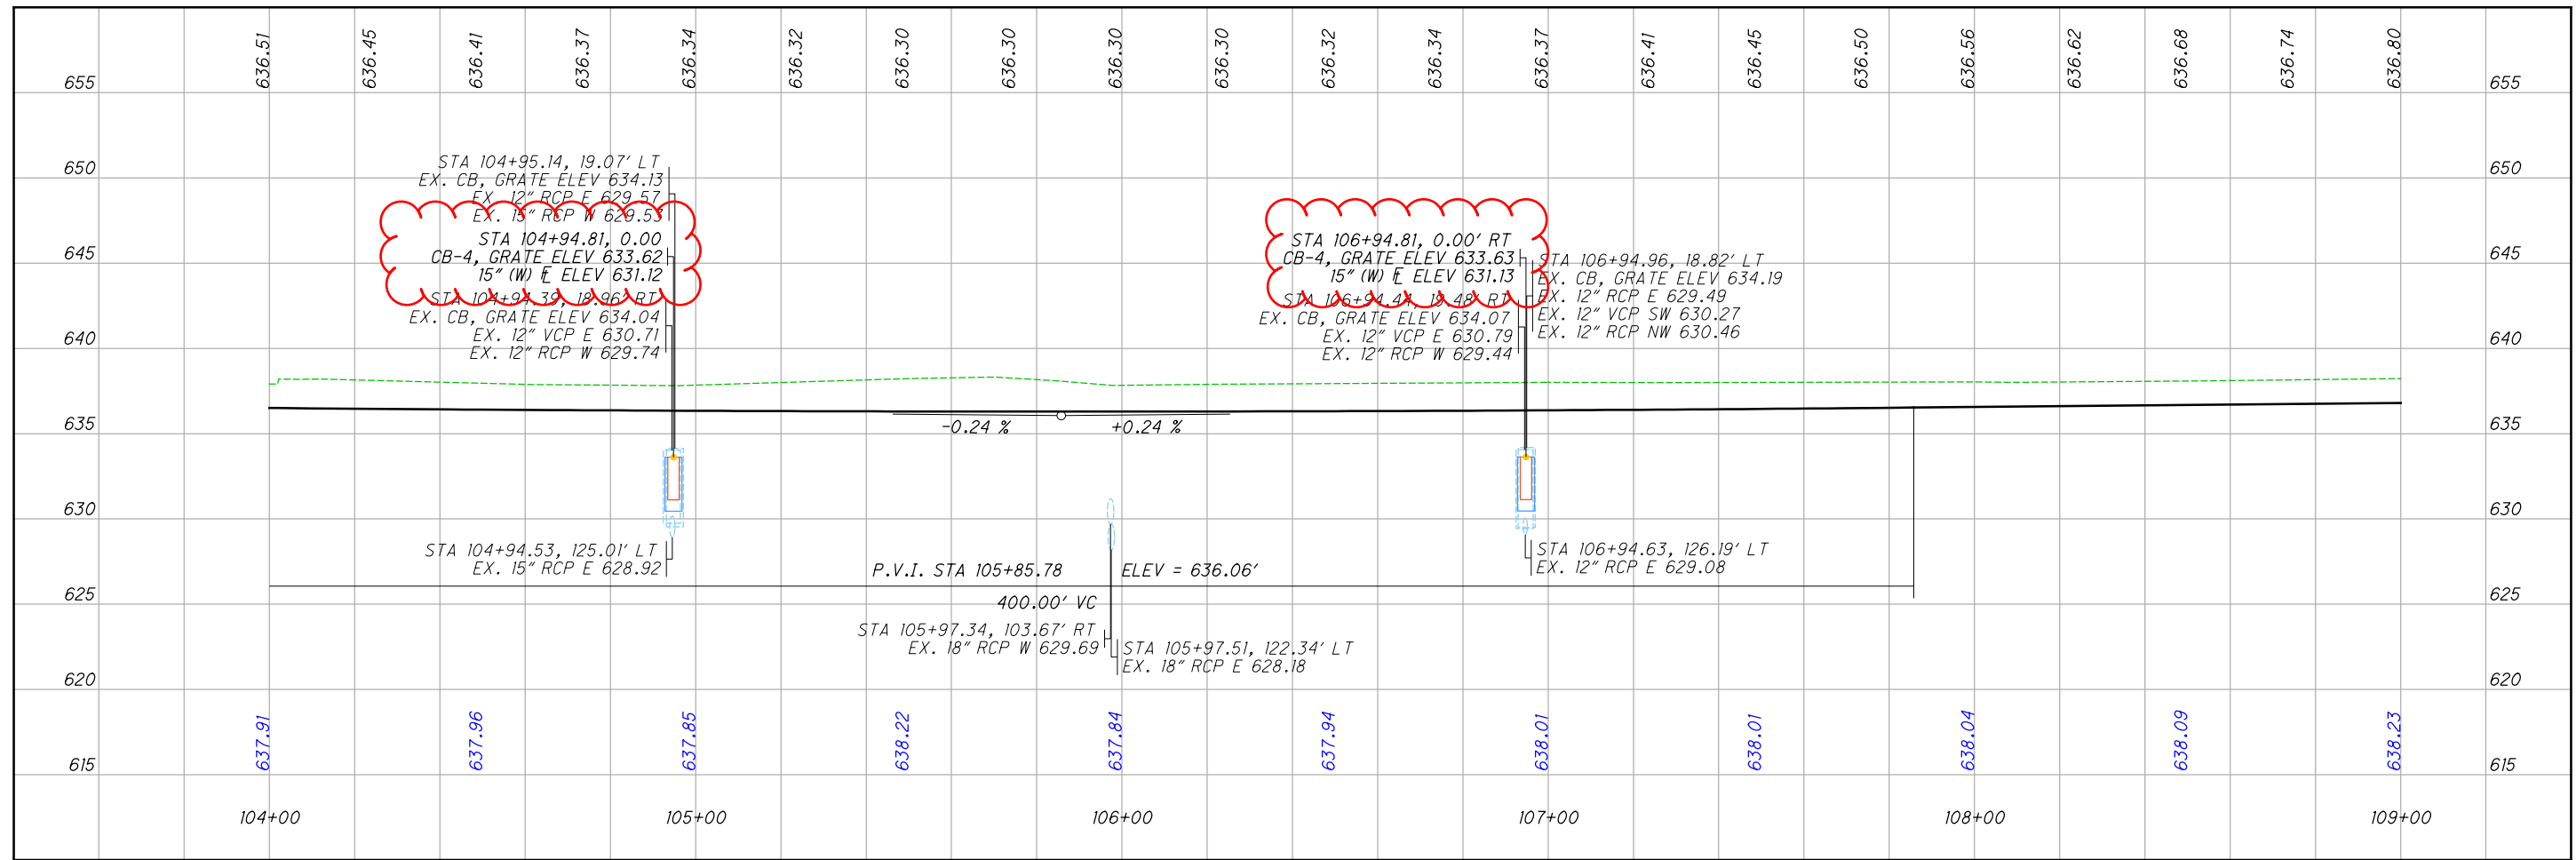

CALCULATED  
JRB  
CHECKED  
XXX



**PROFILE IR 475 - STA. 104+00 TO STA. 114**

**LUC-475-0.09**

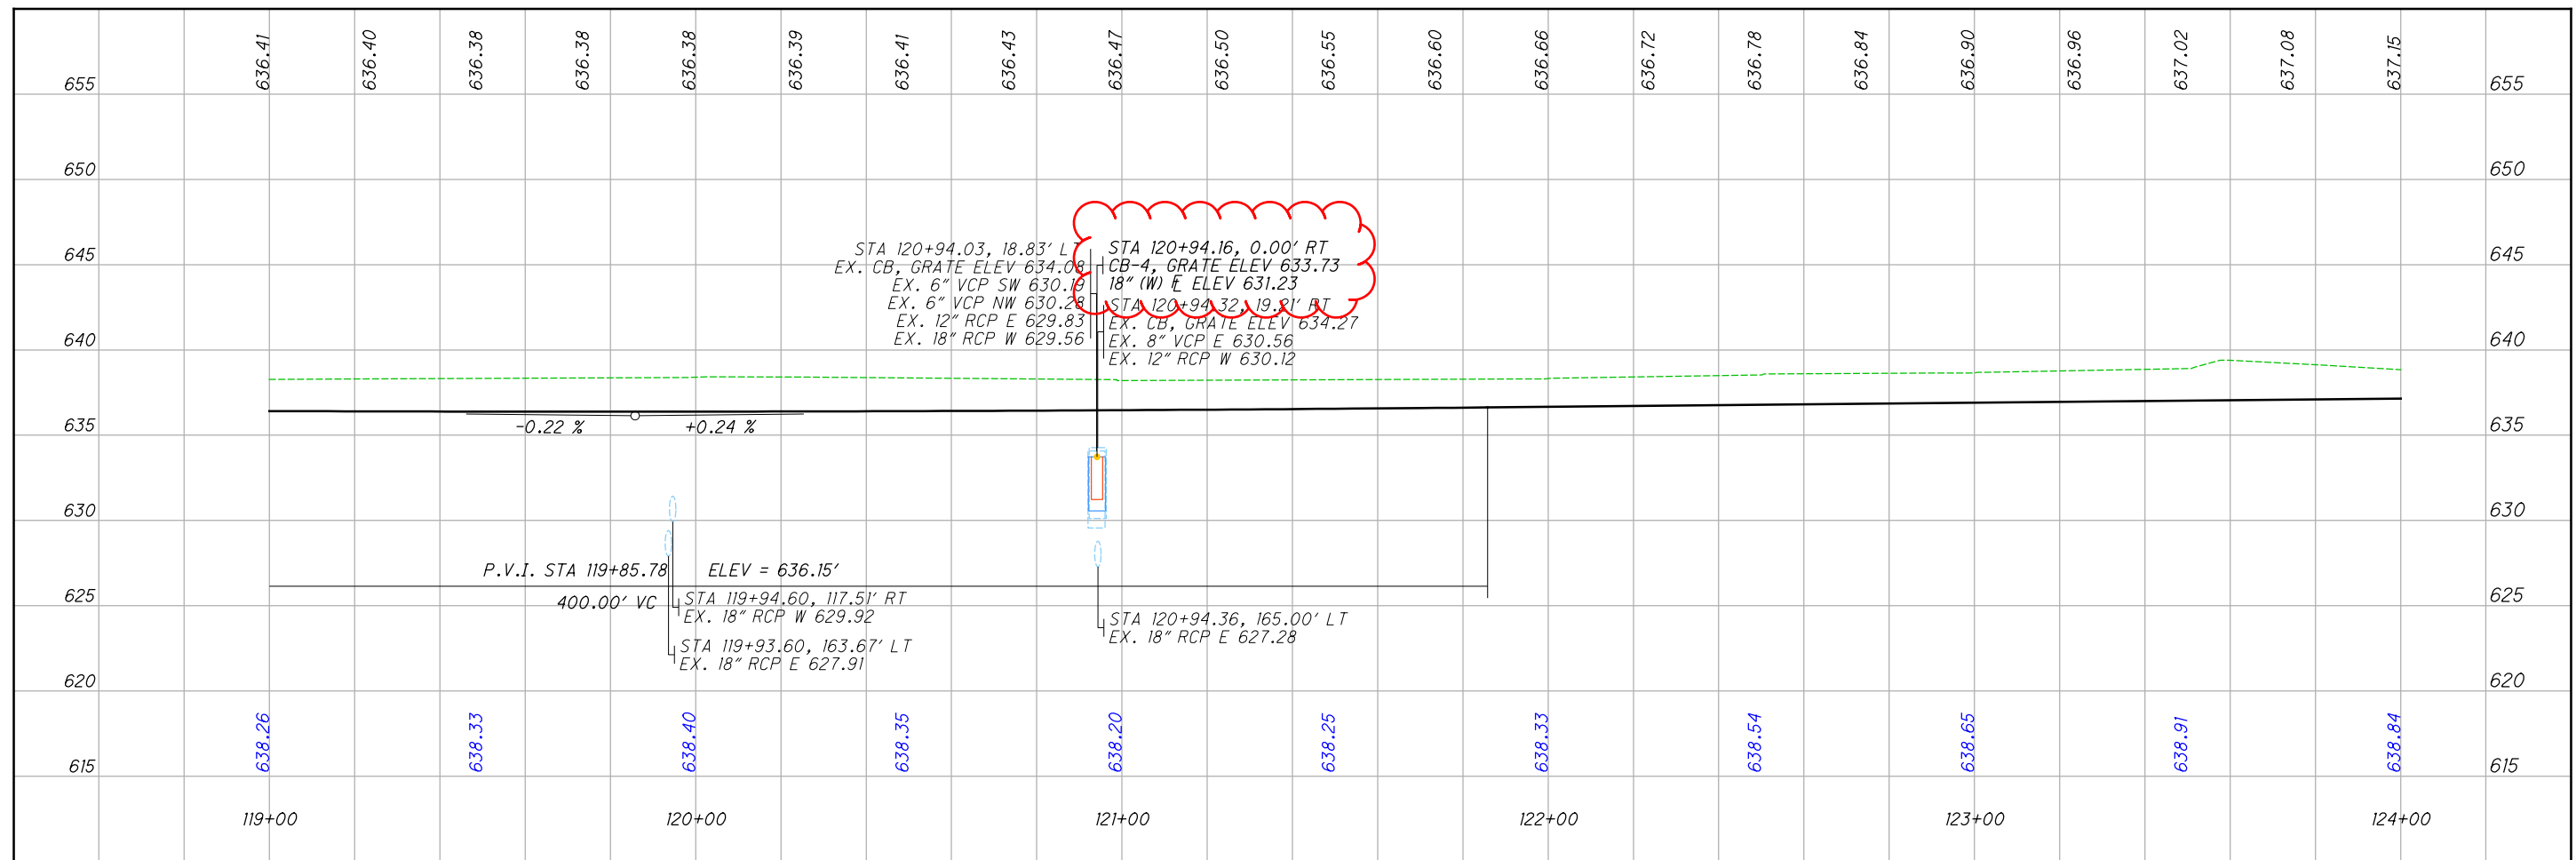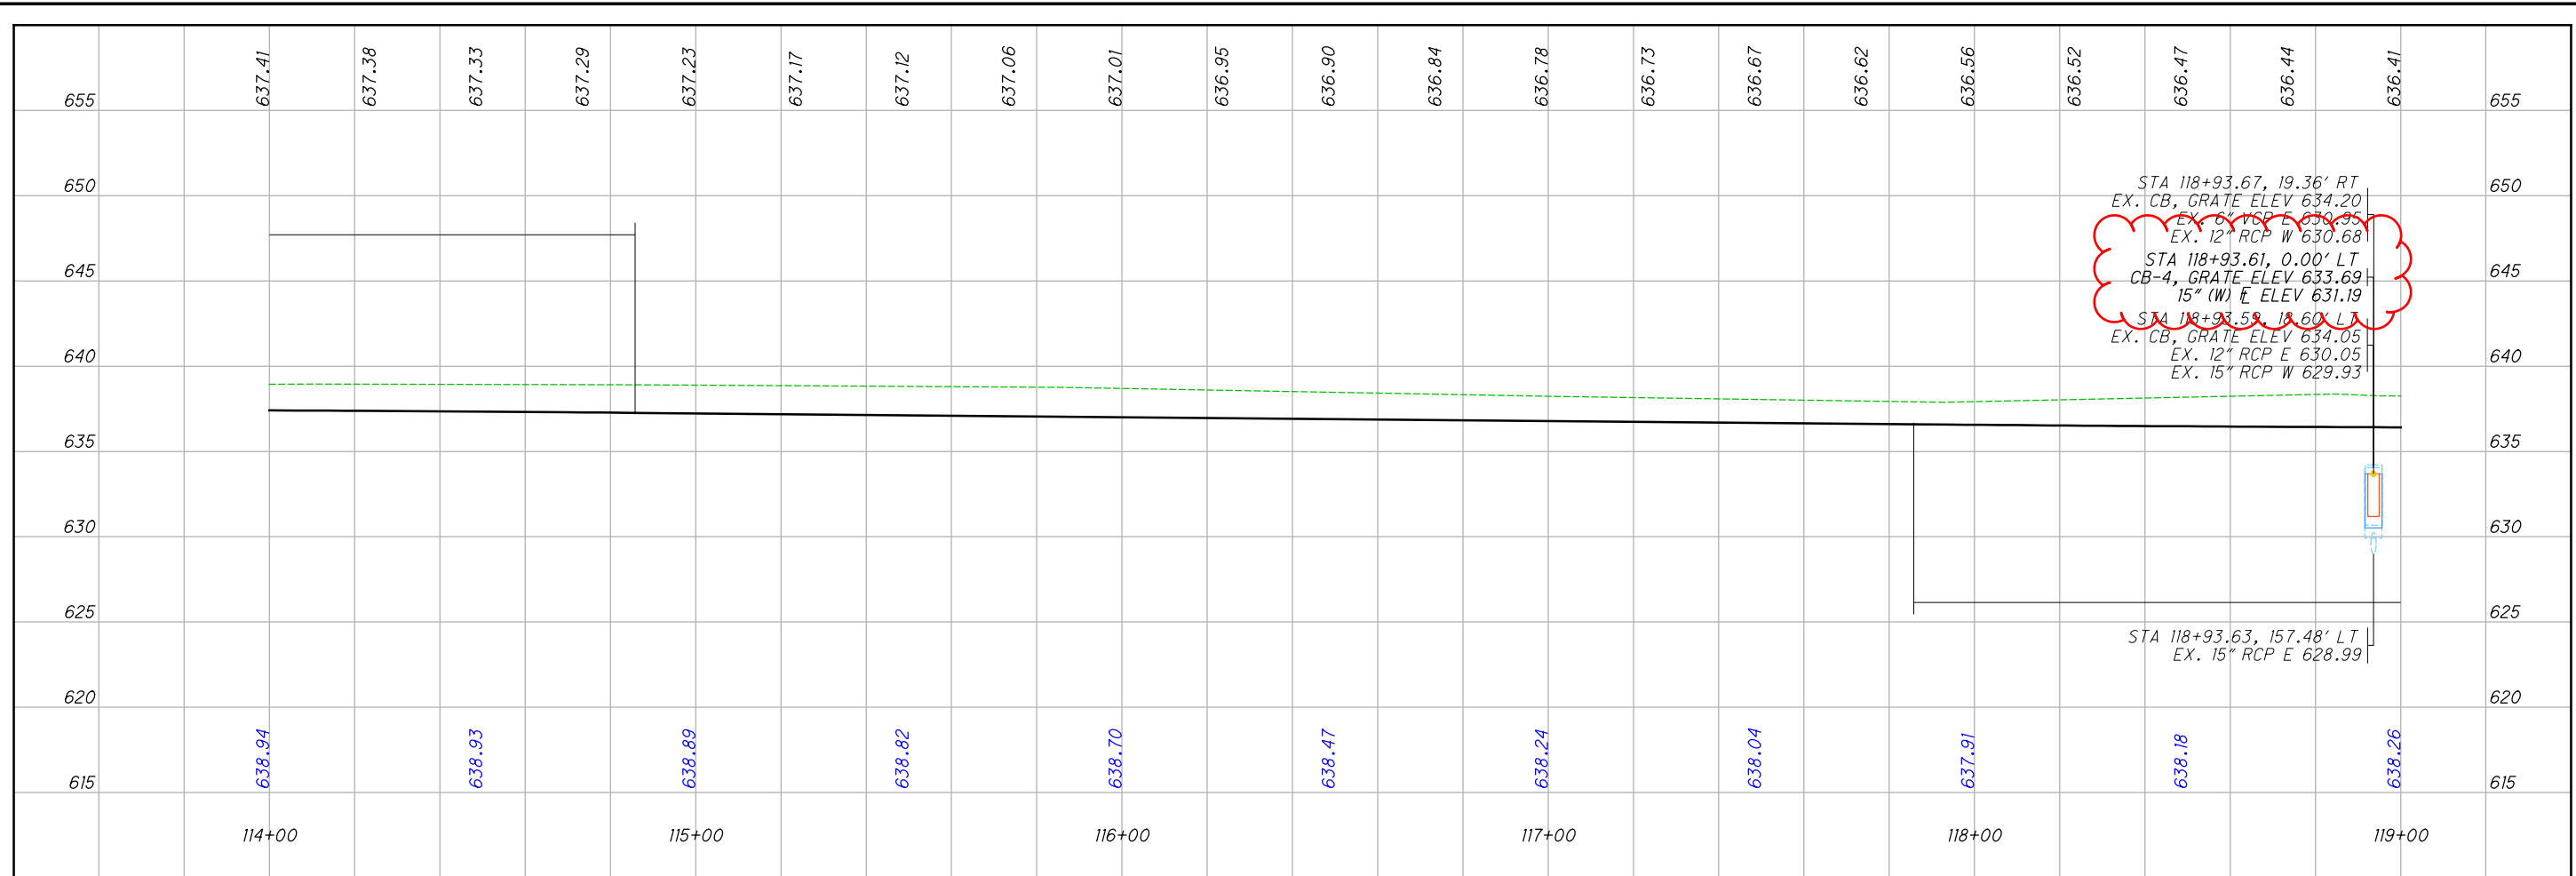



I:\ProjectData\LUC-475-0.09\Design\Roadway\Sheets\95875\_gp028.dgn Sheet 4/27/2022 9:16:27 AM jbding

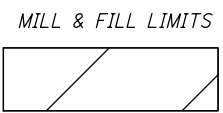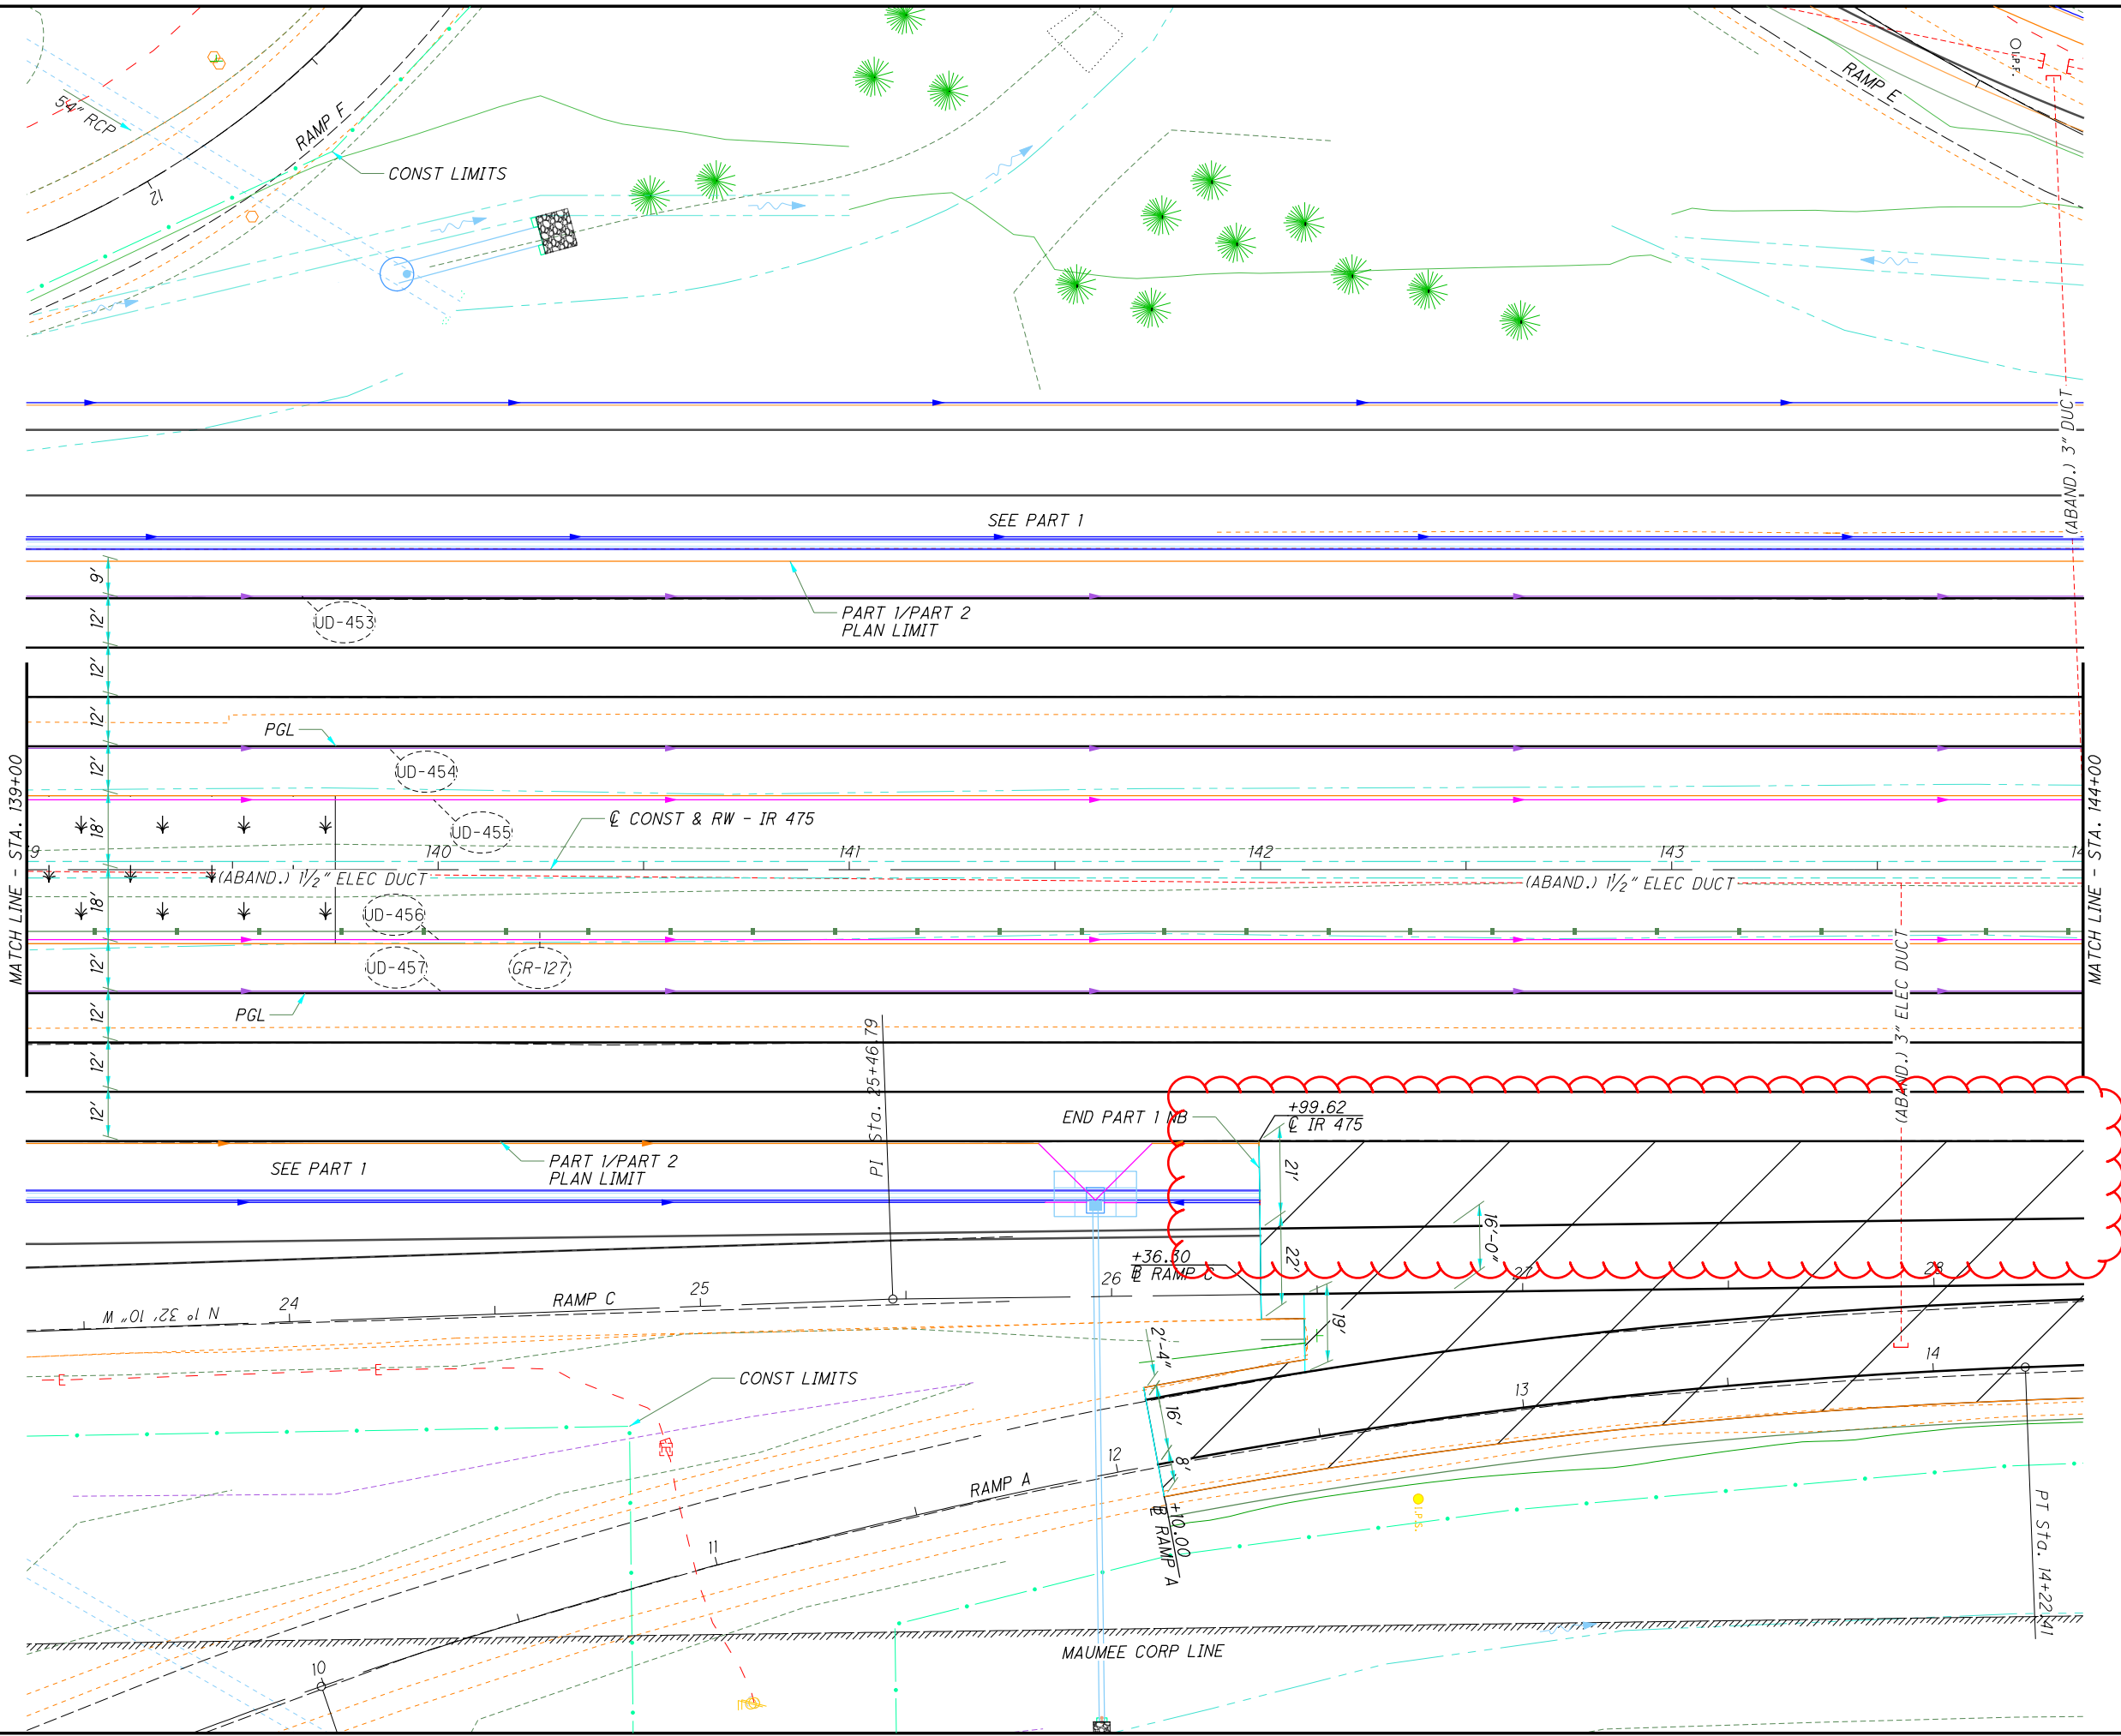

CALCULATED JRB  
CHECKED XXX




0 20 40  
10  
HORIZONTAL SCALE IN FEET

**PLAN SHEET IR 475**  
**STA. 139+00 TO STA. 144+00**

**LUC-475-0.09**

281  
855

I:\ProjectData\LUC\95875\_LUC-475-0.09\Design\Roadway\Sheets\95875\_GPO29.dgn Sheet 4/27/2022 9:16:32 AM jbidinge

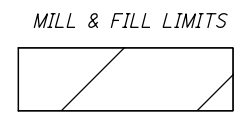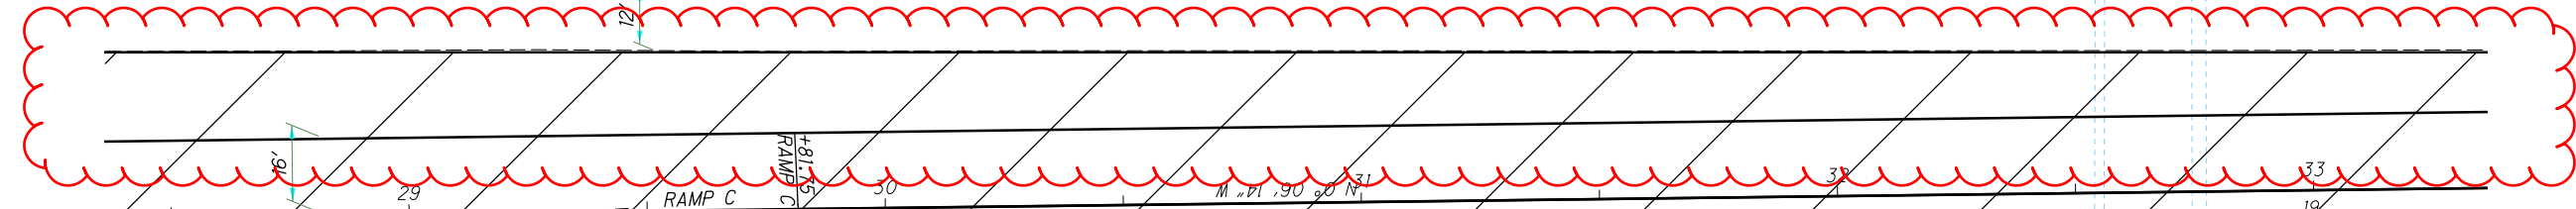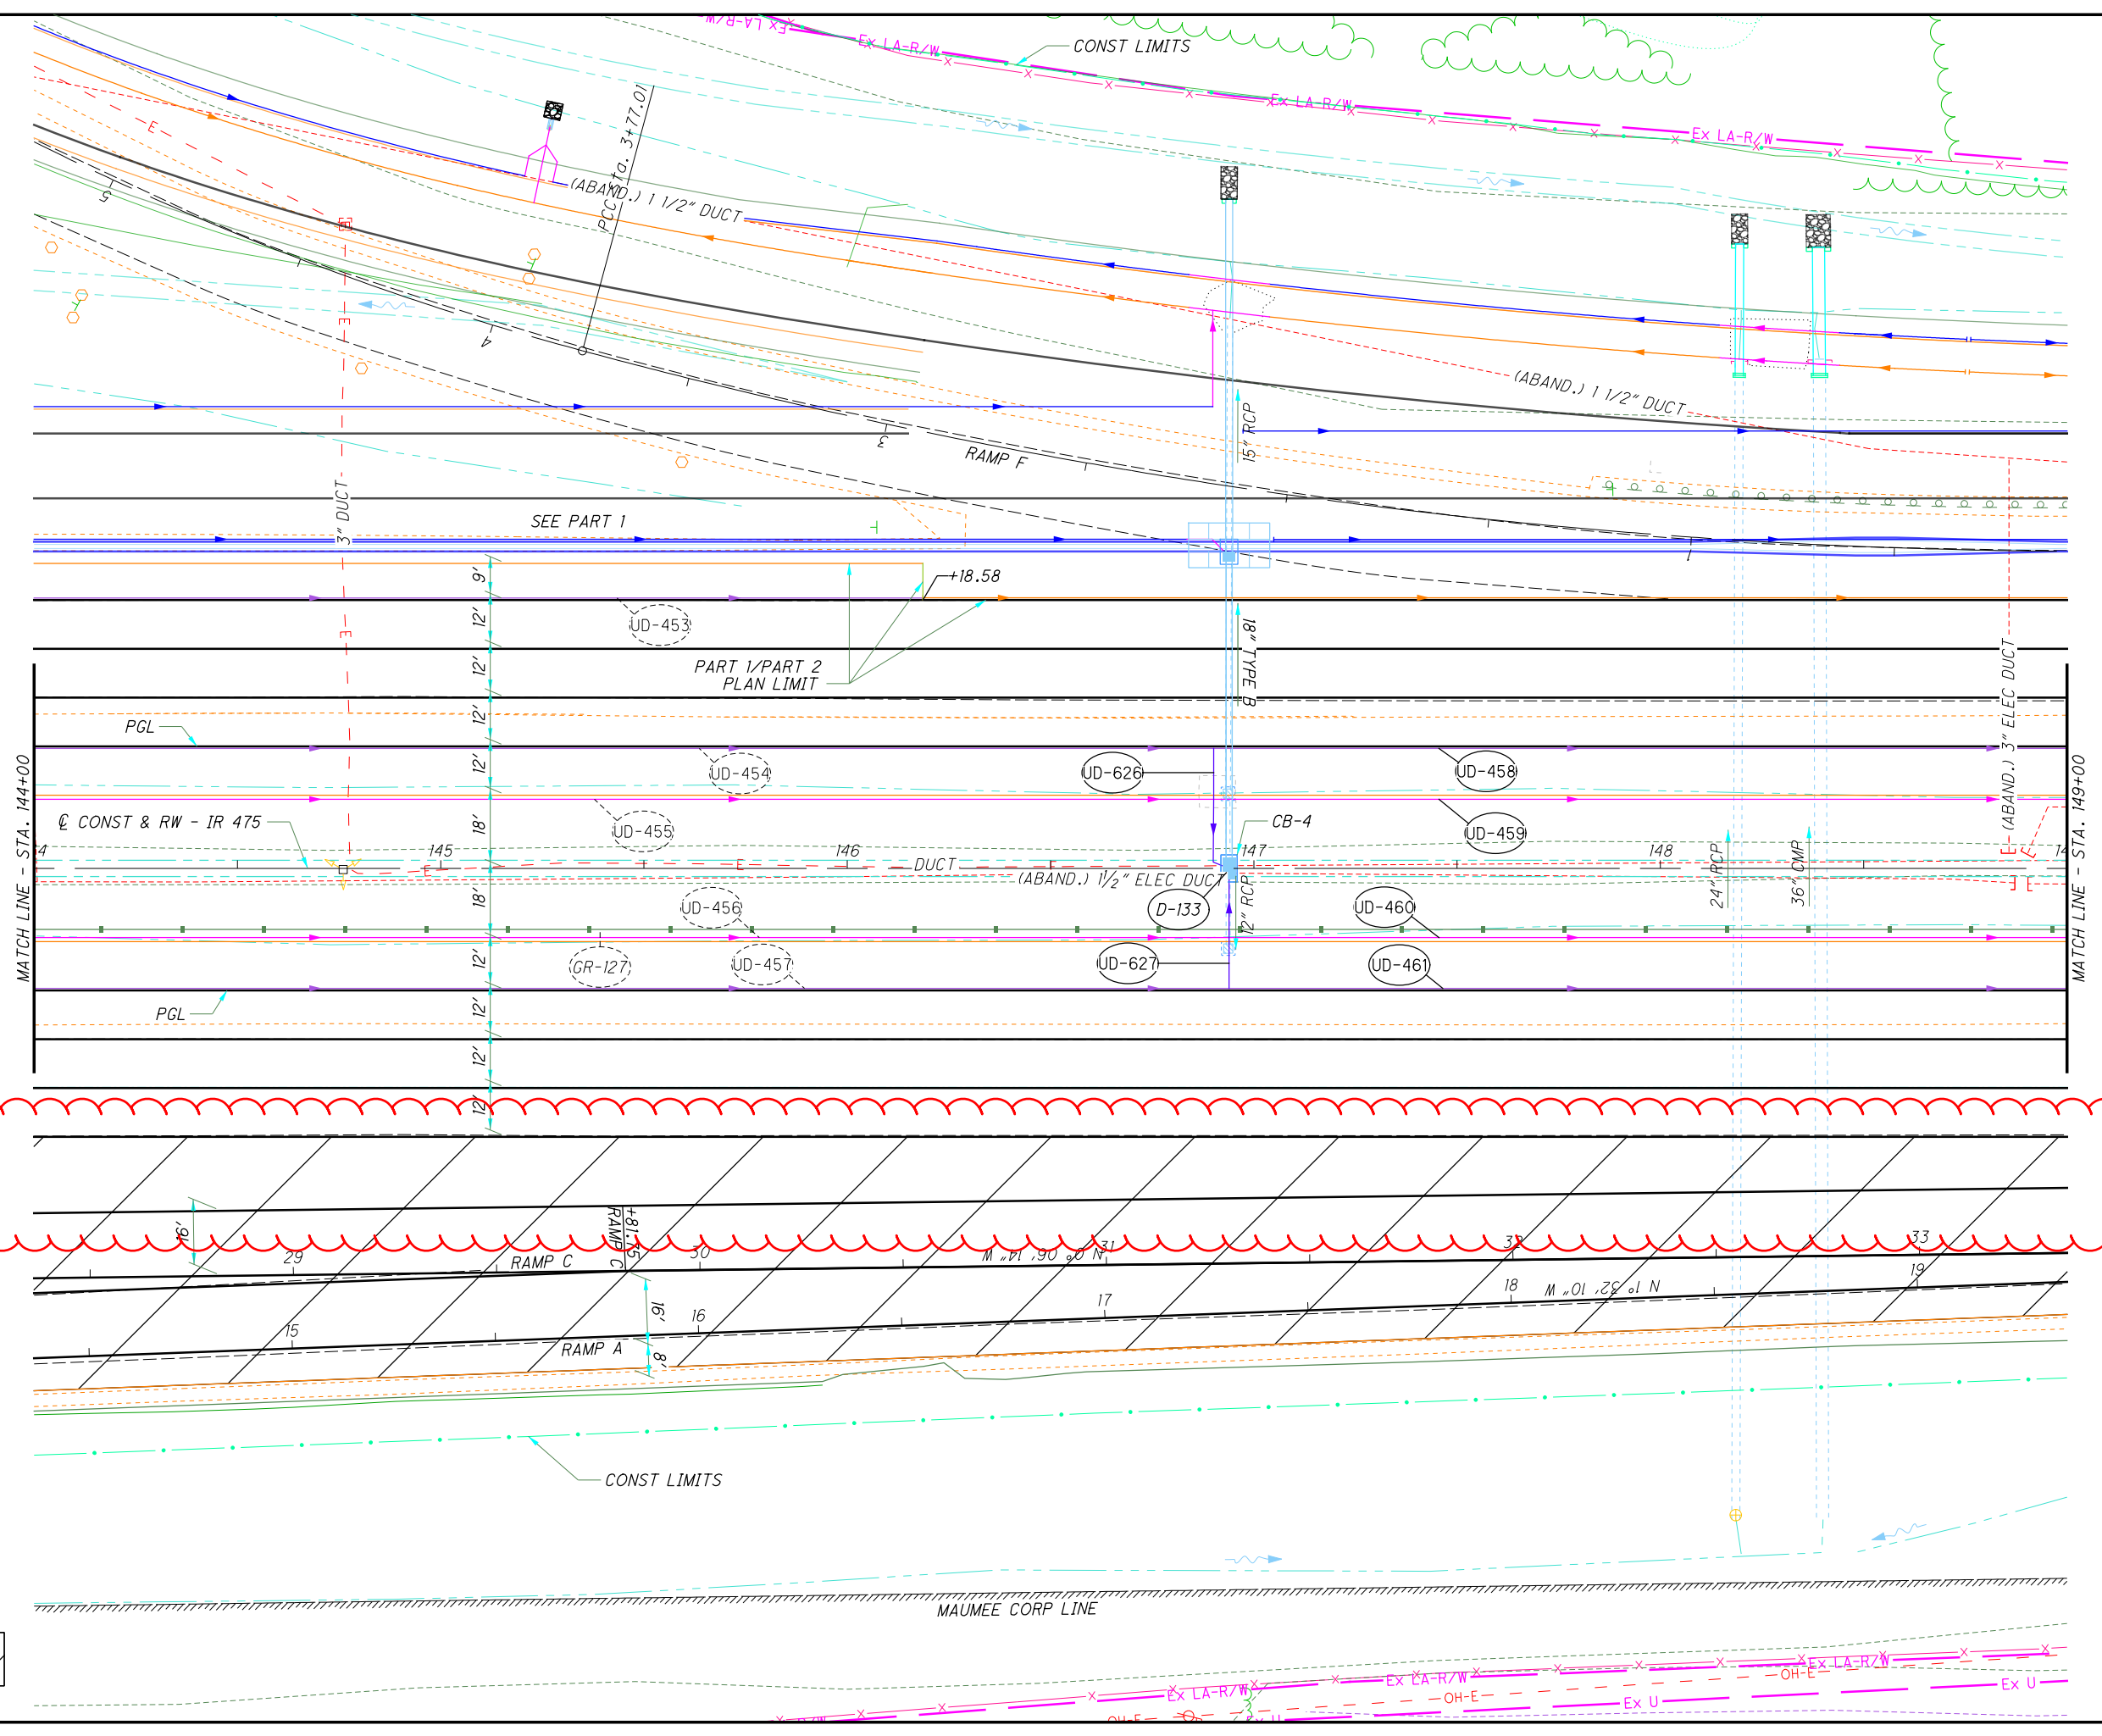





CALCULATED JRB  
 CHECKED XXX

**PLAN SHEET IR 475**  
**STA. 144+00 TO STA. 149+00**


**LUC-475-0.09**

283  
 855

I:\ProjectData\LUC\95875\_LUC-475-0.09\Design\Roadway\Sheets\95875\_GPO30.dgn Sheet 4/27/2022 9:16:38 AM jbidinge

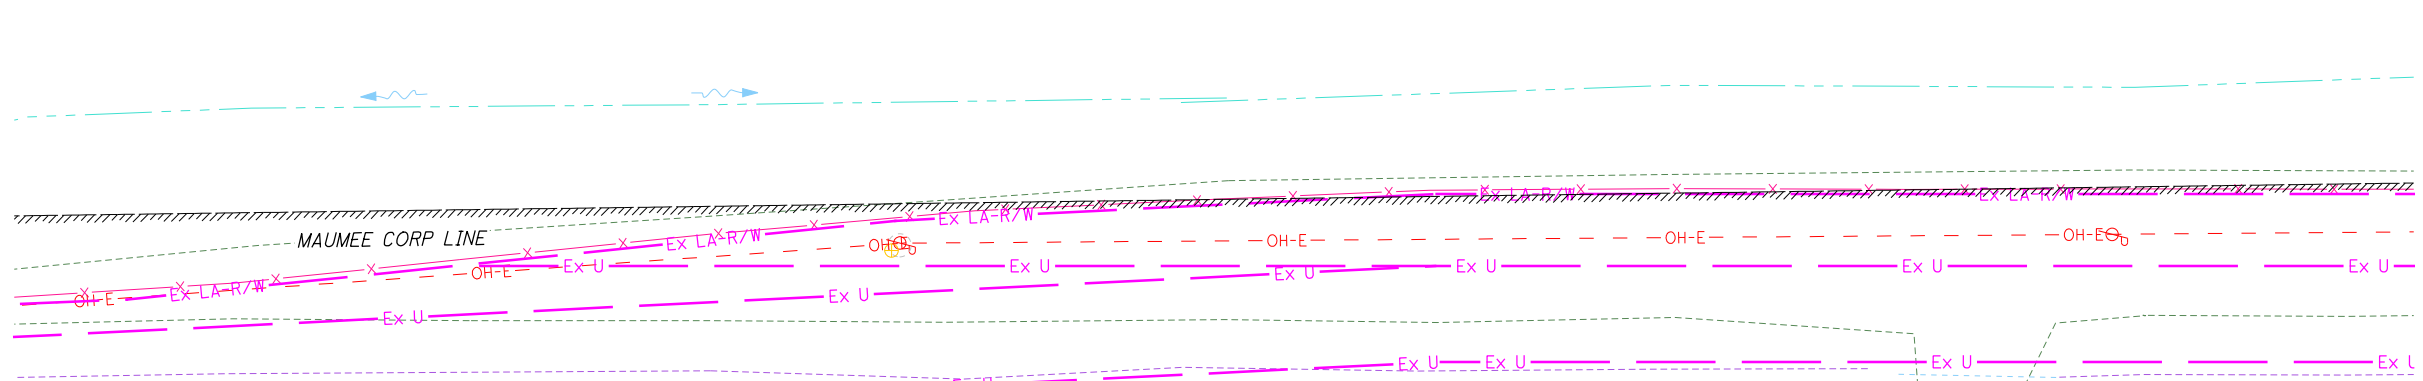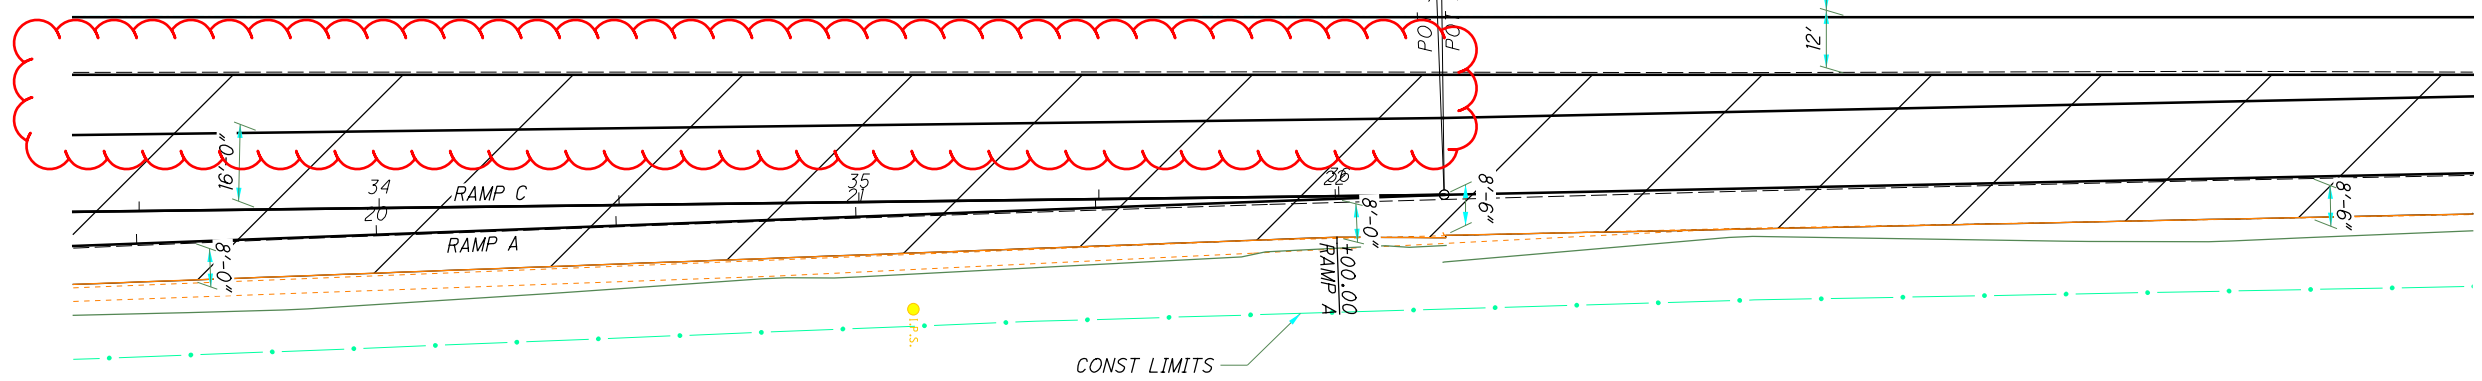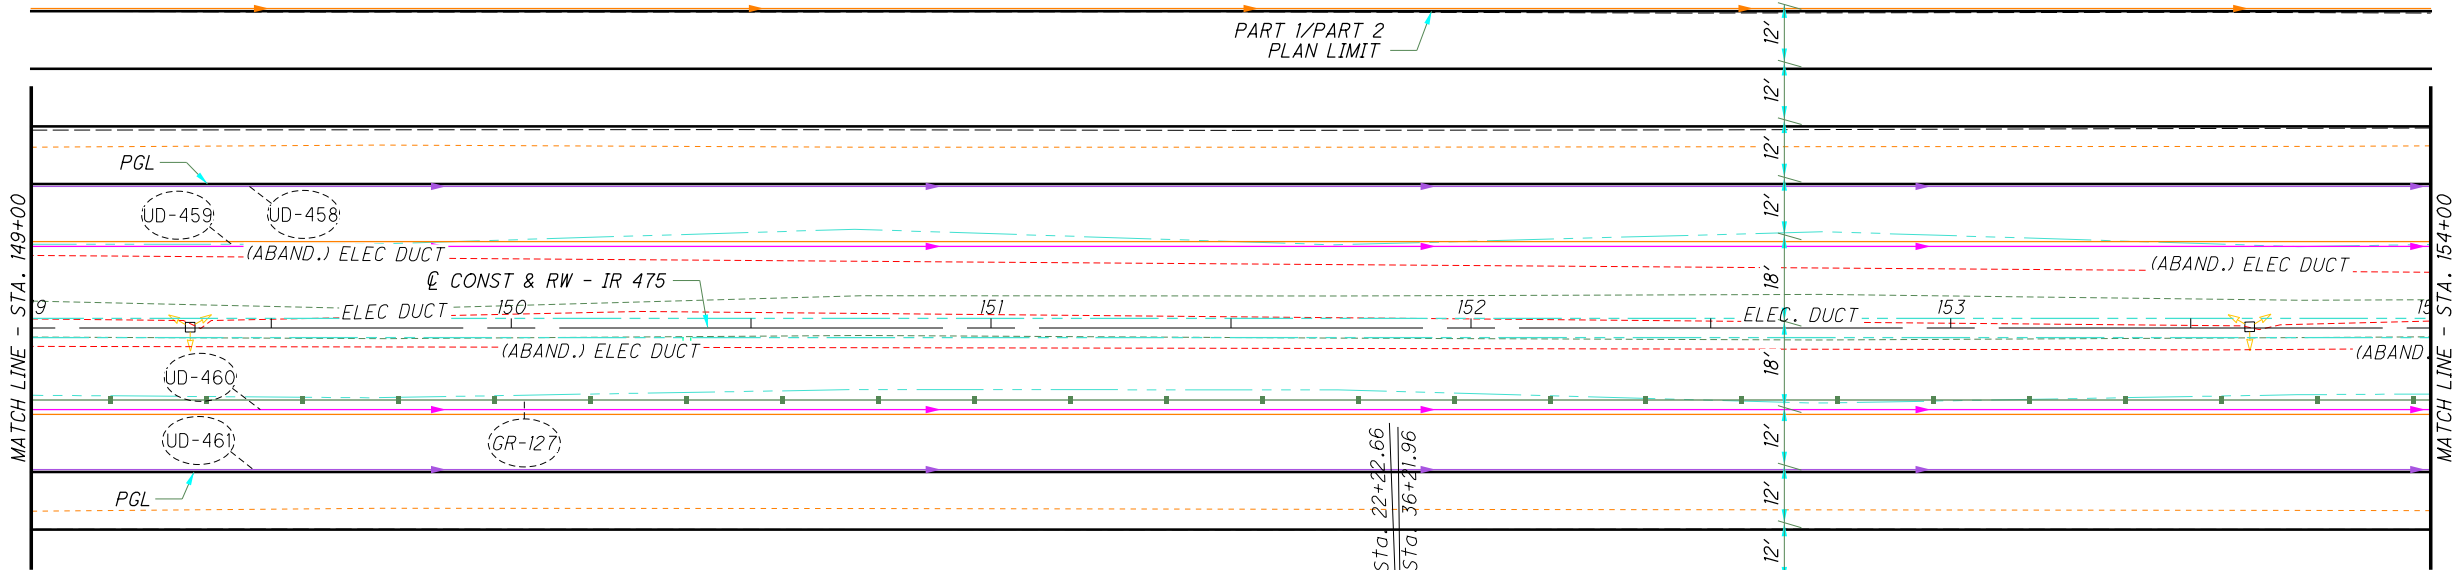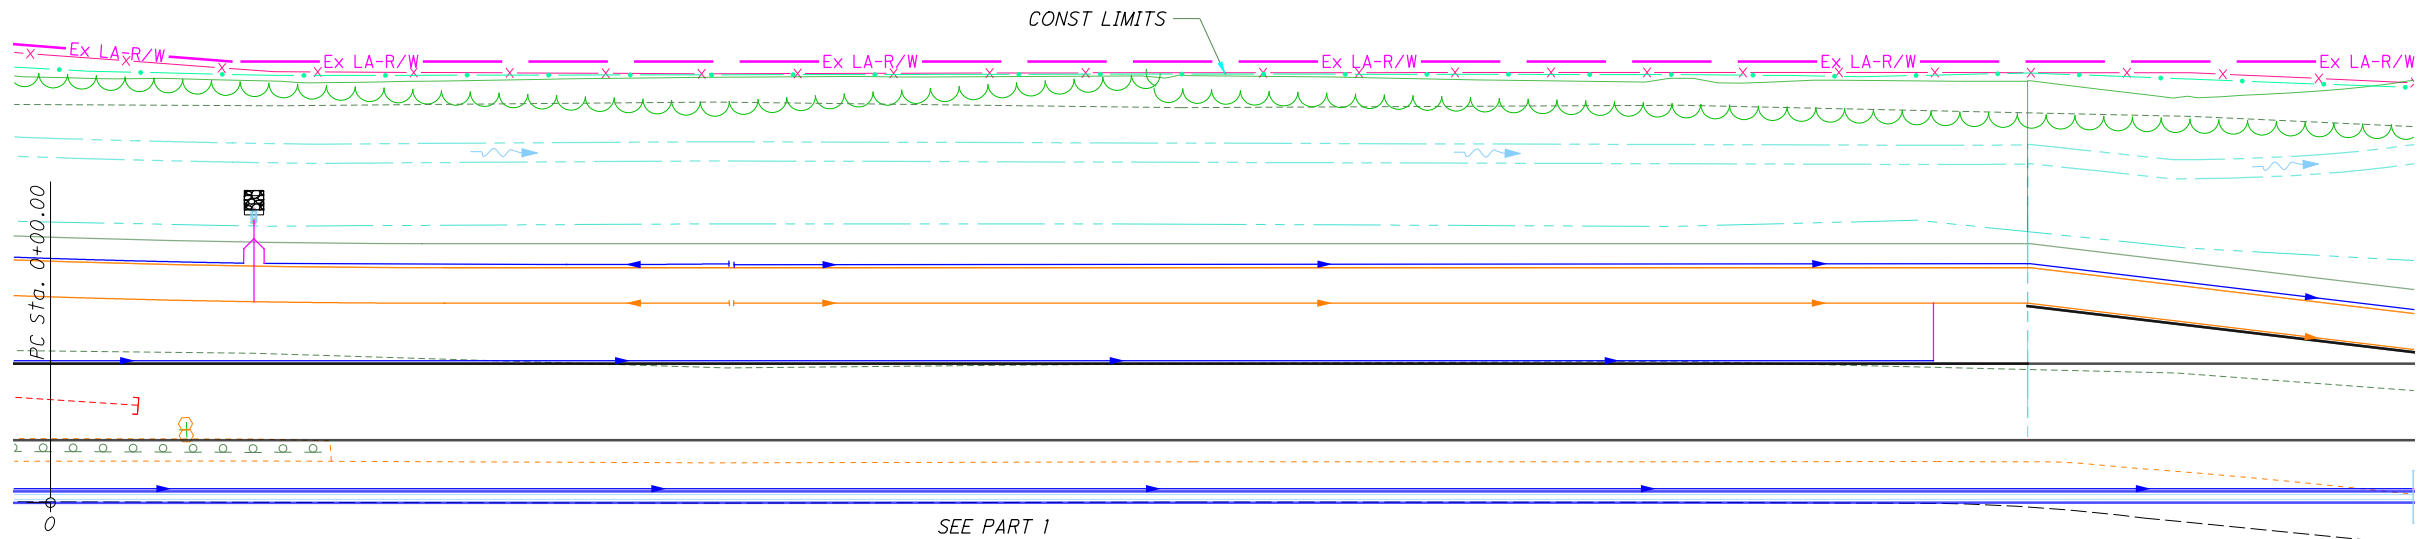

MILL & FILL LIMITS

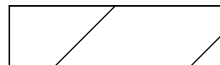


CALCULATED	JRB
CHECKED	XXX

PLAN SHEET IR 475  
STA. 149+00 TO STA. 154+00

LUC-475-0.09

284  
855


SEEDING  
 END SO.  
 WIDTH YDS.  
 402  
 146  
 54  
 202  
 36.2  
 36.2  
 36.2

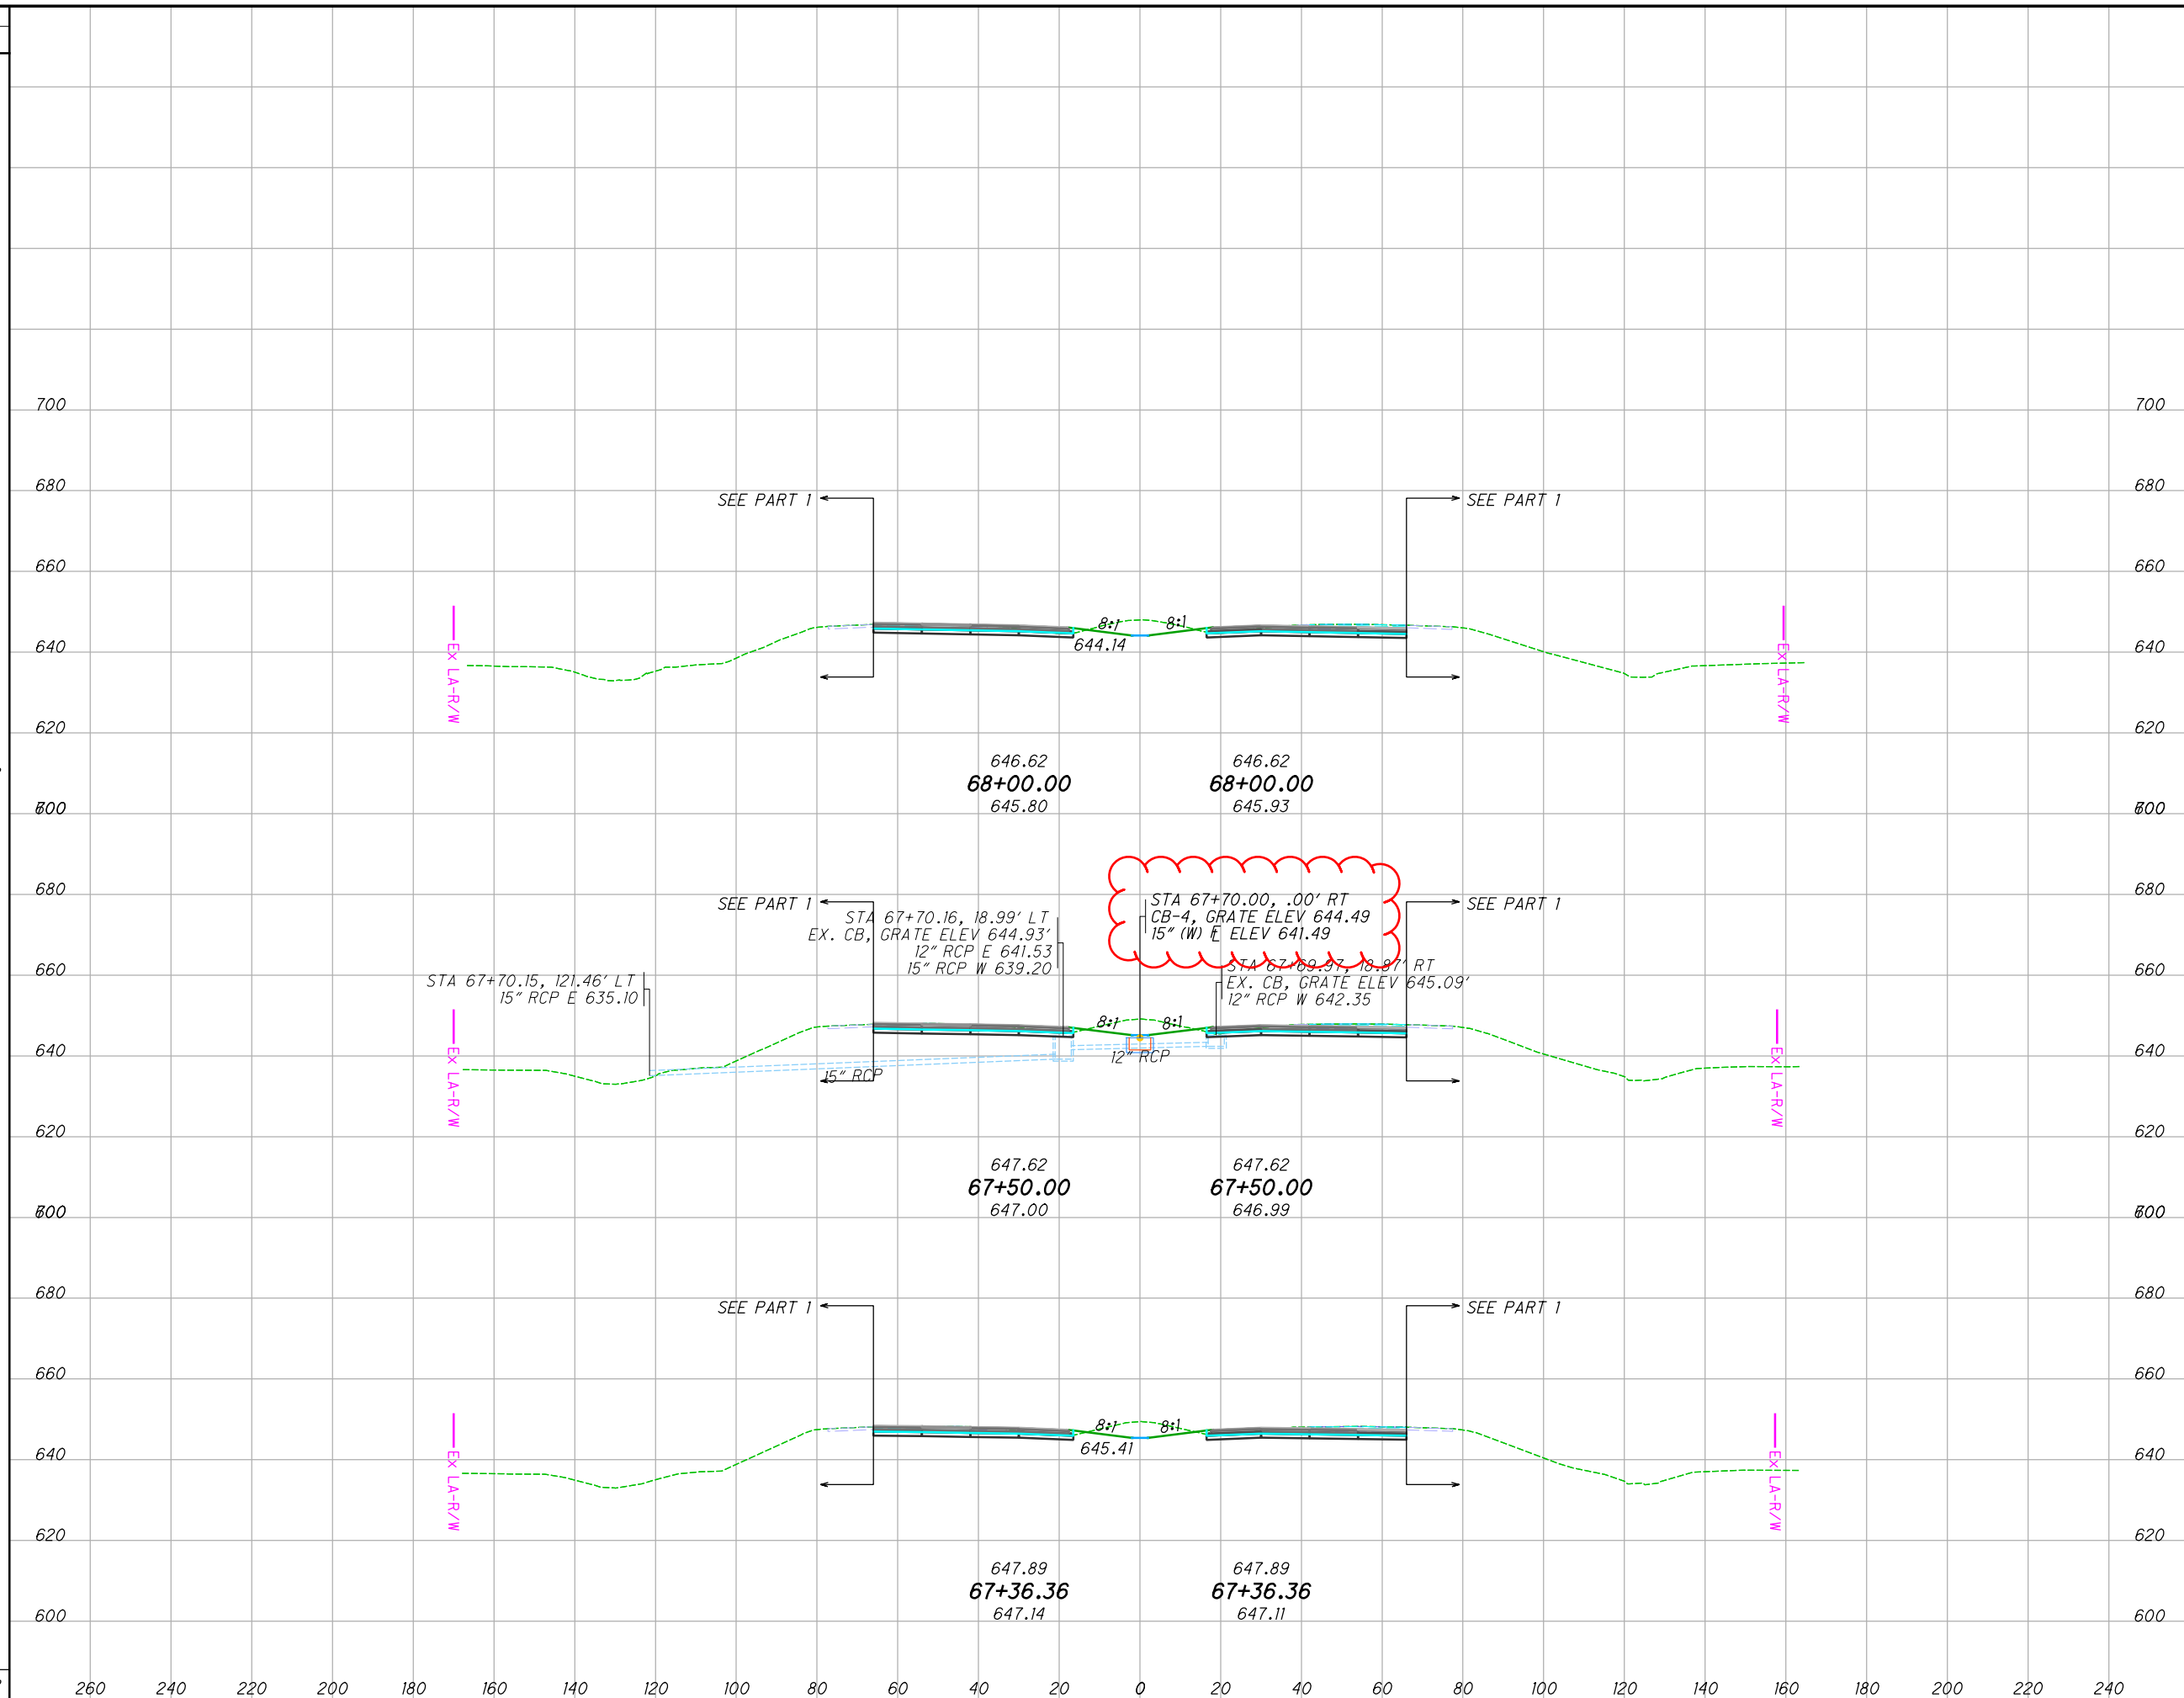

END AREA	VOLUME		CALCULATED	CHECKED
	CUT	FILL		
119		5		
126		4		
123		3		
453	14	8		

**CROSS SECTIONS**  
**STA. 67+36.36 TO STA. 68+00.00**  
**LUC-475-0.9**  
 367  
 855

I:\ProjectData\LUC\95875\_LUC-475-0.09\Design\Roadway\Sheets\95875\_XS001.dgn Sheet 4/26/2022 3:58:38 PM jbding

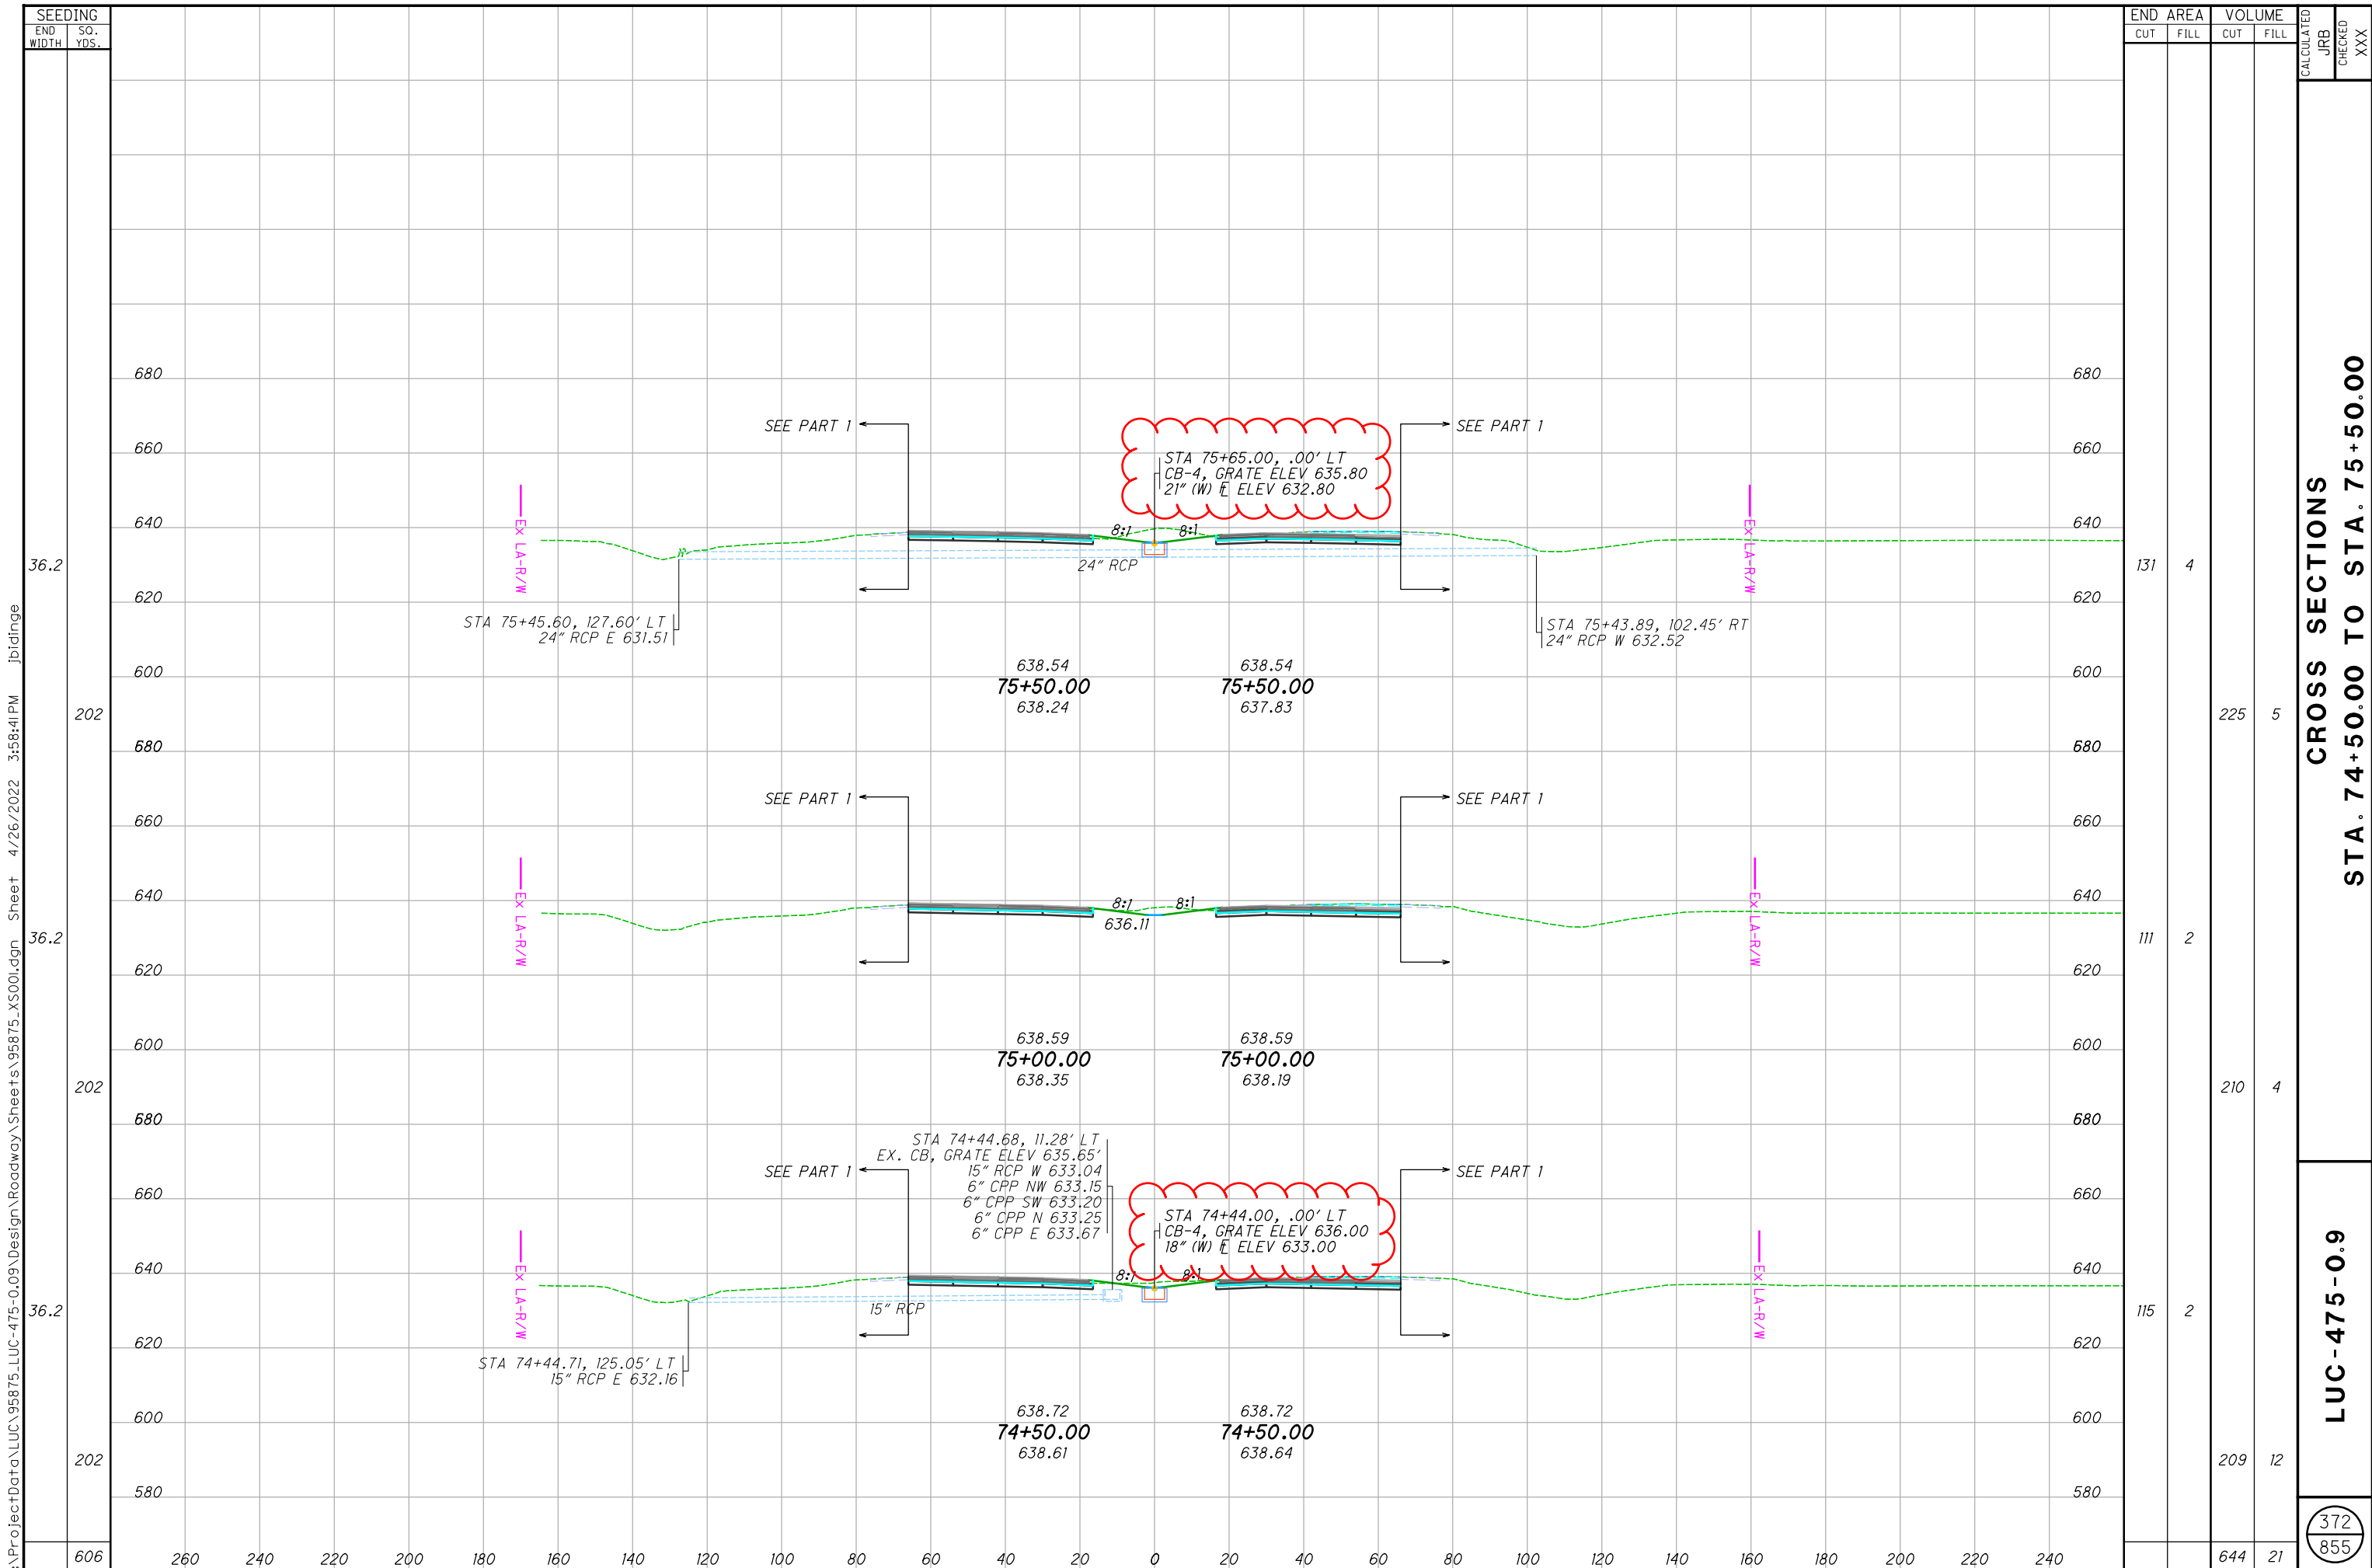

SEEDING	
END WIDTH	SO. YDS.
36.2	202
36.2	202
36.2	202
36.2	202
606	

END AREA		VOLUME		CALCULATED	JRB	CHECKED	XXX
CUT	FILL	CUT	FILL				
131	4	225	5				
111	2	210	4				
115	2	209	12				
		644	21				

**CROSS SECTIONS**  
**STA. 74+50.00 TO STA. 75+50.00**


**LUC-475-0.9**

372  
855

I:\ProjectData\LUC-475-0.9\Design\Roadway\Sheets\95875\_XS001.dgn Sheet 4/26/2022 3:58:41PM jbidinge




SEEDING  
 END SO.  
 WIDTH YDS.  
 606  
 260 240 220 200 180 160 140 120 100 80 60 40 20 0 20 40 60 80 100 120 140 160 180 200 220 240  
 36.2  
 202  
 36.2  
 202  
 36.2  
 202  
 606  
 260 240 220 200 180 160 140 120 100 80 60 40 20 0 20 40 60 80 100 120 140 160 180 200 220 240

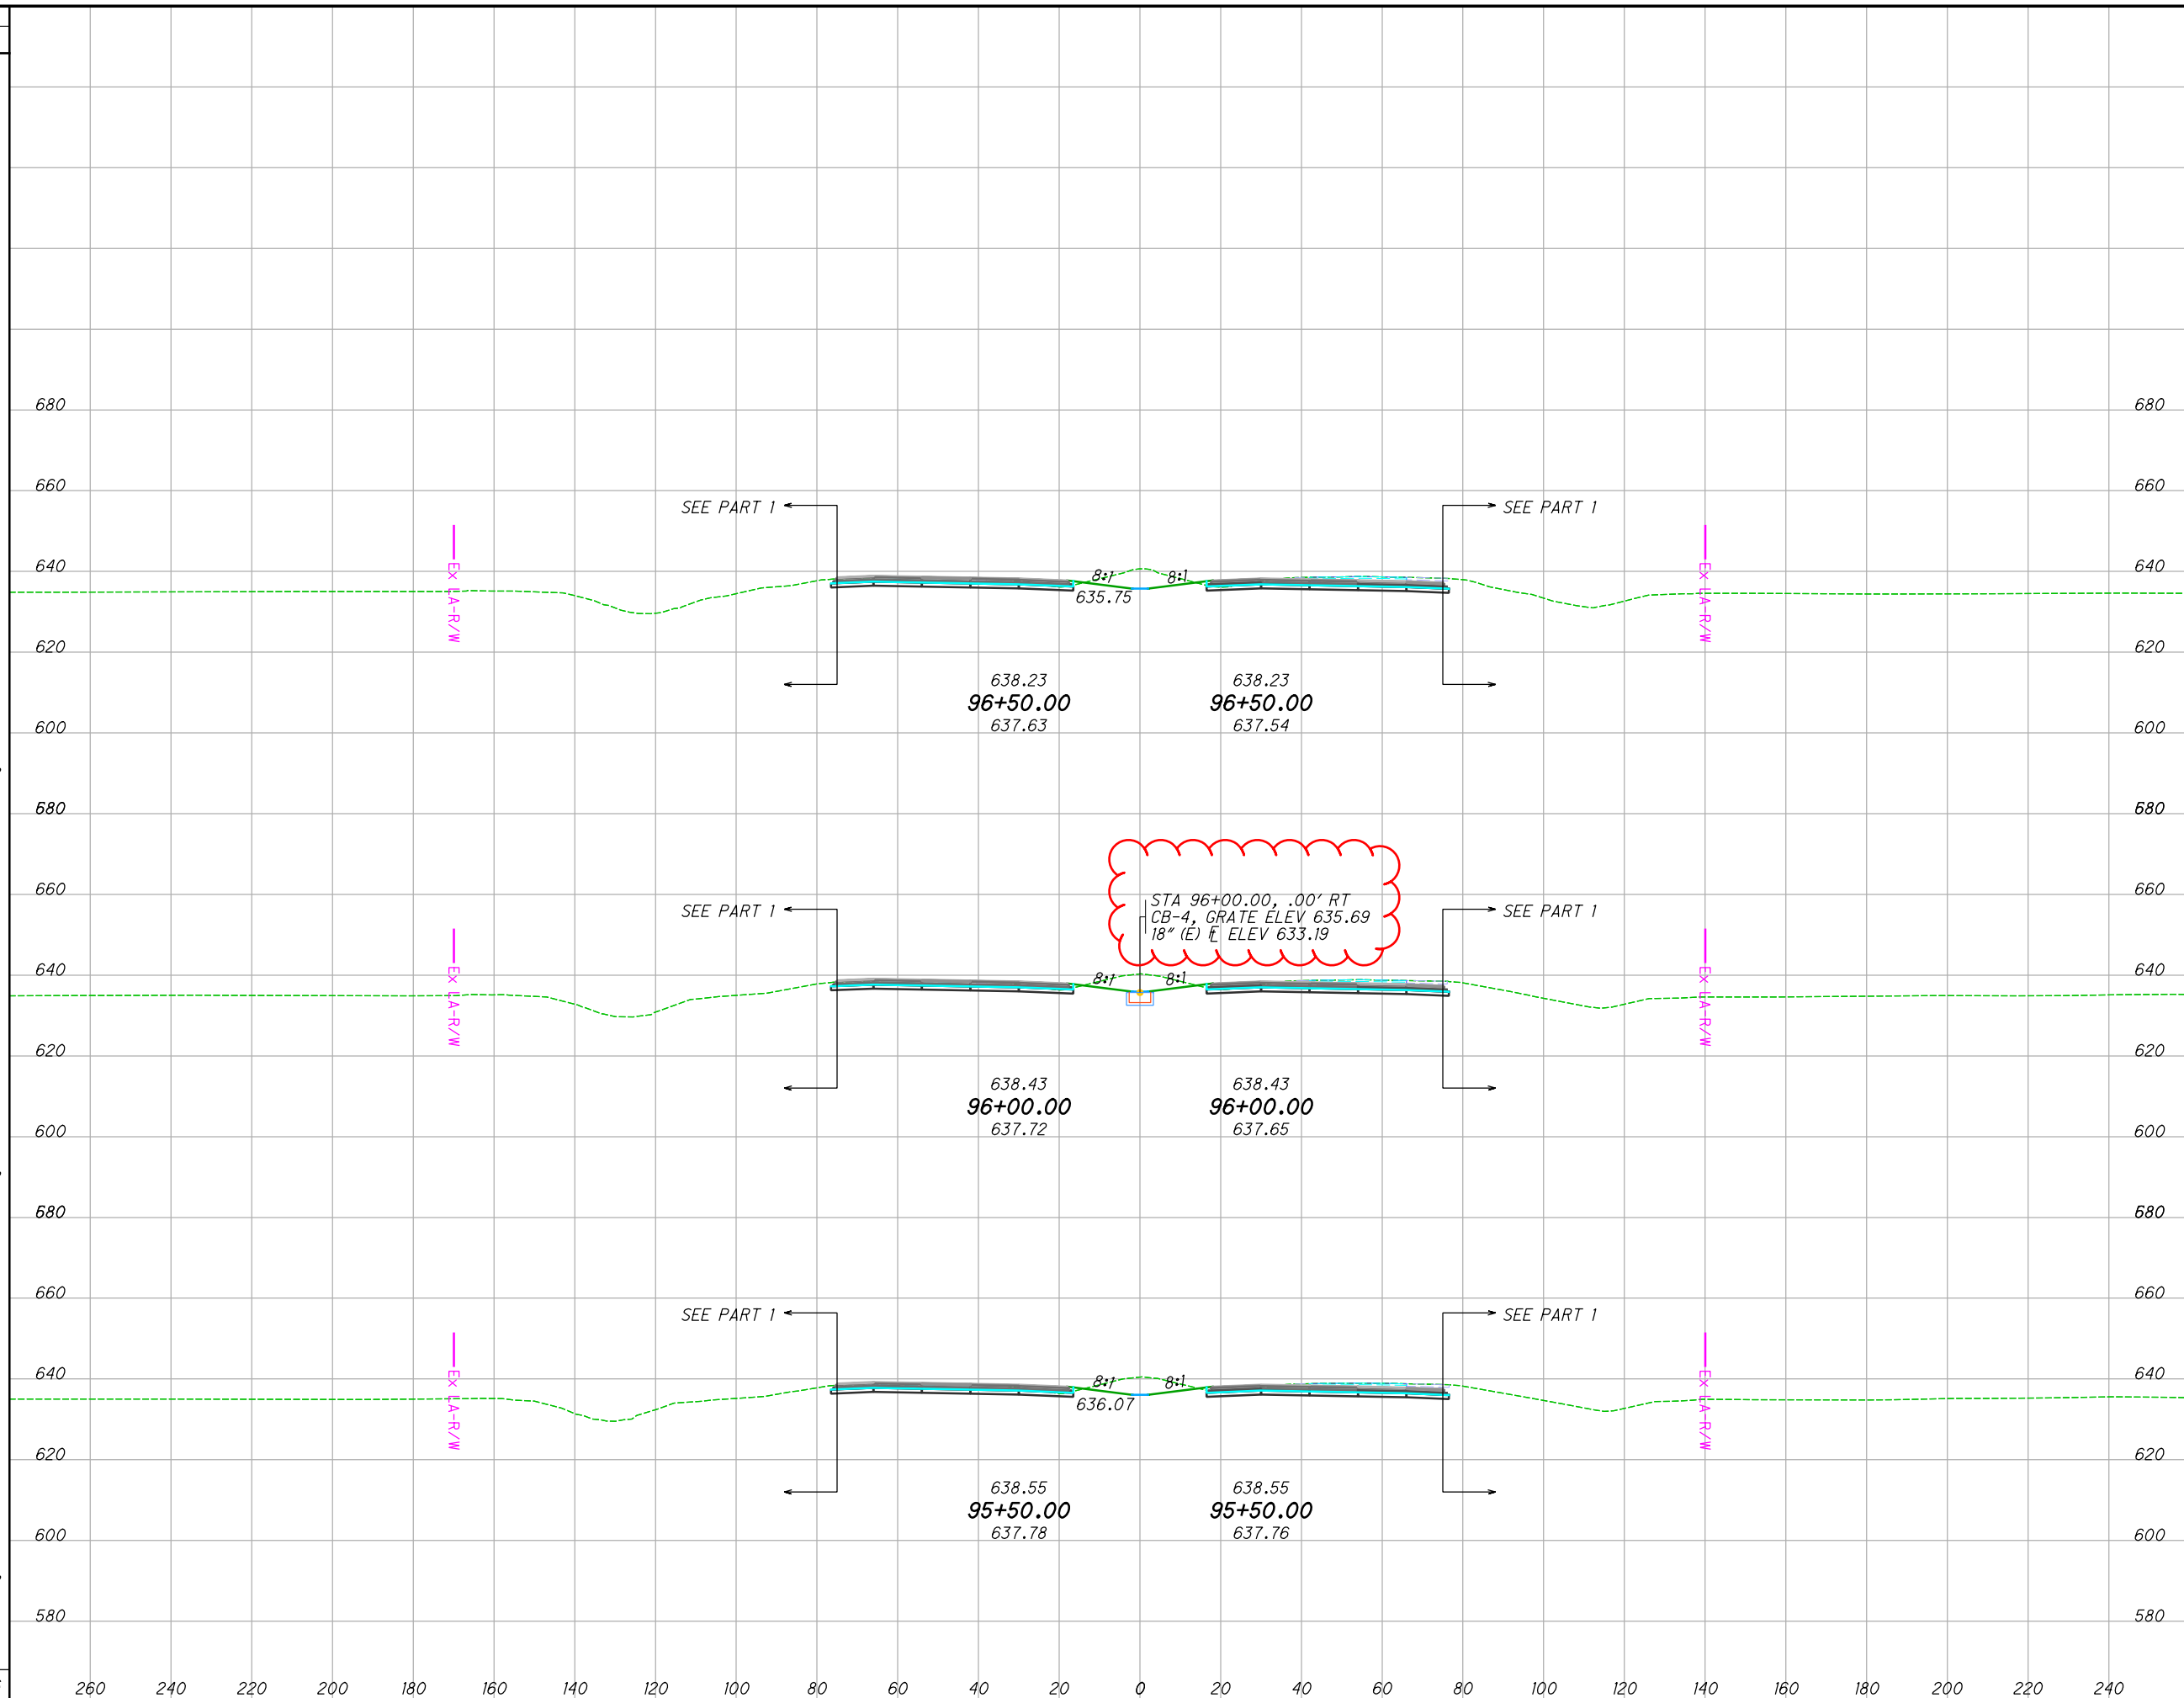

END AREA		VOLUME	
CUT	FILL	CUT	FILL
163	5	295	9
155	4	289	8
157	4	291	8
		875	25

CALCULATED  
 JRB  
 CHECKED  
 XXX  
**CROSS SECTIONS**  
**STA. 95+50.00 TO STA. 96+50.00**  
**LUC-475-0.9**  
 386  
 855

I:\ProjectData\LUC-475-0.9\Design\Roadway\Sheets\95875\_XS001.dgn Sheet 4/26/2022 3:58:44 PM jbidinge

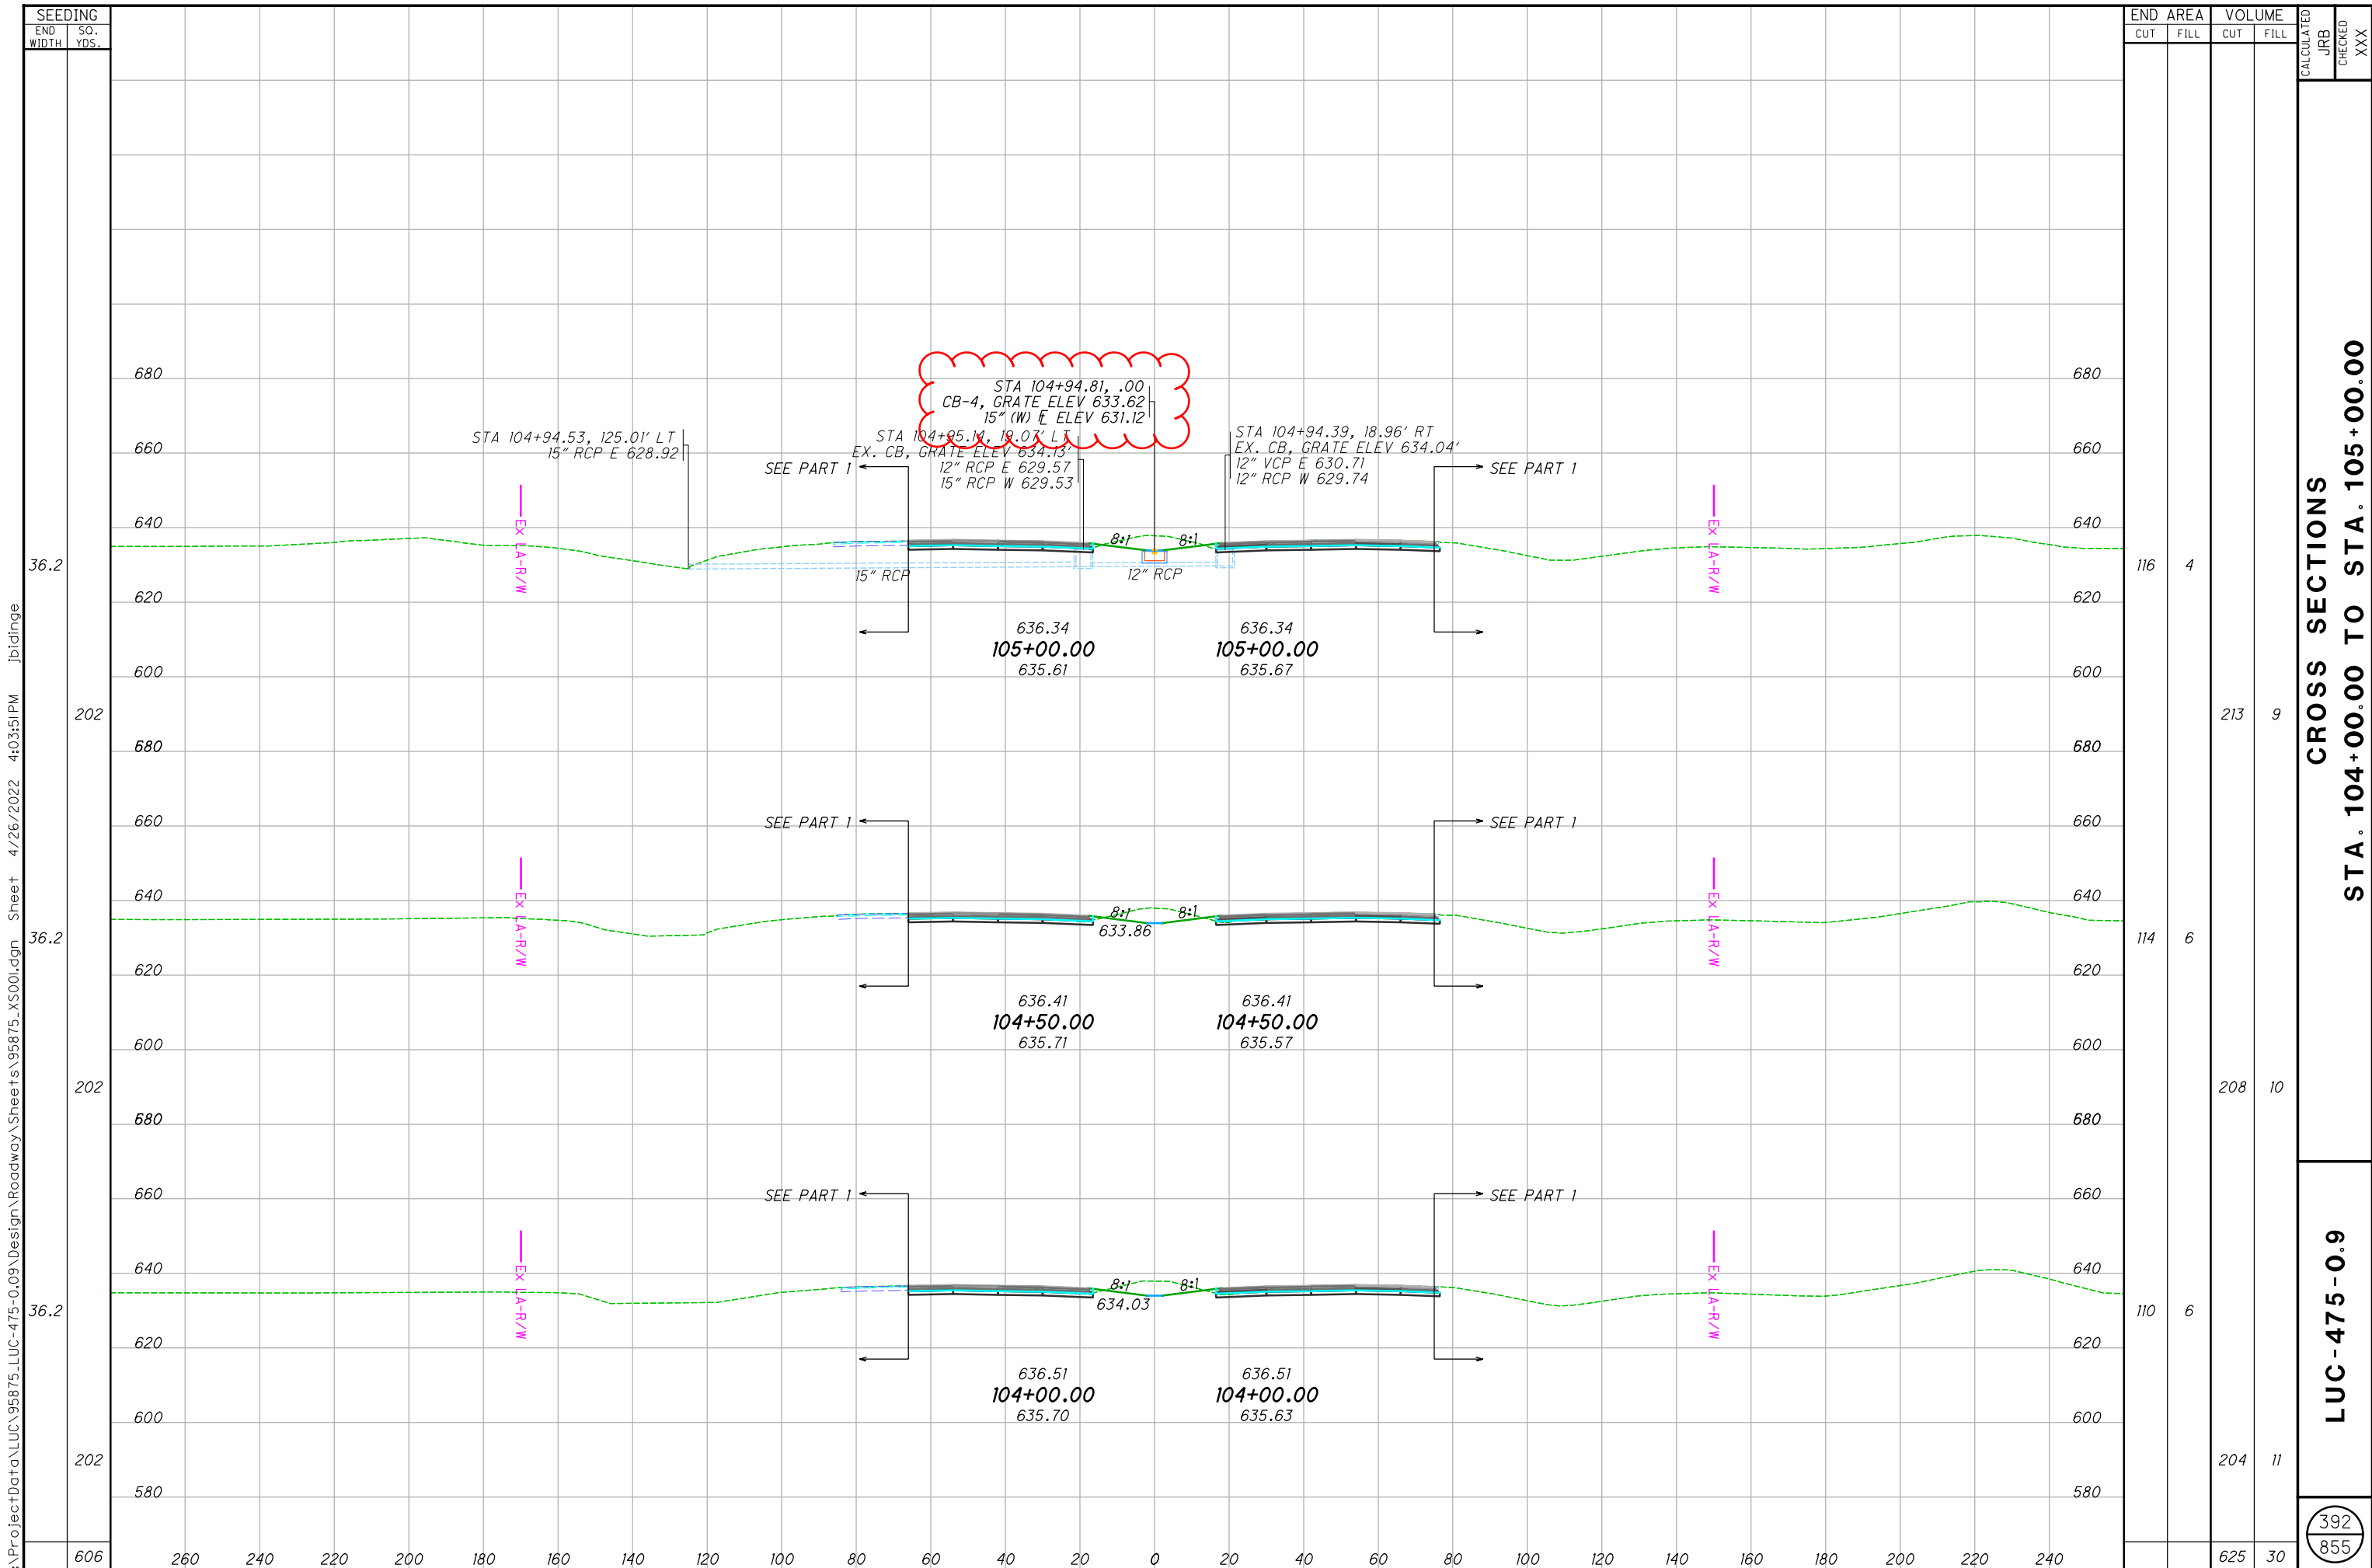

I:\ProjectData\LUC-475-0.09\Design\Roadway\Sheets\95875\_XS001.dgn Sheet 4/26/2022 4:03:51 PM jbidinge

SEEDING		END AREA		VOLUME		CALCULATED	
END WIDTH	SO. YDS.	CUT	FILL	CUT	FILL	JRB	XXX
36.2		116	4	213	9		
202		114	6	208	10		
202		110	6	204	11		
606				625	30		

**CROSS SECTIONS  
STA. 104+00.00 TO STA. 105+00.00**

**LUC-475-0.9**


392  
855



SEEDING  
END SO.  
WIDTH YDS.  
606

END AREA		VOLUME		CALCULATED JRB	CHECKED XXX
CUT	FILL	CUT	FILL		
111	1	208	2		
113	1	210	3		
114	3	207	6		
625	11				

I:\ProjectData\LUC-475-0.09\Design\Roadway\Sheets\95875\_XS001.dgn Sheet 4/26/2022 3:58:52 PM jbding

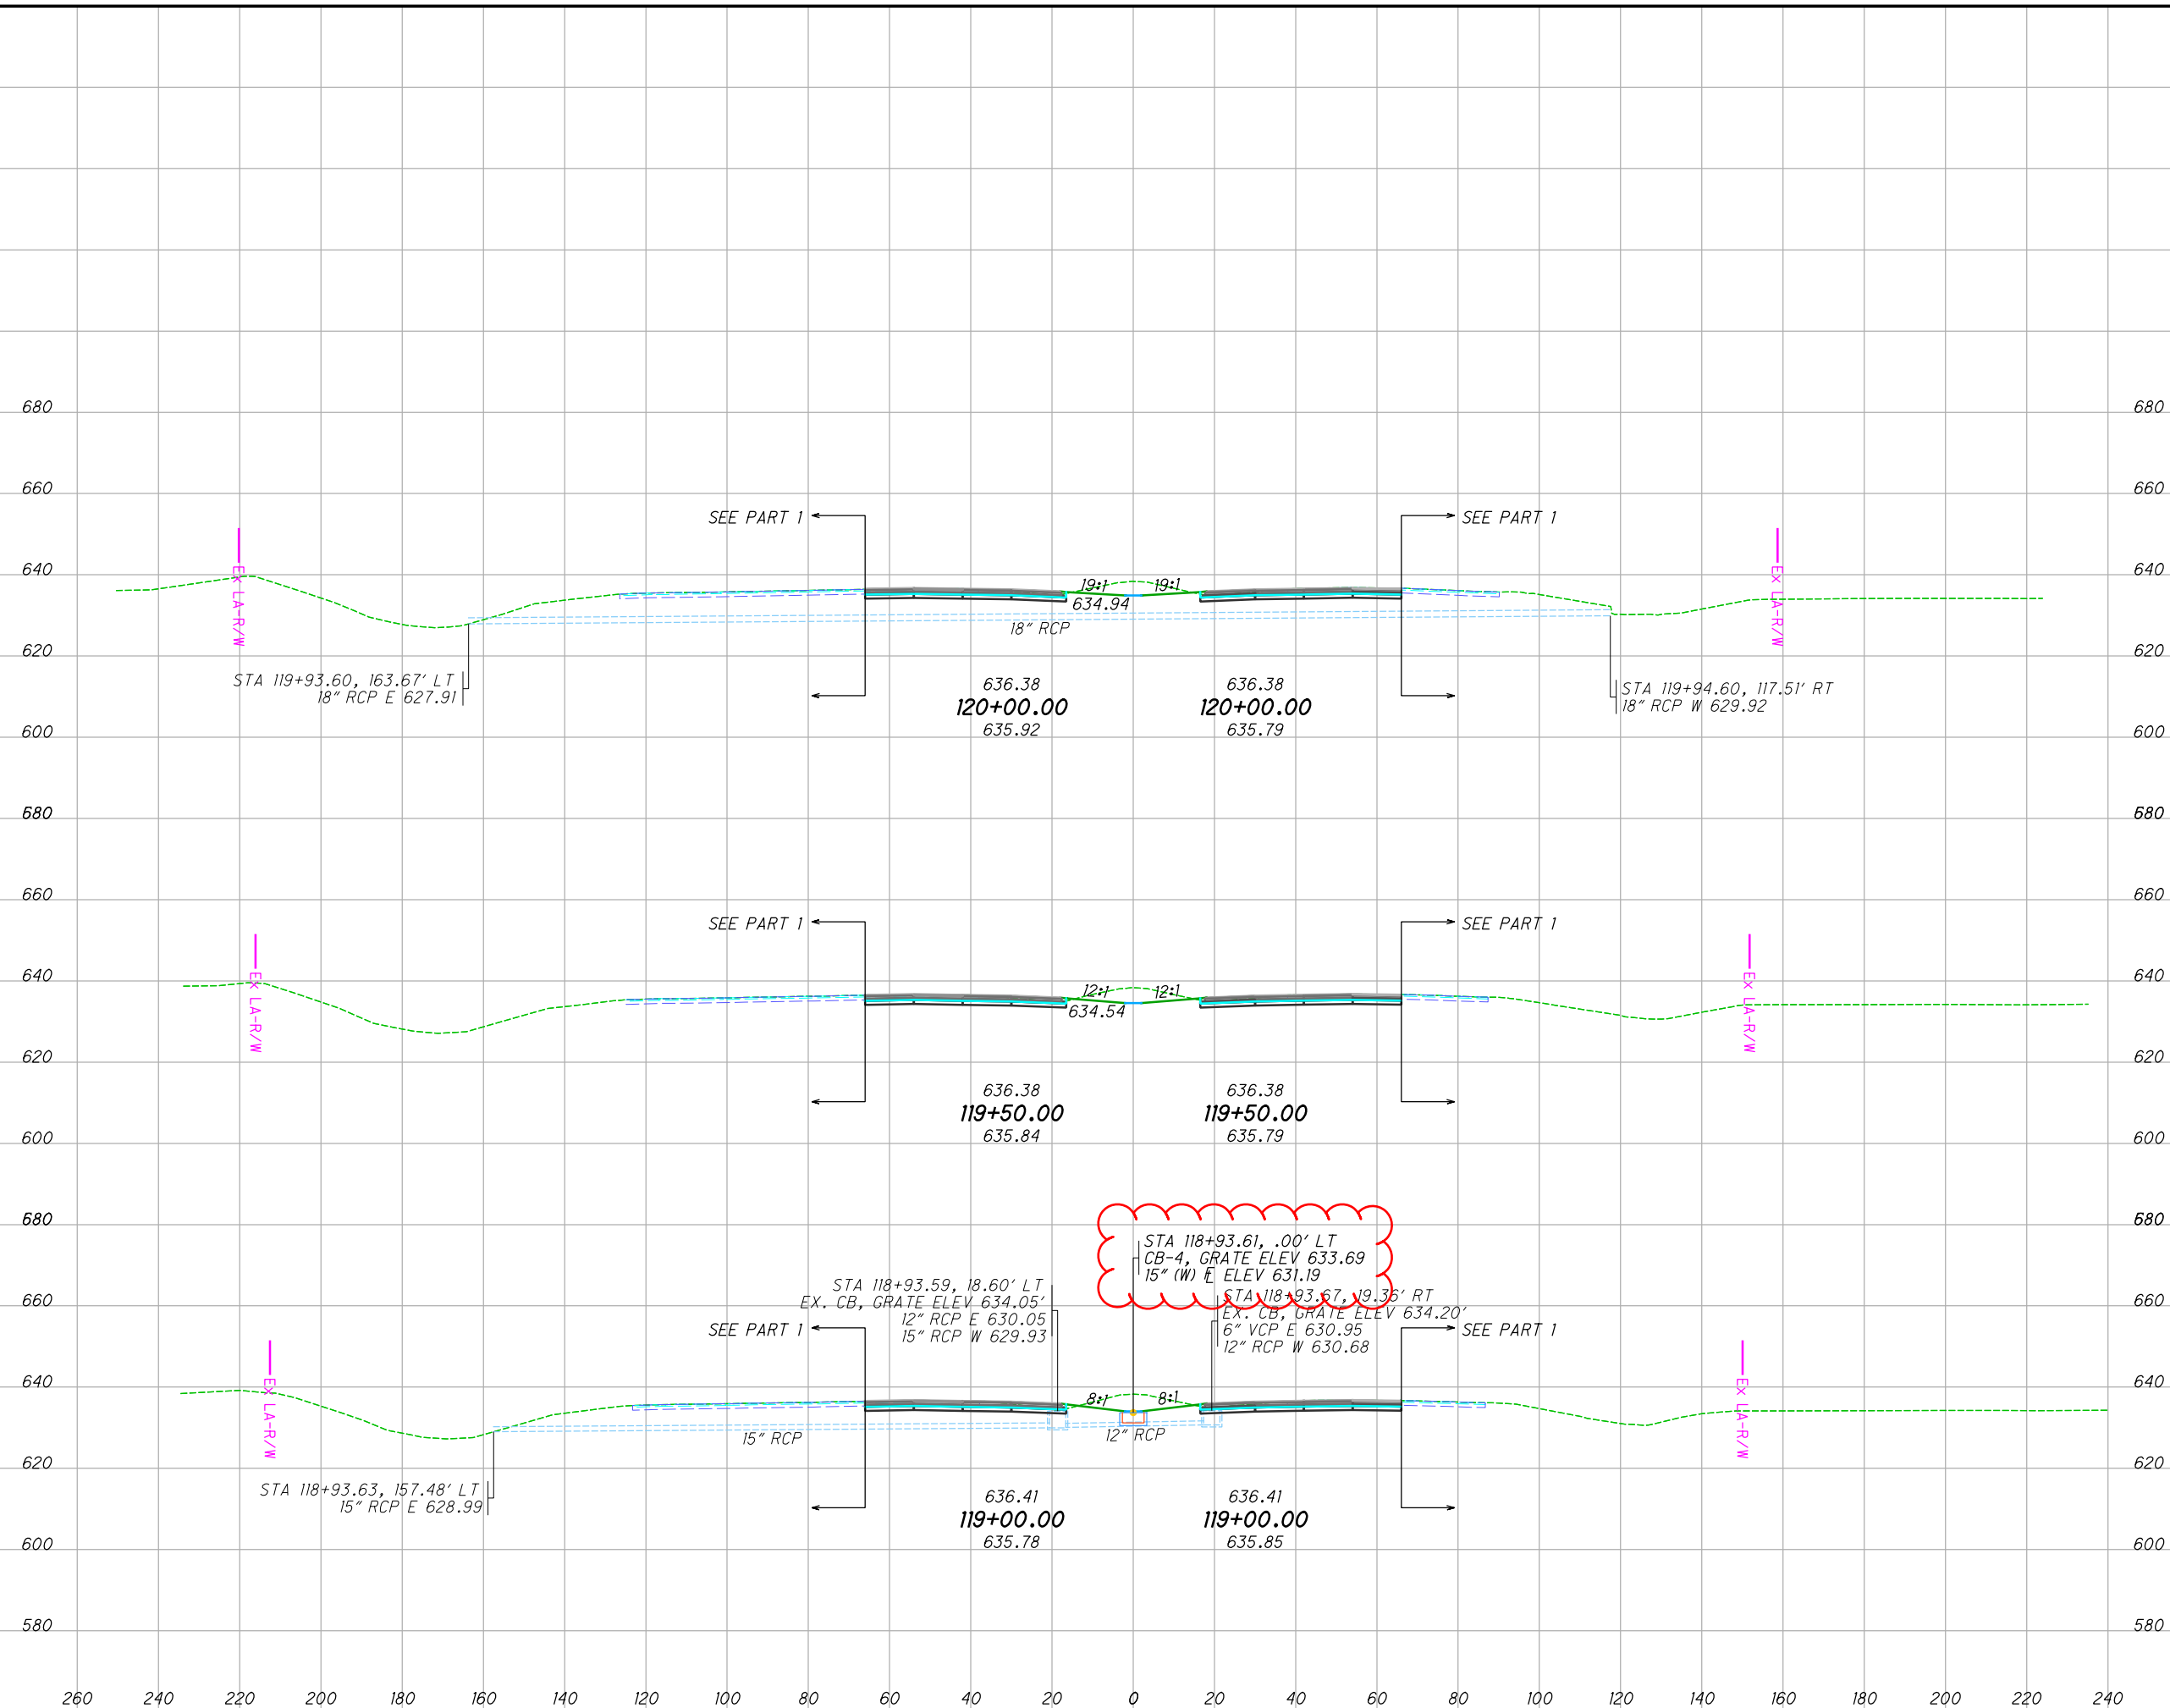


**CROSS SECTIONS**  
**STA. 119+00.00 TO STA. 120+00.00**

**LUC-475-0.9**

402  
855

SEEDING  
 END SO.  
 WIDTH YDS.  
 606  
 260 240 220 200 180 160 140 120 100 80 60 40 20 0 20 40 60 80 100 120 140 160 180 200 220 240

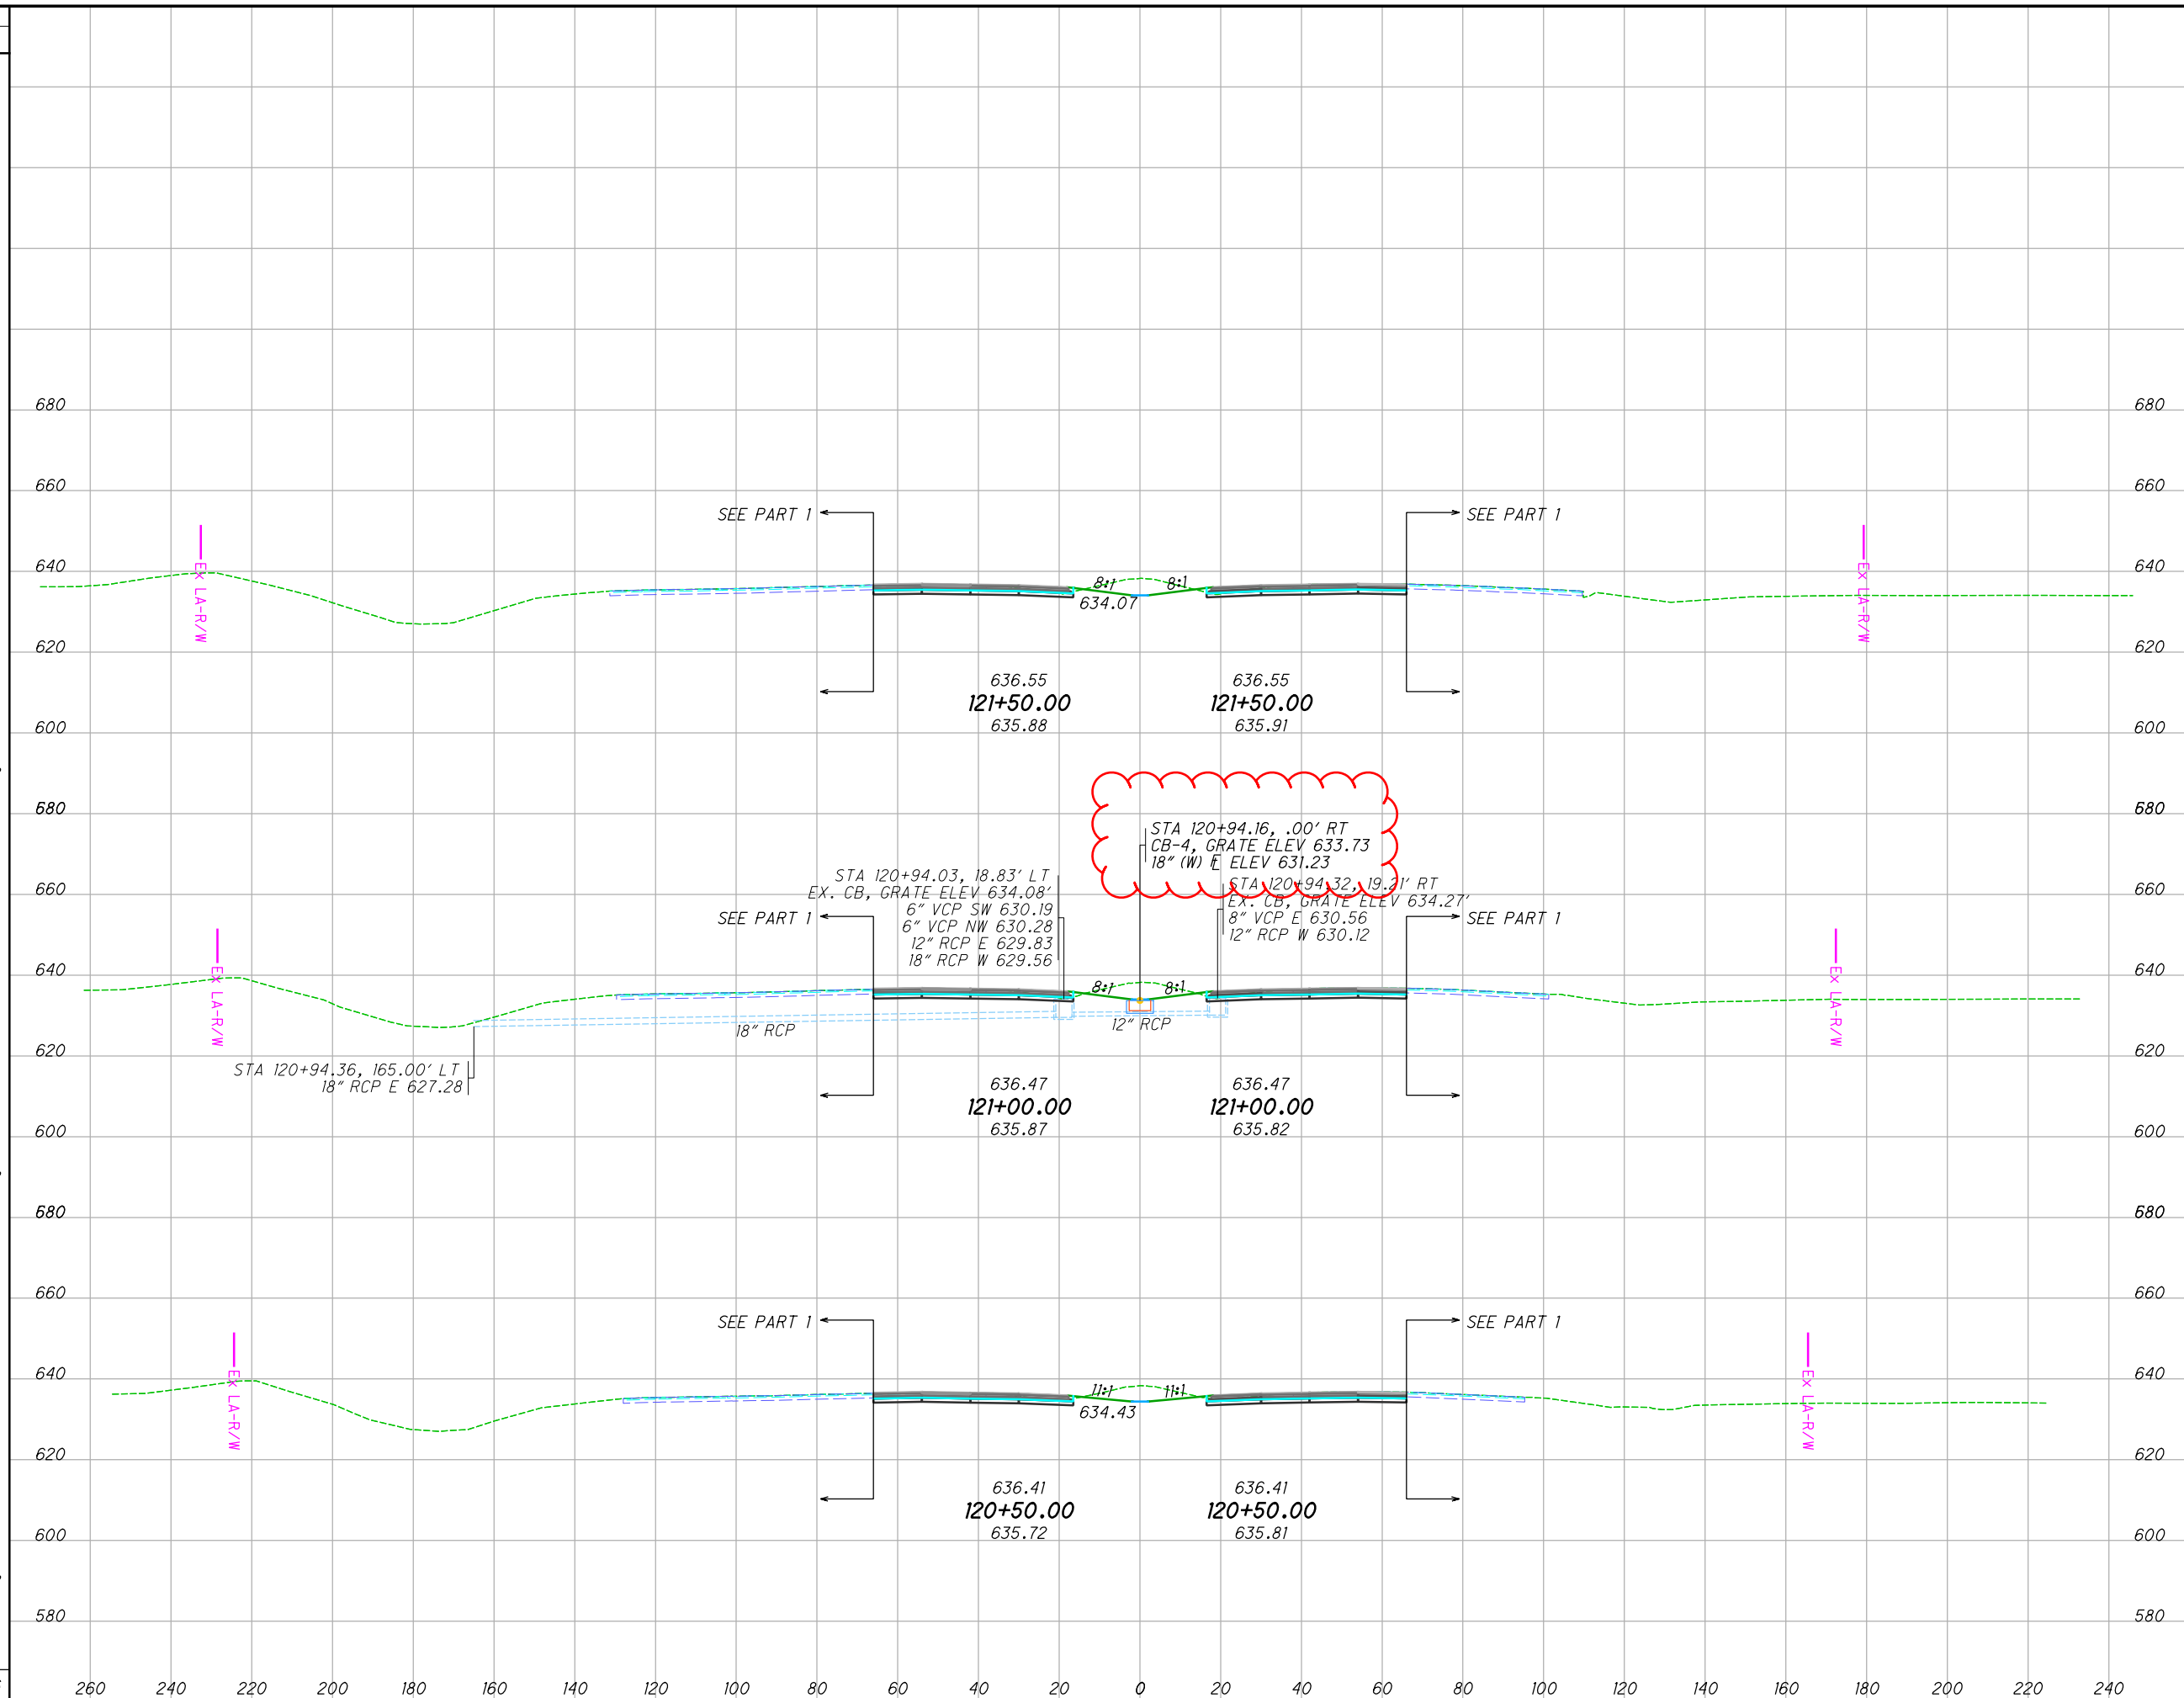

END AREA	VOLUME		CALCULATED	CHECKED
	CUT	FILL		
108	4			
203	8			
111	5			
206	6			
112	1			
207	2			
616	16			

**CROSS SECTIONS**  
**STA. 120+50.00 TO STA. 121+50.00**


**LUC-475-0.9**

403  
855

I:\ProjectData\LUC-475-0.9\Design\Roadway\Sheets\95875\_XS001.dgn Sheet 4/26/2022 3:58:55 PM jbidinge



SEEDING  
 END SO.  
 WIDTH YDS.  
 703  
 260 240 220 200 180 160 140 120 100 80 60 40 20 0 20 40 60 80 100 120 140 160 180 200 220 240  
 43.6  
 261  
 50.1  
 240  
 36.2  
 202

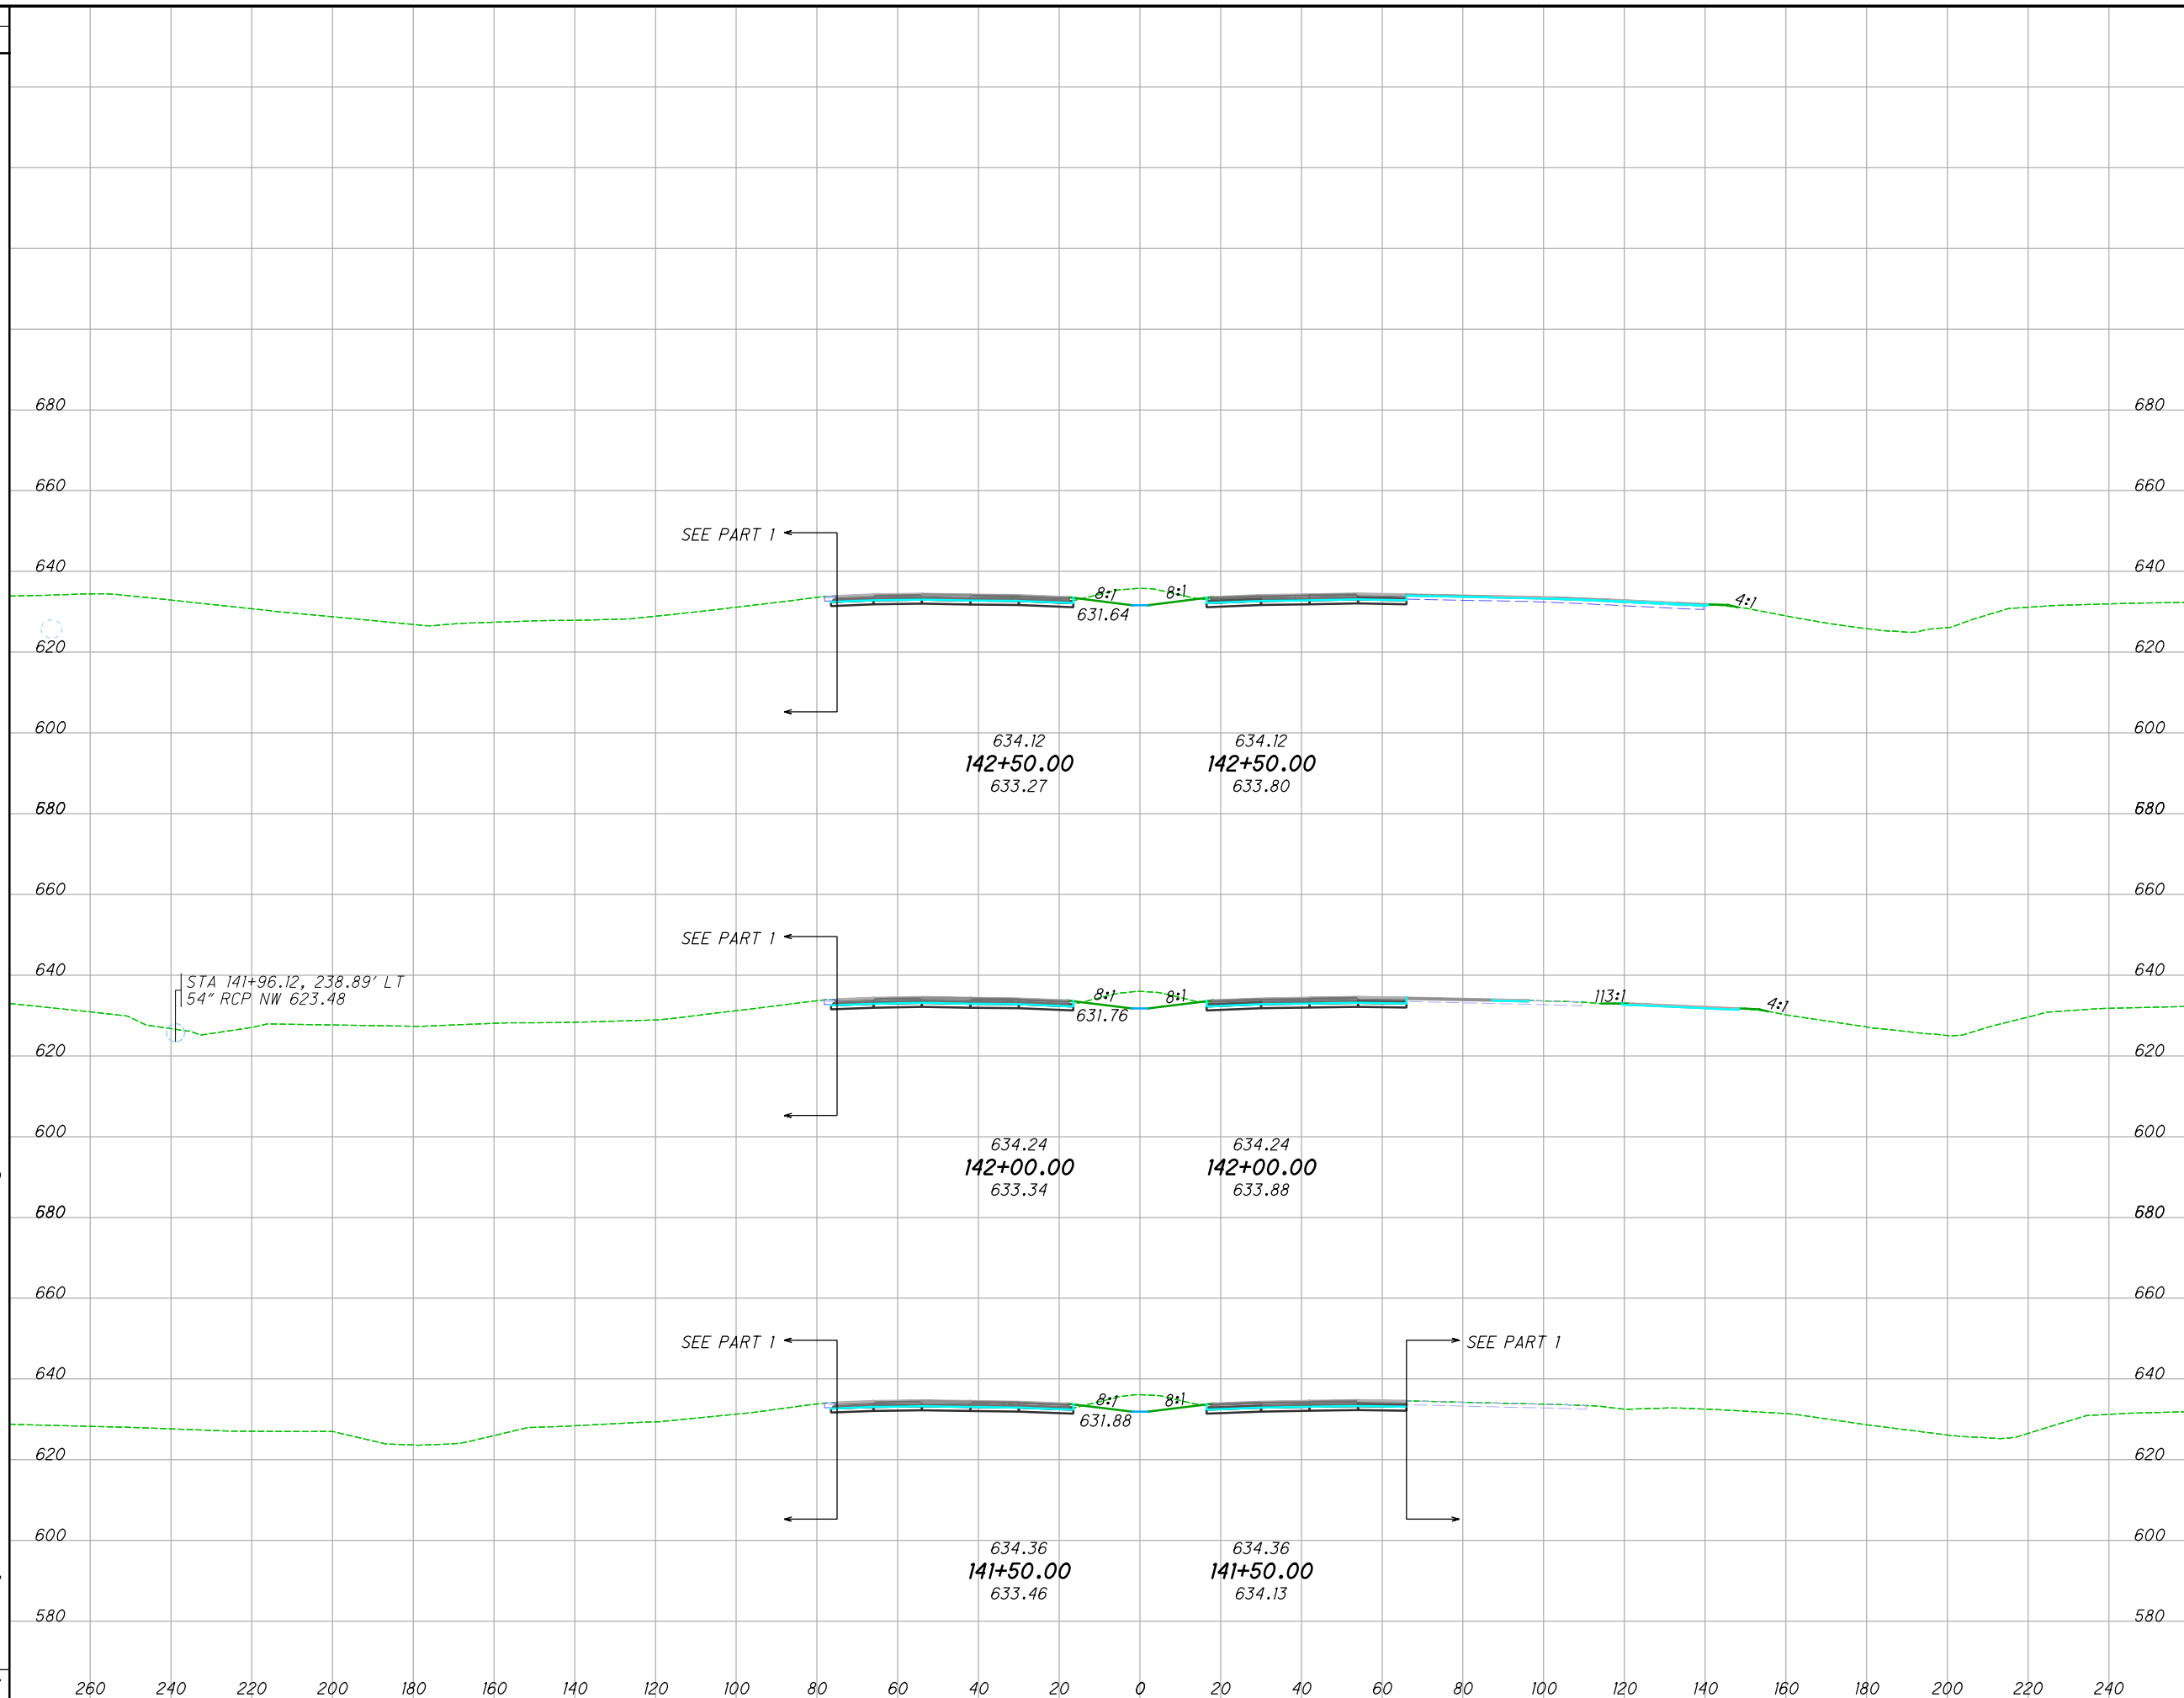


END AREA		VOLUME		CALCULATED	CHECKED
CUT	FILL	CUT	FILL		
123	2	237	4	JRB	XXX
133	2	241	3		
127	1	236	3		
		714	10		

**CROSS SECTIONS  
 STA. 141+50.00 TO STA. 142+50.00**

**LUC-475-0.9**

417  
 855

I:\ProjectData\LUC\95875\_LUC-475-0.09\Design\Roadway\Sheets\95875\_XS001 - Copy.dgn Sheet 4/29/2022 8:35:53 AM jbidinge

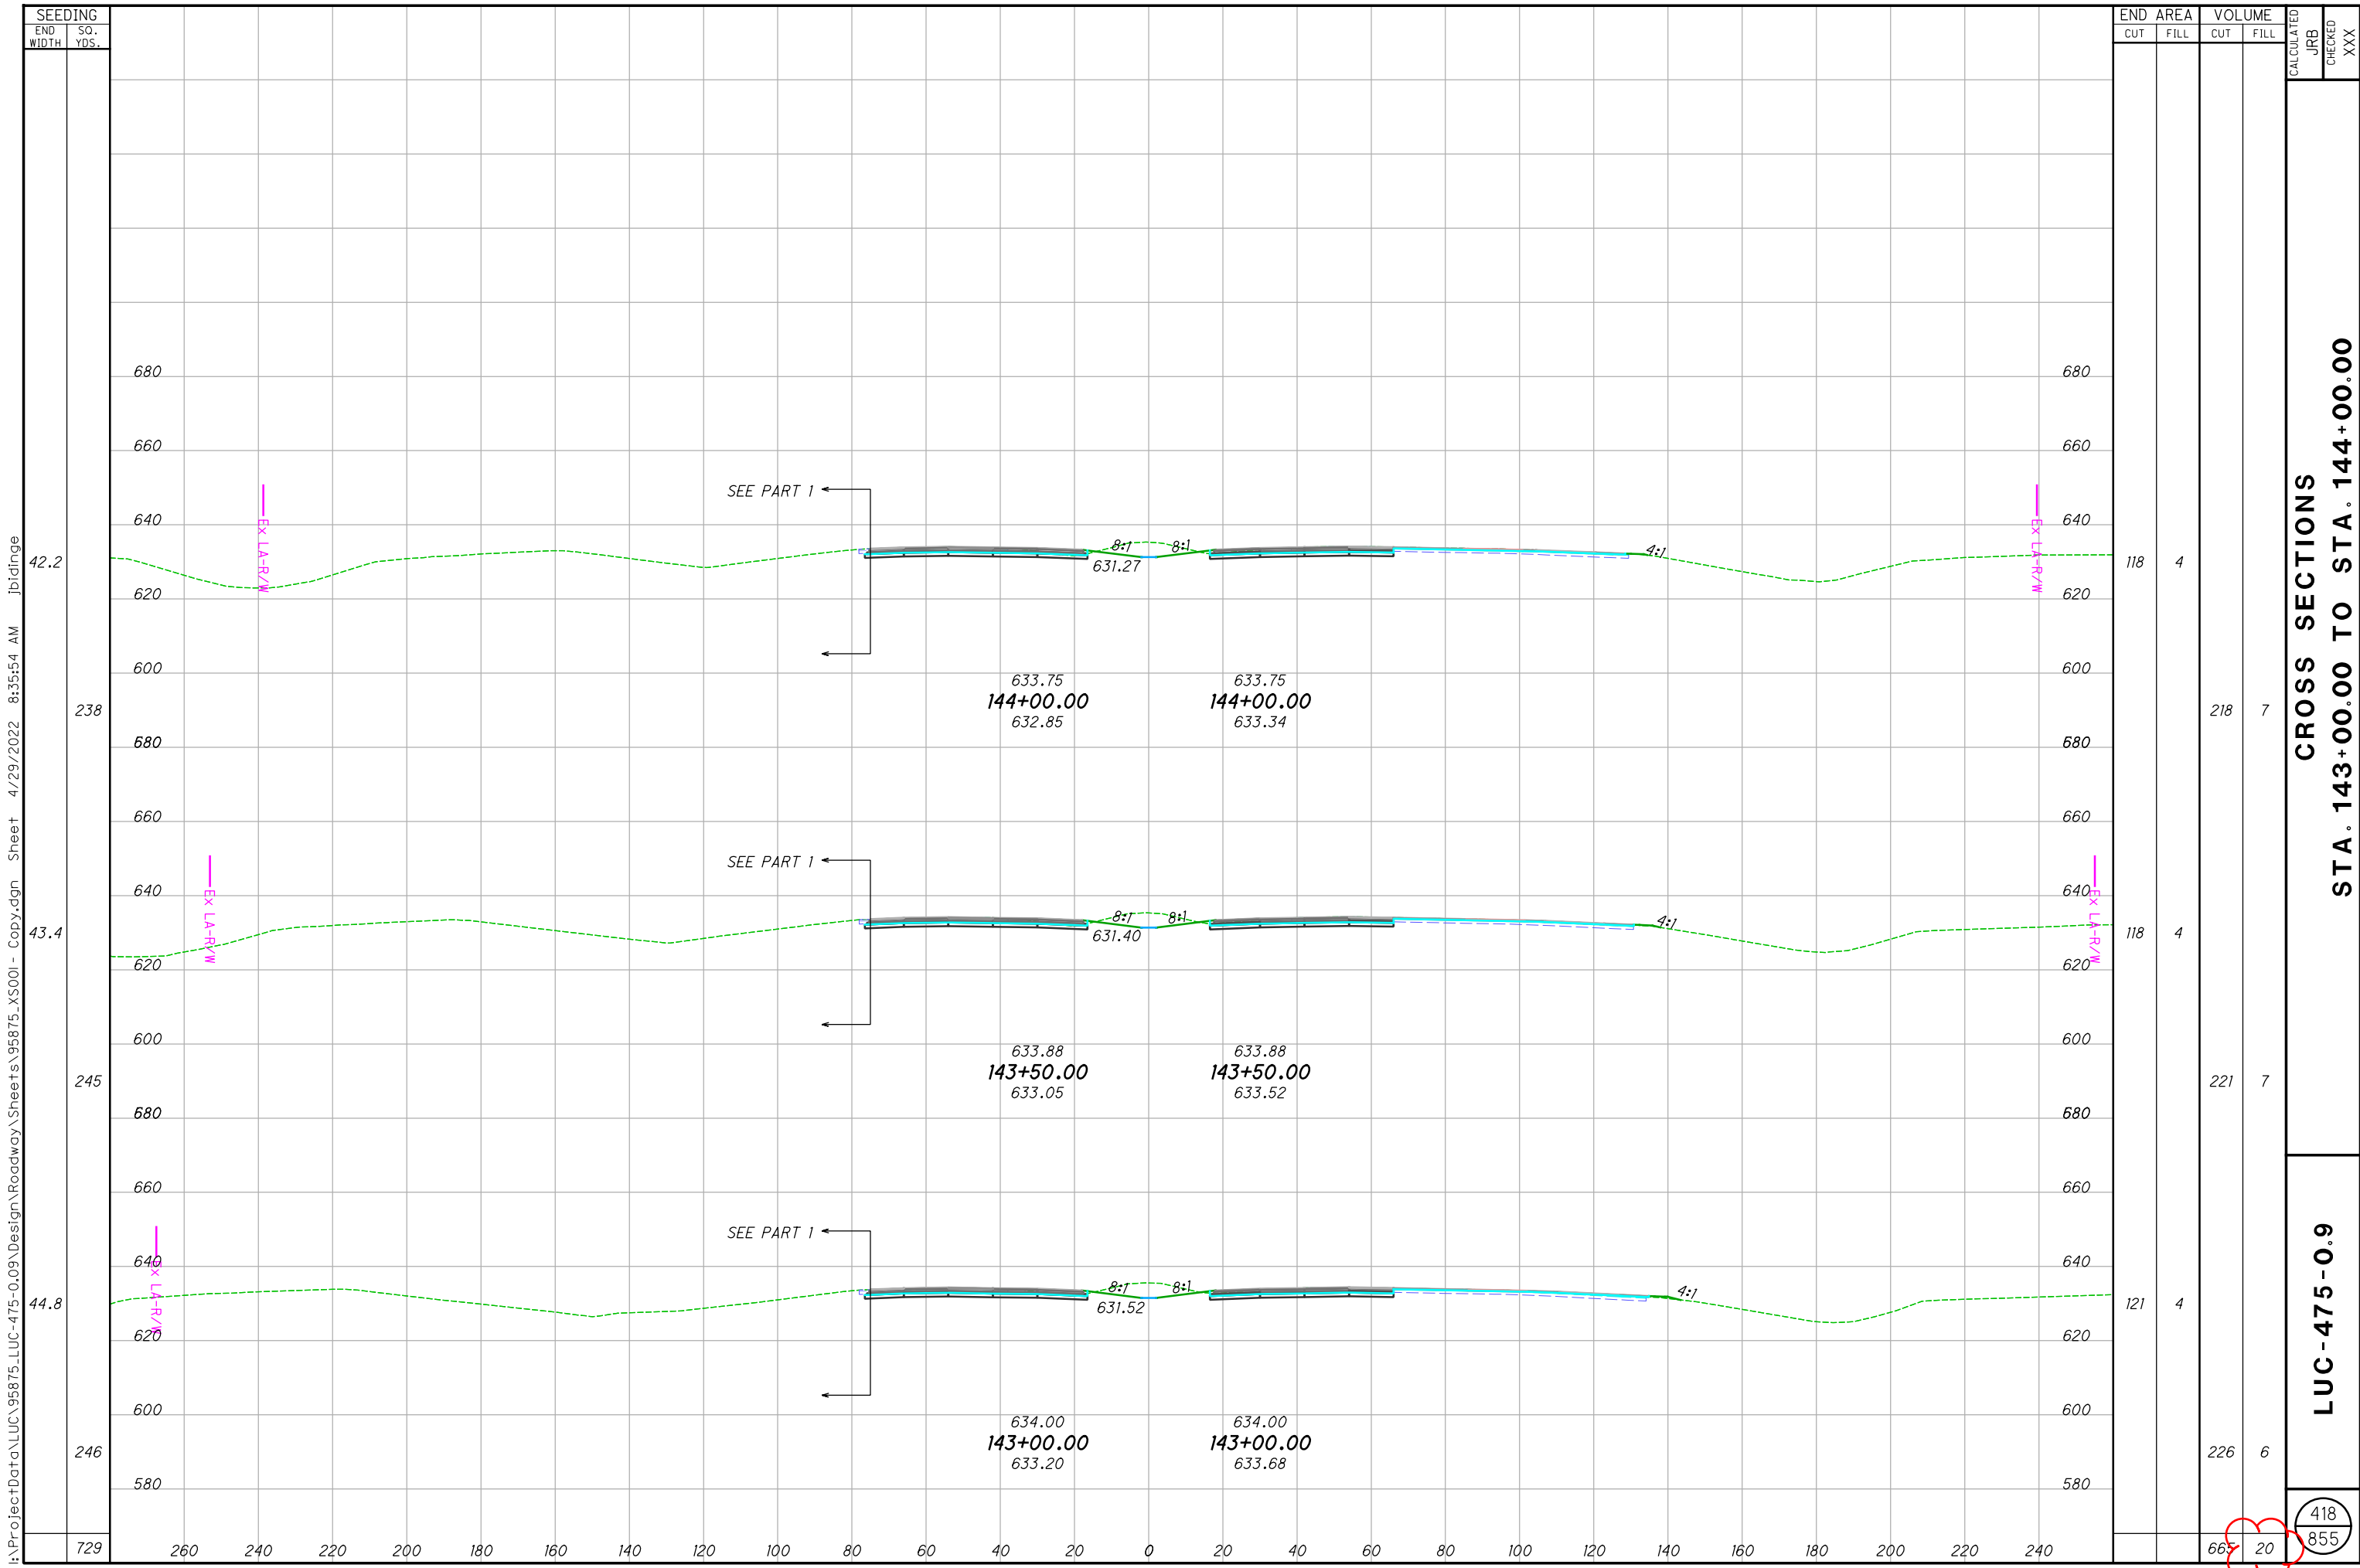

SEEDING	
END WIDTH	SO. YDS.
729	

END AREA		VOLUME		CALCULATED	
CUT	FILL	CUT	FILL	JRB	XXX
118	4	218	7		
118	4	221	7		
121	4	226	6		

**CROSS SECTIONS**  
**STA. 143+00.00 TO STA. 144+00.00**


**LUC-475-0.9**

418  
855

I:\ProjectData\LUC-475-0.9\Design\Roadway\Sheets\95875\_XS001 - Copy.dgn Sheet 4/29/2022 8:35:54 AM jbidinge

I:\ProjectData\LUC\95875\_LUC-475-0.9\Design\Roadway\Sheets\95875\_XS001 - Copy.dgn Sheet 4/29/2022 8:35:55 AM jbidinge

SEEDING	
END WIDTH	SO. YDS.
711	

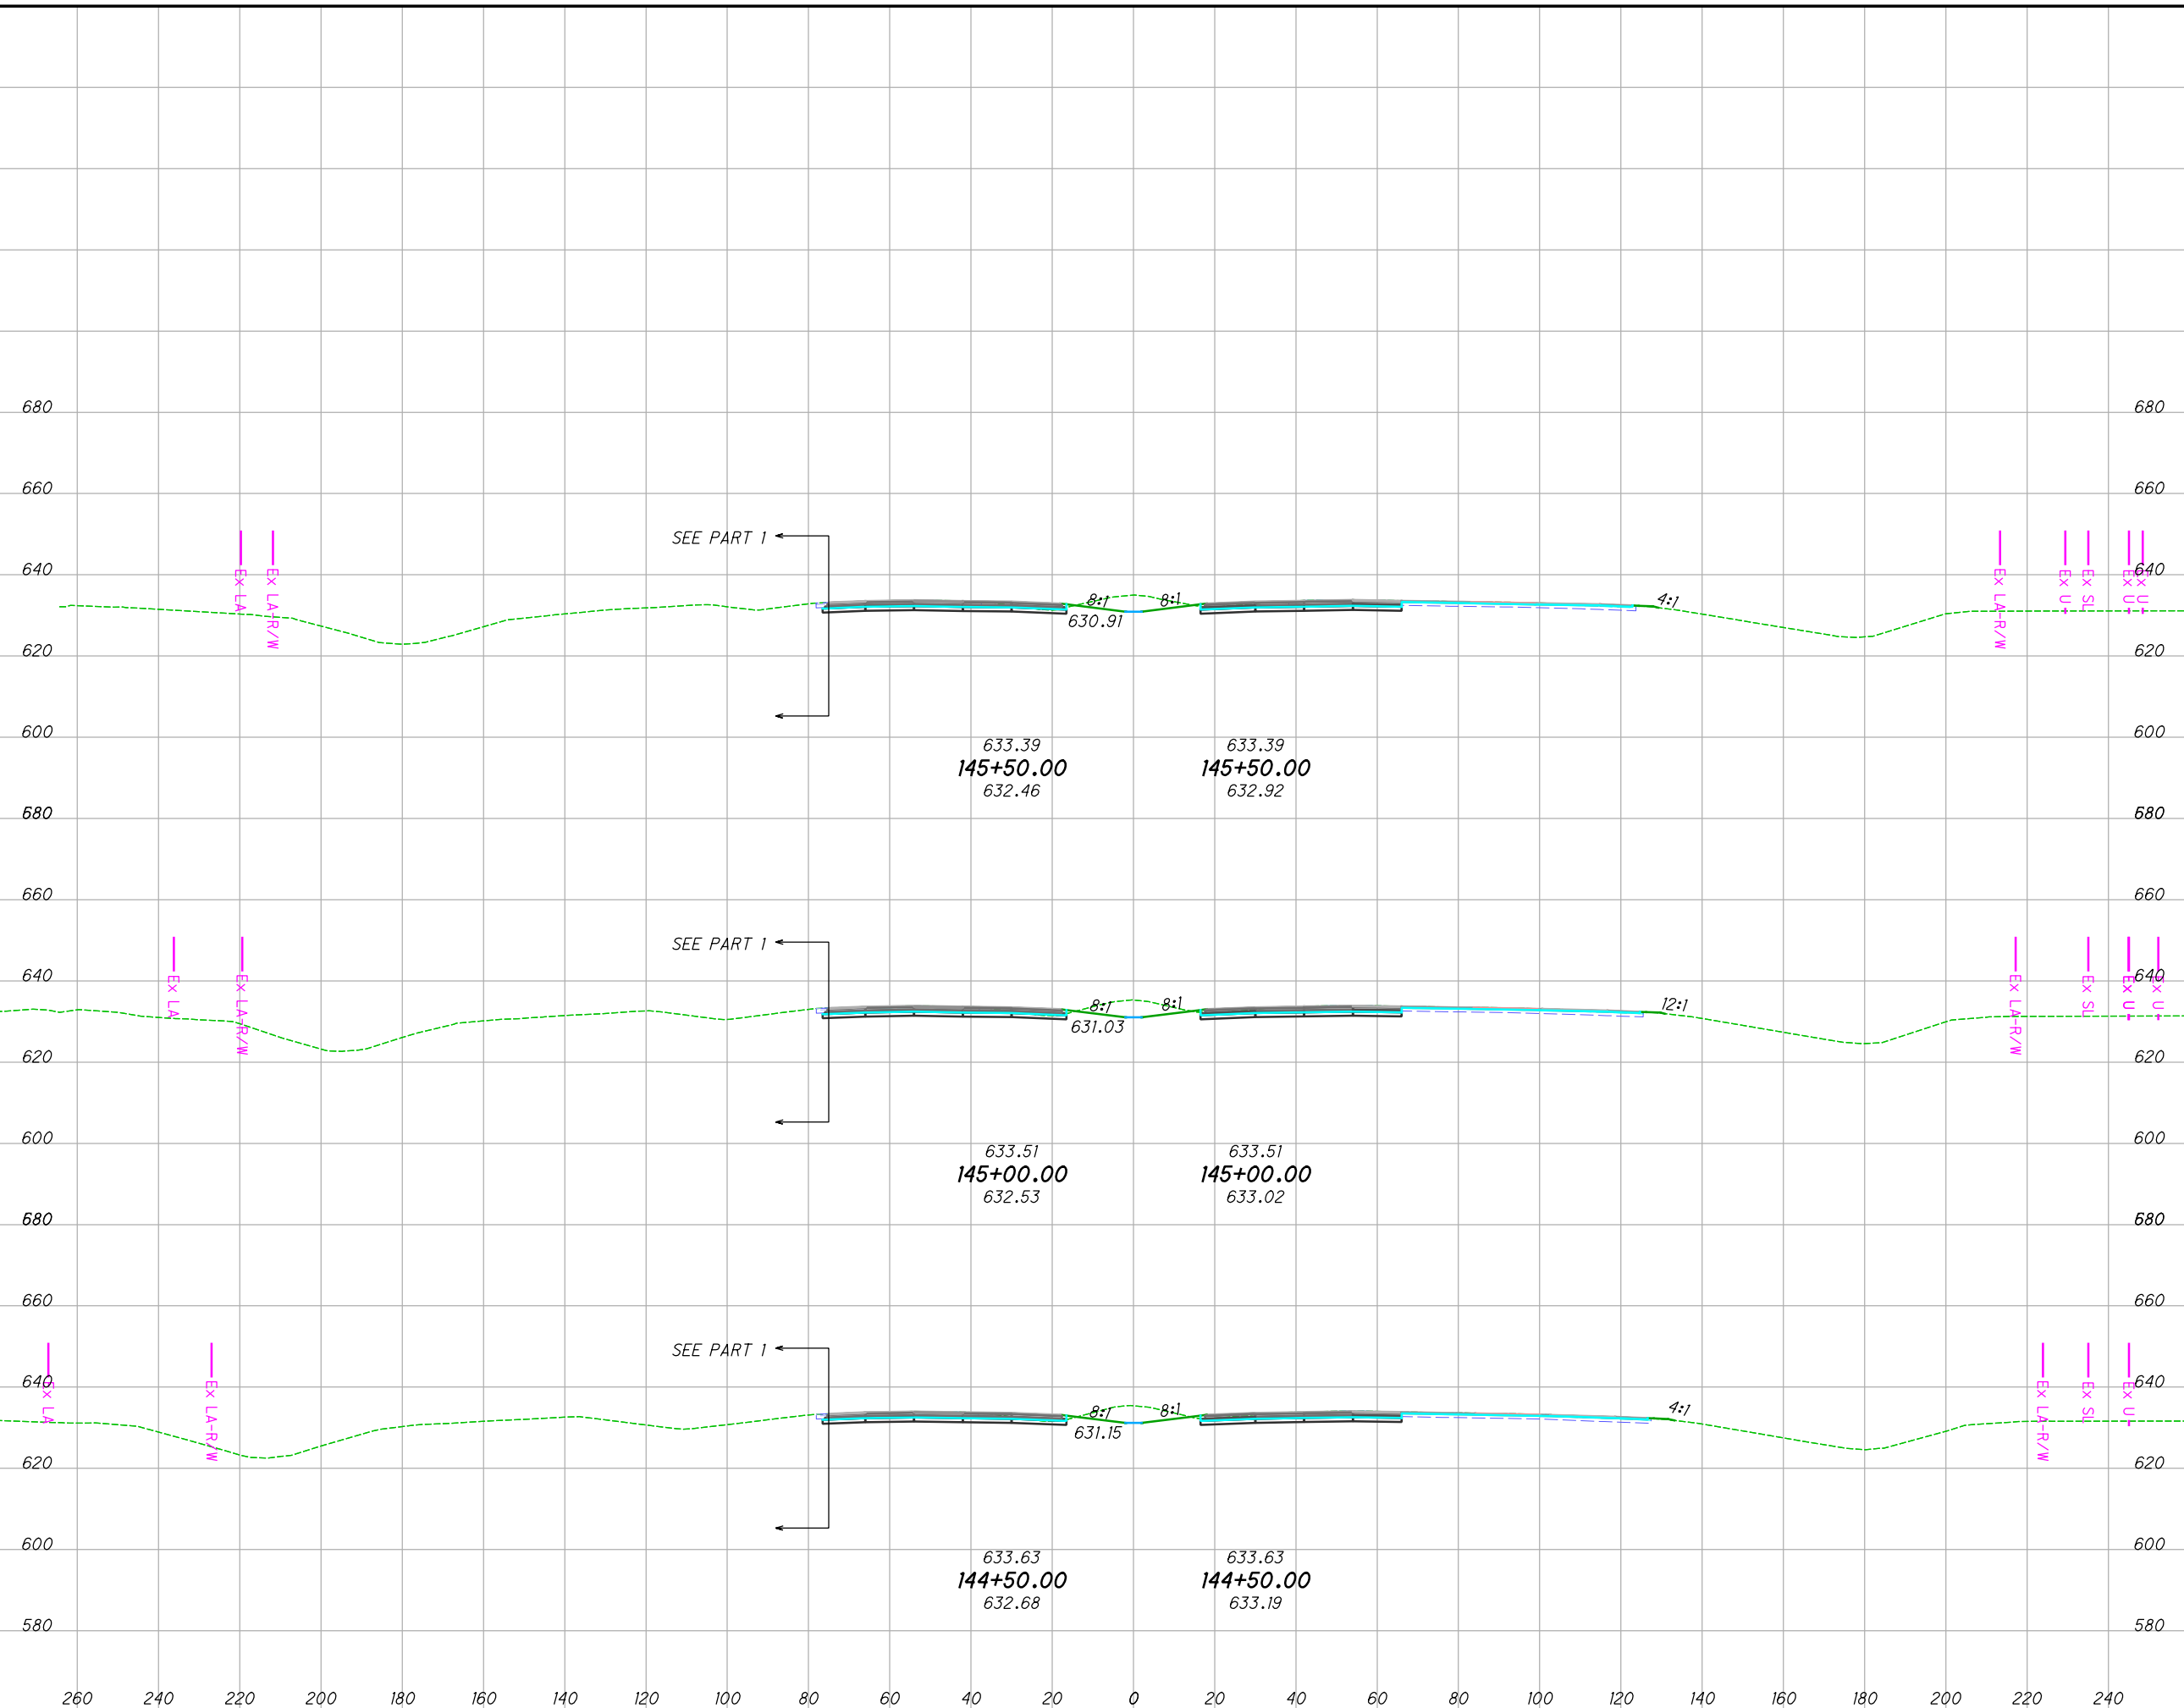

END AREA		VOLUME		CALCULATED	CHECKED
CUT	FILL	CUT	FILL		
117	3	217	7		
118	5	220	9		
119	5	219	8		
				658	24


**CROSS SECTIONS**  
**STA. 144+50.00 TO STA. 145+50.00**

**LUC-475-0.9**

419  
855

I:\ProjectData\LUC-475-0.09\Design\Roadway\Sheets\95875\_XS001 - Copy.dgn Sheet 4/29/2022 8:35:56 AM j\_bdinge

SEEDING	
END WIDTH	SO. YDS.
688	41.6
260	41.8
240	39.6
220	229

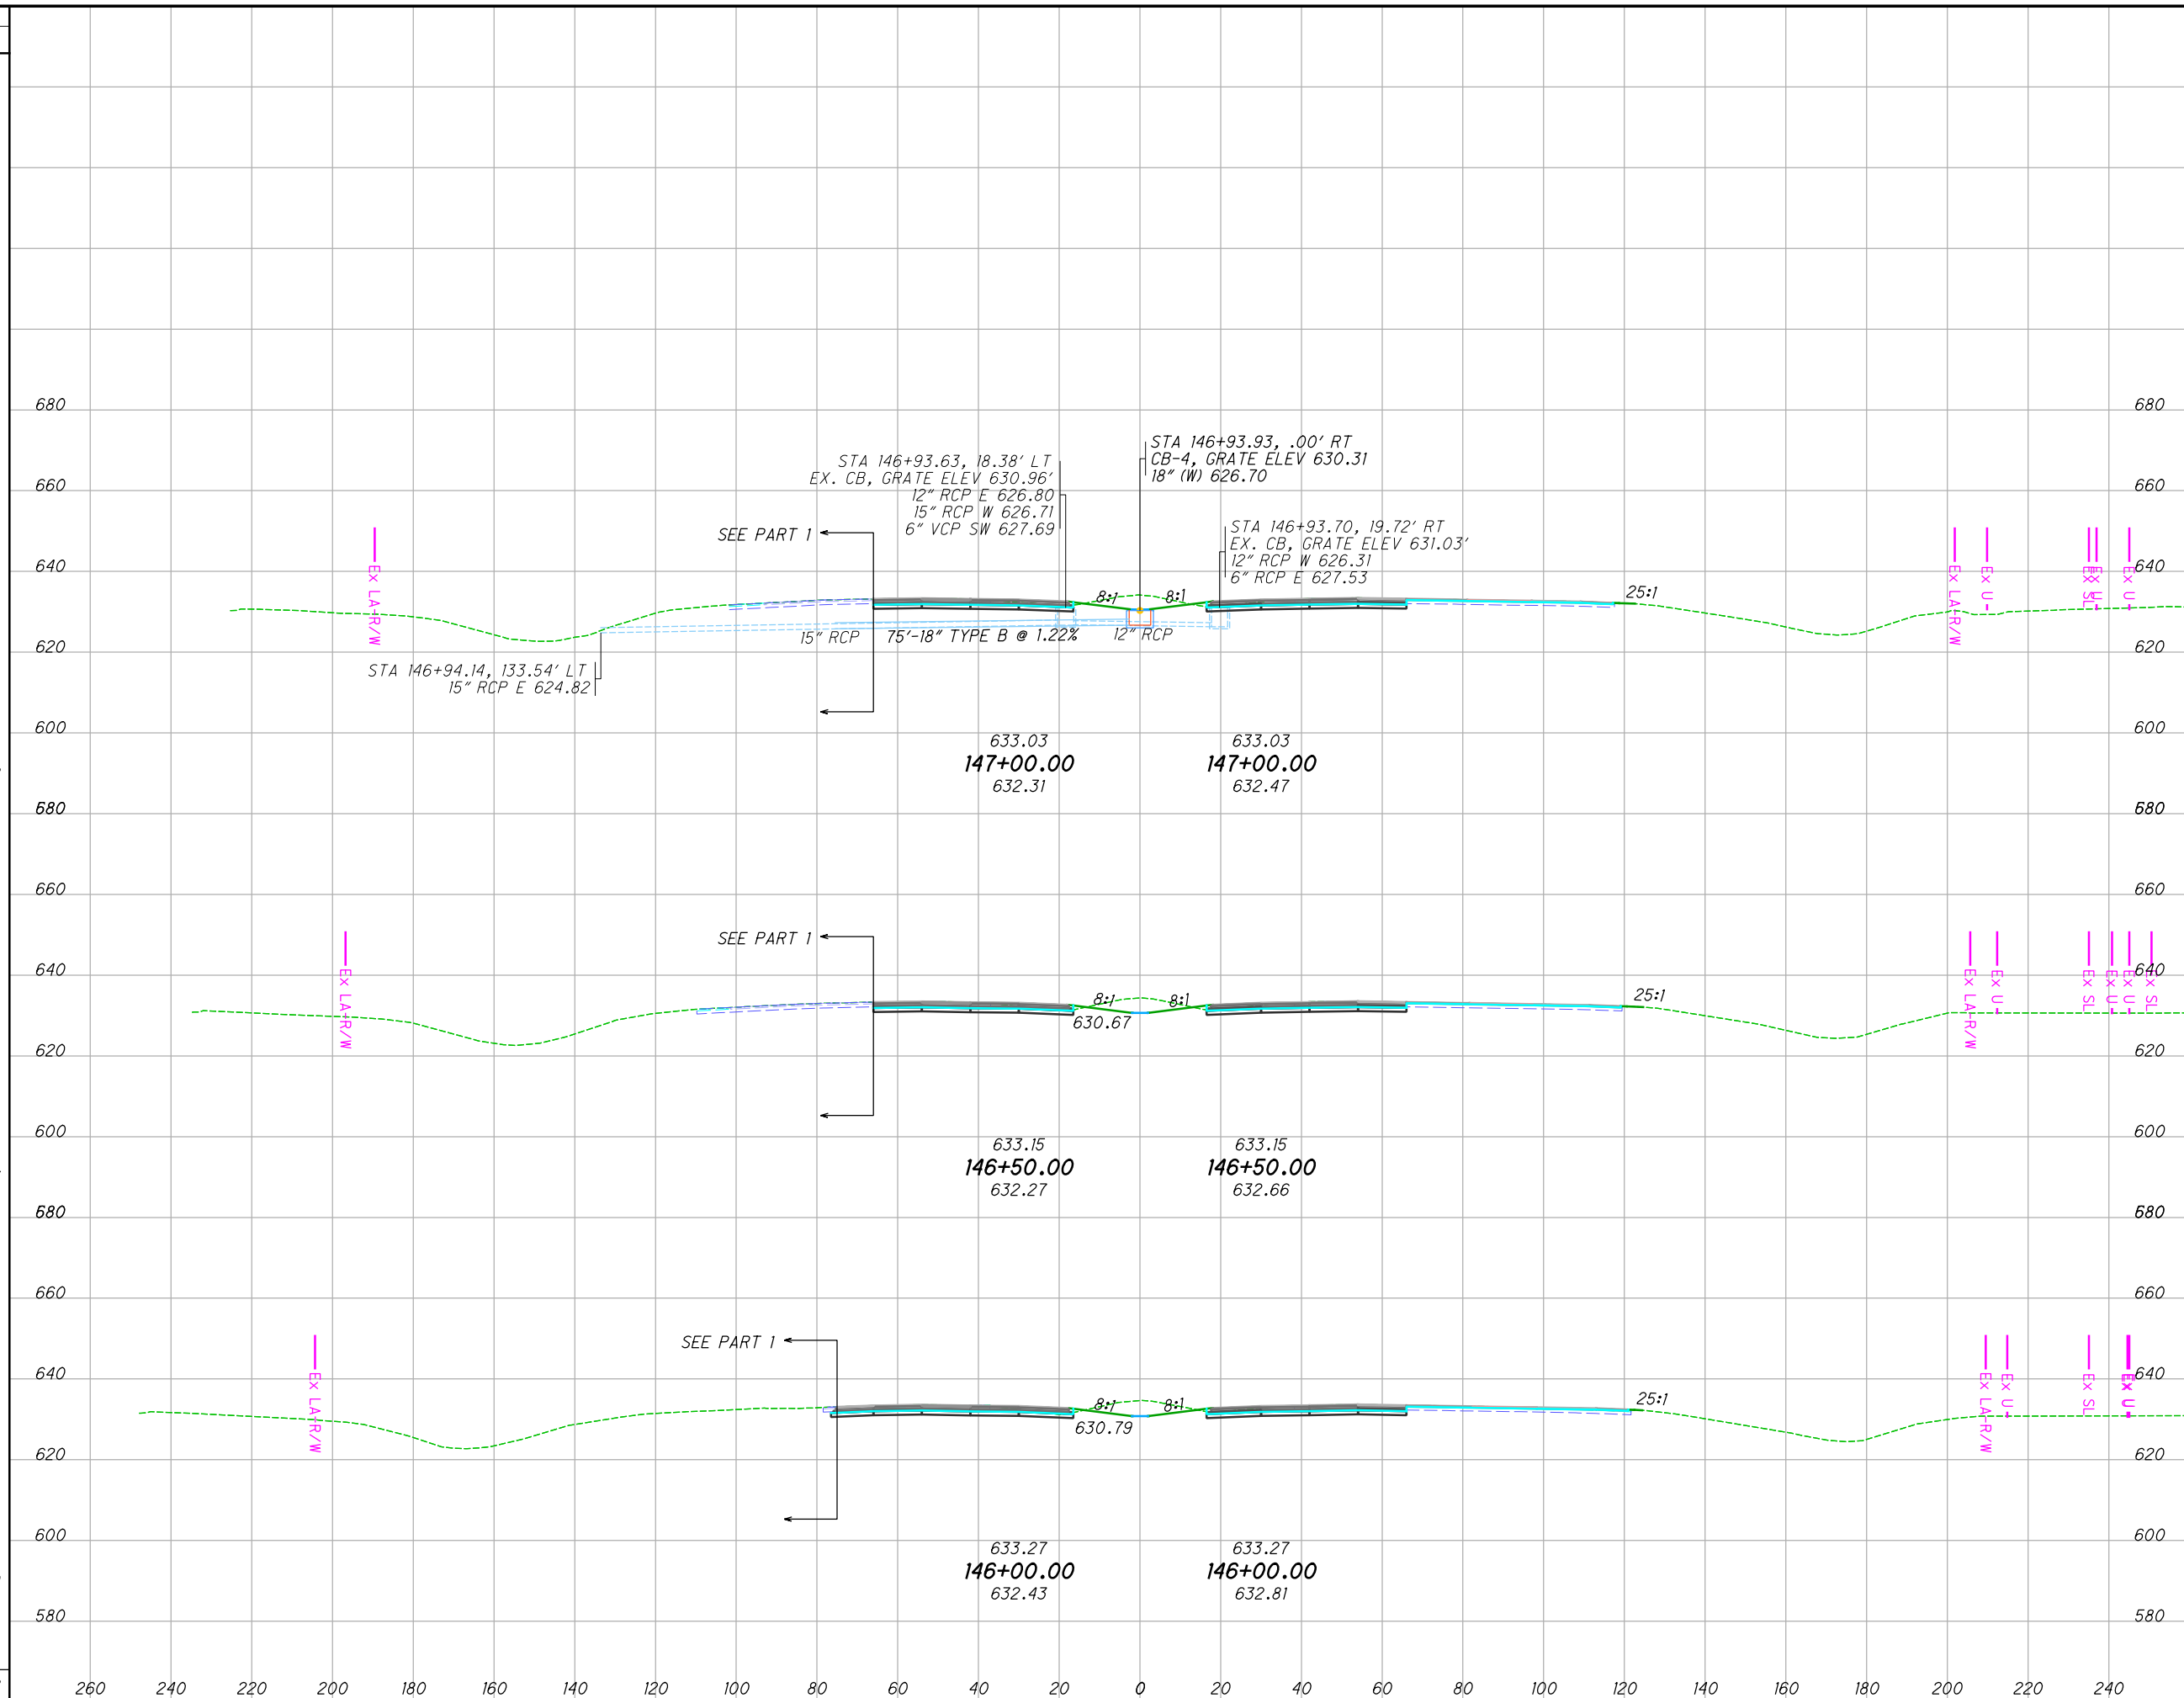


END AREA		VOLUME		CALCULATED JRB	CHECKED XXX
CUT	FILL	CUT	FILL		
100	4	183	7		
98	4	194	6		
111	3	211	6		
		589	19		

**CROSS SECTIONS  
STA. 146+00.00 TO STA. 147+00.00**

**LUC-475-0.9**

420  
855

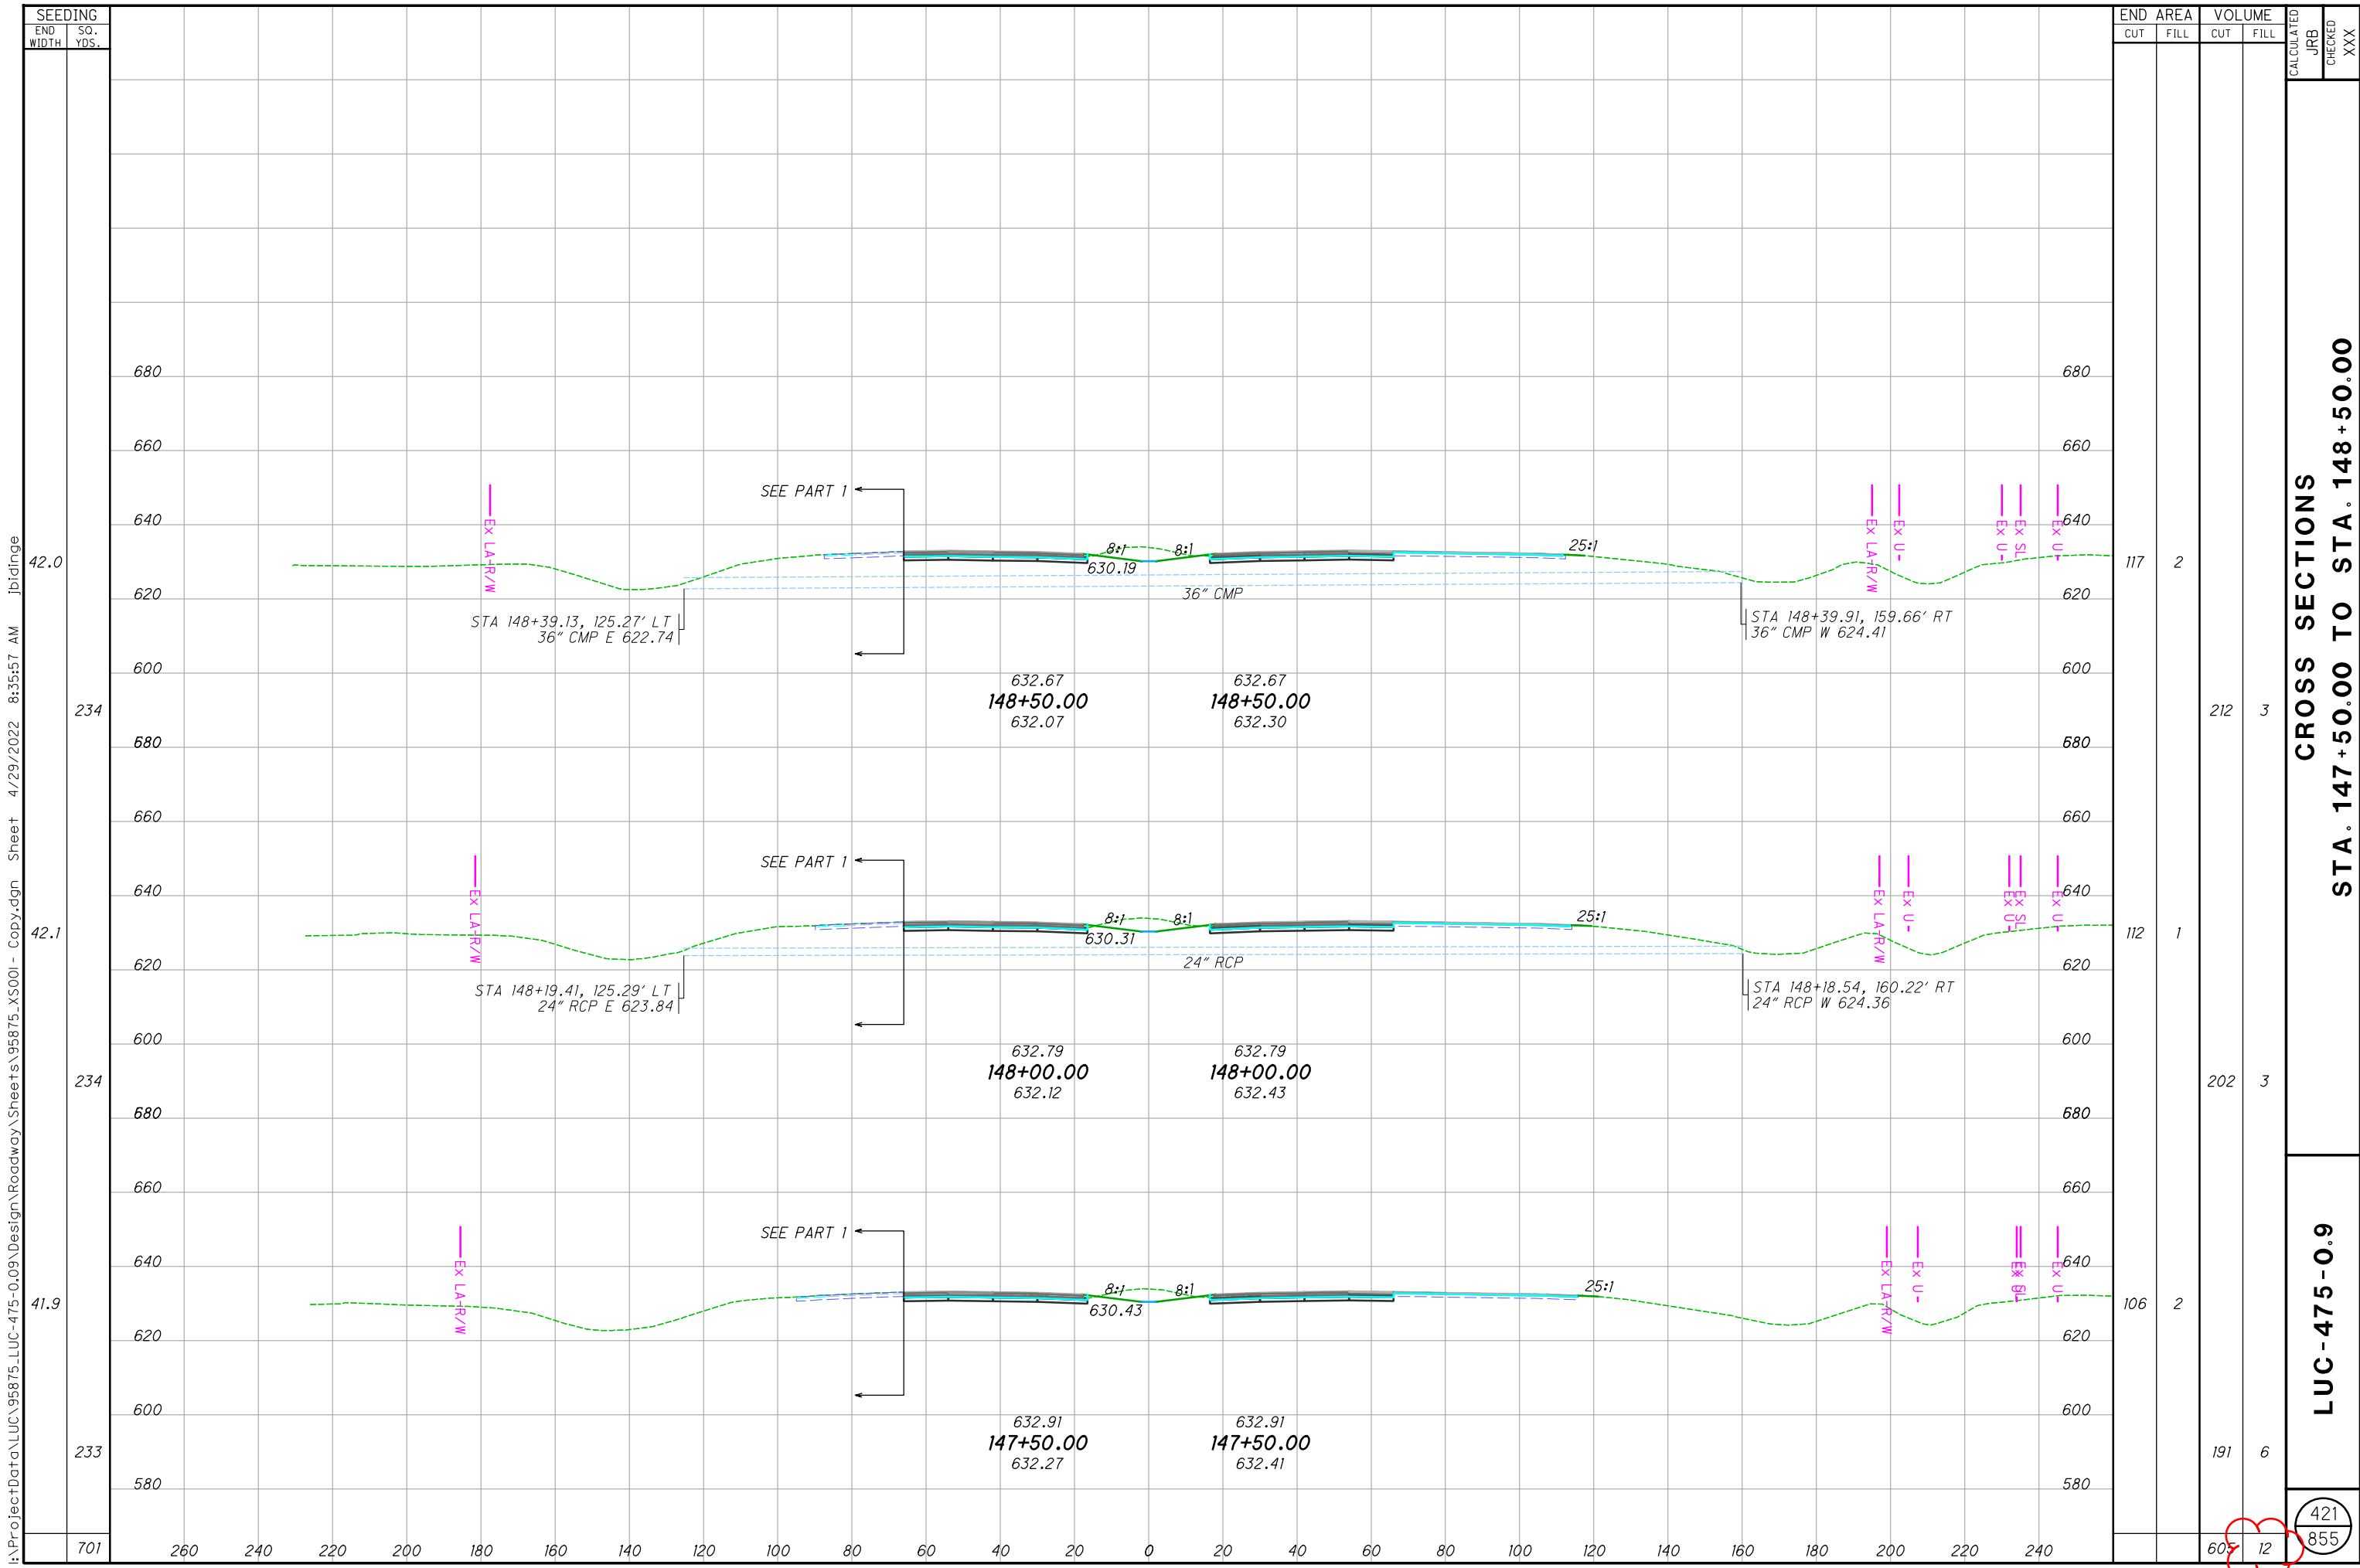

SEEDING	
END WIDTH	SO. YDS.
701	

END AREA		VOLUME		CALCULATED		
CUT	FILL	CUT	FILL	JRB	CHECKED	XXX
117	2	117	2			
112	1	112	1			
106	2	106	2			
605	12	605	12			

**CROSS SECTIONS**  
**STA. 147+50.00 TO STA. 148+50.00**

**LUC-475-0.9**


421  
 855

I:\ProjectData\LUC\95875\_LUC-475-0.9\Design\Roadway\Sheets\95875\_X5001 - Copy.dgn Sheet 4/29/2022 8:35:57 AM jbidinge



I:\ProjectData\LUC\95875\_LUC-475-0.09\Design\Roadway\Sheets\95875\_XS001 - Copy.dgn Sheet 4/29/2022 8:35:58 AM jbidinge

SEEDING	
END WIDTH	SO. YDS.
712	

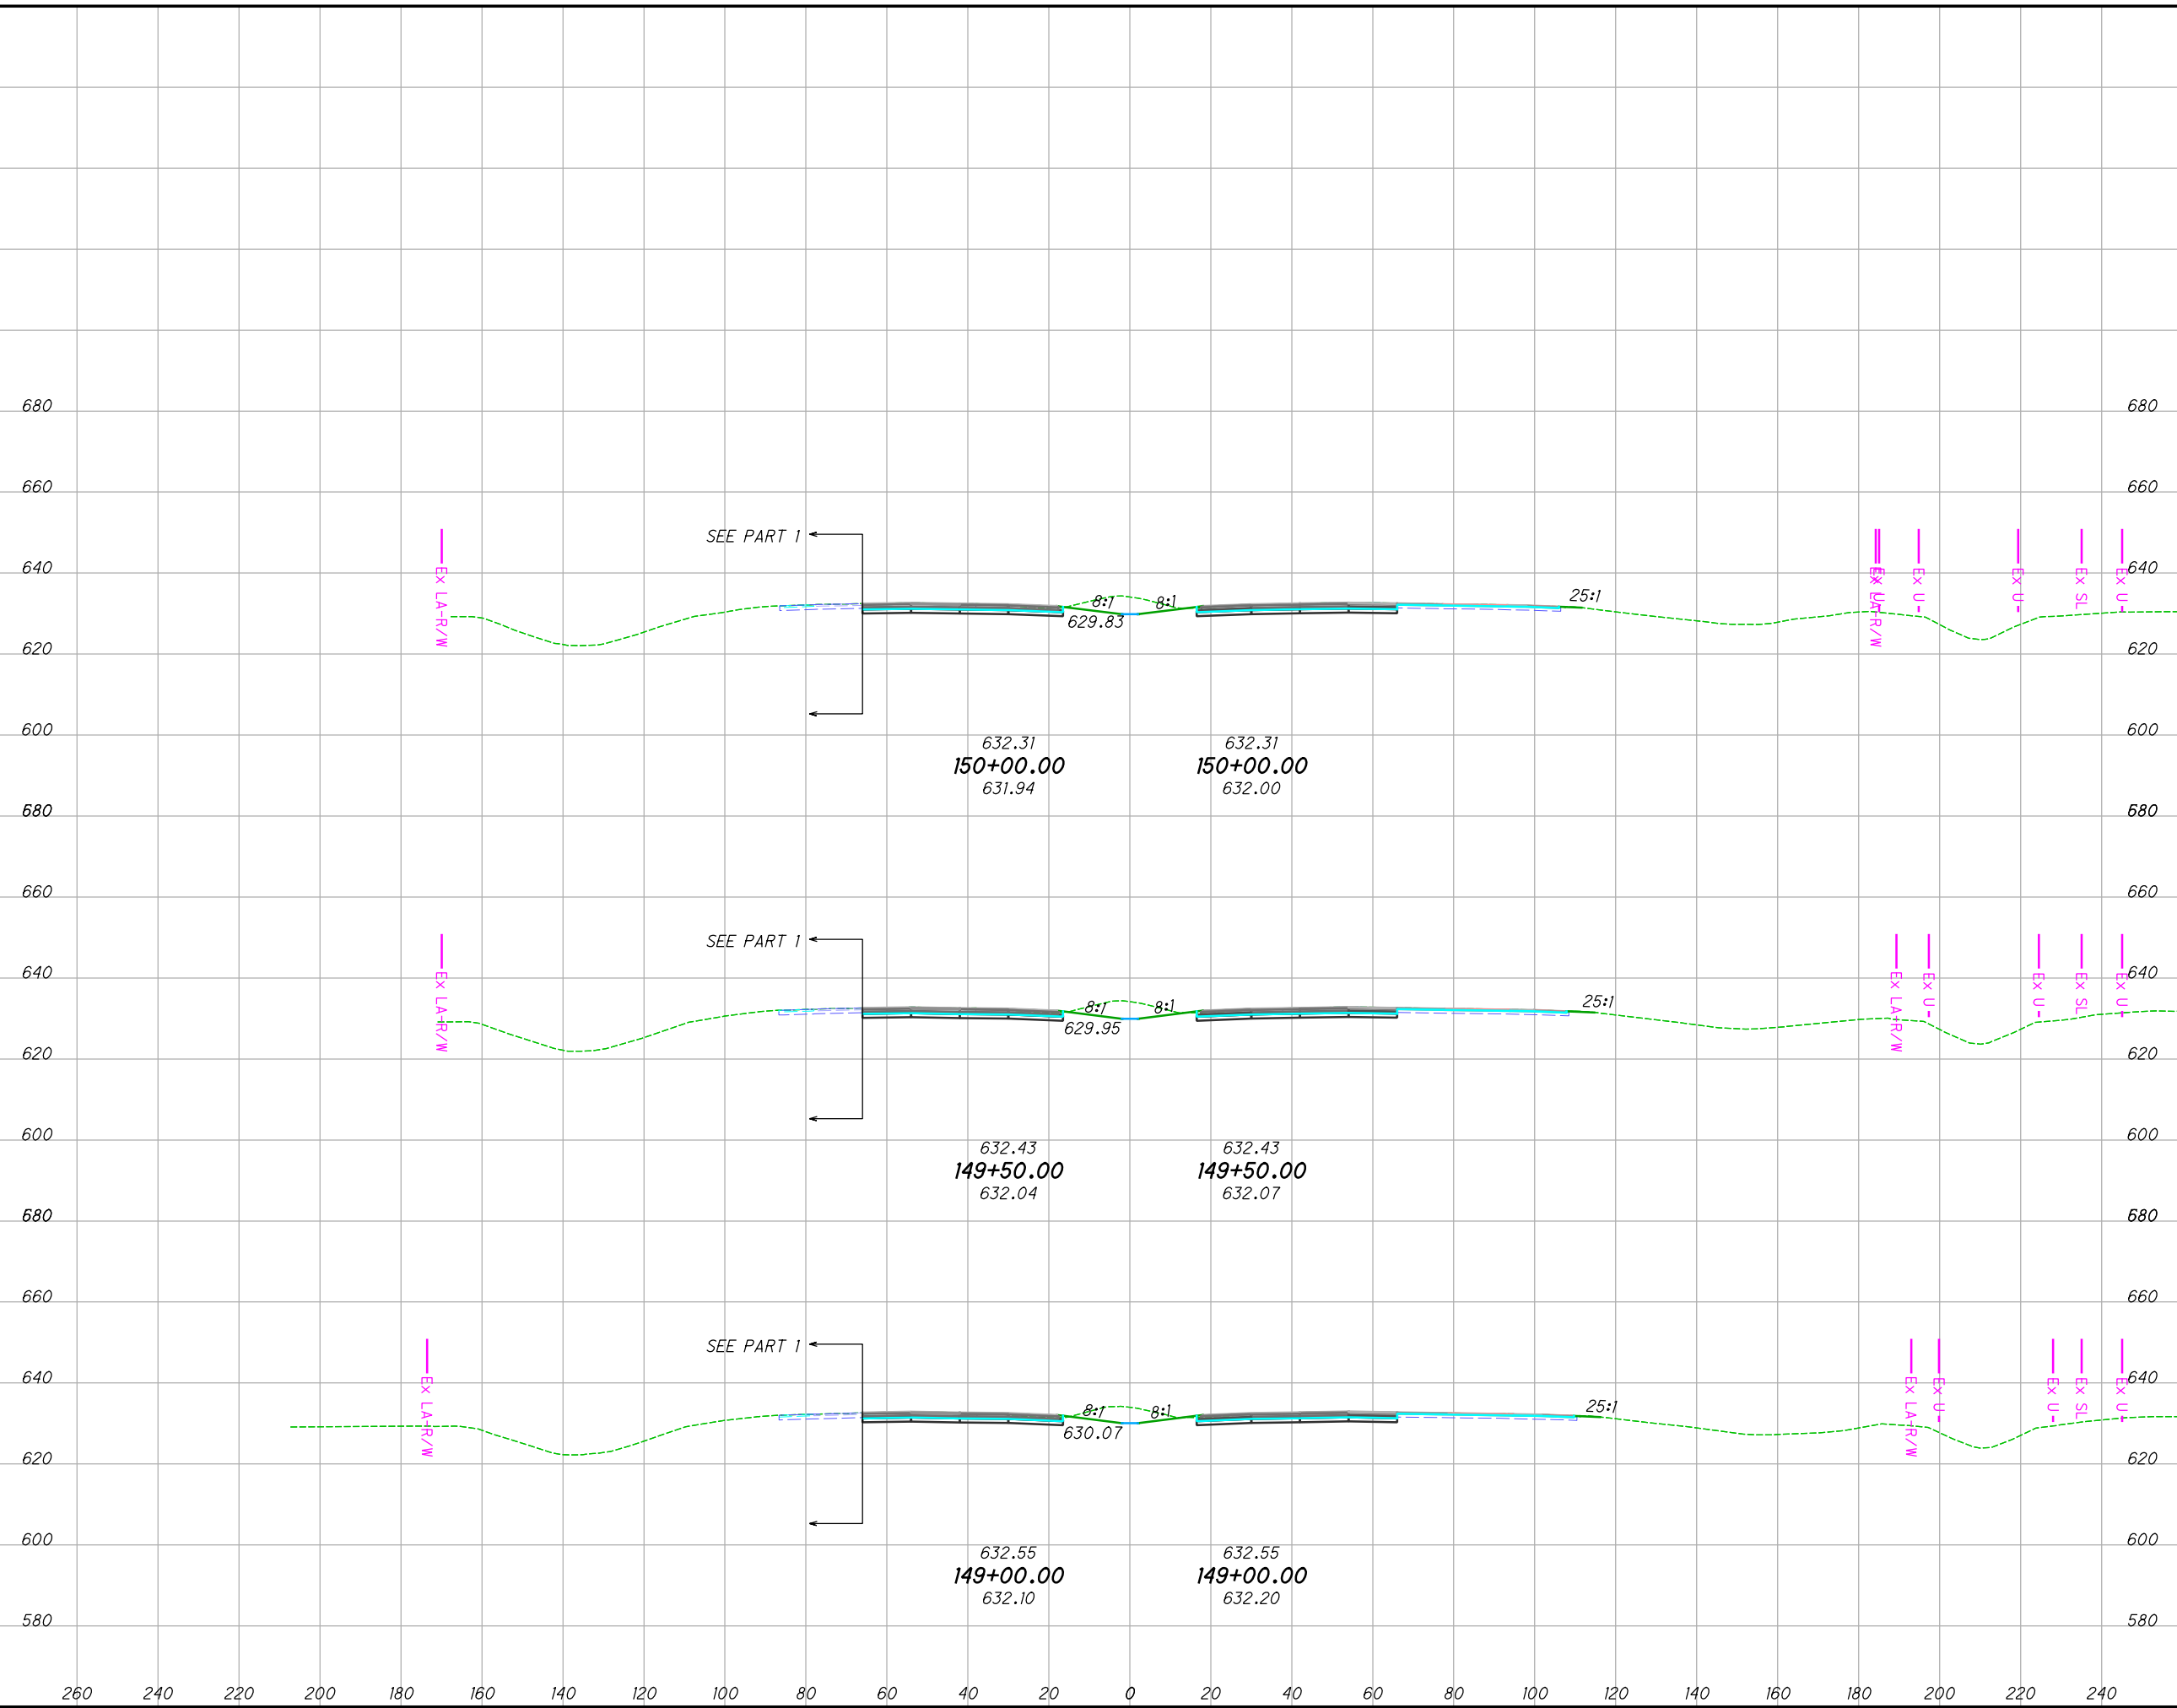


END AREA		VOLUME	
CUT	FILL	CUT	FILL
138	0	252	0
134	0	240	1
125	1	224	3
		716	4

CROSS SECTIONS  
 STA. 149+00.00 TO STA. 150+00.00  
 LUC-475-0.9

422  
 855

I:\ProjectData\LUC\95875\_LUC-475-0.09\Design\Roadway\Sheets\95875\_XS001 - Copy.dgn Sheet 4/29/2022 8:35:59 AM jbdinge

SEEDING	
END WIDTH	SO. YDS.
674	38.7
220	40.2
225	40.5
229	

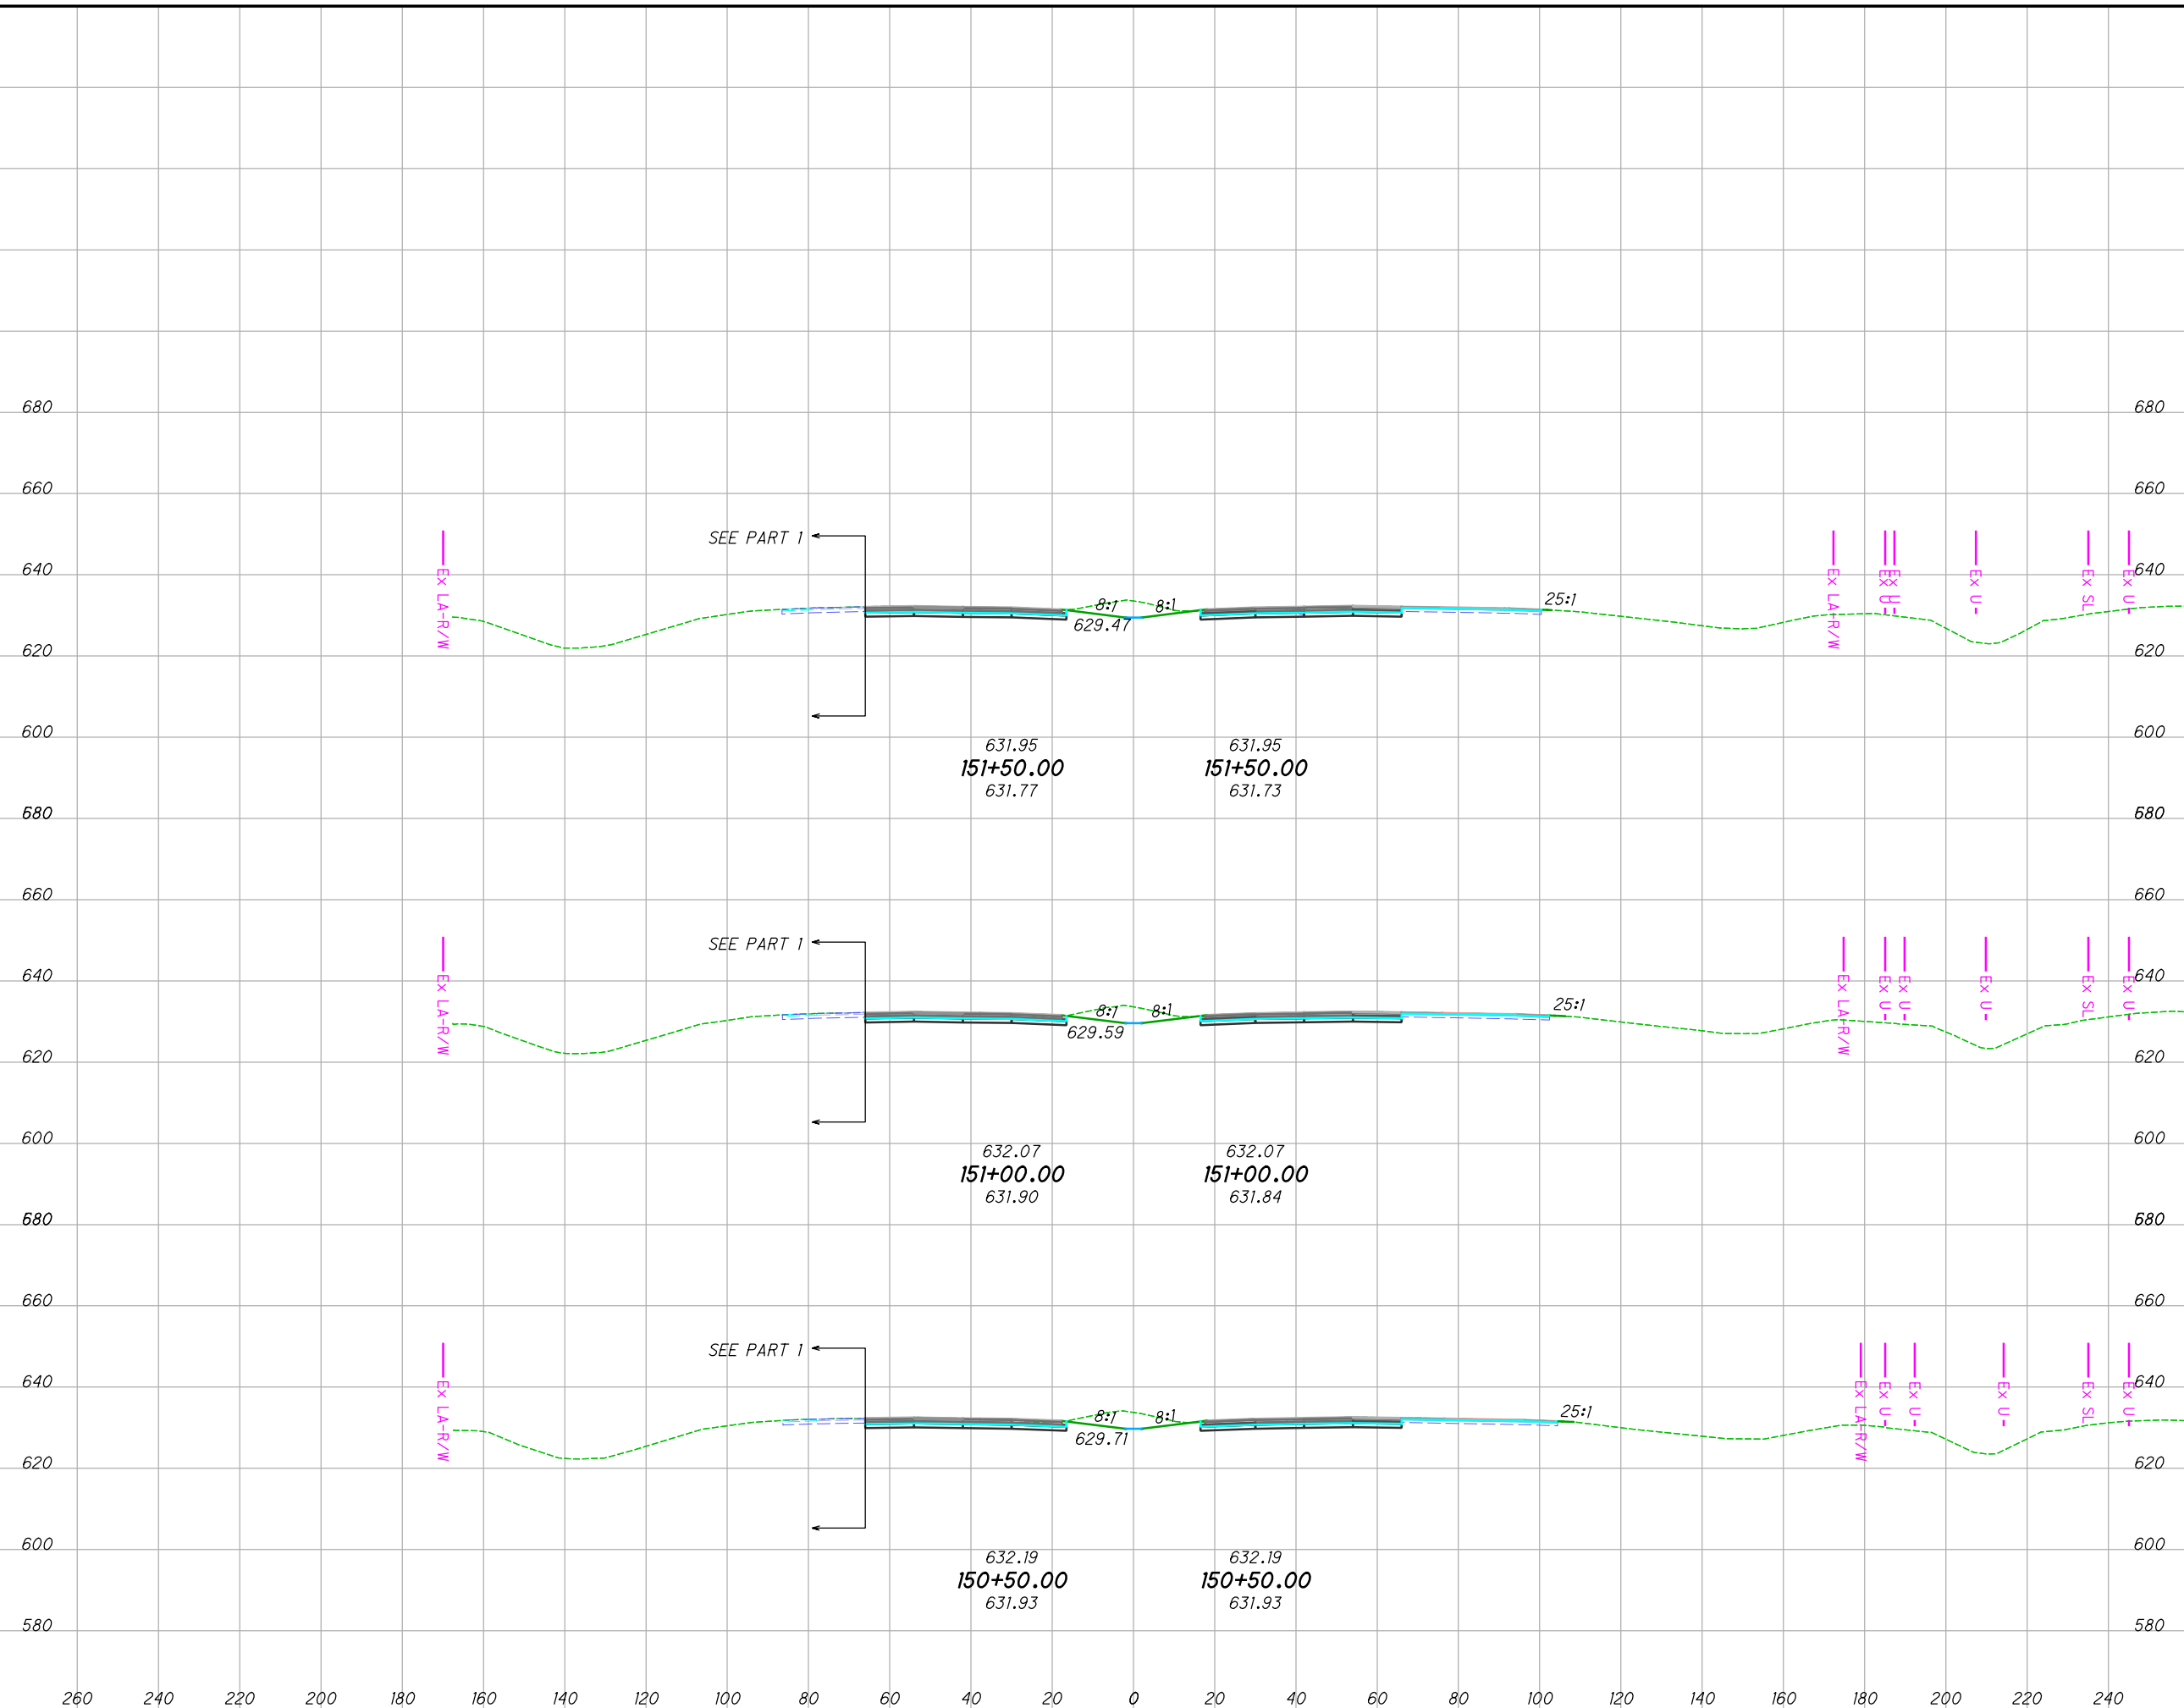

END AREA		VOLUME		CALCULATED	CHECKED
CUT	FILL	CUT	FILL		
		136	1		JRB
		252	1		XXX
		137	0		
		255			
		138	0		
		256			
		767	1		


**CROSS SECTIONS  
STA. 150+50.00 TO STA. 151+50.00**

**LUC-475-0.9**

423  
855

I:\ProjectData\LUC-475-0.09\Design\Roadway\Sheets\95875\_XS001 - Copy.dgn Sheet 4/29/2022 8:36:00 AM jbidinge

SEEDING	
END WIDTH	SO. YDS.
656	
260	
240	
220	
20	
40	
60	
80	
100	
120	
140	
160	
180	
200	
220	
240	

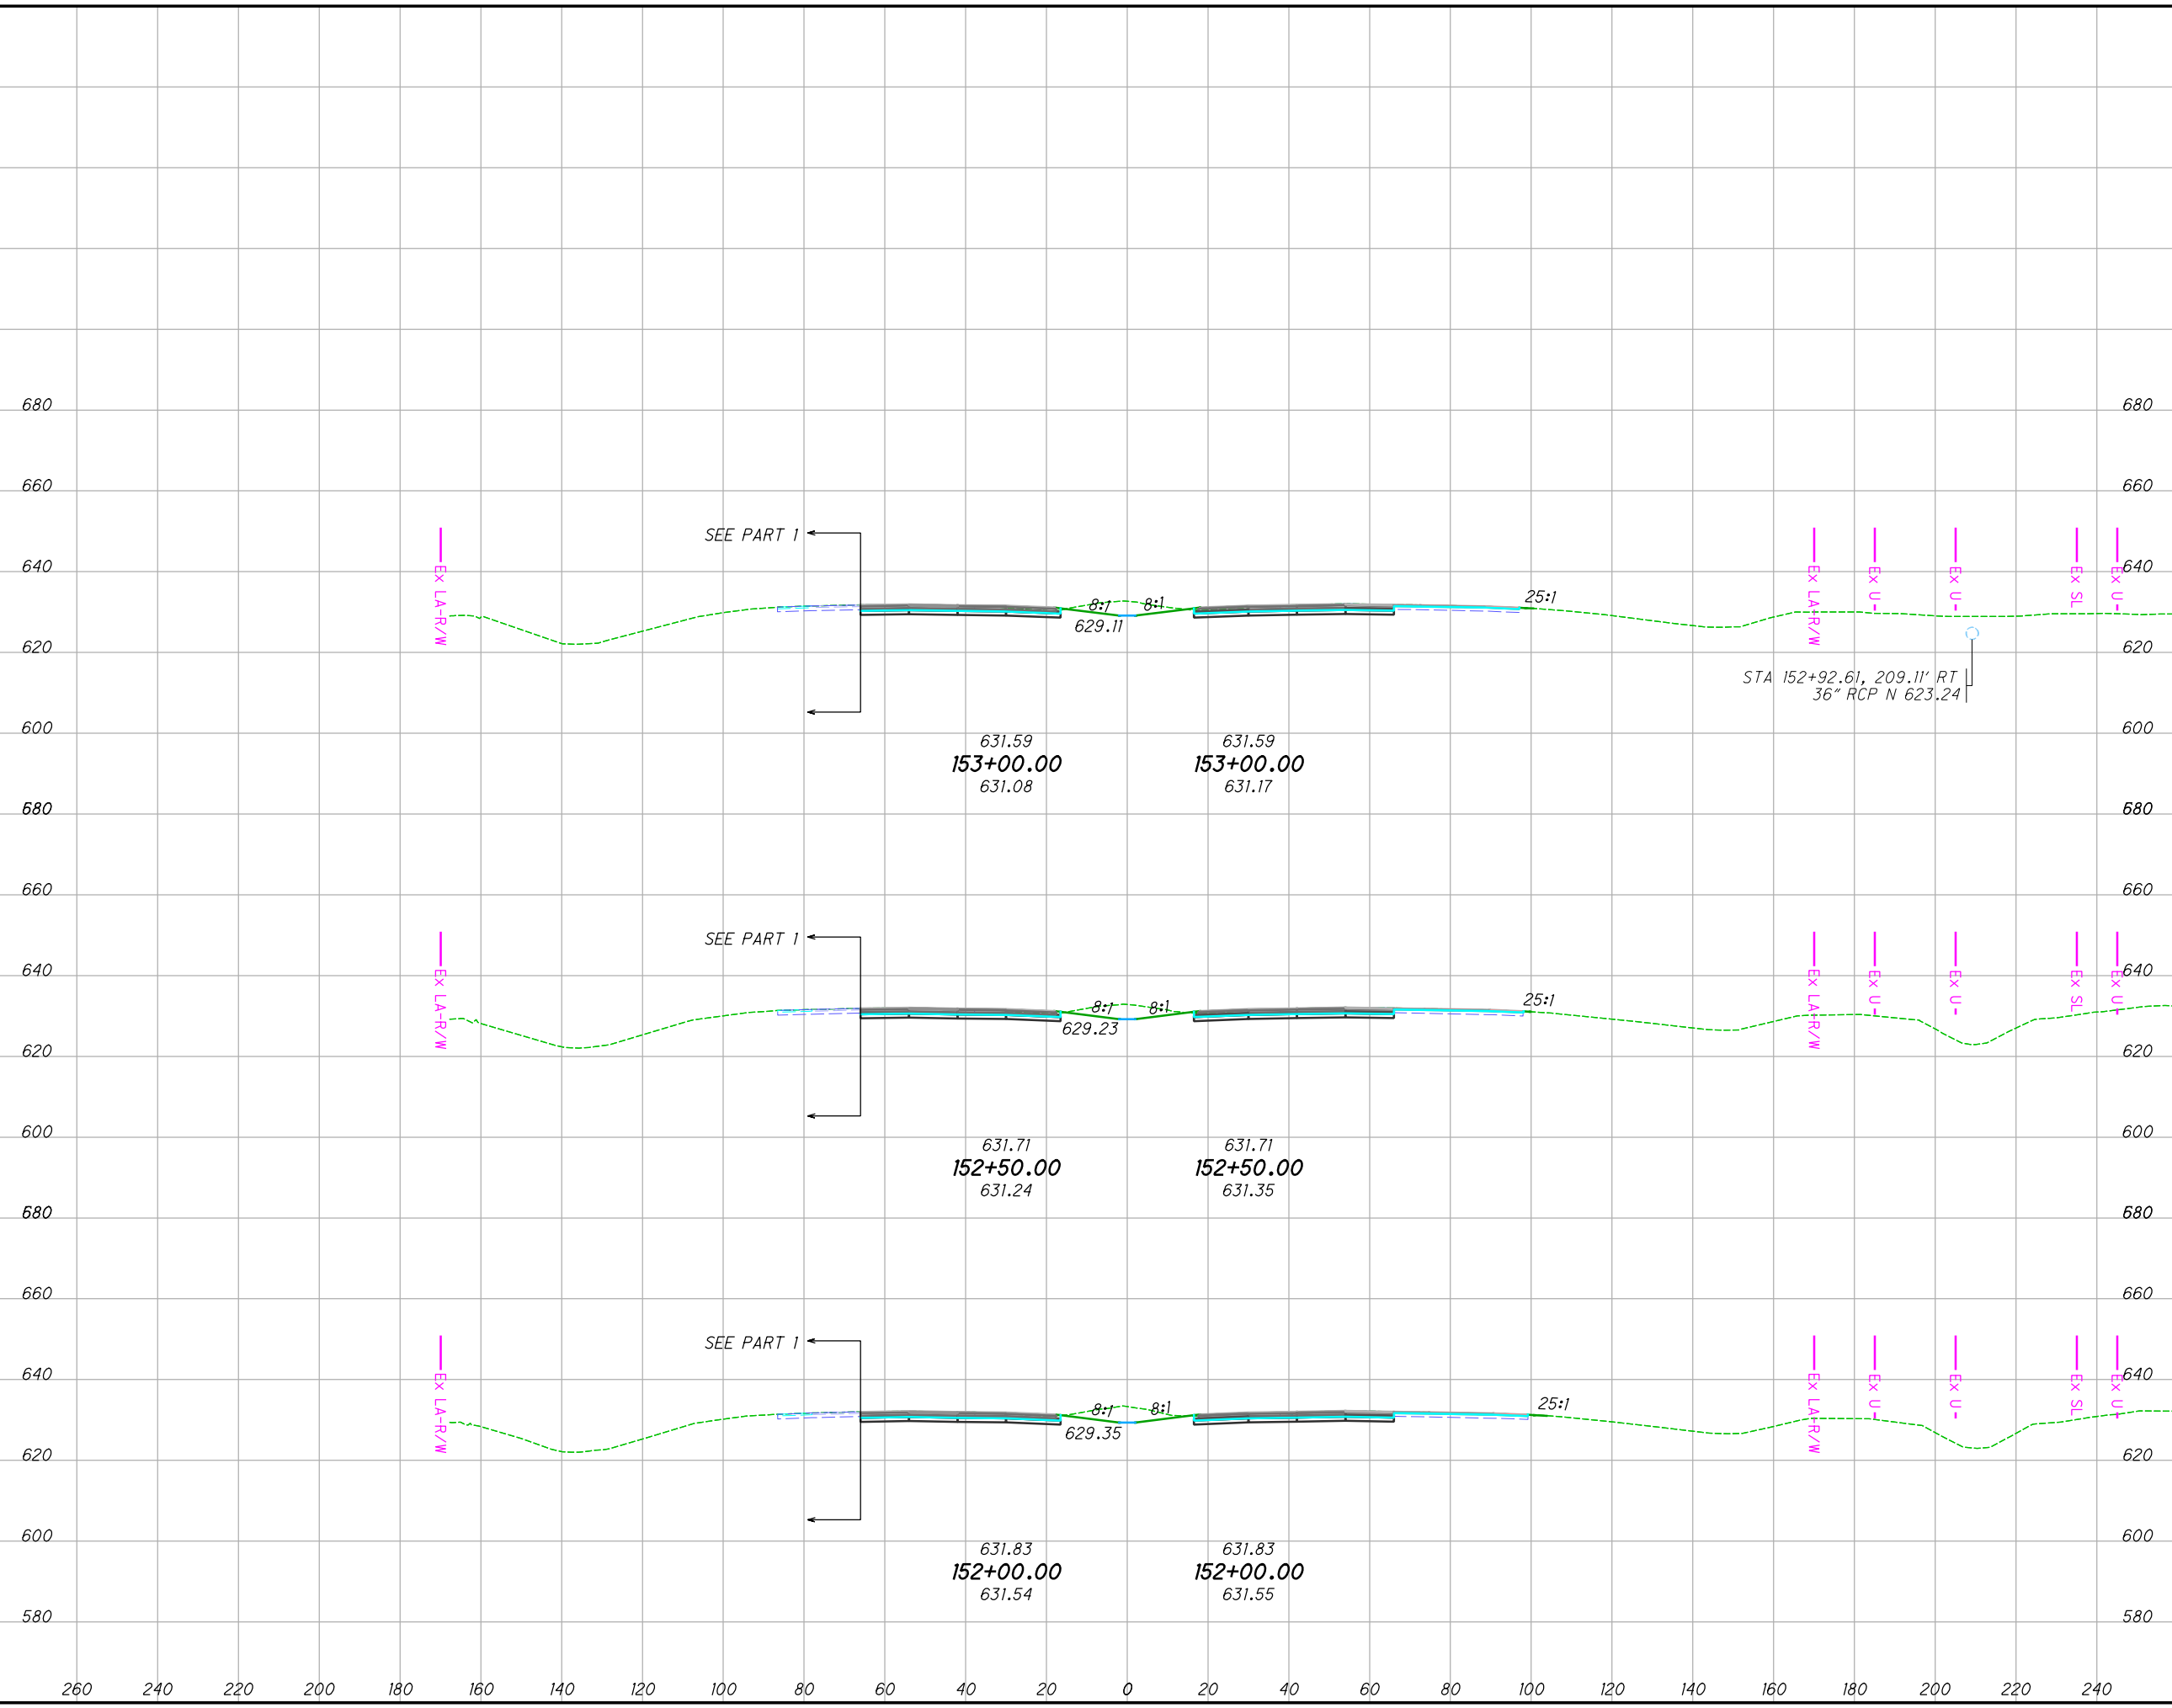

END AREA		VOLUME		CALCULATED		
CUT	FILL	CUT	FILL	JRB	CHECKED	XXX
117	1	221	1			
122	0	234	1			
130	1	246	2			
		70	4			


**CROSS SECTIONS**  
**STA. 152+00.00 TO STA. 153+00.00**

**LUC-475-0.9**

424  
855

I:\ProjectData\LUC-475-0.09\Design\Roadway\Sheets\95875\_XS001 - Copy.dgn Sheet 4/29/2022 8:36:01AM jbidinge

SEEDING	
END WIDTH	SO. YDS.
667	
260	
240	
220	
20	
40	
60	
80	
100	
120	
140	
160	
180	
200	
220	
240	

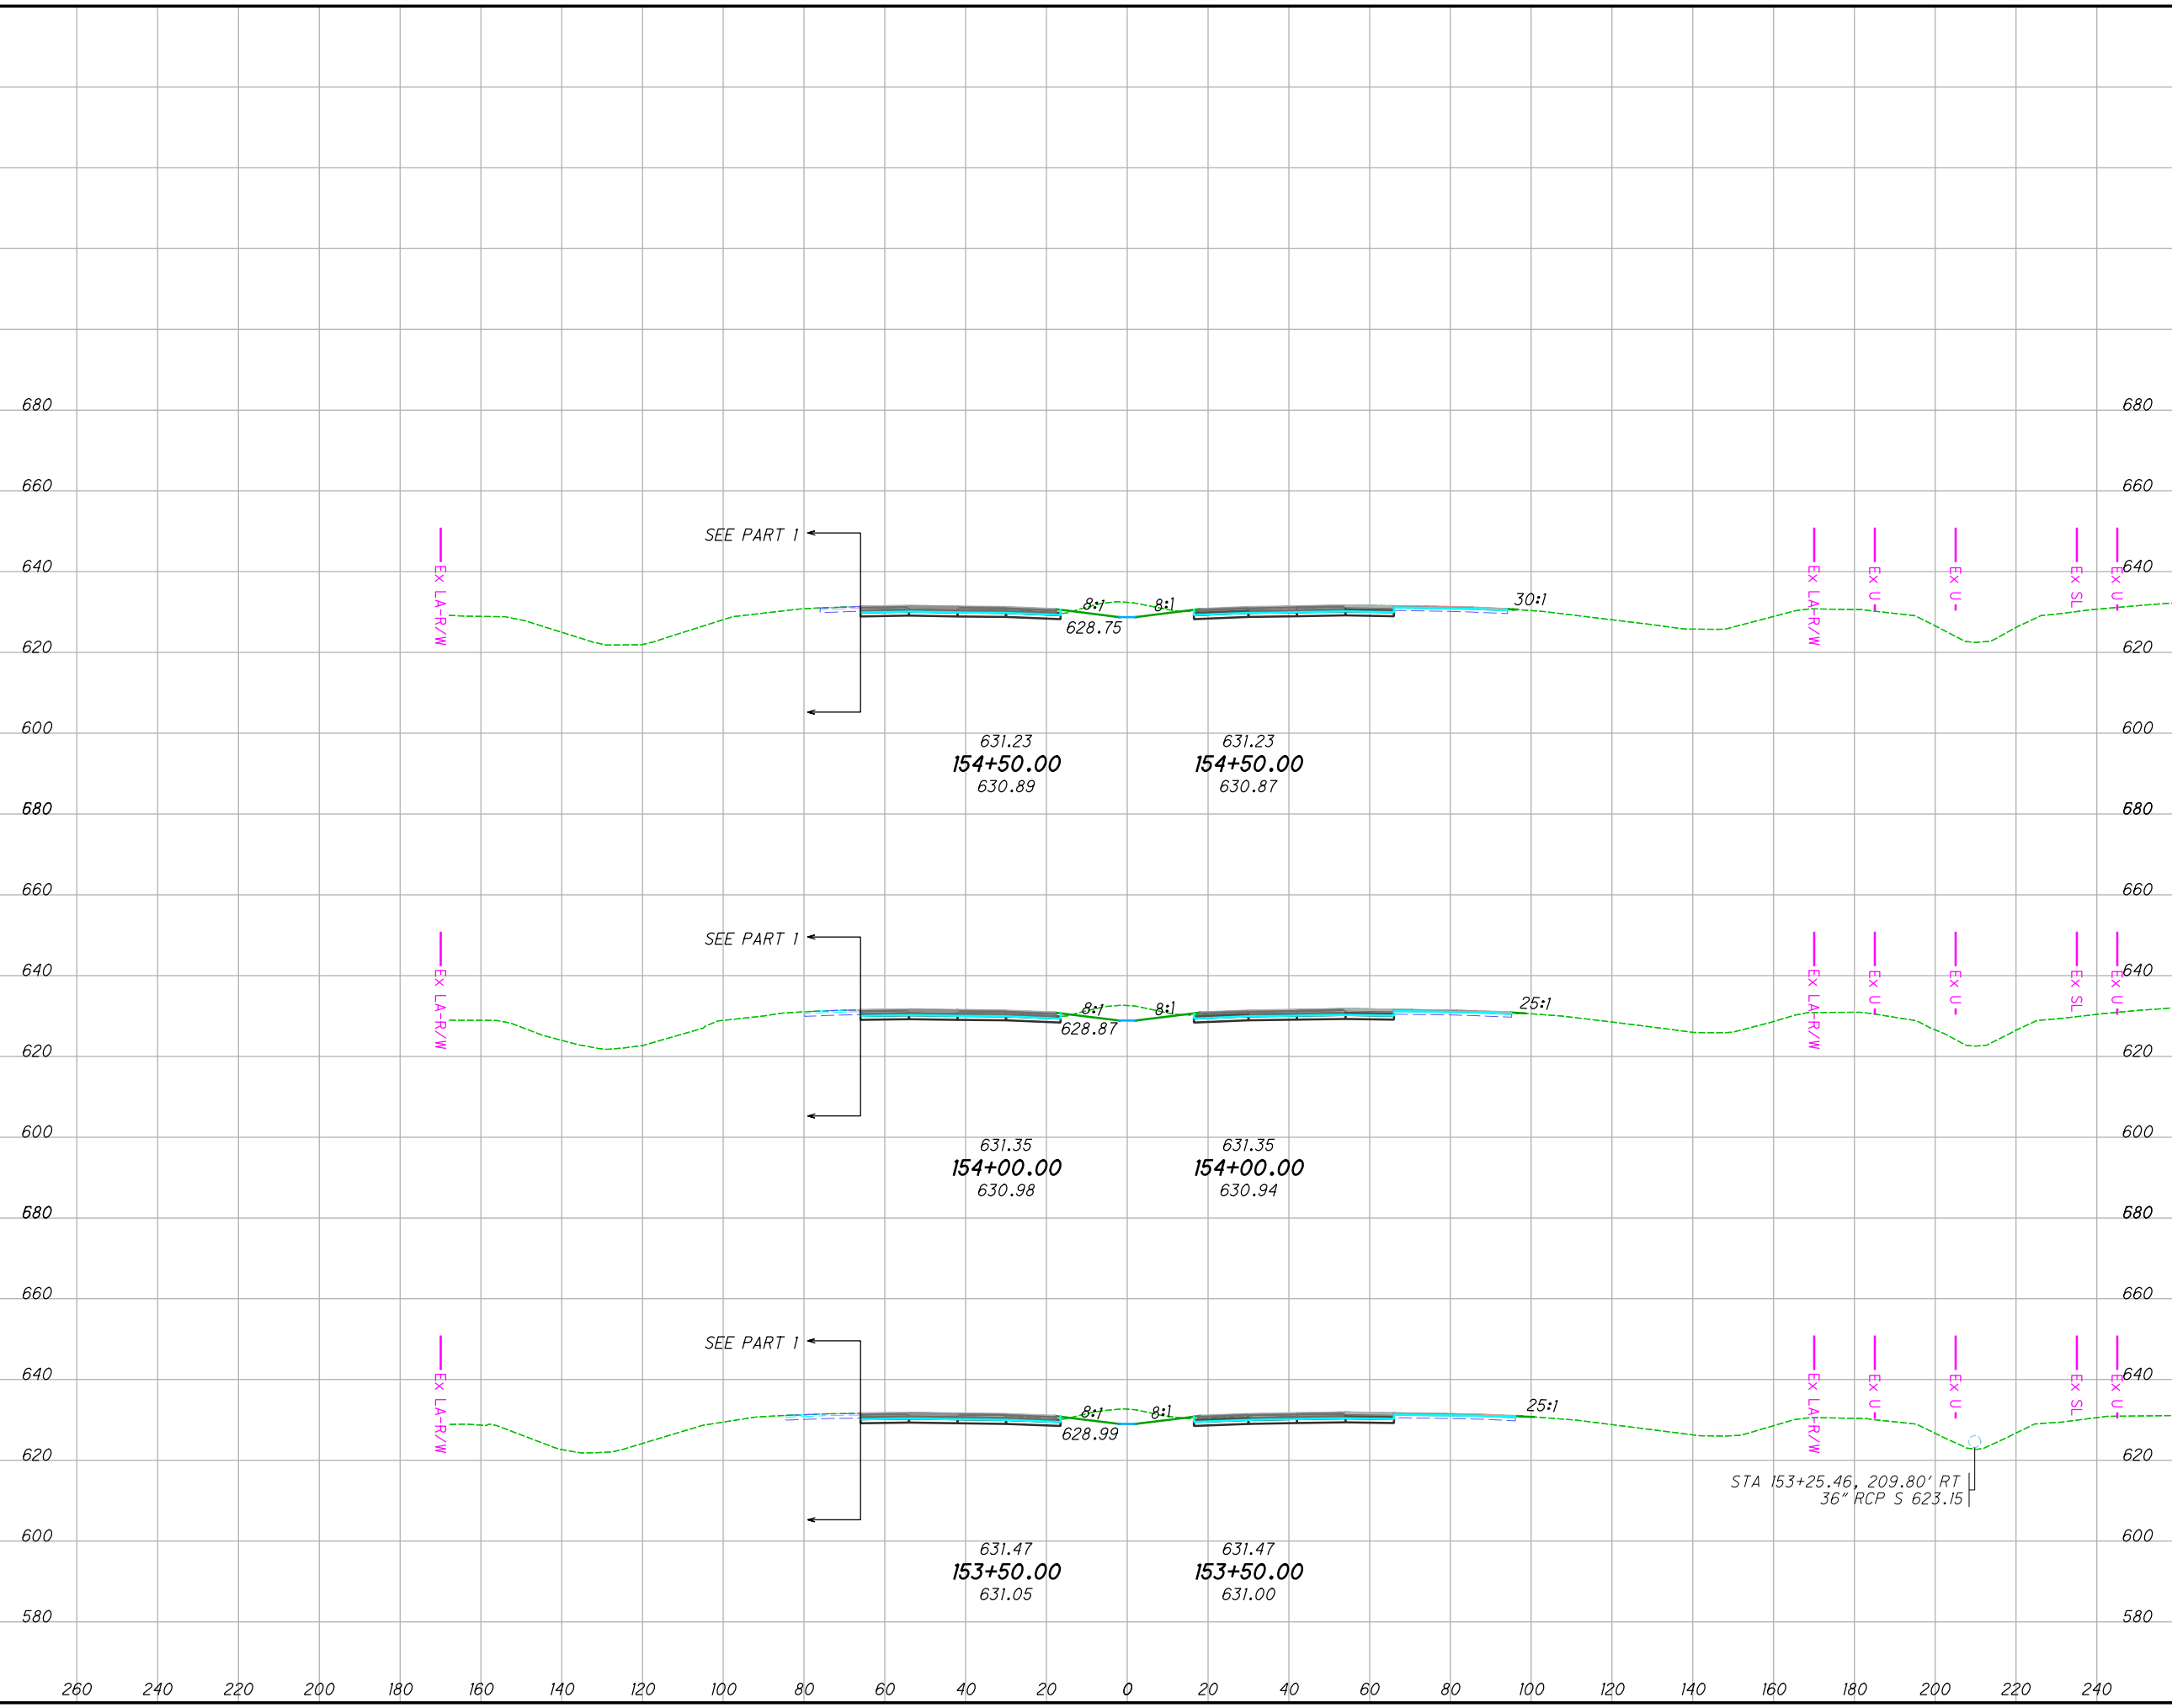

END AREA		VOLUME		CALCULATED	
CUT	FILL	CUT	FILL	JRB	XXX
120	1	221	3		
118	2	218	3		
117	1	217	2		
658	8				


**CROSS SECTIONS**  
**STA. 153+50.00 TO STA. 154+50.00**

**LUC-475-0.9**

425  
855

I:\ProjectData\LUC-475-0.09\Design\Roadway\Sheets\95875\_XS001 - Copy.dgn Sheet 4/29/2022 8:36:02 AM jbdinge

SEEDING	
END WIDTH	SO. YDS.
669	38.4
222	41.1
227	40.3
220	

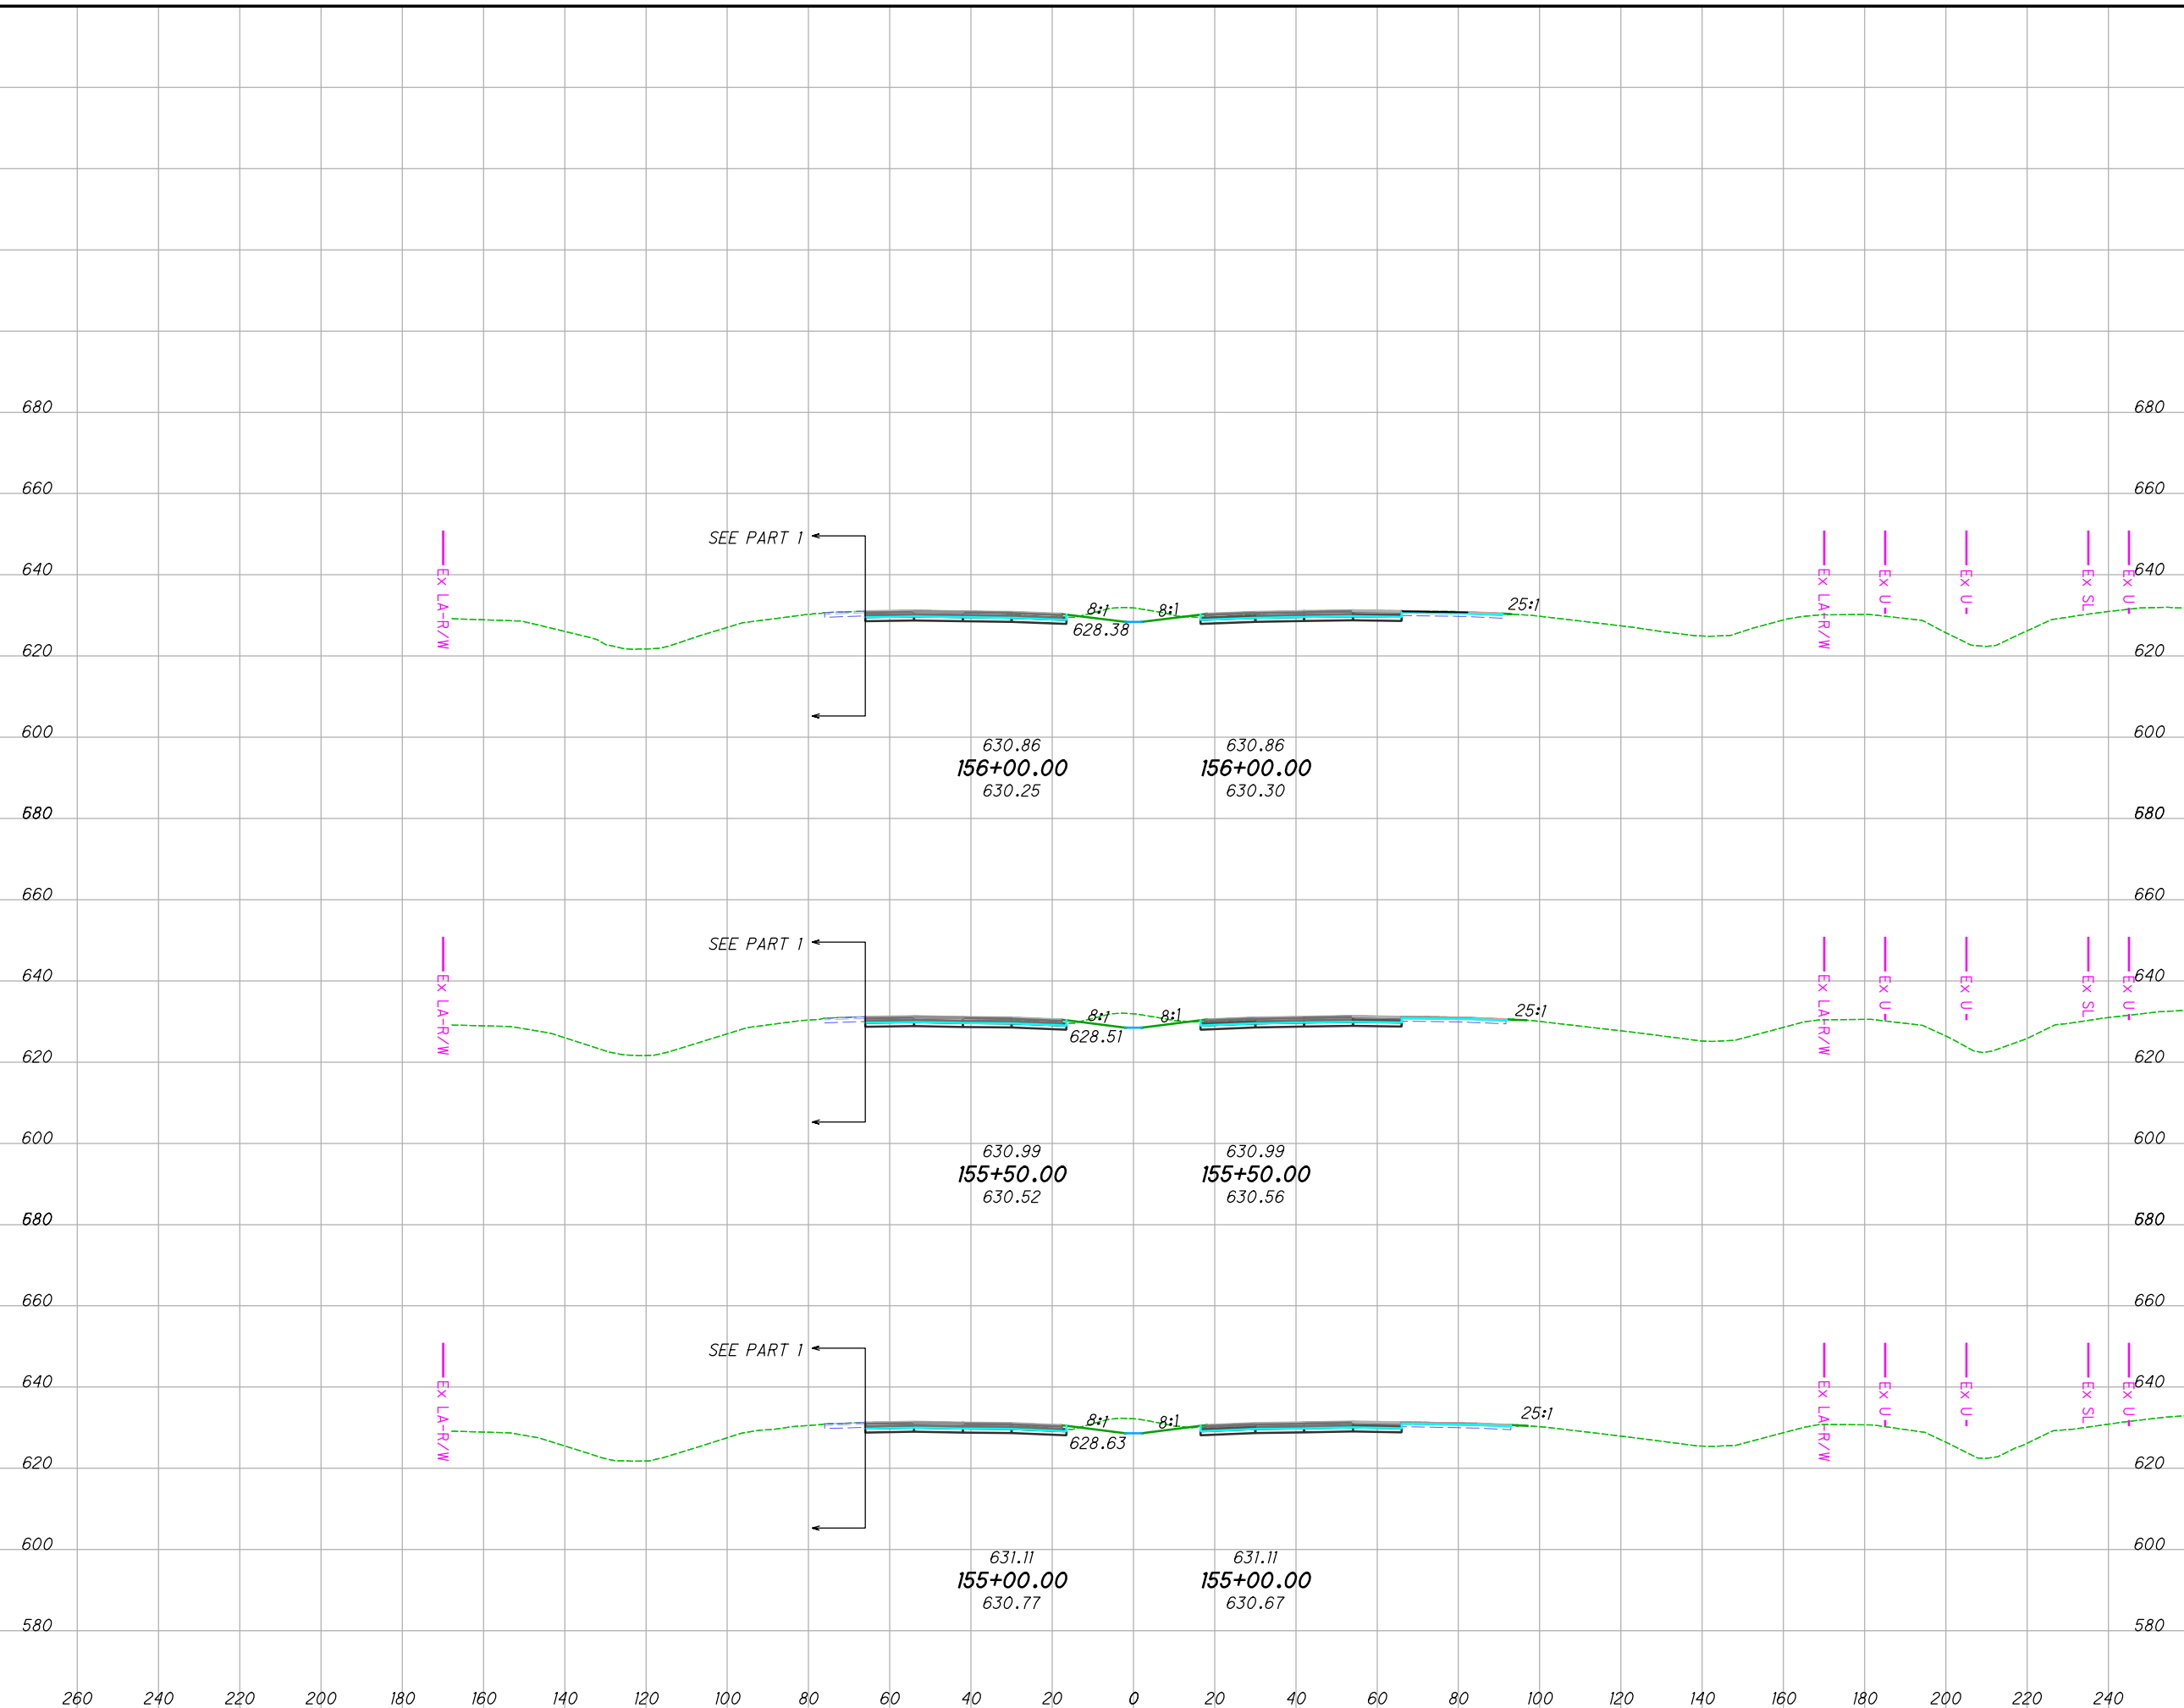

END AREA		VOLUME		CALCULATED		
CUT	FILL	CUT	FILL	JRB	CHECKED	XXX
105	3	201	5			
112	2	213	4			
118	2	220	3			
634	12					


**CROSS SECTIONS**  
**STA. 155+00.00 TO STA. 156+00.00**

**LUC-475-0.9**

426  
855



I:\ProjectData\LUC-475-0.09\Design\Roadway\Sheets\95875\_XS001 - Copy.dgn Sheet 4/29/2022 8:36:03 AM jbdinge

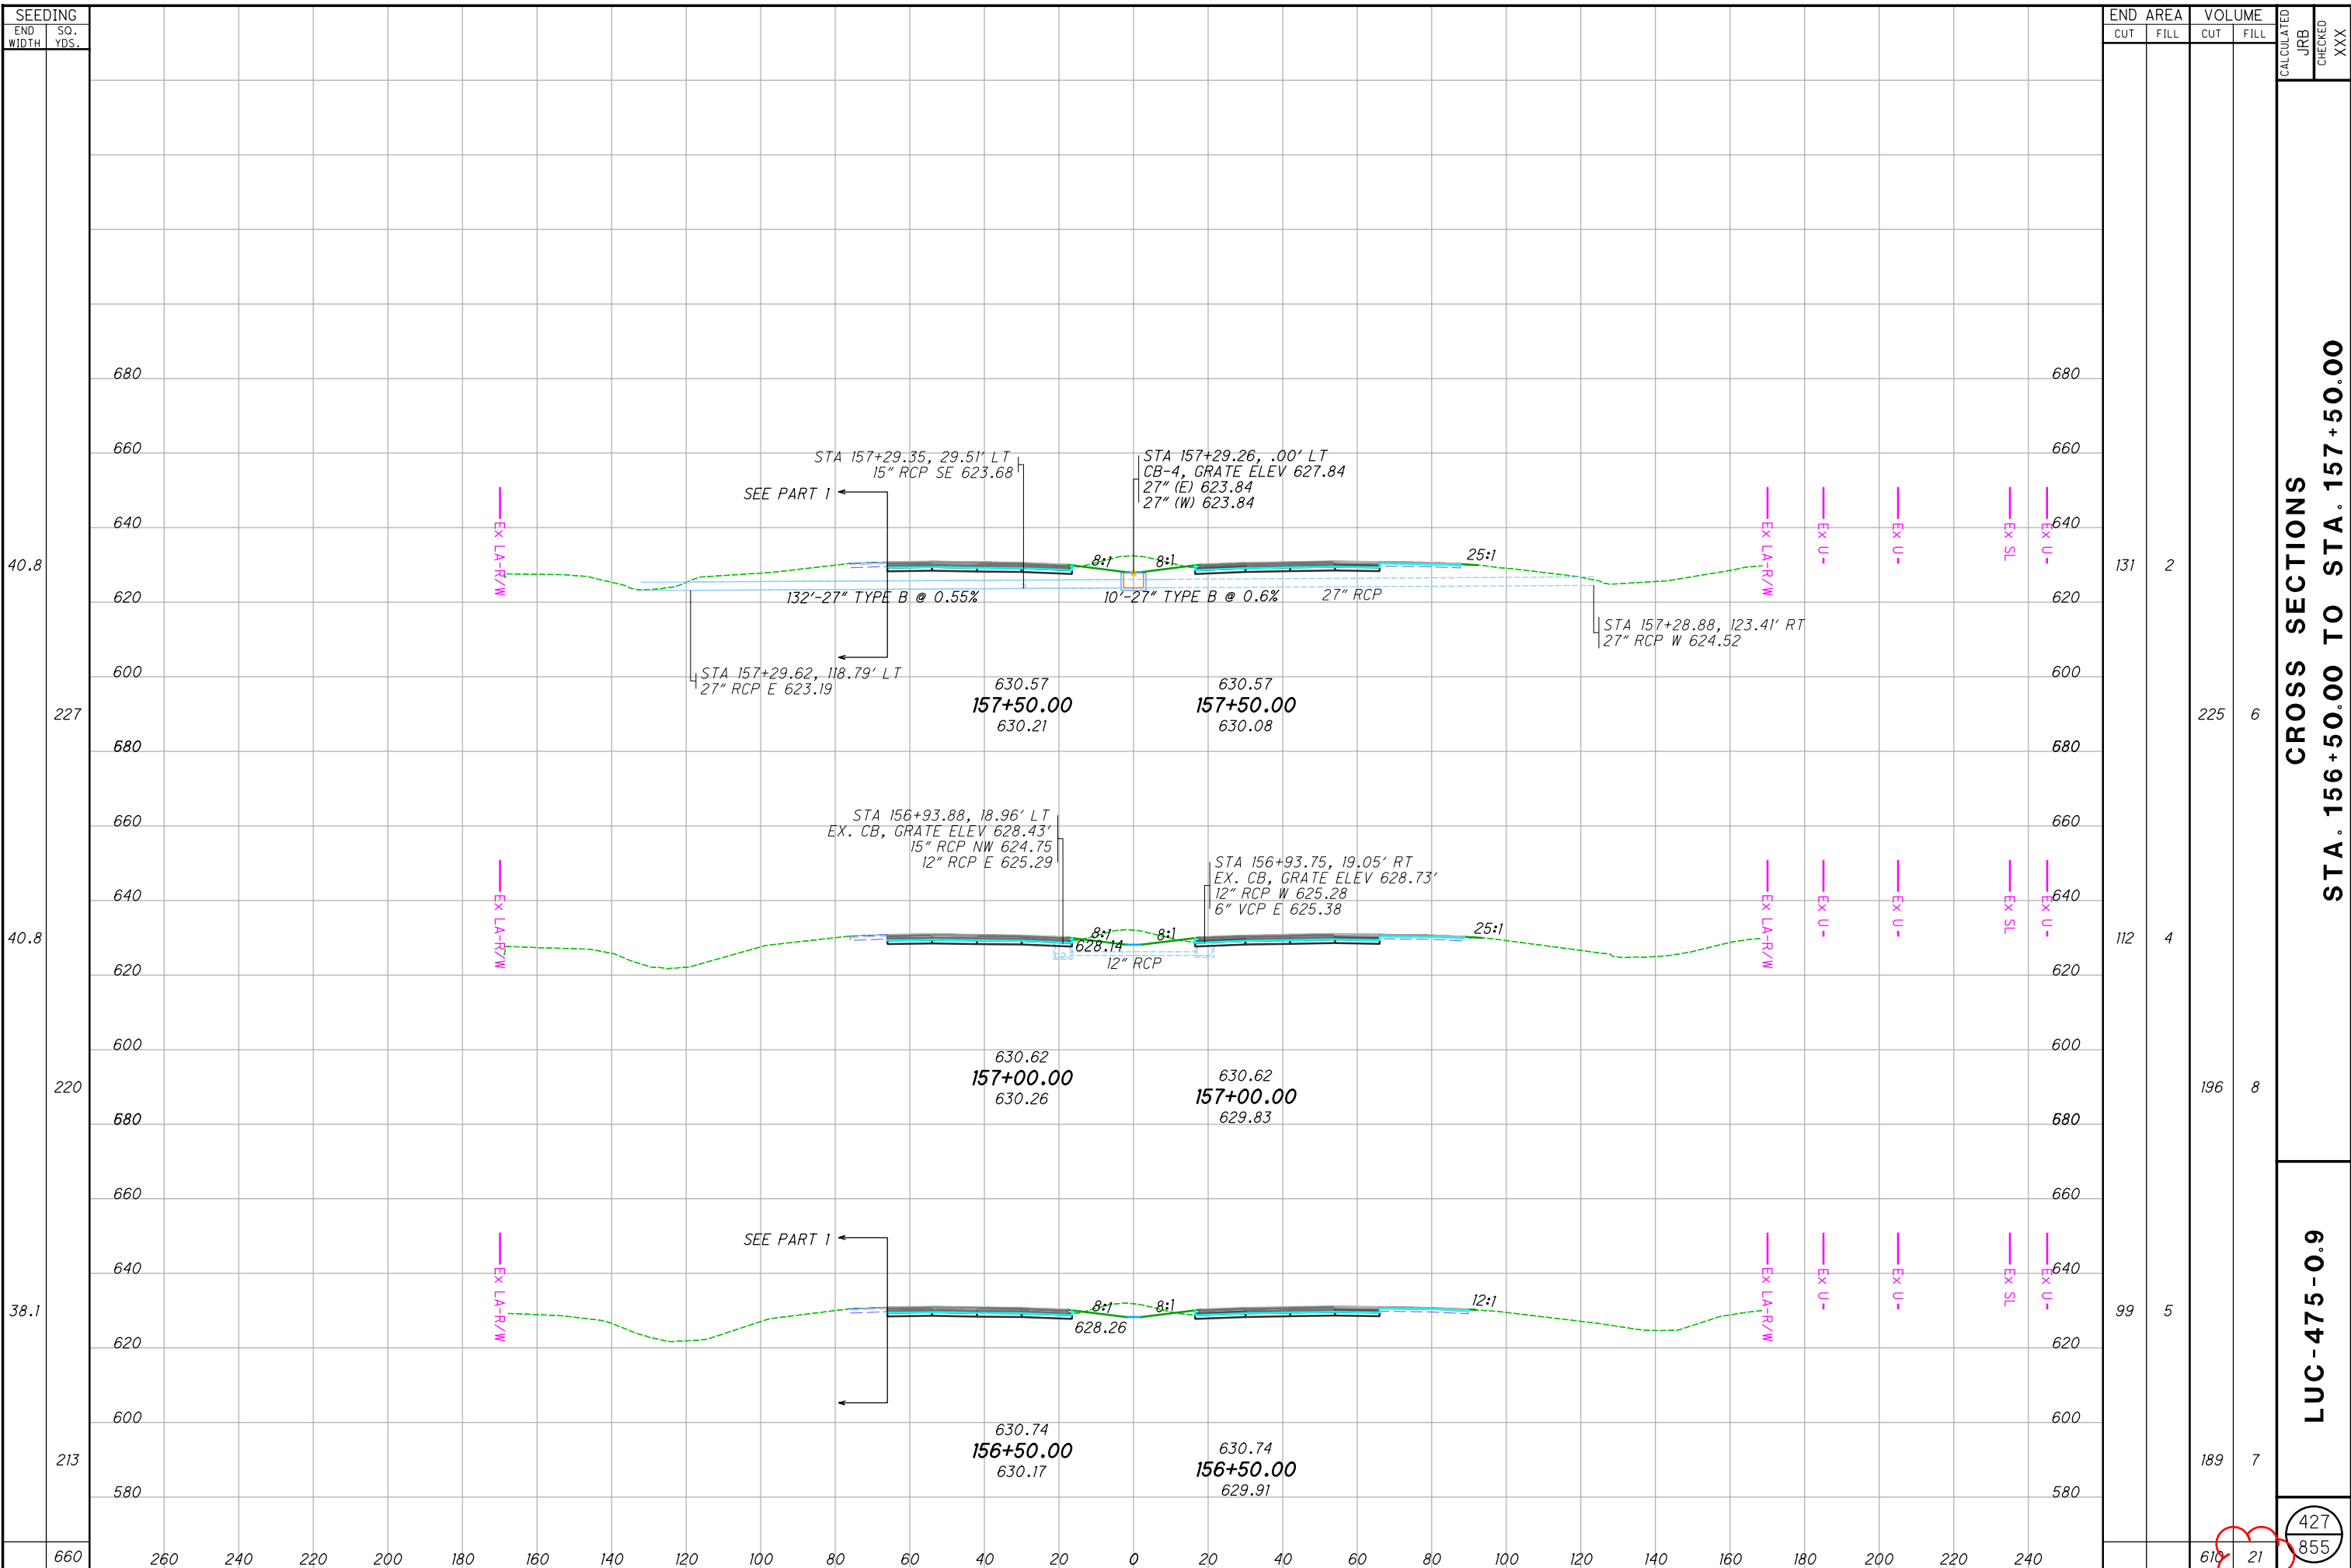

SEEDING	
END WIDTH	SO. YDS.
40.8	
227	
40.8	
220	
38.1	
213	
660	

END AREA		VOLUME		CALCULATED		
CUT	FILL	CUT	FILL	JRB	CHECKED	XXX
131	2	225	6			
112	4	196	8			
99	5	189	7			
		610	21			


**CROSS SECTIONS**  
**STA. 156+50.00 TO STA. 157+50.00**

**LUC-475-0.9**

427  
855

I:\ProjectData\LUC\95875\_LUC-475-0.09\Design\Roadway\Sheets\95875\_XS001 - Copy.dgn Sheet 4/29/2022 8:36:04 AM jbdinge


SEEDING	
END WIDTH	SO. YDS.
675	
260	
240	
220	
20	
40	
60	
80	
100	
120	
140	
160	
180	
200	
220	
240	

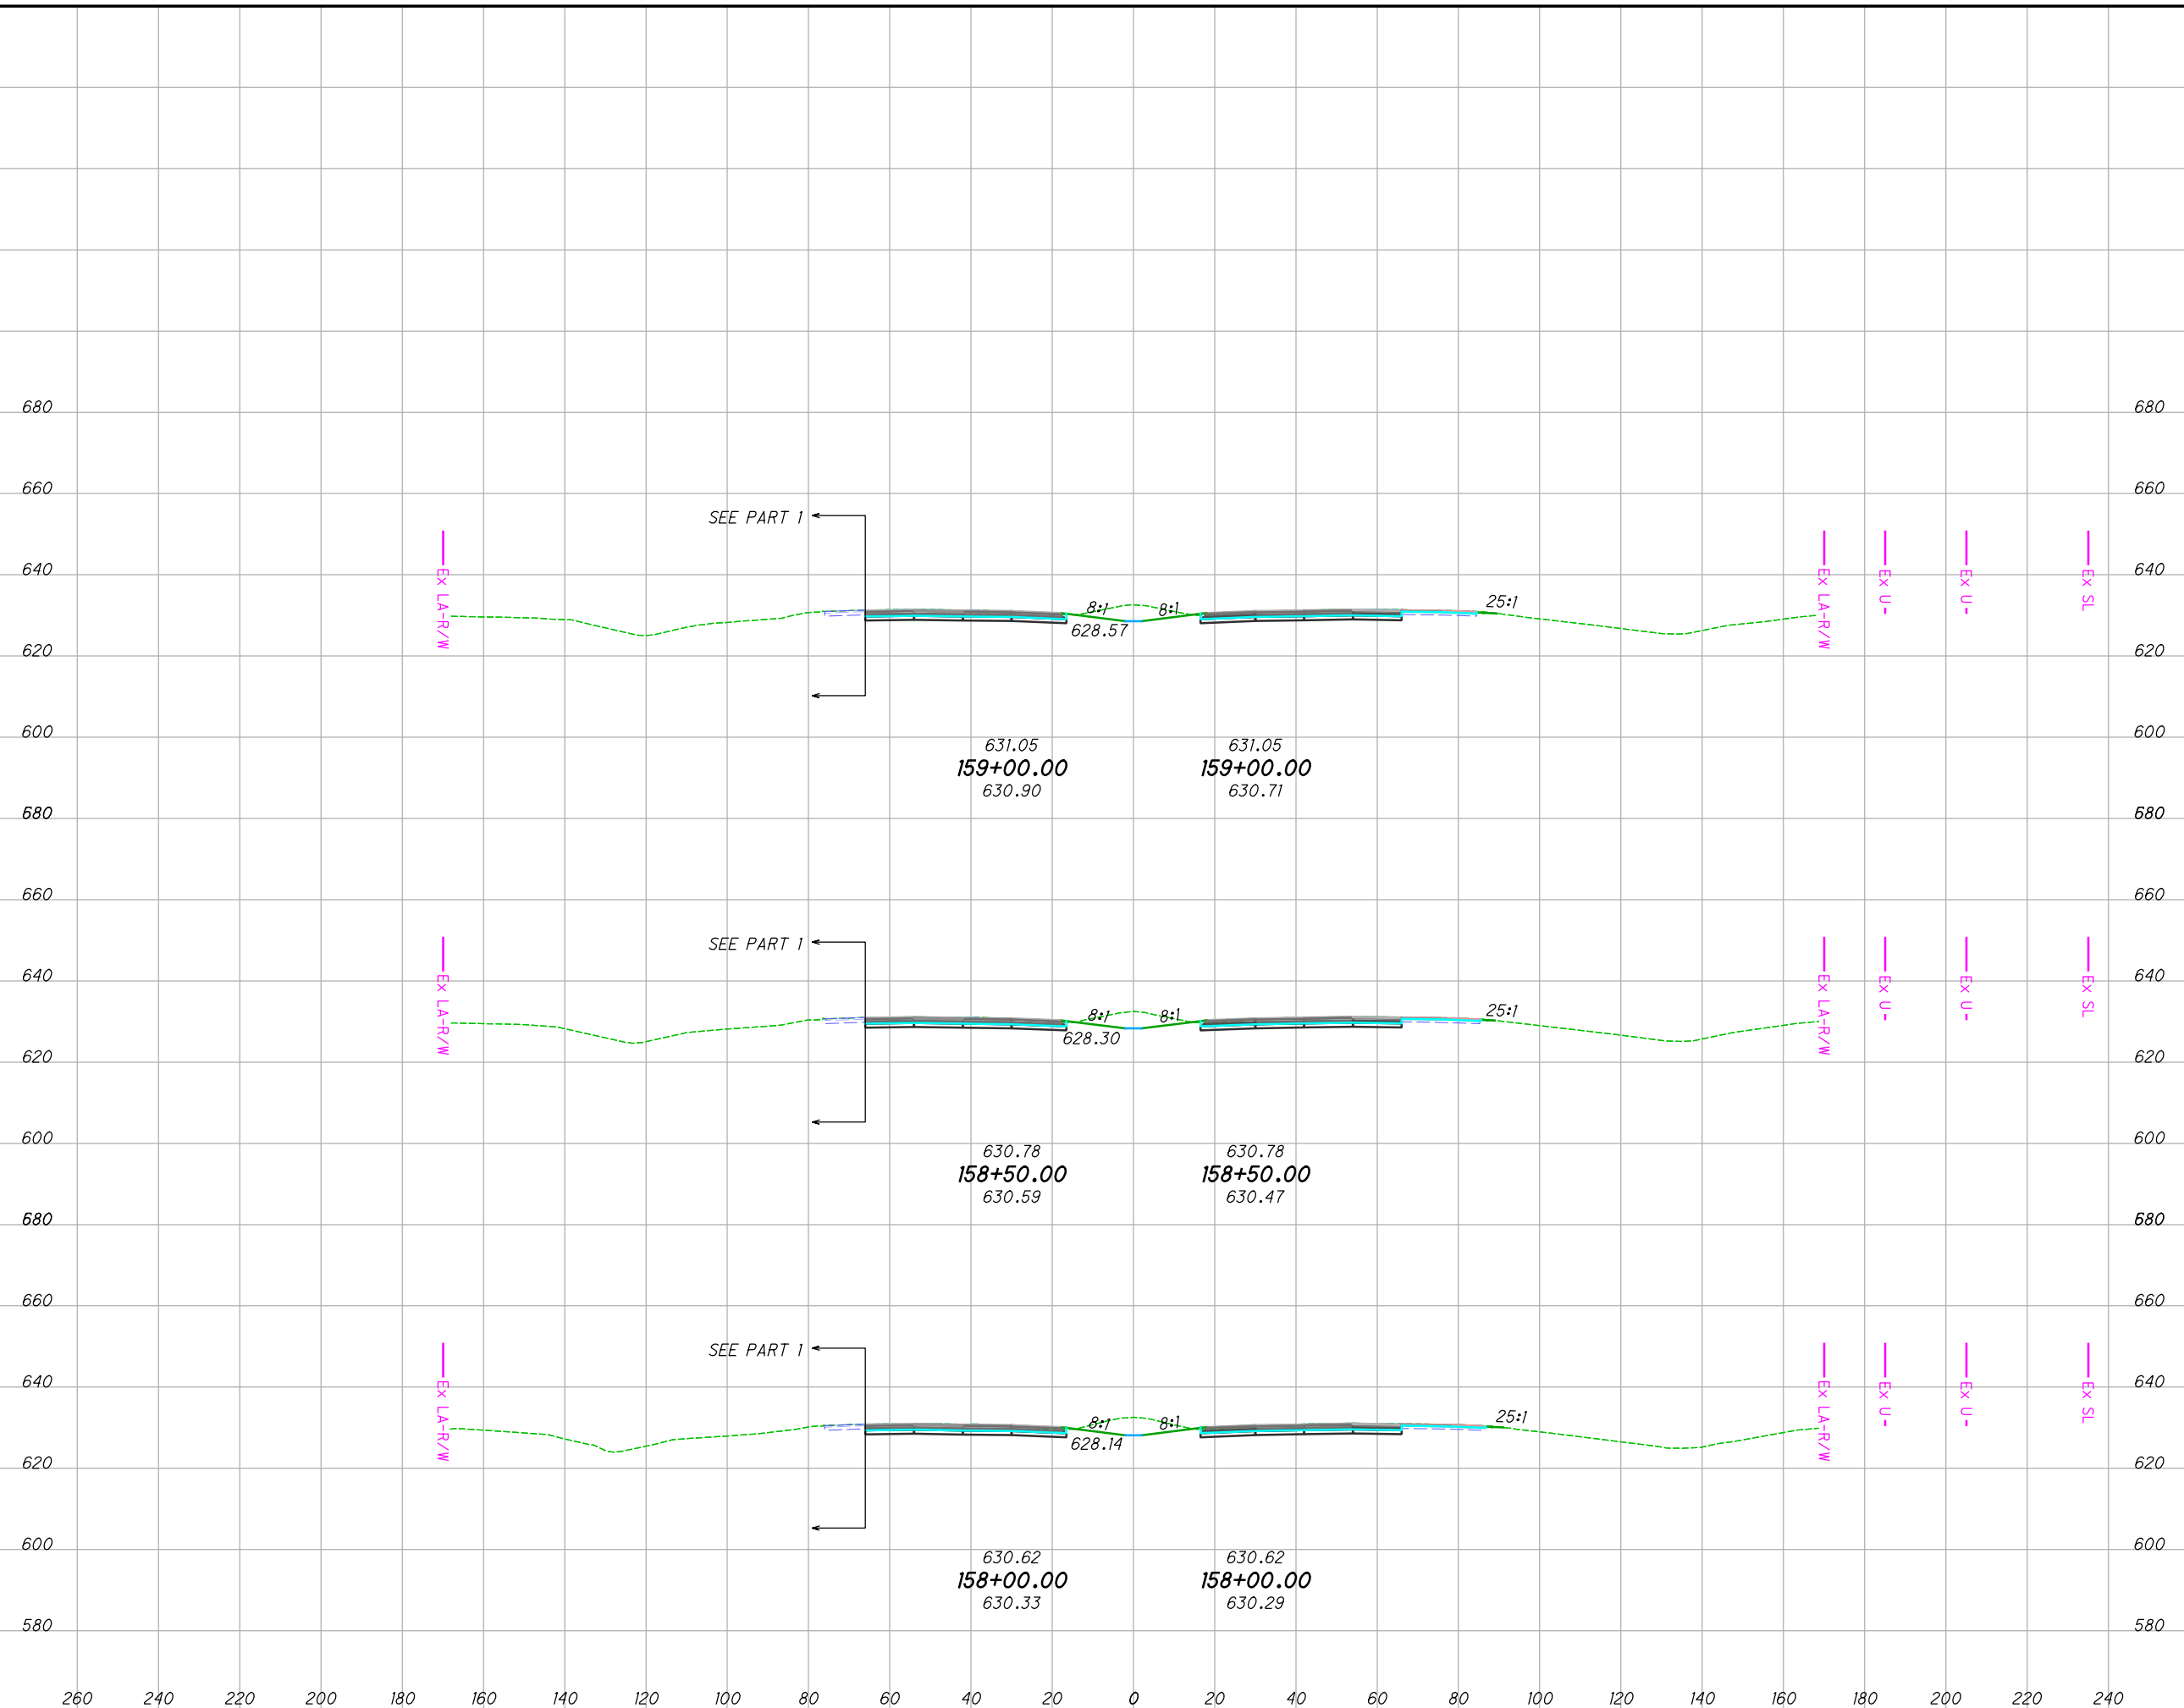

END AREA		VOLUME		CALCULATED		
CUT	FILL	CUT	FILL	JRB	CHECKED	XXX
137	1	252	2			
135	1	256	2			
141	1	252	3			
<b>CROSS SECTIONS</b>						
<b>STA. 158+00.00 TO STA. 159+00.00</b>						
<b>LUC-475-0.9</b>						
				428 855		

I:\ProjectData\LUC\95875\_LUC-475-0.09\Design\Roadway\Sheets\95875\_XS001 - Copy.dgn Sheet 4/29/2022 8:36:05 AM jbdinge

SEEDING	
END WIDTH	SO. YDS.
692	40.7
230	41.8
232	41.6
230	

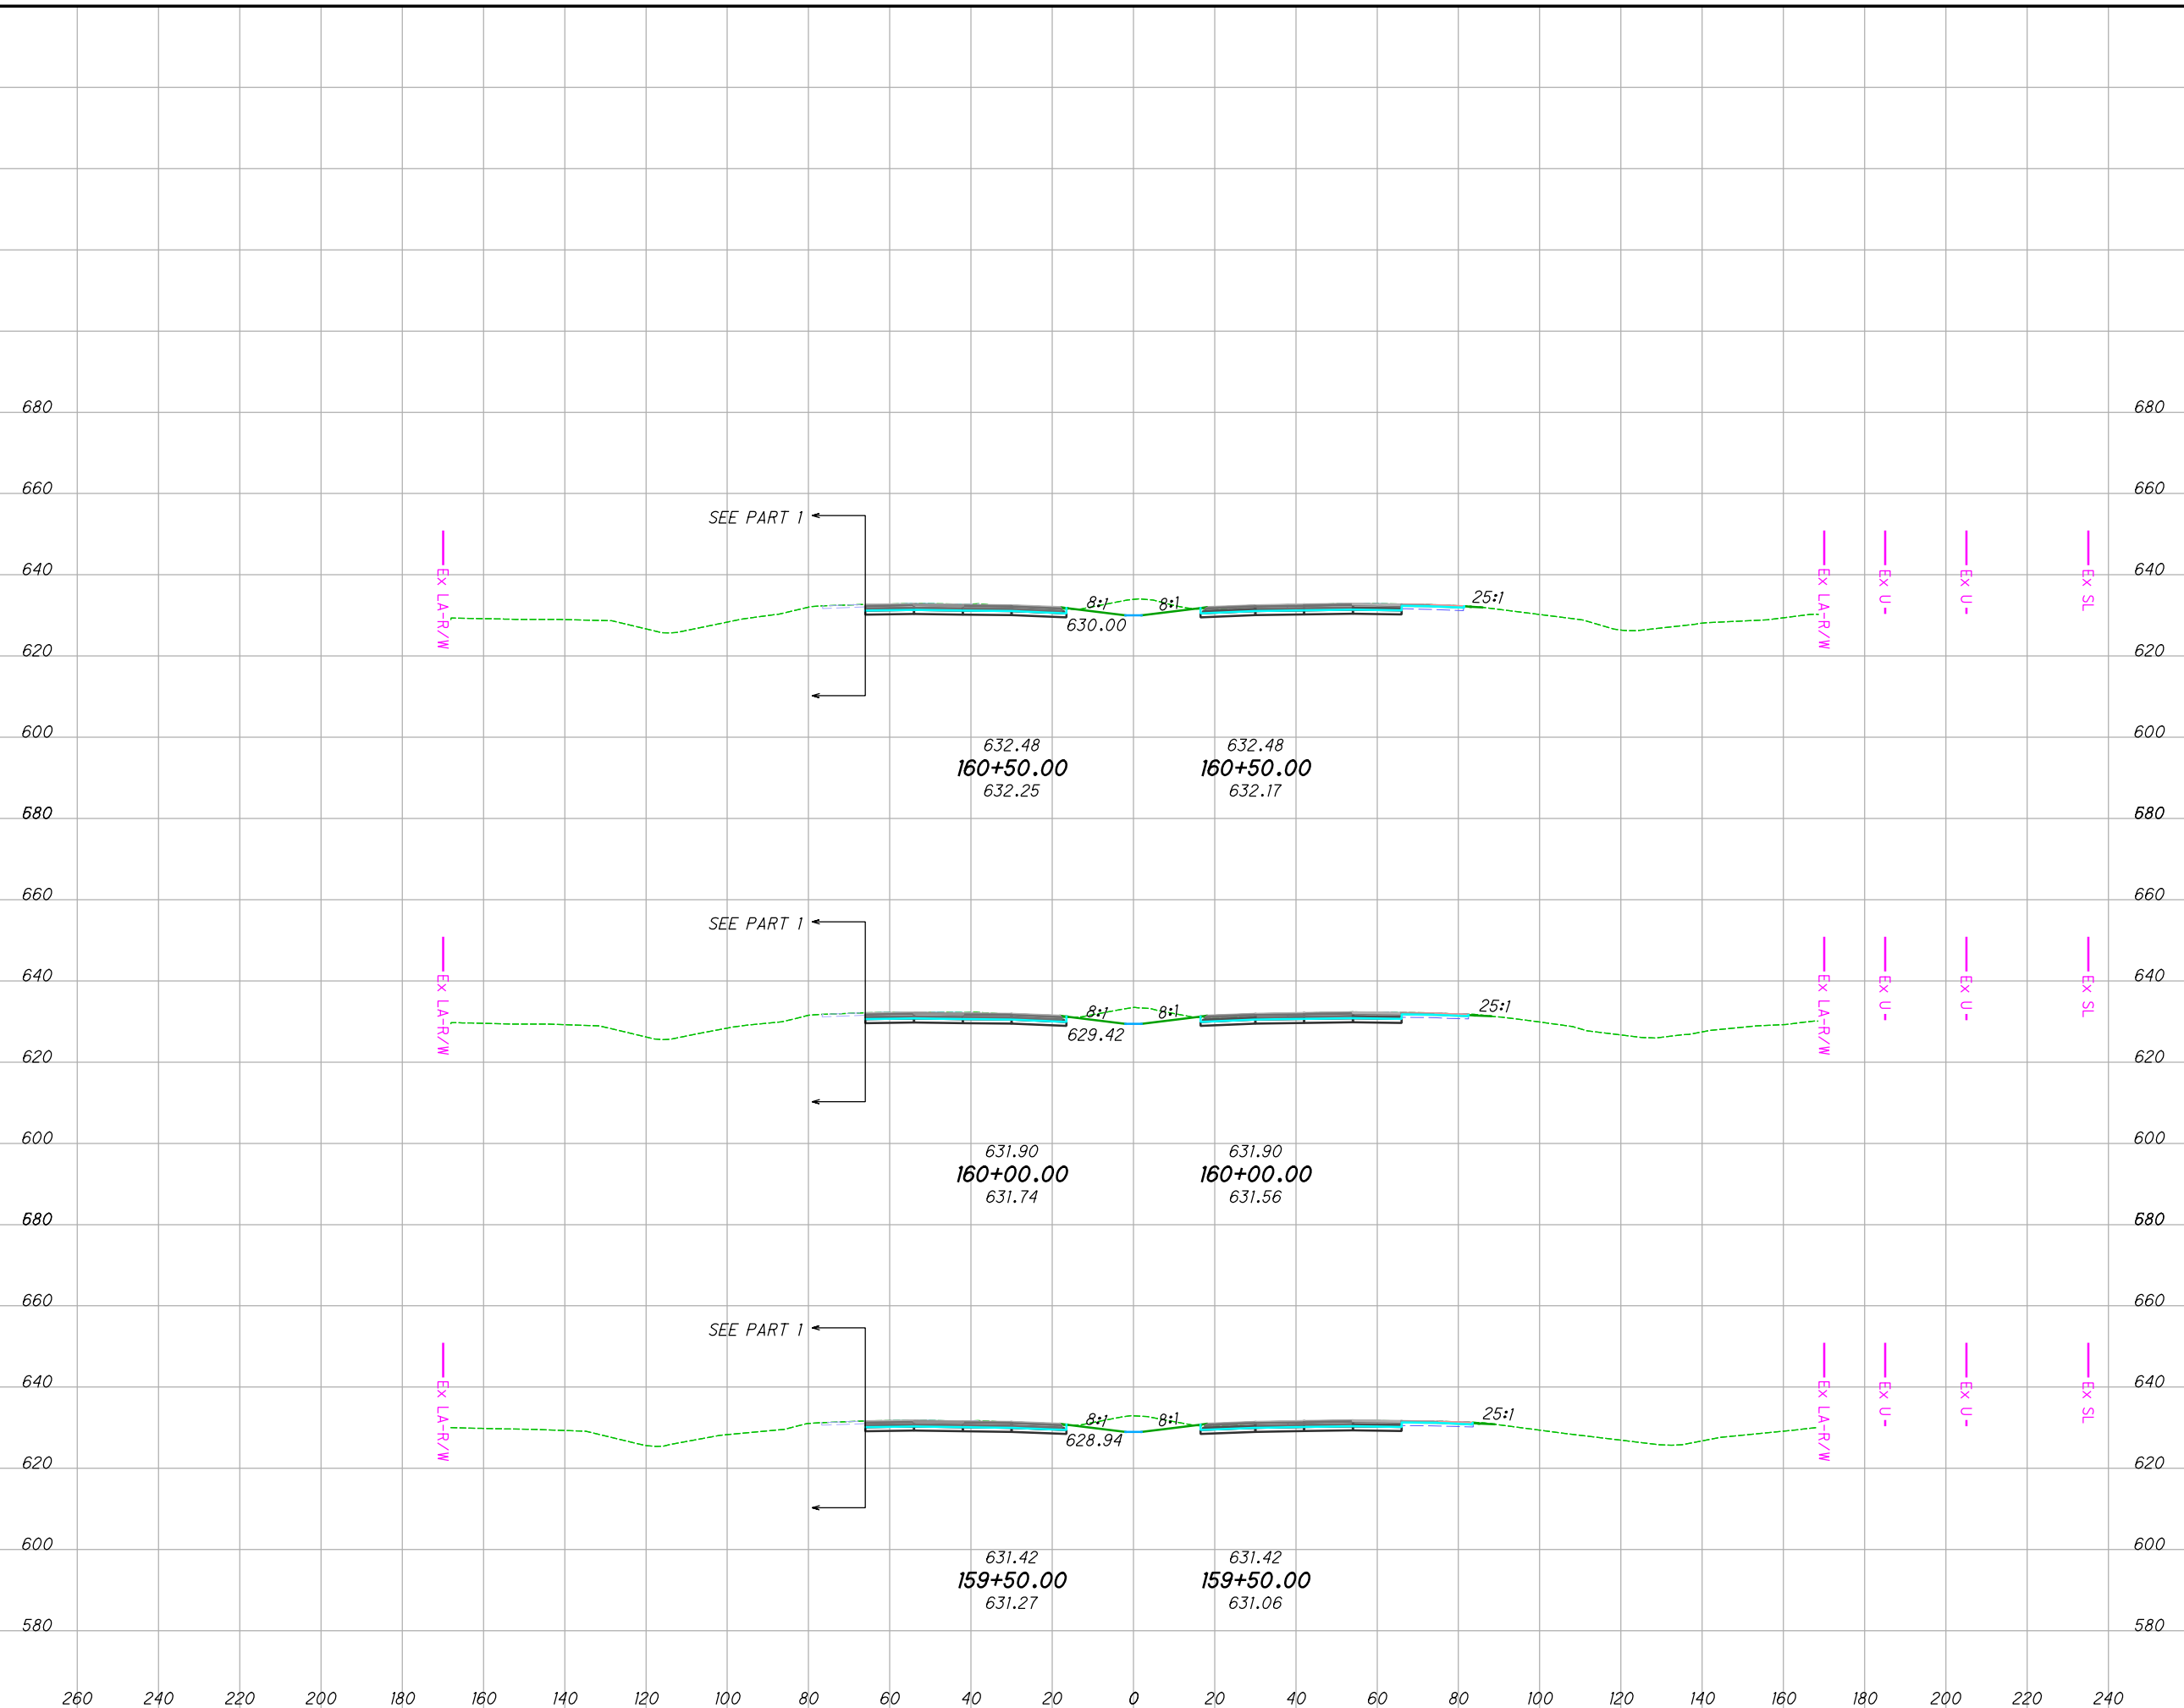


END AREA		VOLUME	
CUT	FILL	CUT	FILL
137	1	257	1
141	0	258	
138	0	255	1
		770	2

CROSS SECTIONS  
 STA. 159+50.00 TO STA. 160+50.00  
 LUC-475-0.9

429  
 855

I:\ProjectData\LUC\95875\_LUC-475-0.09\Design\Roadway\Sheets\95875\_XS001 - Copy.dgn Sheet 4/29/2022 8:36:06 AM jbidinge

SEEDING	
END WIDTH	SO. YDS.
77	40.7
228	41.1
225	39.6
224	

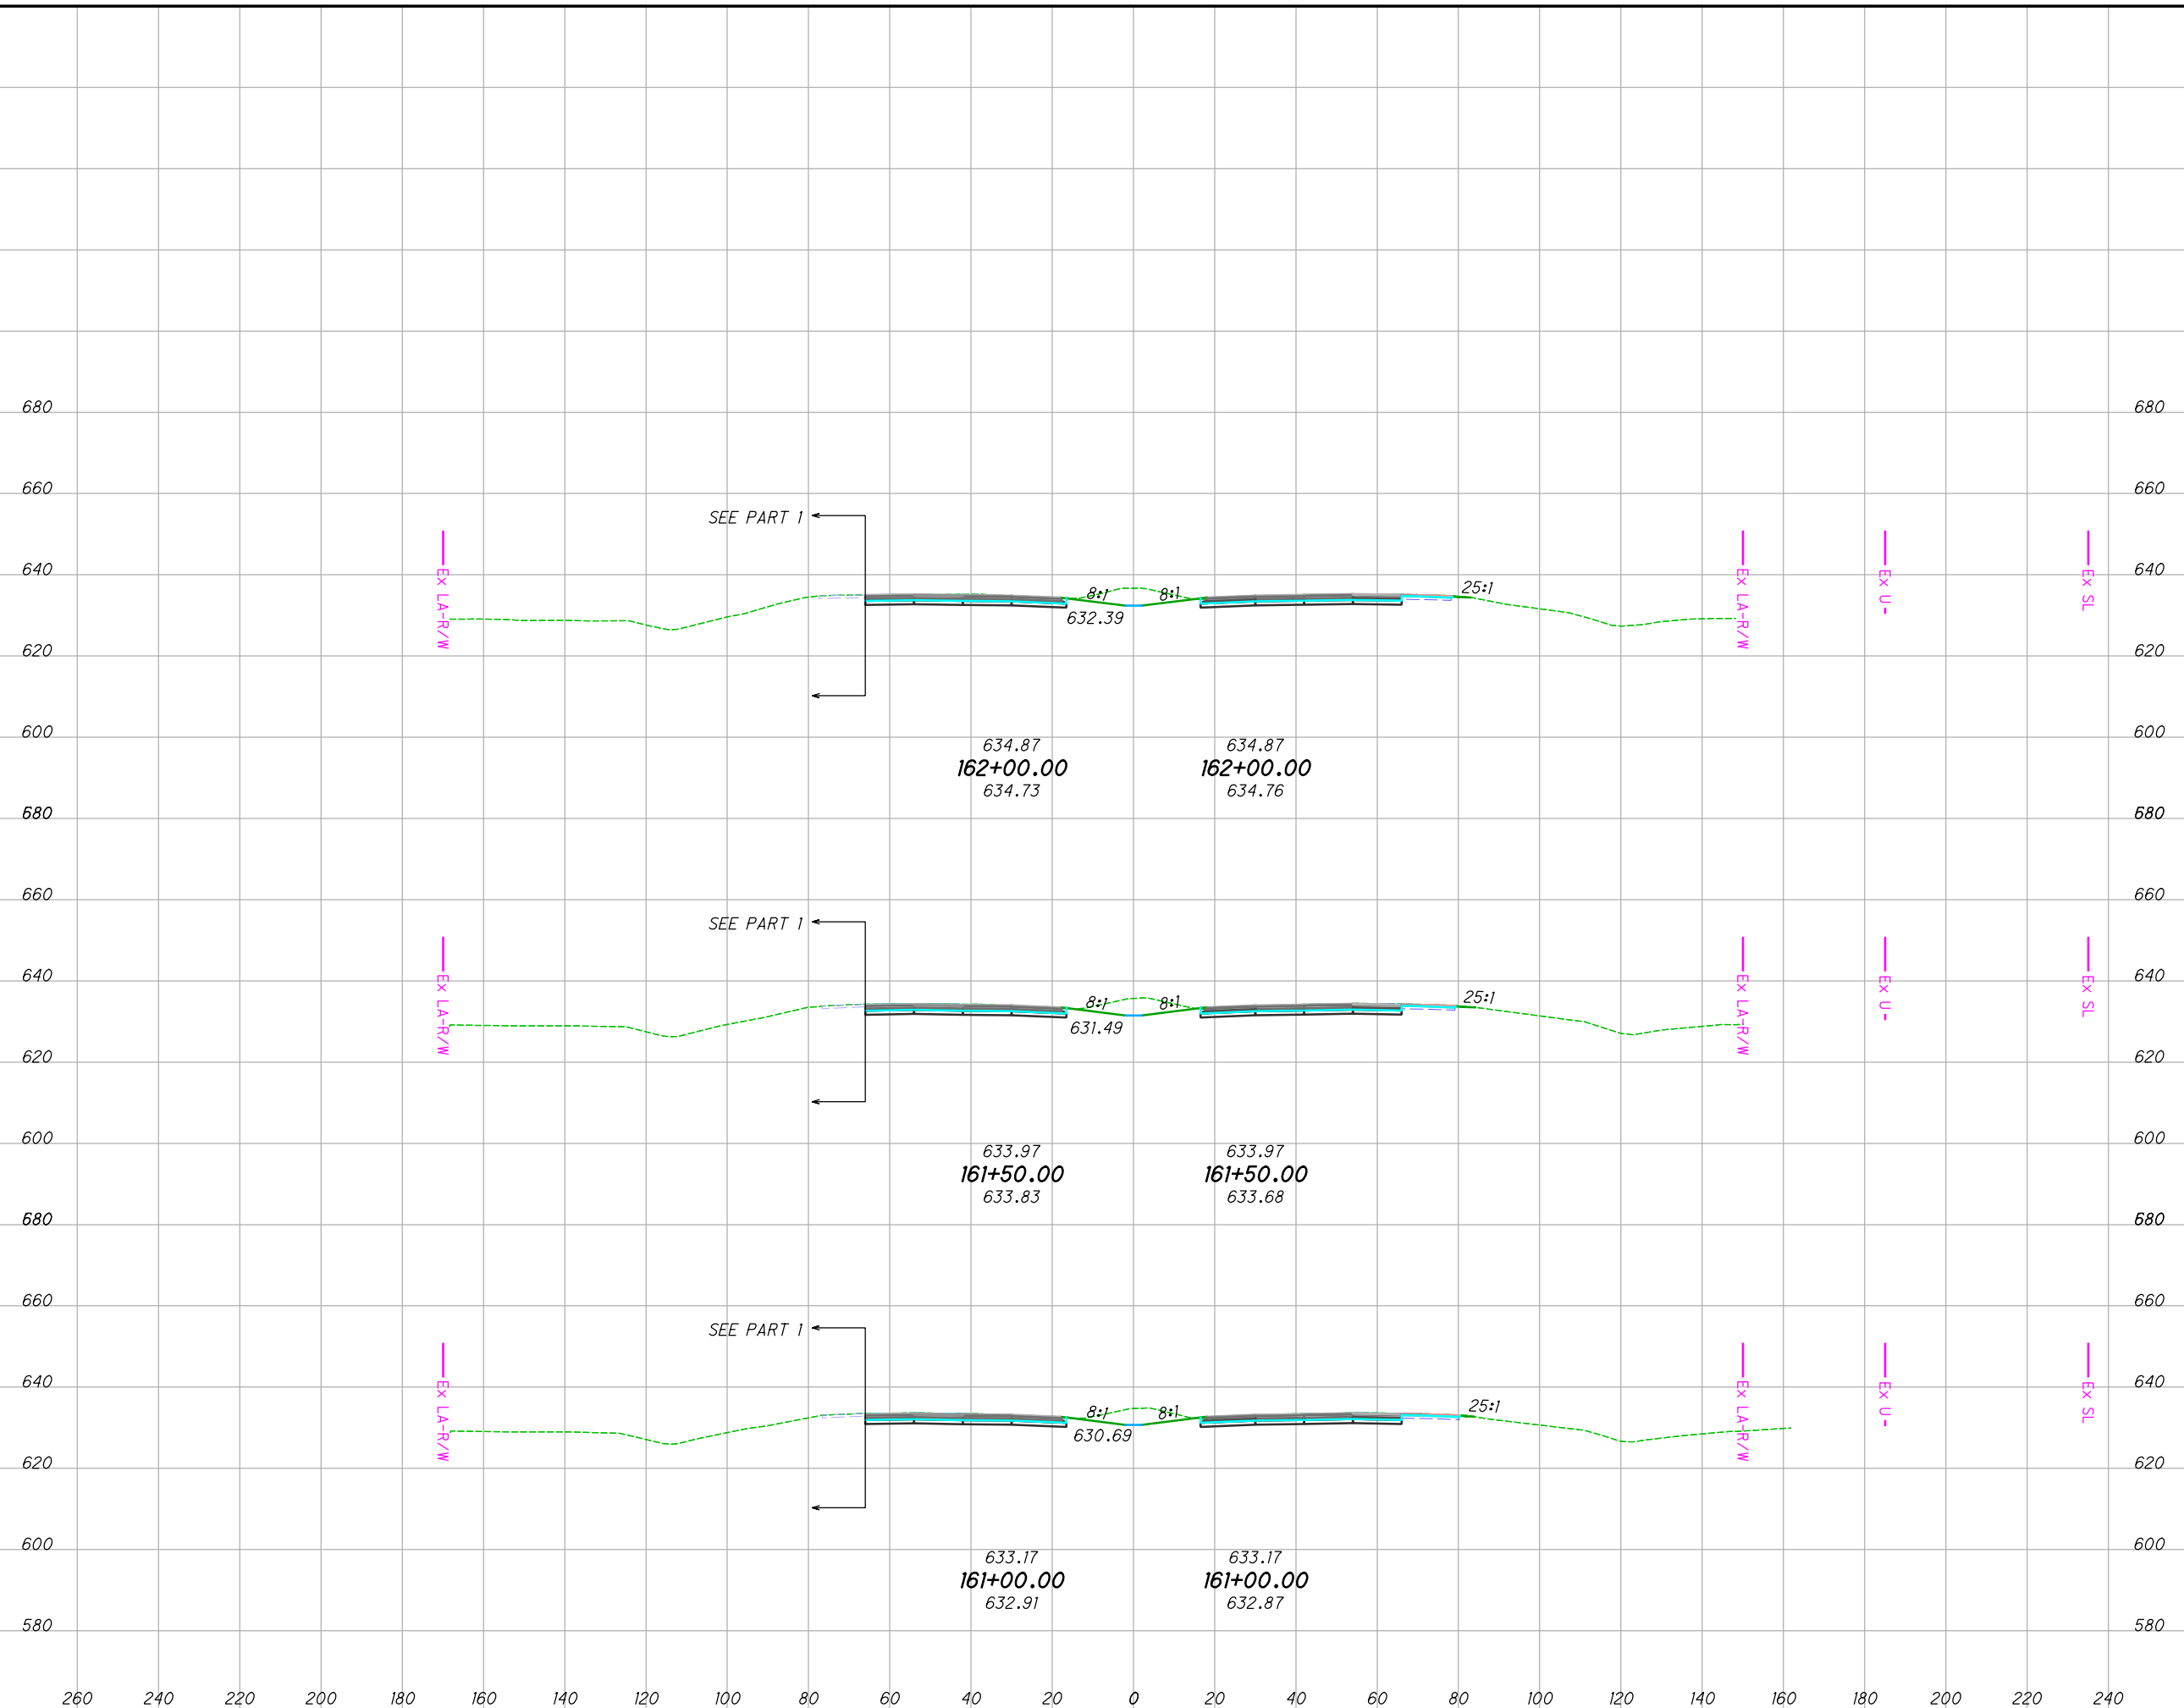


END AREA		VOLUME	
CUT	FILL	CUT	FILL
148	0	273	
148	0	268	1
142	1	258	2
		799	3

CROSS SECTIONS  
 STA. 161+00.00 TO STA. 162+00.00  
 LUC-475-0.9

430  
 855

I:\ProjectData\LUC\95875\_LUC-475-0.09\Design\Roadway\Sheets\95875\_XS001 - Copy.dgn Sheet 4/29/2022 8:36:07 AM jbdinge

SEEDING	
END WIDTH	SO. YDS.
675	43.7
234	40.5
220	38.6
221	

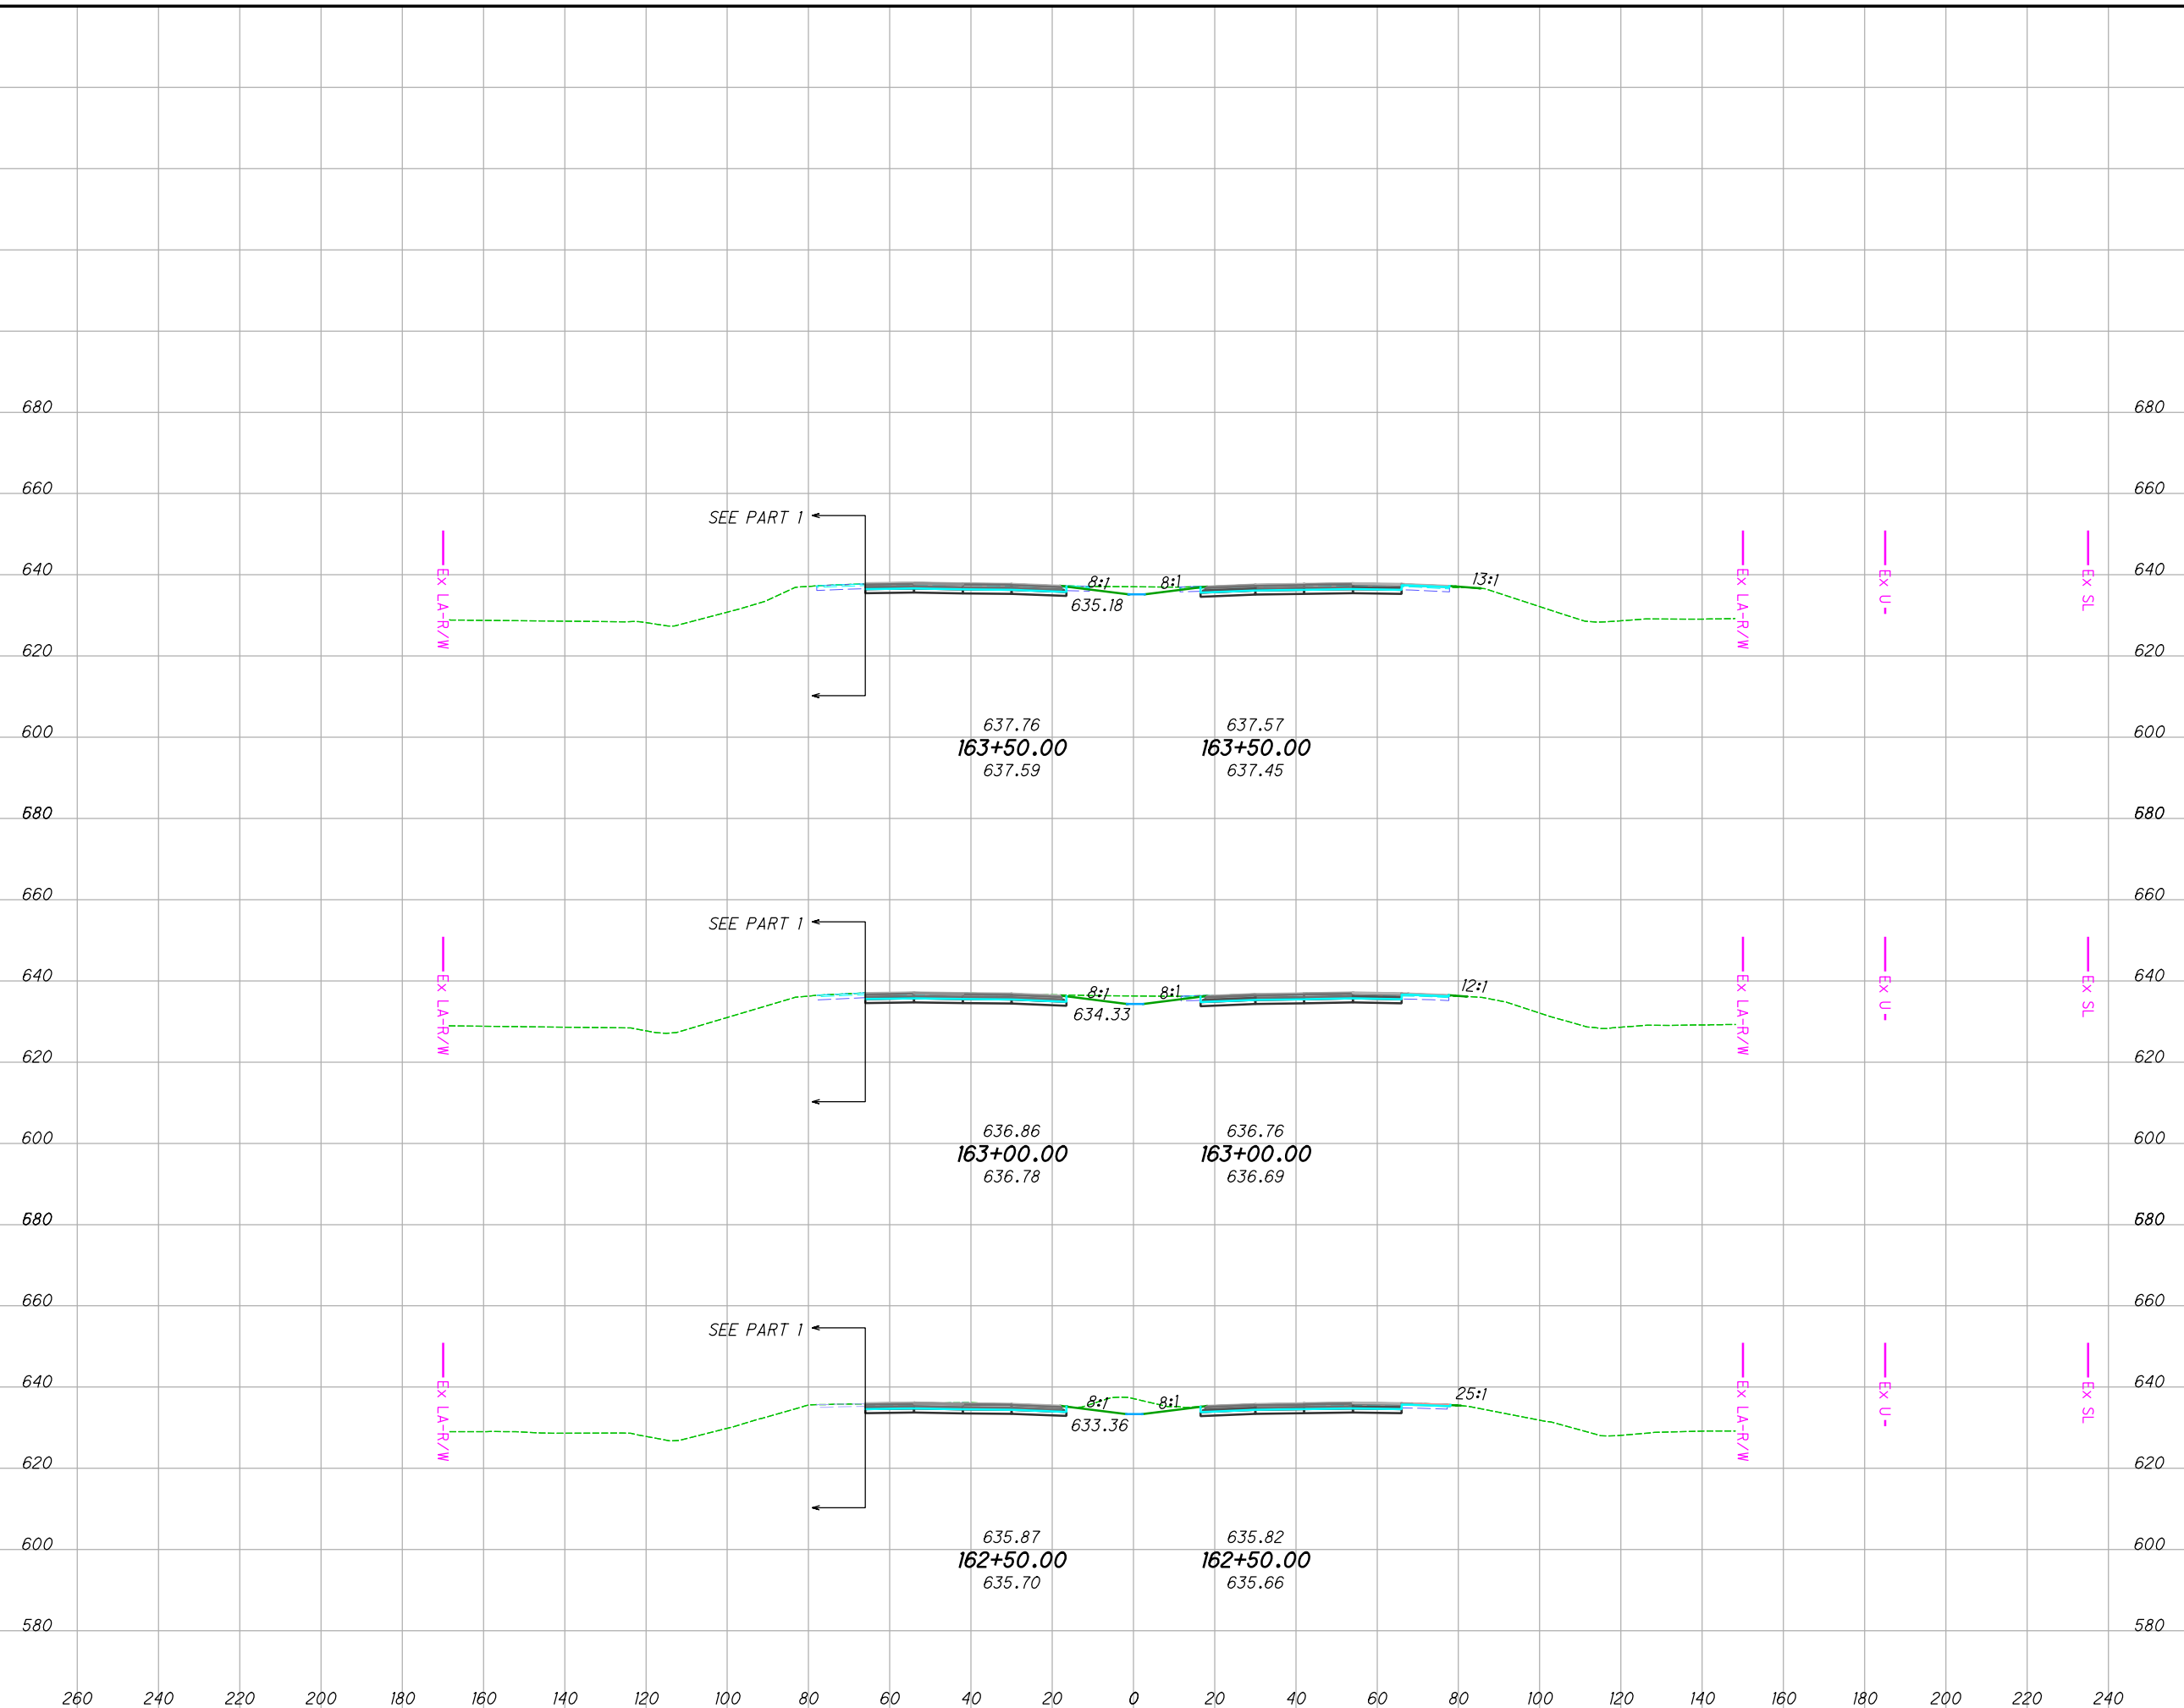

END AREA		VOLUME	
CUT	FILL	CUT	FILL
46	1	113	2
76	1	192	1
132	0	259	3

**CROSS SECTIONS**  
**STA. 162+50.00 TO STA. 163+50.00**

**LUC-475-0.9**


CALCULATED JRB  
 CHECKED XXX

431  
 855



I:\ProjectData\LUC\95875\_LUC-475-0.09\Design\Roadway\Sheets\95875\_XS001 - Copy.dgn Sheet 4/29/2022 8:36:08 AM jbidinge

SEEDING	
END WIDTH	SO. YDS.
702	
260	
240	
220	
20	
40	
60	
80	
100	
120	
140	
160	
180	
200	
220	
240	

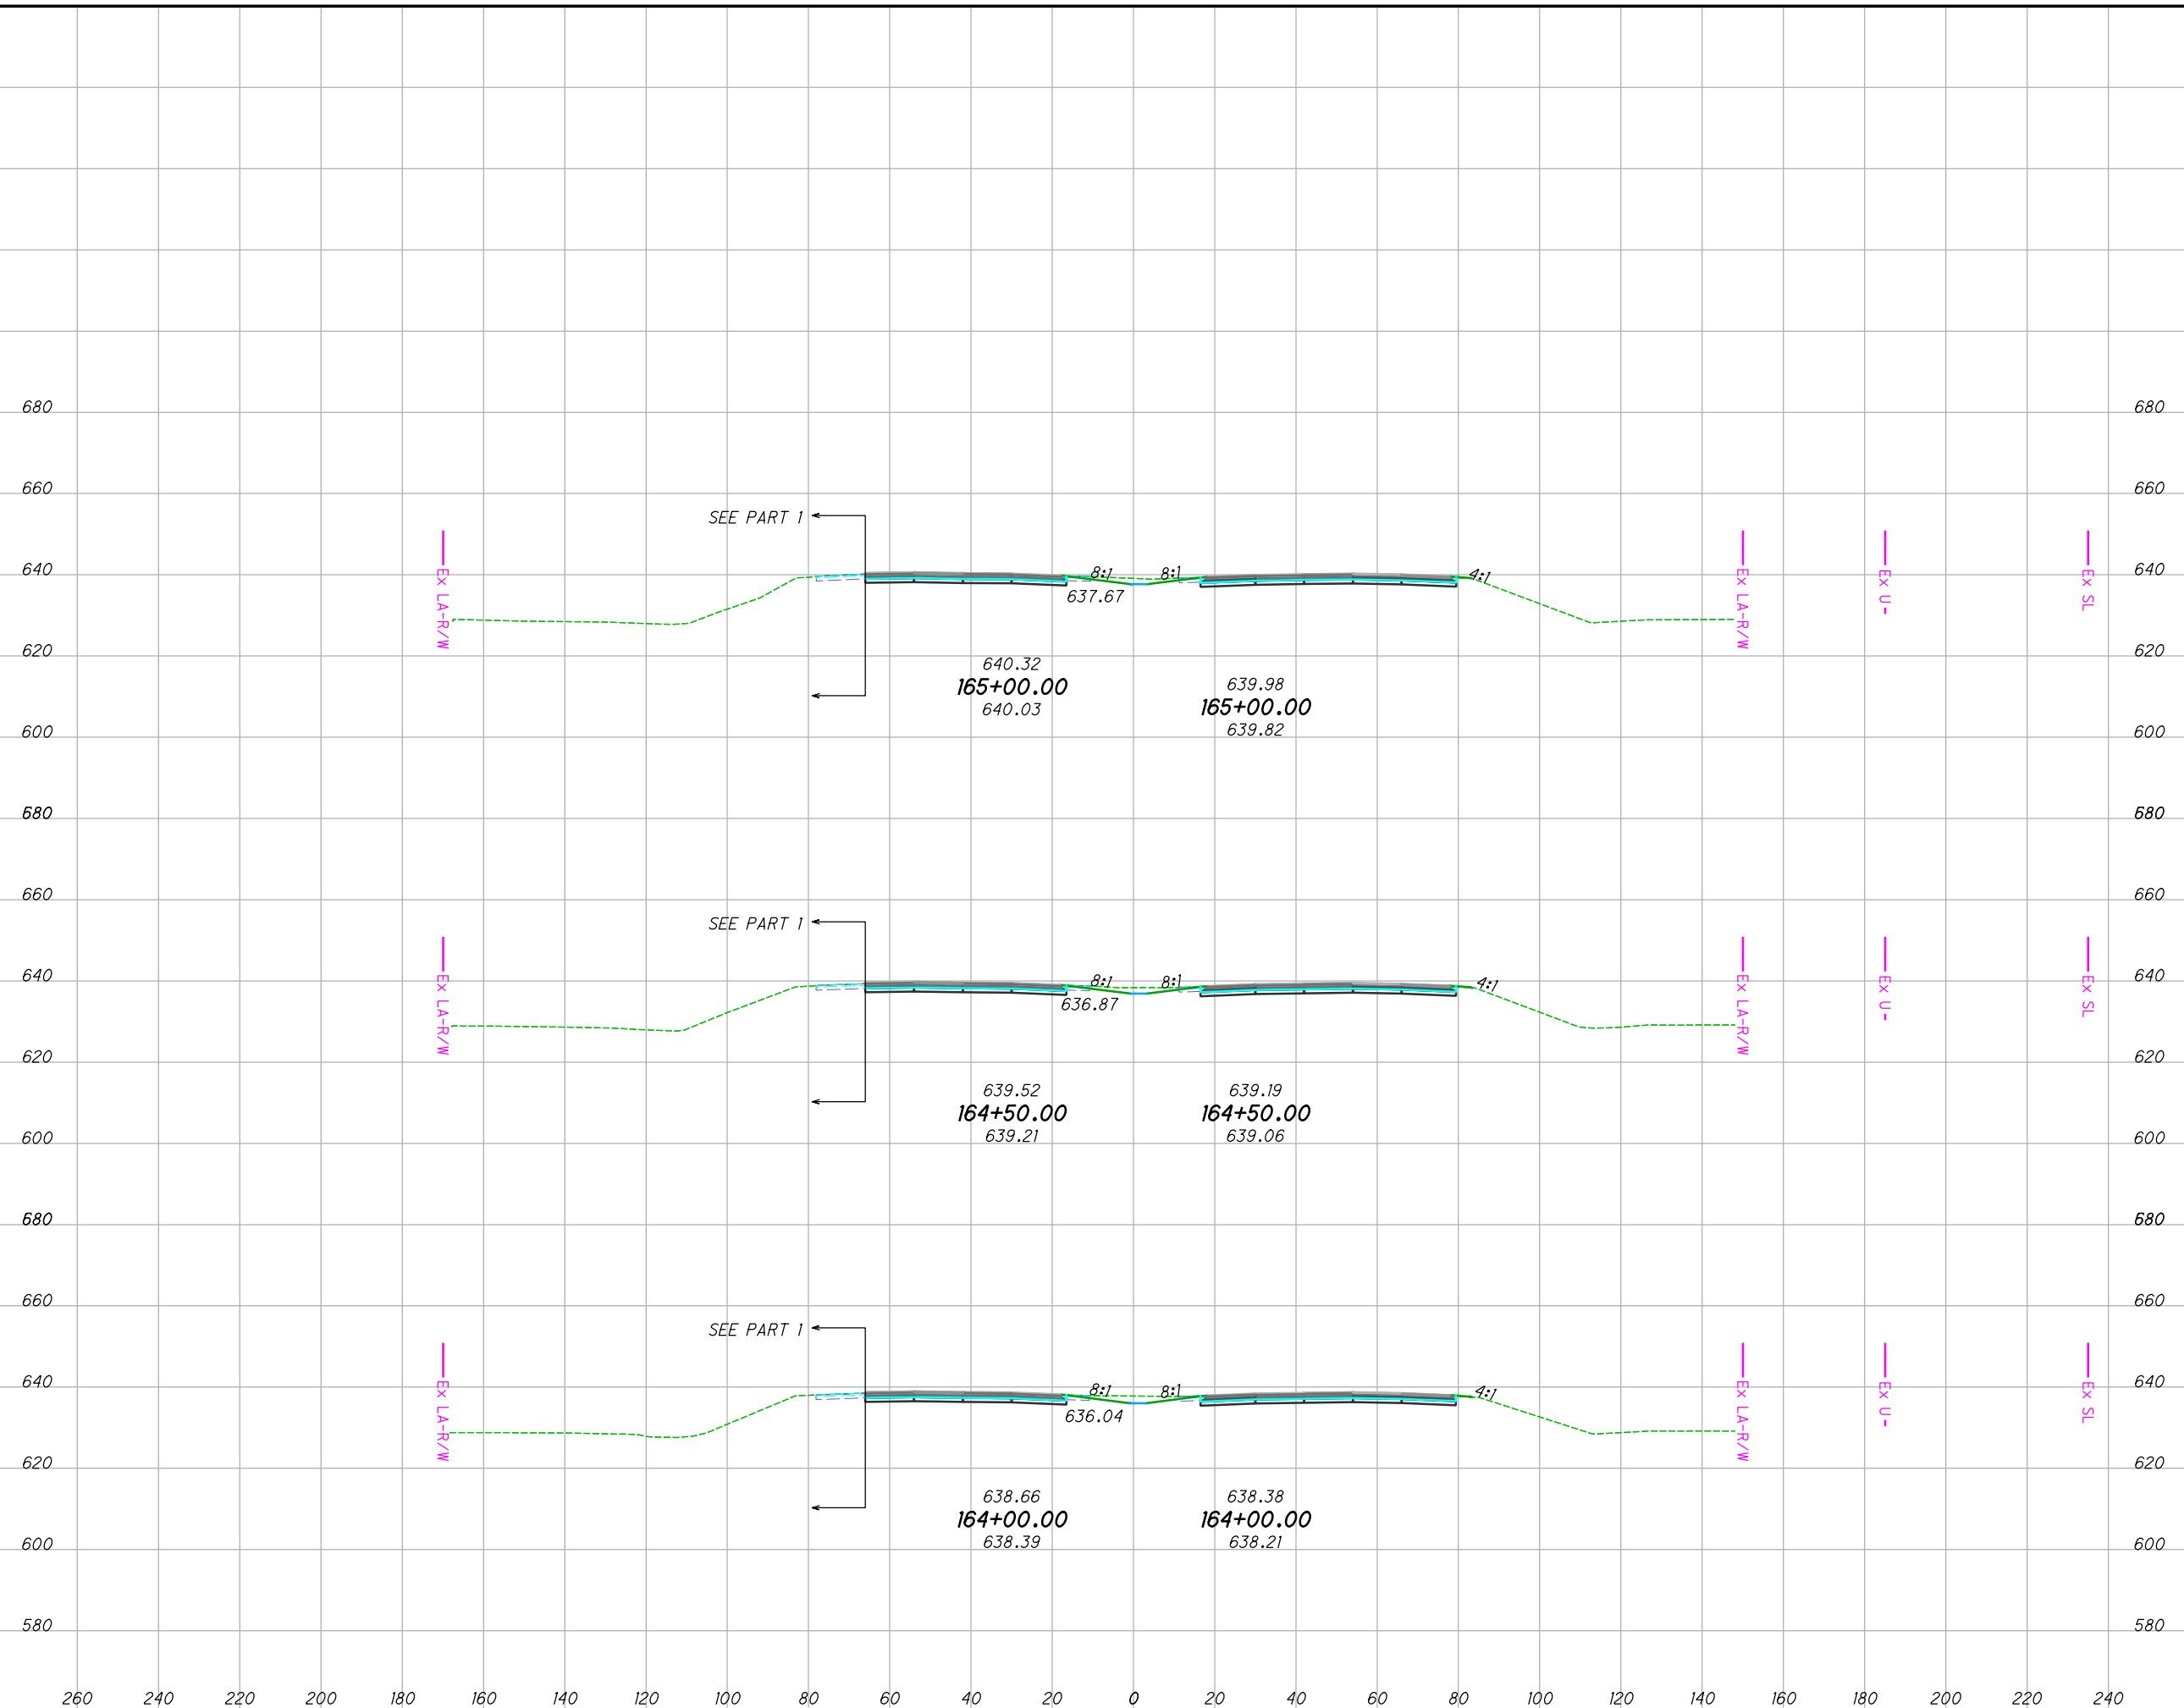

END AREA		VOLUME	
CUT	FILL	CUT	FILL
34	2	65	5
36	3	71	5
41	2	80	3

CALCULATED	
JRB	XXX


**CROSS SECTIONS  
STA. 164+00.00 TO STA. 165+00.00**

**LUC-475-0.9**

432  
855

I:\ProjectData\LUC-475-0.9\Design\Roadway\Sheets\95875\_XS001 - Copy.dgn Sheet 4/29/2022 8:36:09 AM jbdinge

SEEDING	
END WIDTH	SO. YDS.
443	
260	
240	
220	
20	
40	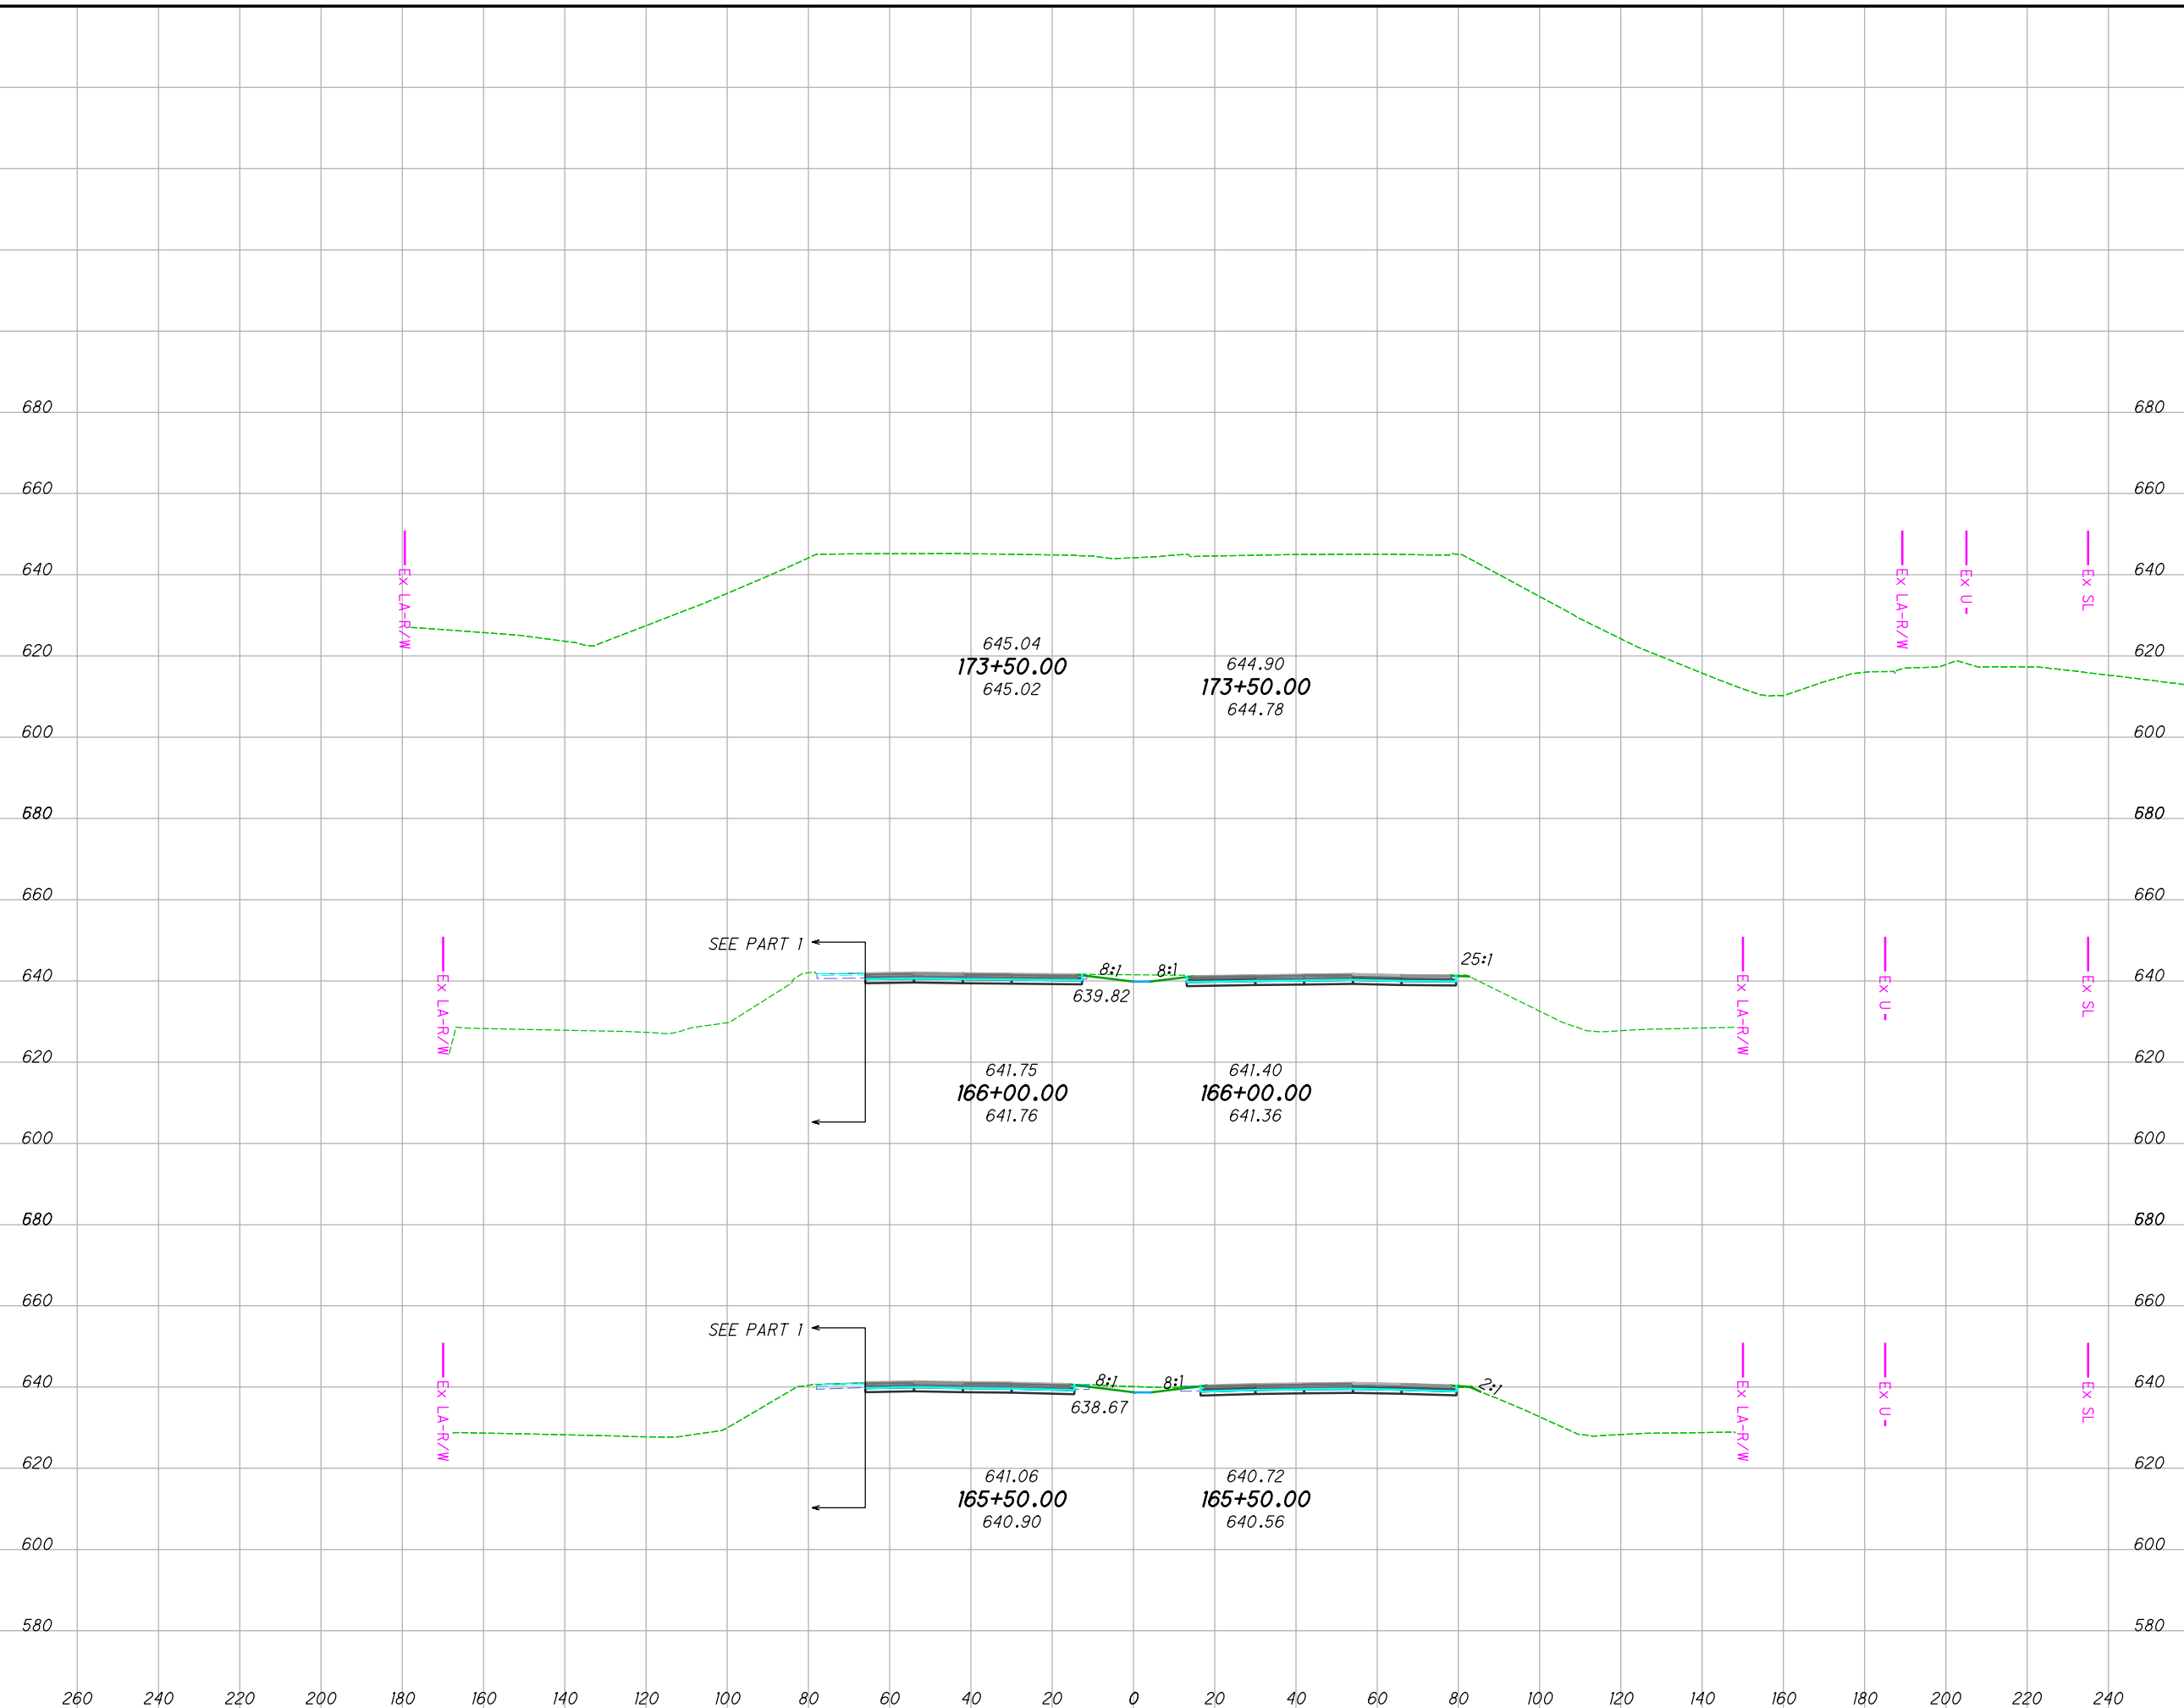
END AREA		VOLUME	
CUT	FILL	CUT	FILL
58	0	87	1
36	1	65	3
		152	4

**CROSS SECTIONS**  
**STA. 165+50.00 TO STA. 173+50.00**

**LUC-475-0.9**

433  
855

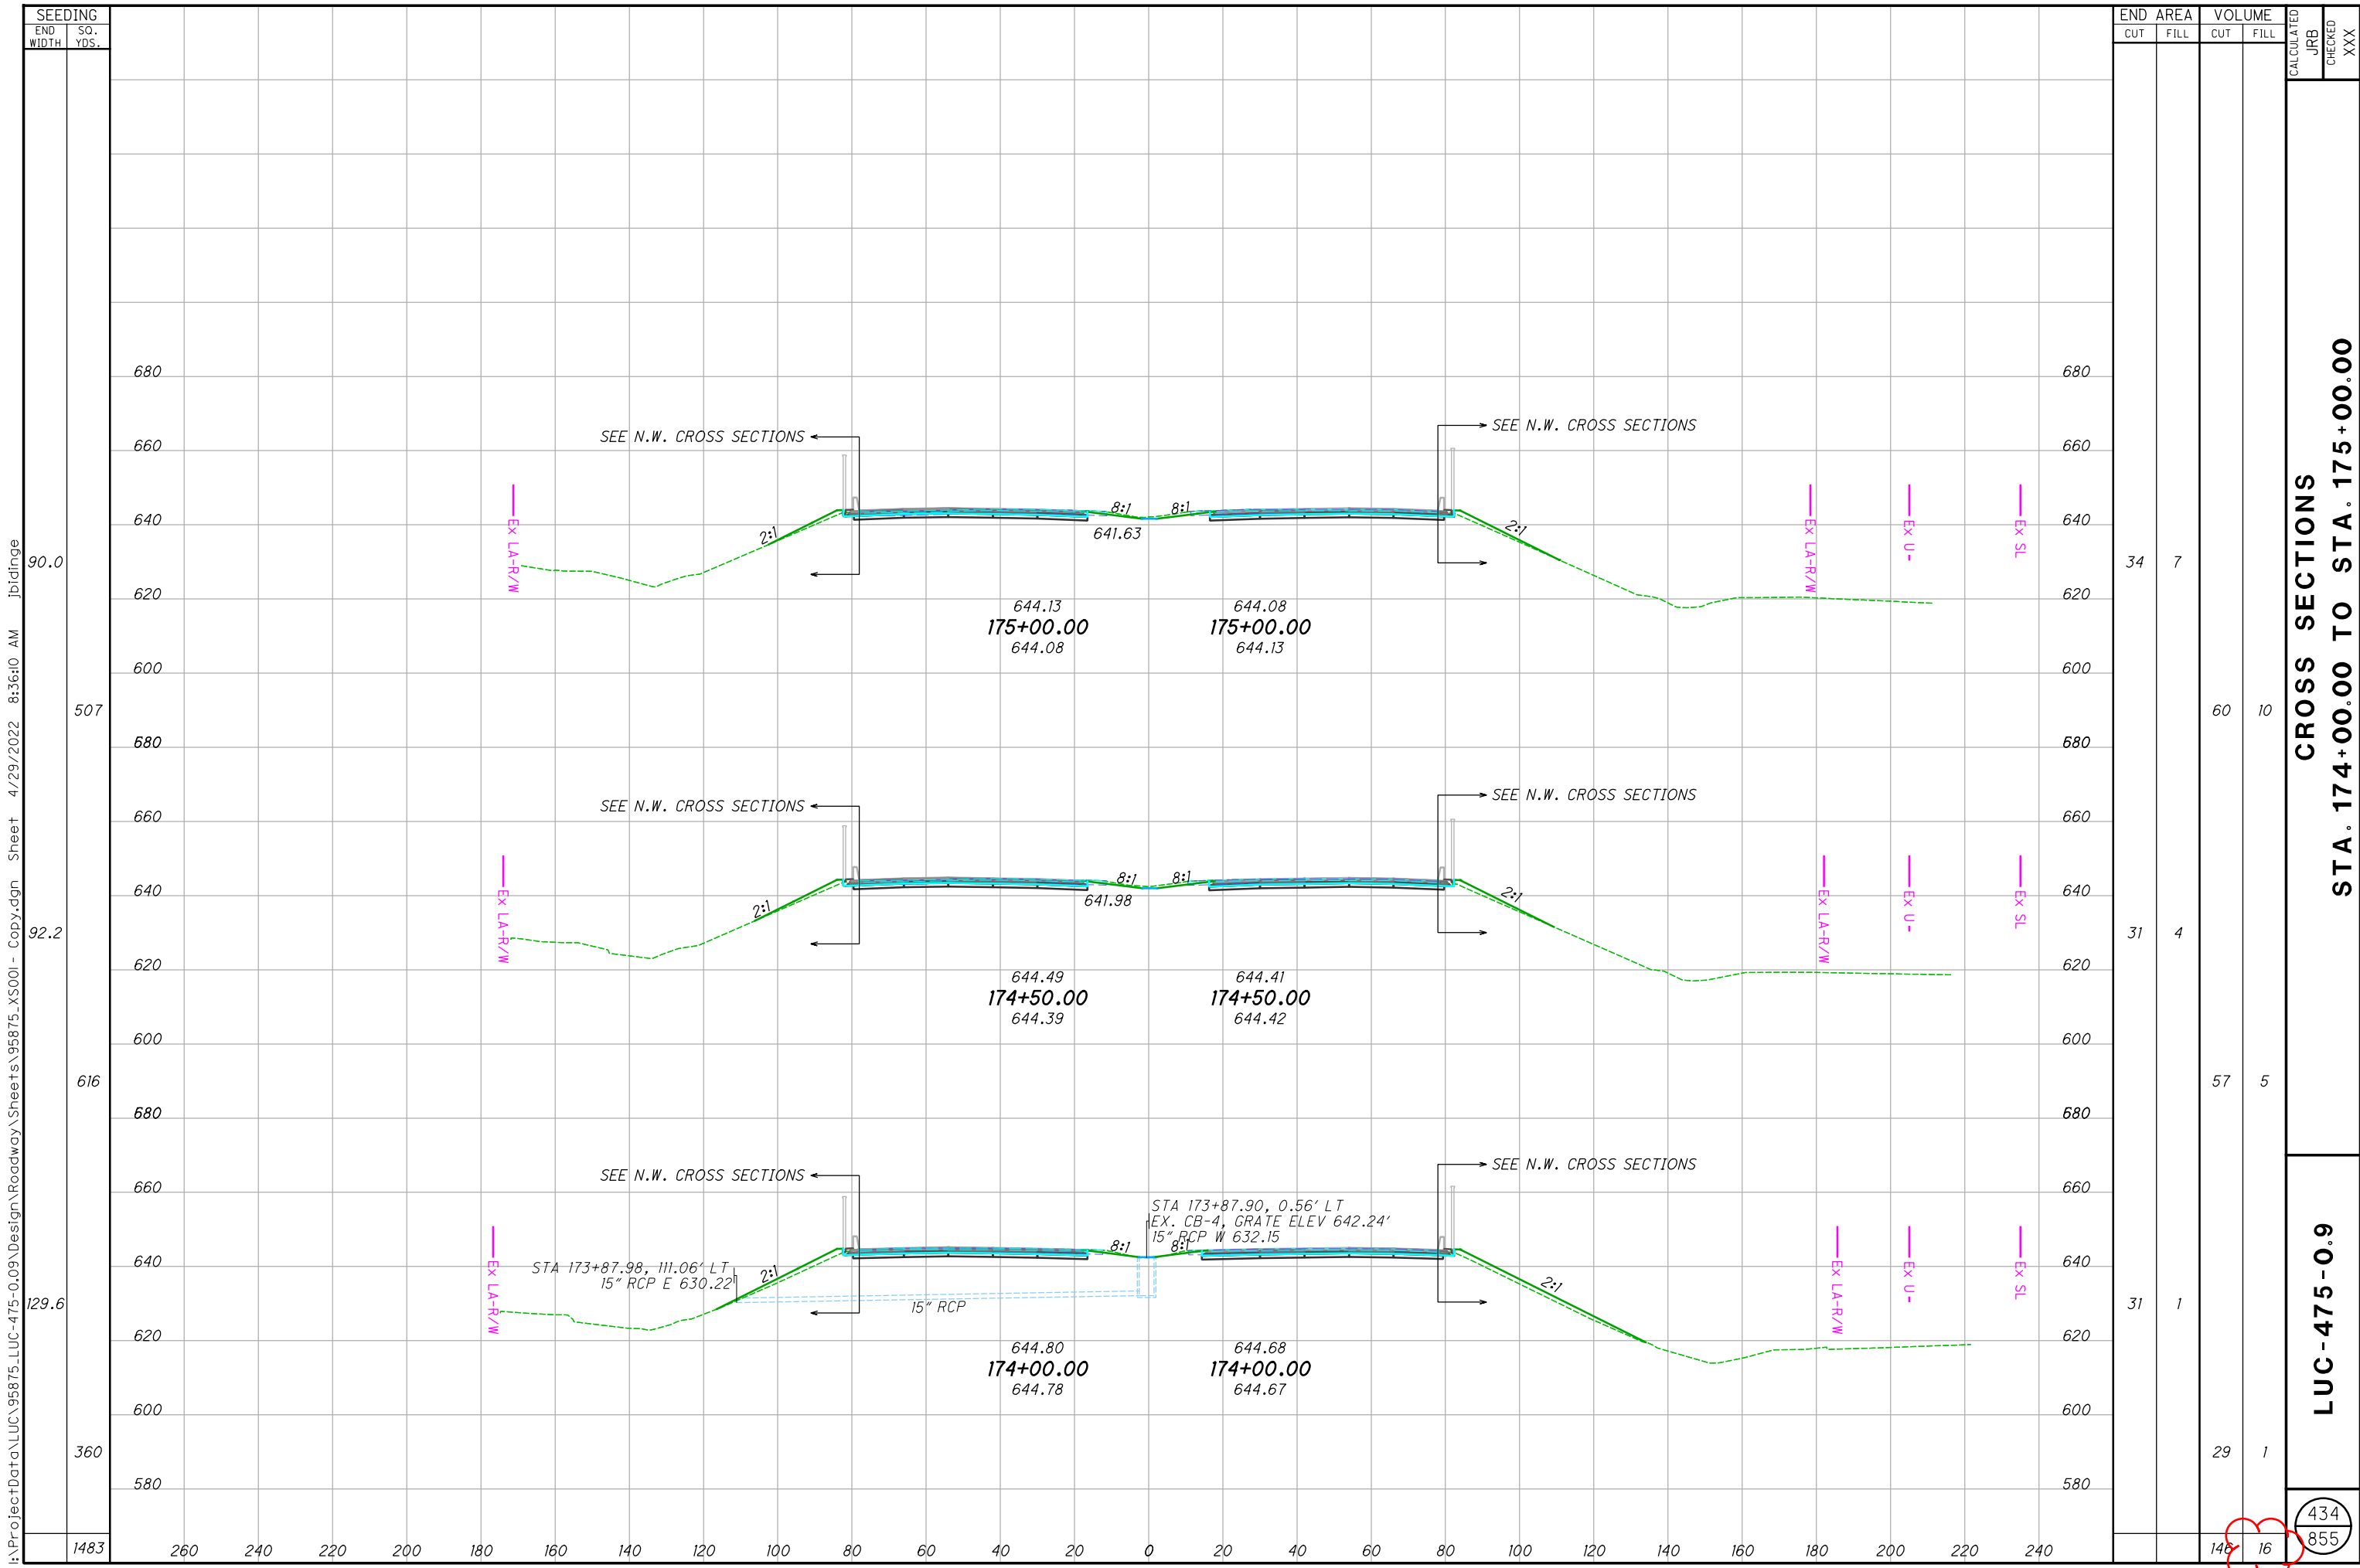

SEEDING	
END WIDTH	SO. YDS.
1483	
260	
240	
220	
20	
40	
60	
80	
100	
120	
140	
160	
180	
200	
220	
240	

END AREA		VOLUME		CALCULATED		
CUT	FILL	CUT	FILL	JRB	CHECKED	XXX
34	7	60	10			
31	4	57	5			
31	1	29	1			


**CROSS SECTIONS**  
**STA. 174+00.00 TO STA. 175+00.00**

**LUC-475-0.9**

434  
 855

I:\ProjectData\LUC-475-0.9\Design\Roadway\Sheets\95875\_X5001 - Copy.dgn Sheet 4/29/2022 8:36:10 AM jbidinge



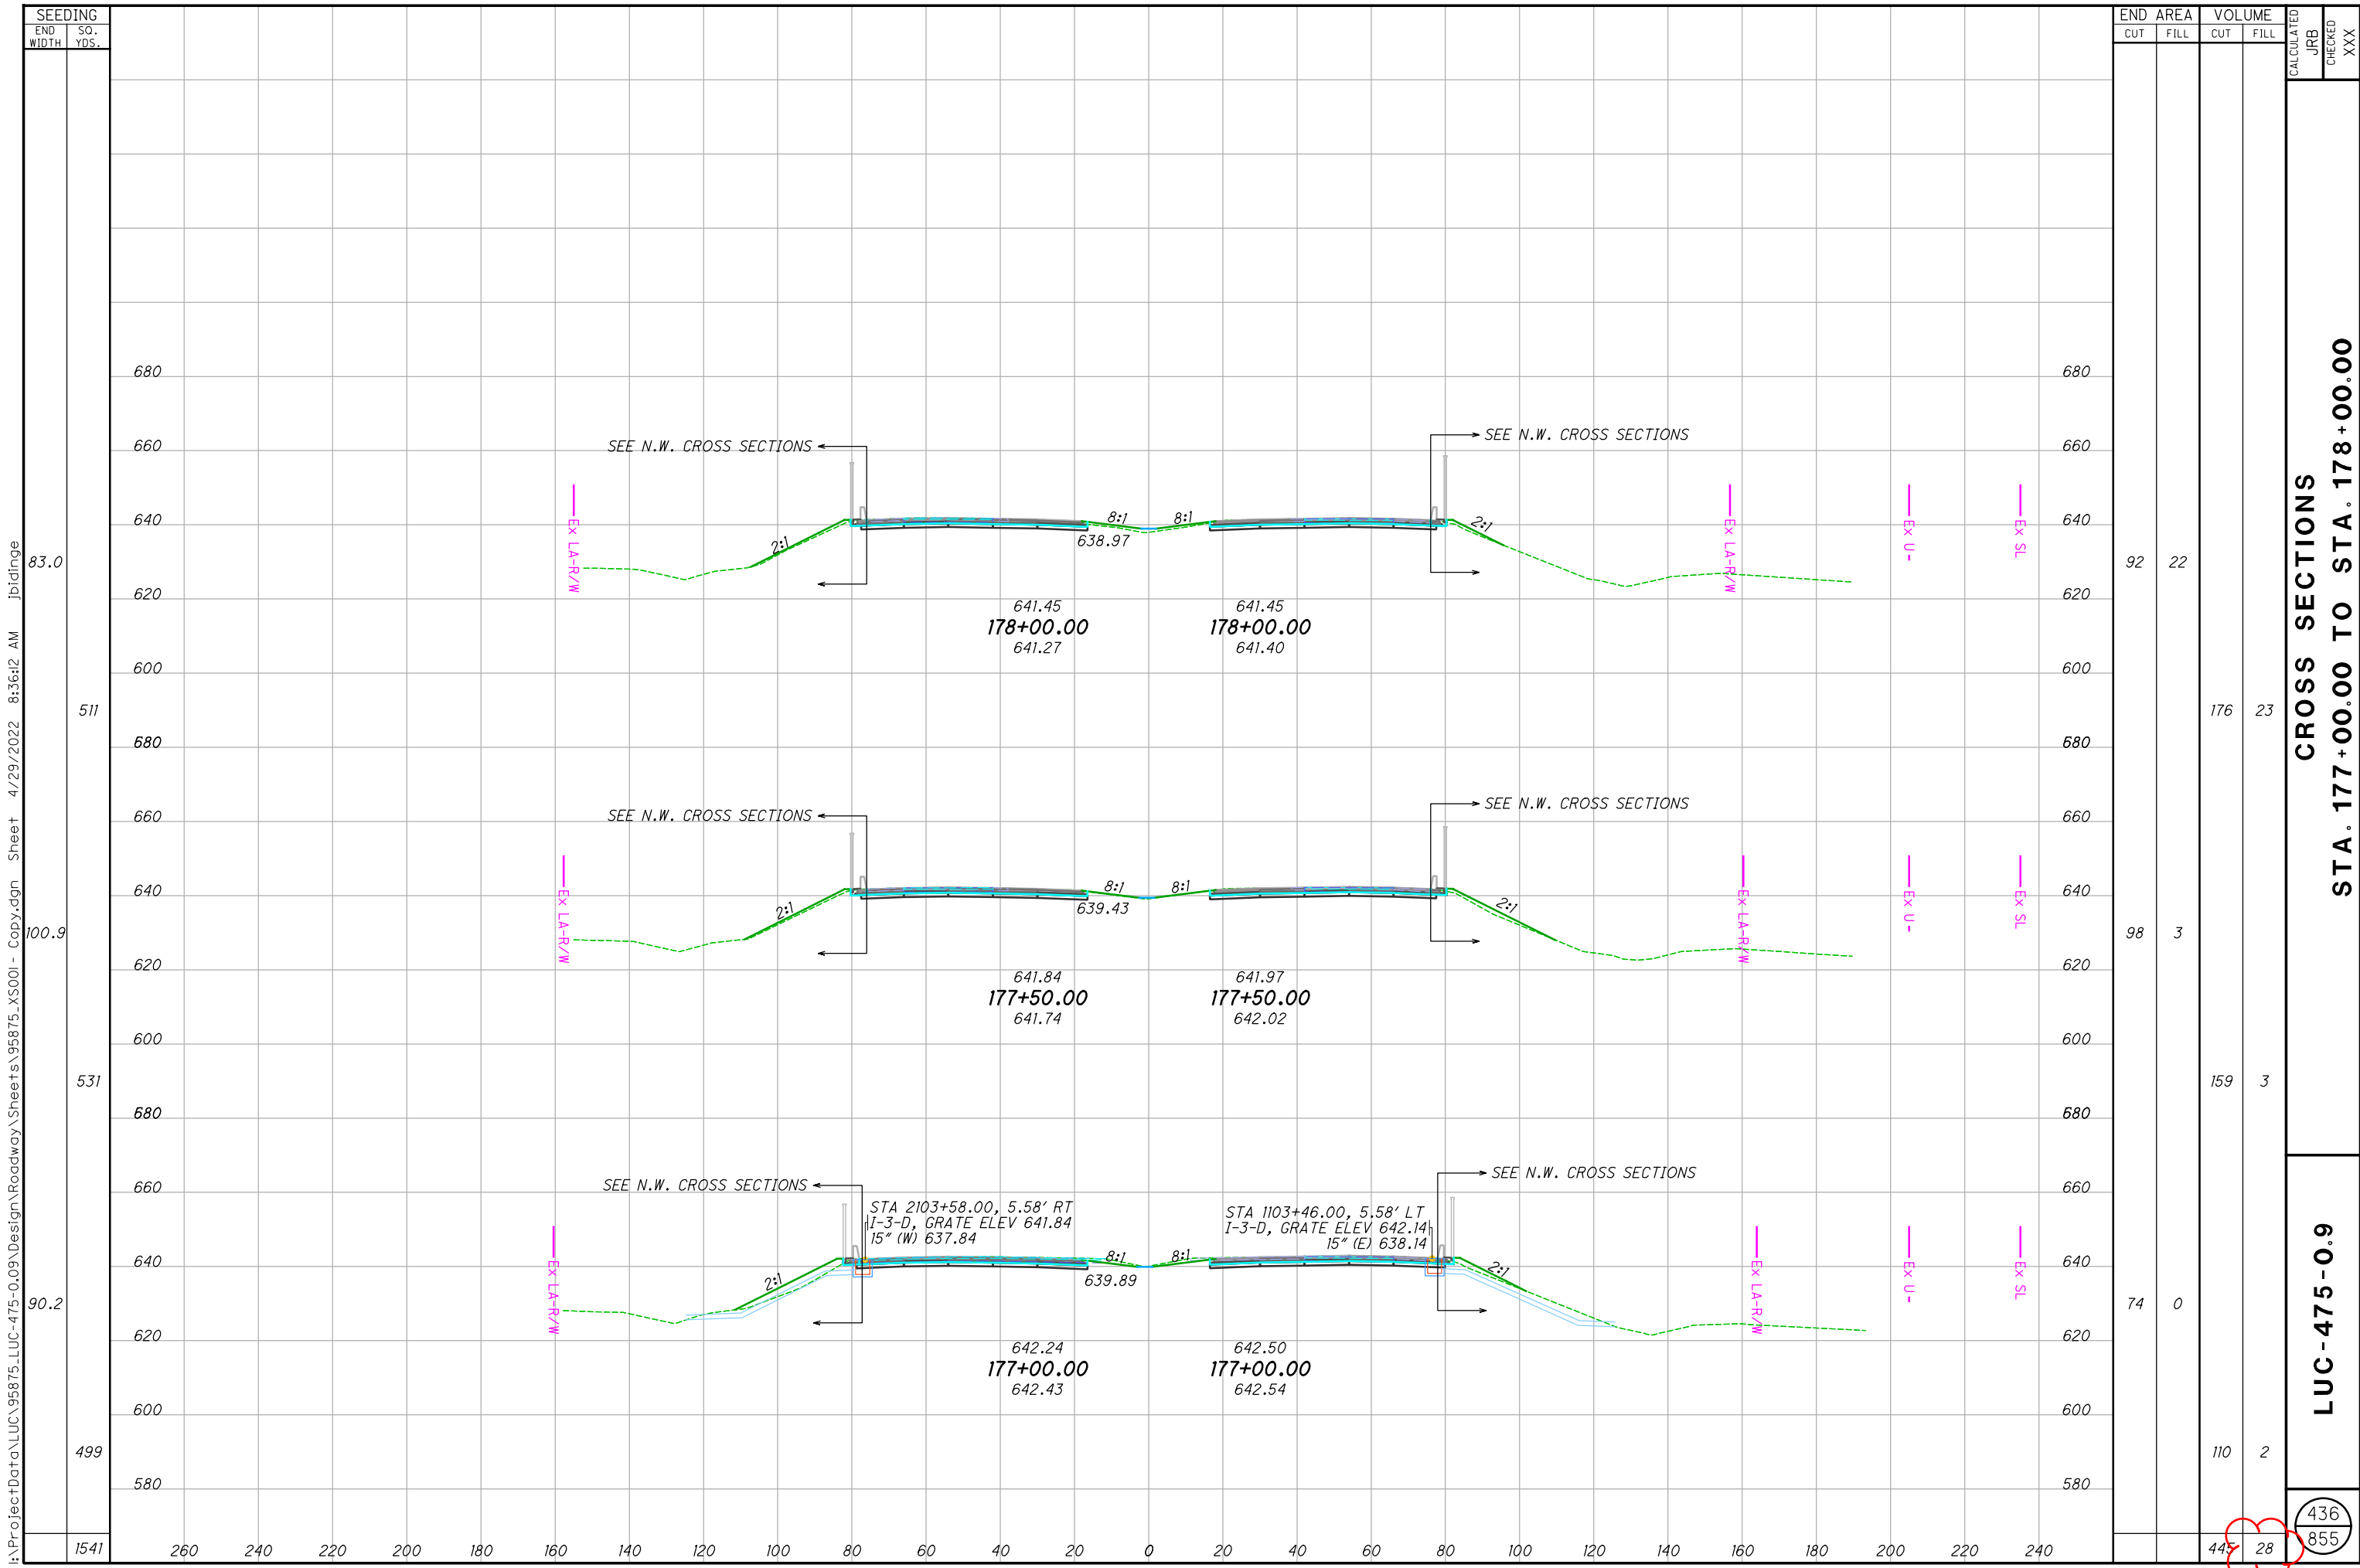

I:\ProjectData\LUC\95875\LUC-475-0.09\Design\Roadway\Sheets\95875\_X5001 - Copy.dgn Sheet 4/29/2022 8:36:12 AM jbidinge

SEEDING	
END WIDTH	SO. YDS.
1541	


END AREA		VOLUME		CALCULATED		
CUT	FILL	CUT	FILL	JRB	CHECKED	XXX
92	22	176	23			
98	3	159	3			
74	0	110	2			
445	28	436	855			

**CROSS SECTIONS**  
**STA. 177+00.00 TO STA. 178+00.00**

**LUC-475-0.9**

436  
855

SEEDING  
END SO.  
WIDTH YDS.  
79.4  
431  
75.8  
410  
72.0  
397  
1238

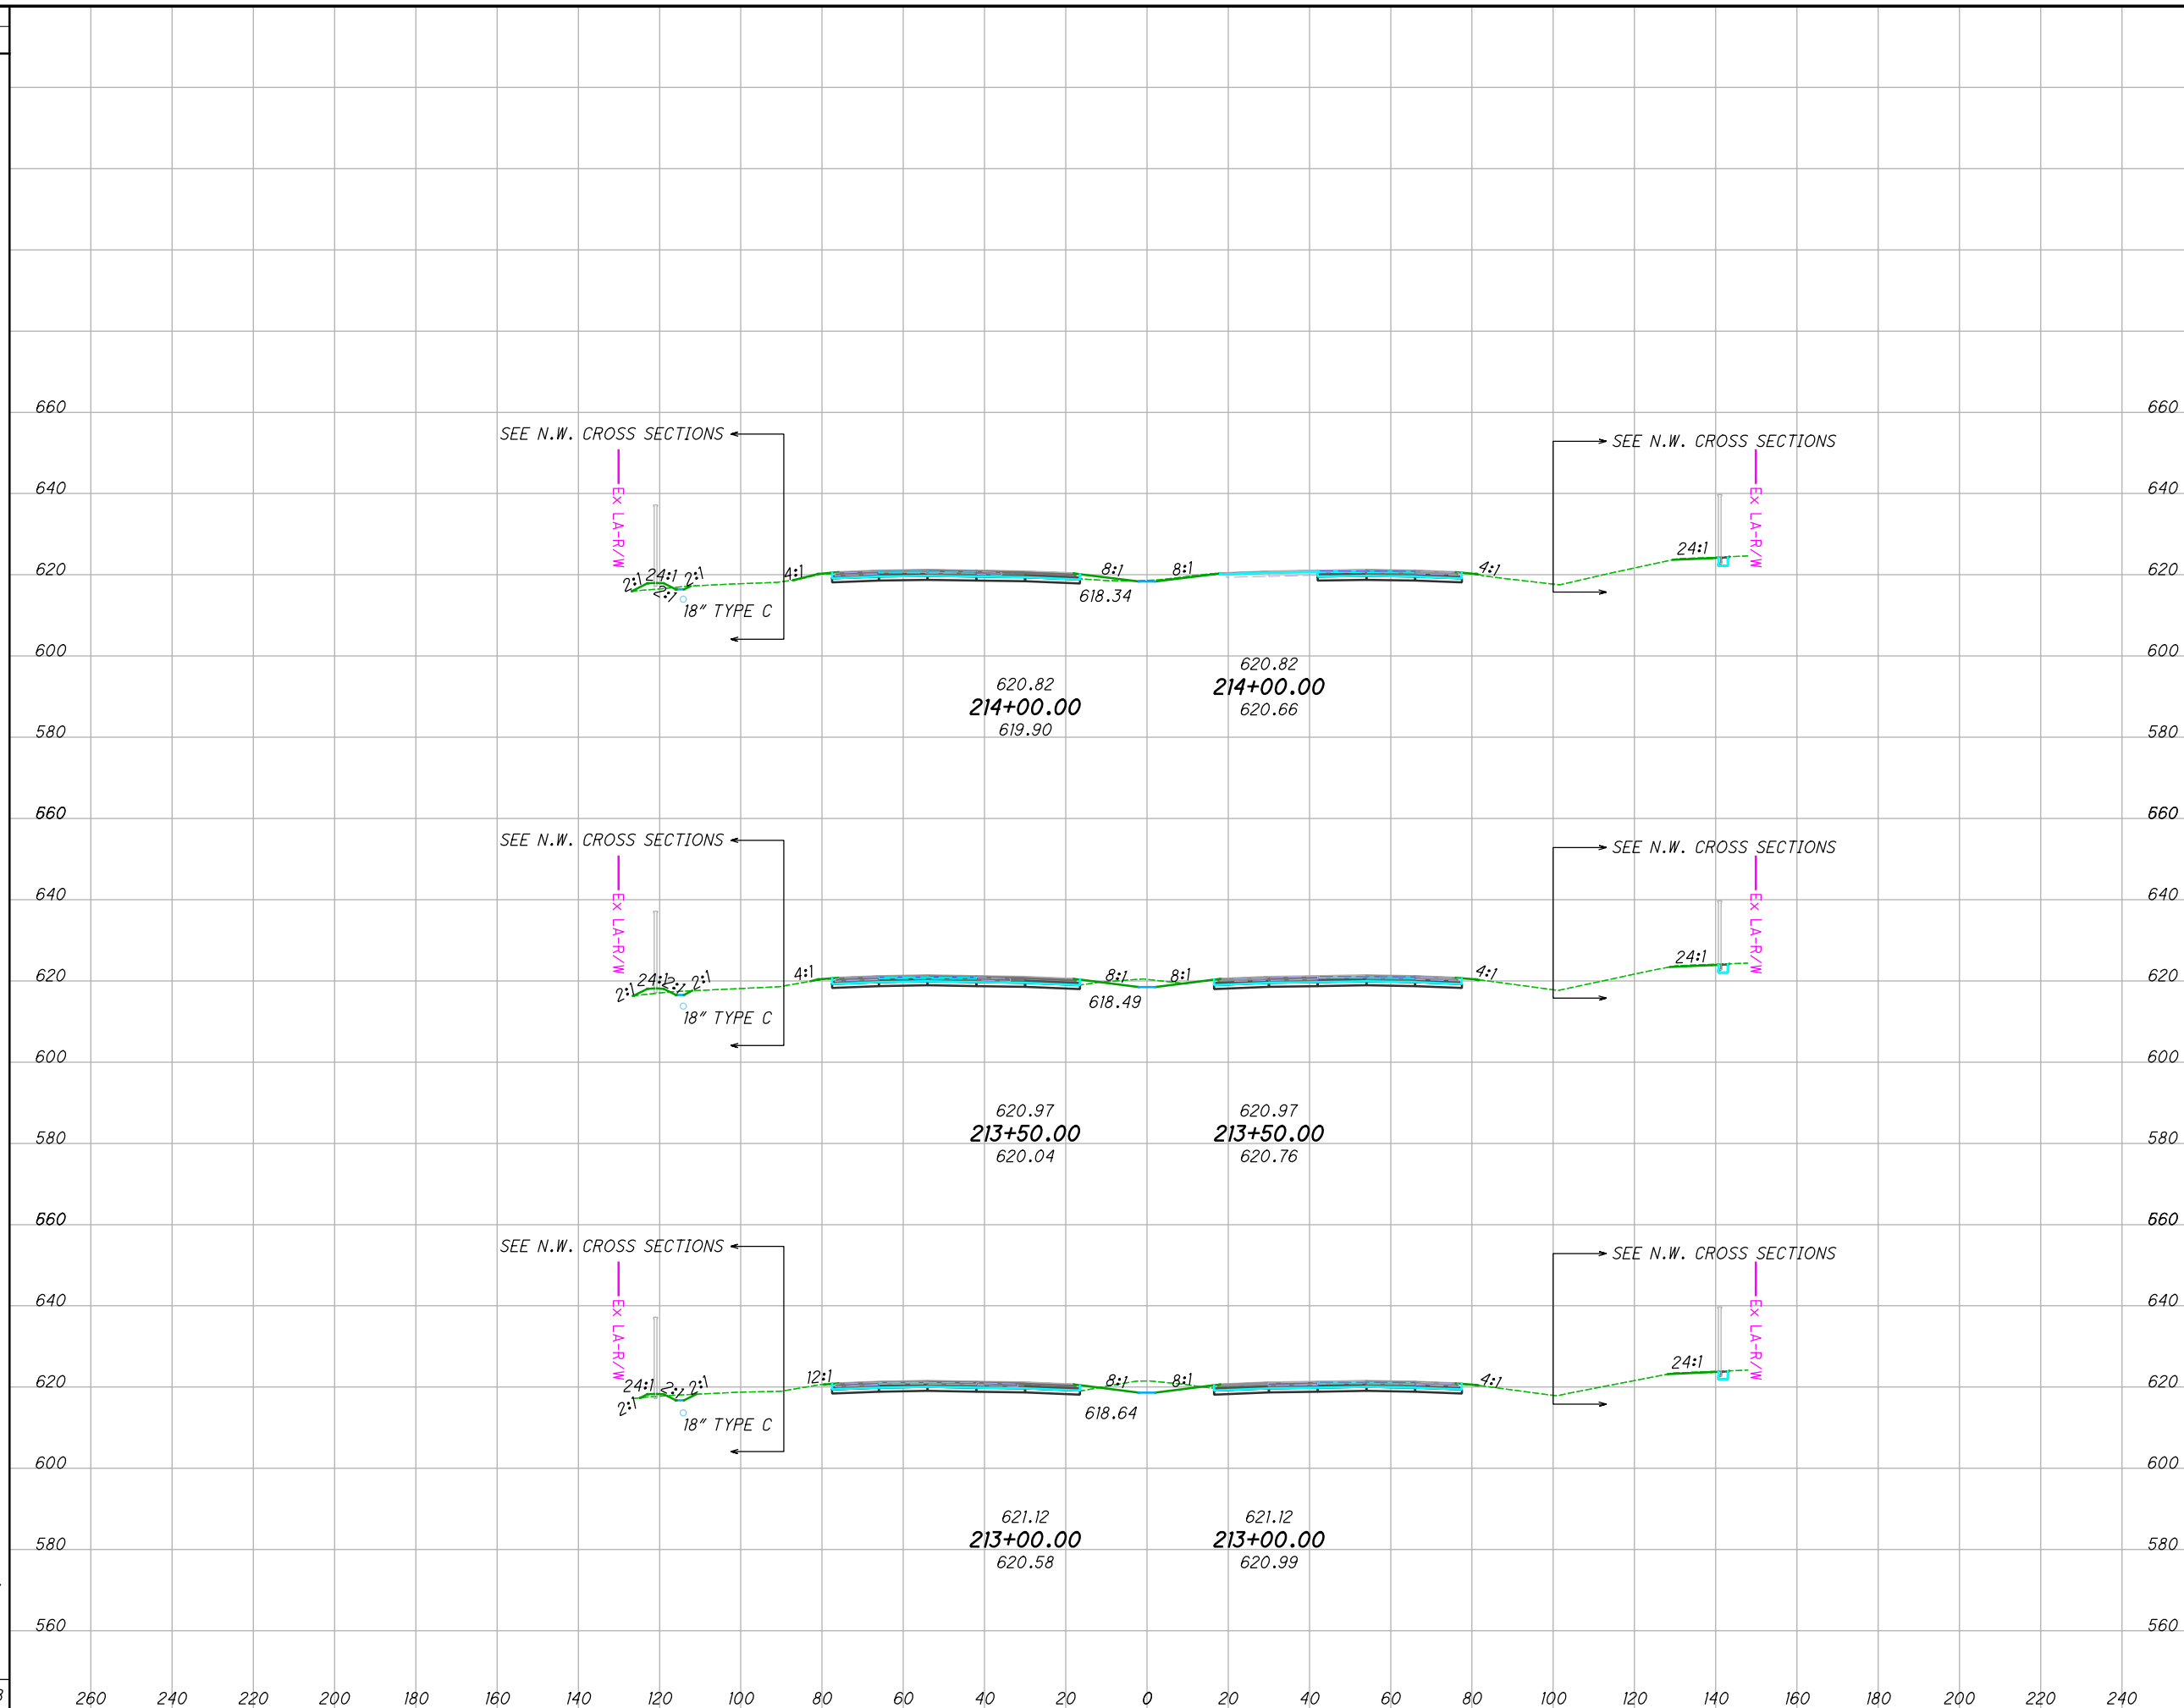

END AREA		VOLUME		CALCULATED	CHECKED
CUT	FILL	CUT	FILL	JRB	XXX
37	11	97	15		
68	5	148	10		
92	6	180	10		
425	35	460	855		

**CROSS SECTIONS  
STA. 213+00.00 TO STA. 214+00.00**


**LUC-475-0.9**

I:\ProjectData\LUC\95875\_LUC-475-0.9\Design\Roadway\Sheets\95875\_XS001 - Copy.dgn Sheet 4/29/2022 8:36:13 AM jbidinge



I:\ProjectData\LUC\95875\_LUC-475-0.9\_Design\Roadway\Sheets\95875\_XS001 - Copy.dgn Sheet 4/29/2022 8:36:14 AM jbidinge

SEEDING	
END WIDTH	SO. YDS.
1128	427
260	74.2
240	366
220	57.6
200	63.1
180	
160	
140	
120	
100	
80	
60	
40	
20	
0	
20	
40	
60	
80	
100	
120	
140	
160	
180	
200	
220	
240	

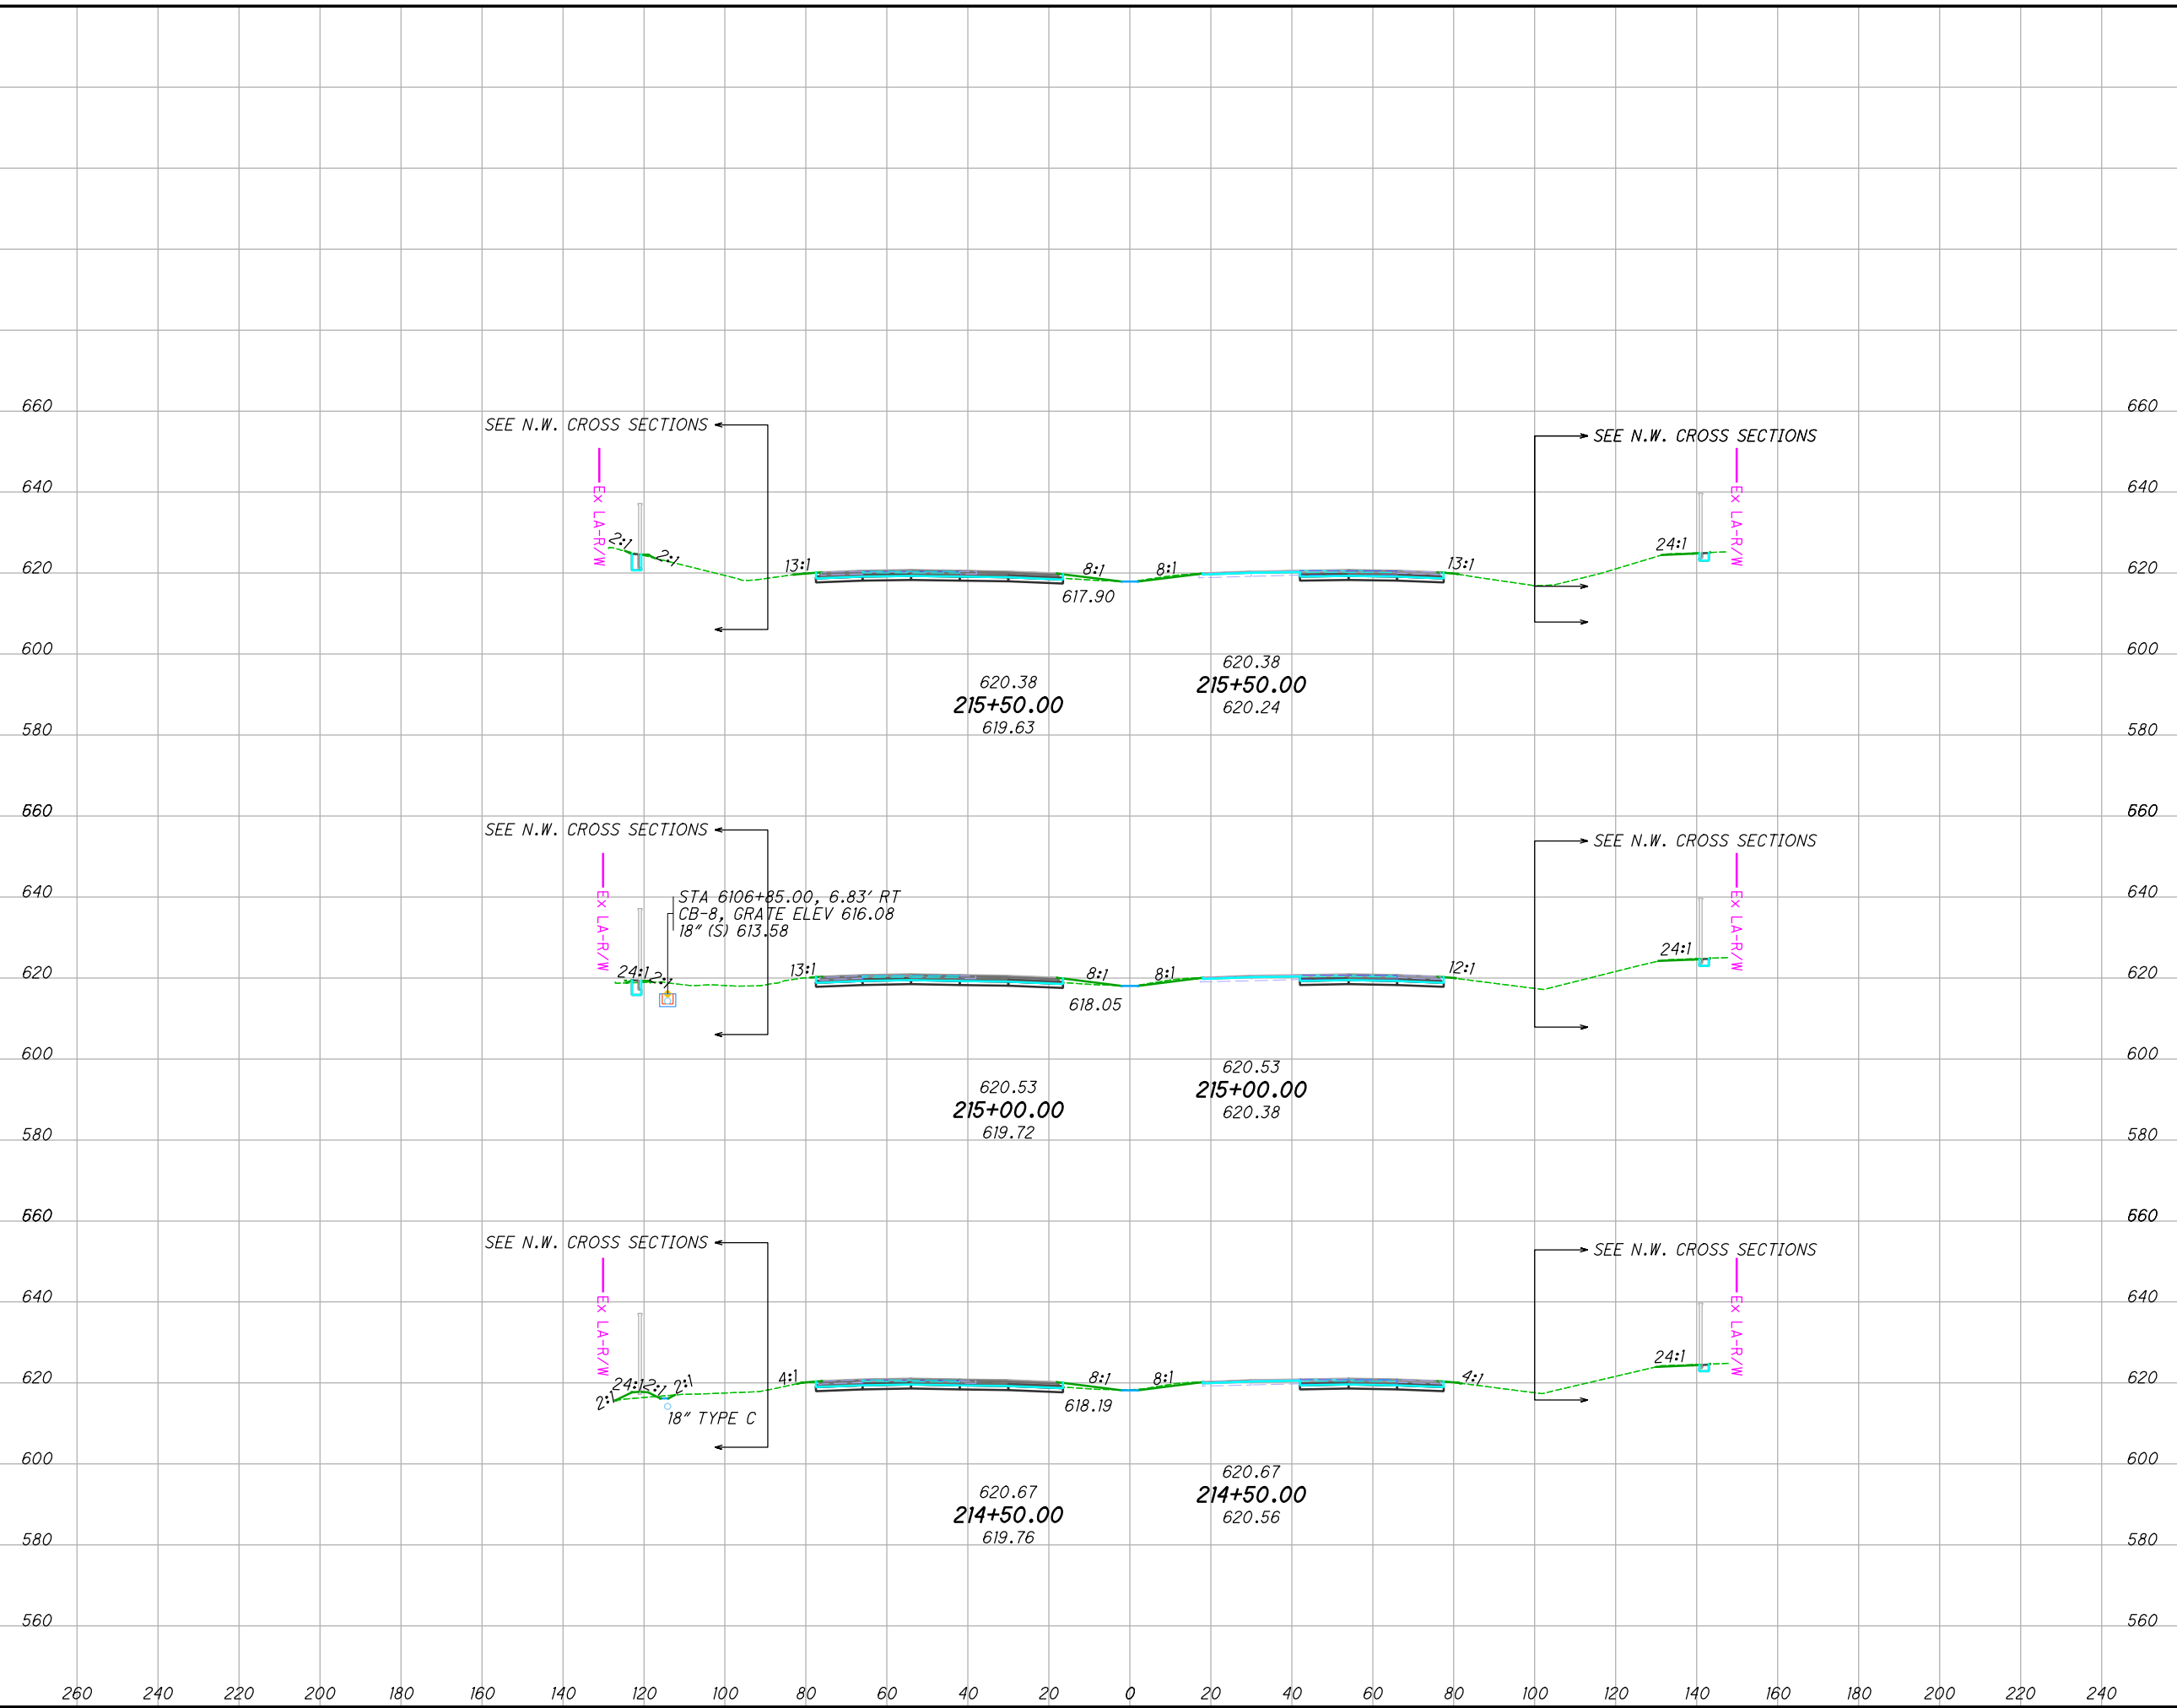


END AREA		VOLUME		CALCULATED	JRB	CHECKED	XXX
CUT	FILL	CUT	FILL				
48	8	85	16				
44	9	79	17				
41	9	72	19				
238	52	461	855				


**CROSS SECTIONS**  
**STA. 214+50.00 TO STA. 215+50.00**

**LUC-475-0.9**

461  
855

I:\ProjectData\LUC\95875\LUC-475-0.09\Design\Roadway\Sheets\95875\_XS001 - Copy.dgn Sheet 4/29/2022 8:36:15 AM jbidinge

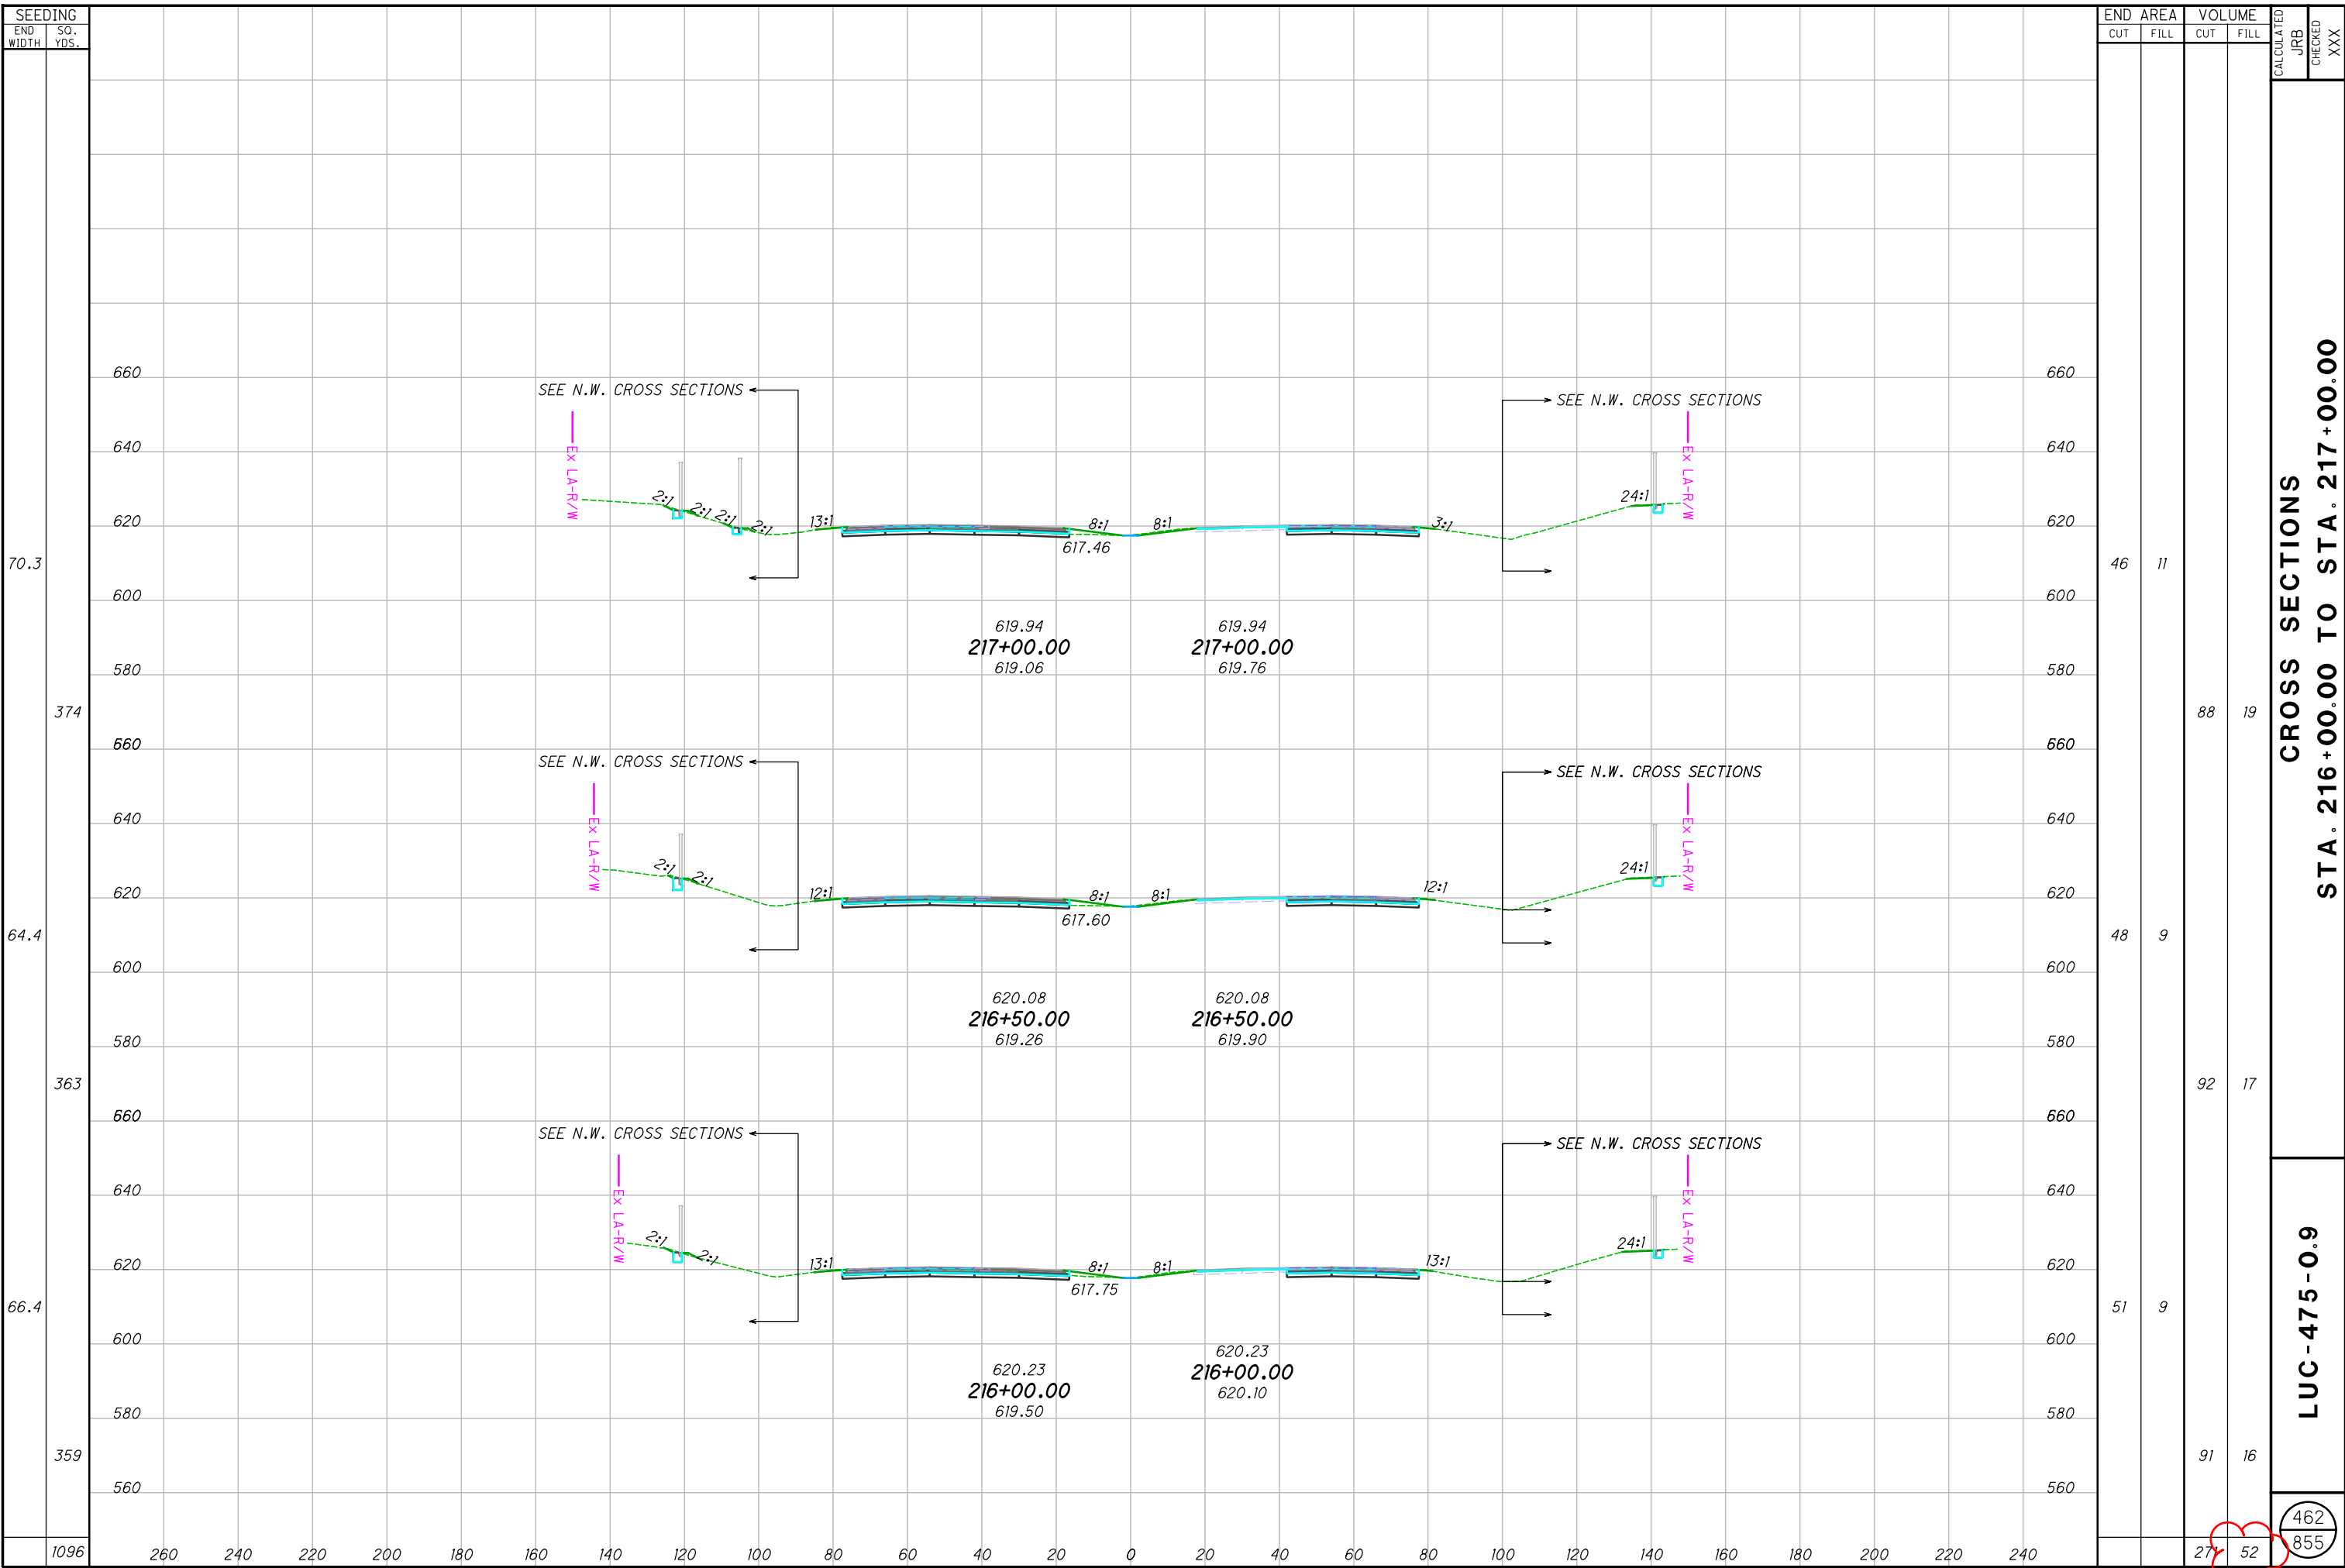

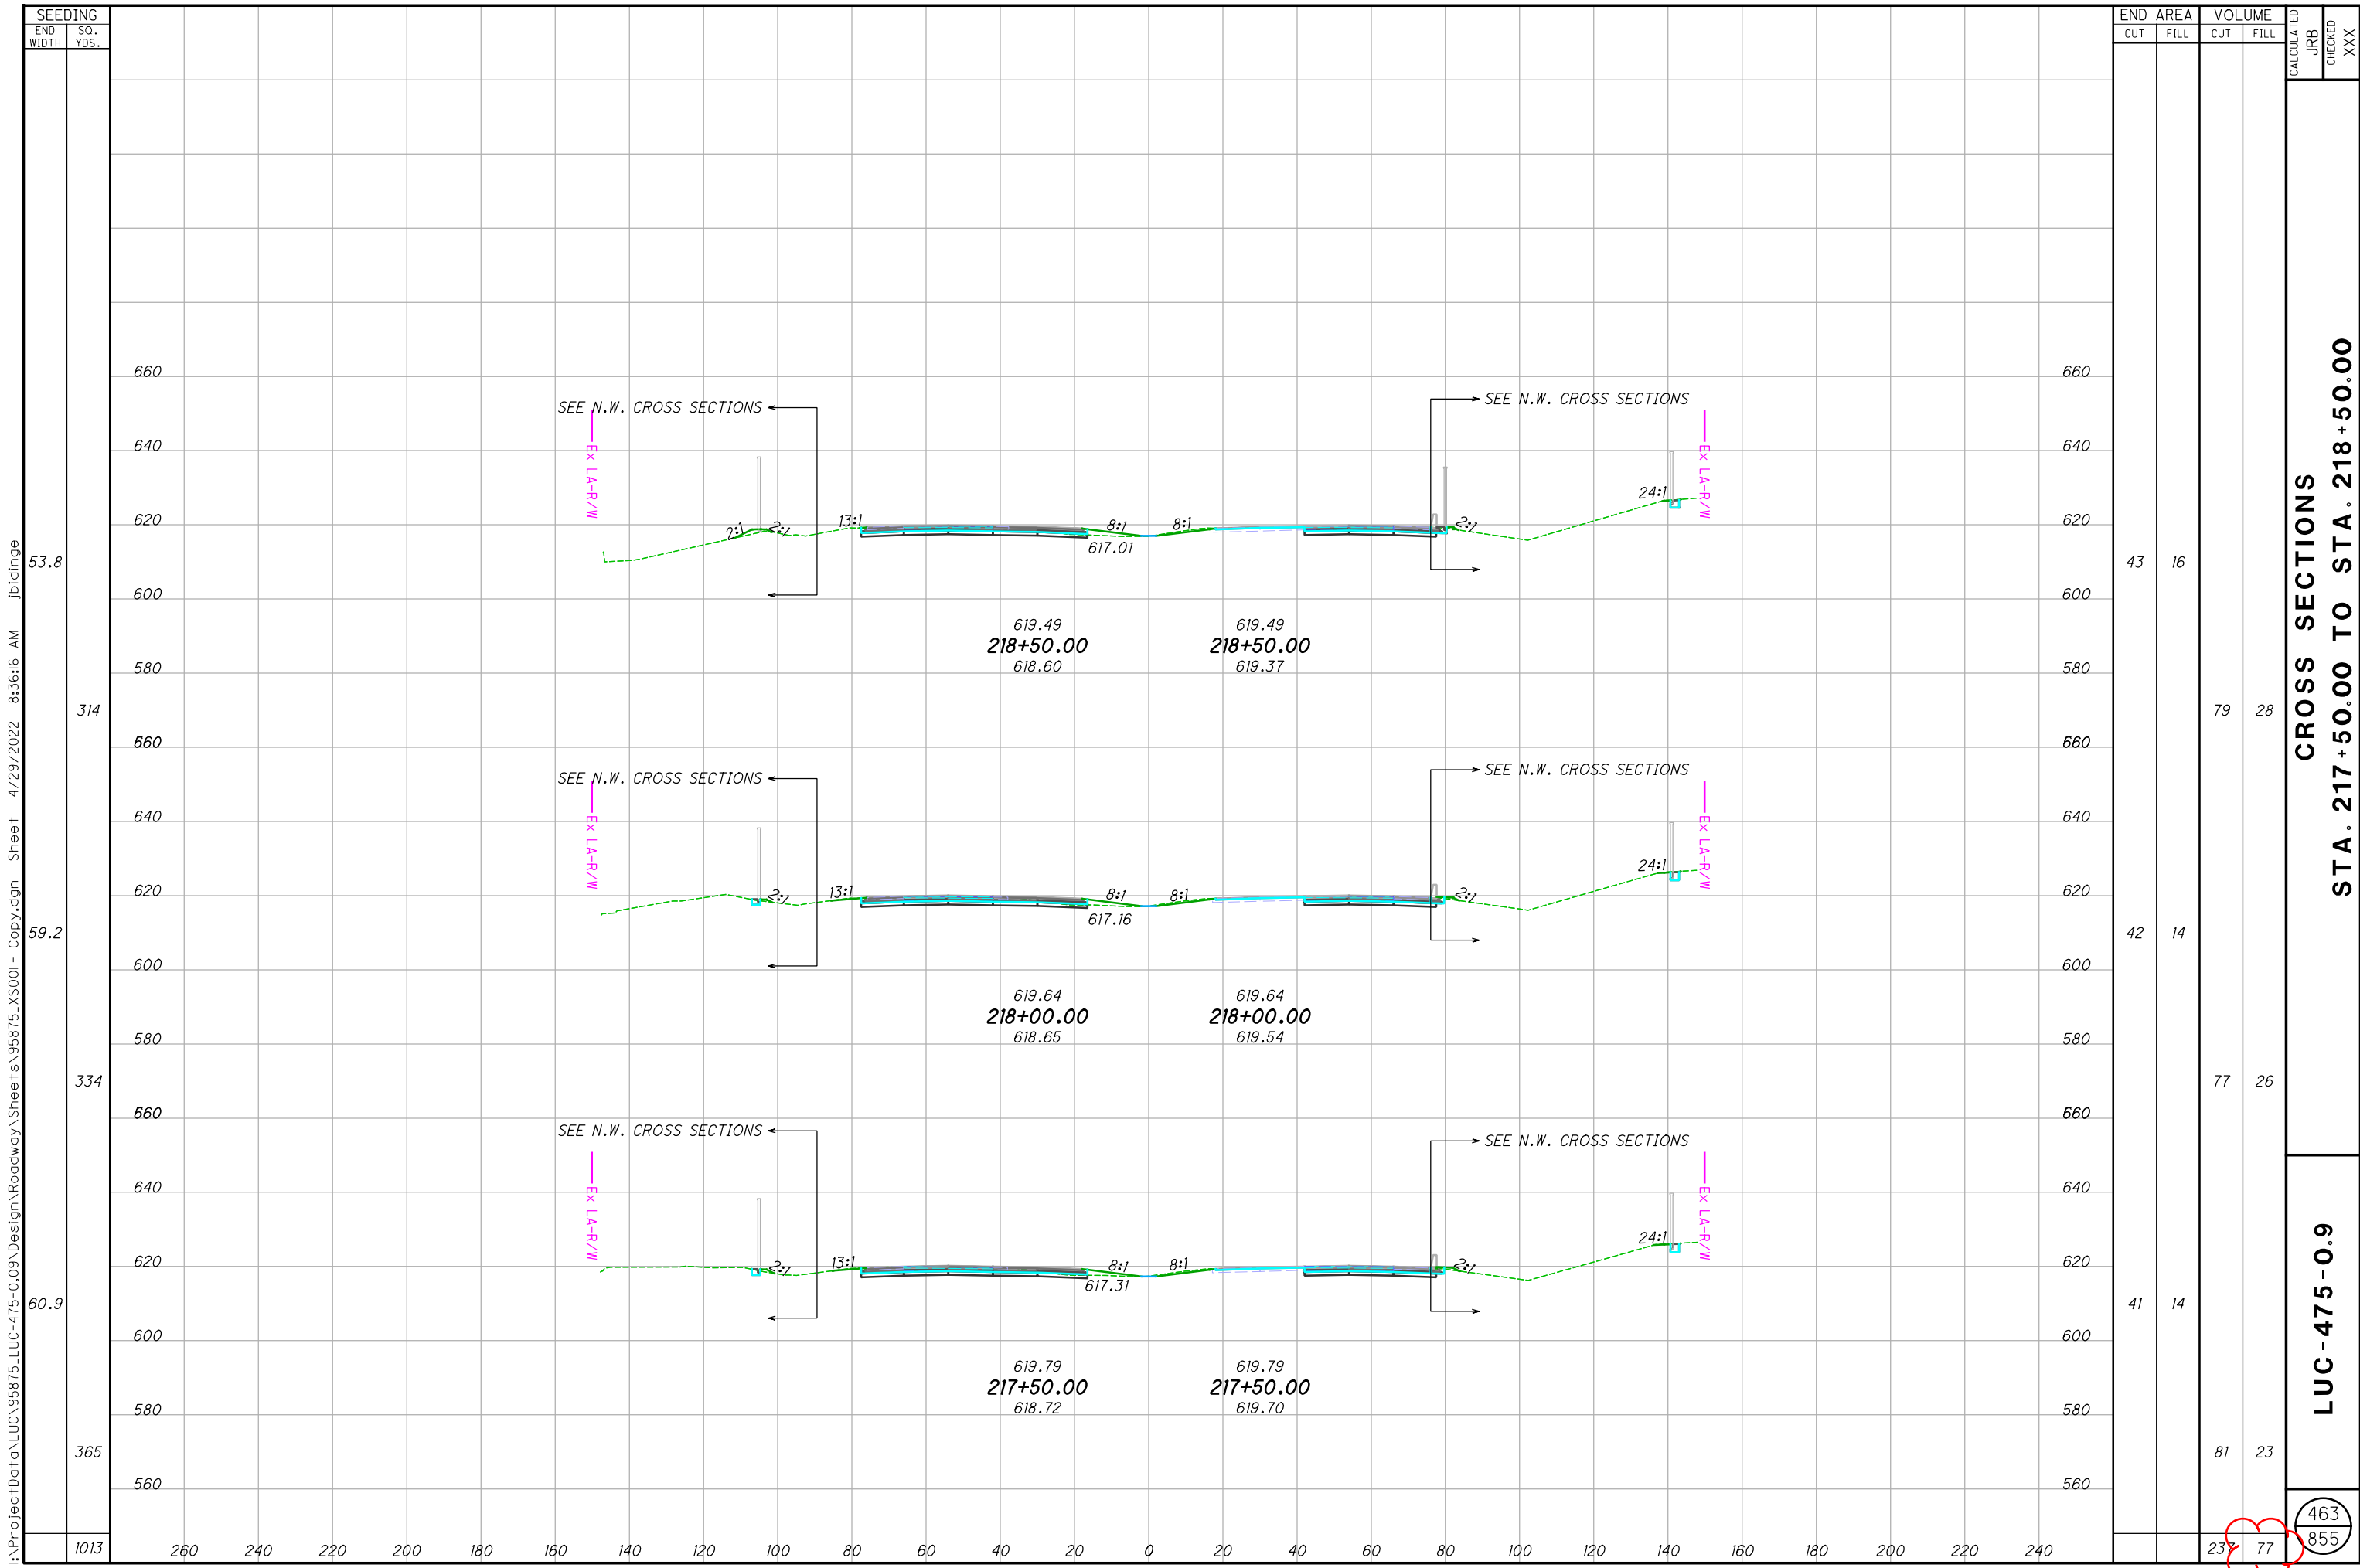

SEEDING	
END WIDTH	SO. YDS.
1013	

END AREA		VOLUME		CALCULATED	
CUT	FILL	CUT	FILL	JRB	XXX
43	16	79	28		
42	14	77	26		
41	14	81	23		
		237	77		

**CROSS SECTIONS**  
**STA. 217+50.00 TO STA. 218+50.00**


**LUC-475-0.9**

463  
 855

I:\ProjectData\LUC\95875\_LUC-475-0.9\Design\Roadway\Sheets\95875\_XS001 - Copy.dgn Sheet 4/29/2022 8:36:16 AM jbidinge

I:\ProjectData\LUC\95875\LUC-475-0.09\Design\Roadway\Sheets\95875\_XS001 - Copy.dgn Sheet 4/29/2022 8:36:17 AM jbidinge

SEEDING	
END WIDTH	SO. YDS.
1027	65.2
260	63.4
240	348
220	61.7
200	321
180	
160	
140	
120	
100	
80	
60	
40	
20	
0	
20	
40	
60	
80	
100	
120	
140	
160	
180	
200	
220	
240	

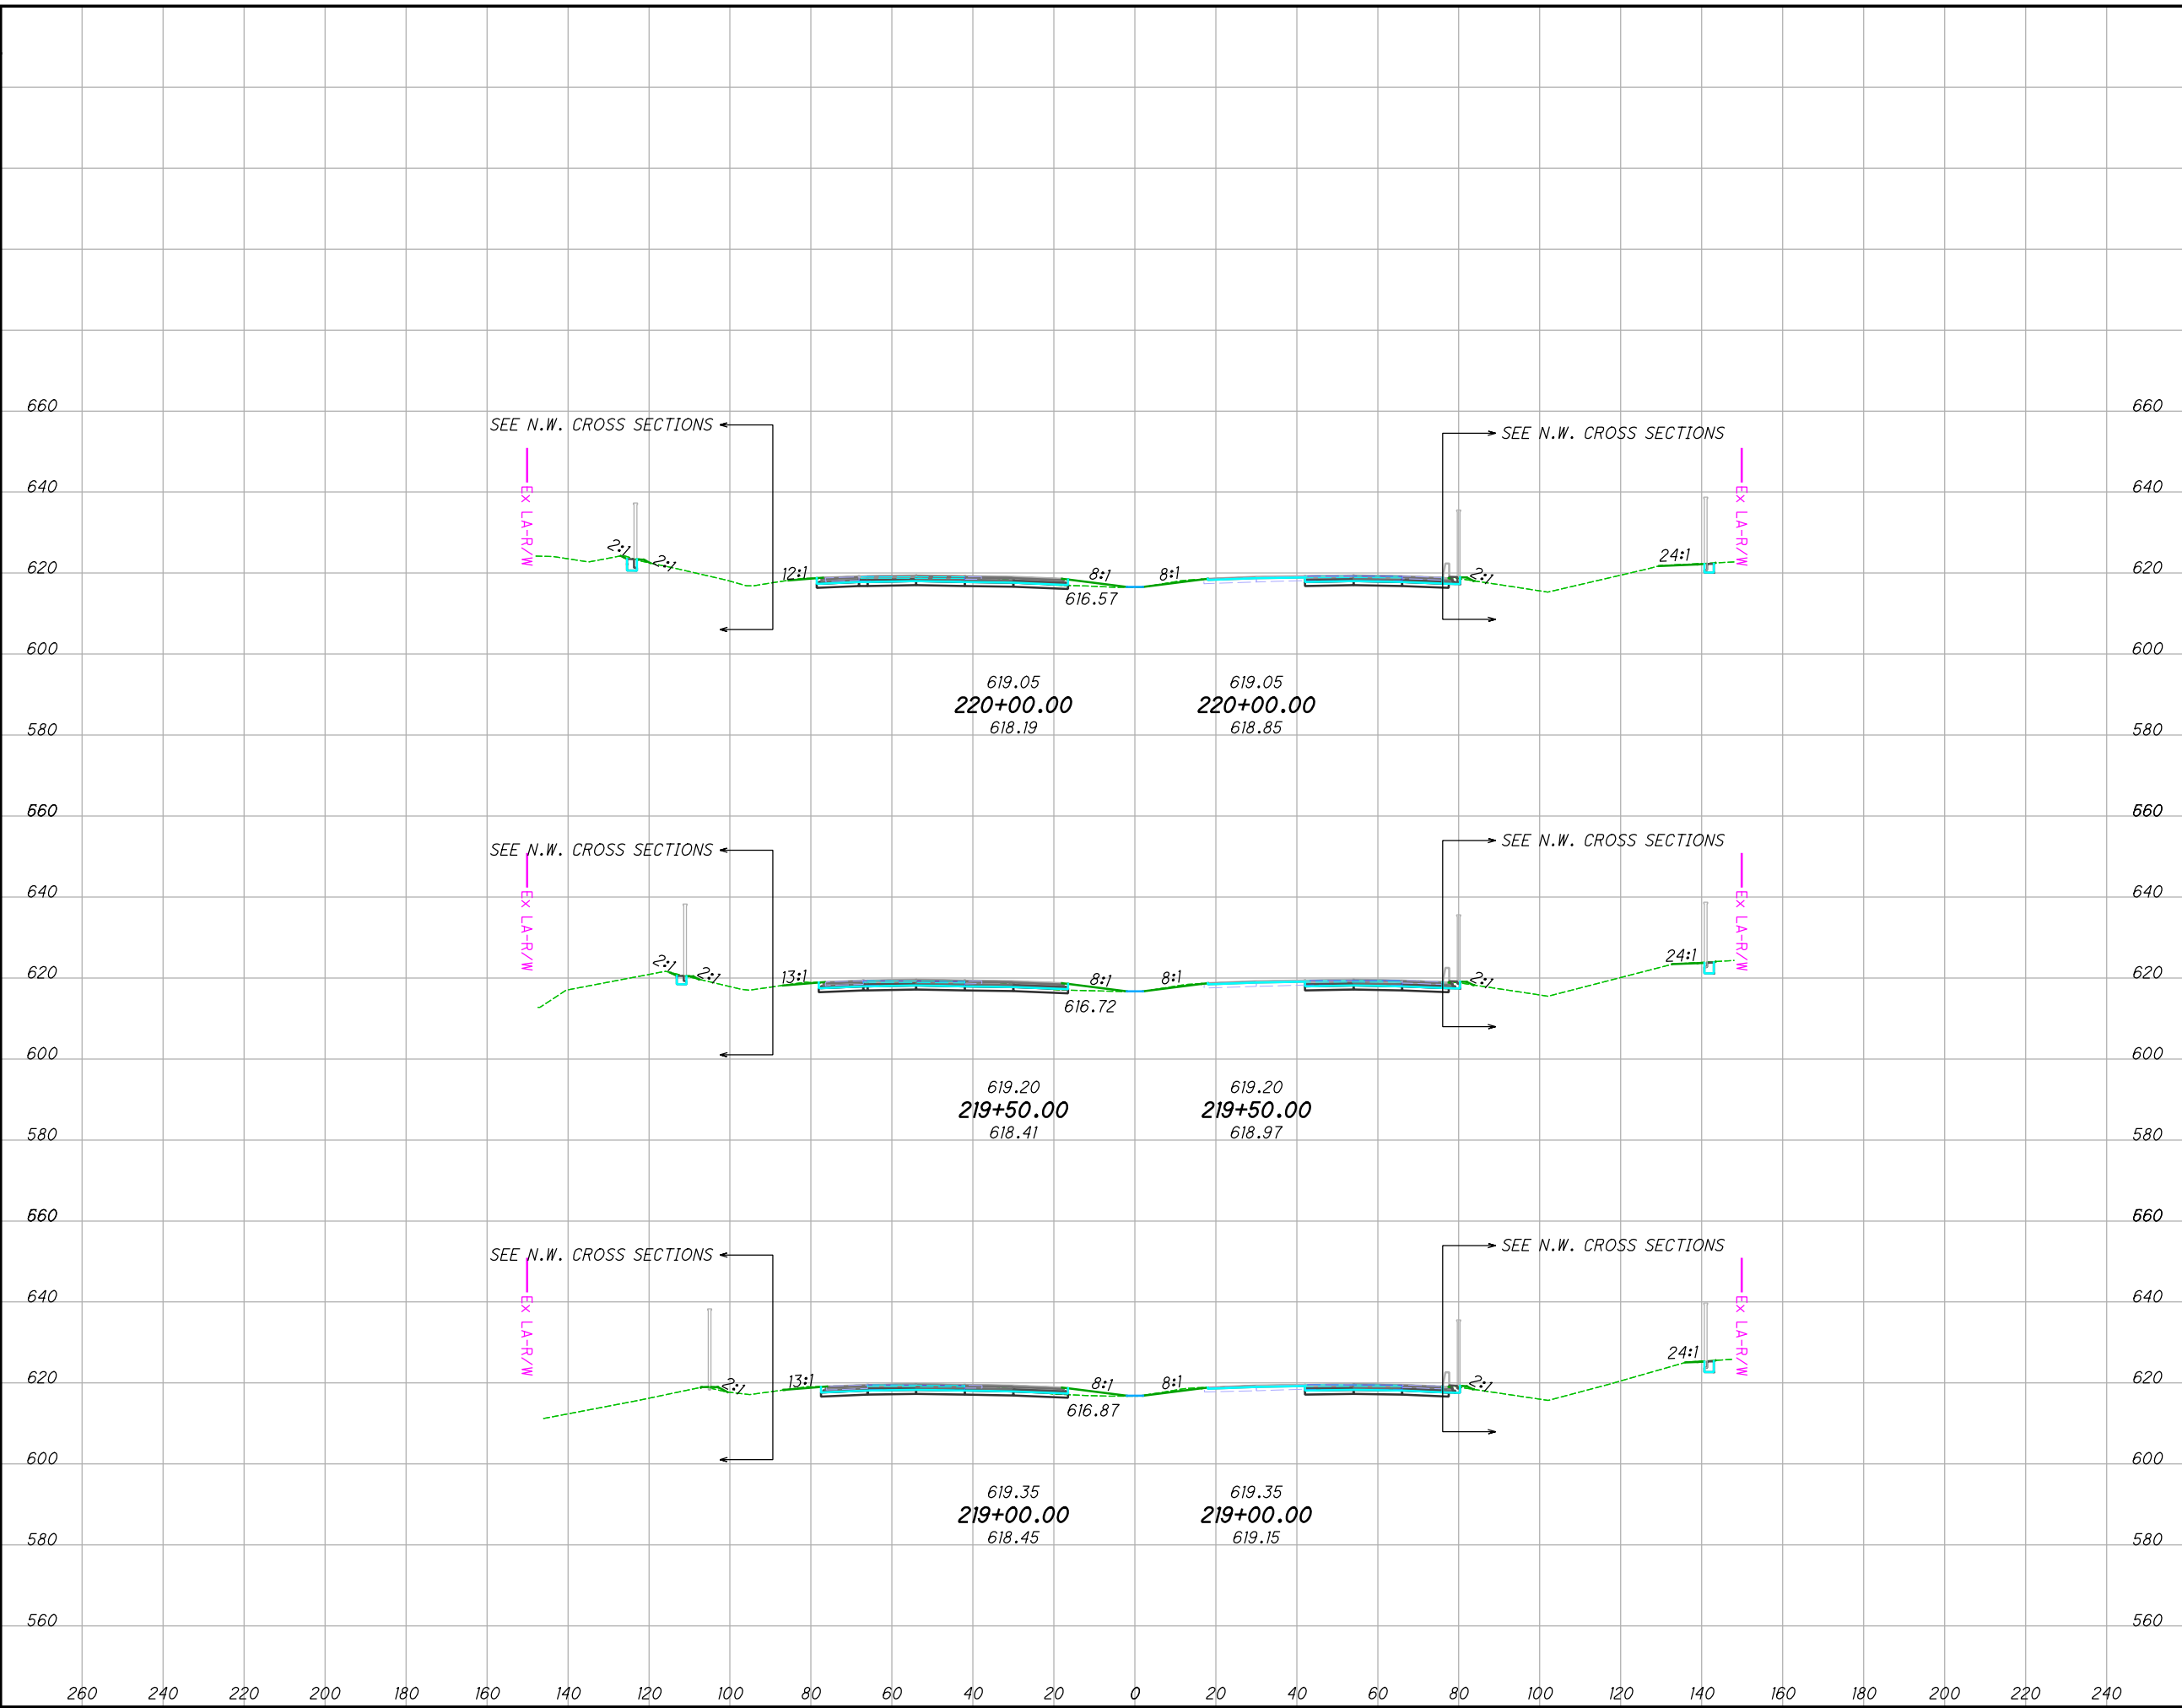

END AREA		VOLUME	
CUT	FILL	CUT	FILL
38	13	71	24
40	13	74	26
40	15	77	29
222	79		


**CROSS SECTIONS**  
**STA. 219+00.00 TO STA. 220+00.00**

**LUC-475-0.9**

CALCULATED: JRB  
 CHECKED: XXX

464  
 855


I:\ProjectData\LUC\95875\LUC-475-0.9\Design\Roadway\Sheets\95875\_XS001 - Copy.dgn Sheet 4/29/2022 8:36:19 AM jbidinge

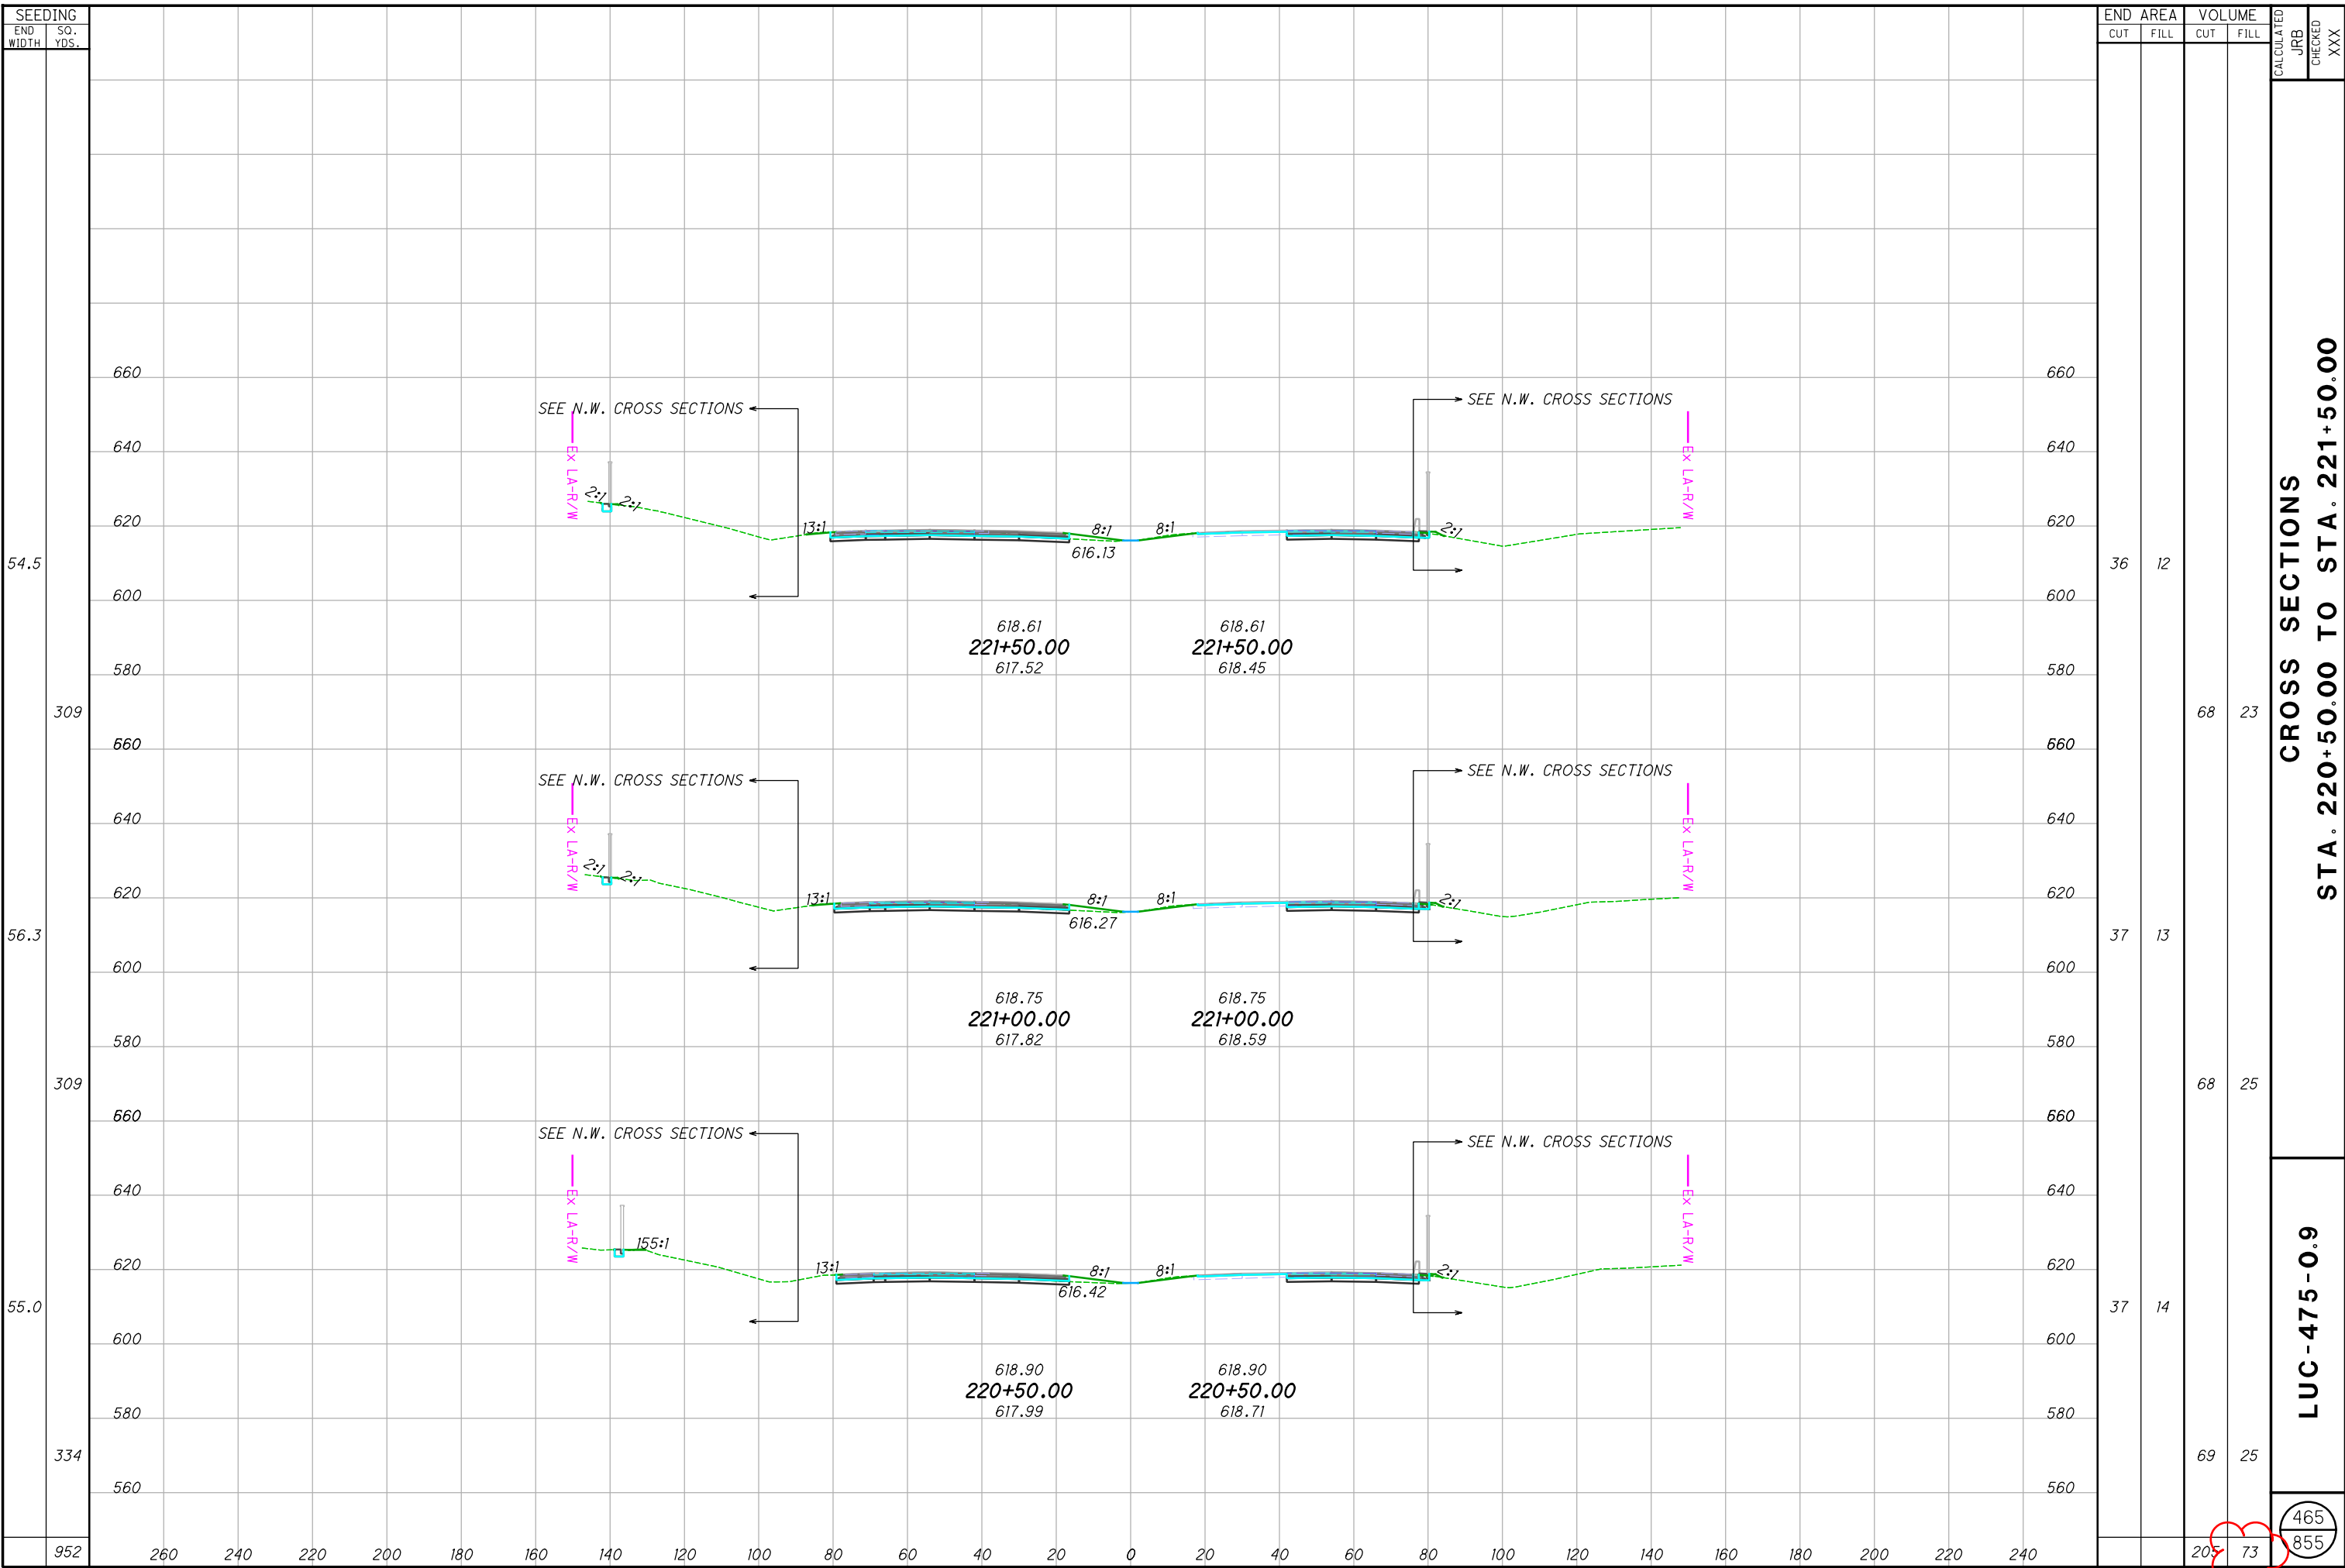

SEEDING		END AREA		VOLUME		CALCULATED		
END WIDTH	SO. YDS.	CUT	FILL	CUT	FILL	JRB	CHECKED	XXX
952								
309	54.5	36	12	68	23			
309	56.3	37	13	68	25			
334	55.0	37	14	69	25			
<b>CROSS SECTIONS</b>						<b>STA. 220+50.00 TO STA. 221+50.00</b>		
<b>LUC-475-0.9</b>						<span style="border: 1px solid black; border-radius: 50%; padding: 2px;">465</span> <span style="border: 1px solid black; border-radius: 50%; padding: 2px;">855</span>		

I:\ProjectData\LUC\95875\_LUC-475-0.09\Design\Roadway\Sheets\95875\_XS001 - Copy.dgn Sheet 4/29/2022 8:36:20 AM jbidinge

SEEDING	
END WIDTH	SO. YDS.
795	45.3
260	254
240	46.2
220	259
200	46.7
180	282
160	
140	
120	
100	
80	
60	
40	
20	
0	
20	
40	
60	
80	
100	
120	
140	
160	
180	
200	
220	
240	

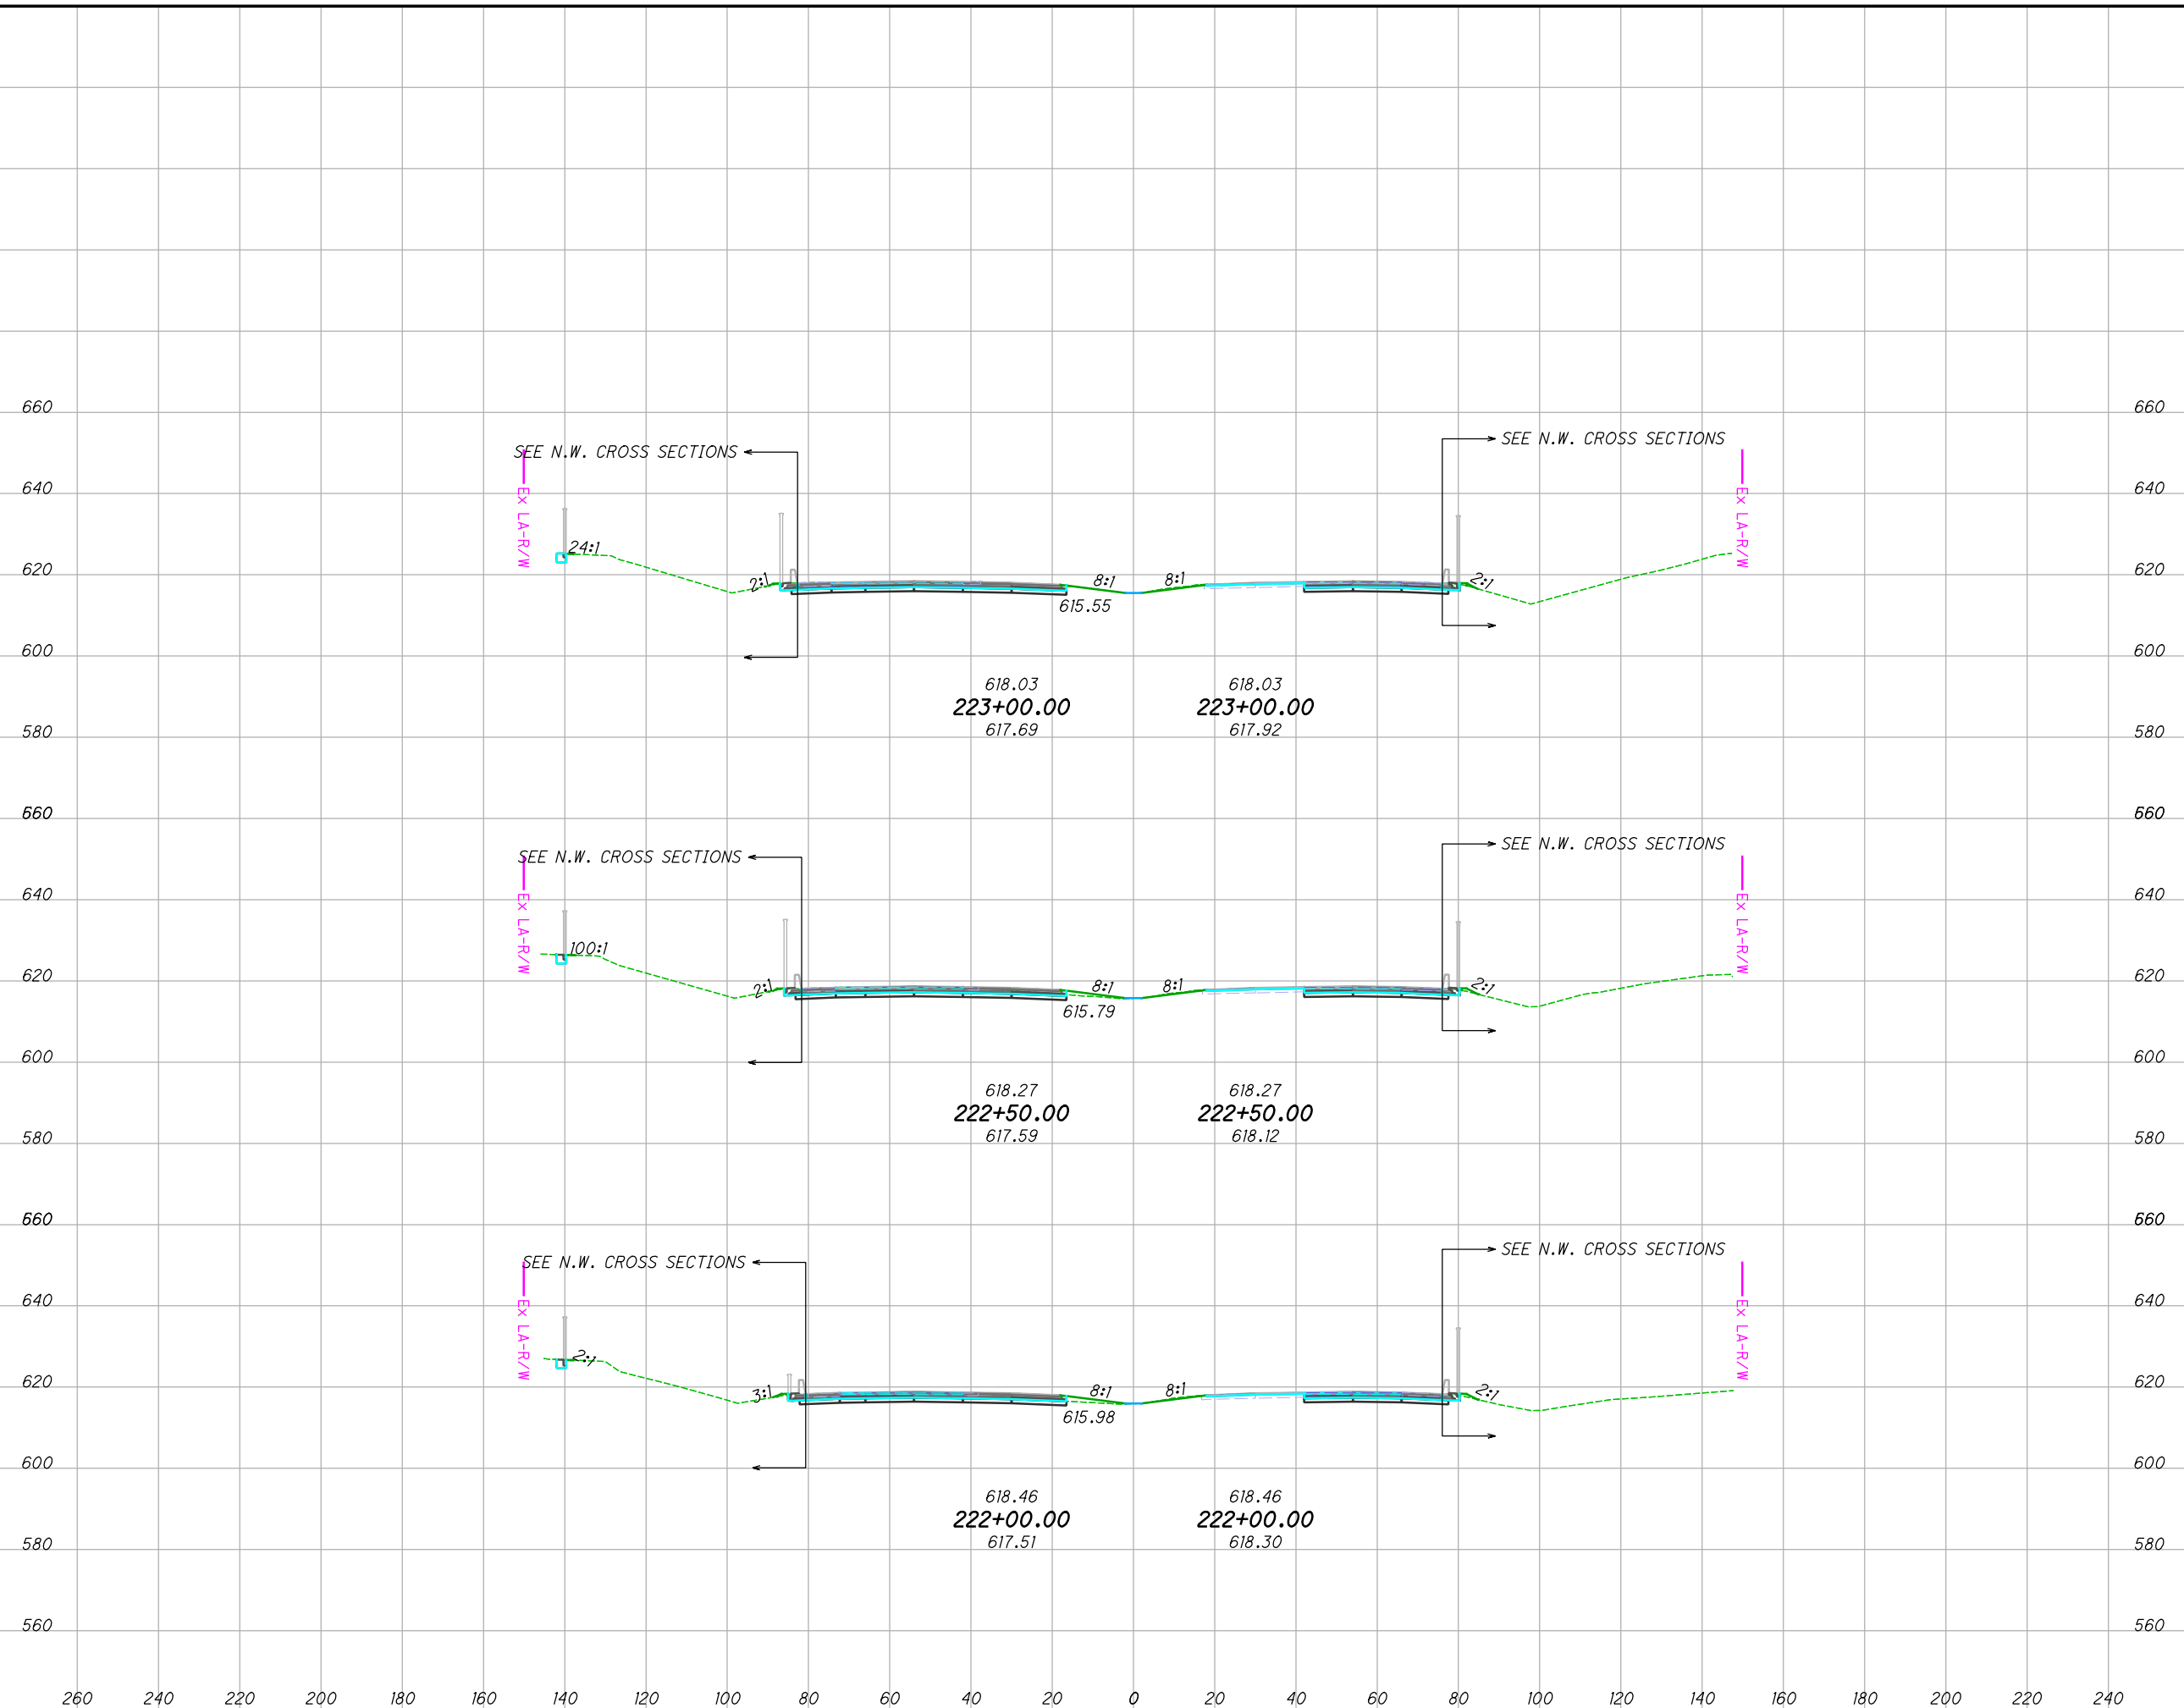

END AREA		VOLUME		CALCULATED	CHECKED
CUT	FILL	CUT	FILL		
62	1	99	9	LUC-475-0.9	466 855
45	9	74	19		
35	11	66	21		
		239	49		

CROSS SECTIONS  
STA. 222+00.00 TO STA. 223+00.00


LUC-475-0.9

466  
855



I:\ProjectData\LUC\95875\_LUC-475-0.09\Design\Roadway\Sheets\95875\_XS001 - Copy.dgn Sheet 4/29/2022 8:36:21AM jbidinge

SEEDING	
END WIDTH	SO. YDS.
377	25.4
122	18.3
90	14.0
165	

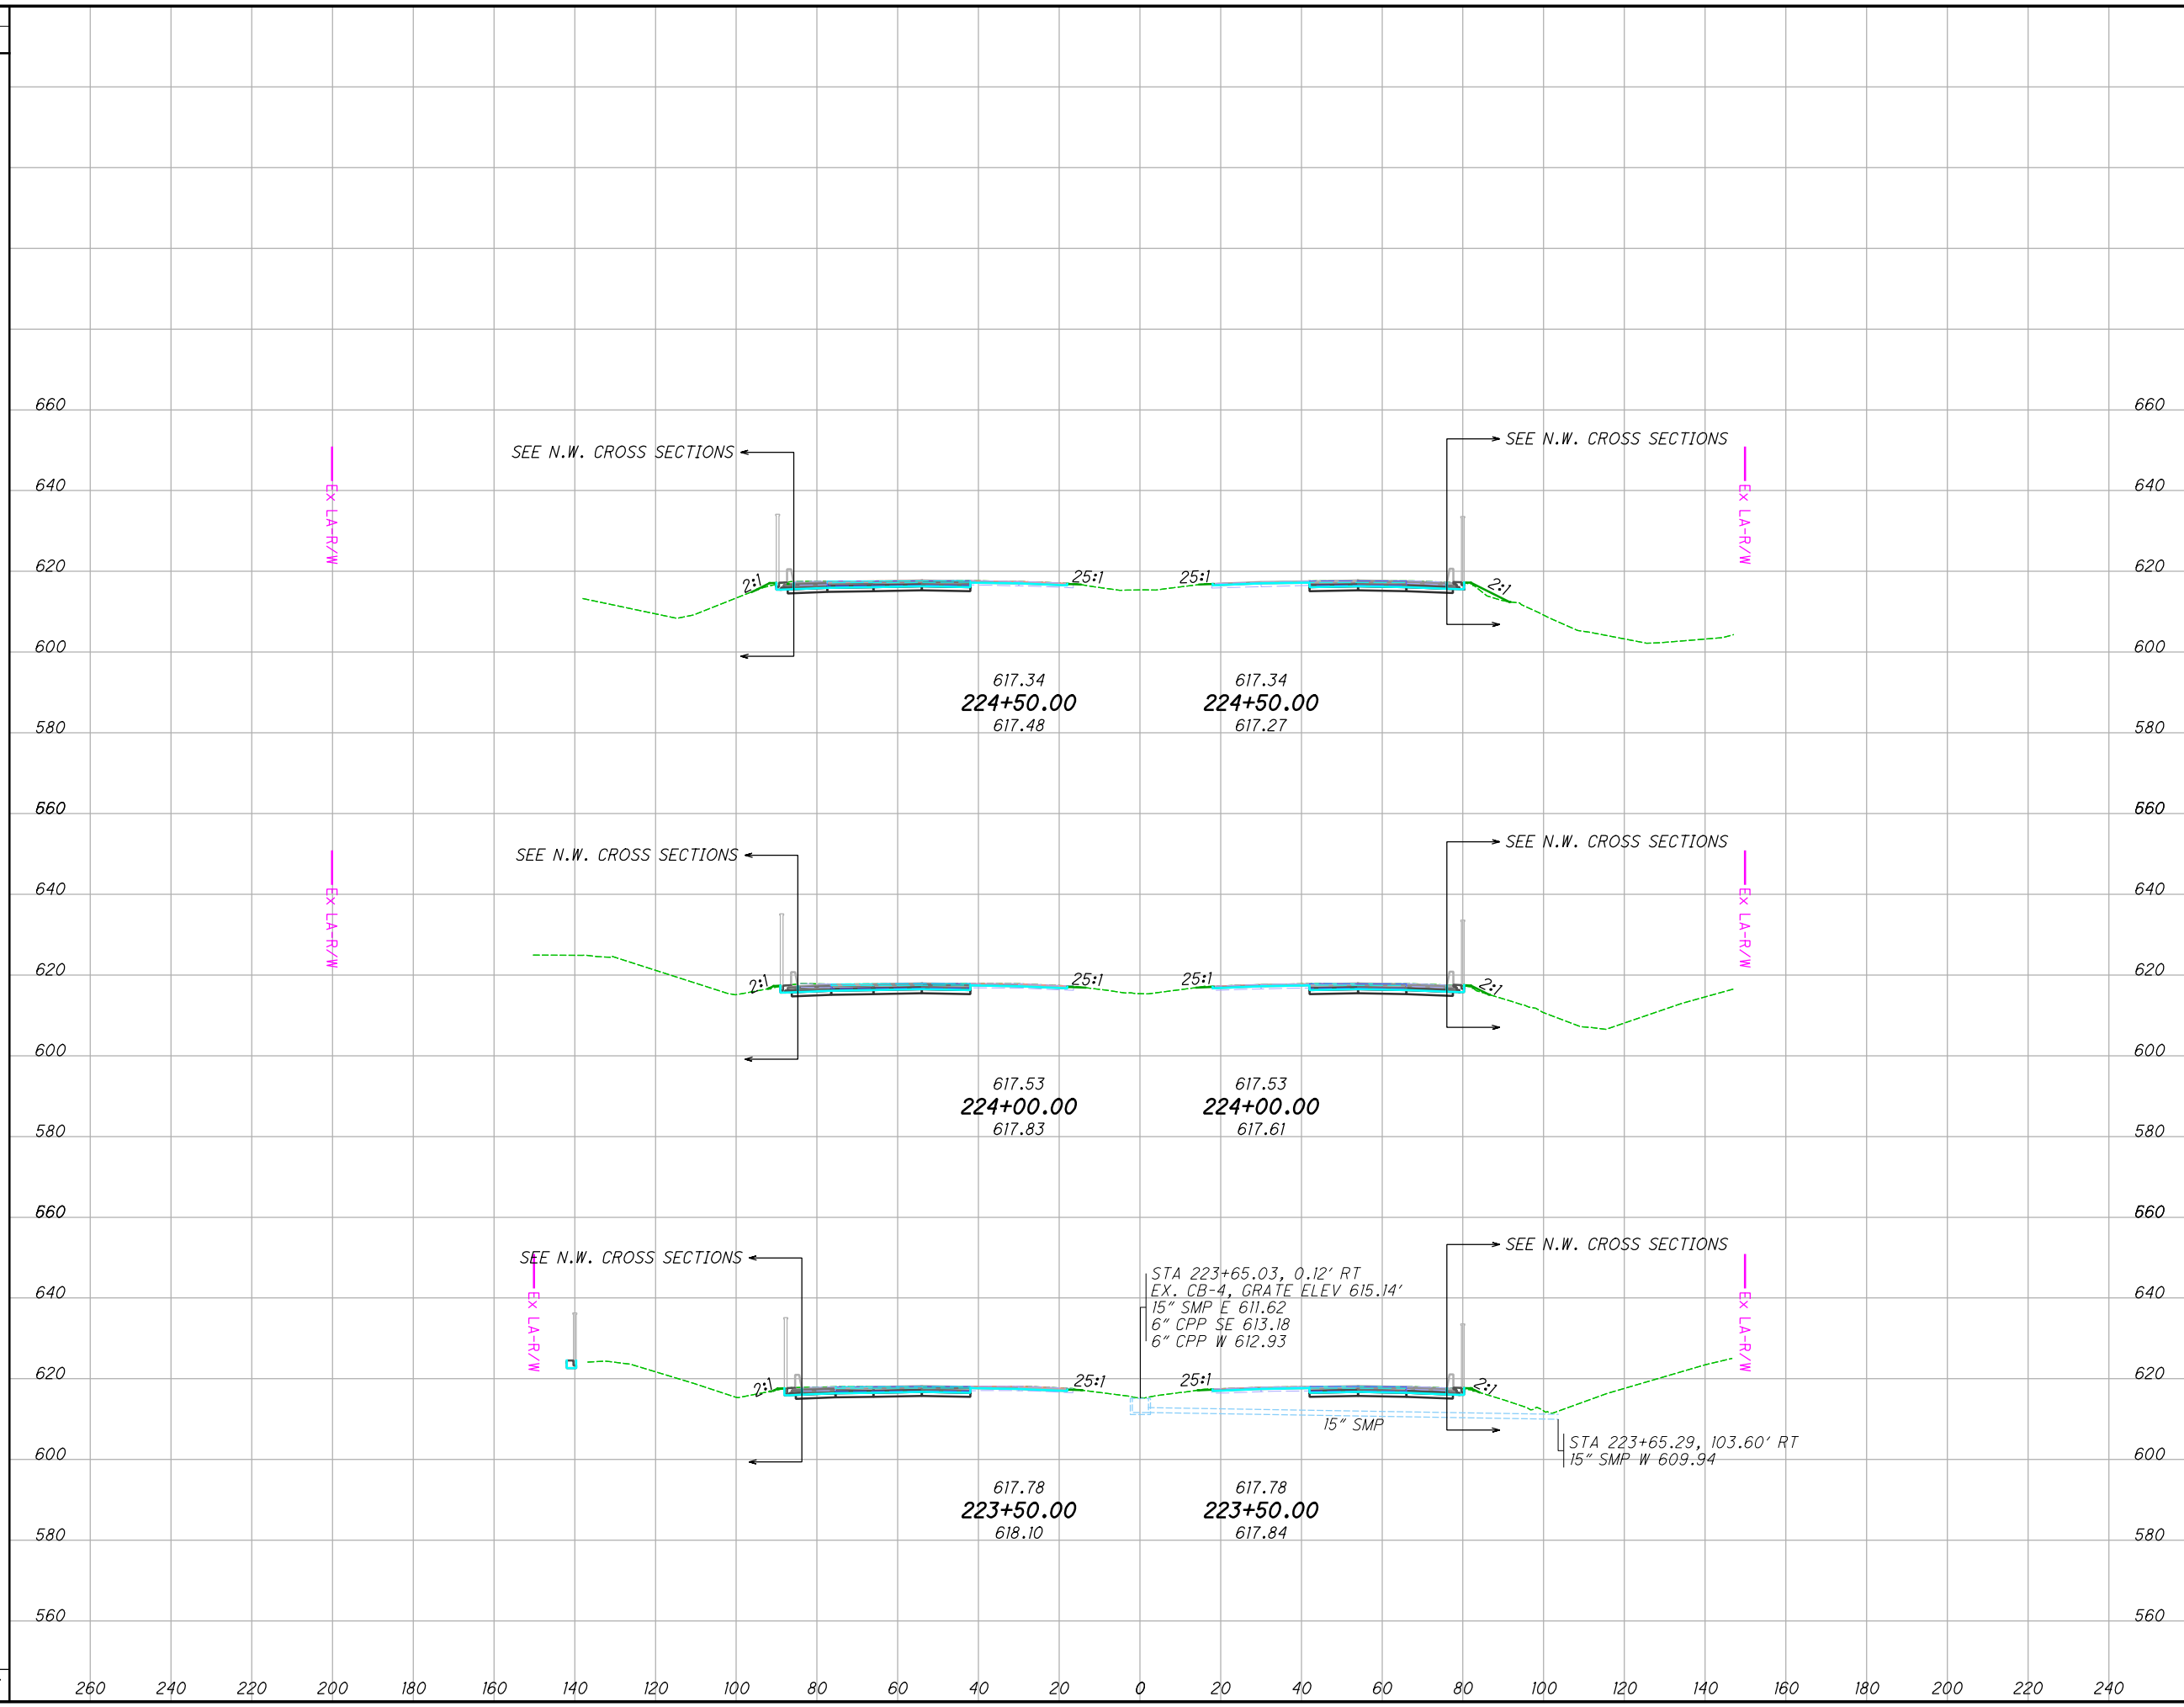

END AREA		VOLUME		CALCULATED		
CUT	FILL	CUT	FILL	JRB	CHECKED	XXX
37	0	71	0			
39	0	67	0			
33	0	88	1			


**CROSS SECTIONS  
STA. 223+50.00 TO STA. 224+50.00**

**LUC-475-0.9**

467  
855

I:\ProjectData\LUC\95875\LUC-475-0.09\Design\Roadway\Sheets\95875\_XS001 - Copy.dgn Sheet 4/29/2022 8:36:22 AM jbinge

SEEDING	
END WIDTH	SO. YDS.
675	193
260	44.0
240	227
220	38.0
200	255
180	53.9

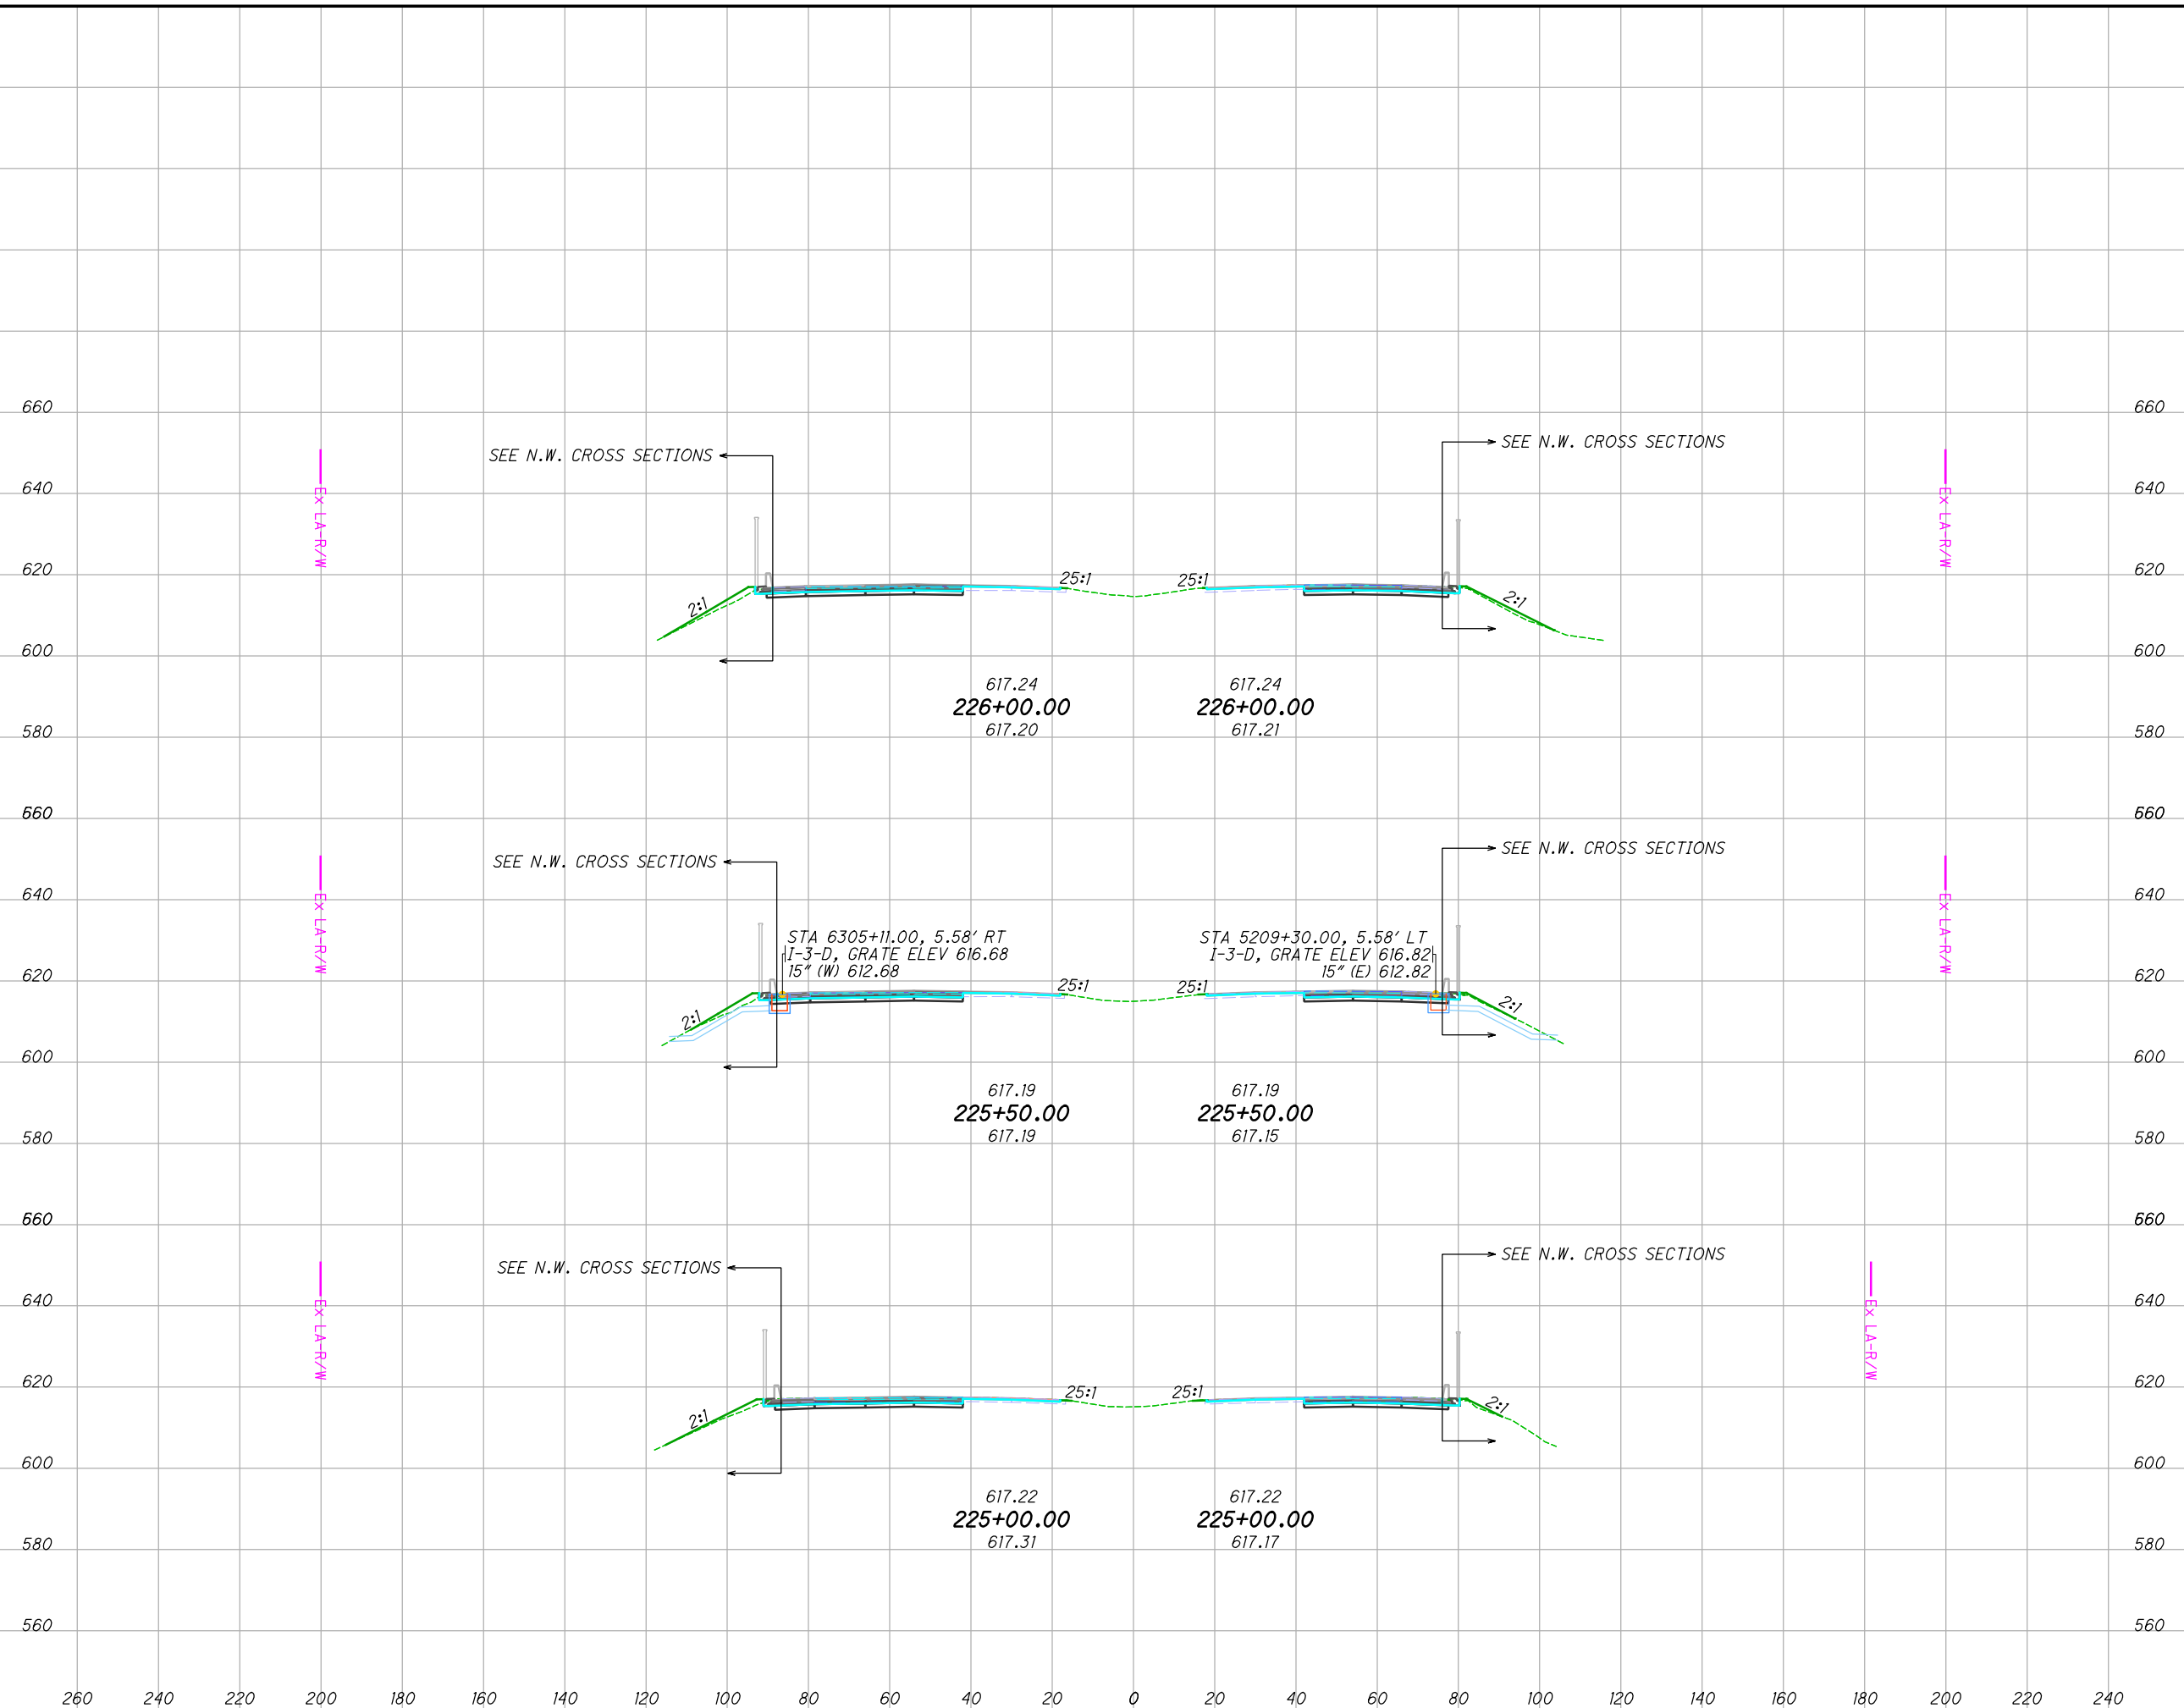

END AREA		VOLUME	
CUT	FILL	CUT	FILL
17	4	34	4
20	0	47	0
31	0	63	0
144	4		

**CROSS SECTIONS**  
**STA. 225+00.00 TO STA. 226+00.00**


**LUC-475-0.9**

CALCULATED JRB  
 CHECKED XXX

468  
855

I:\ProjectData\LUC\95875\LUC-475-0.09\Design\Roadway\Sheets\95875\_X500 - Copy.dgn Sheet 4/29/2022 8:36:23 AM jbdinge

SEEDING	
END WIDTH	SO. YDS.
810	230
260	244
240	58.8
220	336
200	62.1
180	
160	
140	
120	
100	
80	
60	
40	
20	
0	
20	
40	
60	
80	
100	
120	
140	
160	
180	
200	
220	
240	

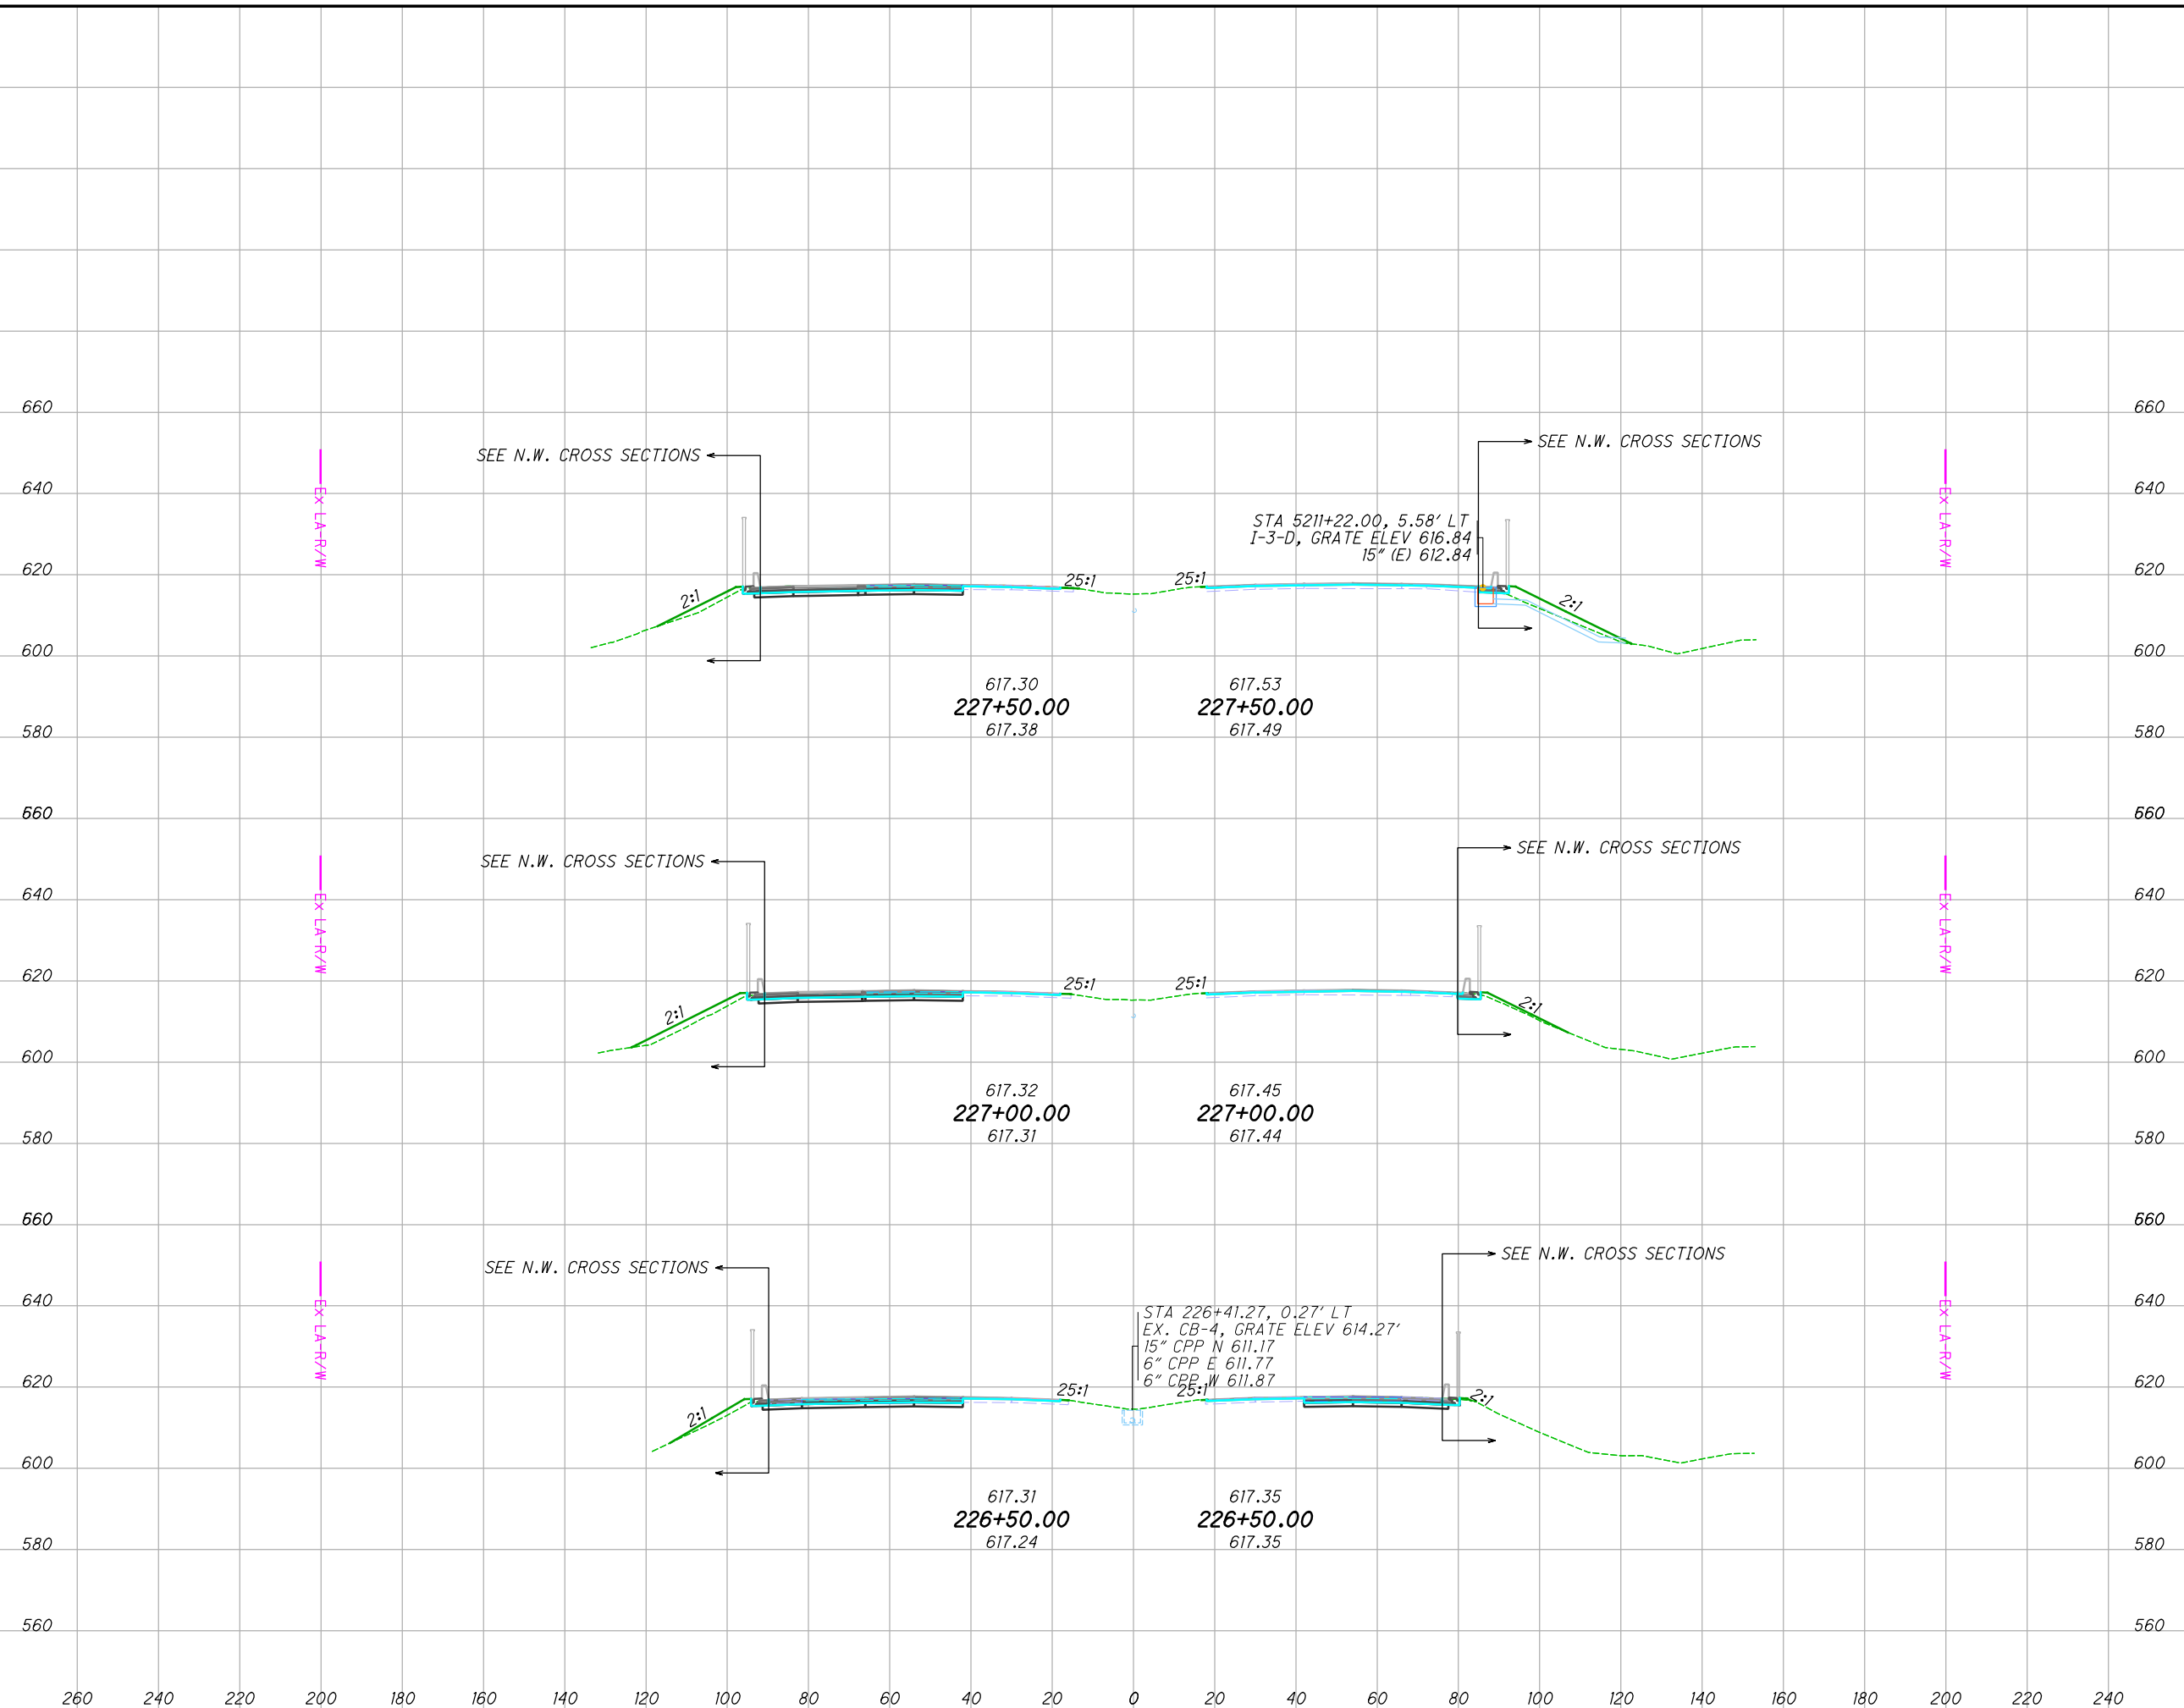


END AREA		VOLUME	
CUT	FILL	CUT	FILL
12	0	16	1
6	1	21	5
17	4	32	7
69	13		

**CROSS SECTIONS**  
**STA. 226+50.00 TO STA. 227+50.00**  
**LUC-475-0.9**

469  
855

I:\ProjectData\LUC\95875\_LUC-475-0.09\Design\Roadway\Sheets\95875\_XS001 - Copy.dgn Sheet 4/29/2022 8:36:24 AM j\_bidinge

SEEDING	
END WIDTH	SO. YDS.
703	11.5
102	25.0
249	64.7
352	

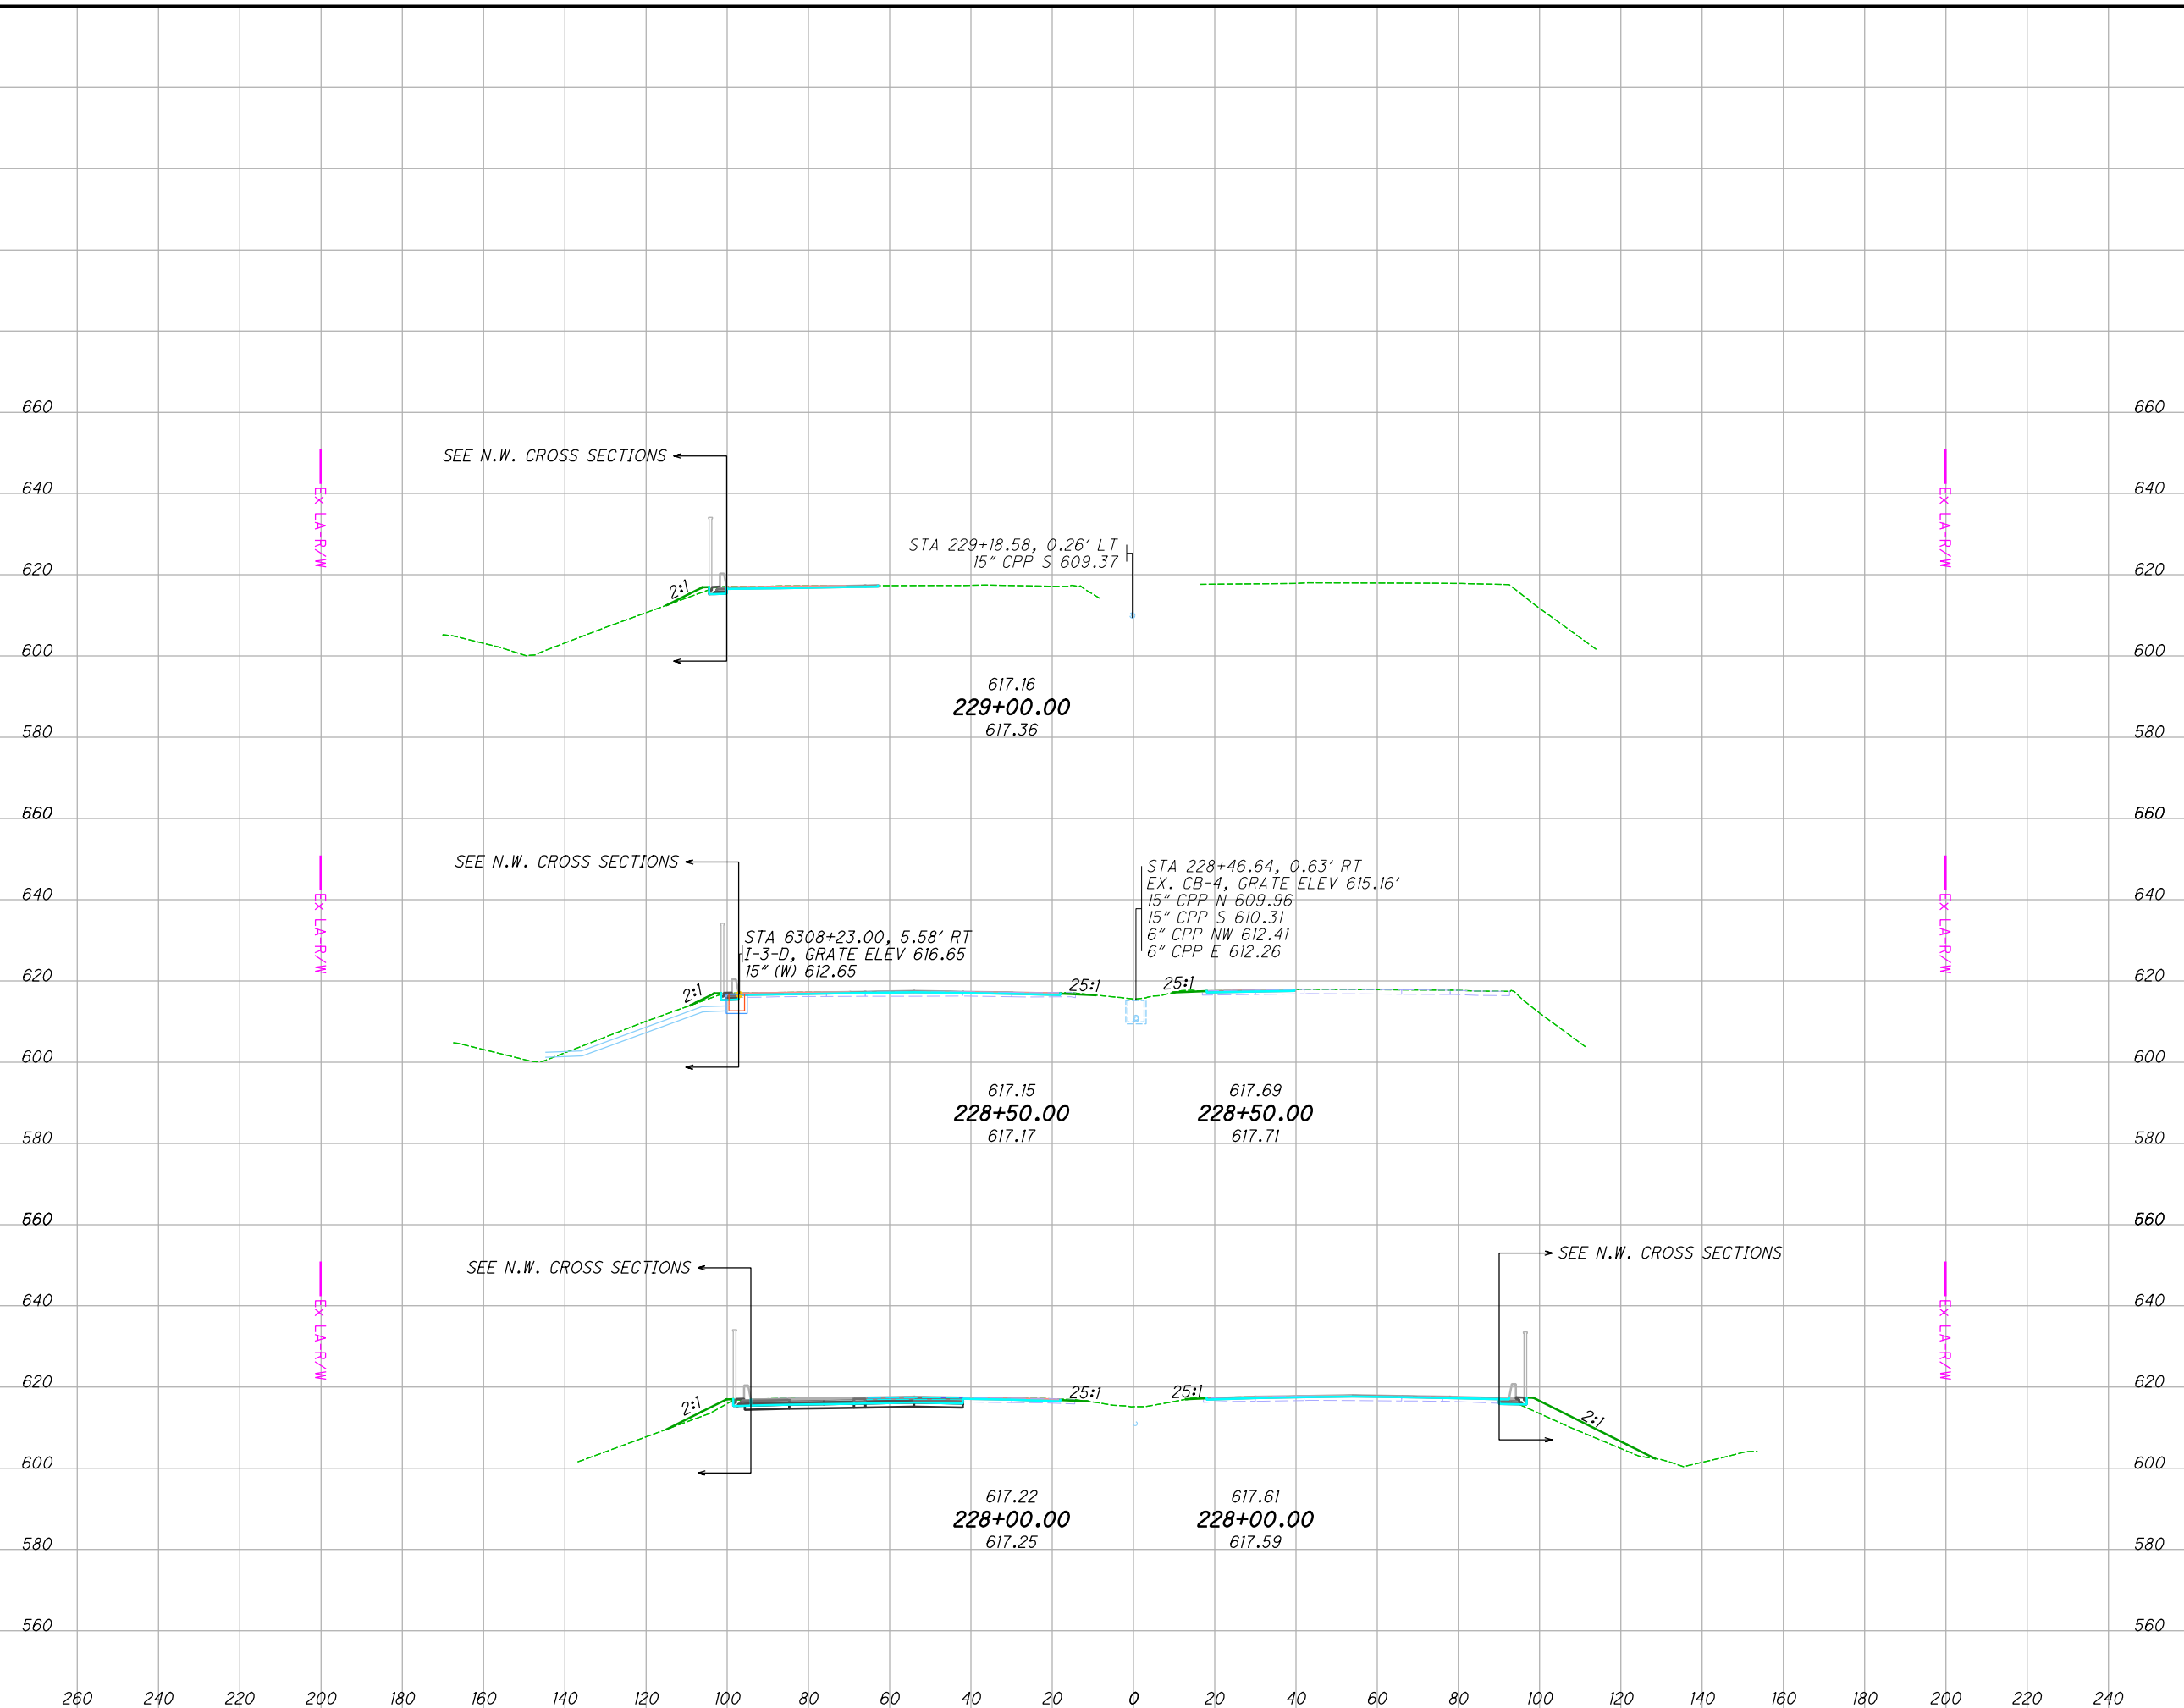

END AREA		VOLUME		CALCULATED		
CUT	FILL	CUT	FILL	JRB	CHECKED	XXX
22	0	28	4			
8	4	22	4			
16	0	76	8			
				470	855	


**CROSS SECTIONS**  
**STA. 228+00.00 TO STA. 229+00.00**

**LUC-475-0.9**

470  
855

I:\ProjectData\LUC\95875\LUC-475-0.09\Design\Roadway\Sheets\95875\_XS001 - Copy.dgn Sheet 4/29/2022 8:36:25 AM jbdinge


SEEDING	
END WIDTH	SO. YDS.
132	

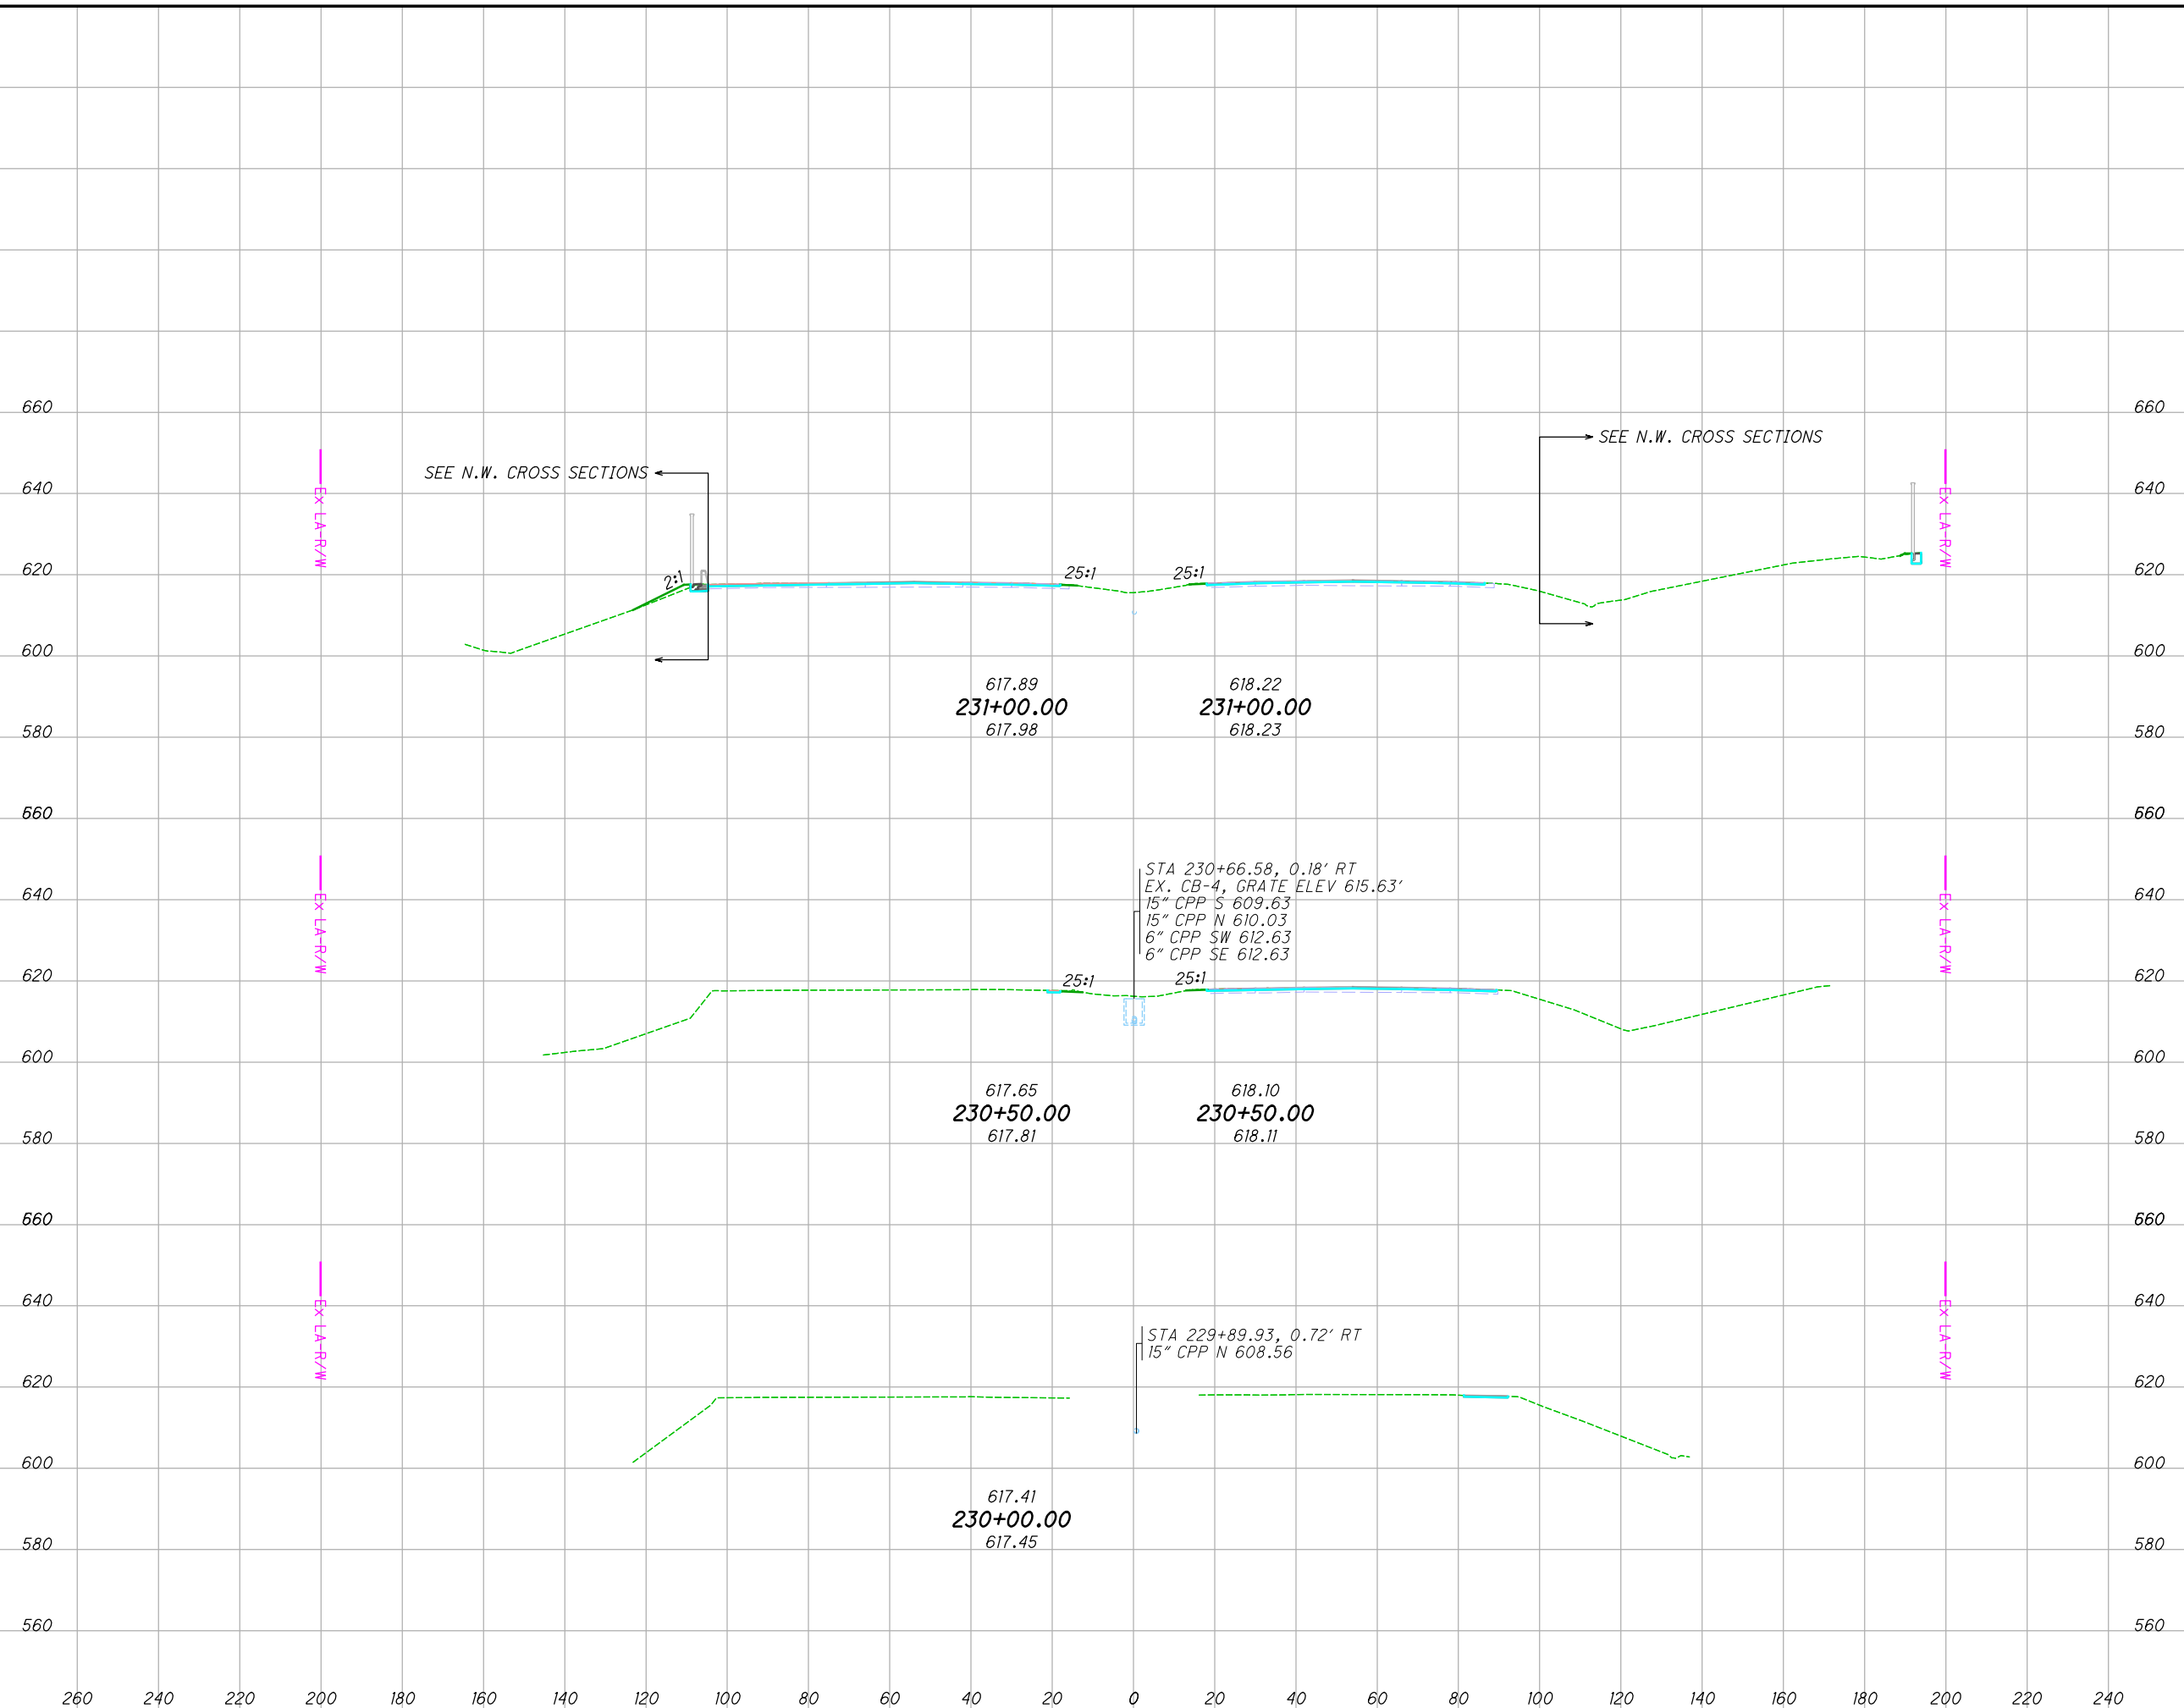

END AREA		VOLUME		CALCULATED	CHECKED	XXX
CUT	FILL	CUT	FILL			
					JRB	
					XXX	
					<b>CROSS SECTIONS</b>	
					<b>STA. 230+00.00 TO STA. 231+00.00</b>	
					<b>LUC-475-0.9</b>	
					471	855

I:\ProjectData\LUC-475-0.09\Design\Roadway\Sheets\95875\_XS001 - Copy.dgn Sheet 4/29/2022 8:36:26 AM jbidinge

SEEDING	
END WIDTH	SO. YDS.
663	19.2
204	54.0
267	42.1
192	

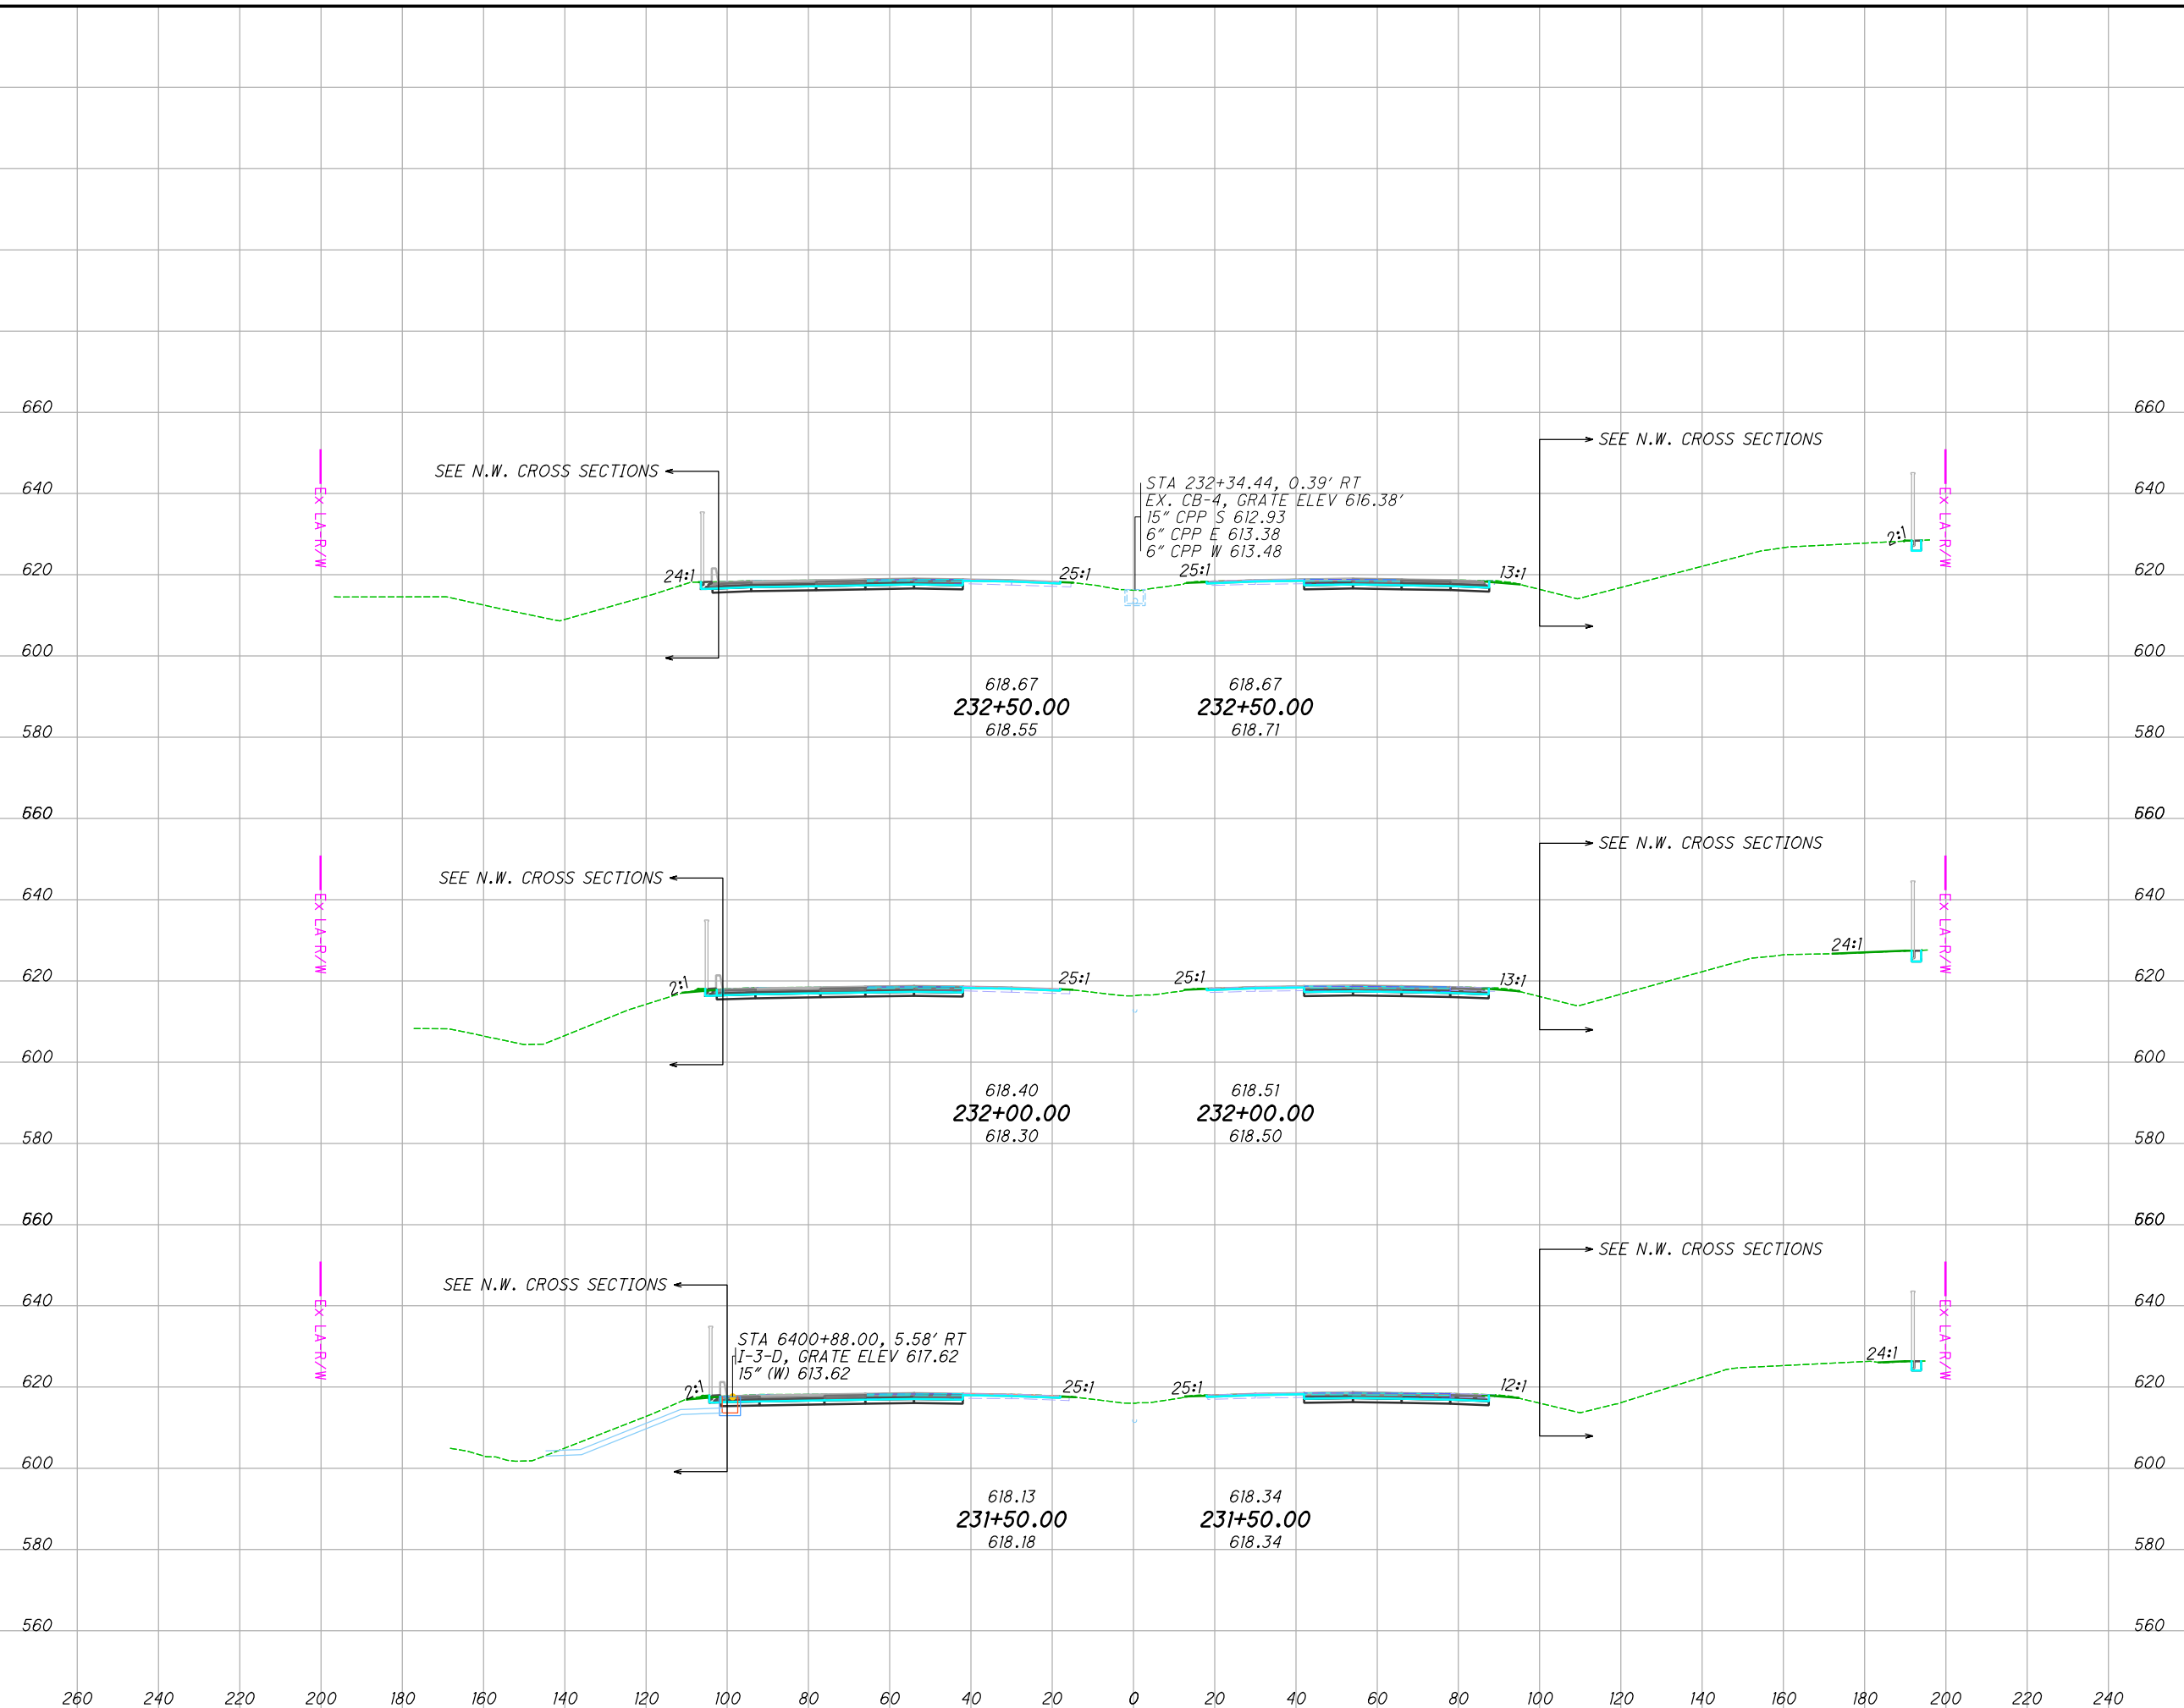

END AREA		VOLUME		CALCULATED	CHECKED
CUT	FILL	CUT	FILL		
		36	0		
		34	1		
		64	2		
		35	1		
		33	1		

**CROSS SECTIONS**  
**STA. 231+50.00 TO STA. 232+50.00**


**LUC-475-0.9**

472  
855



I:\ProjectData\LUC\95875\LUC-475-0.9\Design\Roadway\Sheets\95875\_XS001 - Copy.dgn Sheet 4/29/2022 8:36:27 AM jbdinge

SEEDING	
END WIDTH	SO. YDS.
405	136
260	150
240	24.2
220	119
200	18.6

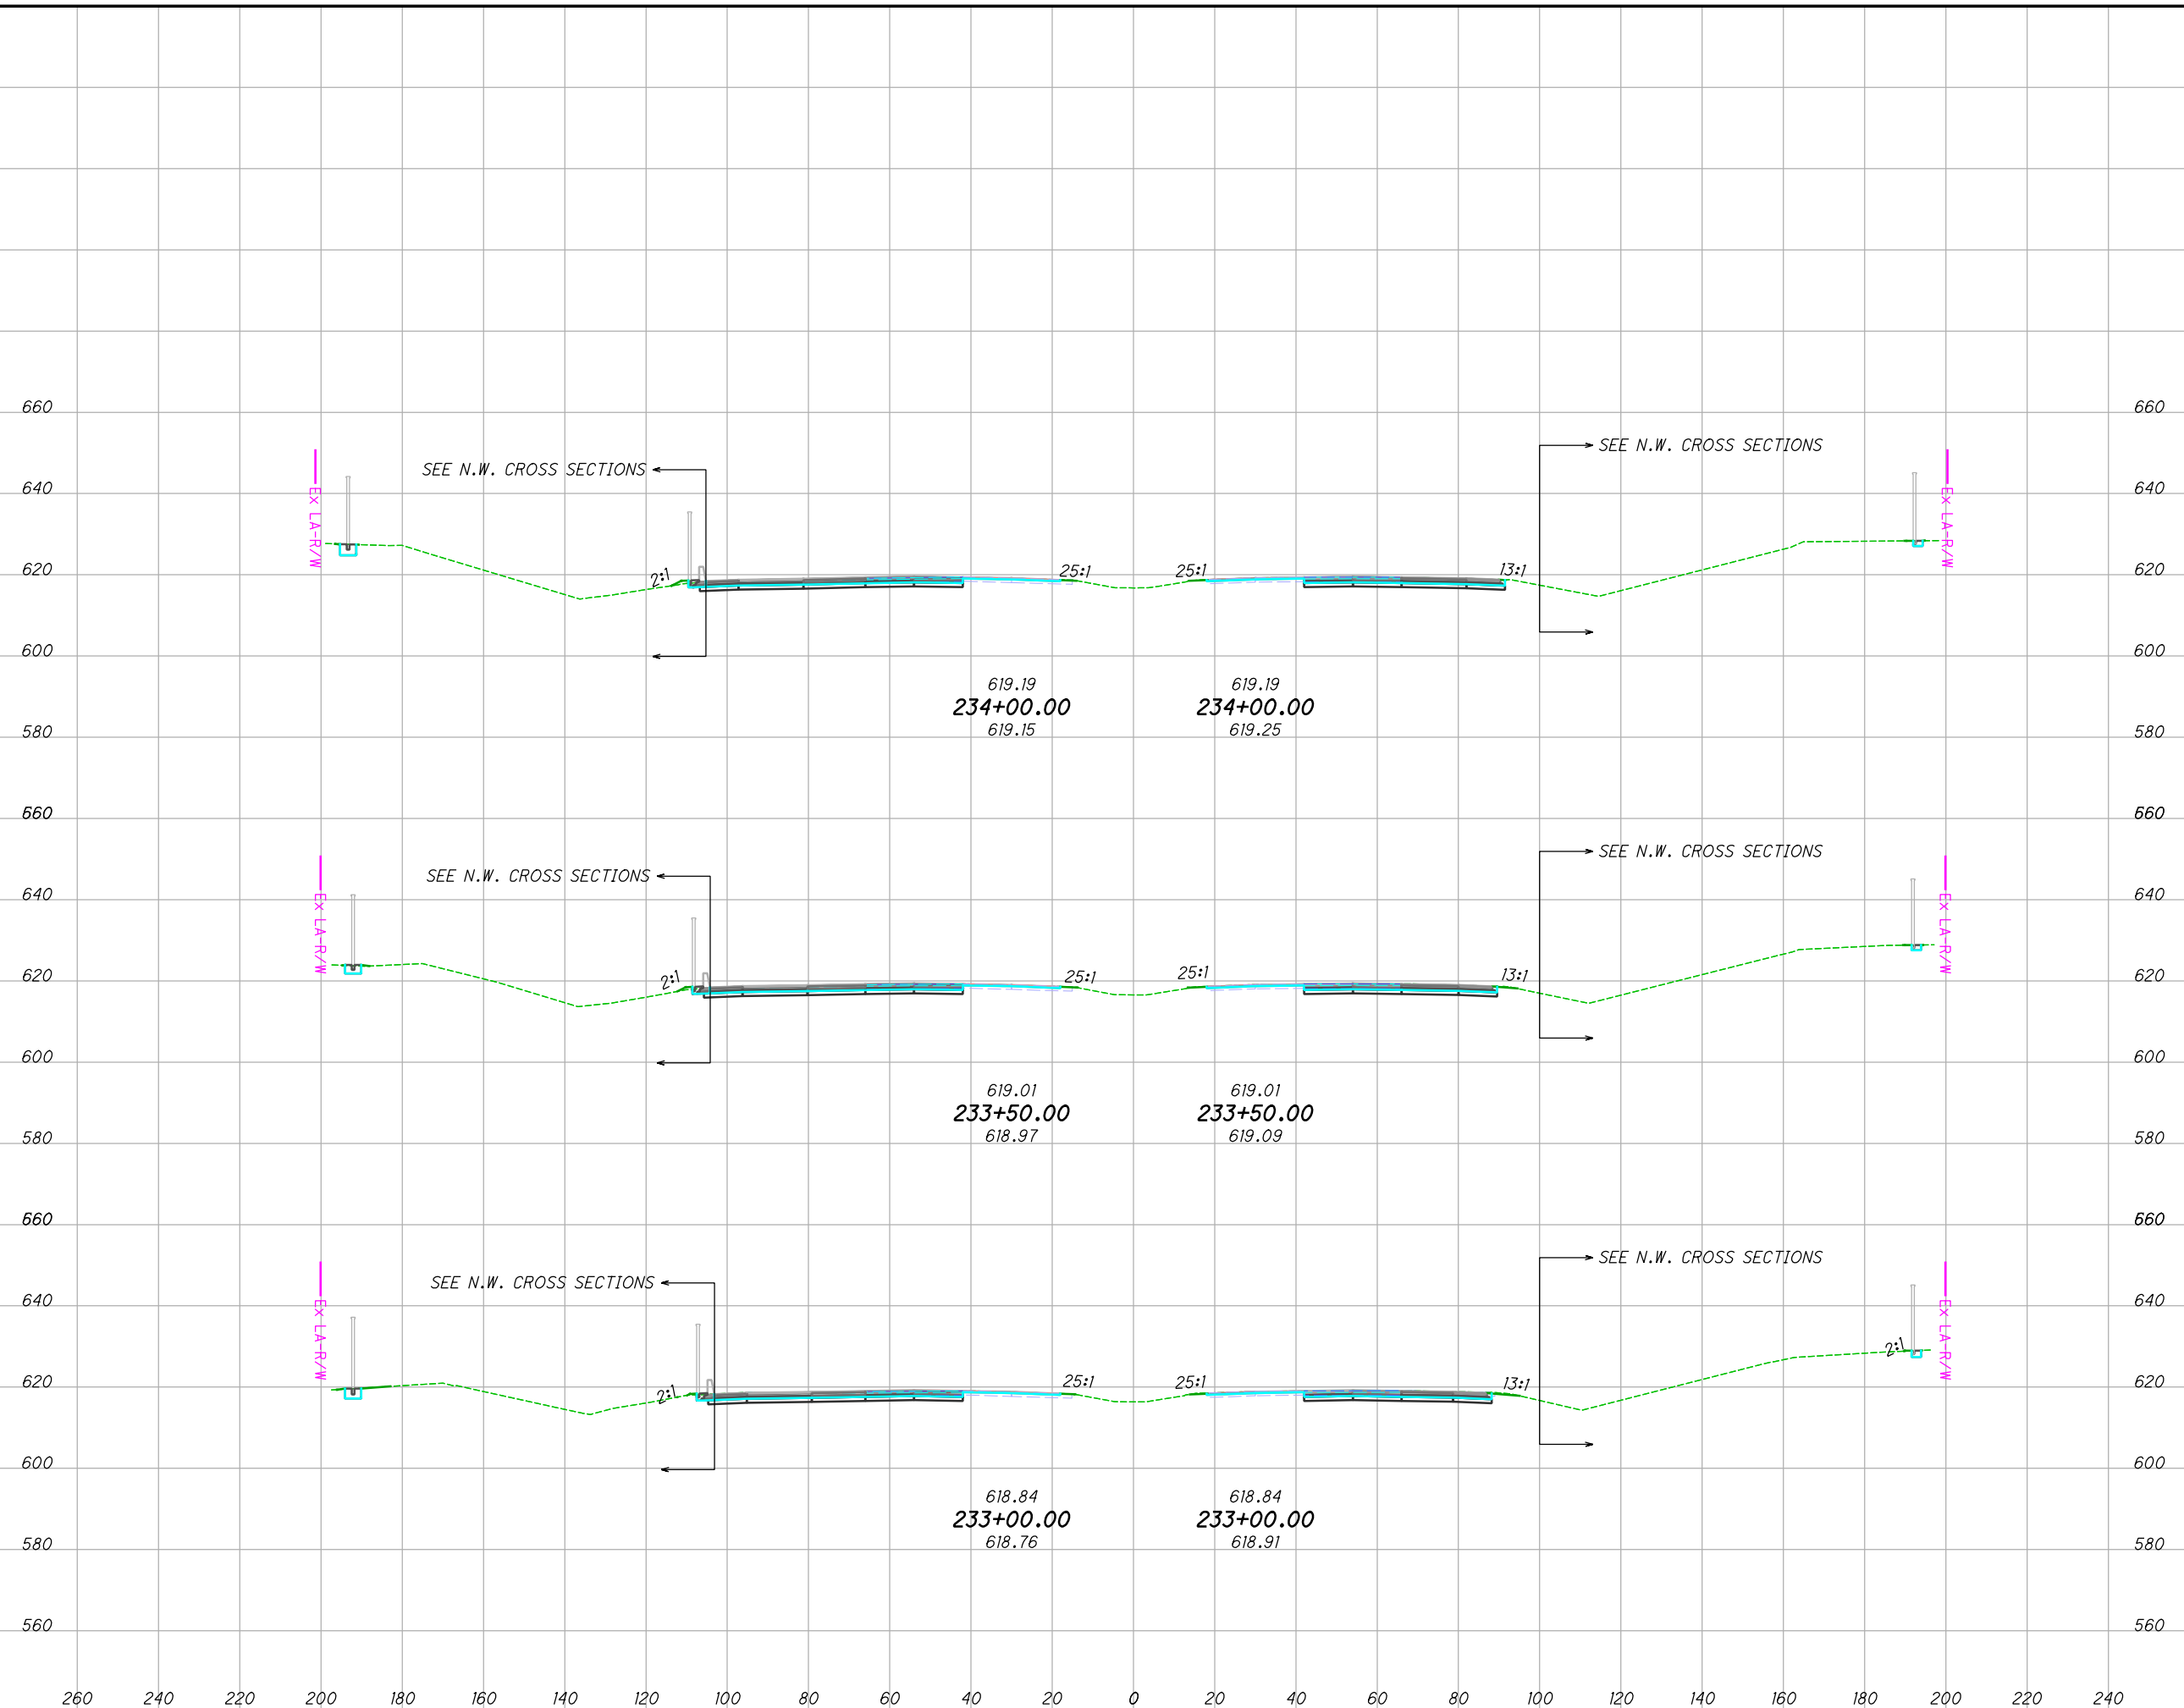

END AREA		VOLUME	
CUT	FILL	CUT	FILL
37	0	68	0
32	0	64	0
28	0	55	0


**CROSS SECTIONS  
STA. 233+00.00 TO STA. 234+00.00**

**LUC-475-0.9**

473  
855

I:\ProjectData\LUC\95875\_LUC-475-0.09\Design\Roadway\Sheets\95875\_X5001 - Copy.dgn Sheet 4/29/2022 8:36:28 AM jbidinge

SEEDING	
END WIDTH	SO. YDS.
389	

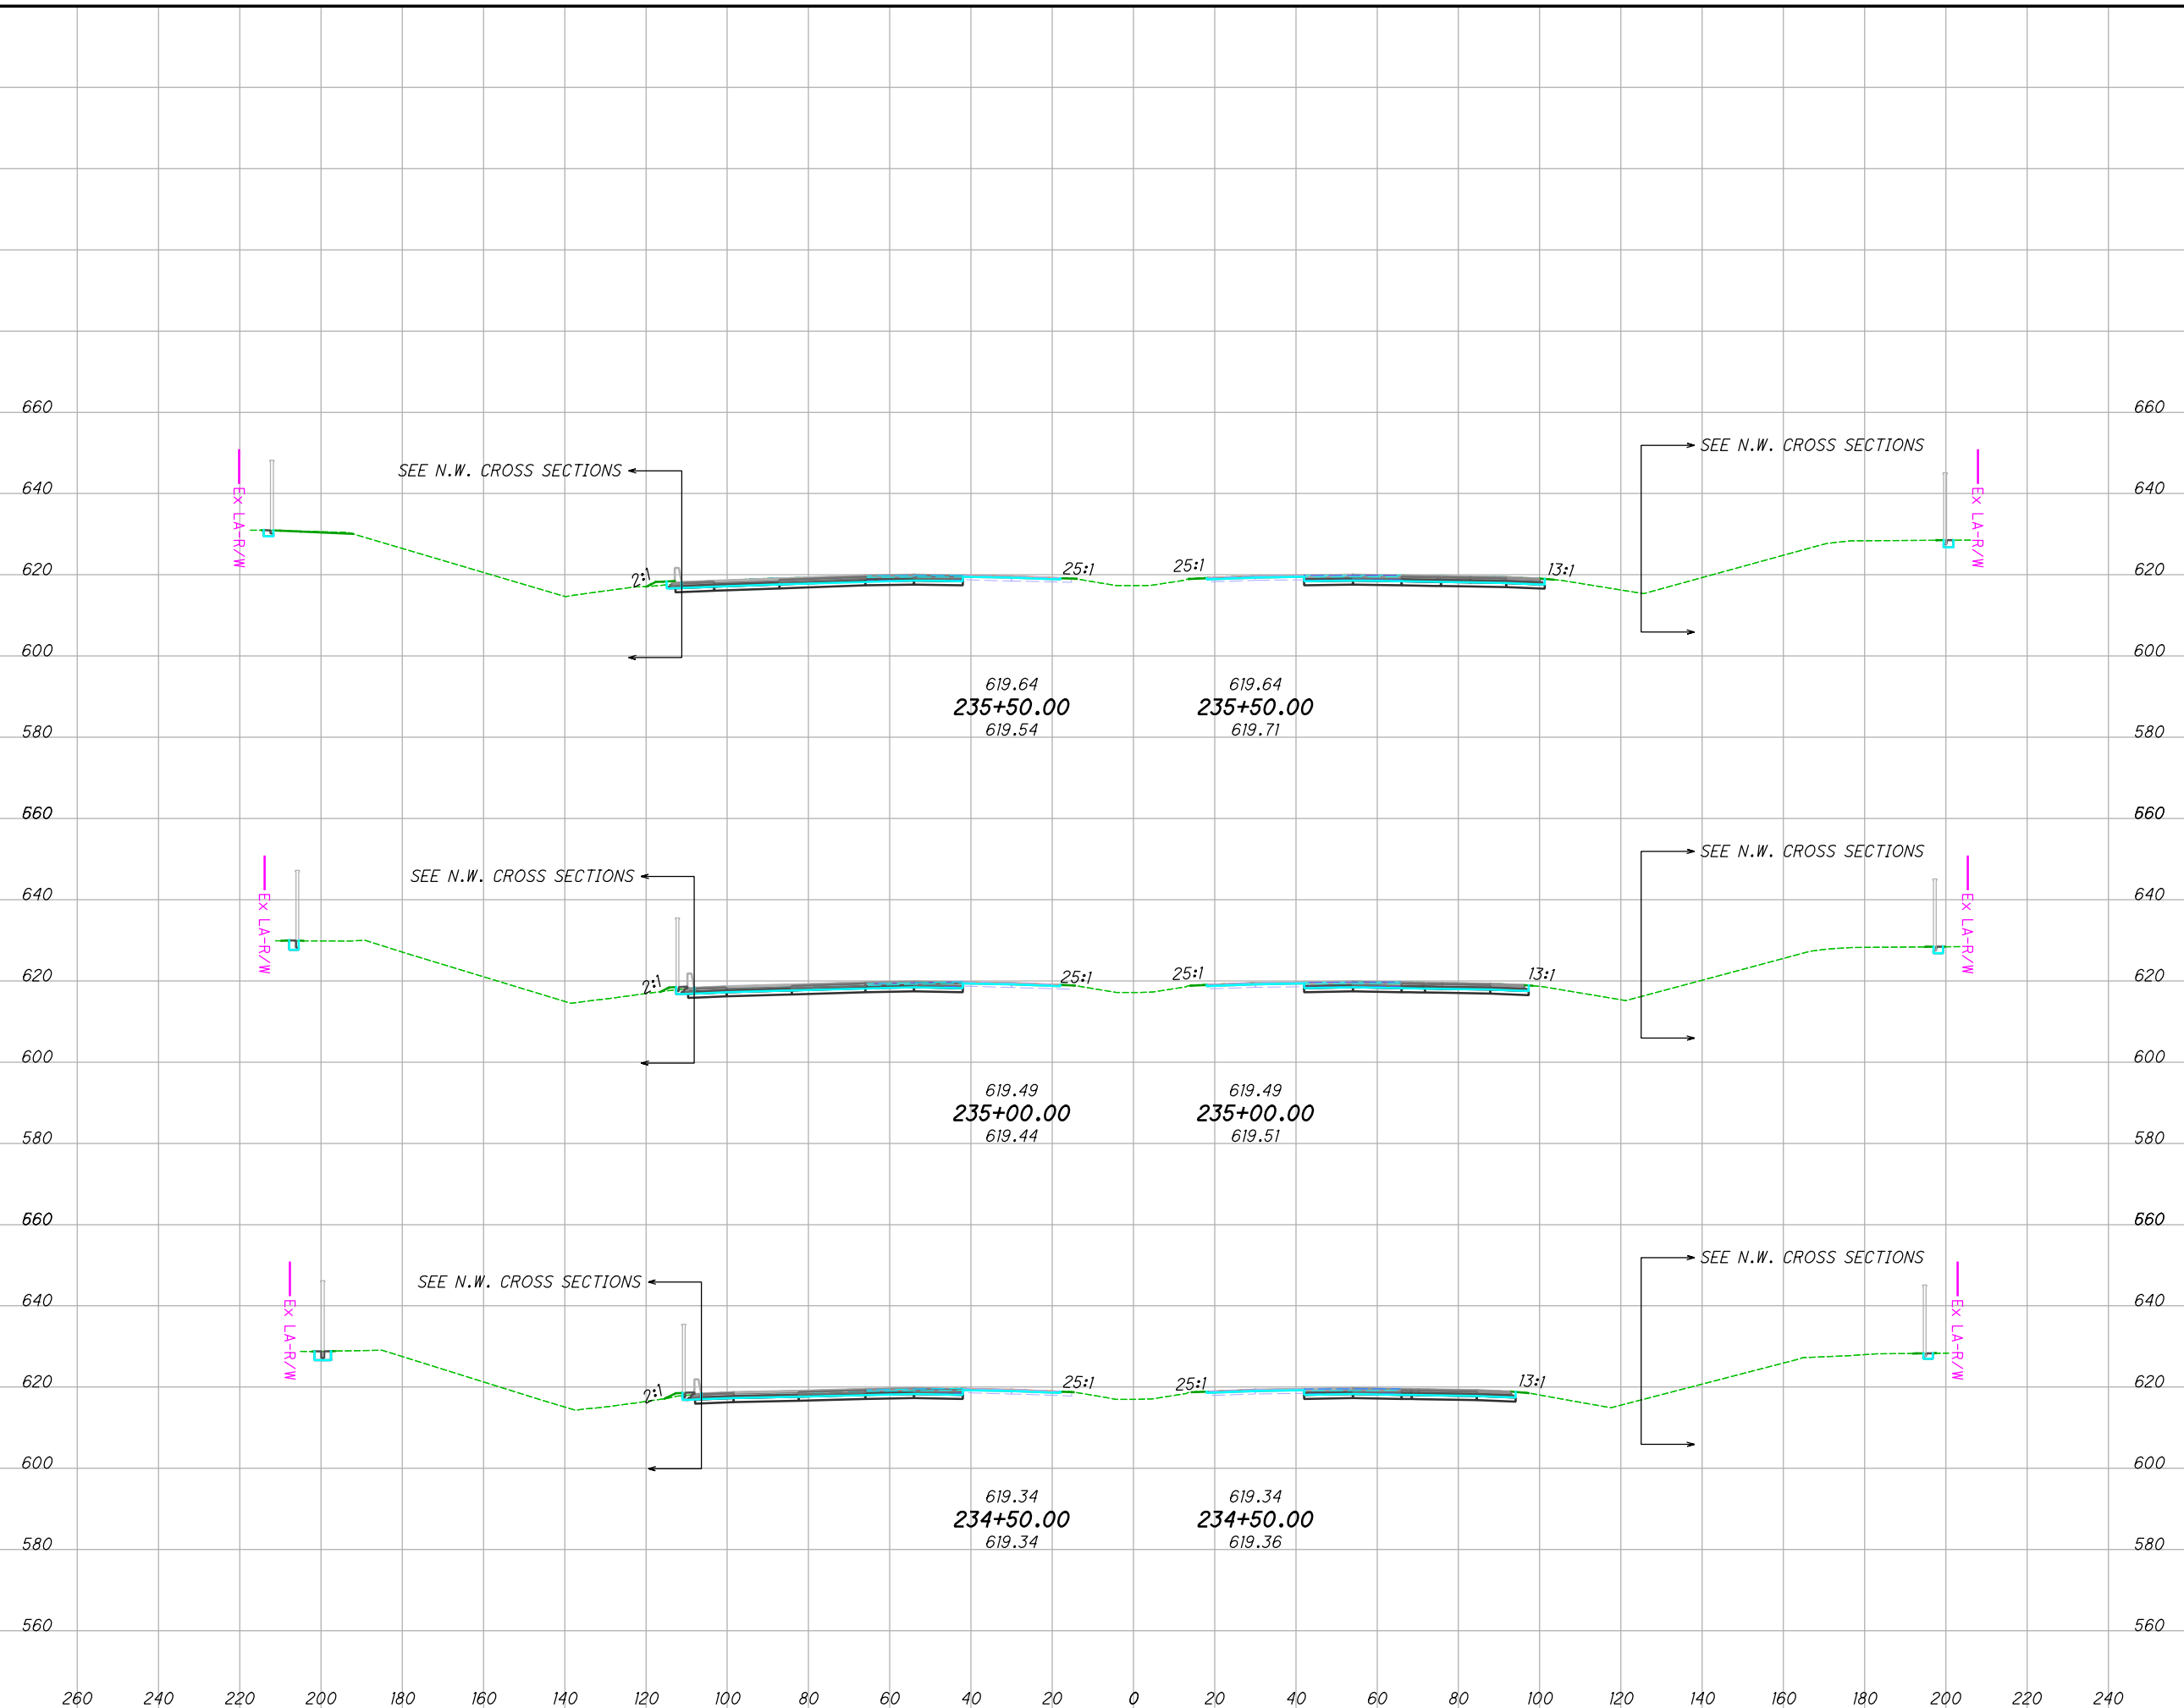

END AREA		VOLUME	
CUT	FILL	CUT	FILL
45	0	69	0
29	0	55	0
30	0	53	0


**CROSS SECTIONS**  
**STA. 234+50.00 TO STA. 235+50.00**  
**LUC-475-0.9**

474  
855

SEEDING  
END SO.  
WIDTH YDS.

41.5  
212  
35  
254  
56.5  
272

I:\ProjectData\LUC\95875\_LUC-475-0.09\Design\Roadway\Sheets\95875\_X5001 - Copy.dgn Sheet 4/29/2022 8:36:29 AM jbidinge

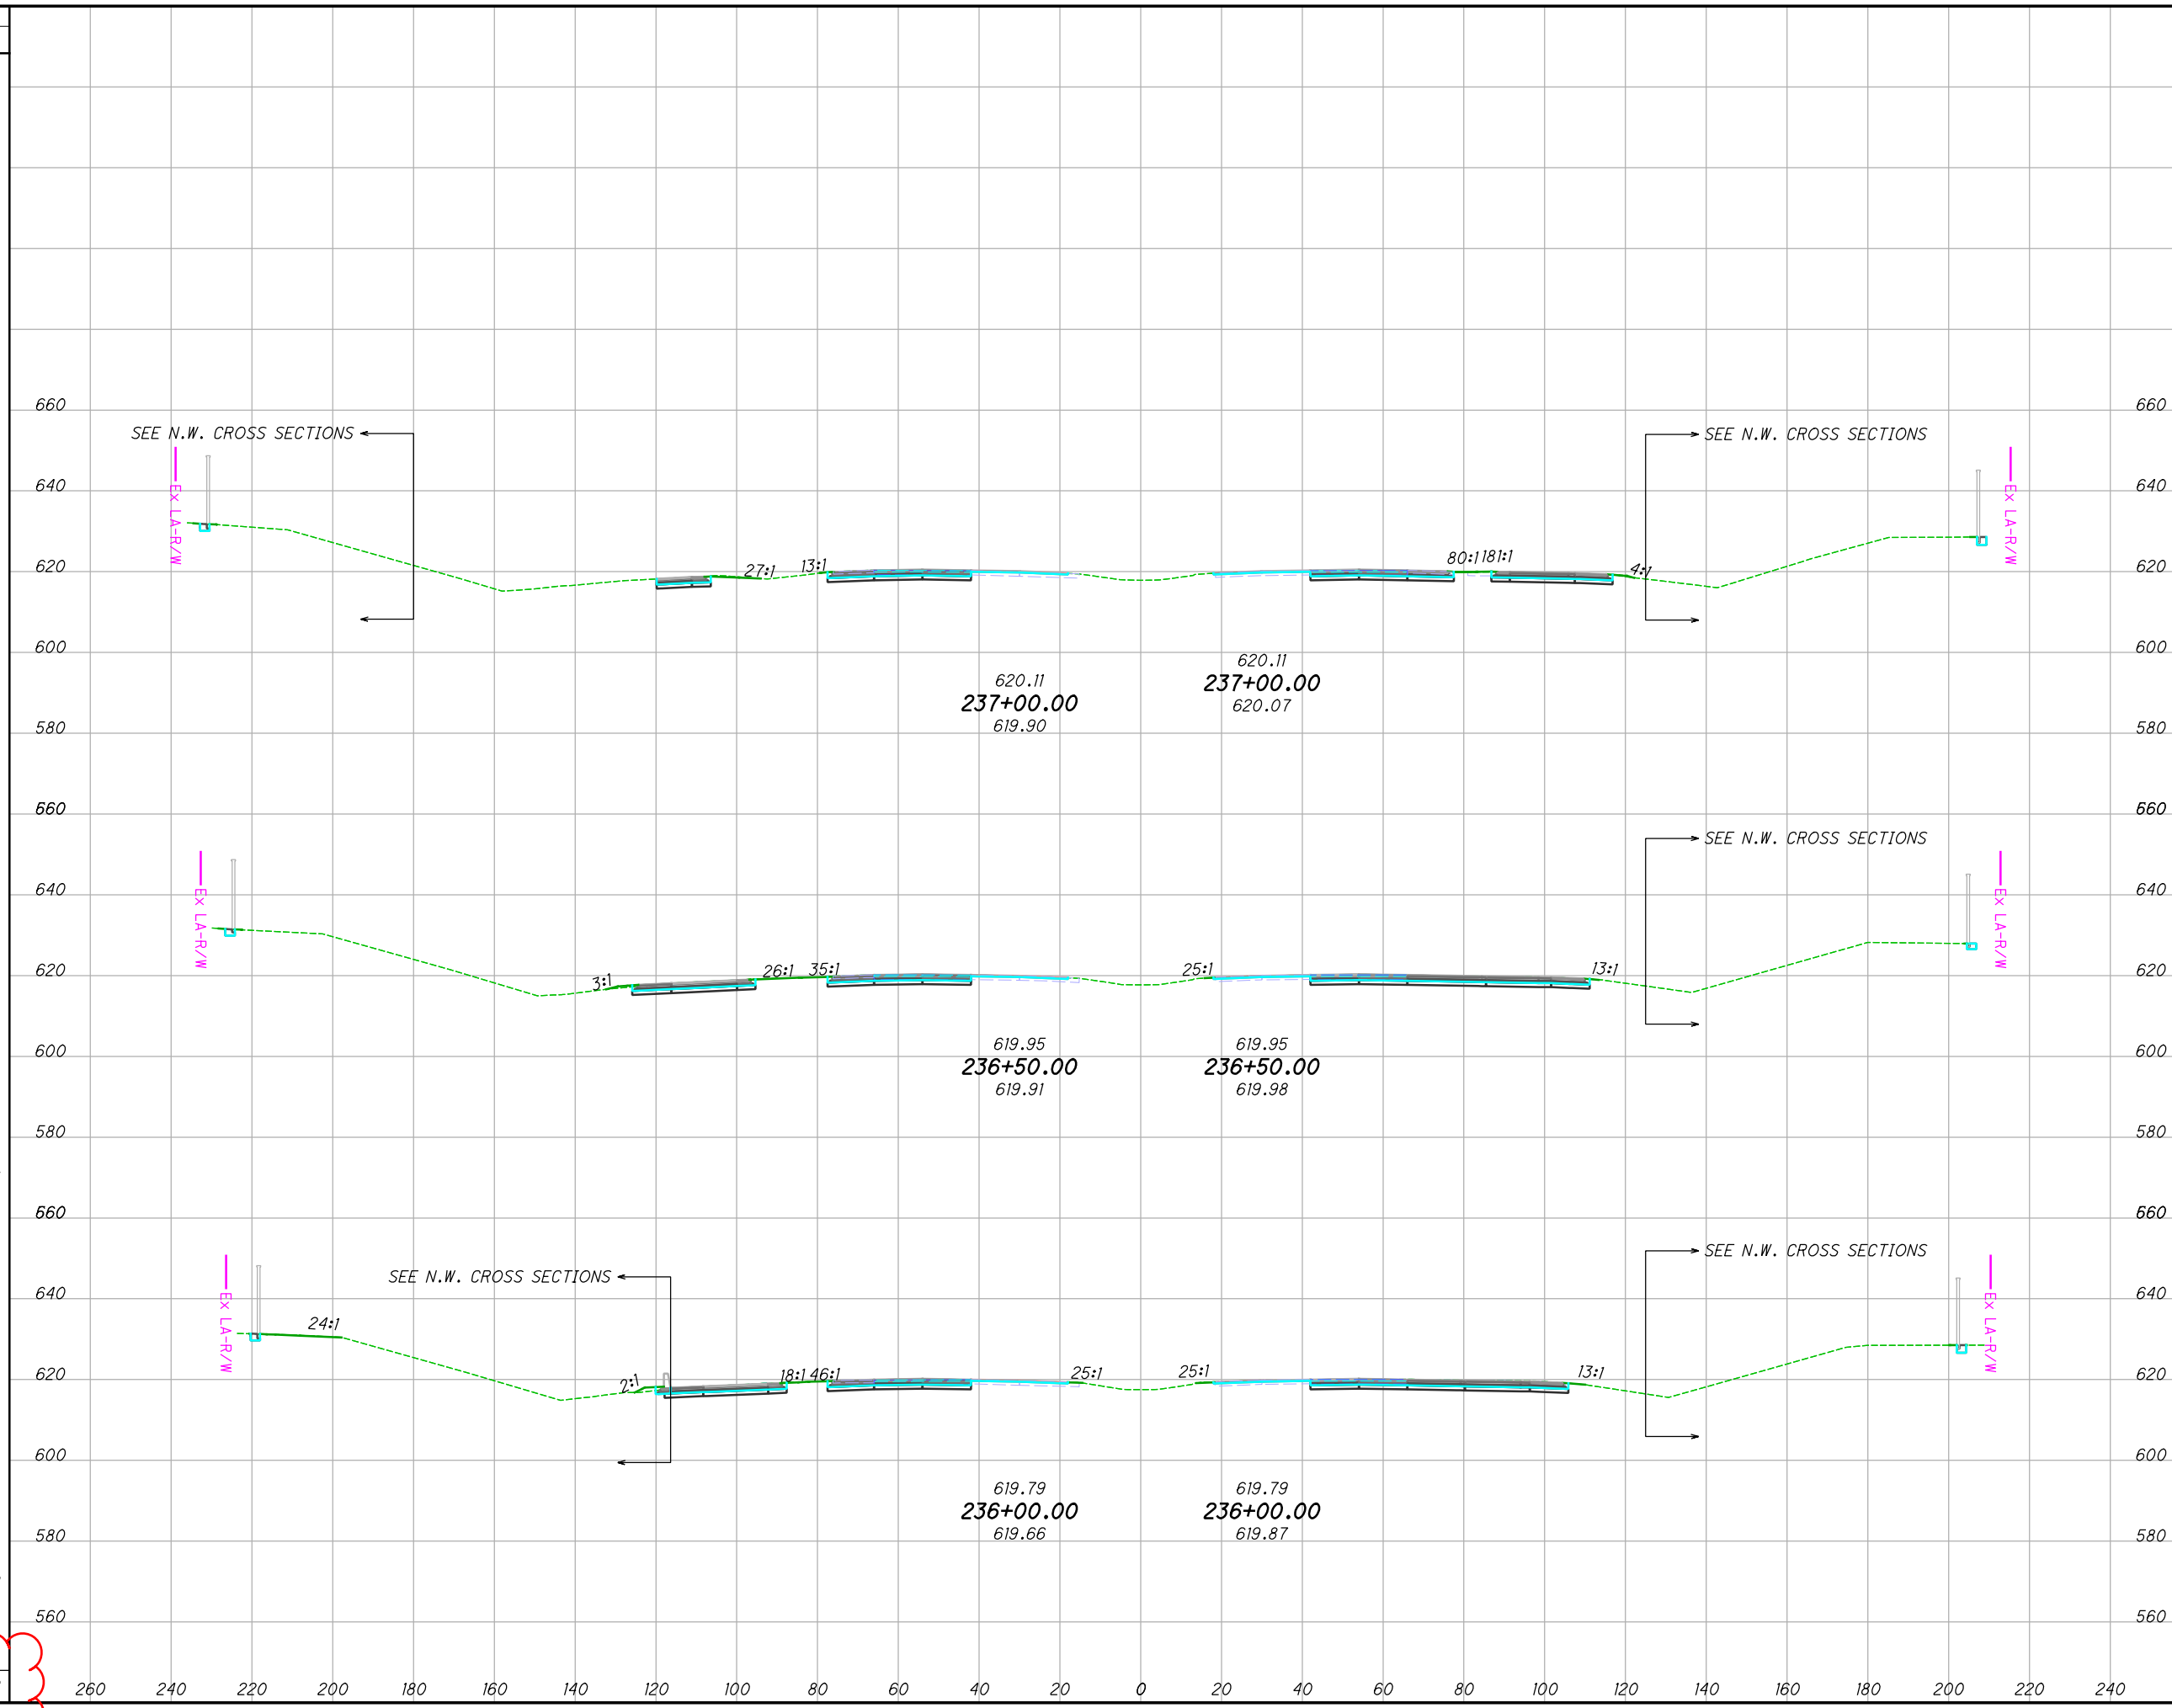

END AREA		VOLUME		CALCULATED JRB	CHECKED XXX
CUT	FILL	CUT	FILL		
52	5	102	6		
58	2	106	2		
57	0	94			
		302	8		

**CROSS SECTIONS  
STA. 236+00.00 TO STA. 237+00.00**

**LUC-475-0.9**


(475)  
855

738

302 8

I:\ProjectData\LUC-475-0.09\Design\Roadway\Sheets\95875\_X5000 - Copy.dgn Sheet 4/29/2022 8:36:30 AM jbidinge

SEEDING	
END WIDTH	SO. YDS.
440	15.9
260	18.2
240	140
220	32.2
200	205

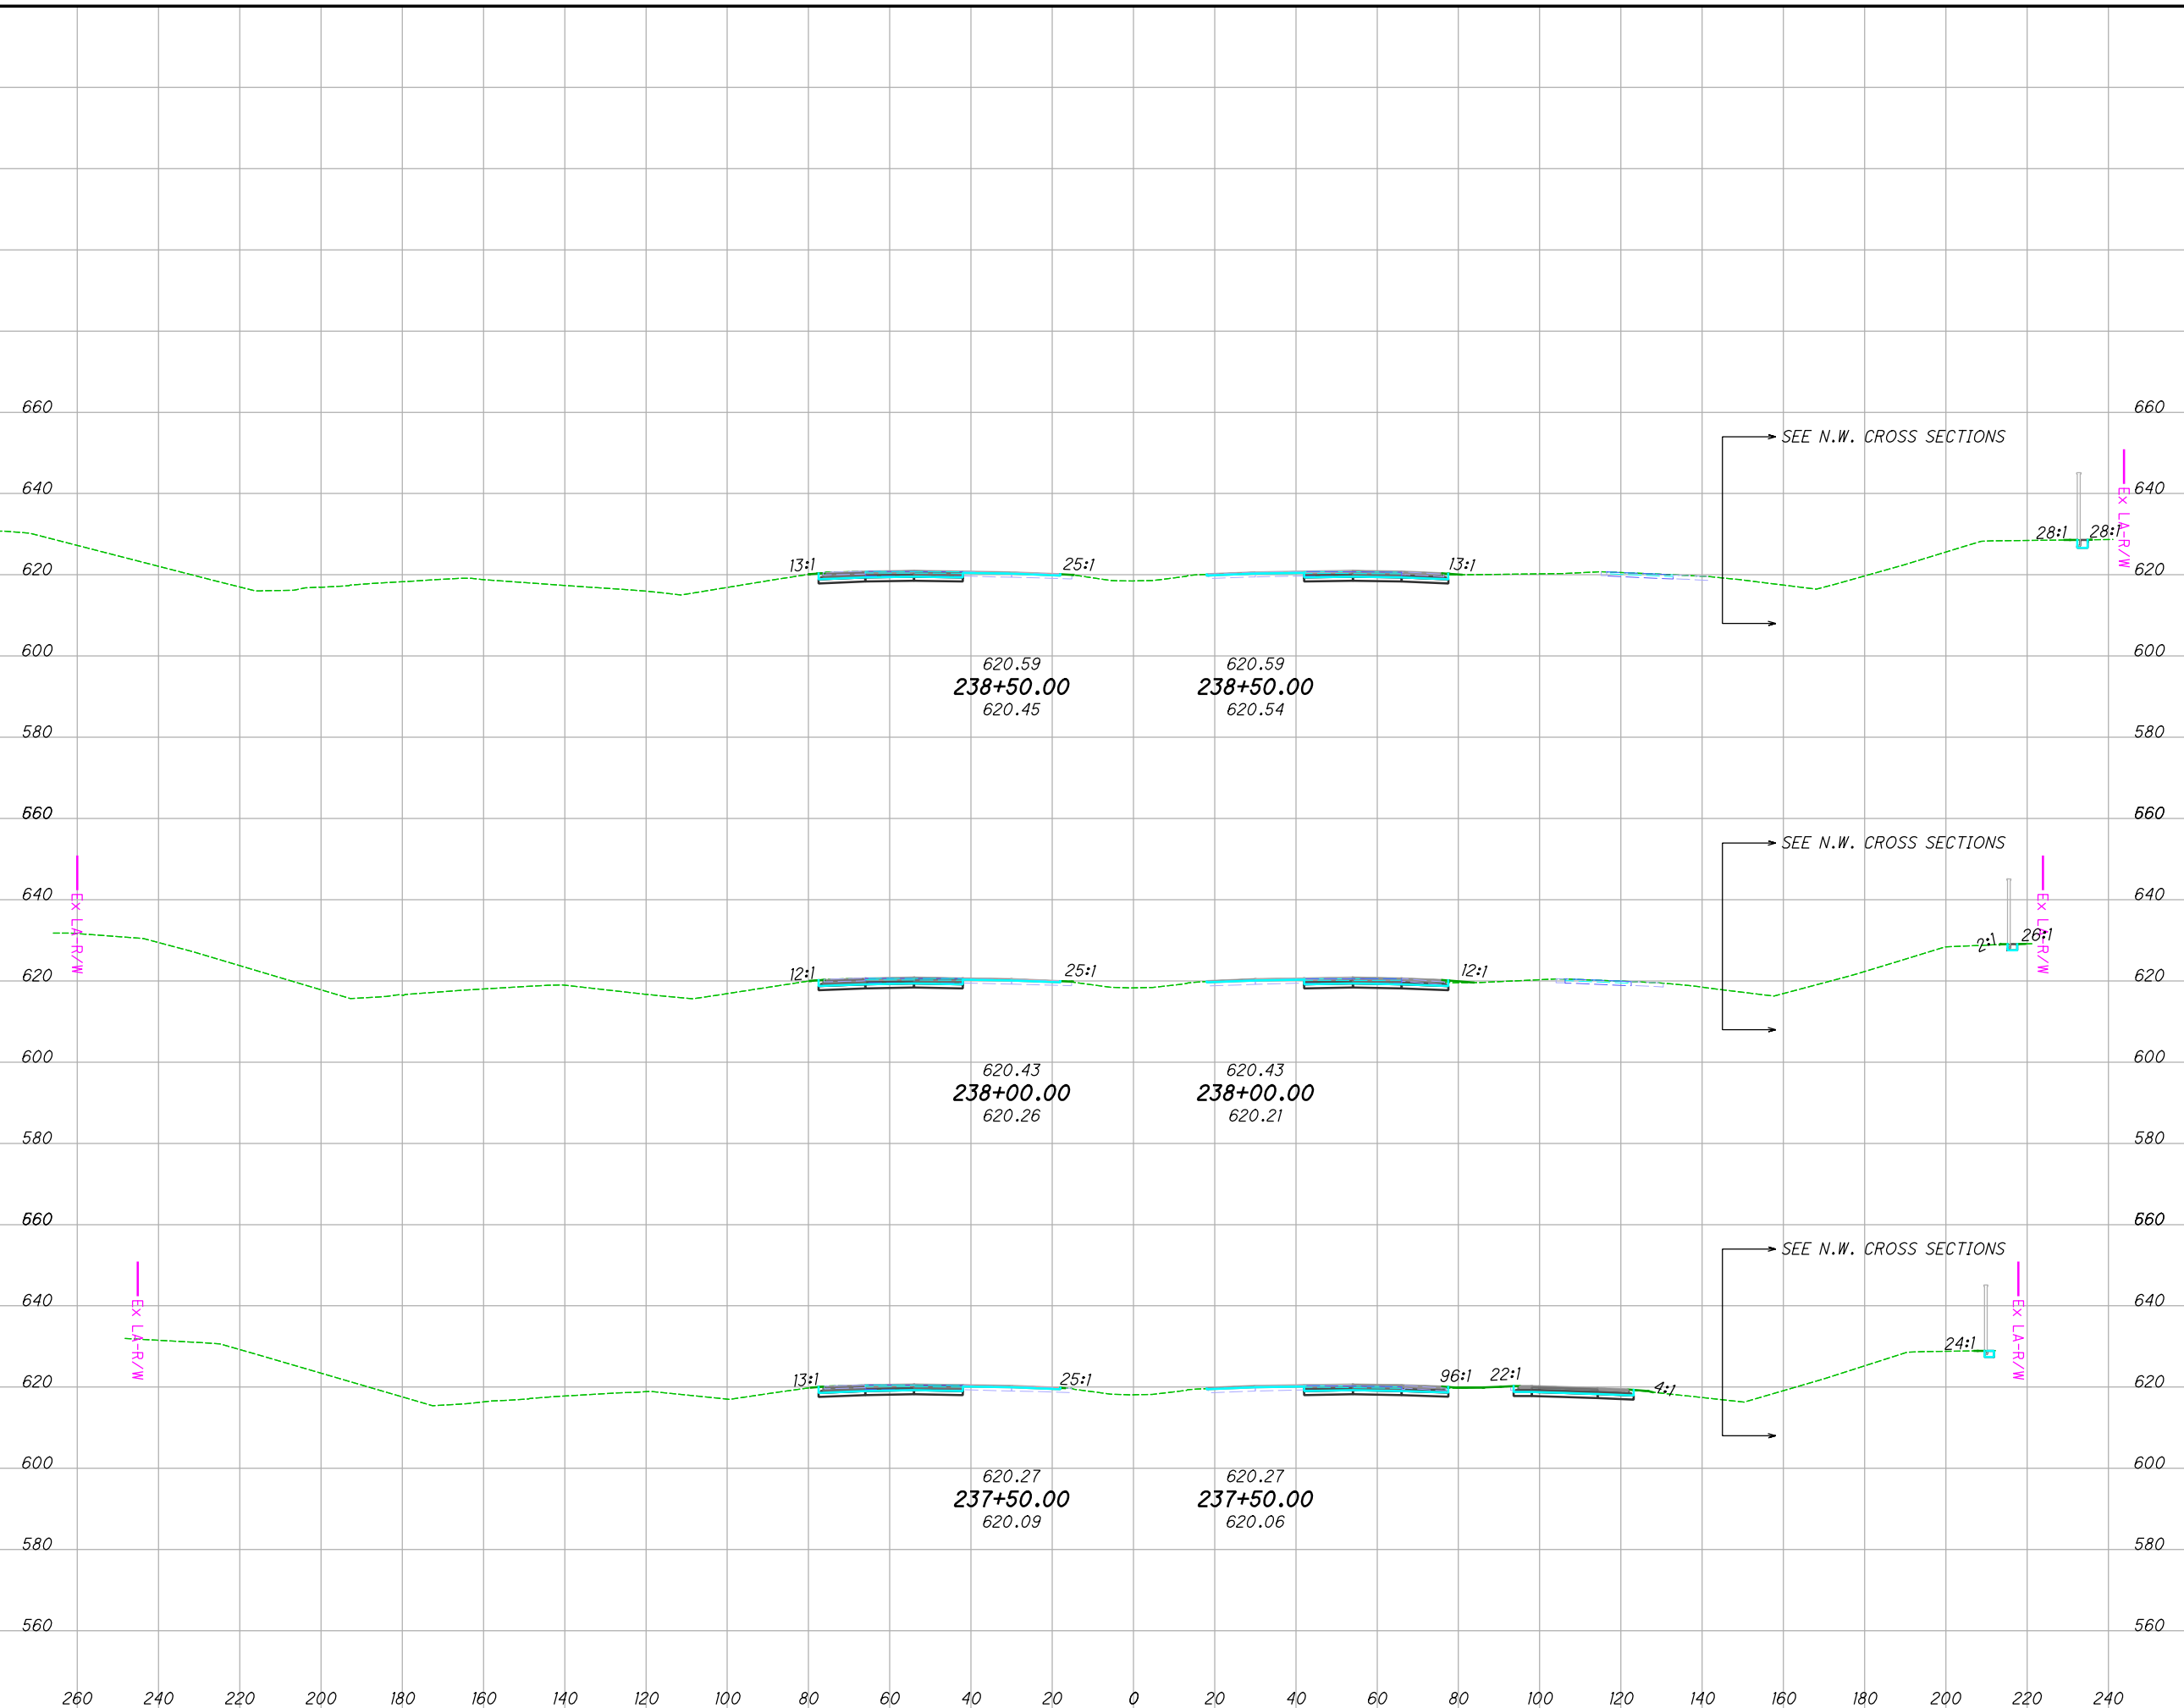

END AREA		VOLUME	
CUT	FILL	CUT	FILL
28	0	50	2
25	2	58	5
38	3	83	7


**CROSS SECTIONS**  
**STA. 237+50.00 TO STA. 238+50.00**

**LUC-475-0.9**

476  
855

I:\ProjectData\LUC\95875\LUC-475-0.09\Design\Roadway\Sheets\95875\_XS001 - Copy.dgn Sheet 4/29/2022 8:36:31AM jbidinge

SEEDING	
END WIDTH	SO. YDS.
289	21.7
103	15.1
92	18.0
94	

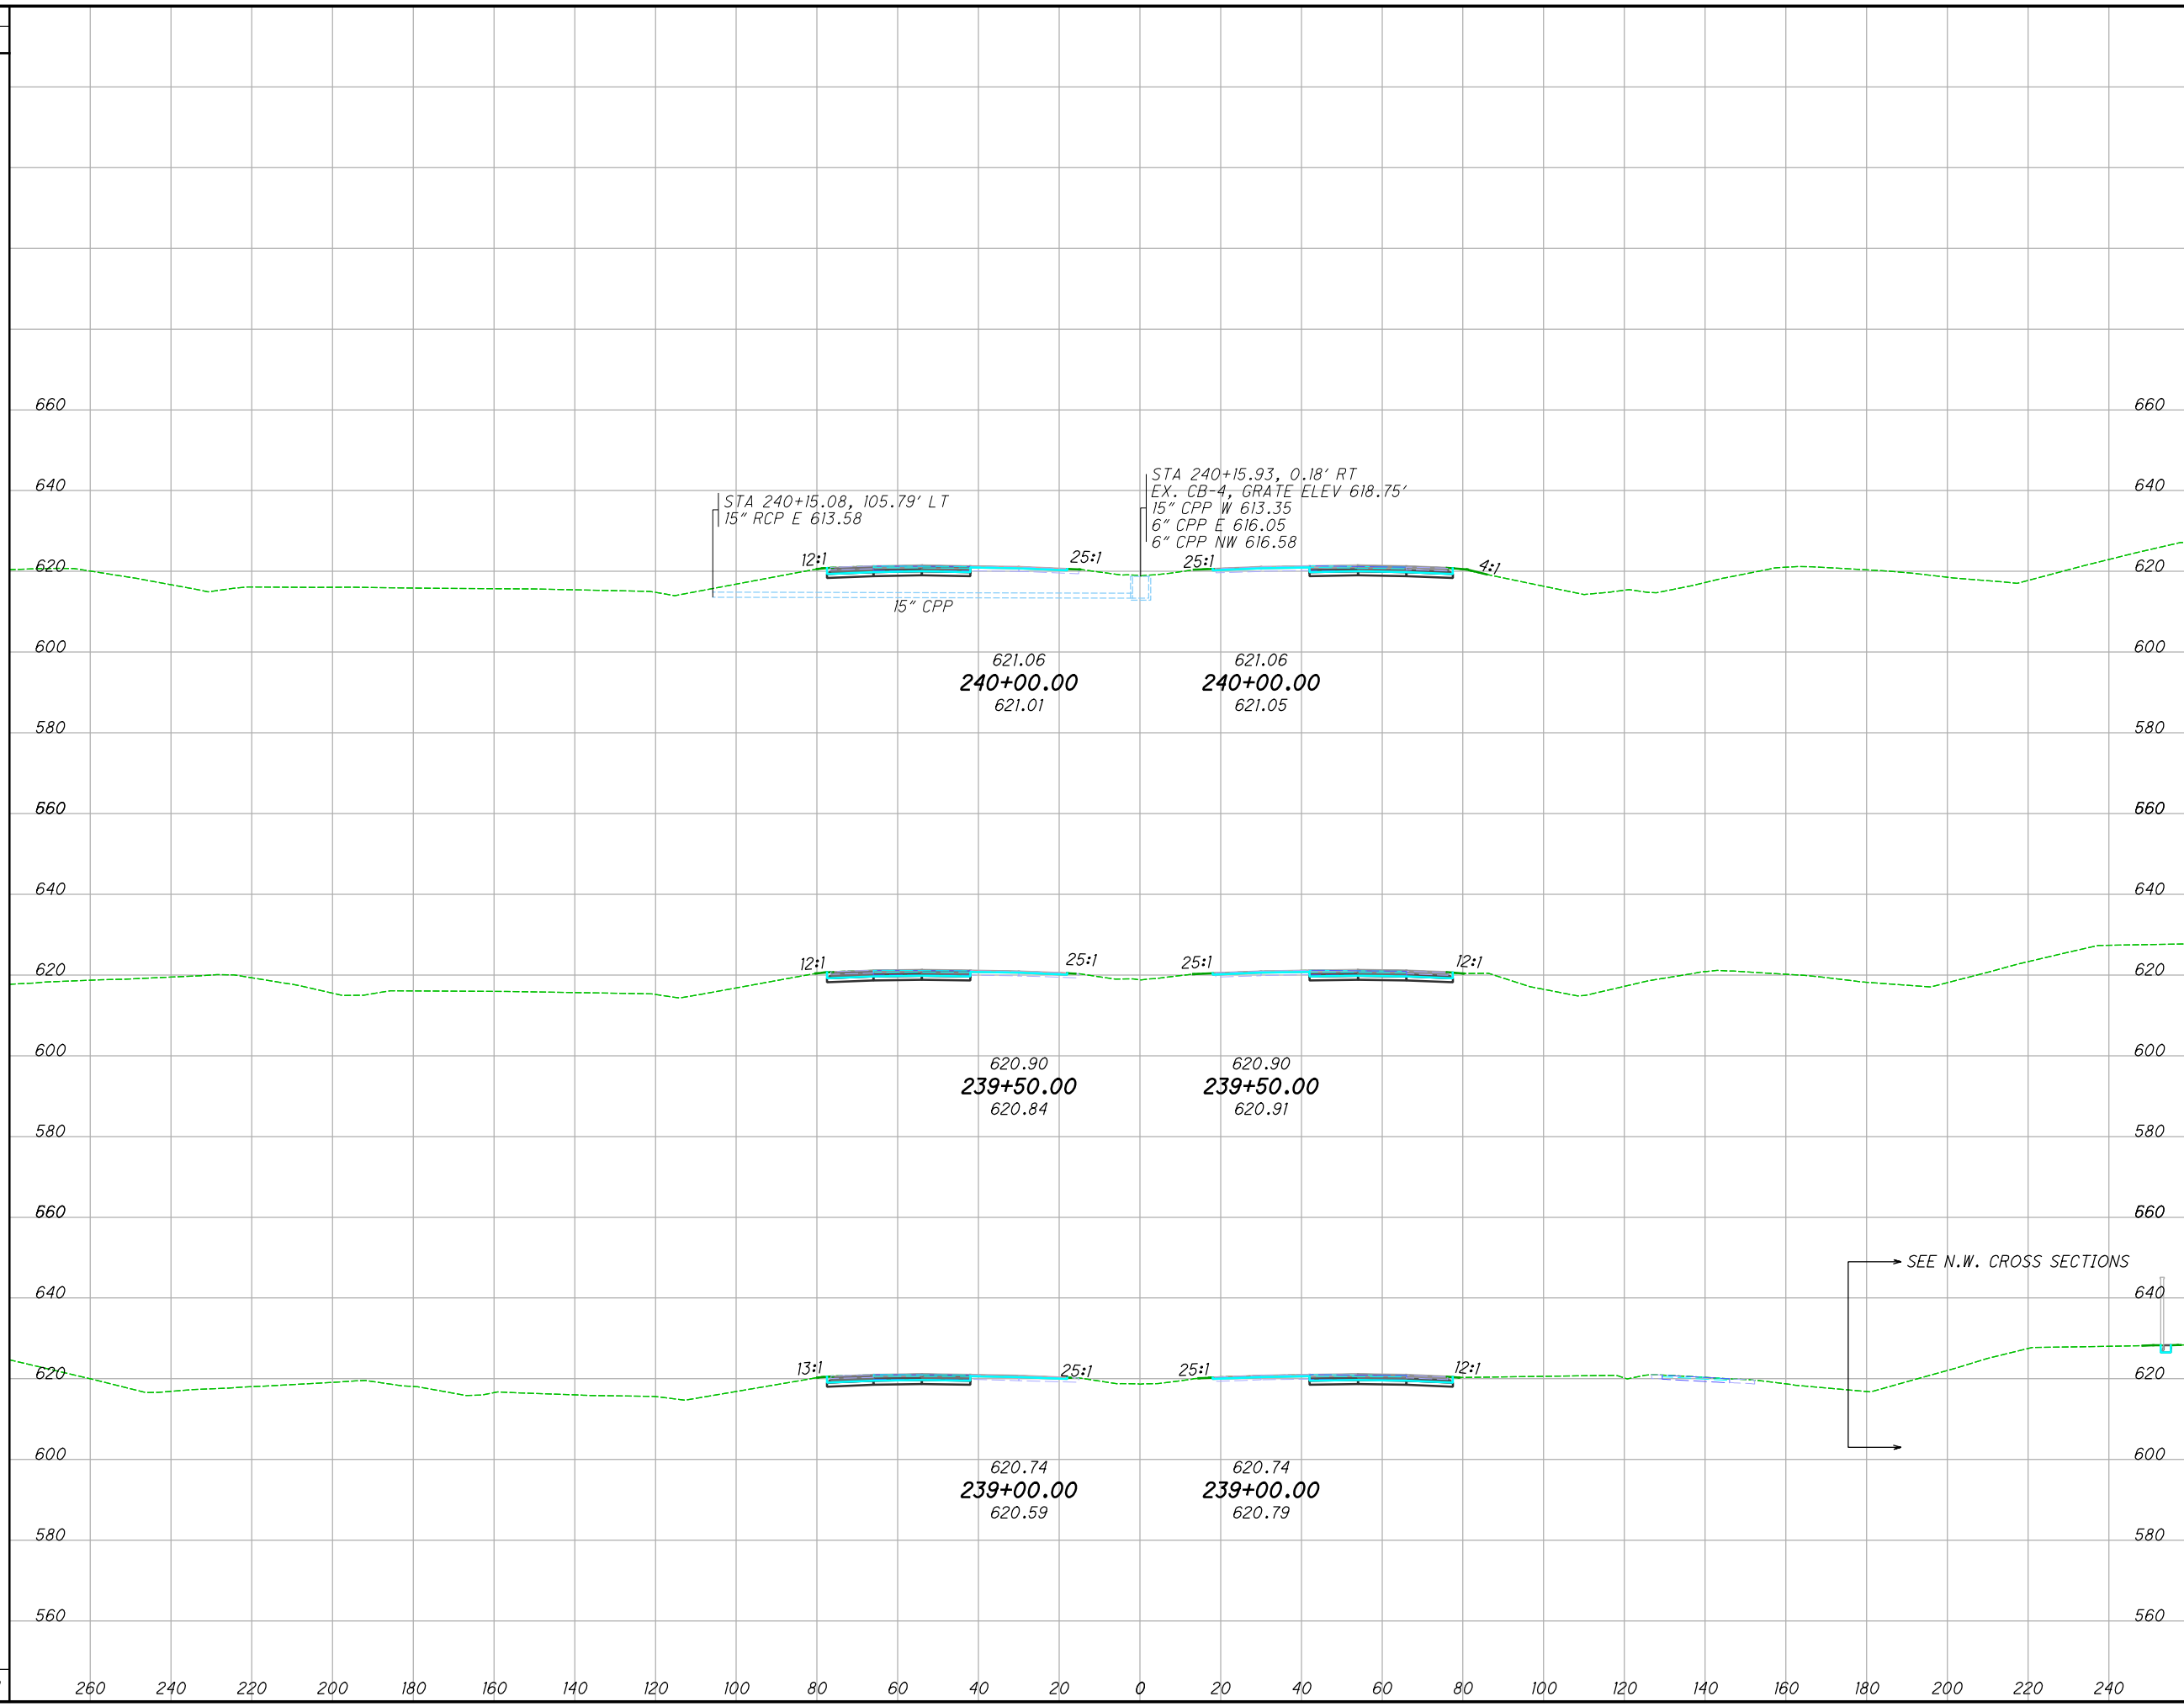

END AREA		VOLUME		CALCULATED		
CUT	FILL	CUT	FILL	JRB	CHECKED	XXX
28	1	53	1			
29	0	55				
30	0	54				
162	1					

**CROSS SECTIONS**  
**STA. 239+00.00 TO STA. 240+00.00**


**LUC-475-0.9**

477  
855

SEE N.W. CROSS SECTIONS

I:\ProjectData\LUC\95875\_LUC-475-0.9\Design\Roadway\Sheets\95875\_XS001 - Copy.dgn Sheet 4/29/2022 8:36:33 AM j\_bidinge

SEEDING	
END WIDTH	SO. YDS.
298	113
260	88
240	97
220	15.7
200	15.9
180	19.0
160	
140	
120	
100	
80	
60	
40	
20	
0	
20	
40	
60	
80	
100	
120	
140	
160	
180	
200	
220	
240	

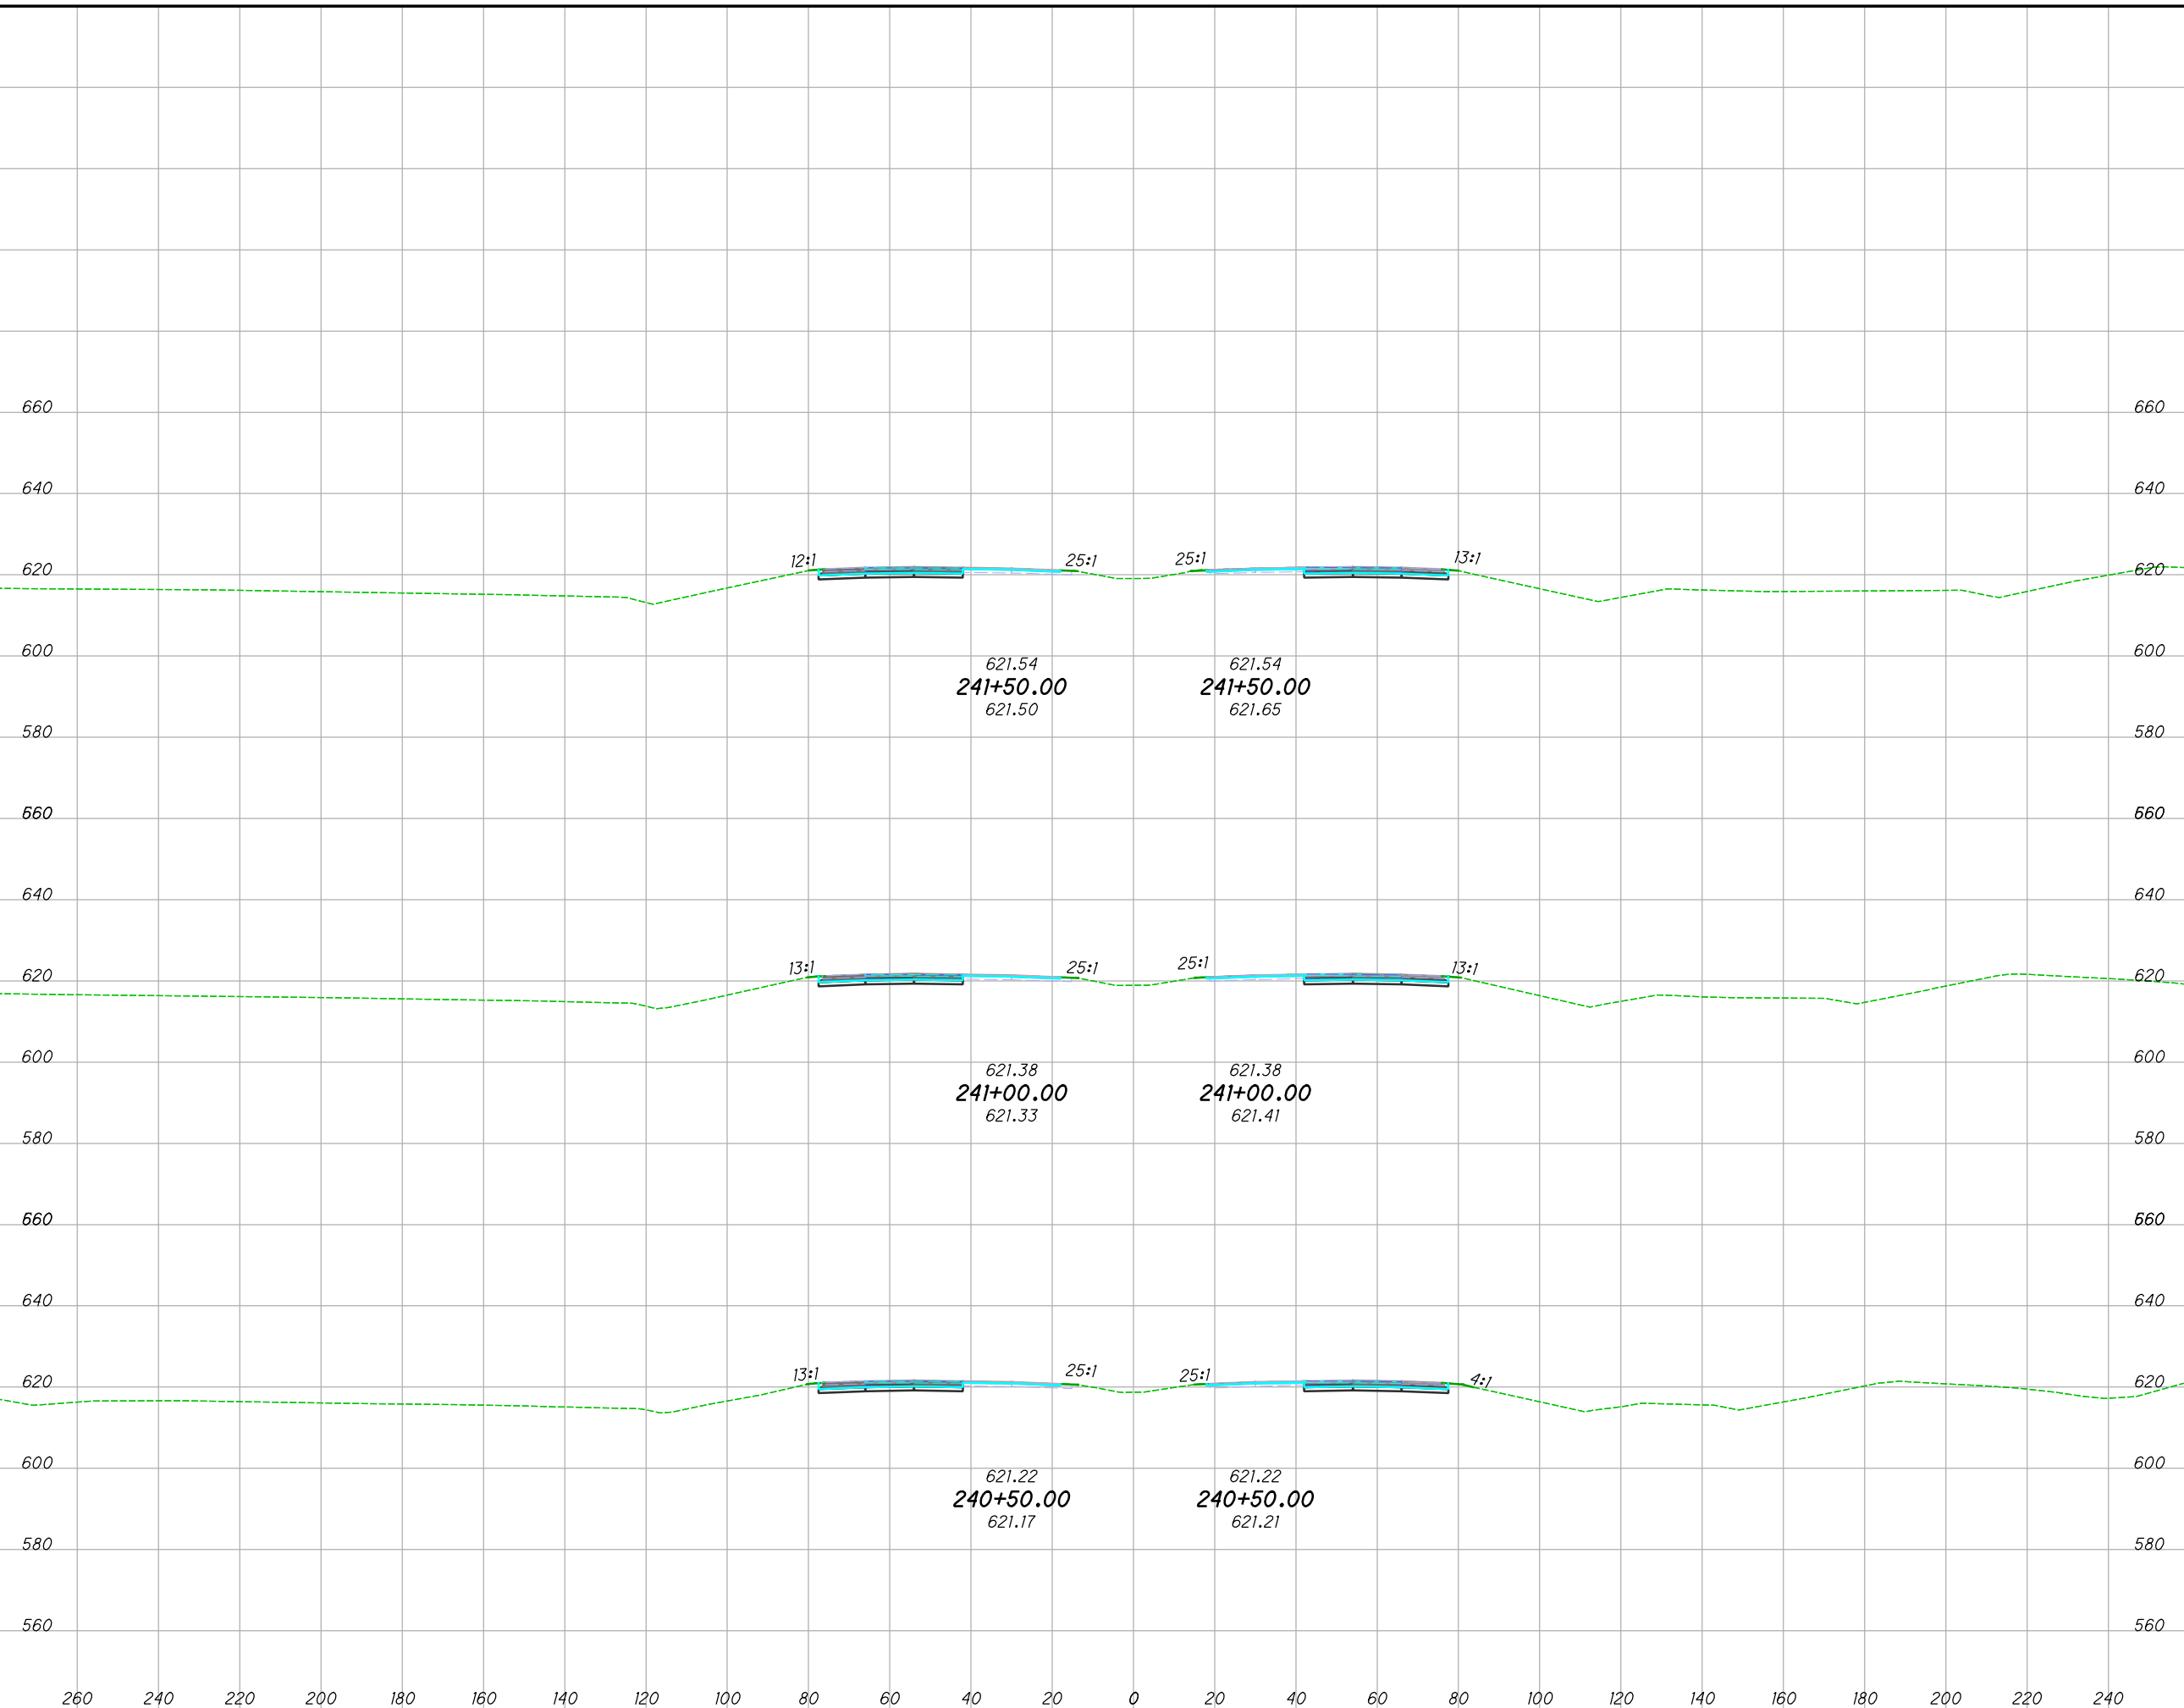

END AREA		VOLUME		CALCULATED		
CUT	FILL	CUT	FILL	JRB	CHECKED	XXX
31	0	57	0			
30	0	56	0			
30	0	54	1			

**CROSS SECTIONS  
STA. 240+50.00 TO STA. 241+50.00**


**LUC-475-0.9**

478  
855





SEEDING  
 END SO.  
 WIDTH YDS.  
 276  
 117  
 84  
 75

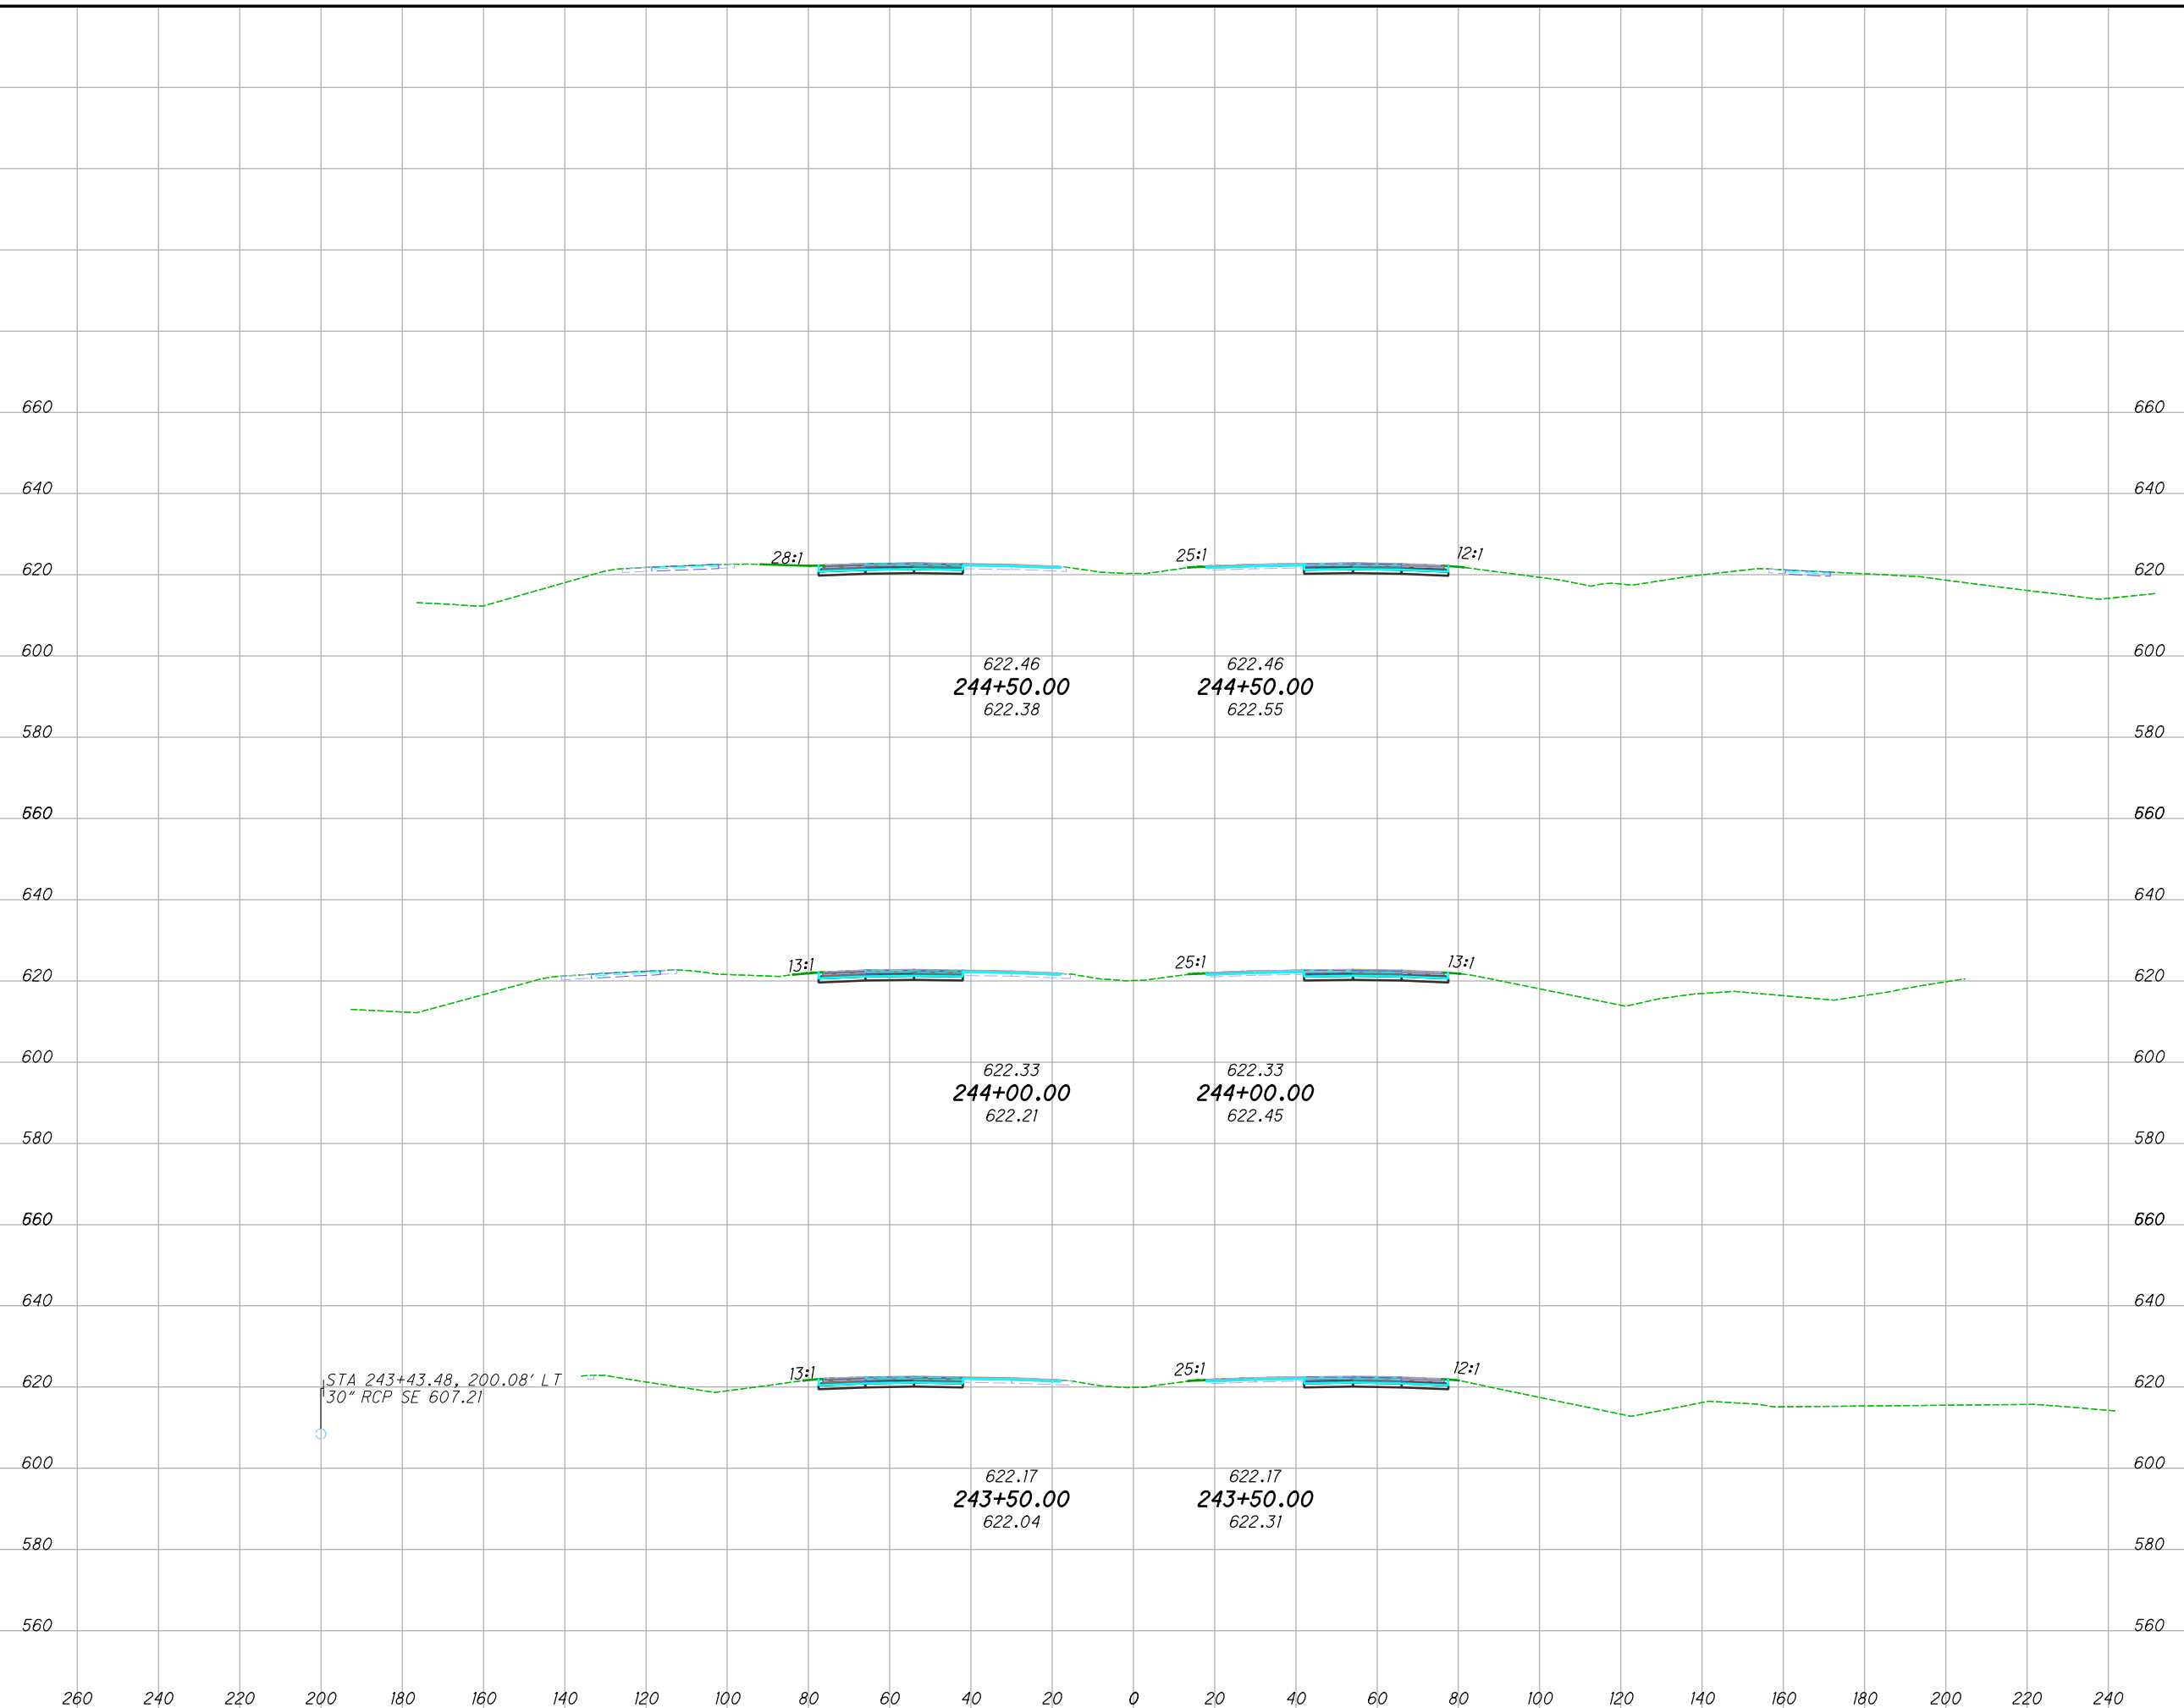

END AREA		VOLUME		CALCULATED JRB	CHECKED XXX
CUT	FILL	CUT	FILL		
34	0	63	0		
34	0	63	0		
34	0	59	0		


**CROSS SECTIONS**  
**STA. 243+50.00 TO STA. 244+50.00**  
**LUC-475-0.9**

480  
 855

I:\ProjectData\LUC\95875\_LUC-475-0.9\_Design\Roadway\Sheets\95875\_XS001 - Copy.dgn Sheet 4/29/2022 8:36:35 AM jbdinge

I:\ProjectData\LUC-475-0.09\Design\Roadway\Sheets\95875\_XS001 - Copy.dgn Sheet 4/29/2022 8:36:36 AM jbidinge

SEEDING	
END WIDTH	SO. YDS.
800	
260	
240	
220	
20	
40	
60	
80	
100	
120	
140	
160	
180	
200	
220	
240	

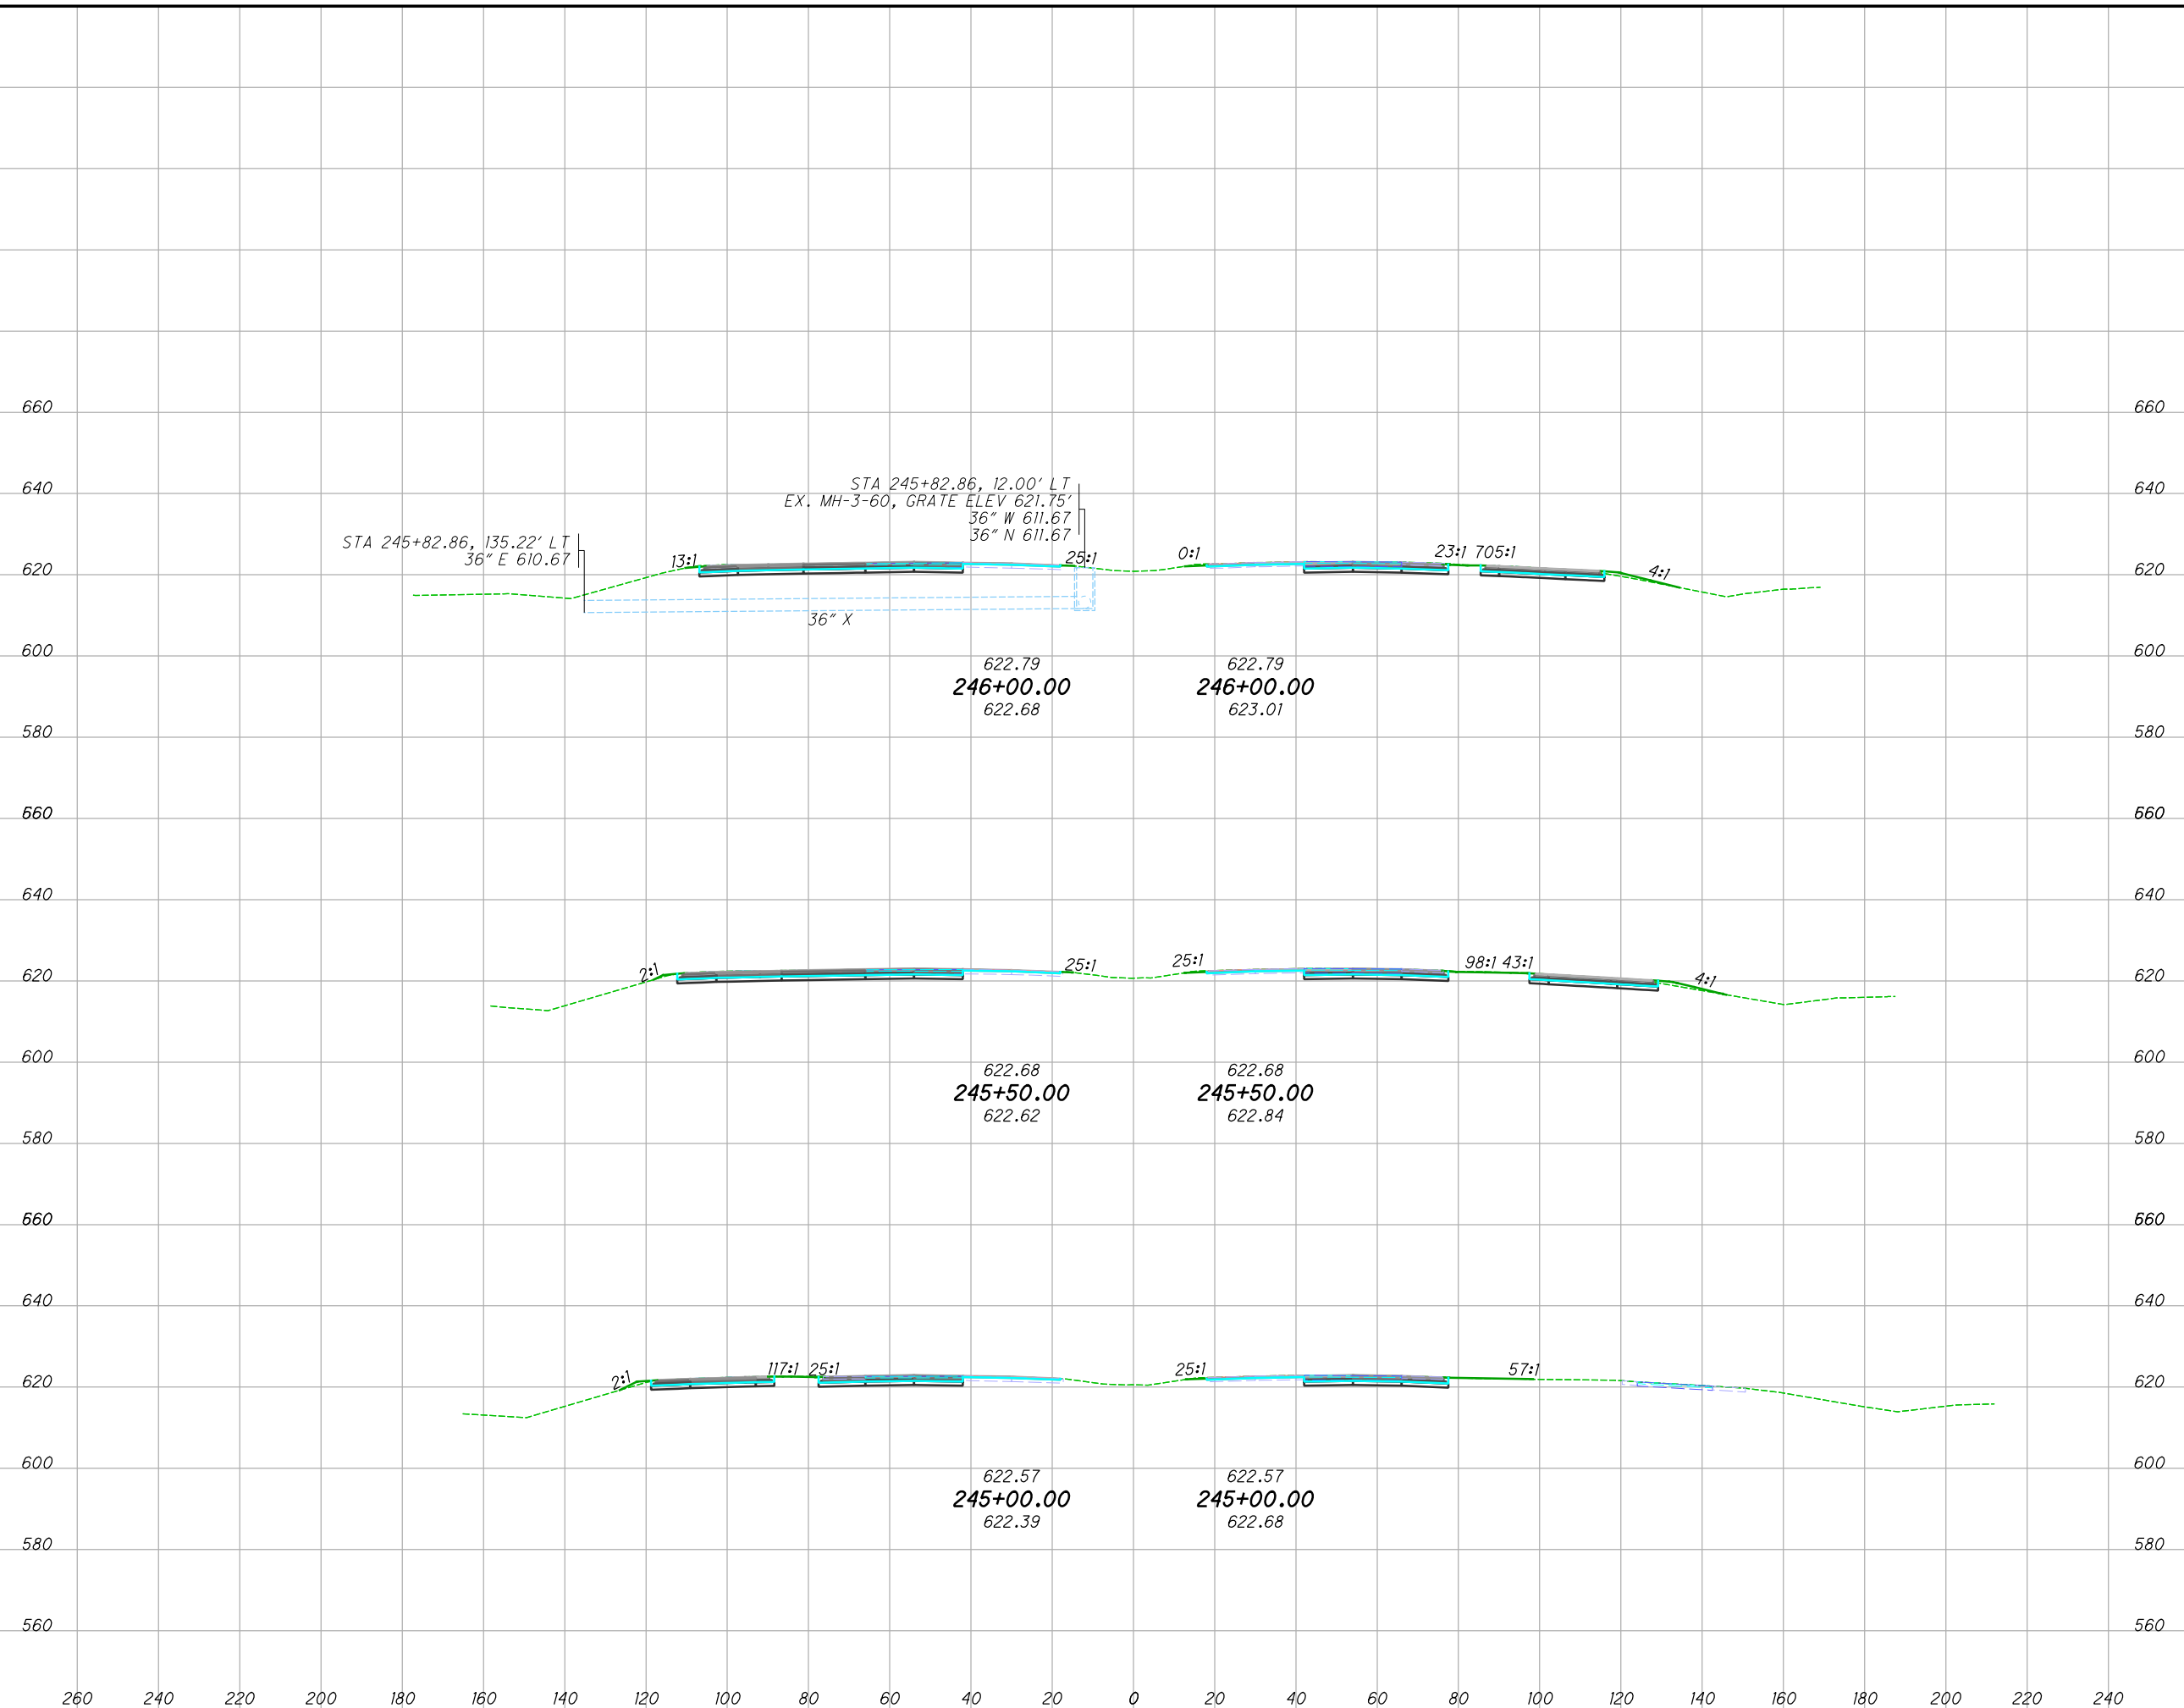

END AREA		VOLUME		CALCULATED		
CUT	FILL	CUT	FILL	JRB	CHECKED	XXX
59	9	113	17			
64	9	102	12			
46	4	74	4			
289	33	481	855			


**CROSS SECTIONS**  
**STA. 245+00.00 TO STA. 246+00.00**

**LUC-475-0.9**

481  
855

I:\ProjectData\LUC-475-0.09\Design\Roadway\Sheets\95875\_XS001 - Copy.dgn Sheet 4/29/2022 8:36:37 AM j\_bidinge

SEEDING	
END WIDTH	SO. YDS.
457	198
260	26.0
240	137
220	23.2
200	122
180	20.4

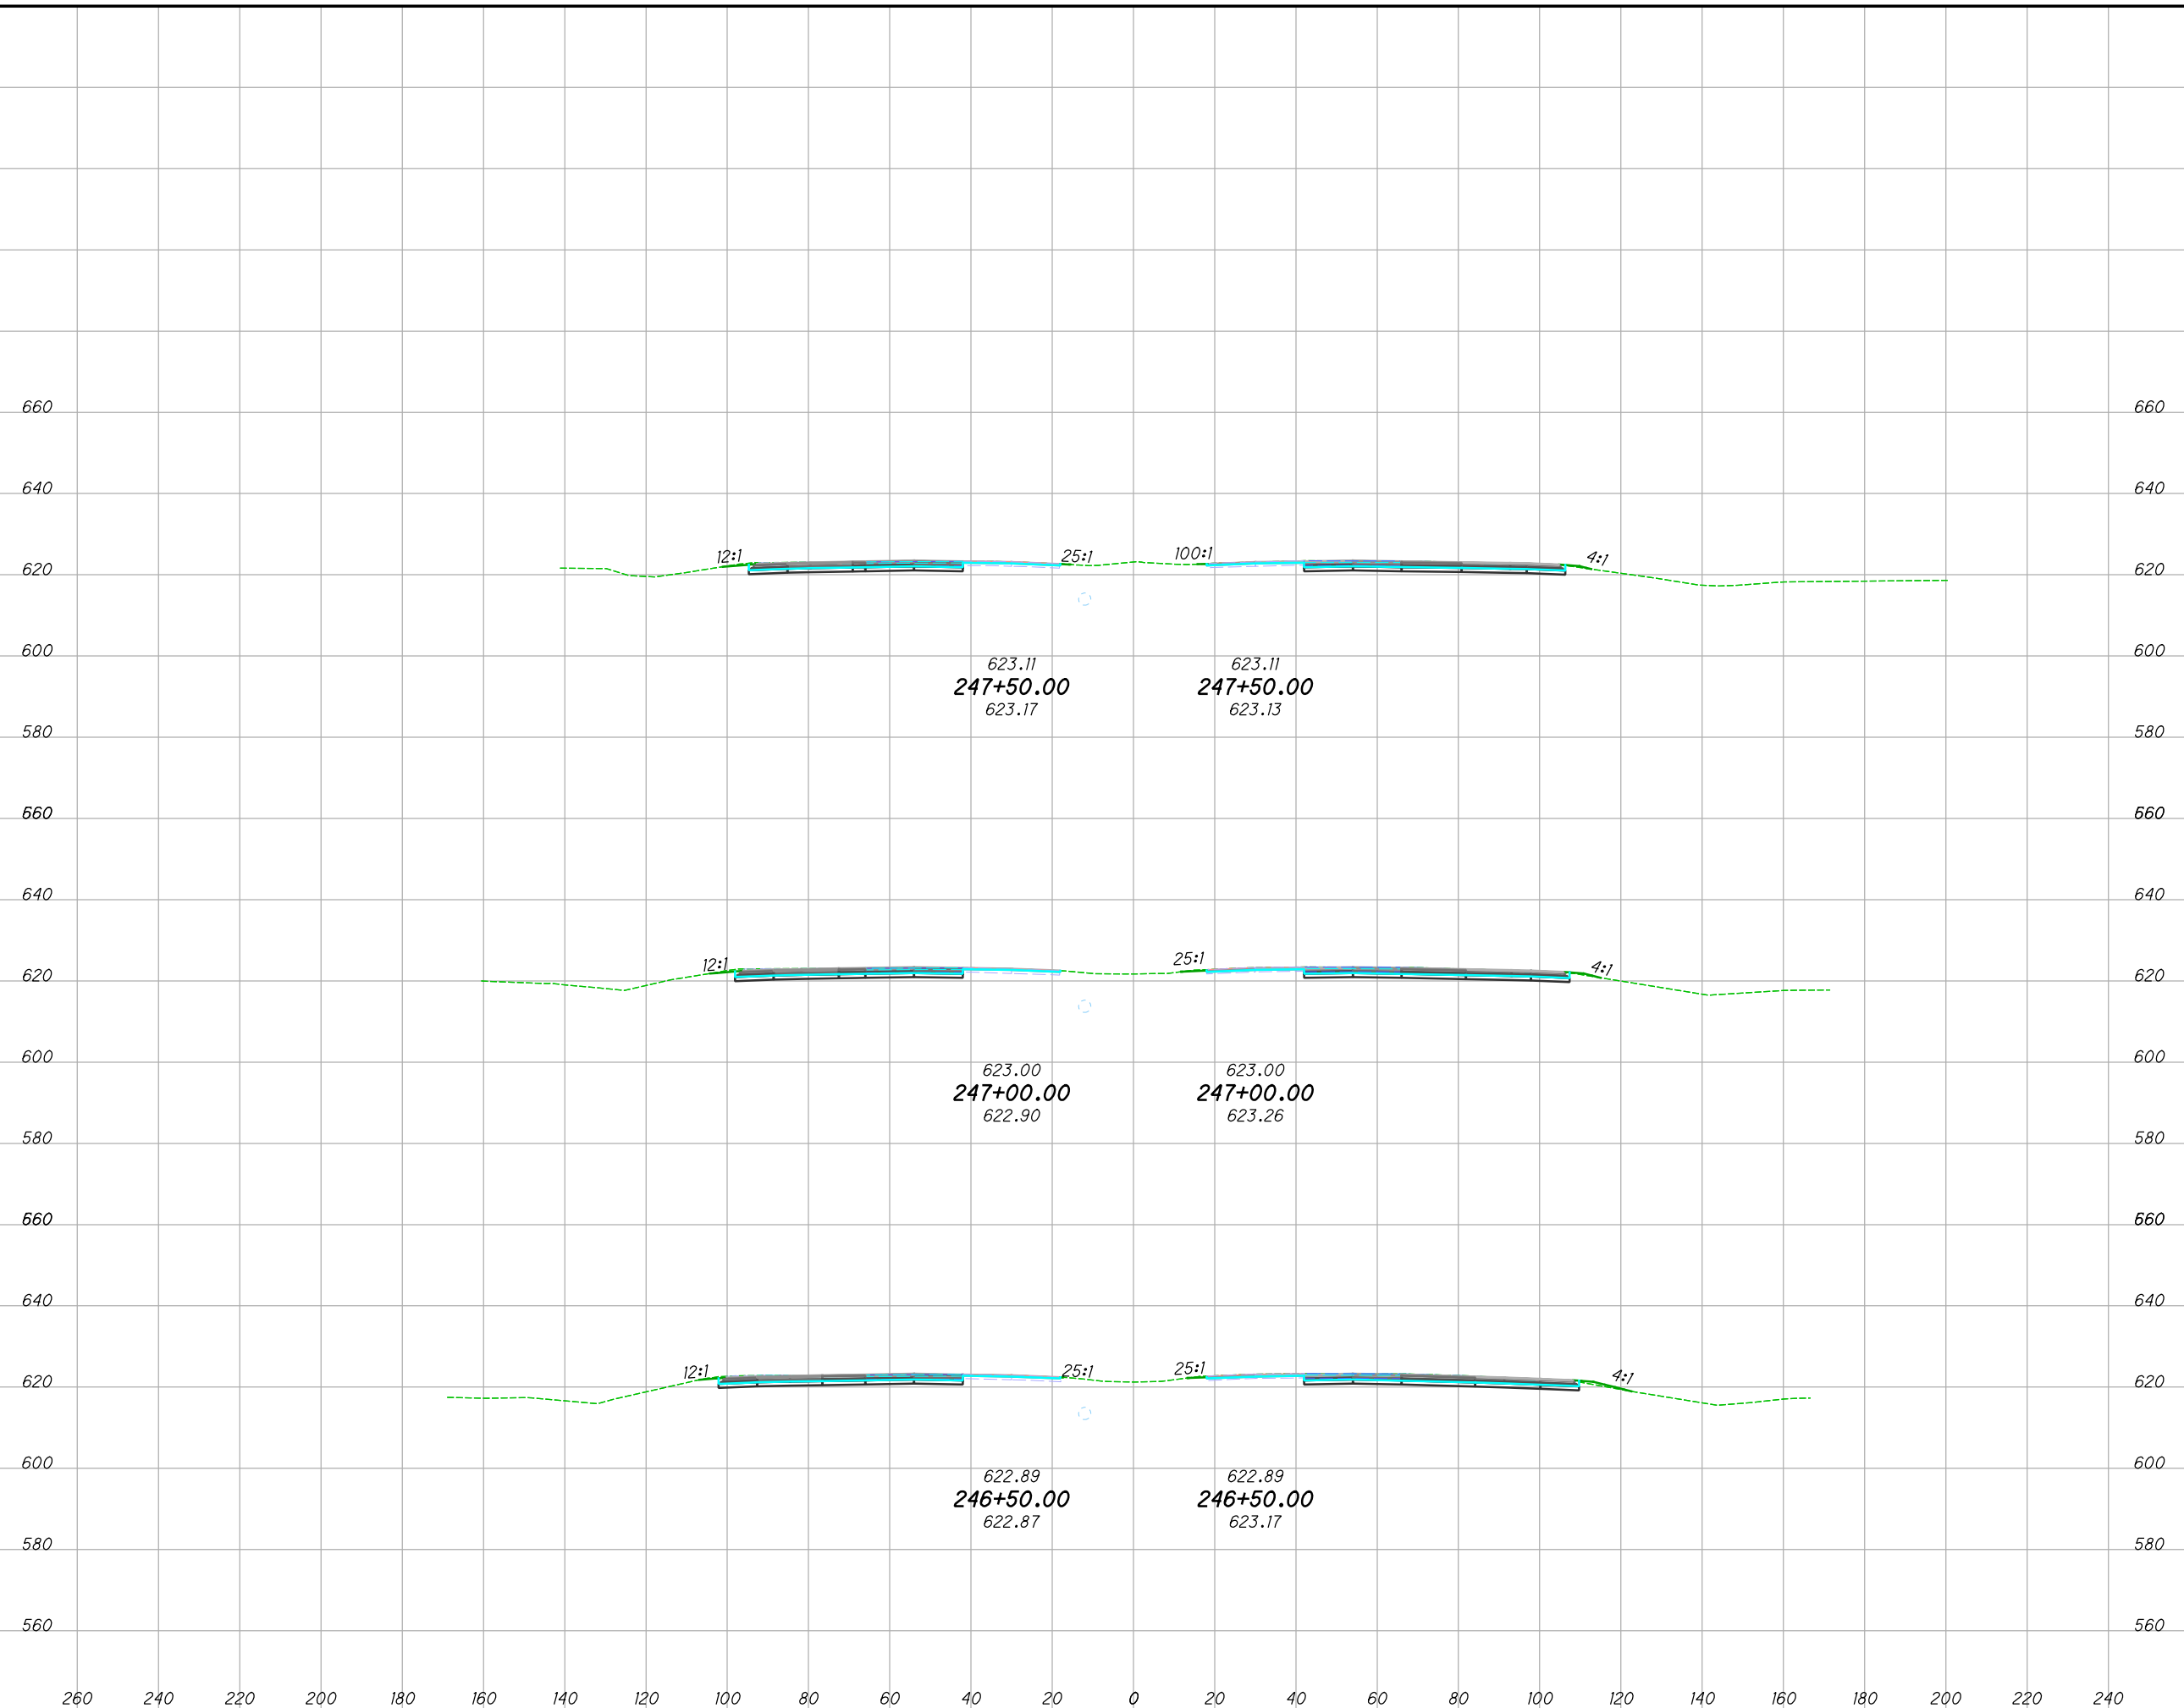

END AREA		VOLUME		CALCULATED	CHECKED
CUT	FILL	CUT	FILL		
41	1	85	3	LUC-475-0.9	482 855
51	2	95	6		
52	5	102	13		


**CROSS SECTIONS**  
**STA. 246+50.00 TO STA. 247+50.00**

**LUC-475-0.9**

482  
855

I:\ProjectData\LUC\95875\_LUC-475-0.09\_Design\Roadway\Sheets\95875\_X5000 - Copy.dgn Sheet 4/29/2022 8:36:38 AM jbidinge

SEEDING	
END WIDTH	SO. YDS.
313	18.5
96	16.2
103	20.7
114	

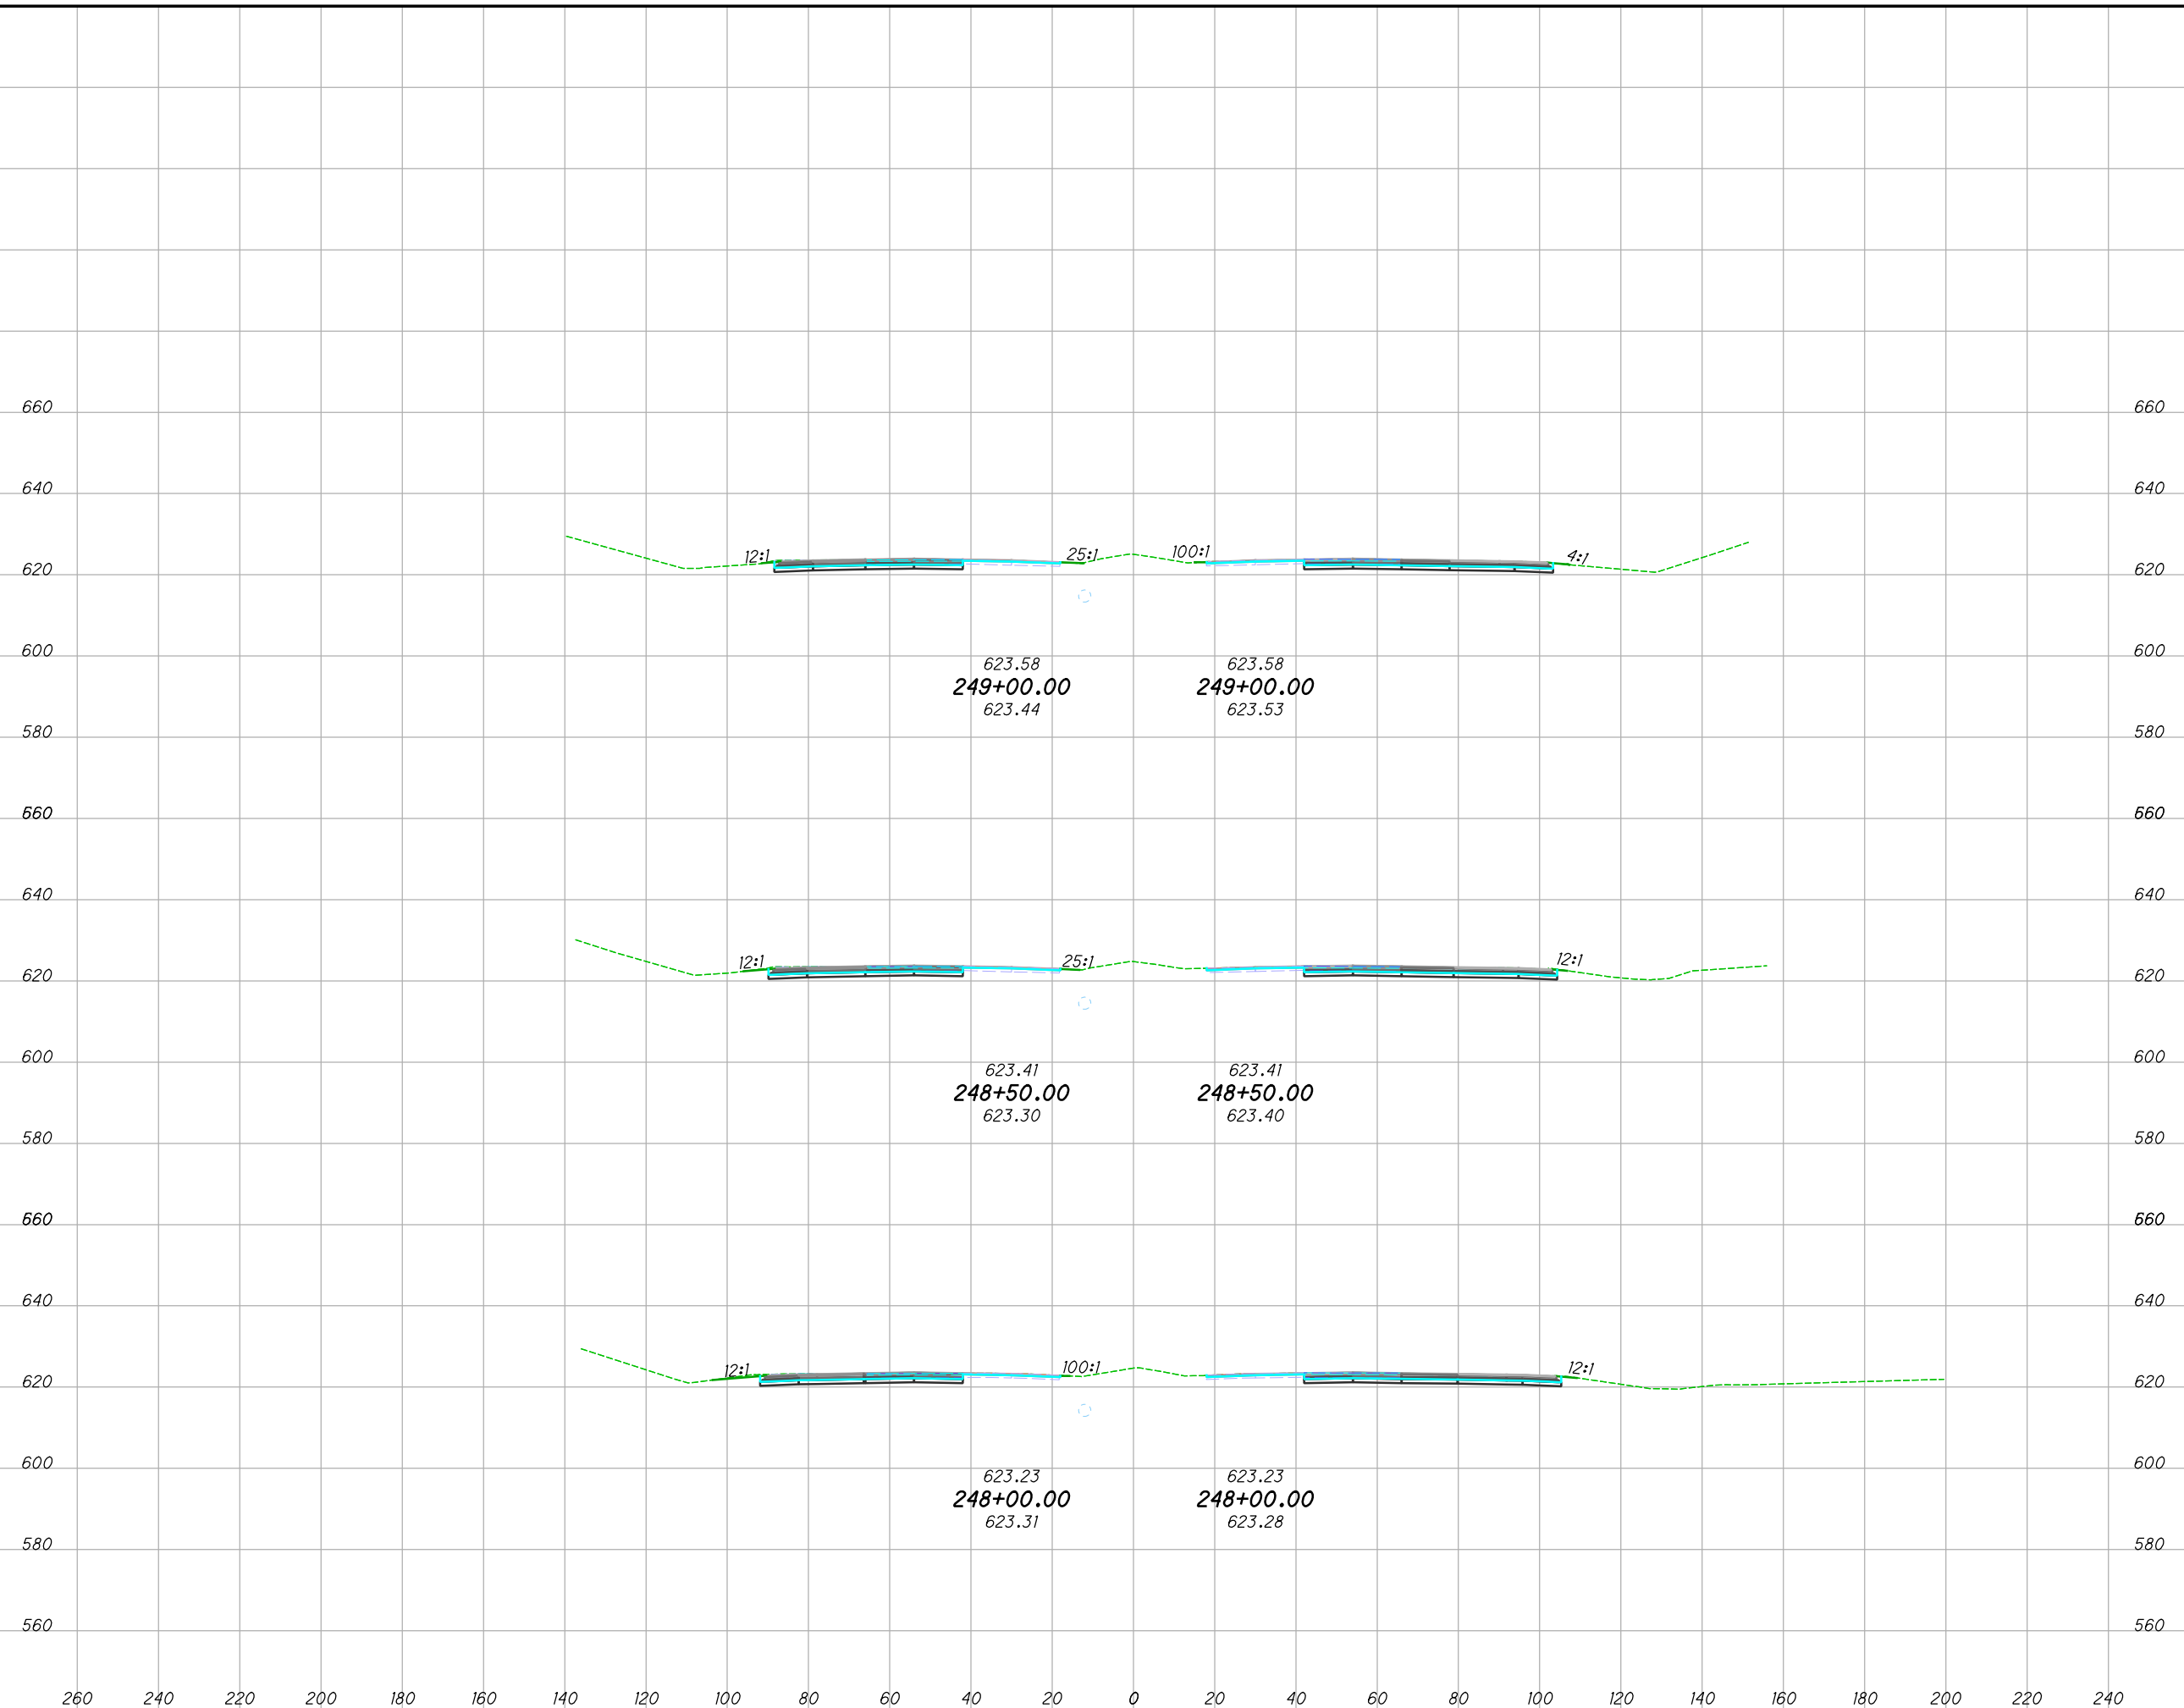

END AREA		VOLUME		CALCULATED		
CUT	FILL	CUT	FILL	JRB	CHECKED	XXX
36	1	69	1			
39	0	75				
42	0	77	1			


**CROSS SECTIONS  
STA. 248+00.00 TO STA. 249+00.00**

**LUC-475-0.9**

483  
855

I:\ProjectData\LUC-475-0.09\Design\Roadway\Sheets\95875\_XS001 - Copy.dgn Sheet 4/29/2022 8:36:39 AM jbdinge

SEEDING	
END WIDTH	SO. YDS.
358	12.5
260	97
240	22.3
220	136
200	26.6
180	125

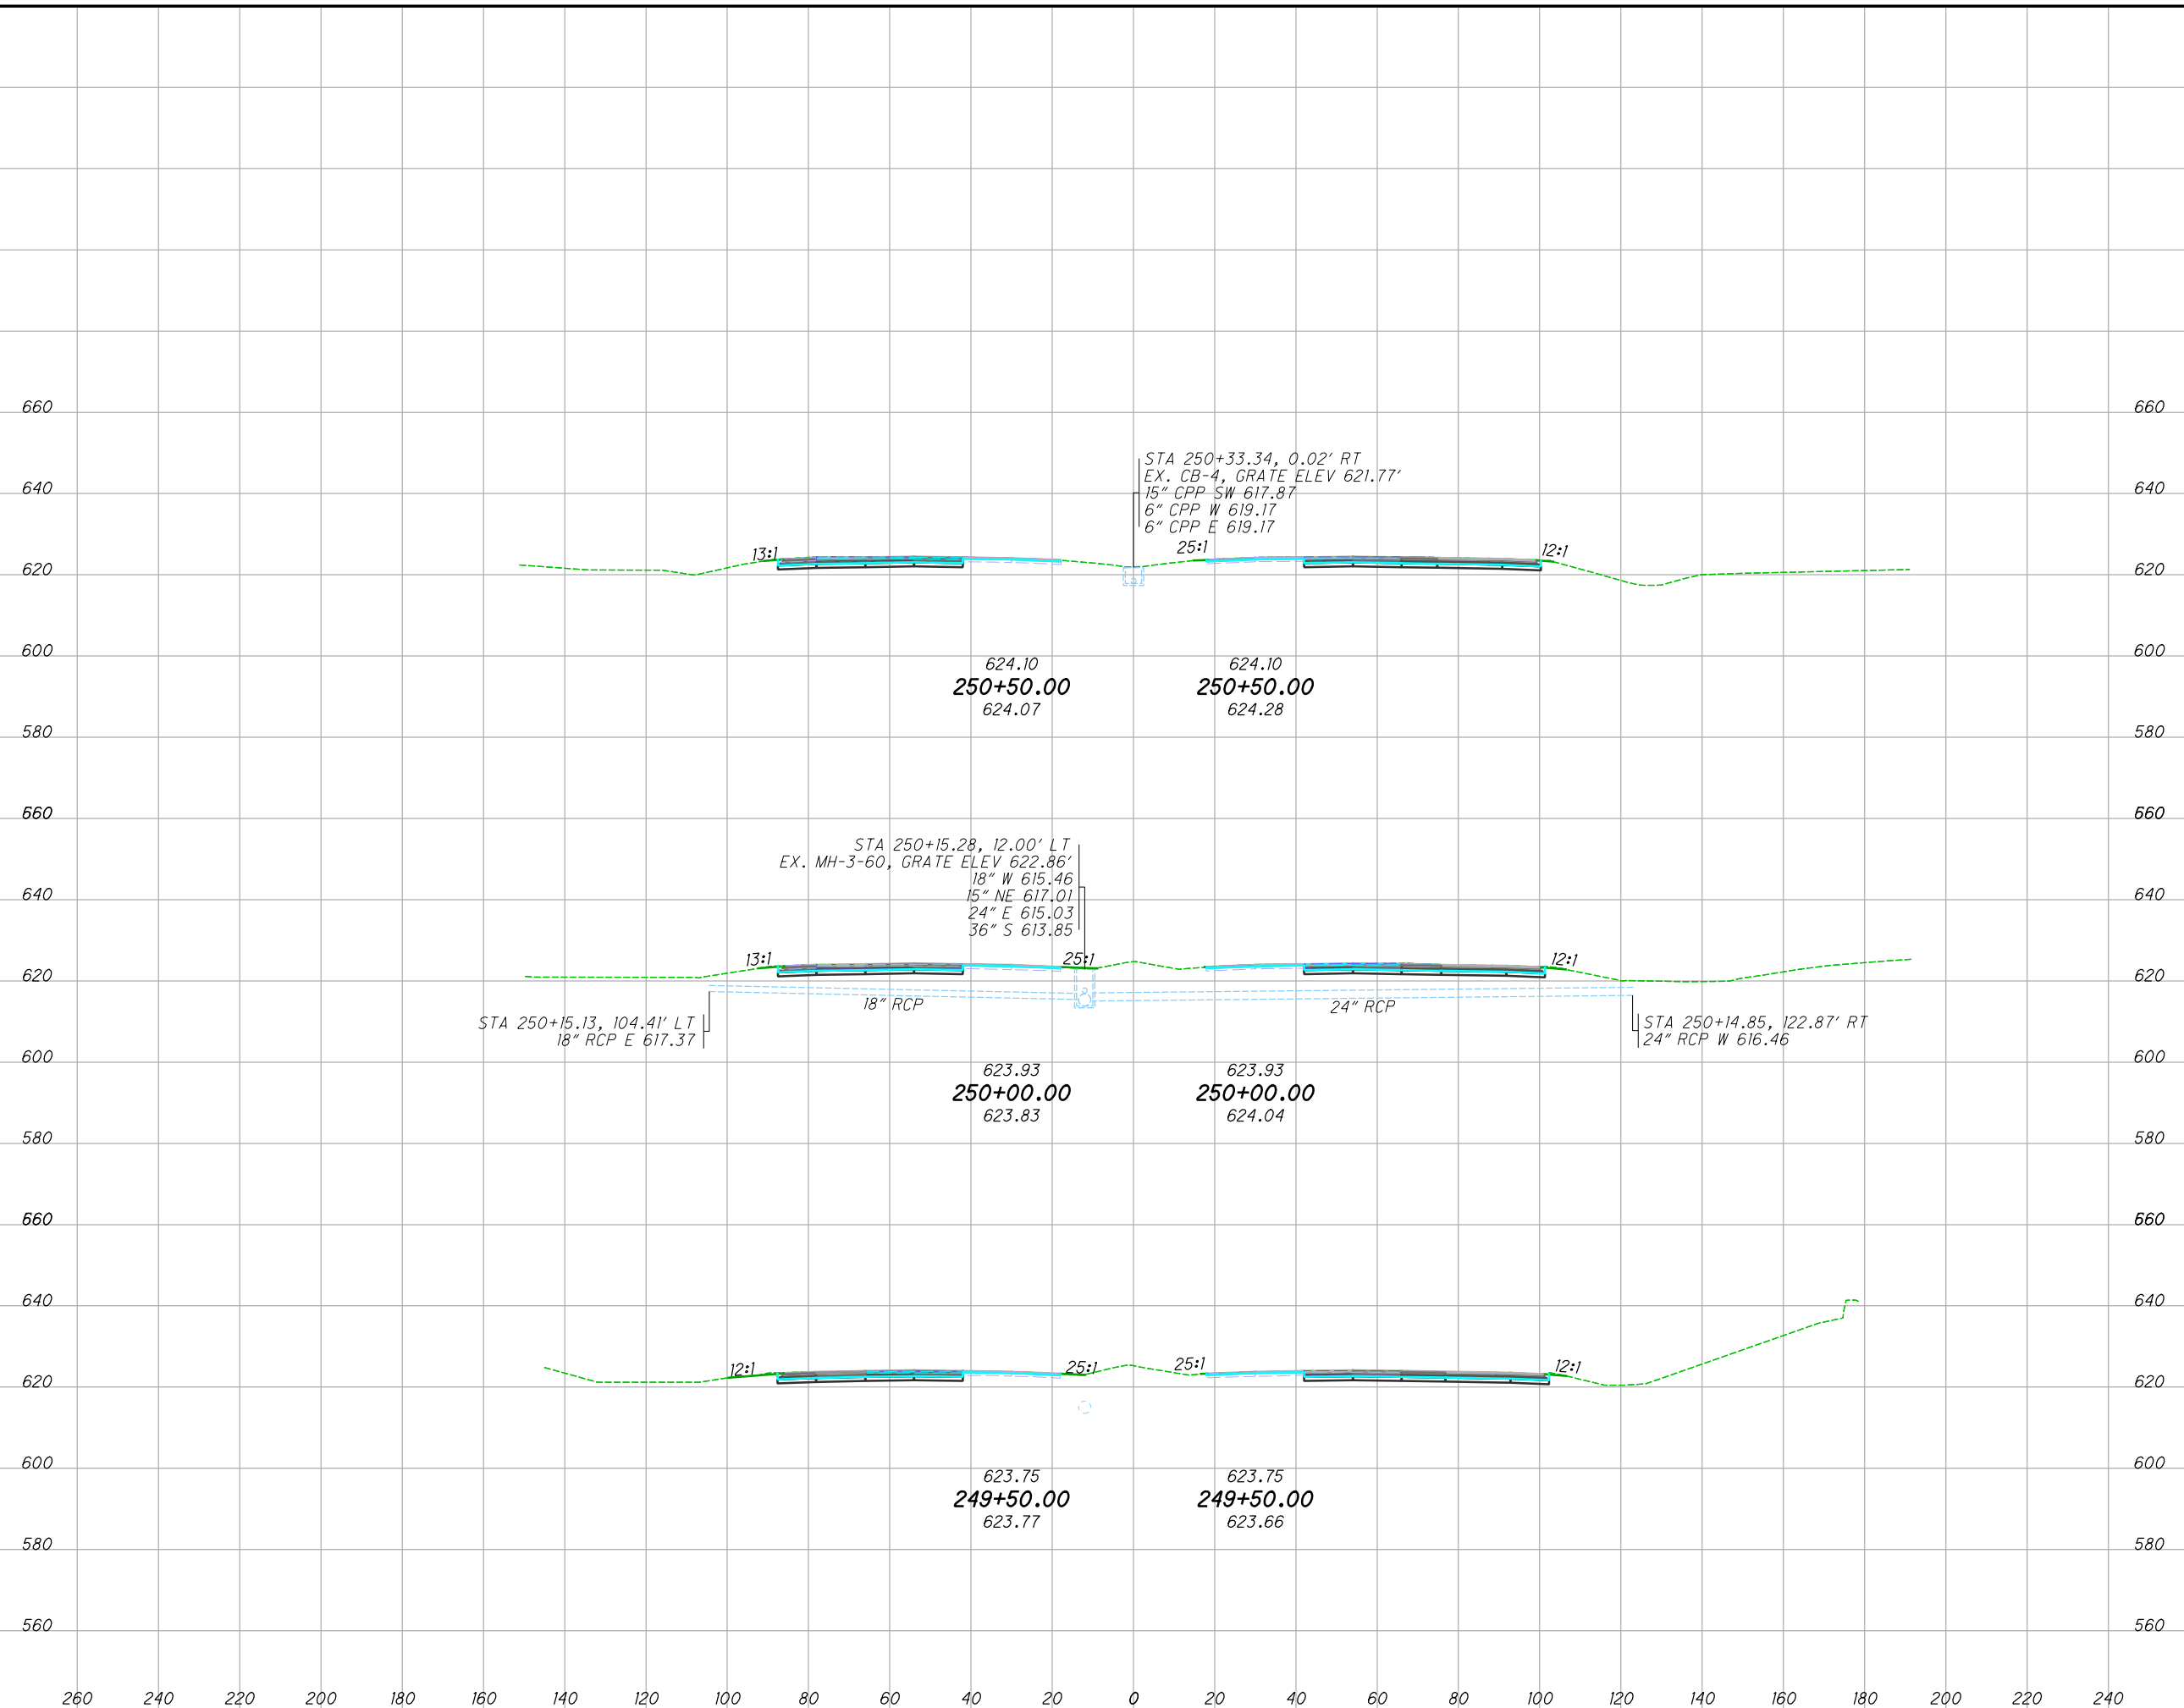

END AREA		VOLUME		CALCULATED		
CUT	FILL	CUT	FILL	JRB	CHECKED	XXX
45	0	79	1			
41	1	71	2			
36	1	66	2			
		216	5			


**CROSS SECTIONS  
STA. 249+50.00 TO STA. 250+50.00**

**LUC-475-0.9**

484  
855

I:\ProjectData\LUC\95875\_LUC-475-0.09\Design\Roadway\Sheets\95875\_XS001 - Copy.dgn Sheet 4/29/2022 8:36:40 AM jbidinge

SEEDING	
END WIDTH	SO. YDS.
376	59
260	8.9
240	123
220	35.4
200	194
180	34.4
160	
140	
120	
100	
80	
60	
40	
20	
0	
20	
40	
60	
80	
100	
120	
140	
160	
180	
200	
220	
240	

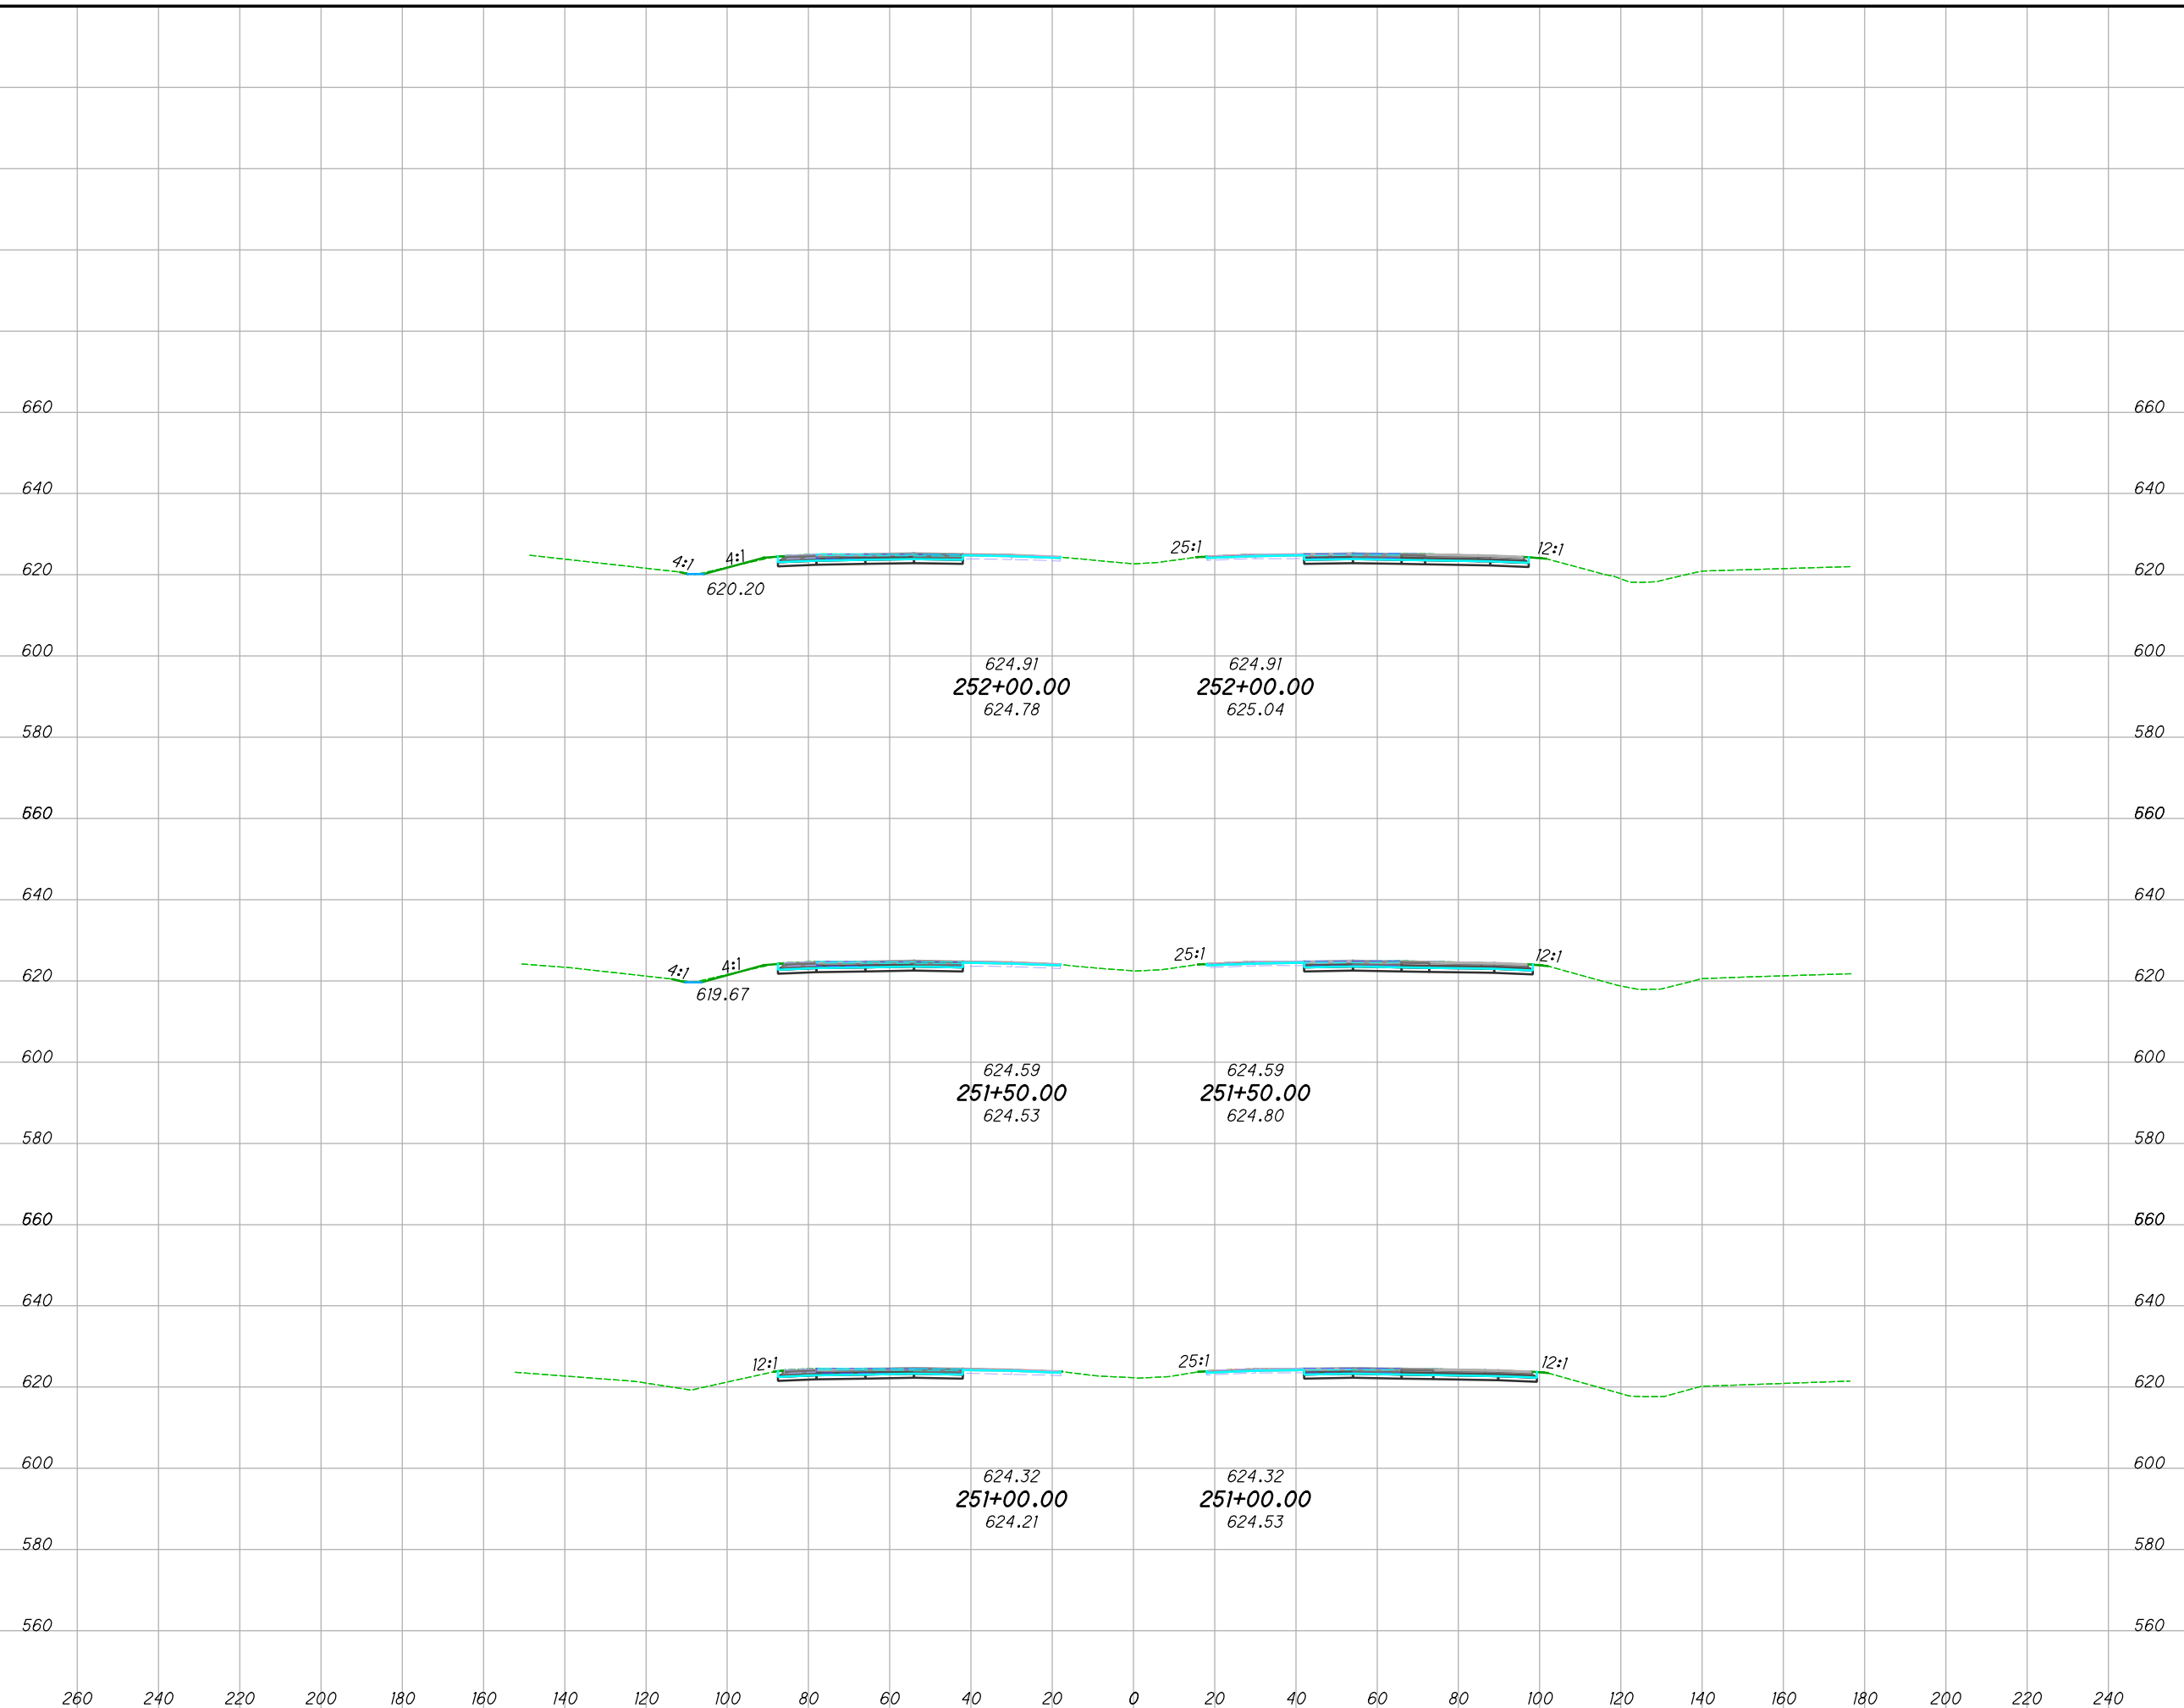

END AREA		VOLUME		CALCULATED	CHECKED
CUT	FILL	CUT	FILL		
38	2	75	3		
42	1	78	1		
42	0	80	0		
237	4				

**CROSS SECTIONS**  
**STA. 251+00.00 TO STA. 252+00.00**


**LUC-475-0.9**

485  
855



I:\ProjectData\LUC\95875\_LUC-475-0.09\Design\Roadway\Sheets\95875\_XS001 - Copy.dgn Sheet 4/29/2022 8:36:41AM jbidinge

SEEDING	
END WIDTH	SO. YDS.
876	
260	
240	
220	
20	
40	
60	
80	
100	
120	
140	
160	
180	
200	
220	
240	
292	
35	

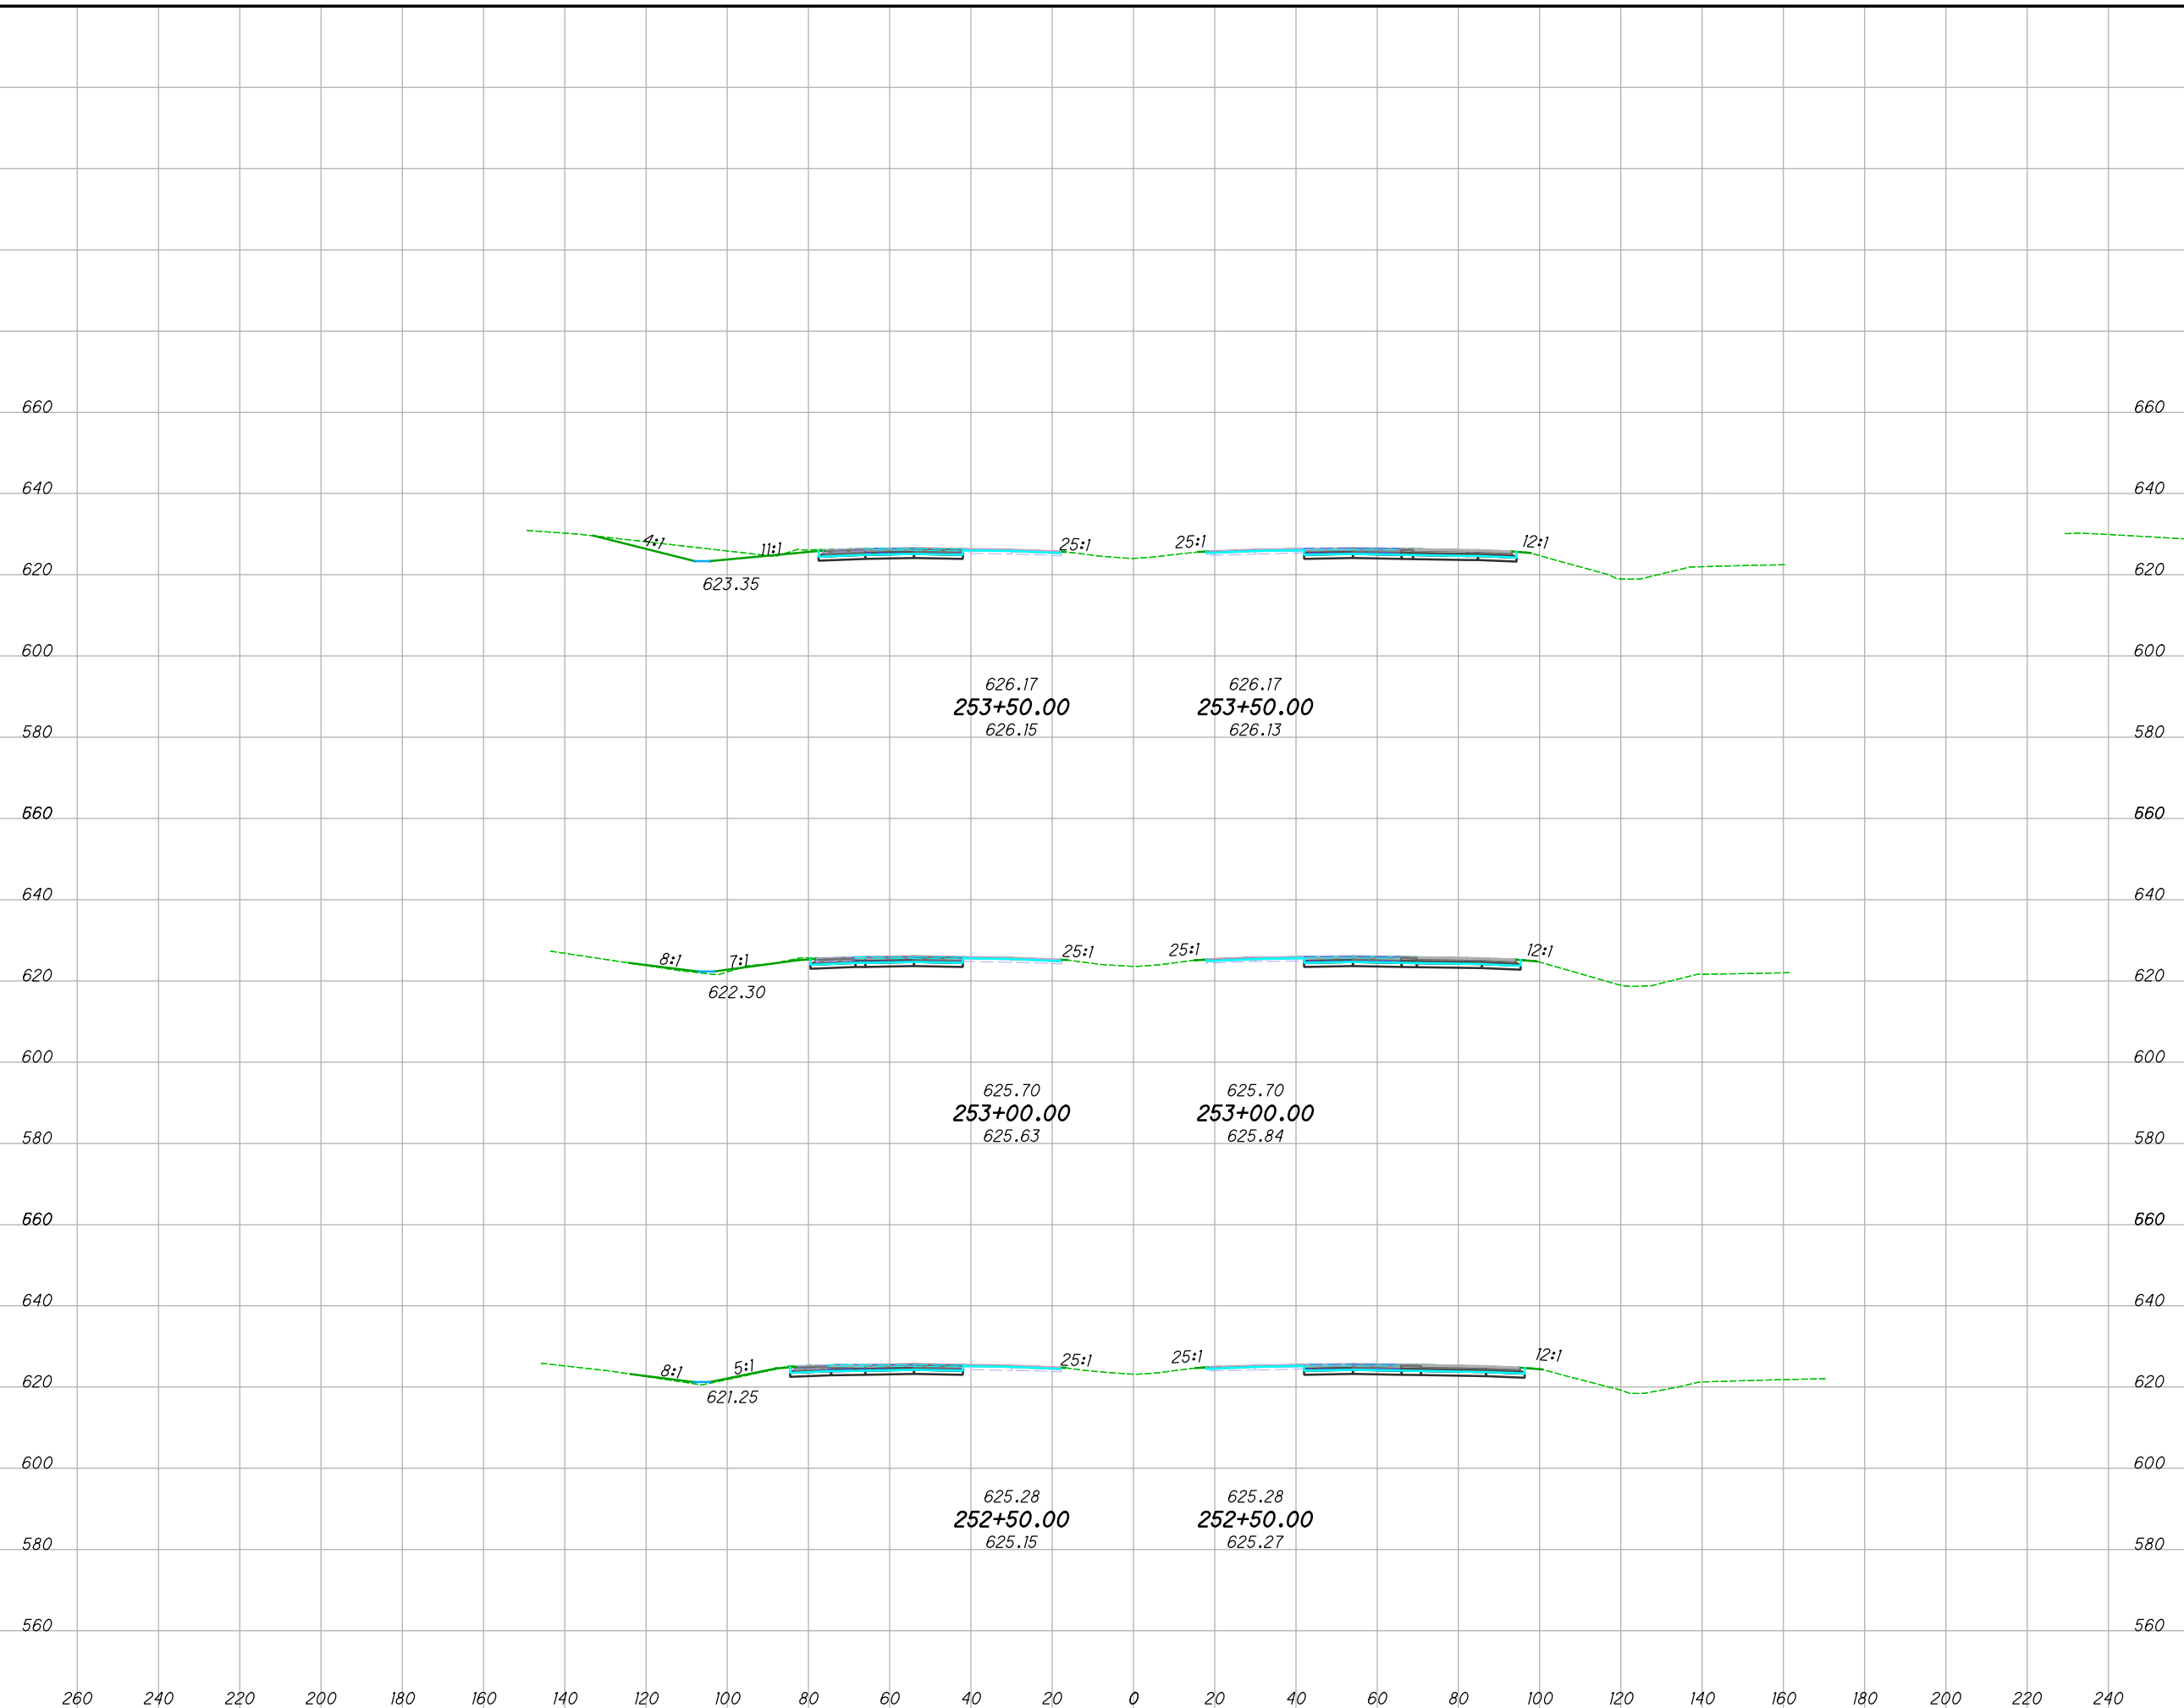


END AREA		VOLUME		CALCULATED	JRB	CHECKED	XXX
CUT	FILL	CUT	FILL				
122	0	149	8				
40	9	72	17				
39	9	71	10				

**CROSS SECTIONS**  
**STA. 252+50.00 TO STA. 253+50.00**

**LUC-475-0.9**

486  
855

SEEDING  
 END SO.  
 WIDTH YDS.  
 1066  
 260  
 240  
 220  
 20  
 40  
 60  
 80  
 100  
 120  
 140  
 160  
 180  
 200  
 220  
 240  
 353  
 61.0  
 323  
 55.2  
 390  
 85.2  
 660  
 640  
 620  
 600  
 580  
 560

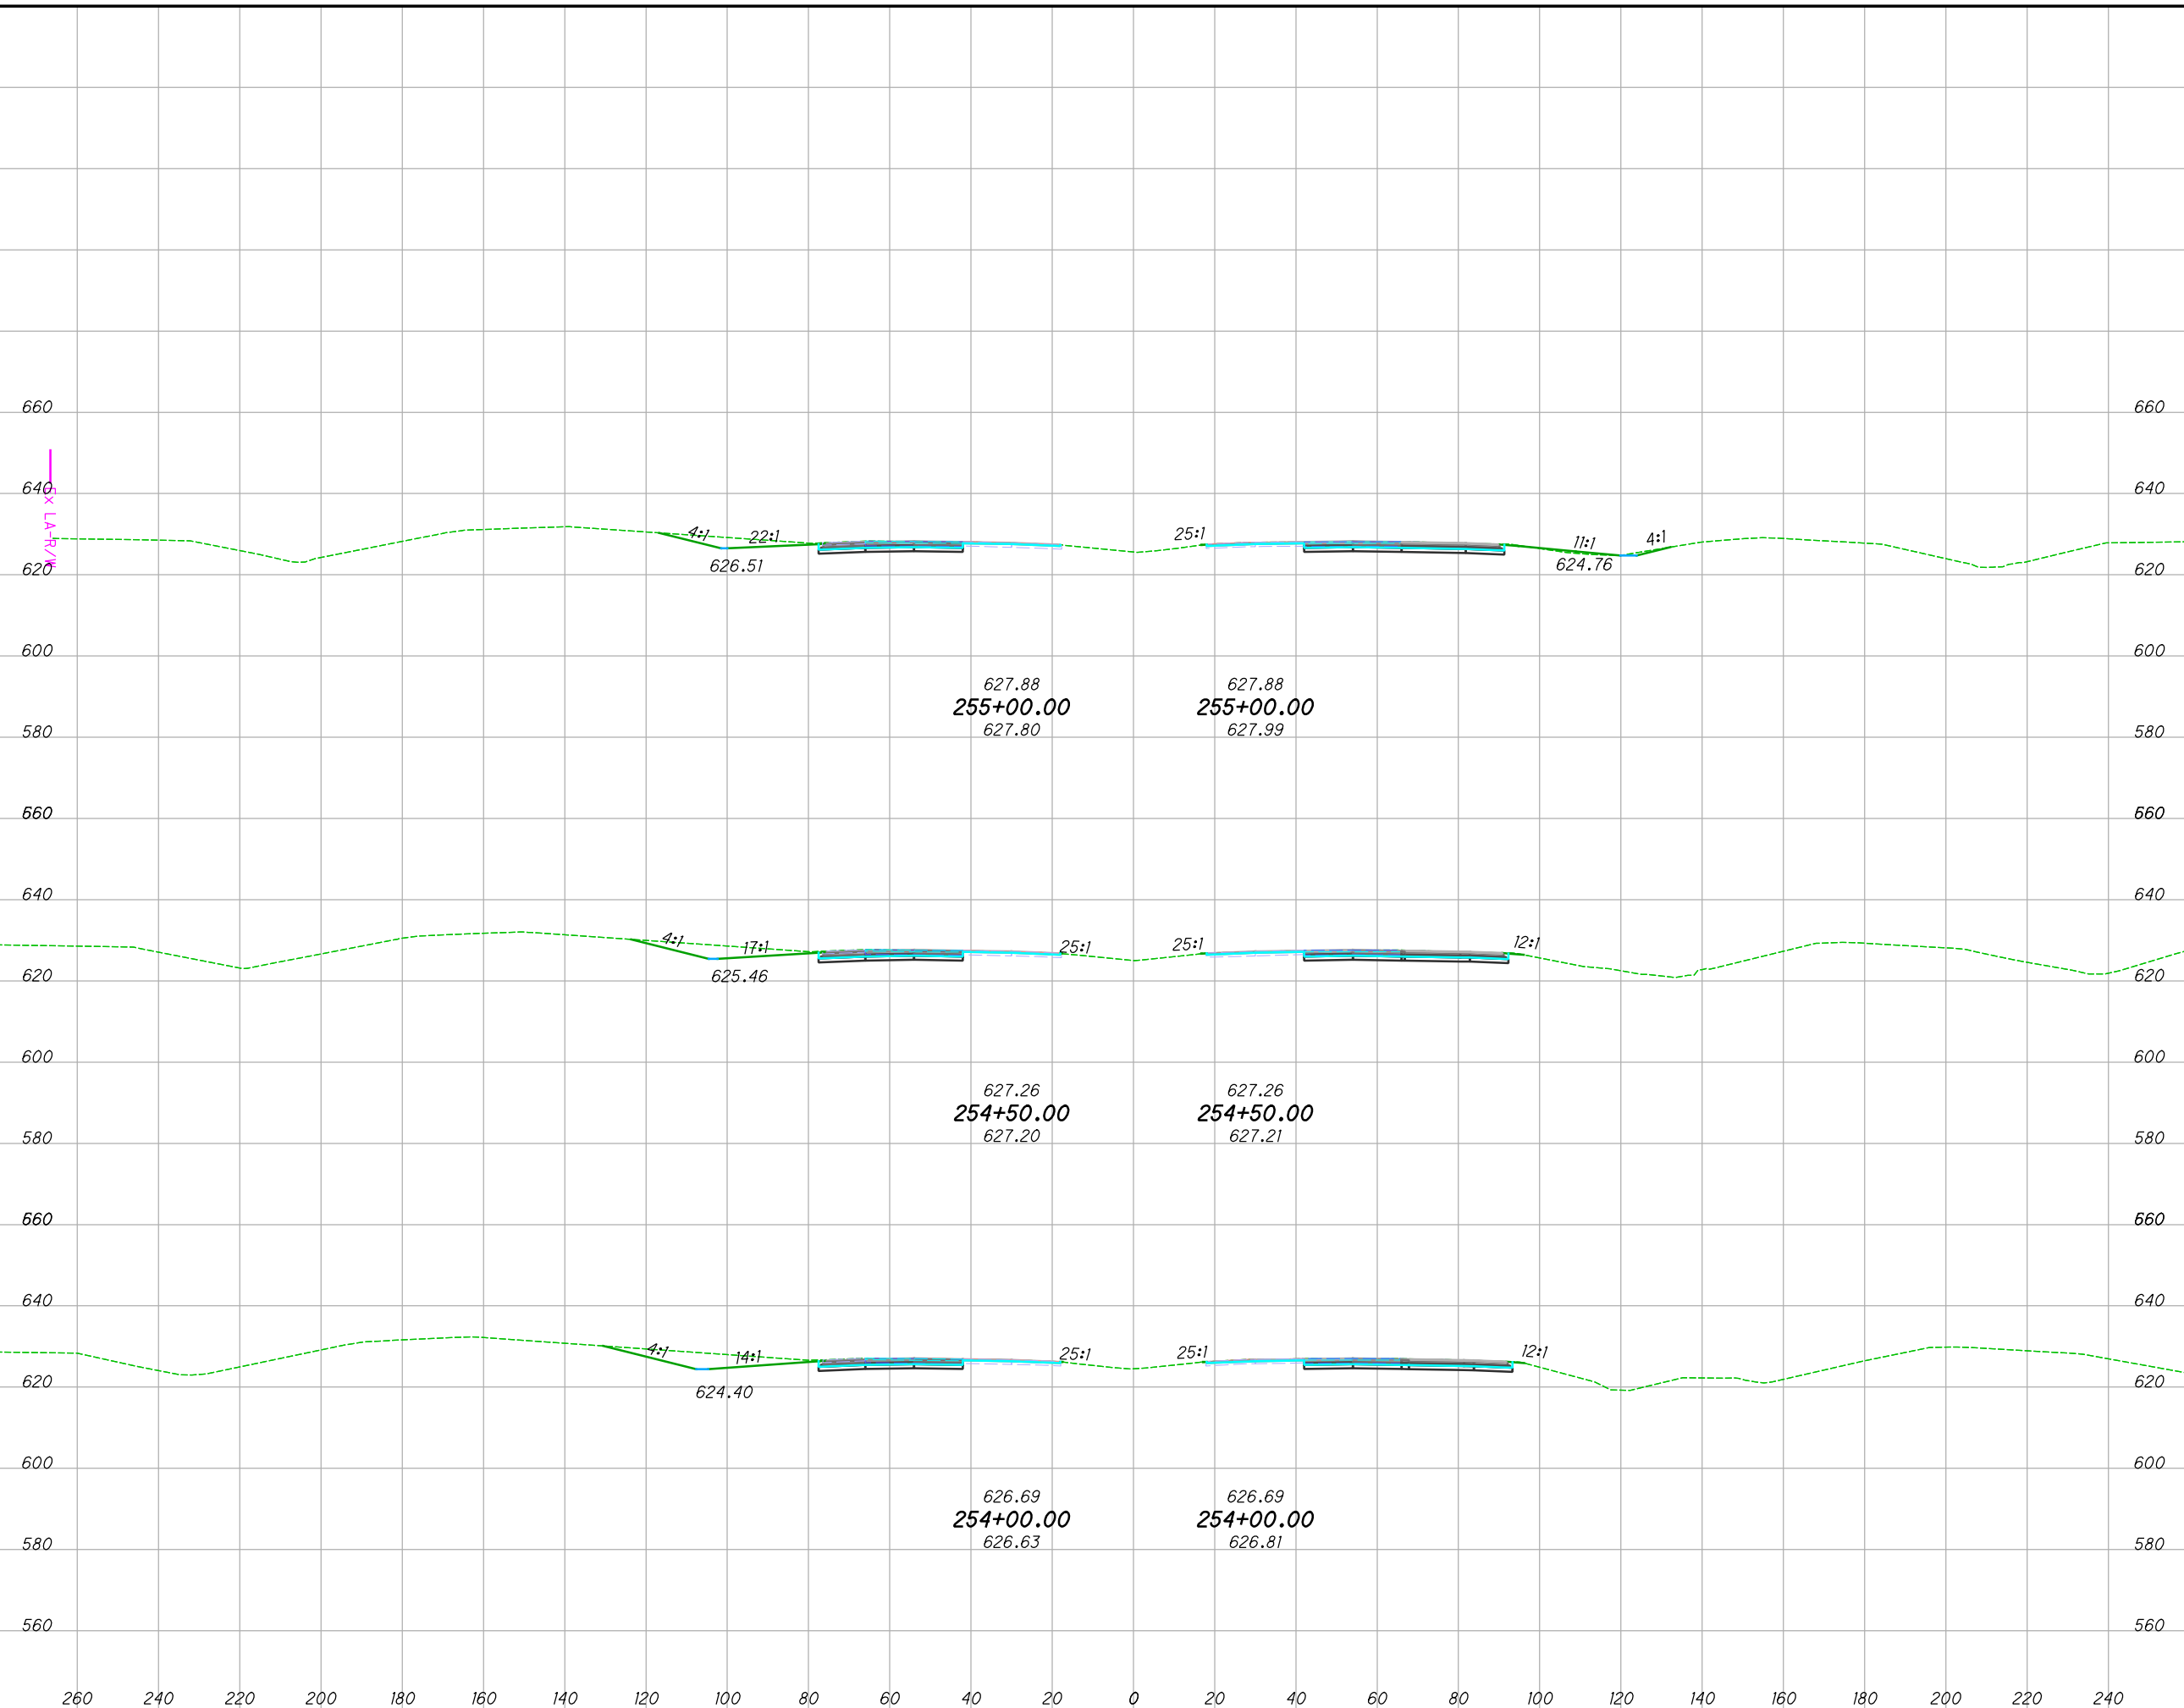

END AREA		VOLUME		CALCULATED JRB	CHECKED XXX
CUT	FILL	CUT	FILL		
101	7	207	6		
123	0	257	0		
155	0	256	0		
720	6				

**CROSS SECTIONS  
 STA. 254+00.00 TO STA. 255+00.00**


**LUC-475-0.9**

487  
 855

I:\ProjectData\LUC-475-0.09\Design\Roadway\Sheets\95875\_XS001 - Copy.dgn Sheet 4/29/2022 8:36:42 AM jbidinge



SEEDING  
 END SO.  
 WIDTH YDS.  
 630  
 260 240 220 200 180 160 140 120 100 80 60 40 20 0 20 40 60 80 100 120 140 160 180 200 220 240  
 46.4  
 235  
 38.1  
 175  
 24.8  
 220  
 630  
 I:\ProjectData\LUC\95875\_LUC-475-0.09\Design\Roadway\Sheets\95875\_X5001 - Copy.dgn Sheet 4/29/2022 8:36:44 AM jbdinge

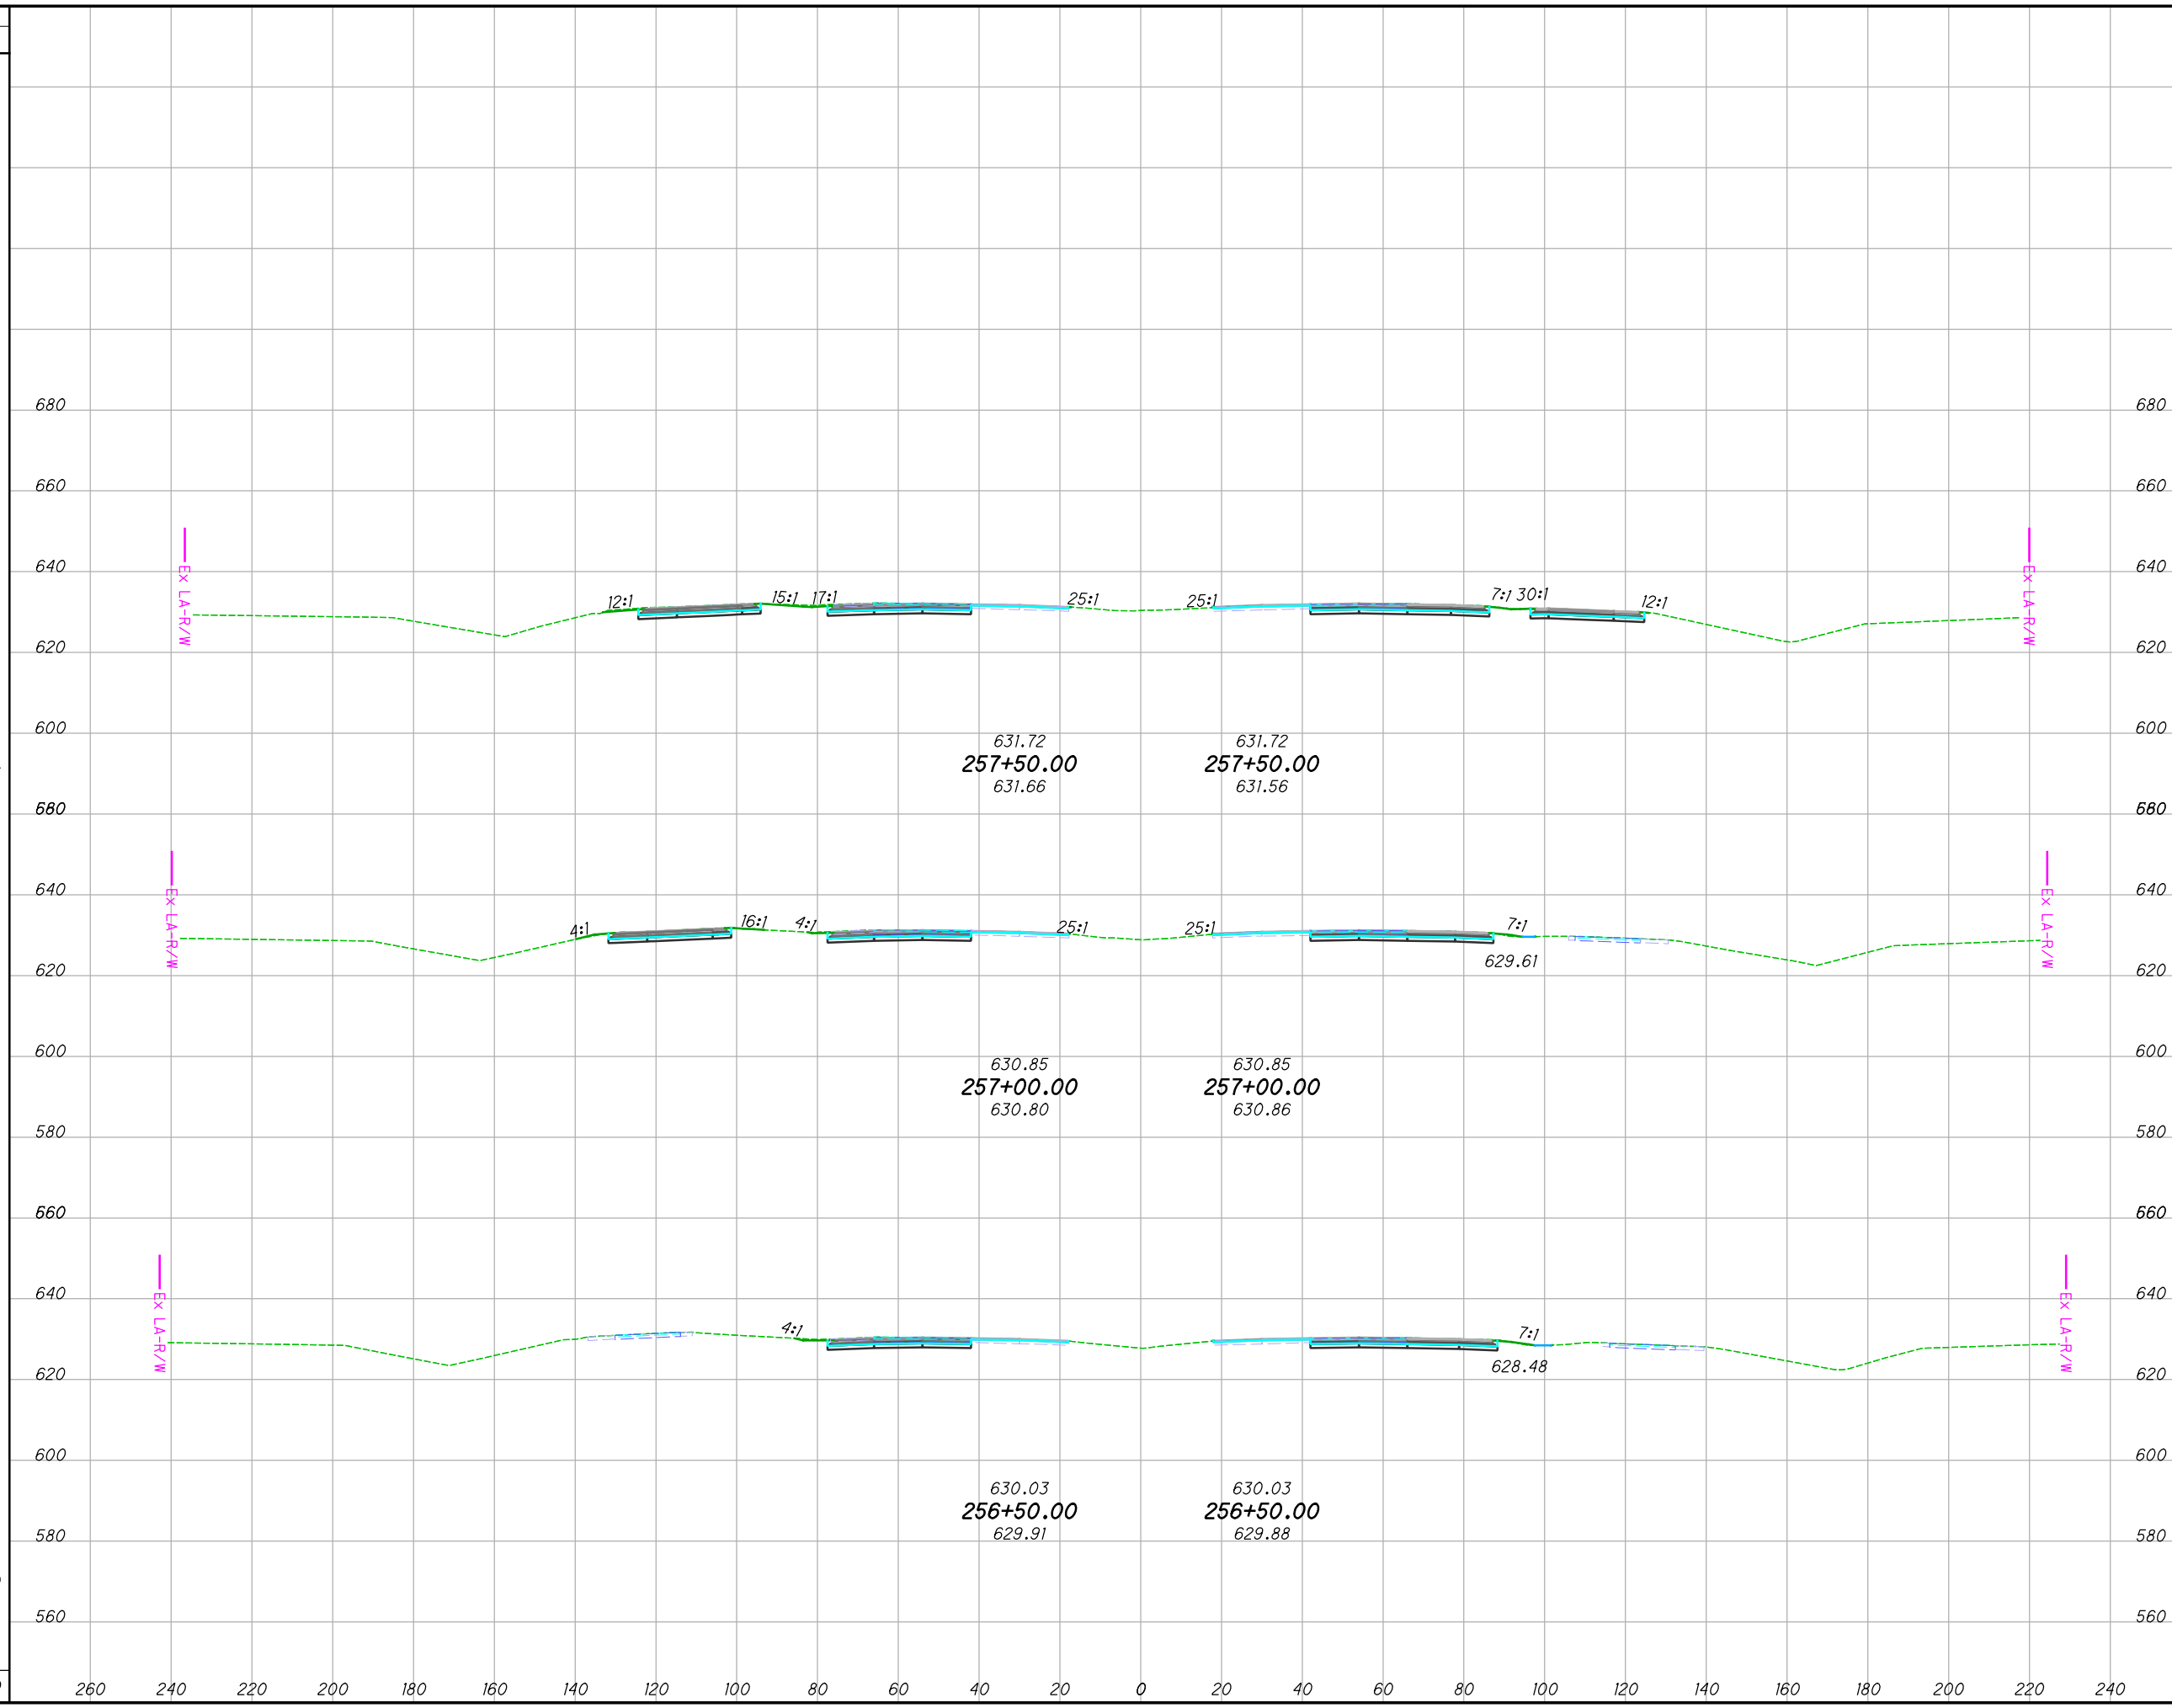

END AREA		VOLUME		CALCULATED JRB	CHECKED XXX
CUT	FILL	CUT	FILL		
84	1	134	4		
61	3	96	4		
43	1	97	1		
		327	9		

**CROSS SECTIONS  
 STA. 256+50.00 TO STA. 257+50.00**


**LUC-475-0.9**

489  
855



I:\ProjectData\LUC-475-0.9\Design\Roadway\Sheets\95875\_XS001 - Copy.dgn Sheet 4/29/2022 8:36:46 AM jbidinge

SEEDING	
END WIDTH	SO. YDS.
209	11.4
209	12.6
209	12.6
209	72

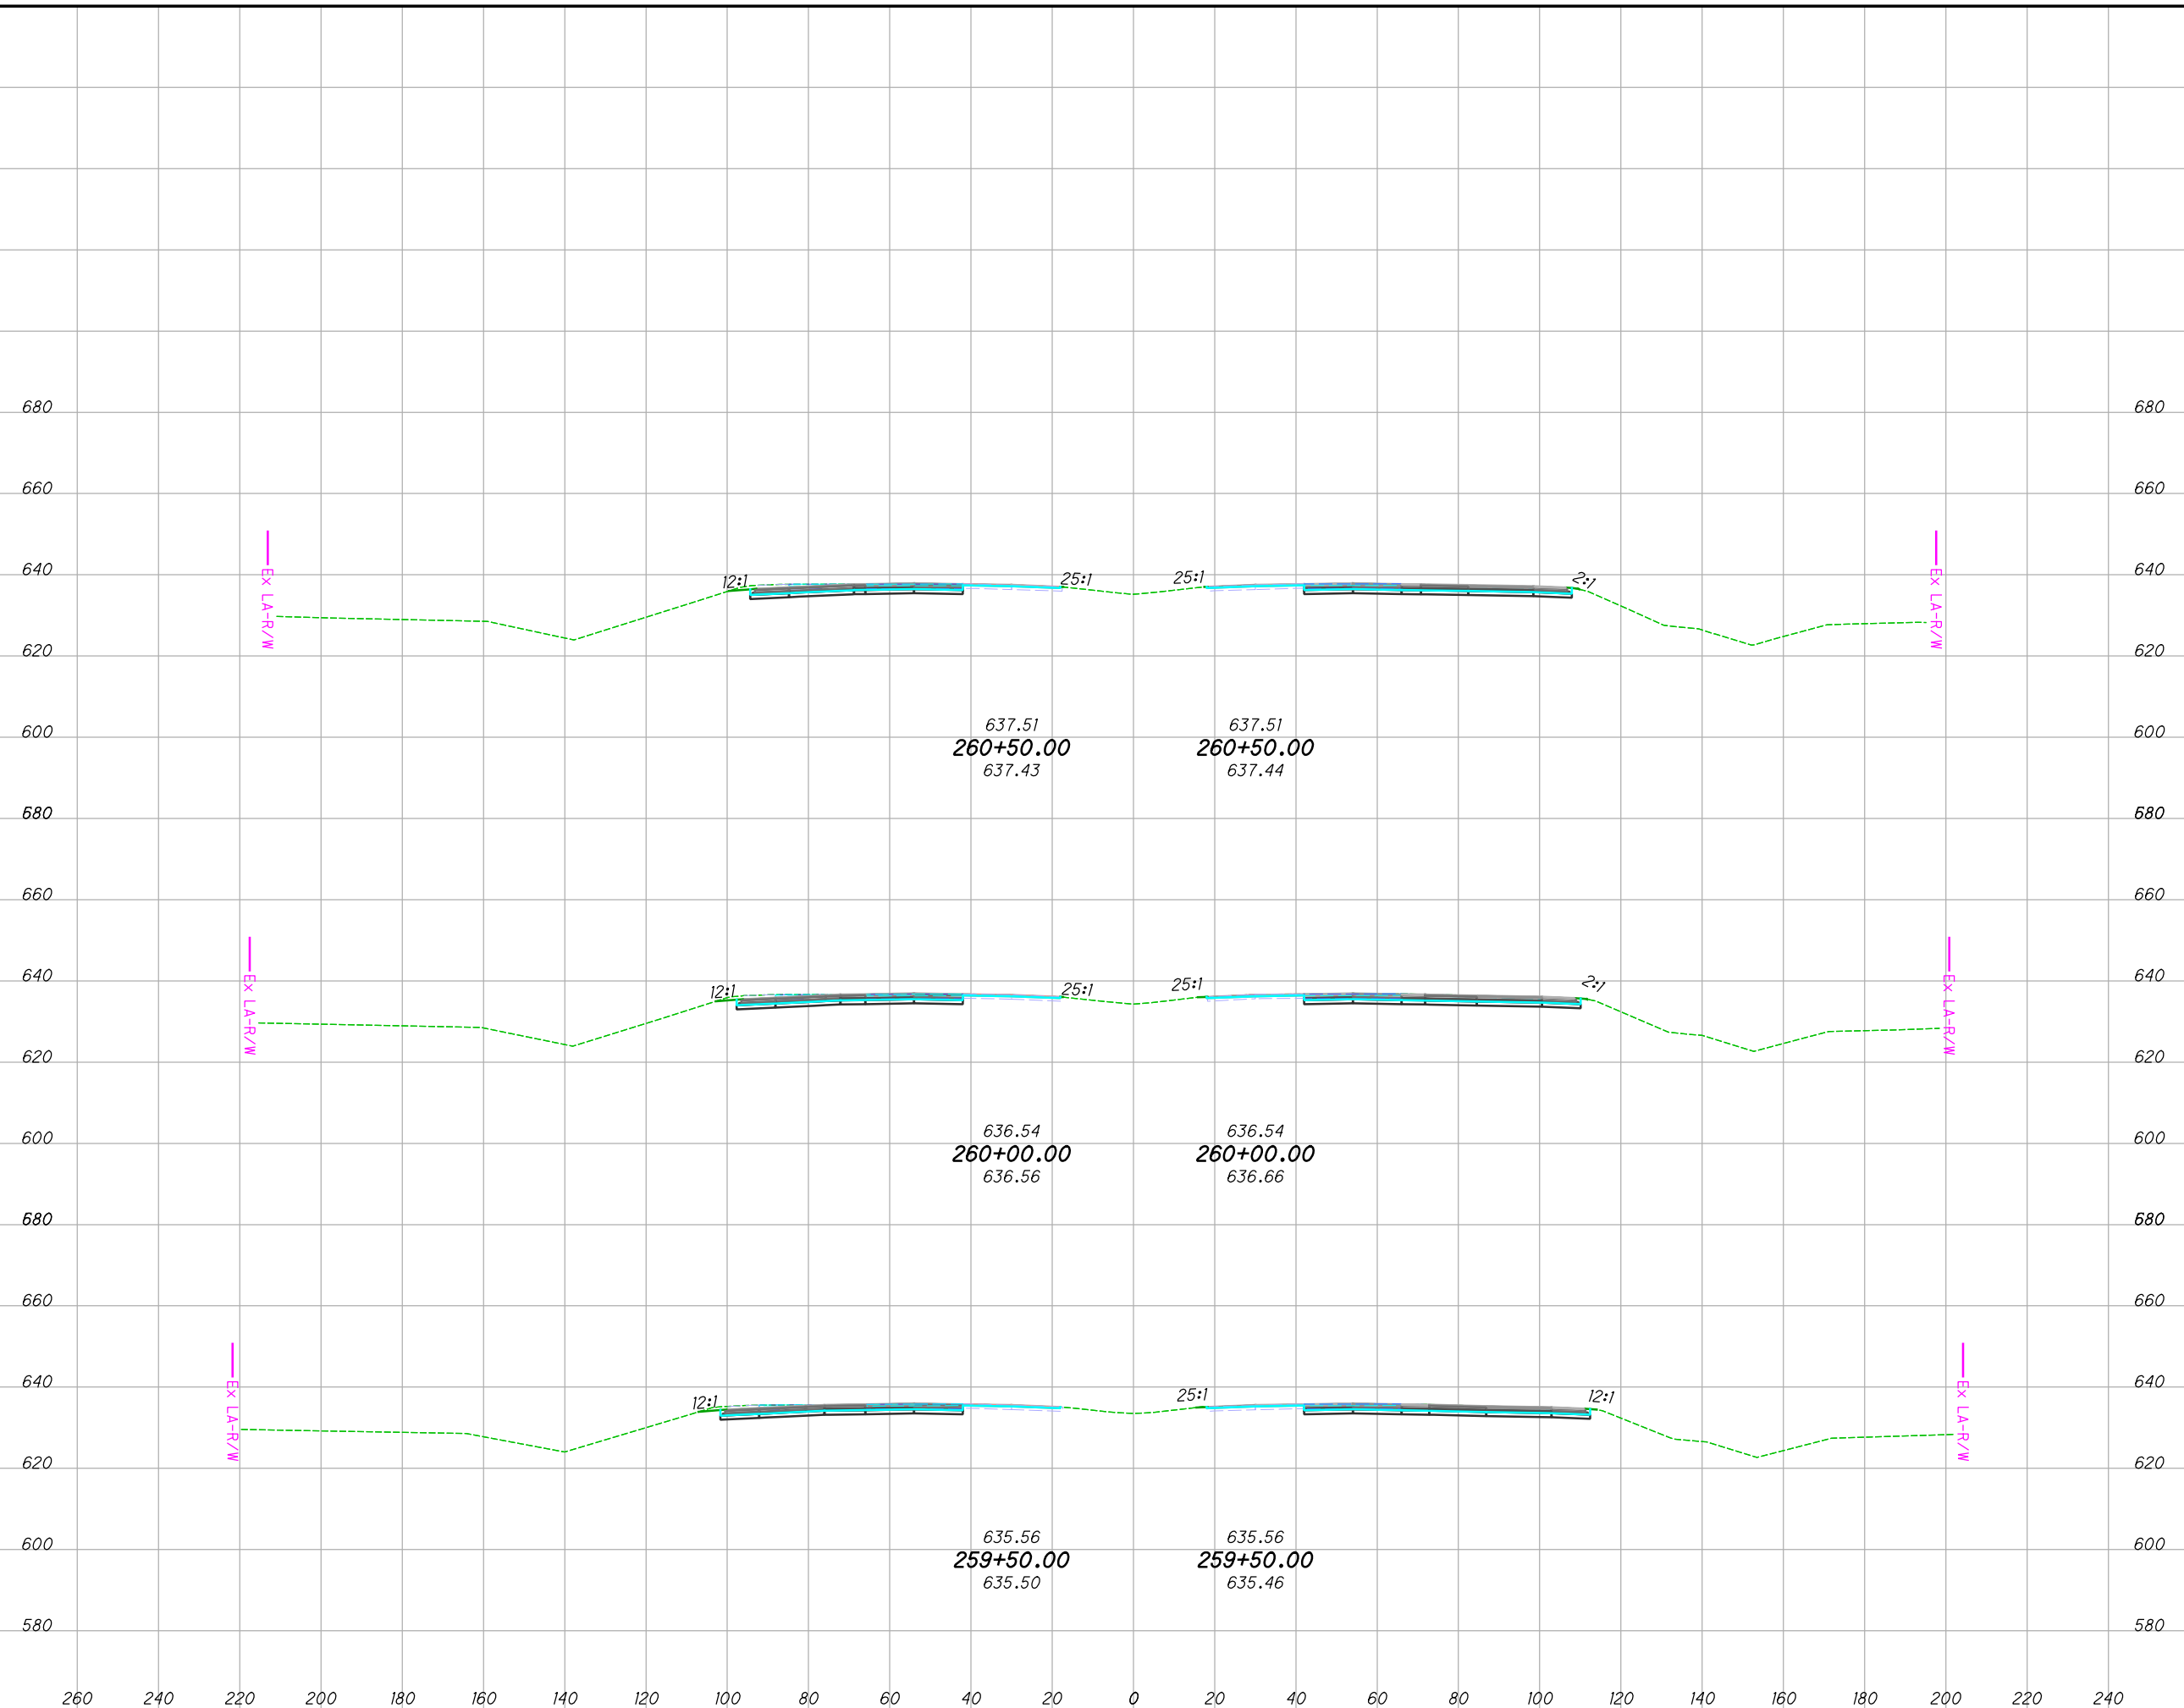

END AREA		VOLUME		CALCULATED		
CUT	FILL	CUT	FILL	JRB	CHECKED	XXX
55	0	103	0			
57	0	108	0			
60	0	115	0			


**CROSS SECTIONS**  
**STA. 259+50.00 TO STA. 260+50.00**

**LUC-475-0.9**

491  
855

I:\ProjectData\LUC\95875\_LUC-475-0.9\Design\Roadway\Sheets\95875\_XS001 - Copy.dgn Sheet 4/29/2022 8:36:47 AM j\_bdinge

SEEDING	
END WIDTH	SO. YDS.
191	70
260	57
240	9.2
220	11.2

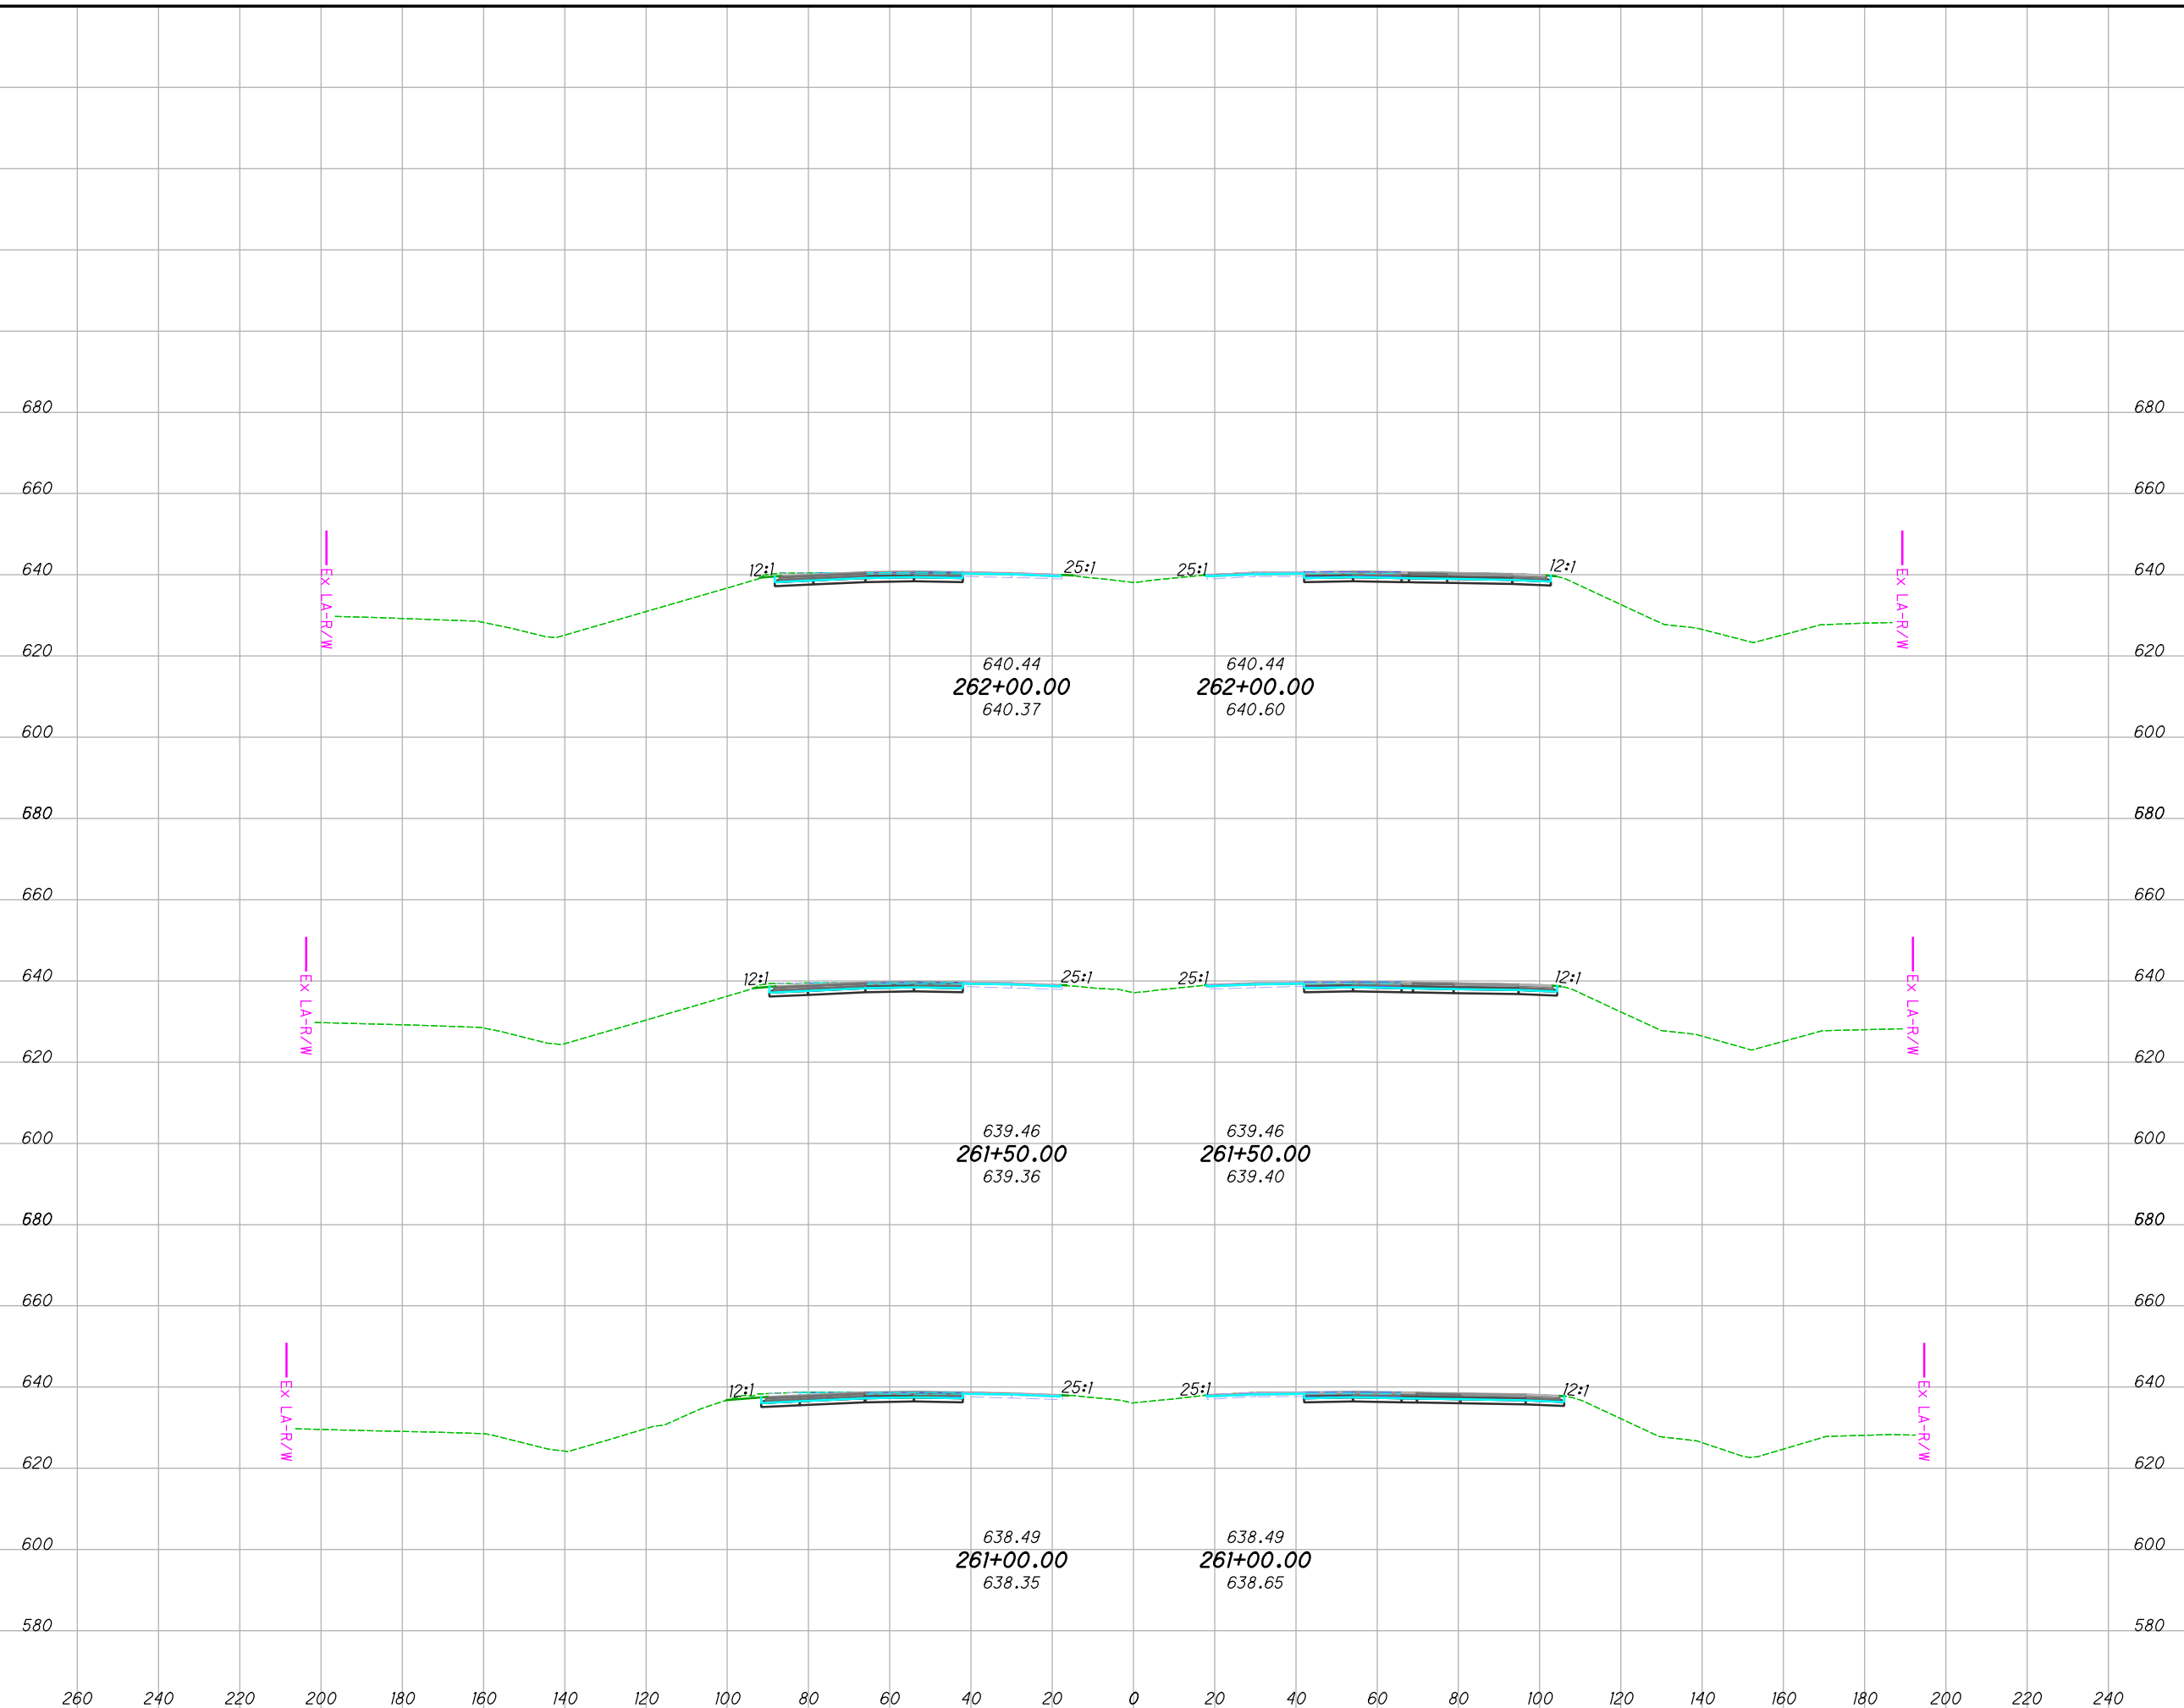

END AREA		VOLUME	
CUT	FILL	CUT	FILL
48	0	89	0
48	0	95	0
55	0	101	0

**CROSS SECTIONS**  
**STA. 261+00.00 TO STA. 262+00.00**


**LUC-475-0.9**

492  
855



I:\ProjectData\LUC-475-0.09\Design\Roadway\Sheets\95875\_XS001 - Copy.dgn Sheet 4/29/2022 8:36:48 AM jbdinge

SEEDING	
END WIDTH	SO. YDS.
195	63
260	65
240	67
220	10.7
200	12.4
180	11.5

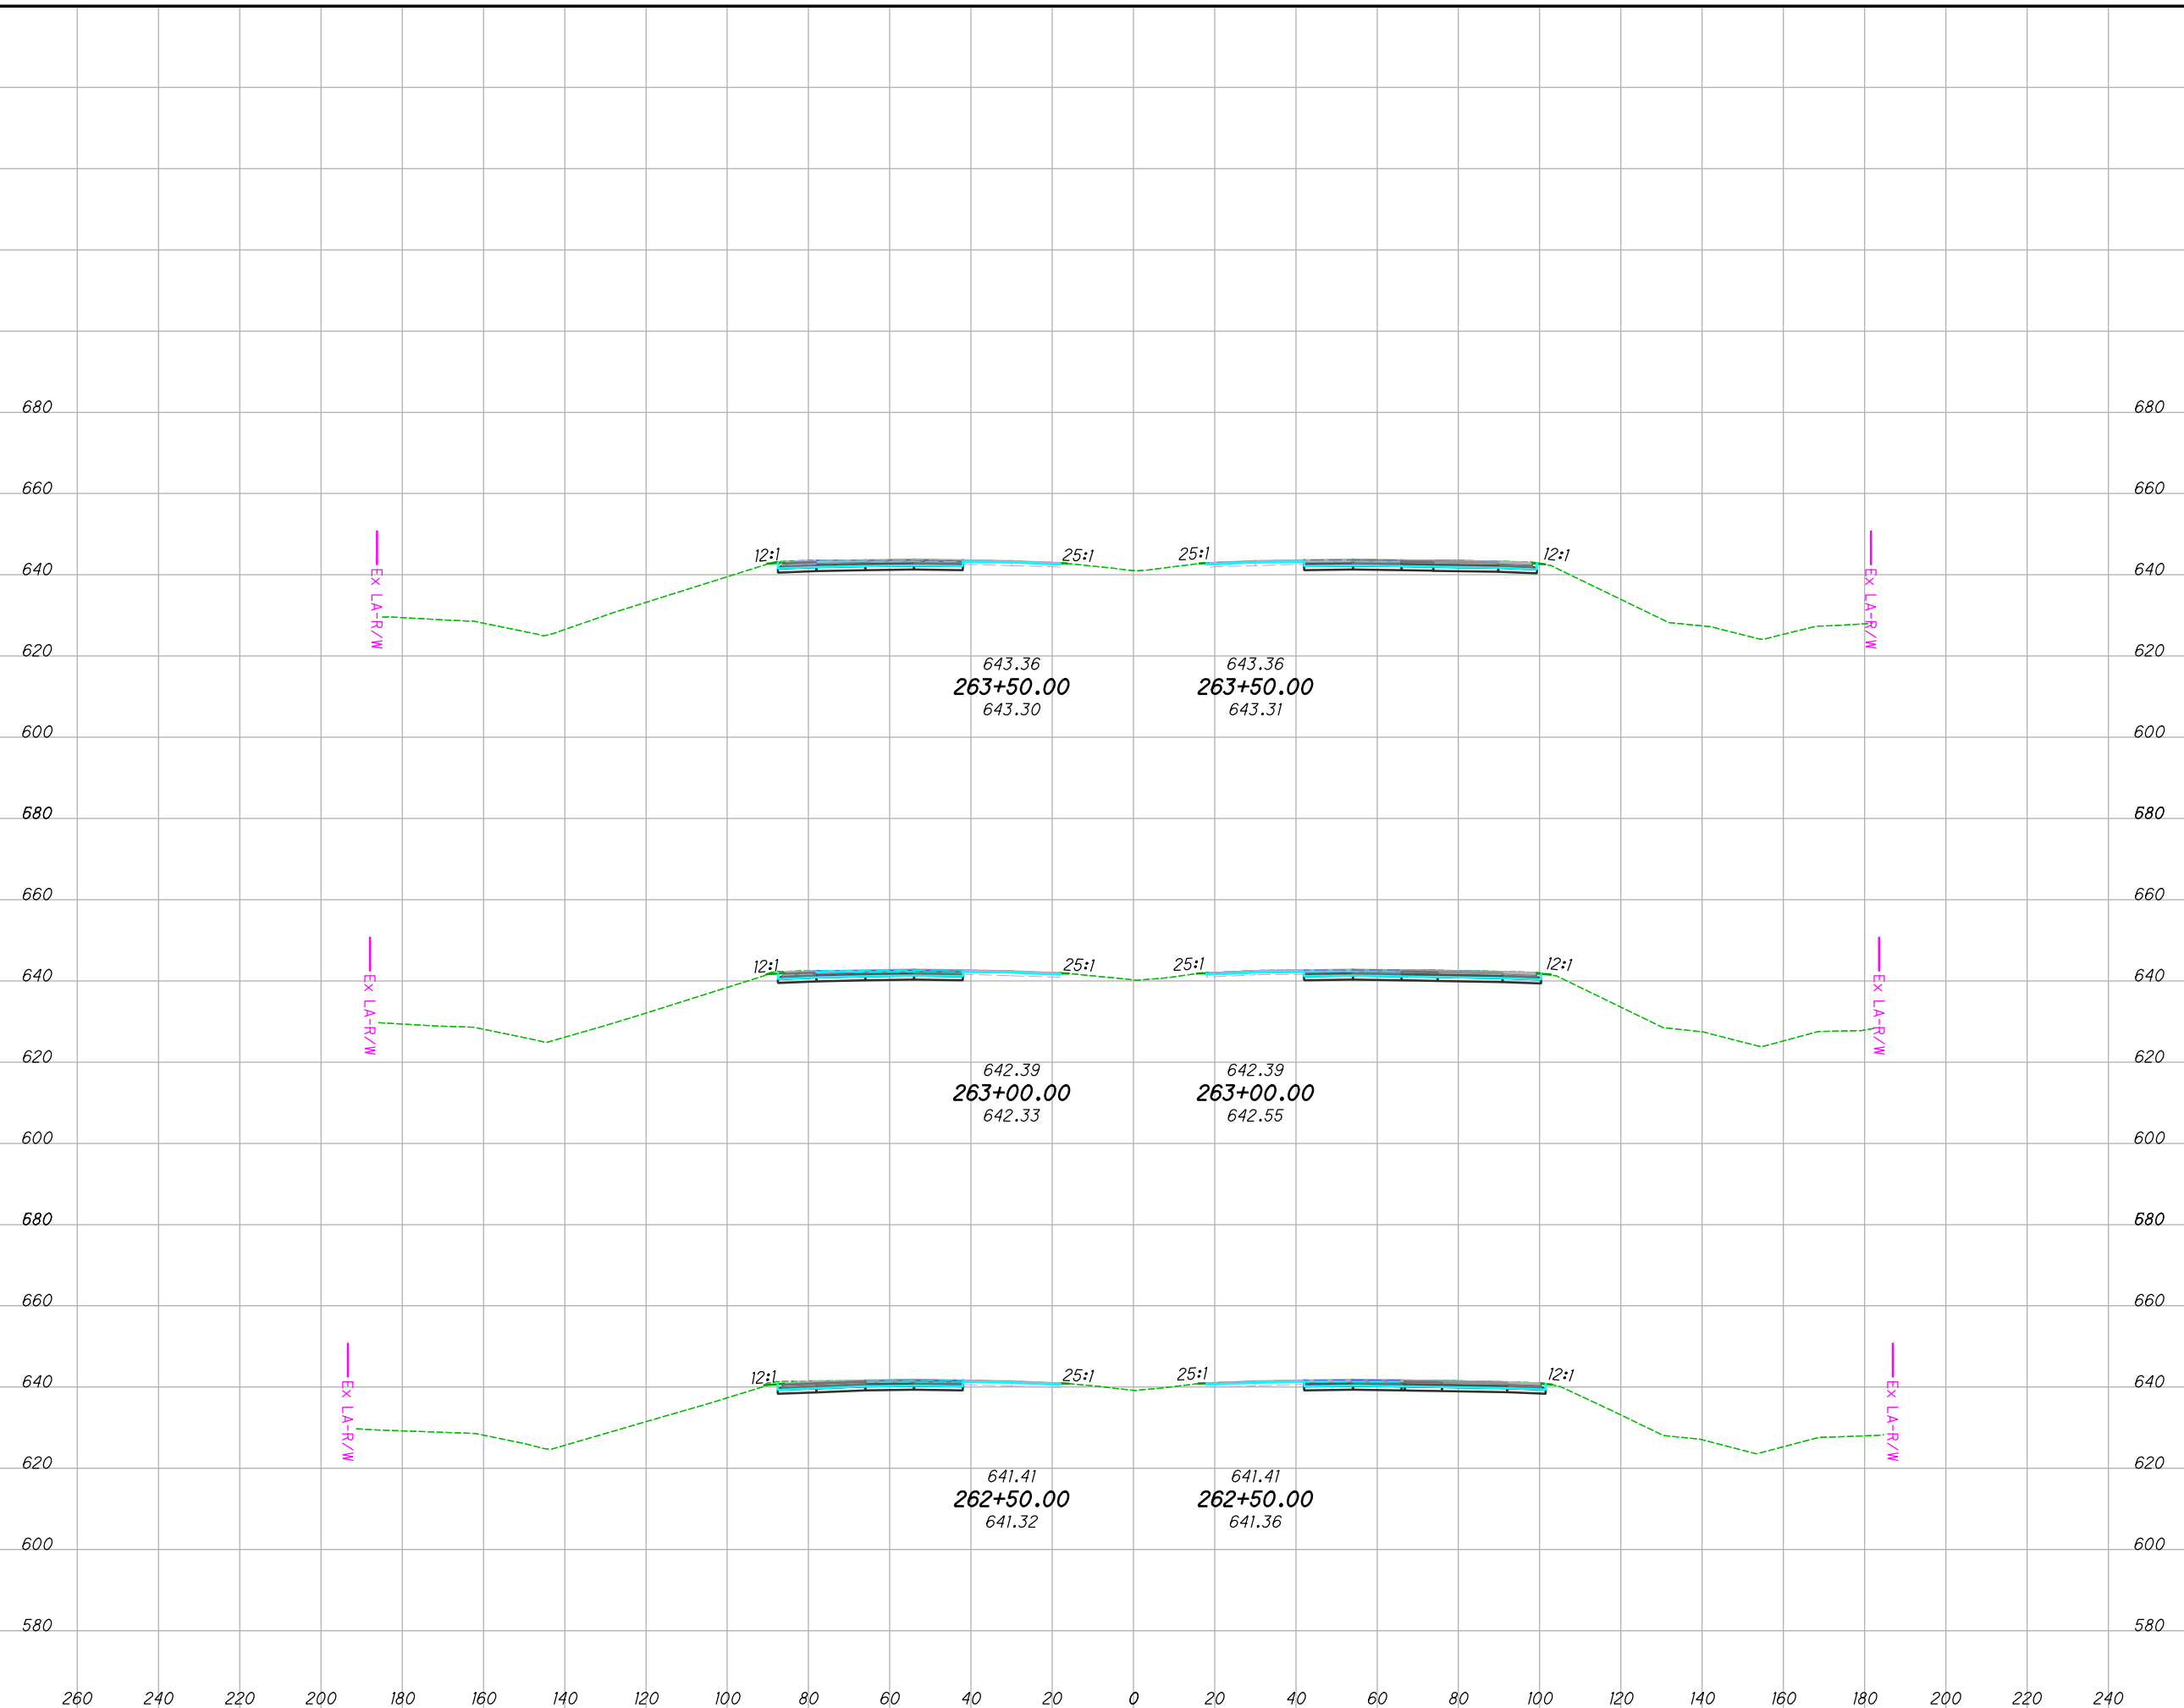

END AREA		VOLUME		CALCULATED		
CUT	FILL	CUT	FILL	JRB	CHECKED	XXX
47	0	90	0			
50	0	92	0			
50	0	90	0			


**CROSS SECTIONS**  
**STA. 262+50.00 TO STA. 263+50.00**

**LUC-475-0.9**

493  
855

I:\ProjectData\LUC\95875\_LUC-475-0.09\Design\Roadway\Sheets\95875\_XS001 - Copy.dgn Sheet 4/29/2022 8:36:49 AM jbdinge

SEEDING	
END WIDTH	SO. YDS.
177	58
260	59
240	60
220	60
20	60
40	60
60	60
80	60
100	60
120	60
140	60
160	60
180	60
200	60
220	60
240	60
255	60

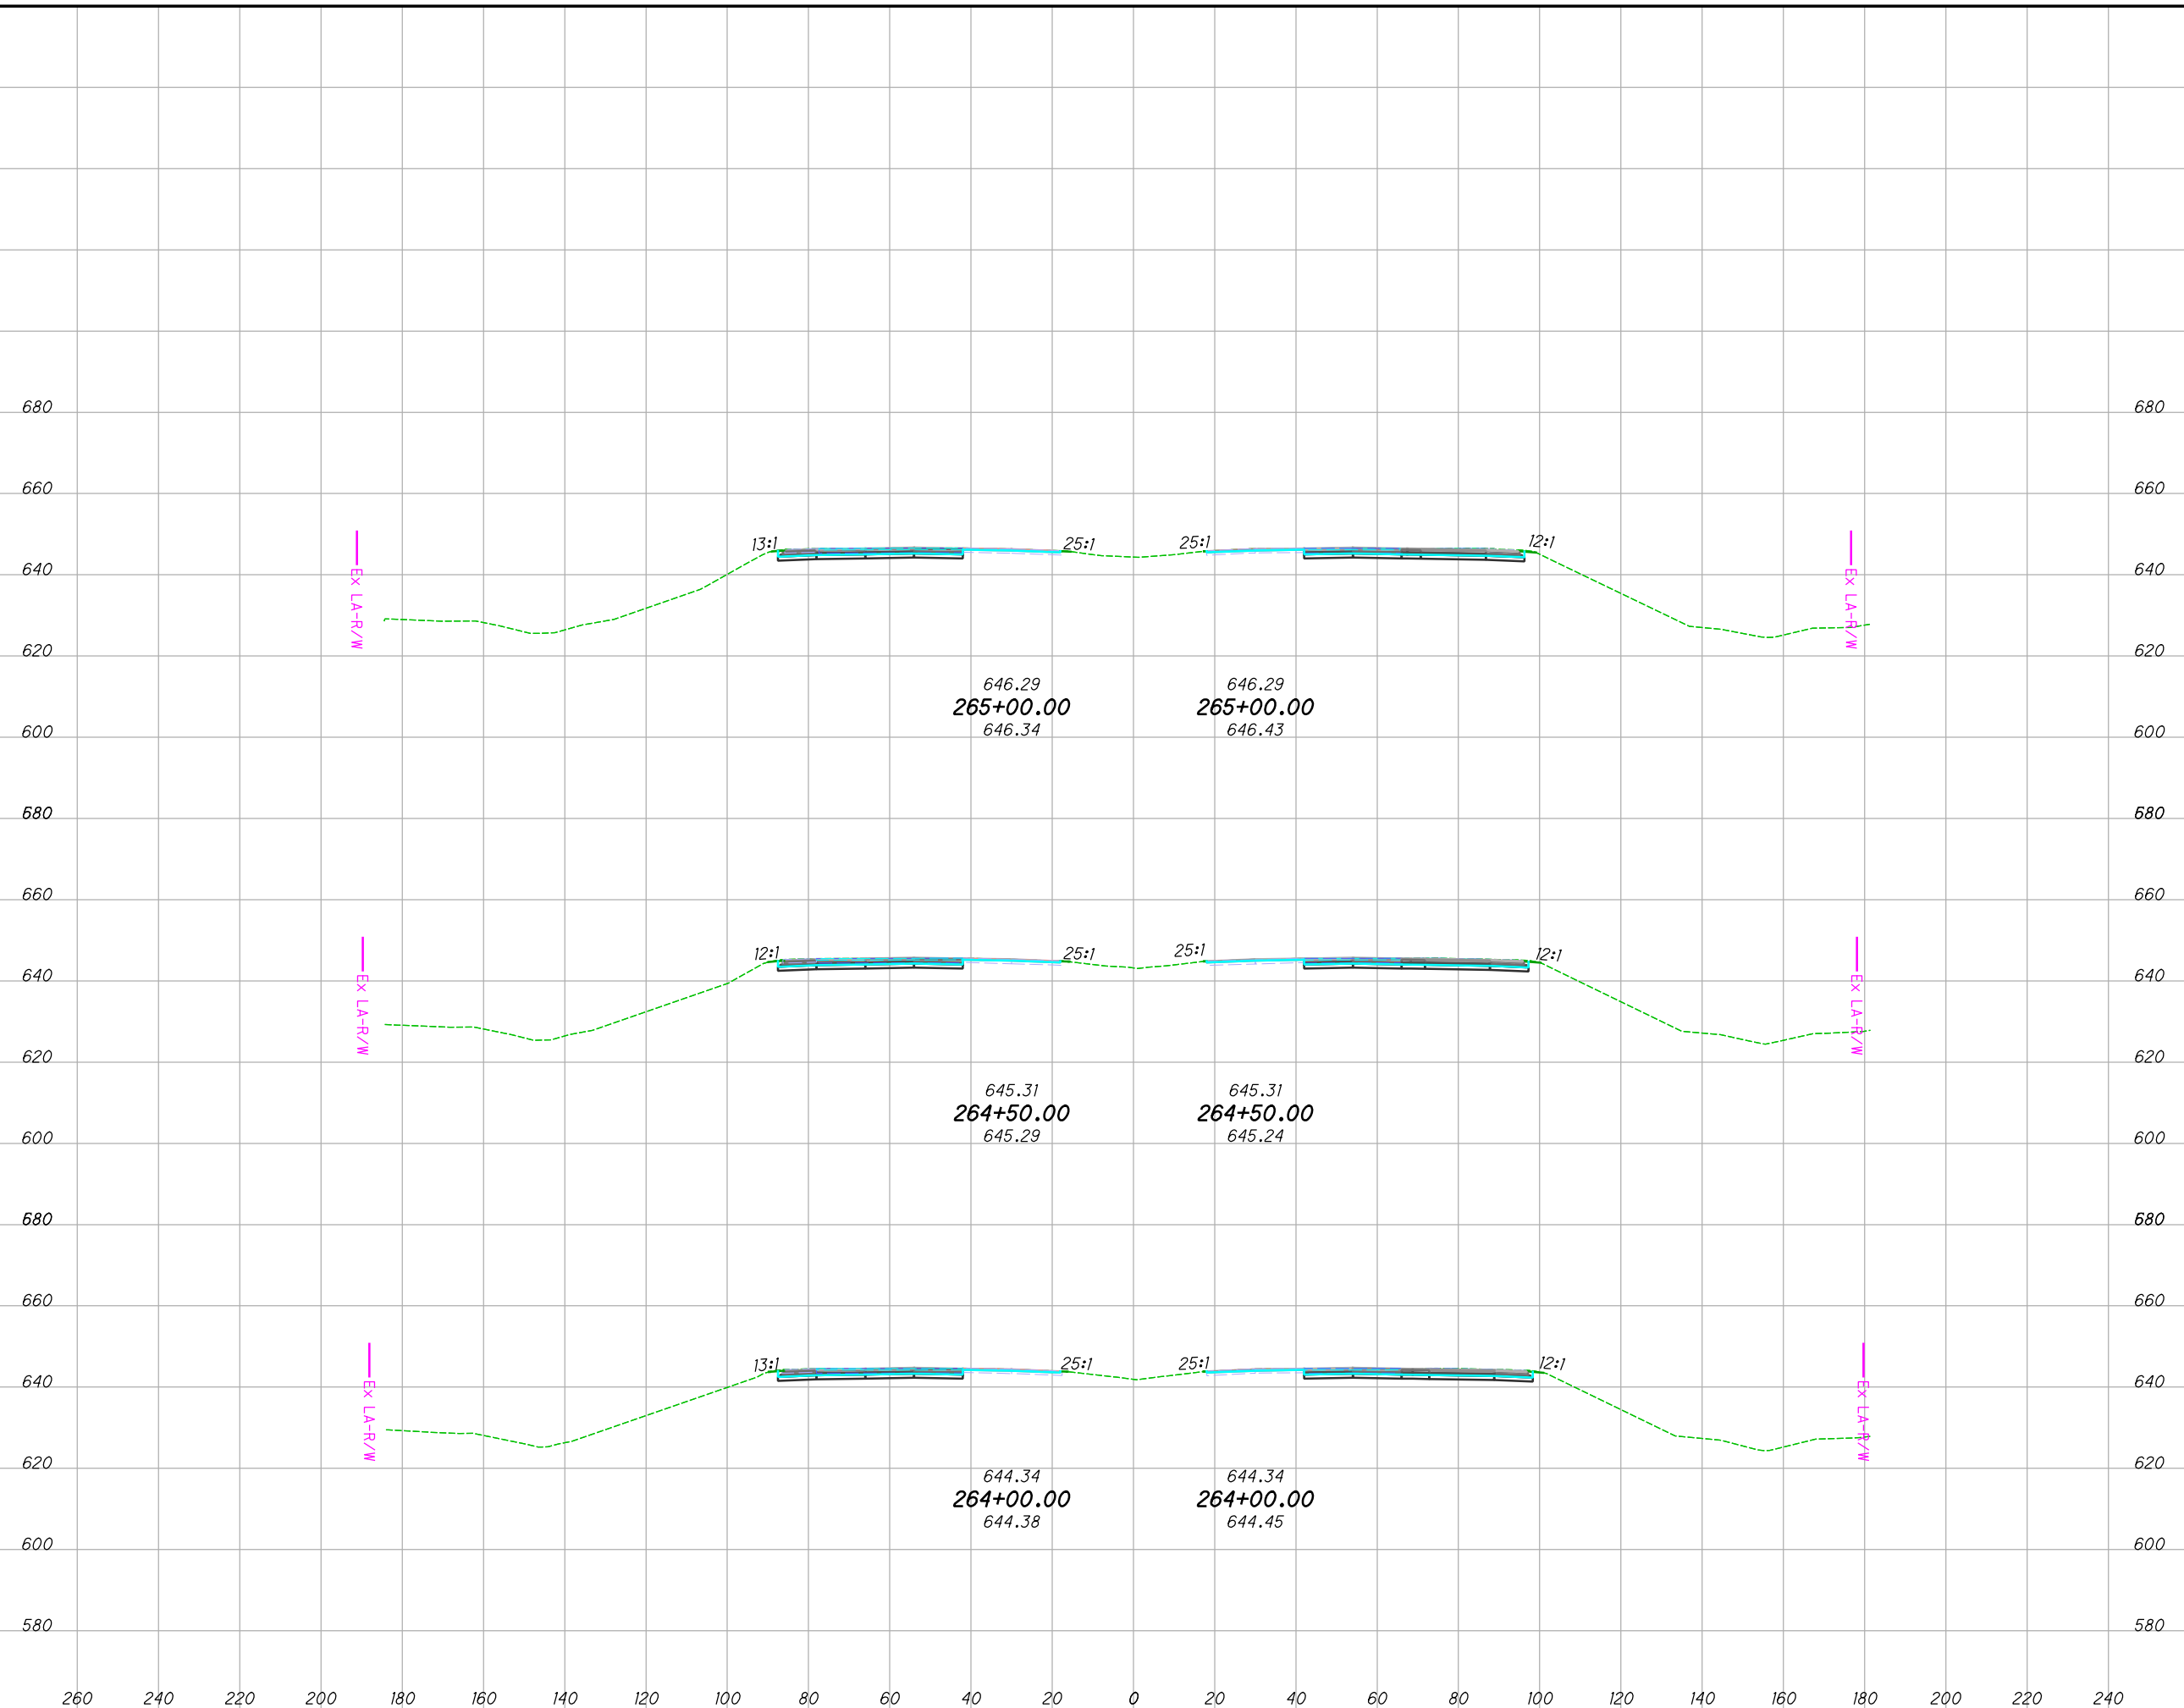

END AREA		VOLUME		CALCULATED		
CUT	FILL	CUT	FILL	JRB	CHECKED	XXX
45	0	84	0			
46	0	85	0			
47	0	86	0			


**CROSS SECTIONS**  
**STA. 264+00.00 TO STA. 265+00.00**

**LUC-475-0.9**

494  
855

I:\ProjectData\LUC-475-0.09\Design\Roadway\Sheets\95875\_XS001 - Copy.dgn Sheet 4/29/2022 8:36:50 AM jbidinge

SEEDING	
END WIDTH	SO. YDS.
197	55
80	62
15.8	80

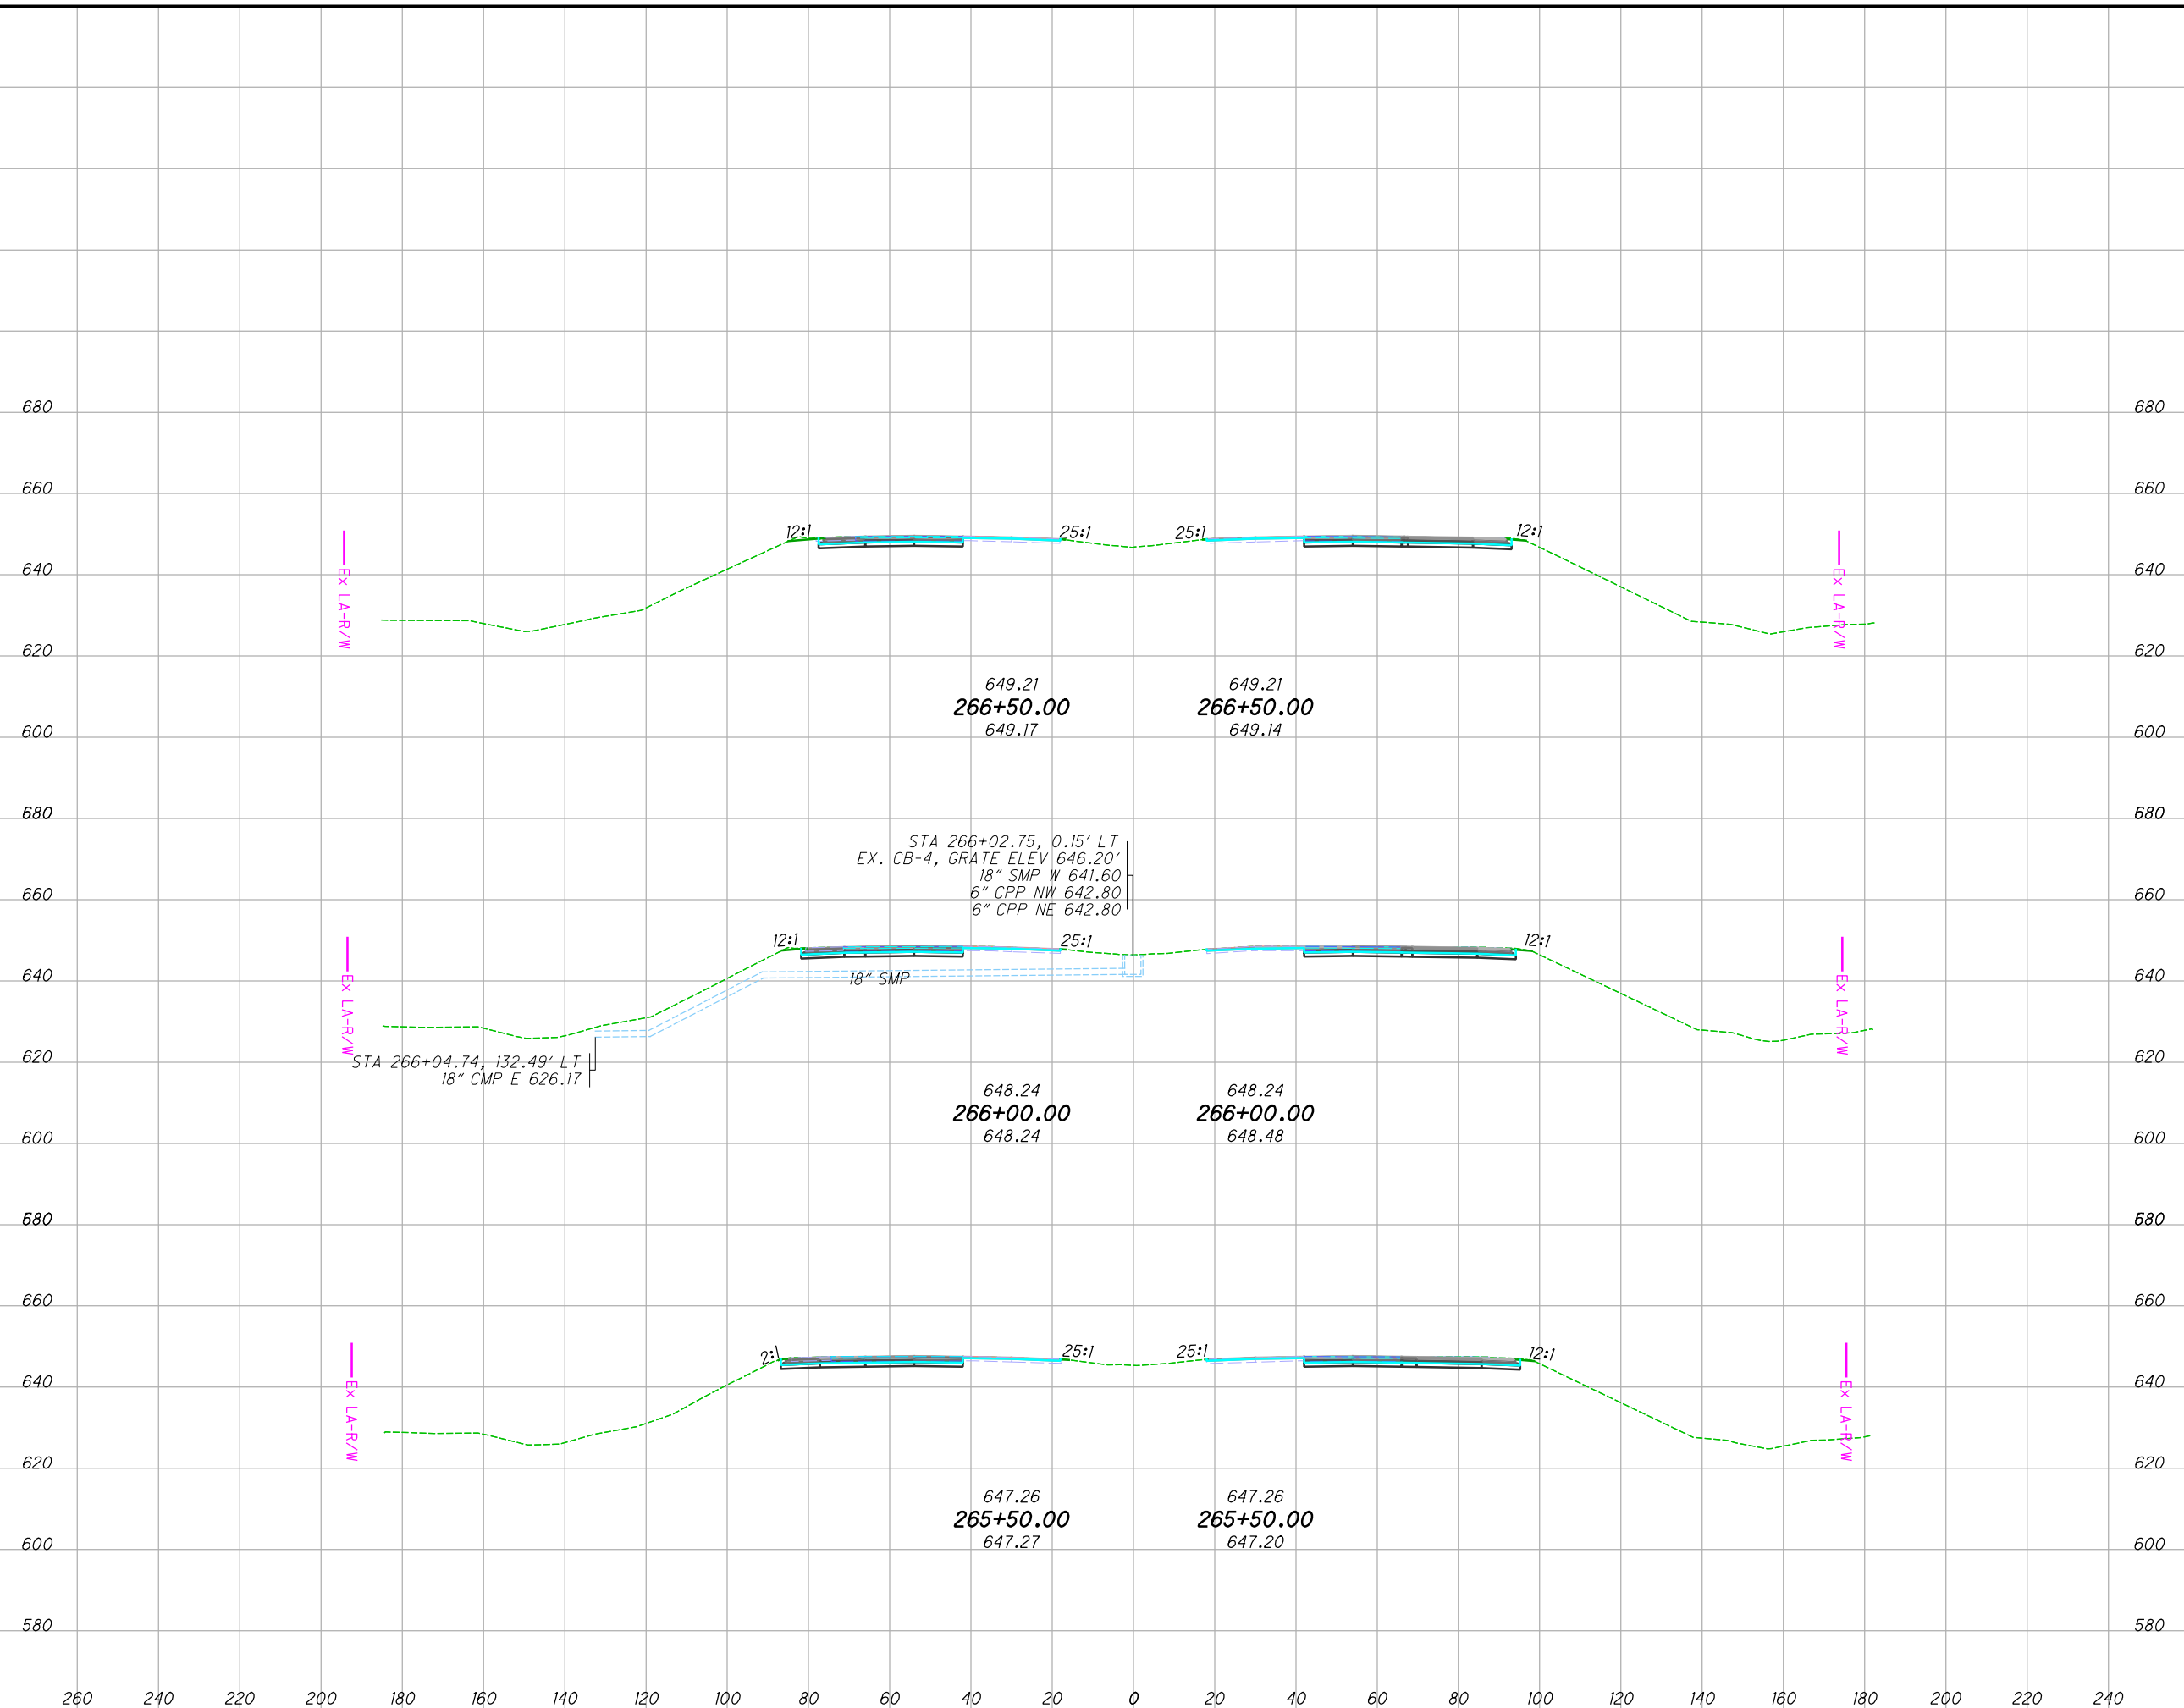


END AREA		VOLUME		CALCULATED	JRB	CHECKED	XXX
CUT	FILL	CUT	FILL				
35	0	65	0				
35	0	73	1				
43	1	82	1				

**CROSS SECTIONS  
 STA. 265+50.00 TO STA. 266+50.00**

**LUC-475-0.9**

495  
855

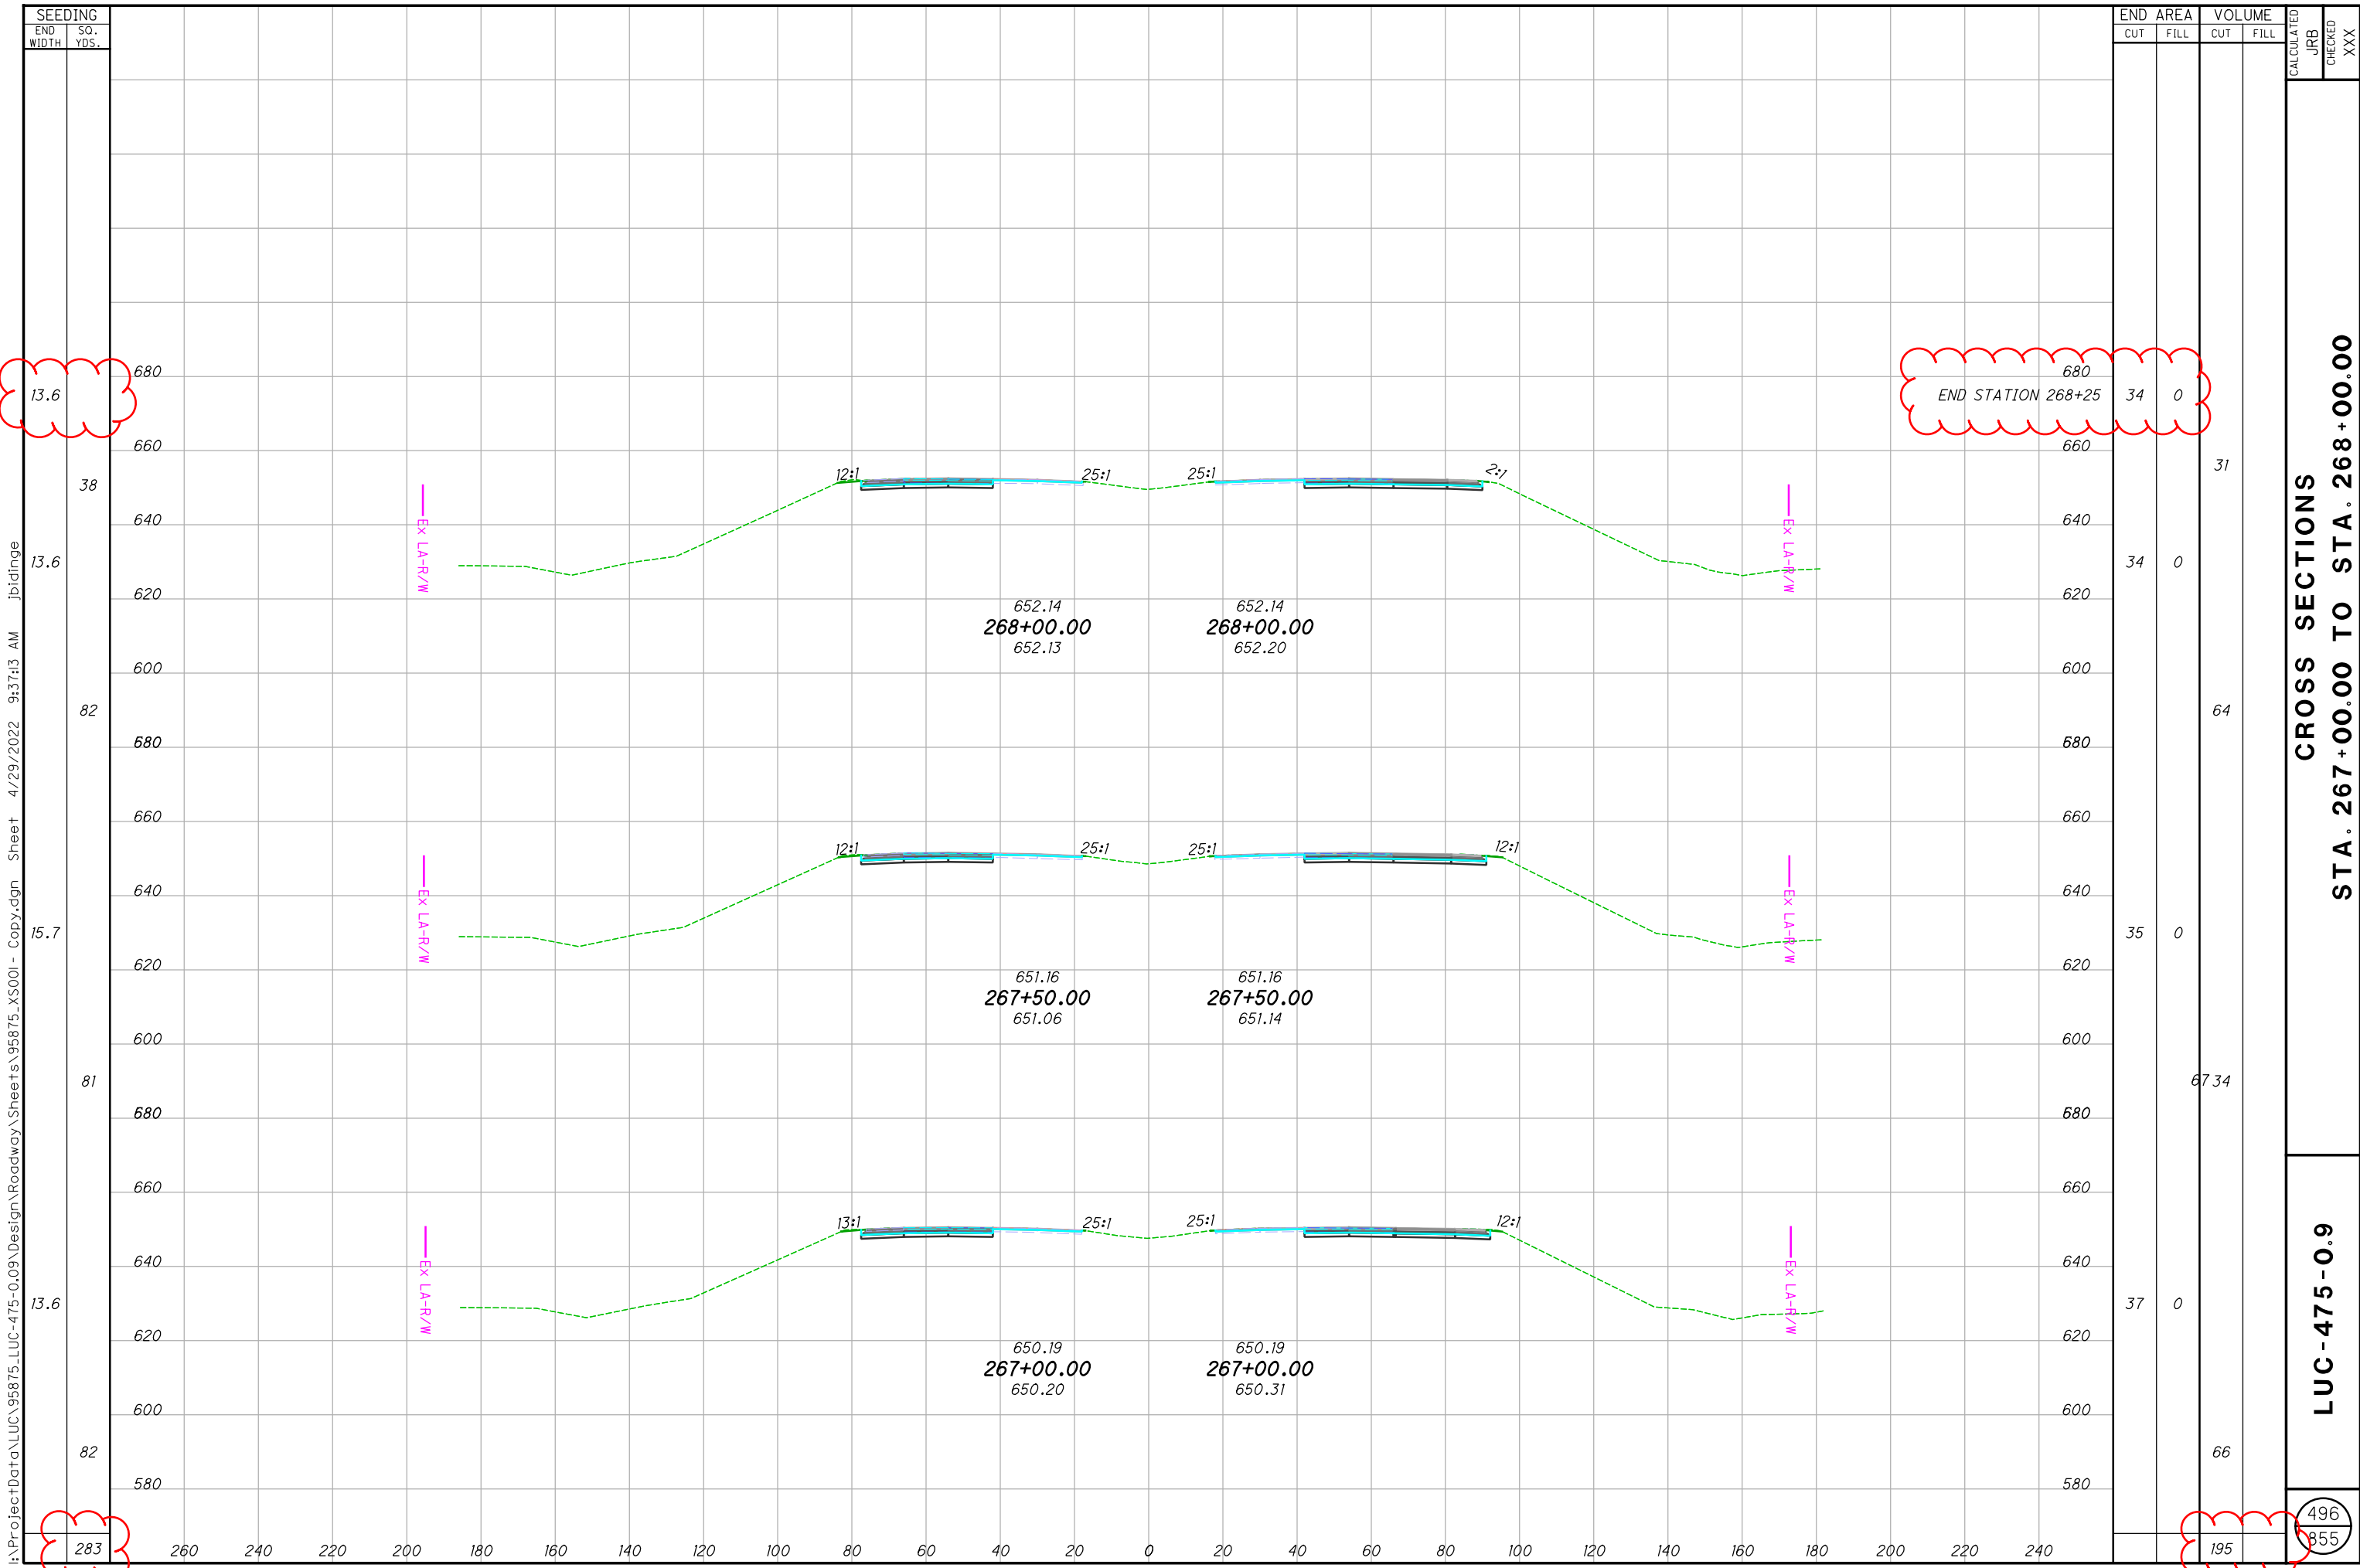

I:\ProjectData\LUC-475-0.09\Design\Roadway\Sheets\95875\_XS001 - Copy.dgn Sheet 4/29/2022 9:37:13 AM jbidinge

**CROSS SECTIONS**  
**STA. 267+00.00 TO STA. 268+00.00**

**LUC-475-0.9**

496  
855

O:\Projects\Ann Arbor\NER\2914\200-12914-1400\CAD\96482\_LUC-475-0.93\Design\Structures\LUC475\_0093L\_Sheets\475\_0093L.dgn Sheet 4/28/2022 10:08:00 PM TRAVIS, RHOADES

ESTIMATED QUANTITIES (04/IMS/BR)

ITEM	EXTENSION	TOTAL	UNIT	DESCRIPTION	ABUT.	PIERS	SUPER.	GEN.	SEE SHEET
202	11003	LS	LS	STRUCTURE REMOVED, OVER 20 FOOT SPAN, AS PER PLAN					2/29
202	22900	266	SY	APPROACH SLAB REMOVED				266	
202	23500	266	SY	WEARING COURSE REMOVED				266	
503	11101	LS	LS	COFFERDAMS AND EXCAVATION BRACING, AS PER PLAN					329
503	21300	LS	LS	UNCLASSIFIED EXCAVATION					
505	11100	LS	LS	PILE DRIVING EQUIPMENT MOBILIZATION					
507	00200	3315	FT	STEEL PILES HP12X53, FURNISHED	3315				
507	00250	3146	FT	STEEL PILES HP12X53, DRIVEN	3146				
507	93300	34	EACH	STEEL POINTS OR SHOES	34				
509	10000	112791	LB	EPOXY COATED REINFORCING STEEL	20796	57402	34593		
509	30020	7239	FT	NO. 4 GFRP DEFORMED BARS			7239		
509	40000	174284	LB	REINFORCING STEEL, MISC.: LOW CARBON CHROMIUM ALLOY REINFORCING STEEL (ASTM A1035 CS GRADE 100)			174284		2/29
511	33418	245	CY	CLASS QC2 CONCRETE WITH QC/QA, SUPERSTRUCTURE			245		
511	34446	716	CY	CLASS QC2 CONCRETE WITH QC/QA, BRIDGE DECK			716		
511	34450	71	CY	CLASS QC2 CONCRETE WITH QC/QA, BRIDGE DECK (PARAPET)			71		
511	41012	203	CY	CLASS QC1 CONCRETE WITH QC/QA, PIER ABOVE FOOTINGS		203			
511	43512	206	CY	CLASS QC1 CONCRETE WITH QC/QA, ABUTMENT INCLUDING FOOTING	206				
512	10050	1903	SY	SEALING OF CONCRETE SURFACES (NON-EPOXY)	224	557	1122		
515	14110	24	EACH	STRAIGHT STRAND PRESTRESSED CONCRETE BRIDGE I-BEAM MEMBERS, LEVEL 2, TYPE WF60-49 (L=60'-7")			24		
515	15110	12	EACH	DRAPED STRAND PRESTRESSED CONCRETE BRIDGE I-BEAM MEMBERS, LEVEL 3, TYPE WF60-49 (L=113'-6")			12		
515	20000	55	EACH	INTERMEDIATE DIAPHRAGMS			55		
516	13200	170	SF	1/2" PREFORMED EXPANSION JOINT FILLER	170				
516	13600	170	SF	1" PREFORMED EXPANSION JOINT FILLER	170				
516	13900	104	SF	2" PREFORMED EXPANSION JOINT FILLER	104				
516	14014	236	FT	INTEGRAL ABUTMENT EXPANSION JOINT SEAL	236				
516	44101	24	EACH	ELASTOMERIC BEARING WITH INTERNAL LAMINATES AND LOAD PLATE (NEOPRENE), AS PER PLAN (2.111" X 14" X 11" WITH 1 1/2" X 15" X 12" LOAD PLATE)	24				
516	44301	48	EACH	ELASTOMERIC BEARING WITH INTERNAL LAMINATES AND LOAD PLATE (NEOPRENE), AS PER PLAN (4.323" X 24" X 13" WITH 1 1/2" X 40" X 14" LOAD PLATE)		48			
518	21200	199	CY	POROUS BACKFILL WITH GEOTEXTILE FABRIC	199				
518	40000	263	FT	6" PERFORATED CORRUGATED PLASTIC PIPE	263				
518	40010	24	FT	6" NON-PERFORATED CORRUGATED PLASTIC PIPE, INCLUDING SPECIALS	24				
524	95434	12	FT	DRILLED SHAFTS, 36" DIAMETER, INTO BEDROCK WITH QC/QA		12			
524	95443	828	FT	DRILLED SHAFTS, 42" DIAMETER, ABOVE BEDROCK WITH QC/QA, AS PER PLAN		828			2/29
526	25010	542	SY	REINFORCED CONCRETE APPROACH SLABS WITH QC/QA (T=15")				542	
526	90010	195	FT	TYPE A INSTALLATION				195	
601	20000	1725	SY	CRUSHED AGGREGATE SLOPE PROTECTION				1725	
601	21060	86	SY	TIED CONCRETE BLOCK MAT, TYPE 2				86	
894	10000	2	EACH	THERMAL INTEGRITY PROFILING (TIP) TEST		2			

DESIGN AGENCY: **TETRA TECH**  
 480 N. MASON AVENUE, SUITE 800  
 TOLEDO, OH 43604

DATE: 1/13/2022  
 REVIEWED DTC: 1/13/2022  
 STRUCTURE FILE NUMBER: 4607082

DRAWN: TSR  
 CHECKED: TLR  
 REVISIONS: 0



DESIGNED: AJF  
 CHECKED: TLR

**BRIDGE ESTIMATED QUANTITIES**  
 LUC-475-0093L  
 I-475 OVER MONCLOVA ROAD AND NSRR

LUC-475-0.09  
 PID No. 99731

3 / 29

680  
855

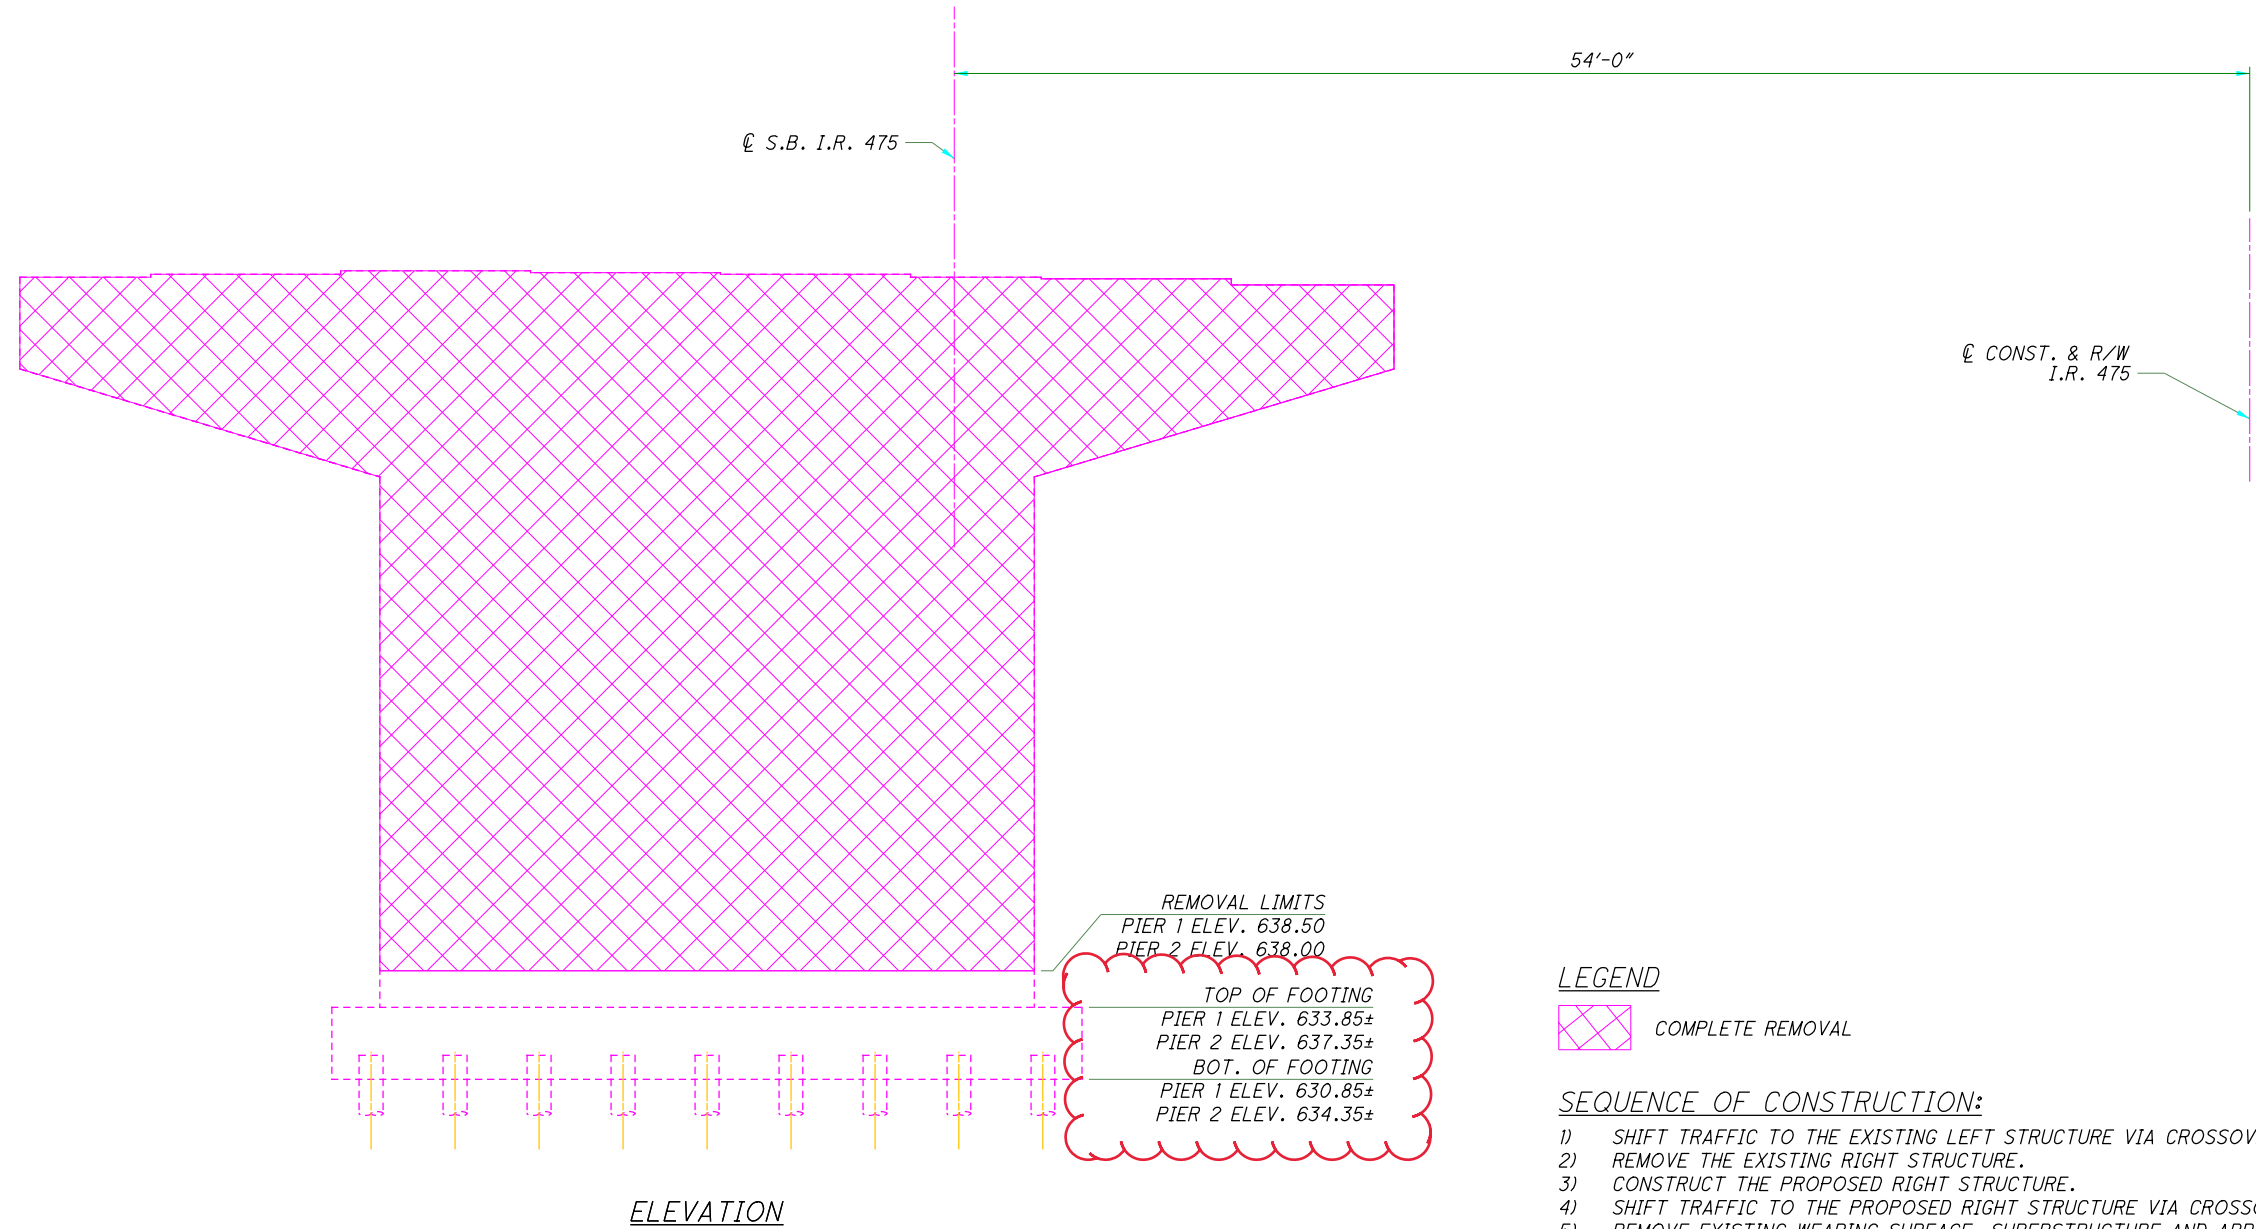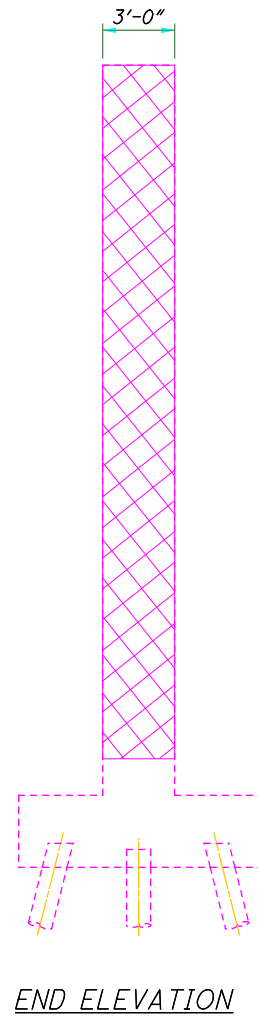

REMOVAL LIMITS  
 PIER 1 ELEV. 638.50  
 PIER 2 ELEV. 638.00

TOP OF FOOTING  
 PIER 1 ELEV. 633.85±  
 PIER 2 ELEV. 637.35±

BOT. OF FOOTING  
 PIER 1 ELEV. 630.85±  
 PIER 2 ELEV. 634.35±

LEGEND

 COMPLETE REMOVAL

SEQUENCE OF CONSTRUCTION:

- 1) SHIFT TRAFFIC TO THE EXISTING LEFT STRUCTURE VIA CROSSOVER.
- 2) REMOVE THE EXISTING RIGHT STRUCTURE.
- 3) CONSTRUCT THE PROPOSED RIGHT STRUCTURE.
- 4) SHIFT TRAFFIC TO THE PROPOSED RIGHT STRUCTURE VIA CROSSOVER.
- 5) REMOVE EXISTING WEARING SURFACE, SUPERSTRUCTURE AND APPROACH SLABS.
- 6) REMOVE EXISTING ABUTMENTS COMPLETELY AND THE EXISTING ABUTMENT PILE FOUNDATIONS TO 1 FOOT BELOW THE PROPOSED GROUND SURFACE.
- 7) REMOVE EXISTING PIERS TO THE LIMITS SHOWN BELOW. EXISTING FOUNDATIONS TO REMAIN.
- 8) CONSTRUCT PROPOSED DRILLED SHAFT FOUNDATIONS FOR PIERS, AND DRIVE PROPOSED ABUTMENT PILE FOUNDATIONS.
- 9) CONSTRUCT PROPOSED SUBSTRUCTURES AND PROPOSED EMBANKMENT SLOPES.
- 10) CONSTRUCT PROPOSED SUPERSTRUCTURE, APPROACH SLABS, AND PROPOSED ROADWAY APPROACHES.
- 11) SHIFT SOUTHBOUND TRAFFIC TO PROPOSED LEFT STRUCTURE.

 <b>TETRA TECH</b> 400 WILSON AVENUE, SUITE 1001 TOLEDO, OH 43604	DESIGN AGENCY	DATE 1/13/2022	REVIEWED DTC	STRUCTURE FILE NUMBER 4807082
DESIGNED AJF	DRAWN TSR	CHECKED TLR	REVISED	
<b>BRIDGE REMOVAL</b> LUC-475-0093L I-475 OVER MONCLOVA ROAD AND NSRR				
LUC-475-0.09	PID No. 99731	4 / 29	681 855	

O:\Projects\Ann Arbor\IER\2914\200-12914-1400\CAD-96482\_LUC-475-0.93\Design\Structures\LUC475\_0093R\_Sheets\475\_0093R\_S0001.dgn Sheet 4/28/2022 1:00:47 PM TRAVIS.RHOADES

ESTIMATED QUANTITIES (04/IMS/BR)

ITEM	EXTENSION	TOTAL	UNIT	DESCRIPTION	ABUT.	PIERS	SUPER.	GEN.	SEE SHEET
202	11003	LS	LS	STRUCTURE REMOVED, OVER 20 FOOT SPAN, AS PER PLAN					2/26
202	22900	242	SY	APPROACH SLAB REMOVED				242	
202	23500	242	SY	WEARING COURSE REMOVED				242	
503	11100	LS	LS	COFFERDAMS AND EXCAVATION BRACING					
503	21300	LS	LS	UNCLASSIFIED EXCAVATION					
505	11100	LS	LS	PILE DRIVING EQUIPMENT MOBILIZATION					
507	00200	3510	FT	STEEL PILES HP12X53, FURNISHED	3510				
<del>507</del>	<del>00250</del>	<del>3330</del>	<del>FT</del>	<del>STEEL PILES HP12X53, DRIVEN</del>	<del>3330</del>				
507	93300	36	EACH	STEEL POINTS OR SHOES	36				
509	10000	119375	LB	EPOXY COATED REINFORCING STEEL	18258	61882	39235		
509	30020	7449	FT	NO. 4 GFRP DEFORMED BARS			7449		
509	40000	197649	LB	REINFORCING STEEL, MISC.: LOW CARBON CHROMIUM ALLOY REINFORCING STEEL (ASTM A1035 CS GRADE 100)			197649		2/26
511	33418	275	CY	CLASS QC2 CONCRETE WITH QC/QA, SUPERSTRUCTURE			275		
511	34446	852	CY	CLASS QC2 CONCRETE WITH QC/QA, BRIDGE DECK			852		
511	34450	73	CY	CLASS QC2 CONCRETE WITH QC/QA, BRIDGE DECK (PARAPET)			73		
511	41012	230	CY	CLASS QC1 CONCRETE WITH QC/QA, PIER ABOVE FOOTINGS		230			
511	43512	209	CY	CLASS QC1 CONCRETE WITH QC/QA, ABUTMENT INCLUDING FOOTING	209				
<del>512</del>	<del>10050</del>	<del>2015</del>	<del>SY</del>	<del>SEALING OF CONCRETE SURFACES (NON-EPOXY)</del>	<del>238</del>	<del>623</del>	<del>1156</del>		
515	14110	26	EACH	STRAIGHT STRAND PRESTRESSED CONCRETE BRIDGE I-BEAM MEMBERS, LEVEL 2, TYPE WF60-49 (L=60'-7")			26		
515	15110	13	EACH	DRAPED STRAND PRESTRESSED CONCRETE BRIDGE I-BEAM MEMBERS, LEVEL 3, TYPE WF60-49 (L=120'-6")			13		
515	20000	60	EACH	INTERMEDIATE DIAPHRAGMS			60		
516	13200	188	SF	1/2" PREFORMED EXPANSION JOINT FILLER	188				
516	13600	188	SF	1" PREFORMED EXPANSION JOINT FILLER	188				
516	13900	106	SF	2" PREFORMED EXPANSION JOINT FILLER	106				
516	14014	259	FT	INTEGRAL ABUTMENT EXPANSION JOINT SEAL	259				
516	44101	26	EACH	ELASTOMERIC BEARING WITH INTERNAL LAMINATES AND LOAD PLATE (NEOPRENE), AS PER PLAN (2.111" X 15" X 11" WITH 1 1/2" X 16" X 12" LOAD PLATE)	26				
516	44301	52	EACH	ELASTOMERIC BEARING WITH INTERNAL LAMINATES AND LOAD PLATE (NEOPRENE), AS PER PLAN (4.323" X 25" X 13" WITH 1 1/2" X 40" X 14" LOAD PLATE)		52			
518	21200	214	CY	POROUS BACKFILL WITH GEOTEXTILE FABRIC	214				
518	40000	277	FT	6" PERFORATED CORRUGATED PLASTIC PIPE	277				
518	40010	24	FT	6" NON-PERFORATED CORRUGATED PLASTIC PIPE, INCLUDING SPECIALS	24				
524	95434	14	FT	DRILLED SHAFTS, 36" DIAMETER, INTO BEDROCK WITH QC/QA		14			
524	95443	966	FT	DRILLED SHAFTS, 42" DIAMETER, ABOVE BEDROCK WITH QC/QA, AS PER PLAN		966			2/26
526	25010	600	SY	REINFORCED CONCRETE APPROACH SLABS WITH QC/QA (T=15")				600	
526	90010	216	FT	TYPE A INSTALLATION				216	
601	20000	1847	SY	CRUSHED AGGREGATE SLOPE PROTECTION				1847	
601	21060	64	SY	TIED CONCRETE BLOCK MAT, TYPE 2				64	
894	10000	2	EACH	THERMAL INTEGRITY PROFILING (TIP) TEST		2			

DESIGN AGENCY: **TETRA TECH**  
 480 N. MASON AVENUE, SUITE 800  
 TOLEDO, OH 43604

DATE: 1/13/2022  
 STRUCTURE FILE NUMBER: 4807112

REVIEWED: DTC  
 DRAWN: TSR  
 CHECKED: TLR

DESIGNED: AJF


**BRIDGE ESTIMATED QUANTITIES**  
 LUC-475-0093R  
 I-475 OVER MONCLOVA ROAD AND NSRR

LUC-475-0.09  
 PID No. 99731

3 / 26

709  
 855



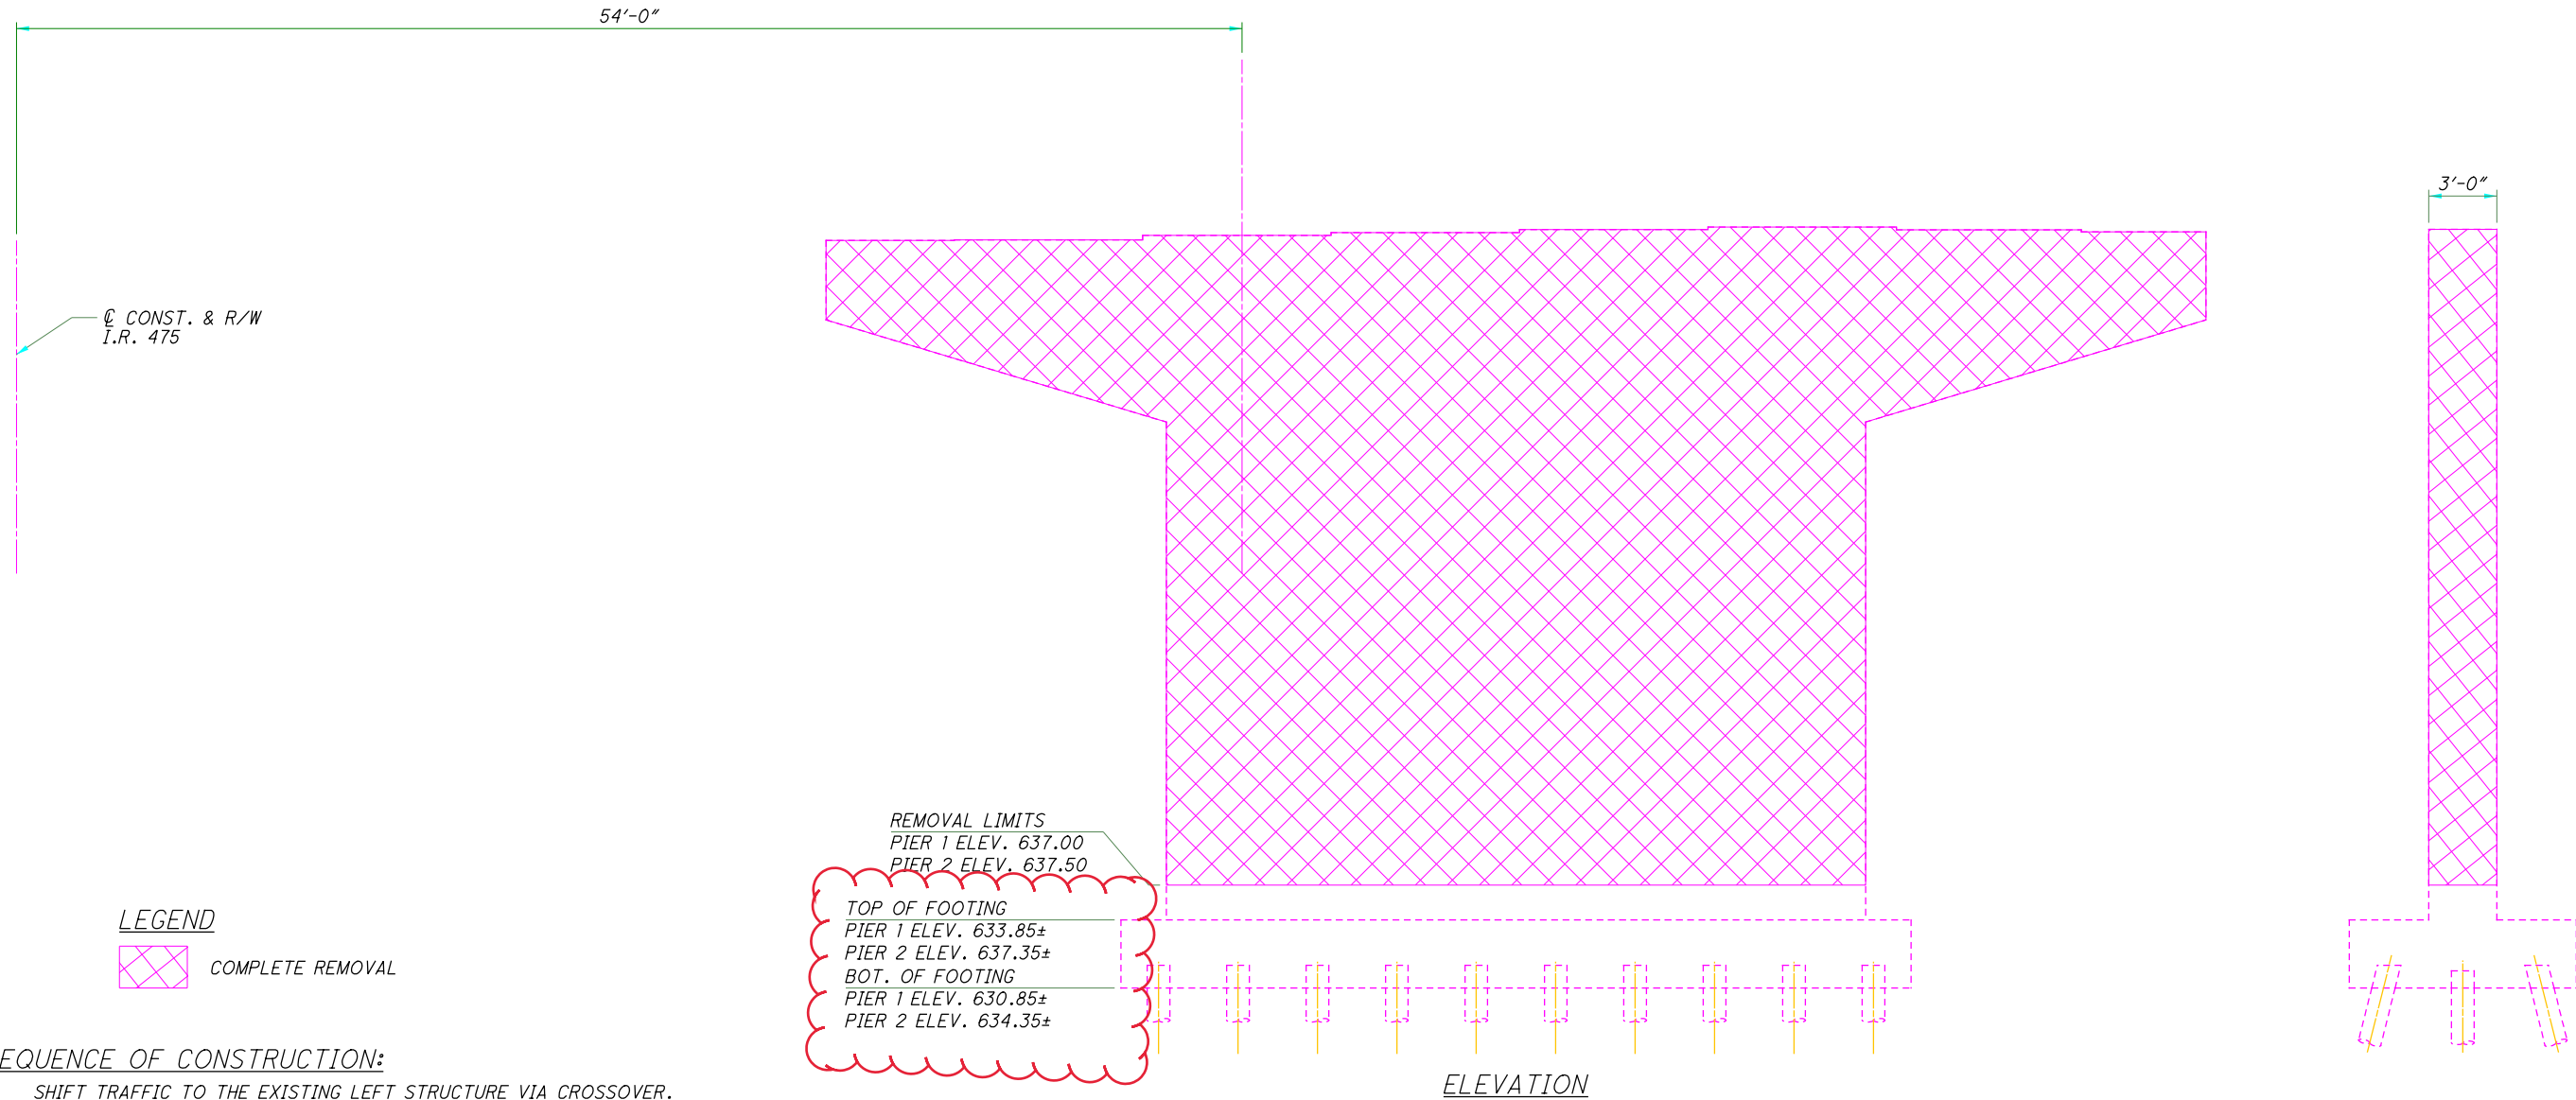

**LEGEND**  
 COMPLETE REMOVAL

- SEQUENCE OF CONSTRUCTION:**
- 1) SHIFT TRAFFIC TO THE EXISTING LEFT STRUCTURE VIA CROSSOVER.
  - 2) REMOVE EXISTING WEARING SURFACE, SUPERSTRUCTURE AND APPROACH SLABS.
  - 3) REMOVE EXISTING ABUTMENTS COMPLETELY AND THE EXISTING ABUTMENT PILE FOUNDATIONS TO 1 FOOT BELOW THE PROPOSED GROUND SURFACE.
  - 4) REMOVE EXISTING PIERS TO THE LIMITS SHOWN BELOW. EXISTING FOUNDATIONS TO REMAIN.
  - 5) CONSTRUCT PROPOSED DRILLED SHAFT FOUNDATIONS FOR PIERS, AND DRIVE PROPOSED ABUTMENT PILE FOUNDATIONS.
  - 6) CONSTRUCT PROPOSED SUBSTRUCTURES AND PROPOSED EMBANKMENT SLOPES.
  - 7) CONSTRUCT PROPOSED SUPERSTRUCTURE, APPROACH SLABS, AND PROPOSED ROADWAY APPROACHES.
  - 8) SHIFT TRAFFIC TO THE PROPOSED RIGHT STRUCTURE VIA CROSSOVER.
  - 9) REMOVE THE EXISTING LEFT STRUCTURE.
  - 10) CONSTRUCT THE PROPOSED LEFT STRUCTURE.
  - 11) SHIFT SOUTHBOUND TRAFFIC TO PROPOSED LEFT STRUCTURE.

ELEVATION

END ELEVATION

**BRIDGE REMOVAL**  
 LUC-475-0093R  
 I-475 OVER MONCLOVA ROAD AND NSRR

**LUC-475-0.09**  
 PID No. 99731

DESIGNED	DRAWN	REVIEWED	DATE
AJF	TSR	DTC	1/13/2022
CHECKED	REVISED	STRUCTURE FILE NUMBER	4807112
TLR			

DESIGN AGENCY  
  
**TETRA TECH**  
 480 WILSON AVENUE, SUITE 800  
 TOLEDO, OH 43604