

DESIGN EXCEPTIONS

NONE REQUIRED

 \bigcirc

 \bigcirc

 \bigcirc

 \bigcirc

STATE OF OHIO DEPARTMENT OF TRANSPORTATION

MAH-76-3.03

NOISE WALL MILTON TOWNSHIP MAHONING COUNTY

INDEX OF SHEETS:

TITLE SHEET	1
SCHEMATIC PLAN	2
GENERAL NOTES	3
MAINTENANCE OF TRAFFIC	4 - 10, 104
GENERAL SUMMARY	11
ROADWAY ESTIMATED QUANTITIES	12
PROJECT SITE PLAN	13
NOISE BARRIER DETAILS	14 - 30
TRAFFIC CONTROL	31 - 35
SOIL PROFILE	

				STANDAR	D CONSTRUCTION	DRAWINGS	SUPPLEMENTAL SPECIFICATIONS	SPECIAL PROVISIONS
	MGS-1.1	7/16/21	TC-22.20	1/17/14			800-2023 7/14/23	
	MGS-2.1	1/19/18	TC-41.20	10/18/13			832 7/15/22	
	MGS-4.3	1/18/13	TC-42.20	10/18/13			992 4/18/14	
ENGINEERS SEAL:	MGS-5.2	7/15/16	TC-51.11	1/15/16				
ENGINEERS SEAL.			TC-51.12	1/15/16				
	NBS-1-09	7/15/22	TC-52.10	10/18/13				
GRAIG GRAIG SCHRADER SC			TC-52.20	1/15/21				
11, 1, 1, 1, 1, 1, 1, 1, 1, 1, 1, 1, 1,	MT-95.45	7/21/23	TC-61.30	7/19/19				
	WIT 80.28	- Villey						
	MT-98.29	1/17/20	J					
E-77433	MT-101.60	4/21/23 7/11/20)					
SSIONAL ENGINI	MT 101.30	7/11/20						
·/////////////////////////////////////	MT-105.10	1/17/20						
	TC-12.31	4/15/22						
	TC-21.21	1/20/23						

м х х у

PROJECT DESCRIPTION

THIS PROJECT WILL CONSTRUCT 2080 FEET OF NOISE WALL BEHIND THE GUARDRAIL NEAR THE TOP OF THE SLOPE ALONG THE NORTH SIDE OF I-76 WESTBOUND AND THE RAMP FROM I-76 WESTBOUND TO SR-534. OTHER WORK ITEMS INCLUDE PROPOSED GUARDRAIL INSTALLATION AND RELOCATION OF EXISTING SIGNS.

EARTH DISTURBED AREAS


PROJECT EARTH DISTURBED AREA:0.91 ACRESESTIMATED CONTRACTOR EARTH DISTURBED AREA:0.25 ACRESNOTICE OF INTENT EARTH DISTURBED AREA:4.90 ACRES

LIMITED ACCESS

THIS IMPROVEMENT IS ESPECIALLY DESIGNED FOR THROUGH TRAFFIC AND HAS BEEN DECLARED A LIMITED ACCESS HIGHWAY OR FREEWAY BY ACTION OF THE DIRECTOR IN ACCORDANCE WITH THE PROVISIONS OF SECTION 5511.02 OF THE OHIO REVISED CODE.

2019 SPECIFICATIONS

THE STANDARD SPECIFICATIONS OF THE STATE OF OHIO, DEPARTMENT OF TRANSPORTATION, INCLUDING SUPPLEMENTAL SPECIFICATIONS LISTED IN THE PLANS AND CHANGES LISTED IN THE PROPOSAL SHALL GOVERN THIS IMPROVEMENT.

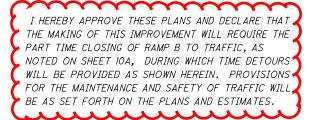





OHIO811, 8-1-1, or 1-800-362-2764 (Non-members must be called directly)

Arthur G. Noirot Jr., P.E. District 04 Deputy Director



Jack Marchbanks, PhD Director, Department of Transportation

E191715	106849		NONE	MAH-76-3.03	1
FEDERAL PROJECT NO.	PID NO.	CONSTRUCTION PROJECT NO.	KAILKUAU INVOLVEMENI		$\overline{(}$

NOTIFICATION OF TRAFFIC RESTRICTIONS

THROUGHOUT THE DURATION OF THE PROJECT, THE CONTRACTOR SHALL NOTIFY THE PROJECT ENGINEER IN WRITING OF ALL TRAFFIC RESTRICTIONS AND UPCOMING MAINTENANCE OF TRAFFIC CHANGES. THE CONTRACTOR SHALL ENSURE THE WRITTEN NOTIFICATION IS SUBMITTED IN A TIMELY MANNER TO ALLOW THE PROJECT ENGINEER TO MEET THE REQUIRED TIME FRAMES SET FORTH IN THE TABLE BELOW TO INFORM THE **SPECIAL HAULING PERMITS SECTION** (HAULING.PERMITS@DOT.OHIO.GOV) AND THE **DISTRICT PUBLIC INFORMATION OFFICE (PIO)**. THIS NOTIFICATION SHALL BE RECEIVED BY THE PROJECT ENGINEER PRIOR TO THE PHYSICAL SETUP OF ANY APPLICABLE SIGNS OR MESSAGE BOARDS.

INFORMATION SHOULD INCLUDE, BUT IS NOT LIMITED TO, ALL CONSTRUCTION ACTIVITIES THAT IMPACT OR INTERFERE WITH TRAFFIC AND SHALL LIST THE SPECIFIC LOCATION, TYPE OF WORK, ROAD STATUS, DATE AND TIME OF RESTRICTION, DURATION OF RESTRICTION, NUMBER OF LANES MAINTAINED, NUMBER OF LANES CLOSED, MINIMUM VERTICAL CLEARANCE, MINIMUM WIDTH OF DRIVABLE PAVEMENT, DETOUR ROUTES, IF APPLICABLE, AND ANY OTHER INFORMATION REQUESTED BY THE PROJECT ENGINEER.

	NOTIFICATION T	IME TABLE				
ITEM	DURATION OF CLOSURE	NOTICE DUE TO PERMITS & PIO				
RAMP & ROAD CLOSURES	>= 2 WEEKS	21 CALENDAR DAYS PRIOR TO CLOSURE				
	> 12 HOURS & < 2 WEEKS	14 CALENDAR DAYS PRIOR TO CLOSURE				
	< 12 HOURS	4 BUSINESS DAYS PRIOR TO CLOSURE				
LANE CLOSURES &	>= 2 WEEKS	14 CALENDAR DAYS PRIOR TO CLOSURE				
RESTRICTIONS	< 2 WEEKS	5 BUSINESS DAYS PRIOR TO CLOSURE				
START OF CONSTRUCTION & TRAFFIC PATTERN CHANGES	NA	14 CALENDAR DAYS PRIOR TO IMPLEMENTATION				

ANY UNFORESEEN CONDITIONS NOT SPECIFIED IN THE PLANS REQUIRING TRAFFIC RESTRICTIONS SHALL ALSO BE REPORTED TO THE PROJECT ENGINEER USING THE NOTICE TO OFFICE OF COMMUNICATIONS TIME TABLE.

TIME LIMITATION ON A DETOUR - CLOSURE #1

PRIOR TO MAY IST 2024 - RAMP B SHALL BE MAINTAINED AT ALL TIMES, EXCEPT FOR I PERIOD NOT TO EXCEED 30 CONSECUTIVE CALENDAR DAYS, WHEN THROUGH TRAFFIC MAY BE DETOURED AS SHOWN ON SHEET 10A. A DISINCENTIVE SHALL BE ASSESSED IN THE AMOUNT OF \$10,000 PER DAY FOR EACH CALENDAR DAY THE ROADWAY REMAINS CLOSED TO TRAFFIC BEYOND THE SPECIFIED LIMIT. CLOSURE #1 MUST BE COMPLETED NO LATER THAN MAY 1, 2024.

TIME LIMITATION ON A DETOUR - CLOSURE #2

AFTER MAY IST 2024 - RAMP B SHALL BE MAINTAINED AT ALL TIMES, EXCEPT FOR I PERIOD NOT TO EXCEED 5 CONSECUTIVE CALENDAR DAYS (MONDAY - FRIDAY), WHEN THROUGH TRAFFIC MAY BE DETOURED AS SHOWN ON SHEET 10A. A DISINCENTIVE SHALL BE ASSESSED IN THE AMOUNT OF \$10,000 PER DAY FOR EACH CALENDAR DAY THE ROADWAY REMAINS CLOSED TO TRAFFIC BEYOND THE SPECIFIED LIMIT. CLOSURE #2 SHALL NOT OCCUR DURING A HOLIDAY WEEK.

NOTICE OF CLOSURE SIGN

NOTICE OF CLOSURE SIGNS (W20-H13) SHALL BE ERECTED BY THE CONTRACTOR PRIOR TO THE SCHEDULED ROAD OR RAMP CLOSURE IN ACCORDANCE WITH THE NOTICE OF CLOSURE TIME TABLE BELOW. AT THE APPROVAL OF THE ENGINEER, PORTABLE CHANGEABLE MESSAGE SIGNS MAY BE USED IN LIEU OF THE STANDARD FLATSHEET SIGN FOR CLOSURE DURATIONS OF LESS THAN 1 WEEK.

THE SIGNS SHALL BE ERECTED ON THE RIGHT-HAND SIDE OF THE ROAD/RAMP FACING TRAFFIC. THEY SHALL BE PLACED SO AS NOT TO INTERFERE WITH THE VISIBILITY OF ANY OTHER TRAFFIC CONTROL SIGNS. ON ROADWAYS, THEY SHOULD BE ERECTED AT OR NEAR THE POINT OF CLOSURE. THE SIGNS MAY BE ERECTED ANYWHERE ON RAMPS AS LONG AS THEY ARE VISIBLE TO THE MOTORISTS USING THE RAMP. ON ENTRANCE RAMPS, THE SIGN SHALL BE ERECTED WELL IN ADVANCE OF THE MERGE AREA TO AVOID DISTRACTING MOTORISTS.

	NOTICE OF CLOSURE S	IGN TIME TABLE
ITEM	DURATION OF CLOSURE	NOTICE DUE TO PERMITS & PIO
	≥ 2 WEEKS	14 CALENDAR DAYS PRIOR TO CLOSURE
RAMP & I CLOSURE	 > 12 HOURS & < 2 WEEKS	7 CALENDAR DAYS PRIOR TO CLOSURE
	≤ 12 HOURS	2 BUSINESS DAYS PRIOR TO CLOSURE

THE SIGN SHALL DISPLAY THE DATE OF THE CLOSURE IN MMM-DD FORMAT AND THE NUMBER OF DAYS OF THE CLOSURE. THE LAST LINE OF THE W20-H13 SIGN LISTS A PHONE NUMBER WHICH A MOTORIST MAY CALL FOR ADDITIONAL INFORMATION. THIS IS TO BE A SPECIFIC OFFICE WITHIN THE DISTRICT RATHER THAN THE GENERAL SWITCHBOARD NUMBER.

mmm

 \bigcirc

 \bigcirc

CALCULATED BER CHECKED SMM
TES
L NC
GENERA
TRAFFIC
ΟF
MAINTENANCE OF TRAFFIC GENERAL NOTES
MAH-76-3.03
5 35


SHEET NO.	PHASE	FIC, 19		614	614 43								+
SHEET NO.	PHASE	FIC,	WIT.	1 🚽	G	1							
		MAINTAINING TRAFFIC, AS PER PLAN	DE LAW ENFORCEMENT OFFICER WITH DE PATROL CAR FOR ASSISTANCE	DETOUR SIGNING	PORTABLE CHANGEABLE MESSAGE								
					5/1////								+
4 10A		LS	20	LS	1								
104					.								+
					k								
			({								+
													-
					\$								
			+)								+
			1										1
			+)								+
									 				<u> </u>
			+		{								+
			+		<u> </u>								+
				[_								
													
					{								
													-
													
)								
													+
													+
													1
			+		(
					<								+
													<u> </u>
			+		<u> </u>								+
													-
													+
													1
				├ ───									
													+
				(1
				(+
	SUB-TOTA	ALS											+
TOTALS CA	RRIED TO GENERAL	LS	20	LS	1								
S	UMMARY							<u> </u>					

 \bigcirc

 \bigcirc

 \bigcirc

				CALCULATED BER CHECKED SMM
				ULA CKE
				SI HE B
				CA (
		 		 ~
				4
				<u> </u>
				Σ
				m
				 U U
				TRAFFIC SUBSUMMARY
				ΟF
				0
				0
				Z
				INTENANCE
				-
				~
				 ш
				Z
				=
				ΜA
				5
				3
				Ö
				-
				()
				 9
				 I
				MAH-76-3.03
				 Ē
				 2
				6
1	1			357

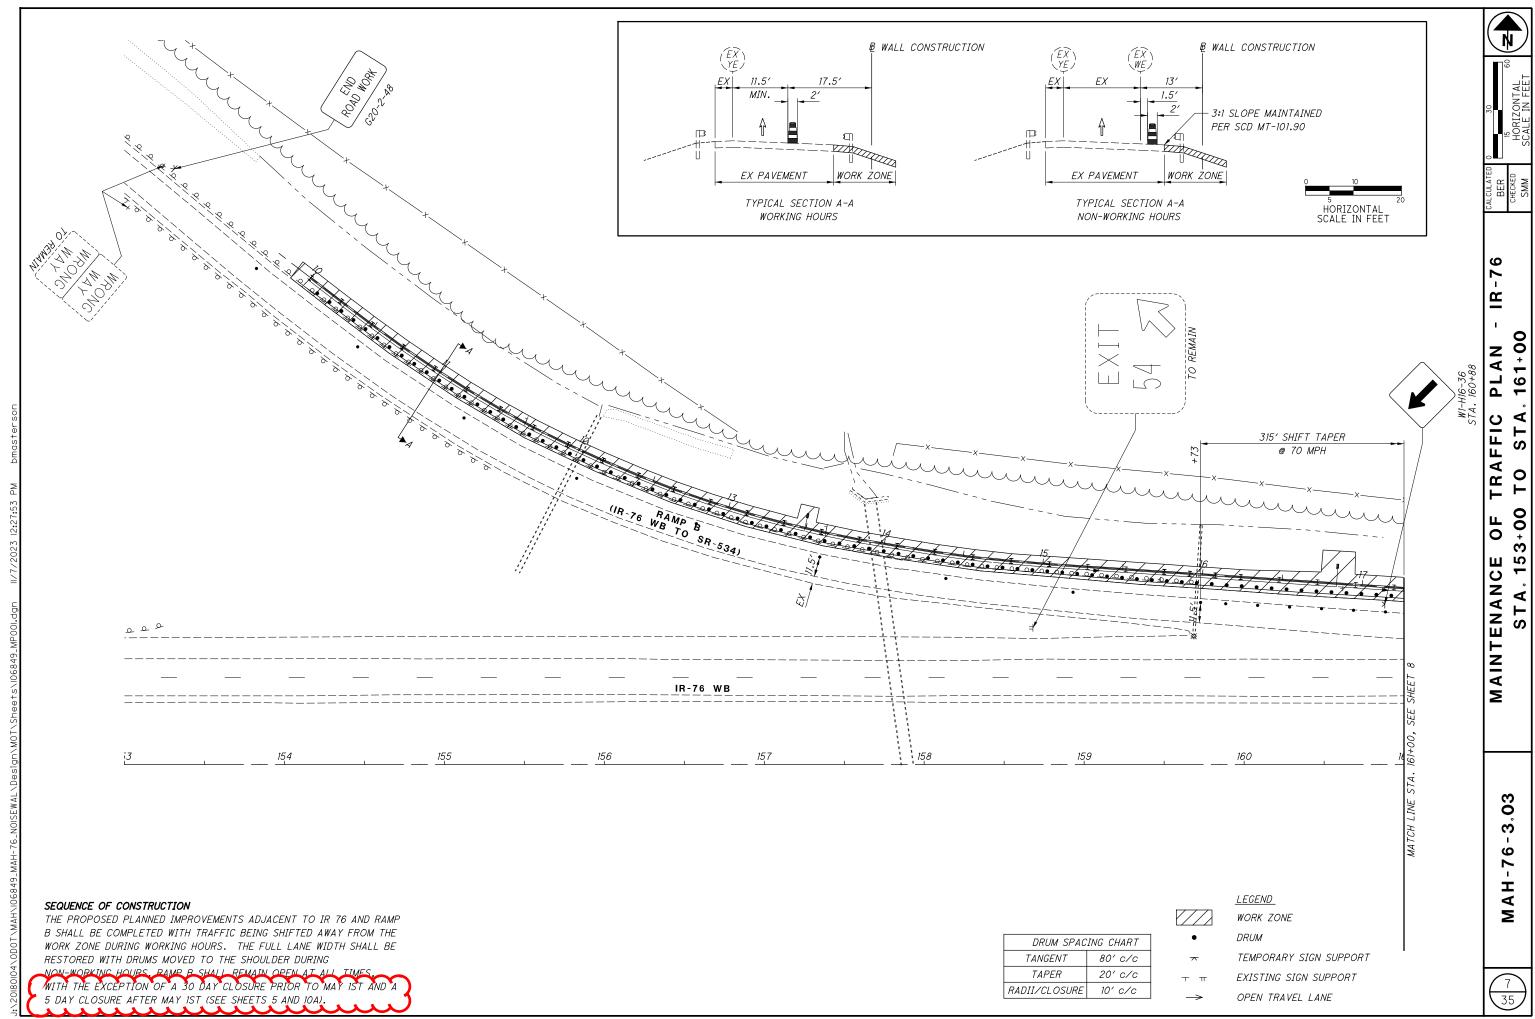


 \bigcirc

 \bigcirc

 \bigcirc

DRUM SPAC	ING CH
TANGENT	80′
TAPER	20'
<i>RADII/CLOSURE</i>	10' 0

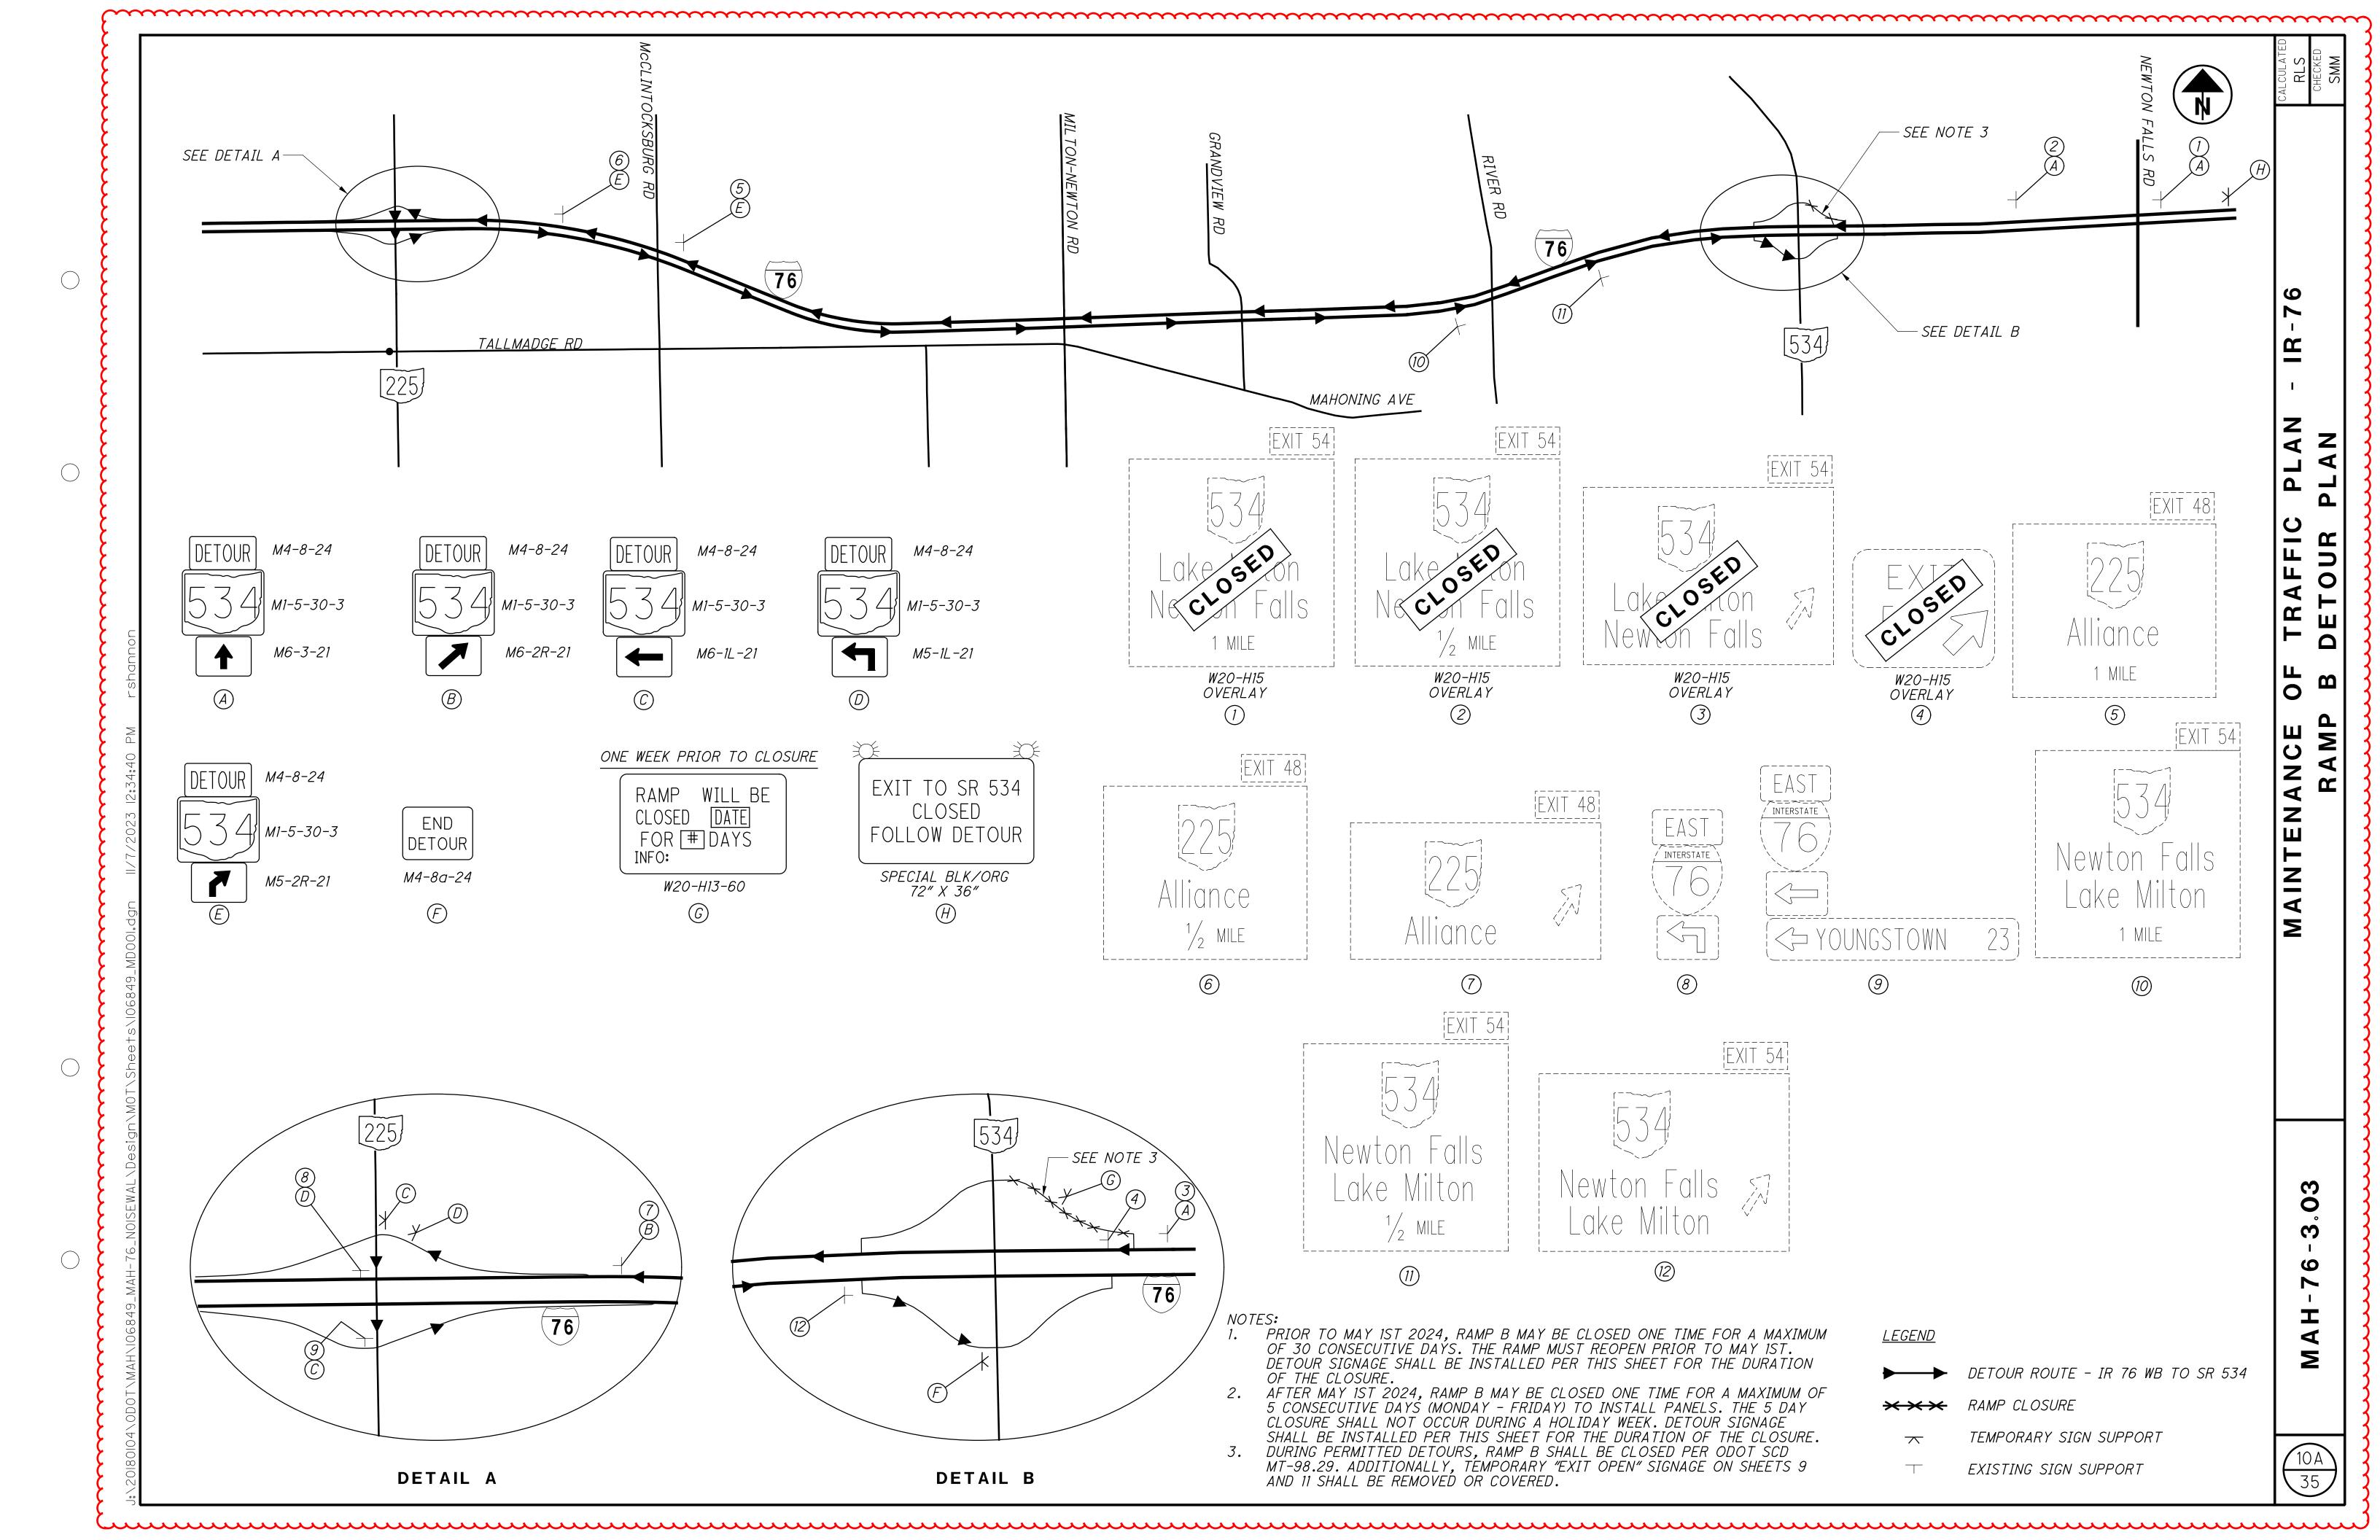

						SI	HEET NU	JM.					PART.	ITEM	ITEM	GRAND	UNIT	
	3	4	12	16	31								01/		ЕХТ	TOTAL		
	LS												LS	201	11000	LS		CLEARING AND GRUBBING
			604										604	207	38000	604	FT	GUARDRAIL REMOVED
			21										21	209	60201	21	STA	LINEAR GRADING, AS PER PLAN
			2,100										2,100	606	15050	2,100	FT	GUARDRAIL, TYPE MGS
			25										25	606	15150	25	FT	GUARDRAIL, TYPE MGS HALF POST SPACIN
\bigcirc			1										1	606	26050	1	EACH	ANCHOR ASSEMBLY, MGS TYPE B
\bigcirc																		
	2												2	659	00100	2	EACH	SOIL ANALYSIS TEST
	259 2,337												259 2,337	659 659	00300 10000	259 2,337	CY SY	TOPSOIL SEEDING AND MULCHING
	117												117	659	14000	117	SY	REPAIR SEEDING AND MULCHING
	0.32												0.32	659	20000	0.32	TON	COMMERCIAL FERTILIZER
\bigcirc	0.48												0.48	659	31000	0.48	ACRE	LIME
\bigcirc	13	-	-	-	-						-		13 LUMP	659	35000 15000	13 LS	MGAL	WATER STORM WATER POLLUTION PREVENTION PL.
													LUMP	832 832	15000	LS		STORM WATER POLLUTION PREVENTION PL
													LUMP	832	15010	LS		STORM WATER POLLUTION PREVENTION INS
(_												12,737	832	30000	12,737	EACH	EROSION CONTROL
	5										 							
(((D		82										82	441	70801	82	СҮ	ASPHALT CONCRETE INTERMEDIATE COURSE
			02										02	77/	10001	02	07	
í.	ā																	
_			29										29	626	00110	29	EACH	BARRIER REFLECTOR, TYPE 2 (BI-DIRECTIC
NO.	- 				30								30	630	03100	30	FT	GROUND MOUNTED SUPPORT, NO. 3 POST
1.8	0				1 13.19								1 13.19	630 630	72340 80100	1 13.19	EACH SF	OVERHEAD SIGN SUPPORT, TYPE TC-12.31, SIGN, FLAT SHEET
<u>c</u>	2:21				210								210	630	80100	210	SF SF	SIGN, OVERHEAD EXTRUSHEET
FC					2.0								210		00227	2.0	0,	
					1								1	630	84510	1	EACH	RIGID OVERHEAD SIGN SUPPORT FOUNDATI
	È				5								5	630	84900	5	EACH	REMOVAL OF GROUND MOUNTED SIGN AND
					1 2								1	630 630	85400 86002	1	EACH EACH	REMOVAL OF GROUND MOUNTED MAJOR SIG REMOVAL OF GROUND MOUNTED POST SUPP
C T					3								3	630	86102	2 3	EACH	REMOVAL OF GROUND MOUNTED FOST SUP
														000	00/02		LAGH	
	5																	
0				26,688									26,688	SPECIAL	60610210	26,688	SF	NOISE BARRIER (REFLECTIVE)
				972									972	SPECIAL	60610920	972	SF	NOISE BARRIER (REFLECTIVE WITH ICON)
(+	<u> </u>																	M
	D	20											20	614 614	11110	20	HOUR	LAW ENFORCEMENT OFFICER WITH PATROL
	2	Ĺs				Lii	\mathbf{m}			ننا		Lii	15	614	11110 12420 18601	LS	Liii	LAW ENFORCEMENT OFFICER WITH PATROL DETOUR SIGNING PORTABLE CHANGEABLE MESSAGE SIGN, AS
0	2													614	18601		SNMT	PORTABLE CHANGEABLE MESSAGE SIGN, AS
																		INCIDENTALS
		LS											LS	614	11001	LS		MAINTAINING TRAFFIC, AS PER PLAN
	5												3	619	16010	3	MNTH	FIELD OFFICE, TYPE B
	D D												LS	623	10000	LS		CONSTRUCTION LAYOUT STAKES AND SURV
- 											 		LS	624	10000	LS		MOBILIZATION
	2				-													
0																		
a d																		
	A WIA		1	1	1	1	1		1	1	1	1						
É																		
	Ž																	
		-	-		-		-											
		-																
ō	>	1	1	1														
· · · ·																		

		D ED
DESCRIPTION	SEE SHEET NO.	CALCULATED RSH CHECKED MJR
ROADWAY		
	3	-
`ING		-
EROSION CONTROL		
		-
		~
PLAN INSPECTIONS		SUMMARY
INSPECTIONS INSPECTION SOFTWARE		M
		sur
PAVEMENT RSE, TYPE 1, (449), (UNDER GUARDRAIL), AS PER PLAN	3	
TRAFFIC CONTROL		GENERAL
TIONAL) T		U E
31, DESIGN 12		GE
TION		
ID DISPOSAL SIGN AND DISPOSAL		
UPPORT AND DISPOSAL URAL BEAM SUPPORT AND DISPOSAL		-
NOISE BARRIERS	15	-
	15	-
MAINTENANCE OF TRAFFIC DL CAR FOR ASSISTANCE		
AS PER PLAN	4	
	4	-
RVEYING		-
		03
		ΰ
		-76
		MAH-76-3.03
		Σ
		35