


# STATE OF OHIO DEPARTMENT OF TRANSPORTATION

## MAH-RIVER/McGAFFNEY/ JACKSON


VILLAGE OF LOWELLVILLE

MAHONING COUNTY

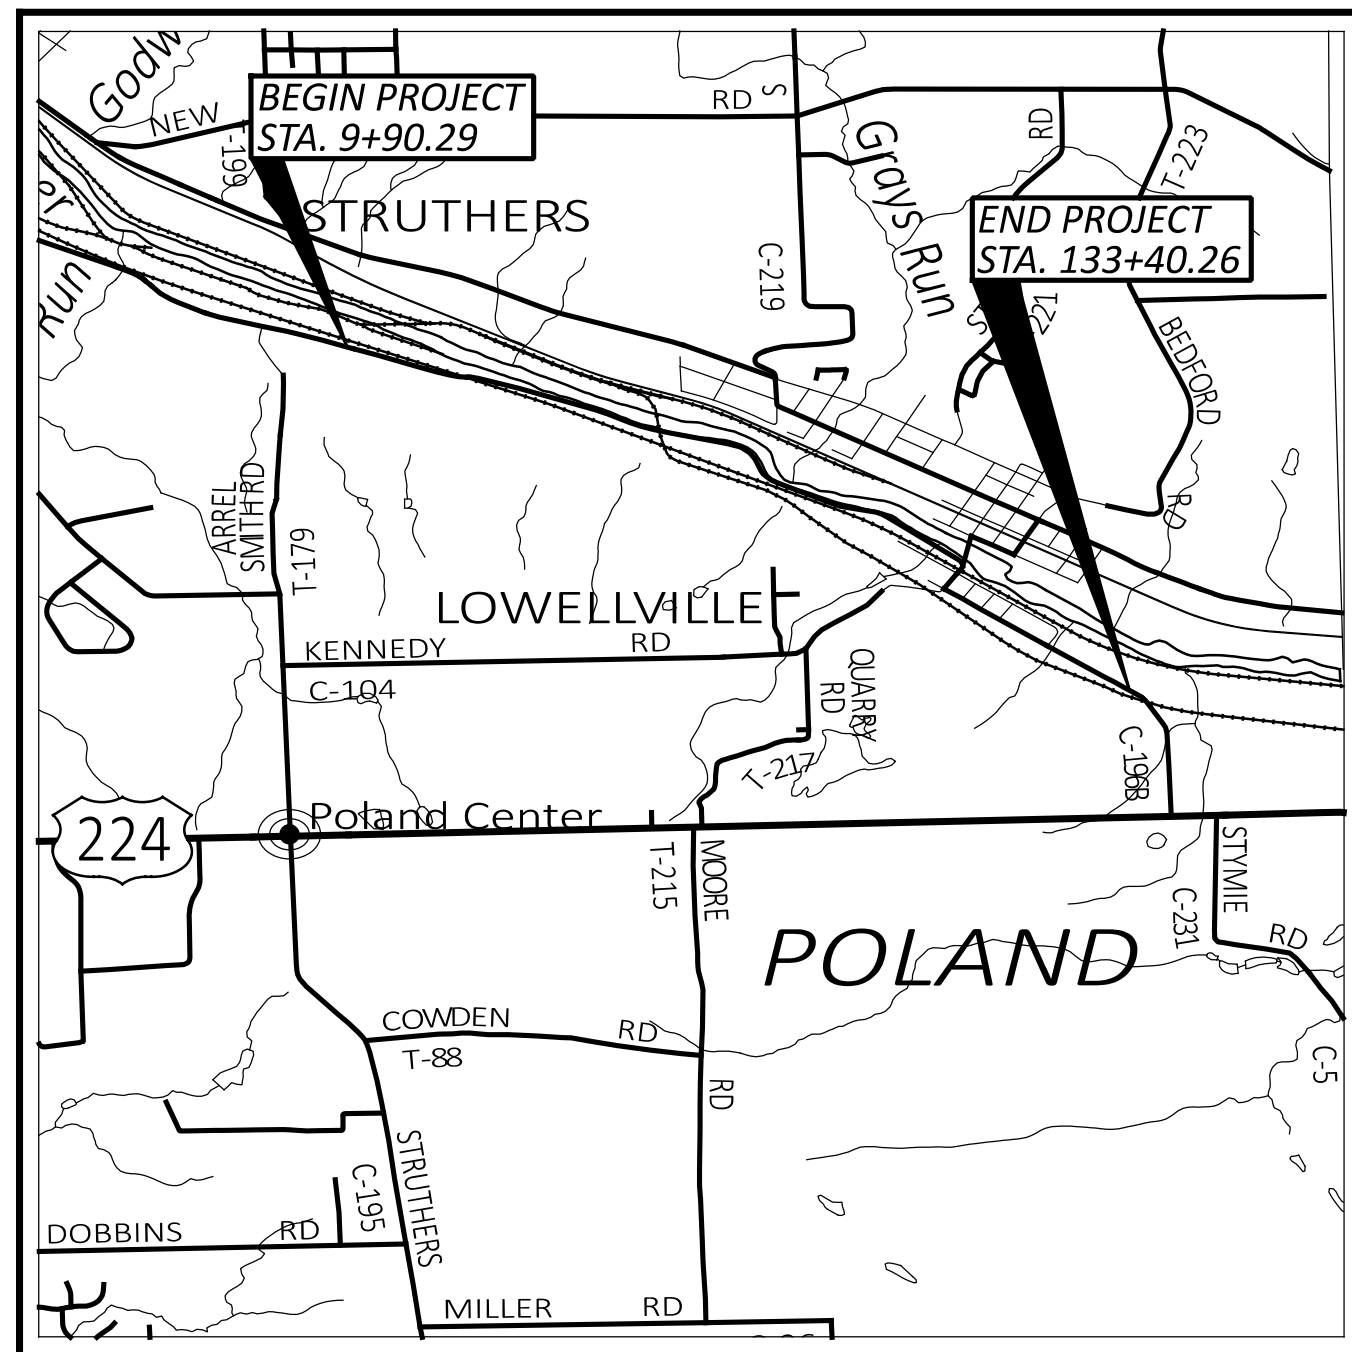

**LOCATION MAP**

LATITUDE: 41°02'26.46" N LONGITUDE: 80°32'27.95" W

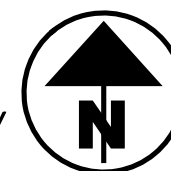

PORTION TO BE IMPROVED	
INTERSTATE HIGHWAY	
FEDERAL ROUTES	
STATE ROUTES	
COUNTY & TOWNSHIP ROADS	
OTHER ROADS	

<b>DESIGN DESIGNATION</b>	<b>RIVER</b>	<b>WASHINGTON</b>	<b>E. McGAFFNEY</b>	<b>JACKSON</b>
CURRENT ADT (2025) (FOR REFERENCE ONLY)	1217	1314	1314	803
DESIGN YEAR ADT (2045)	1344	1451	1451	887
DESIGN HOURLY VOLUME (2045)	122	131	131	81
DIRECTIONAL DISTRIBUTION	51%	53%	53%	52%
TRUCKS (24 HOUR B&C)	3%	3%	3%	4%
DESIGN SPEED	40 MPH	25 MPH	25 MPH	35 MPH
LEGAL SPEED	40MPH	25 MPH	25 MPH	35 MPH
DESIGN FUNCTIONAL CLASSIFICATION: RURAL MINOR ARTERIAL (RIVER), URBAN MINOR ARTERIAL (WASHINGTON, E. McGAFFNEY, JACKSON)				
NHS PROJECT	NO	NO	NO	NO

**DESIGN EXCEPTIONS**

NONE

**ADA DESIGN WAIVERS**

REQUIRED

**UNDERGROUND UTILITIES**  
Contact Two Working Days  
Before You Dig

**OHIO811. 8-1-1. or 1-800-362-2764**  
(Non members must be called directly)

PLAN PREPARED BY:  
CT CONSULTANTS, INC.  
8150 STERLING COURT  
MENTOR, OH 44060

**INDEX OF SHEETS:**

TITLE SHEET	1
SCHEMATIC PLAN	2-4
TYPICAL SECTIONS	5-7
GENERAL NOTES	8-9
MAINTENANCE OF TRAFFIC	10-11
GENERAL SUMMARY	12-13
SUBSUMMARIES	14-17
DRIVEWAY DETAILS	18
PLAN AND PROFILE - RIVER	19-29
PLAN AND PROFILE - WASHINGTON	30
PLAN AND PROFILE - E. McGAFFNEY	31-33
PLAN AND PROFILE - JACKSON	34-38
INTERSECTION AND CURB RAMP DETAILS	39-45
TRAFFIC CONTROL	46-50

**FEDERAL PROJECT NUMBER**

E220530

**RAILROAD INVOLVEMENT**

N/A

**PROJECT DESCRIPTION**

RESURFACING RIVER ROAD FROM THE WEST CORPORATION LINE TO WASHINGTON STREET, WASHINGTON STREET FROM RIVER ROAD TO EAST McGAFFNEY AVENUE, EAST McGAFFNEY AVENUE FROM WASHINGTON STREET TO McGAFFNEY AVENUE EXTENSION, AND JACKSON STREET FROM McGAFFNEY AVENUE EXTENSION TO THE EAST CORPORATION LINE. PROJECT INCLUDES MILL AND FILL, CURB REPLACEMENT, DRIVE APRON REPLACEMENT AND GUARDRAIL REPLACEMENT.

**EARTH DISTURBED AREAS**

PROJECT EARTH DISTURBED AREA:	MAINTENANCE PROJECT
ESTIMATED CONTRACTOR EARTH DISTURBED AREA:	MAINTENANCE PROJECT
NOTICE OF INTENT EARTH DISTURBED AREA:	N/A (NOI NOT REQUIRED)

**2023 SPECIFICATIONS**

THE STANDARD SPECIFICATIONS OF THE STATE OF OHIO, DEPARTMENT OF TRANSPORTATION, INCLUDING SUPPLEMENTAL SPECIFICATIONS LISTED IN THE PLANS, CHANGES LISTED IN THE PROPOSAL, AND THE SUPPLEMENTAL SPECIFICATION 800 VERSION INDICATED ON THE PROPOSAL SHALL GOVERN THIS IMPROVEMENT.

I HEREBY APPROVE THESE PLANS AND DECLARE THAT THE MAKING OF THIS IMPROVEMENT WILL NOT REQUIRE THE CLOSING TO TRAFFIC OF THE HIGHWAY AND THAT PROVISIONS FOR THE MAINTENANCE AND SAFETY OF TRAFFIC WILL BE SET FORTH ON THE PLANS AND ESTIMATES.

Arthur G. Noiro Jr., P.E.  
District 04 Deputy Director

Pamela Boratyn  
Director, Department of Transportation

STANDARD CONSTRUCTION DRAWINGS				SUPPLEMENTAL SPECIFICATIONS	SPECIAL PROVISIONS
BP-3.1	1/19/24	MT-97.12	1/20/17	800-2023	7/19/24
BP-4.1	7/19/13	MT-99.20	4/19/19	832	7/19/24
BP-5.1	7/15/22	MT-101.90	7/17/20	874	4/17/20
BP-7.1	7/19/24	MT-105.10	1/17/20	961	4/17/20
BP-9.2	1/15/21	MT-110.10	7/19/13		
DM-4.4	1/15/16	TC-41.20	10/18/13		
		TC-41.30	4/21/23		
MGS-1.1	7/16/21	TC-42.20	10/18/13		
MGS-2.1	1/19/18	TC-52.10	10/18/13		
MGS-4.1	1/20/17	TC-52.20	1/15/21		
MGS-4.2	7/19/13	TC-61.30	7/19/24		
		TC-64.10	7/21/23		
MT-96.11	7/21/23	TC-71.10	4/21/23		
MT-96.20	7/21/23	TC-74.10	7/21/23		
MT-97.10	4/19/19				

**ENGINEER'S SEAL**  
ROADWAY

MAH-RIVER/McGAFFNEY/JACKSON

MODEL: Sheet PAPER SIZE: 34x22 (in.) DATE: 2/24/2025 TIME: 10:23:12 AM USER: somogyf H:\2023\2315771\17379\400-Engineering\Roadway\Sheets\117379\_ST001.dgn

TITLE SHEET

DESIGN AGENCY	
DESIGNER	TLS
REVIEWER	JMP
PROJECT ID	117379
SHEET TOTAL	P.01   50