


MODEL: Sheet PAPER/SIZE: 34x22 (in.) DATE: 1/14/2026 TIME: 9:26:02 AM PLTDRV: OHDOT_PDF_Color_E+.pltdg PENTBL: OHDOT_PenC.tbl USER: mneider@msconsultants.com WORKSPACE: OHDOTCEV02 WORKSET: 121474 PRODUCT: OpenRoadsDesigner 24.00.00.205 p:\yohiodo-pw-bentley.com\ohiodo-pw-02\Documents\01 Active Projects\District 04\Mahoning_MSConsultants\Roadway\Sheets\121474_1_GT001.dgn

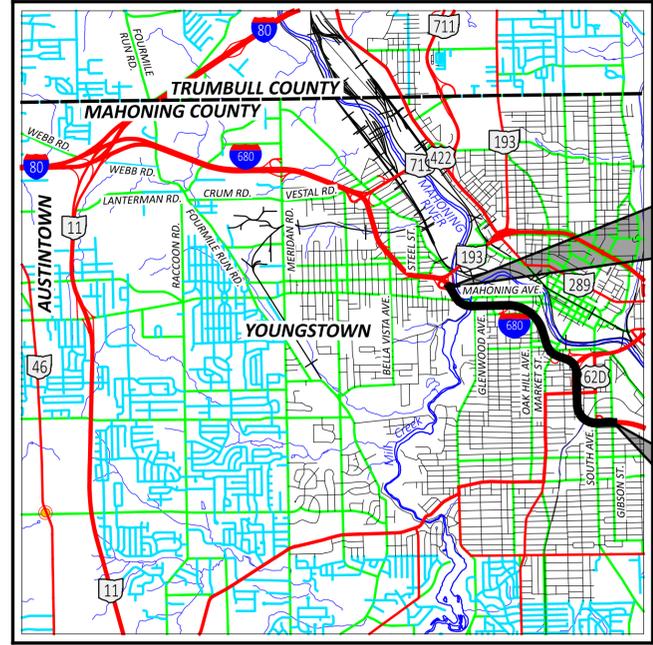

LOCATION MAP
LATITUDE: 41°07'35" N LONGITUDE: 80°44'50" W

- PORTION TO BE IMPROVED
- INTERSTATE HIGHWAY
- FEDERAL ROUTES
- STATE ROUTES
- COUNTY & TOWNSHIP ROADS
- OTHER ROADS

- DESIGN DESIGNATION
SEE SHEET P.2
- DESIGN EXCEPTIONS
SEE SHEET P.2
- ADA DESIGN WAIVERS
NONE REQUIRED

UNDERGROUND UTILITIES
Contact Two Working Days Before You Dig
OHIO811.org Before You Dig
OHIO811, 8-1-1, or 1-800-362-2764 (Non members must be called directly)

INDEX OF SHEETS:

Table listing various sheets including Title Sheet, Design Designation Data, Schematic Plan, Typical Sections, General Notes, Maintenance of Traffic, General Summary, Subsummaries, Project Site Plan, Plan and Profile (Mainline), Plan and Profile (Side Roads, Ramps, etc.), Cross Sections (Mainline), Cross Sections (Side Roads, Ramps, etc.), Superelevation Tables, Intersection, Ramp, and Terminal Details, Barrier Details, Storm Sewer Profiles, Underdrain Details, Drainage Details, Traffic Control, Lighting, Structures (Over 20 Foot Span), Fence Plans, and Geotechnical Profile.

STATE OF OHIO
DEPARTMENT OF TRANSPORTATION
MAH-680-4.58
PART 1
CITY OF YOUNGSTOWN
MAHONING COUNTY
FOR PART 2 SEE MAH-680-4.58

FEDERAL PROJECT NUMBER
E250327
RAILROAD INVOLVEMENT
NONE
PROJECT DESCRIPTION
THE PROJECT CONSISTS OF FULL DEPTH PAVEMENT REPLACEMENT OF MAHONING I.R. 680 FROM THE S.R. 193 INTERCHANGE (SLM-4.58) TO SOUTH OF THE SOUTH AVENUE INTERCHANGE (SLM-7.37), ALL INTERCHANGE RAMPS WITHIN THE CORRIDOR WILL BE RECONSTRUCTED, INCLUDING RAMPS TO AND FROM S.R. 193 AND U.S. 62/S.R. 7. INCLUDES BRIDGE WORK TO MAH-680-4.886 (SFN 5006872). THIS PROJECT ALSO INCLUDES THE REMOVAL OF THE MAHONING AVENUE ENTRANCE RAMP TO I.R. 680 SOUTHBOUND.
ADDITIONAL WORK INCLUDES GUARDRAIL AND CONCRETE BARRIER REPLACEMENT, ROADWAY DRAINAGE IMPROVEMENTS, SIDEWALK, CURB RAMPS, SIGNING, LIGHTING AND PAVEMENT MARKINGS.

EARTH DISTURBED AREAS
PROJECT EARTH DISTURBED AREA: 204.55 ACRES
ESTIMATED CONTRACTOR EARTH DISTURBED AREA: 1.00 ACRES
NOTICE OF INTENT EARTH DISTURBED AREA: 205.55 ACRES
NOTE: EARTH DISTURBED AREAS (EDA) REFLECT THE OVERALL TOTAL OF PROJECTS MAH-680.00 (PID 113321) AND MAH-680-4.58 (PID 121474). BMP DESIGN REFLECTED IN EACH CONSTRUCTION PLAN IS BASED ON THE EDA OF THE COMBINED PROJECTS.

LIMITED ACCESS
THIS IMPROVEMENT IS ESPECIALLY DESIGNED FOR THROUGH TRAFFIC AND HAS BEEN DECLARED A LIMITED ACCESS HIGHWAY OR FREEWAY BY ACTION OF THE DIRECTOR IN ACCORDANCE WITH THE PROVISIONS OF SECTION 5511.02 OF THE OHIO REVISED CODE.

2023 SPECIFICATIONS
THE STANDARD SPECIFICATIONS OF THE STATE OF OHIO, DEPARTMENT OF TRANSPORTATION, INCLUDING SUPPLEMENTAL SPECIFICATIONS LISTED IN THE PLANS AND CHANGES LISTED IN THE PROPOSAL SHALL GOVERN THIS IMPROVEMENT.

R3 01-13-2026, SUPPLEMENTAL SPECIFICATIONS 813 AND 913 ADDED

I HEREBY APPROVE THESE PLANS AND DECLARE THAT THE MAKING OF THIS IMPROVEMENT WILL NOT REQUIRE THE CLOSING TO TRAFFIC OF THE HIGHWAY EXCEPT FOR THE SIDE ROADS AS DESCRIBED ON SHEET P.52 AND THAT PROVISIONS FOR THE MAINTENANCE AND SAFETY OF TRAFFIC WILL BE AS SET FORTH ON THE PLANS AND ESTIMATES.

Arthur G. Noirot Jr., P.E.
District 04 Deputy Director
Pamela Boratyn
Director, Department of Transportation

PLAN PREPARED BY:
ms consultants, inc.
ENGINEERS, ARCHITECTS & PLANNERS
333 E. FEDERAL STREET
YOUNGSTOWN, OHIO 44503
PHONE (330) 744-5321



ENGINEER'S SEAL
LIGHTING 2LMN
STATE OF OHIO
EMILIE M. WORLEY
E-71927
PROFESSIONAL ENGINEER
ENGINEER'S SEAL
TRAFFIC CONTROL THOMAS FOK AND ASSOCIATES, INC.
STATE OF OHIO
STEPHEN D. LETTIERI
E-64079
PROFESSIONAL ENGINEER
ENGINEER'S SEAL
BRIDGE MAH-00680-04.886
ms consultants, inc.
STATE OF OHIO
WILLIAM EARL RUGGLES
E-69834
PROFESSIONAL ENGINEER
ENGINEER'S SEAL
ms consultants, inc.
STATE OF OHIO
CHARLES NASH
PE-91557
PROFESSIONAL ENGINEER

STANDARD CONSTRUCTION DRAWINGS table with columns for drawing ID, date, and description. Includes drawings like BP-2.1, BP-2.2, BP-3.1, etc., and their corresponding dates and descriptions.

SUPPLEMENTAL SPECIFICATIONS and SPECIAL PROVISIONS table. Lists specifications like 800-2023, 807, 809, 813, 825, 831, 832, 836, 850, 902, 905, 909, 913 and special provisions like ASBESTOS REPORT, SFN 5003350, SFN 5006864, SFN 5006872.

BENCHING OF FOUNDATION SLOPES

ALTHOUGH CROSS SECTIONS INDICATE SPECIFIC DIMENSIONS FOR PROPOSED BENCHING OF THE EMBANKMENT FOUNDATIONS IN CERTAIN AREAS, NO WAIVER OF THE SPECIFICATIONS IS INTENDED. BENCH ALL OTHER SLOPED EMBANKMENT AREAS AS SET FORTH IN 203.05 OF THE CONSTRUCTION AND MATERIAL SPECIFICATIONS (C&MS). NO ADDITIONAL PAYMENT WILL BE MADE FOR BENCHING REQUIRED UNDER THE PROVISIONS OF 203.05.

ITEM 619 FIELD OFFICE, TYPE C, AS PER PLAN

THIS WORK CONSISTS OF PROVIDING, MAINTAINING, AND SUBSEQUENTLY REMOVING A FIELD OFFICE FOR THE EXCLUSIVE USE OF THE DEPARTMENT FOR THE DURATION OF THE CONTRACT AT A LOCATION APPROVED BY THE ENGINEER.

FURNISH A COMPLETELY FUNCTIONAL FIELD OFFICE OF THE TYPE SPECIFIED IN THE CONTRACT PRIOR TO BEGINNING WORK.

THE FIELD OFFICE WILL BE A SUITE TYPE OFFICE (NO TRAILER OR MODULAR OFFICE) WITH A MINIMUM OF 2,500 SQUARE FEET AND AT GROUND LEVEL WITH A MINIMUM CEILING HEIGHT OF EIGHT (8) FEET. PROVIDE TWO (2) OUTSIDE DOORS, LOCKABLE VANDAL PROOF CYLINDER TYPE DEAD BOLTS AND LOCKABLE WINDOWS. THE FLOOR SPACE WILL BE DIVIDED INTO A RESTROOM, ONE GENERAL OFFICE AREA (MINIMUM 400 SQUARE FEET), NOT LESS THAN THREE INDIVIDUAL OFFICES (MINIMUM 300 SQUARE FEET EACH), AND ONE CONFERENCE ROOM (MINIMUM 500 SQUARE FEET), AS DEEMED NECESSARY BY THE ENGINEER.

FURNISH EACH FIELD OFFICE WITH A MEANS FOR MAINTAINING ROOM TEMPERATURE BETWEEN 68°F AND 80°F.

FURNISH ELECTRIC SERVICE FOR EACH FIELD OFFICE.

FURNISH NEAT, SANITARY, ENCLOSED TOILET ACCOMMODATIONS CONNECTED TO AN EXISTING SANITARY SEWER LINE FOR THE USE OF THE OCCUPANTS OF THE FIELD OFFICE, MEETING APPLICABLE STATE AND LOCAL CODES AND ORDINANCES. FURNISH ASSOCIATED LAVATORY AND SANITARY SUPPLIES. POTABLE HOT AND COLD RUNNING WATER WILL BE PROVIDED IN THE RESTROOM FOR SANITARY PURPOSES.

FURNISH TRASH COLLECTION SERVICE / DUMPSTER. FURNISH PROFESSIONAL, BONDED AND INSURED JANITORIAL SERVICE WITH A WEEKLY CLEANING OF THE ENTIRE OFFICE TO INCLUDE THE RESTROOM FACILITIES FOR THE DURATION OF THE PROJECT.

FURNISH BOTTLED DRINKING WATER SERVICE WITH A HOT AND COLD DISPENSER AND ASSOCIATED SUPPLIES.

PROVIDE A LOCKABLE WOOD OR METAL STORAGE BOX OF SUFFICIENT SIZE TO STORE A NUCLEAR DENSITY GAUGE AND AN ELECTRICAL CONNECTION FOR THE GAUGE. THE STORAGE BOX MUST BE AT LEAST 15 FEET FROM ANY OCCUPIED WORK AREA.

PROVIDE A BROADBAND INTERNET CONNECTION CAPABLE OF MINIMUM DOWNLOAD SPEEDS GREATER THAN 100 MBPS, UPLOAD SPEEDS GREATER THAN 30 MBPS, AND THE NETWORK LATENCY LESS THAN 50 MILLISECONDS. WHEN MULTIPLE BROADBAND SERVICES ARE AVAILABLE, THE FOLLOWING IS THE PREFERRED ORDER: CABLE, DSL, CELLULAR, AND WIRELESS RADIO. SATELLITE COMMUNICATION IS NOT COMPATIBLE WITH ODOT VPN CONNECTION AND WILL NOT BE ACCEPTED. SUPPLY ALL WIRING, ROUTERS, MODEMS (CAPABLE TO BE CONFIGURED IN BRIDGE MODE), SOFTWARE, AND INCIDENTALS NECESSARY TO CONNECT SIX (6) PERSONAL COMPUTERS, WEBCAM, TELEVISION AND MULTI-FUNCTION COPIER AT SEPARATE LOCATIONS, DESIGNATED BY THE PROJECT ENGINEER, THROUGHOUT THE OFFICE, TO THE SYSTEM.

PROVIDE THE FOLLOWING OFFICE FURNITURE AND EQUIPMENT:

1. ONE (1) TELEPHONE LINE WITH VOICEMAIL CAPABILITY AND ONE (1) PHONE WITH SPEAKER PHONE FOR CONFERENCE ROOM
2. ONE (1) CONFERENCE ROOM WEBCAM WITH SPEAKER FOR THE CONFERENCE ROOM WITH THE FOLLOWING SPECIFICATIONS:
 - a. RESOLUTION: 1080p
 - b. FRAME RATE: 30fps
 - c. AUDIO: 8-mic
 - d. PAN/TILT/ZOOM: AUTO, DIGITAL
 - e. FIELD OF VIEW: 360 degrees
 - f. COMPATIBLE WITH MICROSOFT TEAMS
 - g. ALL ACCESSORIES NECESSARY TO OPERATE
3. ONE MULTI-FUNCTION COLOR COPIER THAT IS SET UP FOR SCANNING, PRINTING, AND COPYING WITH THE FOLLOWING SPECIFICATIONS:
 - a. COLOR PRINT/COPY/SCAN
 - b. COPY/PRINT SPEED: 30 PPM (LETTER), 15 PPM (LEGAL), 15 PPM (LEDGER), OR HIGHER
 - c. DUPLEX PRINTING
 - d. AUTOMATIC DOCUMENT FEEDER WITH 50 SHEET DUPLEXING DOCUMENT FEEDER
 - e. COPIER MEMORY: 1 GB
 - f. INSTALLED HDD: 40 GB
 - g. DATA ENCRYPTION AND HDD ERASE SUPPORT INCLUDED WITH MACHINE
 - h. INTERNAL STAPLER
 - i. PAPER CAPACITY: 250 SHEET X 2 TRAYS, 50 SHEET BYPASS TRAY
 - j. NETWORK INTERFACE: ETHERNET PORT 10/100 BASE-TX, 1000 BASE-TX
 - k. COLOR SCANNING WITH THE FOLLOWING REQUIREMENTS:
 - i. RESOLUTION: UP TO 600 X 600 DPI
 - ii. SCAN AREA UP TO 11-1/2" X 17-1/2"
 - iii. SCANNING PROTOCOL SUPPORT - TCP/IP, SMTP, SMB, FTP, POP3, NCP
 - iv. FILE SCAN TYPES SUPPORTED: SINGLE PAGE TIFF, JPEG, PDF, MULTI-PAGE TIFF, PDF, AND OCR PDF
 - v. SCANNING SUPPORT FOR SCAN-TO-EMAIL, HDD, SMB (FOLDER), URL, AND TWAIN
 - l. NETWORK PROTOCOL SUPPORT FOR TCP/IP
 - m. SUPPORT KERBEROS AUTHENTICATION
 - n. SUPPORT TLS 1.2
 - o. SUPPORT SNMPv3
 - p. SUPPORTS AT LEAST THE BELOW WEB ENCRYPTION CIPHERS:
 - i. AES256-GCM-SHA384
 - ii. AES256-SHA256
 - iii. AES256-SHA
 - iv. AES128-GCM-SHA256
 - v. AES128-SHA256
 - vi. AES128-SHA
 - q. SUPPORTS FIPS 140 COMPLIANCE LIBRARY
 - r. CLIENT AND SERVER PRINT DRIVER SUPPORT FOR PCL PRINT DRIVERS
 - s. SERVER OPERATING SYSTEM SUPPORT FOR WINDOWS SERVER 2016 AND LATER (32 BIT/64BIT)
 - t. CLIENT PRINT DRIVER SUPPORT FOR WINDOWS 10 AND LATER (BOTH PCL/ (32 BIT/64 BIT))
 - u. MINIMUM PRINT/COPY RESOLUTION OF 600 X 600 DPI
 - v. PREFERRED PRINT UNIT: ONE OF THE FOLLOWING MFC MACHINES/SERIES:
 - i. M776dn - #T3U55A
 - ii. Flow M776z - #3WT91A
 - iii. Flow M776zs - #T3U56A
 - w. PROVIDE THE COPIER WITH ALL NECESSARY TONER, PAPER, AND MISCELLANEOUS SUPPLIES NECESSARY FOR ITS PROPER FUNCTION, AND A SERVICE CONTRACT WITH RESPONSE TIME OF 24 HOURS OR LESS FOR MAINTENANCE AND SUPPLIES OF THE COPY MACHINE.

4. EIGHT (8) DESK AND CHAIR SETS.
5. TEN (10) STACKABLE/FOLDABLE CHAIRS (CONFERENCE ROOM).
6. FOUR (4) WORKTABLES, 30" X 60"
7. FOUR (4) WORKTABLES, 30" X 72"
8. TWO (2), 4-DRAWER, LOCKABLE, LEGAL SIZE METAL FILING CABINETS.
9. THREE (3), 2-DRAWER, LOCKABLE, LEGAL SIZE METAL FILING CABINETS.
10. TWO (2) PORTABLE, TYPE 2-A:10-B:C, FIVE POUND SIZE FIRE EXTINGUISHERS.
11. THREE (3) PLAN RACKS, EACH CAPABLE OF HANDLING THE BREAKDOWN OF 22 X 34 INCH SIZED PLANS INTO TEN SECTIONS.
12. TWENTY (20) ALL-WEATHER PARKING SPACES.
13. EIGHT (8) 24-OUART WASTE BASKETS WITH APPROPRIATELY SIZED TRASH BAGS.

14. ONE (1) NEW LED TELEVISION (WALL MOUNTED IN CONFERENCE ROOM) WITH THE FOLLOWING SPECIFICATIONS:
 - a. DIAGONAL SCREEN SIZE - 55"
 - b. NATIVE RESOLUTION 4K(2160p)
 - c. HDMI PORTS 3
 - d. VIDEO INTERFACES - COMPOSITE, HDMI, USB
 - e. ALL ACCESSORIES NECESSARY TO OPERATE
 - f. ALL HARDWARE NECESSARY TO HANG TELEVISION ON THE WALL
- EXPENSES FOR THE OPERATION OF THE FIELD OFFICE TO INCLUDE BUT NOT BE LIMITED TO ELECTRICAL SERVICE, HEATING/COOLING, RUNNING SERVICE, SEWER SERVICE, TELEPHONE SERVICE, JANITORIAL SERVICE, BOTTLED WATER SERVICE, HIGH SPEED ONLINE SERVICE, ETC. WILL BE THE RESPONSIBILITY OF THE CONTRACTOR. THE CONTRACTOR WILL ALSO PROVIDE ALL NECESSARY SUPPLIES AND MAINTENANCE FOR ALL EQUIPMENT THAT THE CONTRACTOR IS REQUIRED TO FURNISH.

THE CONTRACTOR WILL RETAIN RESPONSIBILITY FOR RISK OF LOSS OR DAMAGE TO SAID FIELD OFFICE, FURNISHINGS, AND EQUIPMENT WHILE THE OFFICE IS IN USE FOR THIS CONTRACT.

THE FIELD OFFICE WILL BE APPROVED IN ADVANCE BY THE ENGINEER AND FULLY OPERATIONAL WITHIN 30 DAYS AFTER THE SIGNING AND EXECUTION OF THE CONTRACT OR PRIOR TO THE START OF ANY CONSTRUCTION WORK, WHICHEVER COMES FIRST.

THE DEPARTMENT WILL MEASURE FIELD OFFICE, TYPE C, AS PER PLAN BY THE NUMBER OF MONTHS THE OFFICE IS MAINTAINED. A PARTIAL MONTH AT THE END OF THE PROJECT WILL BE PAID AS A FULL MONTH.

THE DEPARTMENT WILL PAY FOR ACCEPTED QUANTITIES AT THE CONTRACT PRICE FOLLOWS:

ITEM	UNIT	DESCRIPTION
619	28 MONTH	FIELD OFFICE, TYPE C, AS PER PLAN

01-13-2026, QUANTITY REVISED R3

CONNECTION BETWEEN EXISTING AND PROPOSED GUARDRAIL

WHEN IT IS NECESSARY TO SPLICE PROPOSED GUARDRAIL TO EXISTING GUARDRAIL, ONLY THE EXISTING GUARDRAIL SHALL BE CUT, DRILLED, OR PUNCHED. THE CONNECTION SHALL BE MADE USING A W-BEAM, BEAM SPLICE AS SHOWN IN AASHTO M 180-12, EXCEPT THE BEAM WASHERS ARE NOT TO BE USED. PAYMENT SHALL BE INCLUDED IN THE CONTRACT PRICE FOR THE RESPECTIVE GUARDRAIL ITEMS.

ITEM SPECIAL - AS-BUILT CONSTRUCTION PLANS

PRIOR TO FINAL ACCEPTANCE OF THE WORK, THE CONTRACTOR SHALL FURNISH THE DEPARTMENT FORMAL AS-BUILT CONSTRUCTION PLANS. THE FORMAL AS-BUILT CONSTRUCTION PLANS SHALL INCLUDE ALL RED-LINED CHANGES. RED-LINE CHANGE SHALL BE DENOTED UTILIZING CLOUDING IN MICROSTATION (OR OTHER CAD SOFTWARE) OR CLOUDING IN PDF EDITING SOFTWARE. THE AS-BUILT CONSTRUCTION PLANS SHALL HAVE A SIGNED VERIFICATION ON THE TITLE SHEET FROM THE CONTRACTOR INDICATING THAT ALL RED-LINED AND FIELD CHANGES HAVE BEEN INCORPORATED INTO AS-BUILT CONSTRUCTION PLANS.

THE CONTRACTOR'S VERIFICATION STATEMENT INDICATES ALL KNOWN FIELD MODIFICATIONS MADE HAVE BEEN INCLUDED IN THE FORMAL AS-BUILT CONSTRUCTION PLANS. THE CONTRACTOR'S VERIFICATION STATEMENT SHALL BE SIGNED BY THE CONTRACTOR'S PROJECT MANAGER (OR ACCEPTABLE REPRESENTATIVE).

IN ADDITION TO THE INFORMATION SHOWN ON THE CONSTRUCTION PLANS, THE AS-BUILT CONSTRUCTION PLANS SHALL SHOW THE FOLLOWING:

1. ALL DEVIATIONS FROM THE ORIGINAL APPROVED CONSTRUCTION PLANS WHICH RESULT IN A CHANGE OF LOCATION, MATERIAL, TYPE OR SIZE OF WORK.
2. ANY UTILITIES, PIPES, WELLHEADS, ABANDONED PAVEMENTS, FOUNDATIONS OR OTHER MAJOR OBSTRUCTIONS DISCOVERED AND REMAINING IN PLACE WHICH ARE NOT SHOWN, OR DO NOT CONFORM TO LOCATIONS OR DEPTHS SHOWN IN THE PLANS. UNDERGROUND FEATURES SHALL BE SHOWN AND LABELED ON THE AS-BUILT CONSTRUCTION PLANS IN TERMS OF STATION, OFFSET AND ELEVATION.
3. THE FINAL OPTION AND SPECIFICATION NUMBER SELECTED FOR THOSE ITEMS WHICH ALLOW SEVERAL MATERIAL OPTIONS UNDER THE SPECIFICATION (E.G., CONDUIT).
4. CHANGES TO THE PAY ITEMS AND FINAL QUANTITIES AS PAID SHALL BE SHOWN ON THE GENERAL SUMMARY AND SUBSUMMARIES.
5. ADDITIONAL PLAN SHEETS MAY BE NEEDED IF NECESSARY TO SHOW WORK NOT INCLUDED IN THE CONSTRUCTION PLANS. IF ADDITIONAL PLAN SHEETS ARE NEEDED, THEY ARE REQUIRED TO BE PREPARED IN CONFORMANCE WITH THE LOCATION AND DESIGN MANUAL, VOLUME 3, SECTION 1200 - PLAN PREPARATION.

NOTATION SHALL ALSO BE MADE OF LOCATIONS AND THE EXTENT OF USE OF MATERIALS, OTHER THAN SOIL, FOR EMBANKMENT CONSTRUCTION (ROCK, BROKEN CONCRETE WITHOUT REINFORCING STEEL, ETC.).

THE PLAN INDEX SHALL SHOW THE PLAN SHEETS WHICH HAVE CHANGES APPEARING ON THEM.

TWO COPIES OF THE AS-BUILT CONSTRUCTION PLANS SHALL BE DELIVERED TO THE PROJECT ENGINEER FOR APPROVAL UPON COMPLETION OF THE PHYSICAL WORK BUT PRIOR TO THE REQUEST FOR FINAL PAYMENT. AFTER THE DEPARTMENT HAS APPROVED THE AS-BUILT CONSTRUCTION PLANS, THE ASSOCIATED ELECTRONIC FILES SHALL BE DELIVERED TO THE DISTRICT CAPITAL PROGRAMS ADMINISTRATOR. ACCEPTANCE OF THESE PLANS AND DELIVERY OF THE ASSOCIATED ELECTRONIC FILES IS REQUIRED PRIOR TO THE WORK BEING ACCEPTED AND THE FINAL ESTIMATE APPROVED.

PAYMENT FOR ALL THE ABOVE SHALL BE LUMP SUM UPON PROPER EXECUTION OF ALL WORK OF THIS ITEM AS DETERMINED BY THE PROJECT ENGINEER.

DRAINAGE (CONTINUED)

DRAINAGE DISCHARGE CONTINUANCE

FURNISH A DRAINAGE DISCHARGE CONTINUANCE FOR ANY DRAINAGE DISCHARGE DISTURBED BY THE WORK AND NOT SHOWN IN THE PLANS. THE LOCATION, TYPE (CONDUIT OR SWALE), SIZE AND GRADE OF THE DRAINAGE DISCHARGE CONTINUANCE WILL BE AGREED TO BY THE ENGINEER.

FURNISH AN INSPECTION WELL AT THE RIGHT OF WAY LINE IN PER STANDARD CONSTRUCTION DRAWING DM-3.1 FOR EACH DRAINAGE DISCHARGE THAT OUTLETS THROUGH A CURB OPENING OR INTO A STORM SEWER OR DRAINAGE STRUCTURE. THE COST IS INCLUDED IN ITEM 611, INSPECTION WELL.

FURNISH A WELL GRADED TRANSITION BETWEEN THE DITCH AND THE SWALE WHEN OUTLETTING A SWALE TO A DITCH. THE COST FOR THE GRADED TRANSITION IS INCLUDED IN ITEM 203, EMBANKMENT, AS PER PLAN.

FURNISH AN EROSION CONTROL PAD AS SHOWN IN STANDARD CONSTRUCTION DRAWING DM-1.1 WHEN OUTLETTING A CONDUIT TO A DITCH. THE COST FOR THE EROSION CONTROL PAD IS INCLUDED IN ITEM 611, CONDUIT, MISC TYPE F FOR DRAINAGE DISCHARGE CONTINUANCE.

FURNISH A DRILLED HOLE OR A CURB SECTION WHEN OUTLETTING A CONDUIT THROUGH A CURB OPENING. THE COST OF DRILLING OR FURNISHING THE CURB SECTION WITH HOLE IS INCLUDED IN ITEM 611, CONDUIT, MISC TYPE C FOR DRAINAGE DISCHARGE CONTINUANCE.

FURNISH A DRILLED CORE HOLE WHEN OUTLETTING INTO A STORM SEWER OR DRAINAGE STRUCTURE. THE COST OF THE DRILLED CORE HOLE IS INCLUDED IN ITEM 611, CONDUIT, MISC TYPE C FOR DRAINAGE DISCHARGE CONTINUANCE.

DOCUMENTATION

PROVIDE WRITTEN DOCUMENTATION TO THE ENGINEER AND TO THE DISTRICT R/W PERMIT OFFICE. THE DOCUMENTATION INCLUDES THE CONSTRUCTION PROJECT NUMBER, PID, COUNTY, ROUTE, SECTION, LATITUDE AND LONGITUDE OF THE DRAINAGE DISCHARGE AT THE R/W, THE NAME OF PROPERTY OWNER WITH ADDRESS, THE DATE THE DRAINAGE DISCHARGE WAS LOCATED, THE DATE THE DRAINAGE DISCHARGE CONTINUANCE WAS FURNISHED, A DETAILED DESCRIPTION OF THE WORK AND PICTURES OF THE DRAINAGE DISCHARGE CONTINUANCE (IN PDF OR JPEG FORMAT). THE DOCUMENTATION IS INCLUDED IN ITEM 611, CONDUIT, MISC TYPE C FOR DRAINAGE DISCHARGE CONTINUANCE OR ITEM 203, EMBANKMENT, AS PER PLAN

DRAINAGE DISCHARGE CONTINUANCE REMOVAL

THE ENGINEER MAY REQUIRE THE NEWLY INSTALLED DRAINAGE DISCHARGE CONTINUANCE TO BE REMOVED.

REMOVE THE NEWLY INSTALLED CONDUIT AND ANY EXISTING CONDUIT TO THE RIGHT OF WAY LINE. FOR CONDUIT THAT OUTLETS THROUGH THE CURB, RESTORE THE CURB BY FILLING THE HOLE WITH CLASS QC 1 CONCRETE OR REPLACE THE CURB SECTION. FOR CONDUIT THAT OUTLETS TO A STORM SEWER OR DRAINAGE STRUCTURE LEAVE 6 INCHES PROTRUDING OUTSIDE OF THE CONDUIT. PLUG THE PROTRUDING CONDUIT WITH EITHER A MANUFACTURED CAP OR CLASS QC 1 CONCRETE. FOR CONDUIT THAT OUTLETS TO THE DITCH REMOVE THE EROSION CONTROL PAD. RESTORE ALL AREAS AS REQUIRED. PLUG THE EXISTING CONDUIT REGARDLESS OF SIZE AT THE RIGHT OF WAY LINE WITH CLASS QC 1 CONCRETE AND RESTORE ALL AREAS AS REQUIRED. ALL COSTS ARE INCLUDED IN ITEM 202, REMOVAL MISC.: CONDUIT.

DRAINAGE DISCHARGE CONTINUANCE (CONTINUED)

DAM THE SWALE THAT OUTLETS TO THE DITCH AT THE R/W AS DIRECTED BY THE ENGINEER. ALL COSTS ARE INCLUDED IN ITEM 203, EMBANKMENT AS PER PLAN.

REMOVE THE INSPECTION WELL AND RESTORE ALL AREAS AS REQUIRED. THE COST IS INCLUDED IN ITEM 202, REMOVAL MISC.: INSPECTION WELL.

CONDUIT MATERIAL TYPES

THE FOLLOWING CONDUIT MATERIAL TYPES ARE PERMITTED: 707.33, 707.41 NONPERFORATED, 707.42, 707.43, 707.45, 707.46, 707.47 AND 707.51.

PAY ITEMS

EACH OF THE PAY ITEMS LISTED BELOW FOR CONDUIT MISCELLANEOUS TYPES B, C, E AND F FOR DRAINAGE DISCHARGE CONTINUANCE INCLUDE CONDUIT SIZES 2 INCH TO 10 INCH. THERE IS NO COST DIFFERENTIATION FOR SIZE IN THESE PAY ITEMS.

THE FOLLOWING ESTIMATED QUANTITIES HAVE BEEN INCLUDED IN THE GENERAL SUMMARY FOR USE AS DIRECTED BY THE ENGINEER IN MAKING THE ABOVE DRAINAGE DISCHARGE CONTINUANCE:

ITEM 611, INSPECTION WELL	2 EACH
ITEM 611, CONDUIT, MISC.: TYPE C FOR DRAINAGE DISCHARGE CONTINUANCE	10 FT.
ITEM 611, CONDUIT, MISC.: TYPE F FOR DRAINAGE DISCHARGE CONTINUANCE	5 FT.
ITEM 202, REMOVAL MISC.: CONDUIT	15 FT.
ITEM 202, REMOVAL MISC.: INSPECTION WELL	2 EACH
ITEM 203, EMBANKMENT, AS PER PLAN	19 CU.YD.

PIPE CONNECTIONS TO CORRUGATED METAL STRUCTURES

PROVIDE CONNECTIONS OF PROPOSED LONGITUDINAL DRAINAGE TO CORRUGATED METAL STRUCTURES BY MEANS OF A SHOP FABRICATED OR FIELD WELDED STUB ON THE STRUCTURE. FURNISH A STUB MEETING THE REQUIREMENTS OF 707 WITH A MINIMUM LENGTH OF 2 FEET AND A MINIMUM WALL THICKNESS OF 0.064 INCHES.

THE LOCATION AND ELEVATION OF THE STUB ARE TO BE CONSIDERED APPROXIMATE AND MAY BE ADJUSTED BY THE ENGINEER TO AVOID CUTTING THROUGH JOINTS IN THE STRUCTURE.

THOROUGHLY CLEAN AND REGALVANIZE OR OTHERWISE SUITABLY REPAIR THE FIELD WELDED JOINT, IF USED. MEET WELDING REQUIREMENTS OF 513.21.

PROVIDE A MASONRY COLLAR PER STANDARD CONSTRUCTION DRAWING DM-1.1, TO CONNECT THE LONGITUDINAL DRAINAGE TO THE STUB, WHEN PIPE OTHER THAN CORRUGATED METAL IS USED FOR THE LONGITUDINAL DRAINAGE.

PAYMENT FOR CUTTING INTO THE STRUCTURE AND PROVIDING THE CONNECTION DESCRIBED, IS INCLUDED IN THE CONTRACT PRICE FOR ITEM 611 OR 522.

ITEM 202 - MANHOLE ABANDONED, AS PER PLAN

THE CONTRACTOR SHALL ABANDON EXISTING MANHOLES WHERE INDICATED ON THE PLANS. STRUCTURES SHALL BE REMOVED TO A MINIMUM DEPTH OF 2 FEET BELOW THE FINISHED SUBGRADE. DO NOT DAMAGE PIPES THAT ARE TO REMAIN. CONNECT EXISTING PIPES WITH NEW PIPE THROUGH THE STRUCTURES. AFTER CONNECTING THE EXISTING PIPES AND REMOVING THE WALLS TO THE REQUIRED DEPTH, BACKFILL THE REMAINING CAVITIES ACCORDING TO 202.2. CAREFULLY HAND TAMP BACKFILL UNDER AND AROUND THE CONNECTING PIPE ACCORDING TO 202.2.

CROSSINGS AND CONNECTIONS TO EXISTING PIPES AND UTILITIES

WHERE PLANS PROVIDE FOR A PROPOSED CONDUIT TO BE CONNECTED TO, OR CROSS OVER OR UNDER AN EXISTING SEWER OR UNDERGROUND UTILITY, LOCATE THE EXISTING PIPES OR UTILITIES BOTH AS TO LINE AND GRADE BEFORE STARTING TO LAY THE PROPOSED CONDUIT.

IF IT IS DETERMINED THAT THE ELEVATION OF THE EXISTING CONDUIT, OR EXISTING APPURTENANCE TO BE CONNECTED, DIFFERS FROM THE PLAN ELEVATION OR RESULTS IN A CHANGE IN THE PLAN CONDUIT SLOPE, NOTIFY THE ENGINEER BEFORE STARTING CONSTRUCTION OF ANY PORTION OF THE PROPOSED CONDUIT WHICH WILL BE AFFECTED BY THE VARIANCE IN THE EXISTING ELEVATIONS.

IF IT IS DETERMINED THAT THE PROPOSED CONDUIT WILL INTERSECT AN EXISTING SEWER OR UNDERGROUND UTILITY IF CONSTRUCTED AS SHOWN ON THE PLAN, NOTIFY THE ENGINEER BEFORE STARTING CONSTRUCTION OF ANY PORTION OF THE PROPOSED CONDUIT WHICH WOULD BE AFFECTED BY THE INTERFERENCE WITH AN EXISTING FACILITY.

PAYMENT FOR ALL THE OPERATIONS DESCRIBED ABOVE IS INCLUDED IN THE CONTRACT PRICE FOR THE PERTINENT 611 CONDUIT ITEM.

TEMPORARY DRAINAGE ITEMS

TEMPORARY DRAINAGE ITEMS LABELED ON THE MAINTENANCE OF TRAFFIC PLAN ARE ITEMIZED ON THE MOT PLANS AND CARRIED TO THE GENERAL SUMMARY.

ITEM 611 - 12" CONDUIT, TYPE F, AS PER PLAN, 707.33

INCLUDED WITH THIS ITEM IS THE TEE/CLEANOUT THAT IS SHOWN ON THE PIPE PROFILE. THE TEE/CLEANOUT WILL BE THE SAME MATERIAL AS THE CONDUIT AND INCLUDE A CAP THAT IS FLUSH WITH THE GROUNDLINE.

ITEM 611 - 18" CONDUIT, TYPE F, AS PER PLAN, 707.33

INCLUDED WITH THIS ITEM IS THE TEE/CLEANOUT THAT IS SHOWN ON THE PIPE PROFILE. THE TEE/CLEANOUT WILL BE THE SAME MATERIAL AS THE CONDUIT AND INCLUDE A CAP THAT IS FLUSH WITH THE GROUNDLINE.

ITEM 620 - DELINEATOR, POST GROUND MOUNTED, AS PER PLAN

A GROUND POST MOUNTED DELINEATOR SHALL BE PLACED AT THE OUTLET OF THE UNDERDRAINS WHERE THE OUTLET IS NOT TO A DRAINAGE STRUCTURE (MANHOLE, CATCH BASIN, INLET, ETC.). THE COLOR OF THE REFLECTIVE SHEETING SHALL BE BLUE.

ITEM 202 - INLET ABANDONED, AS PER PLAN

THE CONTRACTOR SHALL ABANDON EXISTING INLETS WHERE INDICATED IN THE PLANS. THE CONTRACTOR SHALL REMOVE AND DISPOSE OF THE EXISTING INLET GRATE. THE CONTRACTOR SHALL REMOVE THE UPPER INLET BOX PORTION AND THE EXISTING BARRIER TO CONSTRUCTION JOINT LIMITS. THE CONTRACTOR SHALL SEAL THE EXISTING PIPE TO BE ABANDONED PER ITEM 202. THE CONTRACTOR SHALL BACKFILL THE CAVITY WITH LOW STRENGTH MORTAR (LSM) BACKFILL PER ITEM 613, AND REPLACE THE UPPER BOX PORTION OF THE INLET WITH QC1P CONCRETE. THE CONTRACTOR SHALL REPLACE THE REMOVED BARRIER WITH PROPOSED BARRIER.

ITEM 611 - CONDUIT, MISC.: 33" TYPE C

THE CONTRACTOR SHALL INSTALL 33" TYPE C STORM PIPE CONFORMING TO 706.02 - REINFORCED CONCRETE CIRCULAR PIPE

ITEM 611 - MANHOLE No. 3, BOLTED DOWN, AS PER PLAN

WHEN SPECIFIED, BOLTED DOWN MANHOLE COVERS SHALL BE PROVIDED AND THEIR COSTS SHALL BE INCLUDED IN THE PERTINENT 611 ITEM DESIGNATED, "BOLTED DOWN".

MATERIALS FURNISHED SHALL BE:
FOUR (4) EQUALLY SPACED HALF-INCH (1/2") STAINLESS STEEL HEX CAP SCREWS CONFORMING TO ASTM F-593, ALLOY GROUP 1

COUNTERSINKS, HOLES, THREADING, AND PLACEMENT SHALL BE DONE IN ACCORDANCE WITH THE CASTING MANUFACTURERS RECOMMENDATIONS AND METHODS.

ENSURE THE MANHOLE FRAME AND COVER ARE POSITIONED AS SHOWN IN THE PLANS AND THE LID IS PLACED OUTSIDE OF THE TRAVEL LANES.

EROSION CONTROL

SEEDING AND MULCHING



THE FOLLOWING QUANTITIES ARE PROVIDED TO PROMOTE GROWTH AND CARE OF PERMANENT SEEDED AREAS:

ITEM 659, SOIL ANALYSIS TEST	3 EACH
ITEM 659, TOPSOIL	25,442 CY
ITEM 659, SEEDING AND MULCHING	184,386 SY
ITEM 659, REPAIR SEEDING AND MULCHING	11,460 SY
ITEM 659, INTER-SEEDING	11,460 SY
ITEM 659, COMMERCIAL FERTILIZER	31.96 TONS
ITEM 659, LIME	47.36 ACRES
ITEM 659, WATER	1269 MGAL
ITEM 659, MOWING	515.71 MSF

APPLY SEEDING AND MULCHING TO ALL AREAS OF EXPOSED SOIL BETWEEN THE RIGHT-OF-WAY LINES AND WITHIN THE CONSTRUCTION LIMITS FOR AREAS OUTSIDE THE RIGHT-OF-WAY LINES COVERED BY WORK AGREEMENT OR SLOPE EASEMENT. QUANTITY CALCULATIONS FOR SEEDING AND MULCHING ARE BASED ON THESE LIMITS.

WATER QUALITY

POST CONSTRUCTION STORM WATER TREATMENT

THIS PLAN UTILIZES STRUCTURAL BEST MANAGEMENT PRACTICES (BMP's) FOR POST CONSTRUCTION STORM WATER TREATMENT.

VEGETATED BIOFILTER

THIS PLAN UTILIZES VEGETATED BIOFILTER(S) FOR POST CONSTRUCTION STORM WATER TREATMENT. PLACE ITEM 660 SODDING AS SHOWN IN THE PLANS TO ANY DISTURBED AREA ON THE SHOULDER AND FORESLOPE DRAINING TO A VEGETATED BIOFILTER. THE DITCH FOR EACH VEGETATED BIOFILTER IS TRAPEZOIDAL, AS SHOWN IN THE PLAN CROSS SECTIONS. PROVIDE ITEM 670 AS SPECIFIED IN THE PLANS.

DESIGN AGENCY



DESIGNER

DWH

REVIEWER

CMN 08/29/25

PROJECT ID

121474

SHEET TOTAL

P.50 | 655

ITEM 614 - MAINTAINING TRAFFIC

THIS ITEM SHALL CONSIST OF MAINTENANCE OF TRAFFIC ON EXISTING ROADWAYS AND RAMPS IN ACCORDANCE WITH THE OHIO MANUAL OF UNIFORM TRAFFIC CONTROL DEVICES FOR STREETS AND HIGHWAYS, CURRENT EDITION, LATEST REVISION, THE SPECIFICATIONS AND THE FOLLOWING:

- 1. A MINIMUM OF ONE ELEVEN FOOT LANE IN EACH DIRECTION SHALL BE MAINTAINED ON THE EXISTING, TEMPORARY OR COMPLETED PAVEMENT DURING CONSTRUCTION OF THE WORK.
2. THE CONTRACTOR SHALL INFORM THE DISTRICT OFFICE (330) 786-2208, EIGHTEEN (18) DAYS PRIOR TO THE BEGINNING OF WORK.
3. LANE RESTRICTIONS OR LANE REDUCTIONS SHALL NOT BE PERMITTED AFTER NORMAL WORKING HOURS.
4. TRUCK MOUNTED ATTENUATORS (TMA'S) SHALL BE USED AS SHOWN IN THE STANDARD CONSTRUCTION DRAWINGS.
5. UNDER NO CIRCUMSTANCES SHALL THE CONTRACTOR BE PERMITTED TO HAVE SUCCESSIVE WORK ZONES UNLESS THE DISTANCE BETWEEN THE DRUMS, BARRICADES OR CONES EXCEEDS TWO (2) MILES RURAL OR ONE [1] MILE URBAN.
6. FOR ROUTES NOT ON THE PERMITTED LANE CLOSURE CHART, ONLY DURING OFF-PEAK PERIODS (ie ANY PERIOD OTHER THAN 6-8AM AND 3-6PM) SHALL THE CONTRACTOR INSTALL AND SUBSEQUENTLY RESET ALL TRAFFIC CONTROL NECESSARY FOR THE WORK ZONE FOR EACH CONSTRUCTION PHASE.
7. A QUANTITY OF 500 CU. YDS. OF ITEM 614 ASPHALT CONCRETE FOR MAINTAINING TRAFFIC SHALL BE PROVIDED FOR USE IN MAINTAINING PAVEMENT, SHOULDERS AND OTHER LOCATIONS AS DIRECTED BY THE ENGINEER.
8. PRIOR TO OPENING TO TRAFFIC EACH LANE SHALL BE IN A SAFE, PASSABLE CONDITION.
9. THE CONTRACTOR SHALL INSTALL, MAINTAIN AND SUBSEQUENTLY REMOVE WORK ZONE MARKING SIGNS AND THEIR SUPPORTS WITHIN THE WORK LIMITS.
10. THE CONTRACTOR SHALL SET A WORK ZONE AT THE REQUEST OF THE ENGINEER TO ALLOW THE LAYOUT OF THE PARTIAL/FULL DEPTH PAVEMENT REPAIR AREAS.
11. TO ENSURE THAT WEIGHTED CHANNELIZERS WILL NOT BE BLOWN OVER OR DESPLACED BY WIND AND MOVING TRAFFIC, ALL WEIGHTED CHANNELIZERS UTILIZED ON INTERSTATES AND FREEWAYS SHALL BE FROM MANUFACTURERS ON THE OHIO DEPARTMENT OF TRANSPORTATION, OFFICE OF MATERIAL MANAGEMENT'S QUALIFIED PRODUCTS LIST (QPL) WHICH UTILIZE A MINIMUM OF A 30 POUND BALLAST.

TIME LIMITATIONS AND DISINCENTIVES

INTERIM CONSTRUCTION DATES AND THE ASSOCIATED DISINCENTIVE VALUE FOR EACH MAJOR CONSTRUCTION PHASE AND TEMPORARY TRAFFIC PATTERNS ARE LISTED HEREIN.

MAINTAINING TRAFFIC (SB TRAFFIC CROSSOVER) DURING PHASE 1A - STEP 2, I-680 SB TRAFFIC MAY BE CROSSED OVER ON TO THE EXISTING NB PAVEMENT AND ALL SB RAMPS CLOSED WITHIN THE LIMITS ESTABLISHED BY THIS PHASE. THE CONTRACTOR SHALL BE ASSESSED A DISINCENTIVE OF \$27,400 PER CALENDAR DAY FOR EACH DAY SB TRAFFIC REMAINS IN THE CROSSOVER CONDITION BEYOND OCTOBER 31, 2026.

MAINTAINING TRAFFIC (NB CLOSURE) I-680 NB AND ALL NB RAMPS WITHIN THE LIMITS OF THE CLOSURE ESTABLISHED IN PHASES 1A - STEP 2 AND 1B - STEP 1 MAY BE CLOSED. THE CONTRACTOR SHALL BE ASSESSED A DISINCENTIVE OF \$20,000 PER CALENDAR DAY FOR EACH DAY I-680 NB AND THE ASSOCIATED RAMPS REMAIN CLOSED BEYOND JUNE 18, 2027.

Table with 3 columns: ROAD OR RAMP CLOSURE, CLOSURE PERMITTED DURING PHASE, CLOSURE DISINCENTIVE (\$ PER CALENDAR DAY) OUTSIDE OF PERMITTED PHASE. Rows include Marshall St. to I-680 NB (Ramp G), E. Woodland Ave. to I-680 NB (Ramp N), U.S. 62/S.R. 7 to I-680 NB (Ramp BY), Silliman St. to I-680 SB (Ramp C), S.R. 193 to I-680 SB (Ramp C), Edwards St. to I-680 SB (Ramp H), I-680 SB to U.S. 62 EB/S.R. 7 NB (Ramp BX), I-680 SB Ramp to Edwards St. (Ramp F), I-680 SB Ramp to Market St. (Ramp K), I-680 NB to U.S. 62/S.R. 7 (Ramp NB), I-680 NB to South Ave. (Ramp D), South Ave. to I-680 NB (Ramp B), Powersdale Ave. to I-680 NB (Ramp F), I-680 SB to South Ave (Ramp A), South Ave. to I-680 SB (Ramp C), U.S. 62/S.R. 7 to I-680 SB (Ramp SB).

DETOUR NOTIFICATION

THE CONTRACTOR SHALL ADVISE THE ODOT PROJECT ENGINEER AND THE CITY OF YOUNGSTOWN EIGHTEEN (18) DAYS IN ADVANCE OF WHEN THE DETOUR ROUTE SHOULD BE IN EFFECT. ALL WORK ZONE DEVICES REQUIRED SHALL BE FURNISHED, ERECTED, MAINTAINED, AND SUBSEQUENTLY REMOVED BY THE CONTRACTOR. PAYMENT FOR ALL WORK ASSOCIATED WITH THE DETOUR SHALL BE INCLUDED UNDER THE LUMP SUM BID FOR ITEM 614, DETOUR SIGNING.

LANES OPEN DURING HOLIDAYS OR SPECIAL EVENTS

DURING MAINTENANCE OF TRAFFIC PHASE 1A THROUGH PHASE 2C, TRAFFIC SHALL BE PERMITTED TO REMAIN IN THE CONDITIONS PROPOSED BY THE DETOUR PLANS AND THE MAINTENANCE OF TRAFFIC PLANS DURING HOLIDAYS AND SPECIAL EVENTS. IF WORK IS PERFORMED DURING A HOLIDAY OR SPECIAL EVENT PERIOD, THE CONTRACTOR SHALL ENSURE THAT CONSTRUCTION VEHICLE TRAFFIC DOES NOT IMPEDE THE FLOW OF VEHICULAR TRAFFIC DURING THE HOLIDAY OR SPECIAL EVENT PERIODS AS LISTED BELOW:

Table with 2 columns: HOLIDAY/SPECIAL EVENT, CORRESPONDING PERMITTED LANE CLOSURE CHART. Includes New Year's (Observed), Memorial Day, Fourth of July (Observed), Gen./Reg. Election Day (Nov), Thanksgiving, Christmas (Observed), Labor Day.

DURING ALL PRE-PHASE WORK AND PHASE 3 WORK, THE PERIOD OF TIME THAT THE LANES ARE TO BE OPEN DEPENDS ON THE DAY OF THE WEEK ON WHICH THE HOLIDAY OR SPECIAL EVENT FALLS. THE FOLLOWING SCHEDULE SHALL BE USED TO DETERMINE THIS PERIOD:

Table with 2 columns: DAY OF HOLIDAY OR SPECIAL EVENT, TIME ALL LANES MUST BE OPEN TO TRAFFIC. Lists days from Sunday to Saturday with corresponding time windows.

DURING THE SAME PERIODS, MAINTAIN PEDESTRIAN ACCESS IF PEDESTRIAN ACCESS WAS PRESENT PRIOR TO CONSTRUCTION.

SHOULD THE CONTRACTOR FAIL TO MEET ANY OF THESE REQUIREMENTS, THE CONTRACTOR SHALL BE ASSESSED A DISINCENTIVE PER THE LANE VALUE CONTRACT (PN 127).

NOTICE OF CLOSURE SIGN

NOTICE OF CLOSURE SIGNS (W20-H13) SHALL BE ERECTED BY THE CONTRACTOR PRIOR TO THE SCHEDULED ROAD OR RAMP CLOSURE IN ACCORDANCE WITH THE NOTICE OF CLOSURE TIME TABLE BELOW.

THE SIGNS SHALL BE ERECTED ON THE RIGHT-HAND SIDE OF THE ROAD/RAMP FACING TRAFFIC. THEY SHALL BE PLACED SO AS NOT TO INTERFERE WITH THE VISIBILITY OF ANY OTHER TRAFFIC CONTROL SIGNS. ON ROADWAYS, THEY SHOULD BE ERECTED AT OR NEAR THE POINT OF CLOSURE. THE SIGNS MAY BE ERECTED ANYWHERE ON RAMPS AS LONG AS THEY ARE VISIBLE TO THE MOTORISTS USING THE RAMP. ON ENTRANCE RAMPS, THE SIGN SHALL BE ERECTED WELL IN ADVANCE OF THE MERGE AREA TO AVOID DISTRACTING MOTORISTS.

Table with 3 columns: ITEM, DURATION OF CLOSURE, SIGN DISPLAYED TO PUBLIC. Details sign requirements for Ramp & Road Closures based on duration.

THE SIGN SHALL DISPLAY THE DATE OF THE CLOSURE IN MMM-DD FORMAT AND THE NUMBER OF DAYS OF THE CLOSURE. THE LAST LINE OF THE W20-H13 SIGN LISTS A PHONE NUMBER WHICH A MOTORIST MAY CALL FOR ADDITIONAL INFORMATION. THIS IS TO BE A SPECIFIC OFFICE WITHIN THE DISTRICT (330-786-2208) RATHER THAN THE GENERAL SWITCHBOARD NUMBER.

LANE CLOSURE/REDUCTION REQUIRED

LENGTH OF LANE CLOSURES AND RESTRICTIONS SHALL BE AT THE APPROVAL OF THE ENGINEER. IT IS THE INTENT TO MINIMIZE THE IMPACT TO THE TRAVELING PUBLIC. LANE CLOSURES OR RESTRICTIONS OVER SEGMENTS OF THE PROJECT IN WHICH NO WORK IS ANTICIPATED WITHIN A REASONABLE TIME FRAME, AS DETERMINED BY THE ENGINEER, SHALL NOT BE PERMITTED.

DURATION OF LANE CLOSURES AND RESTRICTIONS SHALL BE AS PER THE PERMITTED LANE CLOSURE CHART. THE PERMITTED LANE CLOSURE CHART USED FOR THIS PROJECT SHALL BE THE MOST CURRENT CHART AVAILABLE ON THE DATE THIS PROJECT SELLS.

THE CHART CAN BE FOUND AT: https://www.transportation.ohio.gov/working/data-tools/resources/permitted-lane-closure

SHOULD THE CONTRACTOR FAIL TO MEET ANY OF THE REQUIREMENTS IN THE CHART, THE CONTRACTOR SHALL BE ASSESSED DISINCENTIVES IN THE AMOUNT OF \$2,500 PER HOUR OR PORTION THEREOF THAT THE LANE REDUCTION REMAINS BEYOND THE SPECIFIED LIMIT.

PERMITTED LANE CLOSURE SCHEDULE (PLCS)

LANE CLOSURE(S) SHALL CONFORM TO THE PLCS. PUBLISHED PLCS INFORMATION CAN BE FOUND ON THE ODOT WEBSITE.

THE MONTHLY PUBLISHED SCHEDULES REQUIRED TO BE USED, FOR EACH PLCS SEGMENT WITHIN THE PROJECT AREA, ARE THOSE THAT COMPRISE THE CONSECUTIVE 12-MONTH PERIOD BEGINNING 15 MONTHS PRIOR TO THE MONTH AND YEAR OF SALE AND ENDING 4 MONTHS PRIOR TO THE MONTH AND YEAR OF SALE. THESE SAME 12 MONTHS APPLY FOR THE LIFE OF THE PROJECT AND SHALL BE APPLIED TO EACH RESPECTIVE MONTH OF CONSTRUCTION (MONTH OF LANE CLOSURE(S) SHALL MATCH MONTH OF PLCS USED).

(FOR EXAMPLE: IF THE SALE DATE FOR THE PROJECT WAS MARCH OF 2021, THE MONTHLY PUBLISHED SCHEDULES FOR EACH APPLICABLE PLCS SEGMENT WOULD BE DECEMBER 2019 TO NOVEMBER 2020. IF THIS WAS A THREE-YEAR PROJECT, YEAR THREE WOULD STILL BE USING THE DECEMBER 2019 TO NOVEMBER 2020 MONTHLY SCHEDULES. IF THE PROJECT DESIRED TO CLOSE TWO LANES IN JUNE 2021, REFERENCE WOULD BE MADE TO THE JUNE 2020 SCHEDULE(S) FOR THE RESPECTIVE PLCS SEGMENT(S).

MORE RESTRICTIVE CHANGES TO THE ALLOWABLE LANE CLOSURE HOURS ARE AT THE DISCRETION OF THE ENGINEER IN ORDER TO COMPLY WITH THE TRAFFIC MANAGEMENT IN WORK ZONES POLICY (21-008(P)) AND STANDARD PROCEDURE (123-001(SP)).

LESS RESTRICTIVE CHANGES TO THE ALLOWABLE LANE CLOSURE HOURS ARE SUBJECT TO THE TRAFFIC MANAGEMENT IN WORK ZONES POLICY (21-008(P)) AND STANDARD PROCEDURE (123-001(SP)) AND SHALL NOT BE IMPLEMENTED UNTIL, AND UNLESS, APPROVED BY THE PROPER ODOT AUTHORITY. EXISTING MOT EXCEPTIONS THAT HAVE ALREADY BEEN APPROVED IN ACCORDANCE TO THE TRAFFIC MANAGEMENT IN WORK ZONES POLICY AND STANDARD PROCEDURE ARE DETAILED IN THE APPROVED MAINTENANCE OF TRAFFIC (MOT) POLICY EXCEPTION(S) PLAN NOTE.

ALLOWABLE LANE CLOSURE HOURS FOR FACILITIES NOT COVERED BY THE PLCS, IF ANY, SHALL BE AS SPECIFIED ELSEWHERE IN THE PLANS.

Design Agency: ms consultants, inc. Designer: KJF, Reviewer: KWR 06/02/25, Project ID: 121474, Sheet: P.52, Total: 655

SEQUENCE OF CONSTRUCTION

PHASE 1 (SHEETS P.80-P.114)

PHASE 1A - STEP 1

1. SHIFT I-680 NB & SB LANES AS SHOWN IN THE PLANS TO REMOVE THE EXISTING MEDIAN BARRIER AND INSTALL TEMPORARY PAVEMENT FOR THE CROSSOVERS AT THE NORTH AND SOUTH ENDS OF PHASE 1A.

PHASE 1A - STEP 2

SOUTHBOUND RAMPS CLOSED:

- SILLIMAN ST. TO I-680 SB (RAMP C)
- S.R. 193 TO I-680 SB (RAMP C)
- MAHONING AVE. TO I-680 SB (RAMP E)
- I-680 SB TO GLENWOOD/MAHONING AVE. (RAMP F)
- GLENWOOD/MAHONING AVE. TO I-680 SB (RAMP H)
- I-680 SB TO MARKET ST. SB (RAMP K)
- I-680 SB TO MARKET ST. NB (RAMP M)
- I-680 SB TO U.S. 62 EB /S.R. 7 NB (RAMP BX)

NORTHBOUND RAMPS CLOSED:

- I-680 NB TO S.R. 193 (RAMP B-3)
- I-680 NB TO SALT SPRINGS RD. (RAMP D)
- MARSHALL ST. TO I-680 NB (RAMP G)
- I-680 NB TO GLENWOOD/MAHONING AVE. (RAMP J)
- MARKET ST. TO I-680 NB (RAMP L)
- WOODLAND AVE. TO I-680 NB (RAMP N)
- U.S. 62 WB/S.R. 7 SB TO I-680 NB (RAMP BY)

1. CLOSE AND DETOUR NORTHBOUND I-680 USING U.S. 62, U.S. 422, AND S.R. 193.

2. CROSS THE TWO SOUTHBOUND LANES OF I-680 OVER TO THE NORTHBOUND LANES JUST SOUTH OF THE S.R. 193 INTERCHANGE.

3. CONSTRUCT THE I-680 SB LANES AND PROPOSED MEDIAN BARRIER. CONSTRUCT ALL SB EXIT AND ENTRANCE RAMPS. CONSTRUCT ALL PROPOSED PAVEMENT UP THROUGH THE INTERMEDIATE COURSE.

PHASE 1B - STEP 1

NORTHBOUND RAMPS CLOSED:

- I-680 NB TO S.R. 193 (RAMP B-3)
- I-680 NB TO SALT SPRINGS RD. (RAMP D)
- MARSHALL ST. TO I-680 NB (RAMP G)
- I-680 NB TO GLENWOOD/MAHONING AVE. (RAMP J)
- MARKET ST. TO I-680 NB (RAMP L)
- WOODLAND AVE. TO I-680 NB (RAMP N)
- U.S. 62 WB/S.R. 7 SB TO WOODLAND AVE. (RAMP CA)
- U.S. 62 WB/S.R. 7 SB TO I-680 NB (RAMP BY)

1. MAINTAIN I-680 NB CLOSURE AND DETOUR FROM PHASE 1A.

2. MAINTAIN I-680 SB TRAFFIC ON THE RECENTLY CONSTRUCTED SB LANES.

3. CONSTRUCT I-680 NB BETWEEN S.R. 193 AND U.S. 62 INCLUDING ALL NB EXIT AND ENTRANCE RAMPS. RAMP CA CONSTRUCTION WILL BEGIN AT STA. 14+00 IN ORDER TO MAINTAIN 2 LANES ON RAMP SB. CONSTRUCT ALL PROPOSED PAVEMENT UP THROUGH THE INTERMEDIATE COURSE. LEAVE A GAP IN THE PROPOSED BARRIER BETWEEN STA. 1034+50 AND STA. 1037+50 FOR FUTURE CROSSOVER USE.

WINTER SHUTDOWN SEASON 1

DURING THE WINTER MONTHS AFTER THE FIRST CONSTRUCTION SEASON, KEEP ALL TRAFFIC IN THE PHASE 1B - STEP 1 CONFIGURATION. CONTINUE WORK ON MAH-680-04.886 STRUCTURE.

PHASE 1B - STEP 1

1. TRAFFIC SHALL BE MAINTAINED ON I-680 AS SHOWN IN PHASE 1B - STEP 1.

2. ONCE THE WORK TO I-680 NB IS COMPLETE AND READY TO OPEN, REDUCE U.S. 62 WB/S.R. 7 SB TO ONE LANE IN ORDER TO CONSTRUCT THE REMAINING PORTION OF RAMP CA THAT WAS NOT BUILT IN PHASE 1B - STEP 1. ONCE WORK IS COMPLETE IN THIS AREA, OPEN UP TO TRAFFIC AND MOVE TO PHASE 2A - STEP 1.

PHASE 2 (SHEETS P.115-P.155)

PHASE 2A - STEP 1

1. SHIFT I-680 NB & SB LANES AS SHOWN IN THE PLANS TO REMOVE THE EXISTING MEDIAN BARRIER AND INSTALL TEMPORARY PAVEMENT FOR THE CROSSOVERS AT THE NORTH AND SOUTH END OF PHASE 2.

PHASE 2A - STEP 2

NORTHBOUND RAMPS CLOSED:

- I-680 NB TO U.S. 62/S.R. 7 (RAMP NB)
- SOUTH AVE. TO I-680 NB (RAMP B)
- I-680 NB TO SOUTH AVE. (RAMP D)
- POWERSDALE AVE. TO I-680 NB (RAMP F)

1. CROSS ONE NB I-680 LANE OVER TO THE SB I-680 PAVEMENT WHILE MAINTAINING THE OTHER NB I-680 LANE ON THE NB I-680 PAVEMENT.

2. CONSTRUCT THE OUTSIDE LANE(S) OF THE I-680 NB AND ALL NB ENTRANCE/EXIT RAMPS BETWEEN U.S. 62 AND THE END OF THE PROJECT. CONSTRUCT ALL PROPOSED PAVEMENT UP THROUGH THE INTERMEDIATE COURSE.

PHASE 2B

SOUTHBOUND RAMPS CLOSED:

- U.S. 62 WB/S.R. 7 SB TO I-680 SB (RAMP SB)
- I-680 SB TO SOUTH AVE. (RAMP A)
- SOUTH AVE. TO I-680 SB (RAMP C)

1. CROSS ONE SB I-680 LANE OVER TO THE NB I-680 PAVEMENT WHILE MAINTAINING THE OTHER SB I-680 LANE ON THE SB I-680 PAVEMENT.

2. CONSTRUCT THE OUTSIDE LANE(S) OF THE I-680 SB PAVEMENT BETWEEN U.S. 62 AND THE END OF THE PROJECT. CONSTRUCT ALL PROPOSED PAVEMENT UP THROUGH THE INTERMEDIATE COURSE.

PHASE 2C

1. SHIFT I-680 NB AND I-680 SB LANES TO THE OUTSIDE AND CONSTRUCT THE INSIDE LANES AND MEDIAN BARRIER FOR I-680. CONSTRUCT ALL PROPOSED PAVEMENT UP THROUGH THE INTERMEDIATE COURSE.

2. REBUILD THE MEDIAN BARRIER AT THE CROSSOVER LOCATIONS.

3. PHASE 2C WORK SHALL HAVE AN INTERIM COMPLETION DATE OF 10/31/2027.

INTERIM COMPLETION DATE

ALL LANES AND RAMPS SHALL BE OPEN TO UNRESTRICTED TRAFFIC NO LATER THAN 10/31/2027. THE CONTRACTOR SHALL BE ASSESSED A DISINCENTIVE IN THE AMOUNT OF \$10,000/DAY FOR EACH DAY THAT RAMPS OR LANES REMAIN RESTRICTED BEYOND THE INTERIM COMPLETION DATE.

PHASE 3 (NO SHEETS PROVIDED)

CONSTRUCT THE FINAL SURFACE COURSE, INCLUDING MILL AND OVERLAY FOR ALL THE RAMPS, FOR THE ENTIRE PROJECT AND INSTALL ALL FINAL PAVEMENT MARKINGS AND TRAFFIC CONTROL DEVICES UTILIZING ALLOWABLE LANE CLOSURES IN ACCORDANCE WITH THE PERMITTED LANE CLOSURE SCHEDULE (PLCS).

DRUM REQUIREMENTS

IN ADDITION TO THE REQUIREMENTS OF THE PLANS, SPECIFICATION AND PROPOSAL, DRUMS FURNISHED BY THE CONTRACTOR SHALL BE NEW AND UNUSED AT THE TIME OF ARRIVAL ON THE PROJECT. ANY DRUMS BROUGHT ON THE PROJECT, WHICH HAVE PREVIOUSLY BEEN USED ELSEWHERE, WILL NOT BE ACCEPTED.

PAYMENT FOR DRUMS SHALL BE INCLUDED IN THE LUMP SUM PRICE BID FOR MAINTAINING TRAFFIC UNLESS SEPARATELY ITEMIZED.

METHOD OF PAYMENT

ALL WORK AND TRAFFIC CONTROL DEVICES SHALL BE IN ACCORDANCE WITH C&MS 614 AND OTHER APPLICABLE PORTIONS OF THE SPECIFICATIONS, AS WELL AS THE OHIO MANUAL OF UNIFORM TRAFFIC CONTROL DEVICES. PAYMENT FOR ALL LABOR, EQUIPMENT AND MATERIALS SHALL BE INCLUDED IN THE LUMP SUM CONTRACT PRICE FOR ITEM 614, MAINTAINING TRAFFIC, UNLESS SEPARATELY ITEMIZED IN THE PLAN.

DUST CONTROL

THE CONTRACTOR SHALL FURNISH AND APPLY WATER FOR DUST CONTROL AS DIRECTED BY THE ENGINEER. THE FOLLOWING ESTIMATED QUANTITIES HAVE BEEN INCLUDED FOR DUST CONTROL PURPOSES:

ITEM 616 - WATER 160 M. GAL.

DESIGN AGENCY



DESIGNER

KJF

REVIEWER

KWR 06/02/25

PROJECT ID

121474

SHEET TOTAL

P.53 655

R3 01-13-2026, ADDED INTERIM COMPLETION DATE

SHEET NUMBER																	PART.	ITEM	ITEM	GRAND	UNIT	DESCRIPTION	SEE SHEET NO.	
P.45	P.47	P.48	P.49	P.50	P.74A	P.163	P.166	P.167	P.168	P.169	P.170	P.171	P.195	P.196	P.292	CALC	01/IMS	EXT	TOTAL					
LS																	LS	201	11001	LS		ROADWAY		
	27										147,232	68,455					215,714	202	23000	215,714	SY	CLEARING AND GRUBBING, AS PER PLAN	P.45	
											467						467	202	23500	467	SY	PAVEMENT REMOVED		
							5,660										5,660	202	30000	5,660	SF	WEARING COURSE REMOVED		
							284										312	202	30600	312	SY	WALK REMOVED		
		350															16,019	202	30700	16,019	FT	CONCRETE MEDIAN REMOVED		
						13,775	1,894										8,073	202	32000	8,073	FT	CONCRETE BARRIER REMOVED		
						977	7,096										10,864	202	35100	10,864	FT	CURB REMOVED		
								3,994	4,120	2,750							1,150	202	35200	1,150	FT	PIPE REMOVED, 24" DIAMETER AND UNDER		
								471	602	77							25,159	202	38000	25,159	FT	PIPE REMOVED, OVER 24" DIAMETER		
						10,871	14,288															GUARDRAIL REMOVED		
						1											1	202	47800	1	EACH	IMPACT ATTENUATOR REMOVED		
								13	11	2							26	202	58000	26	EACH	MANHOLE REMOVED		
								14	20	30							64	202	58100	64	EACH	CATCH BASIN REMOVED		
								16	17	8							41	202	58200	41	EACH	INLET REMOVED		
					3												3	202	58400	3	EACH	INLET ABANDONED		
					1			2	2								5	202	58401	5	EACH	INLET ABANDONED, AS PER PLAN	P.50	
									1								1	202	58701	1	EACH	MANHOLE ABANDONED, AS PER PLAN	P.50	
								176	139								315	SPECIAL	20270000	315	FT	FILL AND PLUG EXISTING CONDUIT	P.49	
													21,010	10,831			31,841	202	75000	31,841	FT	FENCE REMOVED		
				2													2	202	98100	2	EACH	REMOVAL MISC.: INSPECTION WELL	P.50	
				15													15	202	98200	15	FT	REMOVAL MISC.: CONDUIT	P.50	
	47		7,140														35,422	203	10000	42,609	CY	EXCAVATION		
	560																11,102	203	20000	11,662	CY	EMBANKMENT		
				19													19	203	20001	19	CY	EMBANKMENT, AS PER PLAN	P.50	
																		72,634	204	10000	72,634	SY	SUBGRADE COMPACTION	



01-13-2026 QUANTITIES REVISED

GENERAL SUMMARY



DESIGNER MSN
 REVIEWER
 PROJECT ID CMN 08/29/25
 SHEET TOTAL P.156 655

SHEET NUMBER														PART.	ITEM	ITEM	GRAND	UNIT	DESCRIPTION	SEE SHEET NO.
P.47	P.49	P.50	P.51	P.178	P.179	P.180	P.181		P.192	P.193	P.194	P.197		01/IMS	EXT	TOTAL				
	8								80					88	601	21050	88	SY	EROSION CONTROL TIED CONCRETE BLOCK MAT WITH TYPE 1 UNDERLAYMENT	
										142				142	601	32000	142	CY	ROCK CHANNEL PROTECTION, TYPE A WITH FILTER	
25				5	3						161			186	601	32100	186	CY	ROCK CHANNEL PROTECTION, TYPE B WITH FILTER	
		3												8	601	32200	8	CY	ROCK CHANNEL PROTECTION, TYPE C WITH FILTER	
														3	659	00100	3	EACH	SOIL ANALYSIS TEST	
		25,442												25,442	659	00300	25,442	CY	TOPSOIL	
1,670	43,147	184,386												229,203	659	10000	229,203	SY	SEEDING AND MULCHING	
		11,460												11,460	659	14000	11,460	SY	REPAIR SEEDING AND MULCHING	
		11,460												11,460	659	15000	11,460	SY	INTER-SEEDING	
		31.96												31.96	659	20000	31.96	TON	COMMERCIAL FERTILIZER	
		47.36												47.36	659	31000	47.36	ACRE	LIME	
		1,269												1,269	659	35000	1,269	MGAL	WATER	
		515.71												515.71	659	40000	515.71	MSF	MOWING	
												10,836		10,836	660	25000	10,836	SY	SODDING STAKED	
										6,001	3,353	4,518		13,872	670	00720	13,872	SY	DITCH EROSION PROTECTION MAT, TYPE B	
														LS	832	15000	LS		STORM WATER POLLUTION PREVENTION PLAN	
														LS	832	15002	LS		STORM WATER POLLUTION PREVENTION INSPECTIONS	
														LS	832	15010	LS		STORM WATER POLLUTION PREVENTION INSPECTION SOFTWARE	
														350,000	832	30000	350,000	EACH	EROSION CONTROL	
										1,540				1,540	836	10000	1,540	SY	SEEDING AND EROSION CONTROL WITH TURF REINFORCING MAT, TYPE 1	
																			ENVIRONMENTAL / REMEDIATION	
			210											210	SPECIAL	69065016	210	TON	WORK INVOLVING PETROLEUM CONTAMINATED SOIL	P.51
			100											100	SPECIAL	69065022	100	GAL	WORK INVOLVING NON-REGULATED WATER	P.51
			100											100	SPECIAL	69065024	100	GAL	WORK INVOLVING REGULATED WATER	P.51
																			DRAINAGE	
				1.5	1.5	0.3	0.6							3.9	602	20000	3.9	CY	CONCRETE MASONRY	
	25													80,824	605	11110	80,824	FT	6" SHALLOW PIPE UNDERDRAINS WITH GEOTEXTILE FABRIC	
														25	605	13300	25	FT	6" UNCLASSIFIED PIPE UNDERDRAINS	
	300													47,144	605	14020	47,144	FT	6" BASE PIPE UNDERDRAINS WITH GEOTEXTILE FABRIC	
														3,056	611	01500	3,056	FT	6" CONDUIT, TYPE F	
														309	611	04400	309	FT	12" CONDUIT, TYPE B	
														65	611	04400	65	FT	12" CONDUIT, TYPE B, 706.02	
														9	611	04400	9	FT	12" CONDUIT, TYPE B, 707.45	
														46	611	04600	46	FT	12" CONDUIT, TYPE C	
														46	611	05201	46	FT	12" CONDUIT, TYPE F, AS PER PLAN, 707.33	P.50
														6,356	611	05900	6,356	FT	15" CONDUIT, TYPE B	
														1,889	611	06100	1,889	FT	15" CONDUIT, TYPE C	
														18	611	06100	18	FT	15" CONDUIT, TYPE C, 706.02	
														5	611	06100	5	FT	15" CONDUIT, TYPE C, 706.08	
														43	611	06100	43	FT	15" CONDUIT, TYPE C, 707.33	
														1,224	611	07400	1,224	FT	18" CONDUIT, TYPE B	
														14	611	07400	14	FT	18" CONDUIT, TYPE B, 706.02	
														65	611	07600	65	FT	18" CONDUIT, TYPE C	
														217	611	08201	217	FT	18" CONDUIT, TYPE F, AS PER PLAN, 707.33	P.50
														2,274	611	10400	2,274	FT	24" CONDUIT, TYPE B	
														287	611	10600	287	FT	24" CONDUIT, TYPE C	
														10	611	11900	10	FT	27" CONDUIT, TYPE B	
														99	611	13400	99	FT	30" CONDUIT, TYPE B	
														485	611	16400	485	FT	36" CONDUIT, TYPE B	
														318	611	96600	318	FT	CONDUIT, BORED OR JACKED, 30" TYPE B	
		10												10	611	97400	10	FT	CONDUIT, MISC.: TYPE C FOR DRAINAGE DISCHARGE CONTINUANCE	P.50
		5												5	611	97400	5	FT	CONDUIT, MISC.: TYPE F FOR DRAINAGE DISCHARGE CONTINUANCE	P.50
														5	611	97400	5	FT	CONDUIT, MISC.: 33" TYPE C, 706.02	P.50
														1	611	98150	1	EACH	CATCH BASIN, NO. 3	
														21	611	98180	21	EACH	CATCH BASIN, NO. 3A	

R3 01-13-2026, QUANTITIES REVISED

GENERAL SUMMARY

DESIGN AGENCY

 ms consultants inc.
 DESIGNER
MSN
 REVIEWER
CMN 08/29/25
 PROJECT ID
121474
 SHEET TOTAL
P.158 655

SHEET NUMBER														PART.	ITEM	ITEM	GRAND	UNIT	DESCRIPTION	SEE SHEET NO.	
P.48	P.173	P.177	P.428	P.467	P.468	P.469	P.470	P.471	P.472	P.473	P.474			01/IMS	EXT	TOTAL					
																				PAVEMENT (CONT.)	
	367	276													643	609	24510	643	FT	CURB, TYPE 4-C	
		6,388													6,388	609	26000	6,388	FT	CURB, TYPE 6	
		369													369	609	72000	369	SY	CONCRETE MEDIAN	
															9.73	618	40600	9.73	MILE	RUMBLE STRIPS, SHOULDER (ASPHALT CONCRETE)	
																				LIGHTING	
					66	56	32								154	625	00450	154	EACH	CONNECTION, FUSED PULL APART	
					33	28	16								77	625	00460	77	EACH	CONNECTION, UNFUSED PULL APART	
					24	24	3								51	625	00470	51	EACH	CONNECTION, UNFUSED BOLTED	
					33	54	27								114	625	00480	114	EACH	CONNECTION, UNFUSED PERMANENT	
					33	28	16								77	625	10494	77	EACH	LIGHT POLE, LOW MAST, 50'	
2															2	625	10503	2	EACH	LIGHT POLE (INSTALLATION ONLY), AS PER PLAN	P.54
					1	3									4	625	12200	4	EACH	LIGHT TOWER, BBB100	
					10	8	11								29	625	14200	29	EACH	LIGHT POLE FOUNDATION, 24" X 10' DEEP	
2					23	20	5								50	625	14306	50	EACH	MEDIAN LIGHT POLE FOUNDATION, 10' DEEP	
					1	3									4	625	15200	4	EACH	LIGHT TOWER FOUNDATION, 36" X 25' DEEP	
							2								2	625	18000	2	EACH	BRACKET ARM, 10'	
168					5,940	5,040	3,150	24,612	20,631	4,356					49,599	625	23200	49,599	FT	NO. 4 AWG 2400 VOLT DISTRIBUTION CABLE	
								1,938	2,464	2,221					14,298	625	23400	14,298	FT	NO. 10 AWG POLE AND BRACKET CABLE	
															6,623	625	24320	6,623	FT	1-1/2" DUCT CABLE WITH THREE NO. 4 AWG 2400 VOLT CABLES	
															1,370	625	25400	1,370	FT	CONDUIT, 2", 725.04	
								5,762	4,805	1,247					11,814	625	25408	11,814	FT	CONDUIT, 2", 725.051	
								1,782	951	125					2,858	625	25500	2,858	FT	CONDUIT, 3", 725.04	
								85	332						417	625	25906	417	FT	CONDUIT, JACKED OR DRILLED, 725.051, 3"	
								444	162						606	625	25911	606	FT	CONDUIT CLEANED AND CABLES REMOVED, AS PER PLAN	P.467
															12	625	26262	12	EACH	LUMINAIRE, HIGH MAST, SOLID STATE (LED), 447-480W, TYPE V, 69K-72K LUMENS	P.467
															29	625	26272	29	EACH	LUMINAIRE, LOW MAST, SOLID STATE (LED), 330-381W, TYPE III, 40K-45K LUMENS	P.467
															50	625	26272	50	EACH	LUMINAIRE, LOW MAST, SOLID STATE (LED), 308-330W, TYPE V, 49K-51K LUMENS	P.467
2															2	625	27561	2	EACH	LUMINAIRE, INSTALLATION ONLY, AS PER PLAN	P.54
								2,745	3,245	2,256					8,931	625	29000	8,931	FT	TRENCH	
															1	625	29900	1	EACH	JUNCTION BOX	
															16	625	29930	16	EACH	MEDIAN JUNCTION BOX	
															32	625	30700	32	EACH	PULL BOX, 725.08, 18"	
															6	625	30706	6	EACH	PULL BOX, 725.08, 24"	
												15			15	625	31510	15	EACH	PULL BOX REMOVED	
			25		35	34	16								110	625	32000	110	EACH	GROUND ROD	
								1							1	625	33000	1	EACH	STRUCTURE GROUNDING SYSTEM	
								2	2						4	625	34001	4	EACH	POWER SERVICE, AS PER PLAN	P.467
								2	2						4	625	34450	4	EACH	CONTROL CENTER CABINET, COMPLETE	
								2,745	3,245	2,256					8,246	625	36011	8,246	FT	UNDERGROUND WARNING/MARKING TAPE, AS PER PLAN	P.467
															3	625	39520	3	EACH	PULL BOX CLEANED	
				LS											LS	SPECIAL	62540000	LS		MAINTAIN EXISTING LIGHTING	P.467
				10											10	SPECIAL	62540010	10	EACH	REPLACEMENT OF EXISTING LIGHTING UNIT	P.467
												8			8	625	75350	8	EACH	LIGHT TOWER REMOVED	
2												82			82	625	75400	82	EACH	LIGHT POLE REMOVED	
															2	625	75410	2	EACH	LIGHT POLE REMOVED FOR REUSE	
												82			82	625	75500	82	EACH	LIGHT POLE FOUNDATION REMOVED	
												8			8	625	75540	8	EACH	LIGHT TOWER FOUNDATION REMOVED	
1				4											1	625	75800	1	EACH	DISCONNECT CIRCUIT	
															4	625	76000	4	EACH	ARC FLASH CALCULATIONS AND LABEL, CONTROL CENTERS GW, WA, DA & GA	
															2	632	70200	2	EACH	CONDUIT RISER, 1" DIAMETER	
															2	632	89300	2	EACH	WOOD POLE	
															34	809	00530	34	EACH	ITS JUNCTION BOX, 17x24x6 INCHES	
															11	809	01900	11	EACH	ITS PULL BOX WITH PAD AND STANDARD LID ASSEMBLY, 32" WIDE, TYPE 1	
															12,810	809	23900	12,810	FT	CONDUIT, 2" DIAMETER, HDPE	

R3

3 9

R3







R3 01-13-2026, QUANTITIES AND DESCRIPTIONS REVISED, SHEET REFERENCE NO'S. ADDED

GENERAL SUMMARY

DESIGN AGENCY

 ms consultants inc.
 DESIGNER
MSN
 REVIEWER
CMN 08/29/25
 PROJECT ID
121474
 SHEET TOTAL
P.160 655

MAH-680-4.58
 MODEL: 08/18/2024 09:04:00 (Sheet) 12/17/2024 TIME: 14:02:14 PM PLOT: 0/0000 PERFILE: 0/0000 USER: D:\Users\mcc@msiconsultants.com\Documents\121474\PROJECT\OpenRoadsDesign\24.00.02.25
 p:\Users\mcc@msiconsultants.com\Documents\121474\PROJECT\OpenRoadsDesign\24.00.02.25

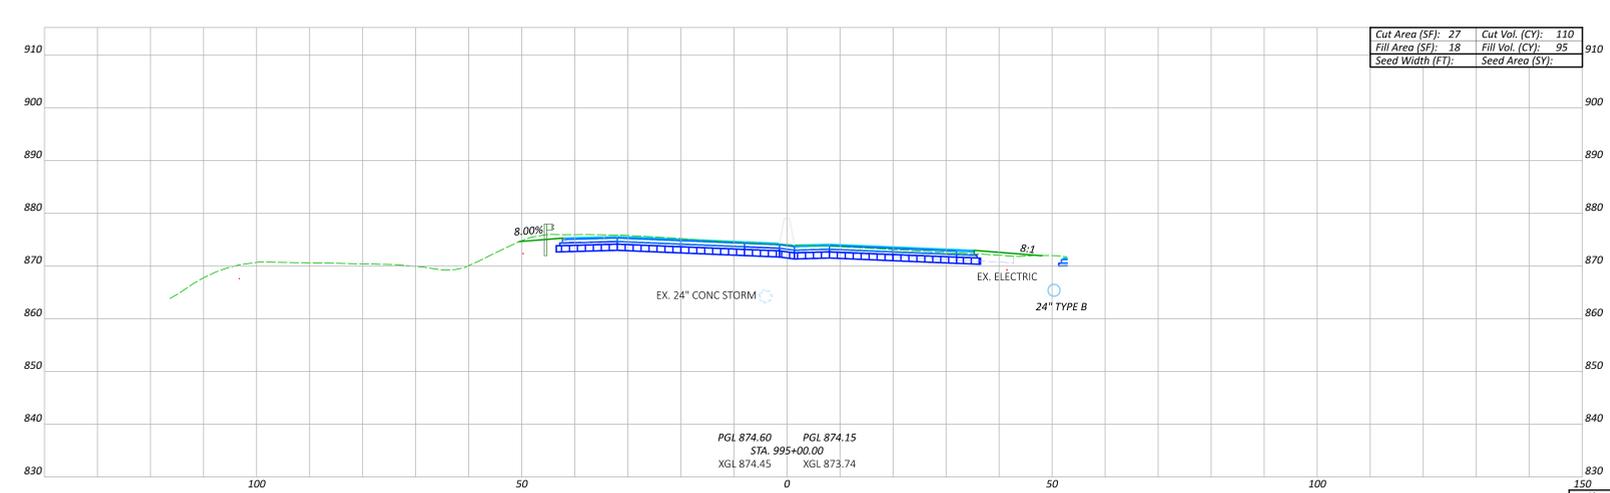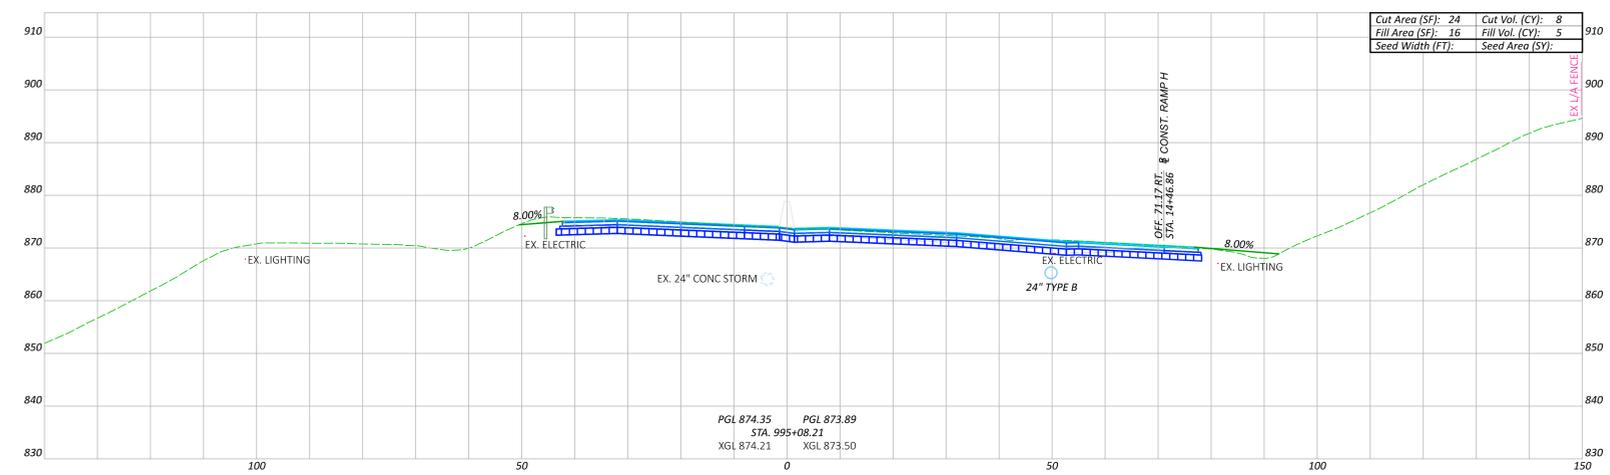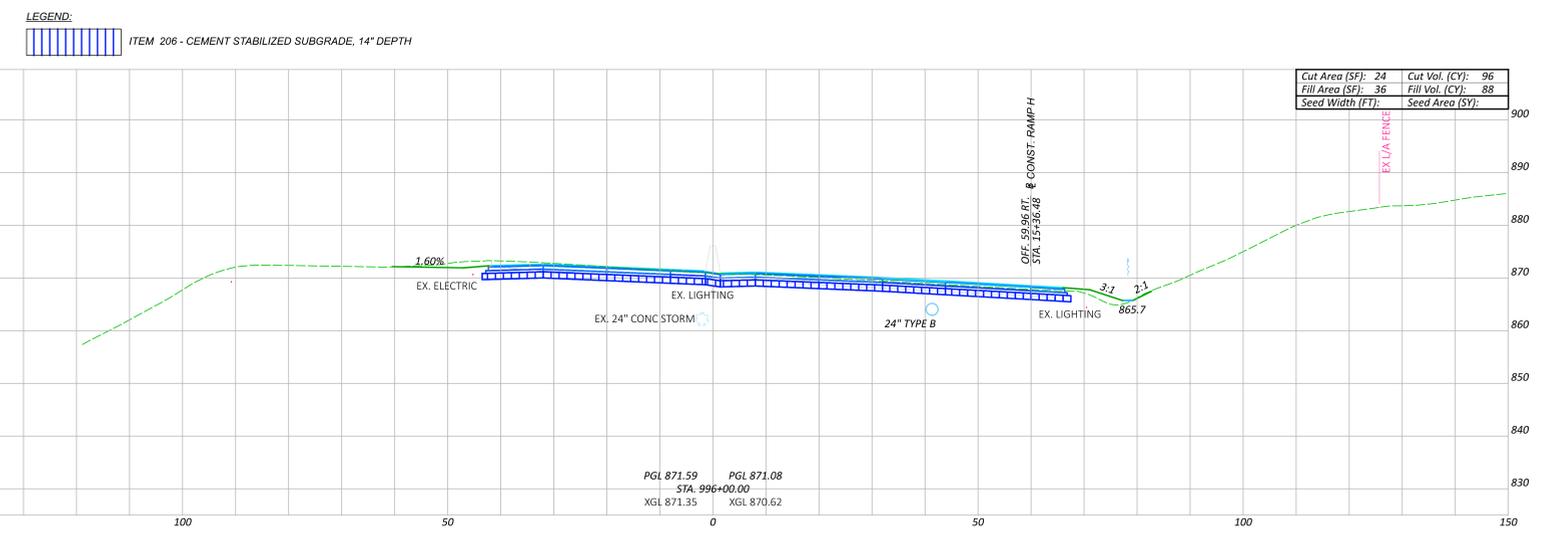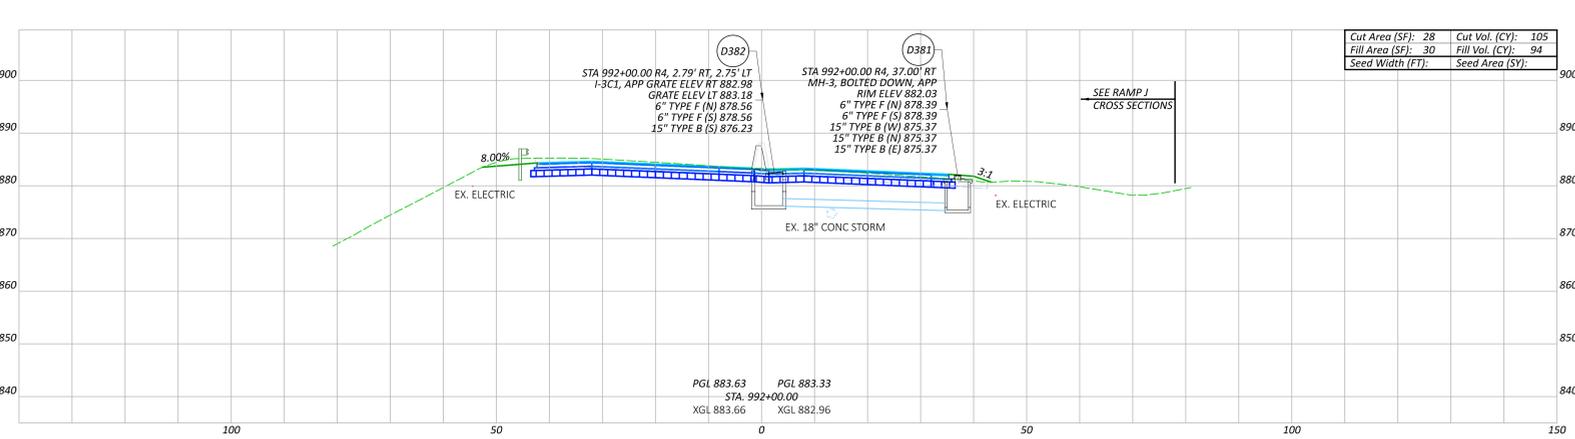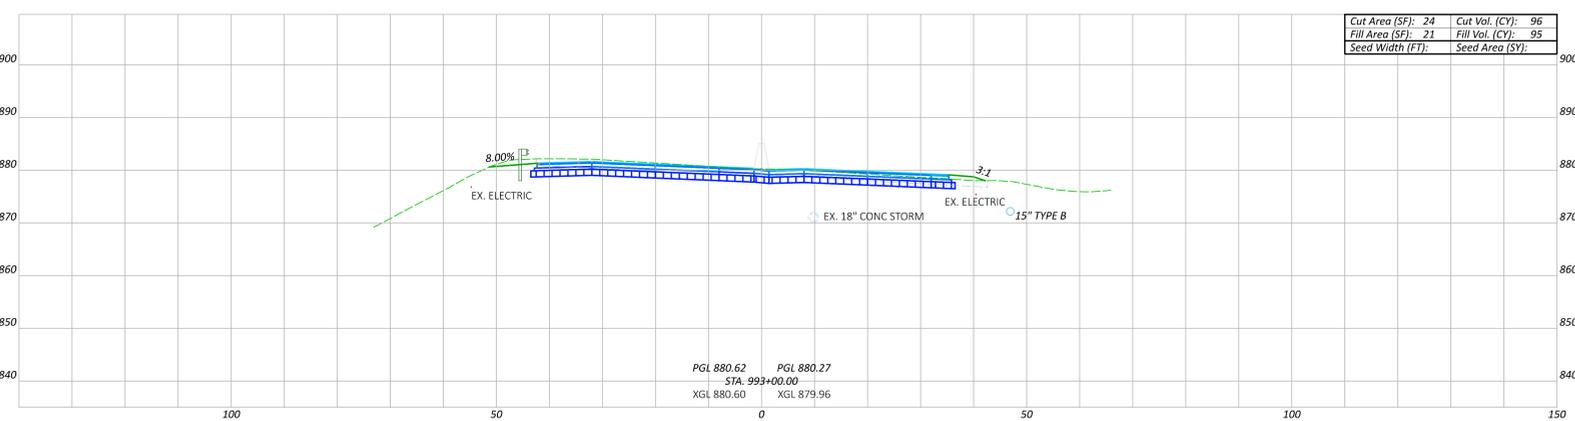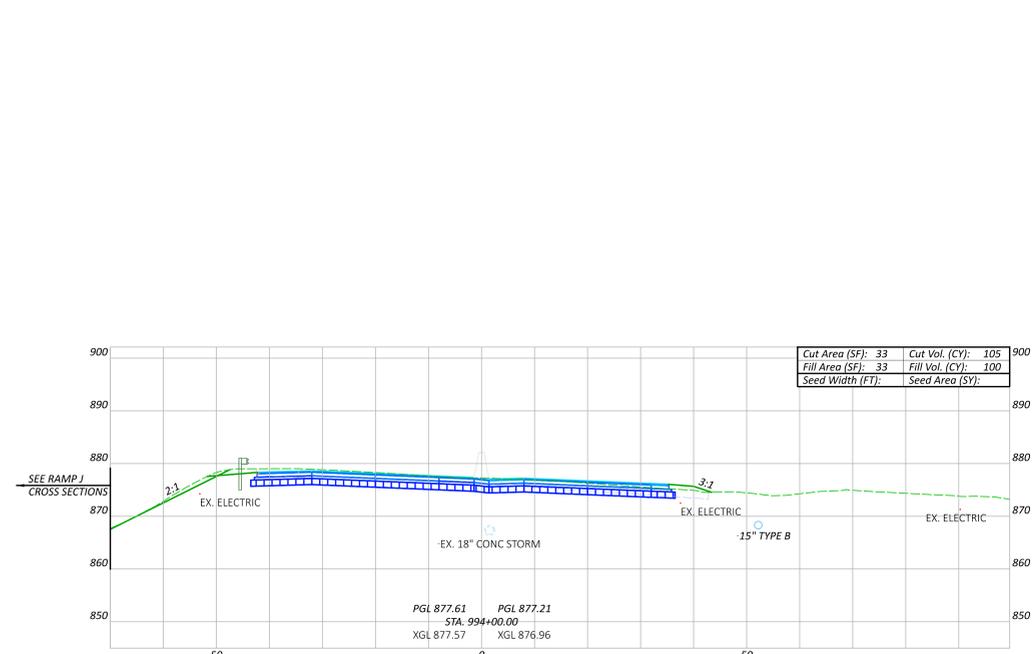

LEGEND:
 ITEM 206 - CEMENT STABILIZED SUBGRADE, 14" DEPTH


CROSS SECTIONS - I.R. 680
 STA. 992+00.00 TO STA. 996+00.00

DESIGN AGENCY

 ms consultants inc.
 DESIGNER
 MSN
 REVIEWER
 CMN 08/29/25
 PROJECT ID
 121474
 SHEET TOTAL
 506 / 477
 P. 271 / 655


R3 01-13-2026, QUANTITIES REVISED
 Sheet Totals: 121474
 Seeding: 506 / 477

LEGEND:
ITEM 206 - CEMENT STABILIZED SUBGRADE, 14" DEPTH

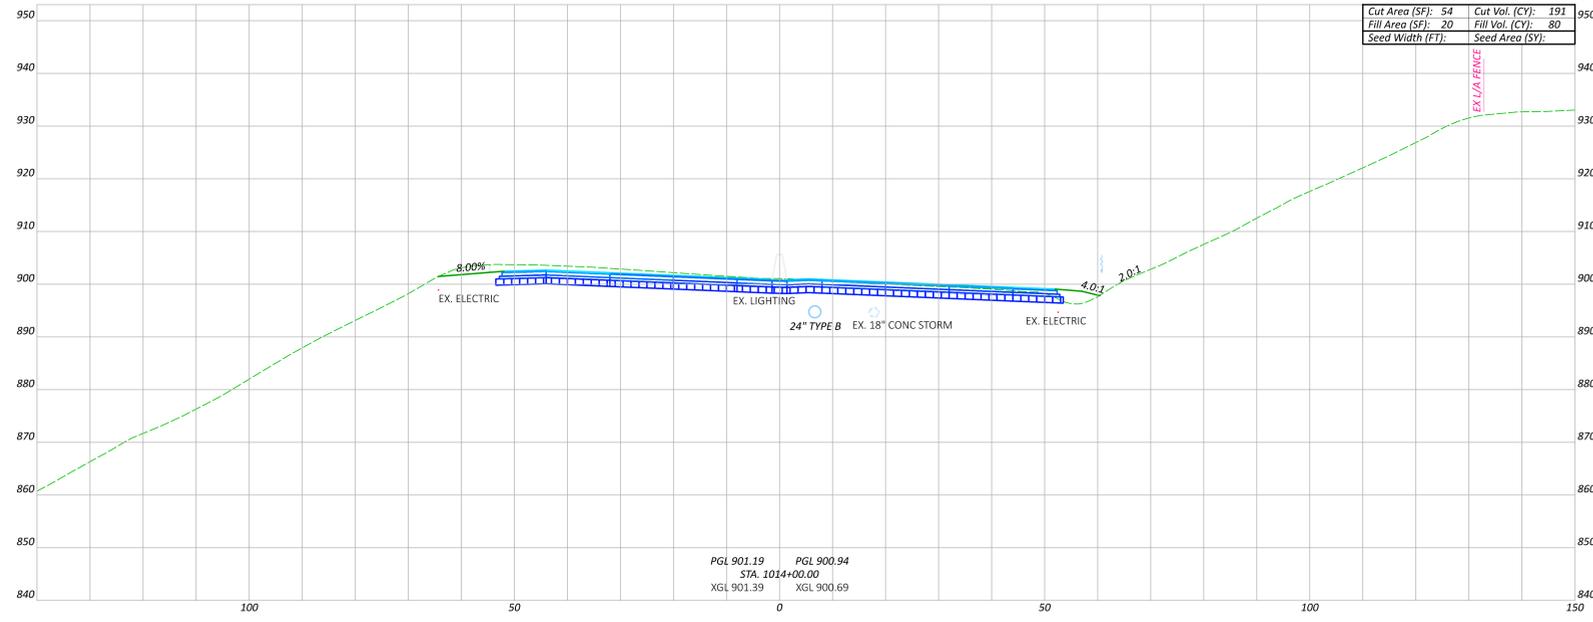


PGL 901.19 STA. 1014+00.00
XGL 901.39 XGL 900.69

Cut Area (SF): 49 Cut Vol. (CY): 143
Fill Area (SF): 23 Fill Vol. (CY): 97
Seed Width (FT): Seed Area (SY):

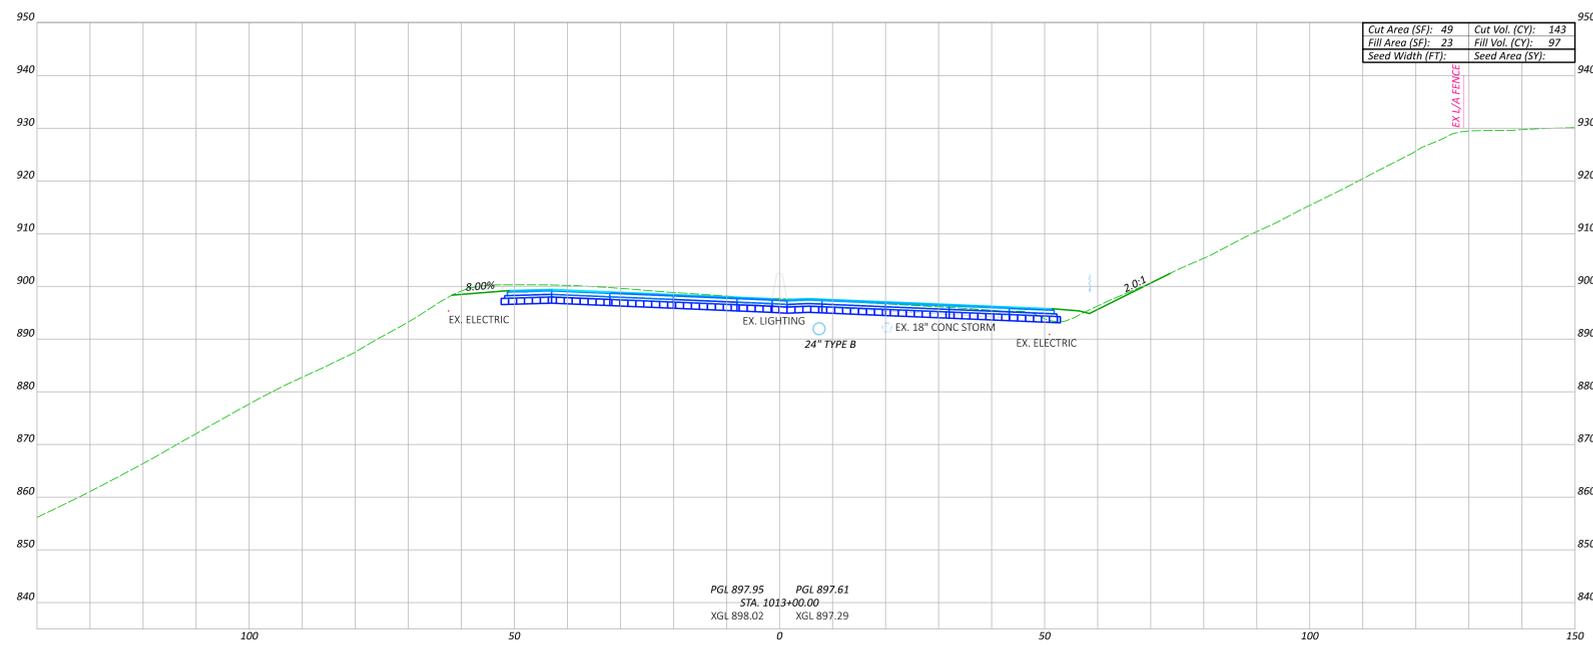


PGL 897.95 STA. 1013+00.00
XGL 898.02 XGL 897.29

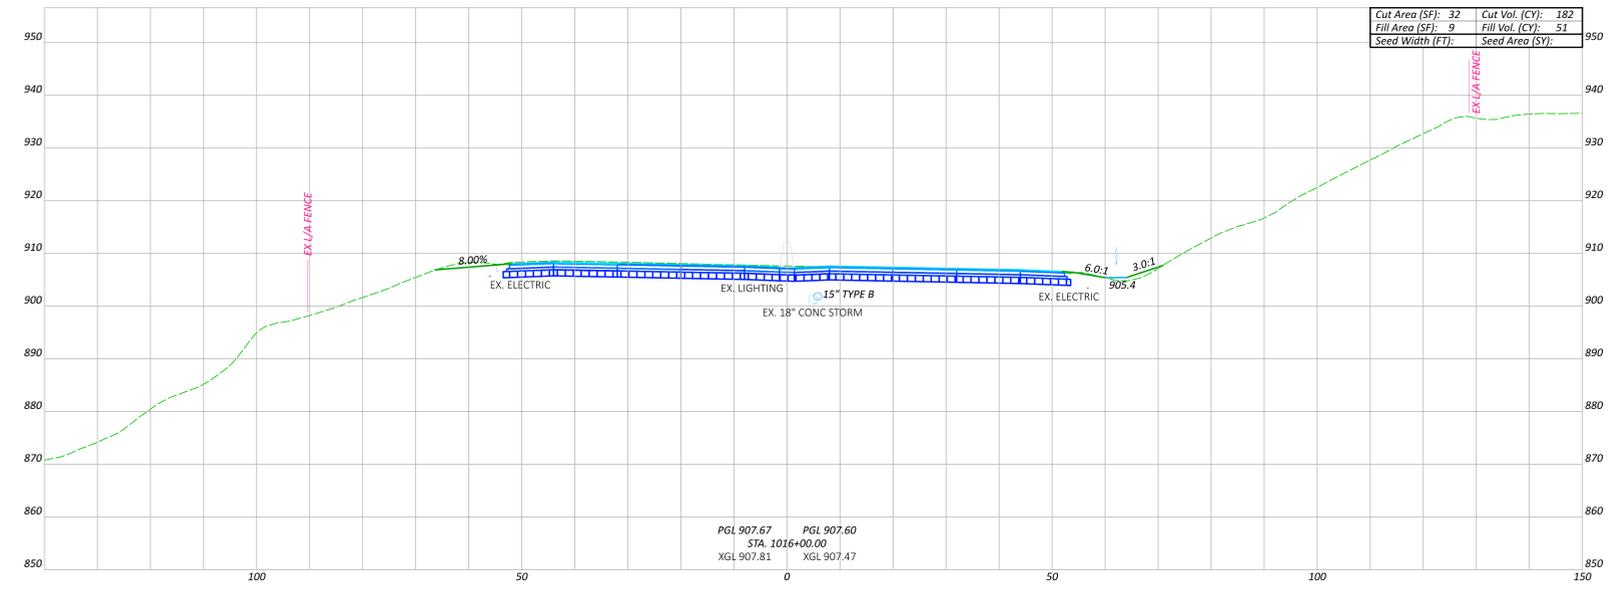

PGL 907.67 STA. 1016+00.00
XGL 907.81 XGL 907.47

Cut Area (SF): 67 Cut Vol. (CY): 225
Fill Area (SF): 18 Fill Vol. (CY): 71
Seed Width (FT): Seed Area (SY):

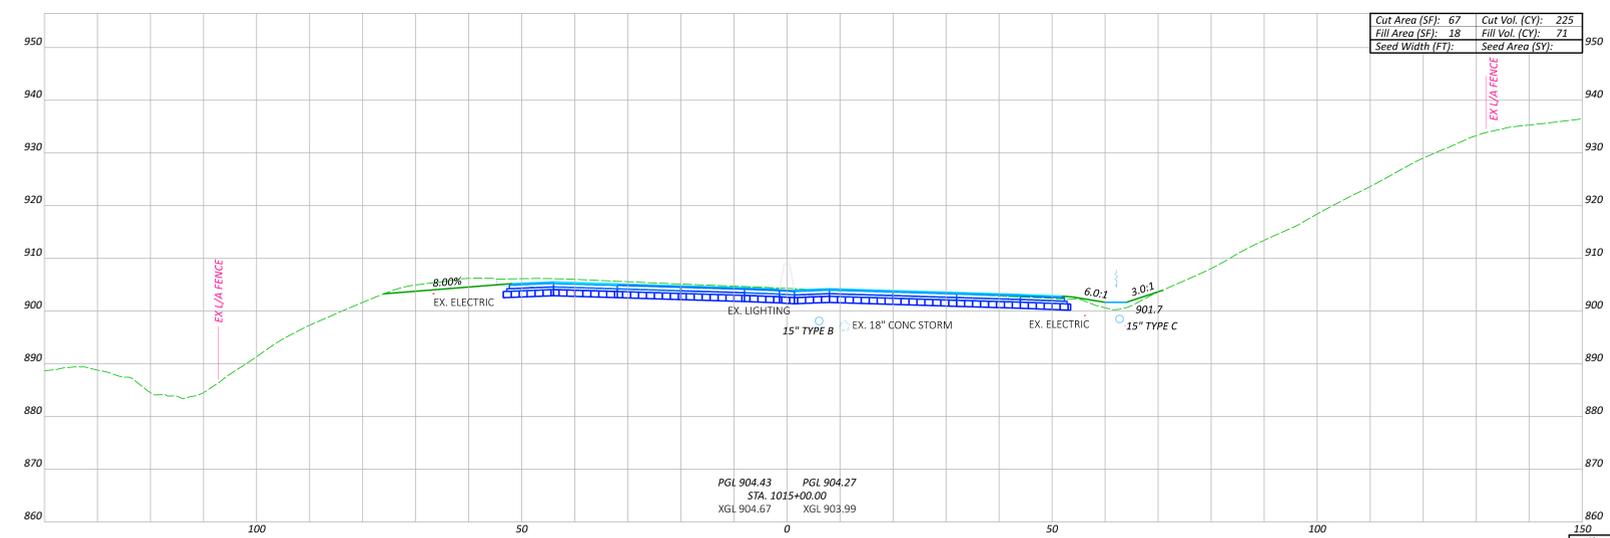







PGL 904.43 STA. 1015+00.00
XGL 904.67 XGL 903.99

R3 01-13-2026, QUANTITIES REVISED

Sheet Totals	121474
Seeding	741
Fill	299
Total	655

MAH-680-4.58
 MODEL: 10/11/2024 10:00 AM (Sheet) PAPER: 11/20/2024 TIME: 4:41:03 PM OUTPUT: C:\Users\paul@msn.com\OneDrive - Paul M. Smith & Associates, Inc.\Projects\121474_Productions\121474_Productions\121474_0001.dwg
 PLOT: 10/11/2024 10:00 AM (Sheet) PAPER: 11/20/2024 TIME: 4:41:03 PM OUTPUT: C:\Users\paul@msn.com\OneDrive - Paul M. Smith & Associates, Inc.\Projects\121474_Productions\121474_Productions\121474_0001.dwg

LEGEND:
 ITEM 206 - CEMENT STABILIZED SUBGRADE, 14" DEPTH

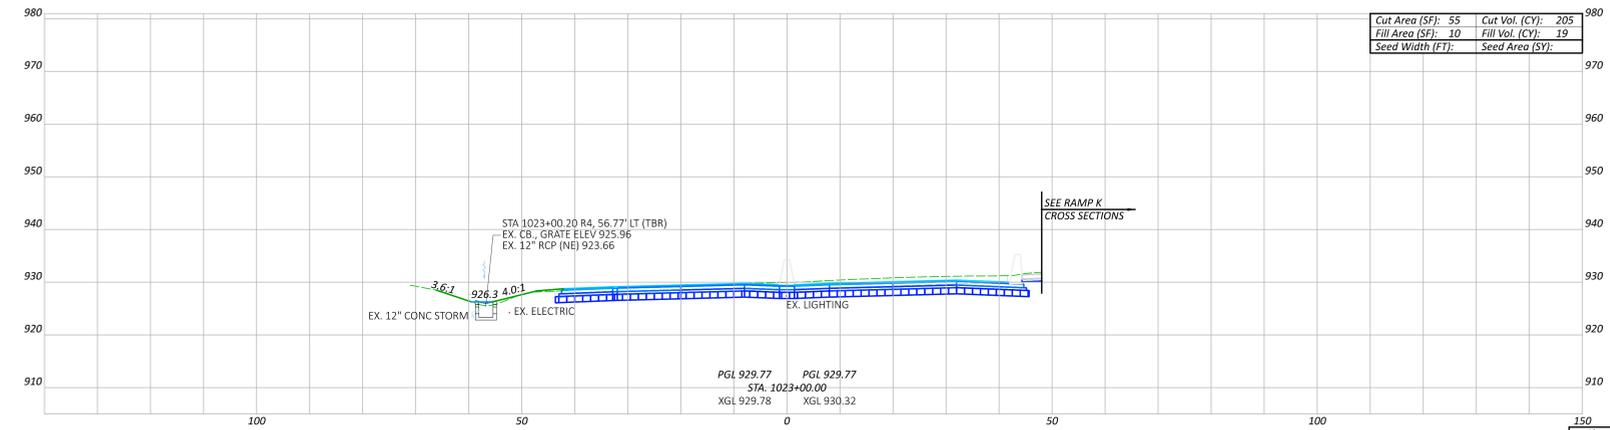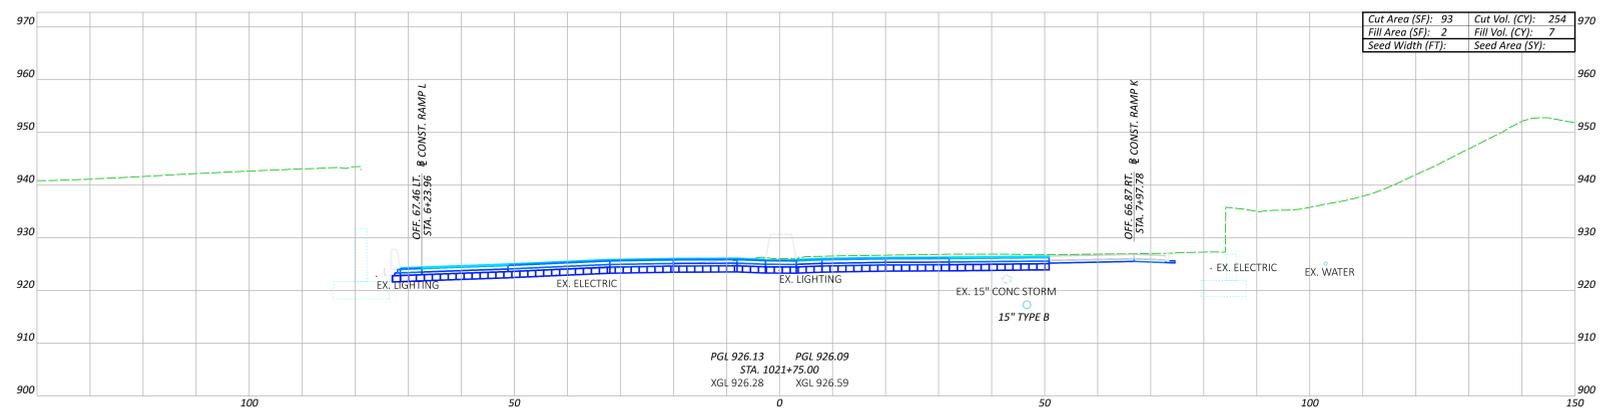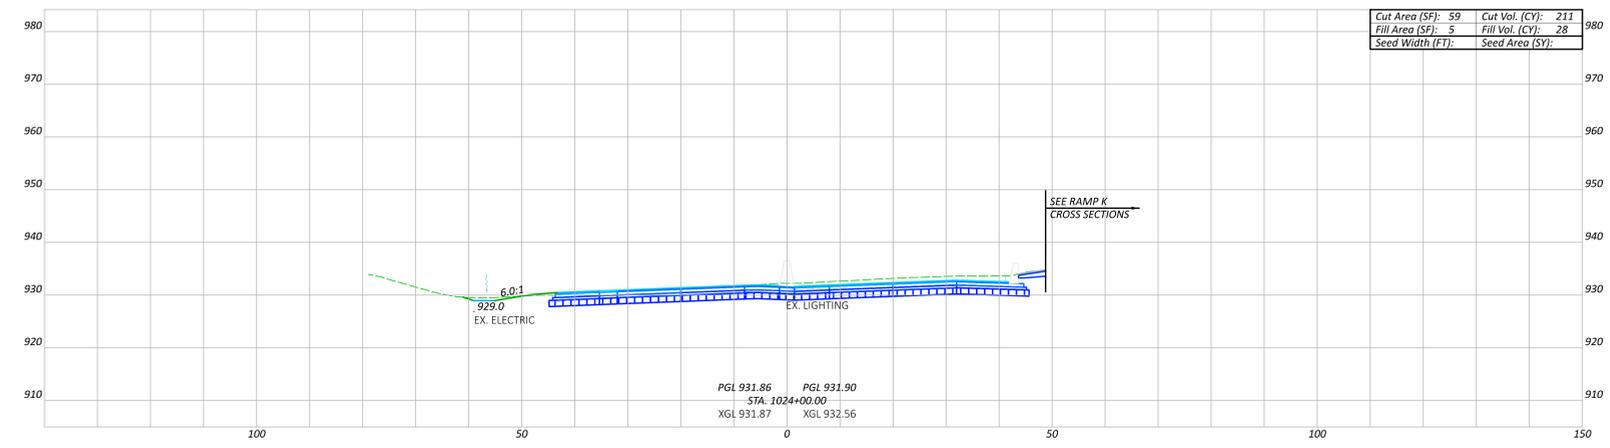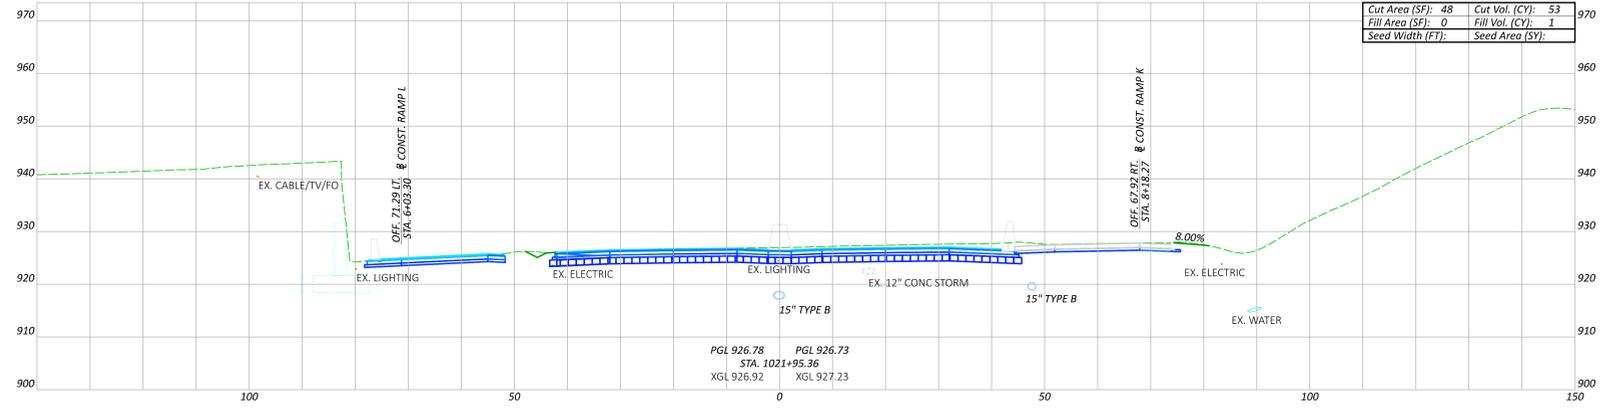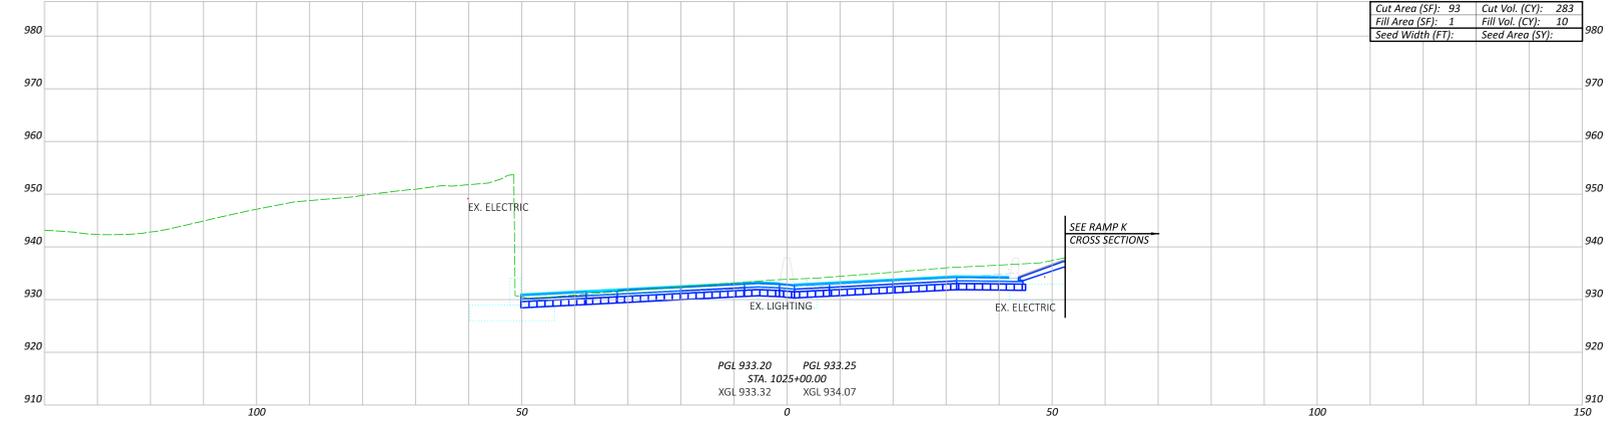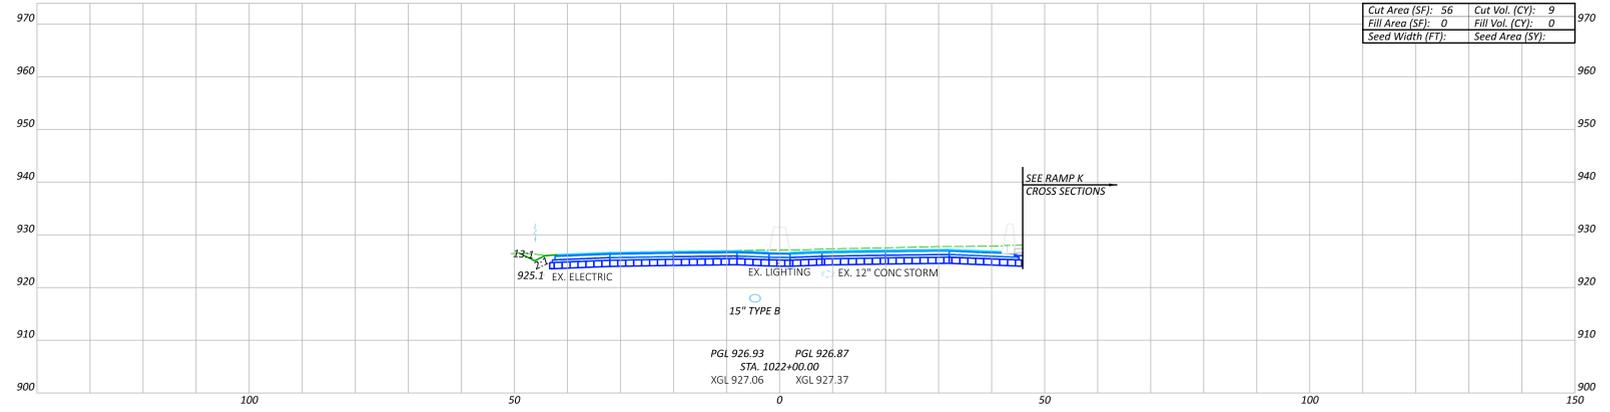

CROSS SECTIONS - I.R. 680
 STA. 1021+75.00 TO STA. 1025+00.00





01-13-2026, QUANTITIES REVISED

Sheet Totals	121474
Seeding	1015
Cut	277
Fill	655




DESIGN AGENCY

 DESIGNER
 MSN
 REVIEWER
 GMM 08/29/25
 PROJECT ID

MAH-680-4.58
 MODEL: C:\p\680_1026+00.00 (Sheet) PAPER: 6804 (in) DATE: 1/12/2026 TIME: 4:41:55 PM AUTHOR: CHDZ, PFL, E, J, H, G, PENTEL, PAV, CUI USER: daniel@msn.com WORKSPACE: CHDZ\CHDZ\WORKSET: 121474_Produ...
 P:\Users\daniel@msn.com\OneDrive - MSN\Documents\121474\121474_X000.dgn

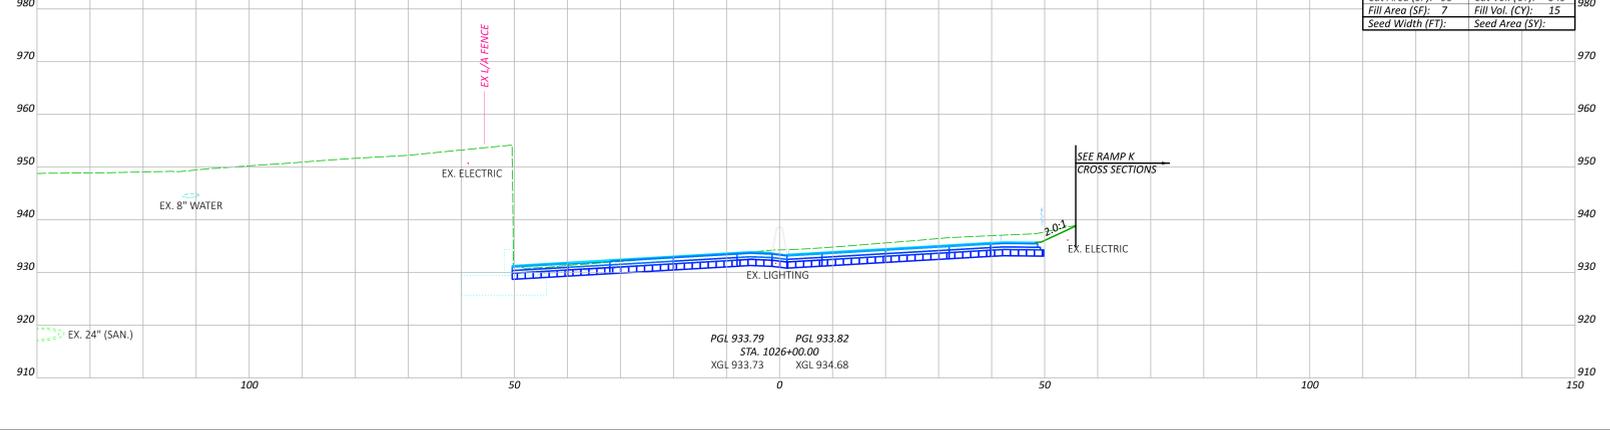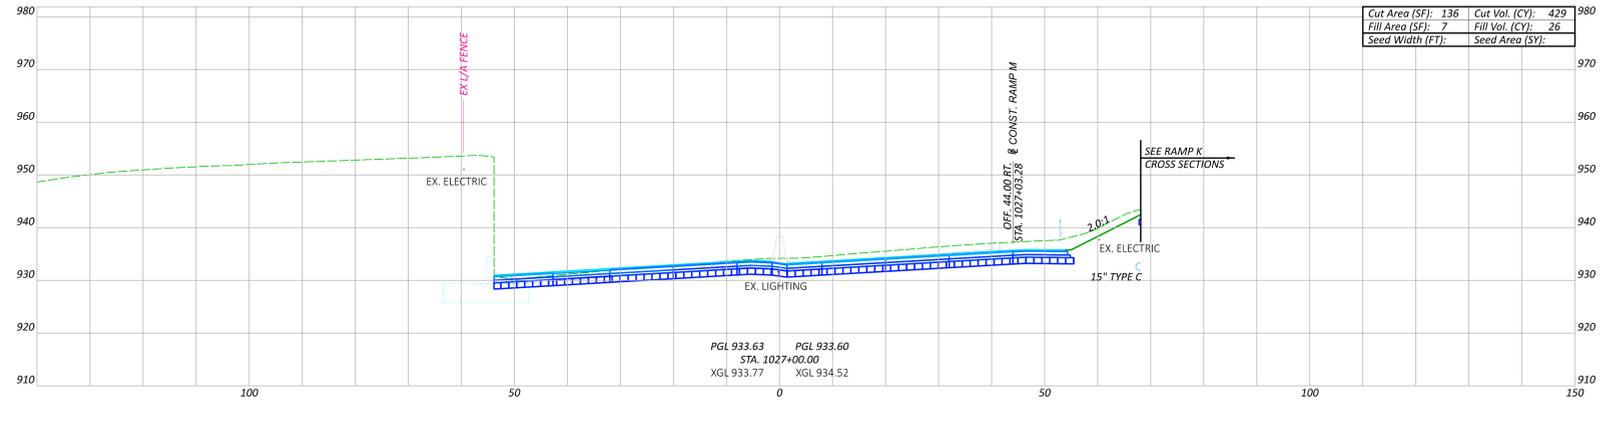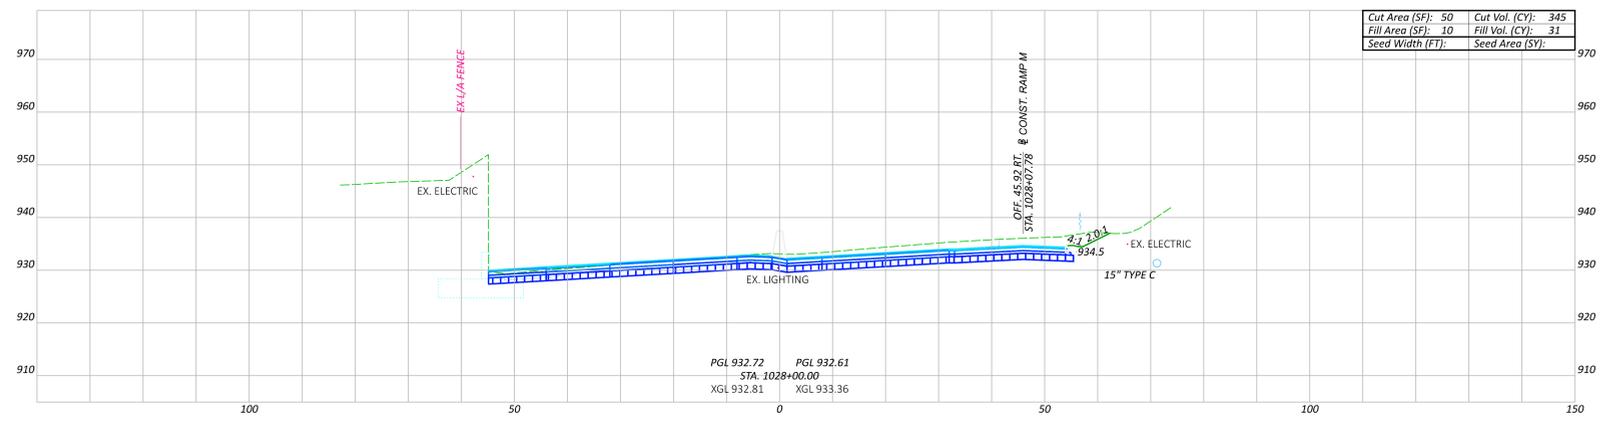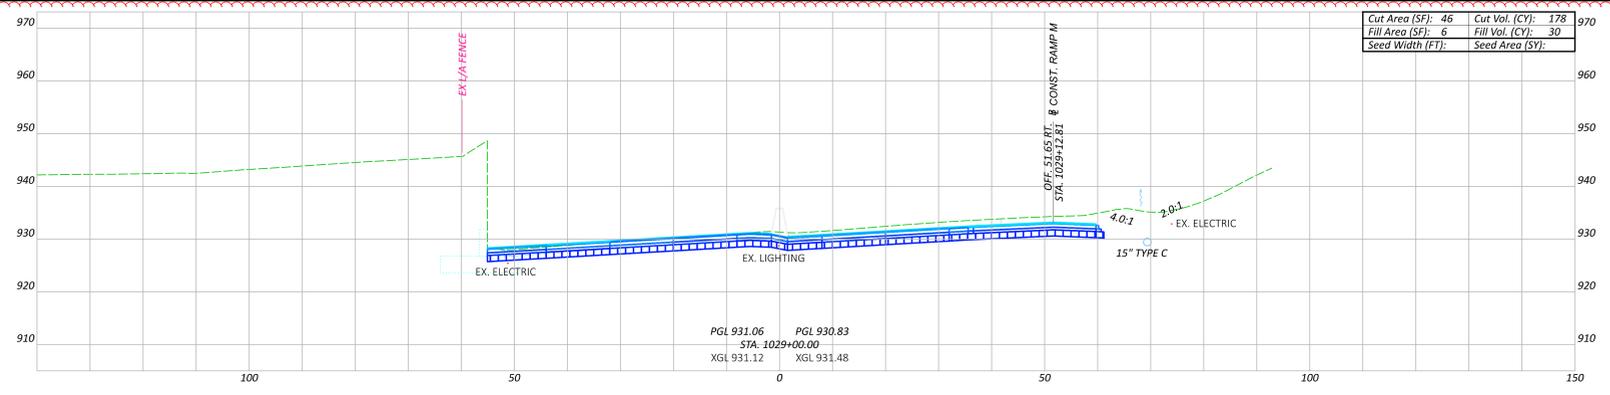









LEGEND:
 ITEM 206 - CEMENT STABILIZED SUBGRADE, 14" DEPTH

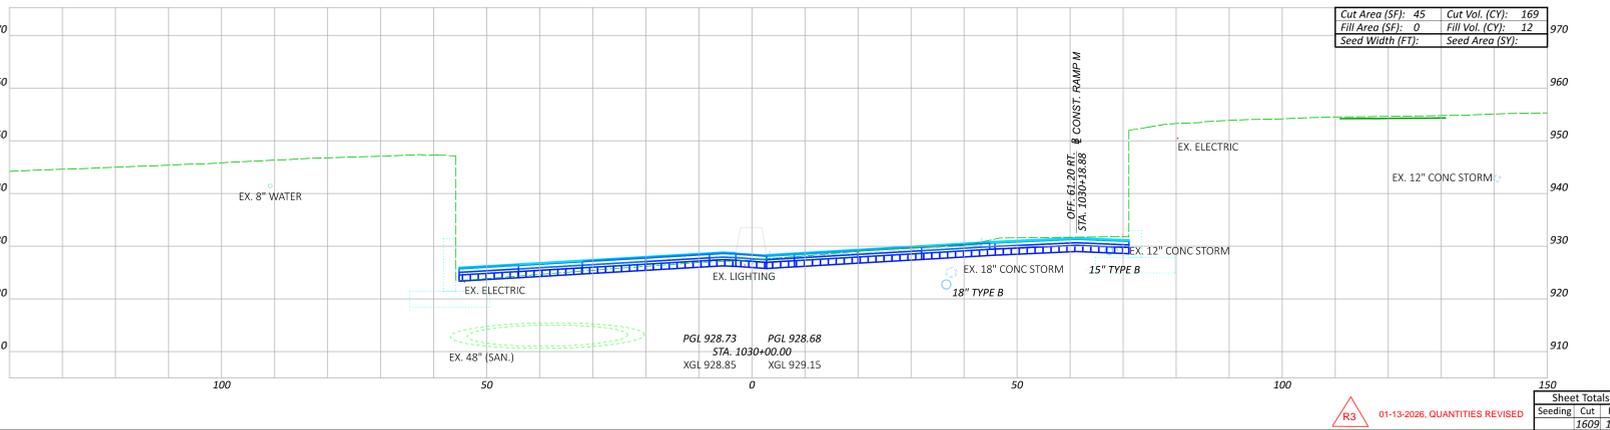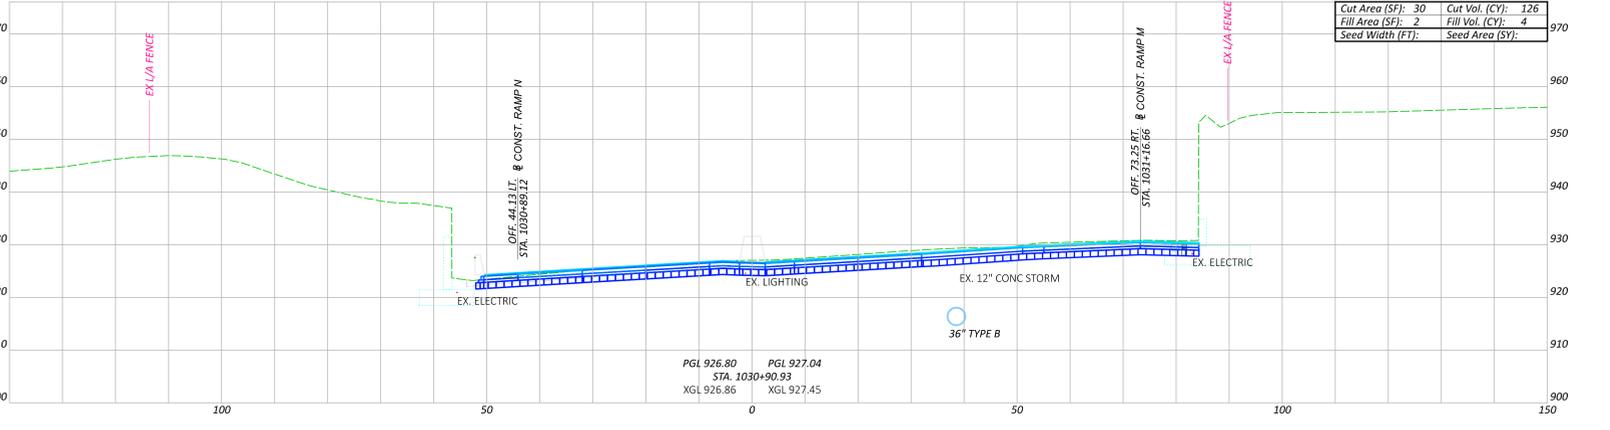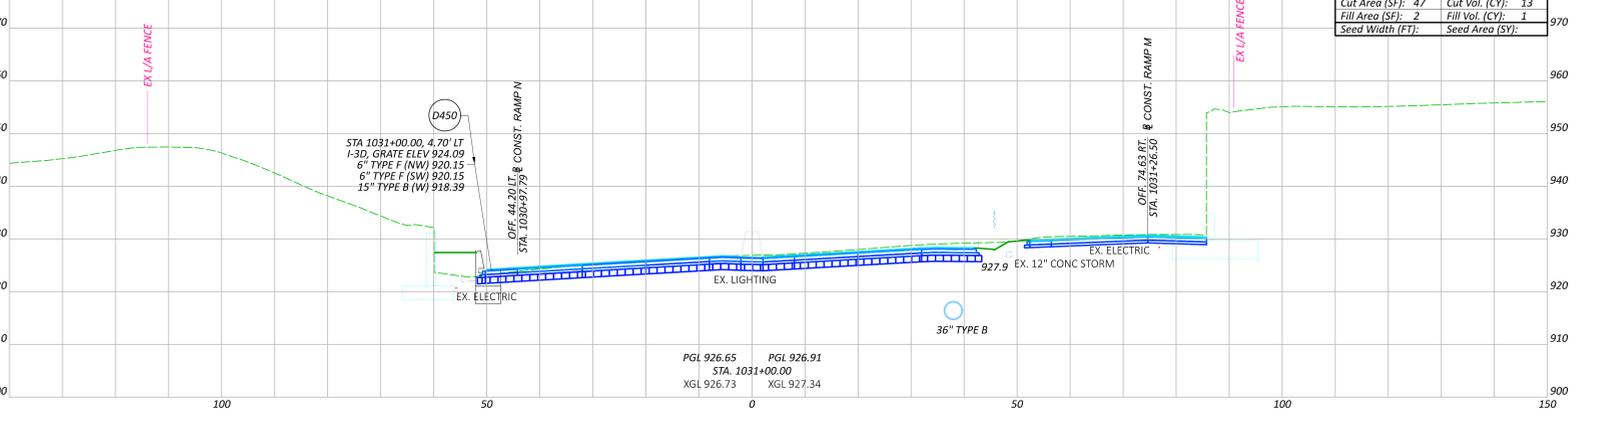

CROSS SECTIONS - I.R. 680
 STA. 1026+00.00 TO STA. 1031+00.00

DESIGN AGENCY

 CONSULTANTS INC.
 DESIGNER
 MSN
 REVIEWER
 CMN 08/29/25
 PROJECT ID
 121474
 SHEET TOTAL
 1609 / 113
 P. 278 / 655
 01-13-2026, QUANTITIES REVISED

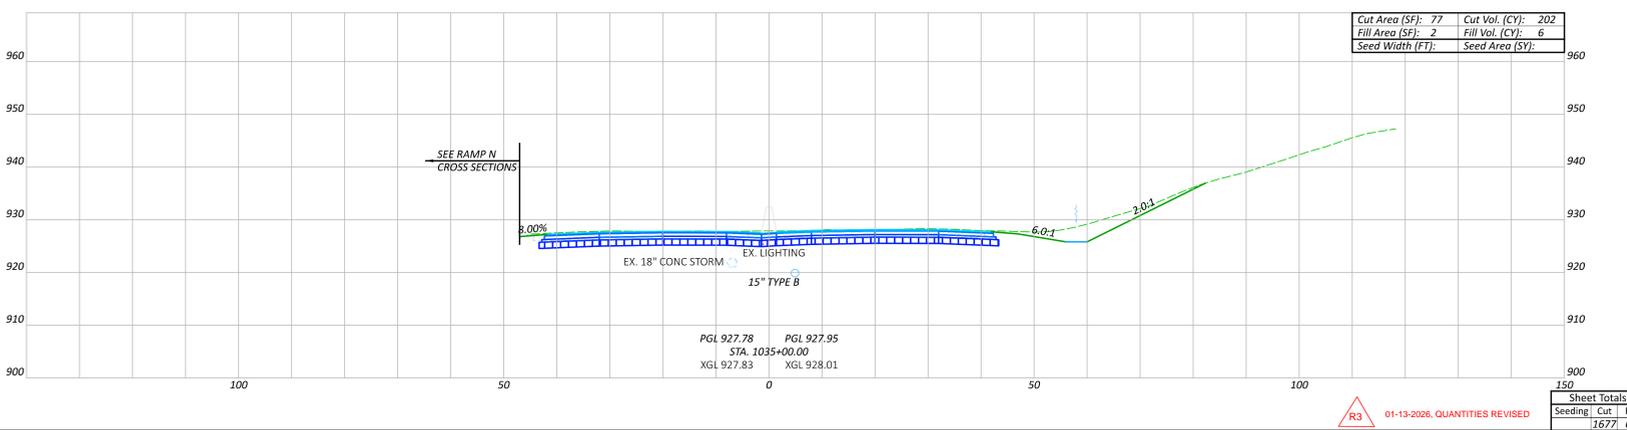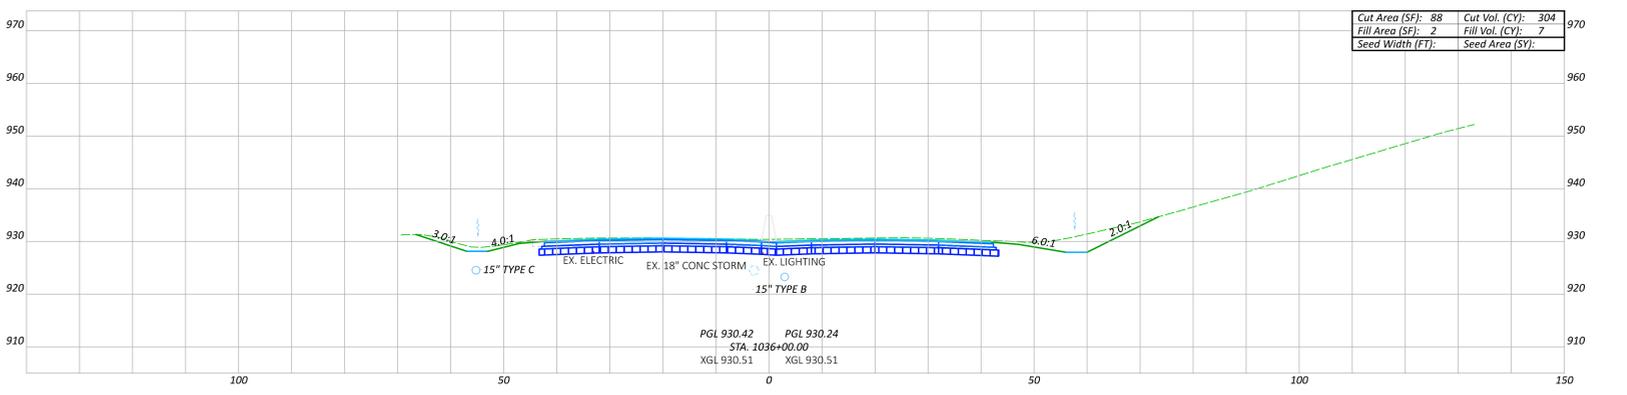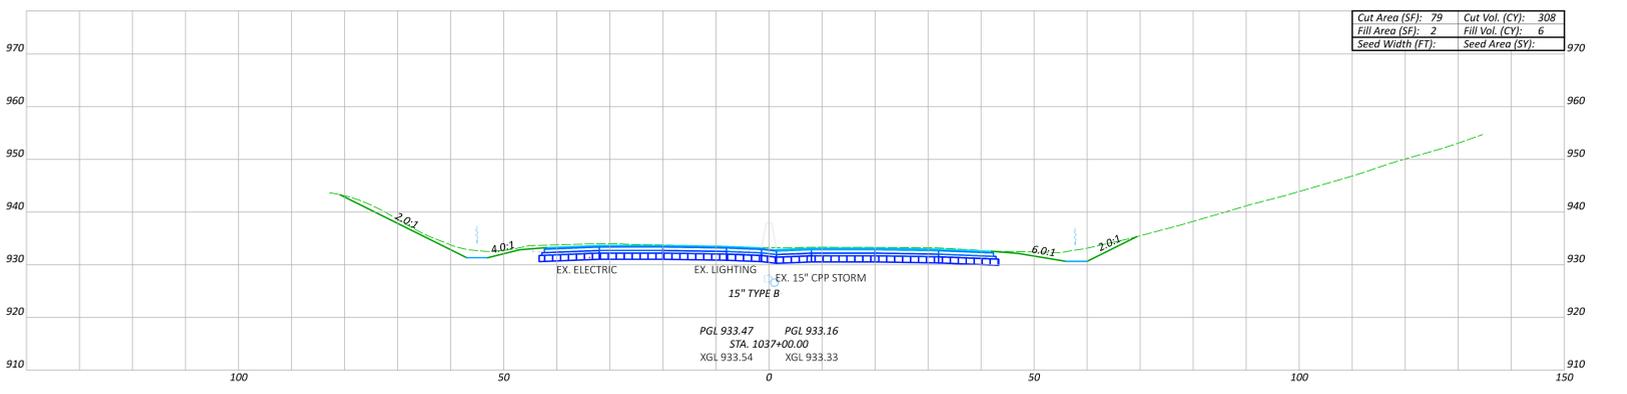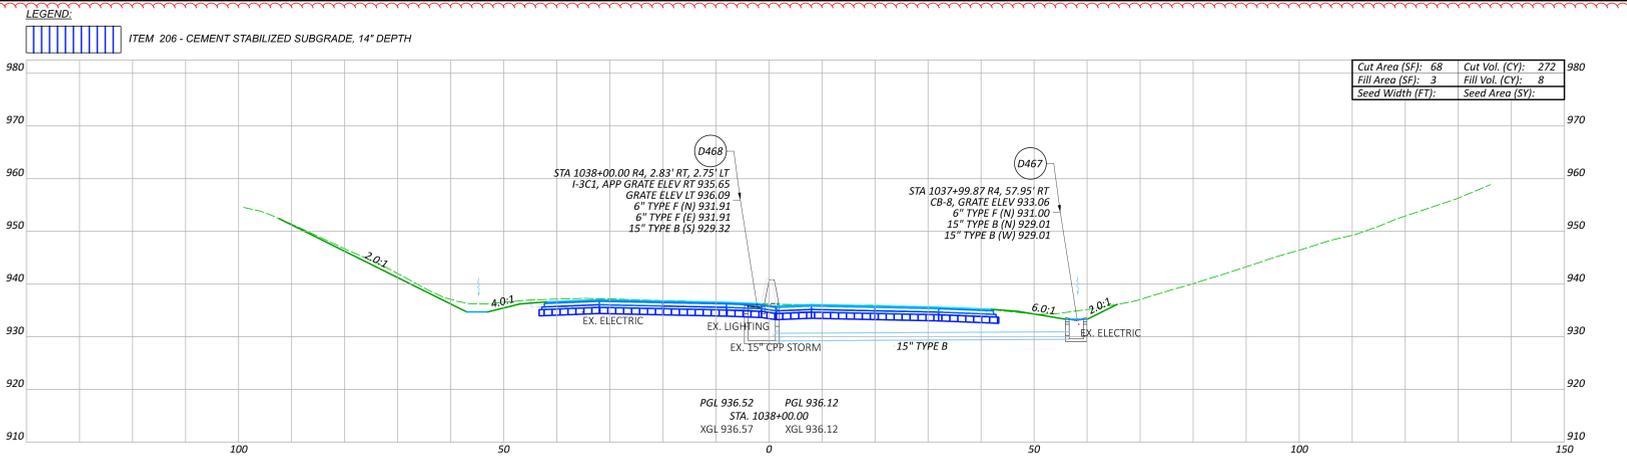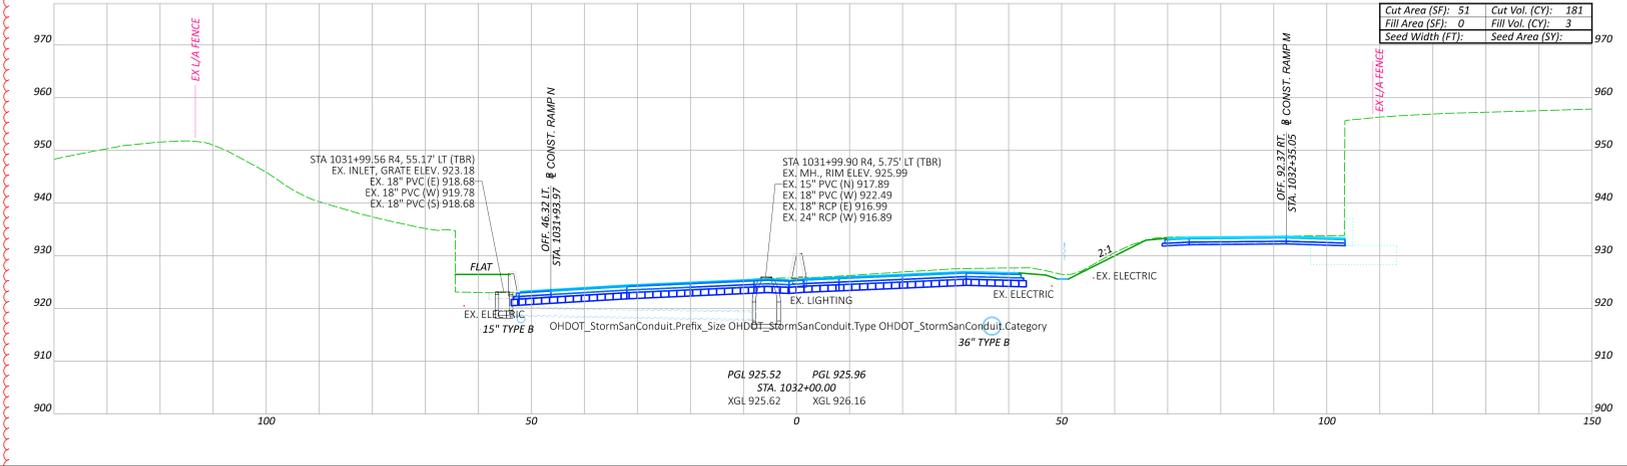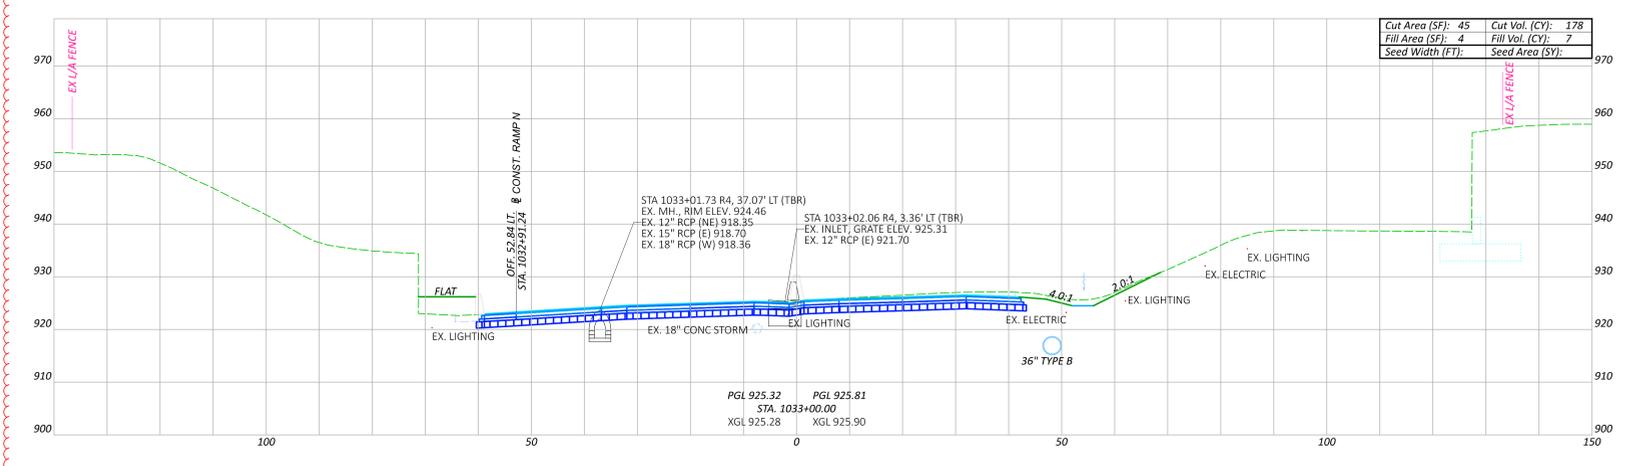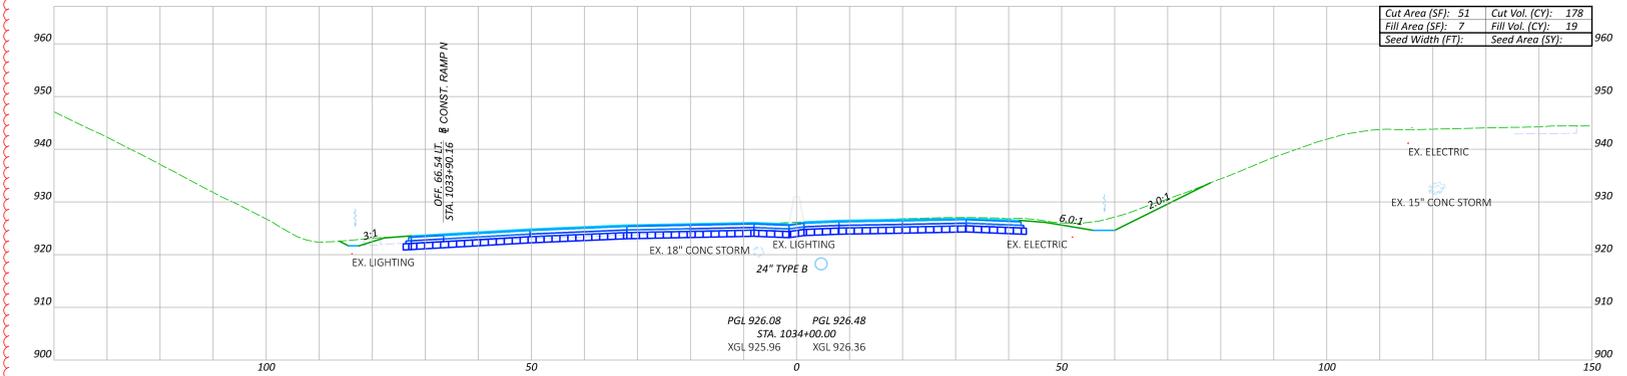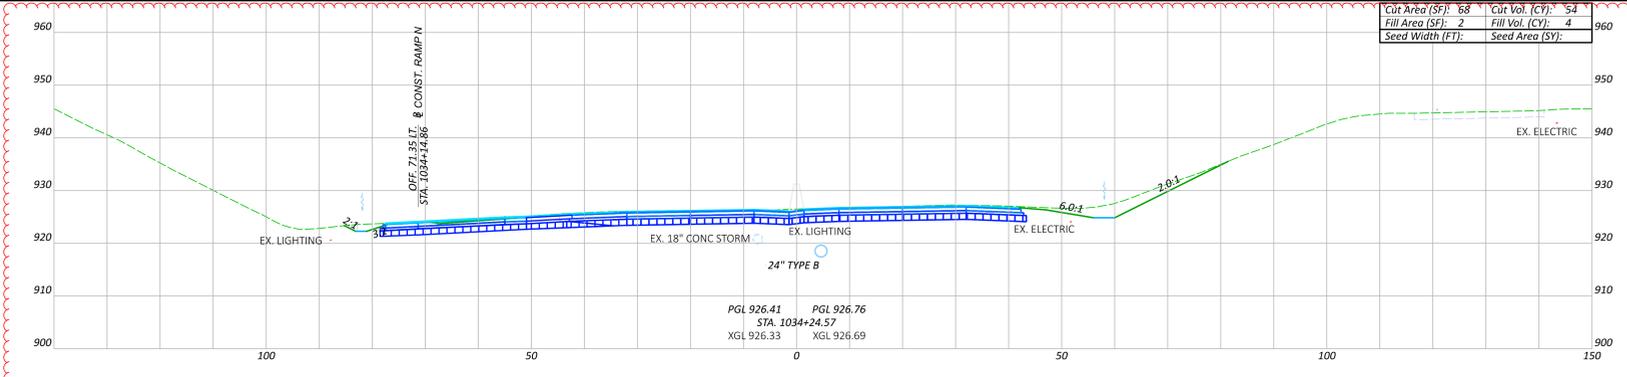








LEGEND:
ITEM 206 - CEMENT STABILIZED SUBGRADE, 14" DEPTH

CROSS SECTIONS - I.R. 680
STA. 1032+00.00 TO STA. 1038+00.00

01-13-2026, QUANTITIES REVISED

LEGEND:

 ITEM 206 - CEMENT STABILIZED SUBGRADE, 14" DEPTH

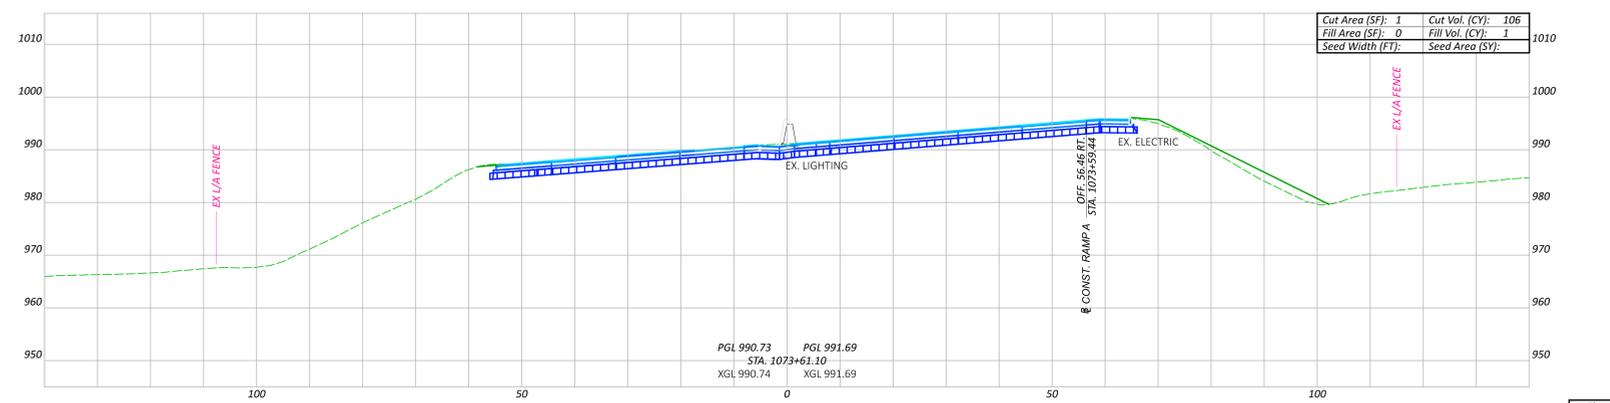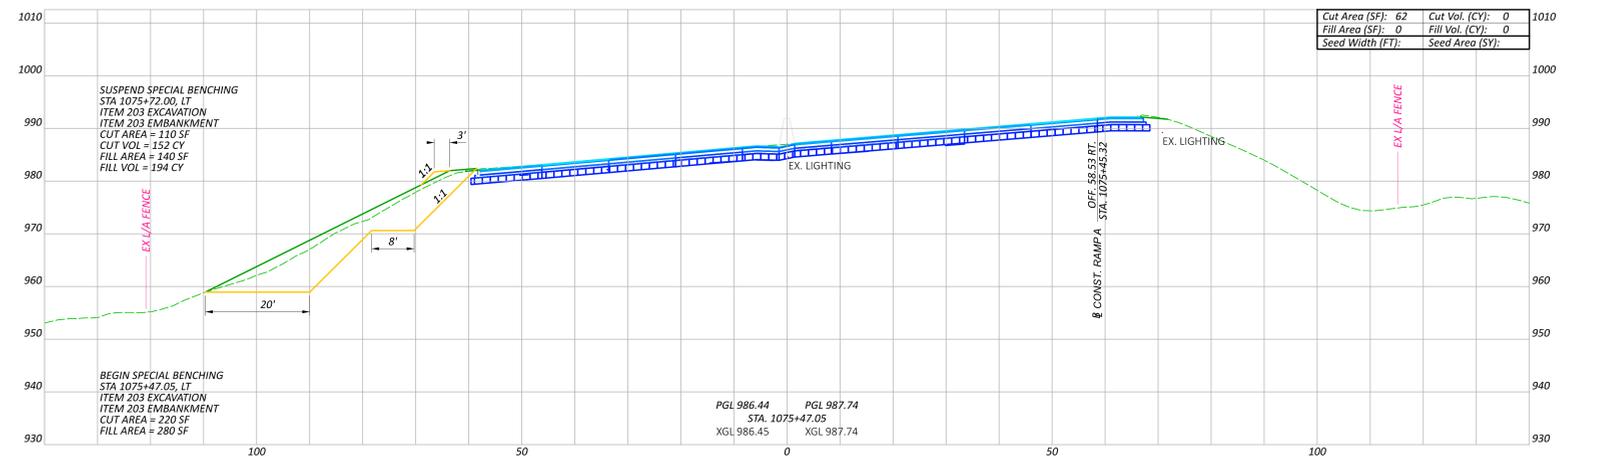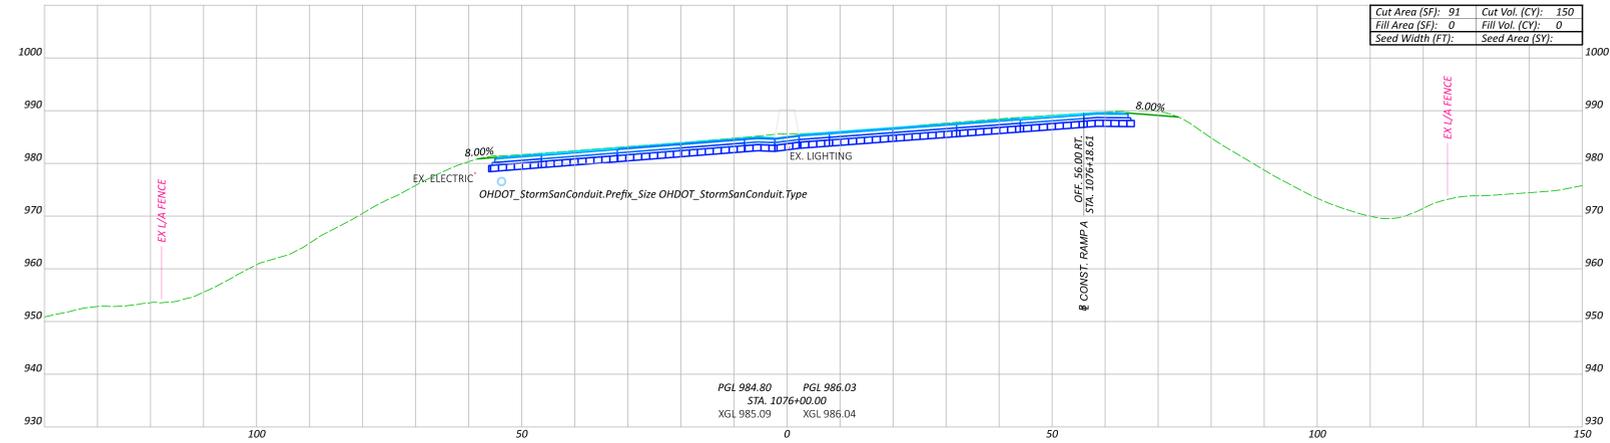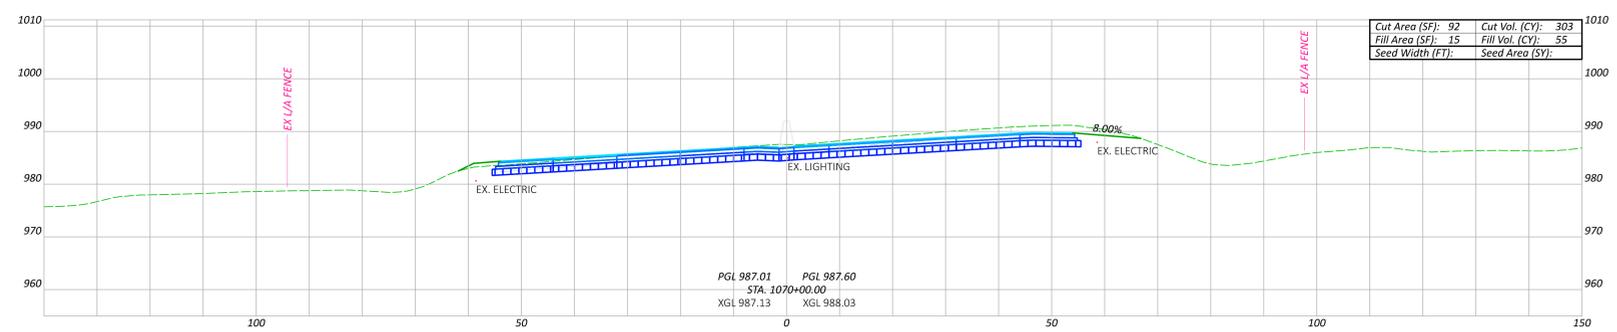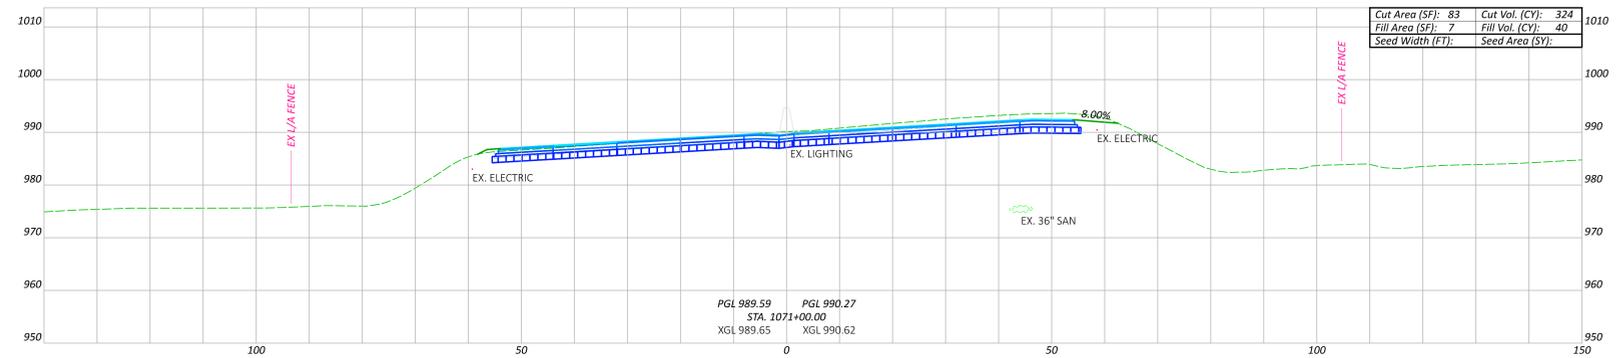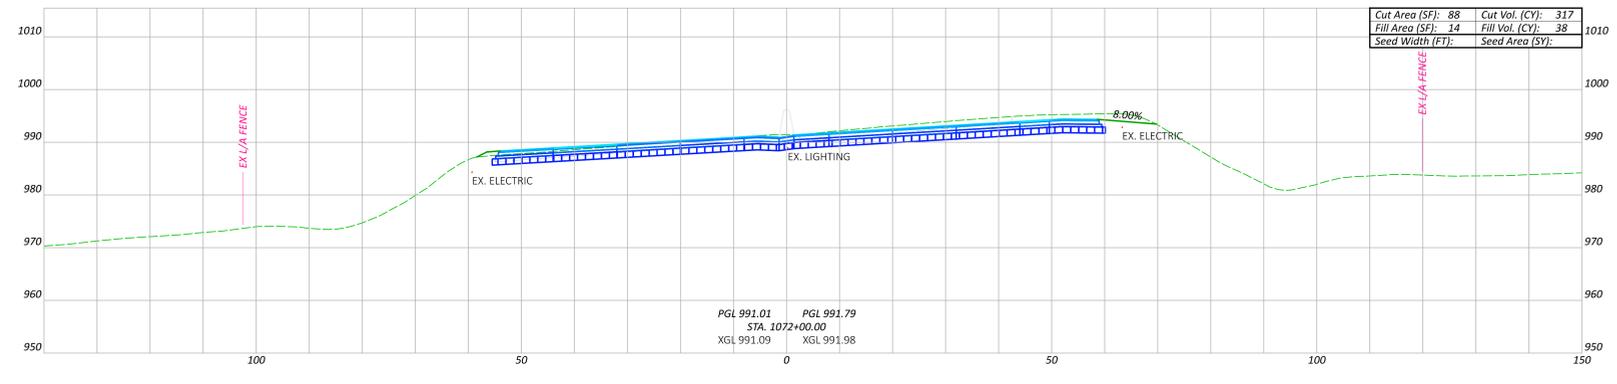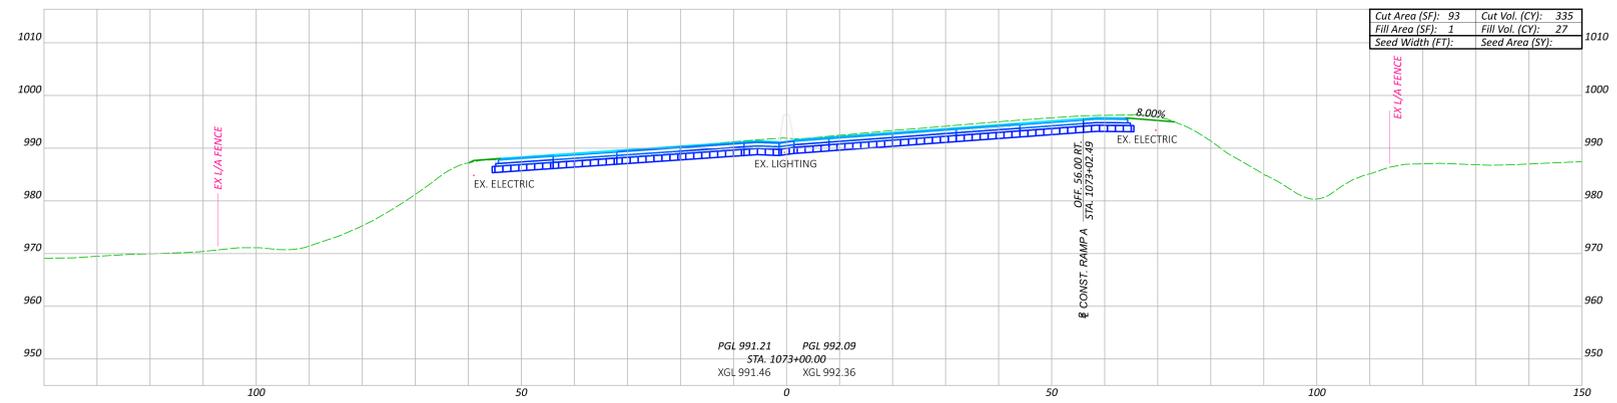

CROSS SECTIONS - I.R. 680
 STA. 1070+00.00 TO STA. 1076+00.00

MAH-680-4.58

MODEL: QIP_680_1070+00.00 (Sheet) PAPER: 6804 (in) DATE: 1/12/2026 TIME: 4:43:57 PM AUTHOR: CHODI, PAV, CUI USER: dchod1@msn.com WORKSPACE: OHDOT_CROSS_SECTION_121474_PRODUCED.ctb PROJECT: OpenRoadsDesigner 24.00.02.25
 P:\Vehicles\msn\entire.com\mshd\paw02\Documents\01_Acme\Projects\Director\121474\02_engineering\MDC\consultants\Bobby\Bobby121474_X000.dgn








DESIGN AGENCY

 DESIGNER: MSN
 REVIEWER: CMN 08/29/25
 PROJECT ID: 121474
 SHEET TOTAL: 1535
 P. 284 655

Sheet Totals
 Seeding: 1535
 Cut: 1535
 Fill: 167
 TOTAL: 167

01-13-2026, QUANTITIES REVISED

LEGEND:
 ITEM 206 - CEMENT STABILIZED SUBGRADE, 14" DEPTH

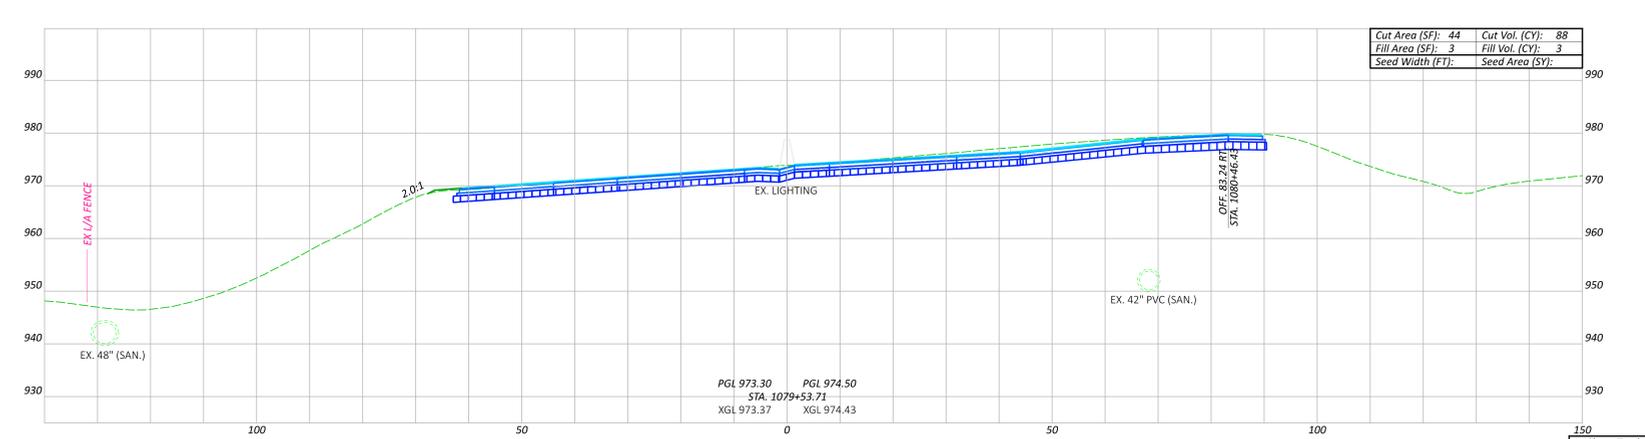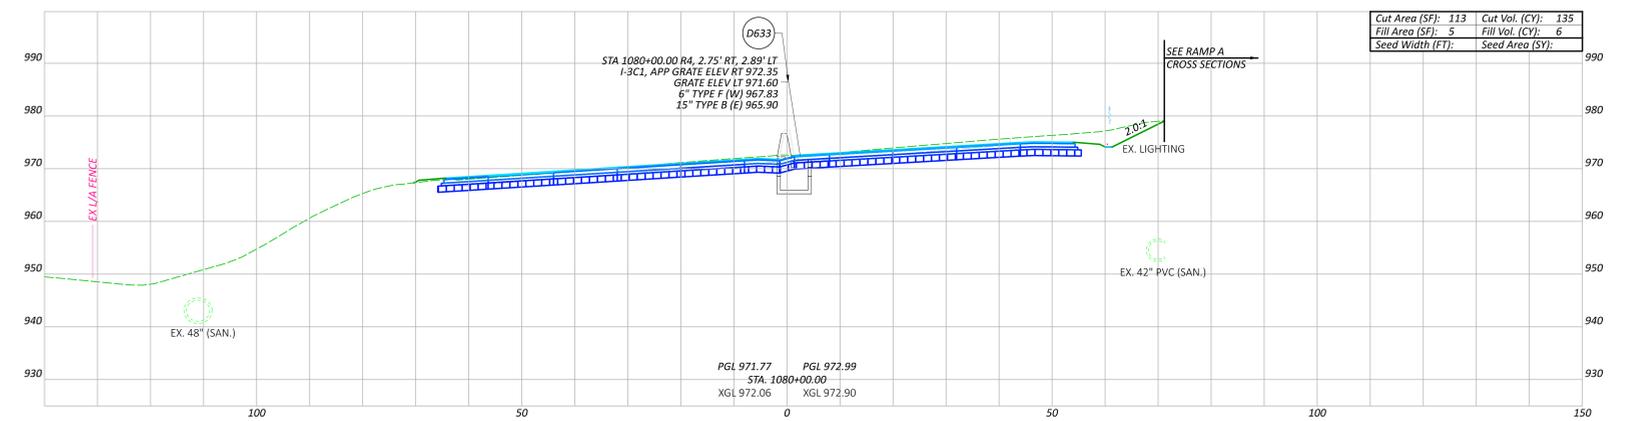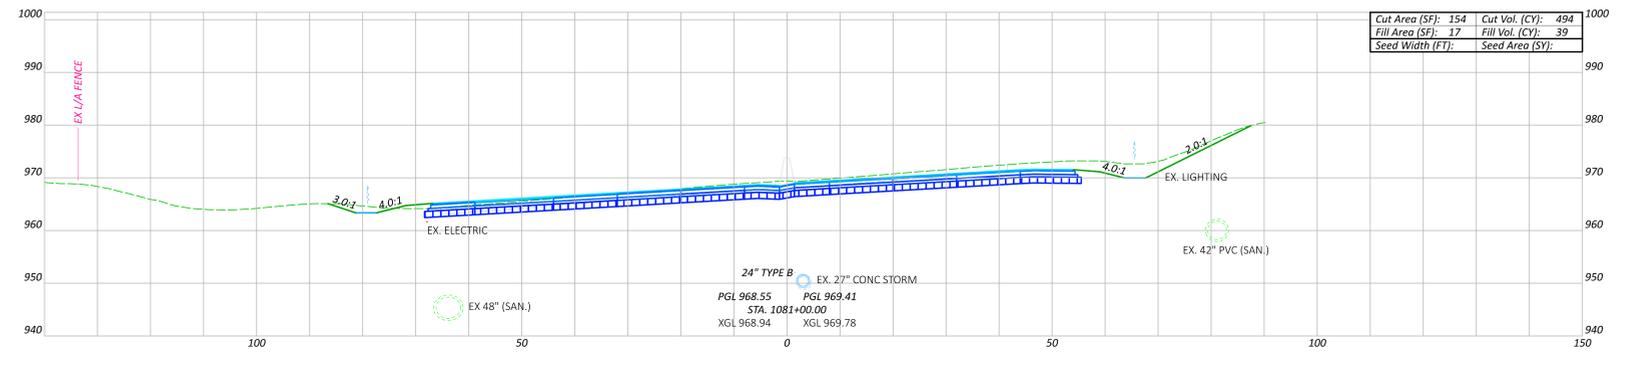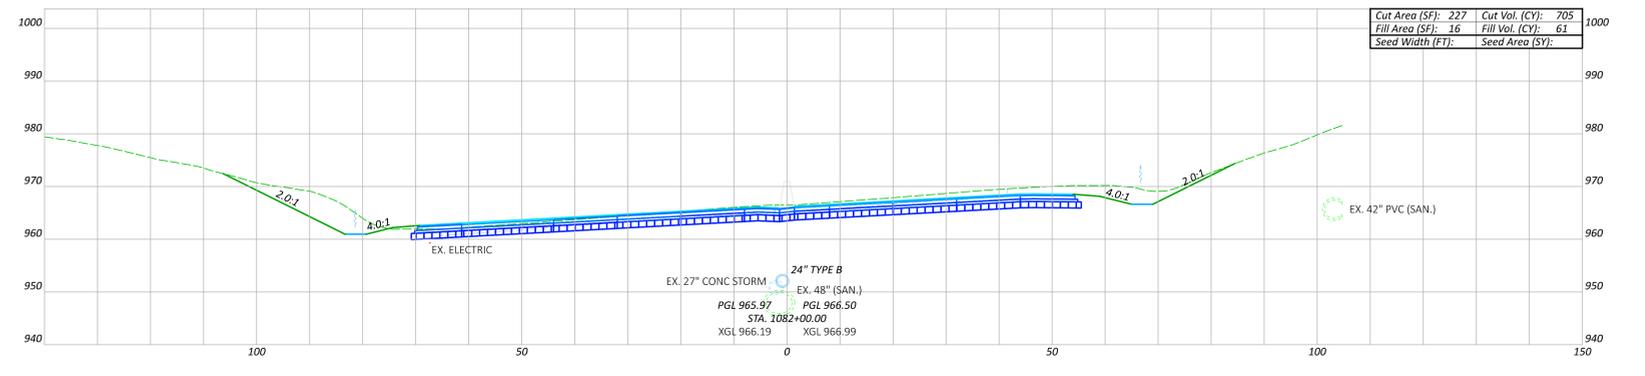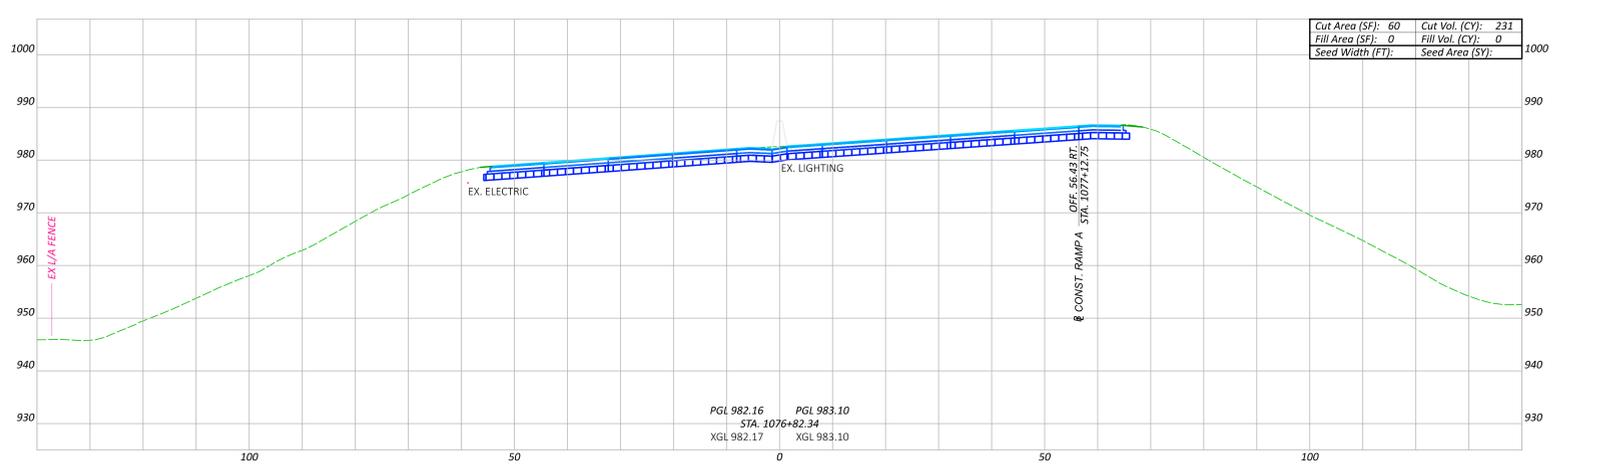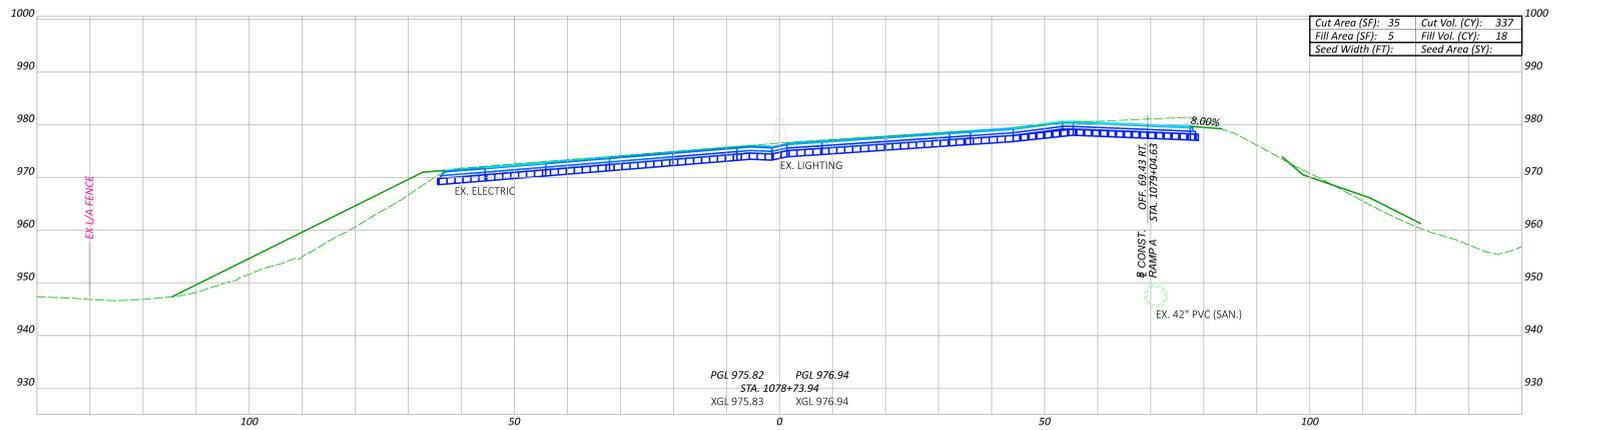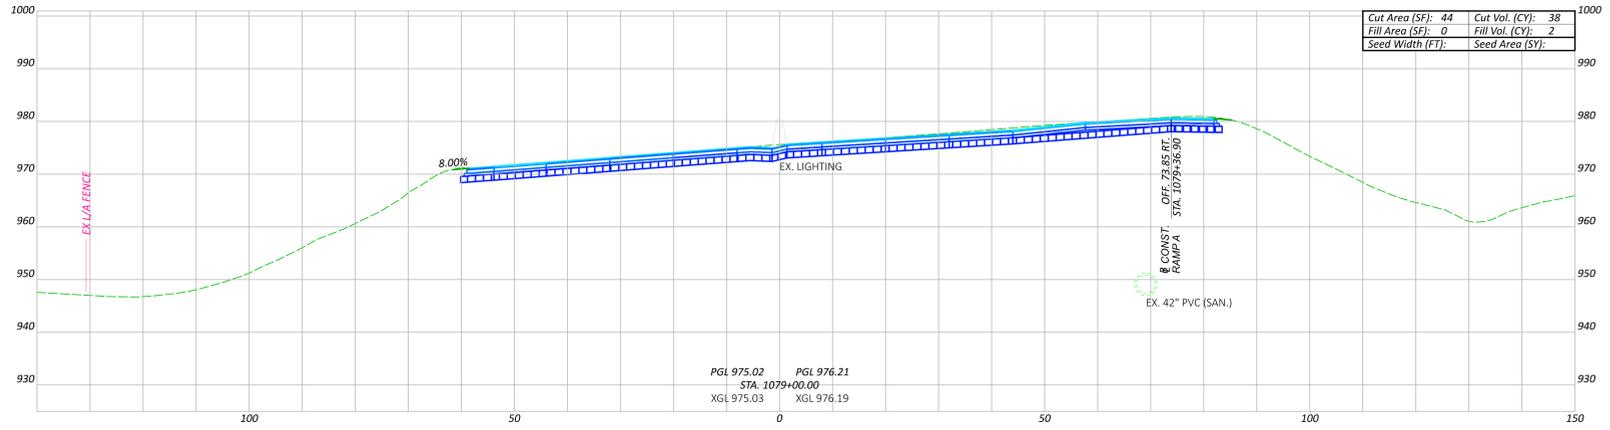

CROSS SECTIONS - I.R. 680
 STA. 1076+82.34 TO STA. 1082+00.00

01-13-2026, QUANTITIES REVISED









Sheet Totals	121474
Seeding	2028
Cut	129
Fill	129
P.285	655

DESIGN AGENCY

 DESIGNER: MSN
 REVIEWER: CMN 08/29/25
 PROJECT ID: 121474

MAH-680-4.58
 MODEL: C:\p\680-1089\00\04\Sheet\PARSESSE_6804.dwg (in DATE: 1/12/2026 TIME: 4:43:12 PM) AUTOCAD: 2026 PLOT: PLOTTER: HP DesignJet 5000 PLOT: USER: dshah@msn.com WORKSPACE: C:\p\680-1089\00\04\Sheet\PARSESSE_6804.dwg
 PROJECT: 121474 PROJECT: OPERATIONAL WORKSET: 121474 PROJECT: OPERATIONAL WORKSET: 121474_X000.dgn
 PLOT: 12/12/2026 10:00:00 AM

LEGEND:
 ITEM 206 - CEMENT STABILIZED SUBGRADE, 14" DEPTH

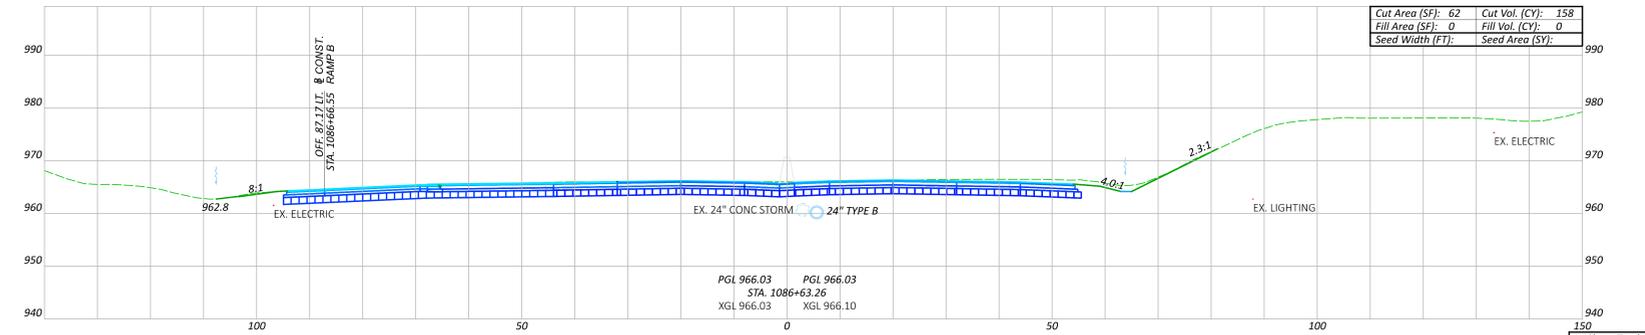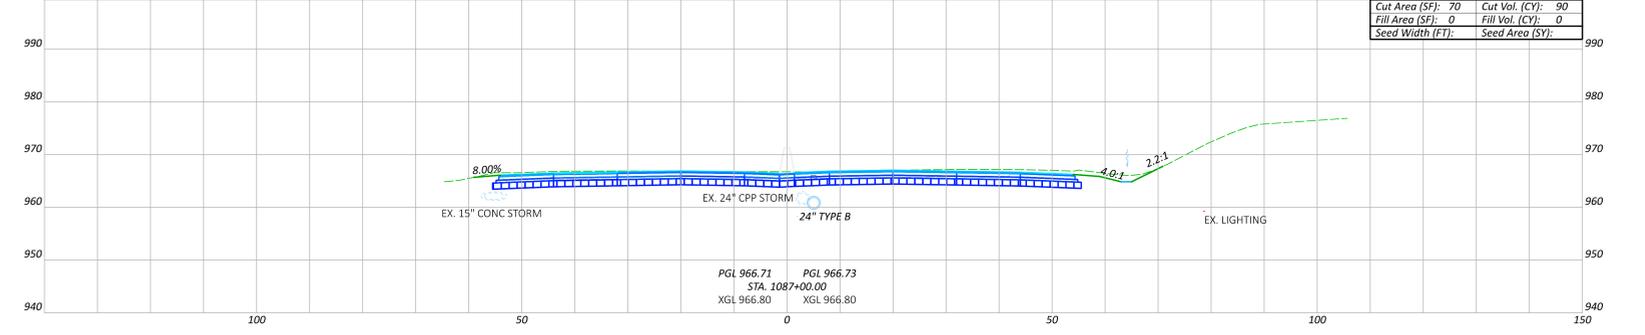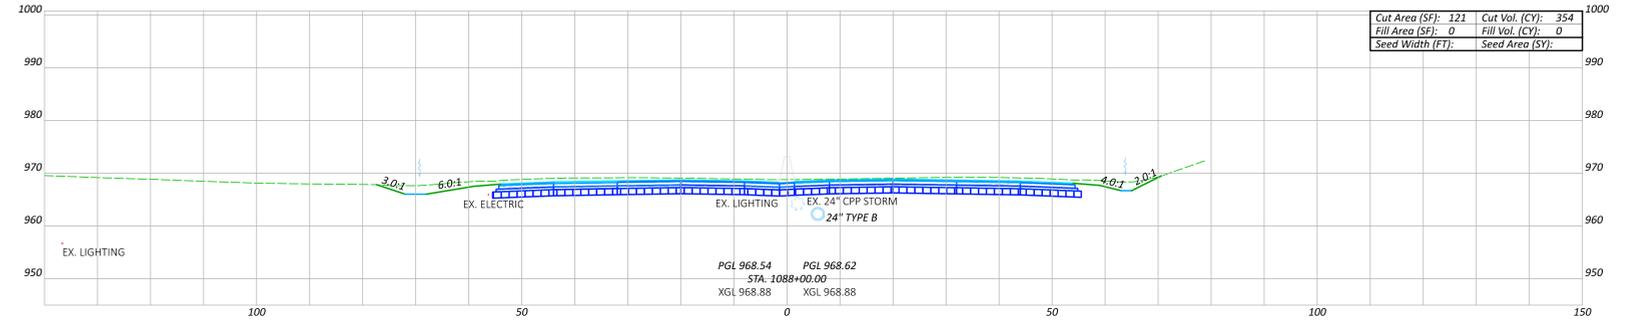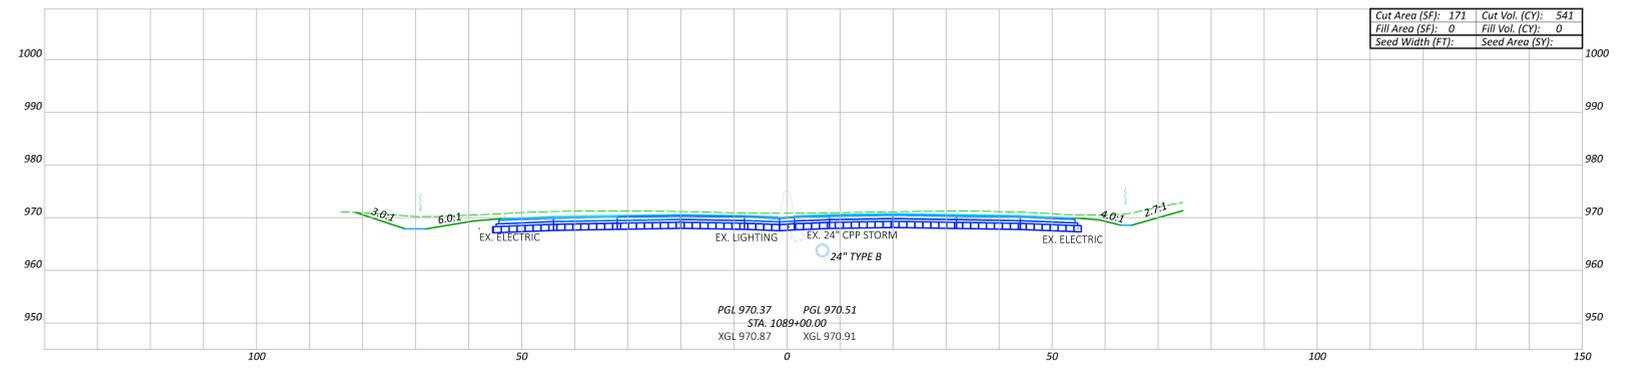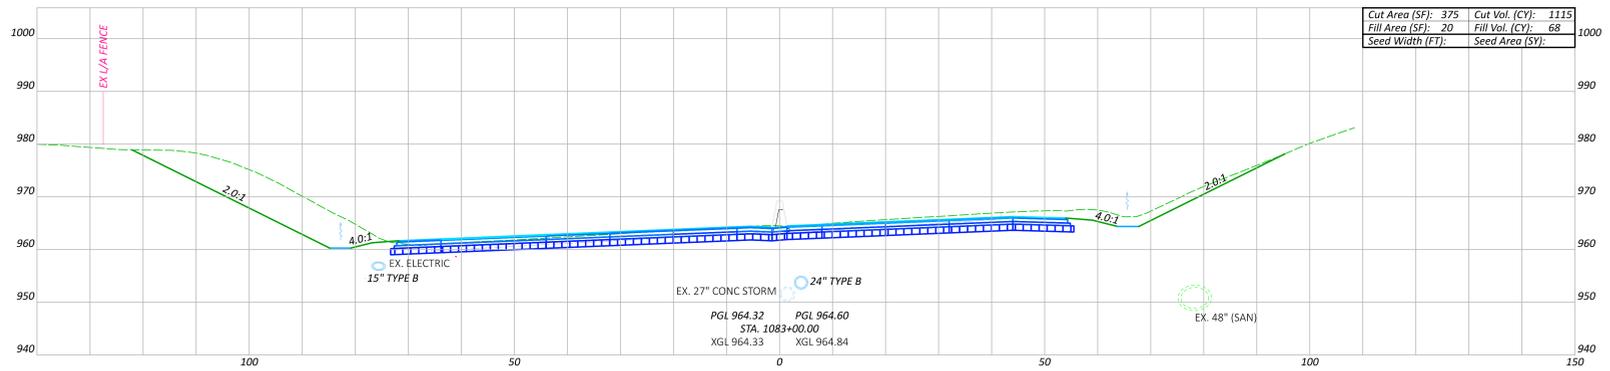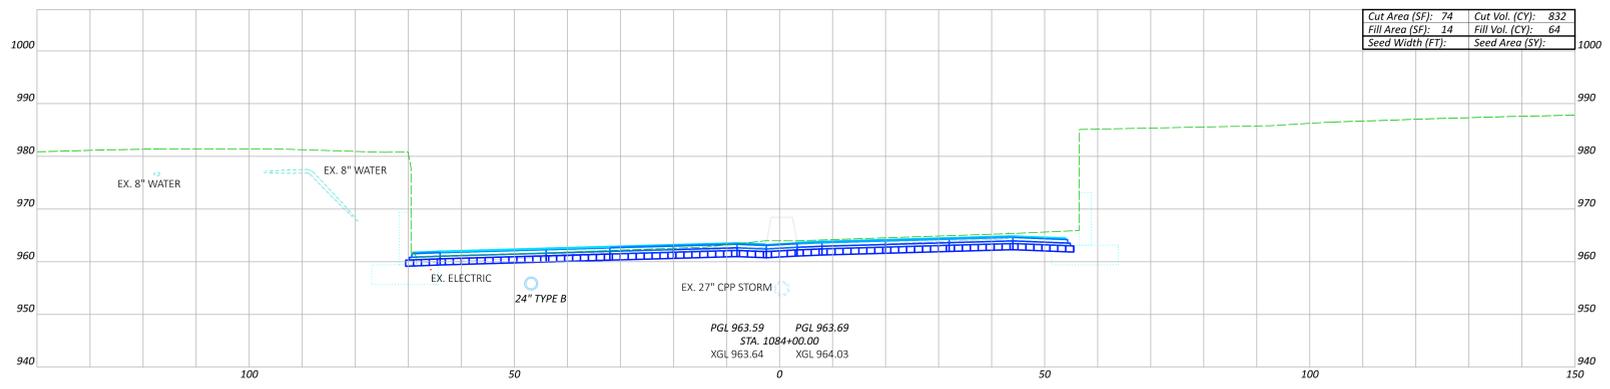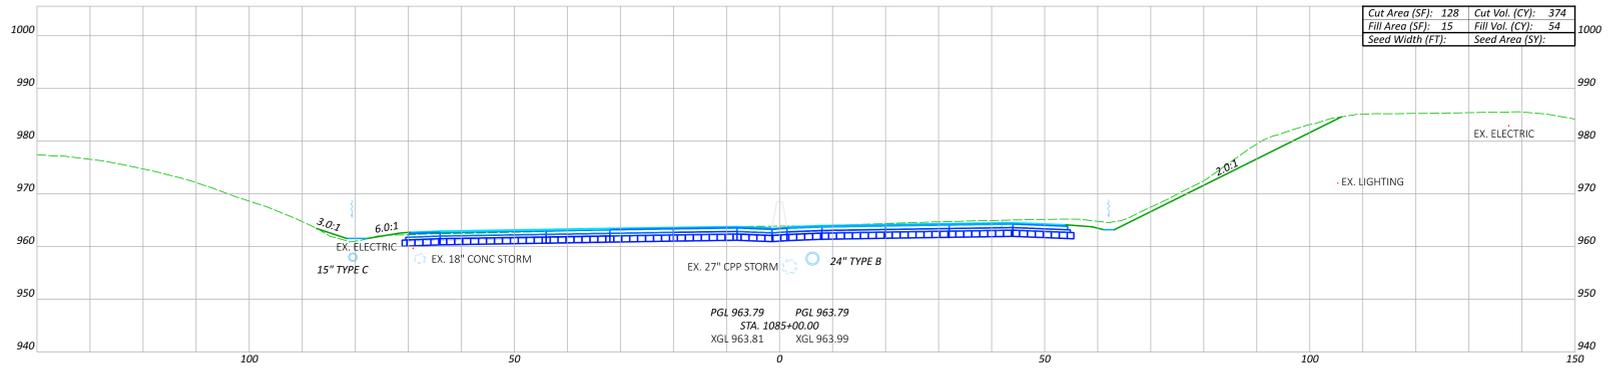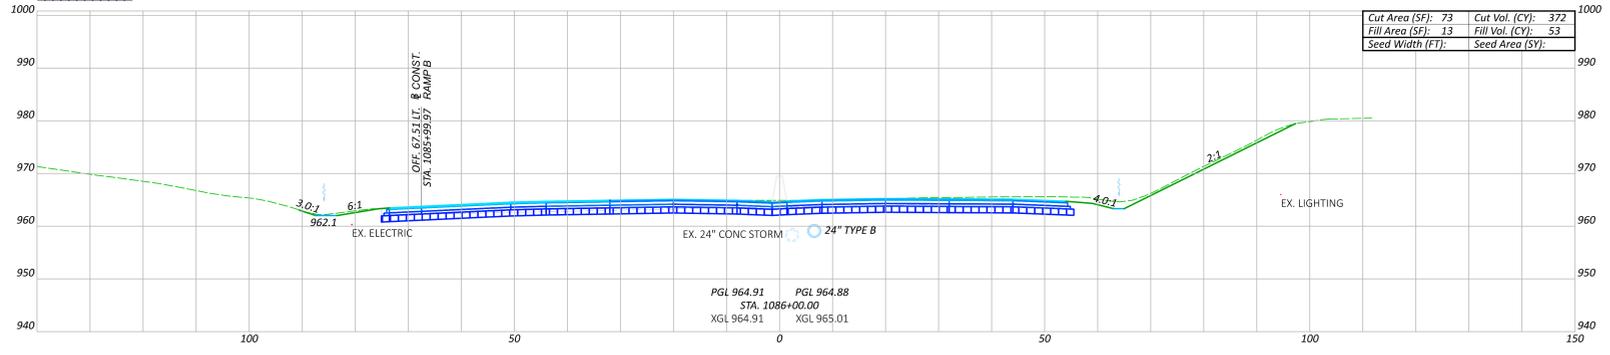

01-13-2026, QUANTITIES REVISED







Sheet Totals	121474
Seeding	3836
Fill	255
Total	655

CROSS SECTIONS - I.R. 680
 STA. 1083+00.00 TO STA. 1089+00.00

DESIGN AGENCY

 ms consultants inc.
 DESIGNER: MSN
 REVIEWER: CMN 08/29/25
 PROJECT ID: 121474

LEGEND:

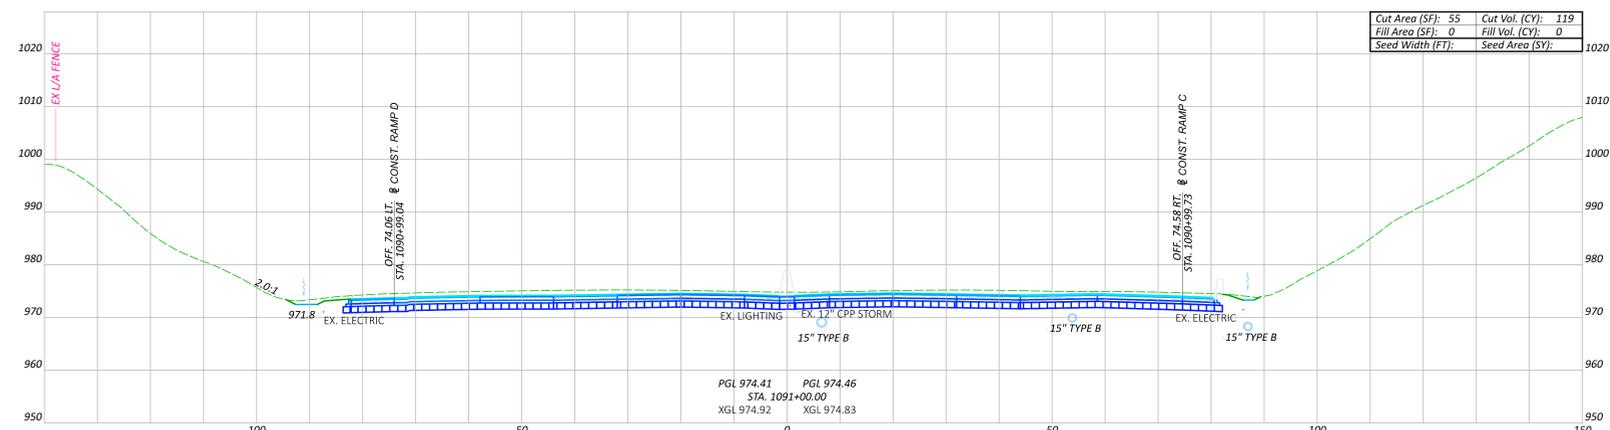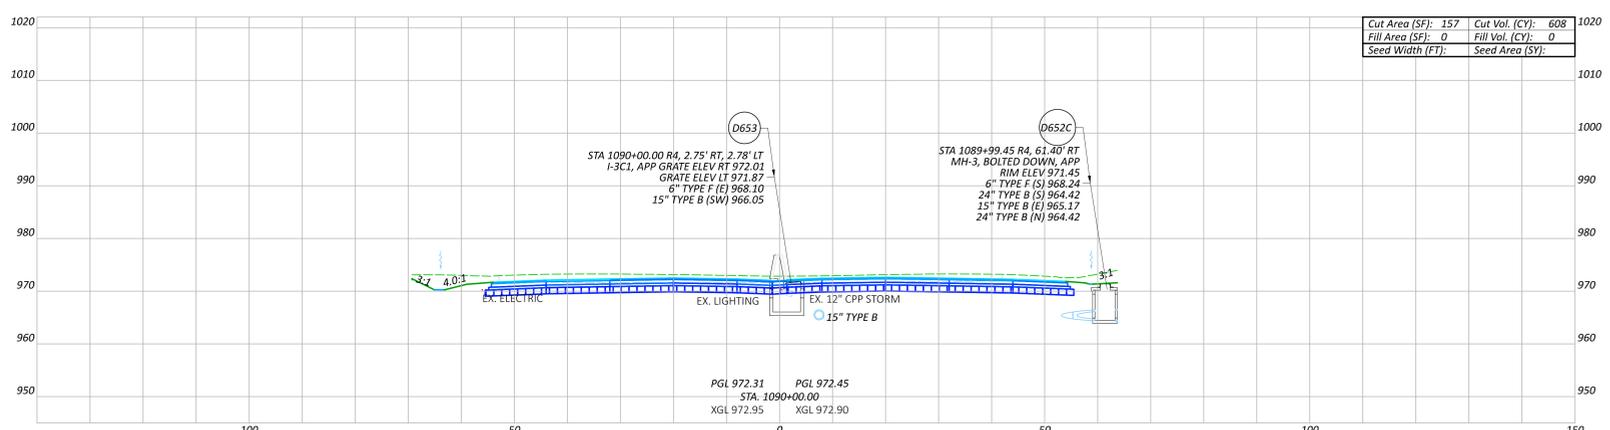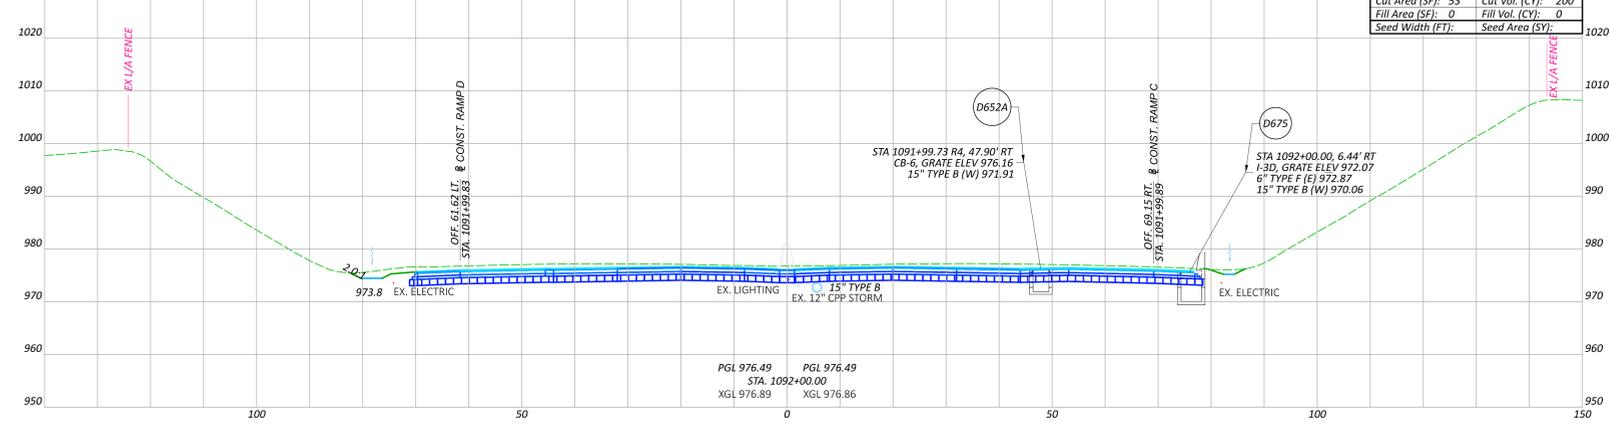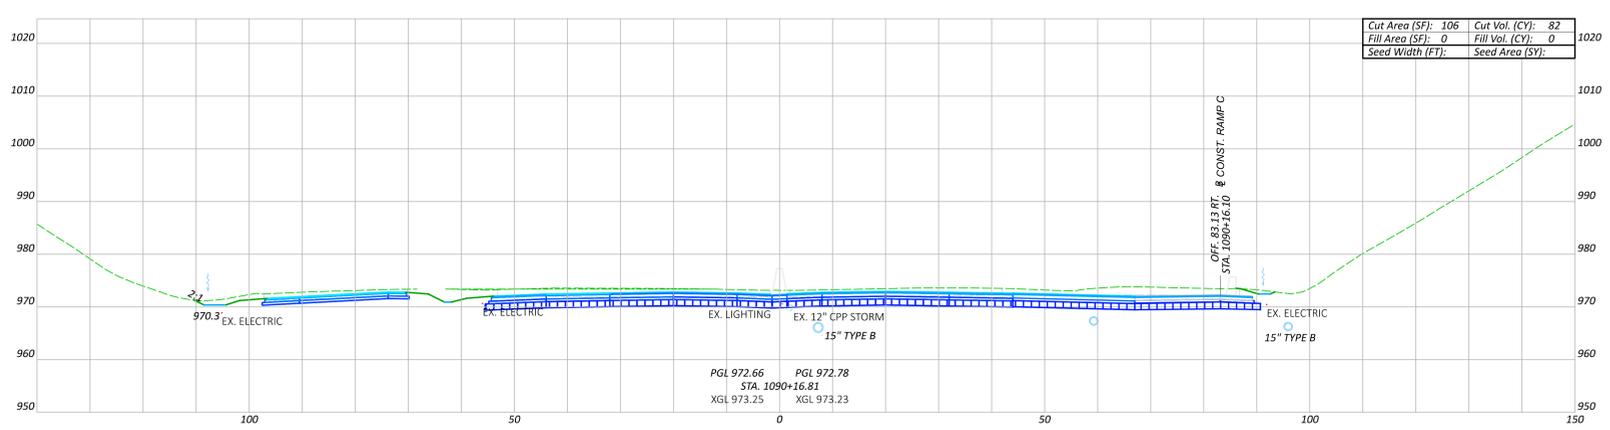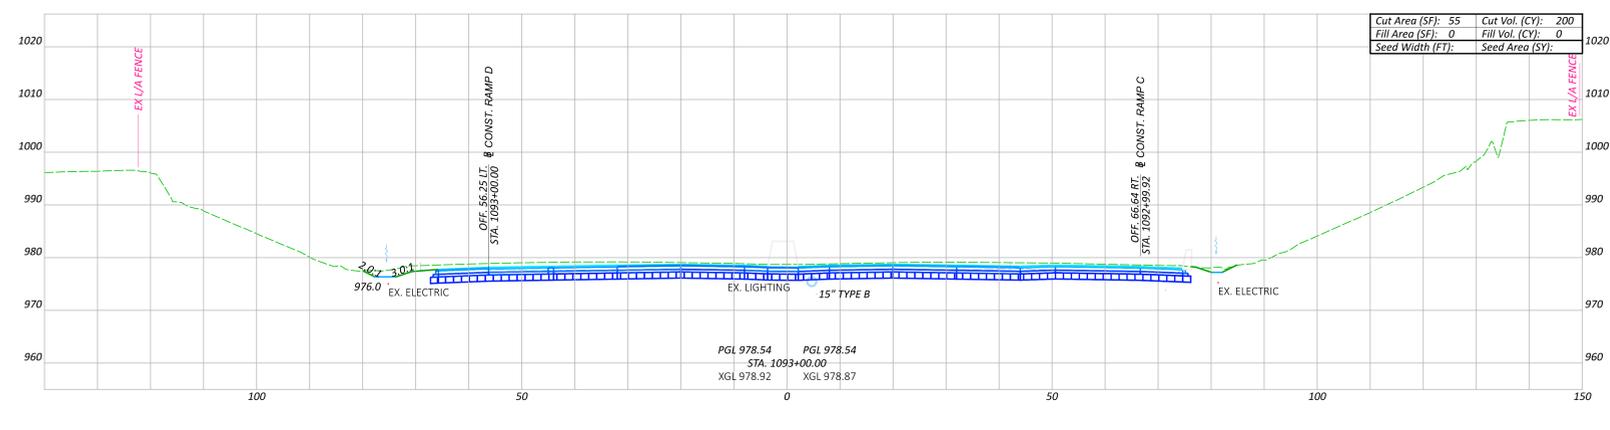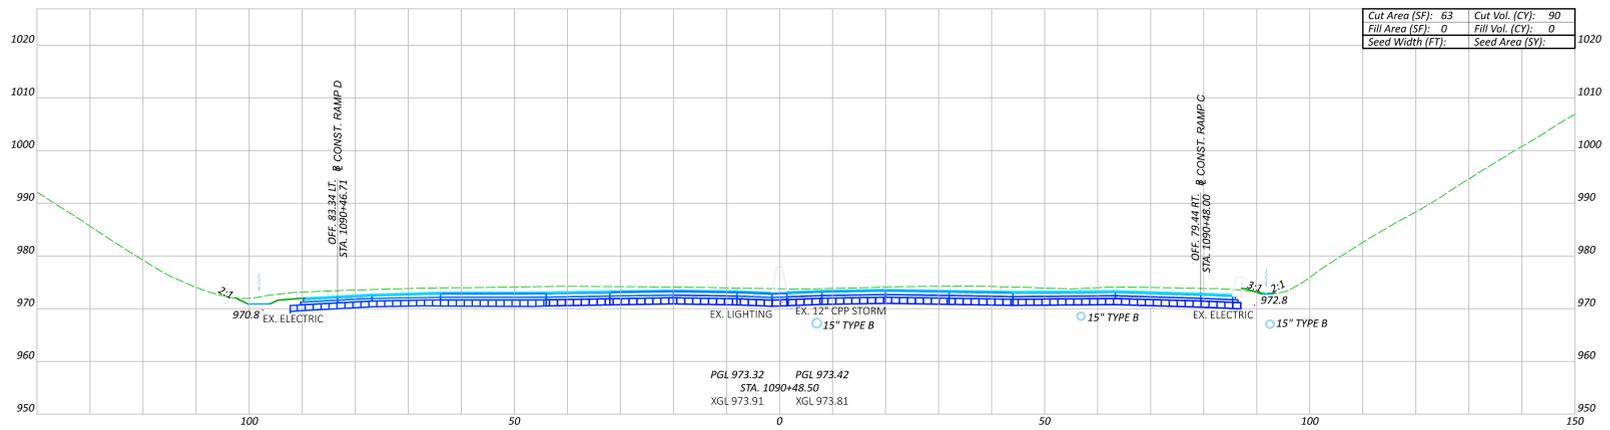

CROSS SECTIONS - I.R. 680
 STA. 1090+00.00 TO STA. 1093+00.00

11-13-2026, QUANTITIES REVISED

Sheet Totals	121474
Seeding	1299
Cut	0
Fill	0






DESIGN AGENCY

 CONSULTANTS, INC.
 DESIGNER: MSN
 REVIEWER: CMN 08/29/25
 PROJECT ID: 121474

LEGEND:

 ITEM 206 - CEMENT STABILIZED SUBGRADE, 14" DEPTH

I.R. 680	TOTALS CARRIED TO CROSS SECTION SHEET P.292
ITEM 203 - EXCAVATION	= 30,965 C.Y.
ITEM 203 - EMBANKMENT	= 6,806 C.Y.
SPECIAL EMBANKMENT	
ITEM 203 - EXCAVATION	= 3,070 C.Y.
ITEM 203 - EMBANKMENT	= 4,193 C.Y.

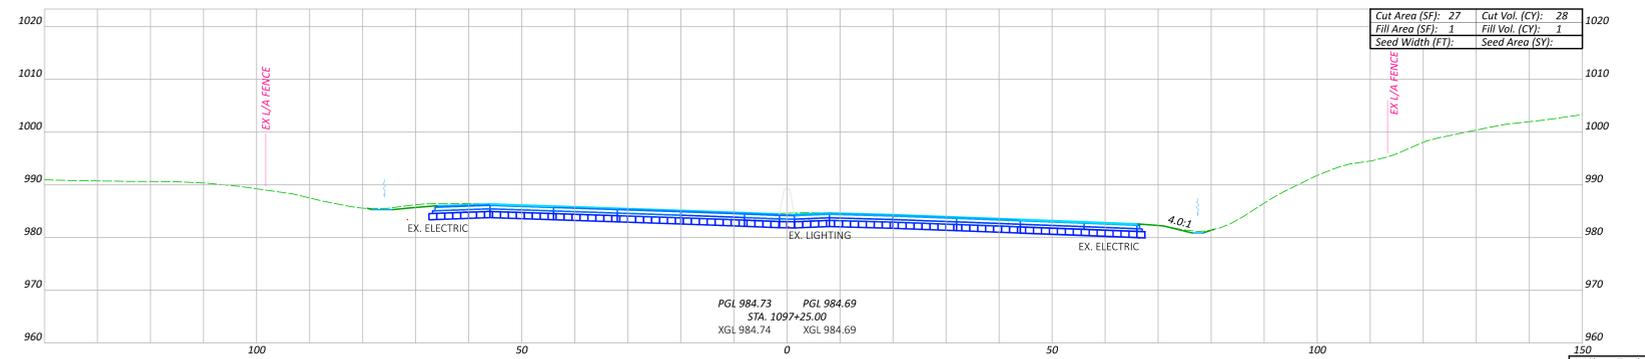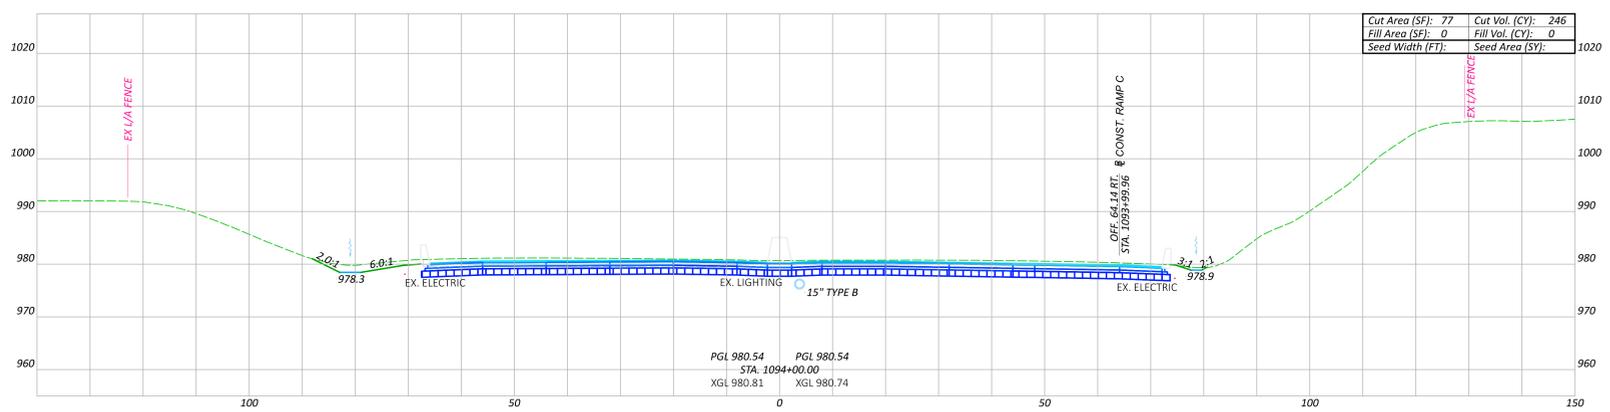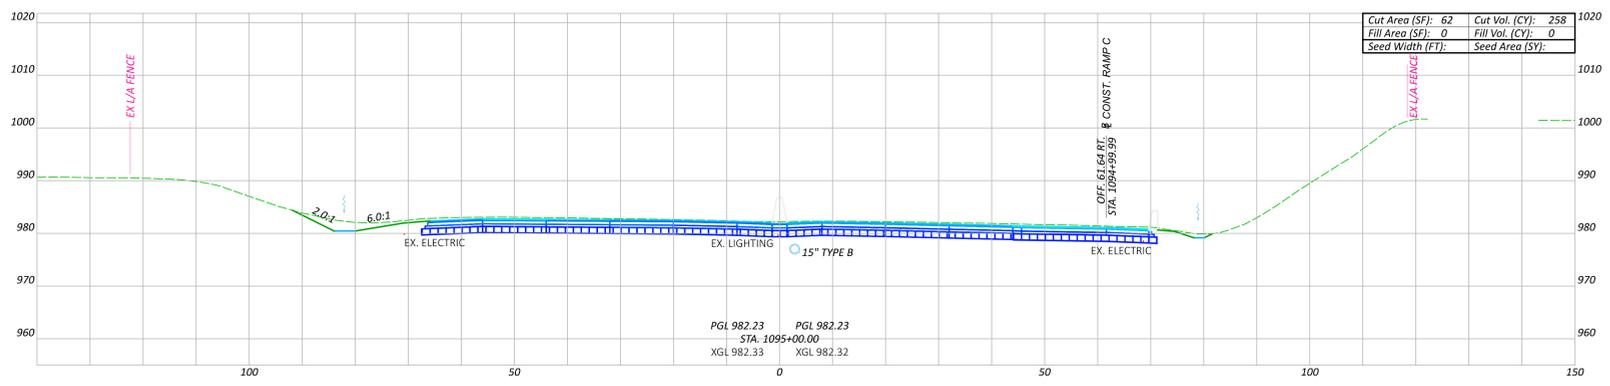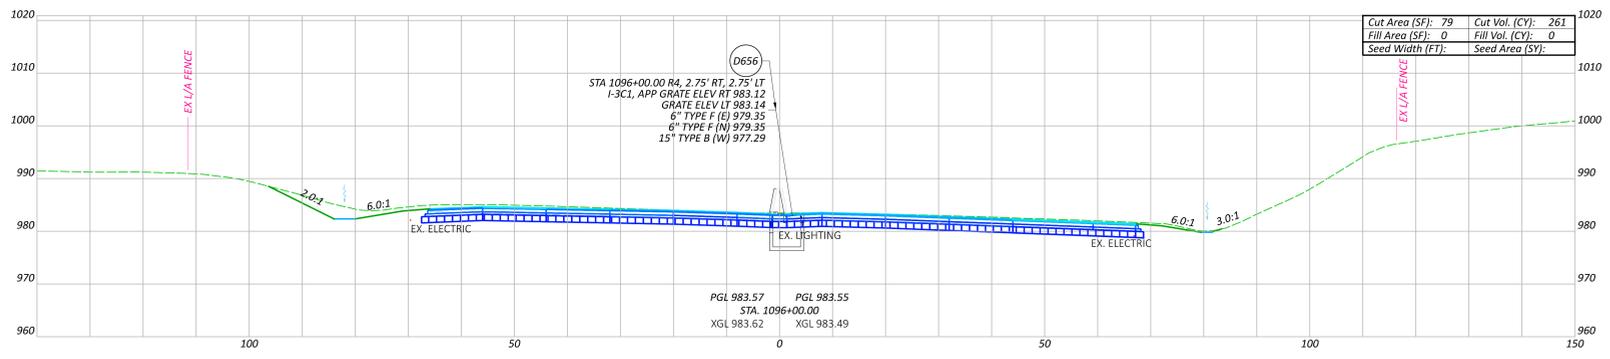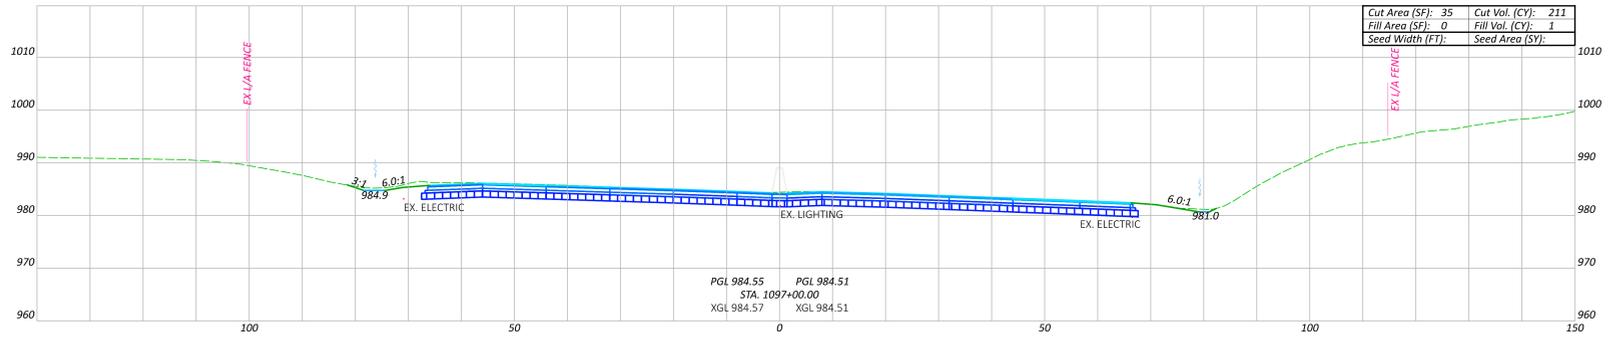

CROSS SECTIONS - I.R. 680
 STA. 1094+00.00 TO STA. 1097+24.61

MAH-680-4.58

MODEL: QIP_680_109400.00 (4) (Sheet) PAPER SIZE: 66x94 (in.) DATE: 1/12/2026 TIME: 4:43:26 PM AUTHOR: CHDDE_PDF_PLOTTER: PLOT DATE: 1/12/2026 11:47:41 AM PROJECT: I-17474_PRODUCT: OpenRoads Designer 24.00.02.25
 PLOT: \\hds0101.cim.hilltop.com\hds0101\Documents\I-17474\Drawings\I-17474\02_Engineering\MCD\Consultants\Boswell\Drawings\I-17474_X004.dgn






DESIGN AGENCY

 MIS CONSULTANTS INC.
 DESIGNER: MSN
 REVIEWER: CMN 08/29/25
 PROJECT ID: 121474
 SHEET TOTAL: 1004
 P.288 655

Sheet Totals 121474
 Seeding Cut Fill
 1004 2

01-13-2026. QUANTITIES REVISED

MAH-680-4.58
 MODEL PLOT: PLOT: 08/29/25 11:58:43 AM DATE: 11/20/25 TIME: 4:48:43 PM PLOT: 08/29/25 11:58:43 AM USER: D:\Users\mshah@msn.com\Documents\121474\PROJECT\OpenRoads\p25\121474_0225.dwg
 PLOT: 08/29/25 11:58:43 AM DATE: 11/20/25 TIME: 4:48:43 PM PLOT: 08/29/25 11:58:43 AM USER: D:\Users\mshah@msn.com\Documents\121474\PROJECT\OpenRoads\p25\121474_0225.dwg

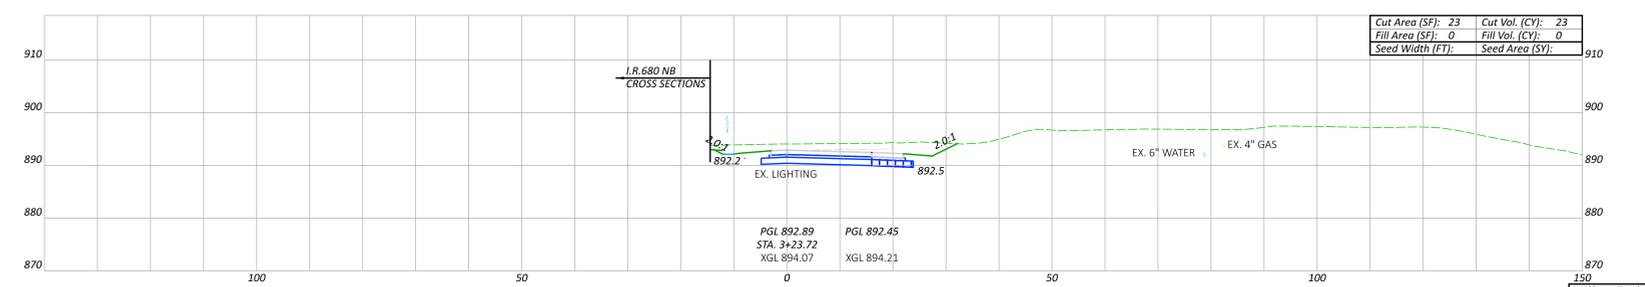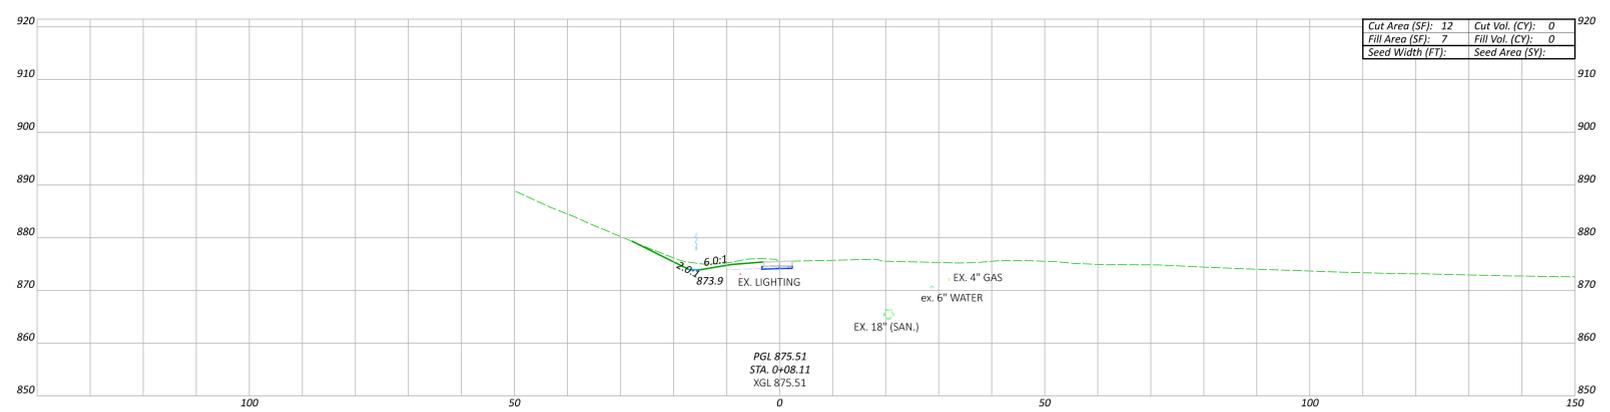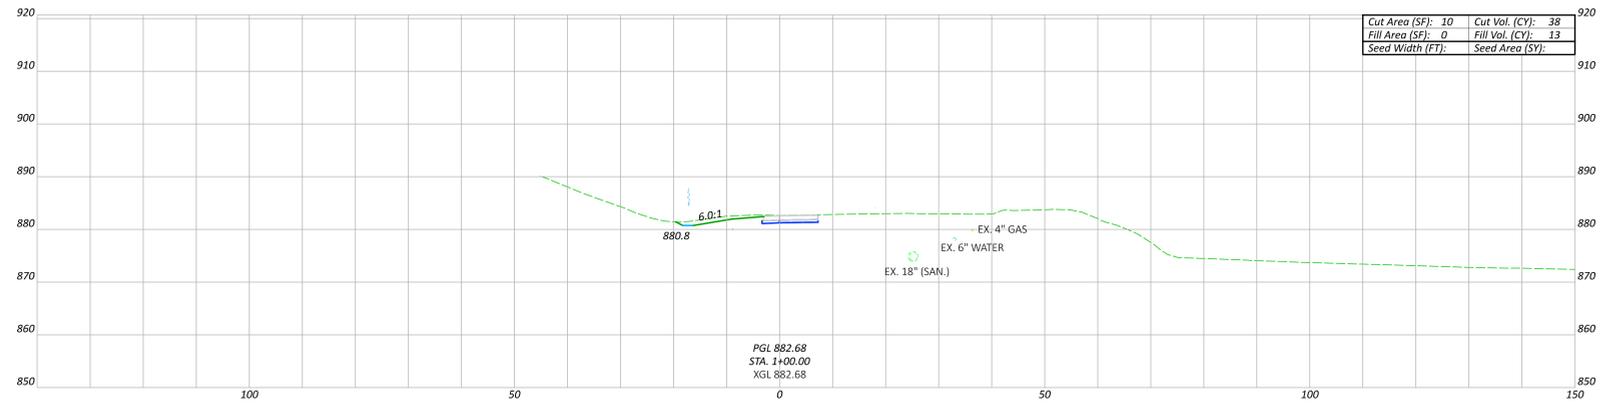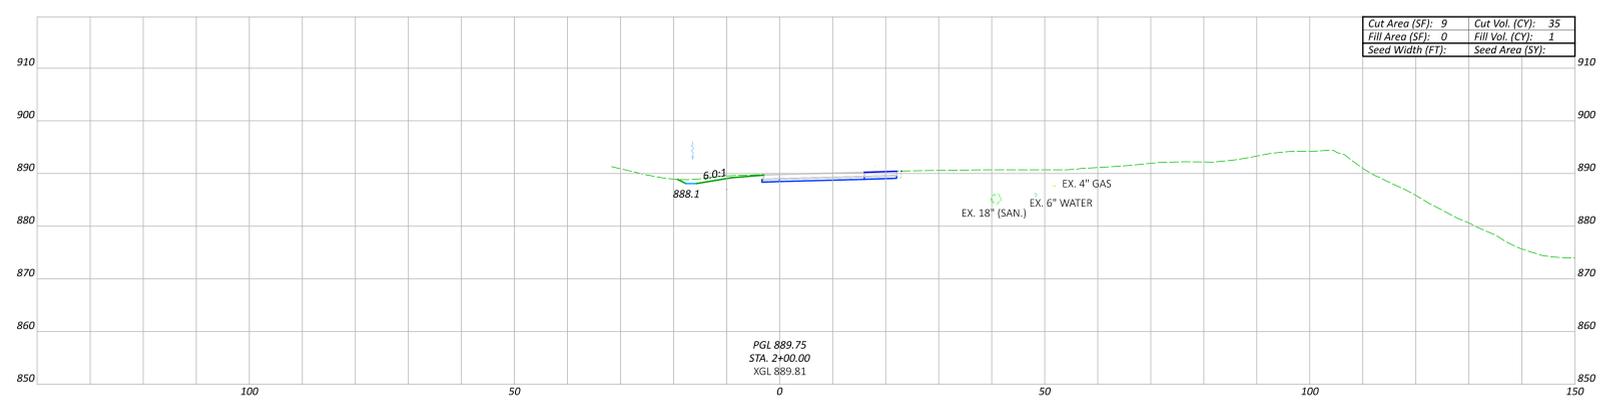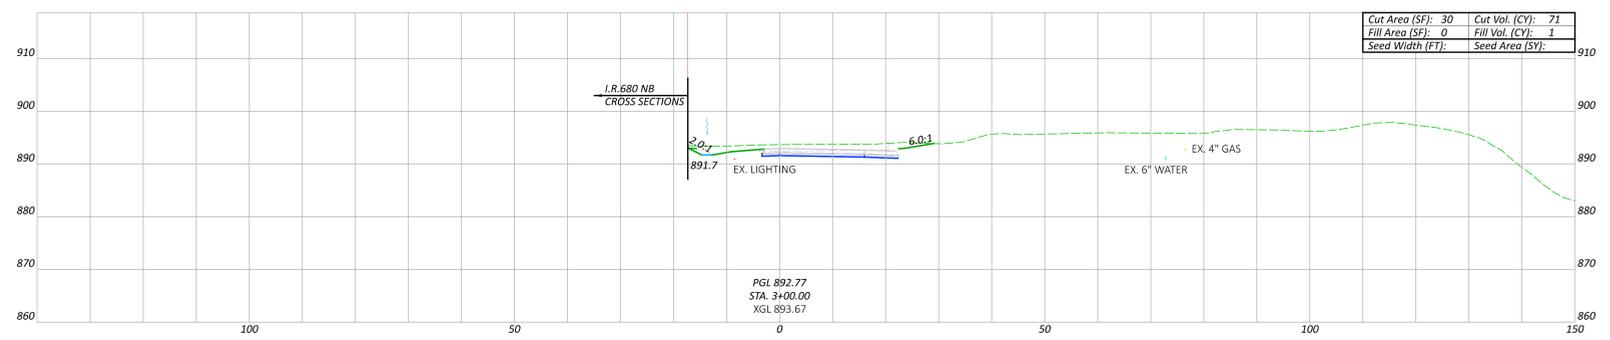

01-13-2026, QUANTITIES REVISED







Sheet Totals	121474
Seeding	167
Cut	15
Fill	15
Sheet TOTAL	167
P.289	655

CROSS SECTIONS - MARSHALL ST. RAMP G
 STA. 0+08.11 TO STA. 3+23.72

DESIGN AGENCY

 ms consultants inc.
 DESIGNER
 MSN
 REVIEWER
 CMN 08/29/25
 PROJECT ID
 121474

MAH-680-4.58
 MODEL: P:\P-140000\Sheet\140000.dwg DATE: 11/22/2016 TIME: 4:44:18 PM PLOT: PLOT DATE: 11/22/2016 TIME: 4:44:18 PM USER: daniel@msn.com WORKSPACE: C:\Users\daniel\Documents\121474_121474.dwg
 PLOT: PLOT DATE: 11/22/2016 TIME: 4:44:18 PM USER: daniel@msn.com WORKSPACE: C:\Users\daniel\Documents\121474_121474.dwg

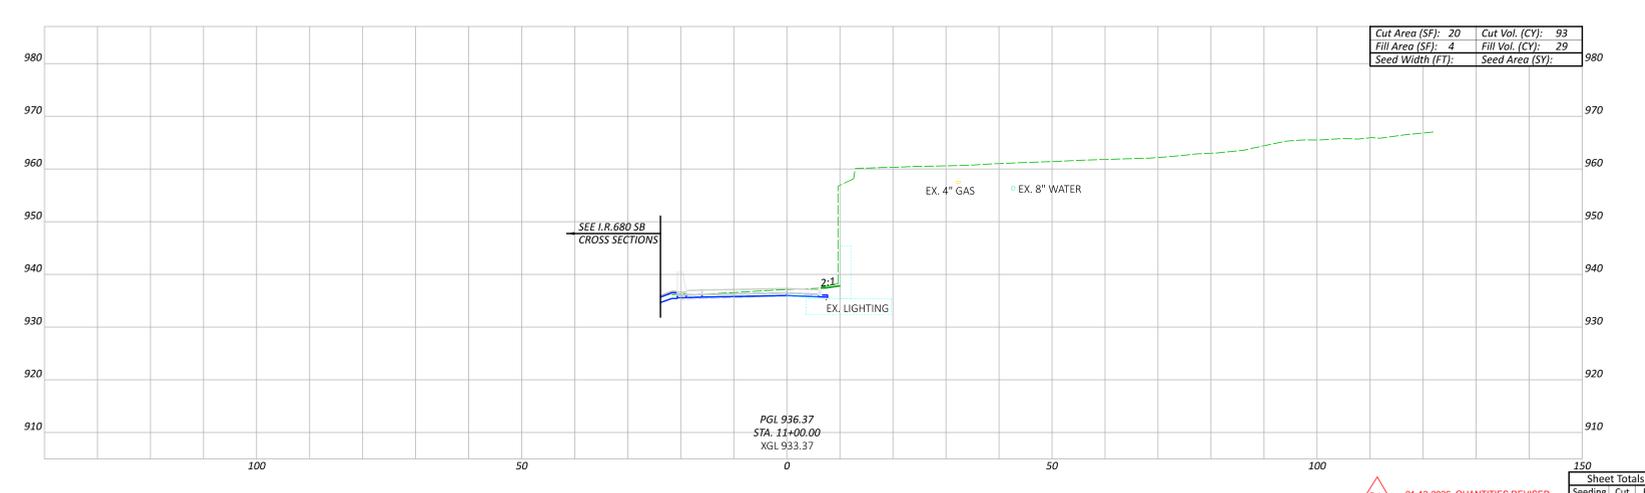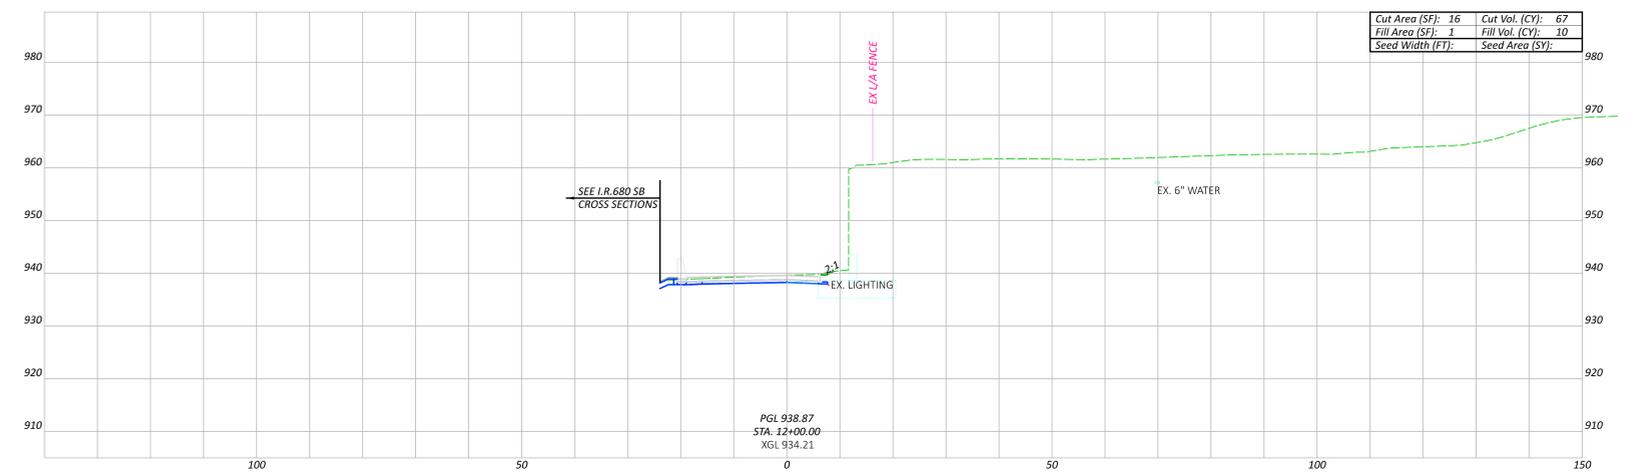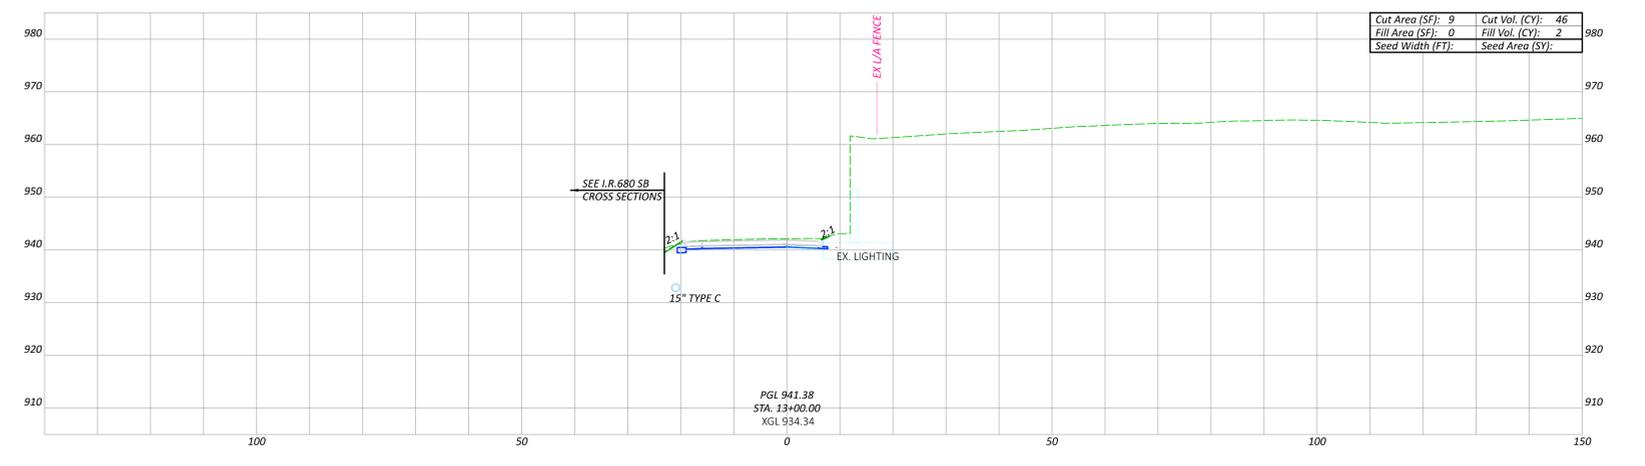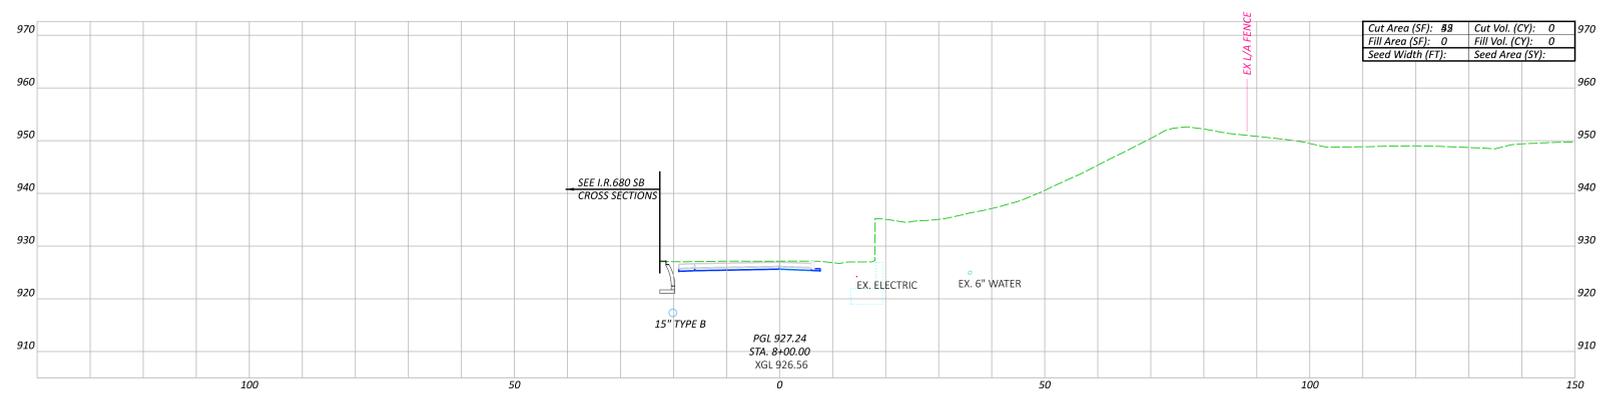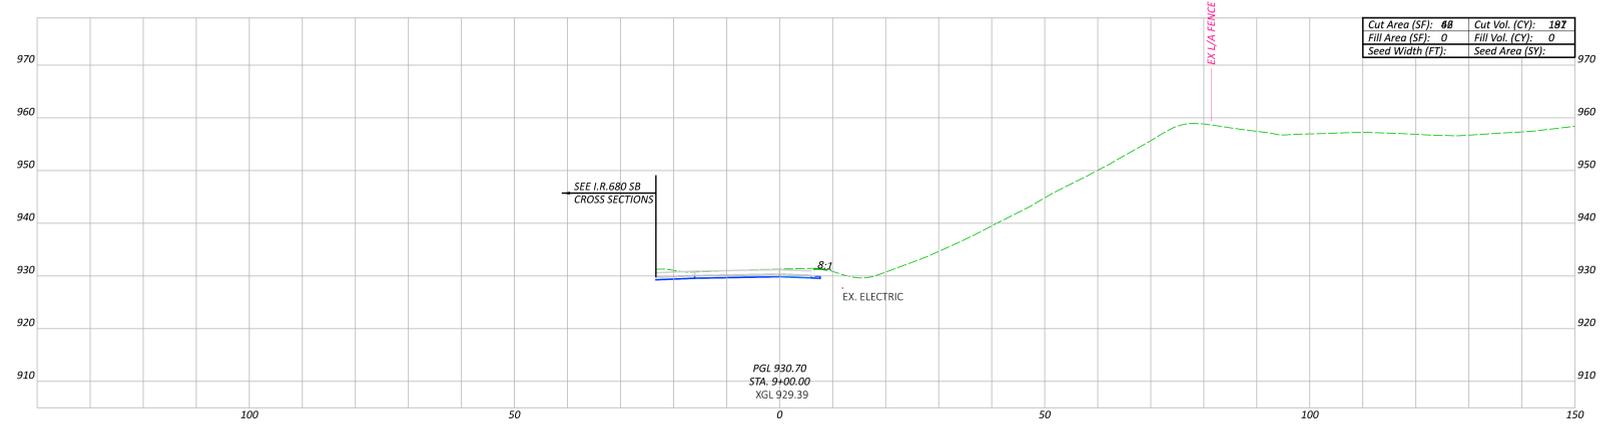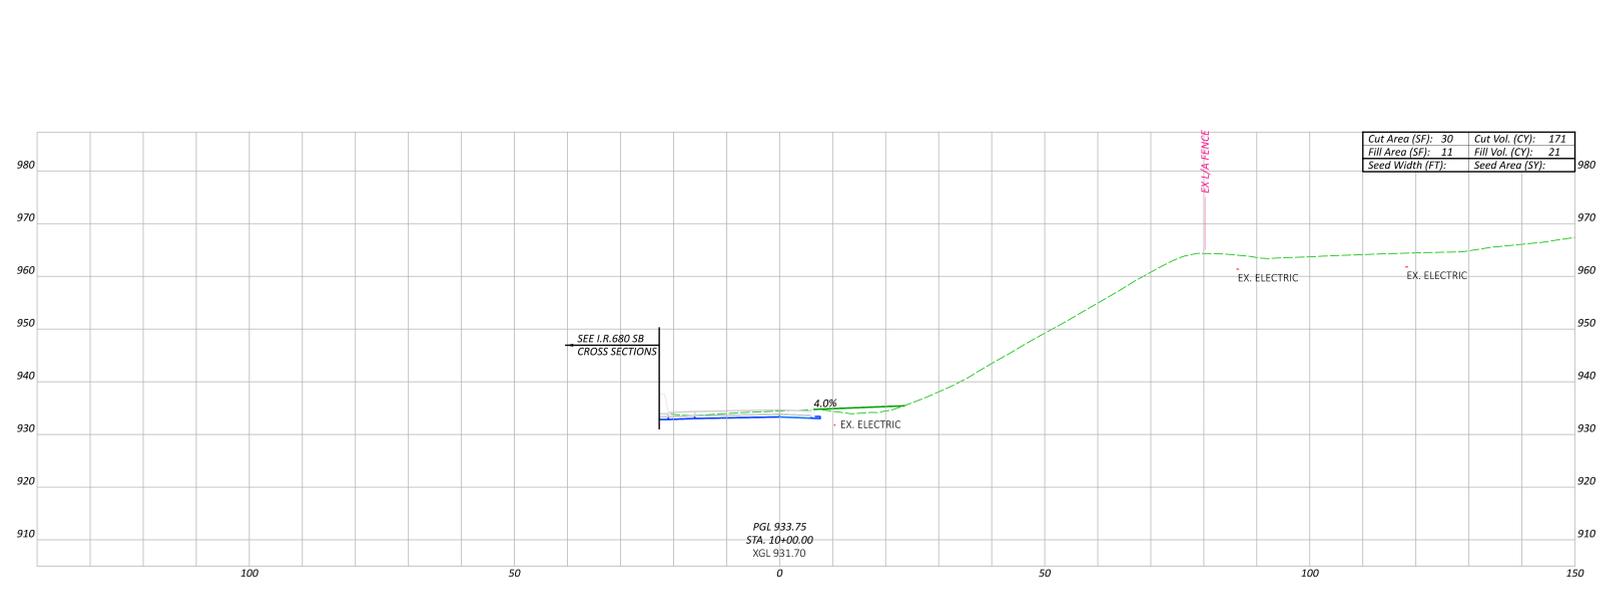

CROSS SECTIONS - RAMP K AT MARKET ST.
 STA. 8+00.00 TO STA. 13+00.00





01-13-2026, QUANTITIES REVISED

Sheet Totals	121474
Seeding	574
Cut	62
Fill	655




DESIGN AGENCY

 CONSULTANTS INC.
 DESIGNER: MSN
 REVIEWER: CMN
 PROJECT ID: 08/29/25

MAH-680-4.58
 MODEL: P:\14-000\Drawings\PROJECTS\680-4.58\122025\122025_PDF_E-Plan.dwg (P:\14-000\Drawings\PROJECTS\680-4.58\122025\122025_PDF_E-Plan.dwg) DATE: 12/22/2025 TIME: 4:42:39 PM PLOTTER: HP DesignJet 5000 PLOT: PLOTTER: HP DesignJet 5000 PLOT: PLOTTER: HP DesignJet 5000
 PLOT: PLOTTER: HP DesignJet 5000 PLOT: PLOTTER: HP DesignJet 5000 PLOT: PLOTTER: HP DesignJet 5000
 PLOT: PLOTTER: HP DesignJet 5000 PLOT: PLOTTER: HP DesignJet 5000 PLOT: PLOTTER: HP DesignJet 5000

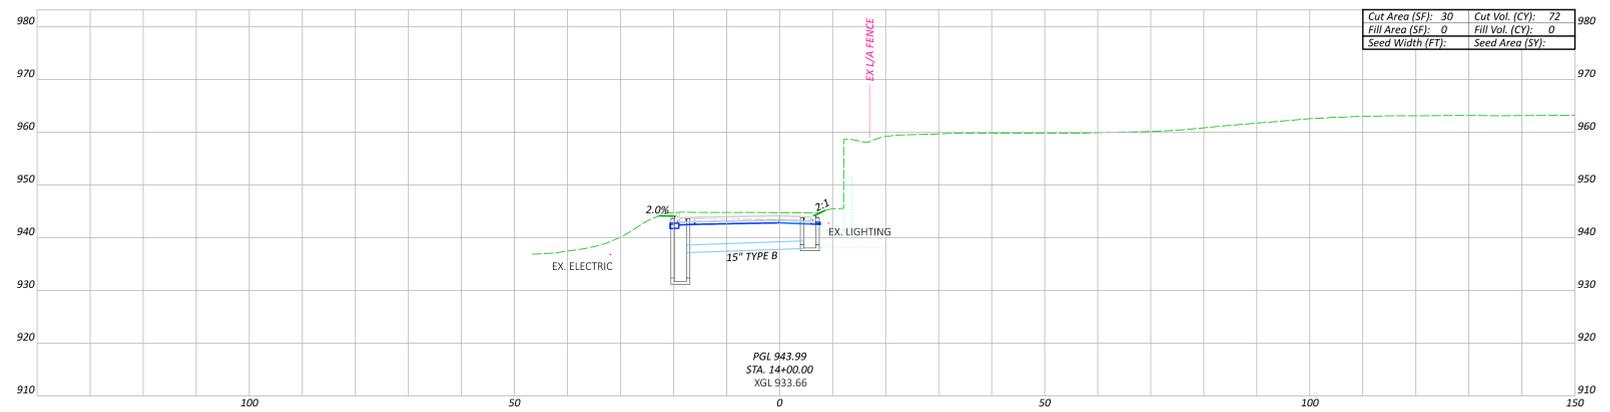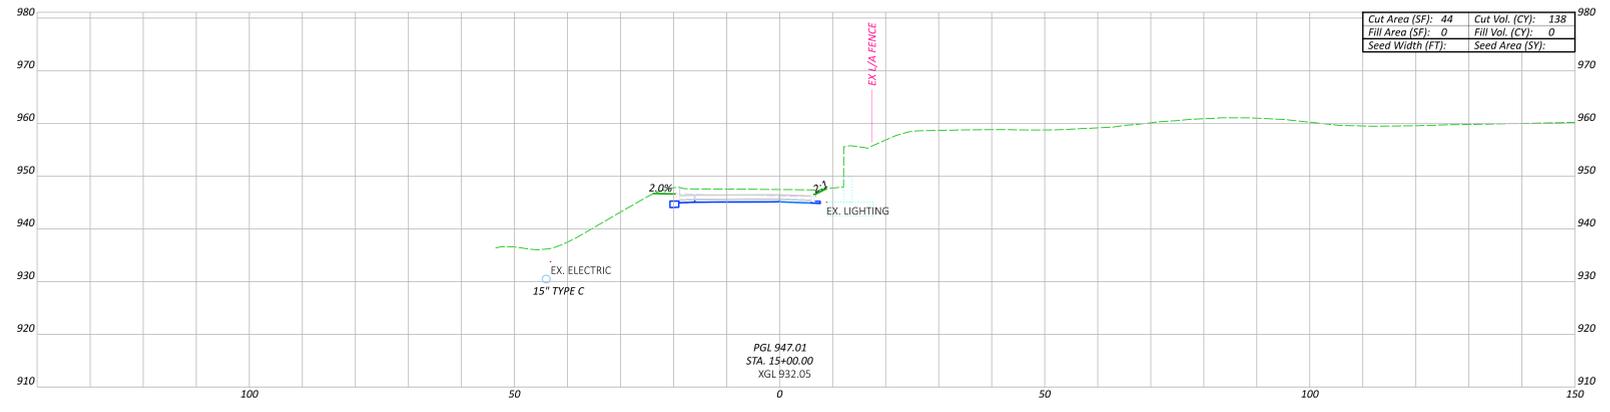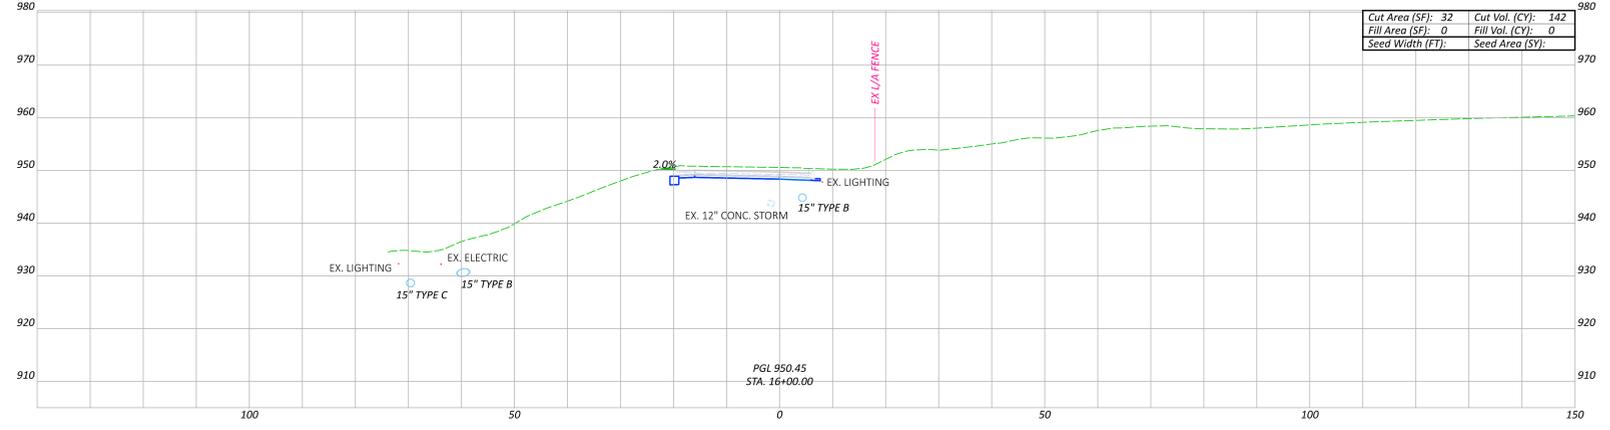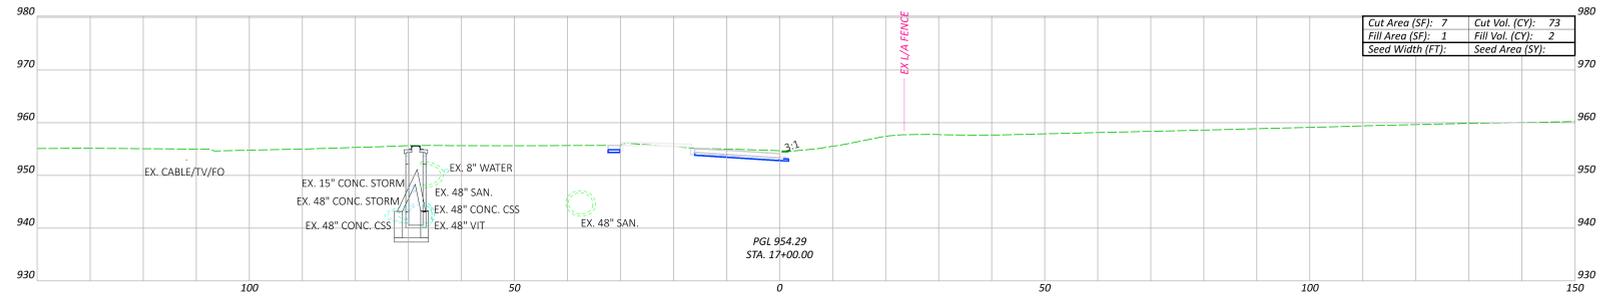

TOTALS	I.R. 680	MARSHALL ST. RAMP G	MARKET ST. RAMP K	SUB-TOTALS
ITEM 203 - EXCAVATION	= 30,965 C.Y.	= 1309 C.Y.	= 1,078 C.Y.	= 32352 C.Y.
ITEM 203 - EMBANKMENT	= 6806 C.Y.	= 15 C.Y.	= 88 C.Y.	= 6909 C.Y.
SPECIAL EMBANKMENT				
ITEM 203 - EXCAVATION	= 3,070 C.Y.	= 0 C.Y.	= 0 C.Y.	= 3,070 C.Y.
ITEM 203 - EMBANKMENT	= 4,193 C.Y.	= 0 C.Y.	= 0 C.Y.	= 4,193 C.Y.
GRAND TOTALS CARRIED TO THE GENERAL SUMMARY				ITEM 203 - EXCAVATION = 35,422 C.Y. ITEM 203 - EMBANKMENT = 11,102 C.Y.

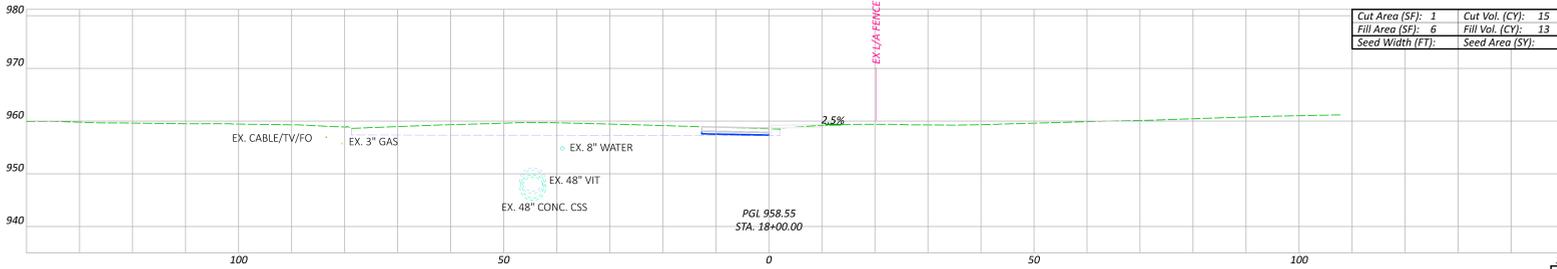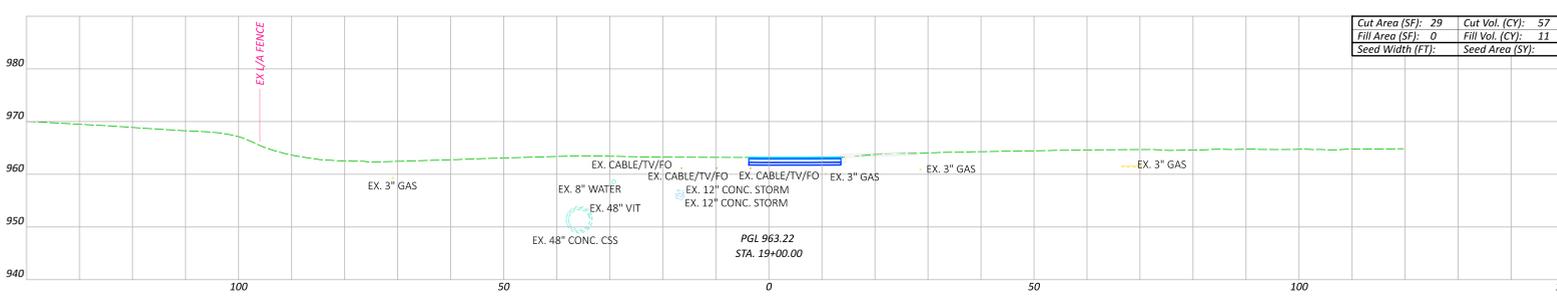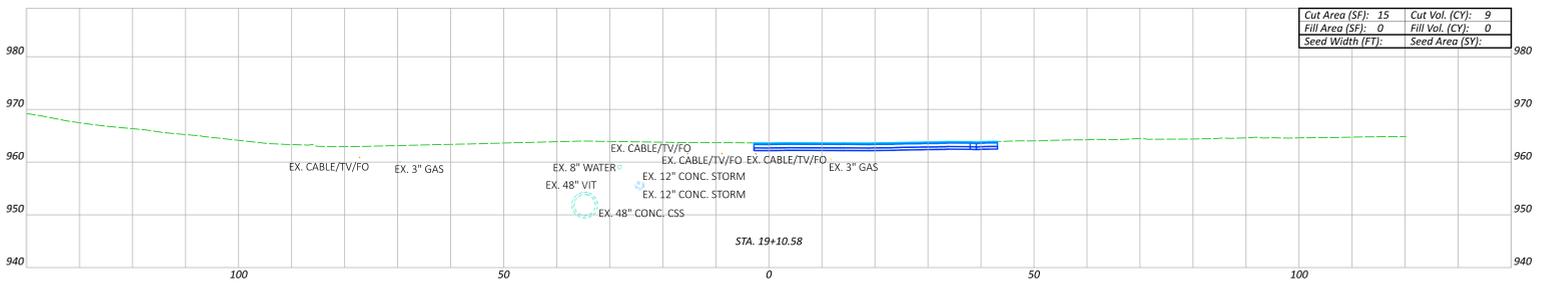

CROSS SECTIONS - RAMP K AT MARKET ST.
 STA. 14+00.00 TO STA. 19+10.58

DESIGN AGENCY
 MIS consultants inc.
 DESIGNER: MSN
 REVIEWER: CMN 08/29/25
 PROJECT ID: 121474
 SHEET TOTAL: 1070
 SHEET: 4
 TOTAL: 655

01-13-2026, QUANTITIES REVISED

625, PULL BOX CLEANED

THIS ITEM OF WORK SHALL CONSIST OF CLEANING AN EXISTING PULL BOX BY REMOVING ANY EXISTING CABLES NOT BEING RECONNECTED, AND DEBRIS SO THAT NEW CABLES CAN BE INSTALLED. ANY UNUSED OPENINGS SHALL BE CLOSED. DISTURBED AREAS NEAR THE PULL BOX SHALL BE CLEARED OF WEEDS OR DEBRIS AND SHALL BE FULLY RESTORED. MATERIAL REMOVED SHALL BECOME THE PROPERTY OF THE CONTRACTOR AND SHALL BE PROPERLY DISPOSED OF OFF OF THE PROJECT SITE.

PAYMENT WILL BE MADE AT THE UNIT PRICE BID UNDER C&MS ITEM 625, "PULL BOX CLEANED" FOR EACH PULL BOX CLEANED WHICH SHALL BE FULL COMPENSATION FOR ALL LABOR, MATERIALS AND INCIDENTALS REQUIRED TO COMPLETE THIS ITEM IN A SATISFACTORY AND WORKMANLIKE MANNER.

625, CONDUIT CLEANED AND CABLES REMOVED, AS PER PLAN

THIS ITEM SHALL CONSIST OF CLEANING AN EXISTING CONDUIT BY REMOVING EXISTING CABLES, MUD AND DEBRIS SO THAT NEW CABLE CAN BE INSTALLED. INCIDENTAL TO THE CLEANING IS THE INSTALLATION OF BUSHINGS AND/OR COUPLINGS ON THE ENDS OF EXISTING CONDUIT AS REQUIRED. MATERIALS REMOVED SHALL BECOME THE PROPERTY OF THE CONTRACTOR FOR PROPER DISPOSAL OFF OF THE PROJECT SITE. DISTURBED AREAS SHALL BE PROPERLY RESTORED.

PAYMENT WILL BE MADE AT THE UNIT PRICE BID UNDER C&MS ITEM 625, "CONDUIT CLEANED AND CABLES REMOVED" PER FOOT OF CONDUIT CLEANED WHICH SHALL BE FULL COMPENSATION FOR ALL LABOR, MATERIALS AND INCIDENTALS REQUIRED TO COMPLETE THIS ITEM IN A SATISFACTORY AND WORKMANLIKE MANNER.

LIGHT POLE ANCHOR BOLTS ON STRUCTURES

WHEN A LIGHT POLE IS MOUNTED ON A PILASTER ON A BRIDGE PARAPET OR ON A RETAINING WALL, THE REQUIRED ANCHOR BOLTS MAY DIFFER IN LENGTH AND/OR SHAPE FROM THOSE REQUIRED WHEN THE POLE IS MOUNTED ON A CAST-IN-PLACE DRILLED SHAFT FOUNDATION. THE COST DIFFERENTIAL FOR FURNISHING SUCH BOLTS IS INCLUDED HEREIN.

IN ADDITION, THERE IS NO FOUNDATION CONSTRUCTION ITEM IN WHICH TO INCLUDE THE SETTING OF THE ANCHOR BOLTS. THUS, THE SETTING OF THE ANCHOR BOLTS INTO THE PILASTER IS ALSO PART OF THIS WORK.

PAYMENT WILL BE MADE AT EACH SUCH POLE LOCATION AT THE UNIT PRICE BID FOR EACH C&MS ITEM 625, "LIGHT POLE ANCHOR BOLTS ON STRUCTURE" AND SHALL BE FULL COMPENSATION FOR FURNISHING AND PLACING THE SET OF ANCHOR BOLTS REQUIRED.

UNDERGROUND WARNING/MARKING TAPE, AS PER PLAN

UNDERGROUND WARNING/MARKING TAPE SHALL BE IN ACCORDANCE WITH CMS 725.22 EXCEPT THE TAPE SHALL NOT BE FURNISHED WITH TRACER WIRE AND THE REQUIRED MINIMUM BREAK STRENGTH SHALL BE WAIVED.

625, POWER SERVICE, AS PER PLAN

IN ADDITION TO THE REQUIREMENTS OF THE SPECIFICATIONS, THE FOLLOWING SHALL APPLY.

THE POWER SUPPLYING AGENCY FOR THIS PROJECT IS:

OHIO EDISON (DISTRIBUTION)
76 S. MAIN STREET
AKRON, OHIO 44308
ATTN: TIMOTHY MARKULIN
tmarkulin@firstenergycorp.com
PH: 330-810-5299

POWER SERVICE: 480 VOLT, 3-WIRE, SINGLE PHASE, GROUNDED NEUTRAL. THIS PROJECT HAS BEEN DESIGNED ON THE BASIS OF 5% VOLTAGE DROP WITH A MAXIMUM UNIFORMITY RATIO OF 4.0 TO 1.0 FOR CONVENTIONAL UNITS AND 3.0 TO 1.0 FOR HIGH MAST UNITS.

ALL POWER SERVICES SHALL BE METERED. THE METER BASE MOUNTING HEIGHT SHALL BE NO MORE THAN FIVE (5) FEET HIGH TO THE CENTER OF THE METER BASE FROM THE GROUND. A NON-FUSED DISCONNECT SHALL BE INSTALLED ON THE POWER SIDE OF THE METER BASE. THE CONTRACTOR SHALL SUPPLY THE NECESSARY METER BASES AND DISCONNECTS.

THE CONTRACTOR SHALL PAY ALL ELECTRICAL ENERGY CHARGES FOR NEW POWER SERVICES ESTABLISHED BY THIS PROJECT. UPON COMPLETION OF THIS PROJECT AND AFTER WRITTEN AUTHORIZATION FROM THE DISTRICT CONSTRUCTION ENGINEER, POWER SERVICE ELECTRICAL ENERGY ACCOUNTS SHALL BE TRANSFERRED TO THE MAINTAINING AGENCY. THIS SHALL INCLUDE NEW POWER SERVICE ESTABLISHED BY THIS PROJECT AS WELL AS REASSIGNMENT OF EXISTING SERVICE DUE TO WORK PERFORMED BY THIS PROJECT. IF POWER SERVICE IS TRANSFERRED PRIOR TO RECEIVING THE WRITTEN AUTHORIZATION, A DISINCENTIVE OF \$100 PER DAY SHALL BE ASSESSED FOR EACH CALENDAR DAY OF NON-COMPLIANCE.

PAYMENT WILL BE MADE AT THE UNIT BID PRICE FOR EACH CMS ITEM 625, "POWER SERVICE, AS PER PLAN" WHICH SHALL BE FULL COMPENSATION FOR ALL LABOR, MATERIALS, AND INCIDENTALS REQUIRED TO COMPLETE THIS ITEM IN A SATISFACTORY AND WORKMANLIKE MANNER.

PADLOCKS AND KEYS

PADLOCKS FURNISHED SHALL BE EITHER BRASS OR BRONZE, EQUAL TO MASTER NO. 4BKA OR WILSON BOHANNAN 660A, AND SHALL BE KEYED IN ACCORDANCE WITH C&MS 631.06. PAYMENT SHALL BE INCLUDED IN THE BID FOR THE ITEM(S) BEING LOCKED.

HIGH VOLTAGE TEST WAIVED

THE HIGH VOLTAGE TEST SHALL NOT BE PERFORMED ON CIRCUIT GW CONSTRUCTED BY THIS PROJECT THAT CONNECTS TO EXISTING LIGHTS, SINCE THE TEST COULD DAMAGE THE PORTION OF THE COMPLETED CIRCUIT WHICH HAS BEEN IN SERVICE PRIOR TO THIS PROJECT.

LUMINAIRE, BY TYPE

THE LUMINAIRES SHALL BE ON THE APPROVED MATERIALS LIST, THE FINISH SHALL BE GREY, AND THE LUMENS ARE AS FOLLOWS:

LOW MAST: 40,000 - 45,000 LUMENS

LOW MAST MEDIAN MOUNTED: 49,000 - 51,000

HIGH MAST 69,000 - 72,000

SPECIAL, MAINTAIN EXISTING LIGHTING

EXISTING ROADWAYS WHICH ARE TO REMAIN OPEN TO TRAFFIC DURING CONSTRUCTION OF THIS PROJECT AND WHICH ARE LIGHTED SHALL HAVE THE LIGHTING MAINTAINED AS DESCRIBED HEREIN.

BEFORE ANY WORK IS STARTED IN THE IMMEDIATE VICINITY OF THE EXISTING LIGHTING CIRCUITS, REPRESENTATIVES OF ODOT, THE MAINTAINING AGENCY AND THE CONTRACTOR SHALL MAKE A VISUAL INSPECTION OF THE EXISTING ROADWAY LIGHTING CIRCUITS TO BE MAINTAINED. DURING THIS INSPECTION, A WRITTEN RECORD OF THE CONDITION OF EXISTING LIGHTING SHALL BE MADE BY ODOT'S REPRESENTATIVE. THIS WRITTEN REPORT SHALL NOTE INDIVIDUAL LUMINAIRES WHICH ARE NOT IN WORKING ORDER, INDIVIDUAL POLES WHICH ARE NOT STANDING, AND INDIVIDUAL CIRCUITS WHICH ARE NOT IN WORKING ORDER. THE COMPLETED REPORT SHALL BE SIGNED BY THE REPRESENTATIVES OF ODOT, THE MAINTAINING AGENCY AND THE CONTRACTOR.

IF, AS A RESULT OF THIS INSPECTION, IT IS DETERMINED THAT THE CONDITION OF THE EXISTING SYSTEM IS BELOW THAT REQUIRED FOR THE SAFETY OF THE TRAVELING PUBLIC, THEN THE MAINTAINING AGENCY SHALL MAKE THE REPAIRS NECESSARY TO RETURN THE SYSTEM TO AN ACCEPTABLE CONDITION. FOLLOWING THESE REPAIRS, THE SYSTEM SHALL AGAIN BE INSPECTED AND A REPORT SHALL BE MADE AND SIGNED AS OUTLINED HEREIN.

WHEN THE EXISTING SYSTEM IS IN AN ACCEPTABLE CONDITION, IT SHALL BE TURNED OVER TO THE CONTRACTOR WHO SHALL THEN BE REQUIRED TO MAINTAIN THE EXISTING LIGHTING TO THE CONDITION OUTLINED IN THIS REPORT WITH THE EXCEPTION OF KNOCKDOWNS DUE TO TRAFFIC ACCIDENTS.

REPLACEMENT OF KNOCKED DOWNED UNITS SHALL BE DONE ONLY WHEN THE ENGINEER HAS DETERMINED THAT THE REPLACEMENT OF THE KNOCKED DOWN UNIT IS NECESSARY AND SHALL BE PAID SEPARATELY ON A UNIT BASIS.

BETTERMENTS SHALL BE COVERED IN ITEMS OF WORK PERTAINING TO THE CONSTRUCTION OF PERMANENT IMPROVEMENT.

WHEN THE SEQUENCE OF CONSTRUCTION ACTIVITIES REQUIRES, OR SHOULD THE CONTRACTOR DESIRE, THE REMOVAL OF THE EXISTING LIGHTING BEFORE THE NEW LIGHTING IS OPERATIONAL, THE CONTRACTOR SHALL BE RESPONSIBLE FOR PROVIDING TEMPORARY LIGHTING OF THIS PORTION OF THE ROADWAY.

PRIOR TO INSTALLING SUCH LIGHTING, THE CONTRACTOR SHALL PREPARE AND SUBMIT FOUR SETS OF THE TEMPORARY LIGHTING PLAN TO THE ENGINEER FOR REVIEW AND APPROVAL.

THIS PLAN SHALL SHOW LOCATIONS OF POLES, LENGTHS OF BRACKET ARMS, STYLES OF LUMINAIRES, MOUNTING HEIGHTS, WIRING METHODS AND OTHER PERTINENT INFORMATION. THE TEMPORARY LIGHTING SHALL PROVIDE AN AVERAGE INITIAL INTENSITY OF 1.2 FOOTCANDLES WITH AN AVERAGE TO MINIMUM UNIFORMITY NOT TO EXCEED 3:1. MOUNTING HEIGHT OF TEMPORARY LUMINAIRES SHALL NOT BE LESS THAN 30 FEET, AND THE MINIMUM OVERHEAD CONDUCTOR CLEARANCE SHALL BE 20 FEET. TEMPORARY OVERHEAD CONSTRUCTION SHALL NOT BE LESS THAN GRADE "B" FOR STRENGTH REQUIREMENTS AS DEFINED BY THE NATIONAL ELECTRIC SAFETY CODE. WOOD POLES WITH OVERHEAD WIRING MAY BE USED. HOWEVER, TEMPORARY LIGHTING SHALL MEET FEDERAL AND STATE SAFETY CRITERIA.

SPECIAL, MAINTAIN EXISTING LIGHTING, CONT

IF BREAKAWAY POLES ARE USED TO MEET THESE CRITERIA, THEN UNDERGROUND WIRING SHALL BE USED. RECONDITIONED OR USED MATERIALS MAY BE FURNISHED FOR TEMPORARY LIGHTING.

ALL MATERIALS NECESSARY TO COMPLETE THE TEMPORARY LIGHTING SHALL BE FURNISHED AND INSTALLED BY THE CONTRACTOR. WHEN NO LONGER NEEDED, THE TEMPORARY LIGHTING INSTALLATION SHALL BE REMOVED AND PROPERLY DISPOSED OF BY THE CONTRACTOR.

WHEN THE PROJECT BEGINS AND THE CONTRACTOR HAS TAKEN OVER MAINTENANCE OF THE EXISTING FACILITIES, THE CONTRACTOR IS RESPONSIBLE FOR ALL REQUIRED LAYOUTS AND LOCATIONS OF THE EXISTING AND PROPOSED ELECTRICAL CIRCUITS AND RELATED ITEMS WITHIN THE PROJECT LIMITS. THE CONTRACTOR SHALL LOCATE AND MARK ALL UNDERGROUND ELECTRICAL CIRCUITS (INCLUDING TRAFFIC LOOPS AND LOOP LEAD-INS) FOR THE DURATION OF THE PROJECT.

THE MAINTAINING AGENCY WILL PAY FOR ELECTRICAL ENERGY CONSUMED BY EXISTING POWER SERVICES AND BY PROPOSED PERMANENT POWER SERVICES AFTER ACCEPTANCE OF THE LIGHTING WORK. THE CONTRACTOR WILL PAY FOR ELECTRICAL ENERGY, INSTALLATION, REMOVAL AND MAINTENANCE OF ANY TEMPORARY POWER SERVICES.

THE LUMP SUM PRICE BID FOR ITEM SPECIAL "MAINTAIN EXISTING LIGHTING" SHALL INCLUDE PAYMENT FOR ALL LABOR, EQUIPMENT, MATERIALS AND INCIDENTALS NECESSARY TO MAINTAIN THE EXISTING LIGHTING AS SPECIFIED HEREIN.

THE UNIT PRICE BID FOR ITEM SPECIAL "REPLACEMENT OF EXISTING LIGHTING UNIT" SHALL BE FULL PAYMENT FOR THE REPLACEMENT OF AN EXISTING LIGHTING UNIT WHICH HAS BEEN KNOCKED DOWN AFTER THE AFOREMENTIONED INSPECTION AND SHALL INCLUDE ALL LABOR, EQUIPMENT, MATERIALS AND INCIDENTALS NECESSARY TO PROVIDE A REPLACEMENT FOR SUCH UNIT.

ITEM SPECIAL MAINTAIN EXISTING LIGHTING - 1 LUMP SUM
ITEM SPECIAL REPLACEMENT OF EXISTING LIGHTING UNIT - 10 EACH

ITEM 625 ARC FLASH CALCULATIONS AND LABEL

THE CONTRACTOR SHALL SATISFY THE REQUIREMENTS OF ODOT SUPPLEMENTAL SPECIFICATION 825 FOR THE CONTROL CENTERS. THE CONTRACTOR MAY BE ABLE TO OBTAIN LABELS FOR THE ODOT MAINTAINED INSTALLATIONS FROM THE ODOT SIGN SHOP, 1606 WEST BROAD ST., COLUMBUS, OH 43223, FOR NON-ODOT MAINTAINED INSTALLATIONS THE CONTRACTOR IS RESPONSIBLE FOR OBTAINING THE LABEL MADE FROM "ENGINEER GRADE" SIGN SHEETING OR AN EQUIVALENT LABEL MATERIAL.

THE ODOT OFFICE OF ROADWAY ENGINEERING AND THE DISTRICT OFFICE HAVE AN EXCEL SPREADSHEET AVAILABLE UPON REQUEST, TO ASSIST WITH MAKING AND DOCUMENTING THE REQUIRED CALCULATIONS.

METHOD OF MEASUREMENT SHALL BE AS PER 825.06. THE FOLLOWING QUANTITIES HAVE BEEN CARRIED TO THE GENERAL SUMMARY.

ITEM 625 ARC FLASH CALCULATION AND LABEL - 4 EACH

R3 1-13-26
LIGHTING CHANGES TO ADD
NOTE FOR LUMINAIRE
CLARIFICATION

REF NO.	SHEET NO.	STATION	625	625	625	625	625	625	625	625	625	625	625	625	625	625	625	625	625	625	625	625	625
			CONNECTION, FUSED PULL APART	CONNECTION, UNFUSED PULL APART	CONNECTION, UNFUSED BOLTED	CONNECTION, UNFUSED PERMANENT	LIGHT POLE, LOW MAST, 50'	LIGHT TOWER, BBB100	LIGHT POLE FOUNDATION, 24" X 10" DEEP	MEDIAN LIGHT POLE FOUNDATION, 10" DEEP	LIGHT TOWER FOUNDATION, 36" X 25" DEEP	NO. 10 AWG POLE AND BRACKET CABLE	LUMINAIRE, HIGH MAST, SOLID STATE (LED), 447-480W, TYPE V, 69K-72K LUMENS	LUMINAIRE, LOW MAST, SOLID STATE (LED), 330-381W, TYPE III, 40K-45K LUMENS	LUMINAIRE, LOW MAST, SOLID STATE (LED), 308-330W, TYPE V, 49K-51K LUMENS	JUNCTION BOX	MEDIAN JUNCTION BOX	PULL BOX, 725.08, 18"	PULL BOX, 725.08, 24"	GROUND ROD	POWER SERVICE, AS PER PLAN	CONTROL CENTER CABINET, COMPLETE	PULL BOX CLEANED
			EACH	EACH	EACH	EACH	EACH	EACH	EACH	FT	EACH	EACH	EACH	EACH	EACH	EACH	EACH	EACH	EACH	EACH	EACH	EACH	
EX-PB-1	475	8+43.07																					1
EX-PB-2	475	8+44.47																					1
PB-GW-01	475	951+77.10																					1
GW-1-01	475	952+57.47	0	0				0		0								0					
GW-1-02	475	955+24.51	0	0				0		0								0					
GW-1-03	475	957+84.62	0	0				0		0								0					
GW-1-04	475	959+79.27	2	1				1		180								1					
PB-GW-02	475	961+81.76			3		3											1					
GW-1-05	475	961+74.82	2	1				1		180								1					
PB-GW-03	475	961+83.11																1					
GW-1-06	476	964+73.40	2	1				1		180								1					
PB-GW-04	476	966+96.16			3																		
GW-1-07	476	967+72.59	2	1				1		180								1					
PB-GW-05	476	969+74.47					3																
PB-GW-06	476	969+74.99			3													1					
PB-GW-07	476	969+75.15																					
CC-GW	476	969+93.66																		1		1	
GW-2-01	476	970+73.68	2	1				1		180								1					
GW-2-02	476	973+50.59	2	1				1		180								1					
PB-GW-08	476	947+45.47			3		3											1					
PB-GW-09	476	2+12.93					3											1					
GW-2-04	476	1+79.39	2	1				1		180								1					
GW-2-03	476	976+28.30	2	1				1		180								1					
GW-2-05	476	978+83.39	2	1				1		180								1					
GW-2-06	476	981+90.21	2	1				1		180								1					
PB-GW-10	476	983+41.34			3		3											1					
PB-GW-11	476	7+89.65					3																
GW-2-07	476	11+21.59	2	1				1		180								1					
PB-GW-12	476	13+91.66					3											1					
GW-2-08	476	15+37.52	2	1				1		180								1					
PB-GW-13	476	3+42.57					3											1					
GW-2-09	476	4+80.18	2	1				1		180								1					
GW-2-10	476	7+84.52	2	1				1		180								1					
GW-2-11	476	10+83.01	2	1				1		180								1					
GW-2-12	476	984+20.17	2	1				1		180								1					
GW-2-13	476	986+19.89	2	1				1		180								1					
GW-2-14	476	988+29.96	2	1				1		180								1					
GW-2-15	476	990+37.10	2	1				1		180								1					
WA-1-01	476	14+87.12	2	1				1		180								1					
PB-WA-01	477	12+87.32					3	0										1					
WA-1-02	477	11+27.52	2	1				1		180								1					
PB-WA-02	477	992+36.51			3			0										1					
WA-1-04	477	994+69.77	2	1				1		180								1					
WA-1-05	477	997+02.47	2	1				1		180								1					
WA-1-06	477	999+50.30	2	1				1		180								1					
WA-1-07	477	1002+06.20	2	1				1		180								1					
WA-1-08	477	1004+77.15	2	1				1		180								1					
WA-1-09	477	1007+31.94	2	1				1		180								1					
WA-1-10	477	1009+92.28	2	1				1		180								1					
WA-1-11	477	1012+39.76	2	1				1		180								1					
WA-1-12	477	1014+63.58	2	1				1		180								1					
WA-1-13	477	1016+62.79	2	1				1		180								1					
WA-1-14	477	1018+61.49	2	1				1		180								1					
WA-1-15	478	1021+06.78	2	1				1		180								1					
PB-WA-03	478	1023+86.04			3		3											1					
PB-WA-04	478	1023+86.04																					
CC-WA	478	10+44.03																					
PB-WA-05	478	1023+84.35					3											1					
WA-2-12	478	1024+41.17							1														
PB-WA-06	478	1026+90.91			3													1					
TOTALS CARRIED TO GENERAL SUMMARY			66	33	24	33	33	1	10	23	1	5940	3	10	23	1	6	9	2	39	2	2	3

R3 1-13-26 LIGHTING CHANGES TO ADD WATTAGE AND LUMENS

R3 1-15-26 LIGHTING CHANGES TO ADD REFLECT 3 LUMINAIRES IN HIGH MAST LIGHTS

REF NO.	SHEET NO.	STATION	625	625	625	625	625	625	625	625	625	625	625	625	625	625	625	625	625	625	625	625	625
			CONNECTION, FUSED PULL APART	CONNECTION, UNFUSED PULL APART	CONNECTION, UNFUSED BOLTED	CONNECTION, UNFUSED PERMANENT	LIGHT POLE, LOW MAST, 50'	LIGHT TOWER, BBB100	LIGHT POLE FOUNDATION, 24" X 10" DEEP	MEDIAN LIGHT POLE FOUNDATION, 10" DEEP	LIGHT TOWER FOUNDATION, 36" X 25" DEEP	NO. 10 AWG POLE AND BRACKET CABLE	LUMINAIRE, HIGH MAST, SOLID STATE (LED), 447-480W, TYPE V, 69K-72K LUMENS	LUMINAIRE, LOW MAST, SOLID STATE (LED), 330-381W, TYPE III, 40K-45K LUMENS	LUMINAIRE, LOW MAST, SOLID STATE (LED), 308-330W, TYPE V, 49K-51K LUMENS	JUNCTION BOX	MEDIAN JUNCTION BOX	PULL BOX, 725.08, 18"	PULL BOX, 725.08, 24"	GROUND ROD	POWER SERVICE, AS PER PLAN	CONTROL CENTER CABINET, COMPLETE	PULL BOX CLEANED
			EACH	EACH	EACH	EACH	EACH	EACH	EACH	FT	EACH	EACH	EACH	EACH	EACH	EACH	EACH	EACH	EACH	EACH	EACH	EACH	
PB-WA-07	478	1029+70.76			3	3																	
PB-WA-08	478	1029+70.76				3																	
WA-2-11	478	1029+71.25							1														
WA-2-10	478	1032+55.32	2	1				1		1	180												
PB-WA-09	478	1034+77.70			3	3																	
PB-WA-10	478	1034+77.70																					
PB-WA-11	478	4+17.67				3																	
PB-WA-12	478	1035+21.60					3																
PB-WA-13	478	1035+29.64																					
WA-2-09	478	2+92.66	2	1				1			180												
WA-2-08	478	1036+44.75	2	1				1			180												
WA-2-07	478	1039+22.98	2	1				1			180												
WA-2-06	478	1035+45.56	2	1				1			180												
PB-WA-14	478	1036+88.11			3	3																	
PB-WA-15	478	1036+88.11																					
PB-WA-16	478	1036+80.52																					
PB-WA-17	478	1036+93.01				3																	
WA-2-05	478	1037+35.73	2	1				1			180												
WA-2-04	478	1039+68.70	2	1				1			180												
WA-2-03	478	1038+36.75	2	1				1			180												
WA-2-02	478	1041+18.25	2	1				1			180												
WA-2-01	478	1044+18.75	2	1				1			180												
DA-1-01	478	1047+03.74	2	1				1			180												
DA-1-02	479	1049+19.97	2	1				1			180												
DA-1-03	479	1051+30.92	2	1				1			180												
DA-1-04	479	1053+28.94	2	1				1			180												
DA-1-05	479	1055+78.04	2	1				1			180												
DA-1-06	479	1058+77.72	2	1				1			180												
DA-1-07	479	1061+52.48	2	1				1			180												
DA-1-08	479	1063+76.32	2	1				1			180												
DA-1-09	479	1066+16.51	2	1				1			180												
DA-1-10	479	1068+51.58	2	1				1			180												
DA-1-11	479	1071+05.23	2	1				1			180												
DA-1-12	479	1073+16.72	2	1				1			180												
PB-DA-04	479	1073+31.70			3																		
PB-DA-03	479	1073+31.70																					
CC-DA	479	1074+61.84																					
PB-DA-01	479	1075+29.58																					
PB-DA-02	479	1075+44.59				3																	
PB-DA-05	479	1075+50.00			3																		
DA-1-13	479	1075+54.95	2	1				1			180												
DA-1-14	479	1076+77.09	2	1				1			180												
GA-1-01	480	1079+13.79	2	1				1			180												
PB-GA-01	480	1082+13.40			3	3																	
PB-GA-02	480	1082+13.39				3																	
GA-1-02	480	1082+26.00																					
PB-GA-03	480	1085+13.40			3																		
PB-GA-04	480	1085+13.37				3																	
GA-1-03	480	1086+69.82																					
PB-GA-05	480	1089+37.56				3																	
PB-GA-06	480	1089+39.94				3																	
GA-1-04	480	1089+61.19	2	1				1			180												
GA-1-05	480	1092+46.47	2	1				1			180												
PB-GA-07	480	1093+72.84				6																	
PB-GA-08	480	1093+69.83																					
CC-GA	480	1093+57.02																					
GA-1-06	480	1095+05.26	2	1				1			180												
PB-GA-13	480	1095+20.36				6																	
PB-GA-12	480	1095+21.06			3																		
PB-GA-11	480	1095+21.06				3																	
TOTALS CARRIED TO GENERAL SUMMARY			56	28	24	54	28	3	8	20	3	5040	9	8	20	8	15	4	46	2	2	2	2

R3 1-13-26 LIGHTING CHANGES TO ADD WATTAGE AND LUMENS

R3 1-15-26 LIGHTING CHANGES TO ADD REFLECT 3 LUMINAIRES IN HIGH MAST LIGHTS

DESIGN AGENCY

 DESIGNER
 ANL
 REVIEWER
 EMW 06/2/25
 PROJECT ID
 121474
 SHEET TOTAL
 P.469 655

REF NO.	SHEET NO.	STATION	625	625	625	625	625	625	625	625	625	625	625	625	625	625	625	625	625	625	625	625	625	632	632
			CONNECTION, FUSED PULL APART	CONNECTION, UNFUSED PULL APART	CONNECTION, UNFUSED BOLTED	CONNECTION, UNFUSED PERMANENT	LIGHT POLE, LOW MAST, 50'	LIGHT TOWER, BBB100	LIGHT POLE FOUNDATION, 24" X 10" DEEP	MEDIAN LIGHT POLE FOUNDATION, 10' DEEP	LIGHT TOWER FOUNDATION, 36" X 25" DEEP	NO. 10 AWG POLE AND BRACKET CABLE	LUMINAIRE, HIGH MAST, SOLID STATE (LED), 447-480W, TYPE V, 69K-72K LUMENS	LUMINAIRE, LOW MAST, SOLID STATE (LED), 330-381W, TYPE III, 40K-45K LUMENS	LUMINAIRE, LOW MAST, SOLID STATE (LED), 308-330W, TYPE V, 49K-51K LUMENS	JUNCTION BOX	MEDIAN JUNCTION BOX	PULL BOX, 725.08, 18"	PULL BOX, 725.08, 24"	GROUND ROD	POWER SERVICE, AS PER PLAN	CONTROL CENTER CABINET, COMPLETE	PULL BOX CLEANED	BRACKET ARM, 10'	CONDUIT RISER, 1" DIAMETER
EACH	EACH	EACH	EACH	EACH	EACH	EACH	EACH	EACH	FT	EACH	EACH	EACH	EACH	EACH	EACH	EACH	EACH	EACH	EACH	EACH	EACH	EACH	EACH	EACH	
GA-1-11	480	1094+38.47	2	1				1		180		1					1								
GA-1-10	480	1091+28.89	2	1				1		180		1					1								
GA-1-09	480	1088+30.17	2	1				1		180		1					1								
PB-GA-10	480	1086+02.45				3										1									
GA-1-08	480	1089+33.94	2	1				1		180		1					1								
PB-GA-09	480	1089+63.20				3										1									
GA-1-07	480	1092+05.83	2	1				1		180		1					1								
GA-2-01	480	1097+21.91	2	1				1	0	180			1				1								
GA-2-02	480	1099+54.89	2	1				1		180			1				1								
GA-2-03	480	1102+22.73	2	1				1		180			1				1								
GA-2-04	480	1104+92.97	2	1				1		180			1				1								
PB-GA-14	480	1105+82.89			3	3										1									
PB-GA-15	480	735+90.31														1									
PB-GA-16	480	735+85.31					3									1									
GA-2-05	480	737+34.54	2	1				1		180			1				1								
GA-2-06	481	1107+67.57	2	1				1		180			1	1			1								
GA-2-07	481	734+36.09	2	1				1		180			1				1								
GA-2-08	481	731+33.87	2	1				1		180			1				1								
GA-2-09	481	728+17.35	2	1				1		180			1				1								
GA-2-10	481	724+99.96	2	1				1		180			1				1								
GA-2-11	481	722+61.27	2	1				1		180			1				1								
PB-GW-A	475	952+46.95				3										1									
PB-GW-B	475	952+35.55				3										1									
PB-GW-C	475	951+75.95				3										1									
PB-GW-D	475	958+14.15				3										1									
PB-GW-E	475	958+13.70				3										1									
GW-1-01	475	952+85.64								135			1									1	1	1	
GW-1-02	475	957+90.40								135			1									1	1	1	
TOTALS CARRIED TO GENERAL SUMMARY			32	16	3	27	16	11	5	3150		11	7		2	8	16				2	2	2		

1-13-26
R3 LIGHTING CHANGES TO ADD WATTAGE AND LUMENS