


TYPICAL #1


MAR 4 SLM 8.37 TO SLM 9.96 = 1.59 MI (STA 442+86.70 TO STA 526+63.40)

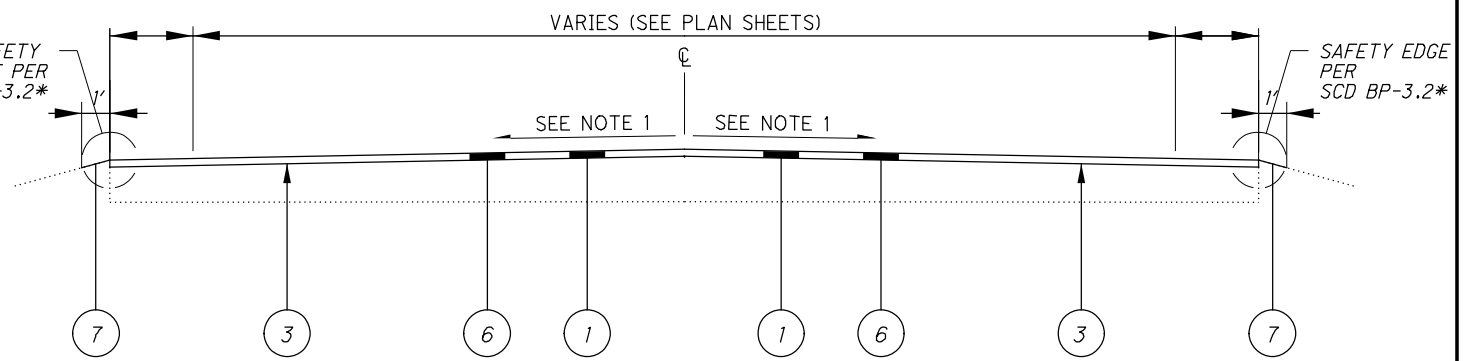

TYPICAL #2

MAR 4 SLM 9.97 TO SLM 10.12 = 0.15 MI (STA 526+99 TO STA 534+75)

* SAFETY EDGE ITEMS ONLY TO BE USED OUTSIDE OF CORPORATION LIMITS

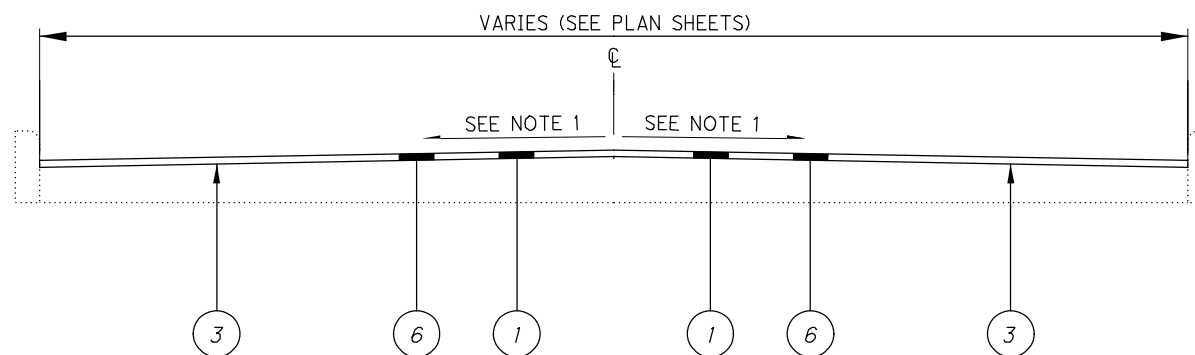

TYPICAL #3

STA 4 SLM 10.12 TO SLM 10.73 = 0.61 MI (STA 534+75.00 TO STA 567+32.50)
 STA 4 SLM 10.96 TO SLM 11.61 = 0.65 MI (STA 579+55.41 TO STA 613+60.00)
 STA 4 SLM 11.85 TO SLM 13.00 = 1.15 MI (STA 626+23.26 TO STA 687+67.68)

LEGEND

- ① ITEM 254 - PAVEMENT PLANING, ASPHALT CONCRETE (1 1/2" DEPTH)
- ② ITEM 254 - PAVEMENT PLANING, ASPHALT CONCRETE (3" DEPTH)
- ③ ITEM 407 - NON-TRACKING TACK COAT (RATE PER CMS TABLE 407.06-1)
- ④ ITEM 441 - ASPHALT CONCRETE SURFACE COURSE, TYPE 1 (446), PG64-22 (1 1/4" DEPTH)
- ⑤ ITEM 441 - ASPHALT CONCRETE INTERMEDIATE COURSE, TYPE 2 (446) (1 3/4" DEPTH)
- ⑥ ITEM 442 - ASPHALT CONCRETE SURFACE COURSE, 12.5MM, TYPE A (446) (1 1/2" DEPTH)
- ⑦ ITEM 617 - COMPACTED SHOULDER AGGREGATE (AVERAGE 2" DEEP AND 1' WIDE)

NOTE 1:
 EXISTING PAVEMENT CROSS SLOPES TO BE MAINTAINED



