


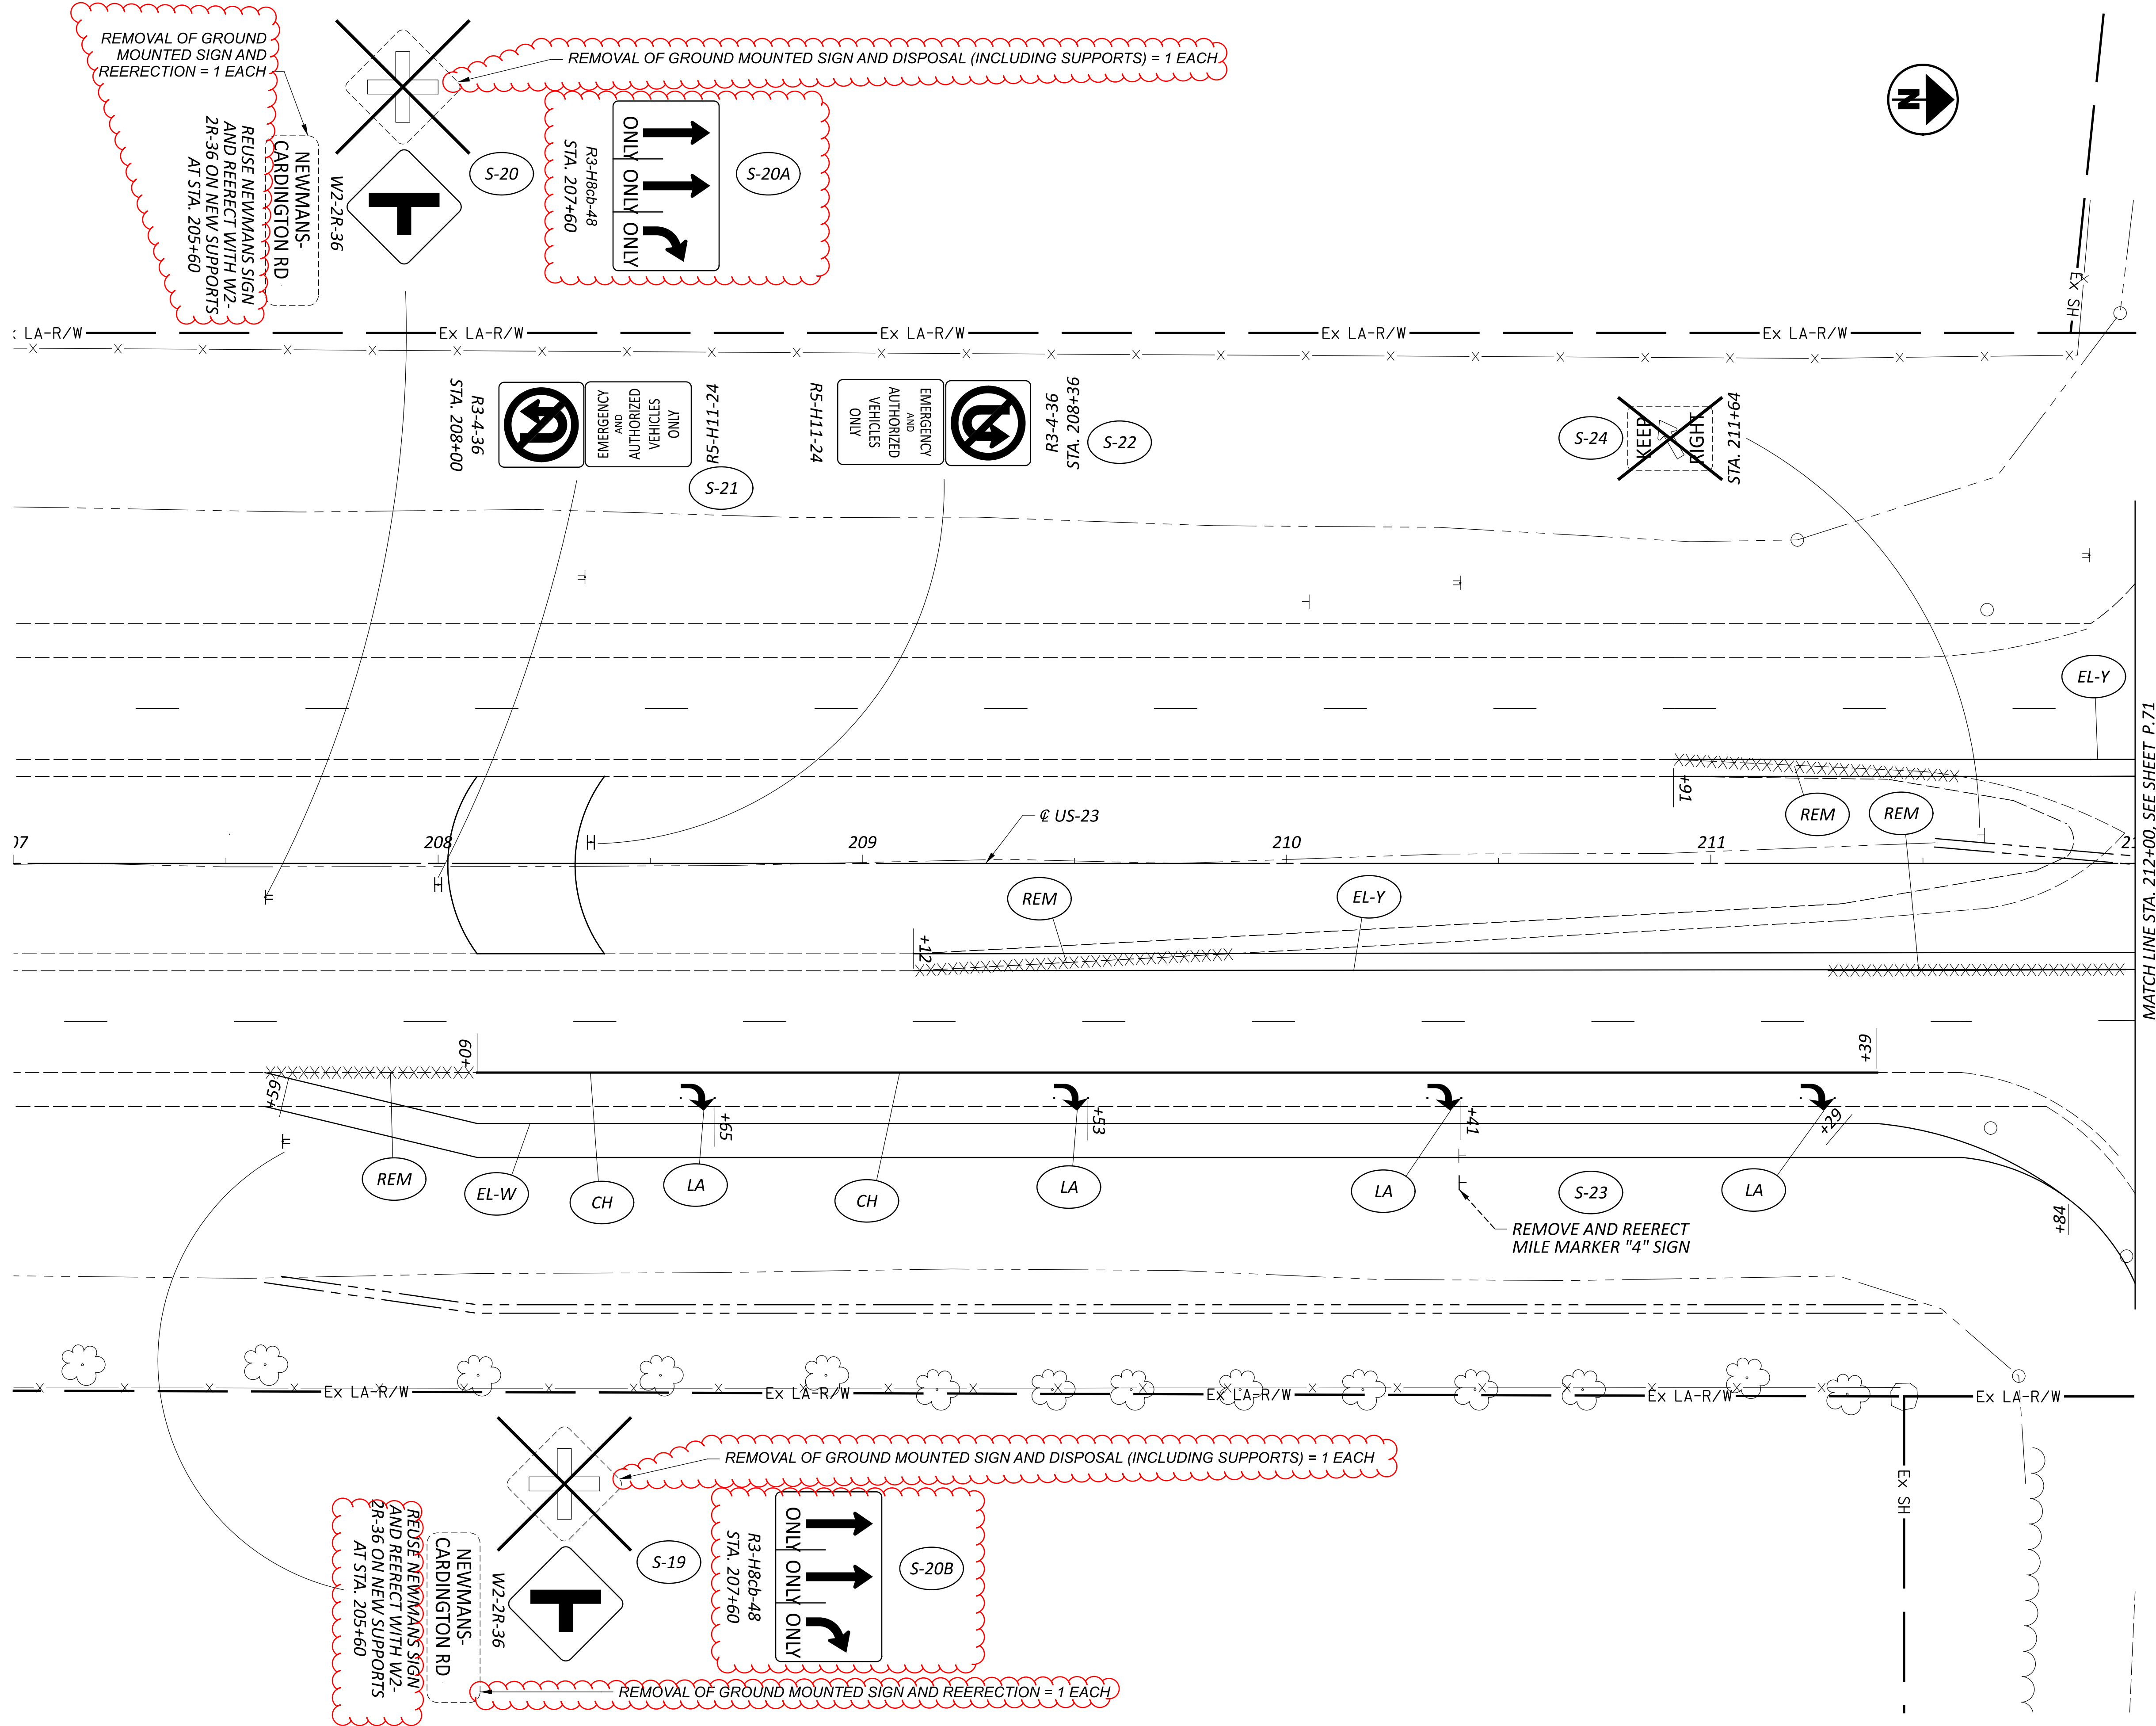
SHEET NUMBER								PARTICIPATION			ITEM	ITEM EXT	GRAND TOTAL	UNIT	DESCRIPTION	SEE SHEET NO.
								01/SAF/21	02/NHS/44	03/STR/44						
P.8	P.9-P.11	P.12	P.22	P.23	P.24	P.56	P.64									
							140	140	630	02100	140	FT	<b>TRAFFIC CONTROL</b>			
							280	280	630	03100	280	FT	GROUND MOUNTED SUPPORT, NO. 2 POST			
							142.50	142.50	630	80100	142.50	SF	GROUND MOUNTED SUPPORT, NO. 3 POST			
							18	18	630	84900	18	EACH	SIGN, FLAT SHEET			
							5	5	630	85100	5	EACH	REMOVAL OF GROUND MOUNTED SIGN AND DISPOSAL			
							0.54	0.53	644	00104	0.54	MILE	REMOVAL OF GROUND MOUNTED SIGN AND REERECTION			
							0.02	0.02	644	00300	0.02	MILE	EDGE LINE, 6"			
							665	665	644	00404	665	FT	CENTER LINE			
							8	8	644	01300	8	EACH	CHANNELIZING LINE, 12"			
0.2									644	01300	8	EACH	LANE ARROW			
								0.2	642	00100	0.2	MILE	EDGE LINE, 4", TYPE 1			
							982	982	644	30000	982	FT	REMOVAL OF PAVEMENT MARKING			
													<b>MAINTENANCE OF TRAFFIC</b>			
100							100	25	614	11110	125	HOURL	LAW ENFORCEMENT OFFICER WITH PATROL CAR FOR ASSISTANCE			
	4						4		614	12380	4	EACH	WORK ZONE IMPACT ATTENUATOR, 24" WIDE HAZARDS, (UNIDIRECTIONAL)			
10								10	614	13000	10	CY	ASPHALT CONCRETE FOR MAINTAINING TRAFFIC			
	43						43		614	13310	43	EACH	BARRIER REFLECTOR, TYPE 1, ONE WAY			
	43						43		614	13350	43	EACH	OBJECT MARKER, ONE WAY			
LS							LS	LS	614	12420	LS		DETOUR SIGNING			
6							6		614	18600	6	SNMT	PORTABLE CHANGEABLE MESSAGE SIGN			
1								1	616	10000	1	MGAL	WATER			
	1960						1960		622	41100	1960	FT	PORTABLE BARRIER, UNANCHORED			
													<b>INCIDENTALS</b>			
								LS	614	11000	LS		MAINTAINING TRAFFIC			
								LS	623	10001	LS		CONSTRUCTION LAYOUT STAKES AND SURVEYING, AS PER PLAN	P.8		
								LS	624	10000	LS		MOBILIZATION			

GENERAL SUMMARY


LOCATION								QUANTITIES										REMARKS						
SHEET NO.	REFERENCE	ROUTE	LOCATION	STA.	OFFSET (FEET)	SIDE	SIGN CODE	630E02100	630E03100	630E80100	630E84900	630E85100	644E00104		644E00300	644E00404	644E01300		644E30000					
								GROUND MOUNTED SUPPORT, NO. 2 POST	GROUND MOUNTED SUPPORT, NO. 3 POST	SIGN, FLAT SHEET	REMOVAL OF GROUND MOUNTED SIGN AND DISPOSAL	REMOVAL OF GROUND MOUNTED SIGN AND REERECTION	EDGE LINE, 6"	CENTER LINE	CHANNELIZING LINE, 12"	LANE ARROW	REMOVAL OF PAVEMENT MARKING							
								FT	FT	SF	EACH	EACH	W	Y	MILE	MILE	FT	EACH	FT					
P.66	S-1	US-23	1	173+05.00		RT					1													
P.66	S-2	US-23	1	173+05.00		LT					1													
P.66	S-3	US-23	1	177+55.00		LT					1													
P.66	S-4	US-23	1	177+75.00		LT					1													
P.66	S-5	US-23	1	177+80.00		LT					1													
P.66	S-6	US-23	1	177+82.00		RT					1													
P.66	S-7	US-23	1	178+26.00		RT					1													
P.66	S-8	US-23	1	178+60.00		RT					1													
P.66	S-9	US-23	1	178+66.00		RT					1													
P.66	S-10	US-23	1	182+87.00		RT					1													
P.66	S-11	US-23	1	182+87.00		LT					1													
P.66		US-23	1			RT							0.03	0.07					249					
P.66		US-23	1			LT							0.03	0.09					284					
P.67	S-12	BETHLEHEM	1				OM4-1-18 (X3)	15	30	6.75														
P.67	S-13	BETHLEHEM	1								1													
P.67	S-14	BETHLEHEM	1				OM4-1-18 (X3)	15	30	6.75														
P.68	S-15	BETHLEHEM/SR-423	1	06+95.00	25	RT	W14-1-30	5	10	6.25														
P.68	S-16	BETHLEHEM/SR-423	1	06+95.00	17	LT	W14-1-30	5	10	6.25														
P.69	S-17	BETHLEHEM/SR-98	1	55+74.00	15	LT	W14-1-30	5	10	6.25														
P.69	S-18	BETHLEHEM/SR-98	1	55+75.00	21	RT	W14-1-30	5	10	6.25														
P.70	S-19	US-23	2	207+60.00	66	RT	W2-2R-36	10	20	9.00	1	1								ERECT SIGN AT 205+60, REUSE EX. NEWMANS SIGN				
P.70	S-20	US-23	2	207+60.00	8	RT	W2-2R-36	10	20	9.00	1	1								ERECT SIGN AT 205+60, REUSE EX. NEWMANS SIGN				
P.70	S-20A	US-23	2	207+60.00	8	RT	R3-H8cb	10	20	10.00														
P.70	S-20B	US-23	2	207+60.00	66	RT	R3-H8cb	10	20	10.00														
P.70	S-21	US-23	2	208+00.00	5	RT	R3-4-36/R-H11-24	5	10	14.00														
P.70	S-22	US-23	2	208+36.00	5	LT	R3-4-36/R-H11-24	5	10	14.00														
P.70	S-23	US-23	2	210+40.00	75	RT						1												
P.70	S-24	US-23	2	211+64.00	7	LT						1												
P.70-P.71		US-23	2			RT							0.08	0.07		330	4		218					
P.70-P.71		US-23	2			LT							0.08	0.08		335	4		231					
P.71	S-25	US-23	2	212+62.00	7	RT					1													
P.71	S-26	US-23	2	217+37.00	8	LT	W2-2R-36	10	20	9.00	1	1								ERECT SIGN AT 219+37, REUSE EX. NEWMANS SIGN				
P.71	S-27	US-23	2	217+37.00	66	LT	W2-2R-36	10	20	9.00	1	1								ERECT SIGN AT 219+37, REUSE EX. NEWMANS SIGN				
P.71	S-28	US-23	2	217+37.00	8	LT	R3-H8cb	10	20	10.00														
P.71	S-29	US-23	2	217+37.00	66	LT	R3-H8cb	10	20	10.00														
P.33		SR-423/BETHLEHEM RD	3										0.01		0.02									
TOTALS CARRIED TO GENERAL SUMMARY								140	280	142.50	18	5	0.54	0.02	665	8	982							

TRAFFIC CONTROL SUBSUMMARY

DESIGN AGENCY  
  
 DESIGNER  
 AMH  
 REVIEWER  
 KM 08/28/23  
 PROJECT ID  
 118182  
 SHEET TOTAL  
 P.64 P.78



MATCH LINE STA. 212+00, SEE SHEET P.71

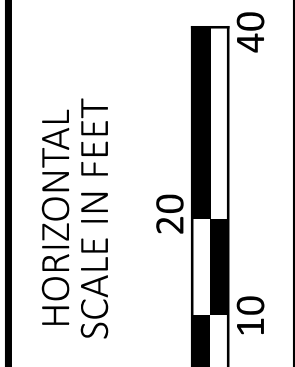

**TRAFFIC CONTROL PLAN - US-23**  
**STA. 207+00.00 TO STA. 212+00.00**

DESIGN AGENCY





DESIGNER  
**AMH**

REVIEWER  
**KM 08/28/23**

PROJECT ID  
**118182**

SHEET	TOTAL
P.70	P.78

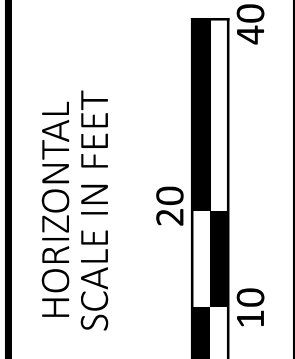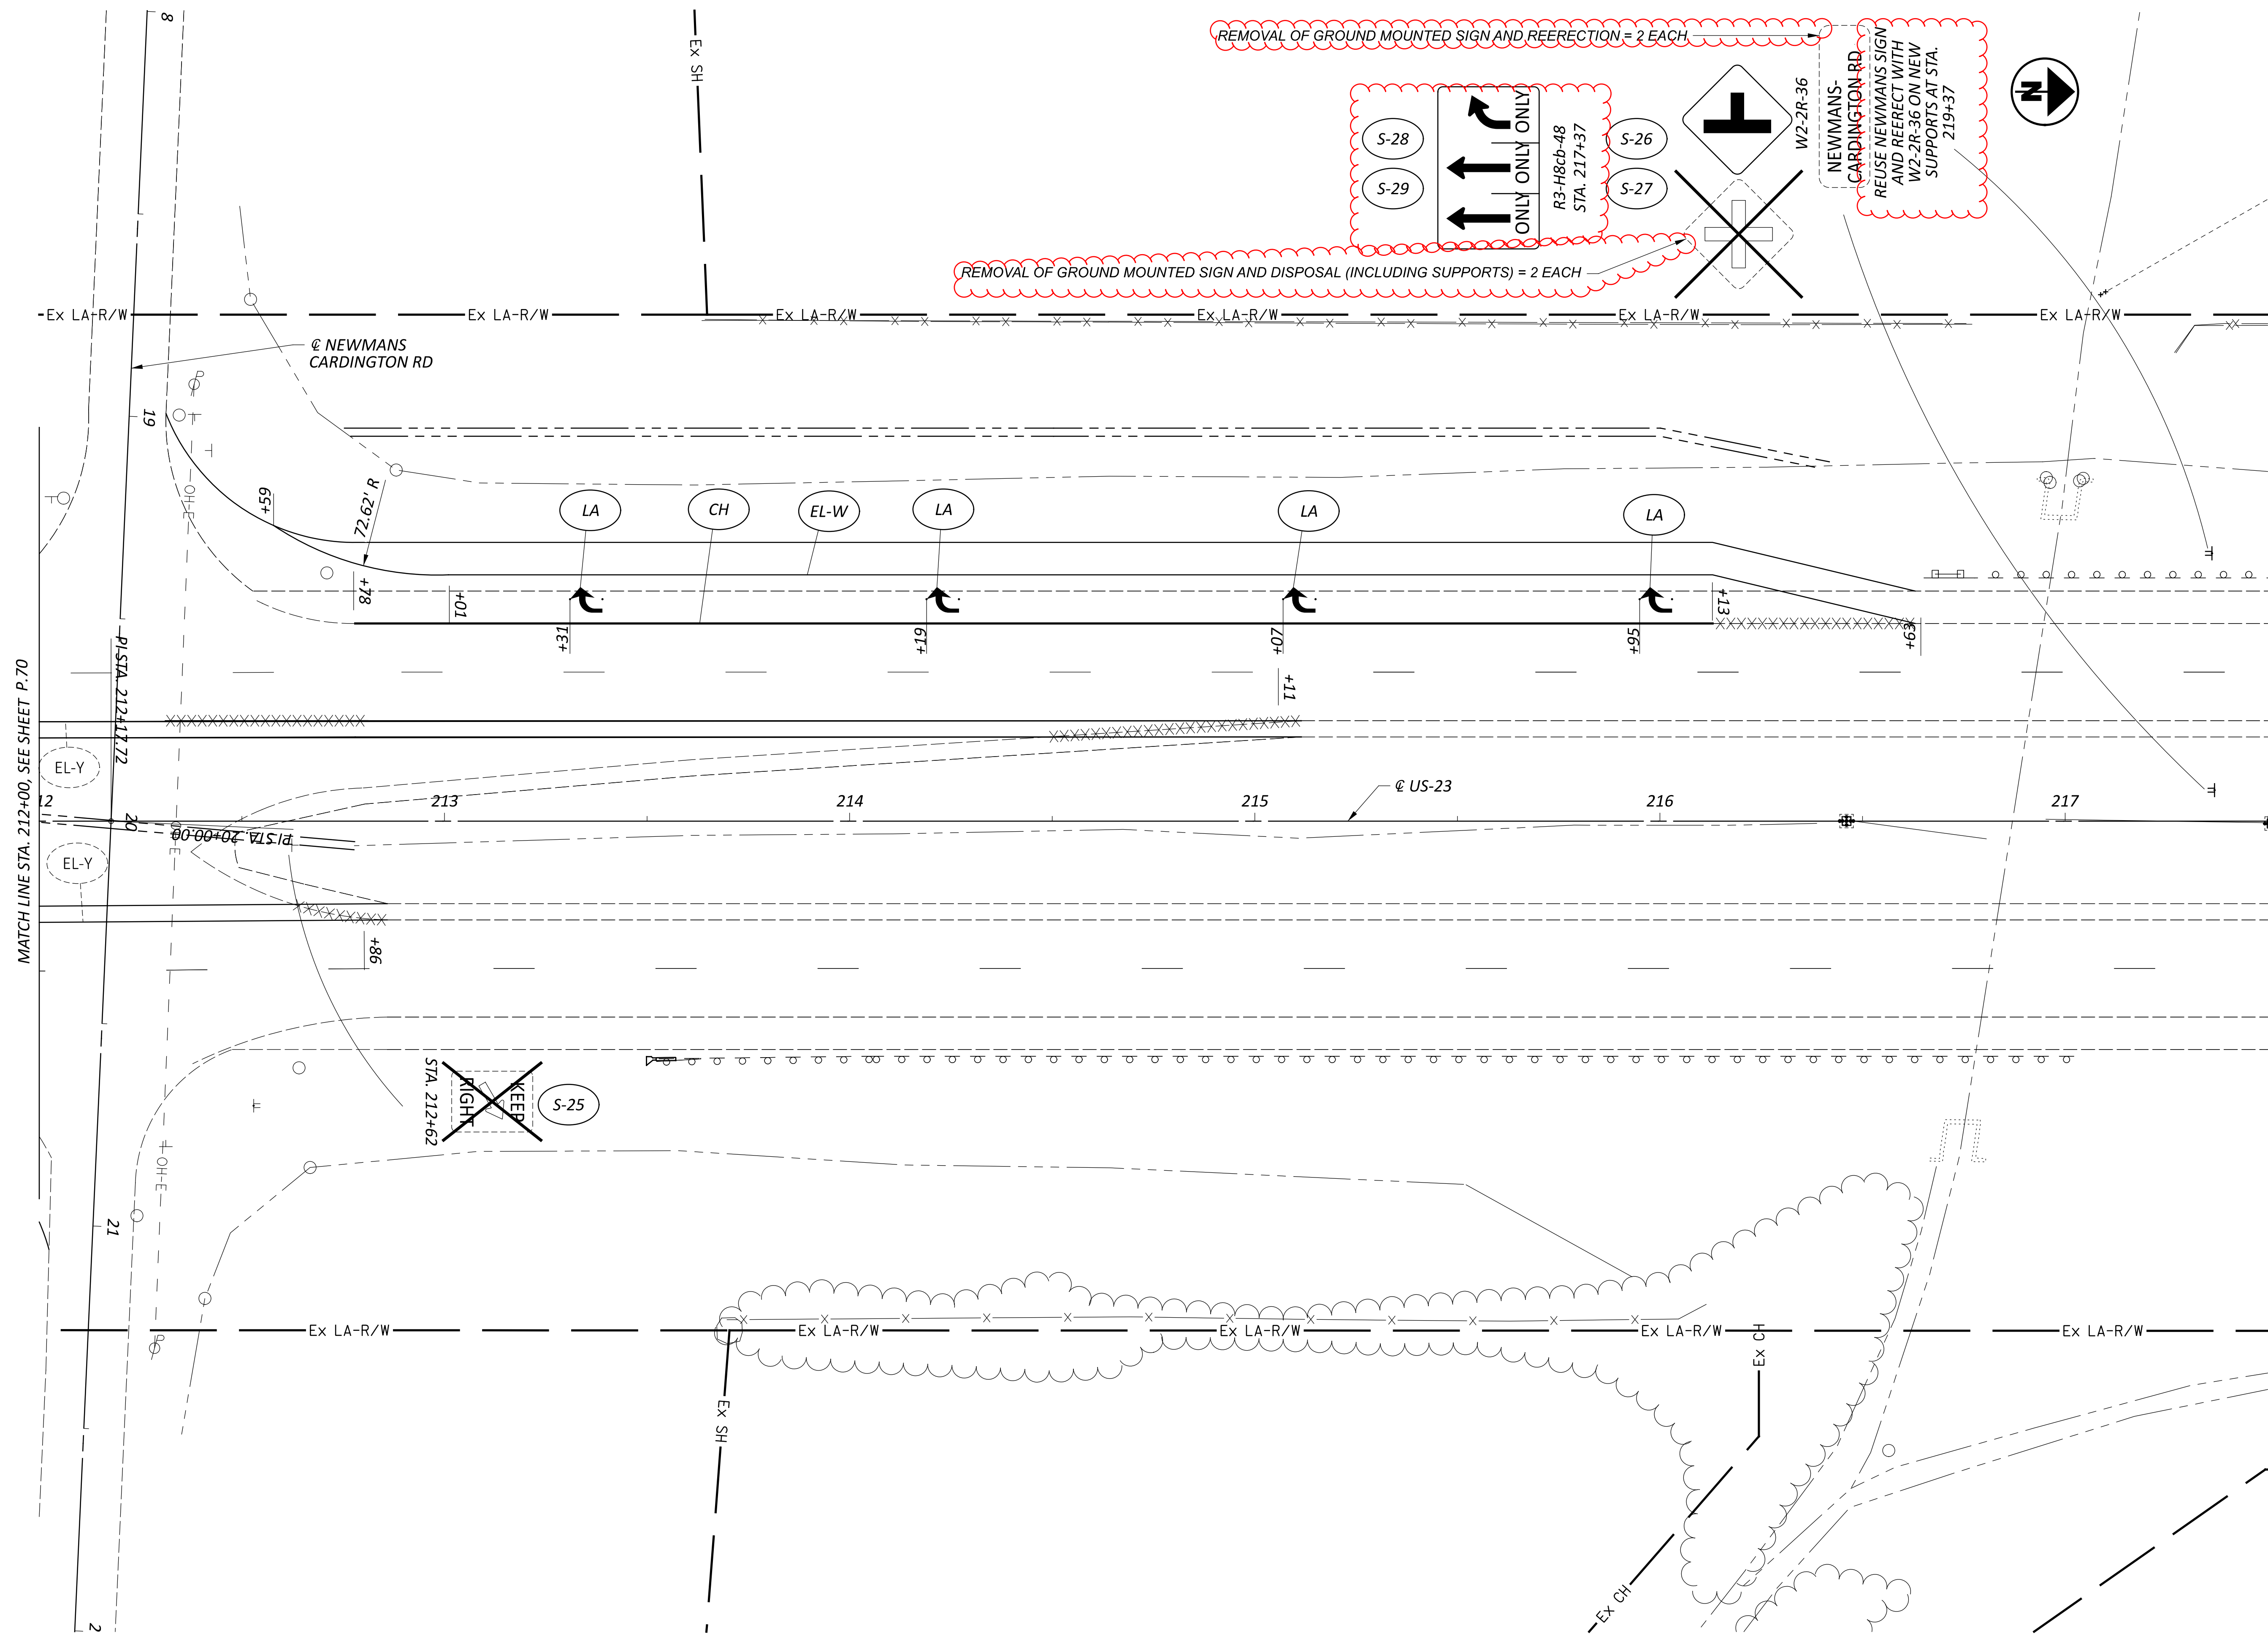

TRAFFIC CONTROL PLAN - US-23  
STA. 212+00.00 TO STA. 217+50.00

DESIGN AGENCY	
DESIGNER	AMH
REVIEWER	KM
PROJECT ID	08/28/23
SHEET	118182
TOTAL	P.71
	P.78