BENCHING OF FOUNDATION SLOPES

ALTHOUGH CROSS-SECTIONS INDICATE SPECIFIC DIMENSIONS FOR PROPOSED BENCHING OF THE EMBANKMENT FOUNDATIONS IN CERTAIN AREAS. NO WAIVER OF THE SPECIFICATIONS IS INTENDED. BENCH ALL OTHER SLOPED EMBANKMENT AREAS AS SET FORTH IN SECTION 203.05 OF THE CONSTRUCTION AND MATERIAL SPECIFICATIONS (C&MS). NO ADDITIONAL PAYMENT WILL BE MADE FOR BENCHING REQUIRED UNDER THE PROVISIONS OF SECTION 203.05.

PART-WIDTH CONSTRUCTION

BECAUSE OF THE NECESSITY TO BUILD THIS PROJECT UNDER TRAFFIC AND TO CONSTRUCT THE FULL PAVEMENT WIDTH IN STAGES, EXERCISE CARE TO PREVENT THE CONSTRUCTION OF A BUTT JOINT IN THE BASE COURSES. LAP LONGITUDINAL JOINTS AS SHOWN ON STANDARD CONSTRUCTION DRAWING BP-3.1.

CONNECTION BETWEEN EXISTING AND PROPOSED GUARDRAIL

WHEN IT IS NECESSARY TO SPLICE PROPOSED GUARDRAIL TO EXISTING GUARDRAIL, ONLY THE EXISTING GUARDRAIL SHALL BE CUT, DRILLED, OR PUNCHED. THE CONNECTION SHALL BE MADE USING A W-BEAM, BEAM SPLICE AS SHOWN IN AASHTO M 180-12, EXCEPT THE BEAM WASHERS ARE NOT TO BE USED. PAYMENT SHALL BE INCLUDED IN THE CONTRACT PRICE FOR THE RESPECTIVE GUARDRAIL ITEMS.

CONTRACTION AND/OR EXPANSION JOINTS

ALTHOUGH SPECIFIC LOCATIONS OF CERTAIN CONTRACTION AND EXPANSION JOINTS HAVE BEEN DETAILED ON THIS PLAN, NO WAIVER OF THE SPECIFICATIONS IS INTENDED. IN ALL CASES, THE PROVISION OF EXPANSION JOINTS AT ALL MAJOR STRUCTURES INCLUDING THE MAXIMUM SPACING BETWEEN CONTRACTION JOINTS IS IN ACCORDANCE WITH STANDARD CONSTRUCTION DRAWING BP-2.2 AND THE SPECIFICATIONS.

CROSSINGS AND CONNECTIONS TO EXISTING PIPES AND UTILITIES

WHERE PLANS PROVIDE FOR A PROPOSED CONDUIT TO BE CONNECTED TO, OR CROSS OVER OR UNDER AN EXISTING SEWER OR UNDERGROUND UTILITY, THE CONTRACTOR SHALL LOCATE THE EXISTING PIPES OR UTILITIES BOTH AS TO LINE AND GRADE BEFORE STARTING TO LAY THE PROPOSED CONDUIT.

IF IT IS DETERMINED THAT THE ELEVATION OF THE EXISTING CONDUIT, OR EXISTING APPURTENANCE TO BE CONNECTED, DIFFERS FROM THE PLAN ELEVATION OR RESULTS IN A CHANGE IN THE PLAN CONDUIT SLOPE. THE ENGINEER SHALL BE NOTIFIED BEFORE STARTING CONSTRUCTION OF ANY PORTION OF THE PROPOSED CONDUIT WHICH WILL BE AFFECTED BY THE VARIANCE IN THE EXISTING ELEVATIONS.

IF IT IS DETERMINED THAT THE PROPOSED CONDUIT WILL INTERSECT AN EXISTING SEWER OR UNDERGROUND UTILITY IF CONSTRUCTED AS SHOWN ON THE PLAN. THE ENGINEER SHALL

BE NOTIFIED BEFORE STARTING CONSTRUCTION OF ANY PORTION OF THE PROPOSED CONDUIT WHICH WOULD BE AFFECTED BY THE INTERFERENCE WITH AN EXISTING FACILITY.

PAYMENT FOR ALL THE OPERATIONS DESCRIBED ABOVE SHALL BE INCLUDED IN THE CONTRACT PRICE FOR THE PERTINENT 611 CONDUIT ITEM.

TEMPORARY DRAINAGE ITEMS

TEMPORARY DRAINAGE ITEMS LABELED ON THE MAINTENANCE OF TRAFFIC (MOT) PLAN ARE ITEMIZED ON THE MOT PLANS. PAYMENT FOR THE TEMPORARY DRAINAGE ITEMS ARE ITEMIZED AND CARRIED TO THE GENERAL SUMMARY.

ITEM 606 - ANCHOR ASSEMBLY, MGS TYPE E

THIS ITEM SHALL CONSIST OF FURNISHING AND INSTALLING ANY OF THE GUARDRAIL END TERMINALS FOR TYPE MGS GUARDRAIL AS LISTED ON ROADWAY ENGINEERING'S WEB PAGE UNDER ROADSIDE SAFETY DEVICES FOR APPROVED GUARDRAIL END TREATMENTS INSTALLATION SHALL BE AT THE LOCATIONS SPECIFIED IN THE PLANS, IN ACCORDANCE WITH THE MANUFACTURER'S SPECIFICATIONS.

THE FACE OF THE TYPE E IMPACT HEAD SHALL BE COVERED WITH A SHEET OF TYPE G REFLECTIVE SHEETING. PER CMS 730.19.

REFER TO THE MANUFACTURER'S INSTRUCTIONS REGARDING THE INSTALLATION OF, AND THE GRADING AROUND THE FOUNDATION TUBES AND GROUND STRUT THE TOP OF ANY FOUNDATION TUBE SHOULD BE LESS THAN 4 INCHES ABOVE THE GROUND. THE PLACEMENT OF THE FOUNDATION TUBES SHOULD BE AN APPROPRIATE DEPTH BELOW THE LEVEL LINE IN ORDER TO MAINTAIN THE FINISHED GUARDRAIL HEIGHT OF 31 INCHES FROM THE EDGE OF THE SHOULDER.

ON-SITE GRADING IS REQUIRED IF THE TOP OF THE FOUNDATION TUBES OR TOP OF THE GROUND STRUT DOES PROJECT MORE THAN 4 INCHES ABOVE THE GROUND LINE.

PAYMENT FOR THE ABOVE WORK SHALL BE MADE AT THE UNIT PRICE BID FOR ITEM 606, ANCHOR ASSEMBLY, MGS TYPE E, EACH, AND SHALL INCLUDE ALL LABOR, TOOLS, EQUIPMENT AND MATERIALS NECESSARY TO CONSTRUCT A COMPLETE AND FUNCTIONAL ANCHOR ASSEMBLY SYSTEM, INCLUDING ALL RELATED TRANSITIONS, REFLECTIVE SHEETING, HARDWARE, GRADING, EMBANKMENT AND EXCAVATION NOT SEPARATELY SPECIFIED, AS REQUIRED BY THE MANUFACTURER.

ITEM 606 - IMPACT ATTENUATOR, TYPE 2 (UNIDIRECTIONAL, SPEED = 60 MPH, HAZAR = 24")

THIS ITEM SHALL CONSIST OF FURNISHING AND INSTALLING ANY OF THE TYPE 2 IMPACT ATTENUATORS AS LISTED ON THE OFFICE OF ROADWAY ENGINEERING'S WEB PAGE (REFER TO THE POSTED SHOP DRAWINGS FOR THE MOST CURRENT APPROVED PRODUCT MODELS). WHEN BI-DIRECTIONAL DESIGNS ARE SPECIFIED. THE CONTRACTOR SHALL SUPPLY APPROPRIATE TRANSITIONS. THE FACE OF THE IMPACT HEAD SHALL BE COVERED WITH TYPE G REFLECTIVE SHEETING, PER CMS 730.19.

PAYMENT FOR THE ABOVE WORK SHALL BE MADE AT THE UNIT PRICE BID FOR ITEM 606, IMPACT ATTENUATOR, TYPE 2 [(SPEED = 60 MPH, HAZAR() = 24"), UNIDIRECTIONAL)], EACH, AND SHALL INCLUDE ALL LABOR, TOOLS, EQUIPMENT AND MATERIALS NECESSARY TO CONSTRUCT A COMPLETE AND FUNCTIONAL IMPACT ATTENUATOR SYSTEM, INCLUDING ALL RELATED BACKUPS/BACKSTOPS TRANSITIONS, HARDWARE AND GRADING, NOT SEPARATELY SPECIFIED. AS REQUIRED BY THE MANUFACTURER. INSTALLATION SHALL BE AT THE LOCATIONS SPECIFIED IN THE PLANS, IN ACCORDANCE WITH THE MANUFACTURER'S SPECIFICATIONS.

ITEM 611 - 12", SLOTTED DRAIN, TYPE 2

THIS ITEM SHALL CONSIST OF 12 INCH DIAMETER SLOTTED DRAIN ALUMINUM COATED STEEL CONDUIT 707.01 WITH 6 INCH TRAPEZOIDAL GALVANIZED SOLID BAR GRATE AS APPROVED BY THE ENGINEER. ALL COSTS FOR LABOR AND MATERIALS, INCLUDING TYPE 2 BEDDING, AND BACKFILLING AS DETAILED ON STANDARD CONSTRUCTION DRAWING DM-1.3 SHALL BE INCLUDED IN THE PRICE BID PER FOOT FOR ITEM 611 - 12" SLOTTED DRAIN, TYPE 2.

REVIEW OF DRAINAGE FACILITIES

BEFORE ANY WORK IS STARTED ON THE PROJECT AND AGAIN BEFORE FINAL ACCEPTANCE BY THE STATE, REPRESENTATIVES OF THE STATE AND THE CONTRACTOR. ALONG WITH LOCAL REPRESENTATIVES, SHALL MAKE AN INSPECTION OF ALL EXISTING SEWERS WHICH ARE TO REMAIN IN SERVICE AND WHICH MAY BE AFFECTED BY THE WORK. THE CONDITION OF THE EXISTING CONDUITS AND THEIR APPURTENANCE SHALL BE DETERMINED FROM FIELD OBSERVATIONS. RECORDS OF THE INSPECTION SHALL BE KEPT IN WRITING BY THE STATE.

ALL NEW CONDUITS, INLETS, CATCH BASINS, AND MANHOLES CONSTRUCTED AS A PART OF THE PROJECT SHALL BE FREE OF ALL FOREIGN MATTER AND IN A CLEAN CONDITION BEFORE THE PROJECT WILL BE ACCEPTED BY THE STATE.

ALL EXISTING SEWERS INSPECTED INITIALLY BY THE ABOVE MENTIONED PARTIES SHALL BE MAINTAINED AND LEFT IN A CONDITION REASONABLY COMPARABLE TO THAT DETERMINED BY THE ORIGINAL INSPECTION. ANY CHANGE IN THE CONDITION RESULTING FROM THE CONTRACTOR'S OPERATIONS SHALL BE CORRECTED BY THE CONTRACTOR TO THE SATISFACTION OF THE ENGINEER.

PAYMENT FOR ALL OPERATIONS DESCRIBED ABOVE SHALL BE INCLUDED IN THE CONTRACT PRICE FOR THE PERTINENT 611 CONDUIT ITEMS.

PROTECTION OF GREAT MIAMI RIVER TRAIL

THE CONTRACTOR SHALL NOT STAGE EQUIPMENT OR MATERIALS ON THE GREAT MIAMI RIVER TRAIL OR OTHERWISE RESTRICT ACCESS TO THE TRAIL.

ANTI-SEGREGATION EQUIPMENT

PROVIDE A MATERIAL TRANSFER VEHICLE (MTV) WITH PAVER HOPPER INSERT; A MATERIAL TRANSFER DEVICE (MTD) WITH PAVER HOPPER INSERT; OR A REMIXING PAVER SPECIFICALLY MANUFACTURED TO ELIMINATE SEGREGATION. USE PAVER HOPPER INSERTS WITH A MINIMUM CAPACITY OF 10 TONS (9 METRIC TONS). REMIXING MAY BE DONE BY THE MTV, MTD, IN THE PAVER HOPPER INSERT, OR BY THE REMIXING PAVER.

DENSITY ACCEPTANCE - FOLLOW THE REQUIREMENTS OF 446 ASPHALT CONCRETE CORE DENSITY ACCEPTANCE, INCLUDING JOINT CORES, EXCEPT AS MODIFIED BELOW:

PROVIDE AND OPERATE EQUIPMENT IN A MANNER THAT DOES NOT RESULT IN PHYSICAL SEGREGATION AND LIMITS TEMPERATURE DIFFERENTIALS TO LESS THAN 35 °F (19.5 °C) THROUGHOUT THE MIXTURE AS MEASURED BEHIND THE PAVER AND BEFORE ROLLING. CONSTRUCT A TEST STRIP ACCORDING TO 401.08.B TO DEMONSTRATE THE EQUIPMENT MEETS THESE REQUIREMENTS.

USE ANTI-SEGREGATION EQUIPMENT FOR PAVING THE 302 BASE COURSE ON ALL LANES AND ADJACENT SHOULDERS INCLUDING MAINLINE LANES, EXPRESS LANES, COLLECTOR DISTRIBUTOR LANES, CONTINUOUS CENTER TURN LANES, ACCELERATION/ DECELERATION LANES, AND RAMP LANES.

ITEM SPECIAL, PAVER MOUNTED THERMAL PROFILING (PMTP)

THIS ITEM CONSISTS OF PROVIDING A PAVER MOUNTED THERMAL PROFILING (PMTP) SYSTEM TO IDENTIFY THE PRESENCE OF ANY THERMAL SEGREGATION OF AN UNCOMPACTED MAT OF HOT MIX ASPHALT. METHODS AND PROCEDURES FOR DETERMINING THE THERMAL PROFILE USING A PAVER-MOUNTED THERMAL IMAGING SYSTEM SHALL CONFORM TO THE SPECIFICATIONS FOUND IN THE SPECIAL PROVISIONS.

ODOT OFFICE OF PAVEMENT ENGINEERING SHALL BE NOTIFIED AT LEAST TWO WEEKS PRIOR TO THE START OF PMTP DATA COLLECTION.

ALL, LABOR, EQUIPMENT, SOFTWARE, AND INCIDENTALS NECESSARY TO INSTALL THE EQUIPMENT AND ANALYZING THE DATA SHALL BE INCLUDED FOR PAYMENT WITH THE LUMP SUM BID FOR ITEM SPECIAL, PAVER MOUNTED THERMAL PROFILING (PMTP).

ITEM 302 - ASPHALT CONCRETE BASE, AS PER PLAN

MIX DESIGN - FOLLOW THE REQUIREMENTS OF 302.02 EXCEPT AS MODIFIED BELOW:

- USE A MAXIMUM F/A RATIO OF 1.4. IF THE F/A RATIO IS GREATER THAN 1.2, RECALCULATE THE F/A RATIO USING THE EFFECTIVE ASPHALT BINDER CONTENT
- THE TSR IS REQUIRED AND THE MINIMUM TSR IS 0.70 AS DETERMINED USING SUPPLEMENT 1051. ADD ANTISTRIP ADDITIVE AS SPECIFIED IN 440.06 IF REQUIRED BASED ON TSR AND ENSURE THE MINIMUM IS 0.80 AFTER ANTISTRIP.

QUALITY CONTROL AND ACCEPTANCE - FOLLOW THE REQUIREMENTS AS SPECIFIED IN 403 USING 446 ACCEPTANCE EXCEPT AS MODIFIED BELOW:

RUN MSG AND AIR VOIDS AND FOLLOW 403.06.G INSTEAD OF 403.06.F Table /03 06-1

	Table 403.06-1
MIX CHARACTERISTIC	OUT OF SPECIFICATION LIMITS ^[5]
ASPHALT BINDER CONTENT ^[1]	-0.5% TO 0.5%
1/2 INCH (12.5 MM) SIEVE ^[1]	-7.0% TO 7.0%
NO. 4 (4.75 MM) SIEVE ^[1]	-6.0% TO 6.0%
NO. 8 (2.36 MM) SIEVE ^[1]	-5.0% TO 5.0%
NO. 200 (75 μM) SIEVE ^[1]	-2.0% TO 2.0%
AIR VOIDS ^[2]	2.5% TO 5.5%
MSG ^[3]	-0.015 TO 0.015
F/A ^[4]	1.4 MAX
VMA	12.0 MIN

[1] DEVIATION FROM THE JMF

[2] FOR DESIGN AIR VOIDS OF 4.0%. COMPACT USING A SIX-INCH MARSHALL HAMMER WITH 70 BLOWS ON BOTH SIDES PER 302.02. [3] DEVIATION FROM THE MTD.

- [4] IF THE F/A RATIO IS GREATER THAN 1.2, RECALCULATE THE F/A RATIO USING THE EFFECTIVE ASPHALT BINDER CONTENT. [5] DO NOT FOLLOW THE MINIMUM 7% RETAINED DURING
- PRODUCTION PER 403.06.F.5.

REPLACE MSG COMPARISON IN TABLE 403.10-1 WITH 0.015. NOTIFY ERIC BIEHL - OMM 614-275-1380 AND JULIA MILLER -OCA 614-466-3165 ONE WEEK PRIOR TO PLANNED BEGINNING PRODUCTION AND PLACEMENT, YOU MAY FMAIL THEM AS WELL


FIELD OPERATIONS - FOLLOW THE REQUIREMENTS OF 401 AND ANTI-SEGREGATION EQUIPMENT IS REQUIRED PER 401.03.C AND IS INCIDENTAL TO THE COST OF THIS ITEM

- OBTAIN 6-INCH DIAMETER CORES ON EACH LIFT PLACED. OBTAIN JOINT CORES AT COLD LONGITUDINAL JOINTS SUCH THAT THE CORE'S CLOSEST EDGE IS 6 INCHES (152 MM) FROM THE EDGE OF THE MAT.
- PAY FACTORS FOR EACH LIFT OF 302 APP WILL BE AS SPECIFIED IN THE FOLLOWING TABLE.

		PAY FACTOR
M	AN OF LOT CORE DENSITY ^[1]	302, APP
	>98.0%	[2]
	>97.0% to 98.0%	[3]
	92.0% to 97.0%	1.00
	91.0% to 91.9%	0.90
	90.0% to 90.9%	0.80
	89.0% to 89.9%	0.70
	<89.0%	[4]
[1]	MEAN OF CORES AS PERCEN	IT OF AVERAGE MSG FOR
	THE PRODUCTION DAY.	
[2]	THE DISTRICT WILL DETERM	INE WHETHER THE MATERIAL
	MAY REMAIN IN PLACE. THE	PAY FACTOR FOR MATERIAL
	ALLOWED TO REMAIN IN PL	ACE IS 0.50.
[3]	THE DISTRICT WILL DETERM	INE WHETHER THE MATERIAL
	MAY REMAIN IN PLACE. THE	PAY FACTOR FOR MATERIAL
	ALLOWED TO REMAIN IN PL	ACE IS 0.70.
[4]	THE DISTRICT WILL DETERM	INE WHETHER THE MATERIAL
	MAY REMAIN IN PLACE. THE	PAY FACTOR FOR MATERIAL
	ALLOWED TO REMAIN IN PL	ACE IS 0.50.
IF	MATERIAL IS REMOVED AN	ID REPLACED THE CONTRACTOR
w	/ILL REMOVE AND REPLACE	THIS COURSE AND ALL COURSES
P/	AVED ON THIS COURSE.	

NOTE GENERAL

ESIGN AGENCY

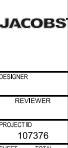


26 732

SEE		DECODIDITION		GRAND	ITEM	ттем		RT.	PAF						м.	EET NU	SH			
HEET NO.		DESCRIPTION	UNIT	TOTAL	EXT	ITEM	04/BRO/14	03/IMS/47	02/IMS/05	01/IMS/04	Office Calcs.	314	308	307	306	305	304	303	27	
		ROADWAY							$ \longrightarrow $	— —		\square								
25		PAVEMENT REMOVED, AS PER PLAN	SY	175,237	23001	202				175,237								175,223	14	
		CONCRETE BARRIER REMOVED	FT	20,408	30700	202		'		20,408								20,408		
		CURB REMOVED		299	32000	202				299								299		
		CURB AND GUTTER REMOVED		459	32500	202				459								459		
		PIPE REMOVED, 24" AND UNDER	FT	3,227	35100	202		L'		3,227	L'							3,227		
								L'			L'	\square								
		PIPE REMOVED, OVER 24"		141	35200	202		Ļ'		141	└── ′	\square						141		
		GUARDRAIL REMOVED		12,046	38000	202		⊢′		12,046	└── ′	└───┘						12,046		
		IMPACT ATTENUATOR REMOVED		1	47800	202		└─── ′	└───┤	1	└───′	└───┘						1		
		MANHOLE REMOVED		1	58000	202		└─── ′	(]	1	└── ′	└───┘						1		
		CATCH BASIN REMOVED	EACH	1	58100	202		└──── ′	├─── ┤	1	└── ′	└───┘						1		
			FACH	44	58200	202		⊢−−−−′	(─────)		└───'	┝───┘						11		
		INLET REMOVED REMOVAL MISC.:PAVED GUTTER REMOVED		41 334	58200 98200	202 202		<u>ا</u>	(────}	41 334	┝───┘	┝───┦						41 334		
		NEMOVAL MISC. PAVED GOTTEN NEMOVED			90200	202		<u>ا</u>	(────→		┝───┘	┝───┦								
		EXCAVATION	СҮ	6,642	10000	203		′	(──────────	6,642	┝───┘	├─── ┦				6,642				
		EMBANKMENT		2,839	20000	203		/	├─── ┤	2,839	├ ───┦	├── ┦				2,839				
			01	2,000	20000	200		[_]	(2,000	<u>├</u> ───┦	├── ┦				2,000				
25		PROOF ROLLING	HOUR	90	45000	204		[/]	┌── ┤	90										,
					-			!			[[]								
		CEMENT	TON	4,628.55	10500	206		· · · · ·		4,628.55	4,628.55									
		CURING COAT	SY	178,867	11000	206				178,867										
		CEMENT STABILIZED SUBGRADE, 12 INCHES DEEP	SY	178,867	15010	206				178,867										
		MIXTURE DESIGN FOR CHEMICALLY STABILIZED SOILS		LS	30000	206				LS										
												\square								
		GUARDRAIL, TYPE MGS		6,338	15050	606		'		6,338							6,338			
		GUARDRAIL, TYPE MGS WITH LONG POSTS		5,913	15100	606		L'		5,913	└── ′	\square					5,913			
		GUARDRAIL, TYPE MGS HALF POST SPACING		25	15150	606		Ļ'		25	<u> </u>	\square					25			
		GUARDRAIL, TYPE MGS QUARTER POST SPACING WITH LONG POSTS		50	15300	606		└─── ′		50	└── ′	\square					50			
		ANCHOR ASSEMBLY, MGS TYPE E, MASH 2016	EACH	13	26150	606		└─── ′	└───┤	13	└───′	└───┘					13			
			FACU	0	26550	606		└──── ′	$ \longrightarrow $		───′	┝───┘						_		
		ANCHOR ASSEMBLY, MGS TYPE T MGS BRIDGE TERMINAL ASSEMBLY, TYPE 1		9	26550	606		⊢ <u> </u>	(────}	9	───′	┝───┦					9			
		MGS BRIDGE TERMINAL ASSEMBLY, TYPE T MGS BRIDGE TERMINAL ASSEMBLY, TYPE 2		15 11	35002 35102	606 606		<u>ا</u>	(────}	15 11	┝───┘	┝───┘					15 11			
		IMPACT ATTENUATOR, TYPE 2 (UNIDIRECTIONAL), SPEED = 60 MPH, HAZARD = 24"		1	60022	606		└──── [/]	(────→	1	┝───┘	┝───┦					1			
			LAON	,	00022	000		′	(──────────	<u> </u>	┝───╯	┝───┦					- '	_		
25	_	FENCE REMOVED AND REBUILT, AS PER PLAN	FT	1,675	35001	607		′	(──────────	1,675	┝───╯	<u>├───</u> ┦								75
20				1,010	00007			′	(1,070	├ ───┦	├── ┦								, o
		CONCRETE BARRIER, SINGLE SLOPE, TYPE B1	FT	3,625	10100	622				3,625							3,625			
		CONCRETE BARRIER, SINGLE SLOPE, TYPE C	FT	1,357	10120	622		'		1,357		├ ──┦					1,357			
27		CONCRETE BARRIER, SINGLE SLOPE, TYPE C, AS PER PLAN A		60	10121	622		,		60							60			
		CONCRETE BARRIER, SINGLE SLOPE, TYPE C1		6,097	10140	622		· · · · ·		6,097							6,097			
		CONCRETE BARRIER, SINGLE SLOPE, TYPE D	FT	5,012	10160	622				5,012		\square					5,012			
								L'				\square								
		BARRIER TRANSITION		6	10200	622		<u> </u>	\square	6	\square	\square					6			
27		BARRIER TRANSITION, AS PER PLAN		14	10201	622		└─── ′		14	L'	└── ┘					14			
		CONCRETE BARRIER END SECTION, TYPE B		1	24840	622		<u>ا</u>	$ \longrightarrow $	1	└── ′	└───┘	L				1			
		CONCRETE BARRIER END SECTION, TYPE D		16	25000	622		└─── ′	\vdash	16	<u> </u>	⊢!					16			
		CONCRETE BARRIER, END ANCHORAGE, REINFORCED, TYPE B	EACH	22	25004	622		<u>ا</u>	┝───┦	22	└── ′	⊢′					22			
		CONCRETE BARRIER, END ANCHORAGE, REINFORCED, TYPE C	EACH	20	25008	622		'	├───┤	20	└─── ′	└── ┦					20			
		CONCRETE BARRIER, END ANCHORAGE, REINFORCED, TYPE C		20 75	25008 25014	622		'	\vdash	75	└─── ′	───┦					20 75			
		CONCRETE BARRIER, END ANCHORAGE, REINFORCED, TYPE CT		23	25014	622		′	├	23	├───┘	├┦					23			
		CONORETE BARRIER, END ANGLORAGE, REINFORCED, TIFE D	LACH	25	23030	022		ا	(────→	- 23	┝───┘	┝───┦					23	_		
								′	├───┤	├───┤		<u>├</u> ──┤								
								′	├ ──┤	<u>├</u> ──-†	'									+
								[_]	├───┤	<u>├</u> ──- 		!								+
								′	┌── ┤			[]								+
								′	├ ──┤	<u> </u>		!								+
								[]												+
								[]												+
								[]												
	I							('												
								[]												
												!								
								· · · · · ·				!								
								· · · · · ·				[]								
								[]				[]								+
										L										

I		1												1 000	1		1				· · · ·					
				606	606	606	606	606 ഗ്ല	606 ഗ	606	606		626 	626								609	609		611	
REF. NO.	SHEET NO.	STATION	SID	T GUARDRAIL, TYPE MGS	GUARDRAIL, TYPE MGS WITH LONG POST	GUARDRAIL, TYPE MGS HALF POST SPACING	GUARDRAIL, TYPE MGS QUARTER POST SPACING WITH LONG POSTS	ANCHOR ASSEMBLY, MGS TYPE E, MASH 2016	ANCHOR ASSEMBLY, MGS TYPE T	MGS BRIDGE TERMINAL ASSEMBLY, TYPE 1	MGS BRIDGE TERMINAL ASSEMBLY, TYPE 2		BARRIER REFLECTOR, TYPE 2, ONE-WAY (WHITE)	BARRIER REFLECTOR, TYPE 2, BIDIRECTIONAL (WHITE/RED)	REF. NO.	SHEET NO.		STA	TION		SIDE	CURB, TYPE 4-C	CURB, TYPE 6		MANHOLE RECONSTRUCTED TO GRADE	
			то	FT	FT	FT	FT	EACH	EACH	EACH	EACH		EACH	EACH	1		FR	ROM		0		FT	FT		EACH	
GR-1	318	I-75 426+80.13 432	2+39.50 RT	37.5	512.5				1		1		7		C-1	319	430-	+95.46	75 431+1	13.61	LT	18.15				
GR-2	319	430+96.61 433	3+70.05 LT	200.0				1		1			4		C-2	320	437-	+76.78	437+9	94.93	RT	18.15				
GR-3 GR-4	320 320		7+93.97 RT 4, RAMP N8 RT					1	1	1	1		4	8	C-3 C-4	321 322		+57.37 +11.73	444+5		RT LT	7.90 6.50				
GR-5	320	438+08.24 444	4+55.12 LT	125.0	512.5				1		1		8		C-5	323	453-	+31.20	453+4	49.35	RT	18.15				
GR-6 GR-7	321 322		4+75.98 LT 0+11.80 RT	25.0	312.5 250.0		50.0	1	1	1	1		6		C-6 C-7	325 327		+39.25 +42.93	463+5		LT RT	18.15 5.60				
GR-8	322	446+62.57, RAMP N7 453	3+48.38 RT	512.5	125.0			1		1				12	C-8	327	473-	+12.27	473+1	11.38	LT	6.95				
GR-9 GR-10	322 323	447+01.03 444+37.70 448+98.44, RAMP N6 455+57.8	0, RAMP N6A LT\R 82, RAMP N6 LT		50.0			1	1	1	1	-		11 15	C-9 C-10	329 329		RAMP N2 RAMP N3	11+73.00, 1 4+35.18, F		LT LT		409.50 331.20			
GR-11	325	461+69.13 471	1+60.04 RT	700.0	275.0					1	1		11		C-11	330	485-	+77.22	485+9	95.37	RT	18.15				≻
GR-12 GR-13	325 327		1+55.22 LT 1, RAMP N2 RT		237.5 1125.0				1	1	1		<u>10</u> 9	14	C-12 C-13	330 330		RAMP N1 +65.68	3+69.25, F 488+7		RT LT	6.40	239.20			Ϋ́Υ
GR-14	327		5, RAMP N3 LT\R		1175.0			1		1			10	7	C-14	332		+97.00	497+1		RT	18.15				Σ
GR-15 GR-16	329 329		5+94.41 RT 6+48.85 LT		175.0 300.0			1	1	1	1		4 5		C-15 C-16	339 341		+08.00 +72.61	533+2 539+9		LT RT	18.15 18.15				SUMMARY
GR-17 GR-18	330 330		7+14.20 LT 1+64.83 RT		612.5 250.0			1	1	1	1		5	6	C-17 C-18	341 343		+74.00 +75.76	541+9 551+9		LT RT	18.15 18.15				ן צר
GR-19	330	488+54.72 496	6+90.66 LT	762.5	200.0			1	,	1	,		10			040			00710			10.10				CB CB
GR-20 GR-21	334 339		94, RAMP N4 LT 5+57.40 LT			25.0		1	1	1	1		4	3	S-1	329	482-	+91.00	482+9	91.00	LT				1	S
GR-22	340	537+41.36 539	9+89.80 RT	175.0				1		1			4													
GR-23 GR-24	340 343		0+48.40 LT 1+92.95 RT	800.0 87.5				1		1			10													Š
					_																					A D
	ι Οταις	CARRIED TO GENERAL		6338	5913	25	50	13	9	15	11		123	76		I ATALS (215	980		1	ROADWAY
	UTALS	CARRIED TO GENERAL	SUMMART		0010			10	Ĵ	10			120			UTALS (JUMMA		210				ш.
ugb.					606		622	622	622	622	622	622	622	622	622	622	622	622	622		626	626	626	626		
əring\Roadway\9		HEET STATI NO.	ON	SIDE	IMPACT ATTENUATOR, TYPE 2 (UNIDIRECTIONAL) SPEED = 60 MPH, HAZARD = 24"		CONCRETE BARRIER, SINGLE SLOPE, TYPE B1	CONCRETE BARRIER, SINGLE SLOPE, TYPE C	CONCRETE BARRIER, SINGLE SLOPE, TYPE C, AS PER PLAN A	CONCRETE BARRIER, SINGLE SLOPE, TYPE C1	CONCRETE BARRIER, SINGLE SLOPE, TYPE D	BARRIER TRANSITION	BARRIER TRANSITION, AS PER PLAN	CONCRETE BARRIER END SECTION, TYPE B	CONCRETE BARRIER END SECTION, TYPE D	CONCRETE BARRIER, END ANCHORAGE, REINFORCED, TYPE B	CONCRETE BARRIER, END ANCHORAGE, REINFORCED, TYPE C	CONCRETE BARRIER, END ANCHORAGE, REINFORCED, TYPE C1	CONCRETE BARRIER, END ANCHORAGE, REINFORCED, TYPE D		Barrier Reflector, Type 1, one-way (white)	BARRIER REFLECTOR, TYPE 1, BIDIRECTIONAL (WHITE/RED)	BARRIER REFLECTOR, TYPE 1, BIDIRECTIONAL (YELLOW/YELLOW)	BARRIER REFLECTOR, TYPE 1, BIDIRECTIONAL (YELLOW/RED)		
acobs. 100-En		FROM	ТО		EACH		FT	FT	FT	FT	FT	EACH	EACH	EACH	EACH	EACH	EACH	EACH	EACH		EACH	EACH	EACH	EACH		
etteJr@jacobs.com 107376/400-Engine	B-1	L75 317 423+95.00	424+95.42	CL			42					1				2							6		-	
	B-2	318 426+91.12	444+57.67	CL						1311		•	2			-		20					38			
R: Joe	B-3 B-4	320 437+94.93 322 447+11.73	438+89.08 455+49.17	RT CL						607	66		1		2			10			3		20		_	
USEI	B-5	325 461+76.52	471+43.51	CL						641			2					14					22			
03 AM	B-6 B-7	327 473+12.27 330 485+95.37	486+59.03 486+80.64	CL RT						1053	36	1	2		1			10 1			2		30	_	_	
00 - M	B-8	330 488+90.56	514+91.59	CL						2059			2					18					56			
6A162	B-9 B-10	332 497+15.16 332 65+41.60, RAMP N4 2	510+29.38 78+34.46, RAMP N4	RT RT	1			509 777	60		590			1	1		4 14		1		14 13			13	- 1	DESIGN AGENCY
9/2023 ents/C	B-11	332 63+60.63, RAMP N4	72+50.19, RAMP N4	LT							724				8							10				
Docum Docum	B-12 B-13	334 77+02.18, RAMP N4 8 335 510+29.38 8	82+10.95, RAMP N4 514+91.59	LT RT				71			460 372	<u>1</u> 1			1		2		1 2		7	7			_	JACOBS
) DA	B-14	336 516+47.64	529+55.00	RT			2502				1097	1				- 20			8		15					
x11 (in DEI	B-15 B-16	336 516+47.64 336 516+47.64	558+07.79 533+08.00	CL LT			3582				1442	1	2			20			8		18		86		<u> </u>	
RSIZE: 17x11 (in.) DATE: 2/9/2023 TIME: 8:22:03 AM USER: Joe Ever 3.jacobs.com:DEN003Upcuments/C6A16200 - MOT-075-14.74/DESIGN 3.jacobs.com:DEN003Upcuments/C6A16200 - MOT-075-14.74/DESIGN	B-17	341 539+90.76 341 539+85.00	540+64.76 541+74.00	RT							45 160				1				1		2 3				_	DESIGNER
ER.jac	B-18 B-19	341 539+85.00 343 551+93.91	552+42.84	LT RT							20				1				1		2				╧╴┝	TES REVIEWER
at PAPE	B-20 B-21	345A 573+04.00 345A 581+89.07	573+52.00 587+01.00	CL CL						0 426			2 1					2					4			JAE 10/01/21
ojectW										-72.V			,					-					1,7		_	PROJECT ID 107376
MODEL: Sheet pw:\\ProjectWise	тот	ALS CARRIED TO GEN	IERAL SUMMA	RY	1		3625	1357	60	6097	5012	6	14	1	16	22	20	75	23		7 9	17	276	13	s	SHEET TOTAL 304 732
				•				-					-			•		-				-	*			

USE 8:22:03 AM TIME: 8 MOT-75-14.74 MODEL: Sheet PAPERSIZE: 1741 (m.) DATE: 29/2023

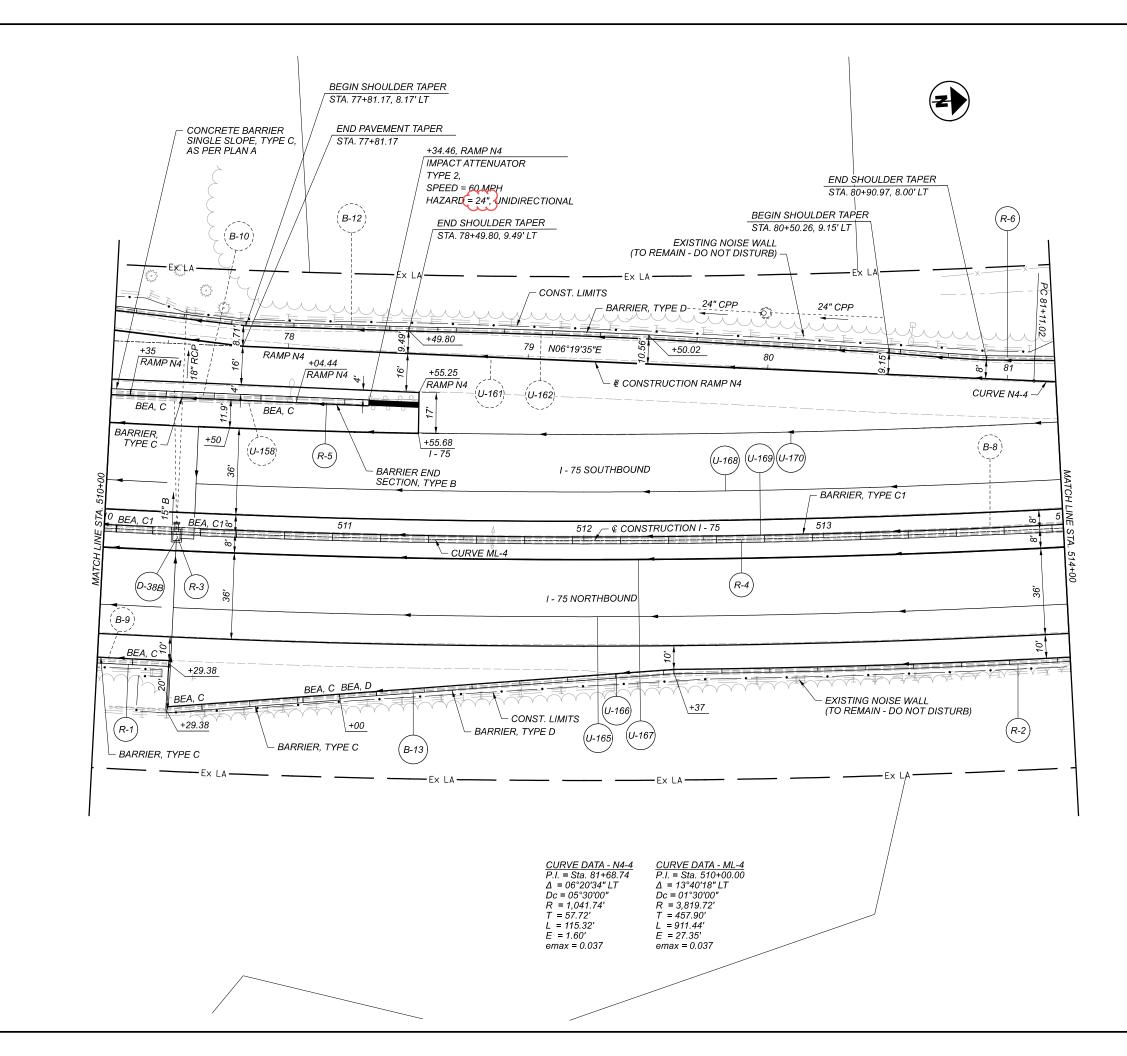

USER: Joe.EveretteJr@jac 14 74\nFsiGN\IN7376\400-F TIME: 8:05:30 AM DATE: 2/9/2023 PAPERSIZE: 17×II (in.) MER focobs com DENIO MOT-75-14.74 œ 75 doh

PROJECT ID	
JACOBS DESIGNER REVIEWER PROJECT ID	PLAN - I-75 STA. 510+00 TO STA. 514+00
DESIGNER REVIEWER PROJECT ID	DESIGN AGENCY
REVIEWER PROJECT ID	JACOBS
PROJECT ID	DESIGNER
	REVIEWER
107376	PROJECT ID 107376

NOTES 1. FOR LEGEND, SEE SHEET 317. BEA, C1 OR C = BARRIER END ANCHORAGE , TYPE C1 OR C BEA, D = BARRIER END ANCHORAGE , TYPE D BEA, B1 = BARRIER END ANCHORAGE , TYPE B1 BTA = BRIDGE TERMINAL ASSEMBLY LON = LENGTH OF NEED

			SHEET	NUM.		 			PA	RT.		ITEM	ITEM	GRAND	UNIT	DESCRIPTION	SH
304	607		608		610	615	616	01/IMS/04	02/IMS/05	03/IMS/47	04/BRO/14	1.5.	EXT	TOTAL	0 Mili		Ν
																TRAFFIC CONTROL	_
		_					14.84	14.84				618	40600	14.84	MILE	RUMBLE STRIPS, SHOULDER (ASPHALT CONCRETE)	
						1,191		1,191				621	00100	1,191		RPM	
								1,191				621	54000	1,191	EACH	RAISED PAVEMENT MARKER REMOVED	_
					19			19				625	32000	19	EACH	GROUND ROD	-
																	+
79								79				626	00102	79		BARRIER REFLECTOR, TYPE 1, ONE-WAY (WHITE)	
17								17				626	00102	17		BARRIER REFLECTOR, TYPE 1, BIDIRECTIONAL (WHITE/RED)	\rightarrow
276 13								276 13				626 626	00102	276 13		BARRIER REFLECTOR, TYPE 1, BIDIRECTIONAL (YELLOW/YELLOW) BARRIER REFLECTOR, TYPE 1, BIDIRECTIONAL (YELLOW/RED)	_
123								123				626	00102	123		BARRIER REFLECTOR, TYPE 2, ONE-WAY (WHITE)	
.20								.20				020		120	2/1011		+
76								76				626	00110	76	EACH	BARRIER REFLECTOR, TYPE 2, BIDIRECTIONAL (WHITE/RED)	
			291					291 108 3				630 630	03100 06400	291 108.3		GROUND MOUNTED SUPPORT, NO. 3 POST GROUND MOUNTED STRUCTURAL BEAM SUPPORT, S4X7.7	+
			108.3 10.5					108.3 10.5				630	06400	108.3		GROUND MOUNTED STRUCTURAL BEAM SUPPORT, S4X7.7	+
		-	6					6				630	08600	6		SIGN POST REFLECTOR	+
			12					12				630	09000	12		BREAKAWAY STRUCTURAL BEAM CONNECTION	
					1			1				630	70001	1		OVERHEAD SIGN SUPPORT, DMS TRUSS, 80', AS PER PLAN	\rightarrow
					1			1				630 630	70050 70070	1		CATWALK, DMS TRUSS CONCRETE BARRIER MEDIAN OVERHEAD SIGN SUPPORT FOUNDATION, DMS TRUSS	+
					1			1				630	70080	1		OVERHEAD SIGN SUPPORT FOUNDATION, DMS TRUSS	+
					2			2				630	72320	2		OVERHEAD SIGN SUPPORT, TYPE TC-12.31, DESIGN 6	+
					1			1				630	72330	1		OVERHEAD SIGN SUPPORT, TYPE TC-12.31, DESIGN 10	\rightarrow
		_			2			2				630 630	72340 72410	2		OVERHEAD SIGN SUPPORT, TYPE TC-12.31, DESIGN 12 OVERHEAD SIGN SUPPORT, TYPE TC-15.116, DESIGN 1	_
					1			1				630	72410	1		OVERHEAD SIGN SUPPORT, TYPE TC-15.116, DESIGN 1	
					6			6				630	75000	6		SIGN ATTACHMENT ASSEMBLY	+
					19			19				630	79500	19		SIGN SUPPORT ASSEMBLY, POLE MOUNTED	
			13		205 F			13				630	79610	13		SIGN SUPPORT ASSEMBLY, BARRIER MOUNTED SIGN, FLAT SHEET	_
			329.5 118		295.5			625 118				630 630	80100 80200	625 118		SIGN, FLAT SHEET	-
					3,580			3,580				630	80224	3,580		SIGN, OVERHEAD EXTRUSHEET	-
					,			,									
			12					12				630	81020	12		CONCRETE MEDIAN BARRIER SIGN BRACKET	\square
					2			$\frac{2}{\sqrt{2}}$				630	82000	$-\frac{2}{\sqrt{2}}$		SIGN BACKING ASSEMBLY	-+
			6		7			$\left(\begin{array}{c} 7 \\ 6 \end{array} \right)$				630 630	84010 84500	$\left(\frac{\sqrt{2}}{6} \right)$		CONCRETE BARRIER MEDIAN OVERHEAD SIGN SUPPORT FOUNDATION, TYPE TC-21.50 GROUND MOUNTED STRUCTURAL BEAM SUPPORT FOUNDATION	+
					10			(10)				630	84510			RIGID OVERHEAD SIGN SUPPORT FOUNDATION	-
	32							32				630	84900	32		REMOVAL OF GROUND MOUNTED SIGN AND DISPOSAL	\square
	21							21				630	86002	21		REMOVAL OF GROUND MOUNTED POST SUPPORT AND DISPOSAL REMOVAL OF GROUND MOUNTED STRUCTURAL BEAM SUPPORT AND DISPOSAL	+
					1	 		5				630 630	86102 87100	5		REMOVAL OF GROUND MOUNTED STRUCTURAL BEAM SUPPORT AND DISPOSAL	+
	41							41				630	87400	41		REMOVAL OF OVERHEAD MOUNTED SIGN AND DISPOSAL	-
															-		+
	18							18				630	87500	18		REMOVAL OF POLE MOUNTED SIGN AND DISPOSAL	
					1			1				630	89100	1		REMOVAL OF OVERHEAD SIGN SUPPORT AND REERECTION, TYPE TO 12.30	\rightarrow
	1							1 12				630 630	89501 89702	1 12		REMOVAL OF OVERHEAD SIGN SUPPORT AND REERECTION, TYPE TC-15. 115, AS PER PLAN REMOVAL OF OVERHEAD SIGN SUPPORT AND DISPOSAL	+
		-						12				000	00702	12	Entori		-
		_															+
		_															+
		-															+
		1															+
				T	T								ļ				-
													ļ				+

JACOBS' DESIGNER MDS REVIEWER RN PROJECT ID 107376 SHEET TOTAL 606 732

DESIGN AGENCY

						625	630	630	630	630	630	630	630	630	630	630	630	630	630	630	630	630	630	630	
REF. S NO.	SHEET NO.	STATION	SIDE	CODE	SIZE (INCHES)	GROUND ROD	OVERHEAD SIGN SUPPORT, DMS TRUSS, 80'	CATWALK, DMS TRUSS	CONCRETE BARRIER MEDIAN OVERHEAD SIGN SUPPORT FOUNDATION, DMS TRUSS	OVERHEAD SIGN SUPPORT FOUNDATION, DMS TRUSS	OVERHEAD SIGN SUPPORT, TYPE TC-12.31, DESIGN 6	OVERHEAD SIGN SUPPORT, TYPE TC-12.31, DESIGN 10	OVERHEAD SIGN SUPPORT, TYPE TC-12.31, DESIGN 12	OVERHEAD SIGN SUPPORT, TYPE TC-15.116, DESIGN 1	OVERHEAD SIGN SUPPORT, TYPE TC-15.116, DESIGN 2	SIGN ATTACHMENT ASSEMBLY	SIGN SUPPORT ASSEMBLY, POLE MOUNTED	SIGN, FLAT SHEET	SIGN, OVERHEAD EXTRUSHEET	SIGN BACKING ASSEMBLY	CONCRETE BARRIER MEDIAN OVERHEAD SIGN SUPPORT FOUNDATION, TYPE TC-21.50	RIGID OVERHEAD SIGN SUPPORT FOUNDATION	REMOVAL OF OVERHEAD MOUNTED SIGN AND REERECTION	REMOVAL OF OVERHEAD SIGN SUPPORT AND REERECTION, TYPE TC-12:30	
					WXH	EACH	EACH	EACH	EACH	EACH	EACH	EACH	EACH	EACH	EACH	EACH	EACH	SF	SF	EACH	EACH	EACH	EACH	EACH	
		I-75 NORTHBOUND																							
				SIGN 1	264 X 96											1			176						
			-	SIGN 2 SIGN 3	192 X 72 132 X 108											1			96 99						
OHS-1	620	423+47	RT	SIGN 4	84 X 24														14						
				SIGN 5 R2-1	84 X 24 48 X 60												1	20	14						
			-		48 X 60												1	20							
OHS-4	621	438+61		SIGN 1 SIGN 2	168 X 72 84 X 24	1													84 14			1		1	
			-	R5-1	48 X 48												1	16	14						
					264 X 06	2													476			4			L X
OHS-7	623	466+21	RT	SIGN 1 SIGN 2	264 X 96 120 X 84	2													176 70		1	1			. I ₹
				SIGN 3	84 X 24														14						SIGN SUBSUMMARY
				SIGN 1	204 X 72	1					1								102			1			15
DHS-12	628	526+32	RT -	SIGN 2	84 X 24	_													14						l SS
		I-75 SOUTHBOUND																							
		THE COOTTIBECTUB																							S S
			_	SIGN 1 SIGN 2	168 X 96 168 X 144	1										1			112 168		1				
			-	SIGN 2 SIGN 3	312 X 168											1			364						
OHS-2	620	428+56		SIGN 4	96 X 24														16						
			-	SIGN 5 R2-1	96 X 24 48 X 60				-								1	20	16		+				
				D9-2	30 X 30													6.25							
				SIGN 1	168 X 144	2									1				168		C1	<u> </u>			
				SIGN 2	276 X 144	-									,				276		- Cim	سن			
OHS-3	621	438+48		SIGN 3	96 X 24														16						
			-	SIGN 4 R2-1	96 X 24 48 X 60												1	20	16						
				0 /0// /																					
OHS-6	623	457+12		SIGN 1 SIGN 2	168 X 72 84 X 24														84 14						
				R5-1	48 X 48												1	16							
				SIGN 1	276 X 144	2								1					276		1	1			
				SIGN 2	192 X 72	_								-					96			•			
OHS-8	624	469+84		SIGN 3 SIGN 4	96 X 24														16 14						
			-		84 X 24 48 X 60												1	20	14						
				R2-1	48 X 60												1	20							
				SIGN 1	300 X 96	1							1						200			1			
0HS-11	627	514+50		SIGN 2	84 X 24														14						
				R5-1	48 X 48												1	16							
				SIGN 1	132 X 108	2								1					99		1	1			
			-	SIGN 2 SIGN 3	192 X 72 264 X 120														96	2			1		DESIGN AGE
DHS-13	629	527+40		SIGN 3	84 X 24														14	2			· ·		
				SIGN 5	84 X 24														14						
			-	W3-5 W3-5	48 X 48 48 X 48												1	16 16							JAC
DHS-14	630	541+37	LT	DMS		2	1	1	1	1															
		<u> </u>																							DESIGNER M
																									REV
																									RN PROJECT IE
		TOTALS	THIS S	HEET		14	1	1	1	1	1	0	1	2	1	6	11	206.25	2962	2	5	77	1	1	PROJECT ID 107

MOT-75-14.74 MODEL:Sheet PAPERSIZE:17x11(In.) DATE:2/10/2023 TME:7:29:40 AM USER:Joe.EveretteJrejacobs.com pw:NProjectWiseAMER.jacobs.com:DEN003NDocumentsNC6A16200 - MOT-075-14.14NDESIGNN107376V400-Engine

<u> </u>			<u>т</u> т		T	625	630	630	630	630	630	630	630	630	630	630	630	630	630	630	630	630	630	630	
REF. NO.	SHEET NO.	STATION	SIDE	CODE	SIZE (INCHES)	GROUND ROD	OVERHEAD SIGN SUPPORT, DMS TRUSS, 80'	CATWALK, DMS TRUSS	CONCRETE BARRIER MEDIAN OVERHEAD SIGN SUPPORT FOUNDATION, DMS TRUSS	OVERHEAD SIGN SUPPORT FOUNDATION, DMS TRUSS	OVERHEAD SIGN SUPPORT, TYPE TC-12.31, DESIGN 6	OVERHEAD SIGN SUPPORT, TYPE TC-12.31, DESIGN 10	OVERHEAD SIGN SUPPORT, TYPE TC-12.31, DESIGN 12	OVERHEAD SIGN SUPPORT, TYPE TC-15.116, DESIGN 1	OVERHEAD SIGN SUPPORT, TYPE TC-15.116, DESIGN 2	SIGN ATTACHMENT ASSEMBLY	SIGN SUPPORT ASSEMBLY, POLE MOUNTED	SIGN, FLAT SHEET	SIGN, OVERHEAD EXTRUSHEET	SIGN BACKING ASSEMBLY	CONCRETE BARRIER MEDIAN OVERHEAD SIGN SUPPORT FOUNDATION, TYPE TC-21.50			REMOVAL OF OVERHEAD SIGN SUPPORT AND REERECTION, TYPE TC-12.30	
		I-75 MEDIAN			WXH	EACH	EACH	EACH	EACH	EACH	EACH	EACH	EACH	EACH	EACH	EACH	EACH	SF	SF	EACH	EACH	EACH	EACH	EACH	
DHS-5	623	455+04		SIGN 1 W8-5	264 X 84 48 X 48	1					1						1	16	154		1				
		RAMP N2	+																						
				SIGN 1	300 X 72	1						1							150			1			
OHS-9	625	5+41	RT	R5-1	48 X 48	/						/					1	16	150			/			
		RAMP N4	+ +																						
				SIGN 1	216 X 84	2								1					126		1	1			
0HS-10	627	76+52	LT	SIGN 1 SIGN 2 R5-1a R5-1a R5-1a R5-1a D10-H5a	210 X 84 156 X 72 42 X 30 42 X 30 42 X 30 42 X 30 42 X 30 30 X 30												1 1 1 1 1 1	8.75 8.75 8.75 8.75 6.25	126 78						SIGN SUBSUMMARY
		RAMP B	+ +																						
0HS-15	631	119+35	RT	SIGN 1 SIGN 2 R5-1	192 X 72 84 X 24 48 X 48	1							1				1	16	96 14			1			
				10-1	40 / 40												,	10							SIC
			+																						
			+																						
			+																						
			++																						
			1 1																						
			+																						
																									DESIGN AGEN
			+																						JACO
			1 1																						
																									DESIGNER
$\neg \uparrow$			+ $ +$																						M
			S THIS SHE		•	5	0	0	0	0	1	1	1	1	0	0	8	89.25	618	0	200	~~~~~~~~~~~~~~~~~~~~~~~~~~~~~~~~~~~~~~~	0	0	REVIE RN
	TOT 41	LS CARRIED				14 19	1	1	1	1	1 2	0	1 2	2	1	6	11 19	206.25 295.50	2962 3580	2	7	10	1	1	PROJECT ID 1073
	IOTAL		IO GEN			''	'	'	1 '	· ·	- -	1 1	1		ı '	I V	13	-30.00	1 3300	l -	1 Gin	L	I '	I '	SHEET 1 610

MOT-75-14.74 MODEL:Sheet PAPERSIZE:17%1(in.) DATE:2/10/2023 TME:7:3H:37 AM USER:JOe.EveretteJrejacobs.com pw:NProjectWiseAMER.jacobs.com:DEN003NDocumentsNCEA16200 - M0T-075-14.74DESIGNN07376.400-Engir