


I:\Project+Data\MOT\109723_S\SR741-046\Design\Roadway\Sheets\109723_GY001.dgn Sheet 7/9/2021 9:18:12 AM cweiss

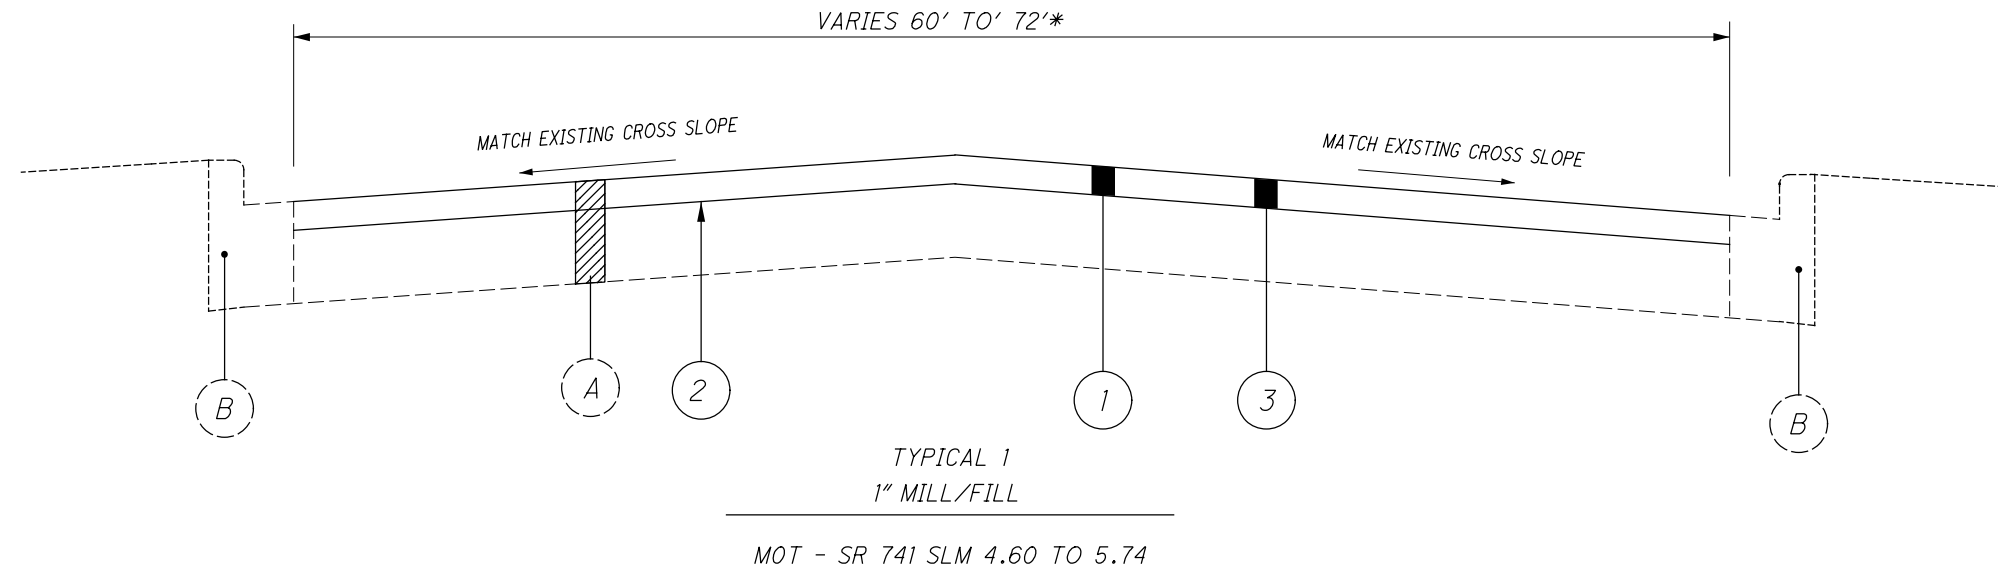

* PAVING WIDTH INCLUDES RIGHT TURN LANE TO VIENNA PARKWAY

LEGEND

- ① - ITEM 424 - 1" FINE GRADED POLYMER ASPHALT CONCRETE, TYPE B
- ② - ITEM 407 - NON-TRACKING TACK COAT @ 0.085 GAL/SY
- ③ - ITEM 897 - PAVEMENT PLANING, ASPHALT CONCRETE, CLASS A (1" DEPTH)
- Ⓐ - EXISTING PAVEMENT (9%± ASPHALT CONCRETE ON AGGEGRATE BASE)
- Ⓑ - EXISTING CURB AND GUTTER