


STATE OF OHIO DEPARTMENT OF TRANSPORTATION

MOT-DENLINGER ROAD RSF-01.51 CITY OF TROTWOOD

MONTGOMERY COUNTY, OHIO

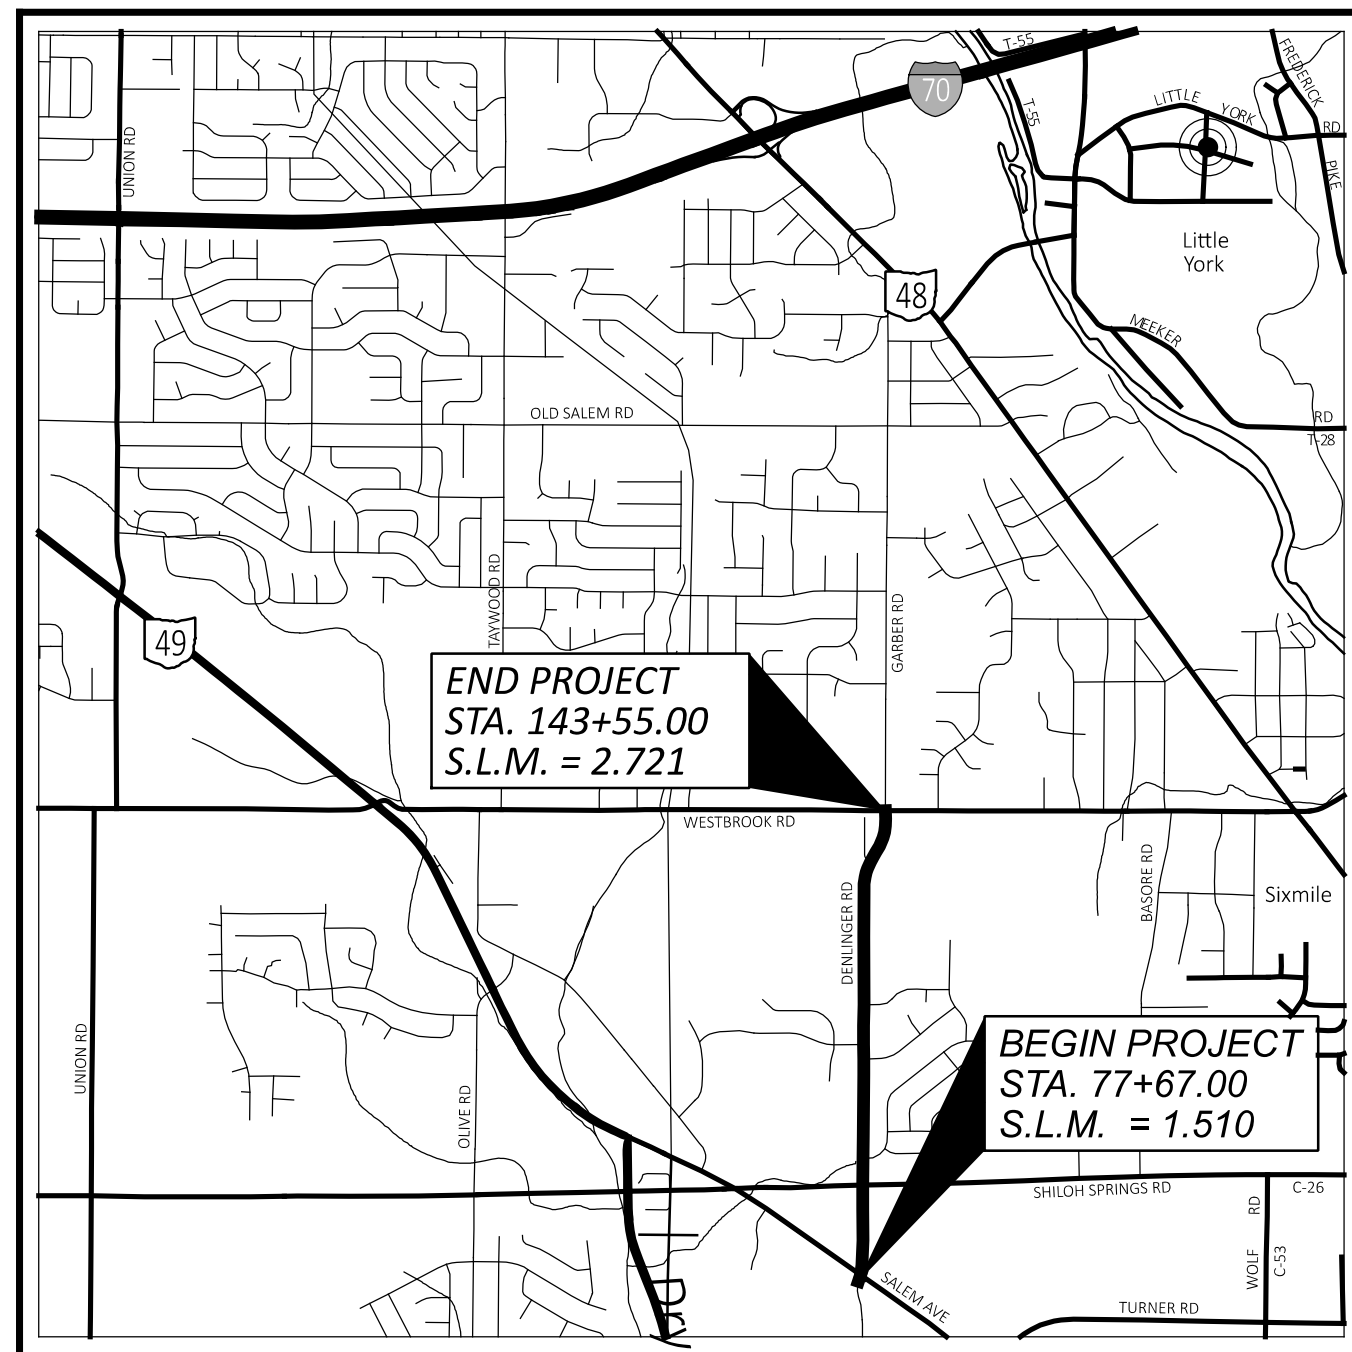

LOCATION MAP

LATITUDE: 39°49'27" LONGITUDE: -84°16'27"



PORTION TO BE IMPROVED	—————
INTERSTATE HIGHWAY	=====
FEDERAL ROUTES	=====
STATE ROUTES	=====
COUNTY & TOWNSHIP ROADS	=====
OTHER ROADS	—————

DESIGN DESIGNATION

CURRENT ADT (2023)	7958
DESIGN YEAR ADT N/A (RESURFACING)	7958
DESIGN SPEED	40
LEGAL SPEED	40
DESIGN FUNCTIONAL CLASSIFICATION: MAJOR COLLECTOR	
NHS PROJECT	NO

DESIGN EXCEPTIONS

NONE

ADA DESIGN WAIVERS

NONE

UNDERGROUND UTILITIES
Contact Two Working Days
Before You Dig

OHIO811.org
Before You Dig

OHIO811, 8-1-1, or 1-800-362-2764
(Non members must be called directly)

PLAN PREPARED BY:

CMT
CRAWFORD, MURPHY & TILLY, INC.

INDEX OF SHEETS:

TITLE SHEET	1
TYPICAL SECTIONS	2
GENERAL NOTES	3
MAINTENANCE OF TRAFFIC	4
GENERAL SUMMARY	5
SUBSUMMARIES	6 - 8
PLAN SHEETS	9 - 15

STANDARD CONSTRUCTION DRAWINGS				SUPPLEMENTAL SPECIFICATIONS	SPECIAL PROVISIONS
BP-3.1	1/19/24			800 7/19/24	
MT-95.31	7/19/19			832 7/19/24	
MT-95.32	4/19/19				
MT-95.60	4/19/19				
MT-95.61	4/19/19				
MT-97.12	1/20/17				
MT-101.90	7/17/20				
MT-105.10	1/17/20				
TC-71.10	4/21/23				
TC-74.10	7/21/23				
TC-82.10	7/19/19				

FEDERAL PROJECT NUMBER

E240427

RAILROAD INVOLVEMENT

NONE

PROJECT DESCRIPTION

THIS PROJECT CONSISTS OF RESURFACING DENLINGER ROAD FROM SALEM AVENUE TO WESTBROOK ROAD IN THE CITY OF TROTWOOD, OHIO. THE IMPROVEMENTS WILL INCLUDE A 2-INCH PAVEMENT PLANING AND ASPHALT OVERLAY WITH FULL DEPTH BASE REPAIRS AT DAMAGED LOCATIONS, ADJUSTING TO GRADE MANHOLES AND WATER VALVE BOXES AND APPLICATION OF NEW PAVEMENT MARKINGS.

EARTH DISTURBED AREAS

PROJECT EARTH DISTURBED AREA:	N/A (MAINTENANCE)
ESTIMATED CONTRACTOR EARTH DISTURBED AREA:	N/A (MAINTENANCE)
NOTICE OF INTENT EARTH DISTURBED AREA:	N/A (MAINTENANCE)

MAINTENANCE OF TRAFFIC

I HEREBY APPROVE THESE PLANS AND DECLARE THAT THE MAKING OF THIS IMPROVEMENT WILL NOT REQUIRE THE CLOSING TO TRAFFIC OF THE HIGHWAY AND THAT PROVISIONS FOR THE MAINTENANCE AND SAFETY OF TRAFFIC WILL BE AS SET FORTH ON THE PLANS AND ESTIMATES.

2023 SPECIFICATIONS

THE STANDARD SPECIFICATIONS OF THE STATE OF OHIO, DEPARTMENT OF TRANSPORTATION, INCLUDING SUPPLEMENTAL SPECIFICATIONS LISTED IN THE PLANS, CHANGES LISTED IN THE PROPOSAL, AND THE SUPPLEMENTAL SPECIFICATION 800 VERSION INDICATED ON THE PROPOSAL SHALL GOVERN THIS IMPROVEMENT.

John W. O'Brien
District 07 Deputy Director

Pamela Boratyn
Director, Department of Transportation

ENGINEER'S SEAL
ROADWAY

SHELBY R. INGLE
E-68116
REGISTERED PROFESSIONAL ENGINEER

DESIGN AGENCY	
DESIGNER	MNM
REVIEWER	SRI
PROJECT ID	119322
SHEET	P.1
TOTAL	15