



0:\2017\056\ProjectData\MOT_99860\Design\Roadway\Sheets\99860_GY001.dgn Sheet 11/3/2020 2:03:41PM pfrj

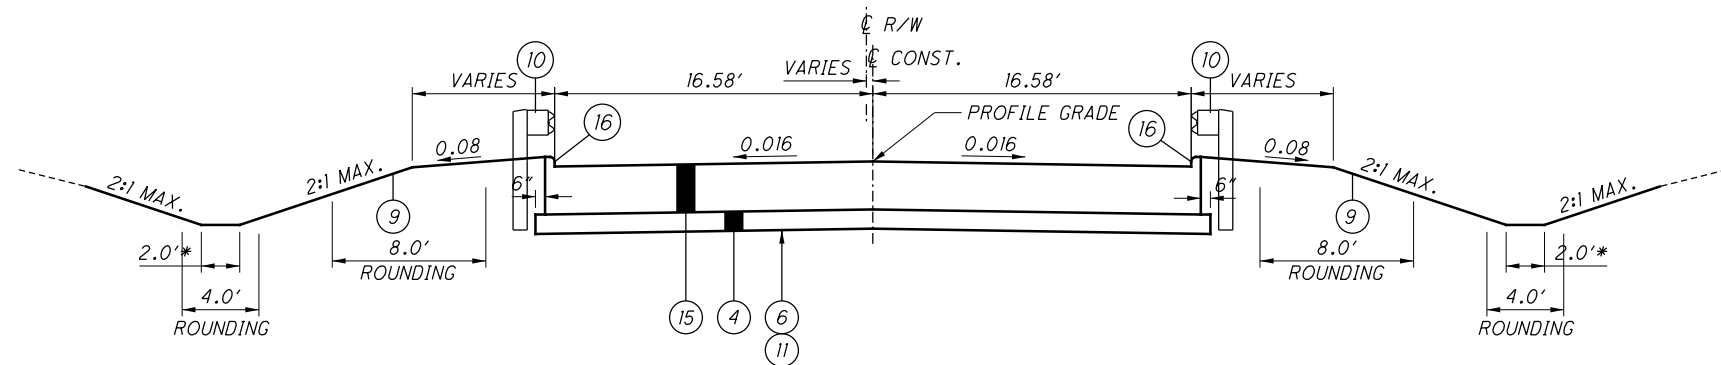


APPROACH SLAB SECTION - CHAMBERSBURG RD., S.R. 235


LIMITING STATIONS
 STA. 13+52.66 TO STA. 13+77.66 = 25.00 L.F.
 STA. 16+22.16 TO STA. 16+47.16 = 25.00 L.F.

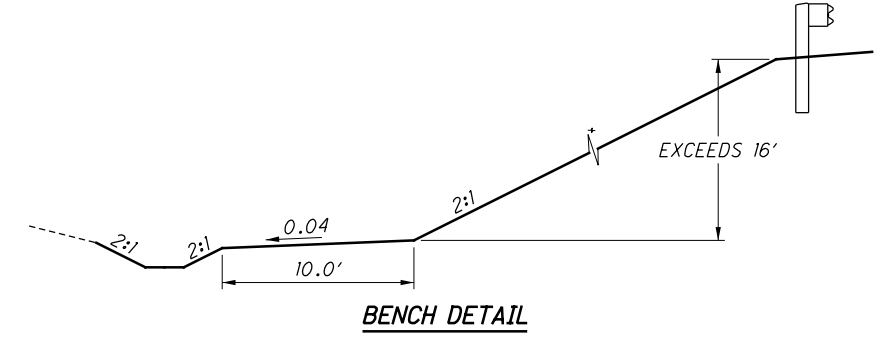

BENCH DETAIL

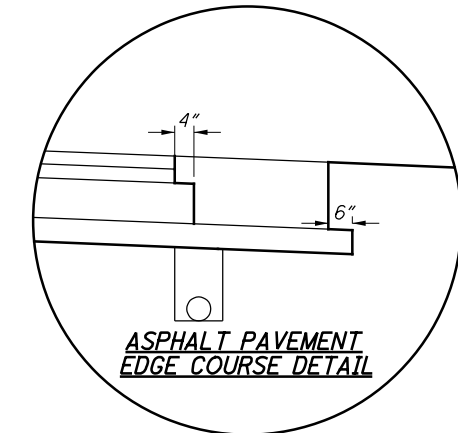


**ASPHALT PAVEMENT
EDGE COURSE DETAIL**

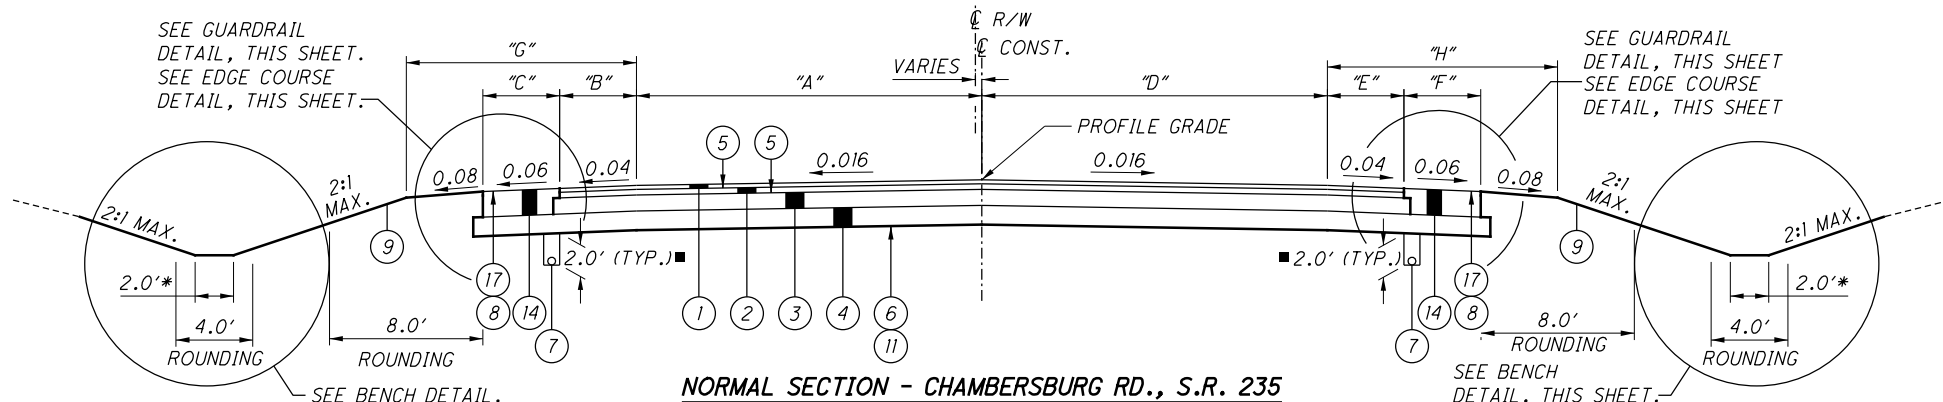

NORMAL SECTION - CHAMBERSBURG RD., S.R. 235

LIMITING STATIONS
 STA. 5+00.00 TO STA. 13+52.66 = 852.66 L.F.
 STA. 16+47.16 TO STA. 27+00.00 = 1052.84 L.F.

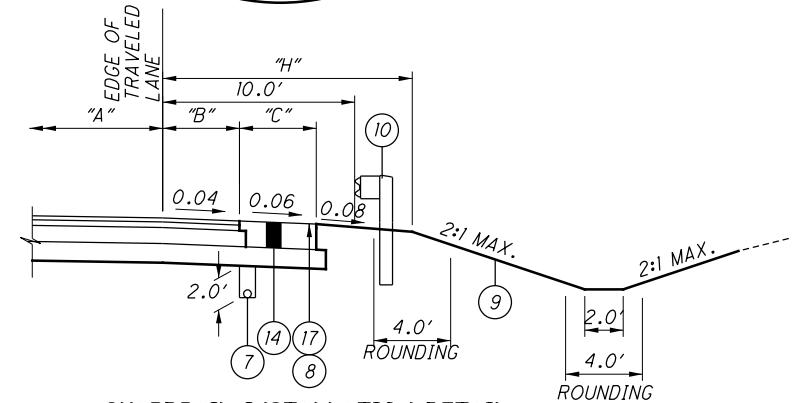

GUARDRAIL INSTALLATION DETAIL

CHAMBERSBURG RD., S.R. 235
 RIGHT SIDE SHOWN, LEFT SIDE SYMMETRICAL
 ABOUT EDGE OF TRAVELED LANE

LEGEND

- ① ITEM 441 - 1 1/2" ASPHALT CONCRETE SURFACE COURSE, TYPE 1, (446), PG64-22
- ② ITEM 441 - 1 3/4" ASPHALT CONCRETE INTERMEDIATE COURSE, TYPE 2, (446)
- ③ ITEM 301 - 5" ASPHALT CONCRETE BASE, PG64-22
- ④ ITEM 304 - 6" AGGREGATE BASE
- ⑤ ITEM 407 - NON-TRACKING TACK COAT (0.04 GAL/S.Y.)
- ⑥ ITEM 204 - SUBGRADE COMPACTION
- ⑦ ITEM 605 - 6" SHALLOW PIPE UNDERDRAINS WITH GEOTEXTILE FABRIC
- ⑧ ITEM 422 - EMULSION, CHIP SEAL
- ⑨ ITEM 659 - SEEDING AND MULCHING
- ⑩ ITEM 606 - GUARDRAIL, TYPE MGS
- ⑪ ITEM 204 - PROOF ROLLING
- ⑫ ITEM 452 - 8" NON-REINFORCED CONCRETE PAVEMENT, CLASS OCI
- ⑬ ITEM 609 - 6" CONCRETE MEDIAN
- ⑭ ITEM 304 - 8 1/4" AGGREGATE BASE
- ⑮ ITEM 526 - REINFORCED CONCRETE APPROACH SLAB, (T=15"), AS PER PLAN
- ⑯ ITEM 609 - CURB, TYPE 2-A **
- ⑰ ITEM 422 - AGGREGATE, SINGLE CHIP SEAL, TYPE A

- (A) EXISTING ASPHALT PAVEMENT (T=6"±)
- (B) EXISTING REINFORCED CONCRETE BASE (T=9"±)
- (C) EXISTING AGGREGATE BASE (T=6"±)
- (D) EXISTING ASPHALT PAVEMENT (T=9"±)
- (E) EXISTING AGGREGATE BASE (T=12"±)
- (F) EXISTING GUARDRAIL
- (G) CONCRETE MEDIAN

REVISIONS		
NO.	DATE	DESCRIPTION
△	11/03/20	ITEM REVISED

* OR AS SHOWN ON CROSS SECTIONS
 ** TO BE PAID FOR UNDER ITEM 15
 EXCEPT RAMPS A AND B
 ■ 2.0' UD DEPTH TYPICAL, EXCEPT AS
 NOTED IN UNDERCUT DETAIL ON SHEET 9

DIMENSION TABLE - CHAMBERSBURG RD./S.R. 235

LEFT SIDE DIMENSIONS				BEGINNING STATION		ENDING STATION		RIGHT SIDE DIMENSIONS			
"G" WIDTH	"C" WIDTH	"B" WIDTH	"A" WIDTH	BEGINNING STATION	ENDING STATION	"D" WIDTH	"E" WIDTH	"F" WIDTH	"H" WIDTH		
8.00' TO 8.00'	4.00' TO 4.00'	4.00' TO 4.00'	19.24' TO 19.24'	5+00.00	7+63.36	16.76' TO 16.76'	4.00' TO 4.00'	-8.76' TO -8.76'	8.00' TO 13.00'		
8.00' TO 8.00'	4.00' TO 4.00'	4.00' TO 4.00'	19.24' TO 25.20'	7+63.36	8+22.97	16.76' TO 16.76'	4.00' TO 4.00'	-8.76' TO -8.76'	13.00' TO 13.00'		
INTERSECTION				8+22.97	9+62.46	16.76' TO 16.76'	4.00' TO 4.00'	-8.76' TO -8.76'	13.00' TO 13.00'		
12.00' TO 12.00'	4.00' TO 4.00'	4.00' TO 4.00'	32.99' TO 28.99'	9+62.46	10+02.46	16.76' TO 16.76'	4.00' TO 4.00'	-8.76' TO -8.76'	13.00' TO 13.00'		
12.00' TO 13.00'	4.00' TO 4.00'	4.00' TO 4.00'	28.99' TO 24.00'	10+02.46	12+76.89						
				9+62.46	10+41.29	16.76' TO 16.76'	4.00' TO 4.00'	-8.76' TO -8.76'	13.00' TO 13.00'		
13.00' TO 13.00'	4.00' TO 4.00'	4.00' TO 4.00'	24.00' TO 12.00'	10+41.29	12+76.89	16.76' TO 12.96'	4.00' TO 4.00'	-8.76' TO -4.96'	13.00' TO 13.00'		
13.00' TO 13.00'	4.00' TO 3.42'	4.00' TO 4.58'	12.00' TO 12.00'	12+76.89	13+26.89	12.96' TO 12.00'	4.00' TO 4.00'	-4.96' TO -4.00'	13.00' TO 13.00'		
13.00' TO 13.00'	4.00' TO 4.00'	4.00' TO 4.58'	12.00' TO 12.00'	13+26.89	13+52.66	12.00' TO 12.00'	4.00' TO 4.58'	-4.00' TO -4.00'	13.00' TO 13.00'		
13.00' TO 13.00'	3.42' TO 4.00'	4.58' TO 4.00'	12.00' TO 12.00'	16+47.16	16+71.30	12.00' TO 12.00'	4.58' TO 4.00'	-4.00' TO -4.00'	13.00' TO 13.00'		
13.00' TO 13.00'	4.00' TO 4.00'	4.00' TO 4.00'	12.00' TO 12.00'	16+71.30	17+49.20	12.00' TO 12.00'	4.00' TO 4.00'	-4.00' TO -4.00'	13.00' TO 13.00'		
13.00' TO 13.00'	4.00' TO 4.00'	4.00' TO 4.00'	12.00' TO 16.00'	17+49.20	18+29.26	12.00' TO 12.00'	4.00' TO 4.00'	-4.00' TO -4.00'	13.00' TO 16.00'		
				18+29.26	18+87.91						
13.00' TO 13.00'	4.00' TO 4.00'	4.00' TO 4.00'	12.00' TO 12.00'	18+87.91	19+22.77						
13.00' TO 13.00'	4.00' TO 4.00'	4.00' TO 4.00'	12.00' TO 12.00'	19+22.77	20+02.77	20.00' TO 12.00'	4.00' TO 4.00'	-12.00' TO -4.00'	15.55' TO 13.00'		
13.00' TO 12.00'	4.00' TO 4.00'	4.00' TO 4.00'	12.00' TO 12.00'	20+02.77	22+88.05	12.00' TO 12.00'			13.00' TO 8.00'		
			12.00' TO 12.00'	22+88.05	24+77.34	12.00' TO 12.00'					
			12.00' TO 12.00'	24+77.34	25+47.23	24.91' TO 23.91'	6.00' TO 4.00'	-16.91' TO -15.91'	8.00' TO 8.00'		
12.00' TO 12.00'	2.00' TO 4.00'	6.00' TO 4.00'	14.96' TO 14.93'	25+47.23	25+57.25	23.91' TO 23.76'	4.00' TO 4.00'	-15.91' TO -15.76'	8.00' TO 8.00'		
12.00' TO 12.00'	4.00' TO 4.00'	4.00' TO 4.00'	14.93' TO 14.43'	25+57.25	27+00.00	23.76' TO 21.72'	4.00' TO 4.00'	-15.76' TO -13.72'	8.00' TO 8.00'		

TYPICAL SECTIONS

MOT - 235 - 0.22L

