


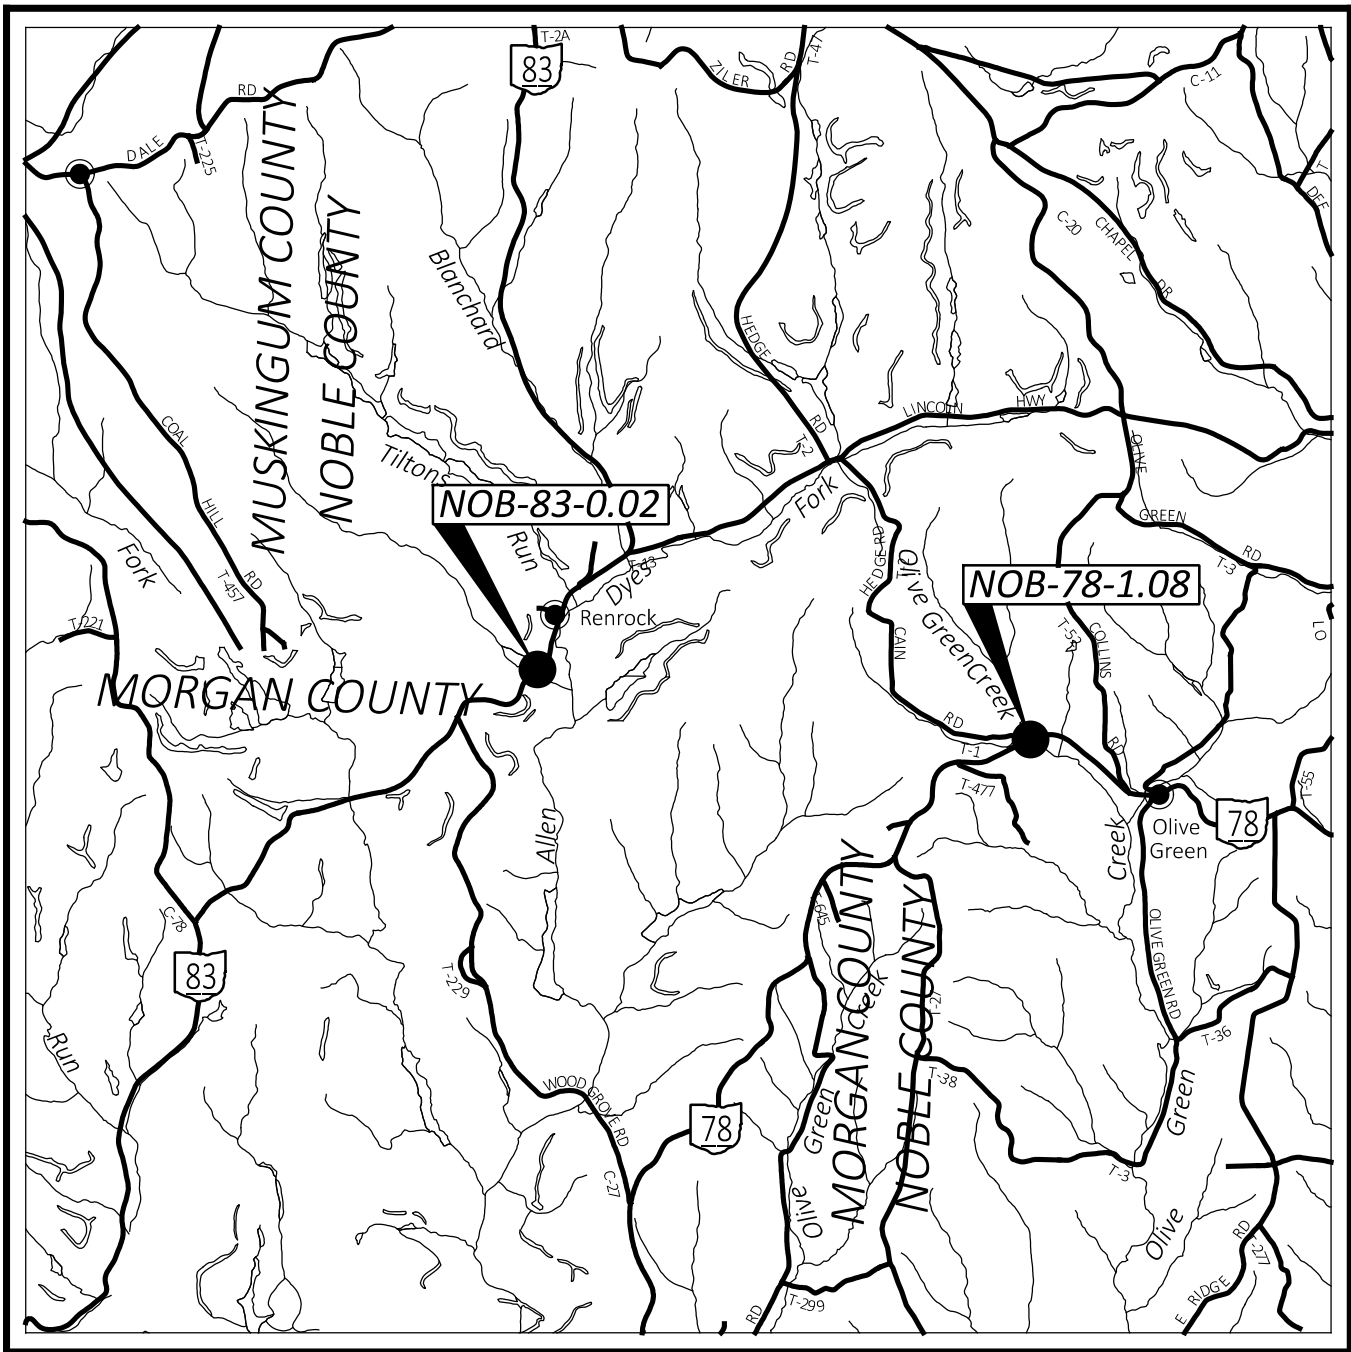

LOCATION MAP

NOB-78: LATITUDE: 39°44'54" LONGITUDE: 81°37'35"
NOB-83: LATITUDE: 39°45'14" LONGITUDE: 81°40'28"



PORTION TO BE IMPROVED	
INTERSTATE HIGHWAY	
FEDERAL ROUTES	
STATE ROUTES	
COUNTY & TOWNSHIP ROADS	
OTHER ROADS	

DESIGN DESIGNATION

	NOB-78	NOB-83
CURRENT ADT (2026)	500	350
DESIGN YEAR ADT (2046)	500	350
DESIGN HOURLY VOLUME (2046)	70	50
DIRECTIONAL DISTRIBUTION	64.0%	63.2%
TRUCKS (24 HOUR B&C)	13%	29%
DESIGN SPEED	55 MPH	55 MPH
LEGAL SPEED	55 MPH	55 MPH
DESIGN FUNCTIONAL CLASSIFICATION:	RURAL MINOR ARTERIAL	RURAL MAJOR COLLECTOR
NHS PROJECT	NO	NO

DESIGN EXCEPTIONS

NONE REQUIRED

ADA DESIGN WAIVERS

NONE REQUIRED

UNDERGROUND UTILITIES


Contact Two Working Days Before You Dig

OHIO811.org
Before You Dig

OHIO811, 8-1-1, or 1-800-362-2764
(Non members must be called directly)

PLAN PREPARED BY:
OHIO DEPARTMENT OF TRANSPORTATION
DISTRICT 10 - ENGINEERING
MARIETTA, OHIO

ENGINEER'S SEAL

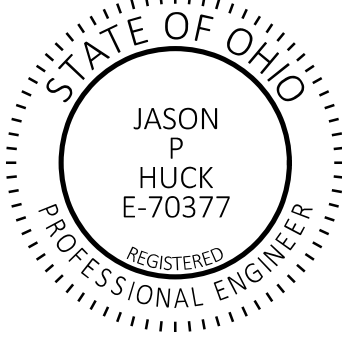

STANDARD CONSTRUCTION DRAWINGS							SUPPLEMENTAL SPECIFICATIONS		SPECIAL PROVISIONS
BP-3.1	1-19-24	AS-1-15	1-20-23				800	7-18-25	OEPA NOTIFICATION OF DEMOLITION (NOB-78-1.08) DATED 8-6-25
		AS-2-15	7-21-23				832	7-18-25	
		DS-1-92	7-15-22				846	4-17-15	
							940	4-17-15	
MGS-2.1	7-18-25	PCB-91	7-17-20						OEPA NOTIFICATION OF DEMOLITION (NOB-83-0.02) DATED 8-21-25
MGS-2.3	7-18-25	SB-1-24	7-18-25						
MGS-3.3	7-18-25	TST-2-21	1-17-25						
MGS-4.1	7-18-25								
MGS-4.2	7-18-25	MT-96.11	7-18-25						WATERWAY PERMITS CONDITIONS DATED 9-5-25
		MT-96.20	7-18-25						
RM-4.2	7-18-25	MT-96.26	1-17-25						
		MT-97.10	7-18-25						
TC-61.30	7-19-24	MT-101.70	7-19-24						
		MT-101.90	7-17-20						
		MT-105.10	1-17-20						

STANDARD CONSTRUCTION DRAWINGS

SUPPLEMENTAL SPECIFICATIONS

SPECIAL PROVISIONS

INDEX OF SHEETS:

TITLE SHEET	1
TYPICAL SECTIONS	2 - 5
GENERAL NOTES	6 - 7
MAINTENANCE OF TRAFFIC	8 - 12
GENERAL SUMMARY	13 - 14
CALCULATIONS	15 - 16
PLAN AND PROFILE (NOB-78)	17 - 18
CROSS SECTIONS (NOB-78)	19 - 31
STRUCTURE 20 FOOT SPAN AND UNDER (BRIDGE No. NOB-78-0109)	32 - 39
PLAN AND PROFILE (NOB-83)	40 - 41
CROSS SECTIONS (NOB-83)	42 - 51
STRUCTURE OVER 20 FOOT SPAN (BRIDGE No. NOB-83-0003)	52 - 64
GEOTECHNICAL EXPLORATION	65 - 69
RIGHT OF WAY	

FEDERAL PROJECT NUMBER

E240 (556)

RAILROAD INVOLVEMENT

NONE

PROJECT DESCRIPTION

NOB-78:
THIS PROJECT CONSISTS OF REPLACING A SINGLE SPAN CONCRETE SLAB BRIDGE WITH AN 18' X 10' REINFORCED CONCRETE BOX CULVERT. PROJECT LENGTH IS 85 FEET AND TOTAL WORK LENGTH IS 700 FEET.

NOB-83:
THIS PROJECT CONSISTS OF REPLACING THE SUPERSTRUCTURE ON A SINGLE SPAN CONCRETE SLAB BRIDGE. PROJECT LENGTH IS 105 FEET AND TOTAL WORK LENGTH IS 618 FEET.

EARTH DISTURBED AREAS


	NOB-78	NOB-83
PROJECT EARTH DISTURBED AREA:	0.77 ACRES	0.54 ACRES
ESTIMATED CONTRACTOR EARTH DISTURBED AREA:	0.12 ACRES	0.12 ACRES
NOTICE OF INTENT EARTH DISTURBED AREA:	0.89 ACRES*	0.66 ACRES*
* NOI NOT REQUIRED		

2023 SPECIFICATIONS


THE STANDARD SPECIFICATIONS OF THE STATE OF OHIO, DEPARTMENT OF TRANSPORTATION, INCLUDING SUPPLEMENTAL SPECIFICATIONS LISTED IN THE PLANS, CHANGES LISTED IN THE PROPOSAL, AND THE SUPPLEMENTAL SPECIFICATION 800 VERSION INDICATED ON THE PROPOSAL SHALL GOVERN THIS IMPROVEMENT.

* I HEREBY APPROVE THESE PLANS AND DECLARE THAT THE MAKING OF THIS IMPROVEMENT WILL NOT REQUIRE THE CLOSING TO TRAFFIC OF THE HIGHWAY AND THAT PROVISIONS FOR THE MAINTENANCE AND SAFETY OF TRAFFIC WILL BE AS SET FORTH ON THE PLANS AND ESTIMATES.


Rich Oster
District 10 Deputy Director

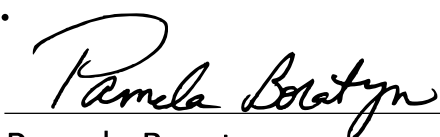
Pamela Boratyn
Director, Department of Transportation

DESIGN AGENCY

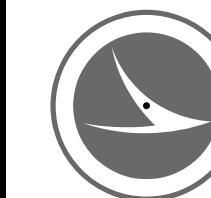

DESIGNER

JPH

REVIEWER

JDC 06-24

PROJECT ID

107057

SHEET

P:1

TOTAL

69