


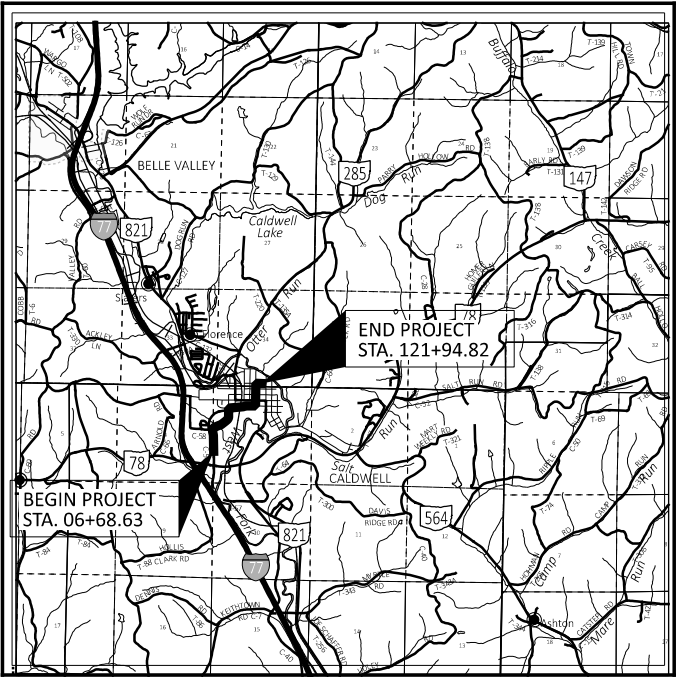

LOCATION MAP

LATITUDE: 39°44'54" LONGITUDE: -81°31'53"



PORTION TO BE IMPROVED	=====
INTERSTATE HIGHWAY	=====
FEDERAL ROUTES	=====
STATE ROUTES	=====
COUNTY & TOWNSHIP ROADS	=====
OTHER ROADS	=====

DESIGN DESIGNATION

	<u>CR 56</u>	<u>CR 58</u>	<u>MAIN ST.</u>	<u>LEWIS ST.</u>	<u>FAIRGROUND ST.</u>
CURRENT ADT (2024)	4176				
DESIGN YEAR ADT (2044)					
DESIGN HOURLY VOLUME (2044)					
DIRECTIONAL DISTRIBUTION					
TRUCKS (24 HOUR B&C)					
DESIGN SPEED	40 MPH		30 MPH		25 MPH
LEGAL SPEED	35 MPH		25 MPH		20 MPH
DESIGN FUNCTIONAL CLASSIFICATION:	LOCAL	LOCAL	LOCAL	LOCAL	LOCAL

NHS PROJECT

DESIGN EXCEPTIONS

NONE

ADA DESIGN WAIVERS

NONE

UNDERGROUND UTILITIES

Contact Two Working Days
Before You Dig


OHIO811.org
Before You Dig

OHIO811, 8-1-1, or 1-800-362-2764
(Non members must be called directly)

PLAN PREPARED BY:



LJB Inc.
2500 Newmark Drive
Miamisburg, OH 45342
(866) 552-3536 | LJBinc.com

ENGINEER'S SEAL

STANDARD CONSTRUCTION DRAWINGS							SUPPLEMENTAL SPECIFICATIONS	SPECIAL PROVISIONS
BP-3.1	1/19/24	TC-41.20	10/18/13				SS 800 1/17/25	
BP-4.1	7/19/13	TC-42.20	10/18/13				SS 832 7/19/24	
BP-5.1	1/17/25	TC-52.10	10/18/13					
BP-7.1	1/17/25	TC-52.20	1/15/21				SS 895 4/18/14	
							SS 916 7/19/24	
RM-2.1	7/19/13	HL-10.11	7/21/23					
RM-5.2	7/21/23	HL-10.12	7/21/23					
RM-6.1	7/18/14	HL-10.13	1/20/23					
		HL-20.11	7/18/25					
MT-101.90	7/17/20	HL-30.31	7/21/23					
MT-101.60	1/17/25	HL-30.22	7/17/25					
		HL-40.20	7/18/25					
		HL-60.11	7/21/17					
		HL-60.12	7/21/23					
		HL-60.31	7/19/24					

1

INDEX OF SHEETS:

TITLE SHEET	1	DRIVEWAY DETAILS	70-74
SCHEMATIC PLAN	2-3	CURB RAMP DETAILS	75-86
TYPICAL SECTIONS	4-8	STORM SEWER PROFILES	87-88
GENERAL NOTES	9-10	LIGHTING PLANS	89-96
MAINTENANCE OF TRAFFIC	11-13	TRAFFIC CONTROL PLAN	97-103, 97A
GENERAL SUMMARY	14-15	RIGHT OF WAY	1
PAVEMENT SUBSUMMARY	16		
ROADWAY SUBSUMMARY	17-19		
DRAINAGE SUBSUMMARY	20		
PROJECT SITE PLAN	21-24		
PLAN	25-34		
CROSS SECTIONS	35-59		
PAVEMENT ELEVATION	60-69		
AND INTERSECTION DETAILS			

FEDERAL PROJECT NUMBER

E240020

RAILROAD INVOLVEMENT

NONE

PROJECT DESCRIPTION

THE PROJECT INVOLVES THE CONSTRUCTION AND RECONSTRUCTION OF WALK BETWEEN CALDWELL ELEMENTARY SCHOOL AND CALDWELL HIGHSCHOOL ALONG CR 56 (FAIRGROUND RD), MAIN ST, LEWIS ST, AND FAIRGROUND ST. NEW CURB AND DRAINAGE IMPROVEMENTS WILL BE CONSTRUCTED ALONG CR 56 AND MAIN ST WEST OF MILLER ST. IT ALSO INVOLVES THE CONSTRUCTION OF WALK, CURB, AND DRAINAGE IMPROVEMENTS ALONG CR 58 (BRONZE HEIGHTS LN).

EARTH DISTURBED AREAS

PROJECT EARTH DISTURBED AREA:	2.02 ACRES
ESTIMATED CONTRACTOR EARTH DISTURBED AREA:	0.01 ACRES
NOTICE OF INTENT EARTH DISTURBED AREA:	2.03 ACRES

REVISED 11/18/25

REVISED 11/25/25

2023 SPECIFICATIONS

THE STANDARD SPECIFICATIONS OF THE STATE OF OHIO, DEPARTMENT OF TRANSPORTATION, INCLUDING SUPPLEMENTAL SPECIFICATIONS LISTED IN THE PLANS, CHANGES LISTED IN THE PROPOSAL, AND THE SUPPLEMENTAL SPECIFICATION 800 VERSION INDICATED ON THE PROPOSAL SHALL GOVERN THIS IMPROVEMENT.

I HEREBY APPROVE THESE PLANS AND DECLARE THAT THE MAKING OF THIS IMPROVEMENT WILL REQUIRE THE PART TIME CLOSING OF THE HIGHWAY TO TRAFFIC, AS NOTED ON SHEET 13. DURING WHICH TIME DETOURS WILL BE PROVIDED AS SHOWN HEREIN. PROVISIONS FOR THE MAINTENANCE AND SAFETY OF TRAFFIC WILL BE AS SET FORTH ON THE PLANS AND ESTIMATES.

APPROVED

DATE NOBLE COUNTY COMMISSIONER

APPROVED

DATE NOBLE COUNTY COMMISSIONER

APPROVED

DATE NOBLE COUNTY COMMISSIONER

APPROVED

DATE NOBLE COUNTY ENGINEER


Rich Oster
District 10 Deputy Director


Pamela Boratyn
Director, Department of Transportation

TITLE SHEET

DESIGN AGENCY



DESIGNER

SHH

REVIEWER

JLM 08/29/25

PROJECT ID

120193

SHEET

TOTAL

1

103