

TYPICAL FULL DEPTH PAVEMENT SECTION
 STA. 259+05.00 TO STA. 260+05.00


PROPOSED PAVEMENT LEGEND

- 1 ITEM 441 - 1½" ASPHALT CONCRETE SURFACE COURSE, TYPE 1, (448), PG64-22
- 2 ITEM 301 - 4¼" ASPHALT CONCRETE BASE, PG64-22, (449)
- 3 ITEM 304 - 6" AGGREGATE BASE
- 4 ITEM 407 - NON-TRACKING TACK COAT
- 5 ITEM 204 - SUBGRADE COMPACTION
- 6 ITEM 617 - 8" COMPACTED AGGREGATE
- 7 ITEM 659 - SEEDING AND MULCHING

EXISTING PAVEMENT LEGEND

- A EXISTING ASPHALT (THICKNESS AS SHOWN)
- B STONE BASE (UNDETERMINED DEPTH)

EDGE COURSE DETAIL

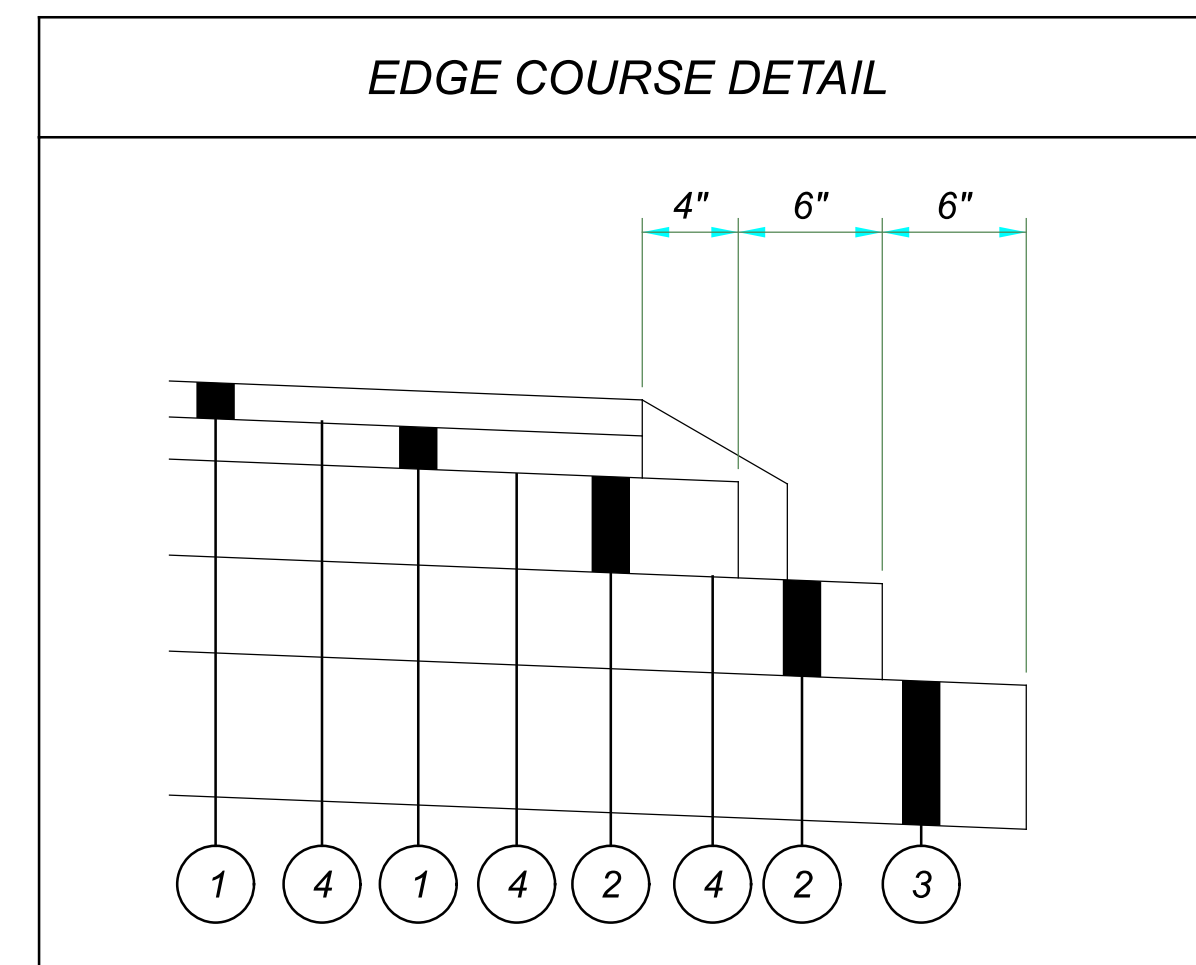

NOTE: DO NOT CONSTRUCT SAFETY EDGE FROM STA. 259+05.00 TO STA. 259+40.33 LT

TYPICAL SECTION

DESIGN AGENCY



DESIGNER
 ADB

REVIEWER
 DJG 10-19-21

PROJECT ID
 110120

SHEET TOTAL
 P.2 26

