# STATE OF OHIO DEPARTMENT OF TRANSPORTATION

PAU-24-0.00

Harrison, Carryall and Crane Townships
Paulding County

# **INDEX OF SHEETS:**

TITLE SHEET	1
LOCATION MAP	2
GENERAL NOTES	3
MAINTENANCE OF TRAFFIC NOTES	4-6
GENERAL SUMMARY	7
PAVEMENT REPAIR SUB-SUMMARY	8
PAVEMENT REPAIR DETAILS	9

DESIGN EXCEPTIONS

NONE REQUIRED

ADA DESIGN WAIVERS

NONE REQUIRED

PAU-24-0.00

UNDERGROUND UTILITIES

Contact Two Working Days
Before You Dig

OHIO811, 8-1-1, or 1-800-362-2764

(Non members must be called directly)

PLAN PREPARED BY:

District One

Ohio Department of Transportation

Lima, Ohio

**SUPPLEMENTAL SPECIAL** STANDARD CONSTRUCTION DRAWINGS **SPECIFICATIONS PROVISIONS** 7/28/00 MT-98.22 7/18/25 1/17/20 DM-4.3 1/15/16 1/21/22 MT-98.28 1/17/20 DM-4.4 1/15/16 1/17/25 1/15/21 MT-98.29 4/20/12 1/17/20 7/19/24 MT-98.30 7/16/21 7/18/25 ENGINEER'S SEAL 1/18/19 MT-101.60 1/17/25 7/21/23 7/19/24 MT-101.70 7/19/24 7/19/19 MT-101.90 7/17/20 MT-95.30 7/19/19 MT-105.10 1/17/20 MT-95.31 7/21/23 MT-95.40 MT-95.41 7/21/23 TC-41.20 10/18/13 **BRUNET** 7/21/23 TC-42.20 10/18/13 7/21/17 TC-52.10 10/18/13 1/17/20 TC-52.20 1/15/21 1/17/20 TC-71.10 4/21/23 4/19/19 TC-72.20 1/17/25 MT-98.21 7/21/23

FEDERAL PROJECT NUMBER

E250(570)

RAILROAD INVOLVEMENT

NONE

**PROJECT DESCRIPTION** 

CONCRETE PAVEMENT REPAIRS ON 12.38 MILES OF US 24 IN PAULDING COUNTY.

# **EARTH DISTURBED AREAS**

PROJECT EARTH DISTURBED AREA: N/A \*

ESTIMATED CONTRACTOR EARTH DISTURBED AREA: N/A \*

NOTICE OF INTENT EARTH DISTURBED AREA: N/A \*

\* - MAINTENANCE PROJECT

# LIMITED ACCESS

THIS IMPROVEMENT IS ESPECIALLY DESIGNED FOR THROUGH TRAFFIC AND HAS BEEN DECLARED A LIMITED ACCESS HIGHWAY OR FREEWAY BY ACTION OF THE DIRECTOR IN ACCORDANCE WITH THE PROVISIONS OF SECTION 5511.02 OF THE OHIO REVISED CODE.

# **2023 SPECIFICATIONS**

THE STANDARD SPECIFICATIONS OF THE STATE OF OHIO, DEPARTMENT OF TRANSPORTATION, INCLUDING SUPPLEMENTAL SPECIFICATIONS LISTED IN THE PLANS, CHANGES LISTED IN THE PROPOSAL, AND THE SUPPLEMENTAL SPECIFICATION 800 VERSION INDICATED ON THE PROPOSAL SHALL GOVERN THIS IMPROVEMENT.

I HEREBY APPROVE THESE PLANS AND DECLARE THAT THE MAKING OF THESE IMPROVEMENTS WILL NOT REQUIRE THE CLOSING TO TRAFFIC OF THE HIGHWAY AND THAT PROVISIONS FOR THE MAINTENANCE AND SAFETY OF TRAFFIC WILL BE AS SET FORTH ON THE PLANS AND ESTIMATES.

Christopher A. Hughes, P.E. District 01 Deputy Director

Pamela Boratyn
Director, Department of Transportation

DESIGN AGENCY

SHEET



esigner **GLI** 

REVIEWER
MPB 9/11/25
PROJECT ID
116665

P.1 TOTAL

# PAU-24-0.00

#### CONTRACTOR'S EQUIPMENT - OPERATION AND STORAGE

IN ADDITION TO THE REQUIREMENTS OF SECTION 614.03(A) OF THE CONSTRUCTION AND MATERIAL SPECIFICATIONS THE FOLLOWING SHALL APPLY. THE CONTRACTOR'S EQUIPMENT SHALL BE OPERATED IN THE DIRECTION OF TRAFFIC WHERE PRACTICAL. EXTREME CAUTION SHALL BE USED WHERE THE CONTRACTOR'S VEHICLES AND EQUIPMENT MERGE WITH THE TRAFFIC STREAM. THE CONTRACTOR'S VEHICLES AND EQUIPMENT SHALL BE EQUIPPED WITH AT LEAST ONE AMBER FLASHING LIGHT. CON-STRUCTION EQUIPMENT MAY BE PARKED IN AREA ALONG THE HIGHWAY, THIRTY FEET (30') FROM THE EDGE OF THE TRAVELED HIGHWAY UNLESS BEHIND GUARDRAIL. WHEN VARIOUS OPERATIONS ARE SCHEDULED TO CONTINUE THE NEXT WORKDAY. EQUIPMENT PARKED BEHIND THE GUARDRAIL SHALL BE AT LEAST 6 FEET FROM THE FACE OF THE GUARDRAIL. NO EQUIPMENT SHALL BE PARKED BEHIND A GUARDRAIL ATTENUATOR. ON WEEKENDS OR AT OTHER TIMES OF SUSPENSION OF WORK, EQUIPMENT SHALL BE STORED AT A STORAGE AREA REMOVED FROM THE INTERSTATE RIGHT OF WAY. NO EQUIPMENT SHALL BE PARKED IN THE MEDIAN OF THE HIGHWAY EXCEPT WHEN TRAFFIC IS MAINTAINED ON THE OUTSIDE LANES. ADEQUATE BARRICADES AND LIGHT SHALL BE PLACED ON THE PAVEMENT SIDE OF THE EQUIPMENT TO IDENTIFY THE LIMITS OF THE EQUIPMENT. ALL OTHER EQUIPMENT. INCLUDING PRIVATE VEHICLES, SHALL BE STORED AT THE APPROVED CONTACTOR'S STORAGE AREA.

#### **PAVEMENT MARKING**

PRIOR TO PLACEMENT OF ANY WORK ZONE PAVEMENT MARKINGS, THE CONTRACTOR SHALL COMPLETELY OBLITERATE, AS PER SPEC. 641.10, ALL EXISTING PAVEMENT MARKINGS THAT WOULD CREATE CONFUSION OR CONFLICT WITH THE WORK ZONE PAVEMENT MARKINGS. PAYMENT FOR THIS COMPLETE REMOVAL SHALL BE INCLUDED IN ITEM 614 MAINTAINING TRAFFIC, AS PER PLAN.

# ITEM 614, LAW ENFORCEMENT OFFICER (WITH PATROL CAR) FOR ASSISTANCE DURING CONSTRUCTION OPERATIONS

USE OF LAW ENFORCEMENT OFFICERS (LEOS) BY CONTRACTORS
OTHER THAN THE USES SPECIFIED BELOW WILL NOT BE
PERMITTED AT PROJECT COST. LEOS SHOULD NOT BE USED
WHERE THE OMUTCD INTENDS THAT FLAGGERS BE USED.

IN ADDITION TO THE REQUIREMENTS OF C&MS 614 AND THE OMUTCD, A UNIFORMED LEO WITH AN OFFICIAL PATROL CAR (CAR WITH TOP-MOUNTED EMERGENCY FLASHING LIGHTS AND COMPLETE MARKINGS OF THE APPROPRIATE LAW ENFORCEMENT AGENCY) SHALL BE PROVIDED FOR THE FOLLOWING TRAFFIC CONTROL TASKS AS APPROVED BY THE ENGINEER:

FOR LANE CLOSURES: DURING INITIAL SET-UP PERIODS,
TEAR DOWN PERIODS, SUBSTANTIAL SHIFTS OF A CLOSURE
POINT OR WHEN NEW LANE CLOSURE ARRANGEMENTS ARE
INITIATED FOR LONG-TERM LANE CLOSURES/SHIFTS (FOR
THE FIRST AND LAST DAY OF MAJOR CHANGES IN TRAFFIC
CONTROL SETUP).

FOR OPERATIONS WITHOUT POSITIVE PROTECTION
OCCURING WITHIN 10 FEET OF AN OPEN TRAVELED LANE.

"WITHOUT POSITIVE PROTECTION" MEANS USE OF DRUMS, CONES, SHADOW VEHICLE, ETC, WITHOUT PROTECTION FROM PORTABLE BARRIER OR OTHER RIGID BARRIER ALONG THE WORK AREA. THIS PHRASE DOES NOT APPLY TO CASES WHERE POSITIVE PROTECTION IS REQUIRED. MOBILE OPERATIONS ARE REGARDED AS "WITHOUT POSITIVE PROTECTION". FOR WORK ZONES USING A COMBINATION OF BARRIER AND TEMPORARY TRAFFIC CONTROL DEVICES (CONES, DRUMS, ECT), THE DESIGNATION SHALL BE BASED UPON THE TYPE OF DEVICES USED IN THE AREA THAT WORKERS ARE LOCATED.

WHEN CONSTRUCTION VEHICLES ARE ENTERING/EXITING THE ZONE DIRECTLY FROM/INTO AN OPEN LANE OF TRAFFIC. IF A LANE HAS BEEN CLOSED TO PROVIDE AN ACCELERATION/DECELERATION LANE FOR THE VEHICLE, THE LEO WILL NOT BE REQUIRED.

IN GENERAL, LEOS SHOULD BE POSITIONED IN ADVANCE OF AND ON THE SAME SIDE AS THE LANE RESTRICTION (OR AT THE POINT OF ROAD CLOSURE).

LEOS SHOULD NOT FORGO THEIR TRAFFIC CONTROL
RESPONSIBILITIES TO APPREHEND MOTORISTS FOR ROUTINE
TRAFFIC VIOLATIONS. HOWEVER, IF A MOTORIST'S ACTIONS
ARE CONSIDERED TO BE RECKLESS, THEN PURSUIT OF THE
MOTORIST IS APPROPRIATE.

THE LEOS WORK AT THE DIRECTION OF THE CONTRACTOR.
THE CONTRACTOR IS RESPONSIBLE FOR SECURING THE
SERVICES OF THE LEOS WITH THE APPROPRIATE AGENCIES
AND COMMUNICATING THE INTENTIONS OF THE PLANS WITH
RESPECT TO DUTIES OF THE LEOS. THE ENGINEER SHALL
HAVE FINAL CONTROL OVER THE LEOS' DUTIES AND PLACEMENT,
AND WILL RESOLVE ANY ISSUES THAT MAY ARISE BETWEEN THE
TWO PARTIES.

ENSURE PROVIDED LEOS HAVE BEEN TRAINED APPROPRIATE TO THE JOB DECISIONS THEY ARE REQUIRED TO MAKE WHILE ON THE PROJECT, IN ACCORDANCE WITH C&MS 614.03.

# ITEM 614, LAW ENFORCEMENT OFFICER (WITH PATROL CAR) FOR ASSISTANCE DURING CONSTRUCTION OPERATIONS (CONTIN.)

THE LEO SHALL REPORT IN TO THE CONTRACTOR PRIOR TO THE START OF THE SHIFT, IN ORDER TO RECEIVE INSTRUCTIONS REGARDING SPECIFIC WORK ASSIGNMENTS DURING HIS/HER SHIFT. THE LEO IS EXPECTED TO STAY AT THE PROJECT SITE FOR THE ENTIRE DURATION OF HIS/HER SHIFT. THE LEO SHALL REPORT TO THE CONTRACTOR AT THE END OF HIS/HER SHIFT. SHOULD IT BE NECESSARY TO LEAVE THE PROJECT SITE, THE LEO SHALL NOTIFY THE ENGINEER. THE CONTRACTOR SHALL PROVIDE THE LEO WITH A TWO-WAY COMMUNICATION DEVICE THAT SHALL BE RETURNED TO THE CONTRACTOR AT THE END OF HIS/HER SHIFT.

LEOS (WITH PATROL CAR) REQUIRED BY THE TRAFFIC
MAINTENANCE TASKS ABOVE SHALL BE PAID FOR ON A UNIT
PRICE (HOURLY) BASIS UNDER ITEM 614, LAW ENFORCEMENT
OFFICER (WITH PATROL CAR) FOR ASSISTANCE. THE FOLLOWING
ESTIMATED QUANTITIES HAVE BEEN CARRIED TO THE GENERAL
SUMMARY.

FOR ASSISTANCE 600 HOURS

THE HOURS PAID SHALL INCLUDE ANY MINIMUM SHOW-UP TIME REQUIRED BY THE LAW ENFORCEMENT AGENCY INVOLVED.

ANY ADDITIONAL COSTS (ADMINISTRATIVE OR OTHERWISE)
INCURRED BY THE CONTRACTOR TO OBTAIN THE SERVICES
OF A LEO ARE INCLUDED WITH THE BID UNIT PRICE FOR
ITEM 614, LAW ENFORCEMENT OFFICER WITH PATROL CAR
FOR ASSISTANCE.

## **FLOODLIGHTING**

FLOODLIGHTING OF THE WORK SITE FOR OPERATIONS CONDUCTED DURING NIGHTTIME PERIODS SHALL BE ACCOMPLISHED SO THAT THE LIGHTS DO NOT CAUSE GLARE TO THE DRIVERS ON THE ROADWAY. TO ENSURE THE ADEQUACY OF THE FLOODLIGHT PLACEMENT, THE CONTRACTOR AND THE ENGINEER SHALL DRIVE THROUGH THE WORK SITE EACH NIGHT WHEN THE LIGHTING IS IN PLACE AND OPERATIVE PRIOR TO COMMENCING ANY WORK. IF GLARE IS DETECTED, THE LIGHT PLACEMENT AND SHEILDING SHALL BE ADJUSTED TO THE SATISFACTION OF THE ENGINEER BEFORE WORK PROCEEDS.

PAYMENT FOR ALL LABOR, EQUIPMENT AND MATERIALS SHALL BE INCLUDED IN THE LUMP SUM CONTRACT PRICE FOR ITEM 614, MAINTAINING TRAFFIC, AS PER PLAN.

## WORK ZONE INCREASED PENALTIES SIGN (R11-H5A)

R11-H5A-48 SIGNS SHALL BE FURNISHED, ERECTED, AND MAINTAINED IN GOOD CONDITION AND/OR REPLACED AS NECESSARY AND SUBSEQUENTLY REMOVED BY THE CONTRACTOR. SIGNS SHALL BE MOUNTED AT THE APPROPRIATE OFFSETS AND ELEVATIONS AS PRESCRIBED BY THE OHIO MANUAL OF UNIFORM TRAFFIC CONTROL DEVICES. THEY SHALL BE MAINTAINED ON SUPPORTS MEETING CURRENT SAFETY CRITERIA.

THE SIGNS MAY BE ERECTED OR UNCOVERED NO MORE THAN FOUR HOURS BEFORE THE ACTUAL START OF WORK. THE SIGNS SHALL BE REMOVED OR COVERED NO LATER THAN FOUR HOURS FOLLOWING RESTORATION OF ALL LANES TO TRAFFIC WITH NO RESTRICTIONS, OR SOONER AS DIRECTED BY THE ENGINEER. TEMPORARY SIGN COVERING AND UNCOVERING DUE TO TEMPORARY LANE RESTORATIONS SHALL BE GUIDED BY THE FOUR-HOUR LIMITATIONS STATED ABOVE. SUCH LANE RESTORATIONS SHOULD BE EXPECTED TO REMAIN IN EFFECT FOR 30 OR MORE CONSECUTIVE CALENDAR DAYS, SUCH AS DURING WINTER SHUT-DOWNS.

THE SIGNS ON THE MAINLINE SHALL BE DUAL MOUNTED UNLESS NOT PHYSICALLY POSSIBLE. THE FIRST SIGN SHALL BE PLACED BETWEEN THE ROAD WORK AHEAD (W20-1) SIGN AND THE NEXT SIGN IN THE SEQUENCE. SIGNS SHALL BE ERECTED ON EACH ENTRANCE RAMP AND EVERY 2 MILES THROUGH THE CONSTRUCTION WORK LIMITS. SIGNS ON THE MAINLINE SHALL BE R11-H5A-48. SIGNS USED ON THE RAMPS SHALL BE R11-H5A-24. R11-H5A-24 SIGNS MAY BE USED IN THE MEDIAN IN LIEU OF R11-H5A-48 SIGNS IF IT IS NOT PHYSICALLY POSSIBLE TO PROVIDE R11-H5A-48 SIGNS IN THE MEDIAN.

THE R11-H5A-48 SIGNS SHALL BE MOUNTED ON 2 NO. 3 POSTS WHEN LOCATED WITHIN CLEAR ZONES.

THE CONTRACTOR MAY USE SIGNS AND SUPPORTS IN USED, BUT GOOD, CONDITION PROVIDED THE SIGNS MEET CURRENT ODOT SPECIFICATIONS. SIGN FACES SHALL BE RETROREFLECTORIZED WITH TYPE G SHEETING COMPLYING WITH THE REQUIREMENTS OF C&MS 730.19.

WORK ZONE INCREASED PENALTIES SIGNS AND SUPPORTS WILL BE MEASURED AS THE NUMBER OF SIGN INSTALLATIONS, INCLUDING THE SIGN AND NECESSARY SUPPORTS. IF A SIGN AND SUPPORT COMBINATION IS REMOVED AND REERECTED AT ANOTHER LOCATION AS DIRECTED BY THE ENGINEER, IT SHALL BE CONSIDERED ANOTHER UNIT.

PAYMENT FOR ACCEPTED QUANTITIES, COMPLETE, IN PLACE WILL BE MADE AT THE CONTRACT UNIT PRICE. PAYMENT SHALL BE FULL COMPENSATION FOR ALL MATERIALS, LABOR, INCIDENTALS AND EQUIPMENT FOR FURNISHING, ERECTING, MAINTAINING, COVERING DURING SUSPENSION OF WORK, AND REMOVAL OF THE SIGN AND SUPPORT.

ITEM 614, WORK ZONE INCREASED PENALTIES SIGN 18 EACH

DESIGN AGENCY

NOTES

**TRAFFIC** 

0

**MAINTENANCE** 



esigner **GLI** 

REVIEWER MPB 9/11/25

116665 T TOTAL

P.4 TOTAL 9

ROJECT ID

# ITEM 614, PORTABLE CHANGEABLE MESSAGE SIGNS, AS PER PLAN

THE CONTRACTOR SHALL FURNISH, INSTALL, MAINTAIN AND REMOVE. WHEN NO LONGER NEEDED. A CHANGEABLE MESSAGE SIGN. THE SIGN SHALL BE OF A TYPE SHOWN ON A LIST OF APPROVED PCMS UNITS AVAILABLE ON THE OFFICE OF MATERIALS MANAGEMENT WEB PAGE.

EACH SIGN SHALL BE TRAILER-MOUNTED AND EQUIPPED WITH A FUNCTIONAL DIMMING MECHANISM, TO DIM THE SIGN DURING DARKNESS, AND A TAMPER AND VANDAL PROOF ENCLOSURE. EACH SIGN SHALL BE PROVIDED WITH APPROPRIATE TRAINING AND OPERATION INSTRUCTIONS TO ENABLE ON-SITE PERSONNEL TO OPERATE AND TROUBLESHOOT THE UNIT. THE SIGN SHALL ALSO BE CAPABLE OF BEING POWERED BY AN ELECTRICAL SERVICE DROP FROM A LOCAL UTILITY COMPANY. THE PCMS SHALL BE DELINEATED IN ACCORDANCE WITH C&MS 614.03.

PLACEMENT, OPERATION, MAINTENANCE AND ALL ACTIVATION OF THE SIGNS BY THE CONTRACTOR SHALL BE AS DIRECTED BY THE ENGINEER. THE PCMS SHALL BE LOCATED IN A HIGHLY VISIBLE POSITION YET PROTECTED FROM TRAFFIC. THE CONTRACTOR SHALL. AT THE DIRECTION OF THE ENGINEER. RELOCATE THE PCMS TO IMPROVE VISIBILITY OR ACCOMMODATE CHANGED CONDITIONS. WHEN NOT IN USE, THE PCMS SHALL BE TURNED OFF. ADDITIONALLY WHEN NOT IN USE, FOR EXTENDED PERIODS OF TIME. THE PCMS SHALL BE TURNED AWAY FROM ALL TRAFFIC.

THE ENGINEER SHALL BE PROVIDED ACCESS TO EACH SIGN UNIT AND SHALL BE PROVIDED WITH APPROPRIATE TRAINING AND OPERATION INSTRUCTIONS TO ENABLE ODOT PERSONNEL TO OPERATE AND TROUBLESHOOT THE UNIT, AND TO REVISE SIGN MESSAGES. IF NECESSARY.

ALL MESSAGES TO BE DISPLAYED ON THE SIGN WILL BE PROVIDED BY THE ENGINEER. THE SIGN SHALL HAVE THE CAPABILTY TO STORE UP TO 99 MESSAGES. MESSAGE MEMORY OR PRE-PROGRAMMED DISPLAYS SHALL NOT BE LOST AS A RESULT OF POWER FAILURES TO THE ON-BOARD COMPUTER. THE SIGN LEGEND SHALL BE CAPABLE OF BEING CHANGED IN THE FIELD. THREE-LINE PRESENTATION FORMATS WITH UP TO SIX MESSAGE PHASES SHALL BE SUPPORTED. PCMS FORMAT SHALL PERMIT THE COMPLETE MESSAGE FOR EACH PHASE TO BE READ AT LEAST TWICE.

THE PCMS SHALL CONTAIN AN ACCURATE CLOCK AND PROGRAMMING LOGIC WHICH WILL ALLOW THE SIGN TO BE ACTIVATED. DEACTIVATED OR MESSAGES CHANGED AUTOMATICALLY AT DIFFERENT TIMES OF THE DAY FOR DIFFERENT DAYS OF THE WEEK.

THE PCMS UNIT SHALL BE MAINTAINED IN GOOD WORKING ORDER BY THE CONTRACTOR IN ACCORDANCE WITH THE PROVISIONS OF C&MS 614.07. THE CONTRACTOR SHALL, PRIOR TO ACTIVATING THE UNIT, MAKE ARRANGEMENTS, WITH AN AUTHORIZED SERVICE AGENT FOR THE PCMS. TO ASSURE PROMPT SERVICE IN THE EVENT OF FAILURE. ANY FAILURE SHALL NOT RESULT IN THE SIGN BEING OUT OF SERVICE FOR MORE THAN 12 HOURS, INCLUDING WEEKENDS, FAILURE TO COMPLY MAY RESULT IN AN ORDER TO STOP WORK AND OPEN ALL TRAFFIC LANES AND/OR IN THE DEPARTMENT TAKING APPROPRIATE ACTION TO SAFELY CONTROL TRAFFIC. THE ENTIRE COST TO CONTROL TRAFFIC, ACCRUED BY THE DEPARTMENT DUE TO THE CONTRACTOR'S NONCOMPLIANCE, WILL BE DEDUCTED FROM MONEYS DUE, OR TO BECOME DUE THE CONTRACTOR ON HIS CONTRACT.

THE CONTRACTOR SHALL BE RESPONSIBLE FOR 24-HOUR-PER-DAY OPERATION AND MAINTENANCE OF THESE SIGNS ON THE PROJECT FOR THE DURATION OF THE PHASES WHEN THE PLAN REQUIRES THEIR USE.

PAYMENT FOR THE ABOVE DESCRIBED ITEM SHALL BE AT THE CONTRACT UNIT PRICE. PAYMENT SHALL INCLUDE ALL LABOR, MATERIALS, EQUIPMENT, FUELS, LUBRICATING OILS, SOFTWARE, HARDWARE AND INCIDENTALS TO PERFORM THE ABOVE DESCRIBED WORK.

ITEM 614. PORTABLE CHANGEABLE MESSAGE SIGN, AS PER PLAN. 12 SIGN MONTH

ASSUMING 4 PCMS SIGNS FOR 3 MONTHS (LANE CLOSURES)

# ITEM 614, REPLACEMENT DRUM

DRUMS FURNISHED BY THE CONTRACTOR IN ACCORDANCE WITH THE REQUIREMENTS OF THE PLANS, SPECIFICATIONS AND PROPOSAL WHICH BECOME DAMAGED BY TRAFFIC FOR REASONS BEYOND THE CONTROL OF THE CONTRACTOR SHALL BE REPLACED IN KIND WHEN ORDERED BY THE ENGINEER. REPLACEMENT DRUMS SHALL BE NEW.

PAYMENT FOR THE NEW DRUMS SHALL BE MADE AT THE CONTRACT PRICE PER EACH FOR ITEM 614. REPLACEMENT DRUM. AND SHALL INCLUDE THE COST OF REMOVING AND DISPOSING OF THE DAMAGED DRUM, AND PROVIDING AND MAINTAINING THE REPLACEMENT DRUM IN ACCORDANCE WITH THE CONTRACT REQUIREMENTS FOR THE ORIGINAL DRUM.

AN ESTIMATED QUANTITY OF 50 EACH HAS BEEN PROVIDED IN THE GENERAL SUMMARY.

#### ITEM 614, REPLACEMENT SIGN

FLATSHEET SIGNS FURNISHED BY THE CONTRACTOR IN ACCORDANCE WITH THE REQUIREMENTS OF THE PLANS. SPECIFICATIONS AND PROPOSAL WHICH BECOME DAMAGED BY TRAFFIC FOR REASONS BEYOND THE CONTROL OF THE CONTRACTOR SHALL BE REPLACED IN KIND WHEN ORDERED BY THE ENGINEER. REPLACEMENT SIGNS SHALL BE NEW. OTHER MATERIALS MAY BE IN USED. BUT GOOD. CONDITION SUBJECT TO APPROVAL BY THE ENGINEER.

PAYMENT FOR THE NEW SIGNS SHALL BE MADE AT THE CONTRACT PRICE PER EACH FOR ITEM 614. REPLACEMENT SIGN, AND SHALL INCLUDE THE COST OF REMOVING AND DISPOSING OF DAMAGED SIGNS, HARDWARE AND SUPPORTS, AND PROVIDING THE NECESSARY REPLACEMENT HARDWARE. SUPPORTS. ETC.

AN ESTIMATED QUANTITY OF 5 EACH HAS BEEN PROVIDED IN THE GENERAL SUMMARY.

# ITEM 617 COMPACTED AGGREGATE, AS PER PLAN

THIS ITEM SHALL MEET ALL REQUIREMENTS FOR ITEM 617 COMPACTED AGGREGATE WITH THE FOLLOWING EXCEPTION:

1) NO RECYCLED ASPHALT CONCRETE PAVEMENT SHALL BE USED IN THIS ITEM

ALL COSTS ASSOCIATED WITH THE EQUIPMENT, LABOR, AND MATERIALS NECCESARY FOR SUPPLYING AND PLACING THIS ITEM SHALL BE INCLUDED IN THE PRICE BID PER CUBIC YARD FOR ITEM 617 COMPACTED AGGREGATE, AS PER PLAN.

THIS ITEM SHALL BE PLACED ON LEFT HAND SHOULDERS IN BOTH EASTBOUND AND WESTBOUND DIRECTIONS TO ELIMINATE MOT SAFETY CONCERNS WHILE TRAFFIC IS DRIVING NEAR THE EDGE OF PAVEMENT. SEE TYPICAL SECTION ON SHEET 8.

# NOTIFICATION OF TRAFFIC RESTRICTIONS

THROUGHOUT THE DURATION OF THE PROJECT. THE CONTRACTOR SHALL NOTIFY THE PROJECT ENGINEER IN WRITING OF ALL TRAFFIC RESTRICTIONS AND UPCOMING MAINTENANCE OF TRAFFIC CHANGES. THE CONTRACTOR SHALL ENSURE THE WRITTEN NOTIFICATION IS SUBMITTED IN A TIMELY MANNER TO ALLOW THE PROJECT ENGINEER TO MEET THE REQUIRED TIME FRAMES SET FORTH IN THE TABLE BELOW TO INFORM THE SPECIAL HAULING PERMITS SECTION (HAULING.PERMITS@DOT.OHIO.GOV) AND THE DISTRICT PUBLIC INFORMATION OFFICE (PIO). THIS NOTIFICATION SHALL BE RECEIVED BY THE PROJECT ENGINEER PRIOR TO THE PHYSICAL SETUP OF ANY APPLICABLE SIGNS OR MESSAGE BOARDS.

INFORMATION SHOULD INCLUDE, BUT IS NOT LIMITED TO, ALL CONSTRUCTION ACTIVITIES THAT IMPACT OR INTERFERE WITH TRAFFIC AND SHALL LIST THE SPECIFIC LOCATION, TYPE OF WORK, ROAD STATUS, DATE AND TIME OF RESTRICTION, DURATION OF RESTRICTION. NUMBER OF LANES MAINTAINED. NUMBER OF LANES CLOSED. MINIMUM VERTICAL CLEARANCE. MINIMUM WIDTH OF DRIVABLE PAVEMENT. DETOUR ROUTES. IF APPLICABLE. AND ANY OTHER INFORMATION REQUESTED BY THE PROJECT ENGINEER.

NOTIFICATION OF TR	AFFIC RESTRICTI	ONS TIME TABLE
ITEM	<b>DURATION OF</b>	NOTICE DUE TO
	CLOSURE	PERMITS & PIO
RAMP &	>= 2 <i>WEEK</i> S	21 CALENDAR DAYS
ROAD CLOSURES		PRIOR TO CLOSURE
	> 12 HOURS	14 CALENDAR DAYS
	& < 2 WEEKS	PRIOR TO CLOSURE
	<= 12 HOURS	4 CALENDAR DAYS
		PRIOR TO CLOSURE
LANE	>= 2 WEEKS	14 CALENDAR DAYS
CLOSURES &		PRIOR TO CLOSURE
RESTRICTIONS	< 2 WEEKS	5 BUSINESS DAYS
		PRIOR TO CLOSURE
START OF	N/A	14 CALENDAR DAYS
CONSTRUCTION &		PRIOR TO
TRAFFIC PATTERN CHANGES		IMPLEMENTATION

ANY UNFORESEEN CONDITIONS NOT SPECIFIED IN THE PLANS REQUIRING TRAFFIC RESTRICTIONS SHALL ALSO BE REPORTED TO THE PROJECT ENGINEER USING THE NOTIFICATION TIME TABLE.

# ITEM 614, MAINTAINING TRAFFIC (LANES OPEN DURING HOLIDAYS OR SPECIAL EVENTS)

NO WORK SHALL BE PERFORMED AND ALL EXISTING LANES SHALL BE OPEN TO TRAFFIC DURING THE FOLLOWING DESIGNATED HOLIDAYS OR SPECIAL EVENTS:

NEW YEAR'S (OBSERVED) GENERAL/REGULAR ELECTION DAY ((NOV) (OTHER HOLIDAY OR SPECIAL EVENT) THANKSGIVING MEMORIAL DAY CHRISTMAS (OBSERVED)

FOURTH OF JULY (OBSERVED)

LABOR DAY

THE PERIOD OF TIME THAT THE LANES ARE TO BE OPEN DEPENDS ON THE DAY OF THE WEEK ON WHICH THE HOLIDAY OR SPECIAL EVENT FALLS. THE FOLLOWING SCHEDULE SHALL BE USED TO DETERMINE THIS PERIOD:

DAY OF HOLIDAY TIME ALL LANES

OR SPECIAL EVENT MUST BE OPEN TO TRAFFIC

SUNDAY 12:00N FRIDAY THROUGH 6:00 AM MONDAY MONDAY 12:00N FRIDAY THROUGH 6:00 AM TUESDAY TUESDAY 12:00N MONDAY THROUGH 6:00 AM WEDNESDAY

5:00 AM TUESDAY THROUGH 12:00 AM WEDNESDAY WEDNESDAY 12:00N TUESDAY THROUGH 6:00 AM THURSDAY THURSDAY 12:00N WEDNESDAY THROUGH 6:00 AM FRIDAY

THURSDAY (THANKSGIVING ONLY)

TUESDAY (GEN./REG. ELECTION)

6:00 AM WEDNESDAY THROUGH 6:00 AM MONDAY 12:00N THURSDAY THROUGH 6:00 AM MONDAY SATURDAY 12:00N FRIDAY THROUGH 6:00 AM MONDAY

DURING THE SAME PERIODS, MAINTAIN PEDESTRAIN ACCESS IF PEDESTRIAN ACCESS WAS PRESENT PRIOR TO CONSTRUCTION.

[NEWLY CONSTRUCTED LANE ADDITIONS, ONCE COMPLETED AND INITIALLY OPENED TO TRAFFIC, SHALL BE OPEN TO TRAFFIC DURING ALL SUBSEQUENT DESIGNATED HOLIDAYS AND SPECIAL EVENTS, AND RELATED PERIODS OF TIME, SPECIFIED ABOVE.]

SHOULD THE CONTRACTOR FAIL TO MEET ANY OF THESE REQUIREMENTS, THE CONTRACTOR SHALL BE ASSESSED A DISINCENTIVE PER THE LANE *VALUE CONTRACT (PN 127).* 

ESIGN AGENCY

**I**ON

FFIC

TRAI

0

**MAINTENANCE** 



ESIGNER GLI

REVIEWER MPB 9/11/25 ROJECT ID

116665

P.5 9

SHEET NUMBER										PART.	ITEM		GRAND	UNIT	DESCRIPTION	SEE SHEET		
	3	4	5	6	8							01/NHS	11211	EXT	TOTAL	ONT	DESCRIT TION	NO.
																	ROADWAY	
																	NOADWAT	
					11,914 26,186							11,914 26,186	255 255	11001 20000	11,914 26,186	SY ET	FULL DEPTH PAVEMENT REMOVAL AND RIGID REPLACEMENT, TYPE 1, CLASS QC1, AS PER PLAN FULL DEPTH PAVEMENT SAWING	3
					82							82	256	10000	82	SF	BONDED PATCHING OF PORTLAND CEMENT CONCRETE PAVEMENT, TYPE A	
																	EDOCIONI CONITROL	
																	EROSION CONTROL	
	1,000											1,000	832	30000	1,000	EACH	EROSION CONTROL	
								1	-		+						PAVEMENT	+
	983				742							742 983	423 SPECIAL	00150 69098000	742	1	CRACK SEALING, TYPE IV  MISC:: INSTALLATION OF DEFORMED BAR	3
	363			3	2,420	YYYYY	XXXXX	· · · · · · · · · · · · · · · · · · ·	****	CYYYYY	YYYYY	2,420	617	10101	2,420		COMPACTED AGGREGATE, AS PER PLAN	5
				4	····	uu	····		m			uu	uuu					
								~~~~	~~~~				~~~~			~~~~	TRAFFIC CONTROL	
					1.69				, , , , ,			1.69	807	10010	1.69	MILE	WET REFLECTIVE TRAFFIC PAINT, EDGE LINE, 6"	
					1.69				_	_	_	1.69	807	10110	1.69 3.38		WET REFLECTIVE TRAFFIC PAINT, LANE LINE, 6"	
				(	3.38			······			·····	3.38	850	20010			GROOVING FOR 6" RECESSED PAVEMENT MARKING, (CONCRETE)	
																	MAINTENANCE OF TRAFFIC	
		600									-	600	614	11110	600)	HOUR	LAW ENFORCEMENT OFFICER WITH PATROL CAR FOR ASSISTANCE	
		000 3	5									5	614	12500	( 000 <u>)</u>		REPLACEMENT SIGN	
			50									50	614	12600	50		REPLACEMENT DRUM	
		18	12									12 18	614 614	18600 12484	12 18		PORTABLE CHANGEABLE MESSAGE SIGN  WORK ZONE INCREASED PENALTIES SIGN	4
		10										10	014	12404	10	LACIT	WORK ZONE INCREASED FENALITES SIGN	
				56								56	808	18700	56	SNMT	DIGITAL SPEED LIMIT (DSL) SIGN ASSEMBLY	6
																	INCIDENTALS	
												LS LS	614 624	11001 10000	LS LS		MAINTAINING TRAFFIC, AS PER PLAN MOBILIZATION	6
								<u> </u>										<b>_</b>
							1				1							
											-							
											_							
					-						1	1	-		-			
					1		1		+		+	1	1		1			<del></del>
					ļ						ļ							
											_							
					1				-		+	1						+
					1		1		+		1	1	<u> </u>					+
					-						1	1	-		-			
						Í		1	1							ļ		

	Compacted	Reflective Traffic Paint, Edge Line, 6"	•	•	Pavement  Marking  (Concrete)	
7	3" AVG. TH.					3
ک	CY	MILE	MILE	MILE	MILE	3
2		YELLOW	WHITE			1
	1210	0.09	0.70	0.79	1.59	7
للما	1210	0.20	0.48	0.68	1.35	
7						$\overrightarrow{A}$
2		0.04	0.18	0.22	0.44	3
	2420	0.34	1.35	1.69	3.38	3
	2420	0.34	1.35	1.69	3.38	3
		3 CRACK SEALING				3

850

**Grooving For** 

6" Recessed


NOTE: ITEM 423 CRACK SEALING SHALL BE APPLIED TO CRACKS REPAIRED WITH ITEM SPECIAL, 69098000, MISC.: INSTALLATION OF DEFORMED BAR

807

Wet

Wet

Wet

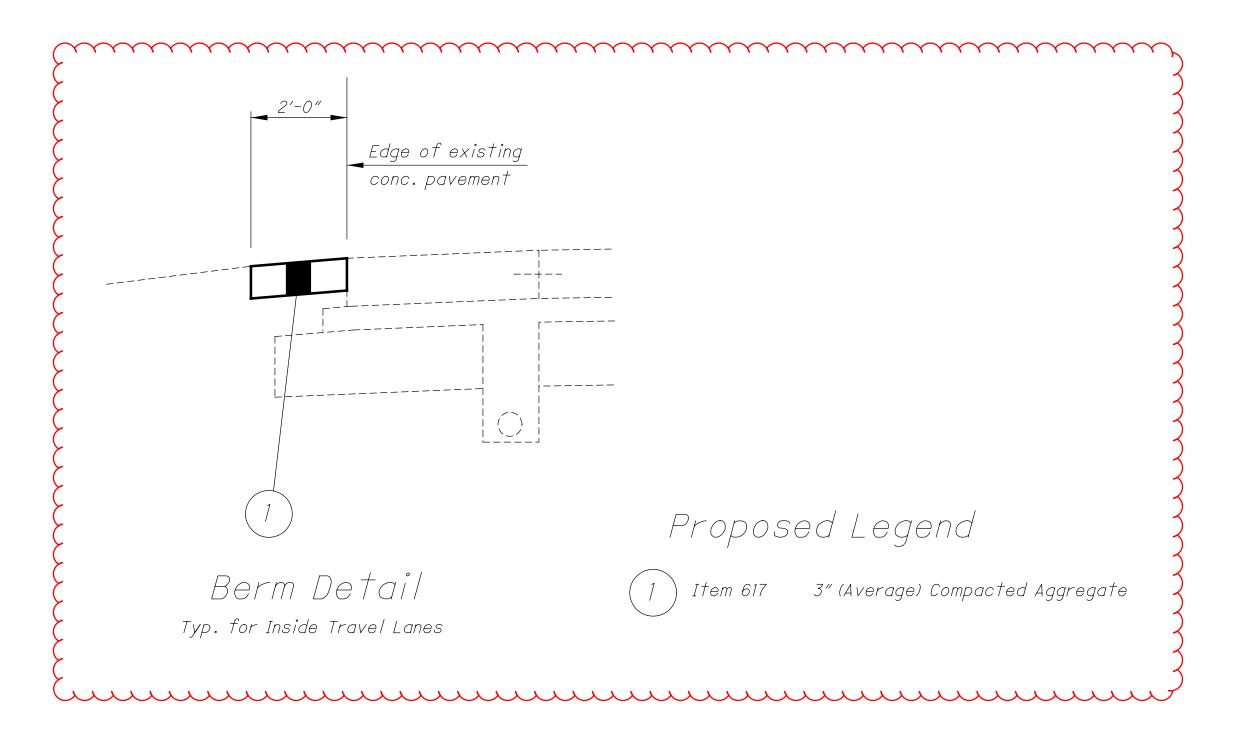

No. of Repair Locations

Slab

Section of

Ramp or

Roadway

MAINLINE

MAINLINE

SUBTOTALS (01/NHS/05)

TOTALS (CARRIED TO SHEET 7)

Location

PAULDING US 24 EB

(SLM 0.00 TO SLM 12.376)

PAULDING US 24 WB

(SLM 0.00 TO SLM 12.376)

CONTINGENCY

1-24-0.00

epth Locations -Replacements

219

150

43

**Bonded Patch Locations** 

18

3

255

Full Depth

Pavement Sawing

Repair

FT

5472

1646

1068

Slab

Repair

FT

7840

7812

2348

18000

26186

256

of PCC Pavement

Type A

SF

49

22

11

82

82

255 (FULL DEPTH REPAIR)

Full Depth Pavement Removal and

Plan

12" THICK +/-

SY

1229

392

243

1864

1864

Bonded Patching Rigid Replacement, Class QC1, As Per

255 (FULL SLAB REPLACEMENT)

Full Depth Pavement Removal and

Rigid Replacement, Class QC1, As Per

Plan

12" THICK +/-

SY

4363

4376

1311

10050

10050

423

LB

625

20

97

742

742

617

DESIGN AGENCY



DESIGNER ISR REVIEWER MPB 9/11/25

PROJECT ID 116665

P.8 9