



PIC-56-(15.48) (19.61), PIC-22-18.28

MODEL: 106262\_G1001 PAPER SIZE: 34x22 (in.) DATE: 1/17/2024 TIME: 8:59:09 AM USER: ahallow1  
 p:\ohio\dot-pw-bentley.com\ohio\dot-pw-02\Documents\01 Active Projects\District 06\Pickaway\106262\400-Engineering\Roadway\Sheets\106262\_G1001.dgn

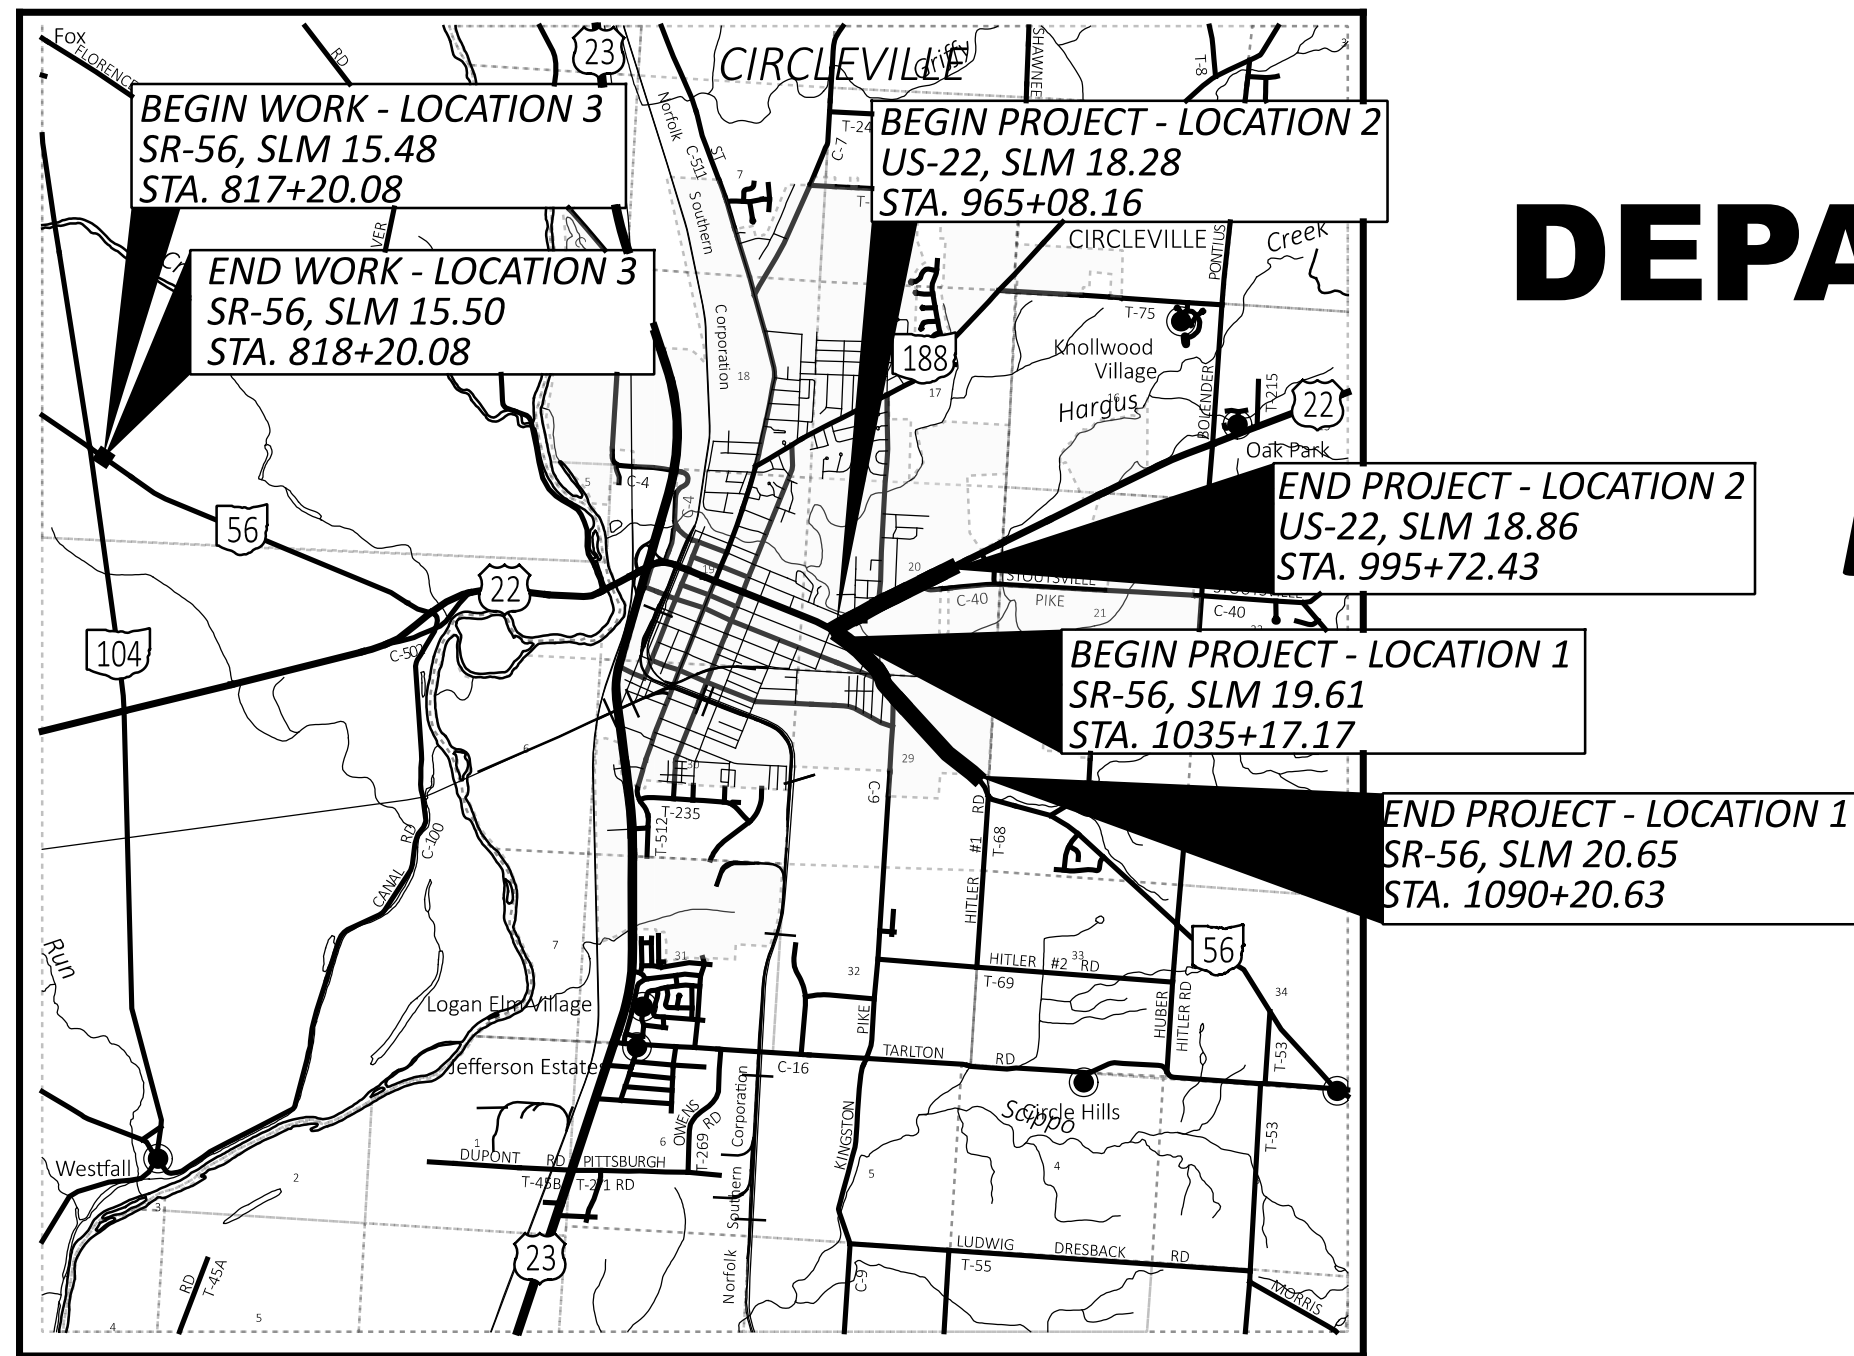

LOCATION MAP

LATITUDE: 39°35'54" LONGITUDE: 82°56'1"

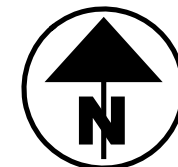

PORTION TO BE IMPROVED	—————
INTERSTATE HIGHWAY	=====
FEDERAL ROUTES	=====
STATE ROUTES	=====
COUNTY & TOWNSHIP ROADS	=====
OTHER ROADS	—————

**DESIGN DESIGNATION**

	SR-56 (LOCATION 1)	US-22 (LOCATION 2)	SR-56 (LOCATION 3)
CURRENT ADT (2024)	9,100	8,000	2,700
DESIGN YEAR ADT (2036)	9,100	9,700	3,300
DESIGN HOURLY VOLUME (2036)	1,100	1,200	500
DIRECTIONAL DISTRIBUTION	67%	69%	58%
TRUCKS (24 HOUR B&C)	6%	5%	11%
DESIGN SPEED	35 MPH	35 MPH	55 MPH
LEGAL SPEED	35 MPH	35 MPH	55 MPH
DESIGN FUNCTIONAL CLASSIFICATION:	05 MAJOR COLLECTOR (URBAN)	05 MINOR ARTERIAL (URBAN)	05 MAJOR COLLECTOR (RURAL)
NHS PROJECT	NO	NO	NO

**DESIGN EXCEPTIONS**

NONE REQUIRED

**ADA DESIGN WAIVERS**

NONE REQUIRED

**UNDERGROUND UTILITIES**  
 Contact Two Working Days Before You Dig


**OHIO811.org**  
 Before You Dig

OHIO811, 8-1-1, or 1-800-362-2764  
 (Non members must be called directly)

PLAN PREPARED BY:



ENGINEER'S SEAL

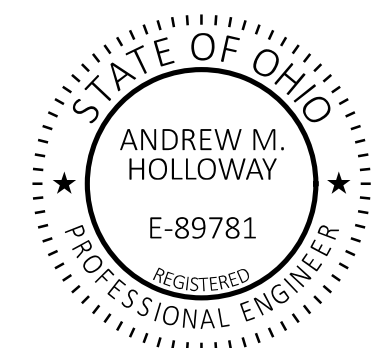

STANDARD CONSTRUCTION DRAWINGS						SUPPLEMENTAL SPECIFICATIONS	
BP-3.1	01/21/22	MT-95.60	04/19/19	TC-41.20	10/18/13	800	10/20/23
		MT-95.61	04/19/19	TC-42.20	10/18/13	821	04/20/12
		MT-97.10	04/19/19	TC-52.10	10/18/13	831	04/21/23
		MT-97.12	01/20/17	TC-52.20	01/15/21	832	07/21/23
		MT-99.20	04/19/19	TC-65.10	01/17/14	878	01/21/12
		MT-101.60	04/21/23	TC-65.11	07/15/22	921	04/20/12
		MT-101.90	07/17/20	TC-71.10	04/21/23		
		MT-105.10	01/17/20	TC-74.10	07/21/23		

**INDEX OF SHEETS:**

TITLE	P.1
SCHEMATIC PLAN	P.2 - P.3
TYPICAL SECTIONS	P.4 - P.5
TYPICAL DETAILS	P.6 - P.7
GENERAL NOTES	P.8 - P.9
MAINTENANCE OF TRAFFIC NOTES	P.10 - P.12
MAINTENANCE OF TRAFFIC PLAN	P.13
GENERAL SUMMARY	P.14 - P.15
PAVEMENT SUBSUMMARY	P.16 - P.18
PLAN SUBSUMMARY	P.19
ROADWAY PLAN - SR-56 (LOCATION 1)	P.20 - P.25
ROADWAY PLAN - US-22 (LOCATION 2)	P.26 - P.29
ROADWAY PLAN - SR-56 (LOCATION 3)	P.30
TRAFFIC CONTROL SUBSUMMARY	P.31
STRUCTURES (OVER 20 FOOT SPAN)	P.32
GEOTECHNICAL DATA	P.33 - P.42

PIC-56-(15.48) (19.61), PIC-22-18.28

**STATE OF OHIO**  
**DEPARTMENT OF TRANSPORTATION**  
**PIC-56-(15.48) (19.61),**  
**PIC-22-18.28**  
 CITY OF CIRCLEVILLE  
 JACKSON AND CIRCLEVILLE TOWNSHIPS  
 PICKAWAY COUNTY

**FEDERAL PROJECT NUMBER**

E191(769)

**RAILROAD INVOLVEMENT**

NONE

**PROJECT DESCRIPTION**

RESURFACING OF 1.04 MILES OF SR-56 IN THE CITY OF CIRCLEVILLE FROM SLM 19.61 TO 20.65. RESURFACING OF 0.51 MILES OF US-22 IN THE CITY OF CIRCLEVILLE FROM SLM 18.28 TO SLM 18.86.

GEOTECHNICAL REPAIR AND FULL-DEPTH PAVEMENT REPLACEMENT OF 0.02 MILES OF SR-56 FROM SLM 15.48 TO 15.50.

**EARTH DISTURBED AREAS**

PROJECT EARTH DISTURBED AREA:	0.06 ACRES
ESTIMATED CONTRACTOR EARTH DISTURBED AREA:	0.00 ACRES
NOTICE OF INTENT EARTH DISTURBED AREA:	N/A (NOI NOT REQUIRED)

**2023 SPECIFICATIONS**

THE STANDARD SPECIFICATIONS OF THE STATE OF OHIO, DEPARTMENT OF TRANSPORTATION, INCLUDING SUPPLEMENTAL SPECIFICATIONS LISTED IN THE PLANS AND CHANGES LISTED IN THE PROPOSAL SHALL GOVERN THIS IMPROVEMENT.

I HEREBY APPROVE THESE PLANS AND DECLARE THAT THE MAKING OF THIS IMPROVEMENT WILL REQUIRE THE PART TIME CLOSING OF THE HIGHWAY TO TRAFFIC, AS NOTED ON SHEET P.13. DURING WHICH TIME DETOURS WILL BE PROVIDED AS SHOWN HEREIN. PROVISIONS FOR THE MAINTENANCE AND SAFETY OF TRAFFIC WILL BE AS SET FORTH ON THE PLANS AND ESTIMATES.

*Anthony C. Turowski*  
 Anthony C. Turowski, P.E.  
 District 06 Deputy Director

*Jack Marchbanks*  
 Jack Marchbanks, PhD  
 Director, Department of Transportation

PID #106262 PIC-56-(15.48) (19.61), PIC-22-18.28

DESIGN AGENCY



DESIGNER  
 AMH

REVIEWER  
 DR 10/11/23

PROJECT ID  
 106262

SHEET TOTAL  
 P.1 P.42

**MANHOLES AND OTHER CASTING STRUCTURES:**

THE CASTING TOPS OF MANHOLES, VALVE BOXES, AND OTHER STRUCTURES OWNED BY PUBLIC SERVICE CORPORATIONS MAY BE ADJUSTED TO GRADE BY THEIR RESPECTIVE OWNERS OR GIVE AUTHORIZATION TO ODOT TO ADJUST AS PART OF THIS CONTRACT. THIS WORK NEEDS TO BE COMPLETED PRIOR TO THE CONSTRUCTION OF THE SURFACE COURSE. THE CONTRACTOR SHALL NOTIFY SUCH PUBLIC SERVICE CORPORATIONS A MINIMUM OF 7 CALENDAR DAYS IN ADVANCE OF WORK OPERATIONS SO THAT WORK MAY BE PROPERLY SCHEDULED.

THE CASTING TOPS OF MANHOLES, VALVE BOXES, AND OTHER STRUCTURES REQUIRING ADJUSTMENT THAT ARE OWNED BY PRIVATE UTILITIES NEED TO BE ADJUSTED TO GRADE BY THEIR RESPECTIVE OWNERS. THE ODOT CONTRACTOR SHALL NOTIFY THE PRIVATE OWNER A MINIMUM OF 7 CALENDAR DAYS IN ADVANCE OF WORK OPERATIONS SO THE WORK MAY BE PROPERLY SCHEDULED.

IF ADJUSTMENTS HAVE NOT BEEN COMPLETED 14 CALENDAR DAYS AFTER NOTIFICATION, THE ODOT CONTRACTOR WILL NOTIFY THE ODOT PROJECT ENGINEER AND PROVIDE SPECIFIC STATION LOCATIONS AND OWNER INFORMATION. THE ODOT PROJECT ENGINEER WILL WORK WITH THE DISTRICT UTILITY COORDINATOR TO ISSUE AND OBSTRUCTION REMOVAL NOTICE WITHIN 5 DAYS OF RECEIPT WHICH WILL INFORM THE PRIVATE UTILITY TO ADJUST THE STRUCTURES AS NECESSARY OR ODOT WILL AUTHORIZE THE ODOT CONTRACTOR TO ADJUST AS NEEDED AND BILL THE OWNER OF THE FACILITY FOR THE ADJUSTMENT TO THE STRUCTURE.

SHOULD THE CONTRACTOR FAIL TO NOTIFY PUBLIC SERVICE CORPORATIONS OR PRIVATE UTILITIES OF EXISTING MANHOLES, VALVE BOXES, AND OTHER STRUCTURES THAT REQUIRE ADJUSTMENTS TO GRADE, AND COVER THESE WITH THE PROPOSED ASPHALT TREATMENT, THE CONTRACTOR WILL BE REQUIRED TO UNCOVER THE MANHOLES, VALVE BOXES, AND OTHER STRUCTURES AT THEIR OWN EXPENSE SO THAT THE NECESSARY ADJUSTMENTS CAN BE MADE. THE METHOD OF REMOVAL AND REPAIR OF THE ASPHALT SHALL MEET ALL REQUIREMENTS OF THE ODOT ENGINEER AND SHALL BE AT THE CONTRACTORS EXPENSE.

THESE ITEMS PROVIDED BELOW ARE CONTINGENCY QUANTITIES TO BE USED AS DIRECTED BY THE PROJECT ENGINEER AT VARIOUS LOCATIONS. THESE ITEMS SHALL INCLUDE THE COST OF ALL MATERIAL, LABOR, EQUIPMENT, AND HARDWARE NECESSARY TO ADJUST CASTINGS TO GRADE TO THE PROPOSED ASPHALT ELEVATION AS DIRECTED.

THE FOLLOWING QUANTITIES HAVE BEEN PROVIDED AND THE TOTALS HAVE BEEN CARRIED TO THE GENERAL SUMMARY.

- ITEM 611 – CATCH BASIN ADJUSTED TO GRADE = 4 EACH
- ITEM 611 – MANHOLE ADJUSTED TO GRADE = 4 EACH
- ITEM 638 – VALVE BOX ADJUSTED TO GRADE = 4 EACH

**ITEM 623 - CONSTRUCTION LAYOUT STAKES AND SURVEYING, AS PER PLAN:**

THIS ITEM SHALL CONSIST OF STATIONING USING 3 FT LATH STAKES. THE STAKES SHALL BE SPACED AT 200 FT INTERVALS AND SHALL EXTEND THROUGHOUT THE LENGTH OF EACH PROJECT LOCATION.

PLACEMENT OF THE STAKES SHALL BE AS DIRECTED BY THE ENGINEER. THE CONTRACTOR IS RESPONSIBLE FOR REPLACING ANY DAMAGED OR MISSING STAKES.

THIS ITEM SHALL ALSO INCLUDE ANY WORK NECESSARY FOR THE CONTRACTOR TO VERIFY EXISTING RIGHT OF WAY, AS DIRECTED BY THE PROJECT ENGINEER.

CONSTRUCTION LAYOUT STAKES, AS PER PLAN WILL BE PAID FOR AT THE CONTRACT LUMP SUM BID, WHICH SHALL BE FULL COMPENSATION FOR ALL SERVICES, MATERIALS, LABOR, EQUIPMENT, TOOLS, AND INCIDENTALS, INCLUDING THE REMOVAL, NECESSARY TO COMPLETE THIS ITEM.

**ITEM 831 - LONGITUDINAL CHANNELIZING DEVICE, AS PER PLAN:**

LONGITUDINAL CHANNELIZERS SHALL BE PROVIDED ALONG THE CENTERLINE TAPER ON US-22 AT PONTIOUS LANE AS SHOWN ON PLAN SHEET P.26. A LONGITUDINAL CHANNELIZER CONSISTS OF A COMBINATION OF VERTICAL COMPONENTS AND LONGITUDINAL BASE COMPONENTS, FIT TOGETHER TO CREATE A CONTINUOUS CHANNELIZING DEVICE, AS DETAILED BELOW. USE OF TUBULAR MARKERS, AS IDENTIFIED IN THE ODOTCD, FIGURE 6F-7, SHALL NOT QUALIFY FOR USE AS A LONGITUDINAL CHANNELIZER.

THE DESIGN OF THE LONGITUDINAL CHANNELIZER MAY VARY FROM MANUFACTURER TO MANUFACTURER. IT SHALL CONSIST OF TWO MAIN COMPONENTS - A BASE COMPONENT CONSISTING OF INTERLOCKING UNITS AND A VERTICAL REBOUNDABLE MARKER/CHANNELIZER COMPONENT. THE SHAPE OF THE VERTICAL COMPONENT MAY VARY FROM MANUFACTURER TO MANUFACTURER. THE WIDTH SHALL BE APPROXIMATELY 8" TO 9" FOR ELLIPTICAL DESIGNS AND 4" TO 6" FOR ROUND (TUBULAR) DESIGNS. THE HEIGHT OF THE VERTICAL COMPONENT SHALL BE WITHIN THE RANGE OF 36" MINIMUM TO 48" MAXIMUM.

THE VERTICAL COMPONENT SHALL BE EQUIPPED WITH RETROREFLECTIVE SHEETING OR WITH RETROREFLECTIVE STRIPES. WHERE STRIPES ARE USED, THE STRIPES SHALL CONSIST OF TWO 3" WIDE BANDS PLACED A MAXIMUM OF 2" FROM THE TOP WITH A MAXIMUM OF 6" BETWEEN THE BANDS.


THE LONGITUDINAL BASE COMPONENT SHALL BE EQUIPPED WITH REFLECTORS. THE COLOR OF THE BASE COMPONENT, INCLUDING THE ATTACHED REFLECTORS, AND OF THE RETROREFLECTIVE SHEETING OR BANDS FOR THE VERTICAL COMPONENTS SHALL BE IN CONFORMANCE WITH THE PAVEMENT MARKING COLORS ESTABLISHED IN THE OHIO MANUAL OF UNIFORM TRAFFIC CONTROL DEVICES.

THE LONGITUDINAL CHANNELIZER SHALL BE NCHRP 350 COMPLIANT. FURNISH LONGITUDINAL CHANNELIZERS FROM THE APPROVED LIST FOUND ON THE OFFICE OF MATERIALS MANAGEMENT WEBSITE. FOR INSTALLATION PROCEDURES, FOLLOW THE MANUFACTURER'S INSTRUCTIONS.

LONGITUDINAL CHANNELIZERS SHALL BE MONITORED THROUGH THE DURATION OF THE PROJECT TO DETERMINE WHETHER THERE IS SIGNIFICANT DAMAGE FROM ERRANT VEHICLES.

THE FOLLOWING QUANTITY HAS BEEN PROVIDED AND CARRIED TO THE GENERAL SUMMARY:

ITEM 831 - LONGITUDINAL CHANNELIZER = 70 FT

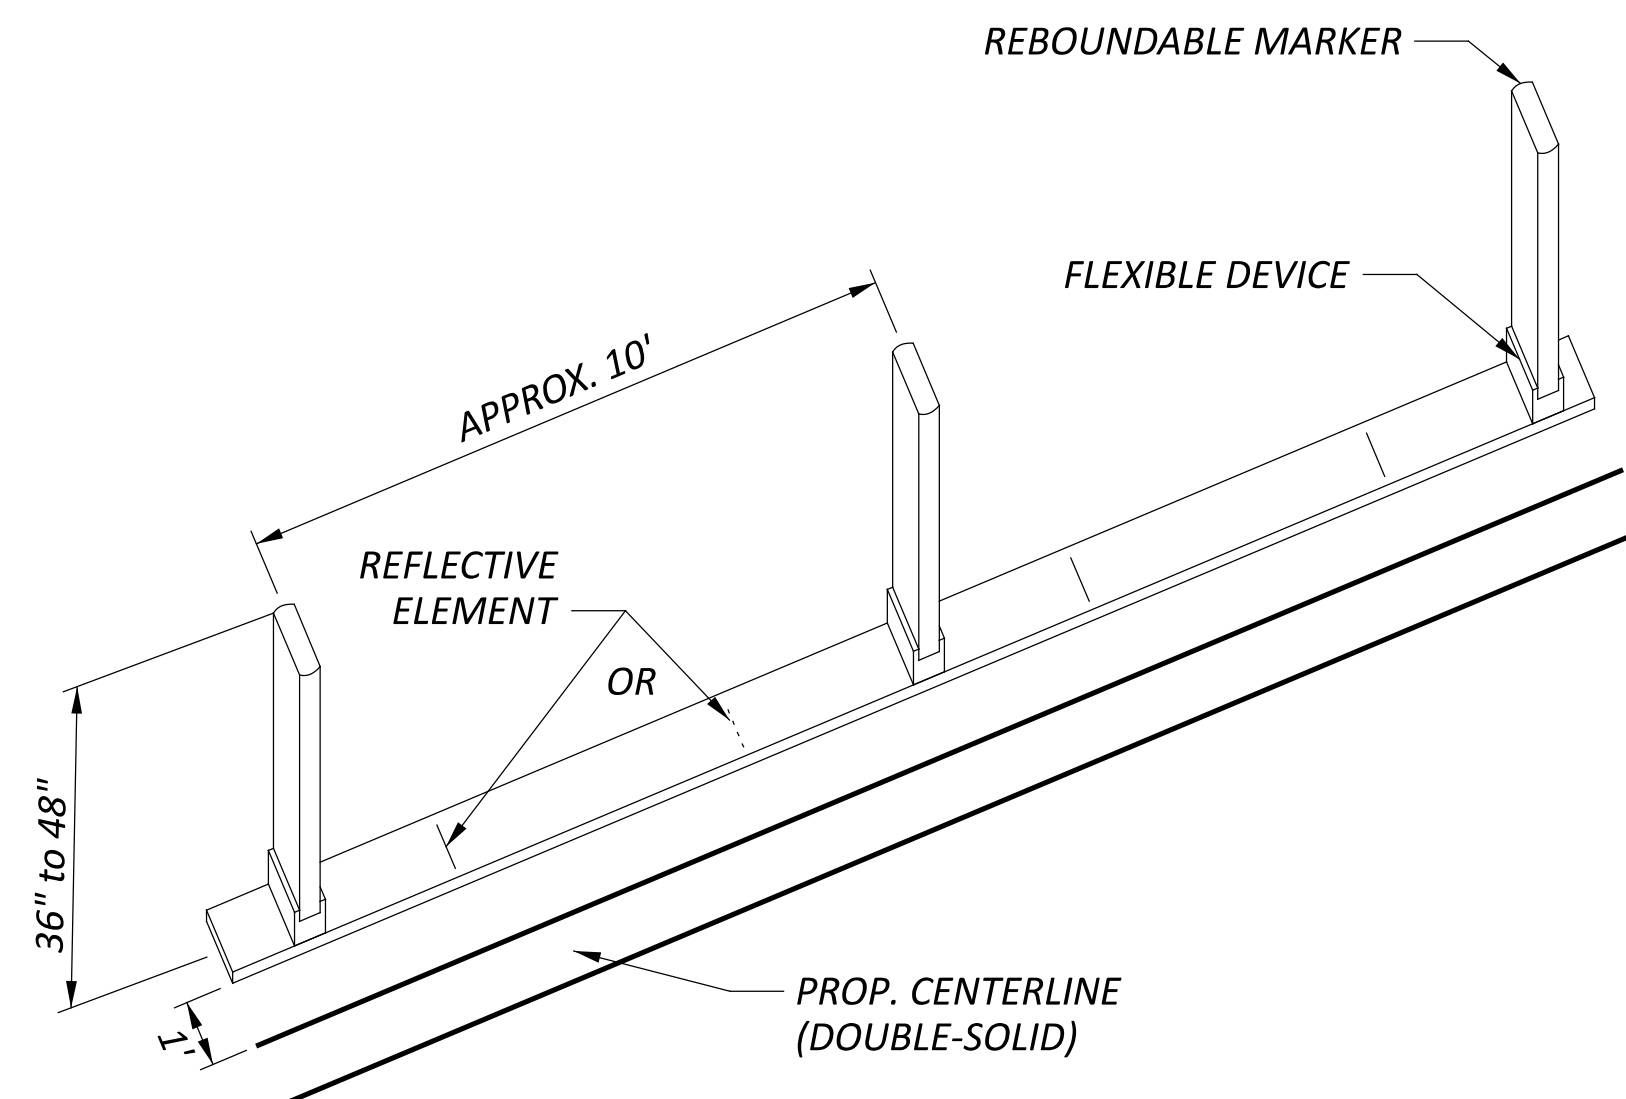

**LONGITUDINAL CHANNELIZER DETAIL**

DESIGN AGENCY



DESIGNER

AMH

REVIEWER

DR 10/11/23

PROJECT ID

106262

SHEET


P.9

TOTAL

P.42

SHEET NUMBER										PARTICIPATION			ITEM	ITEM EXT	GRAND TOTAL	UNIT	DESCRIPTION	SHEET NO.						
										01/S<2/05/COC	02/STR/44	03/55K/04												
P.9	P.10-P.12	P.16	P.17	P.18	P.19	P.31	P.32																	
			3													<b>TRAFFIC SIGNALS</b>								
			7													632	26501	3	EACH	DETECTOR LOOP, AS PER PLAN	P.8			
																632	27200	7	EACH	LOOP DETECTOR TIE IN				
							10													<b>STRUCTURE OVER 20 FOOT SPAN (PIC-22-1837 SFN:6500390)</b>				
																519	12300	10	SY	PATCHING CONCRETE BRIDGE DECK - TYPE B				
																				<b>MAINTENANCE OF TRAFFIC</b>				
	100															80	20	100	LS	LAW ENFORCEMENT OFFICER WITH PATROL CAR FOR ASSISTANCE				
	LS																			DETOUR SIGNING				
	5															4	1	5	SNMT	PORTABLE CHANGEABLE MESSAGE SIGN, AS PER PLAN	P.12			
	1.97															1.95	0.02	1.97	MILE	WORK ZONE CENTER LINE, CLASS III, 642 PAINT				
	2.64															2.60	0.04	2.64	MILE	WORK ZONE EDGE LINE, CLASS III, 4", 642 PAINT				
																1110		1110	FT	WORK ZONE CHANNELIZING LINE, CLASS III, 8", 642 PAINT				
																135		135	FT	WORK ZONE DOTTED LINE, CLASS III, 4", 642 PAINT				
																173		173	FT	WORK ZONE STOP LINE, CLASS III, 642 PAINT				
																210		210	FT	WORK ZONE CROSSWALK LINE, CLASS III, 24", 642 PAINT				
70																		70	FT	LONGITUDINAL CHANNELIZING DEVICE, AS PER PLAN	P.9			
																				<b>INCIDENTALS</b>				
																LS	LS	LS	LS	614	11000	LS	MAINTAINING TRAFFIC	
																LS	LS	LS	LS	623	10001	LS	CONSTRUCTION LAYOUT STAKES AND SURVEYING, AS PER PLAN	P.9
																LS	LS	LS	LS	624	10000	LS	MOBILIZATION	


GENERAL SUMMARY

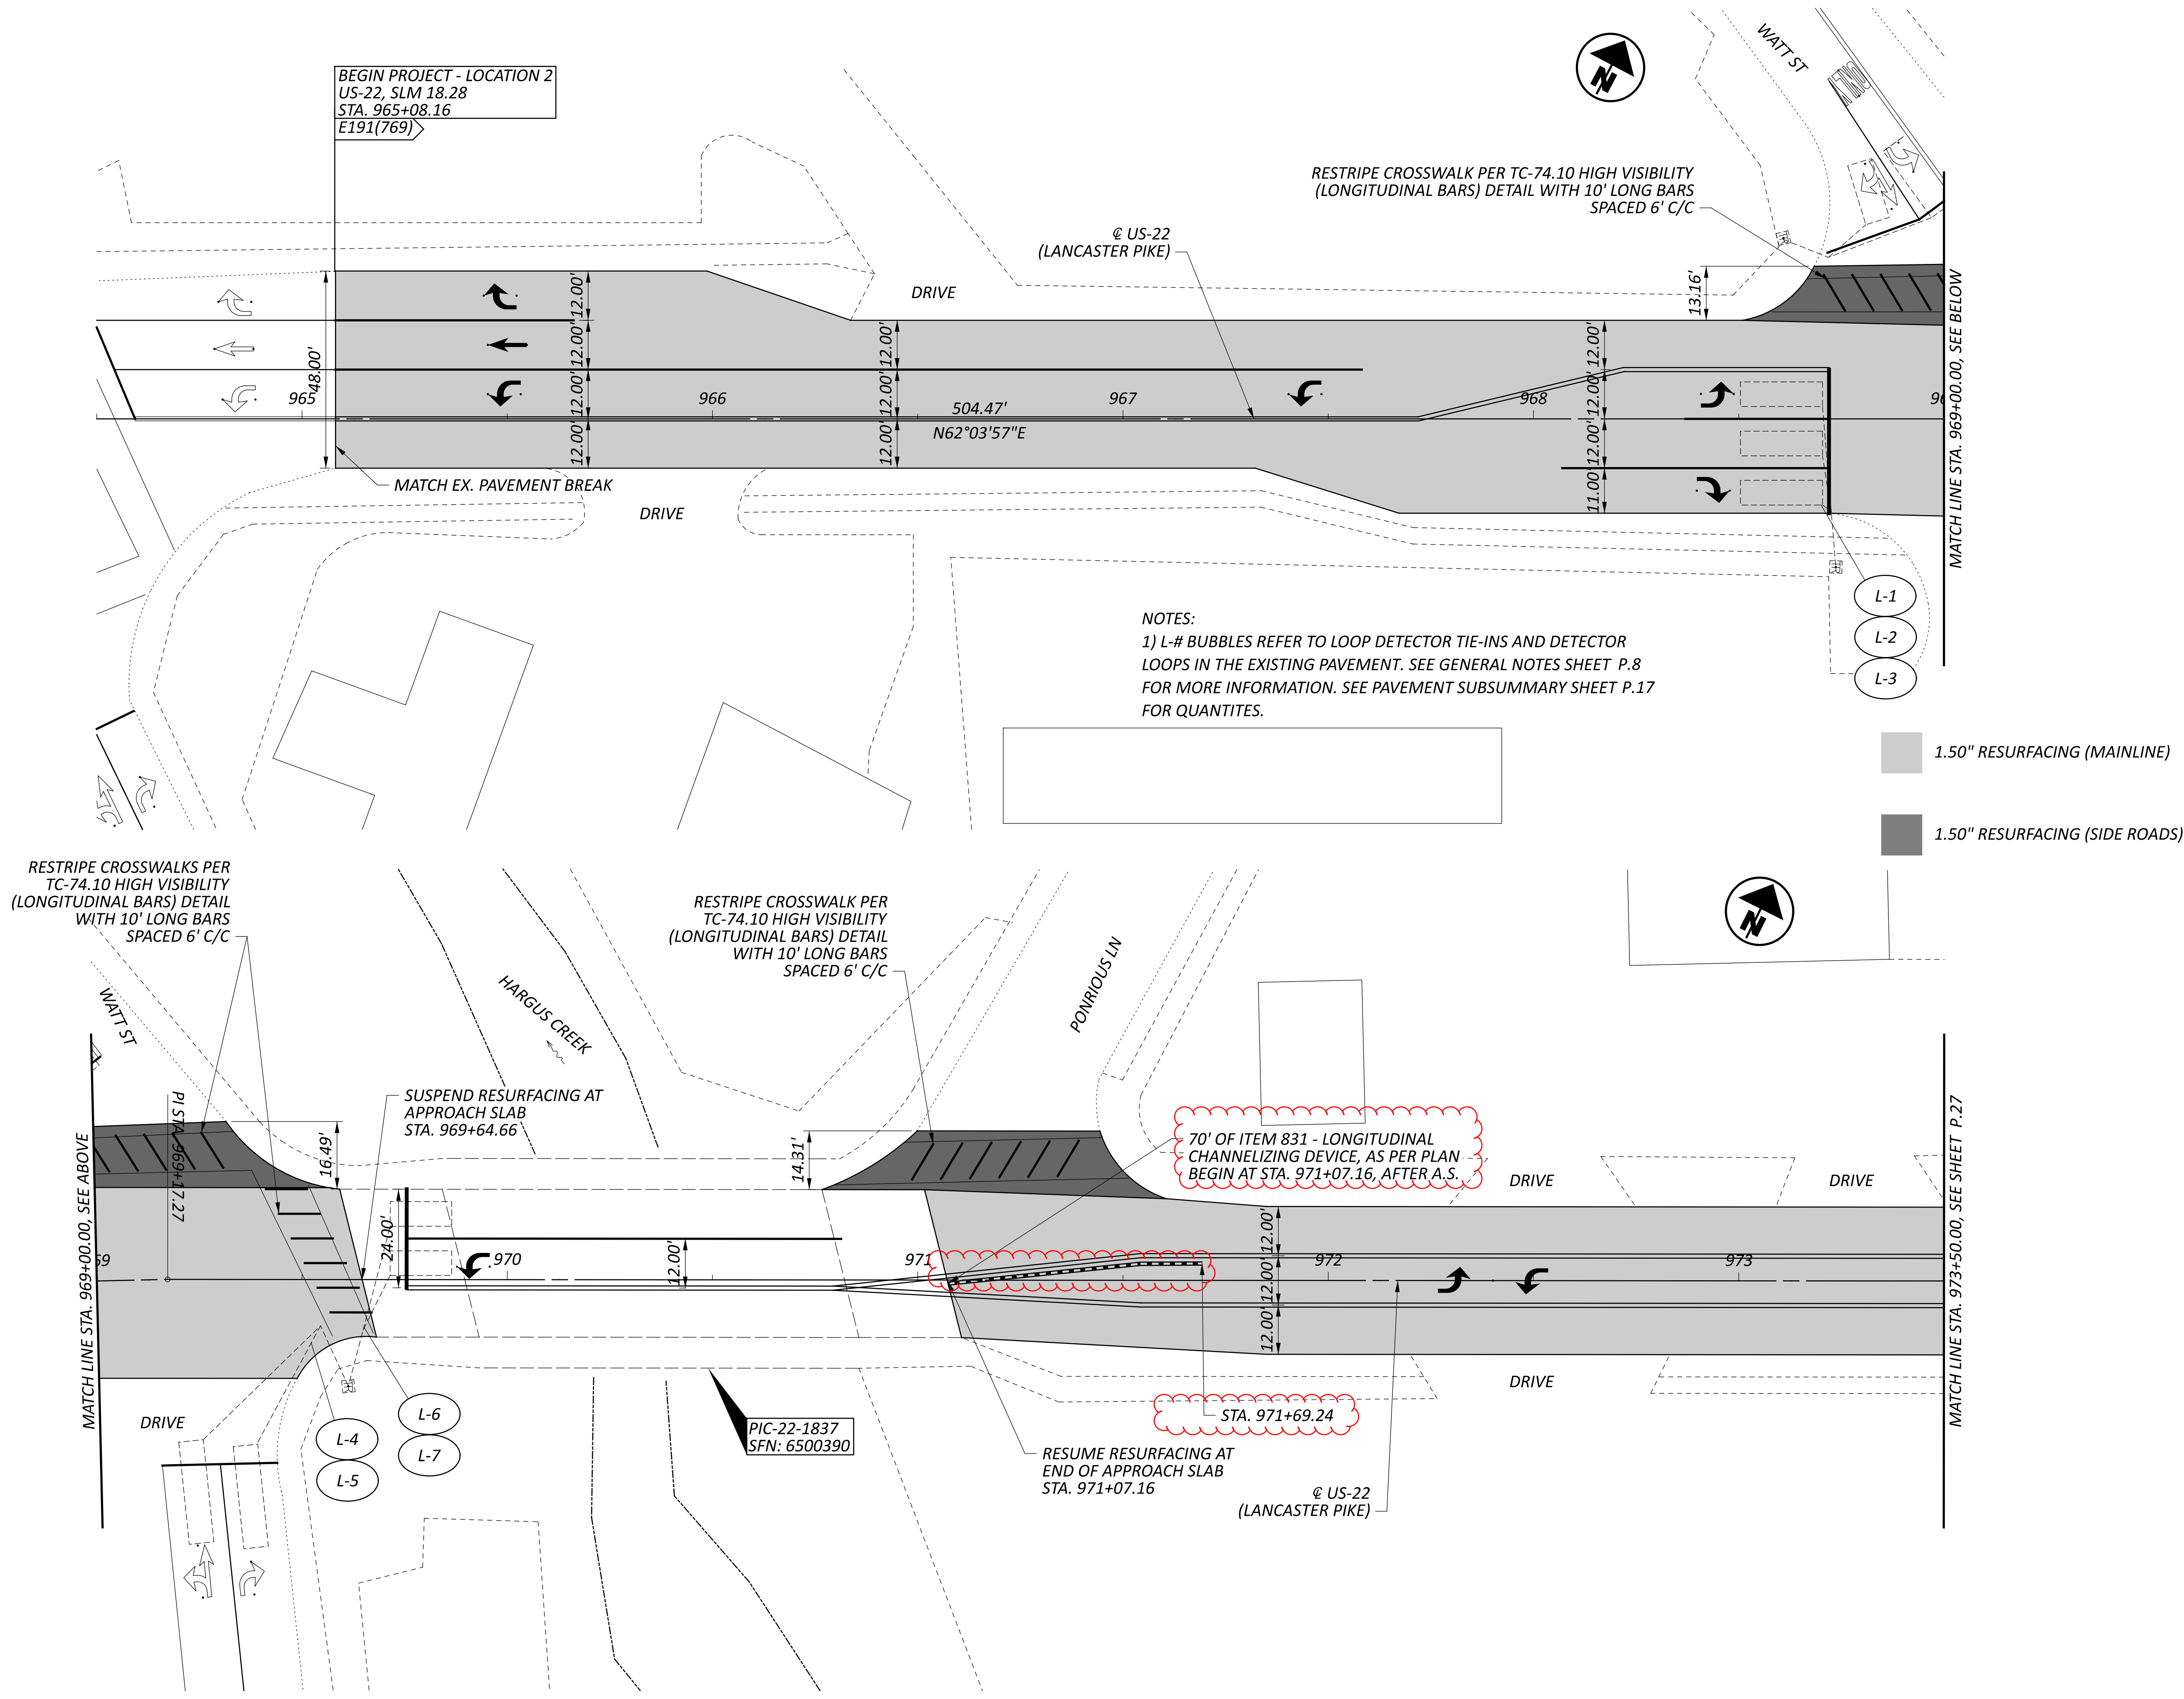

NOTES:  
 1) L-# BUBBLES REFER TO LOOP DETECTOR TIE-INS AND DETECTOR LOOPS IN THE EXISTING PAVEMENT. SEE GENERAL NOTES SHEET P.8 FOR MORE INFORMATION. SEE PAVEMENT SUBSUMMARY SHEET P.17 FOR QUANTITIES.

L-1  
 L-2  
 L-3

1.50" RESURFACING (MAINLINE)  
 1.50" RESURFACING (SIDE ROADS)

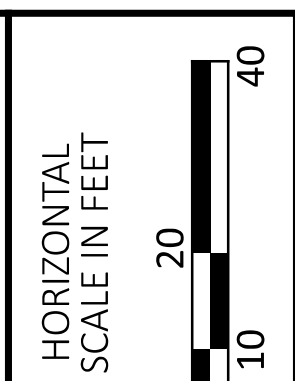

ROADWAY PLAN - US-22 (LOCATION 2)  
 STA. 965+08.16 TO STA. 973+50.00

DESIGN AGENCY



DESIGNER  
 AMH

REVIEWER  
 DR 10/11/23

PROJECT ID  
 106262

SHEET TOTAL  
 P.26 P.42