

SHEET NUM.											PART.		ITEM	ITEM EXT	GRAND TOTAL	UNIT	DESCRIPTION	SEE SHEET NO.
71	72	73	115	116	117	127	128			01/NHS/21								
PAVEMENT																		
	8,993	1,102								10,095		254	01000	10,095	SY	PAVEMENT PLANING, ASPHALT CONCRETE 1.25"		
	1,391	693								2,084		301	56000	2,084	CY	ASPHALT CONCRETE BASE, PG64-22, (449)		
	373	1,307								1,680		304	20000	1,680	CY	AGGREGATE BASE		
		14								14		304	20000	14	CY	AGGREGATE BASE, UNDER GUARDRAIL		
	1,805	584								2,389		407	20000	2,389	GAL	NON-TRACKING TACK COAT		
	500	130								630		441	10100	630	CY	ASPHALT CONCRETE SURFACE COURSE, TYPE 1, (446), PG70-22M		
	268	133								401		441	10200	401	CY	ASPHALT CONCRETE INTERMEDIATE COURSE, TYPE 2, (446)		
		3								3		441	70200	3	CY	ASPHALT CONCRETE INTERMEDIATE COURSE, TYPE 1, (449), UNDER GUARDRAIL		
2,477										2,477		609	24510	2,477	FT	CURB, TYPE 4-C		
1,553										1,553		609	50000	1,553	SY	4" CONCRETE TRAFFIC ISLAND		
58										58		609	54000	58	SY	6" CONCRETE TRAFFIC ISLAND		
	1,970	241								2,211		618	40100	2,211	FT	RUMBLE STRIPS, SHOULDER (ASPHALT CONCRETE)		
LIGHTING																		
							20			20		625	00450	20	EACH	CONNECTION, FUSED PULL APART		
							18			18		625	00480	18	EACH	CONNECTION, UNFUSED PERMANENT		
							2			2		625	10490	2	EACH	LIGHT POLE, CONVENTIONAL, AT10B30		
							8			8		625	10490	8	EACH	LIGHT POLE, CONVENTIONAL, AT22B40		
							2			2		625	14000	2	EACH	LIGHT POLE FOUNDATION, 24" X 6' DEEP		
							8			8		625	14100	8	EACH	LIGHT POLE FOUNDATION, 24" X 8' DEEP		
							909			909		625	23200	909	FT	NO. 4 AWG 2400 VOLT DISTRIBUTION CABLE		
							1,728			1,728		625	23400	1,728	FT	NO. 10 AWG POLE AND BRACKET CABLE		
							2,566			2,566		625	24320	2,566	FT	1-1/2" DUCT CABLE WITH THREE NO. 4 AWG 2400 VOLT CABLES		
							20			20		625	25408	20	FT	CONDUIT, 2", 725.051		
							619			619		625	25902	619	FT	CONDUIT, JACKED OR DRILLED, 725.04, 4"		
							10			10		625	26253	10	EACH	LUMINAIRE, CONVENTIONAL, SOLID STATE (LED), AS PER PLAN, 240V	127	
							1,898			1,898		625	29000	1,898	FT	TRENCH		
							5			5		625	30700	5	EACH	PULL BOX, 725.08, 18"		
							1			1		625	30706	1	EACH	PULL BOX, 725.08, 24"		
							1			1		625	31510	1	EACH	PULL BOX REMOVED		
							10			10		625	32000	10	EACH	GROUND ROD		
							1			1		625	34001	1	EACH	POWER SERVICE, AS PER PLAN	127	
							1,898			1,898		625	36010	1,898	FT	UNDERGROUND WARNING/MARKING TAPE		
							2			2		625	75402	2	EACH	LIGHT POLE REMOVED FOR STORAGE, AS PER PLAN	127	
							2			2		625	75500	2	EACH	LIGHT POLE FOUNDATION REMOVED		
							825			825		625	75550	825	FT	DISTRIBUTION CABLE REMOVED		
						1				1		625	76000	1	EACH	ARC FLASH CALCULATIONS AND LABEL LIGHTING CONTROL CABINET		
							275			275		625	98100	275	FT	LIGHTING, MISC.: FILL AND PLUG EXISTING LIGHTING CONDUIT	127	
TRAFFIC CONTROL																		
					47					47		620	60000	47	EACH	DELINEATOR, POST SURFACE MOUNTED		
					199					199		621	00100	199	EACH	RPM		
					174					174		621	54000	174	EACH	RAISED PAVEMENT MARKER REMOVED		
		630								630		630	03100	630	FT	GROUND MOUNTED SUPPORT, NO. 3 POST		
		91								91		630	04100	91	FT	GROUND MOUNTED SUPPORT, NO. 4 POST		
		253								253		630	06400	253	FT	GROUND MOUNTED STRUCTURAL BEAM SUPPORT, S4X7.7		
		29								29		630	08600	29	EACH	SIGN POST REFLECTOR		
		14								14		630	09000	14	EACH	BREAKAWAY STRUCTURAL BEAM CONNECTION		
		653								653		630	80100	653	SF	SIGN, FLAT SHEET		
		14								14		630	84500	14	EACH	GROUND MOUNTED STRUCTURAL BEAM SUPPORT FOUNDATION		
		43								43		630	84900	43	EACH	REMOVAL OF GROUND MOUNTED SIGN AND DISPOSAL		
		4								4		630	85100	4	EACH	REMOVAL OF GROUND MOUNTED SIGN AND REERECTION		
		27								27		630	86002	27	EACH	REMOVAL OF GROUND MOUNTED POST SUPPORT AND DISPOSAL		
		2								2		630	86010	2	EACH	REMOVAL OF GROUND MOUNTED POST SUPPORT AND REERECTION		
		4								4		630	86102	4	EACH	REMOVAL OF GROUND MOUNTED STRUCTURAL BEAM SUPPORT AND DISPOSAL		
					1.31					1.31		644	00104	1.31	MILE	EDGE LINE, 6"		
					1.33					1.33		644	00204	1.33	MILE	LANE LINE, 6"		
					0.07					0.07		644	00300	0.07	MILE	CENTER LINE, TYPE 1 (DOUBLE SOLID)		
					1,937					1,937		644	00400	1,937	FT	CHANNELIZING LINE, 8"		
					39					39		644	00500	39	FT	STOP LINE		

GENERAL SUMMARY

DESIGN AGENCY



DESIGNER

TGW

REVIEWER

HRB 10/30/24

PROJECT ID


118117

SHEET TOTAL

P.69 137

SHEET NO.	REFERENCE NO.	LOCATION	STATION	SIDE	CODE	SIZE (INCHES)	630													
							SIGN, FLAT SHEET SQ FT	GROUND MOUNTED SUPPORT, NO. 3 POST FT	GROUND MOUNTED SUPPORT, NO. 4 POST FT	GROUND MOUNTED STRUCTURAL BEAM SUPPORT, 54X7.7 FT	REMOVAL OF GROUND MOUNTED SIGN AND DISPOSAL EACH	REMOVAL OF GROUND MOUNTED POST SUPPORT AND DISPOSAL EACH	REMOVAL OF GROUND MOUNTED SIGN AND REERECTION EACH	REMOVAL OF GROUND MOUNTED POST SUPPORT AND REERECTION EACH	SIGN POST REFLECTOR EACH	BREAKAWAY STRUCTURAL BEAM CONNECTION EACH	GROUND MOUNTED STRUCTURAL BEAM SUPPORT FOUNDATION EACH	REMOVAL OF GROUND MOUNTED STRUCTURAL BEAM SUPPORT AND DISPOSAL EACH		
120	S-49	SR 32	1367+19	RT	R6-1L-54	54 X 18						1	1							
120	S-50	SR 32	1367+19	RT	R6-1R-54 R1-1-36 R6-3-30	54 X 18 36 X 36 30 X 24						3	2							
120	S-51	SR 32	1367+58	RT	M2-H4-VAR	66 x 24						1							2	
120	S-52	SR 32	1367+45	RT	R5-1-36	36 X 36	9.0	13.0							1					
120	S-53	SR 32	1367+89	RT	M3-2-36 M1-5-36-2 M6-1-30	36 X 18 36 X 36 30 X 21						3	1							
120	S-54	SR 32	1367+92	RT	M3-2-36 M1-5-45-3 M6-1-30	36 X 18 45 X 36 30 X 21						3	1							
120	S-55	SR 32	1367+82	RT	R4-7b-36	36 X 48						1	2							
120	S-56	SR 32	1367+82	LT	R5-1-36	36 X 36						1								
120	S-57	SR 32	1375+75	RT	W11-H14a-30 W7-3aP-24	30 X 30 24 X 18								2	1					
120	S-58	SR 32	1367+00	RT	M4-5-24 M3-4-24 M1-5-24-2 M1-5-30-3 M5-1-21	24 X 12 24 X 12 24 X 24 30X24 21 X 15	2.0 2.0 4.0 5.0 2.2			18.5							1	1		
120	S-59	SR 32	1367+00	RT	M3-2-24 M1-5-24-2 M1-5-30-3 M5-1-21	24 X 12 24 X 24 30X24 21 X 15	2.0 4.0 5.0 2.2			17.5							1	1		
120	S-60	SR 32	1369+01	RT	R3-H8ca-MOD-48	48 X 30	10.0	13.0 - 13.0												
121	S-61	SR 32	1367+00	RT	M3-1-24 M1-5-30-3 M5-1-21	24X12 30X24 21X15	2.0 5.0 2.2			16.0										
121	S-62	SR 32	1370+62	LT	M3-1-30 M1-5-36-3 M6-1R-24 M3-3-30 M1-5-36-3 M6-1L-24	30 X 15 36 X 30 24 X 18 30 X 15 36 X 30 24 X 18	3.1 7.5 3.0 3.1 7.5 3.0			18.0							1	1		
121	S-63	SR 32	1371+19	LT	R3-H8da-48	54 X 30	11.3	13.0 - 13.0												
121	S-64	SR 32	1372+85	LT	D10-H8-12	12 X 12						1	1							
121	S-65	SR 32	1373+41	LT	R5-1-36	36 X 36	9.0	13.0											1	
121	S-66	SR 32	1373+98	LT	R6-1L-54 R1-2-48	54 X 18 48 X 48	6.8 6.9	15.5 - 15.5											2	
121	S-67	SR 32	1373+75	LT	R6-1L-54	54 X 18	6.8	12.0 - 12.0												
121	S-68	SR 32	1374+00	LT	R5-1-36	36 X 36	9.0	13.0											1	
121	S-69	SR 32	1374+25	LT	R5-1-36	36 X 36	9.0	13.0											1	
121	S-70	SR 32	1374+25	LT	R5-1-36	36 X 36	9.0	13.0											1	
121	S-71	SR 32	1372+81	RT	D10-H8-12	12 X 12						1	1							
TOTALS CARRIED TO SUB SUMMARY SHEET 115							152	159	16	54	15	9	2	1	7	3	3	2		


TRAFFIC CONTROL PLAN - SIGNING SUB-SUMMARY

DESIGN AGENCY

COMPASS INFRASTRUCTURE GROUP
DESIGNER
KMK
REVIEWER
JAH 11/01/24
PROJECT ID
118117
SHEET TOTAL
P.113 137

SHEET NO.	REFERENCE NO.	LOCATION	STATION	SIDE	CODE	SIZE (INCHES)	SIGN, FLAT SHEET	GROUND MOUNTED SUPPORT, NO. 3 POST	GROUND MOUNTED SUPPORT, NO. 4 POST	GROUND MOUNTED STRUCTURAL BEAM SUPPORT, 54X7.7	REMOVAL OF GROUND MOUNTED SIGN AND DISPOSAL	REMOVAL OF GROUND MOUNTED POST SUPPORT AND DISPOSAL	REMOVAL OF GROUND MOUNTED SIGN AND REERECTION	REMOVAL OF GROUND MOUNTED POST SUPPORT AND REERECTION	SIGN POST REFLECTOR	BREAKAWAY STRUCTURAL BEAM CONNECTION	GROUND MOUNTED STRUCTURAL BEAM SUPPORT FOUNDATION	REMOVAL OF GROUND MOUNTED STRUCTURAL BEAM SUPPORT AND DISPOSAL							
							SQ FT	FT	FT	FT	EACH	EACH	EACH	EACH	EACH	EACH	EACH	EACH	EACH	EACH					
120	S-91	SR 32	1367+25	LT	M3-4-24 M1-5-30-3 M5-1-21	24 X 12 30 X 24 21 X 15	2.0 5.0 2.2	14.5																	
121	S-93	SR 32	1371+78	RT	R2-1-24	24 X 30	5.0	14.0																	
121	S-94	SR-32	1373+17	RT	R2-1-24	24 X 30					1	1													
TOTALS THIS SHEET							15	15	14	0	1	1	0	0	0	0	0	0	0	0					
TOTALS FROM SHEET 111							205	169	29	72	0	0	2	1	8	4	4	0							
TOTALS FROM SHEET 112							124	186	0	51	21	14	0	0	10	1	1	2							
TOTALS FROM SHEET 113							152	159	16	54	15	9	2	1	7	3	3	2							
TOTALS FROM SHEET 114							157	101	32	76	6	3	0	0	4	6	6	0							
TOTALS CARRIED TO GENERAL SUMMARY							653	630	91	253	43	27	4	2	29	14	14	4							

630

TRAFFIC CONTROL PLAN - SIGNING SUB-SUMMARY

DESIGN AGENCY

COMPASS
 INFRASTRUCTURE GROUP



DESIGNER
 KMK

REVIEWER
 JAH 11/01/24

PROJECT ID
 118117

SHEET TOTAL
 P.115 | 137

FOR LEGEND, SEE SHEET P.118.

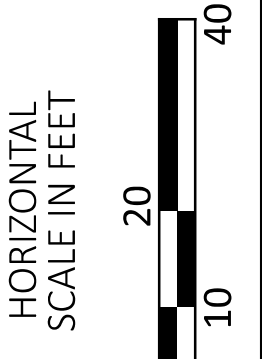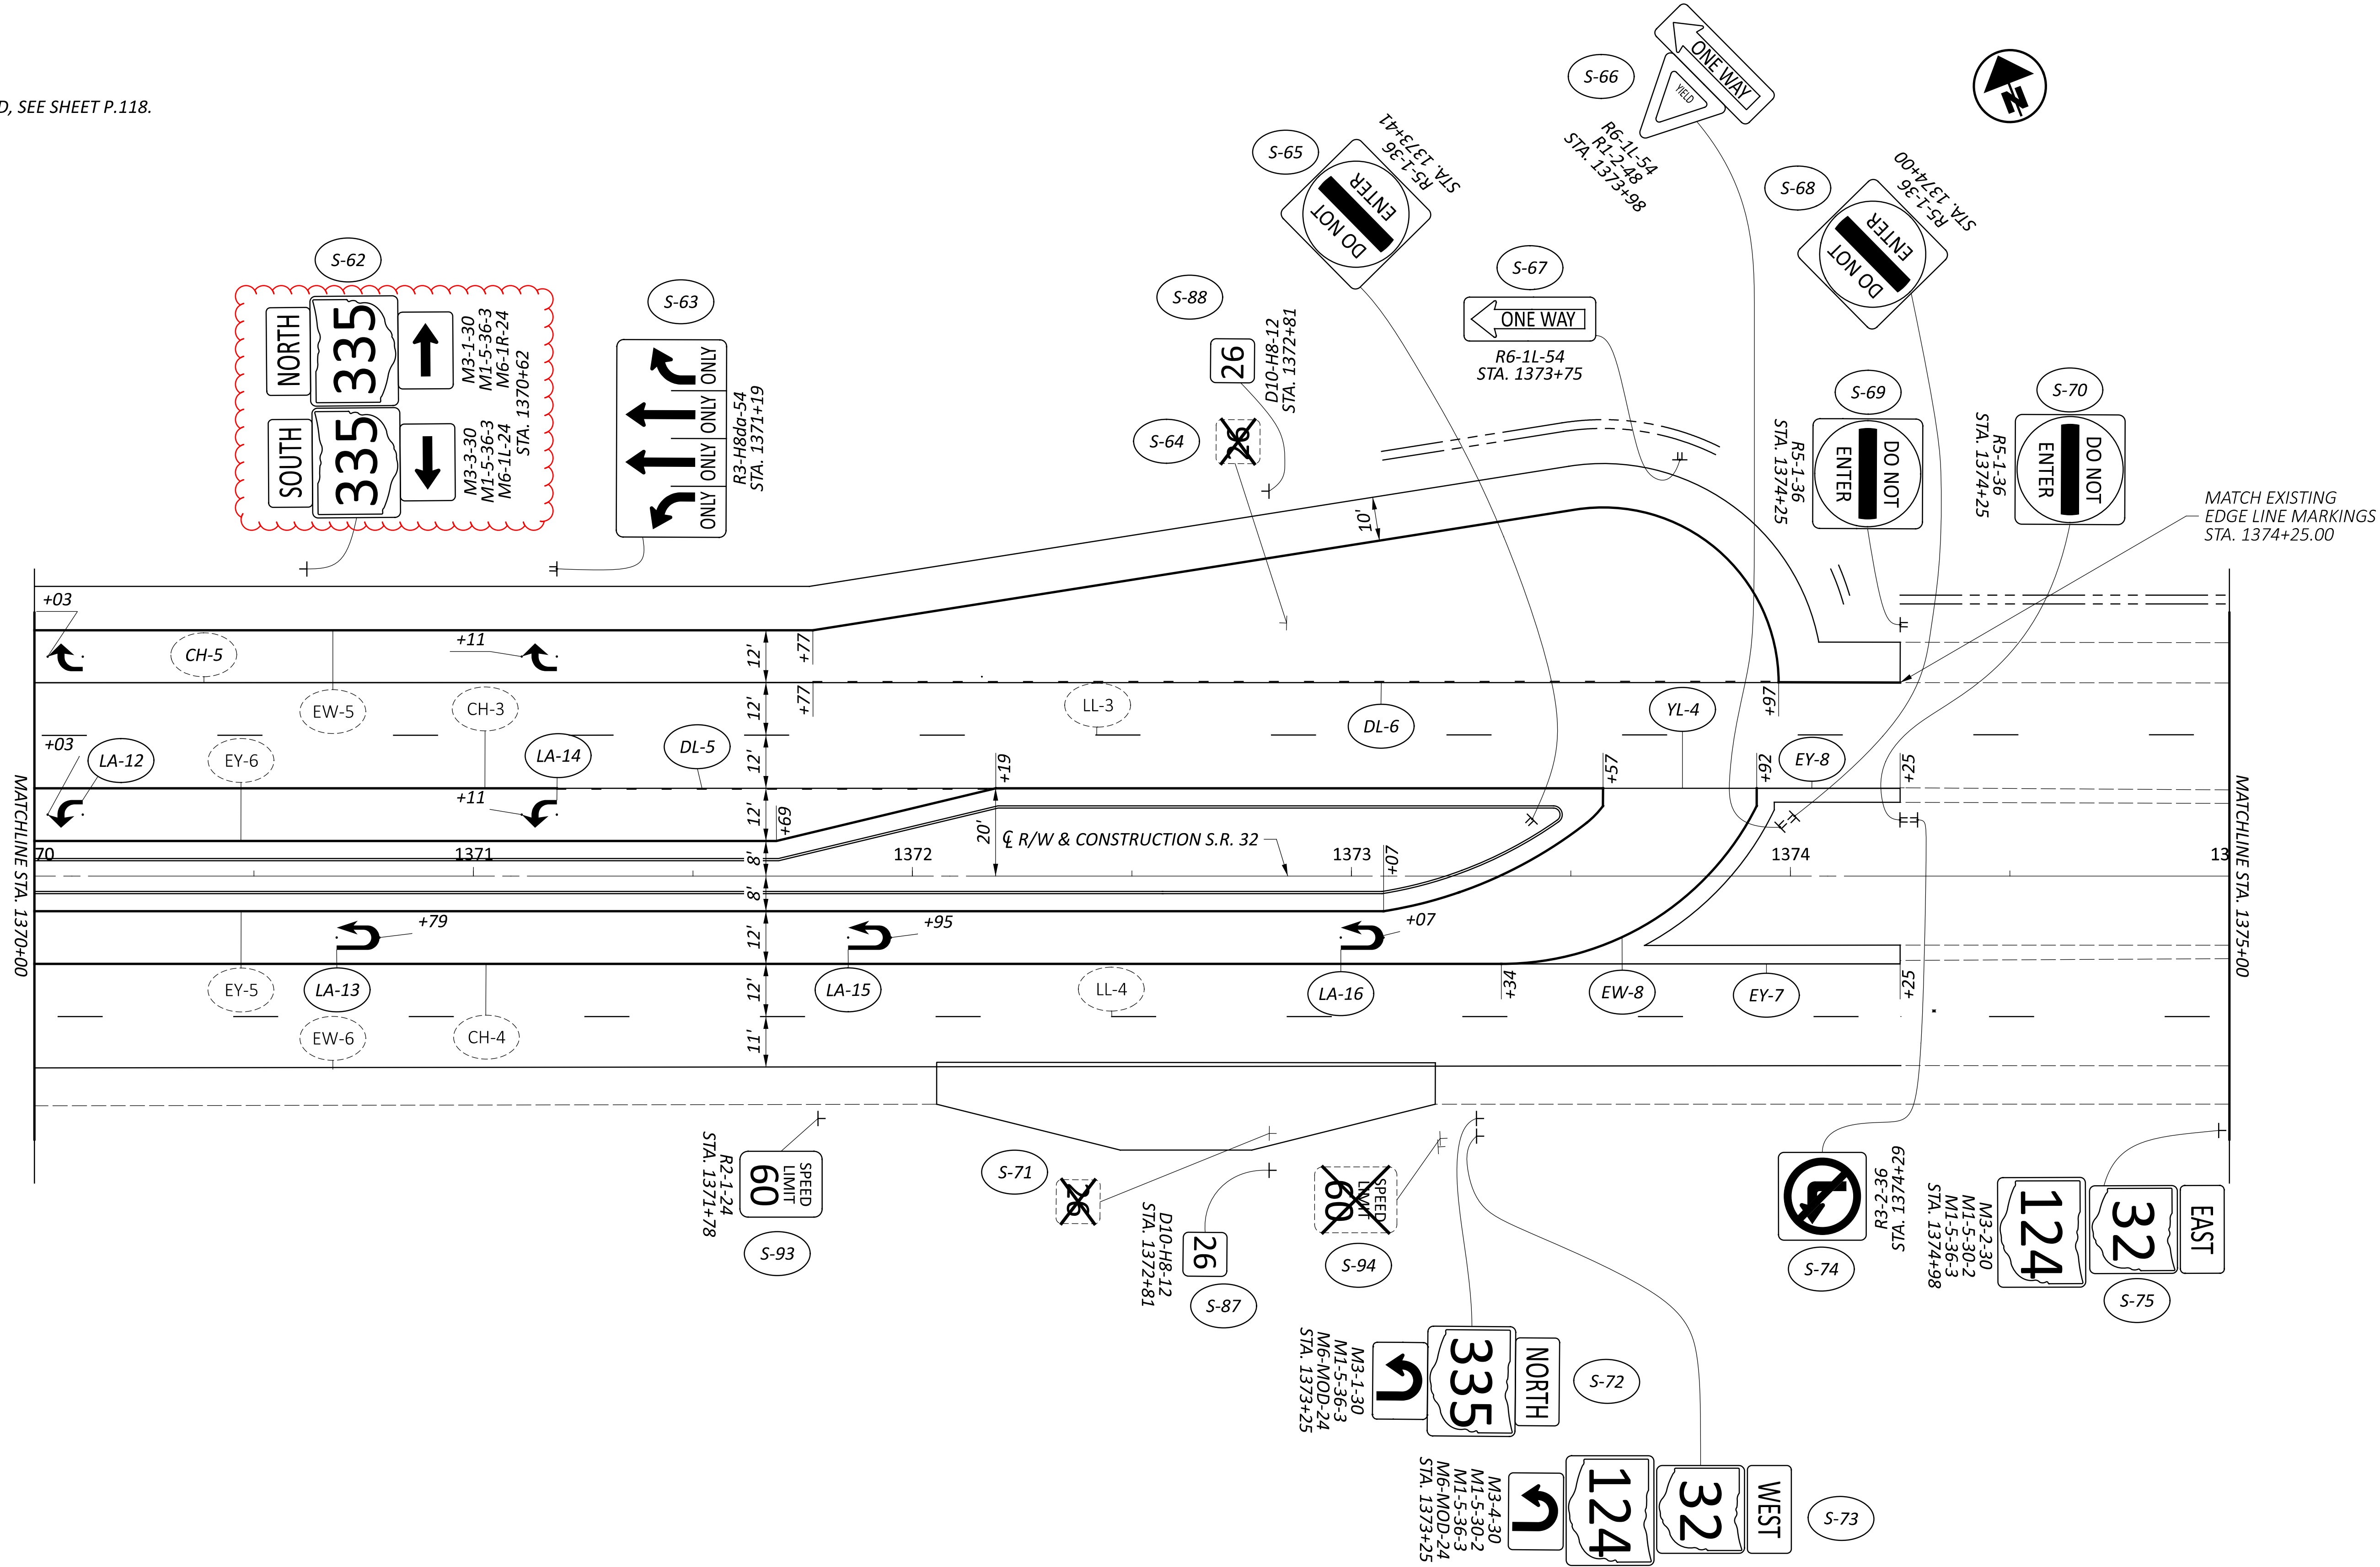

TRAFFIC CONTROL PLAN
STA. 1370+00.00 TO STA. 1375+00.00

DESIGN AGENCY



DESIGNER

KMK

REVIEWER

JAH 11/01/24

PROJECT ID
118117

SHEET TOTAL
P.121 137

