

c:\pwworking\east01\0574921\105860_CG001.dgn 9/23/2021 1:49:44 PM BAVARELL

SHEET NUM.						PART.			ITEM	ITEM EXT	GRAND TOTAL	UNIT	DESCRIPTION	SEE SHEET NO.	CALCULATED	REM CHECKED	M/J/L
6	26	27	39	43	44	1/NHS/BR	2/NHS/OT	3/NHS/OT									
													ROADWAY				
LS						LS	LS		201	1000	LS		CLEARING AND GRUBBING				
		2,474							202	23001	2,474	SY	PAVEMENT REMOVED, AS PER PLAN				29
	444								202	38000	444	FT	GUARDRAIL REMOVED				
			954						203	10000	954	CY	EXCAVATION				
			267						203	20000	267	CY	EMBANKMENT				
		2,701							204	10000	2,701	SY	SUBGRADE COMPACTION				
80									204	13000	80	CY	EXCAVATION OF SUBGRADE				
80									204	30010	80	CY	GRANULAR MATERIAL, TYPE B				
2									204	45000	2	HOUR	PROOF ROLLING				
239									204	50000	239	SY	GEOTEXTILE FABRIC				
	363								606	15050	363	FT	GUARDRAIL, TYPE MGS				
	3								606	26100	3	EACH	ANCHOR ASSEMBLY, TYPE E				7
	1								606	26500	1	EACH	ANCHOR ASSEMBLY, TYPE T				
	4								606	35002	4	EACH	MGS BRIDGE TERMINAL ASSEMBLY, TYPE 1				
													EROSION CONTROL				
	4			15					601	21050	19	SY	TIED CONCRETE BLOCK MAT WITH TYPE 1 UNDERLAYMENT				
	24								601	21060	24	SY	TIED CONCRETE BLOCK MAT WITH TYPE 2 UNDERLAYMENT				
	4								601	32200	4	CY	ROCK CHANNEL PROTECTION, TYPE C WITH FILTER				
2									659	00100	2	EACH	SOIL ANALYSIS TEST				
183	74								659	00300	257	CY	TOPSOIL				
			1,652						659	10000	1,652	SY	SEEDING AND MULCHING				
83									659	14000	83	SY	REPAIR SEEDING AND MULCHING				
83									659	15000	83	SY	INTER-SEEDING				
0.23									659	20000	0.23	TON	COMMERCIAL FERTILIZER				
0.34									659	31000	0.34	ACRE	LIME				
9									659	35000	9	MGAL	WATER				
	670								670	00700	670	SY	DITCH EROSION PROTECTION				
									832	15000	LS		STORM WATER POLLUTION PREVENTION PLAN				
									832	15002	LS		STORM WATER POLLUTION PREVENTION INSPECTIONS				
									832	15010	LS		STORM WATER POLLUTION PREVENTION INSPECTION SOFTWARE				
									8,000	8,000	832	EACH	EROSION CONTROL				
													DRAINAGE				
	0.4								602	20000	0.4	CY	CONCRETE MASONRY				
	926								605	11110	926	FT	6" SHALLOW PIPE UNDERDRAINS WITH GEOTEXTILE FABRIC				
250									605	13410	250	FT	6" UNCLASSIFIED PIPE UNDERDRAINS WITH GEOTEXTILE FABRIC				
				80					611	00200	80	FT	4" CONDUIT, TYPE C				
100									611	01500	100	FT	6" CONDUIT, TYPE F				
	53								611	04600	53	FT	12" CONDUIT, TYPE C				
	2								611	98180	2	EACH	CATCH BASIN, NO. 3A				
4	2			8					611	99710	14	EACH	PRECAST REINFORCED CONCRETE OUTLET				
													PAVEMENT				
		2,232							254	01000	2,232	SY	PAVEMENT PLANING, ASPHALT CONCRETE - 3"				
		662							301	46000	662	CY	ASPHALT CONCRETE BASE, PG64-22				
		449							304	20000	449	CY	AGGREGATE BASE				
		890							407	20000	890	GAL	NON-TRACKING TACK COAT				
100									408	10001	100	GAL	PRIME COAT, AS PER PLAN				7
		202							441	50000	202	CY	ASPHALT CONCRETE SURFACE COURSE, TYPE 1, (448), PG64-22 AS PER PLAN				6
		202							441	50200	202	CY	ASPHALT CONCRETE INTERMEDIATE COURSE, TYPE 1, (448)				
		7							441	50300	7	CY	ASPHALT CONCRETE INTERMEDIATE COURSE, TYPE 2, (448) VARIABLE DEPTH				
	102								609	24000	102	FT	CURB, TYPE 4-A				
	88								609	26000	88	FT	CURB, TYPE 6				
15									617	10101	15	CY	COMPACTED AGGREGATE, AS PER PLAN				7
													LIGHTING				
				24					625	00480	24	EACH	CONNECTION, UNFUSED PERMANENT				
				4					625	13400	4	EACH	LIGHT TOWER, BBBB100				
				3					625	15100	3	EACH	LIGHT TOWER FOUNDATION, 36" X 20' DEEP				
				1					625	15200	1	EACH	LIGHT TOWER FOUNDATION, 36" X 25' DEEP				
				573					625	23200	573	FT	NO. 4 AWG 2400 VOLT DISTRIBUTION CABLE				

GENERAL SUMMARY



POR-14-12.96

24
90

c:\pwworking\east01\d0574921\105860_CS005.dgn 9/23/2021 1:49:51 PM BAVARELL

STATION TO STATION	SIDE	LENGTH L	AVERAGE WIDTH W	SURFACE AREA A (SF) A=LxW	CAD MEASURED AREAS	204		254	301	304	407		441										
						SUBGRADE COMPACTION SY	PAVEMENT REMOVED, APP SY	PAVEMENT PLANING, ASPHALT CONCRETE SY	9" ASPHALT CONCRETE BASE, PG 64-22 CY	6" AGGREGATE BASE CY	NON-TRACKING TACK COAT (0.055 GAL/SY) GAL	NON-TRACKING TACK COAT (0.085 GAL/SY) GAL	1-1/2" ASPHALT CONCRETE SURFACE COURSE, TYPE 1, (448) PG 64-22, APP CY	1-1/2" ASPHALT CONCRETE INTERMEDIATE COURSE, TYPE 1, (448) CY	VAR. DEPTH ASPHALT CONCRETE INTERMEDIATE COURSE, TYPE 2, (448) CY								
S.R. 14																							
689+00.00 690+25.00	LT/RT				10518			1169			64	99	49	49									
690+16.18 690+25.00	LT				102						1		1	1									
					120				3		1												
					132	15				2	1												
					118		13																
690+01.31 690+25.00	RT				212						1		1	1									
					246				7		3												
					267	30				5	2												
					197		22																
689+00.00 691+35.60	LT/RT				6671						41		31	31									
					6848				190		84												
					6955	773				129	42												
					6379		709																
694+10.94 696+00.00	LT/RT				11452						70		54	54									
					11646				324		142												
					11763	1307				218	72												
					11413		1268																
696+00.00 697+68.35	LT/RT				9571			1063			58	90	44	44									
696+00.00 697+68.35	LT				774						5		4	4	7								
					903				28		11												
					980	109				18	6												
					619		69																
RAMP E																							
10+89.74 12+43.96	LT/RT				1702						10		8	8									
					1830				51		22												
					1907	212				35	12												
					1586		176																
12+43.96 13+25.00	LT/RT				2072						13		10	10									
					2137				59		26												
					2294	255				42	14												
					1953		217																
SUB TOTALS						2701	2474	2232	662	449	701	189	202	202	7								
TOTALS CARRIED TO GENERAL SUMMARY						2701	2474	2232	662	449	890		202	202	7								

* - EX. RAISED CONCRETE MEDIAN TO BE REMOVED AND INCLUDED WITH PAYMENT FOR ITEM 202 - PAVEMENT REMOVED, AS PER PLAN. APPROXIMATE LIMITS:
 STA. 690+48.50± TO STA. 691+56.50± - 3'-0"± WIDE
 STA. 693+89.50± TO STA. 694+16.50± - 3'-0"± WIDE

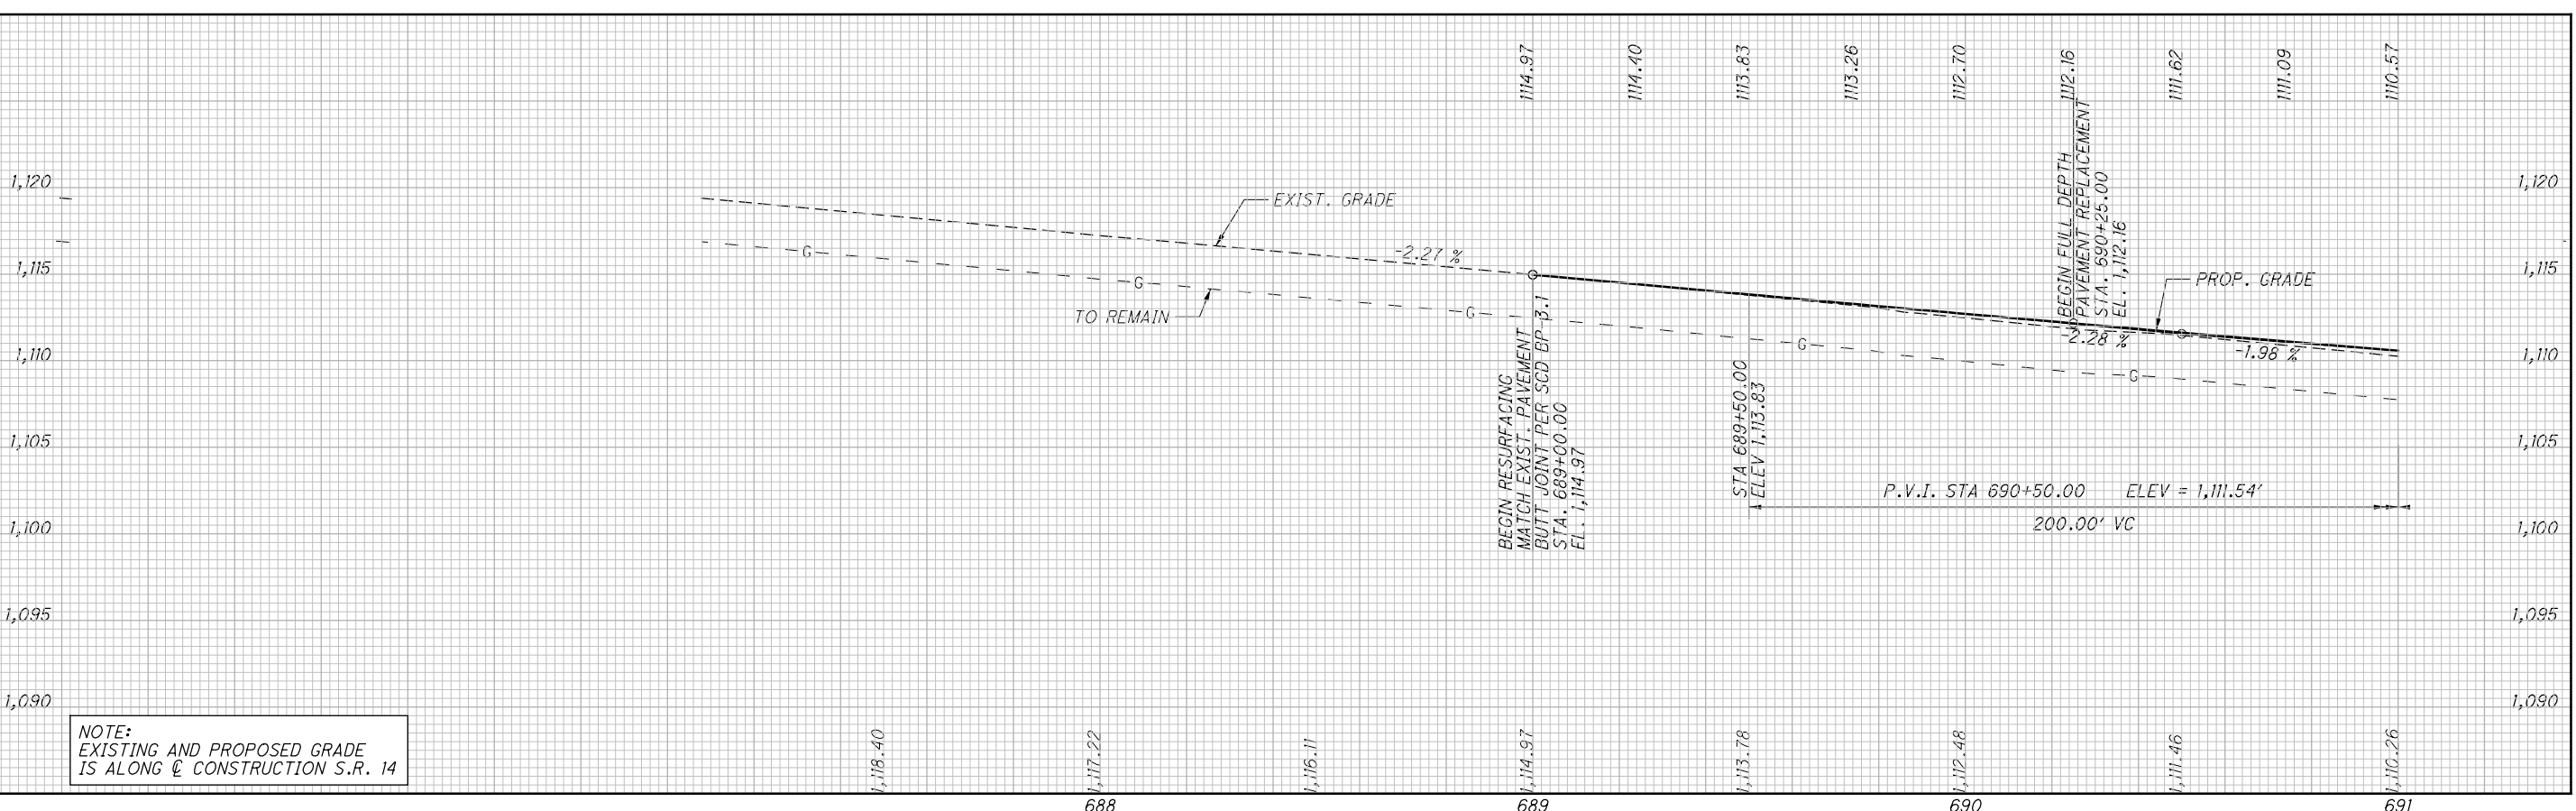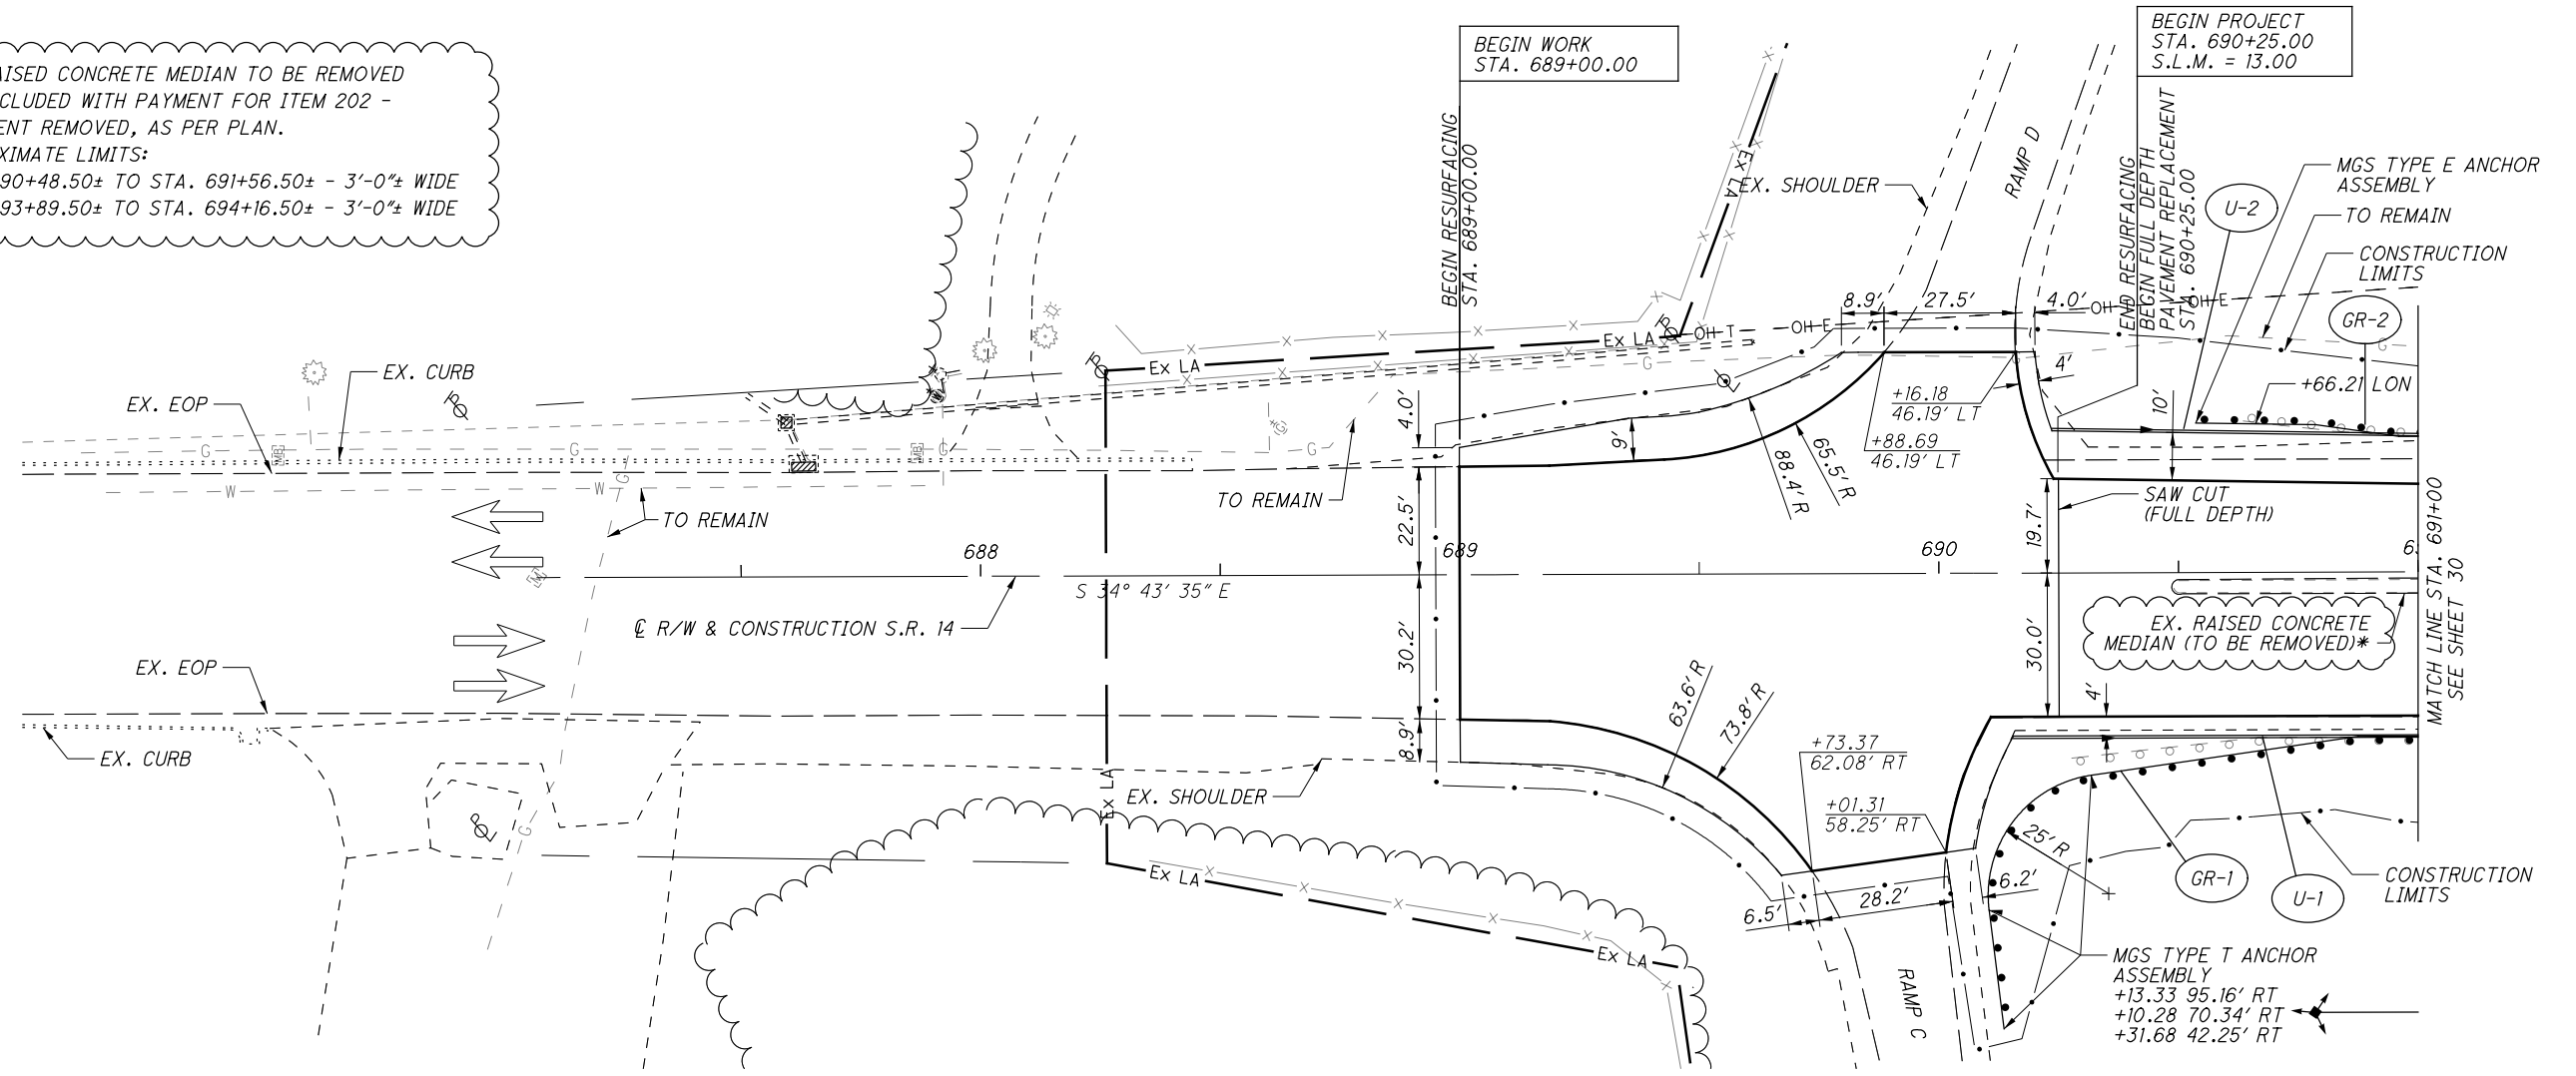

NOTE:
 EXISTING AND PROPOSED GRADE IS ALONG ϕ CONSTRUCTION S.R. 14



CALCULATED REM CHECKED M.J.L.
PLAN AND PROFILE
BEGIN TO 691+00

c:\pwworking\east1\d0574921\105860_GP001.dgn 9/23/2021 1:49:59 PM BAVARELL

ESTIMATED QUANTITIES

CALCULATED BY: CMR DATE: 01/21/2021
 CHECKED BY: JTW DATE: 01/22/2021

ITEM	EXTENSION	TOTAL 01/NHS/BR	TOTAL 03/NHS/OT	UNIT	DESCRIPTION	ABUTMENTS	PIERS	SUPERSTR.	GENERAL	SHEET REF.
202	11203	LS			PORTIONS OF STRUCTURE REMOVED, OVER 20 FOOT SPAN, AS PER PLAN				LS	3 , 4 & 24 / 44
202	22900	306		SY	APPROACH SLAB REMOVED				306	
202	23500	1862		SY	WEARING COURSE REMOVED				1862	
503	11100	LS			COFFERDAMS AND EXCAVATION BRACING				LS	3 / 44
503	21101	130		CY	UNCLASSIFIED EXCAVATION, AS PER PLAN	130				3 / 44
509	10000	176929		LB	EPOXY COATED REINFORCING STEEL	9565	6631	160733		
509	20001	100		LB	REINFORCING STEEL, REPLACEMENT OF EXISTING REINFORCING STEEL, AS PER PLAN				100	3 / 44
509	30020	8092		FT	NO. 4 GFRP DEFORMED BARS			8092		
510	10001	822		EACH	DOWEL HOLES WITH NONSHRINK, NONMETALLIC GROUT, AS PER PLAN	450	372			3 / 44
511	33500	2		EACH	SEMI-INTEGRAL DIAPHRAGM GUIDE	2				
511	34412	69		CY	CLASS QC2 CONCRETE WITH QC/QA, SUPERSTRUCTURE			69		
511	34447	446		CY	CLASS QC2 CONCRETE WITH QC/QA, BRIDGE DECK, AS PER PLAN			446		23 / 44
511	34450	80		CY	CLASS QC2 CONCRETE WITH QC/QA, BRIDGE DECK (PARAPET)			80		31 / 44
511	43212	33		CY	CLASS QC1 CONCRETE WITH QC/QA, PIER		33			
511	43512	58		CY	CLASS QC1 CONCRETE WITH QC/QA, ABUTMENT INCLUDING FOOTING	58				
512	10101	1272		SY	SEALING OF CONCRETE SURFACES (EPOXY-URETHANE), AS PER PLAN	77	570	625		3 & 22 / 44
512	10600	100		FT	CONCRETE REPAIR BY EPOXY INJECTION	50	50			
512	33000	57		SY	TYPE 2 WATERPROOFING	52		5		
512	74000	542		SY	REMOVAL OF EXISTING COATINGS FROM CONCRETE SURFACES	32	510			
513	10201	2192		LB	STRUCTURAL STEEL MEMBERS, LEVEL UF, AS PER PLAN			2192		3 / 44
513	20000	6928		EACH	WELDED STUD SHEAR CONNECTORS			6928		
513	95020	LS			STRUCTURAL STEEL, MISC.: BEAM END REPAIR			LS		26 / 44
513	95030	96		EACH	STRUCTURAL STEEL, MISC.: BEAM RETROFIT PLATES			96		4 & 25 / 44
514	00050	2845		SF	SURFACE PREPARATION OF EXISTING STRUCTURAL STEEL			2845		
514	00056	2845		SF	FIELD PAINTING OF EXISTING STRUCTURAL STEEL, PRIME COAT			2845		
514	00060	2320		SF	FIELD PAINTING OF EXISTING STRUCTURAL STEEL, INTERMEDIATE COAT			2320		
514	00066	2320		SF	FIELD PAINTING OF EXISTING STRUCTURAL STEEL, FINISH COAT			2320		
514	00504	15		MNHR	GRINDING FIN, TEARS, SLIVERS ON EXISTING STRUCTURAL STEEL			15		
514	10000	10		EACH	FINAL INSPECTION REPAIR			10		
516	10010	132		FT	ARMORLESS PREFORMED JOINT SEAL				132	
516	13600	17		SF	1" PREFORMED EXPANSION JOINT FILLER				17	
516	13900	205		SF	2" PREFORMED EXPANSION JOINT FILLER				205	
516	14020	155		FT	SEMI-INTEGRAL ABUTMENT EXPANSION JOINT SEAL	155				
516	44201	16		EACH	ELASTOMERIC BEARING WITH INTERNAL LAMINATES AND LOAD PLATE (NEOPRENE), AS PER PLAN (12"x14"x3.885" WITH 14"x15"x1.50" LOAD PLATE)	16				28 / 44
516	44201	24		EACH	ELASTOMERIC BEARING WITH INTERNAL LAMINATES AND LOAD PLATE (NEOPRENE), AS PER PLAN (14"x16"x3.848" WITH 15"x17"x1.75" LOAD PLATE)		24			29 / 44
516	47001	LS			JACKING AND TEMPORARY SUPPORT OF SUPERSTRUCTURE, AS PER PLAN			LS		4 & 26 / 44
518	21200	98		CY	POROUS BACKFILL WITH GEOTEXTILE FABRIC	98				
518	40001	167		FT	6" PERFORATED CORRUGATED PLASTIC PIPE, AS PER PLAN	167				4 , 12 & 15 / 44
518	40010	130		FT	6" NON-PERFORATED CORRUGATED PLASTIC PIPE, INCLUDING SPECIALS	130				
SPECIAL	51900100	1980		SF	SPECIAL - COMPOSITE FIBER WRAP SYSTEM (SEE PROPOSAL NOTE)		1980			22 / 44
519	11101	220		SF	PATCHING CONCRETE STRUCTURE, AS PER PLAN	25	195			4 / 44
526	25010	359		SY	REINFORCED CONCRETE APPROACH SLABS WITH QC/QA (T=15")				359	
526	90030	131		FT	TYPE C INSTALLATION				131	
SPECIAL	53001300	1540		FT	SPECIAL - STRUCTURES, REMOVAL OF ASBESTOS CONTAINING MATERIAL			1540		4 / 44
601	20001	100		SY	CRUSHED AGGREGATE SLOPE PROTECTION, AS PER PLAN				100	2 & 4 / 44
607	39900	350		FT	VANDAL PROTECTION FENCE, 6' STRAIGHT, COATED FABRIC			350		
SPECIAL	69098400		LS		SPECIAL - DOMINION ENERGY OHIO STABILIZER AND SUPPORTS				LS	4 , 27 & 34 / 44

c:\pwworking\east01\0574940\014_1296C_S0001.dgn 9/23/2021 9:23:59 PM BAVARELL

DESIGN AGENCY: H&R ENGINEERING, INC. 100 SUPERIOR AVE., SUITE 650 CLEVELAND, OHIO 44114 216-912-4240

DATE: 3/2021

REVIEWED: JMS

STRUCTURE FILE NUMBER: 6700691

DESIGNED: BTA

CHECKED: NJH

DRAWN: BTA

REVISED:

ESTIMATED QUANTITIES

BRIDGE NO. POR-14-1296

S.R. 14 OVER S.R. 5


POR-14-12.96

PID No. 105860


5 / 44

51

90

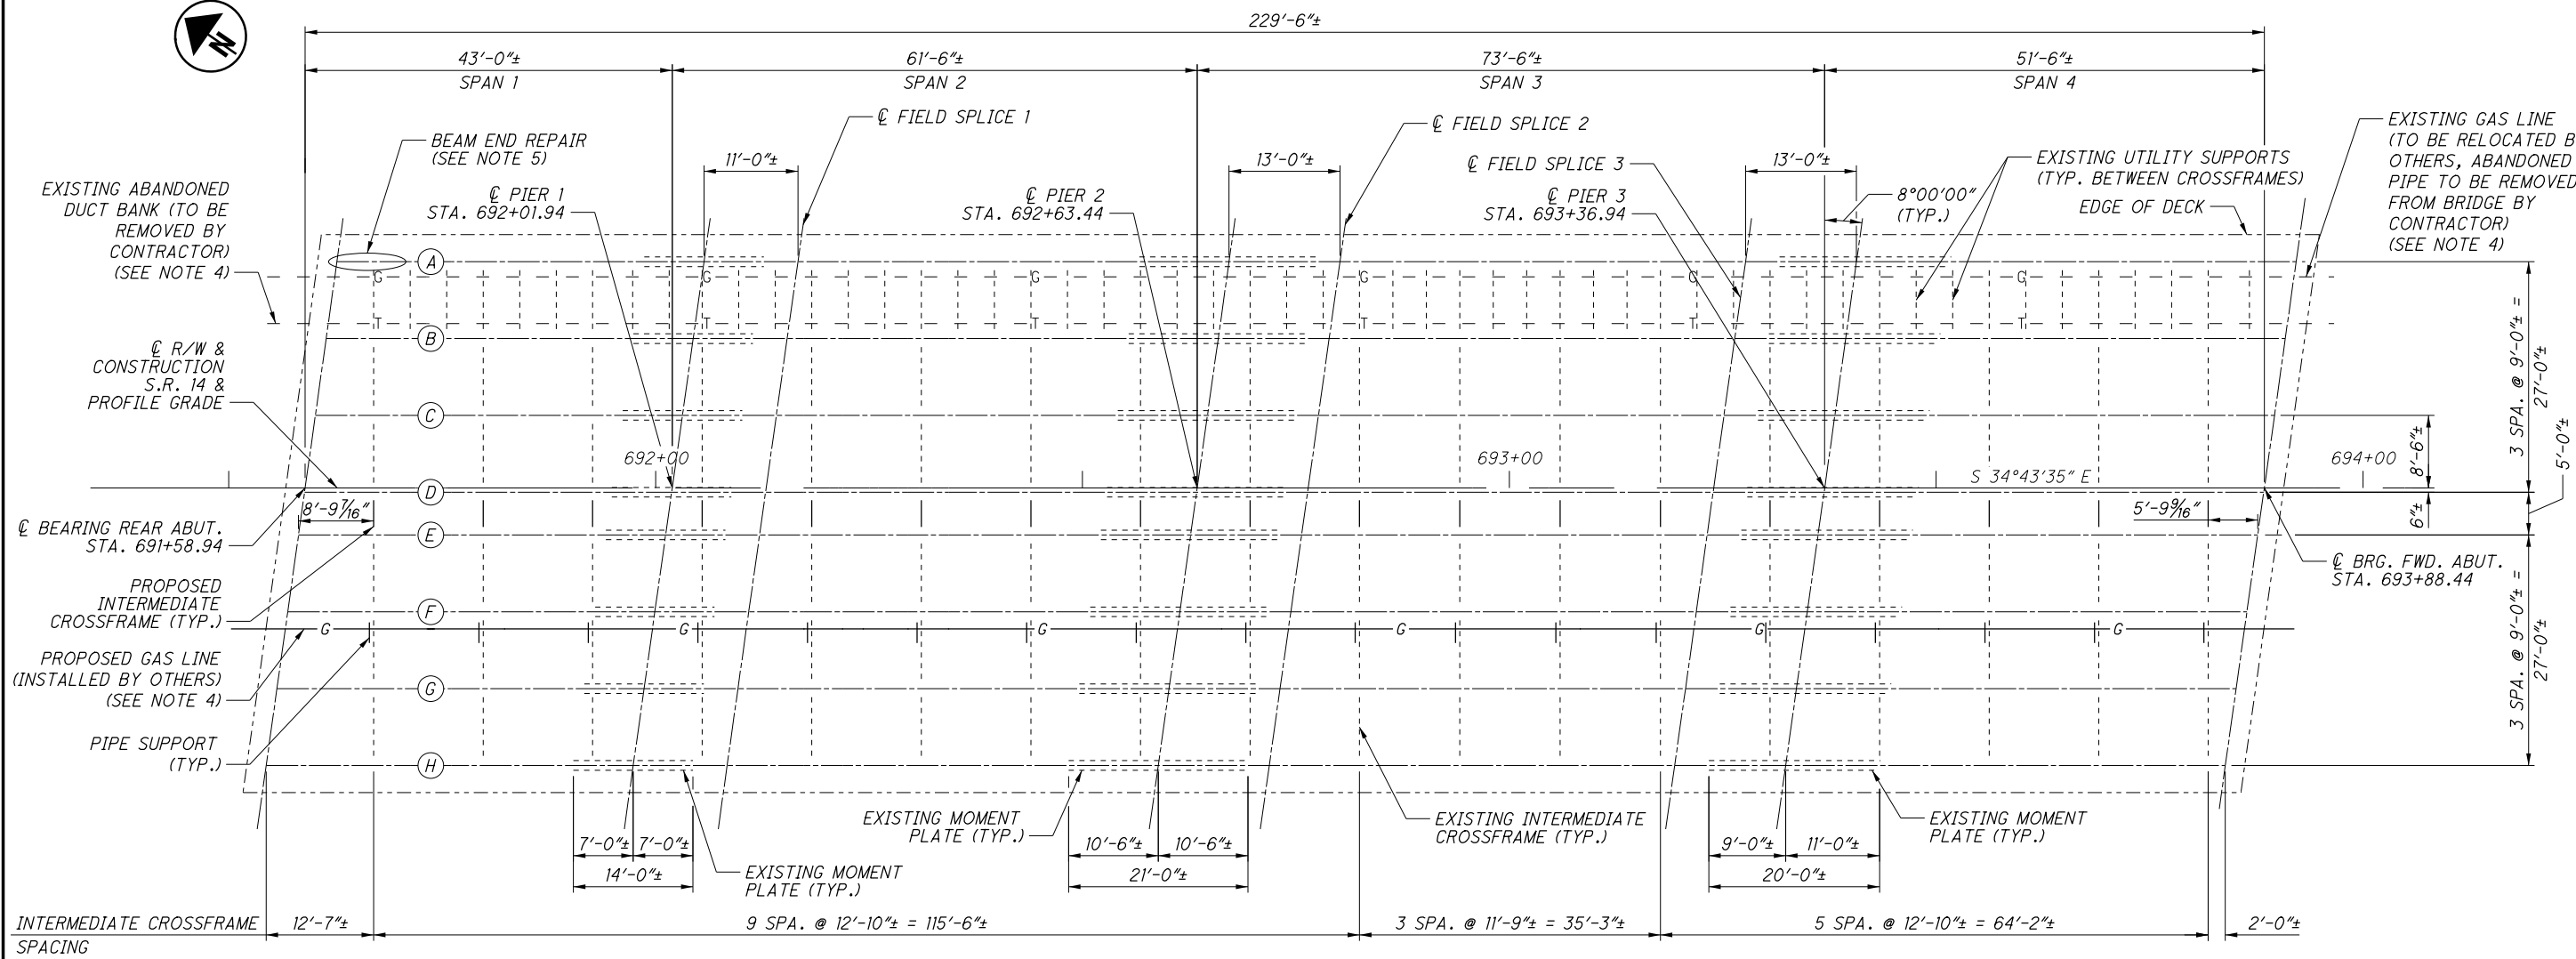

FRAMING PLAN

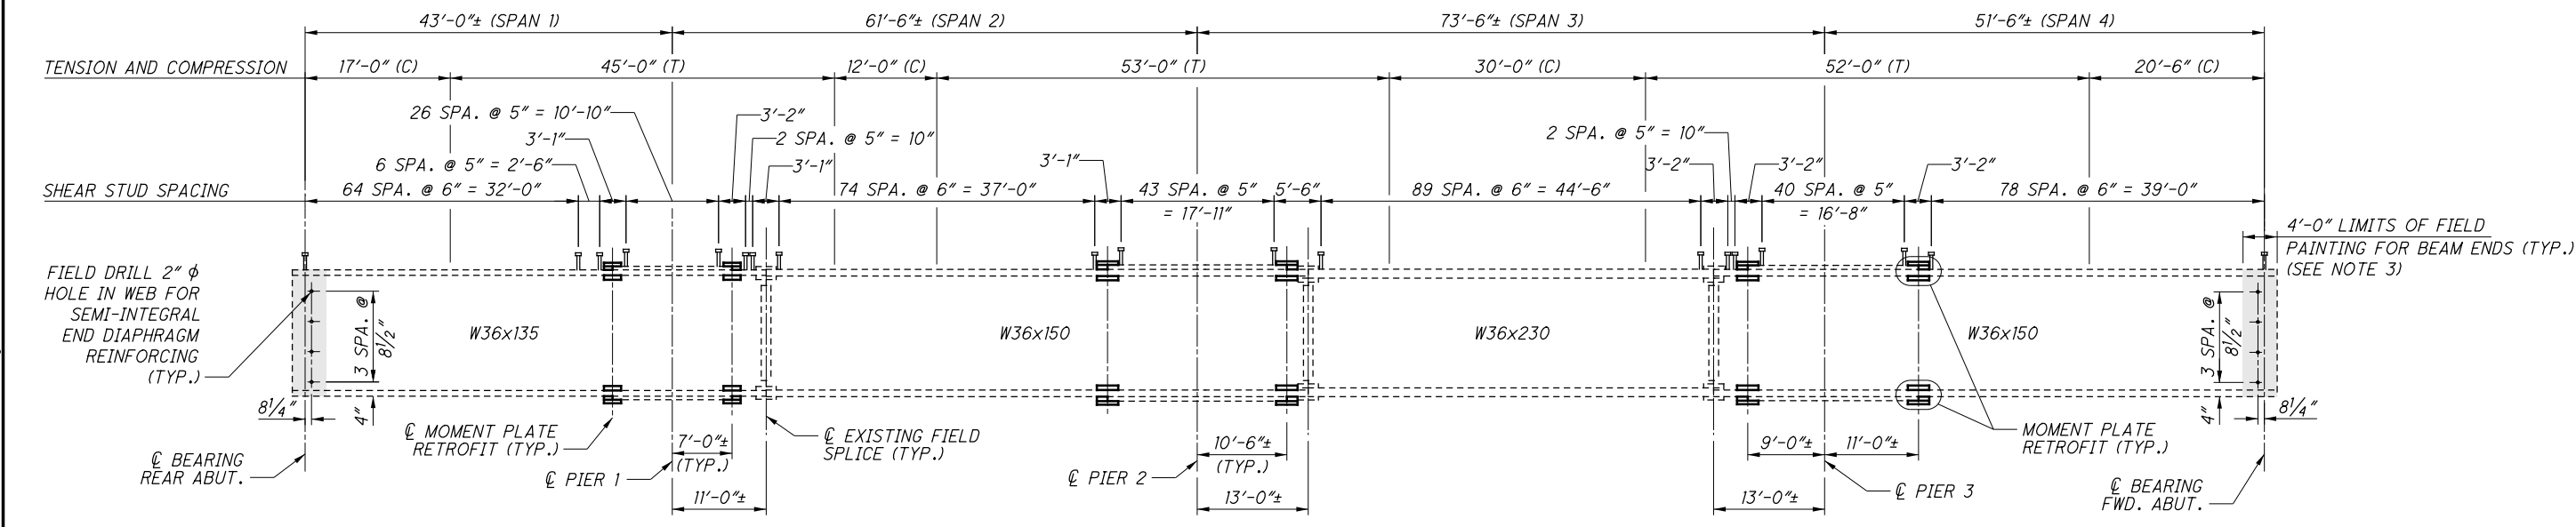

BEAM ELEVATION

LEGEND:

(T) - DENOTES AREA OF TENSION IN THE TOP FLANGE
 (C) - DENOTES AREA OF COMPRESSION IN THE TOP FLANGE

INDICATES LIMITS OF SURFACES TO BE PAINTED WITH SYSTEM OZEU, SEE NOTES THIS SHEET

NOTES:

- DO NOT INSTALL INTERMEDIATE CROSSFRAMES UNTIL BOTH DECK PHASES ARE POURED AND BEFORE THE CASTING OF THE CLOSURE POUR. FOR ADDITIONAL CROSSFRAME DETAILS, SEE SHEET [24/44](#).
- WELD ATTACHMENT OF SUPPORTS FOR CONCRETE DECK FINISHING MACHINE TO AREAS OF THE FASCIA STRINGER FLANGES DESIGNATED "COMPRESSION". DO NOT WELD ATTACHMENTS TO AREAS DESIGNATED "TENSION". FILLET WELDS TO COMPRESSION FLANGES SHALL BE AT LEAST 1" FROM THE EDGE OF THE FLANGE, BE NO MORE THAN 2" LONG, AND BE AT LEAST 1/4" FOR THICKNESSES UP TO 3/4" OR 5/16" FOR GREATER THAN 3/4" THICK. WELDED ATTACHMENTS LEFT IN PLACE SHALL BE GALVANIZED PER CMS 711.02 AND ARE INCIDENTAL TO ITEM 511 - CLASS QC2 CONCRETE WITH QC/QA, BRIDGE DECK, AS PER PLAN.
- FIELD PREPARE AND PAINT THE LAST 4'-0" AT EACH BEAM END, UNLESS NOTED OTHERWISE, WITH AN OZEU PRIME COAT PER CMS 514. FOR ADDITIONAL BEAM A PAINTING AT THE REAR ABUTMENT, SEE SHEET [26/44](#).
- FOR ADDITIONAL INFORMATION SEE GENERAL NOTES FOR ITEMS 202 PORTIONS OF STRUCTURE REMOVED, OVER 20 FOOT SPAN, AS PER PLAN AND 690, SPECIAL - DOMINION ENERGY OHIO STABILIZERS AND SUPPORTS.
- FOR BEAM END REPAIR DETAIL, SEE SHEET [26/44](#).

c:\pwworking\east01\00574940\014_1296C_SS001.dgn 9/23/2021 9:24:01 PM BAVARELL

DESIGN AGENCY
 HOP ENGINEERING, INC.
 1100 SUPERIOR AVE., SUITE 650
 CLEVELAND, OHIO 44114
 216-912-4240




DATE: 3/2021
 REVIEWED: JMS
 DRAWN: JTJ
 CHECKED: NUH
 STRUCTURE FILE NUMBER: 6700691


FRAMING PLAN
 BRIDGE NO. POR-14-1296
 S.R. 14 OVER S.R. 5

POR-14-12.96
 PID No. 105860


c:\pwworking\east01\0574940\014_1296C_SS002.dgn 9/23/2021 9:24:04 PM BAVARELL

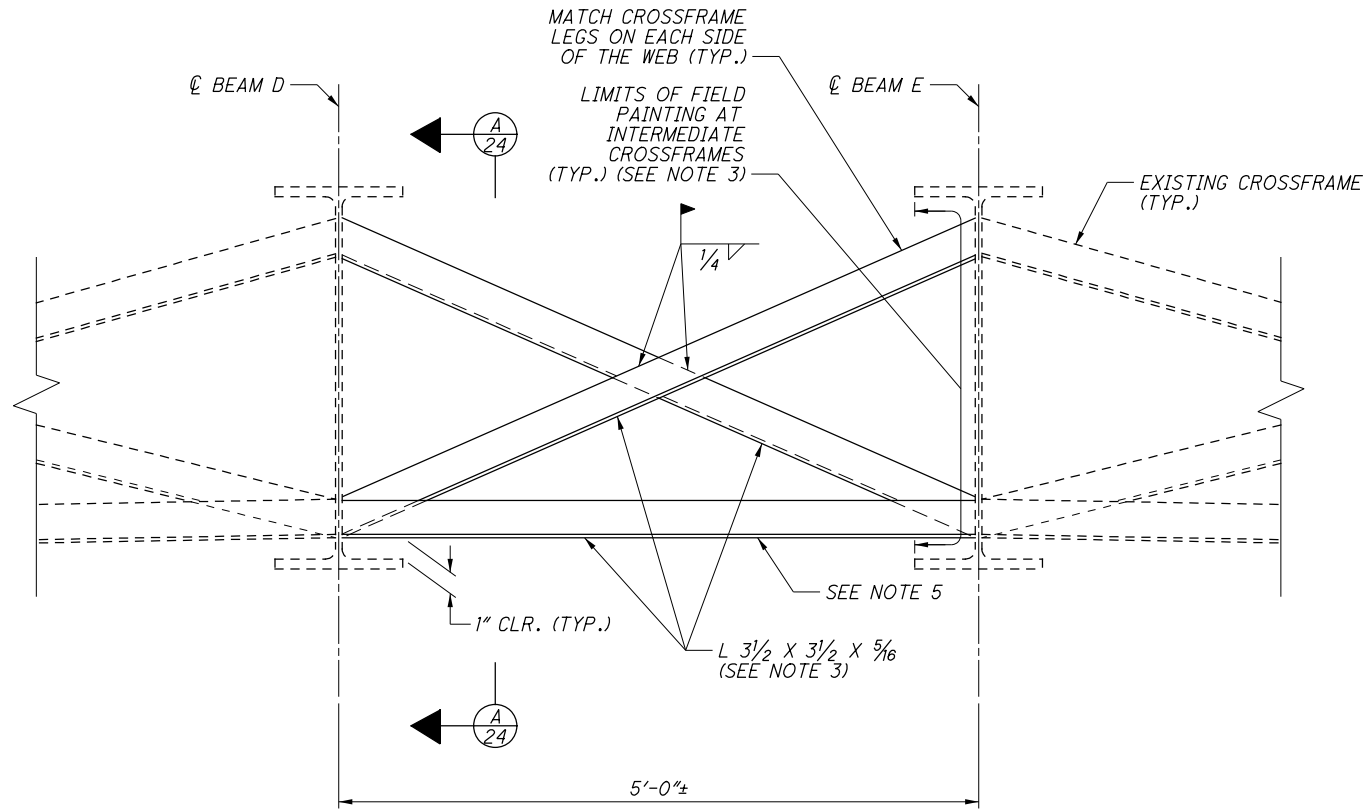


PROPOSED INTERMEDIATE CROSSFRAME

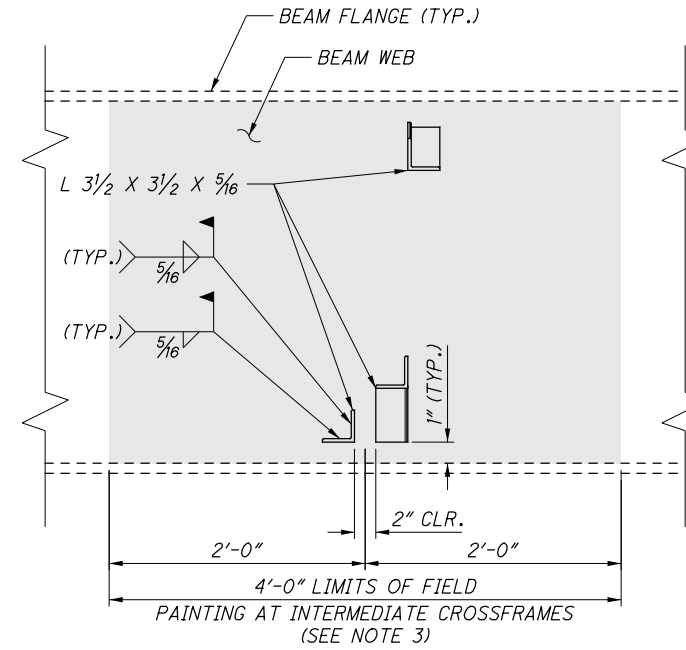

SECTION A-A

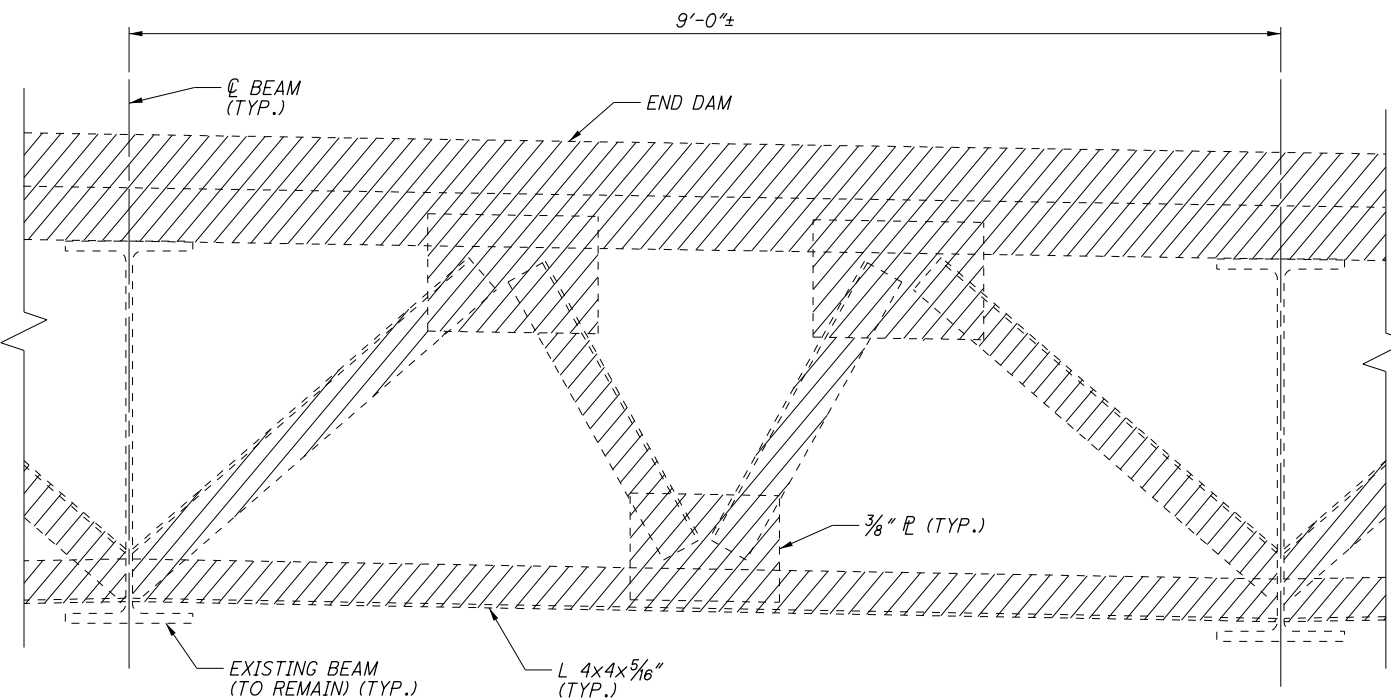

TYPICAL END CROSSFRAME REMOVAL DETAIL

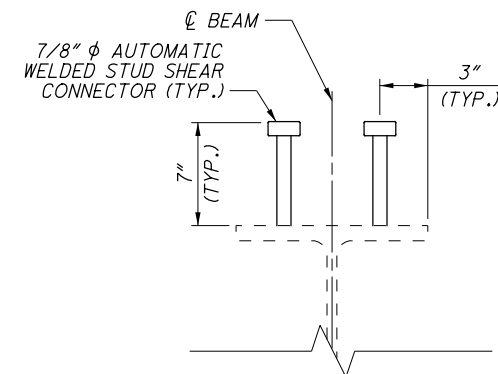

SHEAR STUD DETAIL

NOTES:


1. COORDINATE END CROSSFRAME REMOVAL WITH STAGED CONSTRUCTION. FOR ADDITIONAL DETAILS SEE SHEETS [6/44] AND [7/44].
2. FOR ADDITIONAL END CROSSFRAME DETAILS, SEE THE EXISTING PLANS.
3. PROPOSED INTERMEDIATE CROSSFRAMES SHALL BE SHOP PRIMED AND FIELD PAINTED WITH AN OZEU THREE COAT PAINT SYSTEM PER CMS 514. INTERMEDIATE AND FINISH COATS SHALL BE INCLUDED FOR PAYMENT WITH ITEM 514 - FIELD PAINTING OF EXISTING STRUCTURAL STEEL, INTERMEDIATE COAT AND ITEM 514 - FIELD PAINTING OF EXISTING STRUCTURAL STEEL, FINISH COAT.
4. ALL STRUCTURAL STEEL SHALL BE ASTM A709 GRADE 50 WITH A CVN DESIGNATION.
5. FOR ADDITIONAL CROSSFRAME DETAILS, SEE ARCHIVED STD. DWG. GSD-1-96.

LEGEND:


 - INDICATES AREAS TO BE REMOVED AS PER ITEM 202 - PORTIONS OF STRUCTURE REMOVED, OVER 20 FOOT SPAN, AS PER PLAN.

 - INDICATES LIMITS OF SURFACES TO BE PAINTED WITH SYSTEM OZEU, SEE NOTES THIS SHEET

c:\pwworking\east1\d0574940\014_1296c_SS003.dgn 9/24/2021 9:44:11 AM BAVARELL

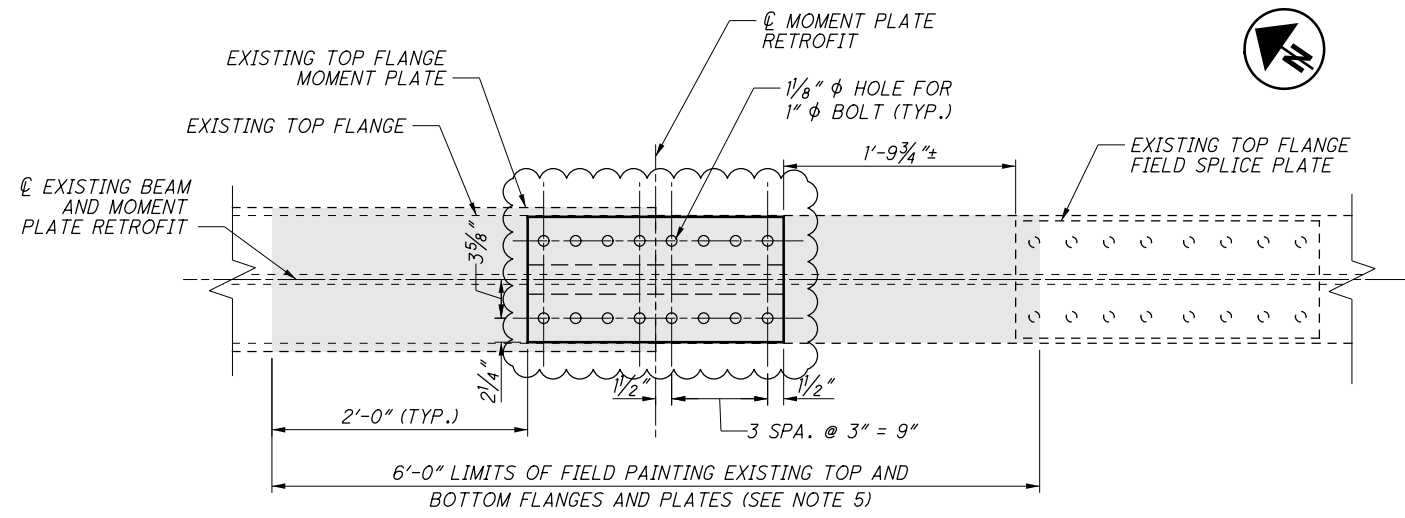


(PIER 1 TOP FLANGE SHOWN, BOTTOM FLANGE SIMILAR)
(BOLT SPACING IS SYMMETRICAL ABOUT CL BEAM AND CL MOMENT PLATE RETROFIT)

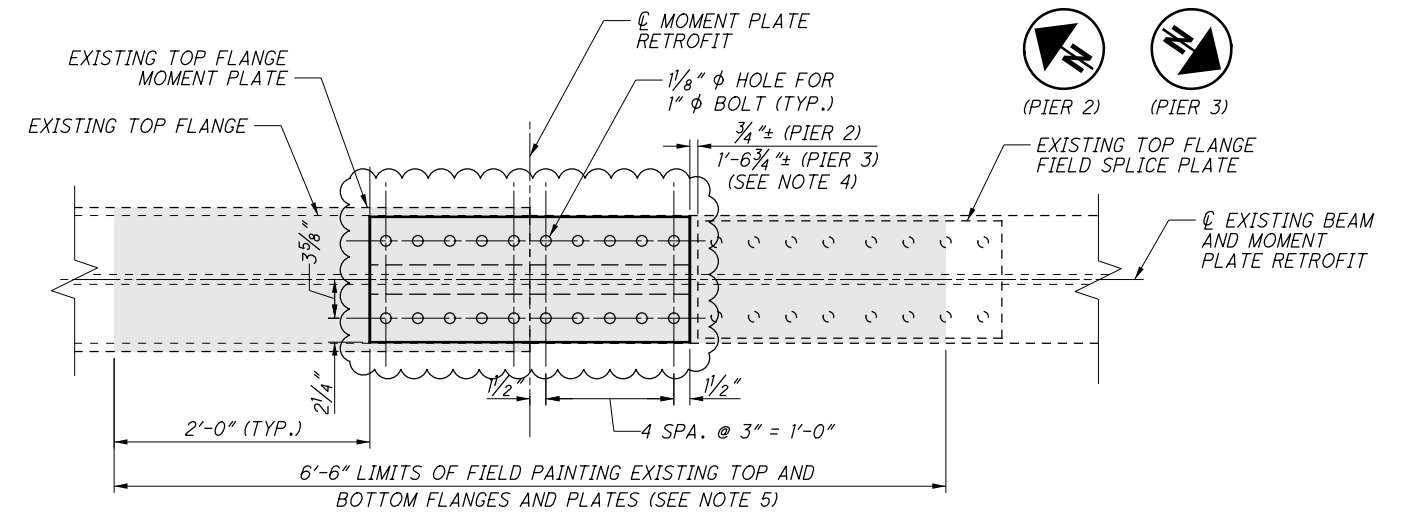


(PIER 2 AND PIER 3 TOP FLANGE SHOWN, BOTTOM FLANGE SIMILAR)
(BOLT SPACING IS SYMMETRICAL ABOUT CL BEAM AND CL MOMENT PLATE RETROFIT)

FLANGE MOMENT PLATE RETROFIT PLAN

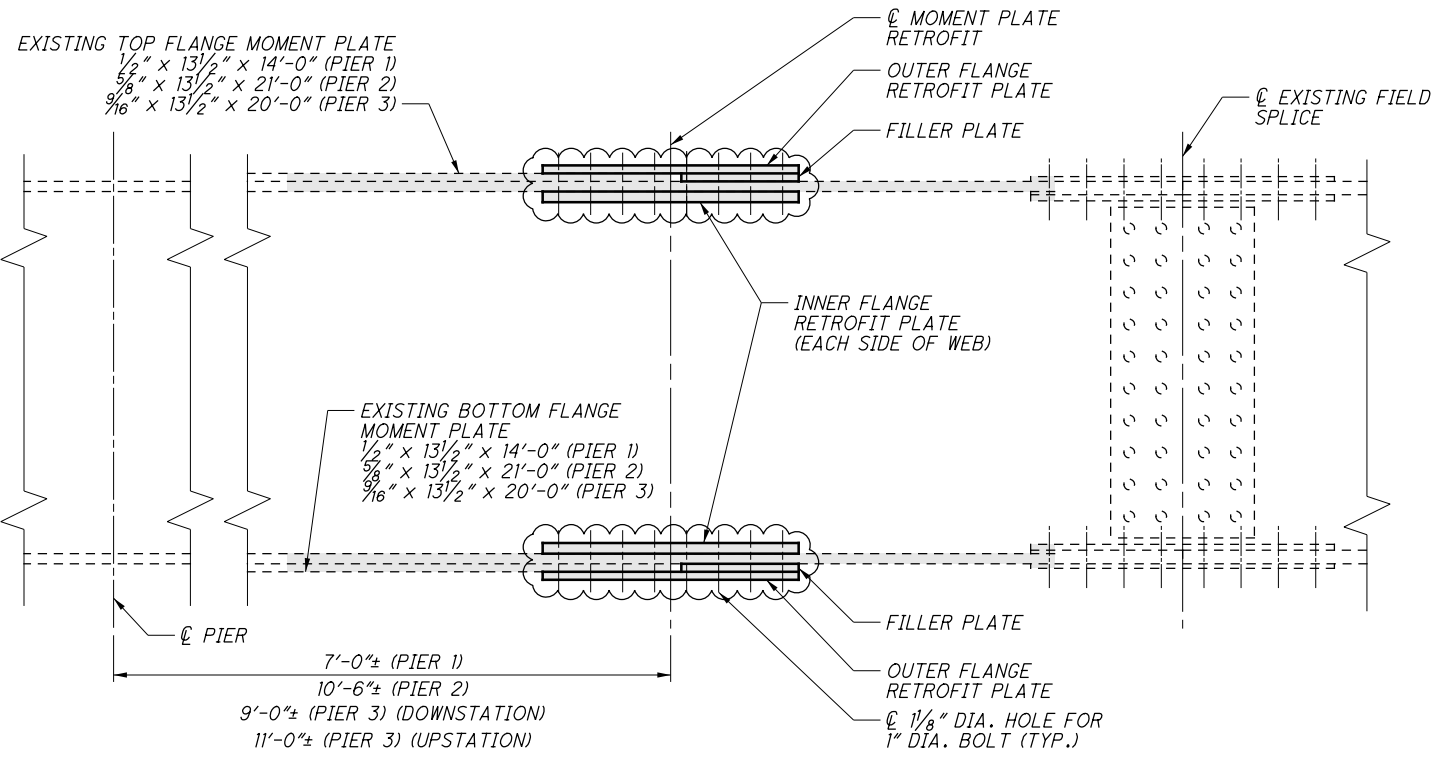

TYPICAL MOMENT PLATE RETROFIT ELEVATION
(PIER 1 OR PIER 2 SHOWN, PIER 3 SIMILAR)

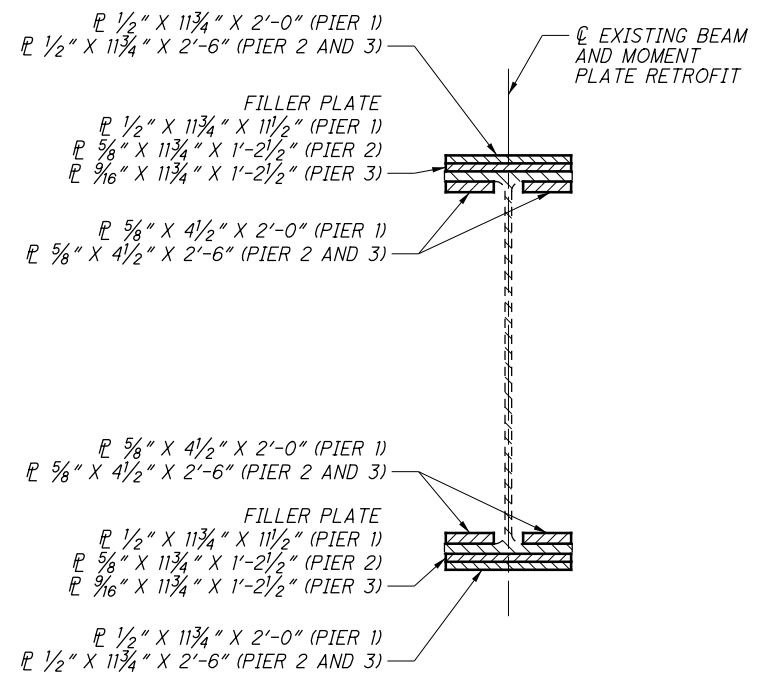

TYPICAL MOMENT PLATE RETROFIT SECTION

LEGEND:
- INDICATES LIMITS OF SURFACES TO BE PAINTED WITH SYSTEM OZEU, SEE NOTES THIS SHEET

NOTES:

- ALL STRUCTURAL STEEL SHALL BE ASTM A709 GRADE 50 WITH A CVN DESIGNATION EXCEPT FILLER PLATES.
- HIGH STRENGTH BOLTS SHALL BE 1" φ ASTM F3125 GRADE A325, TYPE I.
- FOR BEAM ELEVATION, SEE SHEET 23/44.
- FOR ADDITIONAL RETROFIT PLATE INFORMATION, SEE ITEM 513 - STRUCTURAL STEEL MISC.: BEAM RETROFIT PLATES IN THE GENERAL NOTES, SHEET 3/44.
- EXISTING TOP FLANGE STRUCTURAL STEEL AND EXISTING TOP FLANGE MOMENT PLATES, THAT ARE EMBEDDED IN THE DECK HAUNCH, AND WITHIN THE LIMITS DEFINED, SHALL BE SURFACED PREPPED AND PRIMED ONLY WITH AN OZEU PAINT COAT SYSTEM PER CMS 514.

TOP FLANGE OUTER PLATE RETROFITS AND TOP FLANGE FILLER PLATE RETROFITS, THAT ARE EMBEDDED IN THE DECK HAUNCH, SHALL BE SHOP PRIMED ONLY WITH AN OZEU PAINT COAT SYSTEM PER CMS 514.

TOP FLANGE INNER PLATE RETROFITS, BOTTOM FLANGE INNER AND OUTER PLATE RETROFITS, AND BOTTOM FLANGE FILLER PLATE RETROFITS, THAT ARE EXPOSED, SHALL BE SHOP PRIMED AND FIELD PAINTED WITH AN OZEU THREE COAT PAINT SYSTEM PER CMS 514.

EXPOSED EXISTING STRUCTURAL STEEL FLANGES, TOP AND BOTTOM, INCLUDING EXISTING PLATES AND SPLICES, WITHIN THE LIMITS DEFINED, SHALL BE SURFACE PREPPED AND FIELD PAINTED WITH AN OZEU THREE COAT PAINT SYSTEM PER CMS 514. SEE DETAILS THIS SHEET FOR LIMITS OF REPAIR.

DESIGN AGENCY: HOP ENGINEERING, INC. 100 SUPERIOR AVE., SUITE 650 CLEVELAND, OHIO 44114 216-912-4240

DATE: 3/2021

REVIEWED: JMS

DRAWN: JTJ

DESIGNED: KRH

CHECKED: NUH

STRUCTURE FILE NUMBER: 6700691

REVISIONS:

DATE: 3/2021

BY: JMS

REASON: STRUCTURE FILE NUMBER 6700691

BRIDGE NO.: POR-14-1296

S.R.: 14 OVER S.R. 5

POR-14-12.96


PID No. 105860

25/44


71

90


c:\pwworking\east01\d0574940\014_1296C_SS005.dgn 9/24/2021 9:44:13 AM BAVARELL

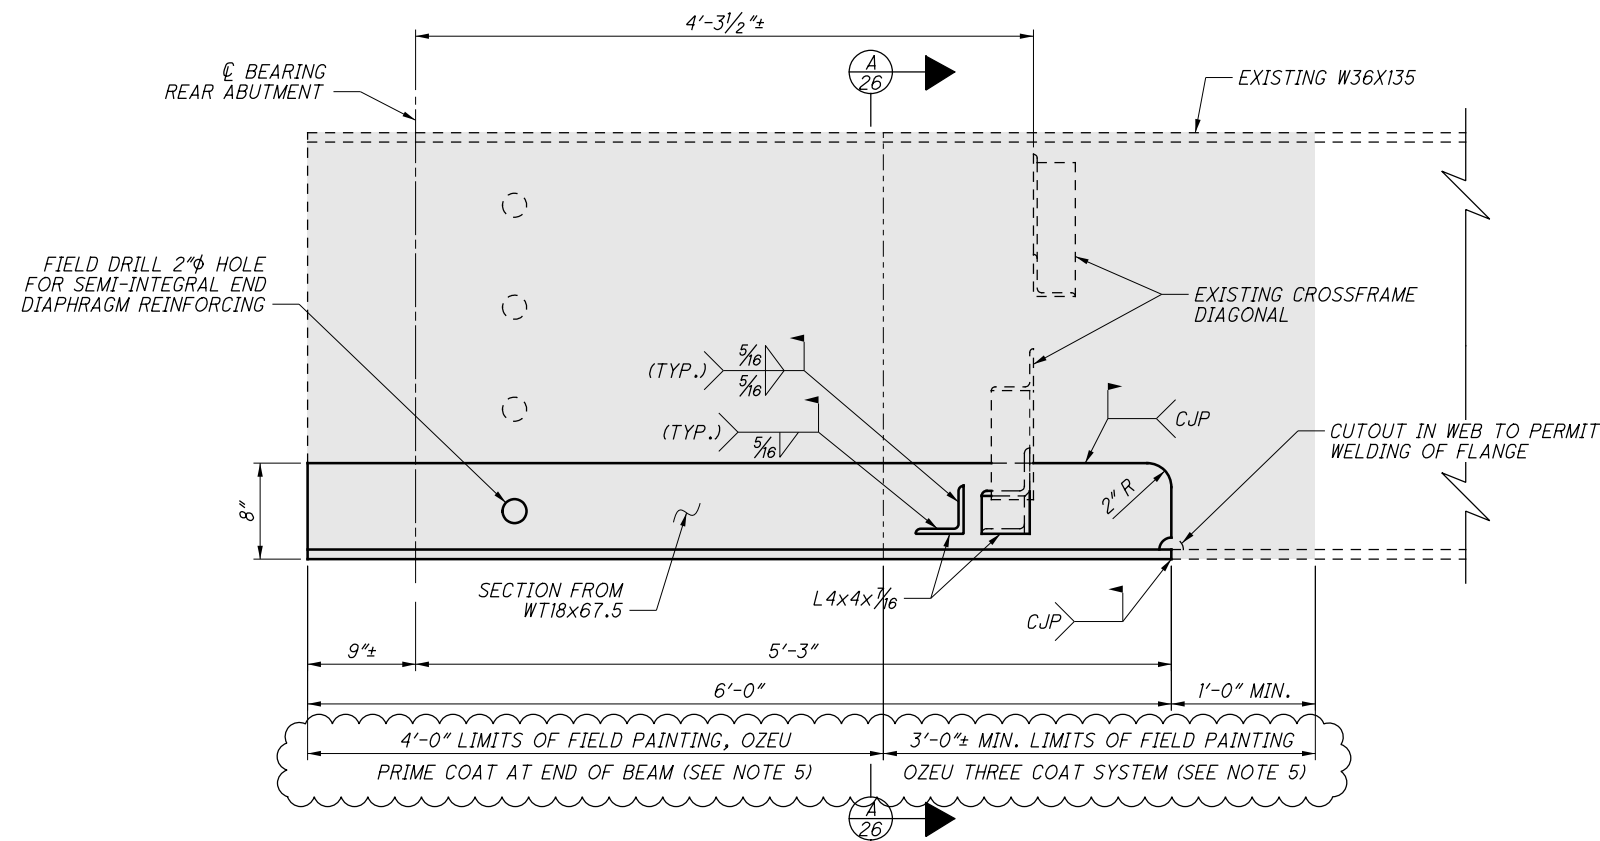


BEAM A END REPAIR ELEVATION VIEW
(ONLY REPAIR AT REAR ABUTMENT)

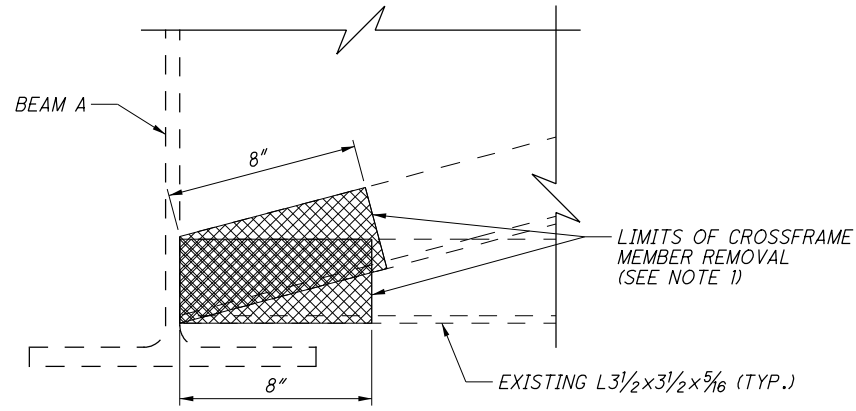


CROSSFRAME REMOVAL DETAIL

LEGEND:
 - INDICATES LIMITS OF SURFACES TO BE PAINTED WITH SYSTEM OZEU, SEE NOTES THIS SHEET

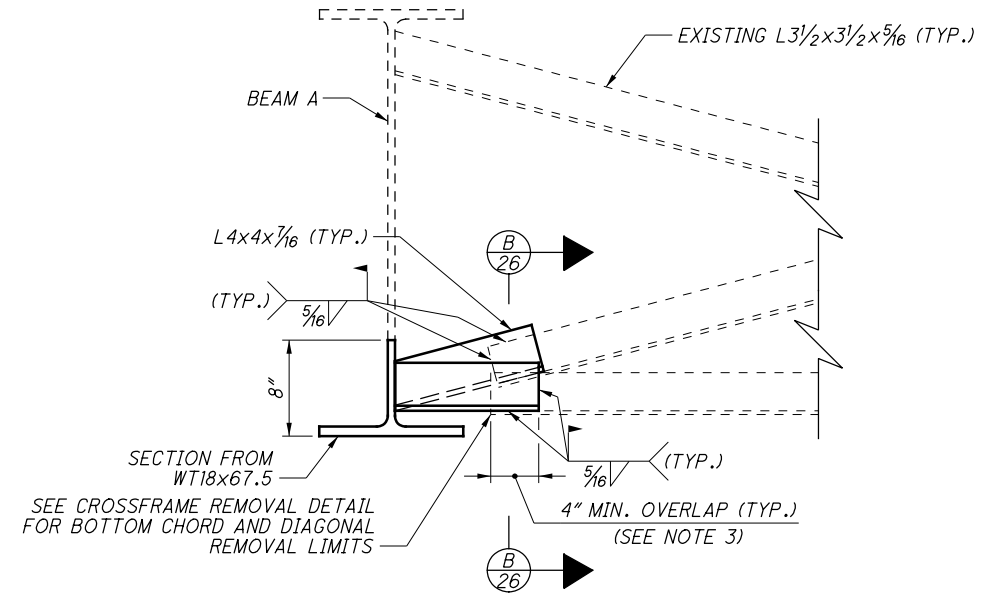

SECTION A-A

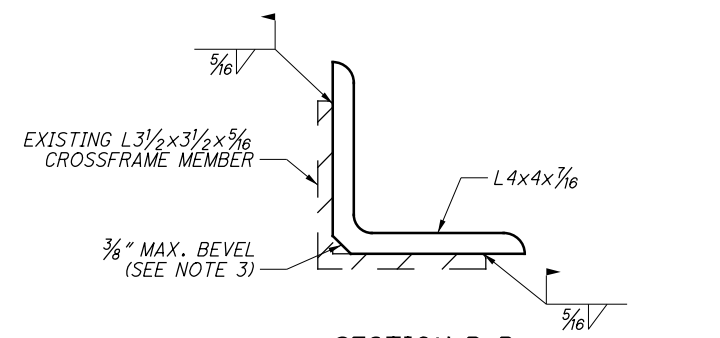

SECTION B-B

(BOTTOM CHORD ANGLE SHOWN, DIAGONAL ANGLE SIMILAR)

NOTES:

1. BEAM END REPAIR, INCLUDING ALL WELDING AND NON-DESTRUCTIVE TESTING, SHALL BE IN ACCORDANCE WITH CMS 513. PERFORM THE COMPLETE PENETRATION WELDING PER CMS 513.21. COMPLETE NON-DESTRUCTIVE TESTING FOR THE FULL LENGTH OF ALL BUTT WELDS PER CMS 513.25A. REPAIR AND WELDING SHALL BE PERFORMED IN THE PRESENCE OF, AND INSPECTED BY, THE ENGINEER. REMOVE PORTIONS OF THE EXISTING CROSSFRAME PRIOR TO REMOVING THE EXISTING END REPAIR SECTION. PAYMENT FOR THIS WORK SHALL BE INCLUDED WITH ITEM 513 - STRUCTURAL STEEL, MISC.: BEAM END REPAIR. TEMPORARY SUPPORT OF BEAM A DURING THE REPAIR IS REQUIRED AND SHALL BE INCLUDED FOR PAYMENT WITH ITEM 516 - JACKING AND TEMPORARY SUPPORT OF SUPERSTRUCTURE, AS PER PLAN.
2. ALL STRUCTURAL STEEL SHALL BE ASTM A709 GRADE 50 WITH A CVN DESIGNATION.
3. IF NECESSARY THE REPLACEMENT CROSSFRAME ANGLES MAY BE BEVELED A MAXIMUM OF 3/8" FOR THE PORTION OVERLAPPING THE EXISTING ANGLE TO ALLOW FULL CONTACT BETWEEN THE LEGS OF THE NEW AND EXISTING ANGLES.
4. CAREFULLY GRIND THE COMPLETED CJP WELD, WT SECTION, EXISTING WEB AND EXISTING FLANGE TO CREATE A SMOOTH TRANSITION BETWEEN THICKNESSES. REMOVE ALL SHARP EDGES AND CORNERS CREATED BY THE BEAM END REPAIR. THE GRINDING SHALL BE IN THE DIRECTION OF THE LONGITUDINAL AXIS OF OF THE BEAM.
5. AT THE BEAM A REPAIR LOCATION, FOR THE FIRST 4'-0"± AT THE END OF THE BEAM A, SURFACE PREPARE AND FIELD APPLY A OZEU PRIME COAT PER CMS 514. FOR THE NEXT 3'-0"±, TERMINATING APPROXIMATELY 1'-0"± PAST THE END OF THE REPAIR, SURFACE PREPARE AND FIELD APPLY A OZEU THREE COAT PAINT SYSTEM PER CMS 514. CAULK ANY OPENINGS OR GAPS PER CMS 514.19.
6. FOR END CROSSFRAME REMOVAL DETAIL, SEE SHEET [24/44].